

INDEX OF SHEETS


SHEET NO. 1 TITLE
SHEET NO. 2-2.6 TYPICAL CROSS SECTIONS
SHEET NO. 3 ESTIMATE OF QUANTITIES
SHEET NO. 3A MISCELLANEOUS QUANTITIES
SHEET NO. - RIGHT OF WAY PLAT
SHEET NO. 4-9 PLAN AND PROFILE STA. 0+00 TO STA. 33+23.6
SHEET NO. 10-14 STANDARD DETAILS
SHEET NO. - DRAINAGE STRUCTURES
SHEET NO. 15-34 CROSS SECTIONS

STATE OF WISCONSIN STATE HIGHWAY COMMISSION OF WISCONSIN

PLAN AND PROFILE OF PROPOSED MAIN STREET CITY OF FOND DU LAC FOND DU LAC COUNTY PROJECT U 4702 (4)

BEGINNING AT THE SOUTH JUNCTION
OF U.S.H. 45 TO MERRILL AVENUE

PLAN 1 IN. = 100 FT.
PROFILE HOR. 1 IN. = 100 FT. VERT. 1 IN. = 10 FT.
CROSS SECTIONS HOR. 1 IN. = 5 FT. VERT. 1 IN. = 5 FT.

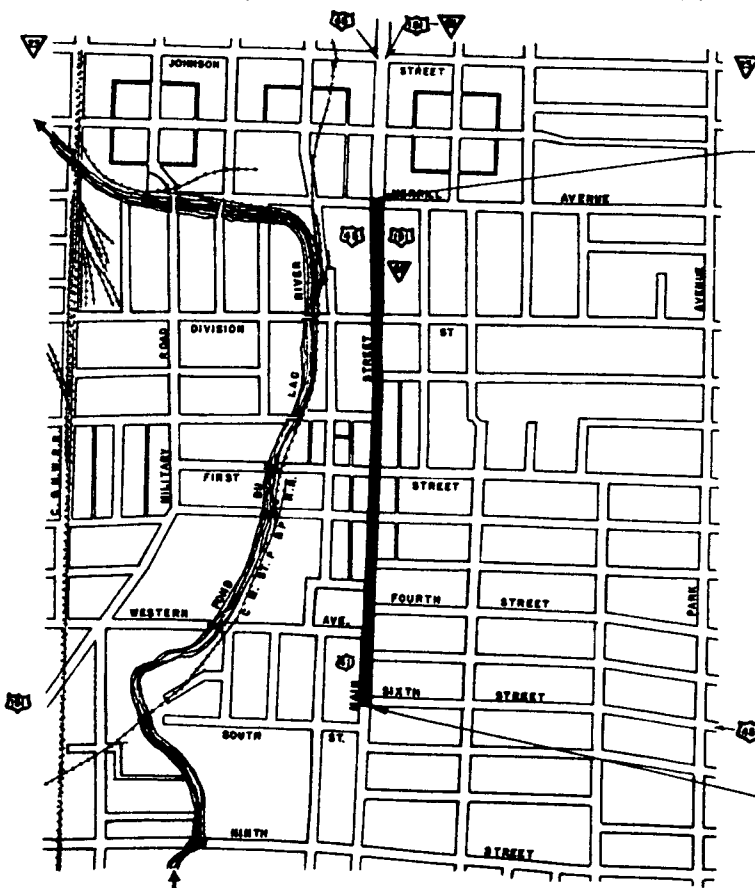

END OF PROJECT U4702(4)
STA 33 + 23.6
STA. 0+00 BEGINNING
PROJ U 4702(2)

BEGINNING OF PROJECT U4702(4)
STA. 0+00

CONVENTIONAL SIGNS

STATE LINE	-----	CULVERTS IN PLACE	-----
COUNTY LINE	-----	CULVERTS REQUIRED	-----
TOWNSHIP OR RANGE LINE	-----	DROP INLET	-----
SECTION LINE	-----	POWER POLE	-----
NEW RIGHT OF WAY LINE	-----	TELEPHONE OR TELEGRAPH POLE	-----
PRESENT RIGHT OF WAY LINE	-----	RIGHT OF WAY MARKERS	-----
WIRE FENCE	-----	REFERENCE STAKE FOR HUBS ONLY	-----
LOT LINE	-----	MARSH	-----
CORPORATE OR CITY LIMITS	-----	HEDGE	-----
PROPERTY LINE	-----	TREES	-----
TRAVELED WAY OR P.E.	-----	GROUND ELEVATION	-----
RAILROADS	-----	GRADE ELEVATION	-----
BASE OR SURVEY LINE	-----		

LAYOUT

SCALE 1" = 100'

TOTAL NET LENGTH OF CENTERLINE = .629 MI.

COUNTY AND HIGHWAY	ROUTE AND SECTION	CLASS AND AGREEMENT	FEDERAL DIVISION OFFICE	SHEET NUMBER	TOTAL SHEETS
201	4702	WIS. 12.4	WIS. 5N	1	34

WHITE CONSOLIDATED
F.M. BALSLEY - RES. ENGR
1953

APPROVED FOR THE CITY OF FOND DU LAC	
<i>Edwin F. Wilson</i> MAYOR	<i>John E. Dwyer</i> COMMISSIONER IN CHARGE OF STREETS
DATE 10/20/52	DATE 10/20/52
STATE HIGHWAY COMMISSION OF WISCONSIN MADISON, WIS.	
SURVEYOR: H.M.L. LP 2 NO. 2 BOOK 2810 DIVISION COMPTROLLER: H.M.L. NO. 0 CHPTREE DIVISION CHIEF: COMPTROLLER	
CORRECT: <i>J.C. Jones</i>	
DATE 1/20/52	
RECOMMENDED FOR APPROVAL	
DISTRICT ENGINEER DATE	
APPROVED: <i>E.E. Rost</i> STATE HIGHWAY ENGINEER	
DIVISION ENGINEER	