


P.A. DIVISION	PROJECT	SHEET NO.	TOTAL SHEETS
WIS. SN	U 4702 (4)	2	34

LEGEND

PRESENT CURB LINE	=====
FACE OF NEW CURB	○ SAN.
PRESENT MANHOLE	○ C.
COAL CHUTE	○ CB.
PRESENT CATCHBASIN CURB TYPE	○ C.B.
PRESENT CATCHBASIN FLAT TYPE	○ F.H.
FIRE HYDRANT PRESENT LOCN.	○ V
WATER VALVE	○ C.B.
STREET LIGHT	○ ST.
NEW CATCHBASINS	○ D.
NEW MANHOLES	○ E.M.H.
UNLOADING DOOR IN WALK	
ELECTRIC MANHOLE	

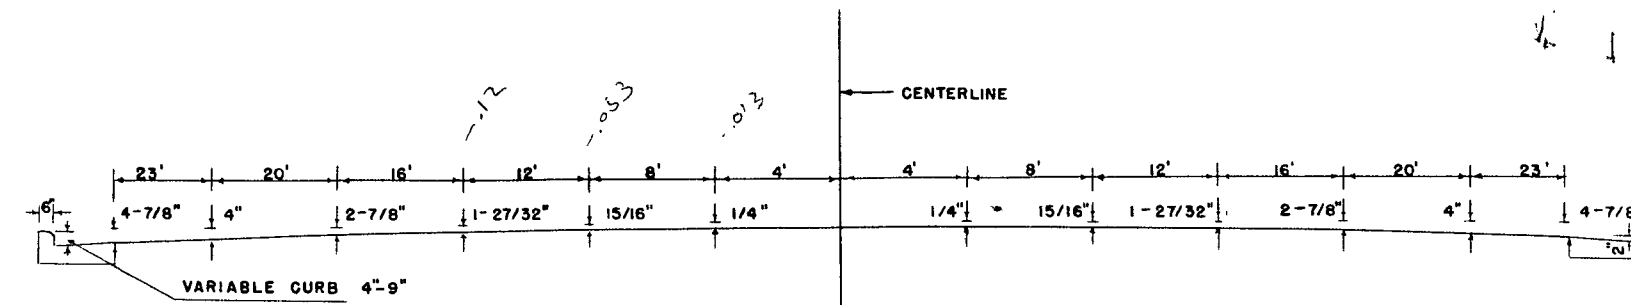

PAVEMENT CROWN

GENERAL NOTES


NO TREES TO BE REMOVED WITHOUT THE APPROVAL OF THE ENGINEER
SHRINKAGE ESTIMATED TO BE 35%
CURB & GUTTER, STORM SEWER LATERALS & CATCH BASINS & RECONSTRUCTED MANHOLES ARE PART OF THIS CONTRACT
PRINCIPAL STORM SEWERS, NEW MANHOLES, NEW DRIVEWAYS & NEW SIDEWALKS ARE PART OF THIS CONTRACT BUT ARE NON FEDERAL OR STATE PARTICIPATING ITEMS, CITY TO EXTEND ALL NECESSARY SANITARY SEWERS, UNDERGROUND ELECTRIC WIRING, WATER MAINS & REMOVE & INSTALL ALL STREET LIGHTS, STOP & GO LIGHTS, STOP SIGNS, FIREHYDRANTS, FIRE SIRENS & PARKING METERS, UNDER ITEM NO. 2520-36, RECONSTRUCTING MANHOLES. THIS ITEM SHALL INCLUDE NEW LOCKING TYPE FRAME & COVERS
SET ALL INLET FLANGES 0.17 OR 2" LOWER THAN GUTTER GRADES UNLESS OTHERWISE SHOWN IN THE PROFILE OR DETAIL SHEETS.

APPROVED DETAIL DRAWINGS


REINF. CONC. CATCHBASIN TO CONFORM WITH TYPE "F" EXCEPT SUMP TO BE OMITTED	5-1.6.1
INLET TYPE "A"	5-2.1.1
REINF. CONC. MANHOLE CONSTRUCTION BARRICADE	5-3.1.1
REINF. CONC. CATCHBASIN TO CONFORM WITH TYPE "G" EXCEPT SUMP TO BE OMITTED	7-4.1.1
	5-1.7.1

STANDARD ABBREVIATIONS

C. = UNCLASSIFIED EXCAVATION
F. = FILL
P.R.C. = POINT OF REVERSE VERTICAL CURVE
C.R. = CENTER OF RADIUS
C.S.P. = CONCRETE SEWER PIPE

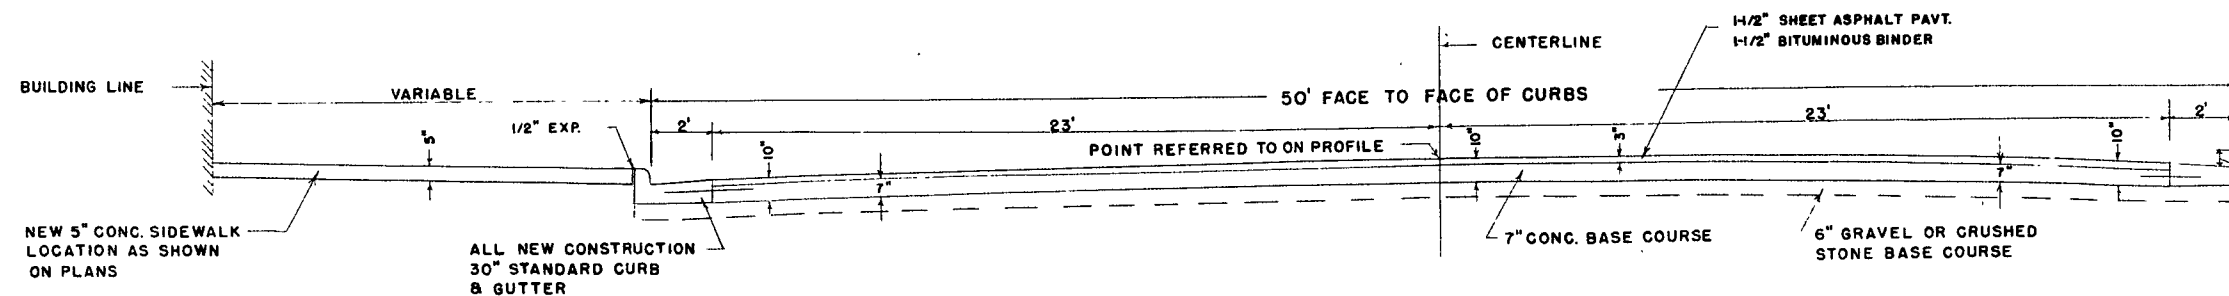

TYPICAL FINISHED SECTION
STA. 0+00 TO STA. 31+38.6
VARIABLE WIDTH STA. 31+38 TO STA. 33+23.6

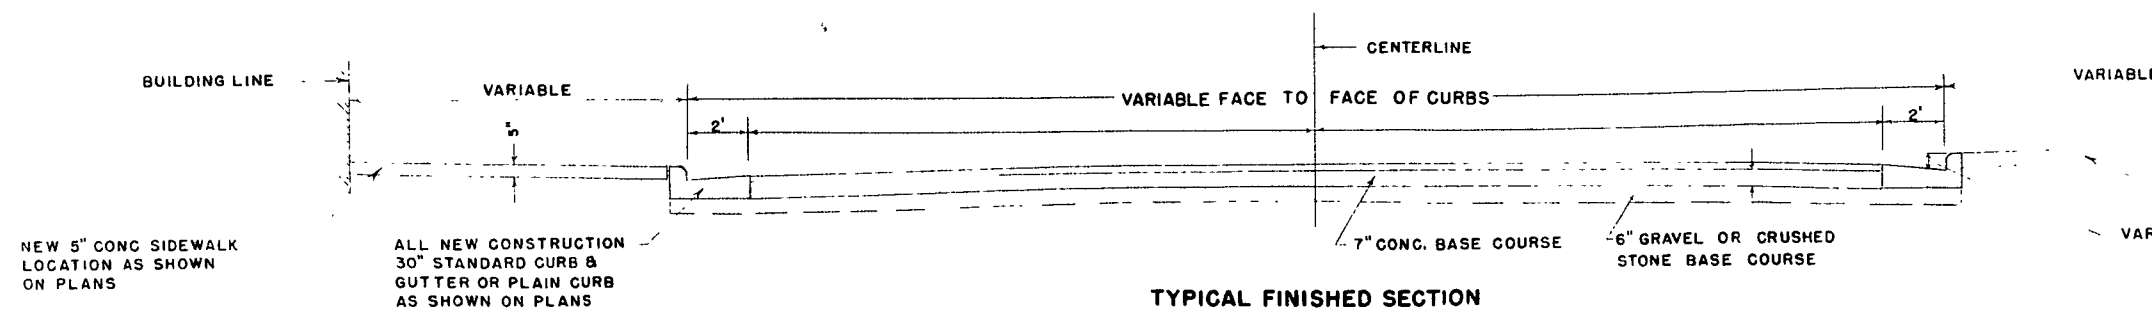


TYPICAL FINISHED SECTION
FOR
SIDE STREETS



R/W LINE 30 FT. TO ϕ ON ALL SIDE STREETS EXCEPT WESTERN AVE. & FOURTH STREET WHICH ARE 33 FT. TO ϕ

TYPICAL CROSS SECTION FOR


46' SHEET ASPHALT PAVT

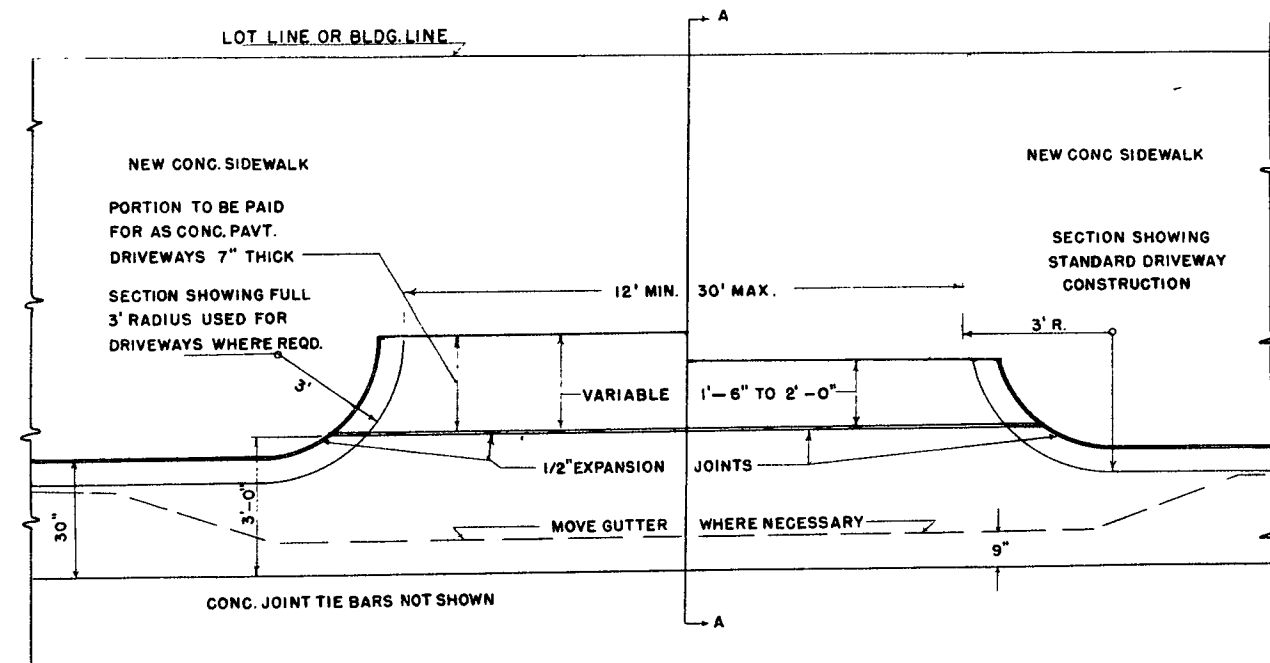


DETAIL OF CONCRETE PAVEMENT DRIVEWAYS - 7"

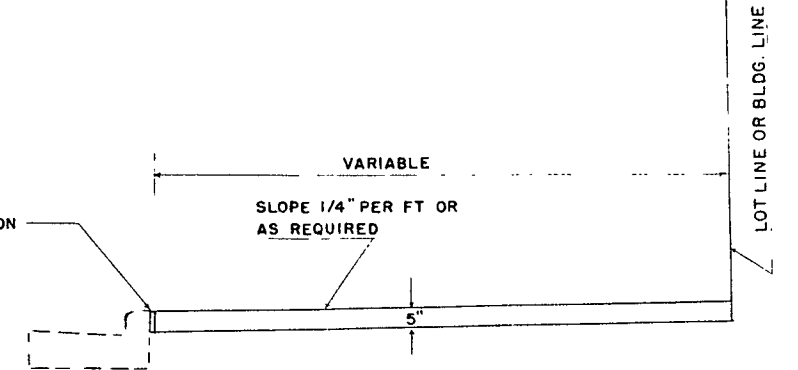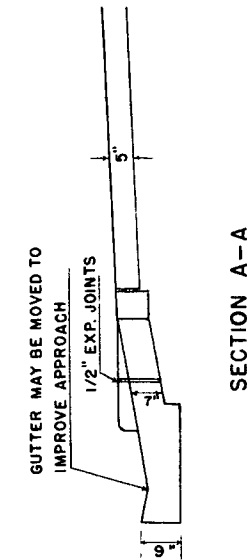

DETAIL OF CONCRETE SIDEWALK 5"

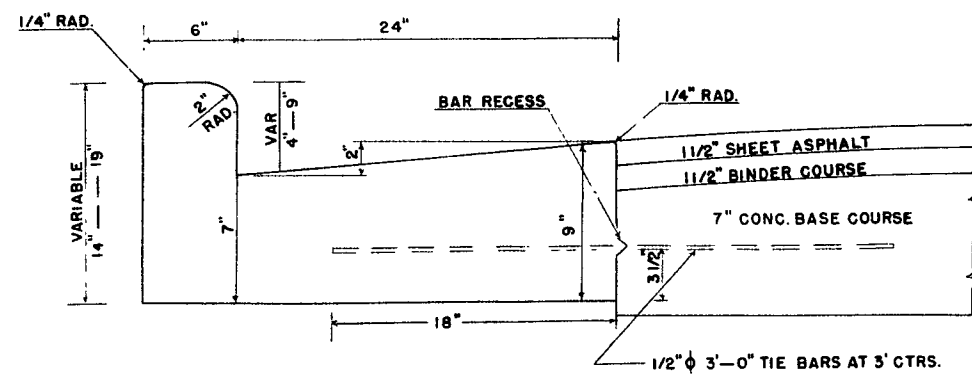

DETAIL OF CONC. COMB. CURB & GUTTER 30" VAR. FACE

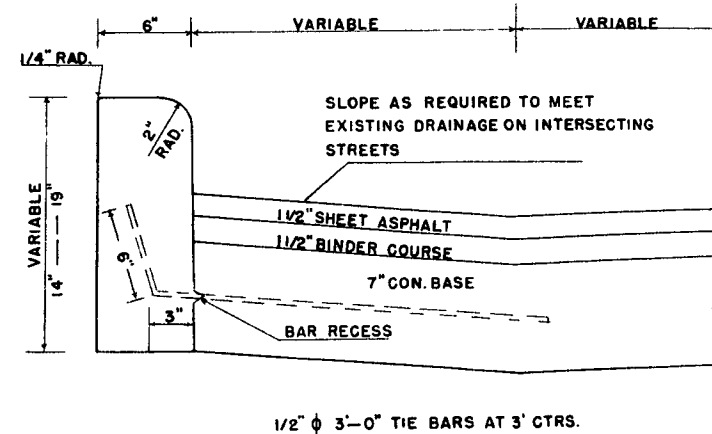

DETAIL OF CONC. CURB VAR. FACE


CONSTRUCTION DETAILS
FOR
MAIN STREET

CITY OF FOND DULAC


SCALE
AS NOTED

P. R. A. DIVISION	PROJECT	SHEET NO.	TOTAL SHEETS
WIS 5N	U 4702 (4)	2.2	34

BEG. OF APPROACH
- 1+40

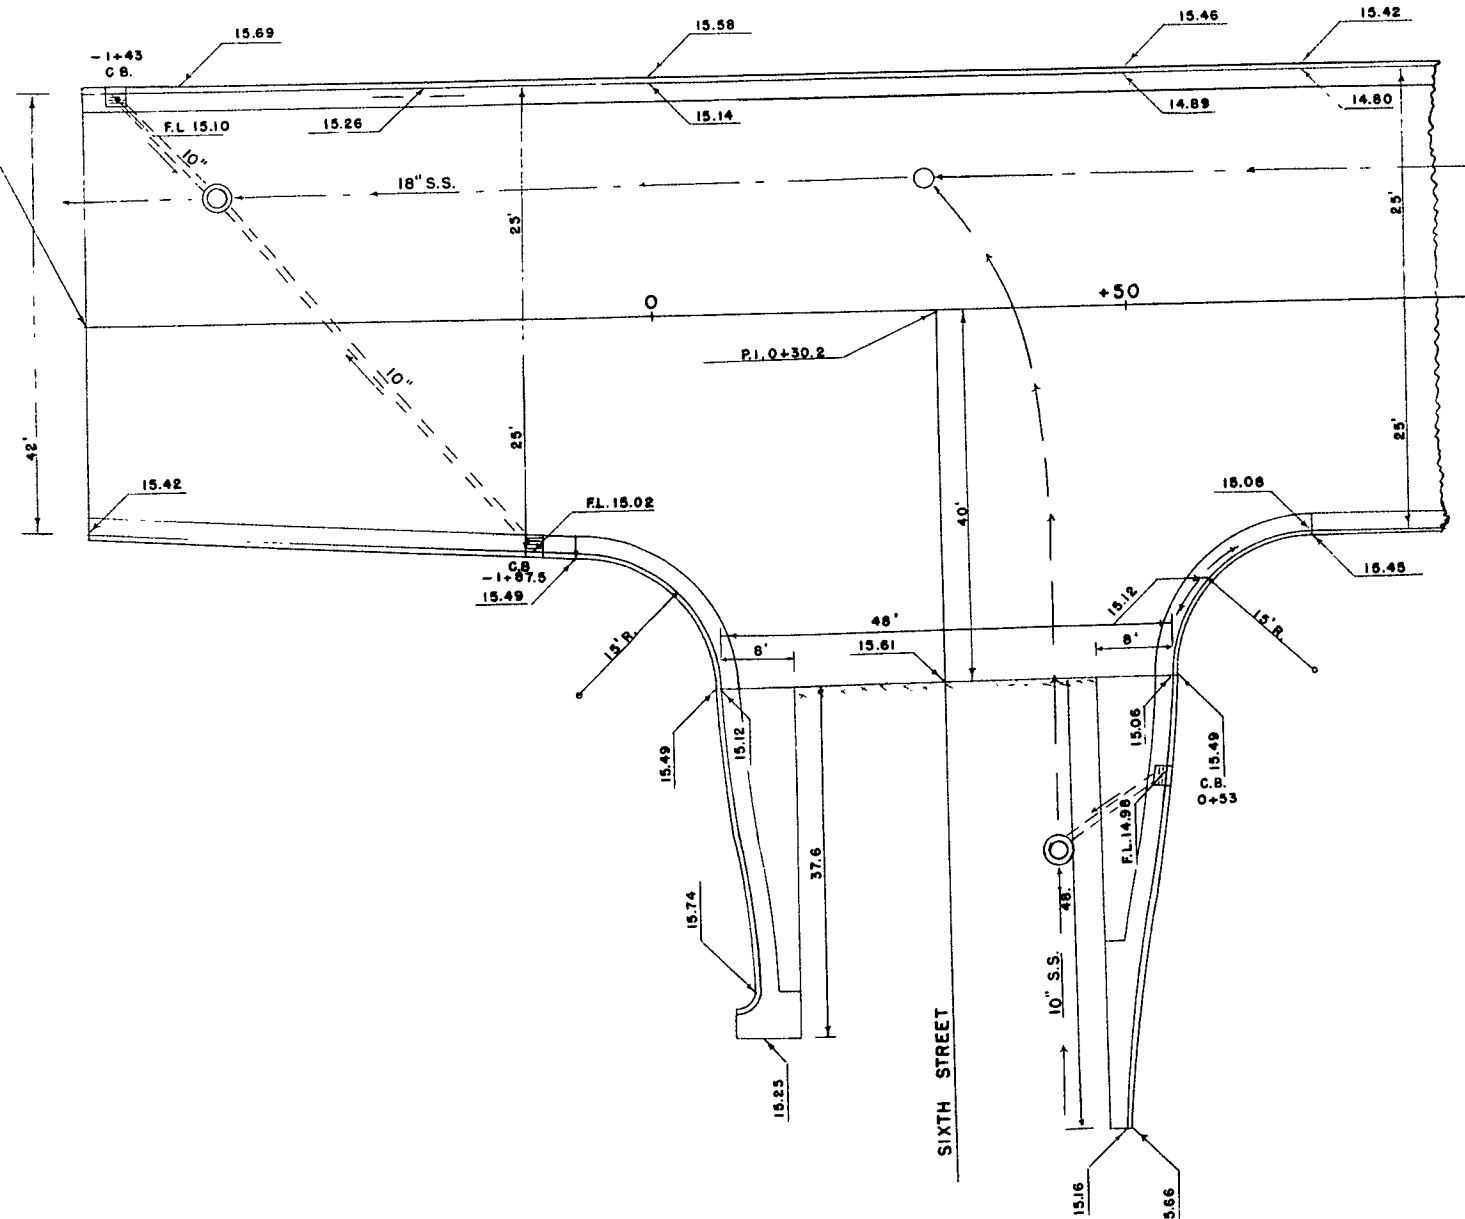

DETAIL
SIXTH & MAIN STREETS

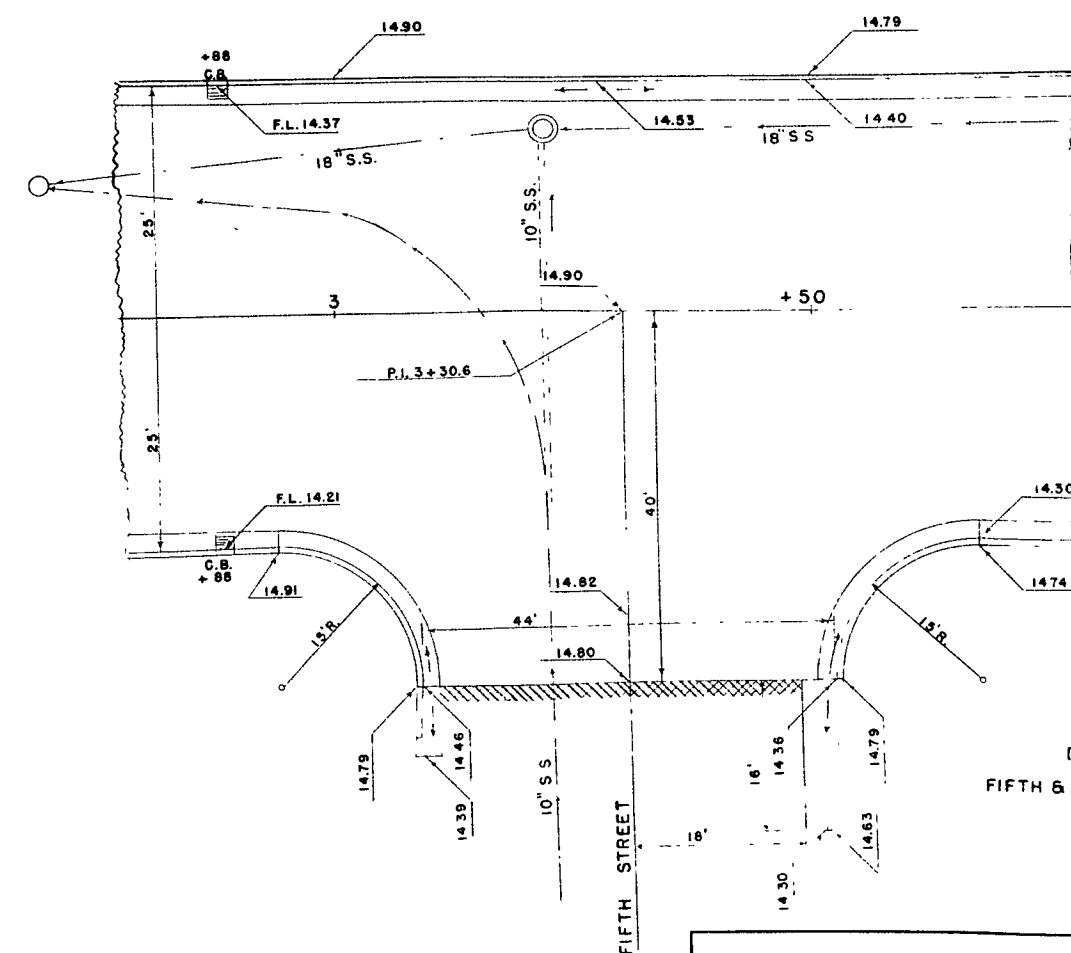



DETAIL
FIFTH & MAIN STREETS

DETAILS

46' SHEET ASPHALT PAVT.

1 INCH = 10 FT

P. R. A. DIVISION	PROJECT	SHEET NO.	TOTAL SHEETS
WIS SN	U 4702 (4)	2.3	34

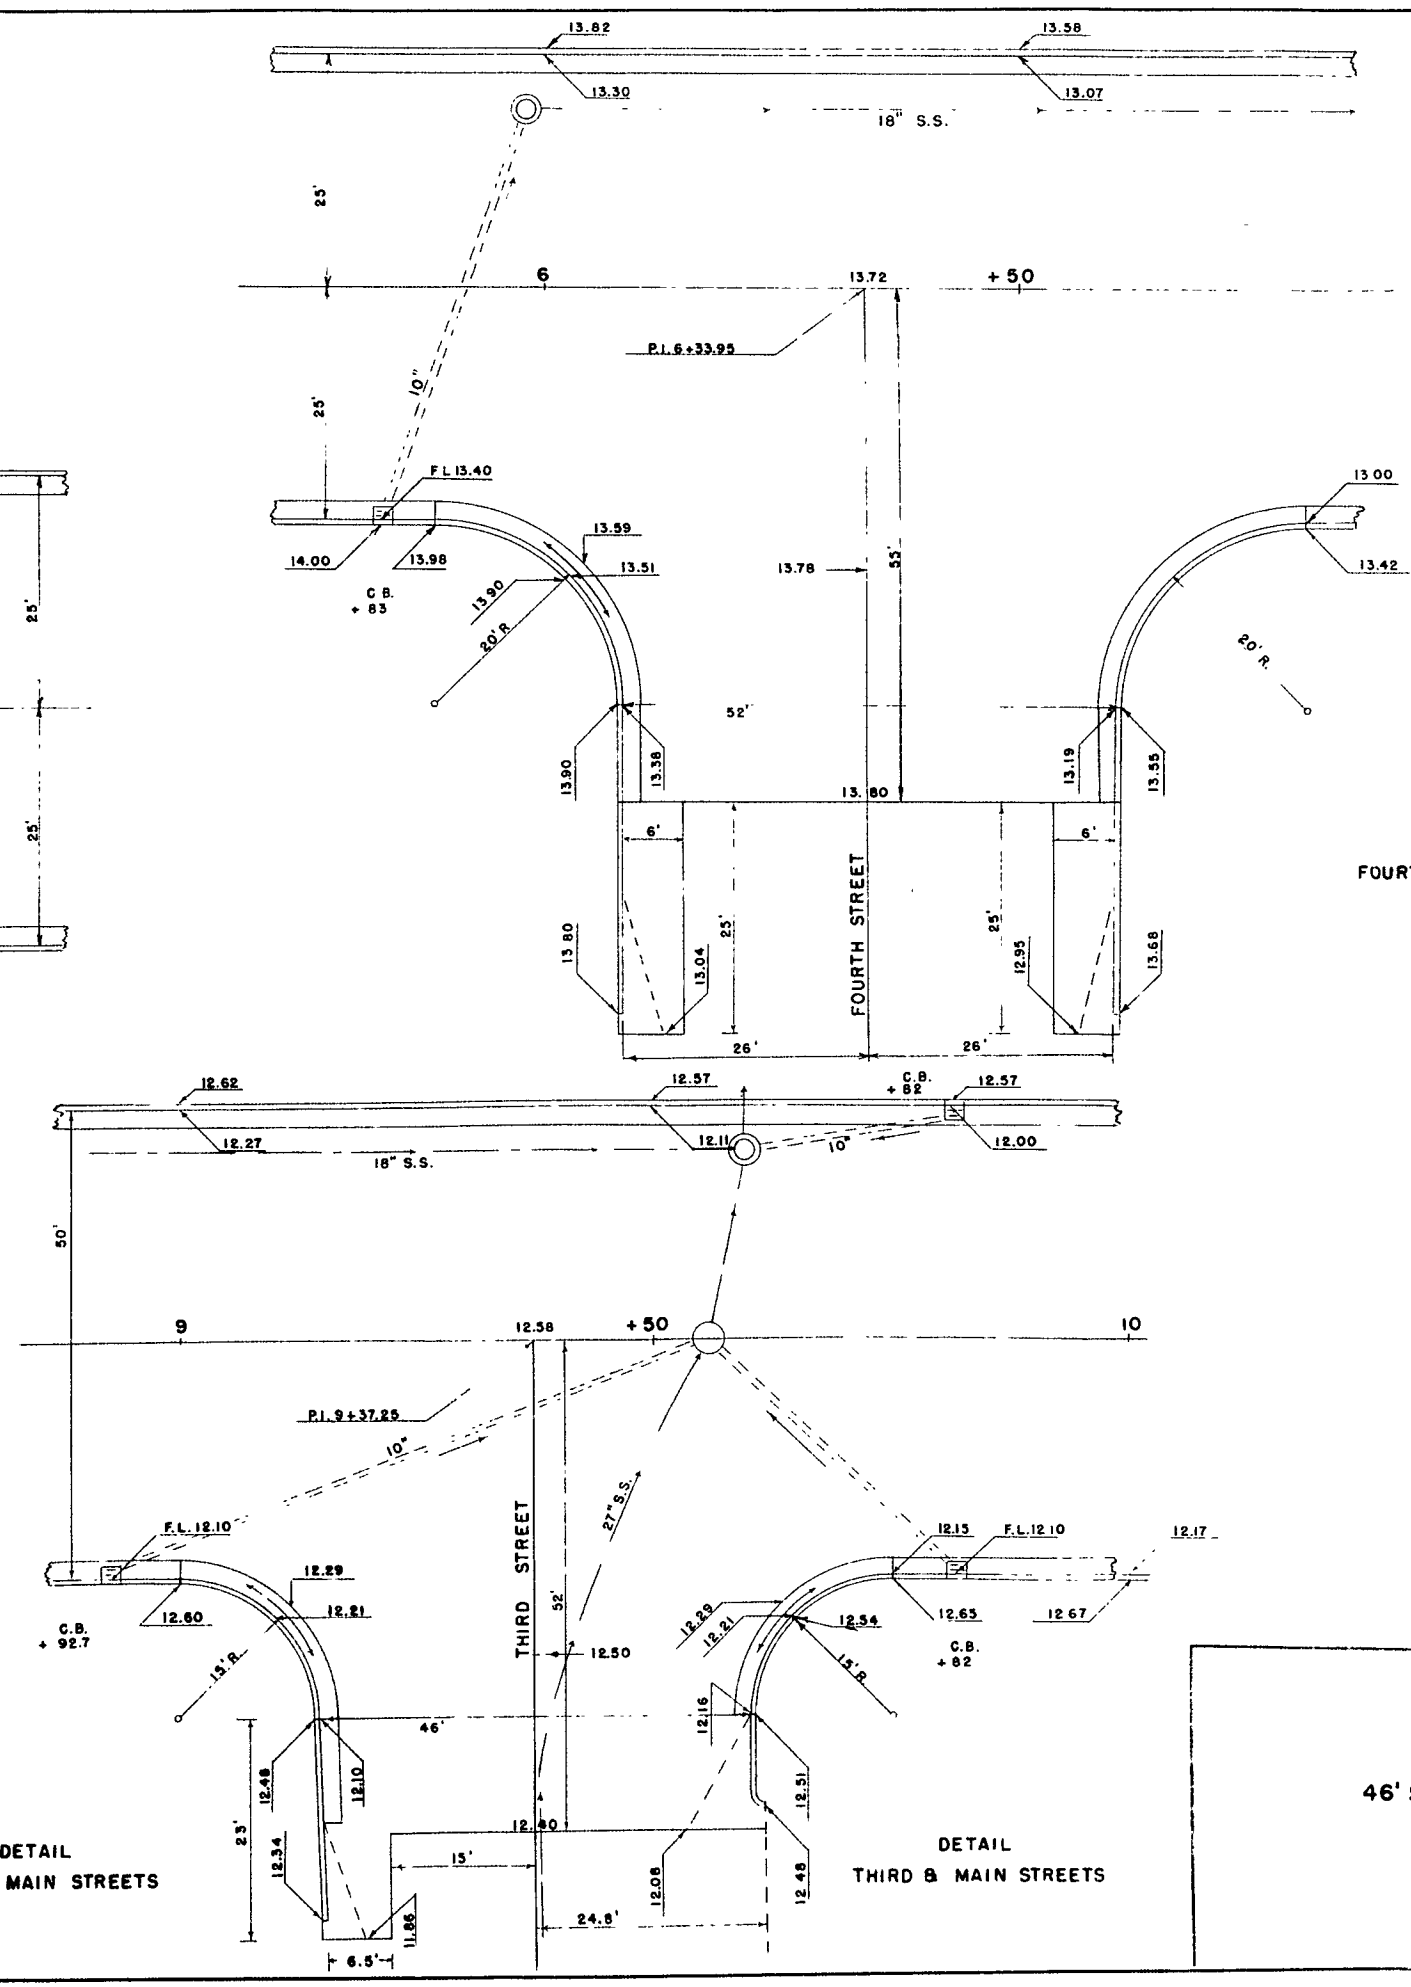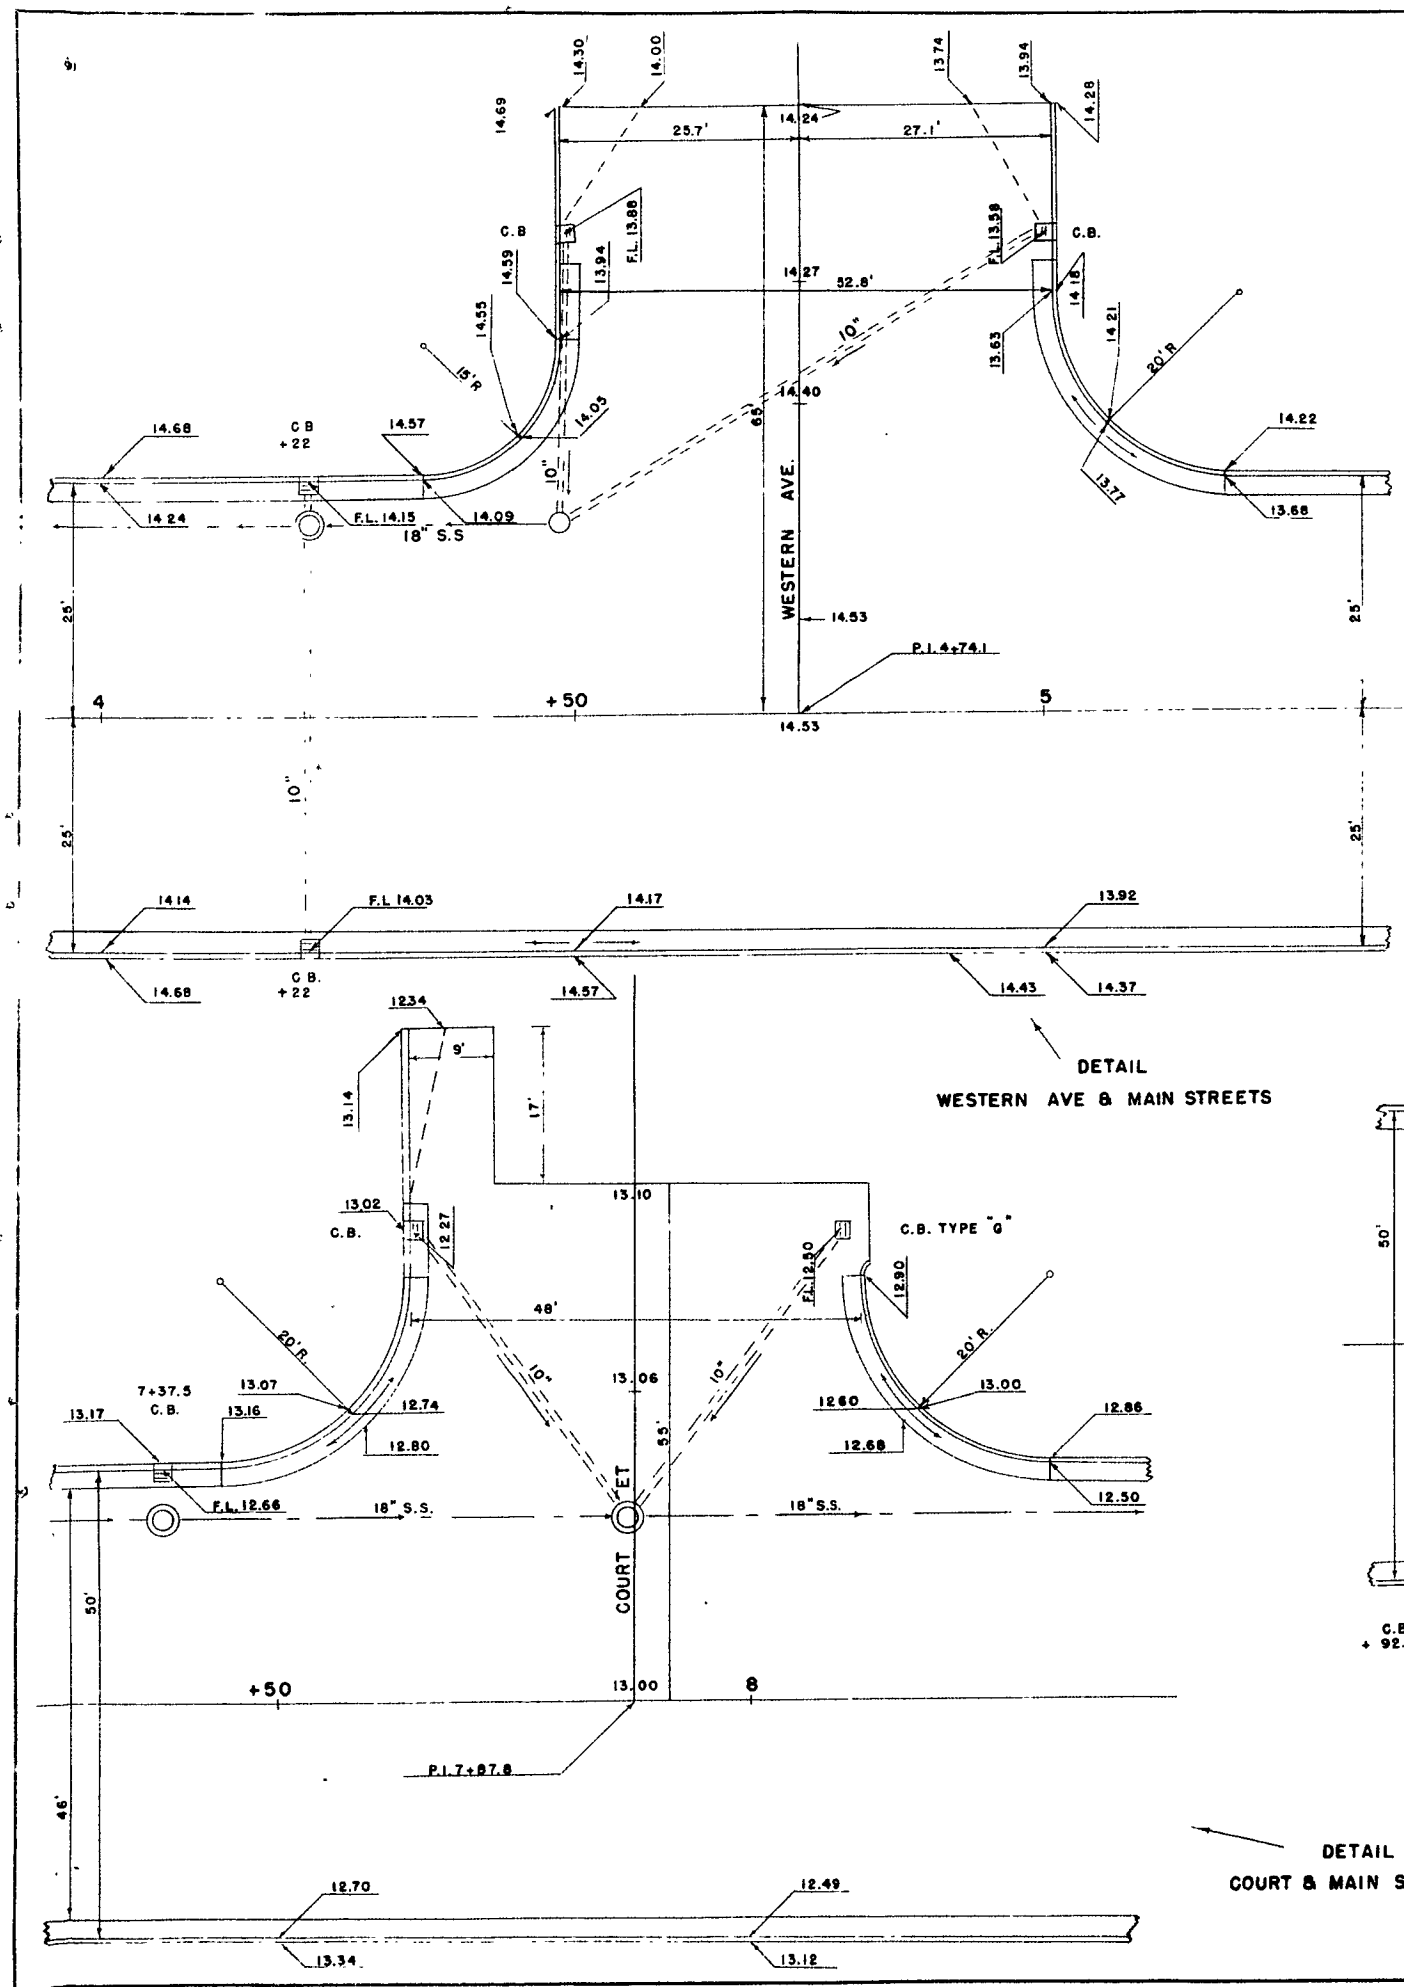

DETAIL
FOURTH & MAIN STREETS


DETAIL
COURT & MAIN STREETS

DETAIL
THIRD & MAIN STREETS


DETAILS
46' SHEET ASPHALT PAVT.

1 INCH = 10 FT.

P. R. A. DIVISION	PROJECT	SHEET NO.	TOTAL SHEETS
WIS. SN	U 4702 (4)	2.4	34

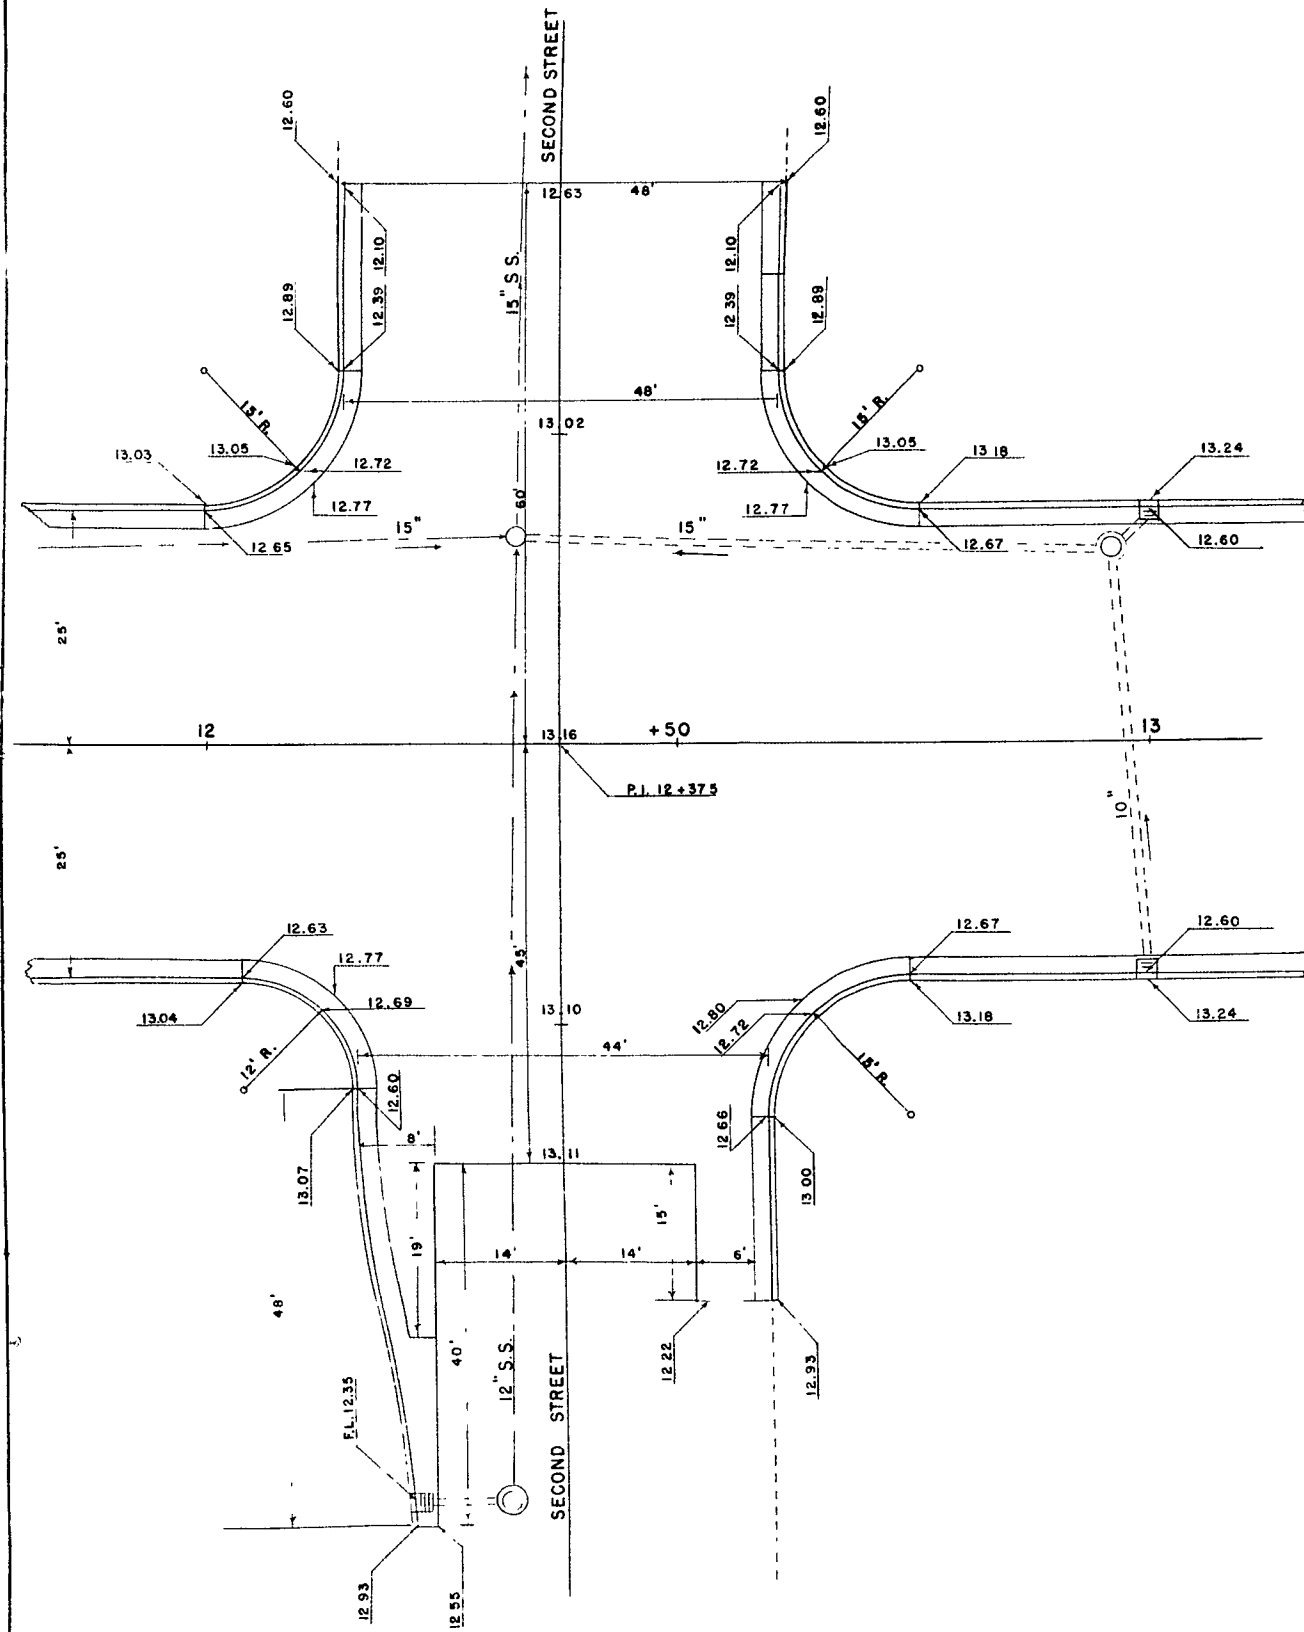

DETAIL
SECOND & MAIN STREETS

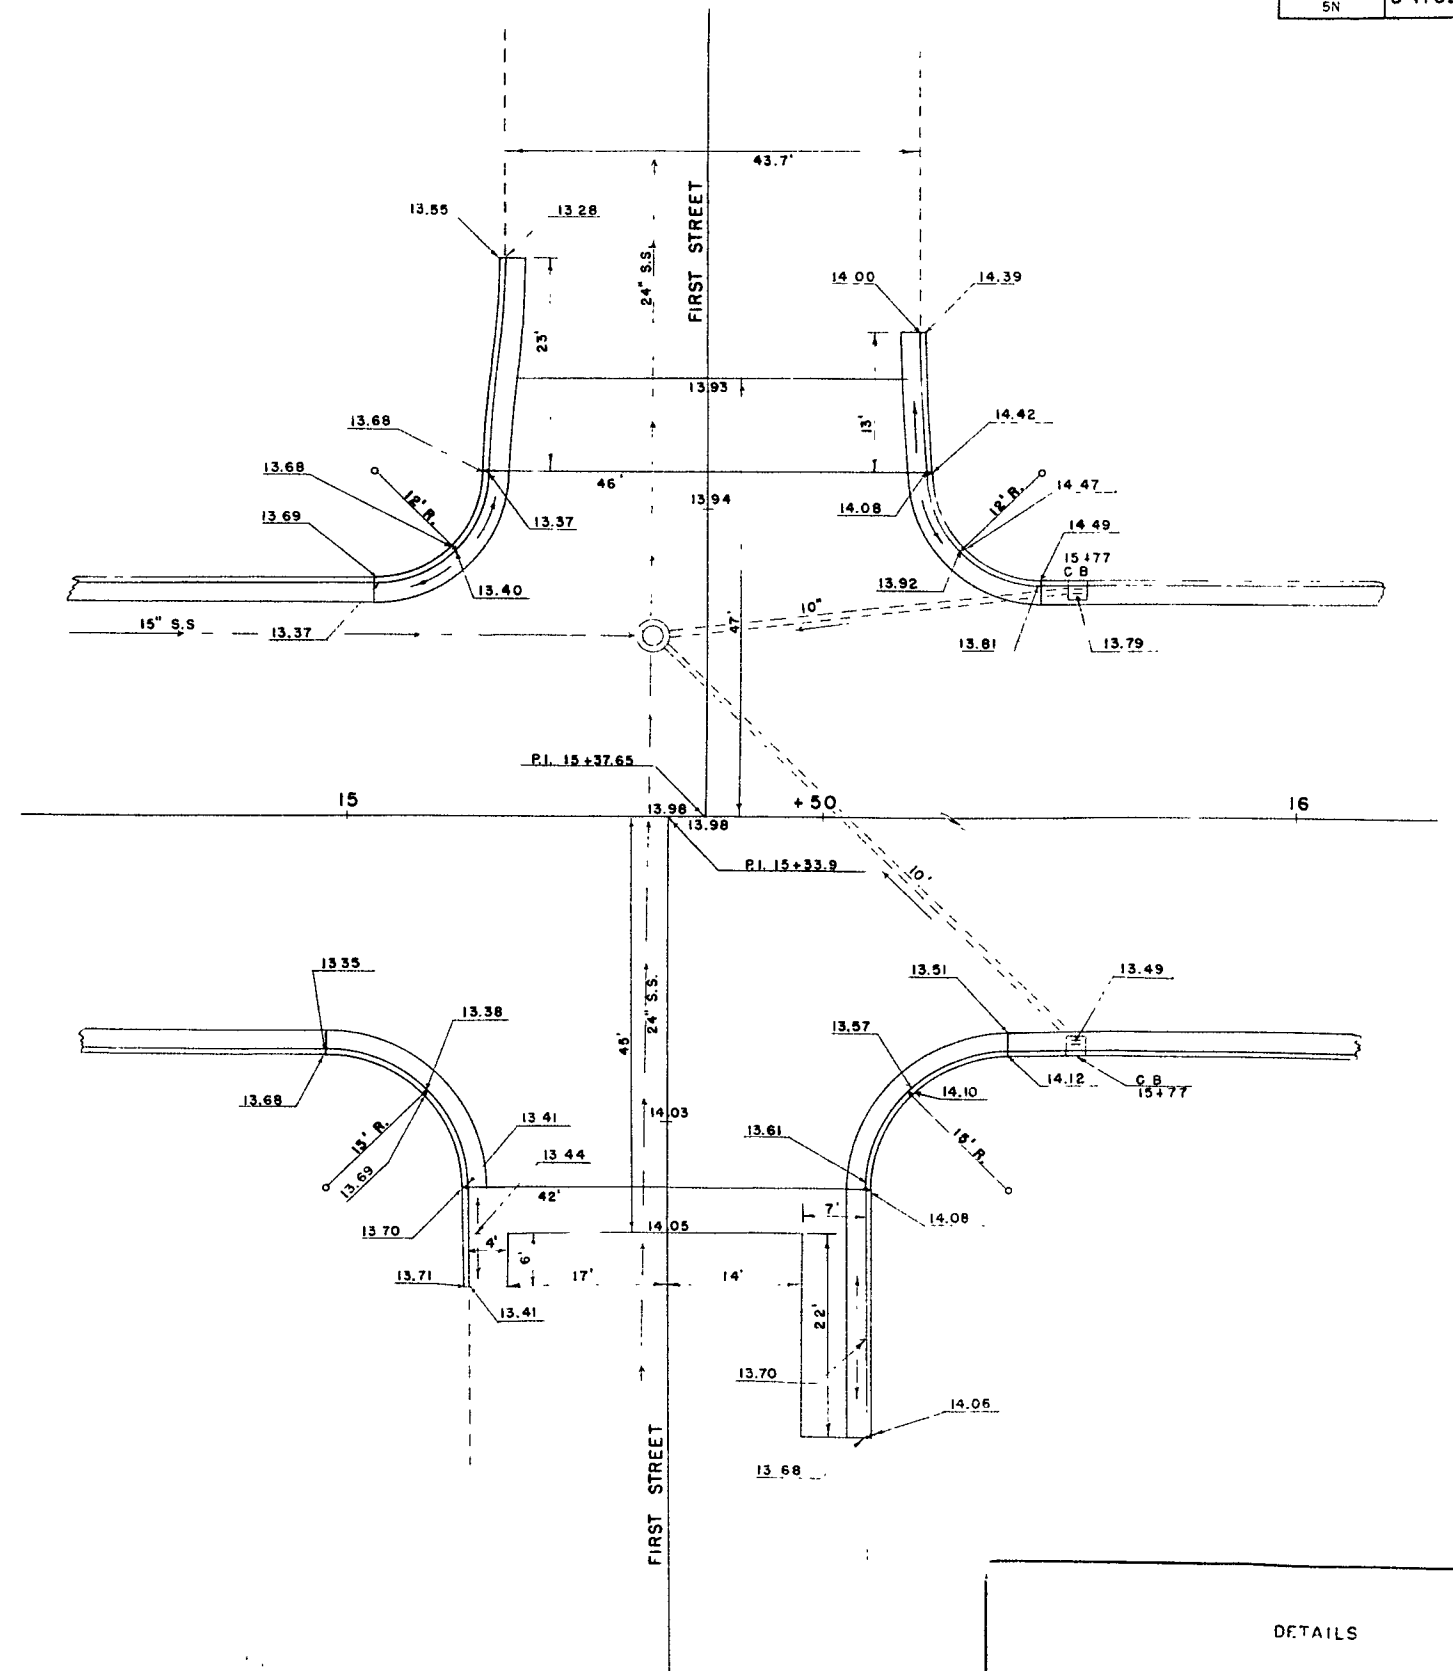


DETAIL
FIRST & MAIN STREETS

DETAILS


46' SHEET ASPHALT PAVT.

1 INCH = 10 FT

P. R. A. DIVISION	PROJECT	SHEET NO.	TOTAL SHEETS
WIS 5N	U 4702 (4)	2.5	34

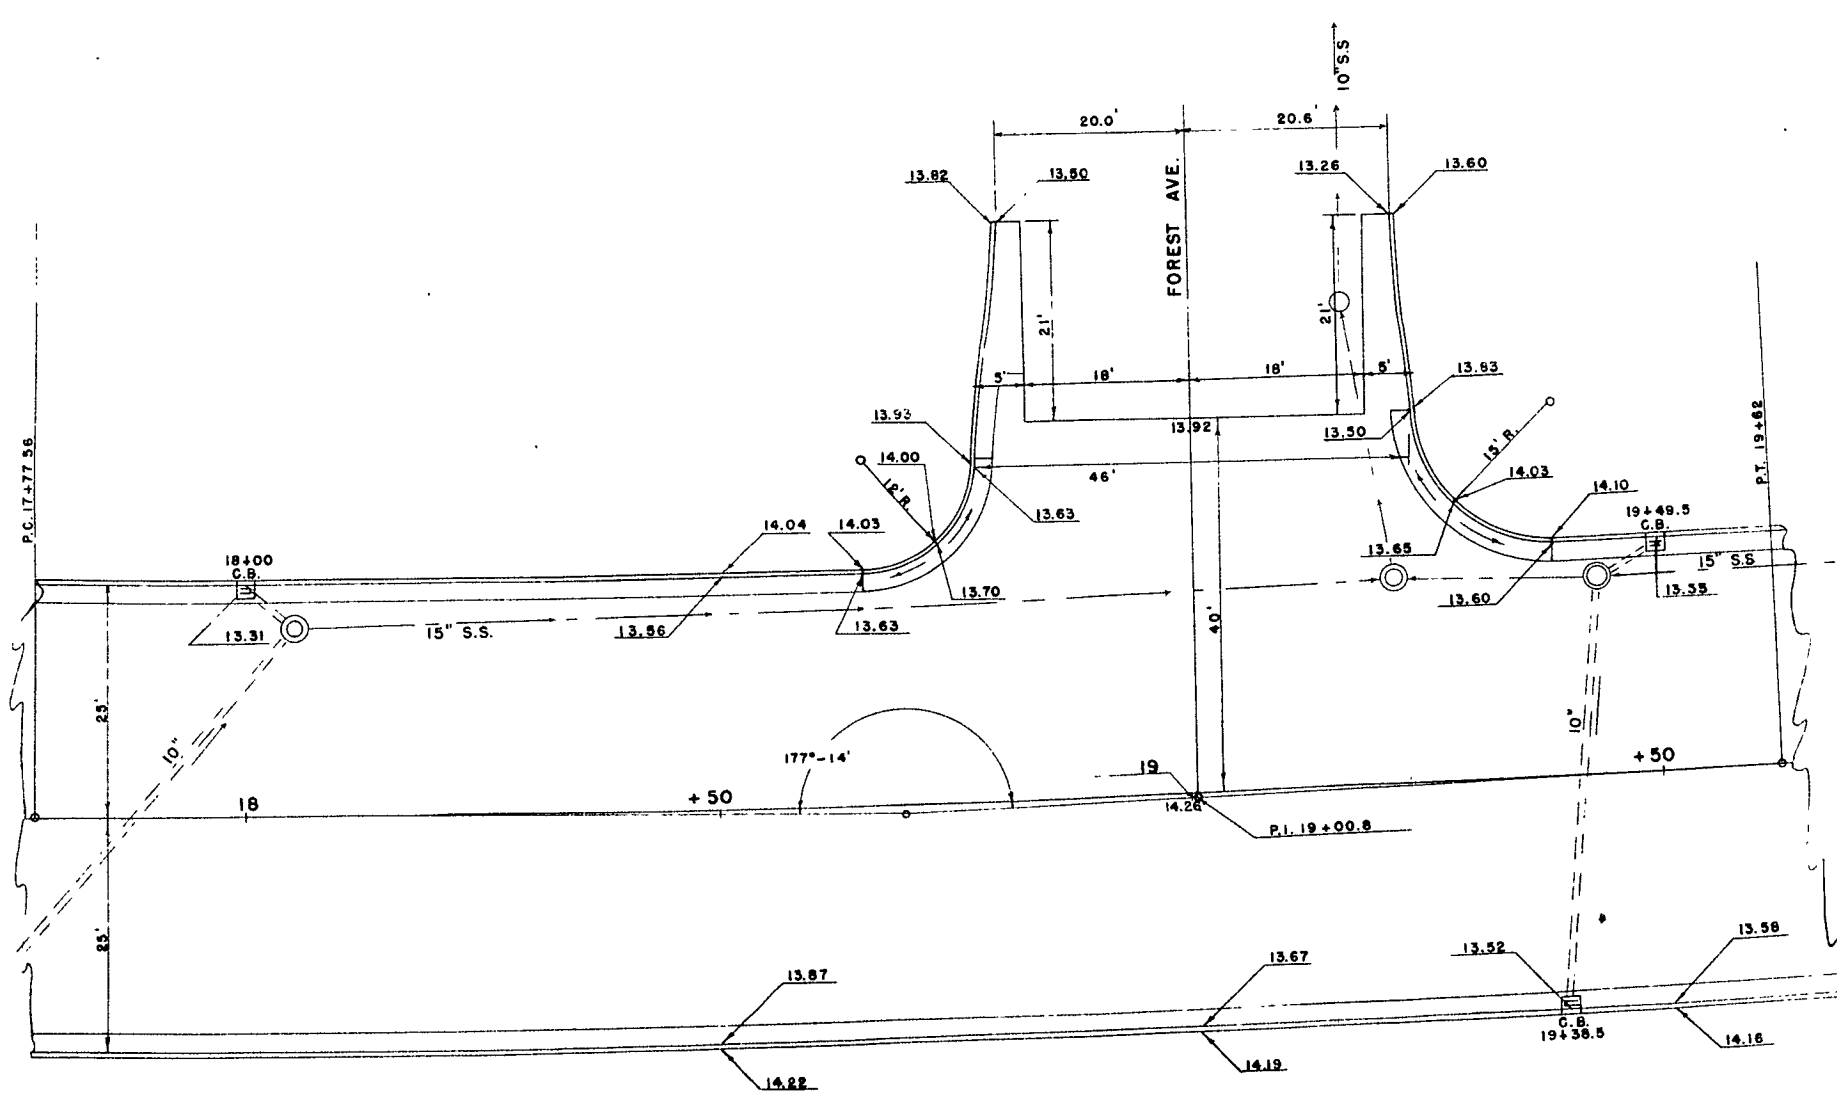


DETAIL
FOREST AVE & MAIN STREETS

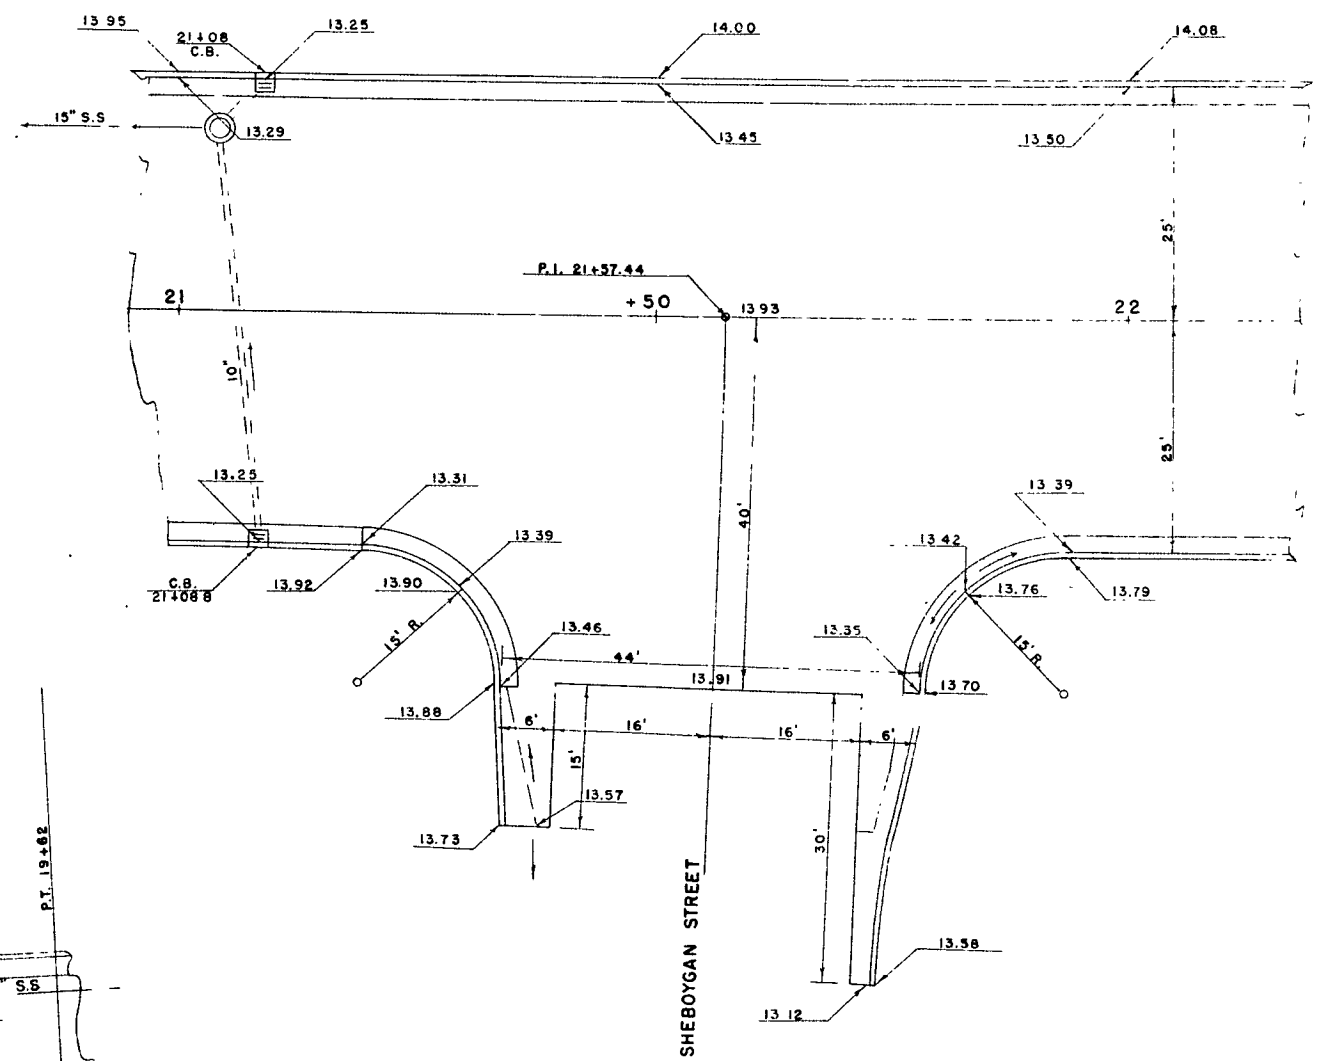


DETAIL
SHEBOYGAN & MAIN STREETS

DETAILS
46' SHEET ASPHALT PAVT.
1 INCH = 10 FT

P. R. A. DIVISION	PROJECT	SHEET NO.	TOTAL SHEETS
WIS SN	U4702 (4)	2.6	34

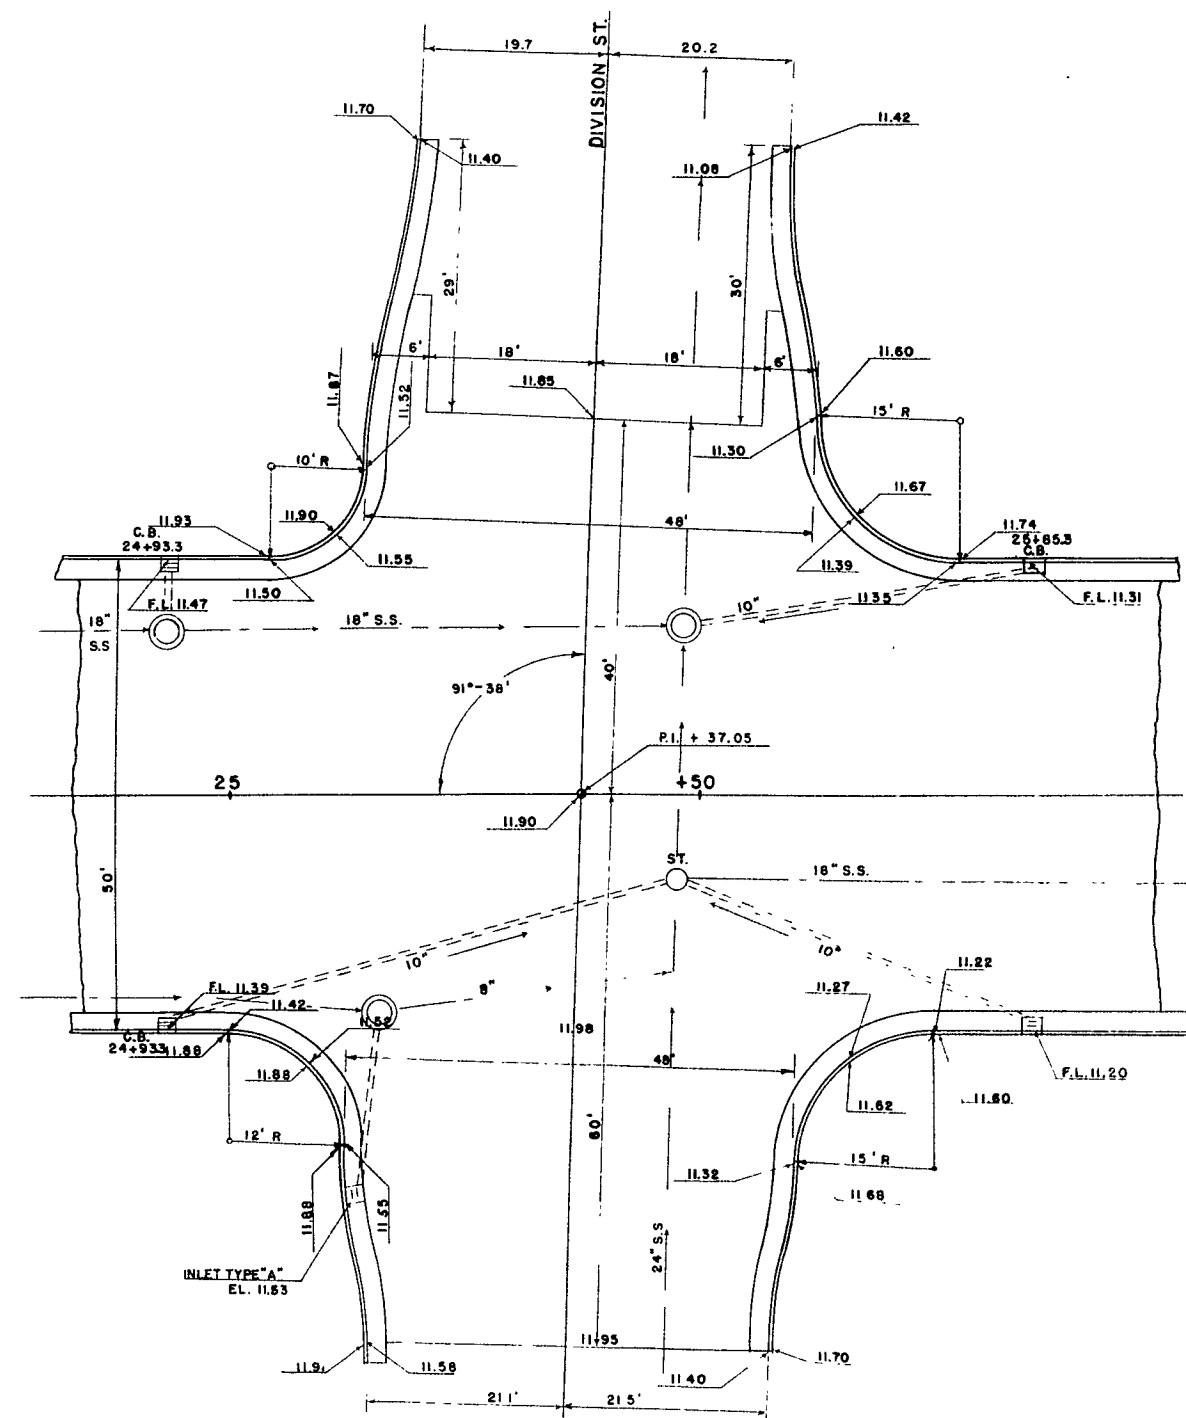

DETAIL
DIVISION & MAIN STREETS

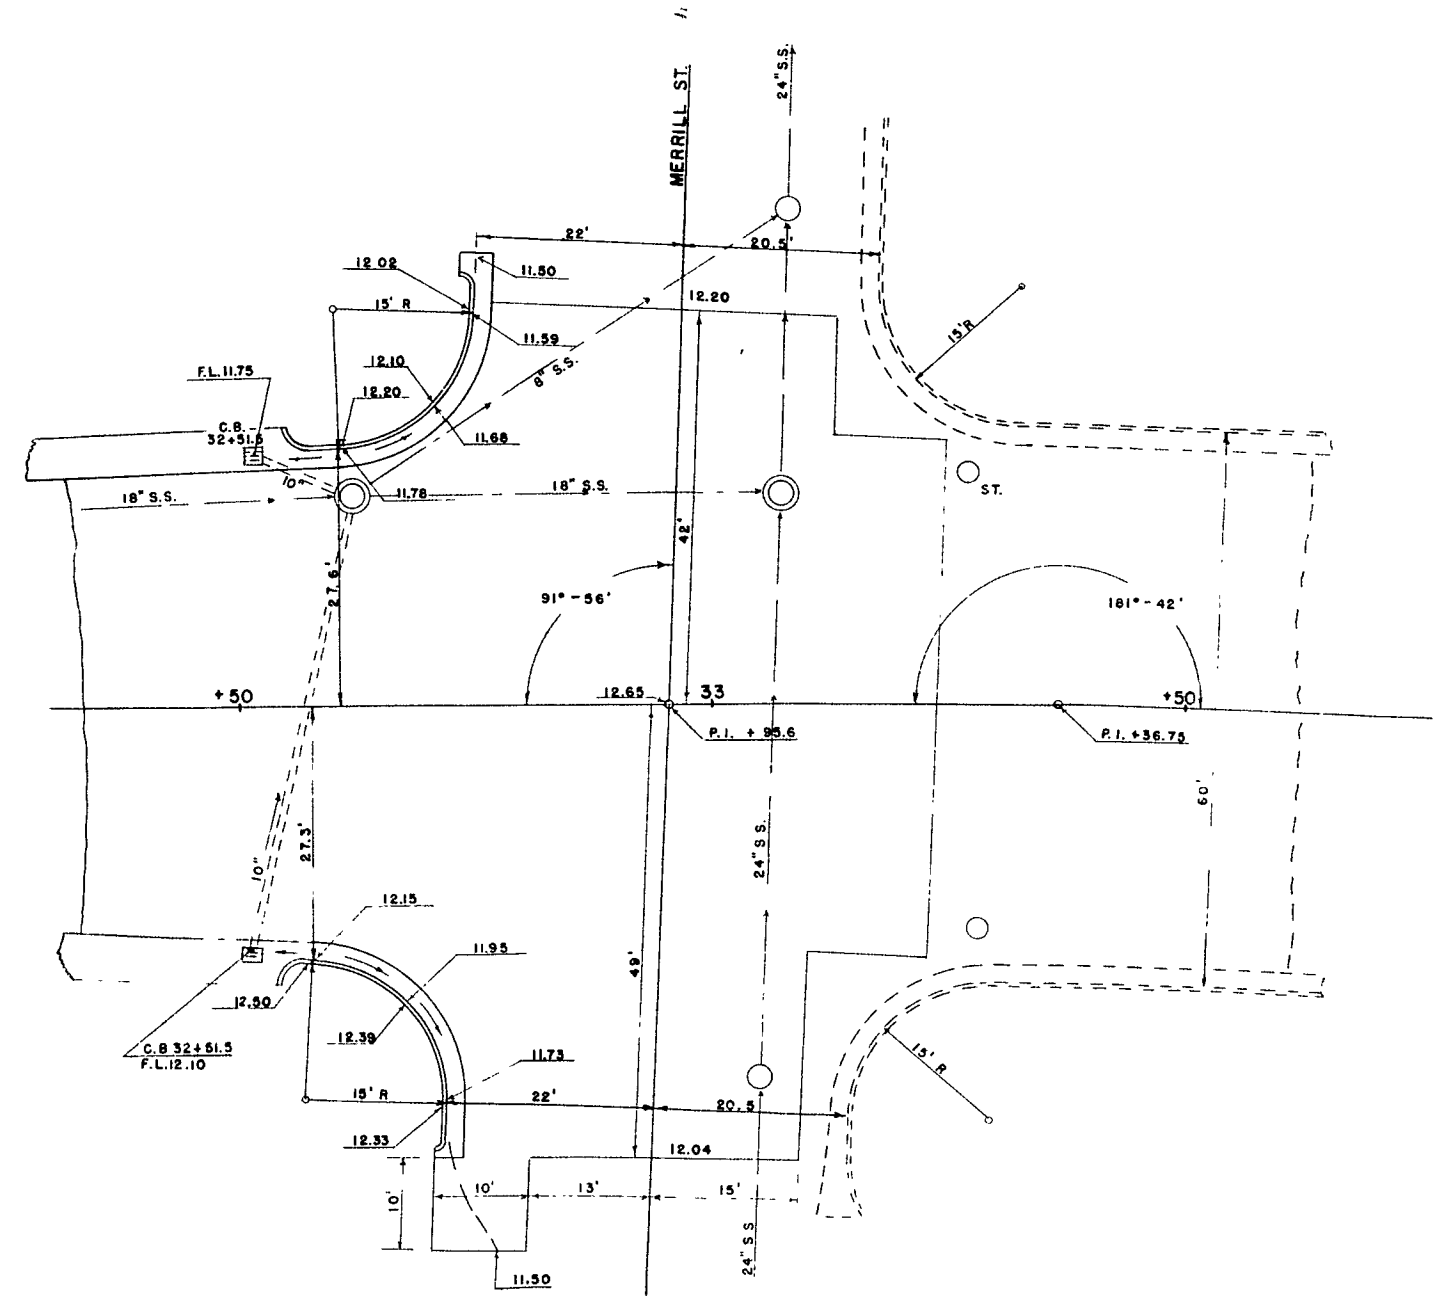

DETAIL
MERRILL & MAIN STREETS

DETAILS

46' SHEET ASPHALT PAVT.

1 INCH = 10 FT