

STATE PROJECT	FEDERAL PROJECT	
	PROJECT	CONTRACT
6200-6-71	STP 03T(4)	1
6200-6-72	BRF 03T(5)	1

STATE OF WISCONSIN
DEPARTMENT OF TRANSPORTATION

PLAN OF PROPOSED IMPROVEMENT

C.T.H. G-S.T.H. 150(WINCHESTER) S.T.H. 116-WINCHESTER

ARROWHEAD RIVER BRIDGE

S.T.H. 110
WINNEBAGO COUNTY

WINNEBAGO COUNTY

INDEX OF SHEETS

- Sheet No. 1 Title
- Sheet No. 2 - 2.14 Typical Sections and Details
- Sheet No. 3 - 3.4 Estimate of Quantities
- Sheet No. 3A - 3F Miscellaneous Quantities
- Sheet No. 4 - 4.18 Right of Way Plat
- Sheet No. 5 - 5.12 Plan and Profile
- Sheet No. 6 - 6.29 Standard Detail Drawings
- Sheet No. - Sign Plates
- Sheet No. 8 - 8.12 Structure Plans
- Sheet No. 9 - 9.2 Computer Earthwork Data
- Sheet No. 9.5 - 9.81 Cross Sections

TOTAL SHEETS = 184



STATE PROJECT NUMBER
6200-6-71

STATE PROJECT NUMBER
6200-6-72


DESIGN DESIGNATION

A.D.T. 1995	•	5,870
A.D.T. 2015	•	8,250
D.H.V.	•	350
D.	•	60-40
T.	•	7.2%
V.	•	60 M.P.H.
ESALS	•	N/A

CONVENTIONAL SIGNS


- COUNTY LINE
- CORPORATE LIMITS
- PROPERTY LINE
- LOT LINE
- LIMITED EASEMENT
- EXISTING RIGHT OF WAY
- NEW RIGHT OF WAY
- REFERENCE LINE
- SLOPE INTERCEPT
- ORIGINAL GROUND
- MARSH OR ROCK PROFILE
- CULVERT IN PLACE
- CULVERT REQUIRED
- CULVERT REQUIRED (Profile)

- COMBUSTIBLE FLUIDS (UNDER PRESSURE)
- UNDERGROUND UTILITIES
- GAS
- ELECTRIC
- TELEPHONE
- SERVICE PEDESTAL
- CABLE MARKER
- POWER POLE
- TELEPHONE POLE
- RAILROADS
- MARSH
- WOODED AREA

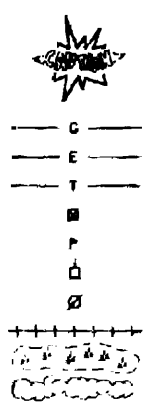

STRUCTURE C-70-50

R - 15 - E R - 16 - E

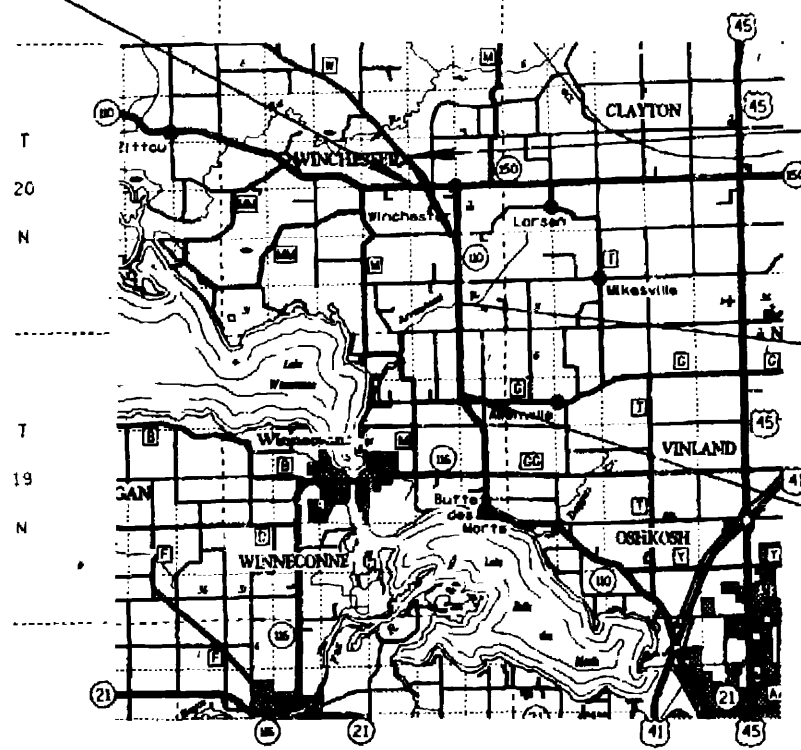

END PROJECT 6200-6-71
STA. 471+00

PROJECT 6200-6-72
EXCEPTION TO NET & LENGTH,
PROJECT 6200-6-71
STRUCTURE B-70-139
STA. 302+66.08 TO
STA. 303+27.92

BEGIN PROJECT 6200-6-71
STA. 230+00
X = 2,350,662.445
Y = 783,941.607

LAYOUT
SCALE 0 2 MI.

NET LENGTH OF CENTERLINE - 4.559 MI. PROJECT 6200-6-71
NET LENGTH OF CENTERLINE - 0.012 MI. PROJECT 6200-6-72
TOTAL NET LENGTH OF CENTERLINE - 4.565 MI.

ALL COORDINATES ON THIS PLAN ARE REFERENCED TO THE WISCONSIN COORDINATE SYSTEM SOUTH ZONE.

AS BUILT PLAN
NO.

SUPERVISOR A. Rozite
RESIDENT Kurt Wranowsky
CONTRACTOR The Zingaro Companies
COMPLETED 6-28-95

STATE OF WISCONSIN DEPARTMENT OF TRANSPORTATION	
PREPARED BY	DISTRICT 3
Surveyor	A. P. ALLARD
Designer	A. P. ALLARD
DISTRICT EXAMINER	W. J. RINGBOM
DISTRICT SUPERVISOR	M. J. BENG
Proj. Dev. Engineer	D. S. LAFORD
C.O. Examiner	J. E. GOODMAN

APPROVED FOR DISTRICT OFFICE
DATE: 10/1/93 Michael J. Beng (Signature)

AUTHORIZED FOR CENTRAL OFFICE DESIGN
DATE: 11/5/93 Michael J. Beng (Signature)

6200-6-71 & 6200-6-72 WINNEBAGO