

INDEX OF SHEETS

Sheet No. 1	Title
Sheet No. 2-1-2-11	Typical Sections and Details
Sheet No. 3-1-3-2	Estimate of Quantities
Sheet No. 3A	Miscellaneous Quantities
Sheet No. 4	Right of Way Plat
Sheet No. 5-1-5-6	Plan and Profile
Sheet No. 6-1-6-8	Standard Detail Drawings
Sheet No. 7-1	Sign Plates
Sheet No. 8-1-8-72	Structure Plans
Sheet No. 9	Computer Earthwork Data
Sheet No. 10	Cross Sections

TOTAL SHEETS = 102



DESIGN DESIGNATION


ADT (2000)	= 10,800 - 15,800
ADT (2020)	= 16,200 - 22,600
DHV (2020)	= 1,782-4,268
T (% ADT)	= 14.4%
DESIGN SPEED	= 70 MPH
D.	= 60-40%
ESAL'S	= 9,521,755

CONVENTIONAL SIGNS


COUNTY LINE	-----
CORPORATE LIMITS	=====
PROPERTY LINE	-----
LOT LINE	-----
LIMITED HIGHWAY EASEMENT	-----
EXISTING RIGHT OF WAY	-----
REFERENCE LINE	-----
SLOPE INTERCEPT	-----
ORIGINAL GROUND	-----
MARSH OR ROCK PROFILE	-----
CULVERT IN PLACE	-----
CULVERT REQUIRED	-----
CULVERT REQUIRED (PROFILE)	-----
SAWCUT AND MATCH EXISTING PAVEMENT	XXXXXXXXXX
COMBUSTABLE FLUID (UNDER PRESSURE)	-----
SOD	-----
EROSION MAT	-----
SILT FENCE	-----
RIPRAP	-----
ABANDON SEWER	-----
REMOVE SEWER	-----

UNDERGROUND UTILITIES	
GAS	----- G -----
ELECTRIC	----- E -----
TELEPHONE	----- T -----
FIBER OPTIC CABLE	----- FOC -----
UTILITY TO BE ABANDONED	XXXXXXXXXX
SERVICE PEDESTAL	-----
CABLE MARKER	-----
POWER POLE, TELEPHONE POLE	-----
TELEPHONE POLE	-----
LIGHT POLE (PRIVATE)	-----
SIGN	-----
INLET	-----
MANHOLE	-----
MARSH	-----
WOODED AREA	-----
RAILROADS	-----
FENCE	-----
TREE TO BE REMOVED	-----
STUMPS	-----
BEAMGUARD	-----

WAUPACA CO.
WINNEBAGO CO.

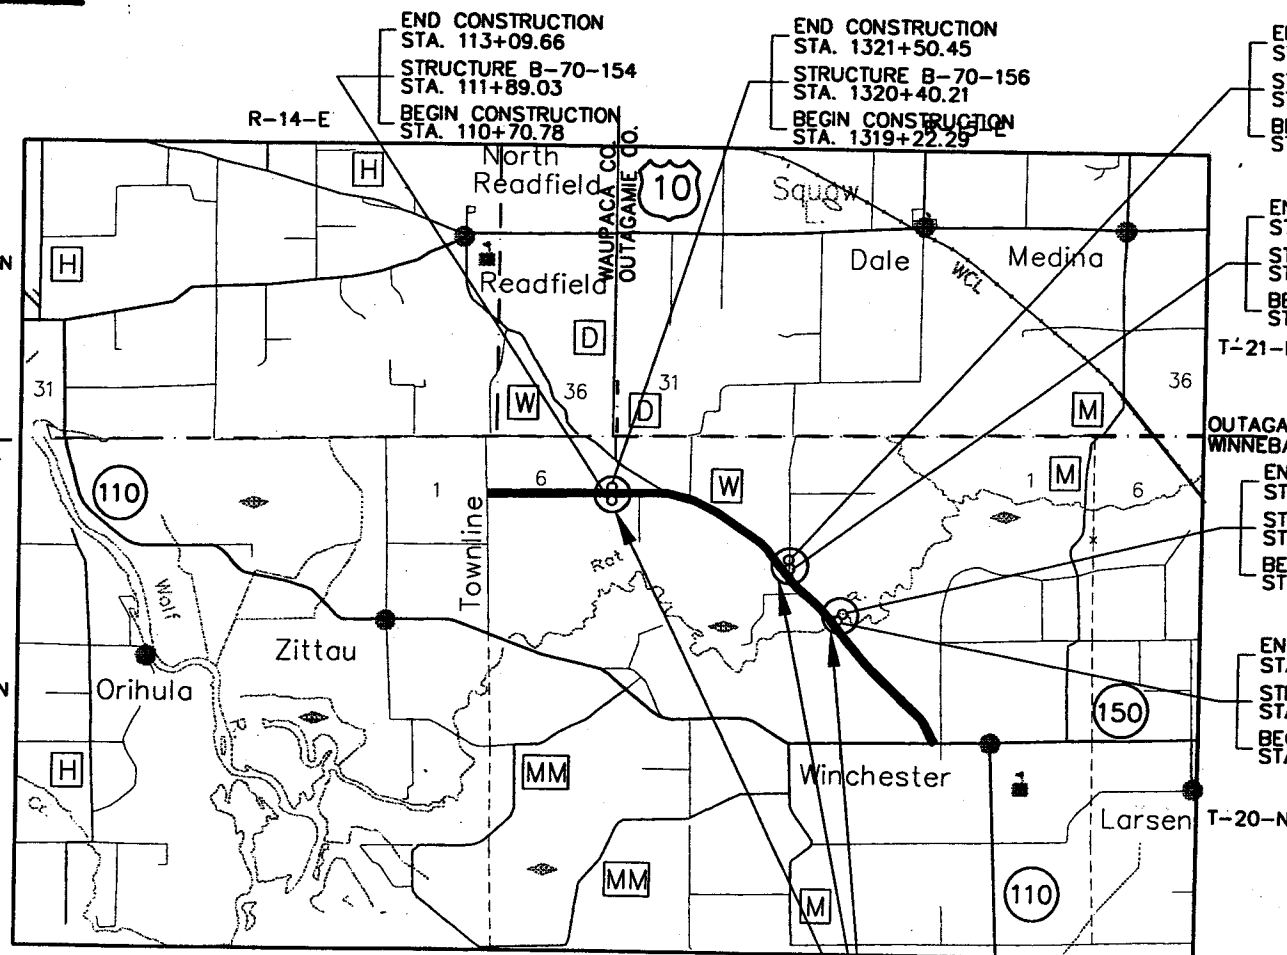

LAYOUT

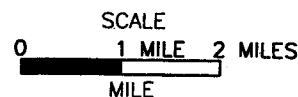

TOTAL NET LENGTH OF CENTERLINE = 0.0000 MI. (RURAL)

ELEVATIONS ARE BASED ON NAVD '29. COORDINATES ON THIS PLAN ARE GRID COORDINATES BASED ON THE WISCONSIN STATE PLANE COORDINATE SYSTEM, CENTRAL ZONE, NAD 27.

STATE OF WISCONSIN DEPARTMENT OF TRANSPORTATION

PLAN OF PROPOSED IMPROVEMENT

CTH D - NORTH LOOP ROAD

RAT RIVER - USH 10/CTH D INTERCHANGE

USH 10

WINNEBAGO COUNTY

AS BUILT PLAN
NO.

SUPERVISOR BRUCE ENKE / ROGER RAHLF

RESIDENT NELSON GOUBEUX / MITCH BOURN

CONTRACTOR LUNDA CONSTRUCTION

COMPLETED 05-05-03 MDB

STATE PROJECT NUMBER

1517 - 04 - 73

STATE PROJECT


1517 - 04 - 73

FEDERAL PROJECT

PROJECT

CONTRACT

ORIGINAL PLANS PREPARED BY
K&A KAPUR & ASSOCIATES
CONSULTING ENGINEERS
MILWAUKEE, WISCONSIN

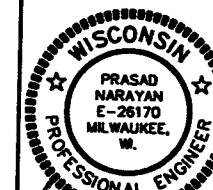

DATE: 11/27/01
Signature: Prasad Narayan

STATE OF WISCONSIN
DEPARTMENT OF TRANSPORTATION

PREPARED BY

Surveyor	WIS DOT 3
Designer	Kapur & Assoc., Inc.
District Examiner	WILLIAM BERTRAND
District Supervisor	BRUCE ENKE
Project Dev. Engineer	BRIAN REVELLO
C.O. Plan Examiner	C. BUJANOWSKI

APPROVED FOR DISTRICT OFFICE

DATE: 12/11/01
Signature: William R. Bertrand