

ORDER OF SHEETS

Section No. 1	Title
Section No. 2	Typical Sections and Details
Section No. 3	Estimate of Quantities
Section No. 5	Miscellaneous Quantities
Section No. 6	Plan
Section No. 7	Standard Detail Drawings
Section No. 8	Structure Plans

TOTAL SHEETS = 170

Section No. 8 ADD SHEET 167A



PROJECT ID: 1440-24-71, 4010-14-71 & 4015-13-60
WITH: 4015-16-71

COUNTY: SHEBOYGAN

CONVENTIONAL SYMBOLS

- PLAN
- CORPORATE LIMITS
- REFERENCE LINE
- COMBUSTIBLE FLUIDS
- UTILITIES
- ELECTRIC
- FIBER OPTIC
- GAS
- SANITARY SEWER
- STORM SEWER
- TELEPHONE
- WATER
- UTILITY PEDESTAL
- POWER POLE
- TELEPHONE POLE

A.A.D.T. 2011	=	21,900
A.A.D.T. 2031	=	27,900
D.H.V.	=	1,710
D.O.	=	62/38
T.	=	11.4%
DESIGN SPEED	=	60 MPH
ESALS	=	4,197,500



Subcontractor List
Highway Landscapers, Inc.
Vista Design and Construction
Barricade Flasher Supply
MegaRentals

SHEBOYGAN COUNTY

STH 23

(SHEBOYGAN RIVER BRIDGE)

1440-24-71
STATE PROJECT NUMBER

SHEBOYGAN COUNTY

STH 28

(VARIOUS STRUCTURES)

4010-14-71
STATE PROJECT NUMBER

SHEBOYGAN COUNTY

STH 57

(SOUTH COUNTY LINE - STH 32)

4015-13-60
STATE PROJECT NUMBER

STATE OF WISCONSIN
DEPARTMENT OF TRANSPORTATION
STATE HIGHWAY REHABILITATION-MAINTENANCE PROJECT


STATE PROJECT	FEDERAL PROJECT	
	PROJECT	CONTRACT
	1440-24-71	1
4010-14-71		1
	WISC 2012 227	1
4015-13-60		

PLYMOUTH - SHEBOYGAN FALLS WALDO - PLYMOUTH WALDO - STH 32

END PROJECT 4015-13-60
STA 1378+61.67
PROJECT 4010-14-71
STRUCTURE B-59-06
PROJECT 4010-14-71
STRUCTURE B-59-05
PROJECT 1440-24-71
STRUCTURE B-59-88
PROJECT 4010-14-71
STRUCTURE B-59-92
PROJECT 4010-14-71
STRUCTURE B-59-13
PROJECT 4015-13-60
STA 100+01.39
X = 158,287.732
Y = 101,004.317

PROJECT ID: 1440-24-71 TOTAL NET LENGTH OF CENTERLINE = 0.050 MI.
PROJECT ID: 4010-14-71 TOTAL NET LENGTH OF CENTERLINE = 0.170 MI.
PROJECT ID: 4015-13-60 TOTAL NET LENGTH OF CENTERLINE = 24.145 MI.

LAYOUT
SCALE 0 3 MI.

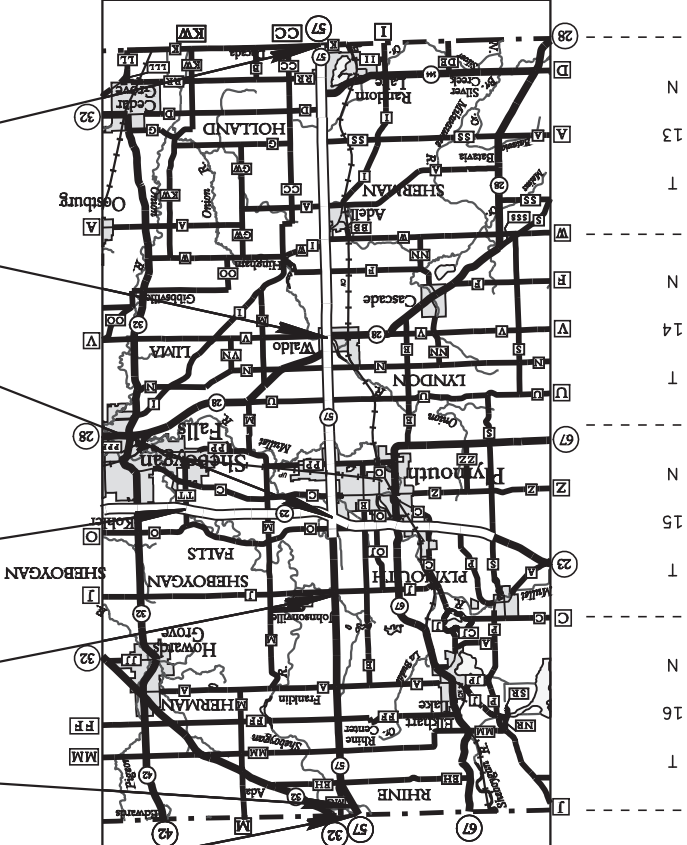

ALIGNMENT DATA IS BASED ON ASBUILTS WITHOUT ANY FIELD SURVEY DATA AND IS TO BE USED FOR REFERENCE ONLY.

APPROVED FOR THE DEPARTMENT
DATE: 2-1-12
(Signature)

PREPARED BY
SURVEYOR
DESIGNER
PROJECT MANAGER
REGIONAL SUPERVISOR
C.O. EXAMINER
S. NOEL
J. RINZEL
P. BRAUER

STATE OF WISCONSIN
DEPARTMENT OF TRANSPORTATION

B-59-13 STA 583+28.10 TO 583+71.10
B-59-15 STA 750+89.80 TO 751+30.62
B-59-04 STA 807+91.61 TO 808+04.89
B-59-05 STA 998+57.51 TO 999+01.51
B-59-308 STA 1158+34.03 TO 1159+75.19
B-59-06 STA 1360+00.75 TO 1360+94.45

AS-BUILT PLAN
SUPERVISOR: JIM THOMPSON
PROJECT MANAGER: PAUL BRAUER
PROJECT LEADER: KEVIN JUMP
CONTRACTOR: VINTON
WORK STARTED: 8/13/12
WORK COMPLETED: 11/27/13

