

DEC 13 2002

INDEX OF SHEETS

Sheet No. 1	Title
Sheet No.	Typical Sections and Details
Sheet No.	Estimate of Quantities
Sheet No.	Miscellaneous Quantities
Sheet No.	Right of Way Plat
Sheet No.	Plan and Profile
Sheet No.	Standard Detail Drawings
Sheet No.	Sign Plates
Sheet No.	Structure Plans
Sheet No.	Computer Earthwork Data
Sheet No.	Cross Sections

TOTAL SHEETS = 231

STATE OF WISCONSIN
DEPARTMENT OF TRANSPORTATION

PLAN OF PROPOSED IMPROVEMENT

CHIPPEWA FALLS - CORNELL ROAD

(C.T.H. 'Y' TO C.T.H. 'R')

STH 178

CHIPPEWA COUNTY

STATE PROJECT NUMBER
8600-02-71

STATE PROJECT	FEDERAL PROJECT	
	PROJECT	CONTRACT
8600-02-71	STP 2003130	1

AS BUILT PLAN
PROJECT ENGINEER RICHARD P. TUMANIEC
GENERAL CONTRACTOR SAN CONSTRUCTION
7/17/2003
BEGIN & END CONSTRUCTION 7/27/2004
CONTRACT COST \$3,044,675.90
C.C.O. #'S 1,2,3,4,5 - \$79,836.65
Contract 20030114037



DESIGN DESIGNATION

A.D.T. (2003)	=	2000
A.D.T. (2023)	=	2400
D.H.V. (2023)	=	
D.	=	60/40
T.	=	8%
DESIGN SPEED	=	55MPH
ESALS	=	365,000

BEGIN PROJECT 8600-02-71

STA. 789+50.878
X = 1638851.503
Y = 447447.077


CONVENTIONAL SYMBOLS

COUNTY LINE	
CORPORATE LIMITS	
PROPERTY LINE	
LOT LINE	
LIMITED EASEMENT	
EXISTING RIGHT OF WAY	
PROPOSED OR NEW R/W LINE	
SURVEY LINE	
SLOPE INTERCEPT	
ORIGINAL GROUND	
MARSH OR ROCK PROFILE (To be noted as such)	
MARSH AREA	
WOODED OR SHRUB AREA	

COMBUSTIBLE FLUIDS	
UNDERGROUND UTILITIES	
GAS	
ELECTRIC	
TELEPHONE OR TELEGRAPH	
COMMUNICATIONS LINE	
SERVICE PEDESTAL	
POWER POLE	
TELEPHONE POLE	
RAILROAD	
SANITARY SEWER	
STORM SEWER	
WATER	
EXISTING CULVERT	
PROPOSED CULVERT (Box or Pipe)	
CULVERT (Profile View)	



G	
E	
T	
C	
SA	
SS	
W	
SA	
SS	
W	

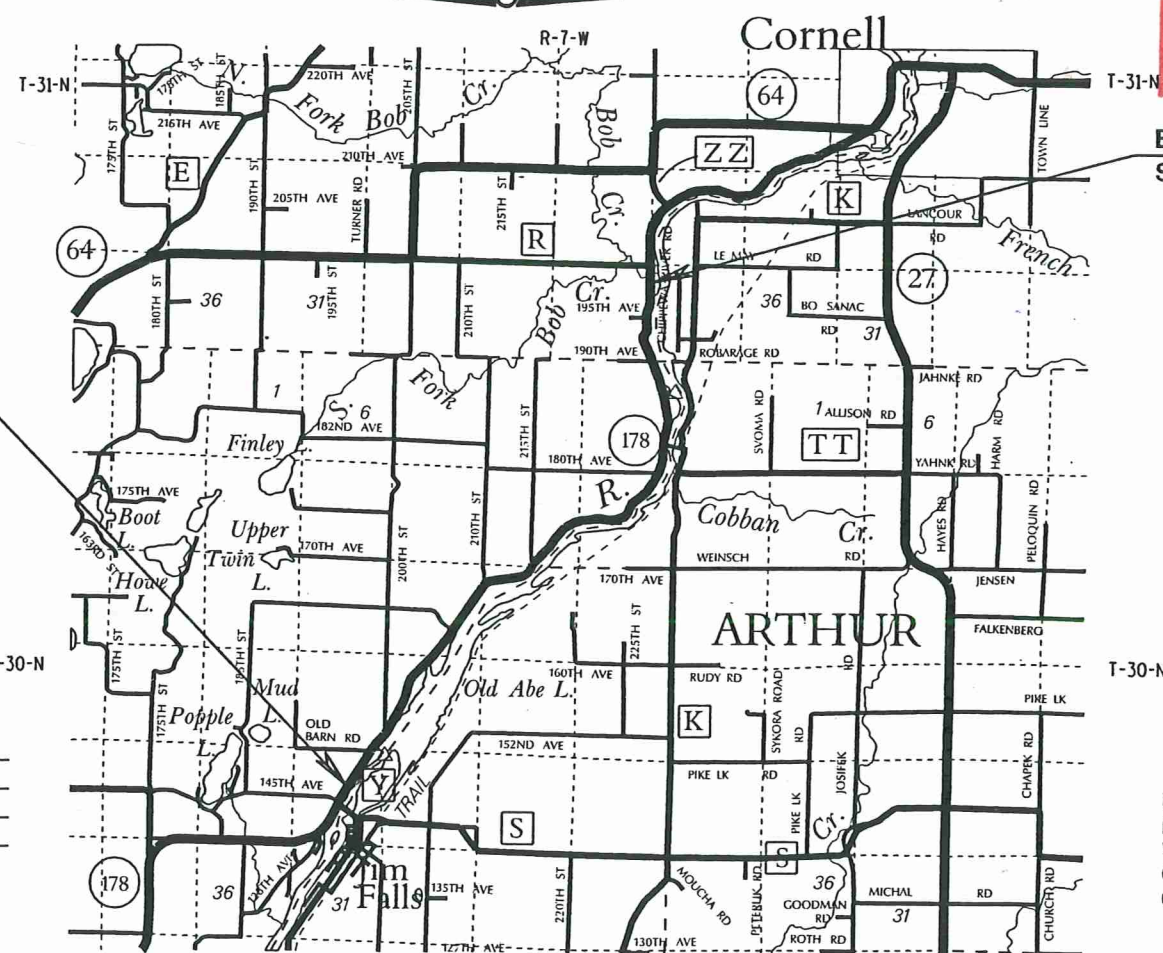

LAYOUT
SCALE 0 1 MI.

TOTAL NET LENGTH OF CENTERLINE = 7.093 MI.

END PROJECT 8600-02-71
STA. 1164+04.542

NOTE: "Coordinates on this plan are referenced to the Wisconsin State Plane Coordinate System, Central Zone, NAD83 (1991)"

STATE OF WISCONSIN
DEPARTMENT OF TRANSPORTATION

PREPARED BY	DISTRICT 6
Surveyor	KARL S. KOPACZ
Designer	S. IVES
District Examiner	R. SHERMO
District Supervisor	M. OSTROWSKI
Proj. Dev. Engineer	C. BUJANOWSKI
C.O. Examiner	

APPROVED FOR DISTRICT OFFICE
DATE: 9/25/02