

DEPARTMENT OF TRANSPORTATION

PLAN OF PROPOSED IMPROVEMENT

I.H.94 - EAU CLAIRE ROAD

(C.T.H. "AA" INTERCHANGE)

U.S.H. 53

EAU CLAIRE COUNTY

STATE PROJECT NUMBER

7255-05-71


AS BUILT

STATE PROJECT	FEDERAL PROJECT	
	PROJECT	CONTRACT
7255 - 05 - 71	_____	—

Index of Sheets

Sheet No.	1	Title
Sheet No.	2 - 2.21	Typical Sections and Details
Sheet No.	3 - 3.4	Estimate of Quantities
Sheet No.	3A- 3E	Miscellaneous Quantities
Sheet No.	4 - 4.3	Right of Way Plat
Sheet No.	5 - 5.6	Plan and Profile
Sheet No.	6 - 6.25	Standard Detail Drawings
Sheet No.	7 - 7.35	Standard Sign Plates
Sheet No.	8 - 8.22	Structure Plans
Sheet No.	-	Computer Earthwork Data
Sheet No.	9 - 9.58	Cross Sections

TOTAL SHEETS = 190

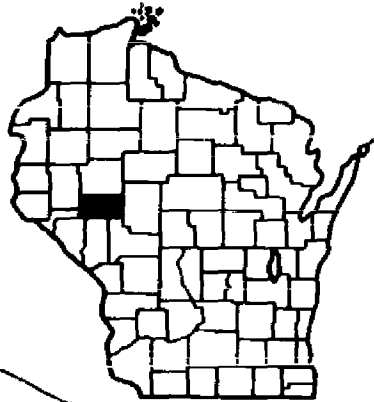

Design Designation

A.D.T.	1986	=	7,300
A.D.T.	2006	=	11,800
D.M.V.		=	1,227
D.		=	60-40
T.		=	6.5%
V.		=	60 MPH.

Conventional Signs

County Line		Caution Symbol (Combustible fluids under pressure)	
Township or Range Line			
Section Line		Woven wire fence.	
Corporate or City Limits		Chain link fence.	
Property line		Culverts in Place	
Lot Line		Culverts Required	
Existing Right of Way Line		Power Pole	
New Right of Way Line		Telephone or Telegraph Pole	
Base or Survey Line		Right of Way Markers	
Slope Intercept		Marsh	
Existing Roadway or Private Entrance		Wooded Area	
		Grade Elevation	

BEGIN CONSTRUCTION
STA. 94 + 00

Y 347,045.16
X 1,626,942.64

789 FEET SOUTH AND 2442 FEET WEST
OF THE EAST QUARTER CORNER SECTION 35,
T-27-N, R-9-W.

Layout

Scale 0 1/2 1 Mi.

Total Net Length of Centerline = 0.000 Mi.

APPROVED FOR

CITY EAU CLAIRE

04/04/85
(Date)


(City Manager)

STATE OF WISCONSIN
DEPARTMENT OF TRANSPORTATION

Surveyor L.T. S.M. District Checker T.H.R.
Designer L.K. C O Checker BUE
District Supervisor L.A.P. C O Coordinator SAW

Approved: _____
Date 4/4/85 T.R. Clark
District Transportation Director

Approved: _____
Date: 5-1-85 _____
Special Agent in Charge

Approved: 4-30-85 [Signature]
Date: 4-30-85 Chief Design Engineer

Approved: E. J. Byrkit
Date: 5/1/85

U.S. DEPARTMENT OF TRANSPORTATION
FEDERAL HIGHWAY ADMINISTRATION
REGION 8 WISCONSIN DIVISION

Approved

Date _____ Division Administrator _____

Vehicle No. 11

ABBREVIATIONS

AGG. AGGREGATE
 AH. AHEAD
 AVE. AVENUE
 A.D.T. AVERAGE DAILY TRAFFIC
 BIT. BITUMINOUS
 BK. BACK
 C-C. CENTER TO CENTER
 COLL. COLLECTOR RD.
 C/L. CENTER LINE
 CONCR. CONCRETE
 C.T.H. COUNTY TRUNK HIGHWAY
 C.P. CULVERT PIPE
 D. DEGREE OF CURVE
 U-H.V. DESIGN HOUR VOLUME
 D. DIRECTIONAL DISTRIBUTION
 E. EAST
 E. (OR X) EAST GRID COORDINATE
 E. EXTERNAL OF CURVE
 I.H. INTERSTATE HIGHWAY
 LT. LEFT
 L. LENGTH OF CURVE, LENGTH
 MAX. MAXIMUM
 MI. MILE
 MIN. MINIMUM
 MISC. MISCELLANEOUS
 NORM. NORMAL
 N. NORTH
 N-E. NORTH EAST
 N. (OR Y) NORTH GRID COORDINATE
 N.W. NORTH WEST
 P.K. PARKER KALON NAIL

P.K. PARKER KALON NAIL
 PAV'T. PAVEMENT
 % PER CENT
 P.C. POINT OF CURVATURE
 P.I. POINT OF INTERSECTION
 P.T. POINT OF TANGENCY
 P.P. POWER POLE
 P.E. PRIVATE ENTRANCE
 R.A.D. (OR R.) RADIUS OF CURVE
 H. RANGE
 R.C.C.P. REINFORCED CONCRETE CULVERT PIPE
 REQ'D. REQUIRED
 RT. RIGHT
 RD. ROAD
 SHDR. SHOULDER
 S.W. SIDEWALK
 S.B. SOUTHBOUND
 S.E. SOUTH EAST
 S.W. SOUTH WEST
 S.Y. SQUARE YARD
 S.D.D. STANDARD DETAIL DRAWINGS
 STA. STATION
 SSD. STOPPING SIGHT DISTANCE
 SUPER. SUPERELEVATION
 T.E. TANGENT, TRUCKS (PERCENT OF), TOWNSHIP
 U.G. UNDERGROUND
 U.S.H. UNITED STATES HIGHWAY
 VAR. VARIABLE
 V. VELOCITY ON DESIGN SPEED
 V.C. VERTICAL CURVE
 W. WEST
 X-SECTION CROSS SECTION

P.K. PARKER KALON NAIL
 PAV'T. PAVEMENT
 % PER CENT
 P.C. POINT OF CURVATURE
 P.I. POINT OF INTERSECTION
 P.T. POINT OF TANGENCY
 P.P. POWER POLE
 P.E. PRIVATE ENTRANCE
 R.A.D. (OR R.) RADIUS OF CURVE
 H. RANGE
 R.C.C.P. REINFORCED CONCRETE CULVERT PIPE
 REQ'D. REQUIRED
 RT. RIGHT
 RD. ROAD
 SHDR. SHOULDER
 S.W. SIDEWALK
 S.B. SOUTHBOUND
 S.E. SOUTH EAST
 S.W. SOUTH WEST
 S.Y. SQUARE YARD
 S.D.D. STANDARD DETAIL DRAWINGS
 STA. STATION
 SSD. STOPPING SIGHT DISTANCE
 SUPER. SUPERELEVATION
 T.E. TANGENT, TRUCKS (PERCENT OF), TOWNSHIP
 U.G. UNDERGROUND
 U.S.H. UNITED STATES HIGHWAY
 VAR. VARIABLE
 V. VELOCITY ON DESIGN SPEED
 V.C. VERTICAL CURVE
 W. WEST
 X-SECTION CROSS SECTION

GENERAL NOTES

NO TREES OR SHRUBS ARE TO BE REMOVED WITHOUT THE APPROVAL OF THE ENGINEER.

EXCAVATION BELOW SUBGRADE (EBS) IS NOT USED TO BALANCE YARDAGE AND IS NOT SHOWN ON THE CROSS SECTIONS BUT IS MEASURED AND PAID FOR AS UNCLASSIFIED EXCAVATION. THE LOCATION FOR EBS WILL BE DETERMINED BY THE ENGINEER.

SELECT BORROW AS SHOWN ON THE TYPICAL SECTIONS IS NOT USED TO BALANCE YARDAGE AND IS NOT SHOWN ON THE CROSS SECTIONS.

THE EXACT LOCATION OF ACCESS POINTS SHALL BE DETERMINED BY THE ENGINEER EXCEPT AT THE CONTROLLED LOCATIONS SHOWN ON THE PLAT.

DISTURBED AREAS WITHIN THE RIGHT OF WAY, EXCEPT THE AREAS WITHIN THE FINISHED SHOULDER POINTS ARE TO BE FERTILIZED AND SEEDED AS DIRECTED BY THE ENGINEER.

STRAW MULCH ALL SLOPES.

WHEN THE QUANTITY OF THE ITEMS OF BASE OR SURFACE COURSE ARE MEASURED FOR PAYMENT BY THE TON, THE DEPTH OR THICKNESS OF THE COURSE SHOWN ON THE PLANS IS APPROXIMATE AND THE ACTUAL THICKNESS WILL DEPEND ON THE DISTRIBUTION OF THE MATERIAL AS DIRECTED BY THE ENGINEER.



THE LOCATIONS OF EXISTING AND PROPOSED UTILITY INSTALLATIONS AS SHOWN ON THE PLANS ARE APPROXIMATE. THERE MAY BE OTHER UTILITY INSTALLATIONS WITHIN THE PROJECT AREA THAT ARE NOT SHOWN.


4 INCH BITUMINOUS CONCRETE PAVEMENT SHALL BE CONSTRUCTED WITH A TWO INCH SURFACE COURSE AND A TWO INCH BINDER COURSE.

UTILITIES


NORTHERN STATES POWER COMPANY
 100 N. BARSTOW ST.
 EAU CLAIRE, WI. 54701
 PHONE: (715) 833-2669
 ATTN: M.L. PELL

WISCONSIN BELL INC.
 304 S. DEWEY ST.
 EAU CLAIRE, WI. 54701
 PHONE: (715) 839-5808
 ATTN: C.S. LEVYHENTZ

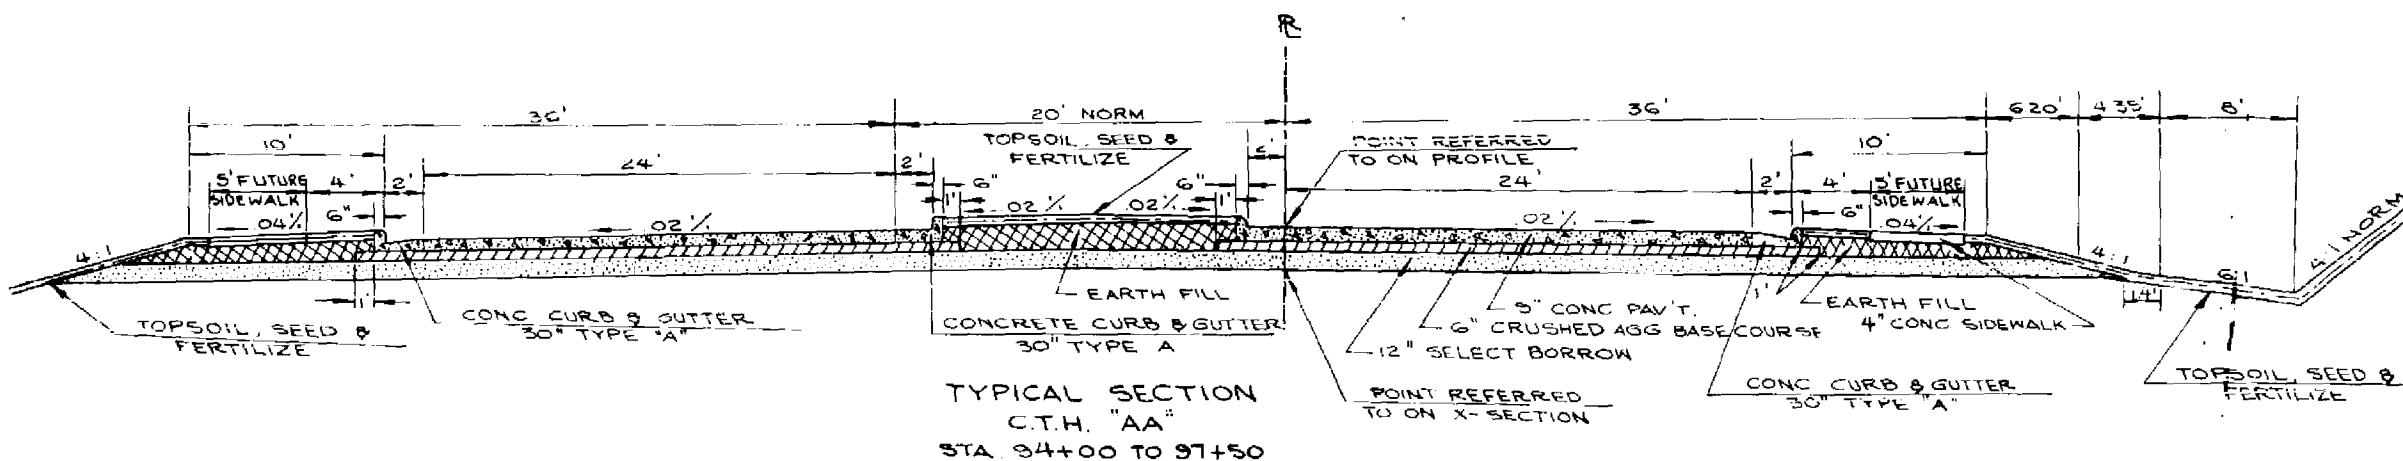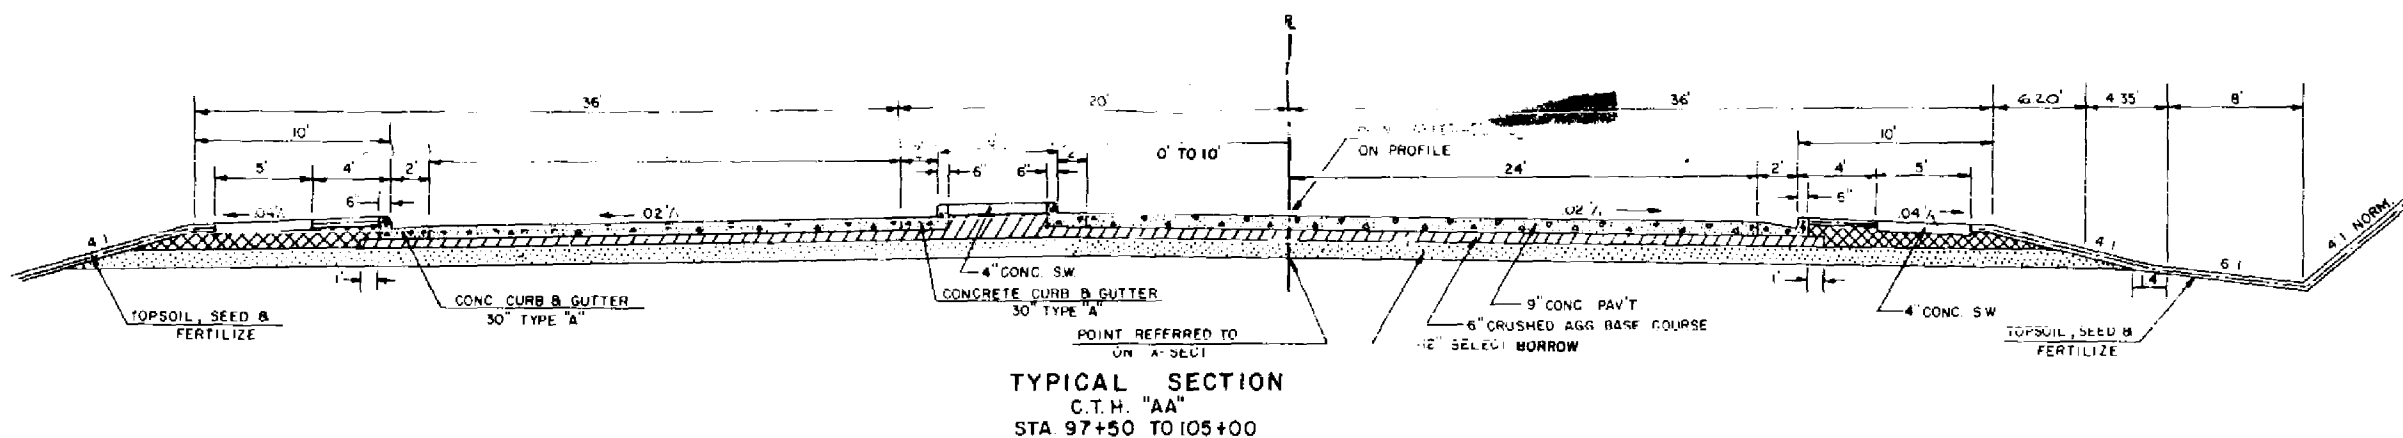


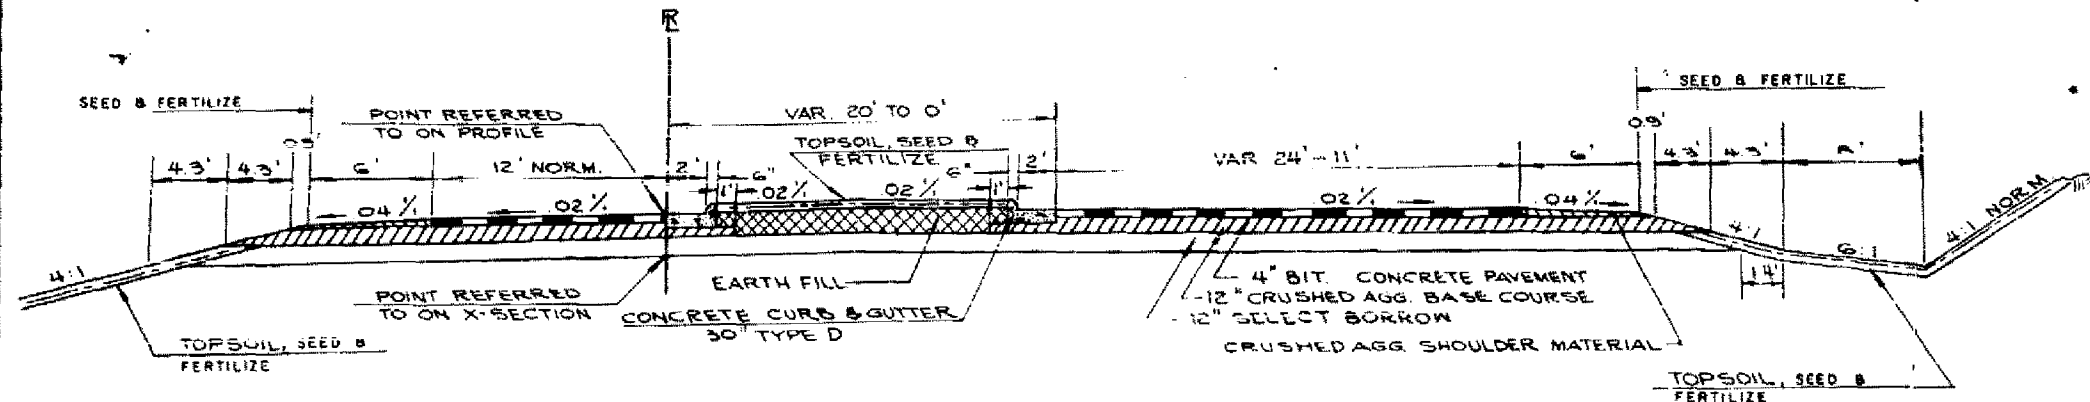


TYPICAL SECTION
C.T.H. "AA"
STA. 107+50 TO 112+67

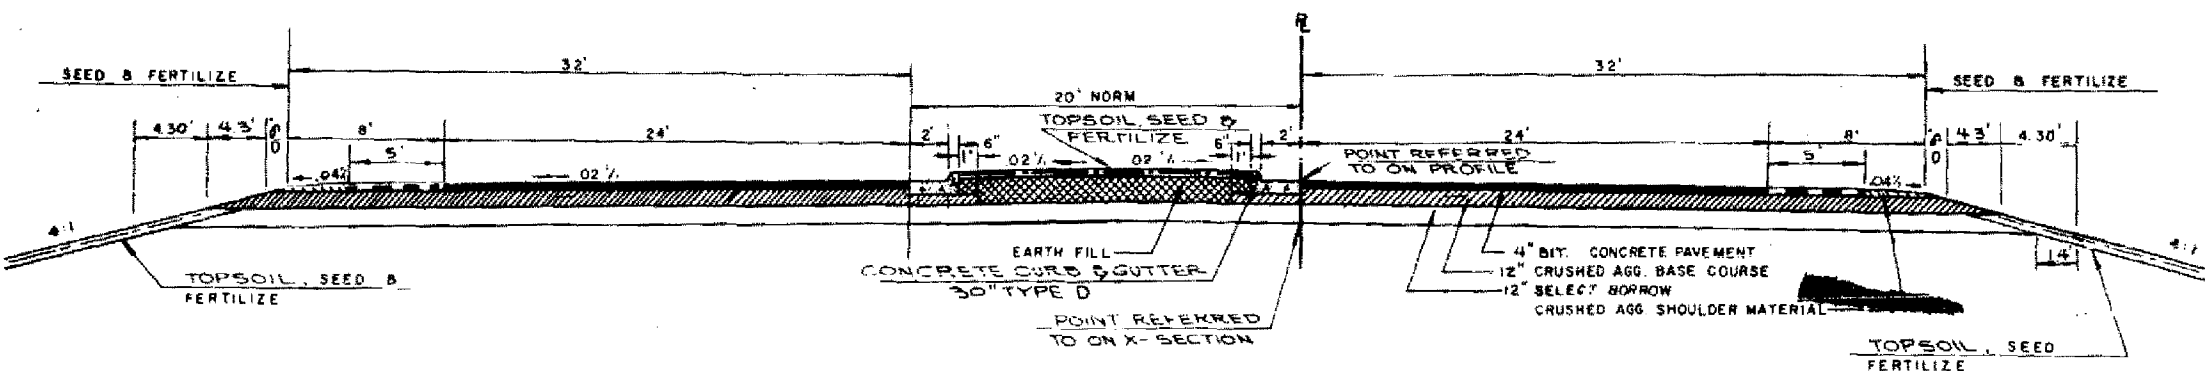

TYPICAL SECTION
C.T.H. "AA"
STA. 105+00 TO 107+50

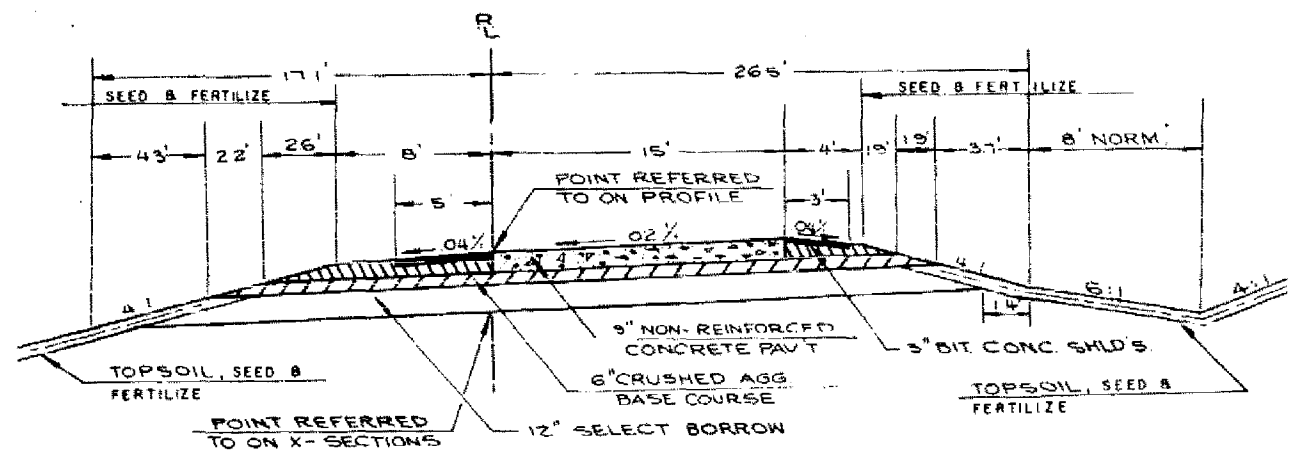

TYPICAL SECTION - NW RAMP
(LOOKING UP STATION)
OR
NORTH

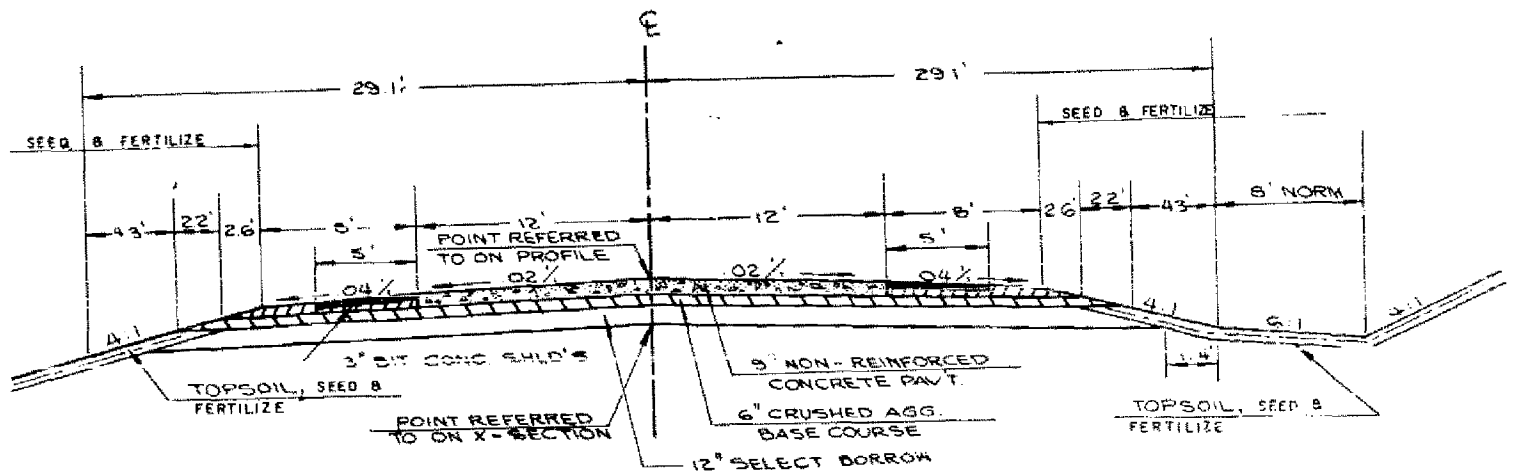


TYPICAL SECTION - N.E. RAMP


STANDARD DETAIL DRAWINGS

SDD NUMBER	TITLE
8A5-3 A	CATCH BASIN, MANHOLE AND INLET COVERS
8C1-4	INLETS, TYPES 1, 2, AND 3.
8D1-8	CONCRETE CURB, CONCRETE CURB AND GUTTER AND PAVEMENT TIES
8D5-8	CURB RAMPS
8E9-1	TEMPORARY SILT FENCE
8F1-9	APRONS ENDWALLS FOR CULVERT PIPE AND PIPE ARCHES
9B2-2	METAL, FIBER AND PVC CONDUIT
9B3-3	TRAFFIC SIGNAL, COUNTER, AND PULL BOX DETAILS
9B7-1	PAVEMENT MARKING SYMBOLS
11A1-2	MAINTENANCE CROSSOVER FOR FREEWAYS
12A2-3	SLOPE PAVING-STRUCTURES (CRUSHED AGGREGATE)
12A3-4	NAME PLATE-STRUCTURES
13B5-3	PAVEMENT MARKING
13C1-6	CONCRETE PAVEMENT LONGITUDINAL JOINTS
13C3-4	TRANSVERSE JOINTS IN NON-REINFORCED CONCRETE PAVEMENT (20' SPACED TRANSVERSE JOINTS WITH POURED TYPE SEALER)
14B2-7 ABRAC	CLASS "A" STEEL PLATE BEAM GUARD
14B3-1	STEEL PLATE BEAM GUARD, CLASS "B"
14B4-1	RAISED MEDIAN AT UNDERPASSES
14B7-6AAB	TEMPORARY PRECAST CONCRETE BARRIER
15B1-6	WOVEN WIRE FENCE
15A2-2	DELINEATOR POSTS, MARKER POSTS AND DELINEATORS
15B2-7	CHAIN LINK FENCE (TYPE A)
15C1-7	CONSTRUCTION BARRICADES AND STANDARD SIGNS


TYPICAL SECTIONS

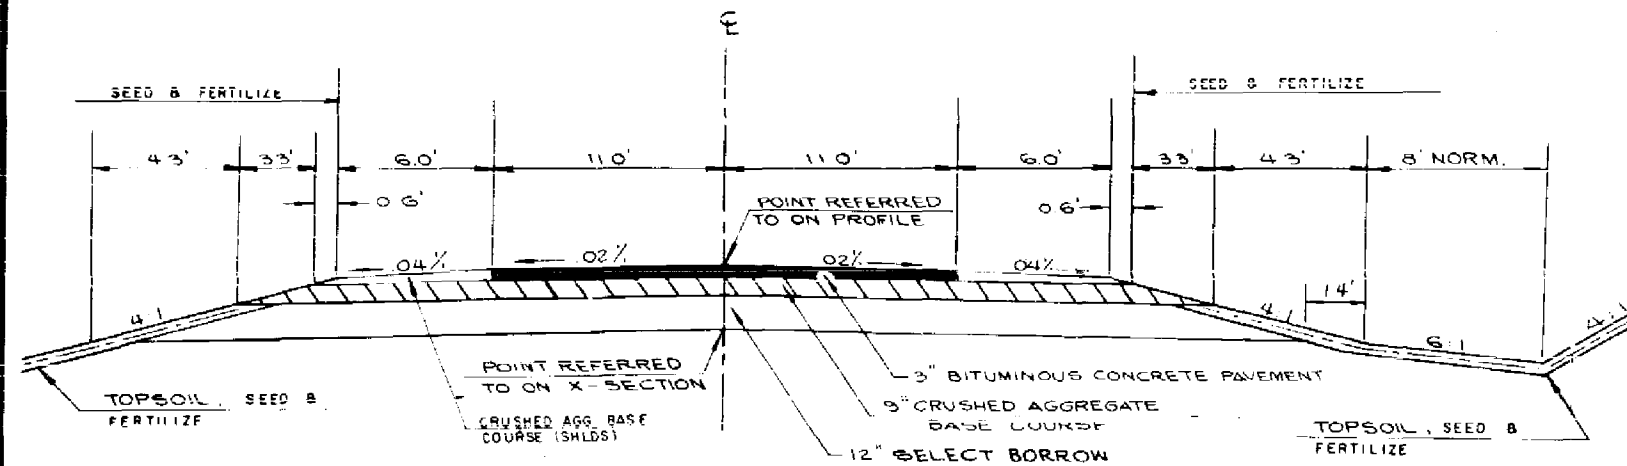


TYPICAL SECTION - EAST
FRONTAGE ROAD

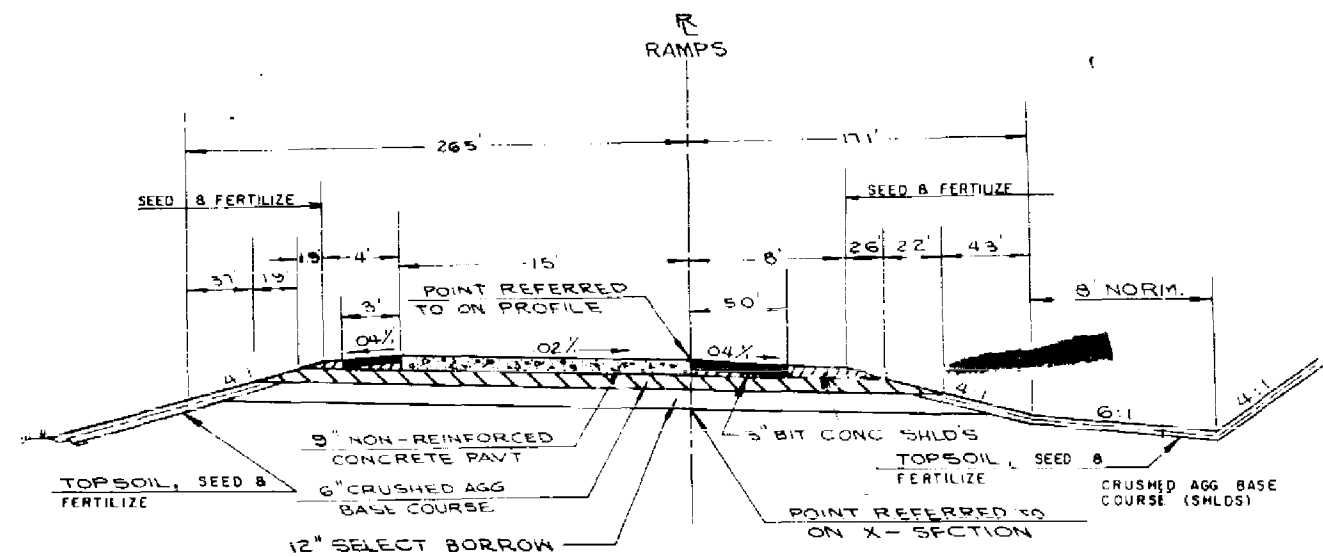


S.W. RAMP (LOOKING DOWN STATION)
S.E. RAMP (LOOKING UP STATION)

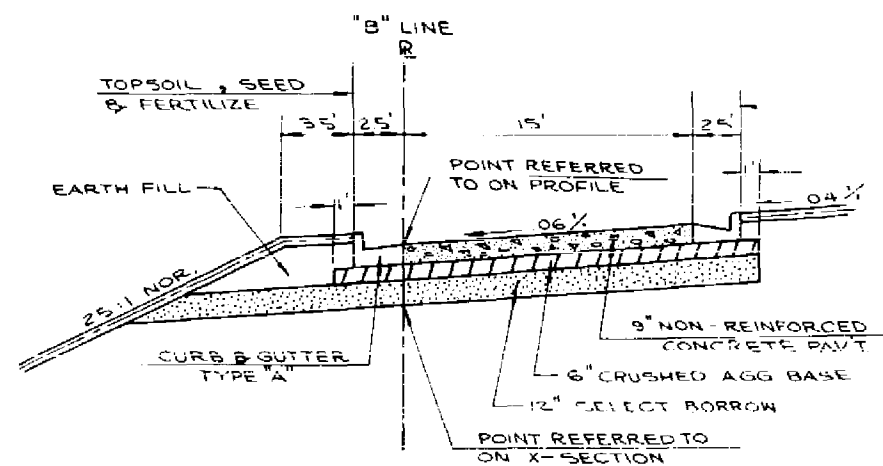


TYPICAL SECTION
"B" LINE
STA. 96+00 - 98+39

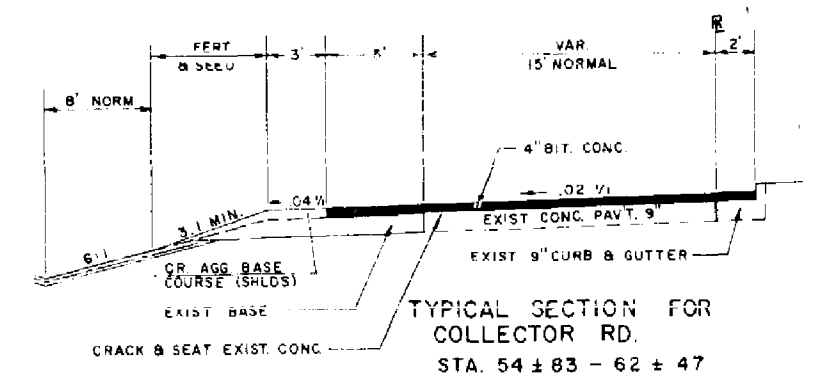

TYPICAL SECTION FOR
COLLECTOR RD.
STA. 54+83 - 62+47

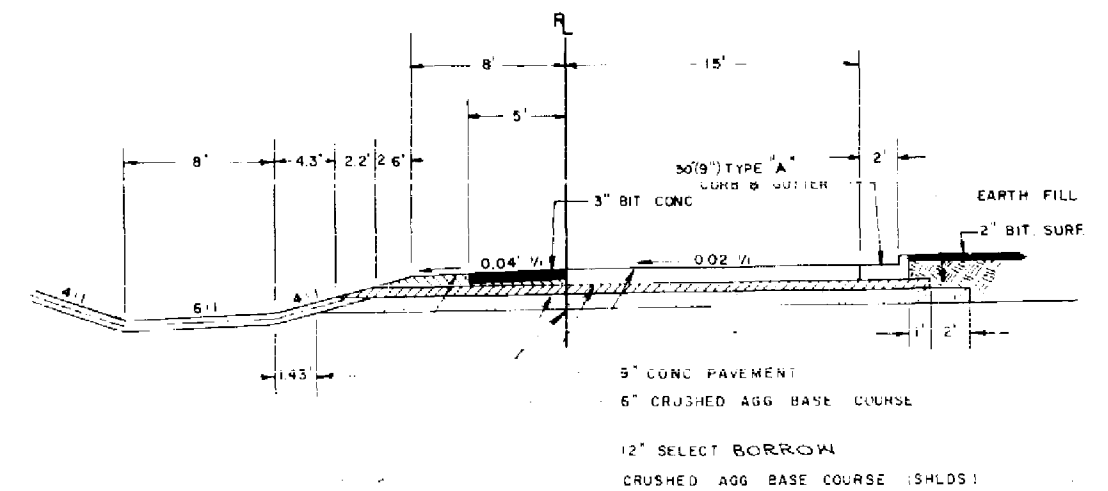

TYPICAL SECTION FOR COLLECTOR ROAD
STA. 63+43 - 66+50

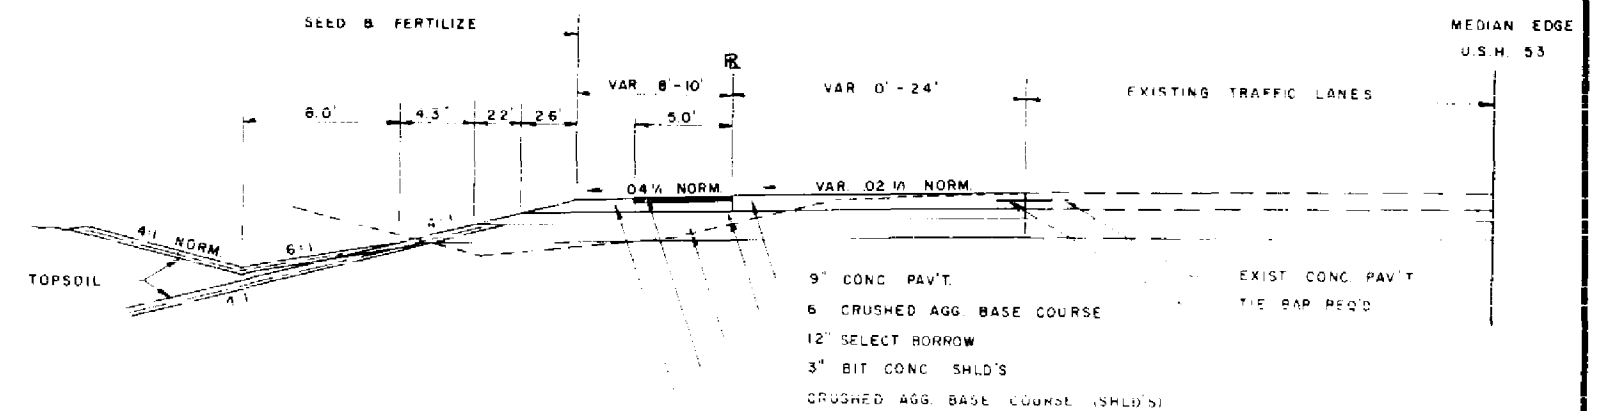

TYPICAL SECTION OF
PAVEMENT WIDENING

STA 66+50 - 84+00 SB LT.
STA 104+50 - 111+42 SB LT.
STA 107+08 - 133+08 NB RT.

5" CHANNELIZING

20'

12"

50'

Diagram illustrating a cross-section of a road construction project. The diagram shows the following layers and dimensions from left to right:

- Left Section:** A 16' wide section with a 4" BIT CONC. layer (0.01 ft thick) and an EXIST 9" CONCRETE PAVT layer.
- Shoulder Section:** A 5' wide section labeled BIT SHLD.
- Base Section:** A 10' wide section with a CR AGG. BASE COURSE (5HDS) layer (0.04 ft thick).
- Right Section:** A 73' wide section labeled SEED & FERTILIZE, with a 10' NORM layer (3.2' thick) and a 4:1 NORM slope (10:1 ratio).

16'


3" BIT SURFACING

6" CRUSHED AGG BASE COURSE


[illegible]

Diagram illustrating the proposed road profile and grading. The profile shows a road surface with a 0.015% grade, a 5' wide shoulder, and a 10' wide road. The road is labeled "SEED & FERTILIZE" and "4:1 NORM". The shoulder is labeled "CR AGG. BASE COURSE (SHLDS)" and "TOPSOIL". The road is labeled "10:1" and "4:1 NORM".

Ca1 No 2130 - D142

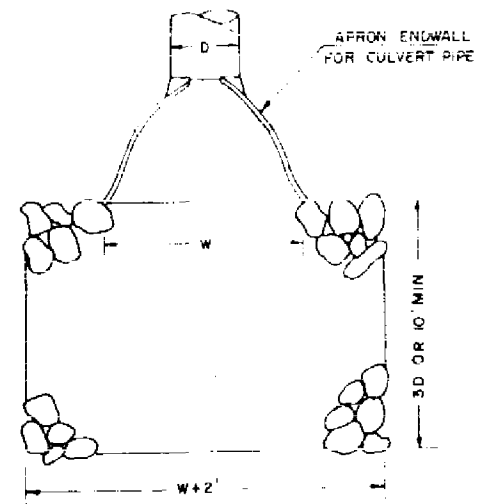


RIPRAP DISCH. APRON
ADJUST TO FIT FIELD CONDITIONS

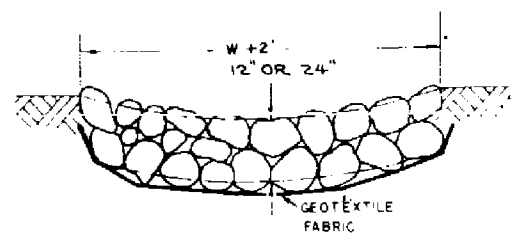


END VIEW OF RIPRAP

SPECIAL DETAIL FOR SOD DITCH

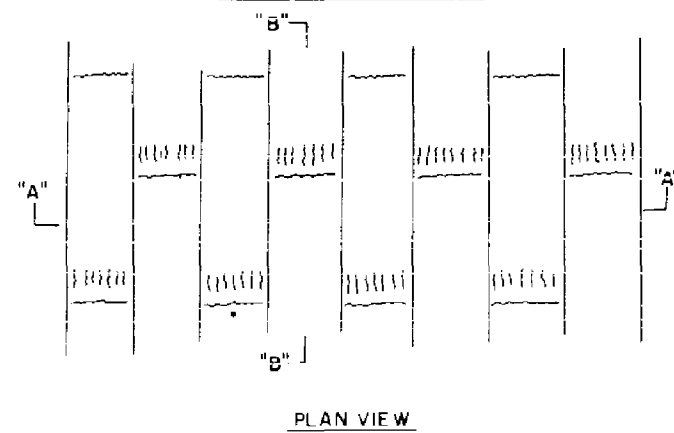


PLAN VIEW

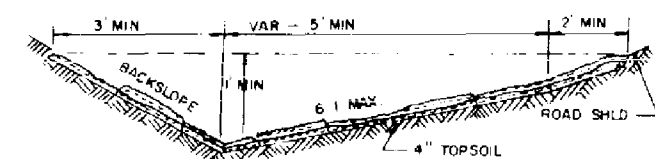


SECTION "A"-"A"




SECTION "B"-"B"

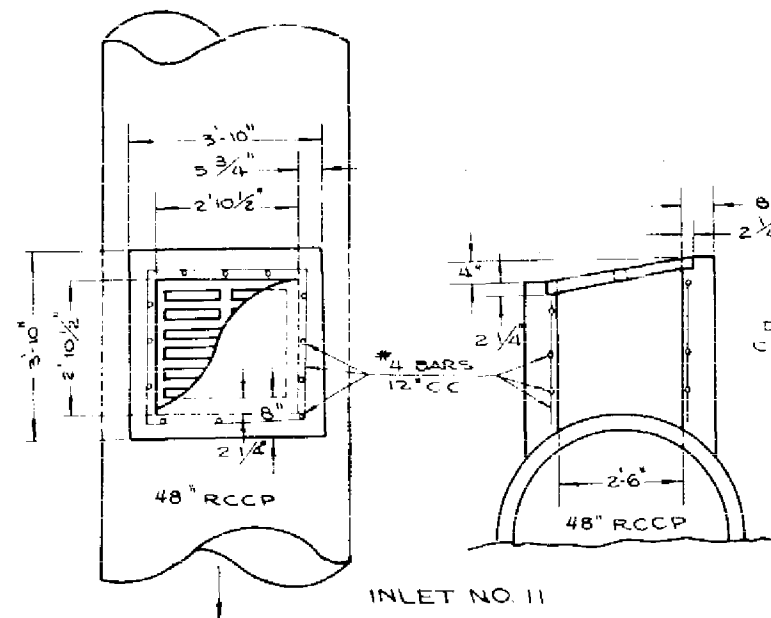


STA. 100+98 N.E. RAMP 52' RT.
TYPE BMS MODIFIED
USE SALVAGED M.S. GRATE

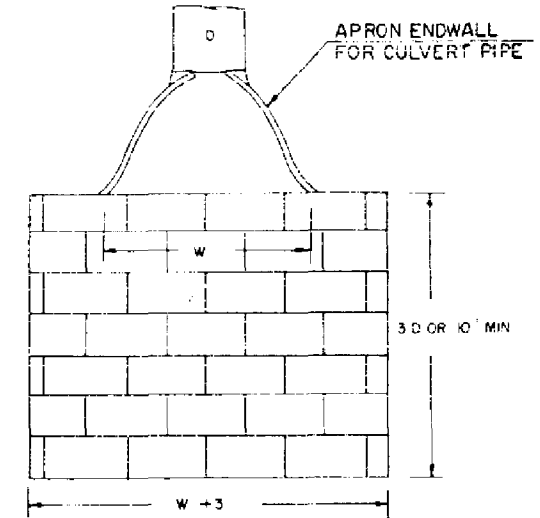


SOD APRON

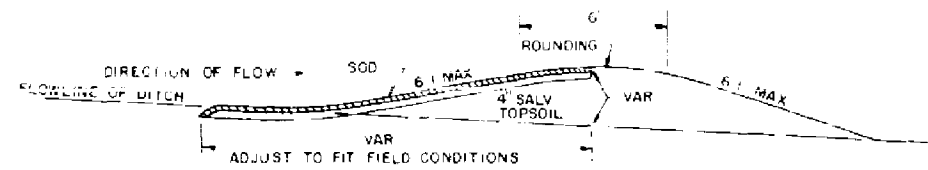


TYPICAL DITCH DAM

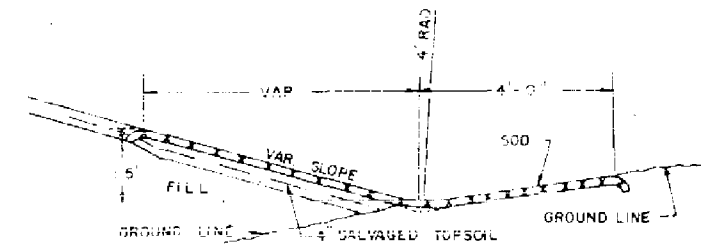


DETAIL FOR SOD AT TOE OF FILL

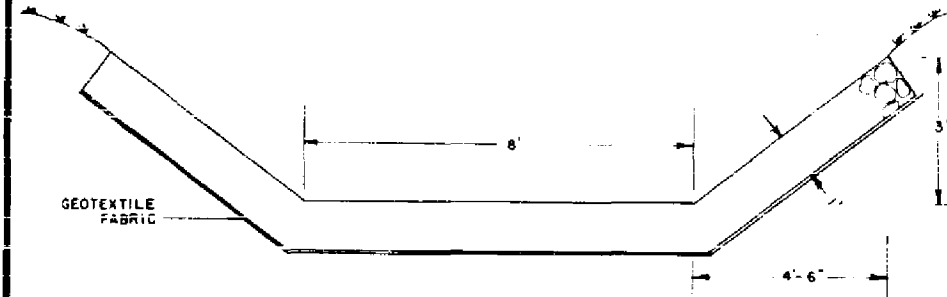


TYPICAL SECTION OF
RIPRAP FOR DRAINAGE CHANNEL

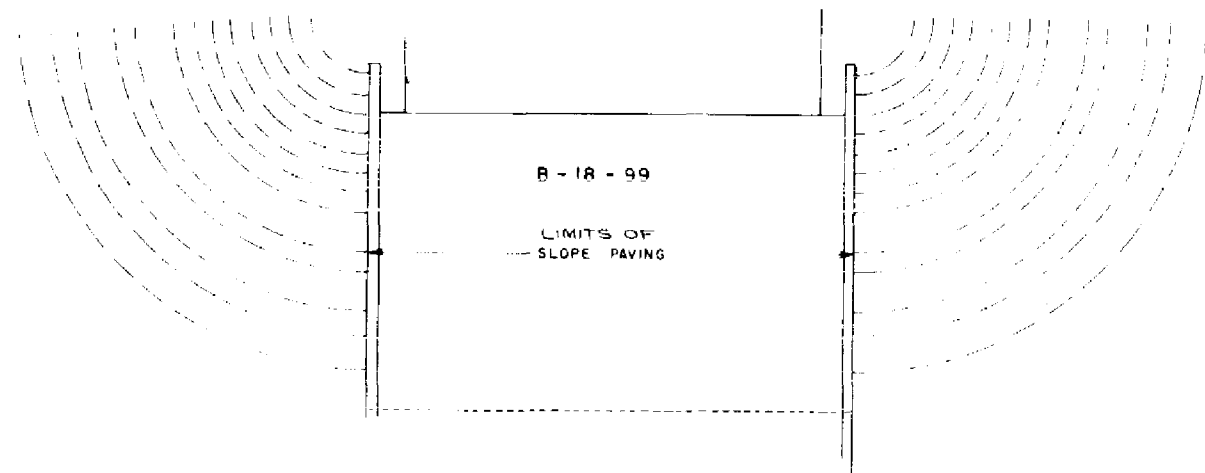


SODDING DETAIL AT STRUCTURE
ALL QUADRANTS

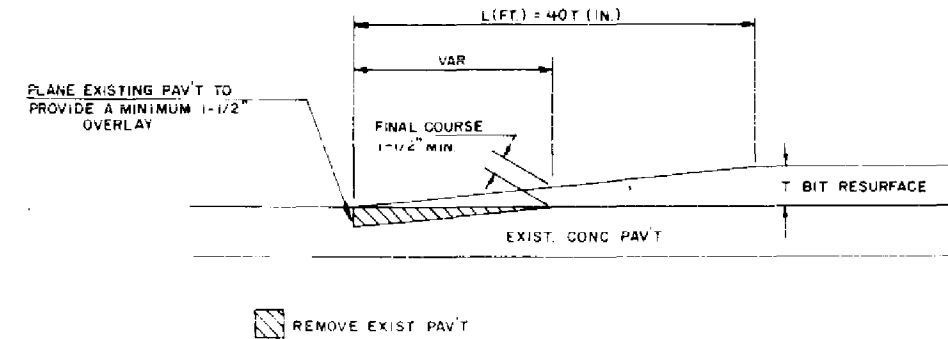



OVERLAP JOINT, BUTTED

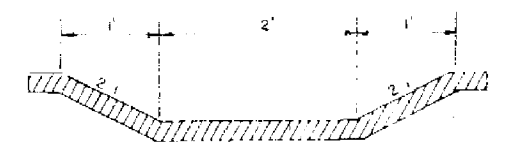


SOD FLUME

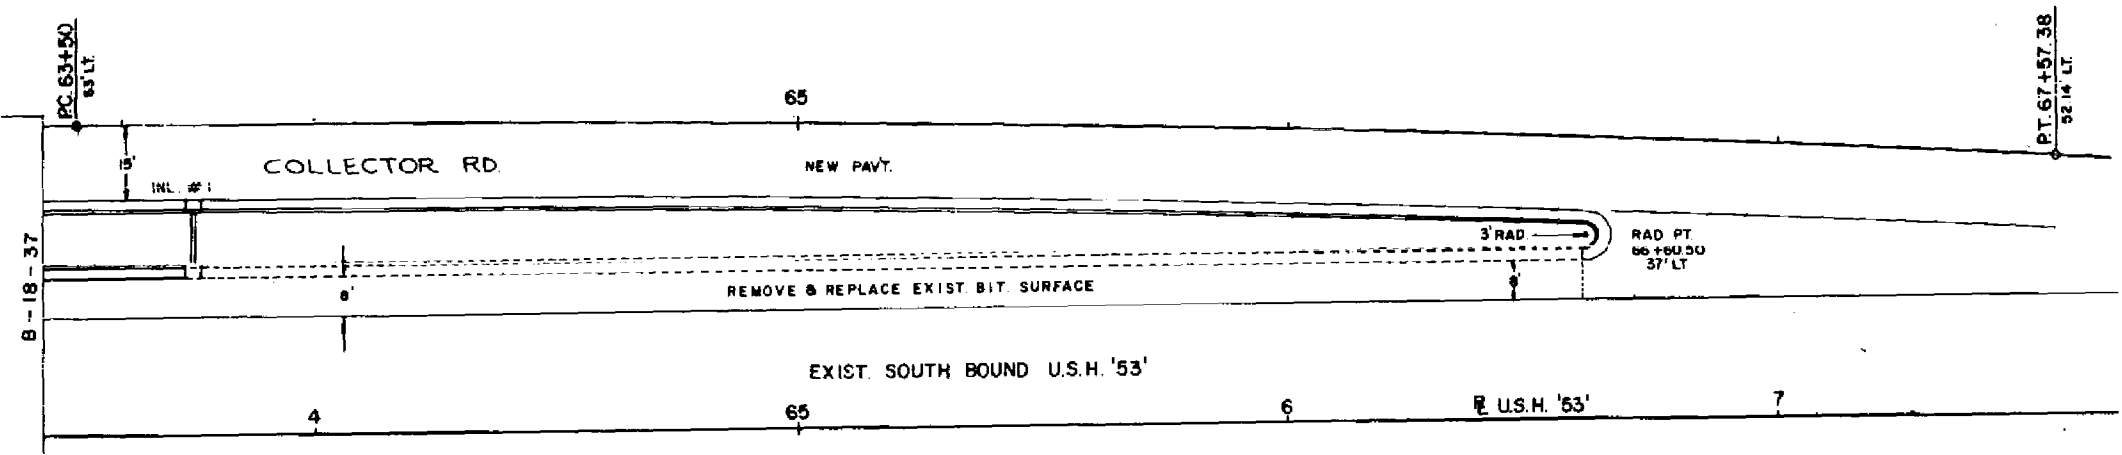

INLET #1
 STA. 63+75 S.B. - 46.5' LT.
 1- TYPE 3M INLET REQ'D.
 FL. ELEV. 927.56
 TOP OF BOX 926.77
 DISCH. ELEV. 924.27
 DEPTH OF BOX 2.5'
 1-12" X 12' RCPSS REQ'D.

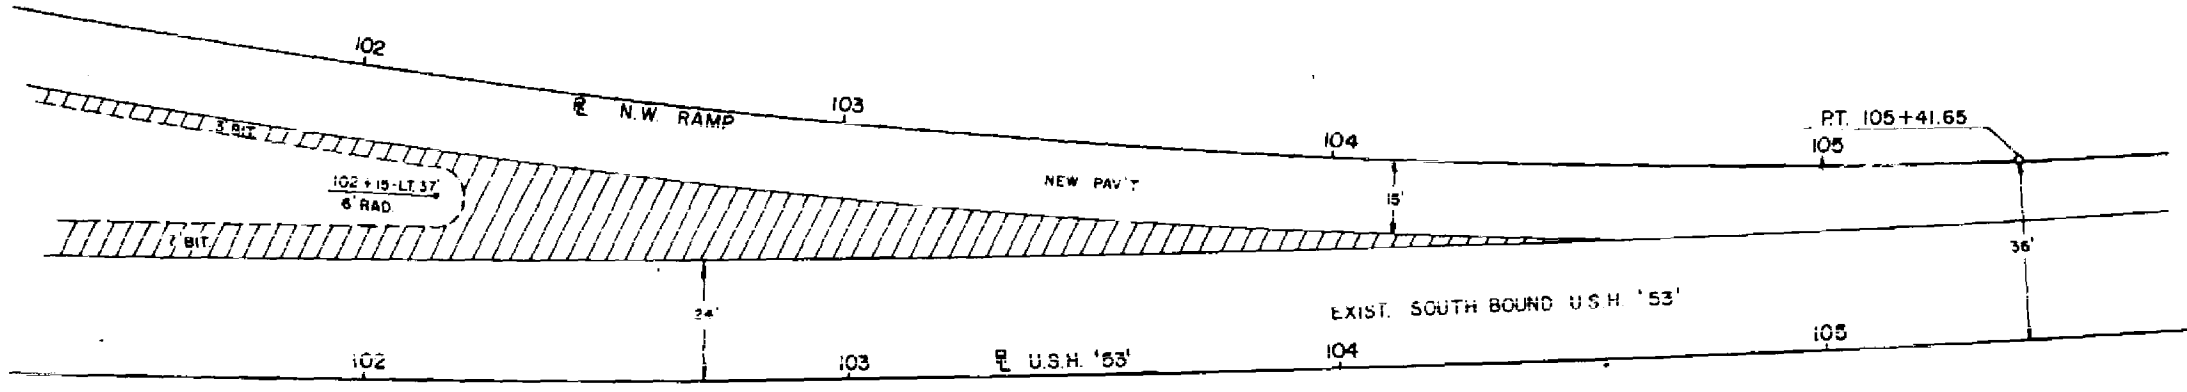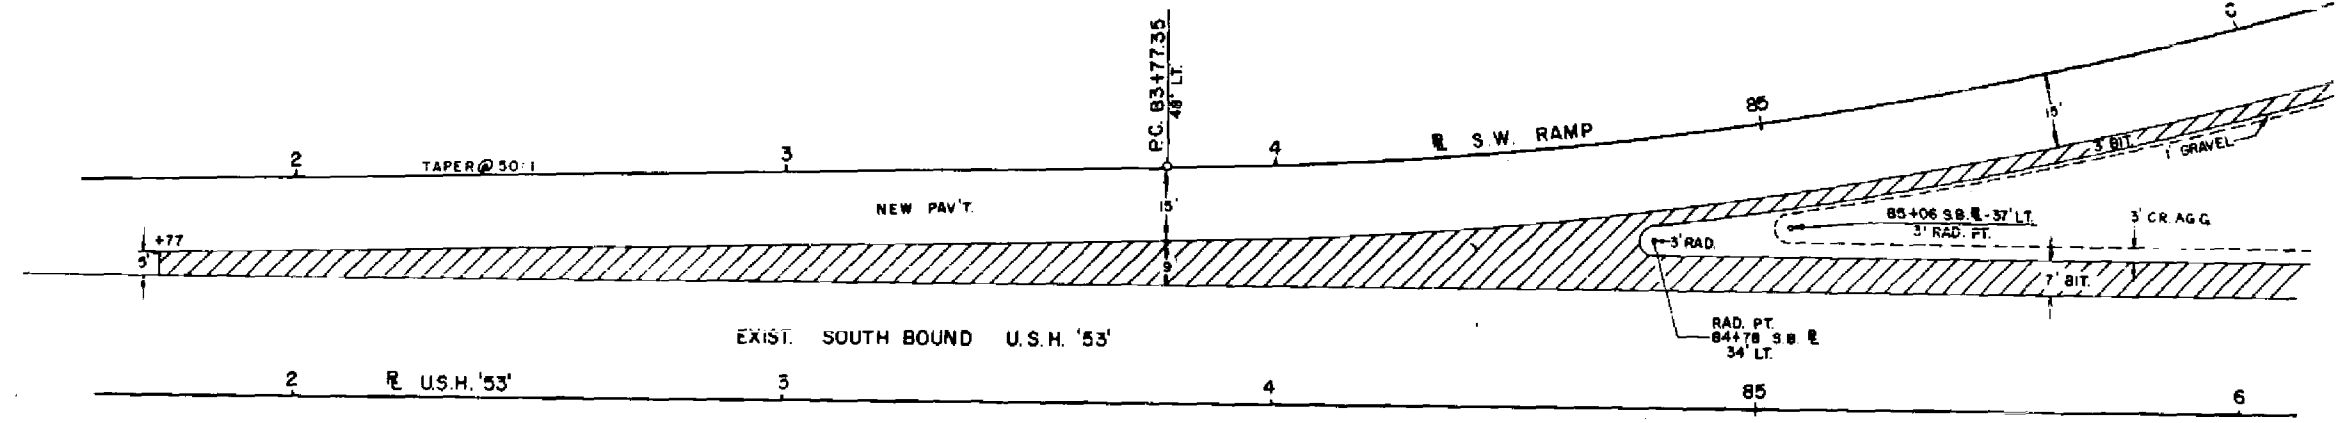

N.W. RAMP
 SCALE 1" = 20'

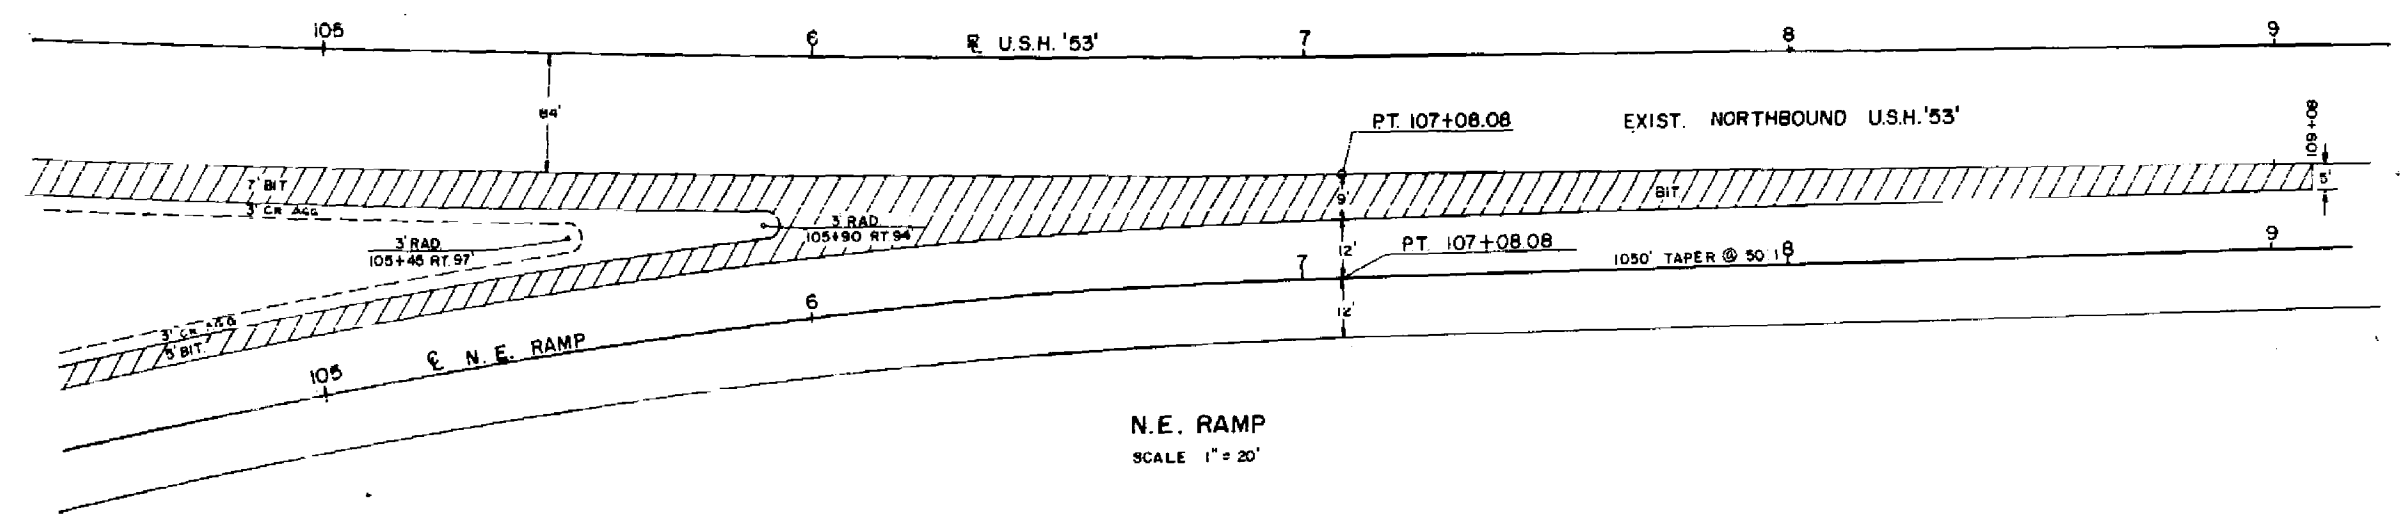

N.E. RAMP
 SCALE 1" = 20'

INLET NO 2
 STA 93+00 N.W. RAMP LT. 3.6'
 1-1A INLET REQ'D.
 FL. ELEV. 902.15
 TOP OF BOX ELEV. 901.36
 INVERT ELEV. 897.86
 DEPTH OF BOX 3.5'
 1-12"X18" RCPSS REQ'D.
 DISCH. TO INLET NO 3

CURVE DATA
 'B' LINE
 PI. 97+05.17
 Δ 53° 52' 04.15"
 D 18° 36' 42"
 T 156.41'
 L 289.43'
 R 301.85'
 E 37.46'



INLET NO 3
 STA 96+38.96 B' LINE LT. 15'
 1-3H INLET REQ'D.
 FL. ELEV. 901.47
 TOP OF BOX ELEV. 900.68
 INVERT ELEV. 897.18
 DEPTH OF BOX 3.5'
 DISCH. TO LT. DITCH
 1-12"X54" RCPSS REQ'D.
 2-20" ELBOWS REQ'D.
 1-APRON ENDWALL REQ'D.

PT. 98' B' + 38.19
 22' LT. OF STA. 93+01.85 NW RAMP


INLET NO. 4
 STA 97+60 CTH "AA" LT. 45.5'
 1-3H INLET REQ'D.
 FL. ELEV. 901.75
 TOP OF BOX ELEV. 906.96
 INVERT ELEV. 903.00
 DEPTH OF BOX 3.96'
 1-12"X110" RCPSS REQ'D.
 2-15° ELBOWS REQ'D.
 1-ARRON ENDWALL REQ'D.
 DISCH. TO LT. DITCH
 STA 98+30 CTH "AA"

INLET NO. 5
 STA 97+92 CTH "AA" LT. 5.0'
 1-1A INLET REQ'D.
 FL. ELEV. 908.59
 TOP OF BOX ELEV. 907.80
 INVERT ELEV. 903.76
 BOX DEPTH 4.04'
 12"X54" RCPSS REQ'D.
 DISCH. TO INLET NO 4


INLET NO. 6
 STA 98+00 CTH "AA"-RT 37.5'
 1-3H INLET REQ'D.
 FL. ELEV. 908.15
 TOP OF BOX ELEV. 907.40
 INVERT ELEV. 903.90
 DEPTH OF BOX 3.5'
 1-12"X44" RCPSS
 DISCH. TO INLET NO 5

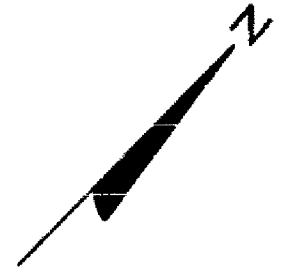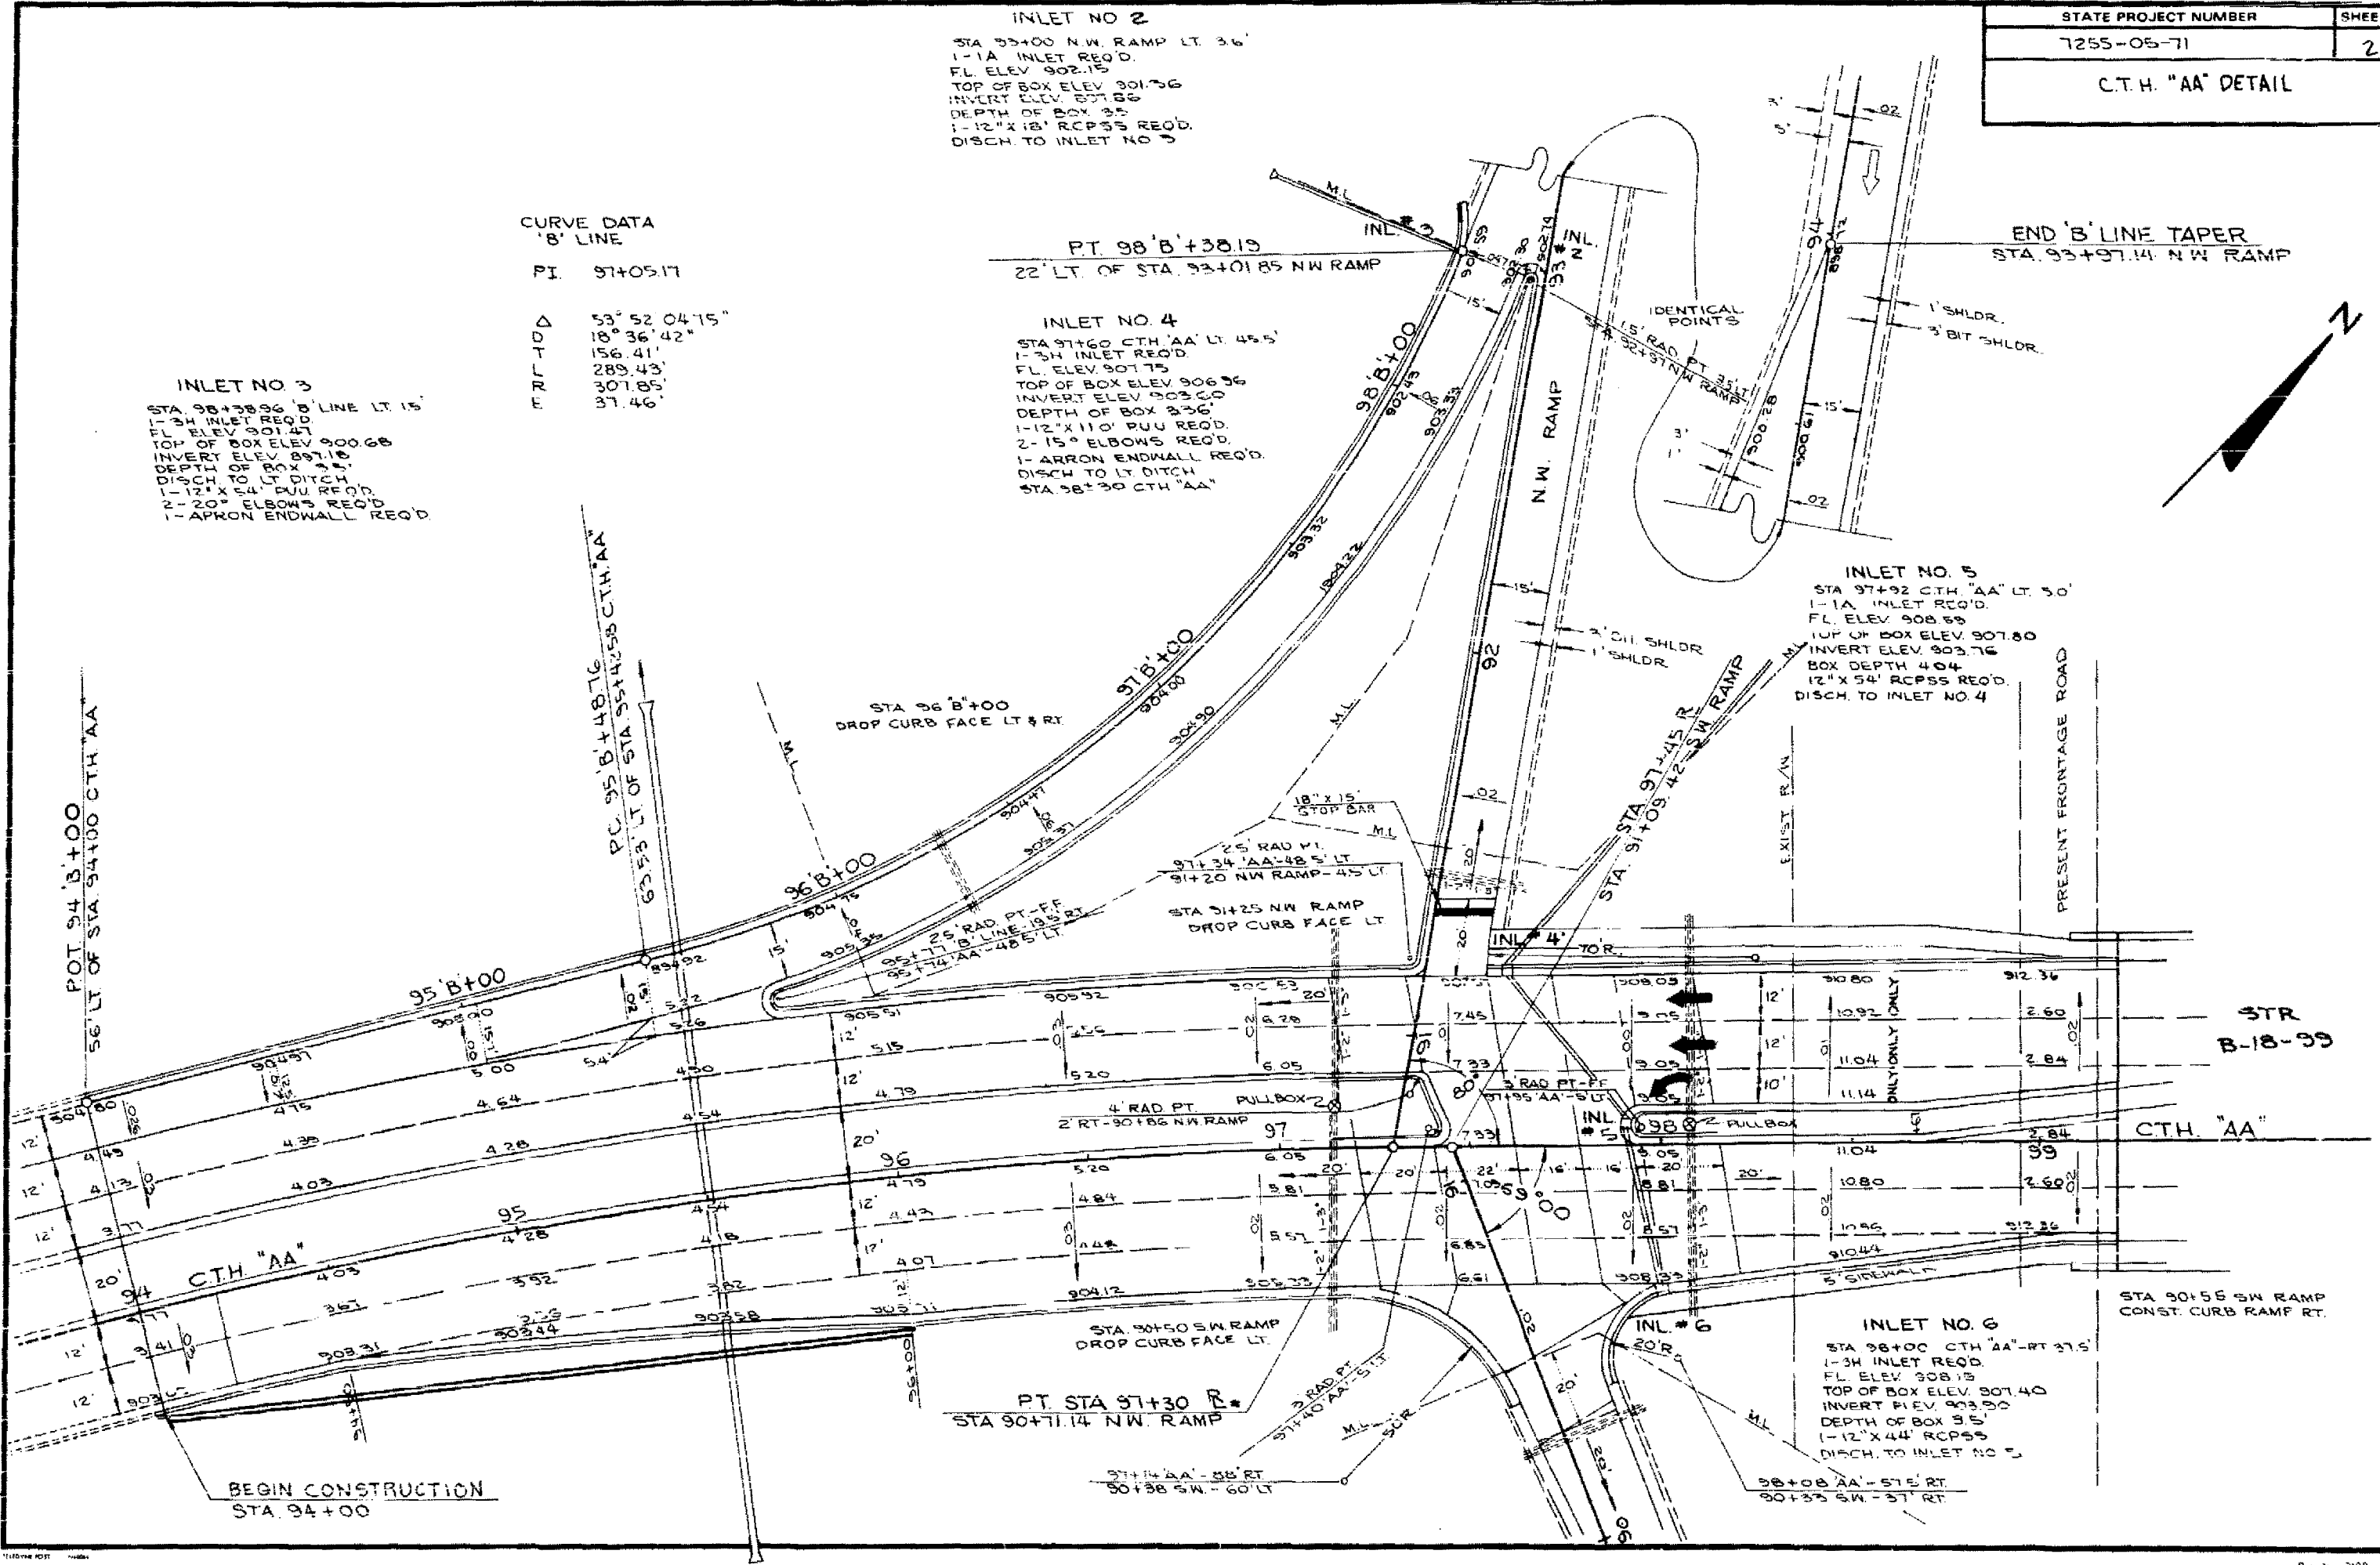


C.T.H. "AA" DETAIL

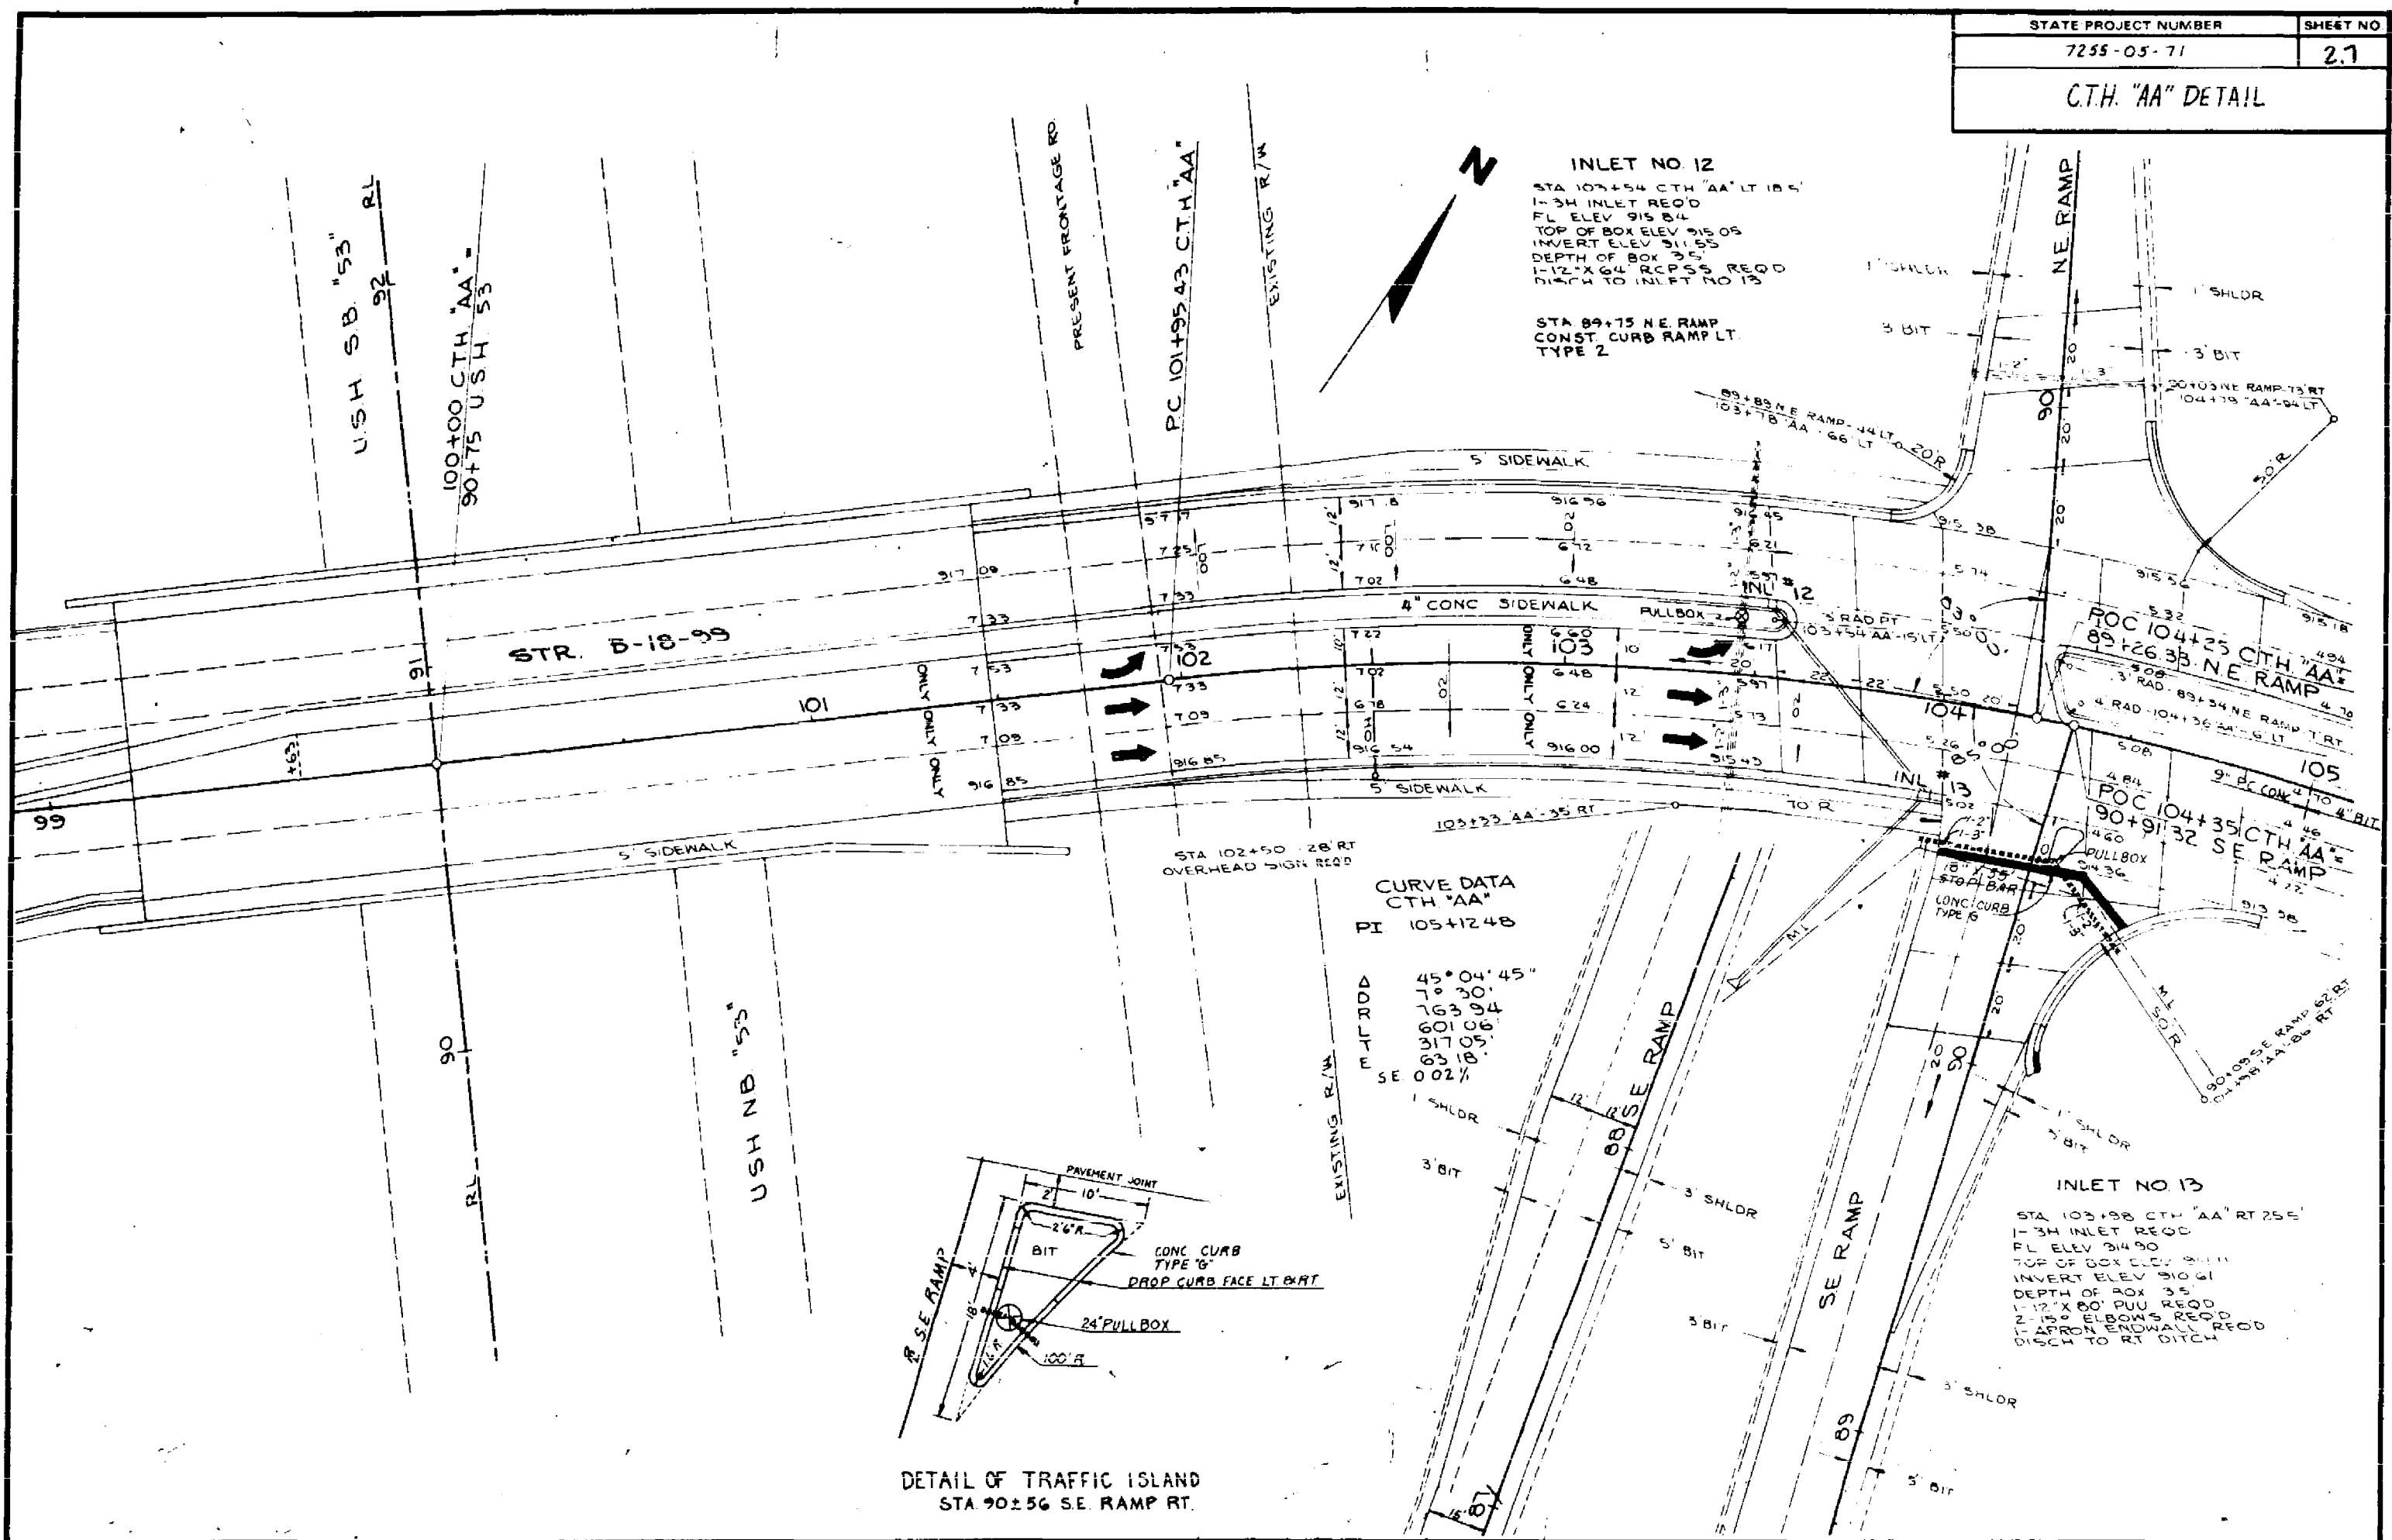


DETAIL OF TRAFFIC ISLAND
STA 90+56 SE RAMP RT.

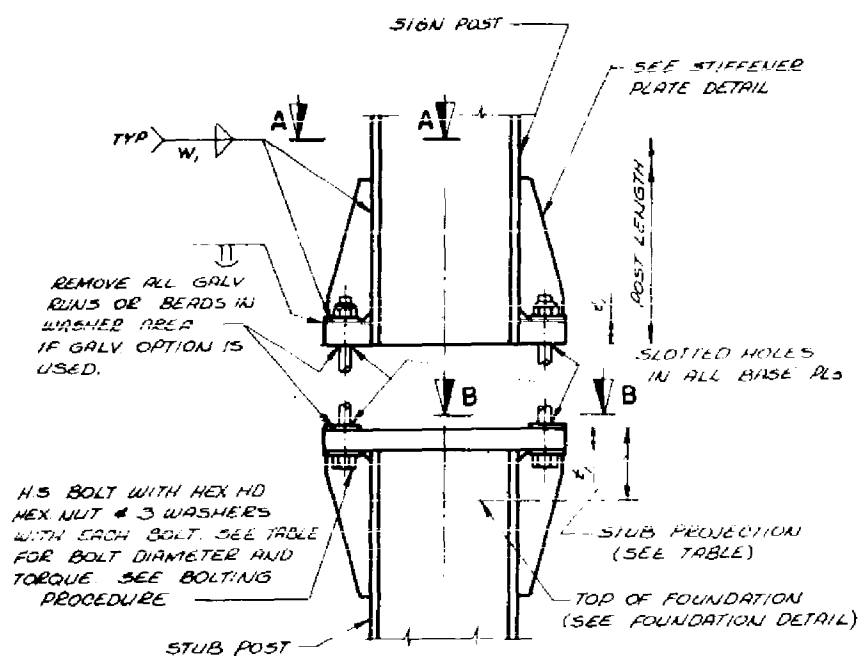


SIGN POST AND STUB POST ELEVATION

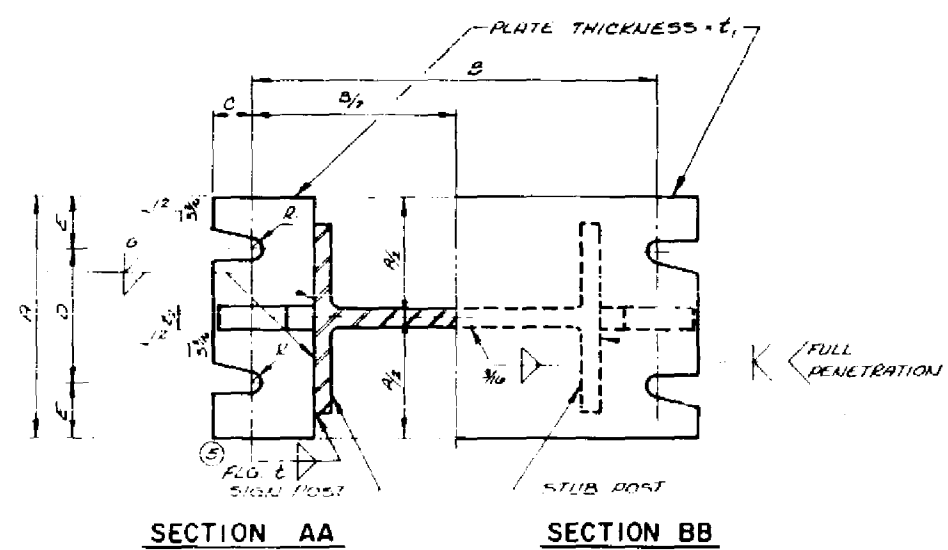

SECTION AA SECTION BB

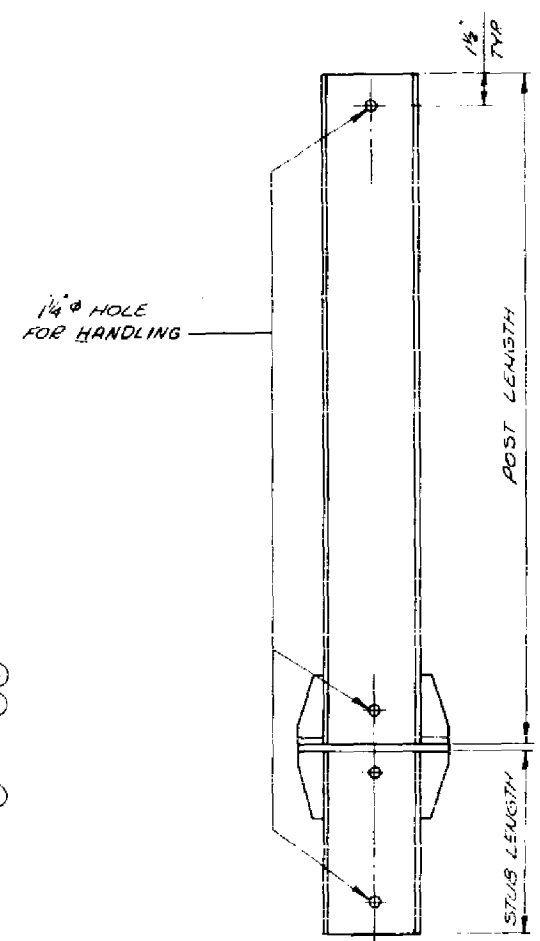

POST DETAIL

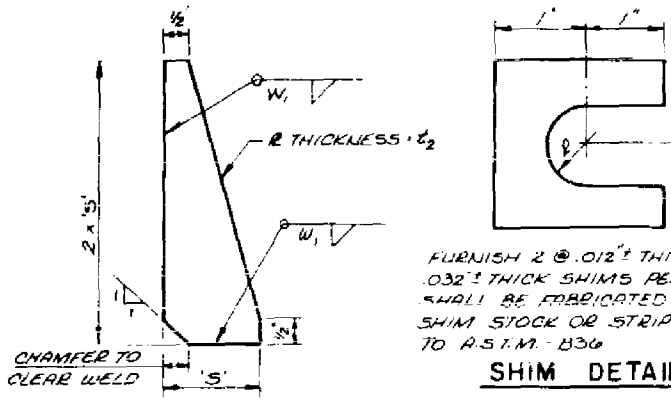


SHIM DETAIL

		BASE CONNECTION DATA TABLE										FOUNDATION DATA				K	
TYPE	DIMENSION POST SIZE	BOLT SIZE & TORQUE	A	B	C	D	E	t ₁	t ₂	W	R	S	STUB LENGTH	STUB PROJECTION	SHAFT DIAMETER		SHAFT LENGTH
A	W 10 x 12.0 #/FT	3/4" @ 75 #/FT	5 1/2	10 3/8	3/8	3 1/2	1 1/8	1 1/2	3/8	3/8	3 1/2	2 1/2	3'-6"	3"	2'-0"	5'-0"	76.0 #
B	W 12 x 16.0 #/FT	7/8" @ 85 #/FT	5 1/2	1 1/4	1	3 1/2	1 1/4	1 1/2	3/8	3/8	3 1/2	3	5'-6"	3 3/4"	2'-0"	7'-0"	146.5 #
C	W 12 x 19.0 #/FT	7/8" @ 85 #/FT	5 1/2	1 1/4	1	3 1/2	1 1/2	1 1/2	3/8	3/8	3 1/2	3	6'-0"	3 3/4"	2'-0"	7'-6"	182.1 #
D	W 12 x 22.0 #/FT	7/8" @ 85 #/FT	5 1/2	1 1/4	1	3 1/2	1 1/2	1 1/2	3/8	3/8	3 1/2	3	6'-6"	3 3/4"	2'-0"	8'-0"	210.5 #
E	W 12 x 24.0 #/FT	1" @ 90 #/FT	7	1 1/4	1 1/4	4	1 1/2	1 1/2	3/8	3/8	3 1/2	3	7'-0"	3 3/4"	2'-0"	8'-6"	293.0 #

STRUCTURAL CARBON STEEL PAY WTS (1 POST) = K*
 (POST LENGTH x POST WGT). *K INCLUDES STUB, BASE PLATES, STIFFS, BOLTS, AND WASHERS.


STIFFENER PLATE DETAIL
 (SEE TABLE FOR DIMENSIONS)

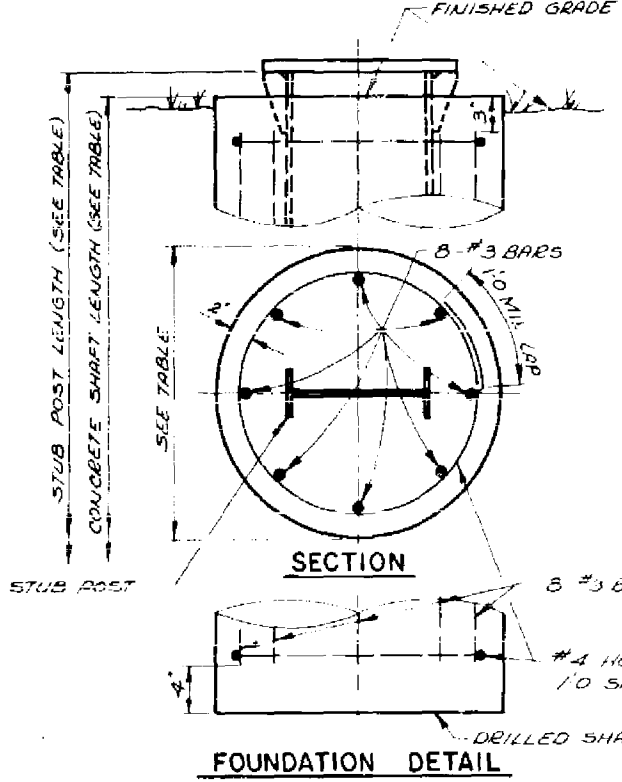

FOUNDATION DETAIL

BOLTING PROCEDURE - BASE CONNECTION


1. ASSEMBLE SIGN POST TO STUB POST WITH BOLTS AND ONE OF THE FLAT WASHERS ON EACH BOLT BETW. PLATES.
 2. SHIM AS REQUIRED TO PLUMB POST.
 3. TIGHTEN ALL BOLTS THE MAXIMUM POSSIBLE WITH 12" OR 15" WRENCH TO BED WASHERS & SHIMS AND TO CLEAN BOLT THREADS, THEN LOOSEN EACH BOLT IN TURN AND RETIGHTEN IN A SYSTEMATIC ORDER TO THE PRESCRIBED TORQUE. (SEE TABLE)
 4. BURY THREADS AT JUNCTION WITH NUT USING A CENTER PUNCH TO PREVENT NUT LOOSENING.
- NOTE: TIGHTEN THE HIGH STRENGTH BOLTS IN THE BASE CONNECTION ONLY TO THE TORQUE SHOWN. DO NOT OVERTIGHTEN.

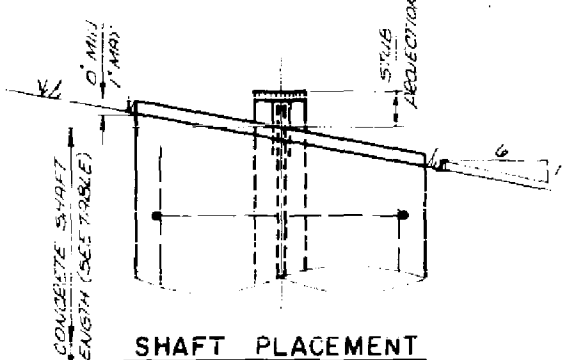

SHAFT PLACEMENT

QUANTITIES FOR 1 FT3		
	CONC. MASONRY CY	REINF. STEEL LBS
A	6	34
B	8	49
C	9	50
D	9	50

REINF.		
TYPE	#3	#4
A	8 @ 4'5"	5 @ 6'3"
B	8 @ 6'5"	7 @ 6'3"
C	8 @ 6'11"	7 @ 6'3"
D	8 @ 7'5"	8 @ 6'3"

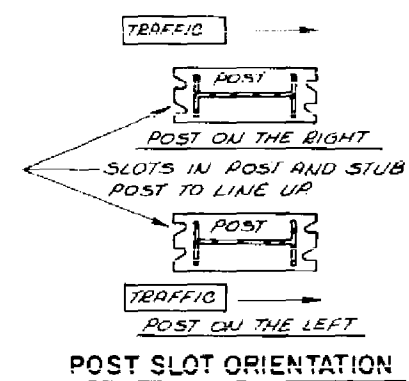

POST SLOT ORIENTATION

GENERAL NOTES

- DRAWINGS SHALL NOT BE SCALED.
 DESIGN CONFORMS WITH A.A.S.H.T.O. SPECIFICATIONS 1975.
 ALL POSTS, POST STUBS & ATTACHMENTS SHALL BE EITHER:
 1. A572 GRADE 50 OR A588.
 IF A572 MATERIAL IS USED, THE POST, BASE PLATES, UPPER SIX INCHES OF STUB POST, FLANGE SPLICE PL. AND FUSE PL. SHALL BE GALVANIZED AFTER FABRICATION.
 H.S. BOLTS, WASHERS & NUTS SHALL BE A325 TYPE 3 NOT GALVANIZED. THIS APPLIES TO A572 AS WELL AS A588 POSTS.

DESIGN DATA

WIND PRESSURE = 75 M.P.H.
 WIND COMPONENTS - NORMAL & 1.0 TRANSVERSE & 0.0
 ICE LOAD = 3 P.S.F.
 GROUP LOADS PERCENT OF ALLOWABLE STRESS:
 I DEAD 100
 II DEAD & WIND 140
 III DEAD, ICE & 1/2 WIND* 140 *25 P.S.F. MIN.
 ALLOWABLE SOIL PRESSURE = 1 1/2 T/30 FT
 WIND LOAD WAS APPLIED TO THE AREA OF THE SIGN AND TO THE SUPPORTING MEMBERS.
 ICE LOAD WAS APPLIED TO ONE FACE OF THE SIGN AND AROUND THE SURFACE OF THE SUPPORTING MEMBERS.





5	12-13-81	BASE CONN. WELD	
4	10-19-79	POST A*B, A572 JR 50, #K	
2	11-28-78	'K' 3 423-79 TYPE 'E'	
1	3-4-78	1/2, 1/2, & W	

STATE OF WISCONSIN
 DEPARTMENT OF TRANSPORTATION
 DIVISION OF HIGHWAYS

TYPE A, B, C, & D

WISCONSIN DEPT OF TRANSPORTATION
 APPROVED *[Signature]*
 CHIEF TRAFFIC ENGINEER
 DATE 11-25-81 PLATE NO. A3-1.9

FOOTING & SIGN SUPPORT
 DETAILS. GROUND MOUNT
 BREAK-AWAY SIGNS SHT. 1 OF 1

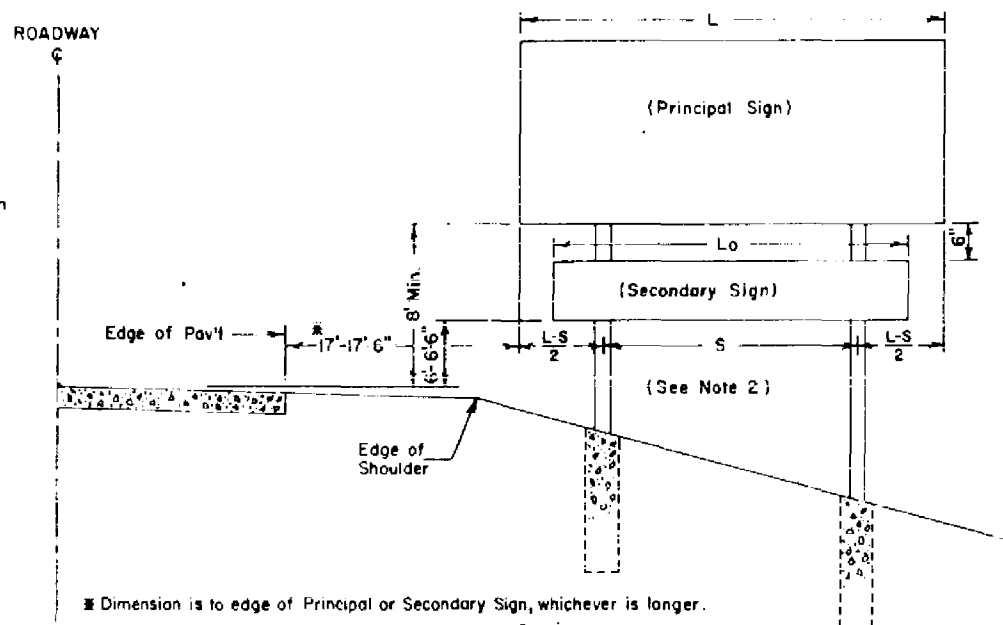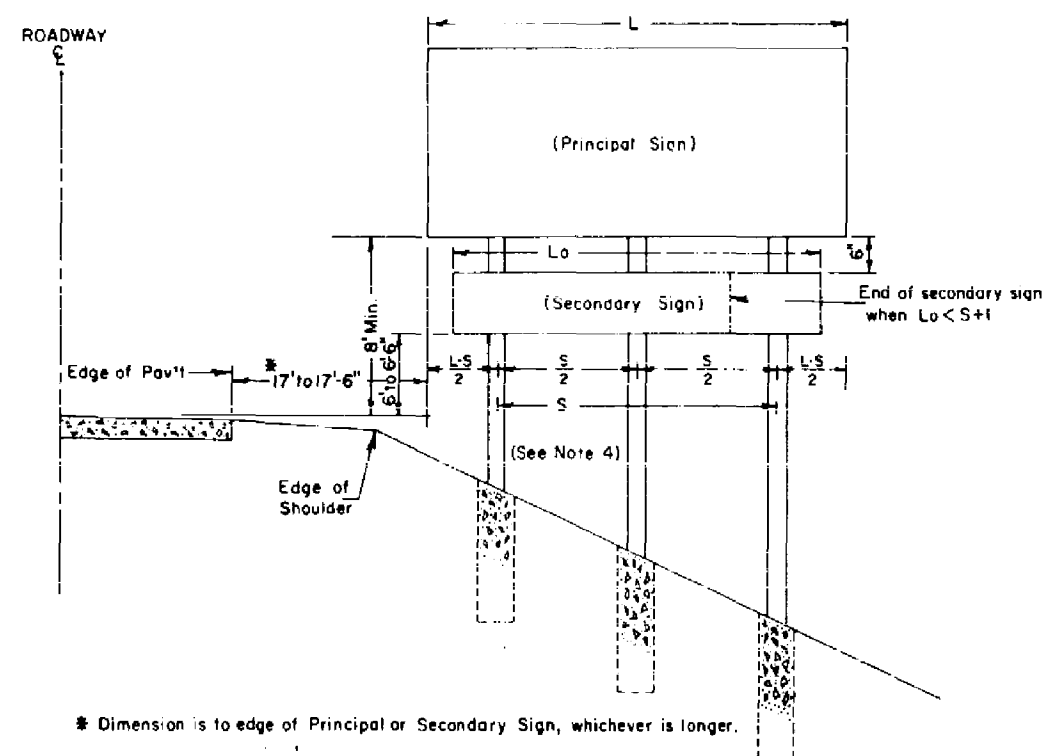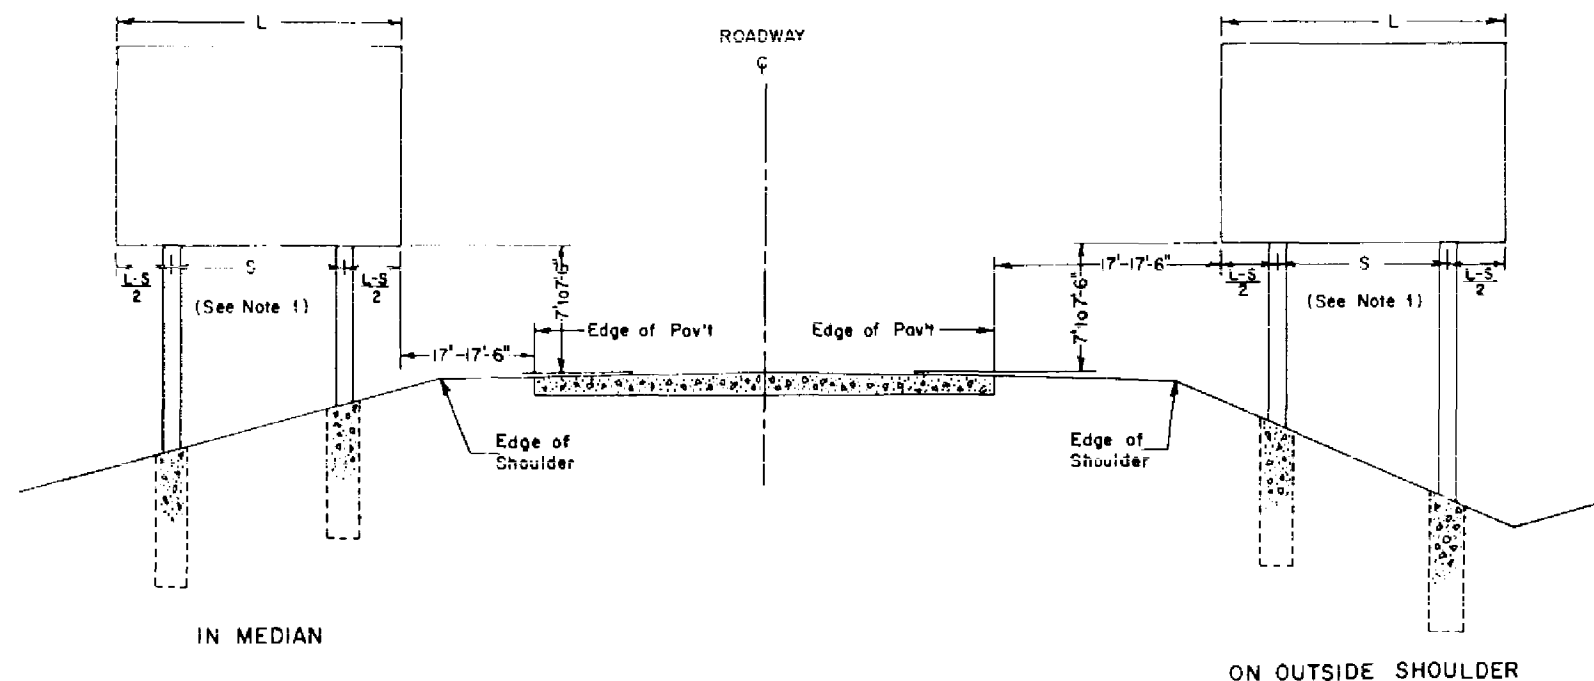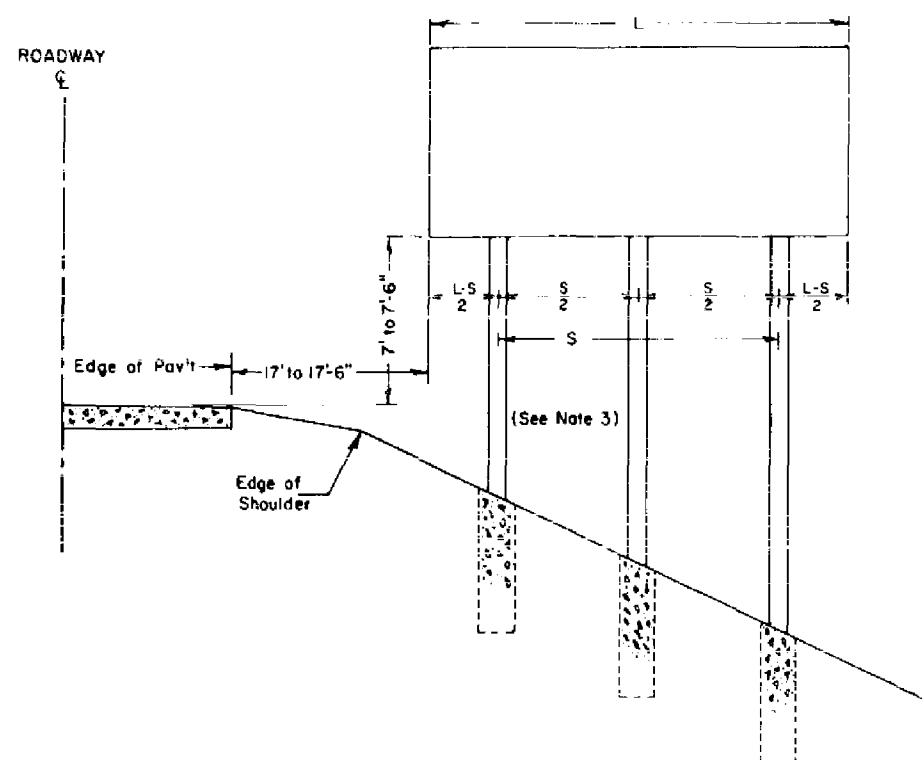

* Dimension is to edge of Principal or Secondary Sign, whichever is longer.

* Dimension is to edge of Principal or Secondary Sign, whichever is longer.

GENERAL NOTES:


1. Single sign mounted on two posts: (a) if L equals or exceeds 15 feet, S equals $\frac{3L}{5}$. (b) if L is less than 15 feet, S equals 9 feet. (Design note: L must equal or exceed 10 feet.)
2. Two signs mounted on two posts: (a) if Lo equals or exceeds S+1 feet as defined in Note 1, use S determined in accordance with Note 1. (b) if Lo is less than S+1 feet as defined in Note 1, use S equals Lo-1 feet. (Design note: L must equal or exceed 10 feet and Lo must equal or exceed $\frac{3}{5}L + 1$ feet or 10 feet whichever is greater.)
3. Single sign mounted on three posts: (a) if L equals or exceeds 30 feet, S equals $\frac{3L}{5}$. (b) if L is less than 30 feet, S equals 18 feet. (Design note: L must equal or exceed 19 feet.)
4. Two signs mounted on three posts: Use S as determined in accordance with Note 3. (a) if Lo equals or exceeds S+1 feet, mount the secondary sign centered on all three posts. (b) if Lo is less than S+1 feet, mount the secondary sign centered on the two posts closest to the roadway without connection to the third post. (Design note: L must equal or exceed 19 feet and Lo must equal or exceed $\frac{3}{5}L + 1$ feet or 10 feet whichever is greater.)

Date Redrawn - 1/13/77	
Date Revised - 8/27/74	
1/13/77	
TYPICAL INSTALLATION OF TYPE I SIGNS ON STEEL BREAKAWAY POSTS	
WISCONSIN, DIVISION OF HIGHWAYS	
APPROVED: <i>Wayne H. Volk</i>	CHIEF TRAFFIC ENGINEER
DATE 1-26-77	PLATE NO. A4-1.3


TABLE OF POST SPACING

L (FEET)	TWO POSTS DIAMOND SHAPE SIGNS S (FEET - INCHES)	TWO POSTS SIGNS OTHER THAN DIAMOND SHAPE S (FEET)	THREE POSTS S (FEET)	FOUR POSTS S (FEET)
L<3		4-1/4		
3<L<5	1'-8"	L-2		
5<L<6	2'-8"			
6<L<7	3L/5		8-1/2'	
7<L<9	3L/5	3L/5		
9<L<13				12-3/4
13<L<15				
15<L<17			2L/3	
17<L<18				3L/4
18<L<24				3L/4


L= HORIZONTAL DIMENSION OF SIGN S= SPACE BETWEEN OUTSIDE POSTS (C-C)

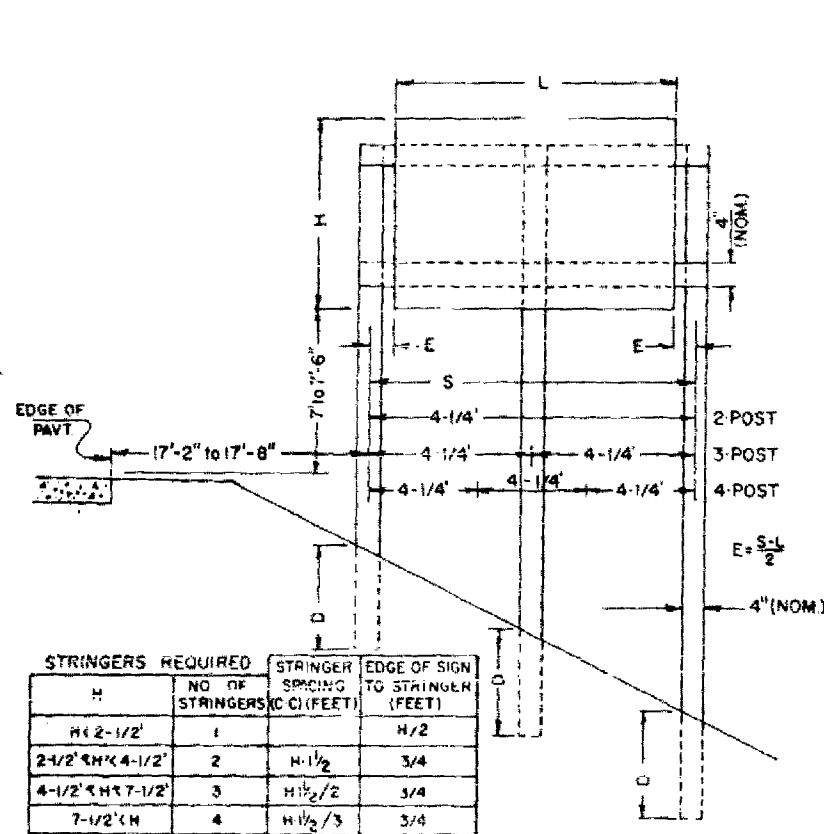


WHEN L<3 (TWO POST INSTALLATION)
OR L<9 (THREE POST INSTALLATION)
OR L<13 (FOUR POST INSTALLATION)

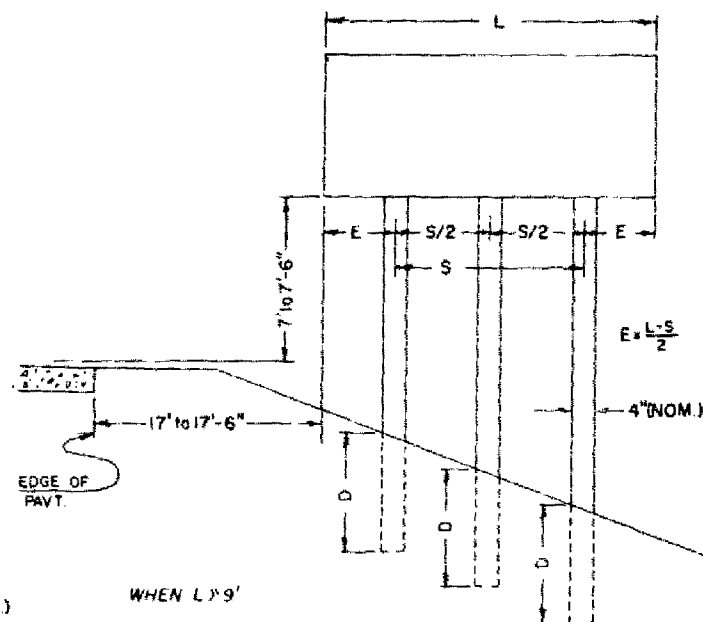

WHEN L>9'

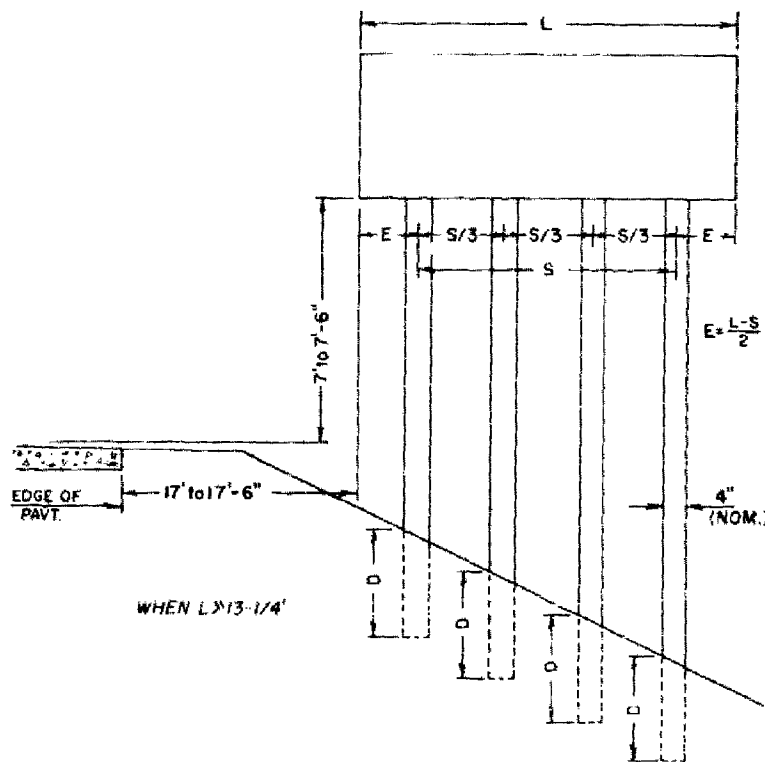

WHEN L>13-1/4'

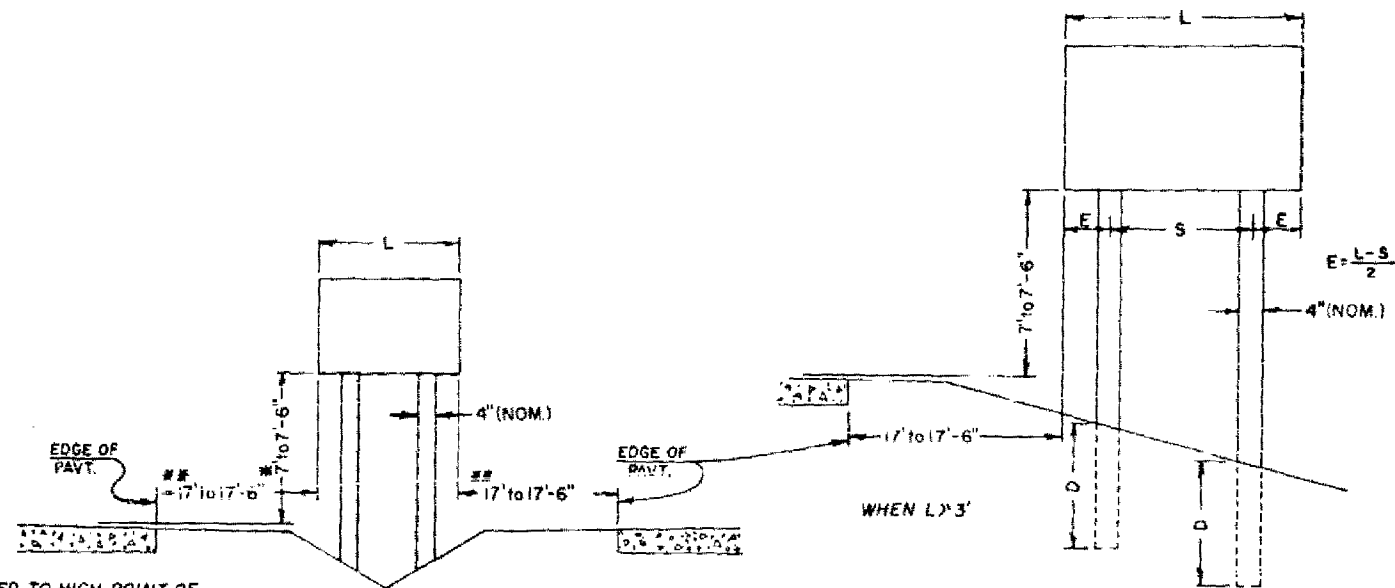

WHEN L>3'

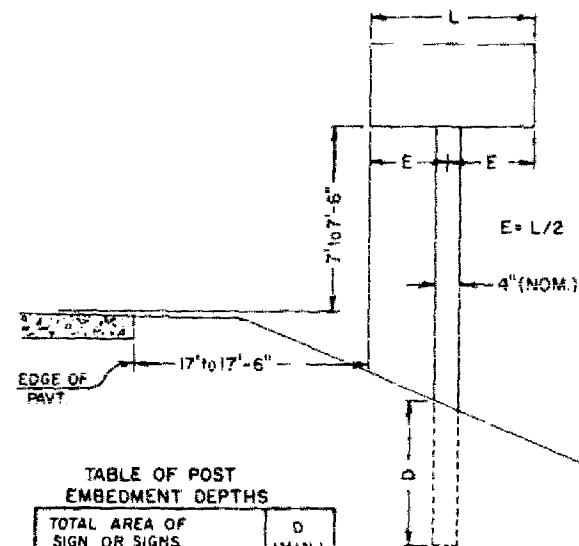



TABLE OF POST EMBEDMENT DEPTHS

TOTAL AREA OF SIGN OR SIGNS IN INSTALLATION (SQ. FT.)	D (MIN) (FEET)
NOT OVER 20	3-1/2
OVER 20 BUT NOT OVER 50	4
OVER 50	5


* MEASURED TO HIGH POINT OF MAINLINE PAVEMENT
** MEASURED TO THE EDGE OF SIGN OR TO EDGE OF NEAREST POST WHICHEVER IS CLOSER TO THE PAVEMENT.

SIGN IN GORE
SPACING OF POSTS IS DEPENDENT ON THEIR NUMBER, SEE OTHER LAYOUTS ON THIS PAGE.


Date Drawn - 1-20-77
Date Revised -
TYPICAL INSTALLATION OF TYPE III SIGNS ON WOOD POSTS
WISCONSIN DIVISION OF HIGHWAYS
APPROVED <i>Wm. N. Volk</i> CHIEF TRAFFIC ENGINEER
DATE 1-26-77 PLATE NO. A4-2.1

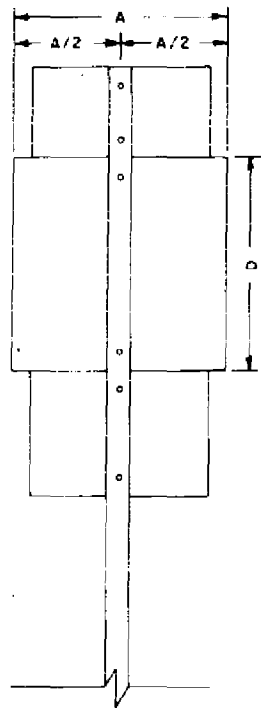


CODE 1 PANEL
WHEN PANEL HEIGHT D=18,24,36 INCHES

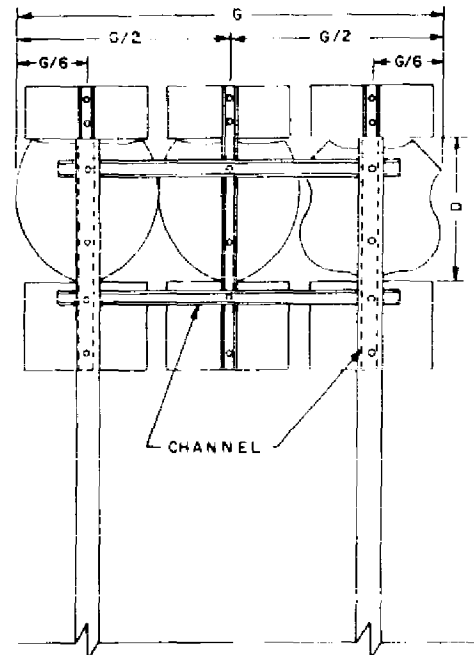


CODE 3 PANEL
WHEN SHIELD HEIGHT D=24,36 INCHES
USING ONE OR MORE CUTOFF MARKERS

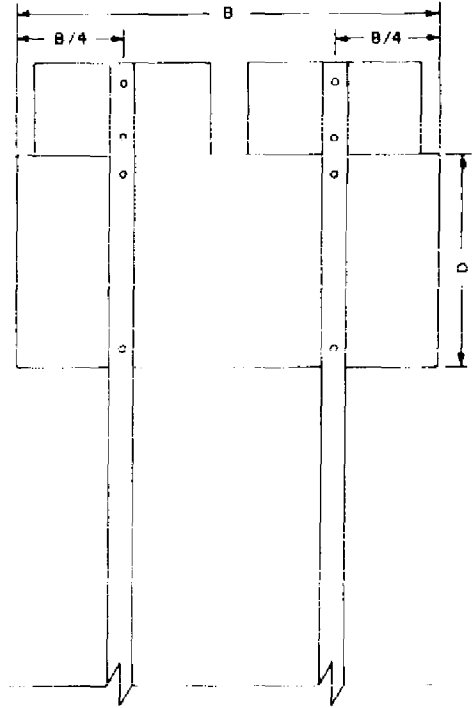


CODE 2 PANEL
WHEN PANEL HEIGHT D=36 INCHES

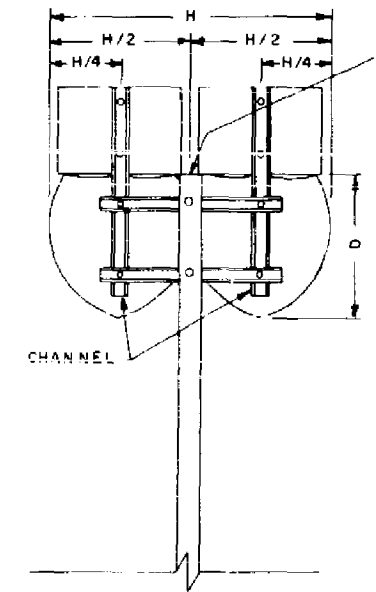


CODE 2 PANEL
WHEN SHIELD HEIGHT D=24,36 INCHES

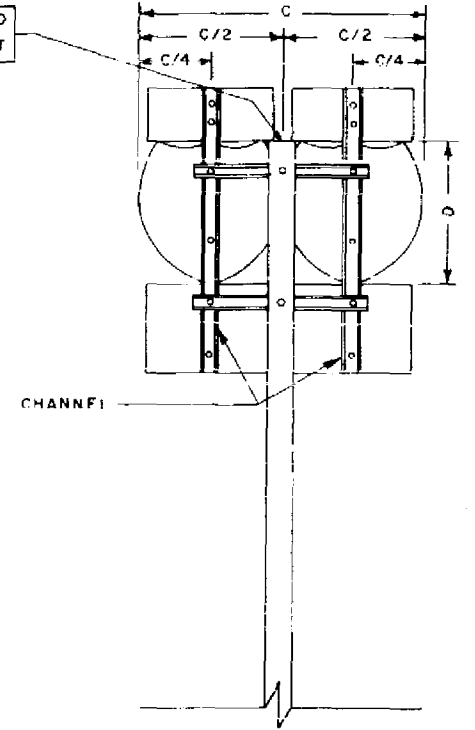


CODE 2 PANEL
WHEN PANEL HEIGHT D=18,24 INCHES

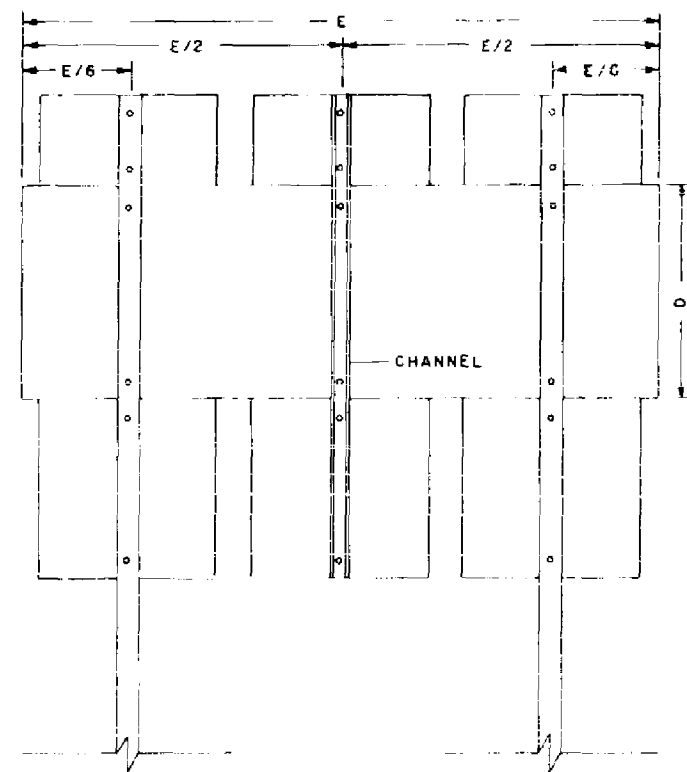

CODE 3 PANEL
WHEN PANEL HEIGHT D=24,36 INCHES
ALL MARKERS ON PANEL

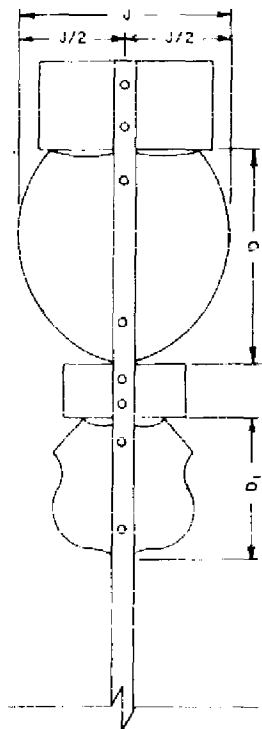

CODE 2 PANEL
WHEN SHIELD HEIGHT D=36 INCHES
D=24 INCHES



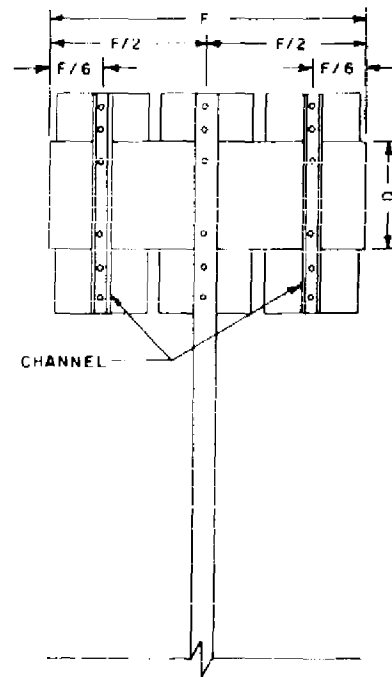


CODE 3 PANEL
WHEN PANEL HEIGHT D=18 INCHES

NOTE
ALL SIGNS WHICH ARE MOUNTED ON VERTICAL CHANNELS
ARE MOUNTED ON HORIZONTAL CHANNELS ATTACHED TO
THE POSTS.

THE CHANNEL SUPPORTING THE COMPONENT PARTS OF THE J1,
J2, J3, J4 TYPE ASSEMBLIES SHALL BE IDENTICAL IN CROSS
SECTION, WEIGHT, AND MATERIAL WITH THE DELINEATOR POST.
ALL OF THE SIGNS ARE ILLUSTRATED IN BACK VIEW.

Date Redrawn— February 18, 1971
Date Revised —
TYPICAL PANEL INSTALLATION FOR TYPE J1, J2, J3 AND J4 ASSEMBLIES
WISCONSIN DIVISION OF HIGHWAYS
APPROVED — CHIEF TRAFFIC ENGINEER
DATE — PLATE NO. 44-8.1

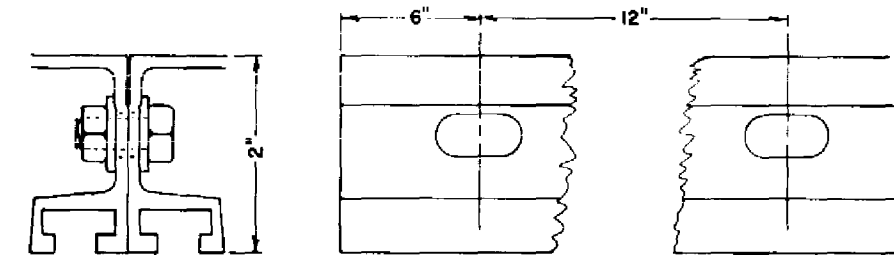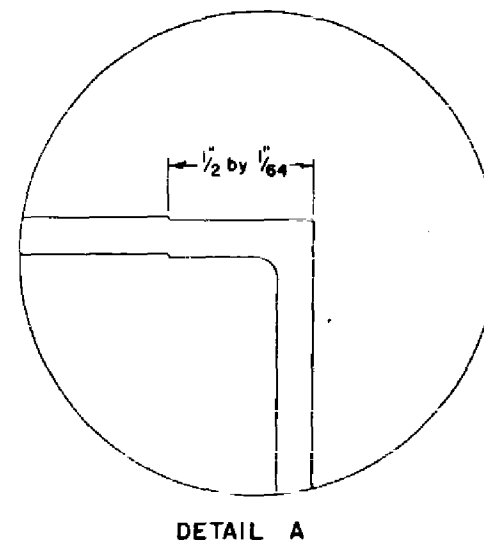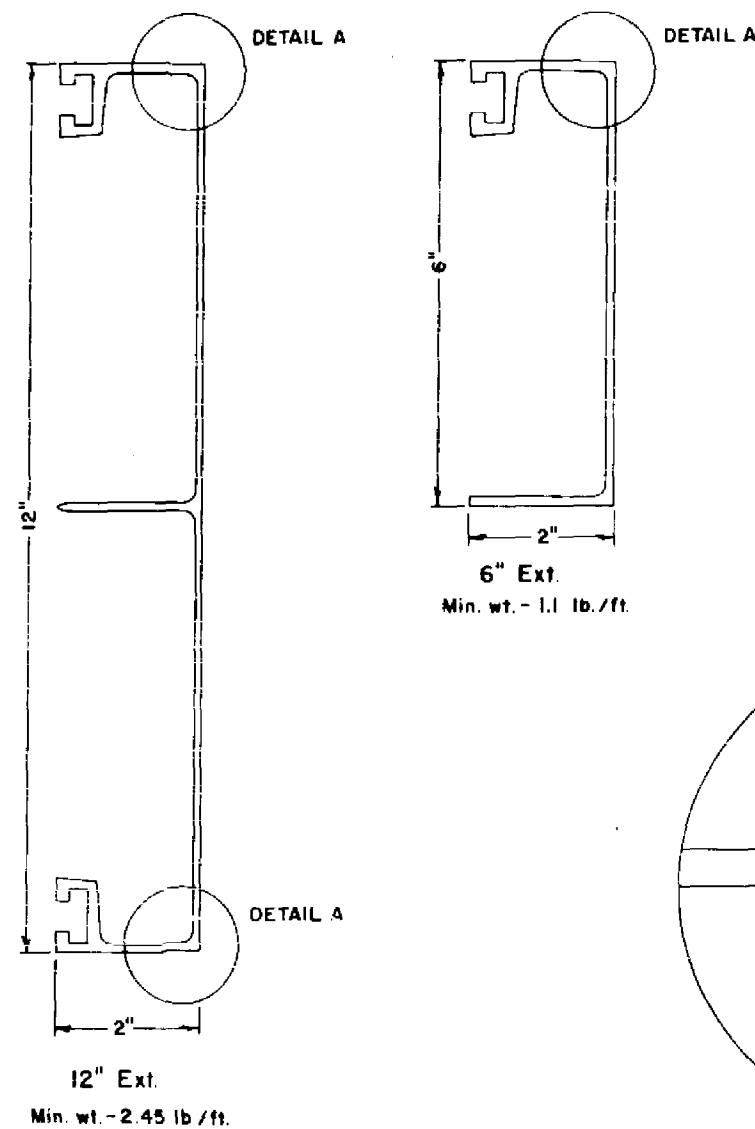

Detail of bolt & washers used to fasten extrusions in fabrication of sign faces.

Punch oval holes beginning 6" in from end of extrusion 12" C to C both edges of 6" and 12" panels, holes to be $\frac{7}{16} \times \frac{7}{8}$.
Max. bolt spacing 24" C-C, Min. 4 bolts & washers connecting any two extrusions.


NOTES

1. The drawings are intended to illustrate acceptable extrusions for base material for Type I signs.
2. The contractor may select any brand of extrusion that conforms to the above but all extrusions used on this contract shall be of the same brand.


Date Drawn -	Date Redrawn - 11-4-83
Date Revised	10-9-73
	3-3-81
	12-10-82
STANDARD STYLE OF ALUMINUM EXTRUSIONS FOR TYPE I SIGN BASE MATERIAL	
WISCONSIN DEPT OF TRANSPORTATION	
APPROVED	<i>St. Louis</i> Chief Traffic Engineer
DATE 11-30-83	PLATE NO. AS-2.5

CROSSROADS, RAMPS & FRONTAGE ROADS

FREEWAY MAIN LINE ROADWAY

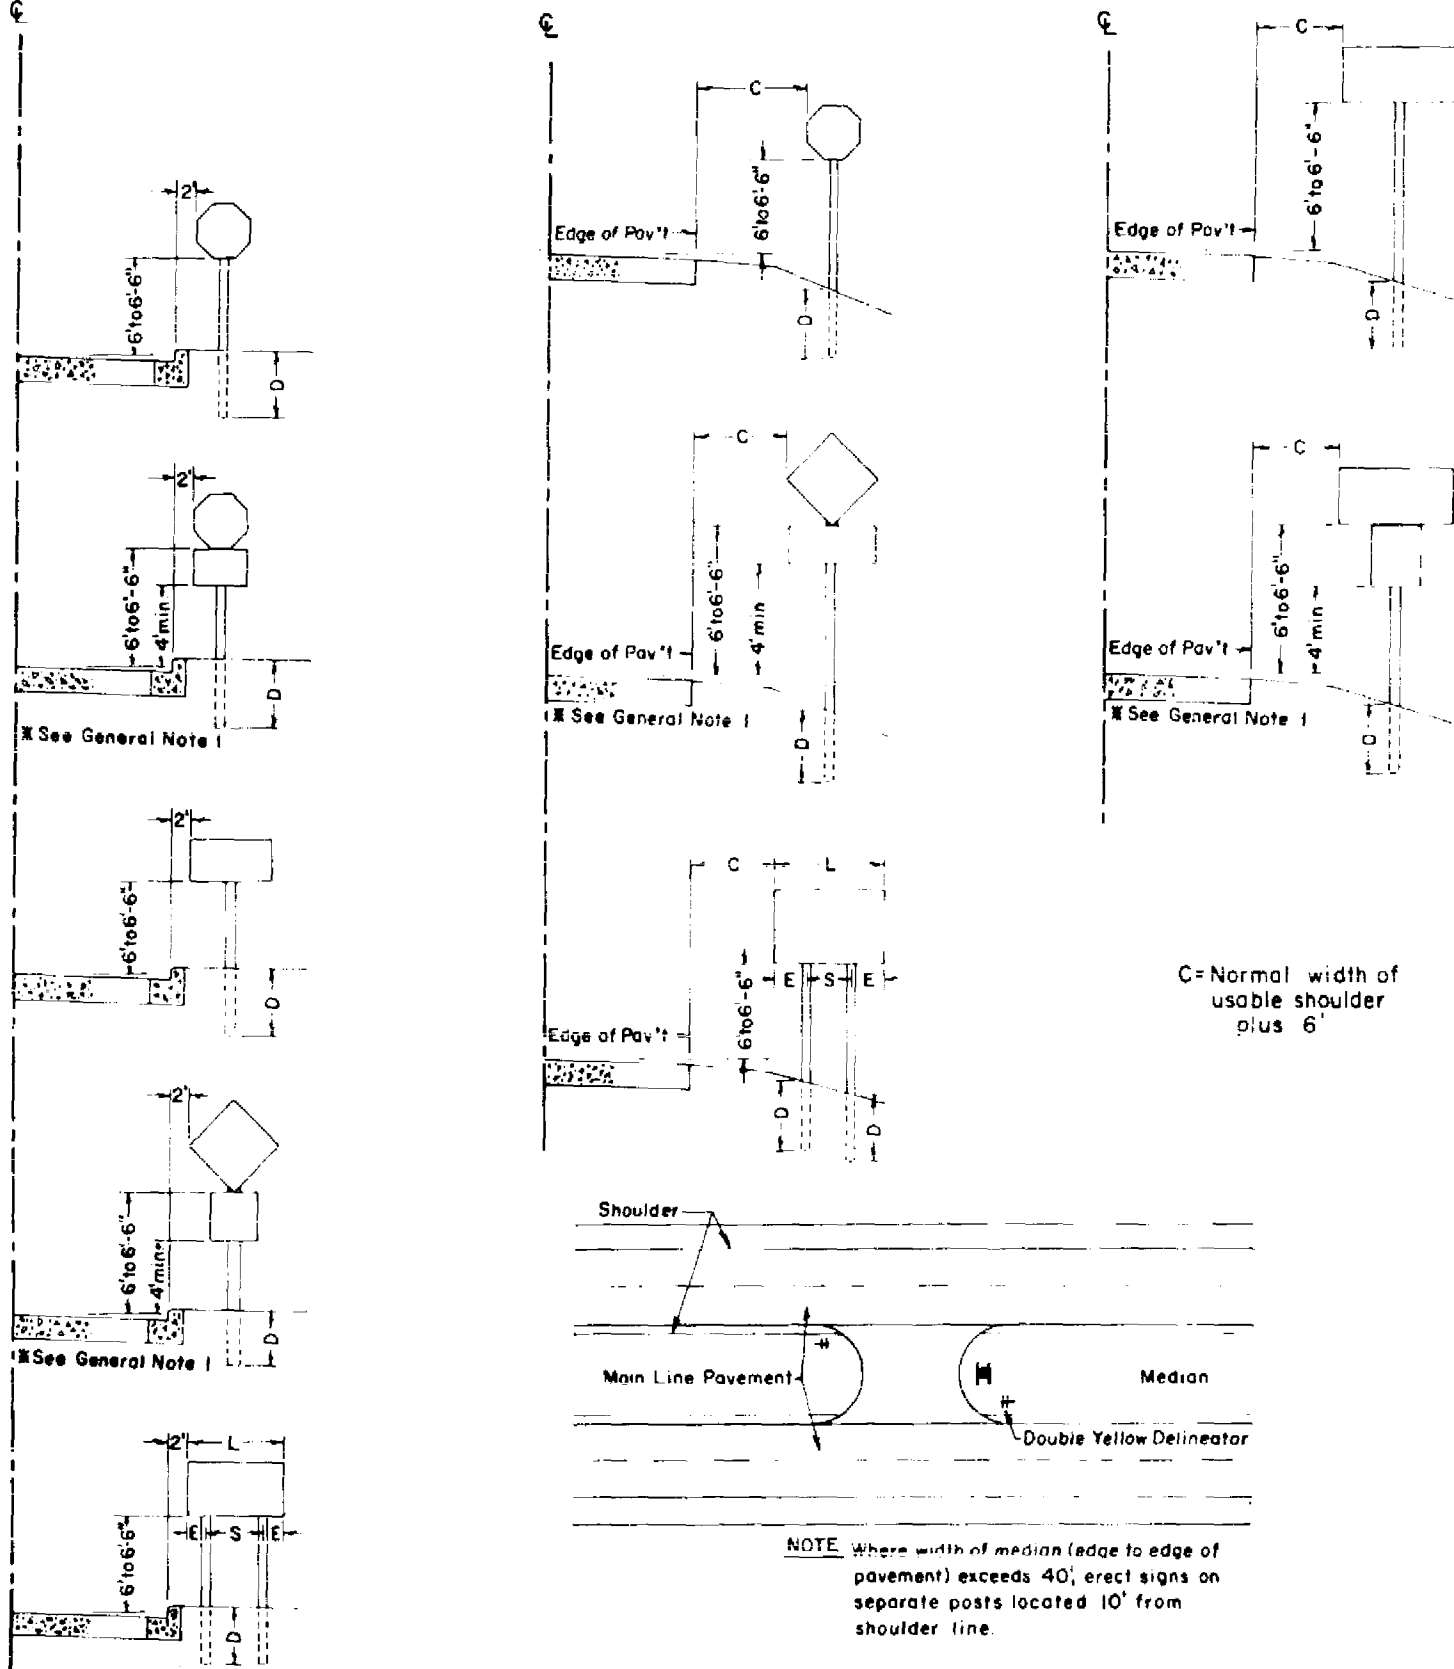

TYPICAL INSTALLATION OF SIGNS ON MEDIAN CROSSOVERS

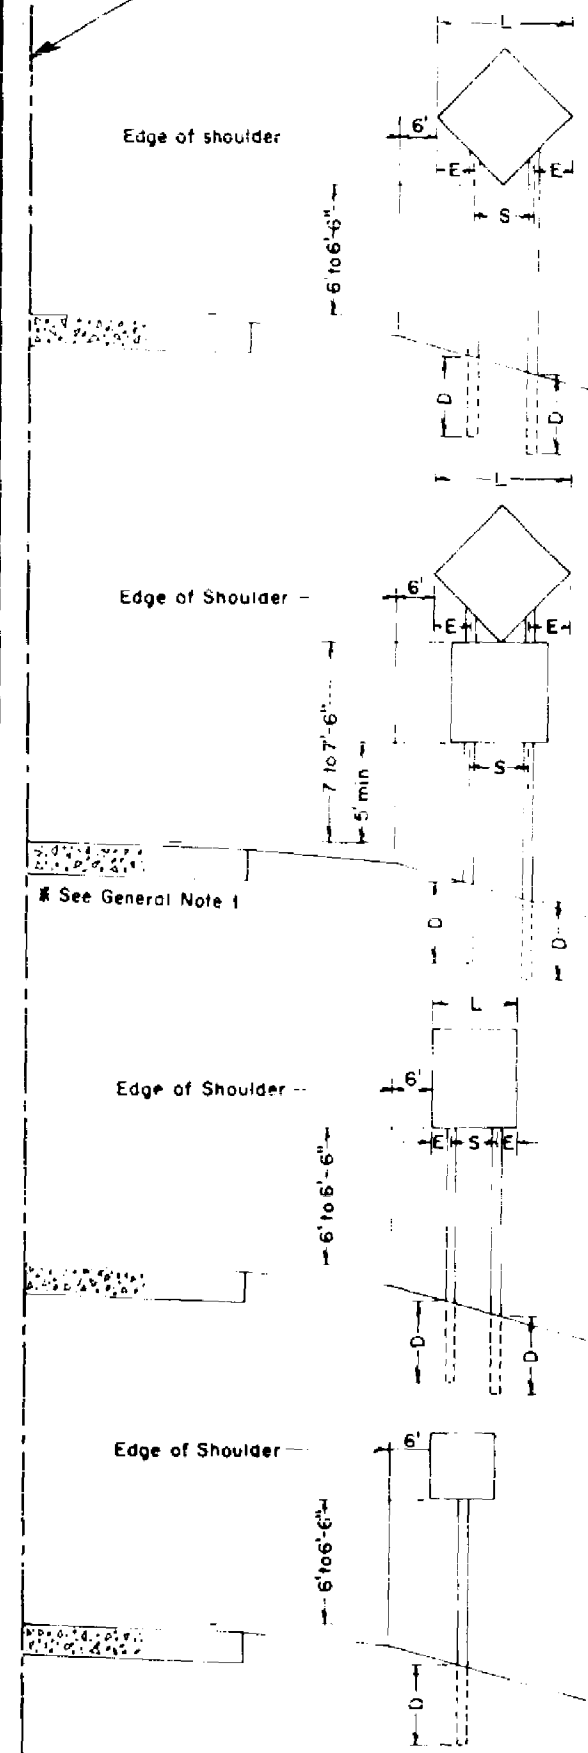

GENERAL NOTES

1. In installations with two or more signs, the maximum height shown for the upper sign may be exceeded when necessitated by the sum of the minimum height of the lower sign and the vertical dimension of the lower sign.
2. Post spacing "S" may be reduced by the minimum amount necessary to accommodate a supplementary sign mounted below the principal sign.
3. For post spacing for installations with 3 or more posts see plate for "Installation of Type III Signs."
4. On fully illuminated freeways, the mounting heights shown for signs on the Freeway mainlines and ramps shall be increased by 1.0 feet.

POST EMBEDMENT DEPTHS

Total Area of Sign or Signs in Installation (Sq. Ft.)	D (Minimum)
Not over 20'	3.5'
Over 20' but not over 50'	4'
Over 50'	5'


POST SPACING FOR SIGNS WITH TWO POSTS (See Note 2 & 3)


DIAMOND SHAPE SIGNS		SIGNS OTHER THAN DIAMOND SHAPE	
L	S	L	S
less than 5'	20"	less than 5'	L-24"
5' or over but less than 6'	32"	5' or over	3L/5
6' or over	3L/5		

$$F = \frac{L-S}{2}$$

Date Redrawn	1-13-84
Date Revised	1-13-84
TYPICAL INSTALLATION OF TYPE II SIGNS	
WISCONSIN DEPT OF TRANSPORTATION	
APPROVED	TRAFFIC ENGINEER
DATE 3-6-83	PLATE NO A4-3.5

SIGNING & FENCING DETAIL

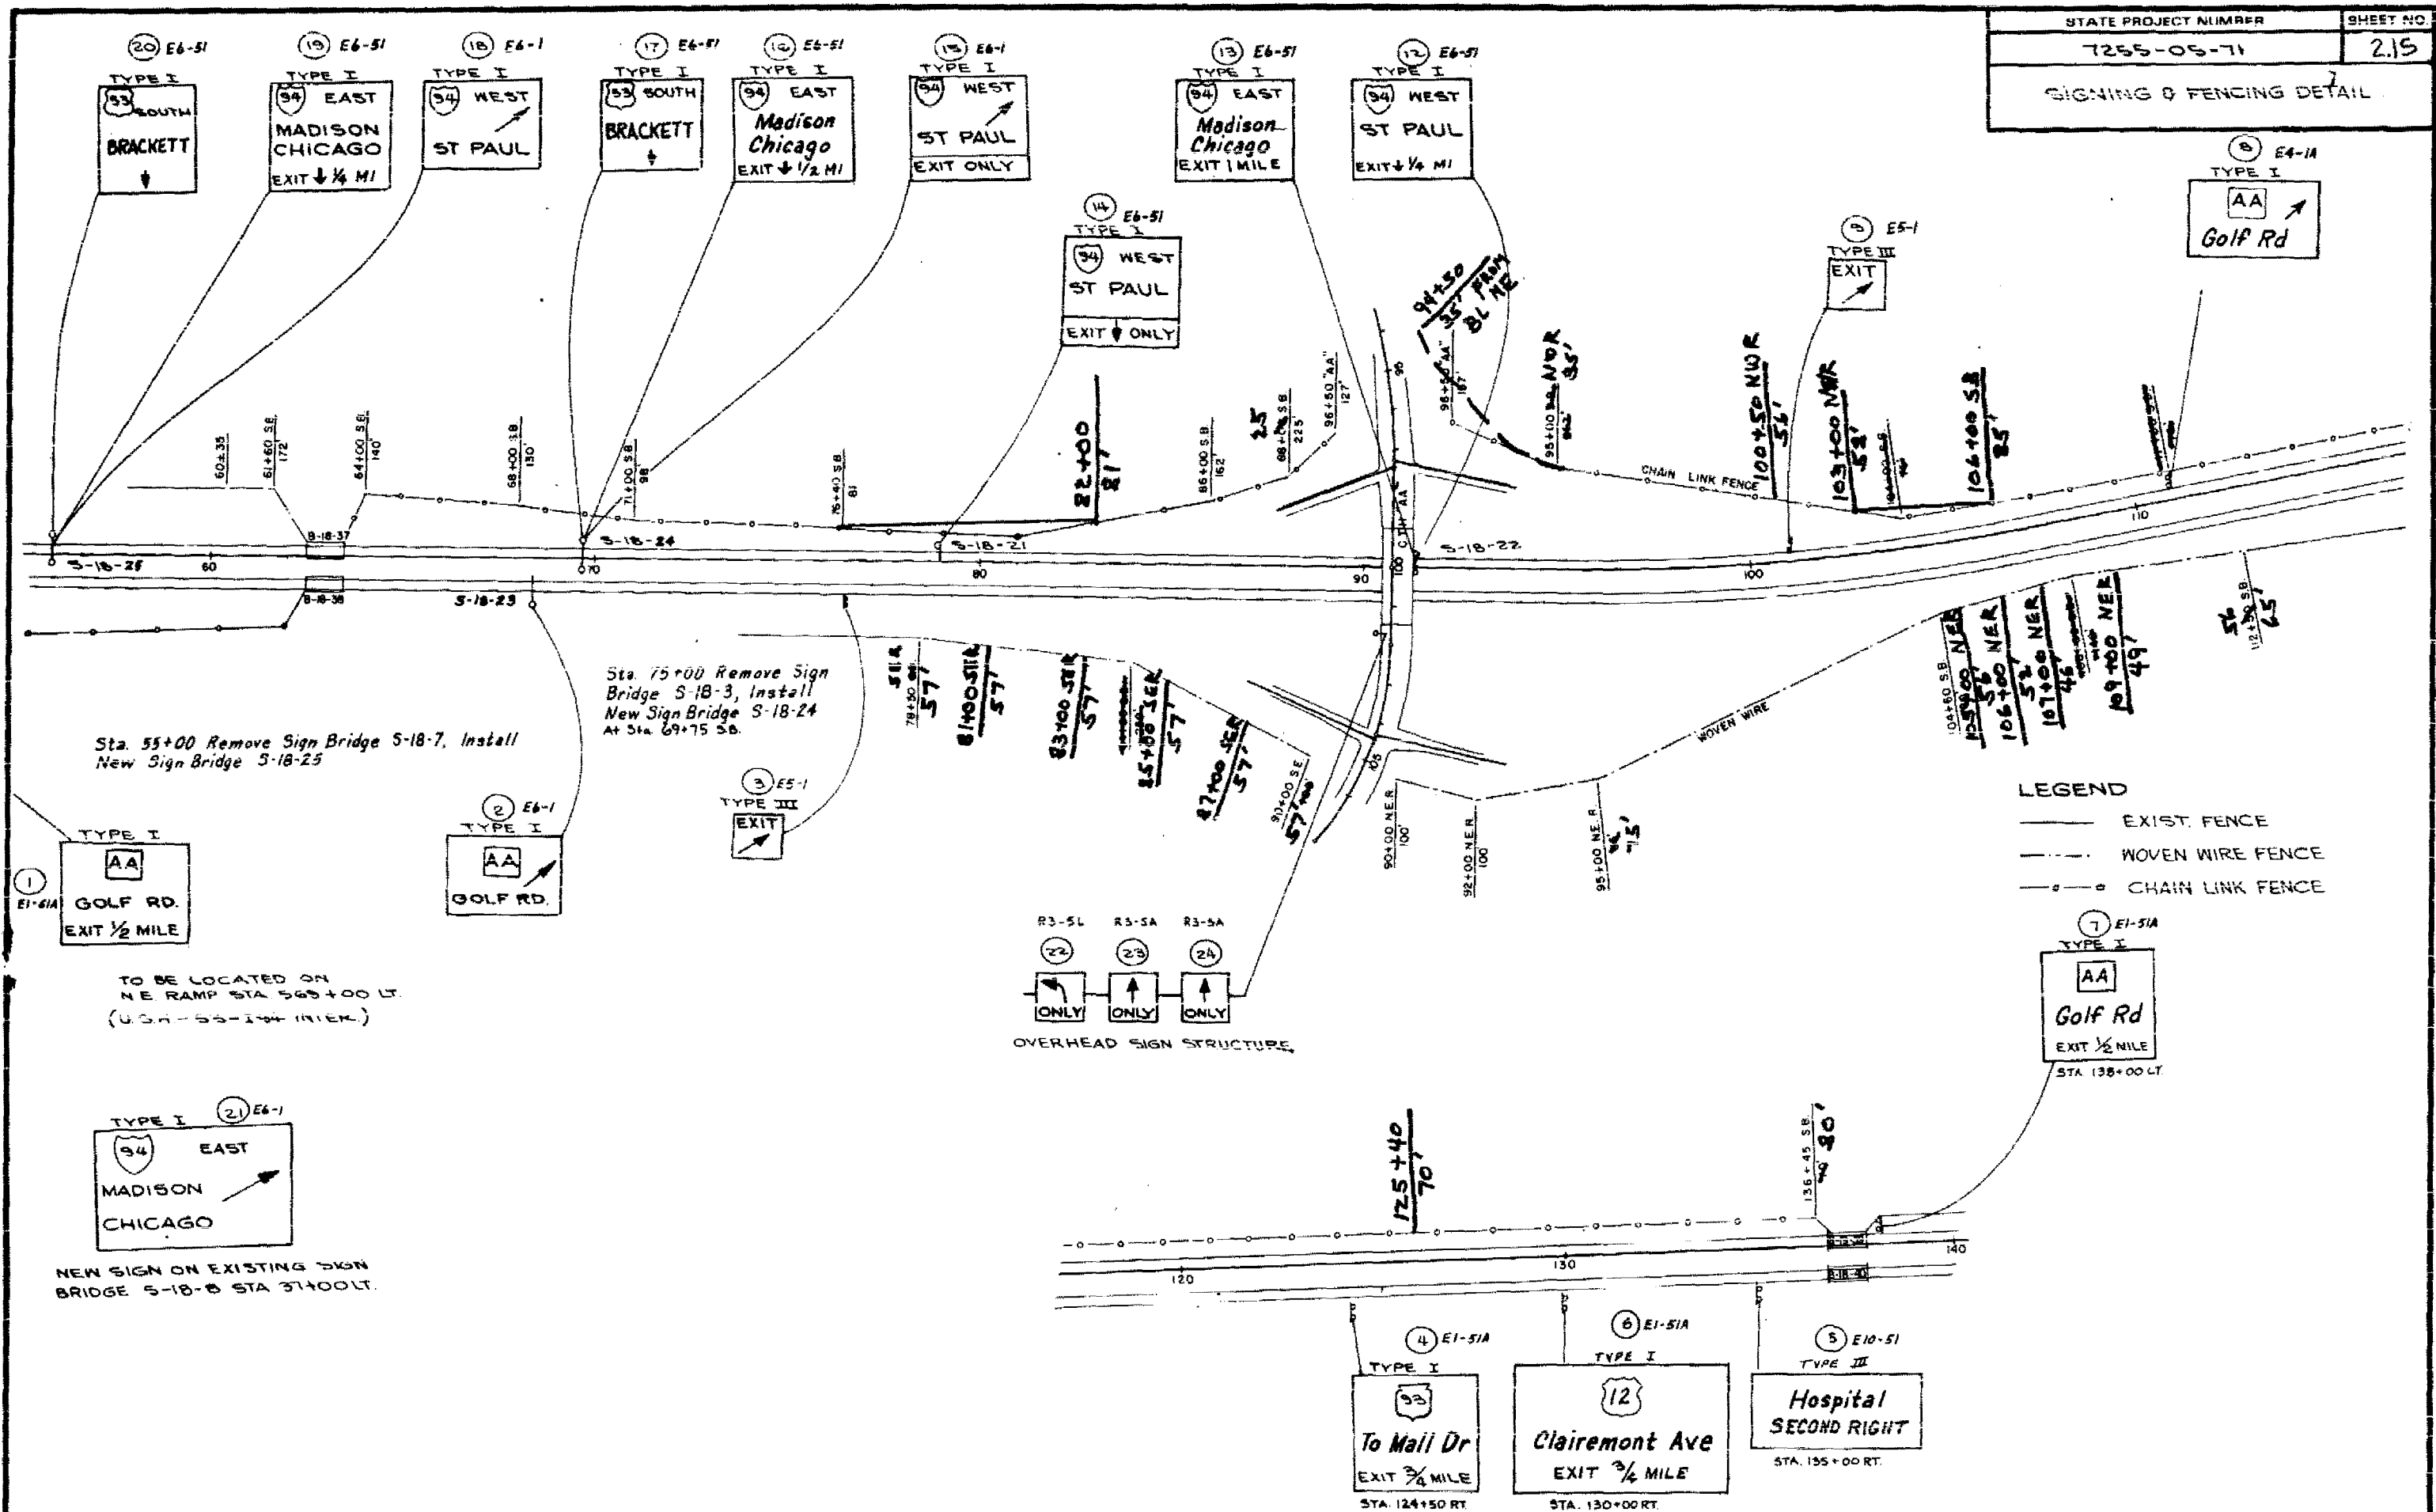

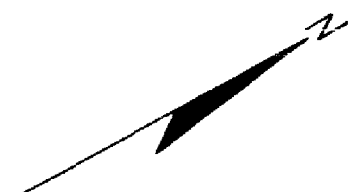

TRAFFIC CONTROL

SPECIAL NOTES

SIGN BRIDGE STA. 74+00 S.B. USH 53
MESSAGES WILL BE COVERED (BY OTHERS)

LEGEND

- POST MOUNTED SIGN
- STEADY BURNING WARNING LIGHTS
- ⊗ FLASHING LIGHTS (TYPE A)
- ⊥ TYPE II BARRICADES
- ⊥ TYPE III BARRICADES WITH TYPE C STEADY BURNING WARNING LIGHTS
- (SYMBOLS APPLY TO THIS SHEET ONLY)
- TEMPORARY PRECAST CONCRETE BARRIER WITH TYPE 'C' STEADY BURNING WARNING LIGHTS

GENERAL NOTES

SIGN LAYOUTS SHALL BE IN ACCORDANCE WITH THE FEDERAL HIGHWAY ADMINISTRATION MANUAL OF STANDARD HIGHWAY SIGNS UNLESS OTHERWISE PROVIDED IN THE PLAN.


ALL ITEMS NOTED ON THIS SHEET SHALL BE PAID FOR UNDER THE ITEM OF TRAFFIC CONTROL, EXCEPT FOR TEMPORARY PRECAST CONCRETE BARRIER WHICH IS PAID FOR UNDER THE PERTINENT CONTRACT ITEM. EACH OPERATION OR SEGMENT UNDER CONSTRUCTION SHALL HAVE ITS OWN TRAFFIC CONTROL.

ALL SIGNS ARE 48" X 48" UNLESS OTHERWISE NOTED.


"W" SIGNS ARE THE SAME AS "M" SIGNS EXCEPT THE BACKGROUND IS ORANGE.

WO 13-1 MESSAGE WILL BE 45 M.P.H.

NOTE: DRAWING IS SCHEMATIC AND INTENDED FOR USE AT BOTH RT. AND LT. LANE CLOSURE (LT. LANE CLOSURE SHOWN)

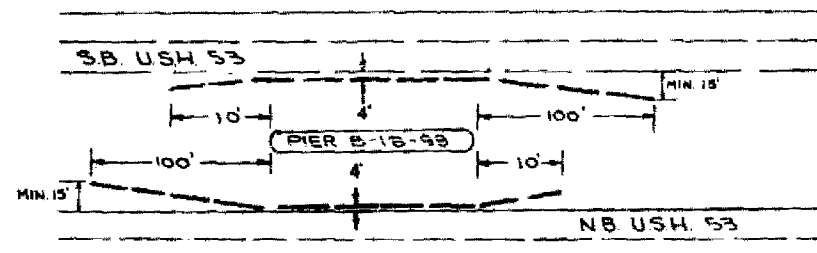

BARRIER DETAIL TRAFFIC CONTROL FOR
PIER CONSTRUCTION (B-18-99)

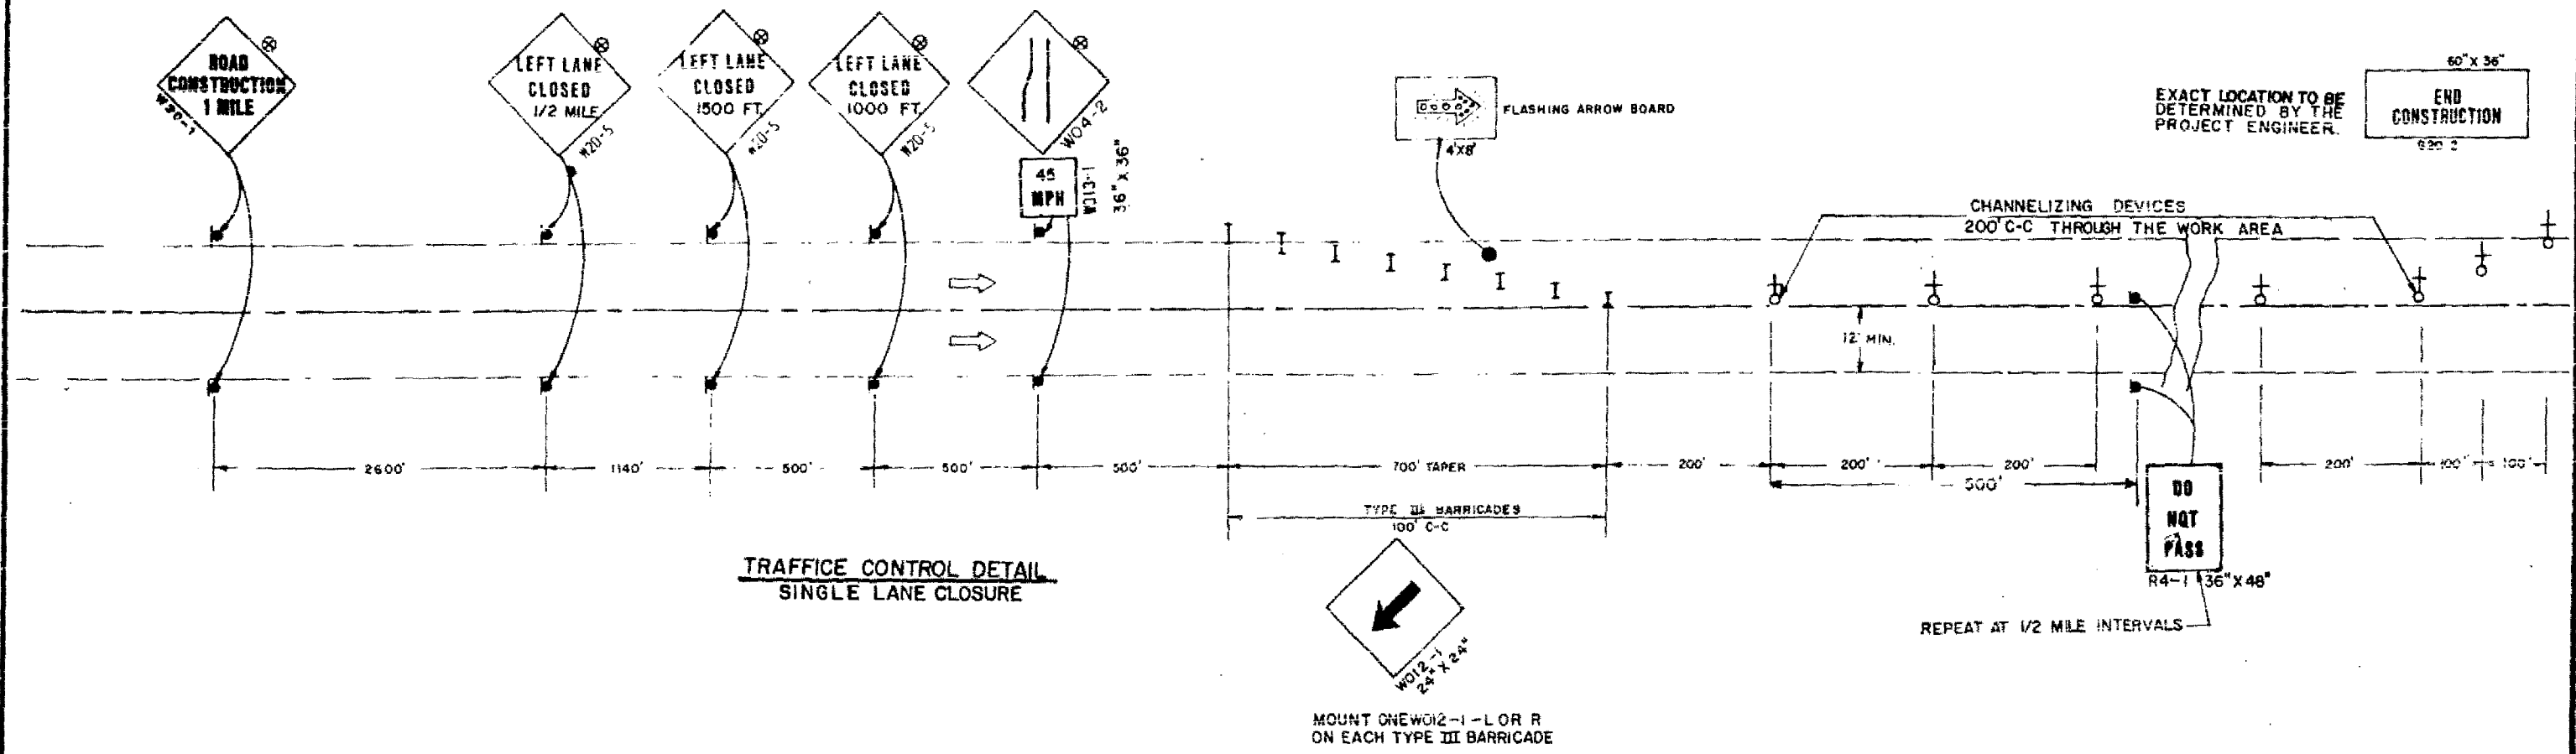

GENERAL NOTES

SIGN LAYOUTS SHALL BE IN ACCORDANCE WITH THE FEDERAL HIGHWAY ADMINISTRATION MANUAL OF STANDARD HIGHWAY SIGNS UNLESS OTHERWISE PROVIDED IN THE PLAN.

ALL SIGNS ARE 48" X 48" UNLESS OTHERWISE NOTED.

"W" SIGNS ARE THE SAME AS "M" SIGNS EXCEPT THE BACKGROUND IS ORANGE.


ALL ITEMS NOTED ON THIS SHEET SHALL BE PAID FOR UNDER THE ITEM OF TRAFFIC CONTROL.


STATE PROJECT NUMBER	SHEET NO.
7255-05-71	2.19

TRAFFIC CONTROL

LEGEND

- SIGNS (POST MOUNTED)
- I TYPE III BARRICADES WITH TYPE C STEADY BURNING WARNING LIGHTS
- † TYPE II BARRICADES
- STEADY BURNING WARNING LIGHTS
- FLASHING LIGHTS (TYPE A)

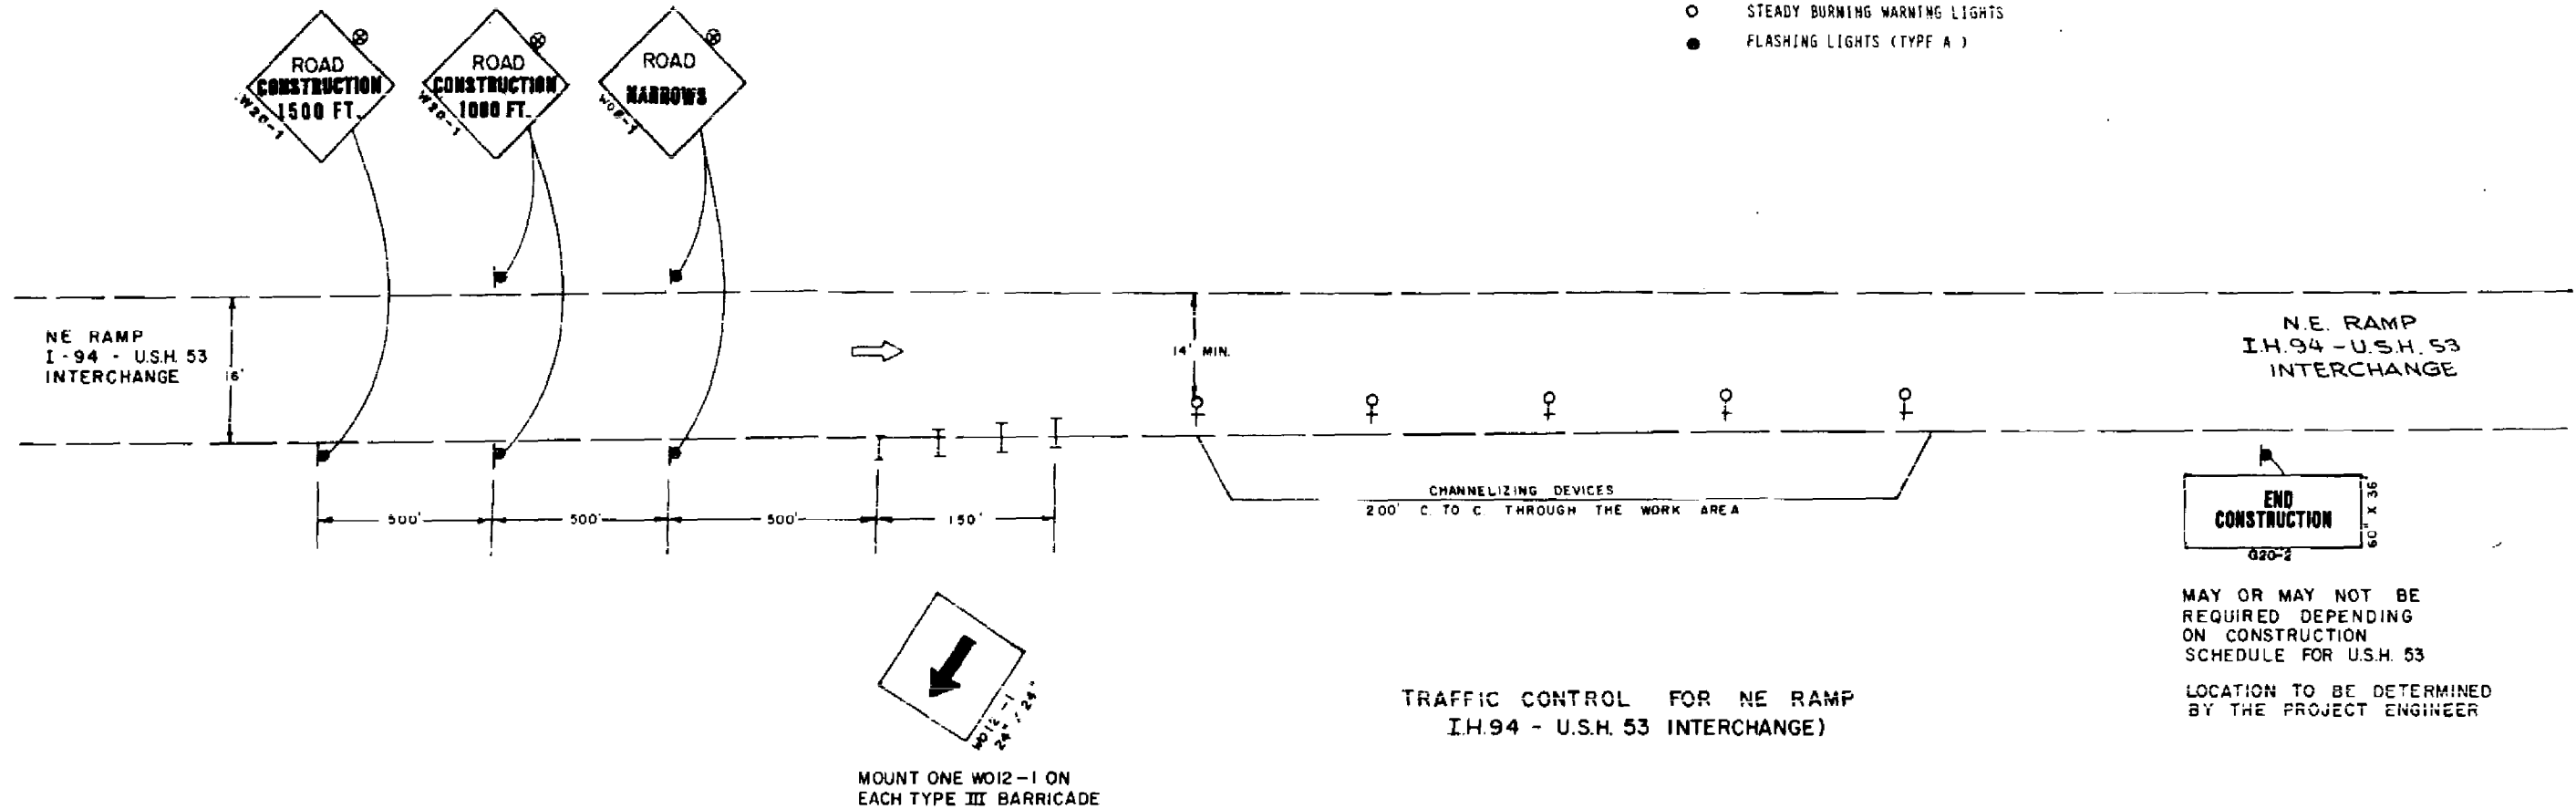

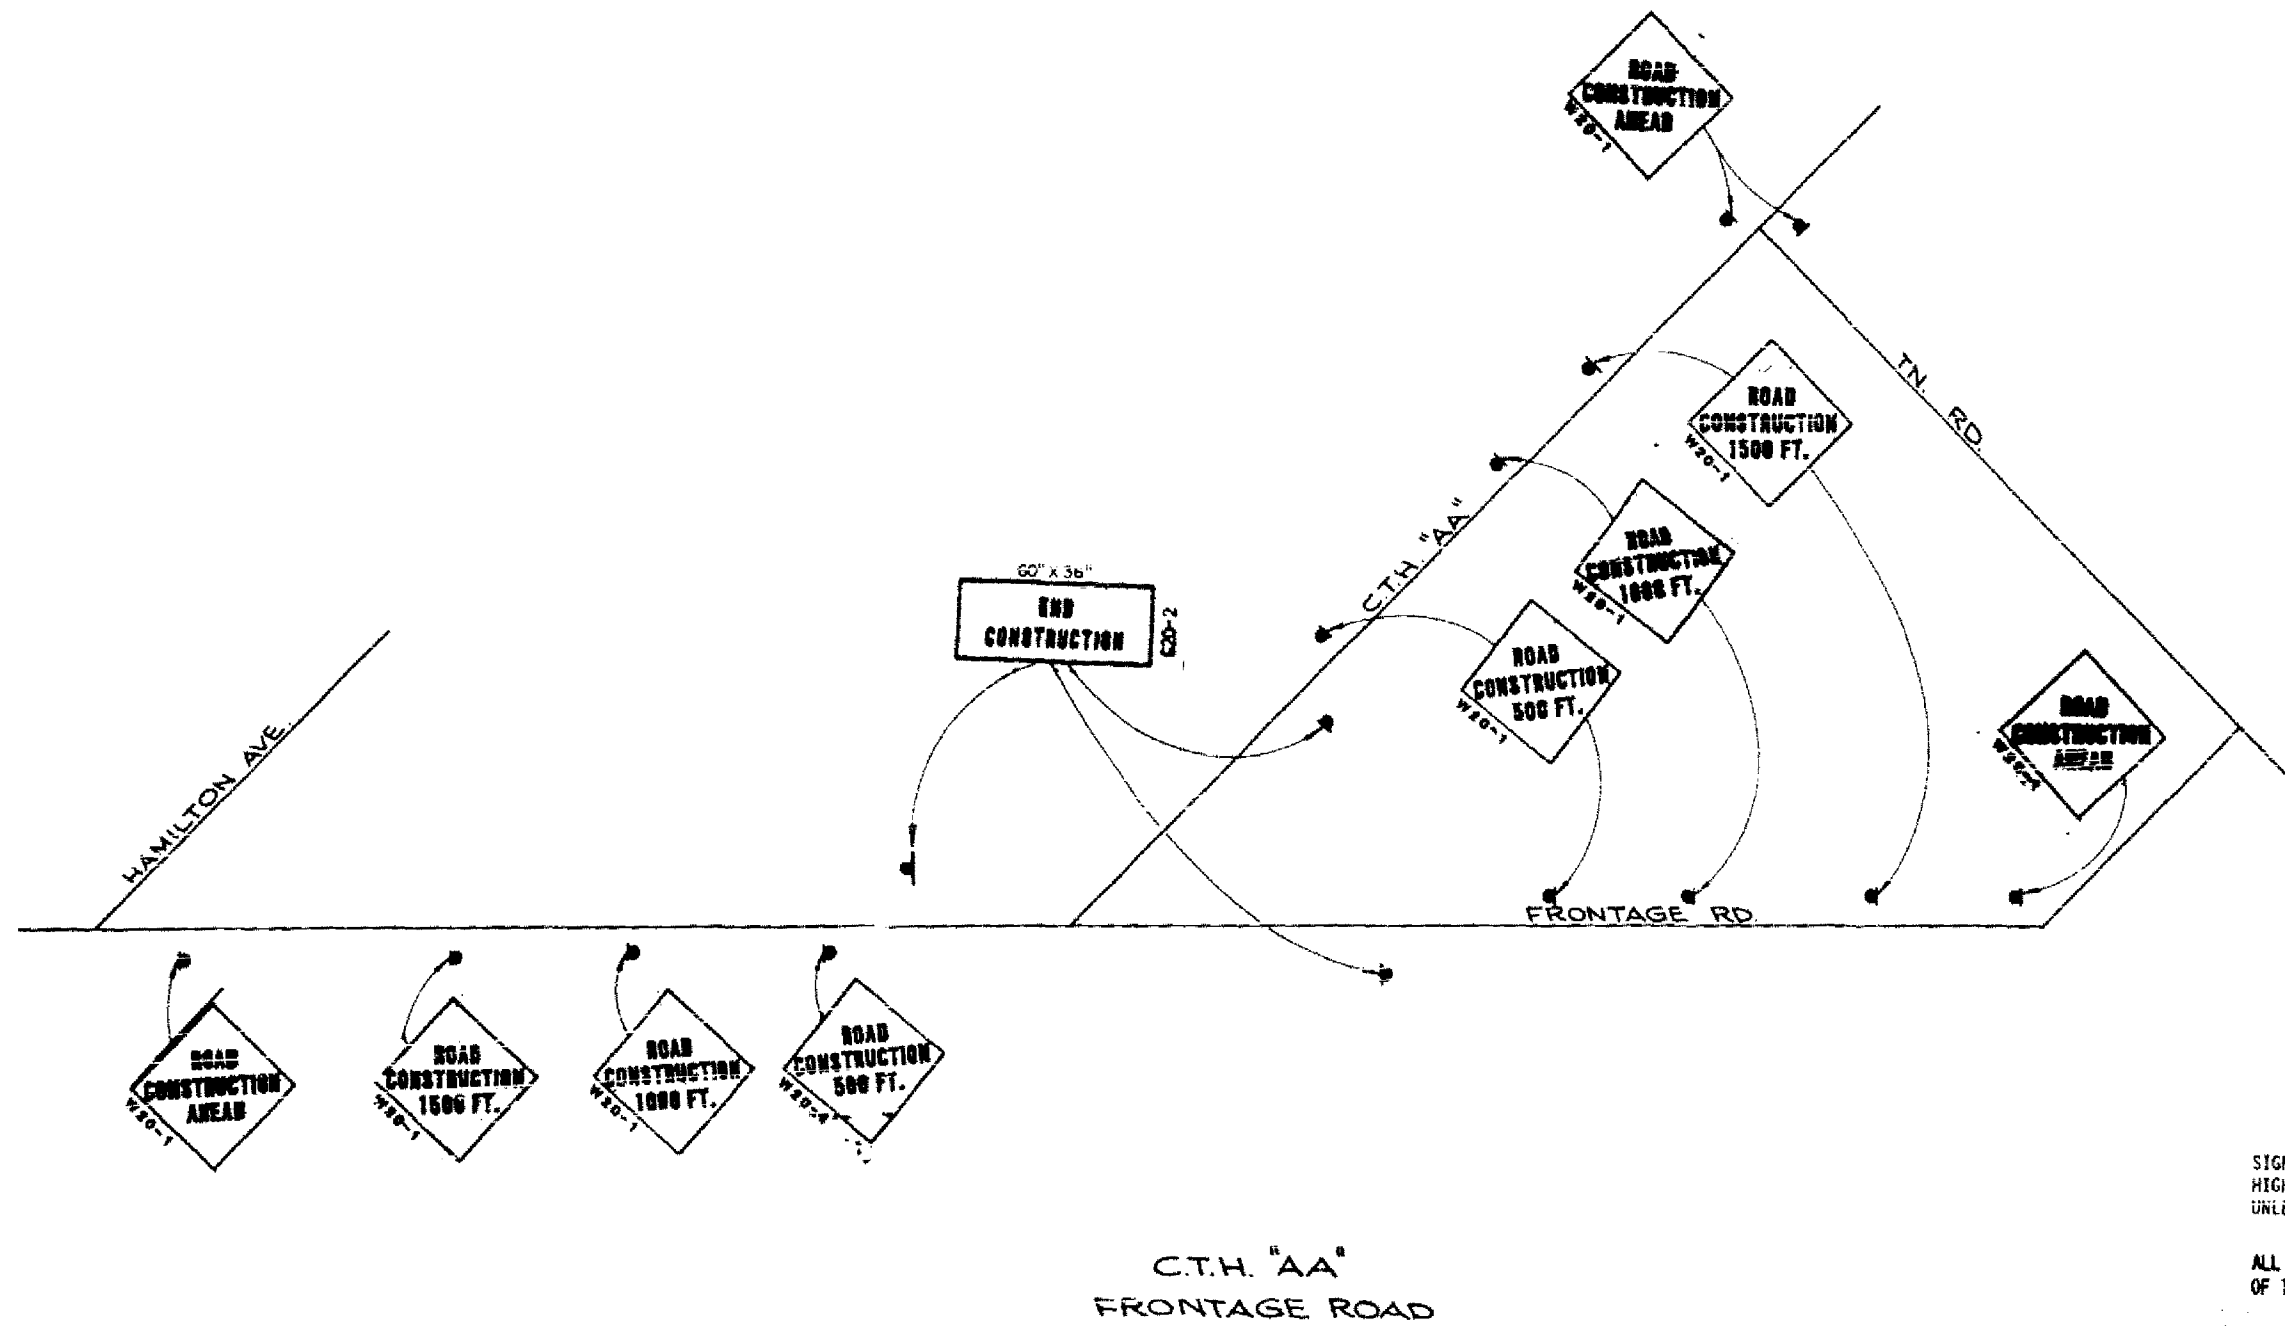


GENERAL NOTES

SIGN LAYOUTS SHALL BE IN ACCORDANCE WITH THE FEDERAL HIGHWAY ADMINISTRATION MANUAL OF STANDARD HIGHWAY SIGNS UNLESS OTHERWISE PROVIDED IN THE PLAN.

ALL ITEMS NOTED ON THIS SHEET SHALL BE PAID FOR UNDER THE ITEM OF TRAFFIC CONTROL.

"W" SIGNS ARE THE SAME AS "W" SIGNS EXCEPT THE BACKGROUND IS ORANGE.


ALL SIGNS ARE 48" X 48" UNLESS OTHERWISE NOTED.

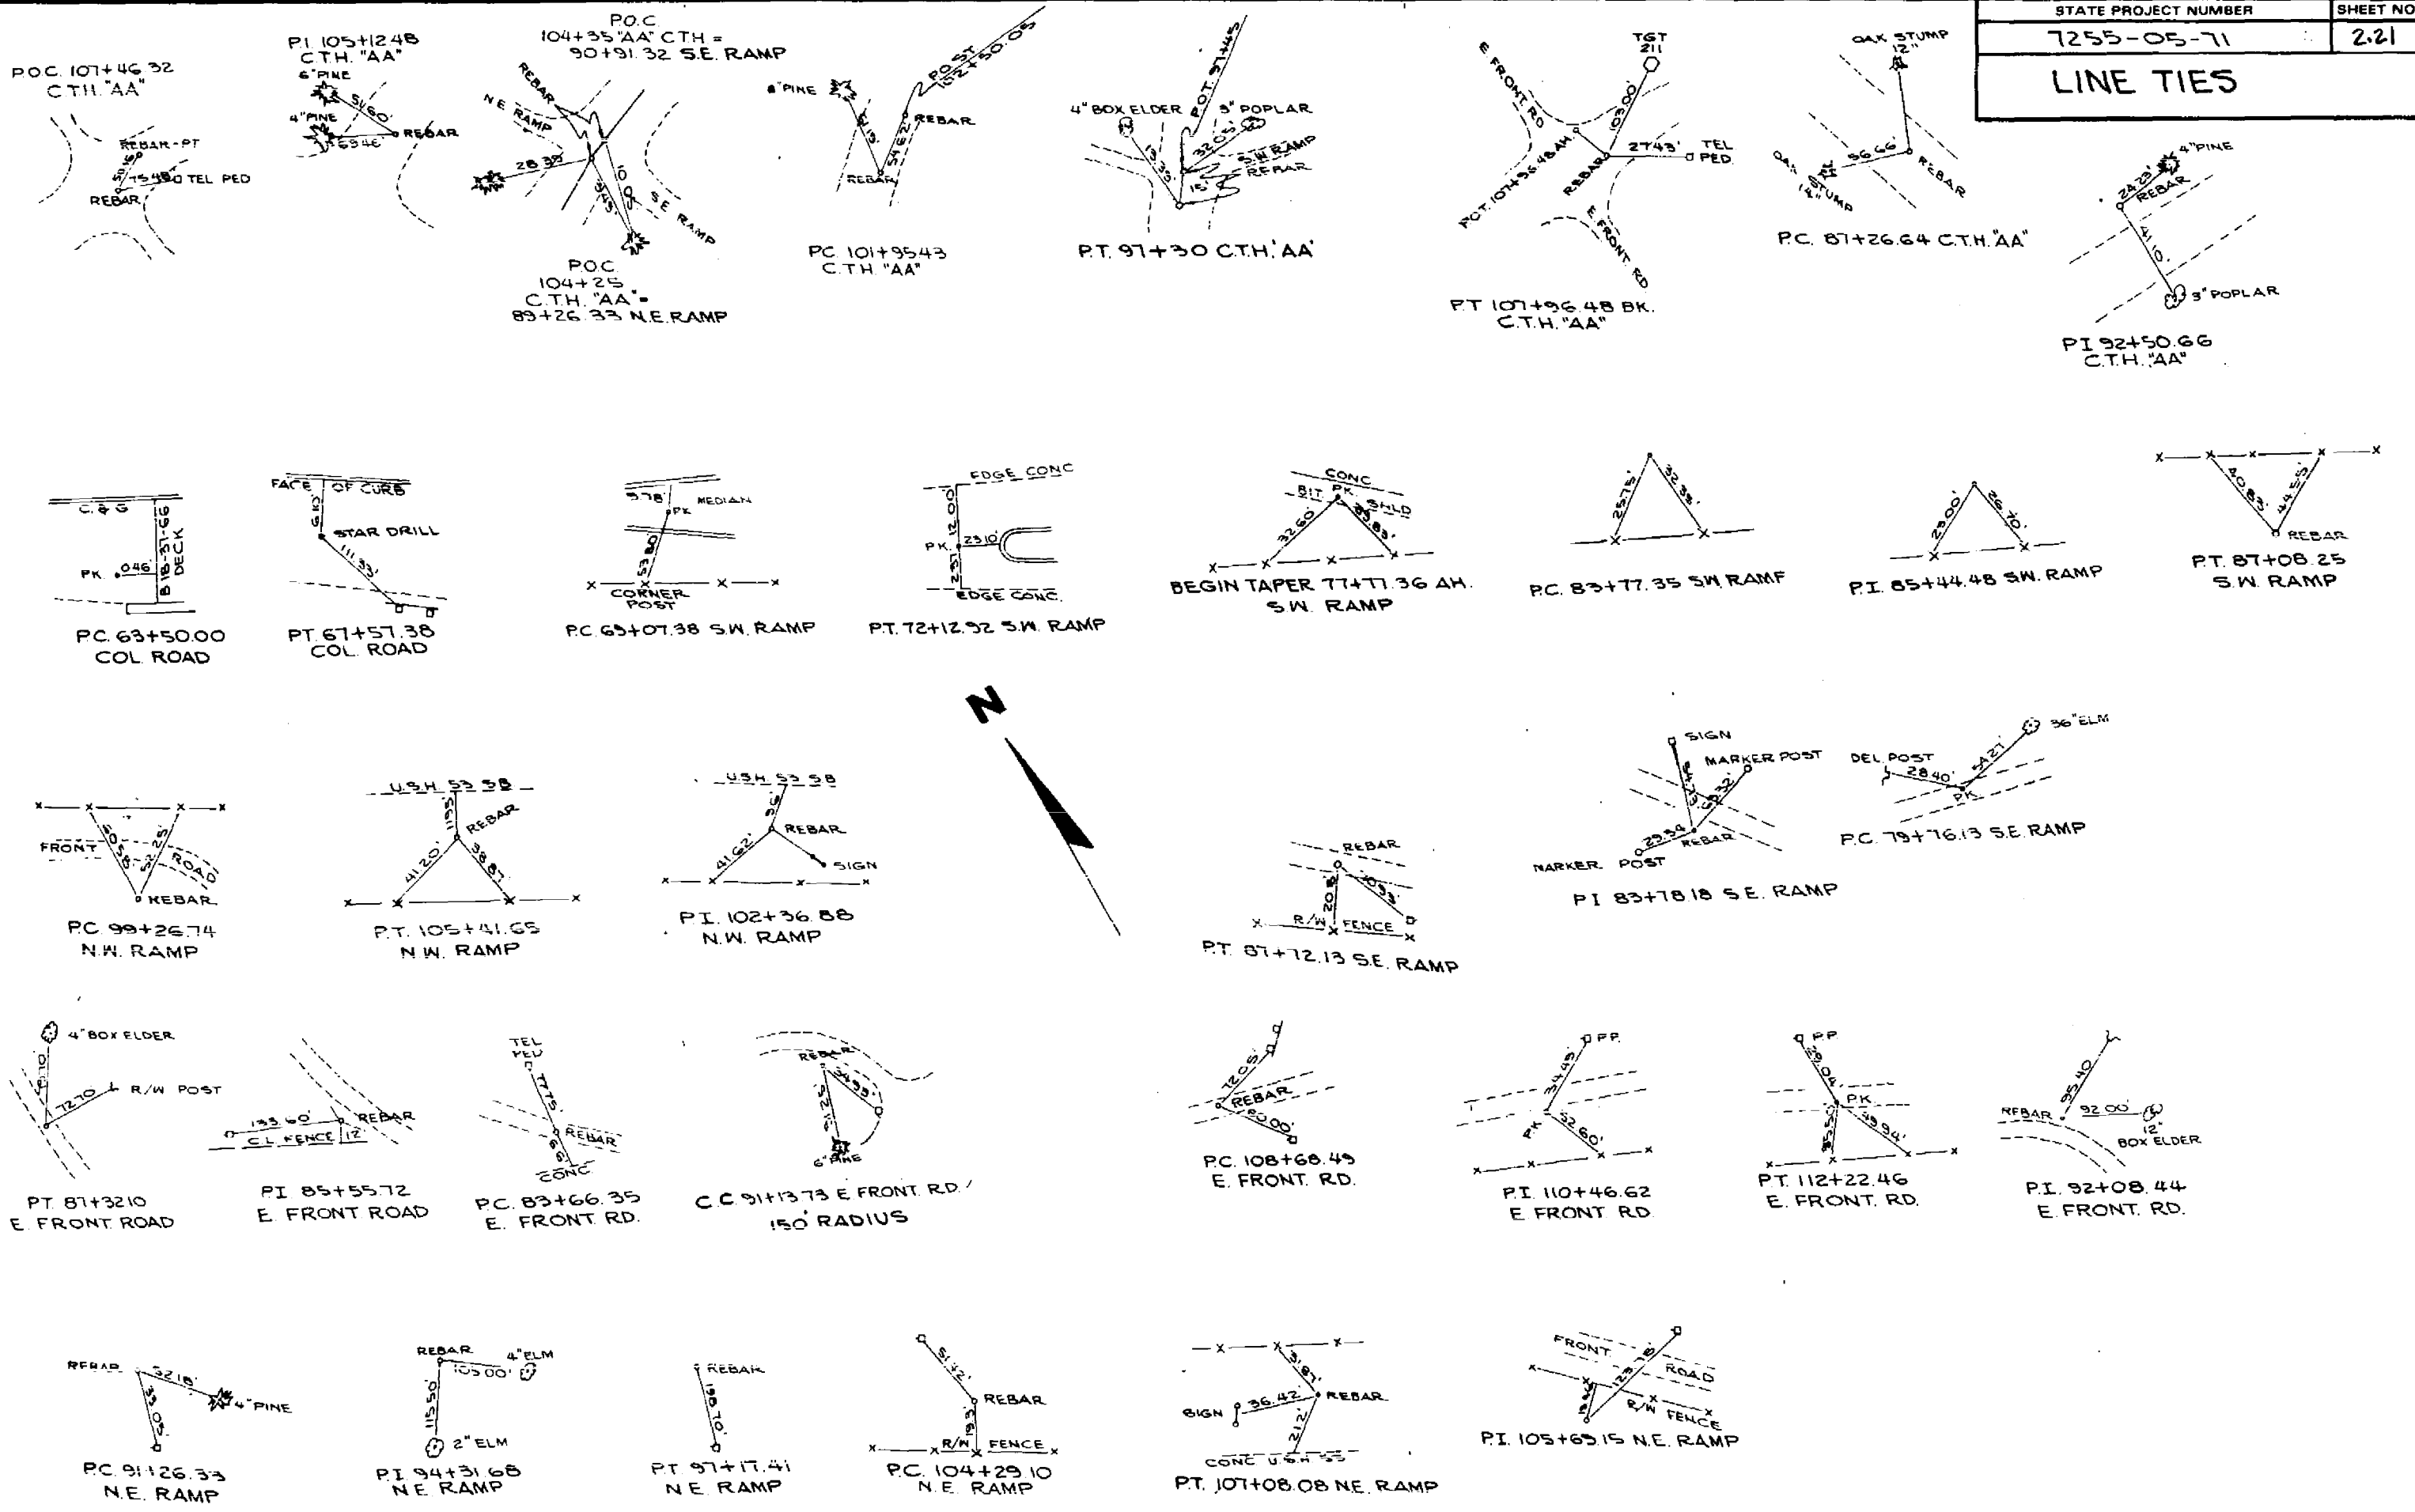


STA 108+25 - 25 RT
PERPETUATE LAND CORNER
IN ACCORDANCE WITH SEC
53.625(2) WIS STATUTES
WORK BY OTHERS

END CONSTRUCTION
STA 112+67 CTH AA
(SAW CUT REQUIRED)

NO	STA	DESCRIPTION	ELEV
3	117+10	PK IN PP 30' N OF CTH AA	90.85
4	550+0 USH 53	KEEL MARK ON E END CONCRETE CULVERT	882.62

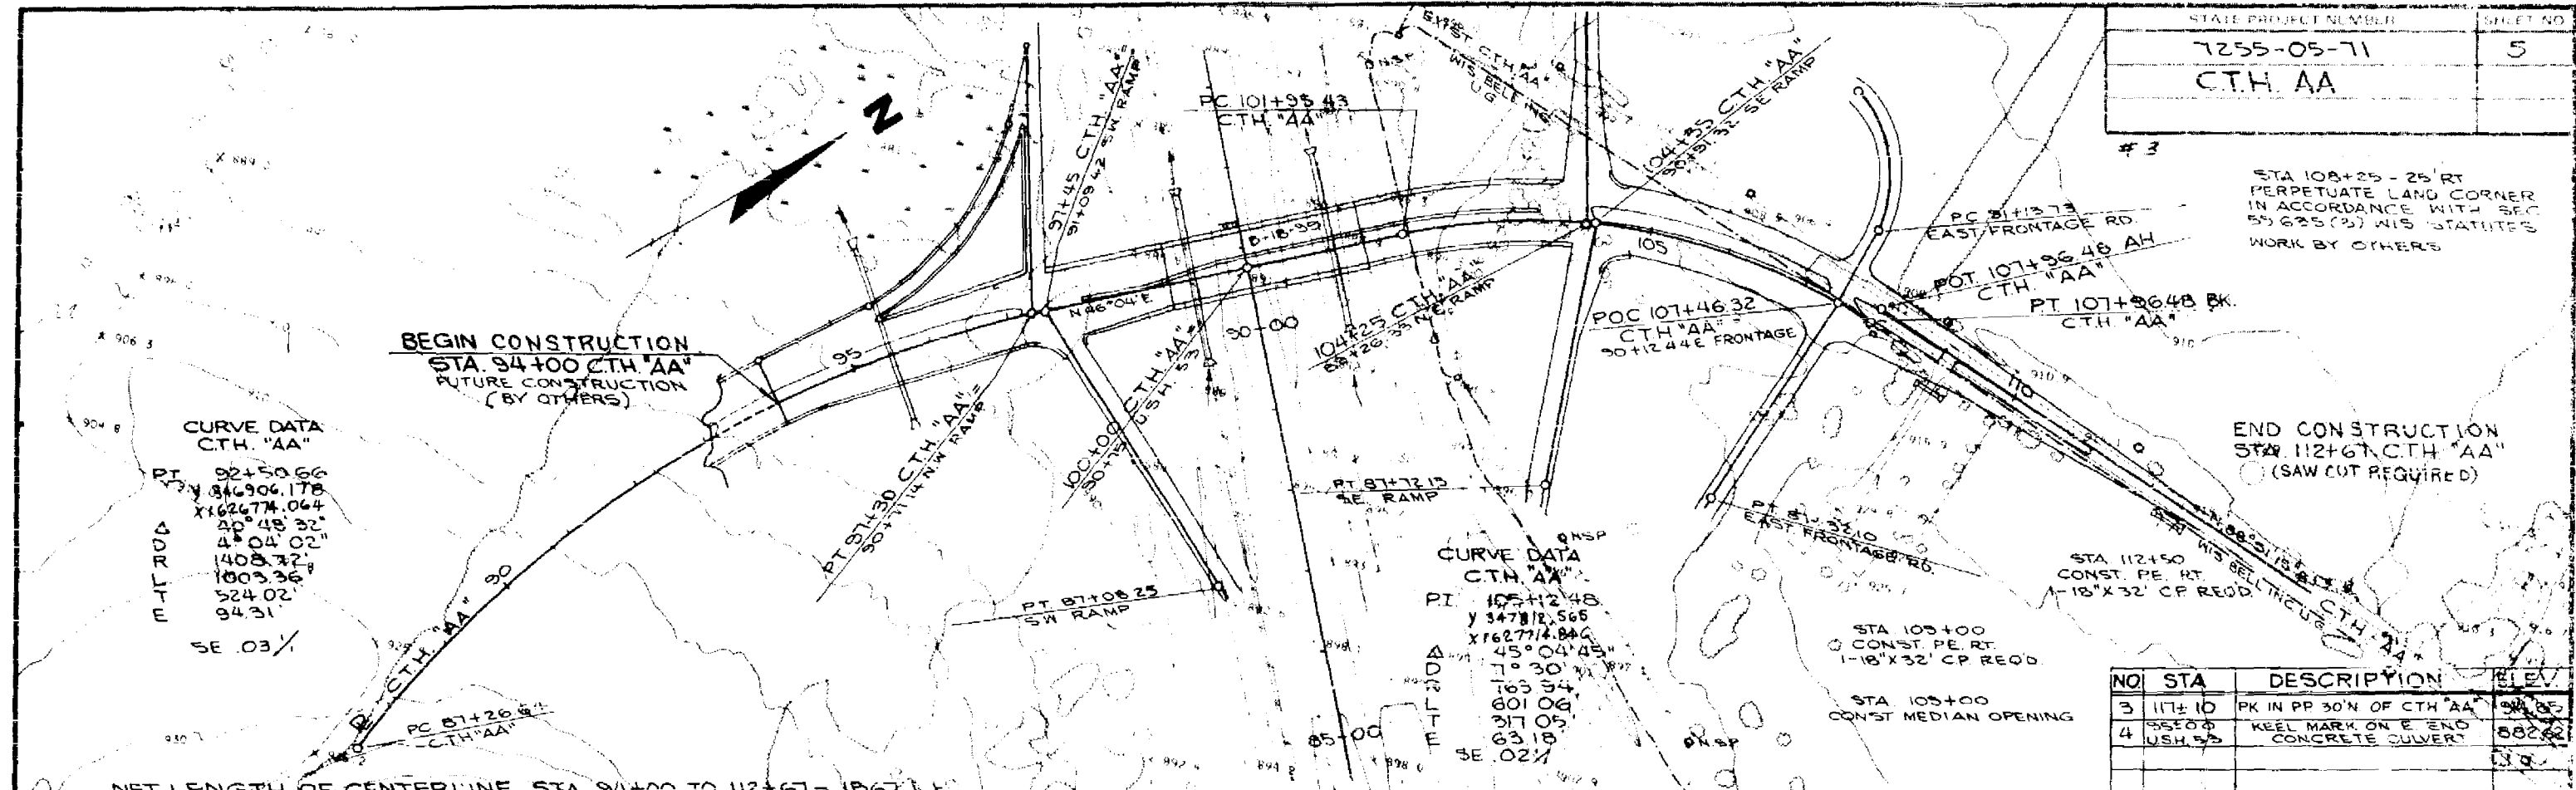


NET LENGTH OF CENTERLINE STA 94+00 TO 112+67 = 1867 L

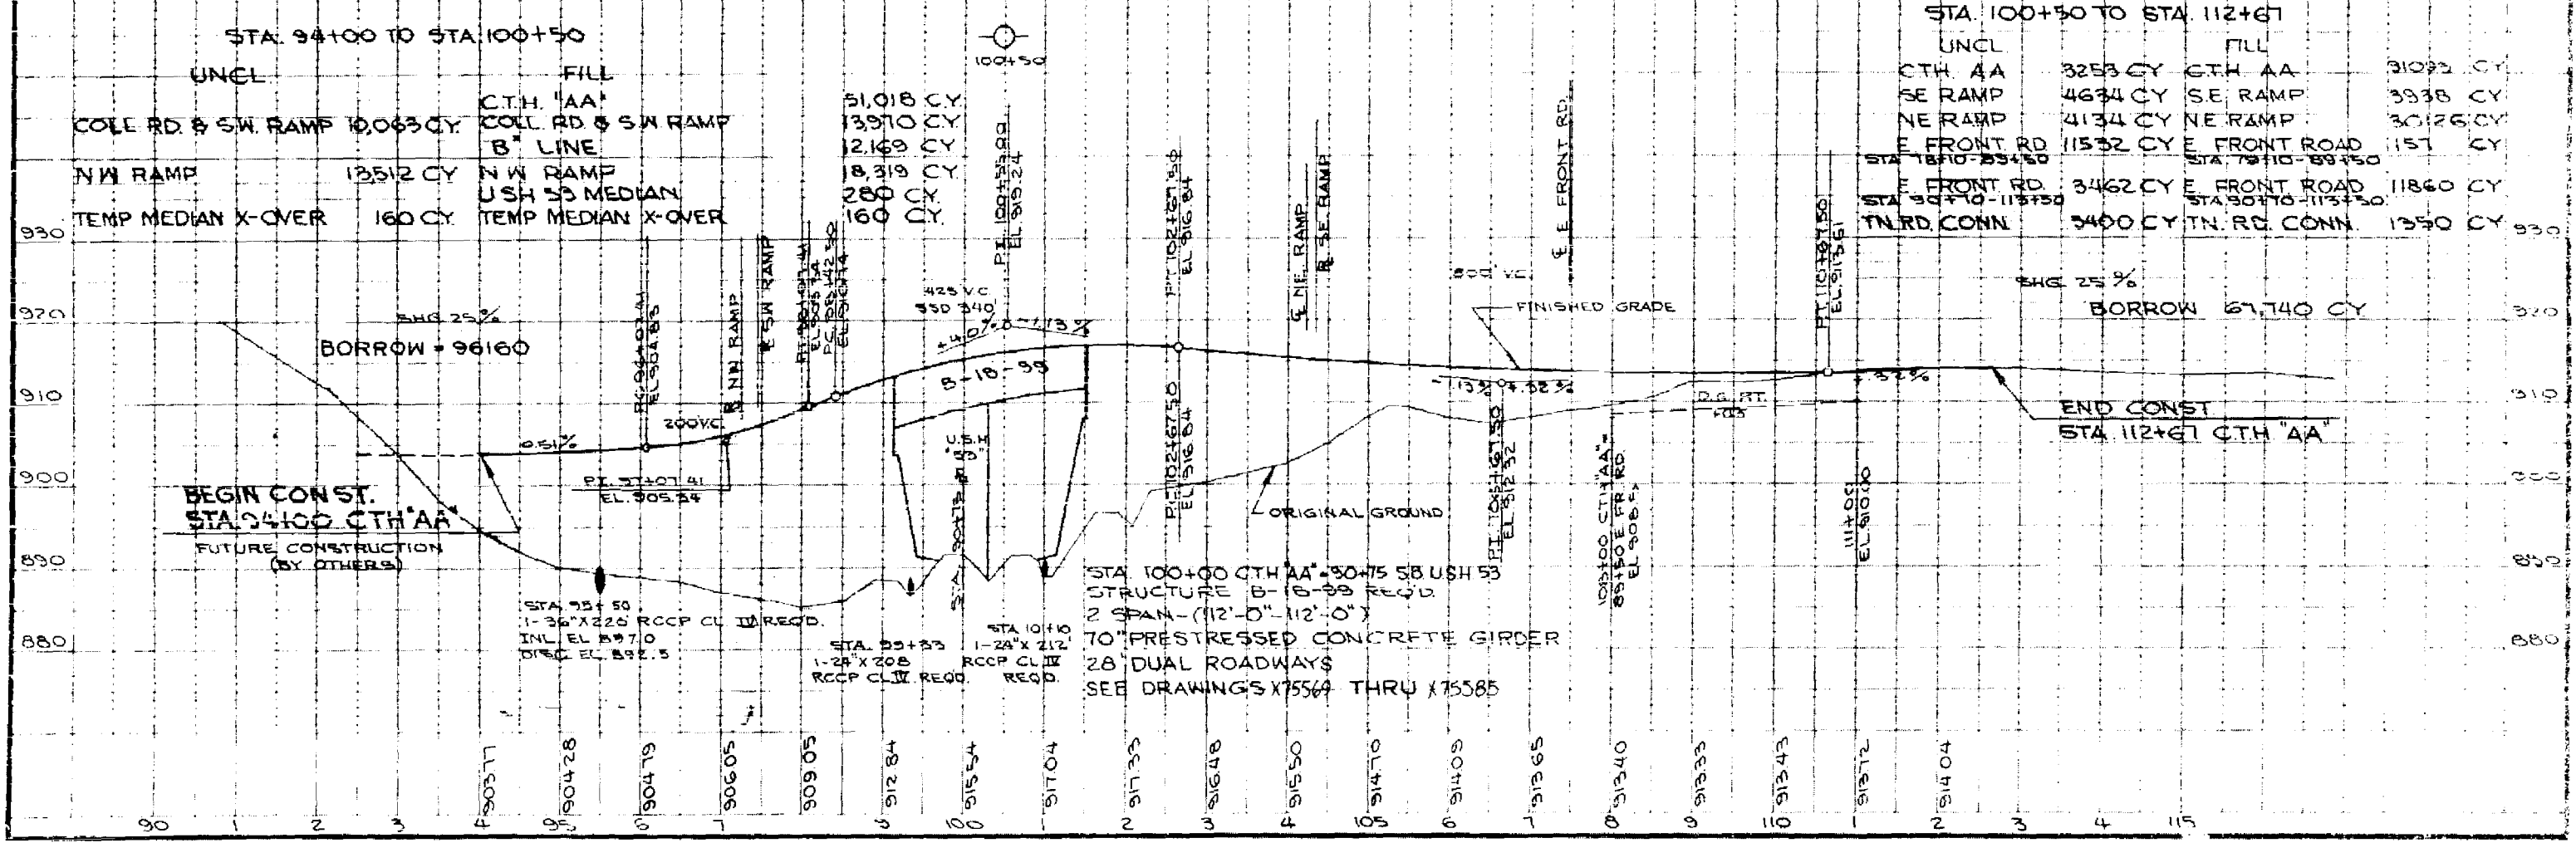

STA 94+00 TO STA 100+50		STA 100+50 TO STA 112+67	
UNCL	FILL	UNCL	FILL
COLL RD & SW RAMP 10,063 CY	CTH AA 31,018 CY	CTH AA 3253 CY	CTH AA 31092 CY
NW RAMP 13512 CY	COLL RD & SW RAMP 13970 CY	SE RAMP 4634 CY	SE RAMP 3938 CY
TEMP MEDIAN X-OVER 160 CY	USH 53 MEDIAN 12,169 CY	NE RAMP 4134 CY	NE RAMP 30,266 CY
	NW RAMP 8,319 CY	E FRONT RD 11532 CY	E FRONT ROAD 157 CY
	TEMP MEDIAN X-OVER 160 CY	E FRONT RD 3462 CY	E FRONT ROAD 11860 CY
		TN RD CONN 3400 CY	TN RD CONN 1350 CY


STA 100+00 CTH AA - 50+75 SB USH 53
STRUCTURE B-16-33 REQ'D
2 SPAN - (12'-0" - 12'-0")
70" PRESTRESSED CONCRETE GIRDER
28' DUAL ROADWAYS
SEE DRAWINGS X75564 THRU X75585

STATE PROJECT NUMBER	SHEET NO.
7255-05-71	52
COLLECTOR RD - SW RAMP	

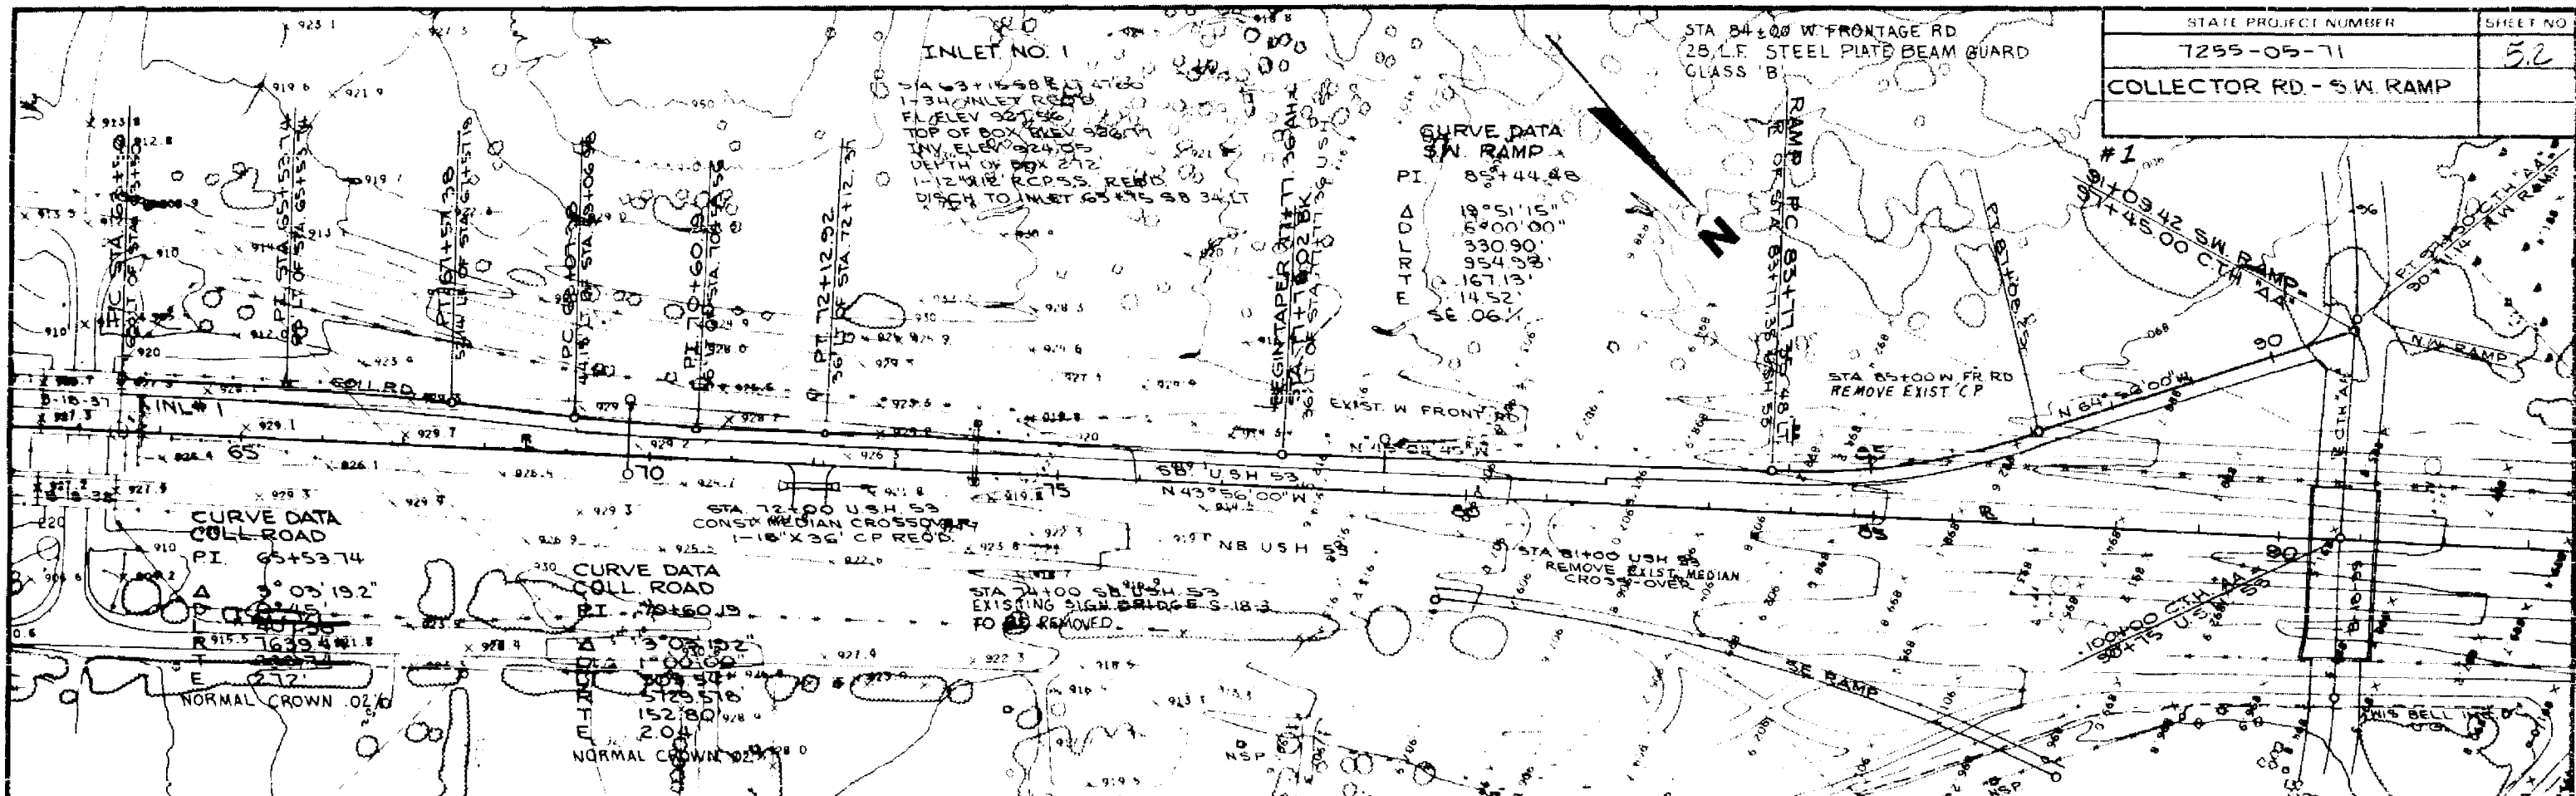


NO	STA	DESCRIPTION	ELEV.
1	62±50	BRASS CAP SE CORNER S-18-35 STAMPED 921.72	921.79
2	80±00	R.R SPIKE IN 48" MAPLE RT OF EXIT RAMP	907.35

S.W. RAMP

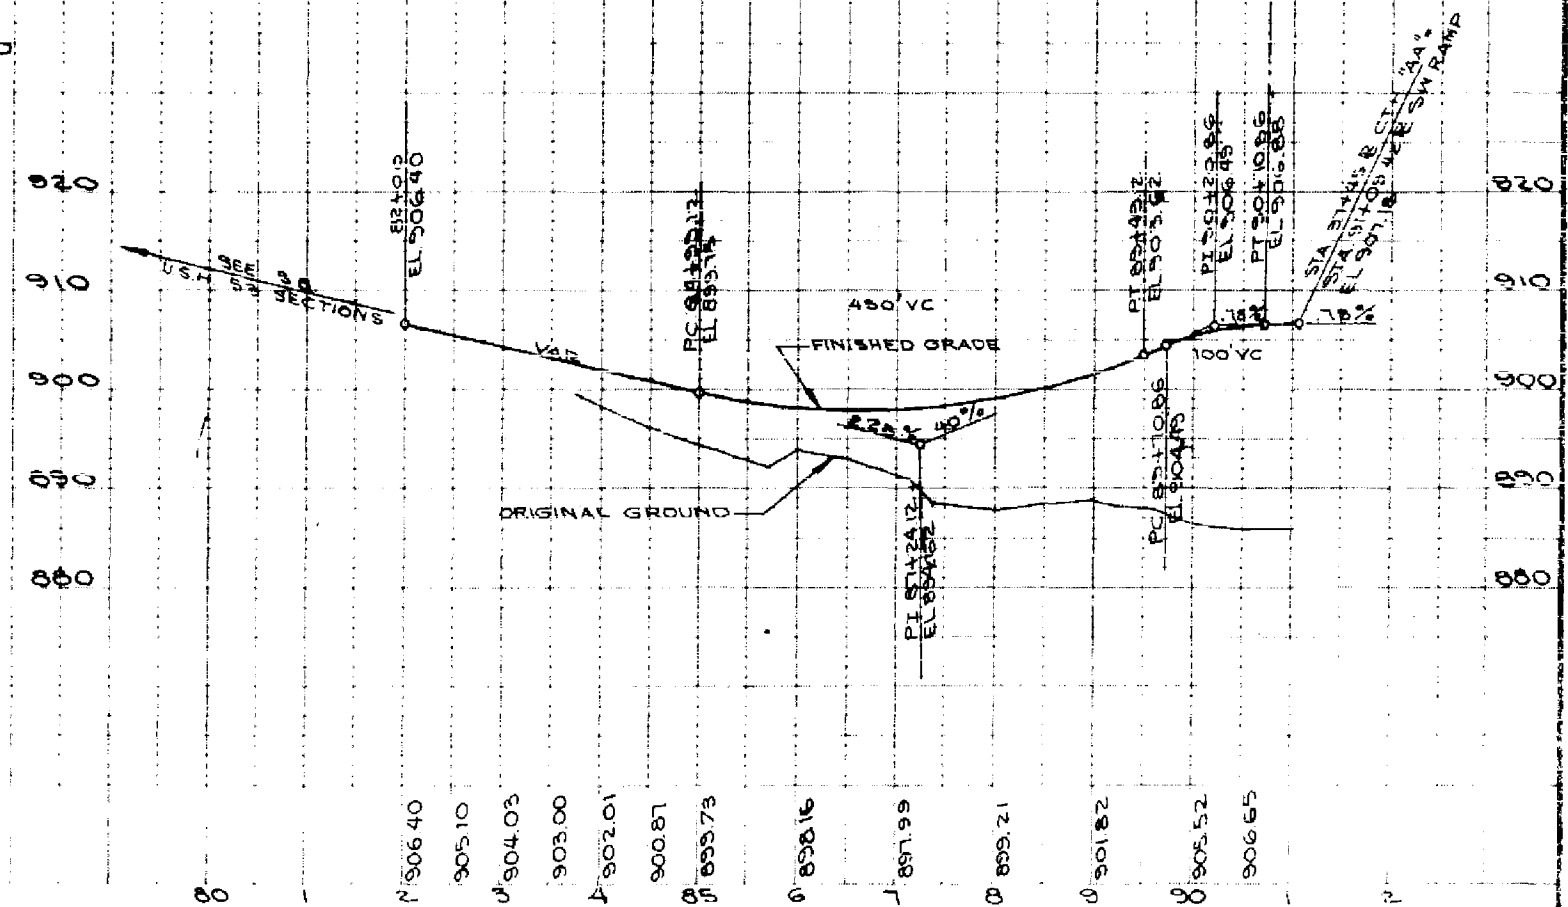




CURVE DATA
U.S.H. 53
(ARC DEFINITION)
P.I. 101+52.68
11°32'50"
1°00'00"
5723.58'
1154.72'
579.32'
29.21'


CURVE DATA
N.W. RAMP
P.I. 102+36.88
18°26'50.58"
37°00'00"
1908.86'
614.91'
210.14'
29.02'
88.06%

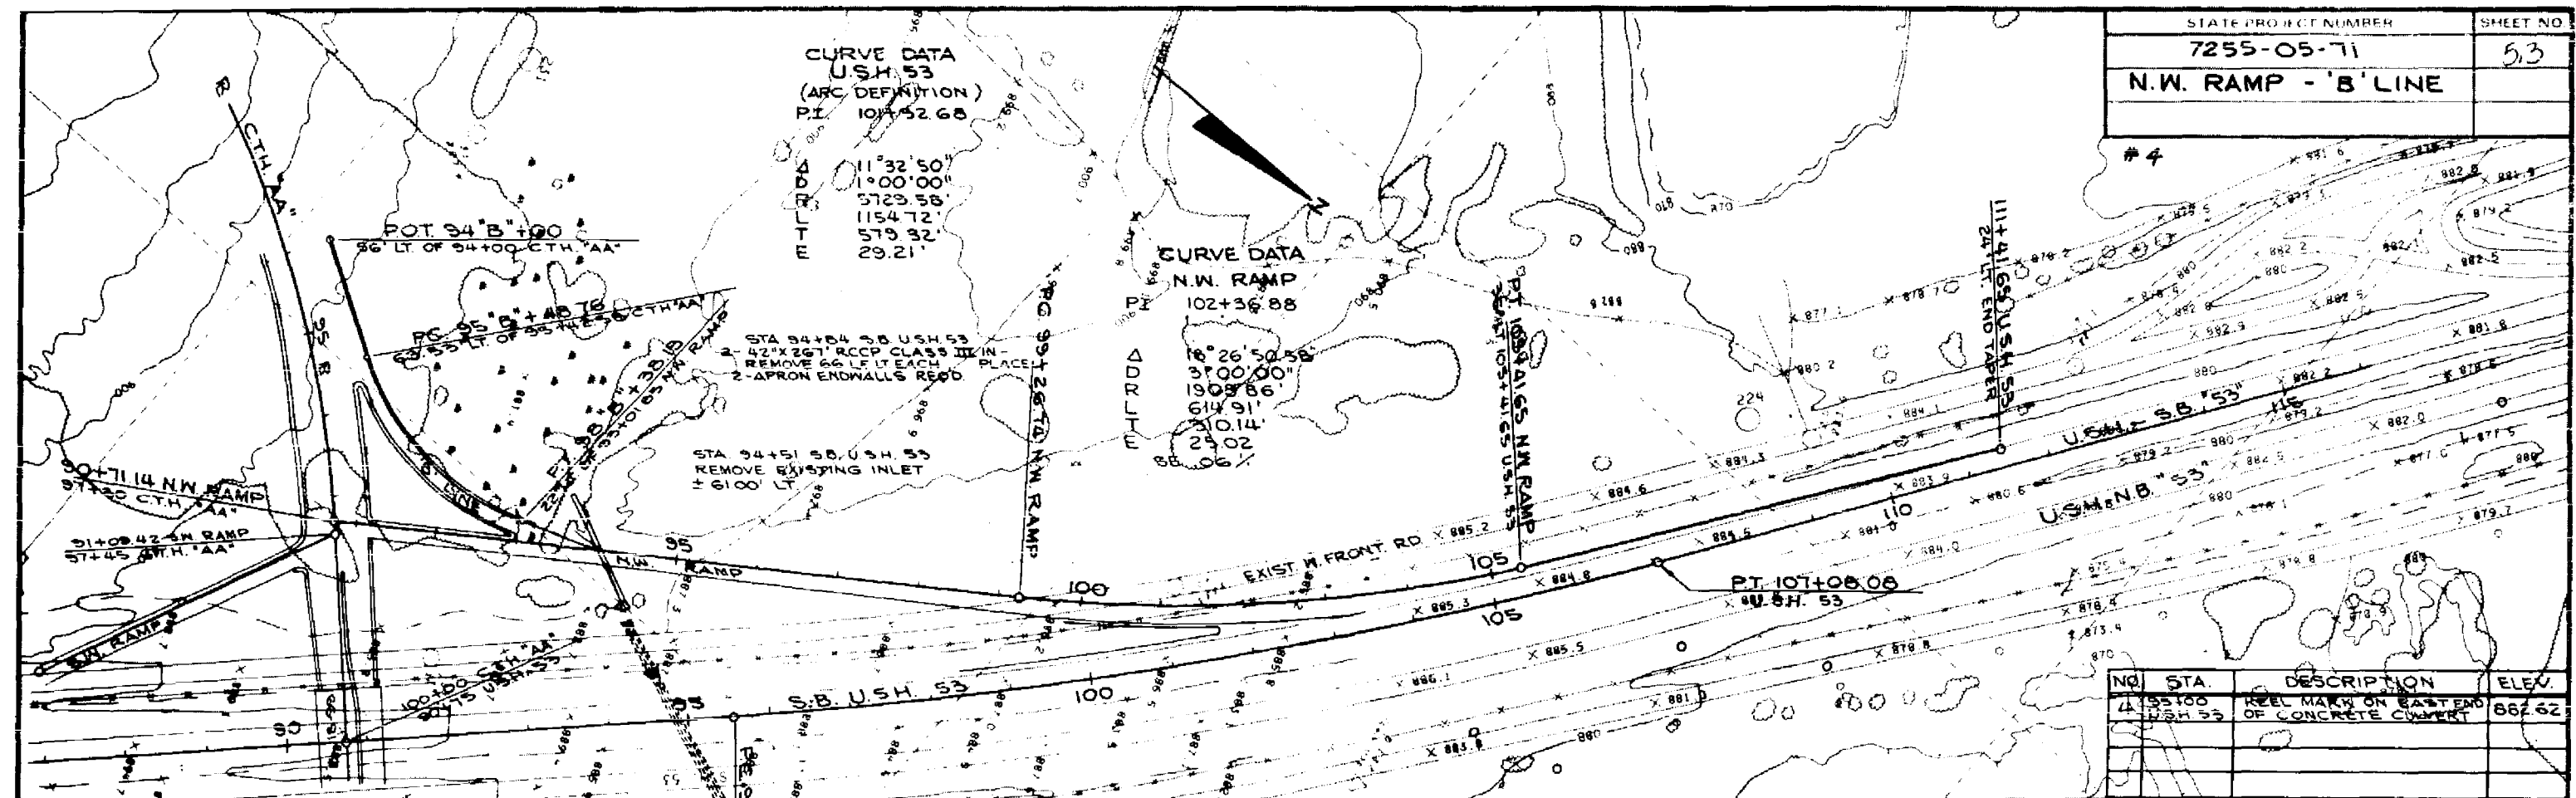



NO.	STA.	DESCRIPTION	ELEV.
4	95+00	REEL MARK ON EAST END OF CONCRETE CURB	862.62

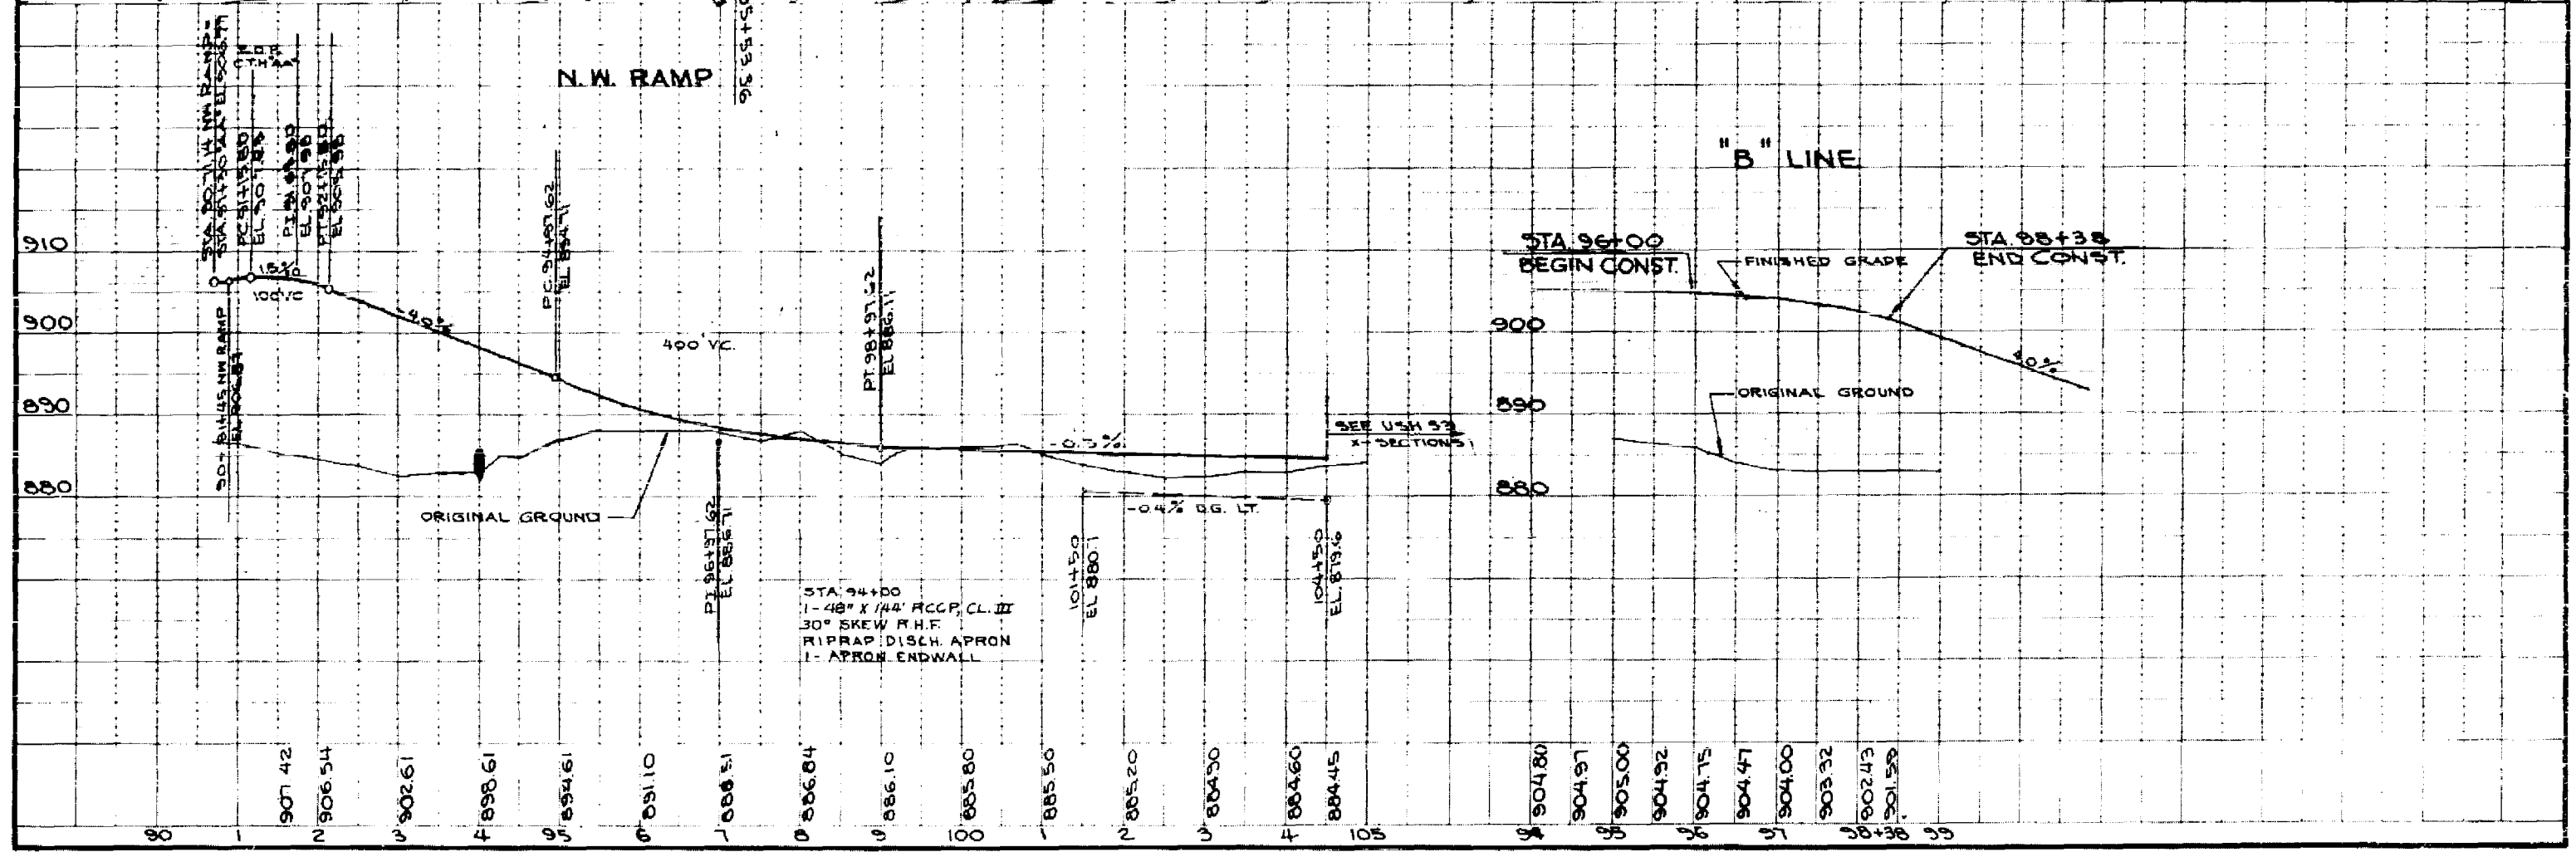


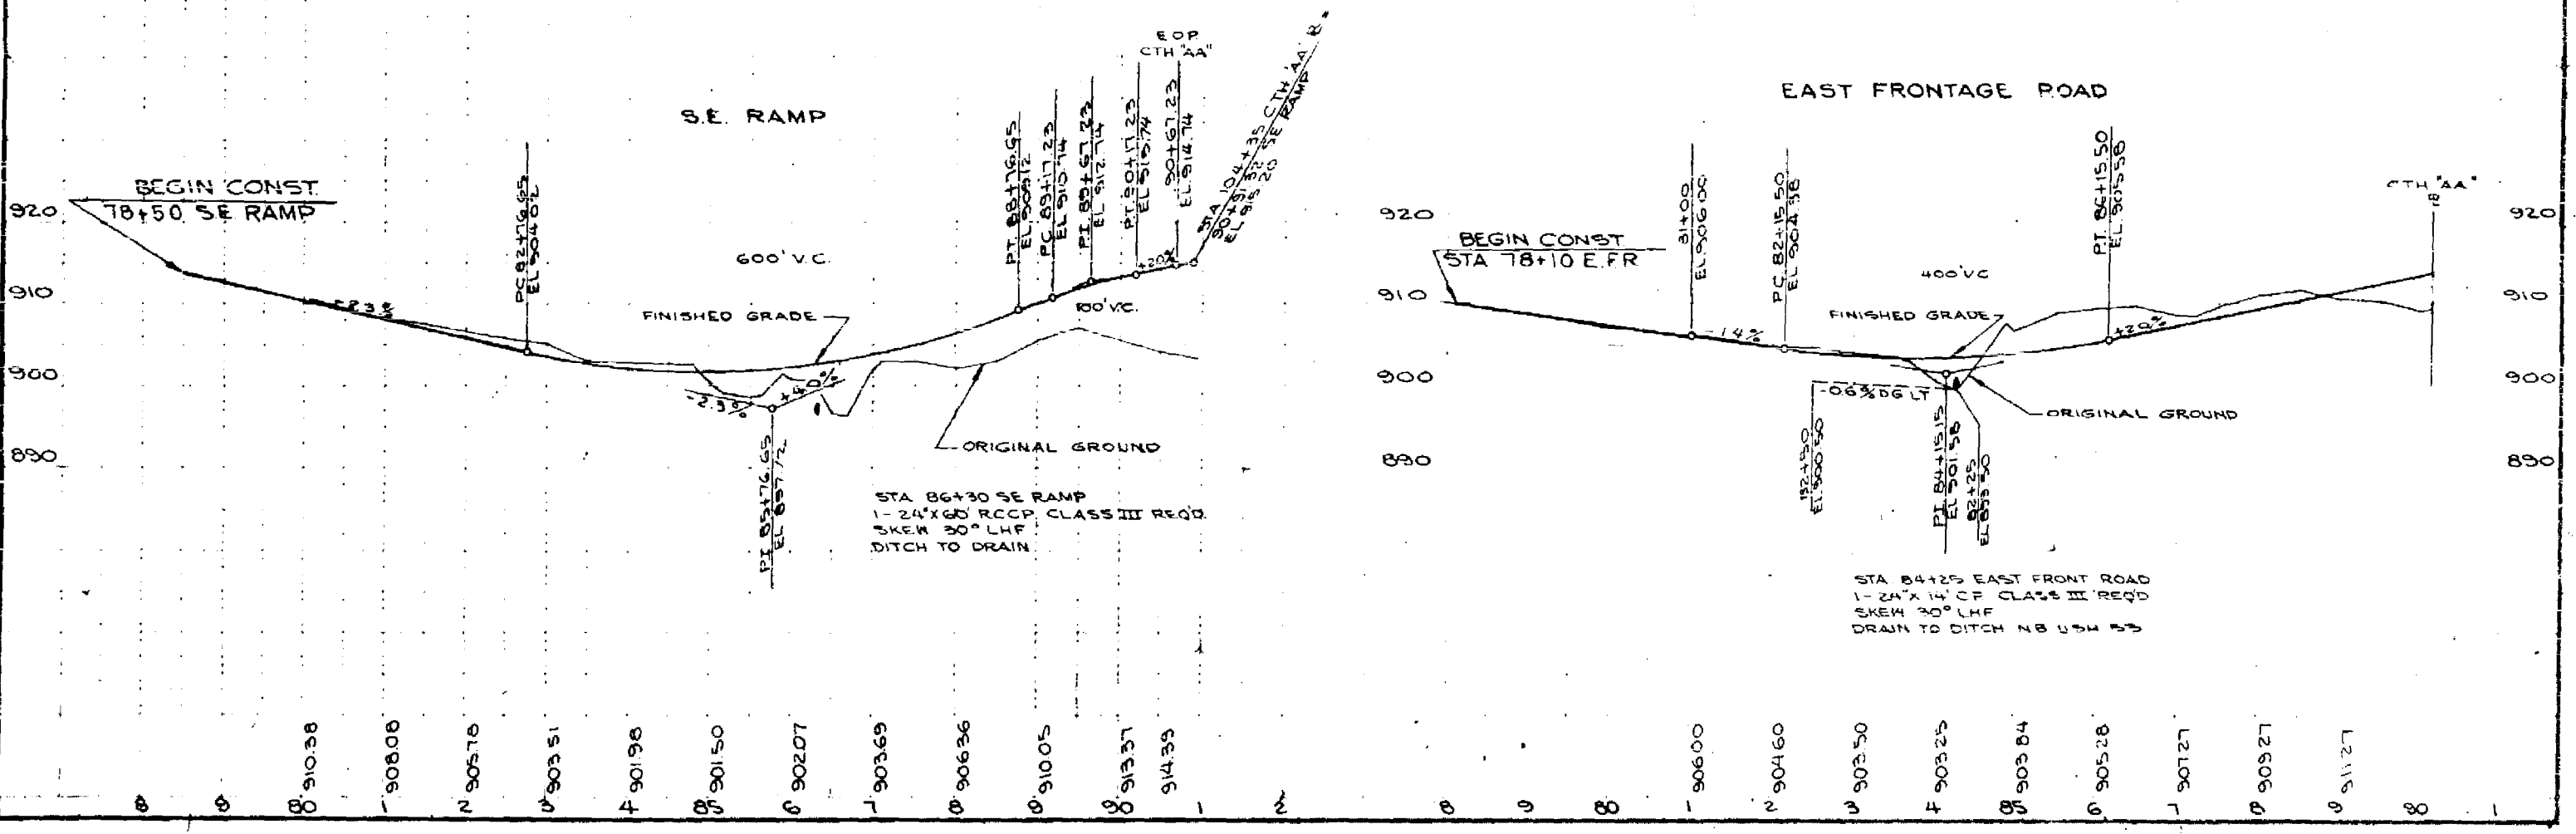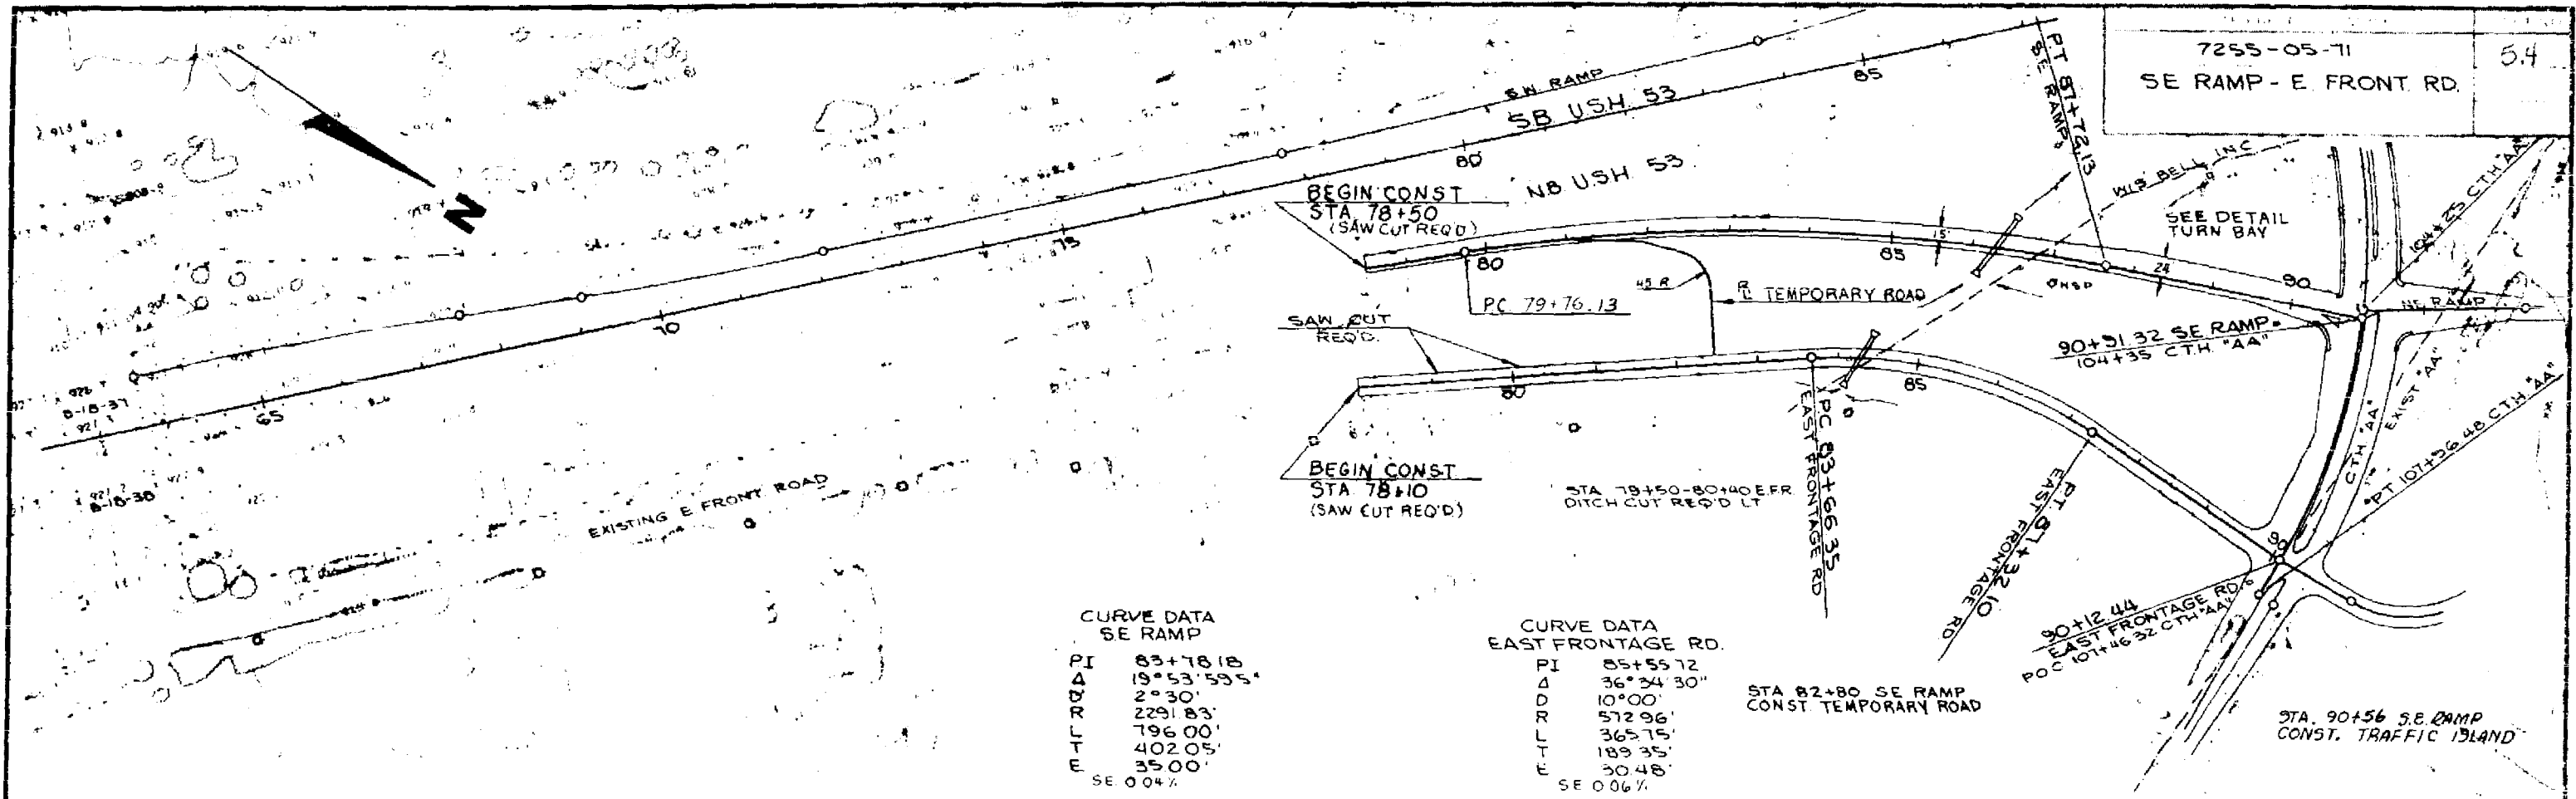

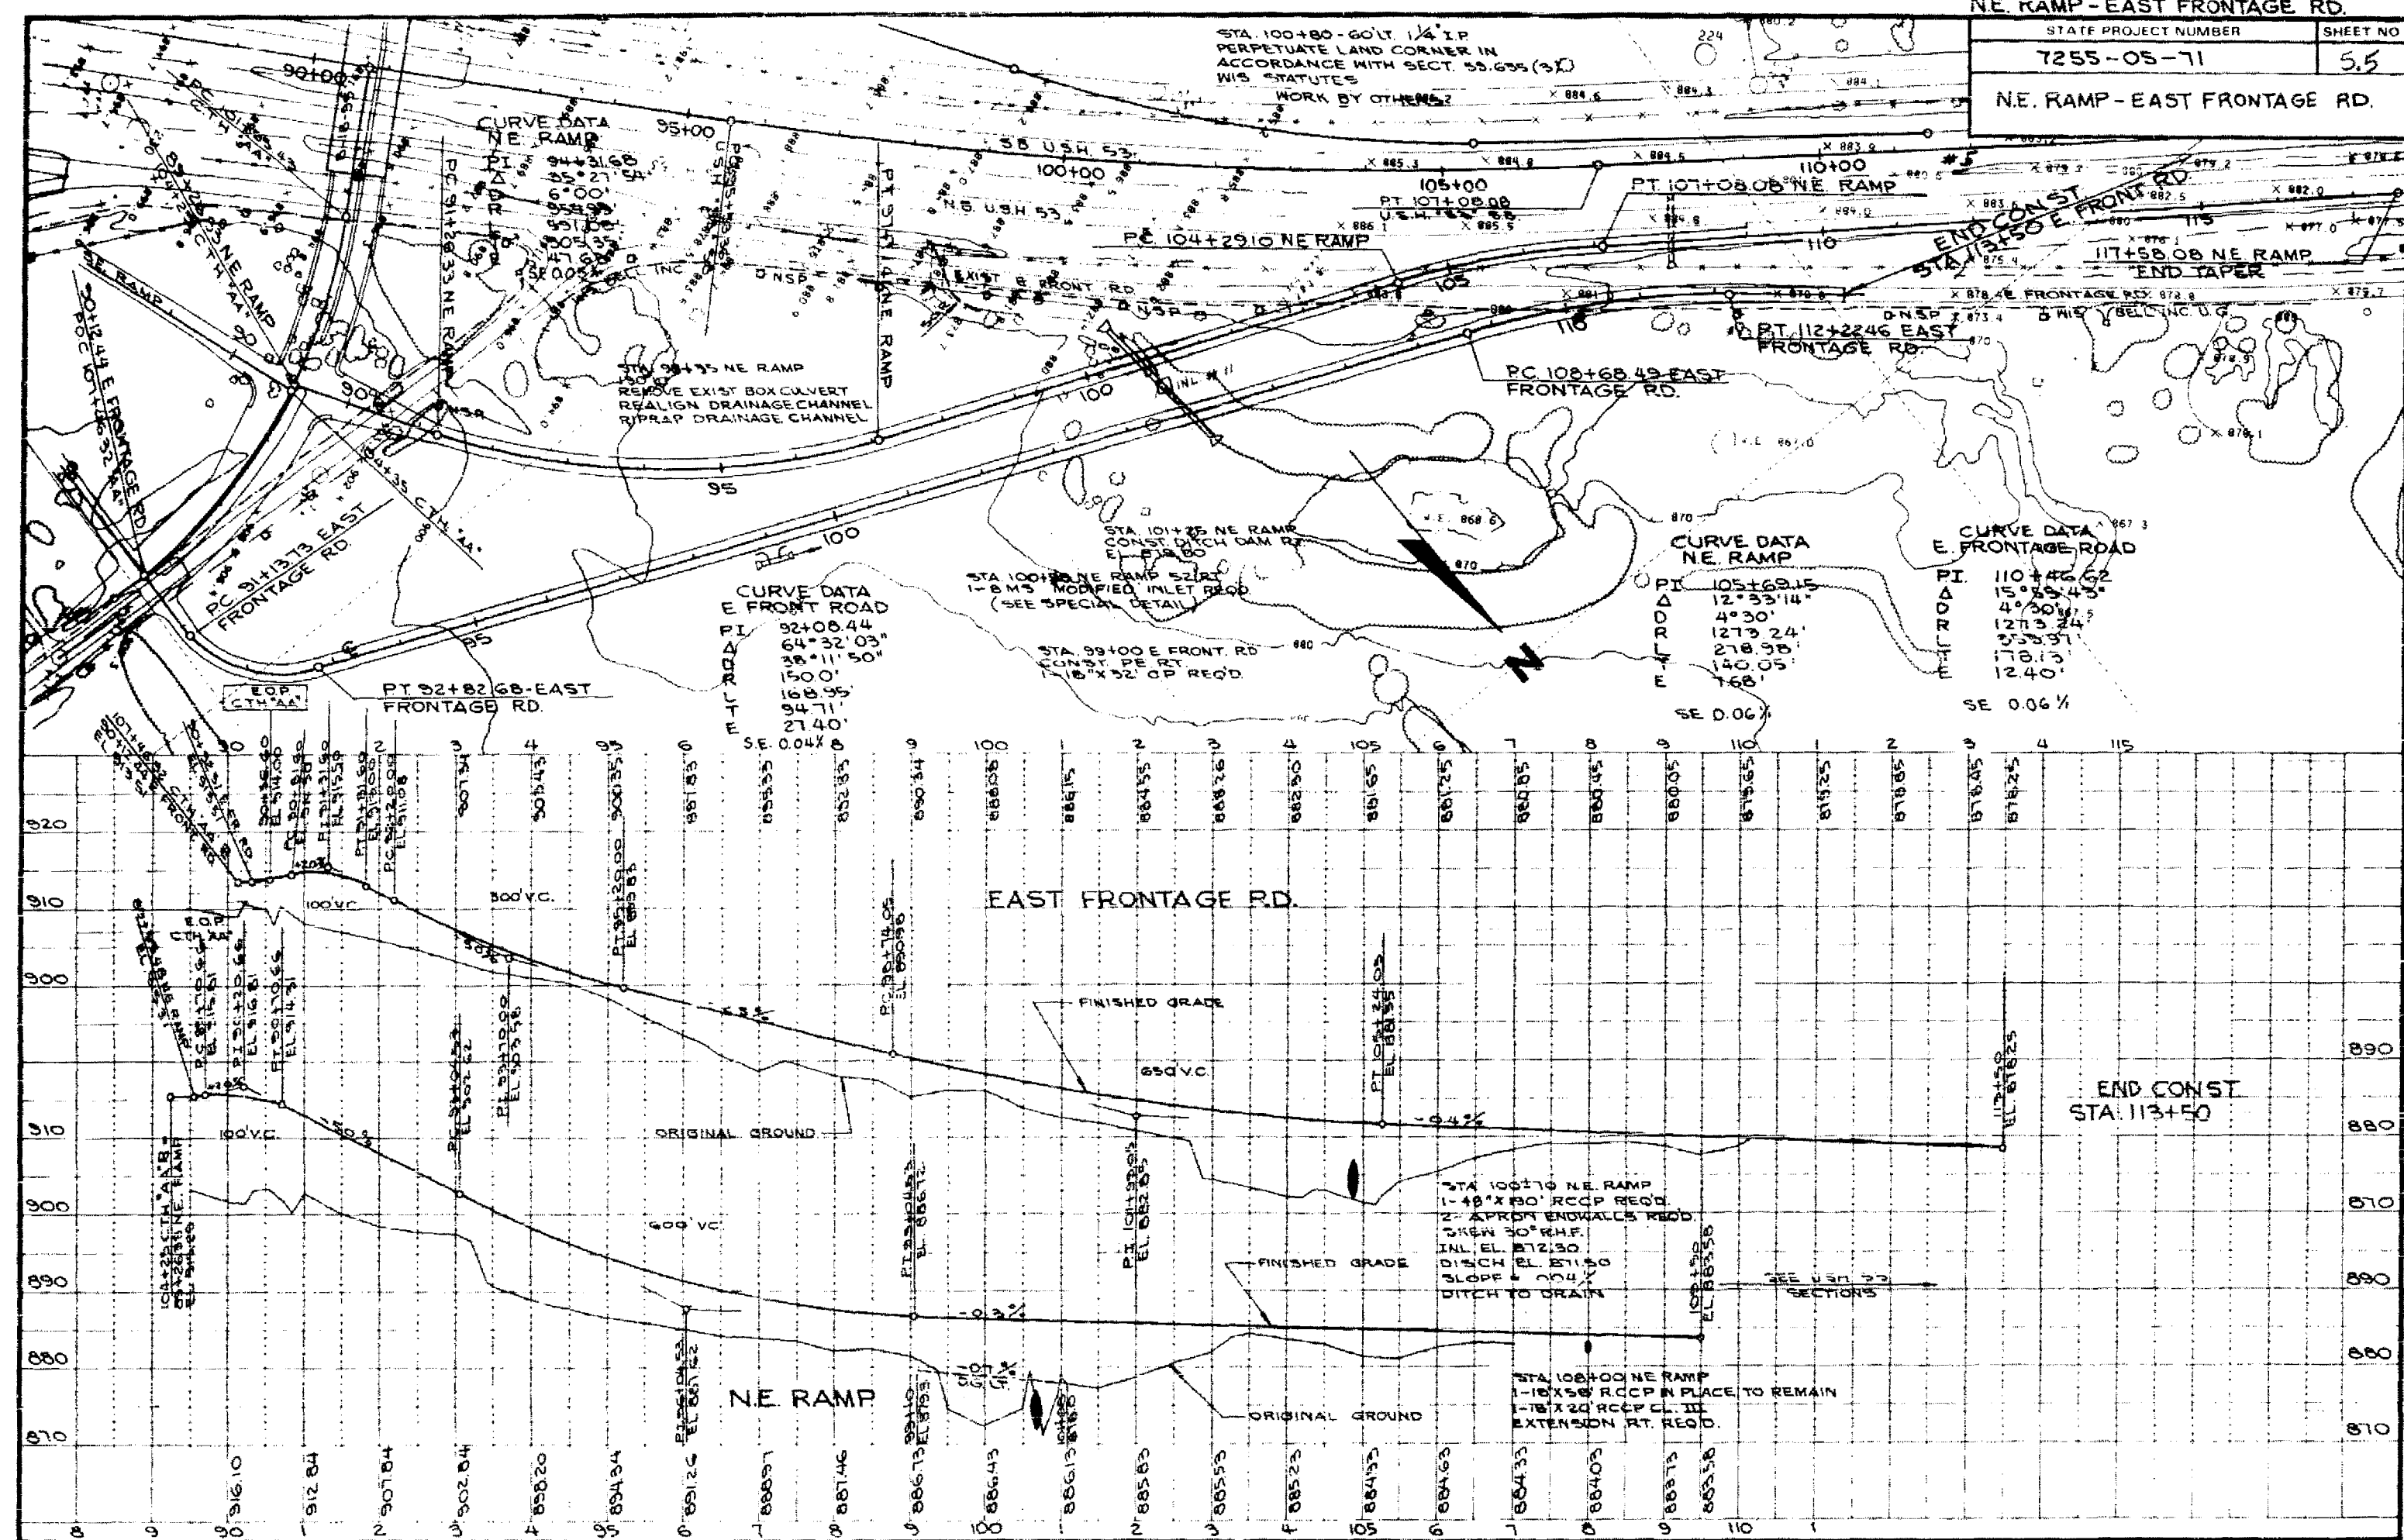


STATE PROJECT NUMBER	SHEET NO.
7255-05-71	5.6
N.E. RAMP	

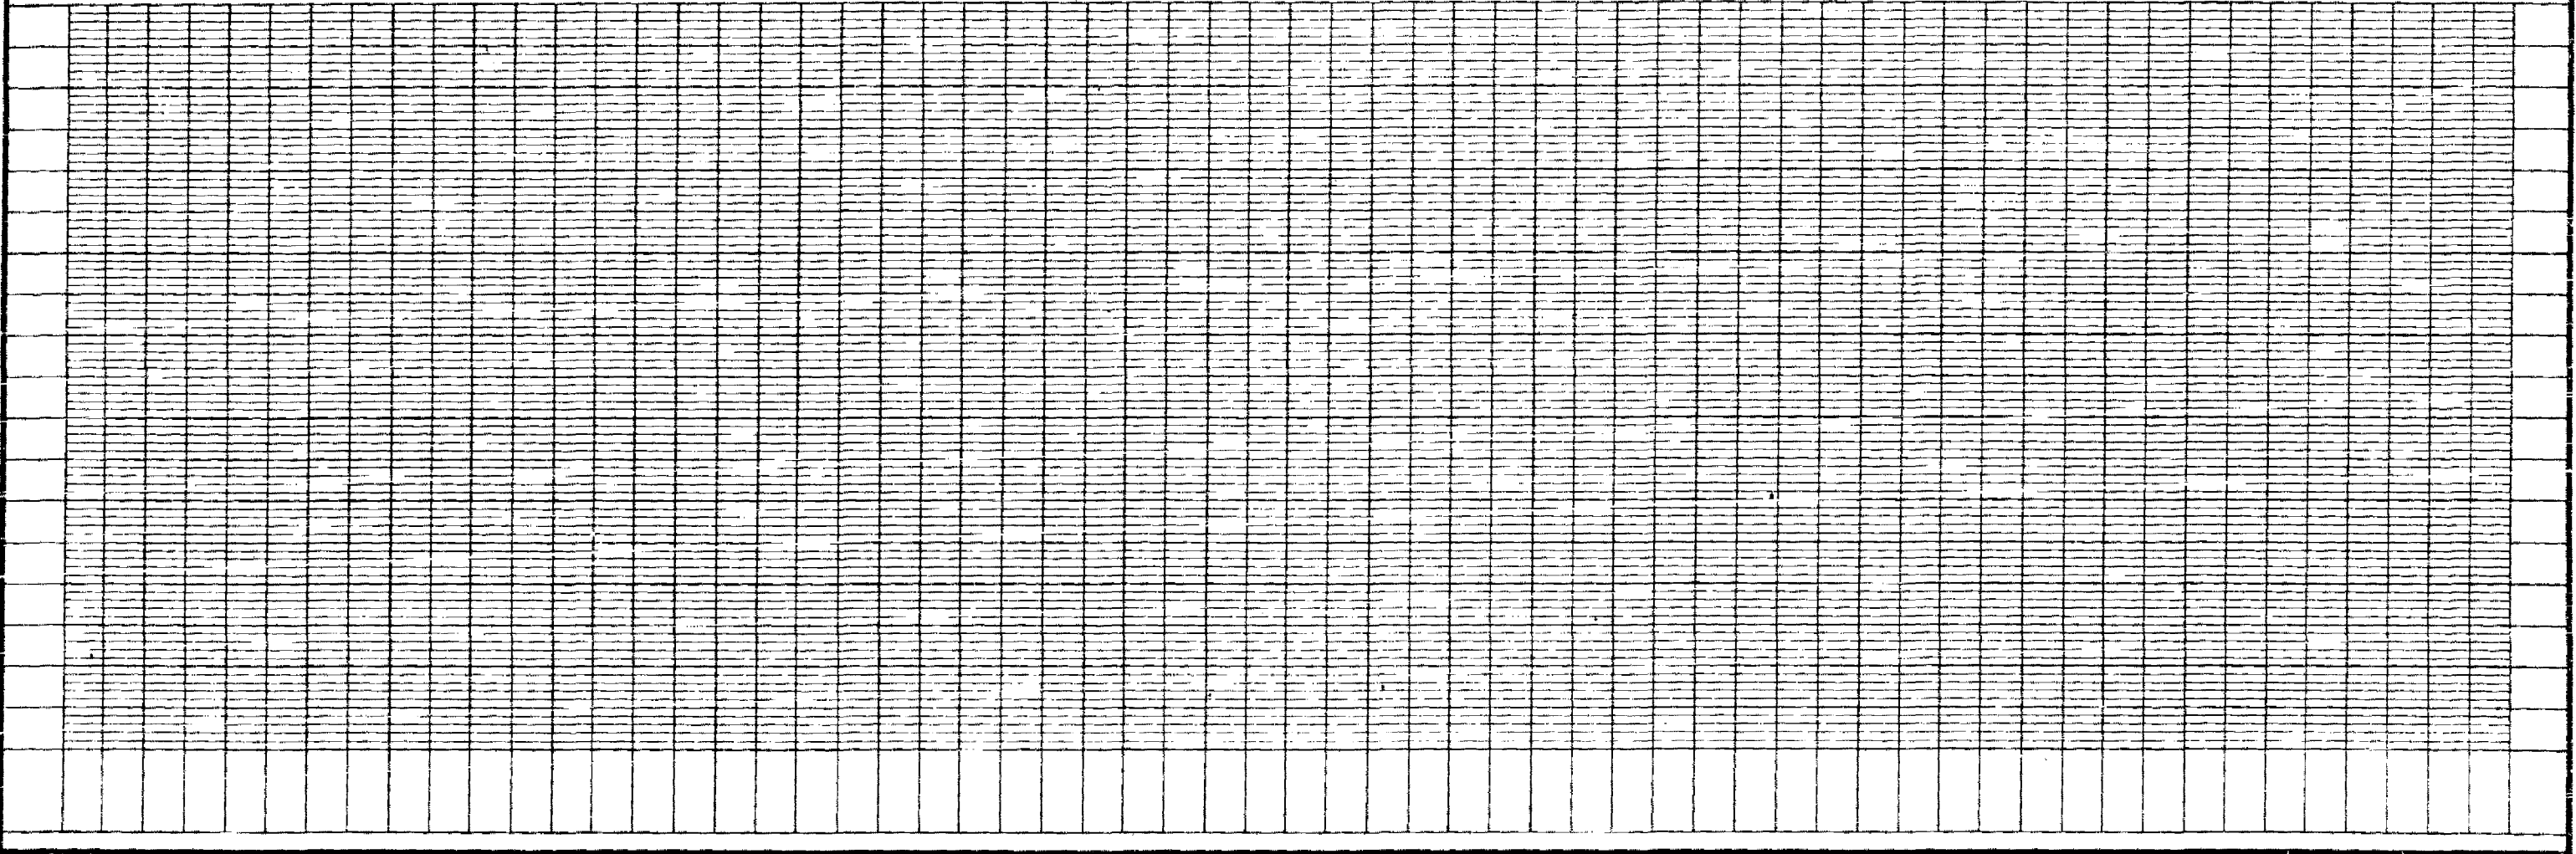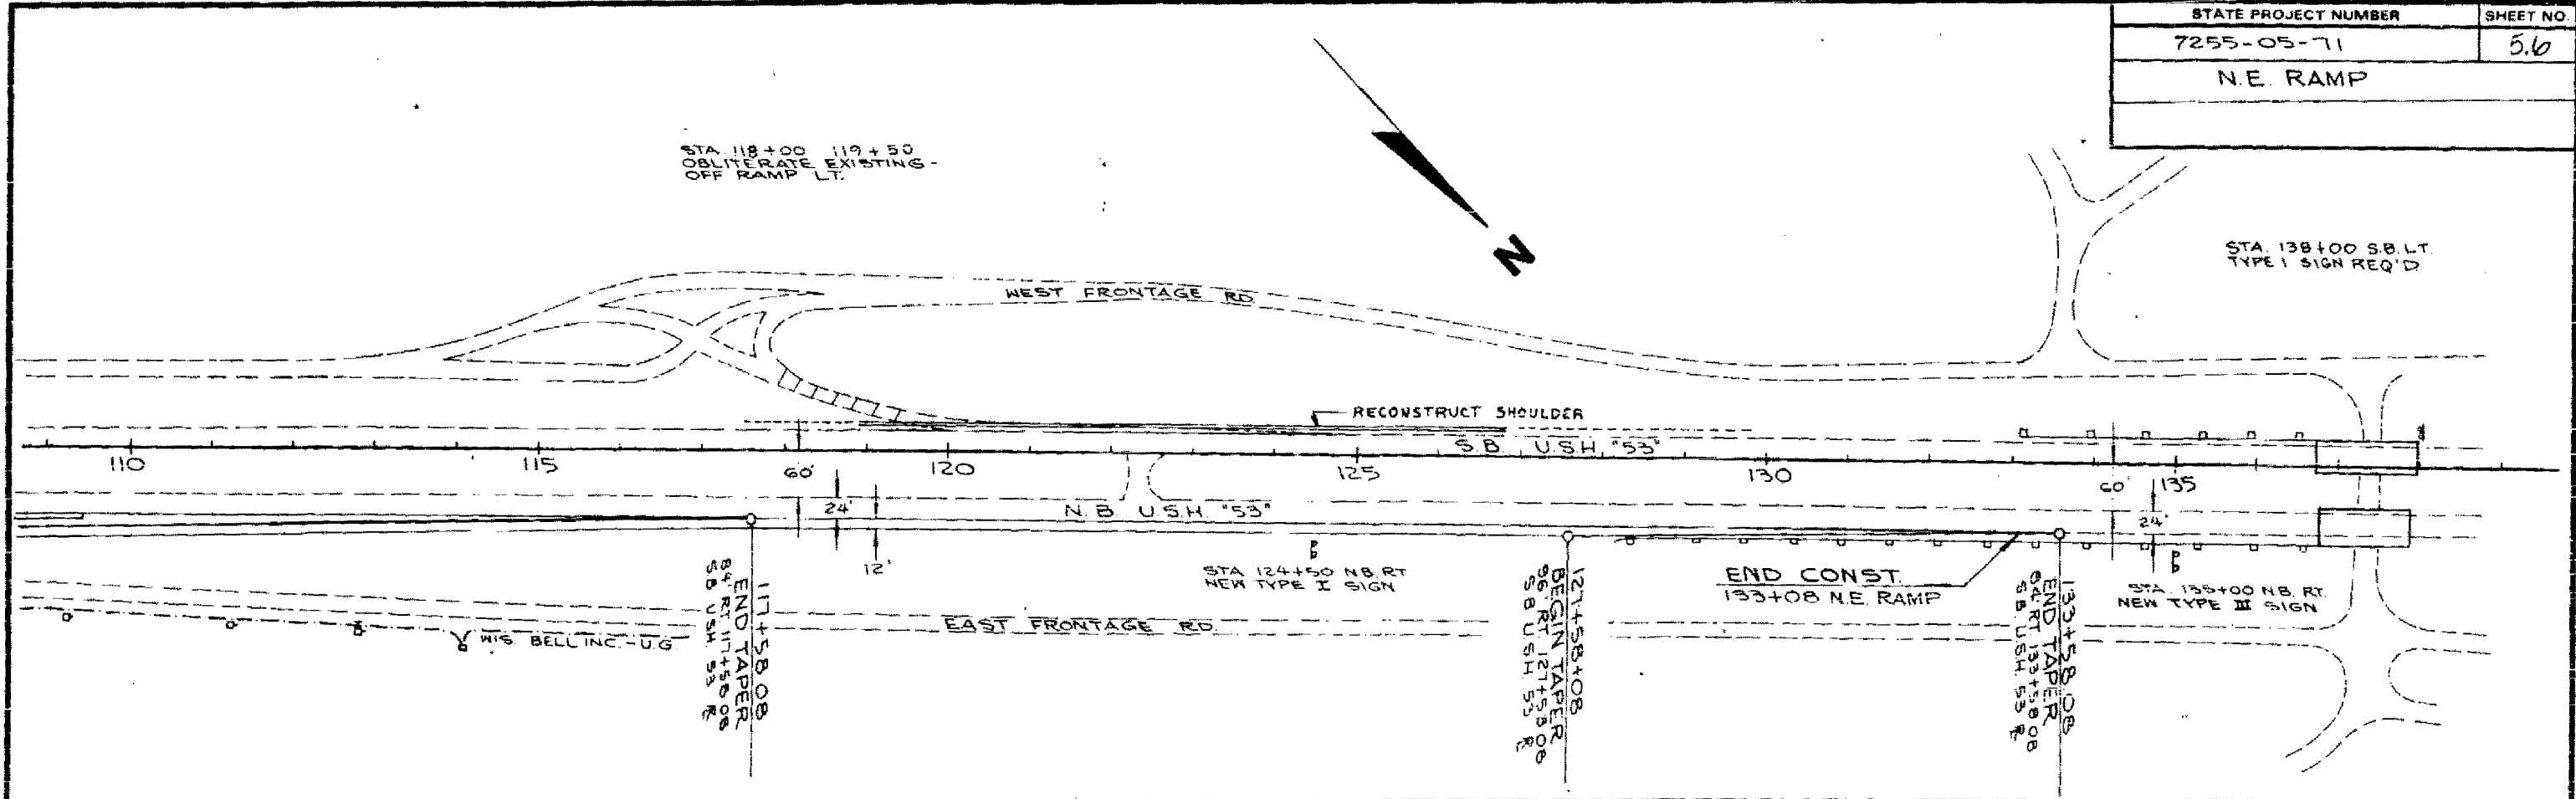

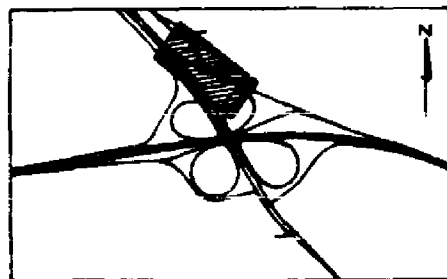

D.P.D.	PROJECT	DATE	BY
7255-5-71	5.7	6/1/66	C.C.O. 02

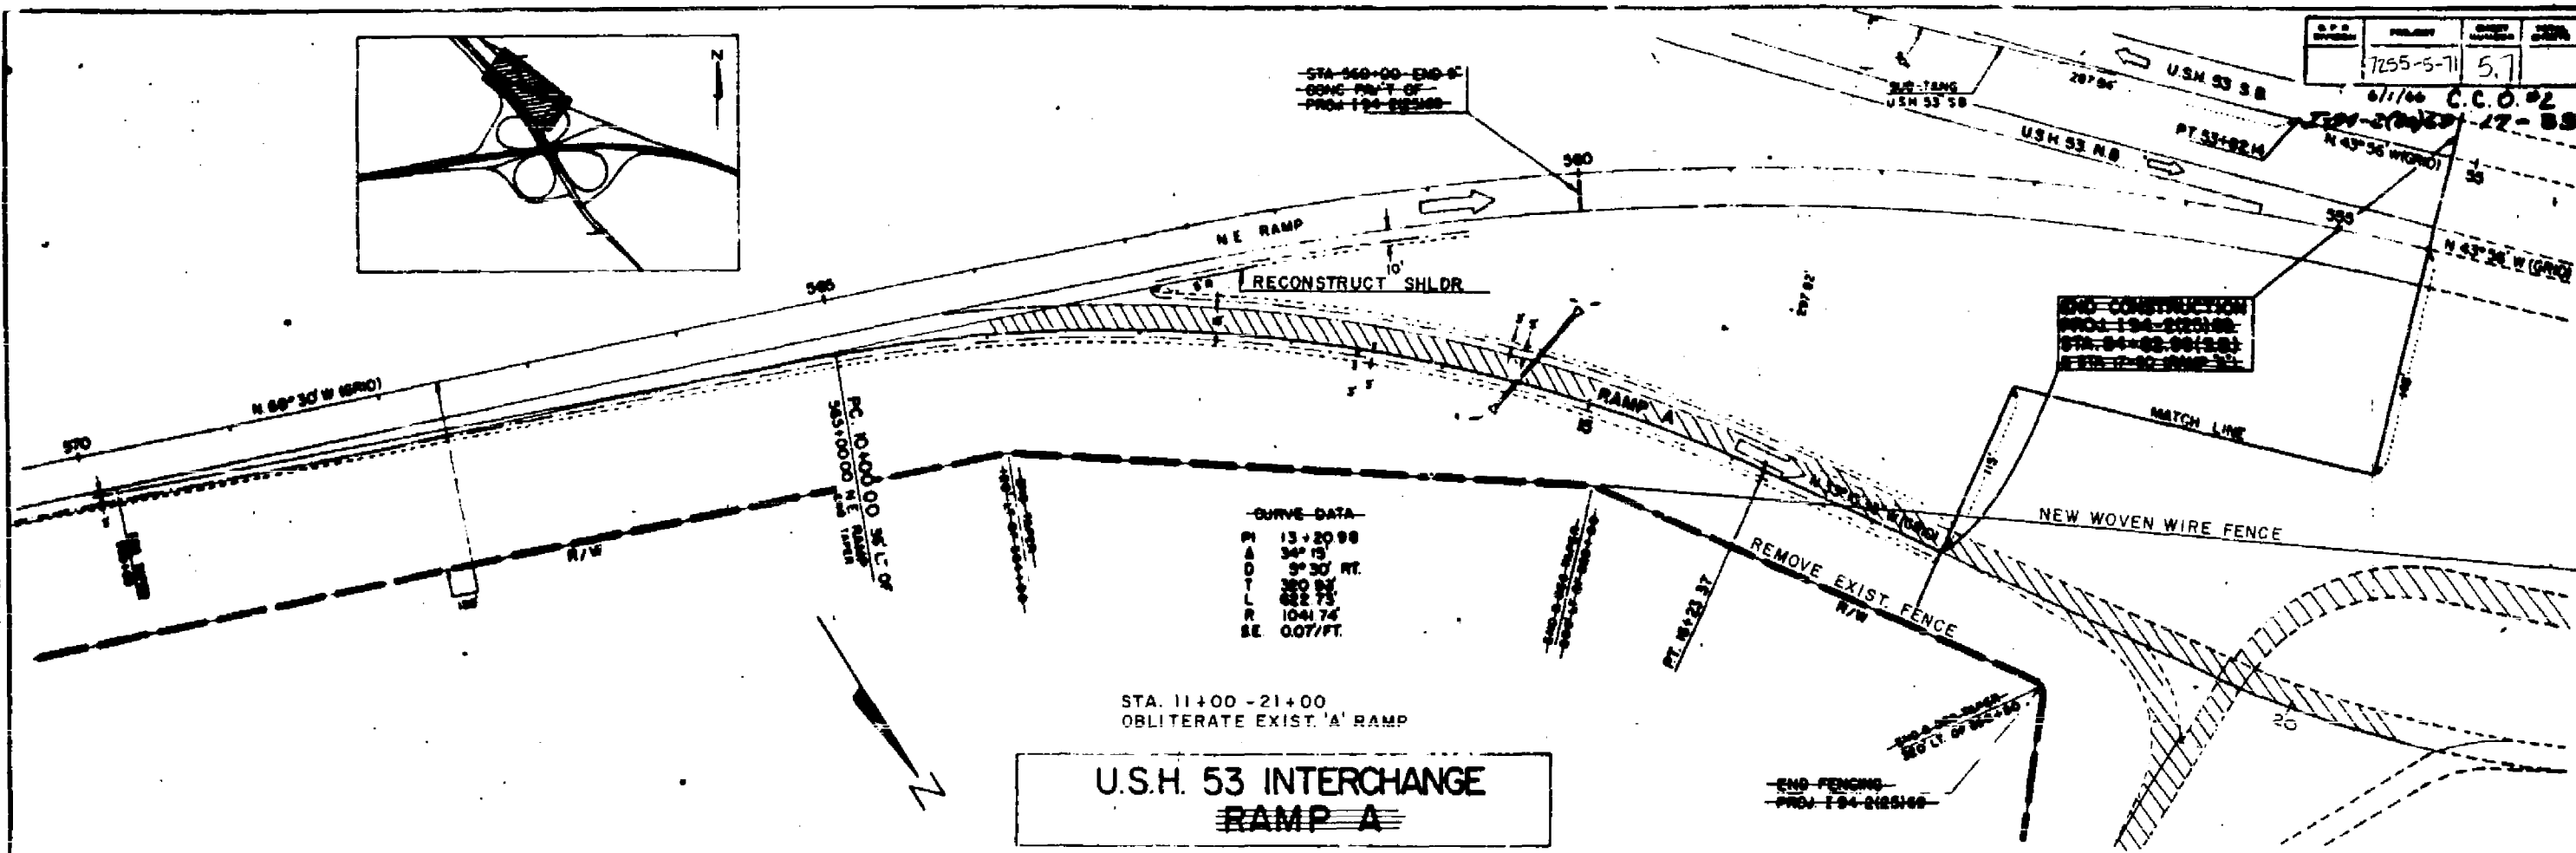

CURVE DATA

P.I. 10+35
 Δ 43° 30' 20"
 D 7° 00'
 T 326.60'
 L 621.51'
 R 818.51'
 S.E. 0.054%



STATE PROJECT NUMBER

7255-05-71

SHEET NO.


5.8

TOWN ROAD CONNECTION

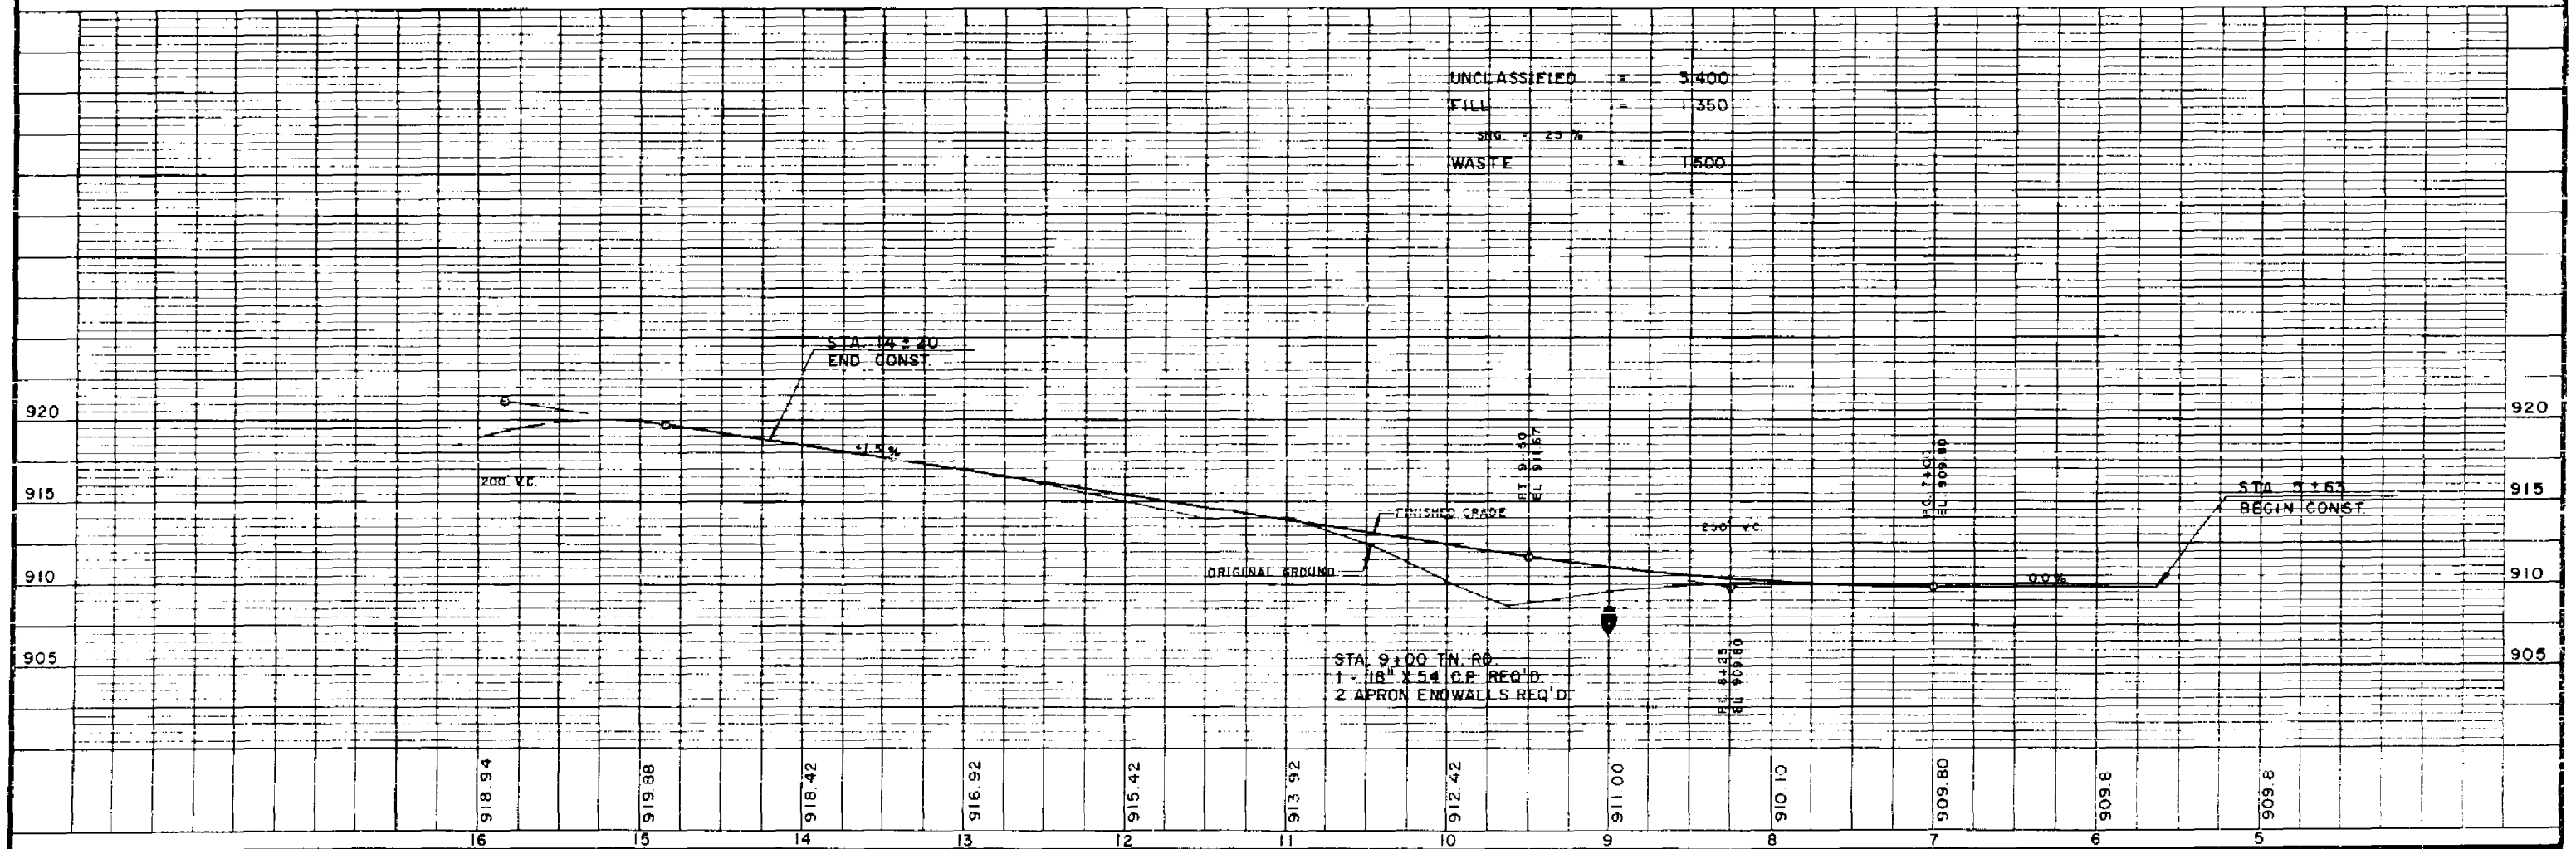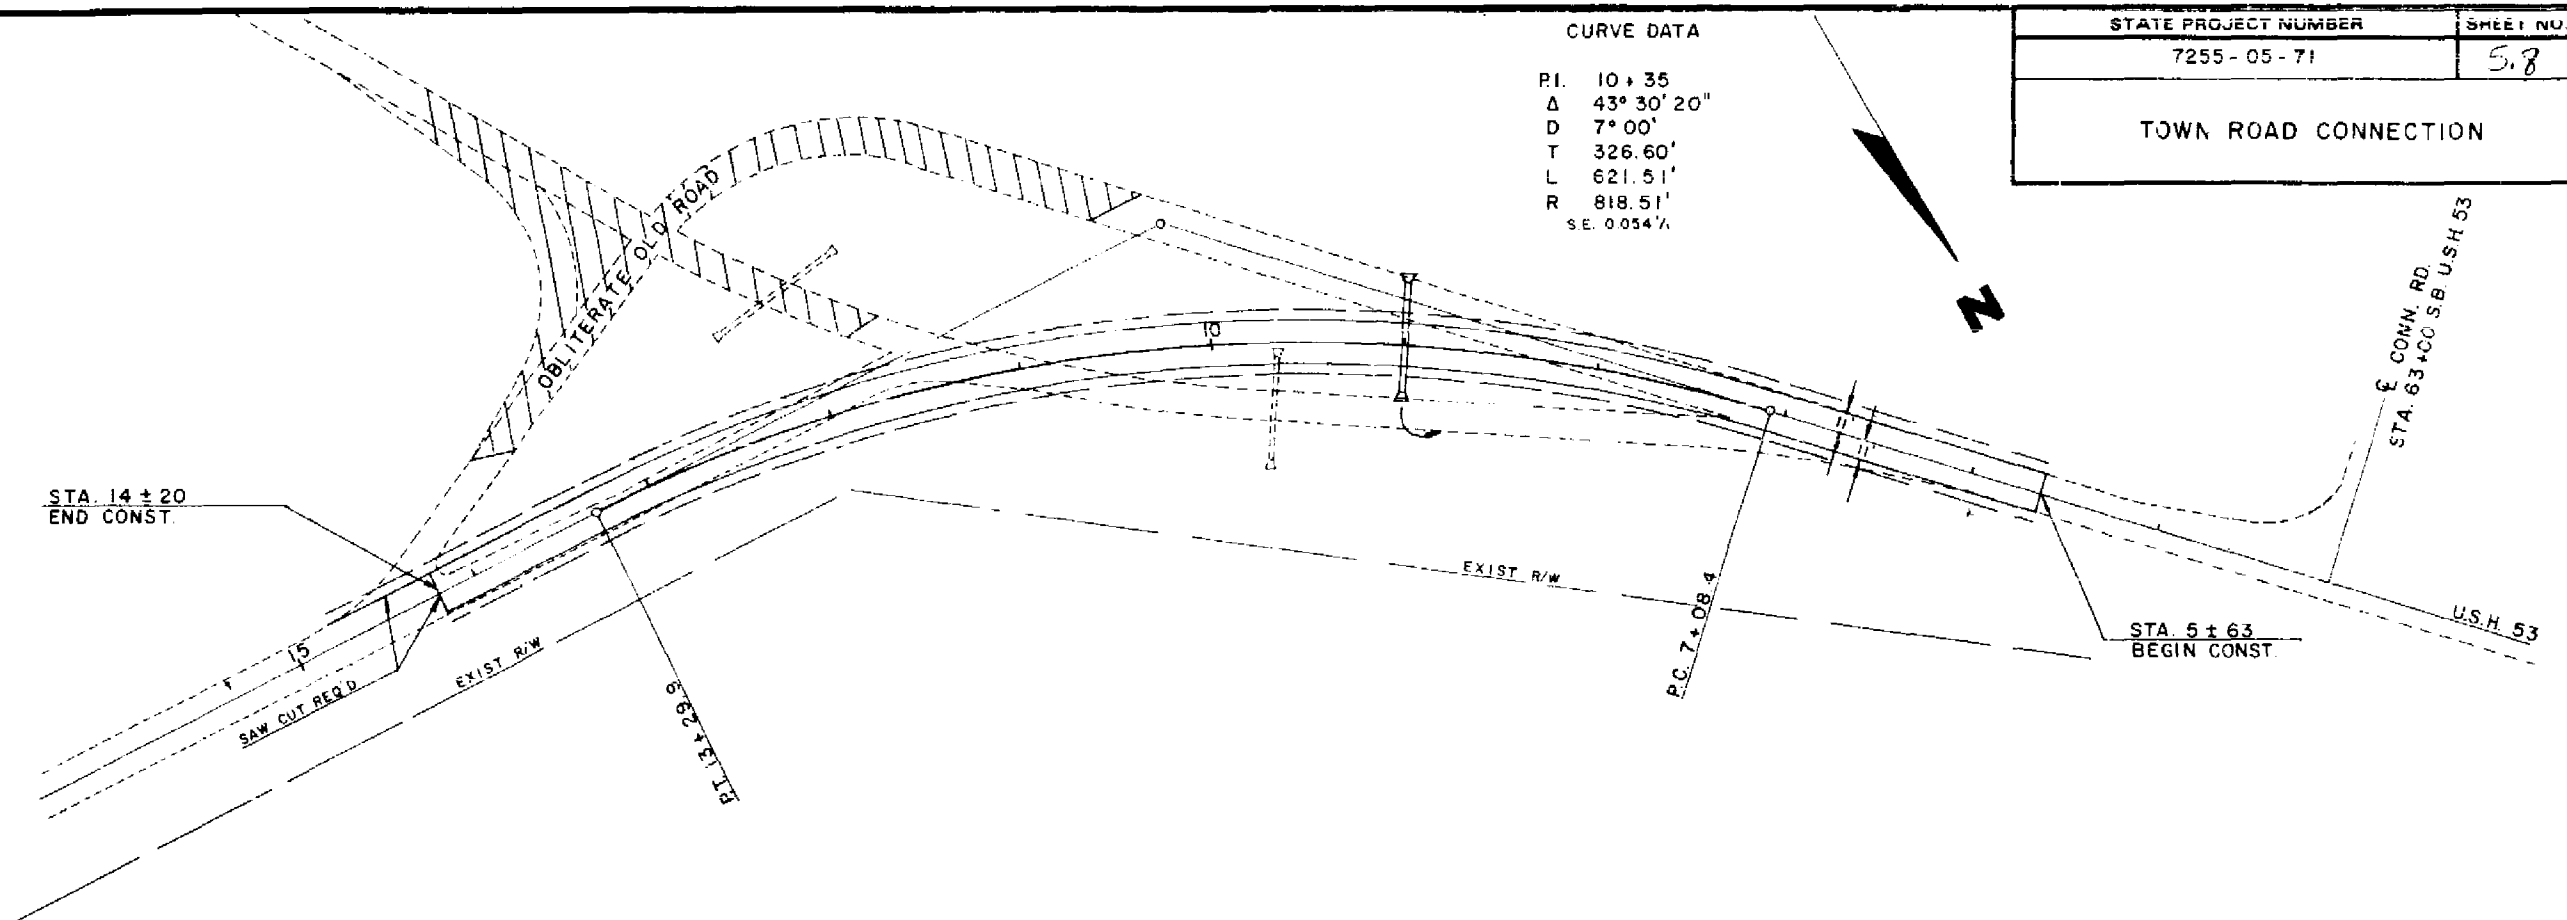

M.L.

STATE PROJECT NUMBER	SHEET NUMBER
7255-05-71	9

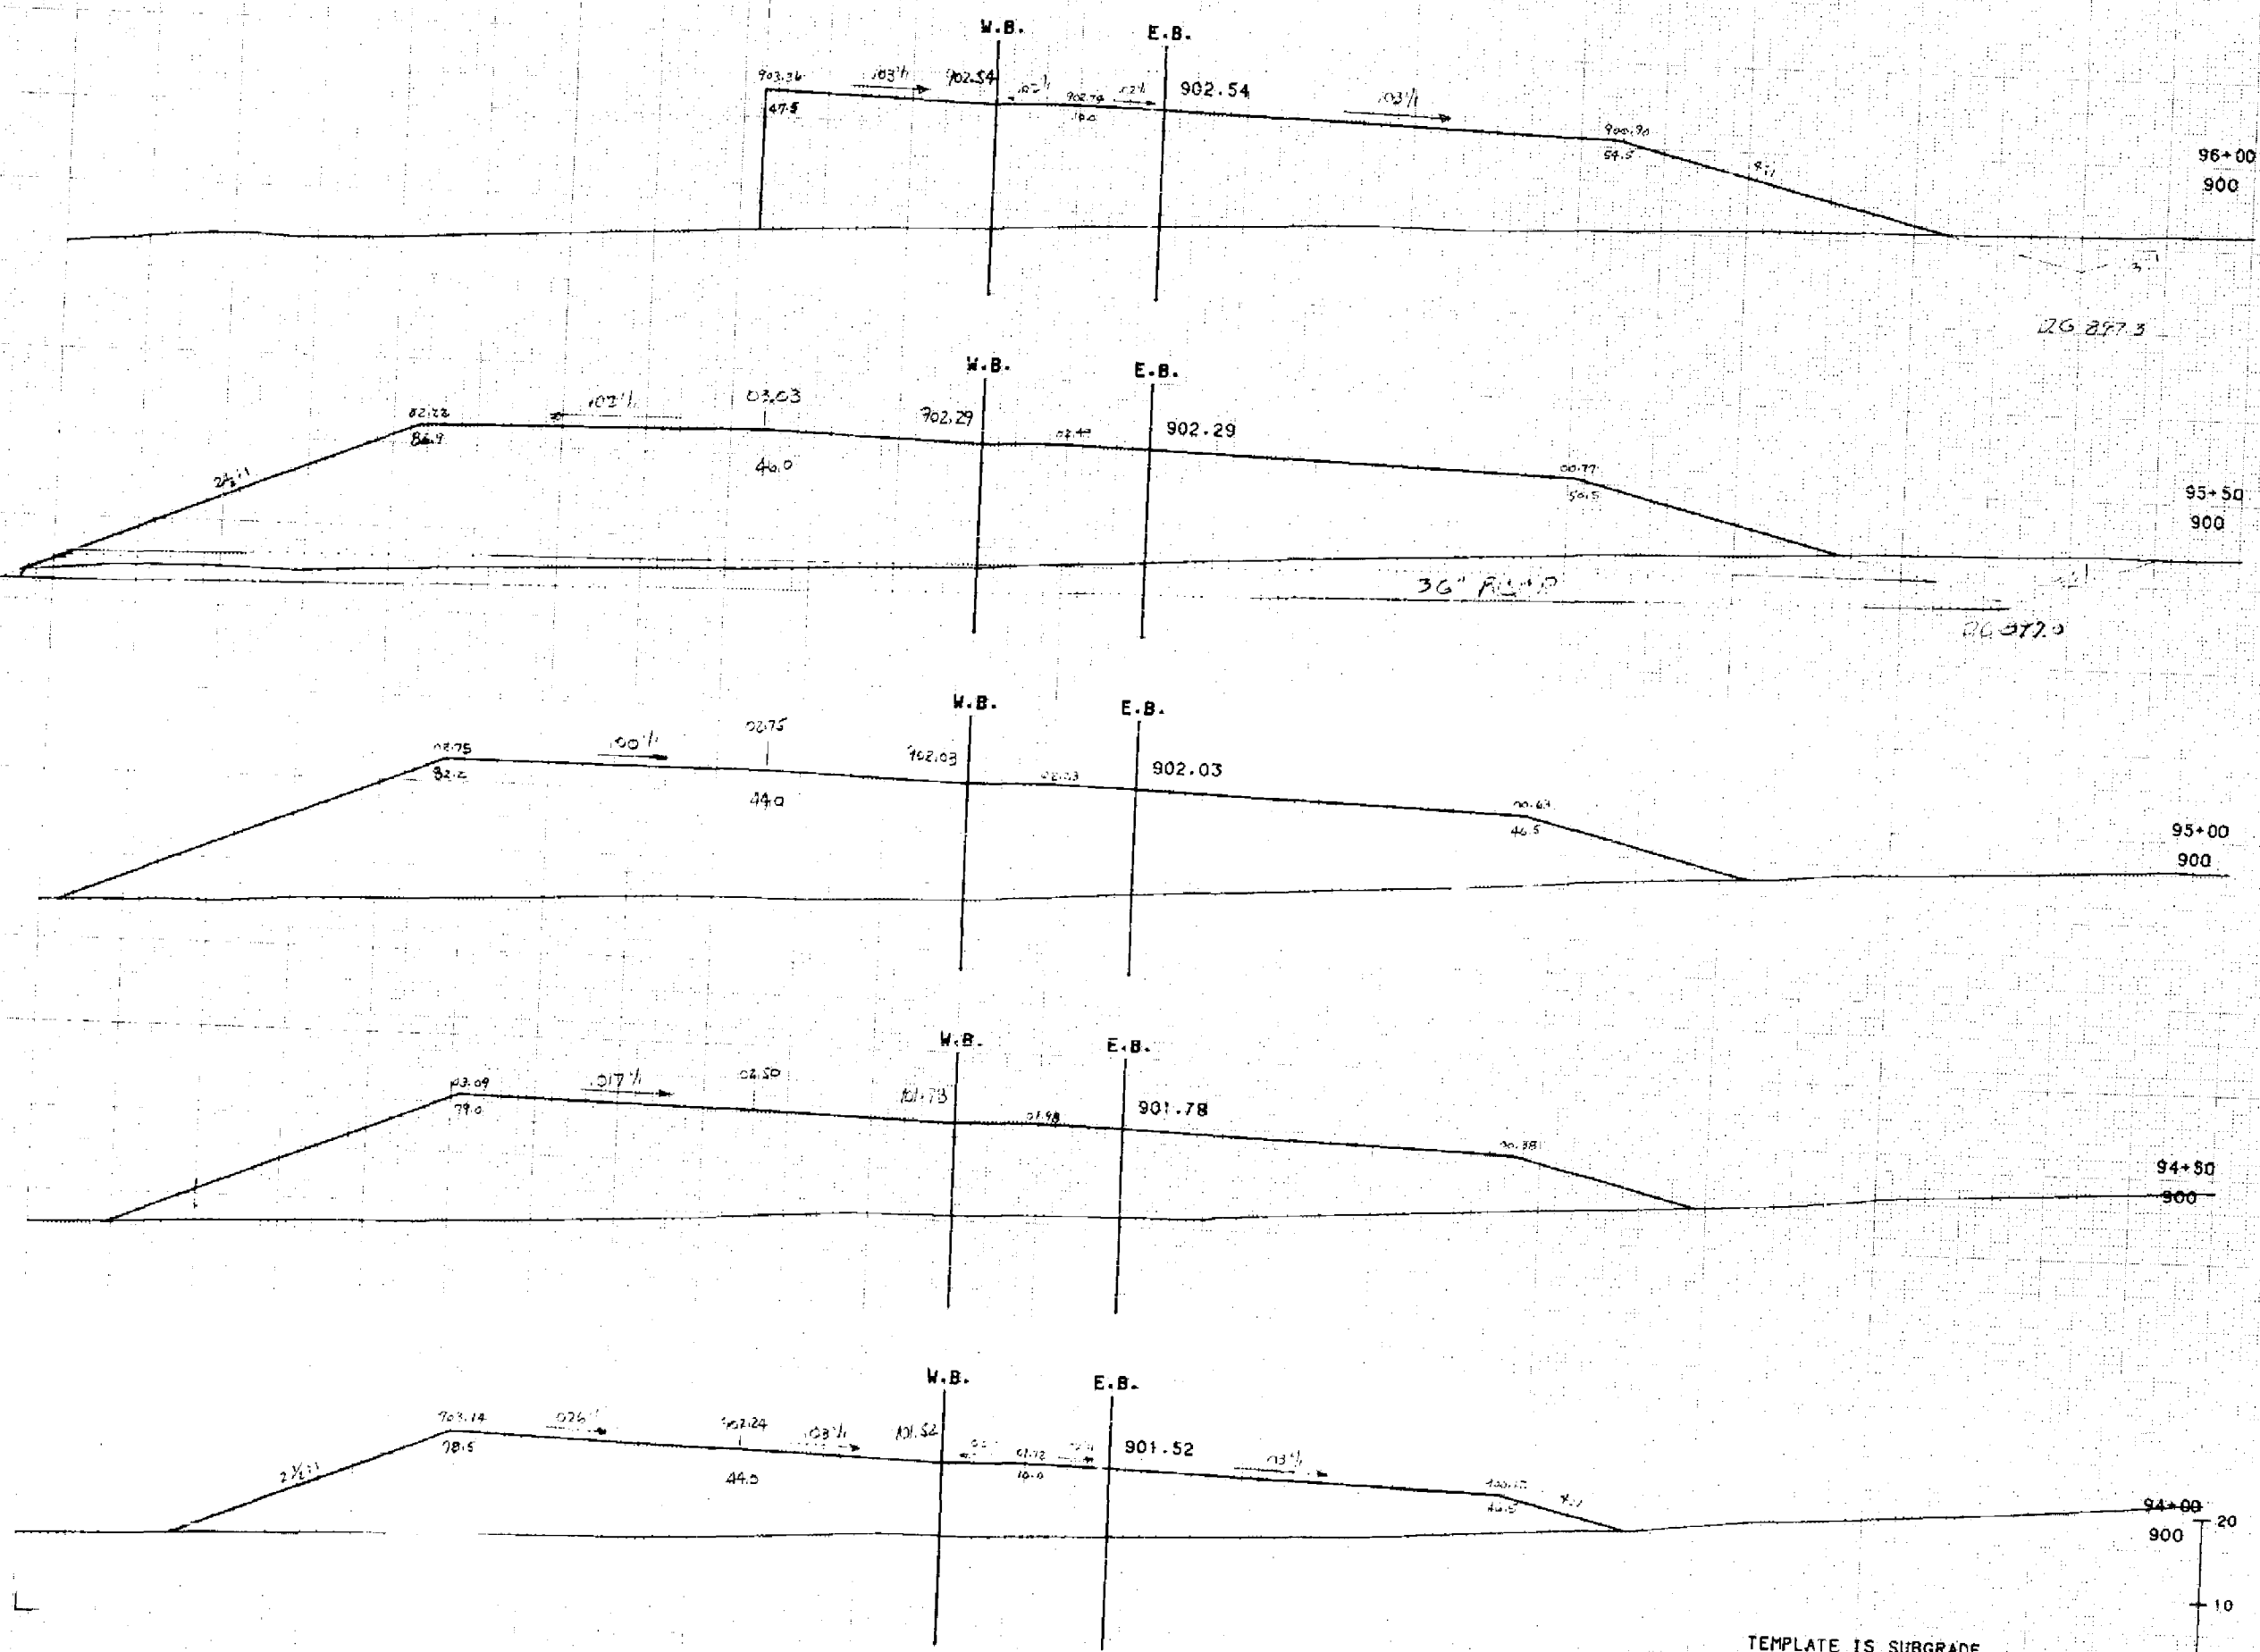


STATION	DISTANCE	YARDAGE	
		EXCAVATION	FILL
94+00	50	0	2863
94+50	50	0	3667
95+00	50	0	4318
95+50	50	0	3775
96+00			
TOTAL	0		14693

TEMPLATE IS SUBGRADE
PRINTED ELEV IS SUBGRADE
SHEET NO 1
SCALE: FEET
6. 7255050013

STATE PROJECT NUMBER	SHEET NUMBER
7255-05-71	91


ROADAGE				
	UNCL			TH
36+00	50	0		3432
36+50	50			4427
37+00	50			5479
37+50	50			5426
38+00	50	0		6449
38+50				
TOTAL	0			25613

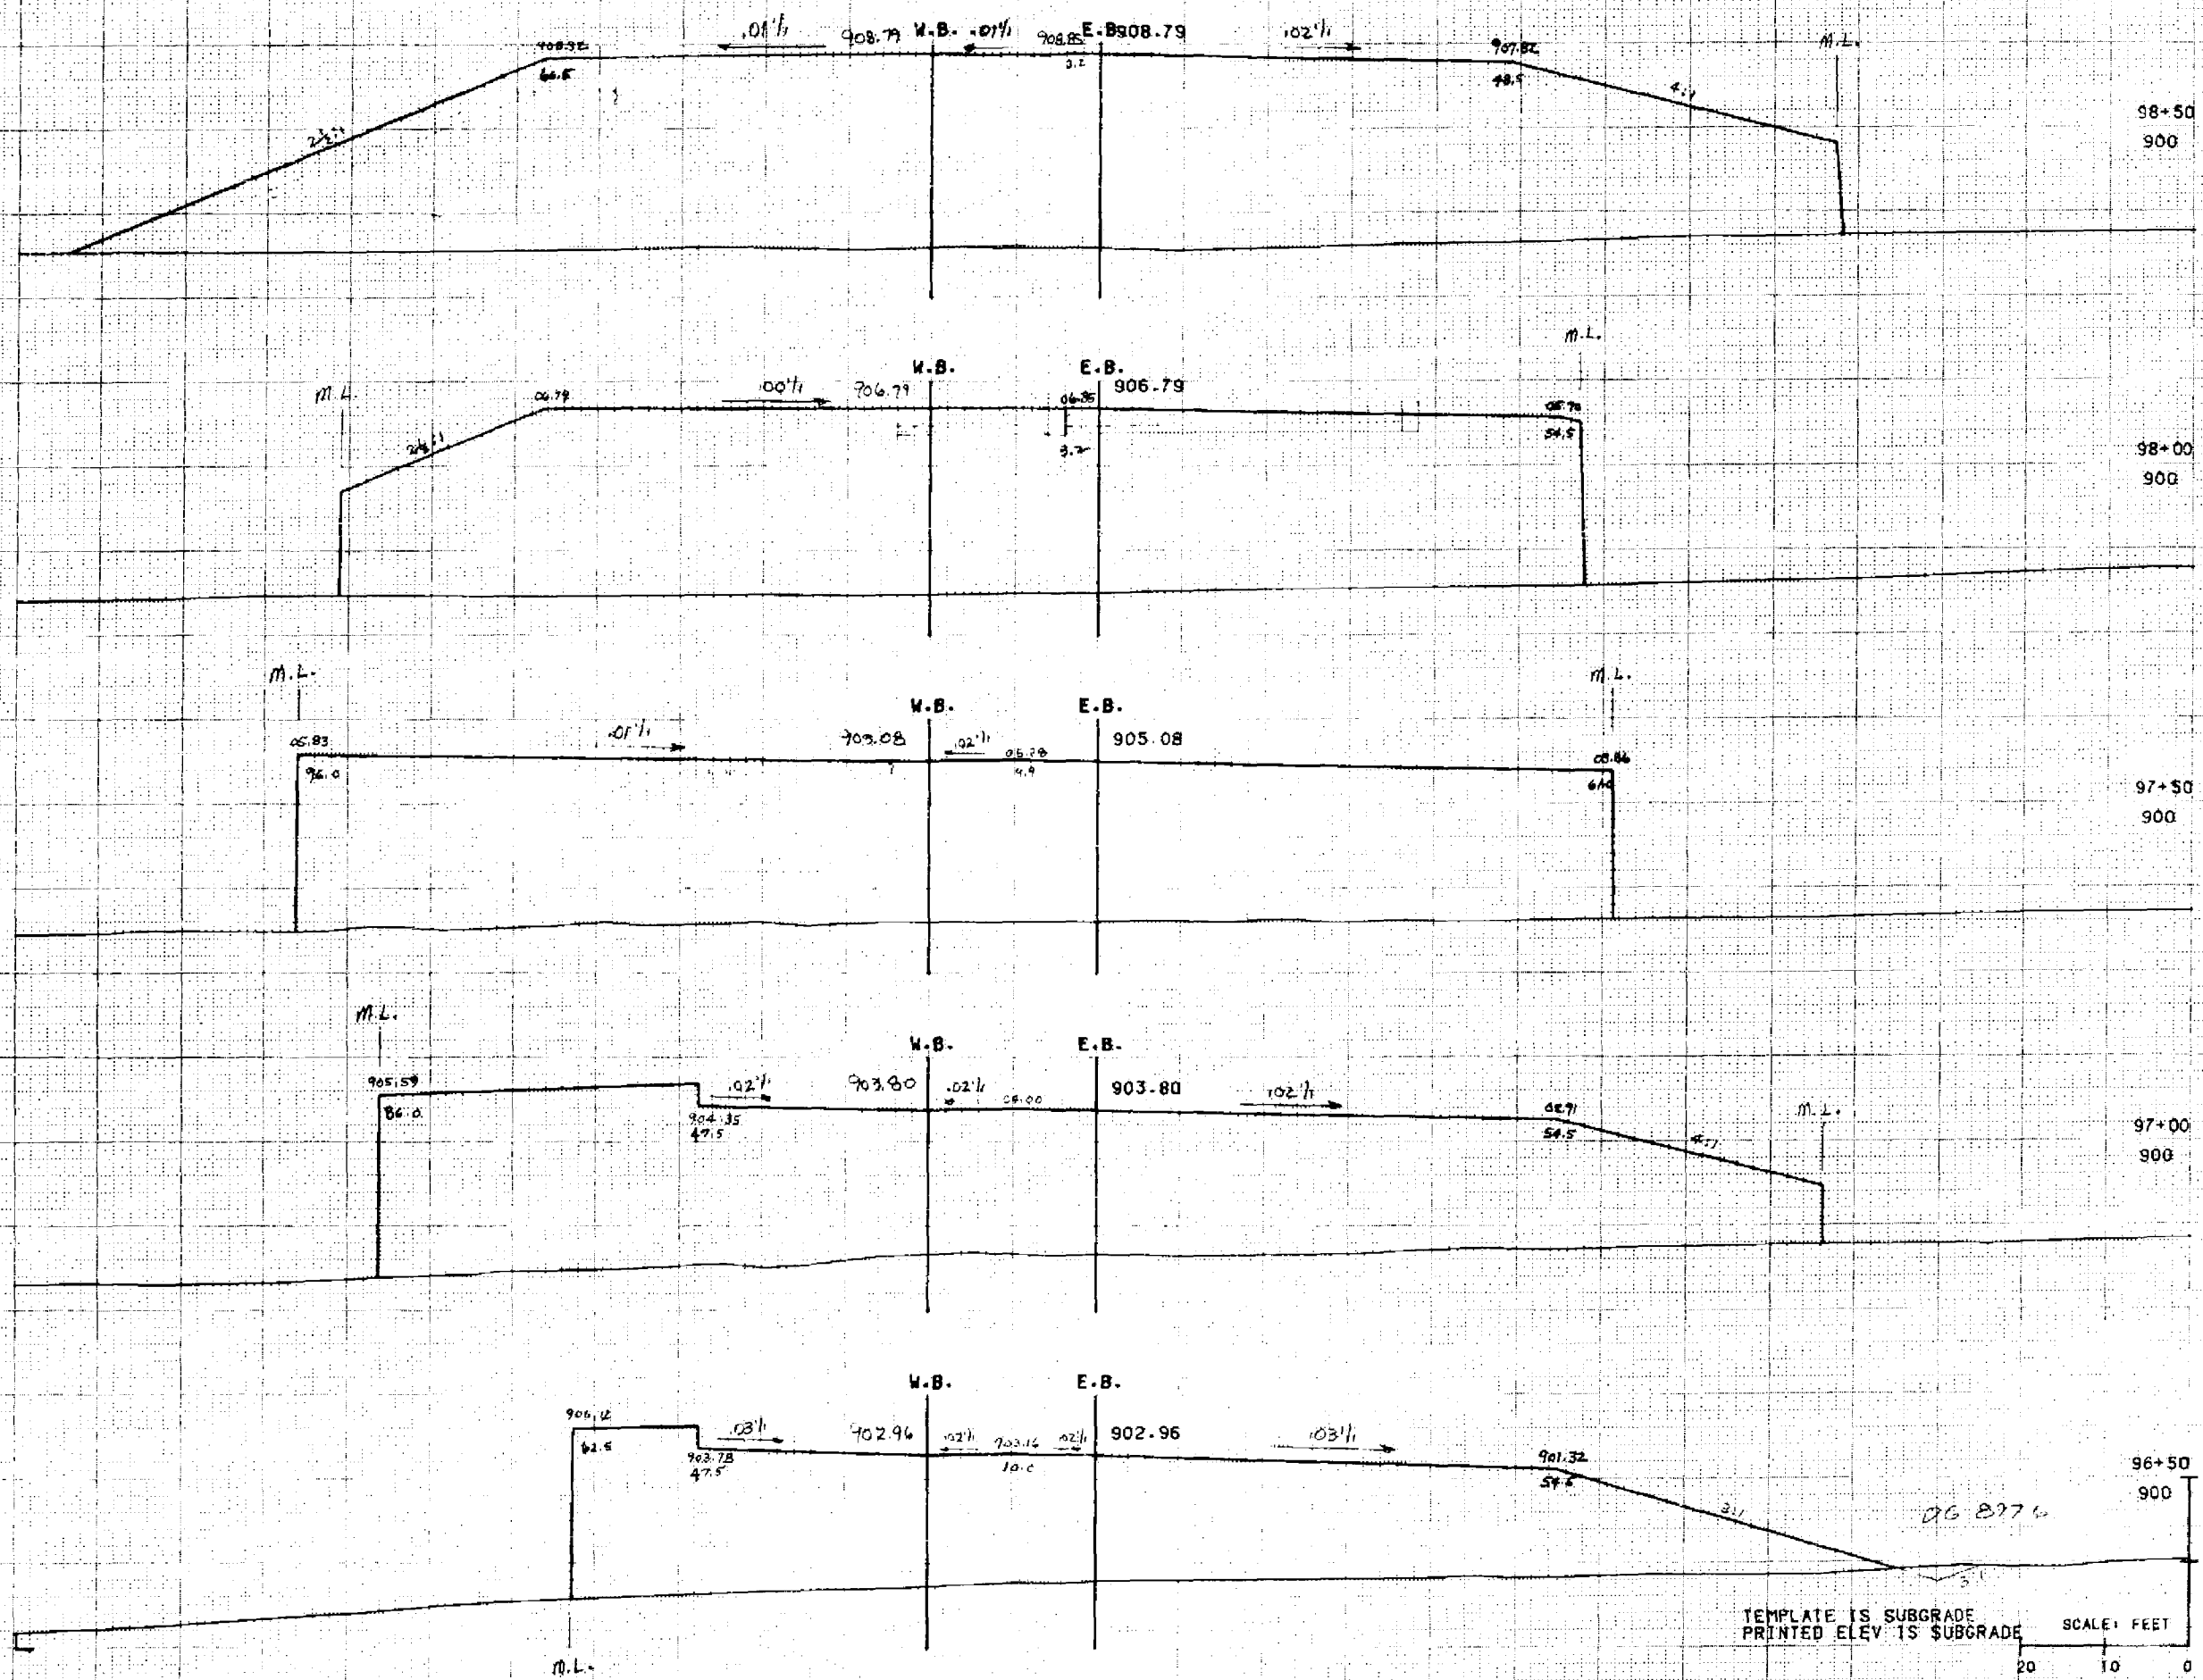

TEMPLATE IS SUBGRADE
PRINTED ELEV. IS SUBGRADE

SCALE: FEET

SHEET NO 2 6 7255050013

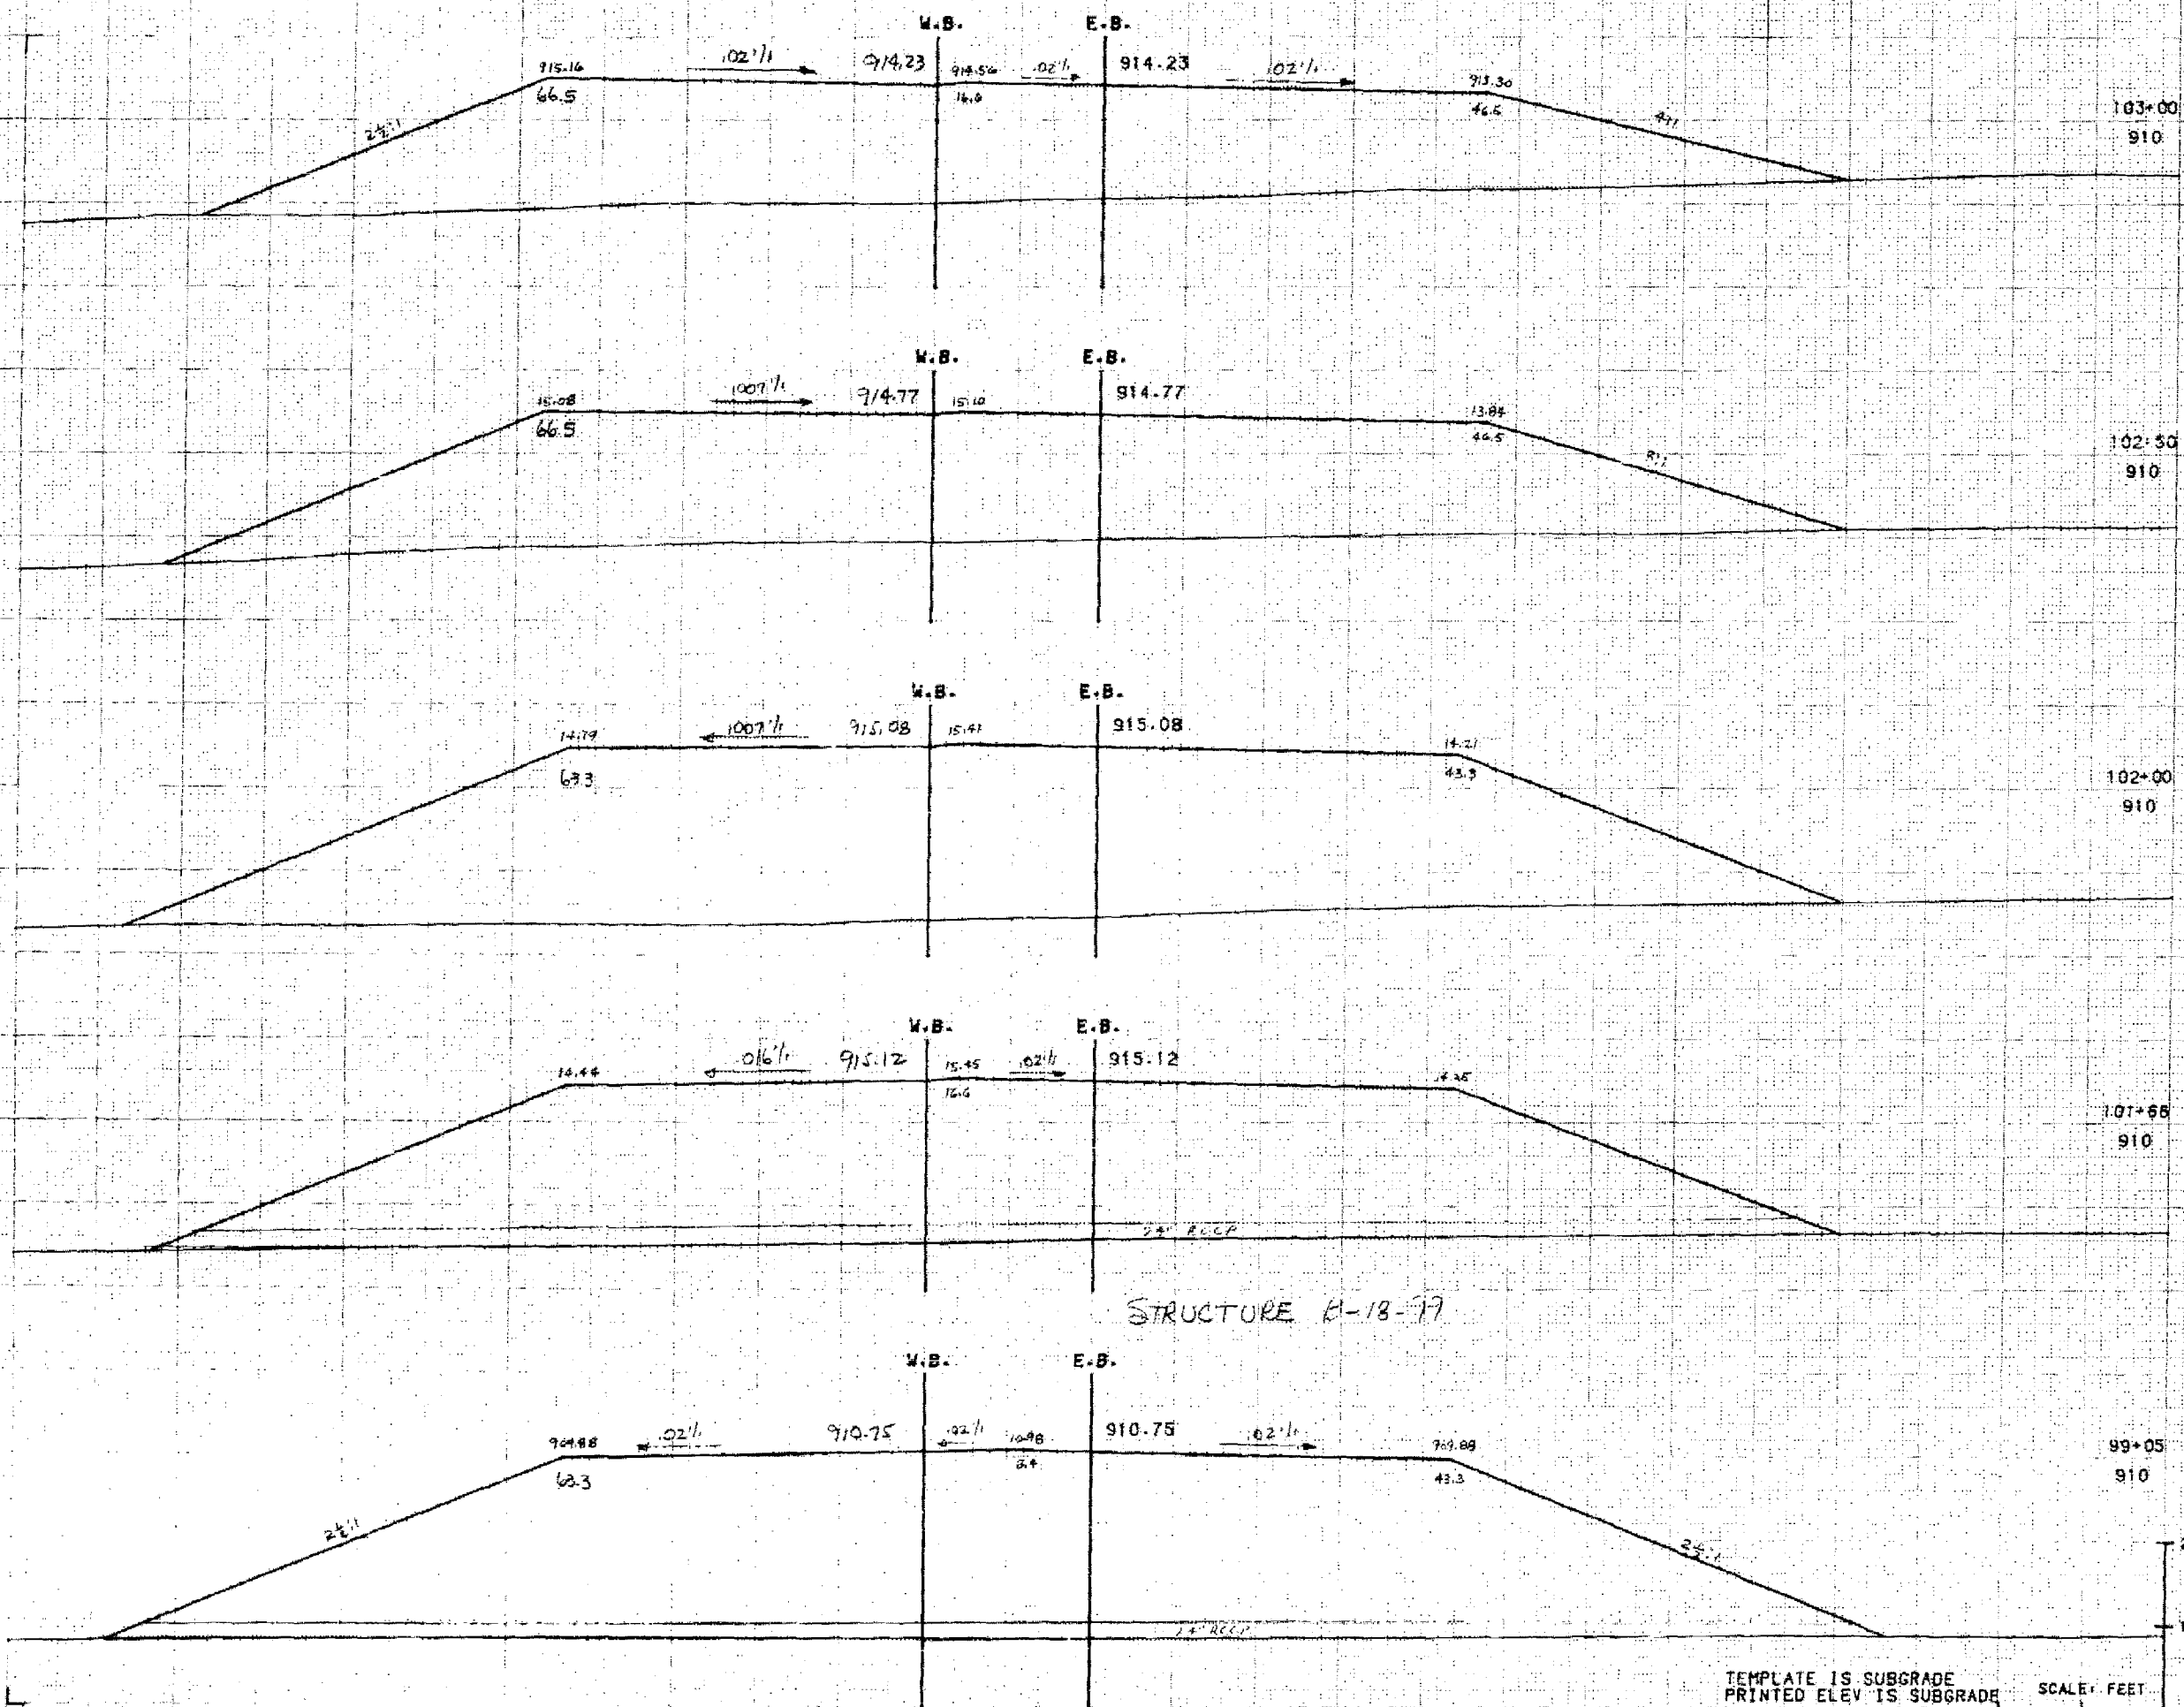

STATE PROJECT NUMBER				SHEET NUMBER
7255-05-71				9.2
STATION	DISTANCE	YARDAGE		FILL
		EXCAVATION		
		UNCL		
98+50	55	0		7523
99+05	50	0		5239
99+55	STRUCTURE B 18-97			
104+05	61	0		3299
101+46	39	0		3812
102+00	50	0		5088
102+50	50	0		4160
103+00	50	0		2710


TEMPLATE IS SUBGRADE
PRINTED ELEV IS SUBGRADE

SCALE: FEET

SHEET NO 3

6 7255050013

STATE PROJECT NUMBER				SHEET NUMBER
7255-05-71				9.3
STATION	DISTANCE	YARDAGE		
		EXCAVATION		FILL
		UNCL.		
103+00	50	0		3809
103+50	50			3075
104+00	50			2311
104+50	50			1733
105+00	50	0		1113
105+50	50	10		782
106+00				

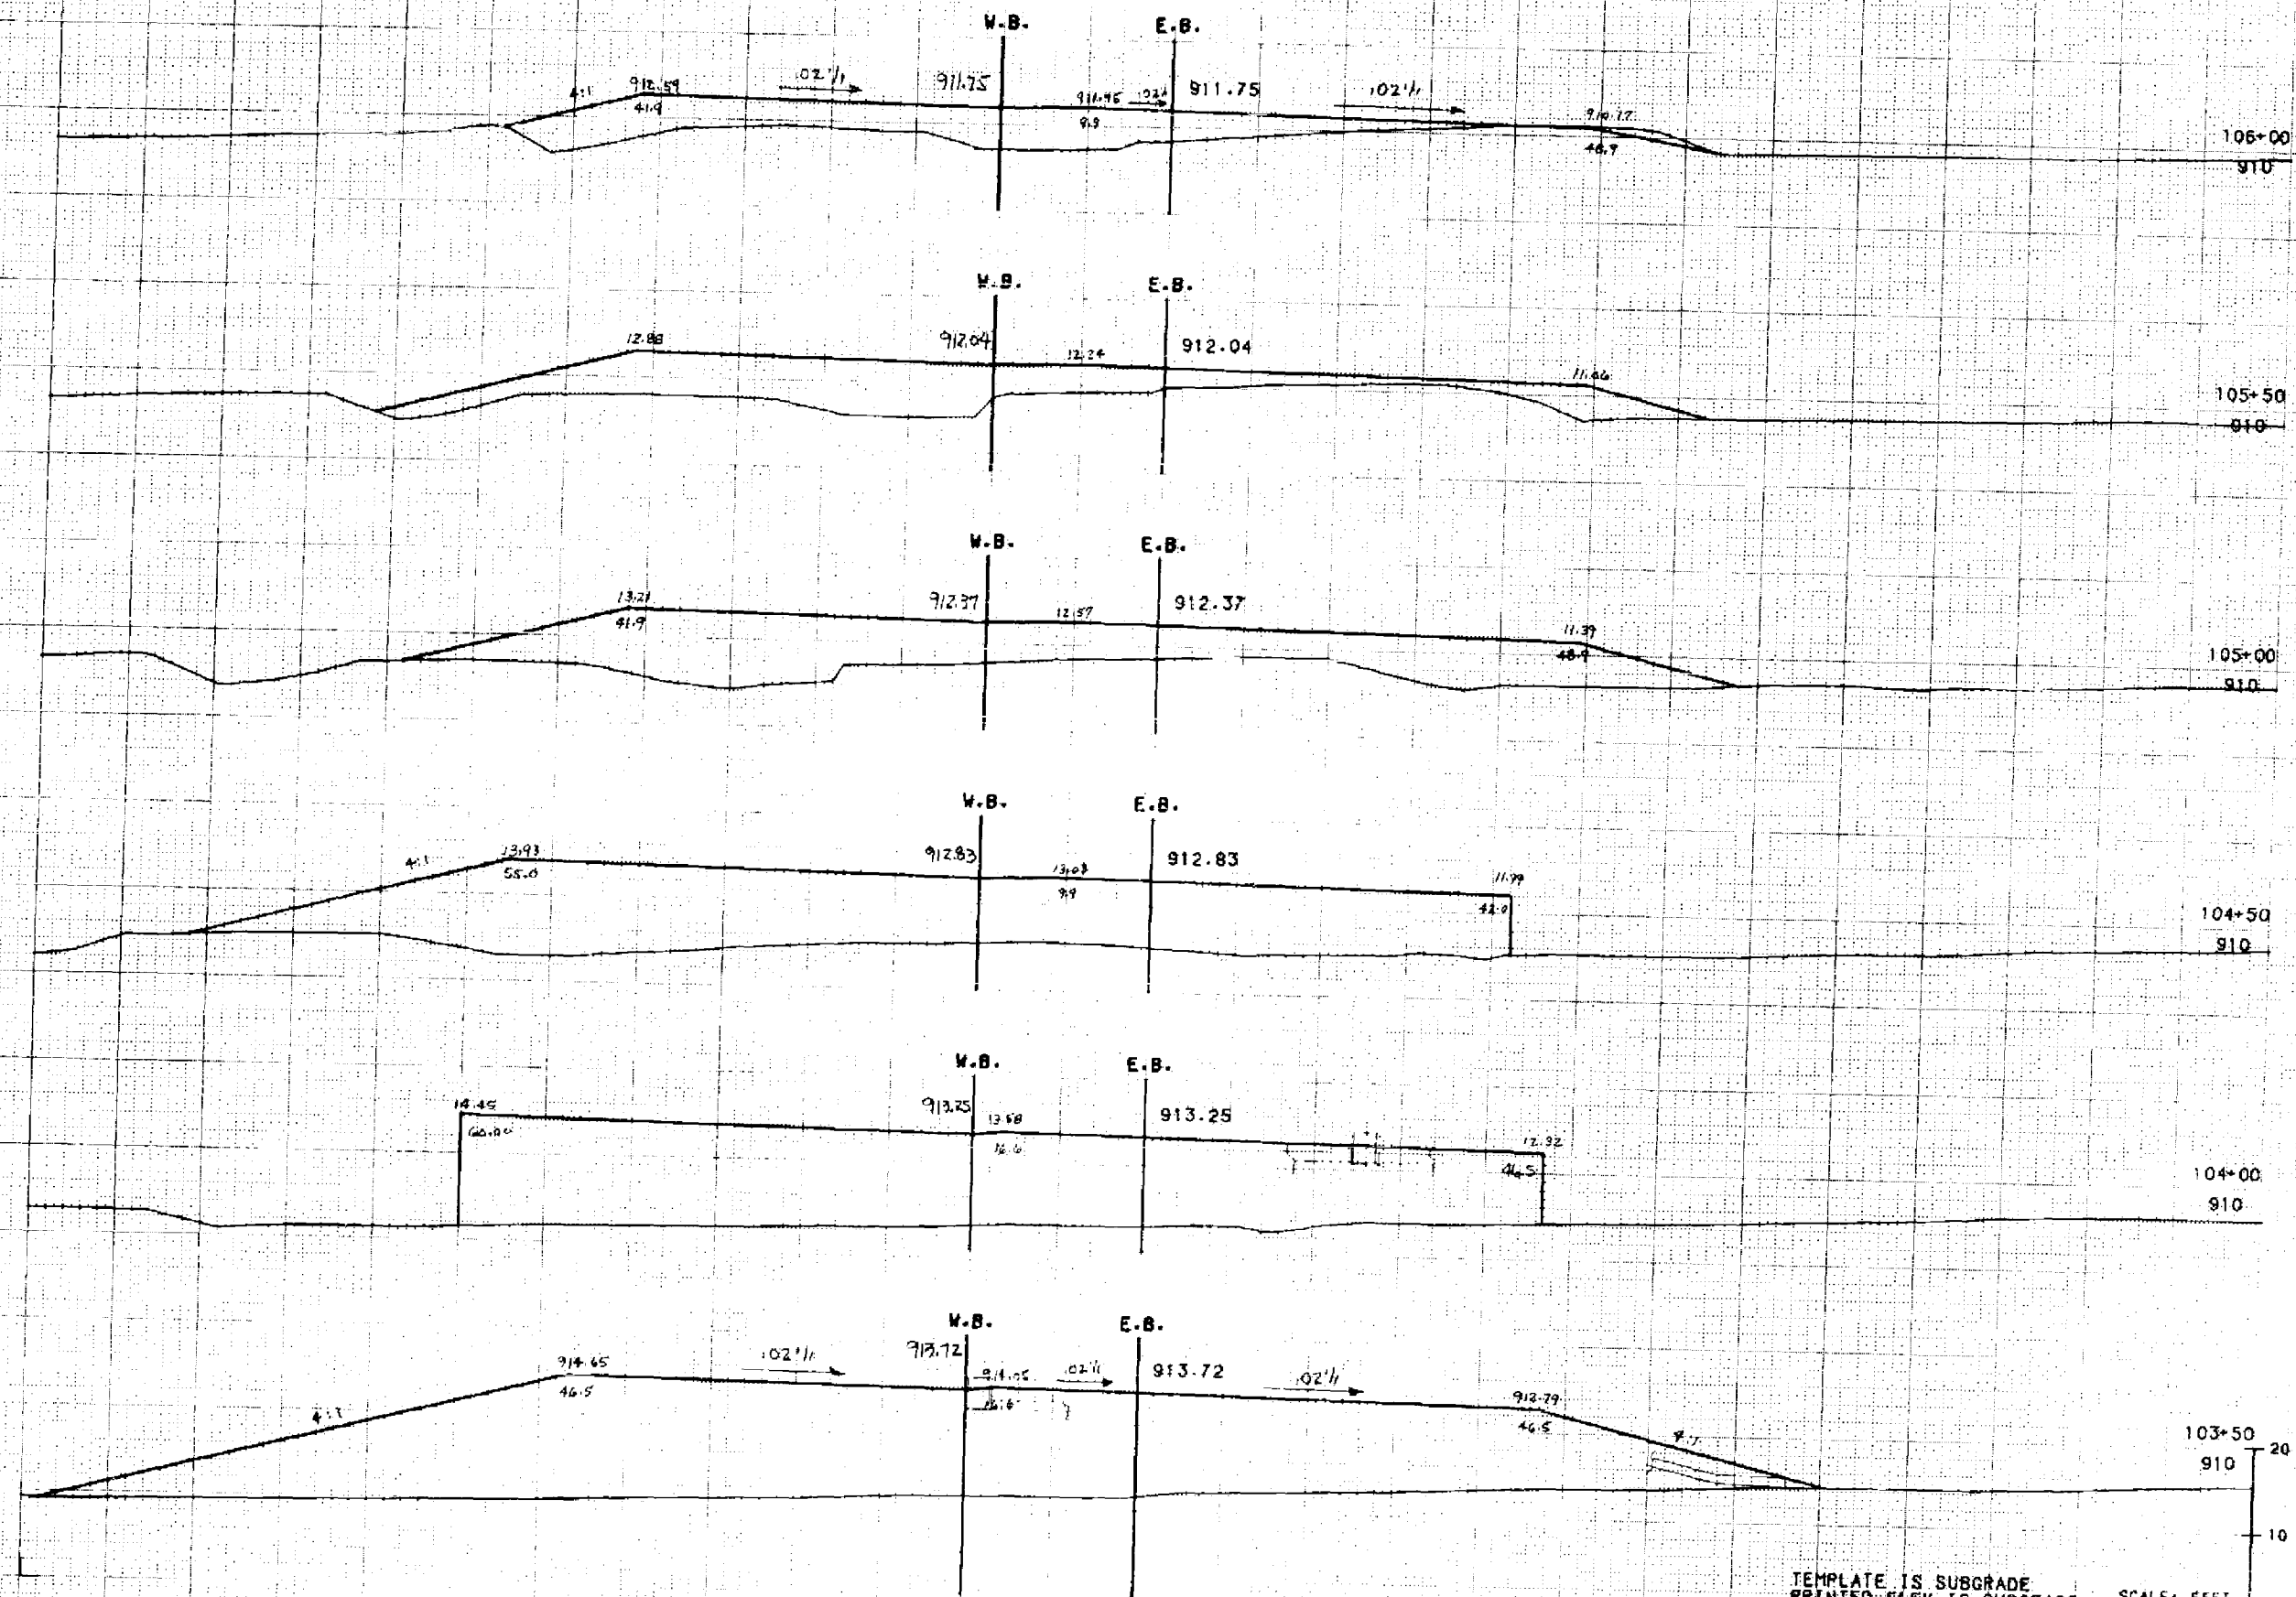


TEMPLATE IS SUBGRADE
PRINTED ELEV IS SUBGRADE

SCALE: FEET

20 10 0

SHEET NO. 4 6 7255050013

CDH AP

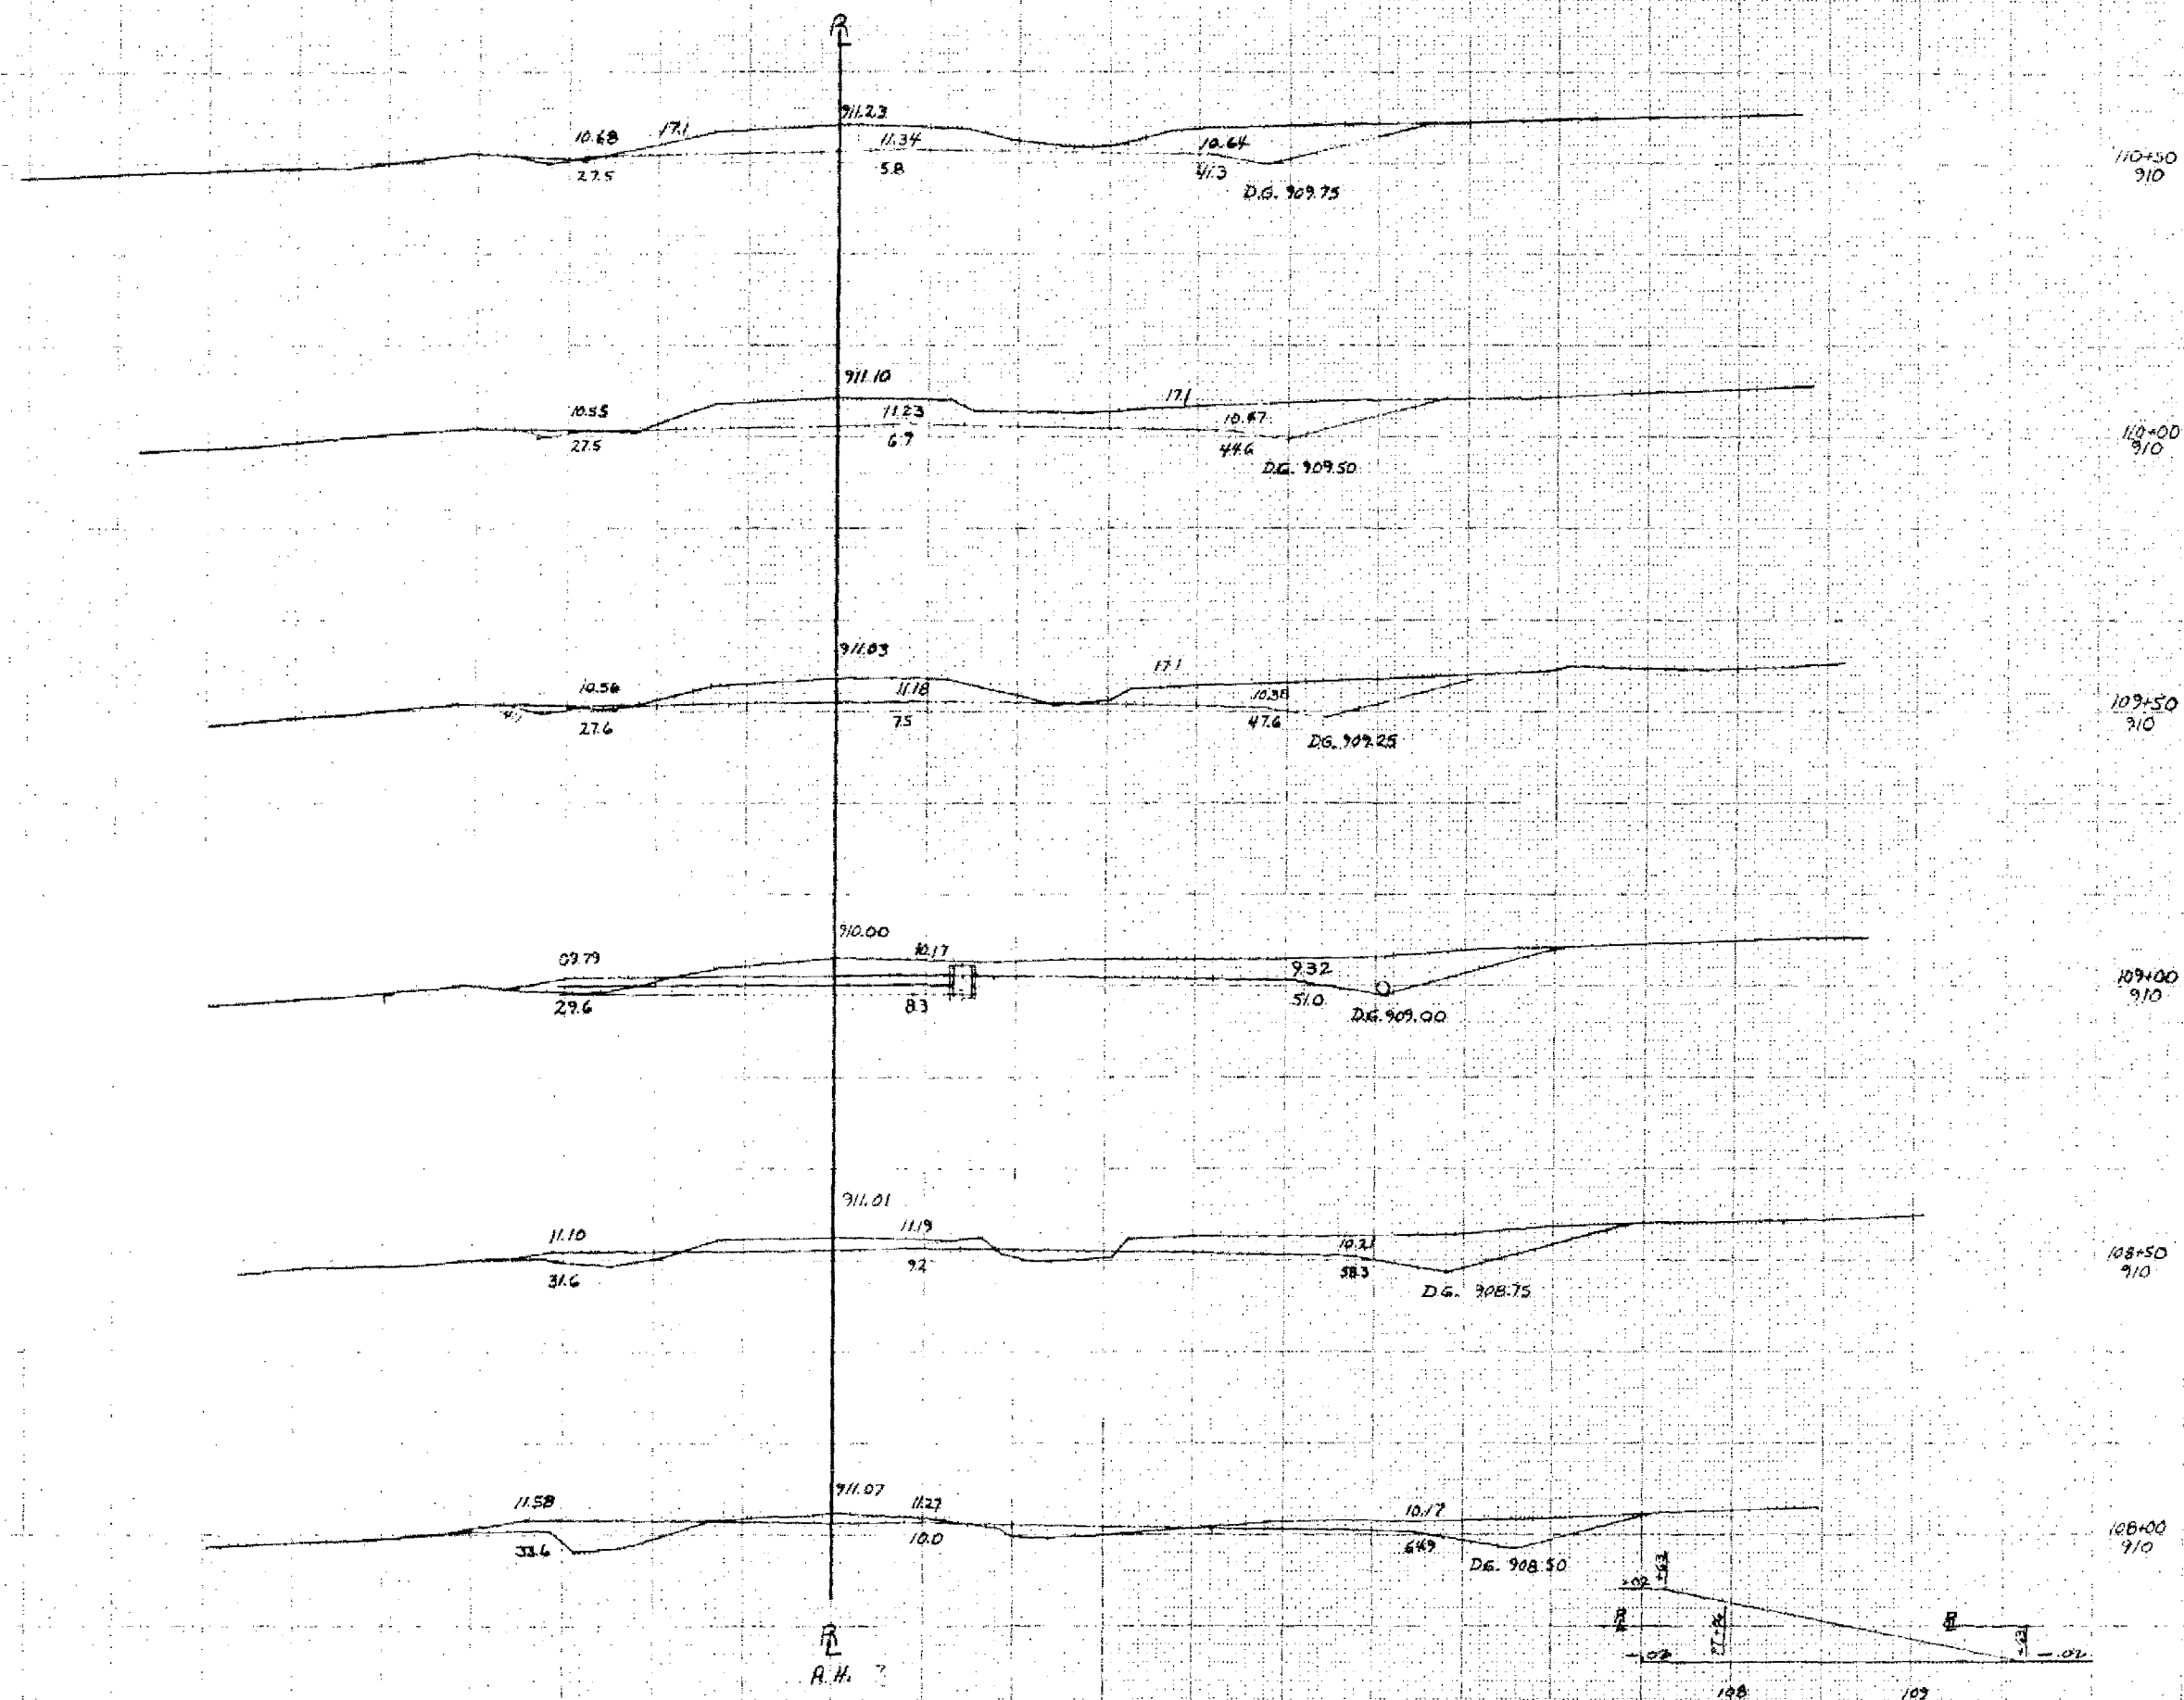

SHEET TOTAL


1641

44

[illegible]

SHEET TOTAL	1528
-------------	------

15

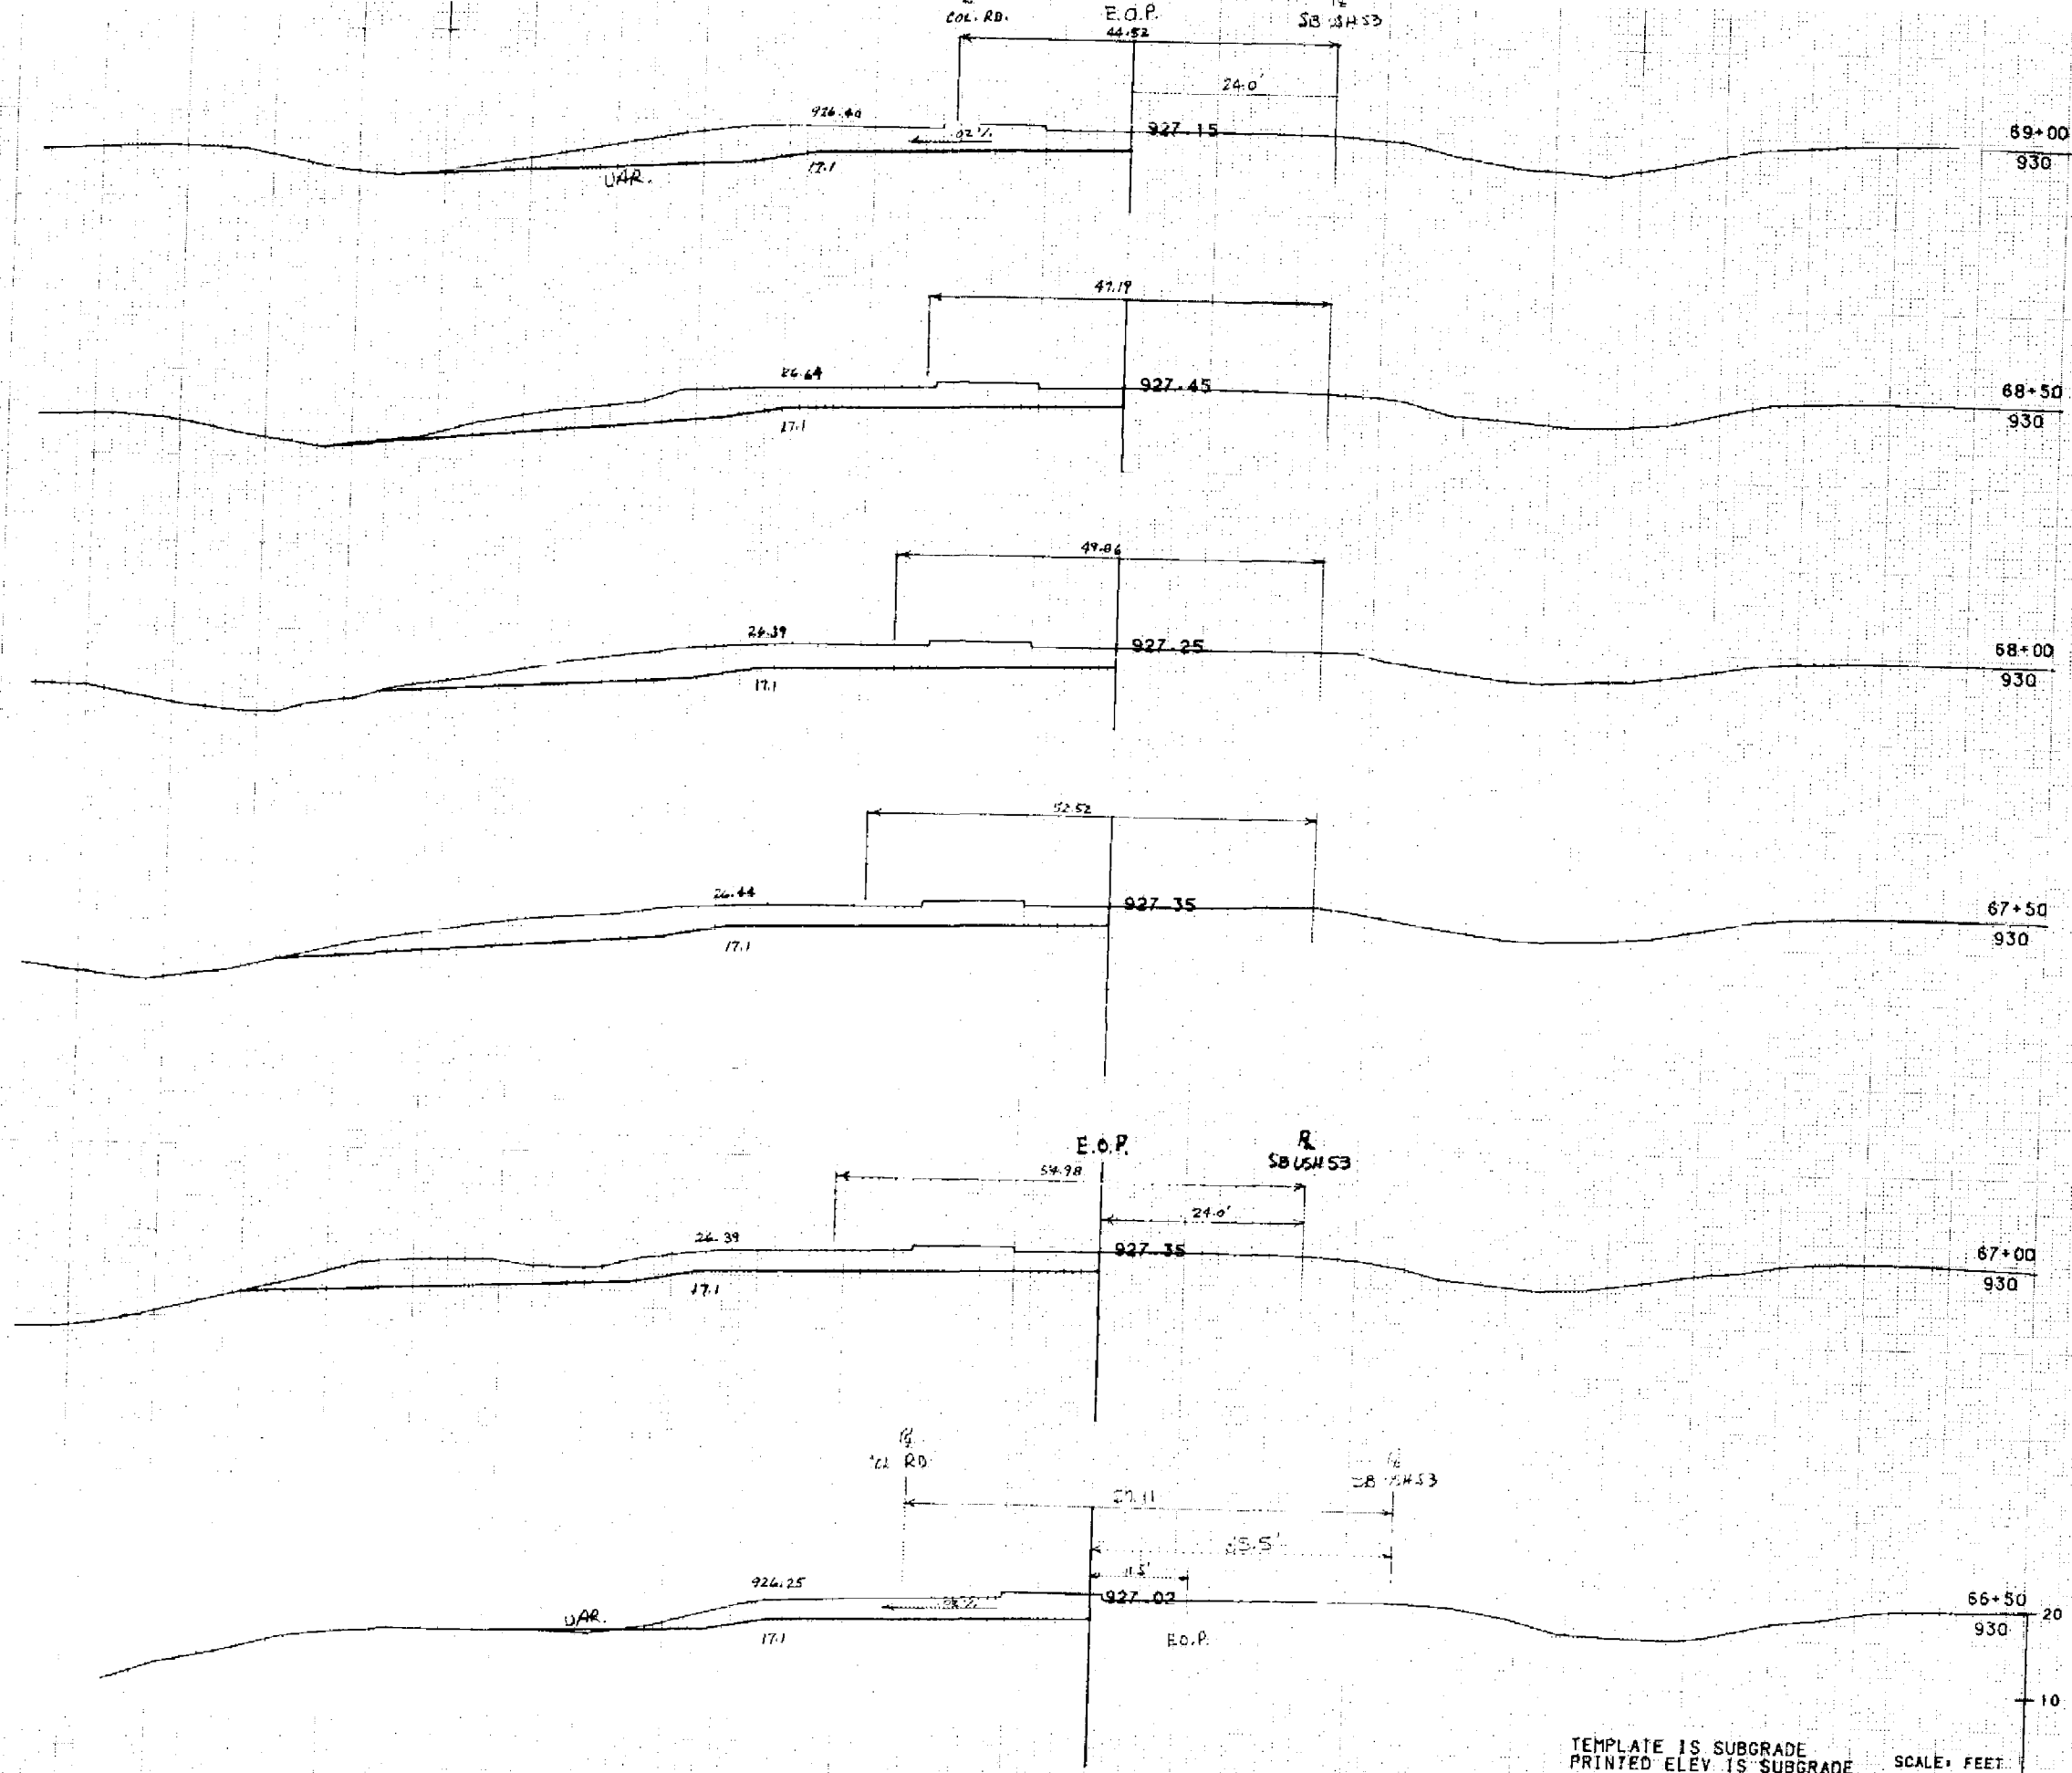


STATE PROJECT NUMBER				SHEET NUMBER	
7255-05-71				98	
STATION	DISTANCE	YARDAGE			FILE
		EXCAVATION			
		UNDER			
66+00	50	231			0
66+50	50	338			
67+00	50	437			
67+50	50	408			
68+00	50	375			
68+50	50	378			0
69+00					
TOTAL		2167			0

TEMPLATE IS SUBGRADE
PRINTED ELEV. IS SUBGRADE

SCALE: FEET

SHEET NO 2 6 7255050013


COLL. RD.

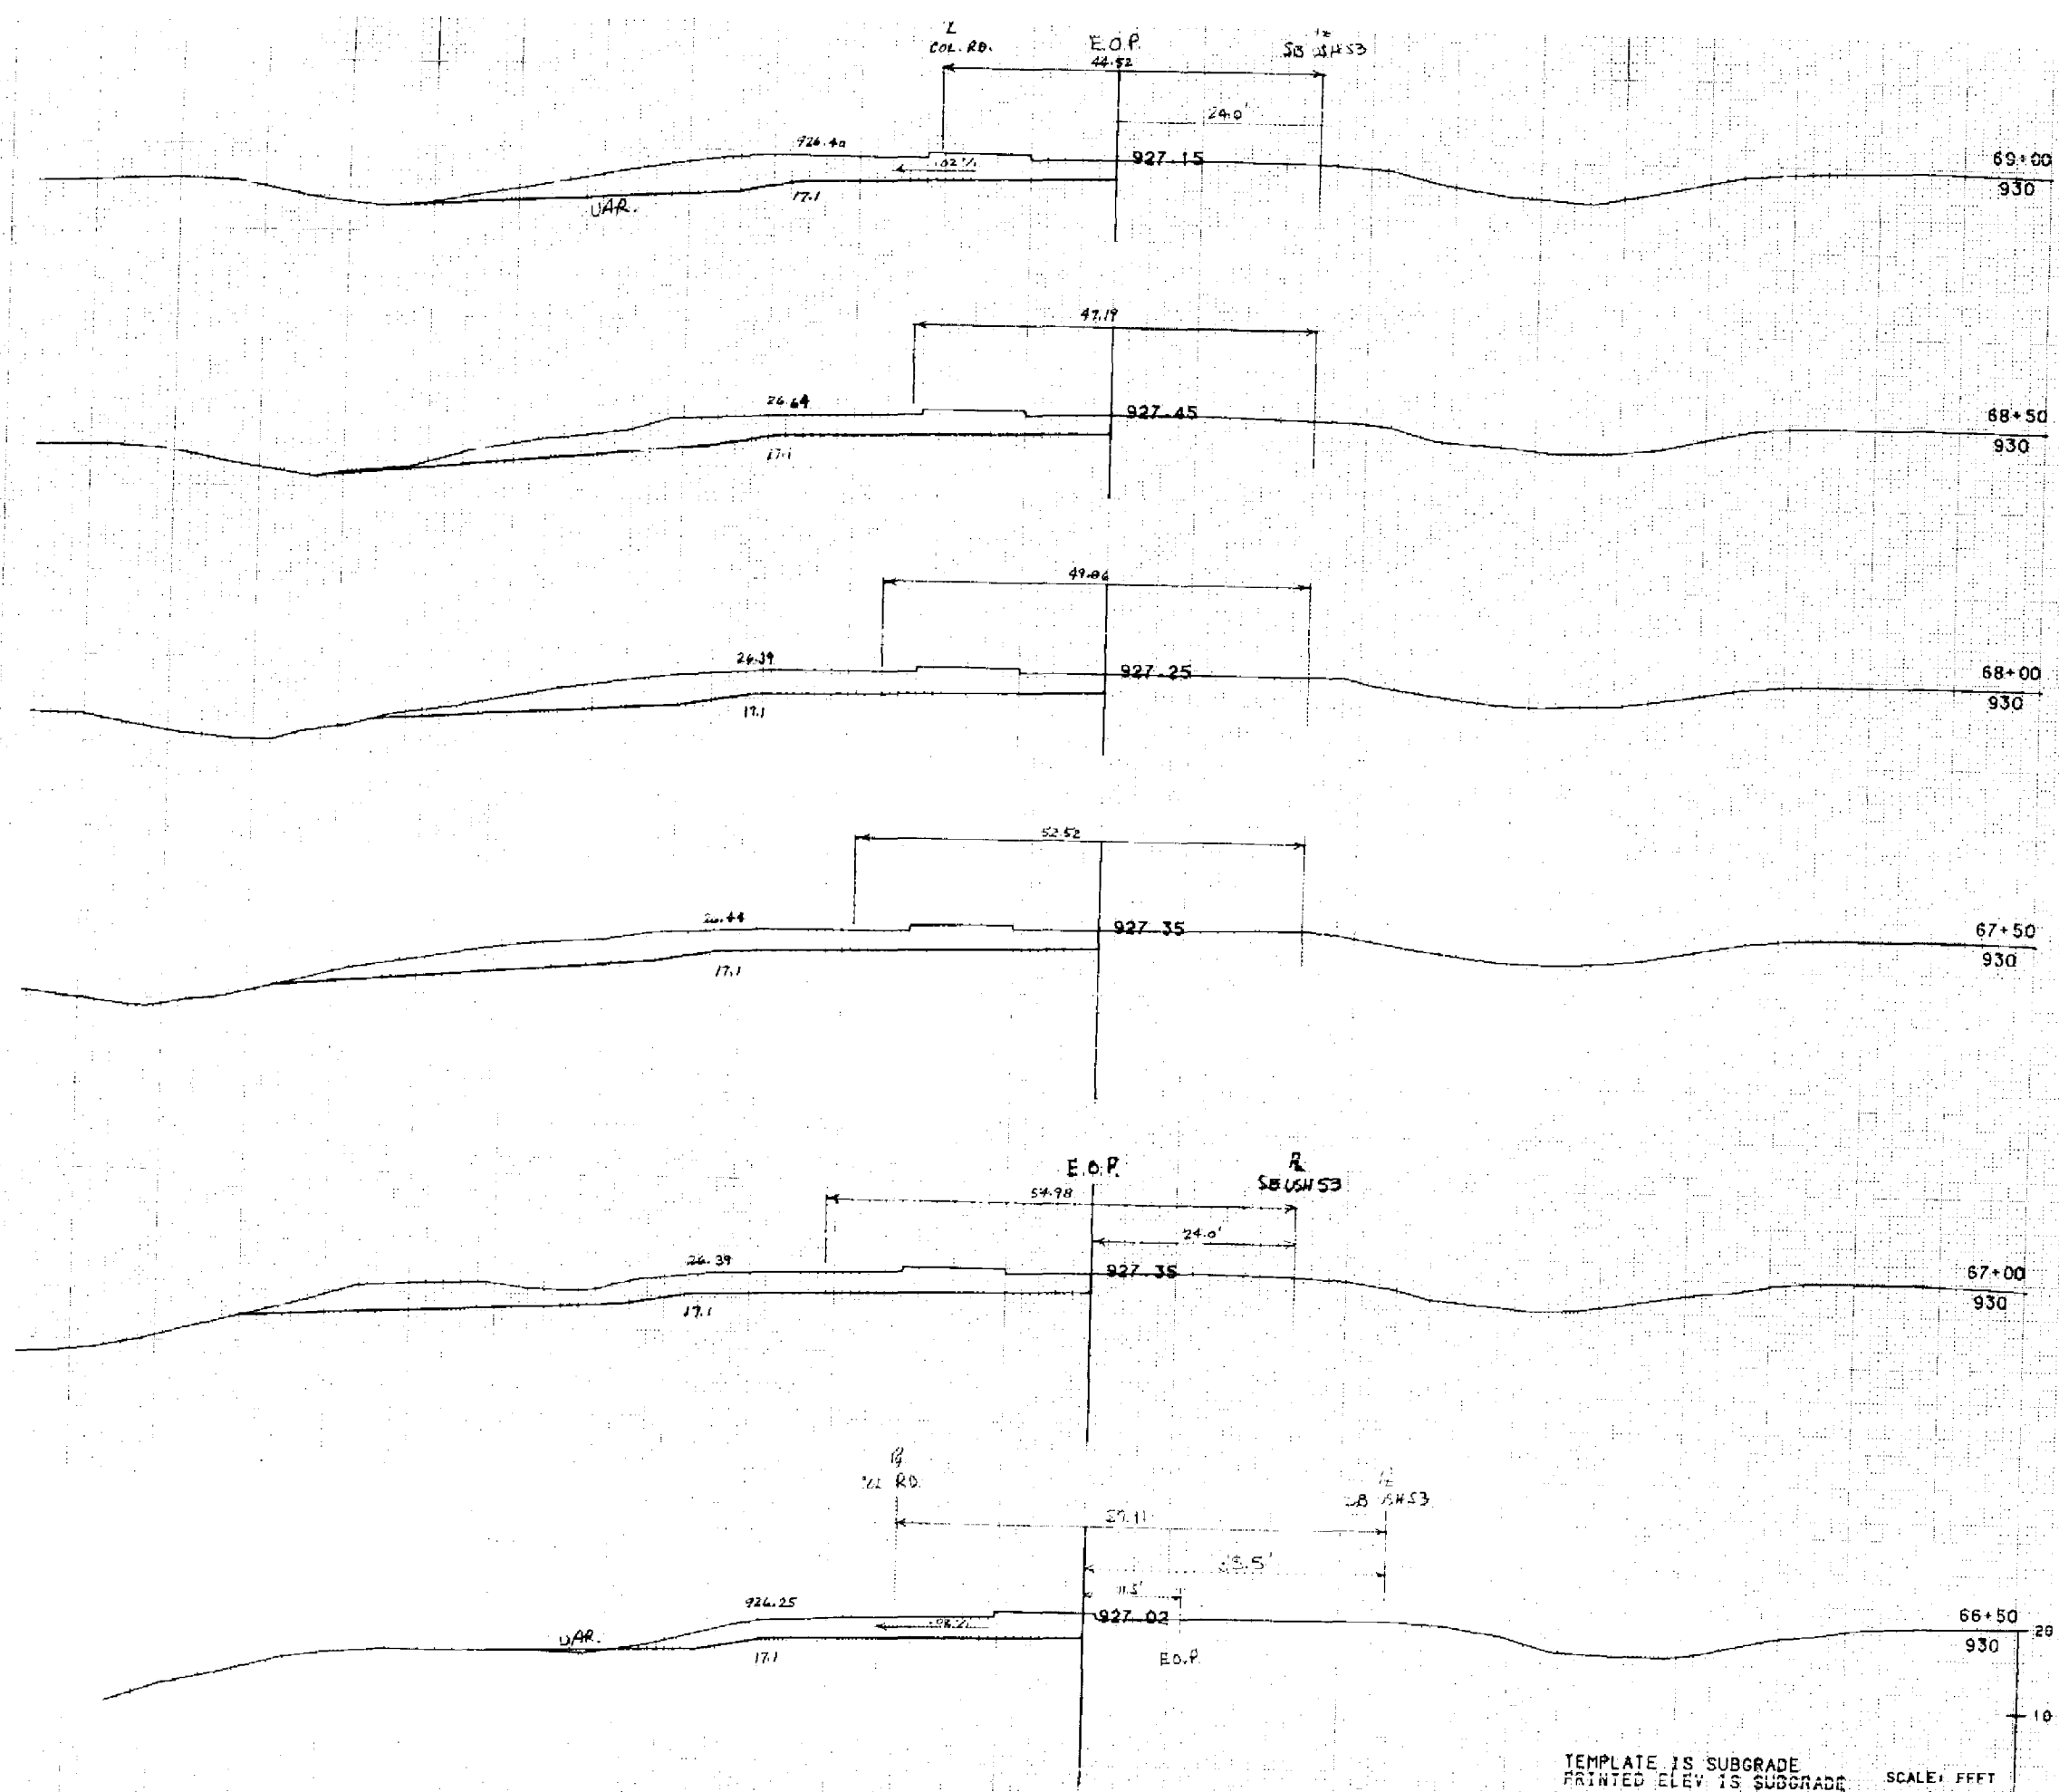

STATE PROJECT NUMBER				SHEET NUMBER
7255-05-71				9.8
STATION	DISTANCE	YARDAGE		
		EXCAVATION		FILL
		UNCL		
66+00	50	231		0
66+50	50	338		
67+00	50	437		
67+50	50	409		
68+00	50	375		
68+50	50	378		0
69+00				
TOTAL		2167		0

TEMPLATE IS SUBGRADE
PRINTED ELEV IS SUBGRADE

SCALE: FEET

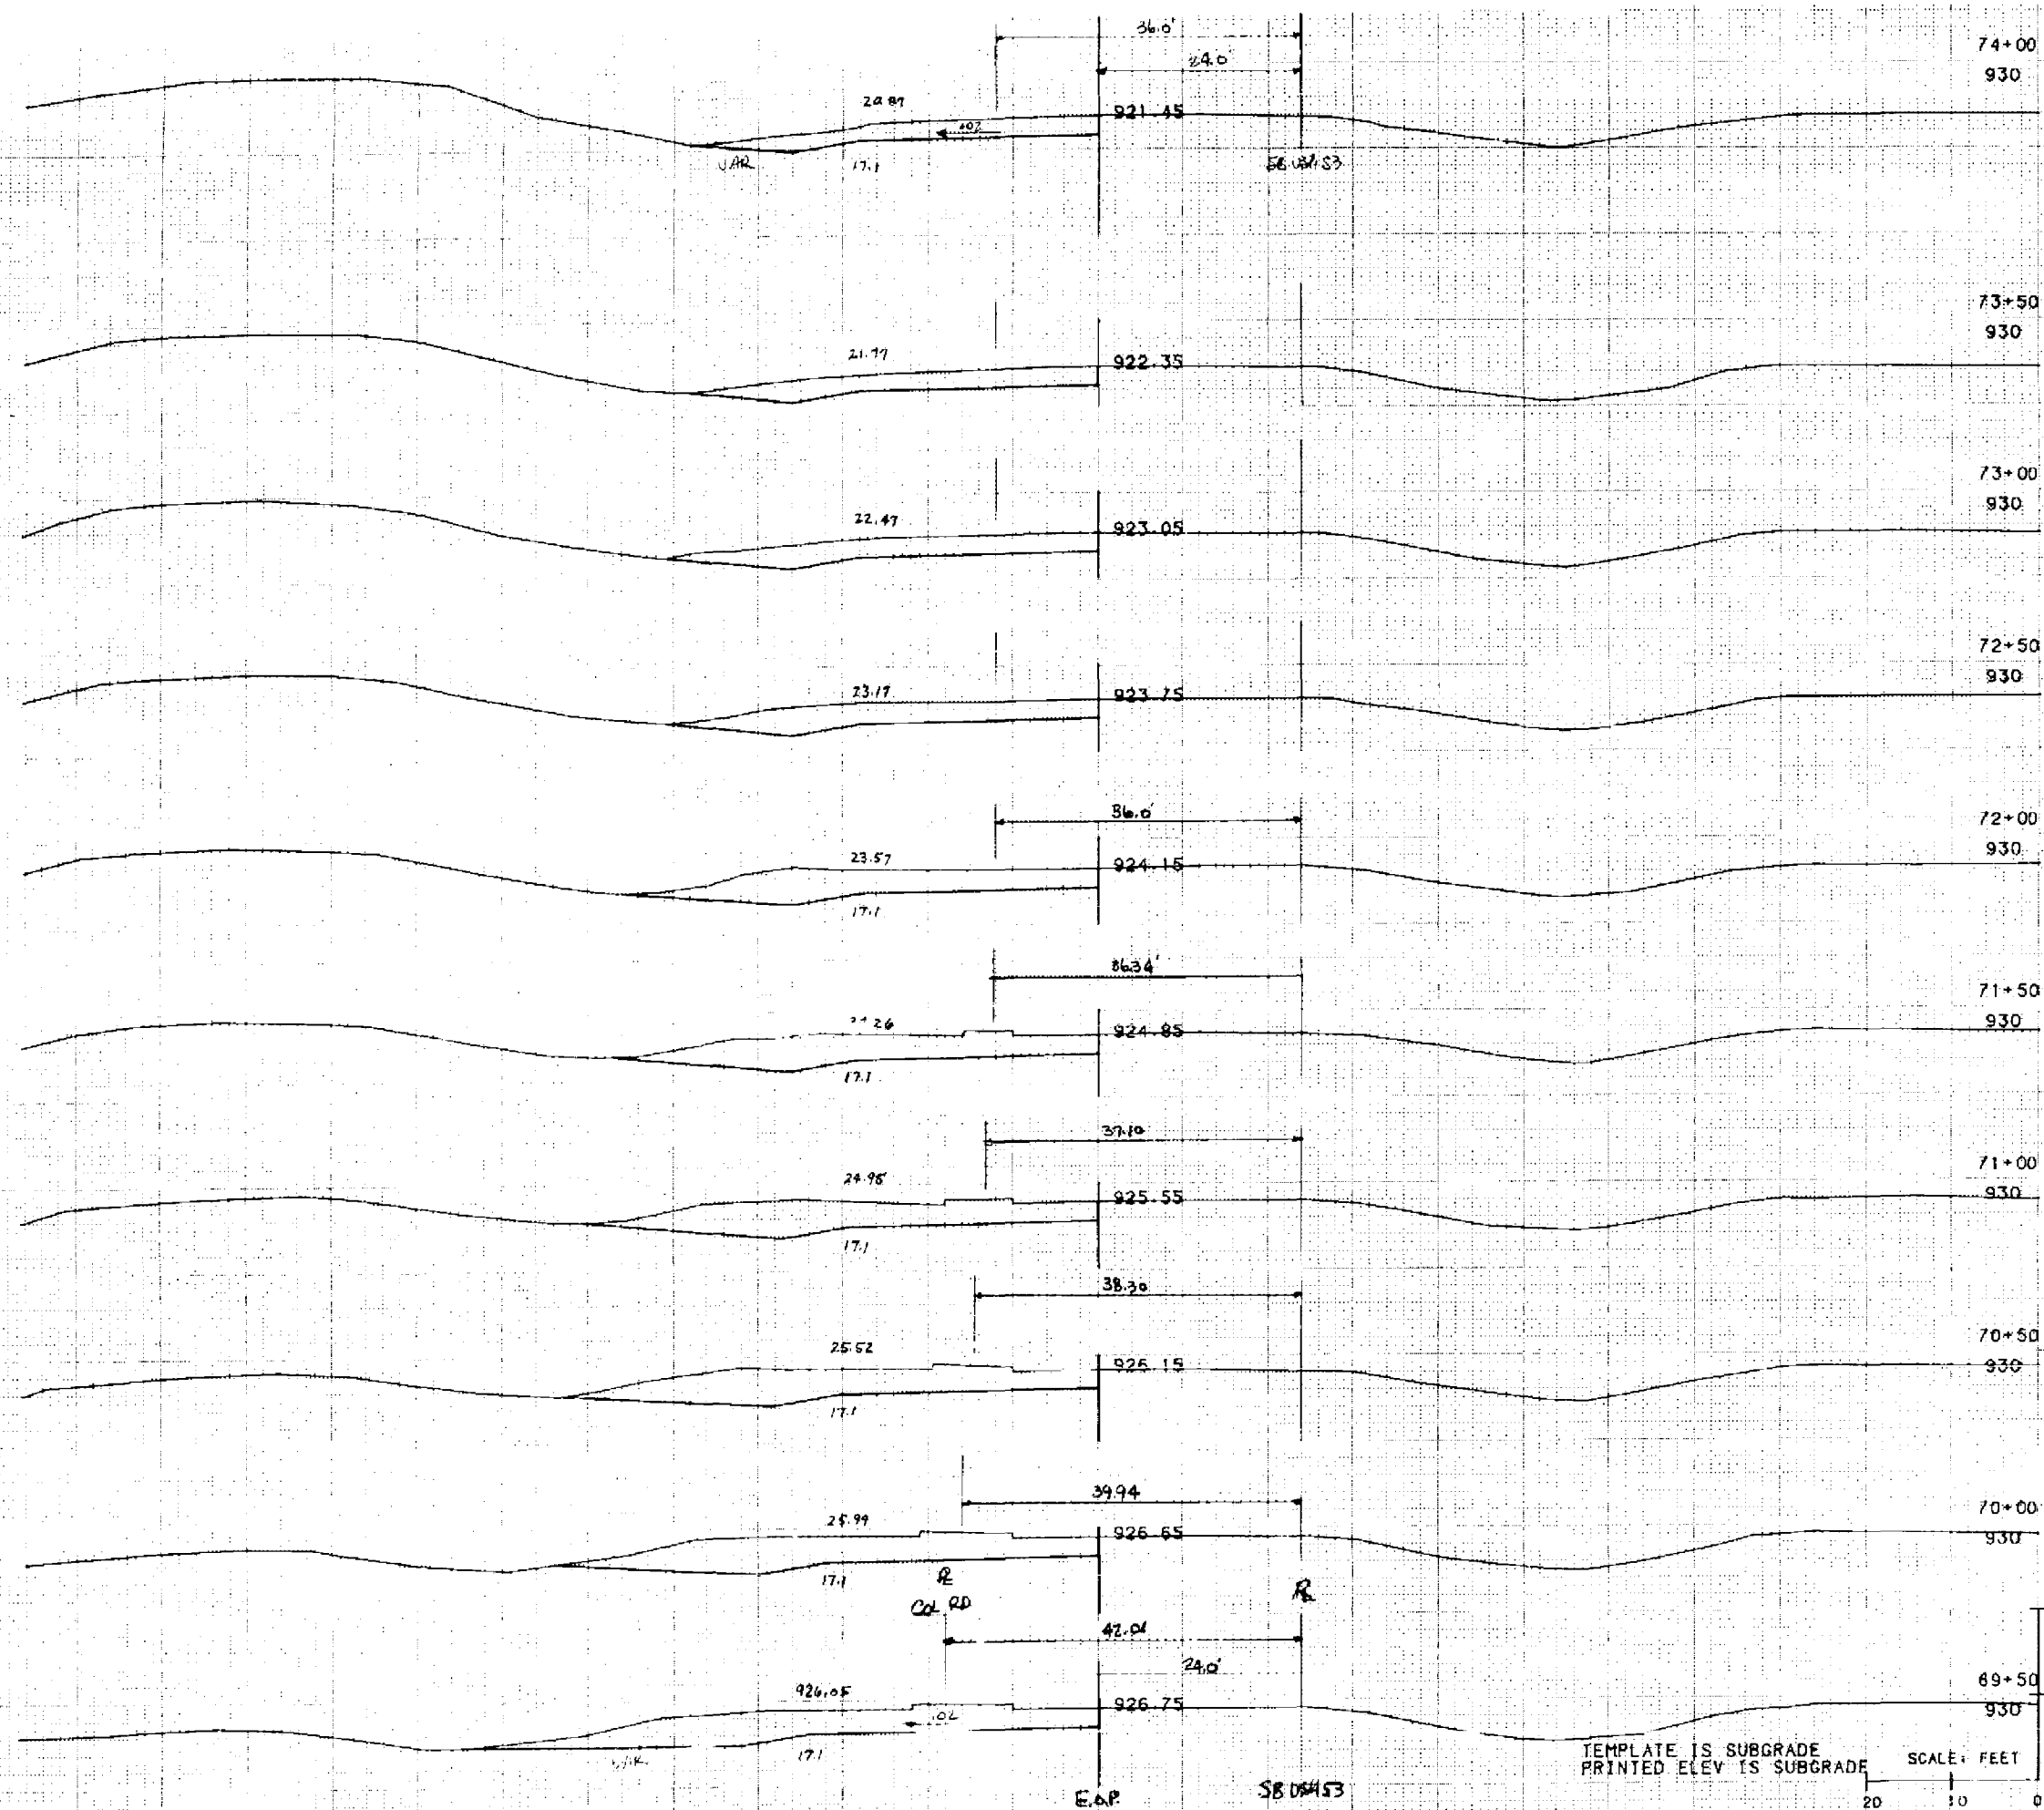

STATE PROJECT NUMBER				SHEET NUMBER	
7255-05-71				99	
STATION	DISTANCE	YARDAGE			FILL
		EXCAVATION			
69+00	UNCL				0
69+50	50	371			0
70+00	50	341			0
	50	327			0
70+50	50	310			0
71+00	50	288			0
71+50	50	264			0
72+00	50	230			0
72+50	50	200			0
73+00	50	182			0
73+50	50	164			0
74+00					
TOTAL		2679			0

TEMPLATE IS SUBGRADE
PRINTED ELEV IS SUBGRADE

SCALE: FEET

STATION	DISTANCE	YARDAGE				FILL
		EXCAVATION				
		W/C				
74+00	50	151				0
74+50	50	137				0
75+00	50	139				0
75+50	50	143				0
76+00	50	139				0
76+50	50	127				0
77+00	50	128				0
77+50						
	TOTAL	964				0




TEMPLATE IS SUBGRADE
PRINTED ELEV IS SUBGRADE

SHEET NO 4 6 7255050013

SCALE: FEET

20 10 0

Coll. RD.

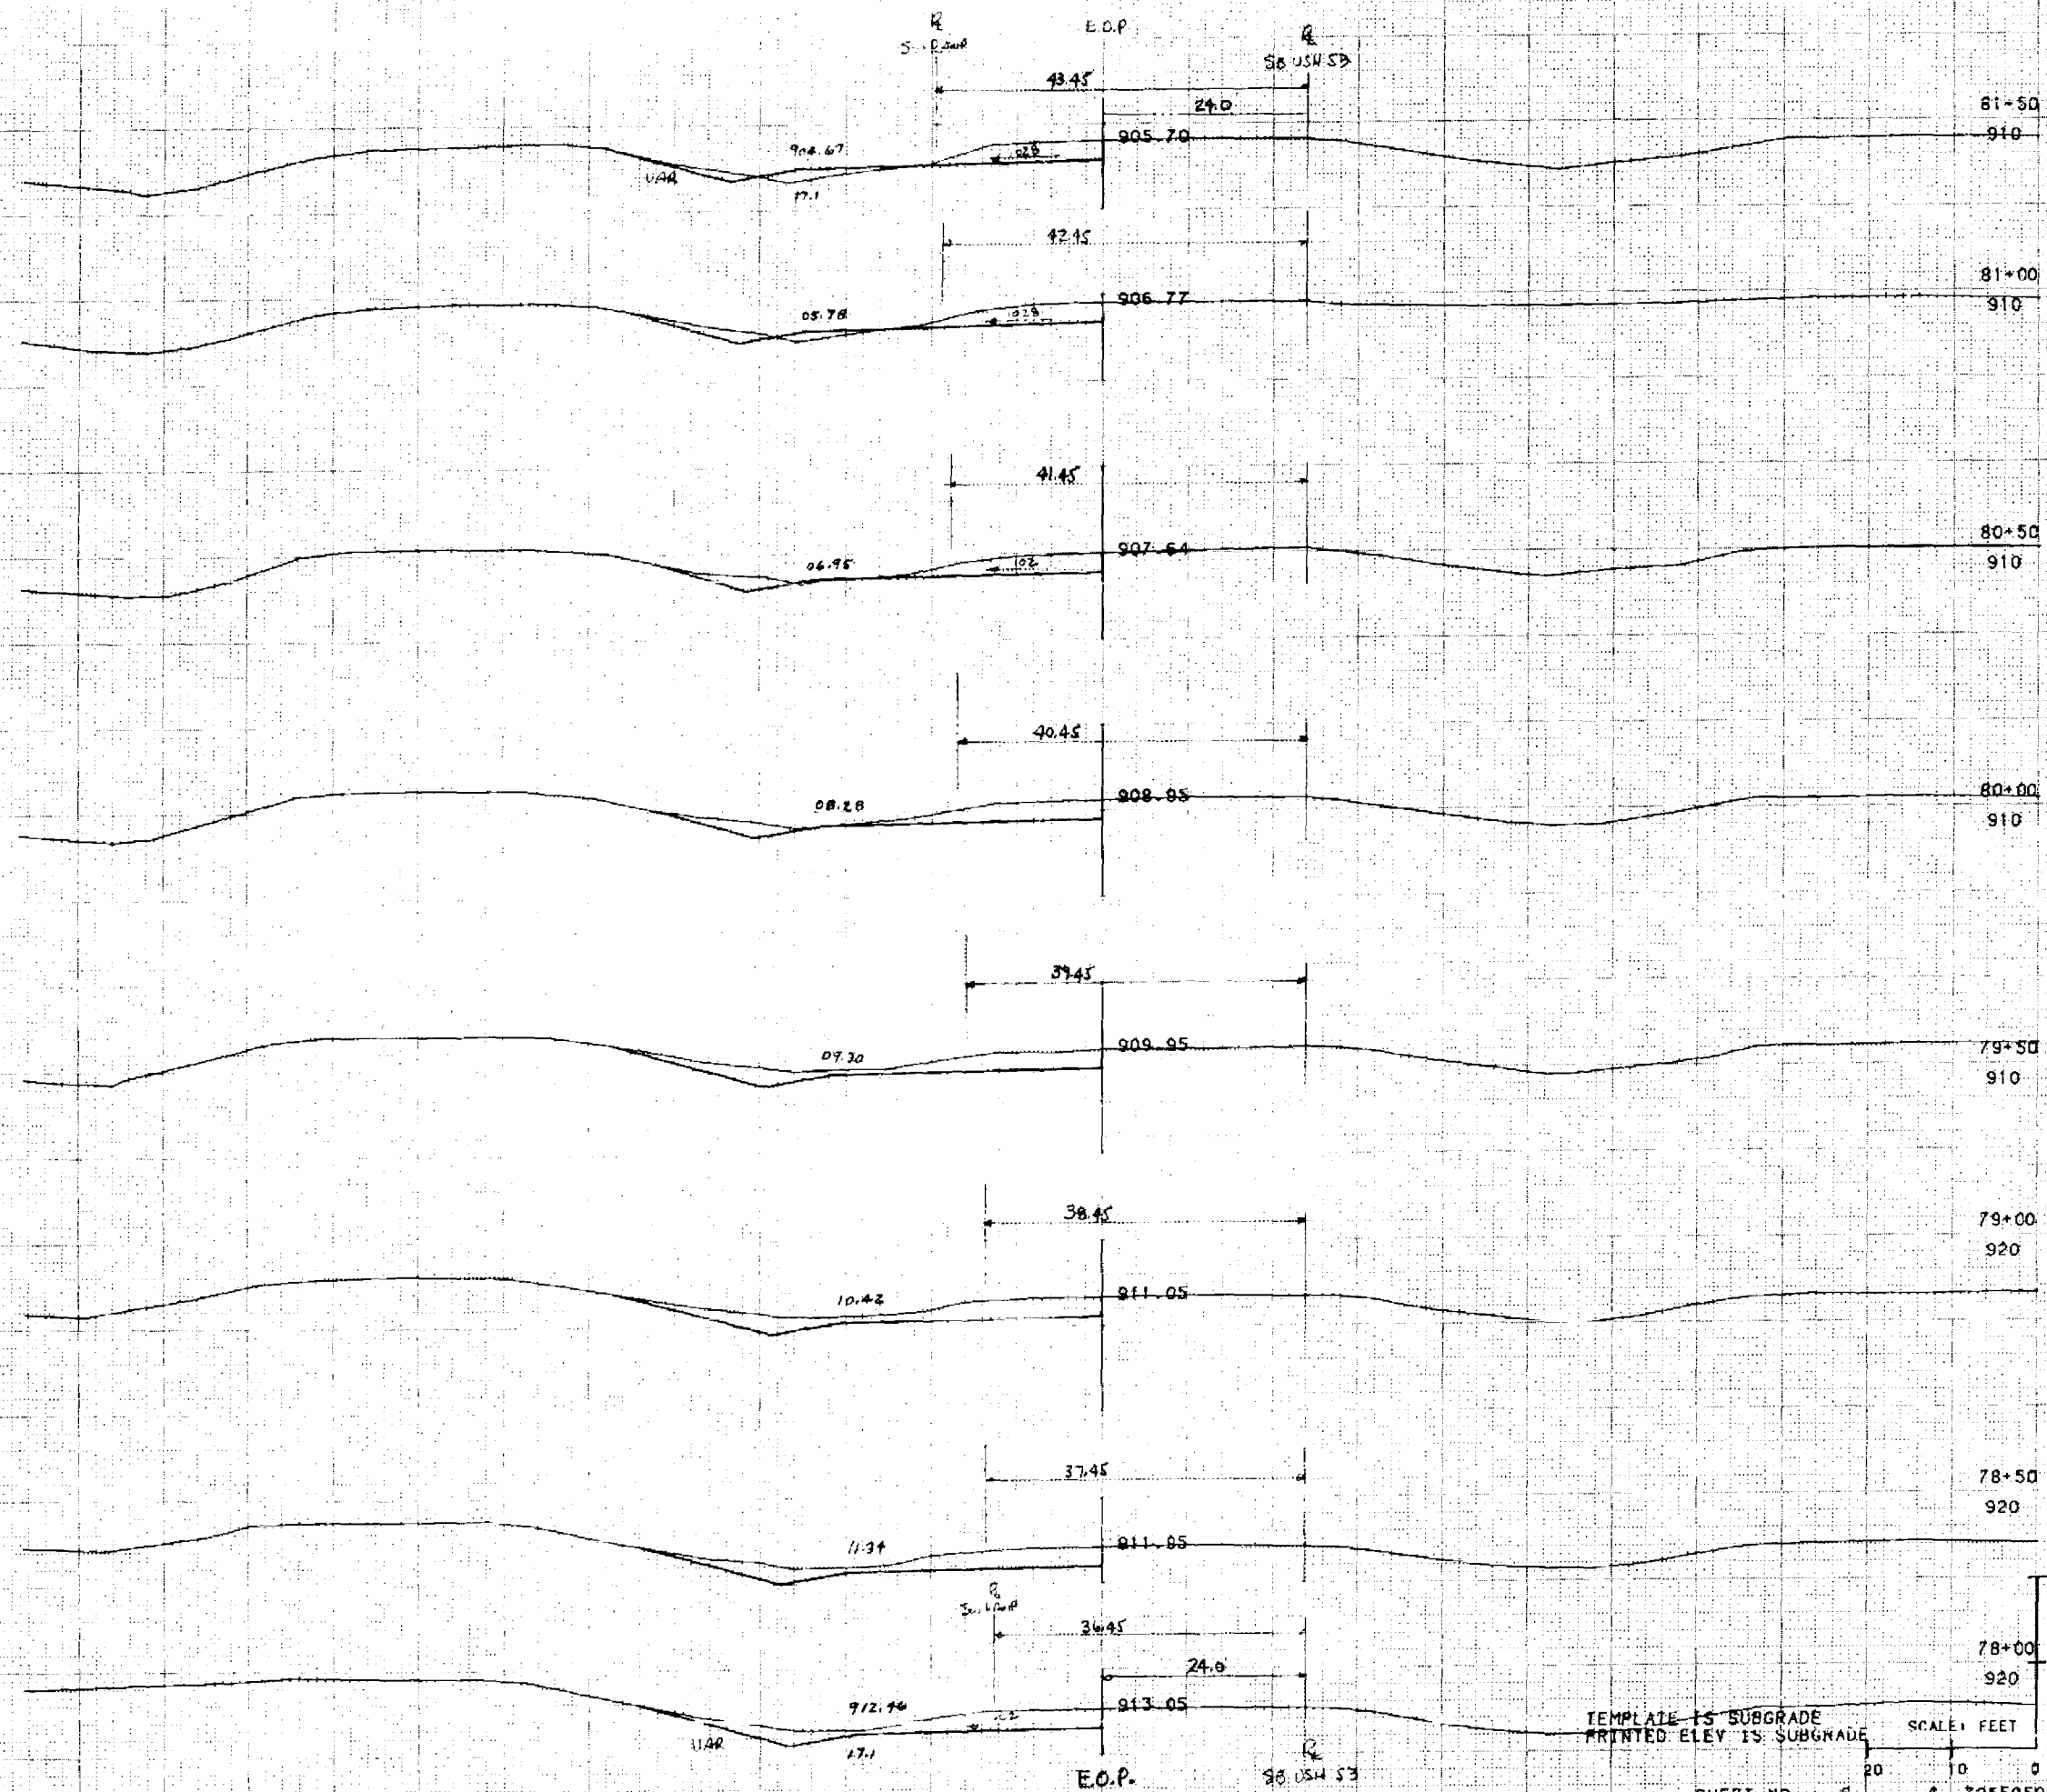


STATE PROJECT NUMBER		SHEET NUMBER		
7255-05-71		9.11		
STATION	DISTANCE	YARDAGE		
		EXCAVATION		FILL
		DITCH		
77+50	50	142		0
78+00	50	144		0
78+50	50	151		0
79+00	50	148		0
79+50	50	127		0
80+00	50	107		1
80+50	50	99		2
81+00	50	92		18
81+50				
TOTAL		1010		20

TEMPLATE IS SUBGRADE
PRINTED ELEV IS SUBGRADE
SCALE: FEET
SHEET NO 5 6 7255050013

STATE PROJECT NUMBER	SHEET NUMBER
7255-05-71	9.12


STATION	DISTANCE	YARDAGE					
		EXCAVATION					FILL
		DIGL					
B1+50	50	246					28
B2+700	50	390					34
B2+50	50	348					35
B3+700	50	293					44
B3+50							
TOTAL		1277					141

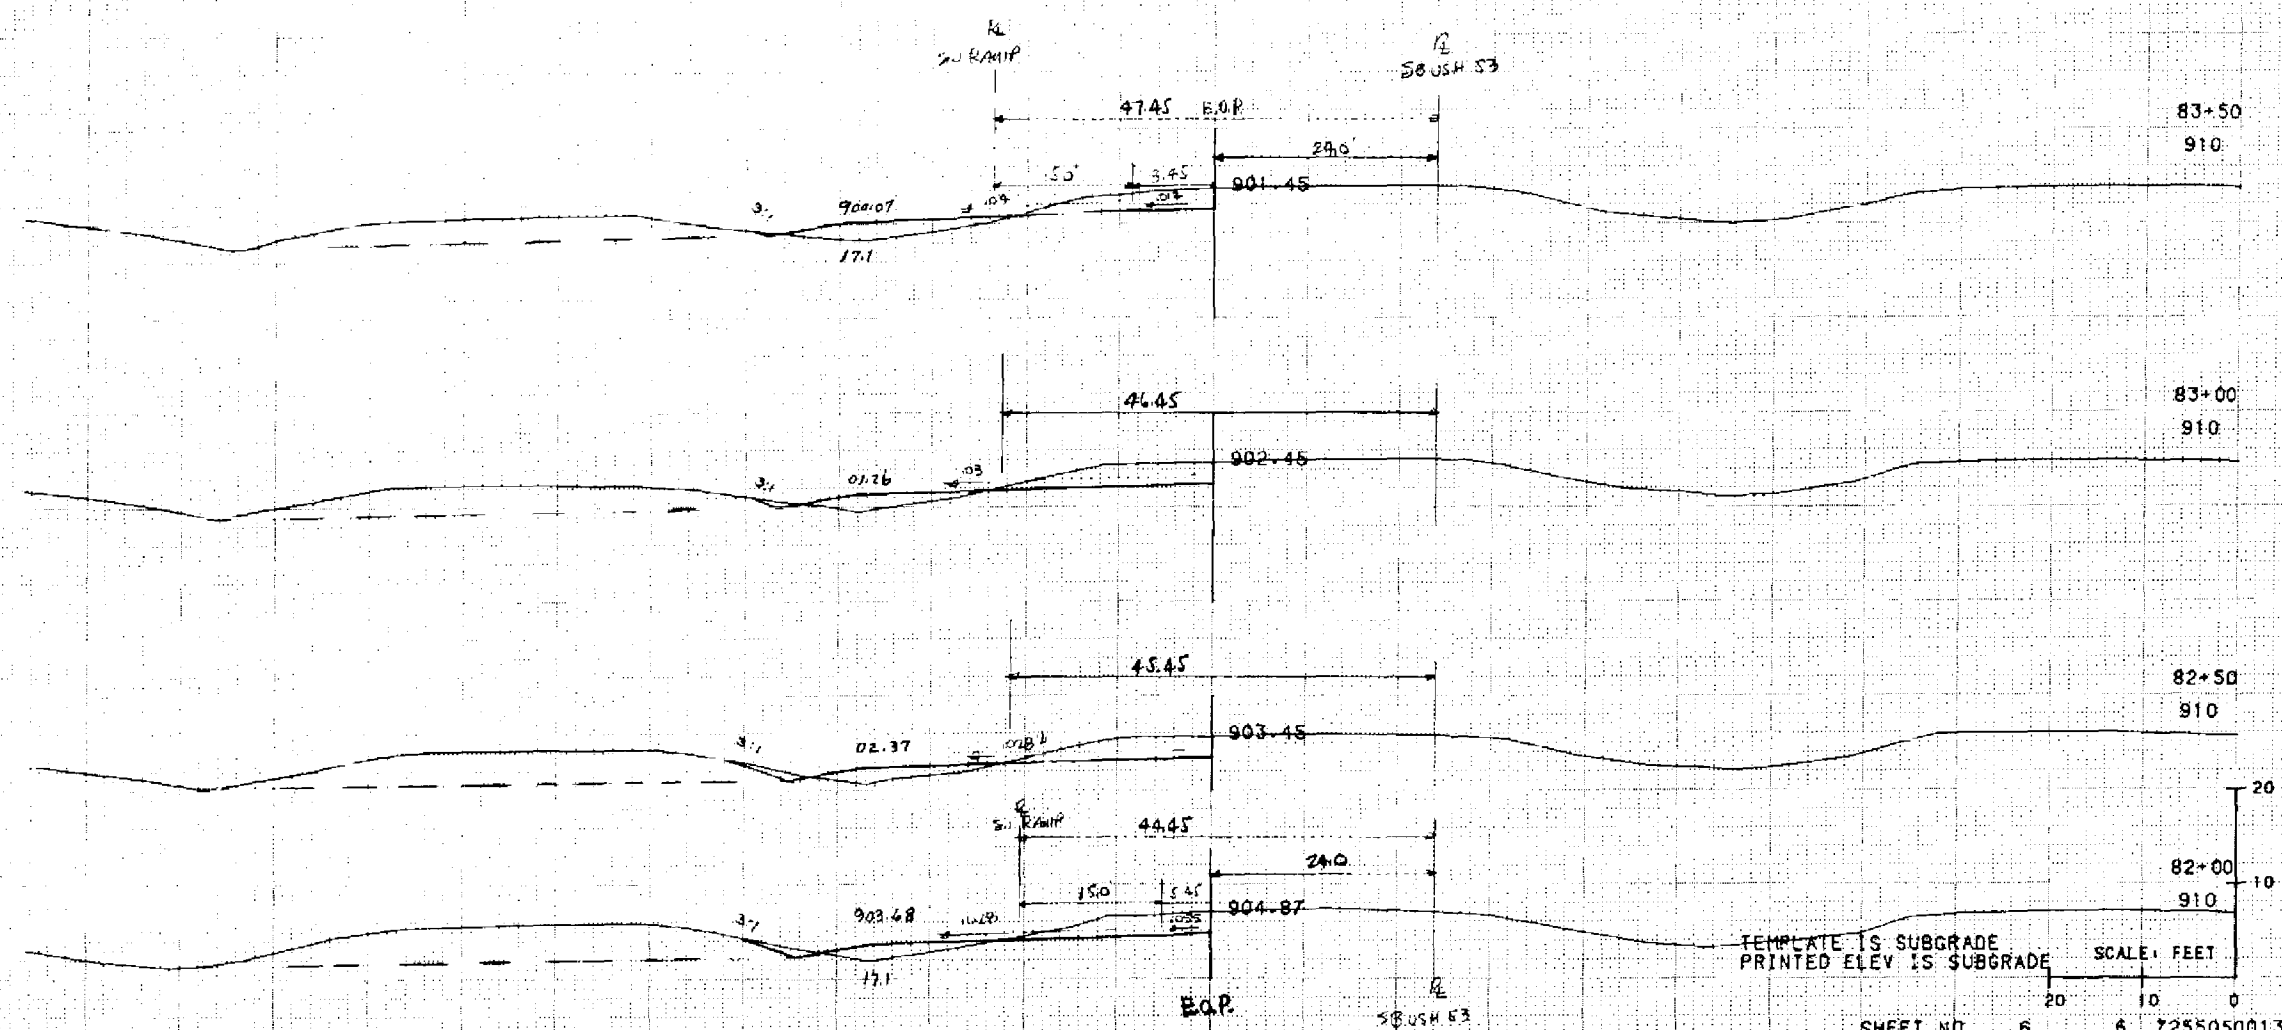

SUB RAMP

STATE PROJECT NUMBER	SHEET NUMBER
7255-05-71	9.13

STATION	DISTANCE	YARDAGE			
		EXCAVATION			FILL
83+50	27	141			30
83+77	23	115			28
84+00	50	248			87
84+50	50	227			118
85+00	20	99			81
85+28	22	52			78
85+50	28	40			94
85+73	27	38			133
86+00	TOTAL	957			651

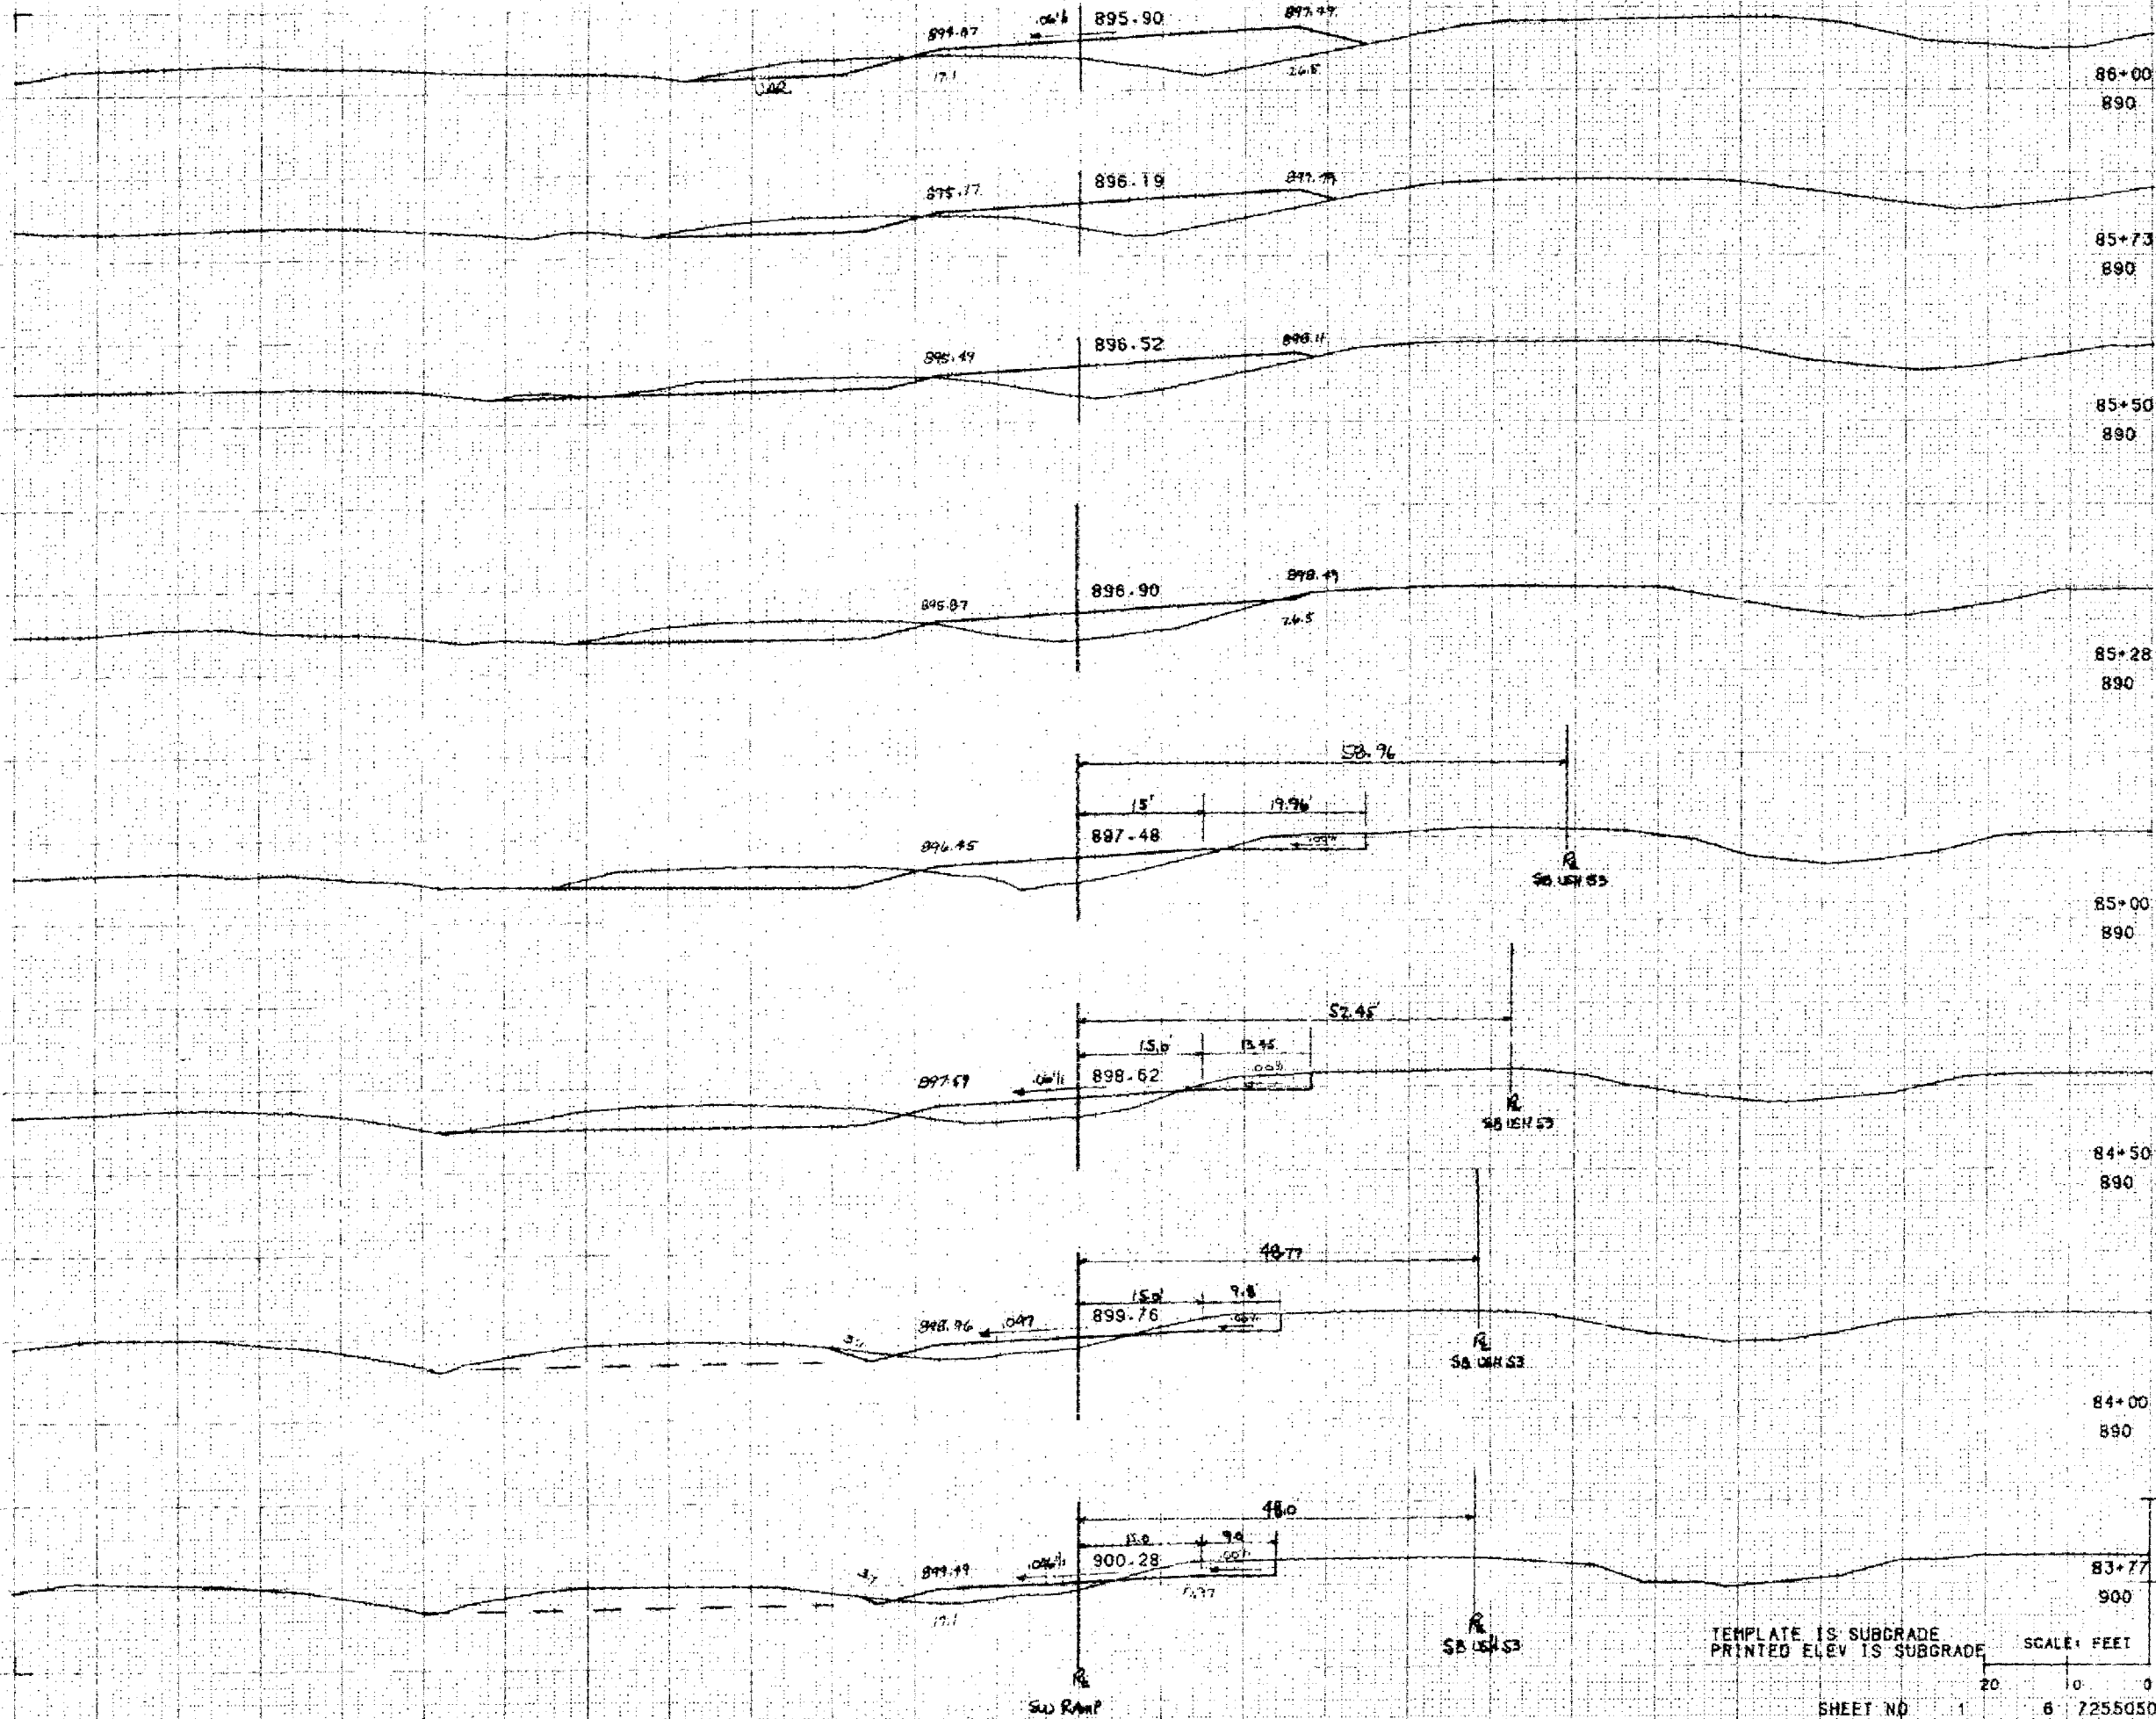


TEMPLATE IS SUBGRADE
PRINTED ELEV IS SUBGRADE

SCALE: FEET

SUB RAMP

STATE PROJECT NUMBER	SHEET NUMBER
7255-05-71	914

STATION	DISTANCE	YARDAGE			
		EXCAVATION			FILL
86+00	50	30			339
86+50	50	0			507
87+00	50	0			696
87+50	50	70			730
88+00	50	31			1257
88+50	50	53			1717
89+00					
TOTAL	124				5246

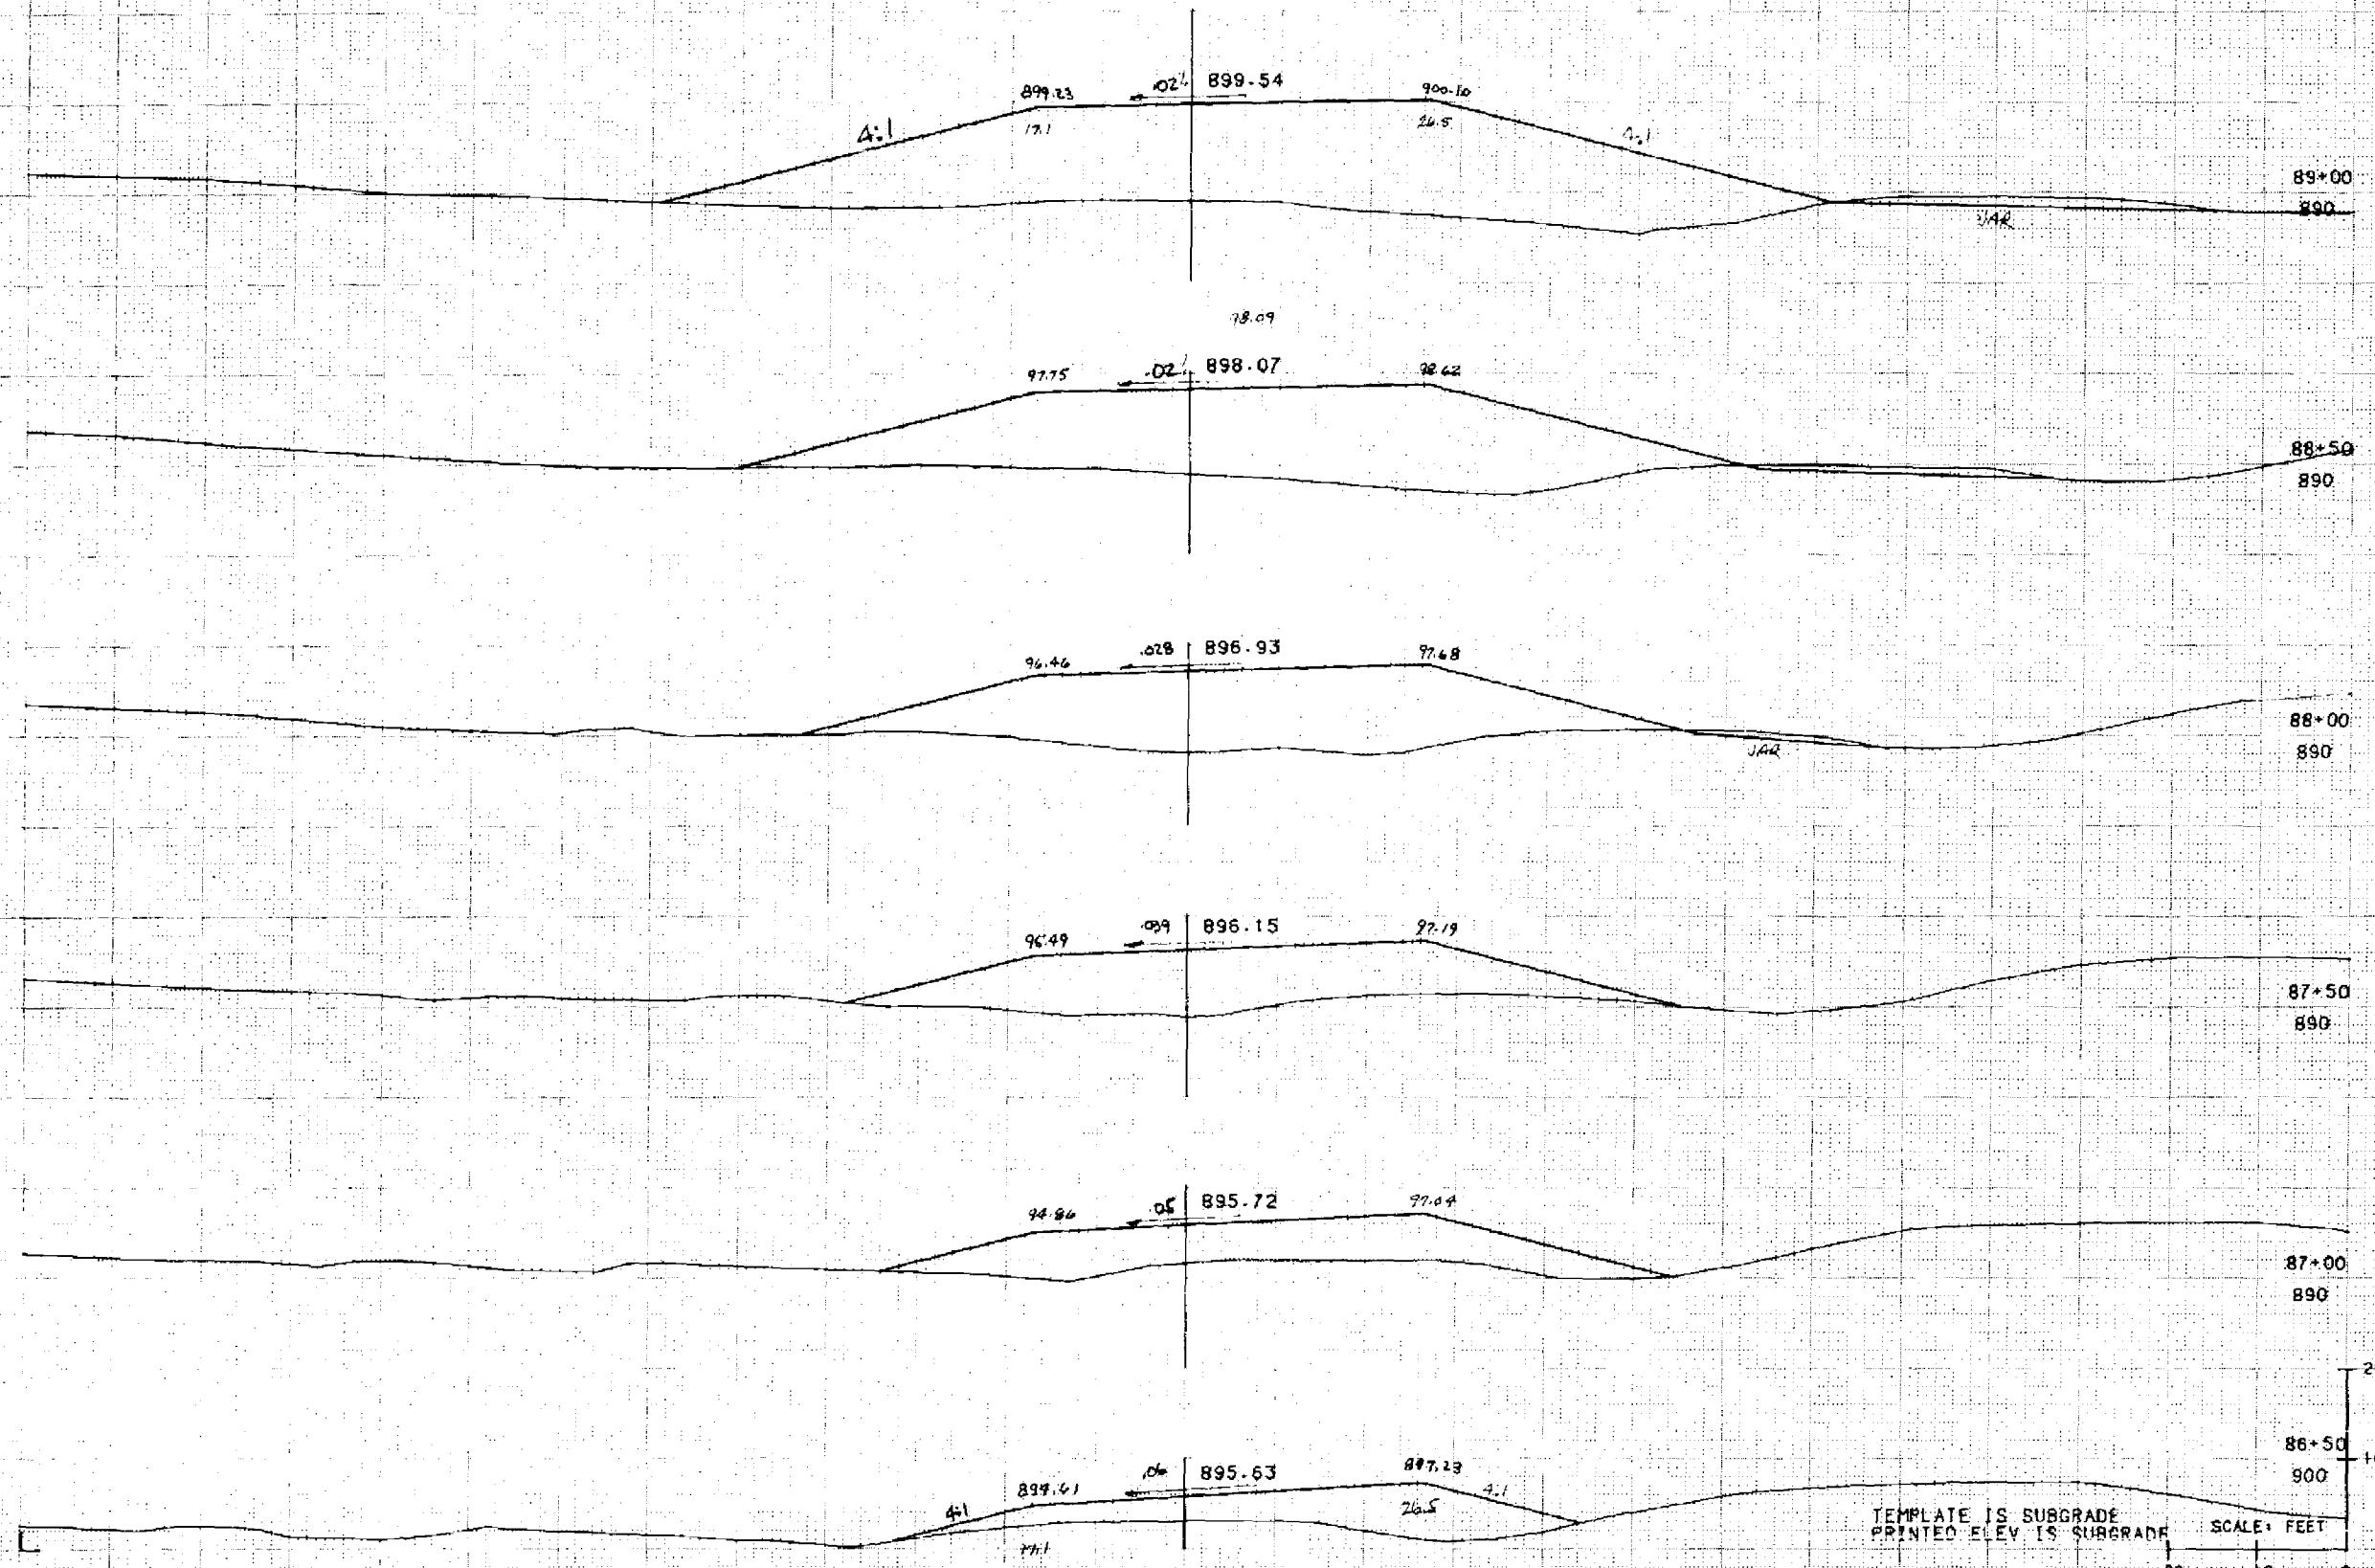

TEMPLATE IS SUBGRADE
PRINTED ELEV IS SURGRADE
SCALE: FEET
SHEET NO. 2 6 7255050013

SURF


END

'B' LINE


[illegible]

STATE PROJECT NUMBER	SHEET NUMBER
7255-05-71	9.18

STATION	DISTANCE	YARDAGE		
		EXCAVATION		FILL
		UNCL		
93+50				
93+75	25	0		1487
94+00	25			1193
94+30	30			1084
94+50	20			884
94+50	50	0		1019
95+00	50	55		520
95+50	50	157		283
96+00				
TOTAL		212		6120

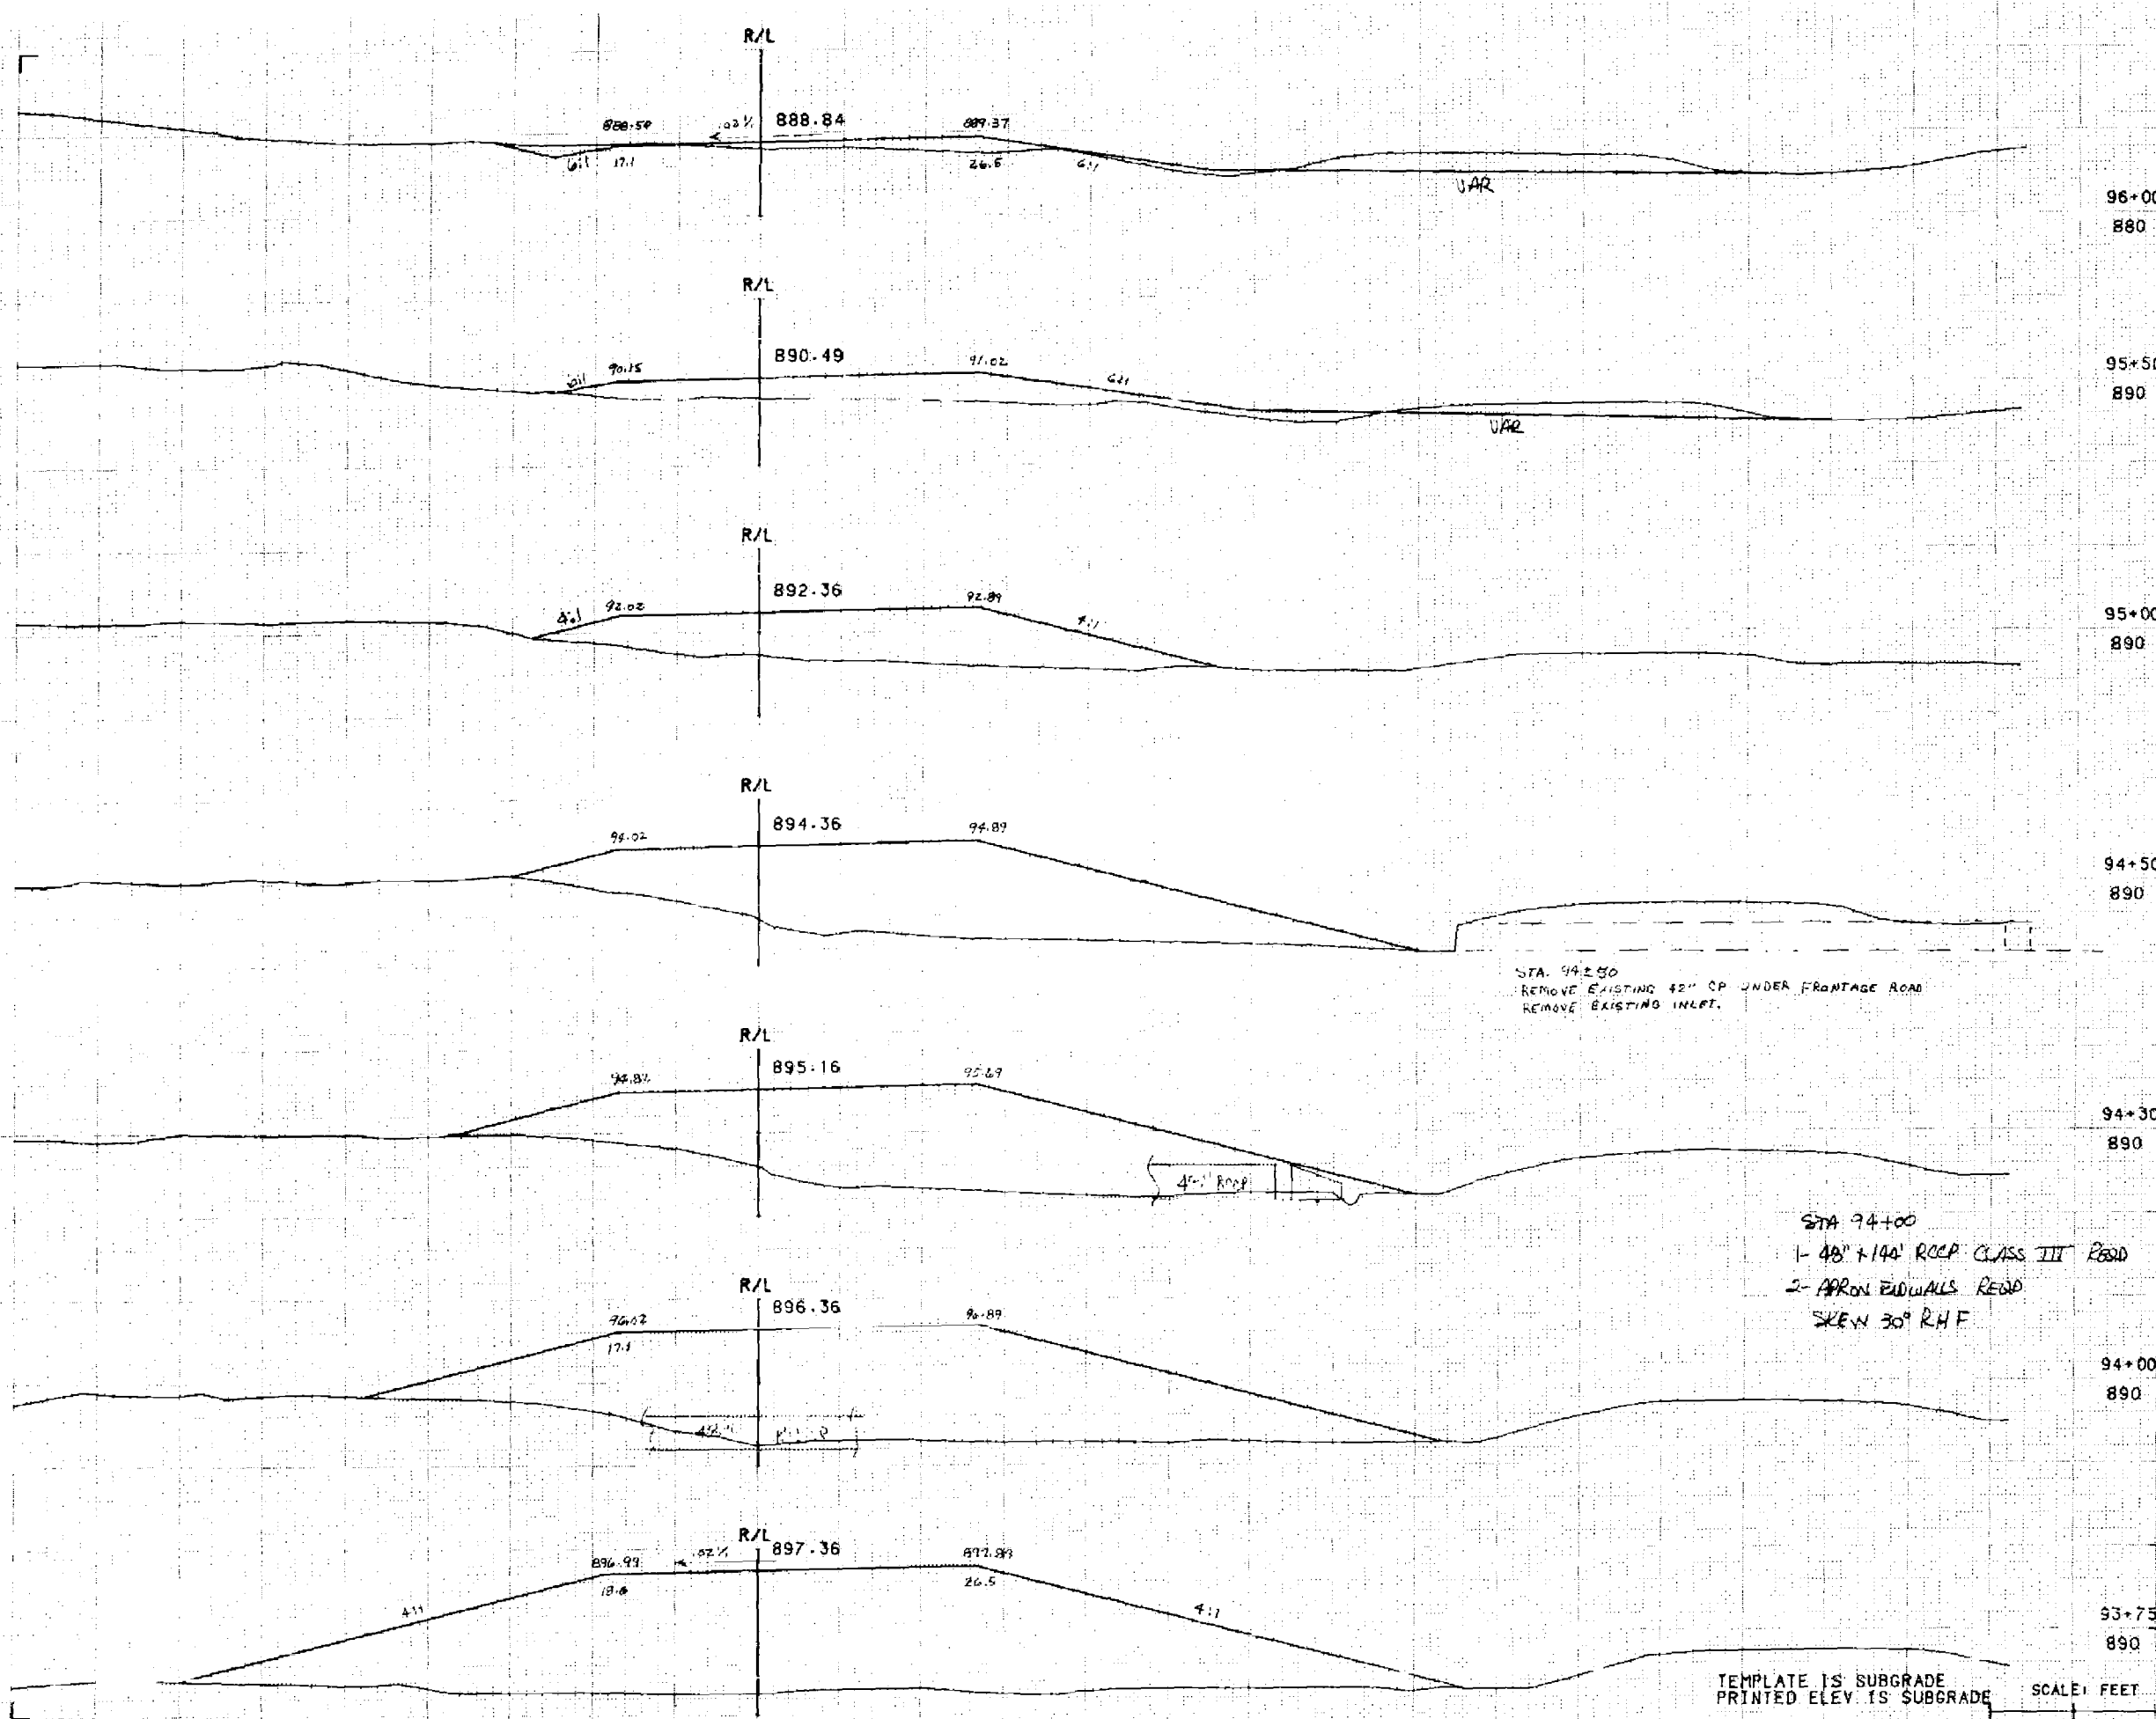


TEMPLATE IS SUBGRADE
PRINTED ELEV IS SUBGRADE

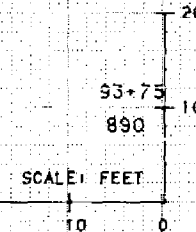


SHEET NO 2 6 7255050013

NW RAMP

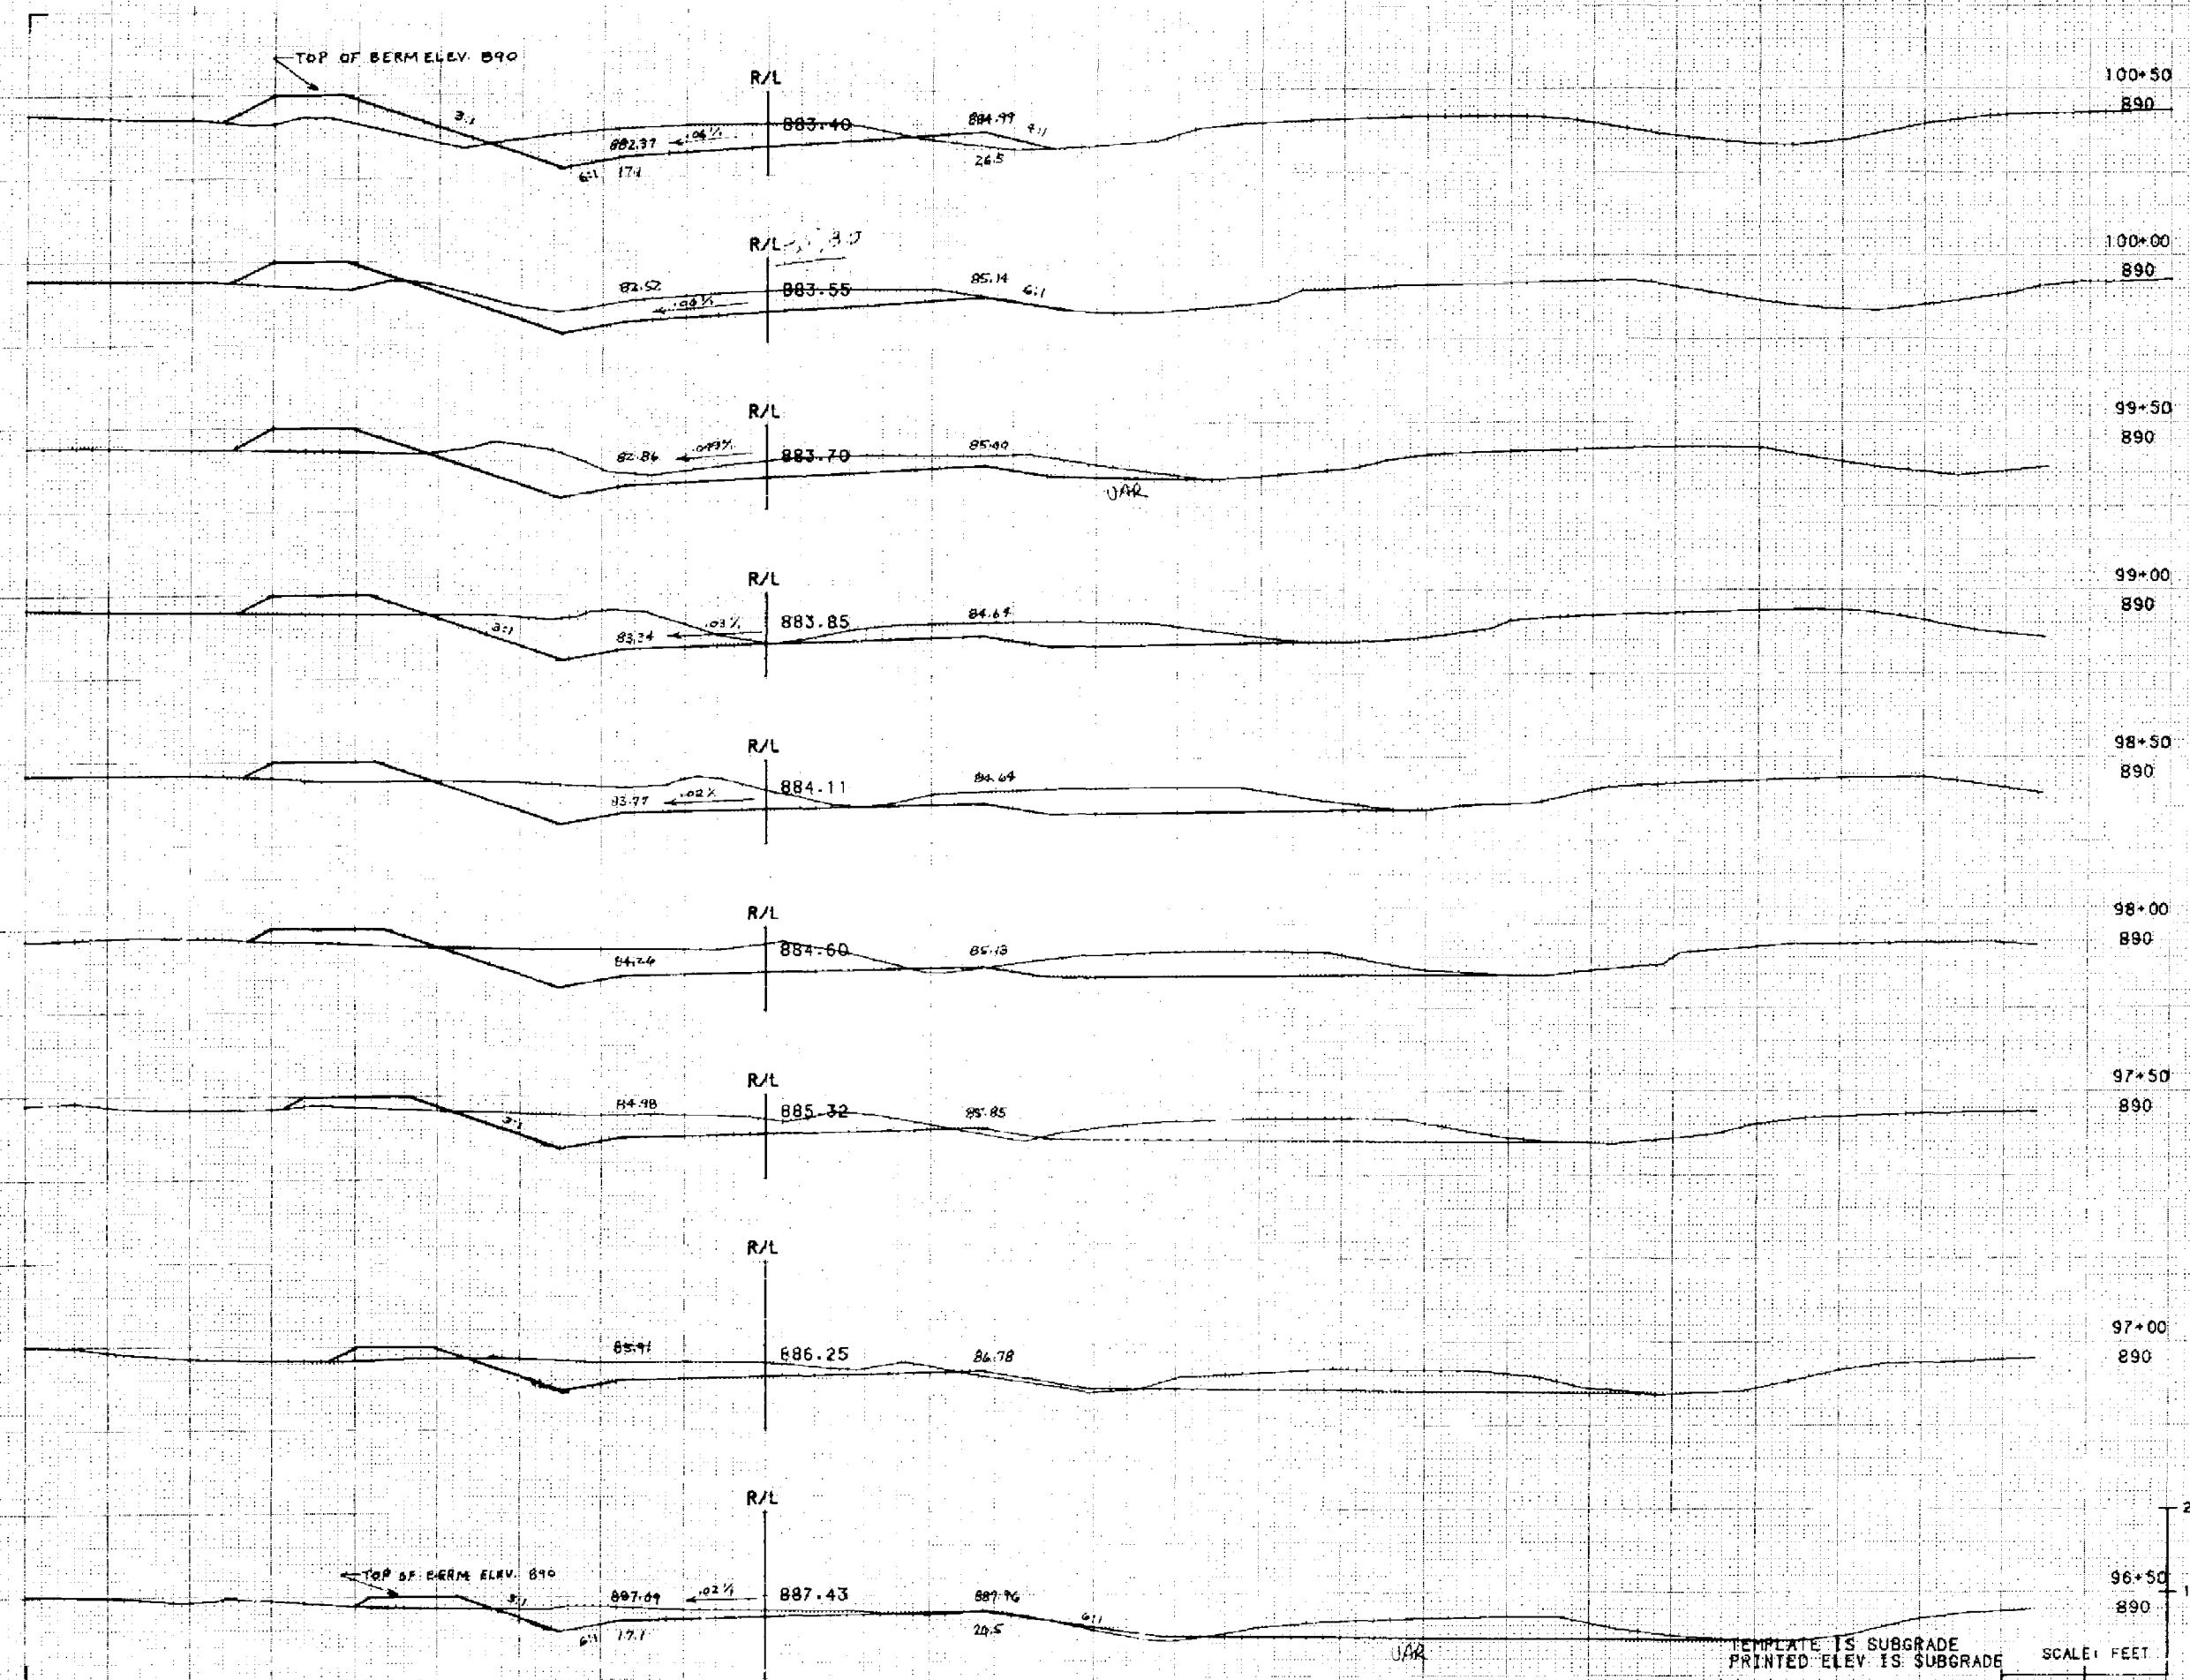

STATION	D. STANCE	YARDAGE				FILL
		EXCAVATION				
		UNCL				
96+00	50	260			60	
96+50	50	363			15	
97+00	50	443			13	
97+50	50	508			9	
98+00	50	532			4	
98+50	50	494			0	
99+00	50	424			0	
99+50	50	347			0	
100+00	50	287			15	
100+50	TOTAL	3658			116	

NW RAMP

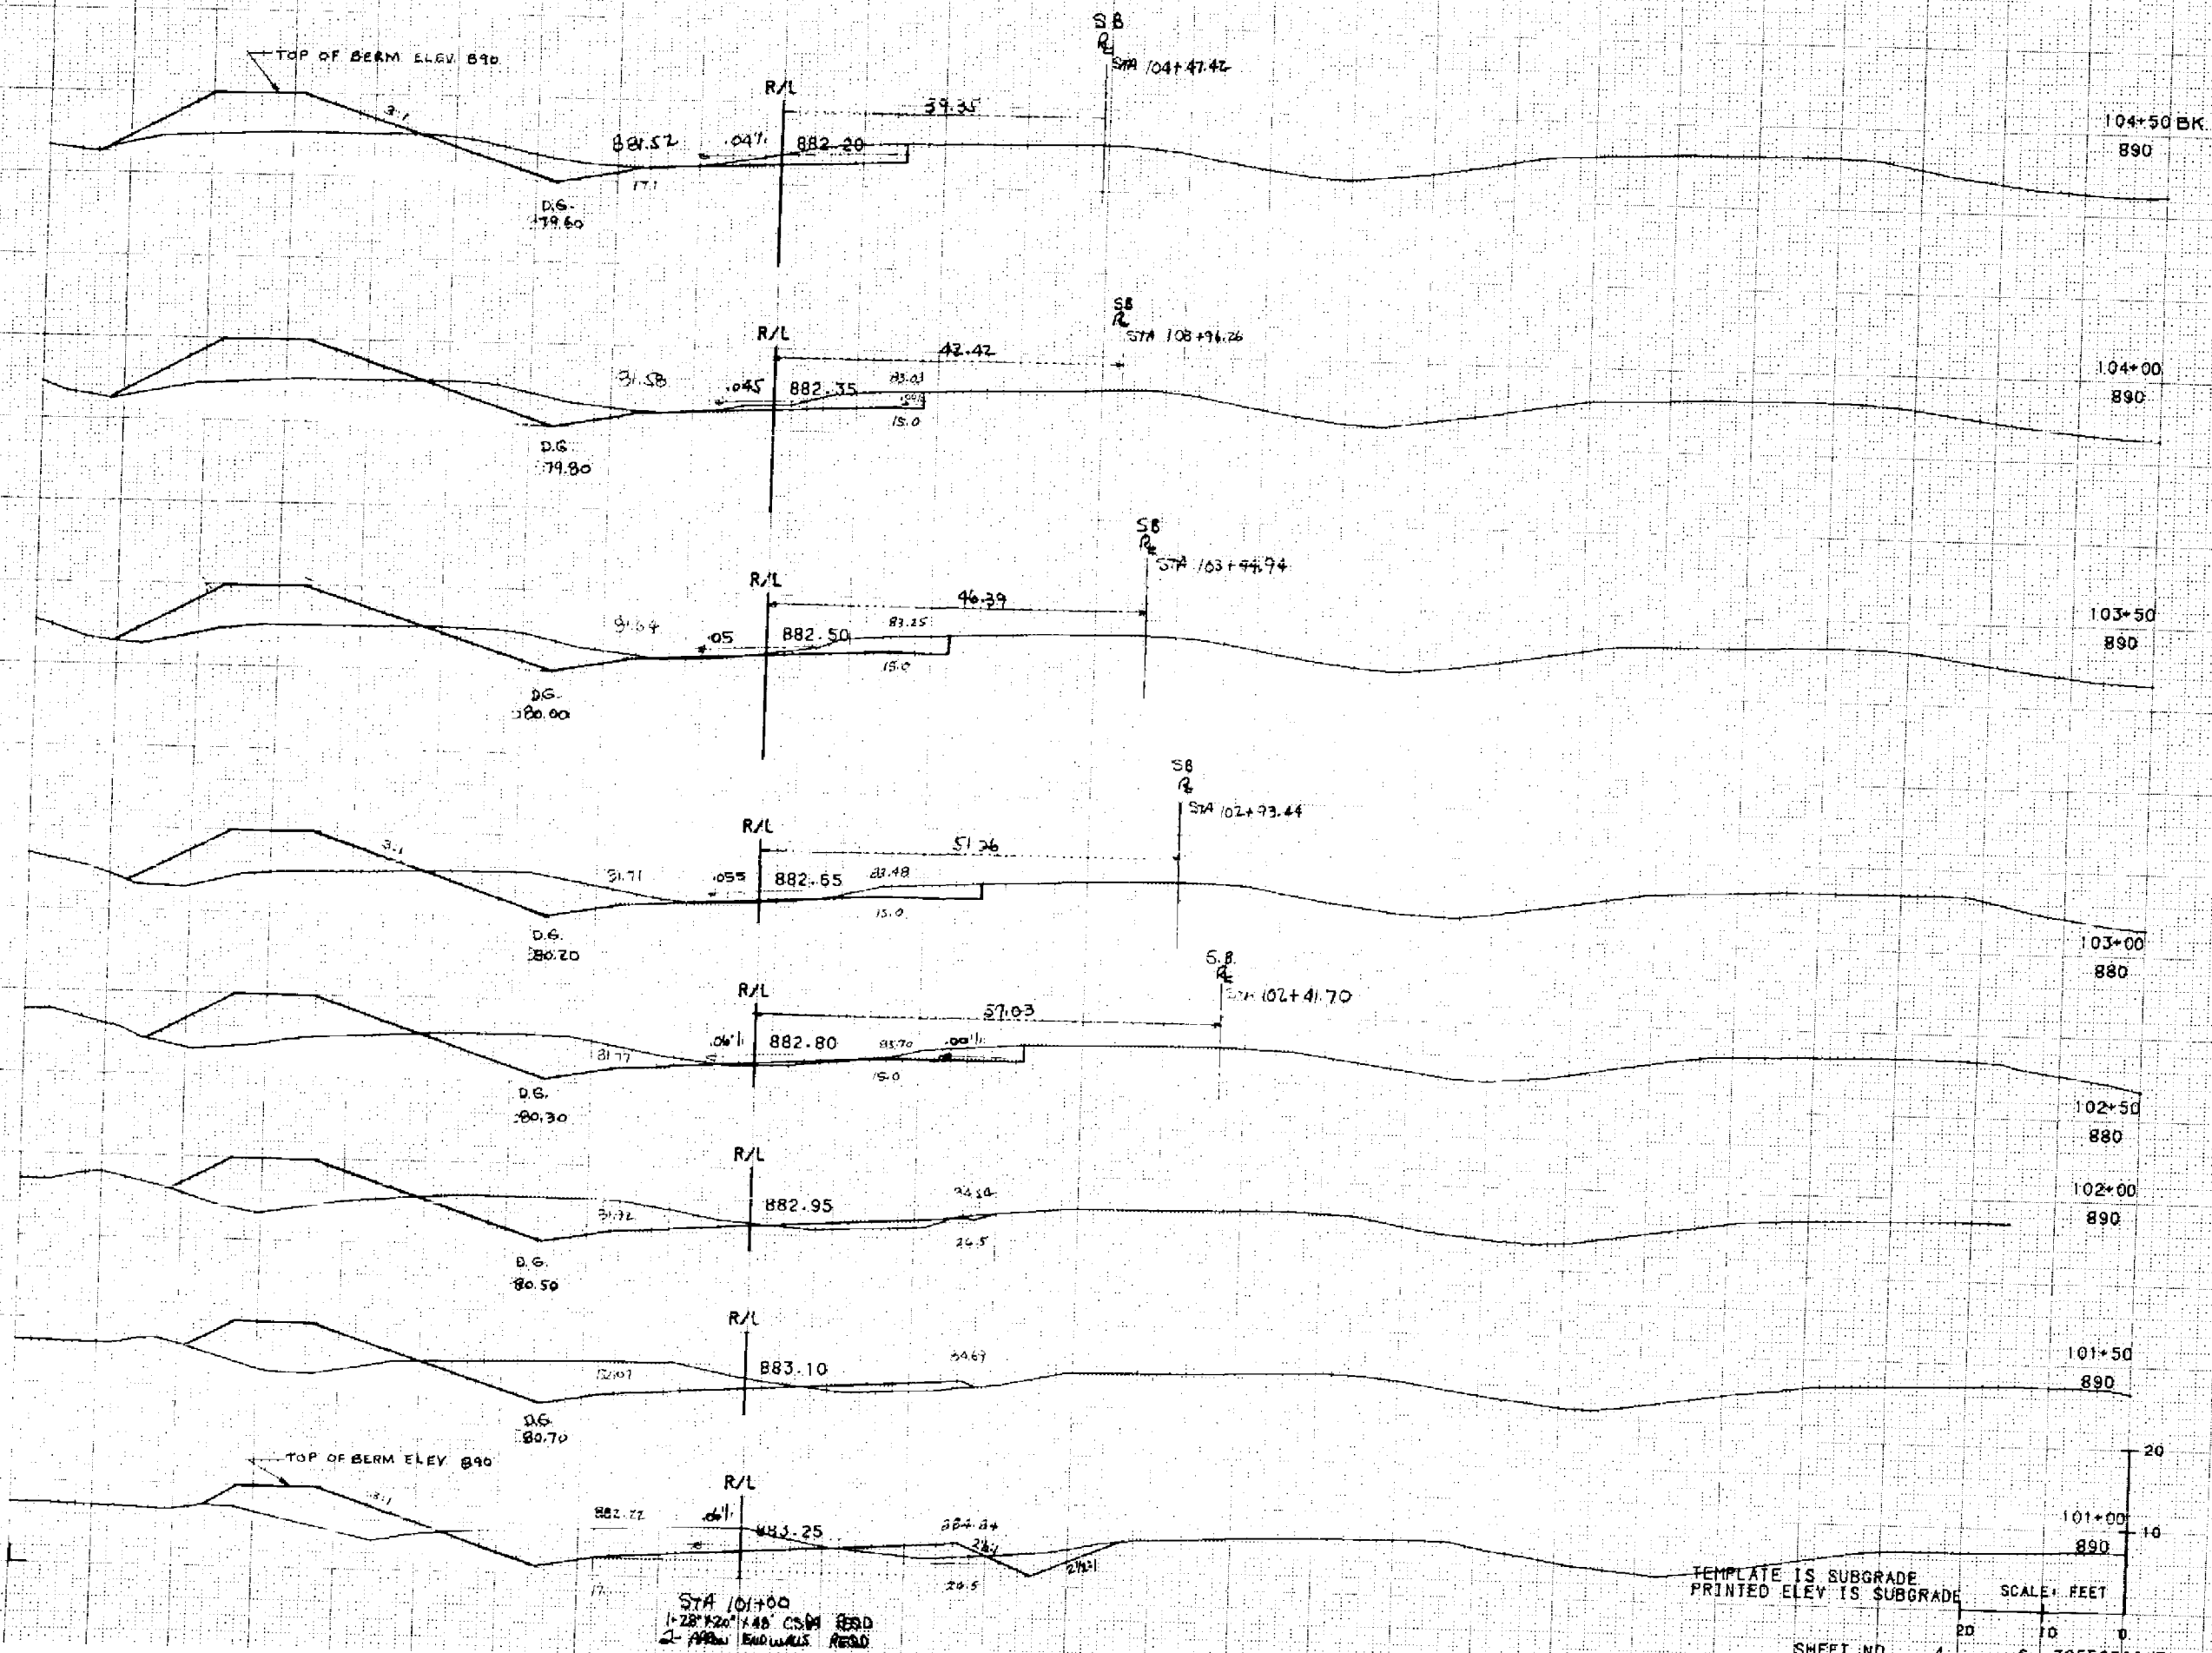


STATION	DISTANCE	YARDAGE	
		EXCAVATION	FILL
100+50	50	272	32
101+00	50	367	32
101+50	50	341	29
102+00	50	290	19
102+50	50	393	7
103+00	50	403	5
103+50	50	425	2
104+00	50	445	0
104+50	TOTAL	2956	126

TEMPLATE IS SUBGRADE
PRINTED ELEV IS SUBGRADE

SCALE: FEET

SHEET NO 4 6 7255050013


RTW RAMP

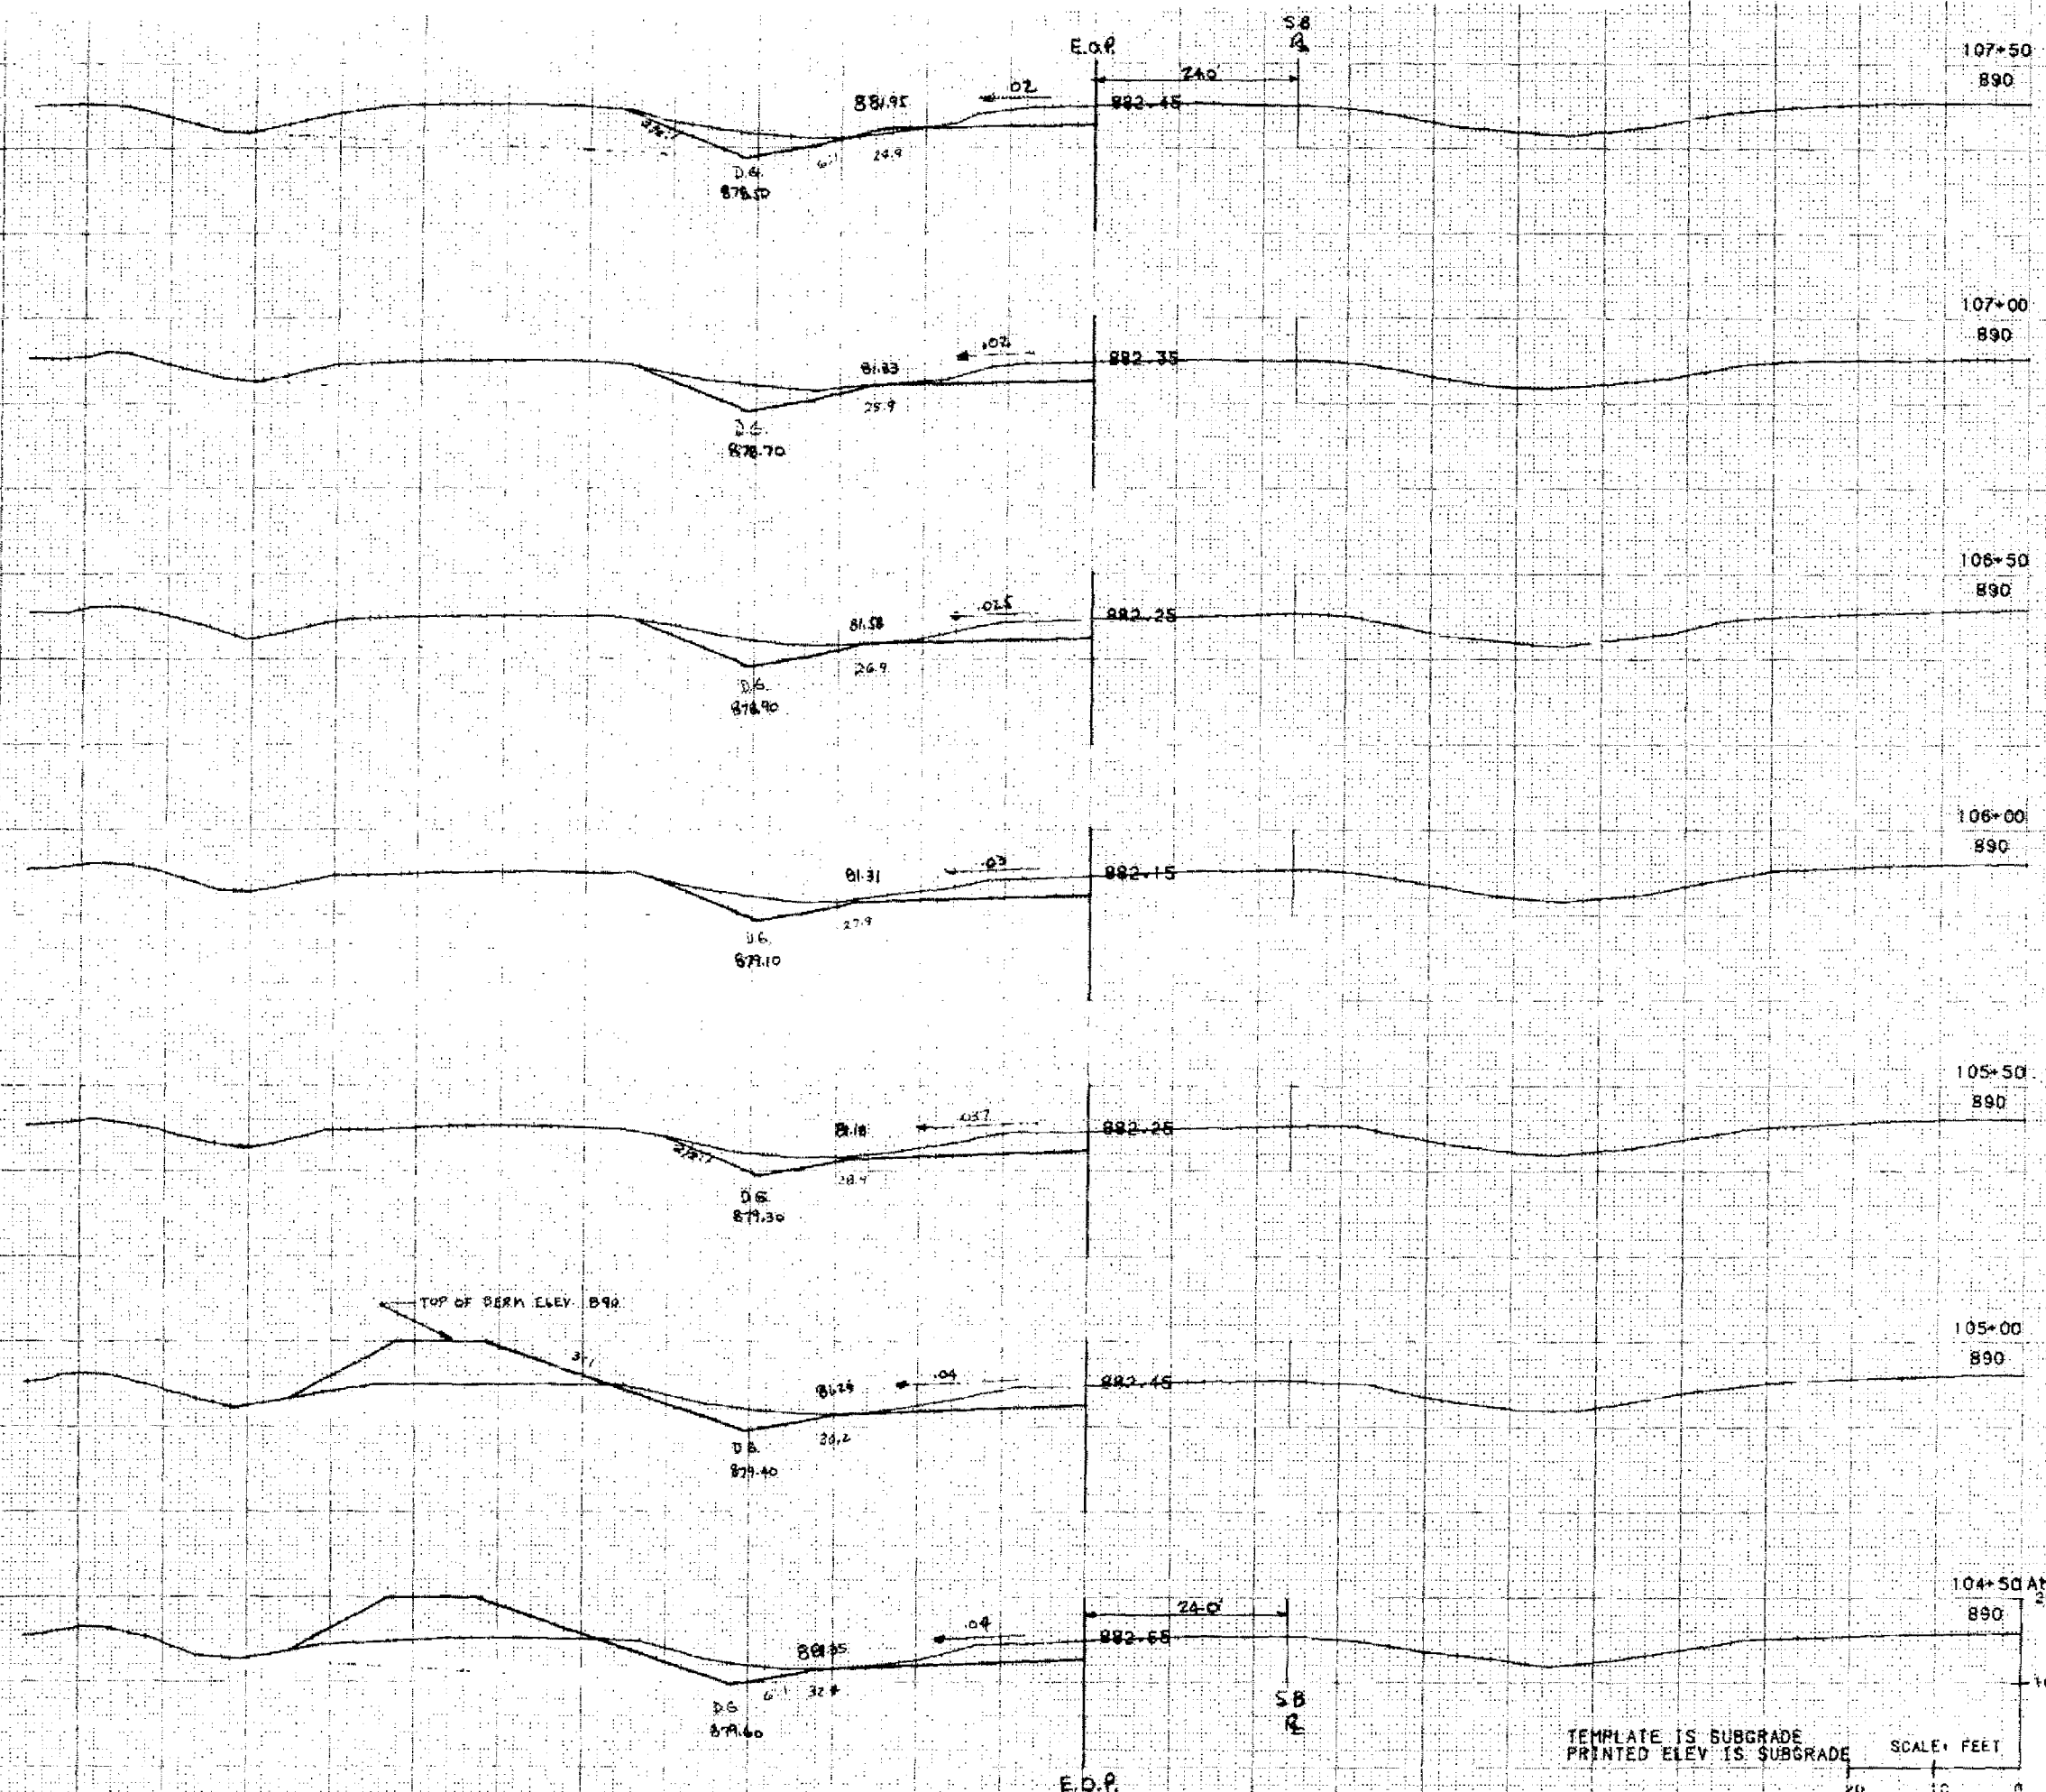

STATE PROJECT NUMBER				SHEET NUMBER
7255-05-71				9.2
STATION	DISTANCE	YARDAGE		
		EXCAVATION		FILL
104+50	50	468		0
105+00	50	479		
105+50	50	482		
106+00	50	489		
106+50	50	487		0
107+00	50	494		3
107+50				
TOTAL		2899		3

TEMPLATE IS SUBGRADE
 PRINTED ELEV. IS SUBGRADE
 SCALE: FEET
 SHEET NO. 1 6 7255050013


NO RAMP

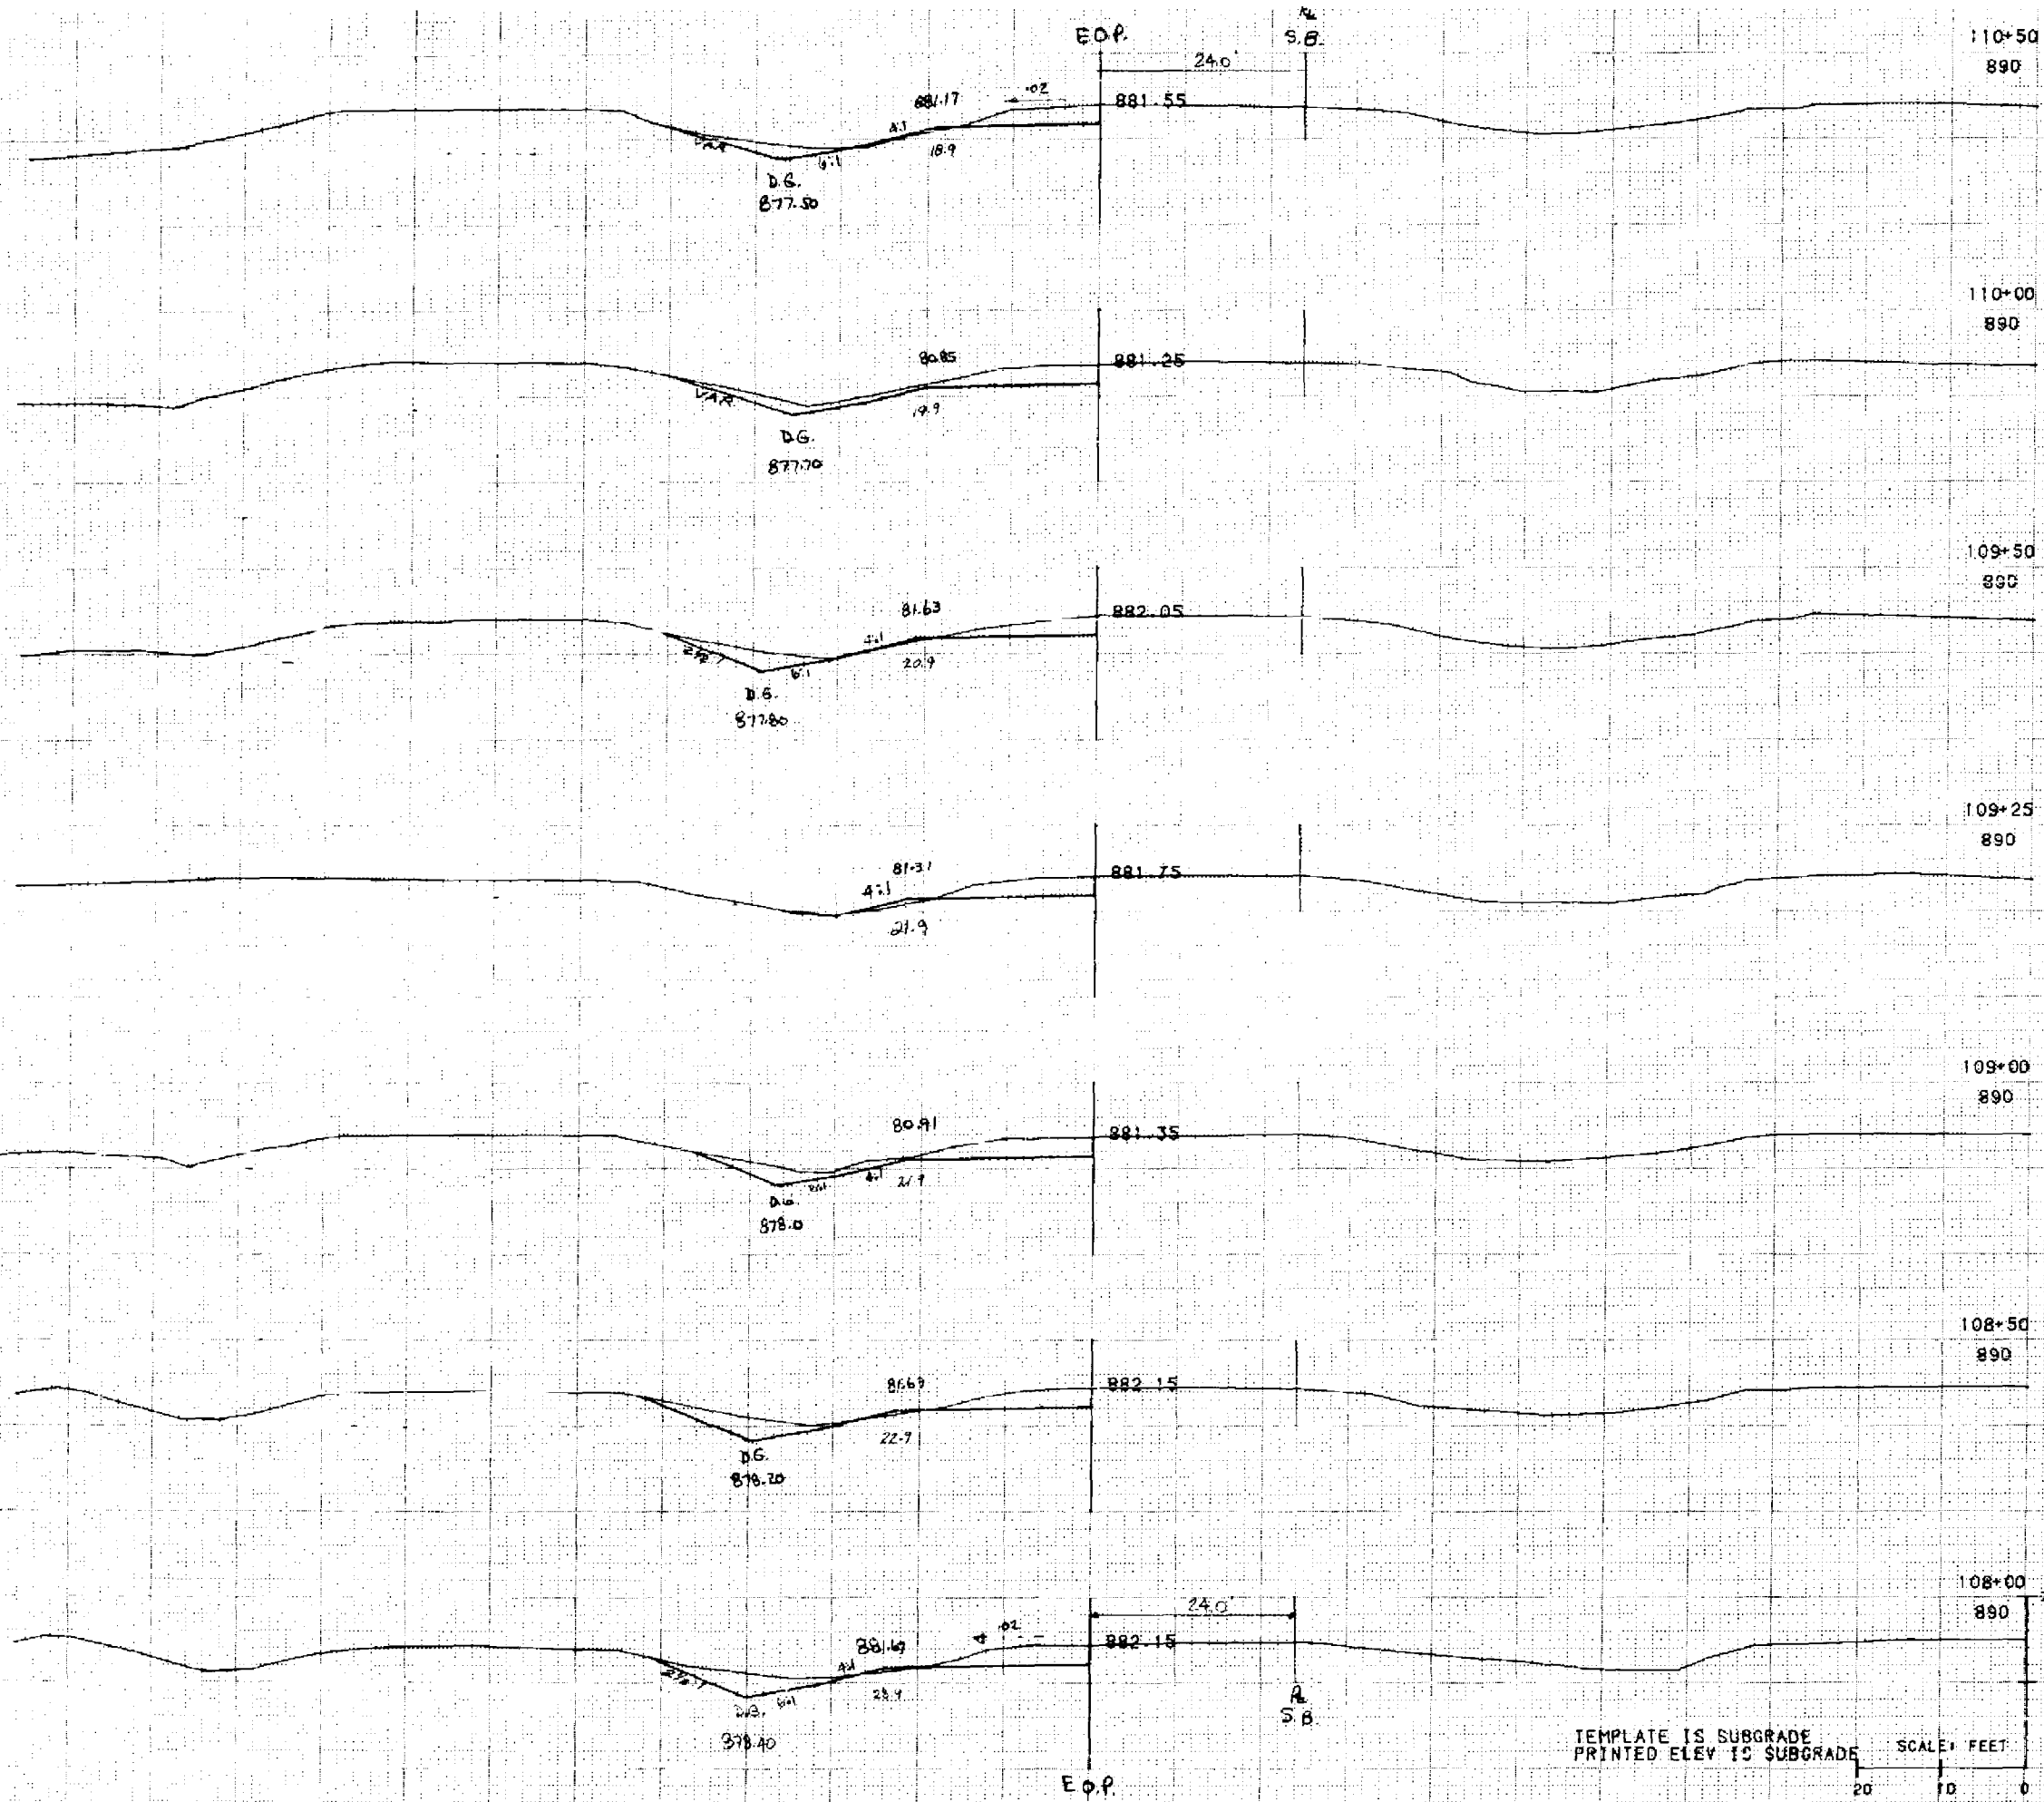

STATE PROJECT NUMBER					SHEET NUMBER
7255-05-71					9.22
STATION	DISTANCE	YARDAGE			
		EXCAVATION			FILL
		DIST.			
107+50	50	302			4
108+00	50	504			2
108+50	50	545			1
109+00	25	207			1
109+25	25	198			2
109+50	50	594			1
110+00	50	606			2
110+50					
TOTAL		3154			13

TEMPLATE IS SUBGRADE
 PRINTED ELEV IS SUBGRADE
 SCALE: FEET
 SHEET NO 2 6 7255050013

NW Ramp

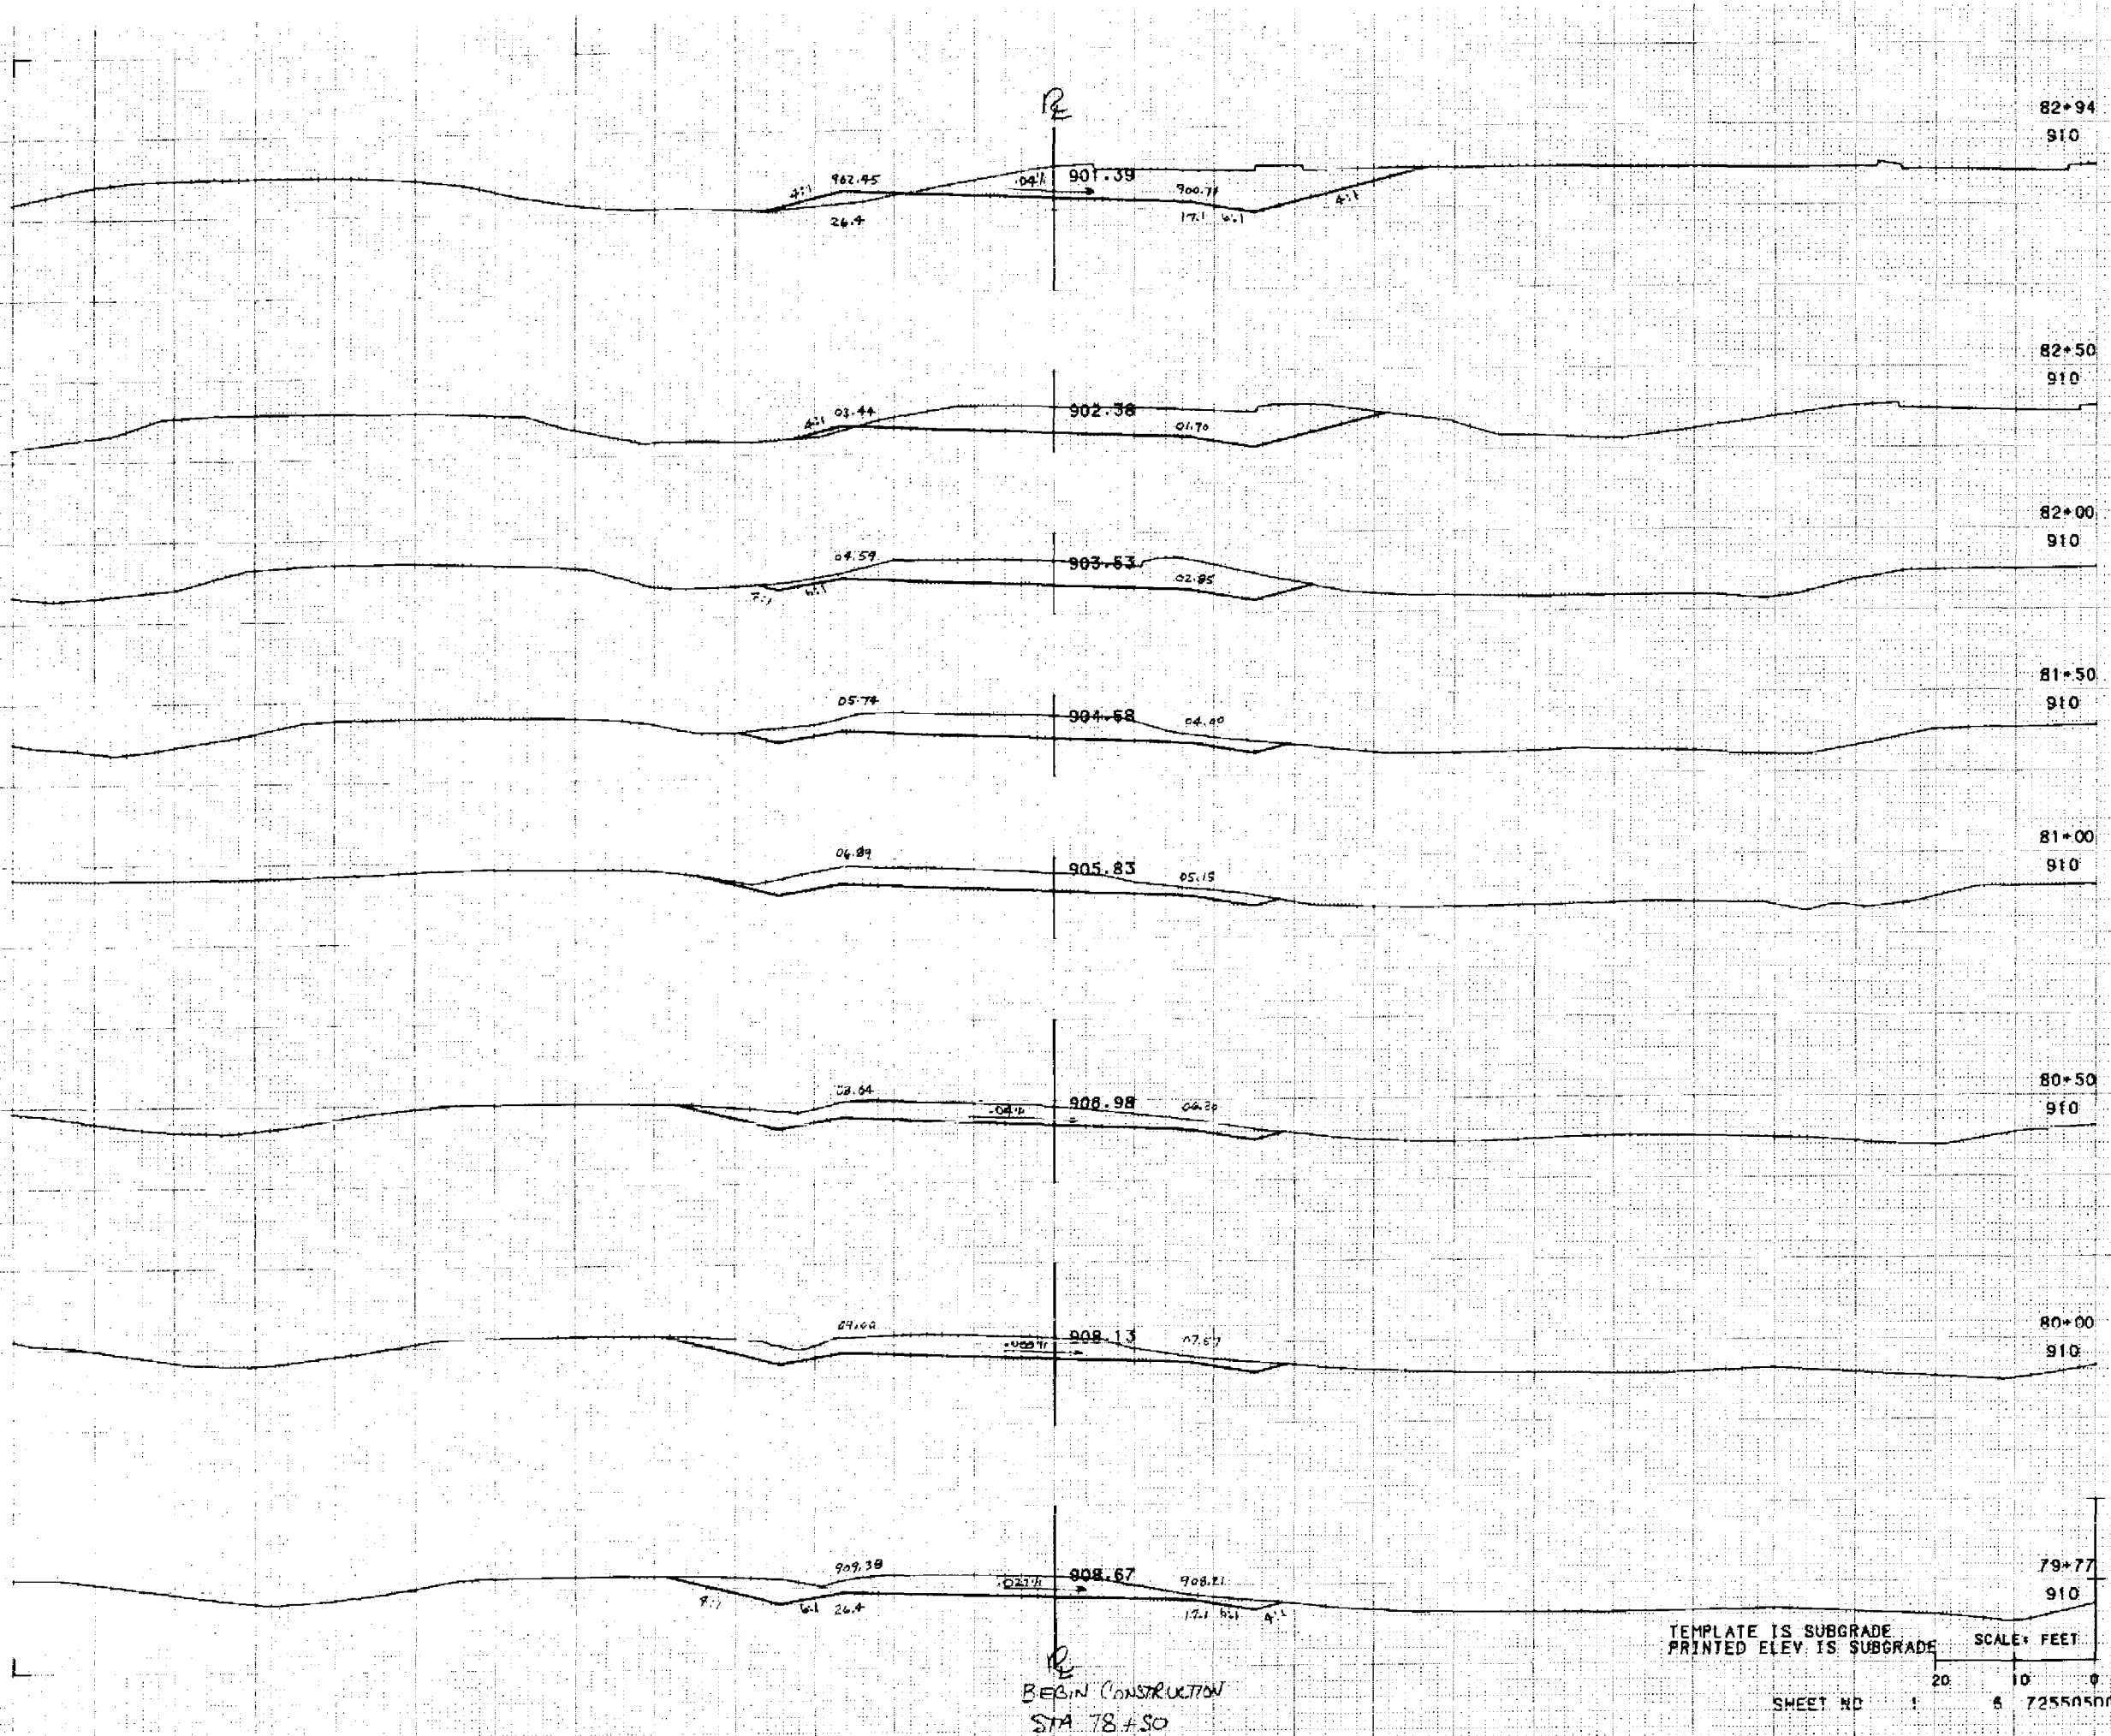

STATE PROJECT NUMBER				SHEET NUMBER	
7255-05-71				9.24	
STATION	DISTANCE	YARDAGE			FILL
		EXCAVATION			
		UNCL.			
78+50					
	127	679			0
79+77					
	23	120			
80+00					
	50	253			
80+50					
	50	239			
81+00					
	50	242			
81+50					
	50	281			0
82+00					
	50	334			3
82+50					
	44	319			15
82+94					
TOTAL		2437			18

TEMPLATE IS SUBGRADE
 PRINTED ELEV. IS SUBGRADE
 SCALE: FEET
 SHEET NO. 1 6 7255050013


BEGIN CONSTRUCTION
 STA 78+50

SE RAMP

R_E

STATE PROJECT NUMBER	SHEET NUMBER
7255-05-71	926

STATION	DISTANCE	YARDAGE			
		EXCAVATION			FILL
		UNCL			
85+18	32	125			11
85+58	15	50			15
85+65	27	87			36
85+72	8	23			8
86+00	30	42			23
86+30	20	1			54
86+50	20	16			123
86+70					
TOTAL		344			275

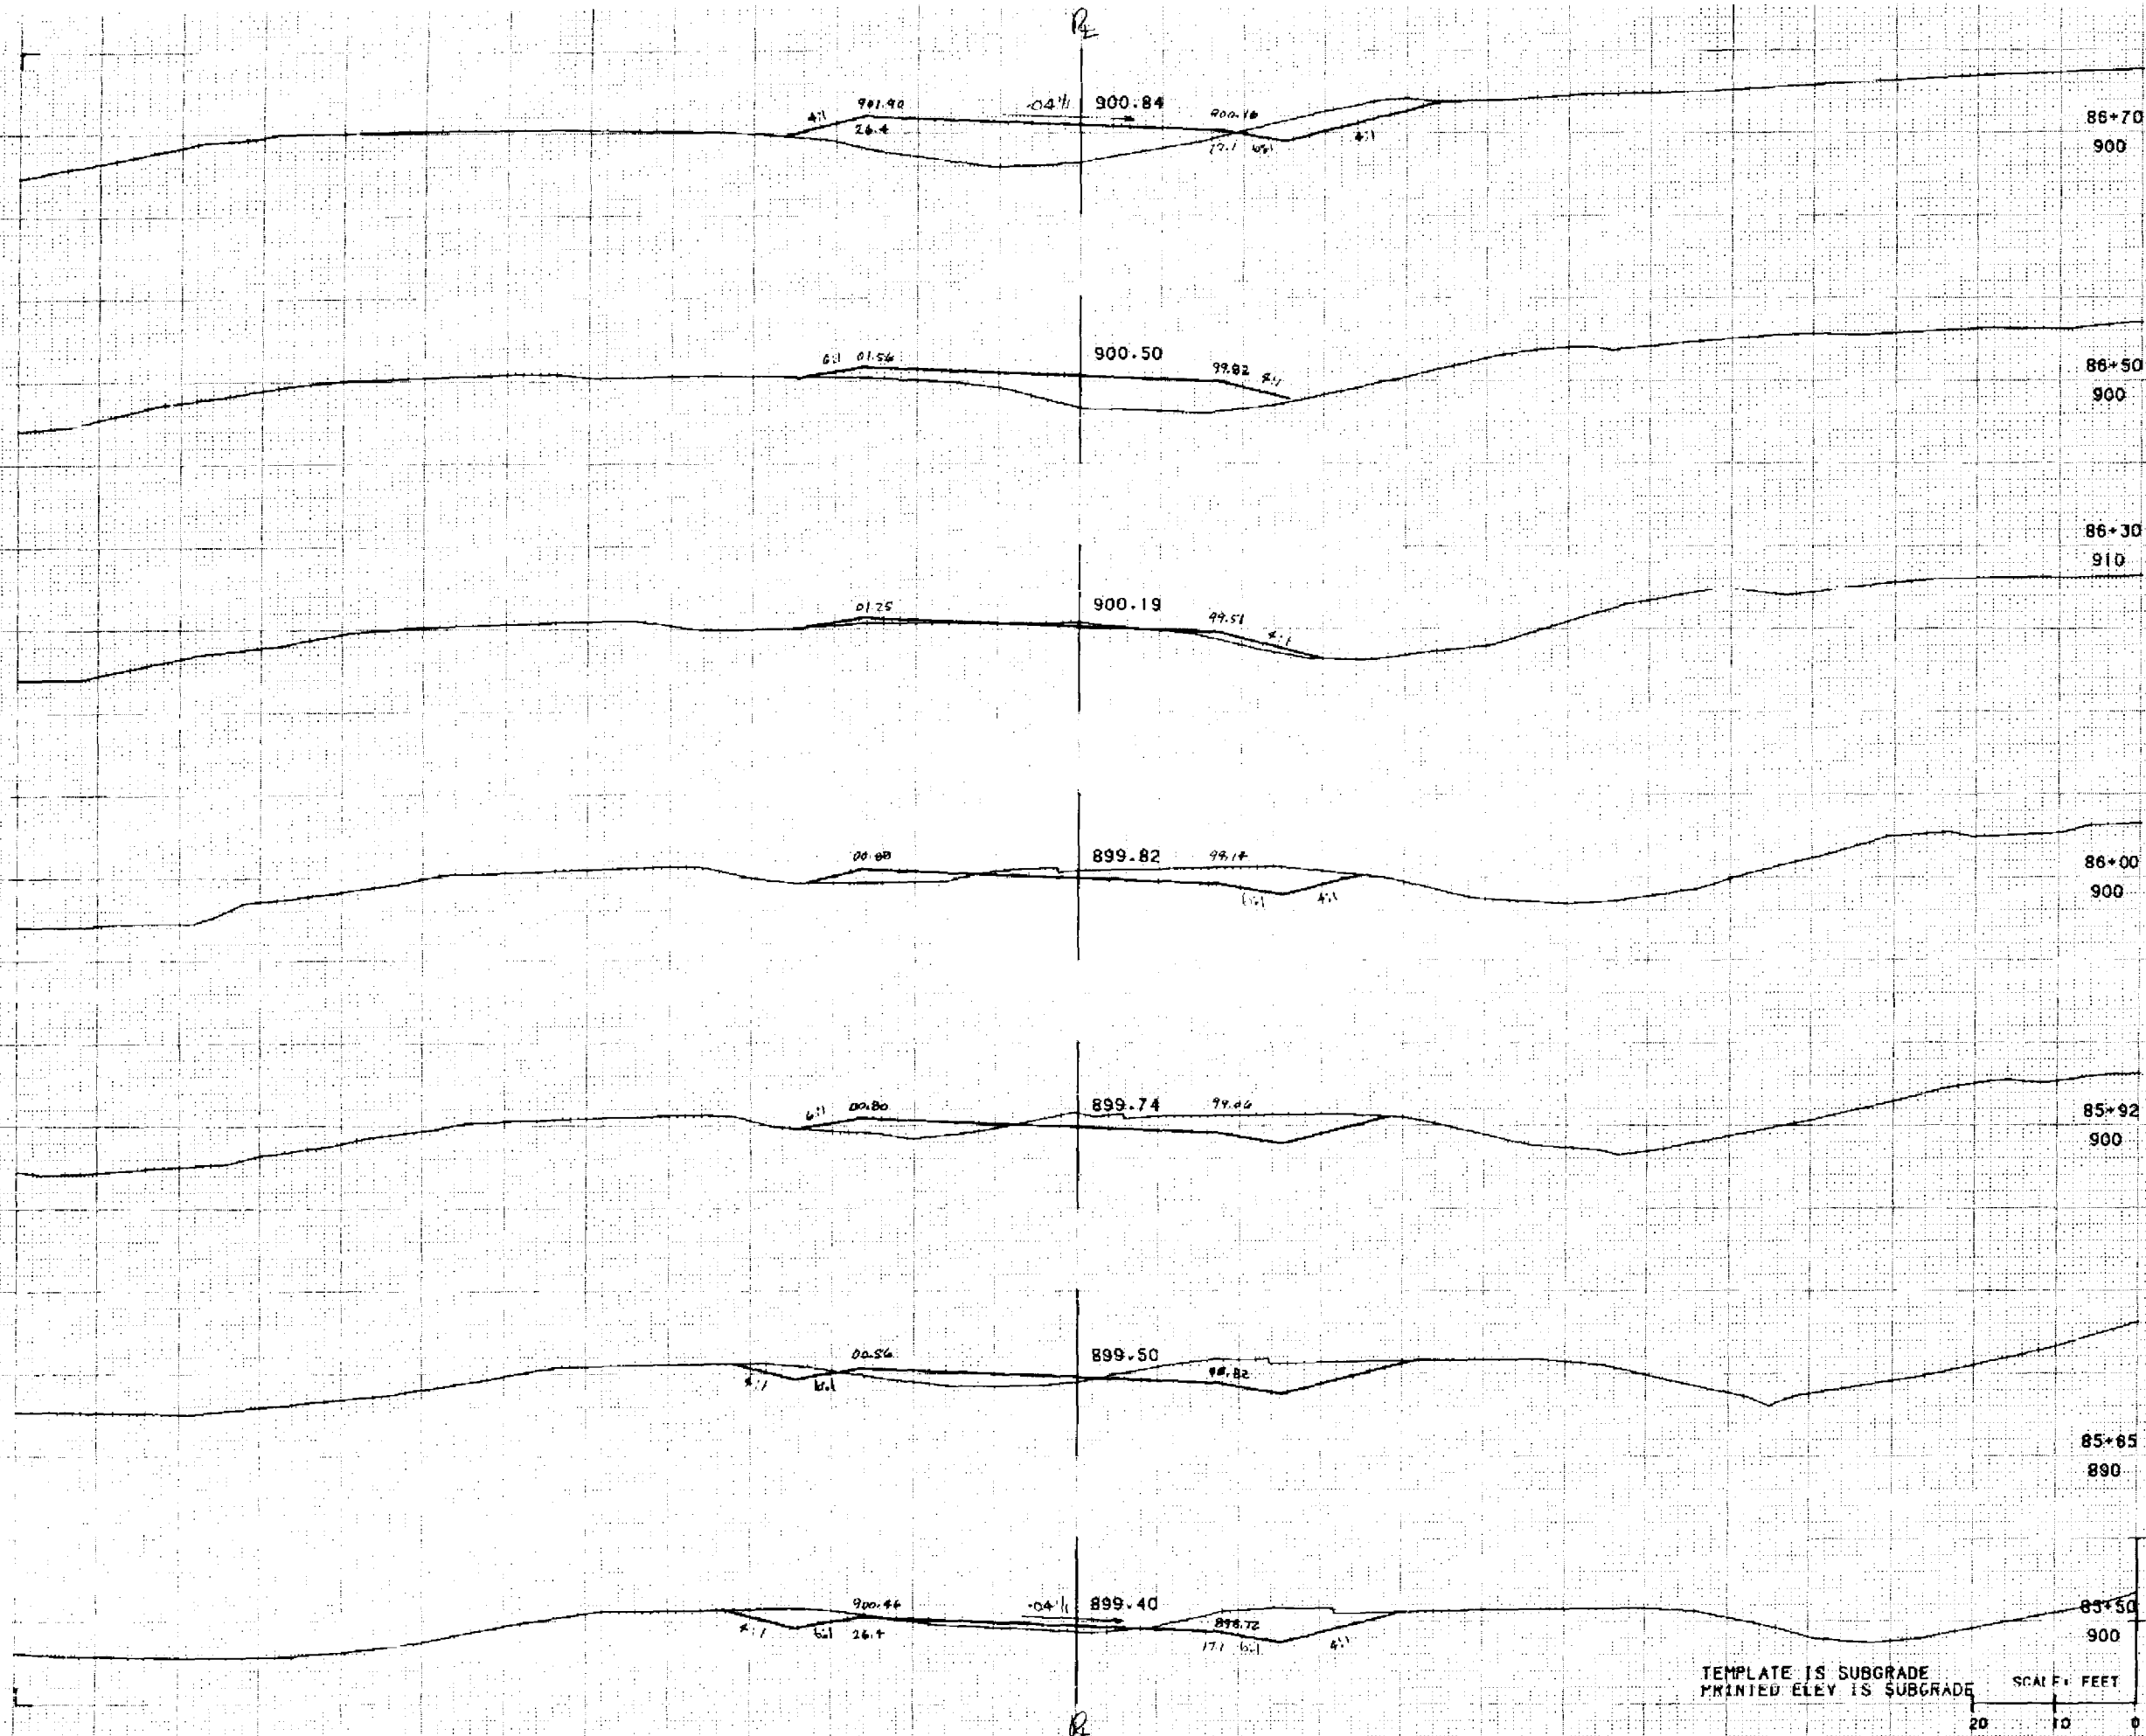


TEMPLATE IS SUBGRADE
PRINTED ELEV IS SUBGRADE

SCALE: FEET

SE RAMP

STATION	DISTANCE	YARDAGE			
		EXCAVATION			FILL
		UNDER			
86+70	30	72			199
87+00	10	32			57
87+10	40	100			197
87+50	50	50			188
88+00	50	0			358
88+50	50	0			397
89+00	30	0			214
89+30					
TOTAL		260			1562

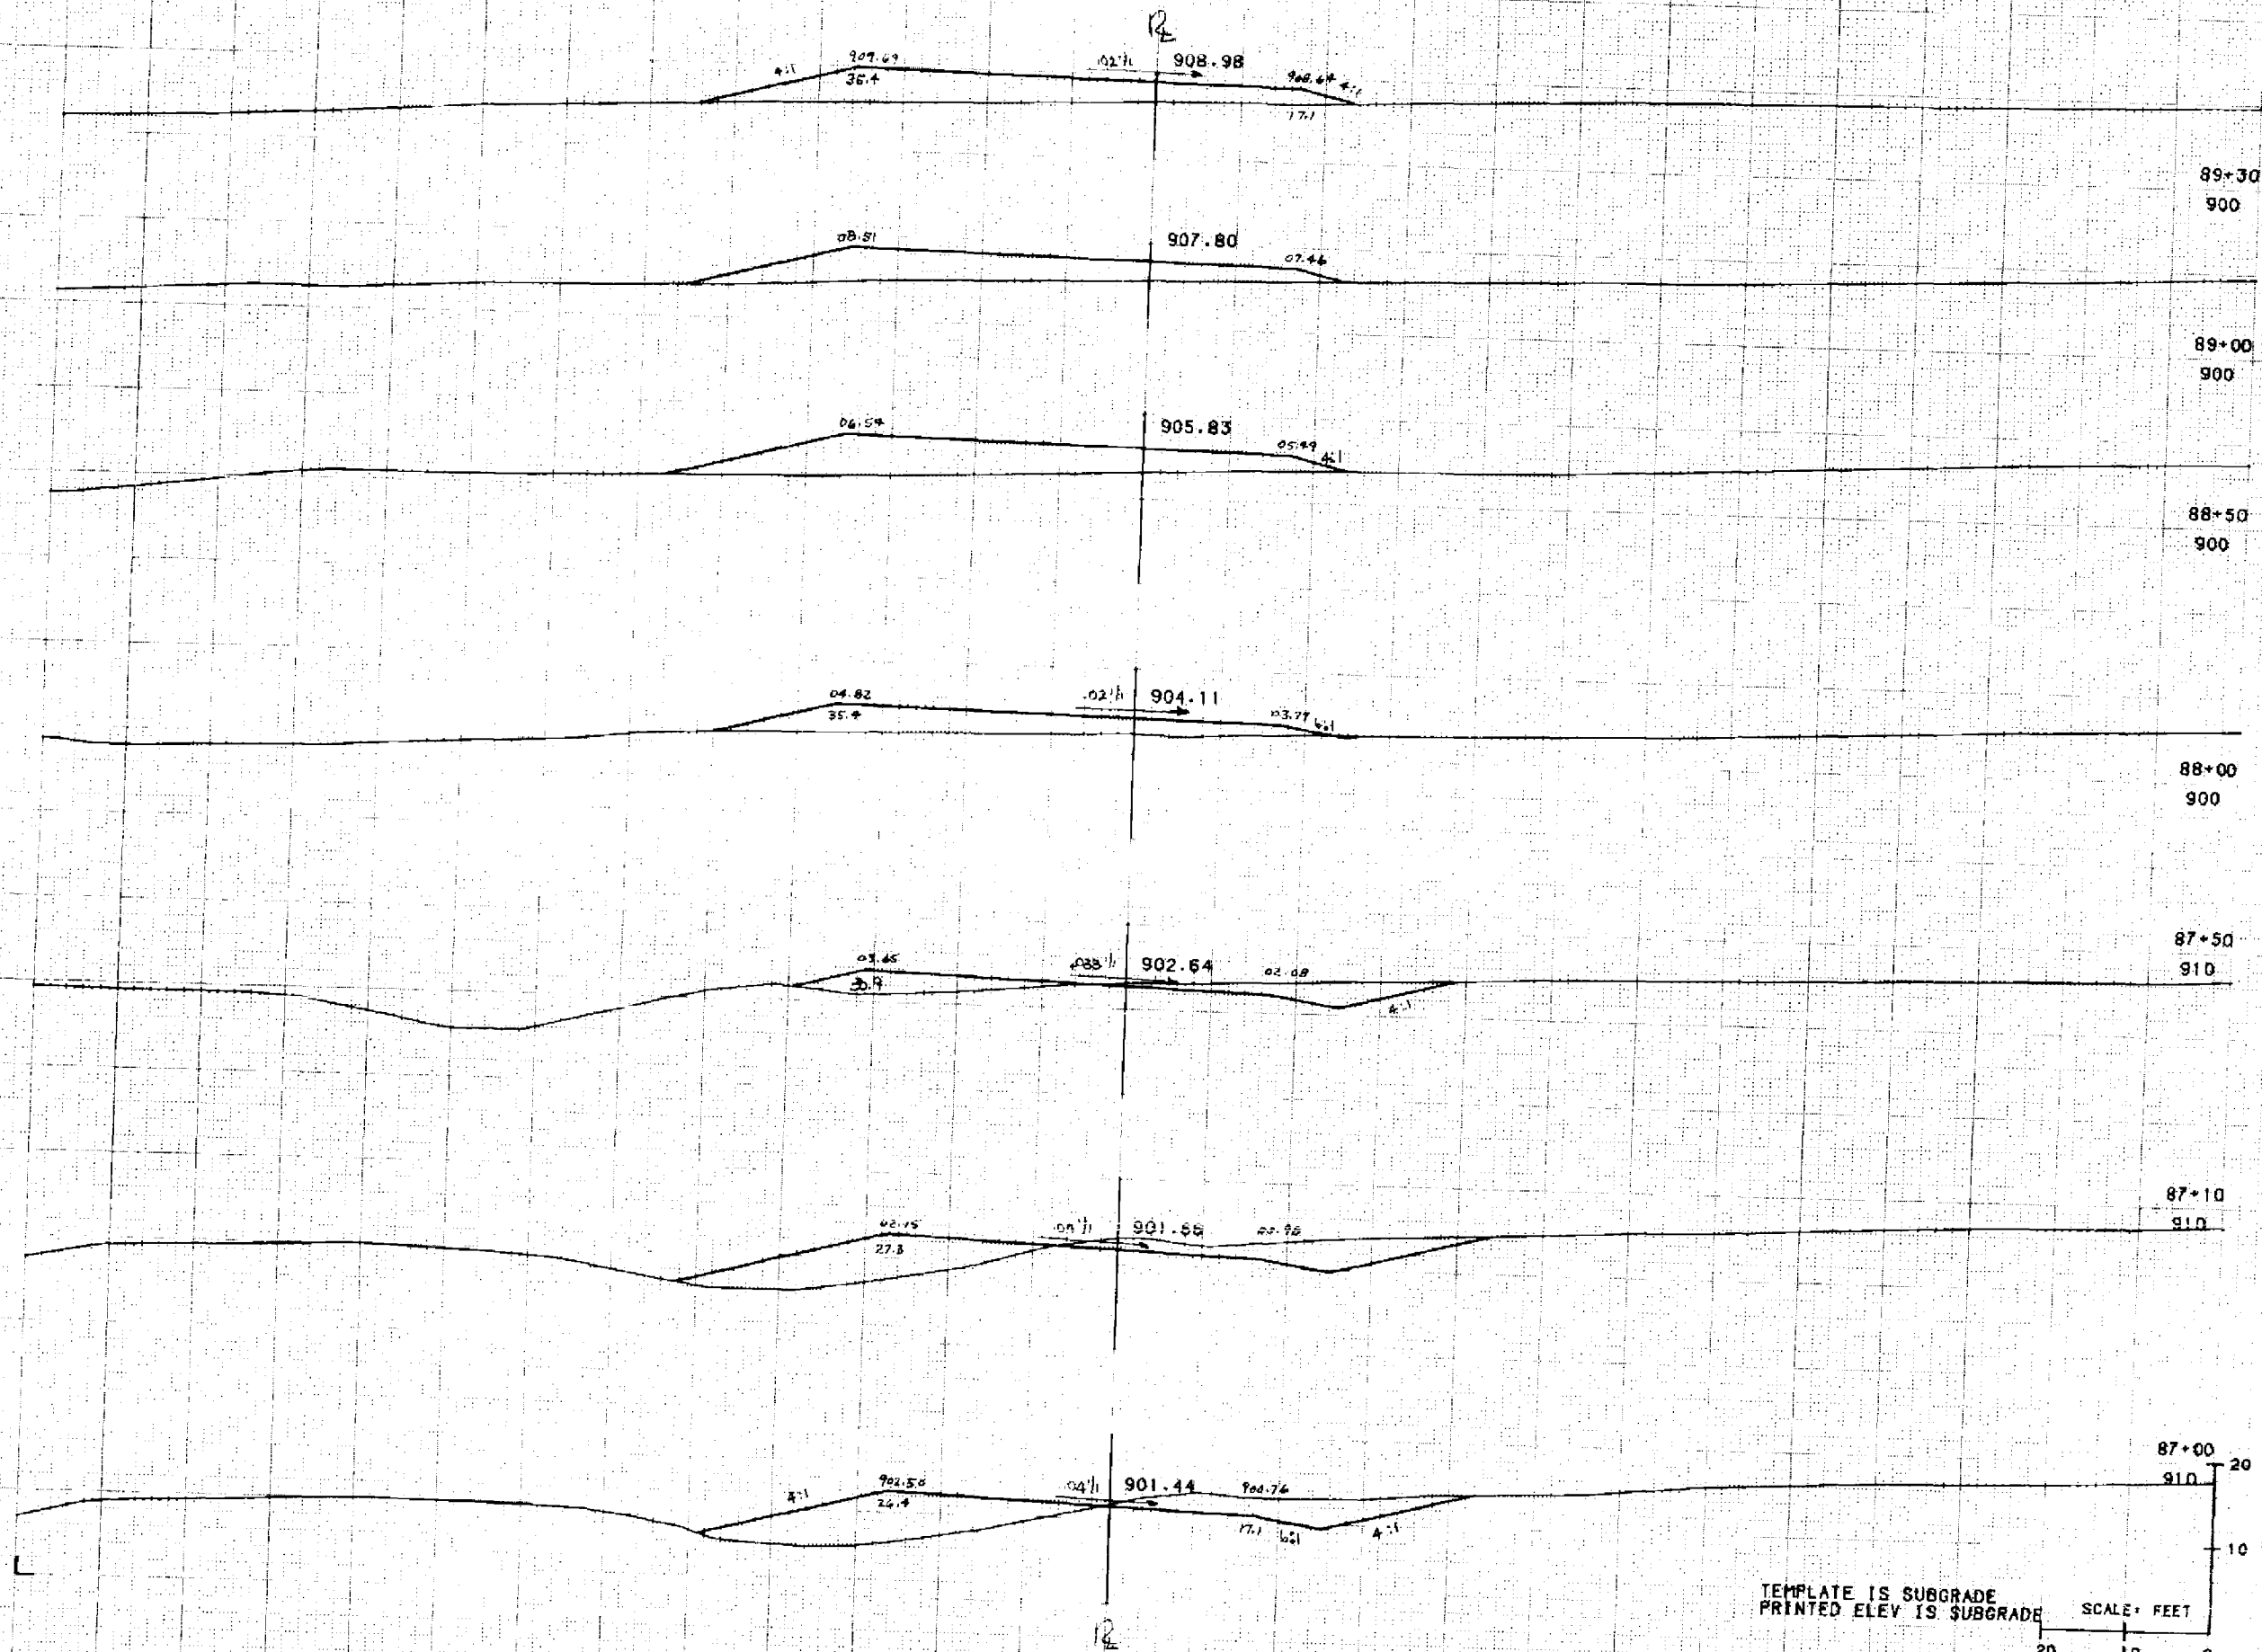


TEMPLATE IS SUBGRADE
PRINTED ELEV IS SUBGRADE

SCALE: FEET

20 10 0

SHEET NO. 4 6 7255050013

SE RAMP

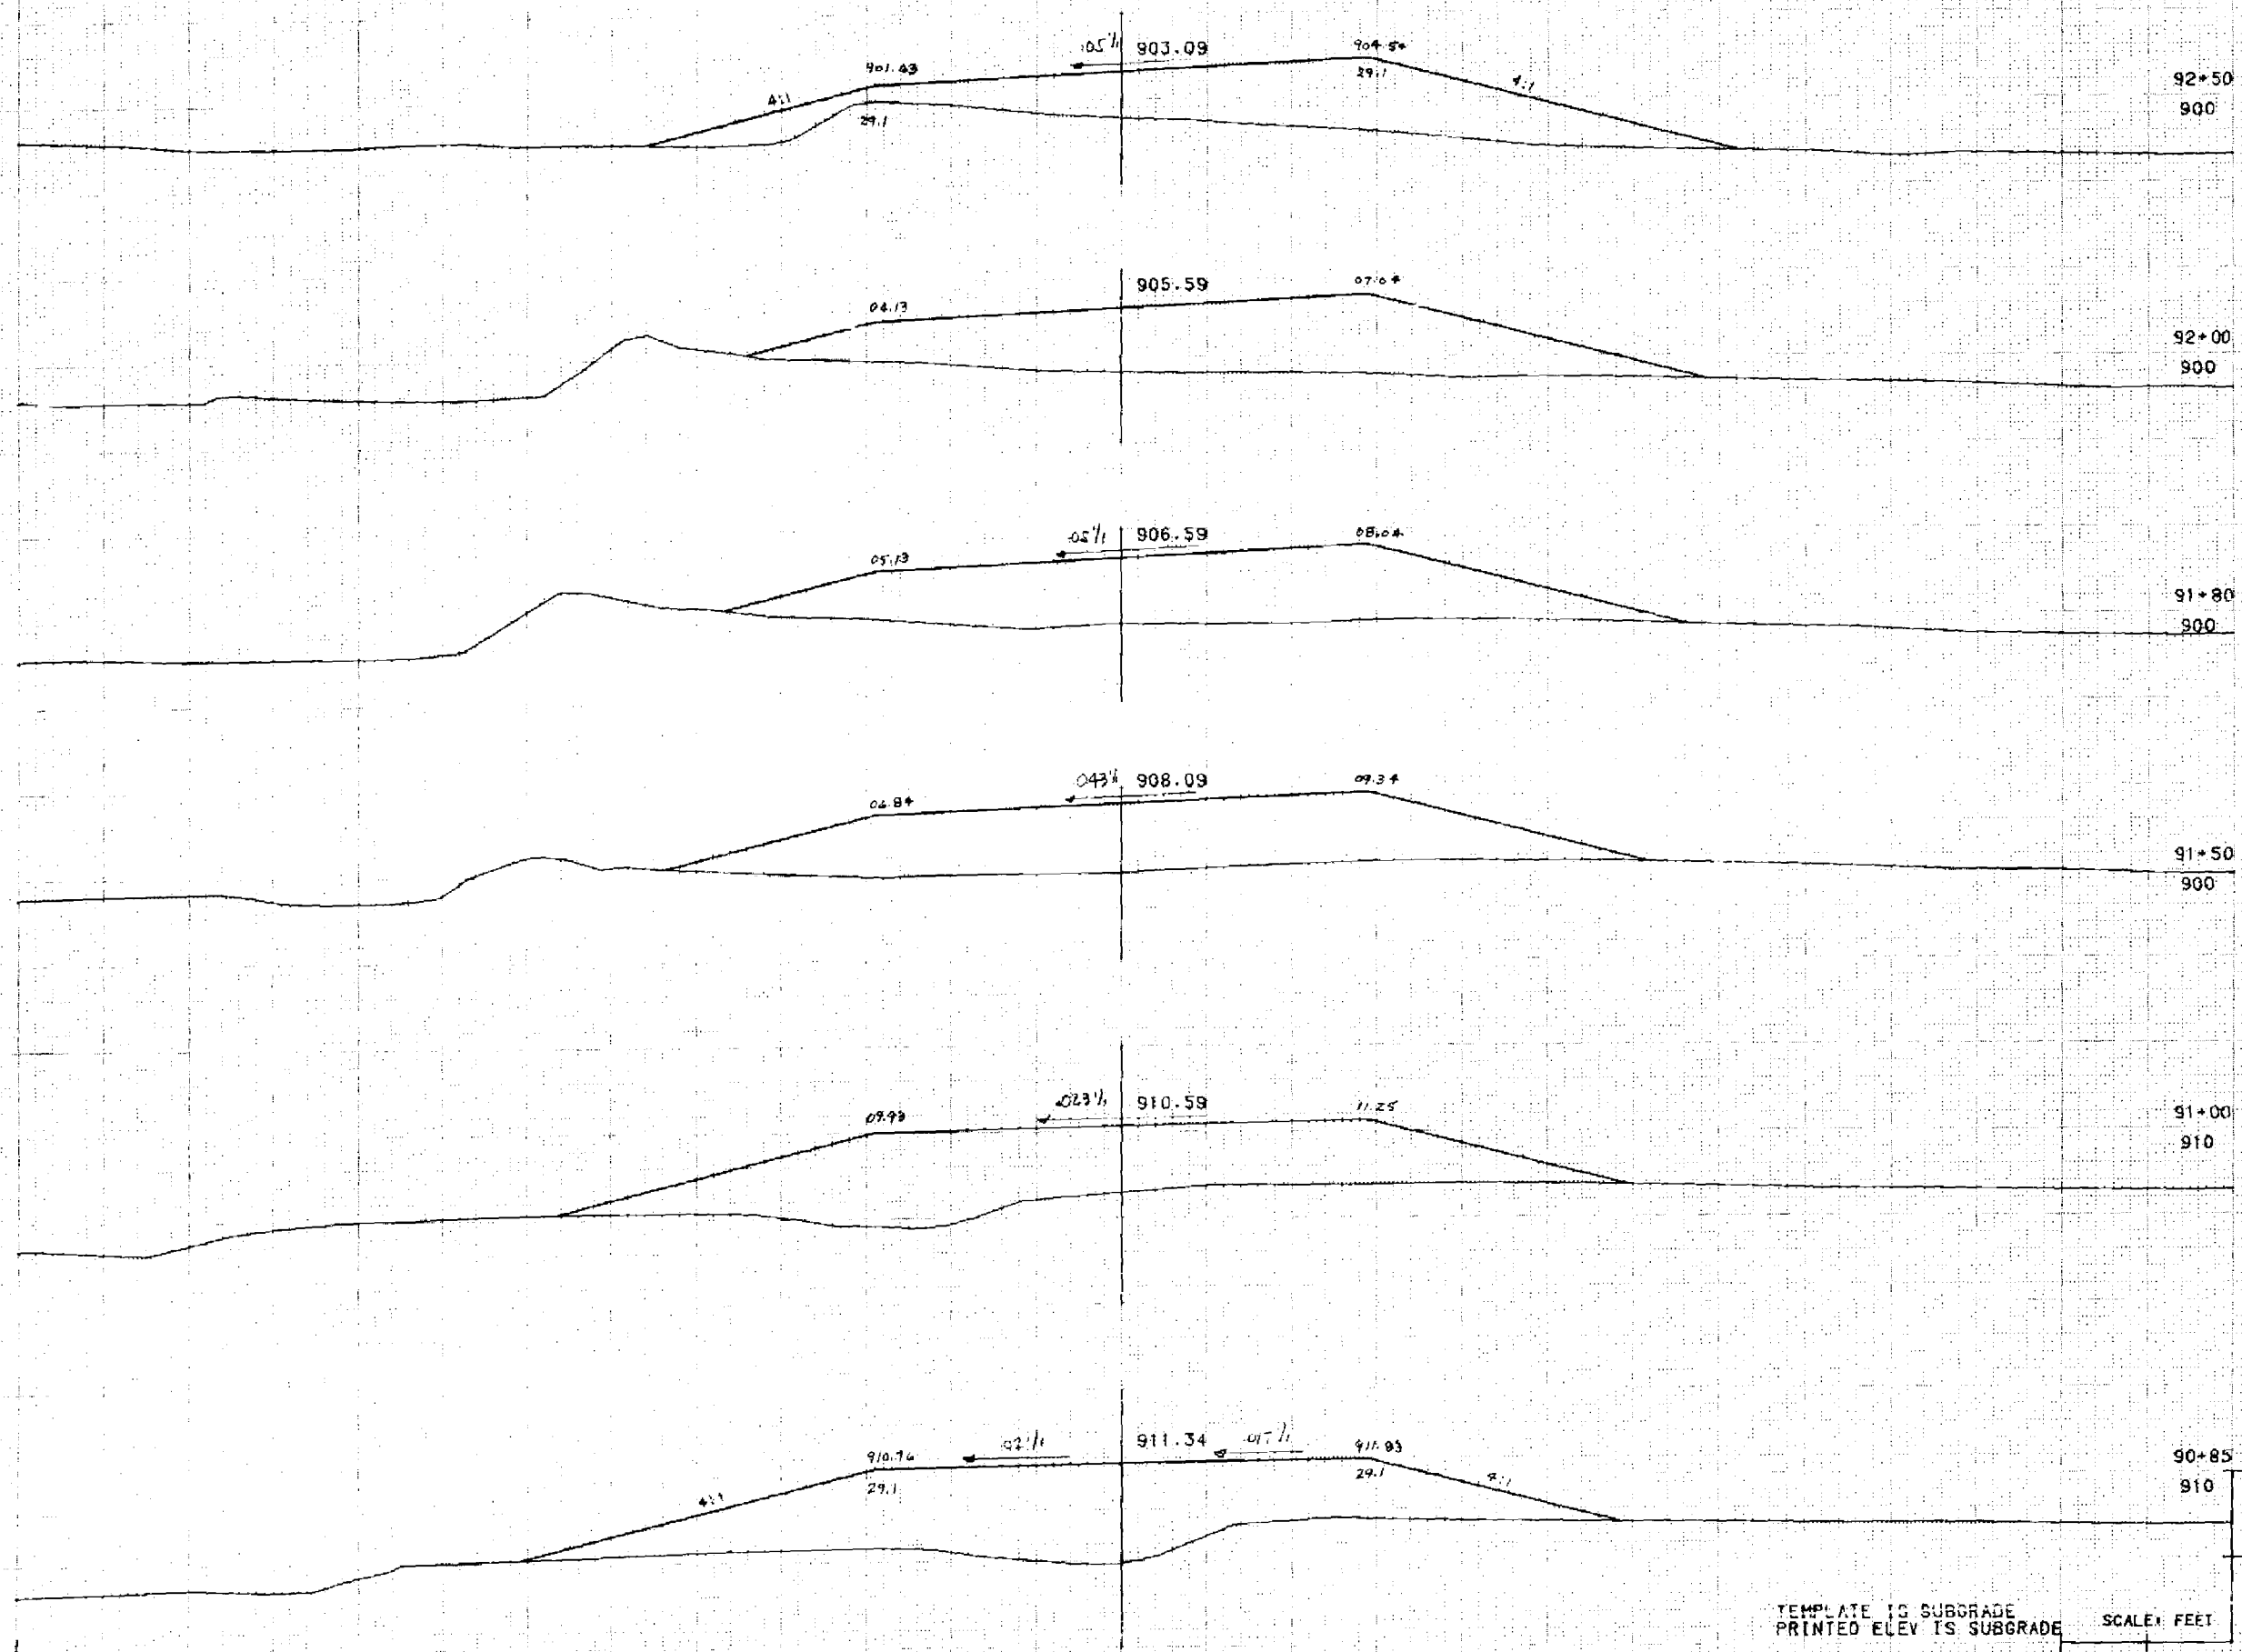


STATION	DISTANCE	YARDAGE			
		EXCAVATION			FILL
90+72	13	0			423
90+86	15				451
91+00	50				1347
91+50	30				734
91+80	20				471
92+00	50	0			1108
92+50					
TOTAL	0				4590

TEMPLATE IS SUBGRADE
PRINTED ELEV IS SUBGRADE

SCALE: FEET

SHEET NO 2 6 725505D013

NE RAMP

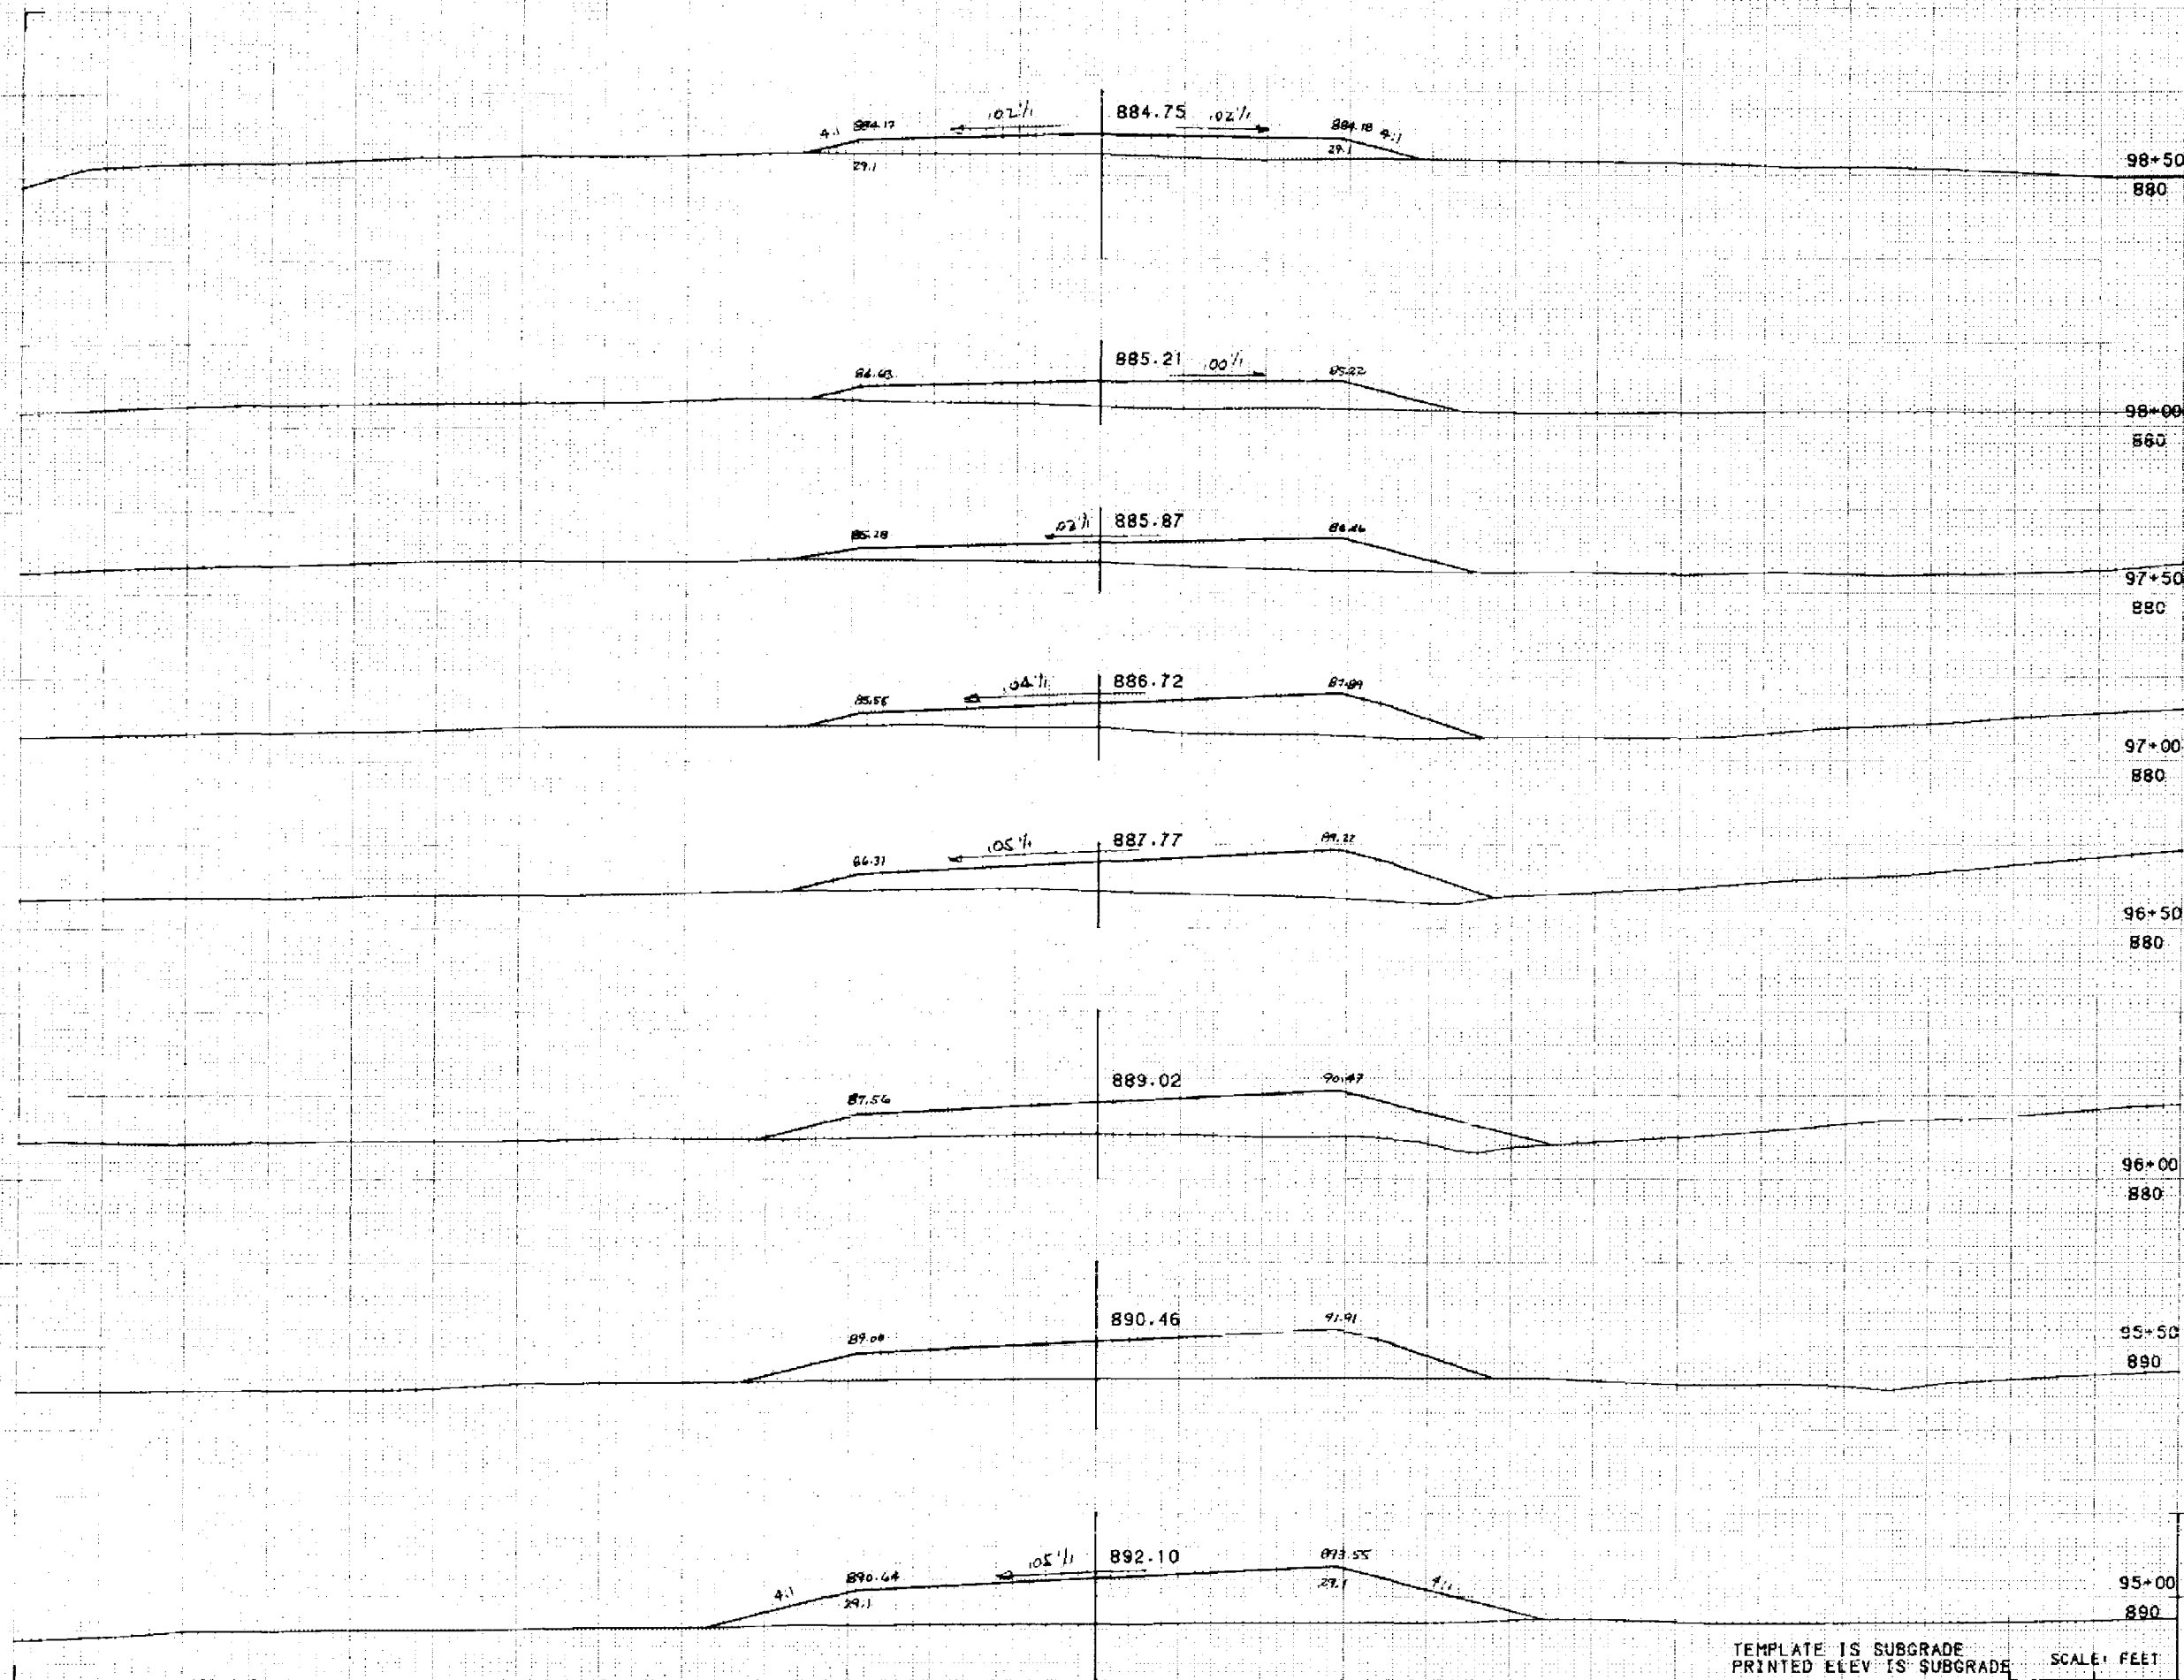


STATION	DISTANCE	YARDAGE			
		EXCAVATION			FILL
		UNDER			
94+50	50	0			900
95+00	50				719
95+50	50				618
96+00	50				563
96+50	50				474
97+00	50				384
97+50	50				343
98+00	50	0			312
98+50	TOTAL	0			4313

TEMPLATE IS SUBGRADE
PRINTED ELEV. IS SUBGRADE

SCALE: FEET


NE RAMP

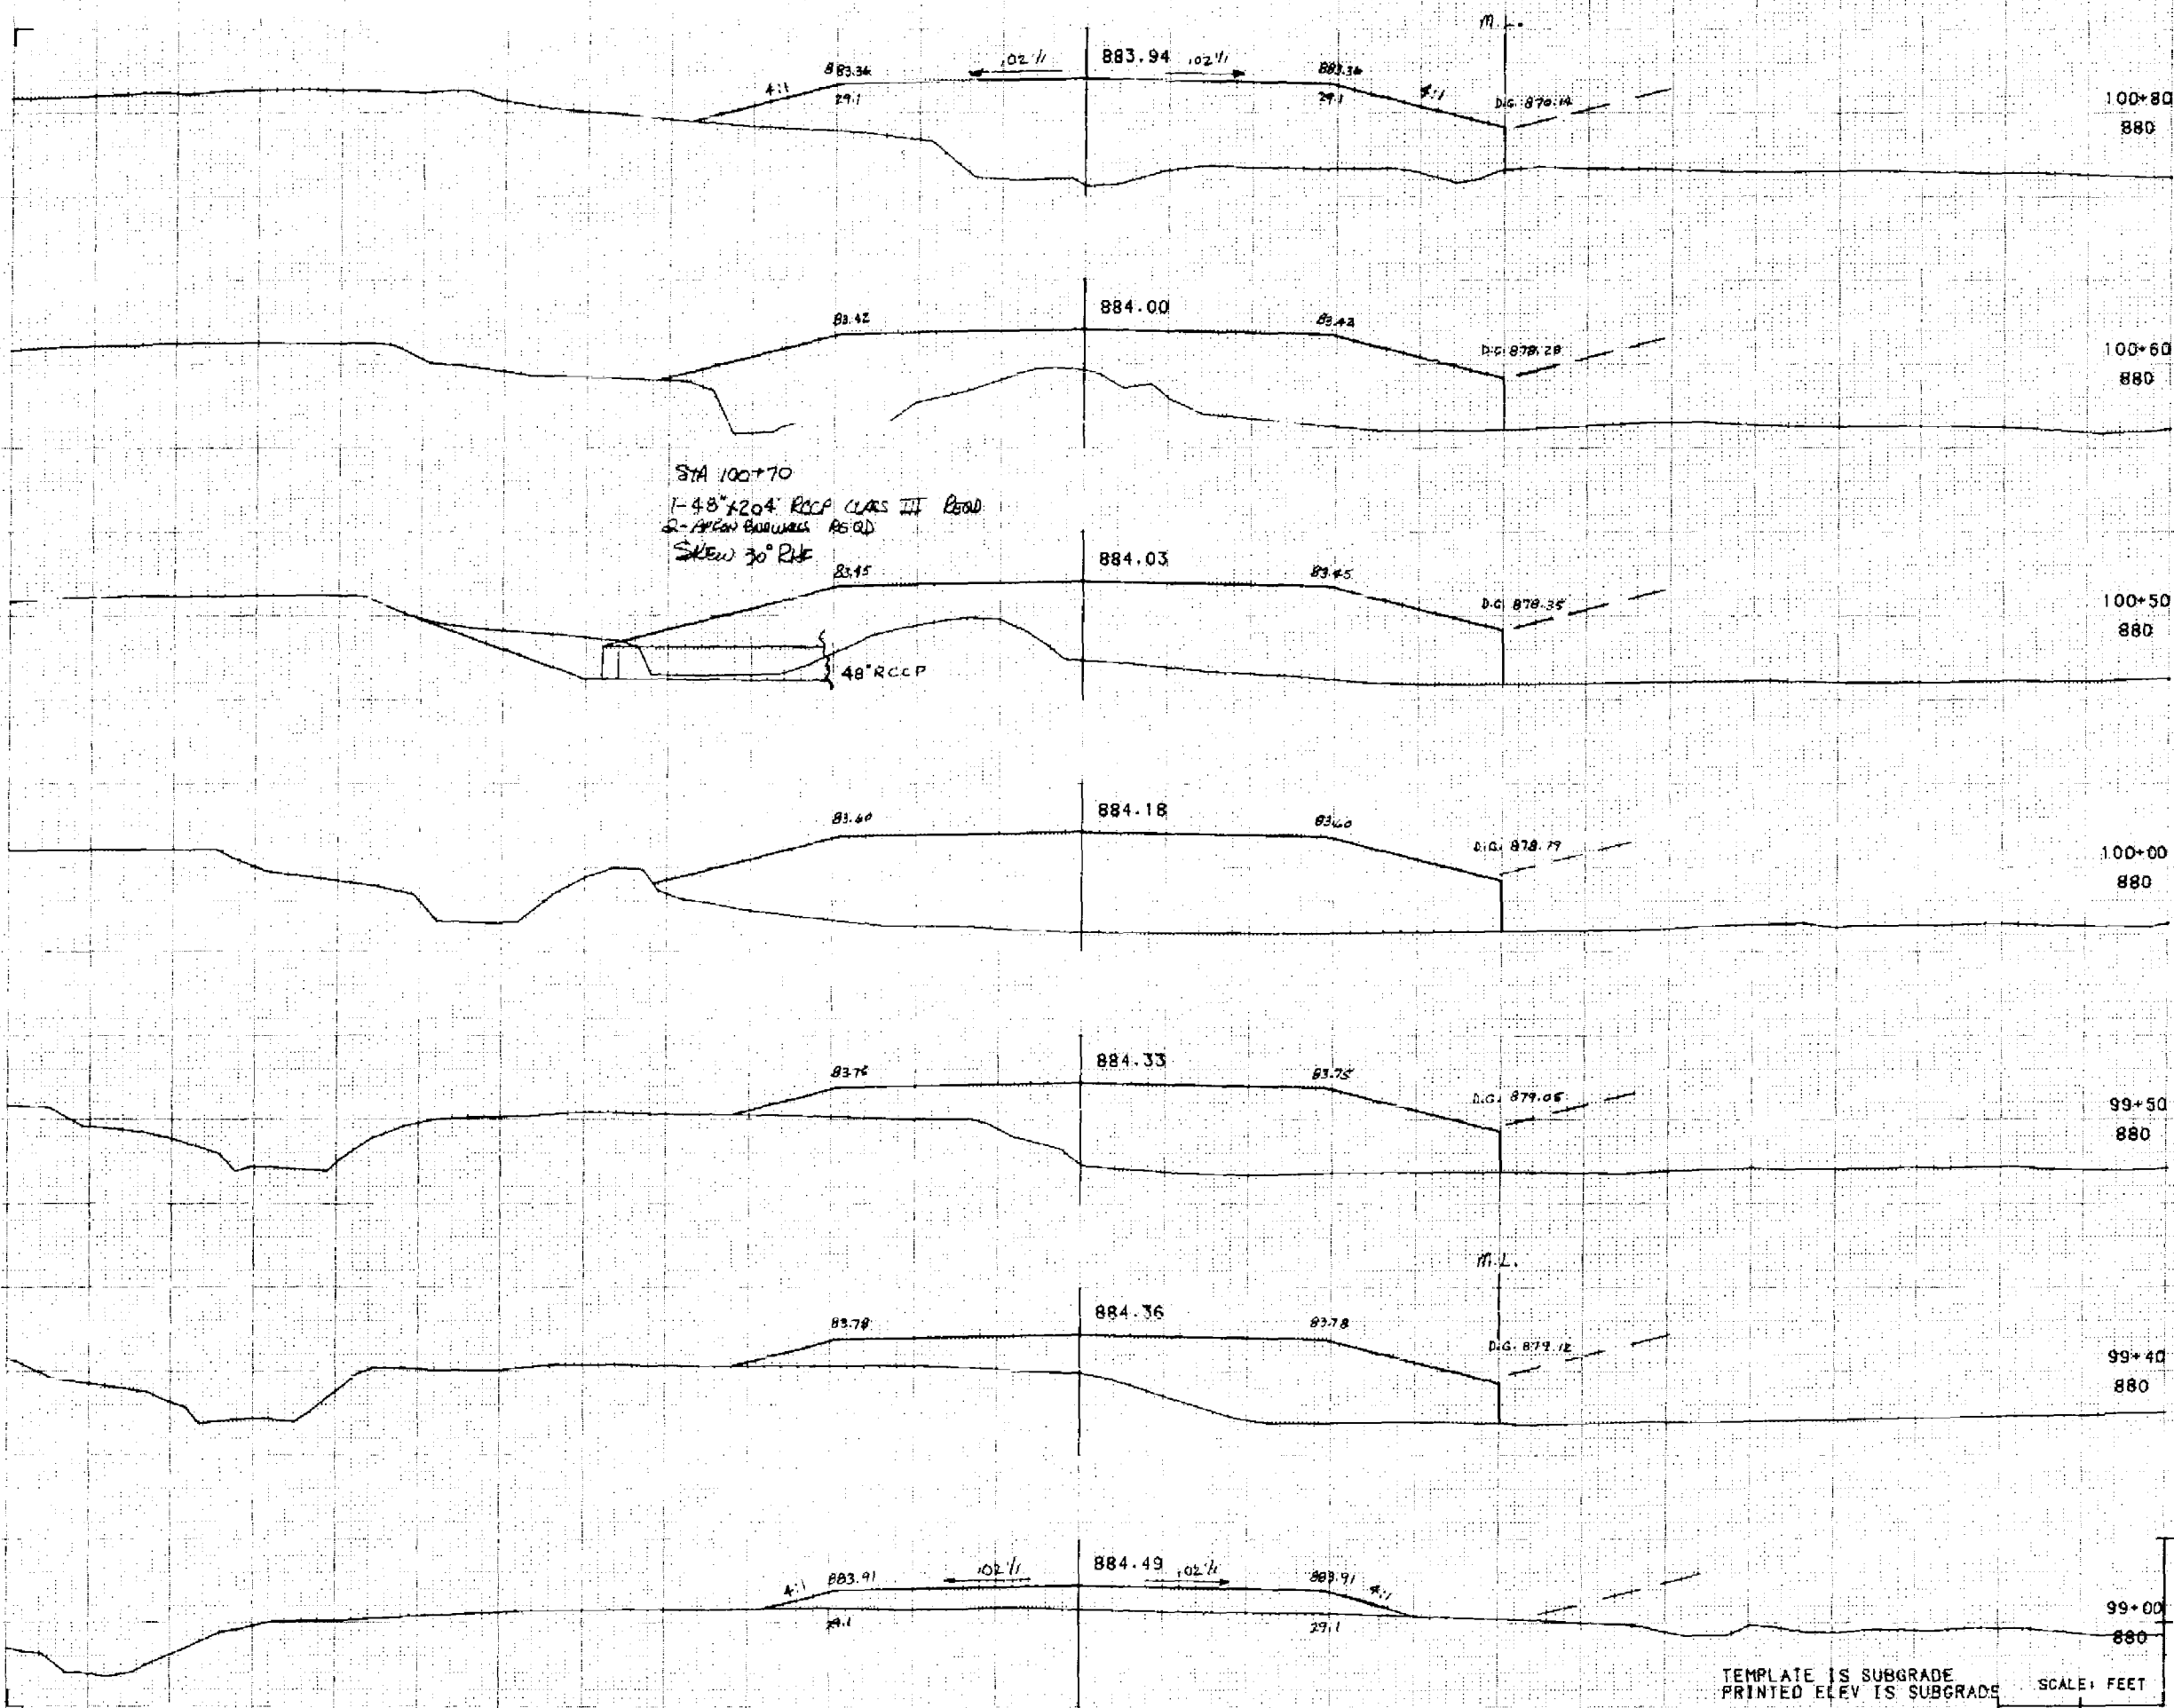

STATE PROJECT NUMBER				SHEET NUMBER
7255-05-71				933
STATION	DISTANCE	YARDAGE		
		EXCAVATION		FILL
		UNCL		
98+50	50	0		306
99+00	40			512
99+40	10			210
99+50	50			1481
100+00	50			1465
100+50	10			300
100+60	20	0		594
100+80				
TOTAL	0			5068

TEMPLATE IS SUBGRADE
 PRINTED ELEV IS SUBGRADE
 SCALE: FEET
 SHEET NO. 5 6 725505001.3

NE RAMP

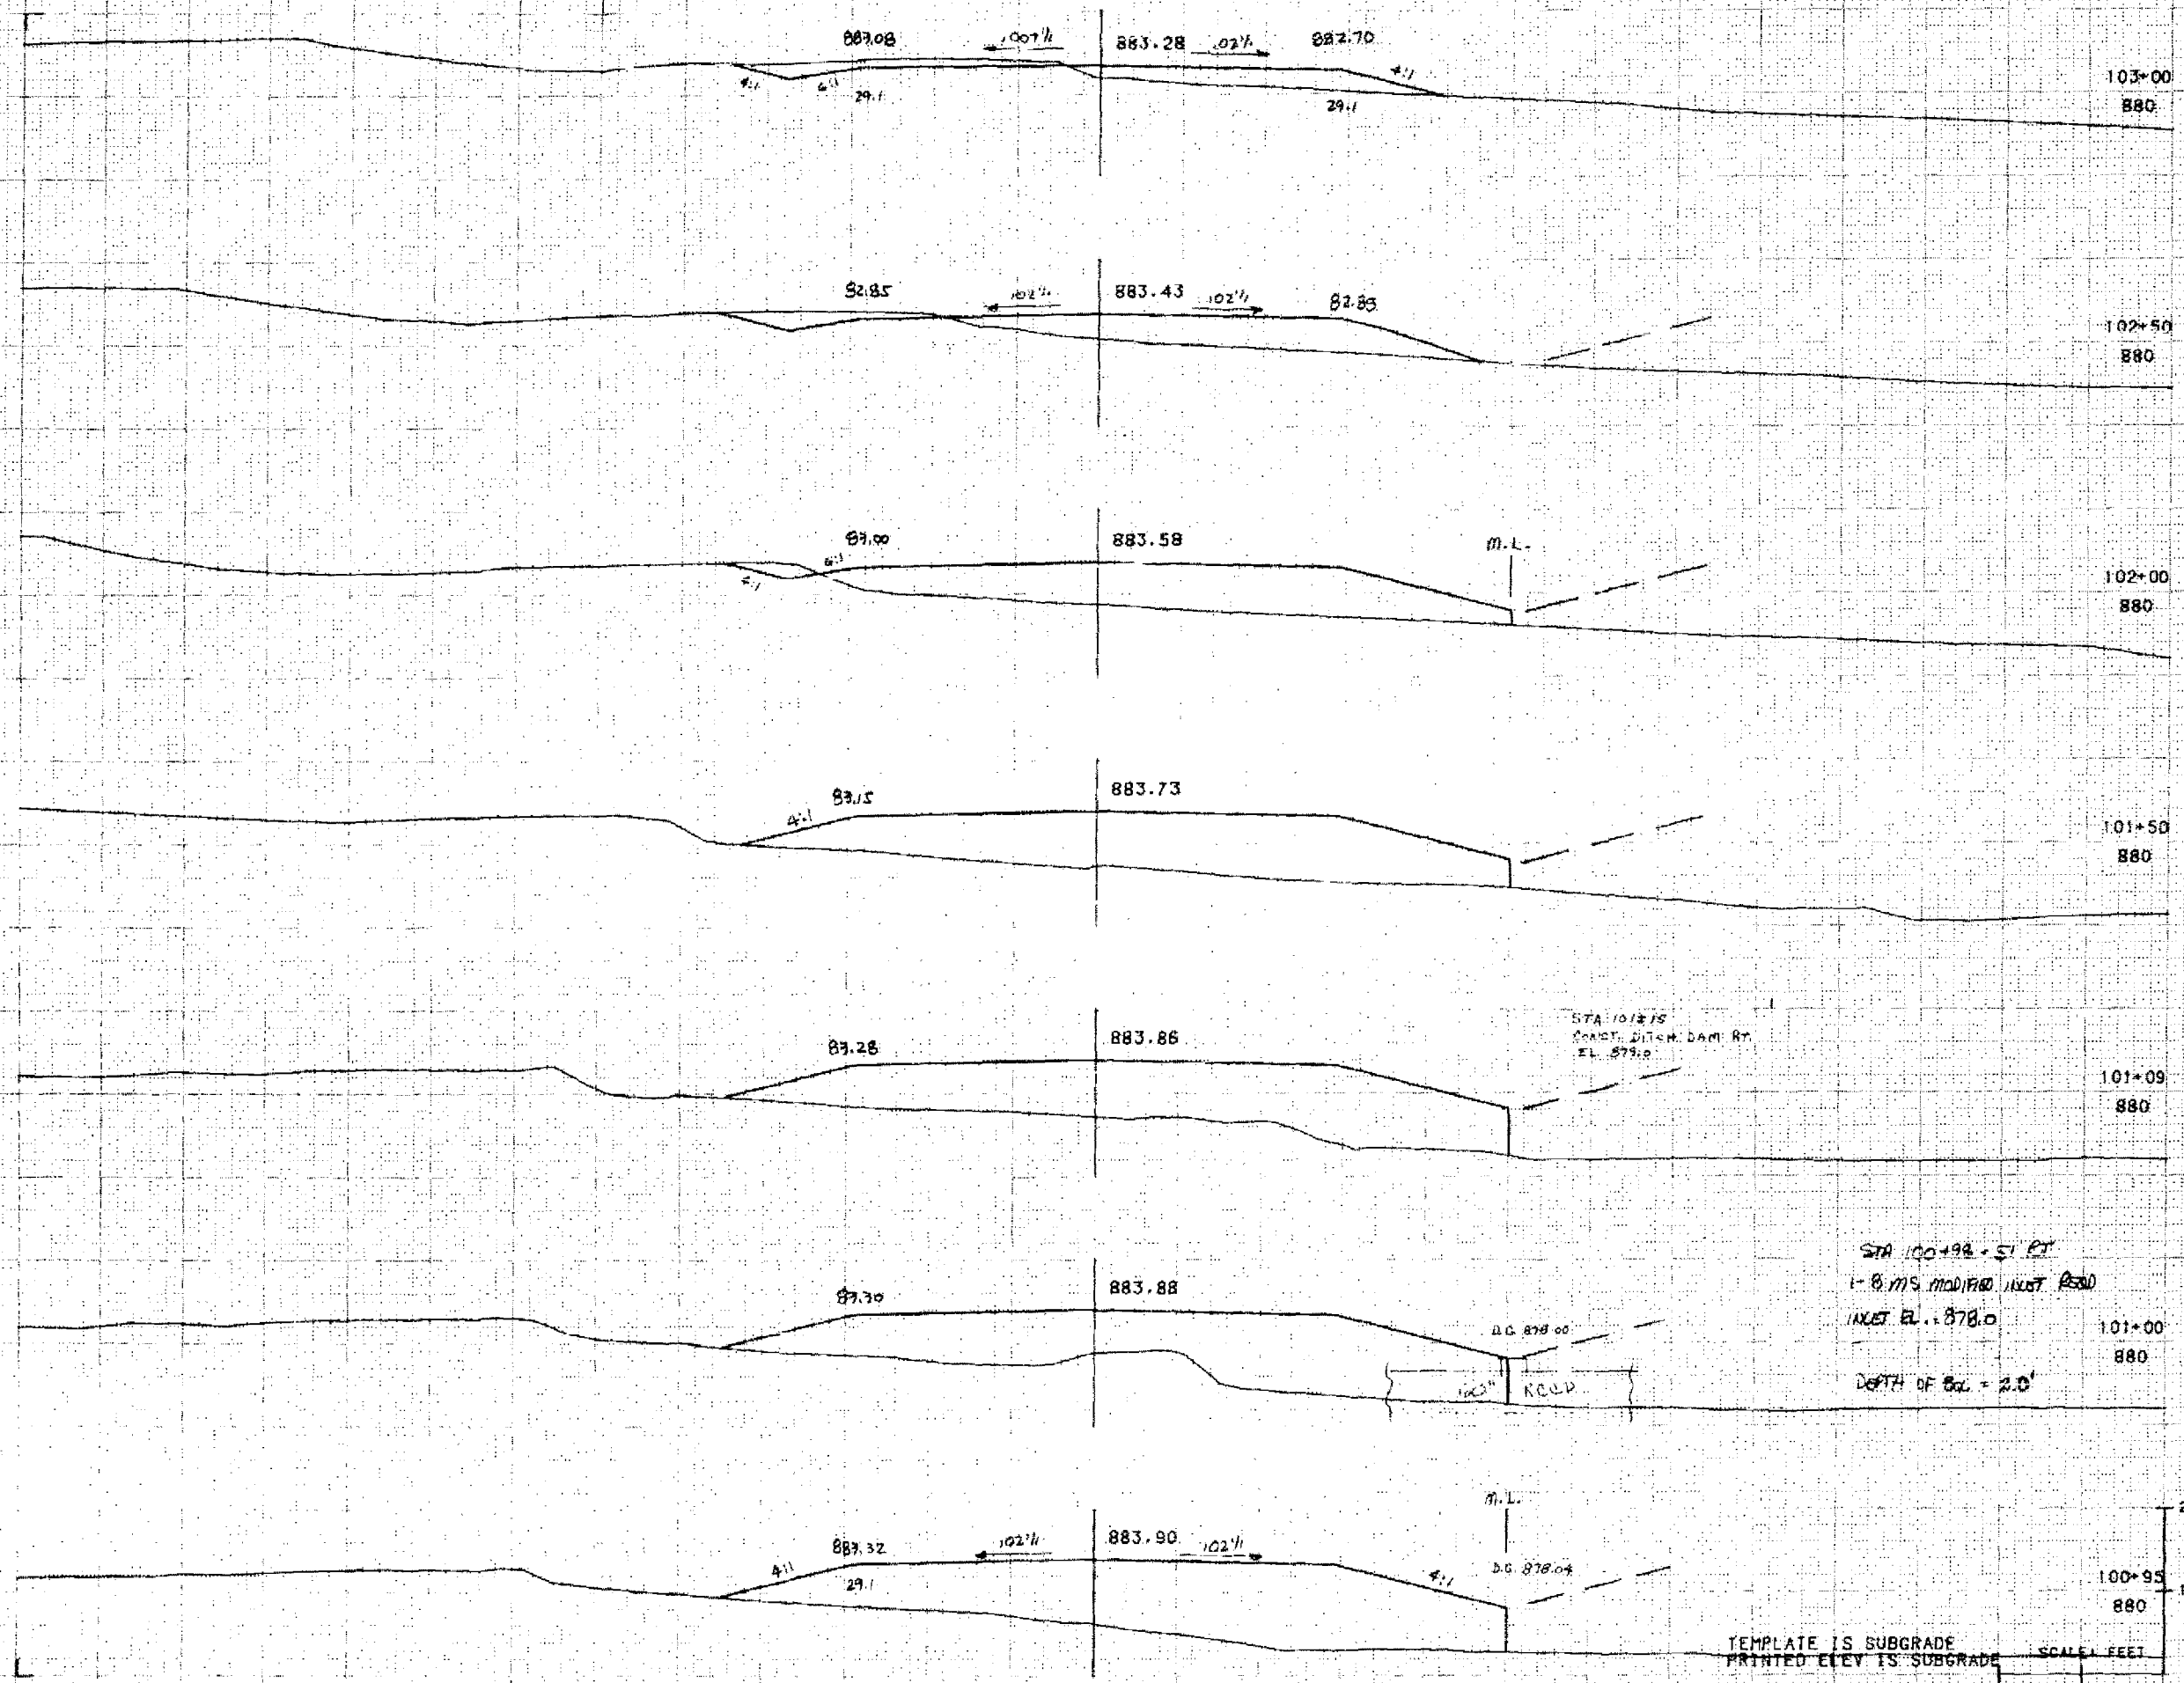

STATION	DISTANCE	YARDAGE			
		EXCAVATION			FILL
100+00	15	0			40.7
100+95	5				11.4
101+00	9				19.2
101+09	41	0			82.5
101+50	50	11			80.8
102+00	50	40			49.3
102+60	50	66			23.1
103+00					
TOTAL		117			30.70

NE RAMP

N.S. USH 33
MEDIAN EDGE

E.O.P.

NE RAMP

108+50
890

STATE PROJECT NUMBER
7255-05-71

SHEET NUMBER
9.90

STATION	DISTANCE	YARDAGE			
		EXCAVATION			FILL
		UNDER			
105+00	50	160			54
105+50	50	125			40
106+00	50	102			28
106+50	50	105			22
107+00	50	90			28
107+50	50	72			67
108+00	50	69			91
108+50					
TOTAL	725				332

STA 108+00
1- 18" X 76" C.S. CP IN PLACE
1- 18" X 20" C.S. CP EXTENSION RT
1 APRON ENDWALL

108+00
890

107+50
890

107+00
890

106+50
890

106+00
890


105+50
890

NE RAMP

TEMPLATE IS SUBGRADE
PRINTED ELEV IS SUBGRADE

SCALE: FEET

SHEET NO 1 6 7255050013

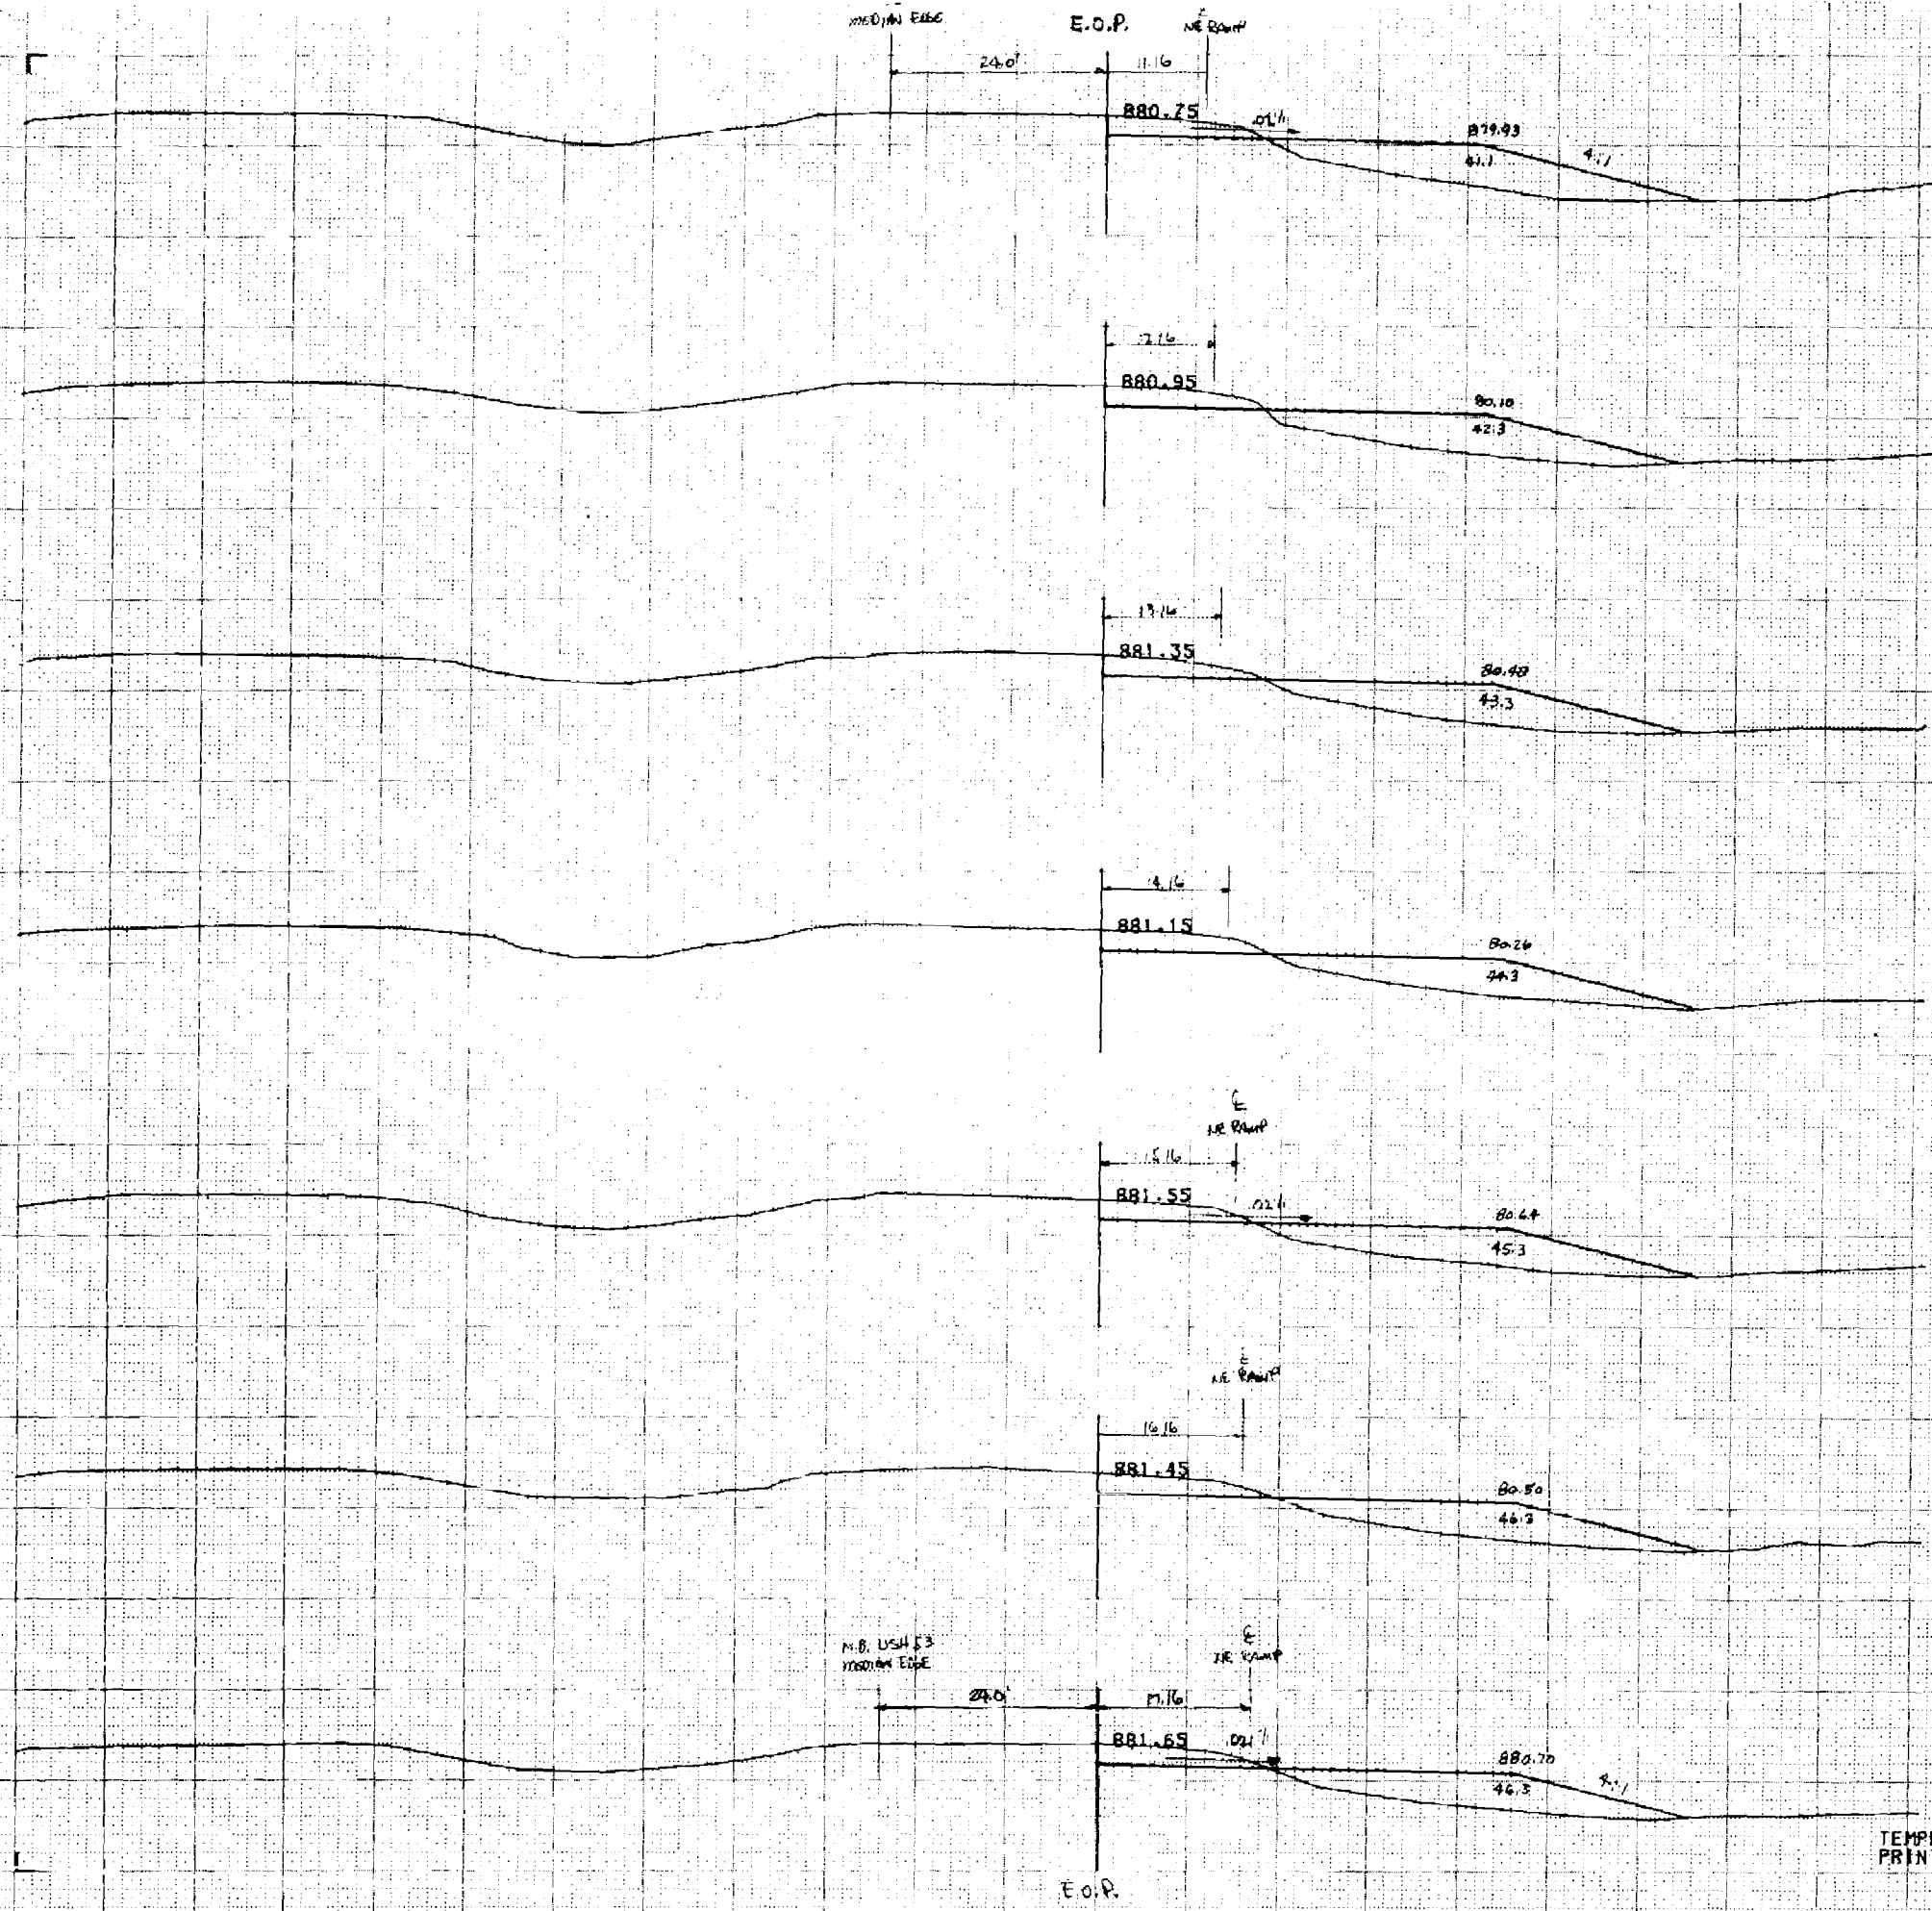

111+50
890

111+00
890

110+50
890

110+00
890

109+50
890

109+25
890

109+00
890

STATE PROJECT NUMBER				SHEET NUMBER	
7255-05-71				931	
STATION	DISTANCE	YARDAGE			FILL
		EXCAVATION			
		UNCL			
108+50	50	62			156
109+00	25	31			111
109+25	25	29			119
109+50	50	59			223
110+00	50	59			223
110+50	50	56			237
111+00	50	57			248
111+50					
TOTAL		353			1312

TEMPLATE IS SUBGRADE
PRINTED ELEV IS SUBGRADE

SHEET NO 2 6 725505b013

SCALE: FEET

20 10 0

N.B. USH. 83
MEDIAN EDGE

E.A.H. 2
N.E. RAMP

24.0'

879.65

878.96

34.3

0.0 75.1

879.95

77.24

35.3

D.G. 74.9

880.05

77.32

36.3

D.G. 74.8

880.05

77.30

37.3

D.G. 74.6

880.25

77.49

38.3

D.G. 74.5

880.65

77.86

39.3

D.G. 74.3

VAR

N.B. USH. 83
MEDIAN EDGE

24.0'

880.35

877.51

40.3

0.0 74.3

115+00

880

114+50

880

114+00

890

113+50

890

113+00

890

112+50

890

112+00


890

STATE PROJECT NUMBER	SHEET NUMBER
7255-05-71	9, 18

STATION	DISTANCE	YARDAGE			
		EXCAVATION			FILL
		UNCL			
111+50	50	50			240
112+00	50	84			227
112+50	50	91			201
113+00	50	69			175
113+50	50	63			172
114+00	50	56			169
114+50	50	63			141
115+00					
TOTAL		482			1331

TEMPLATE IS SUBGRADE
PRINTED ELEV IS SUBGRADE
SCALE: FEET

N.E. RAMP

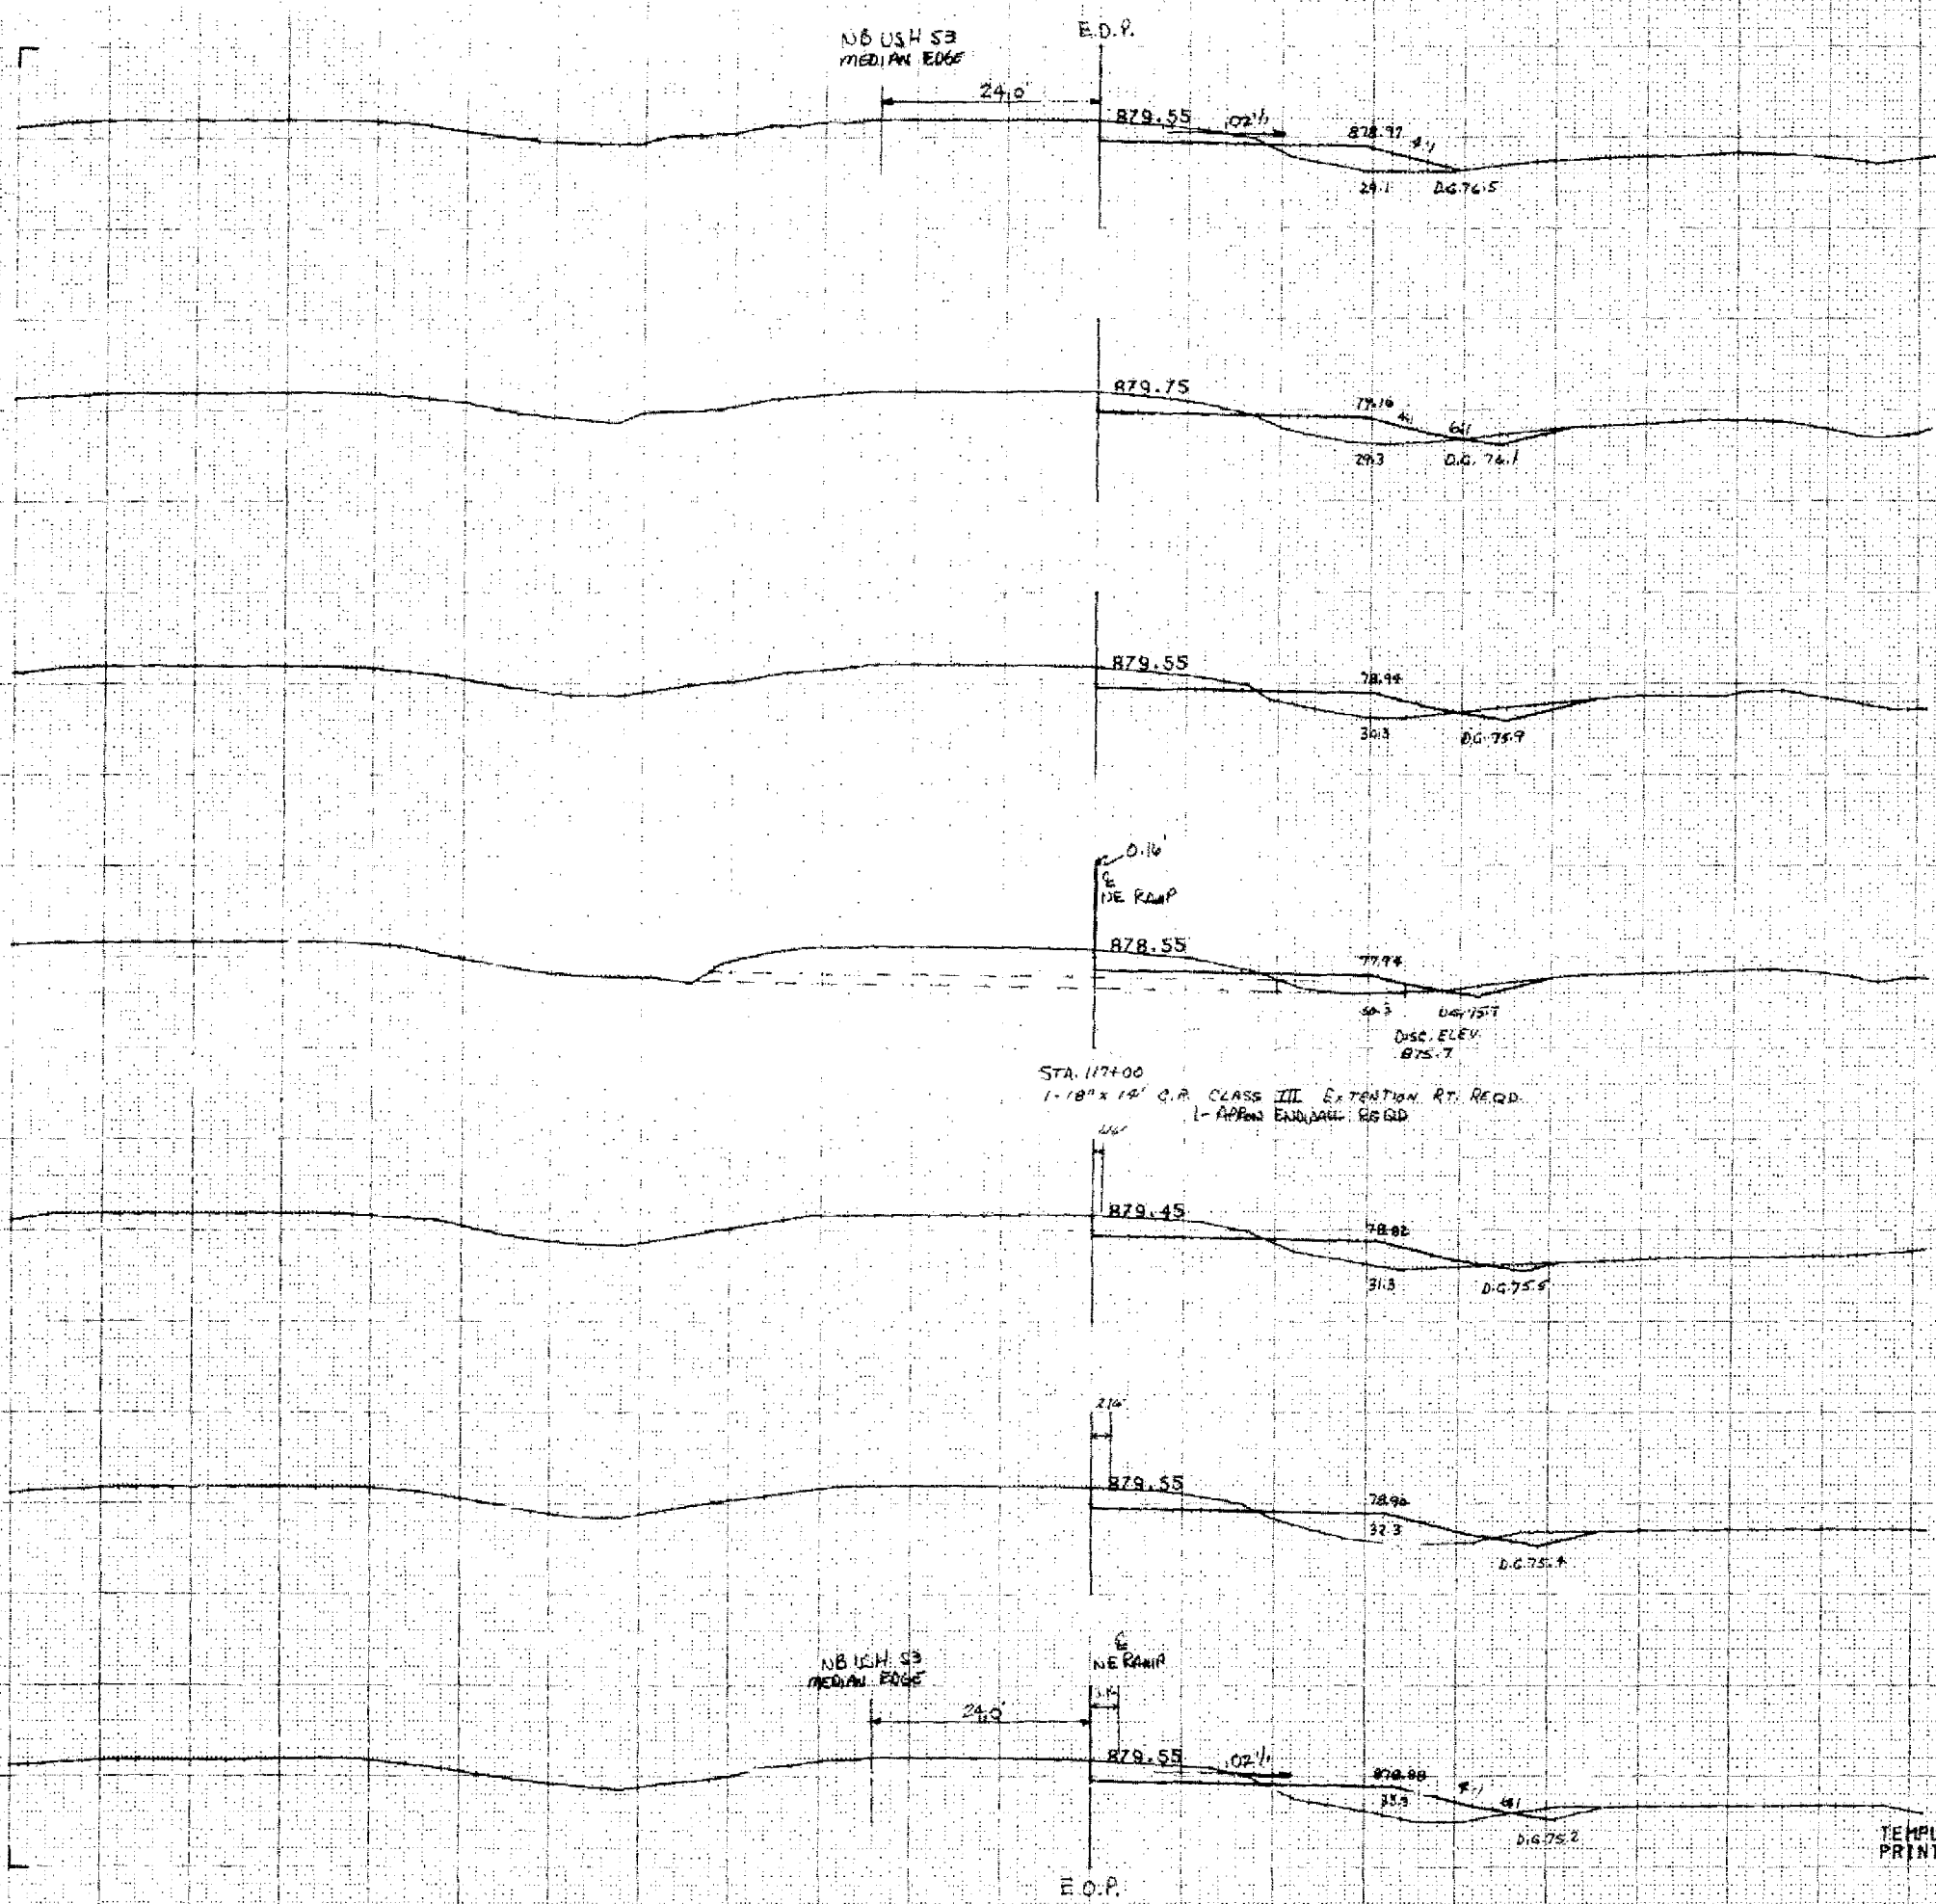

STATE PROJECT NUMBER				SHEET NUMBER	
7255-25-71				939	
STATION	DISTANCE	YARDAGE			FILL
		EXCAVATION			
		LINE			
115+00	50	71			112
115+50		72			98
116+00		68			81
116+50		62			58
117+00		33			28
117+25		32			34
117+50	50	50			46
118+00					
	TOTAL	394			477

STA. 117+00
1-18" x 14' C.R. CLASS III EXTENSION RT. REQD.
1- APPROX ENDORSEMENT REQD.

TEMPLATE IS SUBGRADE
PRINTED ELEV IS SUBGRADE
SCALE: FEET
SHEET NO 4 6 725505D013

NB USH S3
MEDIAN EDGE

E.O.P.

121+50
890

STATE PROJECT NUMBER	SHEET NUMBER
7255-05-71	940

STATION	DISTANCE	YARDAGE				FILL
		EXCAVATION				
		UNCL				
118+00	50	51				63
118+50	50	50				52
119+00	50	61				31
119+50	50	80				12
120+00	50	85				1
120+50	50	69				4
121+00	50	57				10
121+50						
	TOTAL	453				173

121+00
890

120+50
890

120+00
880

119+50
880

119+00
880

20
118+50
880
10

NE RAMP

TEMPLATE IS SUBGRADE
PRINTED FLEV IS SUBGRADE

SCALE: HFT

SHEET NO 5 6 7255050013

NB USH S3
MEDIAN EDGE

E.O.P.

N.B. USH 53
MEDIAN EDGE

E.O.P.

24.0

884.65

.02/11

884.07

29.1

884.05

883.47

883.85

883.27

883.15

882.57

882.65

881.07

881.95

881.37

881.65

880.07

N.B. USH 53
MEDIAN EDGE

24.0

880.95

.02/11

880.37

29.1

E.O.P.

TEMPLATE IS SUBGRADE
PRINTED ELEV IS SUBGRADE

SCALE: FEET

SHEET NO 6 6 7255050013

STATE PROJECT NUMBER
7255-05-71

SHEET
NUMBER
941

STATION	DISTANCE	YARDAGE			FILL
		EXCAVATION			
		UNOL			
121+50	50	54			19
122+00	50	50			25
122+50	50	55			24
123+00	50	54			22
123+50	50	50			22
124+00	50	52			24
124+50	50	57			25
125+00	50	63			37
125+50	TOTAL	435			198

NE RAMP

E.O.P.

NB USH SB
MEDIAN EDGE

24.0'

875.02

02 1/1 094.61

20.3

1/4"

893.55

093.00

22.3

1/4"

892.35

091.84

24.3

4.1

891.45

90.94

25.3

NB USH SB
MEDIAN EDGE

24.0

890.85

01 1/1 090.12

26.3

4.1

E.O.P.

STATE PROJECT NUMBER			SHEET NUMBER
7255-05-71			943
STATION	DISTANCE	YARDAGE	
		EXCAVATION	
		UNDER	FILL
128+50			
29+00	50	49	282
		54	275
29+50			
	50	52	288
130+00	100	93	372
131+00			
	100	93	81
132+00			

132+00
890

131+00
890

130+00
900

129+50
900

129+00
900

20


10

1/4" RAUP

TEMPLATE IS SUBGRADE
PRINTED ELEV IS SUBGRADE

SCALE: FEET

SHEET NO 8 6 7255050013

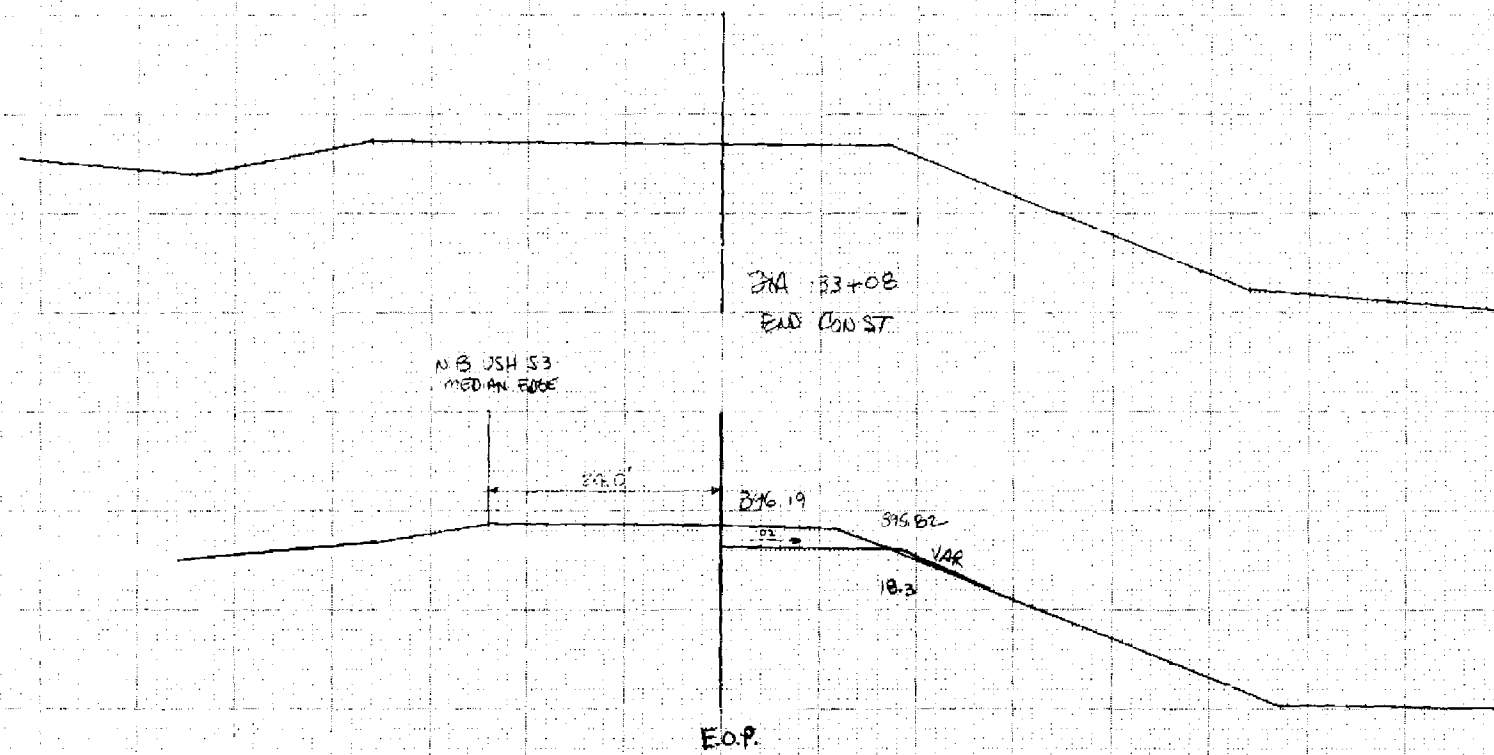[illegible]

133+100
890


NE RAMP

SCALE FEET

SHEET TOTAL

104

33

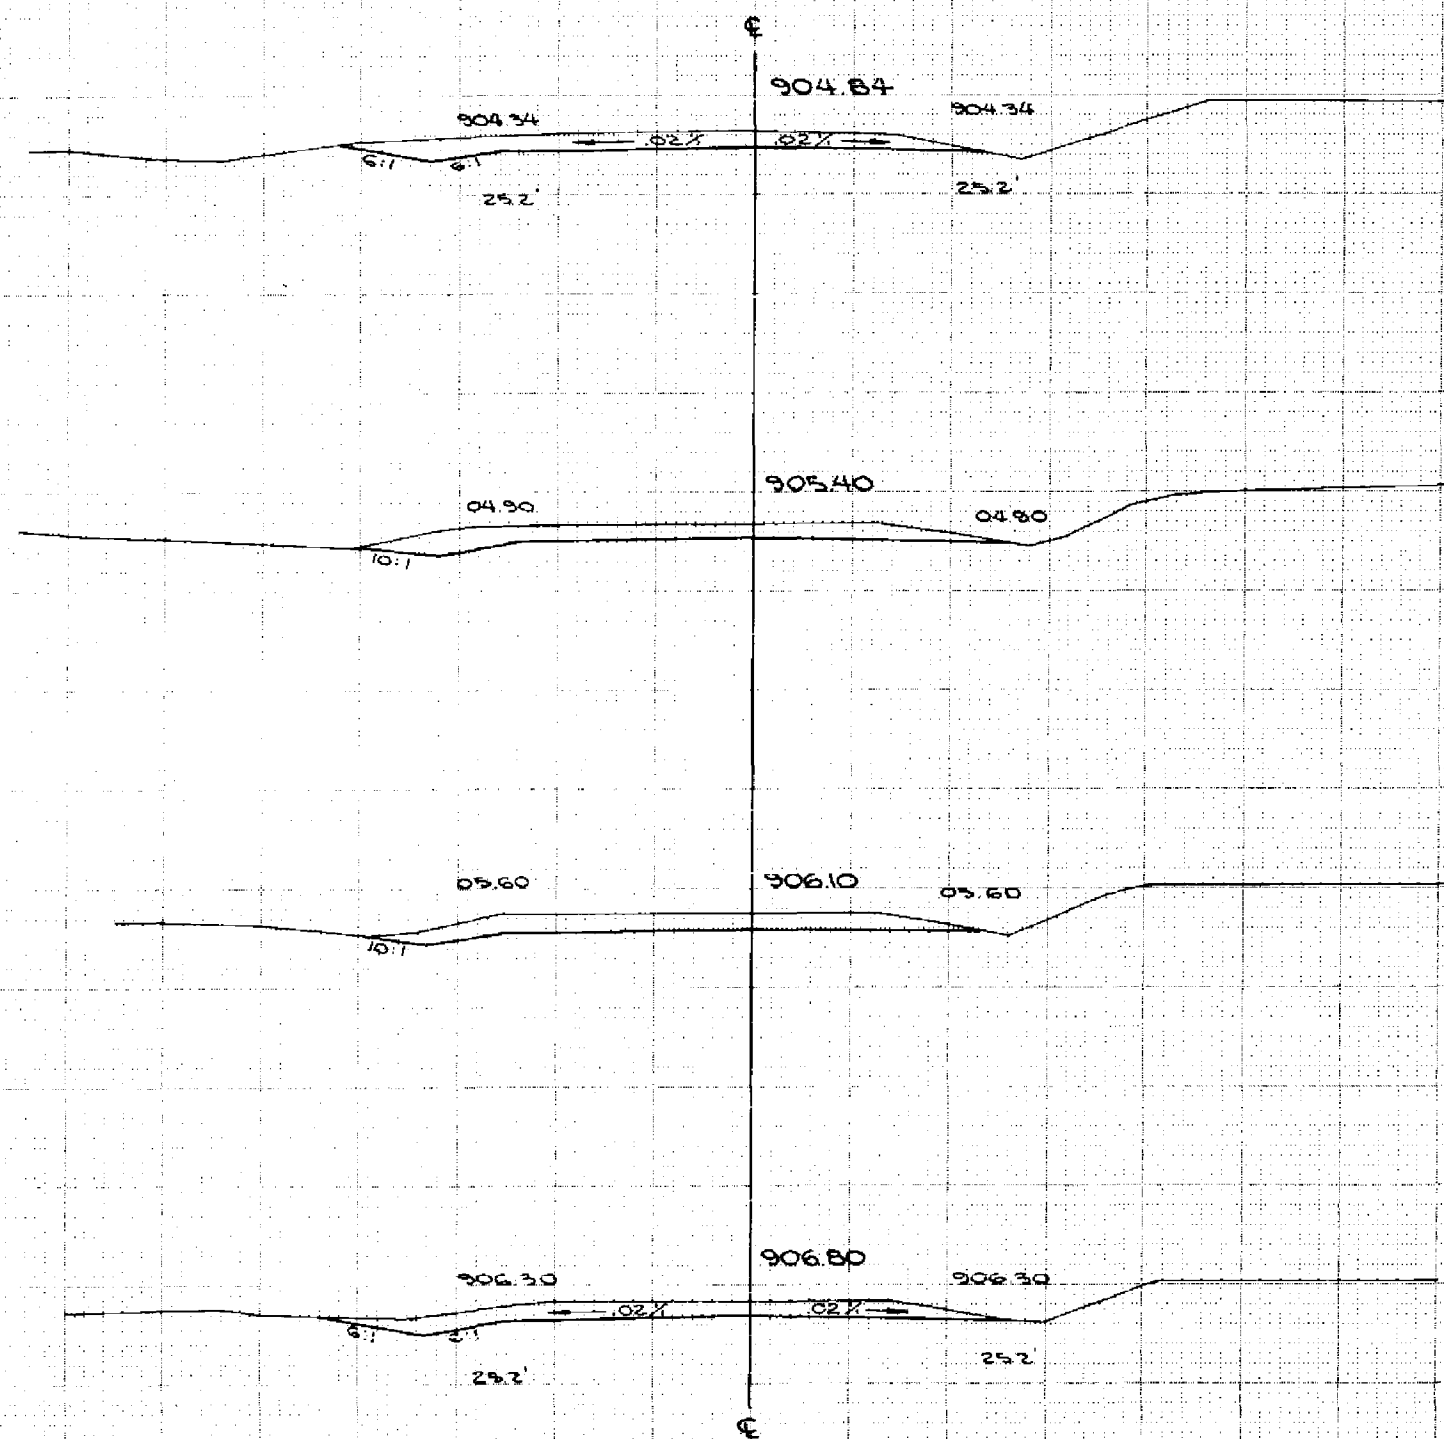


STA. 78+10
BEGIN CONSTRUCTION

E. FRONTAGE ROAD

10' SCALE FT.

STATION	DISTANCE	YARDAGE		
		EXCAVATION		FILL
		UNCL		
78 + 10				
79 + 00	30	200		
79 + 50	50	213		
80 + 00	80	208		
80 + 40	40	174		
		</		

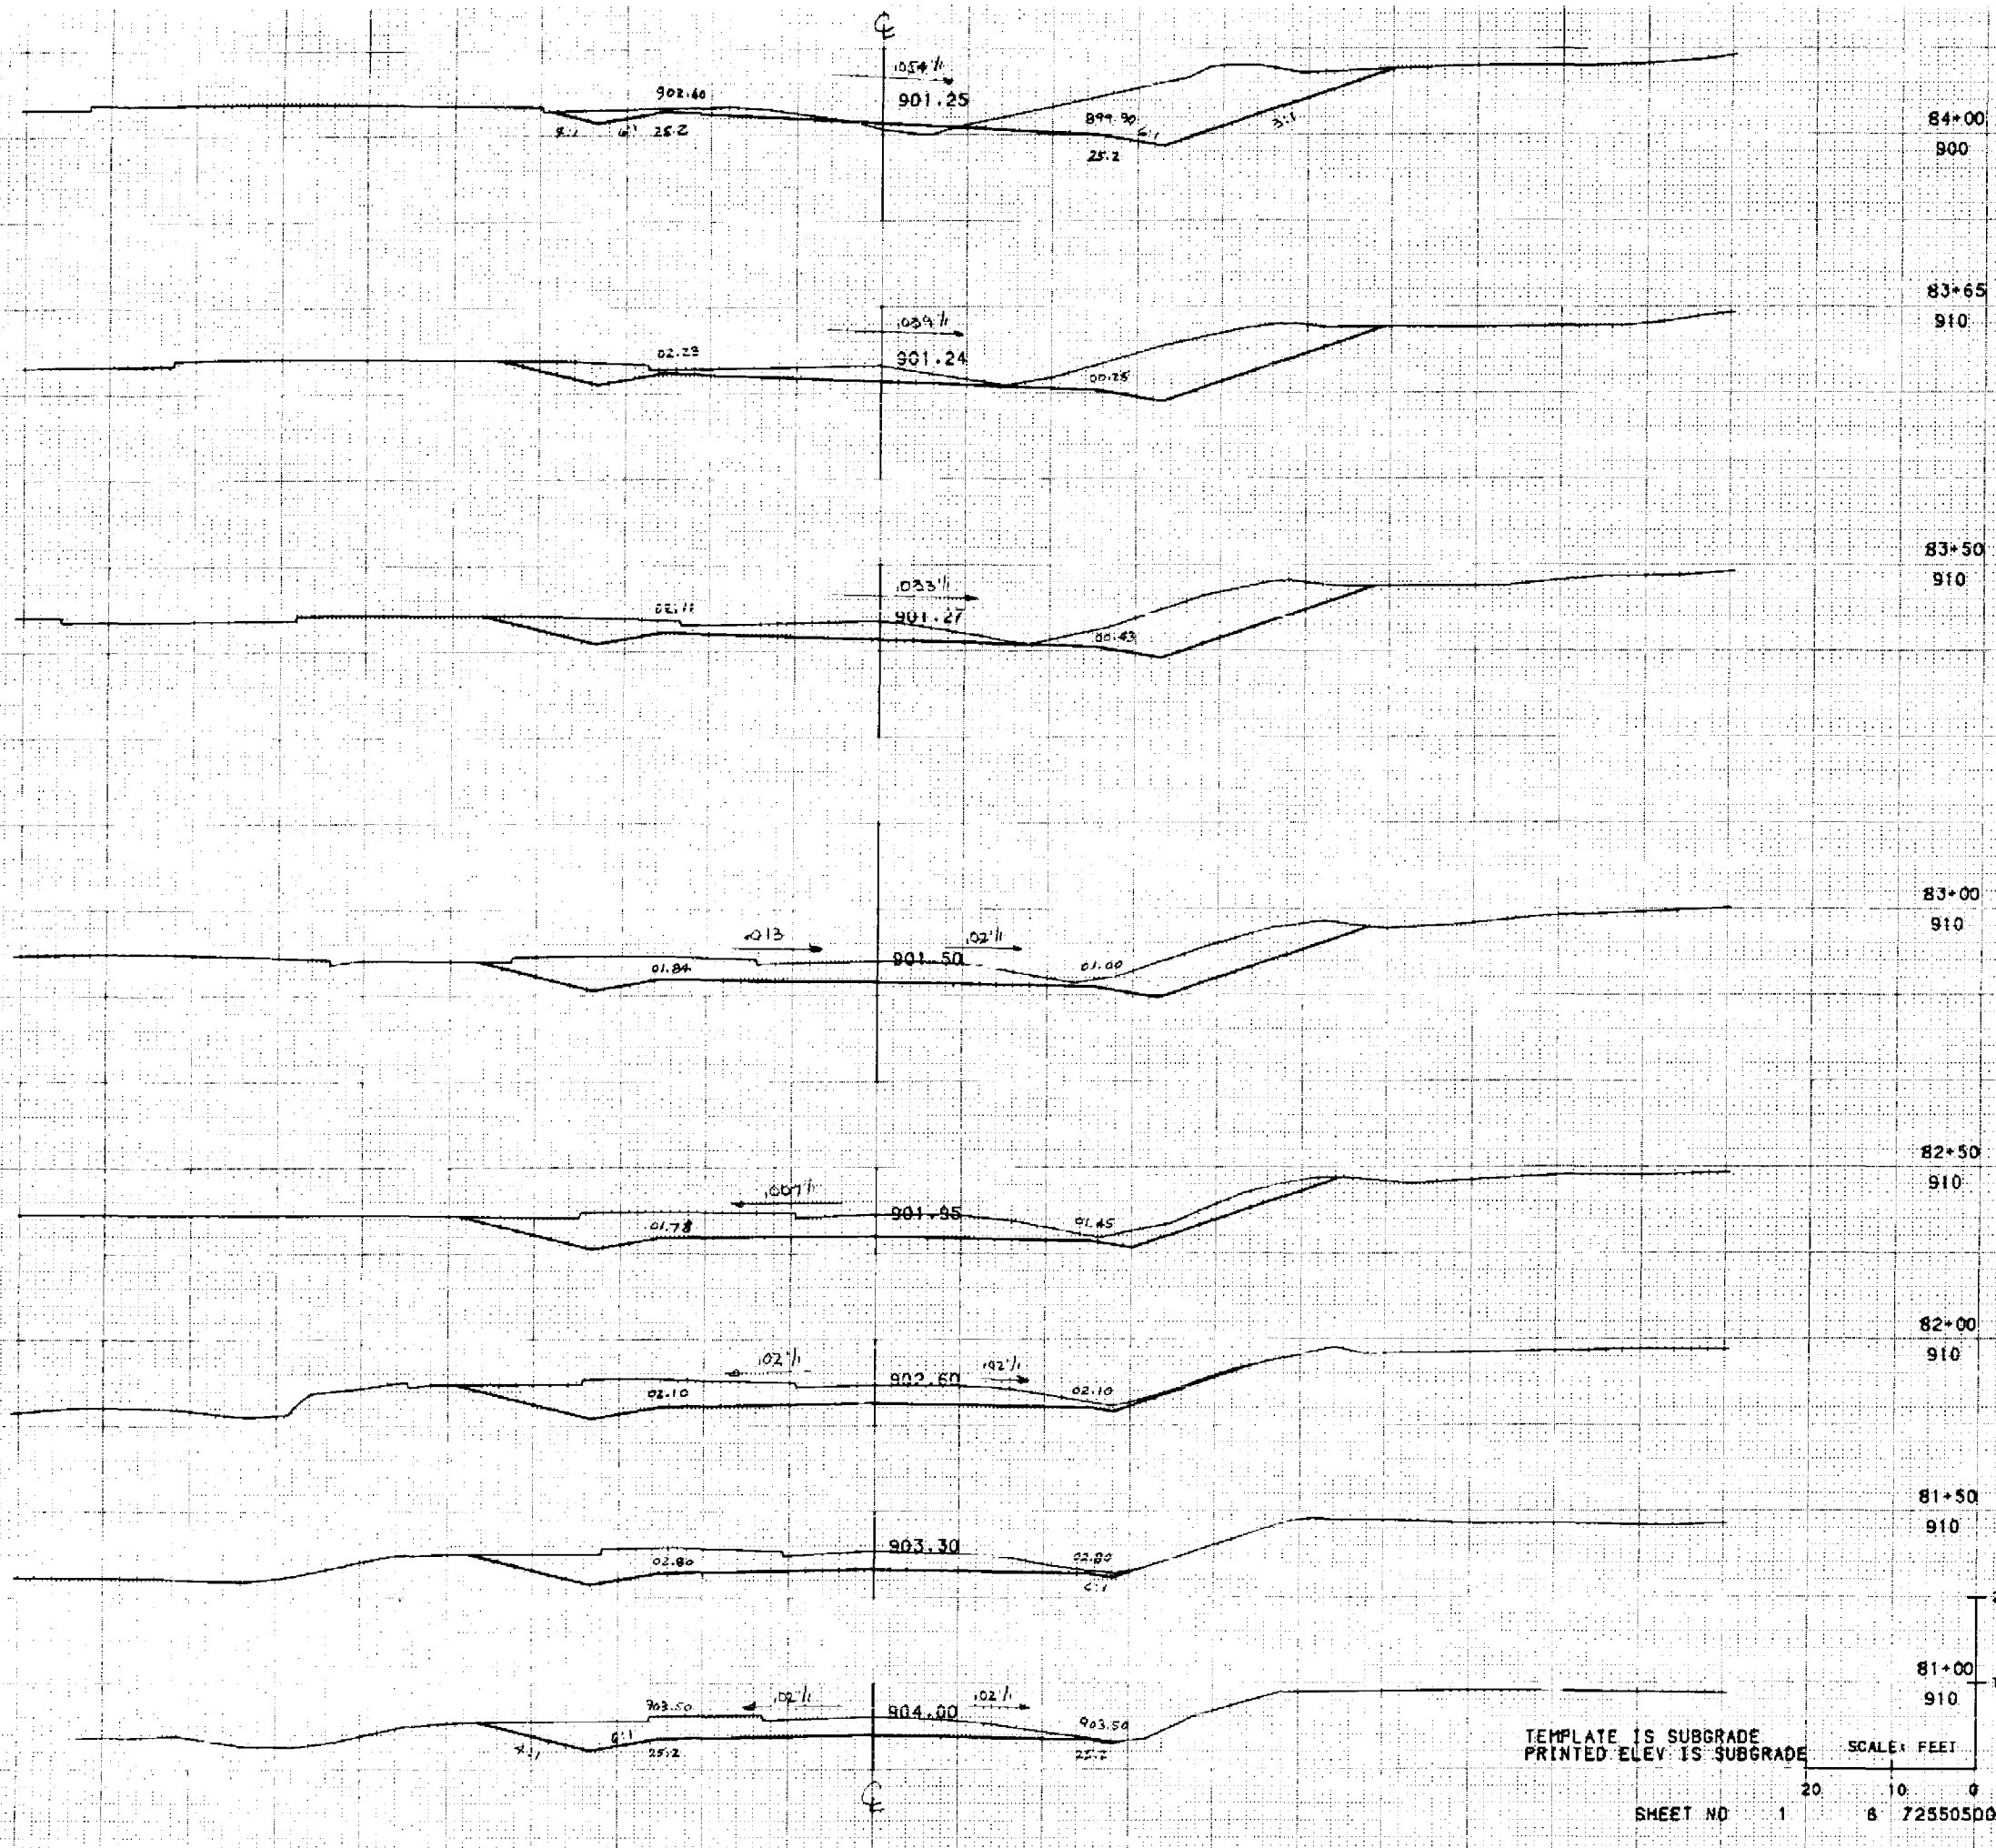

STATE PROJECT NUMBER
72 55-05-71

SHEET NUMBER
9.46


STATION	DISTANCE	YARDAGE			
		EXCAVATION			FILL
		UNCL			
80+40	60	289			0
81+00	50	273			0
81+50	50	311			0
82+00	50	374			0
82+50	50	444			0
83+00	50	450			0
83+50	15	126			0
83+65	35	290			5
84+00					
TOTAL		2557			5

TEMPLATE IS SUBGRADE
PRINTED ELEV IS SUBGRADE

SCALE: FEET

SHEET NO 1 6 7255050013


E FRONTAGE RD.

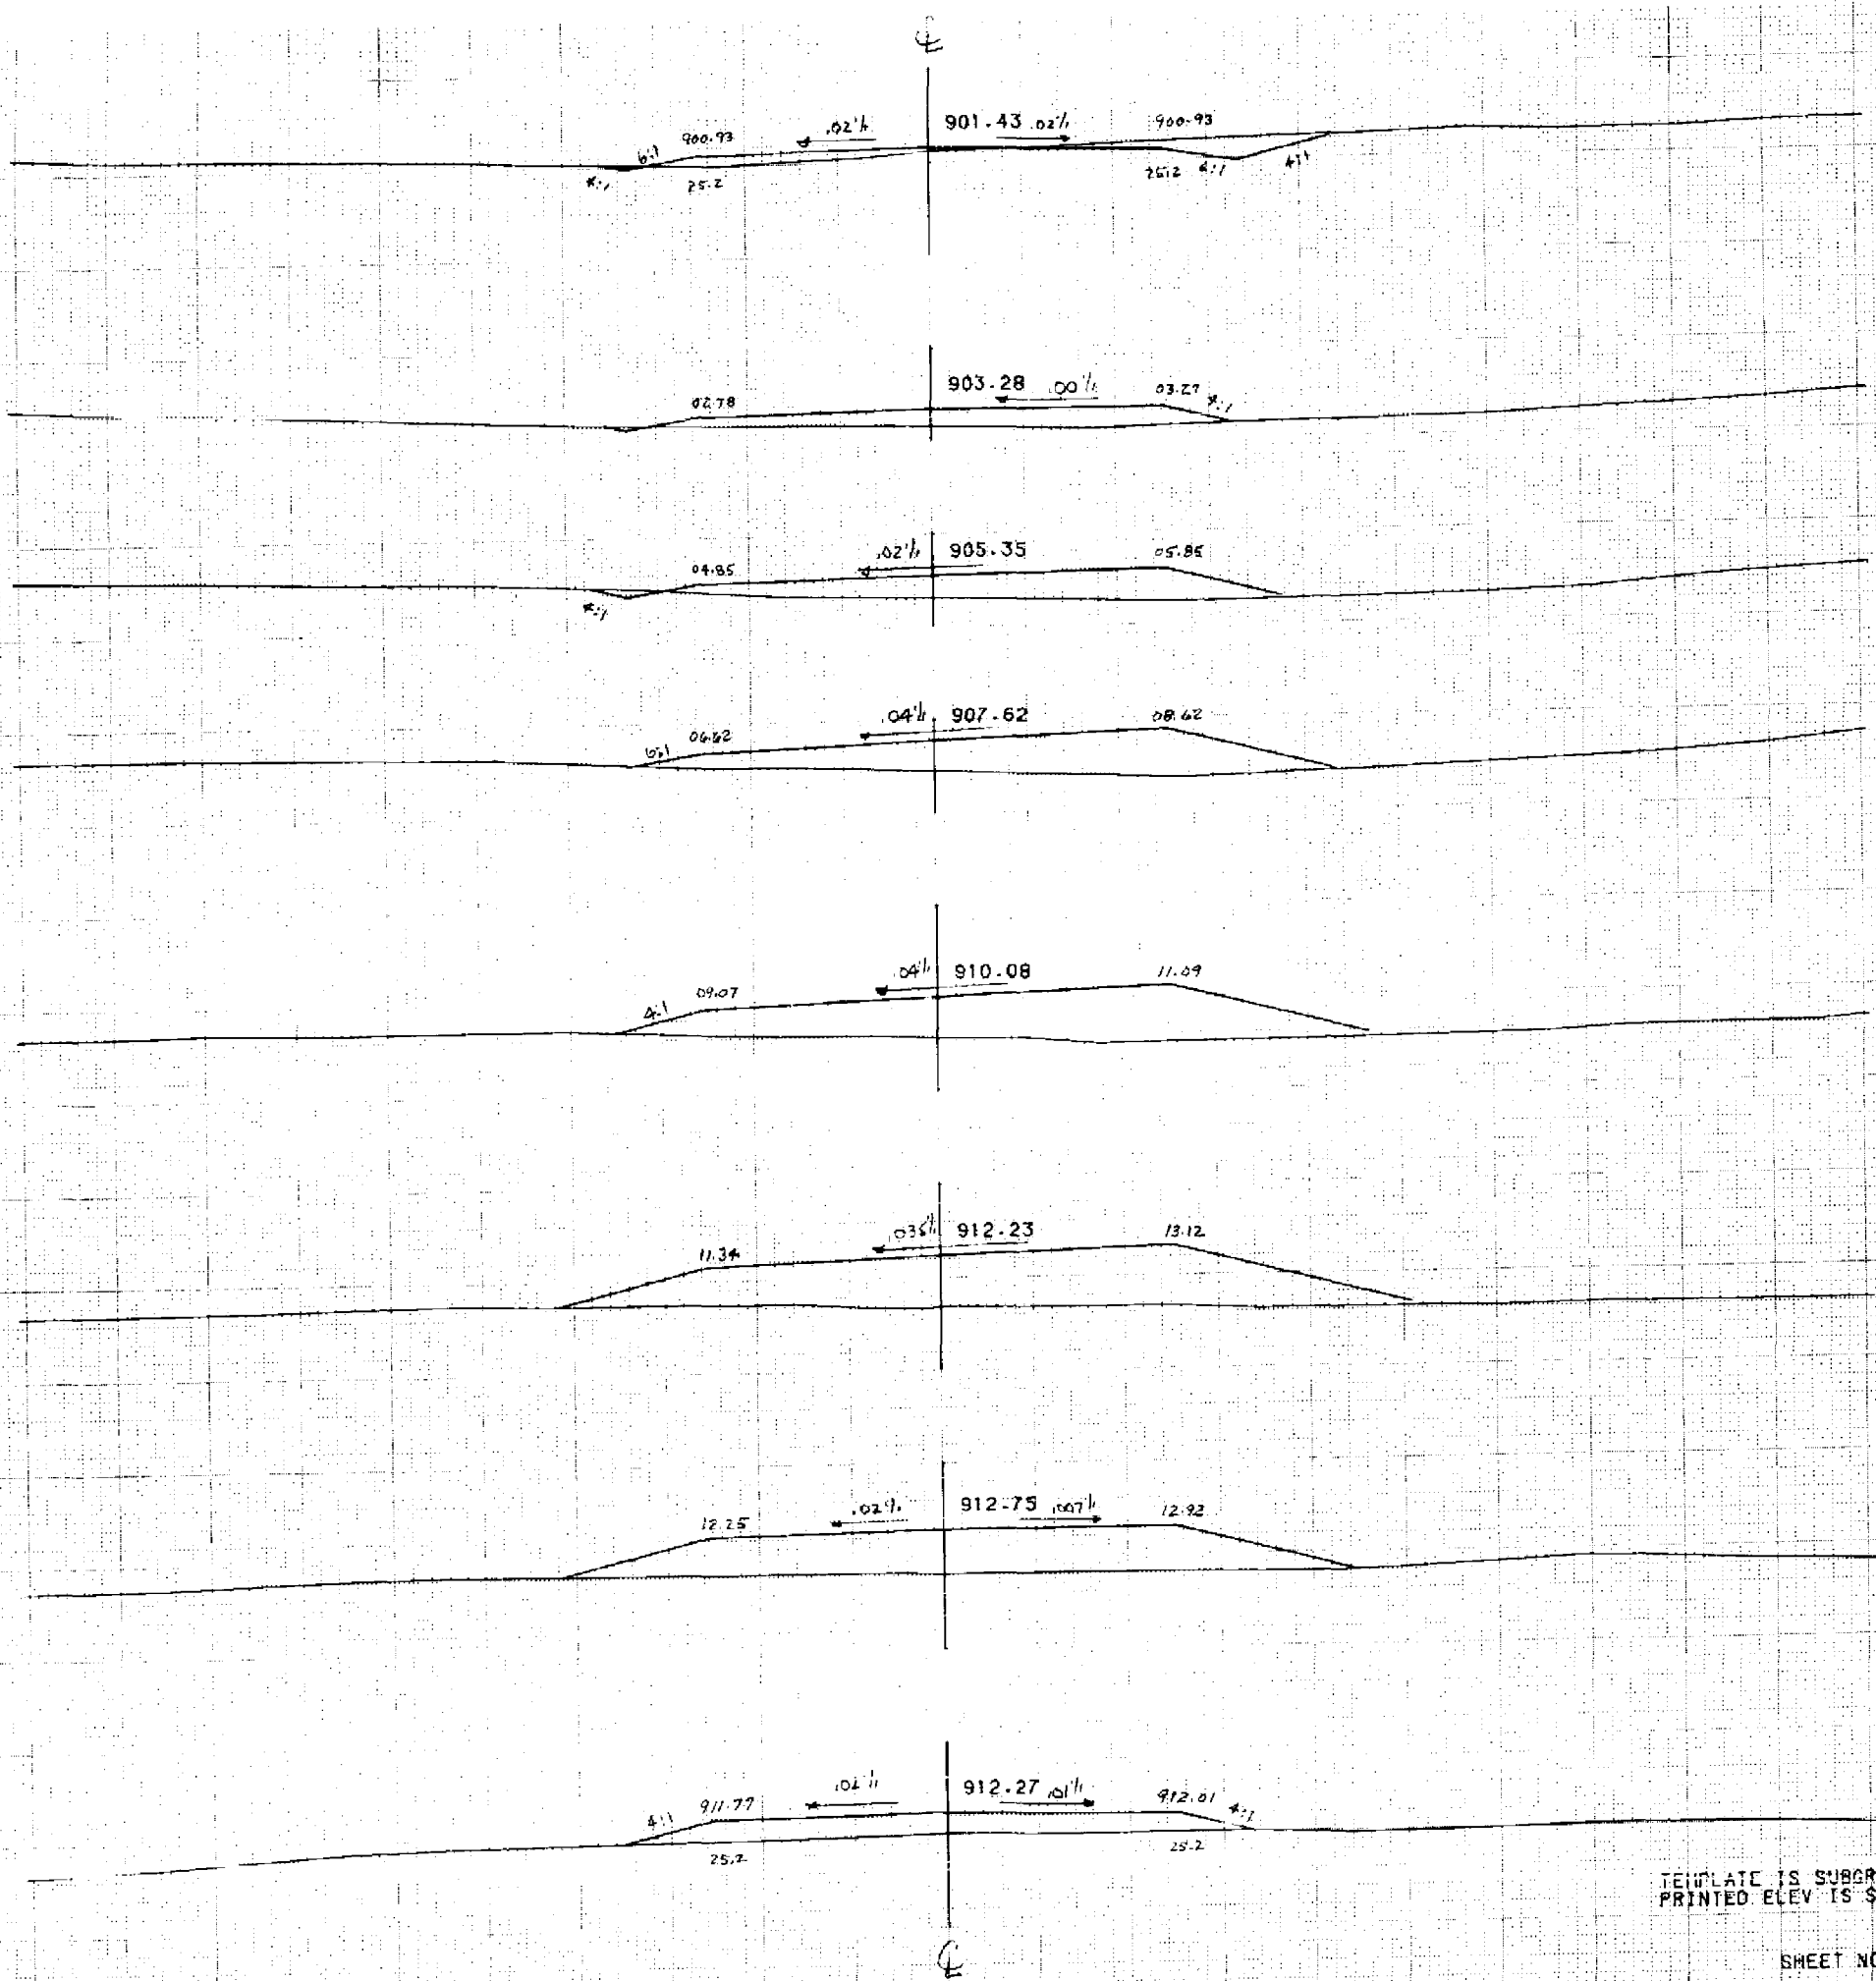

STATE PROJECT NUMBER					SHEET NUMBER
72 55-05-71					950
STATION	DISTANCE	YARDAGE			
		EXCAVATION			FILL
		UNCL			
90+70	30	0			244
91+00	50				654
91+50	50				453
92+00	50	0			486
92+50	50	4			334
93+00	50	5			221
93+50	50	33			115
94+00					
TOTAL		42			2709

TEMPLATE IS SUBGRADE
 PRINTED ELEV IS SUBGRADE
 SCALE: FEET
 SHEET NO 1
 7255050013

E. FRONTAGE RD

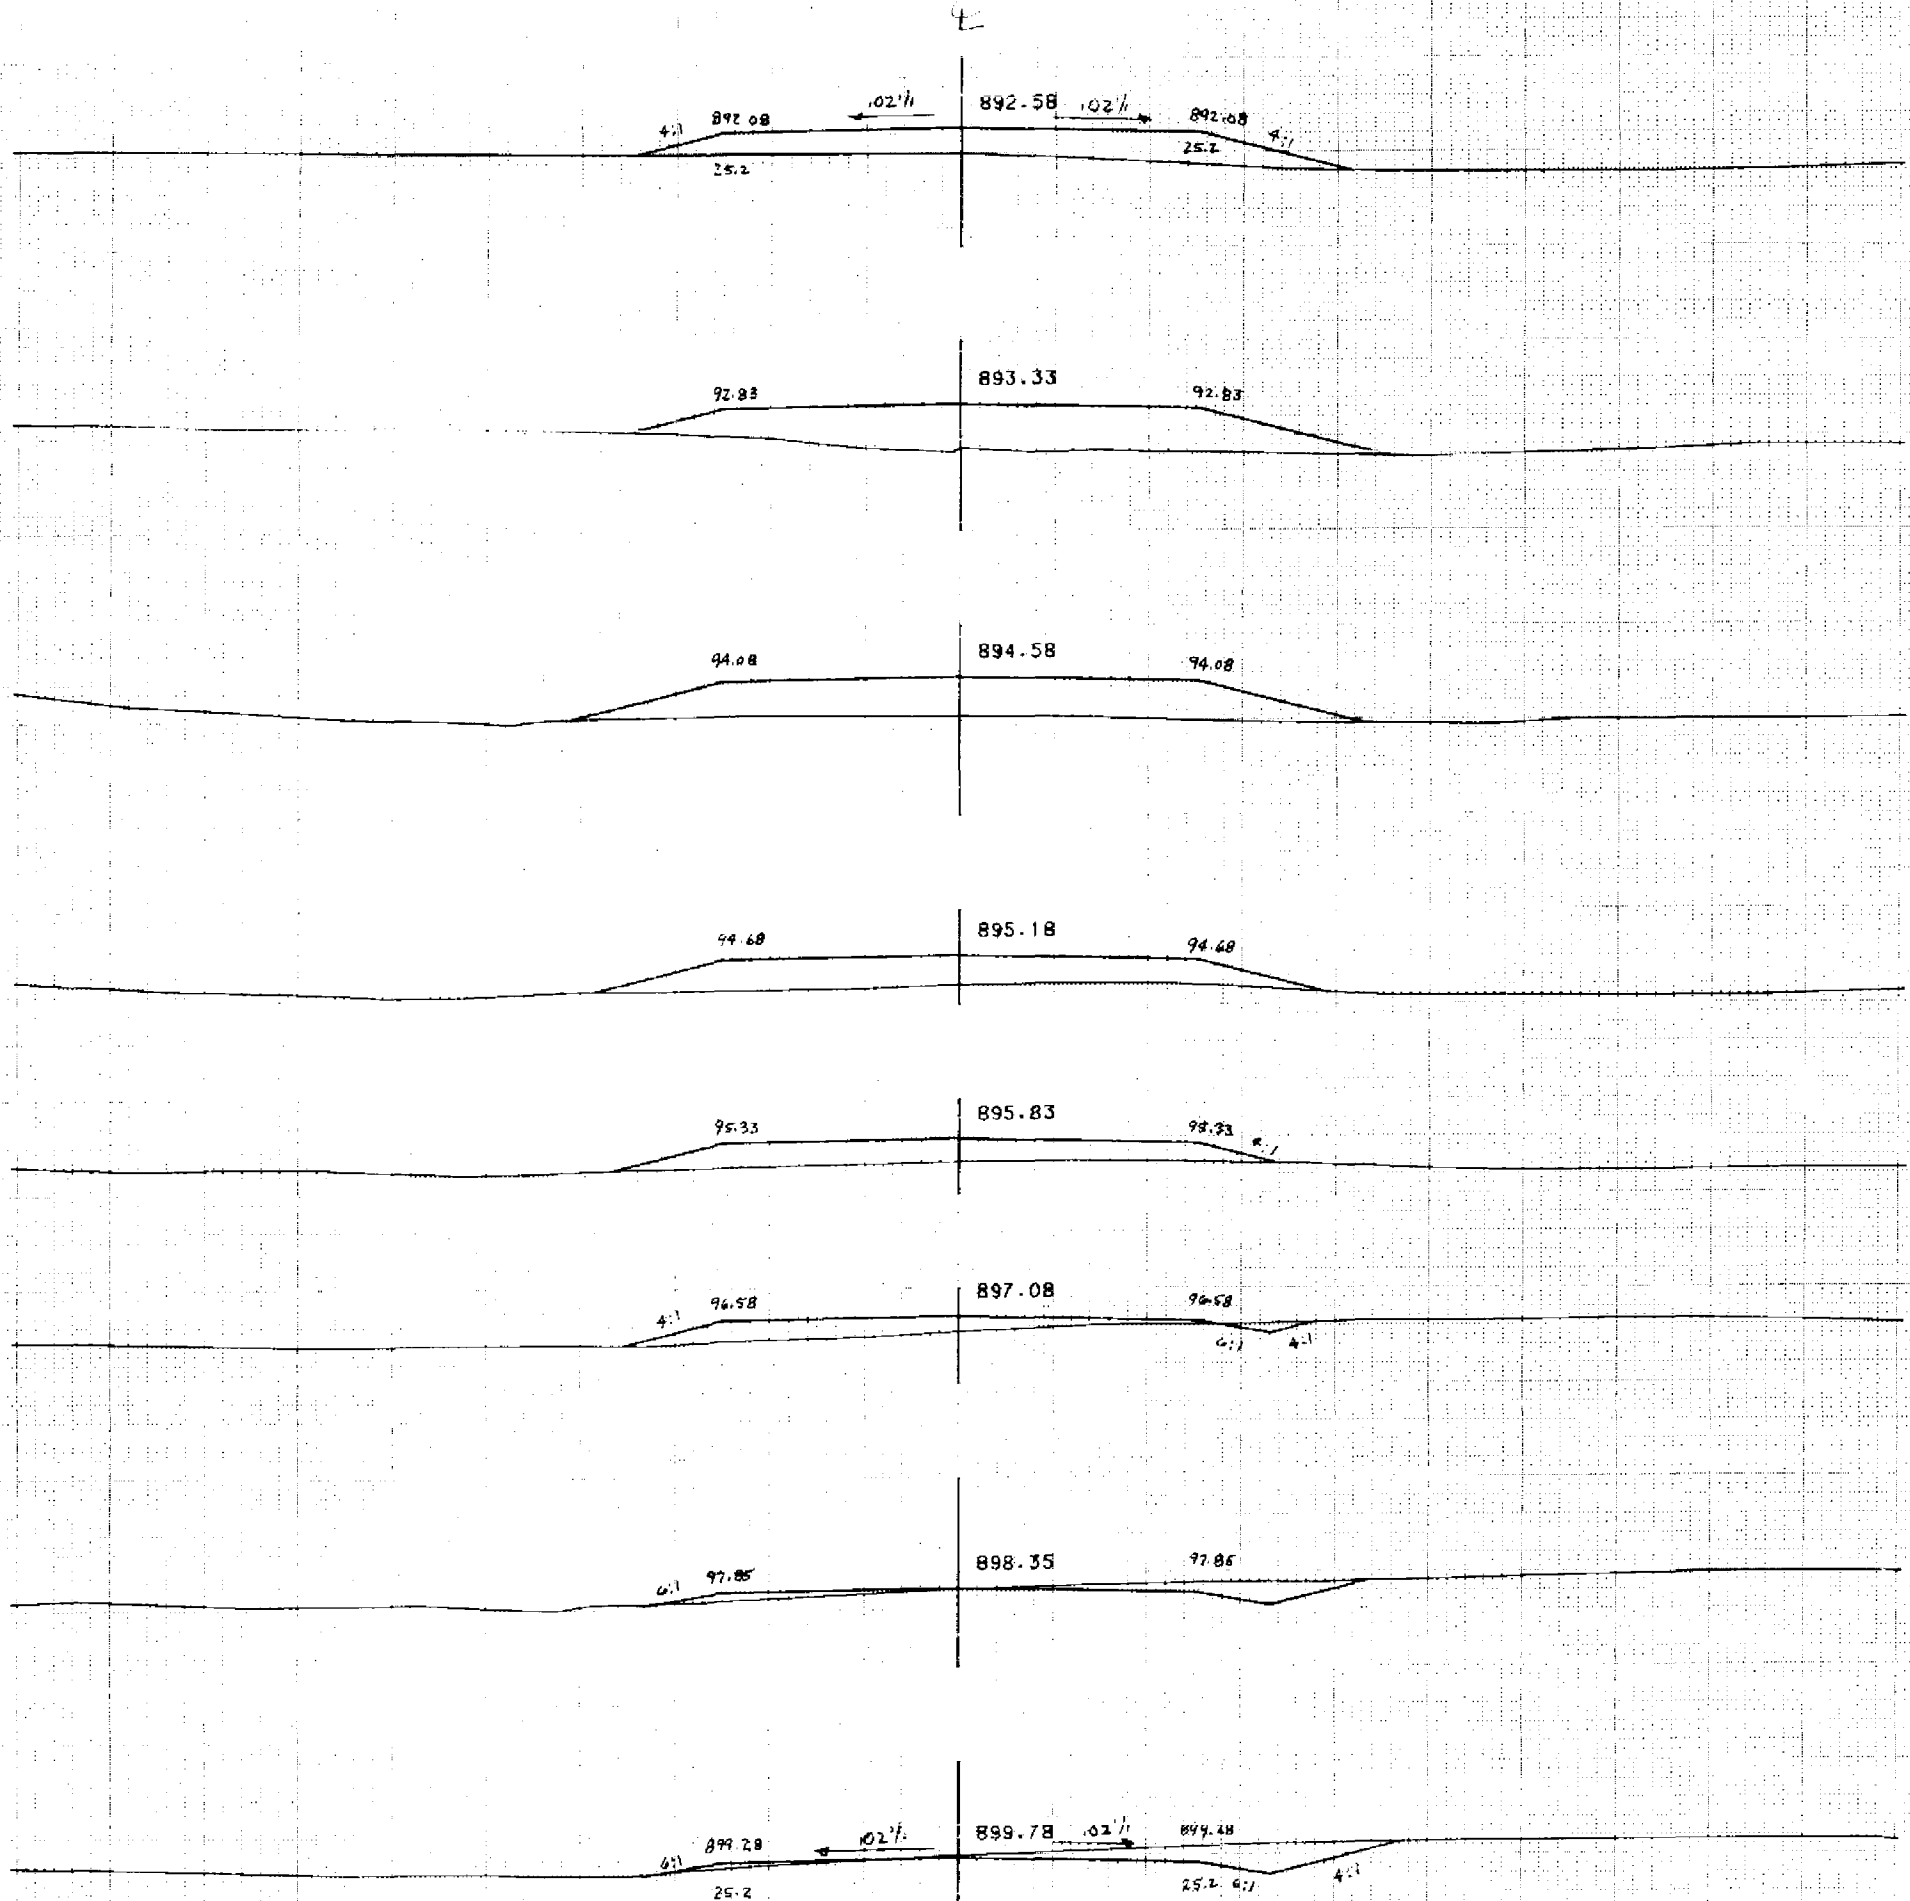

STATE PROJECT NUMBER	SHEET NUMBER
7255-05-71	9.61

STATION	DISTANCE	YARDAGE			
		EXCAVATION			FILL
		UNTIL			
94+00					
94+50	50	99			31
95+00	50	104			19
95+50	50	42			92
96+00	50	5			207
96+26	50	0			159
96+50	50				203
97+00	50				506
97+30	50	0			254
TOTAL	250				1471

97+30
890

97+00
890

96+50
890

96+26
890

96+00
890

95+50
890

95+00
890


20
10
0
94+50
900

TEMPLATE IS SUBGRADE
PRINTED ELEV IS SUBGRADE

SCALE: FEET

SHEET NO 2 6 7255050013

E. FRONTAGE RD

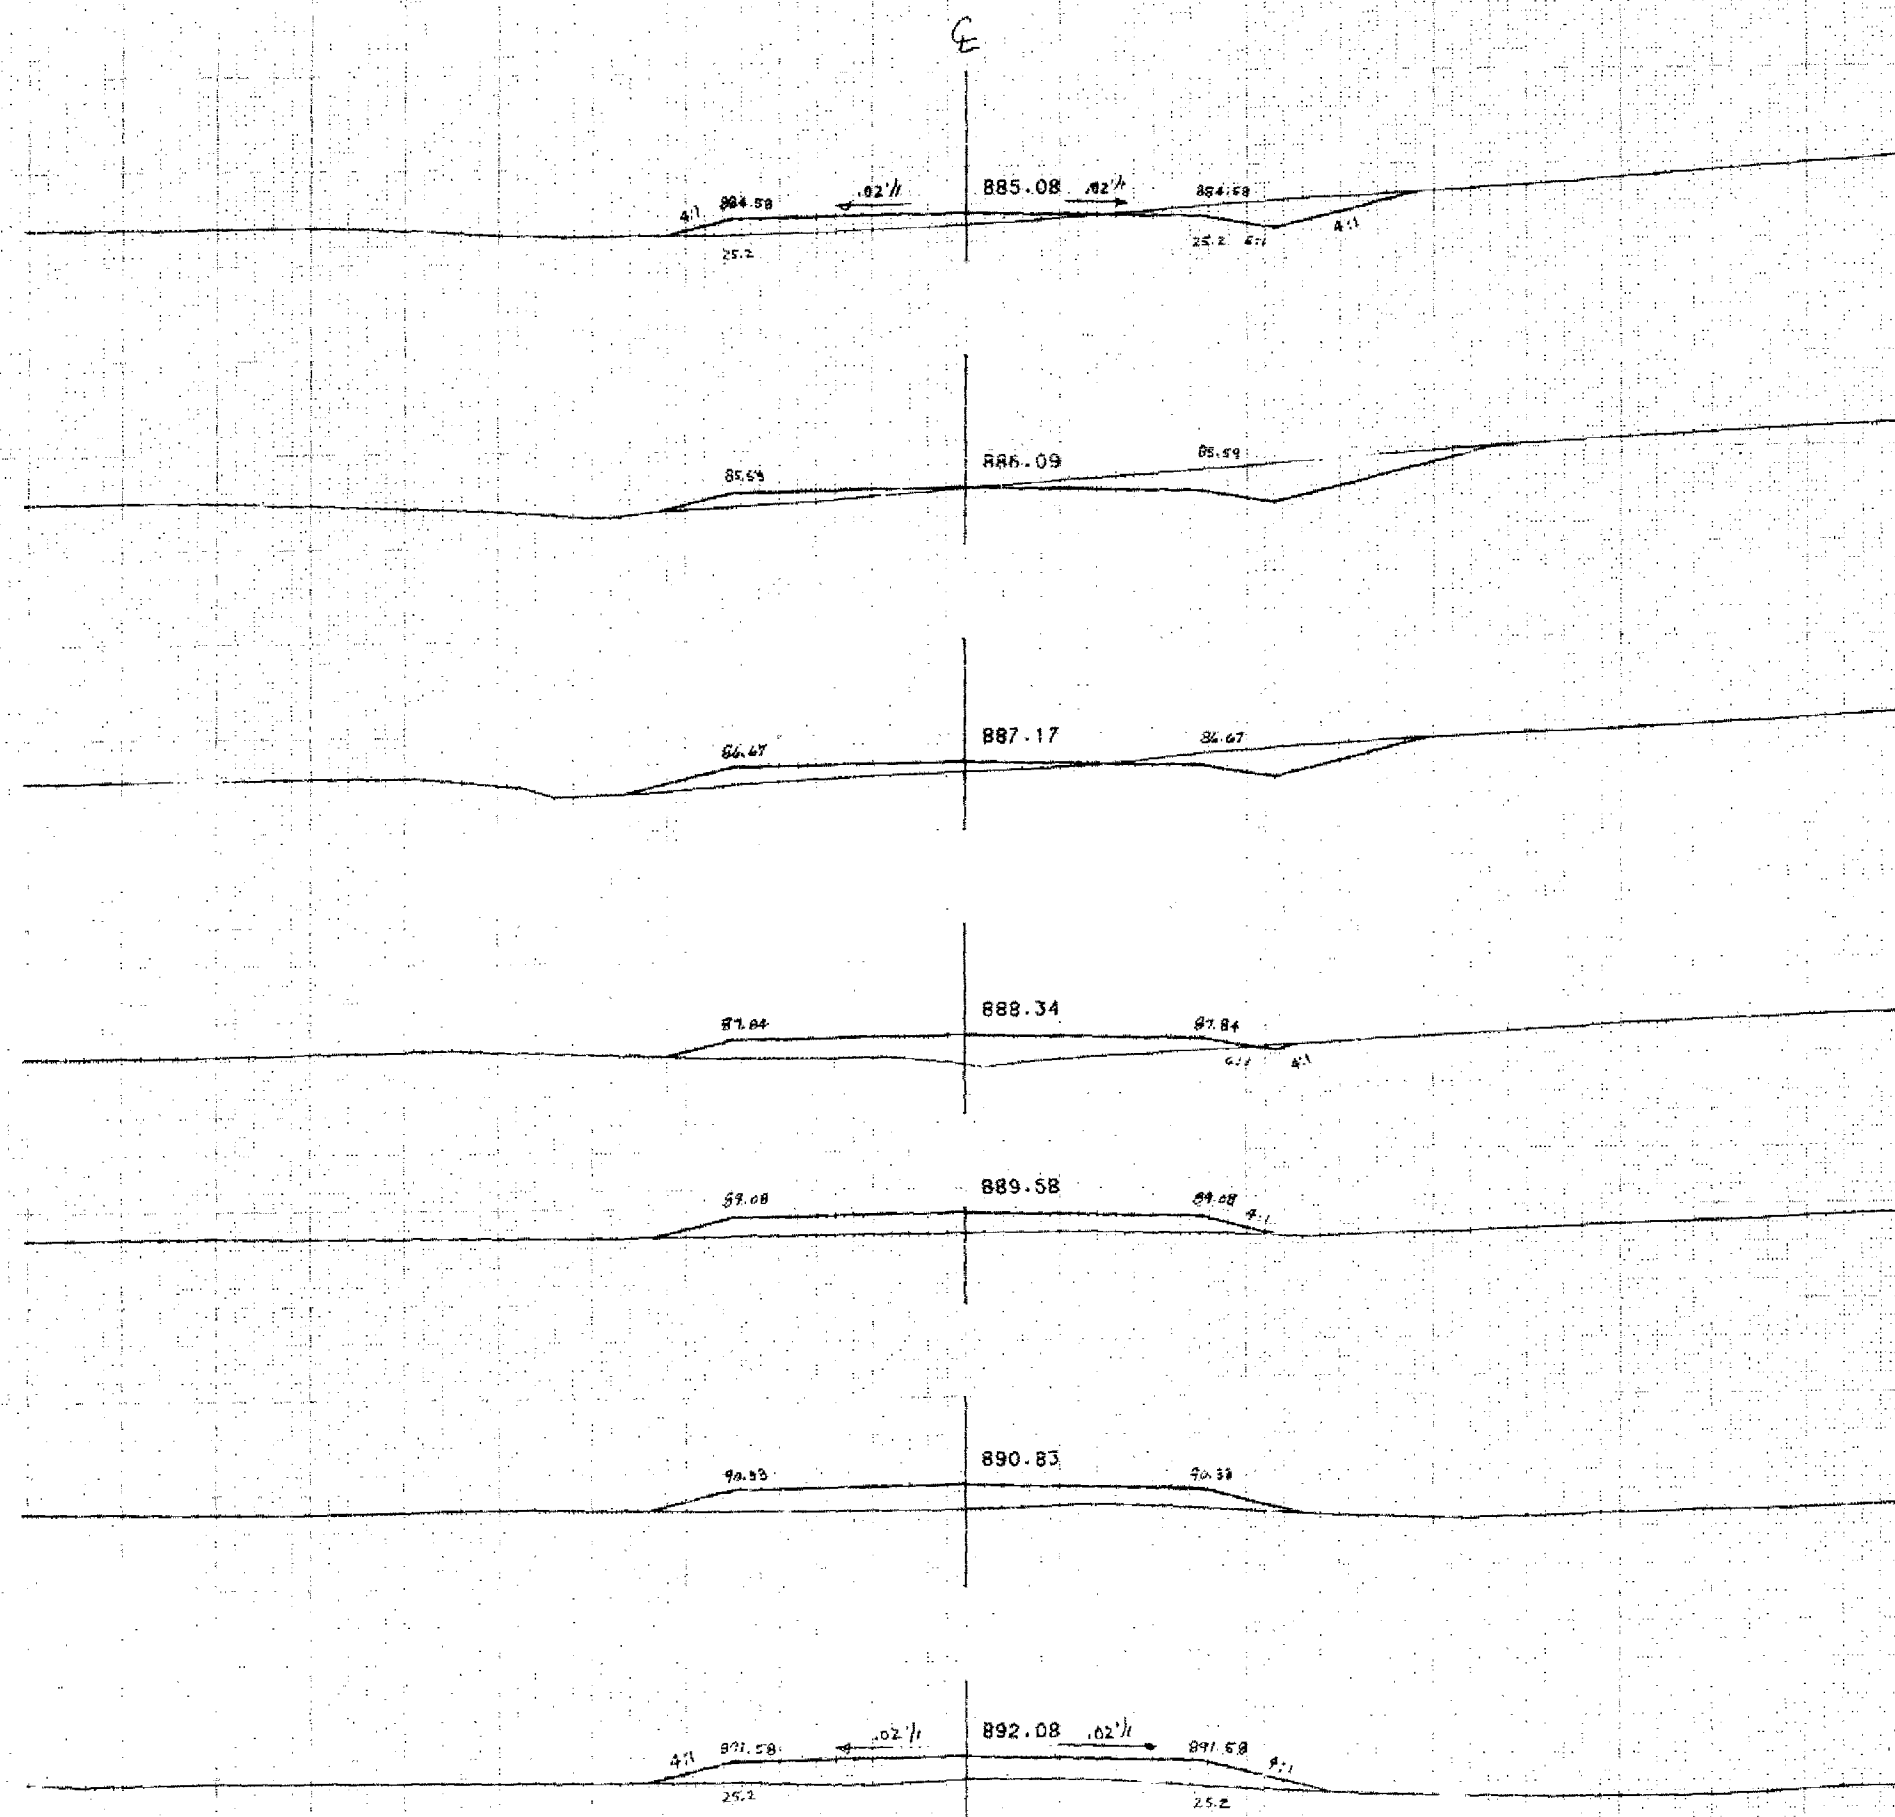

100+50
880

100+00
880

99+50
880

99+00
880

98+50
880

98+00
890

97+50
890


STATE PROJECT NUMBER		SHEET NUMBER	
7255-05-71		9.92	
STATION	DISTANCE	YARDAGE	
		EXCAVATION	FILL
97+30	20	0	22
97+50	50	0	265
98+00	50	0	231
98+50	50	1	221
99+00	50	45	166
99+50	50	130	75
100+00	50	133	74
100+50			
TOTAL		317	1154

TEMPLATE IS SUBGRADE
PRINTED ELEV. IS SUBGRADE

SCALE: FEET

SHEET NO 3 6 7255050013

E. FRONTAGE RD

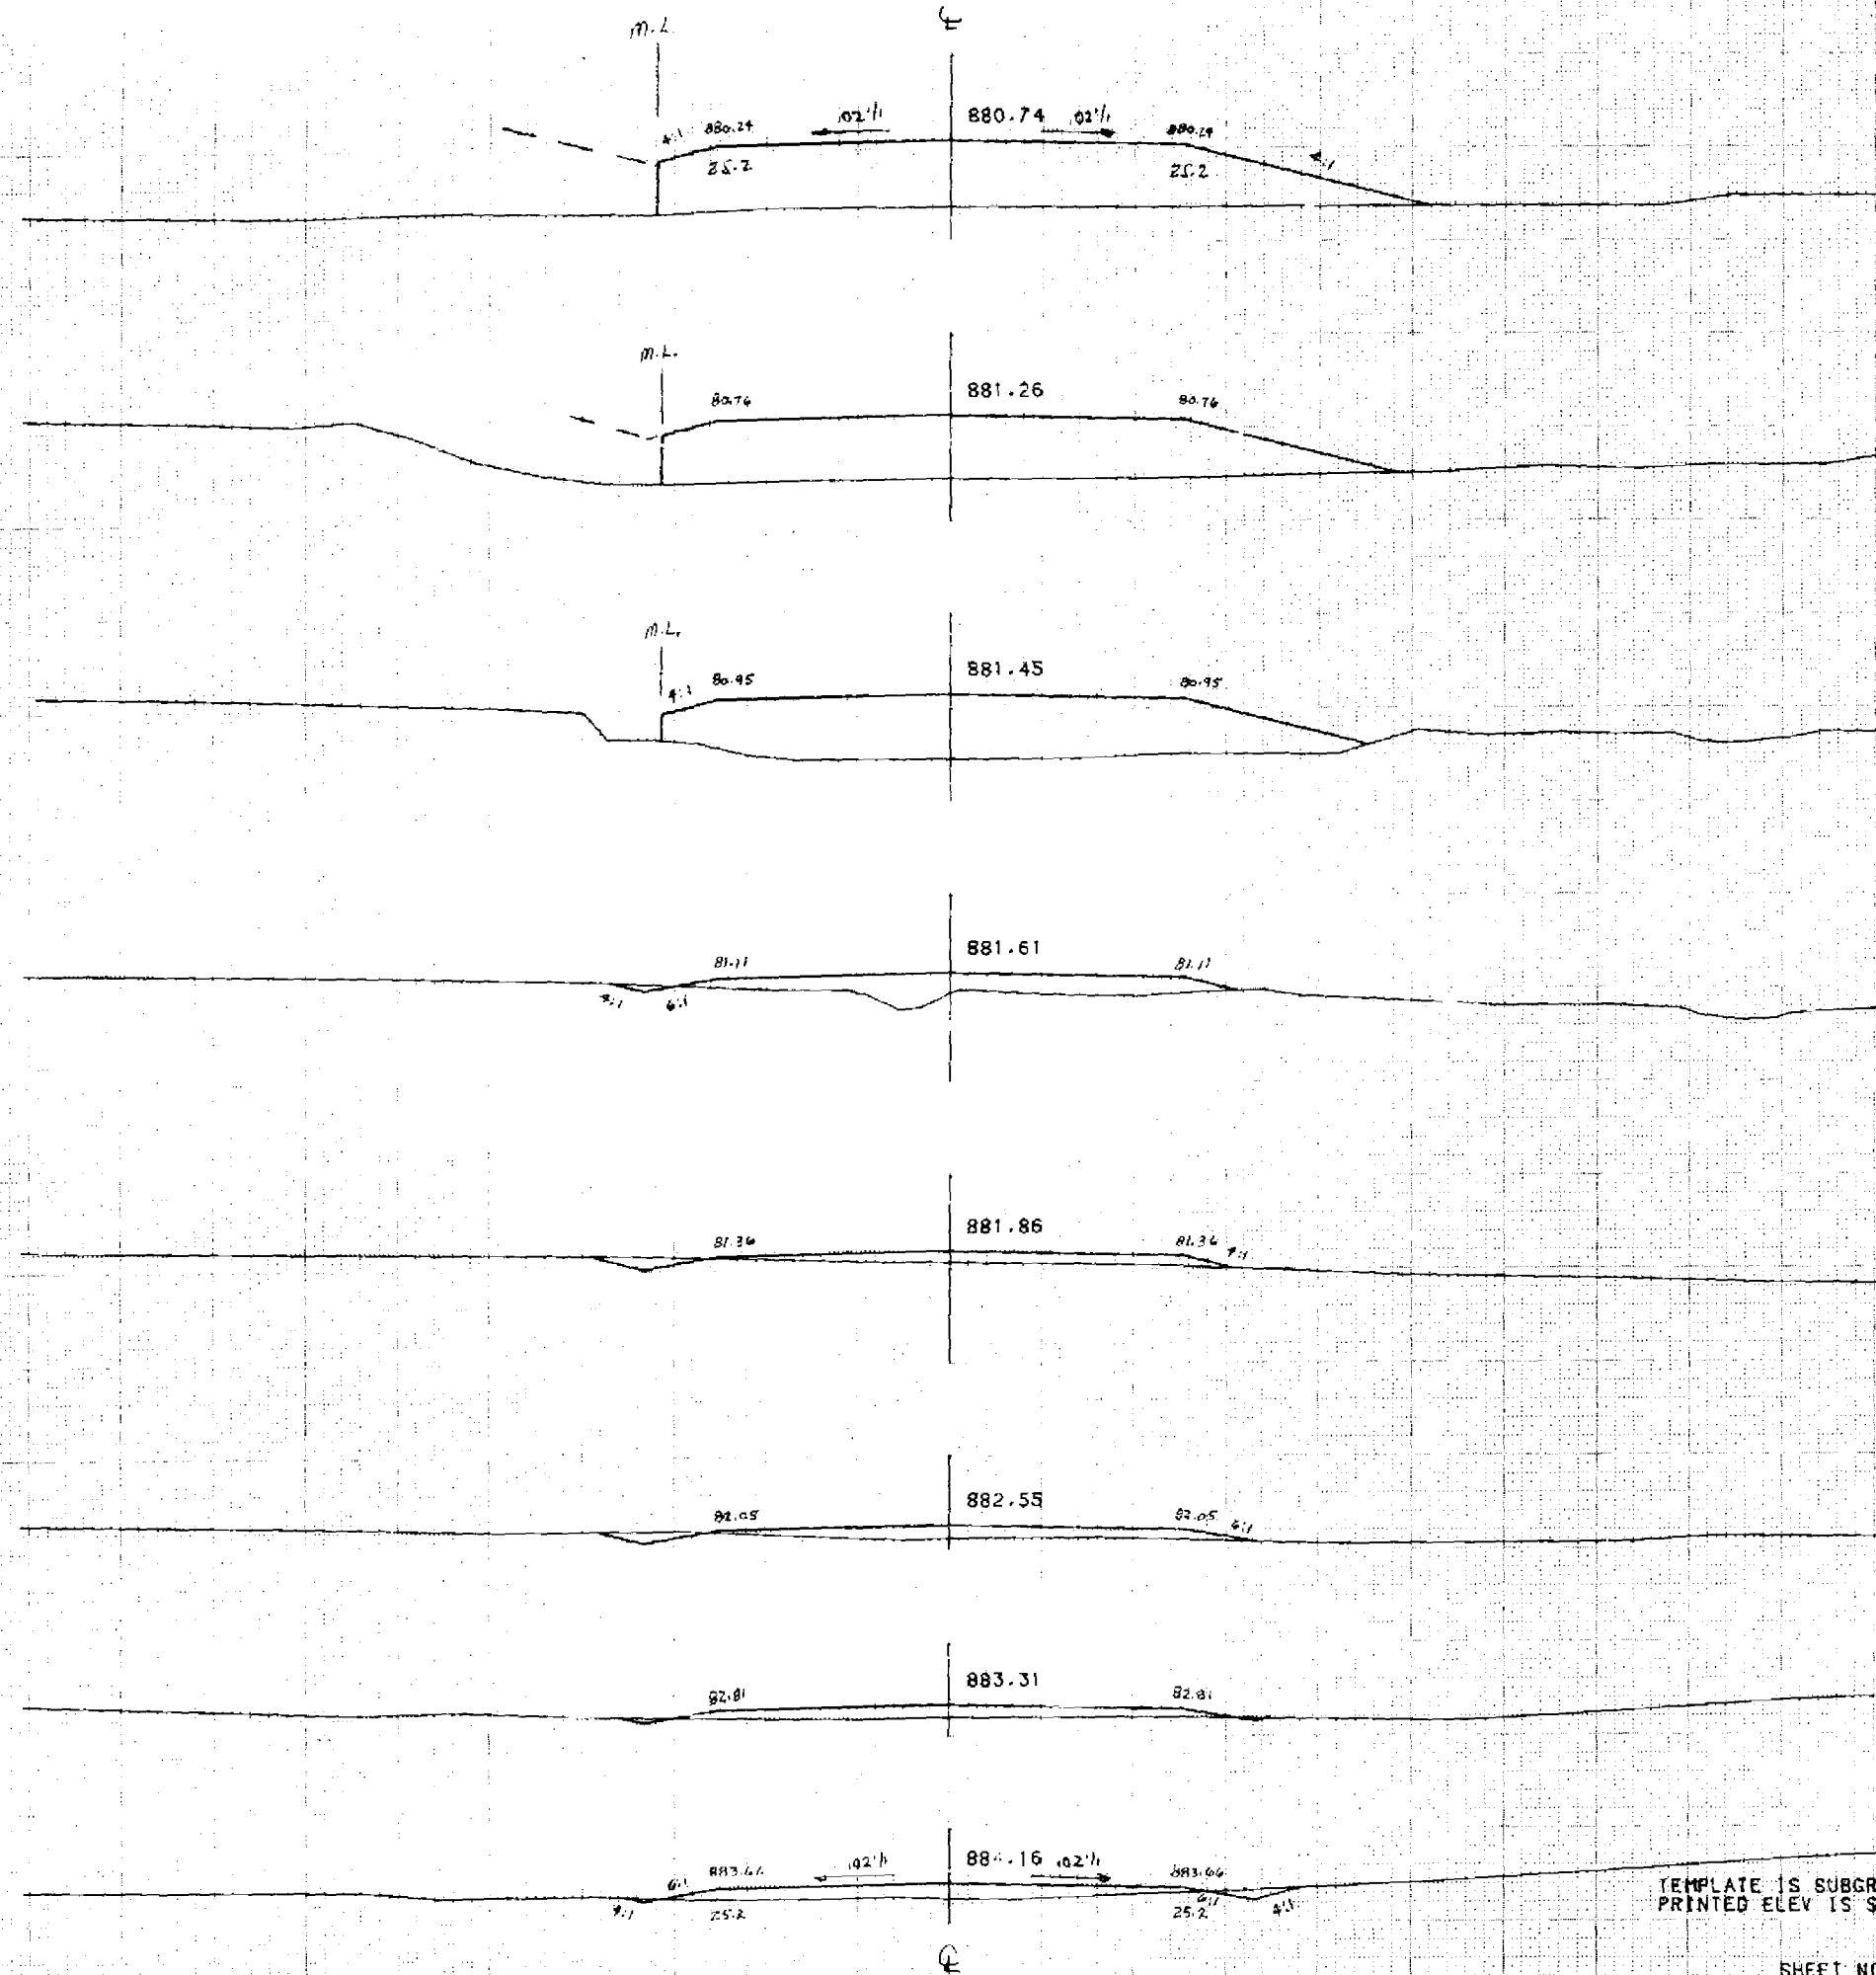

STATE PROJECT NUMBER	SHEET NUMBER
7255-05-71	953

STATION	DISTANCE	YARDAGE			
		EXCAVATION			FILL
		UNCL			
100+50					
101+00	50	47			108
101+50	50	10			114
102+00	50	10			107
102+50	50	16			96
102+70	20	4			58
102+83	13	1			128
103+00	17	0			272
103+50	50	0			856
TOTAL	78	88			1739

103+50
880

103+00
880

102+83
880

102+70
880

102+50
880

102+00
880

101+50
880

101+00
890


TEMPLATE IS SUBGRADE
PRINTED ELEV IS SUBGRADE

SCALE: FEET

SHEET NO 4 6 7255050013

E. FRONTAGE RD

STATION	DISTANCE	YARDAGE			
		EXCAVATION			FILL
		UNCL			
103+50	50	0			944
104+00	18				363
104+18	17				320
104+35	15				260
104+50	50				941
105+00	18				359
105+18	12				222
105+30	20	0			314
105+50	TOTAL	0			3725

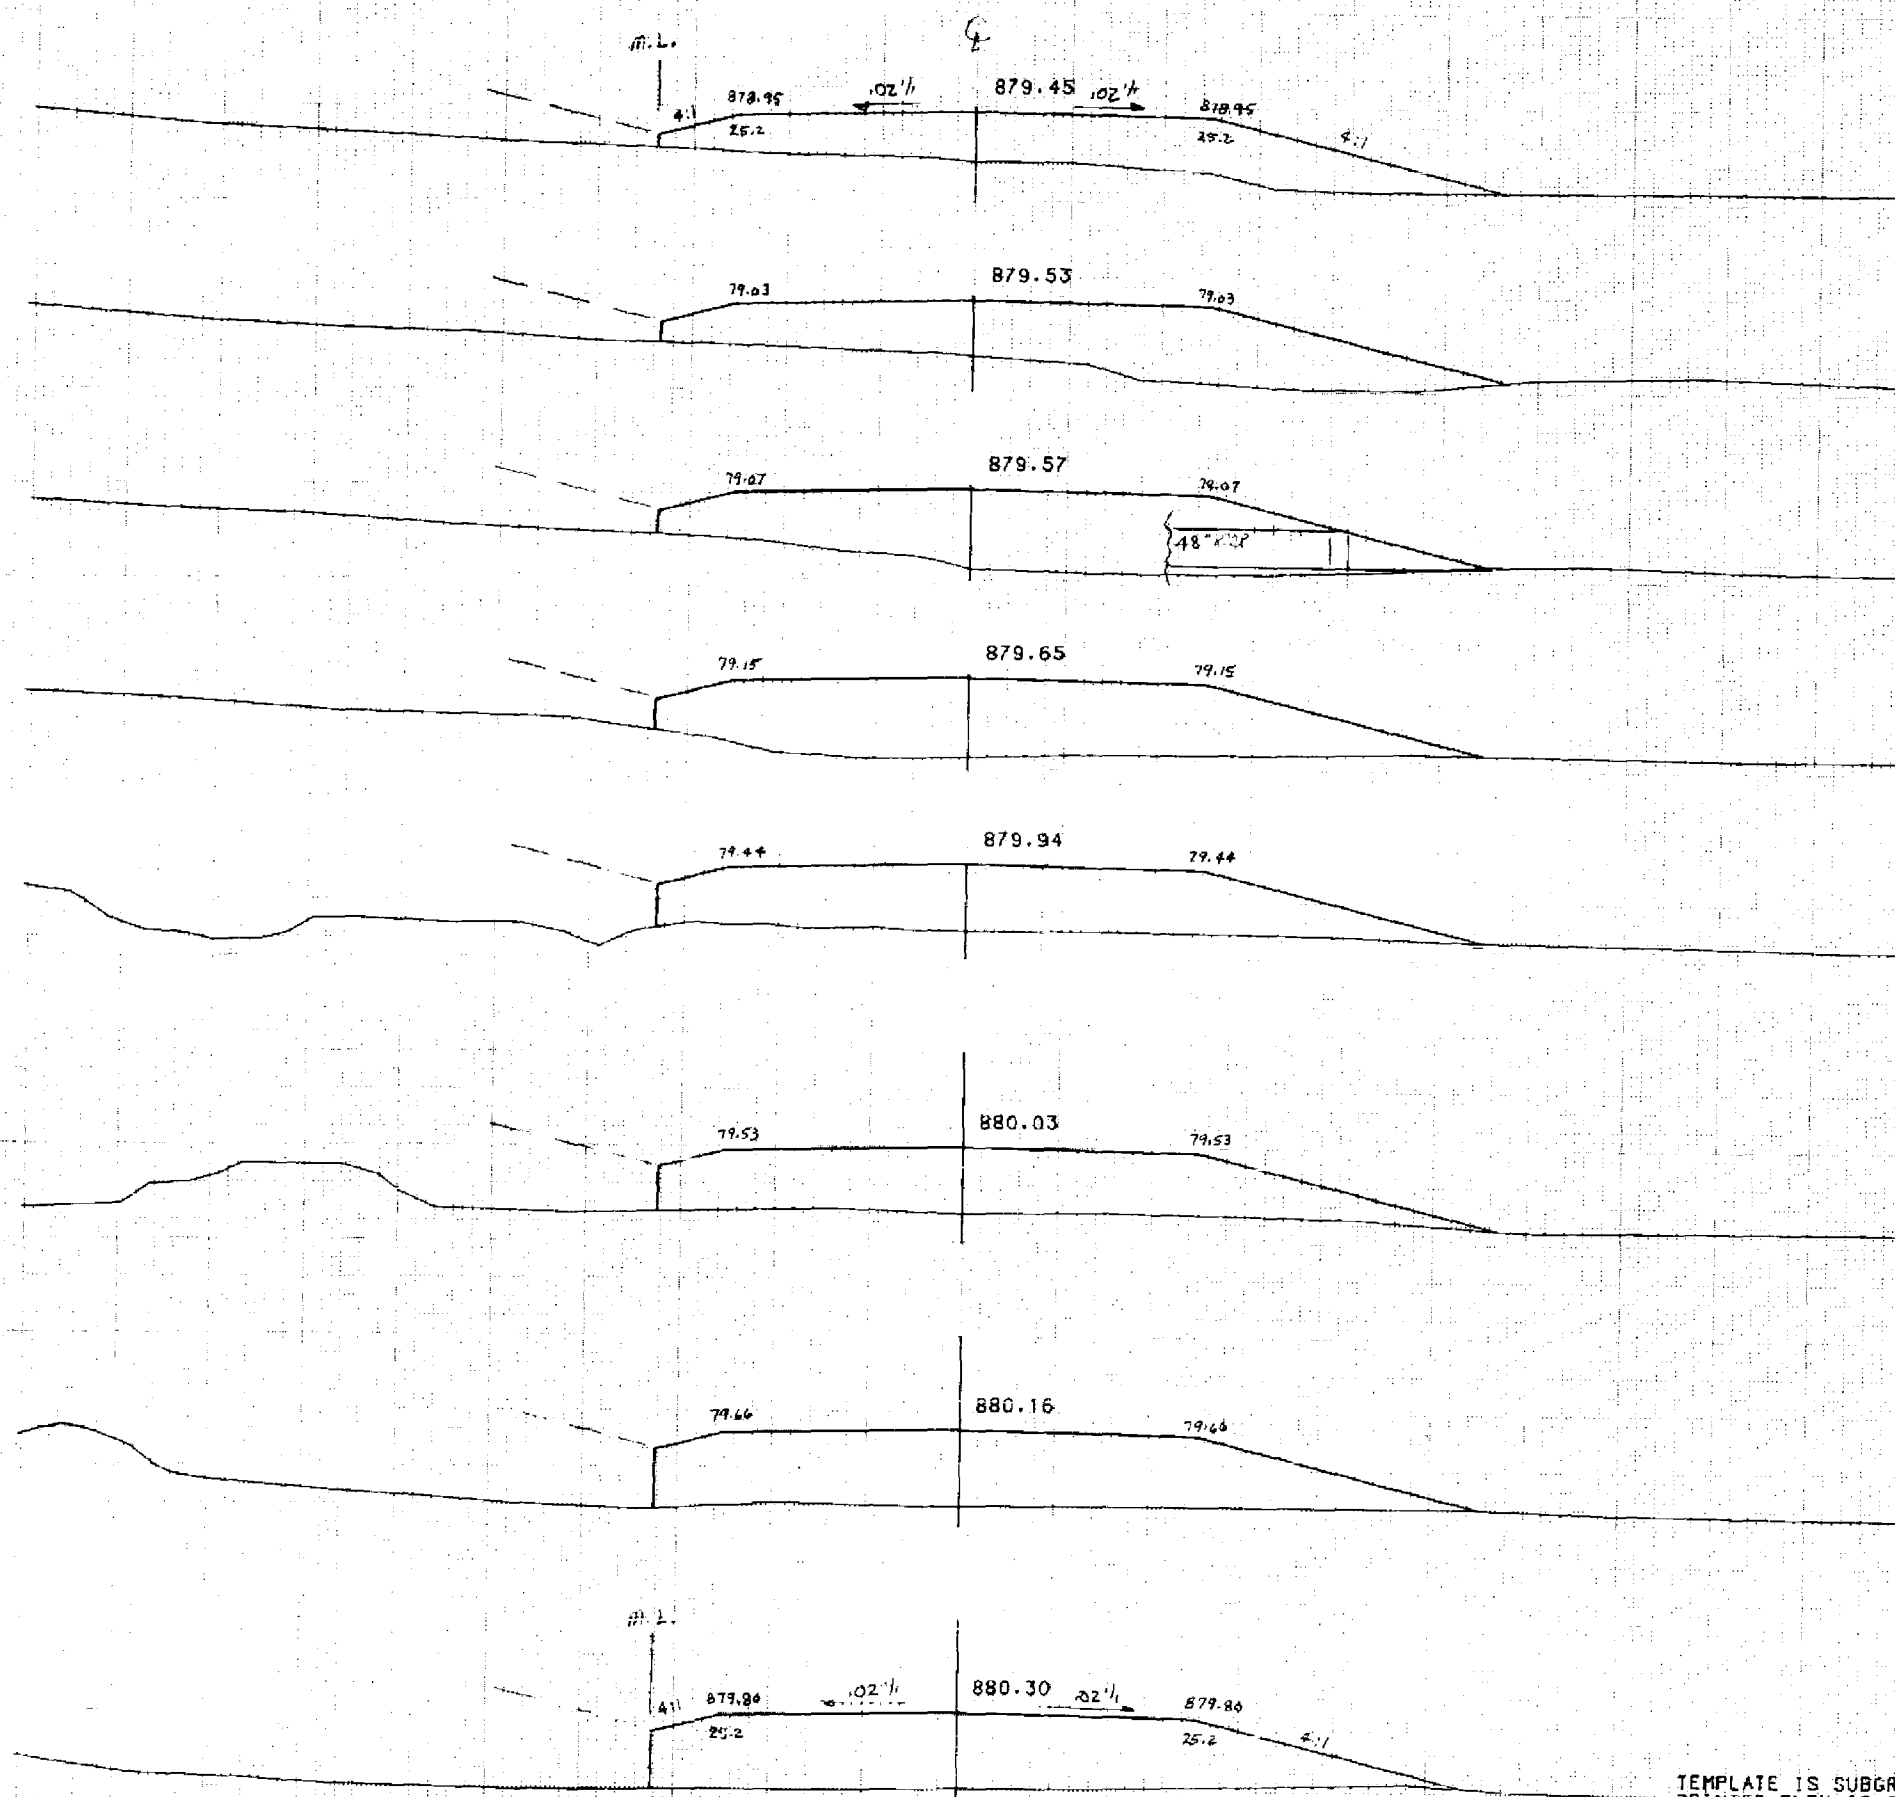

105+50

870

105+30

870

105+18

870

105+00

870

104+50

870

104+35

880

104+18

880


104+00

880

TEMPLATE IS SUBGRADE
PRINTED ELEV IS SUBGRADE

SCALE: FEET

SHEET NO 5 6 7255050013

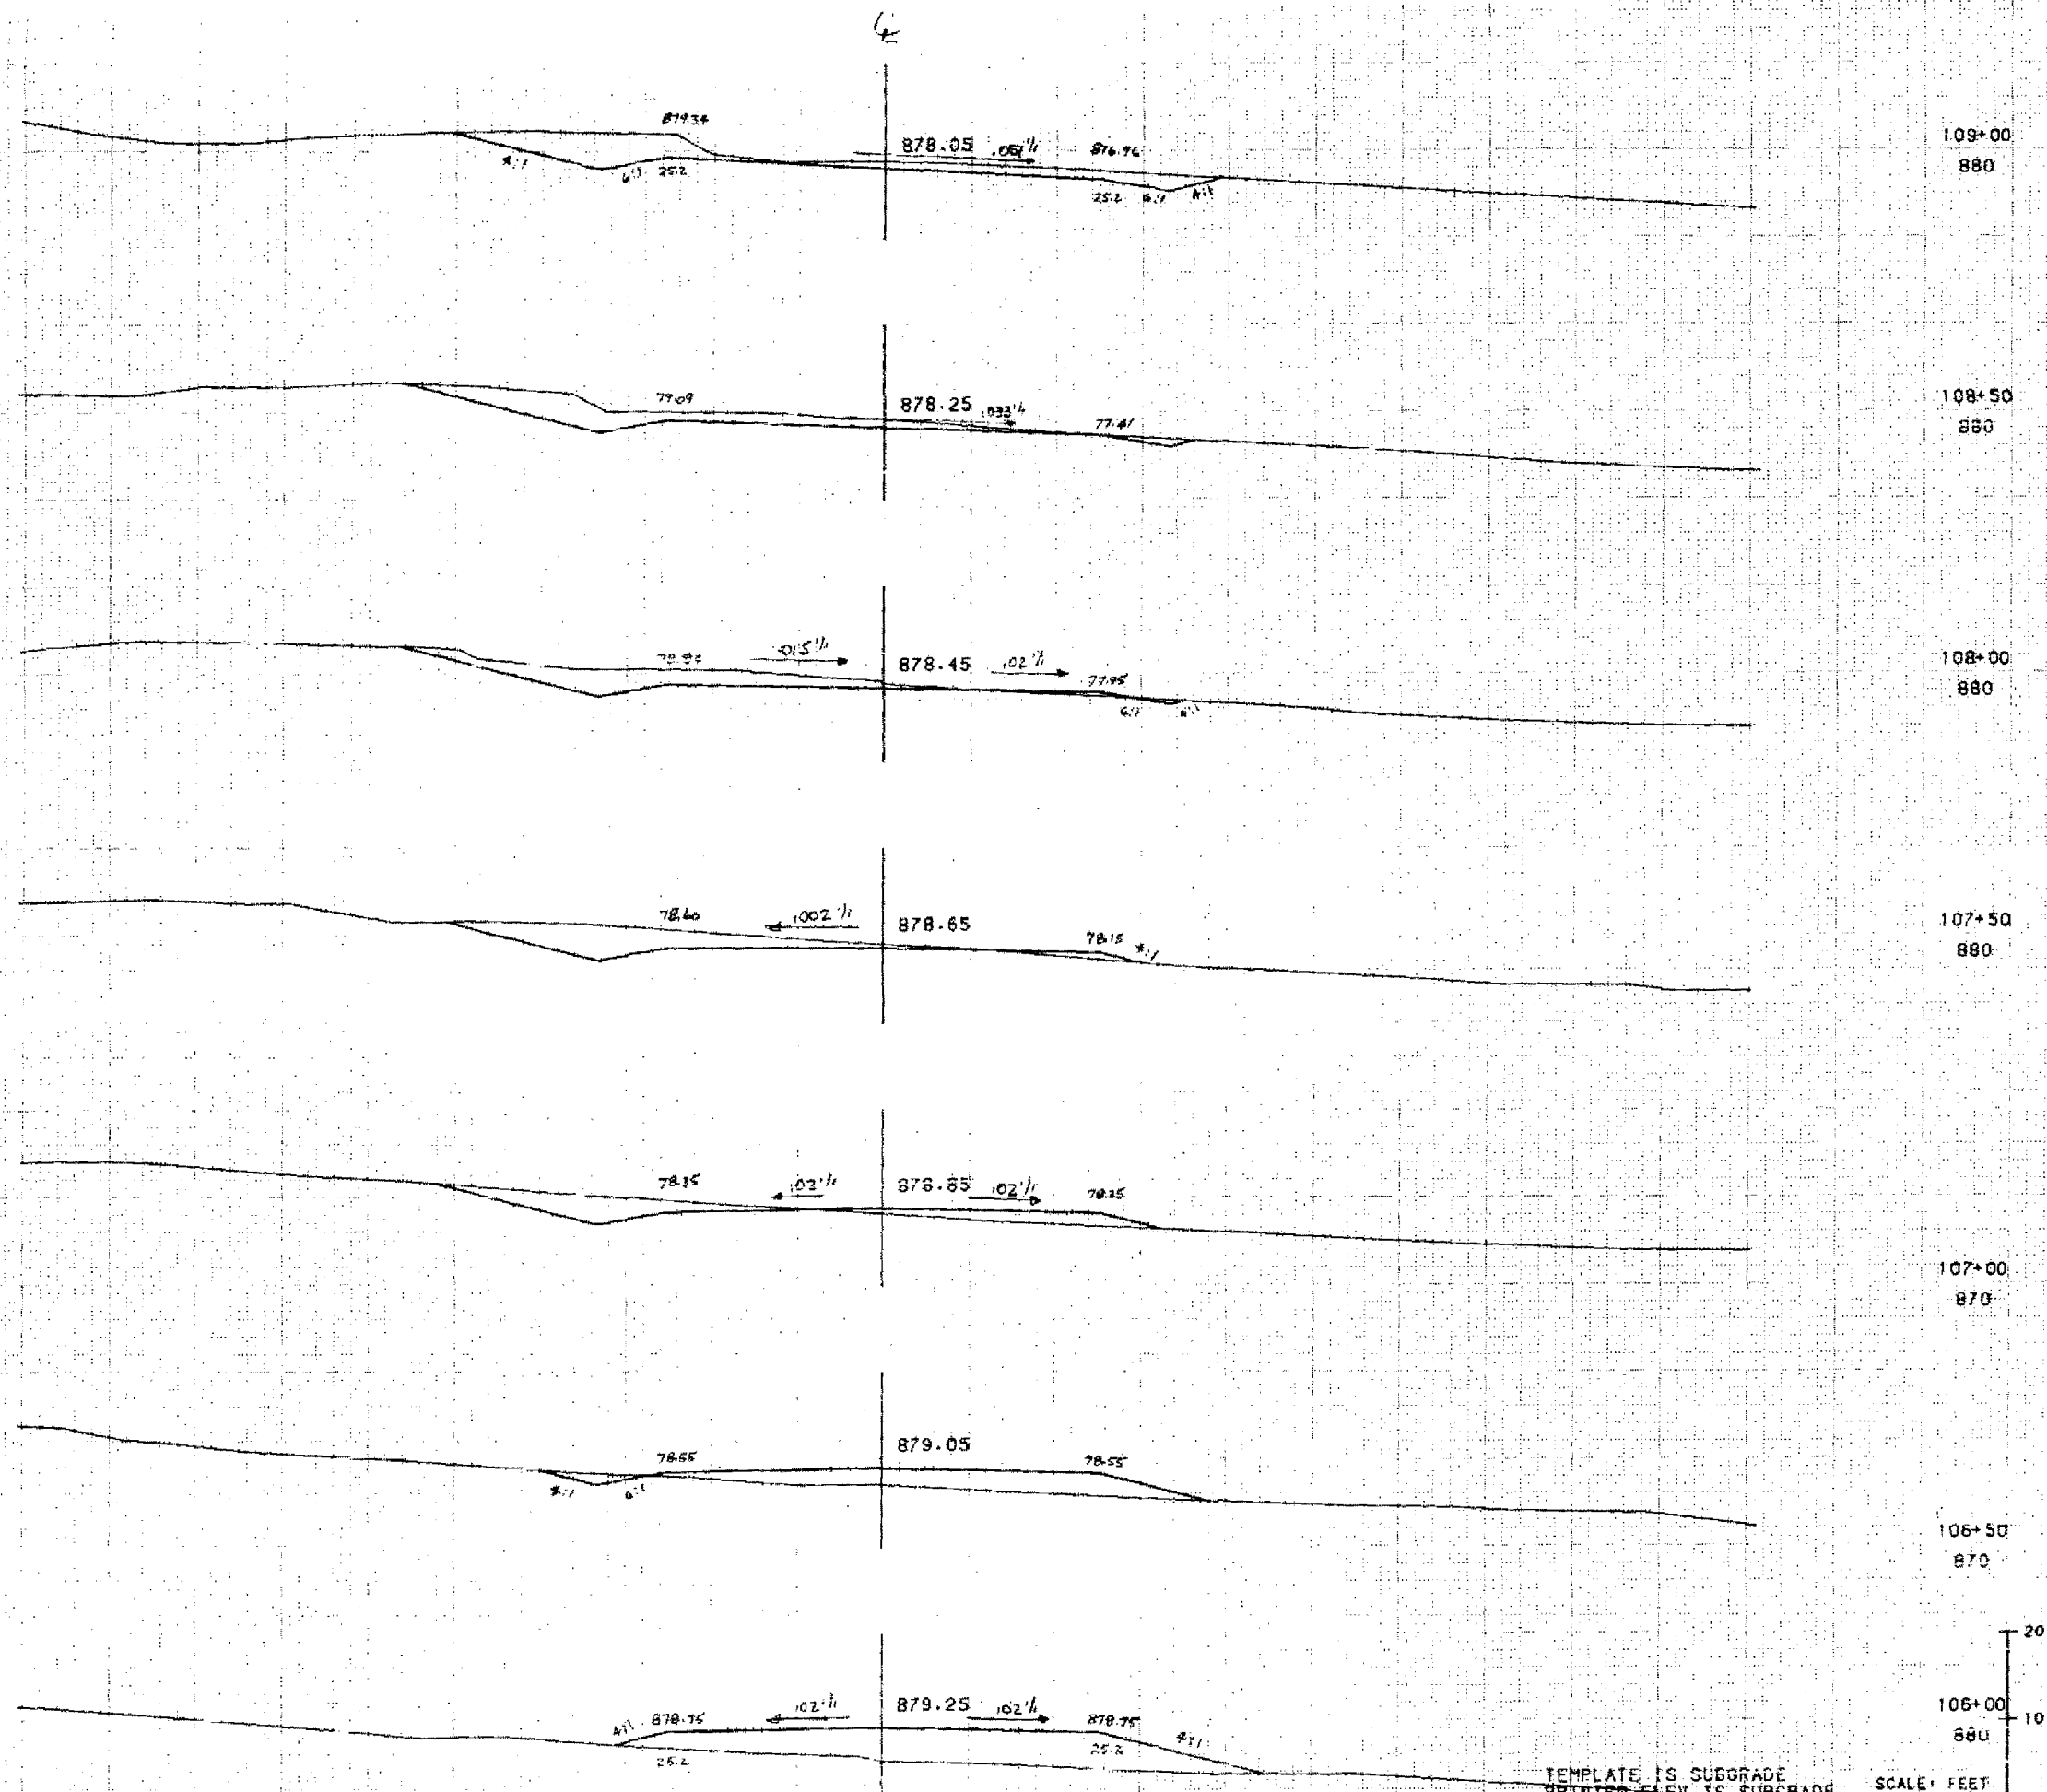

STATE PROJECT NUMBER					SHEET NUMBER
7255-05-71					9.55
STATION	DISTANCE	YARDAGE			
		EXCAVATION		FILL	
		LINE			
105+50	50	0			583
106+00	50	7			302
106+50	50	66			133
107+00	50	150			40
107+50	50	179			10
108+00	50	185			4
108+50	50	216			0
109+00					
TOTAL		803			1042

TEMPLATE IS SUBGRADE
 PRINTED ELEV IS SUBGRADE
 SCALE: FEET
 SHEET NO 6 7255050013

E FRONTAGE RD

END CONST STA. 14+20

MEET EXIST.

14+00
910

13+00
910

12+00
910

11+00
910


10+00
910

9+00
910

8+00
910

7+00
910

6+00
910

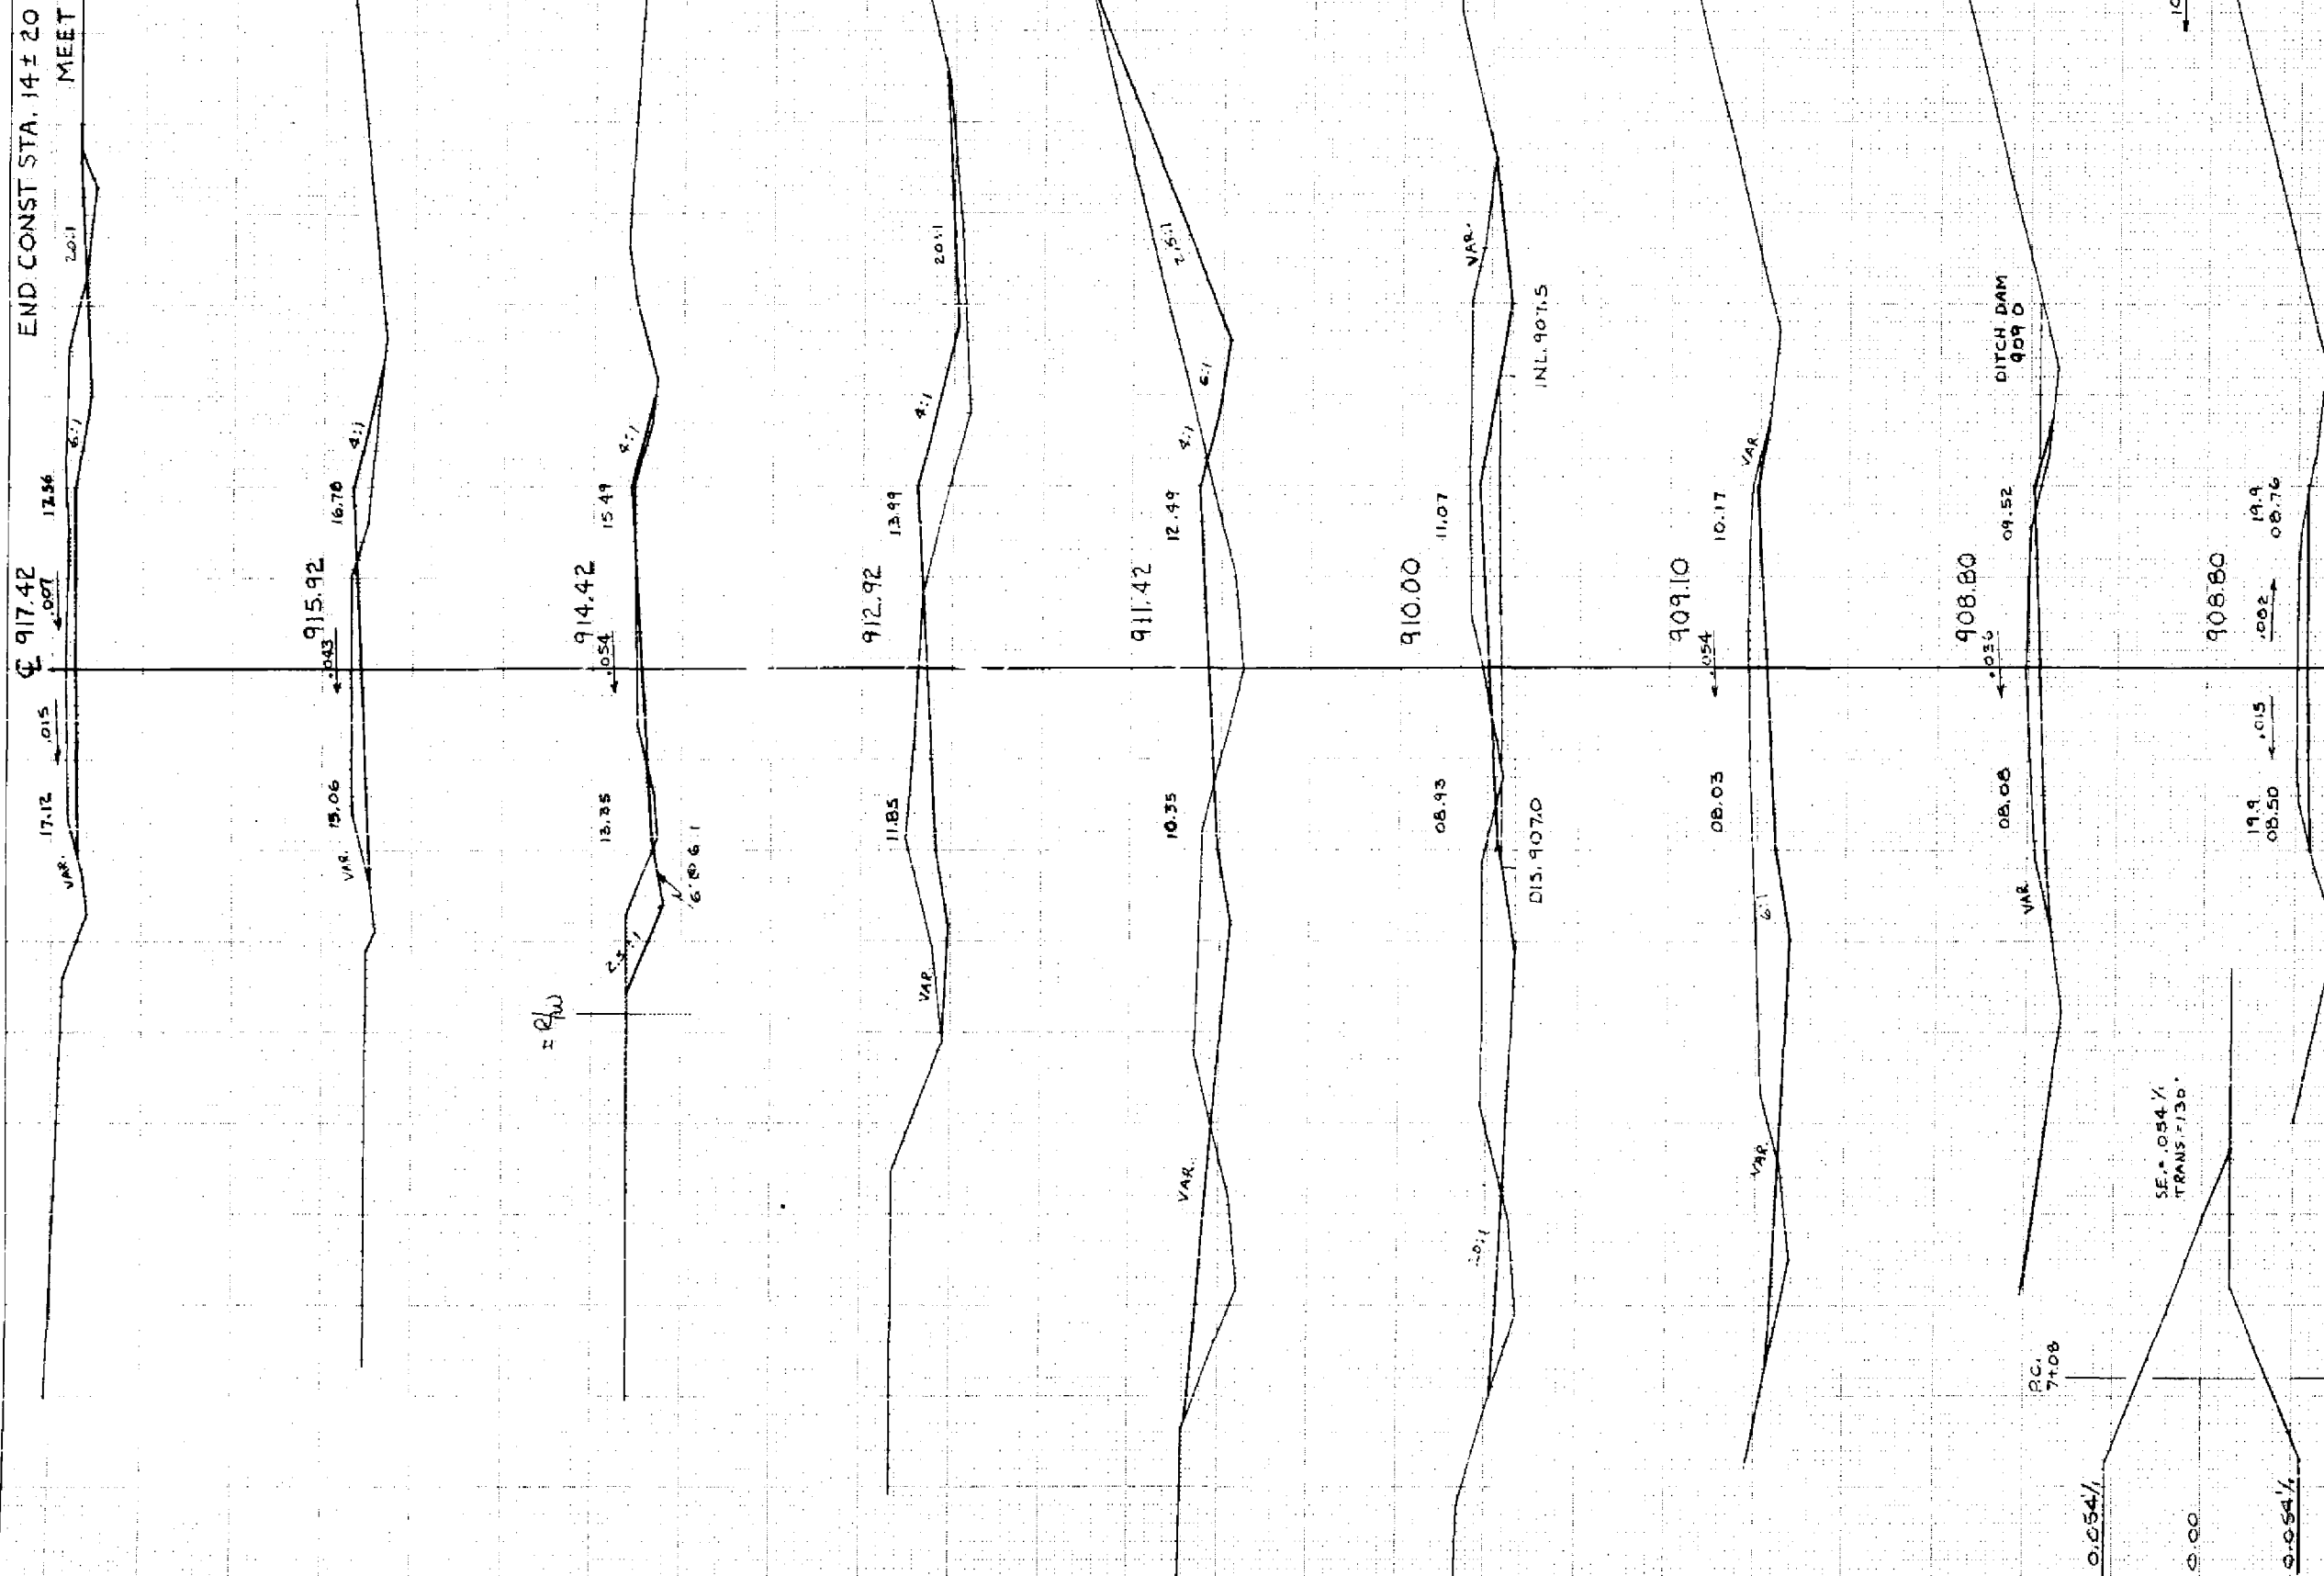

BEGIN CONST STA. 5+63 MEET EXIST.

T.N.R.D.

P.T. 13+30

SHEET TOTAL

STATE PROJECT NUMBER			SHEET NUMBER
7255 - 05 - 71			958
DISTANCE	YARDAGE		
	EXCAVATION		FILL
	UNCL.		
37	56		0
100	174		9
	410		59
	730		106
	830		372
	580		480
	220		180
	130		66
100	220		74
20	50		4
			</