


- AS-BUILT PLAN -

INDEX OF SHEETS

- Sheet No. 1 Title
- Sheet No. 2.1 Typical Sections and Details
- Sheet No. 3.1-3.2 Estimate of Quantities
- Sheet No. 3A Miscellaneous Quantities
- Sheet No. 4 Right-of-Way Plat
- Sheet No. 5.1 Plan and Profile
- Sheet No. 6.1-6.11 Standard Detail Drawings
- Sheet No. 7 Sign Plates
- Sheet No. 8.1-8.10 Structure Plans
- Sheet No. 9 Computer Earthwork Data
- Sheet No. 9.1-9.2 Cross-Sections

TOTAL SHEETS = 29

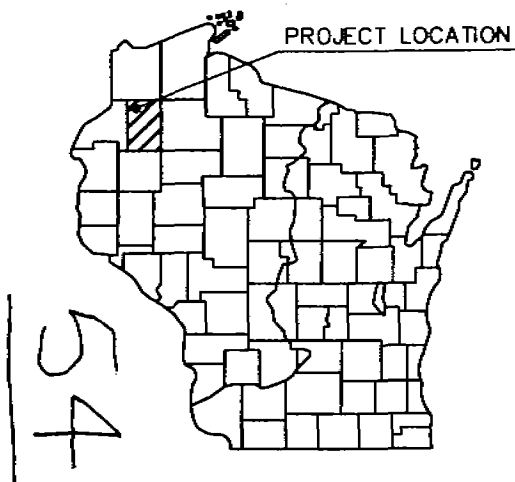

DESIGN DESIGNATION

- A.D.T. (2000) = 475
- A.D.T. (2020) = 705
- D.H.V. (2020) = 88
- D. (%) = 60/40
- T. (% OF A.D.T.) = 8%
- ESALS = N/A
- DESIGN SPEED = 50 mph

CONVENTIONAL SIGNS

- | | | | |
|----------------------------|-------|-------------------------------------|----------|
| COUNTY LINE | ===== | COMBUSTIBLE FLUIDS (UNDER PRESSURE) | |
| CORPORATE LIMITS | ===== | UNDERGROUND UTILITIES | |
| PROPERTY LINE | ===== | GAS | — G — |
| LOT LINE | ===== | ELECTRIC | — E — |
| LIMITED HIGHWAY EASEMENT | ===== | TELEPHONE | — T — |
| EXISTING RIGHT OF WAY | ===== | SERVICE PEDESTAL | ⊠ |
| NEW RIGHT OF WAY | ===== | CABLE MARKER | ⊥ |
| REFERENCE LINE | ===== | POWER POLE | ⊠ |
| SLOPE INTERCEPT | ===== | TELEPHONE POLE | ⊠ |
| ORIGINAL GROUND | ===== | RAILROADS | +++++ |
| MARSH OR ROCK PROFILE | ===== | MARSH | |
| CULVERT IN PLACE | ===== | WOODED AREA | |
| CULVERT REQUIRED | ===== | RIGHT-OF-WAY MARKERS | — O.H. — |
| CULVERT REQUIRED (Profile) | ===== | OVERHEAD LINES | — O.H. — |

STATE OF WISCONSIN
DEPARTMENT OF TRANSPORTATION

PLAN OF PROPOSED IMPROVEMENT


TOTAGATIC RIVER BRIDGE & APPROACHES

NANCY LAKE ROAD, TOWN OF MINONG

TOWN ROAD

WASHBURN COUNTY

STATE PROJECT NUMBER
8476-02-71

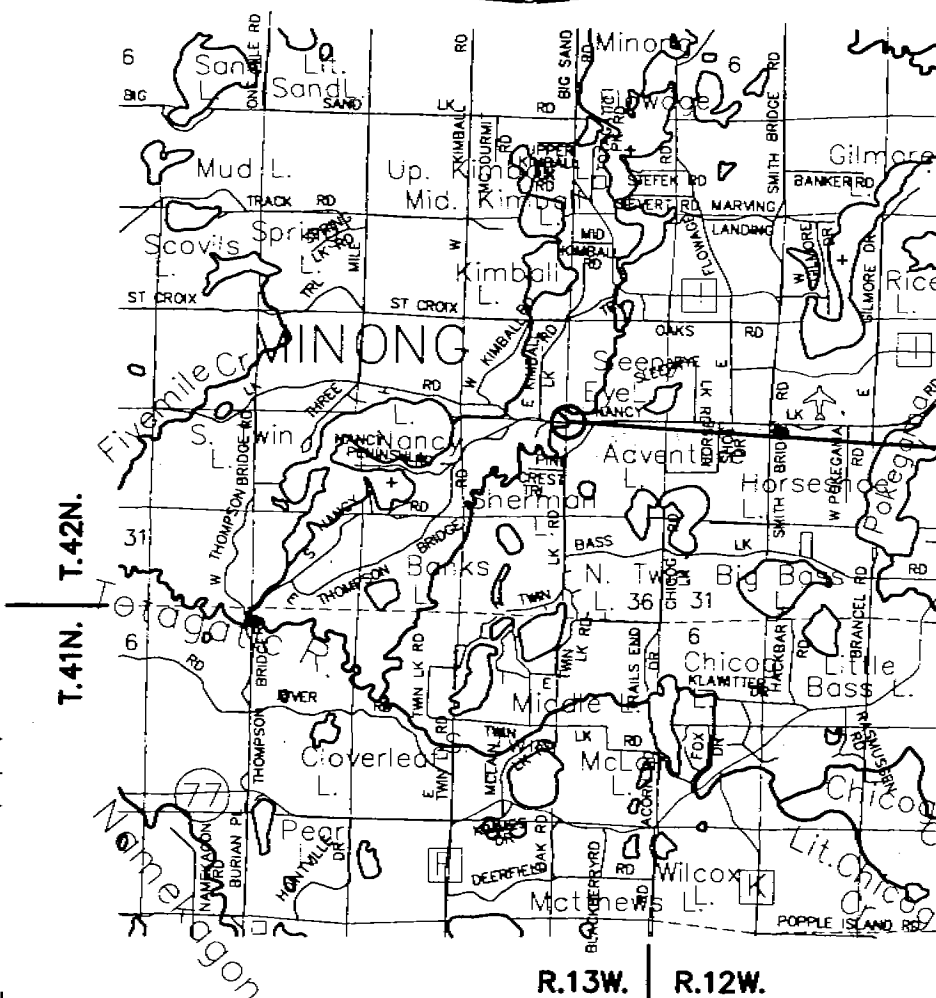

END PROJECT
STA. 12+50

STRUCTURE B-65-46

BEGIN PROJECT
STA. 6+00

X - 1,506,800 ±100'
Y - 346,200 ±100'

LAYOUT
SCALE 0 1 M.
TOTAL NET LENGTH OF CENTERLINE = 0.123MI.

COORDINATES SHOWN ARE REFERENCED TO THE WISCONSIN COORDINATE SYSTEM CENTRAL ZONE, AND SCALED FROM U.S.G.S. TOPOGRAPHIC MAP OF HORSESHOE LAKE, WIS. FOR IDENTIFICATION ONLY.

STATE PROJECT	FEDERAL PROJECT	
	PROJECT	CONTRACT
8476-02-71	STP 2000 495	1


8476-02-71, STP 2000(495)
Totagatic River Bridge and Approaches
Town Road Washburn County
Lunda Construction Company
Chuck Smith

PROJECT COMPLETION DATE - 10/24/00

ACCEPTED FOR
TOWN OF MINONG
12-2-99 *Mark Erickson Jr.*
DATE TOWN CHAIRMAN

ACCEPTED FOR
WASHBURN COUNTY
12/1/99 *Mark Erickson Jr.*
DATE COUNTY COMMISSIONER

ORIGINAL PLANS PREPARED BY
Cedar corporation
504 West Avenue
Manitowish, Wisconsin 54751
715-235-9281
800-477-7372
FAX 715-235-2727
www.cedarcorp.com

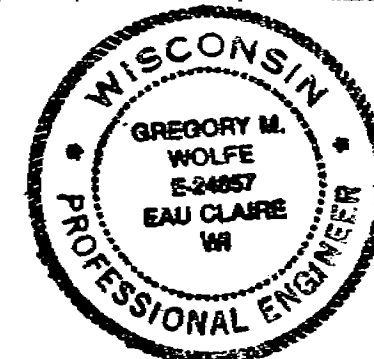

12-3-99 *Gregory M. Wolfe*
DATE

STATE OF WISCONSIN
DEPARTMENT OF TRANSPORTATION

PREPARED BY
Surveyor CEDAR CORP.
Designer CEDAR CORP.
District Examiner P. EAKMAN, PE
District Supervisor R. WASHKUN, PE
Proj. Dev. Engineer
C.O. Examiner DALE MARG

APPROVED FOR DISTRICT OFFICE
12/27/99 *Rick Edman*
DATE DISTRICT DESIGN SUPERVISOR