


INDEX OF SHEETS

SHEET NO. **1** TITLE
 SHEET NO. **2-2.53** TYPICAL SECTIONS AND DETAILS
 SHEET NO. **3-3.5** ESTIMATE OF QUANTITIES
 SHEET NO. **3A-3F** MISCELLANEOUS QUANTITIES
 SHEET NO. **4-4.2** RIGHT OF WAY PLAT
 SHEET NO. **5-5.14** PLAN AND PROFILE
 SHEET NO. **6-6.34** STANDARD DETAIL DRAWINGS
 SHEET NO. **7-7.25** SIGN PLATES
 SHEET NO. **8** STRUCTURE PLANS
 SHEET NO. **9&9.1** COMPUTER EARTHWORK DATA
 SHEET NO. **9.2-9.43** CROSS SECTIONS

TOTAL SHEETS - 190

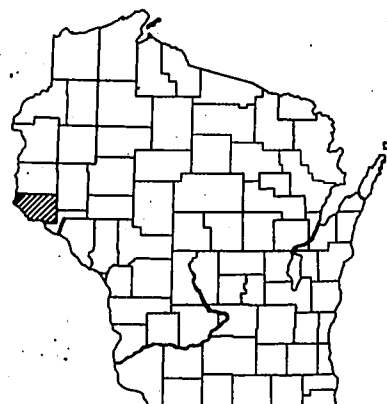

DESIGN DESIGNATION

A.D.T. (1994) : 7,050
 A.D.T. (2014) : 9,300
 D.H.V. : 1,116
 D. : 60-40
 T. : 7.7%
 DESIGN SPEED : 45 MPH
 ESALS : N/A

CONVENTIONAL SIGNS

COUNTY LINE
 CORPORATE LIMITS
 PROPERTY LINE
 LOT LINE
 TEMPORARY LIMITED EASEMENT
 EXISTING RIGHT OF WAY
 NEW RIGHT OF WAY
 REFERENCE LINE
 SLOPE INTERCEPT
 ORIGINAL GROUND
 MARSH OR ROCK PROFILE
 CULVERT IN PLACE
 CULVERT REQUIRED
 CULVERT REQUIRED (PROFILE)
 COMBUSTIBLE FLUIDS (UNDER PRESSURE)
 POWER POLE
 TELEPHONE POLE

UNDERGROUND UTILITIES
 STORM SEWER
 SANITARY SEWER
 WATER
 GAS
 ELECTRIC
 TELEPHONE
 FIBER OPTIC
 CABLE TV
 SERVICE PEDESTAL
 CABLE MARKER

SS
 SAN
 W
 G
 E
 T
 FO
 TV
 P

RAILROADS
 MARSH
 WOODED AREA

STATE OF WISCONSIN DEPARTMENT OF TRANSPORTATION

PLAN OF PROPOSED IMPROVEMENT

PRESCOTT-ELLSWORTH ROAD

STH 35 (SOUTH) - STH 29 (EAST)


U.S.H. 10
 PIERCE COUNTY

STATE PROJECT NUMBER
 1532-09-72

AS BUILT

EQUATION
 STA. 49+23.49 BK.=
 STA. 47+29.35 AH.

BEGIN PROJECT
 STA. 12+93.82
 Y. 347664.52
 X. 1240410.29

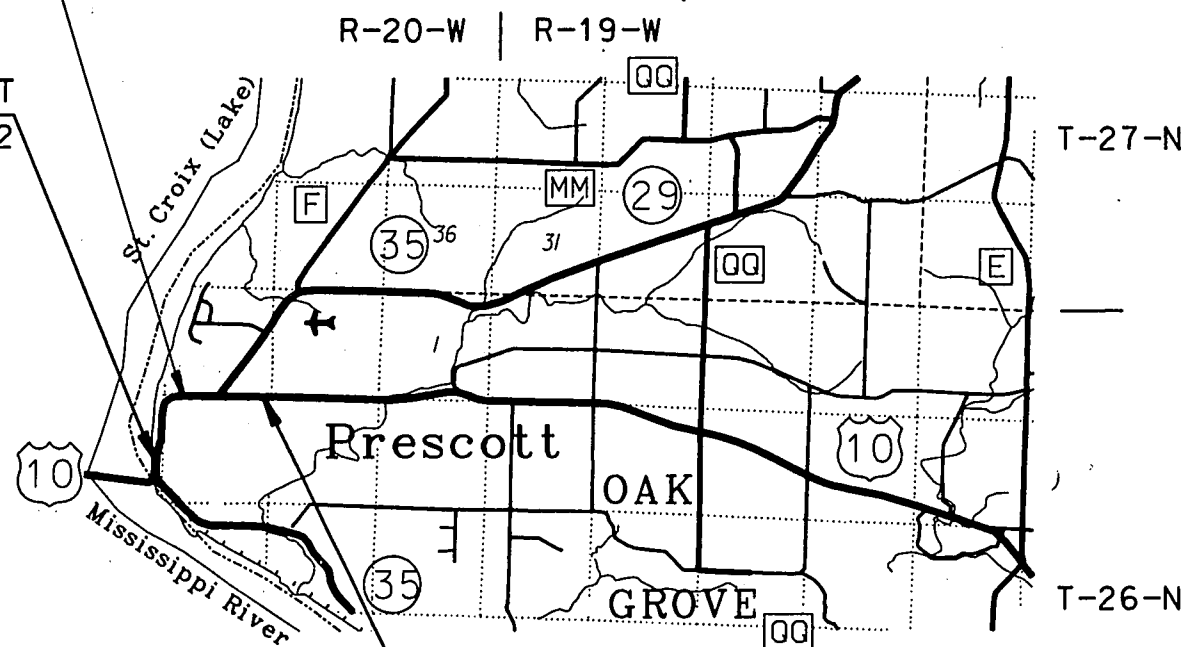

END PROJECT
 STA. 89+03.25

LAYOUT
 SCALE 1 MI.


TOTAL NET LENGTH OF CENTERLINE = 1.068 MI. URBAN
 0.410 MI. RURAL

ALL COORDINATES SHOWN ON THIS PLAN ARE REFERENCED
 TO THE WISCONSIN COORDINATE SYSTEM, CENTRAL ZONE.

STATE PROJECT	FEDERAL PROJECT	
	PROJECT	CONTRACT
1532-09-72	STP 019 (74)	1

ORIGINAL PLANS PREPARED BY

KL Engineering Inc.

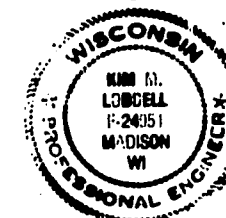

7/27/93 (DATE)
 Kim M. Obdell (SIGNATURE)

STATE OF WISCONSIN
 DEPARTMENT OF TRANSPORTATION

PREPARED BY
 SURVEYOR
 DESIGNER
 DISTRICT EXAMINER
 DISTRICT SUPERVISOR
 PROJ. DEV. ENGINEER
 C. O. EXAMINER

WISDOT & KAPUR ASSOC.
 KL ENGINEERING
 RICHARD GOSNELL
 RICHARD SHERNO
 ROBERT REUKEMA
 N.B. AFFELDT

APPROVED FOR DISTRICT OFFICE
 DATE: 7/30/93
 N.G. Ewert (SIGNATURE)

AUTHORIZED FOR CENTRAL OFFICE TRAFFIC
 DATE: 9/21/93
 John R. Ruch

AUTHORIZED FOR
 DATE: 10/9/93
 Robert W. Long