


INDEX OF SHEETS

- Sheet No. 1 Title
Sheet No. 2-2.13 Typical Sections and Details
Sheet No. 3-3.4 Estimate of Quantities
Sheet No. 3A-3C Miscellaneous Quantities
Sheet No. 4-4.1 Right of Way Plat
Sheet No. 5-5.12 Plan and Profile
Sheet No. 6-6.21 Standard Detail Drawings
Sheet No. 7-7.1 Sign Plates
Sheet No. 8-8.2 Structure Plans
Sheet No. Computer Earthwork Data
Sheet No. 9-9.26 Cross Sections

TOTAL SHEETS = 92

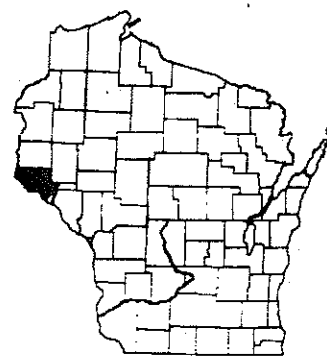

STATE OF WISCONSIN
DEPARTMENT OF TRANSPORTATION

PLAN OF PROPOSED IMPROVEMENT
ELLSWORTH - DURAND ROAD

C.T.H. "A" - EAST COUNTY LINE ROAD
U.S.H. 10
PIERCE & PEPIN COUNTY

STATE PROJECT NUMBER
1530-08-71

STATE PROJECT	FEDERAL PROJECT	
	PROJECT	CONTRACT
1530-08-71	STP 019(92)	1

AS BUILT PLAN
PROJECT ENGINEER DAN L. WINDRICH
GENERAL CONTR. SDR MATHY
BEGIN & END CONSTRUCT. 5-24-96
10-14-96
CONTRACT COST \$1,982,438.54
C.C.O. #S 1

DESIGN DESIGNATION

A.D.T. 1995 = 1720
A.D.T. 2015 = 2210
D.H.V. 2015 = 298
D. = 60-40
T. = 13.0%
V. = 60 MPH
ESALS = 1,119,820

CONVENTIONAL SIGNS


- | | |
|-----------------------------|-------------------------------------|
| COUNTY LINE | COMBUSTIBLE FIELDS (UNDER PRESSURE) |
| CORPORATE LIMITS | UNDERGROUND UTILITIES |
| PROPERTY LINE | GAS |
| LOT LINE | ELECTRIC |
| LIMITED EASEMENT | TELEPHONE |
| EXISTING RIGHT OF WAY | SERVICE PEDESTAL |
| NEW RIGHT OF WAY | CABLE MARKER |
| REFERENCE LINE | POWER POLE |
| SLOPE INTERCEPT | TELEPHONE POLE |
| ORIGINAL GROUND | RAILROADS |
| MARSH OR ROCK PROFILE | WATERS |
| CULVERT IN PLACE | WOODED AREA |
| CULVERT REQUIRED | |
| CULVERT REQUIRED (PROPOSED) | |

BEGIN PROJECT
STA. 0+00
X. = 1,394,100 (±200')
Y. = 312,400 (±200')

EQUATION
STA. 22+43.00 BK. =
STA. 23+84.5 AH.

STA. 28+54.25 TO STA. 29+15.75
EXCEPTION TO NET LENGTH &
B-47-13

EQUATION
STA. 117+50 BK. =
STA. 35+70 AH.

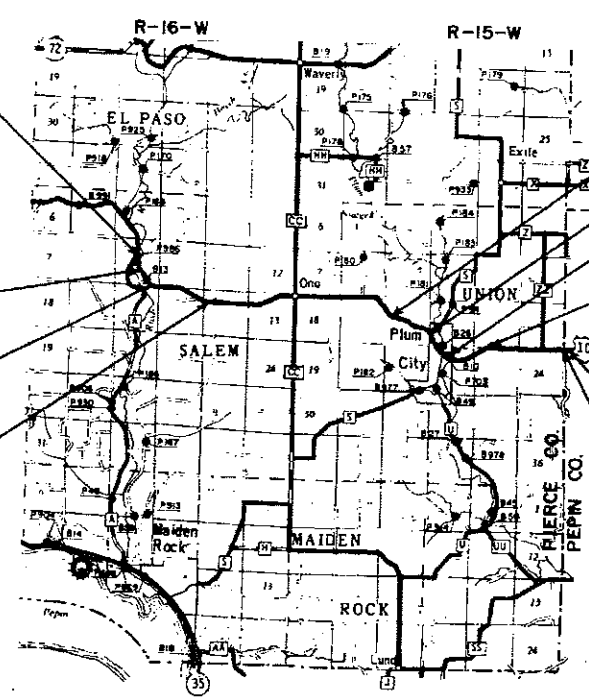

EQUATION
STA. 260+52.7 BK. =
STA. 14+53.92 AH.

EQUATION
STA. 64+00 BK. =
STA. 0+200 AH.

STA. 26+96.75 TO STA. 28+77.25
EXCEPTION TO NET LENGTH &
B-47-10

EQUATION
STA. 96+29.5 BK. =
STA. 0+00 AH.

END PROJECT 1530-08-71
STA. 11+00

EQUATION
STA. 74+48.3 BK. =
STA. 0+00 AH.

LAYOUT
SCALE 0 2 MI.

TOTAL NET LENGTH OF CENTERLINE = 10.823 MI.

COORDINATES SHOWN ON THIS PLAN ARE
REFERENCED TO THE WISCONSIN COORDINATES
SYSTEM, CENTRAL ZONE AND ARE SCALED FROM
U.S.G.S. TOPOGRAPHIC MAPS, MAIDEN ROCK
WISCONSIN QUADRANGLE FOR
IDENTIFICATION ONLY

ORIGINAL PLAN PREPARED BY
Palzkill, Peterson & Associates Consulting Engineers
1407 Lynn Avenue • Altoona, Wisconsin 54720 • 715/632-6400

LYNN A. PETERSON
E-6004
ALTOONA, WIS.
PROFESSIONAL ENGINEER

Lynn A. Peterson 1-28-95
ENGINEER DATE

STATE OF WISCONSIN
DEPARTMENT OF TRANSPORTATION

PREPARED BY
SURVEYOR P&P
DESIGNER P&P
DISTRICT EXAMINER S.E. MELLER
DISTRICT SUPERVISOR C. LINDALL
PROJ. DEV. ENGINEER L.A. STANEK
C.O. EXAMINER N.R. APPELDT

APPROVED FOR DISTRICT OFFICE
DATE: 3/14/95 Normy Lunt
(SIGNATURE)

AUTHORIZED FOR CENTRAL OFFICE DESIGN
DATE: 4-26-95 Donald W. Fack
(SIGNATURE)

STANDARD ABBREVIATIONS		
ABUTMENT	ABUT	PAVEMENT
ACRES	AC	PERMANENT LIMITED EASEMENT
AGGREGATE	AGG	POINT
ASPHALT	ASPH	POINT OF CURVATURE
ASPHALT CEMENT	A C	POINT OF INTERSECTION
AUXILIARY	AUX.	POINT OF TANGENCY
AVERAGE DAILY TRAFFIC	A.D.T	POINT ON CURVE
BACK FACE	B F	POINT ON TANGENT
BENCH MARK	B M	PORTLAND CEMENT CONCRETE
BRIDGE	B OR BR	PRIVATE ENTRANCE
CATCH BASIN	C B	PROJECT
CENTER LINE	C, C/L OR C/L	RADIUS
CENTER TO CENTER	C C	RADIUS POINT
CONCRETE	CUNC	REFERENCE LINE
CORRUGATED	CURR	REFERENCE POINT
CREEK	CR	REINFORCED CONCRETE CULVERT
CRUSHED	CR	PIPE
CULVERT	CULV	REINFORCING OR REINFORCEMENT
CULVERT PIPE	C P	REINFORCEMENT BAR
CURB & GUTTER	C & G	RELOCATED(D)
DEGREE OF CURVE	D	REMAINING
DESIGN HOUR VOLUME	D H V	REQUIRED
DIAMETER	DIA	RIGHT
ELEVATION	EL OR ELEV	RIGHT-HAND FORWARD
EMBANKMENT	EMB	RIGHT-OF-WAY
ENDWALL	E W	SALVAGED
EXCAVATION	EXC	SECTION
EXISTING	EXIST	SHOULDER
EXPAND(ED) OR EXPANSION	EXP	SHRINKAGE
FERTILIZE	FERT	SOUTH
FINISHED GRADE	FG	SOUTHBOUND
FLOW LINE	FL OR F/L	SPECIAL
GRID NORTH	GN	SPECIFICATIONS
HUNDREDWEIGHT	CWT	STANDARD
HYDRANT	HYD.	STANDARD DETAIL DRAWINGS
INLET	INL	STRUCTURE OR STRUCTURAL
INTERSECTION	INTERS.	SUPERELEVATION
INVERT	INV	SURVEY LINE
IRON PIPE OR PIN	I P	TANGENT
JOINT	JT	TELEPHONE
JUNCTION	JCT	TEMPORARY
LEFT HAND FORWARD	L H F	TEMPORARY LIMITED EASEMENT
LENGTH (OF CURVE)	L	TOWN
LINEAR FOOT	LIN FT	TRANSITION
MAINTENANCE	MAINT	TRANSIT LINE
MATCH LINE	M L OR M/L	TYPICAL
NOMINAL	NOM	UNCLASSIFIED
NORMAL CROWN	N C	VERTICAL
NORTHBOUND	N B	VERTICAL
OBLITERATE	OBLIT.	WESTBOUND
OUTSIDE DIAMETER	O.D.	
EQUIVALENT SINGLE	ESALS.	
AXLE LOADS		

GENERAL NOTES

THE LOCATION OF EXISTING AND PROPOSED UTILITY INSTALLATIONS AS SHOWN ON THE PLANS ARE APPROXIMATE. THERE MAY BE OTHER UTILITY INSTALLATIONS WITHIN THE AREA THAT ARE NOT SHOWN.

WHEN THE QUANTITY OF THE ITEM OF BASE COURSE, OR SURFACE COURSE IS MEASURED FOR PAYMENT BY THE TON, THE DEPTH OR THICKNESS OF THE COURSE SHOWN ON THE PLAN IS APPROXIMATE AND THE ACTUAL THICKNESS WILL DEPEND ON THE DISTRIBUTION OF THE MATERIAL AS DIRECTED BY THE ENGINEER.

CURVE DATA IS BASED ON ARC DEFINITION.

NO TREES OR SHRUBS SHALL BE REMOVED WITHOUT THE APPROVAL OF THE ENGINEER.

DISTURBED AREAS WITHIN THE RIGHT-OF-WAY ARE TO BE FERTILIZED, MULCHED, AND SEEDED AS DIRECTED BY THE ENGINEER.

INLET AND DISCHARGE ELEVATIONS FOR DRAINAGE STRUCTURES ARE APPROXIMATE AND SHALL BE DETERMINED BY THE ENGINEER IN THE FIELD.

EXCAVATION BELOW SUBGRADE (EBS) IS NOT USED TO BALANCE YARDAGE AND IS NOT SHOWN ON THE CROSS SECTIONS BUT IF REQUIRED SHALL BE MEASURED AND PAID FOR AS UNCLASSIFIED EXCAVATION. THE LOCATION OF EBS WILL BE DETERMINED BY THE ENGINEER.

ASPHALTIC MATERIAL FOR TACK COAT HAS BEEN ESTIMATED AT .030 GAL / S.Y.

BINDER COURSE SHALL BE 2 1/2" AND SURFACE COURSE SHALL BE 2".

STANDARD DETAIL DRAWINGS

8D1-11	CONCRETE CURB, CONCRETE CURB AND GUTTER AND PAVEMENT TIES
8D4-3	CONCRETE SURFACE DRAIN & ASPHALTIC FLUME
8E9-4	SILT FENCE
8F1-11	APRON ENDWALLS FOR CULVERT PIPE
8F4-5	JOINT TIES
9A1-9a	AT-GRADE SIDE ROAD INTERSECTIONS, TYPE "B", "C", AND "D".
9A1-9b	AT-GRADE SIDE ROAD INTERSECTIONS, TYPE "A" AND PASSING LANES
9C2-1	CONCRETE BASES
12A3-4	NAME PLATES FOR STRUCTURES
14B15-1a	CLASS "A" STEEL PLATE BEAM GUARD, INSTALLATION & ELEMENTS
14B16-1a & b	CLASS "A" STEEL PLATE BEAM GUARD AND TREATMENT WITH ANCHORAGE TYPE 1 & 2
14B18-1a	CLASS "A" STEEL PLATE BEAM GUARD 1 AT BRIDGES, OBSTACLES AND SIDEROADS / DRIVEWAYS
14B20-2a	STEEL THRIE BEAM STRUCTURE APPROACH
14B20-2c	STEEL THRIE BEAM STRUCTURE APPROACH CONNECTION TO SLOPED END PARAPETS
14B20-2d	STEEL THRIE BEAM STRUCTURE APPROACH CONNECTION TO BRIDGE RAILING TYPES "F" AND "H"
15C2-2	BARRICADES AND TRAFFIC CONTROL FOR ROAD CLOSURES
15C7-4a	PAVEMENT MARKING SYMBOLS
15C8-6a & 6b	PAVEMENT MARKING (MAINLINE & INTERSECTIONS)
15C12-2	TRAFFIC CONTROL FOR LANE CLOSURE (SUITABLE FOR MOVING OPERATIONS)
16A1-5	LANDMARK REFERENCE MONUMENTS AND COVERS

UTILITIES

- * GTE NORTH
20 SOUTH WILSON
RICE LAKE, WI 54868
PHONE (715) 234-5528
ATTN: GARY SCHIEFFER
- NELSON TELEPHONE COOPERATIVE
DURAND WI. 54736
PHONE (715) 672-4204
ATTN: DALE GOSS
- * WISCONSIN GAS CO.
1251 WEST MAIN ST.
P.O. BOX 66
SUN PRARIE, WI. 53590
PHONE (715) 423-2800
ATTN: AL ZWICKER
- * N.S.P.
100 N BARSTOW ST
PO BOX 8
EAU CLAIRE WI
PHONE (715) 839-2577
ATTN: ED TRAPP
- * PIERCE-PEPIN ELECTRIC COOPERATIVE
ELLSWORTH, WI 54011
PHONE (715) 273-4355
ATTN: GERALD DE WOLF
- * FOR LOCATING PHONE 1-(800) 242-8511

PAVEMENT CORING LOG

STATION	LOCATION	DEPTH OF ASPHALT (INCHES)
13+20	6' RT	4.75
26+00	6' RT	7.50
39+20	6' RT	7.50
52+30	6' RT	7.25
66+00	6' RT	8.50
79+20	6' RT	10.00
92+40	6' RT	7.00
37+00	6' RT	9.75
50+20	6' RT	8.00
63+40	6' RT	4.00
76+60	6' RT	4.40
89+80	6' RT	7.25
103+00	6' RT	3.75
116+20	6' RT	3.75
129+40	6' RT	3.75
142+60	6' RT	3.75
155+80	6' RT	4.00
169+00	6' RT	4.00
182+20	6' RT	3.75
195+40	6' RT	4.75
208+60	6' RT	4.00
221+80	6' RT	4.00
235+00	6' RT	4.00
248+20	6' RT	4.75
15+40	6' RT	3.75
28+60	6' RT	8.50
41+80	6' RT	5.00
55+00	6' RT	8.50
2+20	6' RT	8.00
15+40	6' RT	6.75
28+60	6' RT	6.00
41+80	6' RT	6.50
55+00	6' RT	6.00
68+20	6' RT	6.75
81+40	6' RT	6.50
94+60	6' RT	8.75
11+50	6' RT	4.25
24+70	6' RT	5.75
37+90	6' RT	4.25
51+10	6' RT	4.00

SUPERELEVATIONS



LOCATION	DEGREE OF CURVE	EXISTING S E	REQ'D S E
0+50 - 7+20	SEC 1	5°	08 1/2%
23+84.5 - 41+22	SEC 1	3°	06 1/2%
43+76.3 - 51+73	SEC 1	0°-45'	02 1/2%
55+45.1 - 60+56.8	SEC 1	0°-30'	02%
62+99.7 - 73+36.3	SEC 1	2°	04 1/2%
73+71.6 - 82+03.3	SEC 1	1°	03 1/2%
94+98 - 100+73	SEC 1	3°	06%
80+50.4 - 90+08.8	SEC 2	3°	06 1/2%
110+30 - 117+99	SEC 2	3°-30'	06 1/2%
211+15.3 - 223+61.8	SEC 2	4°	08 1/2%
242+11.2 - 252+78	SEC 2	4°	08 1/2%
15+194.8 - 22+36.15	SEC 3	3°-30'	07 1/2%
23+42.88 - 32+78.05	SEC 3	5°	08 1/2%
37+19.02 - 55+53.69	SEC 3	5°	08 1/2%
57+41.99 - 64+00	SEC 3	1°-30'	03 1/2%
0+75 - 5+39	SEC 4	3°	05 1/2%
7+76 - 34+57	SEC 4	3°-30'	06 1/2%
60+37.4 - 65+70.7	SEC 4	0°-30'	01 1/2%
82+31.9 - 88+13	SEC 4	3°	06 1/2%
90+23 - 94+80.2	SEC 4	3°	07 1/2%
0+43.3 - 4+05.8	SEC 5	2°	04 1/2%
8+89.2 - 12+50.3	SEC 5	3°	06%
12+50.3 - 20+08.6	SEC 5	2°	04 1/2%
23+04.1 - 33+44.1	SEC 5	2°	04 1/2%
38+28.7 - 45+52	SEC 5	0°-30'	01 1/2%

SECTION AND STATION IDENTIFICATION

- SEC. 1 = STA 0+00 to STA 117+50 BK = STA 35+70 AH
- SEC. 2 = STA 35+70 AH to STA 260+52.7 BK = STA 14+53.92 AH
- SEC. 3 = STA 14+53.92 AH to STA 64+00 BK = STA 0-200 AH
- SEC. 4 = STA 0-200 AH to STA 96+29.5 BK = STA 0+00 AH
- SEC. 5 = STA 0+00 AH to STA 74+48.3 BK = STA 0+00 AH
- SEC. 6 = STA 0+00 AH to STA 11+00

TYPICAL SECTIONS

NOTE: IN SOME LOCATIONS, WIDENING OF SHOULDERS HAS PRODUCED STEEP INSLOPES. THESE MUST BE TRIMMED AND WILL BE PAID FOR AS SHAPING SHOULDERS. (AS DIRECTED BY ENGINEER.)

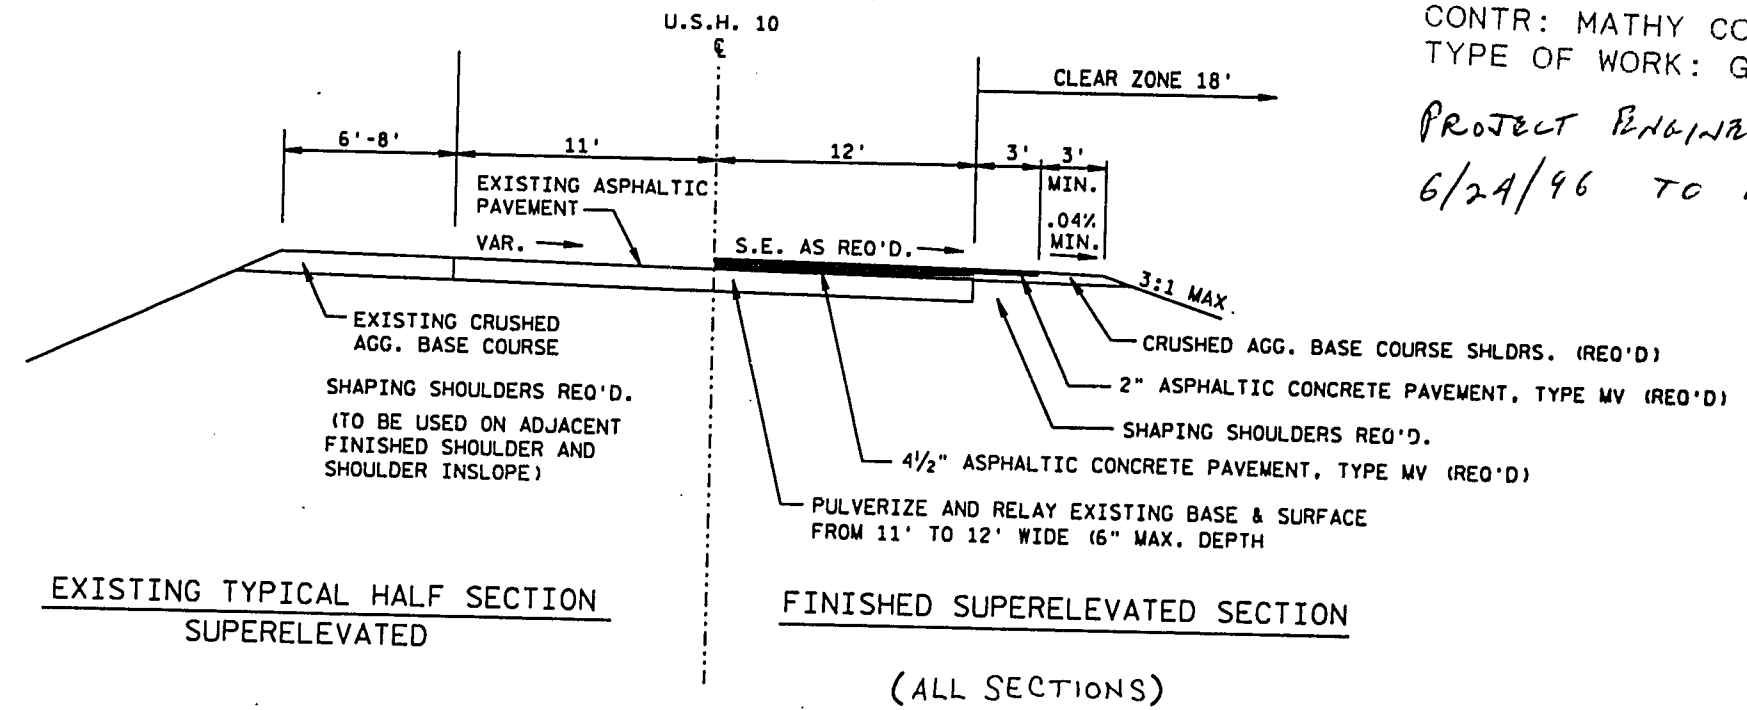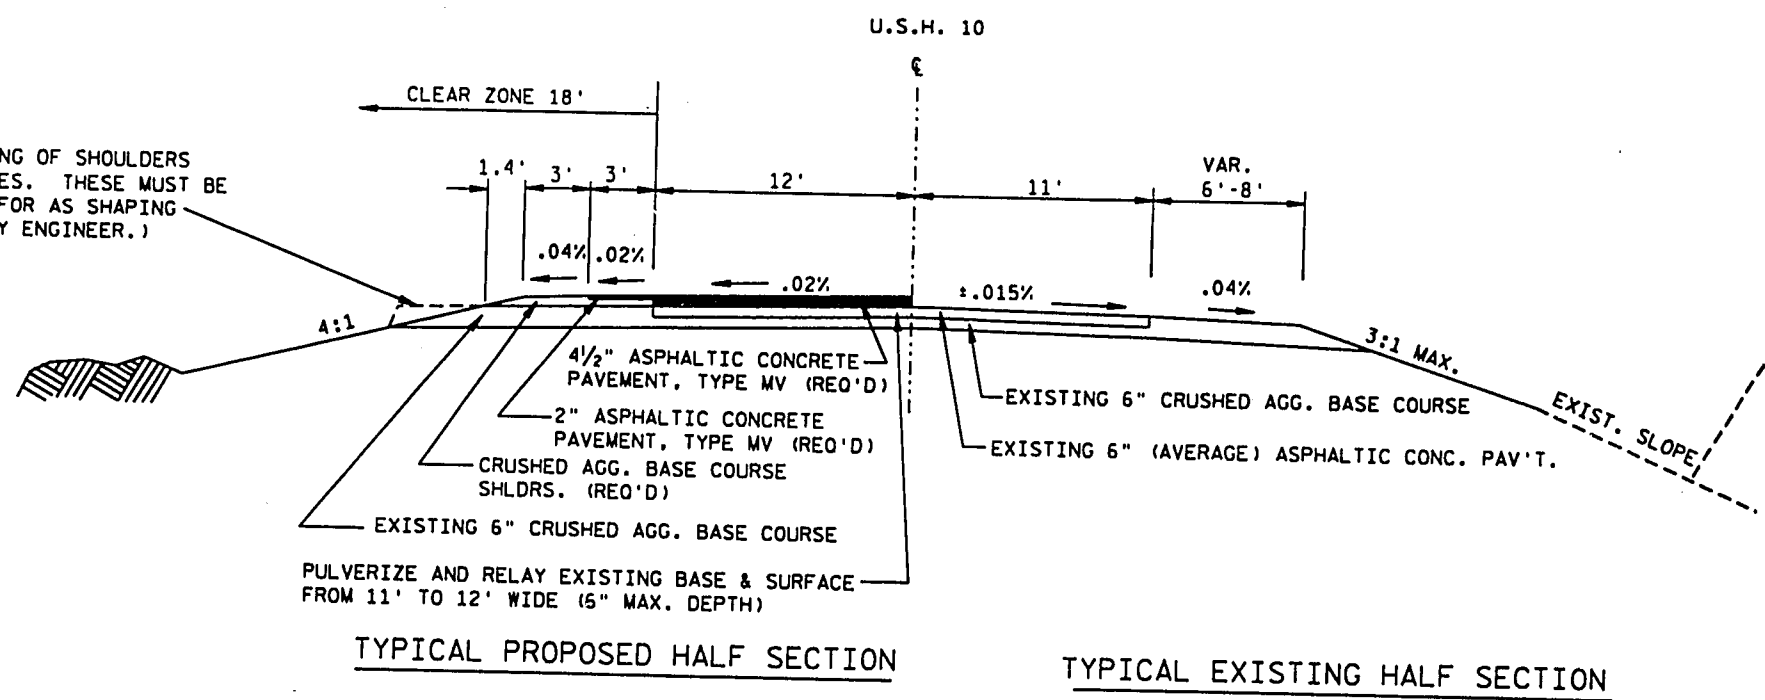

1530-08-71 STP 019(92) DIST 6
 ELLSWORTH - DURAND ROAD
 CTH "A" EAST COUNTY LINE
 USH 10 PIERCE/PEPIN COUNTIES
 CONTR: MATHY CONSTRUCTION COMPANY
 TYPE OF WORK: GEN CONST, ASPH SURF

PROJECT ENGINEER DAN L. W. ARICH
 6/24/96 TO 10/4-96


PLOT SCALE:

PLOT NAME:

REV. DATE: 4-24-95 LEO

ORIGINATOR: DIST. 6, EAU CLAIRE, L. OLSON

LEVELS ON - 1, 2, 3, 62, 63

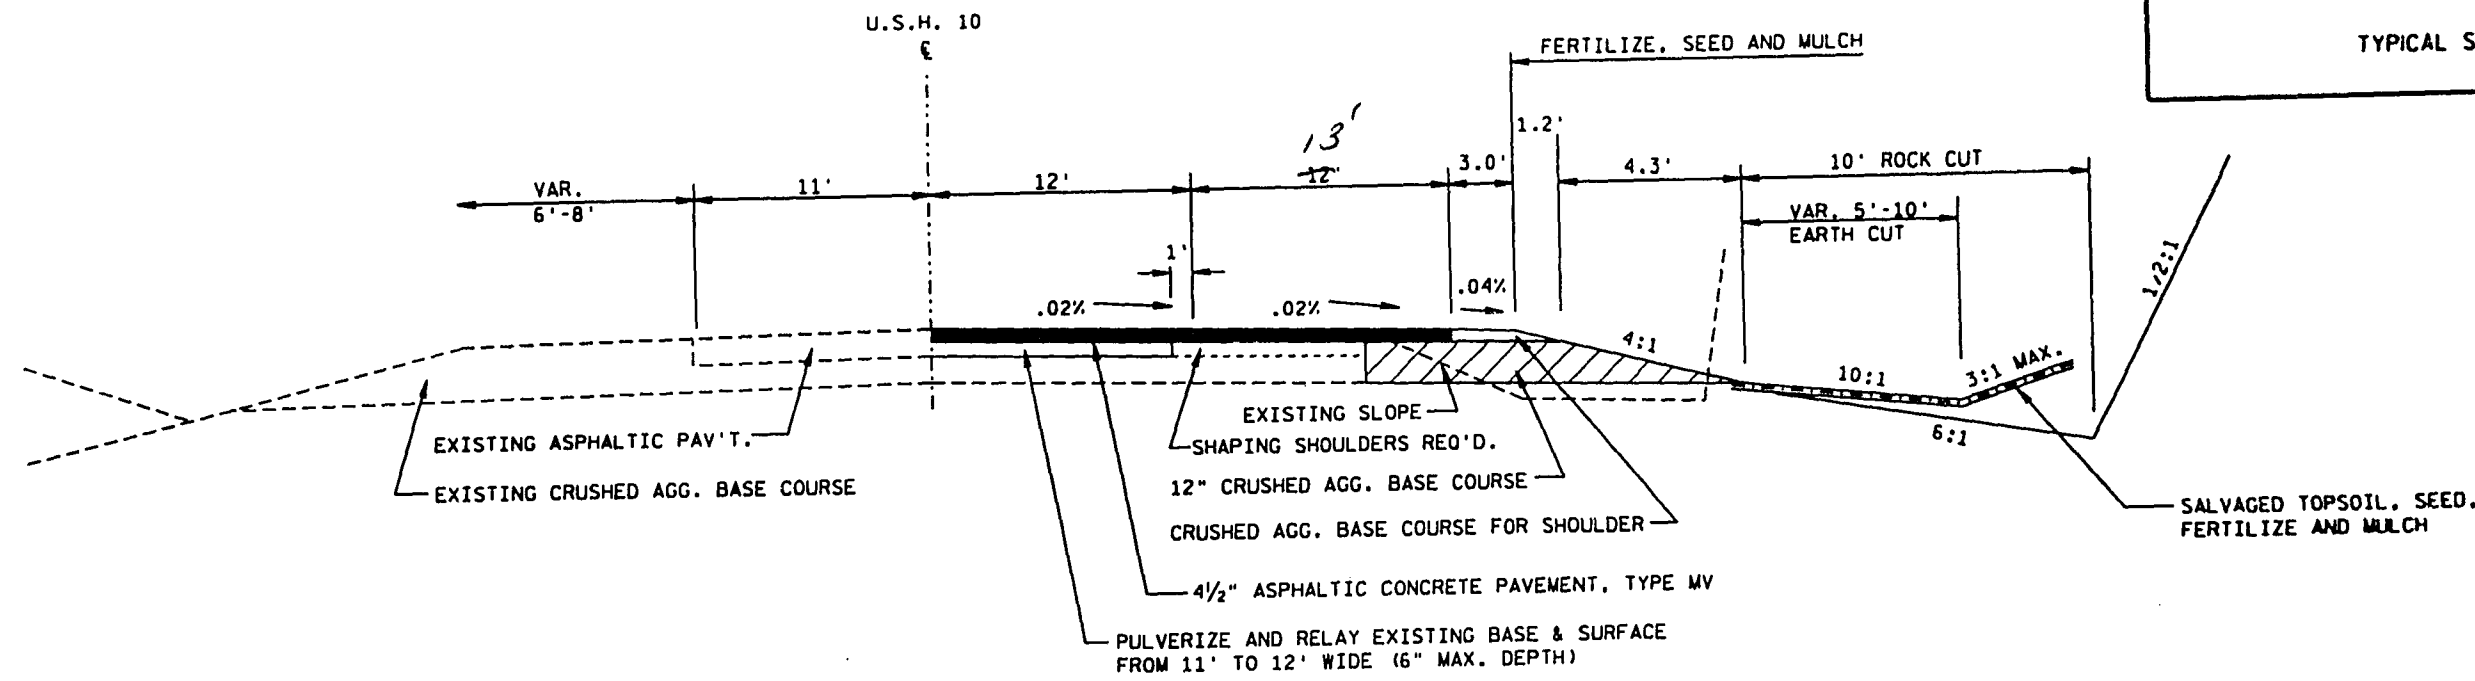


TYPICAL FINISHED HALF SECTION WITH AUXILIARY LANE

STA. 76+50 - STA. 96+29.5 BK. (SECTION 4)
 STA. 0+00 AH. - STA. 45+52 BK. (SECTION 5)
 STA. 45+61.8 AH. - STA. 74+48.30 BK. (SECTION 6)
 STA. 0+00 AH. - STA. 11+00 (SECTION 6)


NOTE FOR SIDE ROAD TYPICAL

1. EXISTING CRUSHED AGGREGATE SIDE ROADS SHALL BE PAVED TO THE RADIUS POINTS A DEPTH OF 3" WITH ASPHALTIC CONCRETE PAVEMENT, TYPE MV
2. EXISTING ASPHALTIC SURFACE SIDE ROADS, WHICH NEED RADIUS WIDENING SHALL BE CONSTRUCTED TO THE SAME PAVEMENT STRUCTURE AS SHOWN IN TYPICAL SECTION FOR SIDE ROADS. EXISTING ASPHALTIC SURFACE SHALL BE PULVERIZED AND RELAIED AND RESURFACED WITH 3" OF ASPHALTIC CONCRETE PAVEMENT, TYPE MV

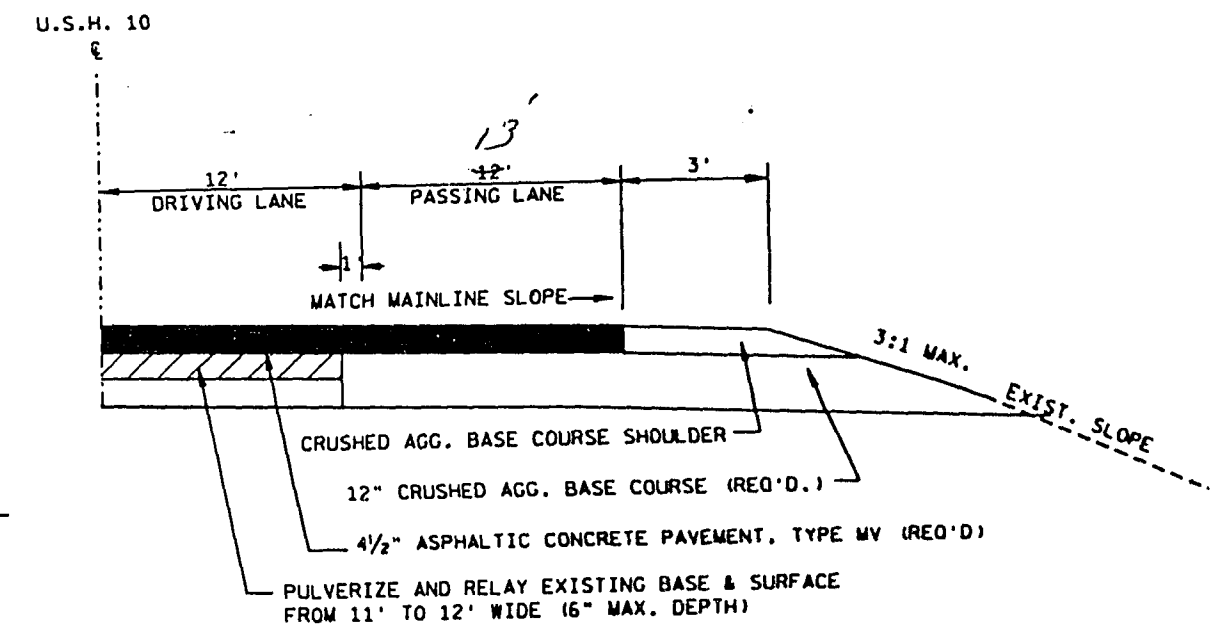


TYPICAL FINISHED HALF SECTION WITH PASSING LANE

SECTION NO. 1 - STA. 4+50 RT. - STA. 12+00 RT.

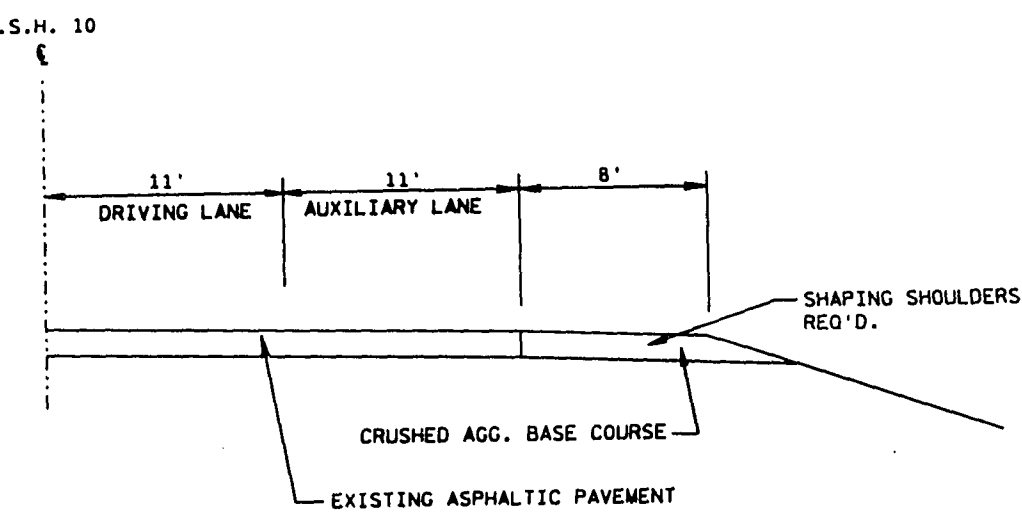


EXISTING HALF SECTION WITH EXISTING AUXILIARY LANE

SECTION NO. 1 - STA. 33+50 RT. - STA. 115+50 RT.
 SECTION NO. 2&3 STA. 207+50 LT. - STA. 56+50 LT.

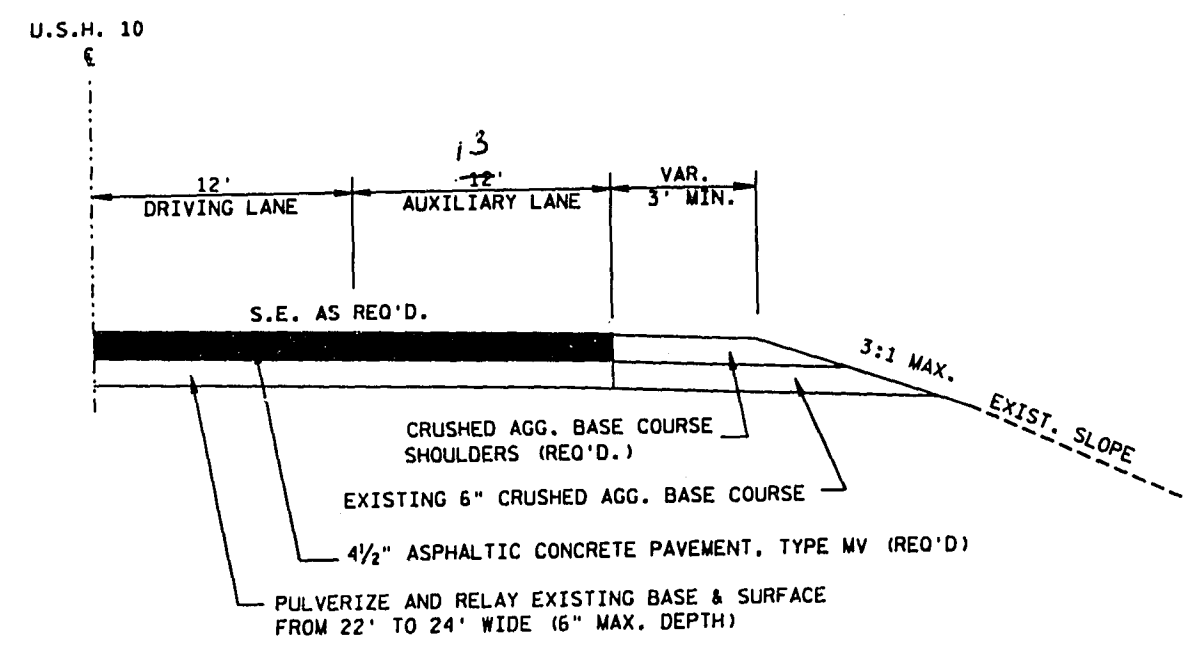



TYPICAL FINISHED HALF SECTION WITH EXISTING AUXILIARY LANE

SECTION NO. 1 - STA. 33+50 RT. - STA. 115+50 RT.
 SECTION NO. 2&3 STA. 207+50 LT. - STA. 56+50 LT.

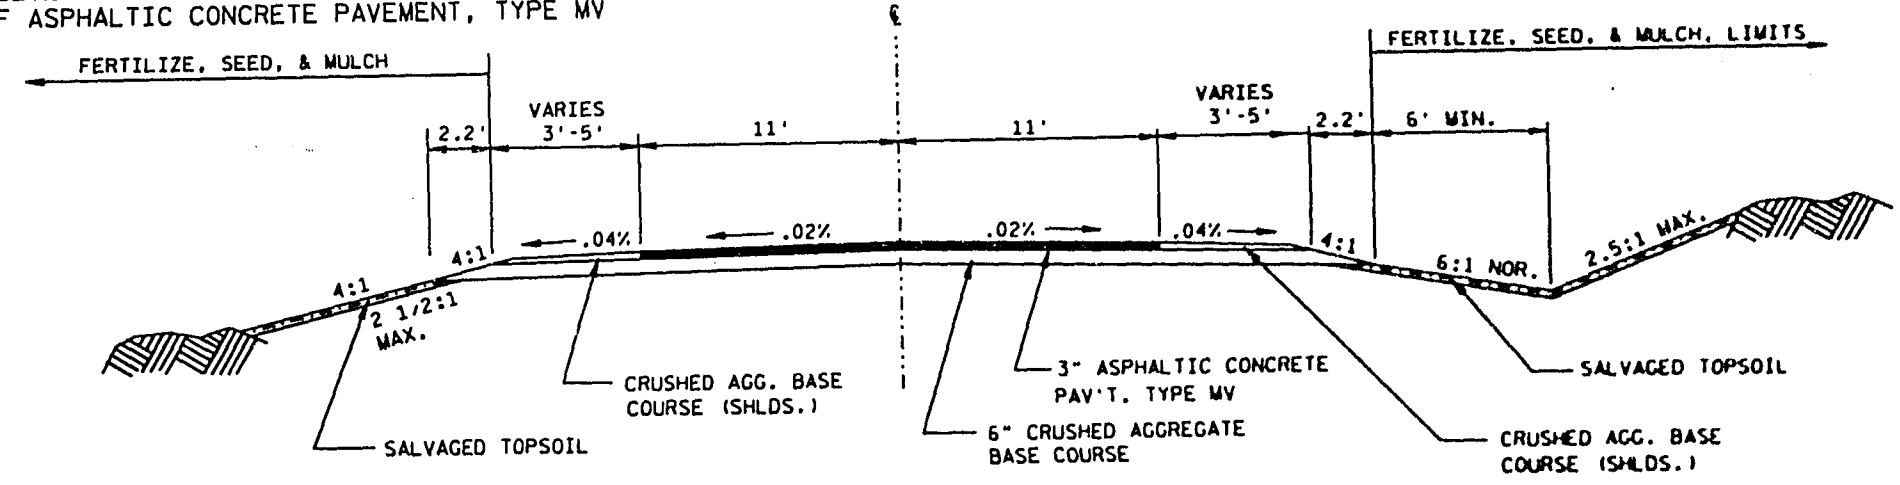


TYPICAL SECTION FOR SIDE ROADS



LEVELS ON - 1, 2, 3, 62, 63

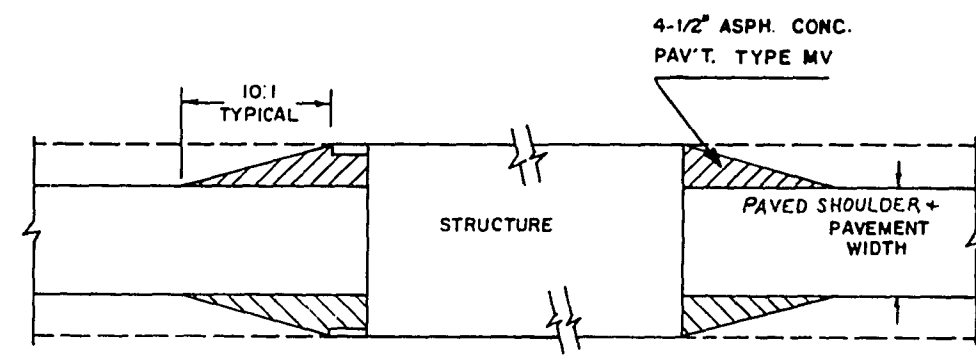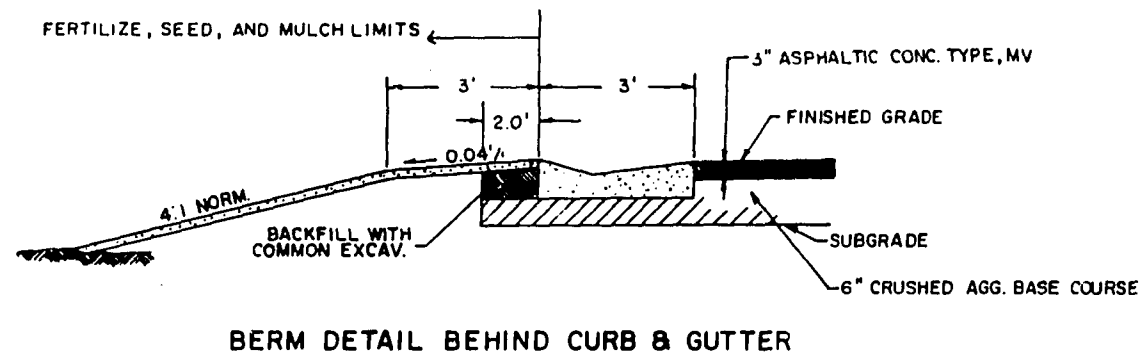

DETAIL FOR ASPHALTIC TAPERS AT STRUCTURES

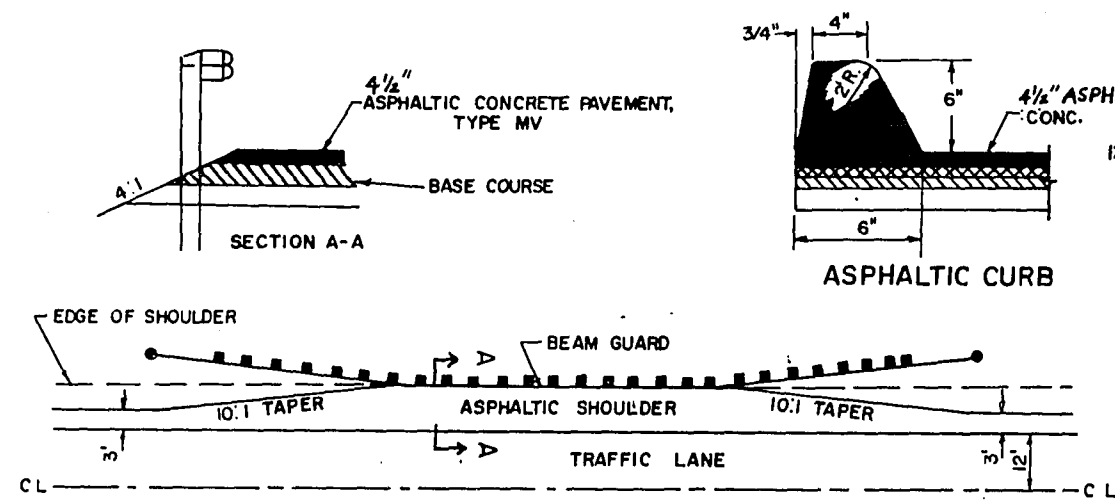


DETAIL FOR ASPHALTIC SHOULDER AT GUARDRAIL

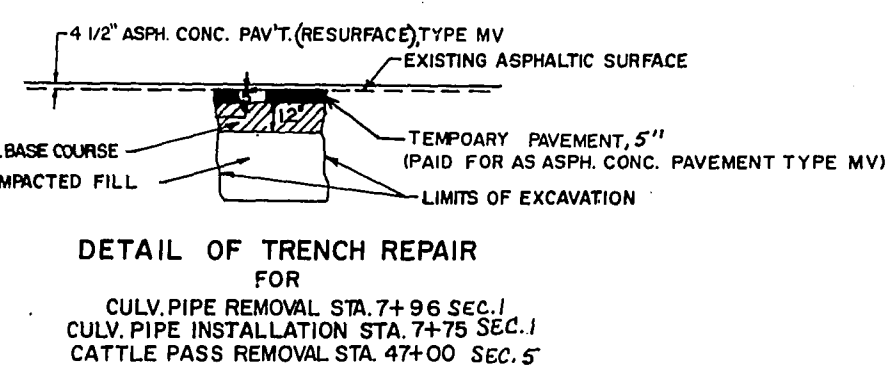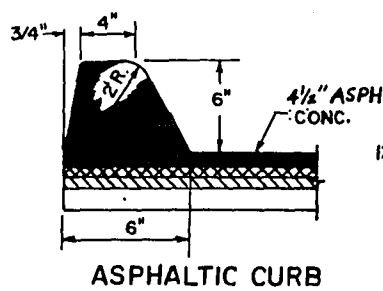


DETAIL OF TRENCH REPAIR


FOR
CULV. PIPE REMOVAL STA. 7+96 SEC. 1
CULV. PIPE INSTALLATION STA. 7+75 SEC. 1
CATTLE PASS REMOVAL STA. 47+00 SEC. 5

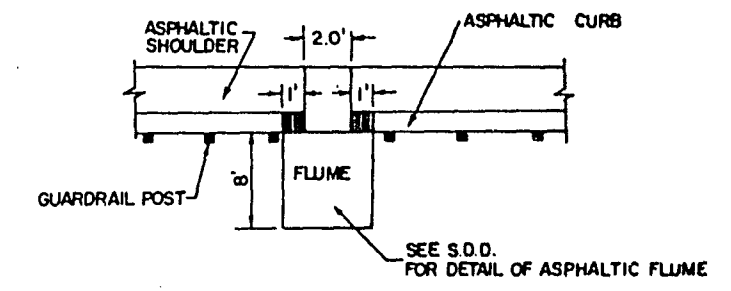


CURB OPENING FOR FLUME
ASPHALTIC CURB LOCATIONS

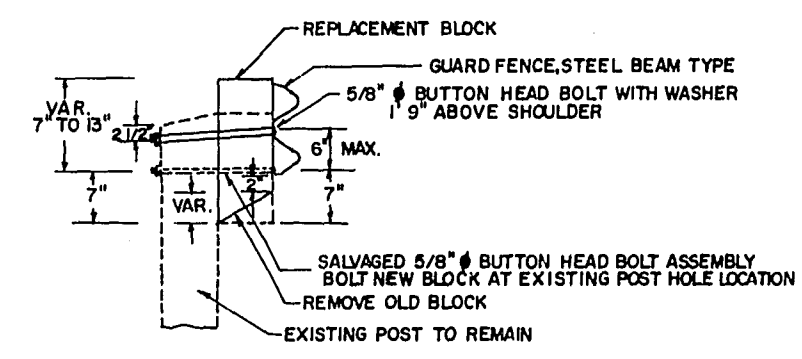


HEIGHT ADJUSTING REPLACEMENT BLOCK
FOR ADJUSTING STEEL PLATE BEAM GUARD

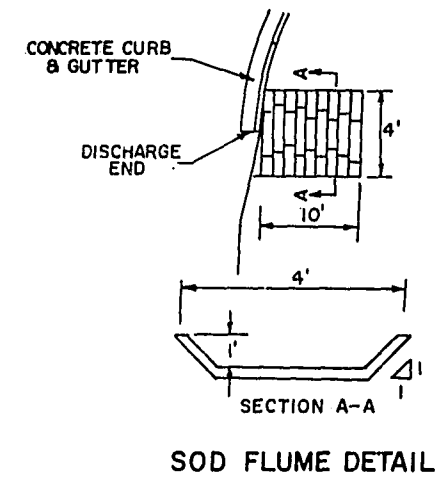


SOD FLUME DETAIL

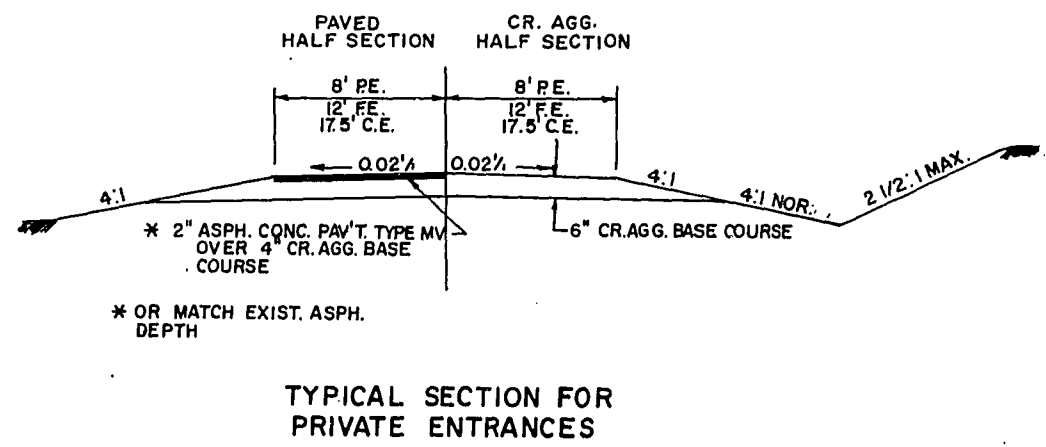


TYPICAL SECTION FOR
PRIVATE ENTRANCES

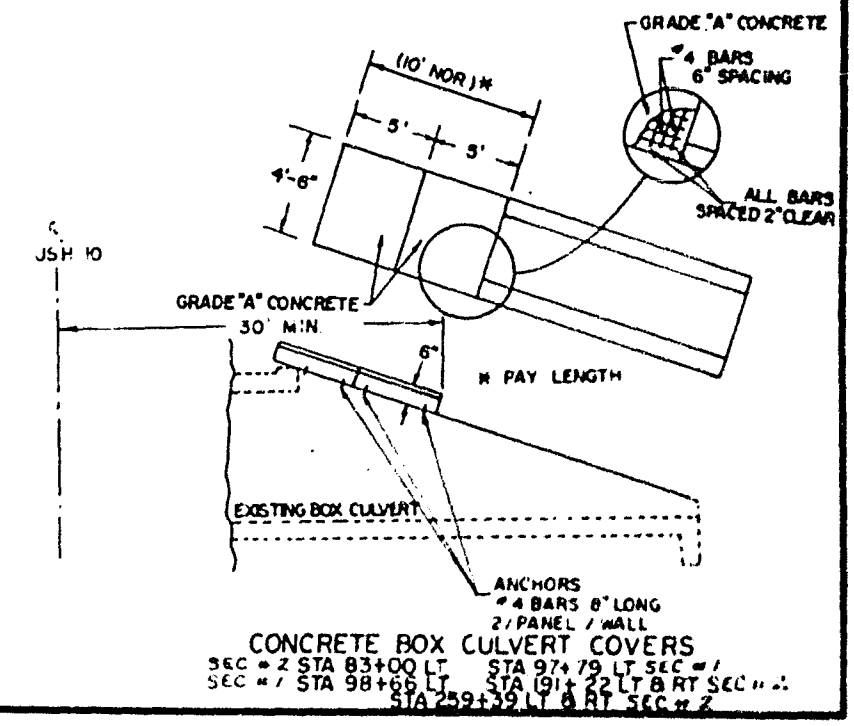


CONCRETE BOX CULVERT COVERS
SEC. 2 STA. 83+00 LT. STA. 97+79 LT. SEC. 1
SEC. 1 STA. 98+00 LT. STA. 191+22 LT. & RT. SEC. 2
STA. 259+32 LT. & RT. SEC. 2

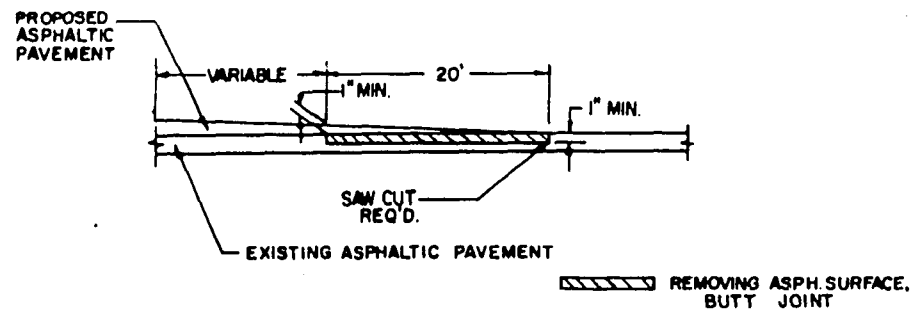


BUTT JOINT DETAIL

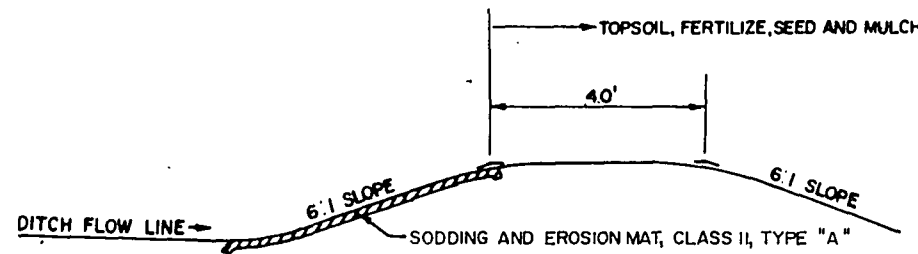


DETAIL FOR DITCH DAM

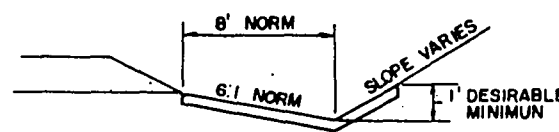


SOD OR EROSION MAT DETAIL
FOR DITCHES

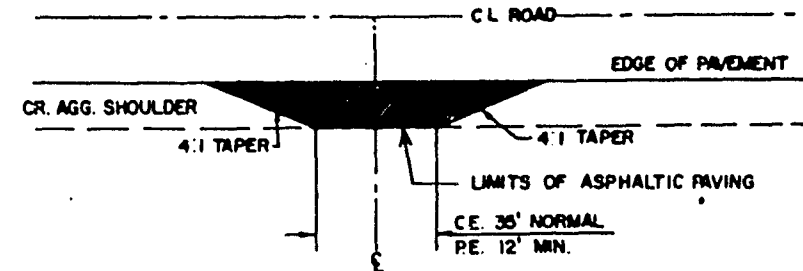

RURAL DRIVEWAY DETAIL

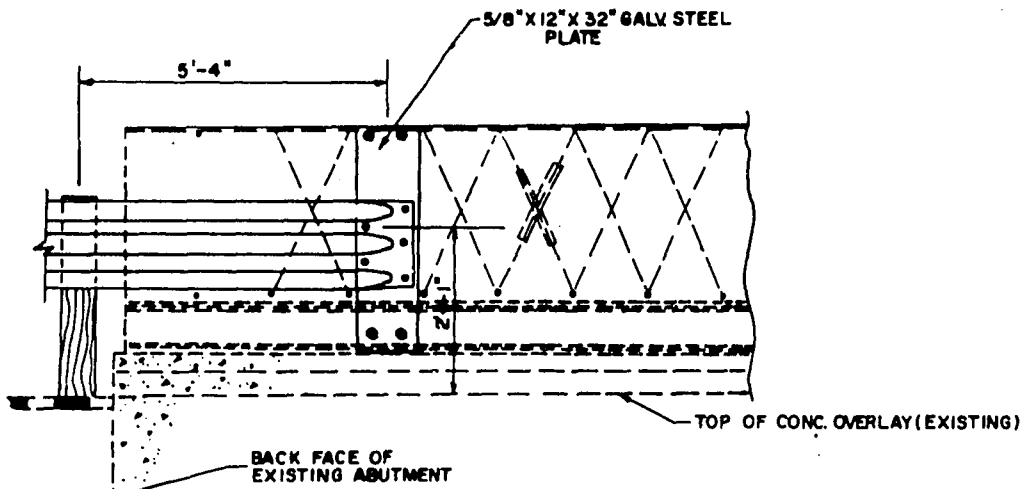


ANCHOR ASSEMBLIES FOR STEEL PLATE BEAM GUARD, SPECIAL
STRUCTURE B-47-986
(BEGINNING OF PROJECT)

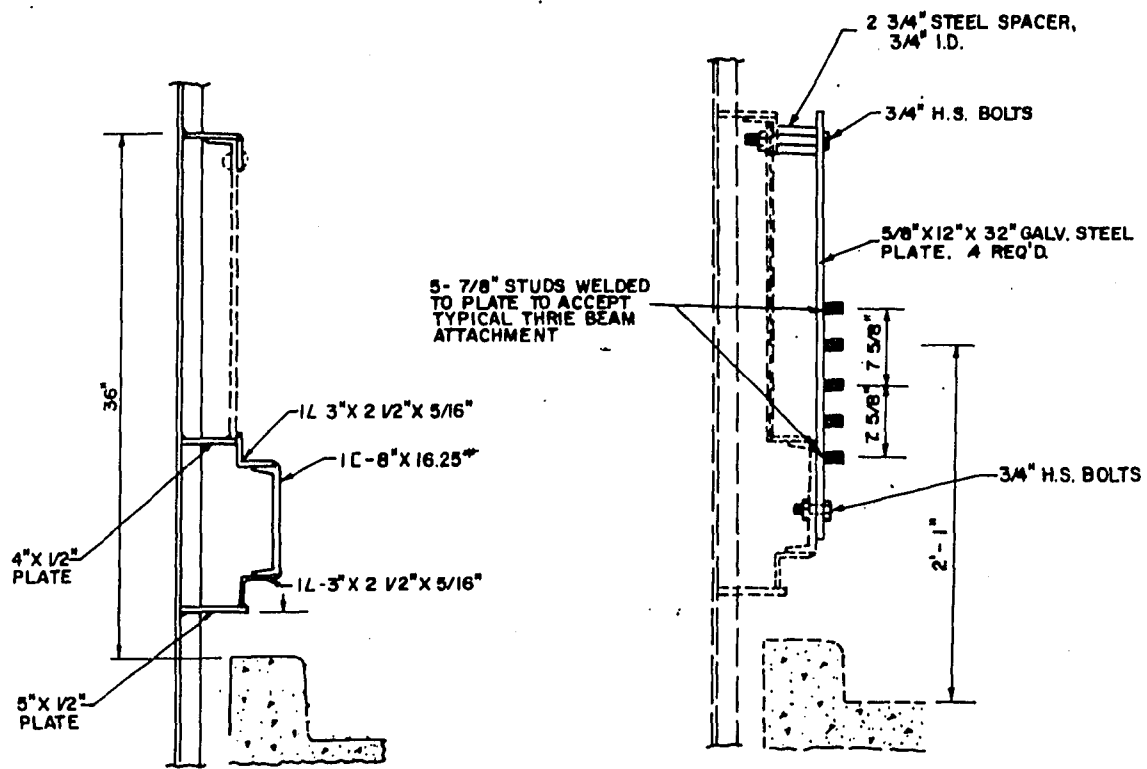


TYPICAL CROSS SECTION OF EXISTING RAILING AT
THE END POST @ STRUCTURE B-47-986

SECTION THRU PROPOSED RAILING
AT END POSTS @ STRUCTURE B-47-986

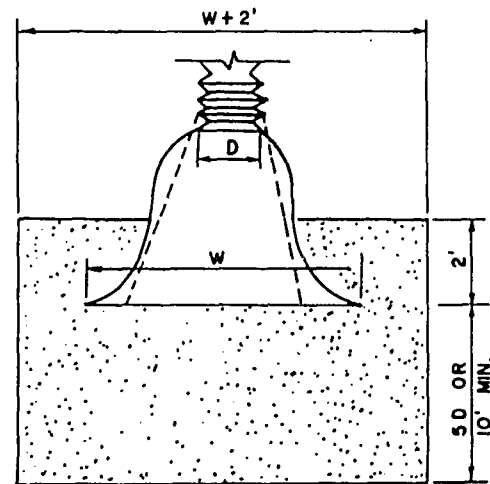

SOD AT PIPE DISCHARGE

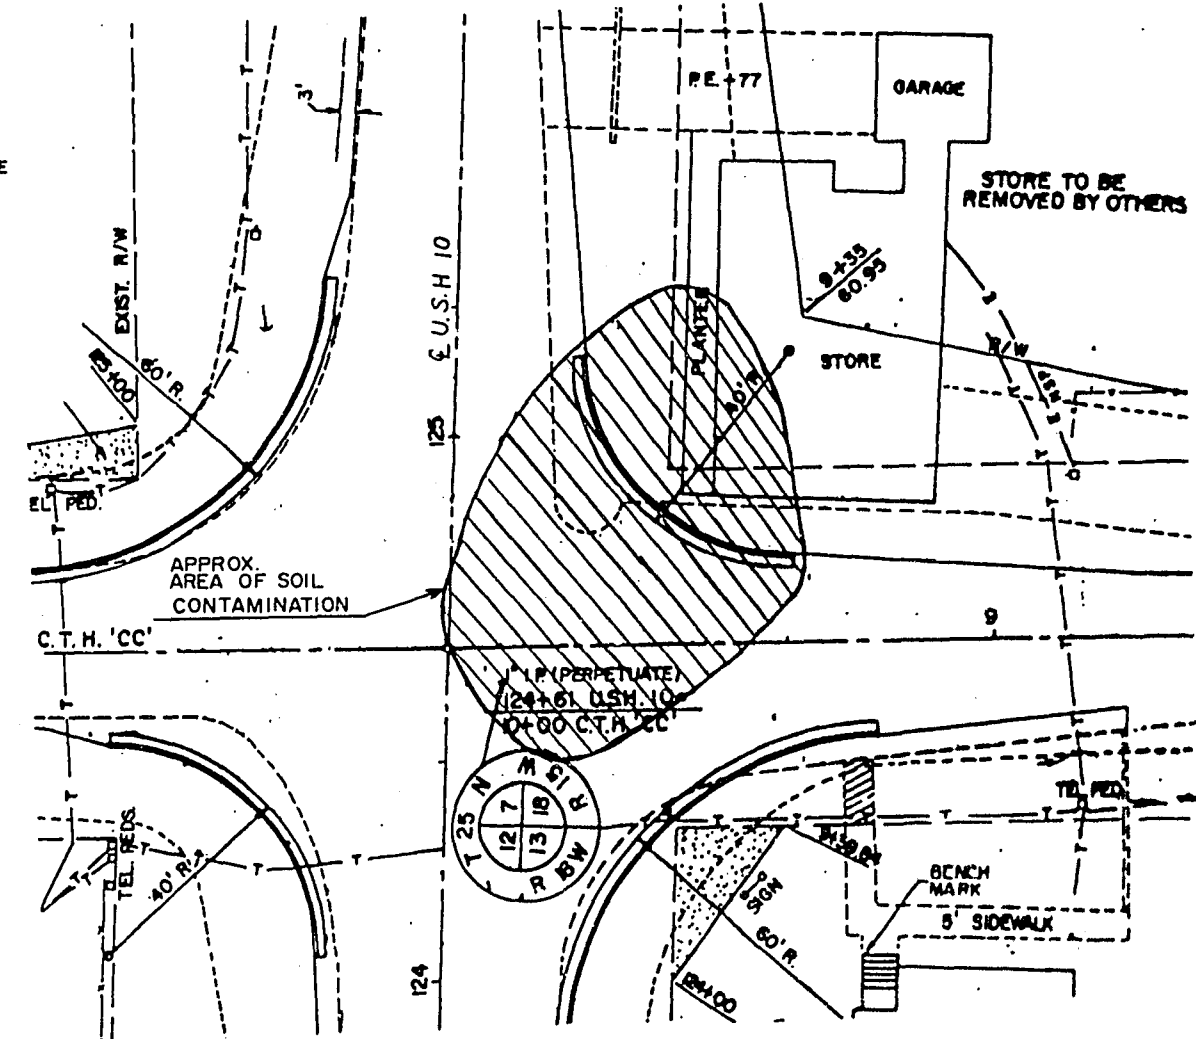

CONTAMINATED SOIL EXCAVATION
STA. 125+00 RT SEC 2

"ANCHOR ASSEMBLIES FOR STEEL PLATE BEAM GUARD, SPECIAL"
STRUCTURE B-47-986
(BEGINNING OF PROJECT)

URBAN AREA





RURAL AREA

GENERAL NOTES

1. Sign assemblies wider than 4 feet or larger than 20 sq. ft. shall be mounted on multiple posts. See plate A4-4 for typical installations.

POST EMBEDMENT DEPTH

Area of Sign Installation (Sq.Ft.)	D (Min)
20 or Less	4'
Greater than 20	5'

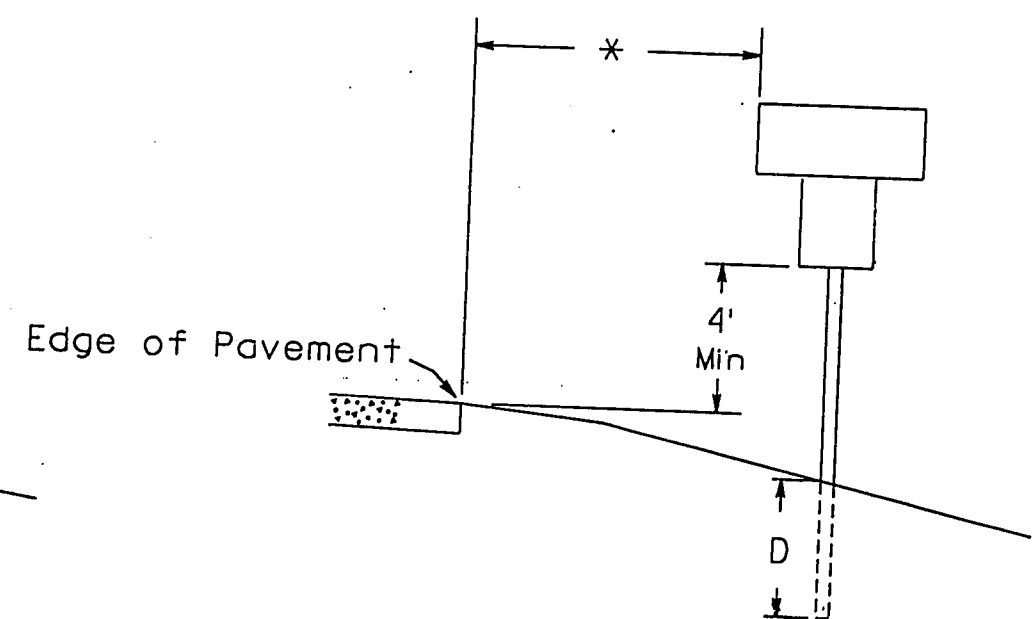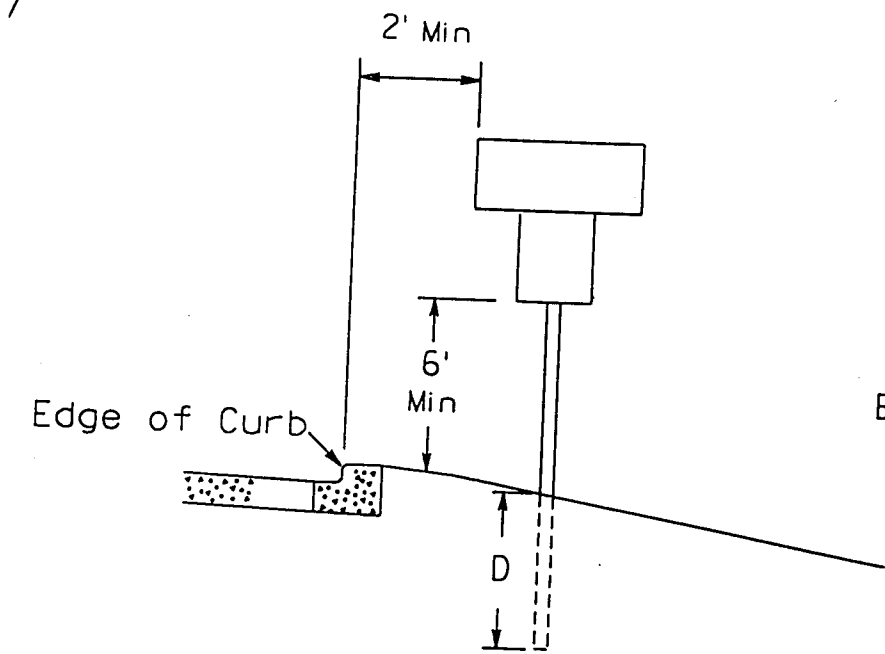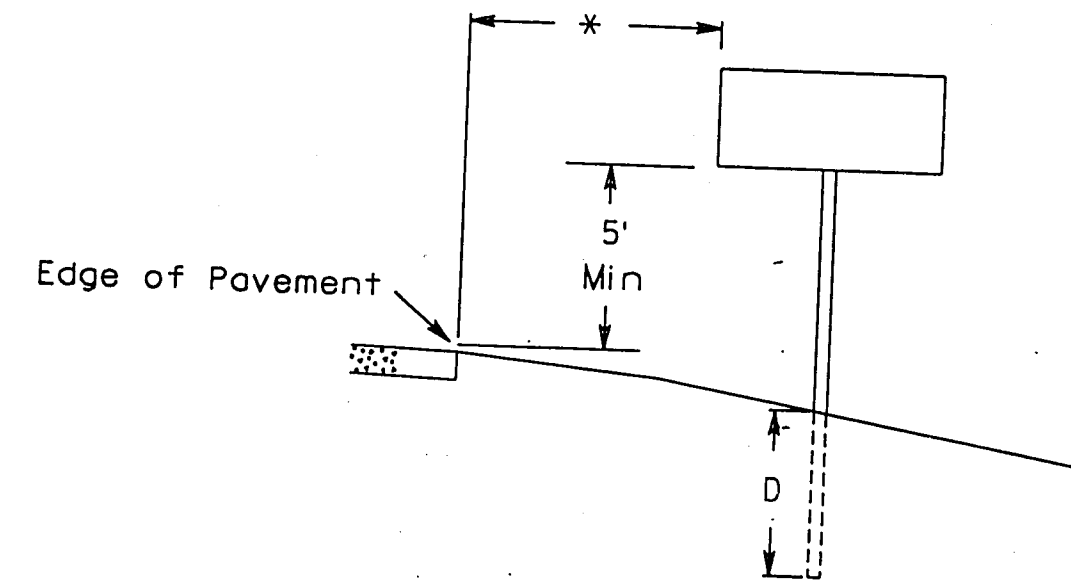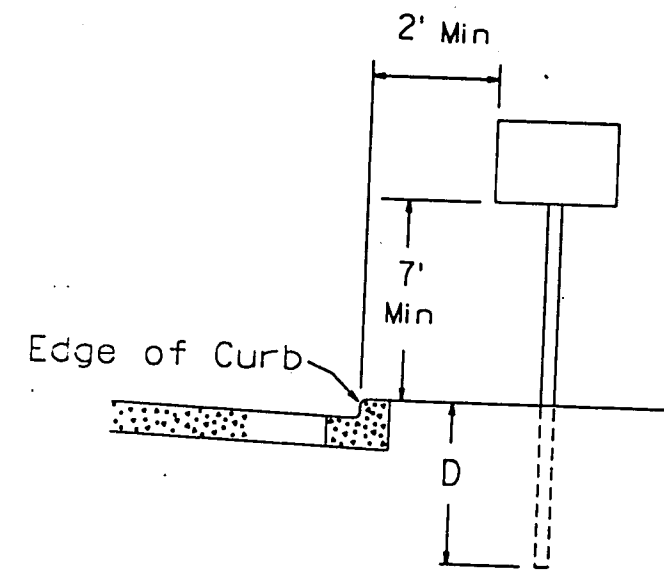

* 12 feet minimum from edge of pavement.
Where there is a paved shoulder, 6' minimum from edge of paved shoulder, but at least 12 feet from edge of pavement.

DATE DRAWN 9-12-91 DATE REDESIGNED


DATE REVISED 1-14-92

TYPICAL INSTALLATION OF
TYPE II SIGNS ON SINGLE POSTS

WISCONSIN DEPT OF TRANSPORTATION

APPROVED
Peter J. Quach
1/21/92

A4-3.0

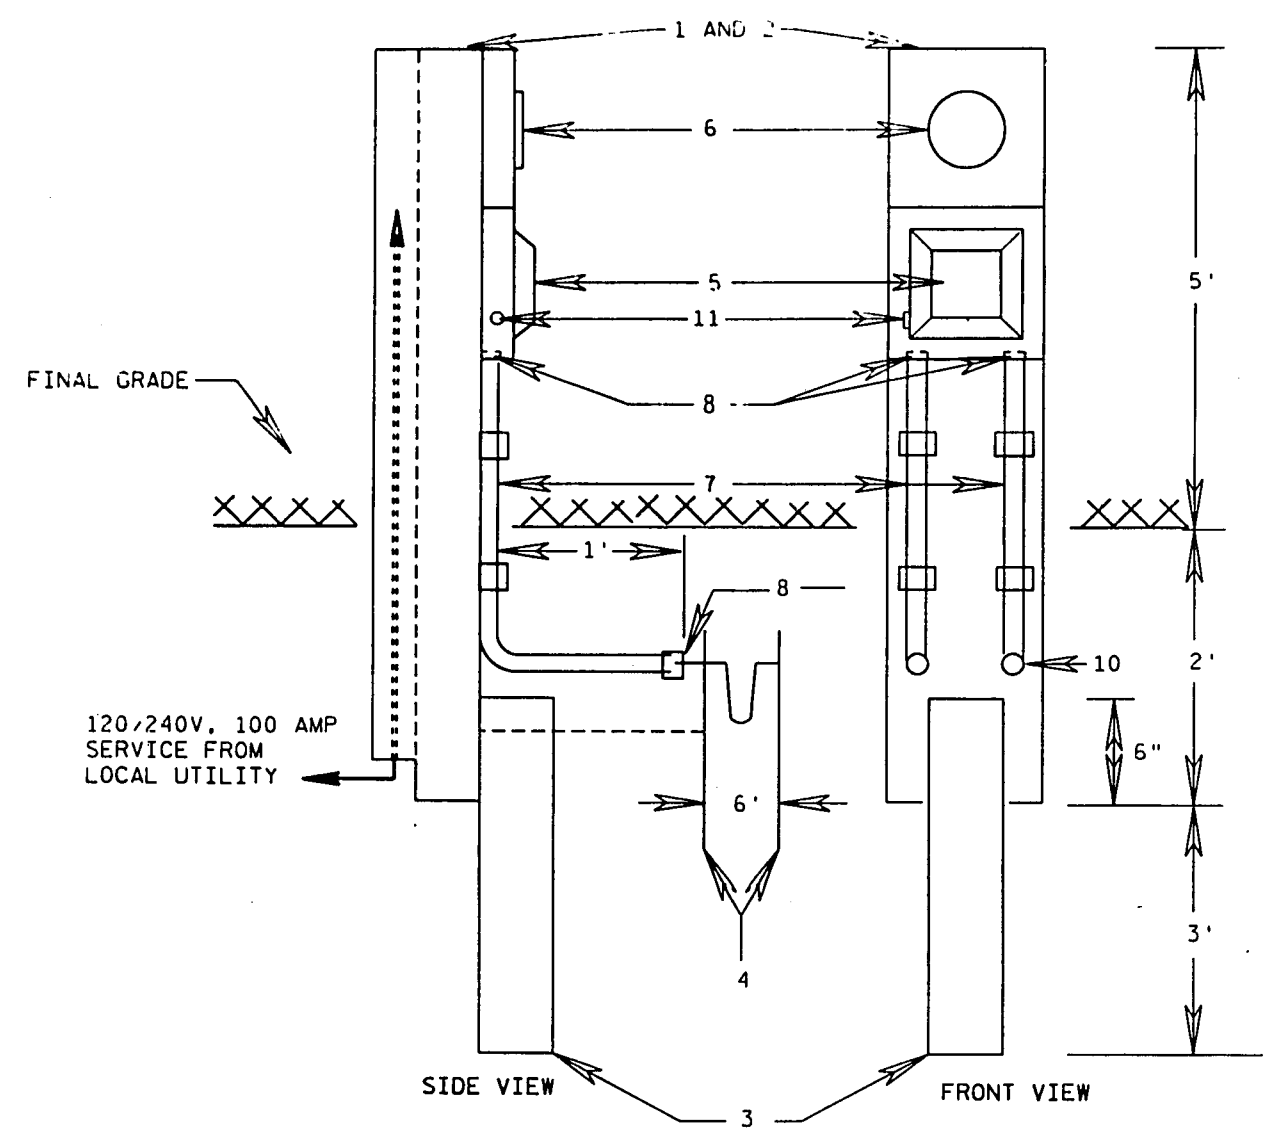


ELECTRICAL SERVICE, LIGHTING, METER BREAKER PEDESTAL
STA. 125+50 RT.

NOTES: ELECTRICAL SERVICE PEDESTAL DETAIL

- *1. THE INSTALLATION SHALL COMPLY WITH CODE, WI DOT, AND POWER COMPANY REQUIREMENTS.
- 2. POWER COMPANY AND WI DOT APPROVED PEDESTAL.
- 3. 6" x 4" OR 6" x 6" PRESSURE TREATED WOOD POST. BOLTED TO PEDESTAL.
- 4. GROUND RODS IF USED, AND GROUNDING CONDUCTOR SHALL NOT BE INSTALLED WITHIN TWO FEET OF THE UNDERGROUND CABLE ROUTE.
PREFERRED GROUNDING METHOD:
A. ONE CONTINUOUS #6 COPPER STRANDED WIRE.
B. TWO 5/8" x 8' COPPER CLAD STEEL RODS, LOCATED 6 FEET APART.
- 5. 100 AMP WEATHERPROOF DISCONNECT. THE SERVICE EQUIPMENT CONTAINING THE DISCONNECTING MEANS, OVERCURRENT PROTECTIVE DEVICES AND RECEPTACLES OR OTHER APPROVED MEANS FOR CONNECTING A SERVICE, SHALL BE LOCATED IN SIGHT OF AND NOT MORE THAN 30' FROM THE PARK-N-RIDE.
- *6. SEALED METER SOCKET. (METER INSTALLATION NOT REQ'D. BY LOCAL UTILITY.)
- 7. CONDUIT (RIGID METAL OR SCHEDULE 80 PVC CONDUIT.)
- 8. BUSHING ON EACH END OF CONDUIT.
- 9. USE SUPPORTING CLAMPS AS REQUIRED.
- 10. CABLE-IN-DUCT TO LUMINAIRES. CABLE-IN-DUCT TO RUN INSIDE CONDUIT 1-FOOT, THEN ELECTRICAL WIRES EXTEND TO METER SOCKET.
- 11. PHOTOCELL



* CONTACT JERRY TOMESH
WI DOT
715-839-3787
AND
DENNIS CLOSE
NORTHERN STATES POWER
715-232-7405

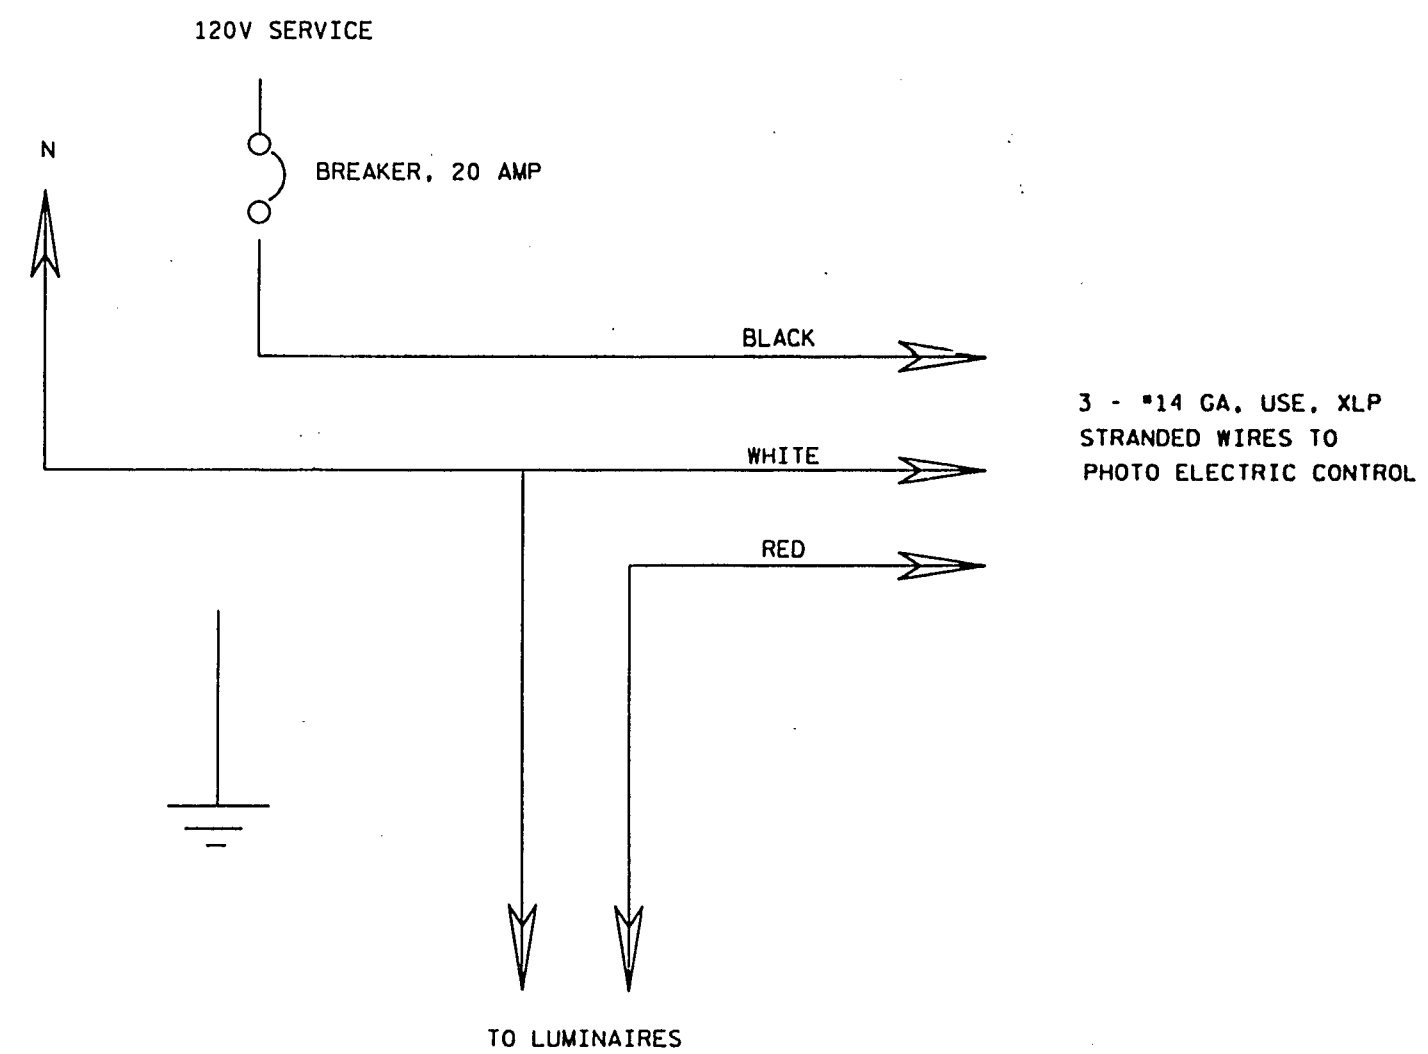

CONTROL WIRING SCHEMATIC
LIGHTING ELECTRICAL SERVICE


LEVELS ON - 1, 2, 3, 62, 63

BENCH MARK		
STATION	DESCRIPTION	ELEV.
10+50	PK. NAIL POWER POLE 33' LT.	97.58

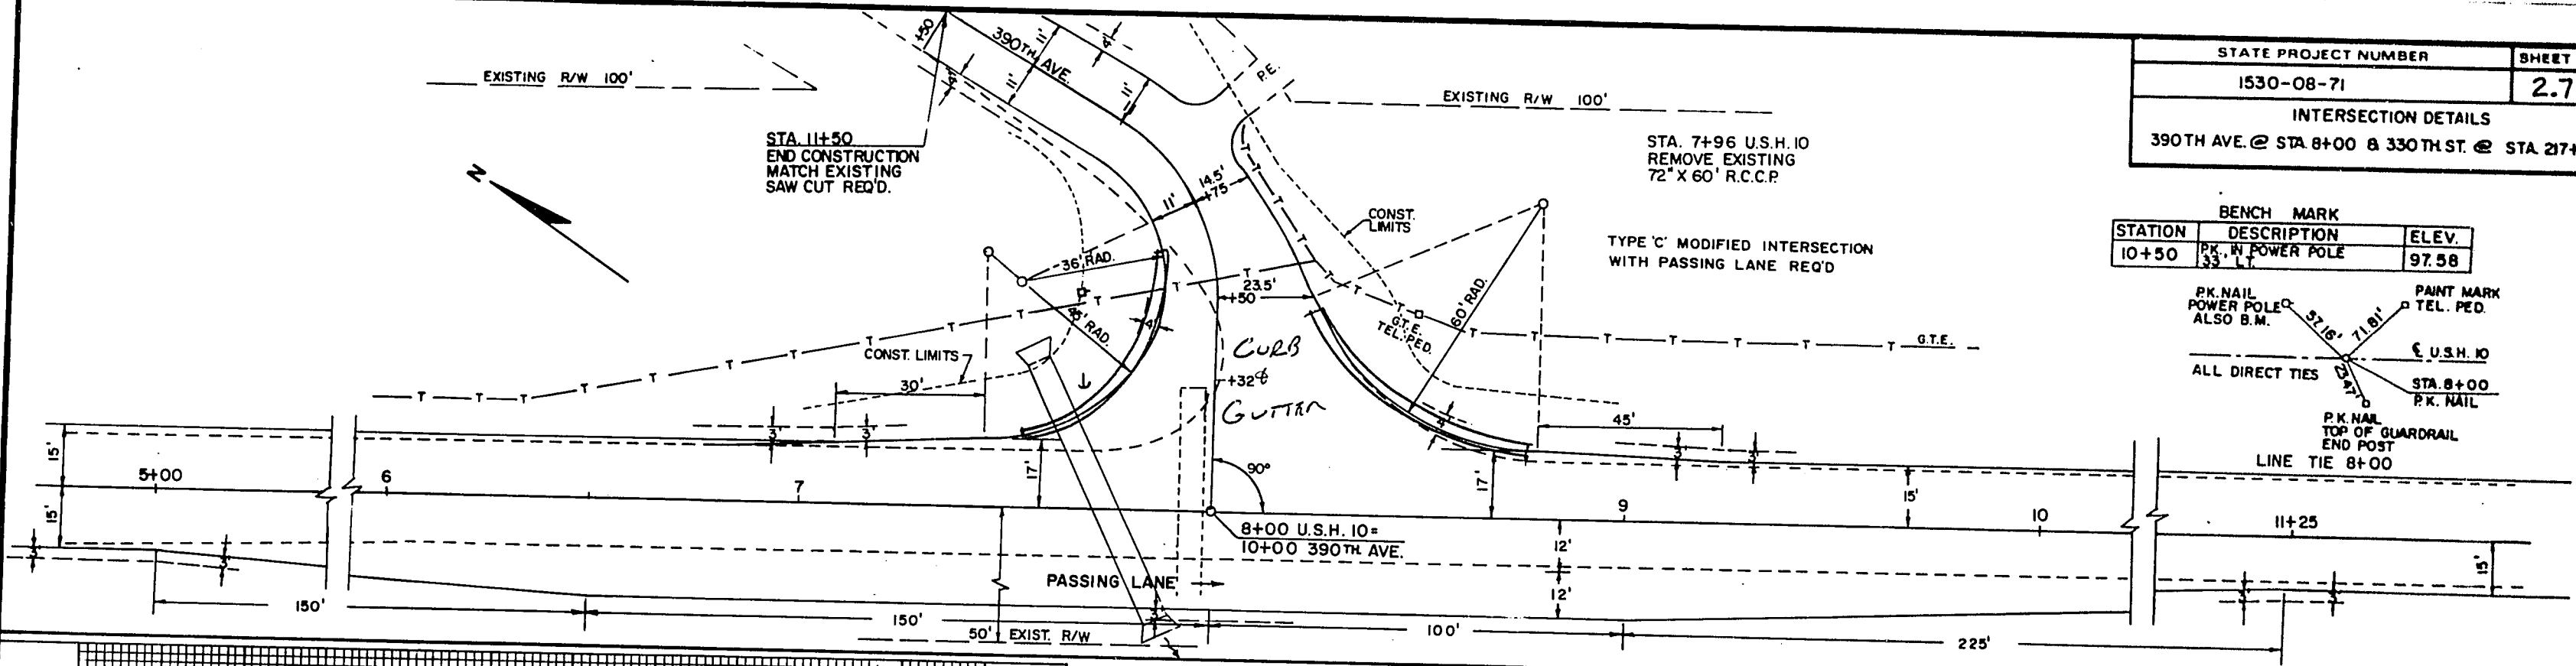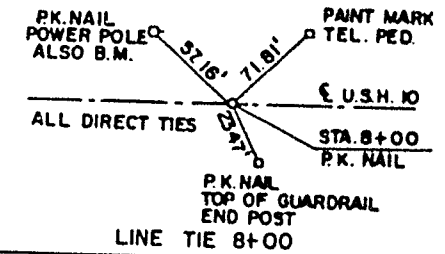


90	90.4	91.72	91.7	90.5	89.0	88.0				90
80										80
	10+00	+27	+50	+75	11	+25	+50	+75		

217+16 U.S.H. 10


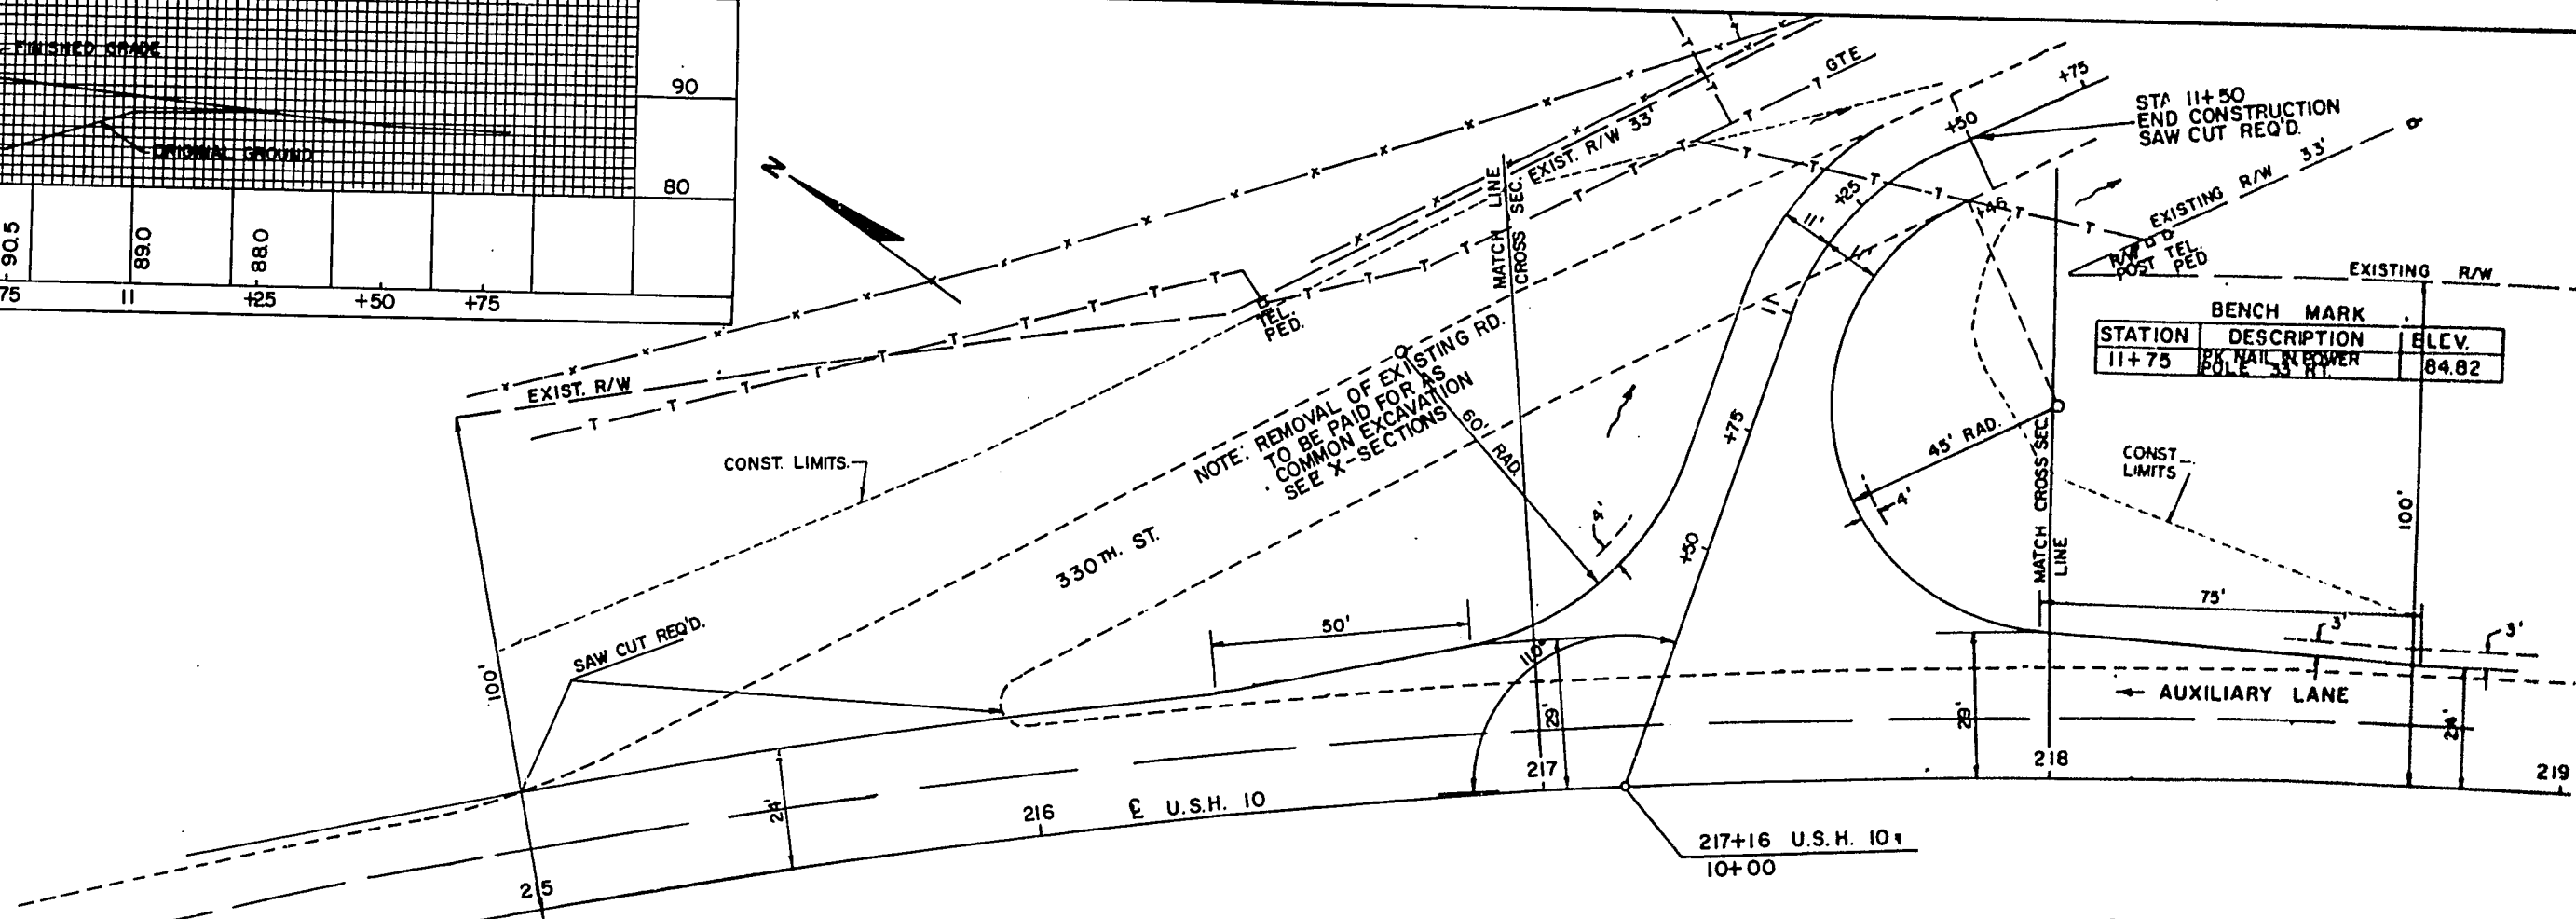


BENCH MARK		
STATION	DESCRIPTION	ELEV.
11+75	PK. NAIL POWER POLE 33' RT.	84.82

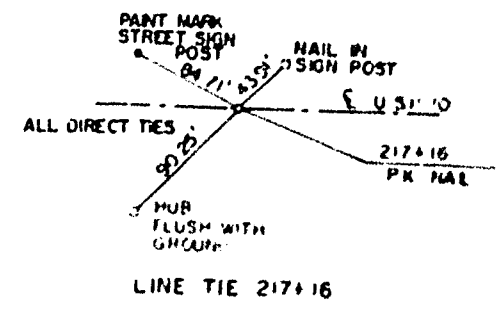


TYPE 'C' INTERSECTION REQ'D

BENCH MARK		
STATION	DESCRIPTION	ELEV.
9+35 RT.	PK NAIL IN 4" TWIN COTTONWOOD TREE	104.64

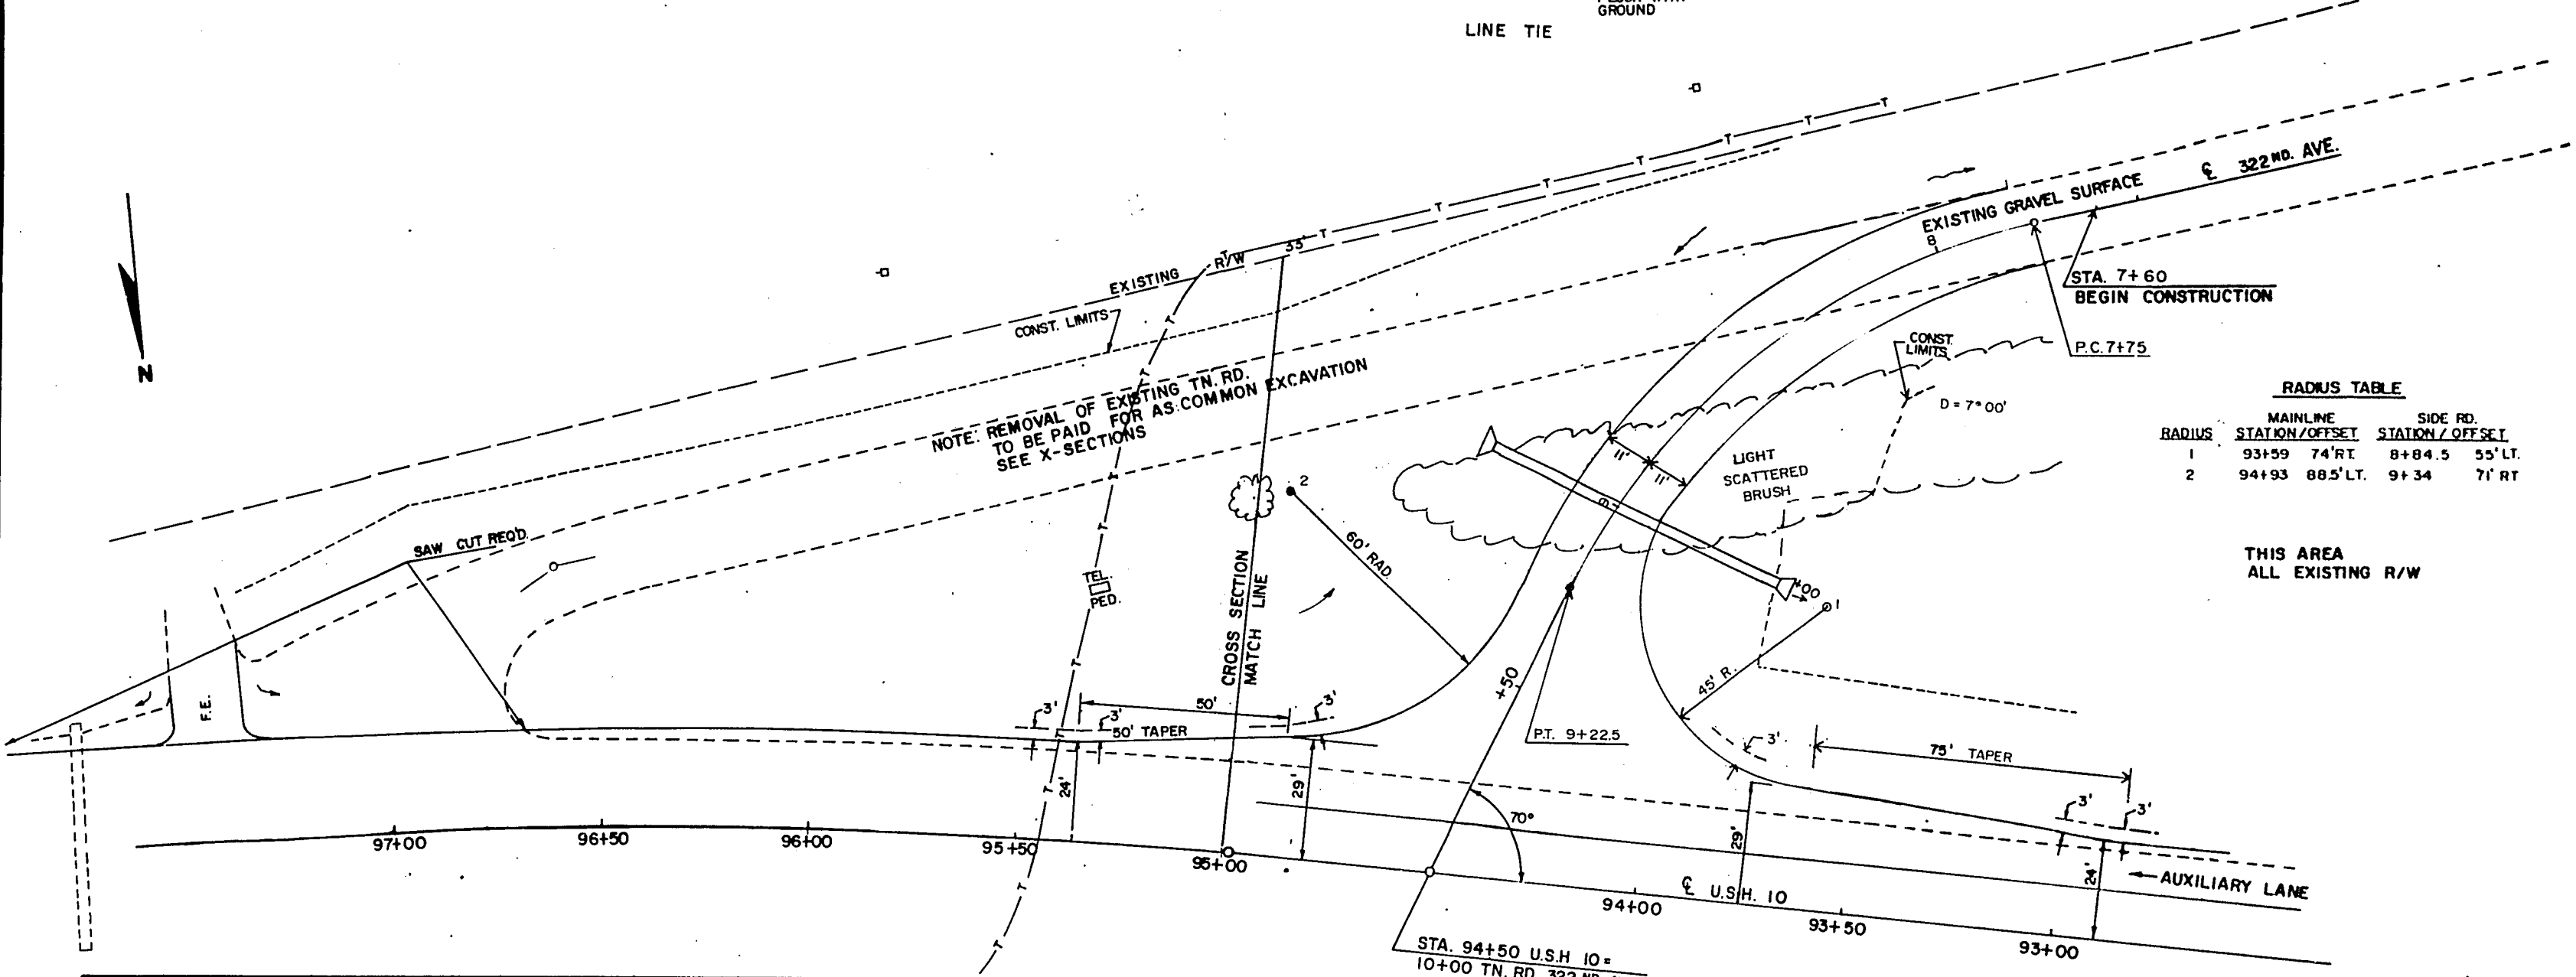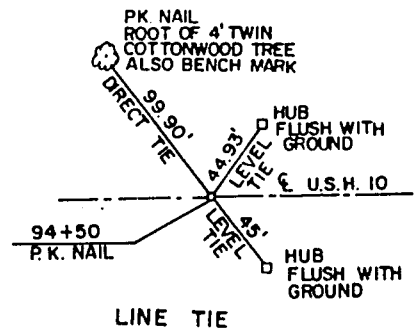


RADIUS TABLE				
RADIUS	MAINLINE		SIDE RD.	
	STATION/OFFSET		STATION/OFFSET	
1	93+59	74' RT.	8+84.5	55' LT.
2	94+93	88.5' LT.	9+34	71' RT.

THIS AREA
ALL EXISTING R/W

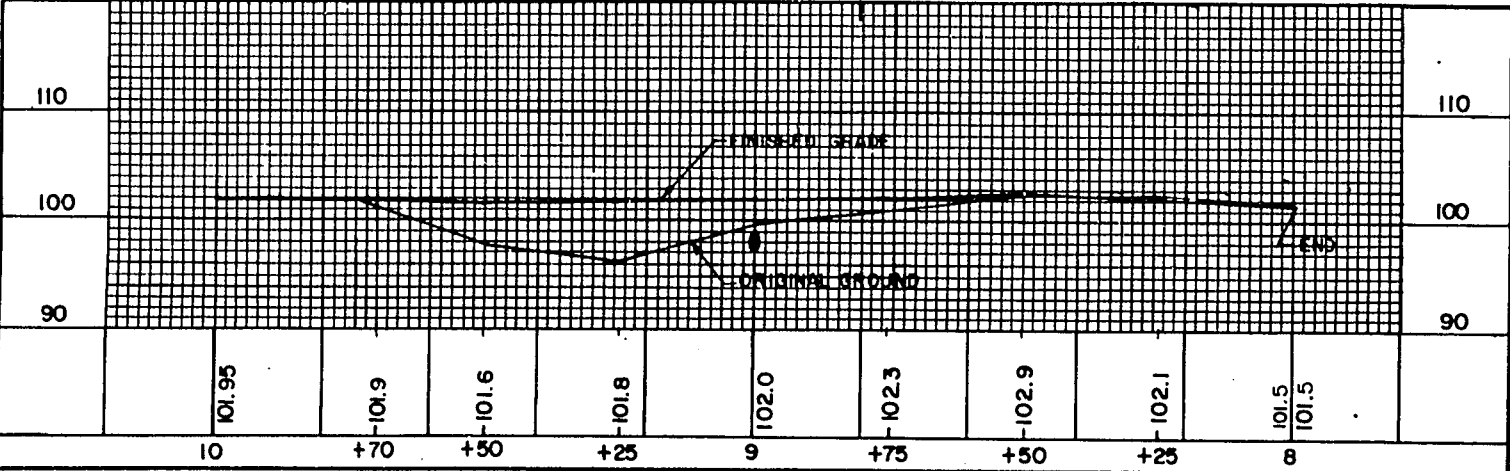

STA. 9+00 TN. RD.
1-24" X 56" C.P. CLASS III REQ'D.
2 APRON ENDWALLS REQ'D.

TYPE 'C' INTERSECTION REQUIRED

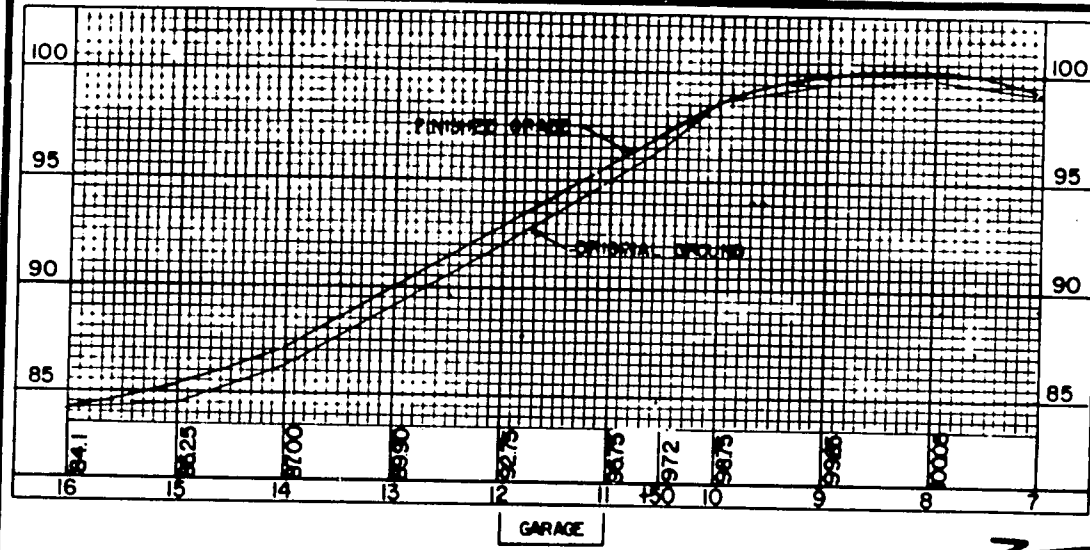

STATE PROJECT NUMBER	SHEET NO
1530-08-71	2.9
C.T.H. 'CC' INTERSECTION STA 124+61, U.S.H. 10	

BENCH MARK	STATION	DESCRIPTION	ELEV
CHURCH STEPS	9+25	CHURCH STEPS	100.00

STA. 13+52 RT.
REMOVE EXISTING 18"X22' C.S.C.P.
1-18"X36' C.P. REQ'D.
2 APRON ENDWALLS REQ'D.

STA. 12+76 RT.
REMOVE EXISTING 18"X22' C.S.C.P.
1-18"X22' C.P. REQ'D.
2 APRON ENDWALLS REQ'D.

STA. 11+48 RT.
REMOVE EXISTING 18"X26' C.S.C.P.
1-18"X22' C.P. REQ'D.
2 APRON ENDWALLS REQ'D.

STA. 125+77 RT.
1-18"X26' C.S.C.P.
TO BE REMOVED

PARK & RIDE LOT
TO BE BUILT UNDER
THIS CONTRACT

SEE PARK & RIDE DETAIL

STORE TO BE
REMOVED BY OTHERS

STA. 7+60
BEGIN CONSTRUCTION
SAW CUT REQ'D.


I.P. (PERPETUATE)
124+61 U.S.H. 10
10+00 C.T.H. 'CC'

TYPE 'B' INTERSECTIONS REQ'D AT
C.T.H. 'CC'
NOTE: ALL DIMENSIONS NOT SHOWN
ON INTERSECTION DETAIL
CONFORM TO THE STANDARD
DETAIL DRAWINGS.


STA. 16+00
END CONSTRUCTION
SAW CUT REQ'D.

STA. 14+48 RT.
REMOVE EXISTING 18"X42' C.S.C.P.
1-18"X42' C.P. REQ'D.
2-APRON ENDWALLS REQ'D.


** SOD FLUME REQ'D.
SEE DETAIL

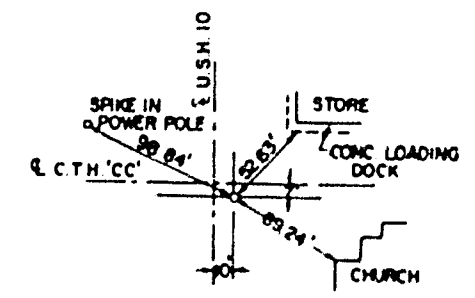


TIE TO SECTION CORNER

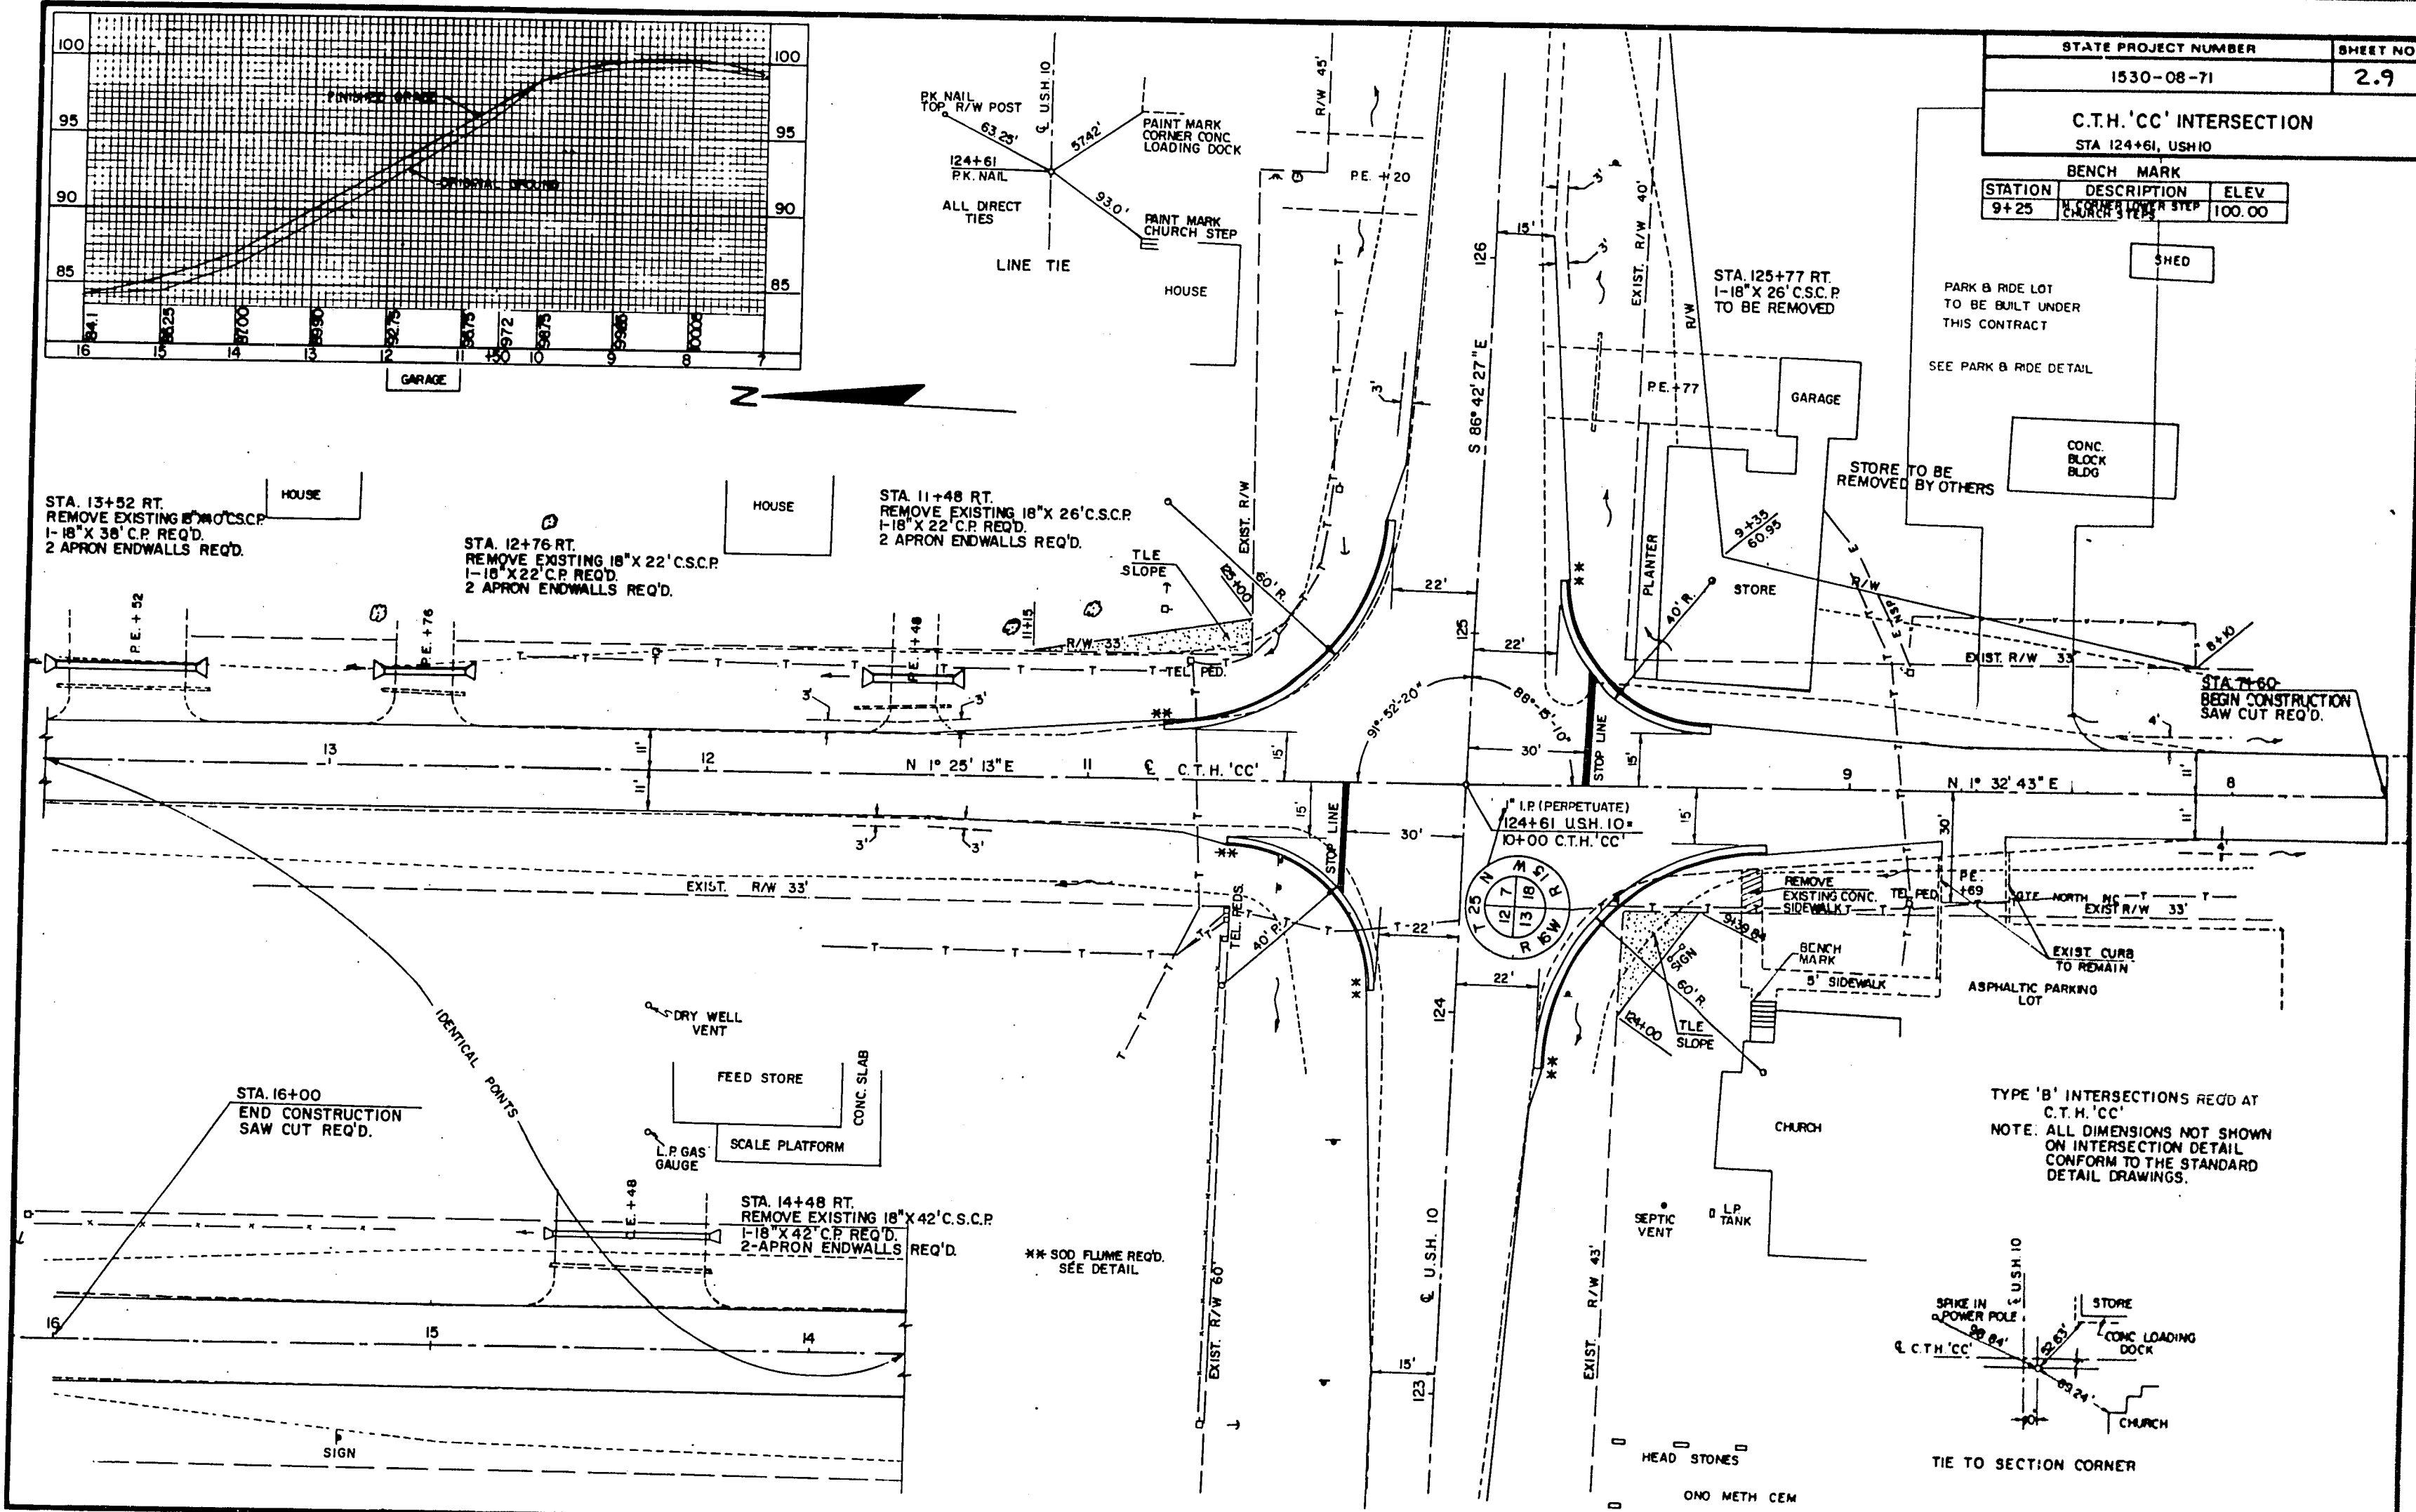

<u>BENCH MARK</u>		
STATION	DESCRIPTION	ELEV.
9-25	N. CORNER LOWER CHURCH STEP	100.00

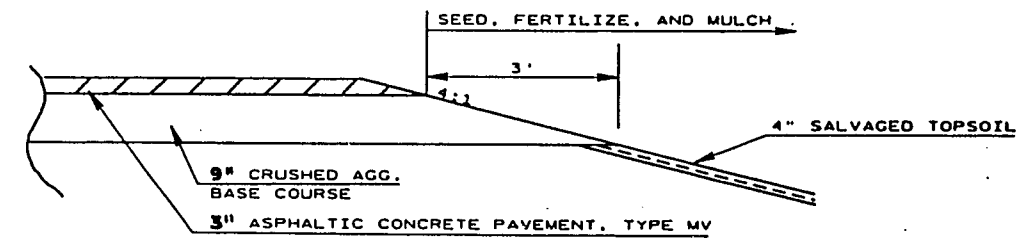

TYPICAL SECTION

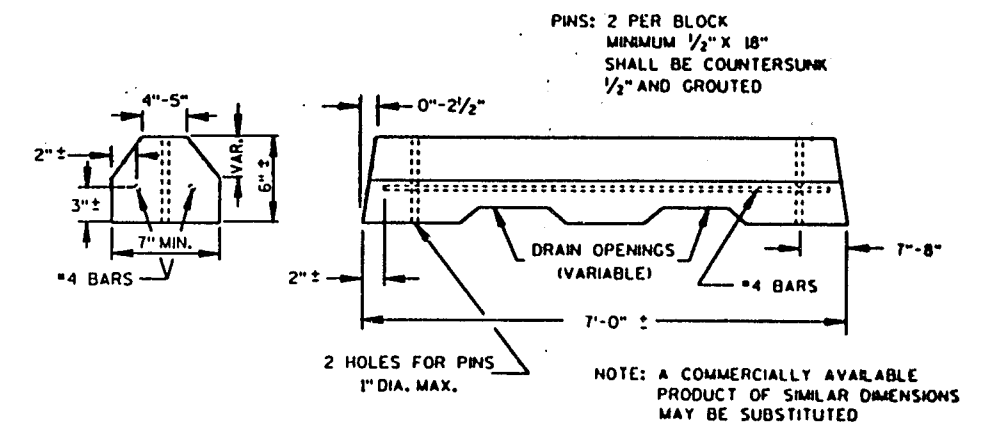

PRECAST CONCRETE CURB
TYPICAL
21 EACH TOTAL REQ'D.

RADIUS TABLE

NO.	STATION	OFFSET	RADIUS
1	8+71	67' RT.	4'
2	8+38	67' RT.	4'
3	8+22	32' RT.	20'
4	8+87	32' RT.	20'

LEGEND


- ✕● LUMINAIRE-PROPOSED
 ☒ METER BREAKER PEDESTAL (METER NOT REQ'D.)
 -CID- CABLE-IN-DUCT, 3 CONDUCTOR. NO. 8
 ✕ TELEPHONE SERVICE

MISCELLANEOUS ITEMS

CABLE-IN-DUCT, 3 CONDUCTOR, NO. 8
POLES, TYPE 5, 30-FOOT
CONCRETE BASES, TYPE 5
LUMINAIRES, 150 WATTS, HIGH PRESSURE SODIUM
MAST ARMS, SINGLE MEMBER, 6-FOOT
ELECTRICAL SERVICE, LIGHTING, METER
SOCKET, STA. 125+50 RT.
WOOD POSTS 4'X4'X10'
SIGNS, TYPE II, REFLECTIVE
TELEPHONE SERVICE, PARK AND RIDE LOT

225 L.F.
2 EACH
2 EACH
2 EACH
2 EACH

1 L.S.
2 EACH
3.5 S.F.
1 L.S.

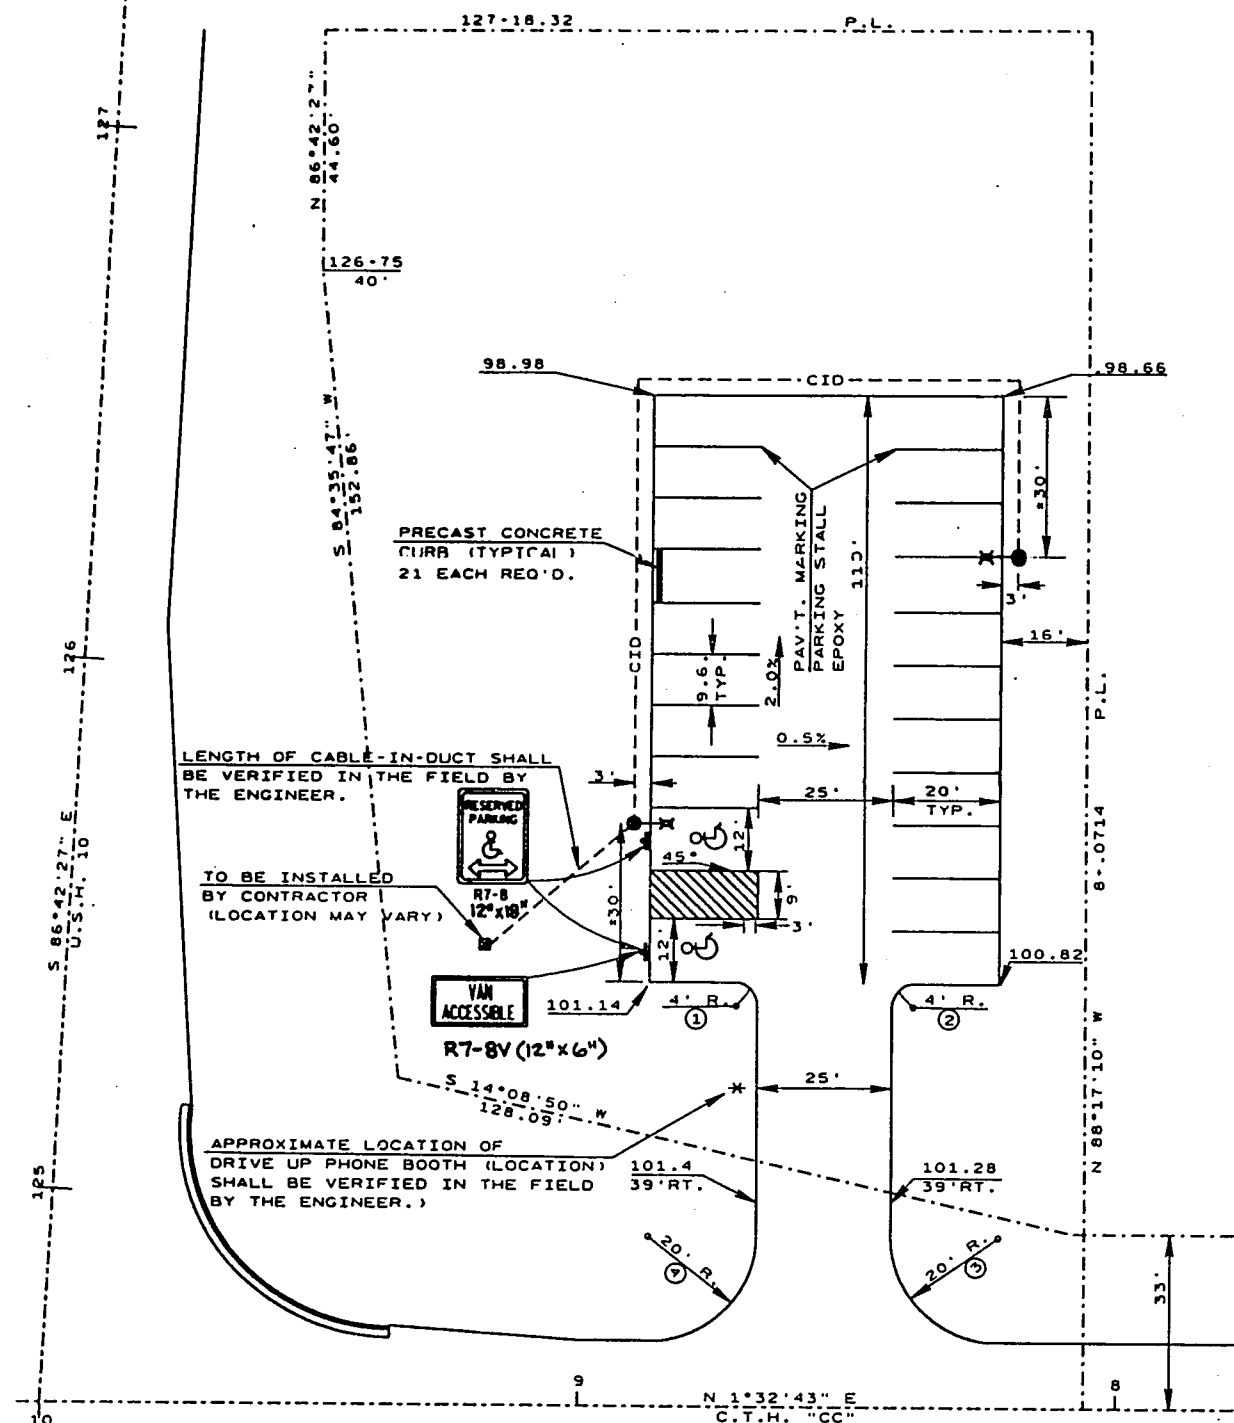

LEVELS ON - 1, 2, 3, 62, 63

BENCH MARKS

STATION	DESCRIPTION	ELEV.
9+25 CTHS	PK. IN TOWER POLE 25 FT.	100.16
10+00 CTH U	PK. IN STREET LIGHT POLE 18 FT.	105.92

LEVEL TIES .
UNLESS NOTED DIRECT LINE TIES

* CURB OPENING FOR FLUME REQ'D.
SEE DETAIL

** SOD FLUME REQ'D
 SEE DETAIL

THIS AREA
ALL EXISTING RIGHT OF WAY

STA. 0+35 'A' LINE
REMOVE EXISTING 18"X52' C.S.C.P.
1-18"X76' C.P CLASS III REQ'D.
2 APRON ENDWALLS REQ'D

STA. 11+50
END CONSTRUCTION
MATCH EXISTING
BUTT JOINT REQ'D

NOTE:
MILL EXISTING ASPHALTIC SURFACES
TO PROVIDE FOR A MINIMUM RESURFACE
OF 1 1/2 INCHES OF ASPHALTIC CONCRETE PAVEMENT
TYPE, MV

TYPE 'B' INTERSECTION REQ'D


N

LINE TIE

Mounting To DRAW

CONVERT NOT
PLCRIN


N

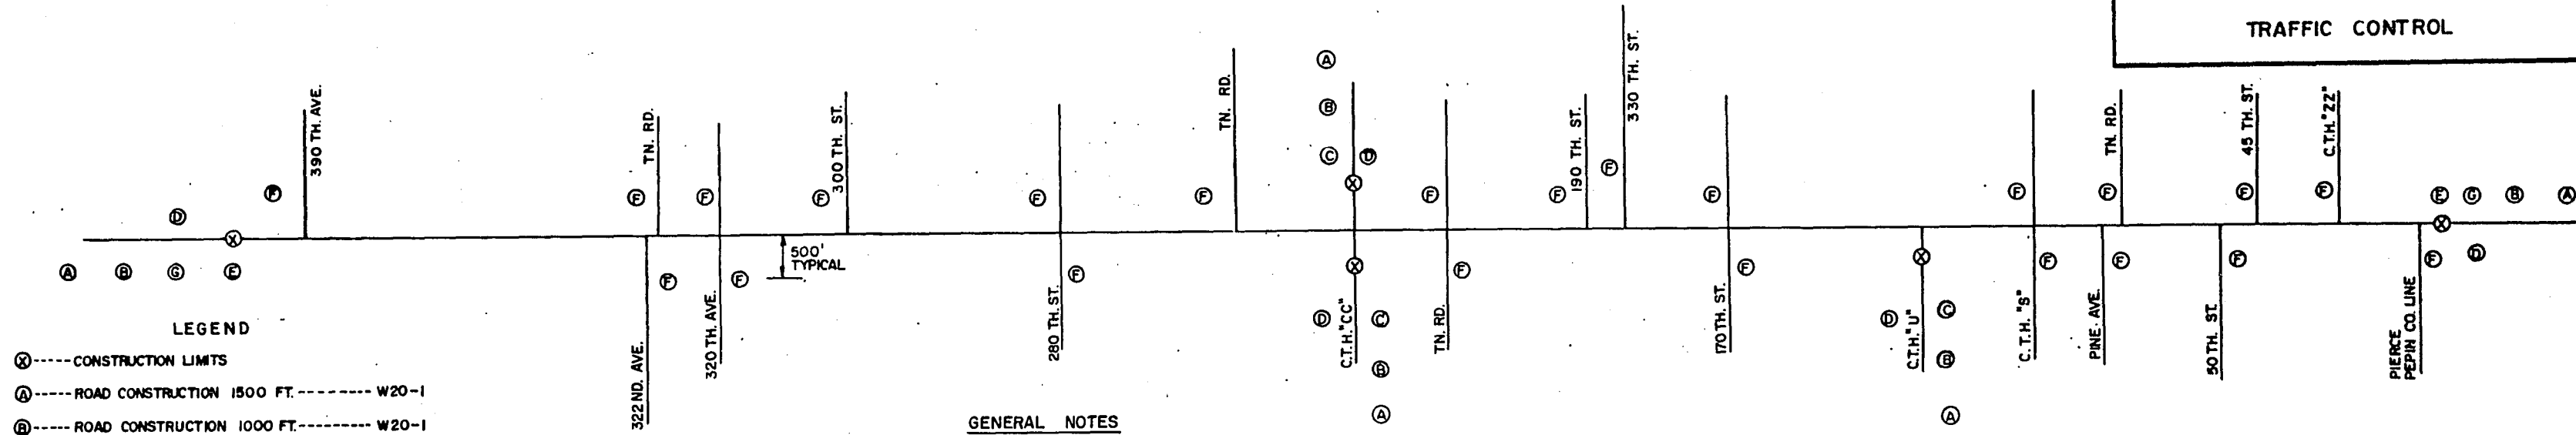

- LEGEND**
- X-----CONSTRUCTION LIMITS
 - A-----ROAD CONSTRUCTION 1500 FT.----- W20-1
 - B-----ROAD CONSTRUCTION 1000 FT.----- W20-1
 - C-----ROAD CONSTRUCTION 500 FT.----- W20-1
 - D-----END CONSTRUCTION----- G20-2 60"x 24"
 - E-----ROAD CONSTRUCTION NEXT X MILES----- G20-1 60"x 36"
 - F-----ROAD CONSTRUCTION AHEAD----- W20-1
 - G-----GROOVED PAVEMENT AHEAD----- W08-52
(SHALL BE PLACED 500' IN ADVANCE OF CONSTRUCTION LIMITS)

GENERAL NOTES

ALL SIGNS ARE 48" X 48" UNLESS OTHERWISE NOTED.
 ALL SIGNS ON THIS PAGE TO BE MOUNTED ON PERMANENT SUPPORTS.
 ROAD CONSTRUCTION WARNING SIGNS TO HAVE TYPE 'A' FLASHERS

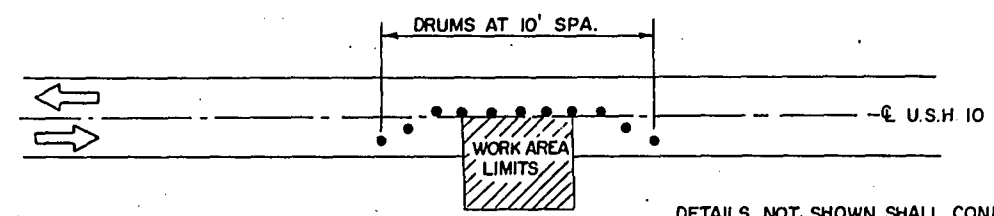

DETAILS NOT SHOWN SHALL CONFORM TO
 SDD TRAFFIC CONTROL FOR LANE CLOSURE

**DETAIL FOR TRAFFIC CONTROL
 FOR
 OPEN TRENCHES ADJACENT TO ONE LANE TRAFFIC**

NOTES

1. Sign is Type II - Reflective - reference
WIS DOT Standard Specification for ROAD
and BRIDGE CONSTRUCTION latest edition.
2. Color:
Background - Yellow
Message - Black
3. Message Series - C
4. Corners may be square or rounded when base
material is plywood but borders shall be rounded
as shown. When base material is metal, the
corners and borders shall be rounded.



W8-52

Metric equivalent
for this sign is:

SIZE	
1	
2	750mm X 750mm
3	
4	900mm X 900mm
5	1200mm X 1200mm

SIZE	A	B	C	D	E	F	G	H	I	J	K	L	M	N	O	P	Q	R	S	T	U	V	W	X	Y	Z	Area sq. ft.
1																											
2	30		1 3/8	1/2	5/8	5	2 1/4	12 1/8		13 1/4	14 1/8																6.25
3																											
4	36		1 5/8	5/8	3/4	6	2 5/8	14 1/2		15 7/8	17																9.0
5	48		2 1/4	3/4	1	8	3 1/2	19 3/8		21 1/4	22 5/8																16.0

STANDARD SIGN

W8-52

WISCONSIN DEPT OF TRANSPORTATION

APPROVED

John F. Rusk
Director, Office of Traffic

DATE 7/15/94

PLATE NO. W8-52.4

DATE 08/03/95

ESTIMATE OF QUANTITIES

ITEM	ITEM DESCRIPTION	UNIT	TOTAL	1530-08-71 QUANTITY
20101	CLEARING	STA.	23.00	23.00
20104	GRUBBING	STA.	28.00	28.00
20301	REMOVING OLD CULVERT, STATION 47+00	L.S.	1.00	1.00
20302	REMOVING OLD CULVERT, STATION 13+70	L.S.	1.00	1.00
20303	REMOVING OLD CULVERT, STATION 17+30	L.S.	1.00	1.00

20304	REMOVING OLD CULVERT, STATION 50+00	L.S.	1.00	1.00
20305	REMOVING OLD CULVERT, STATION 7+96	L.S.	1.00	1.00
20330	REMOVING OLD CULVERTS	EACH	17.00	17.00
20406	REMOVING CONCRETE SIDEWALK	S.Y.	6.00	6.00
20408	REMOVING MASONRY	C.Y.	8.40	8.40

20411	REMOVING GUARDRAIL	L.F.	10,390.00	10,390.00
20412	REMOVING FENCE	L.F.	27.00	27.00
20419	REMOVING ASPHALTIC SURFACE, BUTT JOINTS	S.Y.	520.00	520.00
20501	COMMON EXCAVATION	C.Y.	14,535.00	14,535.00
20502	ROCK EXCAVATION	C.Y.	8,890.00	8,890.00

20620	EXCAVATION FOR STRUCTURES, CULVERTS C-1894 (STA. 13+70)	L.S.	1.00	1.00
20621	EXCAVATION FOR STRUCTURES, CULVERTS C-1895 (STA. 17+30)	L.S.	1.00	1.00
20622	EXCAVATION FOR STRUCTURES, CULVERTS C-1898 (STA. 50+00)	L.S.	1.00	1.00
20801	BORROW EXCAVATION	C.Y.	5,537.00	5,537.00
20901	GRANULAR BACKFILL	C.Y.	942.00	942.00

21301	FINISHING ROADWAY	L.S.	1.00	1.00
30404	CRUSHED AGGREGATE BASE COURSE	TON	15,210.00	15,210.00
30409	SHAPING SHOULDERS	STA.	1,055.00	1,055.00
40204	ASPHALTIC MATERIAL FOR TACK COAT	GAL.	13,410.00	13,410.00
40501	ASPHALTIC MATERIAL FOR PLANT MIXES	TON	3,650.00	3,650.00

40713	ASPHALTIC CONCRETE PAVEMENT, TYPE MV	TON	60,685.00	60,685.00
-------	---	-----	-----------	-----------

SHEET 3

ITEM	ITEM DESCRIPTION	UNIT	TOTAL	1530-08-71 QUANTITY
50250	CONCRETE MASONRY ANCHORS, TYPE L, NO. 5 BARS	EACH	64.00	64.00
50401	CONCRETE MASONRY, CULVERTS	C.Y.	28.80	28.80
50505	HIGH-STRENGTH BAR STEEL REINFORCEMENT, CULVERTS	LB.	2,640.00	2,640.00
52003	CULVERT PIPE, CLASS III, 18-INCH	L.F.	422.00	422.00
52005	CULVERT PIPE, CLASS III, 24-INCH	L.F.	214.00	214.00
52015	CULVERT PIPE, CLASS III, 72-INCH	L.F.	80.00	80.00
52061	APRON ENDWALLS FOR CULVERT PIPE, 18-INCH	EACH	20.00	20.00
52063	APRON ENDWALLS FOR CULVERT PIPE, 24-INCH	EACH	8.00	8.00
52072	APRON ENDWALLS FOR CULVERT PIPE, 72-INCH	EACH	2.00	2.00
52107	CORRUGATED STEEL CULVERT PIPE, 24-INCH	L.F.	32.00	32.00
52109	CORRUGATED STEEL CULVERT PIPE, 30-INCH	L.F.	32.00	32.00
52111	CORRUGATED STEEL CULVERT PIPE, 36-INCH	L.F.	28.00	28.00
52112	CORRUGATED STEEL CULVERT PIPE, 42-INCH	L.F.	6.00	6.00
52115	CORRUGATED STEEL CULVERT PIPE, 60-INCH	L.F.	14.00	14.00
52149	STEEL APRON ENDWALLS FOR CULVERT PIPE, 24-INCH	EACH	4.00	4.00
52150	STEEL APRON ENDWALLS FOR CULVERT PIPE, 30-INCH	EACH	8.00	8.00
52151	STEEL APRON ENDWALLS FOR CULVERT PIPE, 36-INCH	EACH	4.00	4.00
52152	STEEL APRON ENDWALLS FOR CULVERT PIPE, 42-INCH	EACH	2.00	2.00
52155	STEEL APRON ENDWALLS FOR CULVERT PIPE, 60-INCH	EACH	1.00	1.00
60170	CONCRETE CURB AND GUTTER, 36-INCH, TYPE D	L.F.	2,184.00	2,184.00
60602	HEAVY RIPRAP	C.Y.	912.00	912.00

SHEET 3.1

ITEM	ITEM DESCRIPTION	UNIT	TOTAL	1530-08-71 QUANTITY
60604	MEDIUM RANDOM RIPRAP	C.Y.	406.00	406.00
61407	STEEL THRIE BEAM STRUCTURE APPROACH	L.F.	324.00	324.00
61408	STEEL PLATE BEAM GUARD, CLASS A	L.F.	16,254.00	16,254.00
61412	ANCHORAGES FOR STEEL PLATE BEAM GUARD, TYPE 1	EACH	71.00	71.00
61432	ADJUSTING STEEL PLATE BEAM GUARD	L.F.	10,490.00	10,490.00

61801	MAINTENANCE AND REPAIR OF HAUL ROADS	L.S.	1.00	1.00
61910	MOBILIZATION	L.S.	1.00	1.00
62101	LANDMARK REFERENCE MONUMENTS	EACH	3.00	3.00
62201	ASPHALTIC CONCRETE CURB	L.F.	2,624.00	2,624.00
62203	ASPHALTIC FLUMES	S.Y.	69.00	69.00

62502	TOPSOIL	C.Y.	950.00	950.00
62505	SALVAGED TOPSOIL	S.Y.	29,340.00	29,340.00
62702	MULCHING	S.Y.	51,830.00	51,830.00
62817	SILT FENCE MAINTENANCE	L.F.	3,150.00	3,150.00
62818	SILT SCREEN	L.F.	200.00	200.00

62819	MOBILIZATIONS, EROSION CONTROL	EACH	3.00	3.00
62821	MOBILIZATIONS, EMERGENCY EROSION CONTROL	EACH	3.00	3.00
62824	EROSION MAT, DELIVERED, CLASS I, TYPE B	S.Y.	8,666.00	8,666.00
62825	EROSION MAT, INSTALLED, CLASS I, TYPE B	S.Y.	8,666.00	8,666.00
62830	EROSION MAT, DELIVERED, CLASS II, TYPE A	S.Y.	1,027.00	1,027.00

62831	EROSION MAT, INSTALLED, CLASS II, TYPE A	S.Y.	1,027.00	1,027.00
62848	SILT FENCE, SILTY SOIL, DELIVERED	L.F.	3,150.00	3,150.00
62850	SILT FENCE, SILTY SOIL, INSTALLED	L.F.	3,150.00	3,150.00
62905	FERTILIZER, TYPE B	CWT.	23.30	23.30
63002	SEEDING	LB.	940.00	940.00

63101	SOODING	S.Y.	1,027.00	1,027.00
63401	WOOD POSTS, 4X4-INCH X 10-FT.	EACH	2.00	2.00

SHEET 3.2

ITEM	ITEM DESCRIPTION	UNIT	TOTAL	1530-08-71 QUANTITY
63702	SIGNS, TYPE II, REFLECTIVE	S.F.	3.50	3.50
64005	POLES, TYPE 5, 30-FEET	EACH	2.00	2.00
64014	CONCRETE BASES, TYPE 5	EACH	2.00	2.00
64032	LUMINAIRES, 150 WATTS, HIGH PRESSURE SODIUM	EACH	2.00	2.00
64051	MAST ARMS, SINGLE MEMBER, 6-FOOT	EACH	2.00	2.00

64066	CABLE-IN-DUCT, 3 CONDUCTOR, NO. 8	L.F.	225.00	225.00
64202	FIELD OFFICE, TYPE B	L.S.	1.00	1.00
64210	FIELD LABORATORY	L.S.	1.00	1.00
64301	TRAFFIC CONTROL	L.S.	1.00	1.00
64313	TRAFFIC CONTROL, DRUMS	DAYS	6,566.00	6,566.00

64318	TRAFFIC CONTROL, BARRICADES, TYPE III	DAYS	40.00	40.00
64321	TRAFFIC CONTROL, WARNING LIGHTS, TYPE A	DAYS	5,150.00	5,150.00
64326	TRAFFIC CONTROL, SIGNS	DAYS	5,890.00	5,890.00
64406	PAVEMENT MARKING, EPOXY, 4-INCH	L.F.	118,070.00	118,070.00
64414	PAVEMENT MARKING, CHANNELIZING, EPOXY, 8-INCH	L.F.	240.00	240.00

64431	PAVEMENT MARKING, SAME DAY, EPOXY, 4-INCH	L.F.	92,820.00	92,820.00
64437	PAVEMENT MARKING, STOP LINE, EPOXY, 18-INCH	L.F.	170.00	170.00
64484	TEMPORARY PAVEMENT MARKING	L.F.	84,500.00	84,500.00
64494	PAVEMENT MARKING, PARKING STALL, EPOXY	L.F.	580.00	580.00
64496	PAVEMENT MARKING, ISLAND NOSE, EPOXY	S.F.	580.00	580.00

64506	GEOTEXTILE FABRIC, TYPE HR	S.Y.	2,567.00	2,567.00
64601	SAWING EXISTING PAVEMENT	L.F.	316.00	316.00
90001	REMOVING CABLE GUARD	L.F.	3,787.00	3,787.00
90002	CONCRETE BOX CULVERT COVERS	L.F.	65.00	65.00
90003	CONTAMINATED SOIL EXCAVATION	C.Y.	815.00	815.00

90004	ELECTRICAL SERVICE, LIGHTING, METER BREAKER PEDESTAL,	L.S.	1.00	1.00
-------	---	------	------	------

SHEET 3.3

ITEM	ITEM DESCRIPTION	UNIT	TOTAL	1530-08-71 QUANTITY
90005	TELEPHONE SERVICE, PARK AND RIDE LOT	L.S.	1.00	1.00
90006	ANCHOR ASSEMBLIES FOR STEEL PLATE BEAM GUARD, SPECIAL	EACH	4.00	4.00
90329	GRADING, SHAPING AND FINISHING FOR BEAM GUARD ANCHORAGES	EACH	66.00	66.00
90357	PULVERIZE AND RELAY EXISTING BASE AND SURFACE	STA.	574.00	574.00
90365	QUALITY MANAGEMENT PROGRAM, BASE COURSES	TON	15,210.00	15,210.00

90394	PROFILOGRAPH	L.S.	1.00	1.00
90402	QUALITY MANAGEMENT PROGRAM, ASPHALTIC MIXTURE	TON	60,685.00	60,685.00
90568	PRECAST CONCRETE CURB	EACH	21.00	21.00
90777	PAVEMENT MARKING, HANDICAP SYMBOLS, EPOXY	EACH	2.00	2.00
90999	ON-THE-JOB TRAINING	HRS.	300.00	300.00

SHEET 3.4

CLEARING AND GRUBBING

STA. TO STA.	LOCATION	CLEARING GRUBBING STA.
5 + 00 - 6 + 00 SEC. 1	RT.	1
6 + 00 - 7 + 00 SEC. 1	RT.	1
8 + 00 - 10 + 00 SEC. 1	RT.	2
10 + 00 - 12 + 00 SEC. 1	RT.	2
9 + 00 - 10 + 00 322ND AVE.	LT. & RT.	1
89 + 00 - 96 + 25 SEC. 4	RT.	7
0 + 00 - 7 + 00 SEC. 5	RT.	7
11 + 00 - 18 + 00 SEC. 5	RT.	7
TOTAL		23

REMOVING MASONRY

STATION	LOCATION	C.Y.	DESCRIPTION
55 + 20 SEC. NO. 3	RT.	2.4	M.R.M. DITCH DAM
4 + 25 SEC. NO. 4	LT. & RT.	4.0	M.R.M. ENDWALLS
37 + 48 SEC. NO. 4	RT.	2.0	M.R.M. ENDWALL
TOTAL		8.4	

YARDAGE SUMMARY

LOCATION	COMMON EXCAVATION C.Y.	FILL C.Y.	BORROW EXCAVATION C.Y.	ROCK EXCAVATION C.Y.	WASTE C.Y.
390TH AVE.	152	182 *	91		
PASSING LANE RT. STA.4+50 TO 12+00	578	941*	836		
322ND AVE.	1719	576 *			855
C.T.H. 'CC'	524	1504 *	1852		
330TH ST.	1178	1167 *	573		
STA.23+50 - 32+28 LT. (FILL BEHIND C & G SEC. 3)		456 *	684		
C.T.H.'U' & C.T.H.'S'	59	513 *	711		
UNDISTRIBUTED TYPE 'C' INTERSECTIONS			300		
*ABOVE FILL EXPANDED BY 1.5					
AUX. LANE SEC.4-6 STA.75+00 - 11+00	10327	11877 **		8890 ***	7041
AUX. LANE: ** FILL EXPANDED BY 1.10 *** ROCK EX. EXPANDED BY 1.10					
PARK AND RIDE LOT *EXP BY 1.5	14535	327* 17603	490 5537		

GRANULAR BACKFILL

STATION	LOCATION	C.Y.	REMARKS
50 + 00 SEC. NO. 3	RT.	2.0	C-1898
13 + 70 SEC. NO. 3	RT.	1.5	C-1894
17 + 30 SEC. NO. 3	RT.	1.5	C-1895
125 + 00 SEC. NO. 2	RT.	937	CONTAMINATION AREA
		942	

SHAPING SHOULDERS

STA. TO STA.	STA.
SEC. 1	
0 + 00 - 22 + 43	37.3
23 + 84 - 60 + 56.8	73.4
60 + 56 - 117 + 50	113.9
35 + 70 - 52 + 00	32.6
SEC. 2	
52 + 00 - 260 + 52.7	417.0
14 + 53.92 - 32 + 78.05	36.5
32 + 94.72 - 64 + 00	62.2
SEC. 3	
0 - 200 - 81 + 00	166.0
81 + 00 - 96 + 29.5	30.7
0 + 00 - 45 + 52	45.5
45 + 61.8 - 74 + 48.3	28.9
0 + 00 - 11 + 00	11.0
TOTAL	1053.0

REMOVING OLD CULVERT, STATION 7+96

STATION	L.S.	REMARKS
7+96 SEC. NO. 1	1	72' X 60' R.C.C.P.

REMOVING OLD CULVERT, STATION 47+00

STATION	L.S.	REMARKS
47 + 00 SEC. NO. 5	1	3.5' x 6.0' x 56' CONC. CATTLE PASS

CRUSHED AGGREGATE BASE COURSE

STA. TO STA.	LOCATION	BASE TON	SHLDRS. TON
4 + 50 - 12 + 00 SEC. 1	PASSING LANE RT.	1019	48
33 + 50 - 115 + 50 SEC. 1	AUXILIARY LANE RT.		656
207 + 50 - 51 + 50 SEC.2&3	AUXILIARY LANE LT.		720
81 + 00 - 11 + 00 SEC.4-6	AUXILIARY LANE RT.	7712	795
10 + 17 - 11 + 50	390TH AVE.	223	28
8 + 00 - 10 + 29	322ND AVE.	292	23
7 + 60 - 18 + 00	C.T.H. 'CC'	1185	99
10 + 29 - 11 + 50	330TH AVE.	229	16
23 + 50 - 32 + 28 SEC. 3	CONC. C&G LT.	160	
6 + 00 - 11 + 50	C.T.H. 'U' INT.	70	5
9 + 00 - 11 + 00	C.T.H. 'S' INT.	145	12
MINOR SIDE ROADS (12) & DRIVEWAY & FIELD ENT.(63)	LT. & RT.	260	23
UNDISTRIBUTED USH 10	EXISTING LOW SHLDRS.		1000
PARK AND RIDE LOT		510	
TOTAL		11785	3425

REMOVING OLD CULVERTS

STATION	EACH	DESCRIPTION
10 + 40	320TH ST.	24" x 52' C.S.C.P.
10 + 36	280TH ST.	18" x 48' C.S.C.P.
141 + 42	SEC. 2	36" x 18' C.S.C.P.
218 + 71	SEC. 2	36" x 12' C.S.C.P.
125 + 77	SEC. 2	18" x 28' C.S.C.P. (P.E. RT.)
11 + 48	C.T.H. 'CC'	18" x 22' C.S.C.P. (P.E. RT.)
12 + 78	C.T.H. 'CC'	18" x 22' C.S.C.P. (P.E. RT.)
13 + 52	C.T.H. 'CC'	18" x 40' C.S.C.P. (P.E. RT.)
14 + 48	C.T.H. 'CC'	18" x 42' C.S.C.P. (P.E. RT.)
0 + 35	'A' LINE	18" x 52' C.S.C.P.
10 + 42	C.T.H. 'S'	18" x 44' C.S.C.P.
9 + 52	C.T.H. 'S'	24" x 4' C.S.C.P. (2' EA. END)
32 + 15	SEC. 5	18" x 26' C.S.C.P. (P.E. RT.)
43 + 80	SEC. 5	18" x 26' C.S.C.P. (P.E. RT.)
52 + 40	SEC. 5	24" x 34' C.S.C.P. (P.E. RT.)
69 + 87	SEC. 5	18" x 26' C.S.C.P. (P.E. RT.)
6 + 75	SEC. 6	18" x 24' C.S.C.P. (P.E. RT.)
TOTAL	17	

REMOVING CONCRETE SIDEWALK

STATION	S.Y.	REMARKS
9 + 25	6	C.T.H. 'CC' LT.

REMOVING FENCE

STA. TO STA.	LOCATION	L.F.	TYPE
8 + 65 - 8 + 85	C.T.H. 'CC' RT.	27	WOOD RAIL WITH POST

REMOVING ASPHALTIC SURFACE, BUTT JOINTS

STA.	LOCATION	S.Y.
0 + 00	E. ABUT. B-47-986	49
28 + 54	W. ABUT. B-47-13	49
29 + 15	E. ABUT. B-47-13	49
	320TH ST. N & S	53
	300TH ST. NORTH	26
11 + 50	C.T.H. 'U'	49
9 + 00	C.T.H. 'S'	49
11 + 00	C.T.H. 'S'	49
26 + 97	W. ABUT. B-47-10	49
28 + 77	E. ABUT. B-47-10	49
11 + 00	END OF PROJECT	49
TOTAL		520

CROSS DRAINS

STA.	LOCATION	DIAM. INCHES	LENGTH L.F.	TYPE	CLASS	THICKNESS (IN.)	APRON STEEL ALUMINUM EACH	ENDWALLS
7 + 75 SEC. 1	E	72"	60	C.P.*	III	0.138	0.164	2 *
105 + 53 SEC. 1	LT.	30"		C.S.C.P.				1
54 + 26 SEC. 2	RT.	30"	2'	C.S.C.P.	III	0.079		1
69 + 97 SEC. 2	LT.	30"	4'	C.S.C.P.	III	0.079		1
141 + 42 SEC. 2	RT.	36"	18'	C.S.C.P.	III	0.079		1
218 + 71 SEC. 2	LT.	36"	12'	C.S.C.P.	III	0.079		1
55 + 20 SEC. 3	RT.	24"		C.S.C.P.				1
4 + 25 SEC. 4	E	36"		C.S.C.P.				2
37 + 48 SEC. 4	RT.	30"		C.S.C.P.				1
80 + 52 SEC. 4	RT.	30"	4'	C.S.C.P.	III	0.079		1
82 + 46 SEC. 4	RT.	42"	4'	C.S.C.P.	III	0.109		1
87 + 07 SEC. 4	RT.	30"	4'	C.S.C.P.	III	0.079		1
91 + 14 SEC. 4	RT.	30"	10'	C.S.C.P.	III	0.079		1
96 + 21 SEC. 4	RT.	30"	8'	C.S.C.P.	III	0.079		1
7 + 06 SEC. 5	RT.	42"	2'	C.S.C.P.	III	0.109		1
24 + 58 SEC. 5	RT.	60"	14'	C.S.C.P.	III	0.138		1
53 + 96 SEC. 5	RT.	24"	8'	C.S.C.P.	III	0.064		1

* CONCRETE OPTION REQUIRES PIPE TIES FOR APRON ENDWALLS AND FIRST TWO JOINTS

DETAIL SUMMARY OF
MISCELLANEOUS QUANTITIES

SAWING EXISTING PAVEMENT

LOCATION	L.F.
11+50 390TH AVE.	22
96+50 - 97+80 RT. SEC. 2	130
215+00 - 215+98 LT. SEC. 2	98
11+50 330TH ST.	20
7+60 C.T.H. CC	24
16+00 C.T.H. CC	22
TOTAL:	316

CONCRETE BOX CULVERT COVERS

LOCATION	L.F.
97+79 SEC. 1 LT. SIDE ONLY	10
98+66 SEC. 1 LT. SIDE ONLY	10
83+00 SEC. 2 LT. SIDE ONLY	10
191+22 SEC. 2 LT.	10
191+22 SEC. 2 RT.	10
259+39 SEC. 2 LT.	5
259+39 SEC. 2 RT.	10
TOTAL:	65

AVERAGE ESTIMATED QUANTITIES FOR EACH BEAM GUARD ANCHORAGE *

LOCATION	FILL	TOPSOIL	MULCHING	FERT.	SEEDING
EACH	C.Y.	S.Y.	S.Y.	TYPE B CWT.	LB.
	35	100	100	0.06	1.80

* FOR INFORMATIONAL PURPOSES ONLY

PULVERIZE AND RELAY EXISTING BASE AND SURFACE

LOCATION	STA.
0+00 AH. - 22+43 BK. SEC. 1	22.4
23+84 AH. - 60+56 BK. SEC. 1	36.7
60+55.9 AH. - 117+50 BK. SEC. 1	57.0
35+70 AH. - 260+52.7 BK. SEC. 2	224.8
14+53.92 AH. - 32+78.05 BK. SEC. 3	18.2
32+94.72 AH. - 64+00 BK. SEC. 3	31.1
0+200 AH. - 96+29 BK. SEC. 4	98.3
0+00 AH. - 45+52 BK. SEC. 5	45.5
45+62 AH. - 74+48 BK. SEC. 5	29.0
0+00 AH. - 11+00 SEC. 6	11.0
TOTAL:	574.0

GRADING, SHAPING & FINISHING FOR
BEAM GUARD ANCHORAGES

LOCATION	EACH
0+252 SEC. 1 LT. & RT.	2
1+64 SEC. 1 LT.	1
13+88 SEC. 1 LT.	1
15+25 SEC. 1 LT.	1
16+14 SEC. 1 RT.	1
18+03 SEC. 1 LT.	1
19+41 SEC. 1 LT.	1
27+40 SEC. 1 LT. & RT.	2
30+30 SEC. 1 LT. & RT.	2
42+03 SEC. 1 LT.	1
66+91 SEC. 1 LT.	1
49+31 SEC. 1 RT.	1
51+69 SEC. 1 RT.	1
71+15 SEC. 1 LT.	1
71+75 SEC. 1 RT.	1
74+28 SEC. 1 LT.	1
74+38 SEC. 1 RT.	1
81+60 SEC. 1 LT.	1
82+50 SEC. 1 LT.	1
97+45 SEC. 2 LT. & RT.	2
101+23 SEC. 2 RT.	1
101+70 SEC. 2 RT.	1
200+12 SEC. 2 RT.	1
200+40 SEC. 2 LT.	1
11+00 SEC. 2 RT.	1
190TH ST.	
205+62 SEC. 2 RT.	1
226+50 SEC. 2 RT.	1
227+00 SEC. 2 LT.	1
228+50 SEC. 2 RT.	1
229+00 SEC. 2 LT.	1
259+90 SEC. 2 RT.	1
25+49 SEC. 3 RT.	1
258+70 SEC. 2 LT.	1
260+08 SEC. 2 LT.	1
31+30 SEC. 3 RT.	1
46+10 SEC. 3 RT.	1
41+75 SEC. 3 LT.	1
0 - 138 SEC. 4 LT.	1
8+85 SEC. 4 LT.	1
15+22 SEC. 4 LT.	1
14+08 SEC. 4 RT.	1
15+45 SEC. 4 RT.	1
25+83 SEC. 4 RT.	1
26+33 SEC. 4 LT.	1
46+75 SEC. 4 RT.	1
48+04 SEC. 4 LT.	1
48+50 SEC. 4 LT.	1
58+12 SEC. 4 RT.	1
64+00 SEC. 4 LT.	1
64+68 SEC. 4 LT.	1
82+31 SEC. 4 LT.	1
82+98 SEC. 4 LT.	1
9+82 SEC. 5 LT.	1
11+80 SEC. 5 LT.	1
10+75 SEC. 5 LT.	1
45TH ST.	
24+00 SEC. 5 RT.	1
10+75 SEC. 5 RT.	1
45 TH ST.	
28+88 SEC. 5 LT.	1
46+33 SEC. 5 LT.	1
11+38 SEC. 5 LT.	1
C.T.H. 'ZZ'	
11+38 SEC. 5 RT.	1
C.T.H. 'ZZ'	
53+50 SEC. 5 LT.	1
TOTAL:	66

ASPHALTIC ITEMS

LOCATION	ASPH. MATL. FOR PLANT MIXES TON	ASPH. MATL. FOR TACK COAT GALS.	ASPH. CONC. PAVT TYPE MV TON
0+00 - 22+43 BK. SEC. 1	113	455	1872
23+84.5 AH. - 60+56 BK. SEC. 1	226	877	3765
60+55.9 AH. - 117+50 BK. SEC. 1	375	1455	6245
35+70 AH. - 52+00 SEC. 2	85	326	1399
PASSING LANE 4+50-12+00 RT.	10	20	66
INTERSECTION (322ND AVE. LT.)	9	21	150
INTERSECTION (322ND AVE. RT.)	11	25	180
INTERSECTION (320TH ST. RT.)	6		100
INTERSECTION (320TH ST. LT.)	6		100
52+00 - 260+52.7 BK. SEC. 2	1155	4480	19206
14+53.92 AH. - 32+78.05 BK. SEC. 3	122	475	2035
32+94.72 AH. - 64+00 BK. SEC. 3	192	750	3201
INTERSECTION (300TH ST. LT.)	6		100
INTERSECTION (280TH ST. LT.)	6		100
INTERSECTION (280TH ST. RT.)	6		100
INTERSECTION (330TH ST. WEST LT.)	6		100
INTERSECTION (C.T.H. 'CC' RT.)	14	33	240
INTERSECTION (C.T.H. 'CC' LT.)	28	64	460
PARK & RIDE	11	30	175
INTERSECTION @ 164+90 RT.	6		100
INTERSECTION @ 164+90 LT.	6		100
INTERSECTION (190TH ST. LT.)	6		100
INTERSECTION (330TH ST. EAST LT.)	8	19	135
INTERSECTION (170TH ST. LT.)	6		100
INTERSECTION (170TH ST. RT.)	6		100
0+200 AH. - 96+29.5 BK. SEC. 4	535	2070	8889
0+00 AH. - 45+52 BK. SEC. 5	305	1184	5080
45+61.8 AH. - 74+48 BK. SEC. 5	194	750	3221
0+00 AH. - 11+50 SEC. 6	68	265	1131
INTERSECTION (C.T.H. 'U' RT.)	18	31	300
INTERSECTION (C.T.H. 'S' LT.)	12	20	200
INTERSECTION (C.T.H. 'S' RT.)	11	19	180
INTERSECTION (PINE AVE. RT.)	6		100
INTERSECTION @ 37+10 LT.	6		100
INTERSECTION (50TH ST. RT.)	6		100
INTERSECTION (45TH ST. LT.)	6		100
INTERSECTION (C.T.H. 'ZZ' LT.)	14	31	225
INTERSECTION (10TH ST. RT.)	6		100
UNDISTRIBUTED	38	10	630
TOTALS:	3650	13410	60685

PAVEMENT MARKING, HANDICAP SYMBOLS, EPOXY
PAVEMENT MARKING, PARKING STALL, EPOXY

LOCATION	SYMBOLS EACH	PARKING STALL EPOXY L.F.
PARK & RIDE	2	580

PRECAST CONCRETE CURB

LOCATION	EACH
PARK & RIDE	21

LEVELS ON - 1,2,3,4,5,6,7,8,9,10,11,12,13,14,15,16,17,18,19,20,21,22,23,24,25,26,27,28,29,30,31,32,33,34,35,36,37,38,39,40,41,42,43,44,45,46,47,48,49,50,51,52,53,54,55,56,57,58,59,60,61,62,63

SIDEROAD, PRIVATE AND FIELD ENTRANCE PIPES

STA.	LOCATION	DIAM. INCHES	LENGTH L.F.	TYPE	CLASS	THICKNESS (IN.) STEEL	ALUMINUM	APRON ENDWALLS EACH
9 + 00	322ND AVE.	24	56	C.P.	III	0.064	0.075	2
10 + 40	320TH ST.	24	60	C.P.	III	0.064	0.075	2
10 + 36	290TH ST.	24	66	C.P.	III	0.064	0.075	2
11 + 48 RT.	C.T.H. 'CC'	18	22	C.P.	III	0.064	0.060	2
12 + 78 RT.	C.T.H. 'CC'	18	22	C.P.	III	0.064	0.060	2
13 + 52 RT.	C.T.H. 'CC'	18	38	C.P.	III	0.064	0.060	2
14 + 50 RT.	C.T.H. 'CC'	18	42	C.P.	III	0.064	0.060	2
0 + 35	'A'-LINE	18	76	C.P.	III	0.064	0.075	2
9 + 52	C.T.H. 'S'	24	24	C.S.C.P.	III	0.064	0.090	2
10 + 46	C.T.H. 'S'	18	84	C.P.	III	0.064	0.060	2
32 + 15 SEC.5	F.E. RT.	18	40	C.P.	III	0.064	0.060	2
43 + 80 SEC.5	P.E. RT.	18	32	C.P.	III	0.064	0.060	2
52 + 40 SEC.5	P.E. RT.	24	32	C.P.	III	0.064	0.060	2
69 + 87 SEC.5	F.E. RT.	18	40	C.P.	III	0.064	0.060	2
6 + 75 SEC.6	P.E. RT.	18	28	C.P.	III	0.064	0.060	2

CONCRETE CURB AND GUTTER, 36", TYPE 'D'

LOCATION	L.F.
23 + 50 TO 32 + 28 LT. (SEC.3)	878
ISLAND C.T.H. 'U'	430
'A' LINE RT. AT C.T.H. 'U'	106
S.W. RADIUS C.T.H. 'S'	88
S.E. RADIUS C.T.H. 'S'	70
N.W. RADIUS C.T.H. 'S'	64
N.E. RADIUS C.T.H. 'S'	79
S.W. RADIUS C.T.H. 'CC'	64
S.E. RADIUS C.T.H. 'CC'	92
N.W. RADIUS C.T.H. 'CC'	92
N.E. RADIUS C.T.H. 'CC'	64
N.W. RADIUS C.T.H. 'ZZ'	92
N.E. RADIUS C.T.H. 'ZZ'	64
TOTAL	2184

RIPRAP & GEOTEXTILE FABRIC

STA. TO STA.	LOCATION	C.Y.	HEAVY RIPRAP	MEDIUM RIPRAP	FABRIC TYPE HR
5 + 50 - 12 + 50 SEC. 1	RT. SLOPE	912		1594	
10 + 20 - 11 + 00 SEC. 5	RT. DITCH		67	100	
17 + 00 - 18 + 00 SEC. 5	RT. DITCH		83	199	
24 + 58 - 26 + 00 SEC. 5	RT. DITCH		118	263	
45 + 00 - 47 + 65 SEC. 5	RT. DITCH		138	331	
TOTALS		912	406	2567	

STEEL THRIE BEAM STRUCTURE APPROACH

STA. TO STA.	LOCATION	L.F.	ANCHOR ASSEMBLIES FOR STEEL PLATE BEAM GUARD, SPECIAL	REMARKS
-1 + 82 TO -1 + 55 LT.	B-47-906	27	1	
-1 + 82 TO -1 + 55 RT.	B-47-906	27	1	
0 + 00 TO 0 + 27 LT.	B-47-906	27	1	
0 + 00 TO 0 + 27 RT.	B-47-906	27	1	
28 + 27 TO 28 + 54 LT.	B-47-13	27		TYPE F RAIL
28 + 27 TO 28 + 54 RT.	B-47-13	27		TYPE F RAIL
29 + 16 TO 29 + 43 LT.	B-47-13	27		TYPE F RAIL
29 + 16 TO 29 + 43 RT.	B-47-13	27		TYPE F RAIL
26 + 70 TO 26 + 97 LT.	B-47-10	27		TYPE F RAIL
26 + 70 TO 26 + 97 RT.	B-47-10	27		TYPE F RAIL
28 + 77 TO 29 + 04 LT.	B-47-10	27		TYPE F RAIL
28 + 77 TO 29 + 04 RT.	B-47-10	27		TYPE F RAIL
TOTALS		324	4	

ADJUSTING STEEL PLATE BEAM GUARD

STA. TO STA.	LOCATION	L.F.
9 + 23 TO 14 + 84	LT. SEC. 4	580
29 + 04 TO 37 + 00	LT. SEC. 4	796
29 + 04 TO 33 + 00	RT. SEC. 4	396
37 + 20 TO 47 + 66	LT. SEC. 4	1046
48 + 87 TO 63 + 63	LT. SEC. 4	1476
48 + 13 TO 56 + 62	RT. SEC. 4	849
65 + 06 TO 81 + 93	LT. SEC. 4	1687
83 + 36 TO 9 + 44	LT. SEC. 4B5	2237
12 + 17 TO 26 + 00	LT. SEC. 5	1443
TOTAL		10,490

STEEL PLATE BEAM GUARD, CLASS A

STA. TO STA.	LOCATION	L.F.	ANCHORAGES TYPE 1
0 - 252 TO 0 - 182	LT. SEC. 1	70	1
0 - 252 TO 0 - 182	RT. SEC. 1	70	1
0 + 27 TO 1 + 04	LT. SEC. 1	137	1
0 + 27 TO 16 + 14	RT. SEC. 1	1587	1
13 + 88 TO 15 + 25	LT. SEC. 1	137	2
16 + 03 TO 19 + 41	LT. SEC. 1	138	2
27 + 40 TO 28 + 27	LT. SEC. 1	87	1
27 + 40 TO 28 + 27	RT. SEC. 1	87	1
29 + 43 TO 30 + 30	LT. SEC. 1	87	1
29 + 43 TO 30 + 30	RT. SEC. 1	87	1
42 + 03 TO 66 + 91	LT. SEC. 1	2488	2
49 + 31 TO 51 + 69	LT. SEC. 1	238	2
71 + 15 TO 74 + 28	LT. SEC. 1	313	2
71 + 78 TO 74 + 38	RT. SEC. 1	263	2
81 + 00 TO 82 + 50	LT. SEC. 1	90	2
97 + 45 TO 101 + 70	LT. SEC. 2	425	2
97 + 45 TO 101 + 23	RT. SEC. 2	378	2
200 + 40 TO 11 + 00	LT. SEC. 2	425	2
200 + 12 TO 205 + 62	RT. SEC. 2	550	2
227 + 00 TO 229 + 00	LT. SEC. 2	200	2
228 + 50 TO 228 + 50	RT. SEC. 2	200	2
258 + 70 TO 260 + 08	LT. SEC. 2	138	2
259 + 90 TO 25 + 49	RT. SEC. 2B3	1157	2
31 + 30 TO 46 + 10	RT. SEC. 3	1464	2
41 + 75 TO 0 - 136	LT. SEC. 3B4	2287	2
8 + 85 TO 9 + 23	LT. SEC. 4	38	1
14 + 06 TO 15 + 45	RT. SEC. 4	137	2
14 + 84 TO 15 + 22	LT. SEC. 4	38	1
26 + 33 TO 26 + 70	LT. SEC. 4	37	1
25 + 83 TO 26 + 70	RT. SEC. 4	87	1
47 + 06 TO 48 + 04	LT. SEC. 4	37	1
48 + 50 TO 48 + 87	LT. SEC. 4	37	1
46 + 75 TO 46 + 13	RT. SEC. 4	38	1
63 + 63 TO 64 + 00	LT. SEC. 4	37	1
56 + 62 TO 56 + 12	RT. SEC. 4	150	1
64 + 68 TO 65 + 06	LT. SEC. 4	38	1
66 + 70 TO 70 + 70	RT. SEC. 4	200	2
81 + 93 TO 82 + 31	LT. SEC. 4	38	1
82 + 98 TO 83 + 36	LT. SEC. 4	38	1
9 + 44 TO 9 + 82	LT. SEC. 5	38	1
11 + 80 TO 12 + 17	LT. SEC. 5	37	1
26 + 60 TO 10 + 75	LT. SEC. 5	100	1
10 + 75 TO 28 + 88	LT. SEC. 5	188	2
45TH ST.			
24 + 00 TO 28 + 00	RT. SEC. 5	410	2
46 + 33 TO 11 + 38	LT. SEC. 5	240	2
C.T.H. 'ZZ'			
11 + 38 TO 53 + 50	LT. SEC. 5	590	2
C.T.H. 'ZZ'			
45 + 50 TO 51 + 48	RT. SEC. 5	598	2
TOTALS		16,254	71

LANDMARK REFERENCE MONUMENTS

LOCATION	EACH
124 + 54 10' RT. SEC. 2	3

ASPHALTIC CONCRETE CURB

STA. TO STA.	L.F.
258 + 25 TO 25 + 50 RT. SEC. 2B3	1324
33 + 00 TO 46 + 00 RT. SEC. 3	1300
TOTAL	2624

ASPHALTIC FLUMES

LOCATION	S.Y.
15 + 00 RT. SEC. 3	4.0
18 + 00 RT. SEC. 3	4.0
21 + 00 RT. SEC. 3	4.0
24 + 00 RT. SEC. 3	4.0
26 + 00 LT. SEC. 3	11.0
29 + 00 LT. SEC. 3	11.0
32 + 34 LT. SEC. 3	11.0
36 + 00 RT. SEC. 3	4.0
39 + 00 RT. SEC. 3	4.0
42 + 00 RT. SEC. 3	4.0
44 + 00 RT. SEC. 3	4.0
46 + 02 RT. SEC. 3	4.0
TOTAL	69.0

TOPSOIL, SALVAGED TOPSOIL, MULCHING, FERTILIZING & SEEDING

STATION - STATION	LOCATION	TOPSOIL C.Y.	SALVAGE TOPSOIL S.Y.	MULCH S.Y.	FERT. CWT.	SEED LBS.
10 + 20 - 11 + 50	390TH AVE. LT. & RT.		155	386	0.28	7
4 + 00 - 13 + 00	PASSING LANE RT.	54		1,144	0.77	21
8 + 00 - 9 + 70	322ND AVE. LT. & RT.		890	1,192	0.80	21
95 + 00 - 97 + 49	USH 10 RT. AT 322ND AVE.		1,502	1,752	1.15	32
7 + 60 - 16 + 00	C.T.H. 'CC' LT. & RT.		1,297	2,630	1.70	47
122 + 00 - 127 + 00	USH 10 LT. & RT. @ C.T.H. 'CC'		1,068	1,856	1.23	34
10 + 25 - 11 + 50	330TH ST. LT. & RT.		506	589	0.42	11
214 + 75 - 218 + 80	USH 10 LT. @ 330TH ST.		1,303	1,257	0.84	23
23 + 00 - 32 + 50	USH 10 LT. BERM BEHIND C&G		2,217	2,500	1.64	46
8 + 00 - 11 + 00	C.T.H. 'U' & 'A' LINE LT. & RT.		876	876	0.48	12
9 + 00 - 11 + 00	C.T.H. 'S' LT. & RT.		185	310	0.25	6
75 + 00 - 23 + 00 S 4B5	AUXILIARY LANE RT.	846		11,116	7.00	202
23 + 00 - 10 + 00 S 5B6	AUXILIARY LANE RT.		18,641	24,940	5.76	450
UNDISTRIBUTED		50	500	1,000	0.68	16
PARK AND RIDE LOT			400	480	0.3	10
TOTAL		950	29,340	51,830	23.3	540

EROSION MAT, CLASS I, TYPE B, DELIVERED AND INSTALLED

LOCATION	S.Y.	DESCRIPTION
(AUXILIARY LANE SEC. 4B5)		
STA. 82 + 46 TO 96 + 00 RT.	2,257	DITCH
STA. 96 + 21 TO 6 + 50 RT.	1,093	DITCH
STA. 7 + 00 TO 9 + 00 RT.	333	DITCH
STA. 11 + 00 TO 13 + 70 RT.	450	DITCH
STA. 13 + 80 TO 17 + 00 RT.	533	DITCH
STA. 18 + 00 TO 23 + 00 RT.	833	DITCH
STA. 30 + 00 TO 36 + 00 RT.	1,000	DITCH
STA. 44 + 00 TO 45 + 00 RT.	187	DITCH
STA. 50 + 00 TO 53 + 00 RT.	500	DITCH
STA. 54 + 00 TO 61 + 00 RT.	1,167	DITCH
STA. 65 + 00 TO 67 + 00 RT.	333	DITCH
TOTAL	8,666	

SILT FENCE DELIVERED/INSTALLED/MAINTENANCE (SILTY)

L.F.	REMARKS
450	VARIOUS DITCH CHECKS AND PROTECTION AT VARIOUS INLETS AND APRON ENDWALLS
2,700	UNDISTRIBUTED TOE OF SLOPE PROTECTION PLACED AS DIRECTED BY THE ENGINEER.
3,150 TOTAL	

TRAFFIC CONTROL, DRUMS, BARRICADES, WARNING LIGHTS, AND SIGNS

LOCATION	DRUM DAYS	BARRICADES TYPE III	WARNING LIGHTS TYPE 'A'	WARNING LIGHTS TYPE 'A'
MAINLINE (USH 10)			1300	1040
SIDE ROADS			4550	4030
ROAD CLOSURE (C.T.H. 'CC' NORTH) (330TH ST.)	20	40	20	
MAINLINE (USH10 OPEN TRENCHES) 66				
(USH10 ROADWAY EDGES) 6500				
TOTALS	6566	40	80	5890 5070

PAVEMENT MARKING, EPOXY, CHANNELIZING, SAME DAY, STOPLINE, ISLAND NOSE

LOCATION	4-INCH WHITE	4-INCH YELLOW	4-INCH YELLOW	4-INCH DASHED STOP	18-INCH **	8-INCH * CHANNELIZING	ISLAND NOSE
MAINLINE USH 10	111,660	12,150	75,770	6,340	170	240	580
AUXILIARY LANES				70			
PASSING LANE (4+50-12+00)							
SIDEROADS							
TOTALS	111,660 ①	12,150 ②	80,870 ②	6,410 ①	170	240	580

* CTH 'U' ISLAND (SEE INTERSECTION DETAIL)

** CTH 'CC', 'U' & 'S' (SEE INTERSECTION DETAILS)

① PAV'T. MARKING, EPOXY, 4-INCH TOTAL = 118,070 L.F.

② PAV'T. MARKING, SAME DAY, EPOXY, 4-INCH TOTAL = 92,820 L.F.

STATE PROJECT NUMBER

1530-06-71

SHEET NO.

3C

DETAIL SUMMARY OF MISCELLANEOUS QUANTITIES

TEMPORARY PAVEMENT MARKING

LOCATION	DESCRIPTION	L.F.
USH 10 (BINDER COURSE)	NO PASSING (4" SOLID) & (4" X 4" DASHES)	80,670 3,830
TOTAL		84,500

SODDING &

EROSION MAT, CLASS II, TYPE 'A'

LOCATION	S.Y.	REMARKS
USH 10		
STA. 7 + 75 LT. & RT. SEC. 1	52	C.P. INLET & DISCH.
STA. 105 + 53 LT. SEC. 1	15	C.P. INLET
STA. 105 + 53 LT. SEC. 1	40	DITCH DAM
STA. 54 + 26 RT. SEC. 2	15	C.P. INLET
STA. 66 + 97 LT. SEC. 2	15	C.P. INLET
STA. 141 + 42 RT. SEC. 2	17	C.P. DISCH.
STA. 216 + 71 LT. SEC. 2	17	C.P. INLET
STA. 56 + 20 RT. SEC. 3	13	C.P. INLET
STA. 56 + 20 RT. SEC. 3	32	DITCH DAM
STA. 4 + 25 LT. & RT. SEC. 4	43	C.P. INLET & DISCH.
STA. 37 + 48 RT. SEC. 4	13	C.P. DISCH.
STA. 80 + 44 RT. SEC. 4	20	DITCH DAM
STA. 80 + 52 RT. SEC. 4	15	C.P. INLET
STA. 82 + 46 RT. SEC. 4	20	C.P. INLET
STA. 87 + 03 RT. SEC. 4	20	DITCH DAM
STA. 87 + 07 RT. SEC. 4	16	C.P. INLET
STA. 91 + 06 RT. SEC. 4	16	DITCH DAM
STA. 91 + 14 RT. SEC. 4	15	C.P. INLET
STA. 96 + 14 RT. SEC. 4	20	DITCH DAM
STA. 96 + 21 RT. SEC. 4	13	C.P. INLET
STA. 7 + 00 RT. SEC. 5	30	DITCH DAM
STA. 7 + 06 RT. SEC. 5	20	C.P. INLET
STA. 13 + 62 RT. SEC. 5	27	DITCH DAM
STA. 32 + 15 F.F. RT. SEC. 5	22	C.P. INLET & DISCH.
STA. 43 + 80 P.E. RT. SEC. 5	22	C.P. INLET & DISCH.
STA. 52 + 40 P.E. RT. SEC. 5	26	C.P. INLET & DISCH.
STA. 53 + 80 RT. SEC. 5	22	DITCH DAM
STA. 53 + 96 RT. SEC. 5	13	C.P. INLET
STA. 66 + 87 F.E. RT. SEC. 5	22	C.P. INLET & DISCH.
STA. 6 + 75 P.E. RT. SEC. 6	22	C.P. INLET & DISCH.
322ND AVE.		
STA. 9 + 00 LT. & RT.	26	C.P. INLET & DISCH.
C.T.H. 'CC'		
STA. 9 + 70 LT.	4	FLUME
STA. 9 + 75 RT.	4	FLUME
STA. 10 + 25 LT.	5	FLUME
STA. 10 + 60 LT.	5	FLUME
STA. 10 + 60 RT.	3	FLUME
STA. 11 + 48 P.E. RT.	22	C.P. INLET & DISCH.
STA. 12 + 76 P.E. RT.	22	C.P. INLET & DISCH.
STA. 13 + 52 P.E. RT.	22	C.P. INLET & DISCH.
STA. 14 + 50 P.E. RT.	22	C.P. INLET & DISCH.
C.T.H. 'U'		
STA. 8 + 10 LT.	4	FLUME
STA. 0 + 20 'A' LINE RT.	5	FLUME
STA. 0 + 35 'A' LINE	22	C.P. INLET & DISCH.
STA. 0 + 40 'A' LINE RT.	5	FLUME
STA. 0 + 25 'A' LINE LT.	4	FLUME
C.T.H. 'S'		
STA. 9 + 25	26	C.P. INLET & DISCH.
STA. 10 + 48	22	C.P. INLET & DISCH.
STA. 9 + 25 RT.	4	FLUME
STA. 9 + 30 LT.	4	FLUME
STA. 10 + 60 RT.	5	FLUME
STA. 10 + 65 LT.	5	FLUME
TN. RD.		
111 + 56 SEC. 1	26	C.P. INLET & DISCH.
82 + 40 SEC. 2	26	C.P. INLET & DISCH.
UNDISTRIBUTED	78	
	TOTAL 1027	

CONVENTIONAL SIGNS AND ABBREVIATIONS

AC. ACRE
 AM. AHEAD
 A.P. ACCESS POINT
 BK. BACK
 C.S.M. CERTIFIED SURVEY MAP
 D. DEGREE OF CURVE
 E.T. ET AL.
 F.R.L. FRACTIONAL
 FT. FEET
 L. LENGTH OF CURVE
 L.C. LONG CHORD OF CURVE
 L.T. LEFT
 L.P. PROPANE GAS
 P.C. POINT OF CURVATURE
 P.E. POINT OF BEGINNING
 P.I. POINT OF INTERSECTION
 P.T. POINT OF TANGENCY
 P.L.E. PERMANENT LIMITED EASEMENT
 R. REMAINING
 R.M. RIGHT
 R.T. RIGHT OF WAY
 S.F. SQUARE FEET
 T. TANK
 TEMP. TEMPORARY
 T.L.E. TEMPORARY LIMITED EASEMENT
 V. VOLUME

POWER POLE
 TELEPHONE POLE
 SIGN
 TELEPHONE PEDESTAL

NO ACCESS (BY ACQUISITION)
 NO ACCESS (BY STATUTORY AUTHORITY)
 NO ACCESS (BY PREVIOUS PROJECT)

CONVENTIONAL SIGNS

PROPERTY LINE
 LOT LINE
 LIMITED EASEMENT
 EXISTING RIGHT OF WAY
 NEW RIGHT OF WAY
 REFERENCE LINE
 SLOPE INTERCEPT

CULVERT IN PLACE
 CULVERT REQUIRED

COMBUSTIBLE FLUIDS
 (UNDER PRESSURE)

UNDERGROUND UTILITIES

GAS

ELECTRIC

TELEPHONE

SERVICE PEDESTAL

CABLE MARKER

POWER POLE

TELEPHONE POLE

NOTES

COORDINATES AND BEARINGS ON THIS PLAT ARE ORIENTED TO THE WISCONSIN COORDINATE SYSTEM CENTRAL ZONE. ALL PLAT DISTANCES ARE GROUND LENGTH AND MAY BE CONVERTED TO GRID LENGTH BY MULTIPLYING THE DISTANCE BY THE GRID FACTOR PROVIDED ON THE DETAIL SHEETS.

RIGHT OF WAY MONUMENTS ARE AND ARE PLACED PRIOR TO OR AT THE TIME OF LAND TITLE TRANSFER.

RIGHT OF WAY BOUNDARIES ARE DEFINED WITH COURSES OF THE PERIMETER OF THE HIGHWAY LANDS REFERENCED TO THE U.S. PUBLIC LAND SURVEY OR OTHER SURVEYS OF PUBLIC RECORD.

R-16-W R-15-W R-14-W

SCHEDULE OF LANDS & INTERESTS REQUIRED


PARCEL NUMBER	SHEET NUMBER	OWNER	INTEREST REQUIRED	TOTAL ACRES	R/W ACRES REQUIRED	TOTAL ACRES REMAINING	T.L.E. ACRES
1	4	OMO METHODIST EPISCOPAL CHURCH OF GRANGE HALL	T.L.E.	—	—	—	239.50 FT
2	4	RICHARD R. BROCH	FEE	1.11	0.10	0.33	0.43
3	4	PHILLIP A. & MARY L. ROBERTS	T.L.E.	—	—	—	236.50 FT
4	4.1	NORBERT G. KANNEL	FEE	201.00	0.10	1.34	1.44
						199.56	—

R/W PROJECT NUMBER 1530-08-21	SHEET NUMBER 4.0	TOTAL SHEETS
FEDERAL PROJECT NUMBER		
PLAT OF RIGHT OF WAY REQUIRED FOR ELLSWORTH-DURAND ROAD C.T.H. 'A'-EAST COUNTY LINE SECTION		
U.S.H. 10	PIERCE CO.	
1530-08-71	4.0	
GRID FACTOR .9999000		

BEGIN RELOCATION ORDER-SEC.1
 STA. 124+00 U.S.H. 10
 APPROX. 88° 15' 10" N. OF THE S.E. COR.
 OF SEC. 12, T25N, R16W
 Y 307999 (±200')
 X 1412895 (±200')

LOCATION SKETCH
 SCALE 1"=2 MILES
 SEC. 1 = 0.080 MI.
 SEC. 2 = 0.142 MI.
 NET LENGTH OF CENTERLINE=0.202 MI.

END RELOC. ORDER-SEC.2
 STA. 124+30 U.S.H. 10
 APPROX. 88° 15' 10" N. OF THE S.E. COR.
 OF SEC. 12, T25N, R16W
 Y 307999 (±200')
 X 1412895 (±200')
 END RELOC. ORDER-SEC.1
 STA. 124+32 U.S.H. 10
 APPROX. 88° 15' 10" N. OF THE S.W. COR.
 OF SEC. 7, T25N, R15W
 Y 307999 (±200')
 X 1412813 (±200')
 BEGIN RELOC. ORDER-SEC.2
 STA. 67+00 U.S.H. 10
 APPROX. 78° 10' 10" N. OF THE N.E. COR.
 OF SEC. 24, T25N, R15W
 Y 301807 (±200')
 X 1412841 (±200')

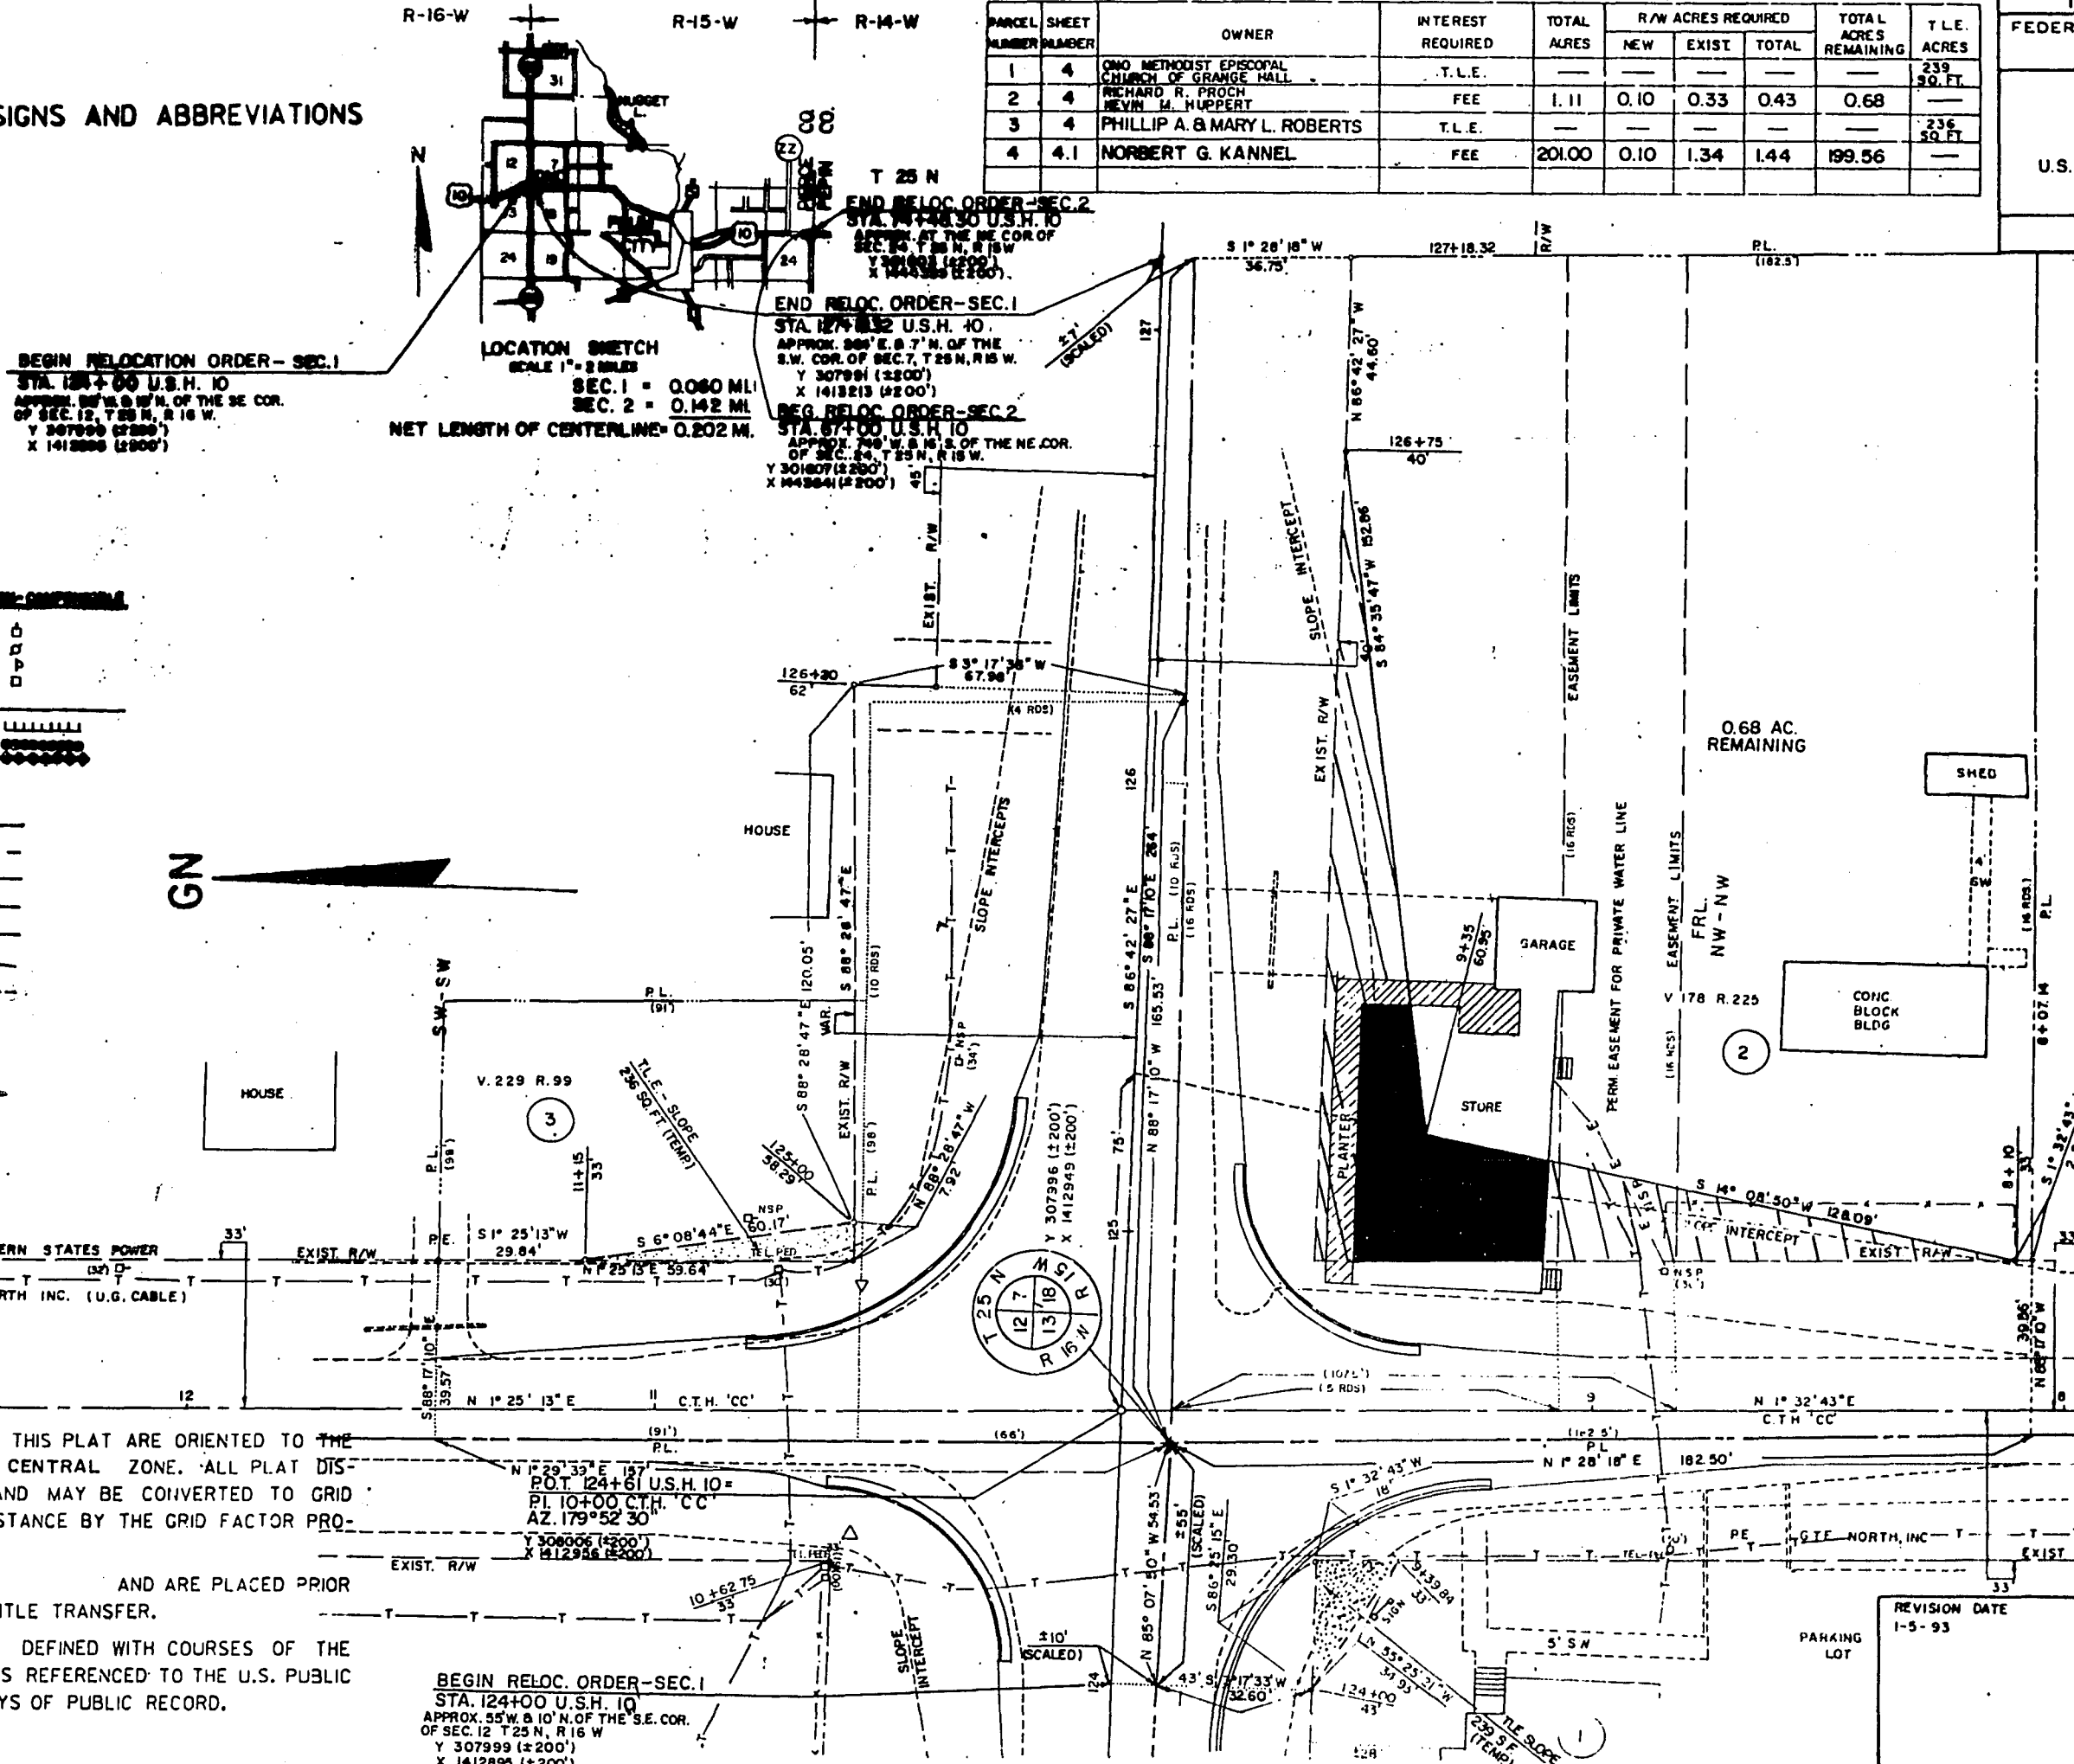

ORIGINAL PLAN PREPARED BY
 Palzkill, Peterson
 & ASSOCIATES
 407 LYN AVE. • AUDUBON, WISCONSIN 54120 • 715/837-0022

7/14/92
 ENGINEER DATE

STATE OF WISCONSIN
 DEPARTMENT OF TRANSPORTATION

REVISION DATE
 1-5-93

PARKING LOT

7/14/92

STA. 0-182 TO STA. 0-155 LT. & RT.
STEEL THRIE BEAM STRUCTURE APPROACH REQ'D.
SEE DETAIL FOR STRUCTURE ATTACHMENTS

STA. 0-252 TO STA. 0-182 LT. & RT.
STEEL PLATE BEAM GUARD CLASS "A" REQ'D.
(2) TYPE I ANCHORS REQ'D.


STATE PROJECT NUMBER

1530-08-71

SHEET NO.

5.0

SECTION 1

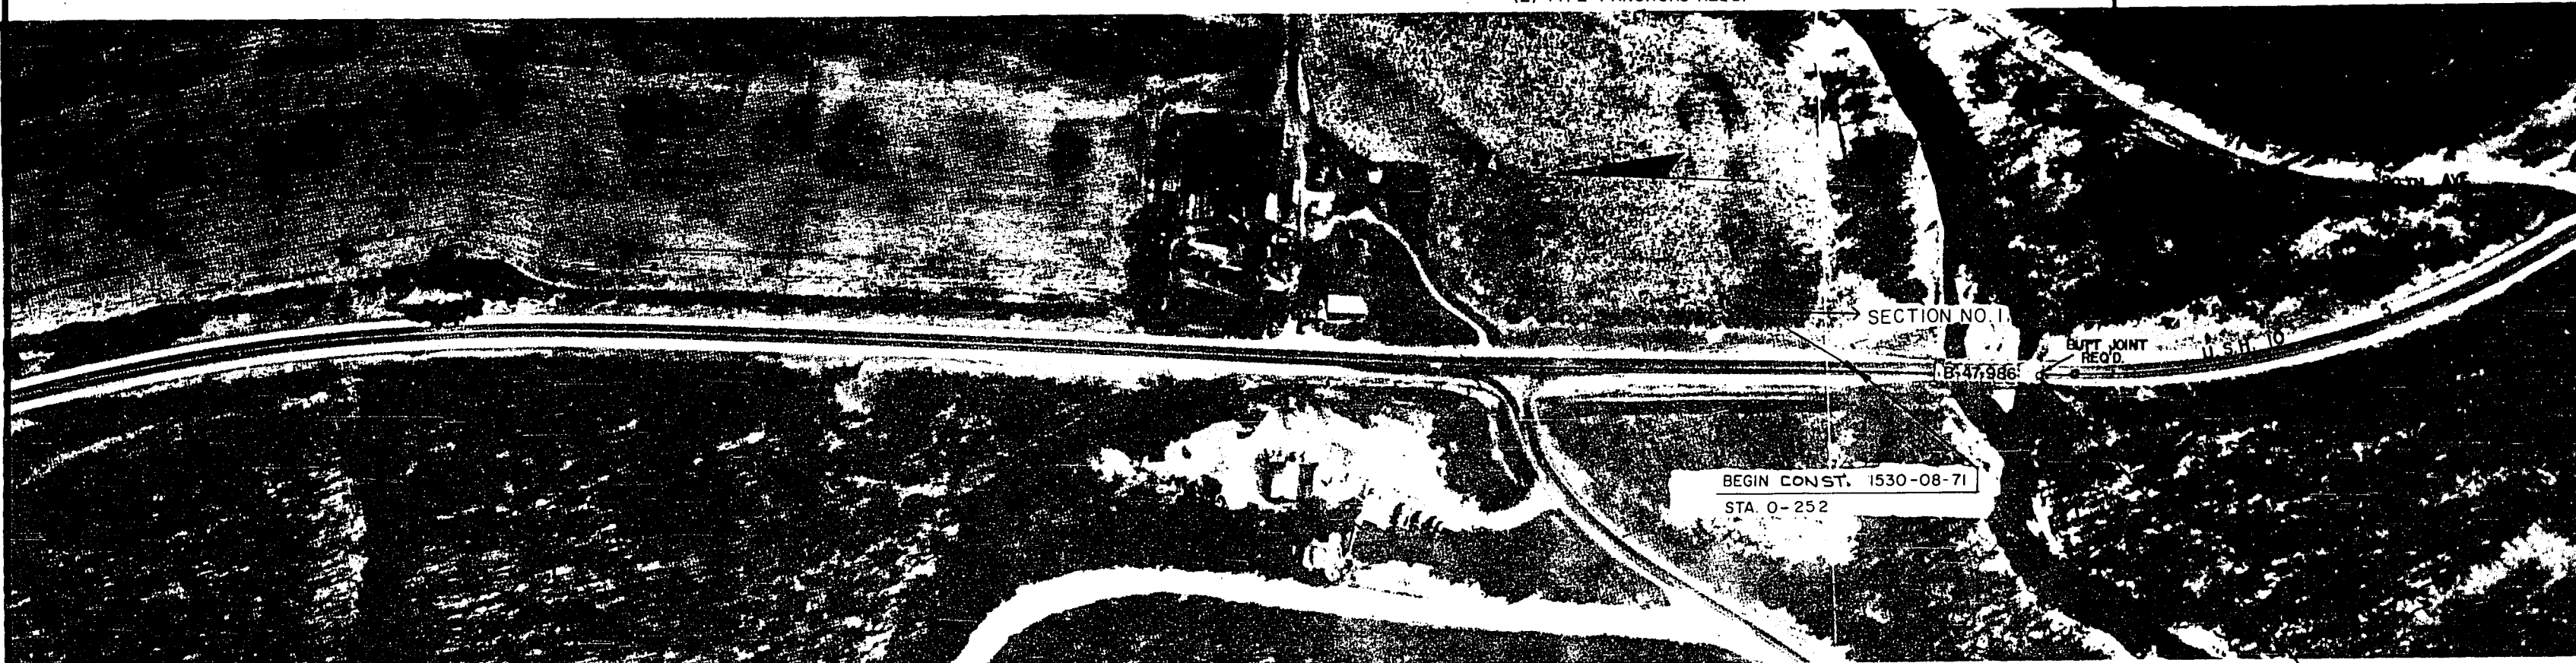

STA. 8+00 CONSTRUCT MODIFIED TYPE "C" INTERSECTION
PASSING LANE REQ'D.
(SEE INTERSECTION DETAIL)

STA. 13+88 TO 15+25 LT.
STEEL PLATE BEAM GUARD CLASS "A" REQ'D.
(2) TYPE I ANCHORS REQ'D.

STA. 0+00 TO 0+27 LT. & RT.
STEEL THRIE BEAM STRUCT. APPROACH REQ'D
SEE DETAIL FOR STRUCTURE ATTACHMENTS.
STA. 0+27 TO 1+64 LT.
STEEL PLATE BEAM GUARD CLASS "A" REQ'D.
(1) TYPE I ANCHOR REQ'D.

BEGIN PROJECT
STA. 0+00

STA. 7+75
1-72' X 80' C.P. CLASS III, REQ'D.
SKEW 25° R.H.F.
(2) APRON ENDWALLS REQ'D.

STA. 7+96
REMOVE 1-72' X 60' R.C.C.P.

STA. 18+03 TO 19+41 LT.
STEEL PLATE BEAM GUARD CLASS "A" REQ'D.
(2) TYPE I ANCHORS REQ'D.

NET LENGTH OF CENTERLINE STA. 0+00.00 TO 30+00.00 = 2,797 LIN. FT.



STA. 0+27 TO 16+14 RT.
STEEL PLATE BEAM GUARD CLASS "A" REQ'D
(1) TYPE I ANCHOR REQ'D.

EQUATION
PC 22+43.0 BK =
23+84.5 AH

EXCEPTION TO NET C LENGTH
28+54.25 TO 29+15.75
(B-47-13) - 61.5'

STA. 28+27 TO 28+54 LT. & RT.
STEEL THRIE BEAM STRUCT. APPROACH REQ'D.
SEE S.D.D. FOR STRUCTURE ATTACHMENT

STA. 29+16 TO 29+43 LT. & RT.
STEEL THRIE BEAM STRUCTURE APPROACH REQ'D.
SEE S.D.D. FOR STRUCTURE ATTACHMENT

STA. 42+03 TO 66+91 LT.
STEEL PLATE BEAM GUARD CLASS "A" REQ'D.
(2) TYPE 1 ANCHORS REQ'D.

STA. 49+31 TO 51+69 RT.
STEEL PLATE BEAM GUARD CLASS "A" REQ'D.
(2) TYPE 1 ANCHORS REQ'D.

STATE PROJECT NUMBER

SHEET NO

1530-08-71

5.1


STA. 27+40 TO 28+27 LT. & RT.
STEEL PLATE BEAM GUARD CLASS "A" REQ'D.
(2) TYPE 1 ANCHORS REQ'D.

STA. 29+43 TO 30+30 LT. & RT.
STEEL PLATE BEAM CLASS "A" REQ'D.
(2) TYPE 1 ANCHORS REQ'D.

STA. 33+50 15' RT.
BEGIN AUX. LANE TAPER

STA. 40+00 24' RT.
BEGIN 12' AUX. LANE

SECTION 1

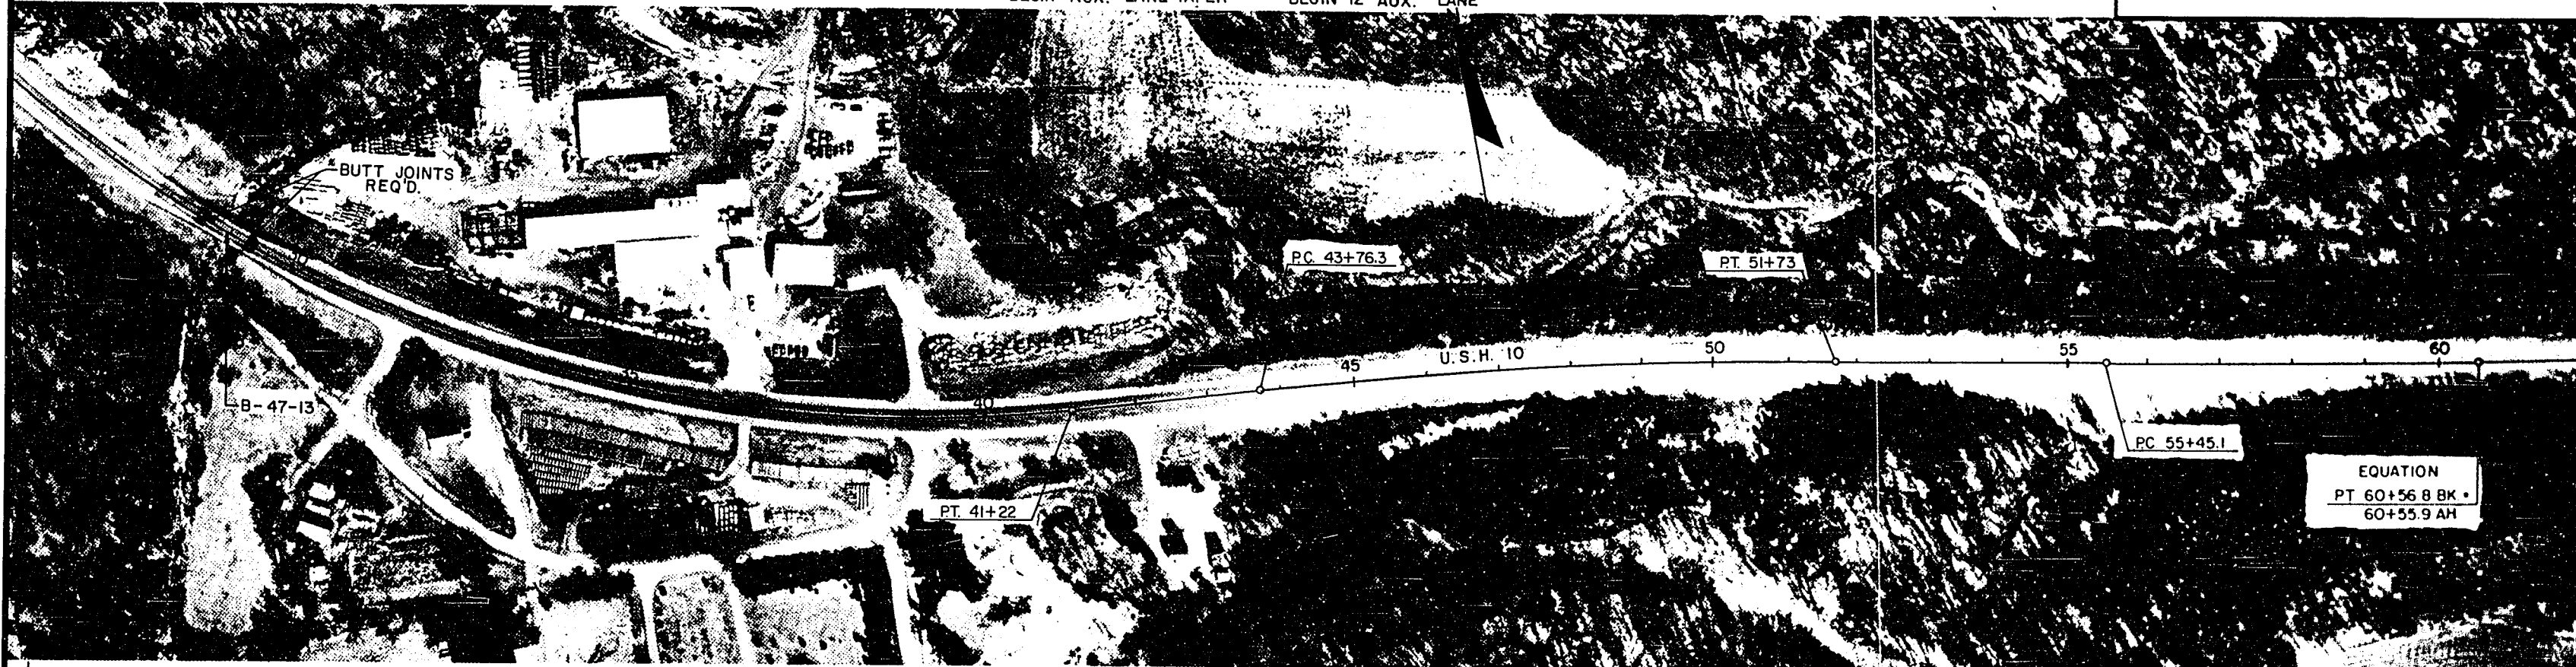

SECTION 1

NET LENGTH OF CENTERLINE STA. 30+00.00 TO 70+00.00 = 4,000.9 LIN. FT.



STA. 71+15 TO 74+28 LT.
STEEL PLATE BEAM GUARD CLASS "A" REQ'D.
(2) TYPE 1 ANCHORS REQ'D.

STA. 71+75 TO 74+38 RT.
STEEL PLATE BEAM GUARD CLASS "A" REQ'D.
(2) TYPE 1 ANCHORS REQ'D.

STA. 81+60 TO 82+50 LT.
STEEL PLATE BEAM GUARD CLASS "A" REQ'D.
(2) TYPE 1 ANCHORS REQ'D.

STA. 94+50 RT.
CONSTRUCT TYPE "C" INTERSECTION
(SEE INTERSECTION DETAILS)

STA. 97+79 LT.
2- CONC. BOX CULVERT COVERS REQ'D.
(SEE DETAIL)

STATE PROJECT NUMBER

1530-08-71

SHEET NO

5.2

SECTION 1 & 2

PT. 73+36.3

PC. 73+71.6

PT. 82+03.3

70

75

80

85

90

CR. AGG. SURFACE

STA. 98+66 LT.
2 CONC. BOX CULVERT COVERS REQ'D.
(SEE DETAIL)

STA. 105+53 LT.
EXISTING 30" C.S.C.P.
(1) APRON ENDWALL REQ'D.
RECONSTRUCT DITCH DAM SLOPES
TO 6:1

STA. 111+58 LT. & RT. 320 TH. ST.
CONST. TYPE "C" INTERSECTION

STA. 10+40 320 TH. ST. REMOVE EXISTING 24" X 52' C.S.C.P.
STA. 10+40 320 TH. ST. 1-24" X 60' C.P. CLASS III REQ'D.
2-APRON ENDWALLS REQ'D.

STA. 111+00 24' RT.
END 12' AUX. LANE

STA. 115+50 RT.
END AUX. LANE TAPER

NET LENGTH OF CENTERLINE STA. 70+00.00 TO 48+00.00 = 5,980 LIN. FT.

PT. 100+73

EQUATION

STA. 117+50 BK. =

STA. 35+70' AH.

END

SECTION 1

BEGIN
SECTION 2

ASPH. SURFACE

STA. 56+00 LT.
CONSTRUCT TYPE "C" INTERSECTION

STA. 69+97 LT.
EXTEND EXISTING 30" C.S.C.P. 4' LT.
(1) APRON ENDWALL REQ'D.

STATE PROJECT NUMBER


SHEET NO

1530 - 08 - 71

5.3

SECTION 2

STA. 54+26 RT.
EXTEND EXISTING 30" C.S.C.P. - 2' RT.
(1) APRON ENDWALL REQ'D.

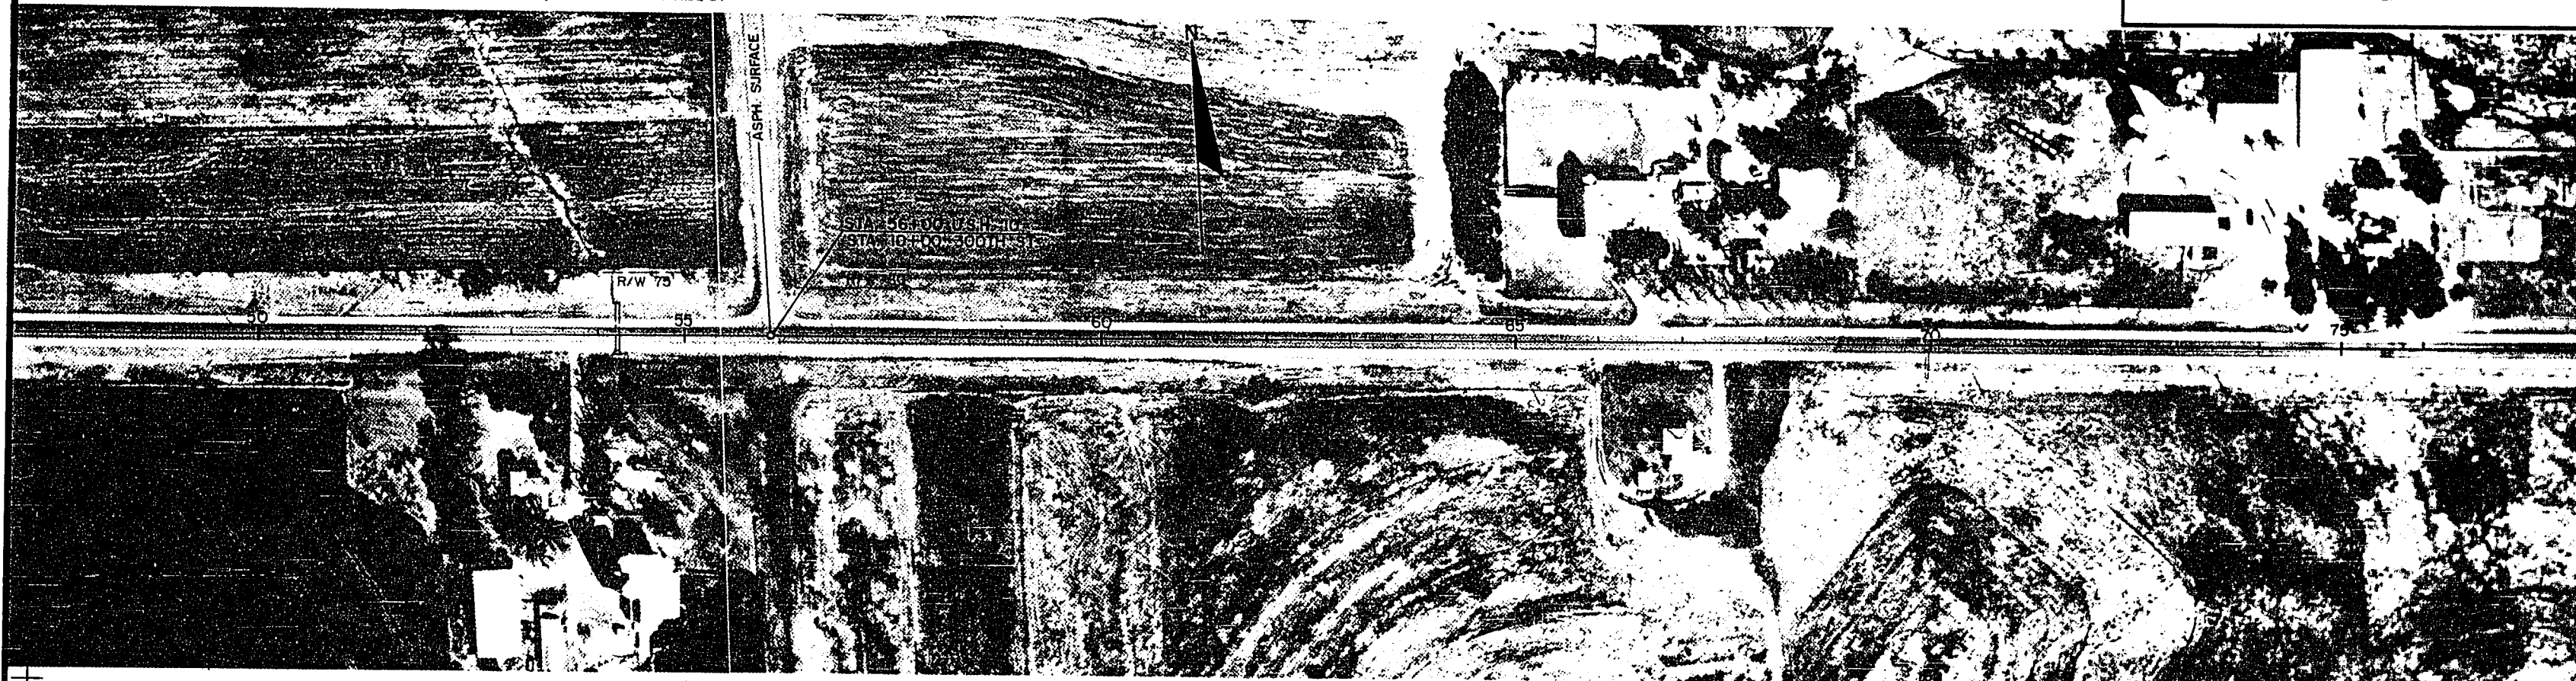


STA. 82+40 LT. & RT. 280 TH. ST.
CONSTRUCT TYPE "C" INTERSECTIONS

STA. 10+36 280 TH. ST.
REMOVE 1-18" X 48" C.S.C.P.
1-24" X 66" C.P. CLASS II REQ'D.
2-APRON ENDWALLS REQ'D.

STA. 83+00 LT.
2- CONC. BOX CULVERT COVERS REQ'D.
(SEE DETAIL)

NET LENGTH OF CENTERLINE STA. 48+00.00 TO 85+00.00 = 3,700 LIN. FT.

SECTION 2

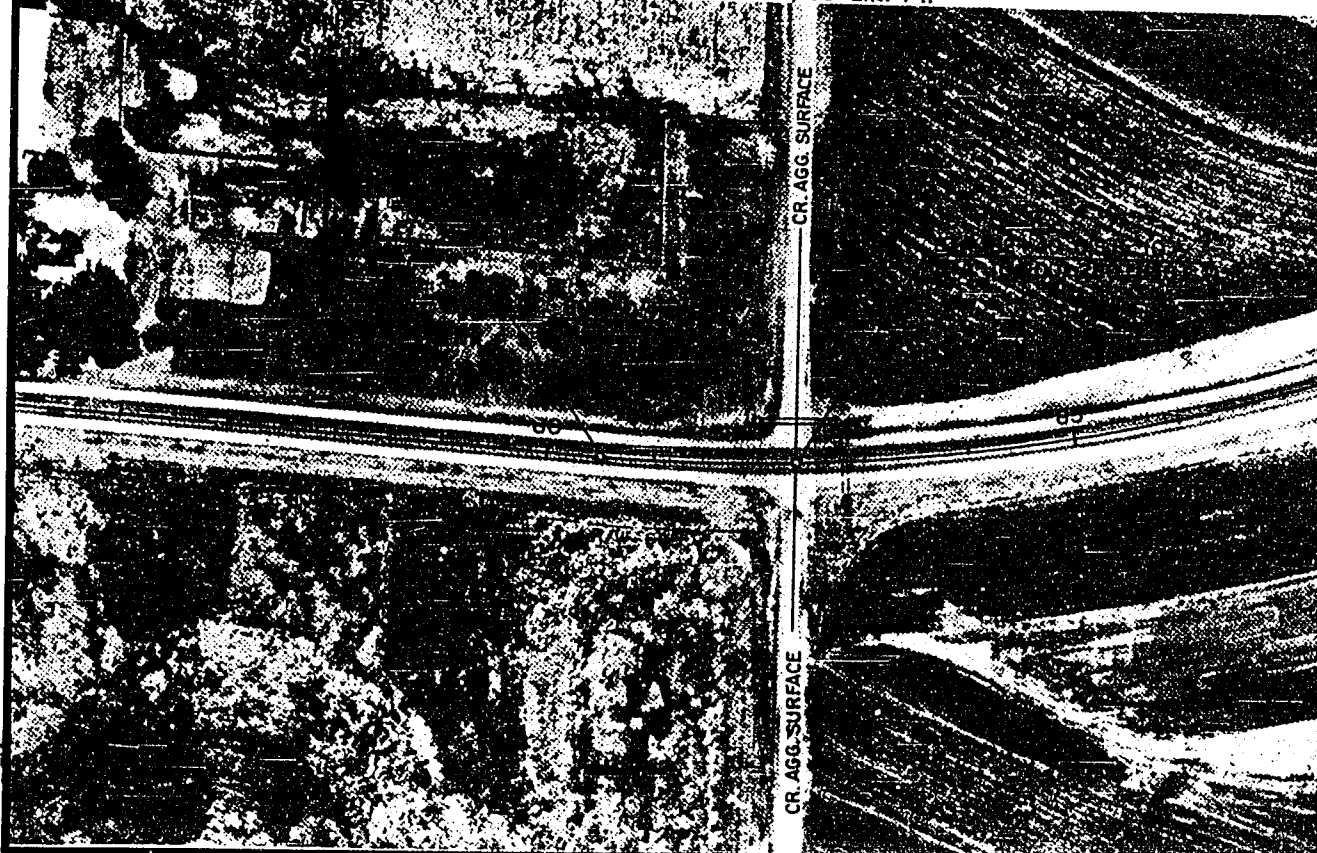

STA. 97+45 TO 101+70 LT.
STEEL PLATE BEAM GUARD CLASS "A" REQ'D.
(2) TYPE 1 ANCHOR REQ'D.

STA. 97+45 TO 101+23 RT.
STEEL PLATE BEAM GUARD CLASS "A" REQ'D.
(2) TYPE 1 ANCHOR REQ'D.

STA. 113+65 LT.
MATCH EXISTING RADII

STATE PROJECT NUMBER

1530-08-71

SHEET NO

5.4

SECTION 2




STA. 124+61 LT. & RT.
CONSTRUCT TYPE "B" INTERSECTIONS
(SEE INTERSECTION DETAILS)

STA 141+42 RT
EXISTING 36" C.S.C.P.
REMOVE 16' OF EXISTING PIPE & REPLACE
1-36" X 16' C.S.C.P. REQ'D CLASS III
(1) APRON ENDWALL REQ'D RT.


SECTION 2

NET LENGTH OF CENTERLINE STA. 85+00.00 TO 145+00.00 = 6,000 LIN. FT.

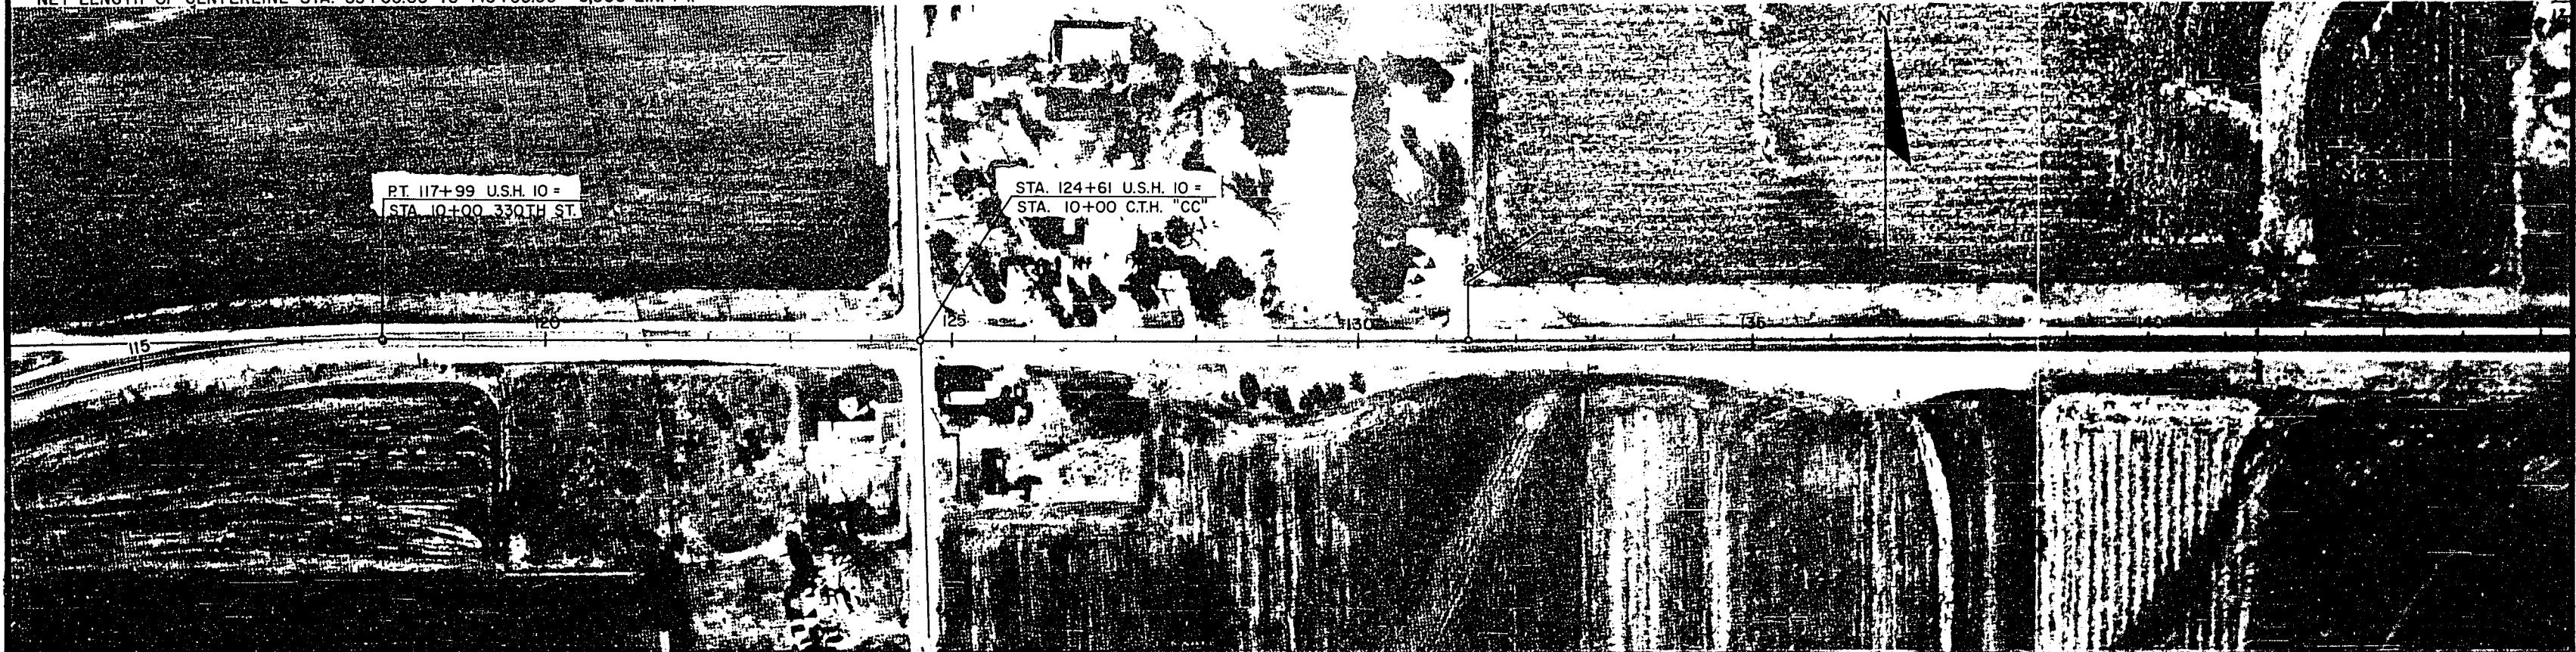

SECTION 2

STA. 164+90
CONSTRUCT TYPE "C" INTERSECTION
LT. & RT.

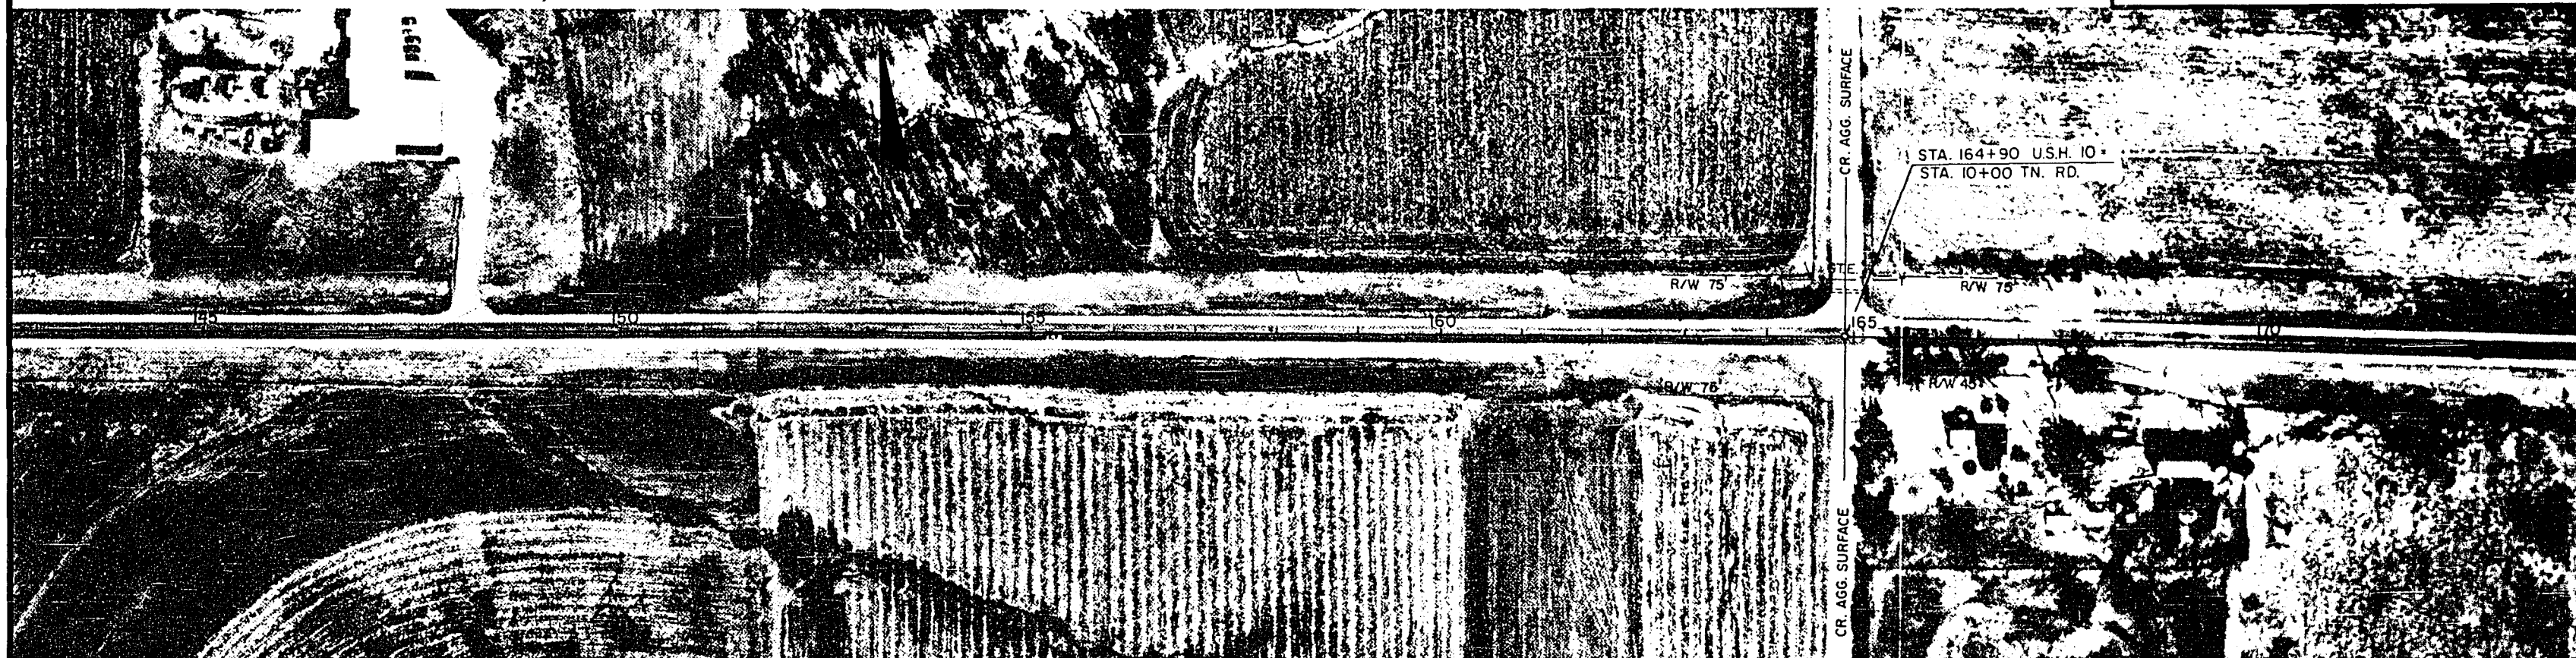


SECTION 2

STA. 191+22 LT. & RT.
4- CONC. BOX CULVERT COVERS REQ'D.
(SEE DETAIL)

STA. 200+40 TO 11+00 190 TH ST. LT.
STEEL PLATE BEAM GUARD CLASS "A" REQ'D
(2) TYPE 1 ANCHORS REQ'D.

NET LENGTH OF CENTERLINE STA. 145+00.00 TO 204+63.00 = 5,963 LIN. FT.

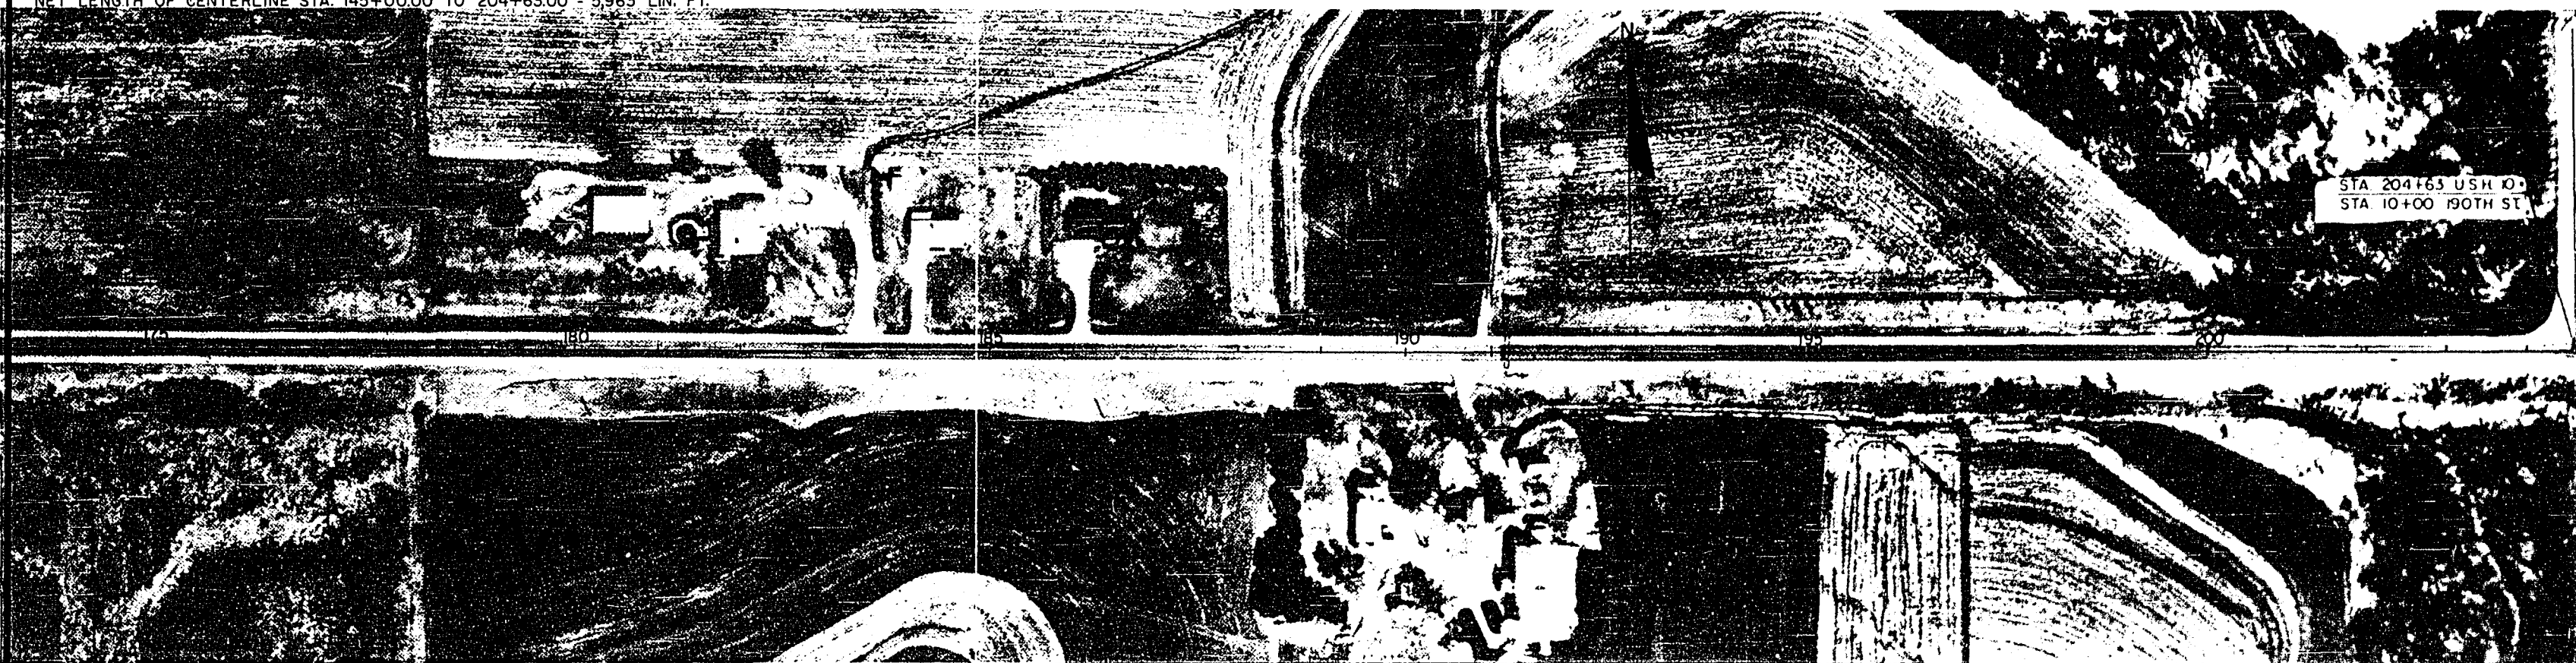

STA. 204+63 LT.
MATCH EXISTING RADII
STA. 200+12 TO 205+62 RT.
STEEL PLATE BEAM GUARD CLASS "A" REQ'D.
(2) TYPE I ANCHORS REQ'D.

STA. 207+50 15' LT.
BEGIN AUX. LANE TAPER (EXISTING)
STA. 212+00 24' LT.
BEGIN 12' AUX. LANE (EXISTING)


STATE PROJECT NUMBER

SHEET NO.

1530 - 08 - 71

5.6

SECTION 2

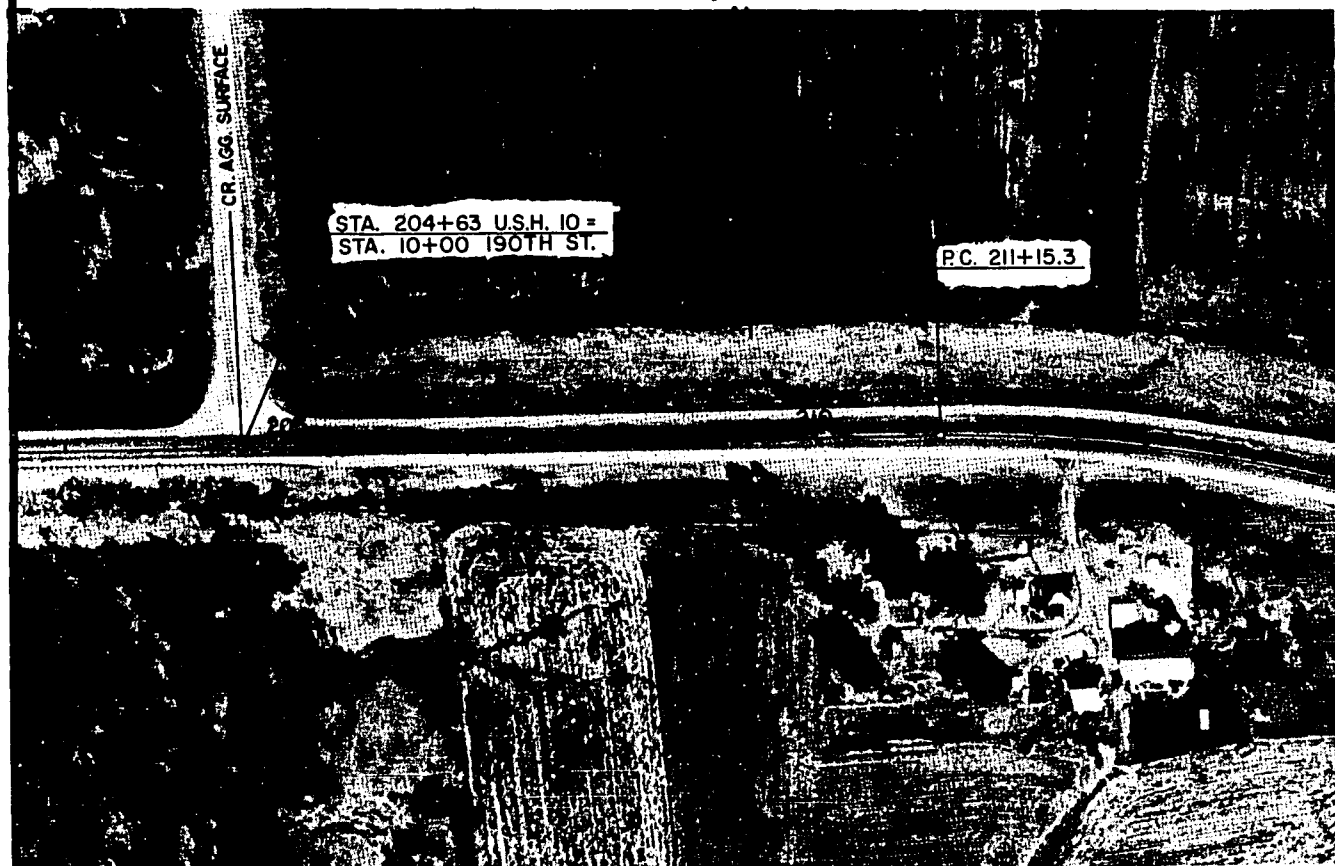

STA. 217+16 LT.
CONSTRUCT TYPE "C" INTERSECTION
(SEE INTERSECTION DETAILS)

SECTION 2


STA. 218+71 LT.
EXISTING 36" C.M.C.P.
REMOVE 12' OF EXISTING PIPE LT. & REPLACE
1-36" X 12' C.S.C.P. CLASS III REQ'D. LT.
(1) APRON ENDWALL REQ'D.

STA. 226+50 TO 228+50 RT.
STEEL PLATE BEAM GUARD CLASS "A" REQ'D.
(2) TYPE I ANCHORS REQ'D.

STA. 227+00 TO 229+00 LT.
STEEL PLATE BEAM GUARD CLASS "A" REQ'D.
(2) TYPE I ANCHORS REQ'D.

STA. 238+15 LT. & RT.
170 TH. ST.
MATCH EXISTING RADII

NET LENGTH OF CENTERLINE STA. 204+63.00 TO 242+11.2 = 3,748.2 LIN. FT.

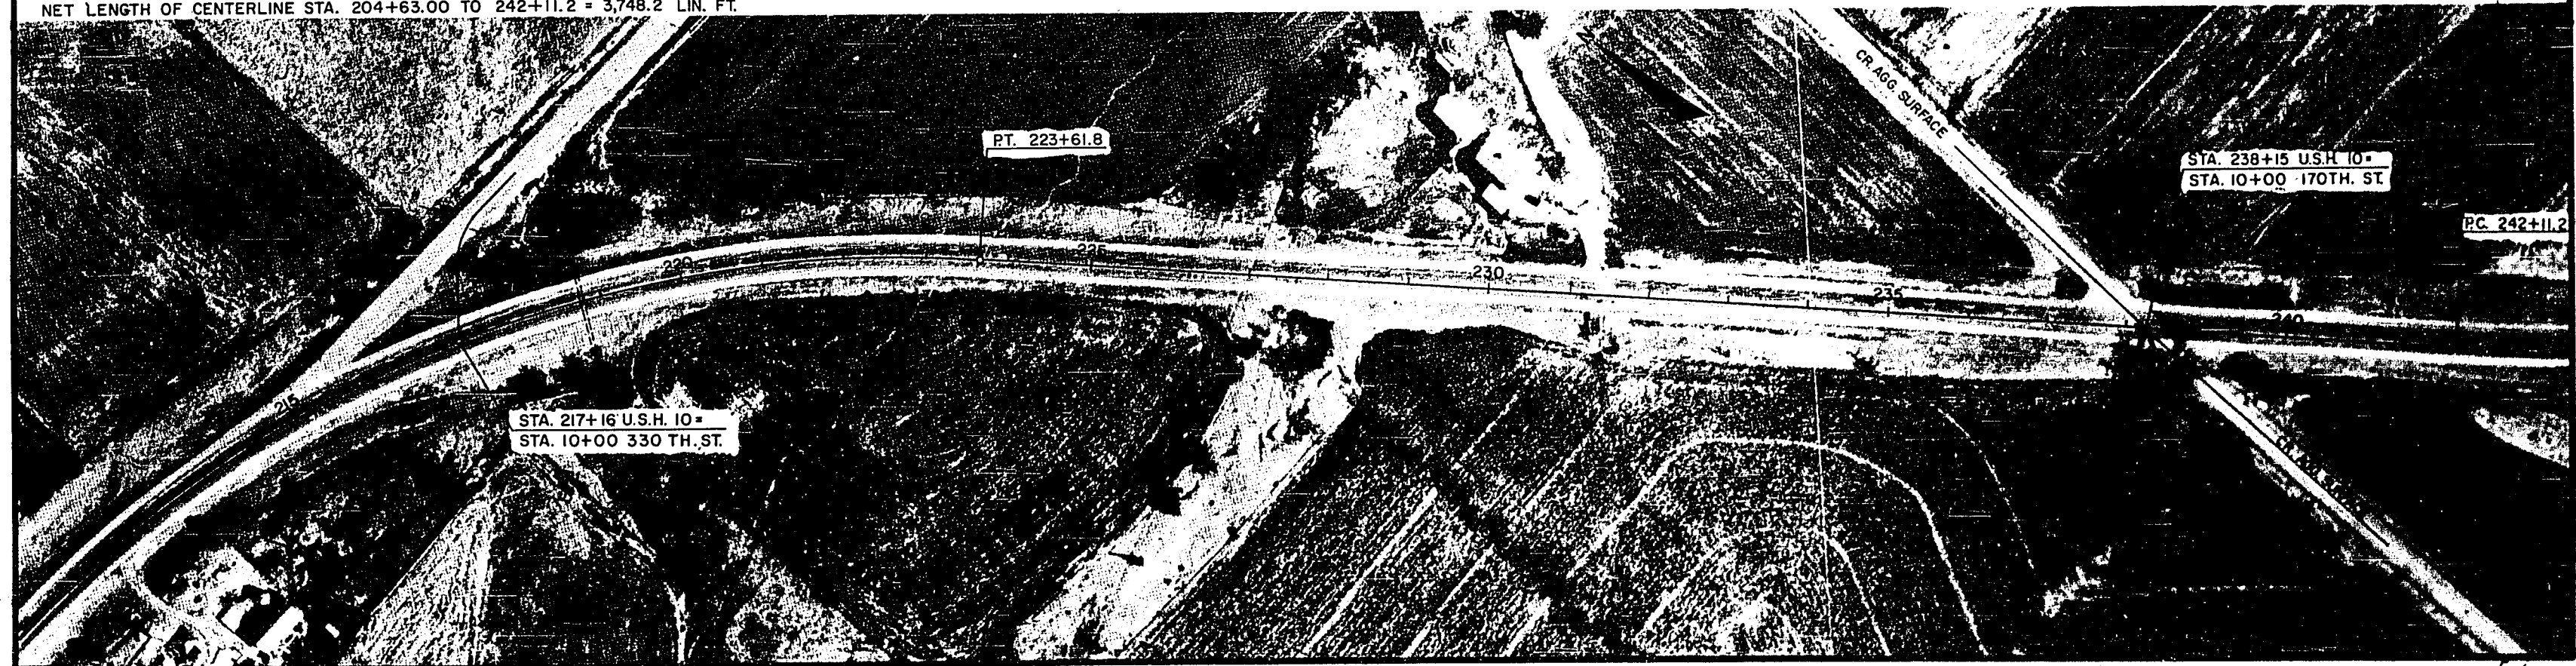

STA. 259+39 LT. & RT.
3 BOX CULVERT COVERS REQ'D.
(SEE DETAIL)

STA. 258+70 TO 260+08 LT.
STEEL PLATE BEAM GUARD CLASS "A" REQ'D
(2) TYPE I ANCHORS REQ'D.

STATE PROJECT NUMBER

1530-08-71



SHEET NO

5.7

SECTION 2 & 3

STA. 259+90 TO 260+52 BK. RT.
STA. 14+53.9 AH. TO 25+49 RT.
STEEL PLATE BEAM GUARD CLASS "A" REQ'D.
(2) TYPE I ANCHORS REQ'D.

STA. 258+25 RT.
BEGIN 10' PAVED SHOULDER
BEGIN ASPHALTIC CURB

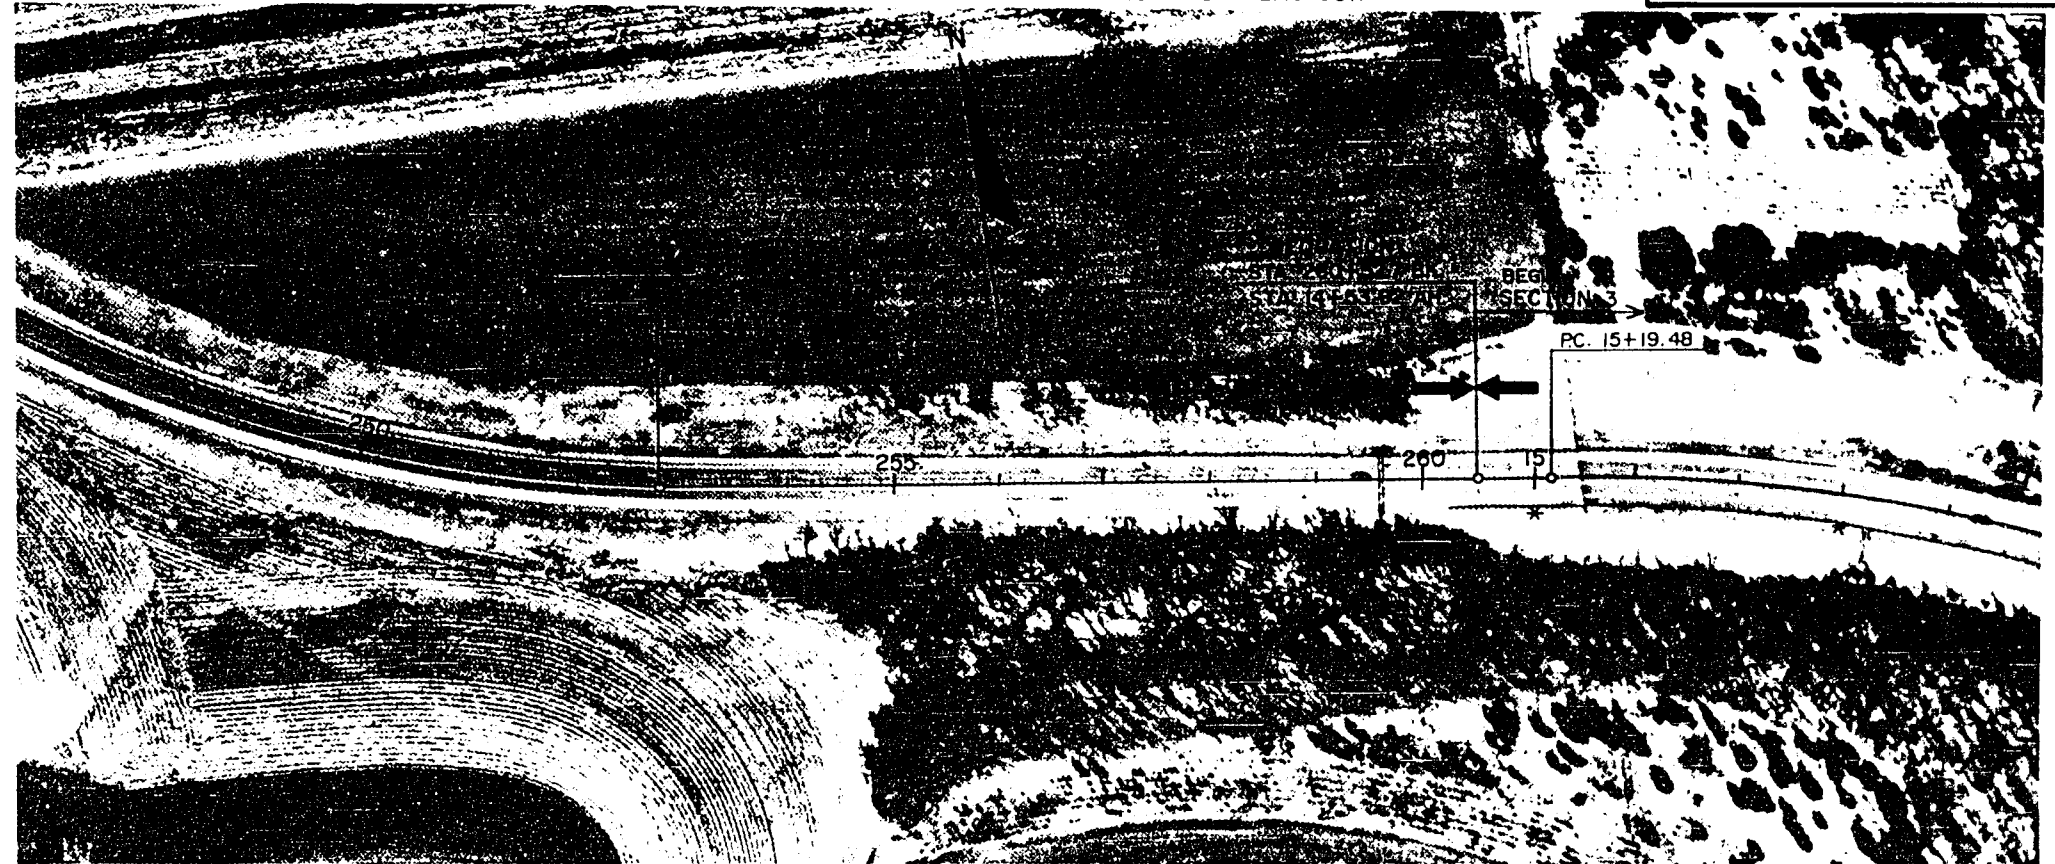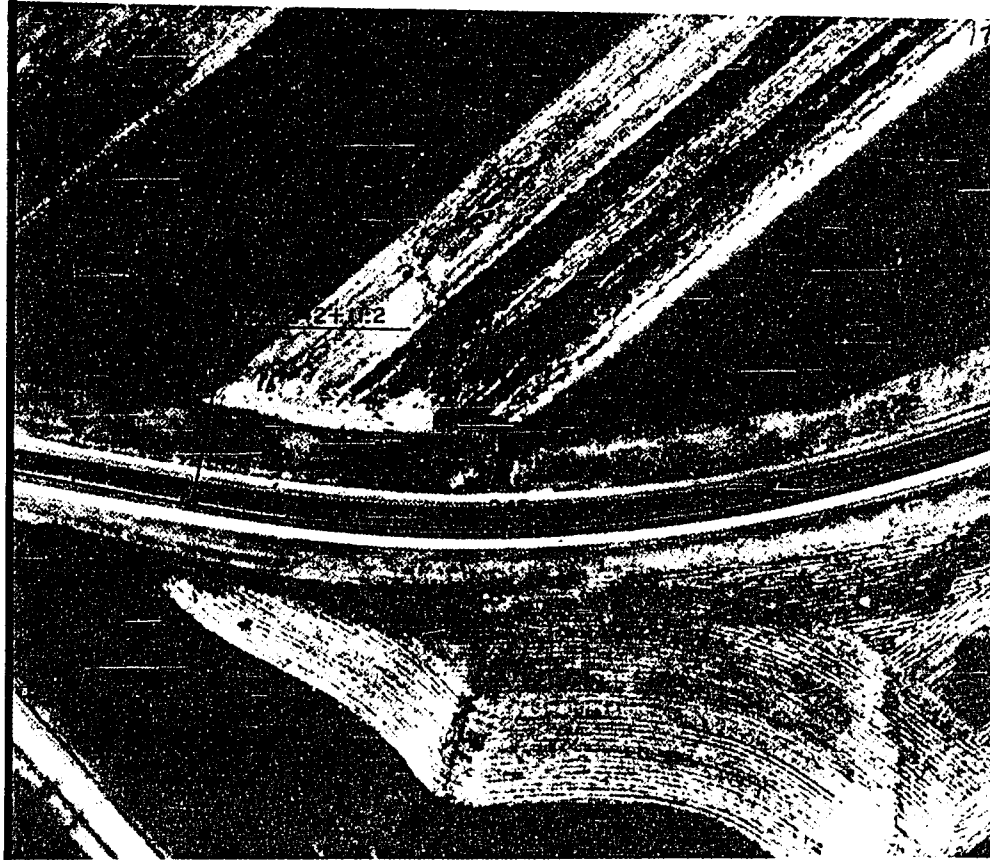



STA. 23+50 TO 32+28 LT.
CONCRETE CURB AND GUTTER, 36-INCH, TYPE D REQ'D.
SEE DETAIL FOR BERM BEHIND CURB AND GUTTER

STA. 25+50 RT.
END 10' PAVED SHOULDER
END ASPHALTIC CURB
ASPHALTIC FLUME REQ'D.
(SEE DETAIL)

STA. 31+30 TO 32+78.5 BK. RT.
STA. 32+94.72 AH. TO 46+10 RT.
STEEL PLATE BEAM GUARD CLASS "A" REQ'D.
(2) TYPE I ANCHORS REQ'D.

STA. 32+34 LT. ASPHALTIC FLUME REQ'D.
FROM END OF CURB AND GUTTER TO
EXISTING MS INLET

NET LENGTH OF CENTERLINE STA. 242+11.20 TO 40+00.00 = 4,370.91 LIN. FT.

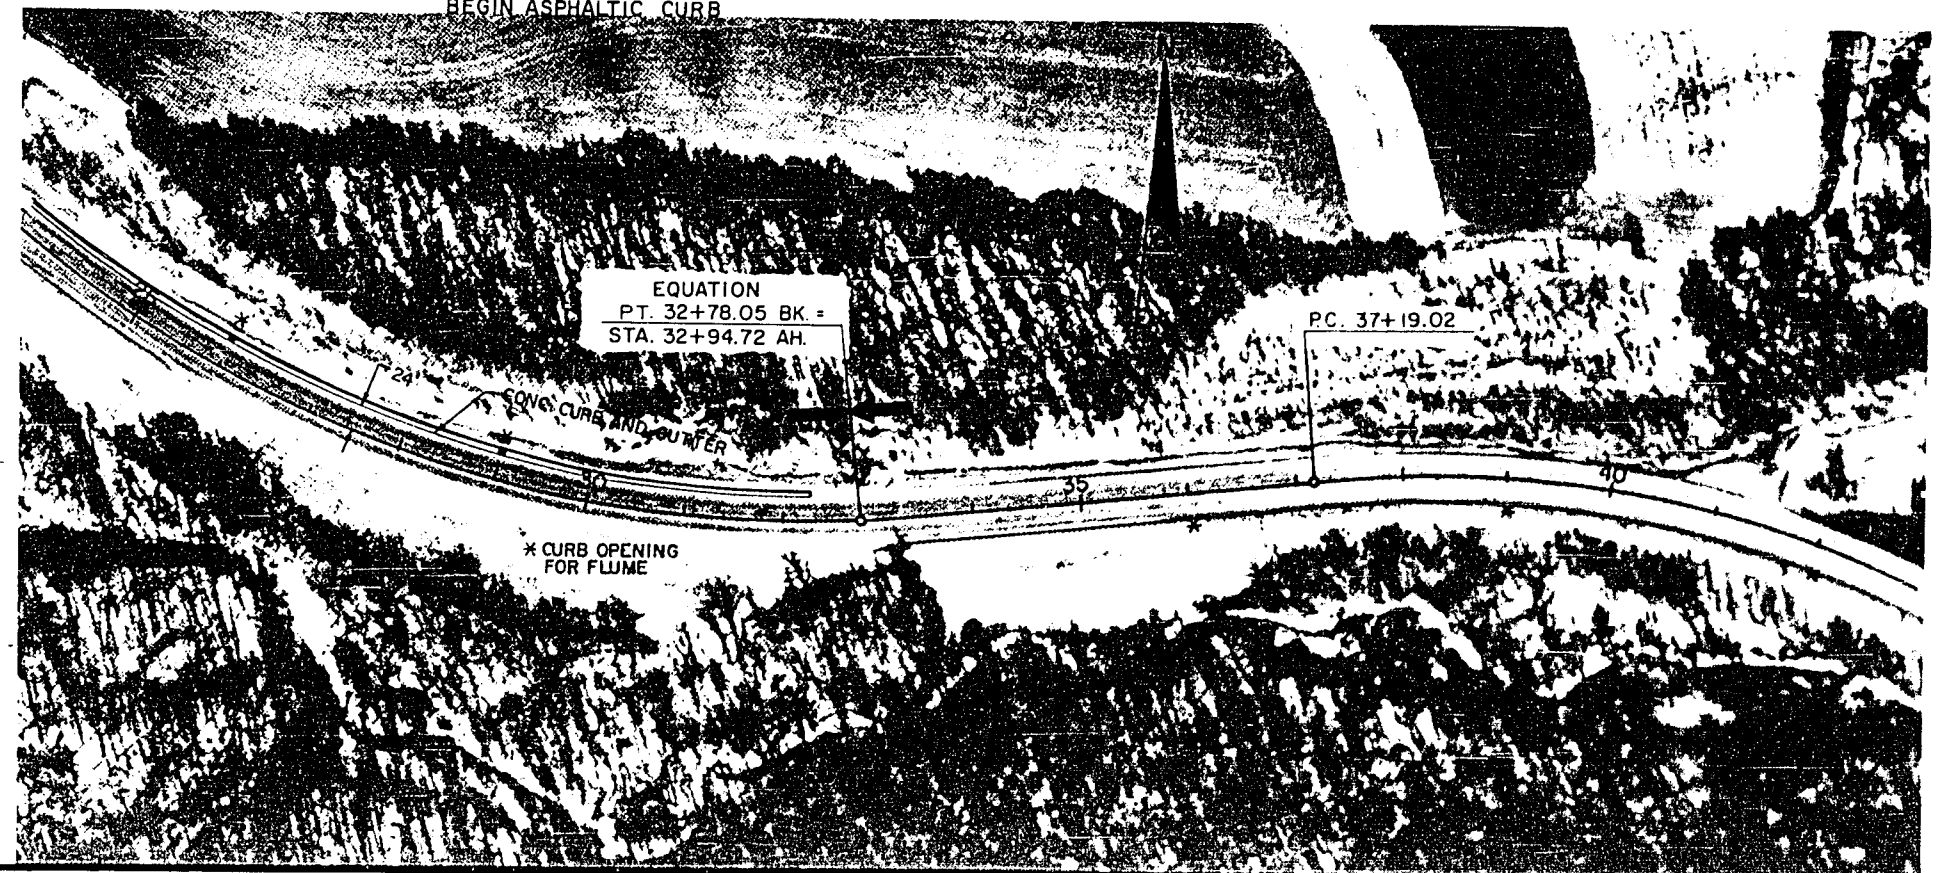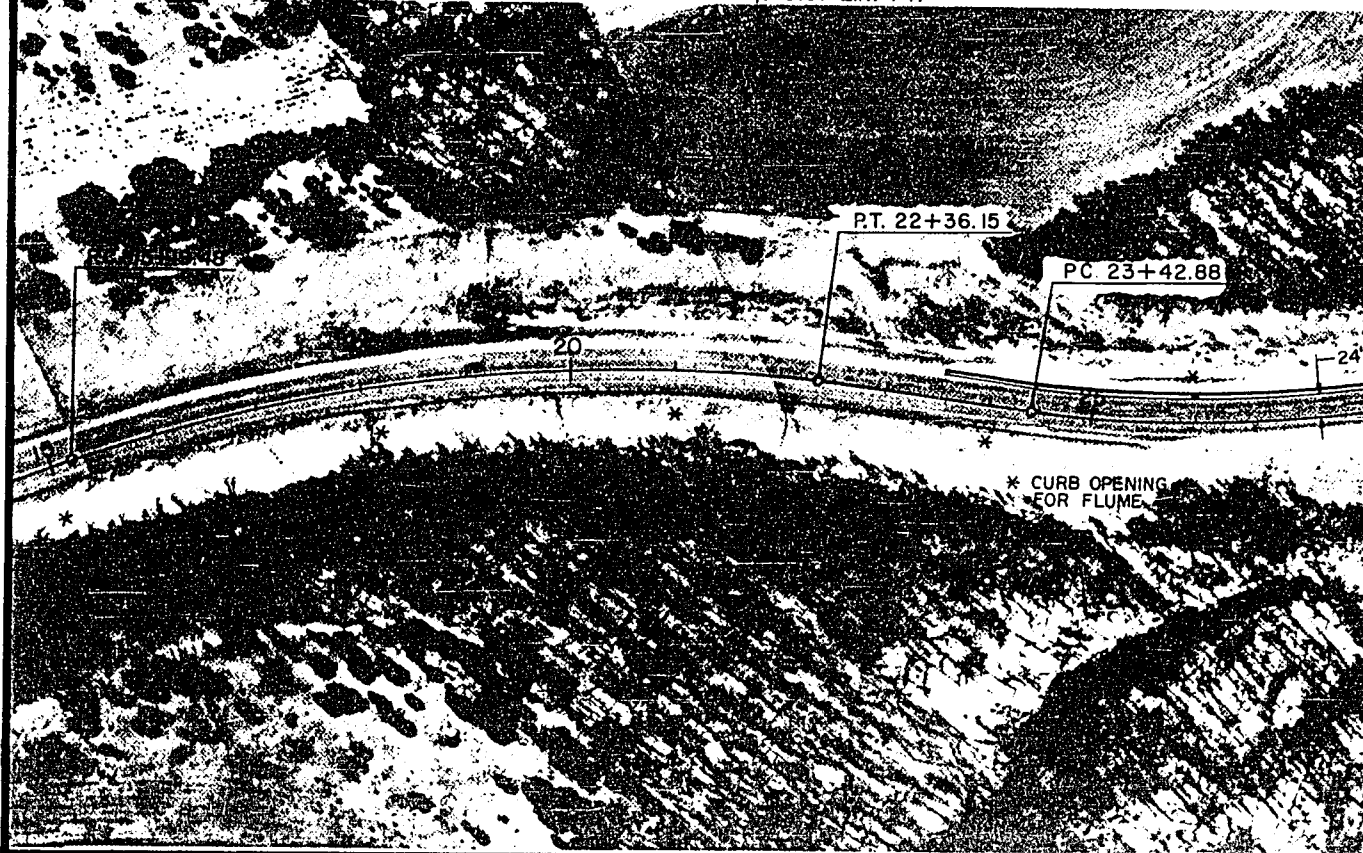

STA. 33+00 RT.
BEGIN 10' PAVED SHOULDER
BEGIN ASPHALTIC CURB

EQUATION
PT. 32+78.05 BK =
STA. 32+94.72 AH.

PC. 37+19.02

PT. 22+36.15

PC. 23+42.88

* CURB OPENING
FOR FLUME

* CURB OPENING
FOR FLUME

SECTION 3 & 4

STA. 46+00 RT.
END 10' PAVED SHOULDER
END ASPHALTIC CURB
ASPHALTIC FLUME REQ'D.
(SEE DETAIL)

STA. 41+75 TO 64+00 BK. LT.
STA. 0-200 TO 0-138 LT.
STEEL PLATE BEAM GUARD CLASS "A" REQ'D
(2) TYPE 1 ANCHORS REQ'D

STA. 51+50 24' LT.
END 12' AUX. LANE (EXISTING)



*15+00 Extended
Box Convert Rt. 6'*

STA. 55+20 RT.
EXISTING 24" C.M.C.P.
(1) APRON ENDWALL REQ'D
REMOVE EXISTING M.R.M. DITCH DAM &
RECONSTRUCT WITH 6:1 SLOPES

STA. 56+00 15' LT.
END AUX. LANE TAPER

NET LENGTH OF CENTERLINE STA. 40+00.00 TO 15+00.00 = 4,100 LIN. FT.


STA. 4+25
EXISTING 36" C.S.C.P.
(2) APRON ENDWALLS REQ'D LT. & RT.
REMOVE M.R.M. ENDWALLS LT. & RT.

STA. 8+85 TO 9+23 LT.
STEEL PLATE BEAM GUARD CLASS "A" REQ'D
(1) TYPE 1 ANCHOR REQ'D

STA. 9+23 TO 14+84 LT.
ADJUST STEEL PLATE BEAM GUARD
STA. 14+84 TO 15+22 LT.
STEEL PLATE BEAM GUARD CLASS "A" REQ'D
(1) TYPE 1 ANCHOR REQ'D

STA. 12+76 RT.
C.T.H. "U" INTERSECTION
(SEE INTERSECTION DETAILS)

STA. 14+08 TO 15+45 RT.
STEEL PLATE BEAM GUARD CLASS "A" REQ'D
(2) TYPE 1 ANCHORS REQ'D

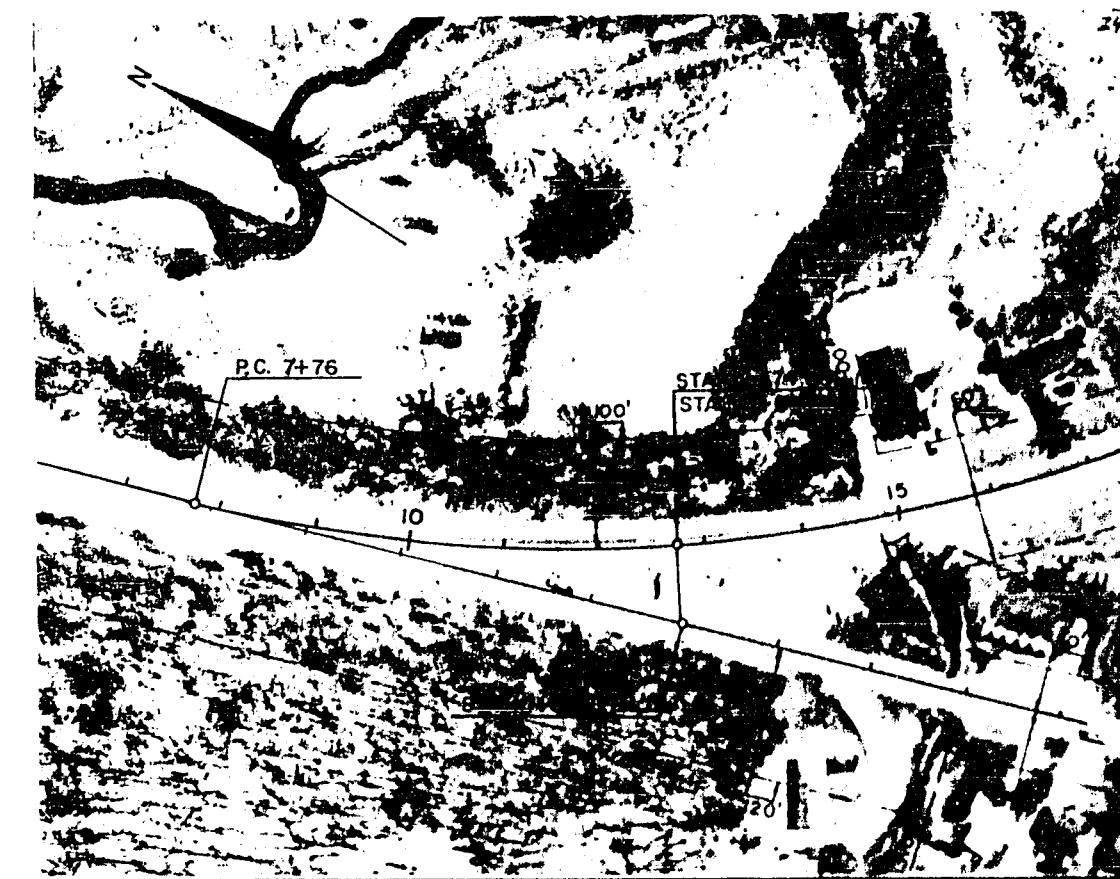

STA. 23+15 C.T.H. 'S'
CONSTRUCT TYPE "B" INTERSECTION
(SEE INTERSECTION DETAILS)

STA. 26+33 TO 26+70 LT.
STEEL PLATE BEAM GUARD CLASS "A" REQ'D.
(1) TYPE I ANCHOR REQ'D.

STA. 25+83 TO 26+70 RT.
STEEL PLATE BEAM GUARD CLASS "A" REQ'D.
(1) TYPE I ANCHOR REQ'D.

STA. 26+70 TO 26+97 LT. & RT.
STEEL THRIE BEAM STRUCT. APPROACH REQ'D.
CONNECT TO B-47-13 AS PER S.D.D.
STA. 28+77 TO 29+04 LT. & RT.
STEEL THRIE BEAM STRUCT. APPROACH REQ'D.
CONNECT TO B-47-13 AS PER S.D.D.

STATE PROJECT NUMBER

1530-08-71

SHEET NO

5.9

SECTION 4



EXCEPTION TO NET & LENGTH
STA. 26+96.75 TO 28+77.25
(180.50') (B-47-10)

BUTT JOINT
REQ'D.

BENCH MARK

LOCATION	DESCRIPTION	ELEV.
B-47-10	CAP S.W. CORNER	827.49

SECTION 4

STA. 29+04 TO 37+00 LT.
ADJUST STEEL PLATE BEAM GUARD

STA. 37+20 TO 47+66 LT.
ADJUST STEEL PLATE BEAM GUARD

STA. 29+04 TO 33+00 RT.
ADJUST STEEL PLATE BEAM GUARD

STA. 47+66 TO 48+04 LT.
STEEL PLATE BEAM GUARD CLASS "A" REQ'D.
(1) TYPE I ANCHOR REQ'D.

STA. 33+50 RT. PINE AVE.
MILL AND RESURFACE EXISTING PAV'T.
MATCH EXISTING RADII

STA. 37+10 LT. TN. RD.
MILL AND RESURFACE EXISTING PAV'T.
MATCH EXISTING RADII

STA. 37+48 RT.
REMOVE EXISTING M.R.M. ENDWALLS
EXISTING 30" C.M.C.P. TO REMAIN
(1) APRON ENDWALL REQ'D.
SEE X-SECTIONS

STA. 48+50 TO 48+87 LT.
STEEL PLATE BEAM GUARD CLASS "A" REQ'D.
(1) TYPE I ANCHOR REQ'D.

STA. 48+87 TO 63+63 LT.
ADJUST STEEL PLATE BEAM GUARD


STA. 63+63 TO 64+00 LT.
STEEL PLATE BEAM GUARD CLASS "A" REQ'D.
(1) TYPE I ANCHOR REQ'D.

STA. 46+75 TO 48+13 RT.
STEEL PLATE BEAM GUARD CLASS "A" REQ'D.
(1) TYPE I ANCHOR REQ'D.

STA. 48+13 TO 56+62 RT.
ADJUST STEEL PLATE BEAM GUARD

STA. 56+62 TO 58+12 RT.
STEEL PLATE BEAM GUARD CLASS "A" REQ'D.
(1) TYPE I ANCHOR REQ'D.

NET LENGTH OF CENTERLINE STA. 15+00.00 TO 60+00.00 = 4,319.5 LIN. FT.

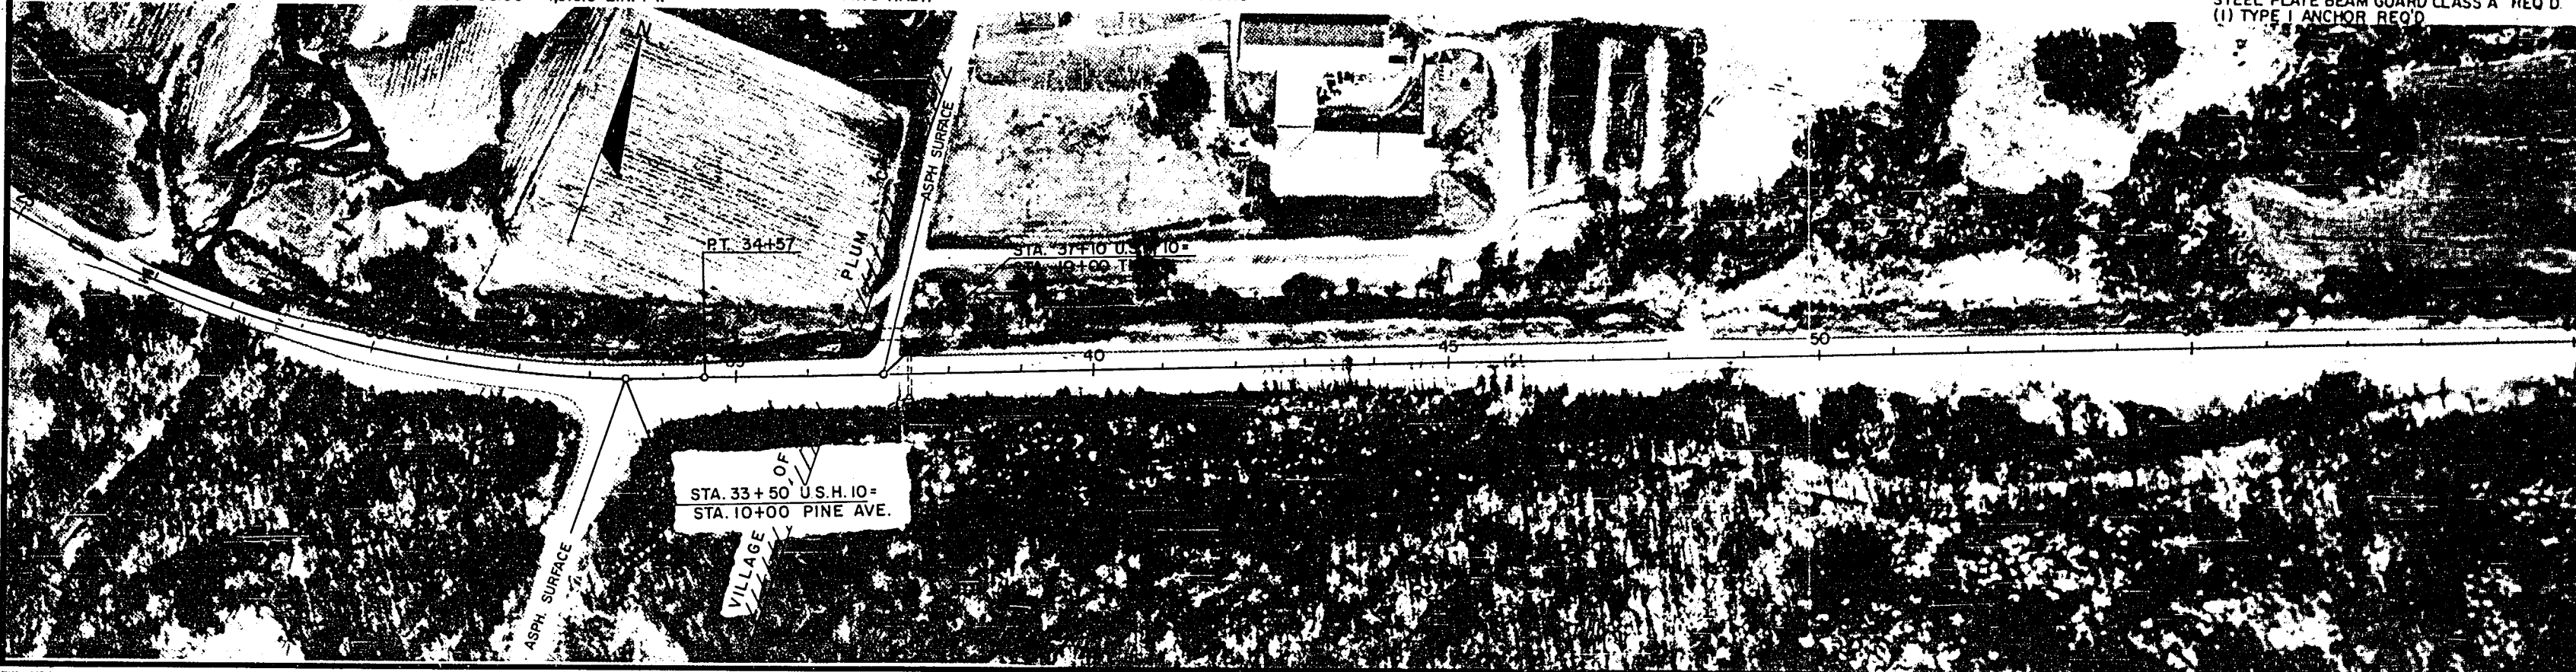

STA. 33+50 U.S.H. 10=
STA. 10+00 PINE AVE.

STA. 64+68 TO 65+06 LT.
STEEL PLATE BEAM GUARD CLASS "A" REQ'D.
(1) TYPE I ANCHOR REQ'D.

STA. 65+06 TO 81+93 LT.
ADJUST STEEL PLATE BEAM GUARD

STA. 80+52 RT.
EXISTING 30" C.S.C.P.
EXTEND 4' RT.
(1) APRON ENDWALL REQ'D.

STA. 81+93 TO 82+31 LT.
STEEL PLATE BEAM GUARD CLASS "A" REQ'D.
(1) TYPE I ANCHOR REQ'D.

STA. 82+98 TO 83+36 LT.
STEEL PLATE BEAM GUARD REQ'D.
CLASS "A"
(1) TYPE I ANCHOR REQ'D.

STATE PROJECT NUMBER

SHEET NO

1530-08-71

5.10


SECTION 4 & 5

STA. 68+70 TO 70+70 RT.
STEEL PLATE BEAM GUARD CLASS "A" REQ'D.
(2) TYPE I ANCHORS REQ'D.

STA. 76+50 15' RT.
BEGIN CONSTRUCTION
AUX. LANE TAPER

STA. 81+00 24' RT.
BEGIN CONSTRUCTION
12' AUX. LANE

STA. 82+46 RT.
EXISTING 42" C.S.C.P. EXTEND 4' RT.
(1) APRON ENDWALL REQ'D.

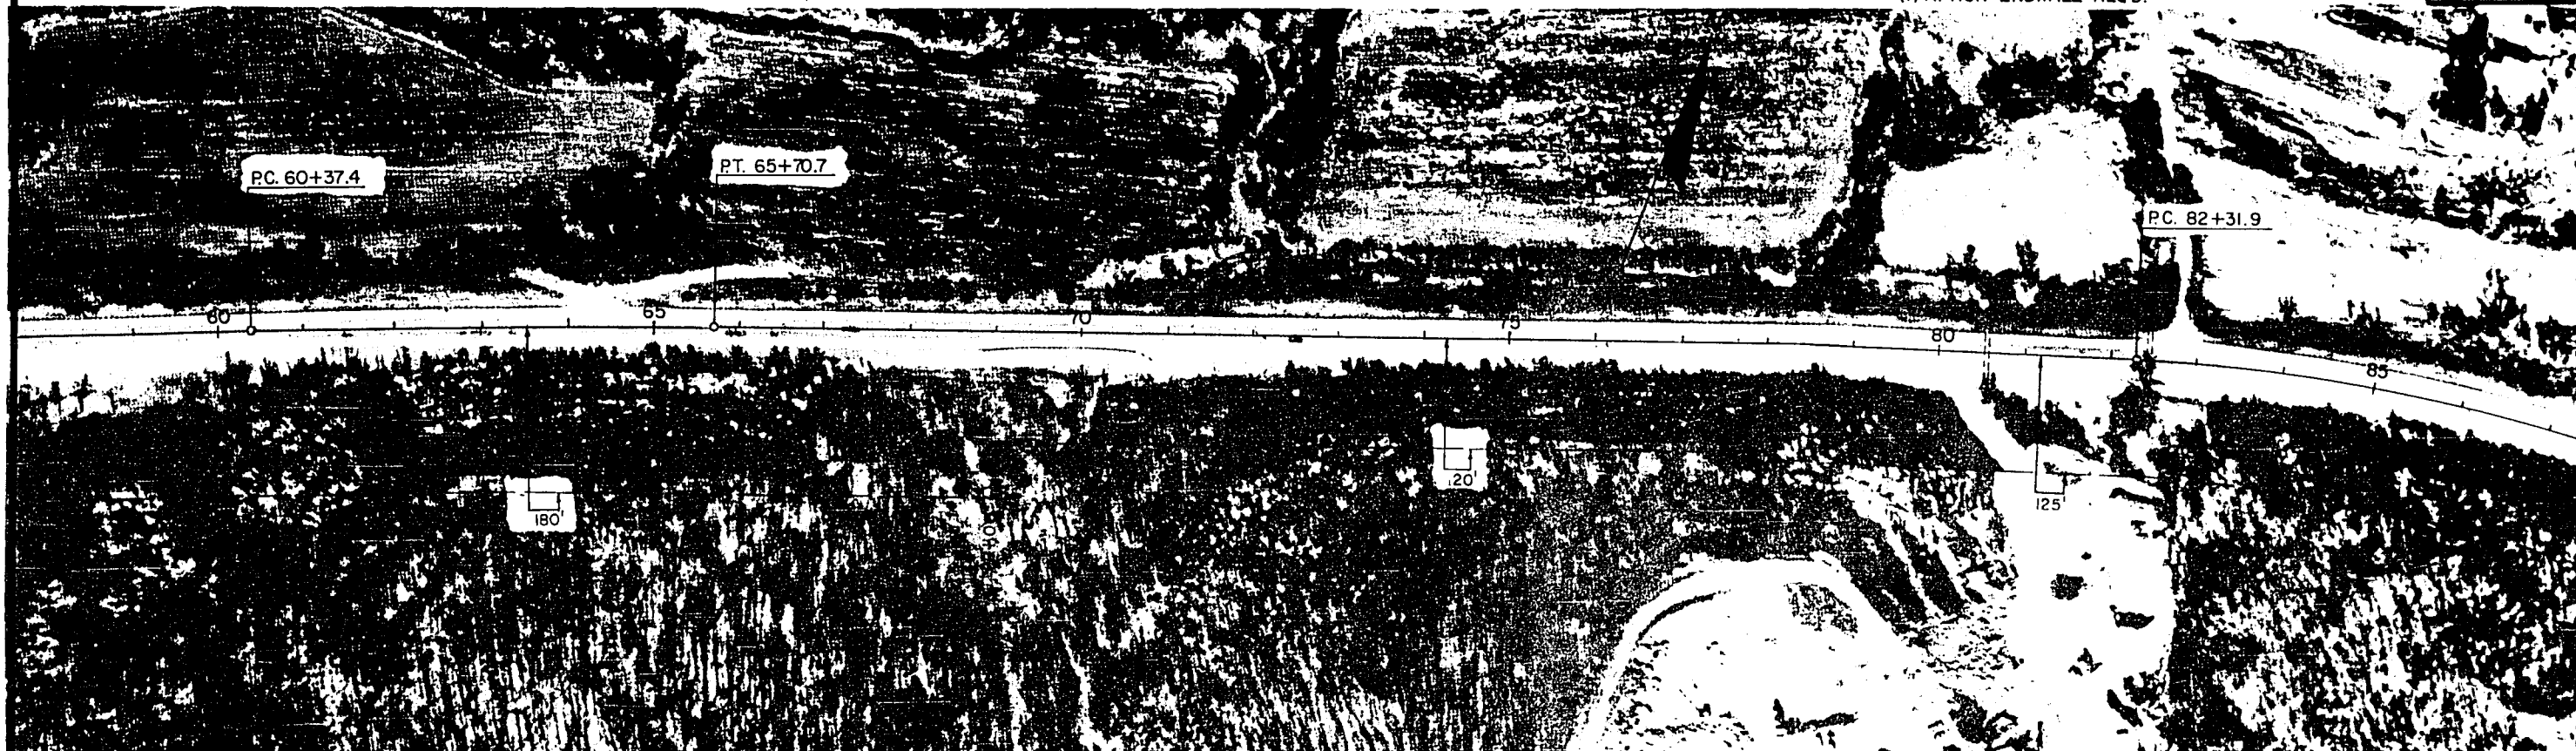

STA. 83+36 TO 96+29 BK. LT.
STA. 0+00 AH. TO 9+44 LT.
ADJUST STEEL PLATE BEAM GUARD

STA. 91+14 RT.
EXTEND EXISTING 30" C.S.C.P.
10' RT.
(1) APRON ENDWALL REQ'D.
(SEE X-SECTIONS)

STA. 96+21 RT.
EXTEND EXISTING 30" C.S.C.P.
8' RT.
(1) APRON ENDWALL REQ'D.
(SEE X-SECTIONS)

STA. 7+06 RT.
EXISTING 42" C.S.C.P.
(1) APRON ENDWALL REQ'D.
EXTEND 2' RT.

STA. 9+44 TO 9+82 LT.
STEEL PLATE BEAM GUARD CLASS "A" REQ'D.
(1) TYPE I ANCHOR REQ'D.

STA. 87+07 RT.
EXTEND EXISTING 30" C.S.C.P. 4'
(1) APRON ENDWALL REQ'D.

NET LENGTH OF CENTERLINE STA. 60+00.00 TO STA. 8+00.00 = 4,429.5 LIN. FT.



EQUATION
STA. 96+29.5 BK. =
STA. 0+00 AH.

STA. 11+80 TO 12+17 LT.
STEEL PLATE BEAM GUARD CLASS "A" REQ'D
(1) TYPE I ANCHOR REQ'D.

STA. 13+70 RT.
EXISTING 36" X 36" CONC. BOX CULVERT C-1894
EXTEND 7' RT. SEE DETAIL DRAWING

STA. 12+17 TO 26+60 LT.
ADJUST STEEL PLATE BEAM GUARD

STA. 26+60 TO 10+75 45 TH. ST.
STEEL PLATE BEAM GUARD, CLASS "A" REQ'D
(1) TYPE I ANCHOR REQ'D.

STA. 17+30
EXISTING 42" X 60" CONC. BOX CULVERT C 1895
EXTEND 13' RT. SEE DETAIL DRAWING

STA. 24+00 RT. 50 TH. ST.
MILL AND RESURFACE EXISTING PAV'T.
MATCH EXISTING RADII

STA. 24+58 RT.
EXTEND EXISTING 60" C.S.C.P.
1-60" X 14" C.S.C.P. CLASS III REQ'D.
(1) APRON ENDWALL REQ'D.

STA. 27+16 LT. 45 TH. ST.
CONST. TYPE C INTERSECTION

STA. 24+00 TO 28+00 RT.
STEEL PLATE BEAM GUARD CLASS "A" REQ'D.
(2) TYPE I ANCHORS REQ'D.

STATE PROJECT NUMBER

SHEET NO

1530-08-71

5.11

SECTION 5

STA. 10+75 45 TH. ST. TO STA 28+88 LT.
STEEL PLATE BEAM GUARD CLASS "A" REQ'D.
(2) TYPE I ANCHORS REQ'D

STA. 11+38 C.T.H. "ZZ" RT TO 53+50 LT.
STEEL PLATE BEAM GUARD CLASS "A" REQ'D
(2) TYPE I ANCHORS REQ'D

STA. 50+00 RT.
EXTEND EXISTING 72" X 72" CONC. BOX C 1898
12' RT. SEE DETAIL DRAWING

STA. 53+96 RT.
EXISTING 24" C.S.C.P.
8' EXTENSION REQ'D RT.
(1) APRON ENDWALL REQ'D

STA. 32+15 RT.
CONST. F.E.
REMOVE 1-18" X 26' C.S.C.P.
1-18" X 40' C.P. CLASS III REQ'D.
2 APRON ENDWALLS REQ'D.

STA. 43+80 RT.
CONST. P.E.
REMOVE 1-18" X 26' C.S.C.P.
1-18" X 32' C.P. CLASS III REQ'D.
2 APRON ENDWALLS REQ'D.

STA. 46+33 TO 11+38 C.T.H. "ZZ" LT.
STEEL PLATE BEAM GUARD
CLASS "A" REQ'D
(2) TYPE I ANCHORS REQ'D

STA. 45+50 TO 51+48 RT.
STEEL PLATE BEAM GUARD
CLASS "A" REQ'D.
(2) TYPE I ANCHORS REQ'D.

STA. 48+25 LT.
CONSTRUCT TYPE "B" INTERSECTION

STA. 47+00
EXISTING CONC. CATTLE PASS 3.5' X 6' X 56'
TO BE REMOVED

STA. 52+40 RT.
CONST. P.E.
REMOVE 1-24" X 36' C.S.C.P.
1-24" X 36' C.S.C.P. CLASS III REQ'D.
2 APRON ENDWALLS REQ'D.

STA. 48+25 U.S.H. 10
STA. 10+00 C.T.H. "ZZ"

NET LENGTH OF CENTERLINE STA. 8+00.00 TO 58+00.00 = 4,990.2 LIN. FT.

STA. 69+87 RT.
CONST. FE.
REMOVE 1-18" X 26' C.S.C.P.
1-18" X 40' C.P. CLASS III REQ'D.
2-APRON ENDWALLS REQ'D.

STA. 0+00 RT.
CONSTRUCT TYPE "C"
INTERSECTION

STA. 5+00 RT. 24'
END 12' AUX. LANE
BEGIN TAPER

STA. 9+50 15' RT.
END AUX. LANE TAPER

STATE PROJECT NUMBER

1530-08-71


SHEET NO

5.12


SECTION 5 & 6


STA. 6+75 RT.
CONSTRUCT PE.
REMOVE 1-18" X 24' C.S.C.P.
1-18" X 26' C.P. CLASS III REQ'D.
2-APRON ENDWALLS REQ'D.

END PROJECT
STA. 11+00
BUTT JOINT RT

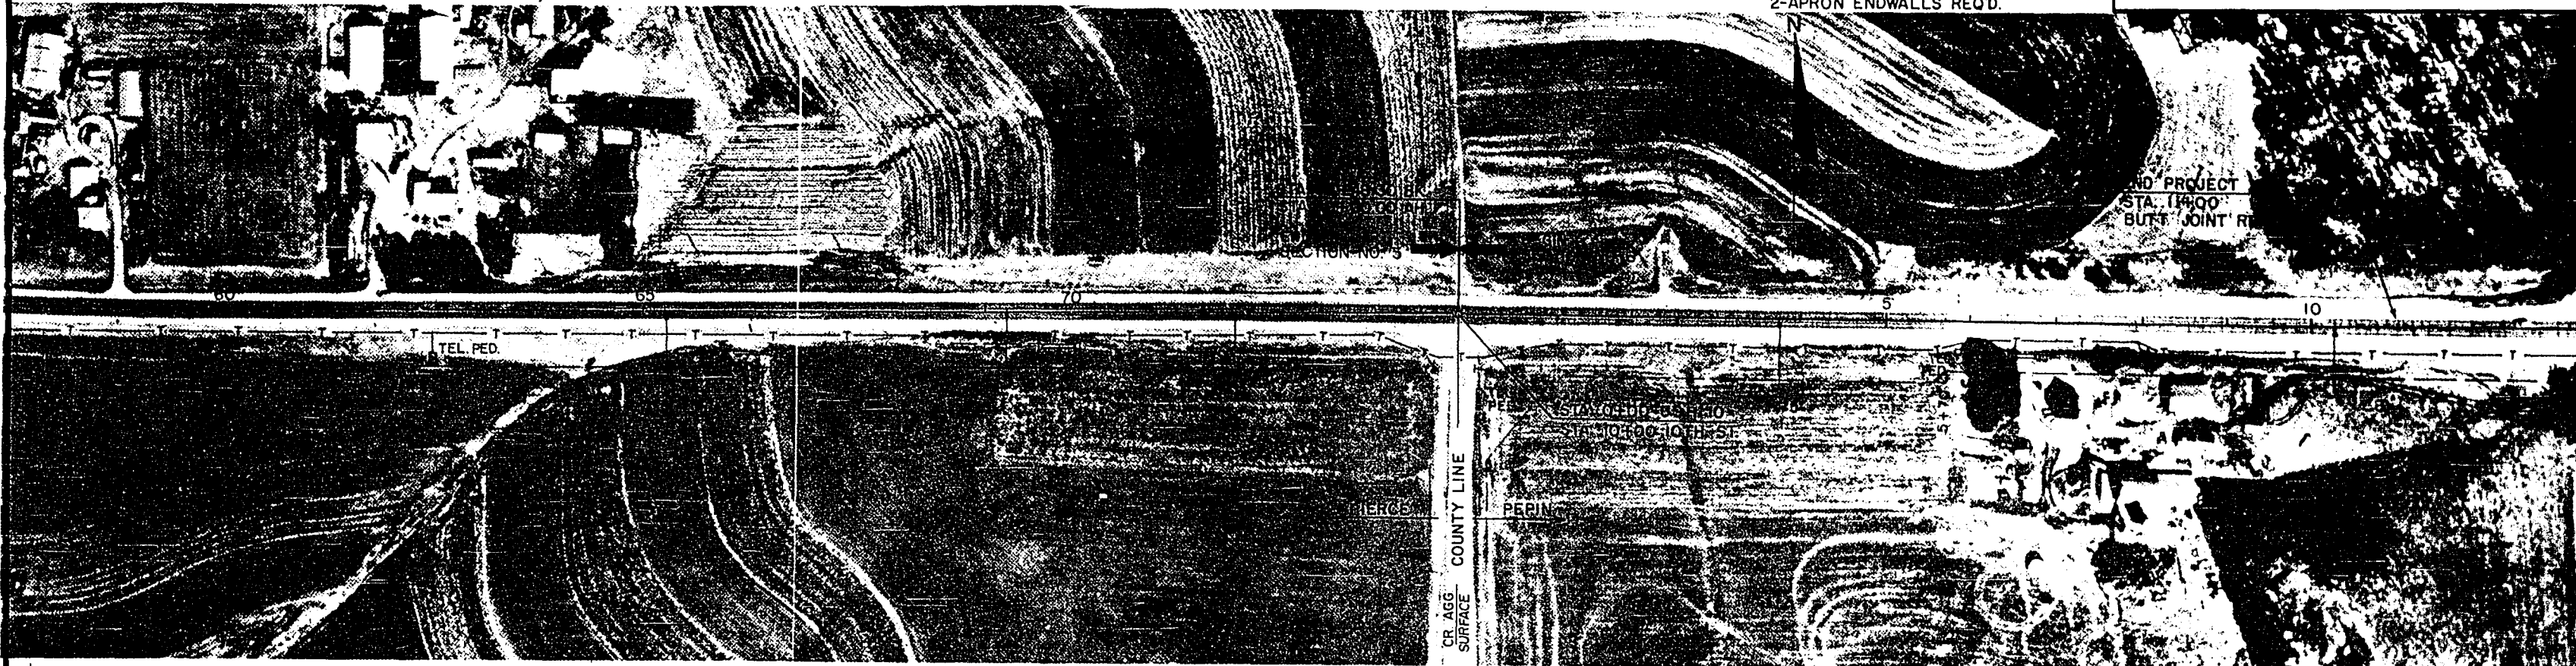


NET LENGTH OF CENTERLINE STA 58+00.00 TO 11+00.00 = 2,748.30 LIN. FT.

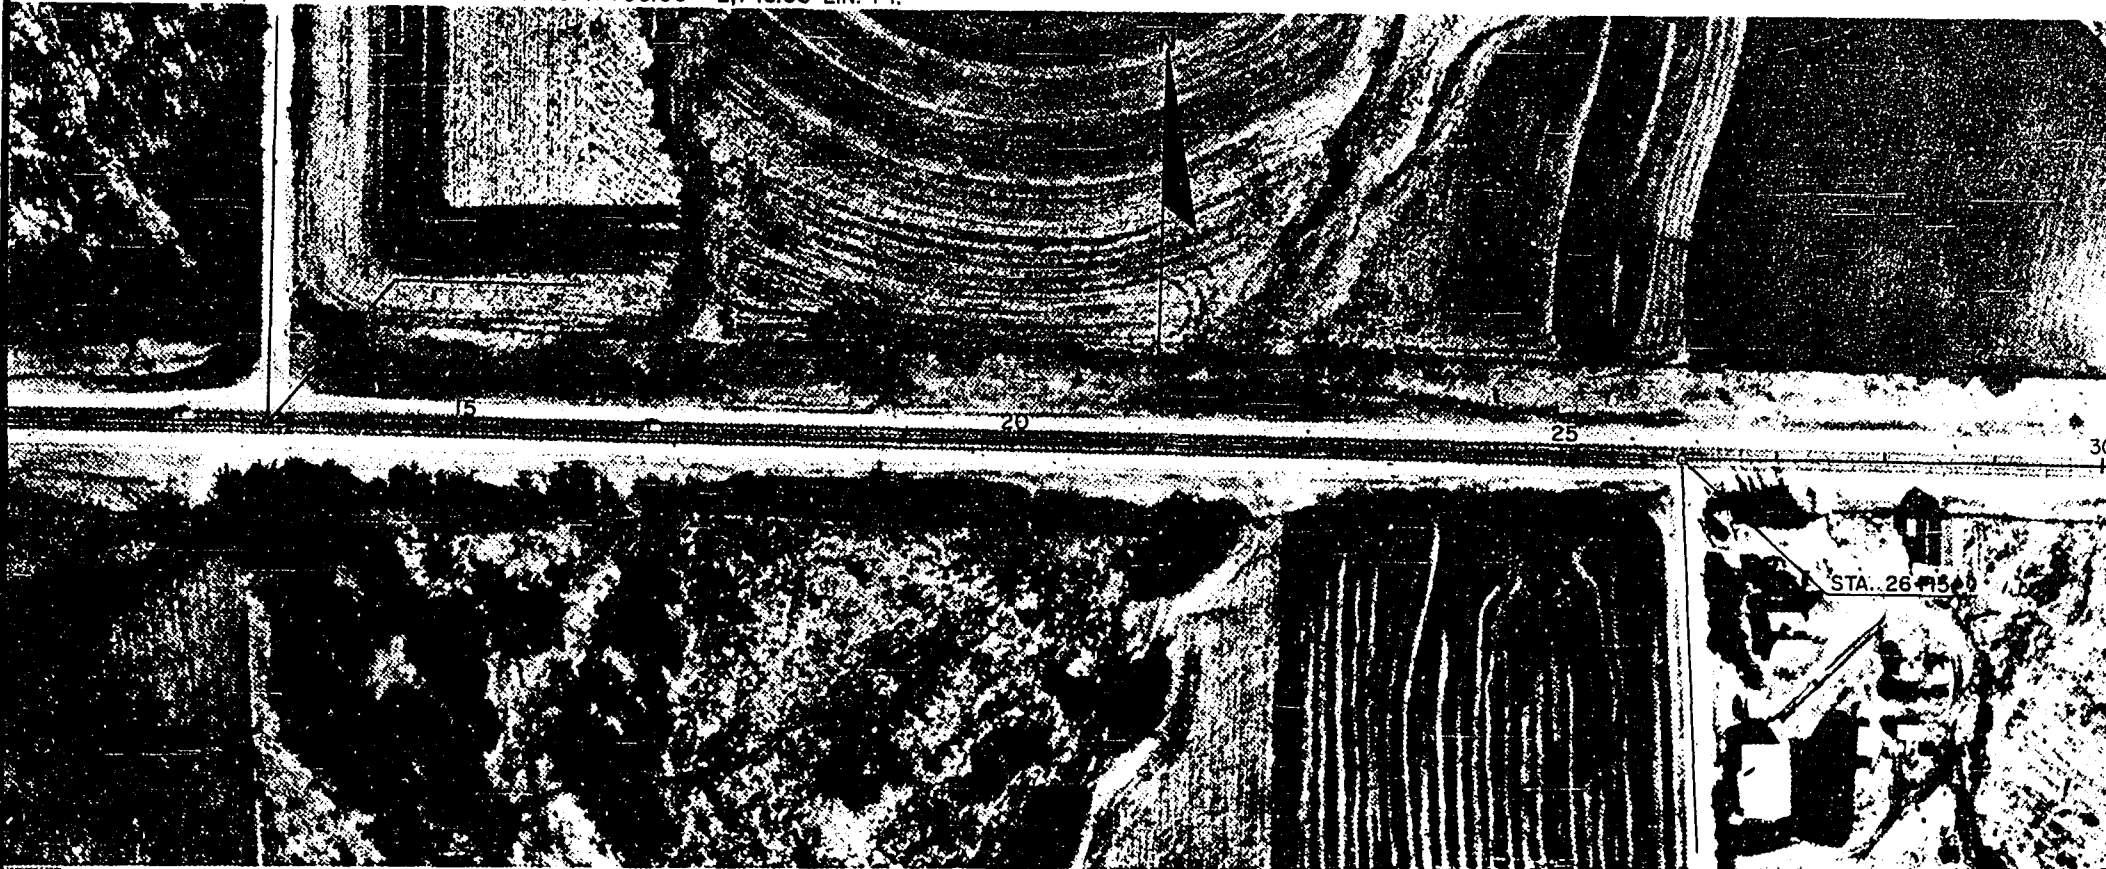


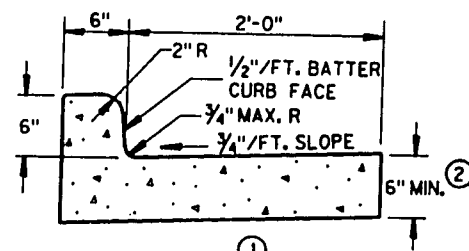


TYPES A & D

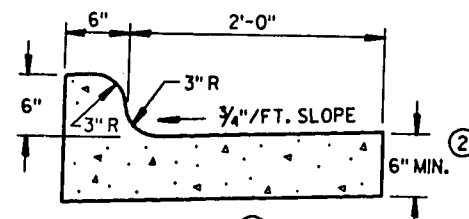


TYPES K & L

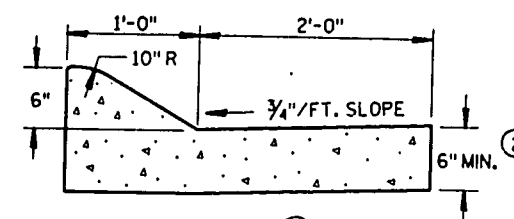


TYPES A & D
CONCRETE CURB & GUTTER 36"

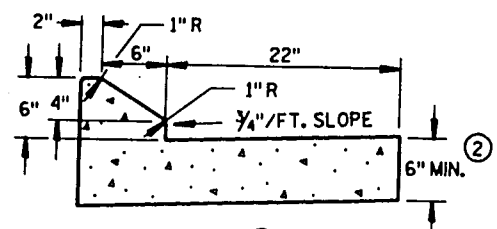

TYPES G & J

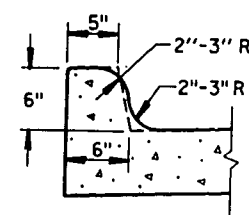


OPTIONAL CURB SHAPE
FOR TYPES K & L

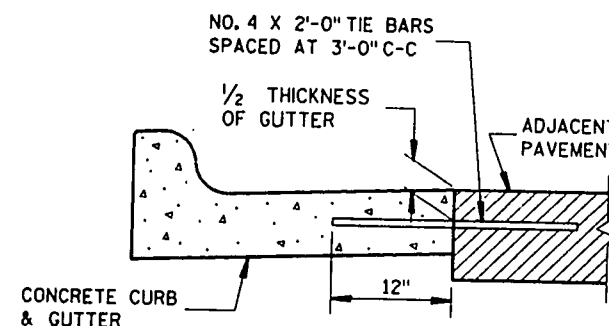

TYPICAL TIE BAR LOCATION

CONCRETE CURB & GUTTER 30"

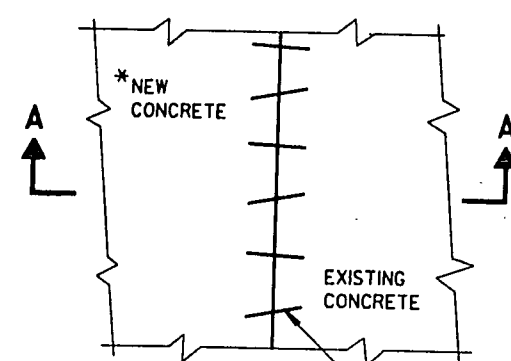


PLAN VIEW

*NEW CURB & GUTTER,
SURFACE DRAINS,
CONCRETE PAVEMENT
OR OTHER NEW CONCRETE.


NO. 6 X 12" DEF. BARS
SPACED 3'-0" C-C,
INSTALLED ON 6:1 SKEW
HORIZONTALLY. DIRECTION
OF SKEW ALTERNATING AFTER
EVERY ONE OR TWO BARS.

THE HOLE FOR THE BAR SHALL
BE DRILLED TO A DEPTH OF
7" AND TO SUCH A DIAMETER
AS TO PROVIDE A TIGHT
DRIVEN FIT


EXISTING
CONCRETE

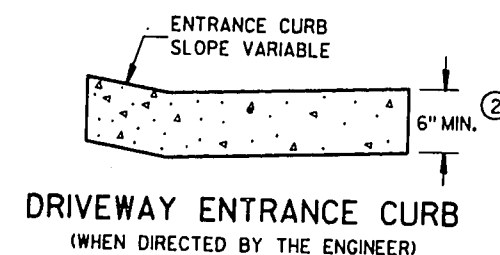


DRIVEWAY ENTRANCE CURB
(WHEN DIRECTED BY THE ENGINEER)

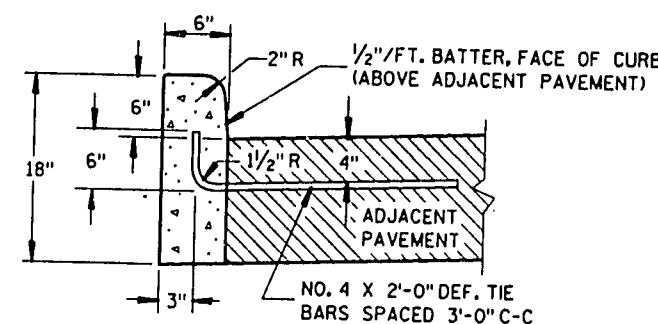

TYPES A & D

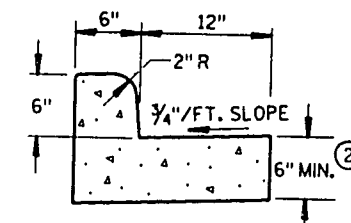

TYPES A & D
CONCRETE CURB & GUTTER 18"

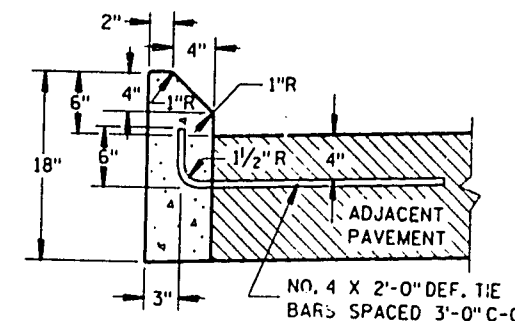

TYPES G & J

CONCRETE CURB

GENERAL NOTES

DETAILS OF CONSTRUCTION, MATERIALS AND WORKMANSHIP NOT SHOWN ON THIS DRAWING SHALL CONFORM TO THE PERTINENT REQUIREMENTS OF THE CONTRACT.

SEALANT IS NOT REQUIRED IN THE JOINTS OF CONCRETE CURB OR CONCRETE CURB & GUTTER EXCEPT AS REQUIRED FOR INTEGRAL GUTTER.

PAVEMENT TIES ARE REQUIRED, WHEN INCLUDED IN THE CONTRACT, WHERE CONCRETE CURB, CONCRETE CURB AND GUTTER OR CONCRETE PAVEMENT IS PLACED ADJACENT TO EXISTING CONCRETE.

PAVEMENT TIES AND TIE BARS SHALL BE EPOXY COATED IN CONFORMANCE WITH SUBSECTION 505.2.4 OF THE STANDARD SPECIFICATIONS.


INTEGRAL CURB & GUTTER SHALL CONFORM TO THE DETAILS SHOWN FOR CONCRETE CURB & GUTTER INCLUDING THE TRANSVERSE GUTTER SLOPE, TIE BARS AND A LONGITUDINAL CONSTRUCTION JOINT ARE NOT REQUIRED WITH THIS ALTERNATE.

PAVEMENT JOINTS SHALL BE EXTENDED THROUGH INTEGRAL CURB & GUTTER. JOINTS IN INTEGRAL GUTTER SHALL HAVE THE SAME DIMENSIONS AS THE JOINTS IN THE ADJACENT PAVEMENT. JOINTS IN INTEGRAL CURB SHALL BE 1/8" WIDE.


JOINTS IN INTEGRAL CURB & GUTTER SHALL BE SEALED TO THE FACE OF CURB WITH THE SAME SEALANT SPECIFIED FOR THE PAVEMENT JOINT. THE COST OF FURNISHING AND INSTALLING THIS SEALANT SHALL BE INCIDENTAL TO THE ITEM CONCRETE CURB & GUTTER.

UNLESS OTHERWISE SHOWN ON THE TYPICAL CROSS SECTIONS, THE BASE COURSE AND UNCLASSIFIED EXCAVATION LIMITS ARE TWO FEET BEHIND THE BACK OF CURBS.

- ① TIE BARS ARE REQUIRED FOR CURB AND GUTTER TYPES A, G AND K.
- ② THE BOTTOM OF CURB AND GUTTER MAY BE CONSTRUCTED EITHER LEVEL OR PARALLEL TO THE SLOPE OF THE SUBGRADE OR BASE COURSE PROVIDED A 6" MINIMUM GUTTER THICKNESS IS MAINTAINED.
- ③ WHEN REVERSE SLOPE GUTTER IS REQUIRED, THE LOCATIONS WILL BE SHOWN ELSEWHERE IN THE PLAN.

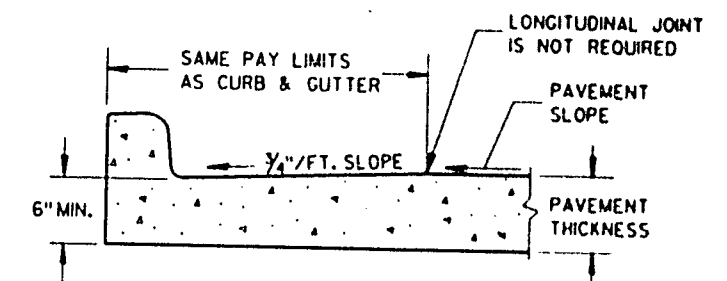

PARTIAL SECTION OF PAVEMENT
WITH INTEGRAL CURB & GUTTER

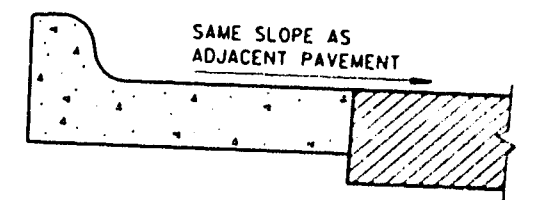

REVERSE SLOPE GUTTER
(TYPICAL FOR ALL CURB & GUTTER TYPES)

CONCRETE CURB, CONCRETE
CURB & GUTTER AND
PAVEMENT TIES

STATE OF WISCONSIN
DEPARTMENT OF TRANSPORTATION

APPROVED
10-23-86
DATE

STATE DESIGN ENGINEER FOR HWYS

FHWA

GENERAL NOTES

WELDED STEEL WIRE FABRIC SHALL BE IN ACCORDANCE WITH AASHTO SPECIFICATION M55.

- ① JOINTS SHALL BE $\frac{1}{8}$ TO $\frac{1}{4}$ INCH WIDE BY $1\frac{1}{2}$ INCHES DEEP AND SPACED AT UNIFORM INTERVALS OF APPROXIMATELY 4 FEET.
- ② GEOTEXTILE FABRIC TYPE "R" SHALL UNDERLAY THE FULL LENGTH AND WIDTH OF THE CONCRETE SURFACE DRAIN AND RIPRAP.
- ③ CONCRETE SURFACE DRAIN WITHOUT CURB AND GUTTER MAY BE USED ON BACKSLOPES WHEN SPECIFIED

EXPANSION JOINT

CONCRETE CURB AND GUTTER

2" MIN. CURB HEIGHT

TAPER CURB TO FLOW LINE

INCREASE ϕ FROM RIGHT ANGLE TO BEST FIT FIELD CONDITIONS

8'-0"

4'-0"

EDGE OF PAVEMENT

3'-0" MIN.

SURFACE DRAIN IS SYMETRICAL WHEN CURB AND GUTTER IS CONTINUED

SHOULDER OR BERM HINGE POINT

JOINTS

W3 WIRE MESH (SEE SECTION D-D)

RIPRAP

6'-0"

OR AS REQUIRED

1'-0" ON CUT SLOPE

DITCH

DITCH

PLAN VIEW

NOTE: TAPER CURB ENDS TO GUTTER IN 1'-0"

INCREASE ϕ FROM RIGHT ANGLE TO BEST FIT FIELD CONDITIONS

CONCRETE CURB AND GUTTER

2'-0"

1'-0"

1'-0"

FLUME

2" MIN. CURB HEIGHT

SEE PLAN VIEW OF FLUME AT CURB END

PLAN VIEW CURB OPENING FOR FLUME

8'-0"

CONCRETE GUTTER, DEPRESS SURFACE 1" MAX. TO SHAPE FLOW PATH

ASPHALT CURB AND FLUME

4'-0"

SHOULDER OR BERM HINGE POINT

12'-0"

7'-0"

3'-0"

1'-0" ON CUT SLOPE

CUT CONDITION IS SHOWN

SOD

DITCH

PLAN VIEW FLUME AT CURB END

SECTION B-B


CONCRETE SURFACE DRAIN & ASPHALTIC FLUME

STATE OF WISCONSIN
DEPARTMENT OF TRANSPORTATION


APPROVED
10/23/09
DATE

[Signature]
STATE DESIGN ENGINEER FOR HWYS


S.D.D. 8 D 4-3

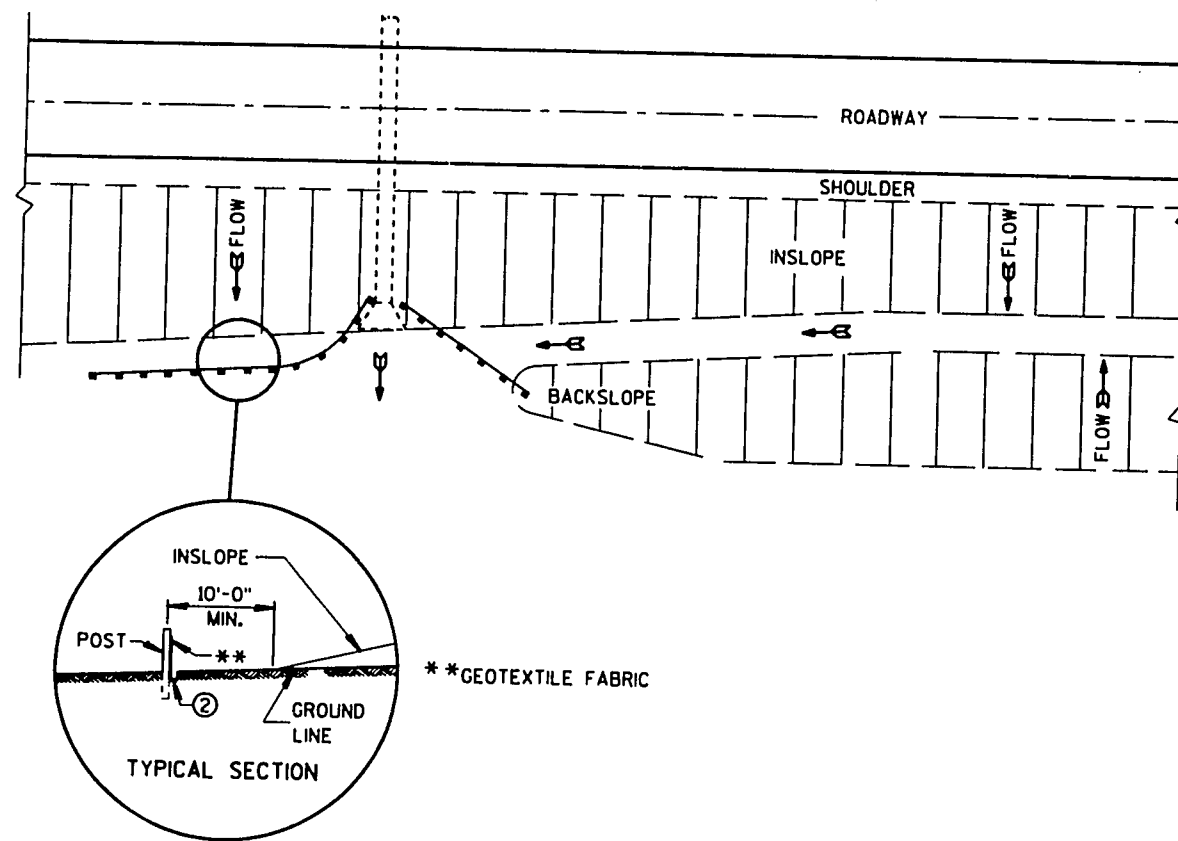


PLAN VIEW
TYPICAL APPLICATIONS OF SILT FENCE

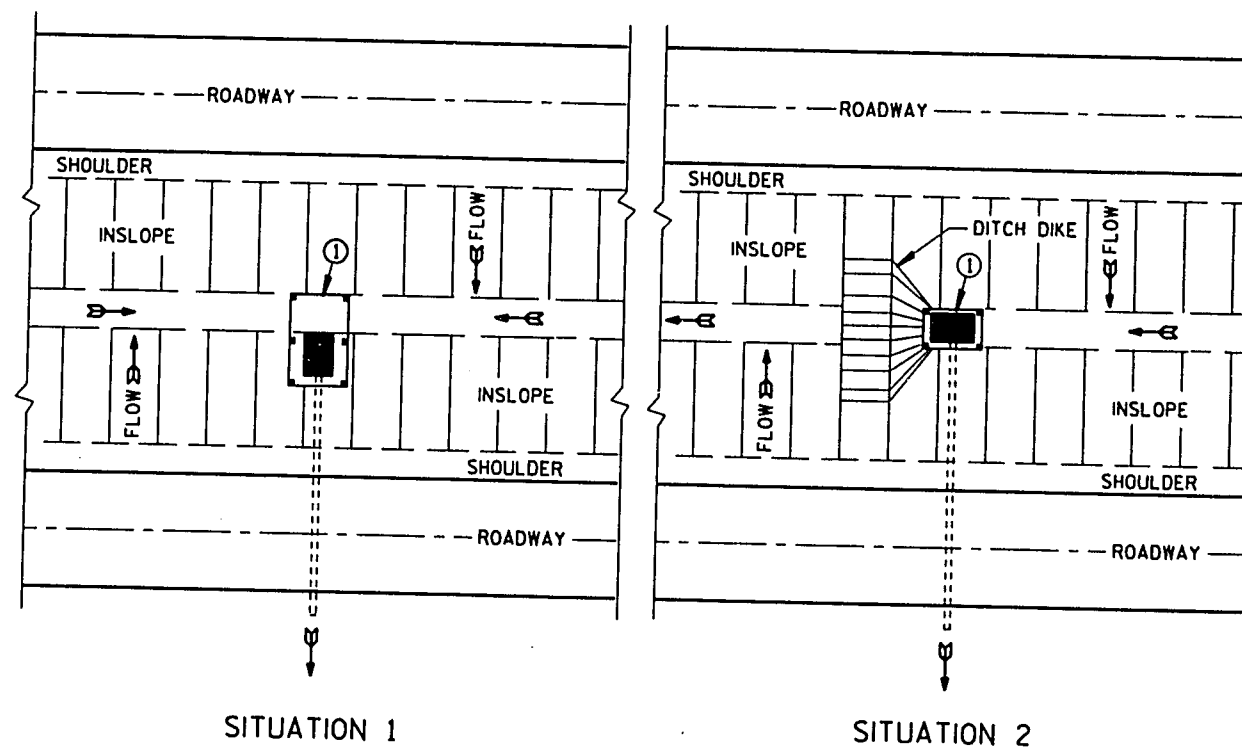


SITUATION 1
SITUATION 2
PLAN VIEW
SILT FENCE AT MEDIAN SURFACE DRAINS

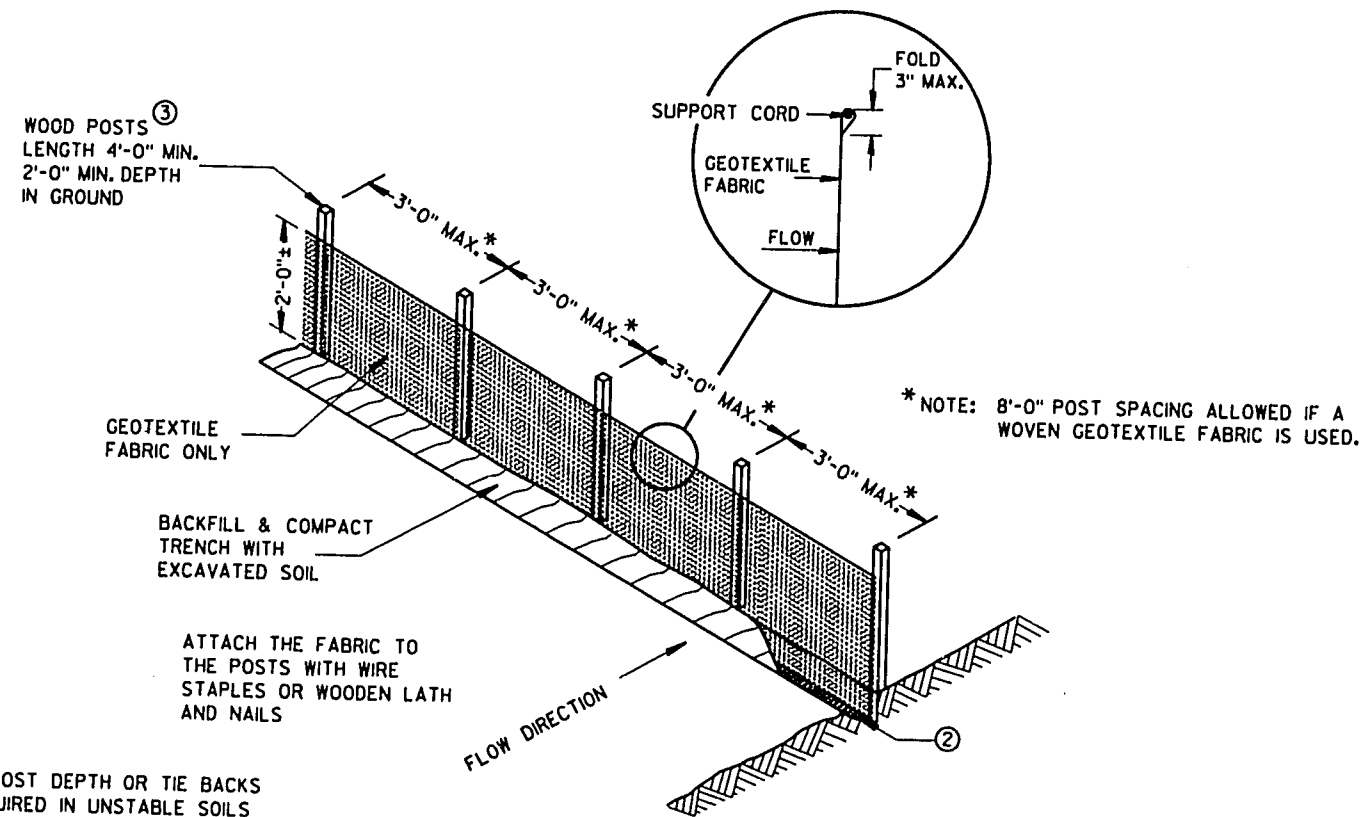

SILT FENCE
(NON-REINFORCED)

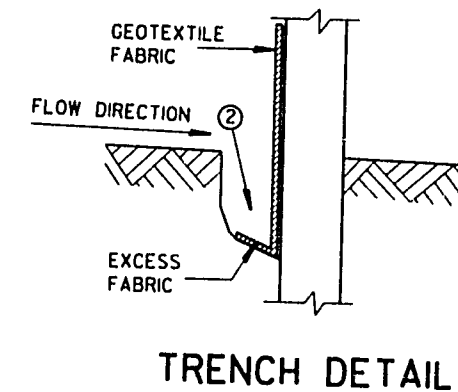

TRENCH DETAIL

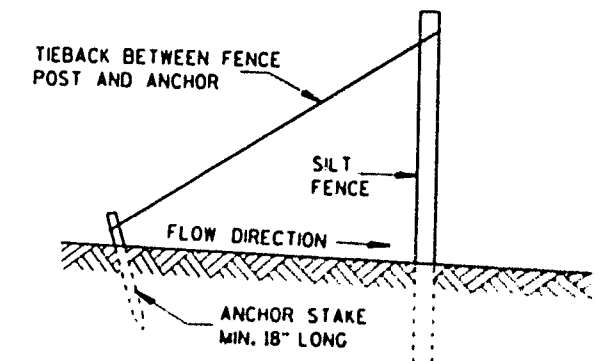

SILT FENCE TIE BACK
(WHEN REQUIRED BY THE ENGINEER)

GENERAL NOTES

DETAILS OF CONSTRUCTION NOT SHOWN ON THIS DRAWING SHALL CONFORM TO THE PERTINENT REQUIREMENTS OF THE STANDARD SPECIFICATIONS AND APPLICABLE SPECIAL PROVISIONS.

- ① HORIZONTAL BRACE WITH 2" X 4" WOODEN FRAME OR EQUIVALENT AT TOP OF POSTS AS DIRECTED BY THE ENGINEER.
- ② TRENCH SHALL BE A MINIMUM OF 4" WIDE & 6" DEEP TO BURY AND ANCHOR THE GEOTEXTILE FABRIC. FOLD MATERIAL TO FIT TRENCH AND BACKFILL & COMPACT TRENCH WITH EXCAVATED SOIL.
- ③ WOOD POSTS SHALL BE A MINIMUM SIZE OF 1 1/2" X 1 1/2" OF OAK OR HICKORY.


SILT FENCE

STATE OF WISCONSIN
DEPARTMENT OF TRANSPORTATION

APPROVED
DATE 6/29/84
DATE 6/29/84
CHIEF ROADWAY DEVELOPMENT ENGINEER
FWBA

METAL APRON ENDWALLS											
PIPE DIA. (IN.)	MIN. THICK. (Inches)		DIMENSIONS (Inches)							APPROX. SLOPE	BODY
	STEEL	ALUM.	A (±1")	B (MAX.)	H (±1")	L (±1/2")	L1 ①	L2 ①	W (±2")		
12	.064	.060	6	6	6	21	12	17 1/2	24	2 1/2 to 1	1 Pc.
15	.064	.060	7	8	6	26	14	21 3/4	30	2 1/2 to 1	1 Pc.
18	.064	.060	8	10	6	31	15	28 1/4	36	2 1/2 to 1	1 Pc.
21	.064	.060	9	12	6	36	18	29 3/8	42	2 1/2 to 1	1 Pc.
24	.064	.075	10	13	6	41	18	37 1/4	48	2 1/2 to 1	1 Pc.
30	.079	.075	12	16	8	51	18	52 1/4	60	2 1/2 to 1	1 Pc.
36	.079	.105	14	19	9	60	24	59 3/4	72	2 1/2 to 1	2 Pc.
42	.109	.105	16	22	11	69	24	75 3/8	84	2 1/2 to 1	2 Pc.
48	.109	.105	18	27	12	78	24	81	90	2 1/4 to 1	3 Pc.
54	.109	.105	18	30	12	84	30	85 1/2	102	2 1/4 to 1	3 Pc.
60	.109x	.105x	18	33	12	87	—	—	114	2 to 1	3 Pc.
66	.109x	.105x	18	36	12	87	—	—	120	2 to 1	3 Pc.
72	.109x	.105x	18	39	12	87	—	—	126	2 to 1	3 Pc.
78	.109x	.105x	18	42	12	87	—	—	132	1 1/2 to 1	3 Pc.
84	.109x	.105x	18	45	12	87	—	—	138	1 1/2 to 1	3 Pc.
90	.109x	.105x	18	37	12	87	—	—	144	1 1/2 to 1	3 Pc.
96	.109x	.105x	18	35	12	87	—	—	150	1 1/2 to 1	3 Pc.


* EXCEPT CENTER PANEL
SEE GENERAL NOTES

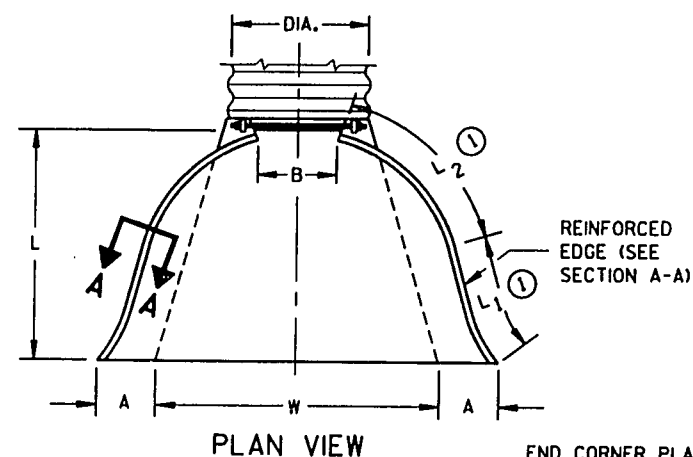


PLAN VIEW

END CORNER PLATES MAY BE FASTENED TO APRON PROPER BY BOLTS, RIVETS, OR RESISTANCE SPOT WELDS WHICH WILL HOLD THE SURFACES TIGHTLY TOGETHER

TOE PLATE (SAME THICKNESS AND METAL AS APRON) SHALL BE FURNISHED WHEN CALLED FOR ON THE PLANS

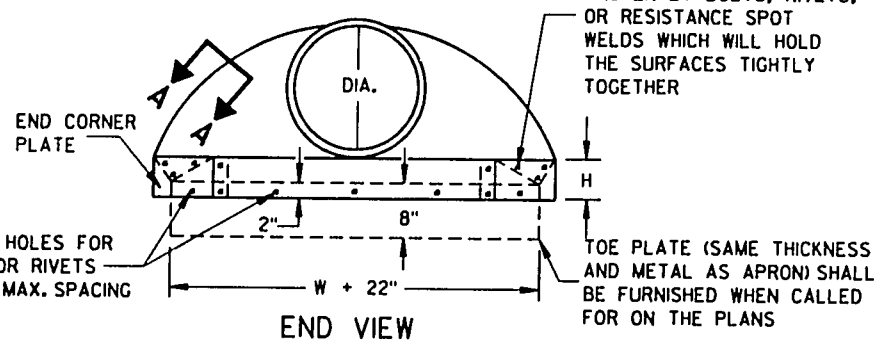


END VIEW

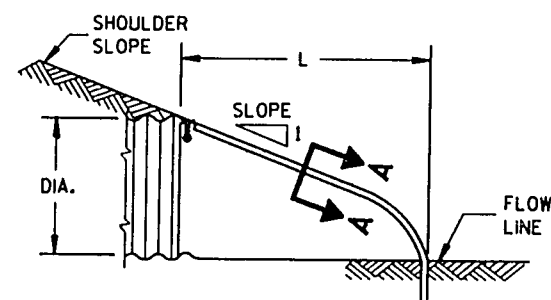


SIDE ELEVATION
METAL ENDWALLS

REINFORCED CONCRETE APRON ENDWALLS											
PIPE DIA. (IN.)	DIMENSIONS (Inches)							APPROX. SLOPE	BODY		
	T	A	B	C	D	E	G				
12	2	4	24	48 1/8	72 3/8	24	2	3 to 1			
15	2 1/4	6	27	46	73	30	2 1/4	3 to 1			
18	2 1/2	9	27	46	73	36	2 1/2	3 to 1			
21	2 3/4	9	36	37 1/2	73 1/2	42	2 3/4	3 to 1			
24	3	9 1/2	43 1/2	30	73 1/2	48	3	3 to 1			
27	3 1/4	10 1/2	49 1/2	24	73 1/2	54	3 1/4	3 to 1			
30	3 1/2	12	54	19 3/4	73 1/2	60	3 1/2	3 to 1			
36	4	15	63	34 3/4	97 3/4	72	4	3 to 1			
42	4 1/2	21	63	35	98	78	4 1/2	3 to 1			
48	5	24	72	26	98	84	5	3 to 1			
54	5 1/2	27	65	33 1/4-35	98 1/4-100	90	5 1/2	2 3/5 to 1			
60	6	30-35	60	39	99	96	5	2 to 1			
66	6 1/2	30-35	72-78	21-27	99	102	5 1/2	2 to 1			
72	7	30-35	78	21	99	108	6	2 to 1			
78	7 1/2	30-35	78	21	99	114	6 1/2	2 to 1			
84	8	36	90 1/2	21	111 1/2	120	6 1/2	1 1/2 to 1			
90	8 1/2	41	87 1/2	24	111 1/2	132	6 1/2	1 1/2 to 1			


* MINIMUM
** MAXIMUM

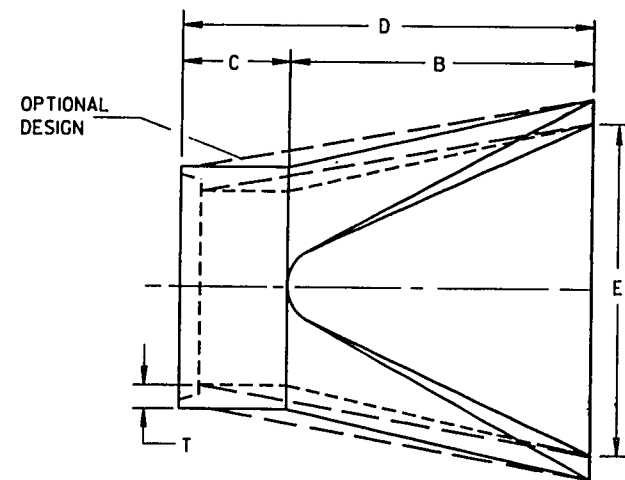

PLAN

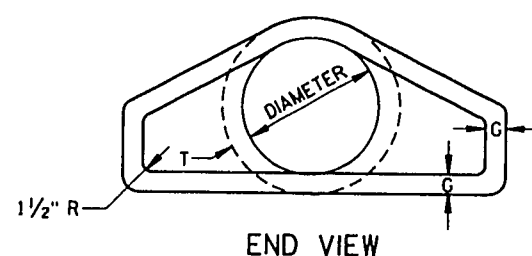


END VIEW

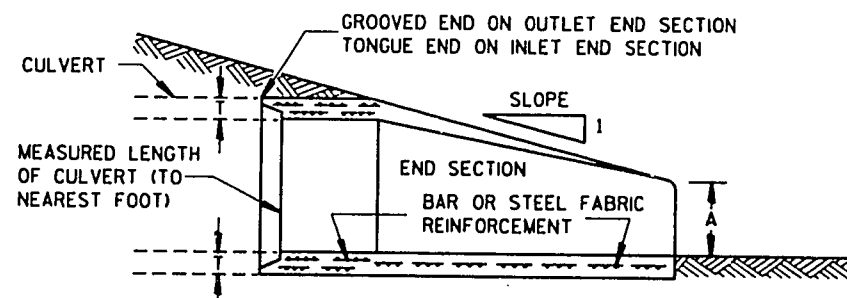


LONGITUDINAL SECTION
CONCRETE ENDWALLS

1" WIDE, 12 GA. (0.109" THICK) GALVANIZED STRAP WITH STANDARD 6" X 1/2" BAND BOLT AND NUT

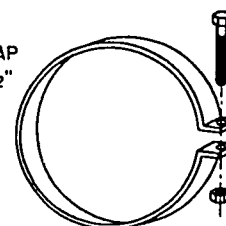


ALTERNATE FOR TYPE 1 CONNECTION
END SECTION CONNECTOR STRAP

THREADED 3/8" DIA. ROD AROUND CULVERT & THROUGH TANK TYPE CONNECTOR LUG OR ALTERNATE CONNECTOR STRAP (SEE DETAIL)

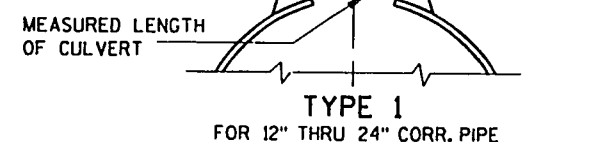


TYPE 1
FOR 12" THRU 24" CORR. PIPE


THREADED 3/8" DIA. ROD OVER TOP OF APRON, SIDE LUGS TO BE RIVETED TO APRON

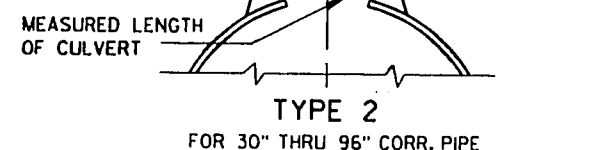

TYPE 2
FOR 30" THRU 96" CORR. PIPE

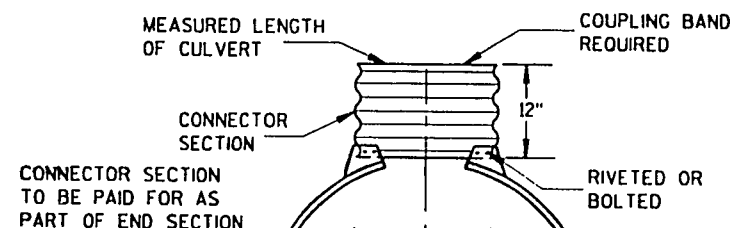

TYPE 3
FOR 42" THRU 96" CORR. PIPE

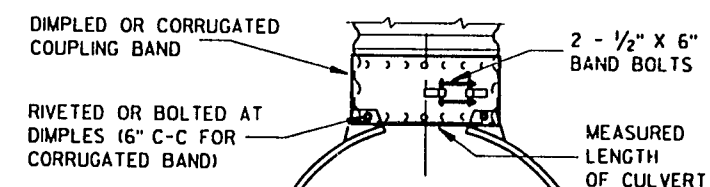

TYPE 5
ALTERNATE FOR:
ALL SIZES CORRUGATED CIRCULAR PIPE


NOTE: DIMPLED BAND FITS OVER OUTSIDE OF ENDWALL, AND CORRUGATED BAND FITS INSIDE ENDWALL. DIMPLED BAND MAY BE USED WITH HELICALLY CORRUGATED PIPE.

FOR CIRCUMFERENTIALLY CORRUGATED PIPE USE ENDWALL CONNECTION DETAILS 1, 2, 3 OR 5 AS APPLICABLE.

FOR HELICALLY CORRUGATED PIPE USE ENDWALL CONNECTION DETAILS 1, 2 OR 5.

FOR HELICALLY CORRUGATED PIPES WITH TWO CIRCUMFERENTIAL CORRUGATIONS AT EACH END USE ENDWALL CONNECTION DETAILS 1, 2 OR 3.

CONNECTION DETAILS

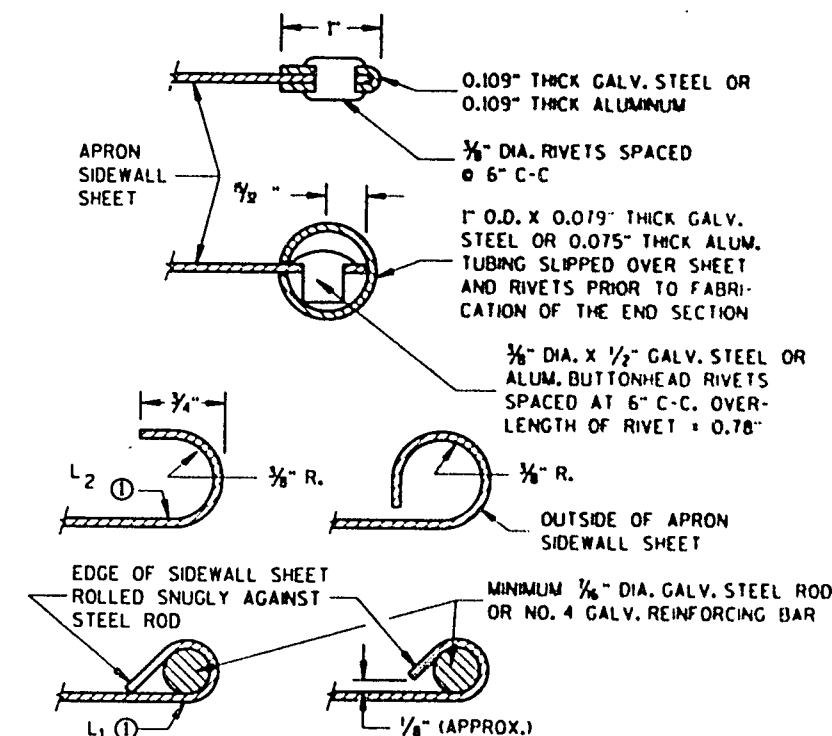

SECTION A-A

GENERAL NOTES

DETAILS OF CONSTRUCTION, MATERIALS AND WORKMANSHIP NOT SHOWN... THIS DRAWING SHALL CONFORM TO THE PERTINENT REQUIREMENTS OF THE STANDARD SPECIFICATIONS AND THE APPLICABLE SPECIAL PROVISIONS.

CONCRETE CULVERT ENDWALLS MAY NOT BE USED WITH GALVANIZED STEEL OR ALUMINUM CULVERT PIPE OR VICE VERSA. GALVANIZED STEEL OR ALUMINUM ENDWALLS SHALL NORMALLY BE INSTALLED ON CULVERT PIPE OF THE SAME METAL.

ALL THREE PIECE STEEL APRON ENDWALLS FOR 60" DIAMETER PIPE AND LARGER SHALL HAVE 0.109" SIDES AND 0.138" CENTER PANELS. ALL THREE PIECE ALUMINUM APRON ENDWALLS FOR 60" DIAMETER PIPE AND LARGER SHALL HAVE 0.105" SIDES AND 0.134" CENTER PANELS. THE WIDTH OF CENTER PANELS SHALL BE GREATER THAN 20 PERCENT OF THE PIPE PERIMETER.

LAP SEAMS SHALL BE TIGHTLY JOINED BY GALVANIZED RIVETS OR BOLTS FOR STEEL UNITS AND ALUMINUM RIVETS AND BOLTS FOR ALUMINUM UNITS. FOR THE 60" THROUGH 96" DIAMETER APRON ENDWALL SIZES, THE REINFORCED EDGES AND CENTER PANEL SEAMS SHALL BE FURTHER REINFORCED WITH GALVANIZED STEEL OR ALUMINUM STIFFENER ANGLES. THE ANGLES SHALL BE ATTACHED BY GALVANIZED NUTS AND BOLTS FOR STEEL UNITS AND ALUMINUM NUTS AND BOLTS FOR ALUMINUM UNITS.


WHERE TWO OR MORE PIPES WITH APRON ENDWALLS ARE LAID ADJACENT TO EACH OTHER, THEY SHALL BE SEPARATED BY A DISTANCE SUFFICIENT TO PROVIDE A MINIMUM CLEARANCE OF 6 INCHES BETWEEN APRON ENDWALLS.

① FOR PIPE SIZES UP TO 60" DIAMETER, A 180° ROLLED EDGE MAY BE USED INSTEAD OF STEEL ROD REINFORCEMENT. SEE SECTION A-A.


APRON ENDWALLS FOR CULVERT PIPE

STATE OF WISCONSIN
DEPARTMENT OF TRANSPORTATION

APPROVED
11/20/94
DATE
CHIEF ROADWAY DEVELOPMENT ENGINEER

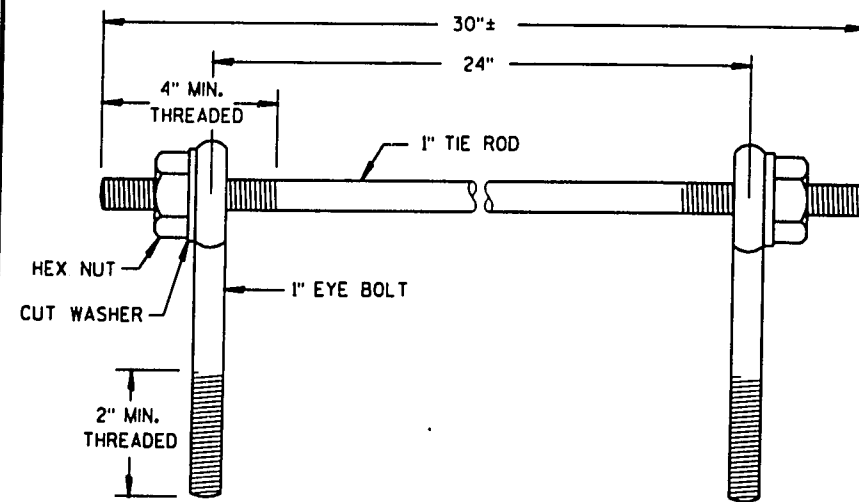

EYE BOLTS AND TIE ROD

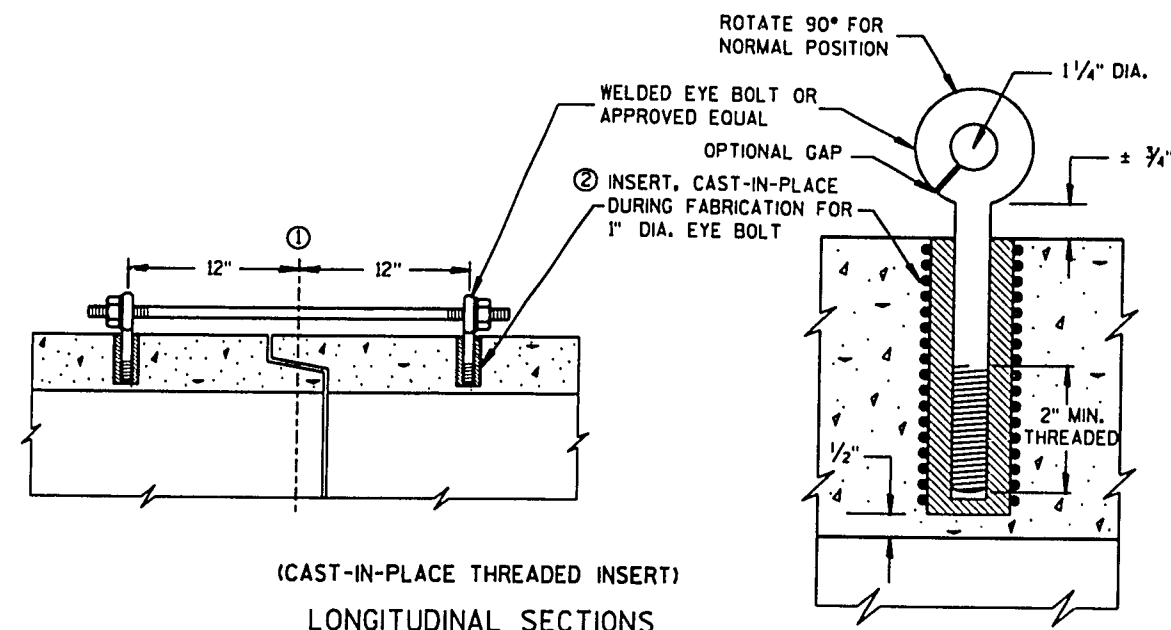

(CAST-IN-PLACE THREADED INSERT)
LONGITUDINAL SECTIONS


GENERAL NOTES

CONCRETE CULVERT PIPE SHALL BE TIED TOGETHER IN THE MANNER ILLUSTRATED BY THIS DETAIL AT LOCATIONS DESIGNATED ON THE PLAN. THE CONTRACTOR MAY USE EITHER ALTERNATE 1, 2 OR 3 FOR DRAINAGE STRUCTURES. ONLY ALTERNATE 1 AND 3 MAY BE USED FOR CATTLE PASSES. UNLESS OTHERWISE STATED IN THE CONTRACT THE MATERIALS, FABRICATION AND WORK NECESSARY TO THE CULVERT PIPE AS INDICATED ON THE PLANS AND BY THIS DETAIL WILL BE CONSIDERED INCIDENTAL TO CULVERT PIPE, REINFORCED CONCRETE CULVERT PIPE, OR REINFORCED CONCRETE PIPE CATTLE PASS.


DETAILED DRAWINGS FOR PROPOSED ALTERNATE DESIGNS FOR JOINT TIES SHALL BE SUBMITTED TO THE ENGINEER FOR APPROVAL.

- ① ϕ OF TONGUE AND GROOVE OR BELL AND SPIGOT JOINTS.
- ② THE INSIDE OF THE THREADED INSERTS SHALL BE CLEAN TO ALLOW THE INSERTION OF THREADED EYE BOLTS.
- ③ HOLES SHALL BE CAST-IN-PLACE OR DRILLED 12" FROM ϕ OF TONGUE AND GROOVE.
- ④ BOLT PROJECTION INSIDE OF PIPE SHALL NOT EXCEED 2".
- ⑤ ROD DIAMETER + 1 INCH.
- ⑥ LENGTH ADEQUATE TO EXTEND TO WITHIN 1/2" INCH OF THE INNER SURFACE OF THE PIPE.

EYE BOLT AND TIE ROD ASSEMBLY (ALTERNATE NO. 1)

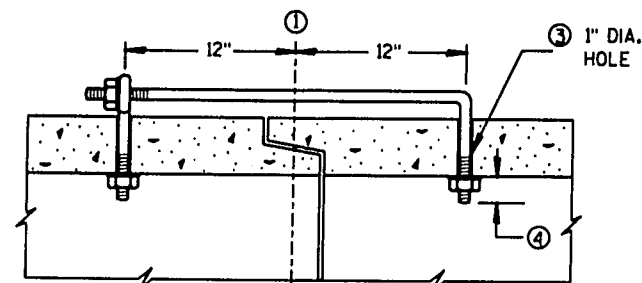

(TONGUE & GROOVE PIPE)

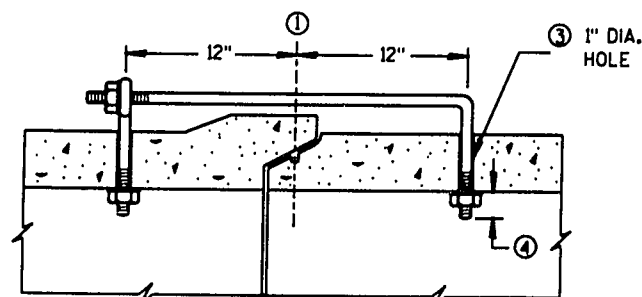

(MODIFIED BELL PIPE)
LONGITUDINAL SECTION


EYE BOLT DIMENSION TABLE

PIPE SIZE	L = LENGTH	
	TONGUE & GROOVE PIPE	MODIFIED BELL PIPE
18" TO 24"	4 1/2"	6 1/4"
30"	5"	7"
36"	5 1/2"	7"
42"	6"	
48"	6 1/2"	
60"	7 1/2"	
66"	8"	


ADJUSTABLE TIE ROD TABLE

PIPE DIAMETER	TIE ROD DIAMETER	D	L ₁	N
12-60	3/8"	3/8"	5	1/2
66-84	3/4"	3/4"	5	1/2
90-108	1"	1"	7	1 1/8

DIMENSIONS SHOWN ARE IN INCHES

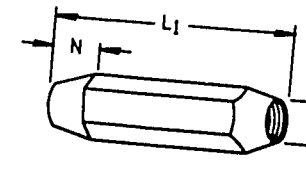


TAPERED

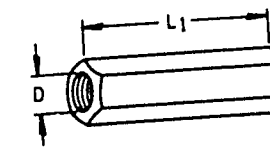


PLAIN

RIGHT AND LEFT THREADS
SLEEVE NUTS

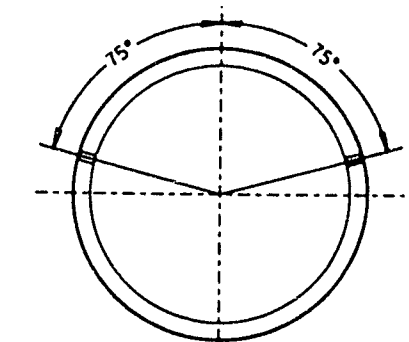


PLACEMENT OF (2) CAST-IN-PLACE INSERTS OR HOLES DURING FABRICATION FOR PIPE SECTIONS REQUIRING TIE RODS

TRANSVERSE SECTION

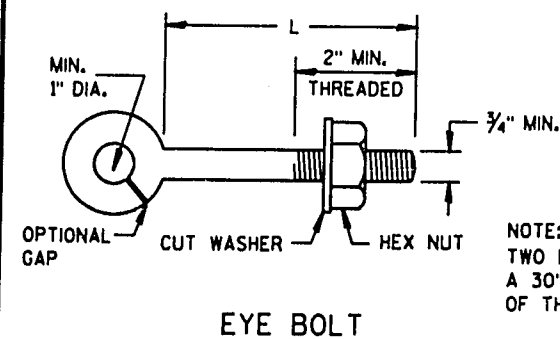

EYE BOLT


NOTE:
TWO EYE BOLTS MAY BE USED WITH A 30" LONG THREADED ROD IN LIEU OF THE 90° BENT TIE ROD.

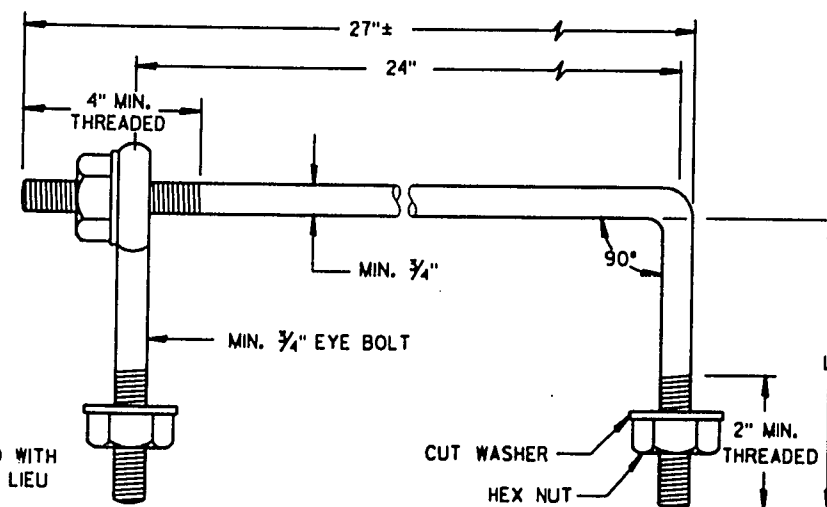

EYE BOLT AND TIE ROD

(JOINT TIES FOR 18" TO 66" DIA. CONCRETE PIPE)

EYE BOLT AND TIE ROD ASSEMBLY (ALTERNATE NO. 2)

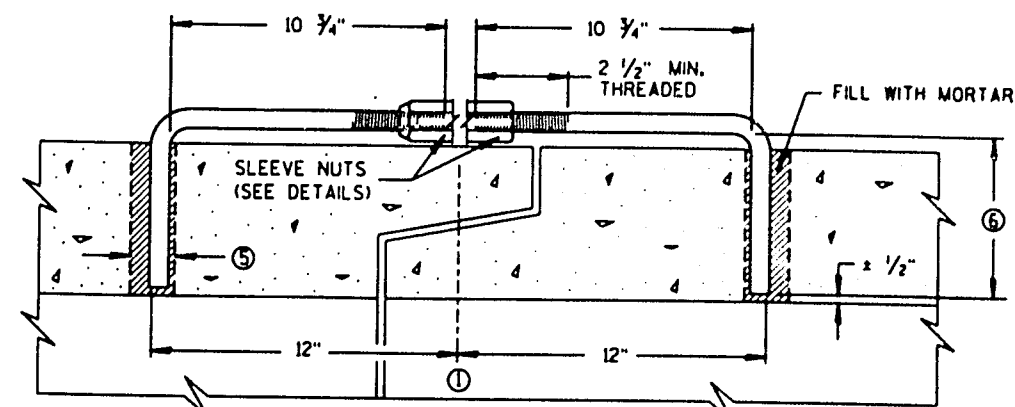

LONGITUDINAL SECTION

(JOINT TIES FOR 12" TO 108" DIA. CONCRETE PIPE)

ADJUSTABLE TIE ROD (ALTERNATE NO. 3)

JOINT TIES FOR CONCRETE PIPE


STATE OF WISCONSIN
DEPARTMENT OF TRANSPORTATION

APPROVED

DATE

STATE DESIGN ENGINEER FOR HD'S

FMSA

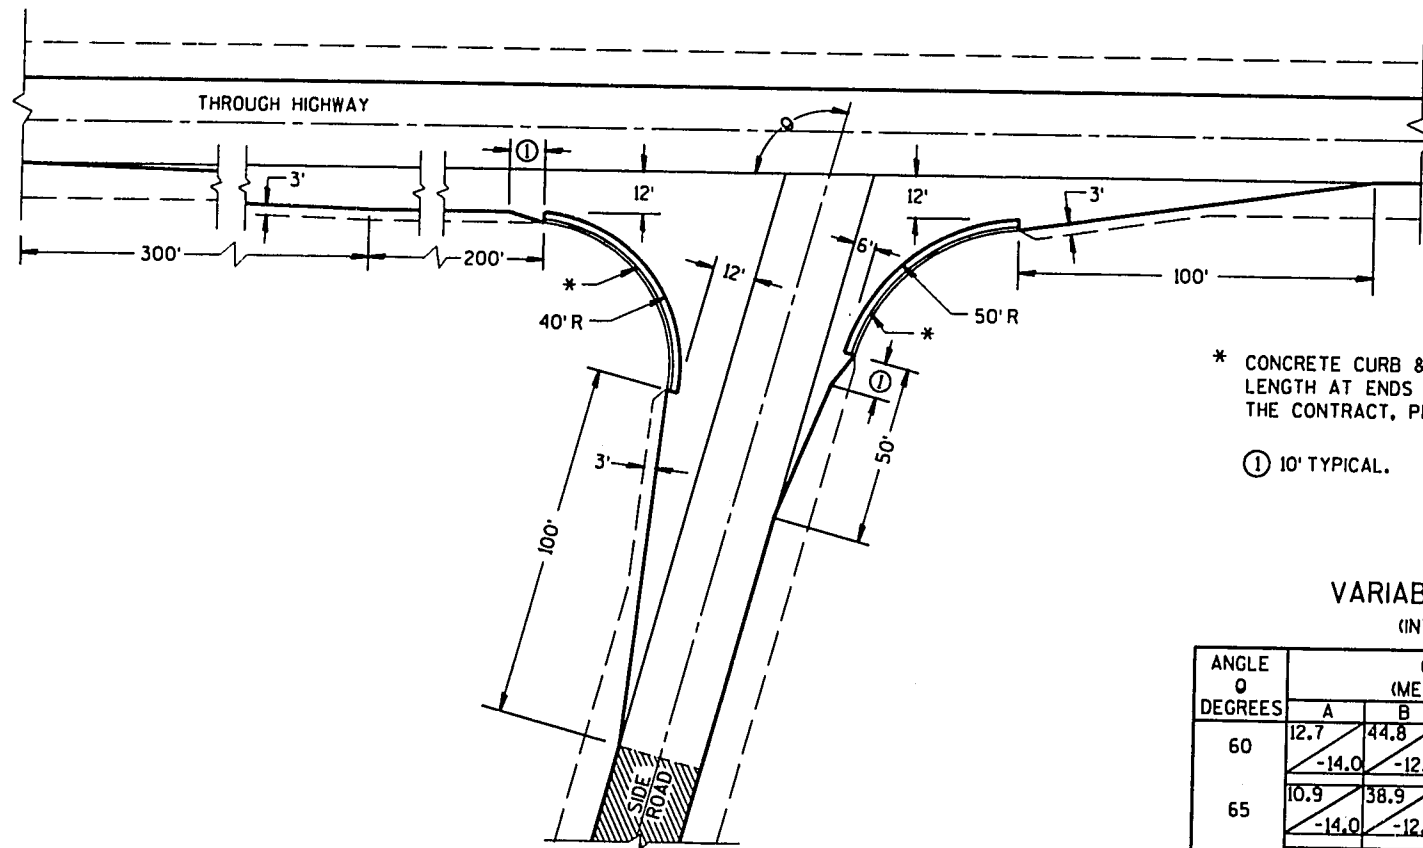


* CONCRETE CURB & GUTTER 36". TAPER CURB HEIGHT 0" TO 6" IN 10'-0" LENGTH AT ENDS OF CURB & GUTTER SECTIONS, WHEN SPECIFIED ELSEWHERE IN THE CONTRACT, PROVIDE CURB OPENING AND FLUME.

① 10' TYPICAL.


TABLE OF DIMENSIONS FOR
VARIABLE SIDE ROAD INTERSECTION ANGLES
(INTERPOLATE VALUES FOR ANGLES NOT SHOWN)

ANGLE θ DEGREES	COORDINATES IN FEET (MEASURED FROM POINT "O")								LENGTH IN FEET				
	A	B	C	D	E	F	G	H	AB	AC	T	OJ	OH
60	12.7	44.8	46.4	41.9	193.9	93.9	60.3	85.0	32.3	67.4	4.9	85.9	169.9
	-14.0	-12.0	-72.4	0.0	0.0	-12.0	-62.9	-147.1					
65	10.9	38.9	37.8	39.4	186.1	86.1	51.7	70.5	28.1	63.6	8.5	80.9	166.9
	-14.0	-12.0	-71.6	0.0	0.0	-12.0	-59.8	-151.3					
70	9.4	33.7	29.8	37.4	179.2	79.2	44.3	56.1	24.6	59.7	11.5	76.1	164.1
	-14.0	-12.0	-70.1	0.0	0.0	-12.0	-56.5	-154.2					
75	7.9	29.2	22.3	35.7	173.0	73.0	37.8	41.8	21.6	55.8	13.8	71.4	161.4
	-14.0	-12.0	-67.9	0.0	0.0	-12.0	-53.3	-155.9					
80	6.5	25.2	15.6	34.4	167.4	67.4	32.2	27.6	18.9	52.0	15.6	66.9	158.9
	-14.0	-12.0	-65.2	0.0	0.0	-12.0	-50.0	-156.5					


TYPE "A" SIDE ROAD INTERSECTION DETAILS

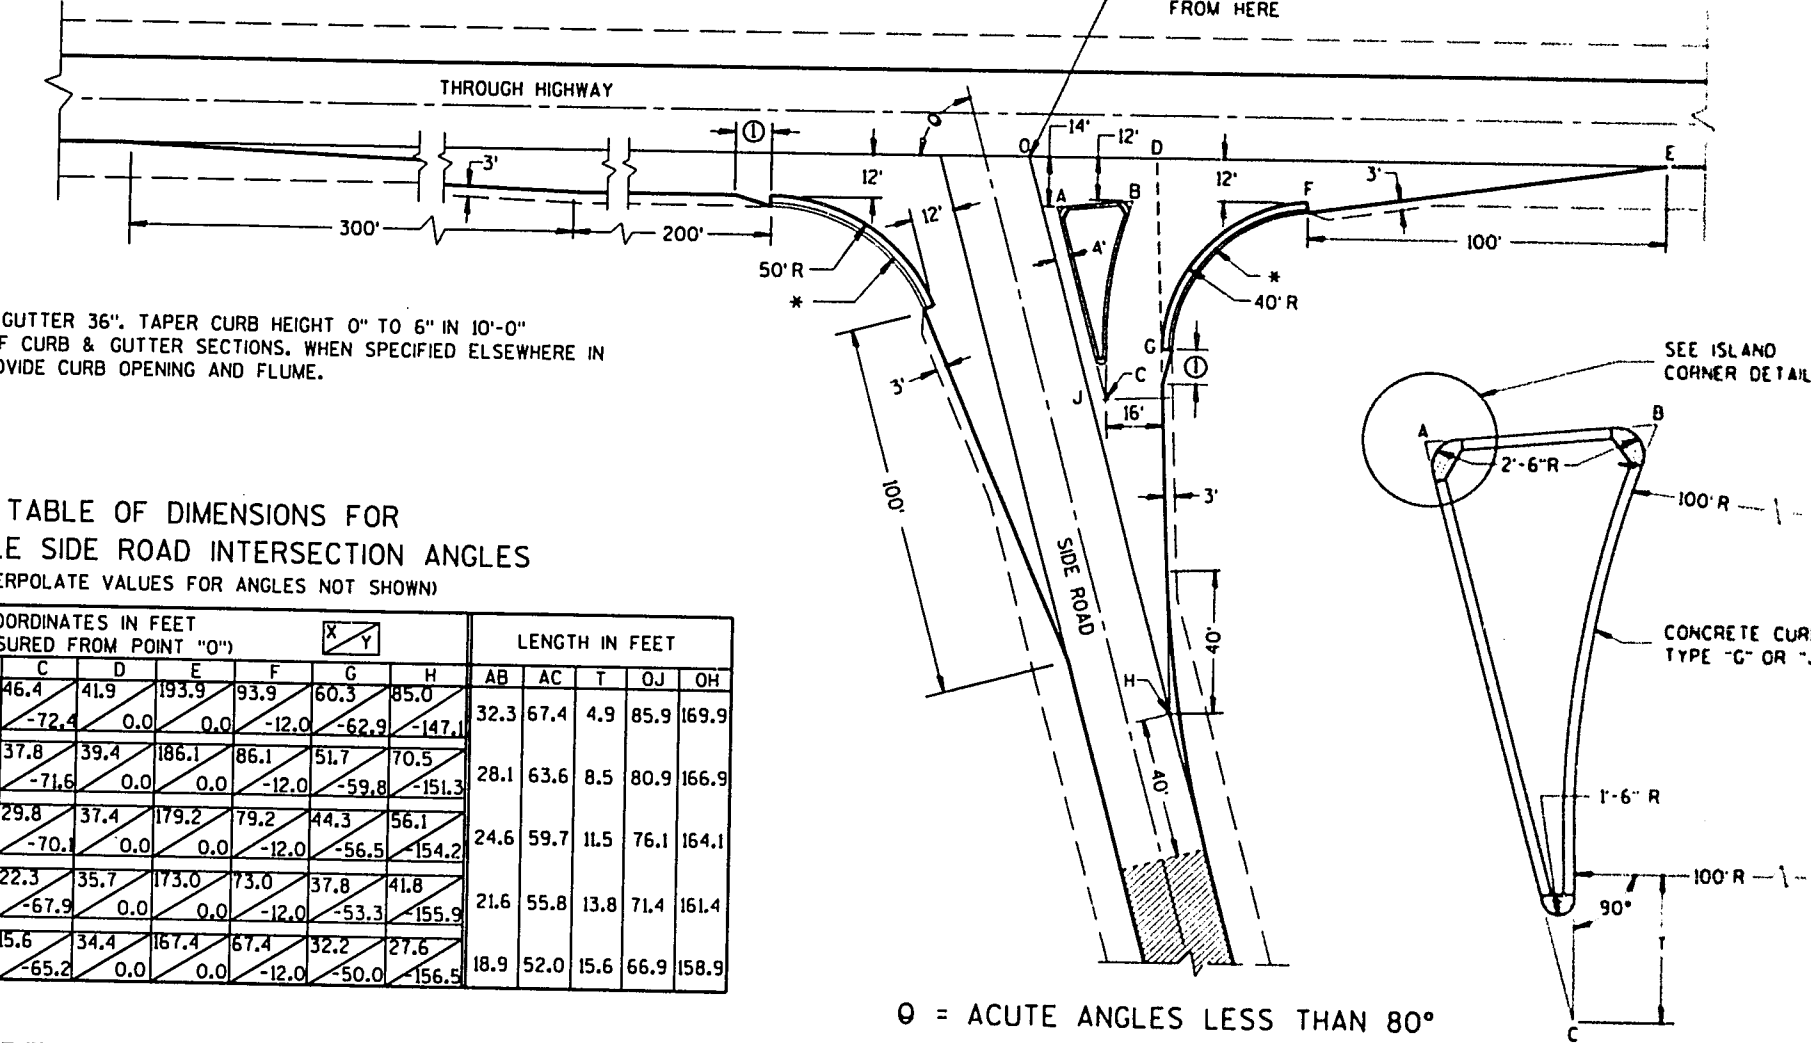

θ = ACUTE ANGLES LESS THAN 80°

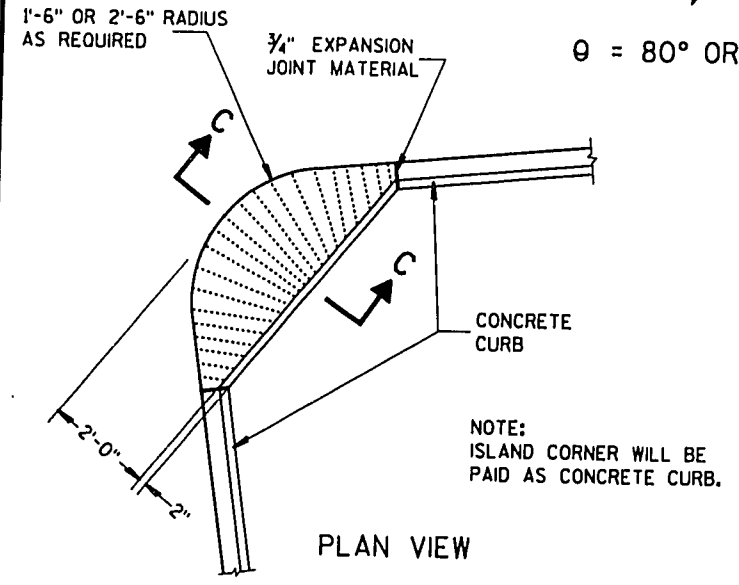


PLAN VIEW

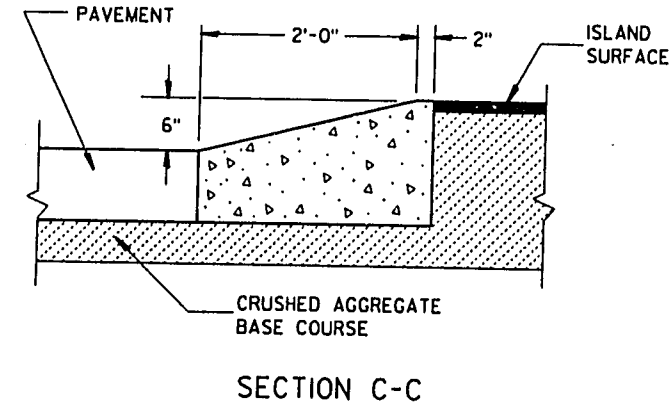

SECTION C-C

ISLAND CORNER DETAIL

(TO BE CONSTRUCTED AT ALL ISLAND CORNERS)

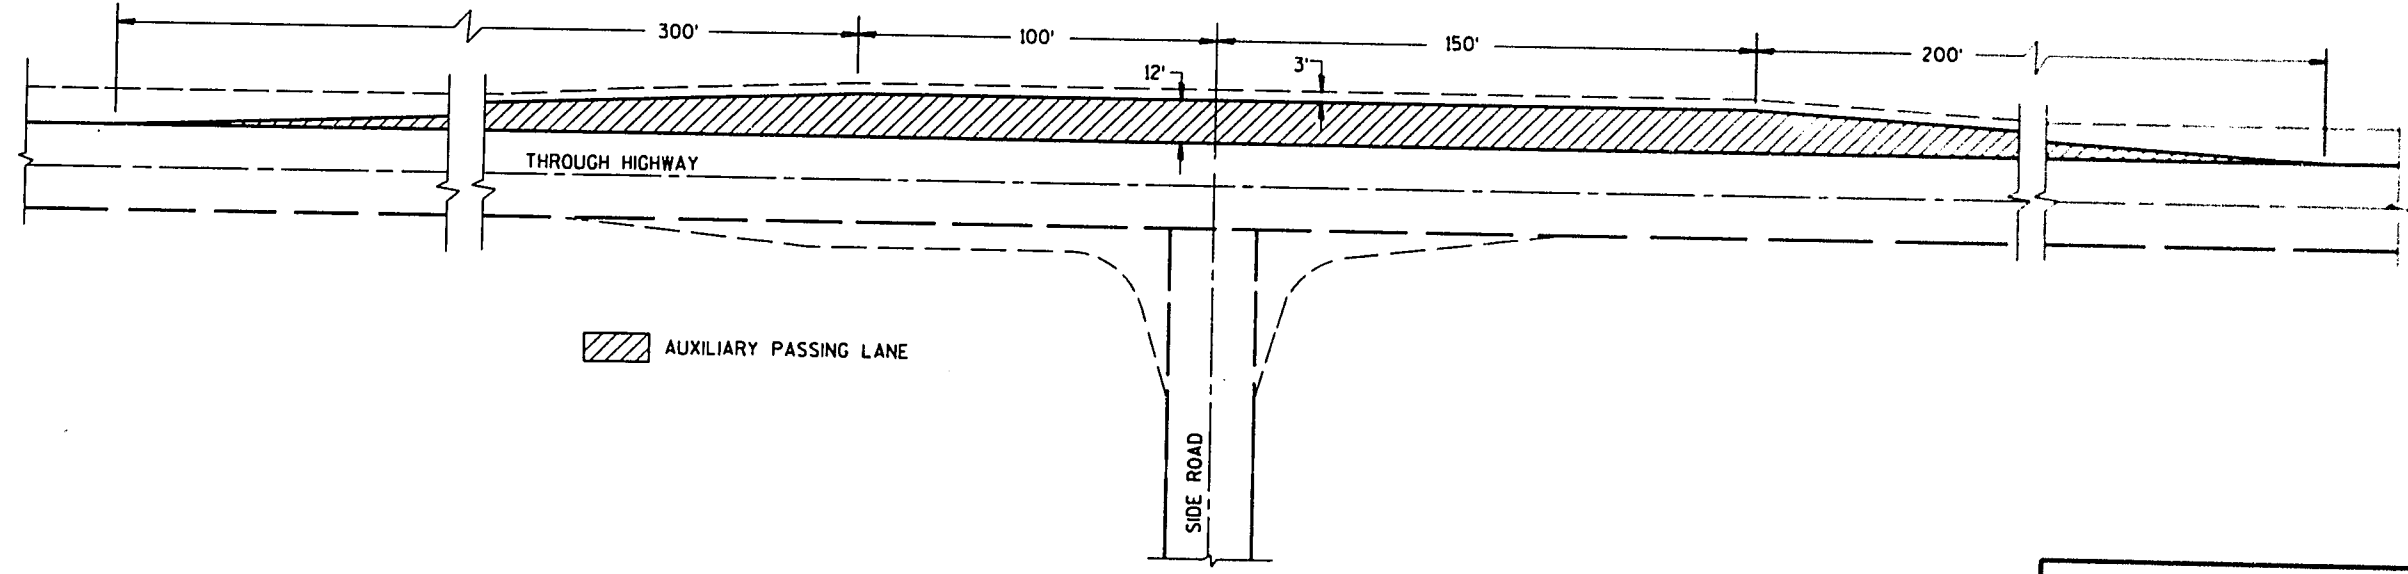


PASSING LANE DETAIL

AT-GRADE SIDE ROAD
INTERSECTION, TYPE "A"
AND PASSING LANE

STATE OF WISCONSIN
DEPARTMENT OF TRANSPORTATION


FORM DEPTH SHALL BE NO MORE THAN 6" BELOW GRADE ON THE LOWER SIDE OF BASE

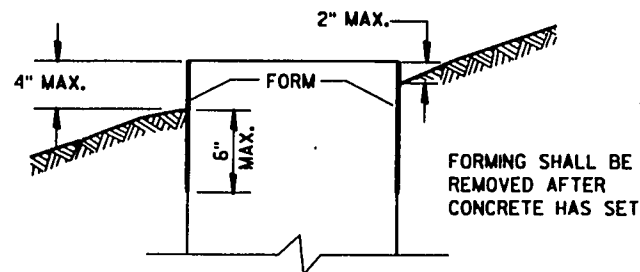

FORMING DETAIL

QUANTITY REQUIREMENTS	CONCRETE BASE TYPE		
	1	2	5
APPROX. CUBIC YARDS OF CONCRETE	.32	.57	.40
LBS. OF HOOP BAR STEEL	NONE	23	16
LBS. OF VERTICAL BAR STEEL	NONE	60	18

WELDING ANCHOR BOLTS TO THE CAGE IS UNACCEPTABLE. TIE WIRES SHALL BE USED.

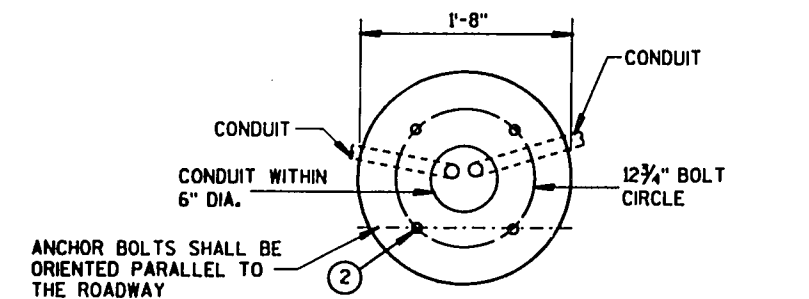

FORM ALL EXPOSED CONCRETE. PROVIDE 1" CHAMFER ALL AROUND

HALF SECTION IN UNPAVED AREA (TYPICAL FOR TYPES 1, 2 & 5)

TOPSOIL AND SEED OR CRUSHED AGGREGATE


HALF SECTION IN PAVEMENT (TYPICAL FOR TYPES 1, 2 & 5)

3/4" PREFORMED FILLER AS APPROVED BY THE ENGINEER

CADWELDED CONNECTION FOR GROUNDING WIRE

5/8" DIA. X 8'-0" COPPERCLAD GROUND ROD REQUIRED


TYPE 1

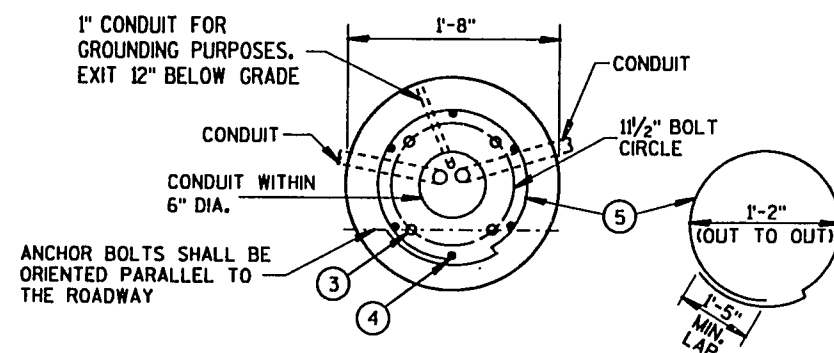

LOCK WASHER (TYPICAL)

FORM ALL EXPOSED CONCRETE. PROVIDE 1" CHAMFER ALL AROUND

TYPE 2

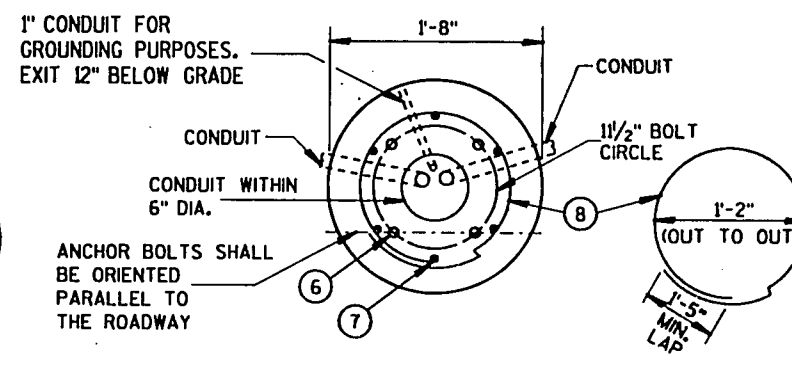

FORM ALL EXPOSED CONCRETE. PROVIDE 1" CHAMFER ALL AROUND

CADWELDED CONNECTION FOR GROUNDING WIRE

5/8" DIA. X 8'-0" COPPERCLAD GROUND ROD REQUIRED

TYPE 5

CONCRETE BASES

GENERAL NOTES

DETAILS OF CONSTRUCTION, MATERIALS AND WORKMANSHIP NOT SHOWN ON THIS DRAWING SHALL CONFORM TO THE PERTINENT REQUIREMENTS OF THE CONTRACT.

BASES SHALL BE EXCAVATED BY USE OF A CIRCULAR AUGER.

TOP SURFACES OF CONCRETE BASES SHALL BE TROWEL FINISHED AND LEVEL.

CONDUIT SIZES AND LOCATIONS SHALL BE AS SHOWN ON THE PLANS.

MINIMUM BENDING RADIUS OF CONDUIT = 6 X THE DIAMETER.

CONDUIT HEIGHT ABOVE CONCRETE BASES SHALL BE 1 INCH. ALL METALLIC CONDUIT ENDS SHALL BE REAMED AND THREADED.

ALL METALLIC CONDUITS IN WHICH WIRE OR CABLE IS NOT TO BE INSTALLED SHALL BE CAPPED WITH THREADED PROTECTIVE CAPS, AS APPROVED BY THE ENGINEER.

ALL NONMETALLIC CONDUITS IN WHICH WIRE OR CABLE IS NOT INSTALLED SHALL BE PLUGGED.

ALL CONDUIT ENDS AT THE TOP OF CONCRETE BASES SHALL BE CAPPED IF METALLIC OR PLUGGED IF NONMETALLIC IMMEDIATELY AFTER PLACEMENT AND BEFORE CONCRETE IS POURED. CONDUITS IN WHICH WIRE OR CABLE IS NOT INSTALLED SHALL REMAIN CAPPED OR PLUGGED.

BELL ENDS SHALL BE INSTALLED ON ALL PVC CONDUIT EXPOSED AT THE TOP OF CONCRETE BASES BEFORE INSTALLATION OF CABLE OR WIRE.

ENDS OF CONDUIT INSTALLED BELOW GRADE FOR FUTURE USE SHALL BE CAPPED IF METALLIC OR PLUGGED IF NONMETALLIC.

WHEN REQUIRED TO CONNECT NONMETALLIC CONDUIT TO METALLIC CONDUIT, ONLY ADAPTER FITTINGS, U.L. LISTED FOR ELECTRICAL USE, SHALL BE USED.

IF A BASE REQUIRES A DEEP FORM BECAUSE OF LOOSE DIRT OR FILL, THE FORM SHALL BE REMOVED BEFORE BACKFILLING AROUND THE BASE. BACKFILL SHALL BE TAMPED TIGHT AGAINST THE BARE CONCRETE BASE IN LAYERS OF 1 FOOT OR LESS.

A NO. 6 AWG. STRANDED COPPER GROUNDING WIRE SHALL BE CADWELDED TO THE GROUND ROD FOR TYPE 2 AND TYPE 5 BASES.

THE GROUNDING WIRE SHALL BE FURNISHED AND INSTALLED TO ENTER THE BASE OF THE TYPE 2 AND TYPE 5 BASES THROUGH A 1 INCH CONDUIT INSTALLED FOR GROUNDING PURPOSES, LEAVING A 4 FOOT COIL OF WIRE ABOVE THE CONCRETE BASE. THE GROUNDING WIRE SHALL BE NEATLY COILED AND THE COILS TIED TOGETHER.

ANCHOR BOLTS SHALL BE THREADED 8" IN LENGTH ON EACH END OF THE BOLT, AND BE MANUFACTURED IN ACCORDANCE WITH SECTION 640.2.9 OF THE STANDARD SPECIFICATIONS, ASTM A-449, OR ASTM A-687 (GRADE 105).

WHEN ANCHOR BOLTS USING THE ALTERNATE "L" BEND ARE FURNISHED, THE 4" "L" BEND SHALL BE IN ADDITION TO THE SPECIFIED ANCHOR BOLT BAR LENGTH. THE "L" BEND END SHALL NOT BE THREADED.

1 THE MINIMUM DEPTH OF CONDUIT EXITING THE CONCRETE BASE AND INSTALLED BELOW THE TRAVELED WAY SHALL BE 24 INCHES. THE MINIMUM DEPTH OF CONDUIT EXITING THE CONCRETE BASE THAT IS NOT INSTALLED BELOW THE TRAVELED WAY SHALL BE 18 INCHES. THE MAXIMUM DEPTH OF ALL CONDUIT SHALL BE 36 INCHES EXCEPT WITH WRITTEN APPROVAL BY THE ENGINEER.

- 2 (4) 1" DIA. X 3'-6" ANCHOR BOLTS.
- 3 (4) 1" DIA. X 5'-0" ANCHOR BOLTS.
- 4 (6) NO. 6 X 6'-8" BAR STEEL REINFORCEMENT.
- 5 (7) NO. 4 X 5'-1" BAR STEEL REINFORCEMENT @ 1'-0" C-C.
- 6 (4) 1" DIA. X 3'-6" ANCHOR BOLTS.
- 7 (6) NO. 4 X 4'-8" BAR STEEL REINFORCEMENT
- 8 (5) NO. 4 X 5'-1" BAR STEEL REINFORCEMENT @ 1'-0" C-C.


CONCRETE BASES

STATE OF WISCONSIN
DEPARTMENT OF TRANSPORTATION


APPROVED
4/21/93
DATE
4/21/93
DATE

STATE ELECTRICAL ENGINEER FOR HWYS
STATE TRAFFIC ENGINEER FOR HWYS


FHWA

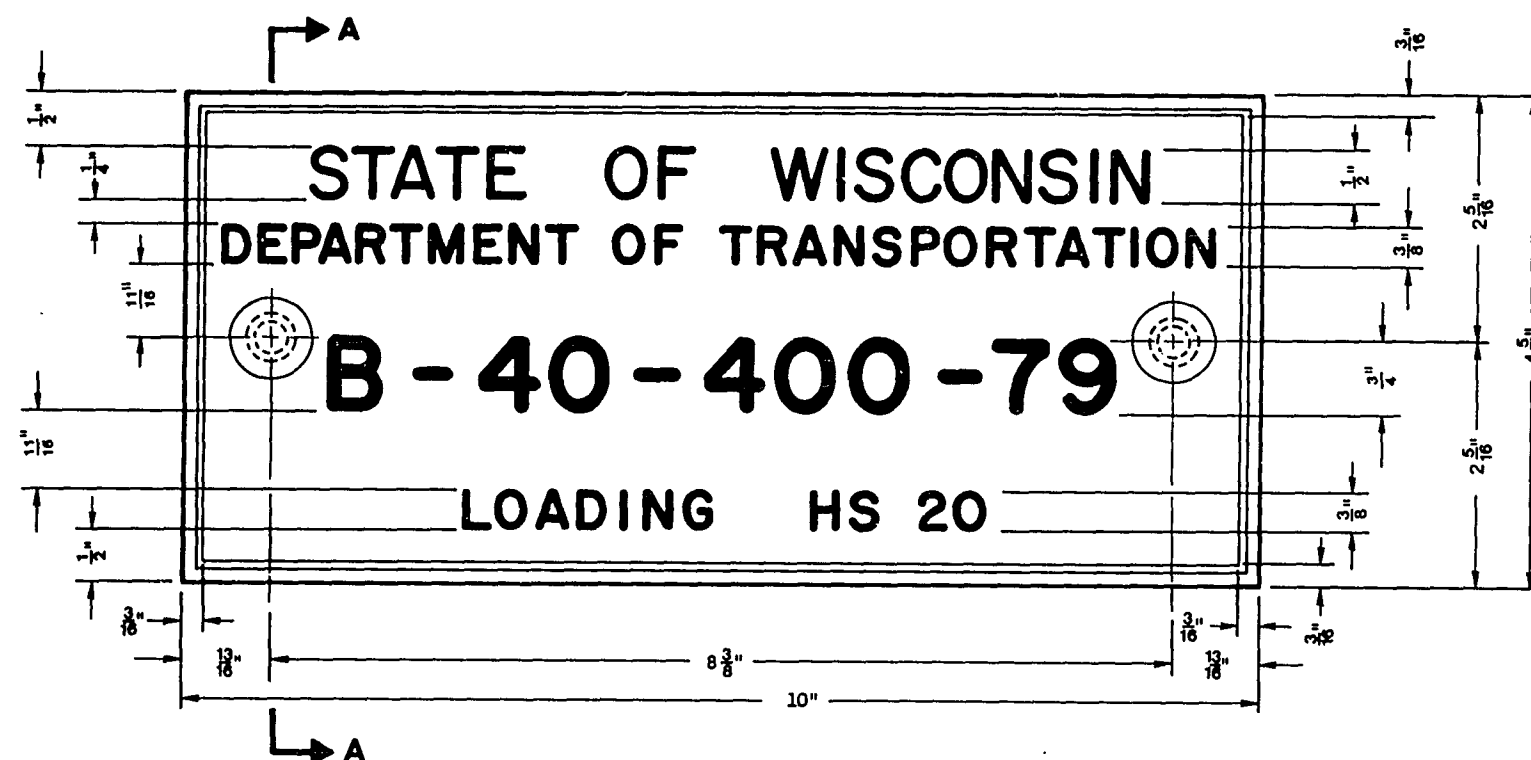


TYPICAL NAME PLATE
(BRIDGES, CULVERTS, AND RETAINING WALLS)

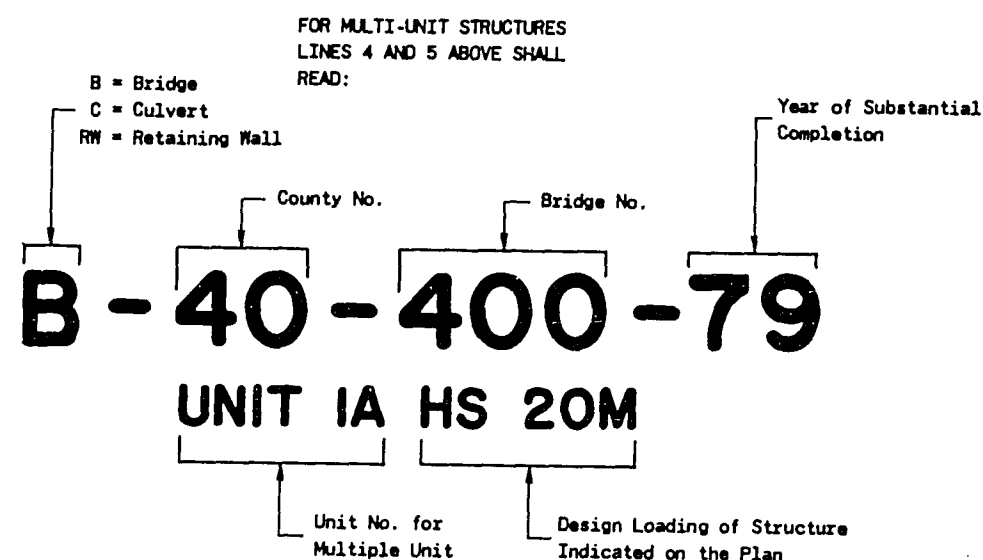

NUMBERING AND LOADING DESIGNATION
MULTI-UNIT STRUCTURES

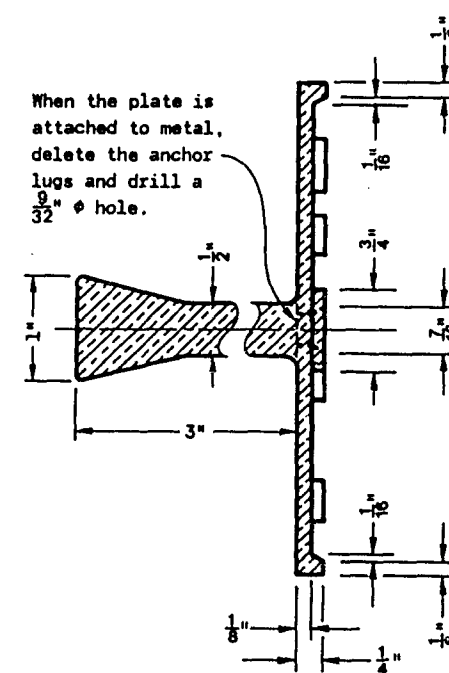

SECTION A-A

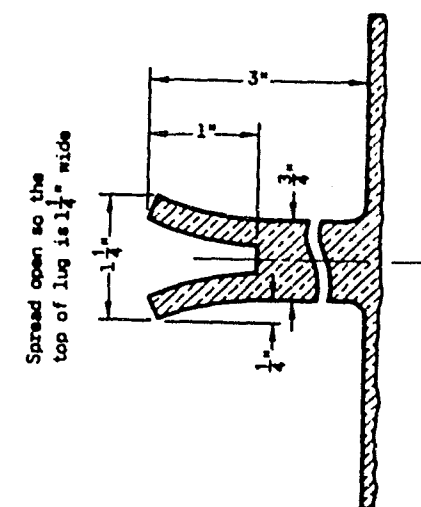

ALTERNATE LUG

GENERAL NOTES

Name Plates to be installed on Bridges, Culverts, and Retaining Walls shall conform to the requirements of Section 506.2.4 of the Standard Specifications.


The Bridge Number and Design Loading shown on this drawing are examples only. See Construction Plans for individual numbering and design loading.

**NAME PLATE
(STRUCTURES)**


State of Wisconsin
Department of Transportation
Division of Transportation Facilities

APPROVED
9-27-79
DATE


[Signature]
CHIEF DESIGN ENGINEER

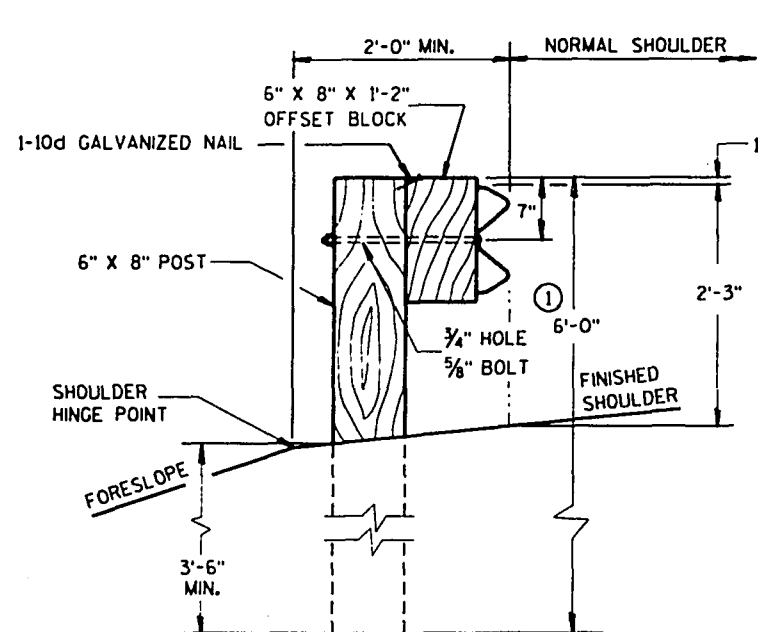


END VIEW
LOCATED ALONG A ROADWAY SHOULDER

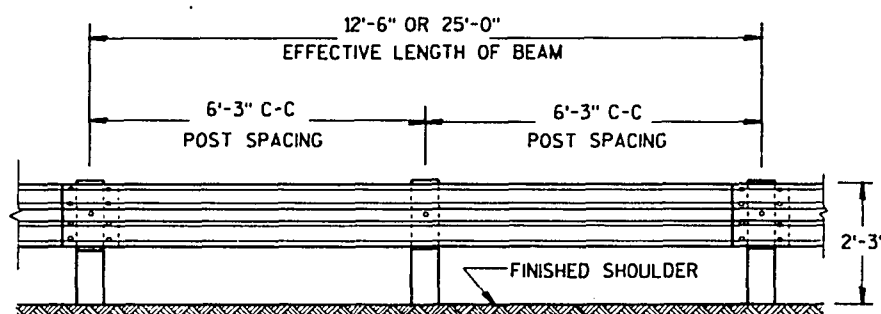

FRONT VIEW

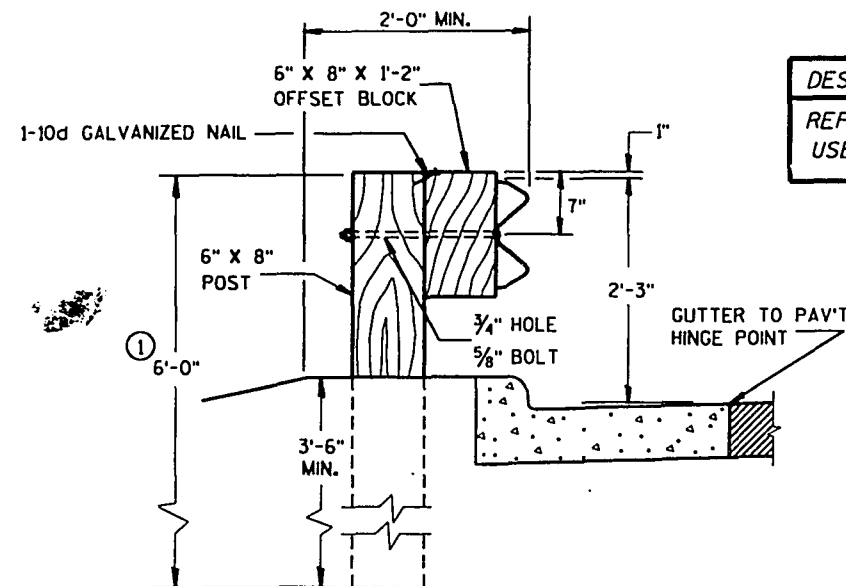


END VIEW
LOCATED ALONG A CURBED ROADWAY

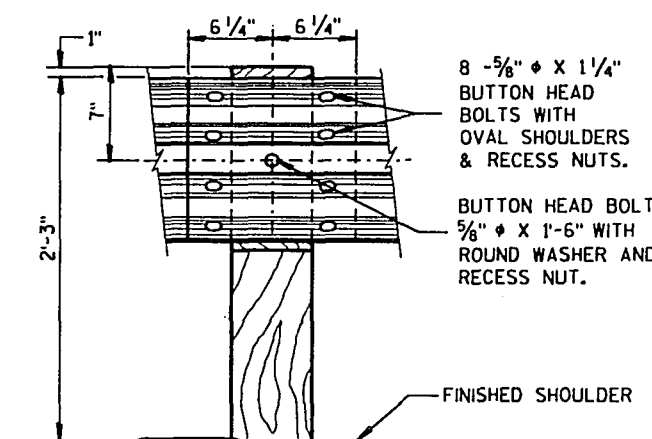


FRONT VIEW
BEAM SPICING AND POST MOUNTING DETAIL


DESIGN NOTE: (WILL NOT APPEAR ON CONTRACT PLANS)
REFER TO PROCEDURE 11-45-1 FOR GUIDANCE ON THE
USE OF BEAM GUARD ON CURBED ROADWAYS.

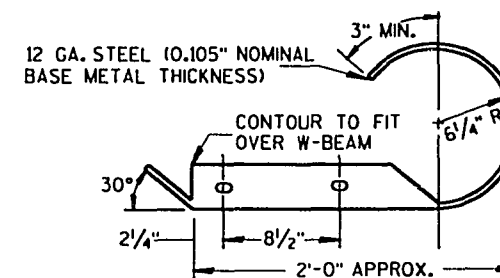


PLAN VIEW

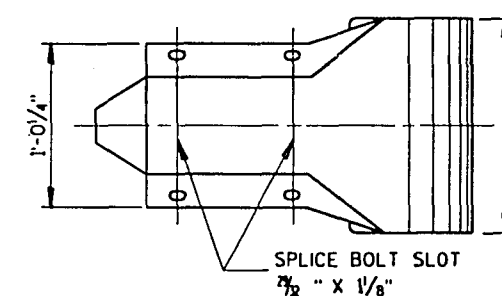

FRONT VIEW
W BEAM END SECTION (ROUNDED)

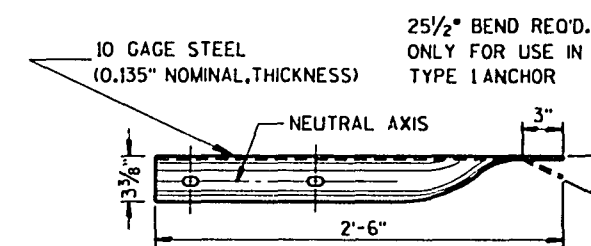

PLAN VIEW

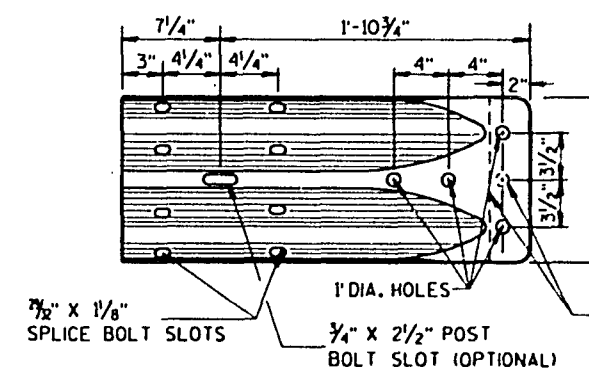


FRONT VIEW
W BEAM TERMINAL CONNECTOR


GENERAL NOTES

DETAILS OF CONSTRUCTION, MATERIALS AND WORKMANSHIP NOT SHOWN ON THIS DRAWING SHALL CONFORM TO THE PERTINENT REQUIREMENTS OF THE STANDARD SPECIFICATIONS, AND THE APPLICABLE SPECIAL PROVISIONS.

- POST LENGTH SHALL BE INCREASED TO PROVIDE A MINIMUM EMBEDMENT OF 3'-6" WHERE THE SHOULDER HINGE POINT IS LOCATED IN FRONT OF THE POST.
- PROVIDE TYPE "H" SILVER REFLECTIVE SHEETING ON ALL REFLECTORS EXCEPT THOSE LOCATED ALONG THE LEFT EDGE OF ONE-WAY ROADWAYS, WHICH SHALL BE PROVIDED WITH TYPE "H" YELLOW REFLECTIVE SHEETING.

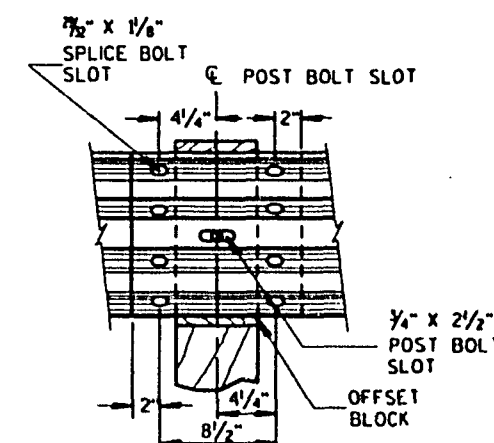

W BEAM SPLICE

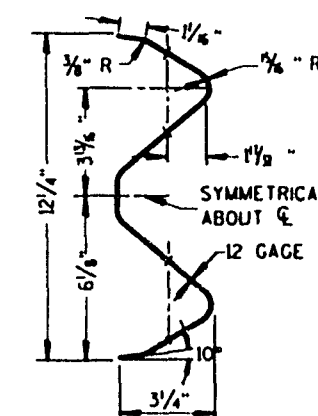

SECTION THRU W BEAM

NOTE:
SHEETS 10 IS OPTIONAL FOR INCLUSION
IN PLANS WHEN APPLICABLE.

CLASS "A"
STEEL PLATE BEAM GUARD,
INSTALLATION & ELEMENTS

STATE OF WISCONSIN
DEPARTMENT OF TRANSPORTATION

APPROVED
S. J. H. / 10/04
DATE
STATE DESIGN ENGINEER FOR HWYS.
FHWA



TYPICAL INSTALLATION OF STEEL PLATE BEAM GUARD

REFLECTOR SPACING


	BEAM GUARD LENGTH	REFLECTOR SPACING	NO. SURFACES REFLECTORIZED	MIN. NO. REFLECTORS
ONE WAY TRAFFIC	< 200'	50' C-C	1	3
	> 200'	100' C-C	1	
TWO WAY TRAFFIC	< 200' *	25' C-C	1 *	6
	> 200' *	50' C-C	1 *	
TWO WAY TRAFFIC	< 200'	50' C-C	2 **	3
	> 200'	100' C-C	2 **	

* EVERY OTHER REFLECTOR REVERSED FOR 2-WAY VISIBILITY. CONTRACTOR MAY FURNISH TWO-SIDED REFLECTORS IN LIEU OF ONE-SIDED REFLECTORS.


** ANGLE OF BEND TO BE 90° ± 1° FOR TWO-SIDED REFLECTORS.

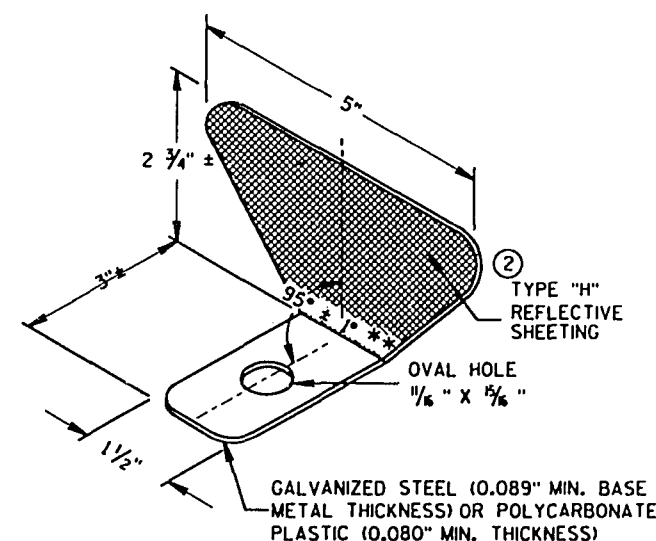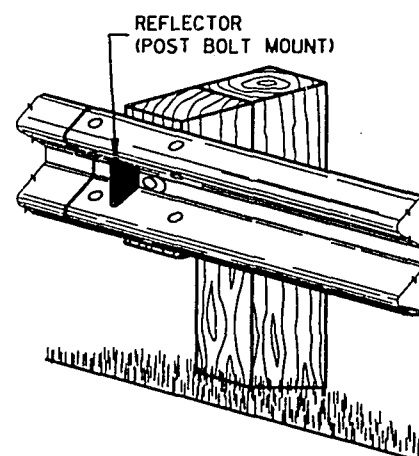


REFLECTOR DETAIL AND TYPICAL INSTALLATION

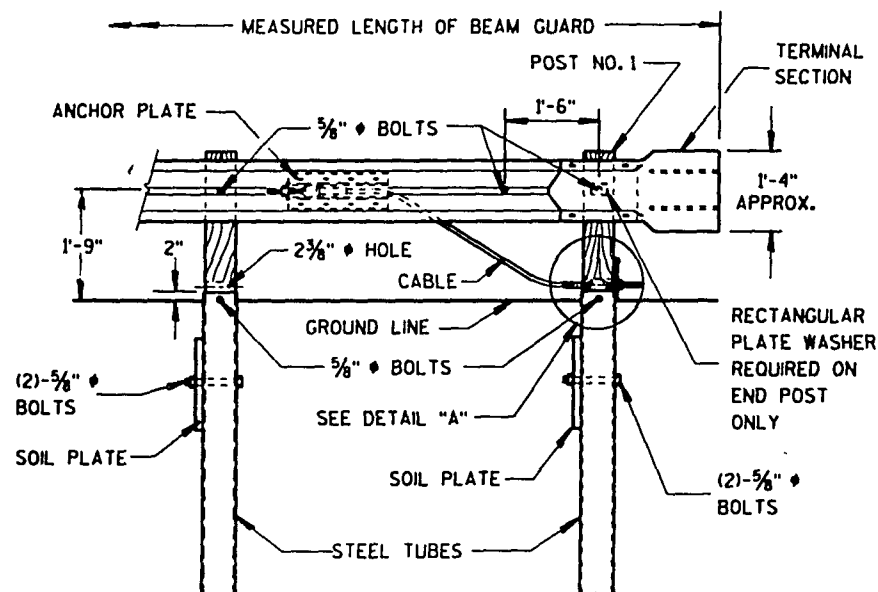

① FRONT VIEW
TYPE 1 ANCHORAGE

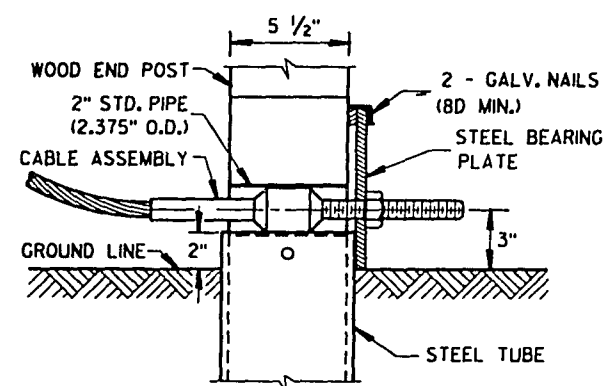


DETAIL "A"
(POST NO. 1)

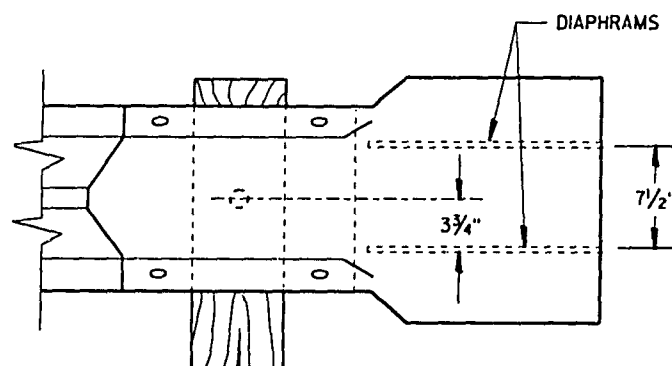

FRONT VIEW


POST NO.	OFFSET (FEET)
1	4.00
2	2.78
3	1.78
4	1.00
5	0.44
6	0.11
7	0.00

**37'-6" INSTALLATION, 6 SPACES AT 6'-3"
TANGENT OFFSET TABLE

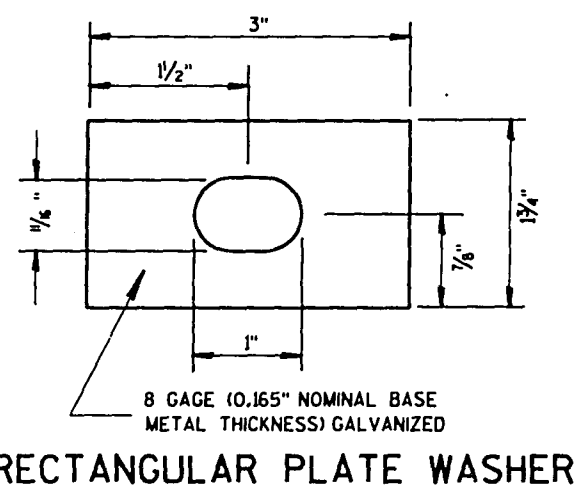


NOTE:
TWO PIECE CONSTRUCTION IS
ILLUSTRATED. A ONE PIECE
TERMINAL IS ACCEPTABLE

TERMINAL SECTION - MIN. 12 GA. STEEL
(0.105" NOMINAL BASE METAL THICKNESS)

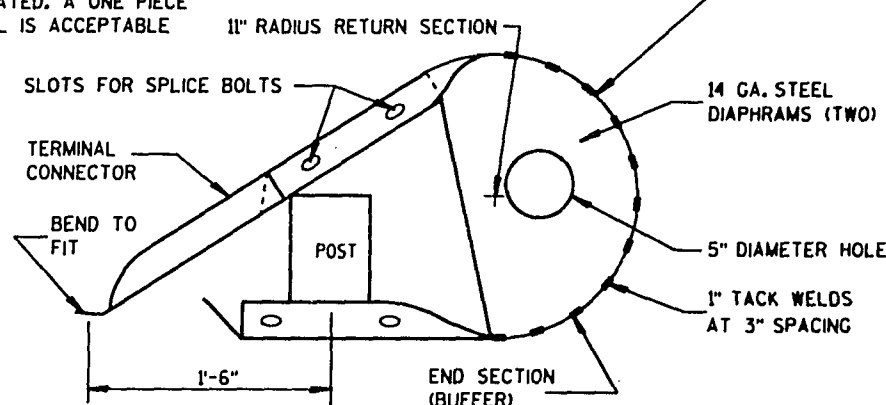

PLAN VIEW

TERMINAL SECTION DETAIL

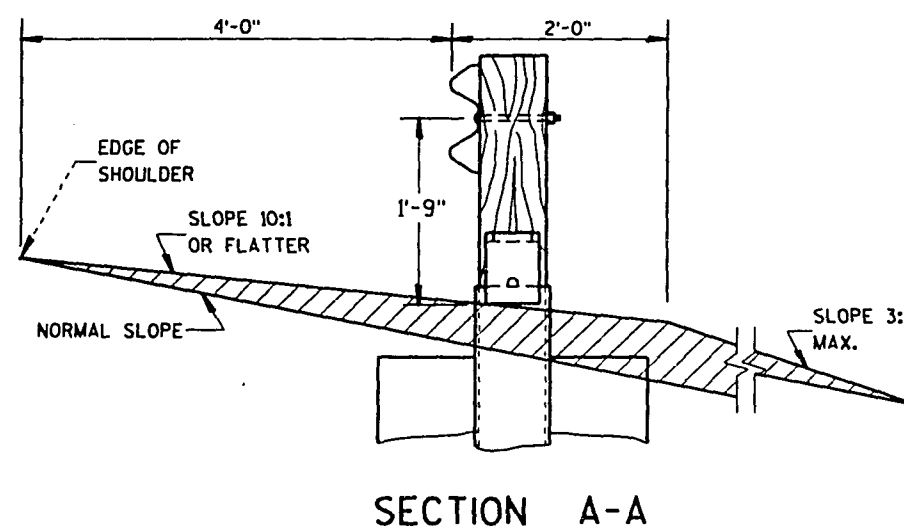


GENERAL NOTES

DETAILS OF CONSTRUCTION, MATERIALS AND WORKMANSHIP NOT SHOWN ON THIS DRAWING SHALL CONFORM TO THE PERTINENT REQUIREMENTS OF THE STANDARD SPECIFICATIONS AND THE APPLICABLE SPECIAL PROVISIONS.


POSTS AT LOCATIONS 1 & 2 SHALL BE WOOD BREAKAWAY POSTS INSERTED AND BOLTED INTO STEEL TUBES.

- ① TYPE 1 AND TYPE 2 ANCHORAGES SHALL CONSIST OF STEEL TUBE(S), SOIL PLATE(S), WOOD BREAKAWAY POST(S), BEARING PLATE, ANCHOR PLATE, CABLE ASSEMBLY AND ALL ASSOCIATED HARDWARE. ALL STEEL PARTS SHALL BE GALVANIZED.

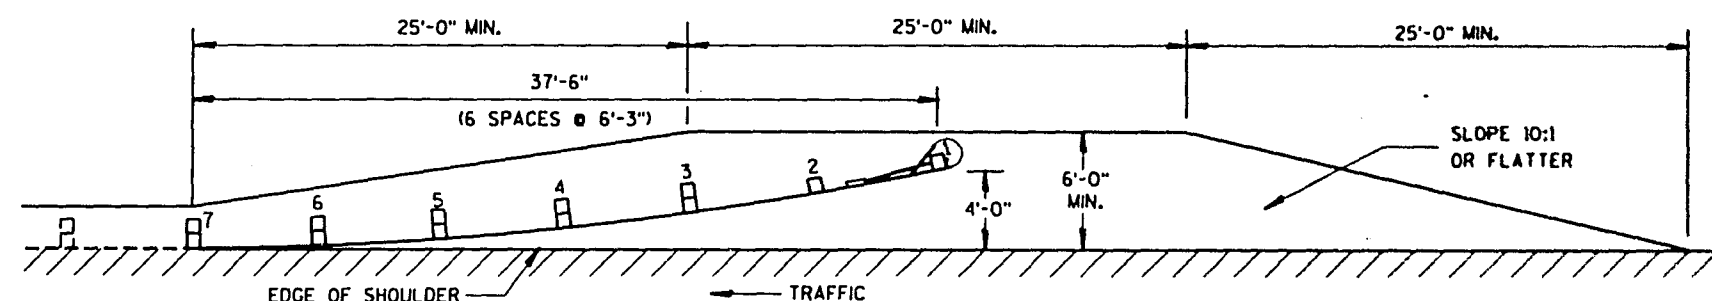

PLAN VIEW

ROADWAY WIDENING FOR TYPE 1 ANCHORAGE

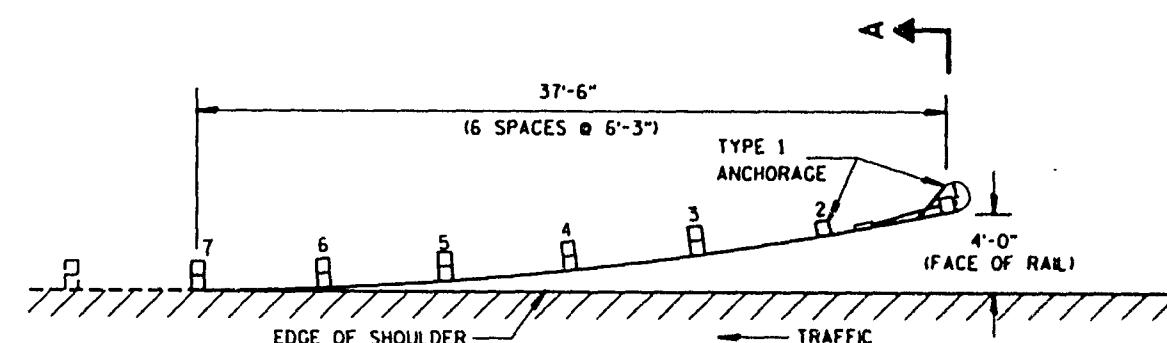


PLAN VIEW

END TREATMENT WITH ANCHORAGE TYPE 1

NOTE:
THIS DRAWING CONSISTS OF TWO SHEETS.
BOTH SHEETS ARE REQUIRED WHEN THIS
DRAWING IS CALLED FOR IN THE PLANS.


CLASS "A" STEEL PLATE BEAM GUARD
END TREATMENT WITH ANCHORAGE,
TYPE 1 & 2

STATE OF WISCONSIN
DEPARTMENT OF TRANSPORTATION

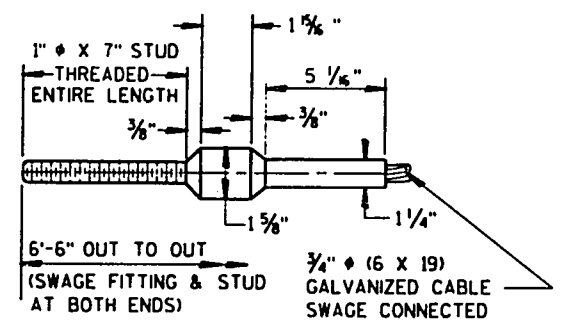


CABLE ASSEMBLY

CABLE, SWAGE FITTING, STUD AND NUT SHALL DEVELOP A MINIMUM BREAKING STRENGTH OF 40,000 LB (TIGHTEN UNTIL TAUT)

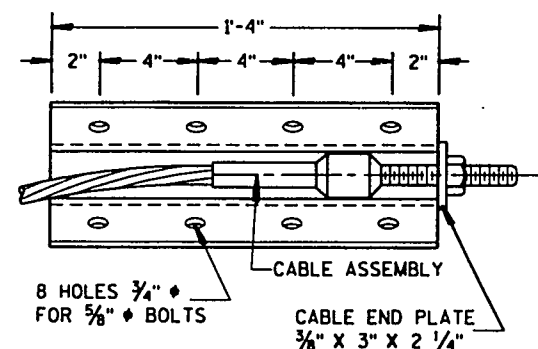


FRONT VIEW


ANCHOR PLATE DETAIL

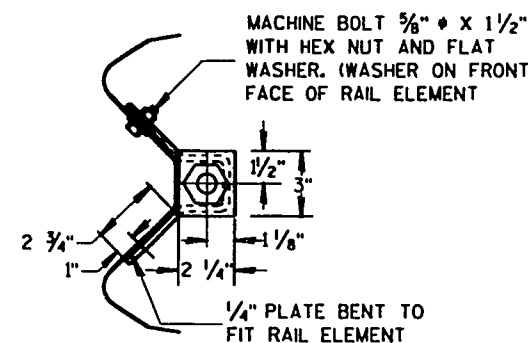


END VIEW

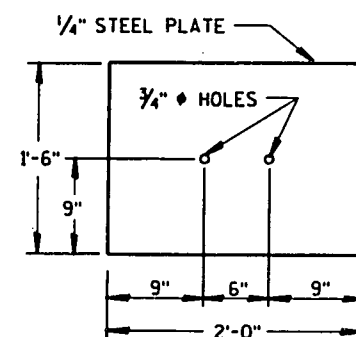


SOIL PLATE

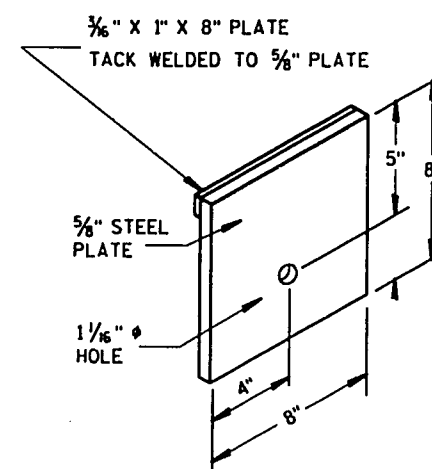

STEEL BEARING PLATE

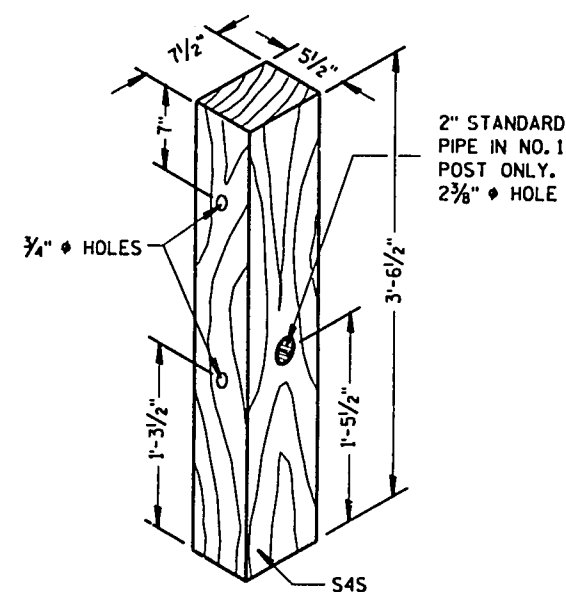

WOOD BREAKAWAY POST

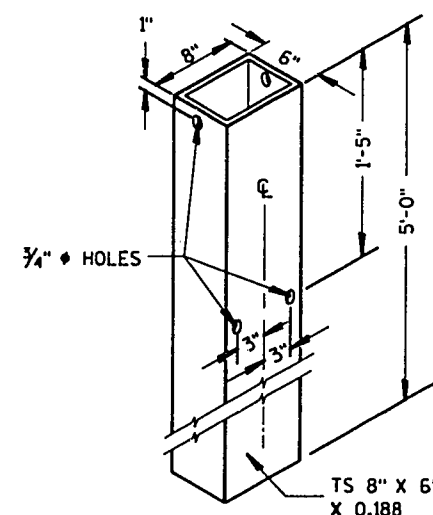

STEEL TUBE


THE STEEL TUBE SHALL CONFORM TO REQUIREMENTS OF ASTM A501

ANCHORAGE COMPONENTS


(COMMON TO BOTH TYPE 1 & 2 ANCHORAGES)

NOTE:


STRUCTURAL TUBING SHALL CONFORM TO THE REQUIREMENTS OF ASTM A-500 GRADE B OR ASTM A-501

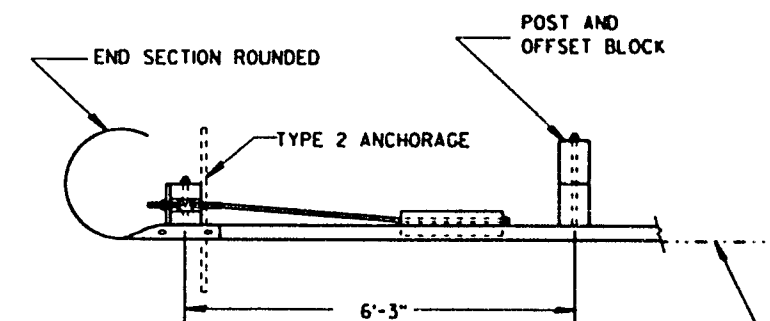

PLAN VIEW

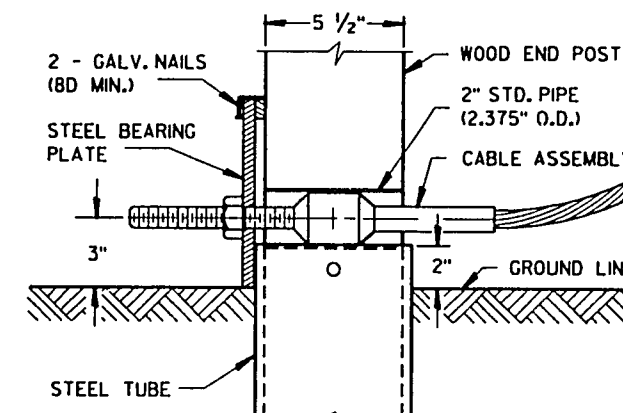

DETAIL "A"
(POST NO. 1)

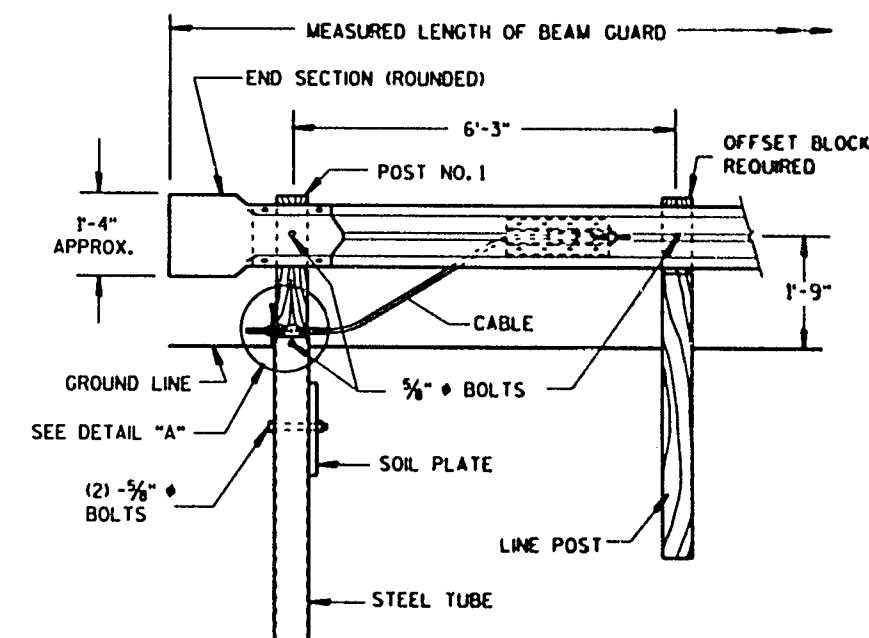

FRONT VIEW
TYPE 2 ANCHORAGE


END TREATMENT WITH ANCHORAGE TYPE 2
(USE ON ONE-WAY ROADWAYS ONLY - DEPARTING END)

NOTE:
THIS DRAWING CONSISTS OF TWO SHEETS.
BOTH SHEETS ARE REQUIRED WHEN THIS
DRAWING IS CALLED FOR IN THE PLANS.


CLASS 'A' STEEL PLATE BEAM GUARD
END TREATMENT WITH ANCHORAGE.
TYPE 1 & 2

STATE OF WISCONSIN
DEPARTMENT OF TRANSPORTATION


APPROVED
5/15/71
DATE
STATE DESIGN ENGINEER FOR HWYS
FMWA

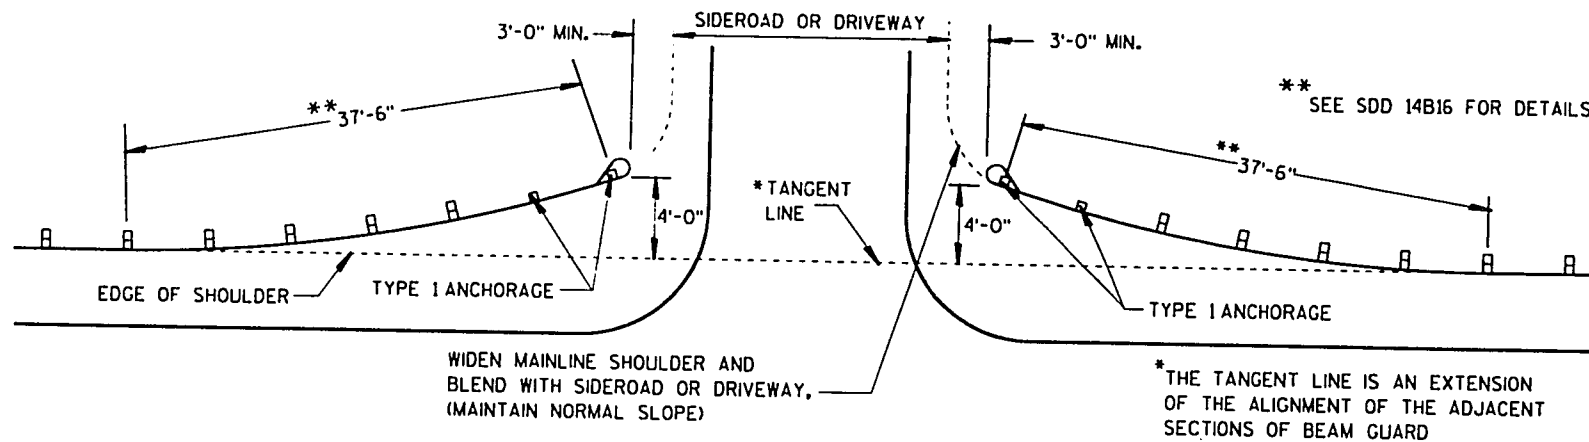


BEAM GUARD AT MINOR SIDEROADS OR DRIVEWAYS

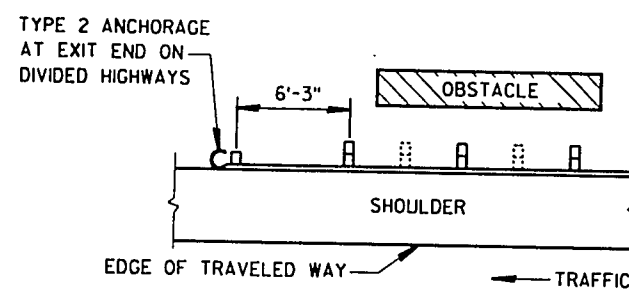

BEAM GUARD AT OBSTACLES
EXIT END - ONE WAY TRAFFIC

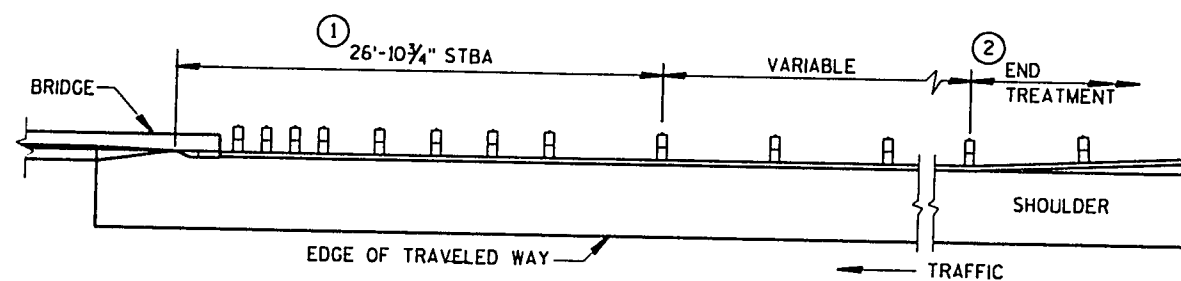

BEAM GUARD AT FULL WIDTH BRIDGES

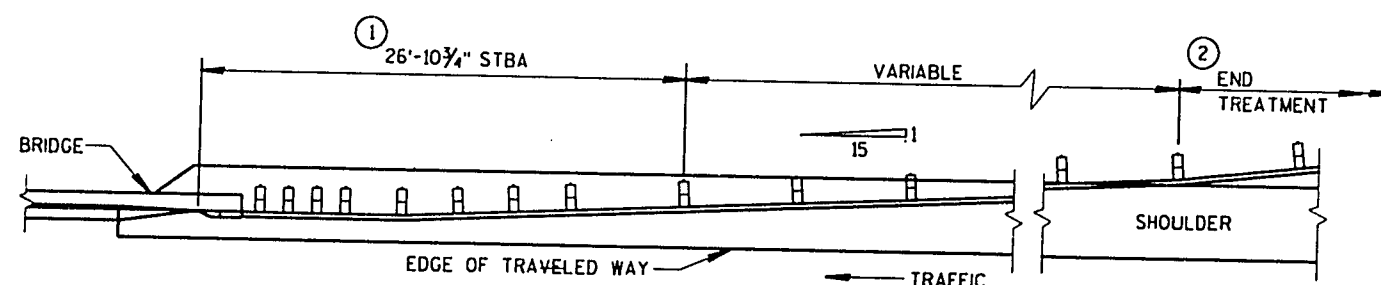


BEAM GUARD AT NARROW BRIDGES

GENERAL NOTES


DETAILS OF CONSTRUCTION, MATERIALS AND WORKMANSHIP NOT SHOWN ON THIS DRAWING SHALL CONFORM TO THE PERTINENT REQUIREMENTS OF THE STANDARD SPECIFICATIONS AND THE APPLICABLE SPECIAL PROVISIONS.

BEAM GUARD LOCATIONS AND LENGTHS ARE SHOWN ELSEWHERE IN THE PLAN.

- ① STEEL THRIE BEAM STRUCTURE APPROACH.
- ② UNLESS OTHERWISE INDICATED, THE FLARED END TREATMENT WITH A TYPE 1 ANCHORAGE SHALL BE USED TO TERMINATE BEAM GUARD ON THE TRAFFIC APPROACH SIDE OF BRIDGES/OBSTACLES. TYPE 2 ANCHORAGE SHALL BE USED ONLY AT THE DOWNSTREAM ENDS OF BEAM GUARD LOCATED ALONG ROADWAYS WITH ONE WAY TRAFFIC.

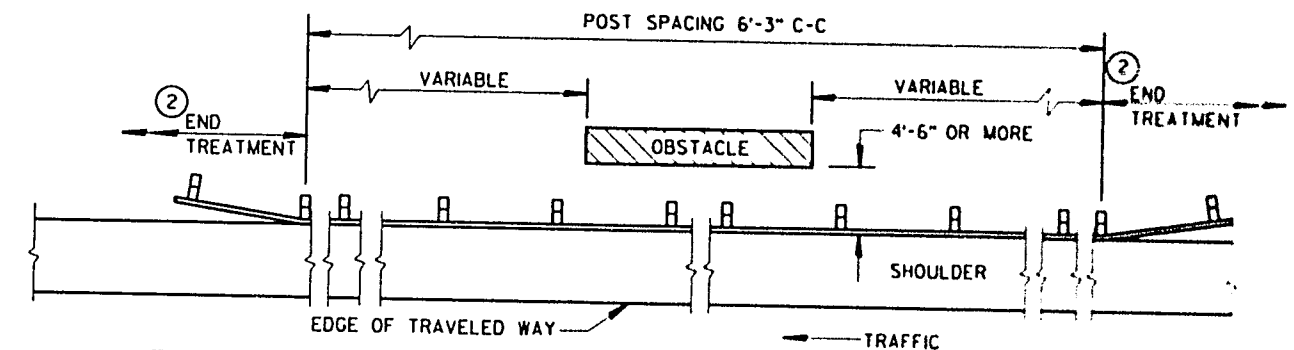

BEAM GUARD AT OBSTACLES - TWO WAY TRAFFIC
(RAIL TO OBSTACLE CLEARANCE 4'-6" OR MORE)

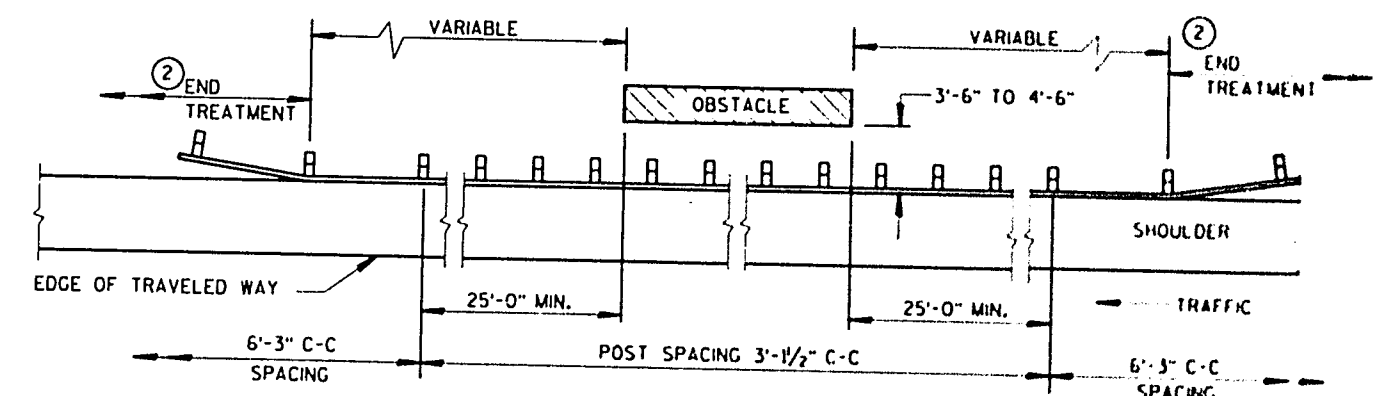

BEAM GUARD AT OBSTACLES - TWO WAY TRAFFIC
(RAIL TO OBSTACLE CLEARANCE 3'-6" TO 4'-6")

CLASS 'A' STEEL PLATE
BEAM GUARD
(AT BRIDGES, OBSTACLES
AND SIDEROADS/DRIVEWAYS)

STATE OF WISCONSIN
DEPARTMENT OF TRANSPORTATION






APPROVED

5/11/91

DATE

STATE DESIGN ENGINEER FOR HWYS

FWA

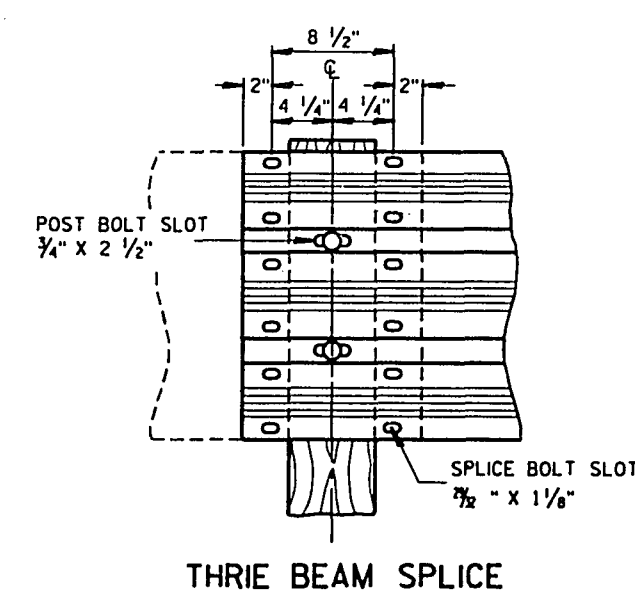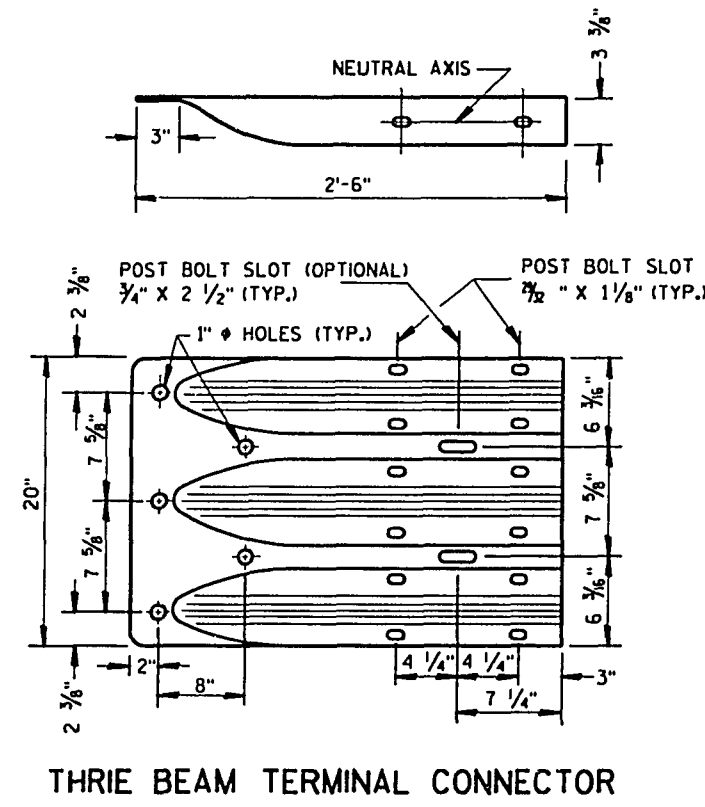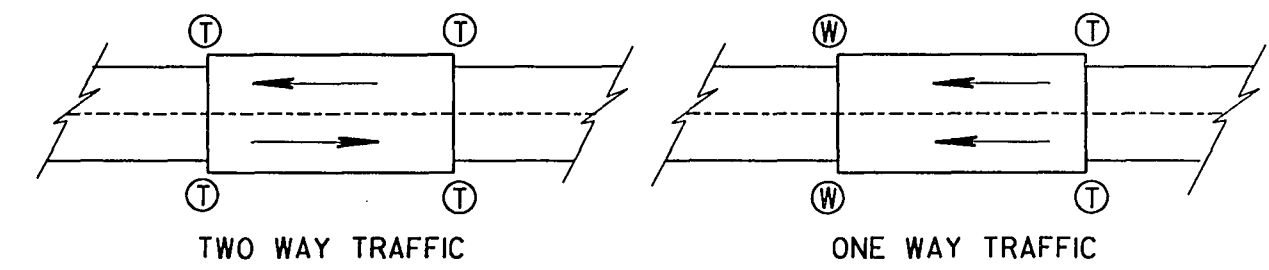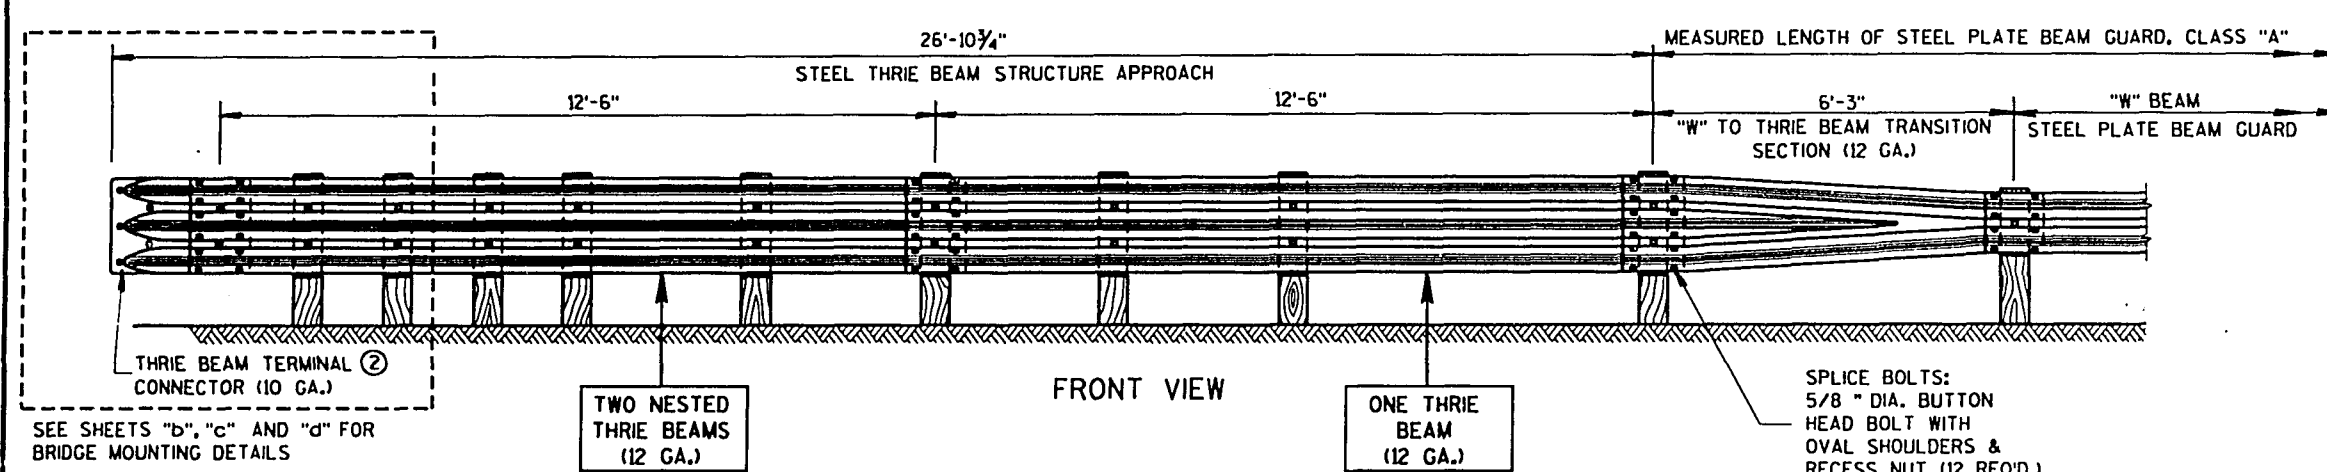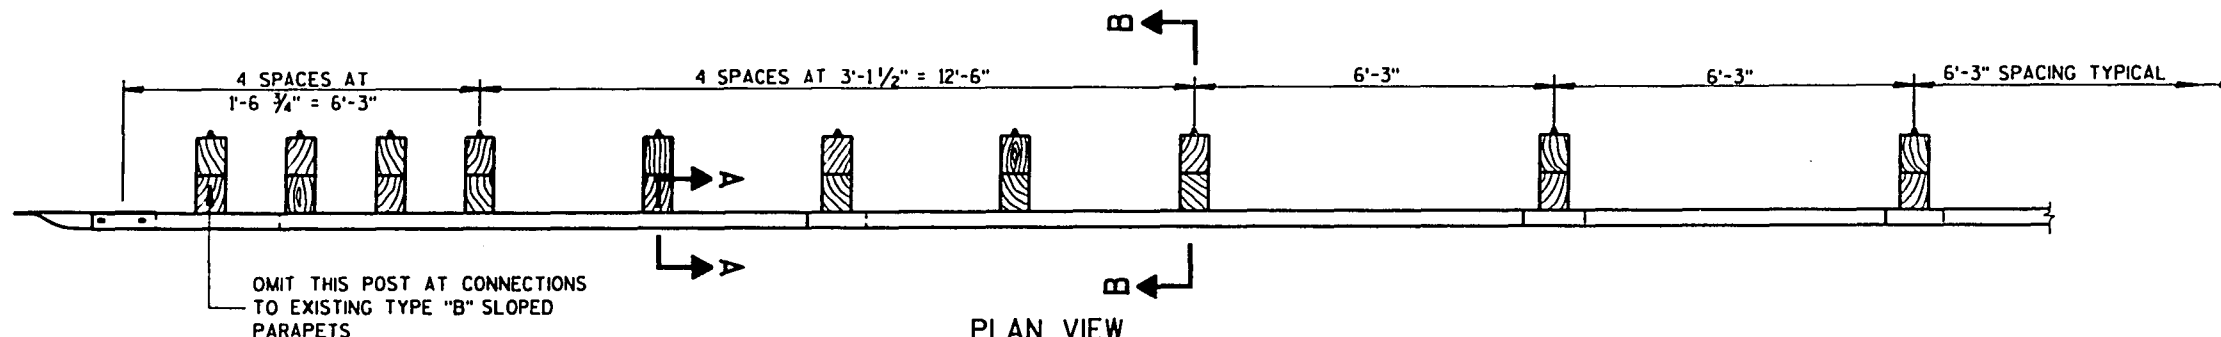

GENERAL NOTES




DETAILS OF CONSTRUCTION, MATERIALS AND WORKMANSHIP NOT SHOWN ON THIS DRAWING SHALL CONFORM TO THE PERTINENT REQUIREMENTS OF THE STANDARD SPECIFICATIONS AND THE APPLICABLE SPECIAL PROVISIONS.

THRIE BEAM STRUCTURE APPROACH SHALL BE FURNISHED AND CONSTRUCTED IN ACCORDANCE WITH THE REQUIREMENTS OF SECTION 614 OF THE STANDARD SPECIFICATIONS. THRIE BEAM SECTIONS SHALL CONFORM TO THE REQUIREMENTS FOR CLASS "A", TYPE 2, BEAM AS SPECIFIED IN AASHTO DESIGNATION W180.

THRIE BEAM SHALL BE BOLTED TO ALL POSTS AND OFFSET BLOCKS. FIELD DRILLING/PUNCHING OF BOLT HOLES IN THE BEAM IS PERMITTED WHERE POST SPACING IS LESS THAN 6'-3".

① POST LENGTH SHALL BE INCREASED TO PROVIDE A MINIMUM EMBEDMENT OF 4'-0" WHERE THE SHOULDER HINGE POINT IS LOCATED IN FRONT OF THE POST.

② A TERMINAL CONNECTOR IS NOT REQUIRED AT CONNECTIONS TO BRIDGE RAILING TYPE "W".

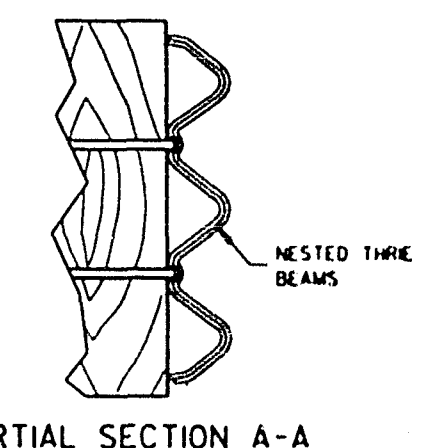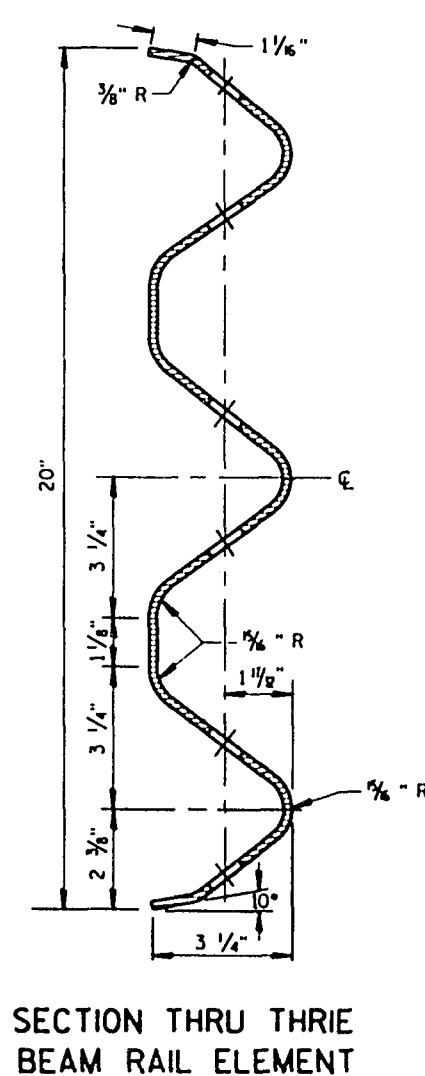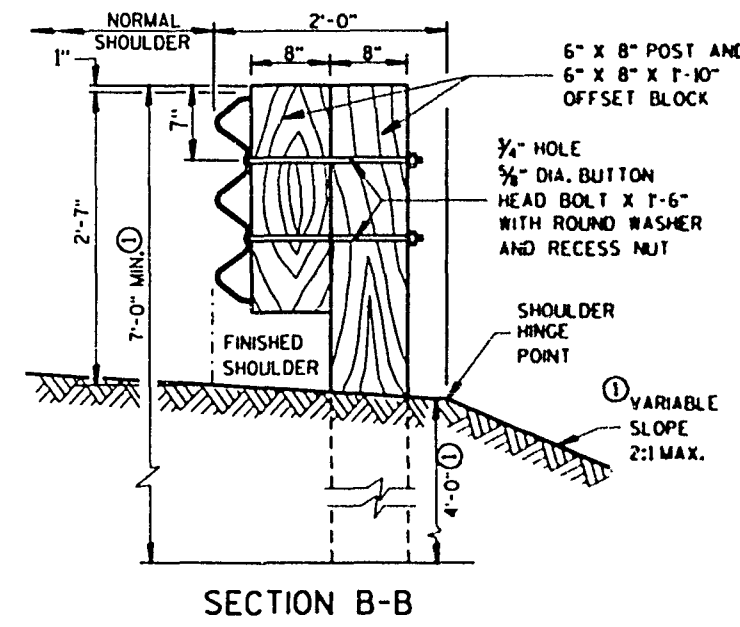


NOTE:
THIS DRAWING CONSISTS OF FOUR SHEETS.
SHEET 2a MUST BE SUPPLEMENTED WITH AT LEAST ONE ADDITIONAL SHEET, 2b, 2c OR 2d WHEN THIS DRAWING IS CALLED FOR IN PLANS.

STEEL THRIE BEAM
STRUCTURE APPROACH




STATE OF WISCONSIN
DEPARTMENT OF TRANSPORTATION

S.D.D. 14 B 20-20


S.D.D. 14 B 20-20

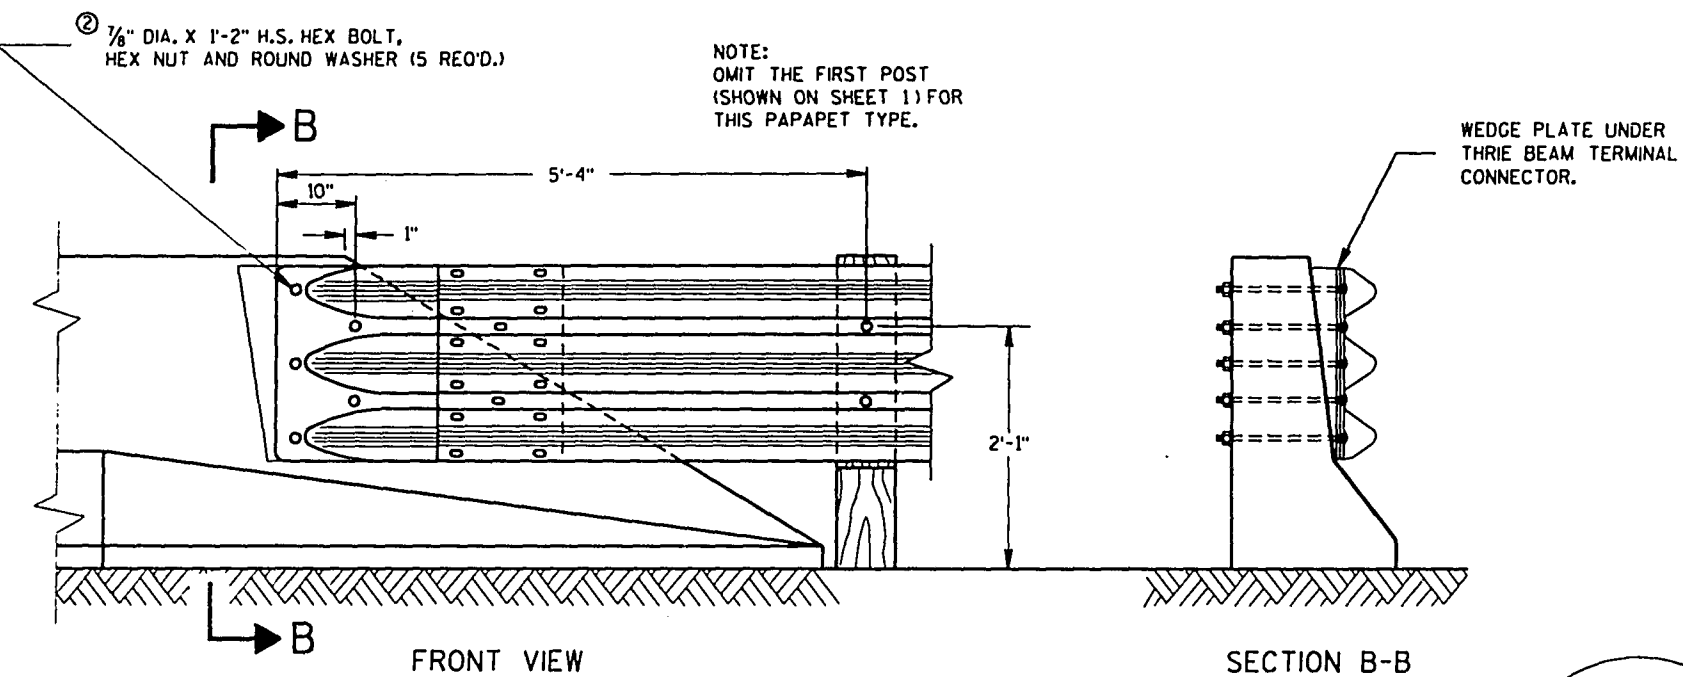


THRIE BEAM CONNECTION TO BRIDGE PARAPETS WITH SLOPED ENDS

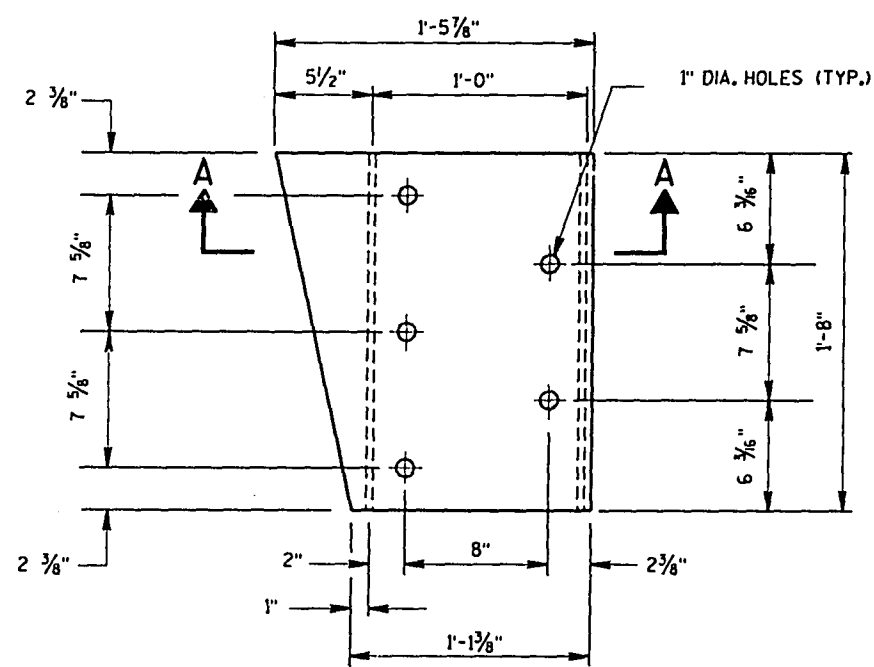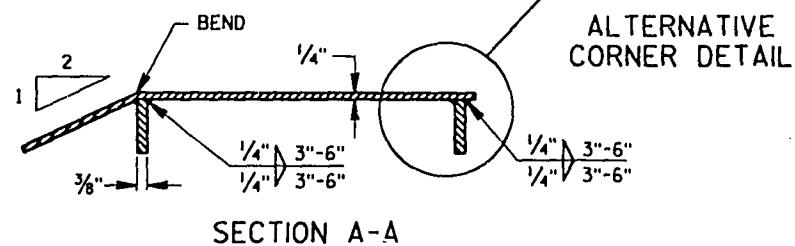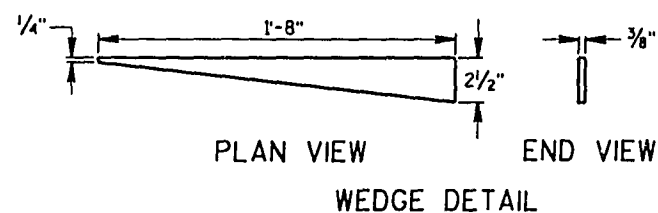

③ RIGHT SIDE WEDGE PLATE

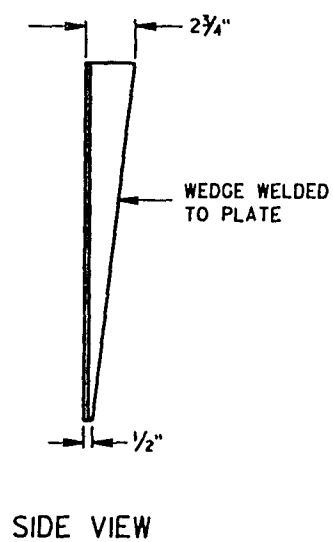

① WEDGE PLATE DETAILS

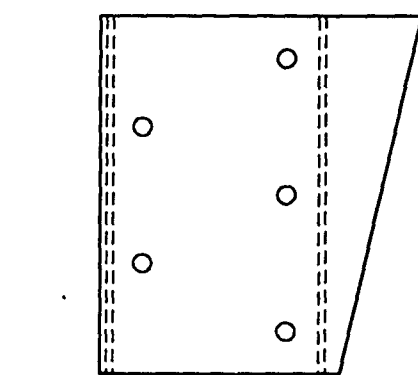



③ LEFT SIDE WEDGE PLATE

GENERAL NOTES

THE CONNECTION DETAILS SHOWN ARE TYPICAL. THE POSITION OF THE CONNECTIONS TO EXISTING BRIDGES SHALL BE ADJUSTED WHERE NECESSARY TO FIT ACTUAL BRIDGE AND SITE DIMENSIONS.

BOLTS, PLATES, NUTS AND WASHERS SHALL CONFORM TO THE REQUIREMENTS OF ASTM SPECIFICATION A 325, AND BE GALVANIZED IN ACCORDANCE WITH ASTM A 153.

- ① PAYMENT FOR DRILLING BOLT HOLES THRU THE PARAPET, WEDGE PLATE AND ALL BOLTS, NUTS AND WASHERS REQUIRED SHALL BE INCLUDED IN THE ITEM STEEL THRIE BEAM STRUCTURE APPROACH.
- ② 2 1/4" O.D. X 3/8" THICK ROUND WASHER REQUIRED WITH EACH BOLT AT THE BACKFACE OF PARAPET.
- ③ WEDGE PLATES ARE DESIGNATED AS "RIGHT" OR "LEFT" IN ACCORDANCE WITH THE PARAPET LOCATION WHEN APPROACHING THE BRIDGE.

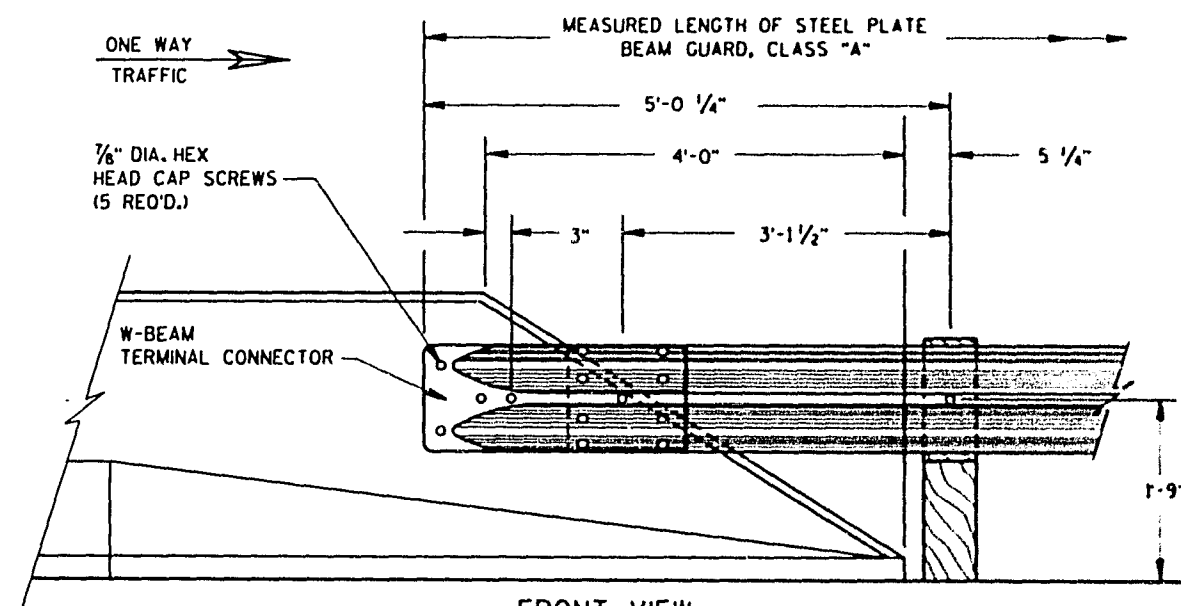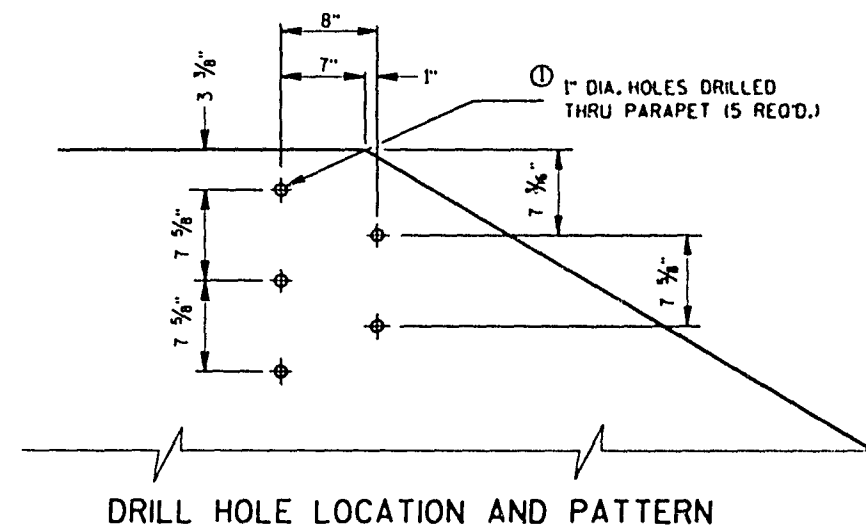

FRONT VIEW
W BEAM CONNECTION TO
PARAPETS WITH SLOPED ENDS
(USE ONLY AT TRAFFIC EXIT END OF ONE WAY BRIDGE)

STEEL THRIE BEAM STRUCTURE
APPROACH, CONNECTION TO
SLOPED END PARAPETS

STATE OF WISCONSIN
DEPARTMENT OF TRANSPORTATION


APPROVED

5/2/91
DATE


STATE DESIGN ENGINEER FOR HWYS

NOTE:
SDD 14 B 20-2a IS REQUIRED WHEN THIS
DRAWING IS CALLED FOR IN PLANS.


FHWA

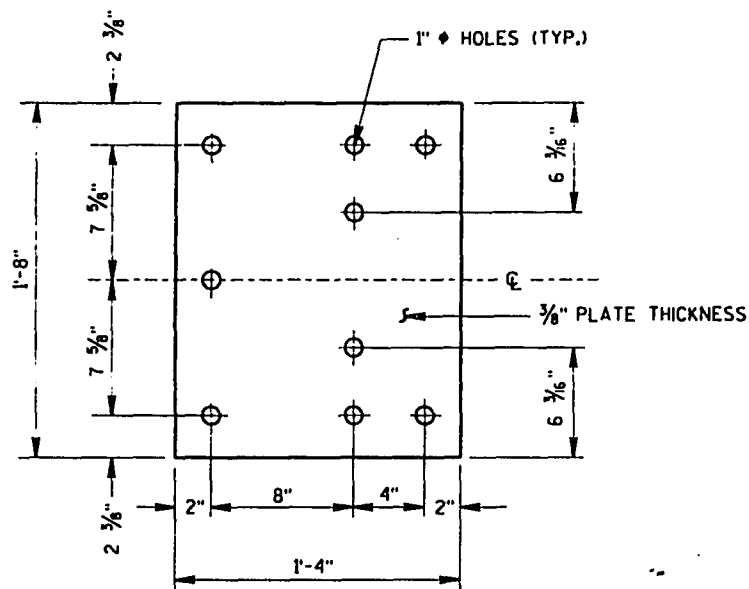


BACK-UP PLATE DETAIL

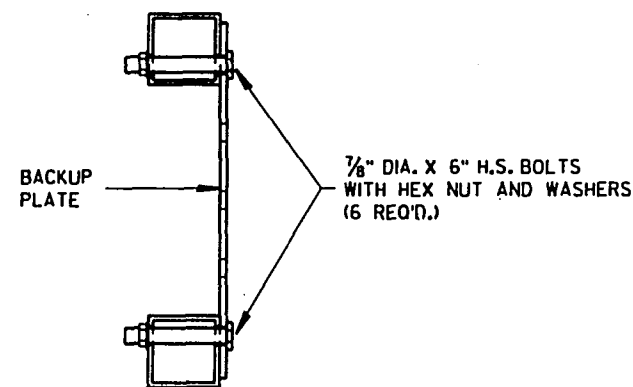

SECTION A-A

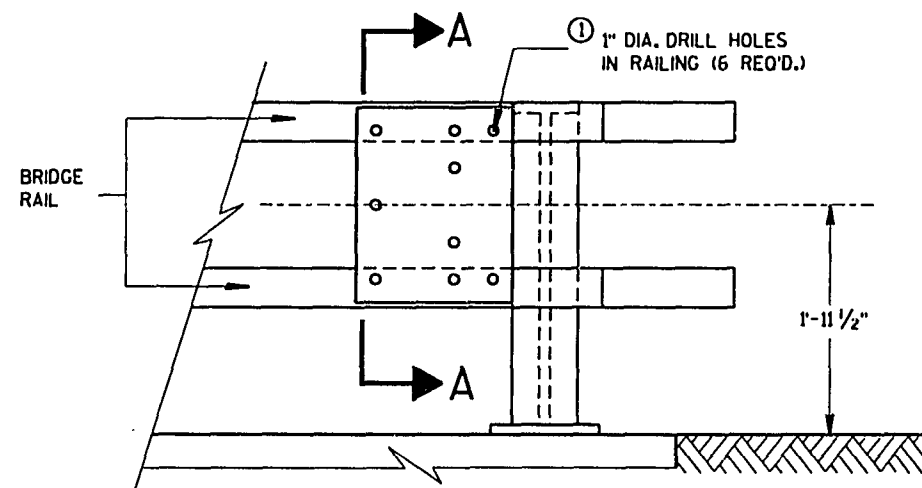


BACK-UP PLATE MOUNTING ONTO BRIDGE RAILING

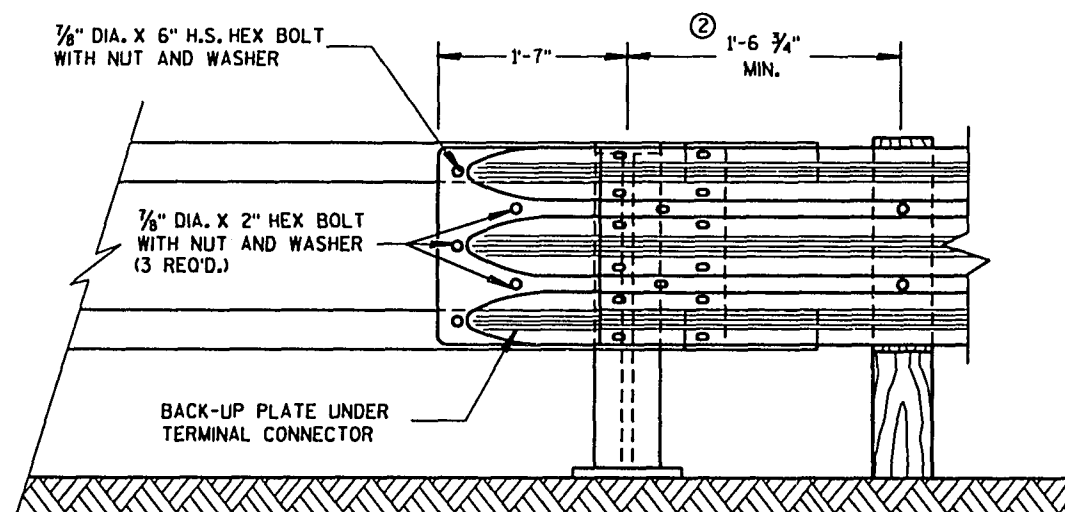

FRONT VIEW

THRIE BEAM CONNECTION TO TUBULAR RAILING TYPE "F"

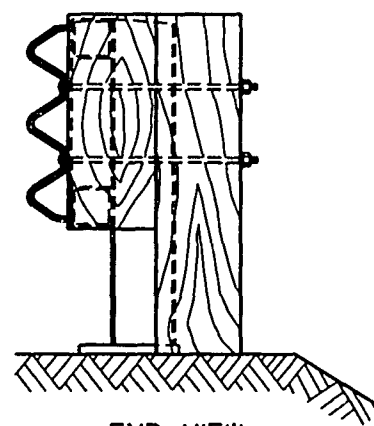


END VIEW

GENERAL NOTES

BOLTS, PLATES, NUTS AND WASHERS SHALL CONFORM TO THE REQUIREMENTS OF ASTM SPECIFICATION A 325 AND BE GALVANIZED IN ACCORDANCE WITH ASTM A 153.

- ① PAYMENT FOR DRILLING HOLES IN RAILING SHALL BE INCLUDED IN THE ITEM STEEL THRIE BEAM STRUCTURE APPROACH.
- ② THIS DIMENSION WILL VARY DEPENDING ON ABUTMENT TYPE, WINGWALL DETAILS, AND SKEW ANGLE. THE FIRST WOOD POST OFF THE BRIDGE SHALL BE PLACED AS CLOSE AS FEASIBLE TO THE STEEL END POST.

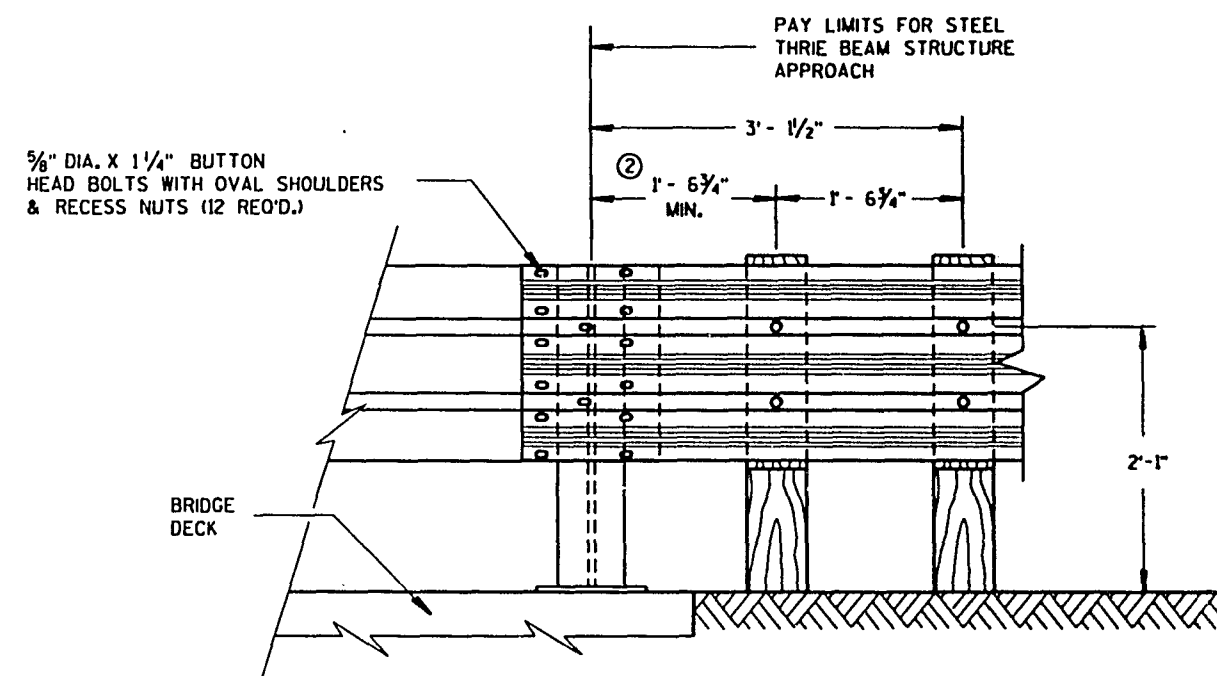

FRONT VIEW
THRIE BEAM CONNECTION TO STEEL RAILING TYPE "W"

NOTE:
SDD 14 B 20-2a IS REQUIRED WHEN THIS DRAWING IS CALLED FOR IN PLANS.

STEEL THRIE BEAM STRUCTURE APPROACH, CONNECTION TO BRIDGE RAILING TYPES "F" AND "W"


STATE OF WISCONSIN
DEPARTMENT OF TRANSPORTATION

APPROVED


DATE

STATE DESIGN ENGINEER FOR HWYS


FHWA

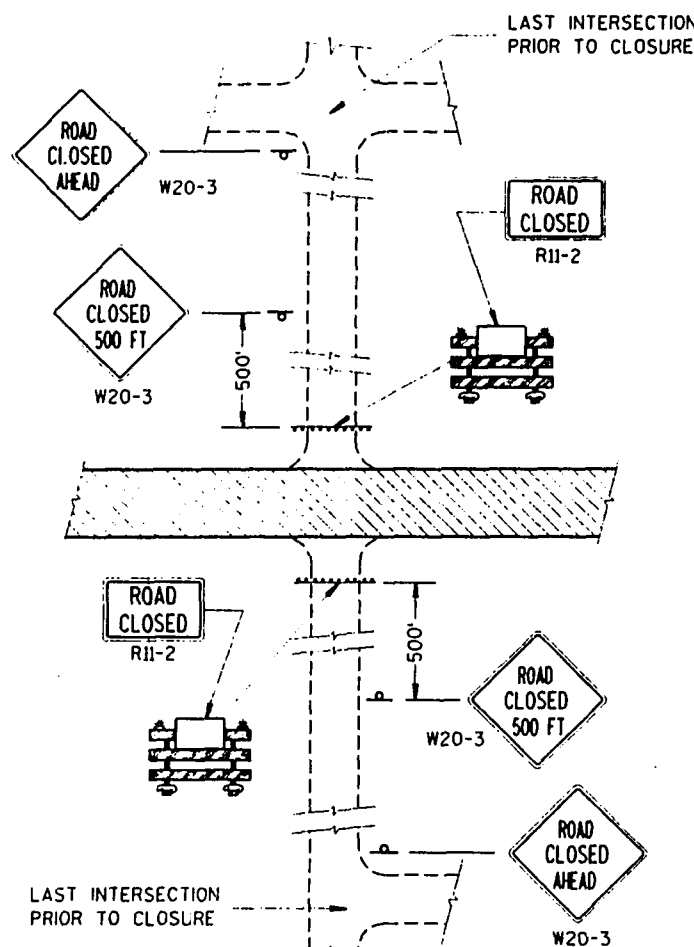

DETAIL 1
(NO ACCESS TO PROJECT)

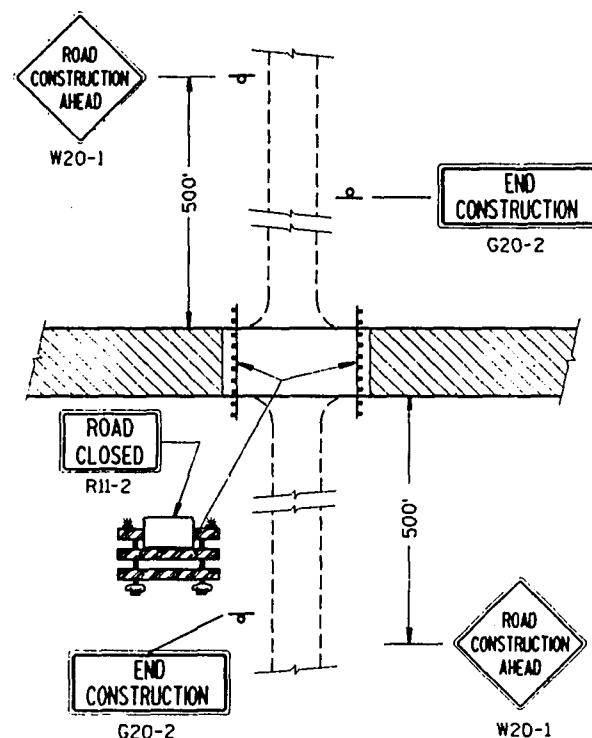


DETAIL 2
(PUBLIC CROSS-TRAFFIC MAINTAINED.
NO ACCESS TO PROJECT).

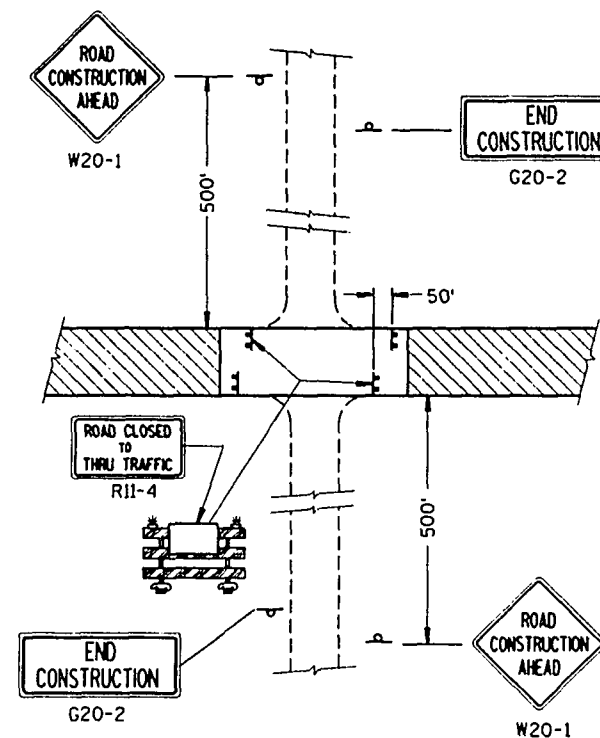


DETAIL 3
(PUBLIC CROSS-TRAFFIC MAINTAINED. CONTRACTOR,
LOCAL BUSINESS AND RESIDENT ACCESS).


SIDEROAD CLOSURES

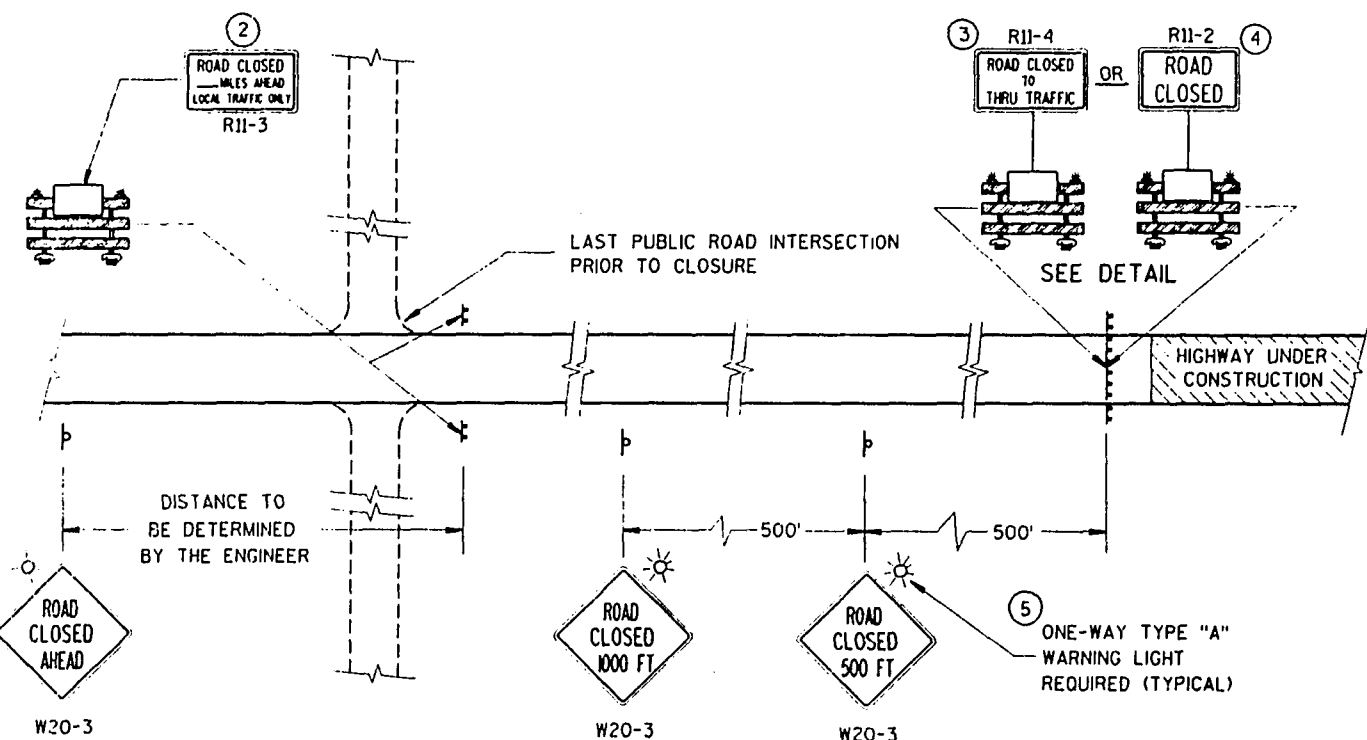

MAINLINE CLOSURE

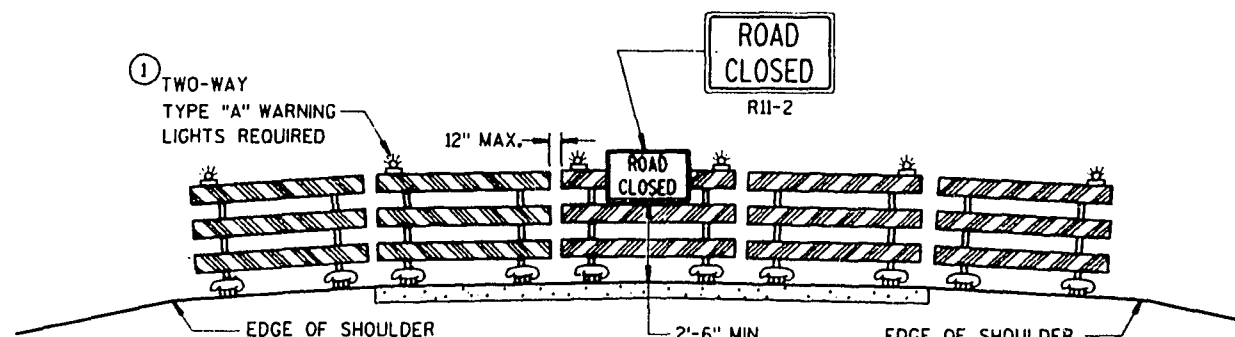

ROAD CLOSURE BARRICADE DETAIL

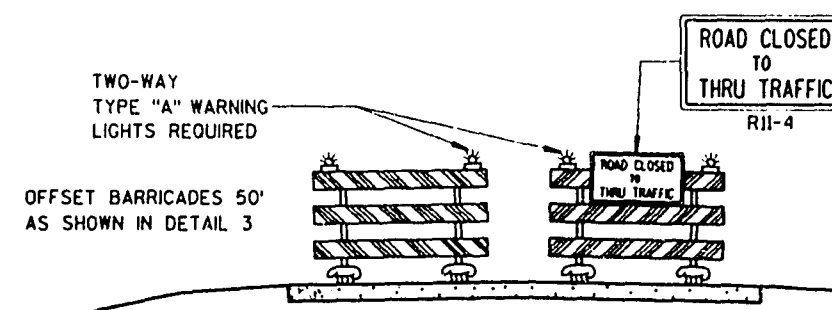

LANE CLOSURE BARRICADE DETAIL

GENERAL NOTES

DETAILS OF TRAFFIC CONTROL DEVICES AND THEIR LOCATION NOT SHOWN ON THIS DRAWING SHALL CONFORM TO THE PERTINENT REQUIREMENTS OF THE WISCONSIN MANUAL OF TRAFFIC CONTROL DEVICES, THE PLANS, SPECIFICATIONS AND CONTRACT.

SIGN AND BARRICADE LOCATIONS MAY BE ADJUSTED IN THE FIELD AS DIRECTED BY THE ENGINEER. ANY EXISTING TRAFFIC SIGNS THAT CONFLICT WITH THIS WORK SHALL BE COVERED AS DIRECTED BY THE ENGINEER. ALL "STOP" OR OTHER REGULATORY SIGNS ON THE SIDE ROADS SHALL NOT BE DISTURBED, EXCEPT WHEN NECESSARY TO COMPLETE THE WORK. THE SIGNS MUST THEN BE IMMEDIATELY REESTABLISHED.

ALL TYPE III BARRICADES SHALL HAVE RAILS REFLECTORIZED ON BOTH FACES. STRIPES SHALL BE PROPERLY SLOPED DOWN TOWARD THE TRAFFIC SIDE OR AS SHOWN IN THE ROAD CLOSURE BARRICADE DETAIL FOR FULL ROAD CLOSURES. TYPE "A" LOW INTENSITY FLASHING WARNING LIGHTS SHALL BE VISIBLE ON BOTH SIDES OF THE BARRICADE.

THE ROAD CLOSED SIGN (R11-2), ROAD CLOSED _____ MILES AHEAD SIGN (R11-3) AND THE ROAD CLOSED TO THRU TRAFFIC SIGN (R11-4) SHALL BE ATTACHED ONLY TO THE TOP RAIL OF THE TYPE III BARRICADE. THE SIGNS SHALL NOT COVER MIDDLE RAIL.

TYPE "H" REFLECTIVE SHEETING SHALL BE USED ON ALL BARRICADES, TYPE I, II AND III, AND ON ALL R11-2, R11-3 AND R11-4 SIGNS.

ALL SIGNS SHALL BE 48" X 48" UNLESS OTHERWISE NOTED BELOW:

R11-2, "ROAD CLOSED" SIGNS SHALL BE 48" X 30".

R11-3, AND R11-4 SIGNS SHALL BE 60" X 30".

G20-2 SIGNS SHALL BE 60" X 24".

- 1 TWO WARNING LIGHTS SHALL BE PROVIDED ON THE CENTER BARRICADE AND AT LEAST ONE WARNING LIGHT SHALL BE PROVIDED ON EACH OF THE OTHER BARRICADES WITHIN THE ROADWAY LIMITS. SPACING OF THE WARNING LIGHTS SHALL BE UNIFORM TO THE EDGE OF ROADWAY AS SHOWN.
- 2 THESE SIGNS AND BARRICADES ARE NOT REQUIRED IF ROAD CLOSURE BEGINS AT INTERSECTION.
- 3 FOR ROAD CLOSURE WITH LOCAL ACCESS TO PROJECT. SEE LANE CLOSURE BARRICADE DETAIL.
- 4 FOR ROAD CLOSURE WITHOUT LOCAL ACCESS TO PROJECT. SEE ROAD CLOSURE BARRICADE DETAIL.
- 5 ONE-WAY LIGHTS SHALL BE PROVIDED ON ALL ADVANCE WARNING SIGNS. THE UNIT SHALL BE POSITIONED SUCH THAT THE LIGHT SOURCE IS OUTSIDE THE SIGN FACE AND AT THE TOP OF THE SIGN.

LEGEND

- POST MOUNTED WARNING SIGN
- TYPE III BARRICADES WITH TYPE "H" REFLECTIVE SHEETING
- TYPE "A" LOW INTENSITY FLASHING WARNING LIGHT (FOR NIGHT USE)
- WORK AREA

**BARRICADES AND TRAFFIC
CONTROL FOR
ROAD CLOSURES**

**STATE OF WISCONSIN
DEPARTMENT OF TRANSPORTATION**








APPROVED

10-31-83




DATE

STATE TRAFFIC ENGINEER FOR HWTS


FWHA

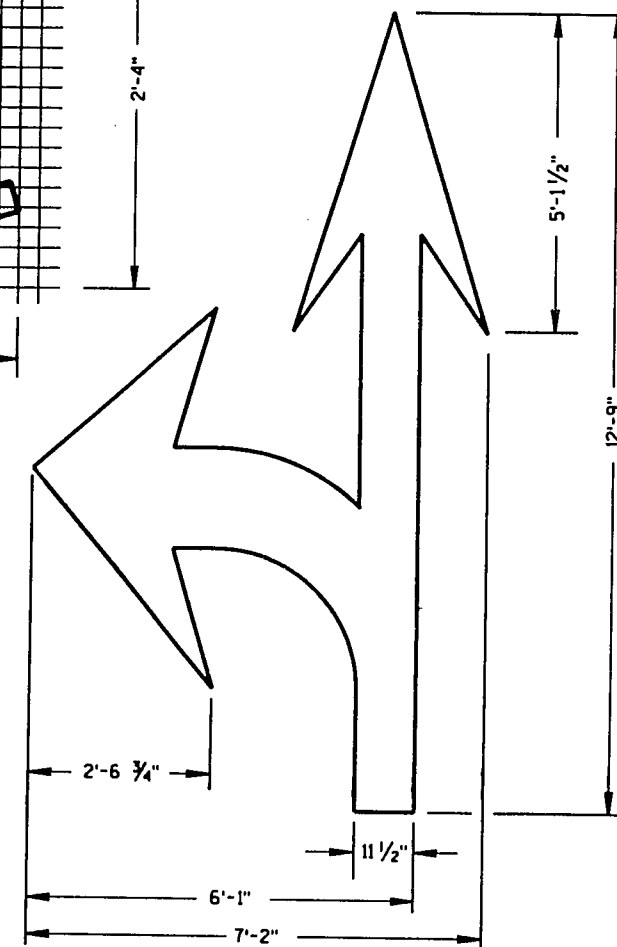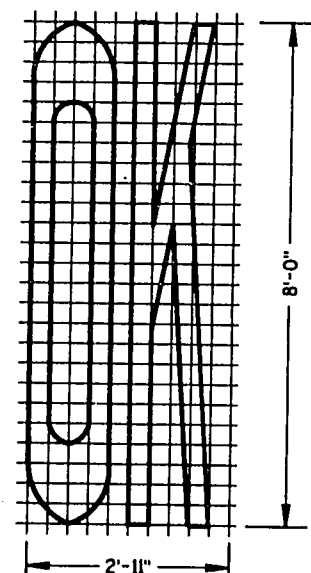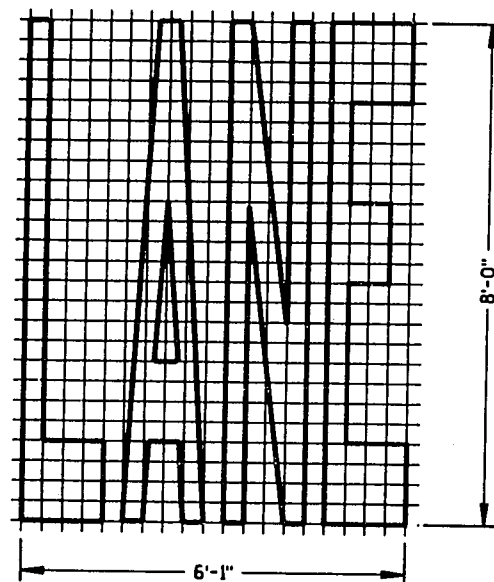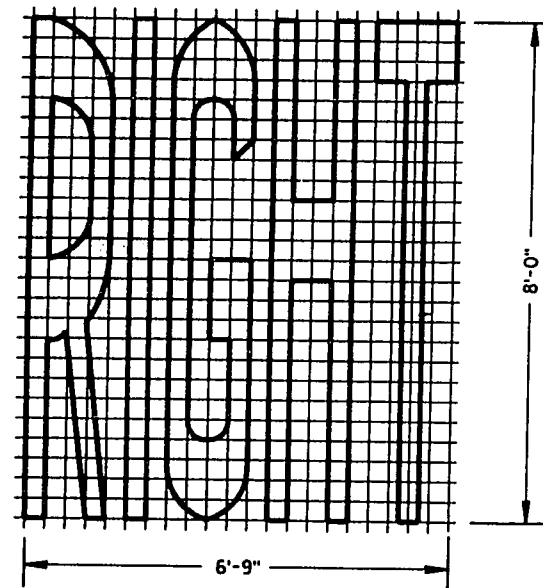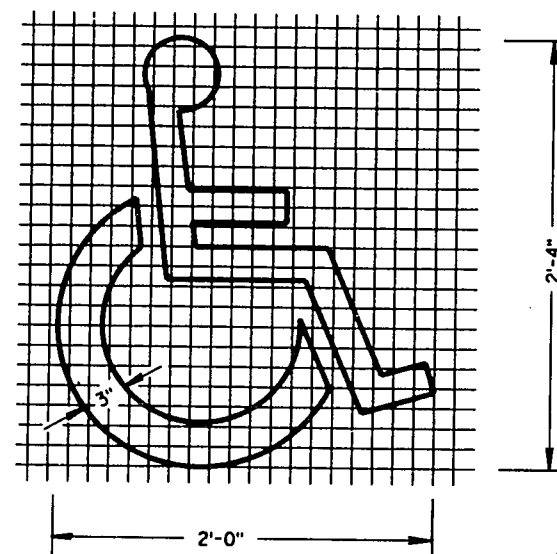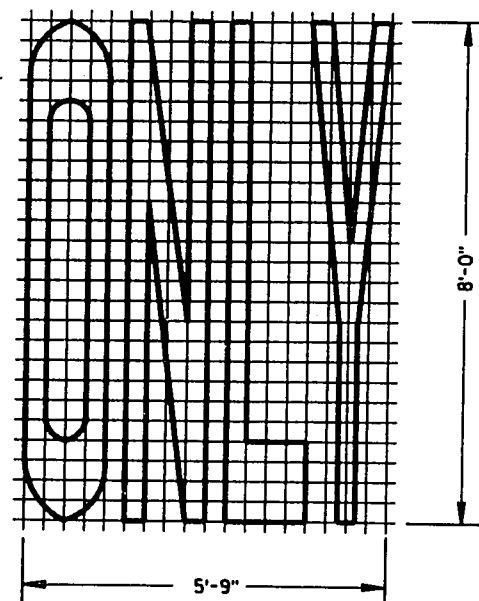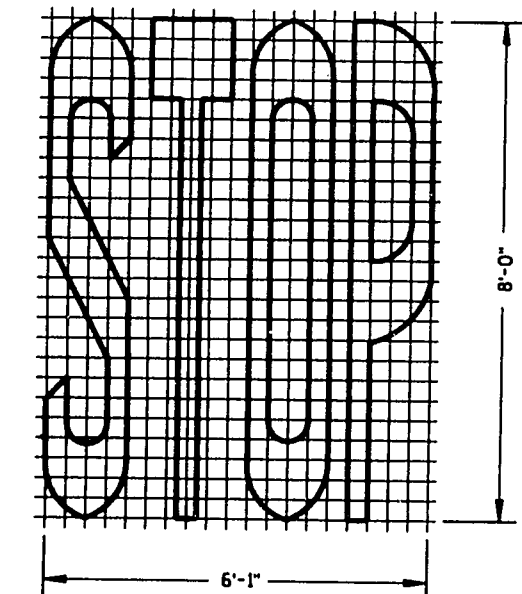

TYPE 3

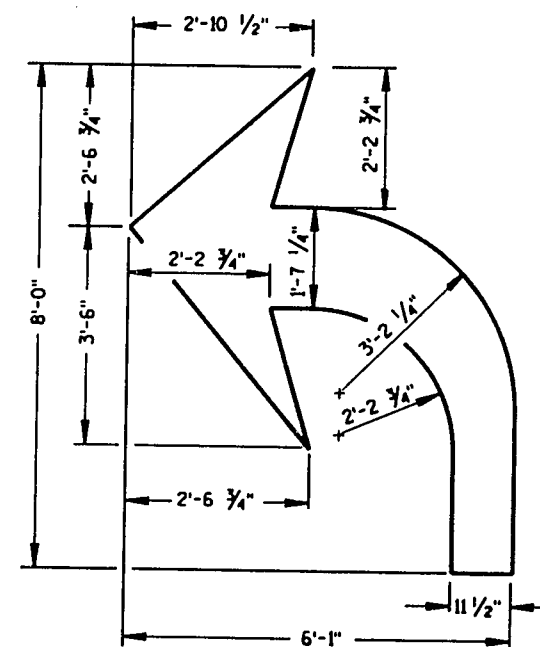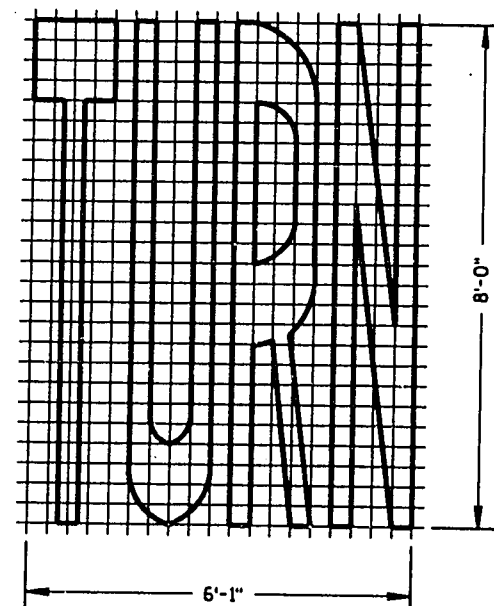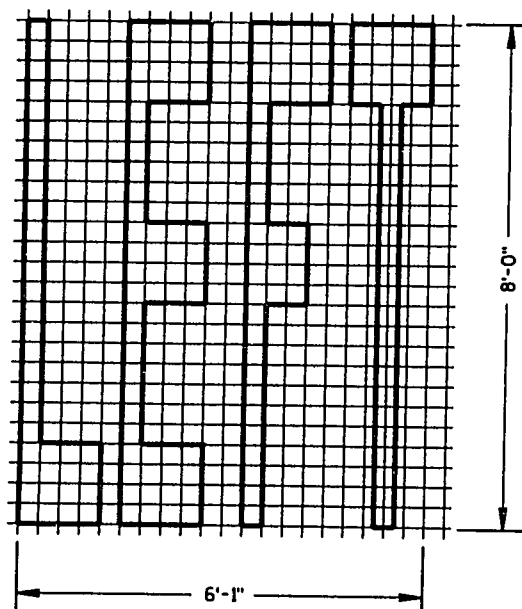

TYPE 2

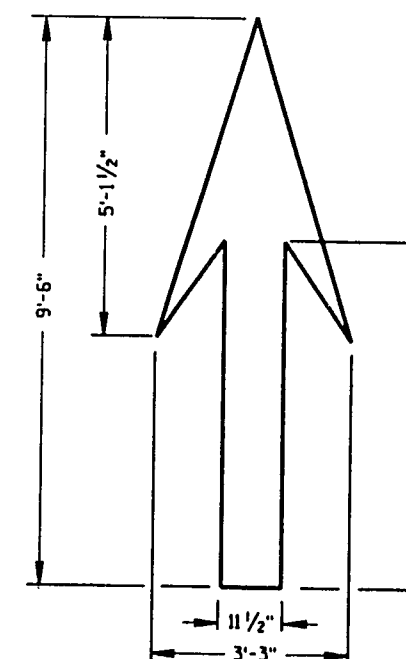


TYPE 1

GENERAL NOTES


DETAILS OF INSTALLATION, MATERIALS AND WORKMANSHIP NOT SHOWN ON THIS DRAWING SHALL CONFORM TO THE PERTINENT REQUIREMENTS OF THE STANDARD SPECIFICATIONS AND APPLICABLE SPECIAL PROVISIONS.

ALL LETTERS AND SYMBOLS SHALL BE IN CONFORMANCE WITH REQUIREMENTS INCLUDED IN "STANDARD ALPHABETS FOR HIGHWAY SIGNS AND PAVEMENT MARKING" BY THE FEDERAL HIGHWAY ADMINISTRATION. ALL LETTERS, ARROWS AND SYMBOLS SHALL BE WHITE AND REFLECTORIZED.

A DETAILED DRAWING OF THE HANDICAPPED PARKING SYMBOL IS ILLUSTRATED IN THE "STANDARD HIGHWAY SIGNS MANUAL" BY THE FEDERAL HIGHWAY ADMINISTRATION.

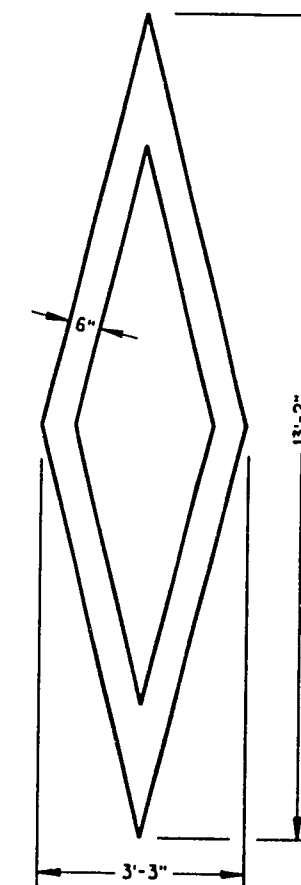

PREFERENTIAL
LANE SYMBOL

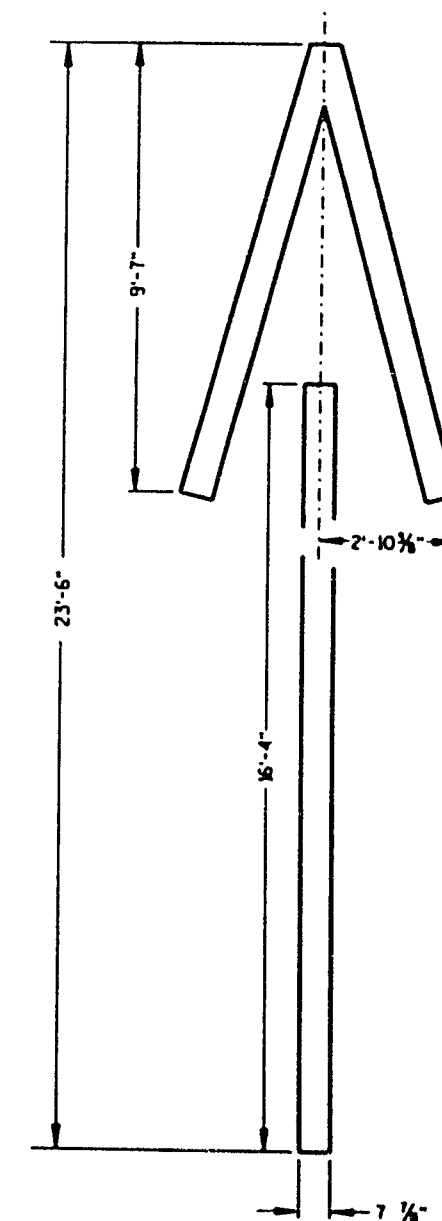

TYPE 4


PAVEMENT MARKING SYMBOLS

STATE OF WISCONSIN
DEPARTMENT OF TRANSPORTATION


APPROVED
DATE

STATE TRAFFIC ENGINEER FOR HWYS

FHWA

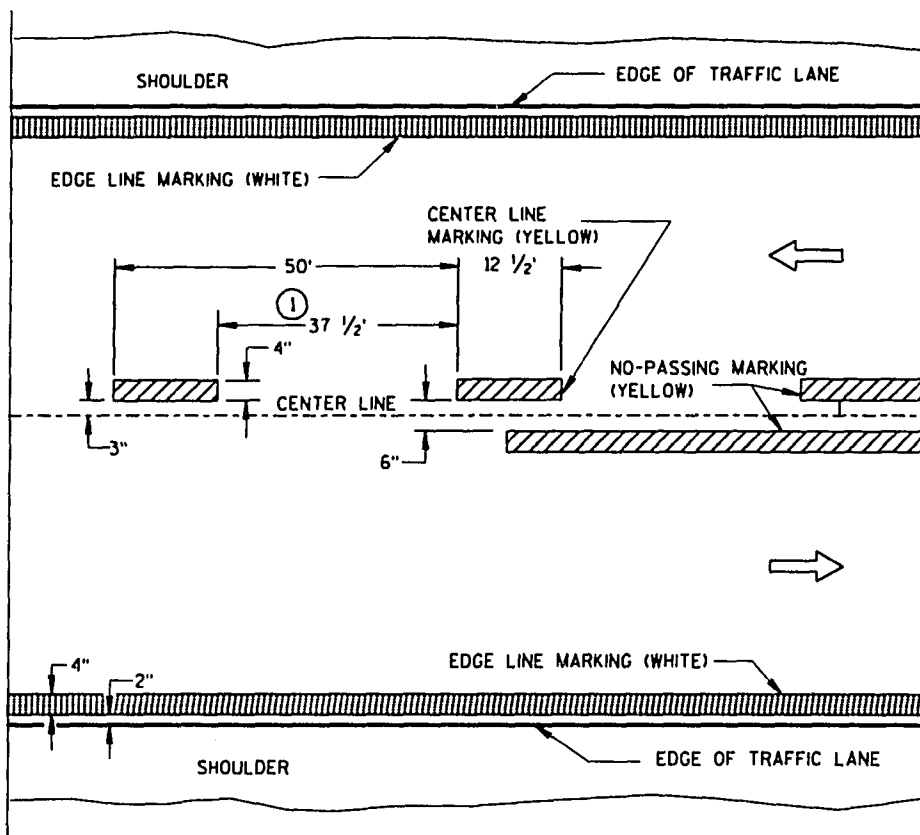


TWO WAY TRAFFIC

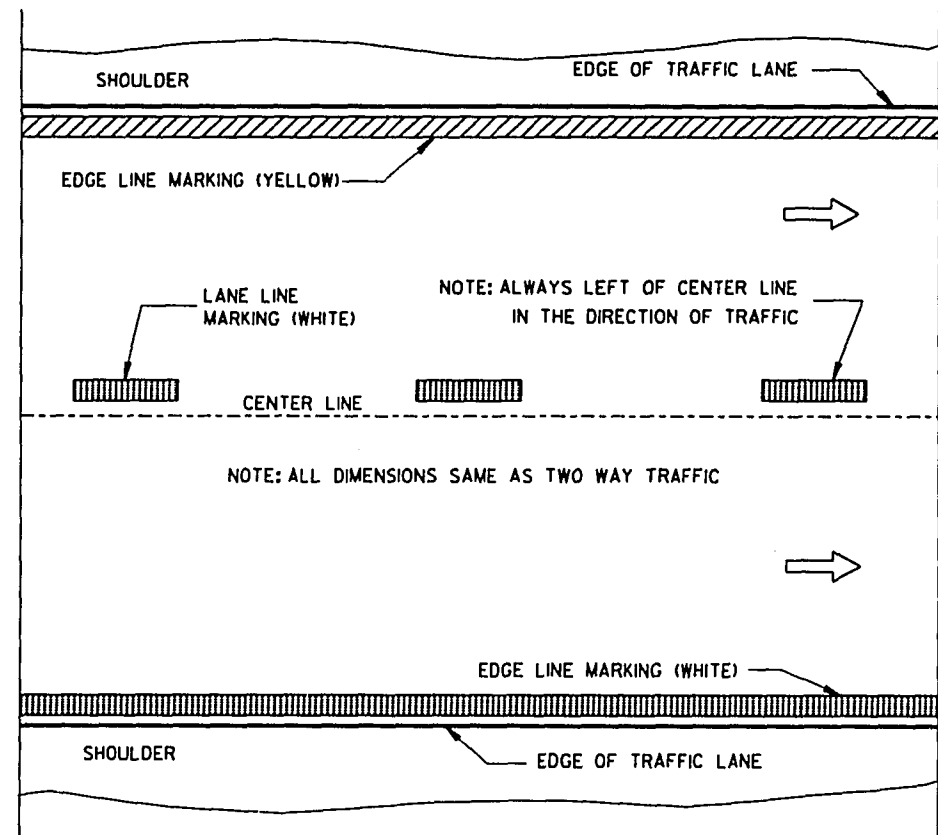


ONE WAY TRAFFIC

PERMANENT PAVEMENT MARKING

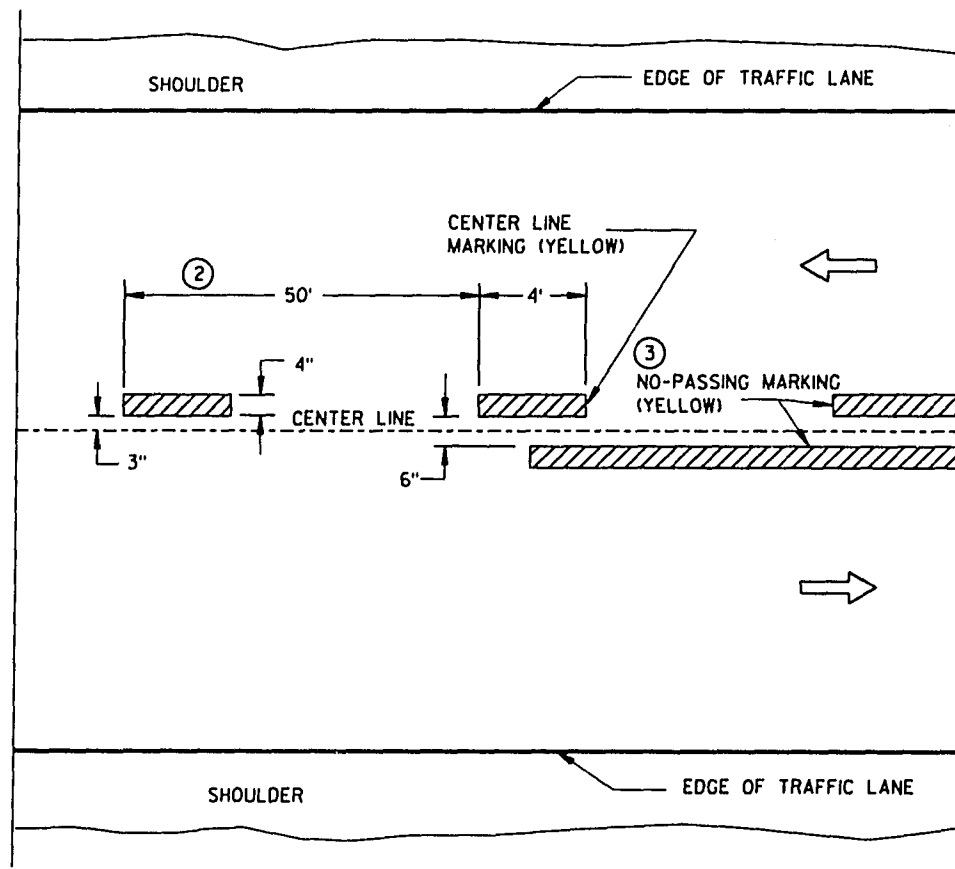

TWO WAY TRAFFIC

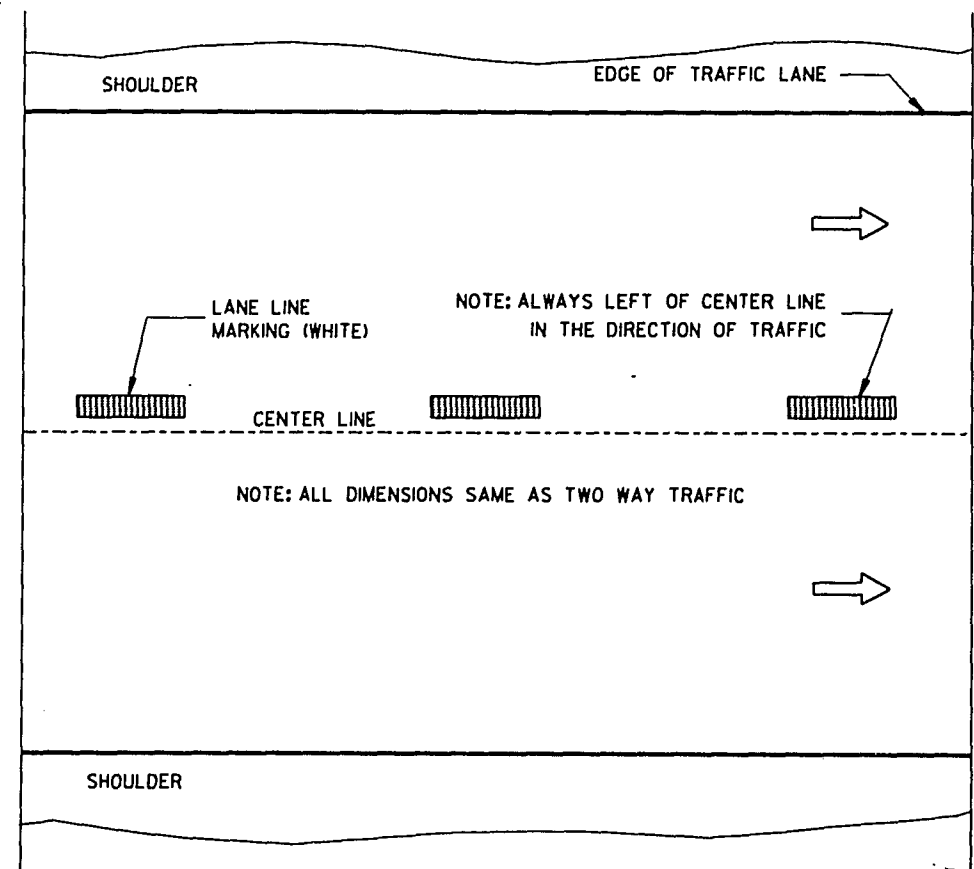

ONE WAY TRAFFIC

TEMPORARY (INTERMEDIATE) PAVEMENT MARKING
(SHOWS CYCLE FOR TEMPORARY CENTER LINE OR TEMPORARY LANE LINE MARKING)

GENERAL NOTES

DETAILS OF CONSTRUCTION NOT SHOWN ON THIS DRAWING SHALL CONFORM TO STANDARD SPECIFICATIONS AND SPECIAL PROVISIONS.

- ① CENTER LINE/LANE LINE MARKINGS SHALL BE 37 1/2 FEET BETWEEN DASHES THROUGHOUT THE PROJECT, INCLUDING THE STARTING OR ENDING GAP FROM THE EXISTING CENTER LINE/LANE LINE MARKING.
- ② HALF CYCLE LENGTHS (25') WITH 2' MINIMUM STRIPE LENGTHS SHALL BE PROVIDED ON ROADWAYS (INCLUDING TEMPORARY TRAVELED WAYS) WITH REVERSE CURVATURE, CURVATURE OF OVER 5 DEGREES OR WHEN DIRECTED BY THE ENGINEER TO MARK UNUSUAL ALIGNMENT OF THE TRAVELED WAY.
- ③ NO PASSING ZONE TEMPORARY PAVEMENT MARKING IS REQUIRED TO BE PLACED, WHERE APPROPRIATE, ALONG WITH CENTERLINE TEMPORARY PAVEMENT MARKING WHEN A SAME DAY PERMANENT PAVEMENT MARKING ITEM IS INCLUDED IN THE CONTRACT.

NOTE


ARROW SYMBOL (→) SHOWS DIRECTION OF TRAVEL

PAVEMENT MARKING (MAINLINE)	
STATE OF WISCONSIN DEPARTMENT OF TRANSPORTATION	
APPROVED 8/18/94 DATE	<i>John F. Pusch</i> DIRECTOR, OFFICE OF TRAFFIC FHWA


NOTES

EDGE LINES SHALL BE OMITTED THROUGH INTERSECTIONS. EDGE LINES SHALL BE CONTINUED THROUGH DRIVEWAYS.


- ① WHEN DISTANCE "A" IS LESS THAN 250 FEET, OMIT LANE LINE.
- ② WHEN DISTANCE "B" IS LESS THAN 100 FEET, OMIT CHANNELIZING LANE LINE.
- ③ NO-PASSING MARKING SHALL BE PROVIDED WHERE SIGHT DISTANCE IS DEFICIENT. THE LENGTH OF NO-PASSING MARKING SHALL BE 500 FEET MINIMUM.
- ④ ALTERNATIVE MARKING SHALL BE PROVIDED WHEN SPECIFIED IN THE CONTRACT. TYPICAL SITUATIONS WHERE THIS MARKING MAY BE REQUIRED ARE WHERE THE INTERSECTION IS ON A SHARP HORIZONTAL CURVE OR CREST VERTICAL CURVE IN AN UNLIGHTED AREA SUCH THAT THE EDGE LINE MAY BE MISLEADING TO THE MOTORIST OR DISAPPEAR FROM SIGHT.
- ⑤ LOCATE THE EDGE LINE ALONG THE TAPER WHERE "W" IS 10' OR MORE.

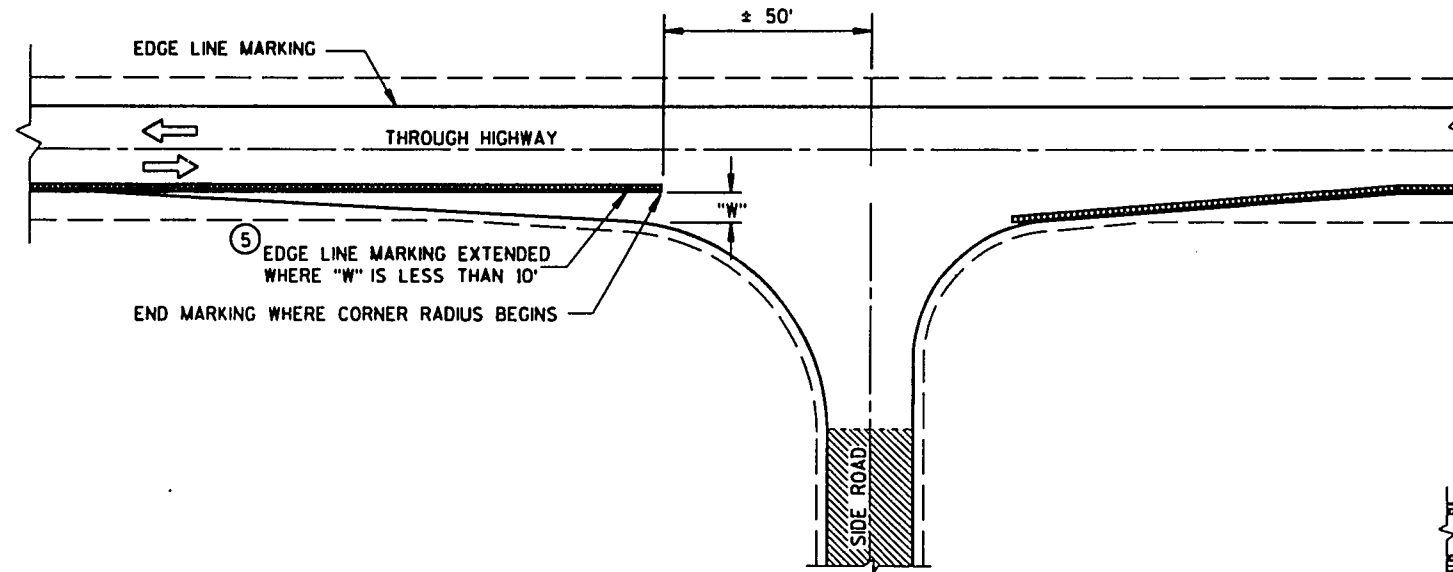


MINOR INTERSECTION WITHOUT CURBS

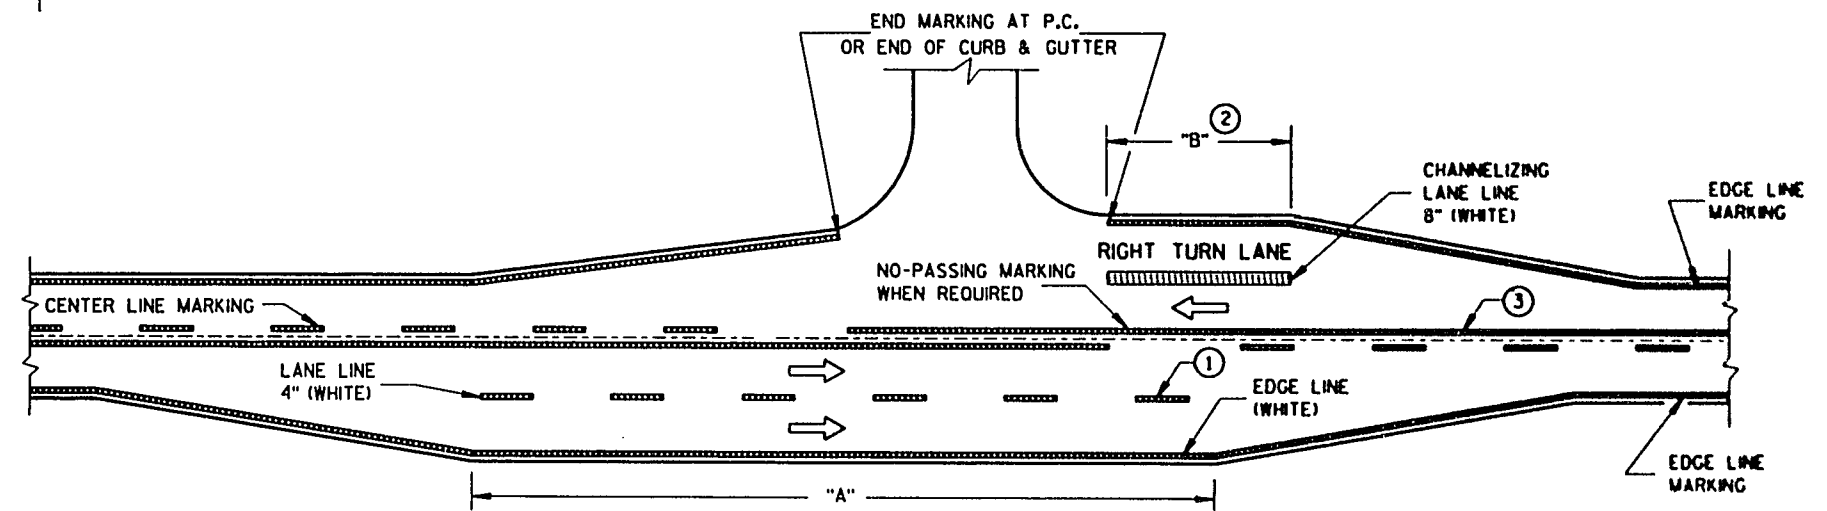

MAJOR INTERSECTIONS
(INTERSECTION WITH FULL RIGHT TURN LANE OR BYPASS LANES)

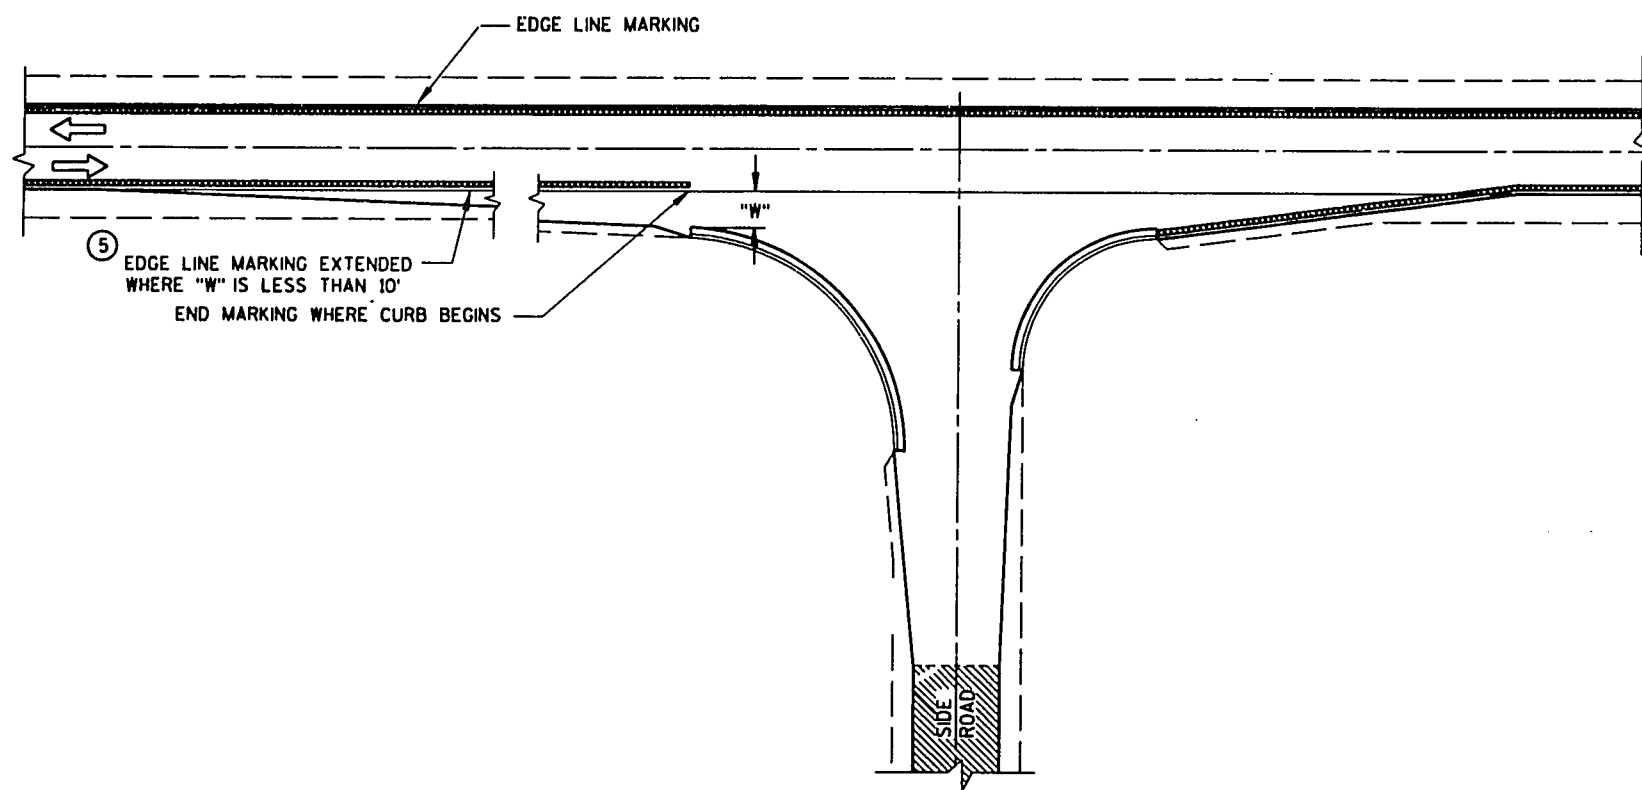


MINOR INTERSECTION WITH CURBS
(TYPICAL MARKING)

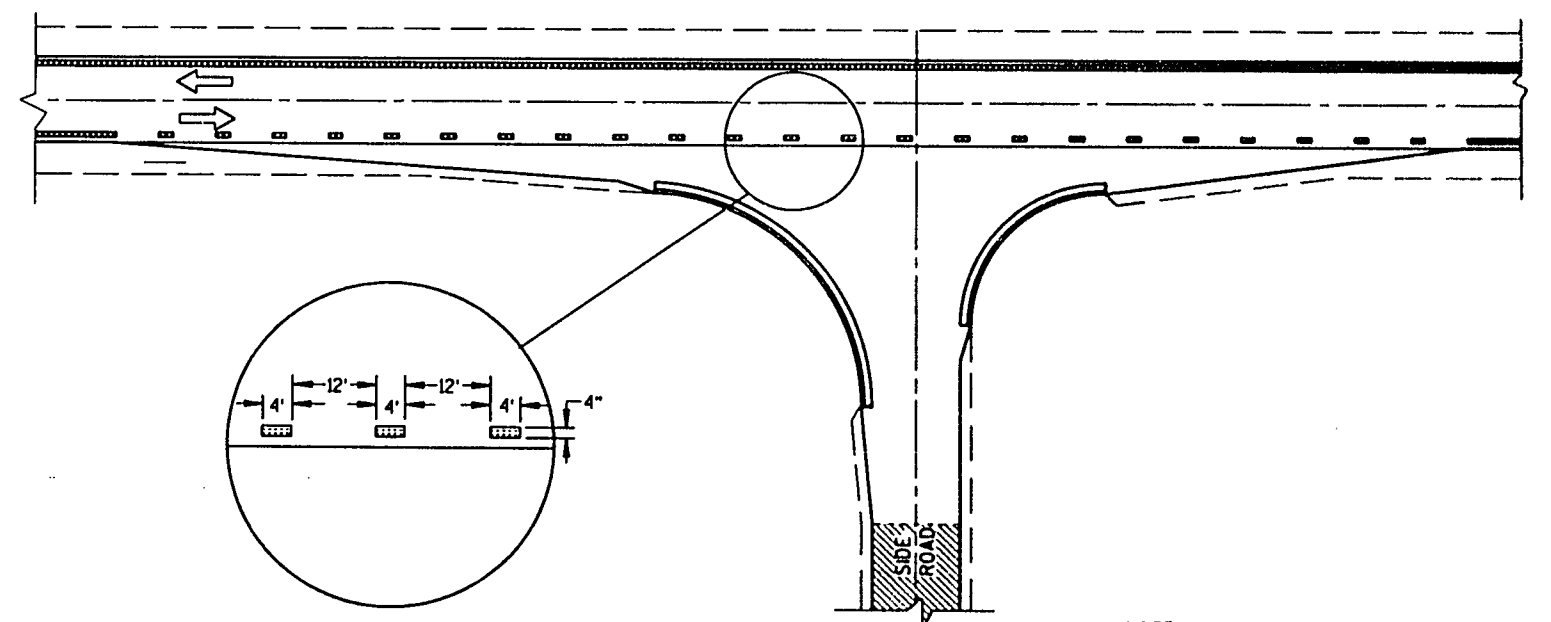


TWO-LANE ROADWAY

SYMBOLS

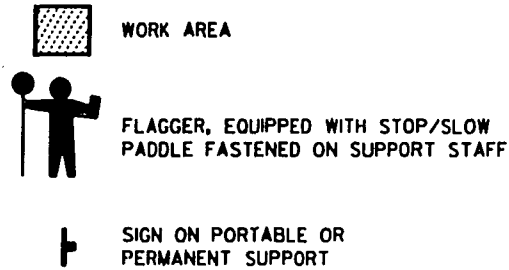

USE OF THE "BE PREPARED TO STOP" SIGN IS OPTIONAL. WHEN USED, THIS SIGN SHALL BE LOCATED BETWEEN THE W20-7a AND W20-4 SIGNS. A 500' TYPICAL SPACING SHALL BE PROVIDED BETWEEN THE SIGNS.

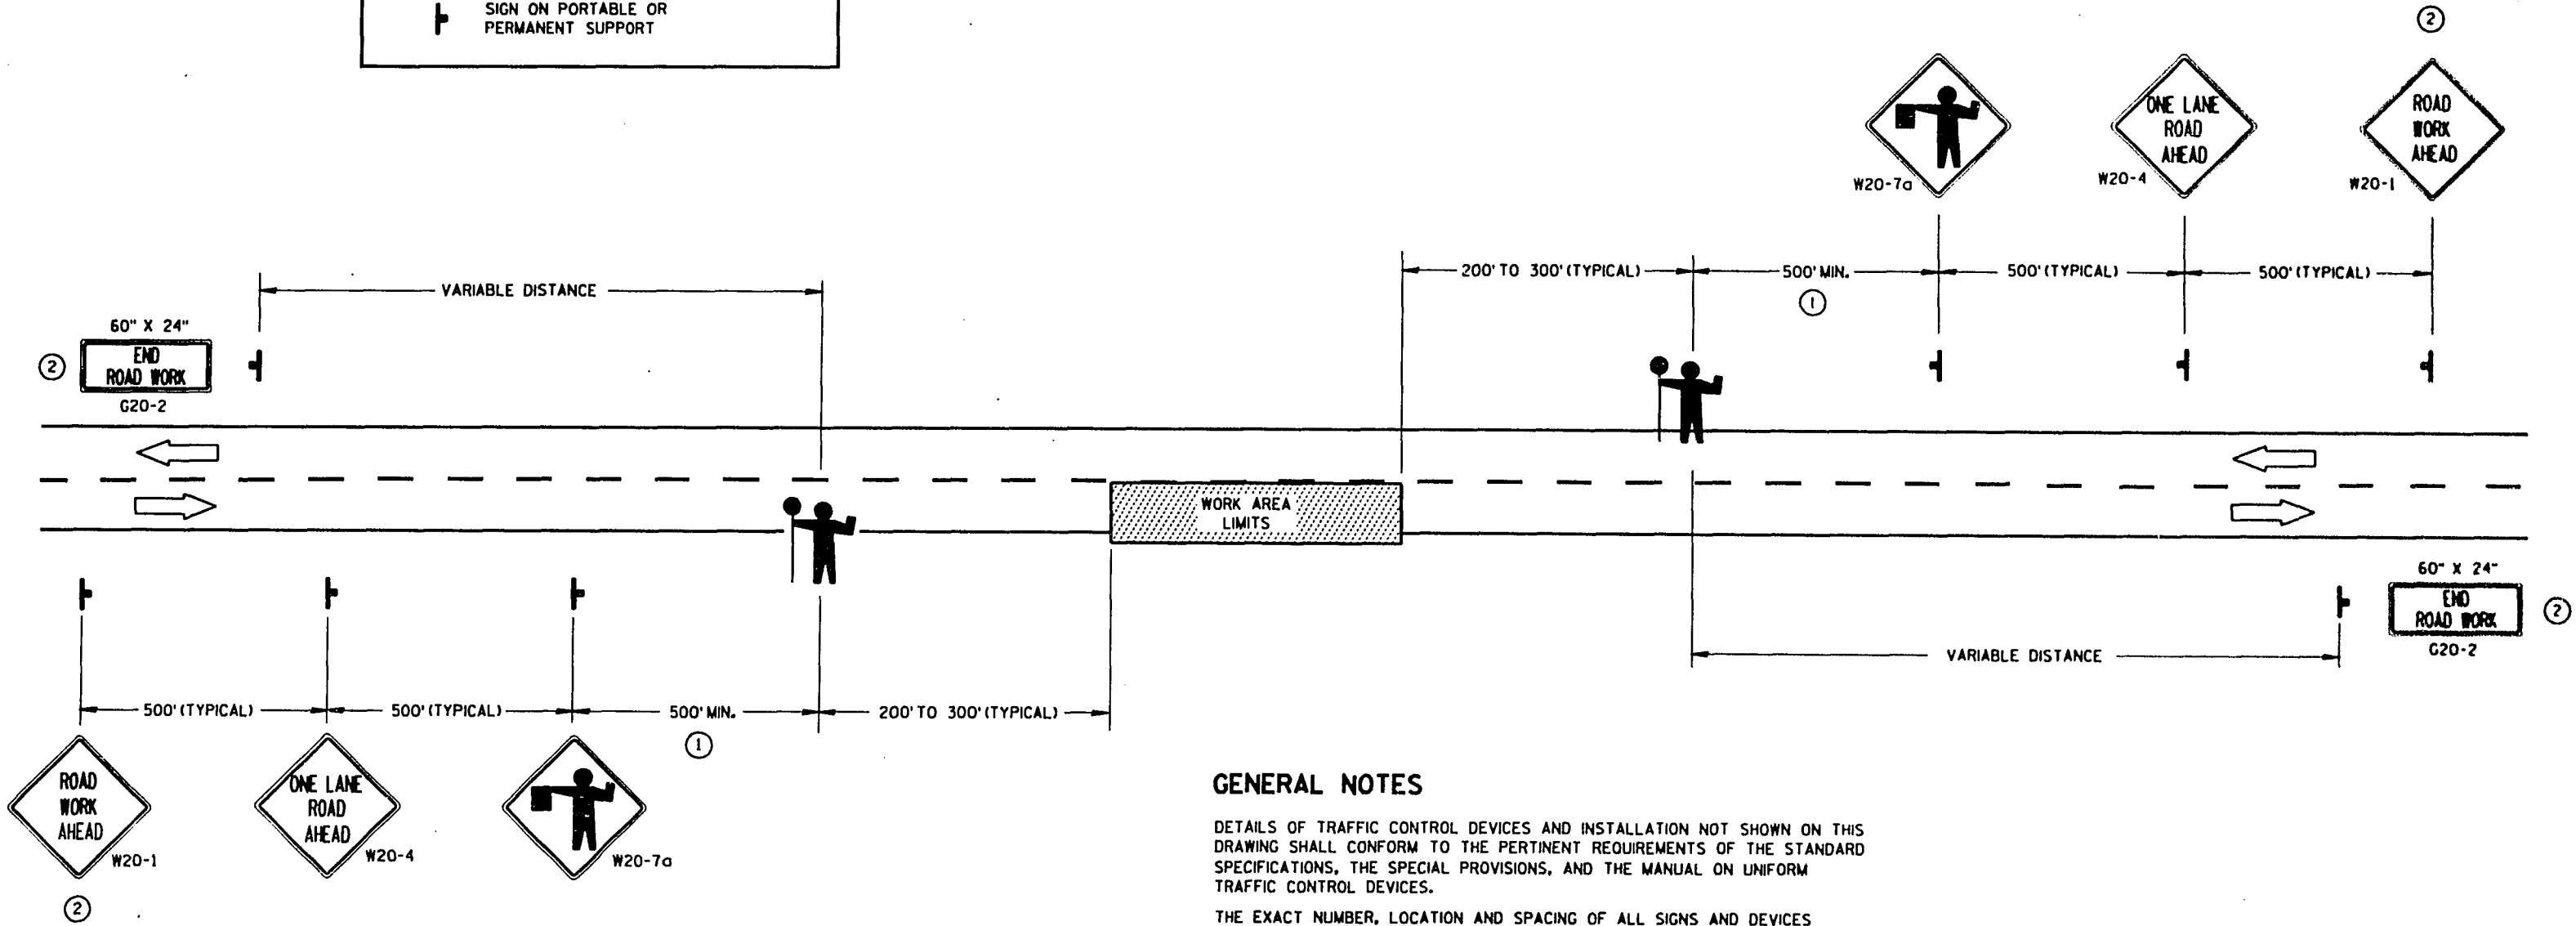

GENERAL NOTES

DETAILS OF TRAFFIC CONTROL DEVICES AND INSTALLATION NOT SHOWN ON THIS DRAWING SHALL CONFORM TO THE PERTINENT REQUIREMENTS OF THE STANDARD SPECIFICATIONS, THE SPECIAL PROVISIONS, AND THE MANUAL ON UNIFORM TRAFFIC CONTROL DEVICES.

THE EXACT NUMBER, LOCATION AND SPACING OF ALL SIGNS AND DEVICES (AND THE LOCATION OF ALL FLAGGERS) SHALL BE ADJUSTED TO FIT FIELD CONDITIONS AS DIRECTED BY THE ENGINEER.

THE FIRST ADVANCE WARNING SIGN SHOULD TYPICALLY BE LOCATED IN ADVANCE OF THE ANTICIPATED TRAFFIC BACKUP OR QUEUE.

WHEN A SIDE ROAD OR RAMP INTERSECTS THE FACILITY ON WHICH THE WORK IS BEING PERFORMED, ADDITIONAL TRAFFIC CONTROLS SHALL BE PROVIDED AS SPECIFIED IN THE PLANS AND/OR THE SPECIAL PROVISIONS OR AS DIRECTED BY THE ENGINEER.


FLAGGERS SHALL BE IN SIGHT OF EACH OTHER OR IN DIRECT COMMUNICATION AT ALL TIMES. THEY SHALL BE EQUIPPED WITH STOP/SLOW PADDLES FASTENED ON SUPPORT STAFFS. WHEN THE FLAGGING OPERATION IS NOT IN EFFECT, THE "FLAGGER AHEAD", THE "ROAD WORK AHEAD" AND THE ONE LANE ROAD AHEAD" SIGNS SHALL BE COVERED OR REMOVED AND THE HIGHWAY RESTORED TO NORMAL OPERATION.

ALL SIGNS ARE 48" X 48" UNLESS OTHERWISE NOTED.


- ① FOR A MOVING WORK OPERATION, SIGNING FOR BOTH DIRECTIONS SHALL BE REESTABLISHED (AS SIMULTANEOUSLY AS PRACTICAL) AT APPROXIMATELY 3500 FOOT INTERVALS IN THE MOVING WORK OPERATION OR AS DIRECTED BY THE ENGINEER.
- ② SIGN NOT REQUIRED IF FLAGGING OPERATION OCCURS WITHIN A SIGNED ROAD WORK ZONE AREA.

TRAFFIC CONTROL FOR LANE CLOSURE (SUITABLE FOR MOVING OPERATIONS)	
STATE OF WISCONSIN DEPARTMENT OF TRANSPORTATION	
APPROVED 2/17/94 DATE	<i>William F. Russell</i> STATE TRAFFIC ENGINEER FOR HWYS FHWA


② MONUMENT MARKER FURNISHED BY OTHERS TO BE CENTERED ON CONCRETE MONUMENT. CONCRETE TO BE FLUSH WITH GROUND SURFACE OR DEPRESSED IN PAVED SURFACE.

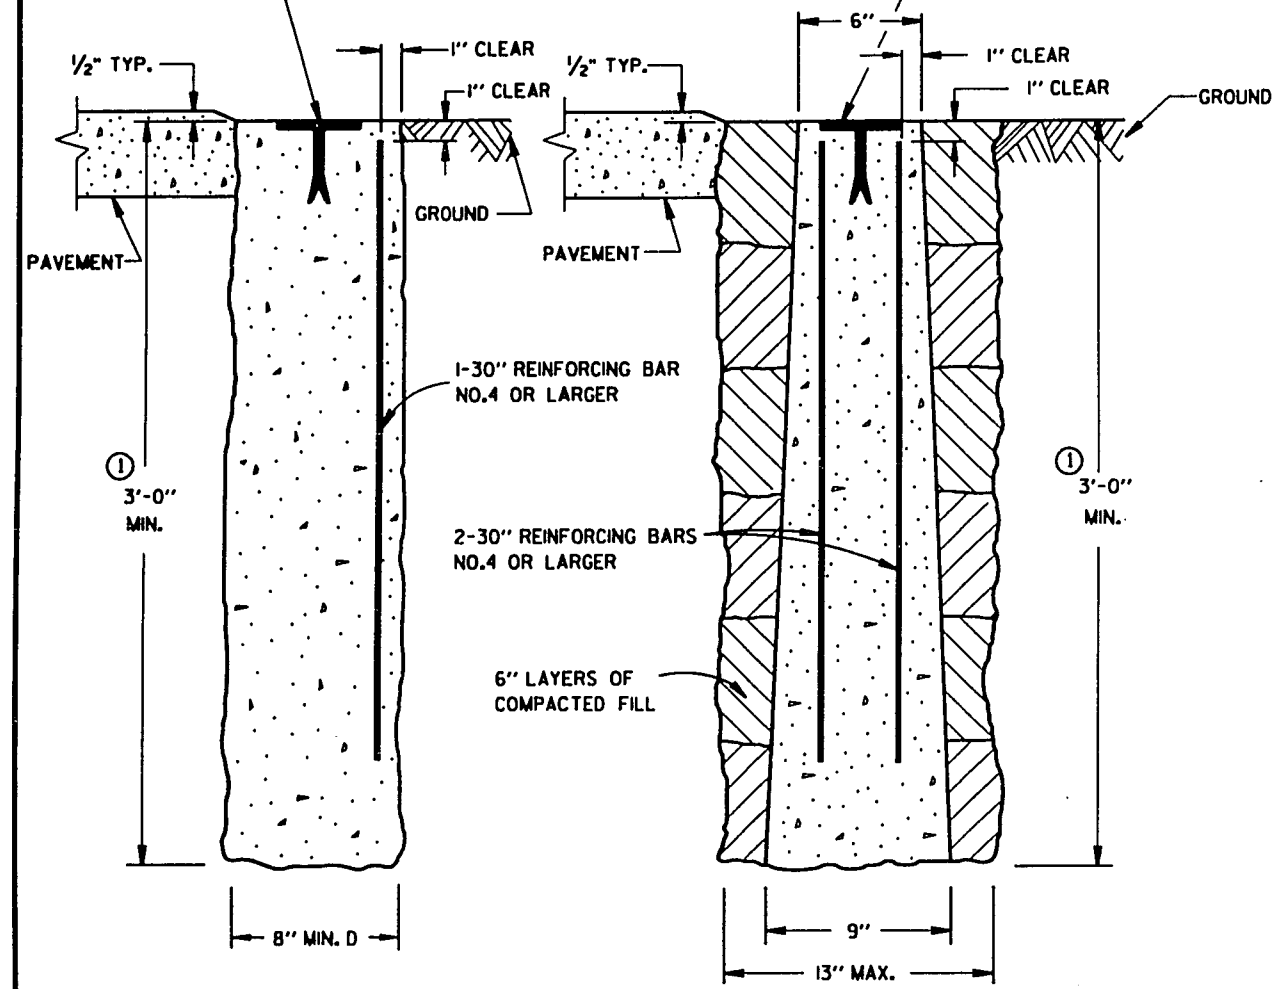

CAST-IN-PLACE
PRECAST
CONCRETE MONUMENTS
TYPE A

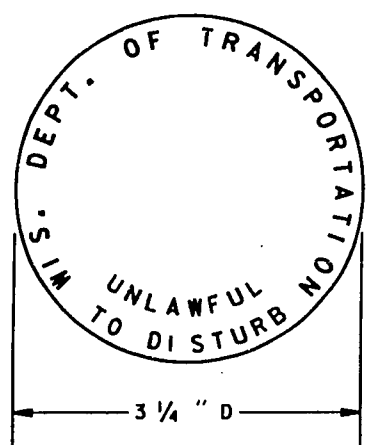

② WIS DOT MONUMENT MARKER LOGO
FOR TYPES "A", "C" & "D"

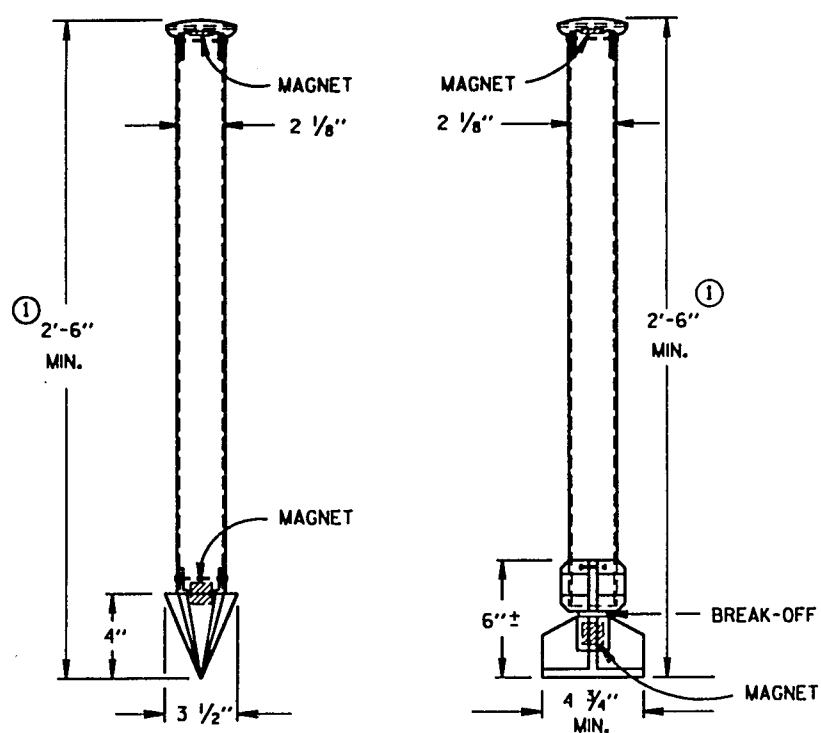

TYPE C
DRIVE-IN MONUMENT
TYPE D
BREAK-OFF MONUMENT
ALUMINUM MONUMENTS
(INCLUDES MARKER)

GENERAL NOTES

DETAILS OF CONSTRUCTION, MATERIALS AND WORKMANSHIP NOT SHOWN ON THIS DRAWING SHALL CONFORM TO THE PERTINENT REQUIREMENTS OF THE STANDARD SPECIFICATIONS AND THE APPLICABLE SPECIAL PROVISIONS.

DETAILED DRAWINGS OF PROPOSED ALTERNATE DESIGNS FOR METAL MONUMENTS OR MONUMENT COVERS SHALL BE SUBMITTED TO THE ENGINEER FOR APPROVAL.

INSTALLED METAL MONUMENTS MUST BE EASILY DETECTED WITH A DIP NEEDLE. INSERT PERMANENT MAGNETS SHALL BE ATTACHED NEAR THE TOP AND BOTTOM OF THOSE MONUMENTS CONSTRUCTED OF A METAL ALLOY WHICH IS NOT ATTRACTIVE TO A DIP NEEDLE.

THE CAST IRON MONUMENT COVER SHALL BE A "NON-ROCKING" TYPE. ADJUSTMENT OF THE COVER TO GRADE MAY BE ACCOMPLISHED BY THE USE OF MORTAR AND BRICK, OR BY EITHER PRECAST OR CAST-IN-PLACE REINFORCED CONCRETE GRADE RINGS.

MONUMENTS SHALL BE LOCATED AND PLACED AT THE DIRECTION OF THE ENGINEER.


ALUMINUM MONUMENTS AND MONUMENT COVERS SHALL BE MADE FROM AN ALUMINUM AND MAGNESIUM ALLOY AS DETERMINED BY THE MANUFACTURER.

THE MONUMENT COVERS DETAILED ON THIS DRAWING ARE NOT EQUAL ALTERNATES. MONUMENT COVERS SHALL BE CAST IRON UNLESS ALUMINUM IS SPECIFIED ELSEWHERE IN THE CONTRACT.


MONUMENT SHALL BE CAST-IN-PLACE CONCRETE UNLESS PRECAST CONCRETE OR ALUMINUM MONUMENTS ARE SPECIFIED IN THE CONTRACT OR PERMITTED BY THE ENGINEER.

① MINIMUM LENGTH SHALL BE 4'-0" FOR MONUMENTS INSTALLED IN PAVED AREAS.


② AN OFFICIAL COUNTY MONUMENT MARKER SUPPLIED BY A COUNTY MAY BE REQUIRED FOR SOME SECTION CORNERS AND WITNESS MONUMENTS INSTEAD OF THIS WIS DOT MARKER.

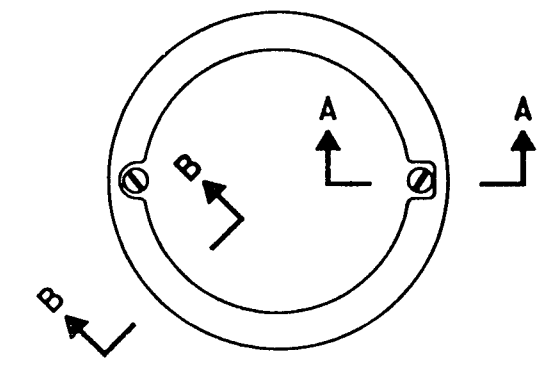

TOP VIEW

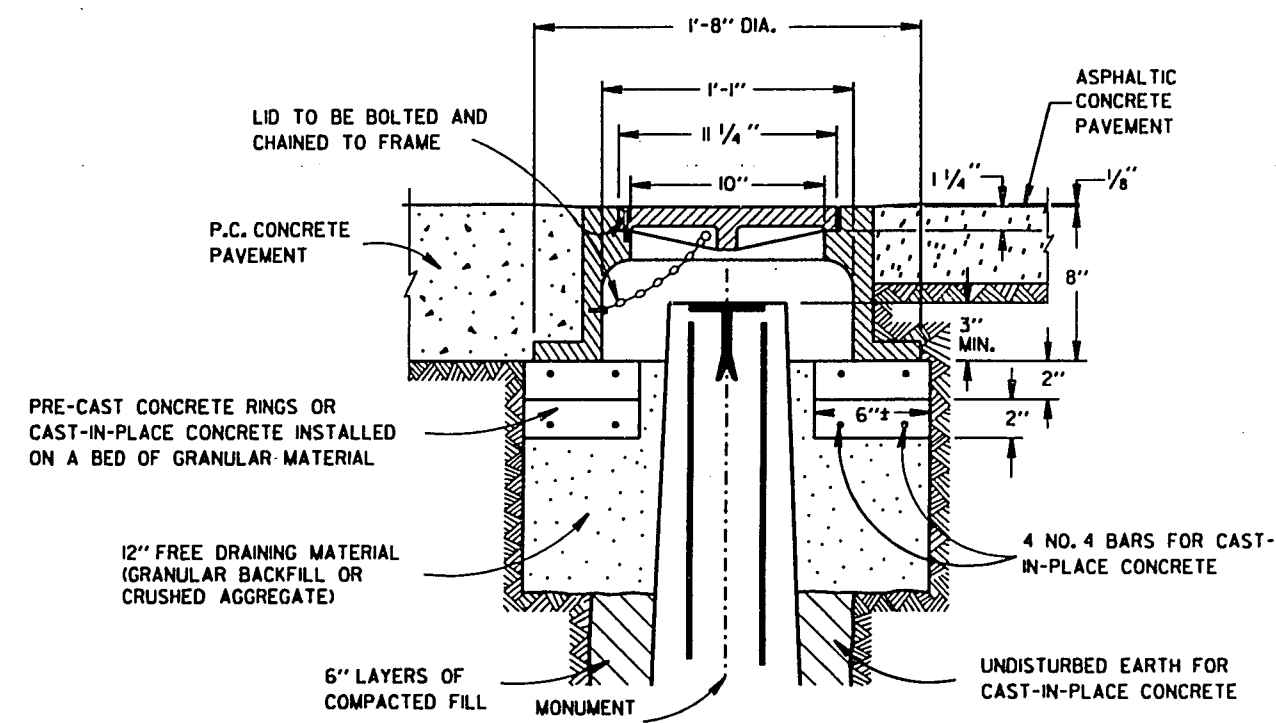

CAST IRON MONUMENT COVER
(APPROXIMATE WEIGHT - 95 LBS.)

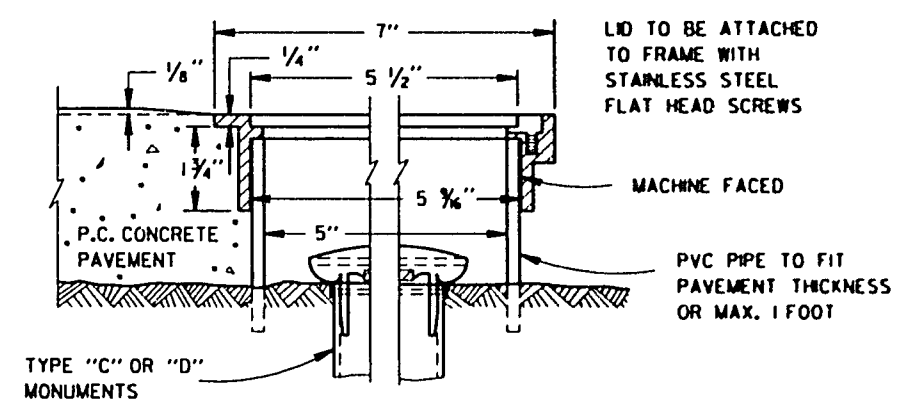

SECTION B-B
SECTION A-A
ALUMINUM MONUMENT COVER

(APPROXIMATE WEIGHT 2 LBS)
(FOR CONCRETE PAVEMENT ONLY)



LANDMARK REFERENCE MONUMENTS AND COVERS

STATE OF WISCONSIN
DEPARTMENT OF TRANSPORTATION


APPROVED
3/31/92
DATE
STATE DESIGN ENGINEER FOR HWYS
FWRA

NOTES

- 1. Sign is Type II - Reflective— reference WIS DOT. Standard Specification for ROAD and BRIDGE CONSTRUCTION latest edition.
- 2. Color:
Background - Sign is white; paraplegic symbol is blue.
Message - Legend and border are green; paraplegic symbol is white.
- 3. Message Series - Lines 1 & 2 - "B"
Lines 3,4,5 & 6 - "C"
- 4. Corners may be square or rounded when base material is plywood but borders shall be rounded as shown. When base material is metal, the corners and borders shall be rounded.
- 5. R7-8R (Right Arrow), R7-8L (Left Arrow), R7-8A (THIS SPACE).
- 6. This drawing may be scaled for standard size only.

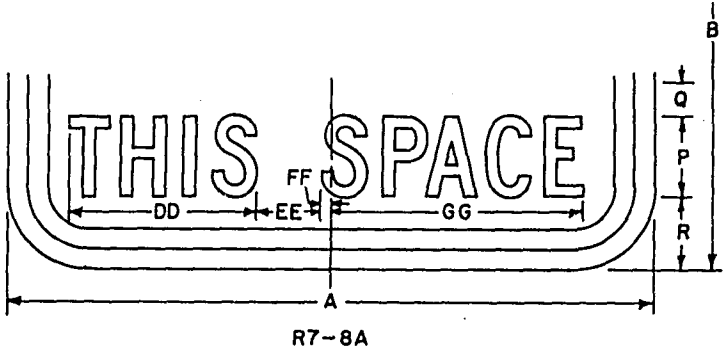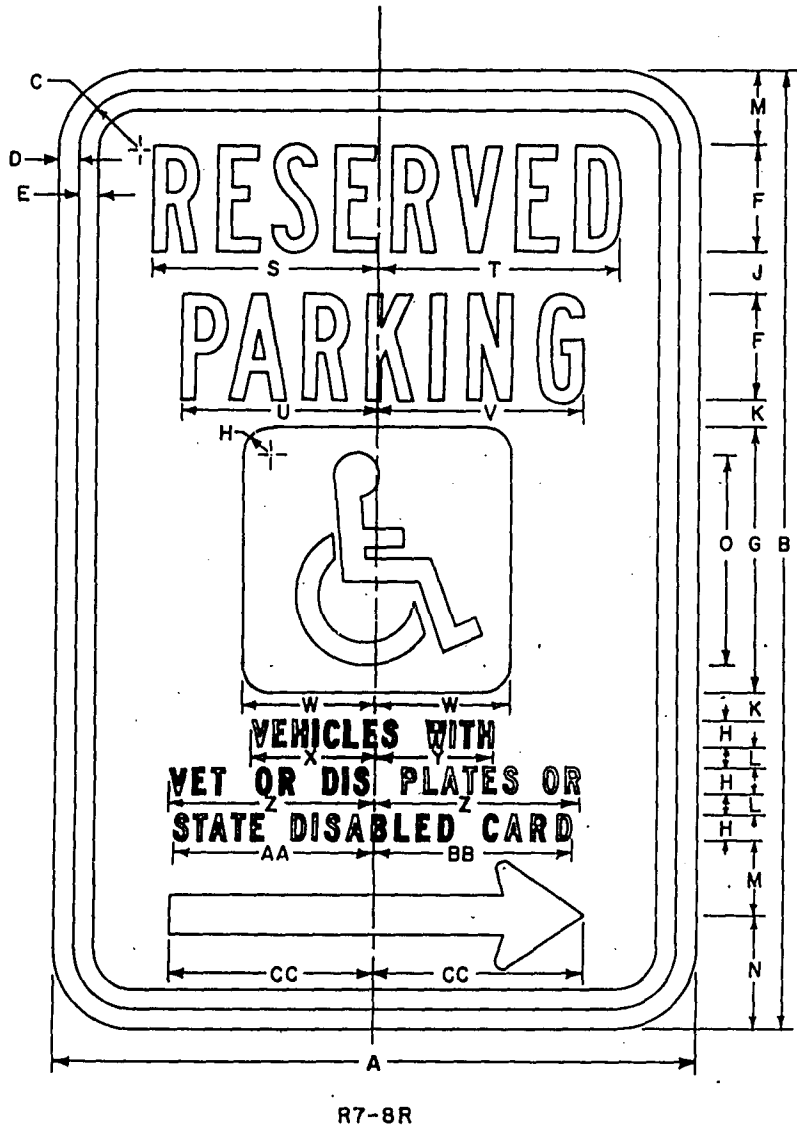


SIZE	CODE SIZE	A	B	C	D	E	F	G	H	I	J	K	L	M	N	O	P	Q	R	S	T	U	V	W	X	Y	Z	Bid Area Sq. Ft.
Minimum	1																											
Standard	2	12	18	1 1/8	3/8	3/8	2	5	1 1/2		3/4	9/16	3/8	1 3/8	2 1/8	4	1 1/2	5/8	1 3/8	4 1/4	4 5/8	3 5/8	3 7/8	2 1/2	2 3/8	2 1/4	3 7/8	
Oversize	3	18	24	1 1/8	3/8	1/2	3	6	3/4		7/8	5/8	7/16	1 7/8	3	5	2	7/8	2	6	6 1/4	5 3/8	5 1/2	3	3 1/4	3 1/8	5	
Exp-way	4																											
Freeway	5																											
Bicycle	6																											
Snowmobile	7																											
		AA	BB	CC	DD	EE	FF	GG	HH	II	JJ	KK	LL	MM	NN	OO	PP	QQ	RR	SS	TT	UU	VV	WW	XX	YY	ZZ	
Minimum	1																											
Standard	2	3 3/4	3 5/8	3 7/8	3 1/2	1 3/16	3/16	4 11/16	3/8	3/4	1/8	7/8	1 1/2															1.50
Oversize	3	4 7/8	4 5/8	5 13/16	4 9/16	1 3/8	3/16	6 3/8	9/16	1 1/8	3/16	1 5/16	2 1/4															3.00
Exp-way	4																											
Freeway	5																											
Bicycle	6																											
Snowmobile	7																											

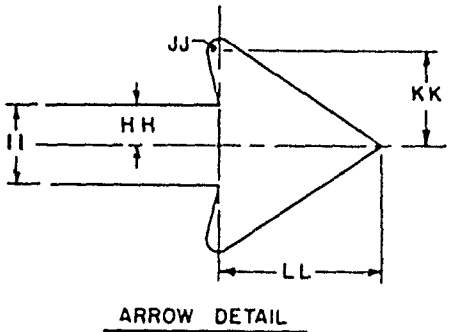

Date Drawn: 1-25-79	Date Revised: 4-15-83
Date Reused: 4-15-83	
STANDARD SIGN R7-8	
WISCONSIN DEPT OF TRANSPORTATION	
[Signature]	

NOTES

1. Sign is Type II - Reflective - reference
WIS DOT Standard Specification for ROAD
and BRIDGE CONSTRUCTION latest edition.
2. Color:
Background -White
Message -Green
3. Message Series -D
4. Corners may be square or rounded when base
material is plywood but borders shall be
rounded as shown. When base material is
metal,the corners and borders shall be
rounded.

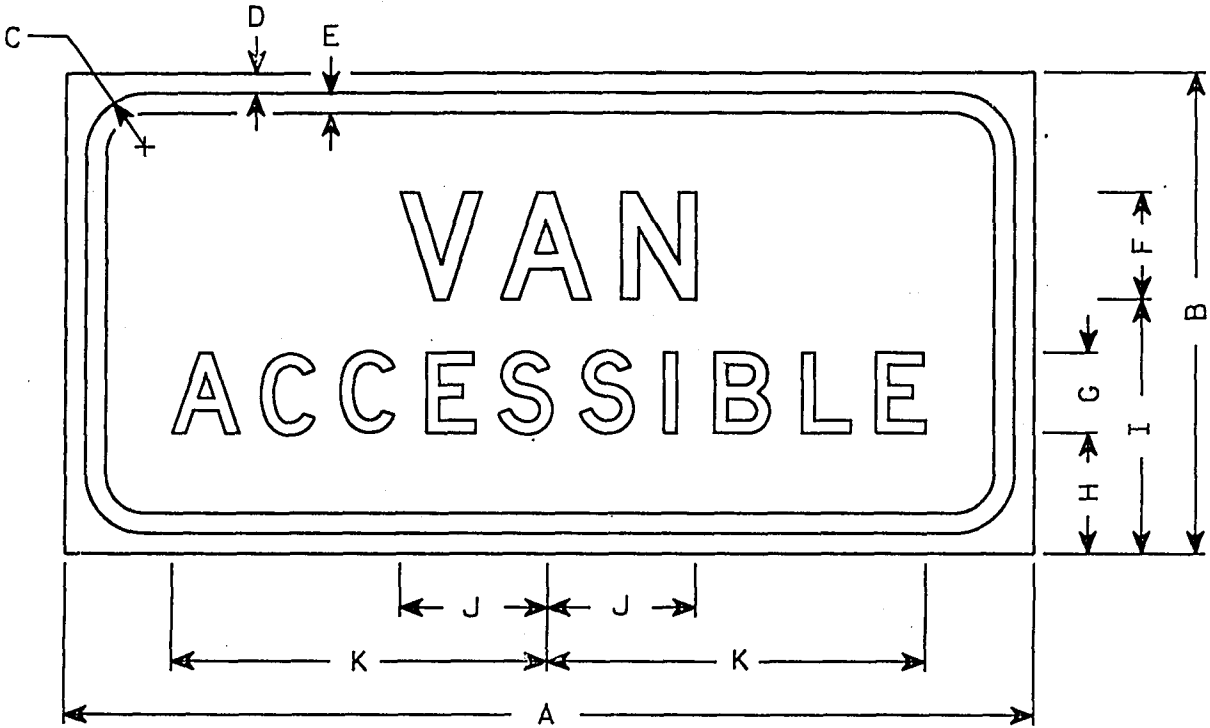

R7-8V

Metric equivalent
for this sign is:






SIZE	
1	
2	300 mm x 150 mm
3	450 mm x 225 mm
4	
5	

SIZE	A	B	C	D	E	F	G	H	I	J	K	L	M	N	O	P	Q	R	S	T	U	V	W	X	Y	Z	Area Sq. Ft.
2	12	6	1 1/8	3/8	3/8	1 1/2	1	1 5/8	3 1/2	2	5 1/4																0.50
3	18	9	1 1/8	3/8	3/8	2	1 1/2	2 1/4	4 3/4	2 3/4	7																1.12
4																											
5																											

STANDARD SIGN
R7-8V

WISCONSIN DEPT. OF TRANSPORTATION

APPROVED

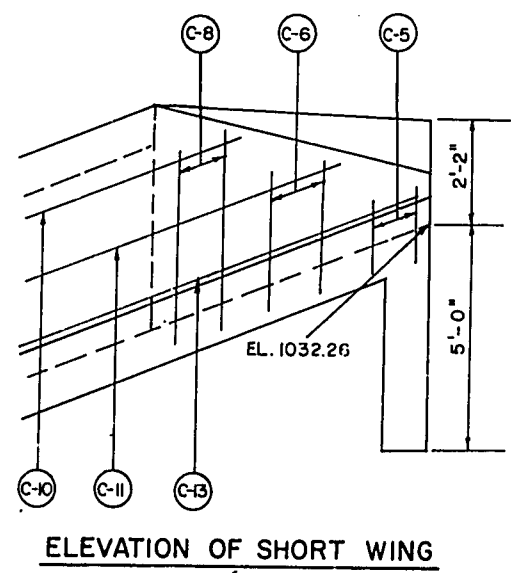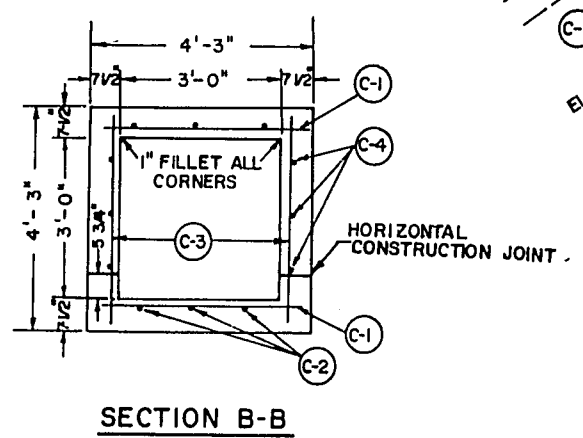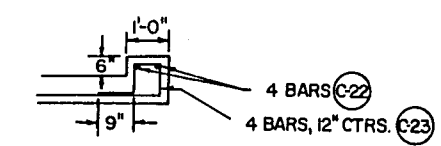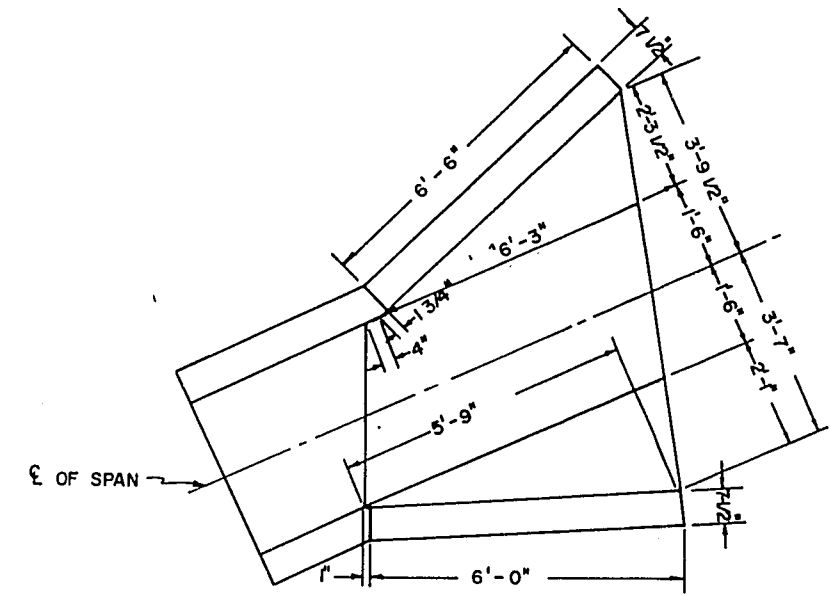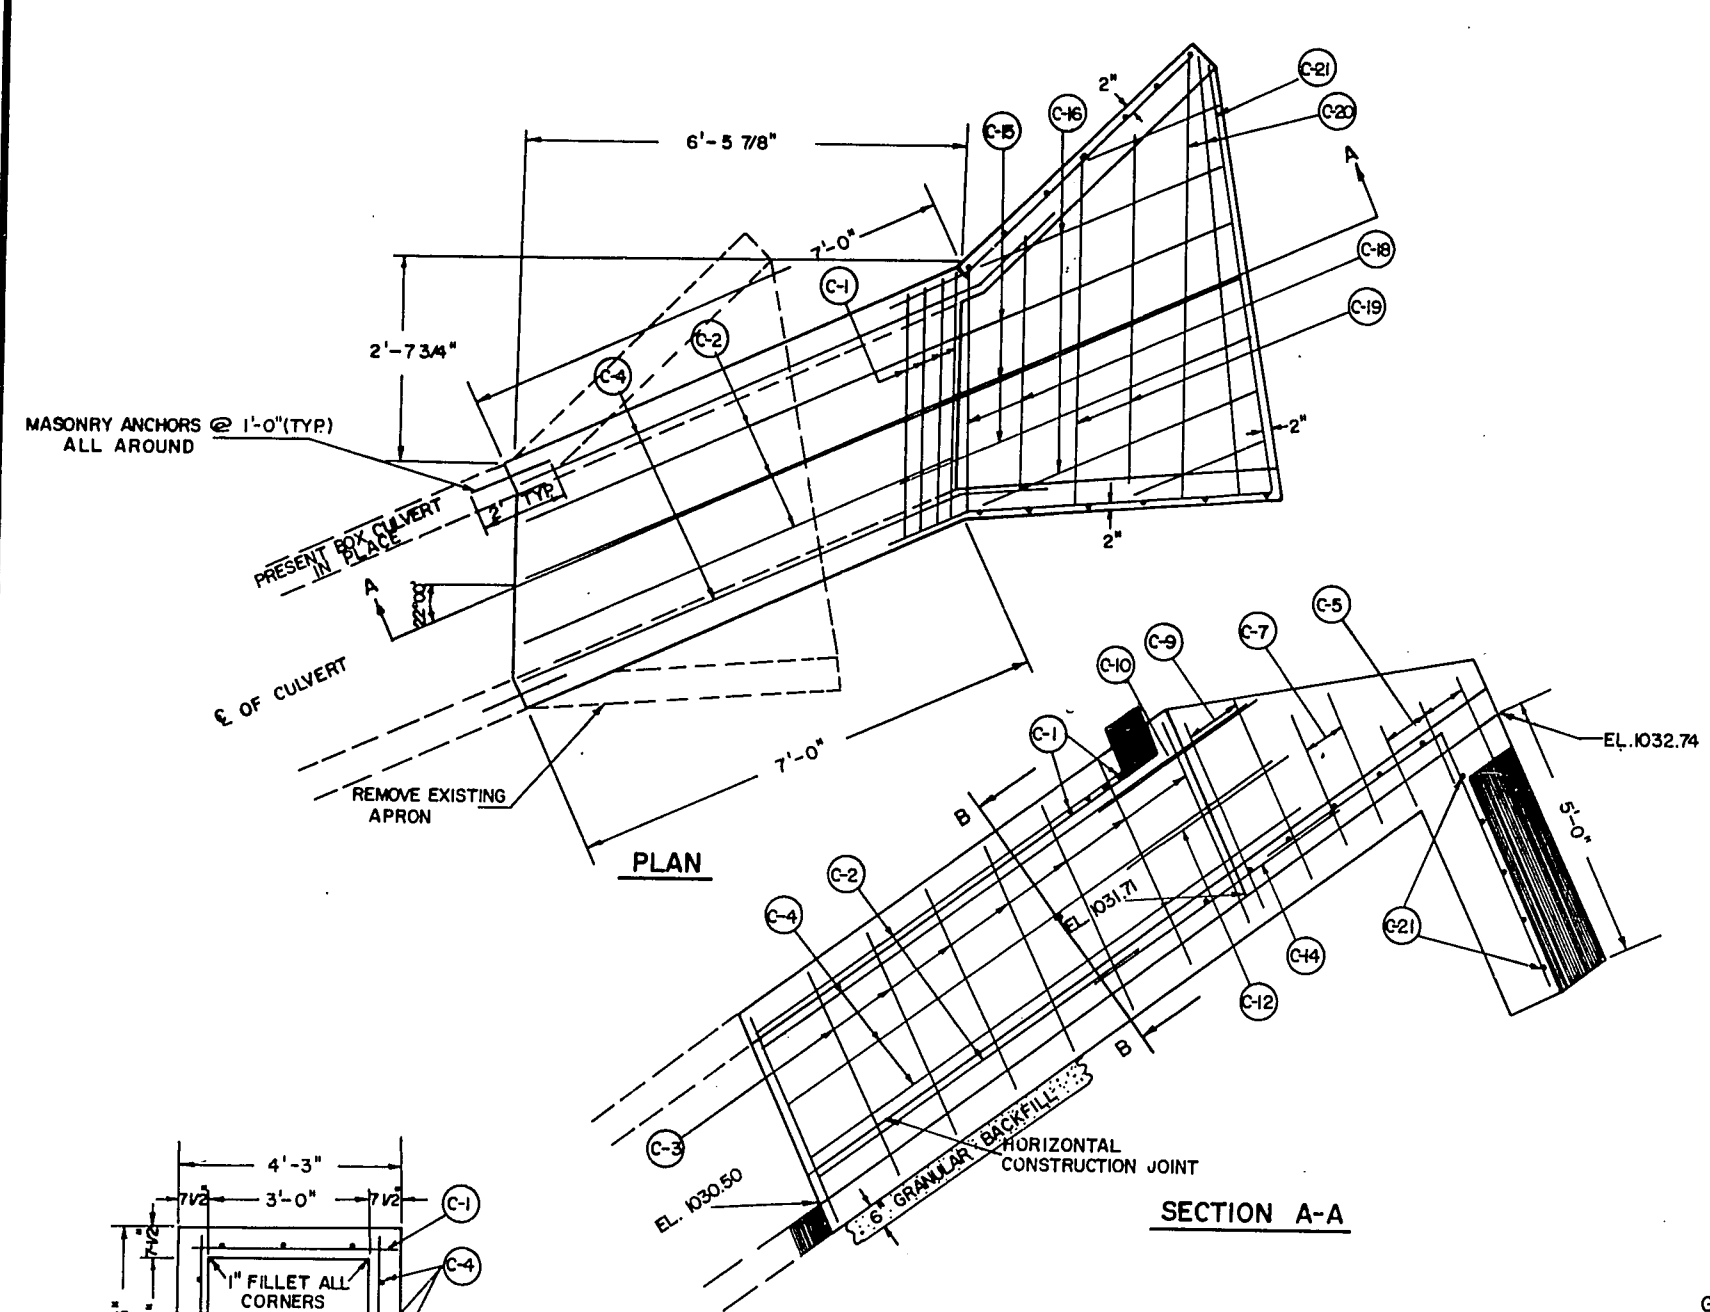

NO.	MARK	SIZE	LENGTH	SPACING	LOCATION
44	C-1	1/2" Ø	4'-3"	4" CTRS	LONGITUDINAL-FLOOR & PAVEMENT
6	C-2	"	6'-10"	1'-0" CTRS	TRANSVERSE-FLOOR & PAVEMENT
16	C-3	"	4'-0"	1'-0"	VERTICAL-SIDES OF BARREL
6"	C-4	"	9'-4"	1'-0"	HORIZONTAL-SIDES OF BARREL
5	C-5	"	3'-6"	1'-0"	VERTICAL-BOTH WINGS
2	C-6	"	4'-6"	1'-0"	" - SHORT "
2	C-7	"	4'-9"	1'-0"	" - LONG "
2	C-8	"	5'-5"	1'-0"	" - SHORT "
2	C-9	"	5'-6"	1'-0"	" - LONG "
2	C-10	"	4'-3"	1'-0"	HORIZONTAL-BOTH WINGS
1	C-11	"	6'-0"	1'-0"	" - SHORT WING
1	C-12	"	6'-9"	1'-0"	" - LONG "
1	C-13	"	8'-0"	1'-0"	" - SHORT "
1	C-14	"	8'-6"	1'-0"	" - LONG "
3	C-15	"	11'-9"	1'-0"	LONGITUDINAL-APRON
2	C-16	"	9'-6"	1'-0"	"
2	C-17	"	7'-0"	1'-0"	"
2	C-18	"	4'-6"	1'-0"	TRANSVERSE - APRON
2	C-19	"	6'-0"	1'-0"	"
2	C-20	"	7'-9"	1'-0"	"
5	C-21	"	8'-3"	1'-0"	HORIZONTAL-CUTOFF WALL
2	C-22	"	4'-3"	AS SHOWN	HEADWALL
5	C-23	"	3'-5"	1'-0"	HEADWALL

GENERAL NOTES

DRAWINGS SHALL NOT BE SCALED

ALL CONCRETE MASONRY SHALL BE GRADE A

BEVEL EXPOSED EDGES OF CONCRETE 1"


ALL VERTICAL STEEL IN WINGS SHALL BE BENT 2'-0" INTO APRON

THE SIDES OF THE BARREL AND THE TOP OF THE BOX CULVERT AT THE JOINT BETWEEN EXISTING AND NEW CONCRETE SHALL BE WATERPROOFED WITH MEMBRANE WATERPROOFING


TOTAL ESTIMATED QUANTITIES	
EXCAVATION FOR STRUCTURES	1 L.S.
CONCRETE MASONRY CULVERTS	55 C.Y.
H.S. BAR STEEL REINFORCEMENT	450 LB.
GRANULAR BACKFILL *	15 C.Y.
REMOVING OLD CULVERT	1 L.S.
CONCRETE MASONRY ANCHORS, TYPE L, NO. 5 BARS	14 EACH
NON BID ITEMS	
MEMBRANE JOINT WATERPROOFING	

* THIS QUANTITY INCLUDED IN THE MISC QUANTITIES SHEET LISTING FOR GRANULAR BACKFILL

DETAILS
FOR
EXTENSION OF
CULVERT C-194
STA. 13+00 TO 13+10
DRAINAGE

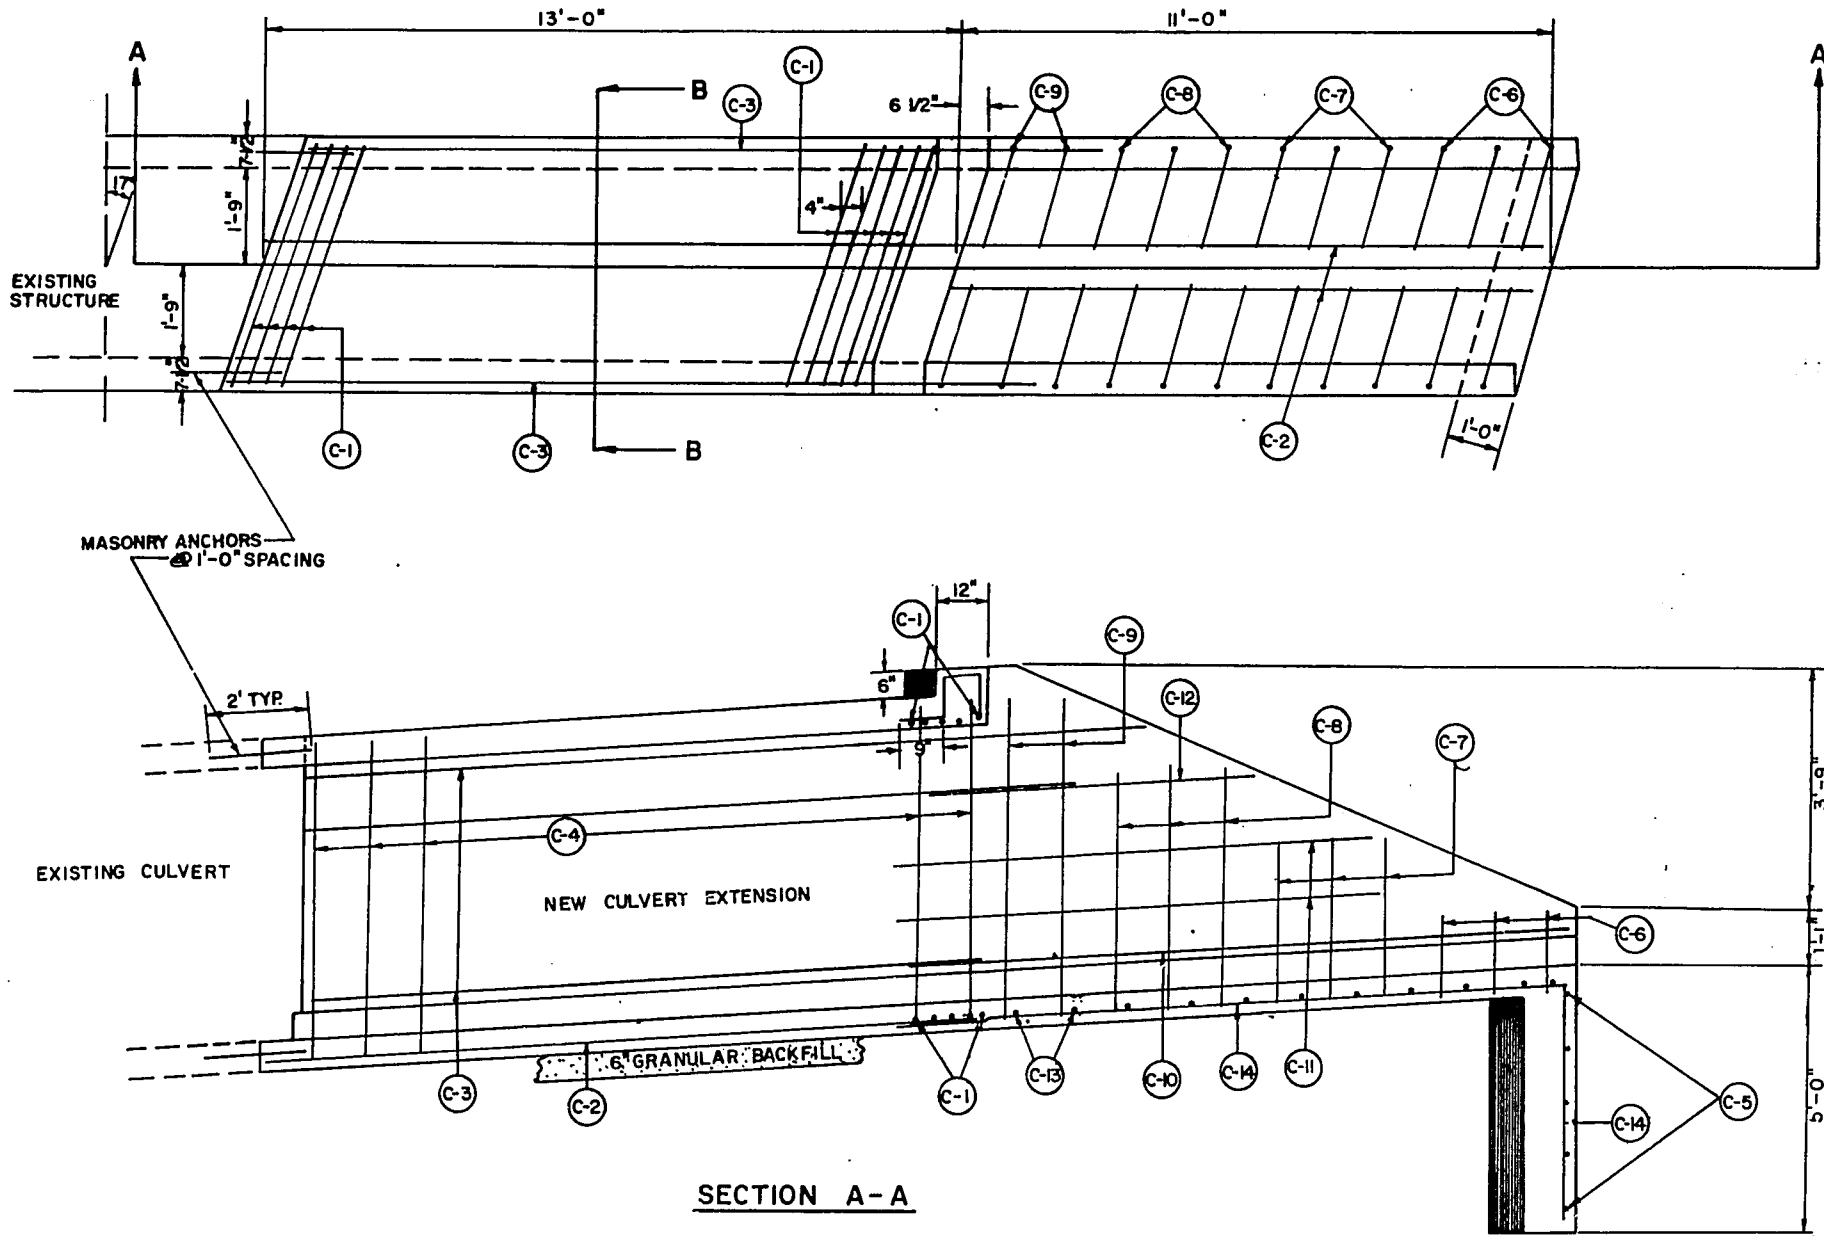

SECTION A-A

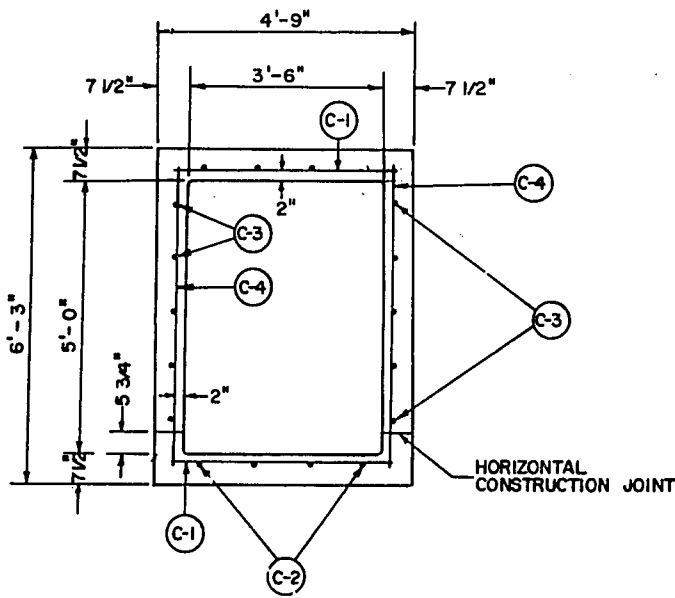

SECTION B-B

NO.	MARK	SIZE	LENGTH	SPACING	LOCATION
80	C-1	4	4'-6"	0'-4"	LONGIT.-FLOOR & PAVEMENT
8	C-2	4	12'-8"	1'-0"	TRANSV.-FLOOR & PAVEMENT
10	C-3	4	12'-10"	1'-0"	HORIZ. — SIDES OF BARREL
26	C-4	4	6'-0"	1'-0"	VERTICAL — SIDES OF BARREL
5	C-5	4	4'-6"	1'-0"	LONGIT. — CUTOFF WALL
6	C-6	4	3'-6"	1'-0"	VERTICAL — WING
6	C-7	4	5'-0"	1'-0"	" "
6	C-8	4	6'-0"	1'-0"	" "
4	C-9	4	7'-0"	1'-0"	" "
2	C-10	4	13'-0"	1'-0"	HORIZ. — WING
4	C-11	4	9'-0"	1'-0"	" "
2	C-12	4	6'-0"	1'-0"	" "
10	C-13	4	4'-6"	1'-0"	LONGIT. — APRON
4	C-14	4	16'-6"	1'-0"	TRANSV. — APRON

GENERAL NOTES

DRAWINGS SHALL NOT BE SCALED
 ALL CONCRETE MASONRY SHALL BE GRADE A
 BEVEL. EXPOSED EDGES OF CONCRETE 1"
 ALL VERTICAL STEEL IN WINGS SHALL BE BENT 2'-0" INTO APRON
 THE SIDES OF THE BARREL AND THE TOP OF THE BOX CULVERT AT THE
 JOINT BETWEEN EXISTING AND NEW CONCRETE SHALL BE WATERPROOFED
 WITH MEMBRANE WATERPROOFING

ESTIMATED QUANTITIES

BID ITEMS

EXCAVATION FOR STRUCTURES	1.0 L.S.
CONCRETE MASONRY CULVERTS	10.0 C.Y.
H.S. BAR STEEL REINFORCEMENT	769 LBS.
REMOVING OLD CULVERT	1.0 L.S.
GRANULAR BACKFILL *	1.5 C.Y.
CONCRETE MASONRY ANCHORS, TYPE L, NO. 5 BARS	22 EACH


NON-BID ITEM

MEMBRANE JOINT WATERPROOFING


* THIS QUANTITY INCLUDED IN THE MISC. QUANTITY SHEET
 LISTING FOR GRANULAR BACKFILL

DETAILS
 FOR
 EXTENSION OF
 CULVERT C- 1895


STA. 17+30.00 U.S.H. 10
 PIERCE CO.

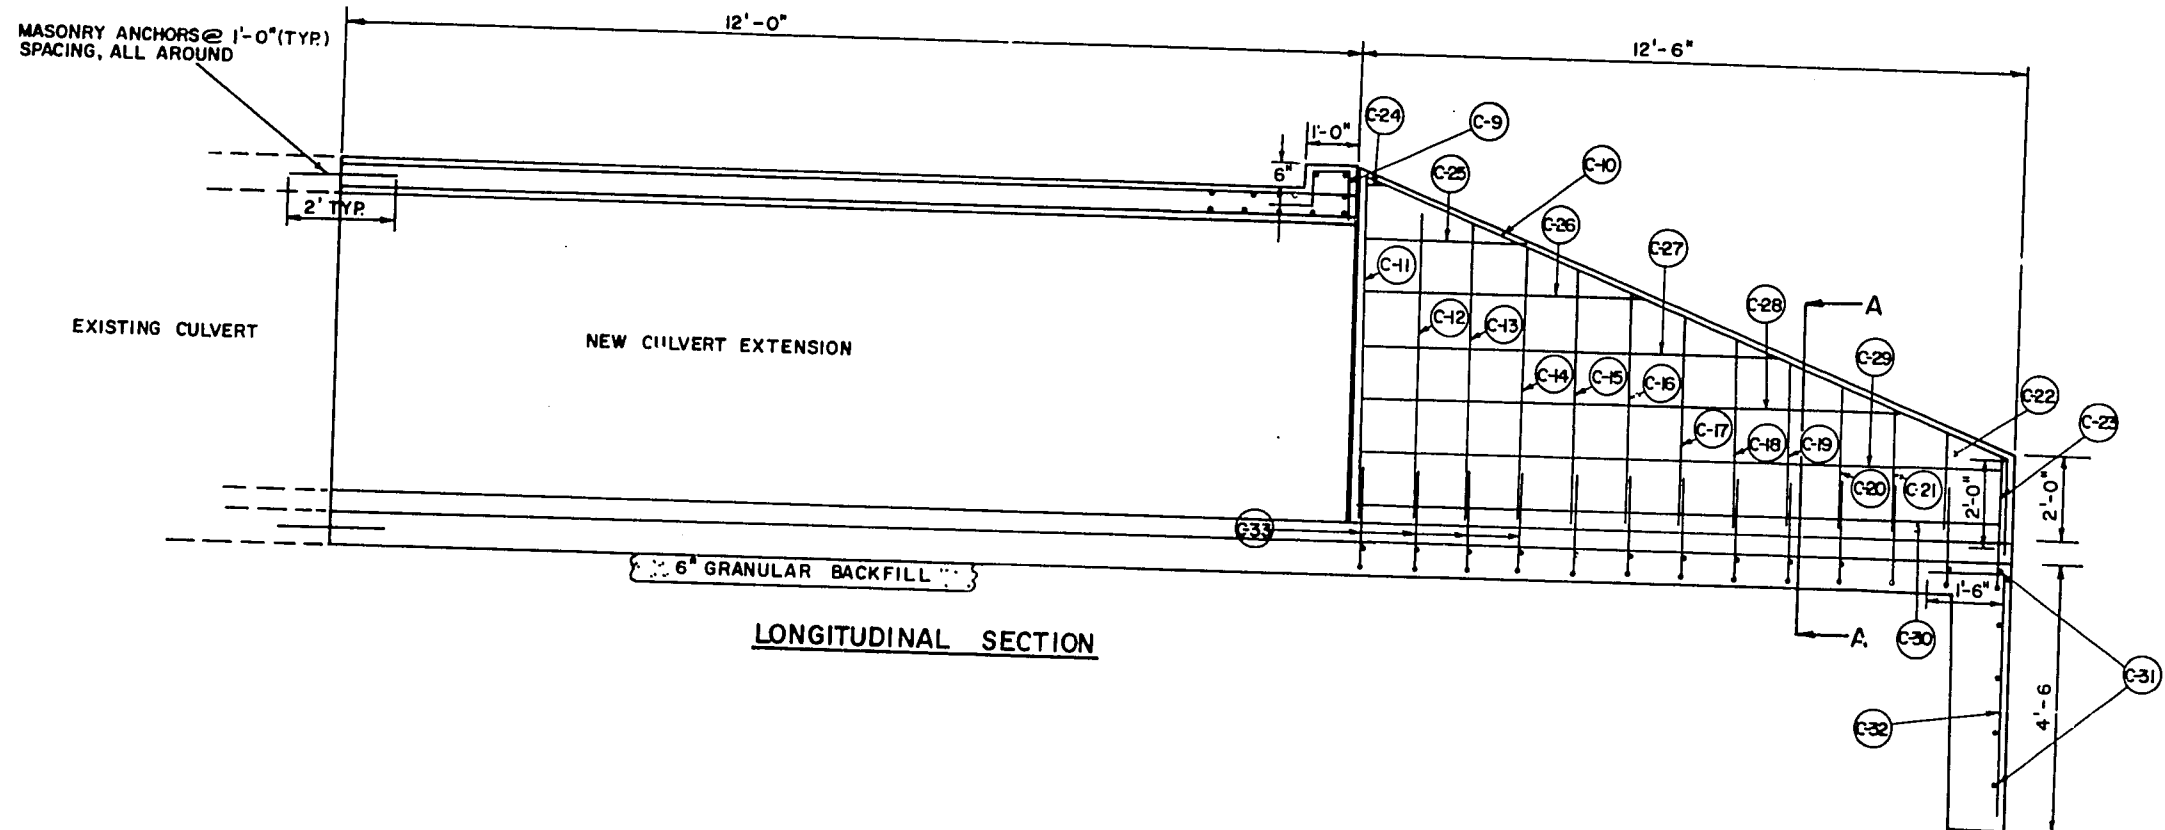


LONGITUDINAL SECTION

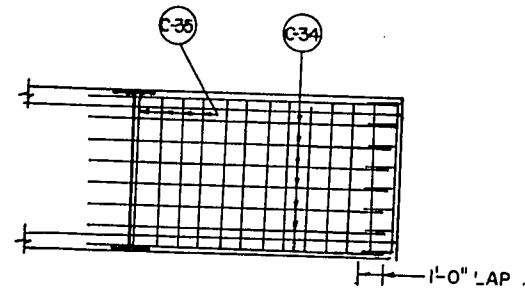

APRON DETAIL

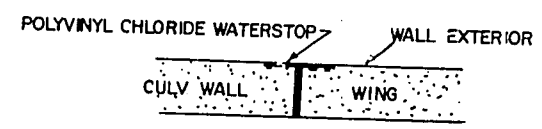


WALL JOINT DETAIL

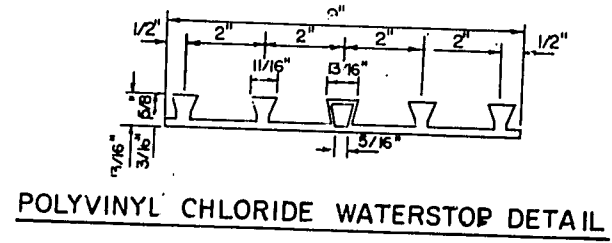


POLYVINYL CHLORIDE WATERSTOP DETAIL

EXTEND FILLER FROM HORIZONTAL CONSTRUCTION JOINT TO TOP OF WING. DO NOT RUN ANY STEEL THRU JOINT FILLER.
FILLER SHALL CONFORM TO AASHTO DESIGNATION M 153 OR M 213.

POLYVINYL CHLORIDE WATERSTOP - EXTEND FROM HORIZONTAL CONST. JOINT TO TOP OF WALL (FLUSH WITH FACE OF CONCRETE) SEE WATERSTOP DETAIL.

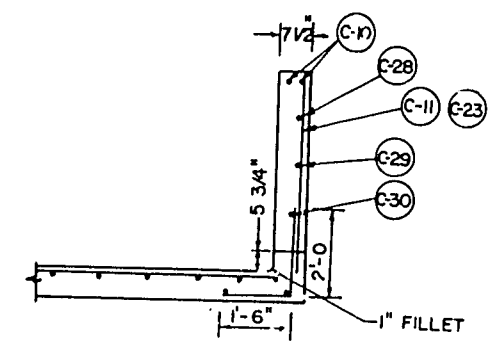

SECTION A-A
SECTION THRU WINGWALL

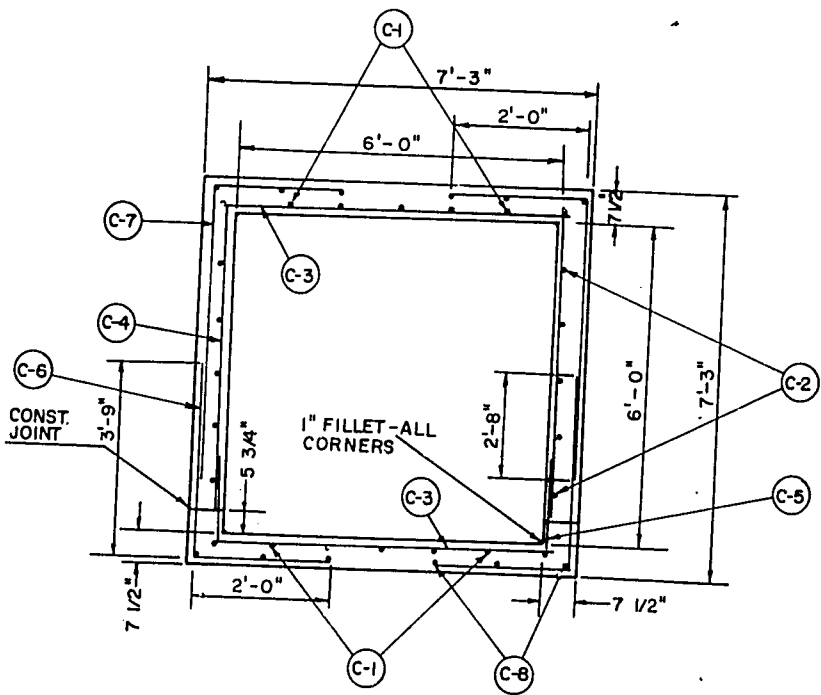

TYPICAL CULVERT CROSS SECTION

NO.	MARK	SIZE	LENGTH	SPACING	LOCATION
10	C-1	4	11'-9"	1'-0"	LONGIT.-TOP OF BARREL
10	C-2	4	11'-9"	1'-0"	HORIZ.- SIDES OF BARREL
34	C-3	6	6'-6"	0'-9"	TRANSV.-TOP & BOTTOM OF BARREL
26	C-4	4	5'-9"	1'-0"	VERTICAL- SIDES OF BARREL
26	C-5	4	2'-3"	1'-0"	" " " "
26	C-6	4	5'-9"	1'-0"	BOTTOM CORNER OF BARREL
26	C-7	4	6'-8"	1'-0"	TOP CORNER OF BARREL
12	C-8	4	11'-9"	1'-0"	HORIZ.-TOP & BOTTOM OF BARREL
9	C-9	3	2'-8"	0'-8"	HEADWALL
4	C-10	5	15'-0"	AS SHOWN	WINGWALLS
2	C-11	4	6'-4"	1'-0"	"
2	C-12	4	5'-11"	AS SHOWN (1'-0" TYP)	"
2	C-13	4	5'-6"	"	"
2	C-14	4	5'-1"	"	"
2	C-15	4	4'-8"	"	"
2	C-16	4	4'-3"	"	"
2	C-17	4	3'-10"	"	"
2	C-18	4	3'-5"	"	"
2	C-19	4	3'-1"	"	"
2	C-20	4	2'-8"	"	"
2	C-21	4	2'-3"	"	"
2	C-22	4	1'-10"	"	"
2	C-23	4	4'-0"	"	"
2	C-24	4	0'-10"	"	"
2	C-25	"	3'-0"	"	"
2	C-26	4	5'-3"	"	"
2	C-27	4	7'-9"	"	"
2	C-28	4	10'-3"	"	"
2	C-29	4	12'-0"	"	"
2	C-30	4	12'-0"	"	"
5	C-31	4	6'-10"	1'-0"	CUTOFF WALL
7	C-32	4	6'-0"	1'-0"	"
24	C-33	4	3'-6"	1'-0"	APRON - HORIZ
8	C-34	4	14'-0"	1'-0"	APRON - HORIZ , LONGIT
12	C-35	4	6'-10"	1'-0"	" - HORIZ , TRANSV

GENERAL NOTES

- DRAWINGS SHALL NOT BE SCALED
- ALL CONCRETE MASONRY SHALL BE GRADE A
- BEVEL ALL EXPOSED EDGES OF CONCRETE 1'
- ALL VERTICAL STEEL IN WINGS SHALL BE BENT 1'-6" INTO APRON.
- BAR STEEL REINFORCEMENT SHALL BE IMBEDDED 2" CLEAR UNLESS OTHERWISE SHOWN OR NOTED.

BID ITEMS

EXCAVATION FOR STRUCTURES
CONCRETE MASONRY CULVERTS
HS. BAR STEEL REINFORCEMENT
GRANULAR BACKFILL
REMOVING OLD CULVERT
CONCRETE MASONRY ANCHORS.
TYPE L NO 5 BARS

1 L.S.
133 CU YDS
1425 LBS
2 CU YDS
1 L.S.
28 EACH

NON-BID ITEMS


POLYVINYL CHLORIDE WATERSTOP FILLER
*THIS QUANTITY INCLUDED IN THE MISC QUANTITIES SHEET LISTING FOR GRANULAR BACKFILL

DETAILS

FOR
EXTENSION OF


CULVERT C-1898


STA 50+00 U.S. 119
PIERCE CO

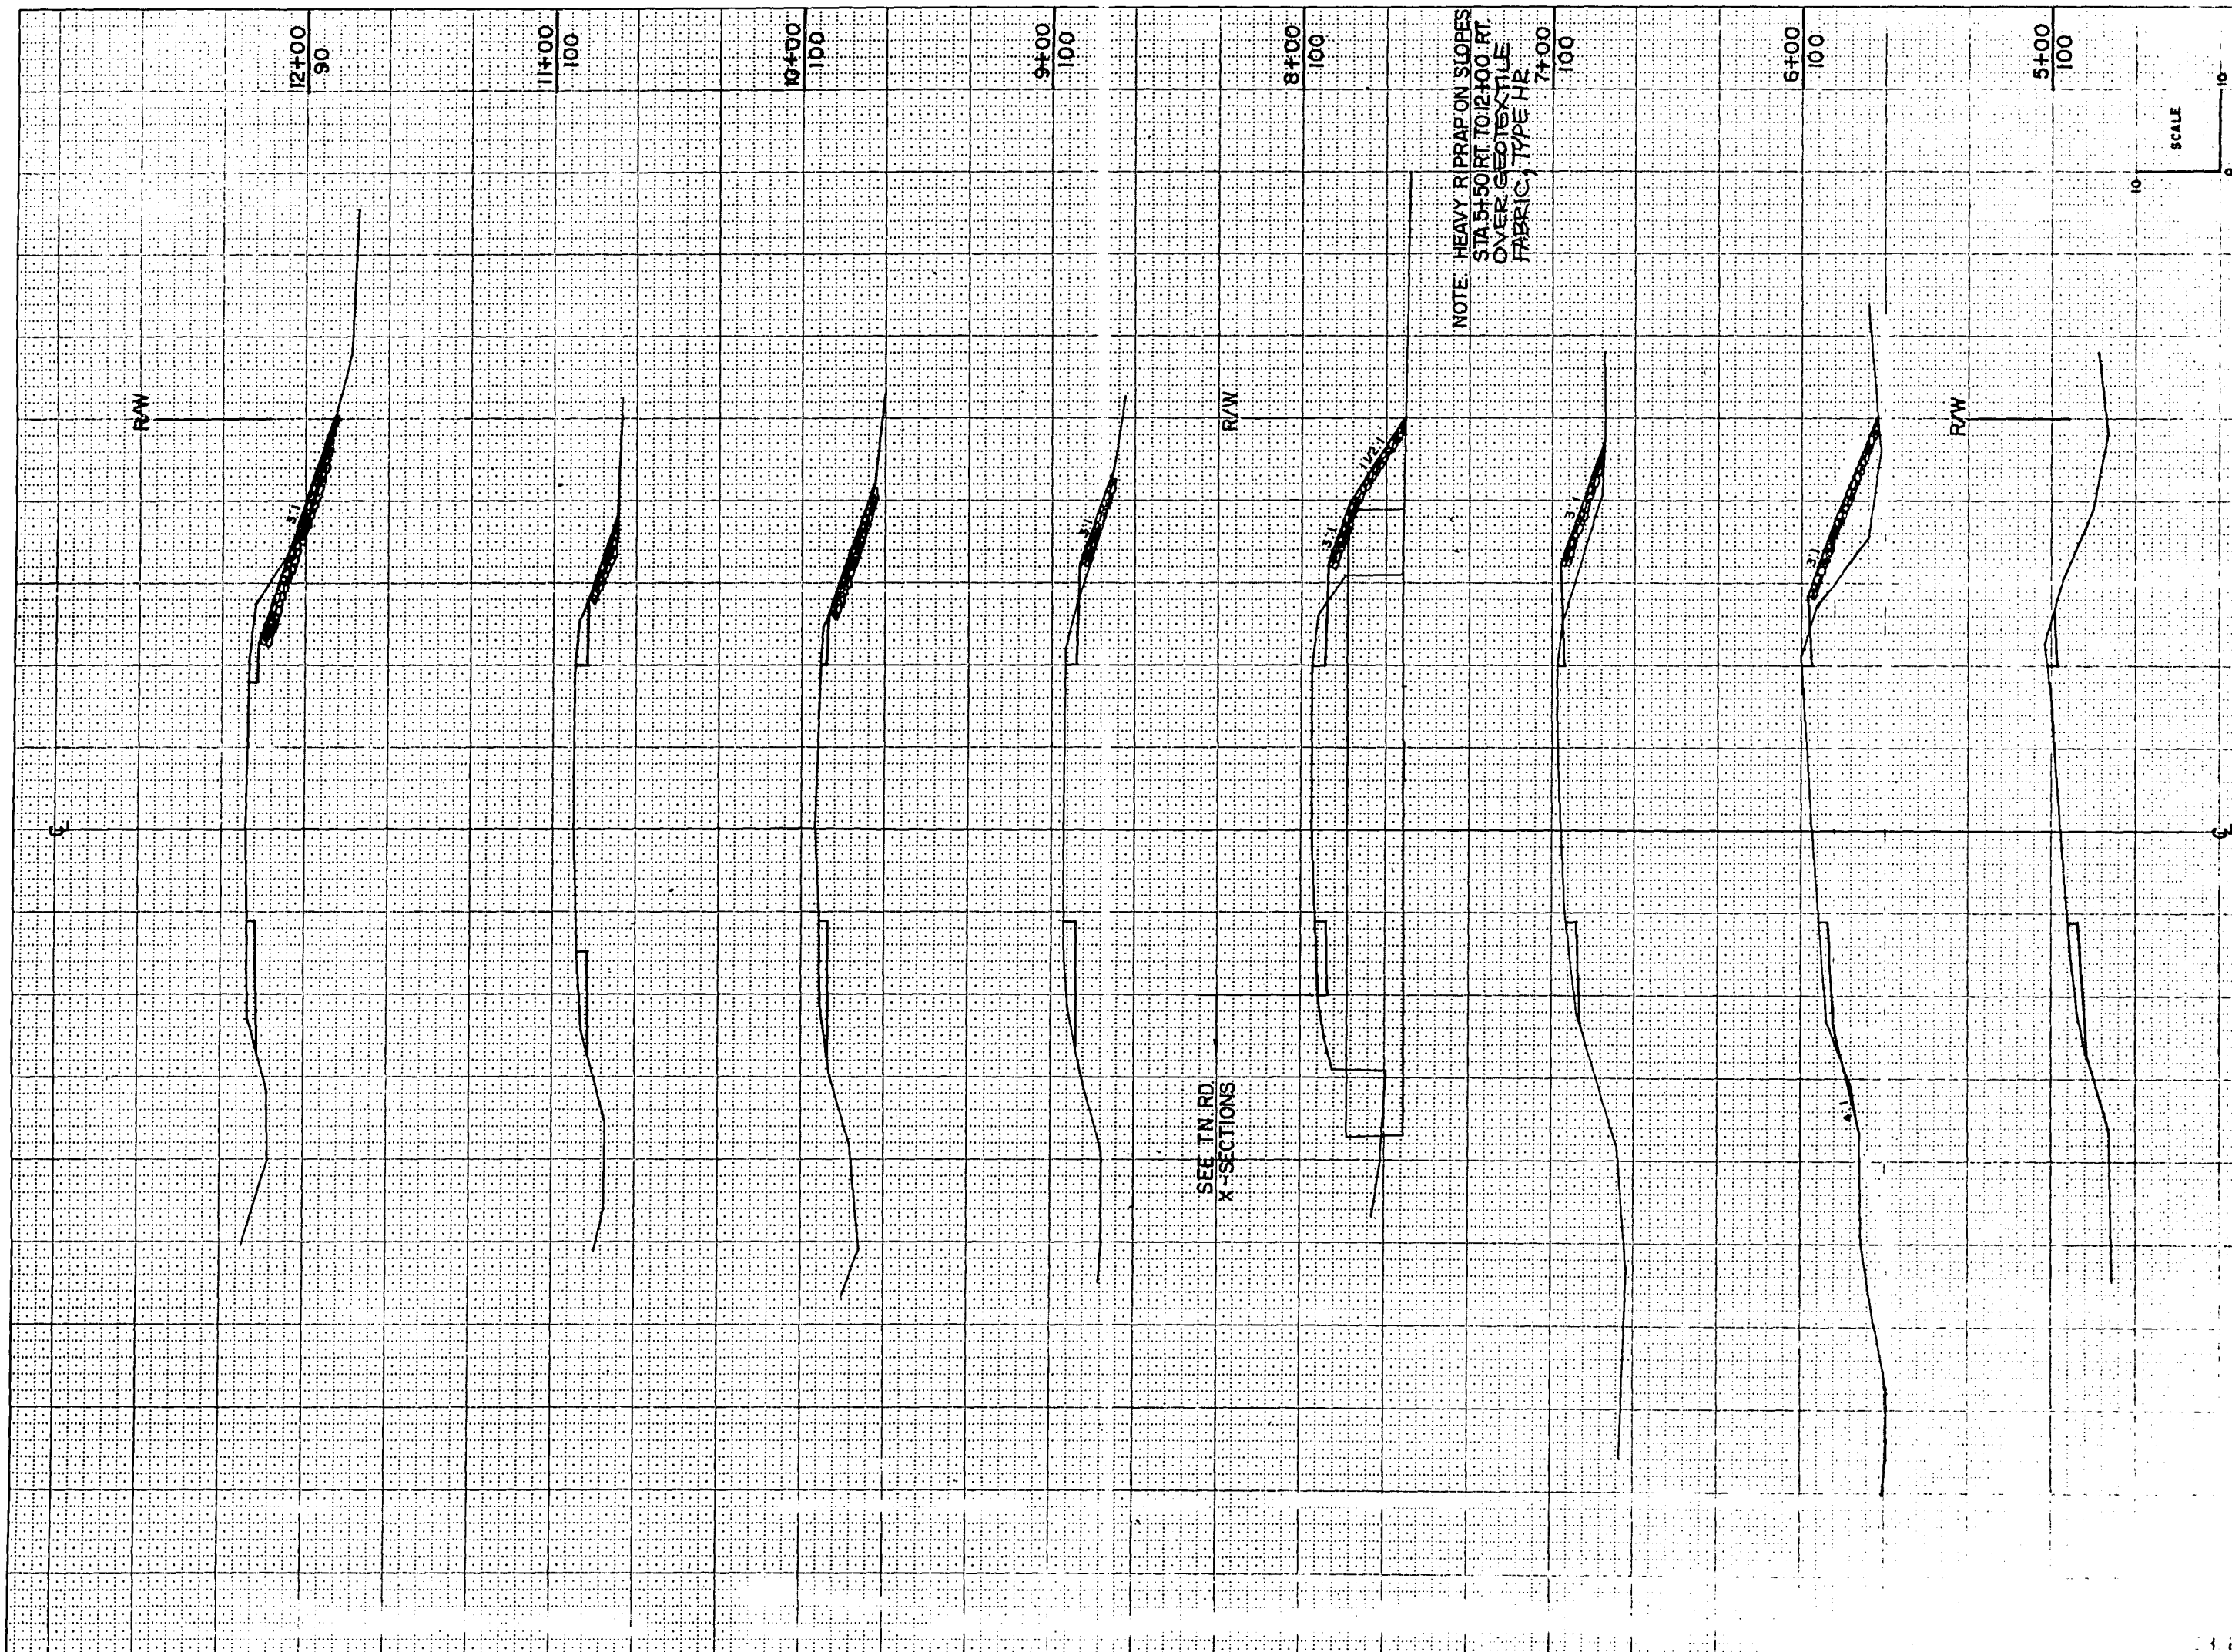


STATE PROJECT NUMBER					SHEET NUMBER
1530-08+71					90
STATION	DISTANCE	YARDAGE			FILL
		EXCAVATION			
		COMMON			
4		0			
5		37			0
6		70			126
7		57			187
8		61			265
9		81			226
10		72			41
11		61			37
12		85			32
13		52			22
			</		

SIDEROAD 390TH AVE. PASSING LANE STA. 4+50 TO 12+00 RT. U.S.H. 10

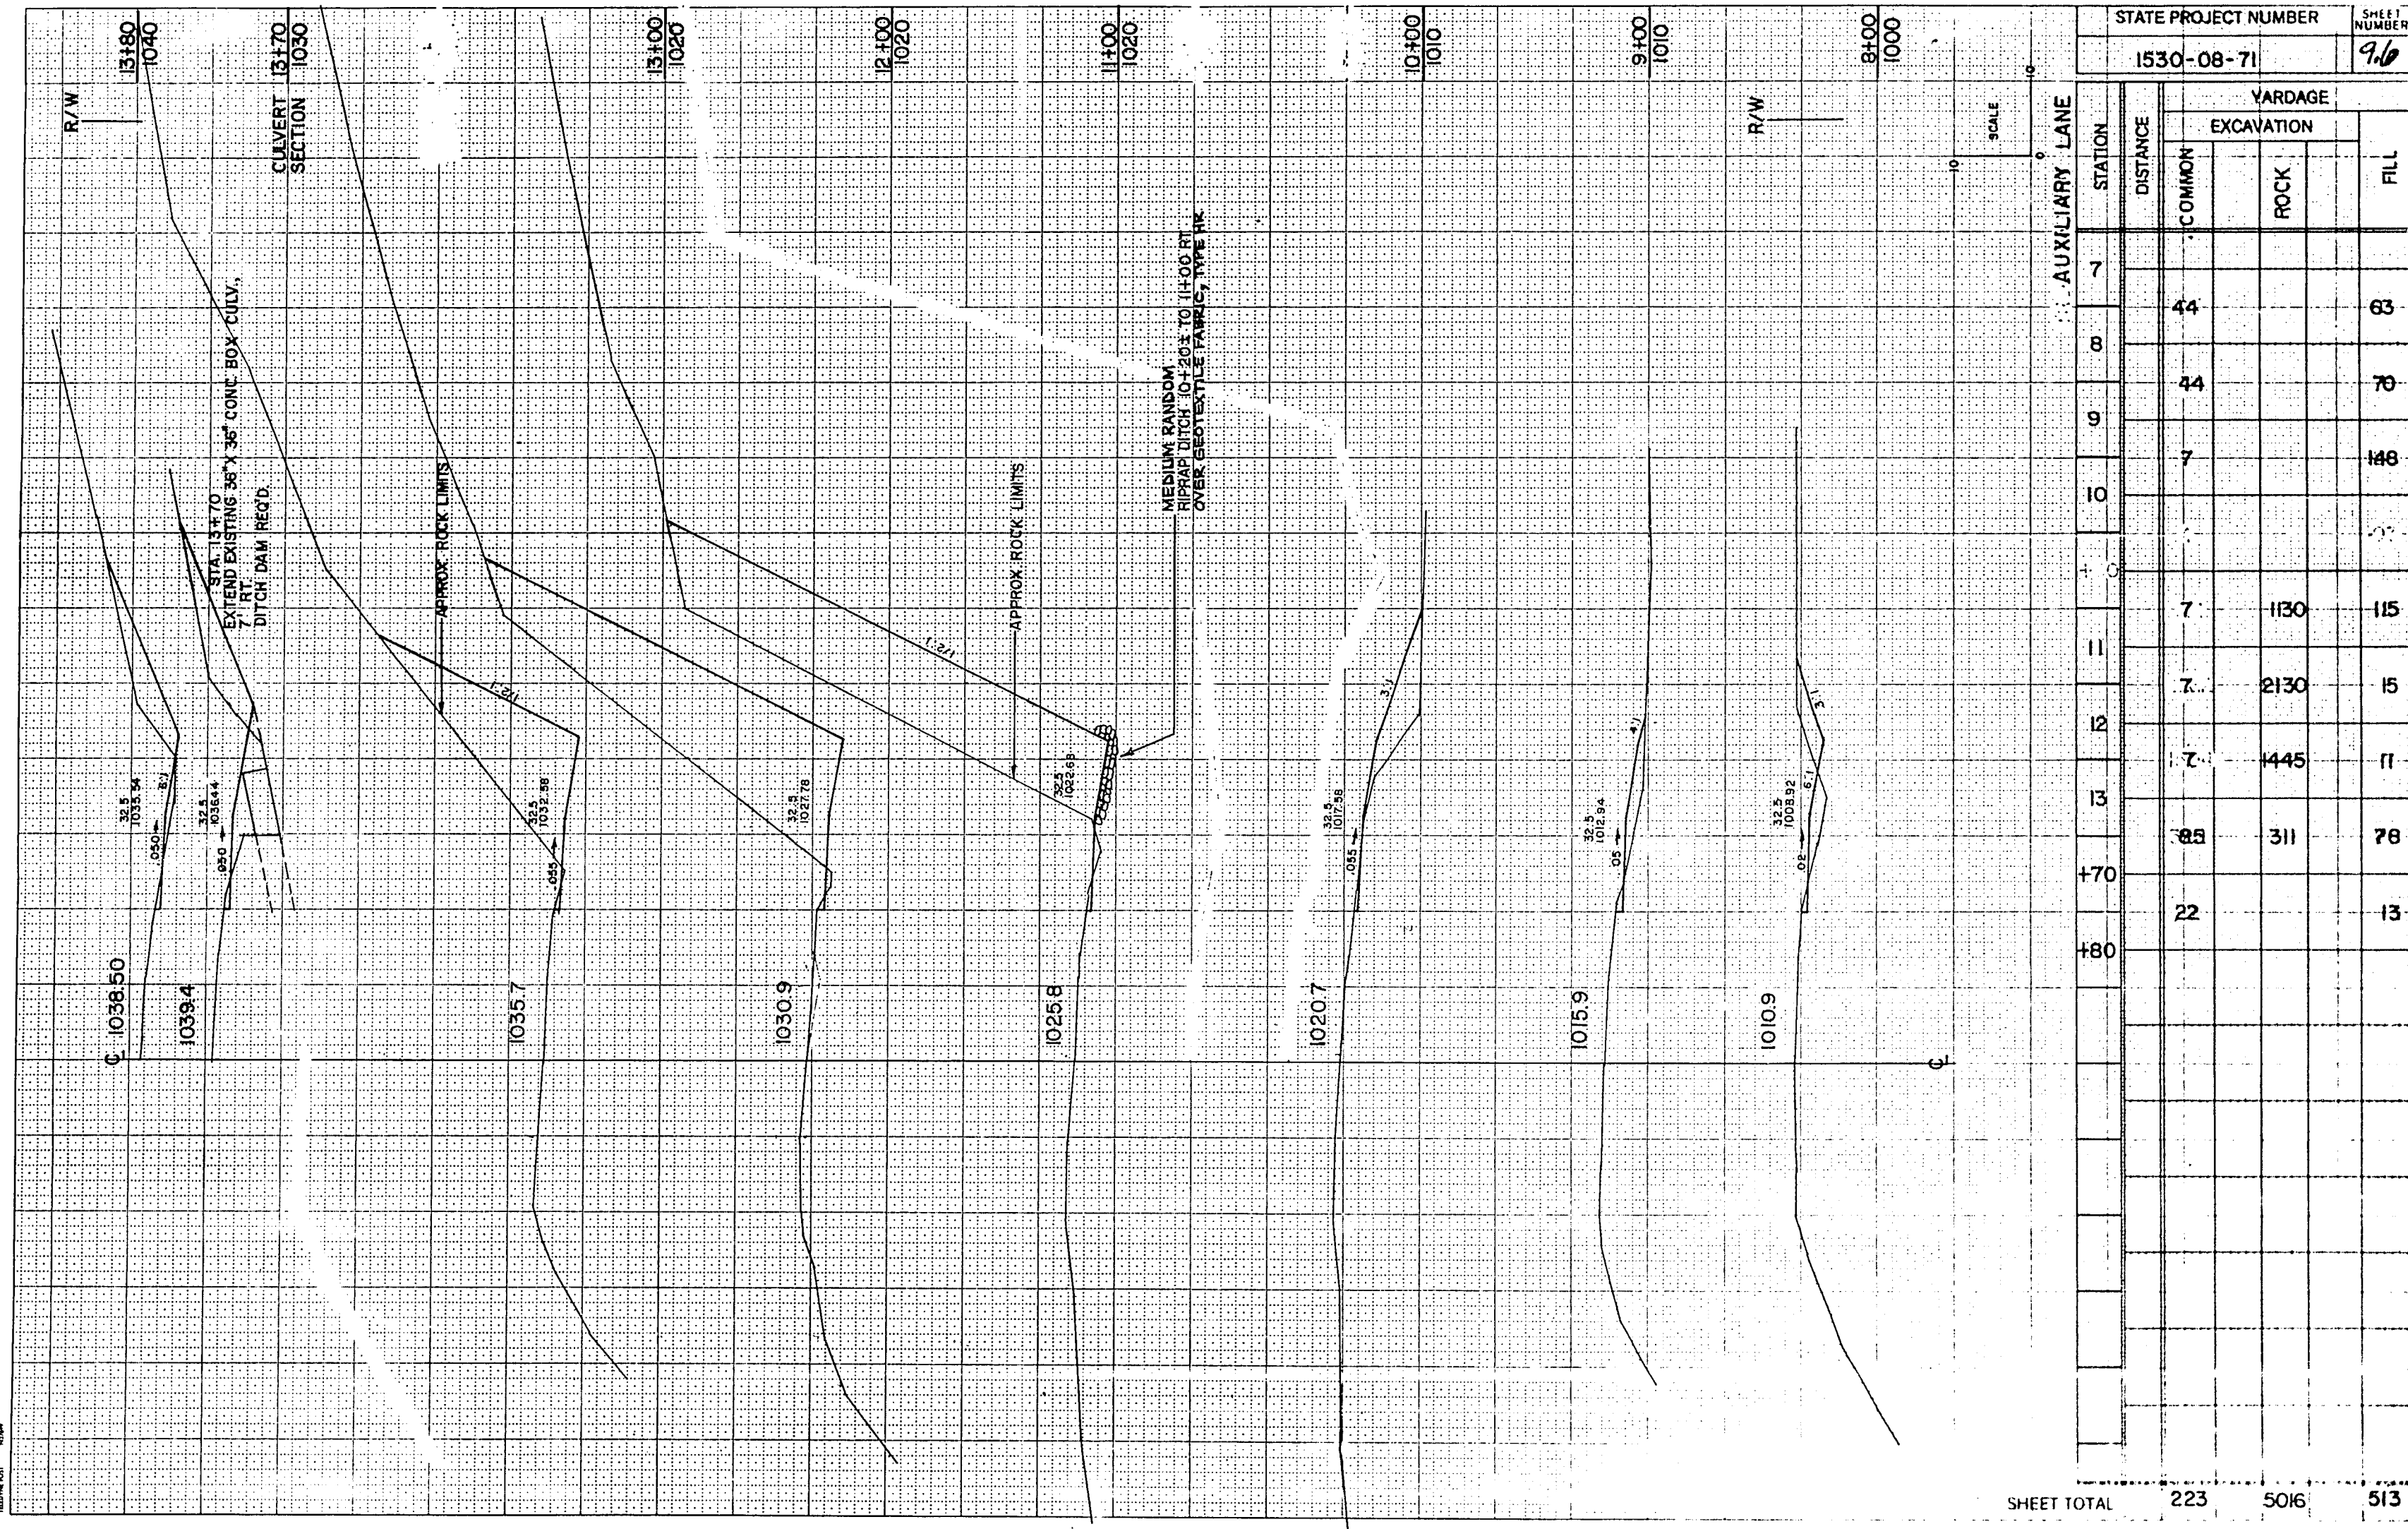

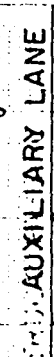


SHEET TOTAL	1157	2288	389
-------------	------	------	-----

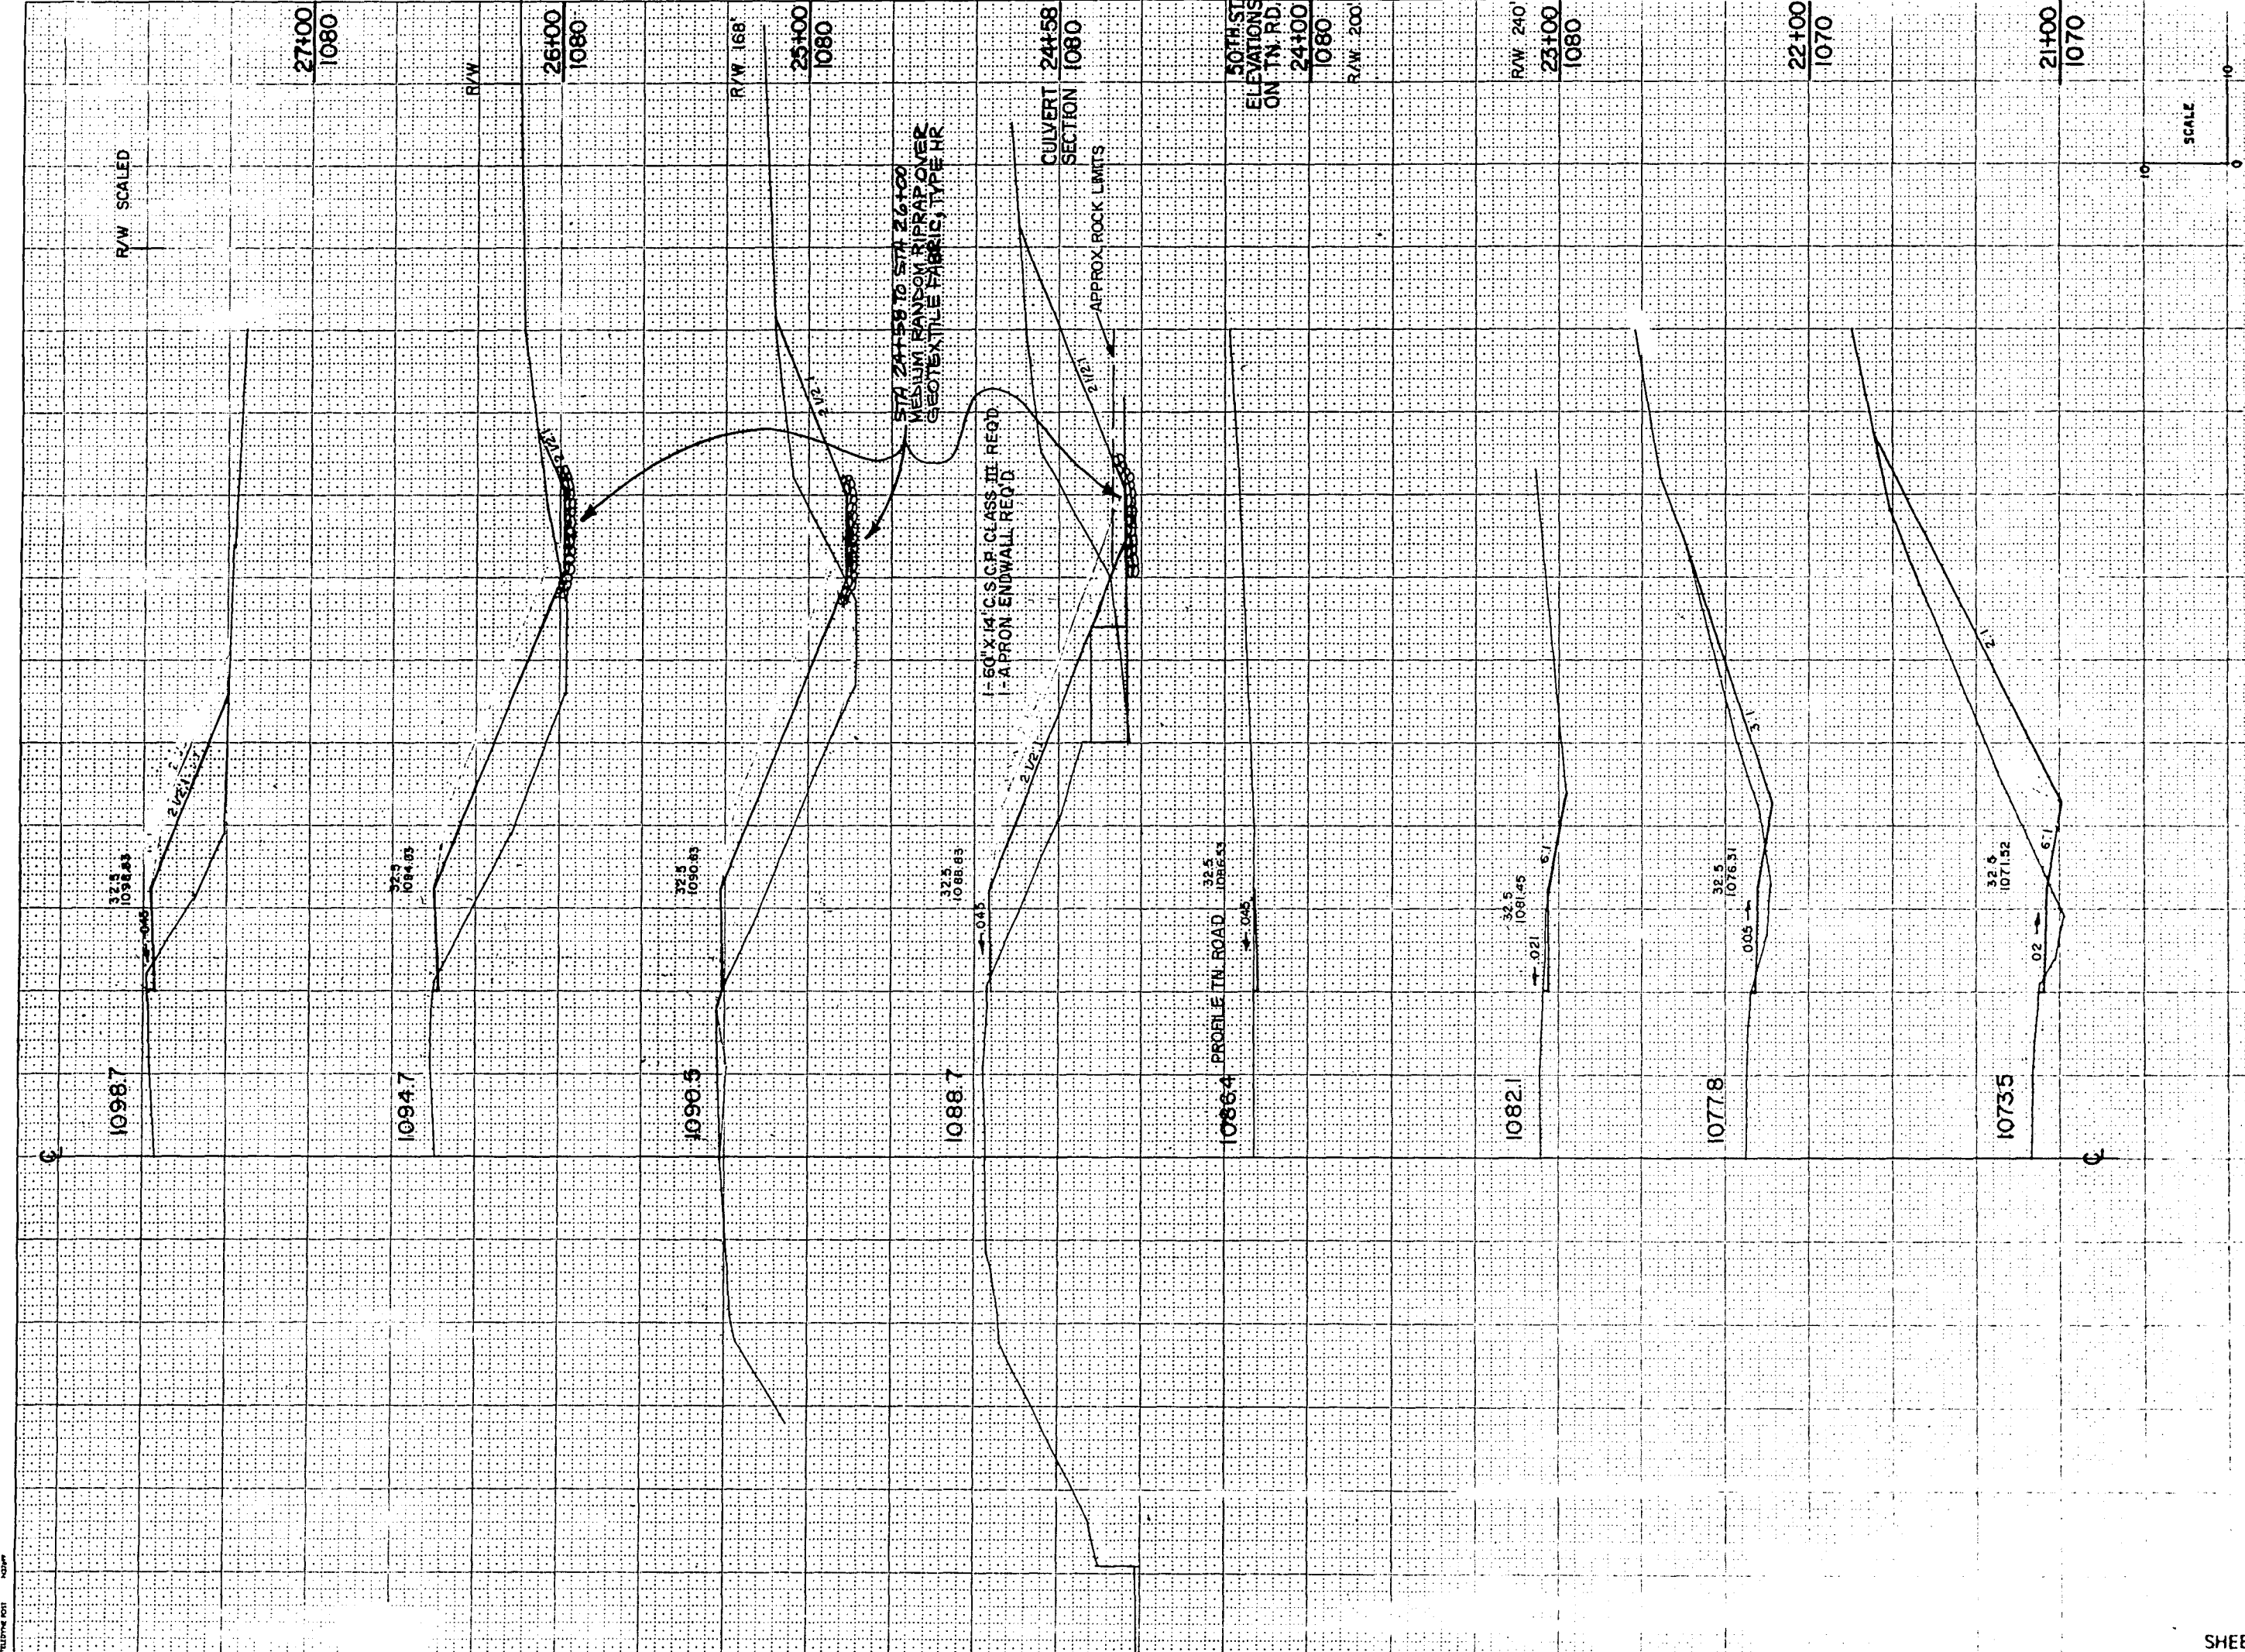


STATE PROJECT NUMBER		SHEET NUMBER		
1530 - 08 - 71		98		
STATION	DISTANCE	YARDAGE		
		EXCAVATION		FILL
		COMMON	ROCK	
20		437		48
21		456		52
22		89		28
23		22		0
24				
24 + 58		220	7	237
25		230	6	341
26		222		833
27		54		661

11/27/76

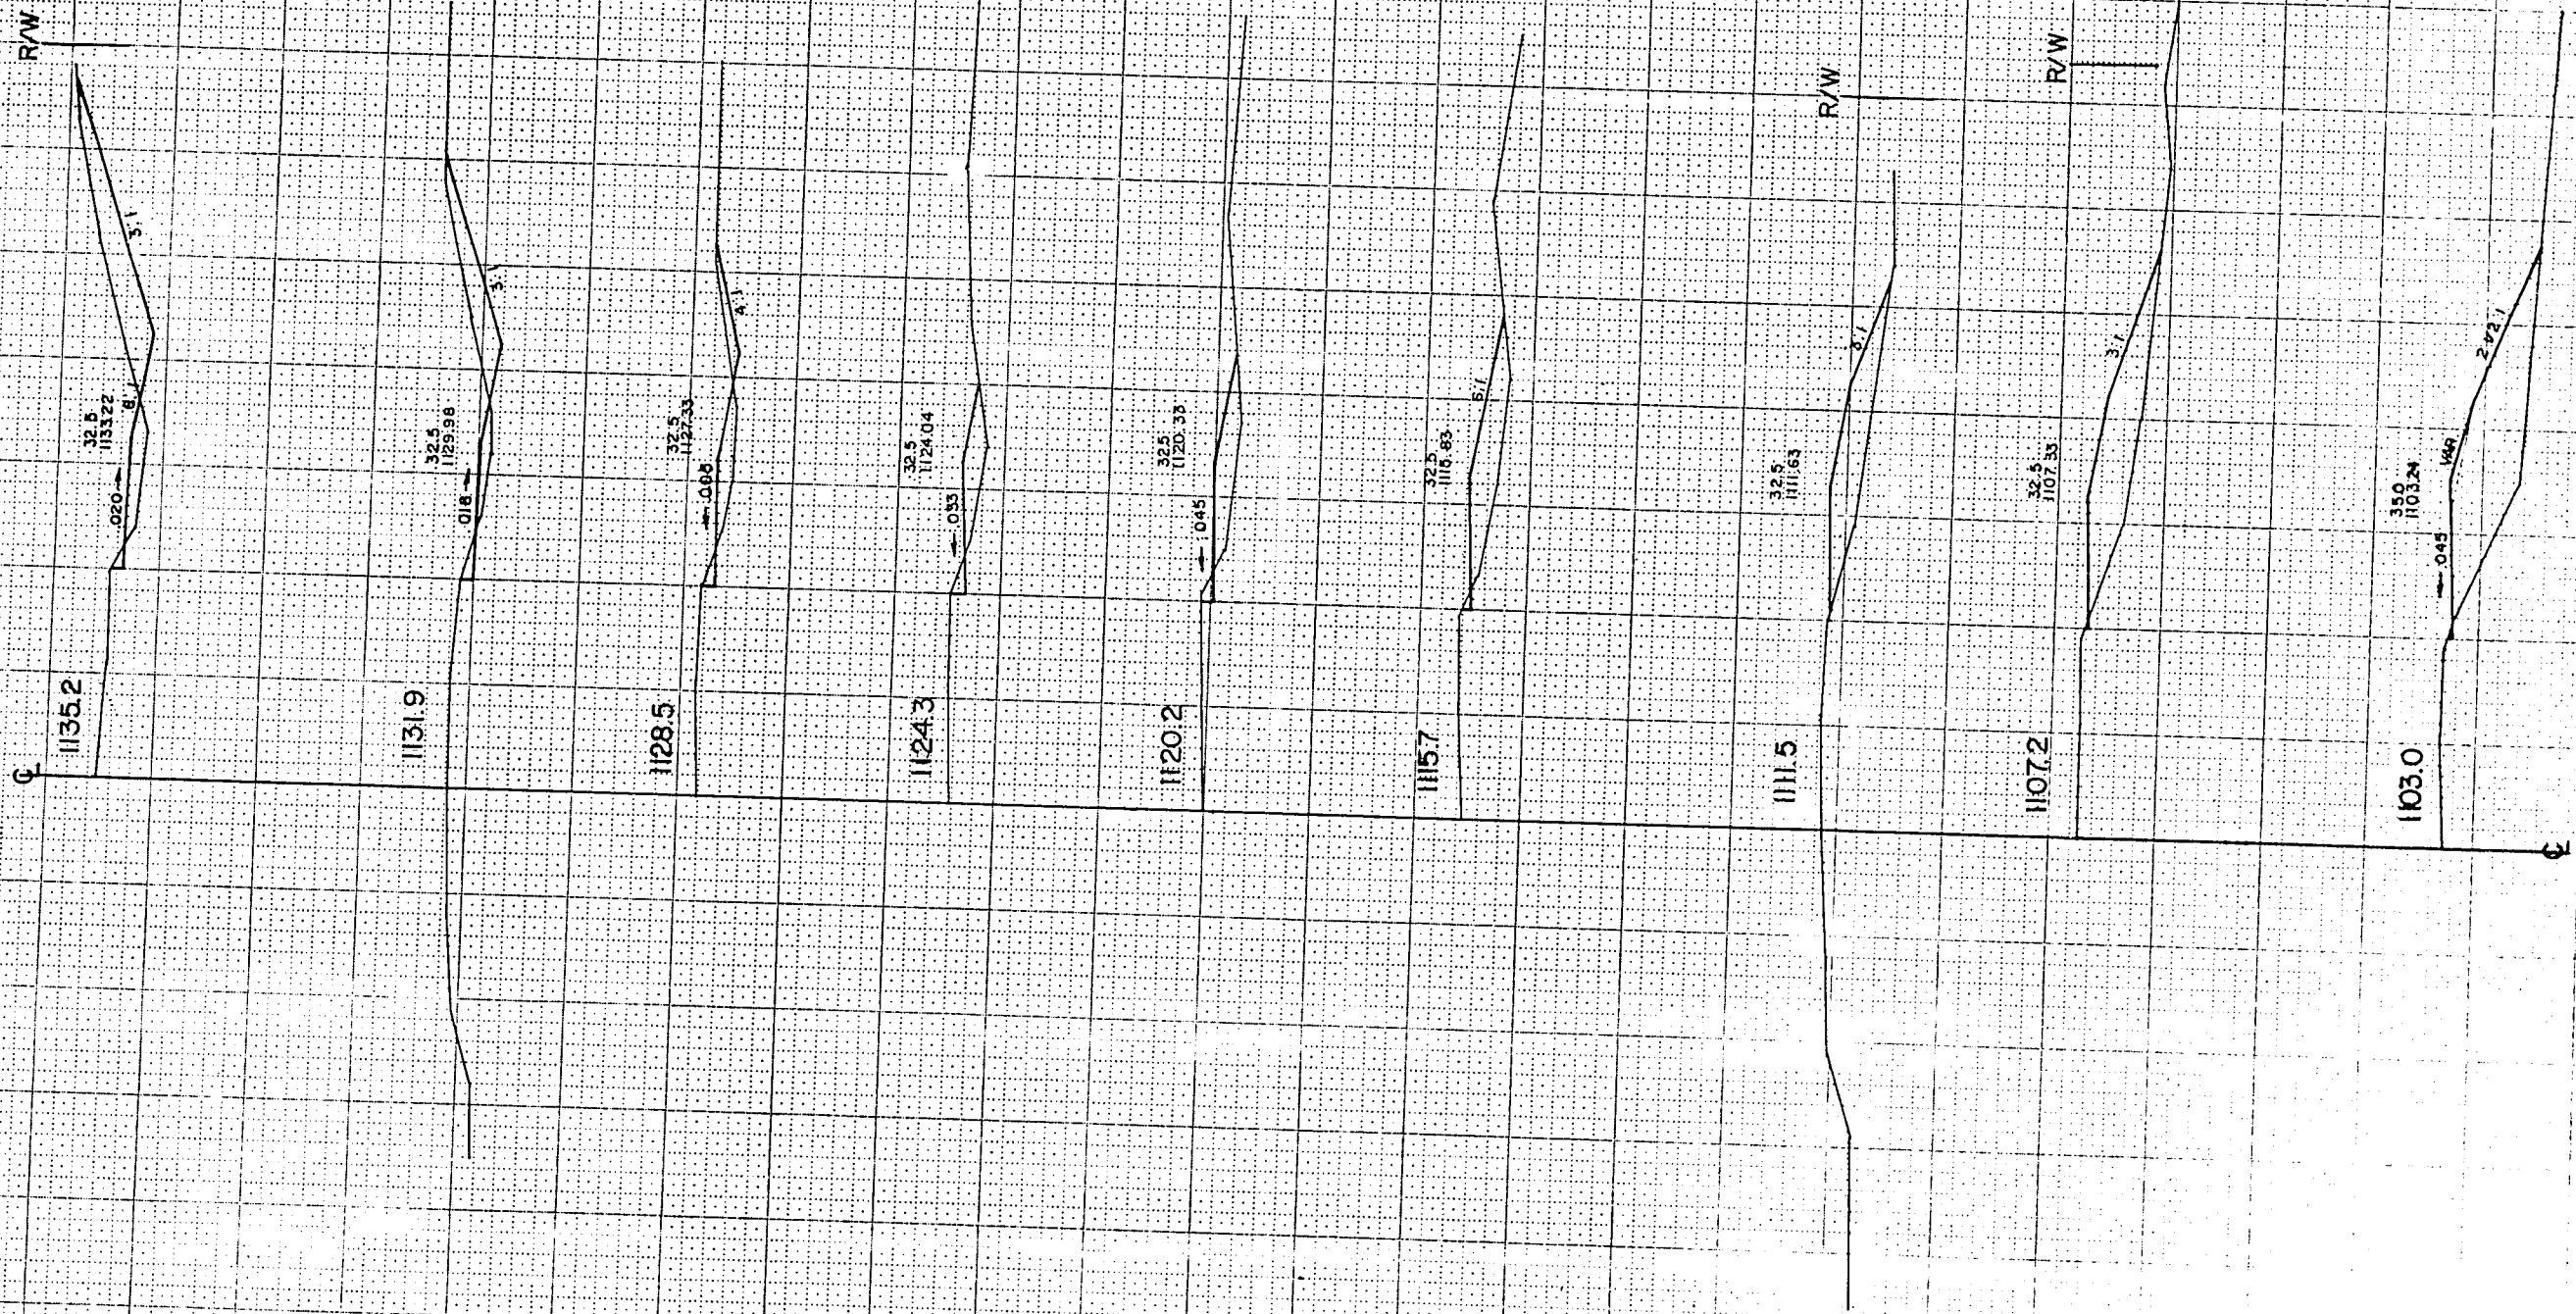


STATE PROJECT NUMBER		SHEET NUMBER			
1530-08-71		99			
STATION	DISTANCE	YARDAGE			
		EXCAVATION			FILL
		COMMON			
27					
28	11				854
29	4				374
30	0				259
31	3				193
32	7				137
33	11				89
34	26				70
35	89				48
36	174				41

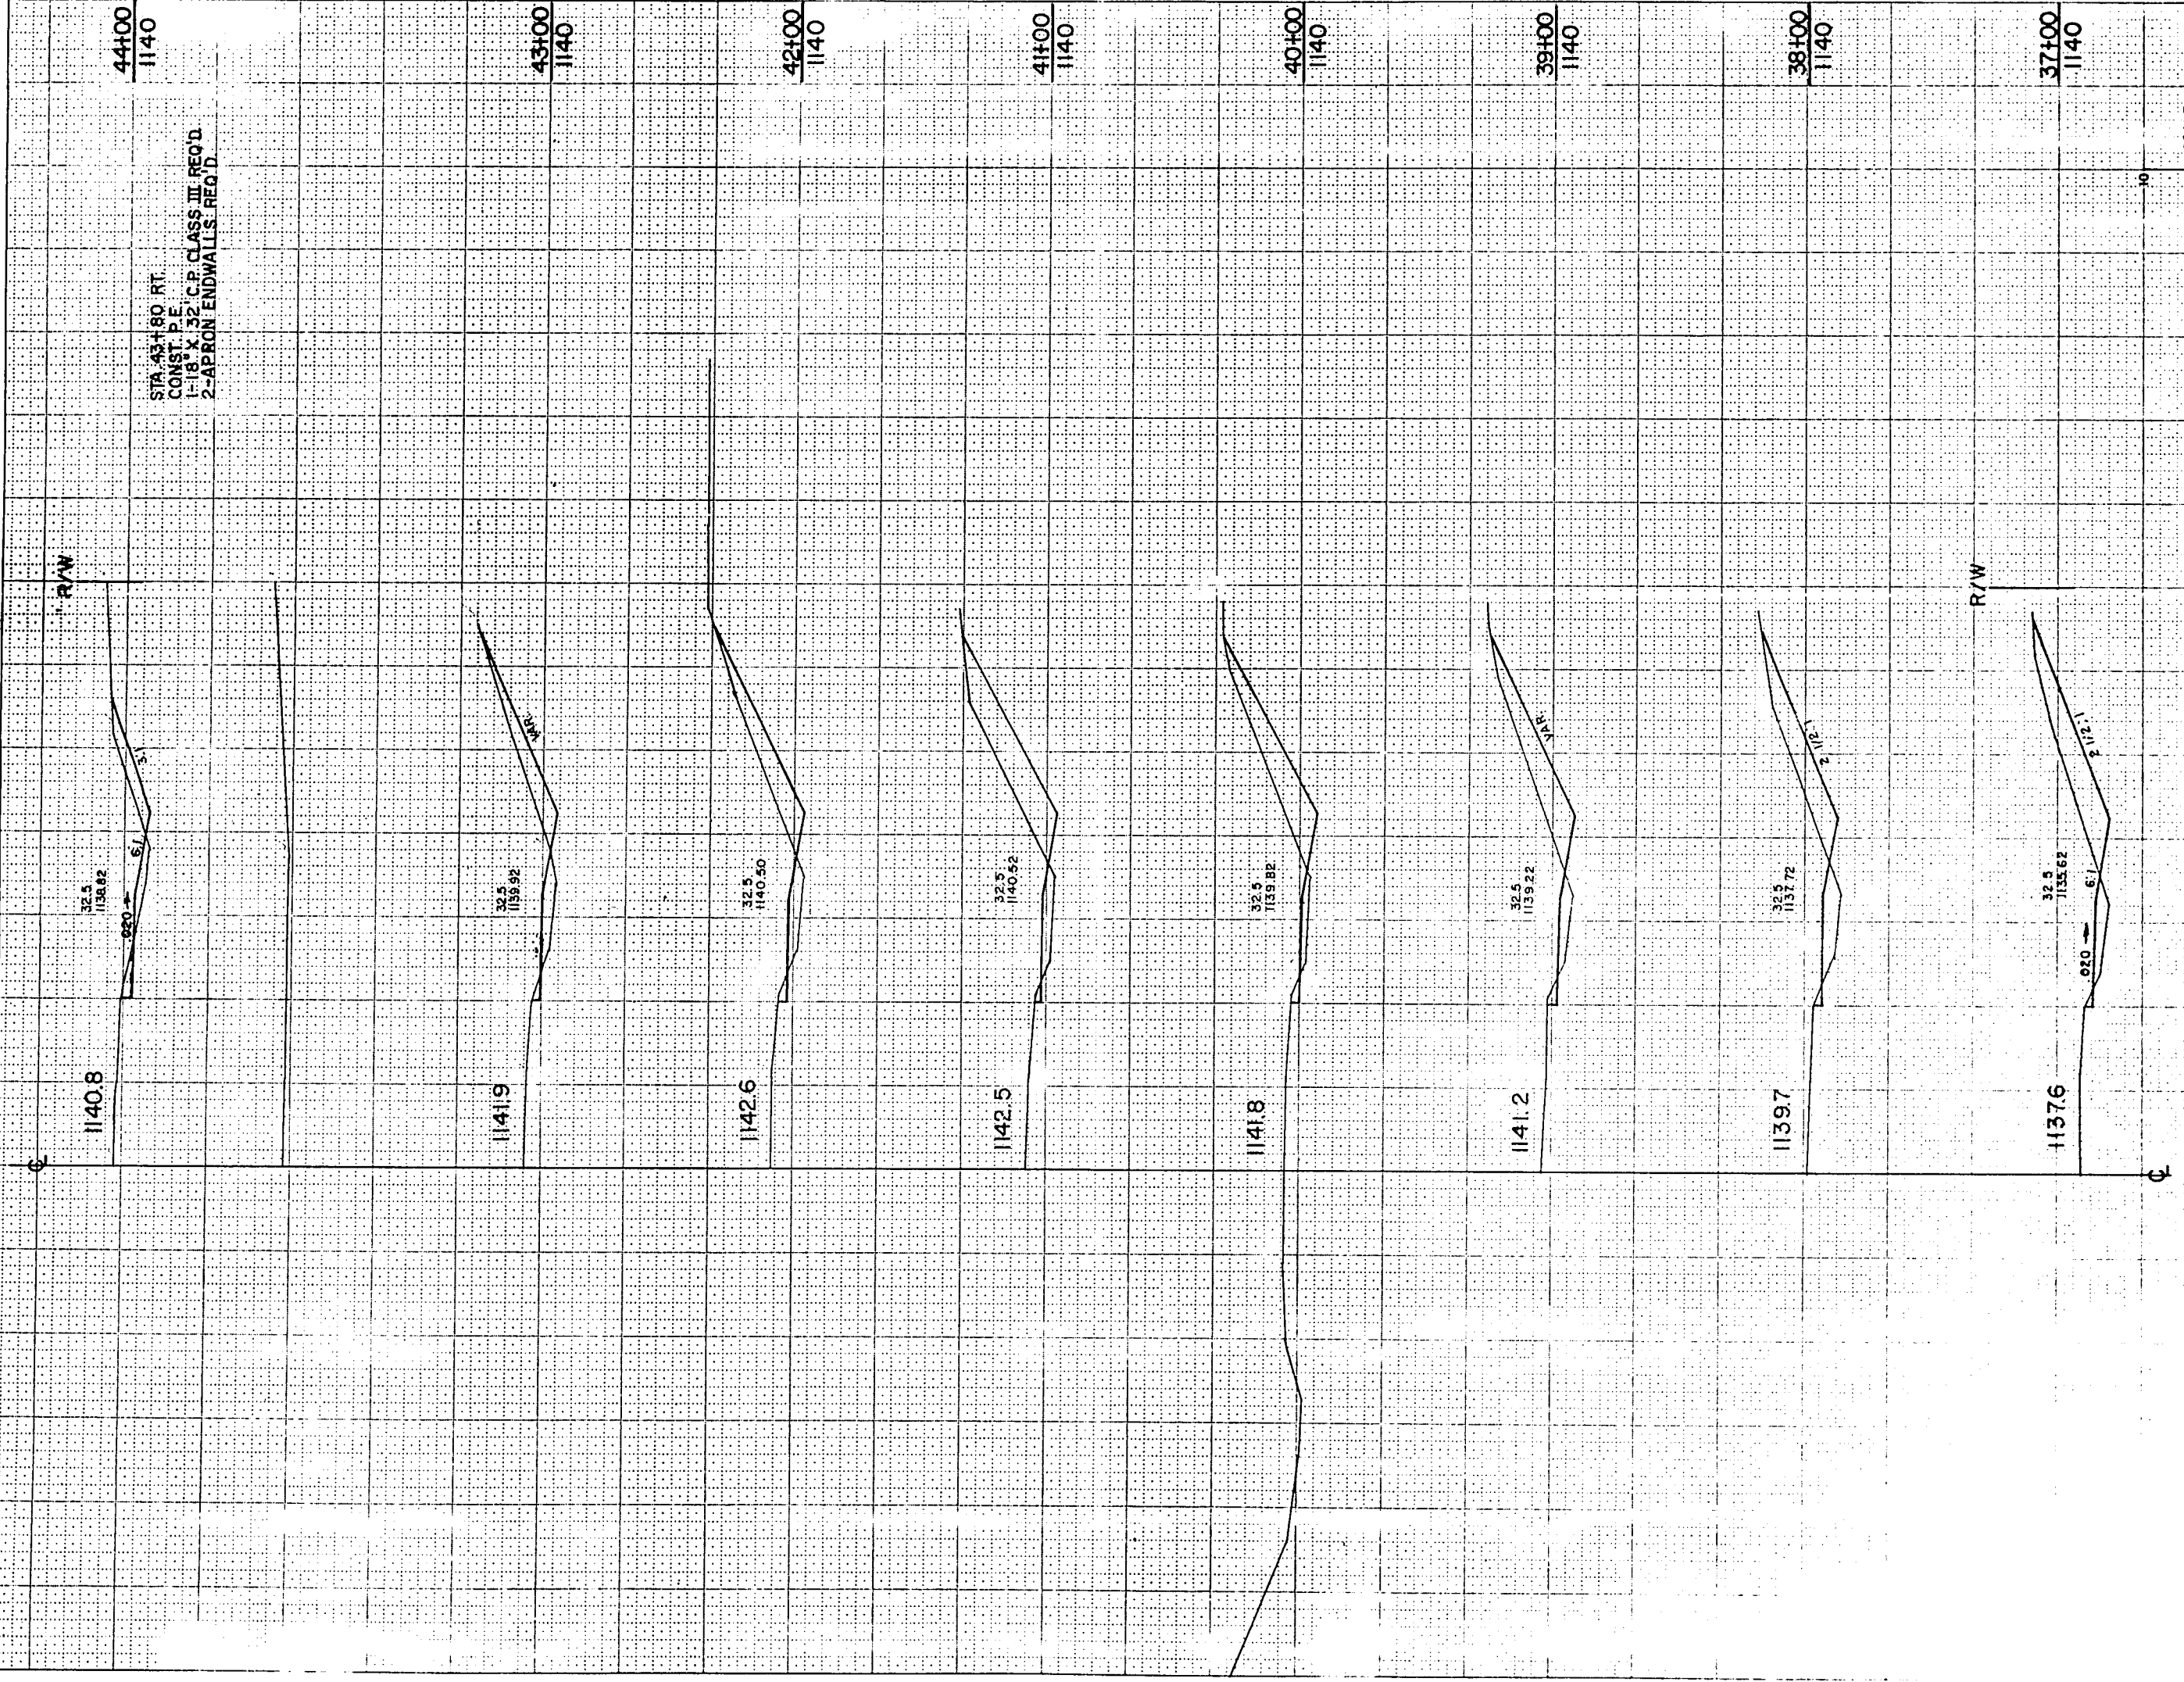

STATE PROJECT NUMBER		SHEET NUMBER		
1530-08-71		9.10		
STATION	DISTANCE	YARDAGE		
		EXCAVATION		FILL
		COMMON		
36		226		52
37		222		68
38		211		59
39		222		41
40		252		44
41		226		56
42		148		56
43		104		44
44				

TITLE SHEET POST NAME

WIDEN FOR ANCHOR
51+48 RT

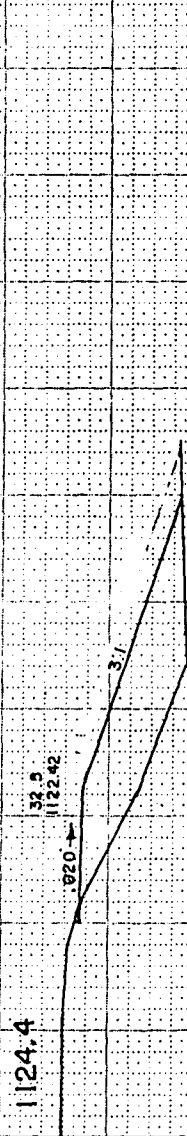

51+00
1120

RAW



50+00
1120

EXTEND EXISTING 72' X 72' BOX CULV.
12 RT

1126.9

32.5
1124.62

3:1

1130.7

32.5
1128.72

3:1

R/W

1133.0

32.5
1131.02

3:1

STA 45+00 TO STA 47+65
MEDIUM RANDOM RIPRAP OVER
GEOTEXTILE FABRIC, TYPE HR

1136.2

32.5
1134.22

4:1


WIDEN FILL SLOPE FOR
BEAM GUARD ANCHOR 45+50 RT

1138.8

32.5
1136.82

6:1

CL

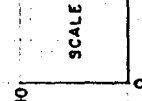

AUXILIARY LANE

STATE PROJECT NUMBER
1530-08-71


SHEET
NUMBER
9.11

STATION	DISTANCE	YARDAGE			
		EXCAVATION			FILL
		COMMON			
44					
45		59			63
46		56			93
47		52			289
47		13			257
+65		3			422
48					
+89		0			67.8
50		3			693
51					


SHEET TOTAL

186

2495

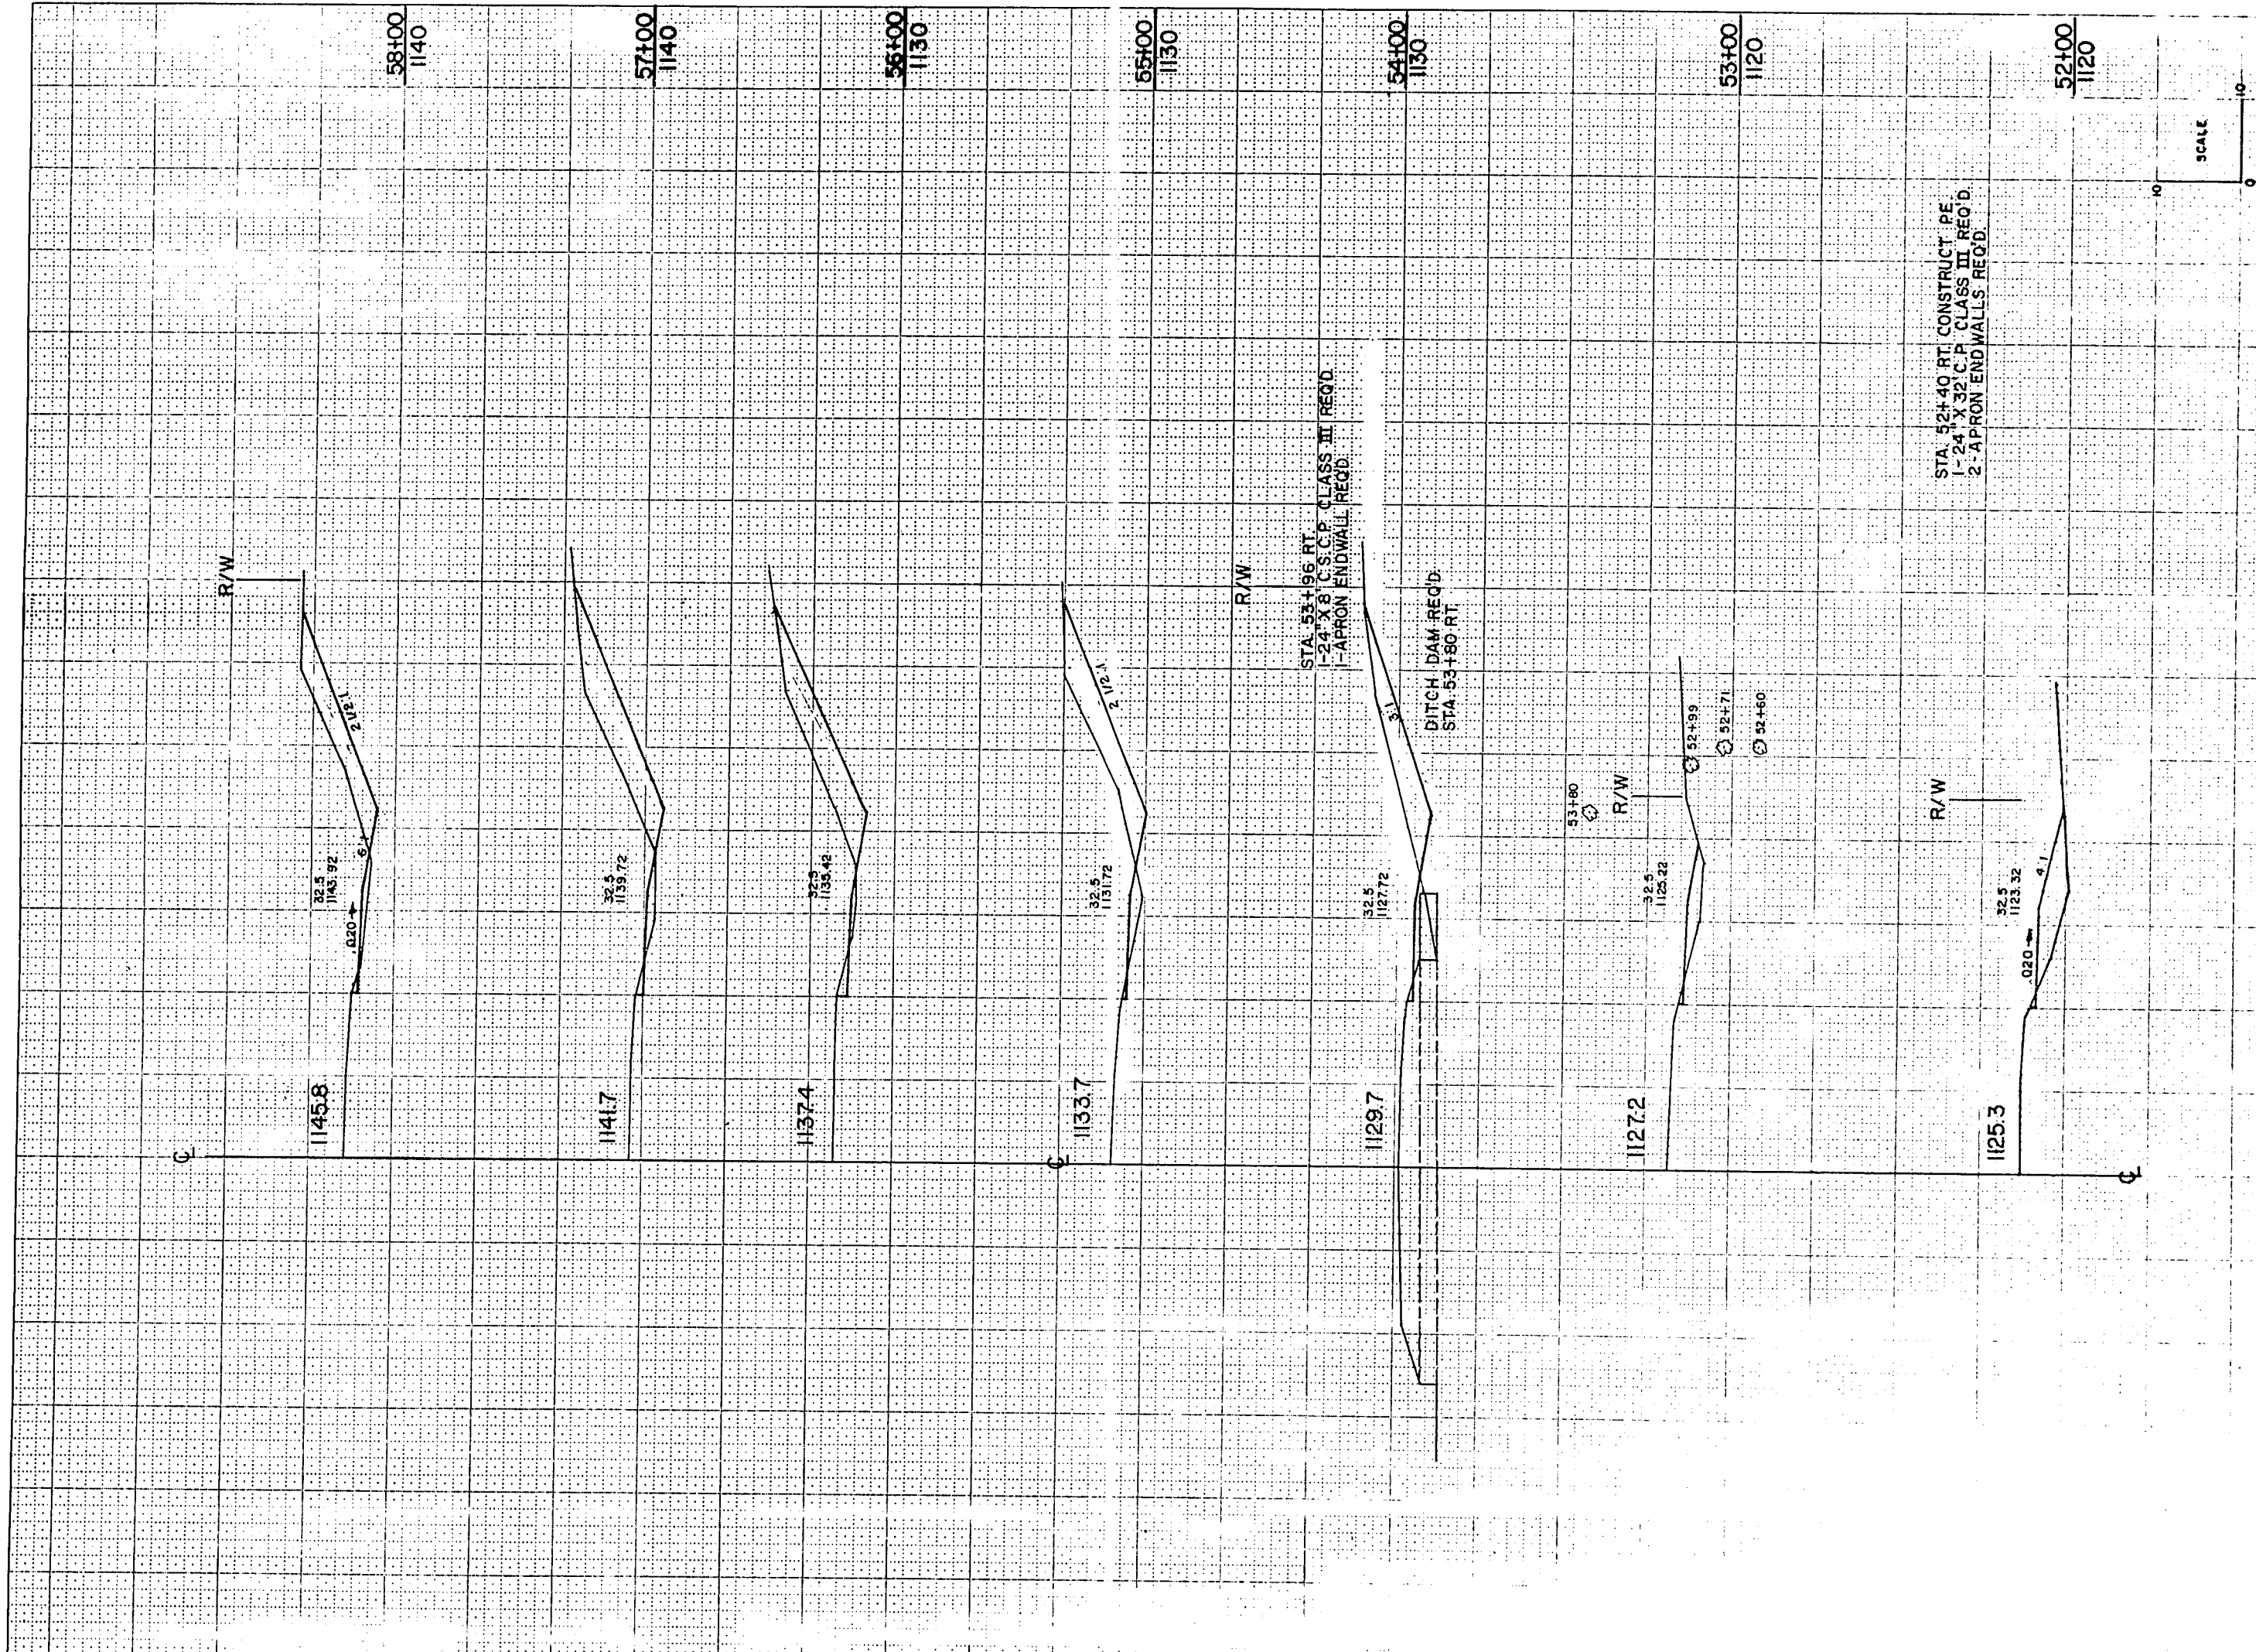


STATE PROJECT NUMBER		SHEET NUMBER		
1530-08-71		9.12		
STATION	DISTANCE	YARDAGE		
		EXCAVATION		FILL
		COMMON		
51		7		341
52		7		107
53		124		67
54		254		52
55		290		26
56		307		22
57		256		30
58				

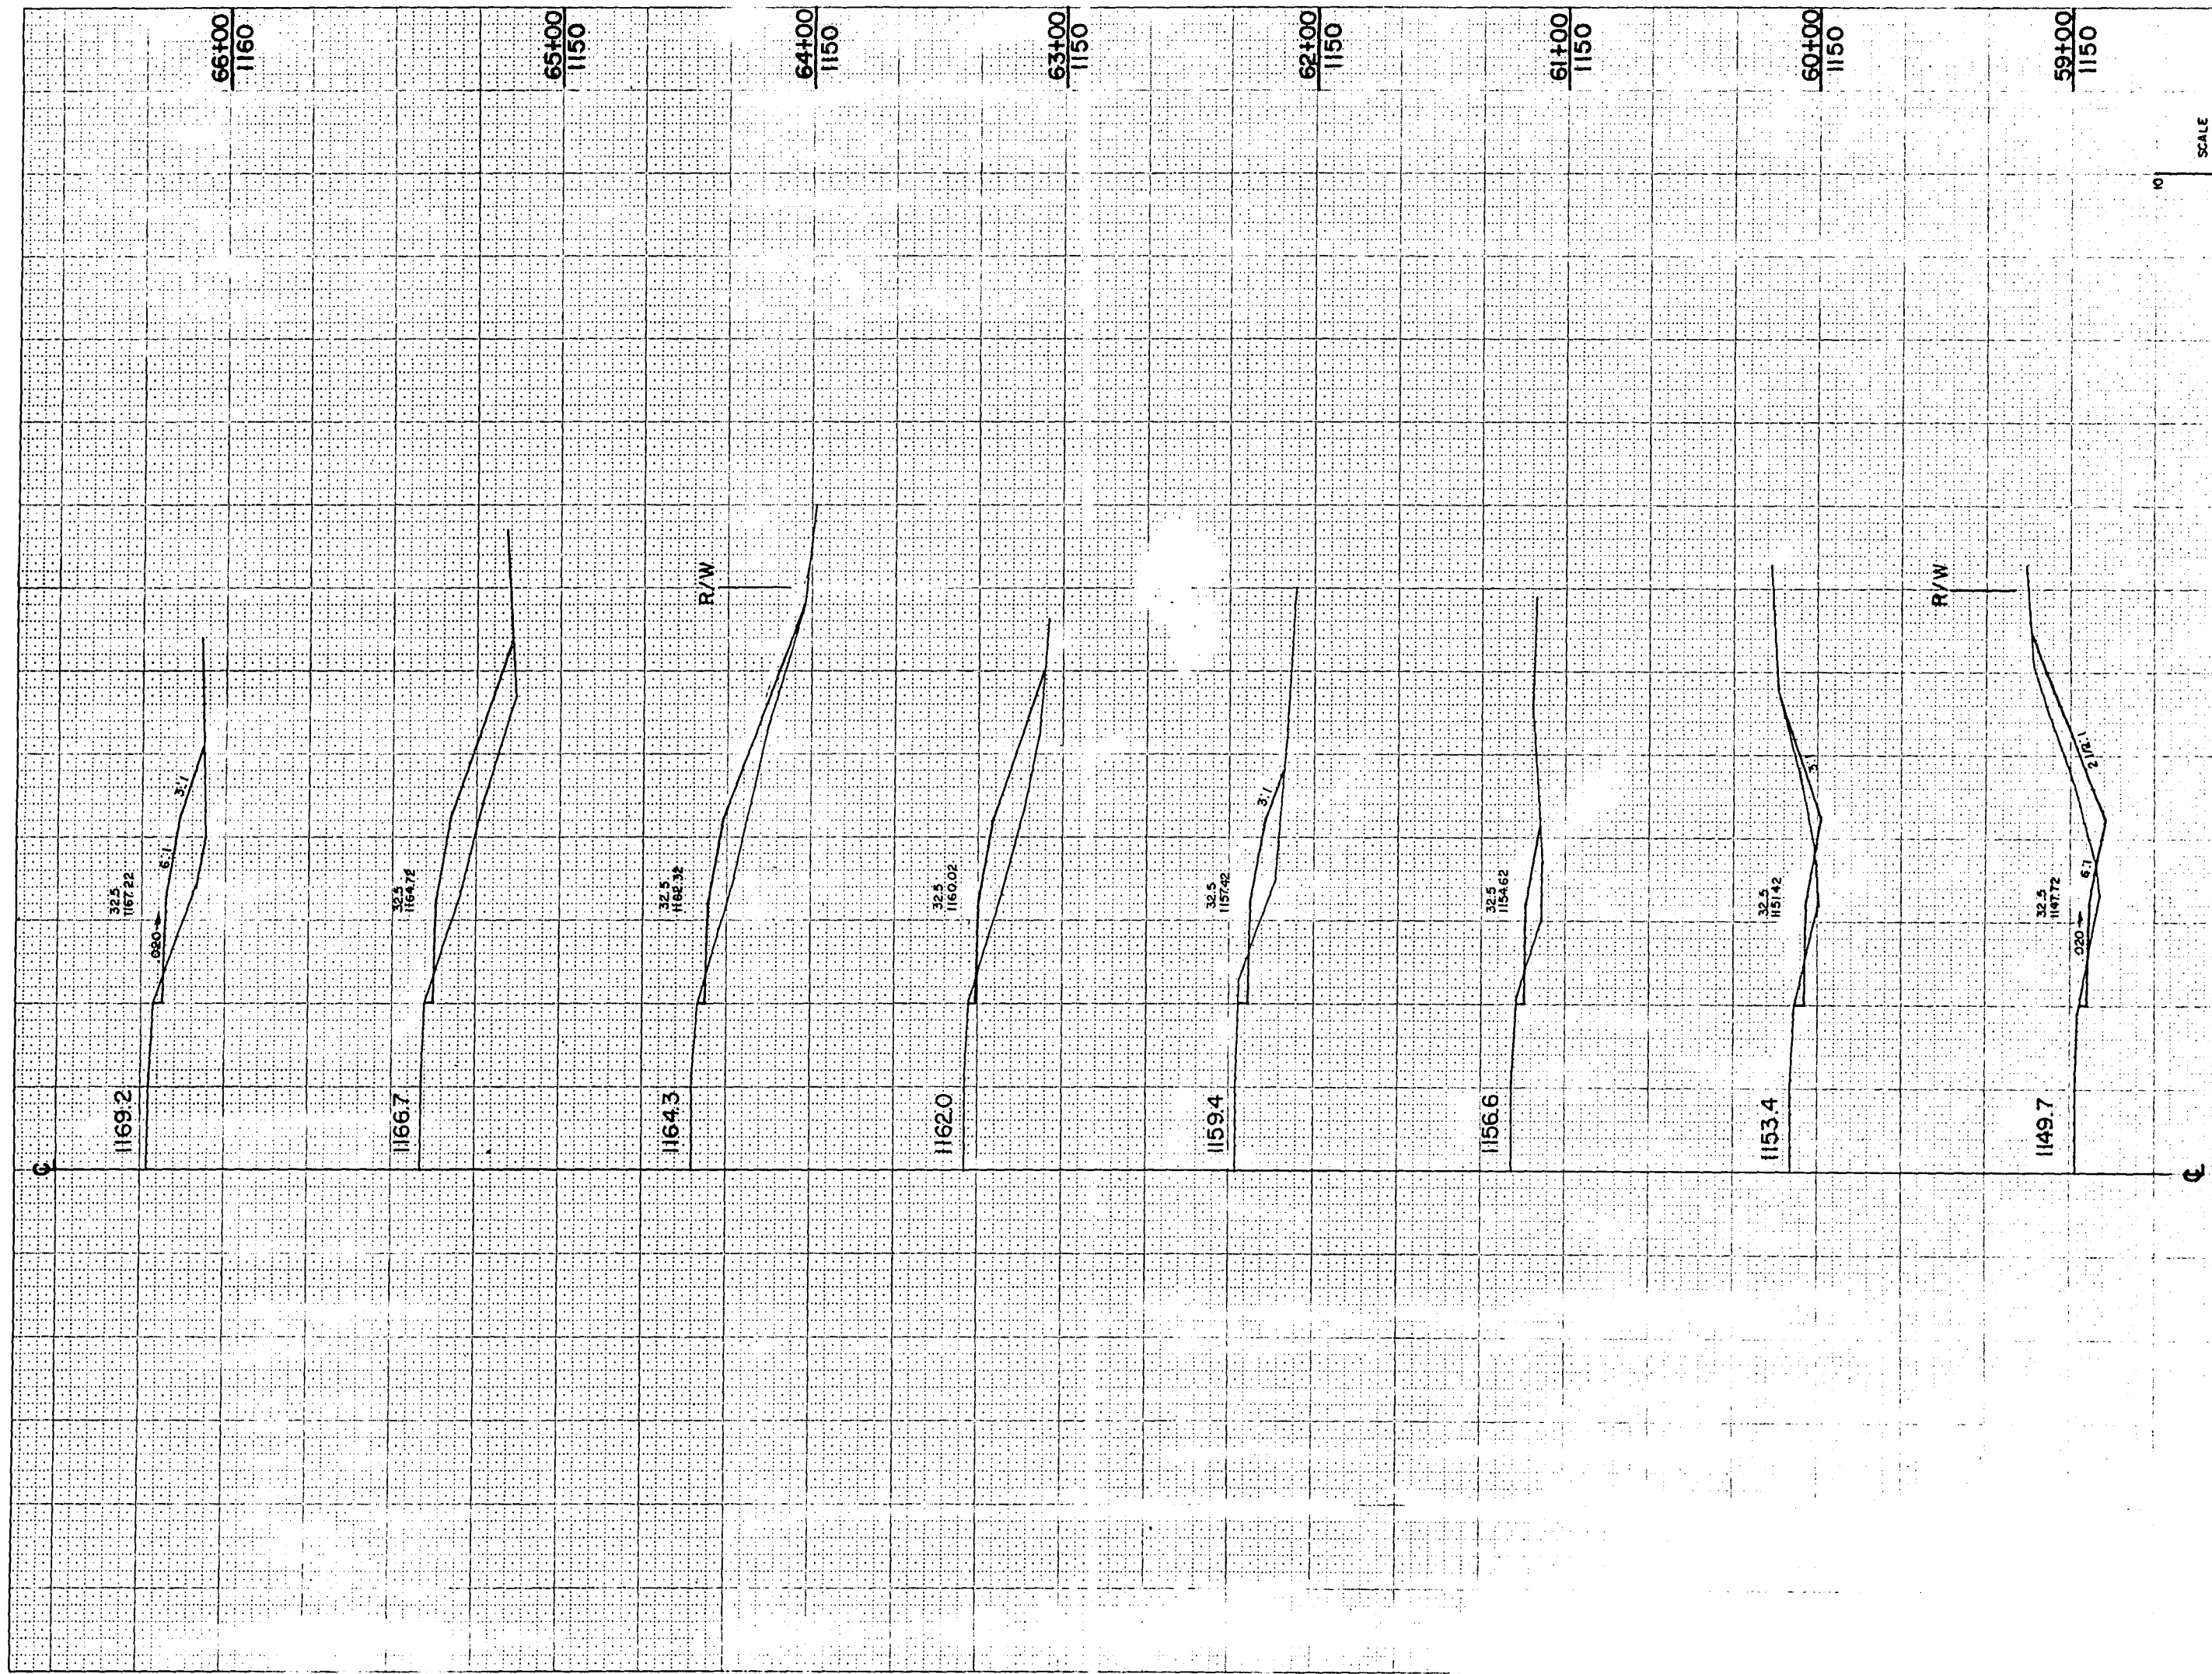


STATE PROJECT NUMBER					SHEET NUMBER
1530-08-71					9.13
STATION	DISTANCE	YARDAGE			
		EXCAVATION			FILL
		COMMON			
58					
		185			30
59					
		107			33
60					
		33			56
61					
		19			100
62					
		15			207
63					
		7			300
64					
		7			333
65					
		7			289
66					
					</

011112

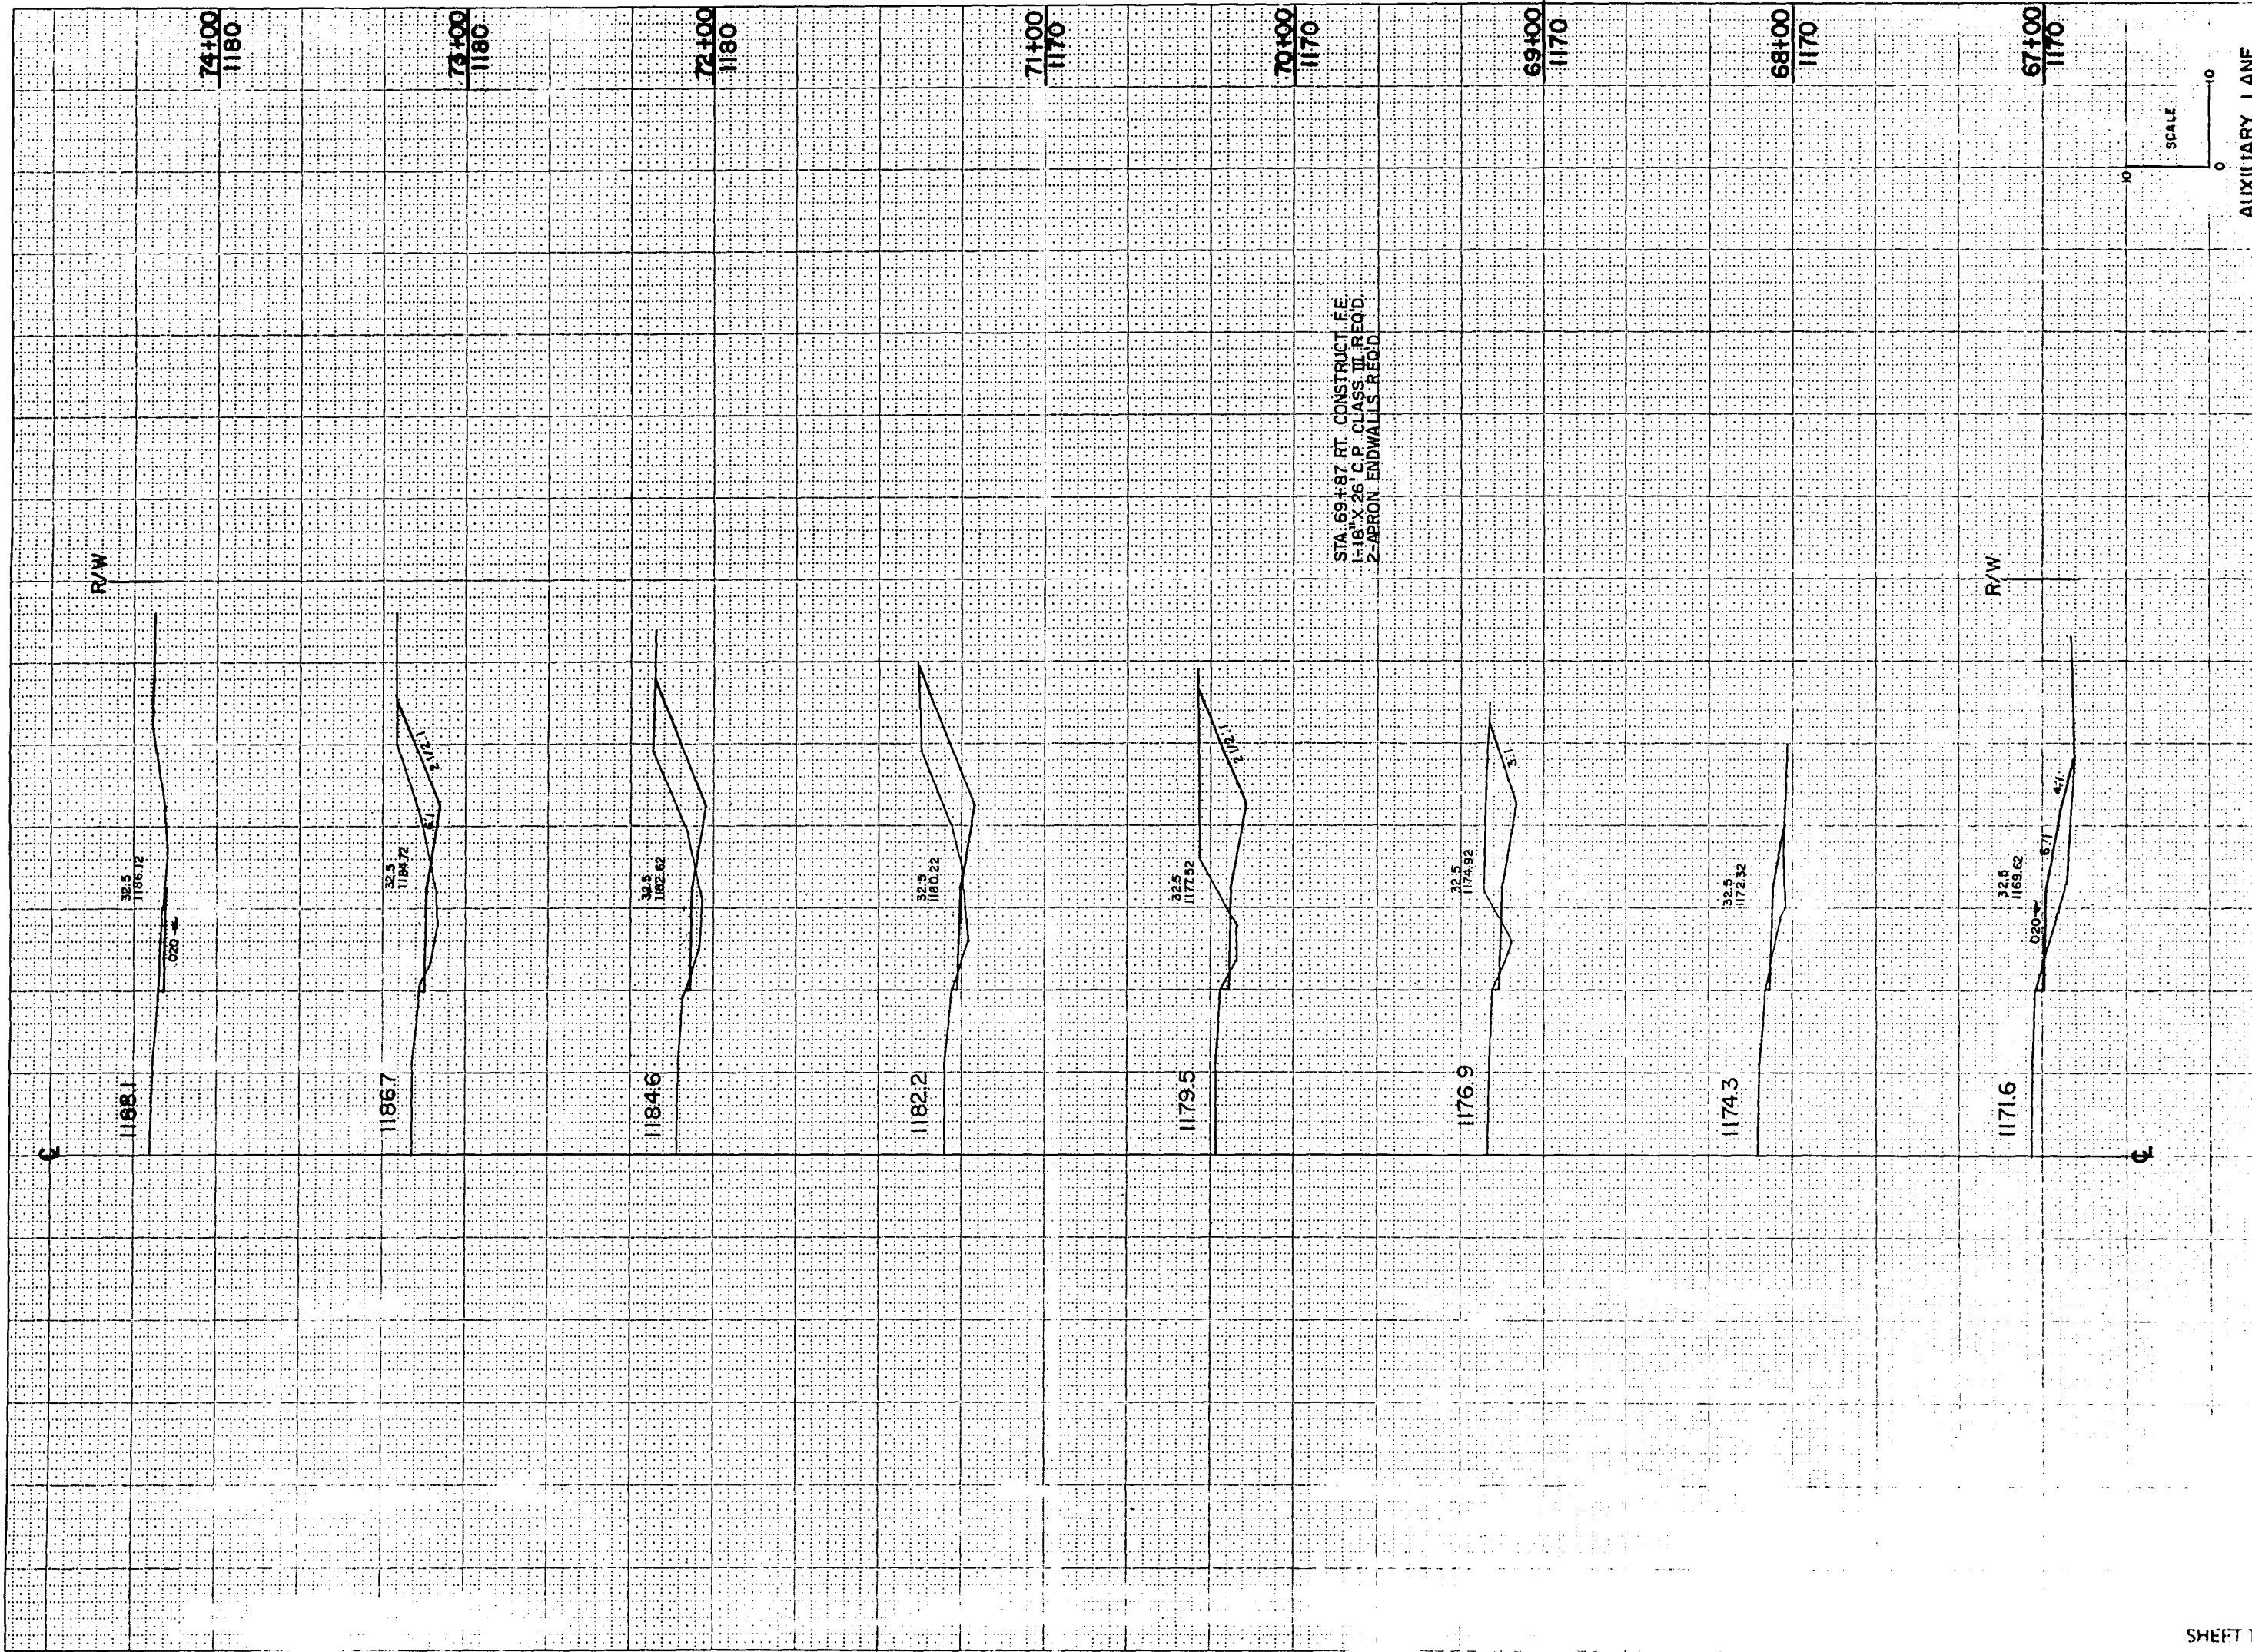

STATE PROJECT NUMBER				SHEET NUMBER
1530-08-71				9.14
STATION	DISTANCE	YARDAGE		
		EXCAVATION		FILL
		COMMON		
66		7		170
67		7		81
68		104		30
69		263		15
70		274		22
71		211		37
72		163		44
73		74		22
74				


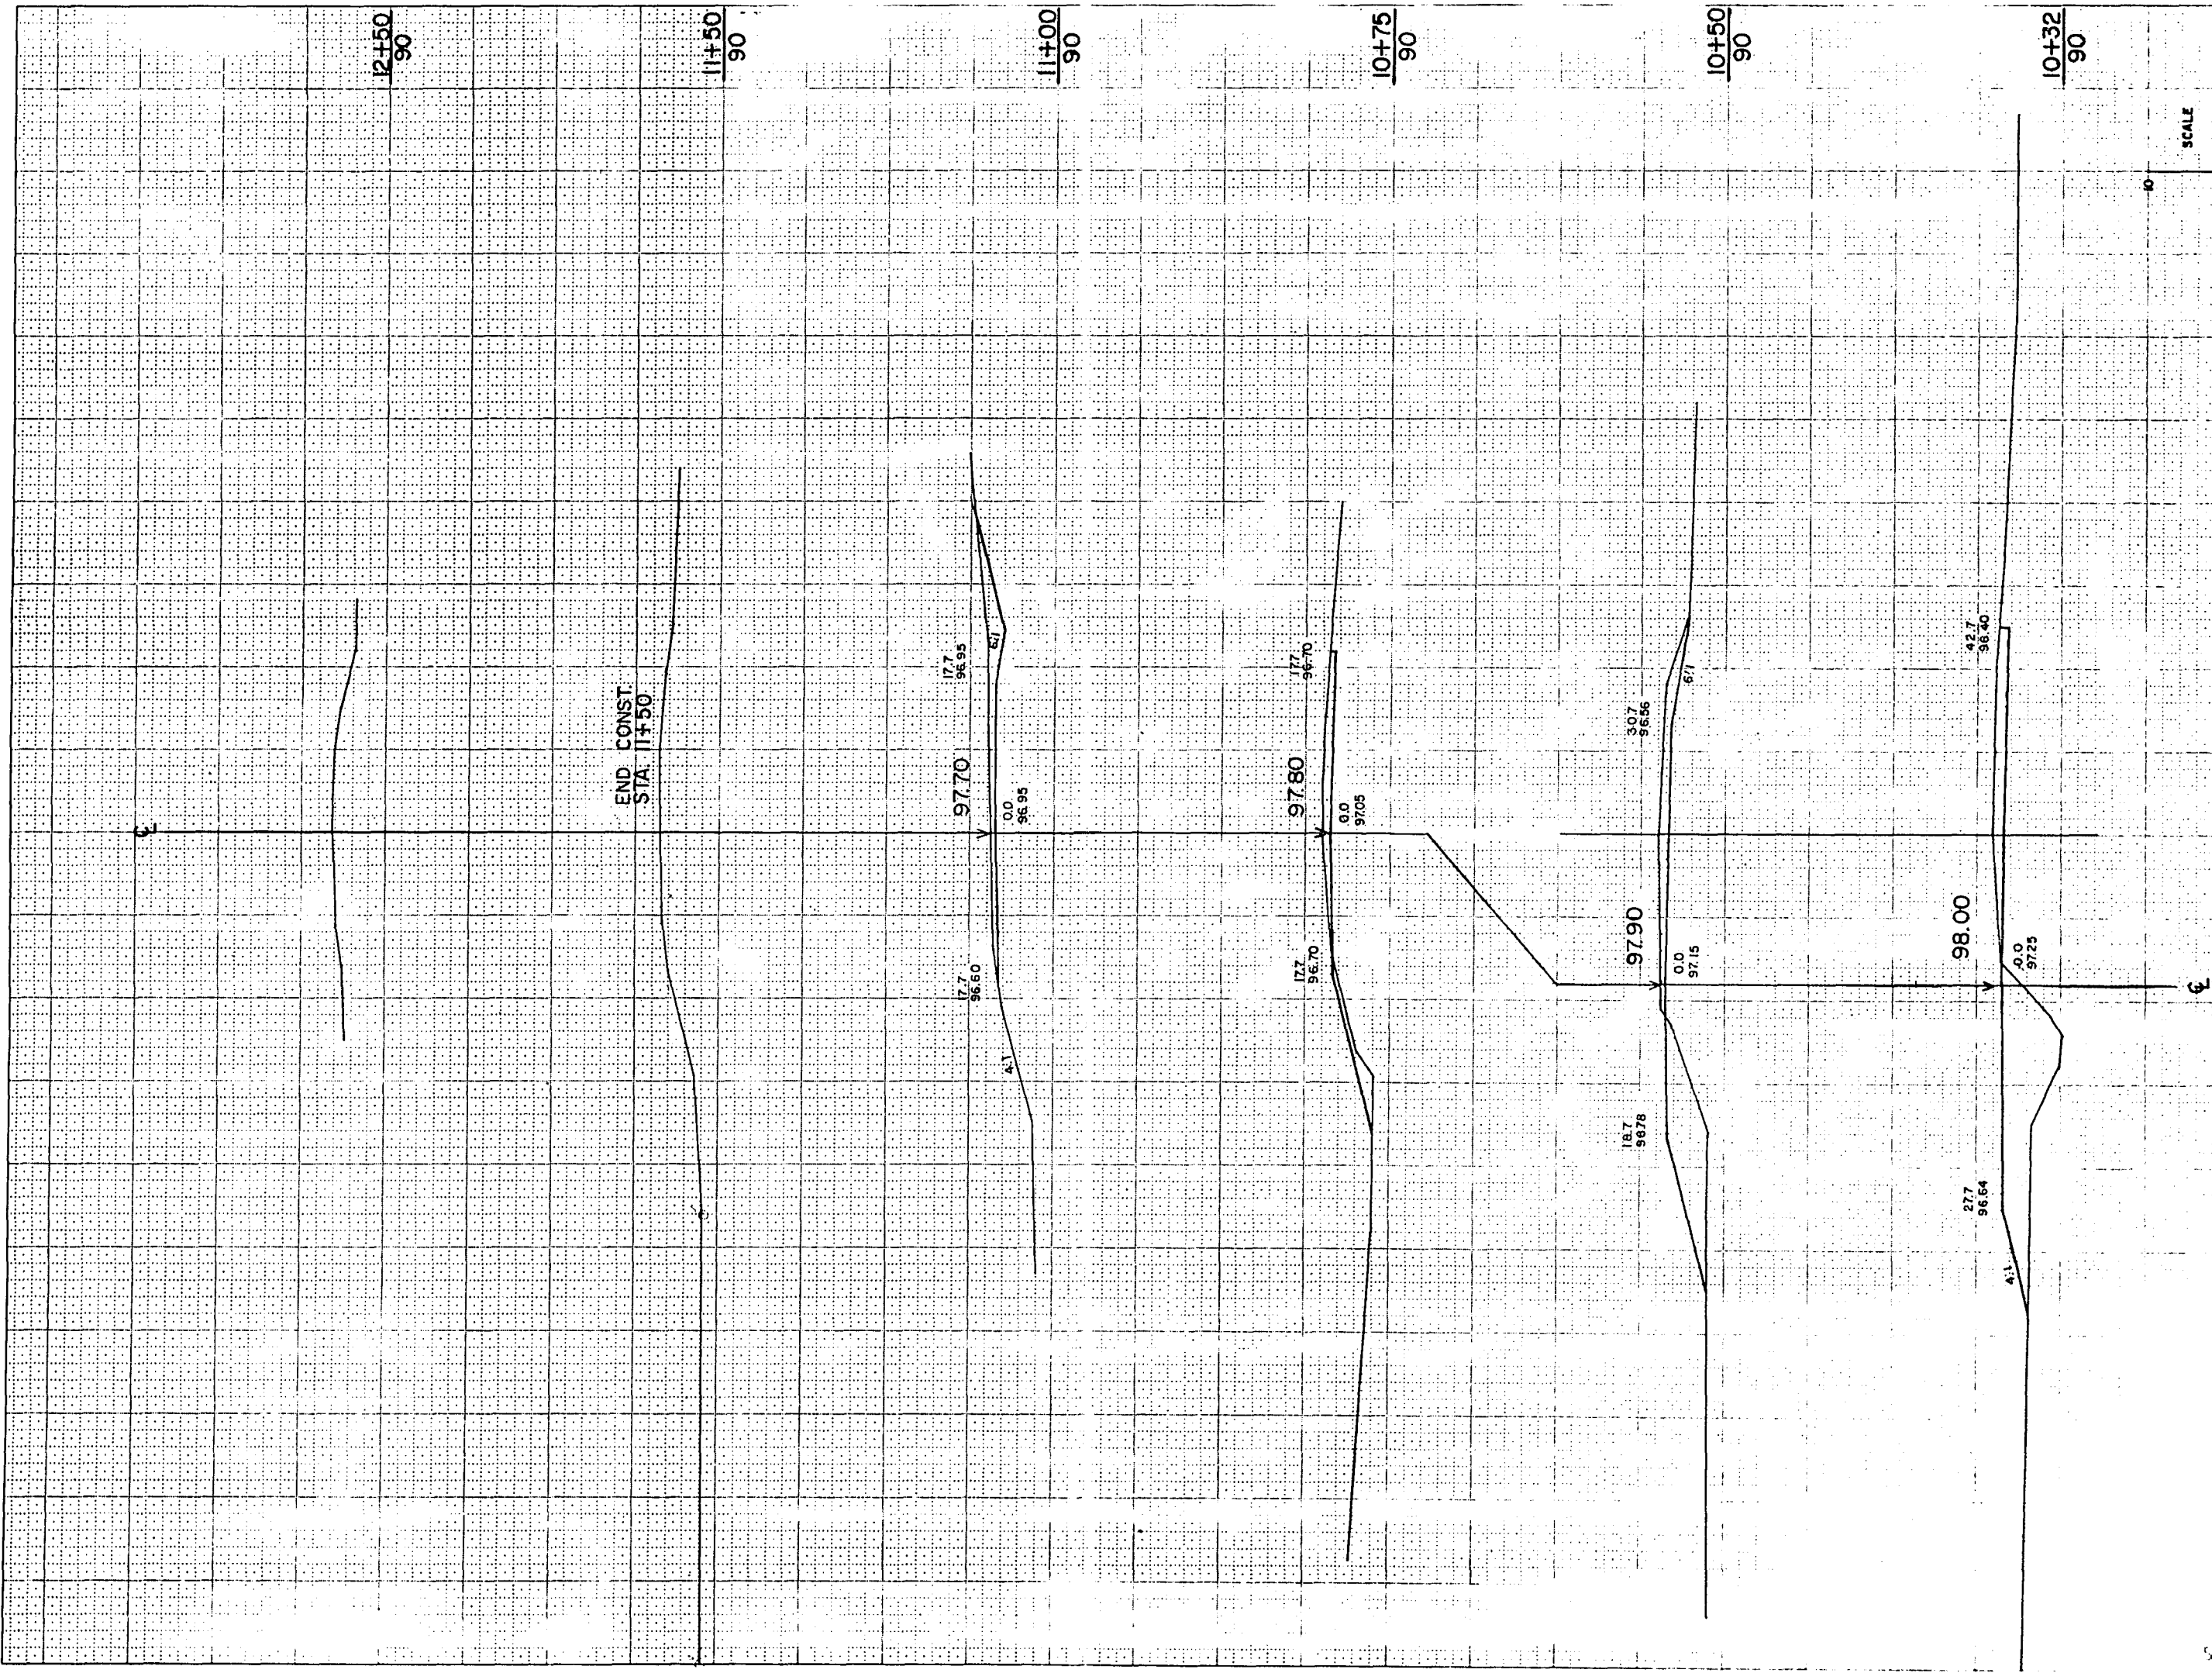


STATE PROJECT NUMBER		SHEET NUMBER		
1530-08-71		9.16		
STATION	DISTANCE	YARDAGE		
		EXCAVATION		FILL
		COMMON		
10 + 20	12	9		33
+32	18	31		78
+50	25	37		44
+75	25	34		7
11	50	41		
+50				

390TH AVE. TN.RD. @ 8+00 U.S.H. 10

SCALE

10

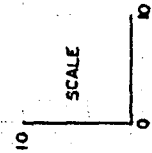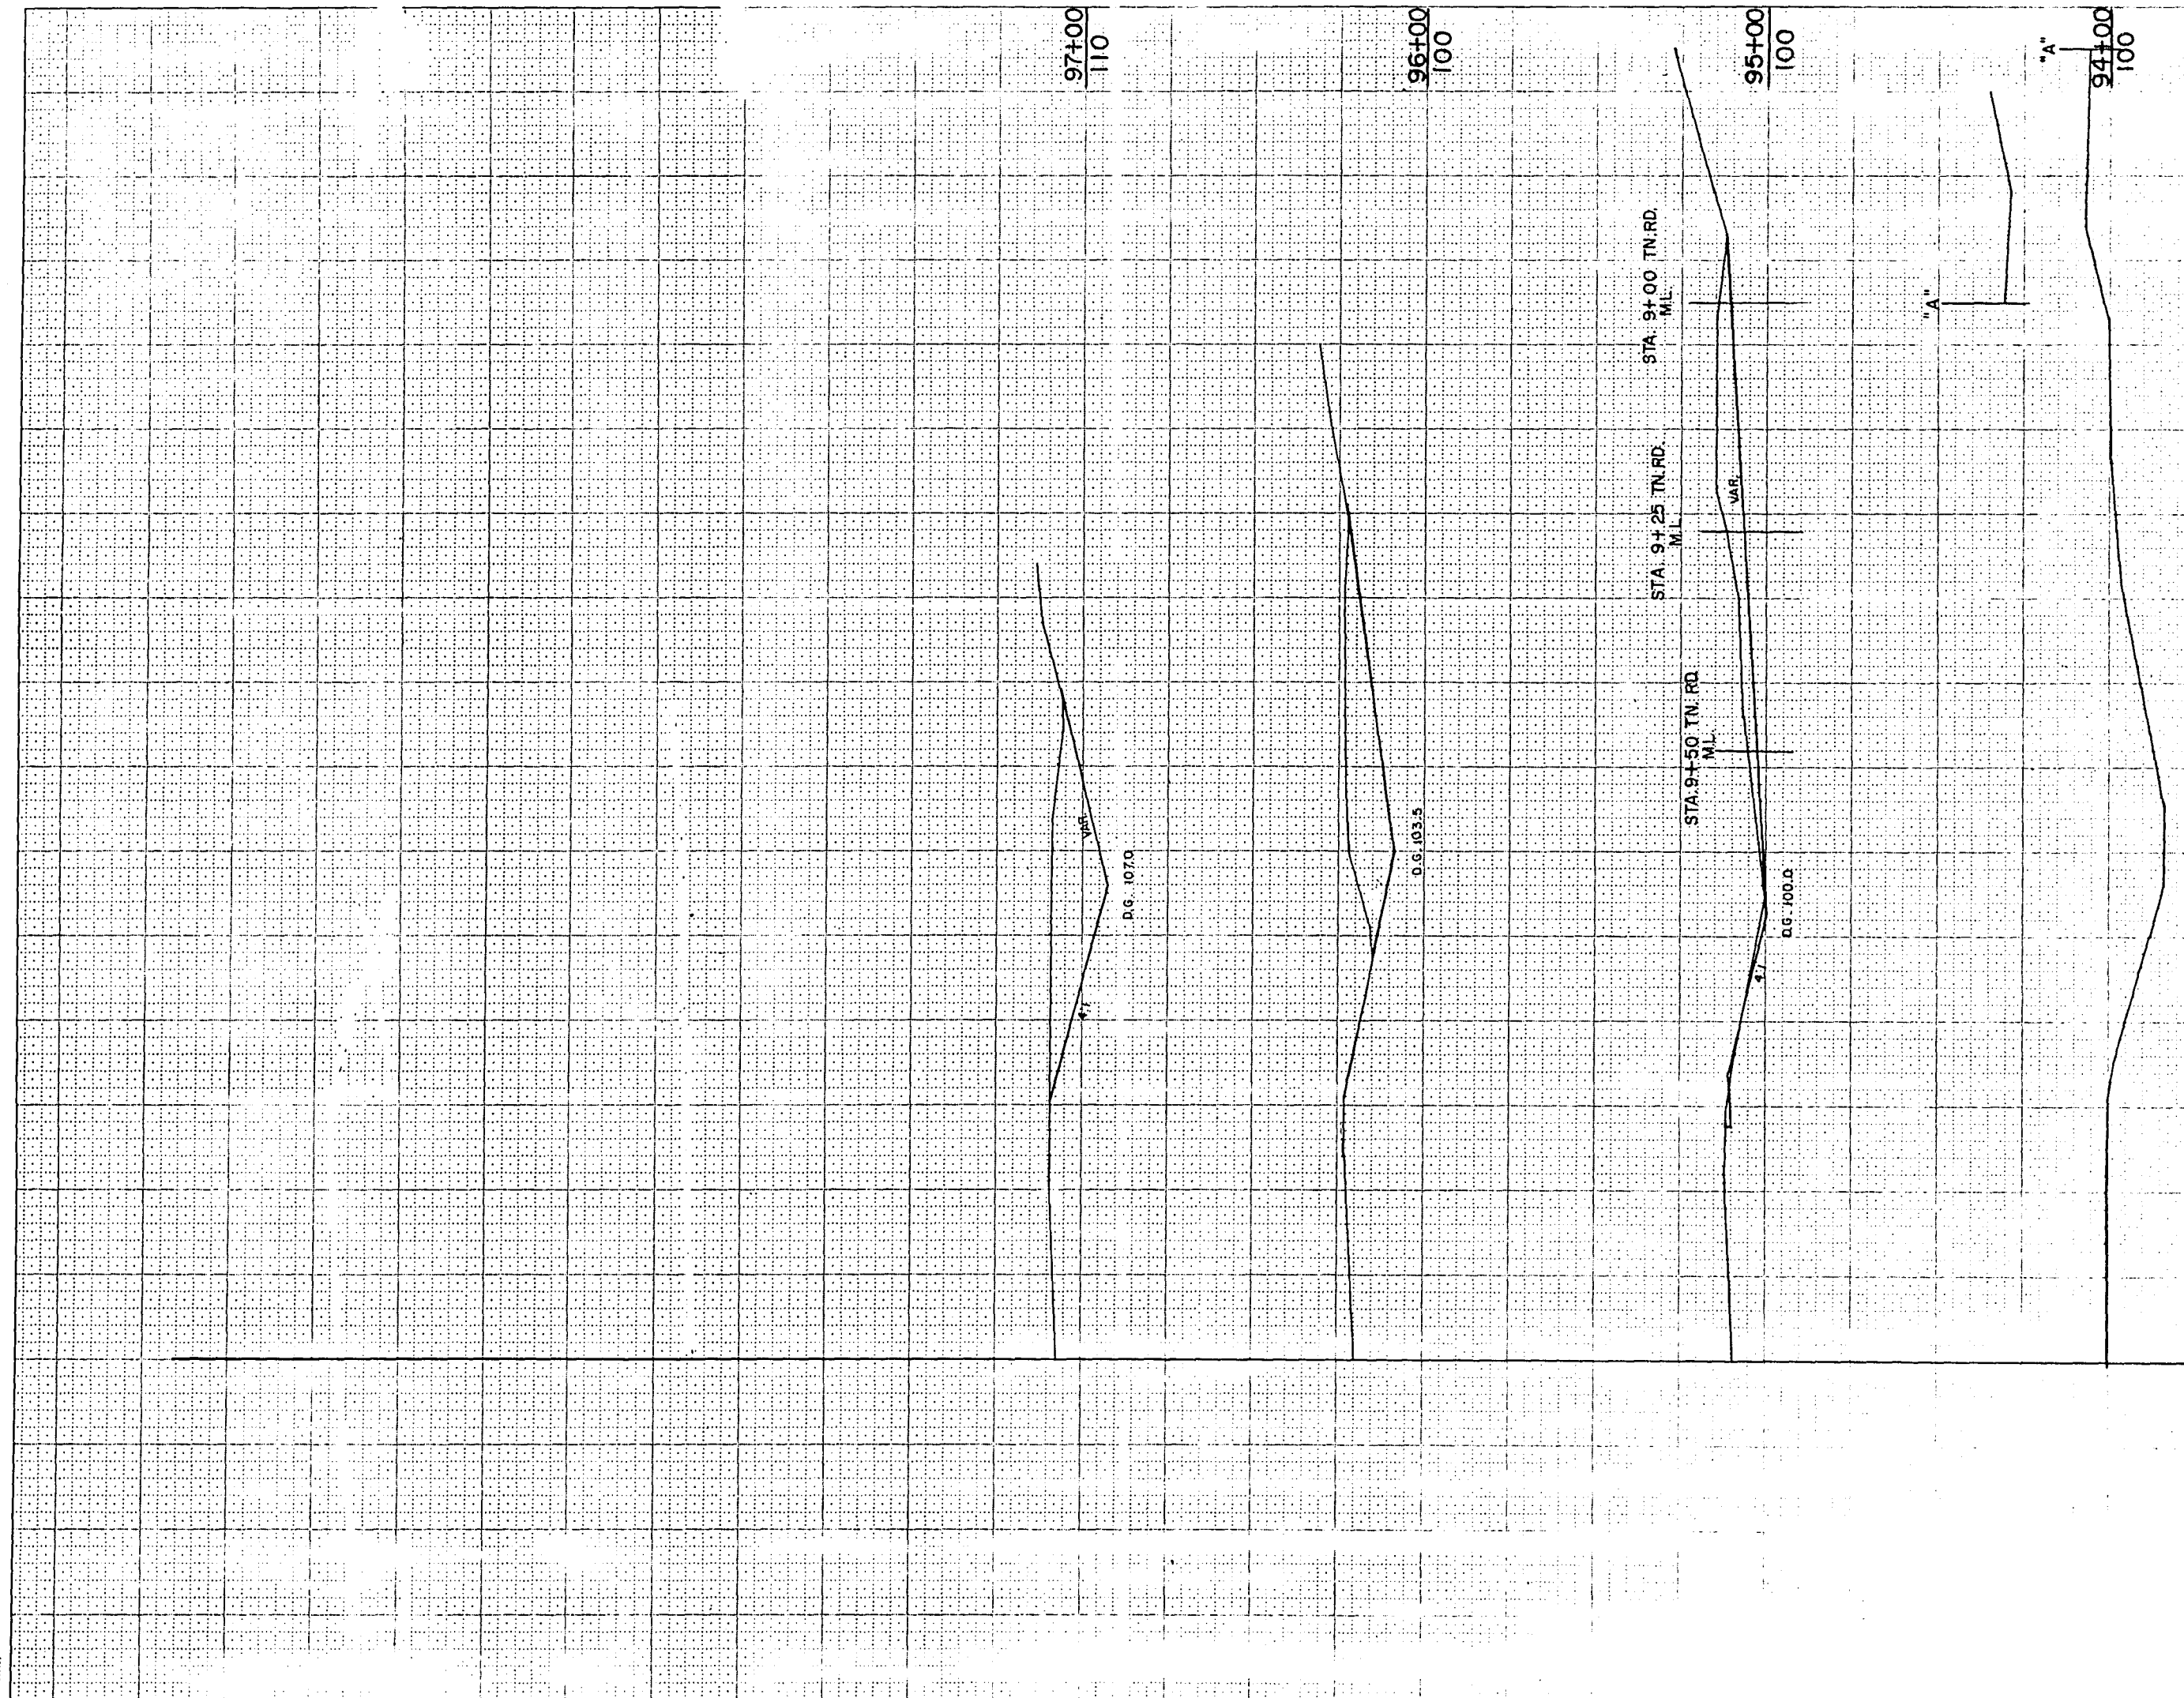

(322ND AVE.)


U.S.H. 10 @ TN. RD. INTERSECTION 94+50


[illegible]


322ND AVE. TN. RD @ STA. 94+50 USH 10

SCALE


STATION	DISTANCE	YARDAGE	
		EXCAVATION	FILL
8			
+25	20		2
+50	46		11
+75	96		20
9	172		61
+25	154		191
+50	57		224
+70	6		67
SHEET TOTAL		551	576

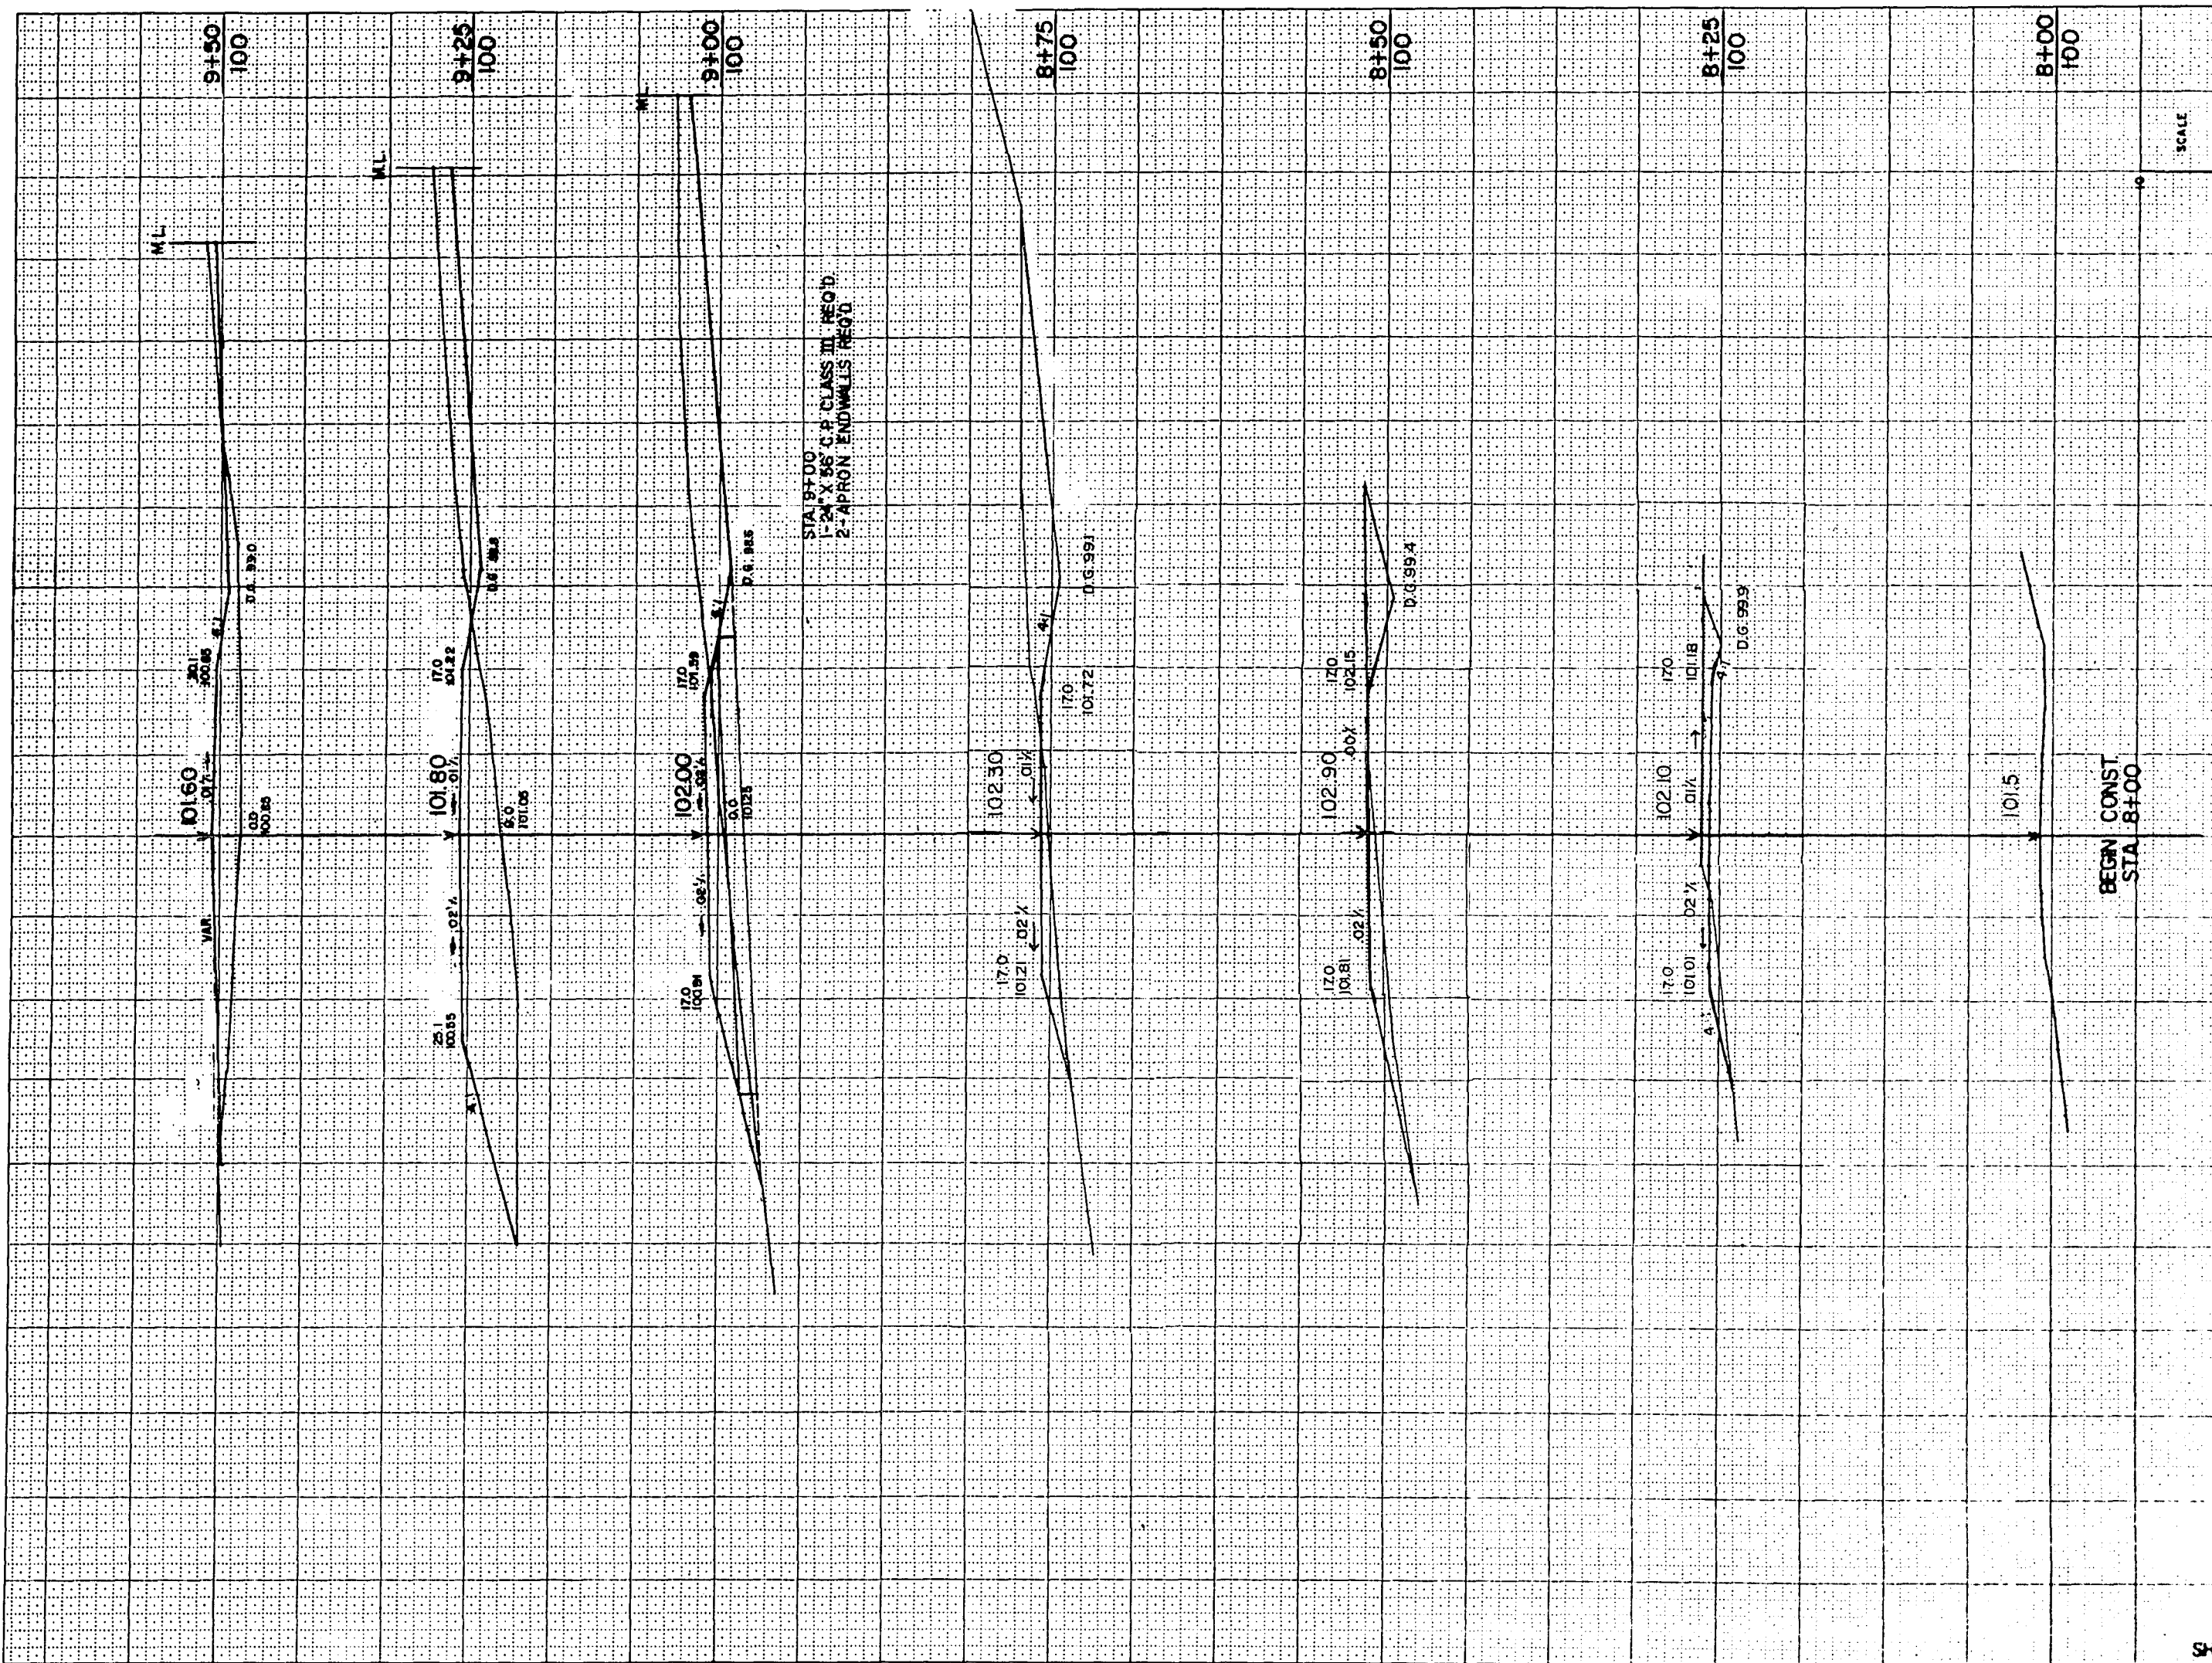

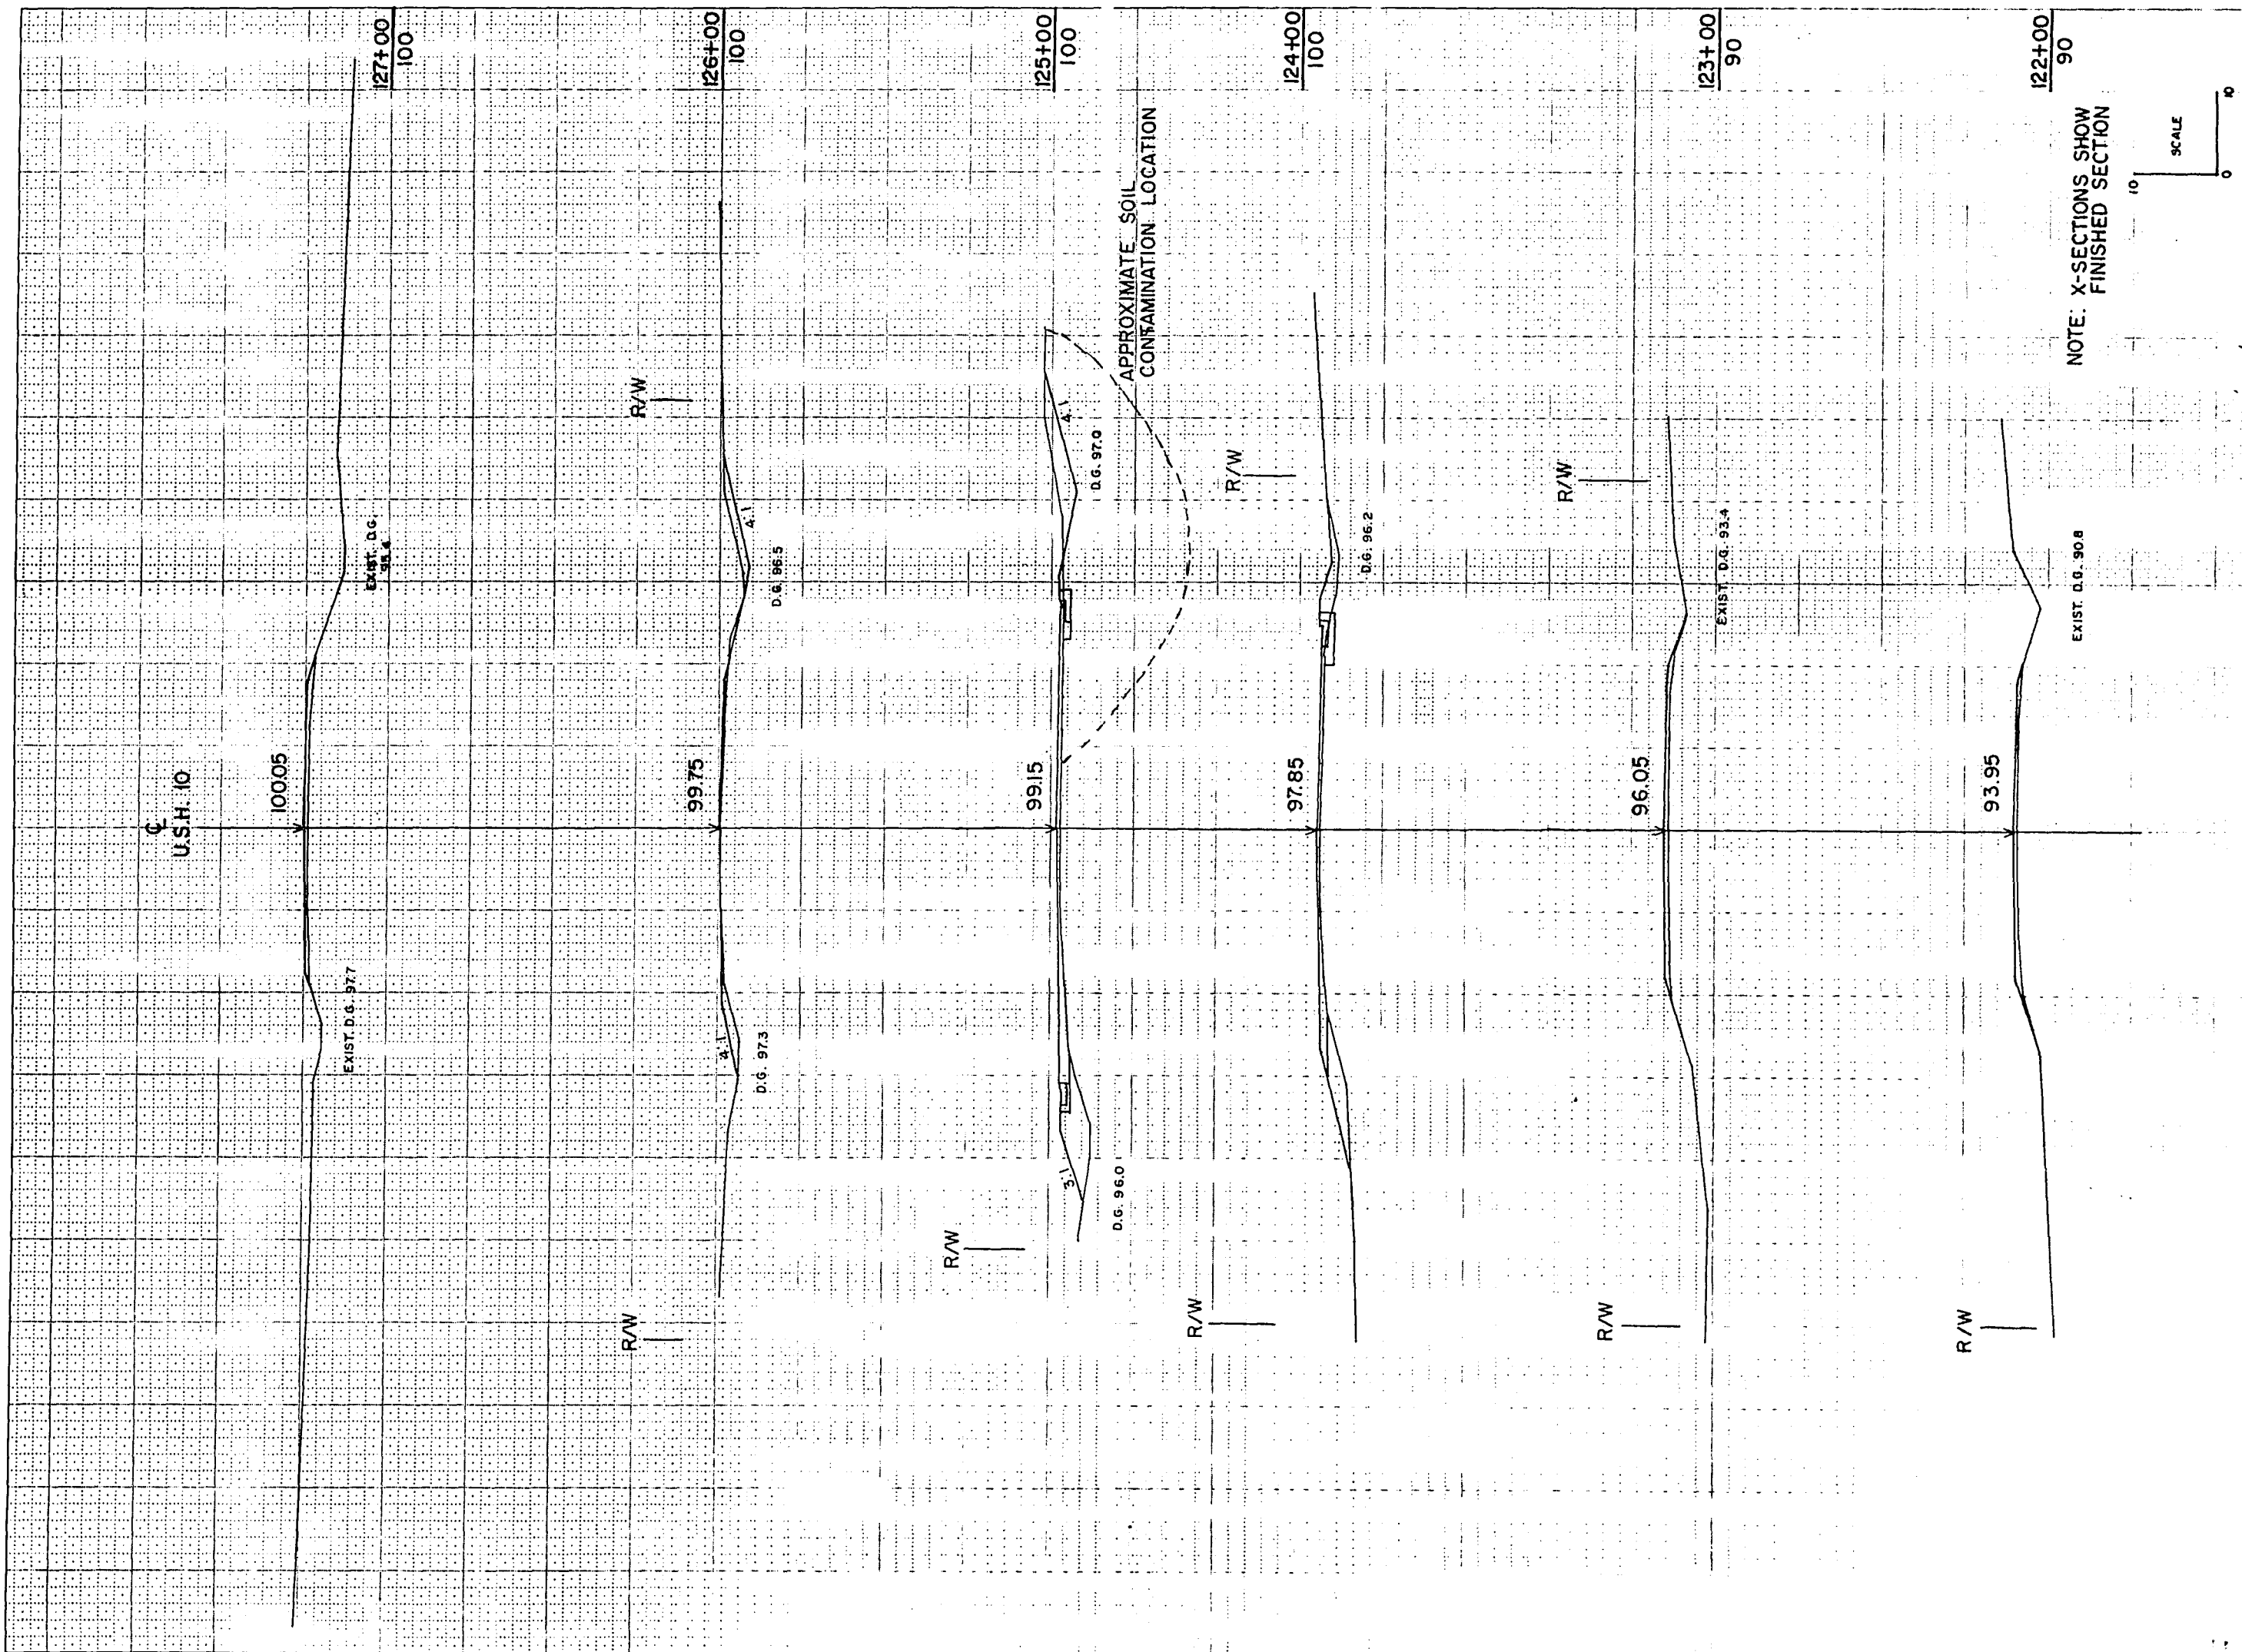[illegible]

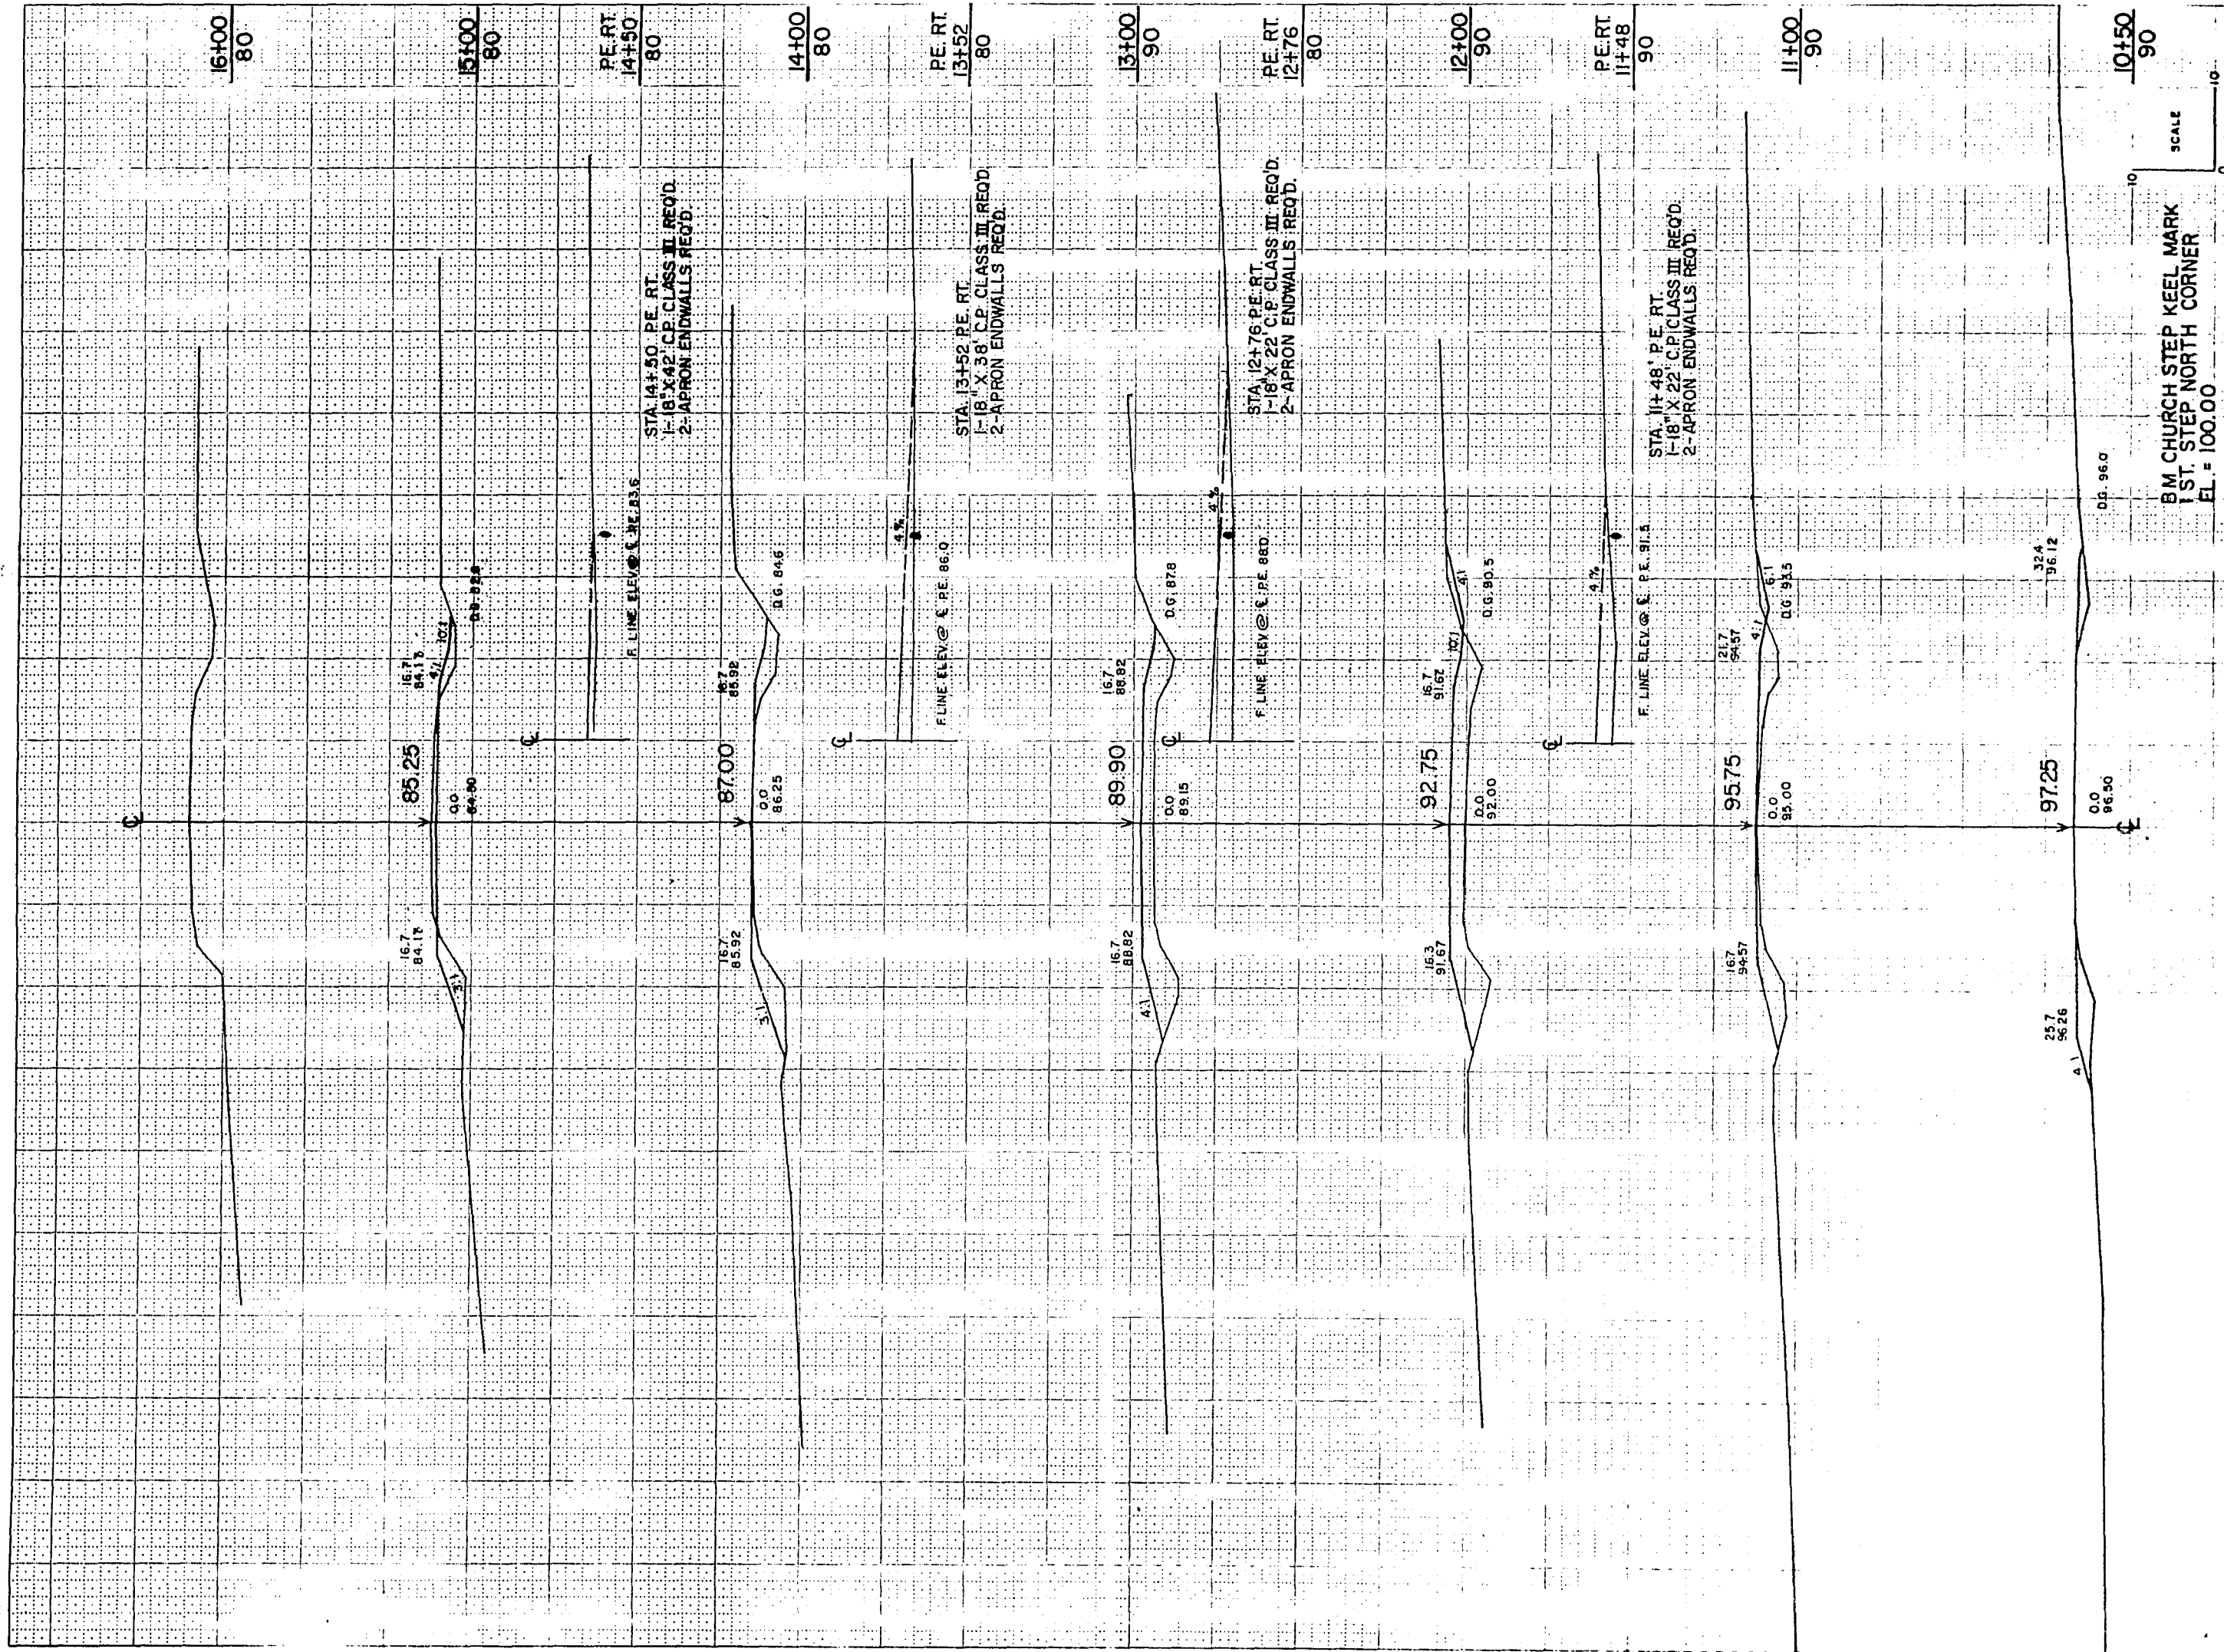



STATE PROJECT NUMBER					SHEET NUMBER
1530-08-71					9.20
STATION	DISTANCE	YARDAGE			
		EXCAVATION			FILL
		COMMON			
10 + 40					
10 + 80		0			6
11		4			72
12		19			307
13		11			415
14		0			318
15		19			181
16		19			63
</					

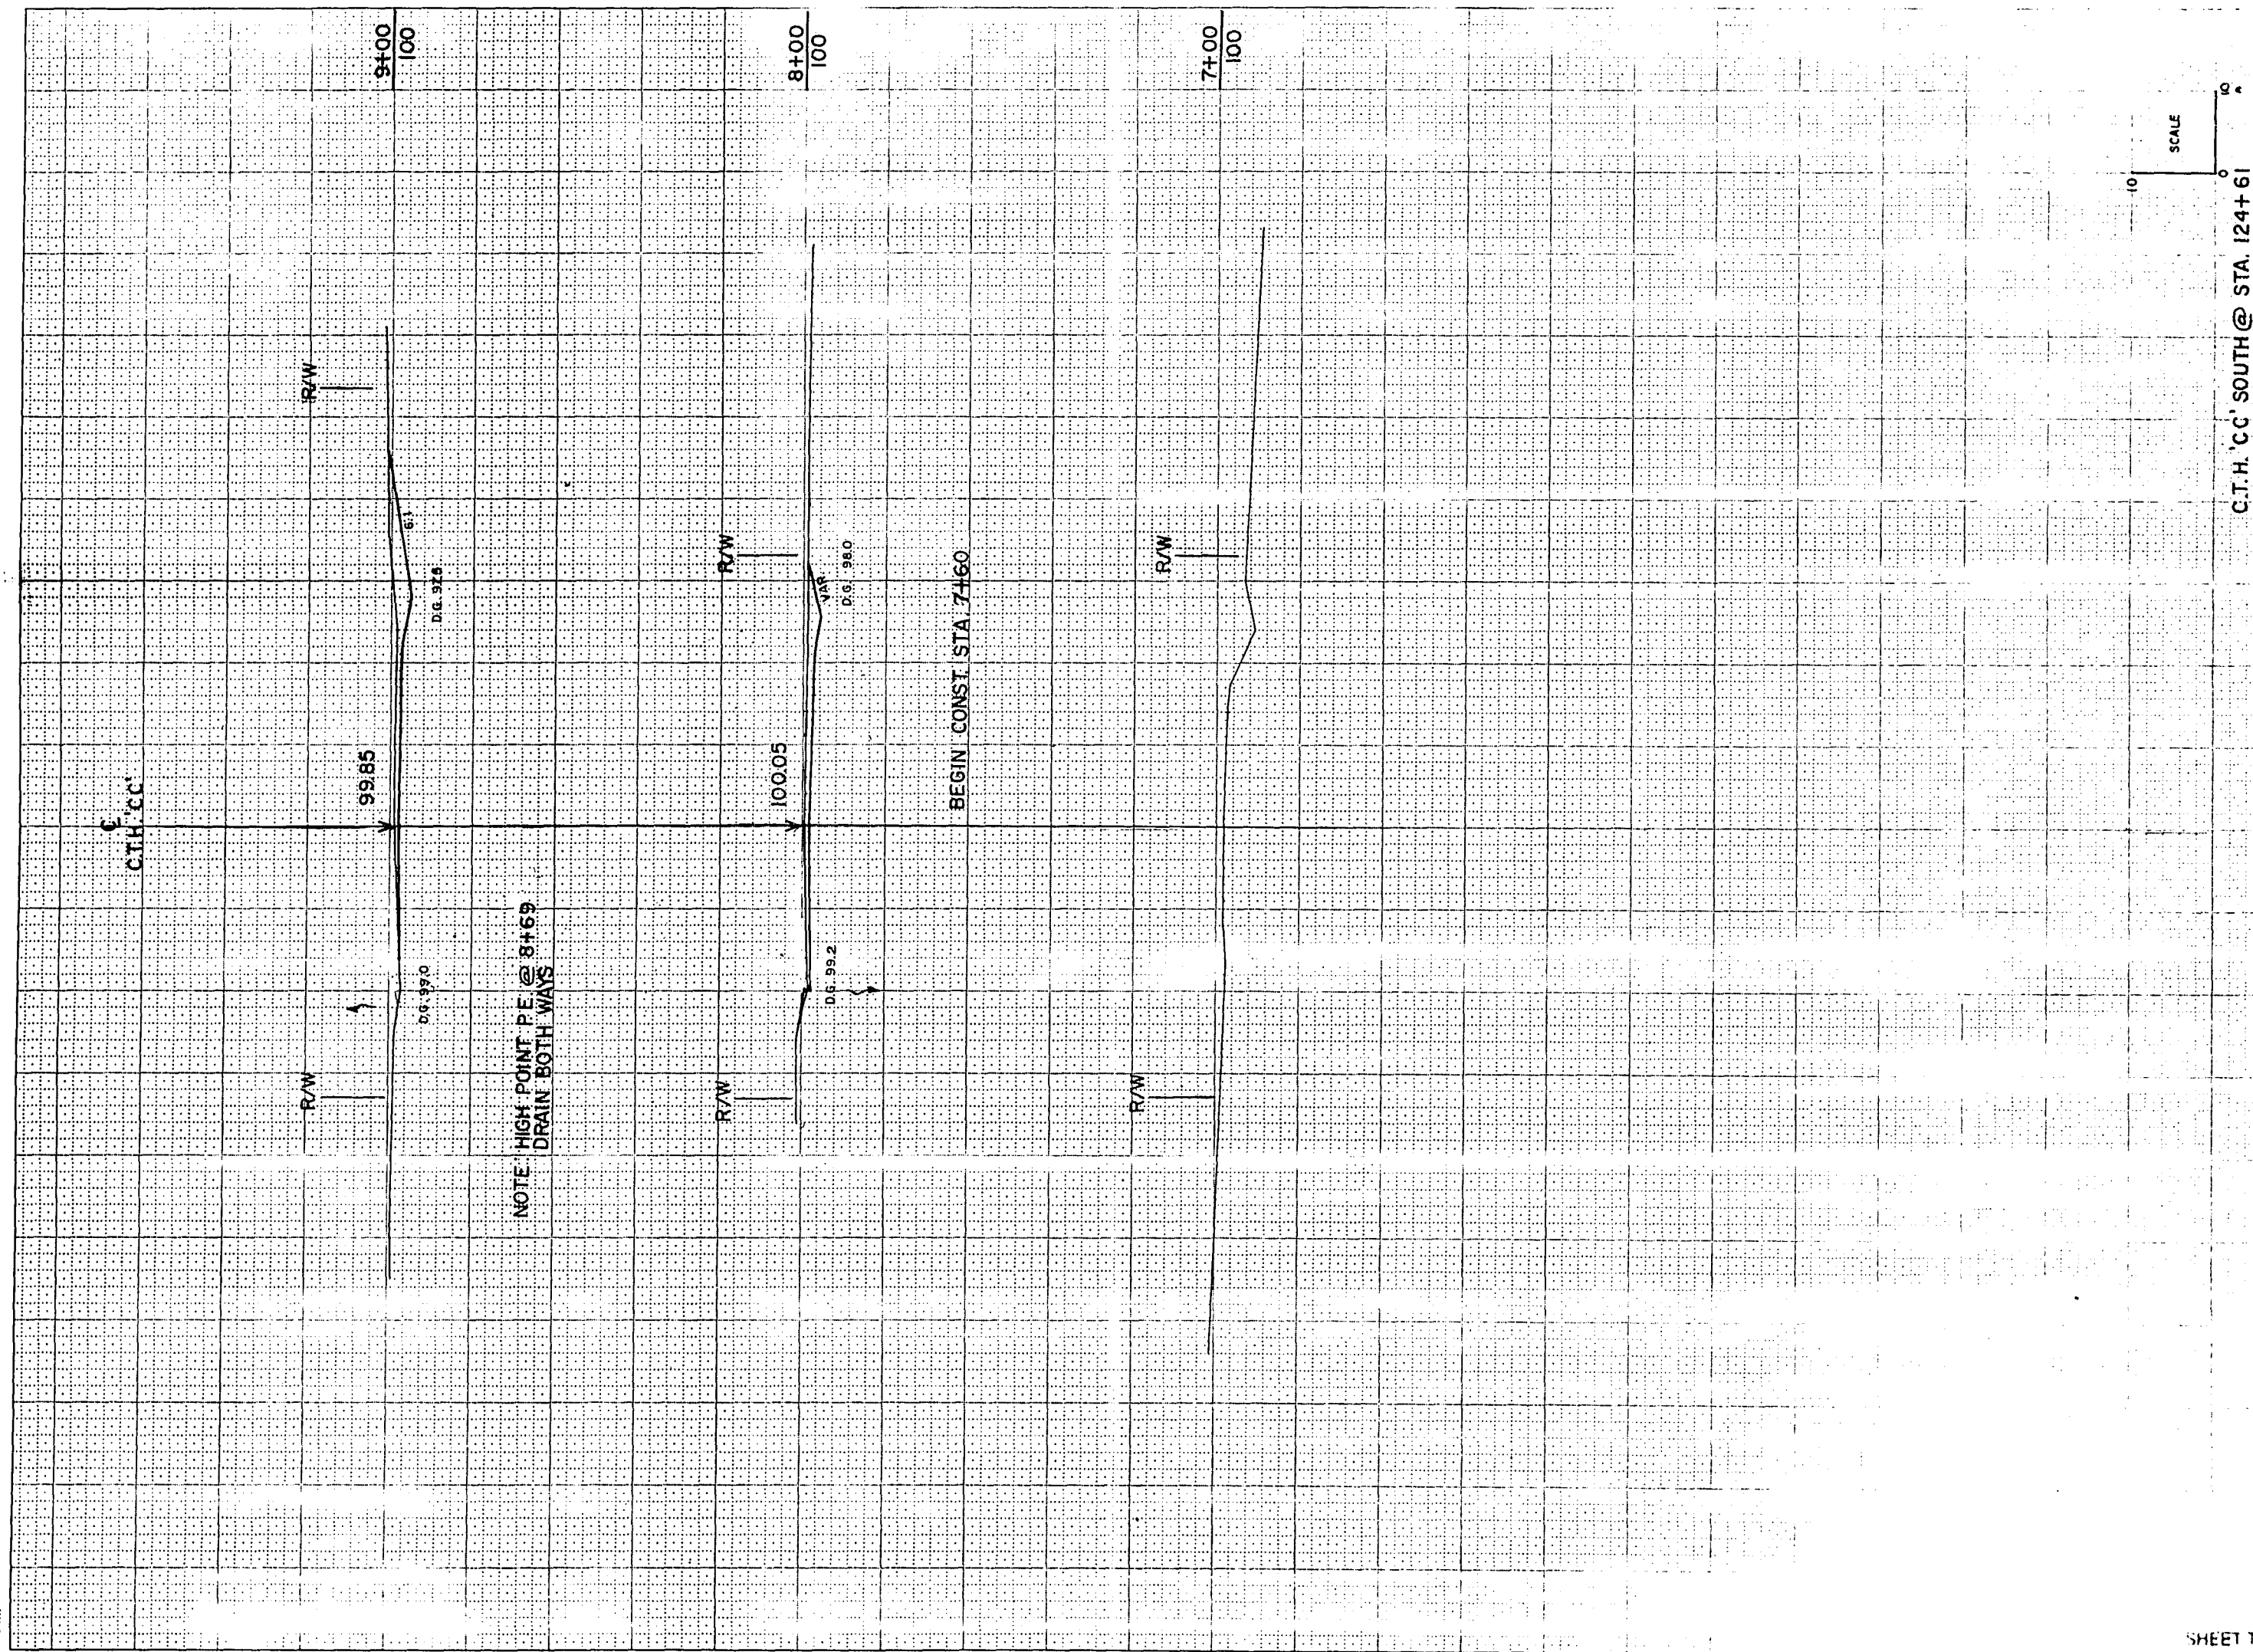


NOTE: HIGH POINT P.E. @ 8+69
DRAIN BOTH WAYS

BEGIN CONST. STA. 7+60

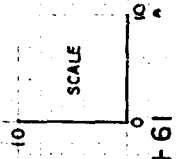
[illegible]

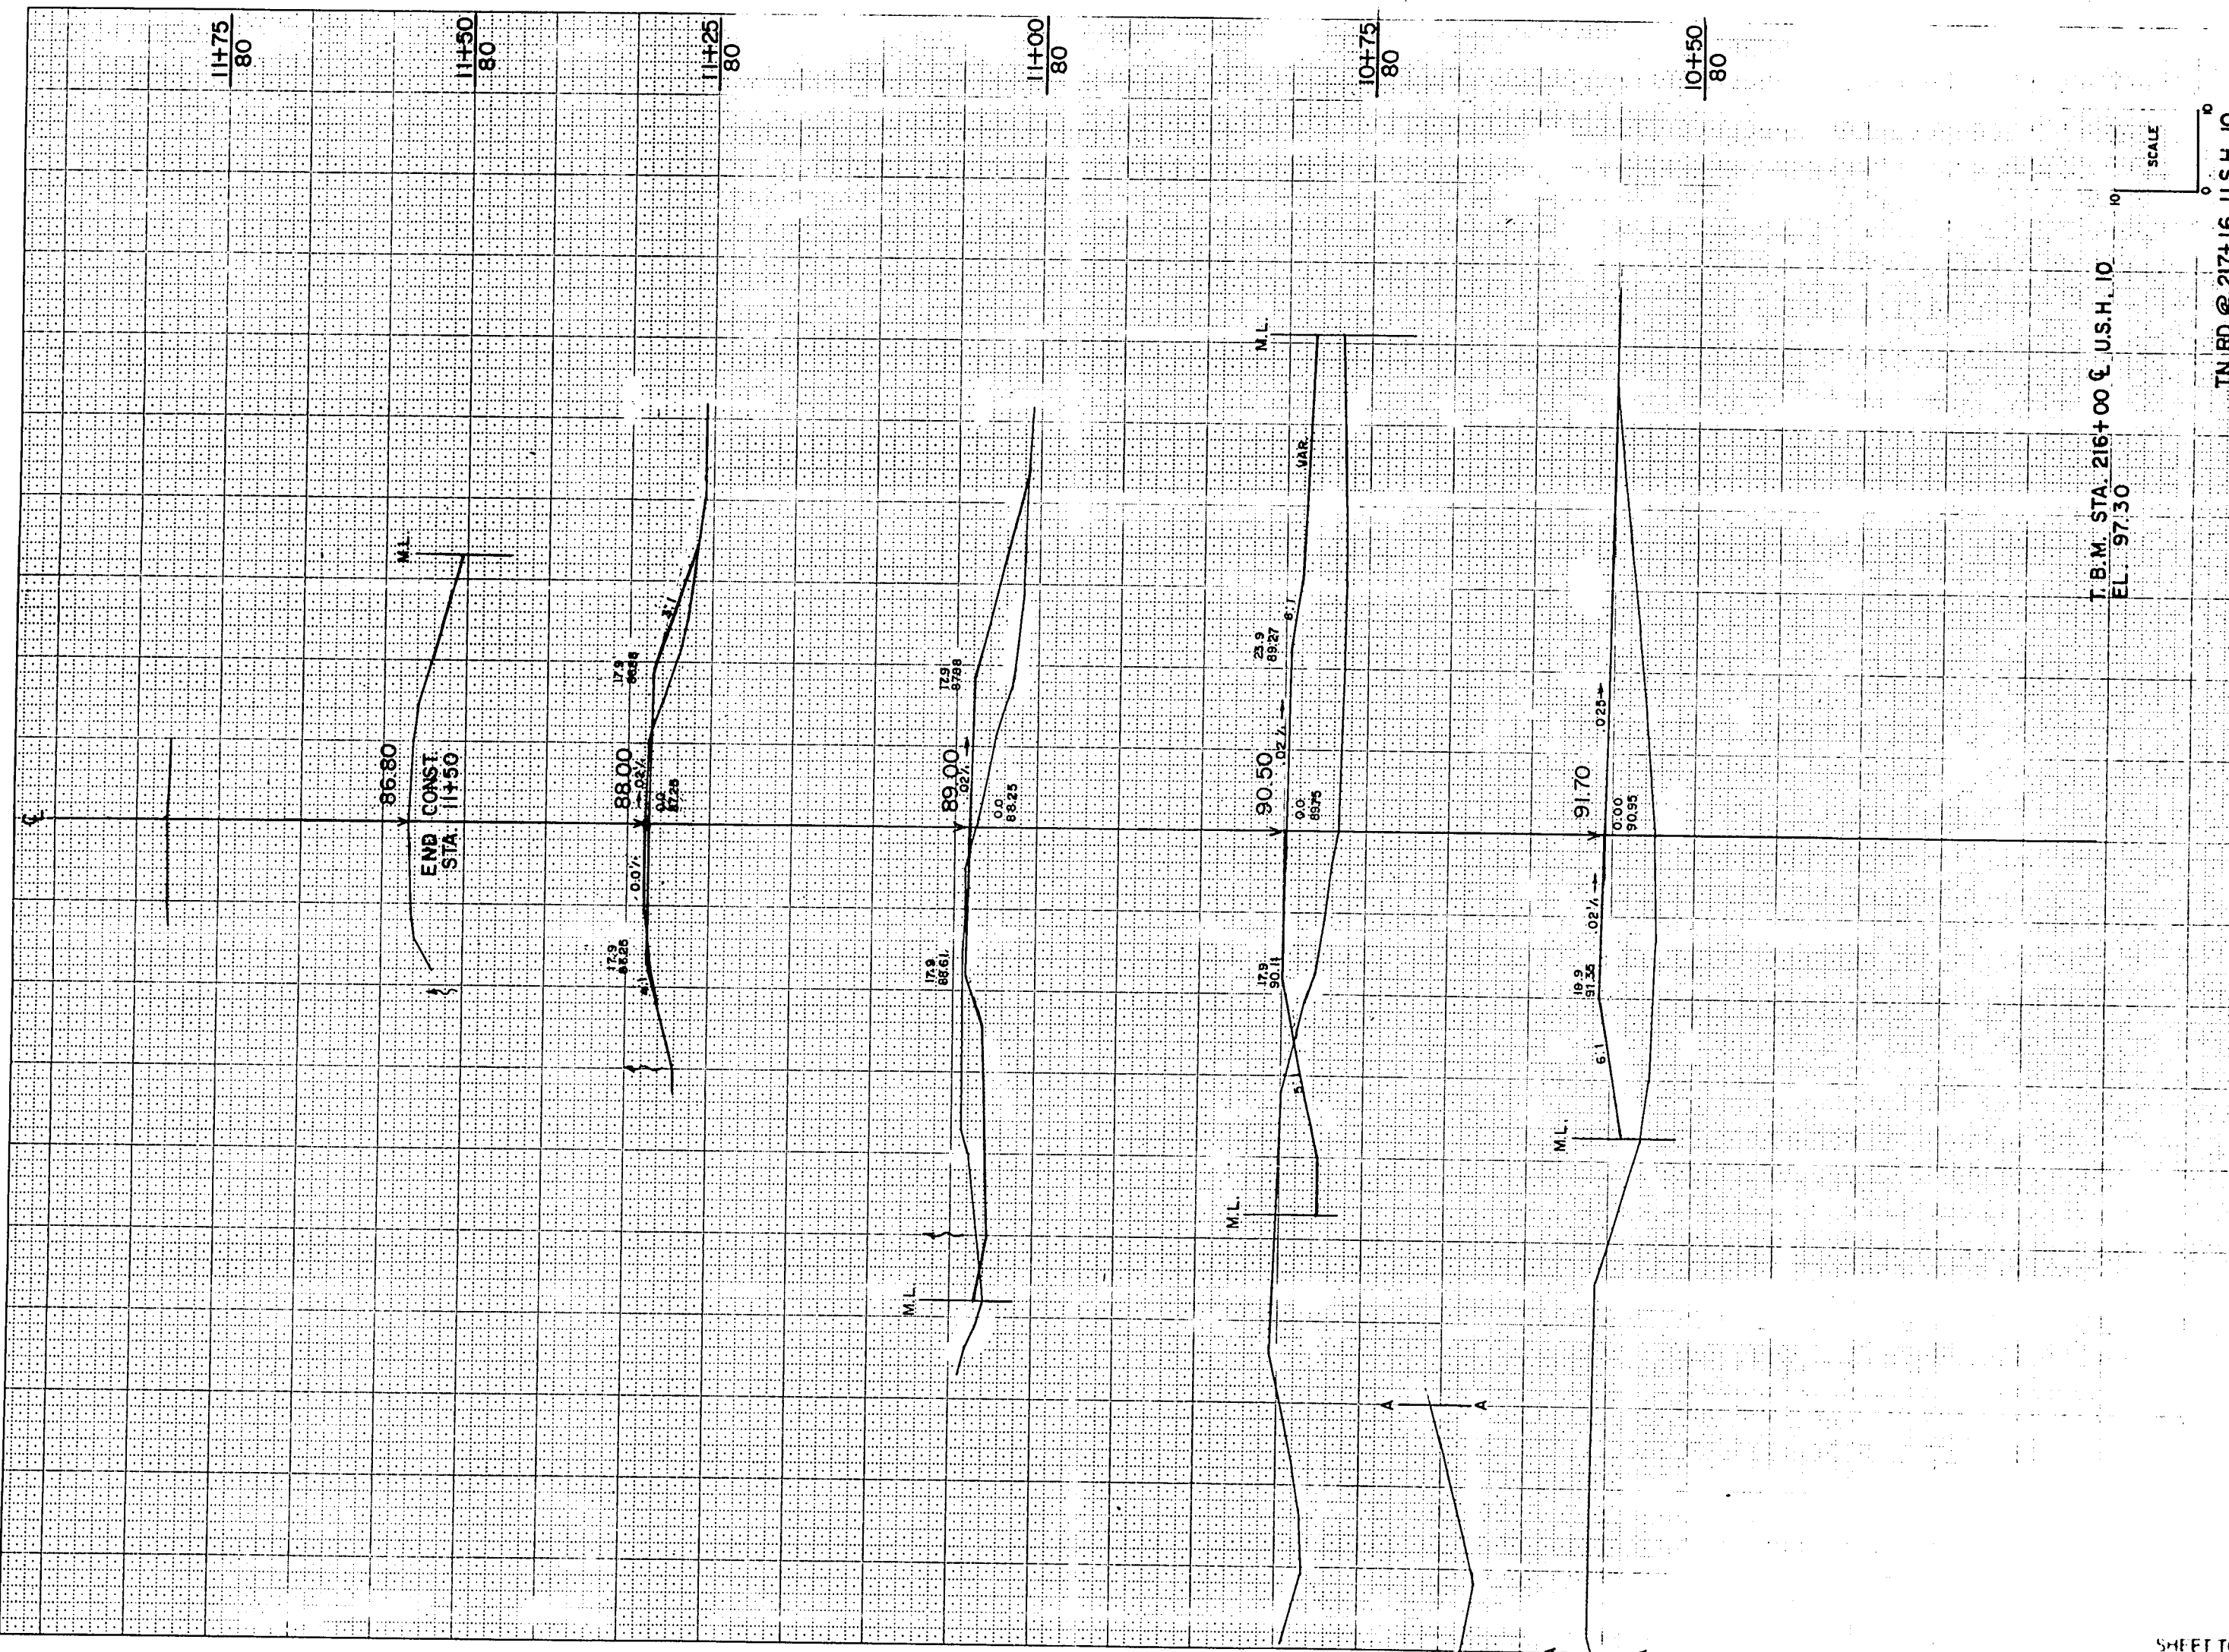

TN. RD. @ 217+16 U.S.H. 10	STATION	DISTANCE	YARDAGE			FILL
			EXCAVATION			
			COMMON			
10 + 25						
+50			0			169
+75			33			363
11			81			244
+25			53			63
+50			0			15


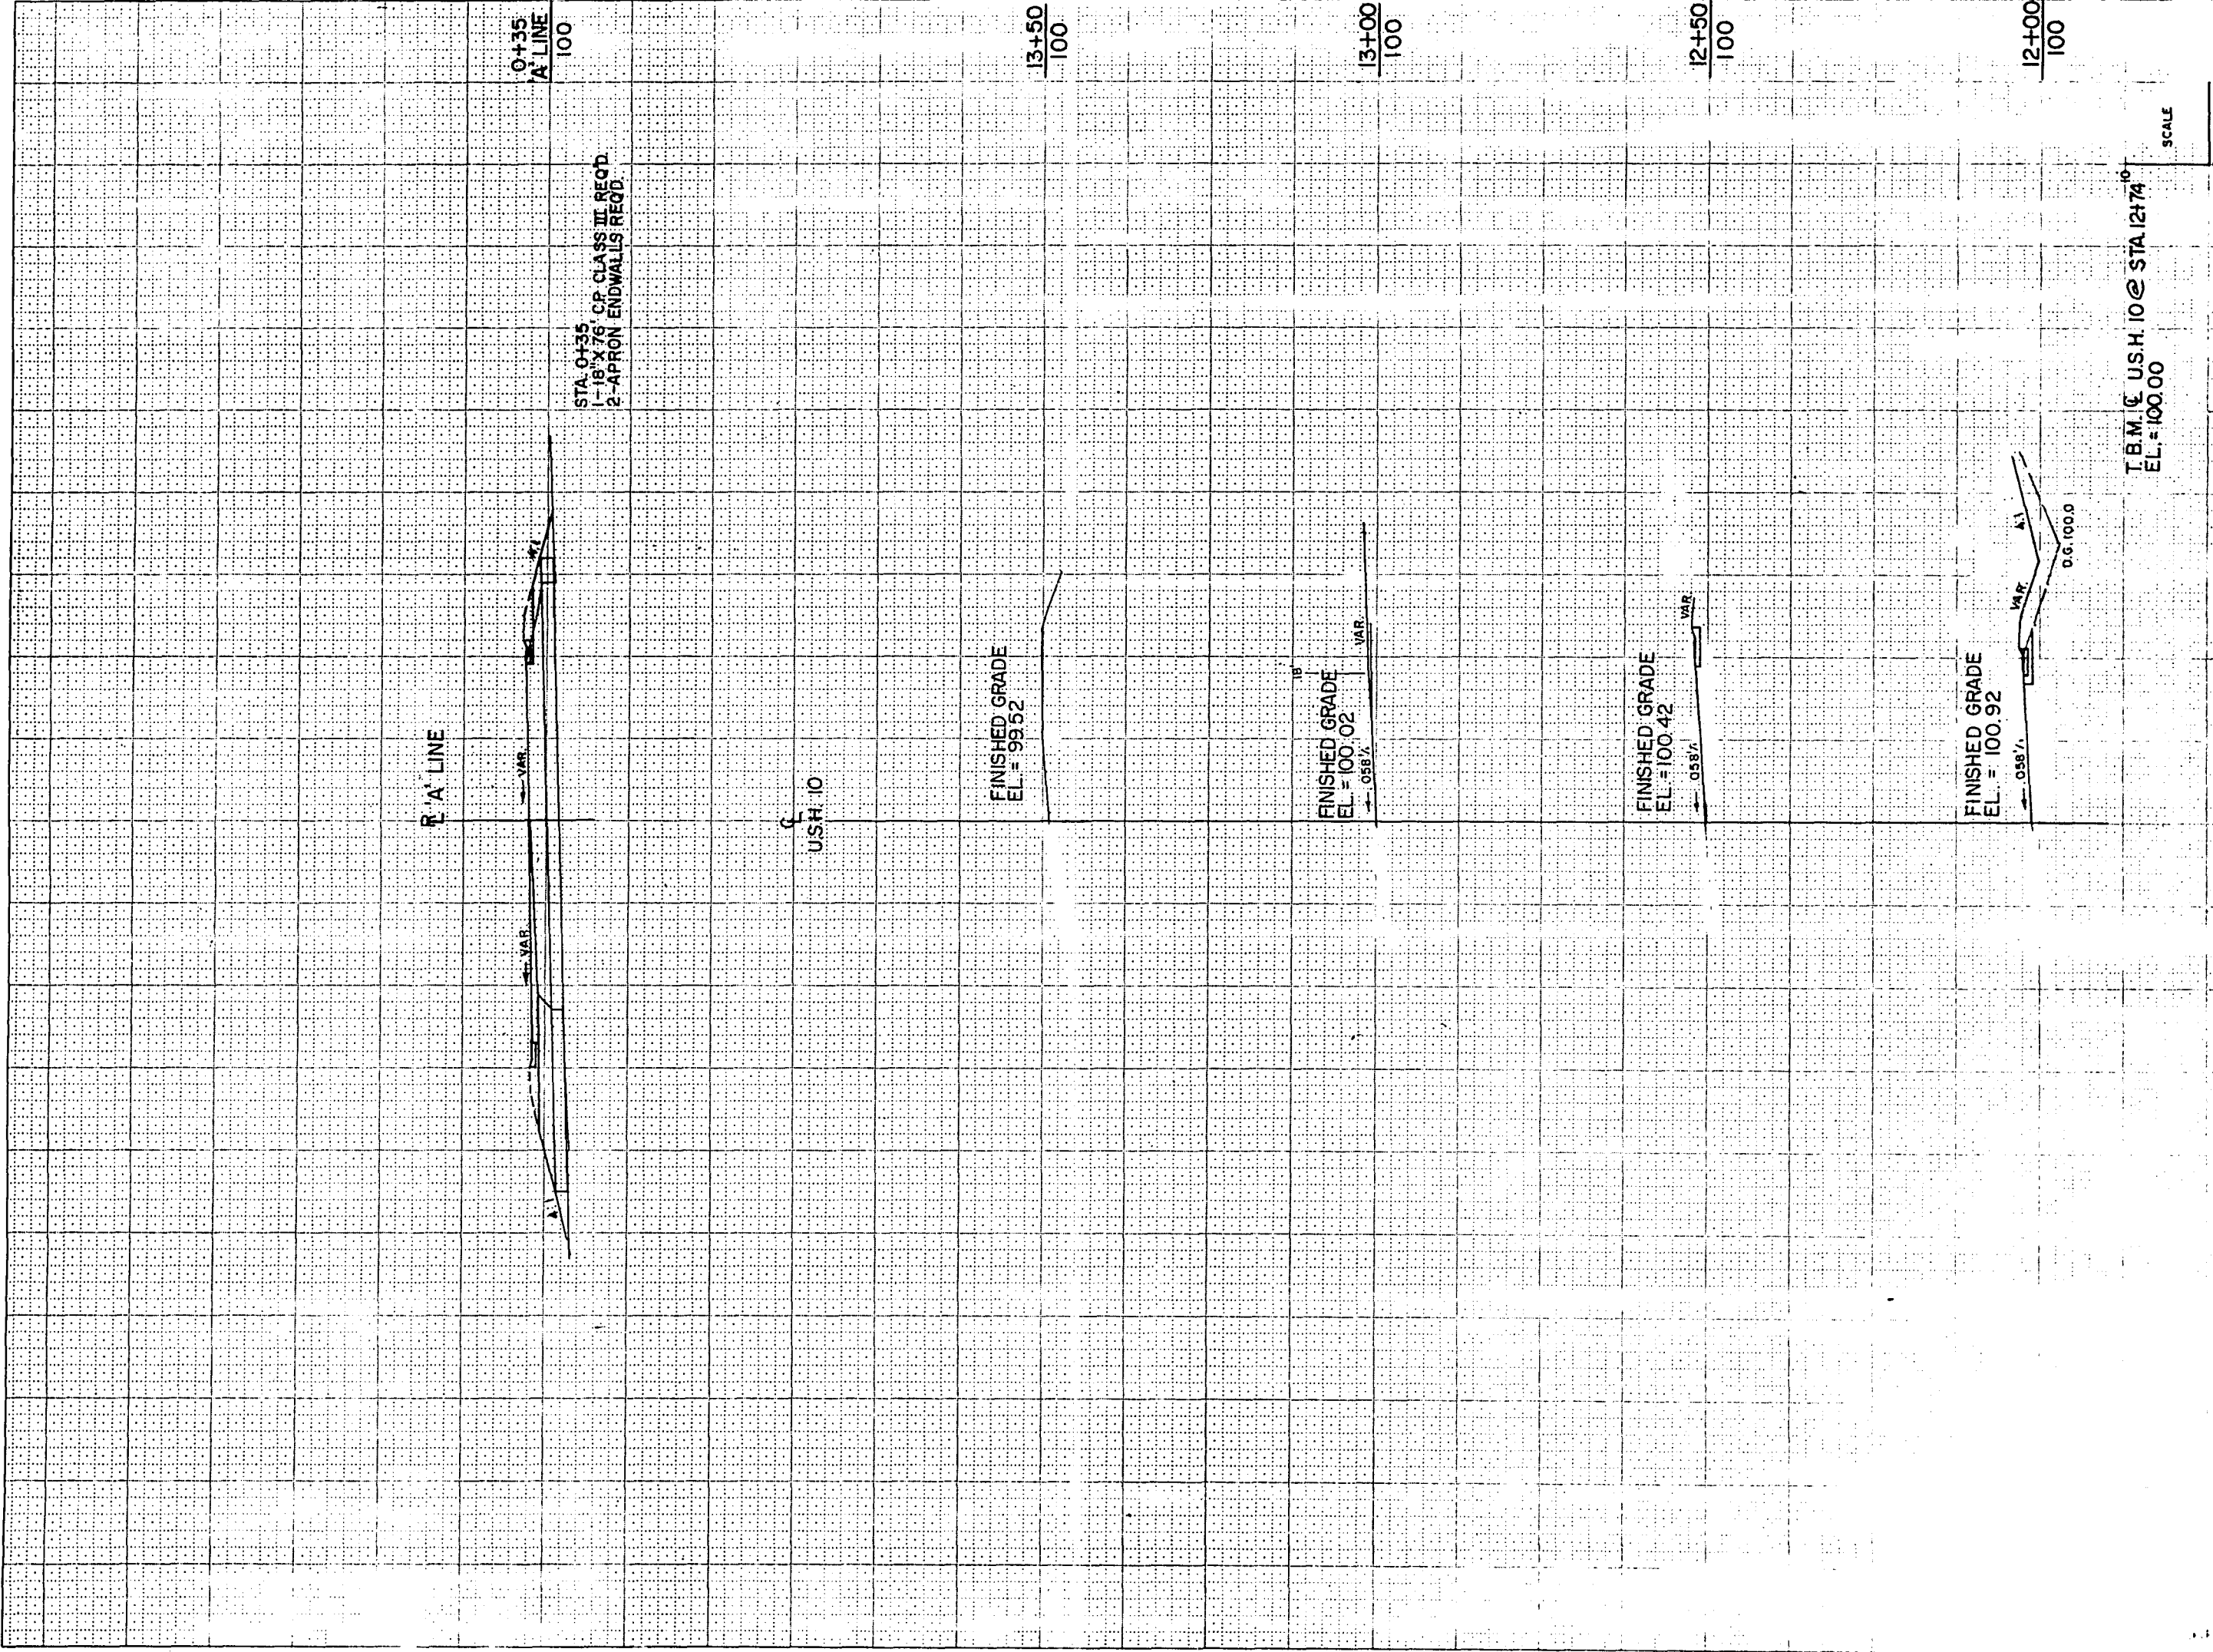


STATE PROJECT NUMBER		SHEET NUMBER			
1530-08-71		9.24			
U.S.H. 10 @ C.T.H. "U"	STATION	DISTANCE	YARDAGE		
			EXCAVATION		
			FIL.		
	11				85
	12				33
	140				118
			"A" LINE		
	0 + 20				24
	0 + 35				69
	0 + 65				93

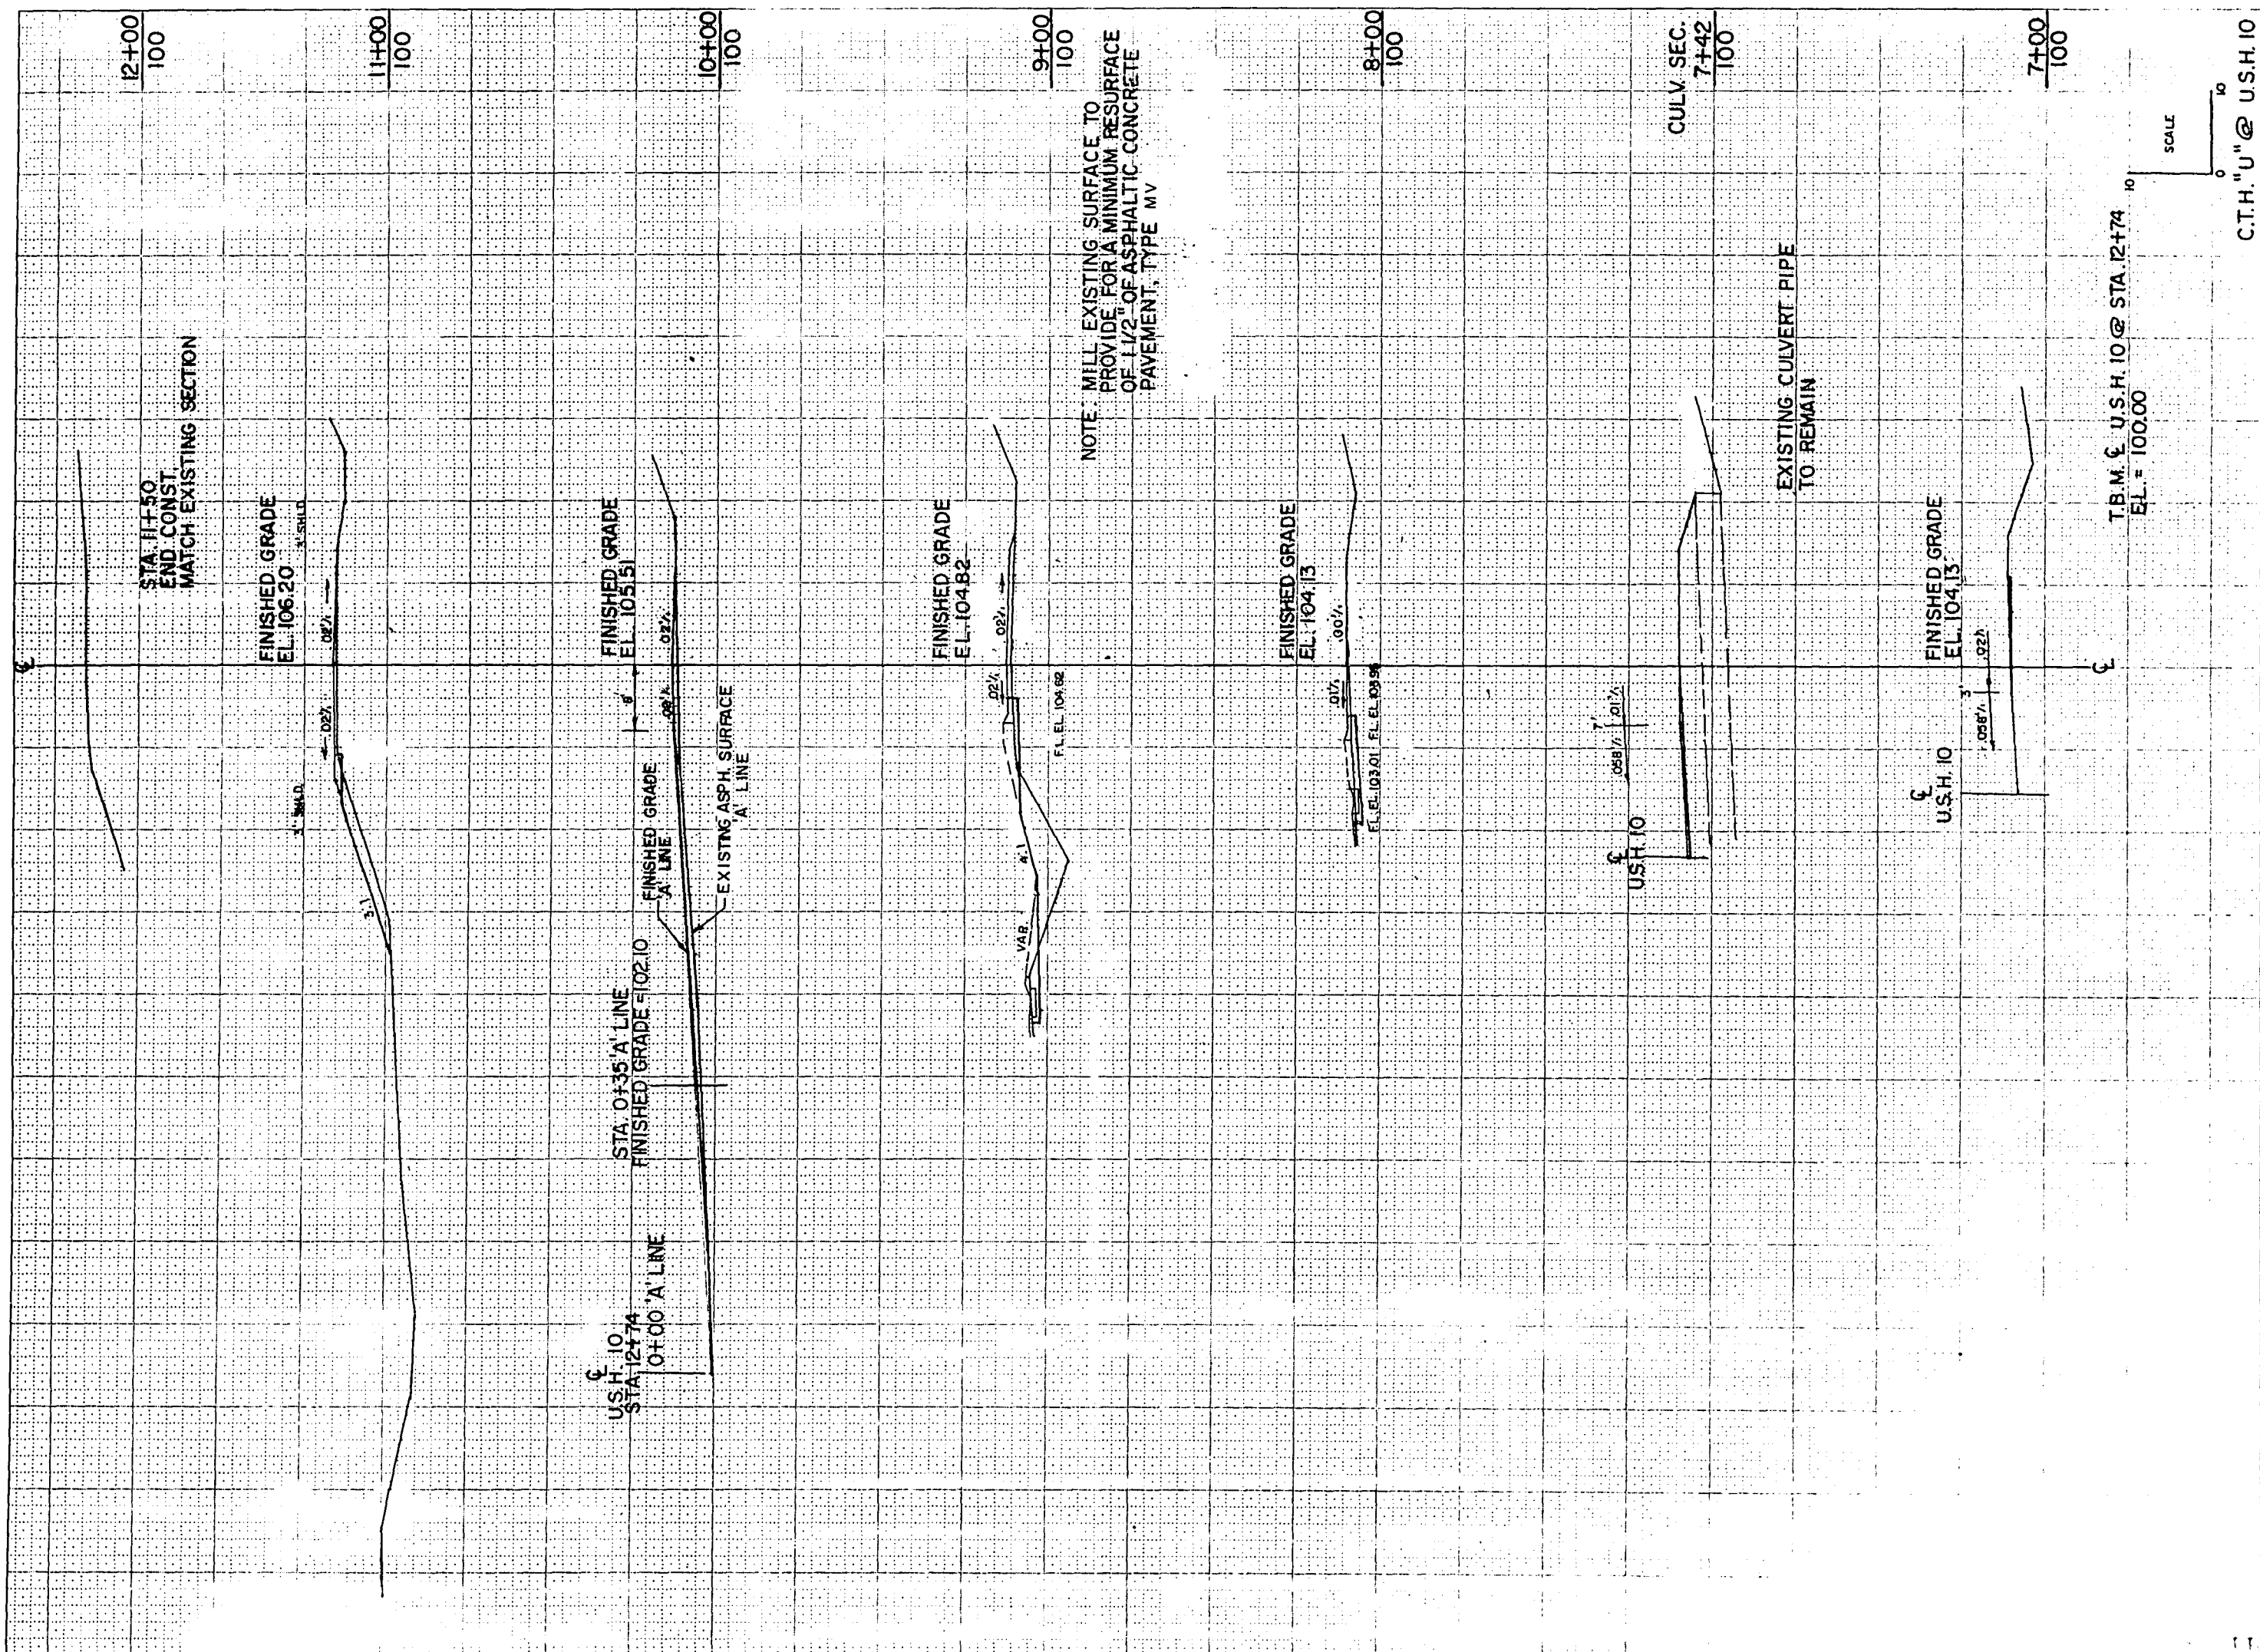

STATE PROJECT NUMBER						SHEET NUMBER
1530-08-71						<u>9.25</u>
	STATION	DISTANCE	YARDAGE			FILL
			EXCAVATION			
			COMMON			
	8					
			15			89
	9					
			11			63
	+70					
	10 + 30					35
	11					
						26
	+50					
TOTAL			26			213

DATE

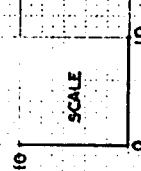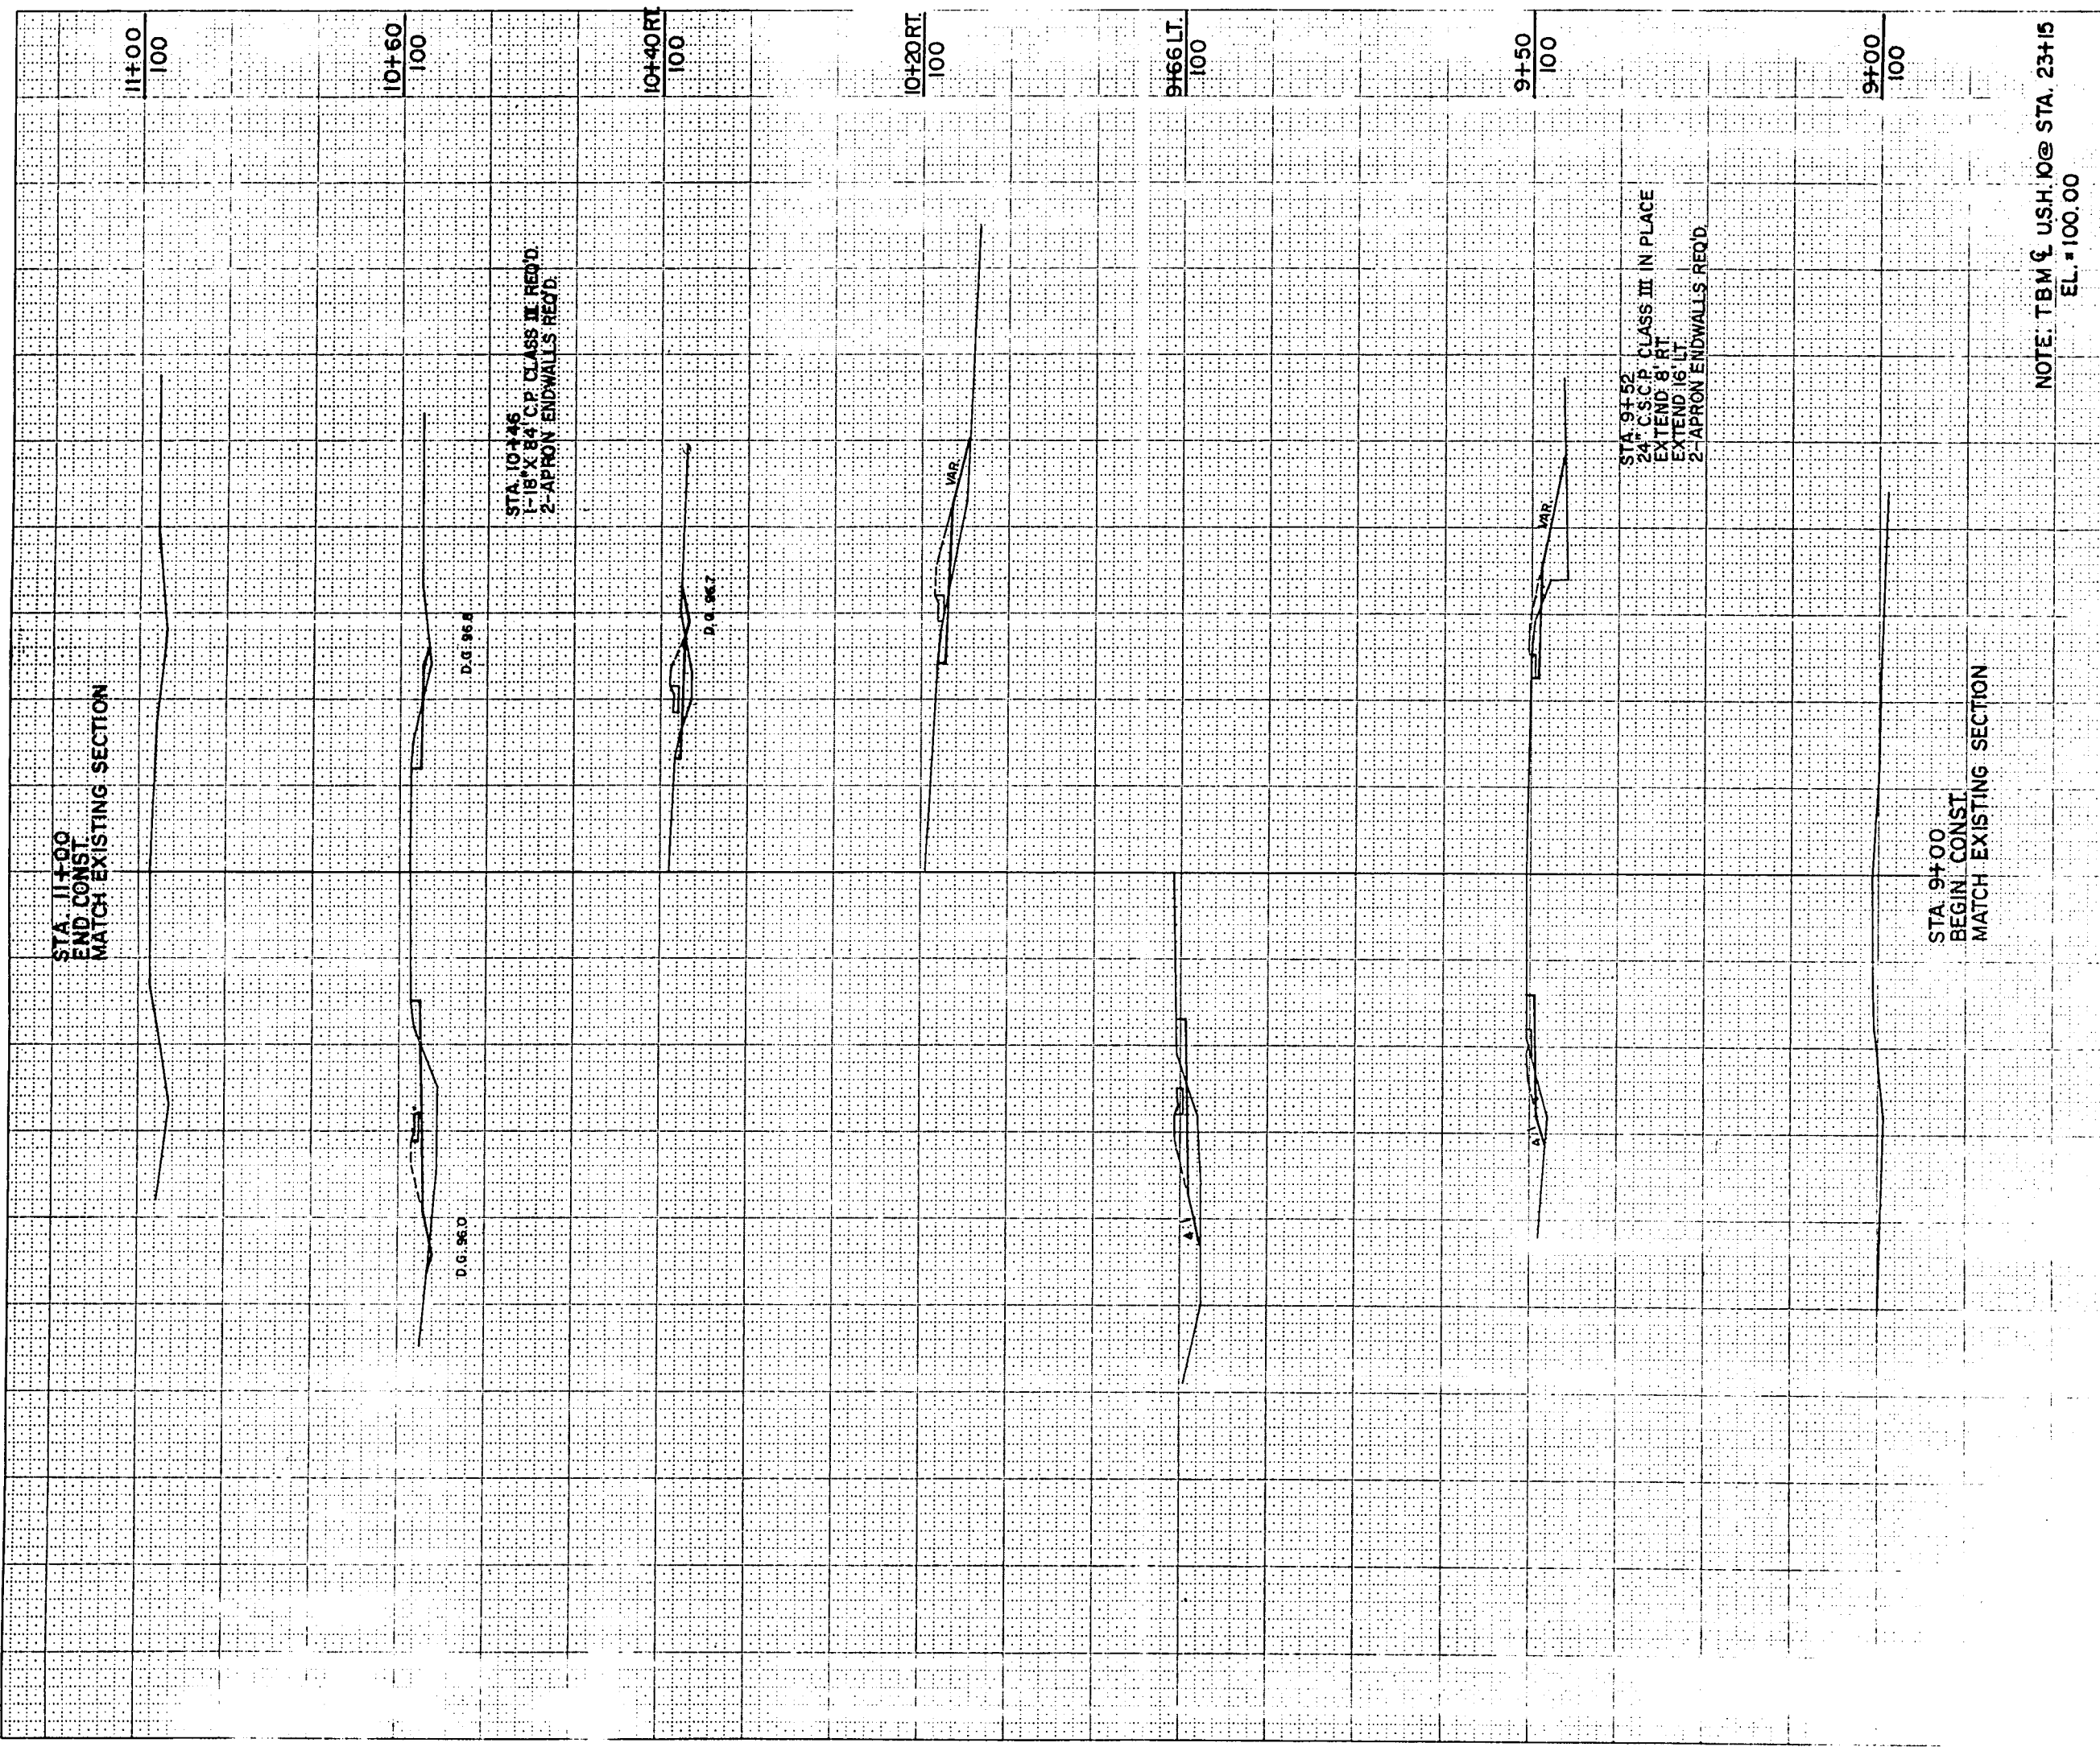

NOTE: TBM & USH 10@ STA. 23+15
EL. = 100.00

C.T.H. S

STATE PROJECT NUMBER		SHEET NUMBER		
		9.26		
STATION	DISTANCE	YARDAGE		
		EXCAVATION		FILL
		COMMON		
9				
+50		11		28
+66		6		15
+75		2		4
10				
+20		4		7
+40		4		13
+60		6		22
11				