


Sheet Number	Total Sheets
1	

Index of Sheets

Sheet No. 1	Title
Sheet No. 2, 2.1, 3	Typical Cross Sections
Sheet No. 3	Estimate of Quantities
Sheet No. 3A	Miscellaneous Quantities
Sheet No. —	Right of Way Plat
Sheet No. 5—5.2	Plan and Profile Sta.
Sheet No. 6—6.3	Standard Details
Sheet No. —	Drainage Structures
Sheet No. —	Cross Sections
TOTAL SHEETS = 12	

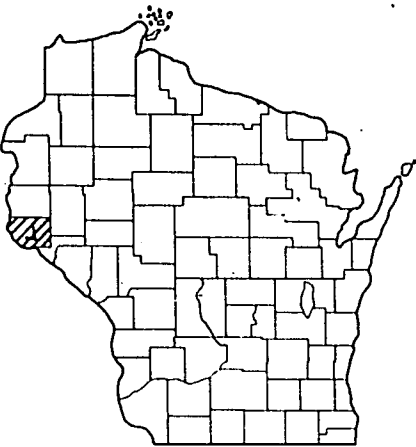

Design Designation

7105-4-71 / RS075(16)			7210-4-71 / RS0289(6)		
A.D.T.	1960	= 1971	A.D.T.	1170	= 1971
A.D.T.	3000	= 1990	A.D.T.	2000	= 1990
D.H.V.	450		D.H.V.	300	
D.	50-50		D.	50-50	
T.	10%		T.	10%	
V.	60 M.P.H.		V.	60 M.P.H.	

Conventional Signs

State Line	-----
County Line	-----
Township or Range Line	-----
Section Line	-----
New Right of Way Line	-----
Present Right of Way Line	-----
Wire Fence	-----
Lot Line	-----
Corporate or City Limits	-----
Property Line	-----
Traveled Way or P.E.	-----
Railroads	-----
Base or Survey Line	-----

Culverts in Place	-----
Culverts Required	-----
Drop Inlet	-----
Power Pole	-----
Telephone or Telegraph Pole	-----
Right of Way Markers	-----
Reference Stake for Hubs Only	-----
Marsh	-----
Hedge	-----
Trees	-----
Ground Elevation	Datum Line
Grade Elevation	Datum Line

STATE OF WISCONSIN

DEPARTMENT OF TRANSPORTATION

DIVISION OF HIGHWAYS

PLAN AND PROFILE OF PROPOSED

ELLSWORTH- MARTELL ROAD

U.S.H. 63
PIERCE COUNTY

PROJECT IDENTIFICATION NUMBER	FEDERAL PROJECT DESIGNATION
7210-4-71	RS 0289(6)


AS BUILT

Scales
Plan 1 in. = 200 ft.

ELLSWORTH- WAVERLY ROAD

U.S.H.63 & S.T.H. 72
PIERCE COUNTY

PROJECT IDENTIFICATION NUMBER	FEDERAL PROJECT DESIGNATION
7105-4-71	RS075(16)

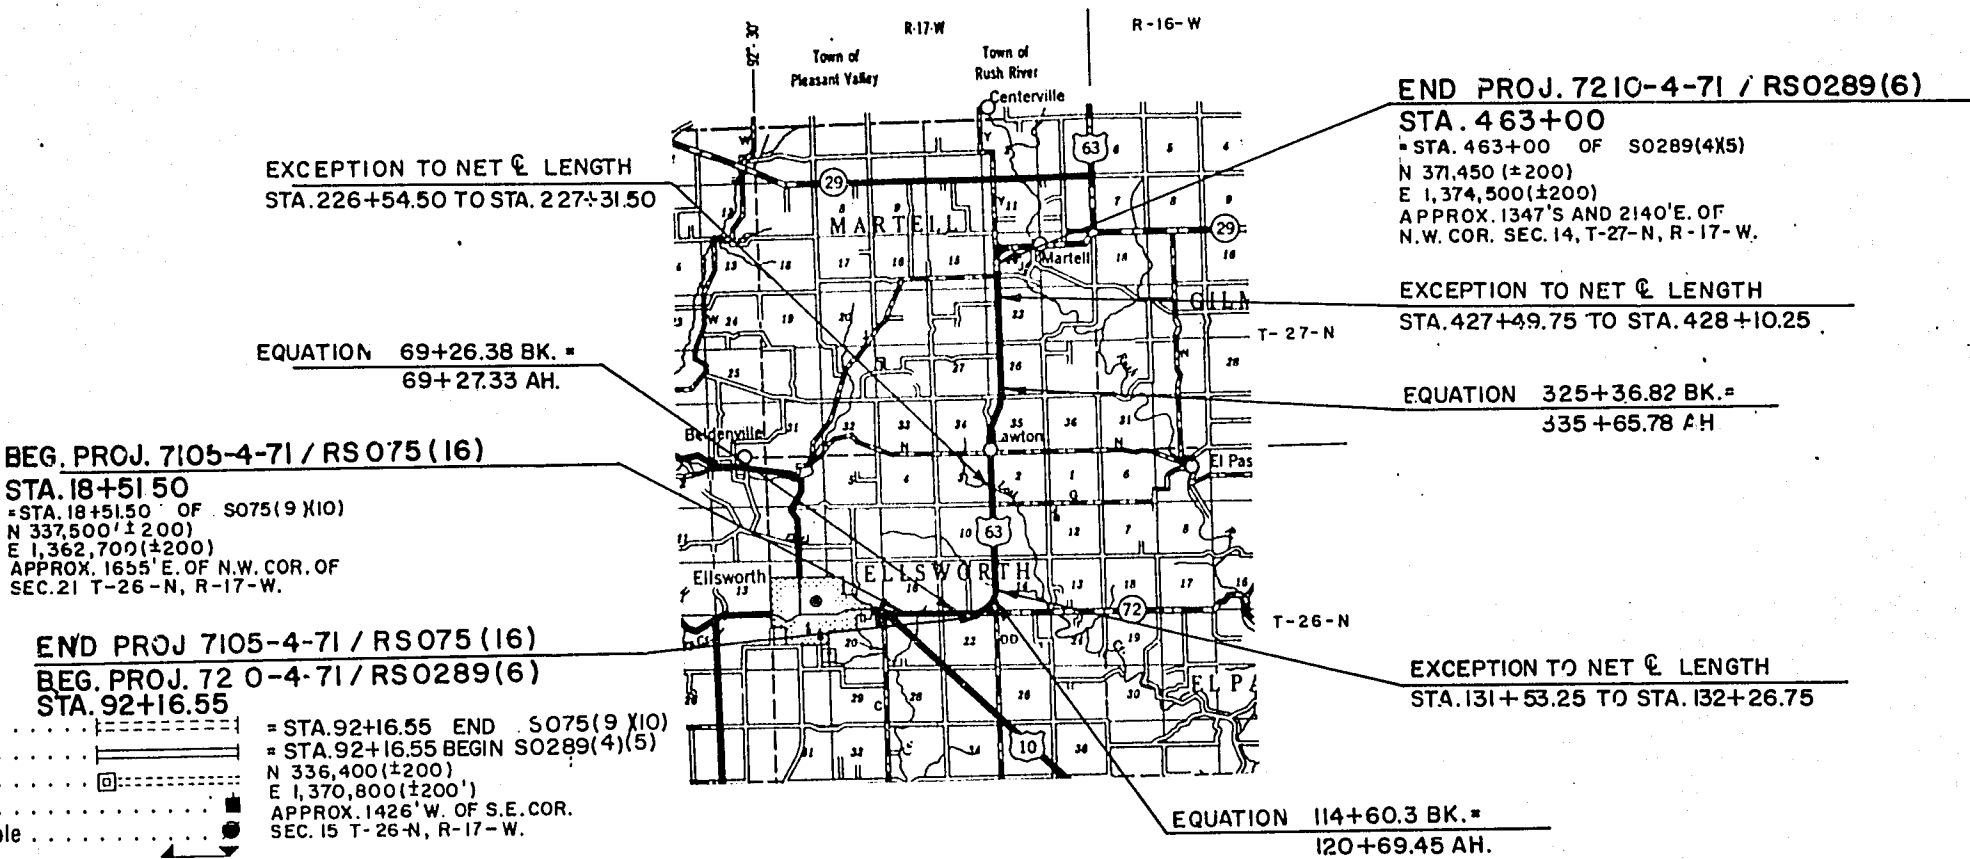

Layout
Scale 0 1 2 MI.


LENGTH OF CENTERLINE = 1.395 MI. 7105-4-71 / RS075(16)
LENGTH OF CENTERLINE = 6.673 MI. 7210-4-71 / RS 0289(6)
TOTAL NET LENGTH OF CENTERLINE = 8.068 MI.

ALL COORDINATES SHOWN ON THIS PLAN ARE REFERENCED TO THE WISCONSIN CO-ORDINATE SYSTEM, CENTRAL ZONE, AND ARE SCALED FROM U.S.G.S. TOPOGRAPHIC MAPS, MAIDEN ROCK AND BALDWIN, WISCONSIN QUADRANGLES FOR IDENTIFICATION ONLY.




STATE OF WISCONSIN DEPARTMENT OF TRANSPORTATION DIVISION OF HIGHWAYS	
Surveyor <u>E.J.E.</u>	Note Book
District Computer <u>E.J.E.</u>	M.O. Checker <u>L.L.J.</u>
District Checker <u>P.R.B.</u>	Correct
Correct	
Date <u>4/16/73</u>	<u>M.J. Schaeffer</u> District Engineer
Recommended for Approval:	
Date <u>5/4/73</u>	<u>J.P. Hennrich</u> CHIEF OF FACILITIES ENGINEER
Approved:	
Date <u>5/8/73</u>	<u>H.L. Giedler</u> State Highway Engineer
U.S. DEPARTMENT OF TRANSPORTATION FEDERAL HIGHWAY ADMINISTRATION	
REGION 4	WISCONSIN DIVISION
Approved:	
Date	Division Engineer



RS 0289(6) / 7210-4-71 RS 075(16) / 7105-4-71

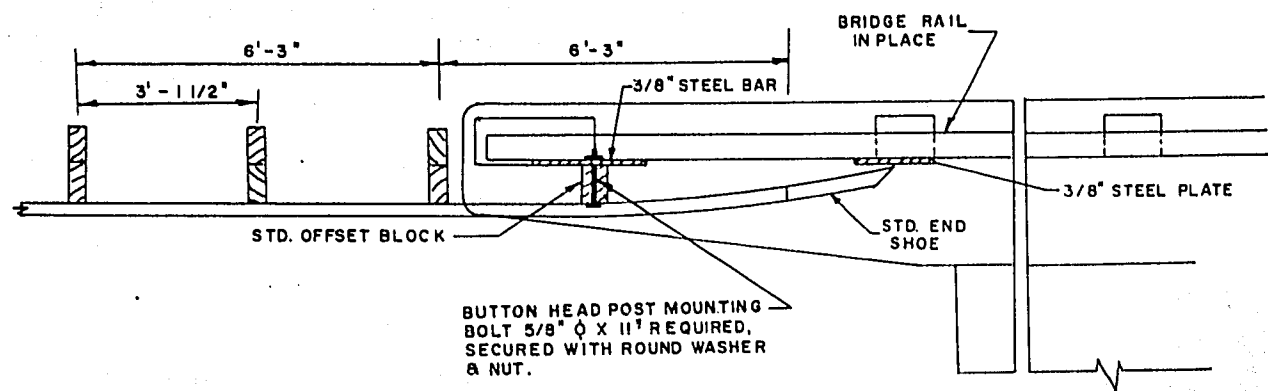


PLAN VIEW

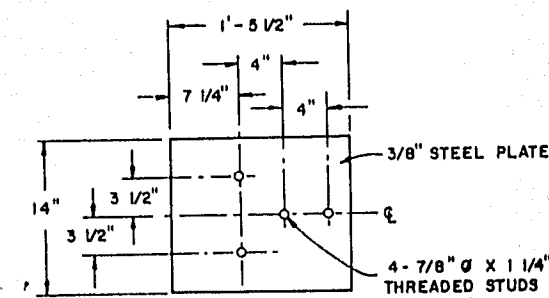

DETAIL A


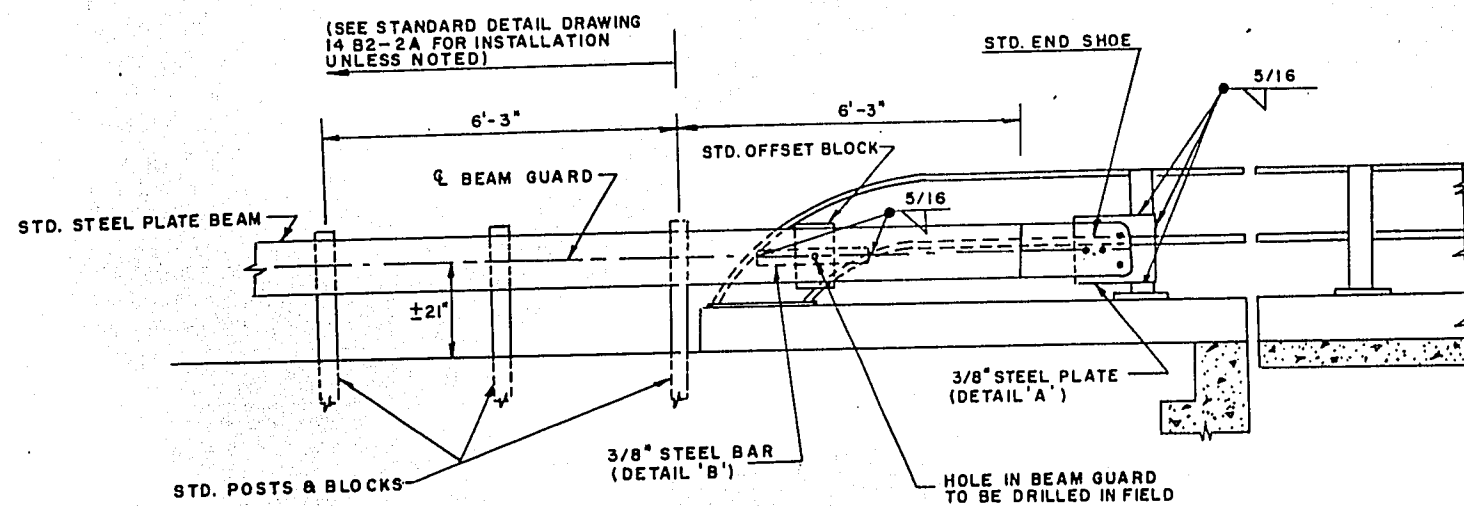
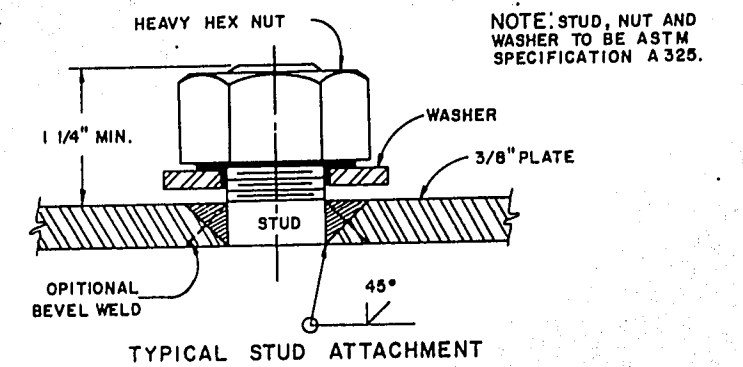


FRONT VIEW

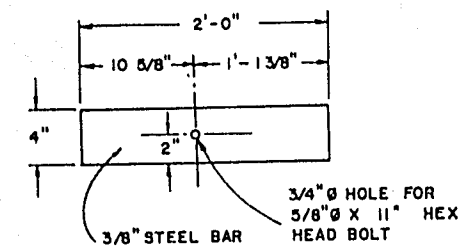

DETAIL B

PROJECT DESIGNATION	SHEET NO.
7210-4-71 / RS0289(6)	2.1
SPECIAL DETAIL GUARD RAIL INSTALLATION	

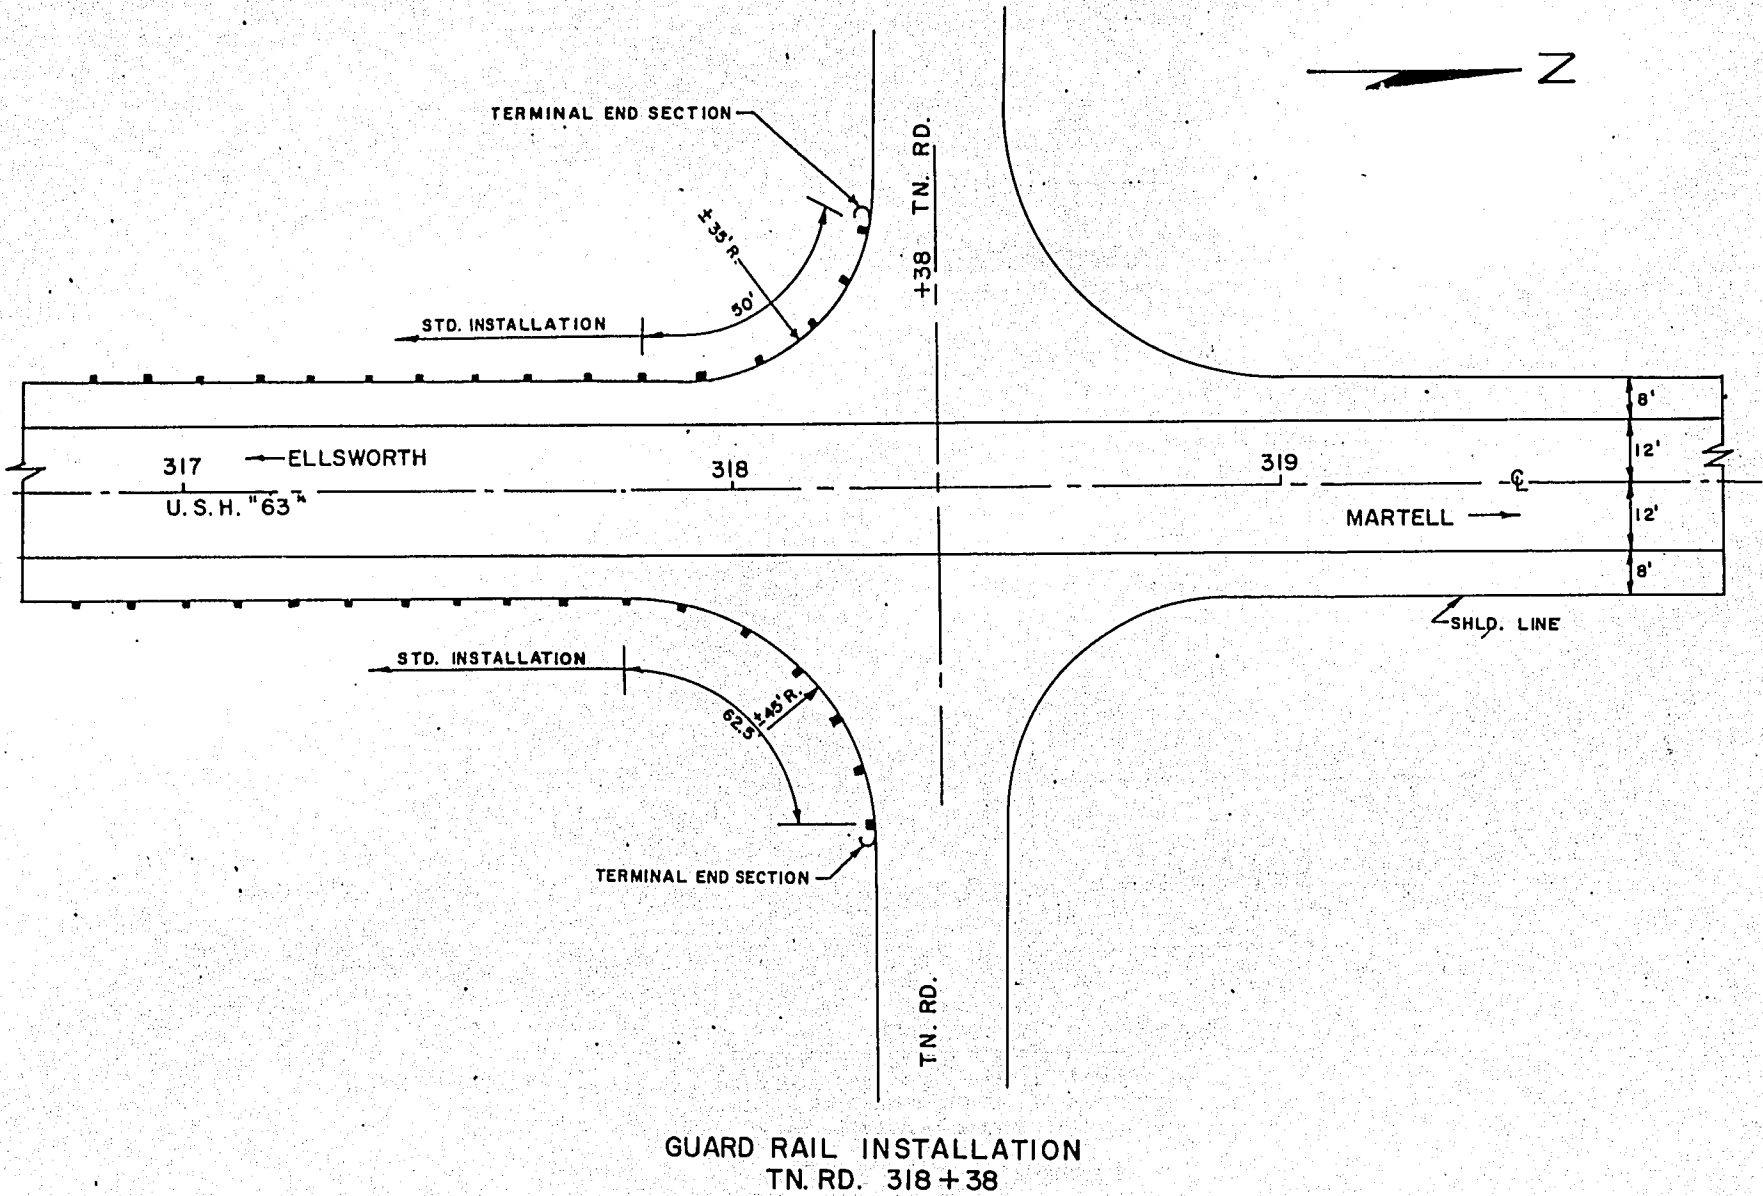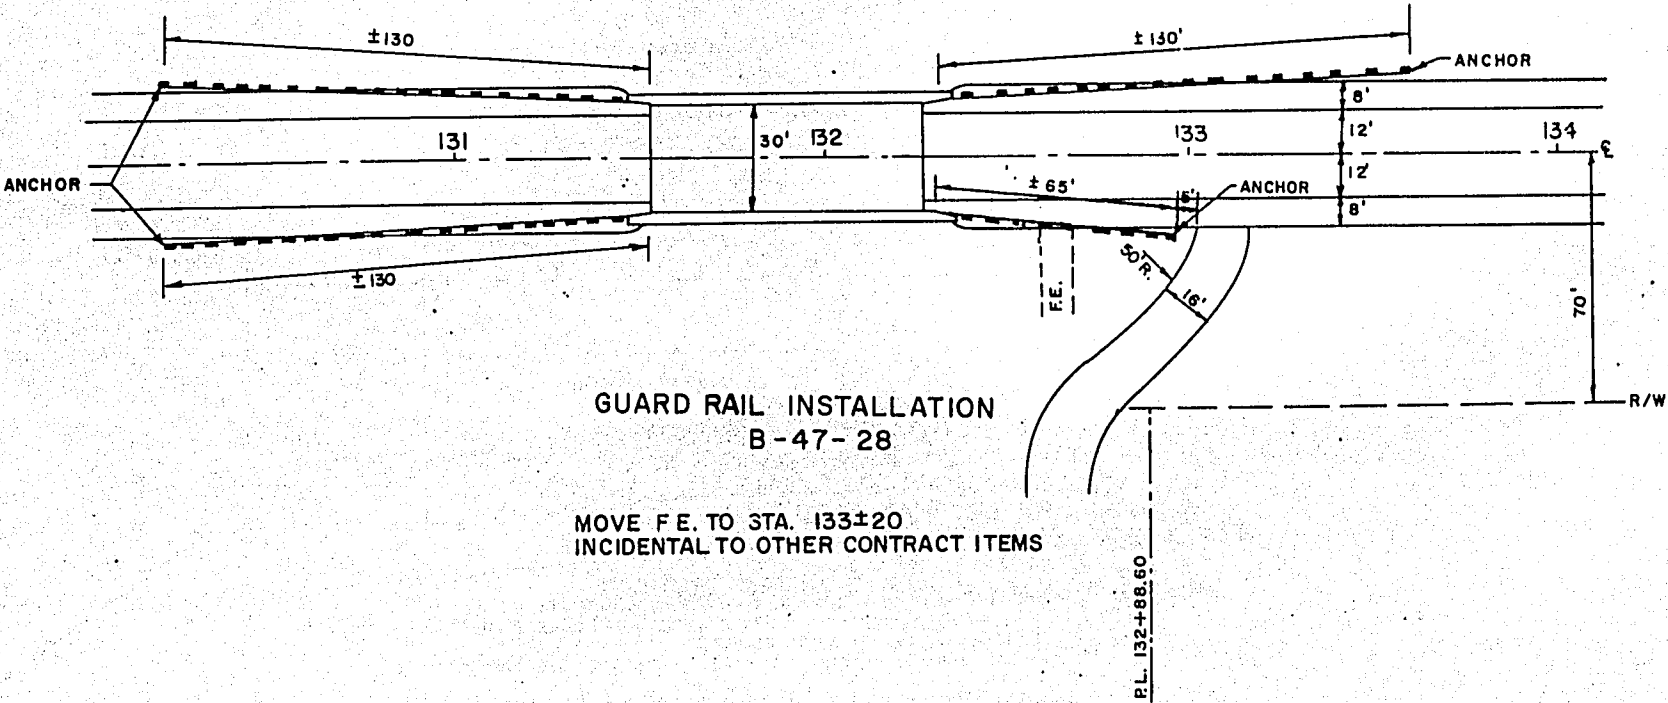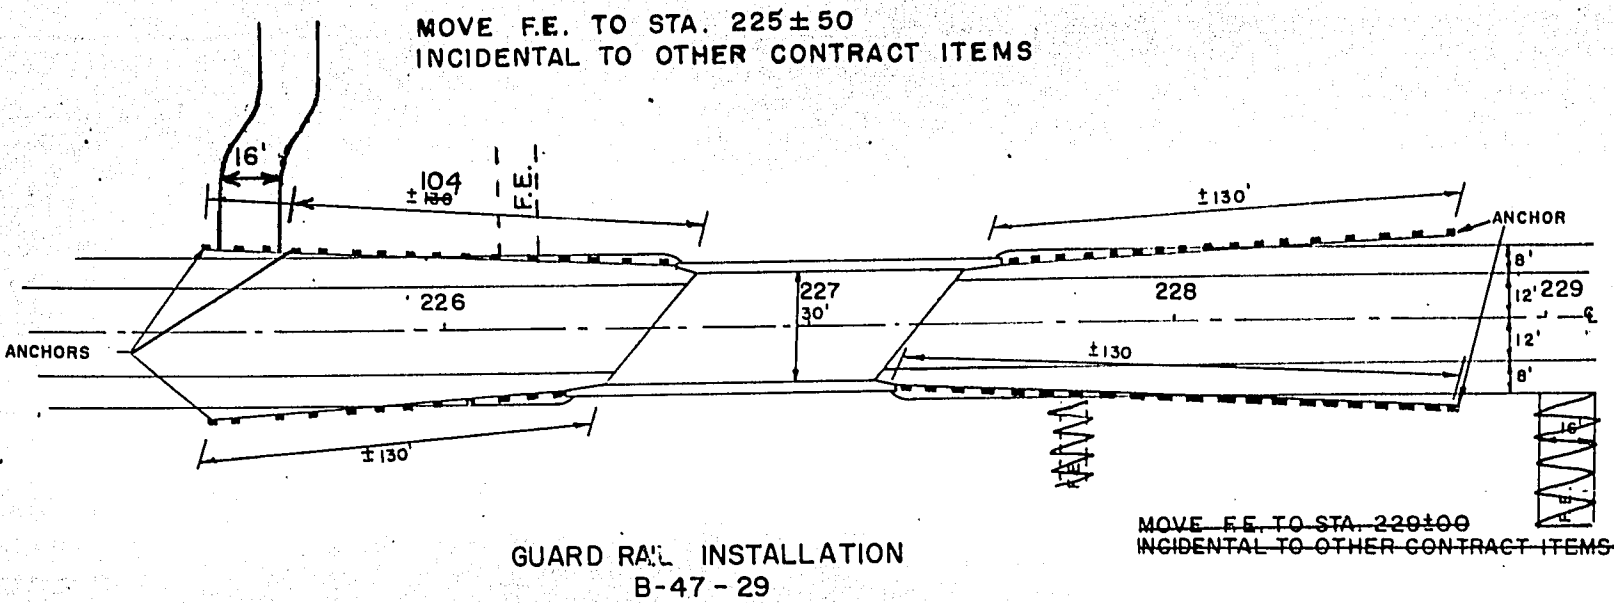

PROJECT DESIGNATION	SHEET NO.
7105-4-71 / RS 075 (16)	3
7210-4-71 / RS 0289 (6)	

CONTRACT NO. 1
BITUMINOUS CONCRETE
PAVEMENT

[illegible]

10' 12' 12' 10'

1' 1' 1' 1'

.04 .015 .015 .04'

3" BIT. CONC. PAV'T.

EXIST. 3" BIT. PAV'T. (TO REMAIN)

EXIST. 5" CEMENT STABILIZED BASE COURSE (TO REMAIN)

CRUSHED AGG. BASE COURSE SHOULDERS

Diagram illustrating the cross-section of a road reconstruction project. The diagram shows a central section of the road with a width of 12' (divided into two 6' sections) and shoulders of 8' on each side. The total width is 28'. The road surface is composed of several layers:

- 3" BIT. CONC PAV'T. (3 inches thick)
- EXIST. 3" BIT. PAV'T. (RECRUSH & RELAY) (3 inches thick)
- EXIST. 5" CEMENT STABILIZED BASE COURSE (RECRUSH & RELAY) (5 inches thick)
- EXIST. GRAVEL BASE COURSE
- EXCESS RECRUSHED MATERIAL OR CRUSHED AGG. BASE COURSE
- CRUSHED AGG. BASE COURSE SHOULDERS

Dimensions and offsets are indicated:

- Shoulder width: 8'
- Main road width: 12' (divided into two 6' sections)
- Offset from shoulder to main road: .04
- Offset from main road to centerline: .015

10' 12' 12' 10'

1' 1'

* VAR. S.E.

3" BIT. CONC. PAV'T.

EXIST. 3" BIT. PAV'T. (TO REMAIN)

EXIST. 5" CEMENT STABILIZED BASE COURSE (TO REMAIN)

WEDGE AS DIRECTED BY ENGINEER

CRUSHED AGG. BASE COURSE SHOULDERS

NOTE: THE GRADE PRIOR TO CRUSHING WILL BE THE FINISHED GRADE OF THE RELAID & RECRUSHED MATERIAL SUBJECT TO ADJUSTMENT AT THE DISCRETION OF THE ENGINEER.
PRIME ONLY FROM STA.122+00 TO STA.463+00

TYPICAL CURVE SECTION

* STA. 271+44 TO STA. 282+33	2°-00'	0.05% S.E.
* STA. 298+30 TO STA. 314+17	1°-30"	0.035% S.E.

DETAIL SUMMARY SHEET OF MISCELLANEOUS QUANTITIES

REMOVE GUARD RAIL

Sec.	Station to Station	
1	62+50 - 66+50	400
	61+50 - 67+50	600
2	131+90 L & R Bridge	168
	170+50 - 172+50 R	205
	226+93 L & R Bridge	166
	282+50 - 287+50 R	505
	282+33 - 287+58 L	530
	307+50 - 317+75 R	1030
	308+50 - 317+75 L	930
	427+80 L & R Bridge	166

61+30 - 67+58 R	400
60+80 - 68+34 L	600
132+26 - 132+92 R	166
168+15 - 173+56 R	505
225+16 - 226+45 R	530
227+42 - 228+71 L	1030
227+22 - 228+51 R	930
281+35 - 288+26 R	166
281+50 - 288+16 L	
307+75 - 318+38 L	
306+75 - 318+38 R	

STEEL PLATE BEAM

Sec.	Station to Station	L. F.	Anc.
1	61+85 - 67+15 R	535	2
	60+85 - 68+15 L	735	2
2	* 130+24 - 131+53 L & R	258	2
	* 132+26 - 133+55 L	129	1
	* 132+26 - 132+55 R	28	1
	169+85 - 173+15 R	334	2
	* 225+25 - 226+54 L & R	258	2
	* 227+31 - 228+60 L	129	1
	* 227+31 - 227+84 R	53	1
	281+85 - 288+15 R	634	2
	281+68 - 288+33 L	659	2
	306+85 - 318+38 L	1155	1
	307+85 - 318+38 R	1057	1
	* 426+21 - 427+50 L & R	258	2
	* 428+10 - 429+39 L & R	258	2

225+61 - 226+65 L

* ATTACH TO EXISTING BRIDGE RAILINGS

BITUMINOUS CONCRETE PAVEMENT

Sec.	Station to Station	Tons
1	18+51.5 - 92+16.55	3435
	Twn. Rds.	150
	Curve Corr.	100
	Jct. '72'	615
2	92+16.55 - 463+00	16470
	Twn. Rds.	750
	Curve Corr.	330

STANDARD ABBREVIATIONS

A.D.T.	ANNUAL DAILY TRAFFIC
BIT.	BITUMINOUS
C.	CENTERLINE
CONC.	CONCRETE
CO.	COUNTY
CONST.	CONSTRUCTION
C.T.H.	COUNTY TRUNK HIGHWAY
C.	CUT
CU.	CUBIC
D.H.V.	DESIGN HOURLY VOLUME
ELEV.	ELEVATION
EXIST.	EXISTING
F.	FILL OR EMBANKMENT
F.L.	FLOW LINE
FT.	FEET
IN.	INCHES
IN. PL.	IN PLACE
LIN.	LINEAR
LT.	LEFT
MI.	MILE
NO.	NUMBER
PAV'T.	PAVEMENT
PROJ.	PROJECT
REQ'D.	REQUIRED
S.T.H.	STATE TRUNK HIGHWAY
STA.	STATION
STRUC.	STRUCTURE
SURF.	SURFACE
SQ.	SQUARE
YD.	YARD
SHLD'S.	SHOULDERS
L	LEFT
R	RIGHT
L.F.	LINE FT.
ANC.	ANCHOR
TWN.RDS.	TOWN ROADS
JCT.	JUNCTIONS
CORR.	CORRECTION
SEC.	SECTION
AGG.	AGGREGATE
S.Y.	SQUARE YARDS
L.S.	LUMP SUM
STD.	STANDARD


GENERAL NOTES:

WHEN THE QUANTITY OF THE ITEMS OF SUBBASE, BASE OR SURFACE COURSE IS MEASURED FOR PAYMENT BY THE TON OR CUBIC YARD, THE DEPTH OR THICKNESS OF THE COURSE SHOWN ON THE PLANS IS APPROXIMATE AND THE ACTUAL THICKNESS WILL DEPEND ON THE DISTRIBUTION OF THE MATERIAL AS DIRECTED BY THE ENGINEER.


UNLESS OTHERWISE SHOWN ON PLANS, ALL INTERSECTIONS SHALL BE TYPE "C".

STANDARD DETAIL DRAWINGS

9A1-1	DESIGN AND LAYOUT DETAILS FOR SIDE ROAD AT-GRADE INTERSECTIONS.
14B2-2a & b	CLASS "A" STEEL PLATE BEAM GUARD & STEEL PLATE BEAM MEDIAN GUARD (2SHEETS).
15C1-2	CONSTRUCTION BARRICADE

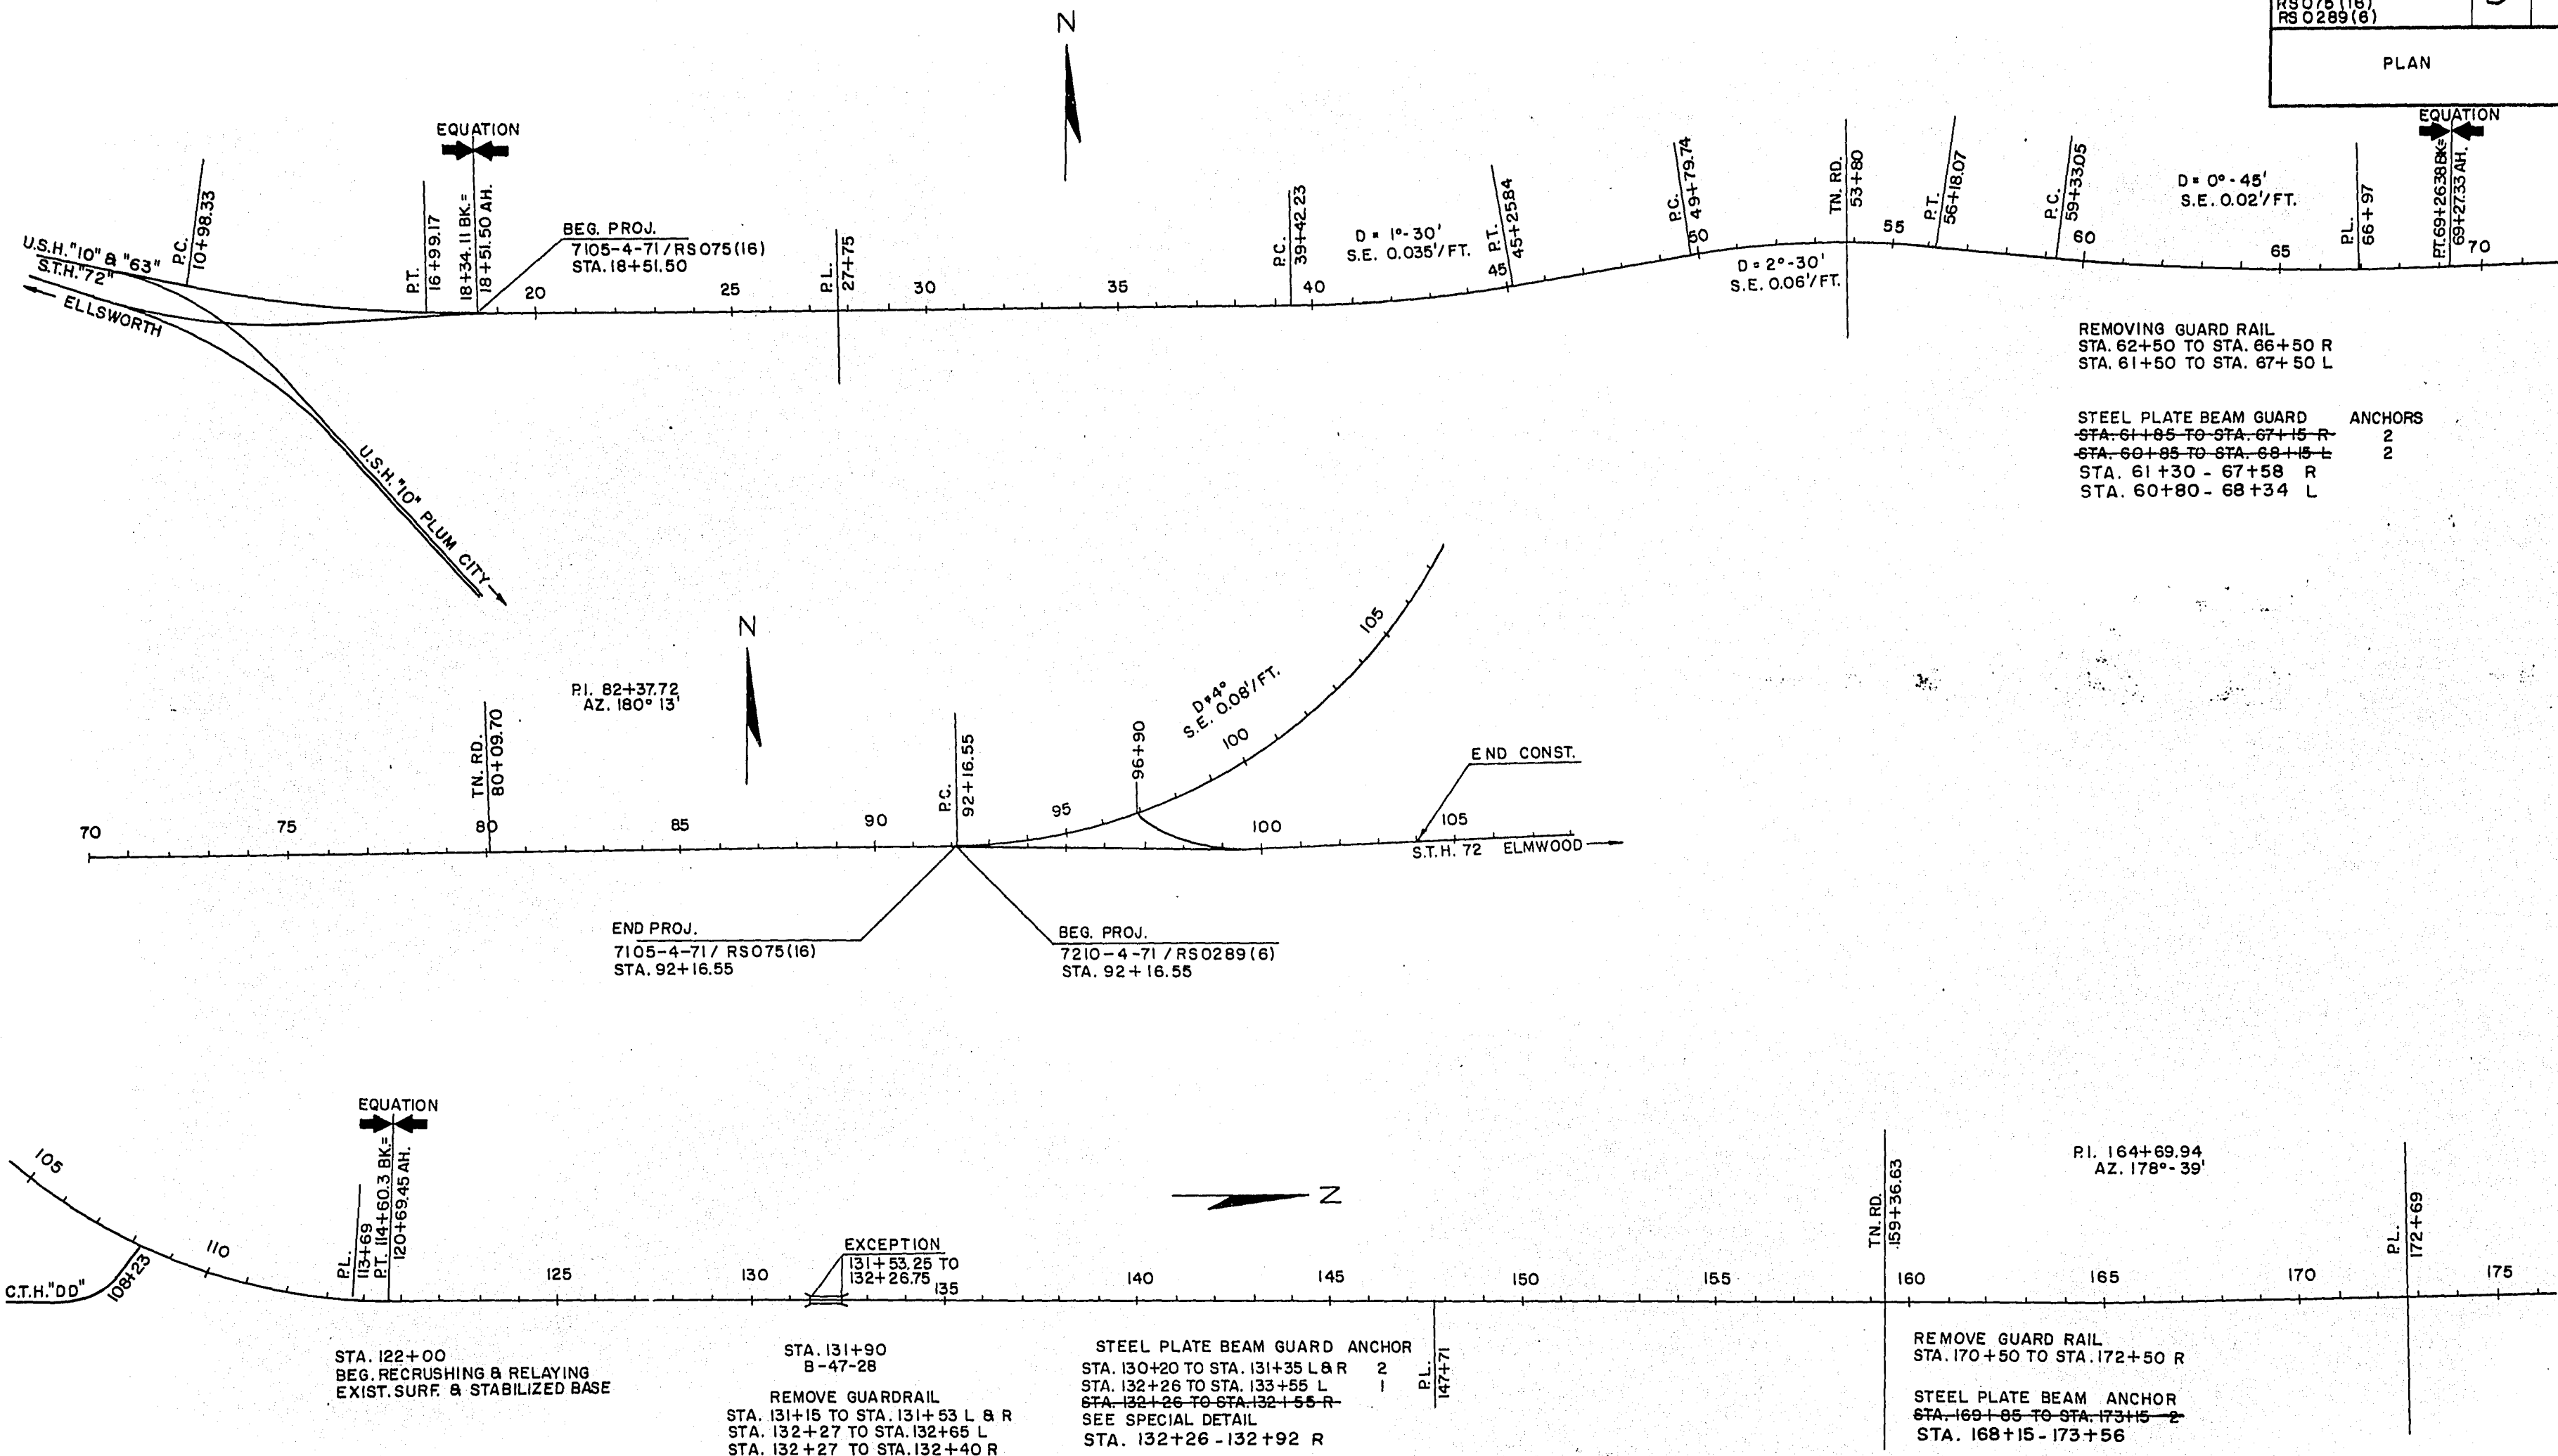


PROJECT I.D.	7210-4-71	SHEET NUMBER	TOTAL SHEETS
FEDERAL PROJECT DESIGNATION	RSO289 (6)	5.1	
PLAN			

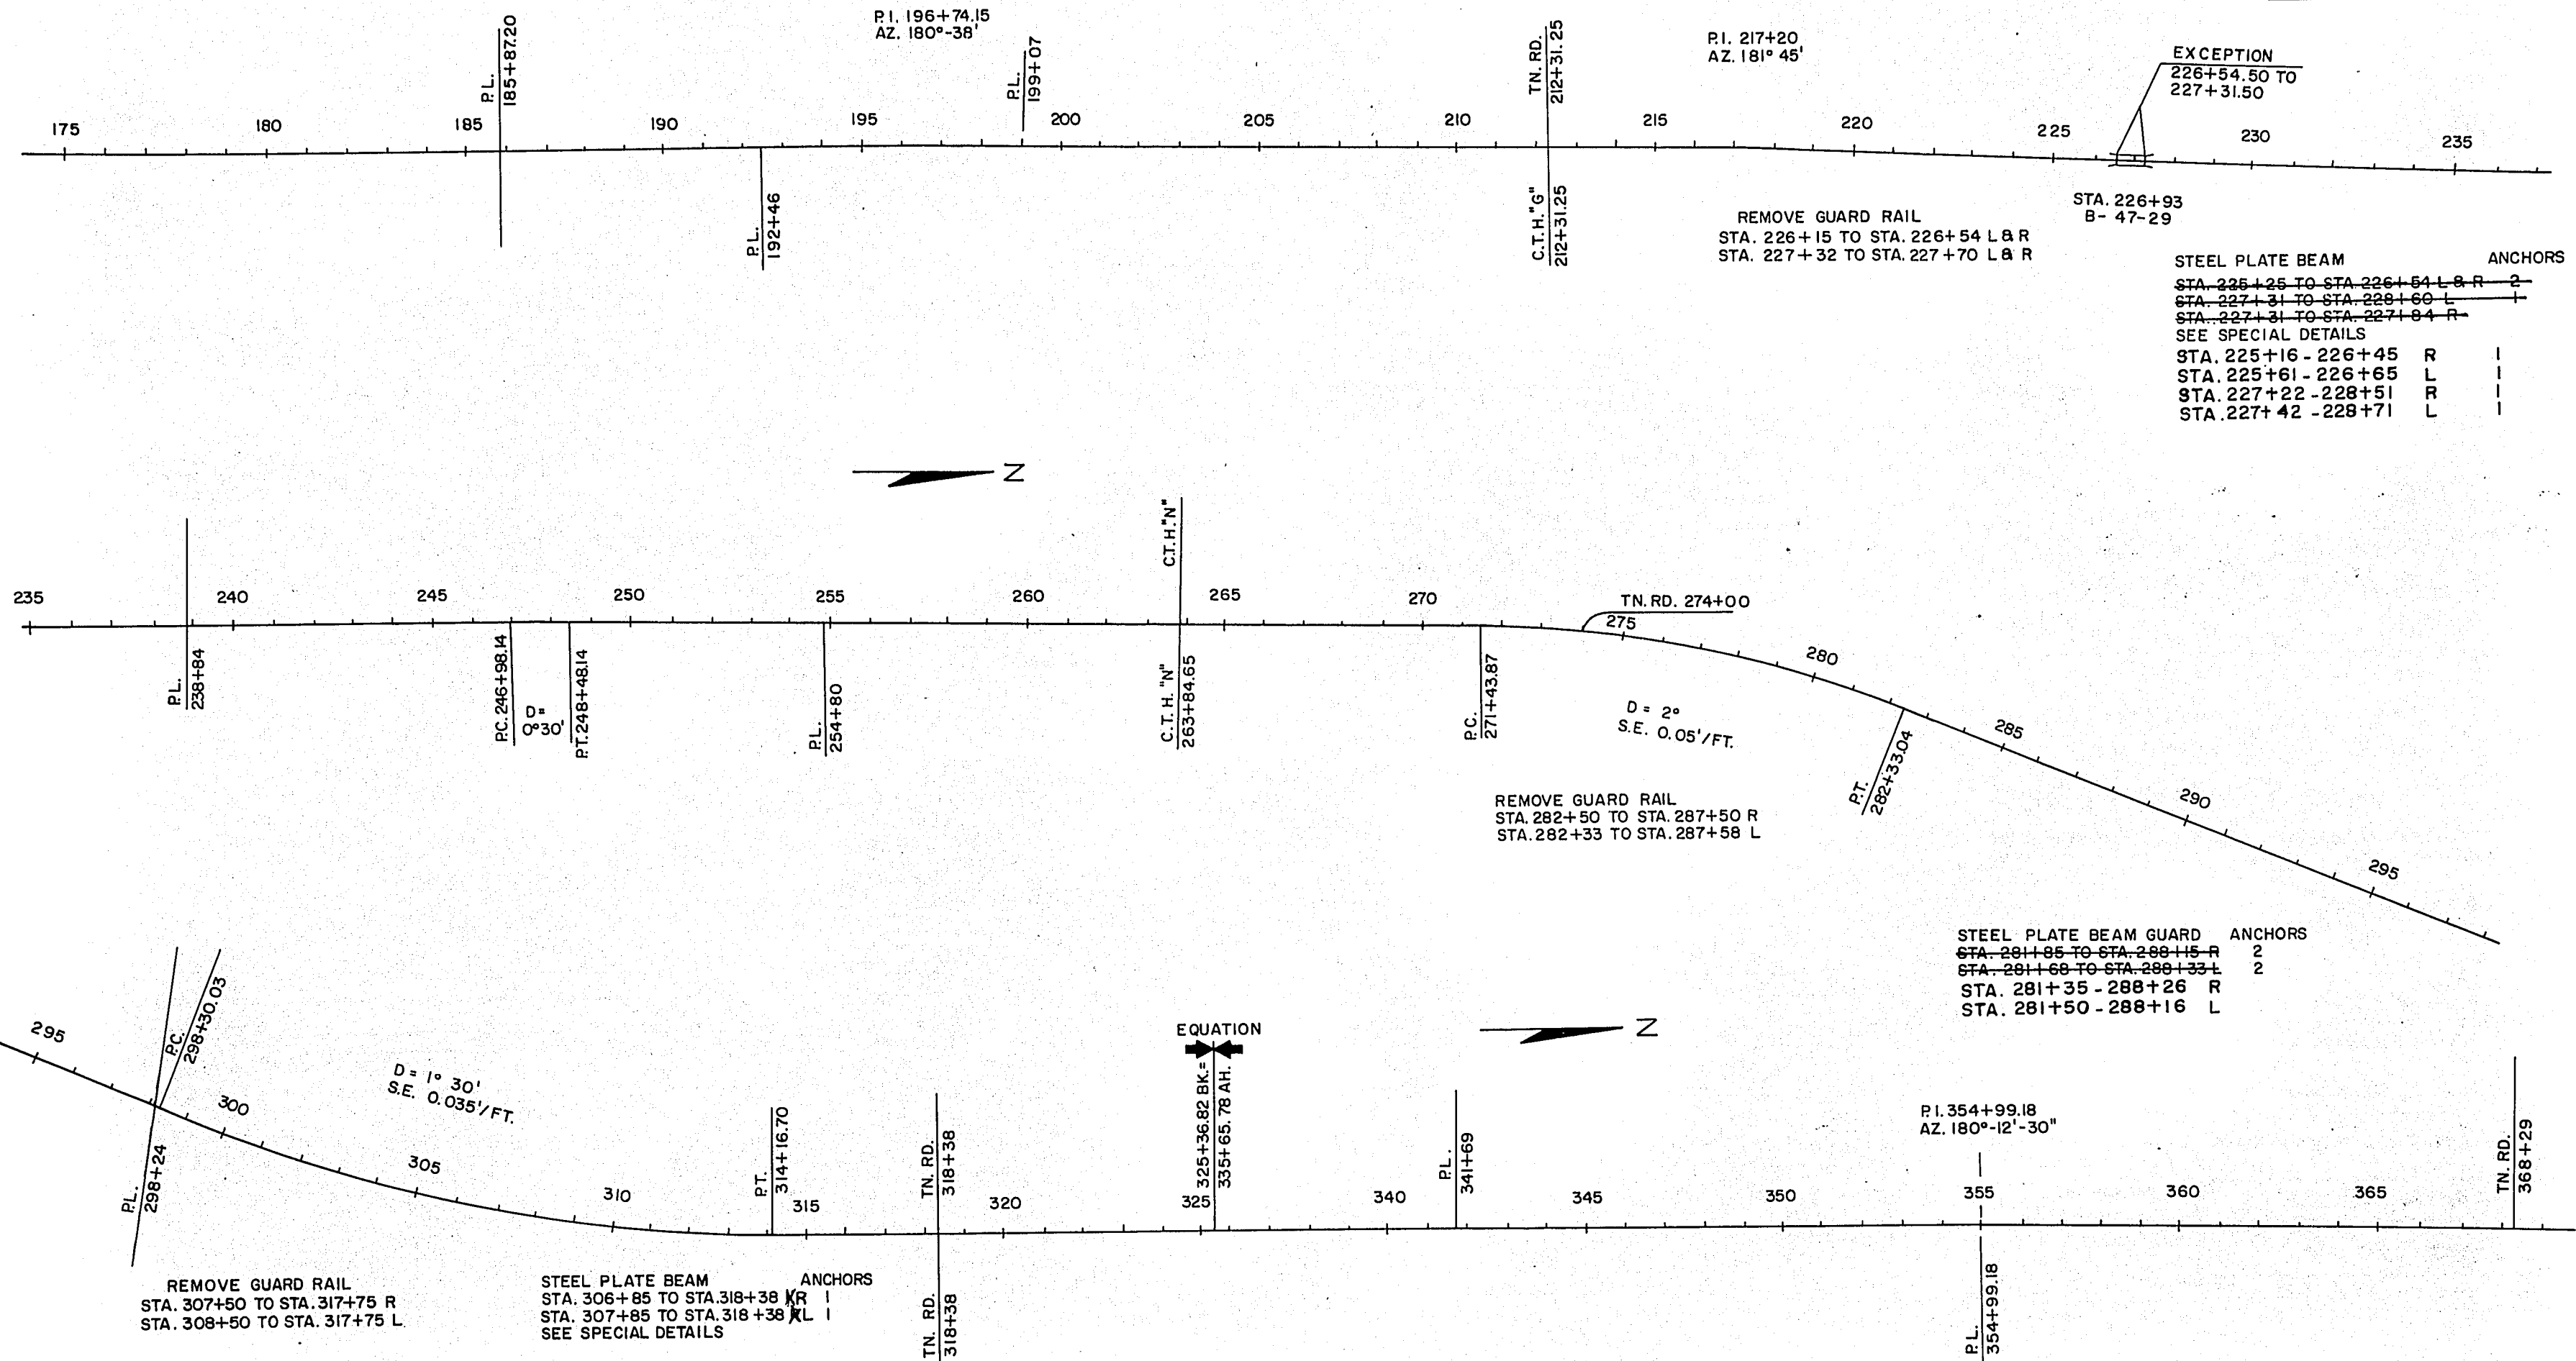


STEEL PLATE BEAM	ANCHORS
STA. 225+25 TO STA. 226+54 L & R	2
STA. 227+31 TO STA. 228+60 L	1
STA. 227+31 TO STA. 227+84 R	1
SEE SPECIAL DETAILS	
STA. 225+16 - 226+45 R	1
STA. 225+61 - 226+65 L	1
STA. 227+22 - 228+51 R	1
STA. 227+42 - 228+71 L	1

STEEL PLATE BEAM GUARD	ANCHORS
STA. 281+85 TO STA. 288+15 R	2
STA. 281+68 TO STA. 288+33 L	2
STA. 281+35 - 288+26 R	
STA. 281+50 - 288+16 L	

PROJECT I.D. 7210-4-71	SHEET NUMBER	TOTAL SHEETS
FEDERAL PROJECT DESIGNATION RSO289 (6)	5.2	
PLAN		

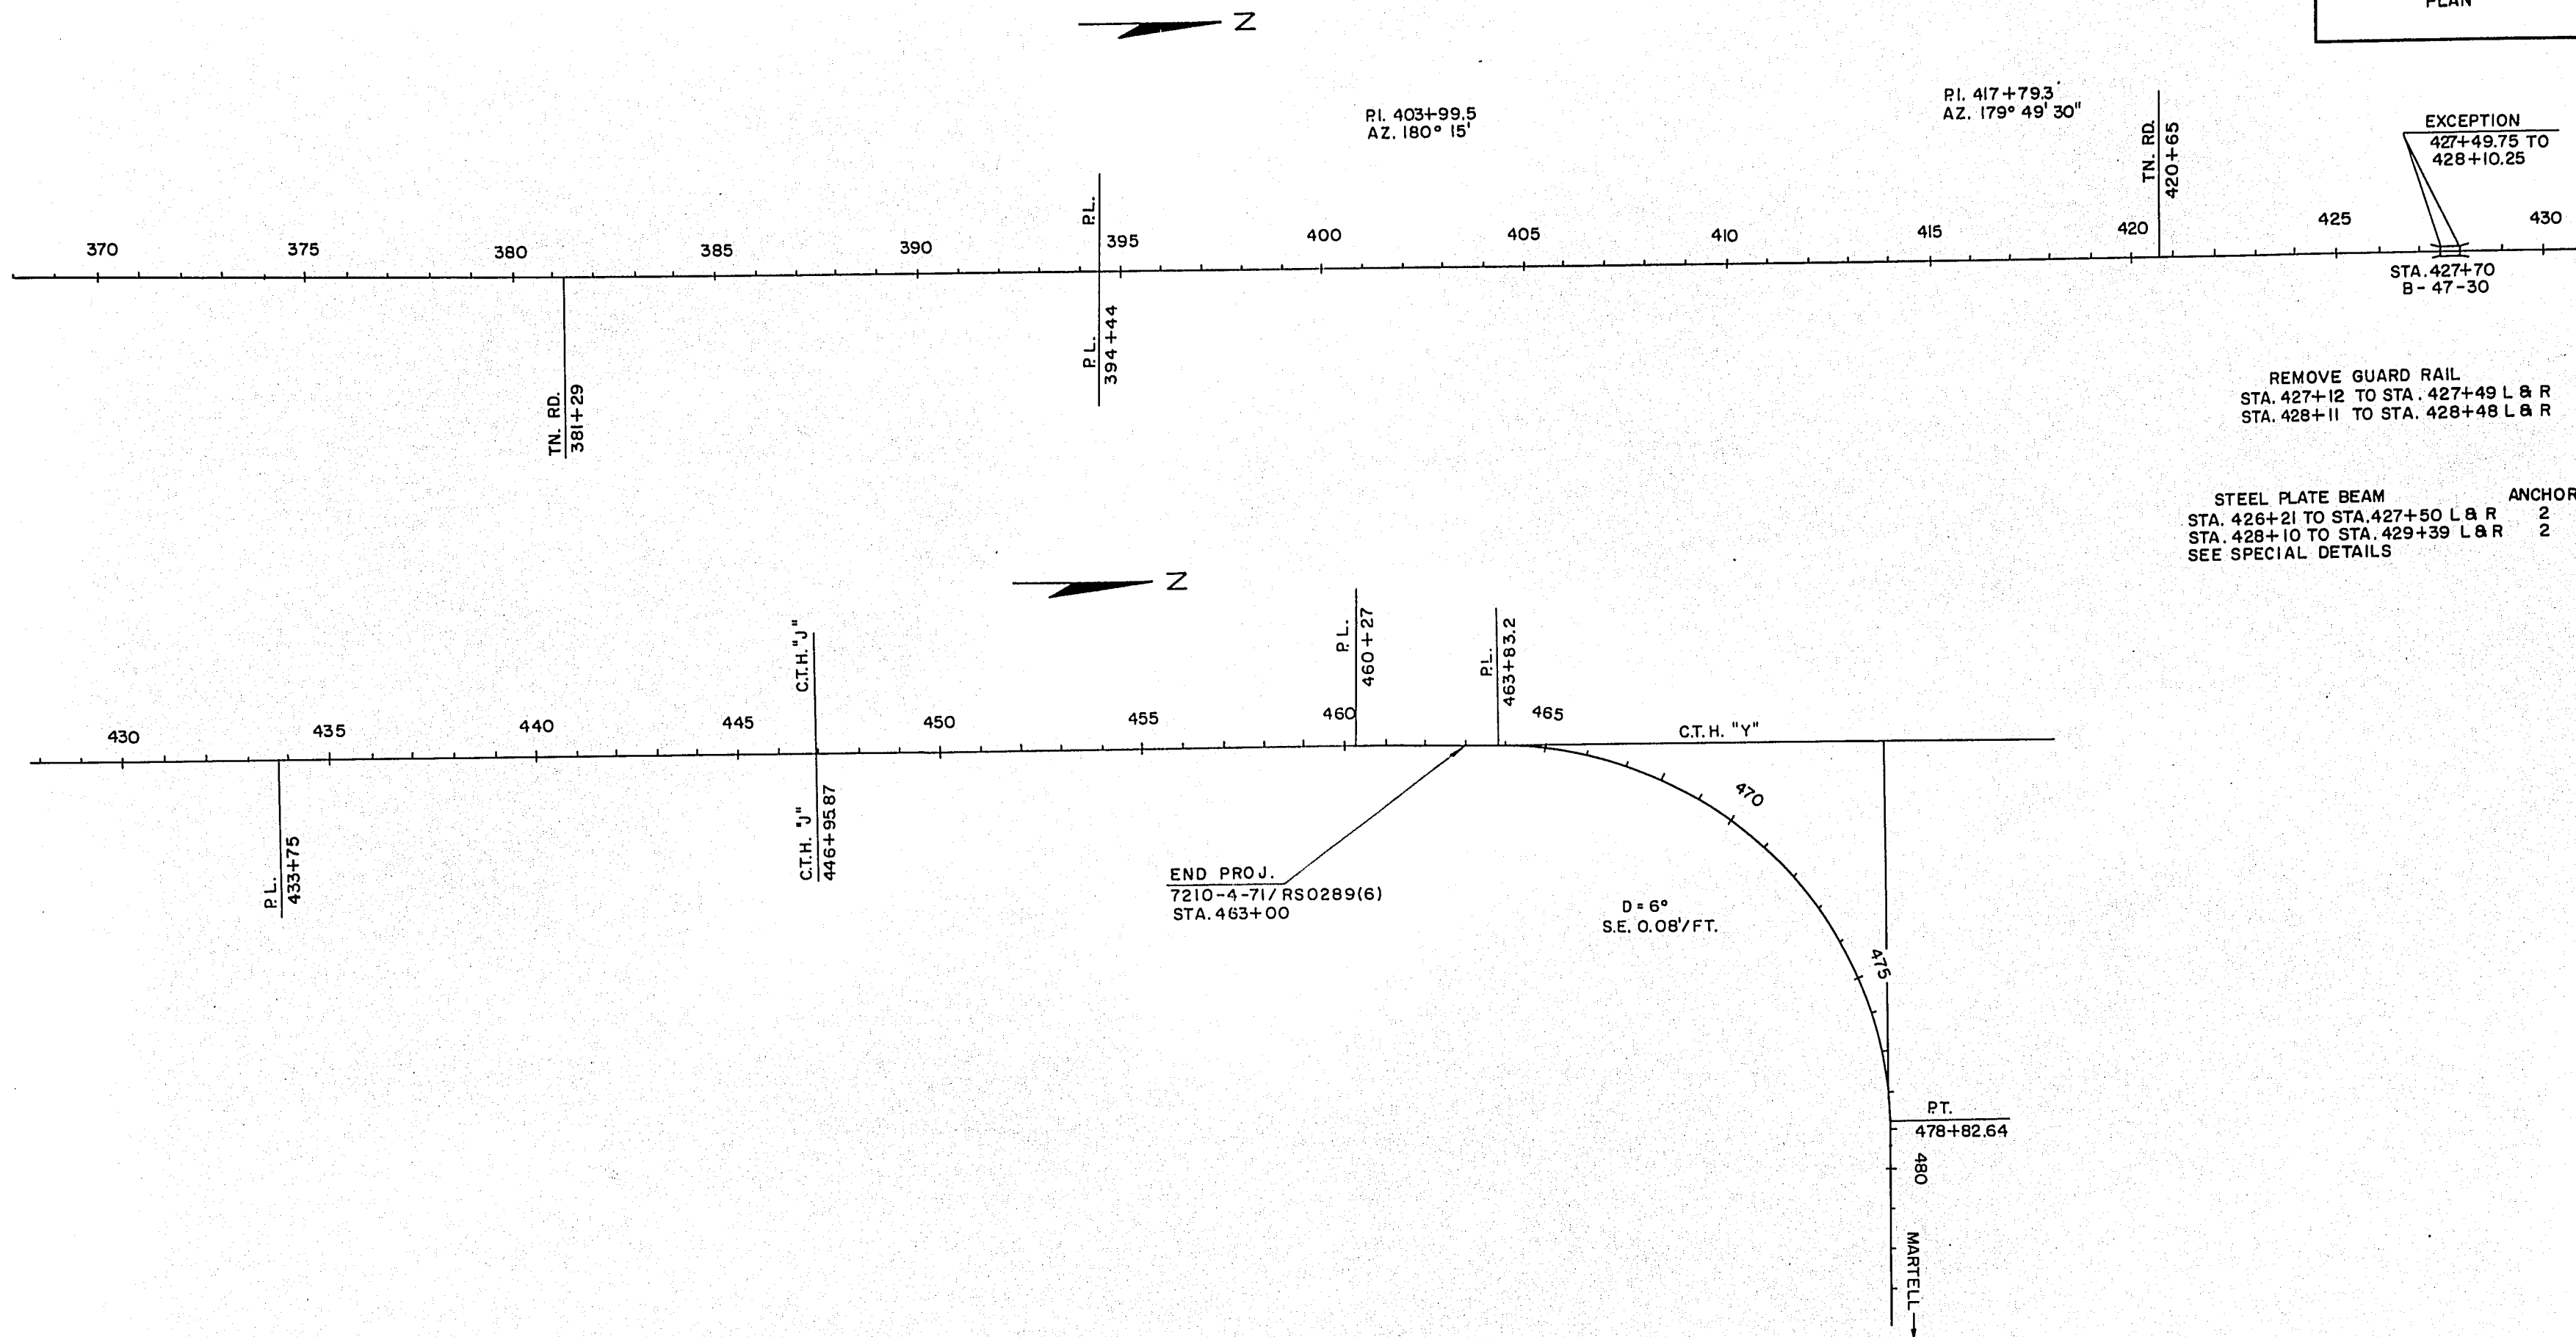


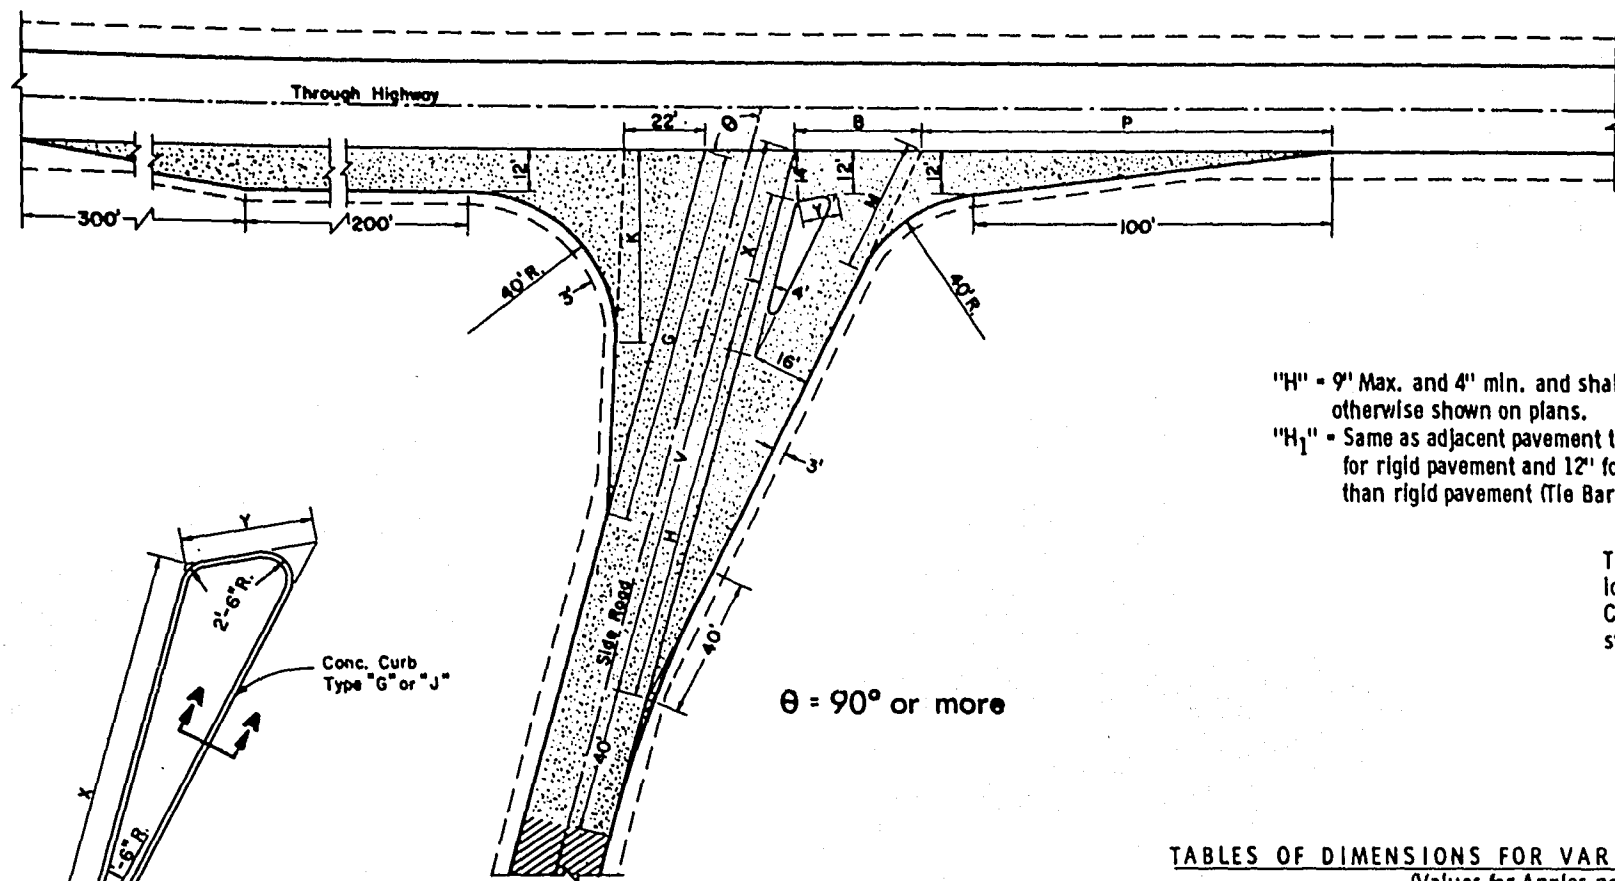

$\theta = 90^\circ$ or more

"H" = 9' Max. and 4' min. and shall be 6' unless otherwise shown on plans.
 "H₁" = Same as adjacent pavement thickness for rigid pavement and 12' for other than rigid pavement (Tie Bars Omitted).

Tie Bar recess positioned in reverse when Concrete Curb is constructed first

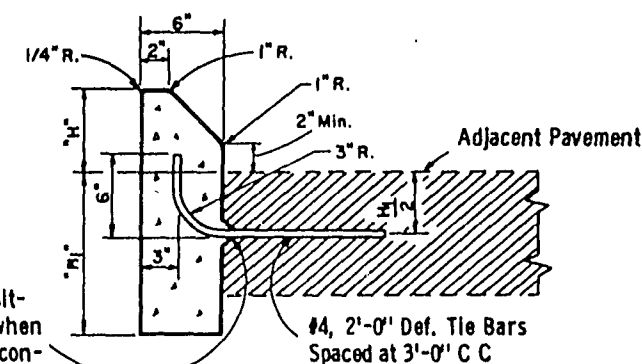

SECTION A-A

Note: To be measured and paid for as Type "G" (Including Tie Bars) or Type "J" (Excluding Tie Bars) Concrete Curbs.

TABLES OF DIMENSIONS FOR VARIABLE SIDE ROAD INTERSECTION ANGLES
 (Values for Angles not shown shall be Interpolated)


θ	G	K	B	V	H	X	Y	P	M
90	90	43.8	33.9	156.0	94	48.0	11.0	125.0	44.2
95	94	46.7	34.0	156.7	96	47.0	11.0	121.3	41.9
100	98	50.0	34.4	157.4	98	45.9	11.0	117.7	39.7
105	102	53.8	35.2	158.3	100	44.9	11.2	114.2	37.8
110	106	58.2	36.4	159.2	102	43.7	11.4	110.6	36.2
115	110	63.4	38.4	161.8	104	42.6	11.7	107.1	34.8
*120	114	69.4	40.1	161.2	106	41.4	12.2	103.4	33.7

*Maximum angle of Intersection

θ	C	G	K	B	V	X	Y	H	P	M	T
*60	19.7	76.3	38.6	41.5	169.9	67.4	29.3	84	144.5	58.8	21.6
65	17.8	82.6	40.6	39.4	166.9	63.6	25.0	86	141.2	54.9	20.7
70	15.8	87.2	43.1	37.4	164.1	59.7	21.9	88	136.8	51.4	19.2
75	15.7	90.9	45.6	35.7	161.4	55.9	19.3	90	132.7	48.2	17.4
80	15.9	94.9	48.3	34.4	158.9	51.9	17.0	92	128.8	45.3	14.9
85	16.2	99.3	51.4	33.4	156.4	48.0	15.0	94	125.2	42.7	10.4

*Desirable Minimum angle of Intersection

TYPE "A" SIDE ROAD INTERSECTION DETAILS

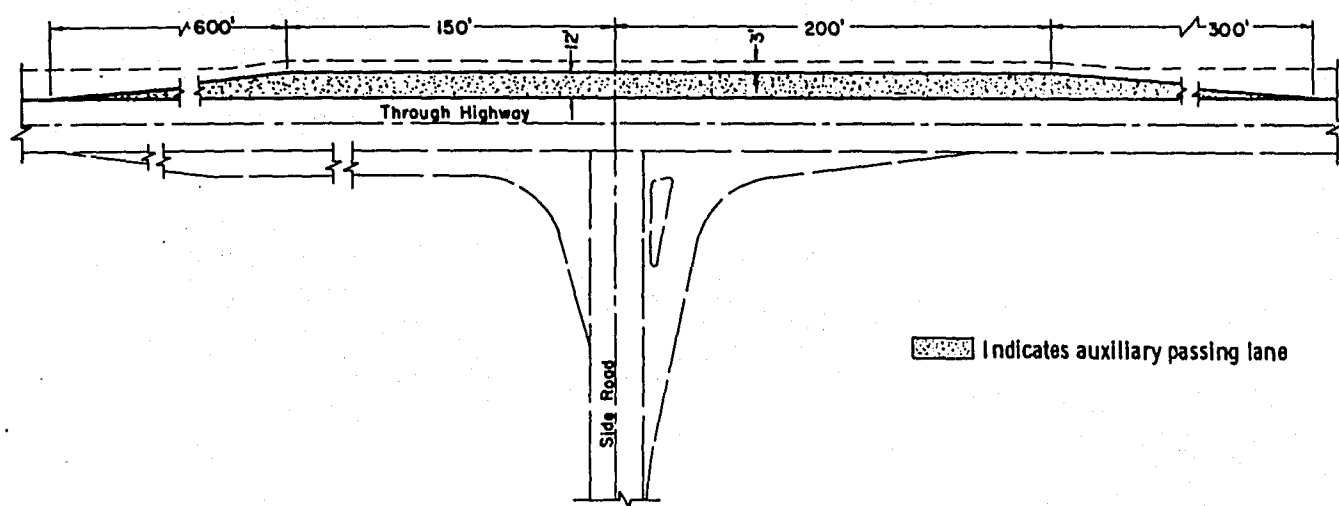


PASSING LANE DETAIL

Indicates auxiliary passing lane

θ	R ₁	R ₂
*60	40	50
65	40	50
70	40	50
75	40	50
80	40	50
85	40	50
90	40	50

*Min. Angle of Intersection

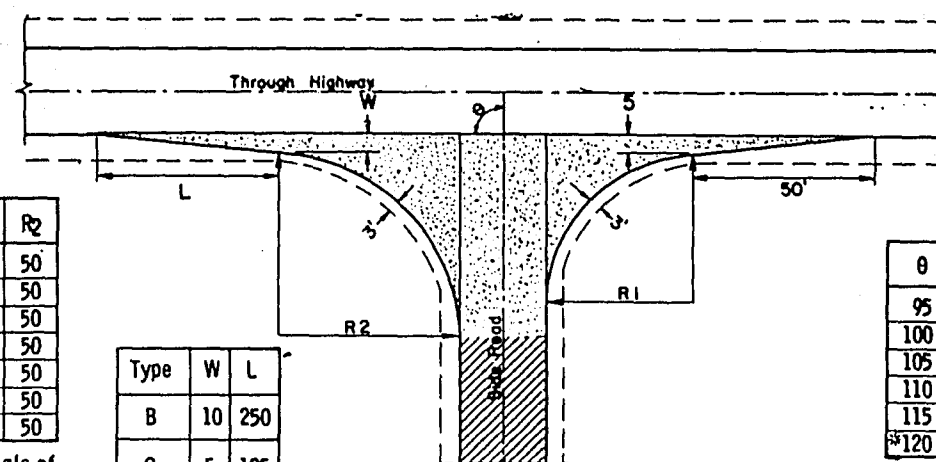

TYPE "B" & "C" SIDE ROAD INTERSECTION DETAILS

Type	W	L
B	10	250
C	5	125

θ	R ₁	R ₂
95	45	49
100	50	48
105	55	47
110	60	46
115	65	45
*120	70	44

*Max. Angle of Intersection

GENERAL NOTES

Designs may be used interchangeably in combination or separately for any one complete intersection depending upon intersection angle and surfacing of each approach roadway.

Details on this drawing are for minimum design only, and not applicable to special conditions, as shown elsewhere on the plans.

SIDE ROAD SURFACING NOTE

If the side road is not presently paved, pavement shall be placed to the limits shown. In the case where the construction limits are beyond the paving limits, gravel or crushed stone surfacing shall be placed between the paving limits and construction limits.

If the side road is presently paved, new pavement shall be placed to the limits of design as shown and beyond, if necessary, to meet existing pavement.


If side road is the construction project, the intersection surfacing shall be the same as for the project.

New Pavement
 Existing Surface


LAYOUT DETAILS FOR AT-GRADE SIDE ROAD INTERSECTIONS

State Highway Commission of Wisconsin

RECOMMENDED FOR APPROVAL: *E.J. Rabel*
 DATE: 8/9/67
 APPROVED: *[Signature]*
 DATE: 6/9/67
 STATE HIGHWAY ENGINEER

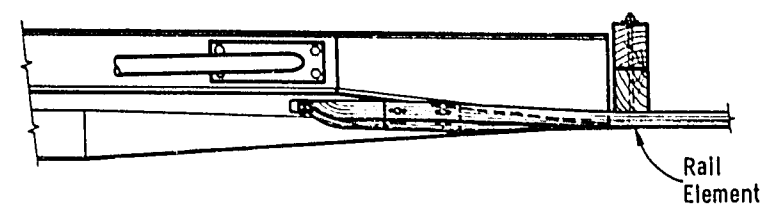

PLAN VIEW

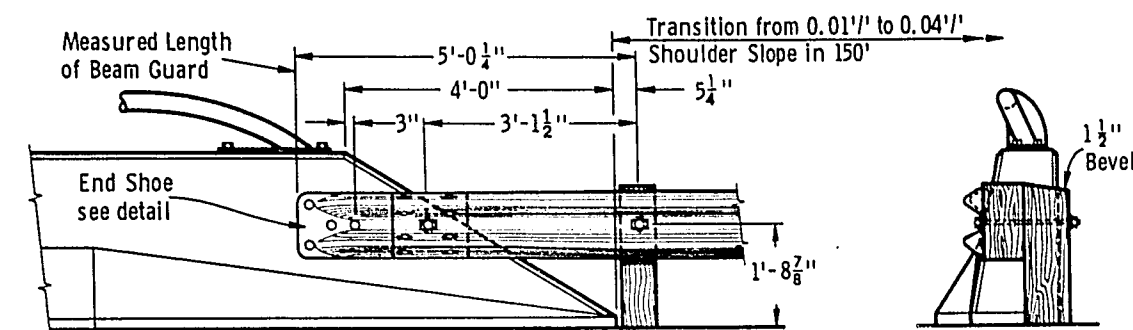


FRONT ELEVATION


END ELEVATION

STRUCTURE MOUNTING DETAIL

SLOPING TYPE PARAPET WALL

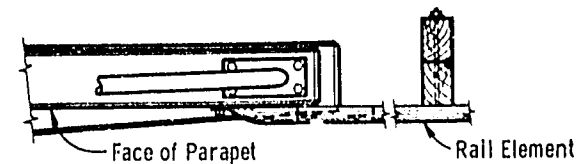

PLAN VIEW

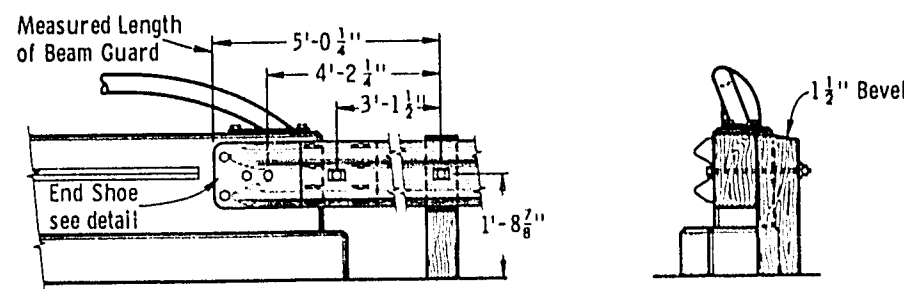


FRONT ELEVATION


END ELEVATION

STRUCTURE MOUNTING DETAIL


VERTICAL TYPE PARAPET WALL

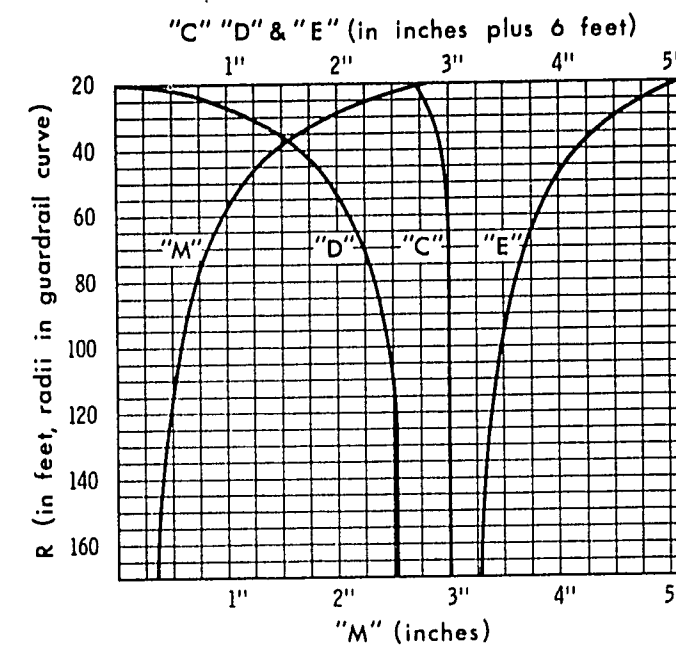


CURVE DATA FOR POST SPACING AND BEAM CURVING

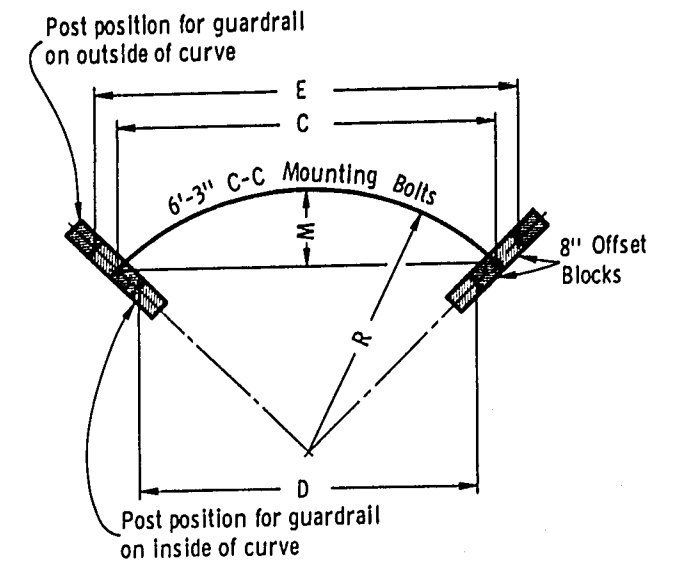

CHORD LENGTHS FOR POST SPACING AND MIDDLE ORDINATES FOR BEAM CURVING

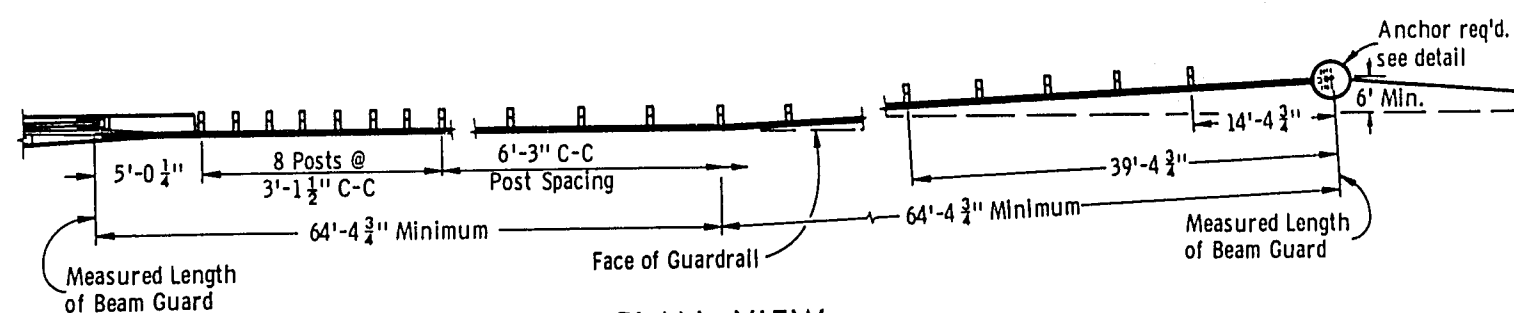


PLAN VIEW

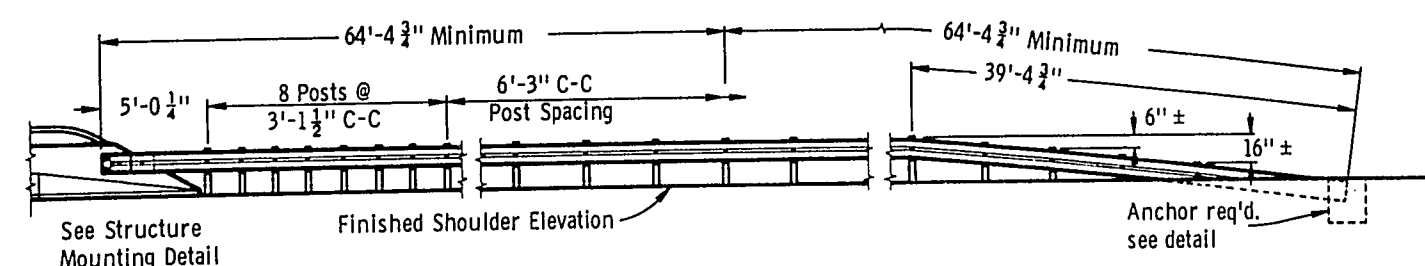


FRONT ELEVATION

TYPICAL OUTSIDE SHOULDER INSTALLATION AT STRUCTURES

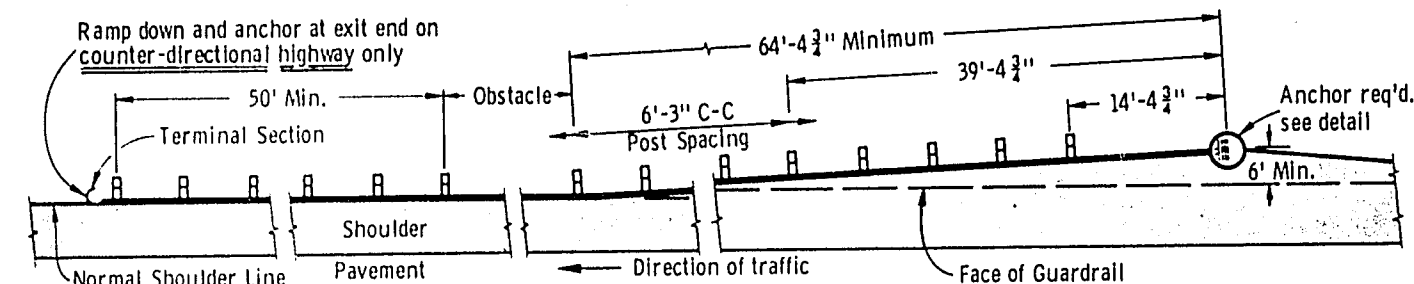

PLAN VIEW

TYPICAL INSTALLATION AT LOCATIONS OTHER THAN STRUCTURES

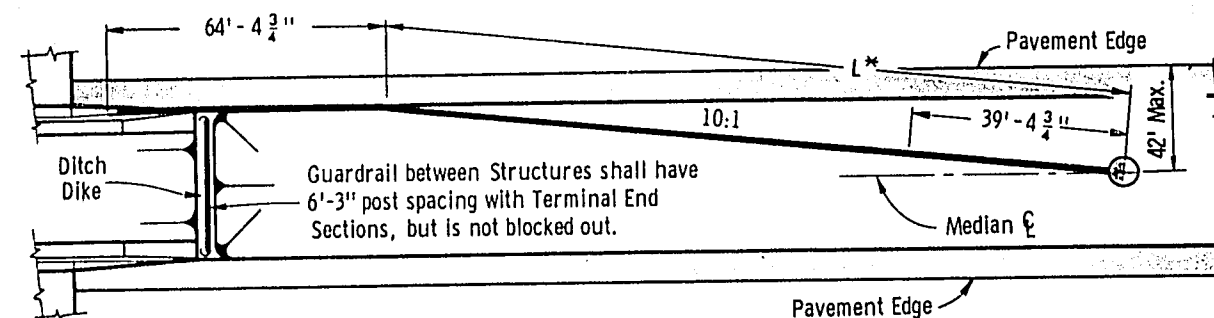

PLAN VIEW

* Variable based on Median width

MEDIAN PROTECTION

GENERAL NOTES

Details of construction, materials and workmanship not shown on this drawing shall conform to the pertinent requirements of the Standard Specifications and the applicable Special Provisions.

The exact location of the beginning and end of each Guardrail installation shall be as shown on the plans or as directed by the Engineer.

Square anchor alternates will be permitted. Square anchors shall be a minimum of 24 inches x 24 inches.

The shoulder widening to accommodate the anchored end of the Guardrail shall be accomplished at a rate of widening not to exceed 50 to 1.

Upon approval of the Engineer, the 6 foot anchor offset may be reduced to nothing for replacement installations where existing conditions will not permit the desirable offset. However, when no offset greater than or equal to 3 feet can be provided, the minimum length of guardrail in advance of an obstacle (obstacle to anchor) shall be 150 feet.


The "Post Footing Details At Piers" shall be used when guardrail posts are over structure footings and less than 3 feet-6 inches of earth is provided over the top of the footing.

NOTE: This Standard Detail Drawing consists of two plates, and both plates are required when this Standard is called for in the plans.


CLASS "A"
STEEL PLATE BEAM GUARD &
STEEL PLATE BEAM MEDIAN GUARD

State of Wisconsin
Department of Transportation
Division of Highways


S D D. 14 B 2-2a

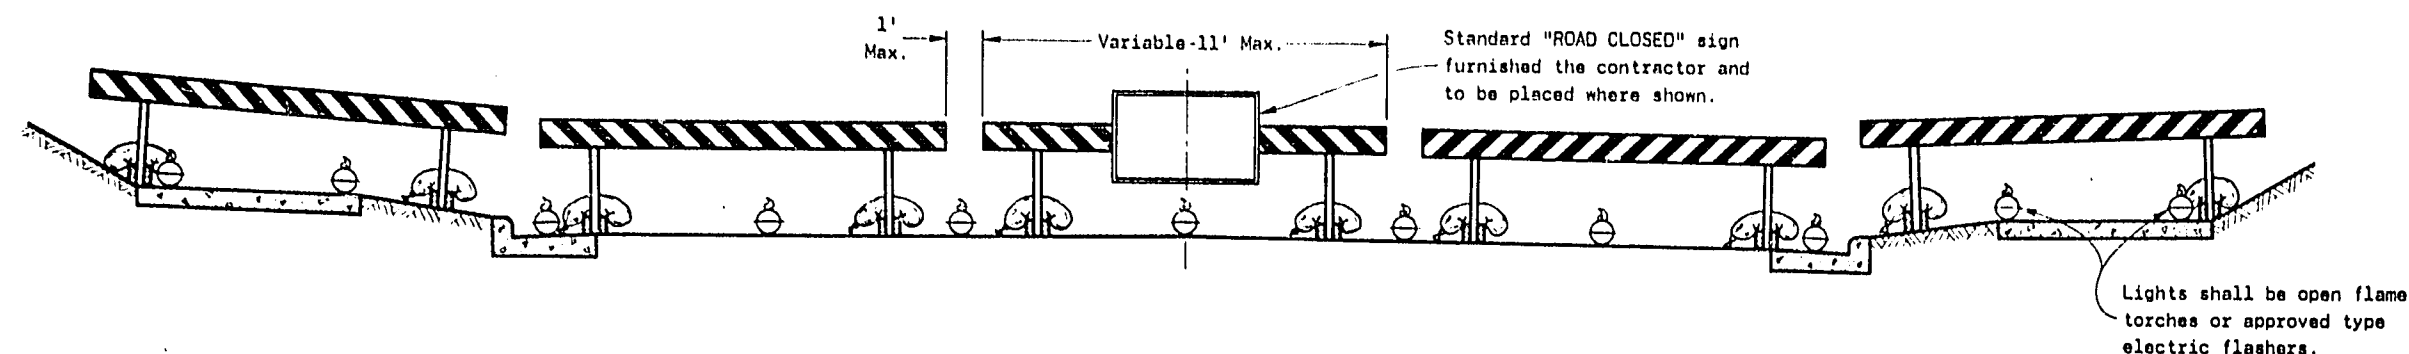

TYPICAL INSTALLATION SHOWING RIGID BARRICADES

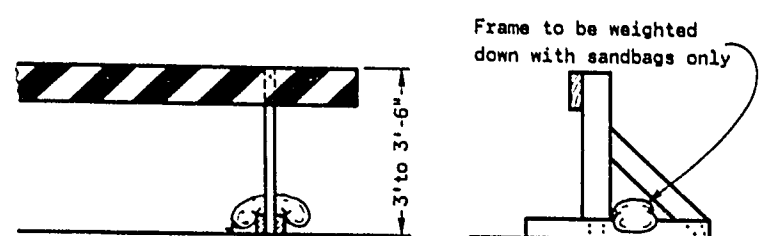


ALTERNATE TYPE INSTALLATION (RIGID)

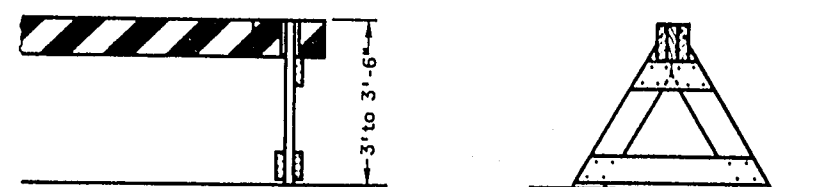


ALTERNATE TYPE INSTALLATION (DEMOUNTABLE)


CLASS I BARRICADES

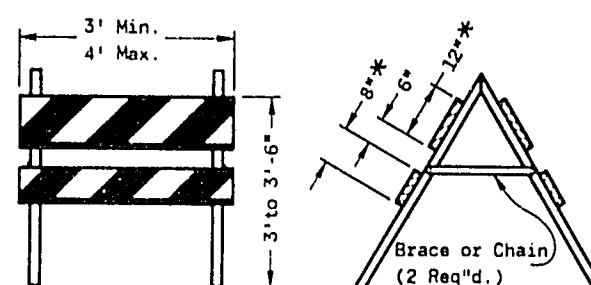



CLASS II BARRICADE

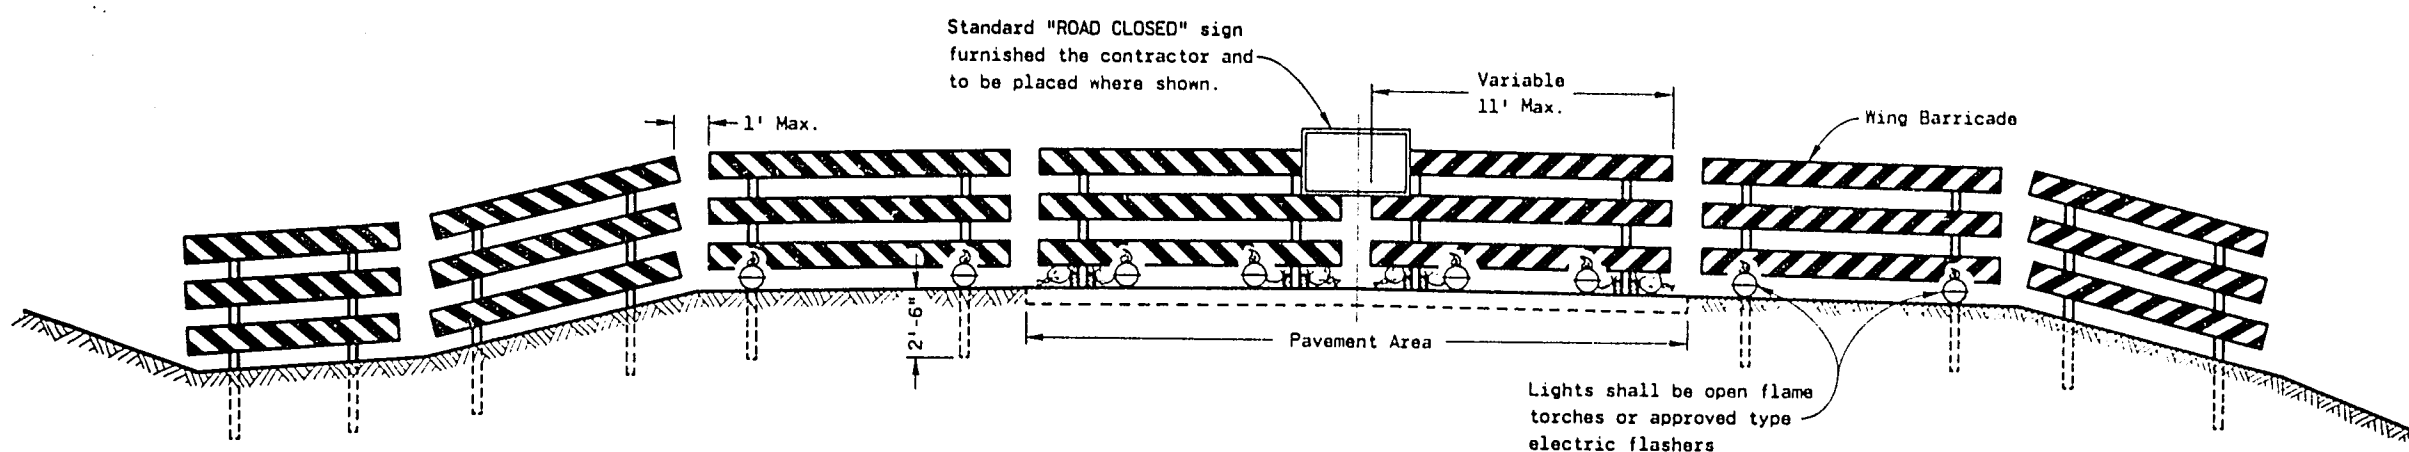


TYPICAL INSTALLATION SHOWING FIXED AND RIGID BARRICADES

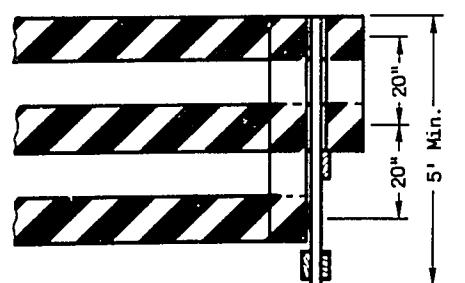

ALTERNATE TYPE INSTALLATION (DEMOUNTABLE)

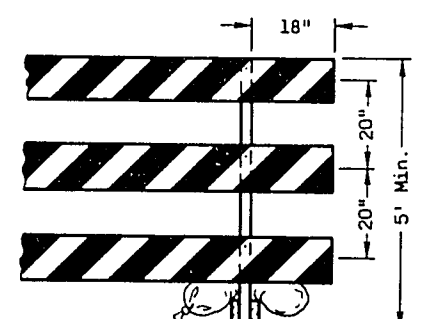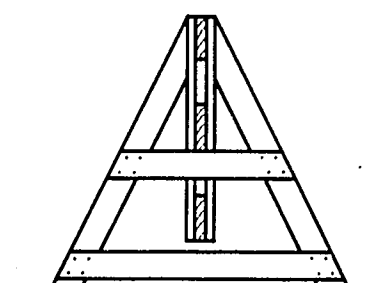

ALTERNATE TYPE INSTALLATION (RIGID)

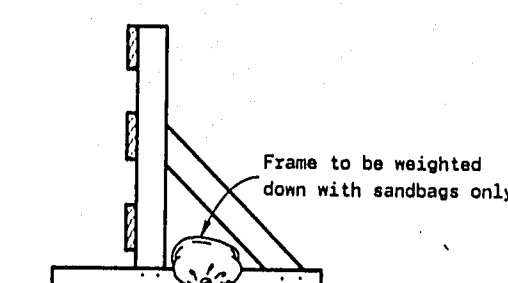

CLASS III BARRICADES

GENERAL NOTES

The contractor shall construct, place and maintain barricades as shown on the drawing and as required by the Standard Specifications or applicable Special Provisions.

CLASS I OR CLASS II BARRICADES:

Class I or II Barricades shall be used only where the hazard to traffic is relatively small, and for the more or less continuous delimiting of a restricted roadway, or for temporary daytime use.

CLASS III BARRICADE:

Class III Barricades shall be of variable length as indicated, and long barricades shall be assembled from these units. The Class III Barricade is the type normally required for major operations, where the barricade will remain in place for extended periods. Class III Barricades shall be used at points where the road is closed to traffic. Gates or movable sections of a barricade shall be provided when necessary, for access of equipment or other authorized vehicles.

Wing Barricades are Class III Barricades erected on the shoulder on one or both sides of the pavement to give traffic the perceptive effect of a narrowing or restricted roadway. The ends closest to traffic of all three members of a Wing Barricade shall be in a vertical line. If used in a series, they should start at the outer edge of the shoulder and be brought progressively closer to the pavement. Wing Barricades may be used as a mounting for the advance warning or guide signs or for flashers. When used on two-way roadways, the back of the Wing Barricade shall be painted white.

MATERIAL AND FABRICATION:

Barricades may be constructed of wood, metal or other suitable material. Lumber shall be of a grade structurally sound and sufficiently rigid to satisfactorily support and maintain the purpose and intent of a barricade facility.

Metal or other suitable material shall be sufficiently rigid to satisfactorily support and maintain the purpose and intent of a barricade facility.

The fabrication of the barricade shall be in accord with good pertinent woodworking and metalworking practices.

PAINTING:

All barricades shall have alternate $6\frac{1}{2}$ inch black and $5\frac{1}{2}$ inch white stripes at a 45 degree angle. Black stripes shall be painted with weather resistant and durable black paint. White stripes shall be primed, followed by a coat of white reflectorized paint or shall consist of reflective wide angle sheeting.

DIRECTION OF DIAGONAL STRIPES:

Where a barricade extends entirely across the roadway with no vehicle access provision, the stripes shall slope downward toward the highway centerline.

Where vehicle access is permitted, the stripes shall slope downward in the direction toward which vehicles must turn in detouring.

Where both right and left turns are provided for, the stripes shall slope downward in both directions from the center.

The stripes on Wing Barricades shall slope downward toward the roadway.


LIGHTING:

Lighting devices for barricades shall conform to the requirements of the Standard Specifications.

MEASUREMENT AND PAYMENT:

All barricades, unless otherwise provided for in the plans and/or Special Provisions shall be furnished, placed and maintained as noted above, and no additional compensation will be allowed, but shall be construed to be included in the price bid for other items.

* Nominal dimensions when barricade is constructed of lumber.

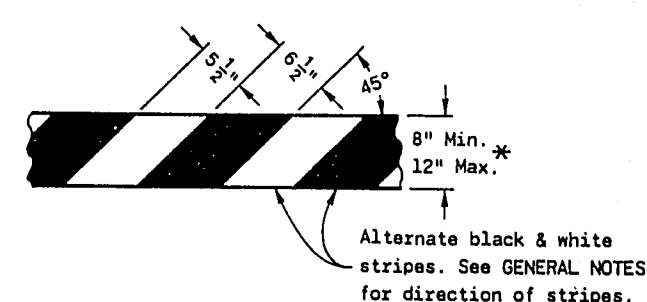

TYPICAL RAIL

Applies to all Classes & Alternate Types of Barricades

CONSTRUCTION BARRICADE

State of Wisconsin
Department of Transportation
Division of Highways

RECOMMENDED FOR APPROVAL:

6-7-72

DATE

APPROVED

6-9-72

DATE

L. C. Hennrich
CHIEF DESIGN ENGINEER
L. E. Hicks
STATE HIGHWAY ENGINEER