

# REHABILITATION STRUCTURE SURVEY REPORT

DT1696 6/2012

Wisconsin Department of Transportation

- ☐ Grade Separation    ☒ Stream Crossing    ☐ Culvert  
☐ Railroad    ☐ Retaining Wall    ☐ Noise Barrier  
☐ Sign Structure    ☐ Other: \_\_\_\_\_

For guidance see: [http://dotnet/dtdi\\_bos/extranet/structures/reports-checklists.htm](http://dotnet/dtdi_bos/extranet/structures/reports-checklists.htm)

Design Project ID 1190-02-34	Construction Project ID 1190-02-64	Highway (Project Name) EAU CLAIRE - CHIPPEWA FALLS		
Final Plan Due Date 05/01/2018	Preliminary Plan Due Date 05/01/2018	<input type="checkbox"/> Town <input type="checkbox"/> Village <input checked="" type="checkbox"/> City ALTOONA		
PS&E Date 08/01/2018	Letting Date 02/12/2019	County EAU CLAIRE		
Structure Number B-18-168		Section 15	Town 27N	Range 09W
Station 367+00.68 - 376+99.32	Latitude: 444929.4 Longitude: 912715.1	<input checked="" type="checkbox"/> YES <input type="checkbox"/> NO    Structure Located on National Highway System		
For Survey and CADD Files Horizontal Coordinate System: Vertical Datum:		<b>Traffic Forecast Data</b>		
Feature On USH 53 SB		Design Year 2014	Average Daily Traffic (ADT) 41300	Roadway Design Speed 70 MPH
Feature Under EAU CLAIRE RIVER		Feature Under 2014	No Traffic (River)	No Traffic (River)
Region Contact: Adam Hetrick (Area Code) Telephone Number(s): 715-836-2855 Email: adam.hetrick@dot.wi.gov		Consultant Contact: (Area Code) Telephone Number(s): Email:		

## Work To Be Performed

## Field Information Required Item Number (see Pages 2-4)

- ☐ A. Structural Repair ..... 1-3, 22  
☒ B. Overlay ..... 1-3, 10-22, 26-28, 32, 34  
     ☐ Concrete Overlay                      ☐ Asphalt Overlay  
     ☐ Polymer Modified Asphalt Overlay    ☒ Thin Bonded Polymer Overlay  
     ☐ Other: \_\_\_\_\_  
☐ C. New Bearings ..... 3, 8, 9, 22  
☐ D. New Railings ..... 15-17, 20-23  
☐ E. Curb and Sidewalk Repair ..... 2, 3, 16, 22, 23  
☐ F. Abutment Repair ..... 2, 3, 12, 16  
☐ G. Pier Repair ..... 2, 3, 12, 16  
☐ H. New Deck ..... 1-6, 9, 10, 13-28, 32-34  
☐ I. Widening ..... 1-28, 30, 32-35  
☐ J. Joint Repair ..... 2, 3, 8, 16, 19, 22  
☐ K. Surface Repair ..... 2, 3, 22  
☐ L. Raising Bridge ..... 3, 6, 9, 16, 20-24  
☐ M. Slope Stabilization ..... 1-3, 30  
☐ N. Scour Repair ..... 1, 2 or 3, 16, 19, 21, 27, 29, 31-35  
☐ O. Painting ..... 16, 22, 24  
☐ P. Other: \_\_\_\_\_

### Field Information Required

If no structure number exists provide the following: Small County Map on which the location of proposed structure is shown in red and any highway relocation in green. In addition, provide Location Map of scale not less than 1" = 2000' showing the structure location and number.

- ☒ 1. Most recent inspection report, brief history of bridge construction date, and description of repairs with dates.
- ☒ 2. Outline deficient areas on existing structure plan or drawing.
- ☒ 3. Photographs of details requiring repairs or modifications, such as: bearings, x-frames, joints, etc. Photograph all deficient areas. Clearly label all photographs.
- ☐ 4. Provide proposed typical section for roadway and structure showing dimensions and cross slopes.
- ☐ 5. Survey beam seat or girder elevations at both sides of bridge at all substructure units.
- ☐ 6. Provide cross-section elevations at 10 foot intervals extending across the structure and a minimum of 100 feet beyond each end. Sections should be normal to centerline and show elevations at centerline roadway and gutter line. Take elevations along joints and at floor drains.
- ☐ 7. Show and identify starting stationing on bridge.
- ☐ 8. Record measurement, temperature of the structure, and date taken for each of the following:
  - (a) Joint opening measured normal to joint at centerline of roadway and both curb lines.
  - (b) Clearance between girder ends at piers.
  - (c) Distance from front face of abutment backwall to closest point of girder end measured parallel to girder.
  - (d) Temperature of structure determined by averaging top and under deck (if accessible) readings.
- ☐ 9. Fixed and expansion bearings - condition and orientation.
- ☒ 10. Number and width of proposed pours including construction staging sequence.
- ☒ 11. Location of existing construction joints in the deck.
- ☒ 12. Estimated Quantities:
 

Preparation, Decks, Type 1	Sq. Yd. <u>0</u>	
Preparation, Decks, Type 2	Sq. Yd. <u>0</u>	
Full Depth Deck Repair	Sq. Yd. <u>0</u>	Galvanic Anodes? <u>NO</u>
Concrete Surface Repair Superstructure	Sq. Ft. <u>0</u>	Galvanic Anodes? <u>NO</u>
Concrete Surface Repair Substructure	Sq. Ft. <u>0</u>	Galvanic Anodes? <u>NO</u>
Curb Repair	LF. <u>0</u>	Galvanic Anodes? <u>NO</u>

☒ 13. Sufficiency number: 100.0 (obtain from HSI Bridge Inventory System)

☒ 14. Appraisal and Condition Rating

	Deck Condition	Superstructure Condition	Substructure Condition	Load Capacity Appraisal	Structural EVAL Appraisal
Current	7	8	8	5	8

☒ 15. Load Ratings

	Inventory	Operational
Current Calculated Date: 8/4/2014	HS29	HS48
After Completed by Bridge Designer		

- ☒ 16. Utilities on/near Structure. (WisDOT policy is to avoid placing utilities on the structure.)

☐ Yes ☒ No

Type	Owner and Contact Information	Size	Opening at Abutment	Weight	Pressure

- ☒ 17. Is existing bridge railing deficient?

☐ Yes ☒ No If Yes – Replacement Rail Type:

- ☒ 18. Drains to be:

☐ Raised ☐ Closed ☐ Downspouted ☐ New

- ☒ 19. Traffic maintained on bridge during work?

☒ Yes ☐ No If Yes – Include sketches

- ☒ 20. Will guard rail be attached?

☐ Yes ☒ No If Yes – Which corners? Existing guardrail to remain at all corners.

- ☒ 21. Will work to be performed eliminate all deficiencies?

☒ Yes ☐ No If No – Explain:

- ☒ 22. Hazardous waste (asbestos) to be removed?

☐ Yes ☒ No If Yes – Explain:

- ☒ 23. Wing location(s) for surface drain anchors: SW

- ☒ 24. Painting?

☐ Yes ☒ No If Yes – Explain on Page 4

(all, part, railing, color system, containment, bid items)

- ☐ 25. Desired roadway width: (new deck / widening) \_\_\_\_\_ Ft.

Desired sidewalk clear width: Left: \_\_\_\_\_ Ft. Right: \_\_\_\_\_ Ft.

- ☒ 26. Maximum increase in grade line elevation 3/8 In.

- ☒ 27. Benchmark description to be shown

- ☒ 28. Desired final cross slopes on bridge 0.02 Ft./Ft.

- ☐ 29. Underwater Inspection Report including:

- Streambed Cross Section With Pier, Footing and Seal Elevations
- Pier Elevation Drawings
- Pier Layout
- Hydrographic Survey

- ☐ 30. Slope stabilization, provide:

Type: \_\_\_\_\_ Quantity: \_\_\_\_\_ CY.

Slope: \_\_\_\_\_ Ft./Ft. Fill: \_\_\_\_\_ CY.

- ☐ 31. Preliminary layout of grout bags or proposed scour repair.

C.I.P. Articulated Mats (for Scour) \_\_\_\_\_ CY.

Grout Bags (for Scour) \_\_\_\_\_ CY.

Heavy Riprap \_\_\_\_\_ CY.

Extra Heavy Riprap \_\_\_\_\_ CY.

- ☒ 32. Report submitted with Preliminary Plan requires **no** CADD file submittal (*See ESubmittal instructions*).
- ☐ 33. Report submitted for development of Preliminary Plan to structure design engineer requires CADD file (if available) submittal and Report submittal to Soils Engineer if project involves foundation modifications.
- ☐ 34. Coordinate with structure design engineer **before** going into the field if existing structure has no available plans, if staged construction is planned, or if there are adjoining/adjacent structures that will remain in place.
- ☐ 35. If project involves substructure widening coordinate with structure and/or hydraulic design engineer to determine if information on the separation and/or stream crossing SSR will be required.

### **Additional Information**

---


Elaborate on other concerns such as: DNR, Local, Utility Conflicts, Aesthetics, Railing Type and Staged Construction.

*Please be as detailed and specific as possible.*

- 1.) Structure built in 2006. No repairs since construction. See attached Bridge Inspection Report.
- 2.) Deficient areas to be determined in the field by the engineer. See attached Bridge Inspection Report. A Polymer Overlay is proposed because of deficiency over the entire structure due to poor bridge deck surface. Cracks are more prevalent in the south two deck pours. Construction joint located between pier 3 and the north abutment. The deck has cracks at midspan with efflorescence.
- 3.) See attached photographs.
- 10.) This work will be constructed half at a time under traffic using single lane closures during non-peak hours with night work. Nighttime ramp closures are anticipated at some structures. All lanes and ramps will be opened to traffic daily.
- 11.) See asbuilt plans.
- 16.) No utilities on or near structure. No conflicts anticipated.
- 18.) Existing drains on the bridge deck to remain.
- 19.) This work will be constructed half at a time under traffic using single lane closures during non-peak hours with night work. Nighttime ramp closures are anticipated at some structures. All lanes and ramps will be opened to traffic daily.
- 22.) See attached Asbestos Inspection Report. No asbestos-containing material was found.
- 27.) To be determined.
- 32.) See preliminary plans.



CDR Map

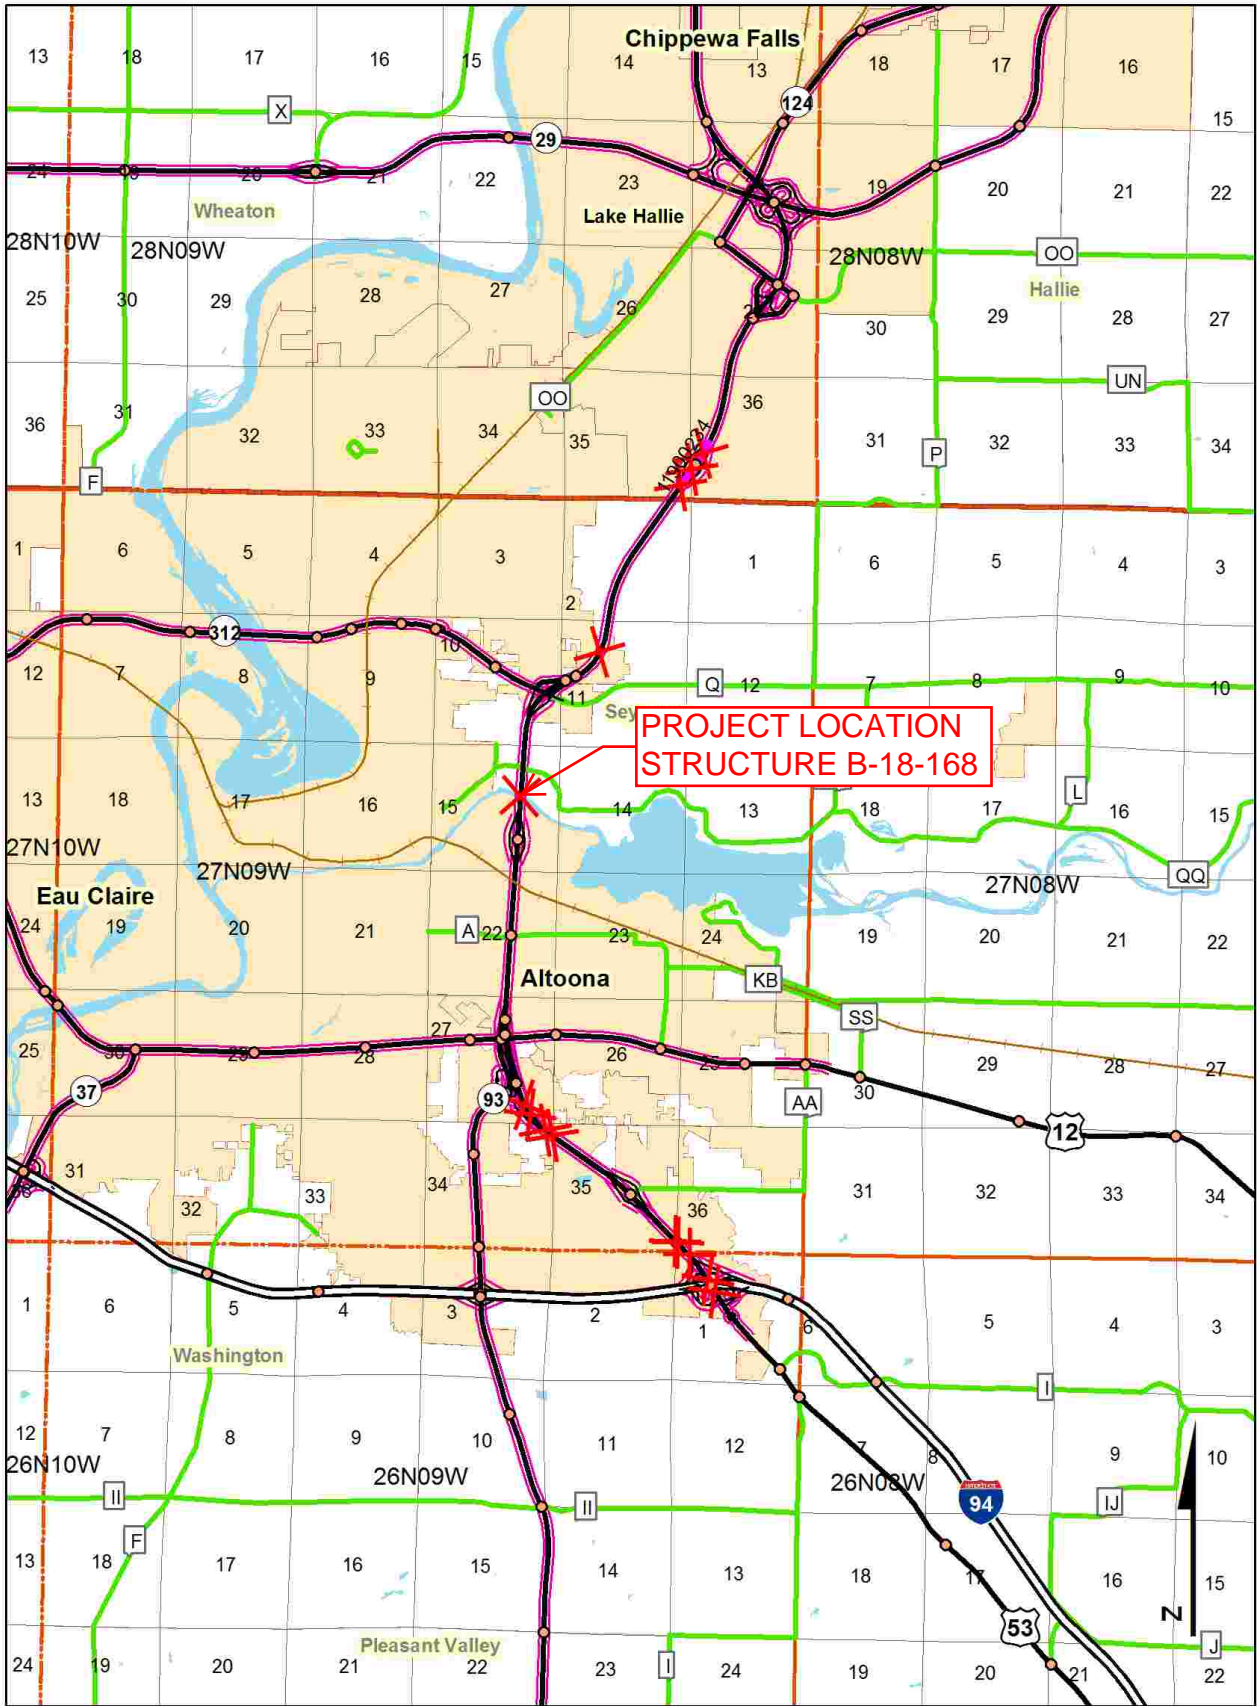


1190-02-64

EAU CLAIRE / CHIPPEWA



Section No. 1	Title
Section No. 2	Typical Sections and Details
Section No. 3	Estimate of Quantities
Section No. 3	Miscellaneous Quantities
Section No. 4	Right of Way Plat
Section No. 5	Plan and Profile
Section No. 6	Standard Detail Drawings
Section No. 7	Sign Plates
Section No. 8	Structure Plans
Section No. 9	Computer Earthwork Data
Section No. 9	Cross Sections

TOTAL SHEETS =


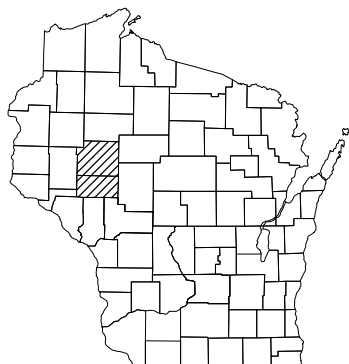


A.A.D.T.	=
A.A.D.T.	=
D.H.V.	=
D.D.	=
T.	=
DESIGN SPEED	=
ESALS	=

 PLAN  
CORPORATE LIMITS  
PROPERTY LINE  
LOT LINE  
LIMITED HIGHWAY EASEMENT  
EXISTING RIGHT OF WAY  
PROPOSED OR NEW R/W LINE

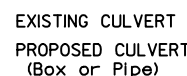

TELEPHONE POLE

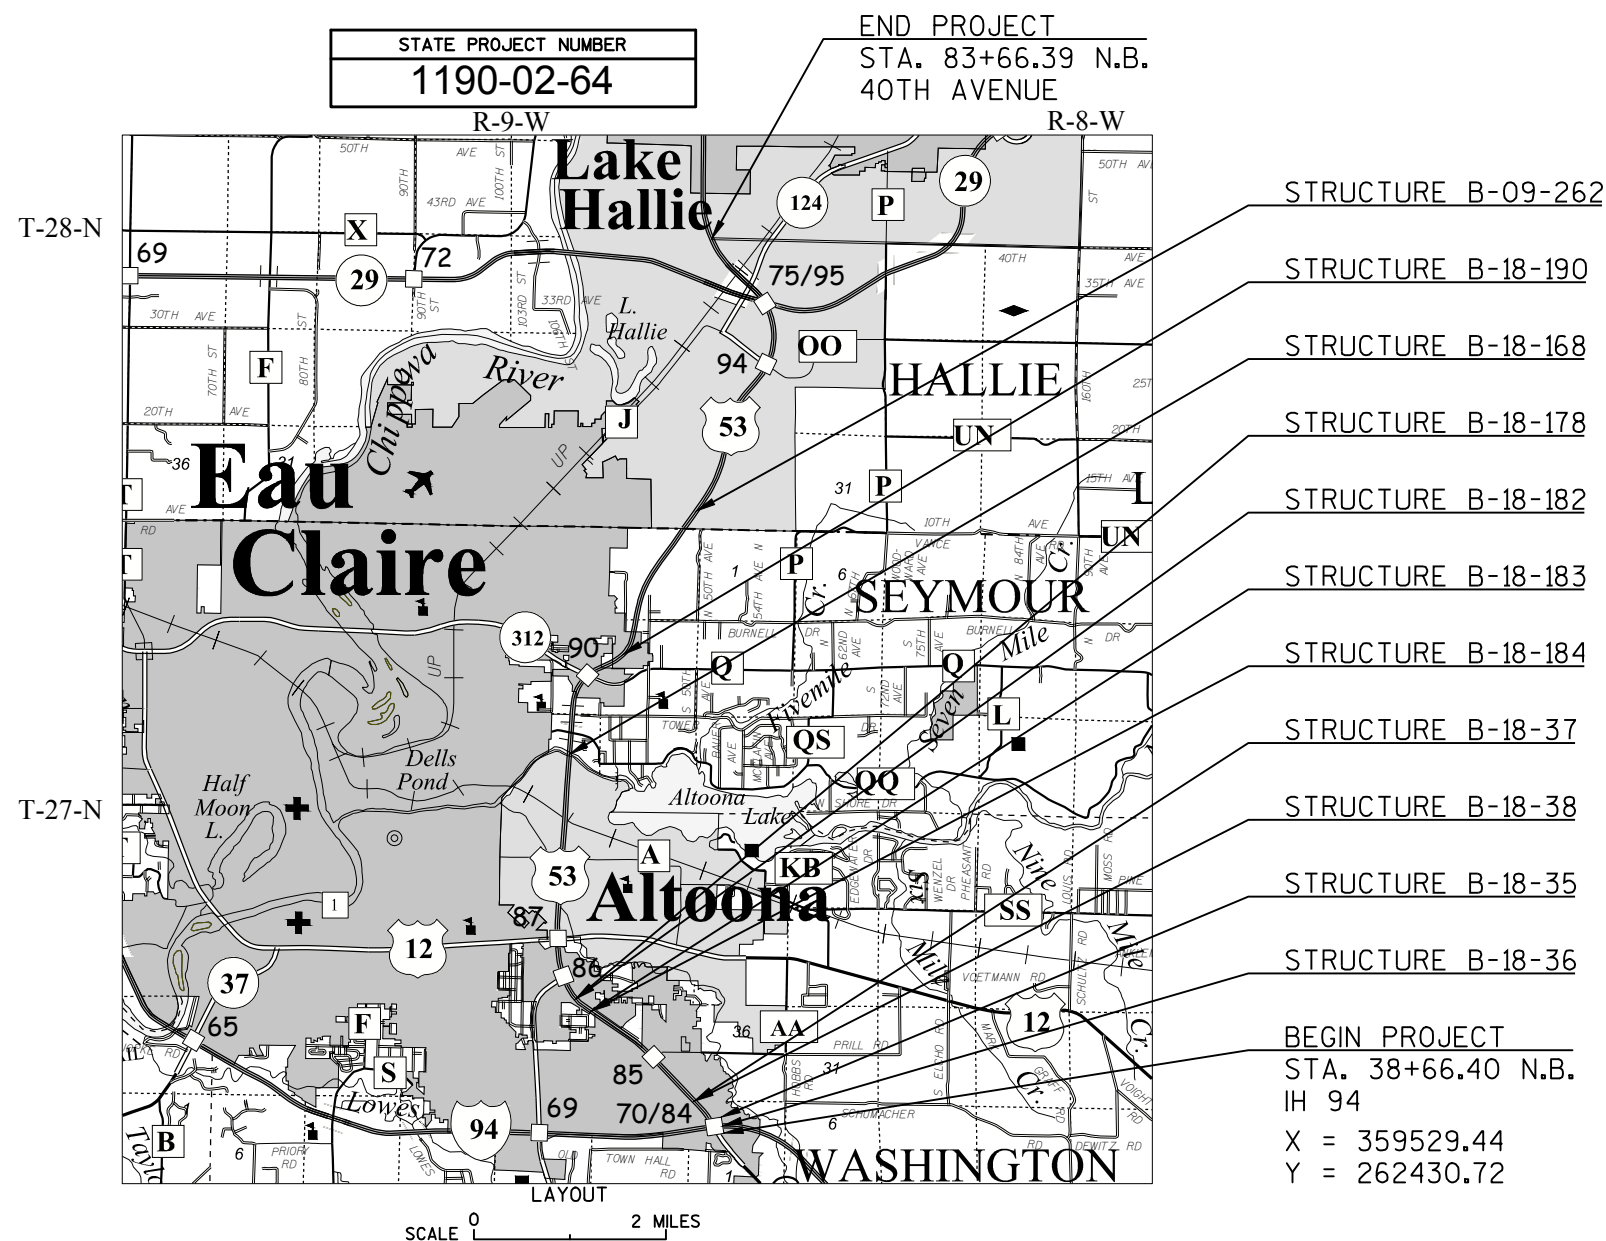 

TOTAL NET LENGTH OF CENTERLINE = 11.26 MILES

HORIZONTAL POSITIONS SHOWN ON THIS PLAN ARE WISCONSIN COUNTY COORDINATES, EAU CLAIRE COUNTY, NAD83 (1991), IN U.S. SURVEY FEET. VALUES ARE GRID COORDINATES, GRID BEARINGS, AND GRID DISTANCES. GRID DISTANCES MAY BE USED AS GROUND DISTANCES.

STATE PROJECT	FEDERAL PROJECT	
	PROJECT	CONTRACT
1190-02-64		

STATE OF WISCONSIN DEPARTMENT OF TRANSPORTATION	
PREPARED BY	
Surveyor	WISDOT
Designer	ADAM HETRICK
Project Manager	DAVID KOEPP
Regional Examiner	REGIONAL EXAMINER
Regional Supervisor	TIMOTHY MASON
APPROVED FOR THE DEPARTMENT	
DATE:	(Signature)





HOSPITAL  
EXIT 89

Eau Claire River





route: 053S county: EAU CLAIRE date: 08/14/2013 plm: 135.823

Lat: 44.82520905 Long: -91.45409372 Elev: 729.04 ft.

\\doteauplog1p\photolog\Rg5\053S\_R5\_2013\Front\Dir\_138\F\_13810.jpg

Copyright 2015 Mandli Communications, Inc.



route: 053S county: EAU CLAIRE date: 08/14/2013 plm: 135.833

Lat: 44.82506379 Long: -91.4541048 Elev: 727.46 ft.

\\doteauplog1p\photolog\Rg5\053S\_R5\_2013\Front\Dir\_138\F\_13811.jpg

Copyright 2015 Mandli Communications, Inc.





route: 053S county: EAU CLAIRE date: 08/14/2013 plm: 135.843

Lat: 44.82491882 Long: -91.45411639 Elev: 725.99 ft.

\\doteauplog1p\photolog\Rg5\053S\_R5\_2013\Front\Dir\_138\F\_13812.jpg

Copyright 2015 Mandli Communications, Inc.



route: 053S county: EAU CLAIRE date: 08/14/2013 plm: 135.853

Lat: 44.82477424 Long: -91.45412853 Elev: 724.69 ft.

\\doteauplog1p\photolog\Rg5\053S\_R5\_2013\Front\Dir\_138\F\_13813.jpg

Copyright 2015 Mandli Communications, Inc.





route: 053S county: EAU CLAIRE date: 08/14/2013 plm: 135.863

Lat: 44.82462873 Long: -91.45414081 Elev: 723.34 ft.

\\doteauplog1p\photolog\Rg5\053S\_R5\_2013\Front\Dir\_138\F\_13814.jpg

Copyright 2015 Mandli Communications, Inc.





route: 053S county: EAU CLAIRE date: 08/14/2013 plm: 135.923

Lat: 44.82376398 Long: -91.45421055 Elev: 718.98 ft.

\\doteauplog1p\photolog\Rg5\053S\_R5\_2013\Front\Dir\_138\F\_13820.jpg

Copyright 2015 Mandli Communications, Inc.



route: 053S county: EAU CLAIRE date: 08/14/2013 plm: 135.993

Lat: 44.8227519 Long: -91.45428389 Elev: 717.52 ft.

\\doteauplog1p\photolog\Rg5\053S\_R5\_2013\Front\Dir\_138\F\_13827.jpg

Copyright 2015 Mandli Communications, Inc.





route: 053S county: EAU CLAIRE date: 08/14/2013 plm: 136.023

Lat: 44.82231669 Long: -91.45431643 Elev: 717.18 ft.

\\doteauplog1p\photolog\Rg5\053S\_R5\_2013\Front\Dir\_138\F\_13830.jpg

Copyright 2015 Mandli Communications, Inc.



**STATE OF WISCONSIN  
DEPARTMENT OF TRANSPORTATION**

**Inspection Report for  
B-18-168**

**53 SB over EAU CLAIRE R  
Jul 15, 2015**



Type	Prior	Frequency (mos)	Performed
Routine	07-15-15	24	X
SI&A	07-18-13	48	

Latitude	44°49'29.40"N	Owner	STATE HIGHWAY DEPT
Longitude	91°27'15.10"W	Maintainer	STATE HIGHWAY DEPT

**Time Log**

**Team members**

Hours	Minutes	
0	55	

	Name	Number	Signature	Date
Inspector	Frueh, Rick J	1003	Completed by HSI System Account(HSI)	
Reviewer				

**BRIDGE INSPECTION REPORT**  
**Wisconsin Department of Transportation**  
**DT2007 2003 s.84.17 Wis. Stats.**

page 2

**Identification & Location**

Feature On: 53 SB	Section Town Range: S15 T27N R09W	Structure Number: <b>B-18-168</b>
Feature Under: EAU CLAIRE R	County: EAU CLAIRE(18)	
Location .3M S CTH QQ	Municipality: CITY-ALTOONA(18201)	Structure Name:

**Geometry**

measurements in feet, except where noted

Approach Roadway Width: 41	Bridge Roadway Width: 41.5	Total Length: 998.6
Approach Pavement Width: 24	Deck Width: 44.0	Deck Area (sq ft): 43938

**Traffic**

	Lanes	ADT	ADT year	Traffic Pattern
On	2	12200	2004	ONE WAY TRAFFIC
Under	0			NO TRAFFIC

**Capacity**

**Load Rating**

Inventory rating: HS29	Overburden depth (in): 0.0	Last rating date:	Controlling: INTERIOR DECK GIRDER Moment
Operating rating: HS48	Deck surface material: CONCRETE	Re-rate for capacity (Y/N):	Control location: 1.0 SPAN 3, 270.0
Posting:	Re-rate notes:		

**Hydraulic**

**Classification**

Scour Critical Code(113): (4) STABLE-CORRECTIVE ACTION REQUIRED	Q100 (ft3/sec): 33000	
High water elevation (ft): 793.3	Velocity (ft/sec): 2.9	Sufficiency #: 100.0

**Span(s)**

Span #	Material	Configuration	Depth (in)	Length (ft)	Main
1	CONT STEEL	DECK GIRDER		220.0	
2	CONT STEEL	DECK GIRDER		270.0	Y
3	CONT STEEL	DECK GIRDER		270.0	
4	CONT STEEL	DECK GIRDER		230.0	

**Expansion joint(s)**

**Temperature:**

File:	New:
-------	------

**Vertical Clearance**

	Measurement file (ft)	File Date	Measurement new (ft)
Highway Minimum Under Cardinal			
Highway Minimum Under Non-Cardinal			
Highway Minimum On			
Railroad Minimum Under			

**BRIDGE INSPECTION REPORT**  
**Wisconsin Department of Transportation**  
**DT2007 2003 s.84.17 Wis. Stats.**

page 3

Structure No.: **B-18-168**

**Elements**

Chk	Element	Defect	Description	UOM	Total	Quantity in Condition State			
						1	2	3	4
X	12		<b>Reinforced Concrete Deck</b>	SF	43,938	0	43,938	0	0
		1130	Cracking (RC) Cracks are more prevalent in the south two deck pours. Construction joint located between pier 3 and north abutment. Cracks at midspan with efflorescence.	SF		0	43,938	0	0
		8000	Wearing Surface (Bare)	SF	43,938	0	43,938	0	0
		3220	Crack (Wearing Surface) Cracks are more prevalent in the south two deck pours. Construction joint located between pier 3 and north abutment.	SF		0	43,938	0	0
X	107	8522	Coated Reinforcing	SF	43,938	0	0	0	0
			<b>Steel Open Girder</b>	LF	3,968	3,944	24	0	0
			4 Girders.						
		1000	Corrosion At construction joint in mid span of span 4 construction joint is leaking onto girders causing minor section loss.	LF		0	24	0	0
		8516	Painted Steel Painted at girder ends and bearings.	SF	4,800	4,320	480	0	0
		3440	Effectiveness (Steel Protective Coatings) Paint is flaking off at girder ends on bottom flange and bearings.	SF		0	480	0	0
		8517	Weathering Steel	SF	101,707	96,907	0	4,800	0
		3430	Oxide Film Degradation - Weathering Steel At construction joint in mid span of span 4 construction joint is leaking onto girders causing minor section loss.	SF		0	0	4,800	0
X	210		<b>Reinforced Concrete Pier Wall</b>	LF	63	63	0	0	0
X	215		<b>Reinforced Concrete Abutment</b>	LF	137	137	0	0	0
X	234		<b>Reinforced Concrete Cap</b>	LF	189	127	62	0	0
		1130	Cracking (RC) Vertical cracks every 3' in all caps	LF		0	62	0	0
X	303		<b>Modular Joint</b> Dirty.	LF	92	92	0	0	0
X	311		<b>Moveable Bearing</b> At both abutments and Piers 1-3. Teflon coming out on girder 4 at south abutment.	EA	16	8	8	0	0
		1000	Corrosion Light rust on all exterior bearings.	EA		0	8	0	0
X	313		<b>Fixed Bearing</b> At pier 2.	EA	4	2	2	0	0
		1000	Corrosion Light rust on all exterior bearings.	EA		0	2	0	0

**BRIDGE INSPECTION REPORT**  
**Wisconsin Department of Transportation**  
**DT2007 2003 s.84.17 Wis. Stats.**

page 4

Structure No.: **B-18-168**

X	331		<b>Reinforced Concrete Bridge Rail</b>	LF	2,037	1,800	237	0	0
			Few vertical cracks (approx 10FT spacing).						
		1080	Delamination - Spall - Patched Area	LF		0	2	0	0
			Northeast corner 2 small spalls.						
		1130	Cracking (RC)	LF		0	235	0	0
			Few vertical cracks (approx 10FT spacing).						
X	8400		<b>Integral Wingwall</b>	EA	4	4	0	0	0

**Assessments**

Chk	Element	Defect	Description	UOM	Total	Quantity in Condition State			
						1	2	3	4
X	9004		<b>Drainage - Deck</b>	EA	4	4	0	0	0
			Need to clean out deck inlets.						
X	9010		<b>Aesthetic Treatments</b>	EA	1	1	0	0	0
			Rustication at abutments. Form liner at piers.						
X	9045		<b>Slope Protection- Riprap</b>	EA	2	2	0	0	0
X	9167		<b>Steel Diaphragm</b>	EA	135	135	0	0	0
X	9322		<b>Approach Roadway - Concrete (non-structural)</b>	EA	2	2	0	0	0

**NBI Ratings**

	File	New
Deck	7	7
Superstructure	8	8
Substructure	8	8
Culvert	N	N
Channel	8	8
Waterway	8	8

**Structure Specific Notes**

**Inspection Specific Notes**

** 8/4/14 was performed with UB 60.
****7/18/2013 Routine inspection was done from North and South Abutment. Boat or Snooper Routine inspection will be done later. (RF)
<b>**7/15/2015 Routine inspection was done from north and south abutment banks so not all element comments could not be verified. (RF)</b>
**5/27/2010 Routine Inspection was done with 50 ft Snooper (RF)

**BRIDGE INSPECTION REPORT**  
**Wisconsin Department of Transportation**  
**DT2007 2003 s.84.17 Wis. Stats.**

page 5

Structure No.: **B-18-168**

**Inspector Site-Specific Safety Considerations**

--

**Structure Inspection Procedures**

--

**Special Requirements**

	Chk	Comments
Traffic Control		
Access Equipment		
Other		

**Construction History**

Year	Work Performed	FOS id
2006	NEW STRUCTURE	1190-00-75

**Maintenance Items History**

Item	Recommended by	Status	Status change	Year completed
------	----------------	--------	---------------	----------------

**Maintenance Items**

Item	Priority	Recommended by	Status	Status change
<b>Deck - Seal Surface Cracks</b>	MEDIUM	Harris, Kyle (6009)	IDENTIFIED	08/14/14
Seal construction joint in span 4				



**Underwater Probe Form  
B-18-168**

**General Site Conditions - Scour**

**General Site Conditions - Embankment Erosion/Conditions**

**Substructure Notes**

Unit	Max Water Depth(ft)	Mode	Notes
Cardinal Abutment			
Pier 1			
Pier 2			
Pier 3			
Non Cardinal Abutment			



**STATE OF WISCONSIN  
DEPARTMENT OF TRANSPORTATION**

## Inspection Report for B-18-168

**53 SB over EAU CLAIRE R**  
Aug 04,2014



Type	Prior	Frequency (mos)	Performed
Initial / Inventory	08-09-06		
Routine	08-04-14	24	X
Underwater V Probe	07-18-13	24	
Uw-Profile	07-18-13	24	
SI&A	07-18-13	48	

Latitude   
Longitude

Owner   
Maintainer

### Time Log

### Team members

Hours 1	Minutes 5	Craig Hampton
------------	--------------	---------------

	Name	Number	Signature	Date
Inspector	Harris, Kyle	6009		
Reviewer				

**BRIDGE INSPECTION REPORT**  
**Wisconsin Department of Transportation**  
**DT2007 2003 s.84.17 Wis. Stats.**

page 2

**Identification & Location**

Feature On: 53 SB	Section Town Range: S15 T27N R09W	Structure Number: <b>B-18-168</b>
Feature Under: EAU CLAIRE R	County: EAU CLAIRE(18)	
Location: .3M S CTH QQ	Municipality: CITY-ALTOONA(18201)	Structure Name:

**Geometry**

measurements in feet, except where noted

Approach Roadway Width: 41	Bridge Roadway Width: 41.5	Total Length: 998.6
Approach Pavement Width: 24	Deck Width: 44.0	Deck Area (sq ft): 43938

**Traffic**

	Lanes	ADT	ADT year	Traffic Pattern
On	2	12200	2004	ONE WAY TRAFFIC
Under	0			NO TRAFFIC

**Capacity**

**Load Rating**

Inventory rating: HS29	Overburden depth (in): 0.0		Controlling: DECK GIRDER Moment
Operating rating: HS49	Deck surface material: CONCRETE	Re-rate for capacity (Y/N):	Control location: 1.0 SPAN 3, 270.0
Posting:	Re-rate notes:		
Last rating date:			

**Hydraulic**

**Classification**

Scour Critical Code(113): (4) STABLE-CORRECTIVE ACTION REQUIRED	Q100 (ft3/sec): 33000	
Scour POA on file:	POA date:	Velocity (ft/sec): 2.9
		Sufficiency #: 98.0

**Span(s)**

Span #	Material	Configuration	Depth (in)	Length (ft)	Main
1	CONT STEEL	DECK GIRDER		220.0	
2	CONT STEEL	DECK GIRDER		270.0	Y
3	CONT STEEL	DECK GIRDER		270.0	
4	CONT STEEL	DECK GIRDER		230.0	

**Expansion joint(s)**

<b>Temperature:</b>	File:	New:
---------------------	-------	------

**Vertical Clearance**

	Measurement file (ft)	File Date	Measurement new (ft)
Highway Minimum Under Cardinal			
Highway Minimum Under Non-Cardinal			
Highway Minimum On			
Railroad Minimum Under			

**BRIDGE INSPECTION REPORT**  
**Wisconsin Department of Transportation**  
**DT2007 2003 s.84.17 Wis. Stats.**

page 3

Structure No.: **B-18-168**

**Elements**

Chk	Element	Protect System	Defect	Description	UOM	Total	Quantity in Condition State			
							1	2	3	4
X	12			Reinforced Concrete Deck	SF	43,938	0	43,938	0	0
			1130	Cracking (RC) <b>Cracks are more prevalent in the south two deck pours. Construction joint located between pier 3 and north abutment. Cracks at midspan with efflorescence.</b>	SF		0	43,938	0	0
			8000	Wearing Surface (Bare)	SF	43,938	0	43,938	0	0
			3220	Crack (Wearing Surface) <b>Cracks are more prevalent in the south two deck pours. Construction joint located between pier 3 and north abutment.</b>	SF		0	43,938	0	0
			8522	Coated Reinforcing	SF	43,938	0	0	0	0
X	107			Steel Open Girder 4 Girders.	LF	3,968	3,944	24	0	0
			1000	Corrosion <b>At construction joint in mid span of span 4 construction joint is leaking onto girders causing minor section loss.</b>	LF		0	24	0	0
			8516	Painted Steel <b>Painted at girder ends and bearings.</b>	SF	4,800	4,320	480	0	0
			3440	Effectiveness (Steel Protective Coatings) <b>Paint is flaking off at girder ends on bottom flange and bearings.</b>	SF		0	480	0	0
			8517	Weathering Steel	SF	101,707	96,907	0	4,800	0
			3430	Oxide Film Degradation - Weathering Steel <b>At construction joint in mid span of span 4 construction joint is leaking onto girders causing minor section loss.</b>	SF		0	0	4,800	0
X	210			Reinforced Concrete Pier Wall	LF	63	63	0	0	0
X	215			Reinforced Concrete Abutment	LF	137	137	0	0	0
X	234			Reinforced Concrete Pier Cap	LF	189	127	62	0	0
			1130	Cracking (RC) <b>Vertical cracks every 3' in all caps</b>	LF		0	62	0	0
X	303			Modular Joint Dirty.	LF	92	92	0	0	0
X	311			Movable Bearing At both abutments and Piers 1-3. Teflon coming out on girder 4 at south abutment.	EA	16	8	8	0	0
			1000	Corrosion <b>Light rust on all exterior bearings.</b>	EA		0	8	0	0
X	313			Fixed Bearing At pier 2.	EA	4	2	2	0	0
			1000	Corrosion <b>Light rust on all exterior bearings.</b>	EA		0	2	0	0
X	331			Reinforced Concrete Bridge Rail Few vertical cracks (approx 10FT spacing).	LF	2,037	1,800	237	0	0
			1080	Delamination - Spall - Patched Area <b>Northeast corner 2 small spalls.</b>	LF		0	2	0	0
			1130	Cracking (RC)	LF		0	235	0	0

**Few vertical cracks (approx 10FT spacing).**

X	8400		Integral Wingwall	EA	4	4	0	0	0
---	------	--	-------------------	----	---	---	---	---	---

## Assessments

Chk	Element	Description	UOM	Total	Quantity in Condition State			
					1	2	3	4
X	9004	Drainage - Deck Need to clean out deck inlets.	EA	4	4	0	0	0
X	9010	Aesthetic Treatments <b>Rustication at abutments. Form liner at piers.</b>	EA	1	1	0	0	0
X	9045	Slope Protection- Riprap	EA	2	2	0	0	0
X	9167	Steel Diaphragm	EA	135	135	0	0	0
X	9322	Approach Roadway - Concrete (non-structural)	EA	2	2	0	0	0

## NBI Ratings

	File	New
Deck	7	7
Superstructure	8	8
Substructure	8	8
Culvert	N	N
Channel	8	8
Waterway	8	8

## Structure Specific Notes

## Inspection Specific Notes

**\*\* 8/4/14 was performed with UB 60.**

\*\*\*\*7/18/2013 Routine inspection was done from North and South Abutment. Boat or Snooper Routine inspection will be done later. (RF)

\*\*5/27/2010 Routine Inspection was done with 50 ft Snooper (RF)

## Inspector Site-Specific Safety Considerations

**BRIDGE INSPECTION REPORT**  
**Wisconsin Department of Transportation**  
**DT2007 2003 s.84.17 Wis. Stats.**

page 5

Structure No.: **B-18-168**

**Structure Inspection Procedures**

--

**Special Requirements**

	Chk	Comments
Traffic Control		
Access Equipment		
Other		

**Construction History**

Year	Work Performed	FOS id
2006	NEW STRUCTURE	1190-00-75

**Maintenance Items**

Item	Priority	Recommended by	Status	Status change
<b>Deck - Seal Surface Cracks</b>	MEDIUM	Harris, Kyle (6009)	IDENTIFIED	08/14/14
Seal construction joint in span 4				

**BRIDGE INSPECTION REPORT**  
**Wisconsin Dept. of Transportation**  
**DT2007 2003 s.84.17 Wis. Stats. Type = UNDERWATER V PROBE INSPECTION**

page 1

**Inventory Data**

<b>Feature On:</b> 53 SB		<b>Maintainer:</b> STATE HIGHWAY DEPT		<b>Structure No:</b> B-18-168	
<b>Feature Under:</b> EAU CLAIRE R		<b>Sect/Twn/Rng:</b> S15 T27N R09W			
<b>Location:</b> .3M S CTH QQ		<b>County:</b> EAU CLAI	<b>Municipality:</b> CITY-ALTOONA (18201)		
<b>Inv Rating:</b> HS29	<b>Rdwy Width (ft):</b> 41.5	<b>Deck Width (ft):</b> 44.0	<b>Existing Posting:</b>		
<b>Oper Rating:</b> HS49	<b>Total Length (ft):</b> 998.6	<b>Deck Area(ft2):</b> 43938	<b>ADT On:</b> 12200 Yr: 2004		<b>ADT Under:</b> Yr:

**Inspection Type** (\* = Supplemental Form Required)

	<b>Routine Visual</b>	<b>Fracture Critical*</b>	<b>In-Depth*</b>	<b>UW-Dive*</b>	<b>UW-Surv*</b>	<b>UW-Probe/Visual*</b>	<b>Movable*</b>
<b>Last Insp.</b>	07-18-13				07-18-13	07-18-13	
<b>Frequency</b>	24				24	24	
<b>Recom. Freq.</b>							
	<b>Initial*</b>	<b>Damage</b>	<b>Interim</b>	<b>Load Posted</b>	<b>SIA Review*</b>		
<b>Last Insp.</b>	08-09-06				07-21-11		
<b>Frequency</b>	N/A				48		
<b>Recom. Freq.</b>	N/A				<b>Item No. Needing Change</b>		

**Load Rating Information**

<b>Overburden</b>	<b>Measurement (in):</b> 0.0	<b>Date:</b>	<b>Deck Surface Type:</b> CONCRETE		
<b>Section Loss</b>	<b>File Meas. (%):</b>	<b>File Insp. Date:</b> 07-18-13	<b>Insp. Measurement (%):</b>	<b>Describe:</b>	
<b>Re-rate for load capacity?</b>	<b>Reason:</b>				<b>Date Last Rated:</b>

**Expansion Joints**

		<b>Temp:</b>			<b>Signing Condition</b>			
<b>Location</b>	<b>Type</b>	<b>File Insp. Date</b>	<b>File Insp. (in)</b>	<b>New Insp. (in)</b>	<b>Type of Marker</b>	<b>File</b>	<b>Y/N</b>	<b>Comments</b>
S ABUT	MODULAR				Bridge Markers	N	N	
N ABUT	MODULAR				Narrow Bridge	N	N	
					One Lane Road	N	N	
					Vertical Clearance	N	N	
					Weight Limit Post	N	N	
					Other(Addl. Sign)	N	N	

**Clearances**(Cardinal = N or E)

	<b>File Meas. (ft.)</b>	<b>File Date</b>	<b>New Meas. (ft.)</b>
<b>Min. Vertical Clearance Under (Cardinal)</b>			
<b>Min. Vertical Clearance Under (non-Cardinal)</b>			
<b>Min. Vertical Clearance On</b>			

**Structure Type**

				<b>Construction/Rehabilitation History</b>			
<b>Material</b>	<b>Configuration</b>	<b># of Spans</b>	<b>Overall Length (ft)</b>	<b>Year</b>	<b>Work Performed</b>	<b>Plan</b>	<b>Shop</b>
CONT STEEL	DECK GIRDER		220.0	2006	NEW STRUCTURE	PLAN	
CONT STEEL	DECK GIRDER		270.0				
CONT STEEL	DECK GIRDER		270.0				
CONT STEEL	DECK GIRDER		230.0				

**Inspection Information**

<b>Special Requirements</b>	<b>Y/N</b>	<b>Comments</b>				
<b>Traffic Control</b>						
<b>Access Equipment</b>						
<b>Other</b>						

**Inspector Information**

<b>Team Leader Name and No. Printed:</b> Frueh, Rick J (1003)		<b>Team Member(s) Name(s) Printed:</b>			
<b>Team Leader Signature:</b>		<b>Inspection Date:</b> 07-18-13		<b>Inspection Agency:</b> STATE HIGHWAY DEPARTMENT (1)	
<b>District/Local Manager and No. Printed:</b>		<b>District/Local Manager Signature:</b>		<b>Review Date:</b>	

## Element Inspection (X) Check Elements Inspected

Element Inspection (X) Check Elements Inspected					Quantity in Condition States				
Ck	Elem./Env.	Description	Unit	Total QTY.	1	2	3	4	5
X	26 / 2	Conc Deck/Coatd Bars	SF	43938		43938			
		Cracks are more prevalent in the south two deck pours. Construction joint located between pier 3 and north abutment.							
X	107 / 2	Paint Stl Opn Girder	LF	3968	3968				
		4 Girders.							
X	172 / 2	Painted Steel Diaphr	EA	135	135				
X	210 / 2	R/Conc Pier Wall	LF	63	63				
X	215 / 2	R/Conc Abutment	LF	137	137				
X	234 / 2	R/Conc Cap	LF	189	188	1			
		Crack in west wing of P1.							
X	303 / 4	Modular Joint	LF	92	92				
		Dirty.							
X	311 / 2	Moveable Bearing	EA	16	16				
		At both abutments and Piers 1-3. Teflon coming out on girder 4 at south abutment.							
X	313 / 2	Fixed Bearing	EA	4	4				
		At pier 2.							
X	321 / 2	R/Conc Approach Slab	EA	2	2				
X	331 / 2	Conc Bridge Railing	LF	2037	1800	237			
		Few vertical cracks (approx 10FT spacing). Northeast corner 2 small spalls.							
X	342 / 2	RipRap Slope Protect	EA	2	2				
X	358 / 4	Deck Cracking SmFlag	EA	1		1			
		Couple longitudinal cracks at deck ends. Diagonal crack at SE corner. Few transverse cracks at piers.							
X	359 / 4	Und Dk Surf Sm Flag	EA	1	1				
		Couple transverse cracks with leaching at mid-spans.							



**Element Inspection (X) Check Elements Inspected**

					Quantity in Condition States				
Ck	Elem./Env.	Description	Unit	Total QTY.	1	2	3	4	5
X	400 / 2	Concrete Wingwall	EA	4	4				
X	405 / 2	Drainage	EA	4	4				
Need to clean out deck inlets.									

**General Inspection/Maintenance Notes**

\*\*\*\*7/18/2013 Routine inspection was done from North and South Abutment. Boat or Snooper Routine inspection will be done later. (RF)

\*\*5/27/2010 Routine Inspection was done with 50 ft Snooper (RF)

**Maintenance Recommendations (See standard code items & numbers)**

<b>Maintenance Item:</b>
<b>Amount:</b> <b>Date(YYYY-MM-DD):</b>
<b>Maintenance item comment:</b>

<b>Maintenance Item:</b>
<b>Amount:</b> <b>Date(MM-DD-YY):</b>
<b>Maintenance item comment:</b>

**NBI Ratings**

NBI	File	New	NBI	File	New
Deck	7	7	Culvert	N	N
Superstructure	8	8	Channel	8	8
Substructure	8	8	Waterway	8	8

<b>Maintenance Item:</b>
<b>Amount:</b> <b>Date(MM-DD-YY):</b>
<b>Maintenance item comment:</b>

**BRIDGE INSPECTION REPORT**  
**Wisconsin Dept. of Transportation**  
**DT2007 2003 s.84.17 Wis. Stats. Type = UW-PROFILE INSPECTION**

page 1

**Inventory Data**

<b>Feature On:</b> 53 SB		<b>Maintainer:</b> STATE HIGHWAY DEPT		<b>Structure No:</b> B-18-168	
<b>Feature Under:</b> EAU CLAIRE R		<b>Sect/Twn/Rng:</b> S15 T27N R09W			
<b>Location:</b> .3M S CTH QQ		<b>County:</b> EAU CLAI	<b>Municipality:</b> CITY-ALTOONA(18201)		
<b>Inv Rating:</b> HS29	<b>Rdwy Width (ft):</b> 41.5	<b>Deck Width (ft):</b> 44.0	<b>Existing Posting:</b>		
<b>Oper Rating:</b> HS49	<b>Total Length (ft):</b> 998.6	<b>Deck Area(ft2):</b> 43938	<b>ADT On:</b> 12200 <b>Yr:</b> 2004		<b>ADT Under:</b> Yr:

**Inspection Type** (\* = Supplemental Form Required)

	<b>Routine Visual</b>	<b>Fracture Critical*</b>	<b>In-Depth*</b>	<b>UW-Dive*</b>	<b>UW-Surv*</b>	<b>UW-Probe/Visual*</b>	<b>Movable*</b>
<b>Last Insp.</b>	07-18-13				07-18-13	07-21-11	
<b>Frequency</b>	24				24	24	
<b>Recom. Freq.</b>							
	<b>Initial*</b>	<b>Damage</b>	<b>Interim</b>	<b>Load Posted</b>	<b>SIA Review*</b>		
<b>Last Insp.</b>	08-09-06				07-21-11		
<b>Frequency</b>	N/A				48		
<b>Recom. Freq.</b>	N/A				<b>Item No. Needing Change</b>		

**Load Rating Information**

<b>Overburden</b>	<b>Measurement (in):</b> 0.0	<b>Date:</b>	<b>Deck Surface Type:</b> CONCRETE		
<b>Section Loss</b>	<b>File Meas. (%):</b>	<b>File Insp. Date:</b> 07-18-13	<b>Insp. Measurement (%):</b>	<b>Describe:</b>	
<b>Re-rate for load capacity?</b>		<b>Reason:</b>		<b>Date Last Rated:</b>	

**Expansion Joints**

		<b>Temp:</b>			<b>Signing Condition</b>			
<b>Location</b>	<b>Type</b>	<b>File Insp. Date</b>	<b>File Insp. (in)</b>	<b>New Insp. (in)</b>	<b>Type of Marker</b>	<b>File</b>	<b>Y/N</b>	<b>Comments</b>
S ABUT	MODULAR				Bridge Markers	N	N	
N ABUT	MODULAR				Narrow Bridge	N	N	
					One Lane Road	N	N	
					Vertical Clearance	N	N	
					Weight Limit Post	N	N	
					Other(Addl. Sign)	N	N	

**Clearances**(Cardinal = N or E)

	<b>File Meas. (ft.)</b>	<b>File Date</b>	<b>New Meas. (ft.)</b>
<b>Min. Vertical Clearance Under (Cardinal)</b>			
<b>Min. Vertical Clearance Under (non-Cardinal)</b>			
<b>Min. Vertical Clearance On</b>			

**Structure Type**

				<b>Construction/Rehabilitation History</b>			
<b>Material</b>	<b>Configuration</b>	<b># of Spans</b>	<b>Overall Length (ft)</b>	<b>Year</b>	<b>Work Performed</b>	<b>Plan</b>	<b>Shop</b>
CONT STEEL	DECK GIRDER		220.0	2006	NEW STRUCTURE	PLAN	
CONT STEEL	DECK GIRDER		270.0				
CONT STEEL	DECK GIRDER		270.0				
CONT STEEL	DECK GIRDER		230.0				

**Inspection Information**

<b>Special Requirements</b>	<b>Y/N</b>	<b>Comments</b>				
<b>Traffic Control</b>						
<b>Access Equipment</b>						
<b>Other</b>						

**Inspector Information**

<b>Team Leader Name and No. Printed:</b> Frueh, Rick J (1003)		<b>Team Member(s) Name(s) Printed:</b>			
<b>Team Leader Signature:</b>		<b>Inspection Date:</b> 07-18-13		<b>Inspection Agency:</b> STATE HIGHWAY DEPARTMENT (1)	
<b>District/Local Manager and No. Printed:</b>		<b>District/Local Manager Signature:</b>		<b>Review Date:</b>	

## Element Inspection (X) Check Elements Inspected

Element Inspection (X) Check Elements Inspected					Quantity in Condition States				
Ck	Elem./Env.	Description	Unit	Total QTY.	1	2	3	4	5
X	26 / 2	Conc Deck/Coatd Bars	SF	43938		43938			
		Cracks are more prevalent in the south two deck pours. Construction joint located between pier 3 and north abutment.							
X	107 / 2	Paint Stl Opn Girder	LF	3968	3968				
		4 Girders.							
X	172 / 2	Painted Steel Diaphr	EA	135	135				
X	210 / 2	R/Conc Pier Wall	LF	63	63				
X	215 / 2	R/Conc Abutment	LF	137	137				
X	234 / 2	R/Conc Cap	LF	189	188	1			
		Crack in west wing of P1.							
X	303 / 4	Modular Joint	LF	92	92				
		Dirty.							
X	311 / 2	Moveable Bearing	EA	16	16				
		At both abutments and Piers 1-3. Teflon coming out on girder 4 at south abutment.							
X	313 / 2	Fixed Bearing	EA	4	4				
		At pier 2.							
X	321 / 2	R/Conc Approach Slab	EA	2	2				
X	331 / 2	Conc Bridge Railing	LF	2037	1800	237			
		Few vertical cracks (approx 10FT spacing). Northeast corner 2 small spalls.							
X	342 / 2	RipRap Slope Protect	EA	2	2				
X	358 / 4	Deck Cracking SmFlag	EA	1		1			
		Couple longitudinal cracks at deck ends. Diagonal crack at SE corner. Few transverse cracks at piers.							
X	359 / 4	Und Dk Surf Sm Flag	EA	1	1				
		Couple transverse cracks with leaching at mid-spans.							

**Element Inspection (X) Check Elements Inspected**

					Quantity in Condition States				
Ck	Elem./Env.	Description	Unit	Total QTY.	1	2	3	4	5
X	400 / 2	Concrete Wingwall	EA	4	4				
X	405 / 2	Drainage	EA	4	4				
Need to clean out deck inlets.									

**General Inspection/Maintenance Notes**

\*\*\*\*7/18/2013 Routine inspection was done from North and South Abutment. Boat or Snooper Routine inspection will be done later. (RF)

\*\*5/27/2010 Routine Inspection was done with 50 ft Snooper (RF)

**Maintenance Recommendations (See standard code items & numbers)**

<b>Maintenance Item:</b>
<b>Amount:</b> <b>Date(YYYY-MM-DD):</b>
<b>Maintenance item comment:</b>

<b>Maintenance Item:</b>
<b>Amount:</b> <b>Date(MM-DD-YY):</b>
<b>Maintenance item comment:</b>

**NBI Ratings**

NBI	File	New	NBI	File	New
Deck	7	7	Culvert	N	N
Superstructure	8	8	Channel	8	8
Substructure	8	8	Waterway	8	8

<b>Maintenance Item:</b>
<b>Amount:</b> <b>Date(MM-DD-YY):</b>
<b>Maintenance item comment:</b>

Wisconsin Dept. of Transportation  
Supplemental Bridge Inspection Report  
Emxx - 01xx Section 84.17 Wis. Statutes

Report Name: Streambed Profile

**Condition, Location, Description and Structure Notes**

See Electronic File: N:\SPO\Operations\Bridge\Stream Inspection Profiles\Eau Claire B-18  
Streambed

**Condition Pictures and/or Sketches**

---

**Wisconsin Dept. of Transportation  
Structure Inventory Data**

**Bridge B180168**

<b>Structure No.:</b> B180168	<b>Municipality:</b> CITY- ALTOONA (18201)	<b>Section:</b>	<b>Town:</b>	<b>Range:</b>	<b>Maintenance Agency:</b> STATE HIGHWAY DEPT	<b>Owner:</b> STATE HIGHWAY DEPT
<b>Replaced Structure No.:</b>	<b>Historical Sig.:</b> 5	<b>Latitude:</b> 444929.4	<b>Longitude:</b> 912715.1	<b>County:</b> EAU CLAIRE (18)	<b>District:</b> 6	

**ABUTMENT DATA (CARDINAL)**

<b>1. Abutment Type:</b> SILL FLEXIBLE/RECT
<b>2. Pile Type:</b> CAST IN PL
<b>3. Pile Size:</b> 254 OR 273 MM (10 OR 10-3/4")
<b>4. Slope Protection Type:</b> RIPRAP
<b>5. Rdwy. Width:</b> 41.5 ft
<b>6. Deck Width:</b> 44.0 ft
<b>7. Wing Type:</b> PARALLEL TO ROADWAY

**ABUTMENT DATA (NON-CARDINAL)**

<b>1. Abutment Type:</b> SILL FLEXIBLE/RECT
<b>2. Pile Type:</b> CAST IN PL
<b>3. Pile Size:</b> 254 OR 273 MM (10 OR 10-3/4")
<b>4. Slope Protection Type:</b> RIPRAP
<b>5. Rdwy. Width:</b> 41.5 ft
<b>6. Deck Width:</b> 44.0 ft
<b>7. Wing Type:</b> PARALLEL TO ROADWAY

**GEOMETRIC DATA**

<b>1. Structure Length:</b> 998.6 ft (Back to Back Abuts. Along Rdwy. Centerline)
<b>2. No. Lanes On:</b> 2
<b>3. L. Sdk. Width On:</b> 0.0 ft
<b>4. R. Sdk. Width On:</b> 0.0 ft
<b>5. Median Type:</b>
<b>6. Median Width:</b> 0.0 ft
<b>7. Skew Angle:</b> 25 Deg.
<b>8. Direction Skew Angle:</b> LEFT
<b>9. Horizontal Curve:</b> 0.0 Radius, ft
<b>10. Dir.-Hor. Curve:</b>
<b>11. Girder Spacing:</b> 12.5 ft
<b>12. Height:</b> ft (Top Pier Footing to Top Deck or Streambed Elev. to Top Deck)
<b>13. NBI Bridge Length Met:</b> true

**APPROACH DATA**

<b>1. Appr. Pavement Width:</b> 24 ft
<b>2. Rt. Shoulder Width:</b> 10 ft
<b>3. Lt. Shoulder Width:</b> 6 ft
<b>4. Total Width (Sum Above):</b> 41 ft
<b>5. Guardrail Termination:</b> 1
<b>6. Guardrail Adequacy:</b> 1
<b>7. Railing Attachment Type:</b> 5 - 22 MM (7/8") BOLTS
<b>8. Railing Design Year:</b> 1965 AASHO
<b>9. Left Outer Railing Type:</b> SLOPED FACE PARAPET LF (91)
<b>10. Right Outer Railing Type:</b> SLOPED FACE PARAPET LF (91)
<b>11. Left Inner Railing Type:</b>
<b>12. Right Inner Railing Type:</b>

**CAPACITY DATA**

<b>1. Design MS:</b> HS20
<b>2. Inventory MS:</b> HS29
<b>3. Operating MS:</b> HS49
<b>4. Max. Veh. Wt.:</b> 250 kips
<b>5. Load Rating Basis:</b> LFR
<b>6. Load Rating Member:</b> DECK GIRDER
<b>7. Deck Composition:</b>
<b>8a. Deck Membrane:</b>
<b>8b. Deck Surface:</b> CONCRETE

**HYDRAULIC DATA**

<b>1. Design Flood Frequency:</b> 100 yrs
<b>2. Design Discharge:</b> 33000 cu-ft/s
<b>3. Max. Velocity:</b> 2.9 ft/s
<b>4. Drainage Area:</b> 815.5 sq. ft
<b>5. High Water Elev.:</b> 793.3 ft
<b>6. Scour Critical Code:</b> 4
<b>7. Scour Calculated?:</b> false

**STRUCTURE SERVICE DATA**

<b>1. Hwy. On Detour Length:</b> 0 ft
<b>2. Type Service On:</b> HIGHWAY
<b>3. Type Service Under:</b> WATERWAY

**APPRAISAL UPDATE**

<b>1. Load Capacity:</b> 5-LEGAL LOAD STRESS NOT EXCEEDED
<b>2. Geom. On:</b> 7-COND BETTER THAN MIN CRITERIA
<b>3. Geom. Under:</b> N-NO UNDERCLEARANCE RECORD EXISTS
<b>4. Appr. Align:</b> 8-COND EQUAL DESIRABLE CRITERIA
<b>5. Horiz. Align:</b>
<b>6. Vert. Align:</b>

**PLANNING DATA**

<b>1. Functional Classification:</b> OTH PRIN ART-RURAL (02)
<b>2. ADT:</b> 12200
<b>3. ADT-Year:</b> 2004
<b>4. Truck ADT %:</b> 0
<b>5. Future ADT:</b> 14125
<b>6. Future ADT-Year:</b> 2024

**CONDITION DATA**

<b>Deck:</b> 7	<b>SuperStructure:</b> 8	<b>SubStructure:</b> 8	<b>Channel:</b> 8
<b>Culvert:</b> N	<b>Waterway:</b> 8		

## Bridge B180168

### CONSTRUCTION DATE

Project ID	Construction Contractor	Construction Designer	Construction Year	Plans Reel Number	Letting Date	Survey Received	Work Performed
1190-00-75	ZENITH TECH, INC.	BRIDGE SECTION DESIGN UNIT 2	2006	PLAN	09-Nov-2004	12-Aug-1997	NEW STRUCTURE

### CLEARANCE DATE

Clearance Lane Number	Minimum Vertical	Minimum Vertical Date	Minimum Horizontal Distance	Right Minimum Lateral

Left Minimum Lateral	Railroad Right Minimum Lateral	Railroad Left Minimum Lateral	Railroad Vertical Distance	Railroad Horizontal Distance

### ROUTE DATE

Number	Direction	Type	Structure Route On / Under	Structure Route Cardinal / NonCardinal
053	S		O	N
			U	C

Number	Structure Route Location	Highway Feature Name	Structure Route Local System	Highway Feature Designation
053	.3M S CTH QQ	53 SB	USH	MAINLINE
		EAU CLAIRE R		WATER / LAND / OTHER

Number	Structure Route Primary Flag	Designed National Network Flag	Structure Defense Highway Designation	Highway On Inventory Route
053	Y	N	0	NHS
	Y	N		

### PIER DATE

Number	Pier Type	Piling Type	Piling Size	Pier Skew Angle	Direction of Skew
1	HAMMERHEAD	STEEL	356 MM (14")		
2	HAMMERHEAD	STEEL	356 MM (14")		
3	HAMMERHEAD	STEEL	356 MM (14")		

### SPAN DATE

Number	Type	Length	Configuration	Material	Girder or Truss Height	Girder or Truss Spacing
1		220.0	DECK GIRDER	CONT STEEL		12.5
2		270.0	DECK GIRDER	CONT STEEL		12.5
3		270.0	DECK GIRDER	CONT STEEL		12.5
4		230.0	DECK GIRDER	CONT STEEL		12.5

### EXPANSIONJOINT DATE

Number	Location	Type	Inactive Date
1	S ABUT	MODULAR JOINT	
2	N ABUT	MODULAR JOINT	



708 Heartland Trail, Suite 3000  
Madison, WI 53717

608.826.3600 PHONE  
608.826.3941 FAX

www.TRCsolutions.com

## Bridge Asbestos Inspection Report

**WisDOT Project ID:** 1190-02-34

**Structure Number:** B-18-0168, B-18-0190

**Structure Name:** USH 53 SB over Eau Claire River, La Salle Street over USH 53

**City/County:** City of Altoona, Town of Seymour, Eau Claire County

**Lat/Long Coordinates:** 444929.4/ 912715.1, 445023.83/ 912631.51

**TRC Project Number:** 235777.0000.0000

**Date Inspected:** October 14, 2015

**Inspected By/License Number:** John Roelke, All-119523

### Findings:

The inspection to identify and collect samples of potential asbestos-containing material (ACM) was completed following WisDOT standard sampling procedure for bridge inspections found in FDM 21-35-45.

None of the materials that were identified as potentially ACM and sampled tested positive for asbestos. The overlay on the bridges can proceed as planned. Standard Special Provision (STSP) 107-125 should be included in the specifications.


Sample Number	Sample Description	Sample Location	Analytical Results and Method	Friable/ Non-friable or No ACM	Quantity of ACM Material
B-18-0168					
1	Caulk	Abutment joint	PLM, non-detect	No ACM	0
2	Caulk	Abutment joint	PLM, non-detect	No ACM	
3	Caulk	Abutment joint	PLM, non-detect	No ACM	
4	Brown paint	Girder	PLM, non-detect	No ACM	0
5	Brown paint	Girder	PLM, non-detect	No ACM	
6	Brown paint	Girder	PLM, non-detect	No ACM	
7	White paint	Girder	PLM, non-detect	No ACM	0
8	White paint	Girder	PLM, non-detect	No ACM	
9	White paint	Girder	PLM, non-detect	No ACM	



Sample Number	Sample Description	Sample Location	Analytical Results and Method	Friable/ Non-friable or No ACM	Quantity of ACM Material
B-18-0190					
1	Paint	Pedestrian fence	PLM, non-detect	No ACM	0
2	Paint	Pedestrian fence	PLM, non-detect	No ACM	
3	Paint	Pedestrian fence	PLM, non-detect	No ACM	
4	Caulk	Around fence attachment plate	PLM, non-detect	No ACM	0
5	Caulk	Around fence attachment plate	PLM, non-detect	No ACM	
6	Caulk	Around fence attachment plate	PLM, non-detect	No ACM	
7	Caulk	Around bolts in fence attachment plate	PLM, non-detect	No ACM	0
8	Caulk	Around bolts in fence attachment plate	PLM, non-detect	No ACM	
9	Caulk	Around bolts in fence attachment plate	PLM, non-detect	No ACM	
10	Caulk	Abutment joint	PLM, non-detect	No ACM	0
11	Caulk	Abutment joint	PLM, non-detect	No ACM	
12	Caulk	Abutment joint	PLM, non-detect	No ACM	
13	Caulk	Parapet expansion joint	PLM, non-detect	No ACM	0
14	Caulk	Parapet expansion joint	PLM, non-detect	No ACM	
15	Caulk	Parapet expansion joint	PLM, non-detect	No ACM	

If you have any questions, please contact me, at (608) 826-3628.

TRC Environmental Corporation

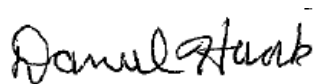

Daniel Haak  
Project Manager



John Roelke  
Asbestos Inspector

Attachments: Location Map, Photos, and Laboratory Reports


\\NTAPB-MADISON\MSN-VOL6\-\WPMSN\PJT2\235777\0000\1190-02-34\_B-18-0168 USH 53 SB OVER EAU CLAIRE RIVER B-18-0190 LA SALLE ST OVER



Report Distribution:

Recipient	Electronic (PDF) Copy	Paper Copy
BTS-ESS <a href="mailto:sharlene.tebeest@dot.wi.gov">sharlene.tebeest@dot.wi.gov</a>	X (via email)	X
REC <a href="mailto:amy.adrihan@dot.wi.gov">amy.adrihan@dot.wi.gov</a> ; <a href="mailto:nicholasA.schaff@dot.wi.gov">nicholasA.schaff@dot.wi.gov</a>	X (via email)	
Project Manager <a href="mailto:david.koepp@dot.wi.gov">david.koepp@dot.wi.gov</a>	X (via email)	
Other		



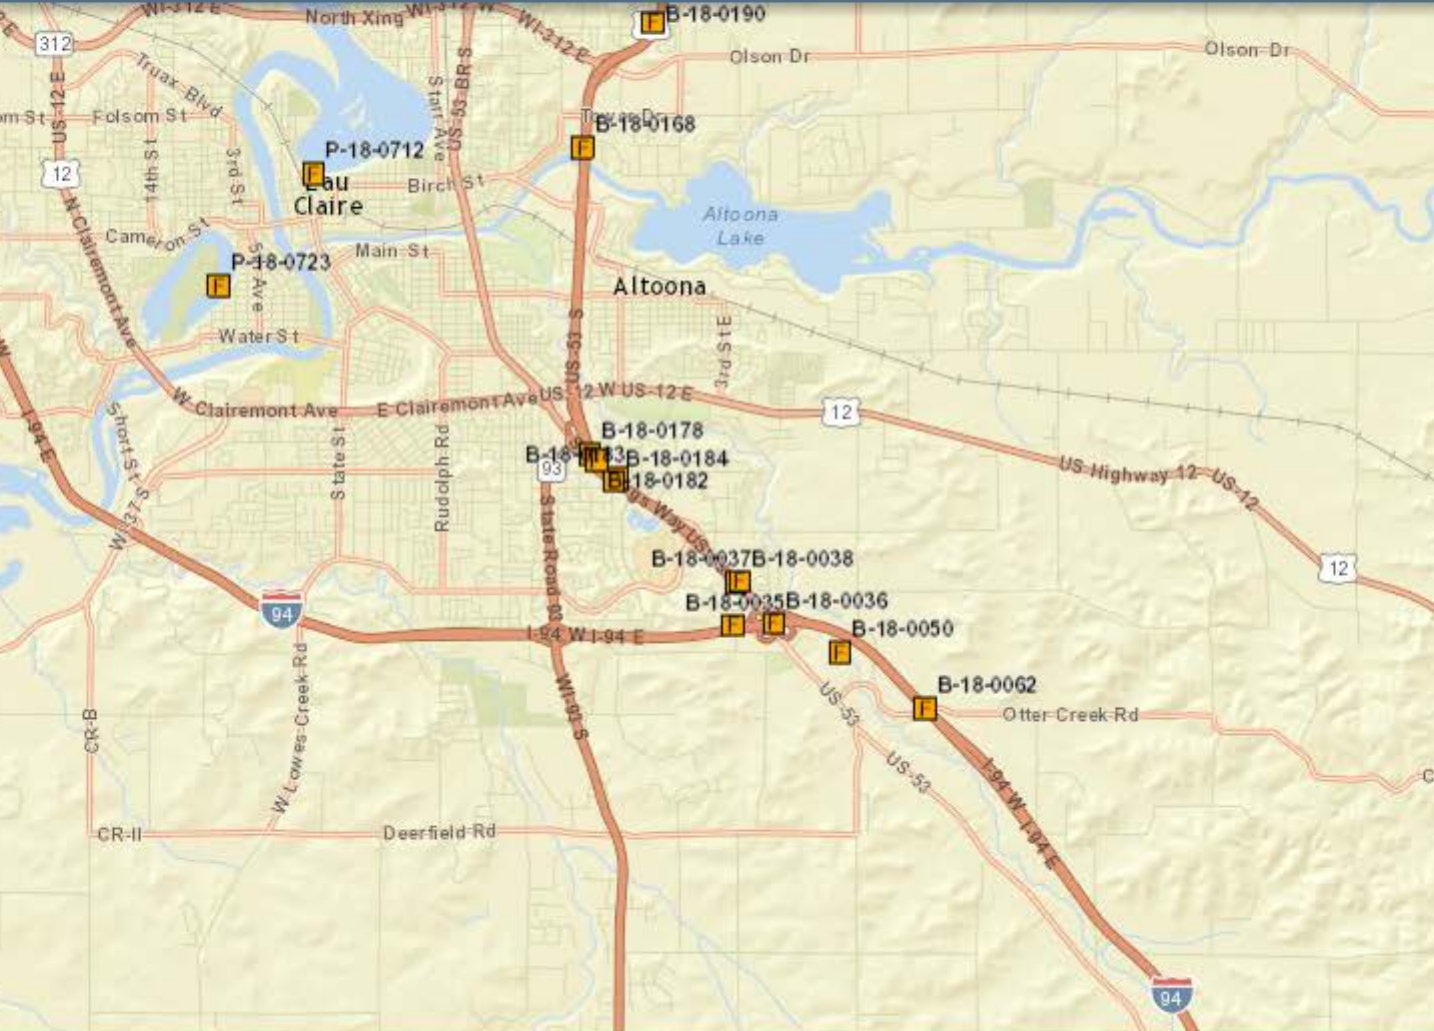

B-18-0168



Caulk in abutment joint





White graffiti paint on girder



Brown graffiti paint on girder



B-18-0190



Paint on fence



Caulk around fence attachment plate



Caulk around bolts in attachment plate



Caulk in abutment joint



Caulk in parapet expansion joint

**BULK ASBESTOS ANALYSIS REPORT**

CLIENT: Wisconsin Department of Transportation

Lab Log #: 0047027  
Project #: 235777.0000.0000  
Date Received: 10/16/2015  
Date Analyzed: 10/19/2015

Site: DOT Bridge Inspection, B-18-168

**POLARIZED LIGHT MICROSCOPY by EPA 600/R-93/116**

Sample No.	Color	Homogenous	Multi-Layered	Layer No.	Other Matrix Materials	Asbestos %	Asbestos Type
B-18-168 (1)	Grey	Yes	No	--	---	ND	None
B-18-168 (2)	Grey	Yes	No	--	---	ND	None
B-18-168 (3)	Grey	Yes	No	--	---	ND	None
B-18-168 (4)	Brown	Yes	No	--	---	ND	None
B-18-168 (5)	Brown	Yes	No	--	---	ND	None
B-18-168 (6)	Brown	Yes	No	--	---	ND	None
B-18-168 (7)	White	Yes	No	--	---	ND	None
B-18-168 (8)	White	Yes	No	--	---	ND	None
B-18-168 (9)	White	Yes	No	--	---	ND	None

**TRC LABORATORY ASBESTOS ANALYTICAL ACCREDITATIONS**

NVLAP Lab Code 101424-0  
RI #AAL-007 TX #300354  
CO# AL-15020

AIHA-LAP,LLC #100122 CT #PH-0426  
VT #AL014538 LA#05011 VA #3333 000283  
PHIL# 461 PA#68-03387

ME LA-0075, LB-0071 MA #AA000052 NY #10980 WV# LT000411  
AZ #A20944 HI #L-09-004 NJ #CT004 CA #2907



**POLARIZED LIGHT MICROSCOPY by EPA 600/R-93/116**

Sample No.	Color	Homogenous	Multi-Layered	Layer No.	Other Matrix Materials	Asbestos %	Asbestos Type
------------	-------	------------	---------------	-----------	------------------------	------------	---------------

Reporting limit- asbestos present at 1%

ND - asbestos was not detected

Trace - asbestos was observed at level of less than 1%

NA/PS - Not Analyzed / Positive Stop

SNA- Sample Not Analyzed- See Chain of Custody for details

Note: Polarized-light microscopy is not consistently reliable in detecting asbestos in floor coverings and similar non-friable organically bound materials. In those cases, EPA recommends, and certain states (e.g. NY) require, that negative results be confirmed by quantitative transmission electron microscopy.

The Laboratory at TRC follows the EPA's Interim Method for the Determination of Asbestos in Bulk Insulation (1982), and the EPA recommended Method for the Determination of Asbestos in Bulk Building Materials (EPA/600/R-93/116), July 1993, R.L. Perkins and B.W. Harvey which utilizes polarized light microscopy (PLM). Our analysts have completed an accredited course in asbestos identification. TRC's Laboratory is accredited under the National Voluntary Laboratory Accreditation Program (NVLAP), for Bulk Asbestos Fiber Analysis, NVLAP Code 18/A01, effective through June 30, 2016. TRC is an American Industrial Hygiene Association (AIHA) accredited lab for PLM effective through October 1, 2016. Asbestos content is determined by visual estimate unless otherwise indicated. Quality Control is performed in-house on at least 10% of samples and the QC data related to the samples is available upon written request from the client.


This report shall not be reproduced, except in full, without the written approval of TRC. This report must not be used by the client to claim product endorsement by NVLAP or any agency of the U.S. Government. This report relates only to the items tested.

Analyzed by:



Kathleen Williamson, Laboratory Manager

Reviewed by:

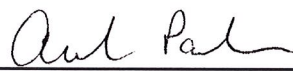

Amanda Parkins, Approved Signatory

Date Issued

10/19/2015

**TRC LABORATORY ASBESTOS ANALYTICAL ACCREDITATIONS**

NVLAP Lab Code 101424-0  
RI #AAL-007 TX #300354  
CO# AL-15020

AIHA-LAP.LLC #100122 CT #PH-0426  
VT #AL014538 LA#05011 VA #3333 000283  
PHIL# 461 PA#68-03387

ME LA-0075, LB-0071  
AZ #A20944

MA #AA000052  
HI #L-09-004

NY #10980 WV# LT000411  
NJ #CT004 CA #2907



**BULK ASBESTOS ANALYSIS REPORT**

CLIENT: Wisconsin Department of Transportation

Lab Log #: 0047038  
Project #: 235777.0000.0000  
Date Received: 10/16/2015  
Date Analyzed: 10/20/2015

Site: DOT Bridge Inspection, B-18-190

**POLARIZED LIGHT MICROSCOPY by EPA 600/R-93/116**

Sample No.	Color	Homogenous	Multi-Layered	Layer No.	Other Matrix Materials	Asbestos %	Asbestos Type
B-18-190 (1)	Black	Yes	No	--	---	ND	None
B-18-190 (2)	Black	Yes	No	--	---	ND	None
B-18-190 (3)	Black	Yes	No	--	---	ND	None
B-18-190 (4)	Grey	Yes	No	--	---	ND	None
B-18-190 (5)	Grey	Yes	No	--	---	ND	None
B-18-190 (6)	Grey	Yes	No	--	---	ND	None
B-18-190 (7)	Grey	Yes	No	--	---	ND	None
B-18-190 (8)	Grey	Yes	No	--	---	ND	None
B-18-190 (9)	Grey	Yes	No	--	---	ND	None
B-18-190 (10)	Grey	Yes	No	--	---	ND	None
B-18-190 (11)	Grey	Yes	No	--	---	ND	None
B-18-190 (12)	Grey	Yes	No	--	---	ND	None
B-18-190 (13)	Grey	Yes	No	--	---	ND	None
B-18-190 (14)	Grey	Yes	No	--	---	ND	None
B-18-190 (15)	Grey	Yes	No	--	---	ND	None

**TRC LABORATORY ASBESTOS ANALYTICAL ACCREDITATIONS**

NVLAP Lab Code 101424-0  
RI #AAL-007 TX #300354  
CO# AL-15020

AIHA-LAP, LLC #100122 CT #PH-0426  
VT #AL014538 LA#05011 VA #3333 000283  
PHIL# 461 PA#68-03387

ME LA-0075, LB-0071 MA #AA000052 NY #10980 WV# LT000411  
AZ #A20944 HI #L-09-004 NJ #CT004 CA #2907



### POLARIZED LIGHT MICROSCOPY by EPA 600/R-93/116

Sample No.	Color	Homogenous	Multi-Layered	Layer No.	Other Matrix Materials	Asbestos %	Asbestos Type
------------	-------	------------	---------------	-----------	------------------------	------------	---------------

Reporting limit- asbestos present at 1%

ND - asbestos was not detected

Trace - asbestos was observed at level of less than 1%

NA/PS - Not Analyzed / Positive Stop

SNA- Sample Not Analyzed- See Chain of Custody for details

Note: Polarized-light microscopy is not consistently reliable in detecting asbestos in floor coverings and similar non-friable organically bound materials. In those cases, EPA recommends, and certain states (e.g. NY) require, that negative results be confirmed by quantitative transmission electron microscopy.

The Laboratory at TRC follows the EPA's Interim Method for the Determination of Asbestos in Bulk Insulation (1982), and the EPA recommended Method for the Determination of Asbestos in Bulk Building Materials (EPA/600/R-93/116), July 1993, R.L. Perkins and B.W. Harvey which utilizes polarized light microscopy (PLM). Our analysts have completed an accredited course in asbestos identification. TRC's Laboratory is accredited under the National Voluntary Laboratory Accreditation Program (NVLAP), for Bulk Asbestos Fiber Analysis, NVLAP Code 18/A01, effective through June 30, 2016. TRC is an American Industrial Hygiene Association (AIHA) accredited lab for PLM effective through October 1, 2016. Asbestos content is determined by visual estimate unless otherwise indicated. Quality Control is performed in-house on at least 10% of samples and the QC data related to the samples is available upon written request from the client.

This report shall not be reproduced, except in full, without the written approval of TRC. This report must not be used by the client to claim product endorsement by NVLAP or any agency of the U.S. Government. This report relates only to the items tested.

Analyzed by: K. Williamson Reviewed by: Amb. Park Date Issued  
Kathleen Williamson, Laboratory Manager Amanda Parkins, Approved Signatory 10/21/2015

#### TRC LABORATORY ASBESTOS ANALYTICAL ACCREDITATIONS

NVLAP Lab Code 101424-0	AIHA-LAP,LLC #100122	CT #PH-0426	ME LA-0075, LB-0071	MA #AA000052	NY #10980	WV# LT000411
RI #AAL-007 TX #300354	VT #AL014538 LA#05011	VA #3333 000283	AZ #A20944	HI #L-09-004	NJ #CT004	CA #2907
CO# AL-15020	PHIL# 461	PA#68-03387				



Nov 04  
ORDER OF SHEETS

Title  
Typical Sections and Details  
(includes erosion control plans)  
Estimate of Quantities  
Miscellaneous Quantities  
Right of Way Plat  
Plan and Profile  
Standard Detail Drawings  
~~Sign Plates~~  
Structure Plans  
~~Computer Earthwork Data~~  
~~Cross Sections~~

TOTAL SHEETS = 104

STATE OF WISCONSIN  
DEPARTMENT OF TRANSPORTATION

PLAN OF PROPOSED IMPROVEMENT

EAU CLAIRE - CHIPPEWA FALLS ROAD

EAU CLAIRE RIVER BRIDGE: B-18-0167 & B-18-0168

U.S.H. 53

EAU CLAIRE COUNTY

STATE PROJECT NUMBER  
1190-00-75

STATE PROJECT	FEDERAL PROJECT	
	PROJECT	CONTRACT
1190-00-75		

AS-BUILT PLAN

PROJECT ENGINEER: CHAD HINES  
WisDOT  
PRIME CONTRACTOR: ZENITH TECH, INC.  
BEGIN CONSTRUCTION: 3-9-2005  
END CONSTRUCTION: 5-31-2006  
FINAL CONTRACT COST: \$10,360,978.85  
CONTRACT MOD #S: 7 - \$60,753.87  
CONTRACT ID: 20041109021

1/25/2007  
GHO

END PROJECT 1190-00-75  
STA. 376'+US'+67.61


STRUCTURE B-18-0167

STRUCTURE B-18-0168

BEGIN PROJECT 1190-00-75  
STA. 366'+US'+68.97  
X = 1591247.34  
Y = 363756.92

RECEIVED  
SEP 16 2004  
DIST. 6

STATE OF WISCONSIN DEPARTMENT OF TRANSPORTATION	
PREPARED BY	DTD DIST. 6
Surveyor	ADAM SARAUER
Designer	
District Examiner	RICK SHERMO
District Supervisor	LARRY JONES
Proj. Dev. Engineer	
C.O. Examiner	
APPROVED FOR DISTRICT OFFICE	
DATE: 7/27/04	<i>Ross Johnson</i> (Signature)

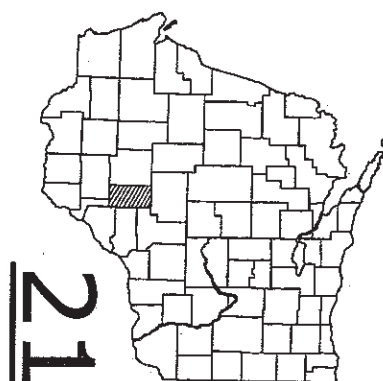


DESIGN DESIGNATION



A.D.T. (2004) = 23,200  
A.D.T. (2024) = 31,100  
D.H.V. (2024) = 3,565  
D. = 50/60  
T. = 7.7  
DESIGN SPEED = 70 MPH  
ESALS = 6,321,800

CONVENTIONAL SYMBOLS

COUNTY LINE  
CORPORATE LIMITS  
PROPERTY LINE  
LOT LINE  
LIMITED EASEMENT  
EXISTING RIGHT OF WAY  
PROPOSED OR NEW R/W LINE  
SURVEY LINE  
SLOPE INTERCEPT  
ORIGINAL GROUND  
MARSH OR ROCK PROFILE  
(To be noted as such)  
MARSH AREA  
WOODED OR SHRUB AREA

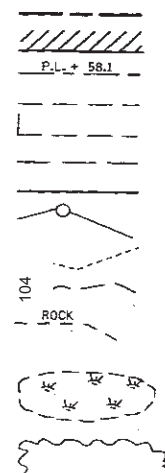

COMBUSTIBLE FLUIDS  
UNDERGROUND UTILITIES  
GAS  
ELECTRIC  
TELEPHONE OR TELEGRAPH  
COMMUNICATIONS LINE  
SERVICE PEDESTAL  
POWER POLE  
TELEPHONE POLE  
RAILROAD  
SANITARY SEWER  
STORM SEWER  
WATER  
EXISTING CULVERT  
PROPOSED CULVERT  
(Box or Pipe)  
CULVERT (Profile View)

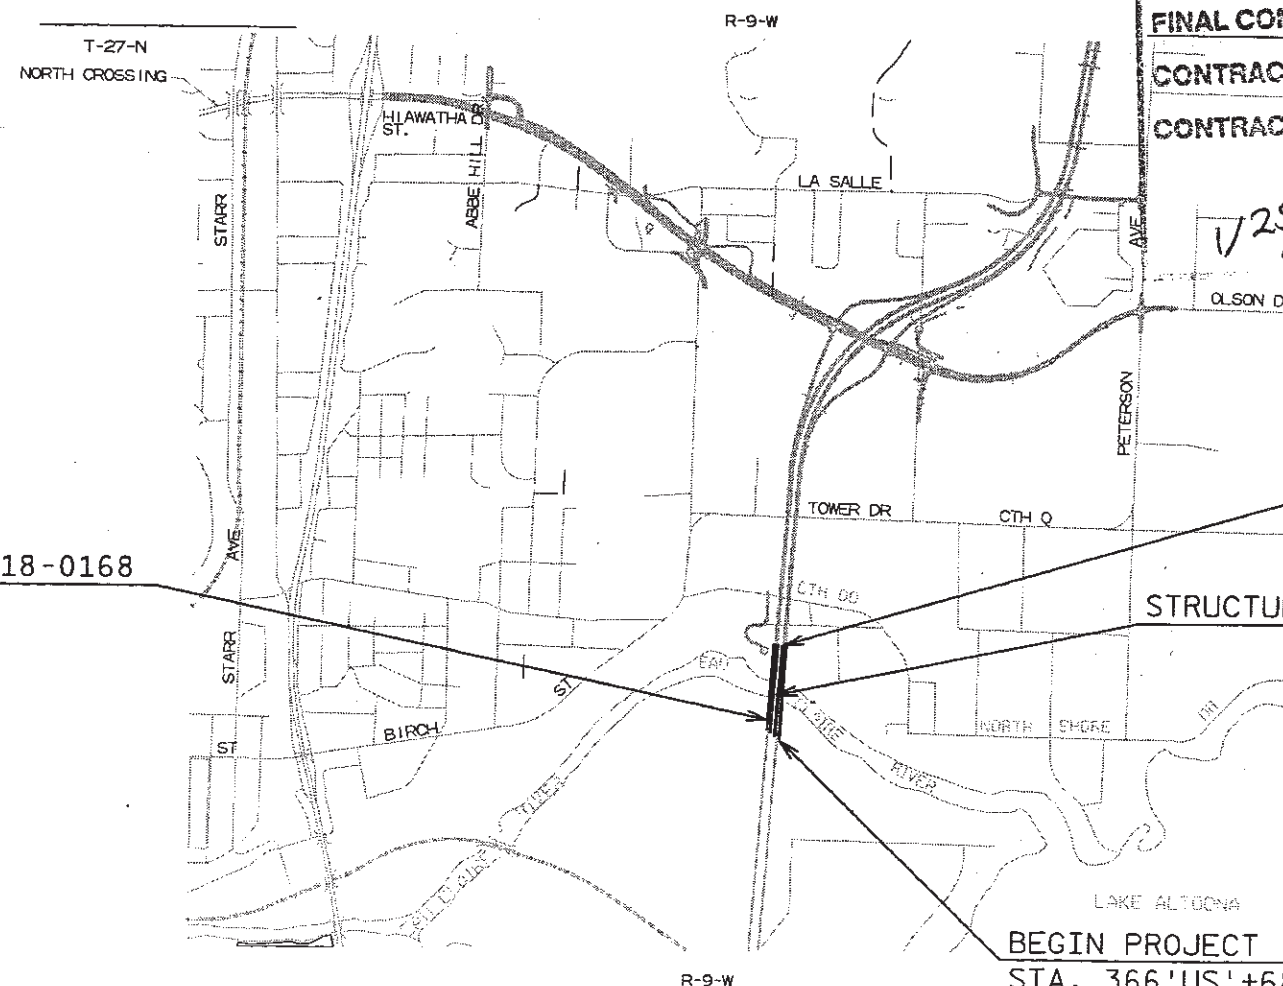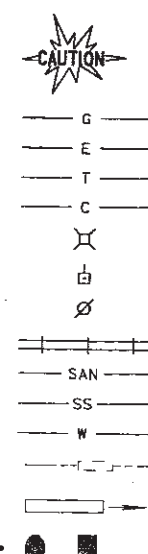

LAYOUT  
SCALE 0 MI.


TOTAL NET LENGTH OF CENTERLINE = 0.00 MI. (1190-00-75)

"Coordinates on this plan are referenced to the Wisconsin State Plane  
Coordinate System (WSPCS), 'Central' Zone."

PROJECT ID: 1190-00-75


COUNTY: EAU CLAIRE

NOV 04

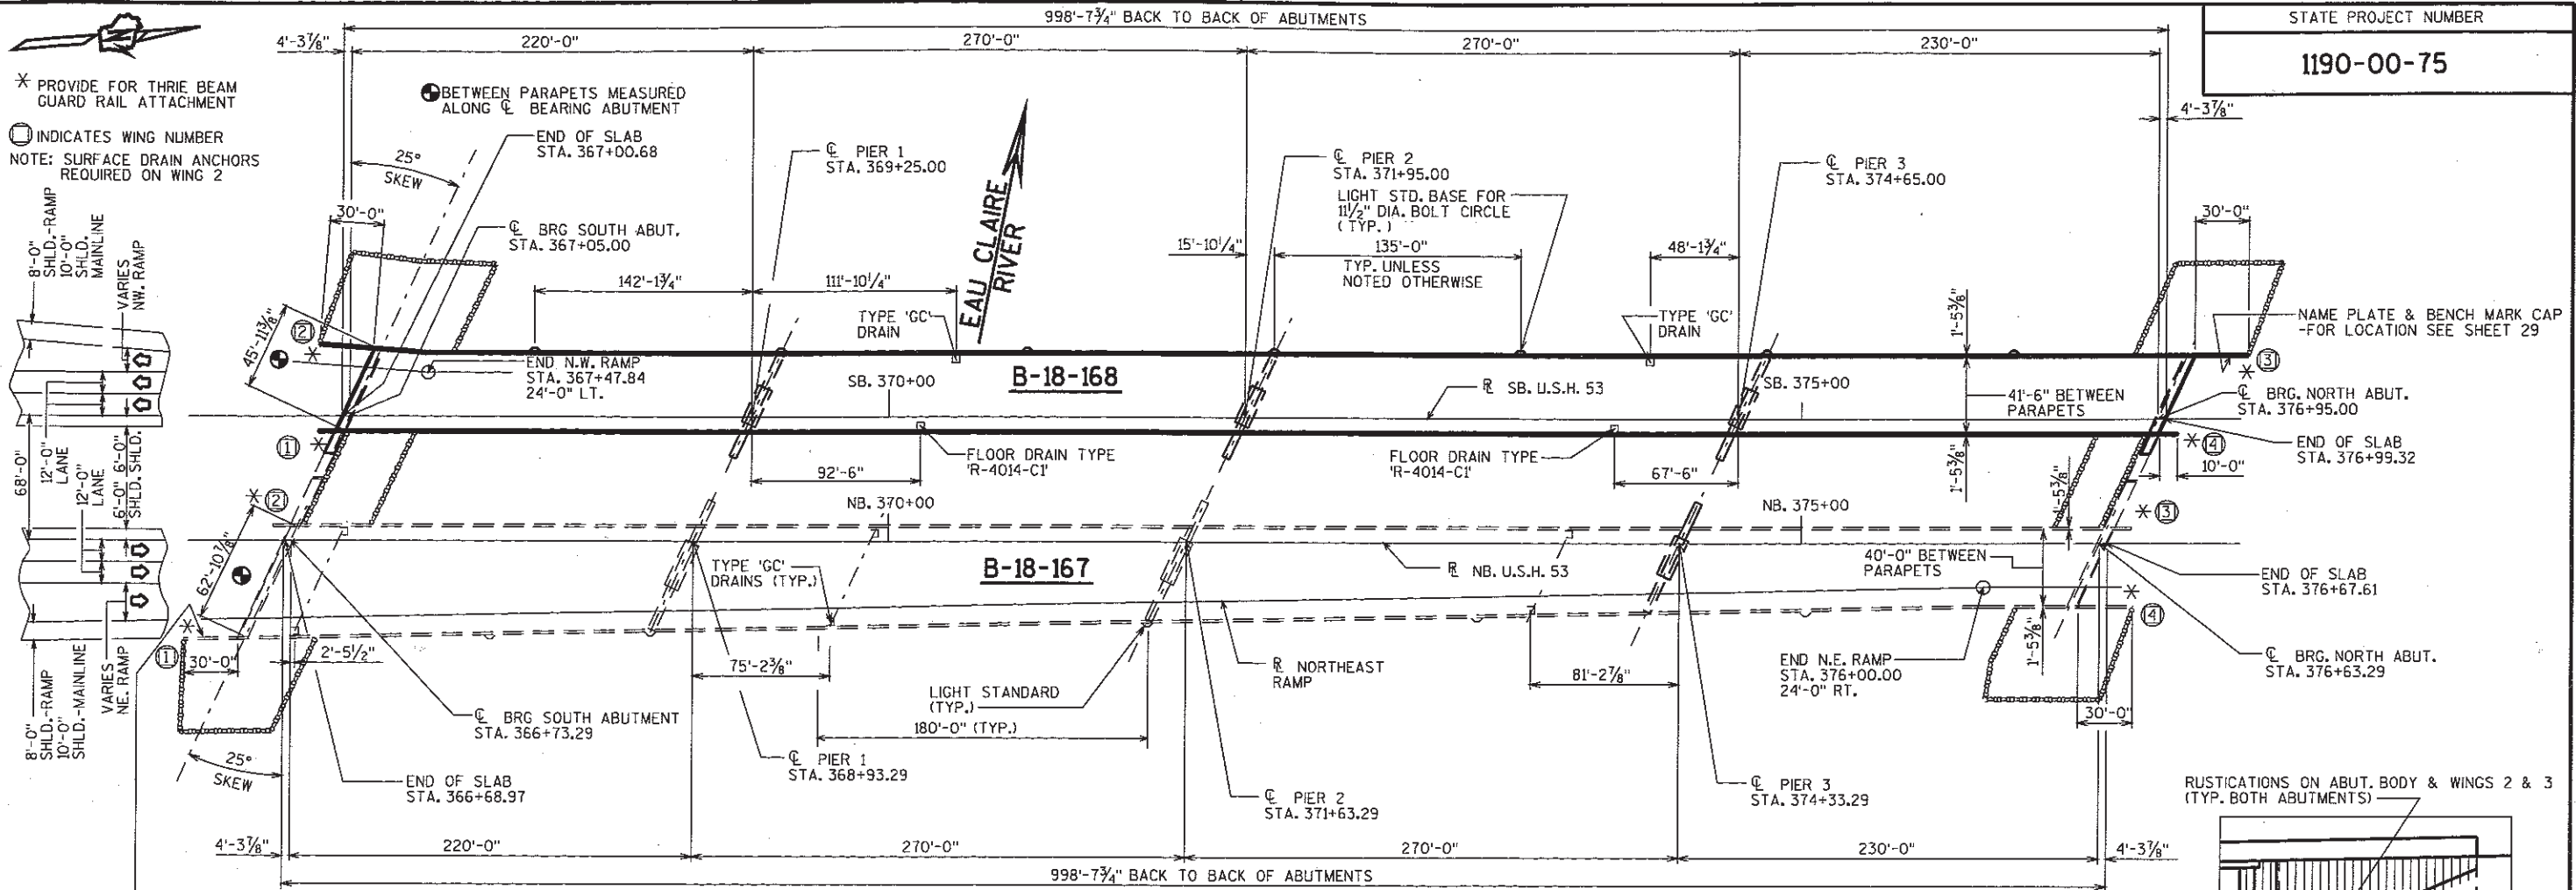

# PLAN

4 SPAN-120" WEB STEEL PLATE GIRDERS

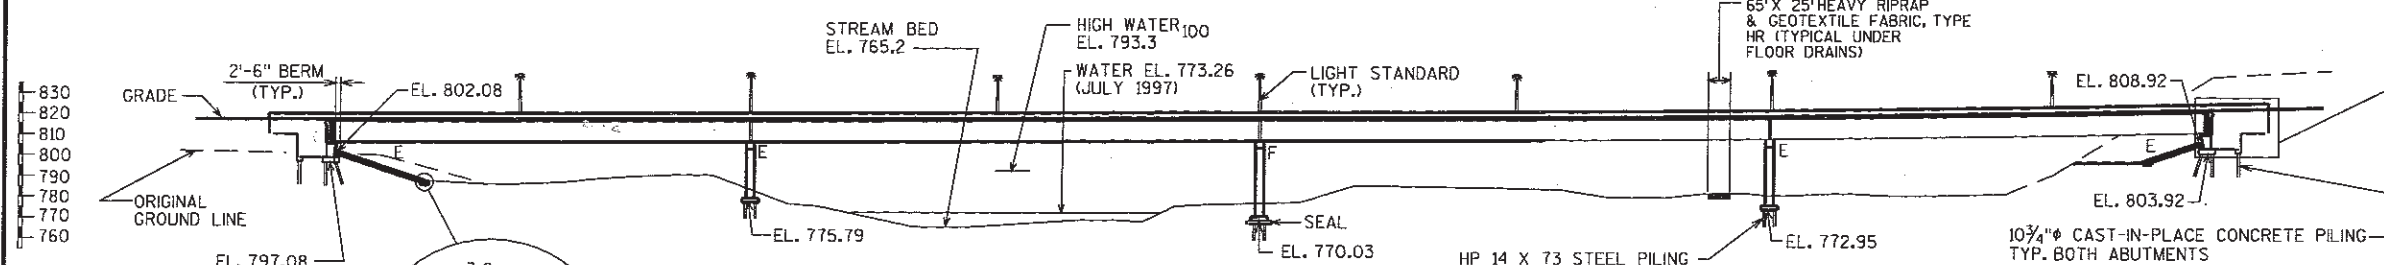

# ELEVATION

## FOUNDATION DATA

ABUTMENTS TO BE SUPPORTED ON 10 3/4" CAST-IN-PLACE CONCRETE PILING DRIVEN TO A MINIMUM BEARING VALUE OF 55 TONS PER PILE.  
 ESTIMATED 75'-0" LONG @ SOUTH ABUTMENT **ACTUAL 45.2'**  
 ESTIMATED 95'-0" LONG @ NORTH ABUTMENT **ACTUAL 38.7'**  
 PIER TO BE SUPPORTED ON HP 14 X 73 STEEL PILING DRIVEN TO A MINIMUM BEARING VALUE OF 95 TONS PER PILE.  
 ESTIMATED 70'-0" LONG @ PIER 1 **ACTUAL 63.8'**  
 ESTIMATED 65'-0" LONG @ PIER 2 **ACTUAL 68.3'**  
 ESTIMATED 90'-0" LONG @ PIER 3 **ACTUAL 94.3'**

## HYDRAULIC DATA

100 YEAR FREQUENCY  
 $Q_{100} = 33000$  C.F.S.  
 $VEL. = 2.9$  F.P.S.  
 $HW. = EL. 793.3$   
 WATERWAY AREA= 11500 SQ. FT.  
 DRAINAGE AREA= 815.5 SQ. MI.  
 ROAD OVERTOPPING = NA  
 SCOUR CRITICAL CODE = 5  
 2 YEAR FREQUENCY  
 $Q_2 = 8600$  C.F.S.  
 $HW_2 = EL. 781.3$

## LIST OF DRAWINGS

1. GENERAL PLAN
2. CROSS SECTION & QUANTITIES
3. SUBSURFACE EXPLORATION
4. SUBSURFACE EXPLORATION
5. SOUTH ABUTMENT
6. SOUTH ABUTMENT DETAILS
7. NORTH ABUTMENT
8. NORTH ABUTMENT DETAILS
9. PIER 1
10. PIER 1 DETAILS
11. PIER 2
12. PIER 2 DETAILS
13. PIER 3
14. PIER 3 DETAILS
15. BEARING DETAILS @ ABUTMENTS
16. BEARING DETAILS @ PIERS
17. GIRDER DETAILS @ SPANS 1 & 2
18. GIRDER DETAILS @ SPANS 3 & 4
19. FRAMING PLAN
20. CROSS FRAMING DETAILS
21. SUPERSTRUCTURE DETAILS
22. SUPERSTRUCTURE CROSS SECTION
23. SUPERSTRUCTURE PLAN
24. SUPERSTRUCTURE BAR DETAILS
25. EXPANSION DEVICE
26. EXPANSION DEVICE DETAILS
27. FLOOR DRAINS TYPE 'GC'
28. FLOOR DRAINS TYPE 'R-4014-C1'
29. SLOPED FACE PARAPET 'LF'
30. LIGHTING DETAILS
31. SLOPED FACE PARAPET 'LF' & FOOTING

## DESIGN DATA

**LIVE LOAD:**  
 DESIGN RATING: HS-20  
 INVENTORY RATING: HS-29  
 OPERATIONAL RATING: HS-49  
 MAXIMUM STANDARD PERMIT VEHICLE LOAD = 250 KIPS.  
 STRUCTURE IS DESIGNED FOR A FUTURE WEARING SURFACE OF 20 POUNDS PER SQUARE FOOT.  
**ULTIMATE DESIGN STRESSES:**  
 CONCRETE MASONRY SLAB— $f'_c = 4,000$  P.S.I. ALL OTHER— $f'_c = 3,500$  P.S.I.  
 BAR STEEL REINFORCEMENT, GRADE 60— $f_y = 60,000$  P.S.I.  
 HIGH STRENGTH STRUCTURAL STEEL (ASTM A709, GRADE 50W)— $f_y = 50,000$  P.S.I.

## TRAFFIC VOLUME

S.B. U.S.H. 53  
 A.D.T.=14,125 (2024)  
 R.D.S.=70 M.P.H.

STRUCTURES DESIGN CONTACTS:  
 KENT BAHLER (608) 266-8490  
 VU THAO (608) 267-2869

NO.	DATE	REVISION	BY

Plans Prepared By **WISDOT**  
**BUREAU OF STRUCTURES**


APPROVED: SDR-8-2-04  
 CHIEF STRUCTURAL DESIGN ENGINEER

**STRUCTURE B-18-168**  
 SB U.S.H. 53 OVER EAU CLAIRE RIVER

COUNTY	EAU CLAIRE	TOWN/CITY/VILLAGE	SEYMOUR
DESIGN SPEC.	AASHTO STD. SPEC. 2003	LOAD	HS-20
DESIGNED BY	MGW	DESIGN	CKD
SDR	SDR	DRAWN BY	CRJ
PLANS	VT	CKD	VT


**GENERAL PLAN**

SHEET 1 OF 31  
 73 73

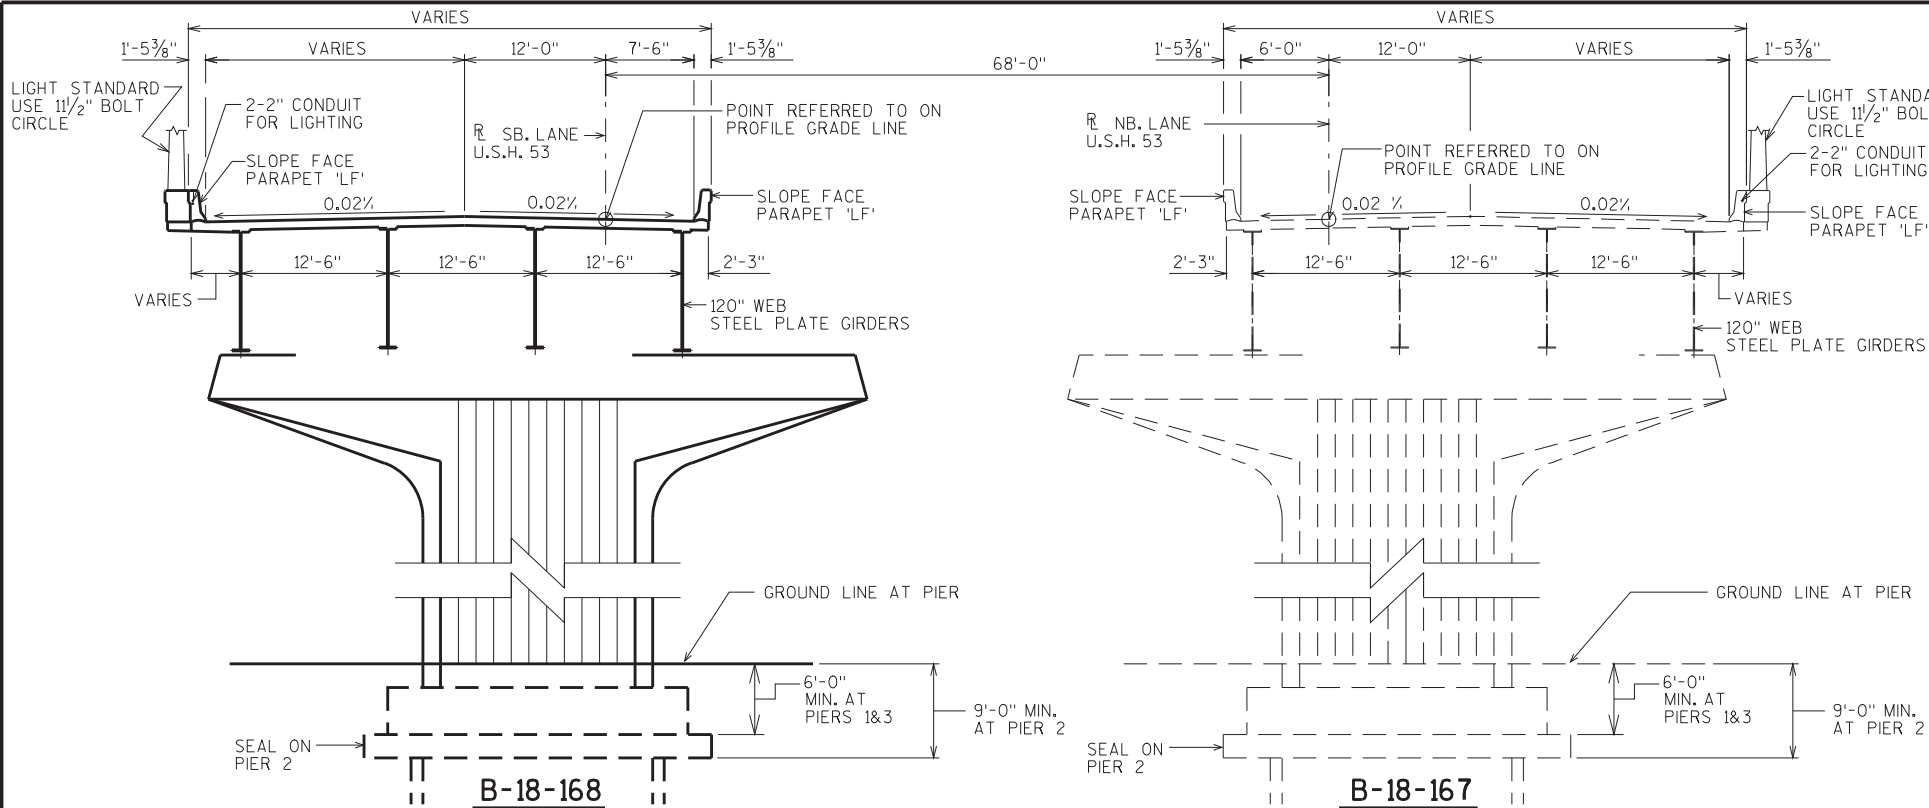


TOTAL ESTIMATED QUANTITIES CROSS SECTION THRU ROADWAY LOOKING NORTH

BID ITEMS	UNIT	SUPER.	SOUTH ABUT.	NORTH ABUT.	PIER 1	PIER 2	PIER 3	TOTALS
EXCAVATION FOR STRUCTURES BRIDGES B-18-168	LS	—	—	—	—	—	—	1
BACKFILL STRUCTURE	CY	—	930	960	—	—	—	1890
CONCRETE MASONRY BRIDGES	CY	1630	250	254	270	273	287	2964
CONCRETE MASONRY SEAL	CY	—	—	—	—	80	—	80
EXPANSION DEVICE MODULAR B-18-168	LS	—	—	—	—	—	—	1
PROTECTIVE SURFACE TREATMENT	SY	5690	—	—	—	—	—	5690
BAR STEEL REINFORCEMENT HS BRIDGES	LB	—	9110	9205	50650	54355	60460	183780
BAR STEEL REINFORCEMENT HS COATED BRIDGES	LB	350955	10320	10540	—	—	—	371815
STRUCTURAL STEEL HS	LB	2,287,285	—	—	—	—	—	2,287,285
FLOOR DRAINS TYPE GC	EACH	2	—	—	—	—	—	2
FLOOR DRAINS TYPE 'R-4014-CI'	EACH	2	—	—	—	—	—	2
RUBBERIZED MEMBRANE WATERPROOFING	SY	—	22	22	—	—	—	44
* RIPRAP HEAVY	CY	—	500	415	—	—	120	1035
PIPE UNDERDRAIN 6-INCH	LF	—	94	94	—	—	—	188
PIPE UNDERDRAIN UNPERFORATED 6-INCH	LF	—	10	10	—	—	—	20
ANCHOR ASSEMBLIES FOR STEEL PLATE BEAM GUARD	EACH	4	—	—	—	—	—	4
ANCHOR ASSEMBLIES LIGHT POLES	EACH	7	—	—	—	—	—	7
GEOTEXTILE FABRIC TYPE DF (SCHEDULE A)	SY	—	79	79	—	—	—	158
* GEOTEXTILE FABRIC TYPE HR	SY	—	790	650	—	—	180	1620
CONDUIT RIGID NONMETALLIC SCHEDULE 40 2-INCH	LF	2020	—	—	—	—	—	2020
OMP CONCRETE STRUCTURES 5-CYLINDER	CY	1630	250	254	270	273	287	2964
INCENTIVE STRENGTH CONCRETE STRUCTURES	DOL	—	—	—	—	—	—	29640
PILING STEEL DELIVERED AND DRIVEN HP 14-INCH X 73LB.	LF	—	—	—	3220	2730	4140	10090
CONDUIT RIGID METALLIC 2-INCH	LF	20	70	70	—	—	—	160
JUNCTION BOXES 18X12X6-INCH	EACH	7	—	—	—	—	—	7
WELDED STUD SHEAR CONNECTORS 7/8X6-INCH	EACH	8004	—	—	—	—	—	8004
BEARING ASSEMBLIES FIXED B-18-168	EACH	—	—	—	—	4	—	4
BEARING ASSEMBLIES EXPANSION B-18-168	EACH	—	4	4	4	—	4	16
COFFERDAMS B-18-168	LS	—	—	—	—	—	—	1
MASONRY ANCHORS TYPE S 5/8-INCH	EACH	—	130	130	—	—	—	260
PILING CIP CONCRETE DELIVERED AND DRIVEN 10 3/4-INCH	LF	—	3375	4275	—	—	—	7650
PROTECTIVE COATING CLEAR	GAL	—	5	5	10	12	12	44
NON-BID ITEMS								
BRIDGE SEAT PROTECTION	L.S.	—	—	—	—	—	—	1
FILLER	SIZE	—	—	—	—	—	—	1/2" & 3/4"

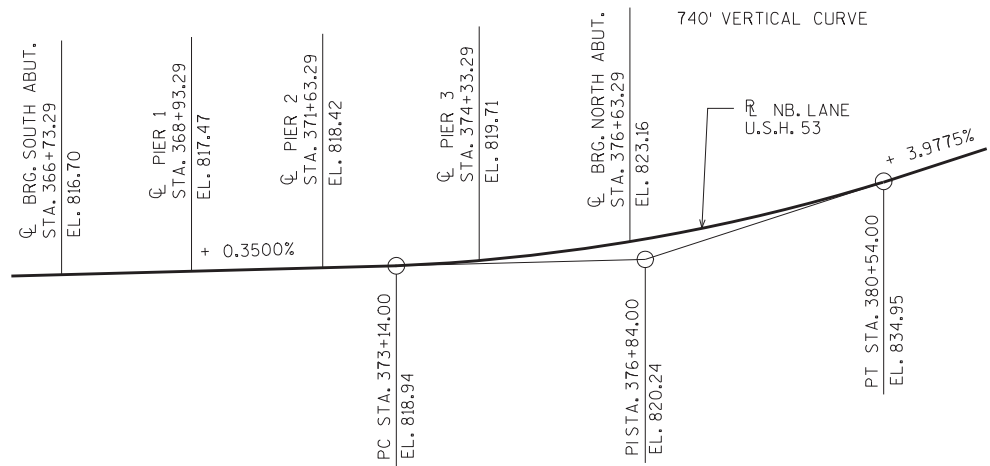

NB. PROFILE GRADE LINE U.S.H. 53

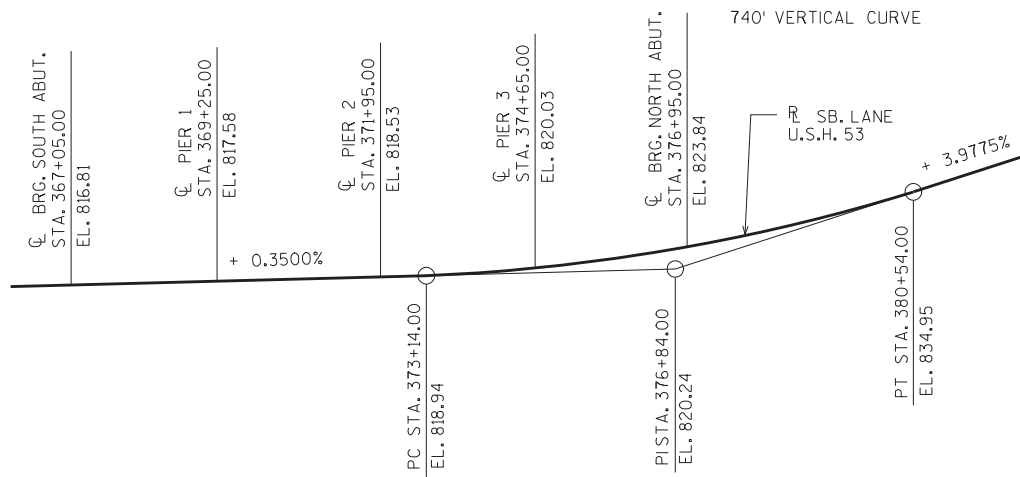

SB. PROFILE GRADE LINE U.S.H. 53

GENERAL NOTES

- DRAWINGS SHALL NOT BE SCALED.
- BAR STEEL REINFORCEMENT SHALL BE EMBEDDED 2" CLEAR UNLESS OTHERWISE SHOWN OR NOTED.
- AT THE BACKFACE OF ABUTMENT ALL VOLUME WHICH CANNOT BE PLACED BEFORE ABUTMENT CONSTRUCTION AND IS NOT OCCUPIED BY THE NEW STRUCTURE SHALL BE BACKFILLED WITH STRUCTURE BACKFILL.
- THE EXISTING GROUND LINE SHALL BE USED AS THE UPPER LIMITS OF EXCAVATION AT THE PIERS.
- THE FIRST OR FIRST TWO DIGITS OF THE BAR MARK SIGNIFIES THE BAR SIZE.
- THE GRADATION OF THE STRUCTURE BACKFILL SHALL MEET THE REQUIREMENTS OF SECTION 209.2.2 OF THE STANDARD SPECIFICATIONS FOR GRADE 1 MATERIAL.
- THE COST OF FORMING RECESSES (RUSTICATION) AT ABUTMENTS AND PIERS SHALL BE INCIDENTAL TO BID ITEM "CONCRETE MASONRY BRIDGES".
- \*PIER 3 QUANTITY LOCATES BELOW FLOOR DRAIN

NO.	DATE	REVISION	BY
STATE OF WISCONSIN DEPARTMENT OF TRANSPORTATION STRUCTURES DESIGN SECTION			
STRUCTURE B-18-168			
DRAWN BY		CRJ	PLANS CK'D. VT
CROSS SECTION & QUANTITIES		SHEET 2	
		74	





8



NO.	DATE	REVISION	BY
STATE OF WISCONSIN DEPARTMENT OF TRANSPORTATION STRUCTURES DESIGN SECTION			
STRUCTURE B-18-168			
DRAWN BY		CRJ	PLANS CK'D. VT
SUBSURFACE EXPLORATION		SHEET 3	
		75	

FILE- 03-1683013.DGN  
SCALE = 19.2

USH 53 OVER EAU CLAIRE RIVER  
EAU CLAIRE BYPASS

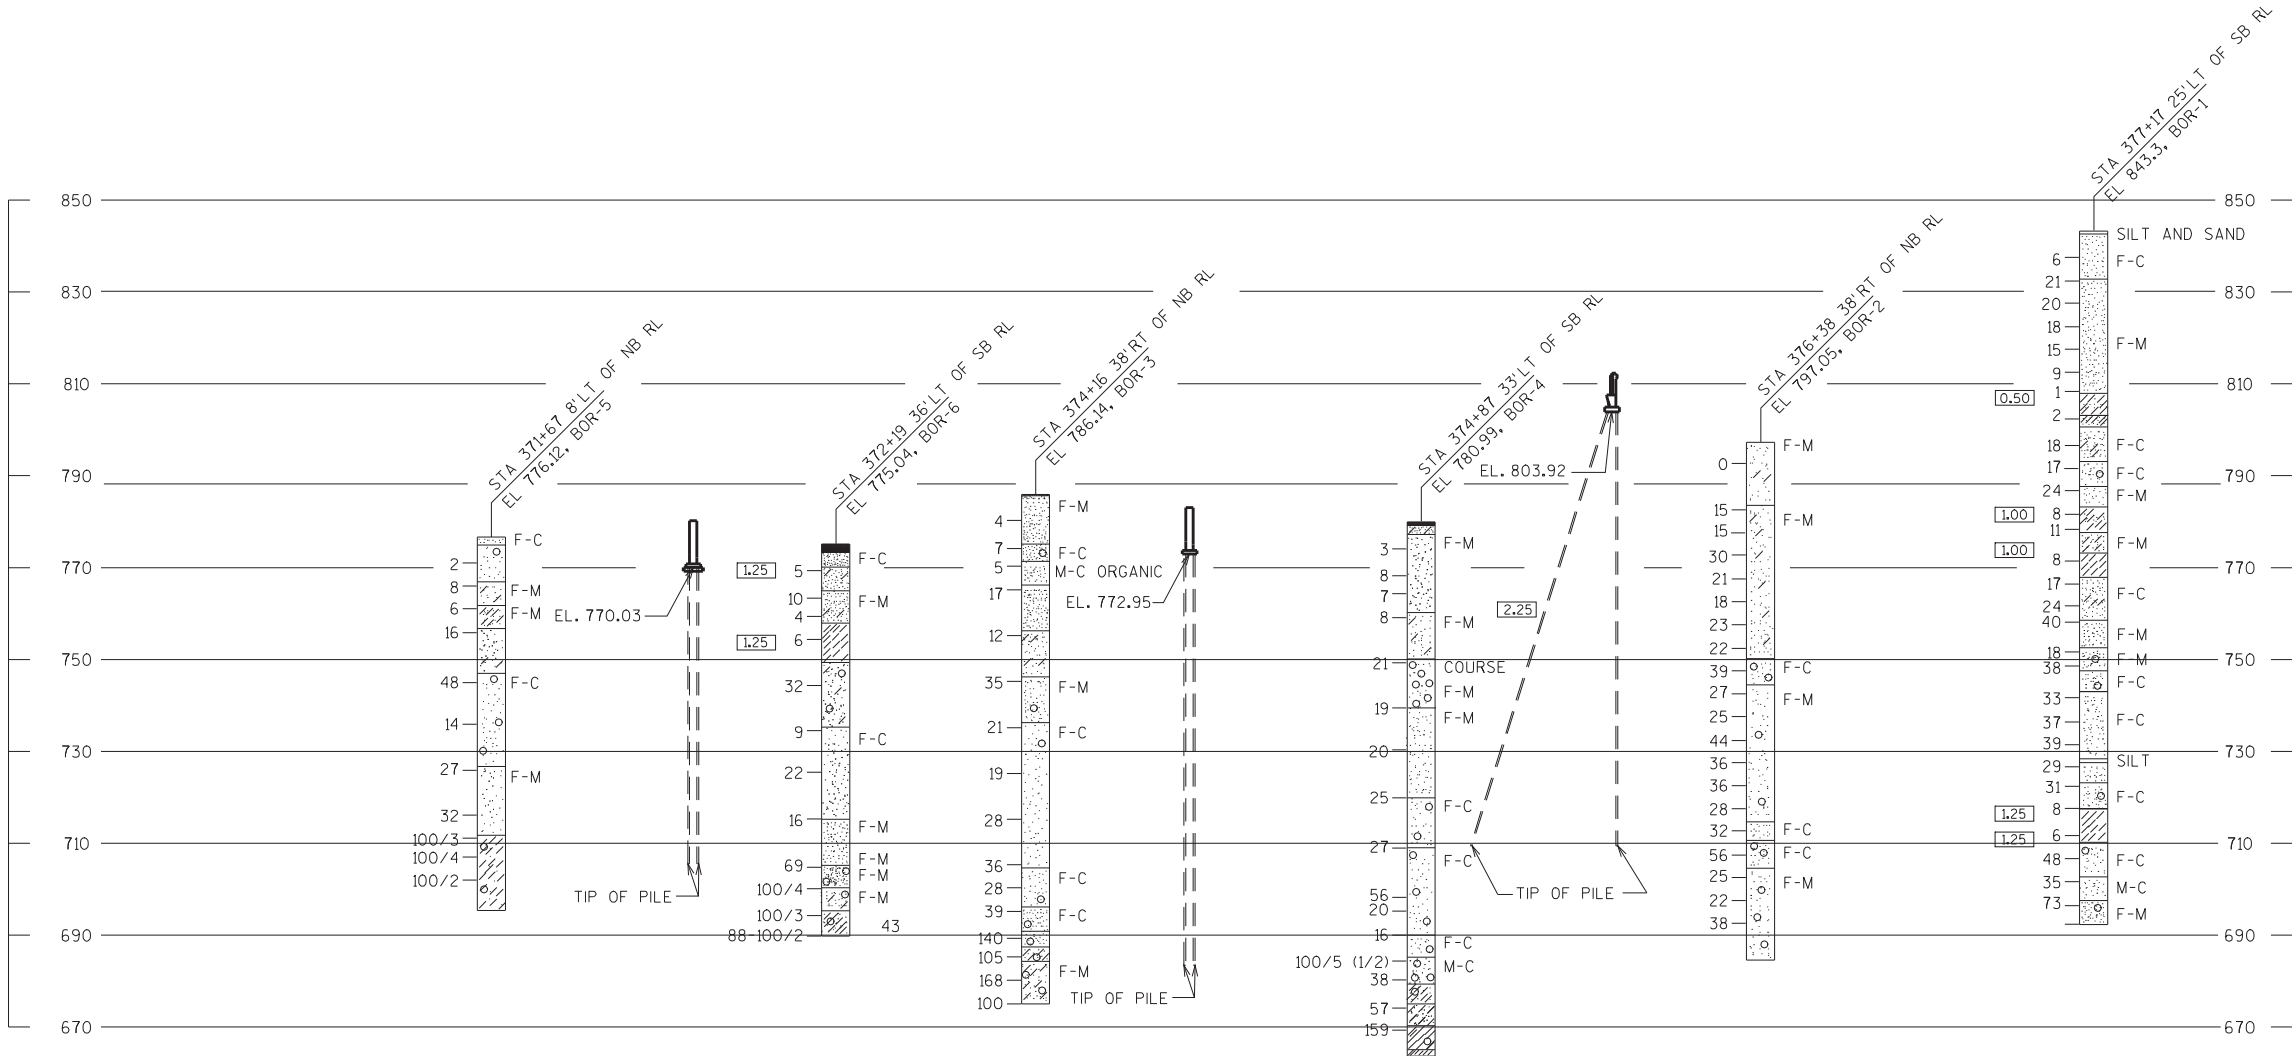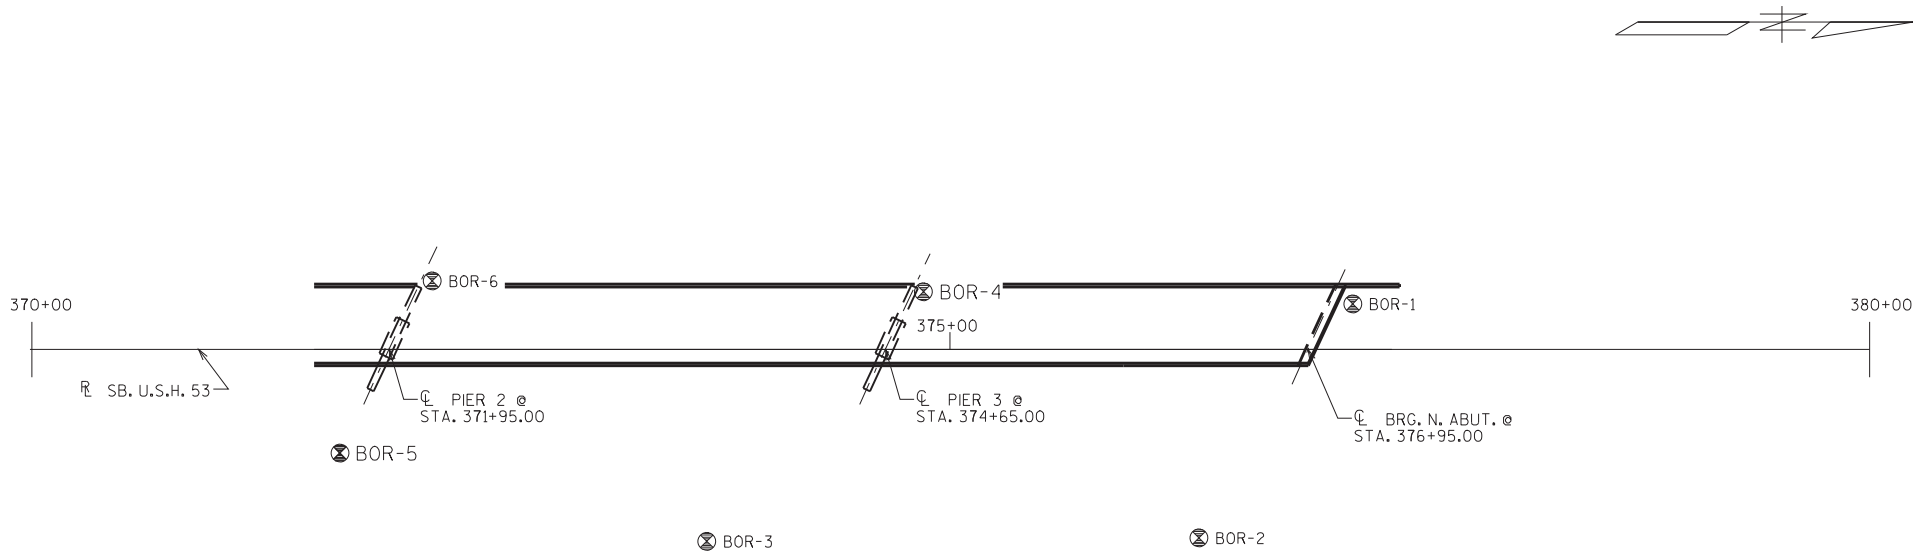

STATE PROJECT NUMBER

1190-00-75

ABBREVIATIONS

F— FINE M— MEDIUM C— COARSE  
WS— WEATHERED SO— SOUND

MATERIAL SYMBOLS

TOPSOIL SILT SANDSTONE  
SAND PEAT LIMESTONE  
GRAVEL CLAY IGNEOUS ROCK

LEGEND OF PROBING

PROBING NO.  
STA.  
ELEVATION  
7 AVERAGE BLOWS PER FOOT  
REFUSAL 95/6  
95/6=95 BLOWS FOR 6"  
PENETRATION  
PROBING TAKEN WITH  
A 350# WT.  
FALLING 18" ON A 2"  
O.D. POINT.

LEGEND OF BORING

ELEV. BORING NO.  
STA.  
UNCONFINED STRENGTH → 7.7  
BLOWS PER FT. USING 140# WT. FALLING 30"  
WASH SAMPLE  
SHELBY TUBE — S.T.  
GROUND WATER ELEVATION  
NO GROUND WATER OBSERVED ABOVE THIS ELEVATION  
SANDY GRAVEL  
F. BOULDERS OR COBBLES  
SAND  
SILTY CLAY  
SO LIMESTONE

UNLESS OTHERWISE SPECIFIED, THE BLOWS PER FOOT AT THE LOCATIONS INDICATED ARE BASED ON DRIVING A 2" O.D. X 1.4" I.D. SPLIT SPOON SAMPLER WITH A 140# HAMMER HAVING A FREE FALL OF 30". THE BLOW COUNT IS TAKEN IN UNDISTURBED SOIL IMMEDIATELY BELOW A CAGED OR OPEN HOLE ELIMINATING SIDE FRICTION ON THE DRIVE PIPE.

SUBSURFACE EXPLORATION FOR FOUNDATION DESIGN AND BIDDERS INFORMATION

TO OBTAIN RELATIVE DATA CONCERNING THE CHARACTER OF MATERIAL IN AND UPON WHICH THE FOUNDATION MIGHT BE BUILT, BORINGS AND/OR SOUNDINGS WERE MADE AT POINTS APPROXIMATELY AS INDICATED ON THIS DRAWING. THE DATA PRESENTED HEREIN REPRESENTS THE FINDINGS OF THE SUBSURFACE EXPLORATIONS MADE. HOWEVER, BECAUSE THE DEPTHS INVESTIGATED ARE LIMITED AND THE AREA OF THE BORINGS AND/OR SOUNDINGS IS VERY SMALL IN RELATION TO THE ENTIRE AREA, THE WISCONSIN DEPARTMENT OF TRANSPORTATION DOES NOT WARRANT CONDITIONS BELOW THE DEPTHS INVESTIGATED OR THAT THE CLASSIFICATION OF MATERIAL ENCOUNTERED IN THESE INVESTIGATIONS IS NECESSARILY TYPICAL OF THE ENTIRE SITE.

NO.	DATE	REVISION	BY
STATE OF WISCONSIN DEPARTMENT OF TRANSPORTATION STRUCTURES DESIGN SECTION			
STRUCTURE B-18-168			
DRAWN BY CRJ		PLANS CK'D. VT	
SUBSURFACE EXPLORATION		SHEET 4	
		76	

FILE= 04-168SOIL S.DGN  
SCALE = 19:2





WING 2



18



1



- |   |      |          |         |                    |
|---|------|----------|---------|--------------------|
| NO.   | DATE | REVISION |         | BY                 |
| STATE OF WISCONSIN<br>DEPARTMENT OF TRANSPORTATION<br>STRUCTURES DESIGN SECTION |      |          |         |                    |
| STRUCTURE B-18-168  |      |          |         |                    |
|   |      | DRAWN BY | CRJ     | PLANS CKD BY<br>VT |
| SOUTH ABUTMENT  |      |          | SHEET 5 | 77 <sup>77</sup>   |



NOTE: THE FIRST OR FIRST TWO DIGITS OF THE  
BAR MARK SIGNIFIES THE BAR SIZE.

Technical drawings of five different L-shaped profiles, each with a table of part numbers and dimensions.

**Profile A707, A408, A809, A410:**

1'-2"	A707
8"	A408
1'-4"	A809
8"	A410

**Profile A411:**

Dimensions: 5'-0" (horizontal), 4'-9" (vertical)

**Profile A414:**

Dimensions: 2'-0" (horizontal)

**Profile A518:**


Dimensions: 2'-1" (horizontal), 1'-0" (vertical), 3" (vertical), 45° (angle)

**Profile A520:**




Dimensions: 1'-3" (horizontal)



NOTE: VERTICAL JOINTS ONLY,  
INCIDENTAL TO  
"CONCRETE MASONRY BRIDGES"

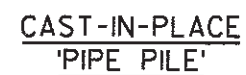

- |   |      |                  |               |
|---|------|------------------|---------------|
|   |      |                  |               |
| NO.   | DATE | REVISION         | BY            |
| STATE OF WISCONSIN<br>DEPARTMENT OF TRANSPORTATION<br>STRUCTURES DESIGN SECTION |      |                  |               |
| STRUCTURE B-18-168  |      |                  |               |
| DRAWN BY  |      | CRJ              | PLANS CK'D/VT |
| SOUTH ABUTMENT  |      | SHEET 6          |               |
| DETAILS   |      | 78 <sup>78</sup> |               |

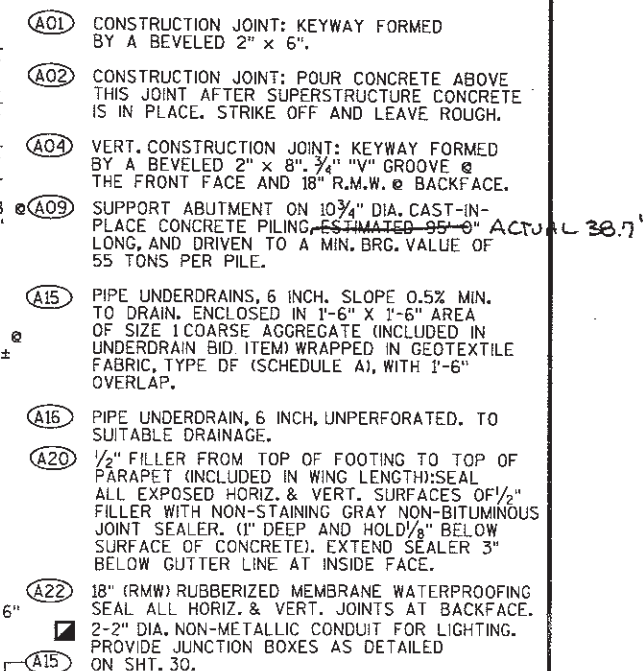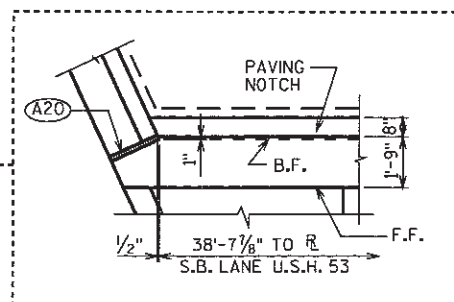
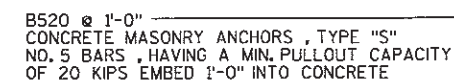


NO.	DATE	REVISION	BY
STATE OF WISCONSIN DEPARTMENT OF TRANSPORTATION STRUCTURES DESIGN SECTION			
STRUCTURE B-18-168			
DRAWN BY		CRJ	PLANS CK'D. V.T. V.T.
NORTH		SHEET 7	
ABUTMENT		79 79	






BAR MARK	COAT	NO. REQ'D.	LENGTH	BENT	BAR SERIES	LOCATION
B401		40	34'-11"			FOOTING TOP & BTM. HORIZ.
B402		24	31'-10"			FOOTING TOP & BTM. HORIZ.-WING
B403		73	8'-8"			FOOTING TOP HORIZ.
B704		73	8'-8"			FOOTING BTM. HORIZ.
B605		31	10'-8"			FOOTING TOP HORIZ.-WING
B906		31	10'-8"			FOOTING BTM. HORIZ.-WING
B707		130	5'-11"	X		FOOTING VERT.-BODY-B.F.
B408		65	4'-1"	X		FOOTING VERT.-BODY-F.F.
B809	X	60	9'-3"	X		FOOTING VERT.-WING-B.F.
B410	X	30	4'-11"	X		FOOTING VERT.-WING-F.F.
B411		65	10'-10"	X		BODY VERT.
B512		12	33'-4"			BODY HORIZ.-TOP
B413		4	26'-0"			BODY HORIZ.-TOP
B414		48	6'-11"	X		BODY VERT.-TOP
B415	X	36	33'-4"			BACKWALL HORIZ.
B516	X	130	12'-1"			BACKWALL VERT.-B.F.
B417	X	65	12'-1"			BACKWALL VERT.-F.F.
B518	X	62	6'-0"	X		BACKWALL PAVING CORBEL
B519	X	27	8'-2"			PAVING BLOCK-HORIZ.
B520	X	130	3'-5"	X		PAVING BLOCK-VERT.
B421	X	25	29'-8"			WING 3 HORIZ.
B422	X	30	17'-5"			WING 3 VERT.-F.F.
B823	X	60	16'-3"			WING 3 VERT.-B.F.
B424	X	11	5'-3"	X		SIDE WALL-HORIZ.
B425	X	4	12'-0"			SIDE WALL-VERT.
B426		12	33'-4"			BODY HORIZ.-F.F.-B.F.
B727		129	4'-8"			BODY-VERT.-B.F.

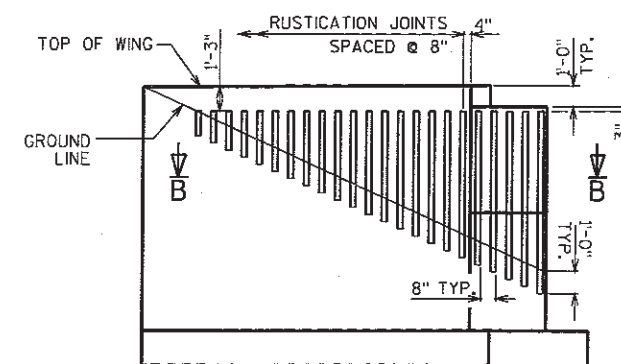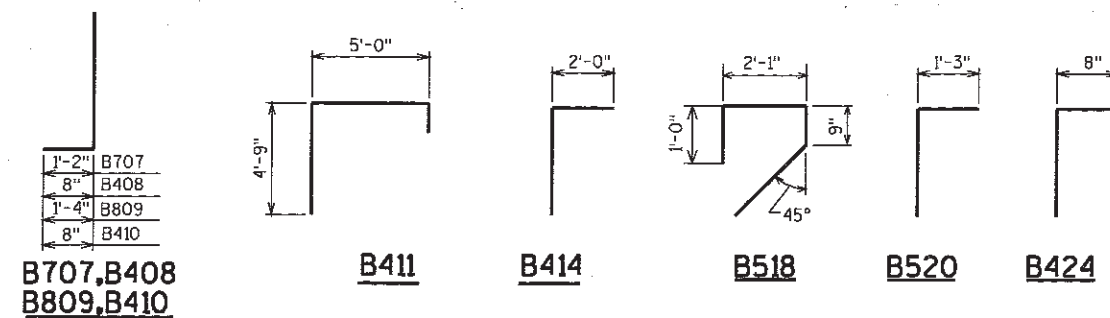


### RUSTICATION DETAIL

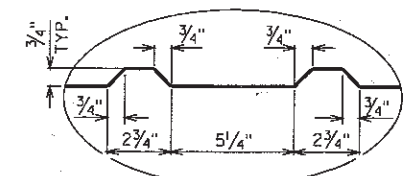


SECTION B-B

NOTE: VERTICAL JOINTS ONLY,  
INCIDENTAL TO  
"CONCRETE MASONRY BRIDGES"

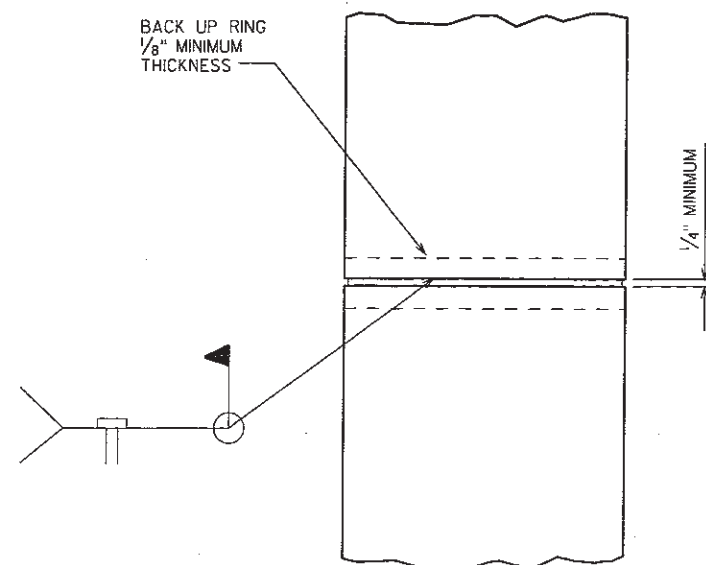


CAST-IN-PLACE  
'PIPE PILE'

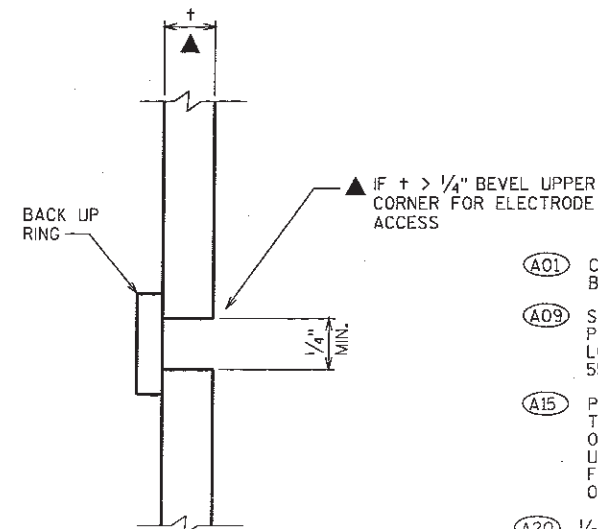


C.I.P. PILE WELD DETAIL

- (A01) CONSTRUCTION JOINT: KEYWAY FORMED BY A BEVELED 2" x 6".
- (A09) SUPPORT WING WALL ON 10 3/4" DIA. CAST-IN-PLACE CONCRETE PILING, ~~ESTIMATED 95.6'~~ ACTUAL 38.7' LONG, AND DRIVEN TO A MIN. BRG. VALUE OF 55 TONS PER PILE.
- (A15) PIPE UNDERDRAINS, 6 INCH. SLOPE 0.5% MIN. TO DRAIN, ENCLOSED IN 1'-6" X 1'-6" AREA OF SIZE 1 COARSE AGGREGATE (INCLUDED IN UNDERDRAIN BID ITEM) WRAPPED IN GEOTEXTILE FABRIC, TYPE DF (SCHEDULE A), WITH 1'-6" OVERLAP.
- (A20) 1/2" FILLER FROM TOP OF FOOTING TO TOP OF PARAPET (INCLUDED IN WING LENGTH); SEAL ALL EXPOSED HORIZ. & VERT. SURFACES OF 1/2" FILLER WITH NON-STAINING GRAY NON-BITUMINOUS JOINT SEALER. (1" DEEP AND HOLD 1/8" BELOW SURFACE OF CONCRETE). EXTEND SEALER 3" BELOW GUTTER LINE AT INSIDE FACE.


NO.	DATE	REVISION	BY
STATE OF WISCONSIN DEPARTMENT OF TRANSPORTATION STRUCTURES DESIGN SECTION			
STRUCTURE B-18-168			
DRAWN BY		CRJ	PLANS VT CKD/VT
NORTH ABUTMENT DETAILS		SHEET 8	
		80 80	

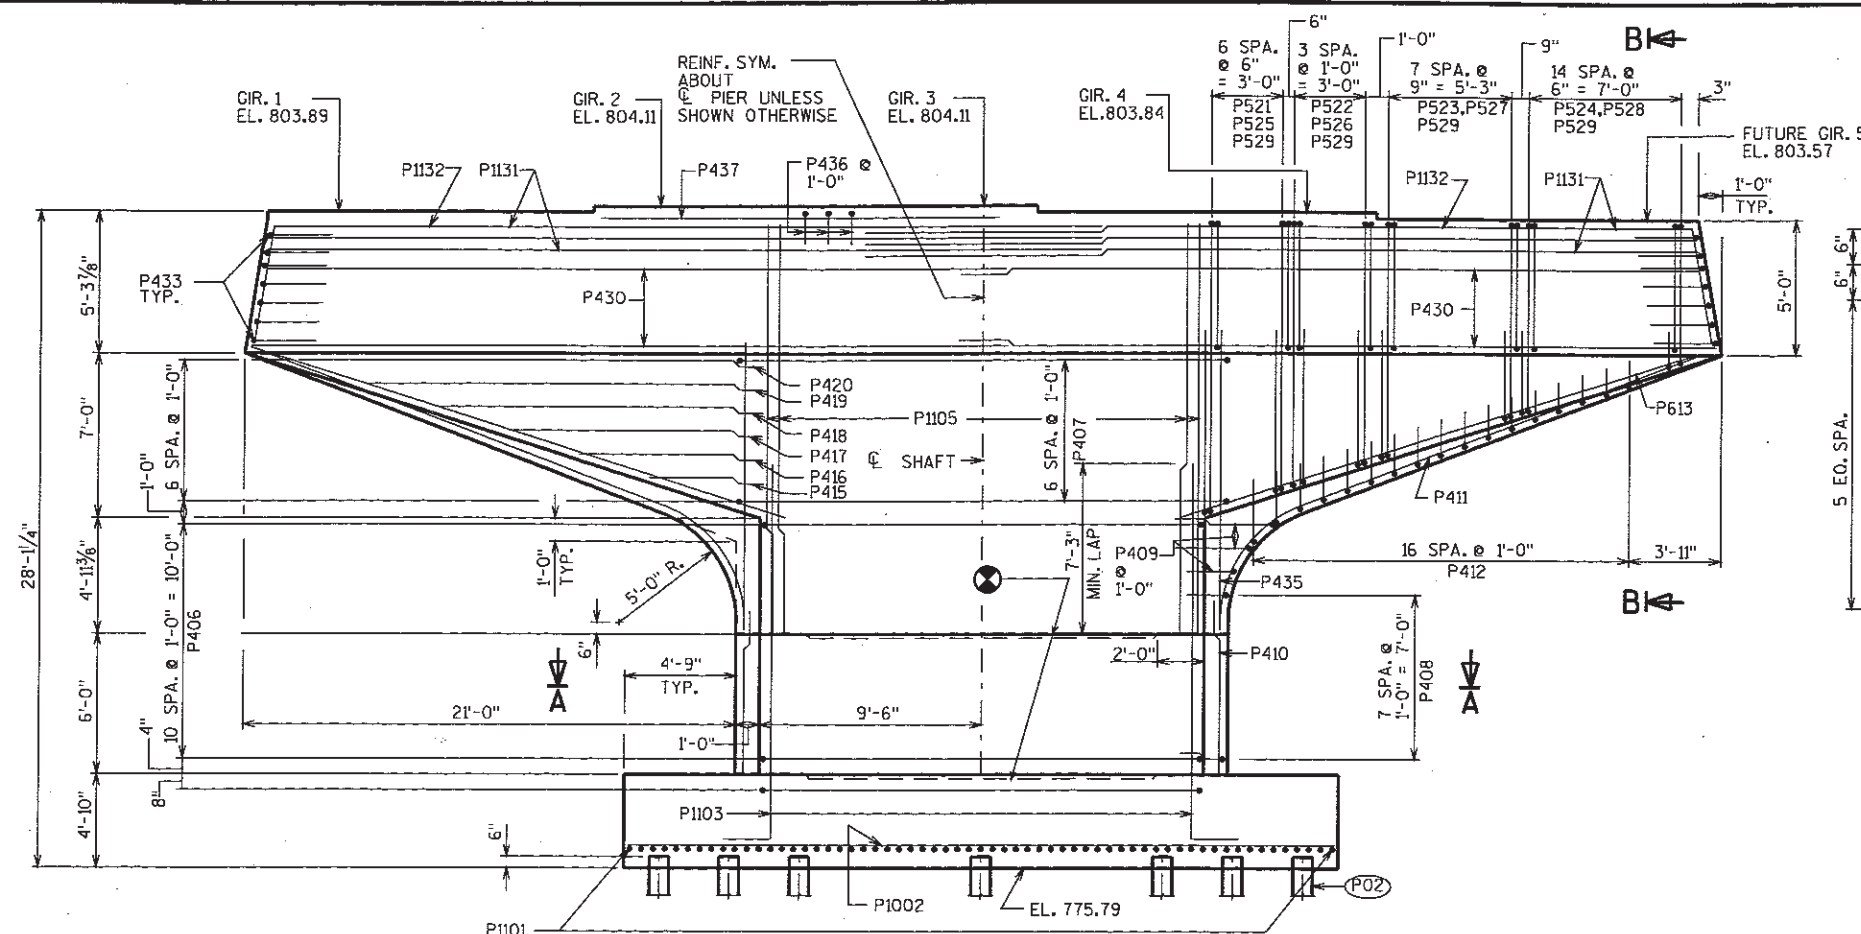


ELEVATION LOOKING NORTH

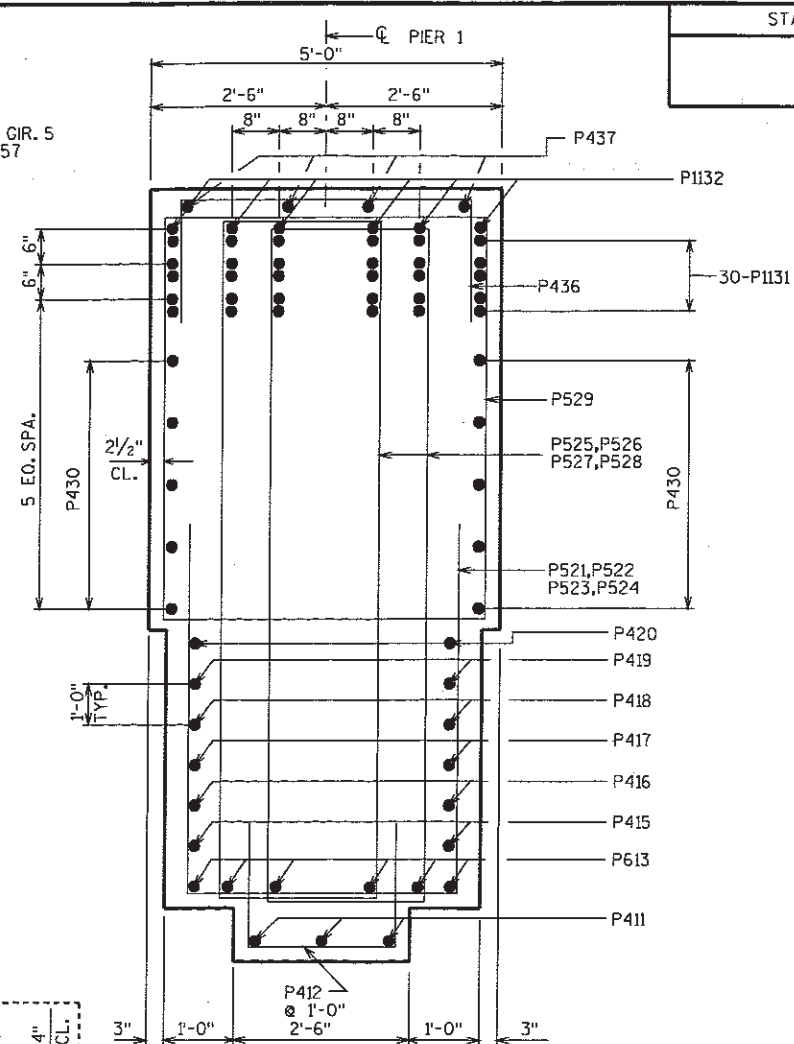

SECTION B-B

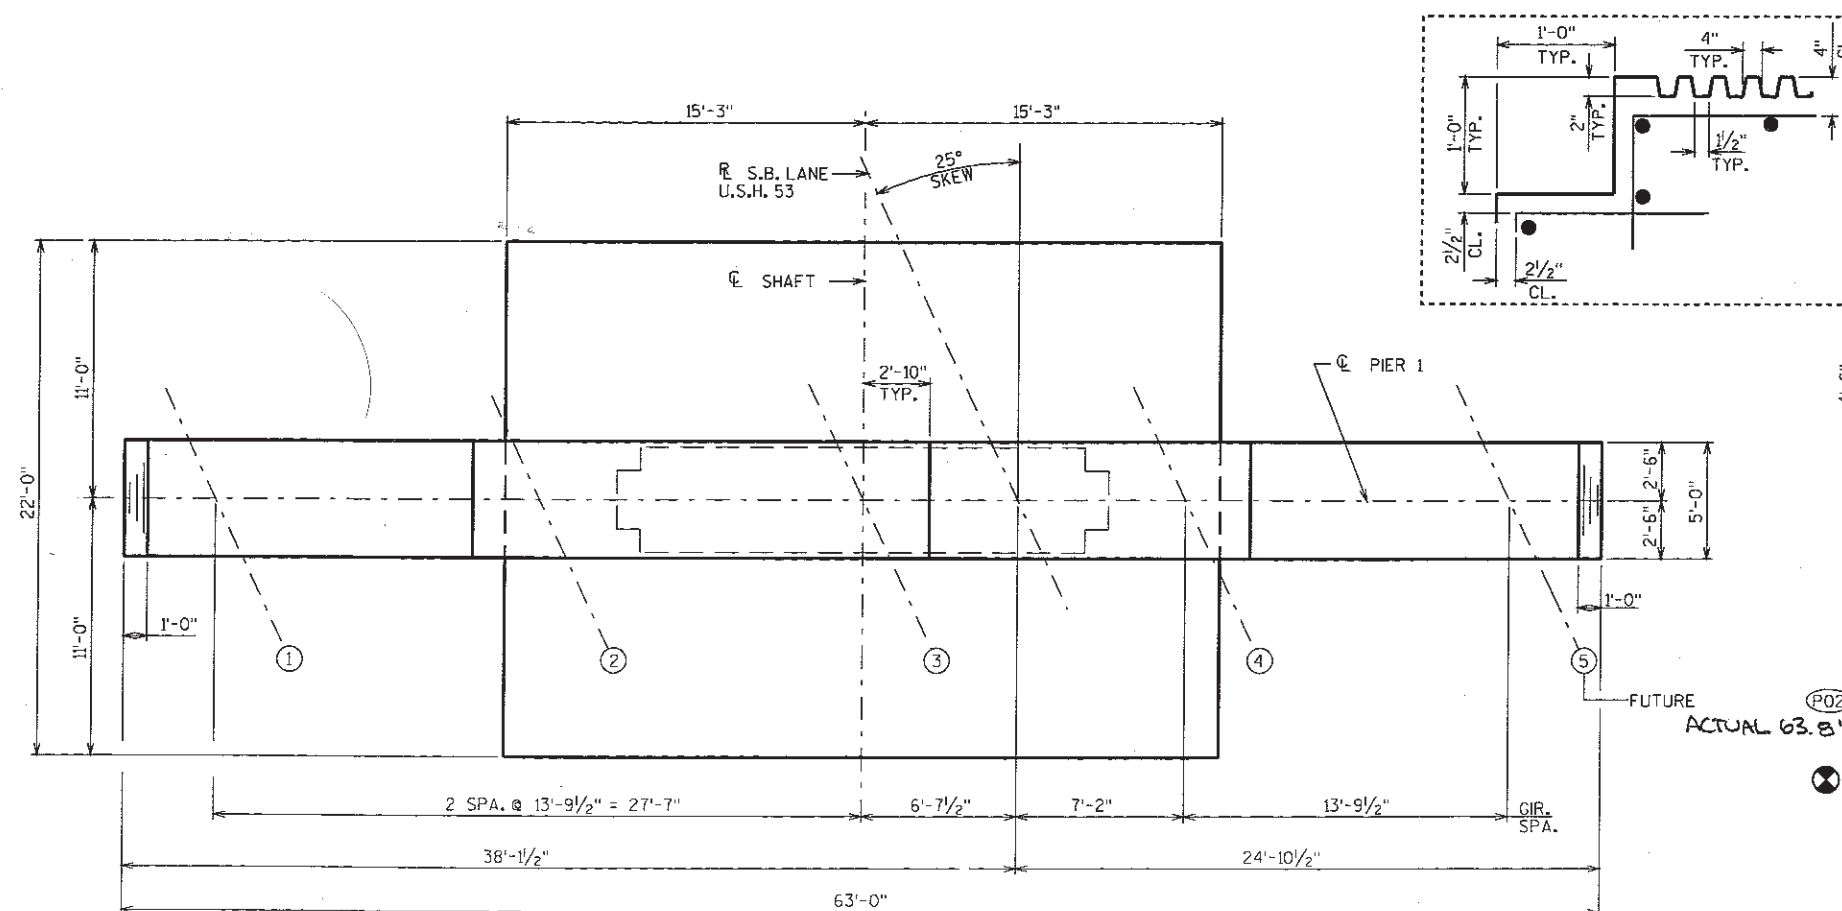BUNDLING  
DETAIL

PLAN

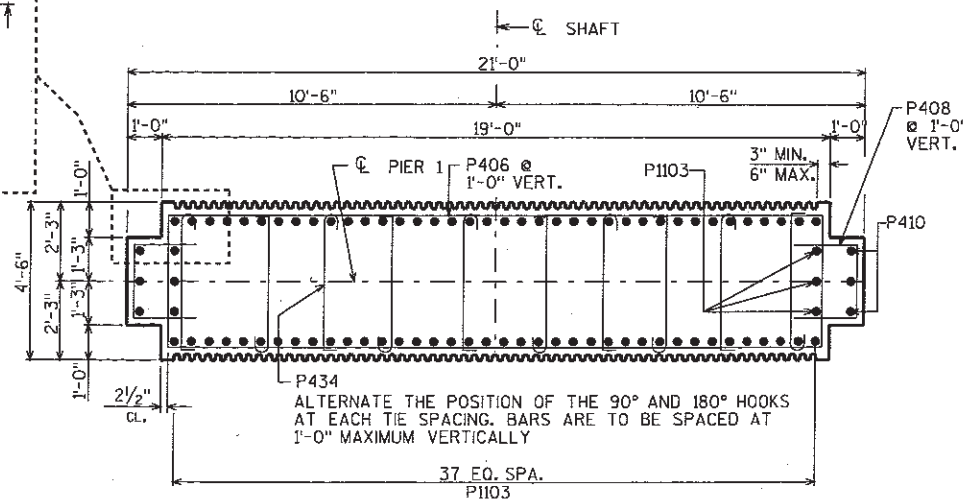

SECTION A-A

⊗ OPT. KEYED CONST. JT. - FORMED BY SURFACED, BEVELED 4" DEEP X 1'-2" WIDE X 15'-0" LONG

⊗ SUPPORT PIER ON HP 14 x 73 STEEL PILING, ESTIMATED 70'-0" LONG & DRIVEN TO A MIN. BRG. VALUE OF 95 TONS PER PILE.

NOTE: FOR PILE PLAN & FTG. RENIF. DETAILS SEE SHT. 10

NO.	DATE	REVISION	BY
STATE OF WISCONSIN DEPARTMENT OF TRANSPORTATION STRUCTURES DESIGN SECTION			
STRUCTURE B-18-168			
DRAWN BY CRJ		PLANS CKT	VT
PIER 1		SHEET 9	
		81	81

BILL OF BARS

NOTE: THE FIRST OR FIRST TWO DIGITS OF THE BAR MARK SIGNIFIES THE BAR SIZE.

BAR MARK	COAT	NO. REQ'D.	LENGTH	BENT	BUN-DLED	LOCATION
P1101		61	21'-8"			FOOTING
P1002		44	30'-2"			FOOTING
P1103		82	19'-3"	X		FOOTING DOWELS
P1104		NOT USED				
P1105		82	17'-0"			SHAFT - VERT.
P406		12	45'-4"	X		SHAFT-HORIZ.-STIRRUPS
P407		7	49'-4"	X		SHAFT-HORIZ.-STIRRUPS
P408		16	5'-11"	X		SHAFT - HORIZ.
P409		6	8'-11"	X		SHAFT - HORIZ.
P410		6	7'-7"			SHAFT - VERT.
P411		6	25'-8"	X		CAP - HORIZ.-BTM.
P412		34	7'-9"	X		CAP - VERT.-BTM.
P613		12	24'-2"			CAP - HORIZ.-BTM.
P414		NOT USED				
P415		4	4'-8"			CAP - HORIZ.
P416		4	7'-10"			CAP - HORIZ.
P417		4	11'-0"			CAP - HORIZ.
P418		4	14'-1"			CAP - HORIZ.
P419		4	17'-3"			CAP - HORIZ.
P420		4	20'-5"			CAP - HORIZ.
P521		14	18'-4"	X		CAP VERT.
P522		8	16'-2"	X		CAP VERT.
P523		16	12'-10"	X		CAP VERT.
P524		30	8'-7"	X		CAP VERT.
P525		28	27'-0"	X		CAP STIRRUPS
P526		16	24'-10	X		CAP STIRRUPS
P527		32	21'-6"	X		CAP STIRRUPS
P528		60	17'-2"	X		CAP STIRRUPS
P529		68	19'-0"	X		CAP STIRRUPS
P430		20	32'-3"			CAP HORIZ.
P1131		60	35'-11		X	CAP HORIZ.
P1132		12	39'-9"	X	X	CAP HORIZ.
P433		14	8'-1"	X		CAP ENDS
P434		180	4'-8"	X		SHAFT TIES
P435		6	12'-10			SHAFT - VERT.
P436		20	7'-7"	X		CAP-VERT. OVER GIRS. 2 & 3
P437		4	19'-1"			CAP-HORIZ. OVER GIRS. 2 & 3

▲ LENGTH SHOWN FOR BAR IS AN AVERAGE LENGTH AND SHOULD ONLY BE USED FOR BAR WEIGHT CALCULATIONS. SEE BAR SERIES TABLE FOR ACTUAL LENGTHS.

BAR SERIES TABLE

MARK	NO. REQ'D.	LENGTH
P521	2 OF 7 SERIES	17'-4" TO 19'-4"
P522	2 OF 4 SERIES	15'-2" TO 17'-2"
P523	2 OF 8 SERIES	11'-2" TO 14'-6"
P524	2 OF 15 SERIES	6'-6" TO 10'-8"

BAR SERIES TABLE


MARK	NO. REQ'D.	LENGTH
P525	4 OF 7 SERIES	26'-0" TO 28'-0"
P526	4 OF 4 SERIES	23'-10" TO 25'-10"
P527	4 OF 8 SERIES	19'-10" TO 23'-2"
P528	4 OF 15 SERIES	15'-0" TO 19'-4"

BUNDLE AND TAG EACH SERIES SEPARATELY. BUNDLE AND TAG EACH SERIES SEPARATELY.

(P02) SUPPORT PIER ON HP 14 x 73 STEEL PILING, ESTIMATED 70'-0" LONG. & DRIVEN TO A MIN. BRG. VALUE OF 95 TONS PER PILE.

NO.	DATE	REVISION	BY
STATE OF WISCONSIN DEPARTMENT OF TRANSPORTATION STRUCTURES DESIGN SECTION			
STRUCTURE B-18-168			
DRAWN BY CRJ		PLANS CK'D. VT	
PIER 1 DETAILS		SHEET 10	
		82	

FILE= 10-168PIERDETAILS.DG  
SCALE = 4

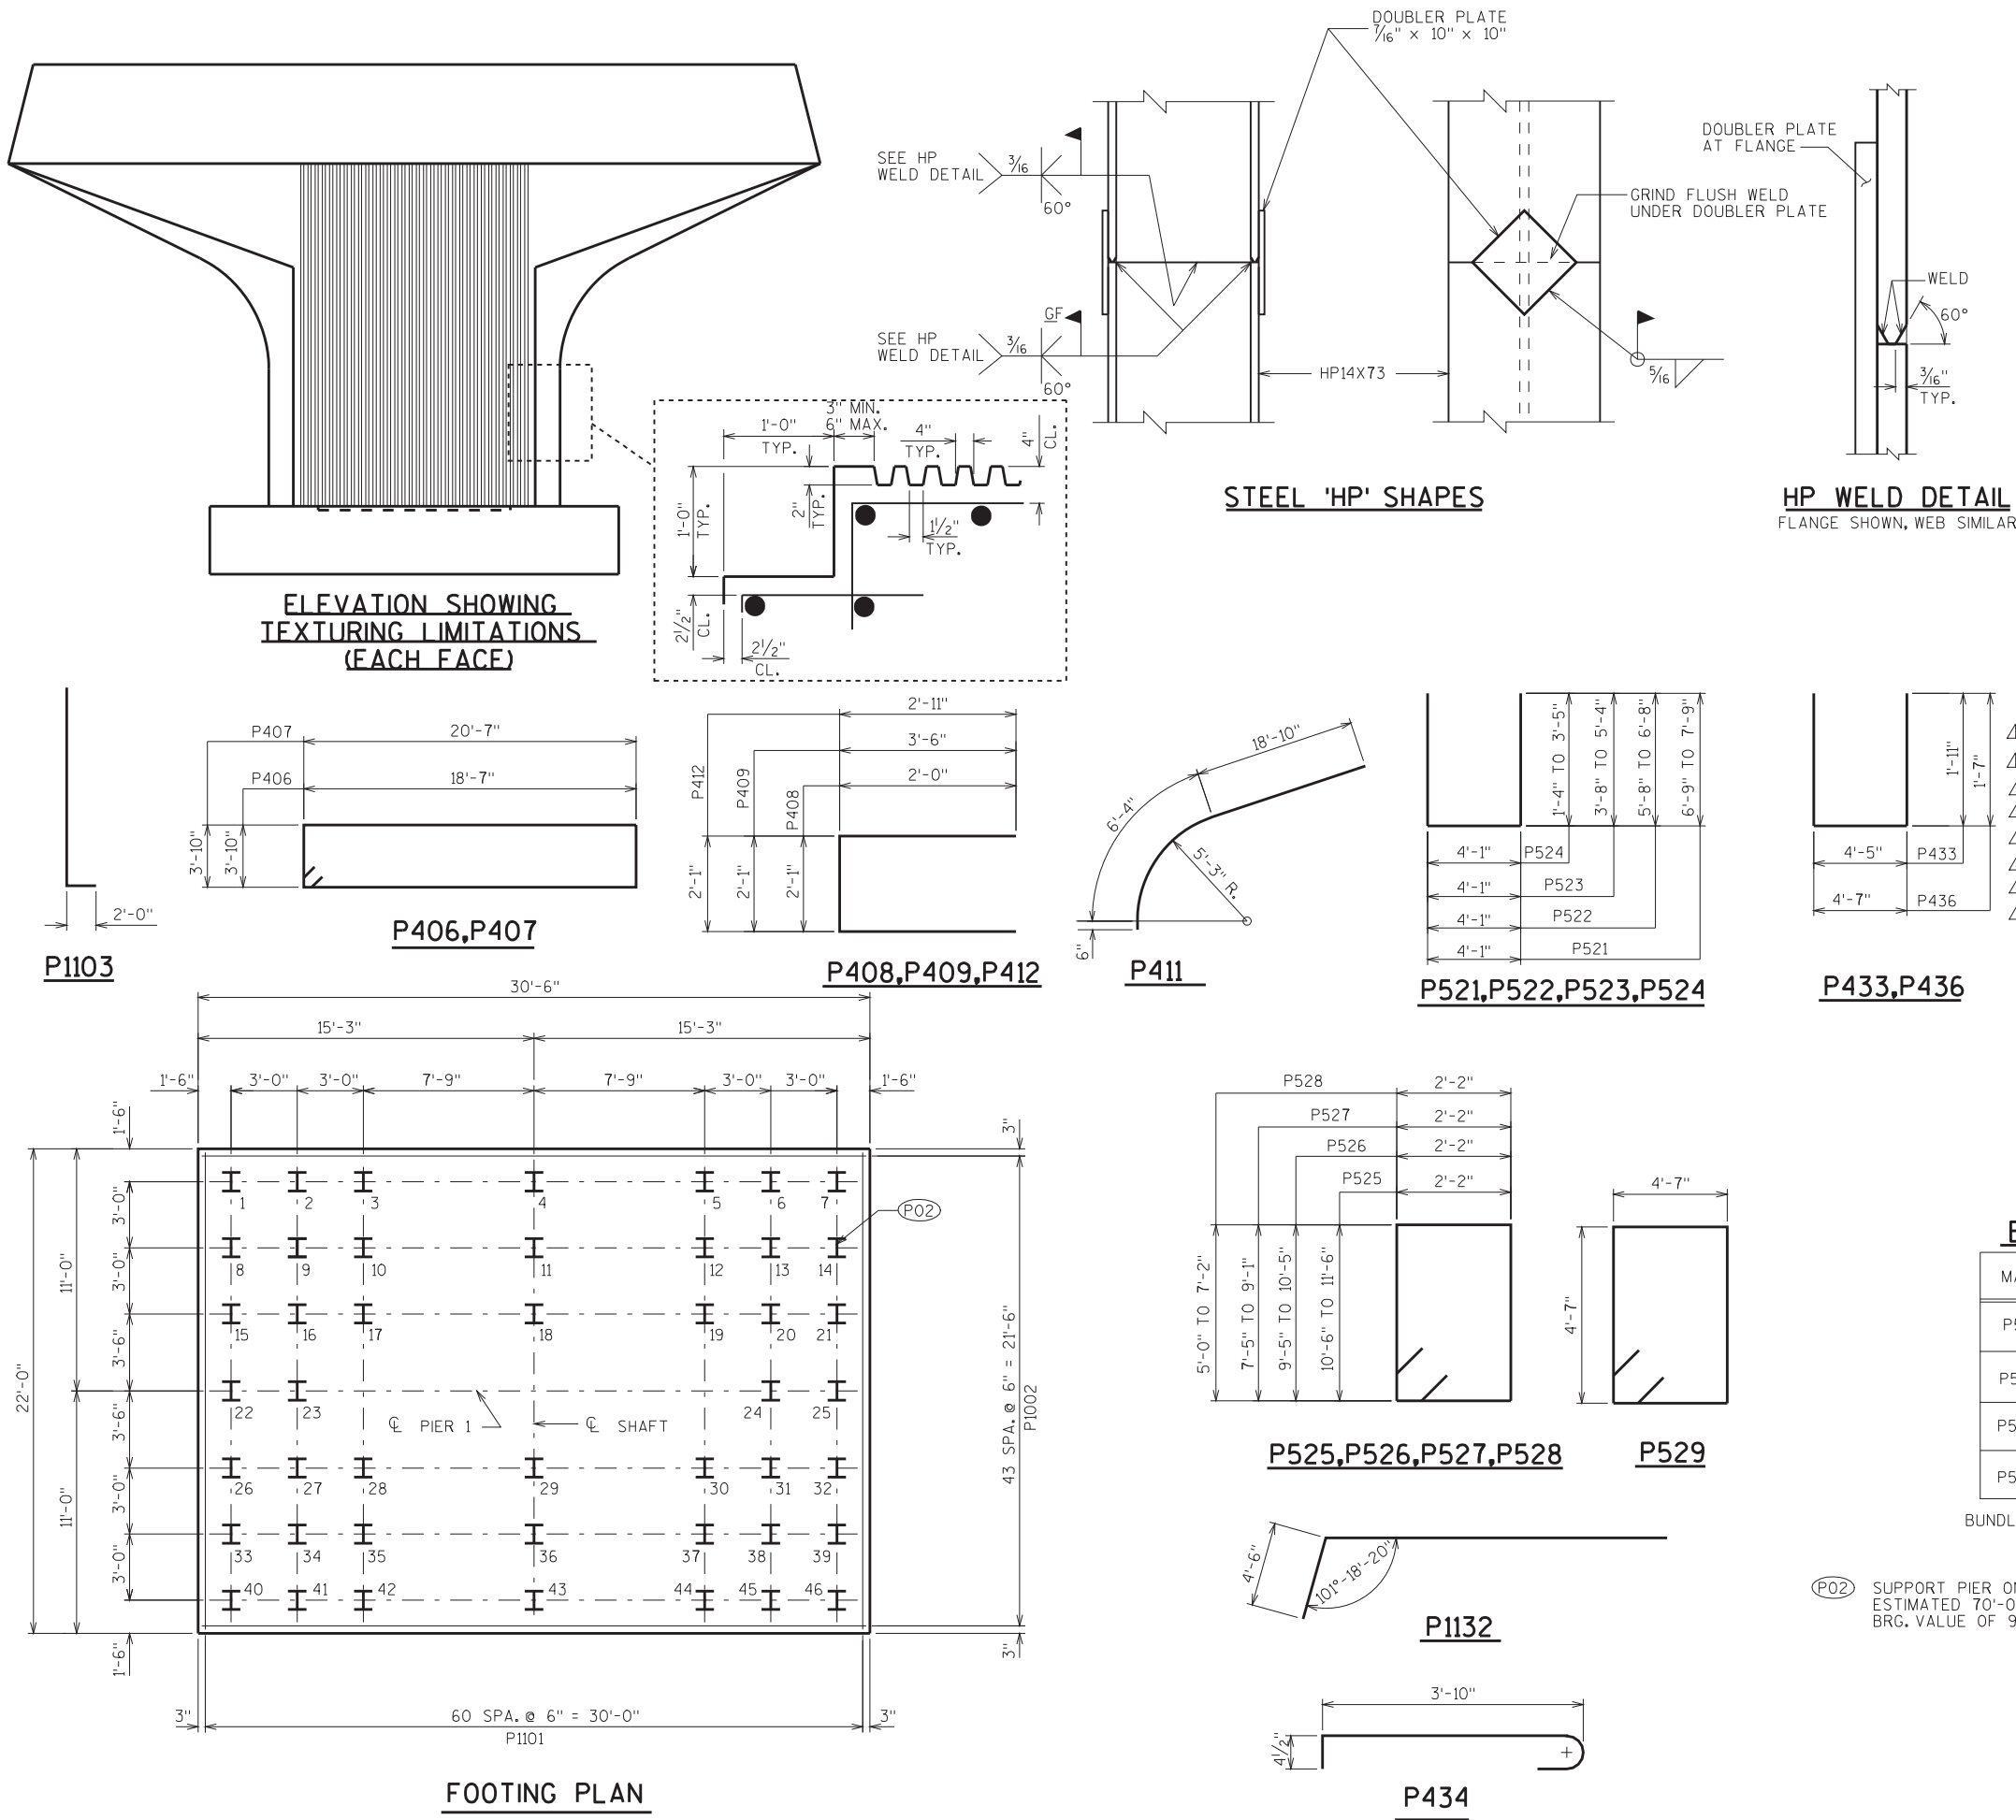





BILL OF BARS

NOTE: THE FIRST OR FIRST TWO DIGITS OF THE BAR MARK SIGNIFIES THE BAR SIZE.

BAR MARK	COAT	NO. REQ'D.	LENGTH	BENT	BUN-DLED	LOCATION
J1001		61	18'-2"			FOOTING
J1002		37	30'-2"			FOOTING
J1103		82	13'-3"	X		FOOTING DOWELS
J1104		82	20'-2"			SHAFT - VERT.
J1105		82	17'-0"			SHAFT - VERT.
J406		19	45'-4"	X		SHAFT-HORIZ.-STIRRUPS
J407		7	49'-4"	X		SHAFT-HORIZ.-STIRRUPS
J408		30	5'-11"	X		SHAFT - HORIZ.
J409		6	8'-11"	X		SHAFT - HORIZ.
J410		6	14'-4"			SHAFT - VERT.
J411		6	25'-8"	X		CAP - HORIZ. BTM.
J412		34	7'-9"	X		CAP - VERT. BTM.
J613		12	24'-2"			CAP - HORIZ. BTM.
J414		NOT USED				
J415		4	4'-8"			CAP - HORIZ.
J416		4	7'-10"			CAP - HORIZ.
J417		4	11'-0"			CAP - HORIZ.
J418		4	14'-1"			CAP - HORIZ.
J419		4	17'-3"			CAP - HORIZ.
J420		4	20'-5"			CAP - HORIZ.
▲ J521		14	18'-4"	X		CAP VERT.
▲ J522		8	16'-2"	X		CAP VERT.
▲ J523		16	12'-10"	X		CAP VERT.
▲ J524		30	8'-7"	X		CAP VERT.
▲ J525		28	27'-6"	X		CAP STIRRUPS
▲ J526		16	25'-4"	X		CAP STIRRUPS
▲ J527		32	22'-0"	X		CAP STIRRUPS
▲ J528		60	17'-8"	X		CAP STIRRUPS
J529		68	19'-0"	X		CAP STIRRUPS
J430		20	32'-3"			CAP HORIZ.
J1131		60	35'-11"		X	CAP HORIZ.
J1132		12	39'-9"	X	X	CAP HORIZ.
J433		14	8'-1"	X		CAP ENDS
J434		250	4'-8"	X		SHAFT TIES
J435		6	12'-10"			SHAFT - VERT.
J436		34	7'-7"	X		CAP-VERT. OVER GIR. 1 THRU 3
J437		4	19'-1"			CAP-HORIZ. OVER GIRS. 2 & 3
J438		4	15'-7"			CAP-HORIZ. OVER GIR. 1

▲ LENGTH SHOWN FOR BAR IS AN AVERAGE LENGTH AND SHOULD ONLY BE USED FOR BAR WEIGHT CALCULATIONS. SEE BAR SERIES TABLE FOR ACTUAL LENGTHS.

(P02) SUPPORT PIER ON HP 14 x 73 STEEL PILING, ESTIMATED 65'-0" LONG, & DRIVEN TO A MIN. BRG. VALUE OF 95 TONS PER PILE.

BAR SERIES TABLE

MARK	NO. REQ'D.	LENGTH
J521	2 SERIES OF 7	17'-4" TO 19'-4"
J522	2 SERIES OF 4	15'-2" TO 17'-2"
J523	2 SERIES OF 8	11'-2" TO 14'-6"
J524	2 SERIES OF 15	6'-6" TO 10'-8"


BUNDLE AND TAG EACH SERIES SEPARATELY.

BAR SERIES TABLE

MARK	NO. REQ'D.	LENGTH
J525	4 SERIES OF 7	26'-6" TO 28'-6"
J526	4 SERIES OF 4	24'-4" TO 26'-4"
J527	4 SERIES OF 8	20'-4" TO 23'-8"
J528	4 SERIES OF 14	15'-6" TO 19'-10"

BUNDLE AND TAG EACH SERIES SEPARATELY.




NO.	DATE	REVISION	BY
STATE OF WISCONSIN DEPARTMENT OF TRANSPORTATION STRUCTURES DESIGN SECTION			
STRUCTURE B-18-168			
DRAWN BY CRJ		PLANS CK'D. VT	
PIER 2 DETAILS		SHEET 12	84

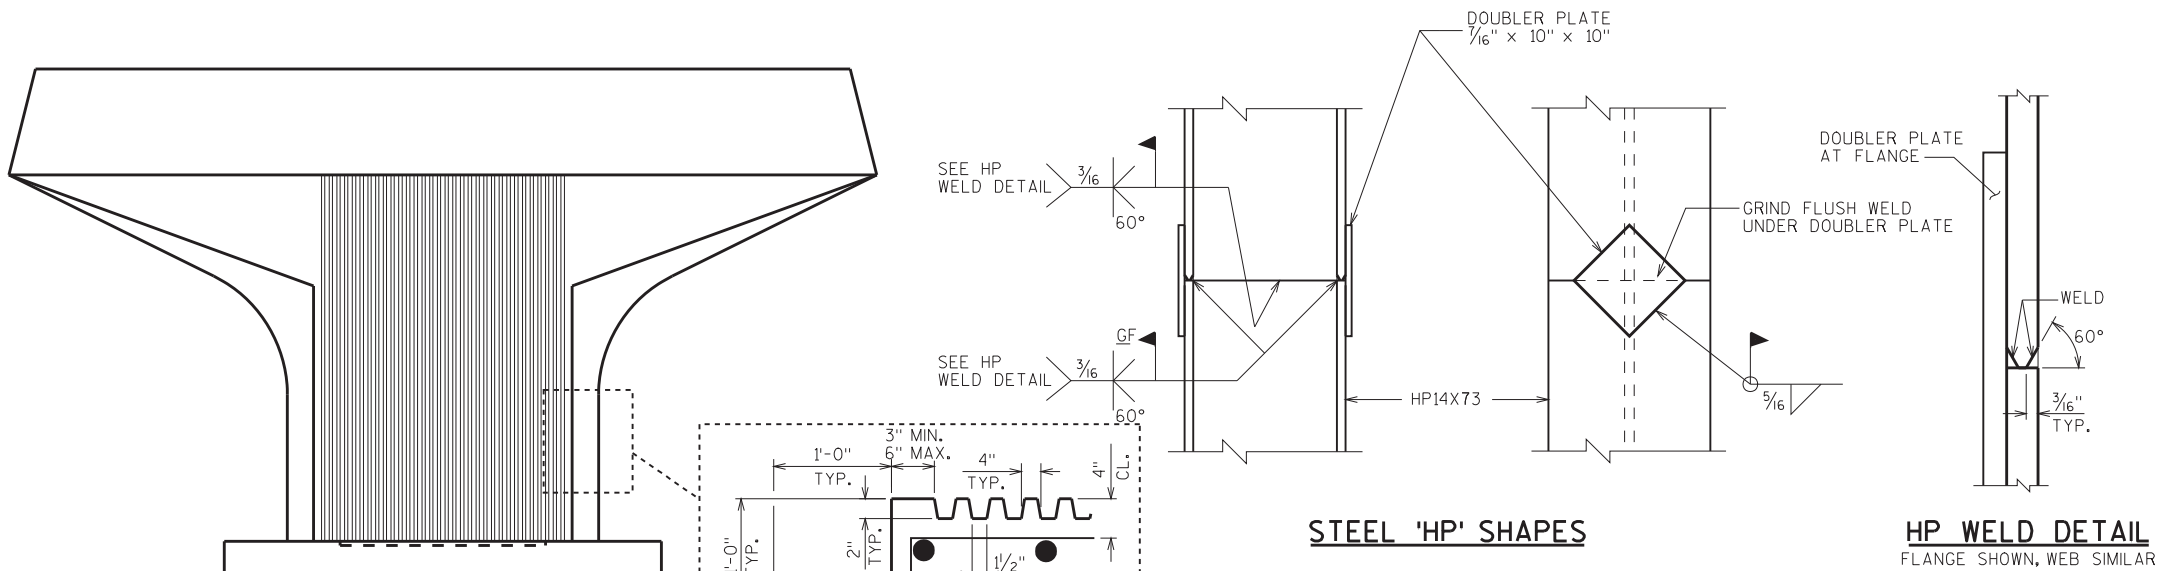


STEEL 'HP' SHAPES

HP WELD DETAIL  
FLANGE SHOWN, WEB SIMILAR

ELEVATION SHOWING  
TEXTURING LIMITATIONS  
(EACH FACE)

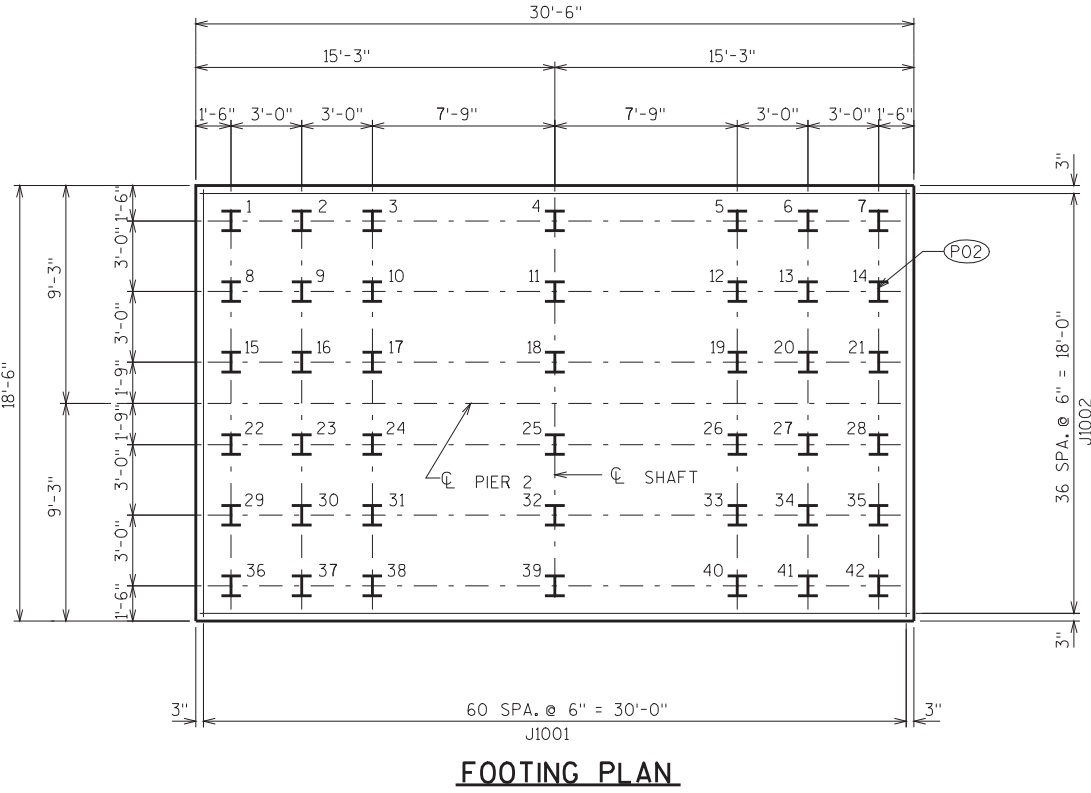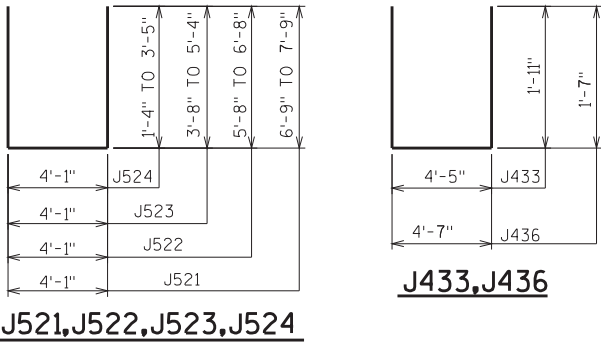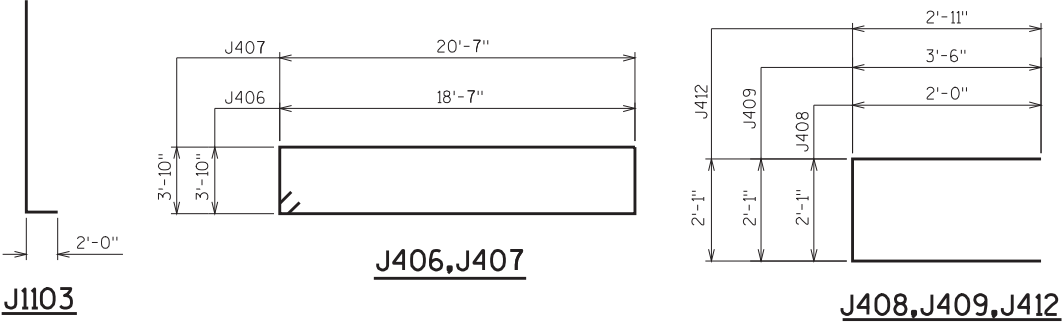


FOOTING PLAN

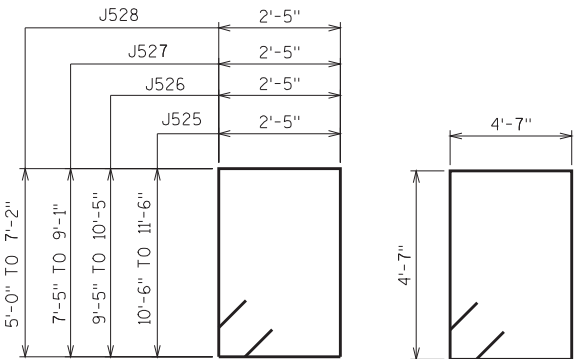

J525, J526, J527, J528





J529

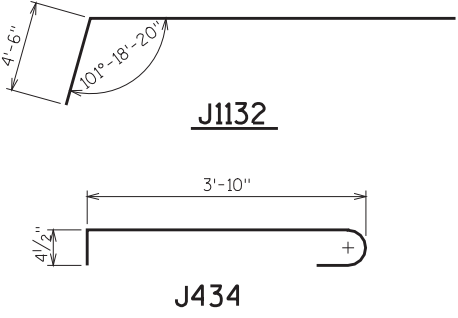

J1132

J434



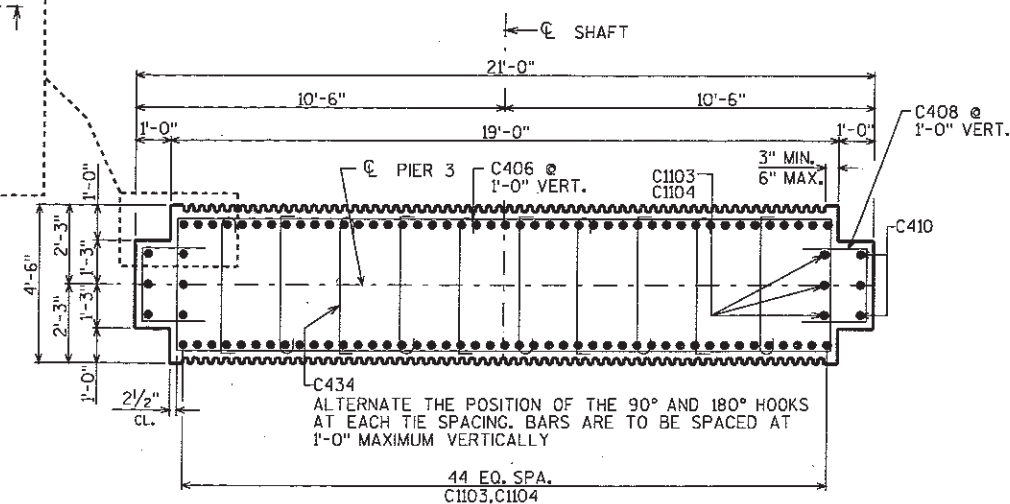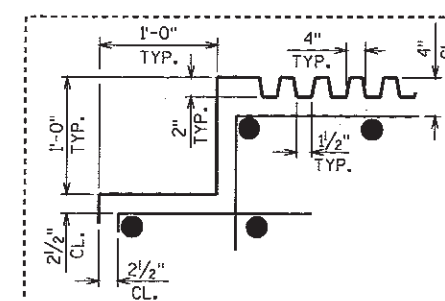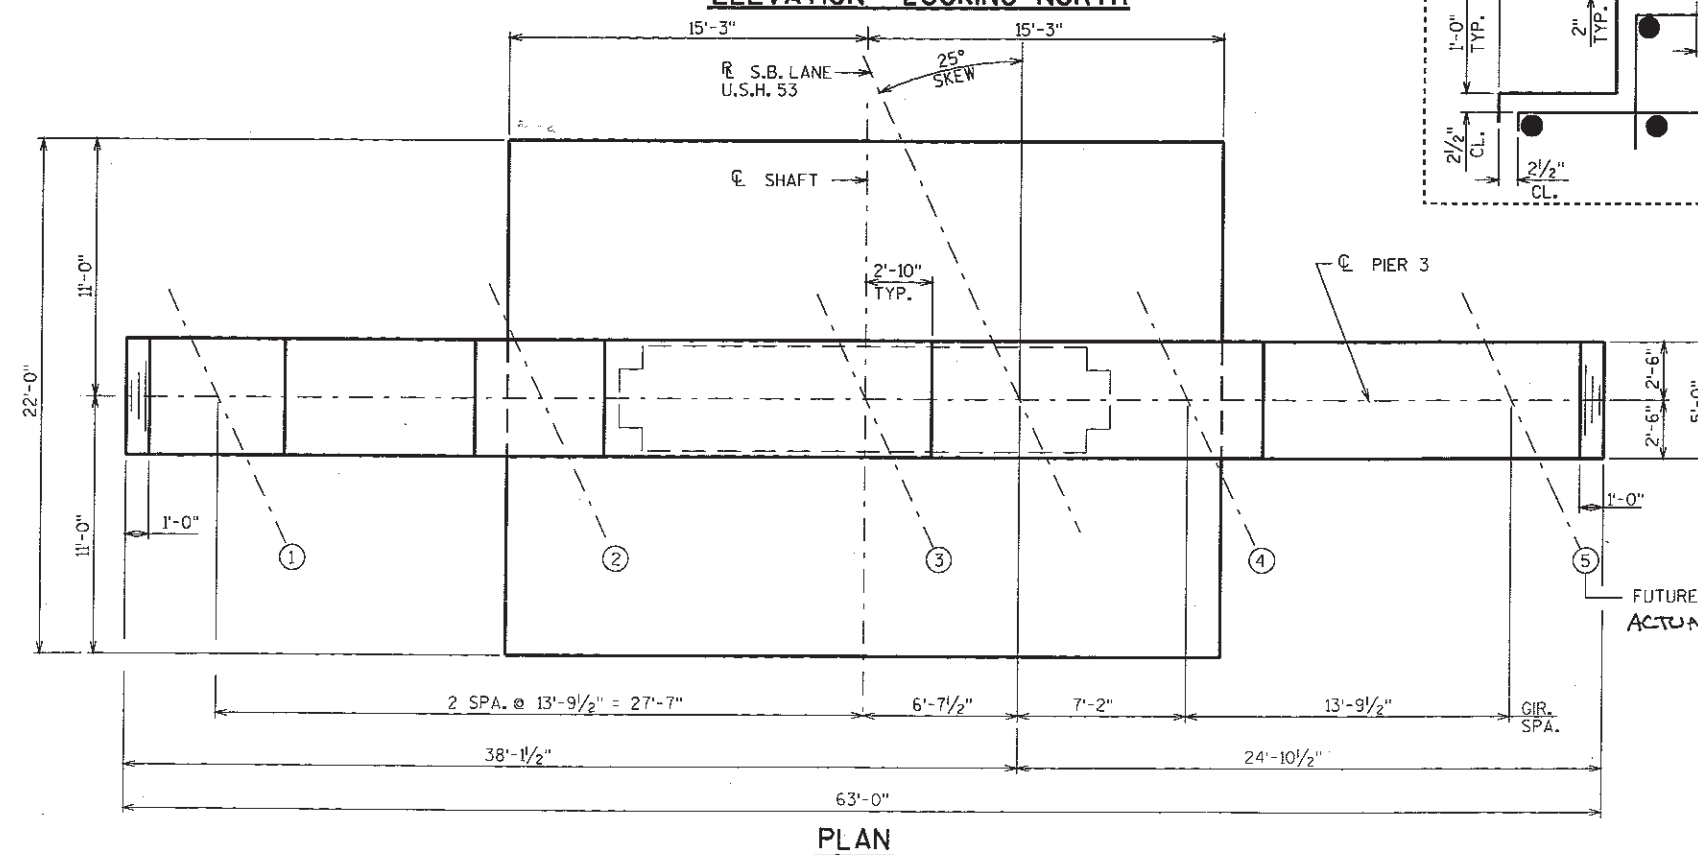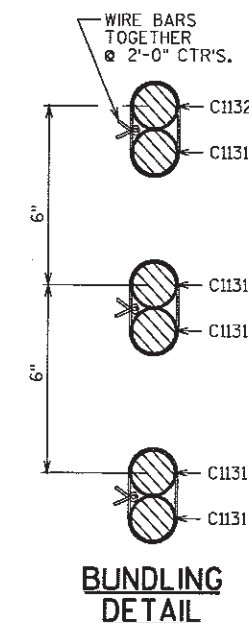

**SECTION A-A**

— FUTURE  
— ACTUAL 94.3' (PO2)

SUPPORT PIER ON HP 14 x 73 STEEL PILING,  
~~ESTIMATED 30'-0" LONG. & DRIVEN TO A MIN.~~  
BRG. VALUE OF 95 TONS PER PILE.

OPT. KEYED CONST. JT. - FORMED BY  
SURFACED, BEVELED 4" DEEP X 1'-2"  
WIDE X 15'-0" LONG

NOTE:  
FOR PILE PLAN & FTG. RENIF.  
DETAILS SEE SHT. 14

NO.	DATE	REVISION	BY
STATE OF WISCONSIN DEPARTMENT OF TRANSPORTATION STRUCTURES DESIGN SECTION			
STRUCTURE B-18-168			
DRAWN BY		CRJ	PLANS CK'D <u>VT</u>
PIER 3		SHEET 13	
		85 <sup>85</sup>	

BILL OF BARS

NOTE: THE FIRST OR FIRST TWO DIGITS OF THE BAR MARK SIGNIFIES THE BAR SIZE.

BAR MARK	COAT	NO. REQ'D.	LENGTH	BENT	BUN-DLED	LOCATION
C1101		61	21'-8"			FOOTING
C1002		44	30'-2"			FOOTING
C1103		96	13'-3"	X		FOOTING DOWELS
C1104		96	18'-8"			SHAFT - VERT.
C1105		96	17'-4"			SHAFT - VERT.
C406		17	45'-4"	X		SHAFT-HORIZ.-STIRRUPS
C407		7	49'-4"	X		SHAFT-HORIZ.-STIRRUPS
C408		26	5'-11"	X		SHAFT - HORIZ.
C409		6	8'-11"	X		SHAFT - HORIZ.
C410		6	12'-10			SHAFT - VERT.
C411		6	25'-8"	X		CAP - HORIZ.-BTM.
C412		34	7'-9"	X		CAP - VERT.-BTM.
C613		12	24'-2"			CAP - HORIZ.-BTM.
C414		NOT USED				
C415		4	4'-8"			CAP - HORIZ.
C416		4	7'-10"			CAP - HORIZ.
C417		4	11'-0"			CAP - HORIZ.
C418		4	14'-1"			CAP - HORIZ.
C419		4	17'-3"			CAP - HORIZ.
C420		4	20'-5"			CAP - HORIZ.
▲ C521		14	18'-4"	X		CAP VERT.
▲ C522		8	16'-2"	X		CAP VERT.
▲ C523		16	12'-10"	X		CAP VERT.
▲ C524		30	8'-7"	X		CAP VERT.
▲ C525		28	27'-0"	X		CAP STIRRUPS
▲ C526		16	24'-10	X		CAP STIRRUPS
▲ C527		32	21'-6"	X		CAP STIRRUPS
▲ C528		60	17'-2"	X		CAP STIRRUPS
C529		68	19'-0"	X		CAP STIRRUPS
C430		20	32'-3"			CAP HORIZ.
C1131		60	35'-11		X	CAP HORIZ.
C1132		12	39'-9"	X	X	CAP HORIZ.
C433		14	8'-1"	X		CAP ENDS
C434		230	4'-8"	X		SHAFT TIES
C435		6	12'-10			SHAFT - VERT.
C436		34	7'-9"	X		CAP-VERT. OVER GIR. 1 THRU 3
C437		4	19'-1"			CAP-HORIZ. OVER GIRS. 2 & 3
C438		4	15'-7"			CAP-HORIZ. OVER GIR. 1

▲ LENGTH SHOWN FOR BAR IS AN AVERAGE LENGTH AND SHOULD ONLY BE USED FOR BAR WEIGHT CALCULATIONS. SEE BAR SERIES TABLE FOR ACTUAL LENGTHS.

(P02) SUPPORT PIER ON HP 14 x 73 STEEL PILING, ESTIMATED 90'-0" LONG. & DRIVEN TO A MIN. BRG. VALUE OF 95 TONS PER PILE.

NO.	DATE	REVISION	BY
STATE OF WISCONSIN DEPARTMENT OF TRANSPORTATION STRUCTURES DESIGN SECTION			
STRUCTURE B-18-168			
DRAWN BY CRJ		PLANS CK'D. VT	
PIER 3 DETAILS		SHEET 14	
		86	

BAR SERIES TABLE

MARK	NO. REQ'D.	LENGTH
C521	2 SERIES OF 7	17'-4" TO 19'-4"
C522	2 SERIES OF 4	15'-2" TO 17'-2"
C523	2 SERIES OF 8	11'-2" TO 14'-6"
C524	2 SERIES OF 15	6'-6" TO 10'-8"

BUNDLE AND TAG EACH SERIES SEPARATELY. BUNDLE AND TAG EACH SERIES SEPARATELY.

BAR SERIES TABLE

MARK	NO. REQ'D.	LENGTH
C525	4 SERIES OF 7	26'-0" TO 28'-0"
C526	4 SERIES OF 4	23'-10" TO 25'-10"
C527	4 SERIES OF 8	19'-10" TO 23'-2"
C528	4 SERIES OF 15	15'-0" TO 19'-4"

STEEL 'HP' SHAPES

HP WELD DETAIL

FLANGE SHOWN, WEB SIMILAR

ELEVATION SHOWING TEXTURING LIMITATIONS (EACH FACE)

C406,C407

C408,C409,C412

C411

C521,C522,C523,C524

C433,C436

C525,C526,C527,C528



C529

C1132

C434

FOOTING PLAN

NO.	DATE	REVISION			BY
STATE OF WISCONSIN DEPARTMENT OF TRANSPORTATION <b>STRUCTURES DESIGN SECTION</b>					
<b>STRUCTURE B-18-168</b>					
		DRAWN BY	CRJ	PLANS C'D.	VT
<b>BEARING DETAILS</b> <b>@ ABUTMENTS</b>			SHEET 15		
			87		

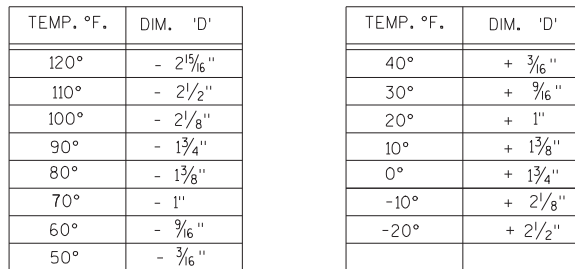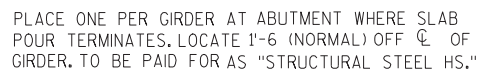[illegible]

## GENERAL NOTES

FOR UNPAINTED STRUCTURES THE UPPER 6" OF ANCHOR BOLTS,  
NUTS AND WASHERS SHALL BE GALVANIZED AS REQUIRED BY  
ASTM DESIGNATION A153, CLASS C OR B633.

OR MATERIAL OF EQUIVALENT YIELD STRENGTH AND ELONGATION.

LOCATION	NO. REQ'D	REACTION (KIPS)	A	B	C	D	E	G VALUES		H	K	M	N	R		PINTLE	
								G = 2'-1						STEM	PLATE	P	Q
								F	L								
PIER 1	4	900-999	2 <sup>3</sup> / <sub>16</sub> "	3 <sup>3</sup> / <sub>16</sub> "	3 <sup>1</sup> / <sub>2</sub> "	1'-4"	3 <sup>3</sup> / <sub>8</sub> "	2'-11"	4'-0"	2'-1 <sup>1</sup> / <sub>2</sub> "	2'-2"	3 <sup>3</sup> / <sub>8</sub> "	1'-6"	1 <sup>5</sup> / <sub>16</sub> "	1 <sup>6</sup> / <sub>64</sub> "	2"φ	3/2"
PIER 3	4	900-999	2 <sup>3</sup> / <sub>16</sub> "	3 <sup>3</sup> / <sub>16</sub> "	3 <sup>1</sup> / <sub>2</sub> "	1'-4"	3 <sup>3</sup> / <sub>8</sub> "	2'-11"	4'-0"	2'-1 <sup>1</sup> / <sub>2</sub> "	2'-2"	3 <sup>3</sup> / <sub>8</sub> "	1'-6"	1 <sup>5</sup> / <sub>16</sub> "	1 <sup>6</sup> / <sub>64</sub> "	2"φ	3/2"

LOCATION	NO. REQ'D	REACTION (KIPS)	A	B	C	G VALUES	H	R		S	T
						G=2'-1"		STEM	PLATE		
						U					
PIER 2	4	900-999	2 $\frac{3}{16}$ "	3 $\frac{7}{16}$ "	3 $\frac{1}{2}$ "	3'-10"	2'-1"	1 $\frac{5}{16}$ "	1 $\frac{1}{4}$ "	2 $\frac{7}{8}$ "	1'-10"

★ 400 K < REACTION < 1000 K, USE  $\frac{5}{8}$ " WELD.  
1000 K < REACTION < 1500 K, USE  $\frac{3}{4}$ " WELD.

NO.	DATE	REVISION	BY
STATE OF WISCONSIN DEPARTMENT OF TRANSPORTATION <b>STRUCTURES DESIGN SECTION</b>			
<b>STRUCTURE B-18-168</b>			
DRAWN BY		CRJ	PLANS CK'D. <b>VT</b>
<b>BEARING DETAILS</b> <b>2 PIERS</b>		SHEET 16	
		88	


FILE= 16-168BRGPIERS.DGN  
SCALE = .0666





PIERS 1 &amp; 3



PIER 2

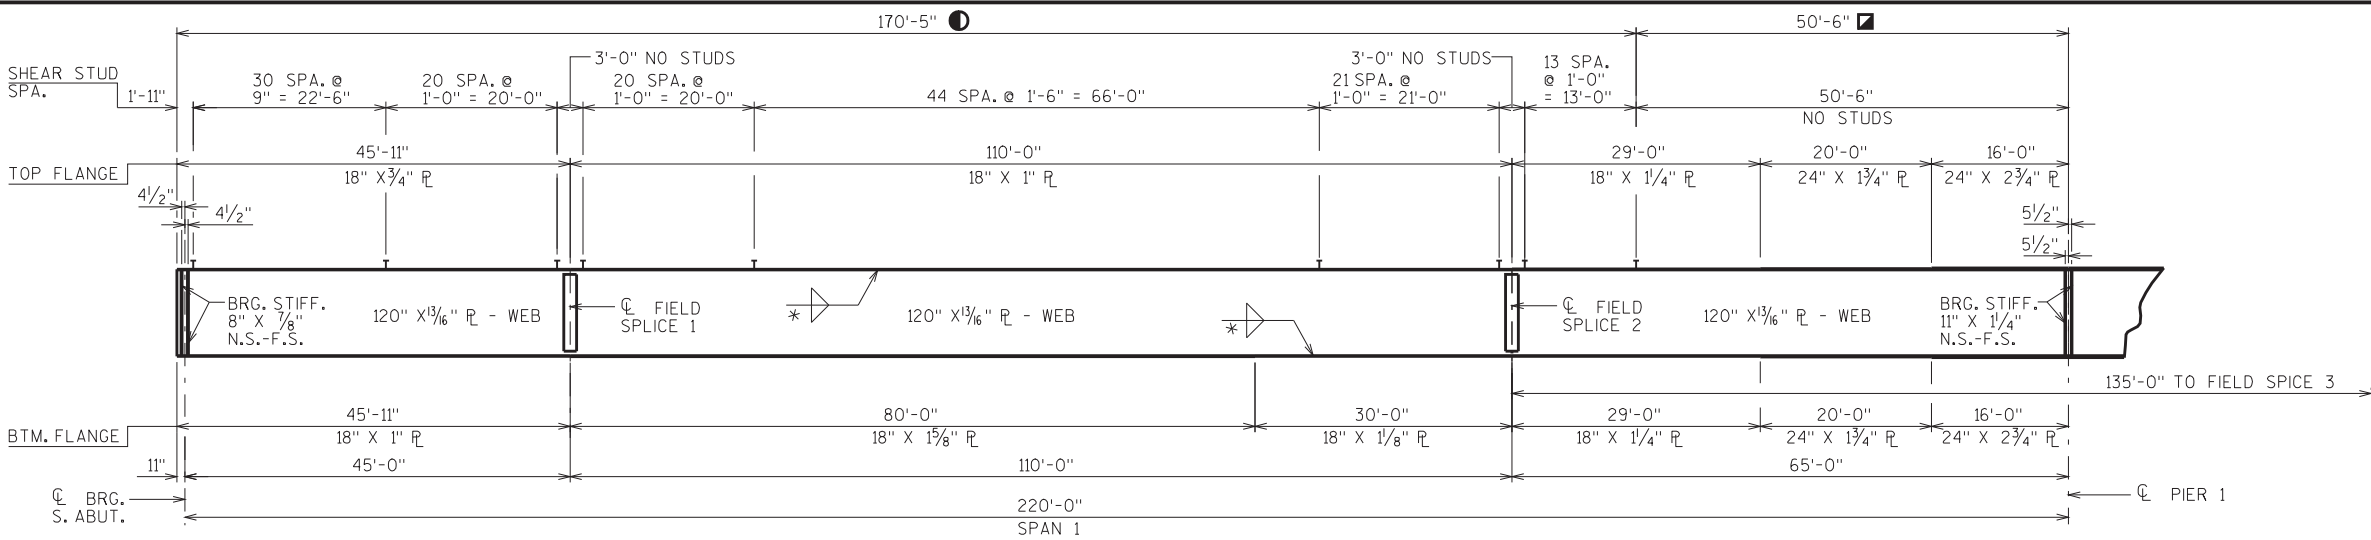

GIRDER ELEVATION SPAN 1

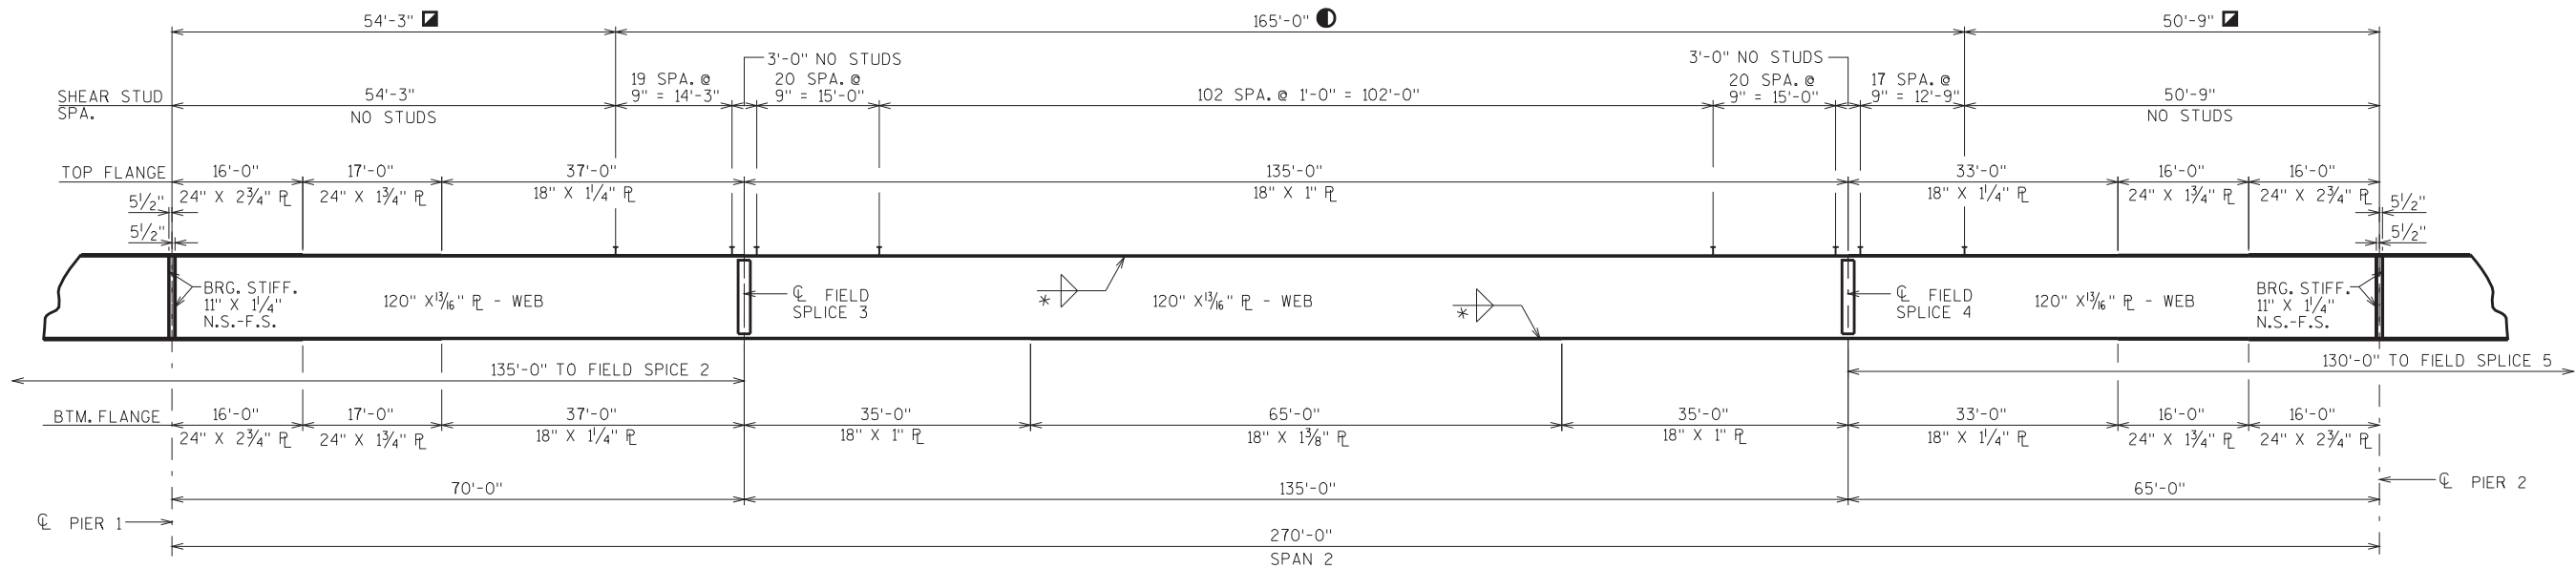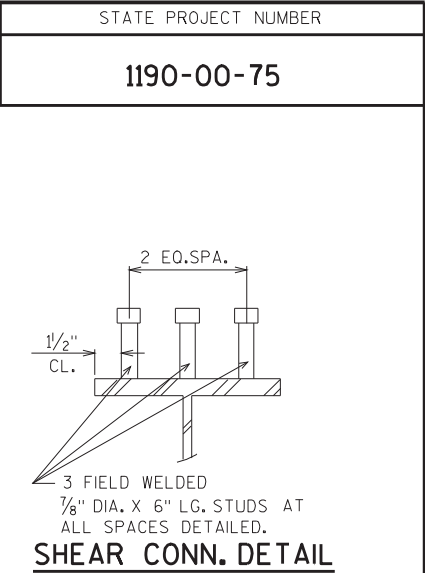

GIRDER ELEVATION SPAN 2

- NO FIELD WELDING TO BOTTOM FLANGE PERMITTED IN THIS AREA. WELD INTERMEDIATE STIFFENER & DIAPH. CONN. PLATES TO TOP (COMPRESSION) FLANGE. SEE "CROSS FRAMING DETAILS" SHEET FOR CONN. DETAILS AT BOTTOM (TENSION) FLANGE.
- NO FIELD WELDING TO TOP FLANGE PERMITTED IN THIS AREA. WELD INTERMEDIATE STIFFENER & DIAPH. CONN. PLATES TO BOTTOM (COMPRESSION) FLANGE. SEE "CROSS FRAMING DETAILS" SHEET FOR CONN. DETAILS AT TOP (TENSION) FLANGE.

NOTE: ALL STRUCTURAL STEEL USED IN SUPERSTRUCTURE IS TO BE ASTM A709, GRADE 50W, UNLESS NOTED OTHERWISE.

OPTIONAL WELDED SHOP SPLICES MAY BE USED FOR ALL FLANGE AND WEB PLATES OVER 60'-0" LONG. IF USED, THE LOCATION OF THE SPICE SHALL BE SHOWN ON SHOP DRAWINGS AND WILL BE SUBJECT TO THE APPROVAL OF THE STRUCTURES DESIGN SECTION.  
ALL CONNECTION BOLTS IN FIELD SPLICES SHALL BE FRICTION TYPE USING 7/8"  $\phi$  HIGH STRENGTH BOLTS (A.S.T.M. A325 ).


\* TABLE OF FILLET WELD SIZES

MATERIAL THICKNESS OF THICKER PART JOINED.	MIN. SIZE OF FILLET WELD
TO 1/2" INCLUSIVE	3/16"
OVER 1/2" TO 3/4"	1/4"
OVER 3/4" TO 1 1/2"	5/16"
OVER 1 1/2" TO 2 1/4"	3/8"
OVER 2 1/4" TO 6"	1/2"


† EXCEPT THAT THE WELD SIZE SHALL NOT EXCEED THE THICKNESS OF THE THINNER PART JOINED.  
Δ MIN. PASS SIZE IS 5/16"

NO.	DATE	REVISION	BY
STATE OF WISCONSIN DEPARTMENT OF TRANSPORTATION STRUCTURES DESIGN SECTION			
STRUCTURE B-18-168			
DRAWN BY CRJ		PLANS CK'D. VT	
GIRDER DETAILS @ SPANS 1 & 2		SHEET 17	
		89	



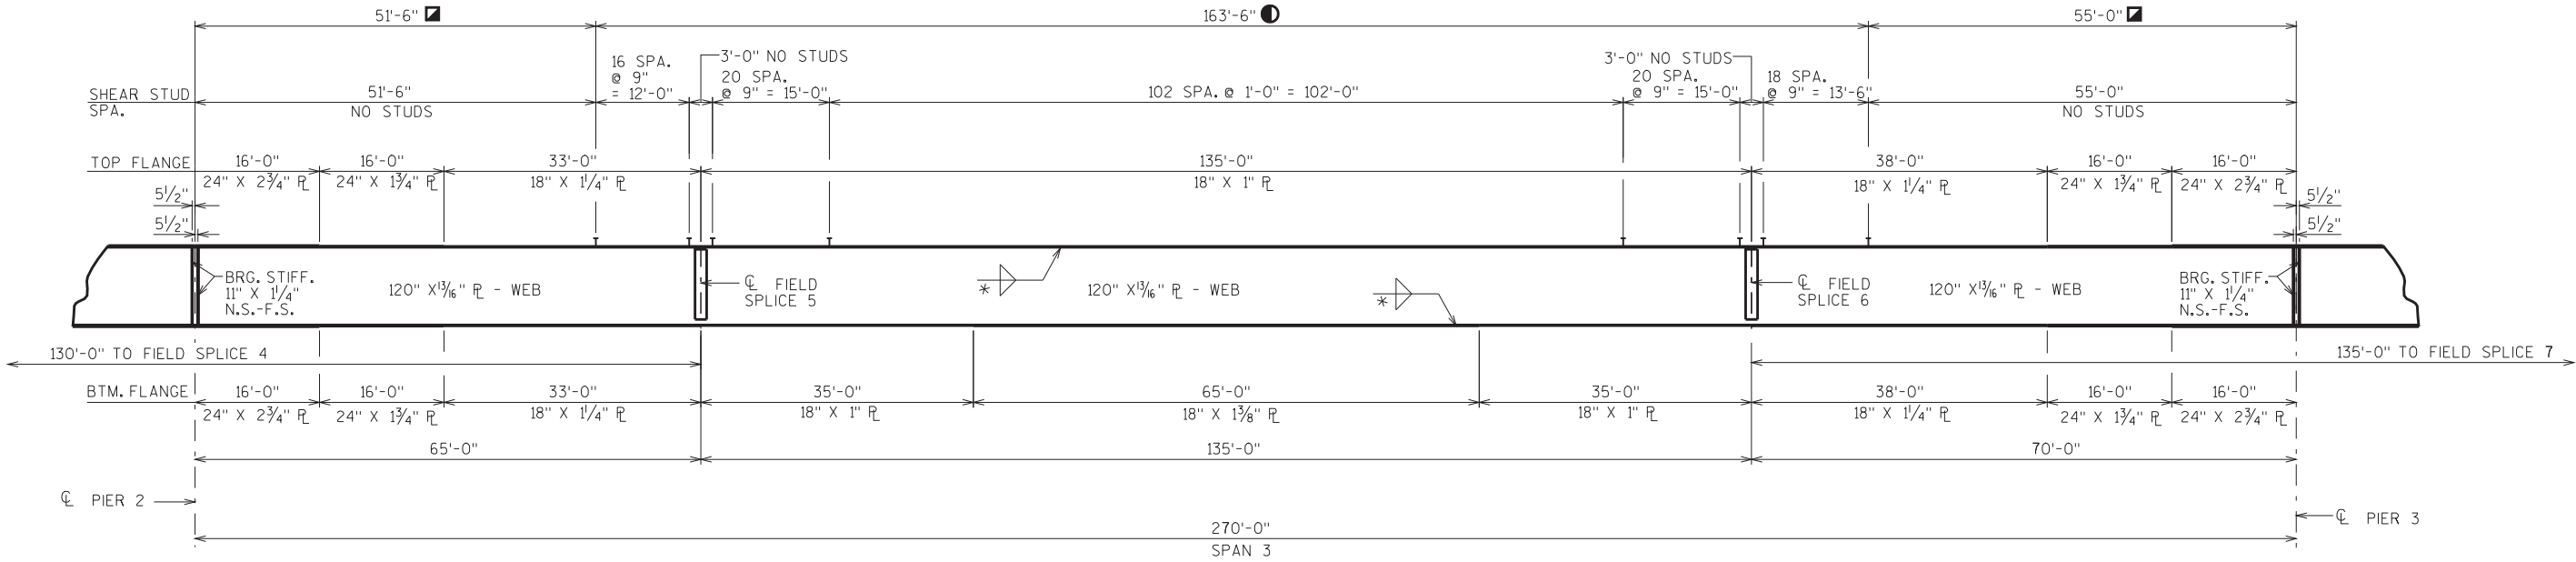

GIRDER ELEVATION SPAN 3

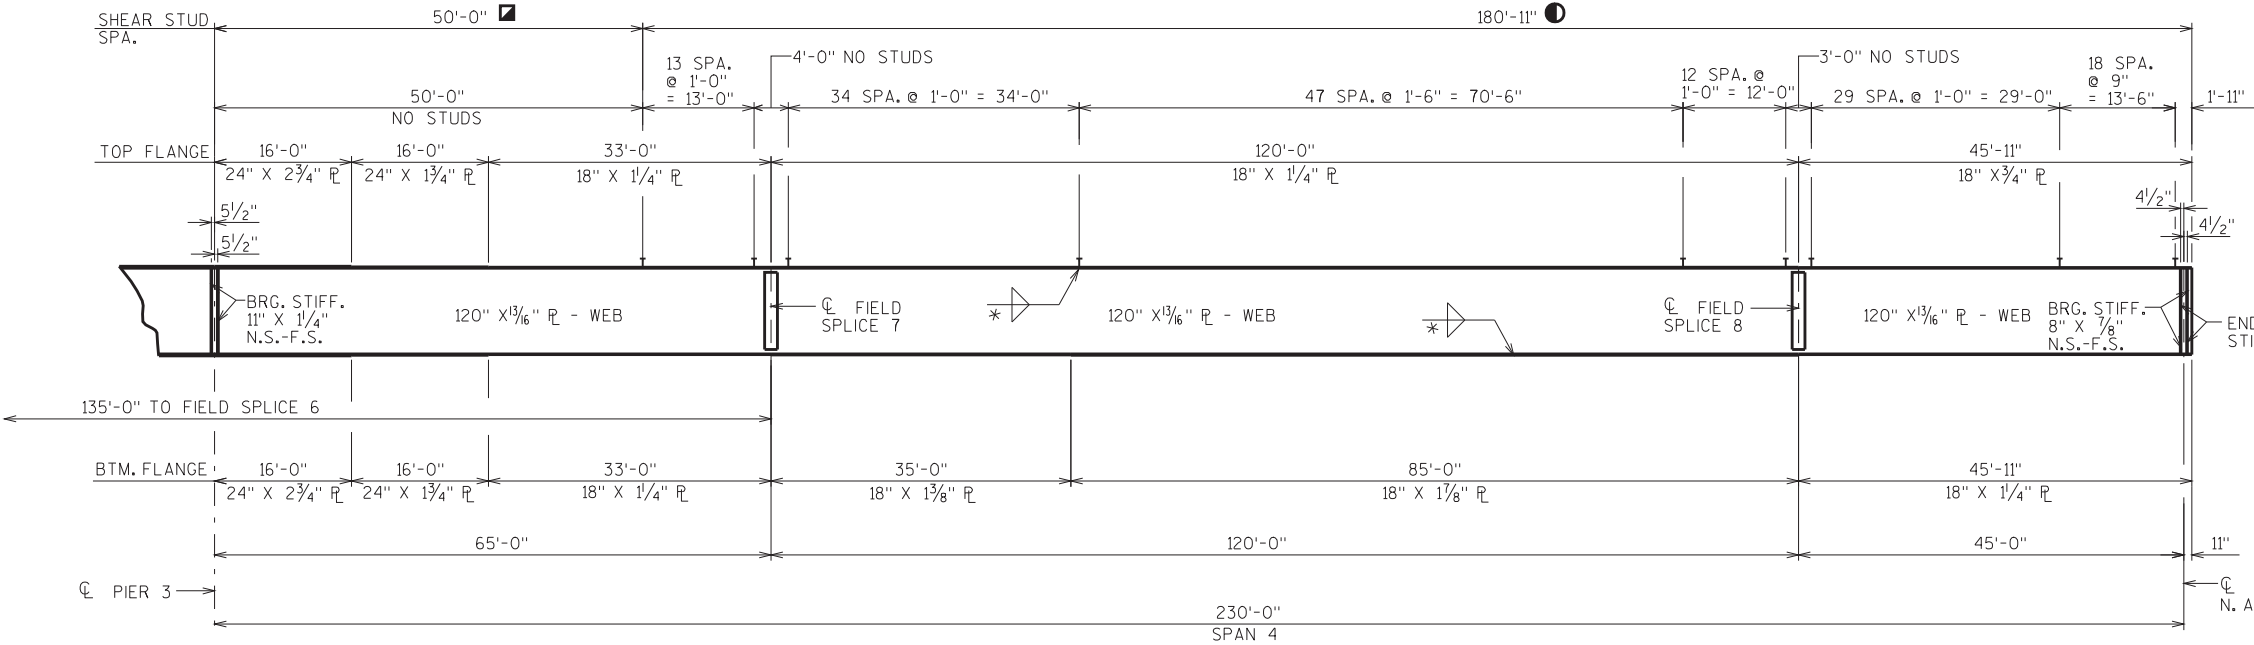

GIRDER ELEVATION SPAN 4

\* TABLE OF FILLET WELD SIZES

MATERIAL THICKNESS OF THICKER PART JOINED.	MIN. SIZE OF FILLET WELD
TO 1/2" INCLUSIVE	3/16"
OVER 1/2" TO 3/4"	1/4"
OVER 3/4" TO 1 1/2"	5/16"
OVER 1 1/2" TO 2 1/4"	3/8"
OVER 2 1/4" TO 6"	1/2"

† EXCEPT THAT THE WELD SIZE SHALL NOT EXCEED THE THICKNESS OF THE THINNER PART JOINED.  
△ MIN. PASS SIZE IS 5/16"




- ❶ NO FIELD WELDING TO BOTTOM FLANGE PERMITTED IN THIS AREA. WELD INTERMEDIATE STIFFENER & DIAPH. CONN. PLATES TO TOP (COMPRESSION) FLANGE. SEE "CROSS FRAMING DETAILS" SHEET FOR CONN. DETAILS AT BOTTOM (TENSION) FLANGE.
- ❷ NO FIELD WELDING TO TOP FLANGE PERMITTED IN THIS AREA. WELD INTERMEDIATE STIFFENER & DIAPH. CONN. PLATES TO BOTTOM (COMPRESSION) FLANGE. SEE "CROSS FRAMING DETAILS" SHEET FOR CONN. DETAILS AT TOP (TENSION) FLANGE.

NOTE: ALL STRUCTURAL STEEL USED IN SUPERSTRUCTURE IS TO BE ASTM A709, GRADE 50W, UNLESS NOTED OTHERWISE.

OPTIONAL WELDED SHOP SPLICES MAY BE USED FOR ALL FLANGE AND WEB PLATES OVER 60'-0" LONG. IF USED, THE LOCATION OF THE SPLICE SHALL BE SHOWN ON SHOP DRAWINGS AND WILL BE SUBJECT TO THE APPROVAL OF THE STRUCTURES DESIGN SECTION.

ALL CONNECTION BOLTS IN FIELD SPLICES SHALL BE FRICTION TYPE USING 7/8" φ HIGH STRENGTH BOLTS (A.S.T.M. A325 ).

NO.	DATE	REVISION	BY
STATE OF WISCONSIN DEPARTMENT OF TRANSPORTATION STRUCTURES DESIGN SECTION			
STRUCTURE B-18-168			
DRAWN BY CRJ		PLANS CK'D. VT	
GIRDER DETAILS @ SPANS 3 & 4		SHEET 18	
		90	

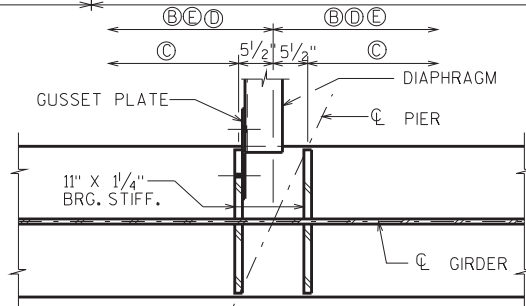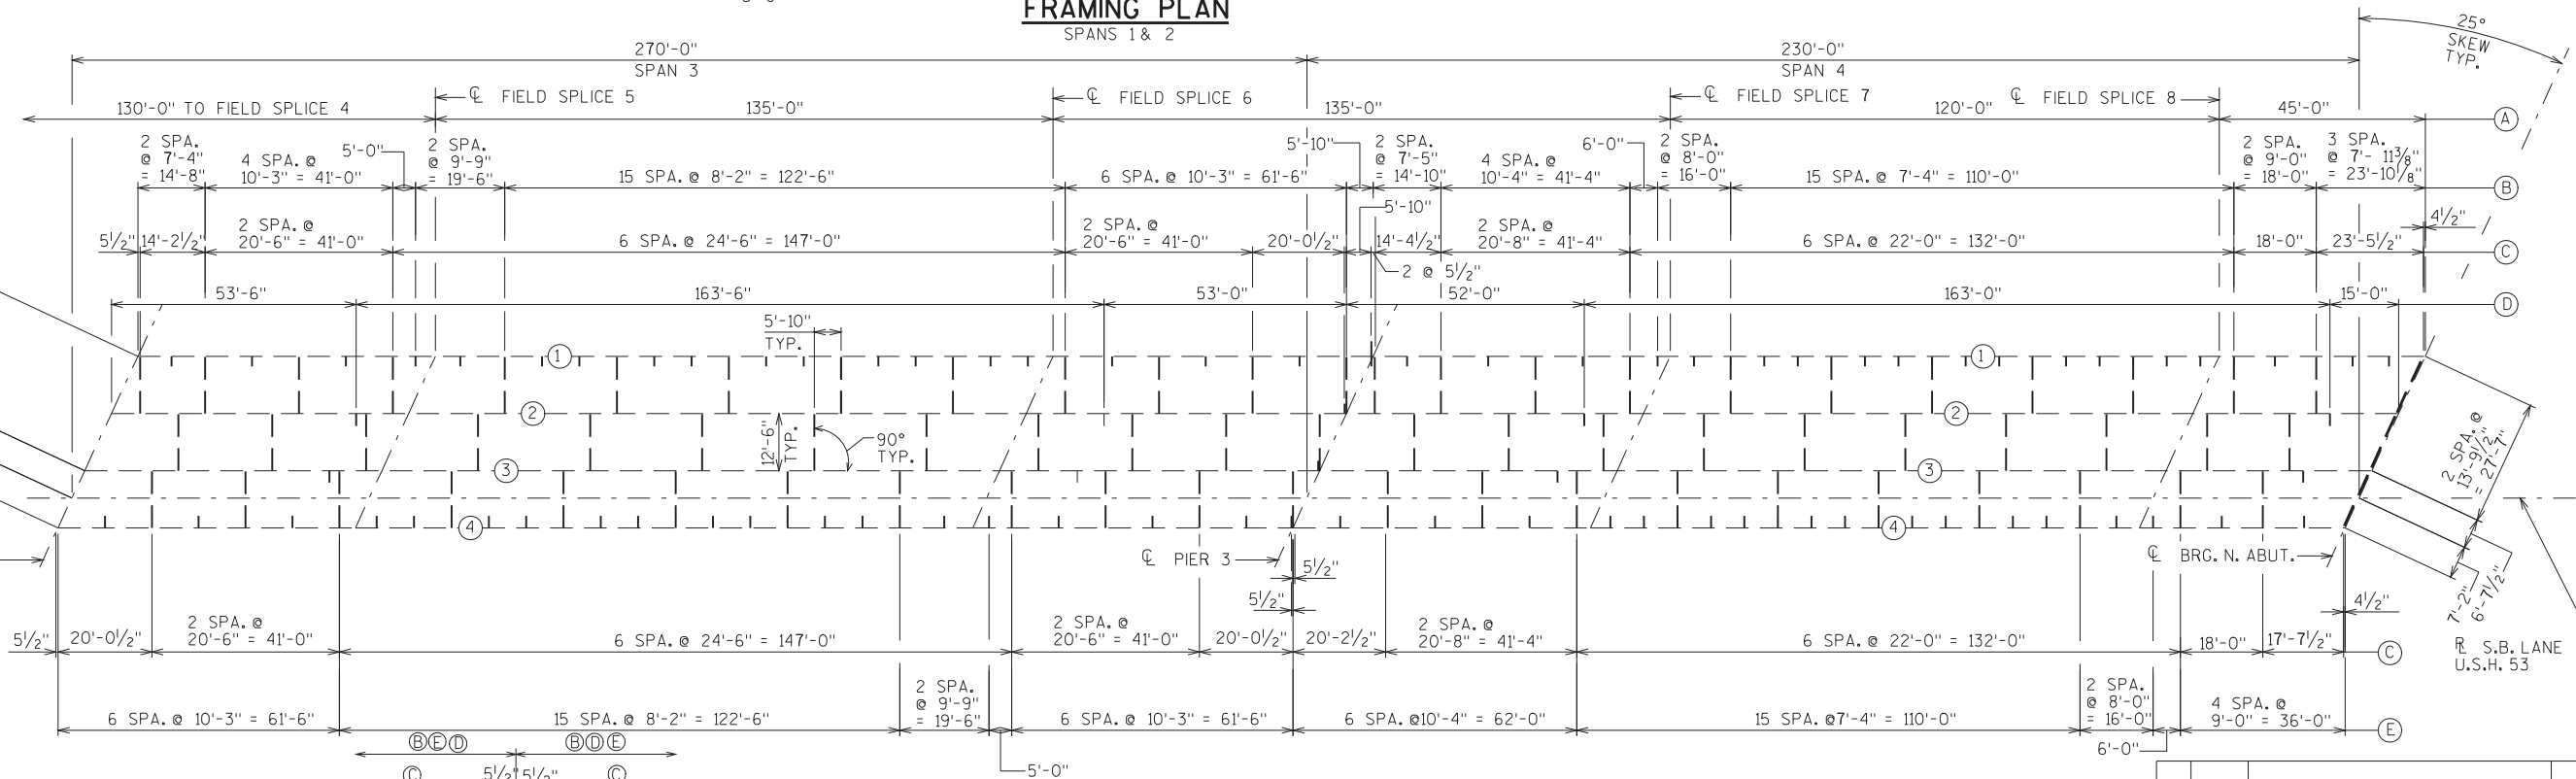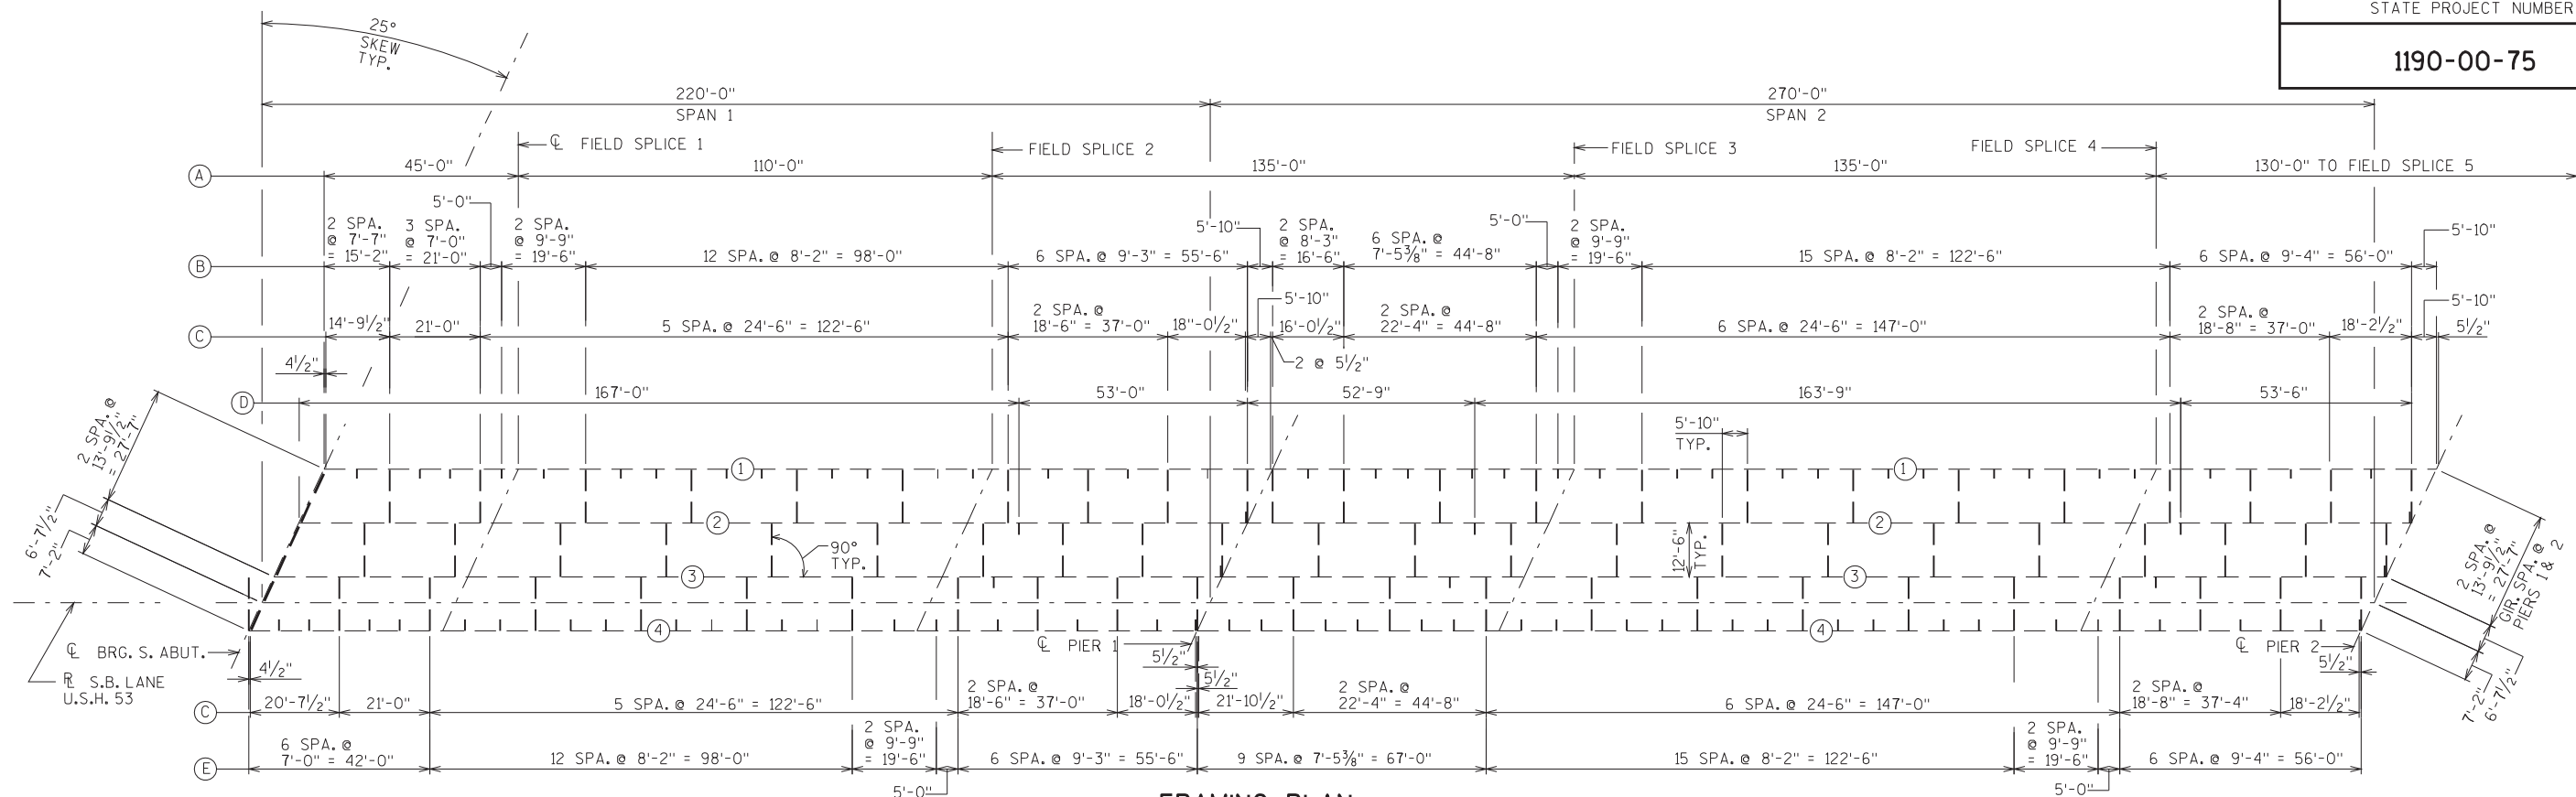

- (A) FIELD SPLICE SPACING
- (B) INTERMEDIATE STIFFENER SPACING @ GIRDER 1
- (C) CROSS FRAMING SPACING
- (D) INTERMEDIATE STIFFENER SPACING @ GIRDERS 2 & 3
- (E) INTERMEDIATE STIFFENER SPACING @ GIRDER 4

NO.	DATE	REVISION	BY
STATE OF WISCONSIN DEPARTMENT OF TRANSPORTATION STRUCTURES DESIGN SECTION			
STRUCTURE B-18-168			
DRAWN BY CRJ		PLANS CK'D. VT	
FRAMING PLAN		SHEET 19	
		91	




FIELD SPLICE	PLATE 'A'	PLATE 'B'	PLATE 'C'	PLATE 'D'	'E' A325 BOLTS	'F' A325 BOLTS	'G' A325 BOLTS	TOTAL BOLTS PER SPLICE
1	18" X 1/2" X 2'-0 1/2"	2 @ 7 1/2" X 1/2" X 2'-0 1/2"	2 @ 7 1/2" X 3/4" X 2'-6 1/2"	18" X 5/8" X 2'-6 1/2"	3 SPA. @ 3"	4 SPA. @ 3"	36 EQ. SPA. 3 LINES/SIDE	294
2	18" X 1/2" X 2'-0 1/2"	2 @ 7 1/2" X 5/8" X 2'-0 1/2"	2 @ 7 1/2" X 5/8" X 2'-6 1/2"	18" X 1/2" X 2'-6 1/2"	3 SPA. @ 3"	4 SPA. @ 3"	33 EQ. SPA. 3 LINES/SIDE	276
3	18" X 1/2" X 2'-0 1/2"	2 @ 7 1/2" X 5/8" X 2'-0 1/2"	2 @ 7 1/2" X 5/8" X 2'-0 1/2"	18" X 1/2" X 2'-0 1/2"	3 SPA. @ 3"	3 SPA. @ 3"	33 EQ. SPA. 3 LINES/SIDE	268
4	18" X 1/2" X 2'-0 1/2"	2 @ 7 1/2" X 5/8" X 2'-0 1/2"	2 @ 7 1/2" X 5/8" X 2'-0 1/2"	18" X 1/2" X 2'-0 1/2"	3 SPA. @ 3"	3 SPA. @ 3"	33 EQ. SPA. 3 LINES/SIDE	268
5	18" X 1/2" X 2'-0 1/2"	2 @ 7 1/2" X 5/8" X 2'-0 1/2"	2 @ 7 1/2" X 5/8" X 2'-0 1/2"	18" X 1/2" X 2'-0 1/2"	3 SPA. @ 3"	3 SPA. @ 3"	33 EQ. SPA. 3 LINES/SIDE	268
6	18" X 1/2" X 2'-0 1/2"	2 @ 7 1/2" X 5/8" X 2'-0 1/2"	2 @ 7 1/2" X 5/8" X 2'-0 1/2"	18" X 1/2" X 2'-0 1/2"	3 SPA. @ 3"	3 SPA. @ 3"	33 EQ. SPA. 3 LINES/SIDE	268
7	18" X 5/8" X 2'-6 1/2"	2 @ 7 1/2" X 3/4" X 2'-6 1/2"	2 @ 7 1/2" X 3/4" X 2'-6 1/2"	18" X 5/8" X 2'-6 1/2"	4 SPA. @ 3"	4 SPA. @ 3"	33 EQ. SPA. 3 LINES/SIDE	284
8	18" X 1/2" X 2'-0 1/2"	2 @ 7 1/2" X 1/2" X 2'-0 1/2"	2 @ 7 1/2" X 1" X 3'-6 1/2"	18" X 3/4" X 3'-6 1/2"	3 SPA. @ 3"	6 SPA. @ 3"	35 EQ. SPA. 3 LINES/SIDE	304

NOTES: ALL CONNECTION BOLTS IN FIELD SPLICES SHALL BE FRICTION TYPE USING 7/8"  $\phi$  HIGH STRENGTH BOLTS (A.S.T.M. A325).



ALL STRUCTURAL STEEL TO BE A.S.T.M. A709 - GRADE 50W UNLESS OTHERWISE SHOWN OR NOTED.

ALL BOLTED CONNECTIONS FOR DIAPHS. & CROSS FRAMES SHALL BE FRICTION TYPE USING 3/4" HIGH STRENGTH BOLTS (A.S.T.M. A325) WITH DOUBLE WASHERS.

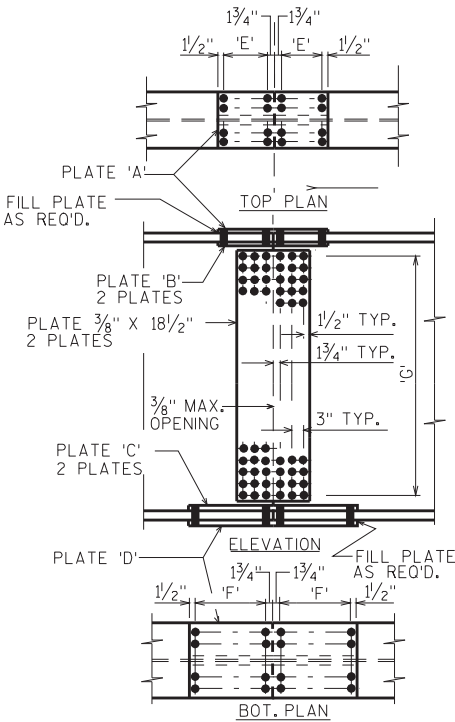


FIELD SPLICE DETAIL

STIFF. & CONN. STIFF. TO WEB/FLANGE  
CONN. WELDS

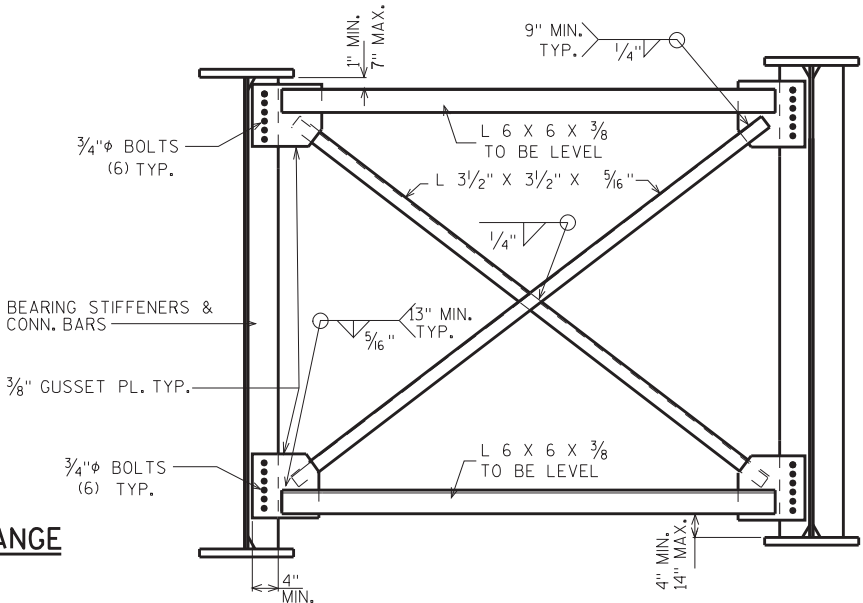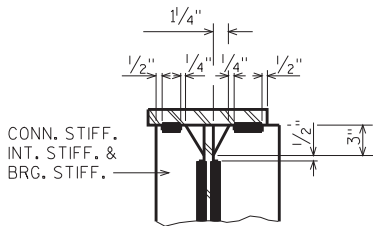


IN-SPAN & PIER CROSS FRAMING DETAILS

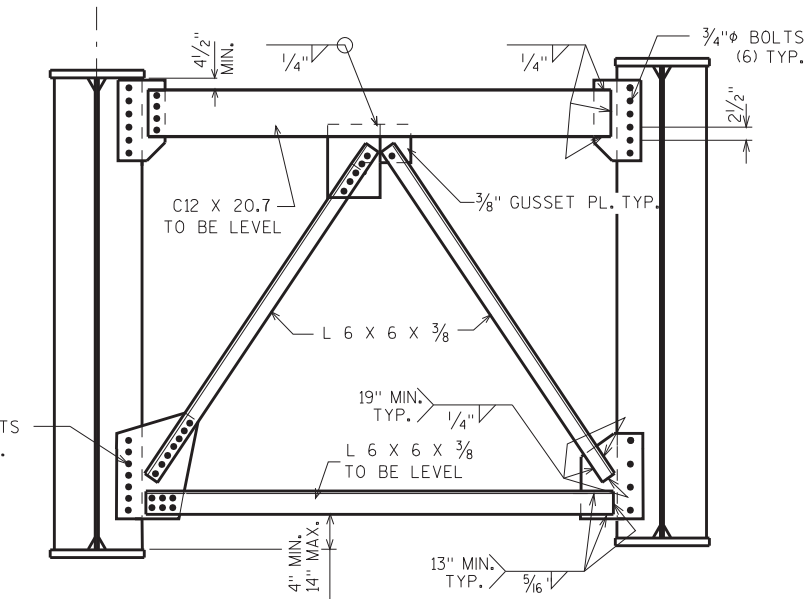


END DIAPH. DETAILS

ABUTMENTS

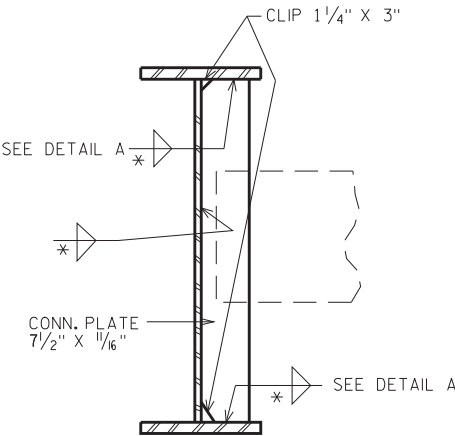


CONNECTION STIFF. DETAILS

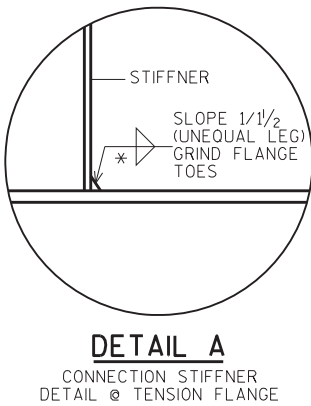


DETAIL A

CONNECTION STIFFNER  
DETAIL @ TENSION FLANGE

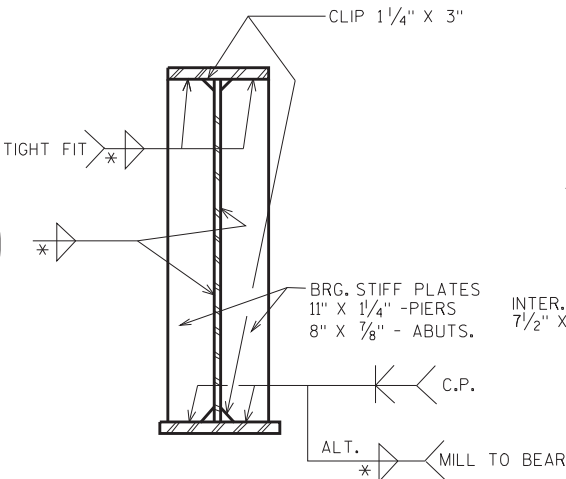

BRG. STIFF. DETAILS  
TYP. AT ABUT. & PIER

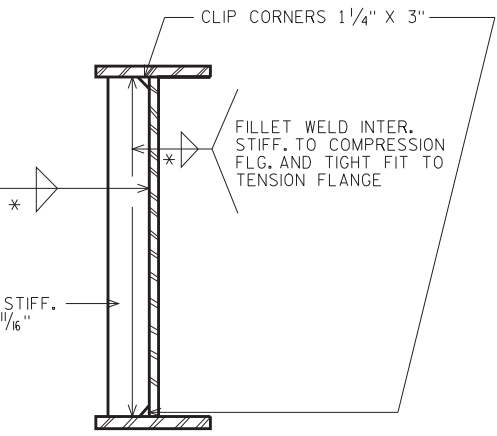

INTERMEDIATE  
STIFF. DETAILS  
(ALL GIRDERS)

\* TABLE OF FILLET WELD SIZES


MATERIAL THICKNESS OF THICKER PART JOINED.	$\pm$ MIN. SIZE OF FILLET WELD
TO 1/2" INCLUSIVE	3/16"
OVER 1/2" TO 3/4"	1/4"
OVER 3/4" TO 1 1/2"	$\Delta$ 5/16"
OVER 1 1/2" TO 2 1/4"	$\Delta$ 3/8"
OVER 2 1/4" TO 6"	$\Delta$ 1/2"

$\pm$  EXCEPT THAT THE WELD SIZE SHALL NOT EXCEED THE THICKNESS OF THE THINNER PART JOINED.

$\Delta$  MIN. PASS SIZE IS 5/16"

NO.	DATE	REVISION	BY
STATE OF WISCONSIN DEPARTMENT OF TRANSPORTATION STRUCTURES DESIGN SECTION			
STRUCTURE B-18-168			
DRAWN BY CRJ		PLANS CK'D. VT	
CROSS FRAMING DETAILS		SHEET 20	
		92	

FILE= 20-168STEELDETAILS.DG  
SCALE = 11

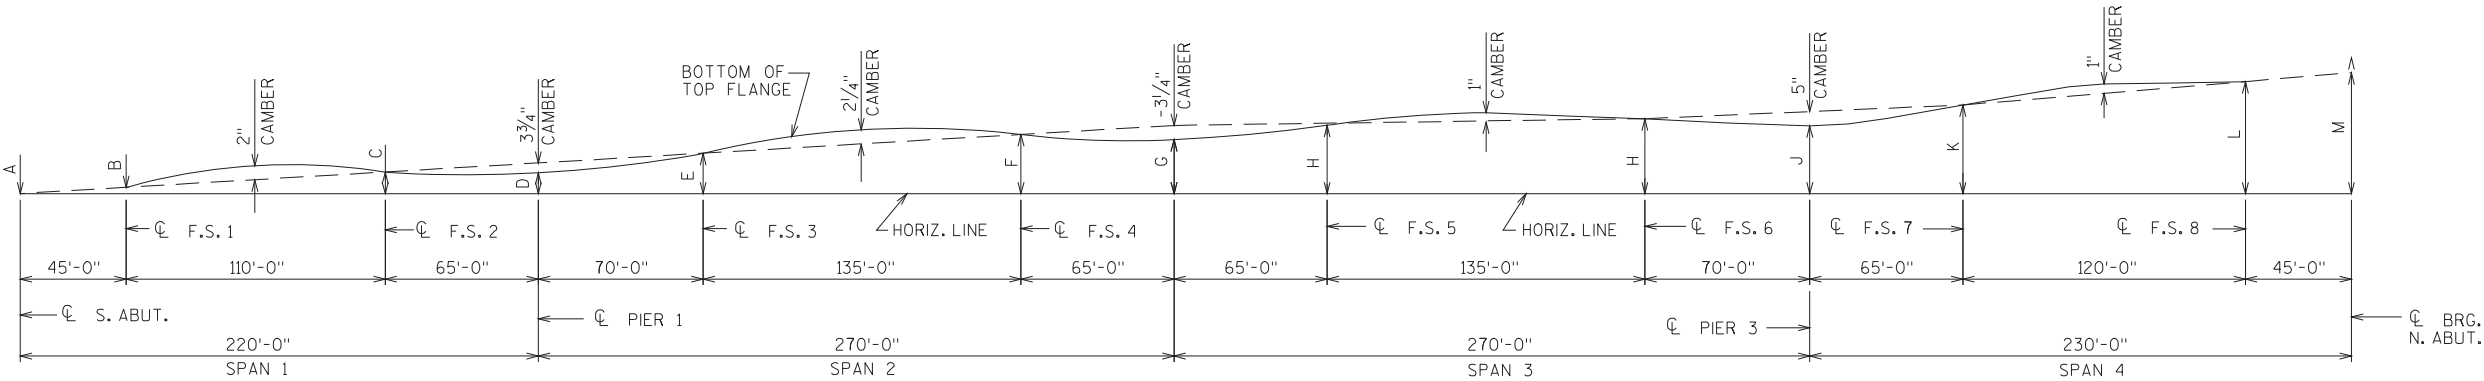

BLOCKING AND CAMBER DIAGRAM

LOCATION	CL BRG. S. ABUT.	CL F.S. 1	CL F.S. 2	CL PIER 1	CL F.S. 3	CL F.S. 4	CL PIER 2	CL F.S. 5	CL F.S. 6	CL PIER 3	CL F.S. 7	CL F.S. 8	CL BRG. S. ABUT.
DIMENSION	A	B	C	D	E	F	G	H	I	J	K	L	M
GIRDER 1	0"	5 1/8"	8 3/8"	7 1/8"	1'-1 1/2"	1'-7 1/4"	1'-6 5/8"	2'-0 1/2"	2'-8 3/4"	3'-2 1/8"	4'-4 5/8"	6'-7 1/4"	7'-3 5/8"
GIRDER 2	0"	5 1/8"	8 3/8"	7 1/8"	1'-1 1/2"	1'-7 1/4"	1'-6 5/8"	2'-0 1/2"	2'-8 3/8"	3'-1 1/2"	4'-3 3/4"	6'-6"	7'-2 1/4"
GIRDER 3	0"	5 1/8"	8 3/8"	7 1/8"	1'-1 1/2"	1'-7 1/4"	1'-6 5/8"	2'-0 1/2"	2'-8 1/8"	3'-1"	4'-3 1/8"	6'-4 7/8"	7'-1"
GIRDER 4	0"	5 1/8"	8 3/8"	7 1/8"	1'-1 1/2"	1'-7 1/4"	1'-6 5/8"	2'-0 1/2"	2'-7 7/8"	3'-0 1/2"	4'-2 3/8"	6'-3 3/4"	6'-11 5/8"


BLOCKING DIMENSION TABLE

GIRDER DEFLECTION TABLE

SPAN	DEFLECTION	1/10 PT.	2/10 PT.	3/10 PT.	4/10 PT.	5/10 PT.	6/10 PT.	7/10 PT.	8/10 PT.	9/10 PT.
1	CONC. ONLY	1 1/2"	2 3/4"	3 3/8"	3 5/8"	3 3/8"	2 7/8"	1 7/8"	1"	1/4"
	TOTAL DEFL.	2"	3 1/2"	4 1/2"	4 7/8"	4 1/2"	3 3/4"	2 1/2"	1 3/8"	3/8"
2	CONC. ONLY	1/8"	1"	2"	2 1/8"	3/4"	2 1/8"	2"	1 1/8"	1/4"
	TOTAL DEFL.	1/4"	1 1/4"	2 5/8"	3 3/4"	4 1/8"	3 3/4"	2 1/8"	1 1/2"	3/8"
3	CONC. ONLY	1/4"	1"	2"	2 3/4"	3"	2 5/8"	1 7/8"	3/4"	1/8"
	TOTAL DEFL.	3/8"	1 3/8"	2 5/8"	3 1/2"	3 7/8"	3 3/8"	2 3/8"	1"	1/8"
4	CONC. ONLY	3/8"	1 1/4"	2 3/8"	3 3/8"	4 1/8"	4 1/4"	3 7/8"	3"	1 3/4"
	TOTAL DEFL.	1/2"	1 3/4"	3 1/4"	4 1/2"	5 1/2"	5 3/4"	5 1/4"	4"	2 1/4"


SHOWING DEADLOAD DEFLECTION ONLY

DEFLECTIONS GIVEN IN INCHES

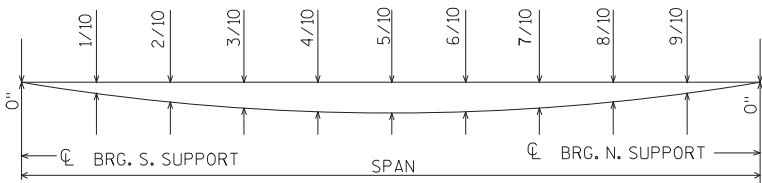

DEFLECTION DIAGRAM

(TYP. ALL SPANS)

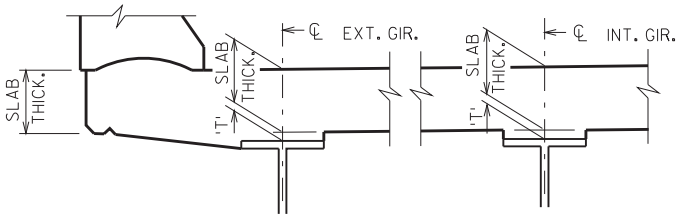

CONCRETE HAUNCH DETAILS

TO DETERMINE 'T': AFTER ALL STRUCTURAL STEEL HAS BEEN ERECTED, ELEVATIONS OF THE TOP FLANGES, TOP OF SPLICE PLATES, OR TOP OF COVER PLATES, WHICHEVER APPLIES, SHALL BE TAKEN AT CENTERLINE OF BEARINGS, CENTERLINE OF FIELD SPLICES, AND AT 1/10 POINTS.

- TOP OF DECK ELEV. AT FINAL GRADE.
- TOP OF STEEL ELEV. AFTER PLACEMENT.
- + DEFLECTION (CONCRETE ONLY)
- SLAB THICKNESS (10")
- = 'T' VALUE FOR SETTING HAUNCH.

TOP OF DECK ELEVATIONS

	CL BRG. S. ABUT.	1/10 PT.	2/10 PT.	3/10 PT.	4/10 PT.	5/10 PT.	6/10 PT.	7/10 PT.	8/10 PT.	9/10 PT.	CL PIER 1	1/10 PT.	2/10 PT.	3/10 PT.	4/10 PT.	5/10 PT.	6/10 PT.	7/10 PT.	8/10 PT.	9/10 PT.	CL PIER 2
GIRDER 1	816.72	816.80	816.88	816.96	817.03	817.11	817.19	817.26	817.34	817.42	817.49	817.59	817.68	817.78	817.87	817.97	818.06	818.16	818.25	818.35	818.44
GIRDER 2	816.95	817.03	817.11	817.19	817.26	817.34	817.42	817.49	817.57	817.65	817.72	817.82	817.91	818.01	818.10	818.20	818.29	818.39	818.48	818.57	818.67
GIRDER 3	816.94	817.02	817.10	817.17	817.25	817.33	817.41	817.48	817.56	817.64	817.71	817.81	817.90	818.00	818.09	818.19	818.28	818.38	818.47	818.56	818.66
GIRDER 4	816.67	816.75	816.83	816.90	816.98	817.06	817.14	817.21	817.29	817.37	817.44	817.54	817.63	817.73	817.82	817.92	818.01	818.10	818.20	818.29	818.39

TOP OF DECK ELEVATIONS



	CL PIER 2	1/10 PT.	2/10 PT.	3/10 PT.	4/10 PT.	5/10 PT.	6/10 PT.	7/10 PT.	8/10 PT.	9/10 PT.	CL PIER 3	1/10 PT.	2/10 PT.	3/10 PT.	4/10 PT.	5/10 PT.	6/10 PT.	7/10 PT.	8/10 PT.	9/10 PT.	CL BRG. N. ABUT.
GIRDER 1	818.44	818.53	818.63	818.72	818.82	818.93	819.09	819.28	819.50	819.76	820.06	820.34	820.64	820.97	821.33	821.71	822.12	822.56	823.02	823.51	824.02
GIRDER 2	818.67	818.76	818.86	818.95	819.05	819.16	819.30	819.48	819.70	819.95	820.24	820.51	820.81	821.14	821.49	821.87	822.27	822.70	823.15	823.63	824.14
GIRDER 3	818.66	818.75	818.85	818.84	819.04	819.14	819.28	819.45	819.66	819.90	820.18	820.45	820.74	821.06	821.41	821.78	822.17	822.60	823.04	823.52	824.02
GIRDER 4	818.39	818.48	818.58	818.67	818.77	818.87	818.99	819.16	819.36	819.60	819.87	820.13	820.42	820.73	821.07	821.43	821.82	822.24	822.68	823.15	823.64

TOP OF STEEL ELEVATIONS


	CL BRG. S. ABUT.	CL F.S. # 1	CL F.S. # 2	CL PIER 1	CL F.S. # 3	CL F.S. # 4	CL PIER 2	CL F.S. # 5	CL F.S. # 6	CL PIER 3	CL F.S. # 7	CL F.S. # 8	CL BRG. N. ABUT.
GIRDER 1	815.72	816.14	816.46	816.49	816.90	817.37	817.44	817.81	818.51	819.06	820.14	822.33	823.02
GIRDER 2	815.95	816.37	816.69	816.72	817.13	817.60	817.67	818.04	818.71	819.25	820.31	822.46	823.14
GIRDER 3	815.94	816.36	816.68	816.71	817.12	817.59	817.66	818.03	818.67	819.19	820.23	822.35	823.02
GIRDER 4	815.67	816.09	816.41	816.43	816.85	817.32	817.39	817.76	818.38	818.88	819.90	821.98	822.64

TOP OF STEEL ELEVATIONS ARE GIVEN TO TOP OF STEEL, (SPLICE & COVER PLATE THICKNESS, IF APPLICABLE, ARE ACCOUNTED FOR) & THEY ARE FOR THE MATERIAL AS ERECTED. THE ELEVATION OF THE TOP OF STEEL AT THE FIELD SPLICE POINTS SHALL BE CHECKED, & CORRECTED, IF POSSIBLE AFTER ERECTION & BEFORE PERMANENTLY BOLTING THE CROSS FRAMING IN PLACE.

NO.	DATE	REVISION	BY
STATE OF WISCONSIN DEPARTMENT OF TRANSPORTATION STRUCTURES DESIGN SECTION			
STRUCTURE B-18-168			
DRAWN BY		CRJ	PLANS CK'D. VT
SUPERSTRUCTURE DETAILS		SHEET 21	
		93	

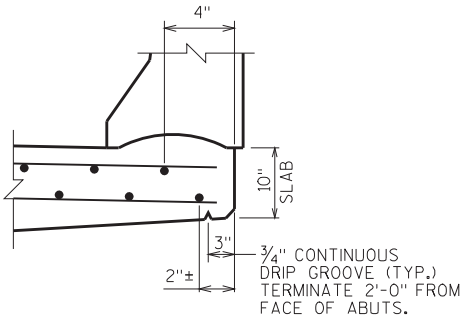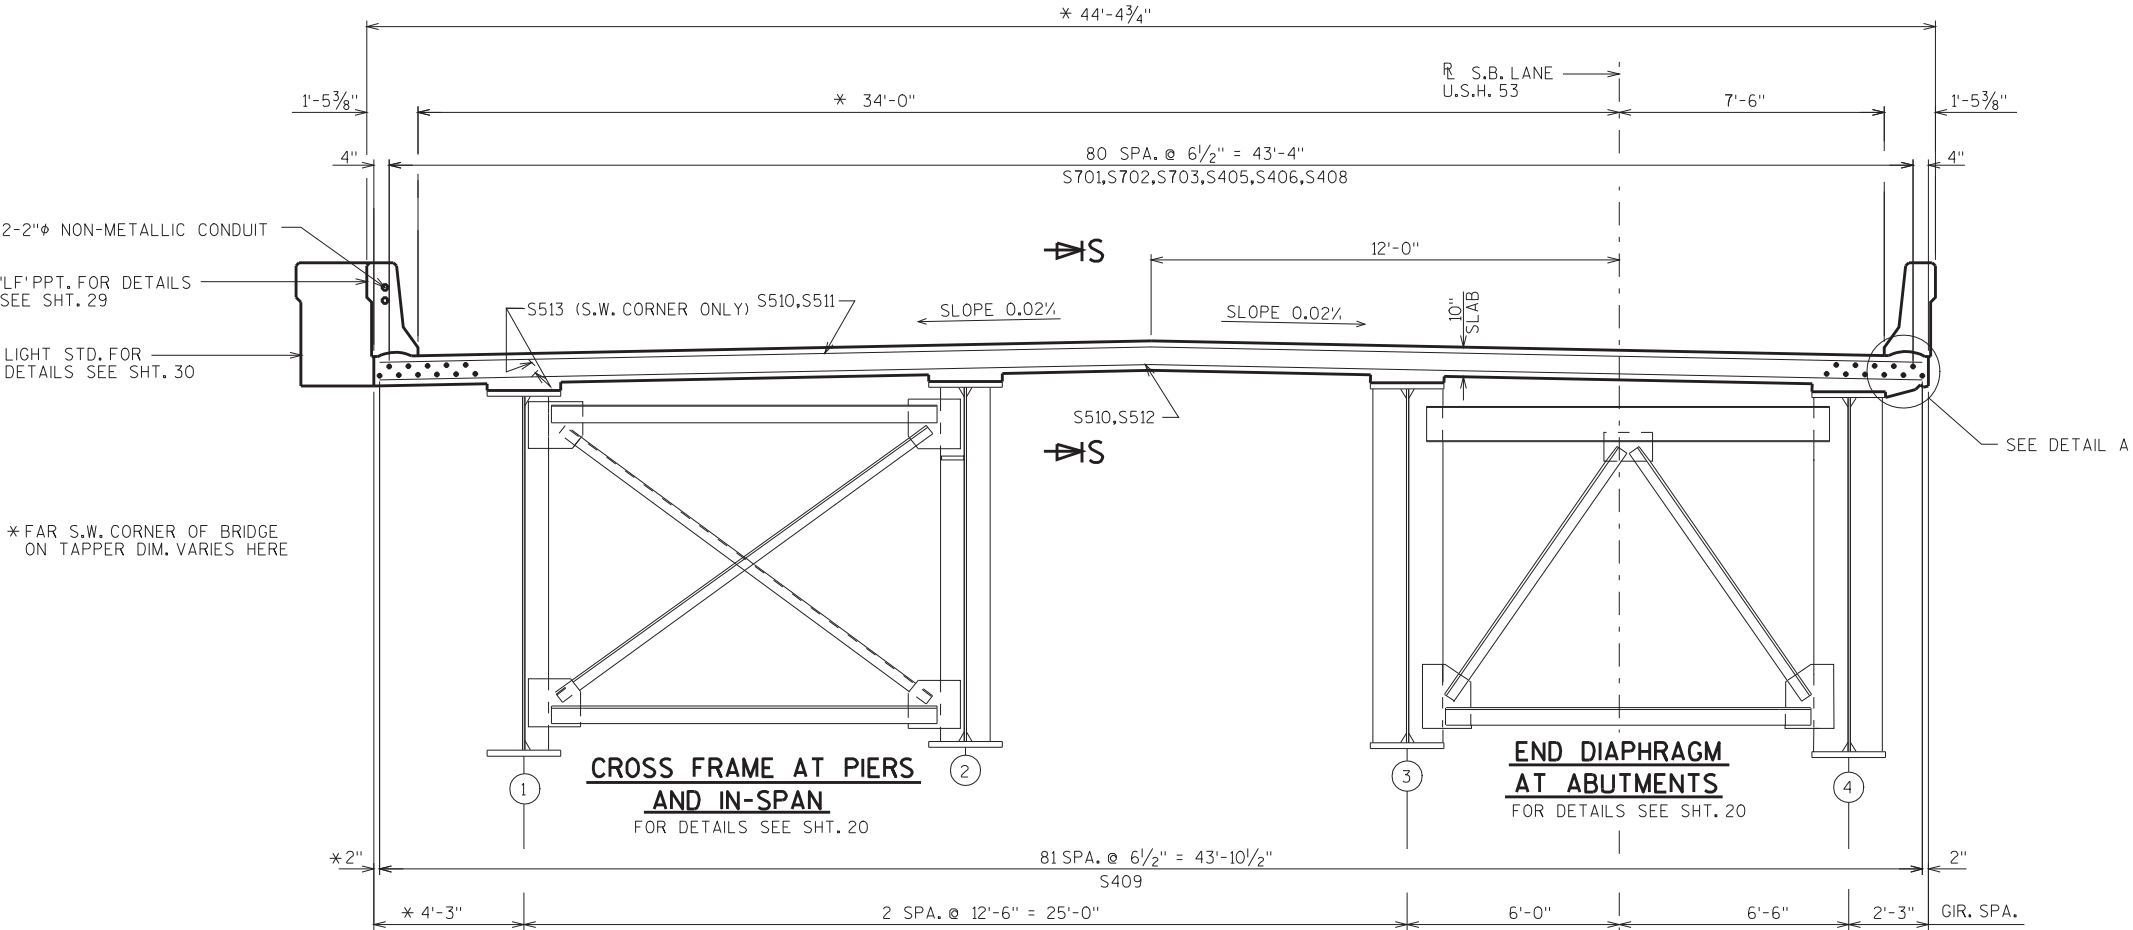


DETAIL A

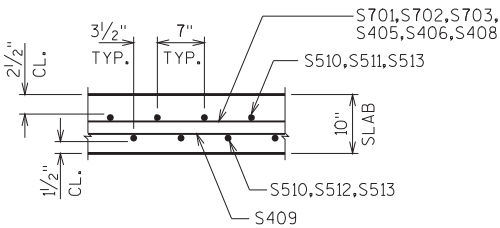


SECTION S

CROSS SECTION THRU ROADWAY  
(LOOKING NORTH)

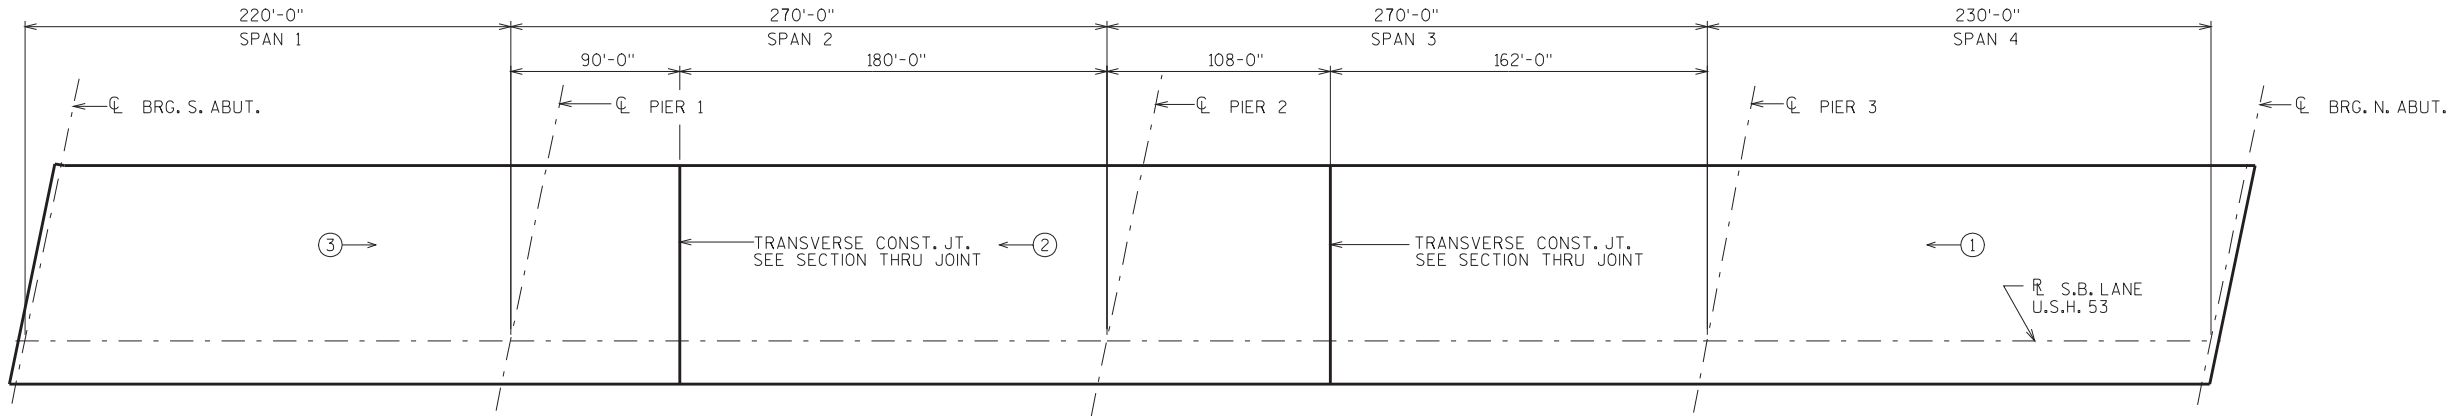

SLAB POURING DIAGRAM

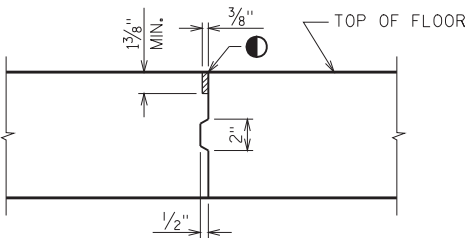

SECTION THRU JOINT

● PREFORMED ELASTOMERIC JOINT SEAL (COMPRESSED) EXTEND SEAL 4" BEYOND GUTTERLINE AND SEAL ENDS. USE UNCOMPRESSED SEAL DIMENSIONS OF 9/16" WIDTH X 1 1/16" HEIGHT WITH A TOLERANCE OF PLUS 1/16" ONLY.

NOTES

THE RATE OF PLACING CONCRETE SHALL EXCEED 80 CU. YDS. PER HOUR TRANSVERSE CONSTRUCTION JOINTS, EXCEPT THOSE ADJACENT TO IN SPAN HINGES, MAY BE OMITTED WITH THE APPROVAL OF THE STRUCTURES DESIGN SECTION.

TWO OR MORE ALTERNATE POURS MAY BE PLACED ON THE SAME DAY.


THE CONTRACTOR MAY SUBMIT AN ALTERNATE POURING SEQUENCE SUBJECT TO THE APPROVAL OF THE STRUCTURES DESIGN SECTION.

LEGEND

←○ INDICATES POUR NUMBER AND REQUIRED DIRECTION OF POUR

NO.	DATE	REVISION	BY
STATE OF WISCONSIN DEPARTMENT OF TRANSPORTATION STRUCTURES DESIGN SECTION			
STRUCTURE B-18-168			
DRAWN BY CRJ		PLANS CK'D. VT	
SUPERSTRUCTURE CROSS SECTION		SHEET 22	
		94	



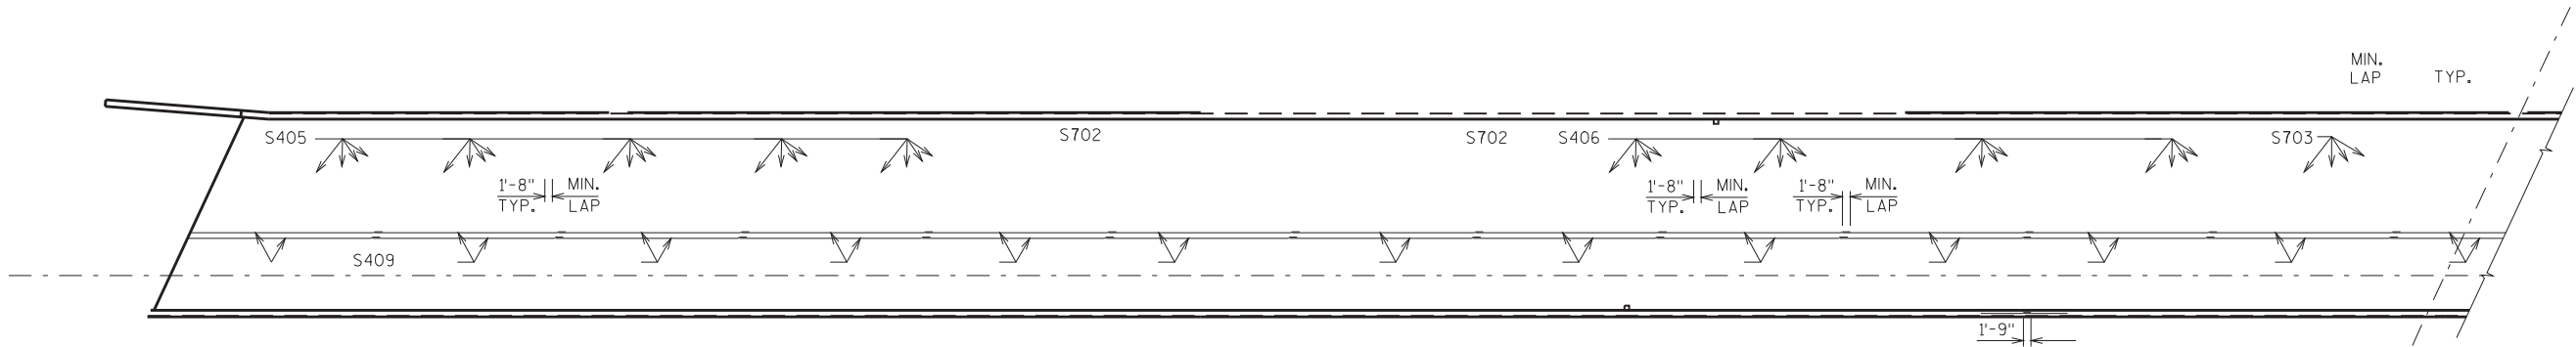

NO.	DATE	REVISION	BY
STATE OF WISCONSIN DEPARTMENT OF TRANSPORTATION STRUCTURES DESIGN SECTION			
STRUCTURE B-18-168			
DRAWN BY CRJ		PLANS CK'D.	VT
SUPERSTRUCTURE PLAN		SHEET 23	
		95	

BILL OF BARS

NOTE: THE FIRST OR FIRST TWO DIGITS OF THE BAR MARK SIGNIFIES THE BAR SIZE.


BAR MARK	COAT	NO. REQ'D.	LENGTH	BENT	BAR SERIES	LOCATION
S701	X	243	45'-0"			SLAB-LONGIT.-TOP-OVER PIERS
S702	X	324	38'-3"			SLAB-LONGIT.-NEAR PIERS 1 & 3
S703	X	162	36'-9"			SLAB-LONGIT.-TOP-NEAR PIER 2
S704	X	NOT	USED			
S405	X	405	35'-6"			SLAB-LONGIT.-TOP-SPAN 1
S406	X	648	41'-1"			SLAB-LONGIT.-TOP-SPAN 2 & 3
S407	X	NOT	USED			
S408	X	405	37'-6"			SLAB-LONGIT.-TOP-SPAN 4
S409	X	2050	41'-6"			SLAB-LONGIT.-BOT.
S510	X	3333	43'-8"			SLAB-TRANS.-TOP & BOT.
▲ S511	X	68	22'-3"		X	SLAB-TRANS.-TOP
▲ S512	X	68	22'-10		X	SLAB-TRANS.-BOT.
S513	X	14	3'-2"			SLAB-TRANS.-TOP & BOT.-S.W. CORNER
S514	X	2978	4'-2"	X		"LF"-PPT.-VERT.
S515	X	2978	4'-10"	X		"LF"-PPT.-VERT.
S516	X	250	41'-5"			"LF"-PPT.- HORIZ.
S517	X	84	9'-1"			LIGHT STD.-HORIZ.
S518	X	84	9'-9"	X		LIGHT STD.-HORIZ.
S519	X	28	6'-0"	X		LIGHT STD.-VERT.
S520	X	28	7'-0"	X		LIGHT STD.-VERT.
S621	X	49	10'-0"	X		LIGHT STD.-HORIZ.
S522	X	14	3'-5"	X		LIGHT STD.-VERT.
S523	X	14	3'-2"	X		LIGHT STD.-VERT.
S524	X	16	5'-0"			SLAB-FOOR DRAINS

▲ LENGTH SHOWN FOR BAR IS AN AVERAGE LENGTH AND SHOULD ONLY BE USED FOR BAR WEIGHT CALCULATIONS. SEE BAR SERIES TABLE FOR ACTUAL LENGTHS.


BAR SERIES TABLE

MARK	NO. REQD.	LENGTH
S511	2 SERIES OF 34	1'-7" TO 42'-10"
S512	2 SERIES OF 34	2'-2" TO 43'-5"


BUNDLE AND TAG EACH SERIES SEPARATELY.

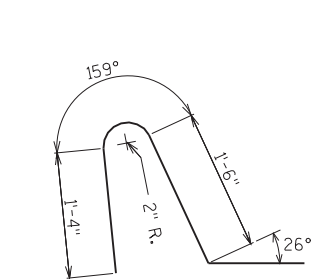


S514

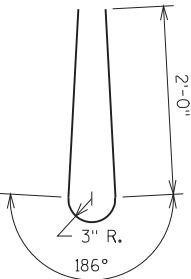


S515

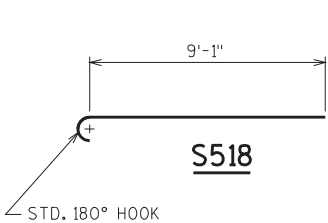


S518

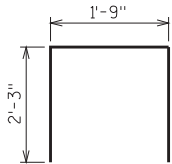


S519

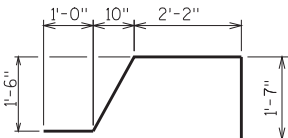


S520

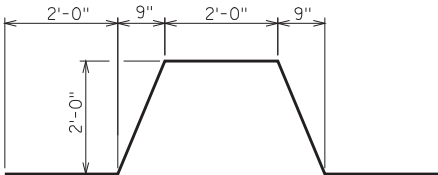

S621

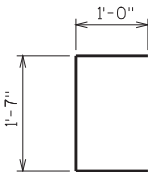

S522

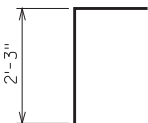

S523

NO.	DATE	REVISION	BY
STATE OF WISCONSIN DEPARTMENT OF TRANSPORTATION STRUCTURES DESIGN SECTION			
STRUCTURE B-18-168			
DRAWN BY CRJ		PLANS CK'D.	VT
SUPERSTRUCTURE BAR DETAILS		SHEET 24	
		96	


**LEGEND**

- ① MODULAR EXPANSION JOINT DEVICE.
- ② 1/2" PLATE, ONE PER GIRDER MIN. PROVIDE 2 - 1" X 2" MIN. SLOTTED HOLES PLACED HORIZONTALLY FOR NO. 4.
- ③ WT 6 X 29 (OR EQUIVALENT BUILT UP T-SECTION), ONE PER GIRDER. PROVIDE 2 - 1" X 3" MIN. SLOTTED HOLES PLACED VERTICALLY IN WEB OF WT FOR BOLTS NO. 4.
- ④ 3/4"  $\phi$  HIGH STRENGTH BOLTS WITH NUTS & WASHERS. (A325 GALV.)
- ⑤ 3/4"  $\phi$  HIGH STRENGTH BOLTS WITH NUTS & WASHERS. FIELD DRILL HOLES IN GIRDER TOP FLANGE. (A325 GALV.)
- ⑤A 3/4"  $\phi$  THREADED ROD WITH 2 NUTS & WASHERS. GROUT THREADED ROD INTO FIELD DRILLED HOLES. (GALV.)
- ⑥ SUPPORT BOX ASSEMBLY FOR SUPPORT BAR (SPA. PER MANUFACTURER). SPACE TO MISS GIRDERS. FABRICATE BOX FROM 1/2" PLATES.
- ⑦ 3/8" BULKHEAD PLATE. WELD TO NO. 1, NO. 8 AND NO. 14.
- ⑧ INSIDE PLATE. FABRICATE FROM 3/8" PLATE.
- ⑨ OUTSIDE PLATE. FABRICATE FROM 5/8" PLATE.
- ⑩ 7/8" SQUARE BAR. WELD TO NO. 8 AS SHOWN.
- ⑪ 3/4"  $\phi$  X 4" LONG STUDS. WELD TO NO. 8, NO. 7 & NO. 14 AS SHOWN.
- ⑫ 3/4"  $\phi$  X 2" STAINLESS STEEL FLAT CTSK. SLOTTED HEAD CAP SCREWS. RECESS 1/16" BELOW PLATE SURFACE.
- ⑬ 1/2" PLATE WITH 5/8"  $\phi$  LOOP ANCHOR FABRICATED AS SHOWN. SPACED AT MANUFACTURER'S SPEC.
- ⑭ INSIDE PLATE. FABRICATE FROM 5/8" PLATE
- ⑮ ADIPRENE BUTTON. SEE DETAIL. SET IN OUTSIDE PLATE.


\* POUR CONC. ABOVE THIS JOINT AFTER SUPERSTRUCTURE CONC. IS IN PLACE. STRIKE OFF & LEAVE ROUGH.

▲ MANUFACTURER'S RECOMMENDED JOINT OPENING BASED ON THE TEMPERATURE ON THE DAY OF PLACEMENT PER TEMPERATURE TABLE.




MFR BY: D.S. BROWN, CHASKA MN  
MODEL D-240 3-CELL MODULAR EXPANSION JOINT

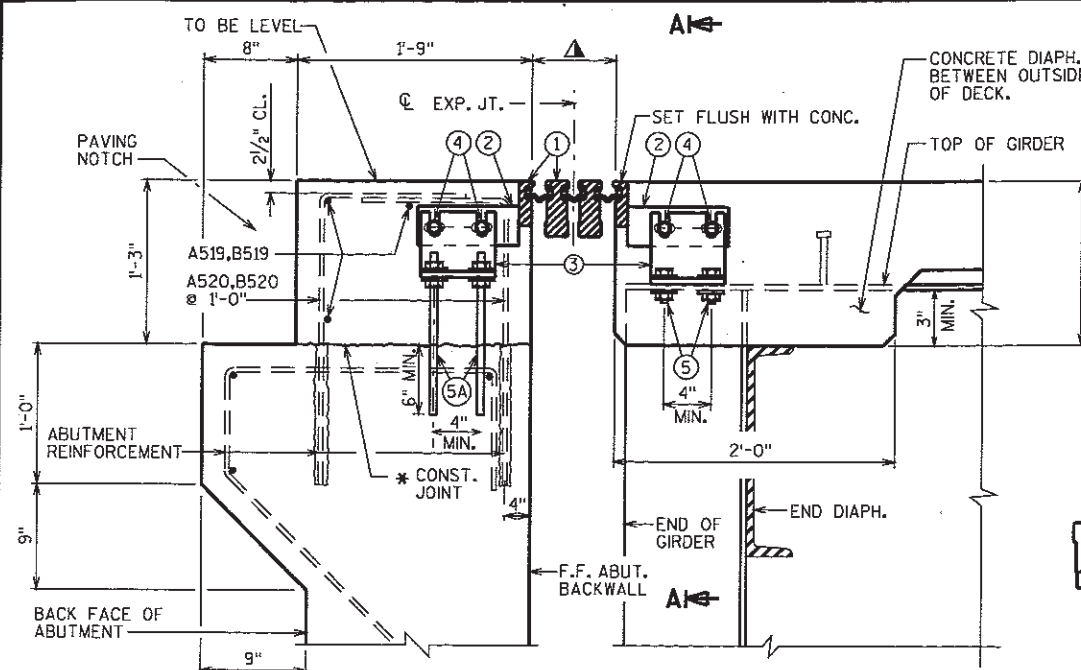


**SECTION THRU JOINT @ ABUTMENT**  
NORMAL TO  $\phi$  SUBSTRUCTURE

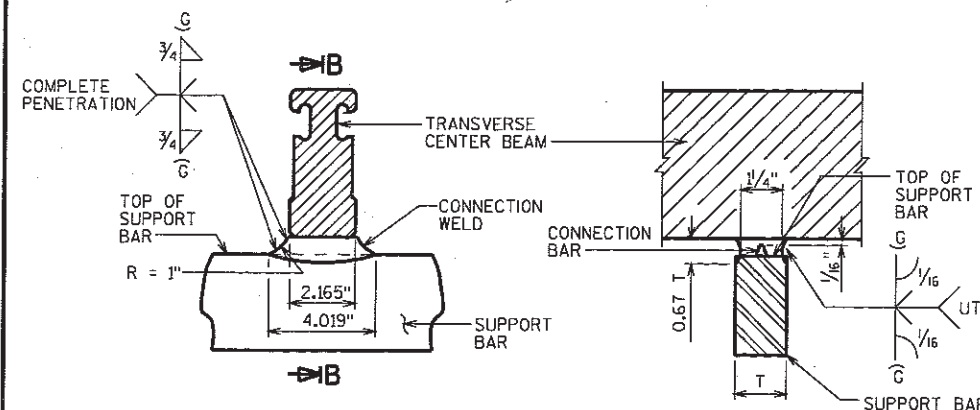


**MODULAR EXPANSION JOINT CONNECTION DETAIL AND WELD SPECIFICATION**

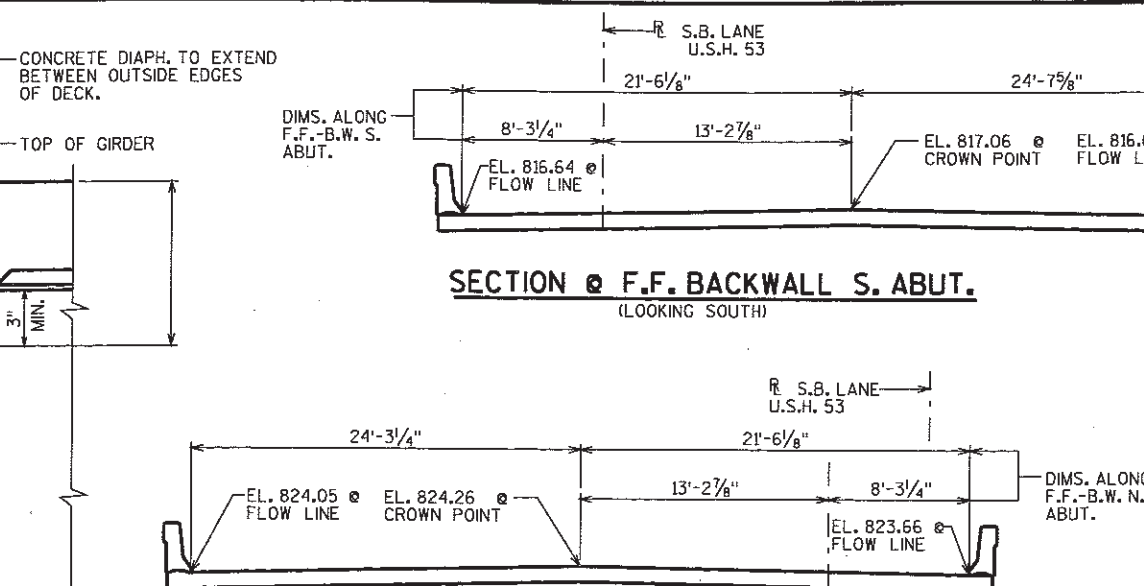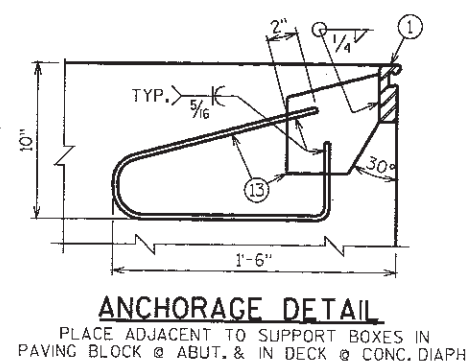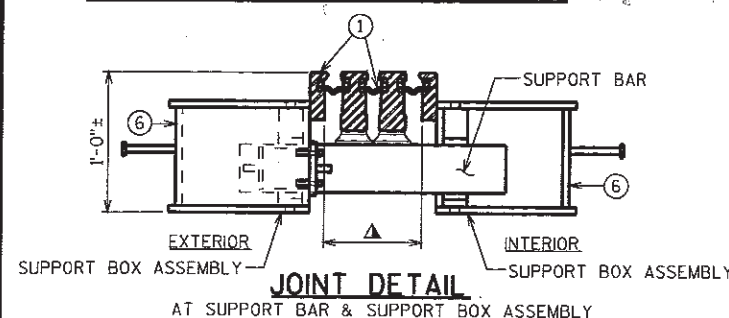

**SECTION @ F.F. BACKWALL S. ABUT.**  
(LOOKING SOUTH)

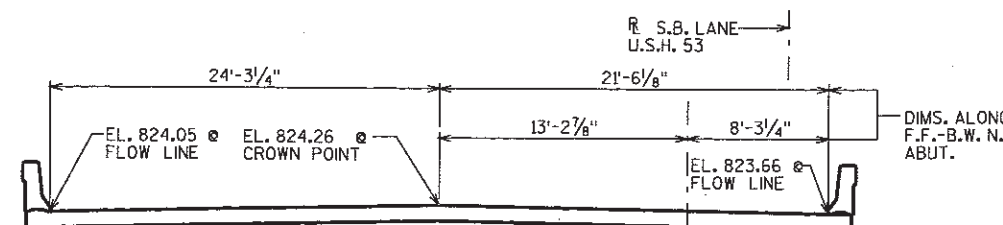

**SECTION @ F.F. BACKWALL N. ABUT.**  
(LOOKING NORTH)

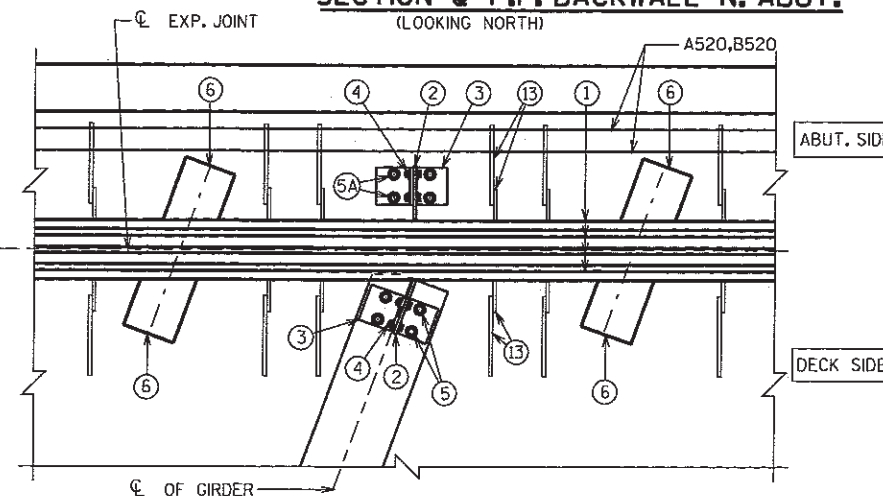

**PART PLAN**

NOTE: FABRICATOR WILL DESIGN EACH JOINT DEPENDING ON THE CONDITIONS AND THE DESIGN CRITERIA USED BY THE SUPPLIER. FABRICATION DRAWING IS SUBJECT TO THE APPROVAL OF THE BUREAU OF STRUCTURES.

SUPPORT BOXES ARE SHOWN FOR GENERAL INFORMATION AND LOCATION MAY VARY ACCORDING TO FABRICATOR DESIGN.

**GENERAL NOTES**

ONE FIELD SPlice PERMITTED IN STEEL EXTRUSIONS. DETAILS SHALL BE SUBMITTED FOR APPROVAL. NO SPLICING PERMITTED IN NEOPRENE GLAND.

AFTER FABRICATION, BUT BEFORE SHIPMENT, STRAIGHTEN STEEL EXTRUSIONS SUCH THAT THEY SHALL BE FREE FROM WARP, TWIST & SWEEP.

NO EXPANSION JOINT PROTRUSIONS PERMITTED ABOVE ROADWAY SURFACE, ON PARAPET ROADWAY FACE OR ABOVE SIDEWALK SURFACE (FOR RAISED SIDEWALK).


THE EXPANSION JOINT SEALS SHALL BE PLACED, BONDED & SEALED AS RECOMMENDED BY THE MANUFACTURER. FORM WORK SHALL BE PLACED BETWEEN THE SUPPORT BOXES TO PREVENT CONCRETE INTRUSION INTO THE SUPPORT BOX. A TECHNICAL REPRESENTATIVE OF THE MANUFACTURER SHALL BE PRESENT DURING INSTALLATION. PRIOR TO SETTING THE JOINT ASSEMBLY INTO POSITION, THE PROJECT ENGINEER SHALL DETERMINE THE PROPER JOINT OPENING.

EXPANSION JOINT EXTRUSIONS SHALL BE FABRICATED TO CONFORM TO ROADWAY CROWN & GRADE. FABRICATOR SHALL PROVIDE MEANS OF KEEPING GALVANIZED EXTRUSIONS CLEAN & SMOOTH DURING SHIPMENT AND PRIOR TO APPLYING LUBRICANT ADHESIVE FOR NEOPRENE GLAND INSTALLATION.

SANDBLAST BARS, PLATES, WT-SECTION, ANCHORAGE LOOP, & EXTRUSIONS AFTER FABRICATION IN ACCORDANCE WITH SSPC SP. #6 "COMMERCIAL BLAST CLEANING". AFTER BLAST CLEANING, THIS ASSEMBLY SHALL BE HOT DIPPED GALVANIZED.

COST OF FURNISHING & PLACING OF THE EXPANSION JOINTS COMPLETE WITH PARAPET PLATES & SIDEWALK PLATES SHALL BE PAID FOR UNDER THE PRICE BID FOR "EXPANSION DEVICE MODULAR B-18-168".

BAR STEEL REINF. IN DECK AND CONC. DIAPHRAGM SHALL BE RESPAVED AS NECESSARY TO ALLOW PLACEMENT OF JOINT ASSEMBLY.

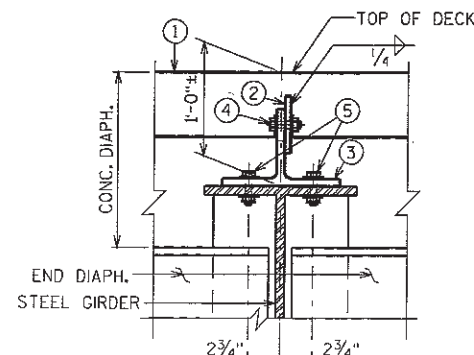

**SECTION A-A**

**TEMP. TABLE**




TEMPERATURE TABLE FOR SETTING JOINT OPENINGS TO BE DETERMINED BY JOINT MANUFACTURER WITH THE FOLLOWING DESIGN DATA:

1. 3/4" IN. OF MOVEMENT PER 10° F
2. MEDIAN TEMPERATURE OF 45° F
3. TEMP. RANGE IN TABLE FROM (- 5° F) TO (+ 95° F)




A TABLE OF JOINT OPENINGS BASED ON ABOVE DATA SHALL BE SUBMITTED TO THE ENGINEER FOR APPROVAL.

NO.	DATE	REVISION	BY
STATE OF WISCONSIN DEPARTMENT OF TRANSPORTATION STRUCTURES DESIGN SECTION			
STRUCTURE B-18-168			
DRAWN BY		CRJ	PLANS CK'D. VJT
EXPANSION DEVICE		SHEET 25	
		97 <sup>97</sup>	



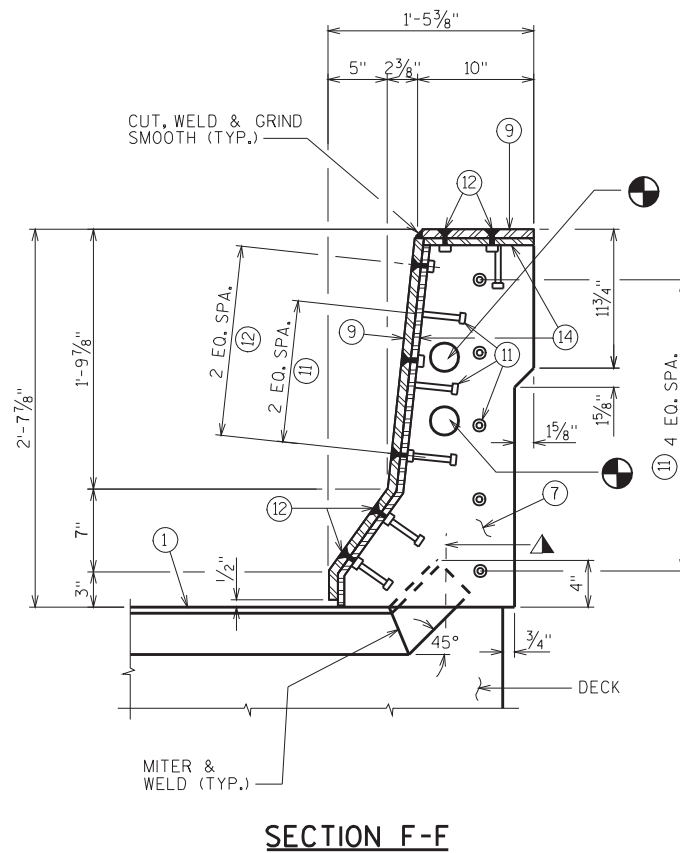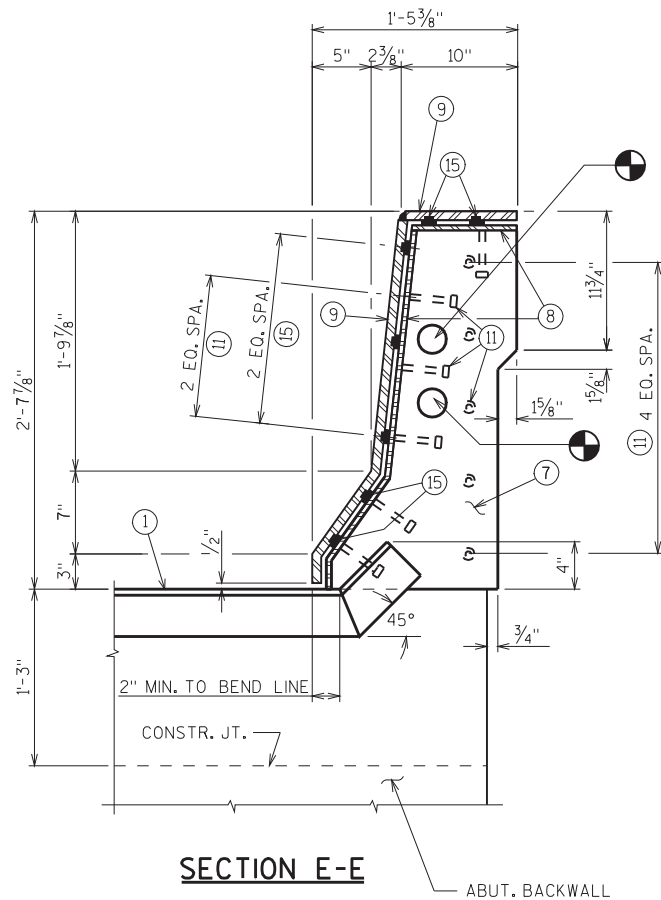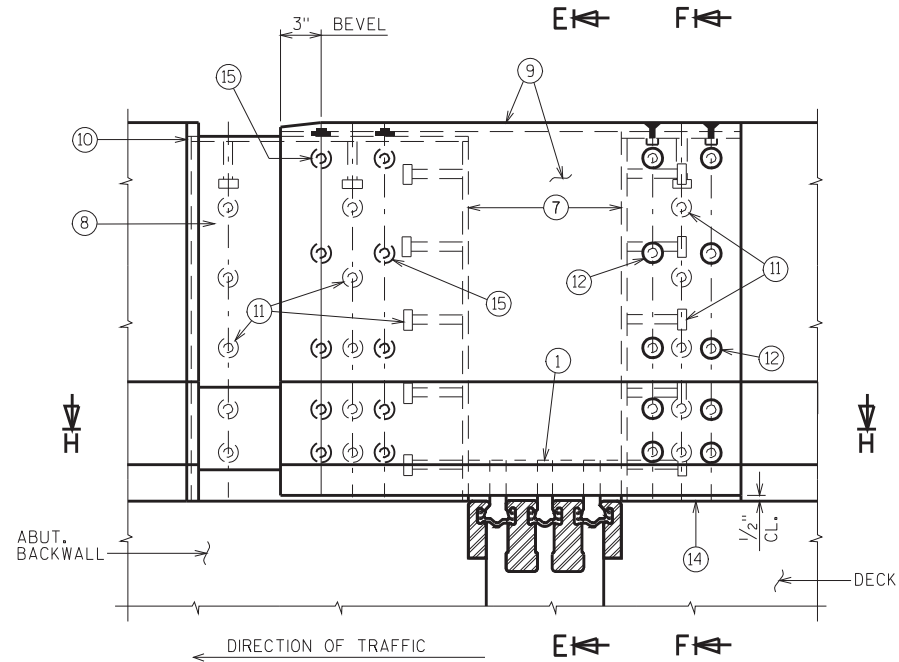

AT WINGS 2 & 3, PROVIDE HOLES IN BULKHEAD PLATES FOR CONDUITS, AS DETAILED ON LIGHTING SHTS

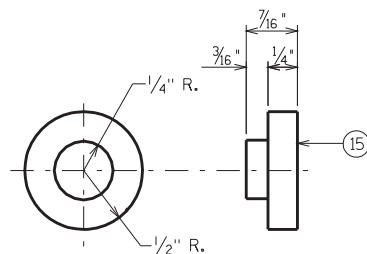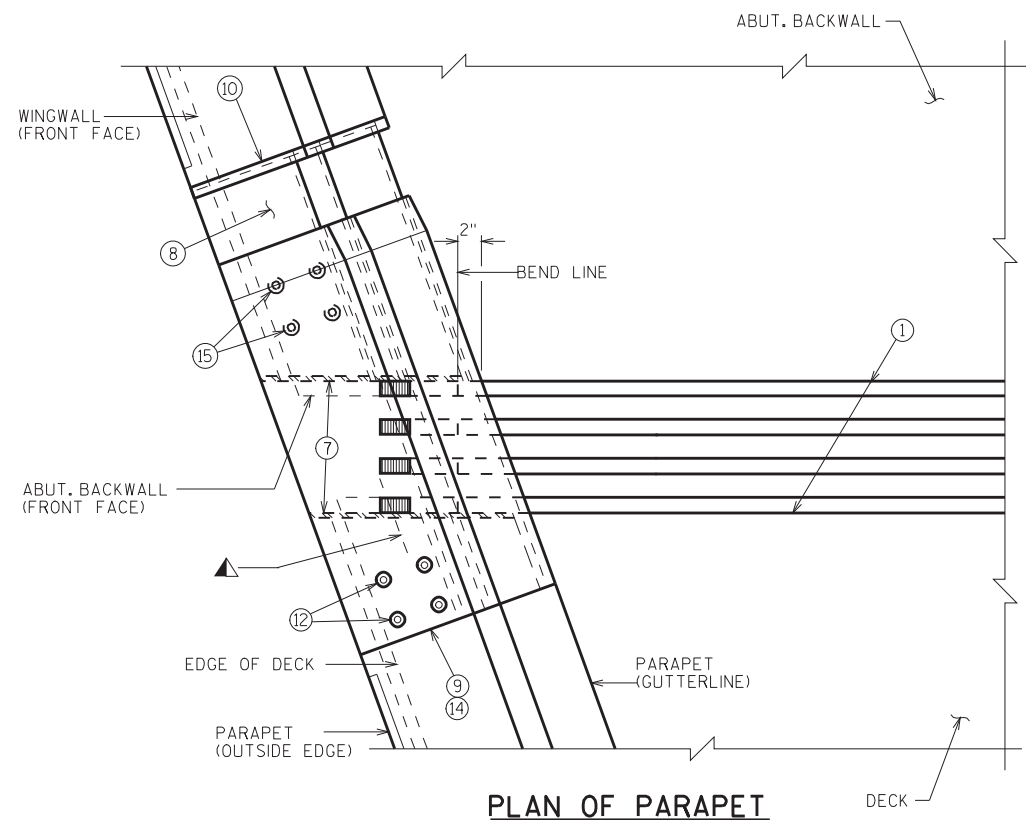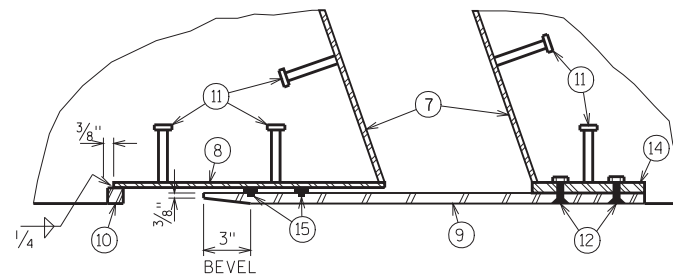

MITER EXTRUSION ENDS AS REQ'D TO PROVIDE CLEARANCE

NO.	DATE	REVISION	BY
STATE OF WISCONSIN DEPARTMENT OF TRANSPORTATION STRUCTURES DESIGN SECTION			
STRUCTURE B-18-168			
DRAWN BY CRJ		PLANS CK'D. VT	
EXPANSION DEVICE DETAILS		SHEET 26	
		98	


ALL MATERIAL FOR TYPE "GC"  
CASTING, EXCLUDING GRATE HOLD DOWN  
SCREWS, SHALL BE GRAY IRON CONFORMING  
TO A.S.T.M. A48, CLASS 30. (APPROX.  
WEIGHT = 225#)

THE CONTRACTOR MAY PROPOSE  
AN ALTERNATE TYPE OF BRACKET. THE  
PROPOSED ALTERNATE DETAILS SHALL BE  
SUBMITTED AND SUBJECT TO THE APPROVAL  
OF THE ENGINEER.

FLANGED 6" DIA. DOWNSPOUTS SHALL BE  
EITHER CAST MATERIAL OR FIBERGLASS  
CONFORMING TO A.S.T.M. D2996, GRADE I, CLASS A.



ATTACH GRATE TO  
FRAME FOR SHIPMENT

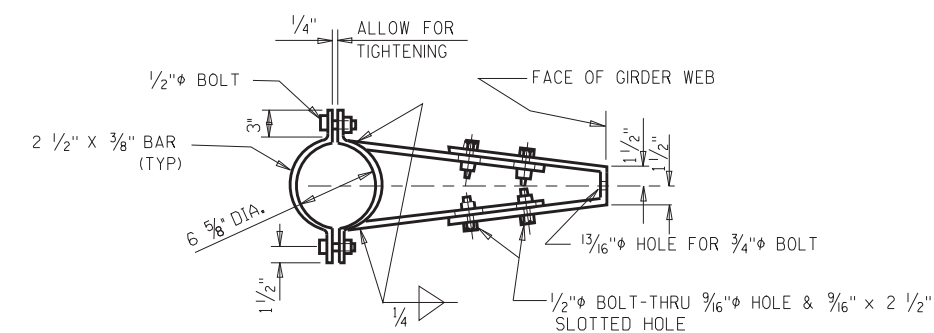

BRACKET DETAIL




MOVE DRAINS TO MISS STIFFENERS  
AND CROSS FRAMING IF NECESSARY



NO.	DATE	REVISION	B
STATE OF WISCONSIN DEPARTMENT OF TRANSPORTATION STRUCTURES DESIGN SECTION			
STRUCTURE B-18-168			
DRAWN BY		CRJ	PLANS CK'D. VT
FLOOR DRAIN TYPE ' GC '		SHEET 27	
		99	


FLANGED 6" DIA. DOWNSPOUTS SHALL BE  
EITHER CAST MATERIAL OR FIBERGLASS  
CONFORMING TO A.S.T.M. D2996, GRADE I, CLASS A.

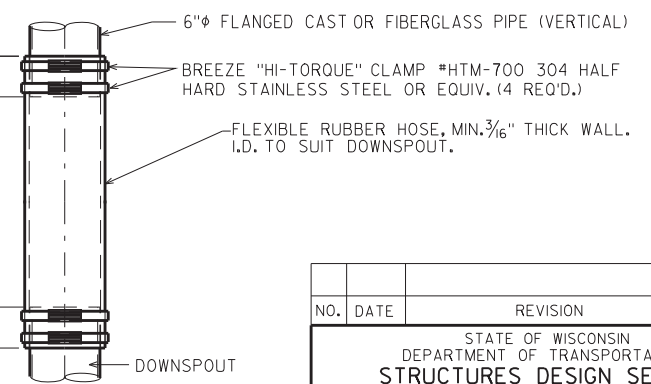


NO.		DATE		REVISION		BY	
STATE OF WISCONSIN DEPARTMENT OF TRANSPORTATION <b>STRUCTURES DESIGN SECTION</b>							
<b>STRUCTURE B-18-168</b>							
				DRAWN BY		CRJ PLANS CK'D. <b>VT</b>	
<b>FLOOR DRAIN          TYPE 'R-4014-C1'</b>						SHEET 28	
						100	

**BILL OF BARS**  
FOR ABUTMENT PARAPETS


BAR MARK	COAT	S. ABUT.	N. ABUT.	LENGTH	BENT	BAR SERIES	LOCATION
R501	X	14	14	4'-7"	X		PARAPET VERT.
R502	X	8	8	2'-4"	X		PARAPET VERT.
R503	X	40	39	4'-7"	X		PARAPET VERT.
R504	X	4	4	29'-8"			PARAPET HORIZ.
R505	X	54	53	4'-10"	X		PARAPET VERT.
R506	X	1	1	29'-8"	X		PARAPET HORIZ.
R507	X	1		1'-8"			PARAPET HORIZ.
R508	X		5	1'-2"			PARAPET HORIZ.
R509	X	4		2'-0"			PARAPET HORIZ.

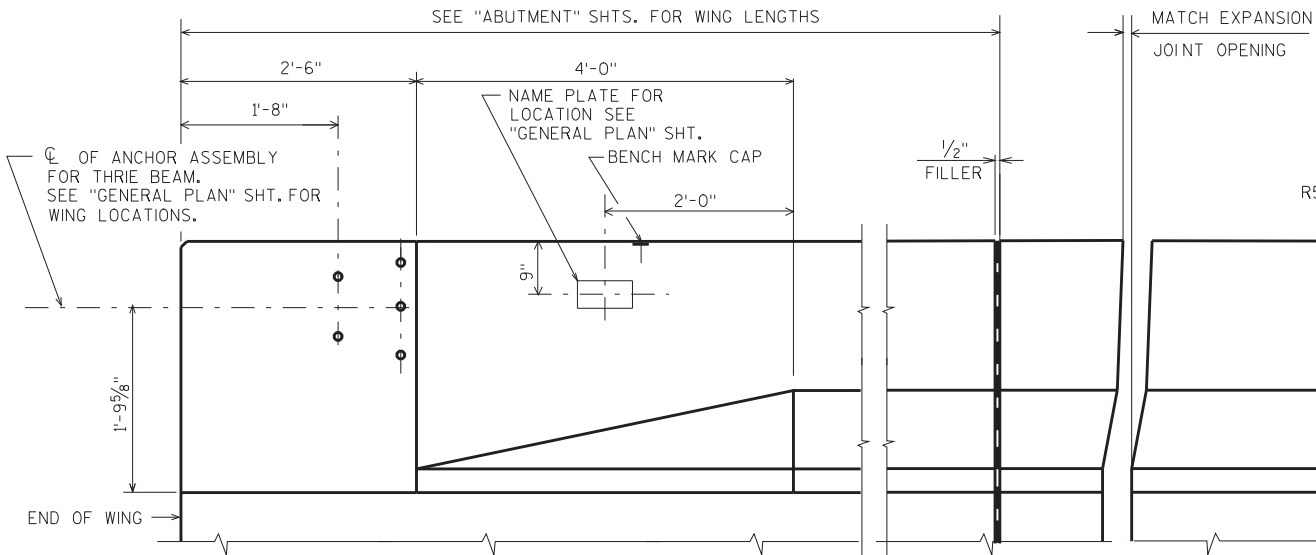


**INSIDE ELEVATION**

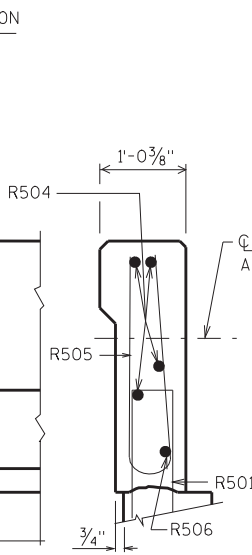


**SECTION A**

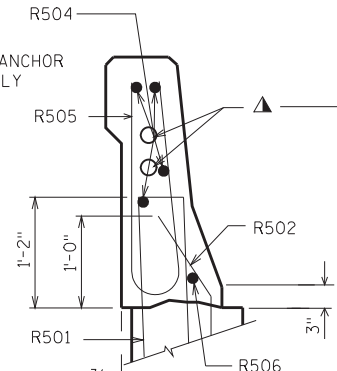


**SECTION B**

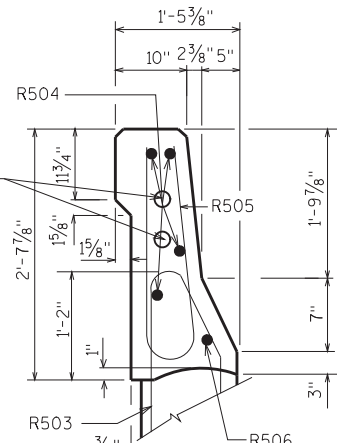


**SECTION C**

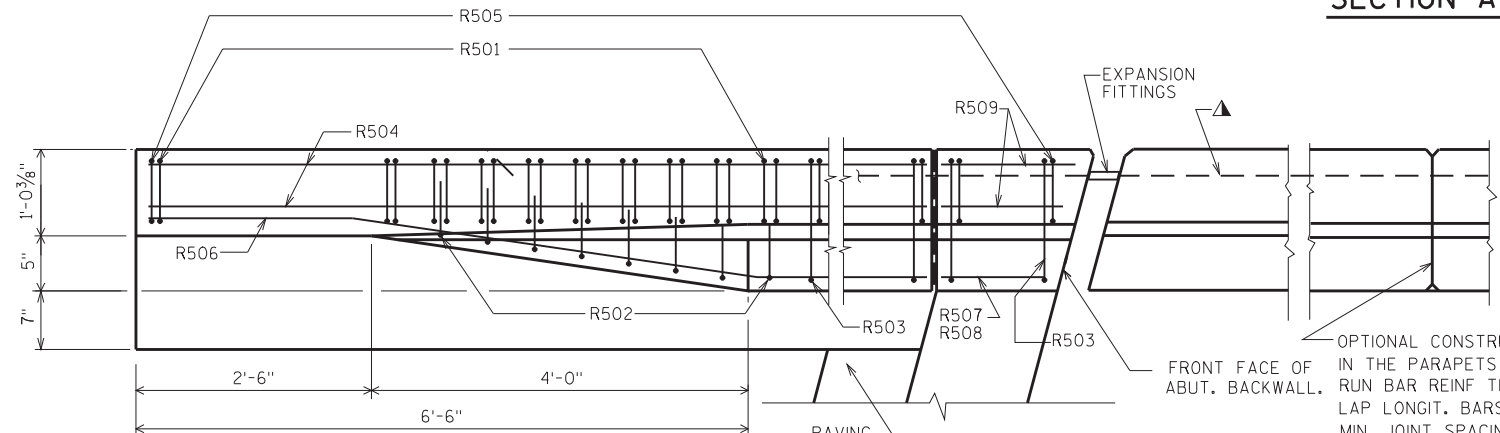


**PLAN**

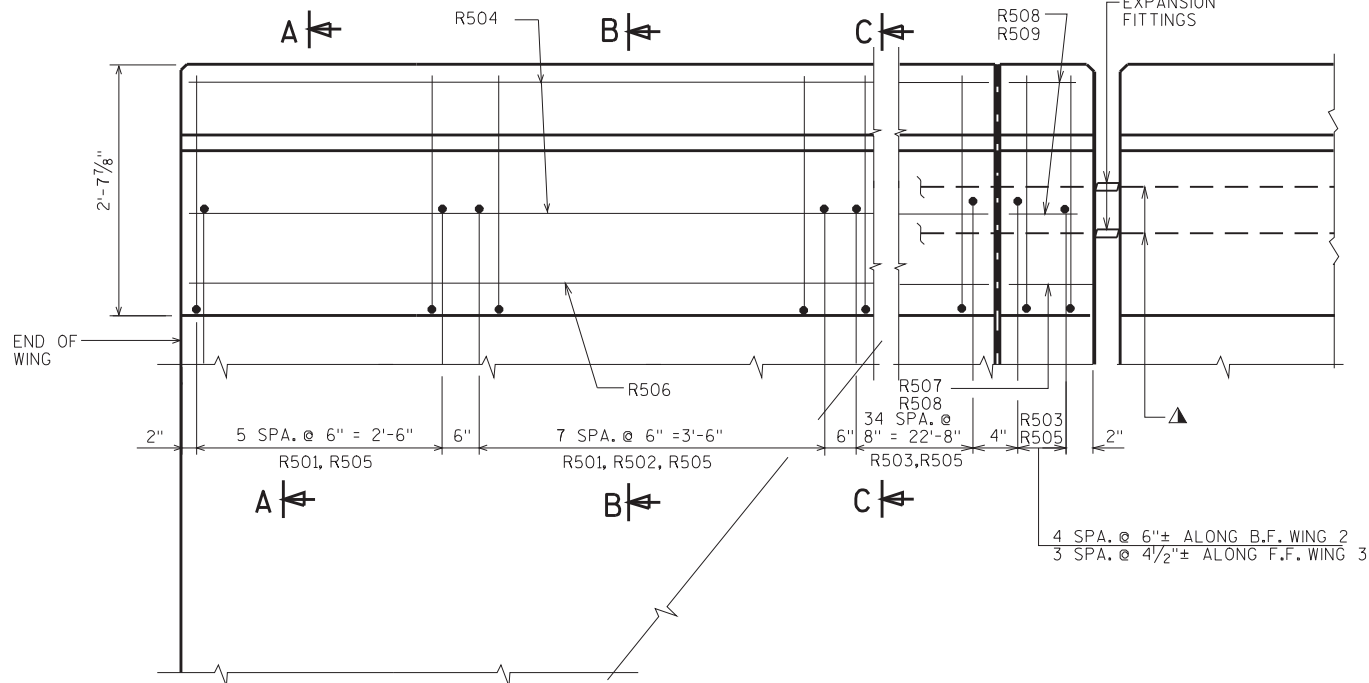


**OUTSIDE ELEVATION**

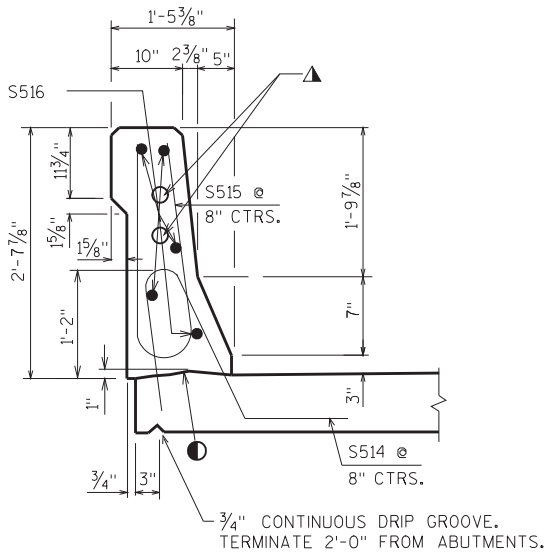


**SECTION THRU PARAPET ON BRIDGE**

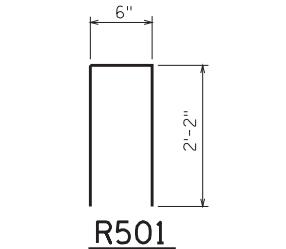


**R501**

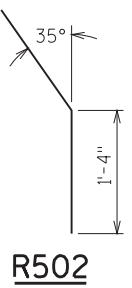


**R502**

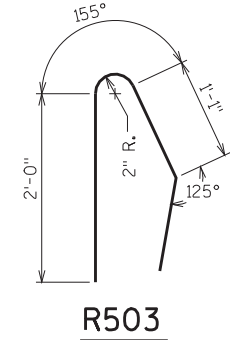

**R503**

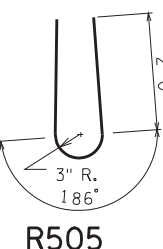


**R505**

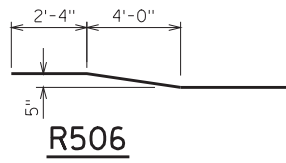

**R506**

THREADED INSERTS FOR 7/8"  $\phi$  X 2" LONG GALVANIZED HEX. HEAD CAP SCREWS. CAP SCREWS TO BE THREADED A MIN. OF 1 1/8" AND SHALL BE SUPPLIED, INCLUDING WASHERS, WITH ASSEMBLY. INSERTS TO BE THREADED A MINIMUM OF 1 3/4"

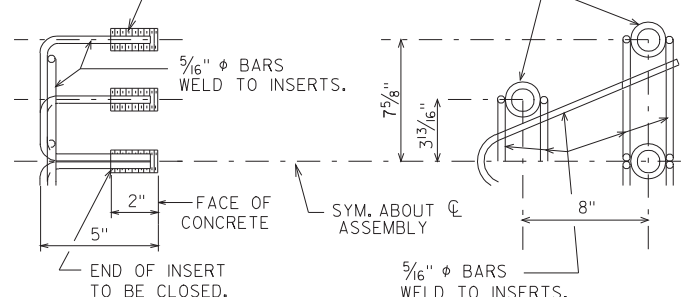


**DETAIL OF ANCHOR ASSEMBLY**

NOTE: HEX. HEAD CAP SCREWS & WASHERS TO BE GALVANIZED IN ACCORDANCE WITH AASHTO M232 CLASS C.


- CONST. JOINT - STRIKE OFF AS SHOWN.
- ▲ 2"  $\phi$  CONDUIT SEE LIGHTING DETAIL SHT.

NO.	DATE	REVISION	BY
STATE OF WISCONSIN DEPARTMENT OF TRANSPORTATION STRUCTURES DESIGN SECTION			
STRUCTURE B-18-168			
DRAWN BY CRJ		PLANS CK'D. VT	
SLOPED FACE PARAPET LF		SHEET 29	
		101	



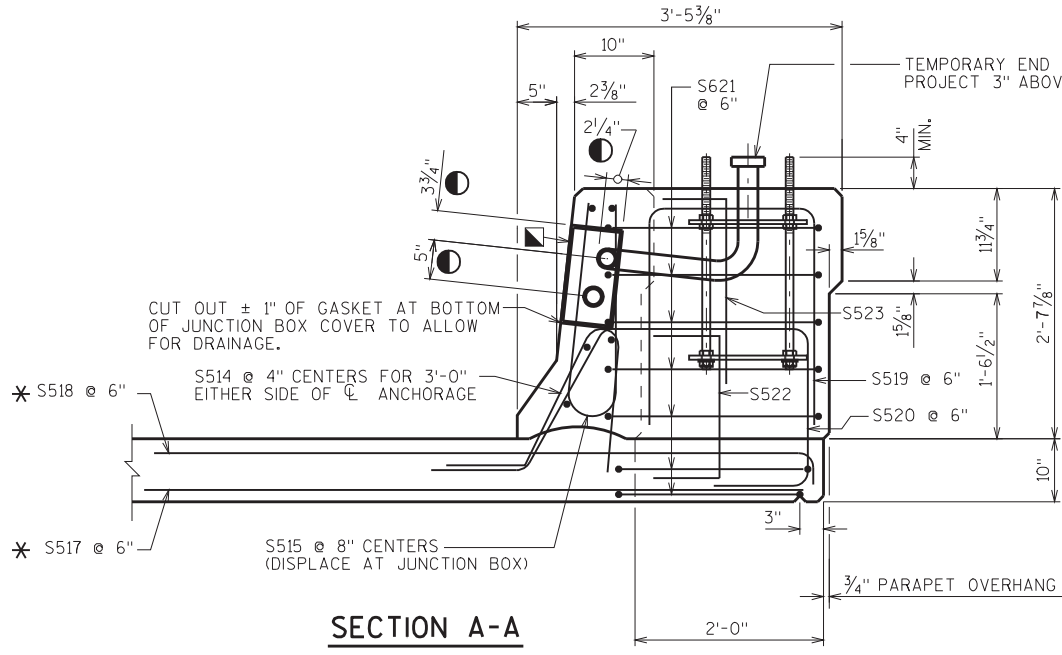

SECTION A-A

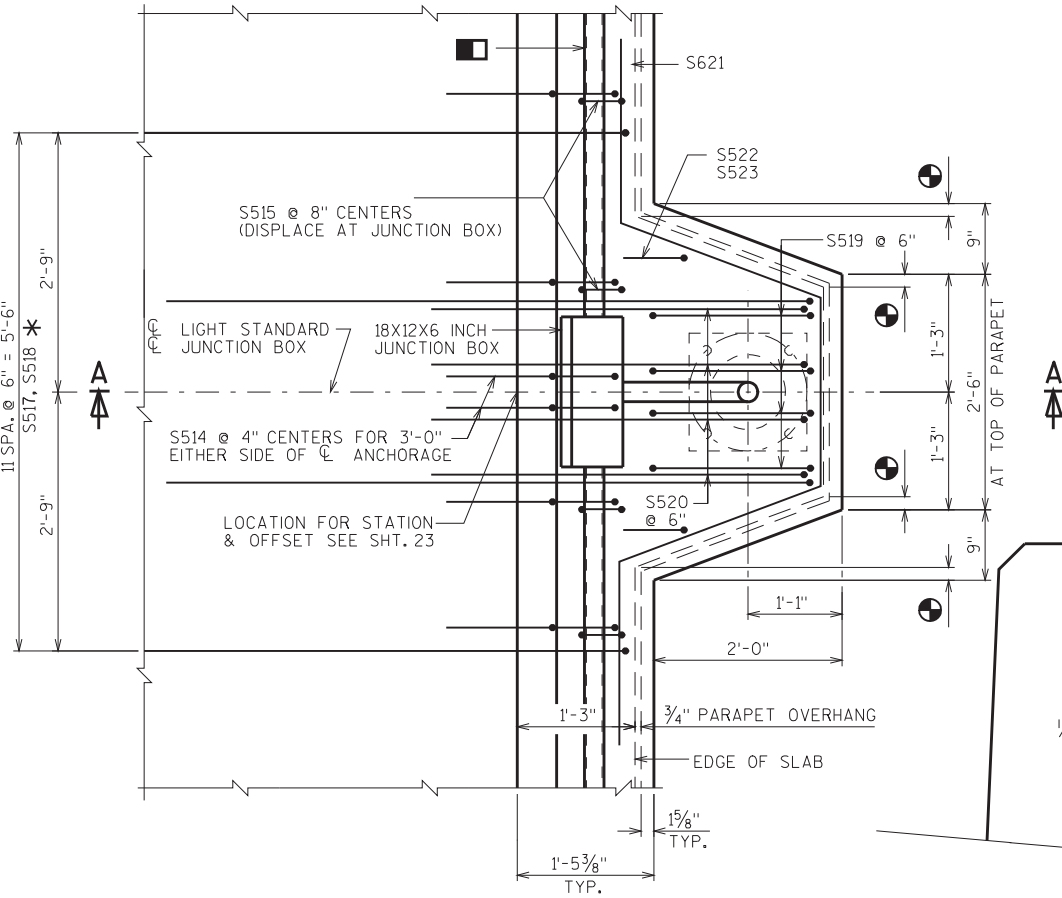

PLAN AT LIGHT STANDARD

POSITION MOVABLE END OF CONDUIT INSIDE EXPANSION FITTING, SUCH THAT IT WILL HAVE THE SAME ALLOWANCE FOR MOVEMENT (EXPANSION/CONTRACTION) AS THE EXPANSION DEVICE SET IN PLACE IN THE DECK BELOW IT. TAKE CARE TO INSTALL EXPANSION FITTING AND CONDUIT EXACTLY PARALLEL TO BRIDGE MOVEMENT.



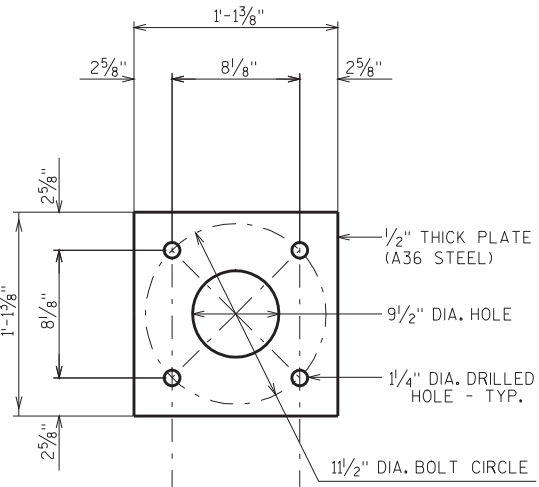


PLATE DETAIL

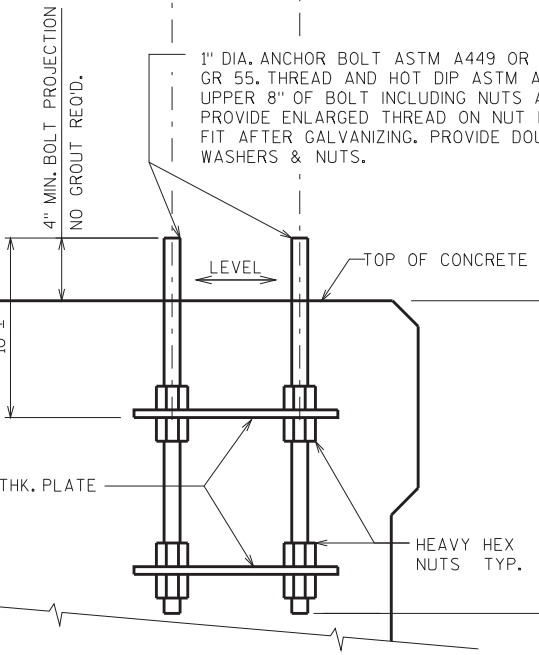


ANCHORAGE DETAIL

TO BE PAID FOR AS  
"ANCHOR ASSEMBLIES LIGHT POLES"  
(7 REQ'D.)

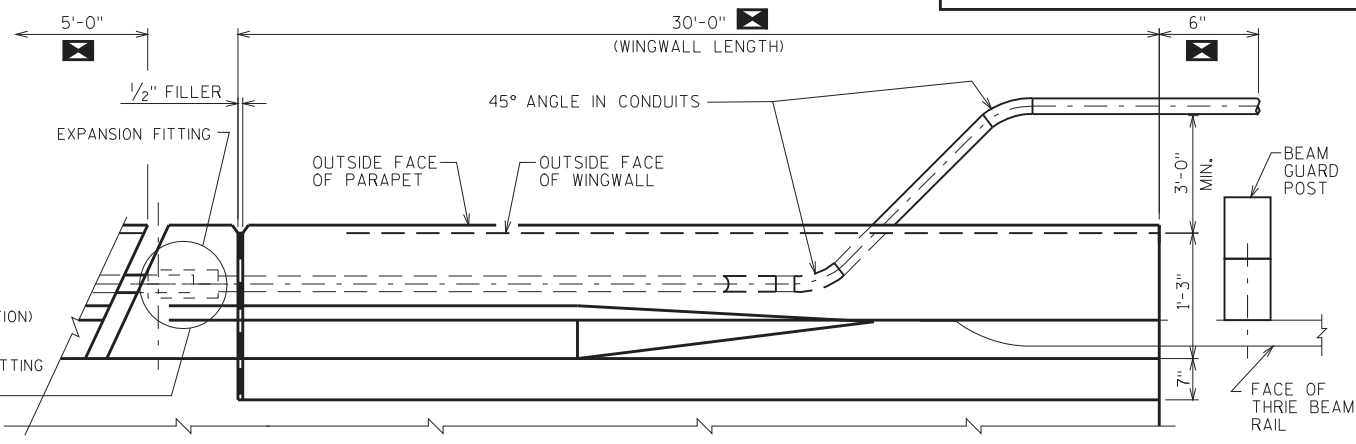

PLAN OF PARAPET AT WINGWALL

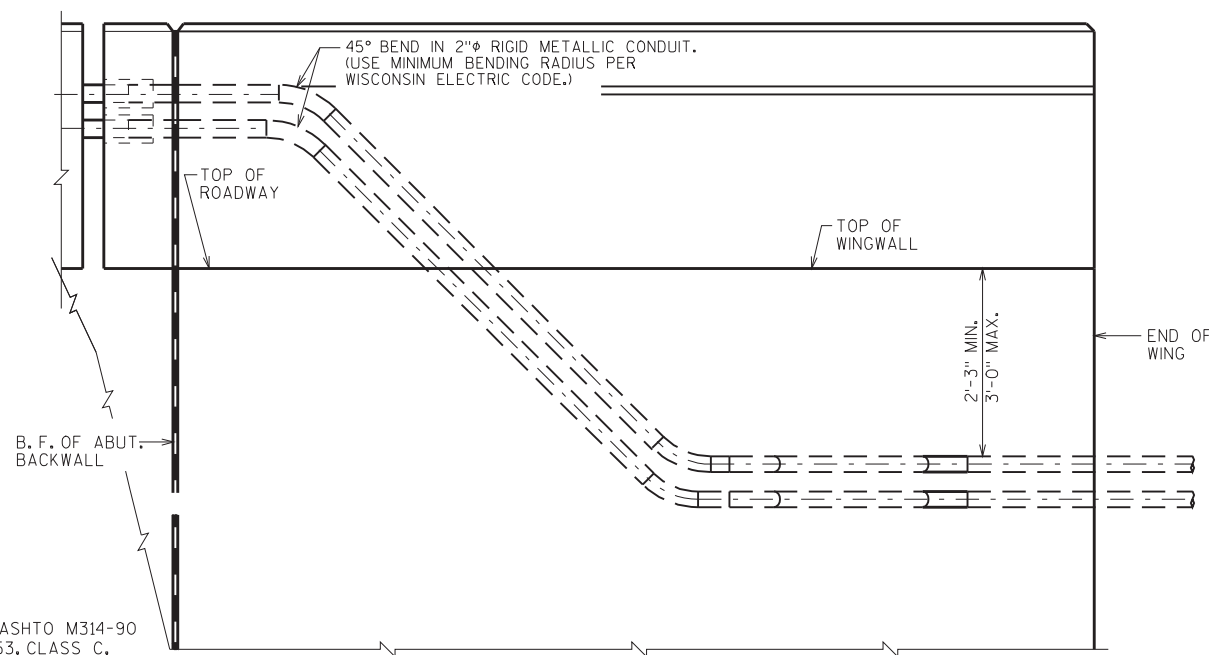

OUTSIDE ELEVATION OF PARAPET AT WINGWALL

- USE 2-2" RIGID NONMETALLIC CONDUIT EXCEPT AT EXPANSION FITTING AT 5'-0" FROM THE EXPANSION JOINT AND WING WALL.
- 2-2" RIGID METALLIC CONDUIT WITH TEMPORARY END CAPS.

NOTES

BID ITEMS SHALL BE:  
"JUNCTION BOXES 18X12X6-INCH", EACH.  
"CONDUIT RIGID NONMETALLIC SCHEDULE 40 2-INCH"  
"CONDUIT RIGID METALLIC 2-INCH".  
EXPANSION FITTINGS, ANGLES AND ADAPTER FITTINGS TO BE INCIDENTAL TO "CONDUIT RIGID METALLIC 2-INCH".  
  
WHEN CONNECTING NONMETALLIC CONDUIT TO METALLIC CONDUIT, ONLY ADAPTER FITTINGS U.L. LISTED FOR ELECTRICAL USE SHALL BE USED.  
  
EXPANSION FITTING SHALL BE O-Z GENDNEY TYPE EX-200 WITH PBS-200-12S AND BONDING JUMPER, OR EQUIVALENT.


- \* THESE BARS ARE IN ADDITION TO STANDARD TRANSVERSE BARS IN DECK.
- JUNCTION BOX - O-Z GEDNEY - MODEL YR-181206 OR APPROVED EQUIVILANT, (CAST IRON CONSTRUCTION, HOT DIPPED GALVANIZED, NEOPRENE GASKET, STAINLESS STEEL COVER SCREWS.)

- 1 5/8"-DISTANCE TO EDGE OF SLAB AT BOTTOM OF PARAPET
- MEASURED FROM OUTSIDE OF JUNCTION BOX


NO.	DATE	REVISION	BY
STATE OF WISCONSIN DEPARTMENT OF TRANSPORTATION STRUCTURES DESIGN SECTION			
STRUCTURE B-18-168			
DRAWN BY		CRJ	PLANS CK'D. VT
LIGHTING DETAILS		SHEET 30	
		102	

BILL OF BARS


BAR MARK	COAT	S. ABUT.	N. ABUT.	LENGTH	BENT	LOCATION
K501	X	14	14	4'-7"	X	PARAPET VERT.
K502	X	8	8	2'-4"	X	PARAPET VERT.
K503	X	9	9	4'-7"	X	PARAPET VERT.
K504	X	8	8	6'-1"		PARAPET HORIZ.
K505	X	23	23	4'-10"	X	PARAPET VERT.
K506	X	1	1	9'-8"	X	PARAPET HORIZ.
K407	X	8	8	5'-9"	X	PARAPET FTG.-VERT.
K408	X	14	14	6'-11"		PARAPET FTG.-HORIZ.
K509	X	19	15	8'-1"	X	PARAPET FTG.-HORIZ.
K410	X	9	9	7'-5"		PARAPET FTG.-HORIZ.
K411	X	20	20	6'-10"		PARAPET FTG.-HORIZ.
K512	X	5	5	1'-7"		PARAPET HORIZ.

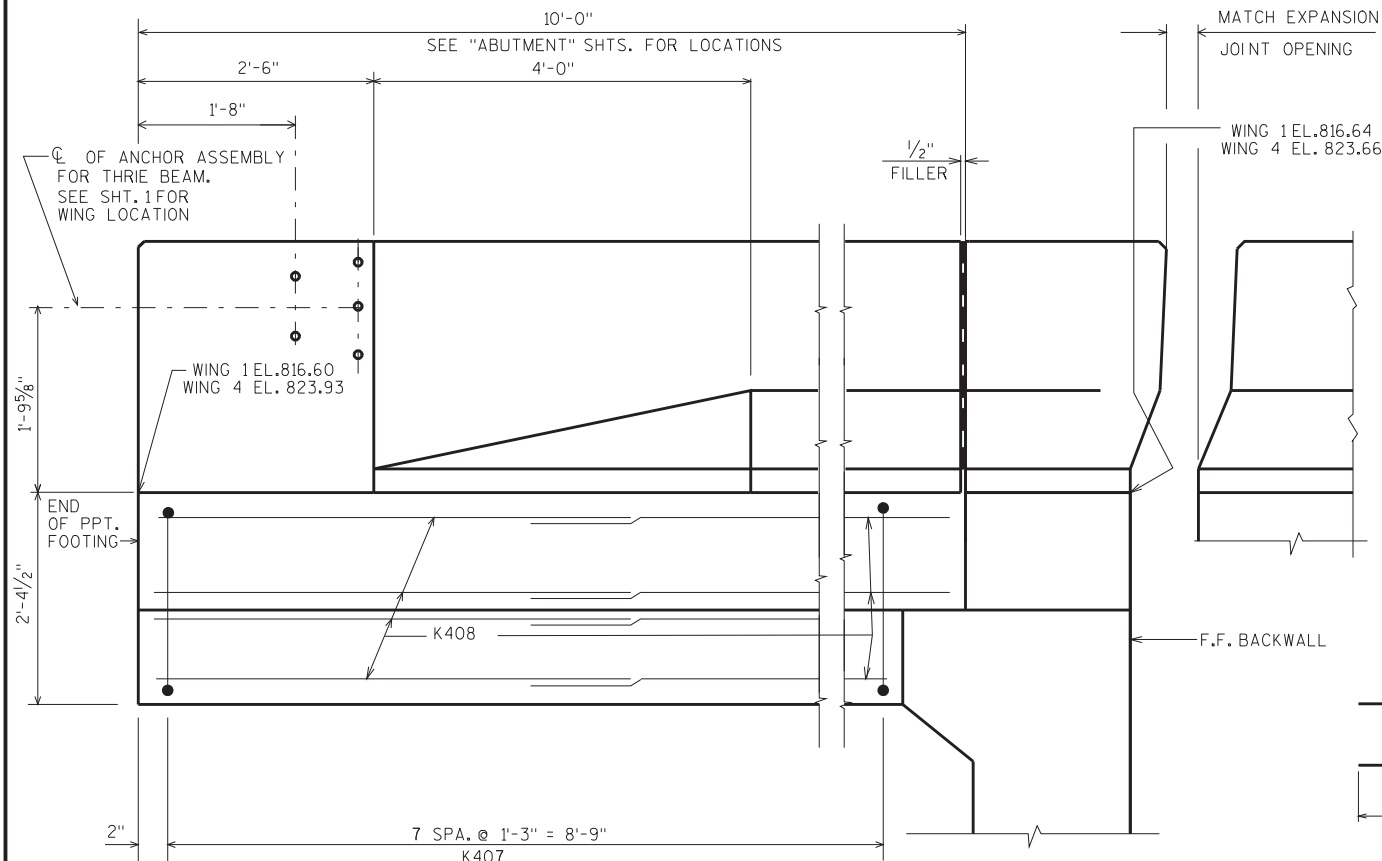


INSIDE ELEVATION

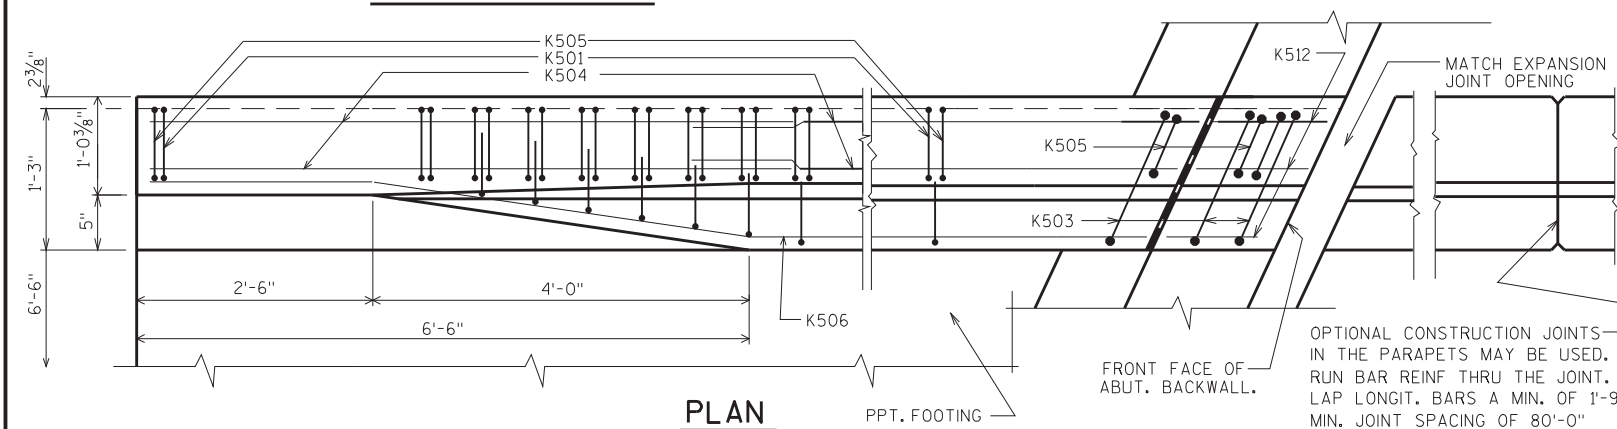

PLAN

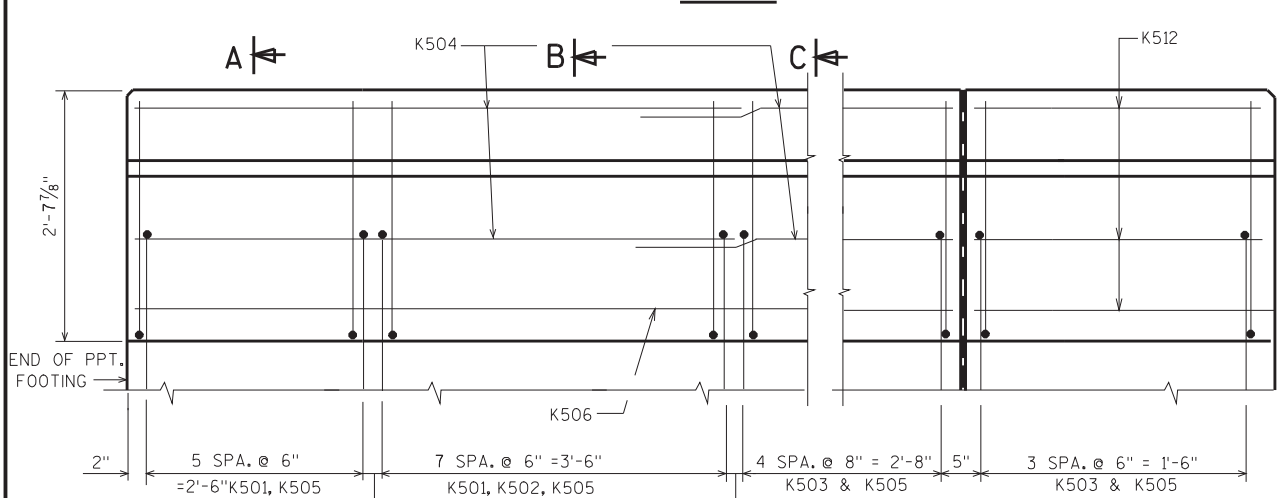

OUTSIDE ELEVATION

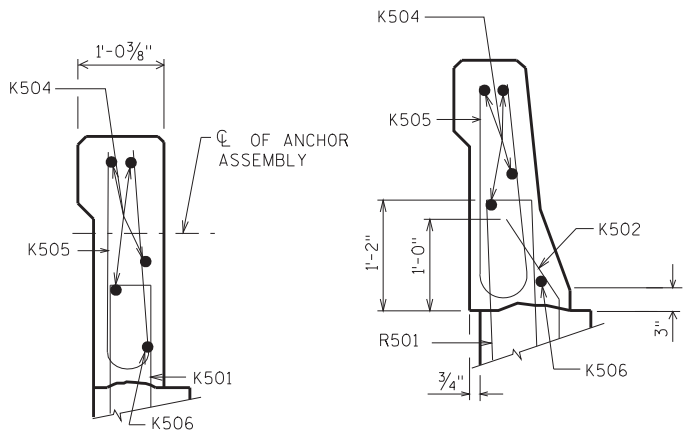


SECTION A

(SEE SECTION C FOR FOOTING DETAILS)

SECTION B

(SEE SECTION C FOR FOOTING DETAILS)

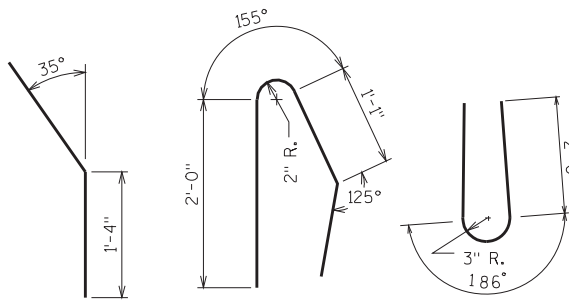


K501


K502

K503

K505

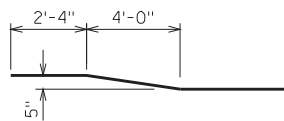


K506

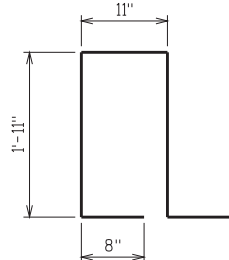

K407



K509

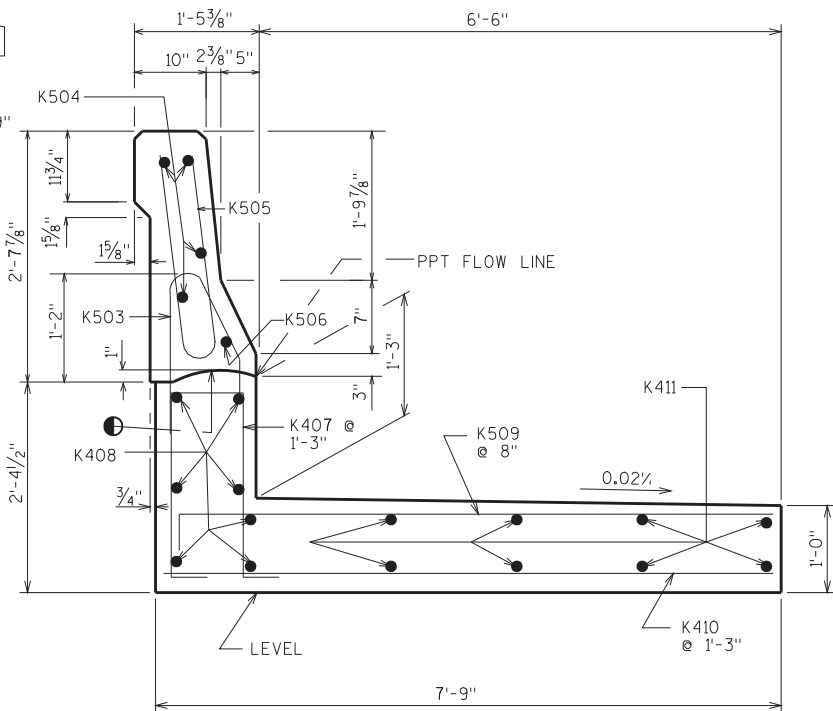

SECTION C

CONST. JOINT - STRIKE OFF AS SHOWN.

NO.	DATE	REVISION	BY
STATE OF WISCONSIN DEPARTMENT OF TRANSPORTATION STRUCTURES DESIGN SECTION			
STRUCTURE B-18-168			
DRAWN BY CRJ		PLANS CK'D. VT	
SLOPED FACE PARAPET 'LF' & FOOTING		SHEET 31	
		103	