

# REHABILITATION STRUCTURE SURVEY REPORT

DT1696 6/2012

Wisconsin Department of Transportation

- ☒ **Grade Separation**
☐ **Stream Crossing**
☐ **Culvert**  
☐ **Railroad**
☐ **Retaining Wall**
☐ **Noise Barrier**  
☐ **Sign Structure**
☐ **Other:** \_\_\_\_\_

For guidance see: [http://dotnet/dtdi\\_bos/extranet/structures/reports-checklists.htm](http://dotnet/dtdi_bos/extranet/structures/reports-checklists.htm)

Design Project ID 1190-02-34	Construction Project ID 1190-02-64	Highway (Project Name) EAU CLAIRE - CHIPPEWA FALLS		
Final Plan Due Date 05/01/2018	Preliminary Plan Due Date 05/01/2018	<input type="checkbox"/> Town <input type="checkbox"/> Village <input checked="" type="checkbox"/> City EAU CLAIRE		
PS&E Date 08/01/2018	Letting Date 02/12/2019	County EAU CLAIRE		
Structure Number B-18-182		Section 27	Town 27N	Range 09W
Station 237+55.76 - 239+11.60	Latitude: 444712.5 Longitude: 912706.7	<input checked="" type="checkbox"/> YES <input type="checkbox"/> NO Structure Located on National Highway System		
For Survey and CADD Files Horizontal Coordinate System: Vertical Datum:		<b>Traffic Forecast Data</b>		
Feature On USH 53 NB		Design Year 2008	Average Daily Traffic (ADT) 18800	Roadway Design Speed 70 MPH
Feature Under HASTINGS WAY		Feature Under 2014	15400	50 MPH
Region Contact: Adam Hetrick (Area Code) Telephone Number(s): 715-836-2855 Email: adam.hetrick@dot.wi.gov		Consultant Contact: (Area Code) Telephone Number(s): Email:		

## Work To Be Performed

## Field Information Required Item Number (see Pages 2-4)

- ☐ A. Structural Repair ..... 1-3, 22  
☒ B. Overlay ..... 1-3, 10-22, 26-28, 32, 34  
     ☐ Concrete Overlay                      ☐ Asphalt Overlay  
     ☐ Polymer Modified Asphalt Overlay      ☒ Thin Bonded Polymer Overlay  
     ☐ Other: \_\_\_\_\_  
☐ C. New Bearings ..... 3, 8, 9, 22  
☐ D. New Railings ..... 15-17, 20-23  
☐ E. Curb and Sidewalk Repair ..... 2, 3, 16, 22, 23  
☐ F. Abutment Repair ..... 2, 3, 12, 16  
☐ G. Pier Repair ..... 2, 3, 12, 16  
☐ H. New Deck ..... 1-6, 9, 10, 13-28, 32-34  
☐ I. Widening ..... 1-28, 30, 32-35  
☐ J. Joint Repair ..... 2, 3, 8, 16, 19, 22  
☐ K. Surface Repair ..... 2, 3, 22  
☐ L. Raising Bridge ..... 3, 6, 9, 16, 20-24  
☐ M. Slope Stabilization ..... 1-3, 30  
☐ N. Scour Repair ..... 1, 2 or 3, 16, 19, 21, 27, 29, 31-35  
☐ O. Painting ..... 16, 22, 24  
☐ P. Other: \_\_\_\_\_

### Field Information Required

If no structure number exists provide the following: Small County Map on which the location of proposed structure is shown in red and any highway relocation in green. In addition, provide Location Map of scale not less than 1" = 2000' showing the structure location and number.

- ☒ 1. Most recent inspection report, brief history of bridge construction date, and description of repairs with dates.
- ☒ 2. Outline deficient areas on existing structure plan or drawing.
- ☒ 3. Photographs of details requiring repairs or modifications, such as: bearings, x-frames, joints, etc. Photograph all deficient areas. Clearly label all photographs.
- ☐ 4. Provide proposed typical section for roadway and structure showing dimensions and cross slopes.
- ☐ 5. Survey beam seat or girder elevations at both sides of bridge at all substructure units.
- ☐ 6. Provide cross-section elevations at 10 foot intervals extending across the structure and a minimum of 100 feet beyond each end. Sections should be normal to centerline and show elevations at centerline roadway and gutter line. Take elevations along joints and at floor drains.
- ☐ 7. Show and identify starting stationing on bridge.
- ☐ 8. Record measurement, temperature of the structure, and date taken for each of the following:
  - (a) Joint opening measured normal to joint at centerline of roadway and both curb lines.
  - (b) Clearance between girder ends at piers.
  - (c) Distance from front face of abutment backwall to closest point of girder end measured parallel to girder.
  - (d) Temperature of structure determined by averaging top and under deck (if accessible) readings.
- ☐ 9. Fixed and expansion bearings - condition and orientation.
- ☒ 10. Number and width of proposed pours including construction staging sequence.
- ☒ 11. Location of existing construction joints in the deck.
- ☒ 12. Estimated Quantities:
 

Preparation, Decks, Type 1	Sq. Yd. <u>0</u>	
Preparation, Decks, Type 2	Sq. Yd. <u>0</u>	
Full Depth Deck Repair	Sq. Yd. <u>0</u>	Galvanic Anodes? <u>NO</u>
Concrete Surface Repair Superstructure	Sq. Ft. <u>0</u>	Galvanic Anodes? <u>NO</u>
Concrete Surface Repair Substructure	Sq. Ft. <u>0</u>	Galvanic Anodes? <u>NO</u>
Curb Repair	LF. <u>0</u>	Galvanic Anodes? <u>NO</u>

☒ 13. Sufficiency number: 96.2 (obtain from HSI Bridge Inventory System)

☒ 14. Appraisal and Condition Rating

	Deck Condition	Superstructure Condition	Substructure Condition	Load Capacity Appraisal	Structural EVAL Appraisal
Current	8	8	7	5	7

☒ 15. Load Ratings

	Inventory	Operational
Current Calculated Date: 6/6/2013	HS26	HS70
After Completed by Bridge Designer		

- ☒ 16. Utilities on/near Structure. (WisDOT policy is to avoid placing utilities on the structure.)

☐ Yes ☒ No

Type	Owner and Contact Information	Size	Opening at Abutment	Weight	Pressure

- ☒ 17. Is existing bridge railing deficient?

☐ Yes ☒ No If Yes – Replacement Rail Type:

- ☐ 18. Drains to be:

☐ Raised ☐ Closed ☐ Downspouted ☐ New

- ☒ 19. Traffic maintained on bridge during work?

☒ Yes ☐ No If Yes – Include sketches

- ☒ 20. Will guard rail be attached?

☐ Yes ☒ No If Yes – Which corners? Existing guardrail to remain at all corners.

- ☒ 21. Will work to be performed eliminate all deficiencies?

☒ Yes ☐ No If No – Explain:

- ☒ 22. Hazardous waste (asbestos) to be removed?

☐ Yes ☒ No If Yes – Explain:

- ☐ 23. Wing location(s) for surface drain anchors:

- ☒ 24. Painting?

☐ Yes ☒ No If Yes – Explain on Page 4

(all, part, railing, color system, containment, bid items)

- ☐ 25. Desired roadway width: (new deck / widening) \_\_\_\_\_ Ft.

Desired sidewalk clear width: Left: \_\_\_\_\_ Ft. Right: \_\_\_\_\_ Ft.

- ☒ 26. Maximum increase in grade line elevation 3/8 In.

- ☒ 27. Benchmark description to be shown

- ☒ 28. Desired final cross slopes on bridge SE = 0.06 Ft./Ft.

- ☐ 29. Underwater Inspection Report including:

- Streambed Cross Section With Pier, Footing and Seal Elevations
- Pier Elevation Drawings
- Pier Layout
- Hydrographic Survey

- ☐ 30. Slope stabilization, provide:

Type: \_\_\_\_\_ Quantity: \_\_\_\_\_ CY.

Slope: \_\_\_\_\_ Ft./Ft. Fill: \_\_\_\_\_ CY.

- ☐ 31. Preliminary layout of grout bags or proposed scour repair.

C.I.P. Articulated Mats (for Scour) \_\_\_\_\_ CY.

Grout Bags (for Scour) \_\_\_\_\_ CY.

Heavy Riprap \_\_\_\_\_ CY.

Extra Heavy Riprap \_\_\_\_\_ CY.

- ☒ 32. Report submitted with Preliminary Plan requires **no** CADD file submittal (*See ESubmittal instructions*).
- ☐ 33. Report submitted for development of Preliminary Plan to structure design engineer requires CADD file (if available) submittal and Report submittal to Soils Engineer if project involves foundation modifications.
- ☐ 34. Coordinate with structure design engineer **before** going into the field if existing structure has no available plans, if staged construction is planned, or if there are adjoining/adjacent structures that will remain in place.
- ☐ 35. If project involves substructure widening coordinate with structure and/or hydraulic design engineer to determine if information on the separation and/or stream crossing SSR will be required.

### **Additional Information**


---

Elaborate on other concerns such as: DNR, Local, Utility Conflicts, Aesthetics, Railing Type and Staged Construction.

*Please be as detailed and specific as possible.*

- 1.) Structure built in 2006. No repairs since construction. See attached Bridge Inspection Report.
- 2.) Deficient areas to be determined in the field by the engineer. See attached Bridge Inspection Report. A Polymer Overlay is proposed because of deficiency over the entire structure due to poor bridge deck surface. The deck has a few hairline transverse/diagonal cracks. The deck has minor cracking at the southeast corner. The northeast, northwest, and southeast approach shoulders have settled about 1.5 inches.
- 3.) See attached photographs.
- 10.) This work will be constructed half at a time under traffic using single lane closures during non-peak hours with night work. Nighttime ramp closures are anticipated at some structures. All lanes and ramps will be opened to traffic daily.
- 11.) See asbuilt plans.
- 16.) No utilities on or near structure. No conflicts anticipated.
- 19.) This work will be constructed half at a time under traffic using single lane closures during non-peak hours with night work. Nighttime ramp closures are anticipated at some structures. All lanes and ramps will be opened to traffic daily.
- 22.) See attached Asbestos Inspection Report. No asbestos-containing material was found.
- 27.) To be determined.
- 32.) See preliminary plans.

# CDR Map

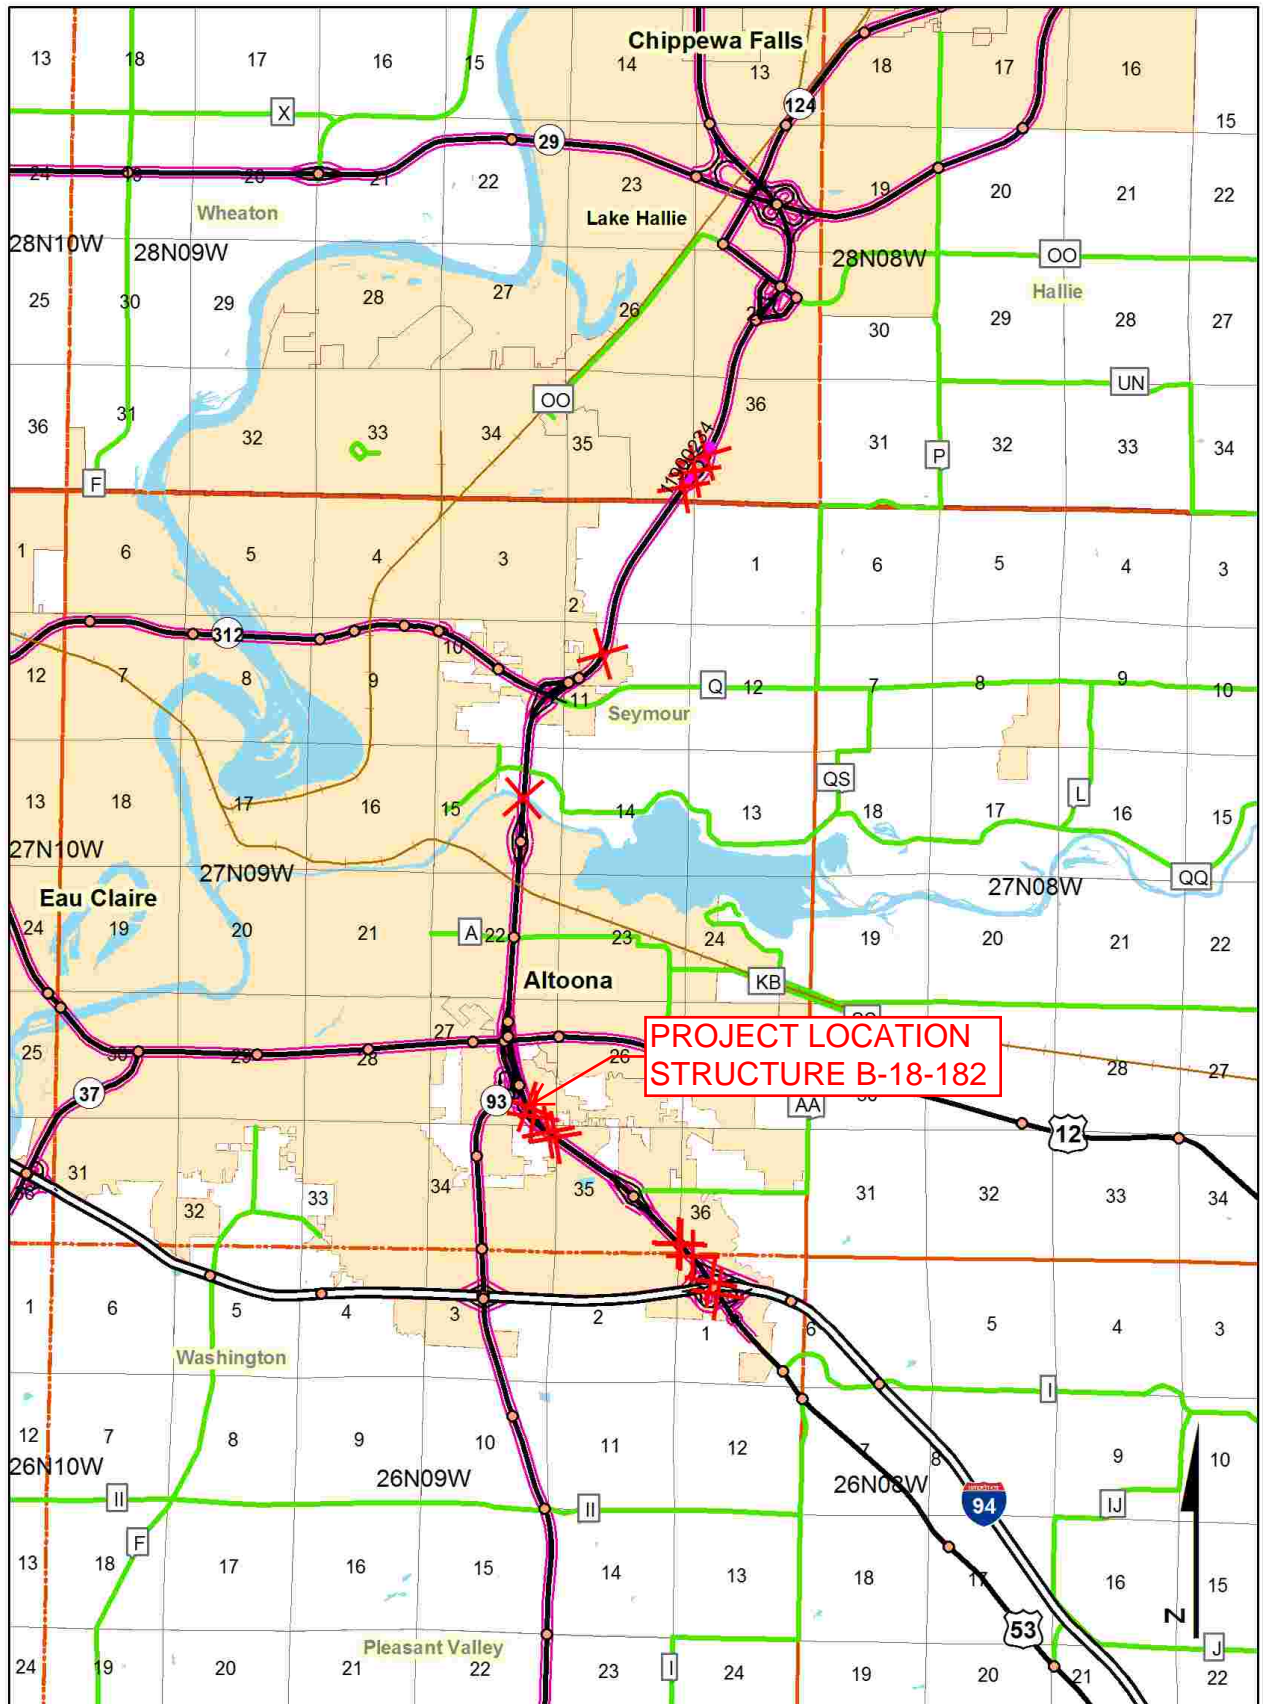

1190-02-64

EAU CLAIRE / CHIPPEWA

Section No. 1	Title
Section No. 2	Typical Sections and Details
Section No. 3	Estimate of Quantities
Section No. 3	Miscellaneous Quantities
Section No. 4	Right of Way Plat
Section No. 5	Plan and Profile
Section No. 6	Standard Detail Drawings
Section No. 7	Sign Plates
Section No. 8	Structure Plans
Section No. 9	Computer Earthwork Data
Section No. 9	Cross Sections

A.A.D.T.	=
A.A.D.T.	=
D.H.V.	=
D.D.	=
T.	=
DESIGN SPEED	=
ESALS	=

PLAN  
CORPORATE LIMITS  
PROPERTY LINE  
LOT LINE  
LIMITED HIGHWAY EASEMENT  
EXISTING RIGHT OF WAY  
PROPOSED OR NEW R/W LINE

SLOPE INTERCEPT  
 REFERENCE LINE  
 EXISTING CULVERT  
 PROPOSED CULVERT  
 (Box or Pipe)  
 COMBUSTIBLE FLUIDS

MARSH AREA 

WOODED OR SHRUB AREA 


PROFILE  
 GRADE LINE  
 ORIGINAL GROUND  
 MARSH OR ROCK PROFILE  
 (To be noted as such)  
 SPECIAL DITCH  
  
 GRADE ELEVATION  
  
 CULVERT (Profile View)  
 UTILITIES  
 ELECTRIC  
 FIBER OPTIC  
 GAS  
 SANITARY SEWER  
 STORM SEWER  
 TELEPHONE  
 WATER  
 UTILITY PEDESTAL  
 POWER POLE  
 TELEPHONE POLE

## PLAN OF PROPOSED IMPROVEMENT

## IH 94 TO 40TH AVENUE (11 BRIDGES)

# USH 53

## EAU CLAIRE AND CHIPPEWA COUNTIES

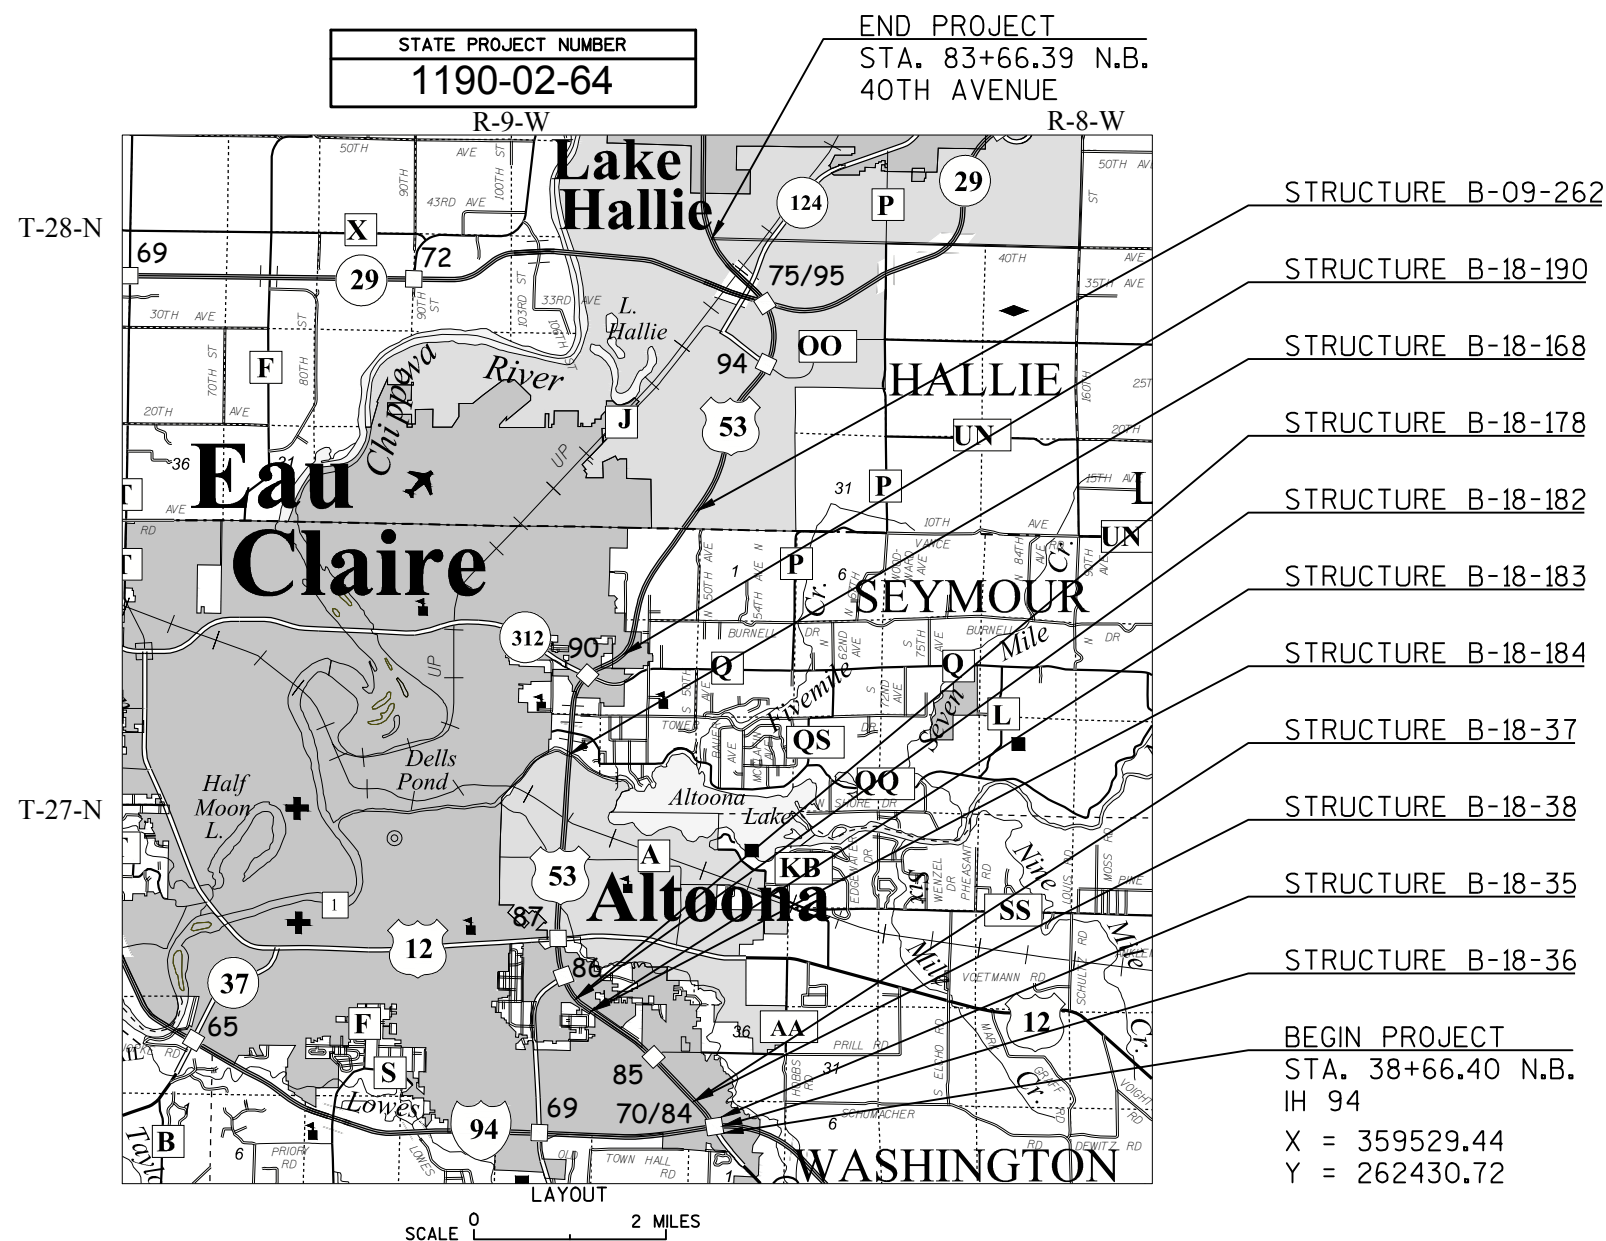

HORIZONTAL POSITIONS SHOWN ON THIS PLAN ARE WISCONSIN COUNTY COORDINATES, EAU CLAIRE COUNTY, NAD83 (1991), IN U.S. SURVEY FEET. VALUES ARE GRID COORDINATES, GRID BEARINGS, AND GRID DISTANCES. GRID DISTANCES MAY BE USED AS GROUND DISTANCES.

STATE PROJECT	FEDERAL PROJECT	
	PROJECT	CONTRACT
1190-02-64		

STATE OF WISCONSIN DEPARTMENT OF TRANSPORTATION	
PREPARED BY	
Surveyor	_____ WISDOT _____
Designer	_____ ADAM HETRICK _____
Project Manager	_____ DAVID KOEPP _____
Regional Examiner	_____ REGIONAL EXAMINER _____
Regional Supervisor	_____ TIMOTHY MASON _____
APPROVED FOR THE DEPARTMENT	
DATE: _____	_____ (Signature)





route: 053N county: EAU CLAIRE date: 08/13/2013 plm: 064.847

Lat: 44.7861771 Long: -91.45134724 Elev: 805.08 ft.

\\doteauplog1p\photolog\Rg5\053N\_R5\_2013\Front\Dir\_067\F\_06787.jpg

Copyright 2015 Mandli Communications, Inc.



route: 053N county: EAU CLAIRE date: 08/13/2013 plm: 064.867

Lat: 44.78640624 Long: -91.45159724 Elev: 804.1 ft.

\\doteauplog1p\photolog\Rg5\053N\_R5\_2013\Front\Dir\_067\F\_06789.jpg

Copyright 2015 Mandli Communications, Inc.





route: 053N county: EAU CLAIRE date: 08/13/2013 plm: 064.887

Lat: 44.78664557 Long: -91.4518264 Elev: 802.81 ft.

\\doteauplog1p\photolog\Rg5\053N\_R5\_2013\Front\Dir\_067\F\_06791.jpg

Copyright 2015 Mandli Communications, Inc.



route: 053N county: EAU CLAIRE date: 08/13/2013 plm: 064.897

Lat: 44.78676844 Long: -91.45193381 Elev: 801.93 ft.

\\doteauplog1p\photolog\Rg5\053N\_R5\_2013\Front\Dir\_067\F\_06792.jpg

Copyright 2015 Mandli Communications, Inc.





route: 053N county: EAU CLAIRE date: 08/13/2013 plm: 064.907

Lat: 44.78689303 Long: -91.45203786 Elev: 801.06 ft.

\\doteauplog1p\photolog\Rg5\053N\_R5\_2013\Front\Dir\_067\F\_06793.jpg

Copyright 2015 Mandli Communications, Inc.



route: 053N county: EAU CLAIRE date: 08/13/2013 plm: 064.917

Lat: 44.78701962 Long: -91.45213852 Elev: 800.22 ft.

\\doteauplog1p\photolog\Rg5\053N\_R5\_2013\Front\Dir\_067\F\_06794.jpg

Copyright 2015 Mandli Communications, Inc.





route: 053N county: EAU CLAIRE date: 08/13/2013 plm: 064.927

Lat: 44.7871469 Long: -91.45223505 Elev: 799.31 ft.

\\doteauplog1p\photolog\Rg5\053N\_R5\_2013\Front\Dir\_067\F\_06795.jpg

Copyright 2015 Mandli Communications, Inc.



STATE OF WISCONSIN  
DEPARTMENT OF TRANSPORTATION

Inspection Report for  
B-18-182

USH 53 NB over HASTINGS WAY  
Jul 15, 2015

Type	Prior	Frequency (mos)	Performed
Routine	07-15-15	24	X
SI&A	07-18-11	48	X

Latitude	44°47'12.50"N	Owner	STATE HIGHWAY DEPT
Longitude	91°27'06.70"W	Maintainer	STATE HIGHWAY DEPT

Time Log

Team members

Hours	Minutes	
1	0	

	Name	Number	Signature	Date
Inspector	Frueh, Rick J	1003		
Reviewer			Completed by HSI System Account(HSI)	

**BRIDGE INSPECTION REPORT**  
**Wisconsin Department of Transportation**  
**DT2007 2003 s.84.17 Wis. Stats.**

page 2

**Identification & Location**

Feature On: USH 53 NB	Section Town Range: S27 T27N R09W	Structure Number: <b>B-18-182</b>
Feature Under: HASTINGS WAY	County: EAU CLAIRE(18)	
Location 0.9M E JCT CTH KK	Municipality: CITY-EAU CLAIRE(18221)	Structure Name:

**Geometry**

measurements in feet, except where noted

Approach Roadway Width: 57	Bridge Roadway Width: 55.4	Total Length: 156.3
Approach Pavement Width: 24	Deck Width: 58.2	Deck Area (sq ft): 9096

**Traffic**

	Lanes	ADT	ADT year	Traffic Pattern
On	3	20000	2004	ONE WAY TRAFFIC
Under	2			NO TRAFFIC

**Capacity**

**Load Rating**

Inventory rating: HS26	Overburden depth (in): 0.0	Last rating date: 06-06-13	Controlling: INTERIOR DECK GIRDER Positive Moment
Operating rating: HS70	Deck surface material: CONCRETE	Re-rate for capacity (Y/N):	Control location: SPAN 1
Posting:	Re-rate notes:		

**Hydraulic**

**Classification**

Scour Critical Code(113): (N) NO WATERWAY	Q100 (ft3/sec): 0	
High water elevation (ft): 0.0	Velocity (ft/sec): 0.0	Sufficiency #: 96.2

**Span(s)**

Span #	Material	Configuration	Depth (in)	Length (ft)	Main
1	PREST CONCRETE	DECK GIRDER	70	149.8	Y

**Expansion joint(s)**

**Temperature:**

File:	New:
-------	------

**Vertical Clearance**

	Measurement file (ft)	File Date	Measurement new (ft)
Highway Minimum Under Cardinal	16.5	29-Apr-2003	
Highway Minimum Under Non-Cardinal			
Highway Minimum On			
Railroad Minimum Under			

**BRIDGE INSPECTION REPORT**  
**Wisconsin Department of Transportation**  
**DT2007 2003 s.84.17 Wis. Stats.**

page 3

Structure No.: **B-18-182**

**Elements**

Chk	Element	Defect	Description	UOM	Total	Quantity in Condition State			
						1	2	3	4
X	12		<b>Reinforced Concrete Deck</b>	SF	9,096	9,080	16	0	0
		1130	Cracking (RC) <b>Few hairline transverse cracks in cast in place panels.</b>	SF		396	16	0	0
		8000	Wearing Surface (Bare)	SF	9,096	8,987	109	0	0
		3220	Crack (Wearing Surface) <b>Few hairline transverse/diagonal cracks.</b>	SF		411	109	0	0
		8522	Coated Reinforcing Minor cracking at the SE corner.	SF	9,096	0	0	0	0
X	109		<b>Prestressed Concrete Open Girder</b>	LF	1,508	1,508	0	0	0
			10 Girders.						
X	215		<b>Reinforced Concrete Abutment</b>	LF	204	188	16	0	0
			MSE wall.						
		1080	Delamination - Spall - Patched Area <b>2 panels delam and spalled.</b>	LF		0	5	0	0
		1130	Cracking (RC) <b>Couple of the panels are cracked.</b>	LF		0	11	0	0
X	8400		<b>Integral Wingwall</b>	EA	4	3	1	0	0
		8902	Wingwall Movement <b>Northeast wingwall tipped outward about 1". Monitor minor settlement behind northwest wing.</b>	EA		0	1	0	0



**BRIDGE INSPECTION REPORT**  
**Wisconsin Department of Transportation**  
**DT2007 2003 s.84.17 Wis. Stats.**

page 4

Structure No.: **B-18-182**

**Assessments**

Chk	Element	Defect	Description	UOM	Total	Quantity in Condition State			
						1	2	3	4
X	9167		<b>Steel Diaphragm</b> <b>Between girders.</b>	EA	18	18	0	0	0
X	9322		<b>Approach Roadway - Concrete (non-structural)</b> Northeast, northwest and southeast approach shoulders have settle about 1 1/2". Mainline ok.	EA	2	2	0	0	0

**NBI Ratings**

	File	New
Deck	8	8
Superstructure	8	8
Substructure	7	7
Culvert	N	N
Channel	N	N
Waterway	N	N

**Structure Specific Notes**

3 Lanes across bridge.  
 At north joint lanes split with outside lane exiting (exit 87) to hwy 93.

**Inspection Specific Notes**

One retaining wall panel cracked adjacent to SE corner of Abutment, also another panel has a broken corner.

**Inspector Site-Specific Safety Considerations**

**Structure Inspection Procedures**

**Special Requirements**

	Chk	Comments
Traffic Control		
Access Equipment		
Other		

**Construction History**

Year	Work Performed	FOS id
2006	NEW STRUCTURE	1190-00-72

**Maintenance Items History**

Item	Recommended by	Status	Status change	Year completed
------	----------------	--------	---------------	----------------

**Maintenance Items**

Item	Priority	Recommended by	Status	Status change
<b>Drainage - Repair Washouts / Erosion</b>	HIGH	Frueh, Rick J (1003)	COMPLETE	07/26/15
Check top of all MSE walls where wall meets back side of bridge for holes/washout.				

# STRUCTURE INVENTORY AND APPRAISAL FIELD REVIEW FORM

**B-18-182**  
**USH 53 NB over HASTINGS WAY**

## LOCATION

(3) Municipality:  
 (16) Latitude(° ' "):  
 (17) Longitude(° ' "):

CITY-EAU CLAIRE(18221)
44°47'12.50"N
91°27'06.70"W

## TRAFFIC SERVICE

(28A) Lanes On:  
 (28B) Lanes Under:  
 (102) Traffic Pattern On:  
 (102) Traffic Pattern Under:  
 (19) Detour Length(mi):

3
2
-NO TRAFFIC <input checked="" type="checkbox"/> -ONE WAY TRAFFIC -TWO WAY TRAFFIC
<input checked="" type="checkbox"/> -NO TRAFFIC -ONE WAY TRAFFIC -TWO WAY TRAFFIC
3

## GEOMETRY

(49) Structure Length(ft):  
 (50) Sidewalk Width(ft):  
 (50) Curb Width(ft):  
 (52) Culvert Barrel Length(ft):  
 (34) Skew:  
 (51) Bridge Roadway(ft):  
 (52) Deck(ft):  
 (32) Approach Roadway(ft):  
 (47) Minimum Horizontal(ft):  
 (55) Minimum Right Lateral(ft):  
 (55) Minimum Left Lateral(ft):

156.3	
Left: 0.0	Right: 0.0
Angle(°): 54	Direction: -RIGHT FORWARD X-LEFT FORWARD
Cardinal Width	Non-Cardinal Width
55.4	55.4
58.2	58.2
57	57
Cardinal Under Clearance	Non-Cardinal Under Clearance
75.0	
17.0	
40.0	

## RAILING APPRAISAL

(36A) Bridge Rail Adequacy:  
 (36B) Transition Adequacy:  
 (36C) Approach Guardrail Adequacy:  
 (36D) Guardrail Termination Adequacy:  
 Outer Rail:

-SUB-STANDARD <input checked="" type="checkbox"/> -STANDARD -NOT APPLICABLE		
-SUB-STANDARD <input checked="" type="checkbox"/> -STANDARD -NOT APPLICABLE		
-SUB-STANDARD <input checked="" type="checkbox"/> -STANDARD -NOT APPLICABLE		
-SUB-STANDARD <input checked="" type="checkbox"/> -STANDARD -NOT APPLICABLE		
Left	Right	Type
		TYPE F (TWO SQUARE TUBES) - STEEL(8)
		TYPE F (3 SQUARE TUBES) - STEEL(65)
		TYPE F (4 SQUARE TUBES) - STEEL(72)
		TYPE M-STEEL 3 SQUARE TUBES(93)
X	X	SLOPED FACE PARAPET LF(91)
		SLOPED FACE PARAPET HF(92)
		VERTICAL FACE PARAPET TYPE A(74)
		TYPE W-THRIE BEAM(79)
		TYPE H ON VERTICAL PARAPET(80)
		TIMBER(38)
		OTHER(99) (Please specify)

Transition Type:

	CONT GUARD RAIL
	NO APP GRDRL
	NO ATTACHMENT
5	22 MM(7/8") BOLT (Please enter quantity)
	25 MM(1") BOLT (Please enter quantity)
	OTHER (Please specify)

Guardrail Termination Type:

<input checked="" type="checkbox"/>	(01) ENERGY ABSORBING TERMINAL/EAT
	(02) TURN DOWN
	(99) OTHER (Please specify)

## ROADWAY ALIGNMENT APPRAISAL

(72) Approach Alignment Appraisal:

	(3) INTOLERABLE- Horizontal or Vertical curvature requires a substantial reduction in vehicle operating speed
	(6) FAIR- Horizontal or Vertical curvature requires a very minor speed reduction
<input checked="" type="checkbox"/>	(8) GOOD- No speed reduction required



708 Heartland Trail, Suite 3000  
Madison, WI 53717

608.826.3600 PHONE  
608.826.3941 FAX

www.TRCSolutions.com

## Bridge Asbestos Inspection Report

**WisDOT Project ID:** 1190-02-34  
**Structure Number:** B-18-0178, B-18-0182  
**Structure Name:** USH 53 over Hastings Way  
**City/County:** City of Eau Claire, Eau Claire County  
**Lat/Long Coordinates:** 444715.0/ 912710.6, 444712.5/ 912706.7  
**TRC Project Number:** 235777.0000.0000  
**Date Inspected:** October 14, 2015  
**Inspected By/License Number:** John Roelke, All-119523

### Findings:


The inspection to identify and collect samples of potential asbestos-containing material (ACM) was completed following WisDOT standard sampling procedure for bridge inspections found in FDM 21-35-45.

None of the materials that were identified as potentially ACM and sampled tested positive for asbestos. The overlay on the bridges can proceed as planned. Standard Special Provision (STSP) 107-125 should be included in the specifications.

Sample Number	Sample Description	Sample Location	Analytical Results and Method	Friable/ Non-friable or No ACM	Quantity of ACM Material
B-18-0178					
1	Caulk	Abutment joint	PLM, non-detect	No ACM	0
2	Caulk	Abutment joint	PLM, non-detect	No ACM	
3	Caulk	Abutment joint	PLM, non-detect	No ACM	
B-18-0182					
1	Caulk	Abutment joint	PLM, non-detect	No ACM	0
2	Caulk	Abutment joint	PLM, non-detect	No ACM	
3	Caulk	Abutment joint	PLM, non-detect	No ACM	

If you have any questions, please contact me, at (608) 826-3628.

TRC Environmental Corporation

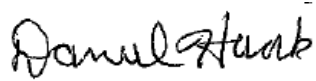

Daniel Haak  
Project Manager



John Roelke  
Asbestos Inspector


Attachments: Location Map, Photos, and Laboratory Reports

Report Distribution:

Recipient	Electronic (PDF) Copy	Paper Copy
BTS-ESS <a href="mailto:sharlene.tebeest@dot.wi.gov">sharlene.tebeest@dot.wi.gov</a>	X (via email)	X
REC <a href="mailto:amy.adrihan@dot.wi.gov">amy.adrihan@dot.wi.gov</a> ; <a href="mailto:nicholasA.schaff@dot.wi.gov">nicholasA.schaff@dot.wi.gov</a>	X (via email)	
Project Manager <a href="mailto:david.koepp@dot.wi.gov">david.koepp@dot.wi.gov</a>	X (via email)	
Other		





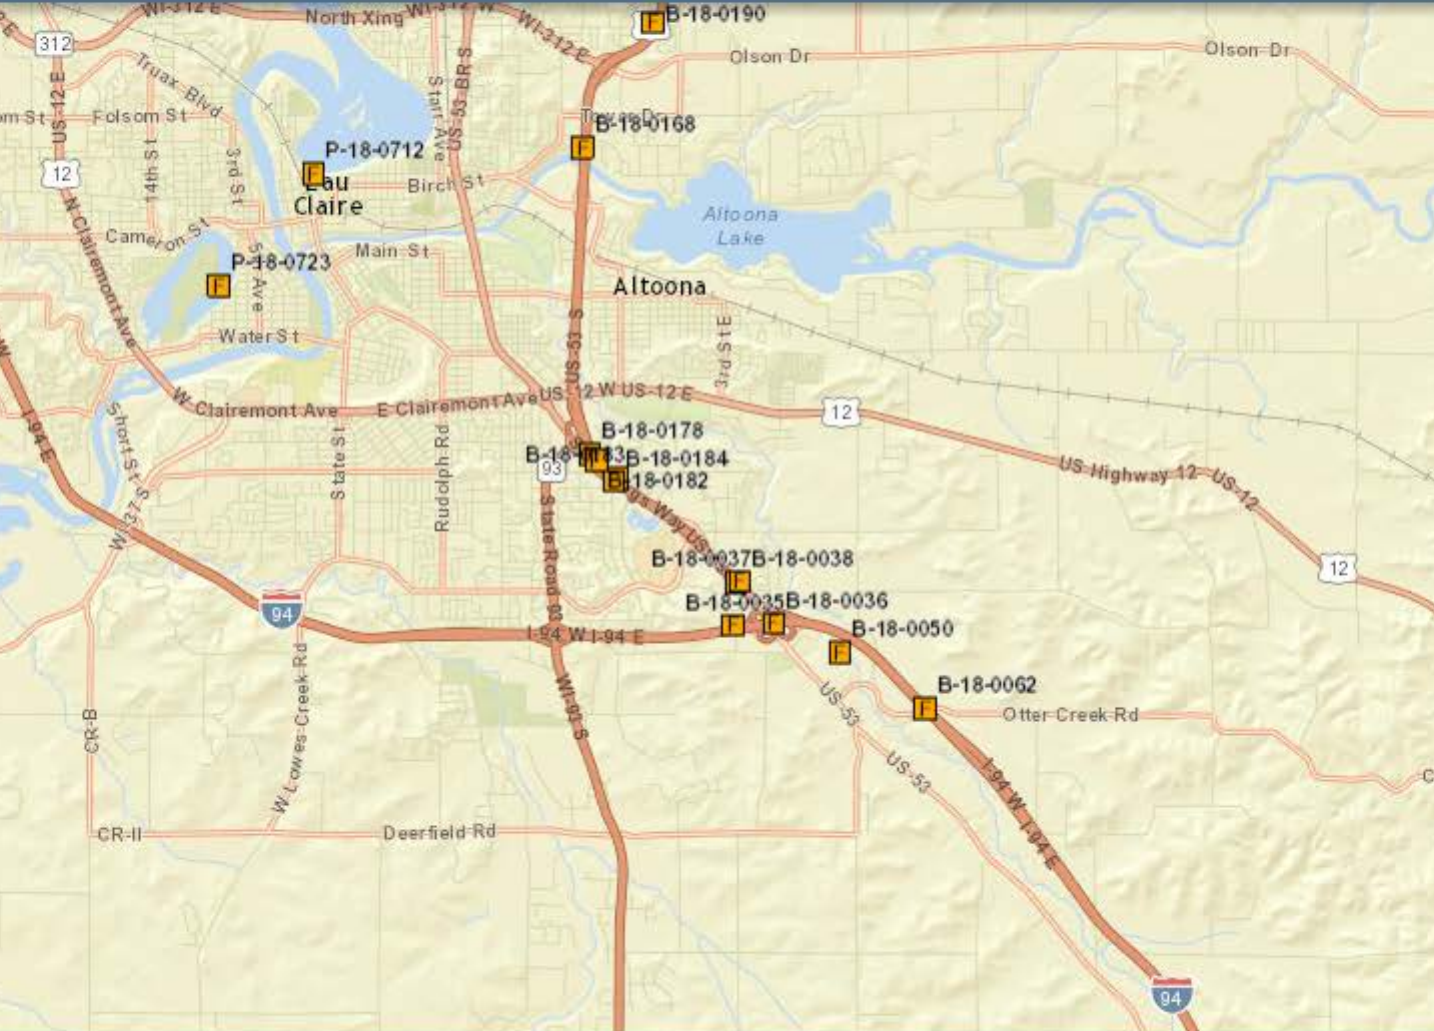

B-18-0178



Caulk in abutment joint

B-18-0182



Caulk in abutment joint





**BULK ASBESTOS ANALYSIS REPORT**

CLIENT: Wisconsin Department of Transportation

Lab Log #: 0047026  
Project #: 235777.0000.0000  
Date Received: 10/16/2015  
Date Analyzed: 10/19/2015

Site: DOT Bridge Inspection, B-18-178

**POLARIZED LIGHT MICROSCOPY by EPA 600/R-93/116**

Sample No.	Color	Homogenous	Multi-Layered	Layer No.	Other Matrix Materials	Asbestos %	Asbestos Type
B-18-178 (1)	Grey	Yes	No	--	---	ND	None
B-18-178 (2)	Grey	Yes	No	--	---	ND	None
B-18-178 (3)	Grey	Yes	No	--	---	ND	None

Reporting limit- asbestos present at 1%

ND - asbestos was not detected

Trace - asbestos was observed at level of less than 1%

NA/PS - Not Analyzed / Positive Stop

SNA- Sample Not Analyzed- See Chain of Custody for details

Note: Polarized-light microscopy is not consistently reliable in detecting asbestos in floor coverings and similar non-friable organically bound materials. In those cases, EPA recommends, and certain states (e.g. NY) require, that negative results be confirmed by quantitative transmission electron microscopy.

The Laboratory at TRC follows the EPA's Interim Method for the Determination of Asbestos in Bulk Insulation (1982), and the EPA recommended Method for the Determination of Asbestos in Bulk Building Materials (EPA/600/R-93/116), July 1993, R.L. Perkins and B.W. Harvey which utilizes polarized light microscopy (PLM). Our analysts have completed an accredited course in asbestos identification. TRC's Laboratory is accredited under the National Voluntary Laboratory Accreditation Program (NVLAP), for Bulk Asbestos Fiber Analysis, NVLAP Code 18/A01, effective through June 30, 2016. TRC is an American Industrial Hygiene Association (AIHA) accredited lab for PLM effective through October 1, 2016. Asbestos content is determined by visual estimate unless otherwise indicated. Quality Control is performed in-house on at least 10% of samples and the QC data related to the samples is available upon written request from the client.

This report shall not be reproduced, except in full, without the written approval of TRC. This report must not be used by the client to claim product endorsement by NVLAP or any agency of the U.S. Government. This report relates only to the items tested.

Analyzed by: K. Williamson  
Kathleen Williamson, Laboratory Manager

Reviewed by: Aud. Parks  
Amanda Parks, Approved Signatory

Date Issued  
10/20/2015

**TRC LABORATORY ASBESTOS ANALYTICAL ACCREDITATIONS**

NVLAP Lab Code 101424-0  
RI #AAL-007 TX #300354  
CO# AL-15020

AIHA-LAP,LLC #100122 CT #PH-0426  
VT #AL014538 LA#05011 VA #3333 000283  
PHIL# 461 PA#68-03387

ME LA-0075, LB-0071  
AZ #A20944

MA #AA000052  
HI #L-09-004

NY #10980 WV# LT000411  
NJ #CT004 CA #2907





**BULK ASBESTOS ANALYSIS REPORT**

CLIENT: Wisconsin Department of Transportation

Lab Log #: 0047032  
Project #: 235777.0000.0000  
Date Received: 10/16/2015  
Date Analyzed: 10/19/2015

Site: DOT Bridge Inspection, B-18-182

**POLARIZED LIGHT MICROSCOPY by EPA 600/R-93/116**

Sample No.	Color	Homogenous	Multi-Layered	Layer No.	Other Matrix Materials	Asbestos %	Asbestos Type
B-18-182 (1)	Grey	Yes	No	--	---	ND	None
B-18-182 (2)	Grey	Yes	No	--	---	ND	None
B-18-182 (3)	Grey	Yes	No	--	---	ND	None

Reporting limit- asbestos present at 1%

ND - asbestos was not detected

Trace - asbestos was observed at level of less than 1%

NA/PS - Not Analyzed / Positive Stop

SNA- Sample Not Analyzed- See Chain of Custody for details

Note: Polarized-light microscopy is not consistently reliable in detecting asbestos in floor coverings and similar non-friable organically bound materials. In those cases, EPA recommends, and certain states (e.g. NY) require, that negative results be confirmed by quantitative transmission electron microscopy.

The Laboratory at TRC follows the EPA's Interim Method for the Determination of Asbestos in Bulk Insulation (1982), and the EPA recommended Method for the Determination of Asbestos in Bulk Building Materials (EPA/600/R-93/116), July 1993, R.L. Perkins and B.W. Harvey which utilizes polarized light microscopy (PLM). Our analysts have completed an accredited course in asbestos identification. TRC's Laboratory is accredited under the National Voluntary Laboratory Accreditation Program (NVLAP), for Bulk Asbestos Fiber Analysis, NVLAP Code 18/A01, effective through June 30, 2016. TRC is an American Industrial Hygiene Association (AIHA) accredited lab for PLM effective through October 1, 2016. Asbestos content is determined by visual estimate unless otherwise indicated. Quality Control is performed in-house on at least 10% of samples and the QC data related to the samples is available upon written request from the client.

This report shall not be reproduced, except in full, without the written approval of TRC. This report must not be used by the client to claim product endorsement by NVLAP or any agency of the U.S. Government. This report relates only to the items tested.

Analyzed by: K. Williamson Reviewed by: Aud. Parkins **Date Issued**  
Kathleen Williamson, Laboratory Manager Amanda Parkins, Approved Signatory 10/21/2015

**TRC LABORATORY ASBESTOS ANALYTICAL ACCREDITATIONS**

NVLAP Lab Code 101424-0 AIHA-LAP.LLC #100122 CT #PH-0426 ME LA-0075, LB-0071 MA #AA000052 NY #10980 WV# LT000411  
RI #AAL-007 TX #300354 VT #AL014538 LA#05011 VA #3333 000283 AZ #A20944 HI #L-09-004 NJ #CT004 CA #2907  
CO# AL-15020 PHIL # 461 PA#68-03387

## DESIGN DATA

## LIVE LOAD:

DESIGN RATING; HS-20  
 INVENTORY RATING; HS-23  
 OPERATIONAL RATING; HS-70  
 MAXIMUM STANDARD PERMIT VEHICLE LOAD = 250 KIPS.

STRUCTURE IS DESIGNED FOR A FUTURE WEARING  
 SURFACE OF 20 POUNDS PER SQUARE FOOT.

## ULTIMATE DESIGN STRESSES:

CONCRETE MASONRY SLAB —  $f'_c = 4,000$  P.S.I. ALL OTHER —  $f'_c = 3,500$  P.S.I.  
 BAR STEEL REINFORCEMENT, GRADE 60 —  $f_y = 60,000$  P.S.I.  
 70" PRESTRESSED GIRDERS, CONCRETE MASONRY —  $f'_c = 7,500$  P.S.I.  
 STRANDS - 0.6"  $\phi$  WITH ULTIMATE TENSILE STRENGTH OF 270,000 P.S.I.

## FOUNDATION DATA

ABUTMENTS TO BE SUPPORTED ON  $10\frac{3}{4}$ "  $\phi$  C.I.P. CONC. PILING  
 DRIVEN TO A MINIMUM BEARING VALUE OF 55 TONS PER PILE.  
 ESTIMATED 100'-0" LONG @ S. ABUT. & 90'-0" LONG @ N. ABUT.

## TRAFFIC VOLUME

U.S.H. 53	HASTINGS WAY
A.D.T.=25,750 (2024)	A.D.T.=5,600 (2024)
R.D.S.=70 M.P.H.	R.D.S.=50 M.P.H.

## CURVE DATA

R'UT' (SB. LANE U.S.H. 53)	R'US' (NB. LANE U.S.H. 53)
----------------------------	----------------------------

P.I. = STA. 234+24.11  
 $\Delta = 36^\circ-06'-38.5''$   
 $D = 2^\circ-40'-16.1''$   
 $T = 699.24'$   
 $L = 1351.89'$   
 $R = 2145.00'$   
 $S.E. = 0.06\%$   
 $P.C. = STA. 227+24.87$   
 $P.T. = STA. 240+76.76$

P.I. = STA. 234+67.33  
 $\Delta = 36^\circ-06'-38.5''$   
 $D = 2^\circ-44'-52.8''$   
 $T = 679.68'$   
 $L = 1314.07'$   
 $R = 2085.00'$   
 $S.E. = 0.06\%$   
 $P.C. = STA. 227+87.65$   
 $P.T. = STA. 241+01.72$


BRIDGE OFFICE CONTACTS: BILL DREHER (608) 261-8205  
 JOEL HUENINK (608) 266-5160

## LIST OF DRAWINGS


1. GENERAL PLAN
2. CROSS SECTION & QUANTITIES
3. SUBSURFACE EXPLORATION
4. SOUTH ABUTMENT
5. SOUTH ABUTMENT DETAILS
6. NORTH ABUTMENT
7. NORTH ABUTMENT DETAILS
8. SUPERSTRUCTURE
9. SUPERSTRUCTURE DETAILS
10. 70" PRESTRESSED GIRDER DETAILS
11. STEEL DIAPHRAGM
12. SLOPED FACE PARAPET LF

NO.	DATE	REVISION	BY


 Plans Prepared By <b>WISDOT</b> BUREAU OF STRUCTURES <i>John Hubbard</i> APPROVED CHIEF STRUCTURAL DESIGN ENGINEER	<b>3-2-2004</b> DATE
	<b>STRUCTURE B-18-182</b>
U.S.H. 53 OVER HASTINGS WAY	
COUNTY EAU CLAIRE	TOWN/CITY/VILLAGE <del> </del>
DESIGN SPEC. AASHTO STD. SPEC. 2002	LOAD HS-20 CONST. SPEC. 2003
DESIGNED BY WCD	DRAWN BY JHG PLANS CK'D. JPH
<b>GENERAL PLAN</b>	
SHEET 1 OF 12	

FILE= 01-182GP.DGN  
 SCALE = 30

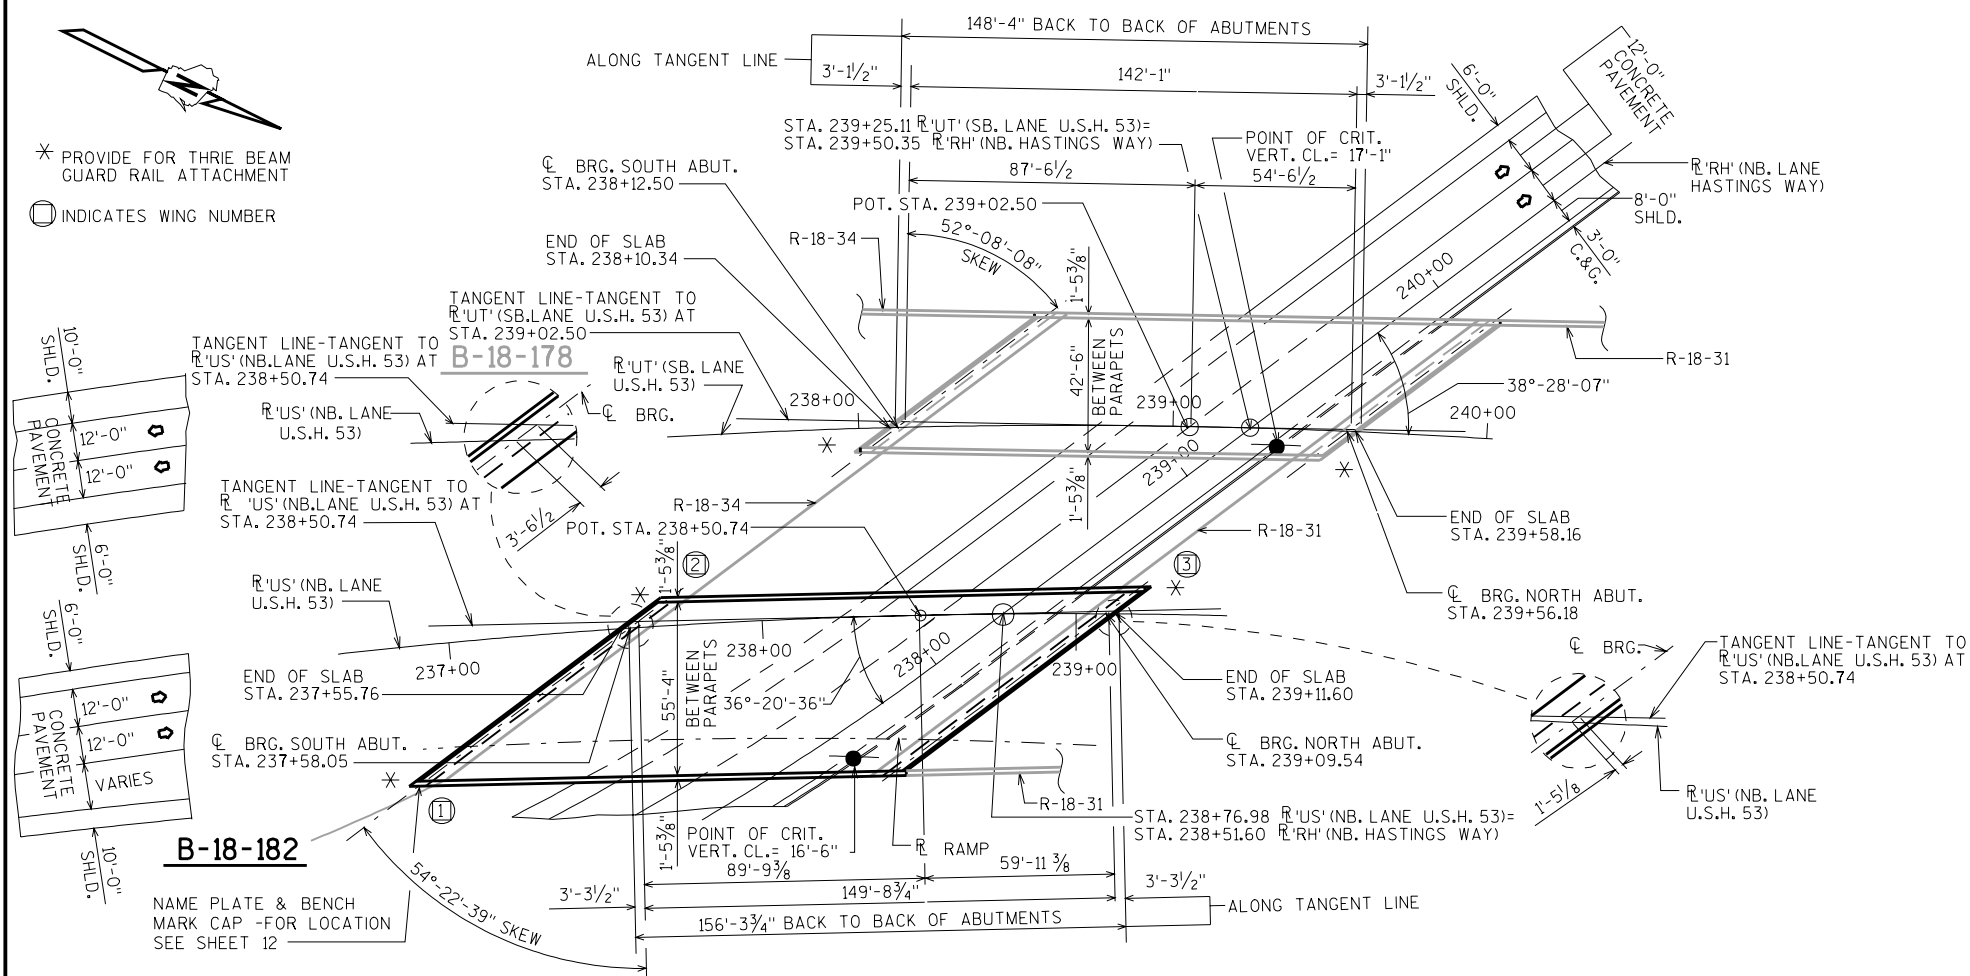


## PLAN

SINGLE SPAN-70" PRESTRESSED GIRDERS

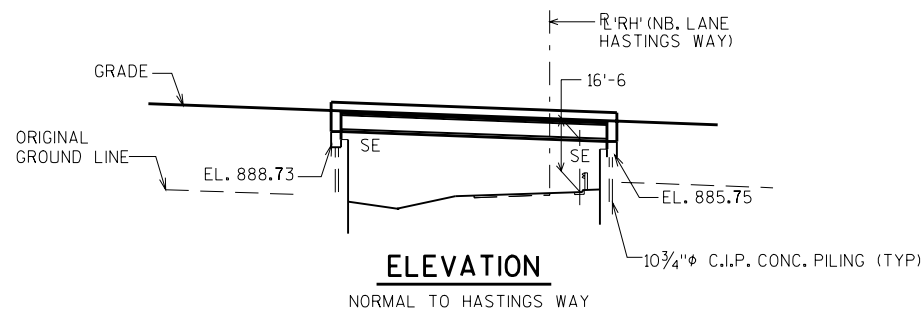


## ELEVATION


NORMAL TO HASTINGS WAY

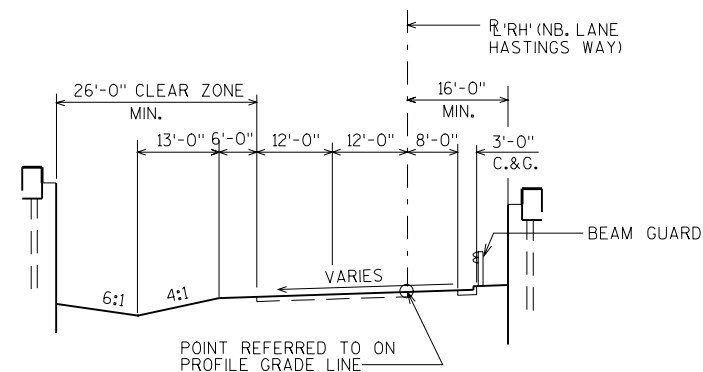


## TYPICAL SECTION THRU HASTINGS WAY

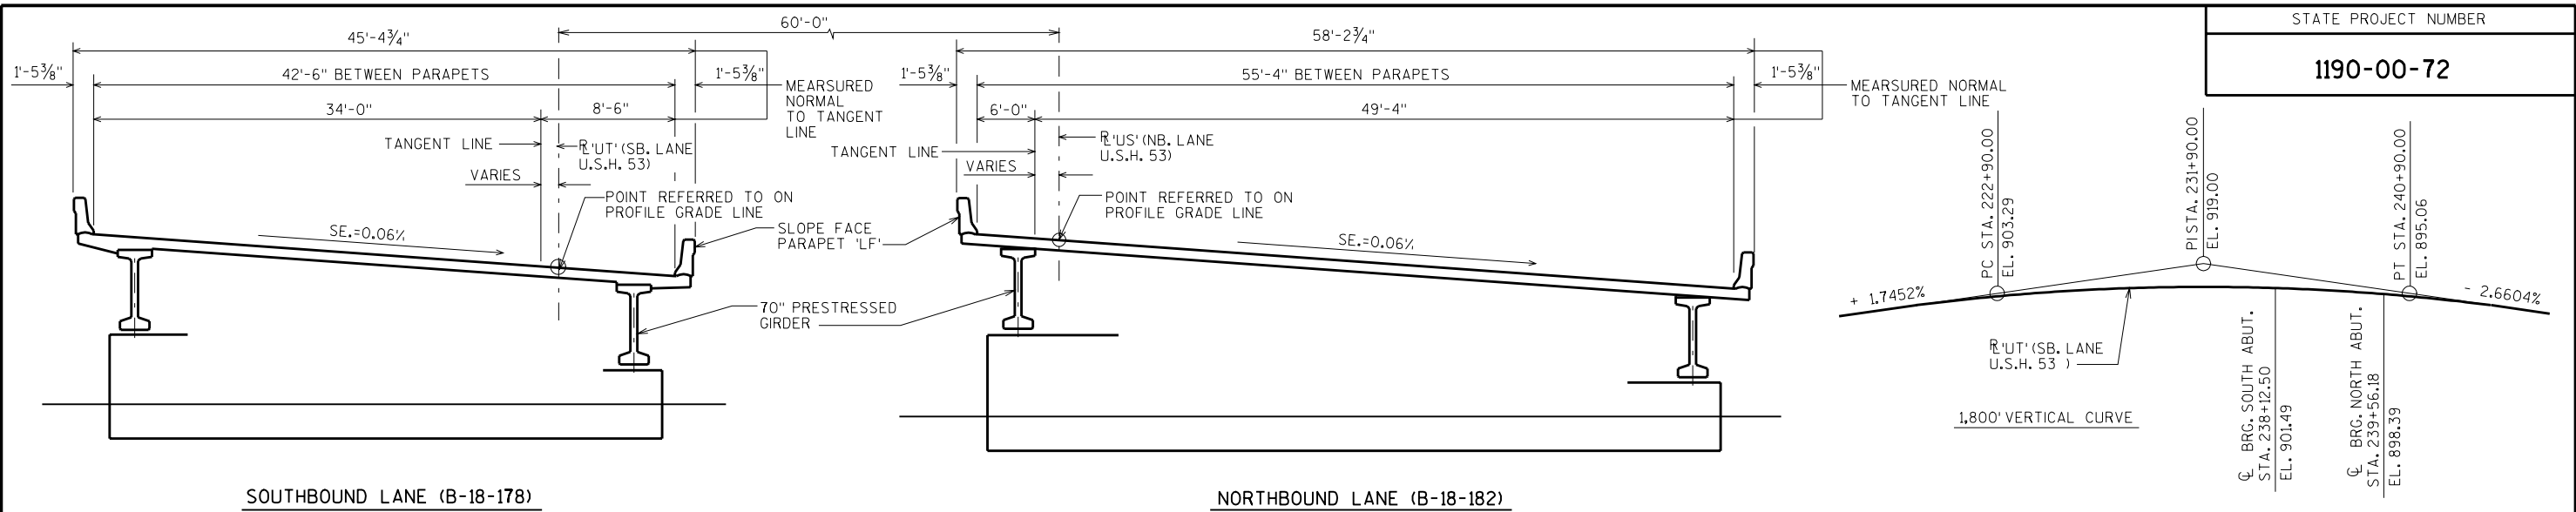

CROSS SECTION THRU ROADWAY LOOKING NORTH

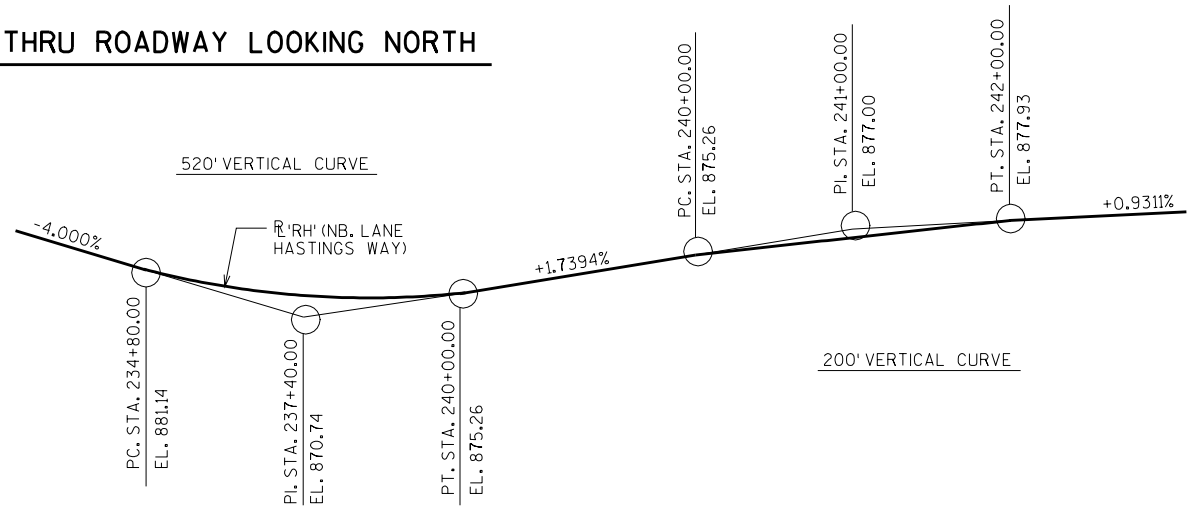

PROFILE GRADE LINE R'RH' (NB. HASTINGS WAY)

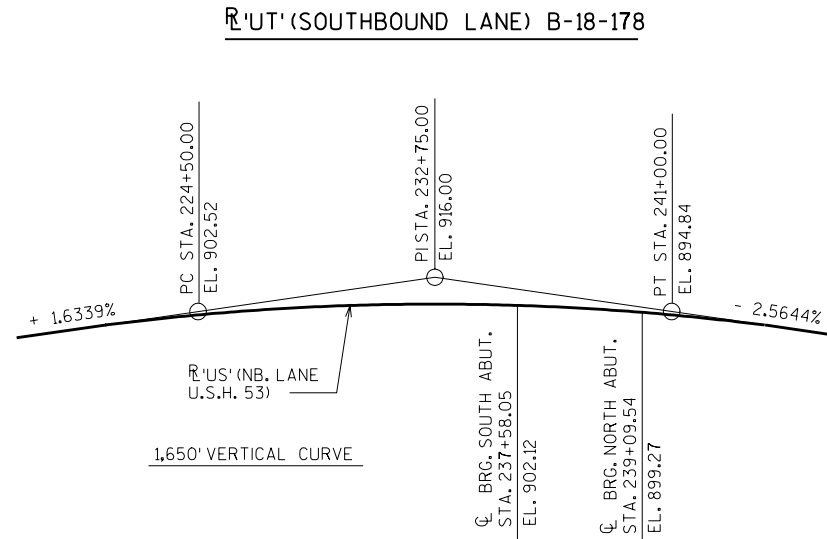

R'US' (NORTHBOUND LANE) B-18-182

PROFILE GRADE LINE U.S.H. 53

TOTAL ESTIMATED QUANTITIES

BID ITEMS	UNIT	SUPER.	SOUTH ABUT.	NORTH ABUT.	TOTALS
EXCAVATION FOR STRUCTURES BRIDGES B-18-182	L.S.	—	—	—	1
BACKFILL STRUCTURE	C.Y.	—	650	650	1300
CONCRETE MASONRY BRIDGES	C.Y.	425	76	73	574
PROTECTIVE SURFACE TREATMENT	S.Y.	1080	—	—	1080
PRESTRESSED GIRDER TYPE I 70-INCH	L.F.	1508	—	—	1508
BAR STEEL REINFORCEMENT HS BRIDGES	LB.	—	4890	4960	9850
BAR STEEL REINFORCEMENT HS COATED BRIDGES	LB.	55240	700	370	56310
BEARING PADS ELASTOMERIC NON-LAMINATED	EACH	20	—	—	20
STEEL DIAPHRAGMS STRUCTURE B-18-182	EACH	18	—	—	18
PILING CIP CONCRETE DELIVERED AND DRIVEN 10 3/4-INCH	L.F.	—	2100	1890	3990
RUBBERIZED MEMBRANE WATERPROOFING	S.Y.	—	24	21	45
CONCRETE STAINING B-18-182	LS	—	—	—	1
SLOPE PAVING CRUSHED AGGREGATE	S.Y.	—	20	20	40
ANCHOR ASSEMBLIES FOR STEEL PLATE BEAM GUARD	EACH	3	—	—	3
OMP CONCRETE STRUCTURES 5-CYLINDER	C.Y.	425	76	73	574
INCENTIVE STRENGTH CONCRETE STRUCTURES	DOL.	4250	760	730	5740
NON-BID ITEMS					
FILLER	SIZE	—	—	—	1/2" & 3/4"

GENERAL NOTES

DRAWINGS SHALL NOT BE SCALED.  
BAR STEEL REINFORCEMENT SHALL BE EMBEDDED 2" CLEAR UNLESS OTHERWISE SHOWN OR NOTED.

ELASTOMERIC BEARING PADS NEED NOT BE INDIVIDUALLY MOLDED PROVIDED THE CUT EDGES ARE SMOOTH AND TRUE.

AT THE BACKFACE OF ABUTMENT ALL VOLUME WHICH CANNOT BE PLACED BEFORE ABUTMENT CONSTRUCTION AND IS NOT OCCUPIED BY THE NEW STRUCTURE SHALL BE BACKFILLED WITH STRUCTURE BACKFILL.

THE FIRST OR FIRST TWO DIGITS OF THE BAR MARK SIGNIFIES THE BAR SIZE.

THE GRADATION OF THE STRUCTURE BACKFILL SHALL MEET THE REQUIREMENTS OF SECTION 209.2.2 OF THE STANDARD SPECIFICATIONS FOR GRADE 1 MATERIAL.

THE FOLLOWING COMPONENTS SHALL BE STAINED LIGHT GRAY (FEDERAL STANDARD COLOR NO. 36622) IN ACCORDANCE WITH THE SPECIAL PROVISIONS:

- THE UNDERSIDE OF THE DECK OVERHANGS TO THE EXTERIOR GIRDERS.
- THE EDGES OF THE DECK.
- THE BACK FACES OF THE PARAPETS.
- ALL EXPOSED VERTICAL SURFACES OF THE ABUTMENTS TO 1'-0" BELOW FINISHED GROUNDLINE.
- ALL EXPOSED VERTICAL SURFACES OF THE ABUTMENT DIAPHRAGMS EXCEPT BETWEEN GIRDERS.


THE FOLLOWING COMPONENTS SHALL BE STAINED DARK GRAY (FEDERAL STANDARD COLOR NO. 26293) IN ACCORDANCE WITH THE SPECIAL PROVISIONS:

- THE OUTSIDE FACE AND UNDERSIDE OF THE BOTTOM FLANGE OF THE EXTERIOR GIRDERS.

PROTECTIVE SURFACE TREATMENT SHALL BE APPLIED TO THE TOP SURFACE OF THE DECK AND THE INSIDE FACE AND TOP OF PARAPETS.

NO.	DATE	REVISION	BY
STATE OF WISCONSIN DEPARTMENT OF TRANSPORTATION STRUCTURES DESIGN SECTION			
STRUCTURE B-18-182			
CONST. SPEC.	2003	DRAWN BY JHG	PLANS CK'D. JPH
CROSS SECTION & QUANTITIES		SHEET 2	

USH 53 OVER NB HASTINGS WAY  
EAU CLAIRE BYPASS, EAU CLAIRE COUNTY

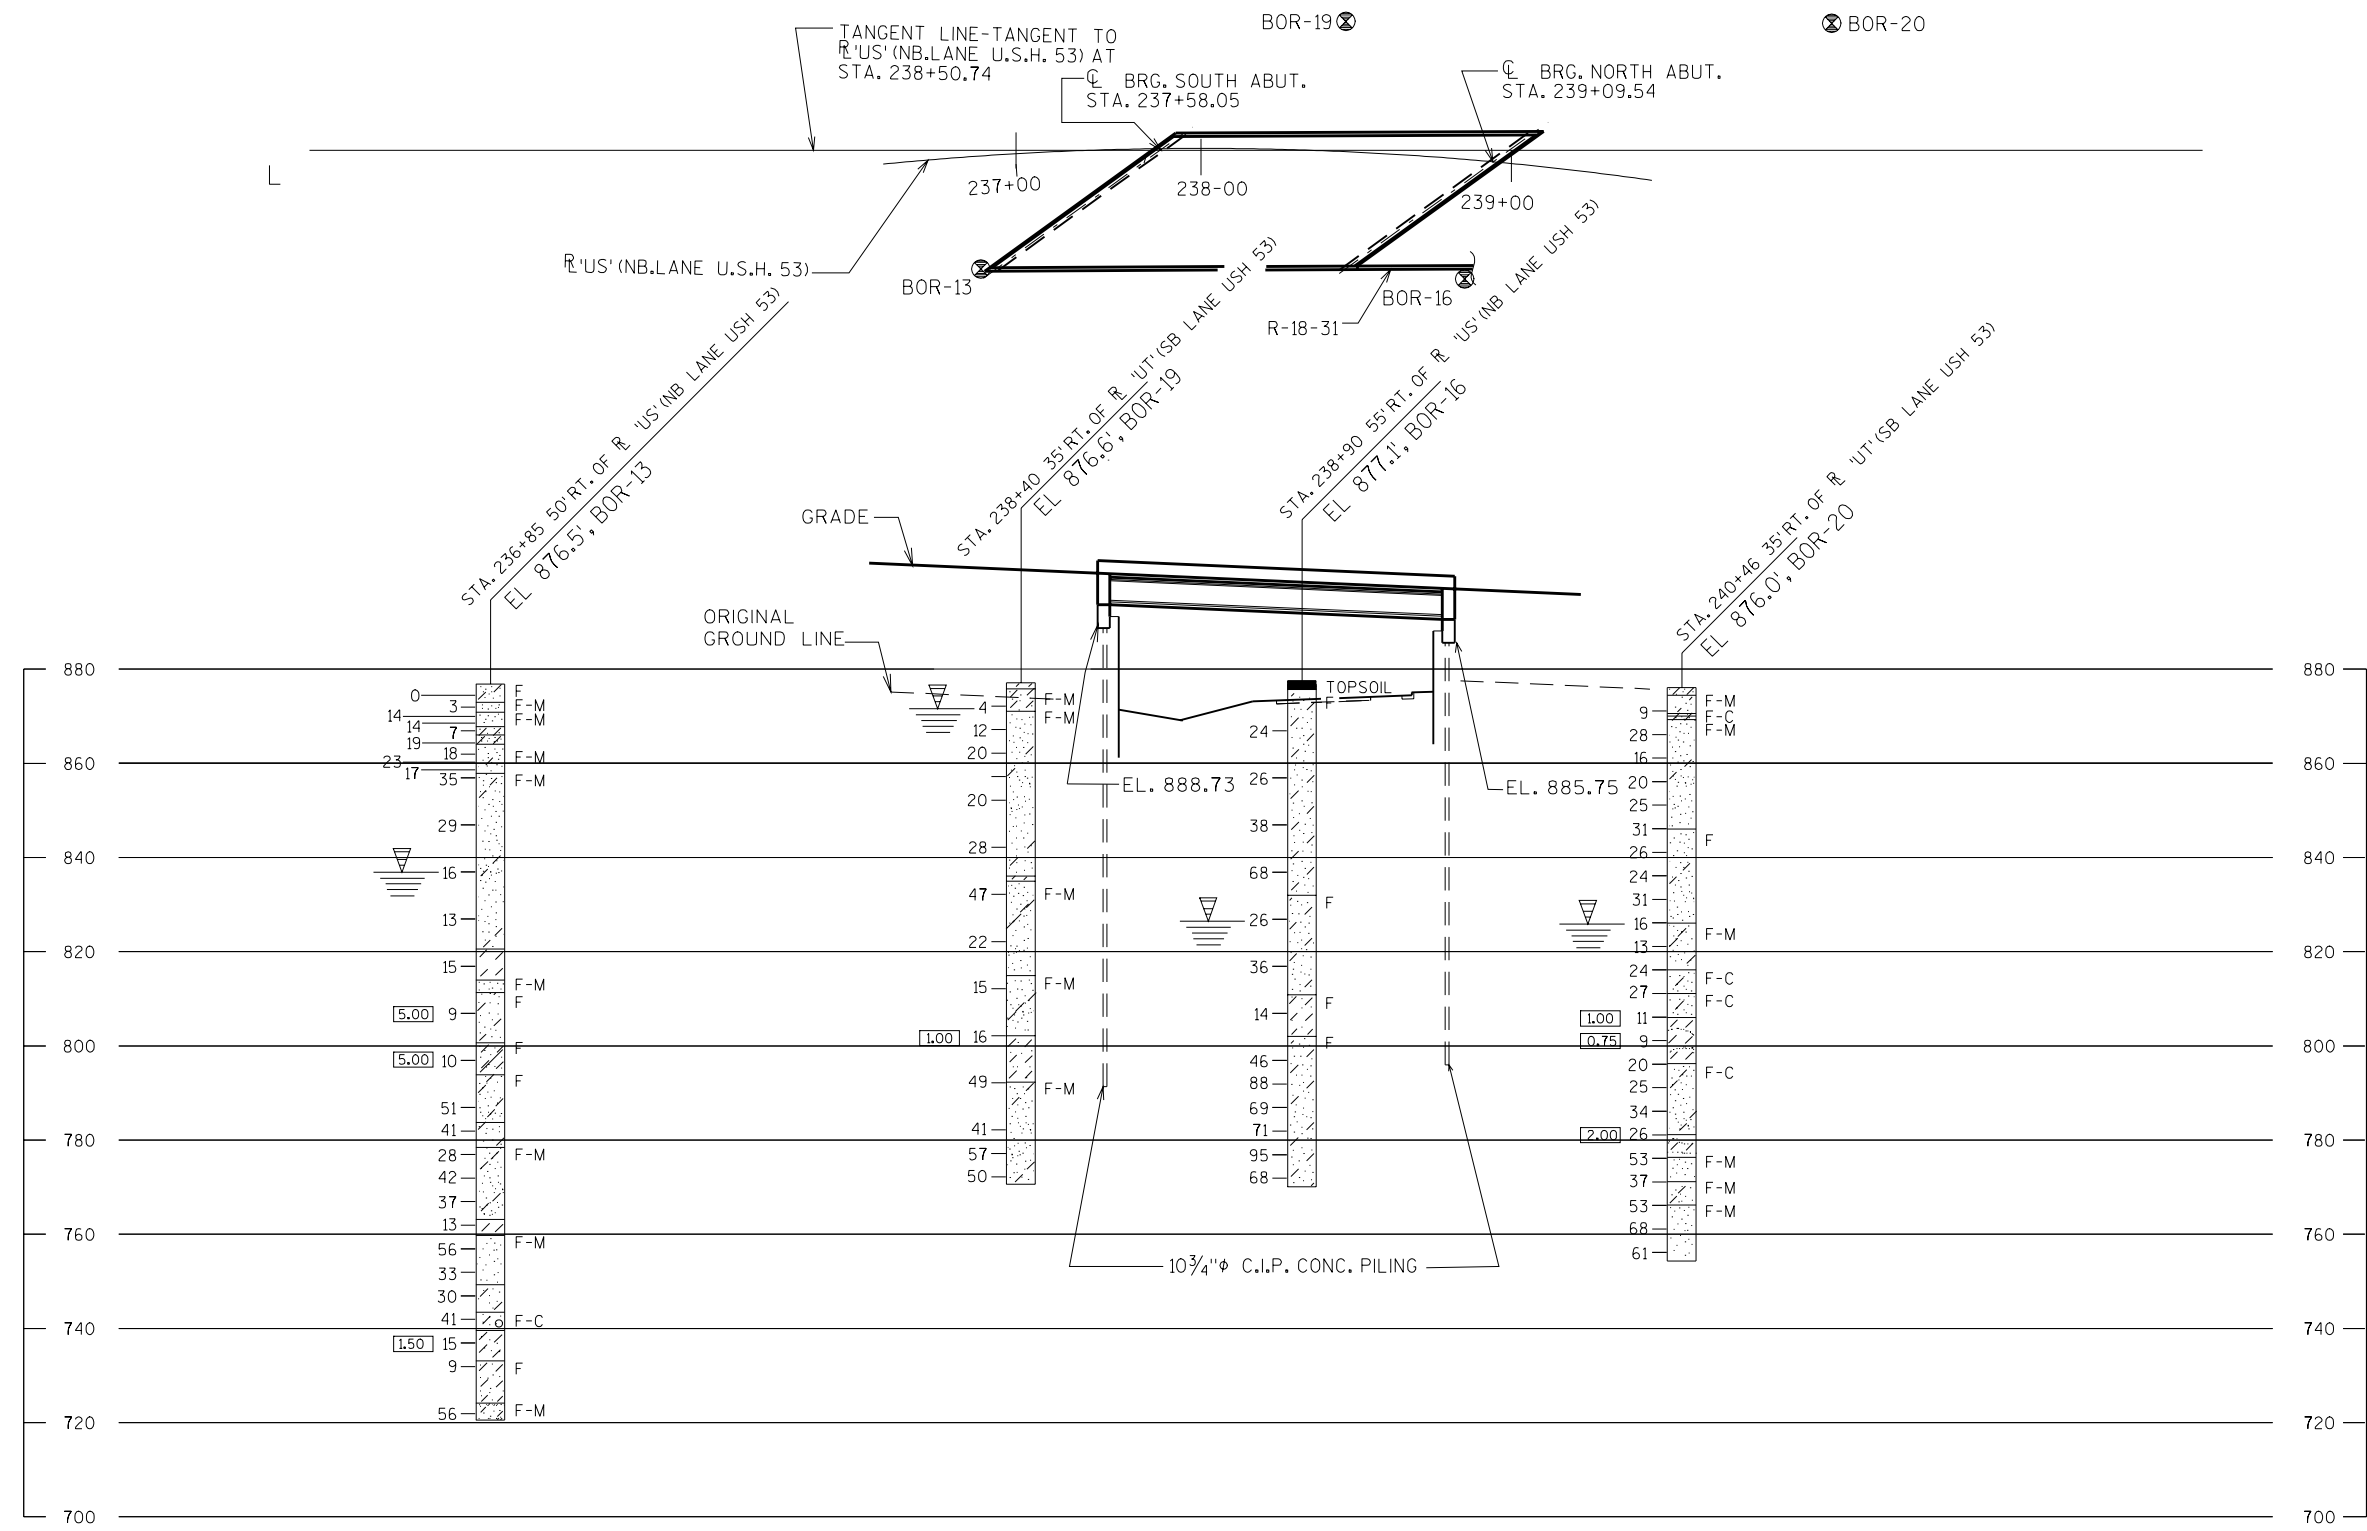

STATE PROJECT NUMBER

1190-00-72

ABBREVIATIONS

F — FINE M — MEDIUM C — COARSE  
WS — WEATHERED SO — SOUND

MATERIAL SYMBOLS

TOPSOIL SILT SANDSTONE  
SAND PEAT LIMESTONE  
GRAVEL CLAY IGNEOUS ROCK

LEGEND OF PROBING

PROBING NO.  
STA.  
ELEVATION  
7 AVERAGE BLOWS PER FOOT  
REFUSAL 95/6  
95/6=95 BLOWS FOR 6" PENETRATION  
PROBING TAKEN WITH A 350# WT. FALLING 18" ON A 2" O.D. POINT.

LEGEND OF BORING

ELEV. BORING NO. STA.  
UNCONFINED STRENGTH 7.7  
BLOWS PER FT. USING 140# WT. FALLING 30"  
WASH SAMPLE  
SHELBY TUBE — S.T.  
GROUND WATER ELEVATION  
NO GROUND WATER OBSERVED ABOVE THIS ELEVATION  
SANDY GRAVEL  
F. BOULDERS OR COBBLES  
SAND  
SILTY CLAY  
SO LIMESTONE

UNLESS OTHERWISE SPECIFIED, THE BLOWS PER FOOT AT THE LOCATIONS INDICATED ARE BASED ON DRIVING A 2" O.D. X 1.4" I.D. SPLIT SPOON SAMPLER WITH A 140# HAMMER HAVING A FREE FALL OF 30". THE BLOW COUNT IS TAKEN IN UNDISTURBED SOIL IMMEDIATELY BELOW A CAGED OR OPEN HOLE ELIMINATING SIDE FRICTION ON THE DRIVE PIPE.

SUBSURFACE EXPLORATION FOR FOUNDATION DESIGN AND BIDDERS INFORMATION




TO OBTAIN RELATIVE DATA CONCERNING THE CHARACTER OF MATERIAL IN AND UPON WHICH THE FOUNDATION MIGHT BE BUILT, BORINGS AND/OR SOUNDINGS WERE MADE AT POINTS APPROXIMATELY AS INDICATED ON THIS DRAWING. THE DATA PRESENTED HEREIN REPRESENTS THE FINDINGS OF THE SUBSURFACE EXPLORATIONS MADE. HOWEVER, BECAUSE THE DEPTHS INVESTIGATED ARE LIMITED AND THE AREA OF THE BORINGS AND/OR SOUNDINGS IS VERY SMALL IN RELATION TO THE ENTIRE AREA, THE WISCONSIN DEPARTMENT OF TRANSPORTATION DOES NOT WARRANT CONDITIONS BELOW THE DEPTHS INVESTIGATED OR THAT THE CLASSIFICATION OF MATERIAL ENCOUNTERED IN THESE INVESTIGATIONS IS NECESSARILY TYPICAL OF THE ENTIRE SITE.

NO.	DATE	REVISION	BY
STATE OF WISCONSIN DEPARTMENT OF TRANSPORTATION STRUCTURES DESIGN SECTION			
STRUCTURE B-18-182			
CONST. SPEC.	2003	DRAWN BY JHG	PLANS CK'D. JPH
SUBSURFACE EXPLORATION		SHEET 3	



8

FILE= 03-182SOIL.S.DGN  
SCALE = 40

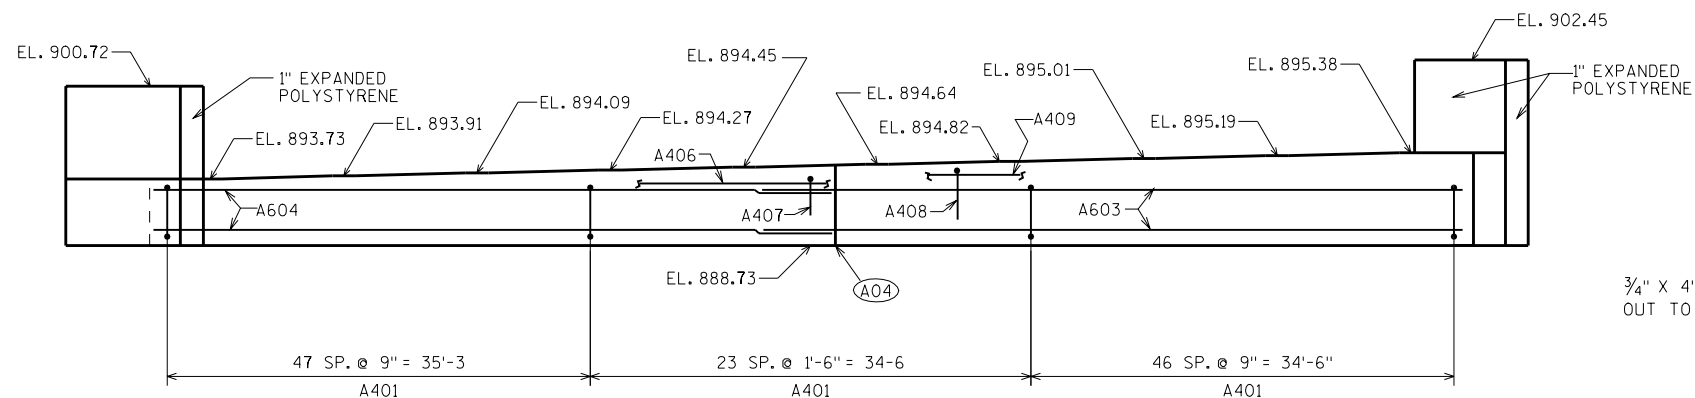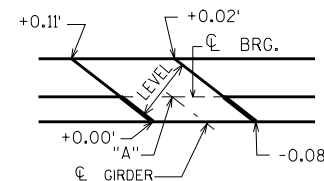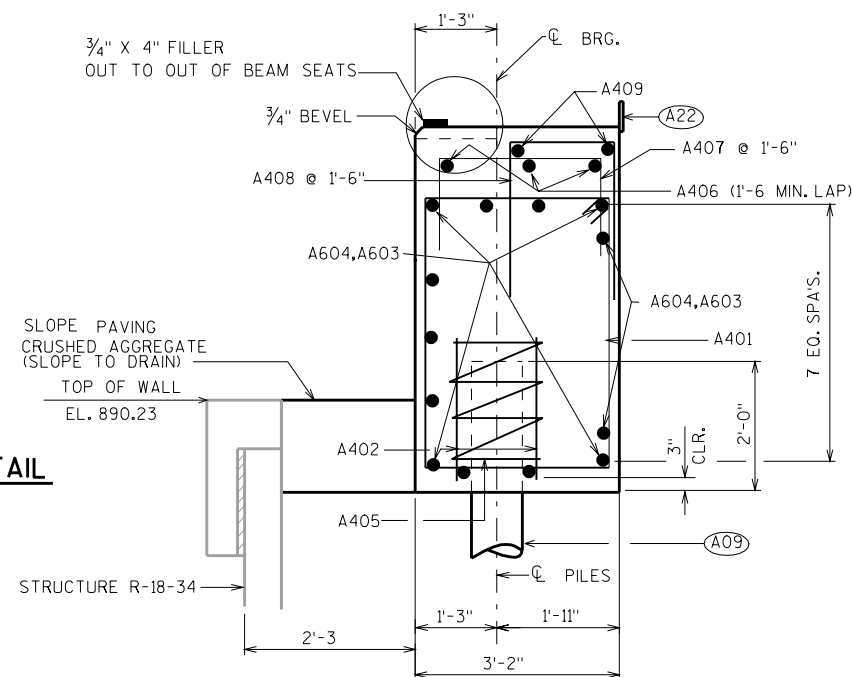

**ELEVATION LOOKING SOUTH**BEAM SEAT ELEVATIONS ARE AT LOCATION "A"  
(SEE BEAM SEAT DETAIL)**SLOPED BEAM SEAT DETAIL**SEE "ELEVATION LOOKING SOUTH"  
FOR ELEVATION AT "A"STEEL TROWEL TOP SURFACE OF ABUTMENT  
PLACE MULTIPLE LAYERS OF POLYETHYLENE  
SHEETING OVER ENTIRE ABUTMENT BEFORE  
PLACING BEARING PADS.  
(TOTAL THICKNESS TO BE 0.03" MIN)**SECTION THRU BODY**

- (A04) VERT. CONSTRUCTION JOINT: KEYWAY FORMED BY A BEVELED 2 x 8, (3/4" "V" GROOVE @ THE FRONT FACE) (18" R.M.W. @ BACKFACE). PLACE ON SKEW.
- (A09) SUPPORT ABUTMENT ON 10 3/4" DIA. CAST-IN-PLACE CONCRETE PILING, ESTIMATED 100'-0" LONG, AND DRIVEN TO A MIN. BRG. VALUE OF 55 TONS PER PILE.
- (A21) 3/4" CORK UP VERT. FACES OF BEAM SEATS.
- (A22) 18" (RMW) RUBBERIZED MEMBRANE WATERPROOFING SEAL ALL HORIZ. & VERT. JOINTS AT BACKFACE.

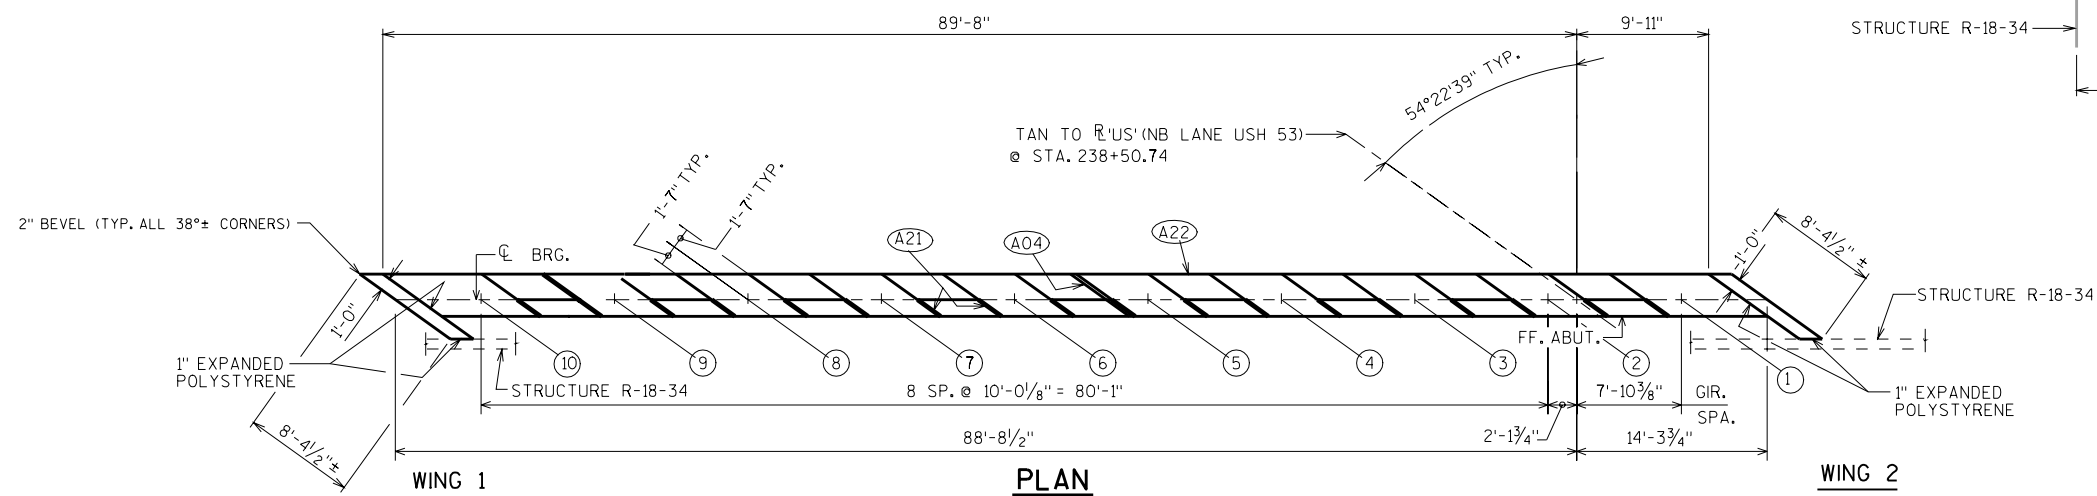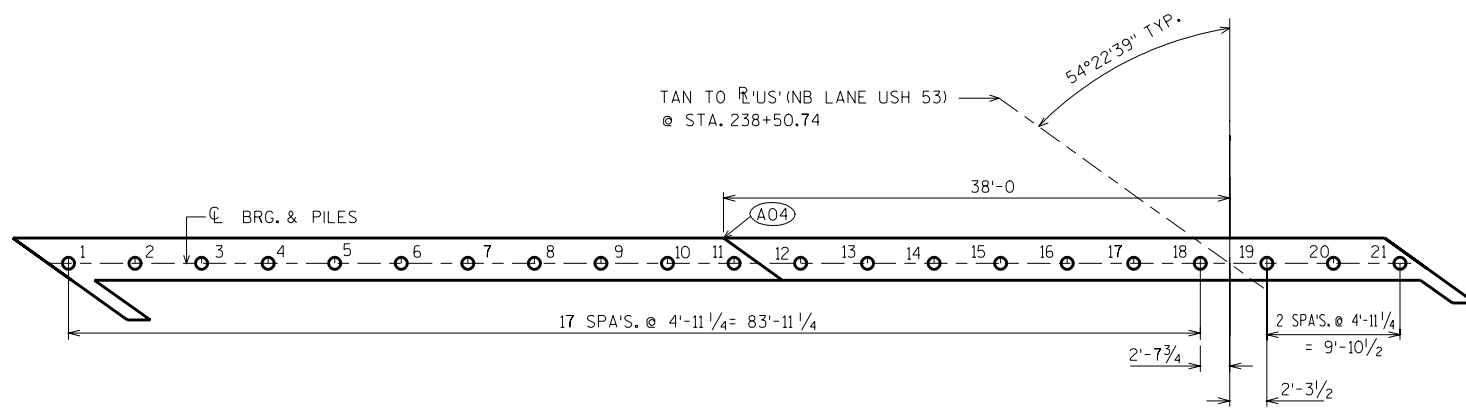**PLAN****PILE PLAN**

NO.	DATE	REVISION	BY
STATE OF WISCONSIN DEPARTMENT OF TRANSPORTATION STRUCTURES DESIGN SECTION			
STRUCTURE B-18-182			
CONST. SPEC.	2003	DRAWN BY JHG	PLANS CK'D. JPH
SOUTH ABUTMENT		SHEET 4	








(A03) OPTIONAL CONST. JOINT: KEYWAY FORMED BY  
BEVELED 2 x 6. (18" R.M.W. @ B.F. & 3/4"  
"V" GROOVE @ F.F. IF JOINT IS USED).

STATE PROJECT NUMBER

1190-00-72

BILL OF BARS


BAR MARK	COAT	NO. REQ'D.	LENGTH	BENT	BAR SERIES	LOCATION
A401		117	14'-10"	X		BODY-STIRRUPS
A402		42	2'-3"			PILES- 2 PER PILE
A603		17	52-10			BODY-HORIZONTAL
A604		17	52-10			BODY-HORIZONTAL
A405		21	28'-0"	X		PILES-1 PER PILE
A406		9	27'-9			BODY-HORZ. OVER GIRS. 1-8
A407		51	8'-7"	X		BODY-TOP OVER GIRS. 1-8
A408		27	3'-11"	X		BODY-BETWEEN BEAM SEATS
A409		18	4'-0			BODY-HORZ. EXT
A510	X	14	11'-7			WING 1-VERTICAL OUTSIDE FACE
A411	X	4	8'-4			WING 1-VERTICAL RDWY. FACE
A412	X	2	11'-7			WING 1-VERTICAL RDWY. FACE
A413	X	16	7'-9			WING 1-HORIZONTAL OUTSIDE FACE
A414	X	4	4'-1			WING 1-HORIZONTAL RDWY. FACE
A415	X	5	7'-9			WING 1-HORIZONTAL RDWY. FACE
A516	X	14	13'-4			WING 2-VERTICAL OUTSIDE FACE
A417	X	4	8'-5			WING 2-VERTICAL OUTSIDE FACE
A418	X	2	13'-4			WING 2-VERTICAL RDWY. FACE
A419	X	19	7'-9			WING 2-HORIZONTAL OUTSIDE FACE
A420	X	5	4'-1			WING 2-HORIZONTAL RDWY. FACE
A421	X	5	7'-9			WING 2-HORIZONTAL RDWY. FACE

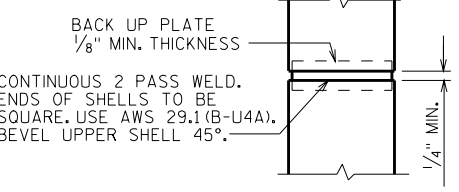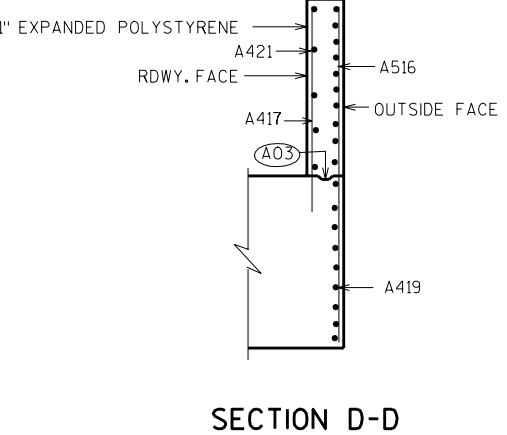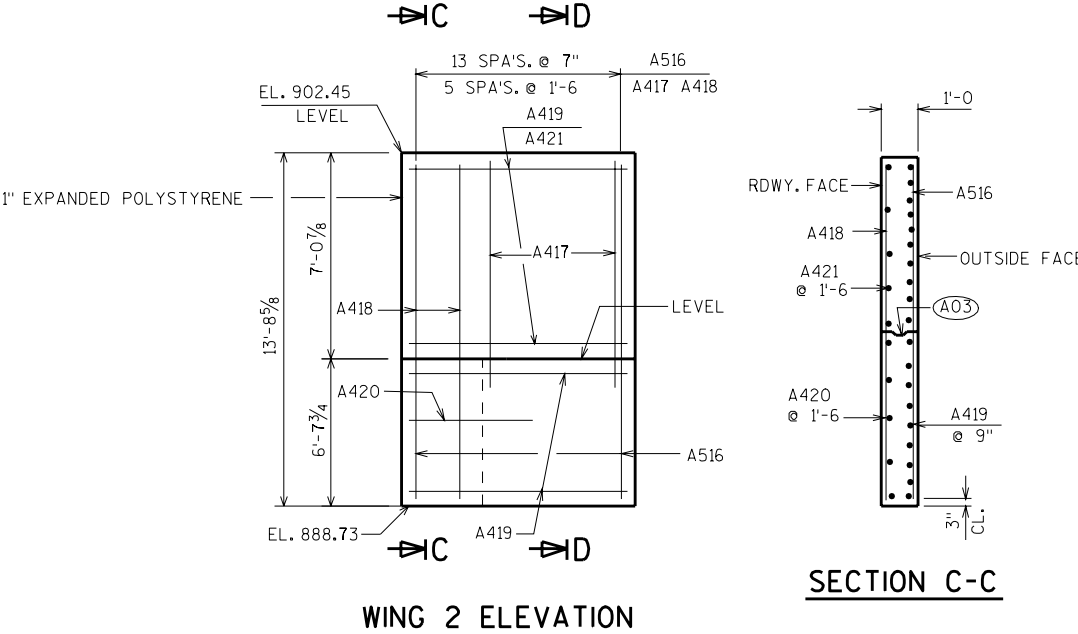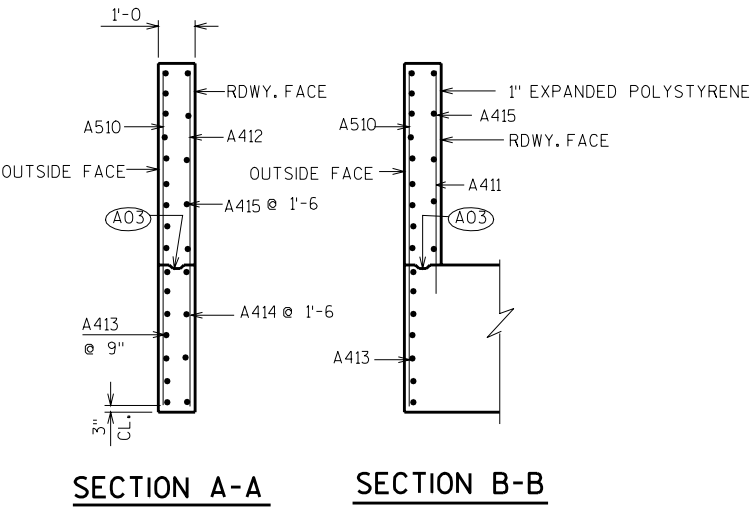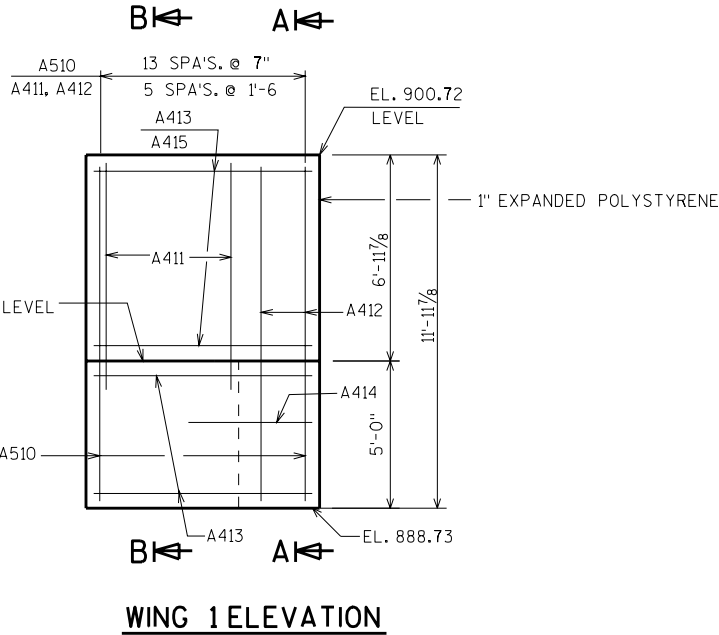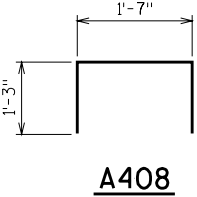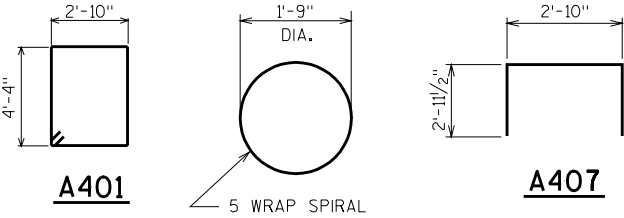

NO.	DATE	REVISION	BY
STATE OF WISCONSIN DEPARTMENT OF TRANSPORTATION STRUCTURES DESIGN SECTION			
STRUCTURE B-18-182			
CONST. SPEC.	2003	DRAWN BY JHG	PLANS CK'D. JPH
SOUTH ABUTMENT DETAILS		SHEET 5	


FILE= 05-182ABUTSODET.DGN  
SCALE = 3/2



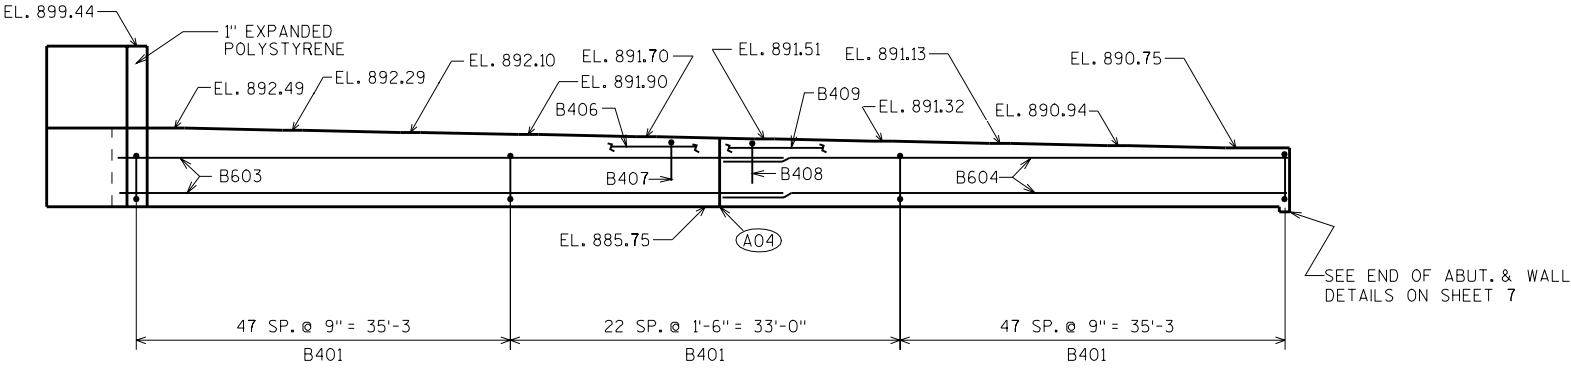


**ELEVATION LOOKING NORTH**

BEAM SEAT ELEVATIONS ARE AT LOCATION "A"  
(SEE BEAM SEAT DETAIL)

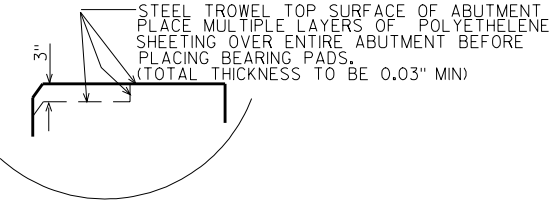


3/4" X 4" FILLER  
OUT TO OUT OF BEAM SEATS

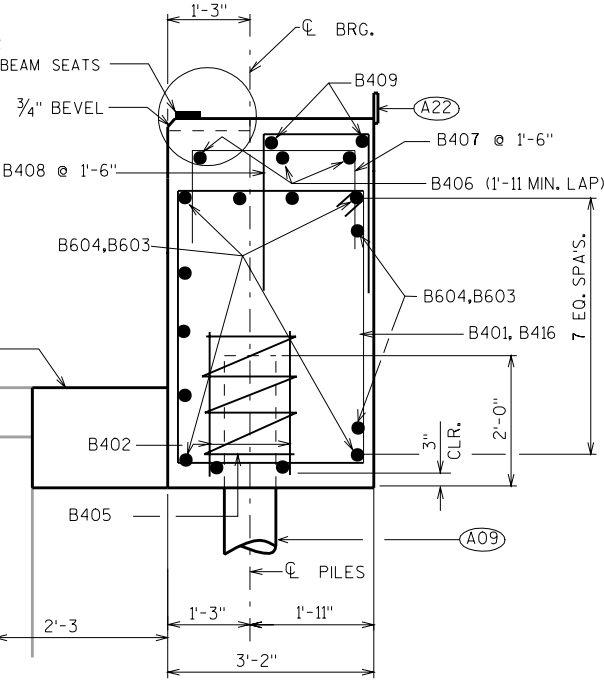

**SECTION THRU BODY**

- (A04) VERT. CONSTRUCTION JOINT: KEYWAY FORMED BY A BEVELED 2 x 8, (3/4" "V" GROOVE @ THE FRONT FACE) (18" R.M.W. @ BACKFACE). PLACE ON SKEW.
- (A09) SUPPORT ABUTMENT ON 10 3/4" DIA. CAST-IN-PLACE CONCRETE PILING, ESTIMATED 90'-0" LONG, AND DRIVEN TO A MIN. BRG. VALUE OF 55 TONS PER PILE.
- (A21) 3/4" CORK UP VERT. FACES OF BEAM SEATS.
- (A22) 18" (RMW) RUBBERIZED MEMBRANE WATERPROOFING SEAL ALL HORIZ. & VERT. JOINTS AT BACKFACE.

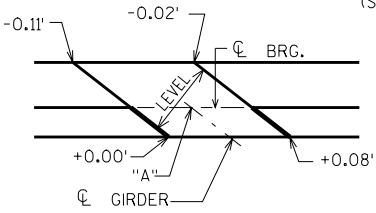


**SLOPED BEAM SEAT DETAIL**

SEE "ELEVATION LOOKING NORTH"  
FOR ELEVATION AT "A"

SLOPE PAVING  
CRUSHED AGGREGATE  
(SLOPE TO DRAIN)


TOP OF WALL  
EL. 887.25

STRUCTURE R-18-31

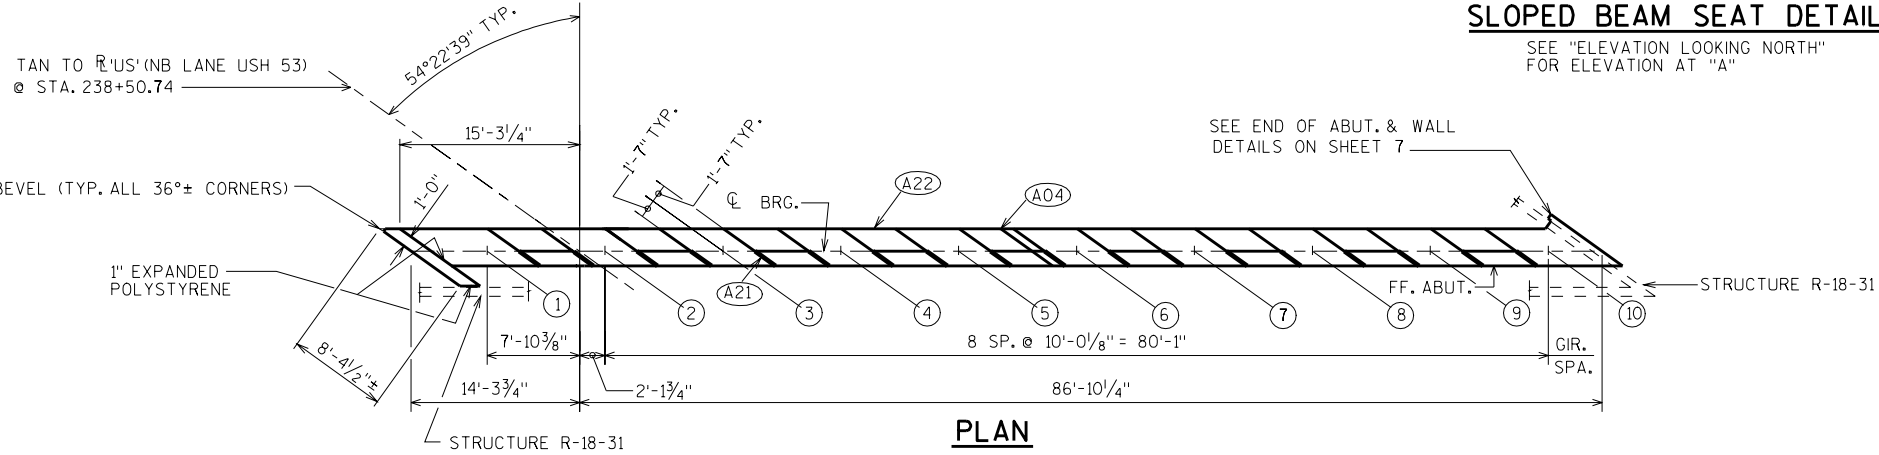

**PLAN**

WING 3




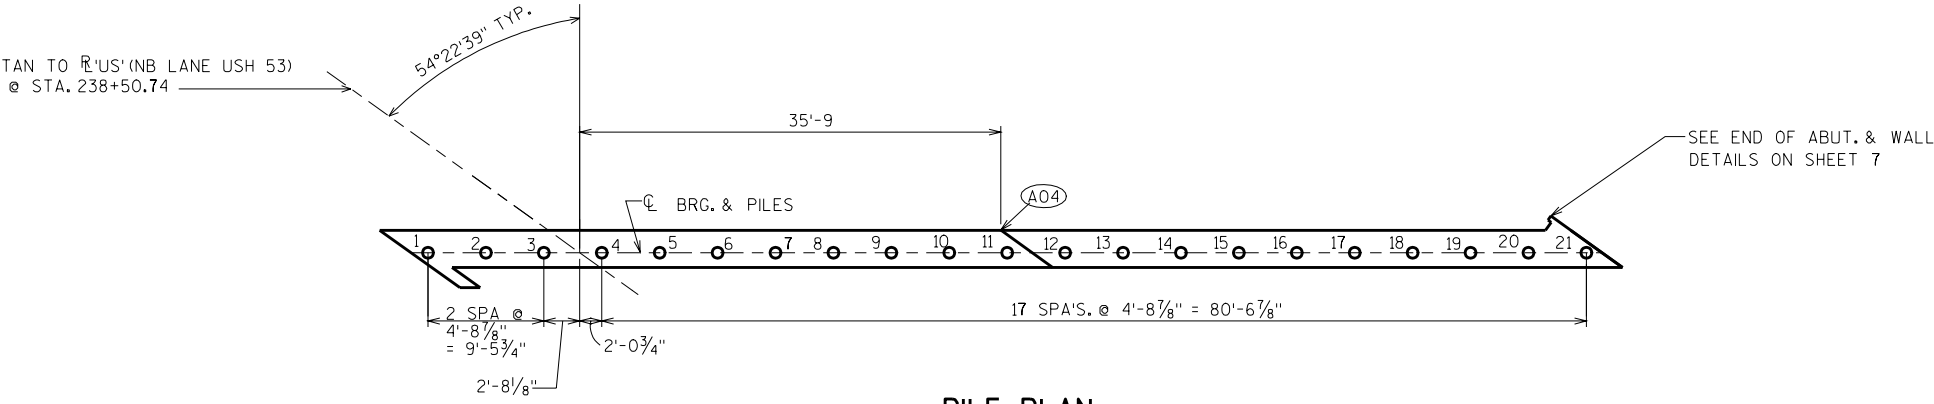


**PILE PLAN**



NO.	DATE	REVISION	BY
STATE OF WISCONSIN DEPARTMENT OF TRANSPORTATION STRUCTURES DESIGN SECTION			
STRUCTURE B-18-182			
CONST. SPEC.	2003	DRAWN BY JHG	PLANS CK'D. JPH
NORTH ABUTMENT			SHEET 6

BILL OF BARS

BAR MARK	COAT	NO. REQ'D.	LENGTH	BENT	BAR SERIES	LOCATION
B401		117	14'-10"	X		BODY-STIRRUPS
B402		42	2'-3"			PILES- 2 PER PILE
B603		17	57'-6"			BODY-HORIZONTAL
B604		17	47'-9"			BODY-HORIZONTAL
B405		21	28'-0"	X		PILES-1 PER PILE
B406		9	29'-5"			BODY-HORZ. OVER GIRS. 1-8
B407		55	8'-6"	X		BODY-TOP OVER GIRS. 1-8
B408		27	3'-11"	X		BODY-BETWEEN BEAM SEATS
B409		18	4'-0"			BODY-HORZ. EXT
B510	X	14	13'-3"			WING 3-VERTICAL OUTSIDE FACE
B411	X	4	8'-4"			WING 3-VERTICAL RDWY. FACE
B412	X	2	13'-3"			WING 3-VERTICAL RDWY. FACE
B413	X	19	7'-9"			WING 3-HORIZONTAL OUTSIDE FACE
B414	X	5	4'-0"			WING 3-HORIZONTAL RDWY. FACE
B415	X	5	7'-9"			WING 3-HORIZONTAL RDWY. FACE
B416		5	7'-0"			BODY HORIZ. - EAST END
B417		6	6'-3"	X		BODY VERT. - EAST END

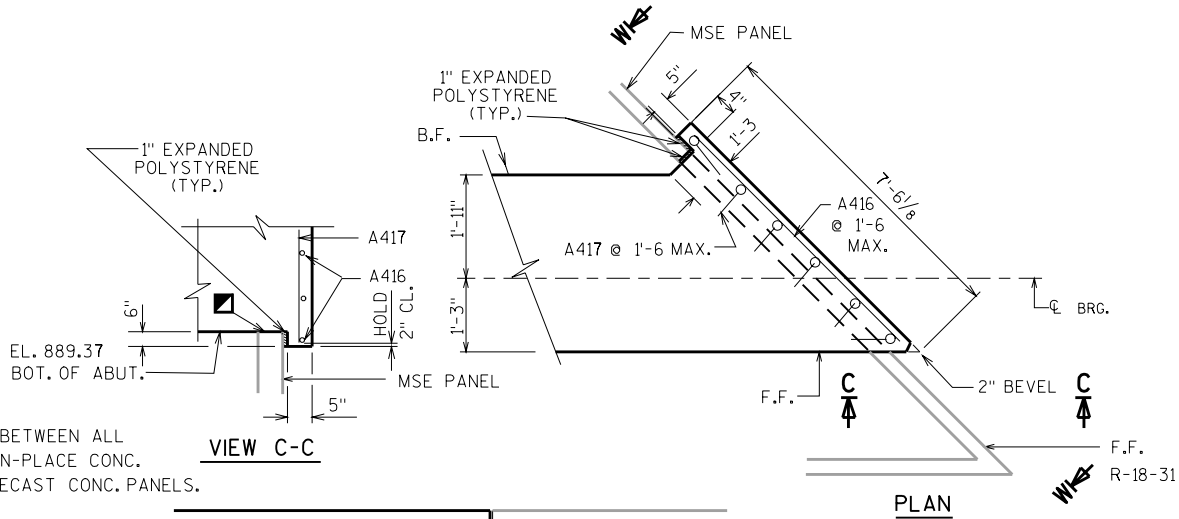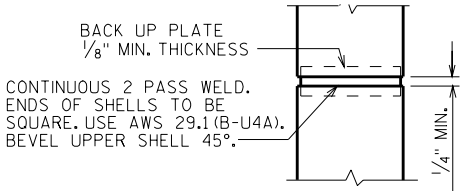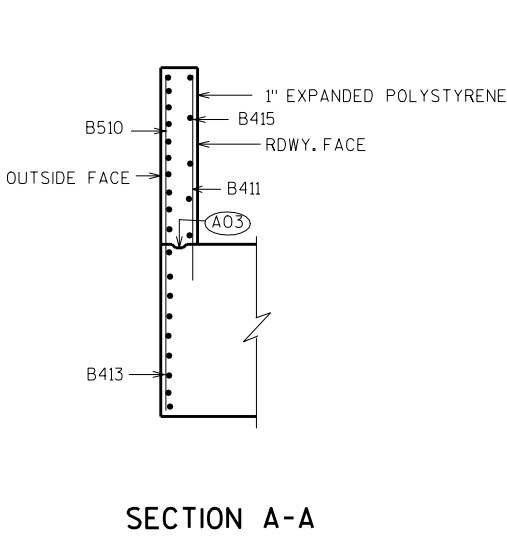
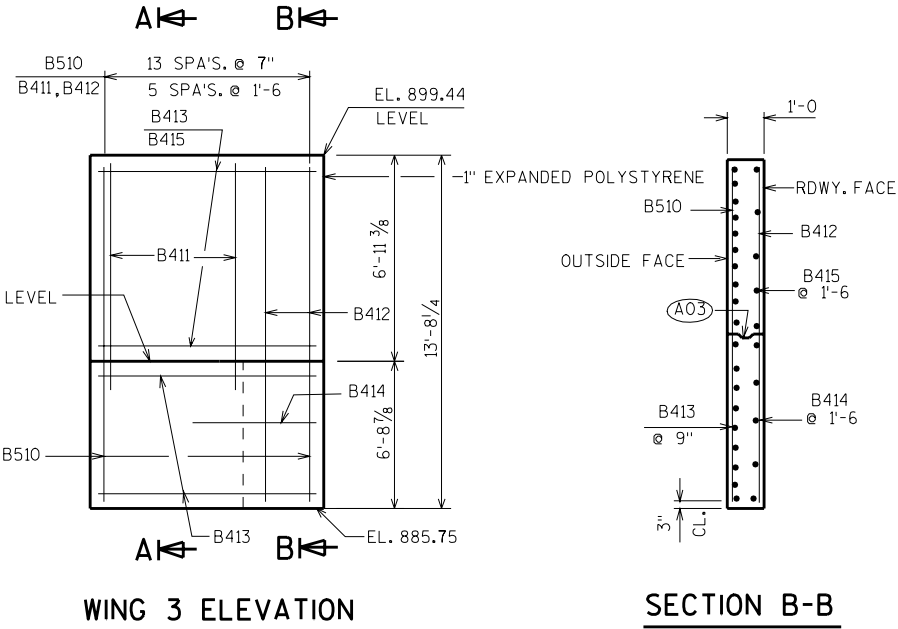


■ BOND BREAKER BETWEEN ALL B-18-182 CAST-IN-PLACE CONC. AND R-18-34 PRECAST CONC. PANELS.

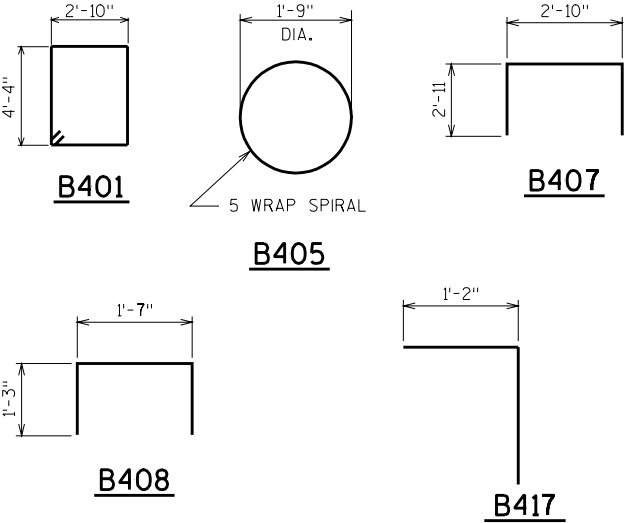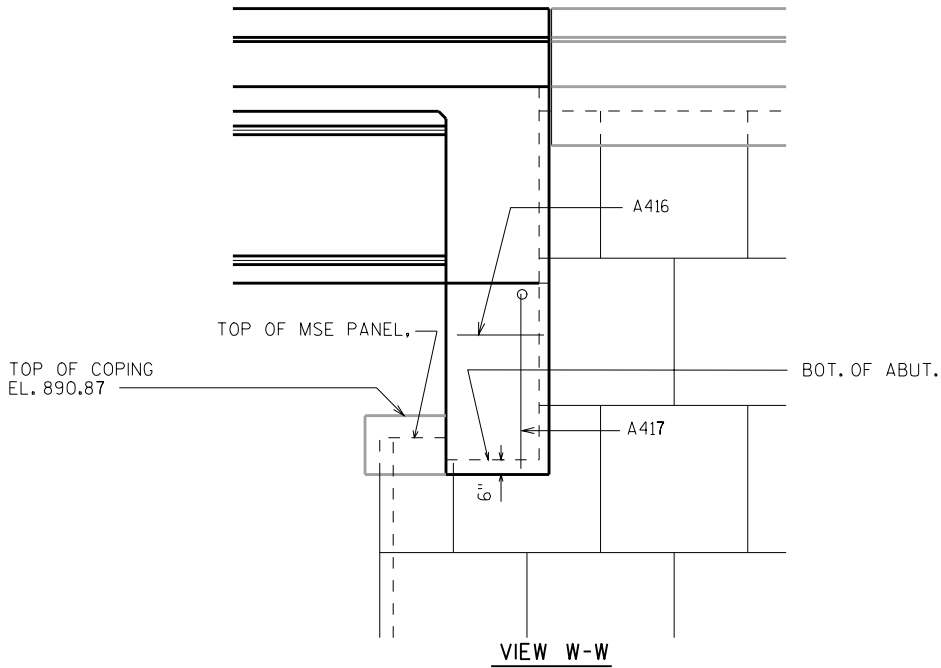


END OF ABUT. & WALL @ EAST END OF N. ABUT.


NO.	DATE	REVISION	BY
STATE OF WISCONSIN DEPARTMENT OF TRANSPORTATION STRUCTURES DESIGN SECTION			
STRUCTURE B-18-182			
CONST. SPEC.	2003	DRAWN BY JHG	PLANS CK'D. JPH
NORTH ABUTMENT DETAILS			SHEET 7

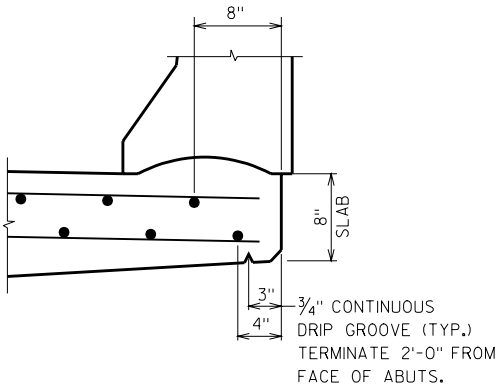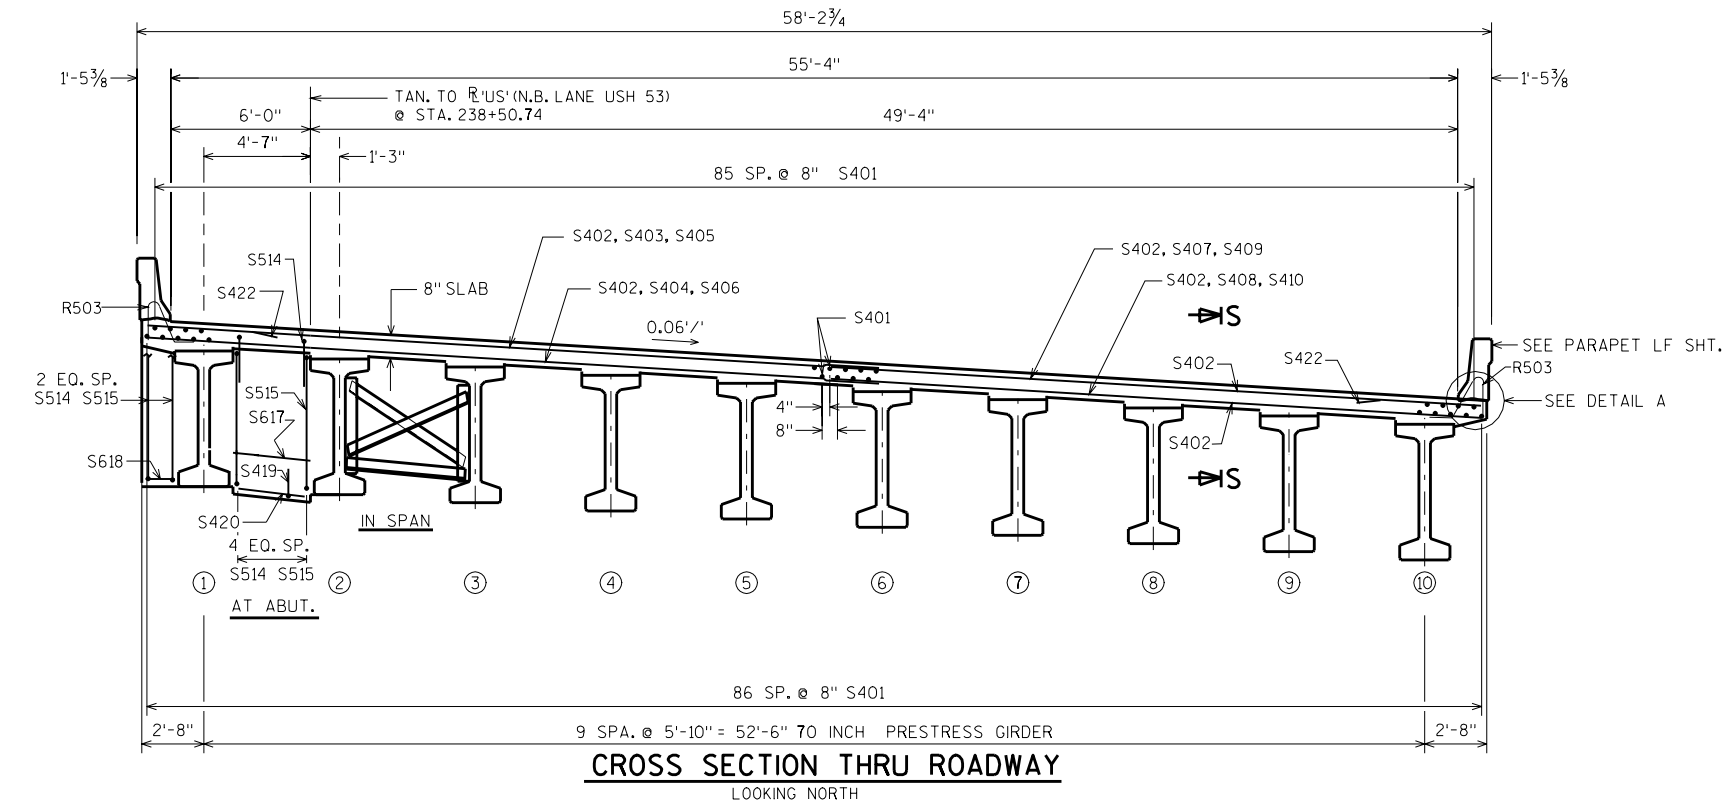

DETAIL A

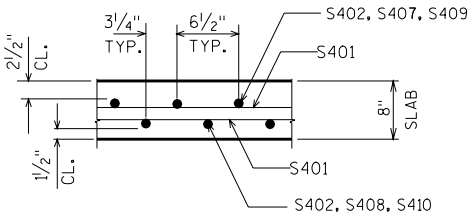

SECTION S-S

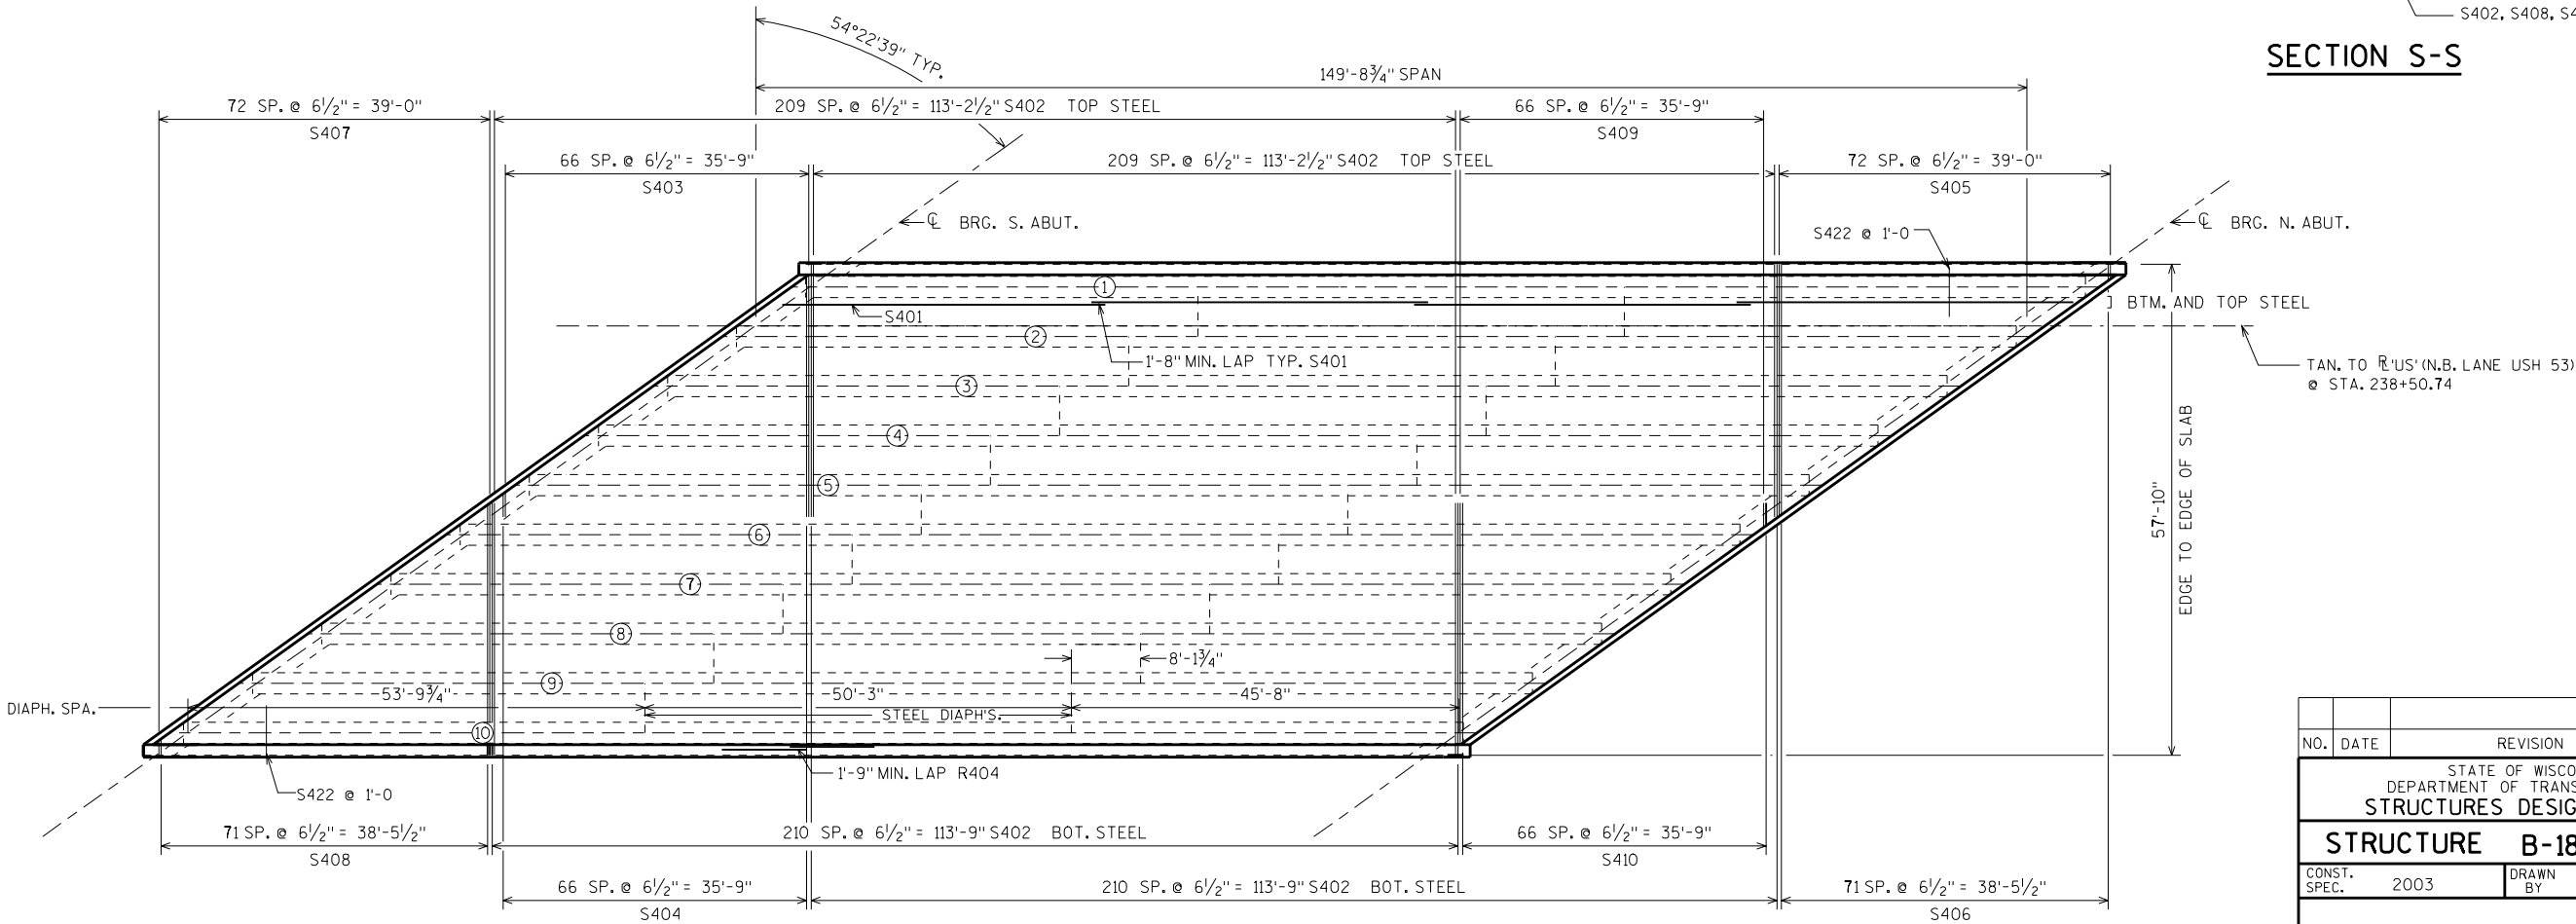

PLAN


NO.	DATE	REVISION	BY
STATE OF WISCONSIN DEPARTMENT OF TRANSPORTATION STRUCTURES DESIGN SECTION			
STRUCTURE B-18-182			
CONST. SPEC.	2003	DRAWN BY JHG	PLANS CK'D. JPH
SUPERSTRUCTURE			SHEET 8

BILL OF BARS

▲ LENGTH SHOWN FOR BAR IS AN AVERAGE LENGTH AND SHOULD ONLY BE USED FOR BAR WEIGHT CALCULATIONS. SEE BAR SERIES TABLE FOR ACTUAL LENGTHS.


BAR MARK	COAT	NO. REQ'D.	LENGTH	BENT	BAR SERIES	LOCATION
S401	X	692	39'-8"			LONGITUDINAL TOP & BOTTOM
S402	X	842	29'-7"			TRANSVERSE
S403	X	67	15'-4"		▲	TRANSVERSE
S404	X	67	15'-2"		▲	TRANSVERSE
S405	X	73	15'-4"		▲	TRANSVERSE
S406	X	72	15'-4"		▲	TRANSVERSE
S407	X	73	15'-4"		▲	TRANSVERSE
S408	X	72	15'-4"		▲	TRANSVERSE
S409	X	67	15'-4"		▲	TRANSVERSE
S410	X	67	15'-2"		▲	TRANSVERSE
S412	X	2	6'-6"			N. ABUT. DIAPHRAGM - EAST END- VERT.
S413	X	6	1'-8"			N. ABUT. DIAPHRAGM - EAST END - HORIZ.
S514	X	102	7'-8"	X		ABUT. DIAPHRAGM
S515	X	102	21'-8"	X		ABUT. DIAPHRAGM
S616	X	36	51'-2"			ABUT. DIAPHRAGM
S617	X	126	5'-2"			ABUT. DIAPHRAGM
S618	X	28	1'-10"			ABUT. DIAPHRAGM
S419	X	72	3'-11"	X		ABUT. DIAPHRAGM
S420	X	36	4'-0"			ABUT. DIAPHRAGM
S521	X	40	6'-0"			ABUT. DIAPHRAGM
S422	X	282	4'-2"			TOP TRANS. BARS @ EDGE

\* BUNDLE TO EVERY OTHER TOP TRANS. BAR. SEE BUNDLING DETAIL BELOW.

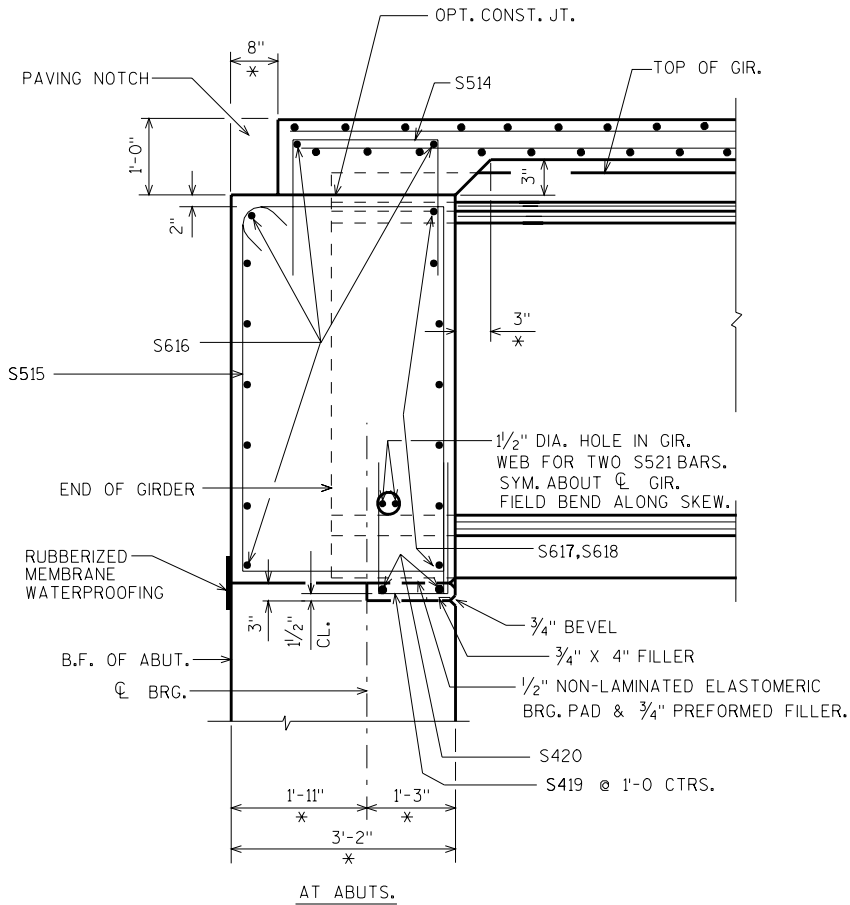


PART. LONGIT. SECTION

\* DIMENSION IS TAKEN NORMAL TO CL SUBSTRUCTURE UNITS.

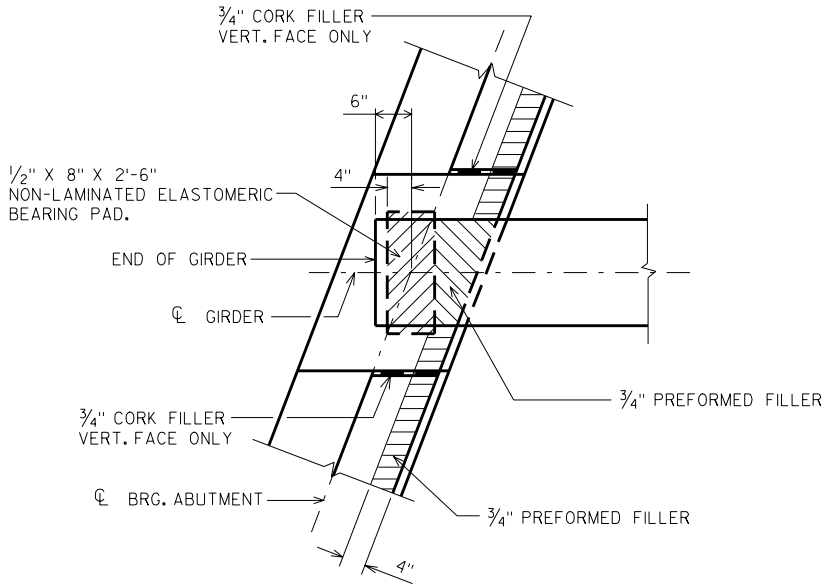

BEARING PAD DETAIL

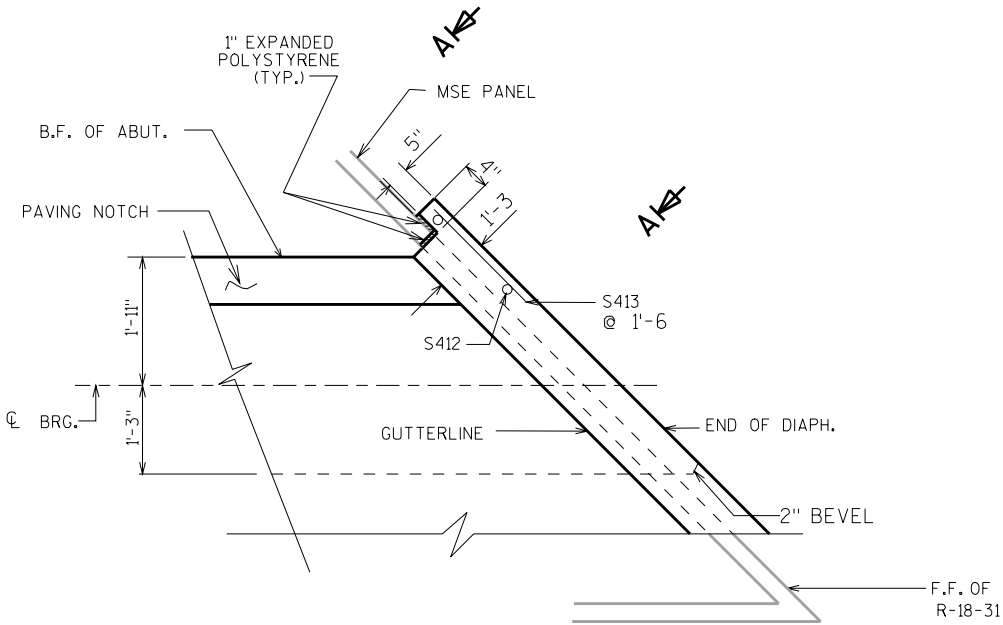

PLAN OF EAST SIDE AT N. ABUT. DIAPH.


TOP OF DECK ELEVATIONS

	S. ABUT.	1/8	2/8	3/8	4/8	5/8	6/8	7/8	N. ABUT.
GIR. 1	902.34	901.97	901.61	901.25	900.88	900.52	900.16	899.81	899.45
GIR. 2	902.15	901.78	901.42	901.06	900.69	900.33	899.97	899.61	899.25
GIR. 3	901.97	901.60	901.23	900.87	900.50	900.14	899.78	899.41	899.06
GIR. 4	901.78	901.41	901.04	900.68	900.31	899.95	899.58	899.22	898.86
GIR. 5	901.60	901.23	900.86	900.49	900.12	899.76	899.39	899.03	898.66
GIR. 6	901.41	901.04	900.67	900.30	899.94	899.57	899.20	898.84	898.47
GIR. 7	901.23	900.86	900.49	900.12	899.75	899.38	899.01	898.64	898.28
GIR. 8	901.05	900.68	900.31	899.93	899.56	899.19	898.82	898.45	898.09
GIR. 9	900.87	900.50	900.12	899.75	899.38	899.01	898.64	898.27	897.90
GIR. 10	900.69	900.32	899.94	899.57	899.19	898.82	898.45	898.08	897.71

BAR SERIES TABLE


BUNDLE AND TAG EACH SERIES SEPARATELY

MARK	NO. REQD.	LENGTH
S403	1 SERIES OF 67	2'-7" TO 28'-2"
S404	1 SERIES OF 67	2'-4" TO 28'-0"
S405	1 SERIES OF 73	1'-5" TO 29'-4"
S406	1 SERIES OF 72	1'-7" TO 29'-2"
S407	1 SERIES OF 73	1'-5" TO 29'-4"
S408	1 SERIES OF 72	1'-7" TO 29'-2"
S409	1 SERIES OF 67	2'-7" TO 28'-2"
S410	1 SERIES OF 67	2'-4" TO 28'-0"

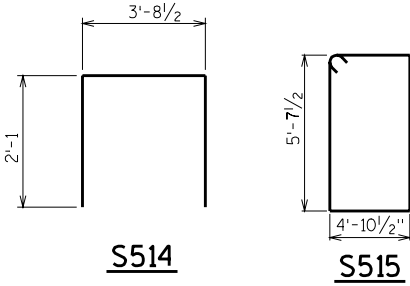

S514

S515

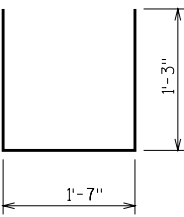

S419

WIRE BARS TOGETHER @ 2'-0" CTRS.

BUNDLING DETAIL

NO.	DATE	REVISION	BY
STATE OF WISCONSIN DEPARTMENT OF TRANSPORTATION STRUCTURES DESIGN SECTION			
STRUCTURE		B-18-182	
CONST. SPEC.	2003	DRAWN BY JHG	PLANS CK'D. JPH
SUPERSTRUCTURE DETAILS		SHEET 9	

TOP OF GIRDER TO BE ROUGH FLOATED AND BROOMED TRANSVERSELY, EXCEPT THE OUTSIDE 2" OF GIRDER, WHICH SHALL BE TROWEL FINISHED.

THE GIRDERS SHALL BE PROVIDED WITH A SUITABLE LIFTING DEVICE FOR HANDLING AND ERECTING THE GIRDERS.

PRESTRESSING STRANDS SHALL BE 0.6"φ - 7 WIRE LOW-RELAXATION STRANDS WITH AN ULTIMATE STRENGTH OF 270,000 PSI AND SHALL BE FLUSH WITH THE ENDS OF THE GIRDER.

BEND EACH END OF #4 STIRRUPS 4 1/2", #7 STIRRUP 12".

FOR DIAPHRAGM INSERT & CONNECTION DETAILS SEE "STEEL DIAPHRAGM" SHEET.

ON MULTIPLE SPAN STRUCTURES, SET THE END BLOCK LENGTHS OF GIRDERS RESTING ON THE SAME PIER TO ± 2". ON SIMPLE SPANS, SET THE END BLOCK LENGTH ON BOTH GIRDER ENDS TO ± 2".

IF THE CONTRACTOR USES BOTTOM FLANGE TO SUPPORT CONSTRUCTION FORMS, THE CONTRACTOR SHALL SUBMIT FALSEWORK PLANS FOR APPROVAL OF THE STRUCTURES DESIGN SECTION.


ALL GIRDERS SHALL BE CAST FULL LENGTH AS SHOWN.

SPACING SHOWN FOR #4 STIRRUPS IS FOR GRADE 60 REINFORCEMENT. IF THE FABRICATOR WANTS TO BUILD A BAR STEEL CAGE BY WELDING LONGITUDINAL REINFORCEMENT TO THE #4 STIRRUPS, 2 OPTIONS ARE AVAILABLE:


- USE ASTM A706, GRADE 60 REINFORCEMENT AND THE STIRRUP SPACING AS SHOWN ON THE PLANS.
- USE ASTM A615, GRADE 40 REINFORCEMENT AND A MODIFIED STIRRUP SPACING SUBMITTED TO AND APPROVED BY THE STRUCTURES DEVELOPMENT SECTION.

AN ALTERNATE EQUIVALENT OF WELDED WIRE FABRIC (WWF) MAY BE SUBSTITUTED FOR THE STIRRUP REINFORCEMENT SHOWN, UPON APPROVAL OF THE STRUCTURES DEVELOPMENT SECTION.


WELDED WIRE FABRIC SHALL CONFORM TO THE REQUIREMENTS OF ASTM A497.

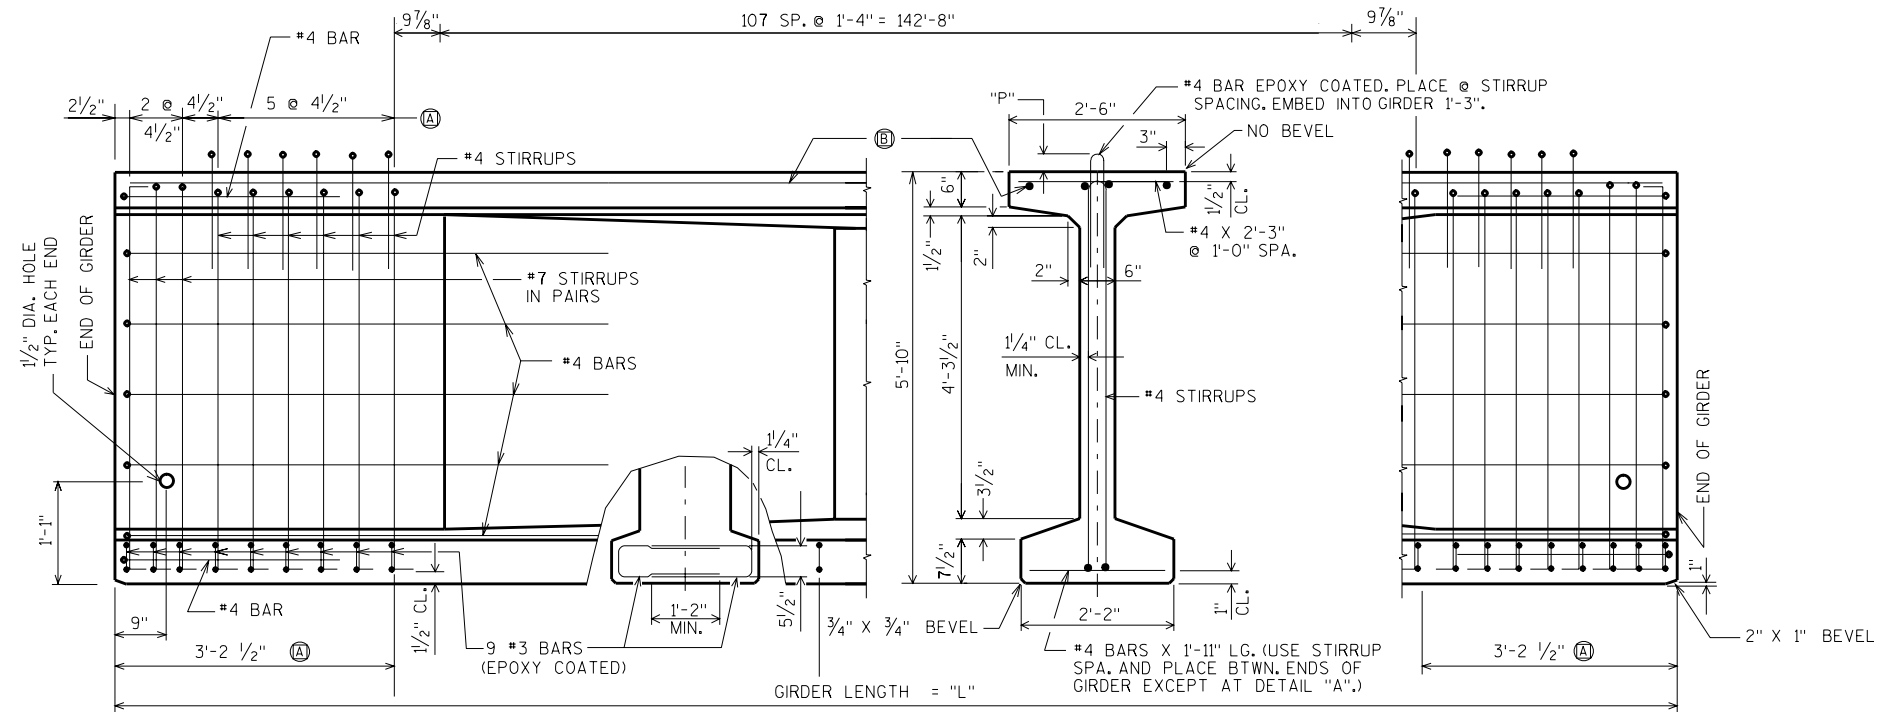


(A) DETAIL TYP. AT EACH END.  
(B) 4, #6 BARS, FULL LENGTH, 2'-11" MIN. LAP

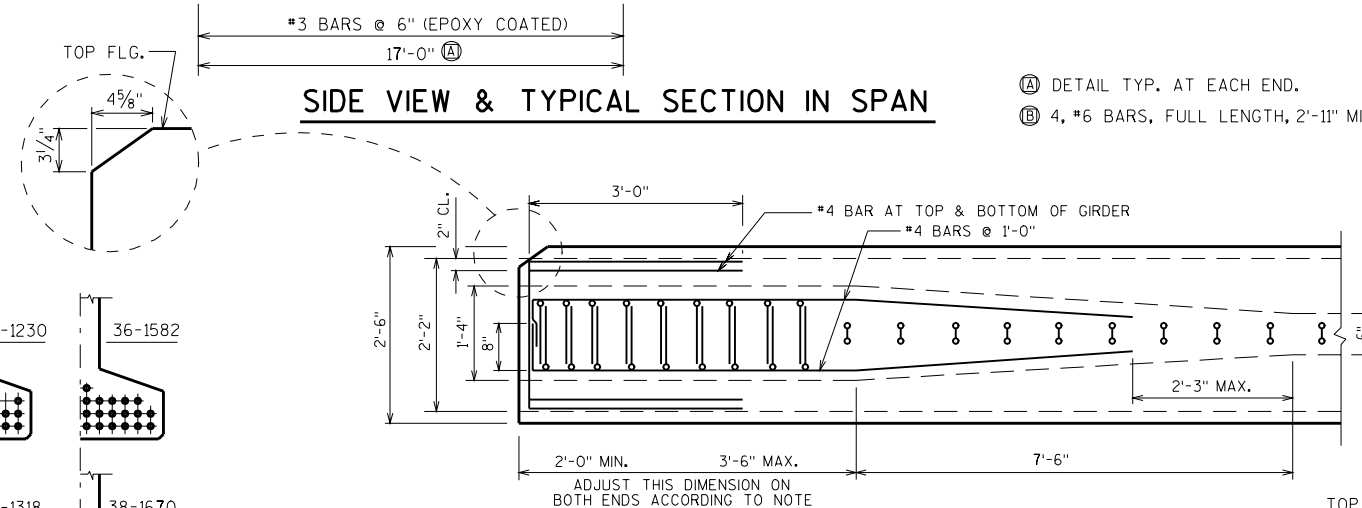


TOP VIEW OF GIRDER (A)

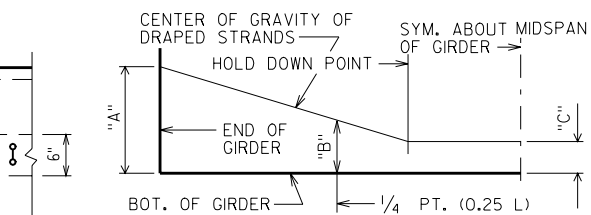

### DRAPED STRAND PROFILE

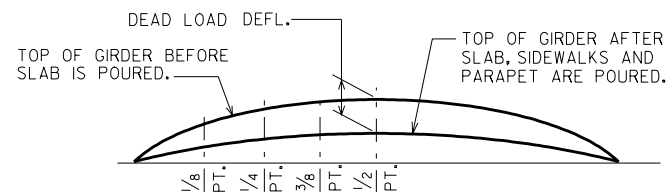

DEAD LOAD DEFLECTION DIAGRAM

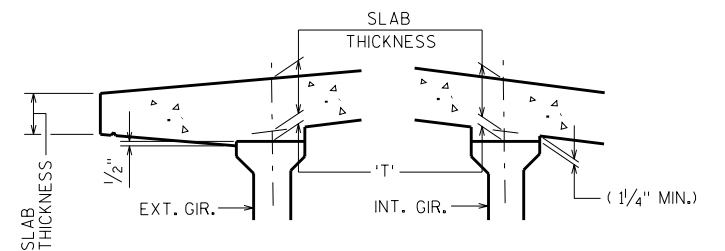


### SLAB HAUNCH DETAIL

IF 1 1/4" MINIMUM HAUNCH HEIGHT AT EDGE OF GIRDER CANNOT BE MAINTAINED, THE GRADE LINE MAY BE REVISED BY THE ENGINEER AT THE OPTION OF THE CONTRACTOR. THE PLAN SLAB THICKNESS SHALL BE HELD. NOTIFY BRIDGE OFFICE FOR HAUNCH HEIGHTS OVER 4".


TO DETERMINE 'T', ELEV. OF TOP OF GIR'S. AT  $\frac{1}{8}$  OF SUBSTRUCTURE UNITS  
& AT  $\frac{1}{8}$  POINTS OF EACH SPAN SHALL BE TAKEN. THEN FOLLOW THIS  
PROCESS:

TOP OF DECK ELEV. AT FINAL GRADE  
- TOP OF GIRDER ELEVATION  
+ DEAD LOAD DEFLECTION  
- SLAB THICKNESS  
-----  
= HAUNCH HEIGHT 'T'


NOTE: AN AVERAGE HAUNCH ('T') OF 4" WAS USED IN THE QUANTITY "CONCRETE MASONRY BRIDGES".

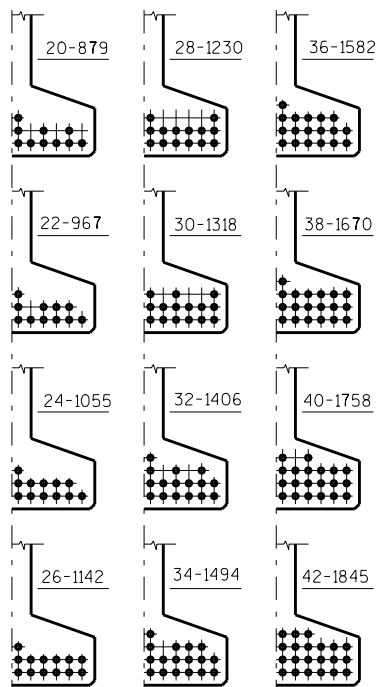

## DRAPED PATTERN

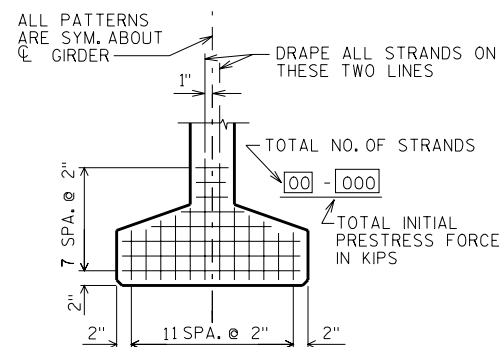

TYP STRAND PATTERN

 P=8" FOR END 21'-1" OF GIRDERS  
 P=7" FOR MIDDLE 108'-6 $\frac{3}{4}$ " OF GIRDERS

\* MINIMUM CYLINDER STRENGTH OF CONCRETE @ TIME OF TRANSFER OF PRESTRESS FORCE.

[illegible]

NO.	DATE	REVISION	BY
STATE OF WISCONSIN DEPARTMENT OF TRANSPORTATION <b>STRUCTURES DESIGN SECTION</b>			
<b>STRUCTURE</b>		<b>B-18-182</b>	
CONST. SPEC.	2003	DRAWN BY	PLANS Ck'D. <b>JPH</b>
<b>70" PRESTRESSED GIRDER DETAILS</b>		SHEET 10	

NOTES


ALL DIAPHRAGM MATERIAL NOT EMBEDDED IN THE CONCRETE GIRDER SHALL BE PAID FOR AT THE UNIT PRICE BID FOR "STEEL DIAPHRAGM".

EACH DIAPHRAGM BETWEEN GIRDERS SHALL CONSTITUTE ONE UNIT.


ALL DIAPHRAGM STRUCTURAL STEEL SHALL BE ASTM A709 GRADE 36. ALL BOLTS, NUTS AND WASHERS SHALL BE ASTM A325 TYPE 1.

ALL DIAPHRAGM STRUCTURAL STEEL SHOWN SHALL BE HOT-DIPPED GALVANIZED. ALL BOLTS, NUTS AND WASHERS SHALL BE HOT-DIPPED GALVANIZED IN ACCORDANCE WITH ASTM A153 CLASS C. GALVANIZED NUTS SHALL BE TAPPED OVERSIZE IN ACCORDANCE WITH THE REQUIREMENTS OF ASTM A563 AND SHALL MEET THE REQUIREMENTS OF SUPPLEMENTARY REQUIREMENT S1 OF ASTM A563, LUBRICANT AND TEST FOR COATED NUTS.


SECTION AT INTERIOR GIRDERS  
(FOR STAGGERED DIAPHRAGMS )

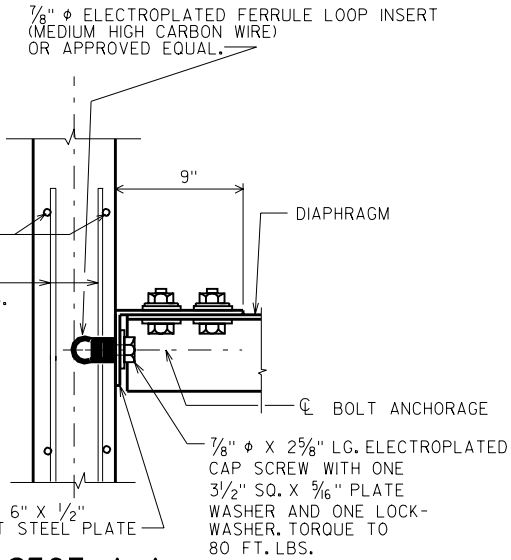

SECT. A-A  
(FOR EXTERIOR ATTACHMENT)

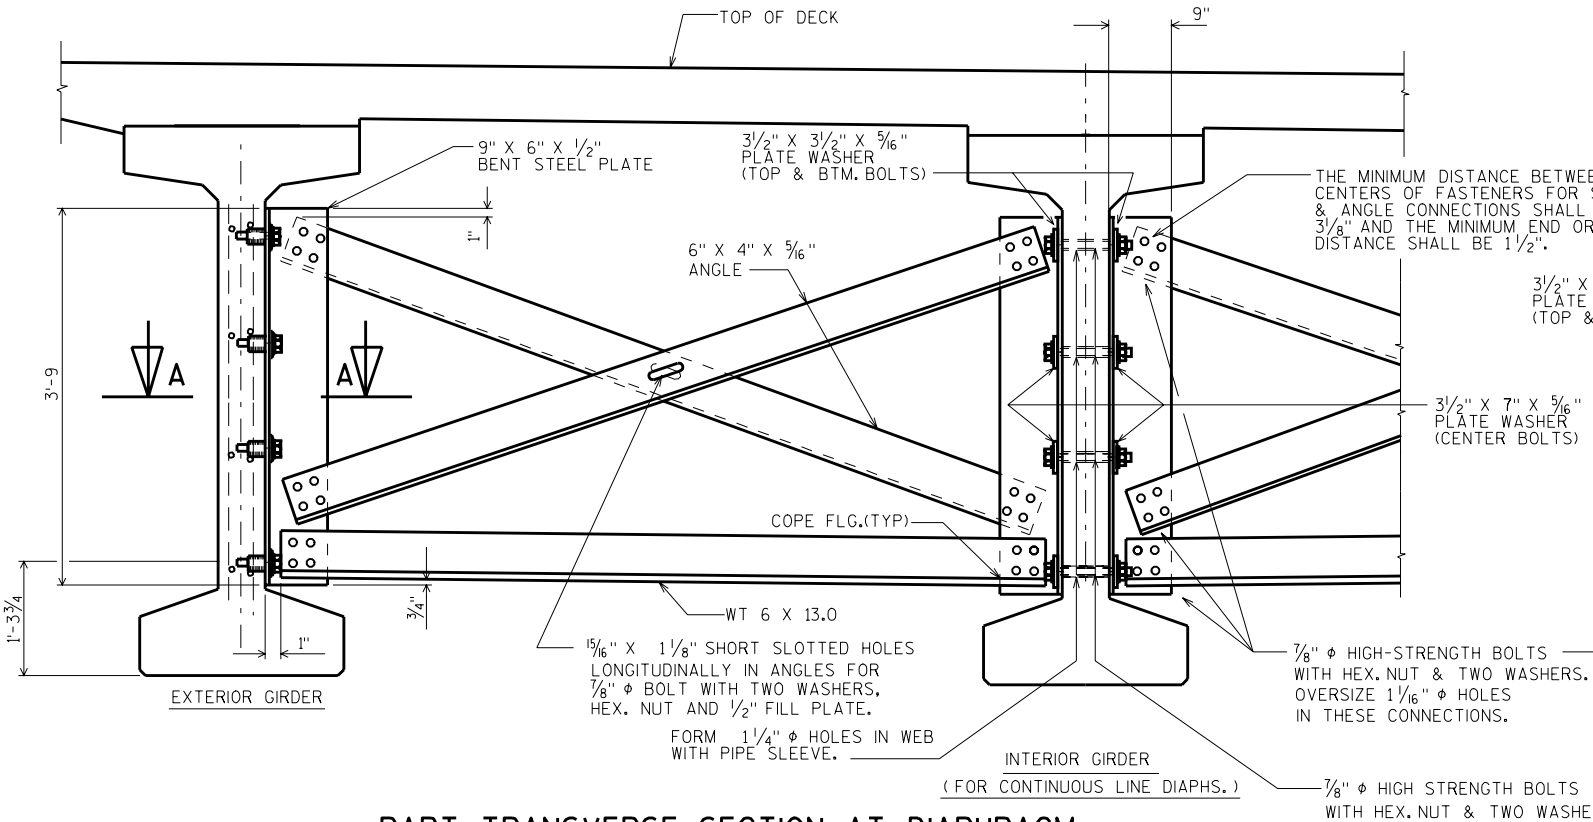

PART TRANSVERSE SECTION AT DIAPHRAGM


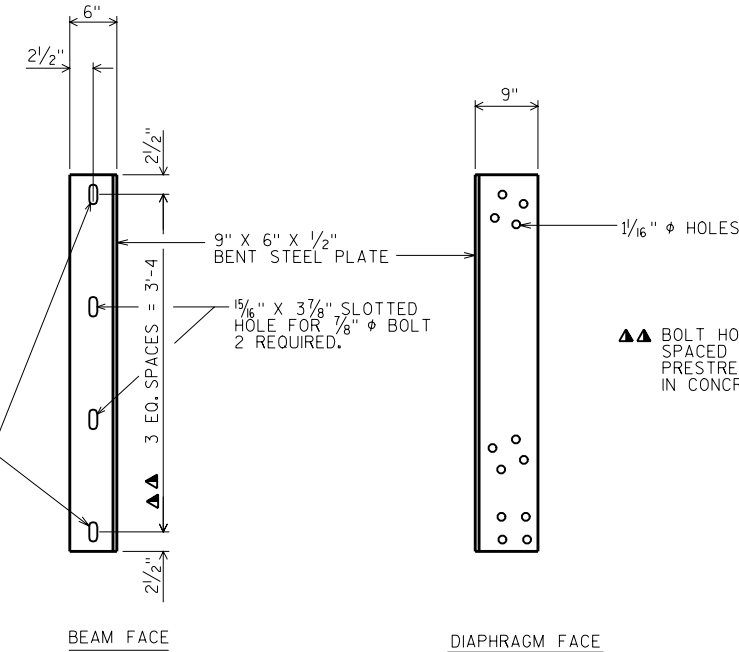


DIAPHRAGM SUPPORT


NO.	DATE	REVISION	BY
STATE OF WISCONSIN DEPARTMENT OF TRANSPORTATION STRUCTURES DESIGN SECTION			
STRUCTURE		B-18-182	
CONST. SPEC.	2003	DRAWN BY JHG	PLANS CK'D. JPH
STEEL DIAPHRAGM		SHEET 11	



BAR MARK	COAT	NO. REQ'D.	LENGTH	BENT	BAR SERIES	LOCATION
R501	X	42	4-5	X		PARAPET VERT.
R502	X	24	3-2	X		PARAPET VERT.
R503	X	439	4-2	X		PARAPET VERT.
R504	X	37	40-4			PARAPET HORIZ.
R505	X	481	4-10	X		PARAPET VERT.
R506	X	3	40-4	X		PARAPET HORIZ.

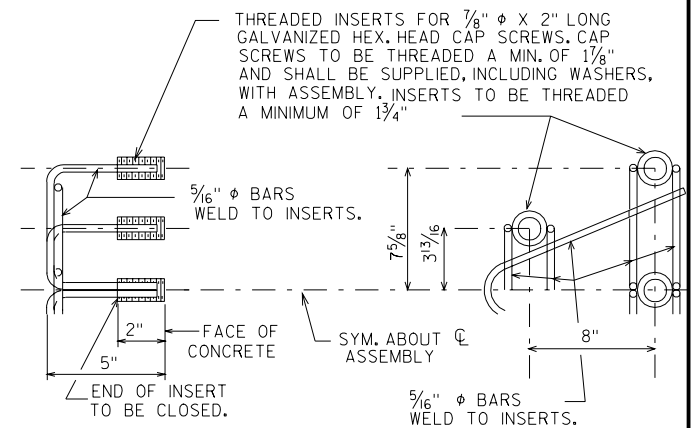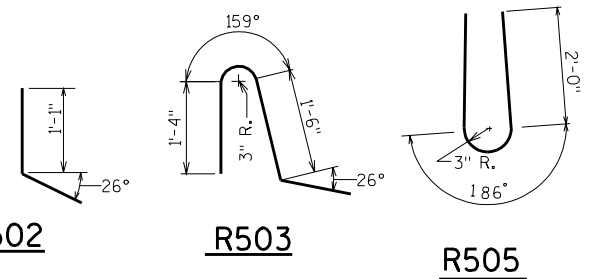

NOTE: HEX. HEAD CAP SCREWS & WASHERS TO BE GALVANIZED IN ACCORDANCE WITH AASHTO M232 CLASS C.

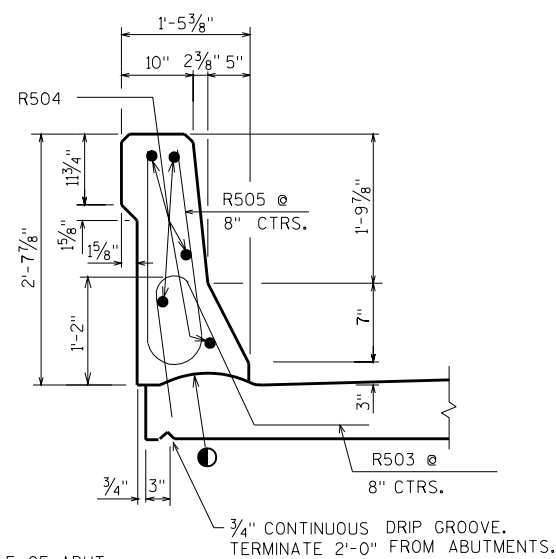

## SECTION C

● CONST. JOINT - STRIKE OFF  
AS SHOWN.

NO.	DATE	REVISION	BY
STATE OF WISCONSIN DEPARTMENT OF TRANSPORTATION STRUCTURES DESIGN SECTION			
STRUCTURE B-18-182			
CONST. SPEC.	2003	DRAWN BY	PLANS C/K'D. JPH
SLOPED FACE PARAPET LF		SHEET 12	