

REHABILITATION STRUCTURE SURVEY REPORT

DT1696 6/2012

Wisconsin Department of Transportation

- ☒ **Grade Separation**
☐ **Stream Crossing**
☐ **Culvert**
☐ **Railroad**
☐ **Retaining Wall**
☐ **Noise Barrier**
☐ **Sign Structure**
☐ **Other:** _____

For guidance see: http://dotnet/dtid_bos/extranet/structures/reports-checklists.htm

Design Project ID 1190-02-34	Construction Project ID 1190-02-64	Highway (Project Name) EAU CLAIRE - CHIPPEWA FALLS		
Final Plan Due Date 05/01/2018	Preliminary Plan Due Date 05/01/2018	<input type="checkbox"/> Town <input type="checkbox"/> Village <input checked="" type="checkbox"/> City EAU CLAIRE		
PS&E Date 08/01/2018	Letting Date 02/12/2019	County EAU CLAIRE		
Structure Number B-18-183		Section 27	Town 27N	Range 09W
Station 223+66.74 - 224+64.24	Latitude: 444704.31 Longitude: 912653.17	<input checked="" type="checkbox"/> YES <input type="checkbox"/> NO Structure Located on National Highway System		
For Survey and CADD Files Horizontal Coordinate System: Vertical Datum:		Traffic Forecast Data		
Feature On USH 53 NB		Design Year 2008	Average Daily Traffic (ADT) 18800	Roadway Design Speed 70 MPH
Feature Under CYPRESS RD		Feature Under		Functional Class Principal Arterial
Region Contact: Adam Hetrick (Area Code) Telephone Number(s): 715-836-2855 Email: adam.hetrick@dot.wi.gov		Consultant Contact: (Area Code) Telephone Number(s): Email:		

Work To Be Performed

Field Information Required Item Number (see Pages 2-4)

- ☐ A. Structural Repair 1-3, 22
☒ B. Overlay 1-3, 10-22, 26-28, 32, 34
 ☐ Concrete Overlay ☐ Asphalt Overlay
 ☐ Polymer Modified Asphalt Overlay ☒ Thin Bonded Polymer Overlay
 ☐ Other: _____
☐ C. New Bearings 3, 8, 9, 22
☐ D. New Railings 15-17, 20-23
☐ E. Curb and Sidewalk Repair 2, 3, 16, 22, 23
☐ F. Abutment Repair 2, 3, 12, 16
☐ G. Pier Repair 2, 3, 12, 16
☐ H. New Deck 1-6, 9, 10, 13-28, 32-34
☐ I. Widening 1-28, 30, 32-35
☐ J. Joint Repair 2, 3, 8, 16, 19, 22
☐ K. Surface Repair 2, 3, 22
☐ L. Raising Bridge 3, 6, 9, 16, 20-24
☐ M. Slope Stabilization 1-3, 30
☐ N. Scour Repair 1, 2 or 3, 16, 19, 21, 27, 29, 31-35
☐ O. Painting 16, 22, 24
☐ P. Other: _____

Field Information Required

If no structure number exists provide the following: Small County Map on which the location of proposed structure is shown in red and any highway relocation in green. In addition, provide Location Map of scale not less than 1" = 2000' showing the structure location and number.

- ☒ 1. Most recent inspection report, brief history of bridge construction date, and description of repairs with dates.
- ☒ 2. Outline deficient areas on existing structure plan or drawing.
- ☒ 3. Photographs of details requiring repairs or modifications, such as: bearings, x-frames, joints, etc. Photograph all deficient areas. Clearly label all photographs.
- ☐ 4. Provide proposed typical section for roadway and structure showing dimensions and cross slopes.
- ☐ 5. Survey beam seat or girder elevations at both sides of bridge at all substructure units.
- ☐ 6. Provide cross-section elevations at 10 foot intervals extending across the structure and a minimum of 100 feet beyond each end. Sections should be normal to centerline and show elevations at centerline roadway and gutter line. Take elevations along joints and at floor drains.
- ☐ 7. Show and identify starting stationing on bridge.
- ☐ 8. Record measurement, temperature of the structure, and date taken for each of the following:
 - (a) Joint opening measured normal to joint at centerline of roadway and both curb lines.
 - (b) Clearance between girder ends at piers.
 - (c) Distance from front face of abutment backwall to closest point of girder end measured parallel to girder.
 - (d) Temperature of structure determined by averaging top and under deck (if accessible) readings.
- ☐ 9. Fixed and expansion bearings - condition and orientation.
- ☒ 10. Number and width of proposed pours including construction staging sequence.
- ☒ 11. Location of existing construction joints in the deck.
- ☒ 12. Estimated Quantities:

Preparation, Decks, Type 1	Sq. Yd. <u>0</u>	
Preparation, Decks, Type 2	Sq. Yd. <u>0</u>	
Full Depth Deck Repair	Sq. Yd. <u>0</u>	Galvanic Anodes? <u>NO</u>
Concrete Surface Repair Superstructure	Sq. Ft. <u>0</u>	Galvanic Anodes? <u>NO</u>
Concrete Surface Repair Substructure	Sq. Ft. <u>0</u>	Galvanic Anodes? <u>NO</u>
Curb Repair	LF. <u>0</u>	Galvanic Anodes? <u>NO</u>

☒ 13. Sufficiency number: 94.7 (obtain from HSI Bridge Inventory System)

☒ 14. Appraisal and Condition Rating

	Deck Condition	Superstructure Condition	Substructure Condition	Load Capacity Appraisal	Structural EVAL Appraisal
Current	8	8	8	5	8

☒ 15. Load Ratings

	Inventory	Operational
Current Calculated Date: 7/11/2013	HS25	HS54
After Completed by Bridge Designer		

- ☒ 16. Utilities on/near Structure. (WisDOT policy is to avoid placing utilities on the structure.)

☒ Yes ☐ No

Type	Owner and Contact Information	Size	Opening at Abutment	Weight	Pressure

- ☒ 17. Is existing bridge railing deficient?

☐ Yes ☒ No If Yes – Replacement Rail Type:

- ☐ 18. Drains to be:

☐ Raised ☐ Closed ☐ Downspouted ☐ New

- ☒ 19. Traffic maintained on bridge during work?

☒ Yes ☐ No If Yes – Include sketches

- ☒ 20. Will guard rail be attached?

☐ Yes ☒ No If Yes – Which corners? Existing guardrail to remain at all corners.

- ☒ 21. Will work to be performed eliminate all deficiencies?

☒ Yes ☐ No If No – Explain:

- ☒ 22. Hazardous waste (asbestos) to be removed?

☐ Yes ☒ No If Yes – Explain:

- ☐ 23. Wing location(s) for surface drain anchors:

- ☒ 24. Painting?

☐ Yes ☒ No If Yes – Explain on Page 4

(all, part, railing, color system, containment, bid items)

- ☐ 25. Desired roadway width: (new deck / widening) _____ Ft.

Desired sidewalk clear width: Left: _____ Ft. Right: _____ Ft.

- ☒ 26. Maximum increase in grade line elevation 3/8 In.

- ☒ 27. Benchmark description to be shown

- ☒ 28. Desired final cross slopes on bridge 0.02 Ft./Ft.

- ☐ 29. Underwater Inspection Report including:

- Streambed Cross Section With Pier, Footing and Seal Elevations
- Pier Elevation Drawings
- Pier Layout
- Hydrographic Survey

- ☐ 30. Slope stabilization, provide:

Type: _____ Quantity: _____ CY.

Slope: _____ Ft./Ft. Fill: _____ CY.

- ☐ 31. Preliminary layout of grout bags or proposed scour repair.

C.I.P. Articulated Mats (for Scour) _____ CY.

Grout Bags (for Scour) _____ CY.

Heavy Riprap _____ CY.

Extra Heavy Riprap _____ CY.

- ☒ 32. Report submitted with Preliminary Plan requires **no** CADD file submittal (*See ESubmittal instructions*).
- ☐ 33. Report submitted for development of Preliminary Plan to structure design engineer requires CADD file (if available) submittal and Report submittal to Soils Engineer if project involves foundation modifications.
- ☐ 34. Coordinate with structure design engineer **before** going into the field if existing structure has no available plans, if staged construction is planned, or if there are adjoining/adjacent structures that will remain in place.
- ☐ 35. If project involves substructure widening coordinate with structure and/or hydraulic design engineer to determine if information on the separation and/or stream crossing SSR will be required.


Additional Information

Elaborate on other concerns such as: DNR, Local, Utility Conflicts, Aesthetics, Railing Type and Staged Construction.

Please be as detailed and specific as possible.

- 1.) Structure built in 2005. No repairs since construction. See attached Bridge Inspection Report.
- 2.) Deficient areas to be determined in the field by the engineer. See attached Bridge Inspection Report. A Polymer Overlay is proposed because of deficiency over the entire structure due to poor bridge deck surface. The deck has a few hairline transverse/diagonal cracks. The roadway approach slab on the south end is failing.
- 3.) See attached photographs.
- 10.) This work will be constructed half at a time under traffic using single lane closures during non-peak hours with night work. Nighttime ramp closures are anticipated at some structures. All lanes and ramps will be opened to traffic daily.
- 11.) See asbuilt plans.
- 16.) Conduit for lighting is attached to the North abutment. No conflicts anticipated.
- 19.) This work will be constructed half at a time under traffic using single lane closures during non-peak hours with night work. Nighttime ramp closures are anticipated at some structures. All lanes and ramps will be opened to traffic daily.
- 22.) See attached Asbestos Inspection Report. No asbestos-containing material was found.
- 27.) To be determined.
- 32.) See preliminary plans.

CDR Map

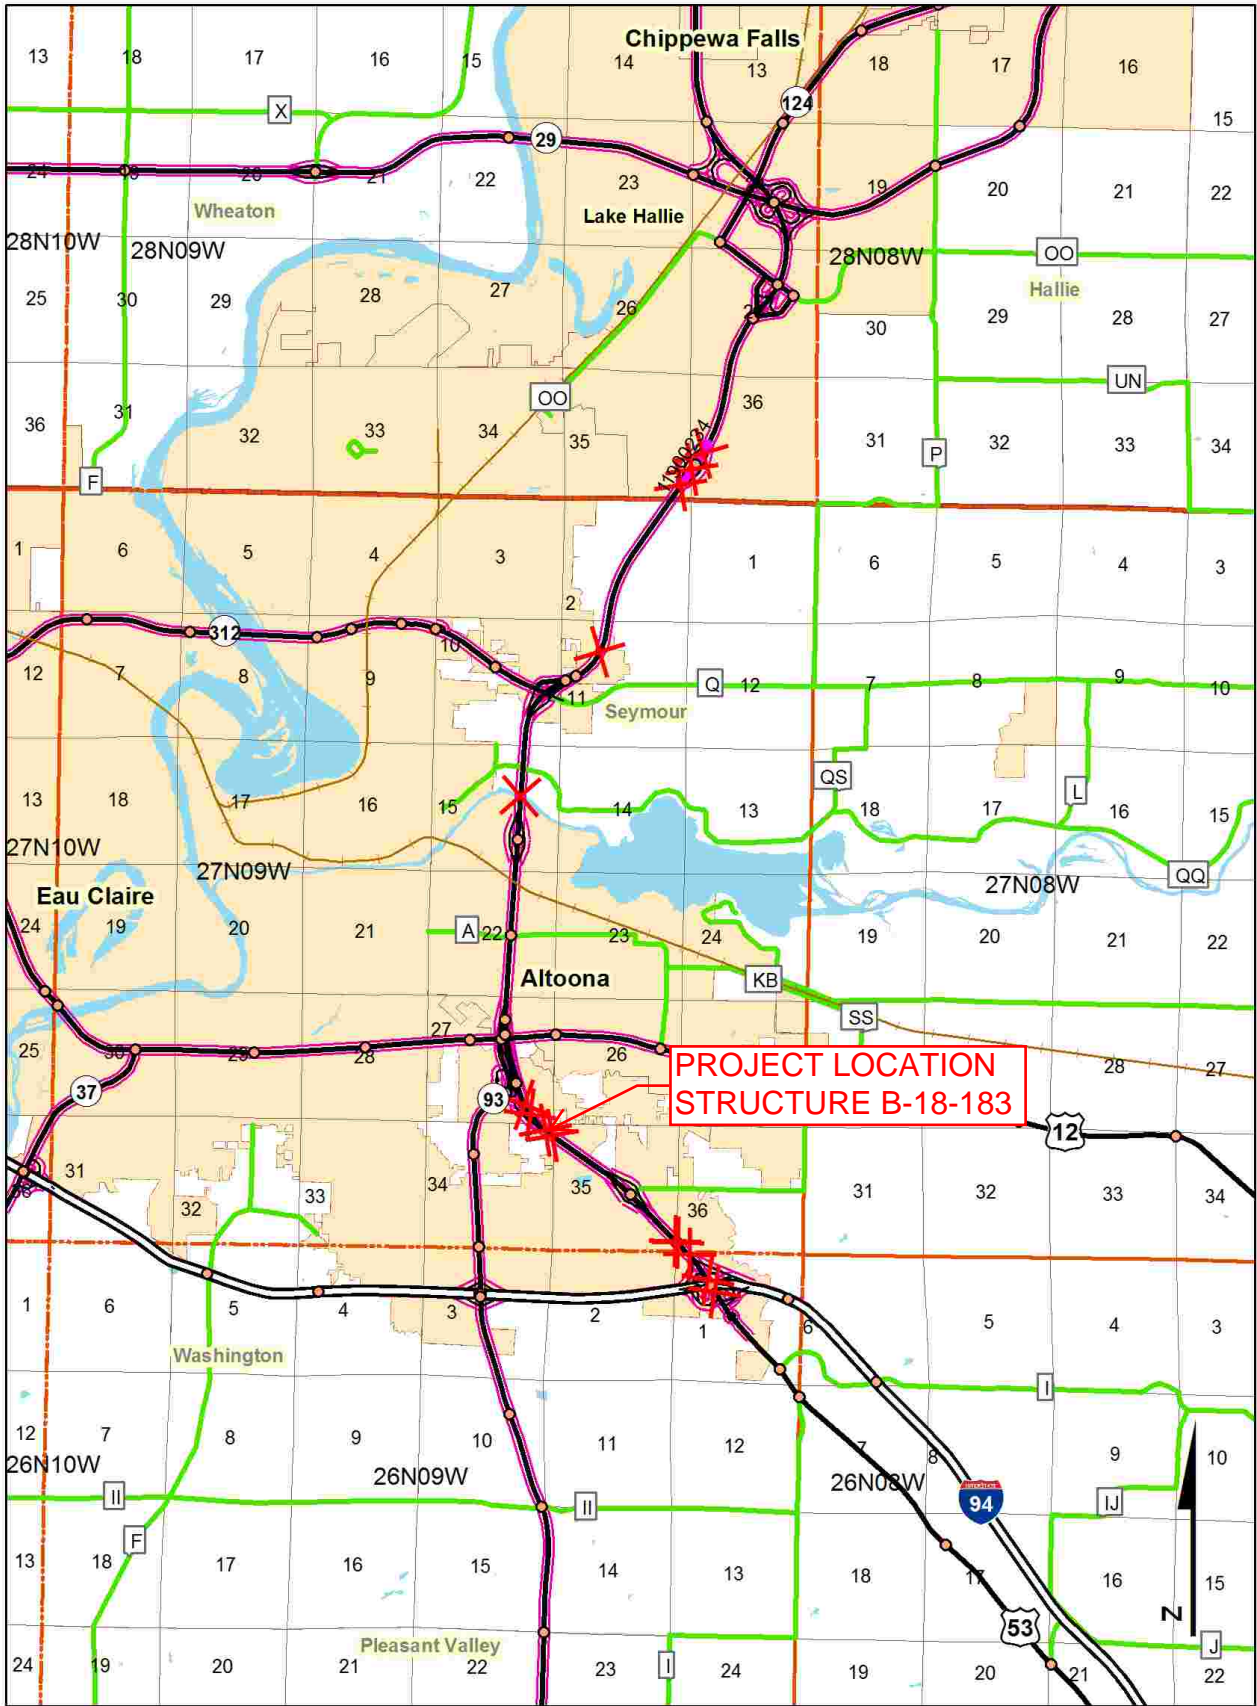

1190-02-64

EAU CLAIRE / CHIPPEWA

Section No. 1	Title
Section No. 2	Typical Sections and Details
Section No. 3	Estimate of Quantities
Section No. 3	Miscellaneous Quantities
Section No. 4	Right of Way Plat
Section No. 5	Plan and Profile
Section No. 6	Standard Detail Drawings
Section No. 7	Sign Plates
Section No. 8	Structure Plans
Section No. 9	Computer Earthwork Data
Section No. 9	Cross Sections

A.A.D.T.	=
A.A.D.T.	=
D.H.V.	=
D.D.	=
T.	=
DESIGN SPEED	=
ESALS	=

PLAN
CORPORATE LIMITS
PROPERTY LINE
LOT LINE
LIMITED HIGHWAY EASEMENT
EXISTING RIGHT OF WAY
PROPOSED OR NEW R/W LINE

SLOPE INTERCEPT
 REFERENCE LINE
 EXISTING CULVERT
 PROPOSED CULVERT
 (Box or Pipe)
 COMBUSTIBLE FLUIDS

MARSH AREA 

WOODED OR SHRUB AREA 

PROFILE
 GRADE LINE
 ORIGINAL GROUND
 MARSH OR ROCK PROFILE
 (To be noted as such)
 SPECIAL DITCH

 GRADE ELEVATION

 CULVERT (Profile View)
 UTILITIES
 ELECTRIC
 FIBER OPTIC
 GAS
 SANITARY SEWER
 STORM SEWER
 TELEPHONE
 WATER
 UTILITY PEDESTAL
 POWER POLE
 TELEPHONE POLE

95.36

E
 FO
 G
 SAN
 SS
 T
 W

0


PLAN OF PROPOSED IMPROVEMENT

EAU CLAIRE - CHIPPEWA FALLS

IH 94 TO 40TH AVENUE (11 BRIDGES)

USH 53

EAU CLAIRE AND CHIPPEWA COUNTIES

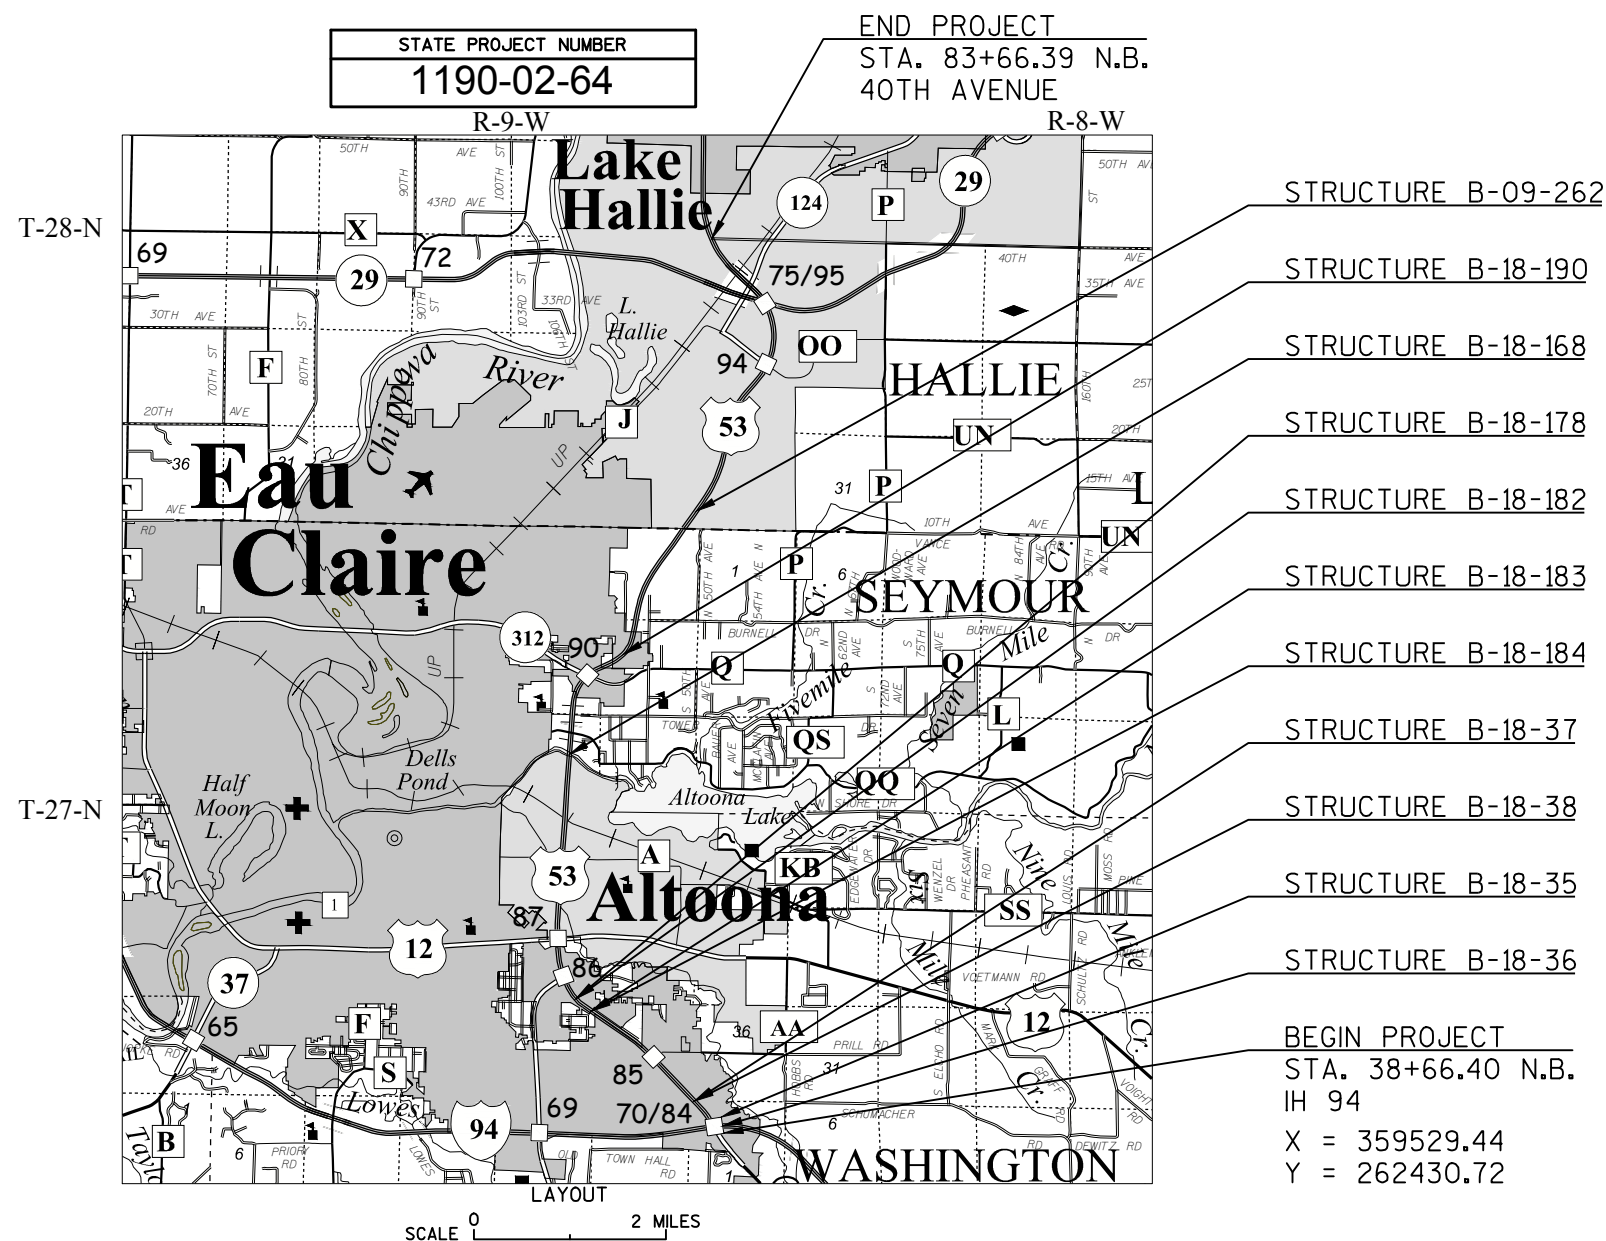

HORIZONTAL POSITIONS SHOWN ON THIS PLAN ARE WISCONSIN COUNTY COORDINATES, EAU CLAIRE COUNTY, NAD83 (1991), IN U.S. SURVEY FEET. VALUES ARE GRID COORDINATES, GRID BEARINGS, AND GRID DISTANCES. GRID DISTANCES MAY BE USED AS GROUND DISTANCES.

STATE PROJECT	FEDERAL PROJECT	
	PROJECT	CONTRACT
1190-02-64		

STATE OF WISCONSIN DEPARTMENT OF TRANSPORTATION	
PREPARED BY	
Surveyor	WISDOT
Designer	ADAM HETRICK
Project Manager	DAVID KOEPP
Regional Examiner	REGIONAL EXAMINER
Regional Supervisor	TIMOTHY MASON
APPROVED FOR THE DEPARTMENT	
DATE:	(Signature)



route: 053N county: EAU CLAIRE date: 08/13/2013 plm: 064.587

Lat: 44.78389848 Long: -91.44717597 Elev: 795.99 ft.

\\doteauplog1p\photolog\Rg5\053N_R5_2013\Front\Dir_067\F_06761.jpg

Copyright 2015 Mandli Communications, Inc.



route: 053N county: EAU CLAIRE date: 08/13/2013 plm: 064.597

Lat: 44.78397799 Long: -91.4473439 Elev: 797.01 ft.

\\doteauplog1p\photolog\Rg5\053N_R5_2013\Front\Dir_067\F_06762.jpg

Copyright 2015 Mandli Communications, Inc.



route: 053N county: EAU CLAIRE date: 08/13/2013 plm: 064.607

Lat: 44.78405846 Long: -91.44751341 Elev: 797.86 ft.

\\doteauplog1p\photolog\Rg5\053N_R5_2013\Front\Dir_067\F_06763.jpg

Copyright 2015 Mandli Communications, Inc.



route: 053N county: EAU CLAIRE date: 08/13/2013 plm: 064.617

Lat: 44.78413824 Long: -91.44768139 Elev: 798.99 ft.

\\doteauplog1p\photolog\Rg5\053N_R5_2013\Front\Dir_067\F_06764.jpg

Copyright 2015 Mandli Communications, Inc.



route: 053N county: EAU CLAIRE date: 08/13/2013 plm: 064.627

Lat: 44.78421814 Long: -91.44784973 Elev: 799.85 ft.

\\doteauplog1p\photolog\Rg5\053N_R5_2013\Front\Dir_067\F_06765.jpg

Copyright 2015 Mandli Communications, Inc.



route: 053N county: EAU CLAIRE date: 08/13/2013 plm: 064.637

Lat: 44.78429859 Long: -91.44801906 Elev: 800.85 ft.

\\doteauplog1p\photolog\Rg5\053N_R5_2013\Front\Dir_067\F_06766.jpg

Copyright 2015 Mandli Communications, Inc.



route: 053N county: EAU CLAIRE date: 08/13/2013 plm: 064.647

Lat: 44.78437858 Long: -91.44818855 Elev: 801.73 ft.

\\doteauplog1p\photolog\Rg5\053N_R5_2013\Front\Dir_067\F_06767.jpg

Copyright 2015 Mandli Communications, Inc.



route: 053N county: EAU CLAIRE date: 08/13/2013 plm: 064.657

Lat: 44.78445866 Long: -91.44835926 Elev: 802.63 ft.

\\doteauplog1p\photolog\Rg5\053N_R5_2013\Front\Dir_067\F_06768.jpg

Copyright 2015 Mandli Communications, Inc.



**STATE OF WISCONSIN
DEPARTMENT OF TRANSPORTATION**

**Inspection Report for
B-18-183**

**USH 53 NB HASTINGS WAY over CYPRESS RD
Jul 14, 2015**



Type	Prior	Frequency (mos)	Performed
Routine	07-14-15	24	X
SI&A	07-11-13	48	

Latitude	44°47'04.31"N	Owner	STATE HIGHWAY DEPT
Longitude	91°26'53.17"W	Maintainer	STATE HIGHWAY DEPT

Time Log		Team members
Hours	Minutes	
0	46	

	Name	Number	Signature	Date
Inspector	Frueh, Rick J	1003	Completed by HSI System Account(HSI)	
Reviewer				

BRIDGE INSPECTION REPORT
Wisconsin Department of Transportation
DT2007 2003 s.84.17 Wis. Stats.

page 2

Identification & Location

Feature On: USH 53 NB HASTINGS WAY	Section Town Range: S27 T27N R09W	Structure Number: B-18-183
Feature Under: CYPRESS RD	County: EAU CLAIRE(18)	
Location AT CYPRESS RD	Municipality: CITY-EAU CLAIRE(18221)	Structure Name:

Geometry

measurements in feet, except where noted

Approach Roadway Width: 90	Bridge Roadway Width: 86.2	Total Length: 98.8
Approach Pavement Width: 74	Deck Width: 89.1	Deck Area (sq ft): 8803

Traffic

	Lanes	ADT	ADT year	Traffic Pattern
On	4	1500	2003	ONE WAY TRAFFIC
Under	4	100	2003	TWO WAY TRAFFIC

Capacity

Load Rating

Inventory rating: HS25	Overburden depth (in): 0.0	Last rating date:	Controlling: INTERIOR DECK GIRDER Positive Moment
Operating rating: HS54	Deck surface material: CONCRETE	Re-rate for capacity (Y/N):	Control location: SPAN 1
Posting:	Re-rate notes:		

Hydraulic

Classification

Scour Critical Code(113): (N) NO WATERWAY	Q100 (ft3/sec): 0	
High water elevation (ft): 0.0	Velocity (ft/sec): 0.0	Sufficiency #: 94.7

Span(s)

Span #	Material	Configuration	Depth (in)	Length (ft)	Main
1	PREST CONCRETE	DECK GIRDER	45	95.0	Y

Expansion joint(s)

Temperature:

File:	New:
-------	------

Vertical Clearance

	Measurement file (ft)	File Date	Measurement new (ft)
Highway Minimum Under Cardinal	15.0	17-Nov-2005	
Highway Minimum Under Non-Cardinal	15.0	17-Nov-2002	
Highway Minimum On			
Railroad Minimum Under			

BRIDGE INSPECTION REPORT
Wisconsin Department of Transportation
DT2007 2003 s.84.17 Wis. Stats.

page 3

Structure No.: **B-18-183**

Elements

Chk	Element	Defect	Description	UOM	Total	Quantity in Condition State			
						1	2	3	4
X	12		Reinforced Concrete Deck	SF	7,680	7,680	0	0	0
			4 north bound lanes divided by a concrete median.						
		8000	Wearing Surface (Bare)	SF	7,680	7,666	14	0	0
			4 north bound lanes divided by a concrete median.						
		3220	Crack (Wearing Surface)	SF		169	14	0	0
			Few hairline transverse/diagonal cracks.						
	8522		Coated Reinforcing	SF	7,680	0	0	0	0
			4 north bound lanes divided by a concrete median.						
X	109		Prestressed Concrete Open Girder	LF	1,540	1,540	0	0	0
			16 Girders						
X	215		Reinforced Concrete Abutment	LF	224	220	4	0	0
			Decorative concrete face on both abutments. North abutment has electrical lights mounted on it.						
		1130	Cracking (RC)	LF		14	4	0	0
			Crack under G1 south abutment.						
X	331		Reinforced Concrete Bridge Rail	LF	200	175	25	0	0
			East concrete rail has a chain link fence on top. Southeast corner has vehicle hit.						
		1130	Cracking (RC)	LF		33	25	0	0
			Concrete rail has a few hairline vertical cracks.						
X	8400		Integral Wingwall	EA	4	4	0	0	0
			There are no wing walls.						
		8902	Wingwall Movement	EA		0	0	0	0
			Northeast and Southeast roadway concrete retaining walls coming up to the wing parapet is settling at both ends.						

BRIDGE INSPECTION REPORT
Wisconsin Department of Transportation
DT2007 2003 s.84.17 Wis. Stats.

page 4

Structure No.: **B-18-183**

Assessments

Chk	Element	Defect	Description	UOM	Total	Quantity in Condition State			
						1	2	3	4
X	9007		Median	EA	1	1	0	0	0
			Low profile concrete median at center of bridge. Dividing 4 lanes of north bound traffic. Sidewalk next to north abutment. Few hairline transverse cracks.						
			Utilities	EA	1	1	0	0	0
			Conduit for lighting is attached to the North Abutment.						
X	9167		Steel Diaphragm	EA	28	28	0	0	0
			Between girders.						
X	9322		Approach Roadway - Concrete (non-structural)	EA	2	2	0	0	0
			North approach has plow scrapes.						
X	9337		Protective Screening	EA	2	2	0	0	0
			center of chain link fence has been hit.						

NBI Ratings

	File	New
Deck	8	8
Superstructure	8	8
Substructure	8	8
Culvert	N	N
Channel	N	N
Waterway	N	N

Structure Specific Notes

Inspection Specific Notes

Inspector Site-Specific Safety Considerations

Structure Inspection Procedures

Walk around.

Special Requirements

	Chk	Comments
Traffic Control		
Access Equipment		
Other		

Construction History

Year	Work Performed	FOS id
2005	NEW STRUCTURE	1190-00-72

Maintenance Items History

Item	Recommended by	Status	Status change	Year completed
------	----------------	--------	---------------	----------------

BRIDGE INSPECTION REPORT
Wisconsin Department of Transportation
DT2007 2003 s.84.17 Wis. Stats.

page 5

Structure No.: **B-18-183**

Maintenance Items

Item	Priority	Recommended by	Status	Status change
------	----------	----------------	--------	---------------

Routine
Document Comment/Description



Routine
Document Comment/Description





708 Heartland Trail, Suite 3000
Madison, WI 53717

608.826.3600 PHONE
608.826.3941 FAX

www.TRCSolutions.com

Bridge Asbestos Inspection Report

WisDOT Project ID: 1190-02-34

Structure Number: B-18-0183, B-18-0184

Structure Name: USH 53 over Cypress Road

City/County: City of Eau Claire, Eau Claire County

Lat/Long Coordinates: 444704.31/ 912653.17, 444703.22/ 912655.68

TRC Project Number: 235777.0000.0000

Date Inspected: October 14, 2015

Inspected By/License Number: John Roelke, All-119523

Findings:

The inspection to identify and collect samples of potential asbestos-containing material (ACM) was completed following WisDOT standard sampling procedure for bridge inspections found in FDM 21-35-45.


None of the materials that were identified as potentially ACM and sampled tested positive for asbestos. The overlay on the bridges can proceed as planned. Standard Special Provision (STSP) 107-125 should be included in the specifications.

Sample Number	Sample Description	Sample Location	Analytical Results and Method	Friable/ Non-friable or No ACM	Quantity of ACM Material
B-18-0183					
1	Paint	Fence	PLM, non-detect	No ACM	0
2	Paint	Fence	PLM, non-detect	No ACM	
3	Paint	Fence	PLM, non-detect	No ACM	
4	Caulk	Around fence attachment plate	PLM, non-detect	No ACM	0
5	Caulk	Around fence attachment plate	PLM, non-detect	No ACM	
6	Caulk	Around fence attachment plate	PLM, non-detect	No ACM	

Sample Number	Sample Description	Sample Location	Analytical Results and Method	Friable/ Non-friable or No ACM	Quantity of ACM Material
7	Caulk	Abutment joint	PLM, non-detect	No ACM	0
8	Caulk	Abutment joint	PLM, non-detect	No ACM	
9	Caulk	Abutment joint	PLM, non-detect	No ACM	
B-18-0184					
1	Paint	Fence	PLM, non-detect	No ACM	0
2	Paint	Fence	PLM, non-detect	No ACM	
3	Paint	Fence	PLM, non-detect	No ACM	
4	Caulk	Around fence attachment plate	PLM, non-detect	No ACM	0
5	Caulk	Around fence attachment plate	PLM, non-detect	No ACM	
6	Caulk	Around fence attachment plate	PLM, non-detect	No ACM	
7	Caulk	Abutment joint	PLM, non-detect	No ACM	0
8	Caulk	Abutment joint	PLM, non-detect	No ACM	
9	Caulk	Abutment joint	PLM, non-detect	No ACM	

If you have any questions, please contact me, at (608) 826-3628.

TRC Environmental Corporation



Daniel Haak
Project Manager



John Roelke
Asbestos Inspector


Attachments: Location Map, Photos, and Laboratory Reports

Report Distribution:

Recipient	Electronic (PDF) Copy	Paper Copy
BTS-ESS sharlene.tebeest@dot.wi.gov	X (via email)	X
REC amy.adrihan@dot.wi.gov ; nicholasA.schaff@dot.wi.gov	X (via email)	
Project Manager david.koepp@dot.wi.gov	X (via email)	
Other		

\\NTAPB-MADISON\MSN-VOL6\-\WPMSN\PTJ2\235777\0000\1190-02-34_B-18-0183 AND B-18-0184 USH 53 OVER CYPRESS ROAD, EAU CLAIRE



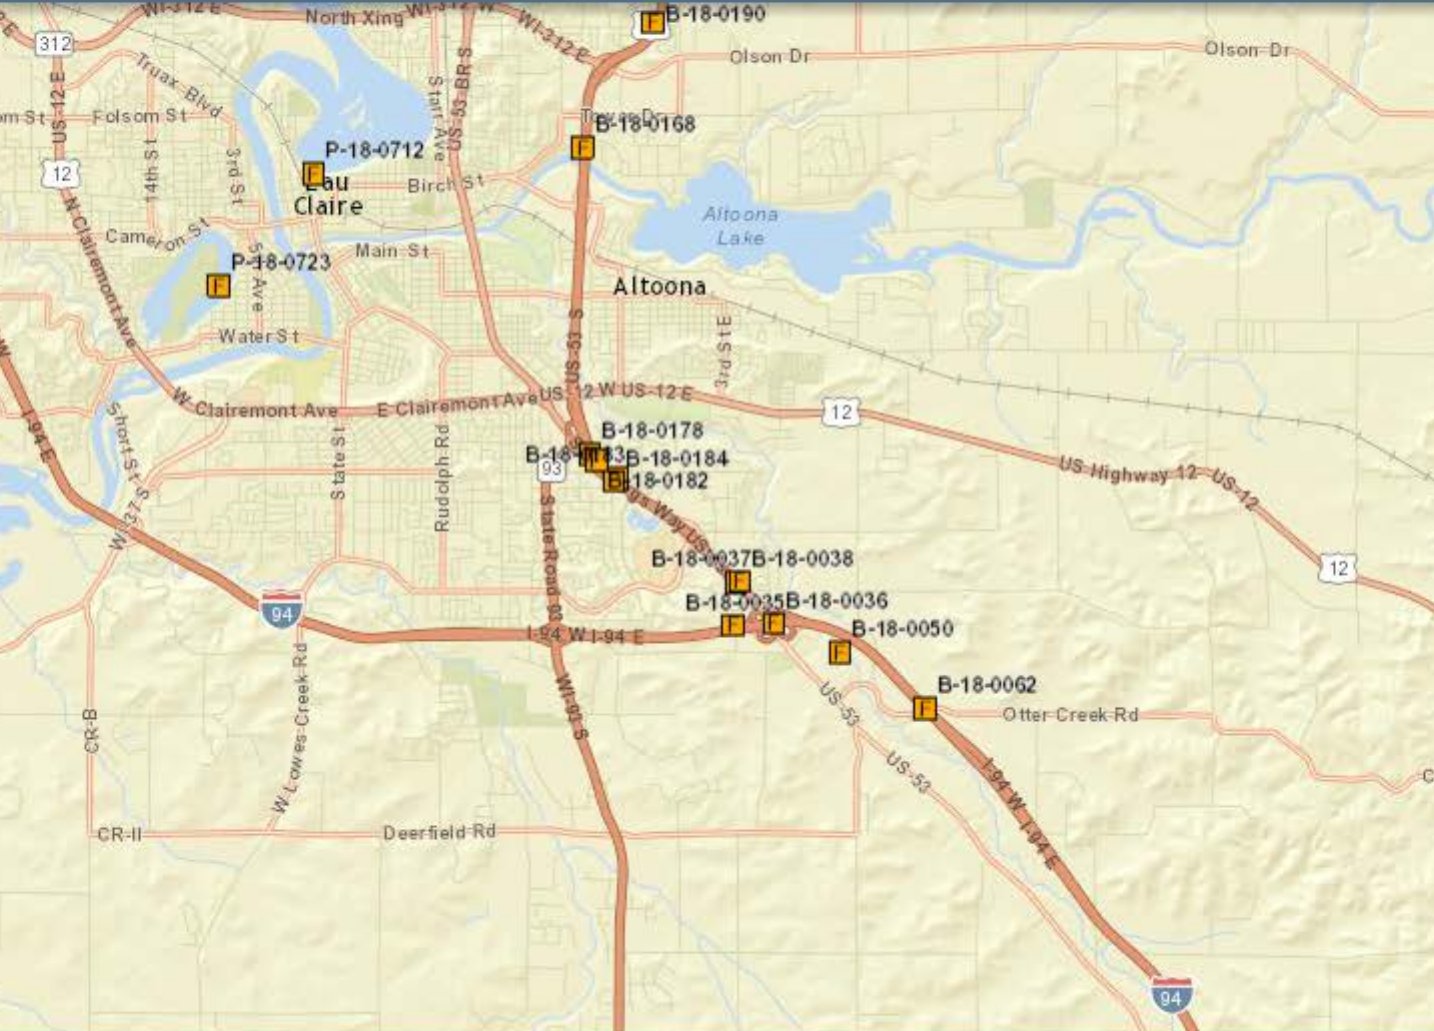

B-18-0183



Paint on fence



Caulk around fence attachment plate



Caulk in abutment joint

B-18-0184



Paint on fence



Caulk around fence attachment plate



Caulk in abutment joint



BULK ASBESTOS ANALYSIS REPORT

CLIENT: Wisconsin Department of Transportation

Lab Log #: 0047028
Project #: 235777.0000.0000
Date Received: 10/16/2015
Date Analyzed: 10/19/2015

Site: DOT Bridge Inspection, B-18-183

POLARIZED LIGHT MICROSCOPY by EPA 600/R-93/116

Sample No.	Color	Homogenous	Multi-Layered	Layer No.	Other Matrix Materials	Asbestos %	Asbestos Type
B-18-183 (1)	Black	Yes	No	--	---	ND	None
B-18-183 (2)	Black	Yes	No	--	---	ND	None
B-18-183 (3)	Black	Yes	No	--	---	ND	None
B-18-183 (4)	Grey	Yes	No	--	---	ND	None
B-18-183 (5)	Grey	Yes	No	--	---	ND	None
B-18-183 (6)	Grey	Yes	No	--	---	ND	None
B-18-183 (7)	Grey	Yes	No	--	---	ND	None
B-18-183 (8)	Grey	Yes	No	--	---	ND	None
B-18-183 (9)	Grey	Yes	No	--	---	ND	None

TRC LABORATORY ASBESTOS ANALYTICAL ACCREDITATIONS

NVLAP Lab Code 101424-0
RI #AAL-007 TX #300354
CO# AL-15020

AIHA-LAP,LLC #100122 CT #PH-0426
VT #AL014538 LA#05011 VA #3333 000283
PHIL# 461 PA#68-03387

ME LA-0075, LB-0071 MA #AA000052 NY #10980 WV# LT000411
AZ #A20944 HI #L-09-004 NJ #CT004 CA #2907

POLARIZED LIGHT MICROSCOPY by EPA 600/R-93/116

Sample No.	Color	Homogenous	Multi-Layered	Layer No.	Other Matrix Materials	Asbestos %	Asbestos Type
------------	-------	------------	---------------	-----------	------------------------	------------	---------------

Reporting limit- asbestos present at 1%

ND - asbestos was not detected

Trace - asbestos was observed at level of less than 1%

NA/PS - Not Analyzed / Positive Stop

SNA- Sample Not Analyzed- See Chain of Custody for details

Note: Polarized-light microscopy is not consistently reliable in detecting asbestos in floor coverings and similar non-friable organically bound materials. In those cases, EPA recommends, and certain states (e.g. NY) require, that negative results be confirmed by quantitative transmission electron microscopy.

The Laboratory at TRC follows the EPA's Interim Method for the Determination of Asbestos in Bulk Insulation (1982), and the EPA recommended Method for the Determination of Asbestos in Bulk Building Materials (EPA/600/R-93/116), July 1993, R.L. Perkins and B.W. Harvey which utilizes polarized light microscopy (PLM). Our analysts have completed an accredited course in asbestos identification. TRC's Laboratory is accredited under the National Voluntary Laboratory Accreditation Program (NVLAP), for Bulk Asbestos Fiber Analysis, NVLAP Code 18/A01, effective through June 30, 2016. TRC is an American Industrial Hygiene Association (AIHA) accredited lab for PLM effective through October 1, 2016. Asbestos content is determined by visual estimate unless otherwise indicated. Quality Control is performed in-house on at least 10% of samples and the QC data related to the samples is available upon written request from the client.

This report shall not be reproduced, except in full, without the written approval of TRC. This report must not be used by the client to claim product endorsement by NVLAP or any agency of the U.S. Government. This report relates only to the items tested.

Analyzed by: <u>K. Williamson</u> Kathleen Williamson, Laboratory Manager	Reviewed by: <u>Aud. Parks</u> Amanda Parkins, Approved Signatory	Date Issued 10/19/2015
---	---	----------------------------------

TRC LABORATORY ASBESTOS ANALYTICAL ACCREDITATIONS

NVLAP Lab Code 101424-0	AIHA-LAP, LLC #100122	CT #PH-0426	ME LA-0075, LB-0071	MA #AA000052	NY #10980	WV# LT000411
RI #AAL-007 TX #300354	VT #AL014538	LA #05011	VA #3333 000283	AZ #A20944	HI #L-09-004	NJ #CT004 CA #2907
CO# AL-15020	PHIL# 461		PA#68-03387			



BULK ASBESTOS ANALYSIS REPORT

CLIENT: Wisconsin Department of Transportation

Lab Log #: 0047033
Project #: 235777.0000.0000
Date Received: 10/16/2015
Date Analyzed: 10/19/2015

Site: DOT Bridge Inspection, B-18-184

POLARIZED LIGHT MICROSCOPY by EPA 600/R-93/116

Sample No.	Color	Homogenous	Multi-Layered	Layer No.	Other Matrix Materials	Asbestos %	Asbestos Type
B-18-184 (1)	Black	Yes	No	--	---	ND	None
B-18-184 (2)	Black	Yes	No	--	---	ND	None
B-18-184 (3)	Black	Yes	No	--	---	ND	None
B-18-184 (4)	Black	Yes	No	--	---	ND	None
B-18-184 (5)	Black	Yes	No	--	---	ND	None
B-18-184 (6)	Black	Yes	No	--	---	ND	None
B-18-184 (7)	Grey	Yes	No	--	---	ND	None
B-18-184 (8)	Grey	Yes	No	--	---	ND	None
B-18-184 (9)	Grey	Yes	No	--	---	ND	None

TRC LABORATORY ASBESTOS ANALYTICAL ACCREDITATIONS

NVLAP Lab Code 101424-0
RI #AAL-007 TX #300354
CO# AL-15020

AIHA-LAP,LLC #100122 CT #PH-0426
VT #AL014538 LA#05011 VA #3333 000283
PHIL# 461 PA#68-03387

ME LA-0075, LB-0071 MA #AA000052 NY #I0980 WV# LT000411
AZ #A20944 HI #L-09-004 NJ #CT004 CA #2907



POLARIZED LIGHT MICROSCOPY by EPA 600/R-93/116

Sample No.	Color	Homogenous	Multi-Layered	Layer No.	Other Matrix Materials	Asbestos %	Asbestos Type
------------	-------	------------	---------------	-----------	------------------------	------------	---------------

Reporting limit- asbestos present at 1%

ND - asbestos was not detected

Trace - asbestos was observed at level of less than 1%

NA/PS - Not Analyzed / Positive Stop

SNA- Sample Not Analyzed- See Chain of Custody for details

Note: Polarized-light microscopy is not consistently reliable in detecting asbestos in floor coverings and similar non-friable organically bound materials. In those cases, EPA recommends, and certain states (e.g. NY) require, that negative results be confirmed by quantitative transmission electron microscopy.

The Laboratory at TRC follows the EPA's Interim Method for the Determination of Asbestos in Bulk Insulation (1982), and the EPA recommended Method for the Determination of Asbestos in Bulk Building Materials (EPA/600/R-93/116), July 1993, R.L. Perkins and B.W. Harvey which utilizes polarized light microscopy (PLM). Our analysts have completed an accredited course in asbestos identification. TRC's Laboratory is accredited under the National Voluntary Laboratory Accreditation Program (NVLAP), for Bulk Asbestos Fiber Analysis, NVLAP Code 18/A01, effective through June 30, 2016. TRC is an American Industrial Hygiene Association (AIHA) accredited lab for PLM effective through October 1, 2016. Asbestos content is determined by visual estimate unless otherwise indicated. Quality Control is performed in-house on at least 10% of samples and the QC data related to the samples is available upon written request from the client.

This report shall not be reproduced, except in full, without the written approval of TRC. This report must not be used by the client to claim product endorsement by NVLAP or any agency of the U.S. Government. This report relates only to the items tested.

Analyzed by: K. Williamson

Kathleen Williamson, Laboratory Manager

Reviewed by: Aud. Parkins

Amanda Parkins, Approved Signatory

Date Issued

10/21/2015

TRC LABORATORY ASBESTOS ANALYTICAL ACCREDITATIONS

NVLAP Lab Code 101424-0	AIHA-LAP,LLC #100122	CT #PH-0426	ME LA-0075, LB-0071	MA #AA000052	NY #10980	WV# LT000411
RI #AAL-007	TX #300354	VT #AL014538	LA#05011	VA #3333 000283	AZ #A20944	HI #L-09-004
CO# AL-15020	PHIL# 461	PA#68-03387			NJ #CT004	CA #2907

* PROVIDE FOR THREE BEAM
GUARD RAIL ATTACHMENT

○ INDICATES WING NUMBER

STATE PROJECT NUMBER

1190-00-72

DESIGN DATA

LIVE LOAD:

DESIGN RATING; HS-20
INVENTORY RATING; HS-24
OPERATIONAL RATING; HS-55
MAXIMUM STANDARD PERMIT VEHICLE LOAD = 250 KIPS.

STRUCTURE IS DESIGNED FOR A FUTURE WEARING
SURFACE OF 20 POUNDS PER SQUARE FOOT.

ULTIMATE DESIGN STRESSES:

CONCRETE MASONRY SLAB — $f'_c = 4,000$ P.S.I. ALL OTHER — $f'_c = 3,500$ P.S.I.
BAR STEEL REINFORCEMENT, GRADE 60 — $f_y = 60,000$ P.S.I.
45" PRESTRESSED GIRDERS, CONCRETE MASONRY — $f'_c = 6,000$ P.S.I.
STRANDS — $1/2"$ ϕ WITH ULTIMATE TENSILE STRENGTH OF 270,000 P.S.I.

FOUNDATION DATA

ABUTMENTS TO BE SUPPORTED ON $10\frac{3}{4}"$ ϕ CAST-IN-PLACE CONC. PILING
DRIVEN TO A MINIMUM BEARING VALUE OF 55 TONS PER PILE.
ESTIMATED 100'-0" LG. @ S. ABUT. & 90'-0" LG. @ N. ABUT.


TRAFFIC VOLUME

USH 53/HASTINGS WAY

A.D.T.=13,000 (2024)
R.D.S.=70 M.P.H.


CYPRESS ROAD

A.D.T.=25,750 (2024)
R.D.S.=40 M.P.H.

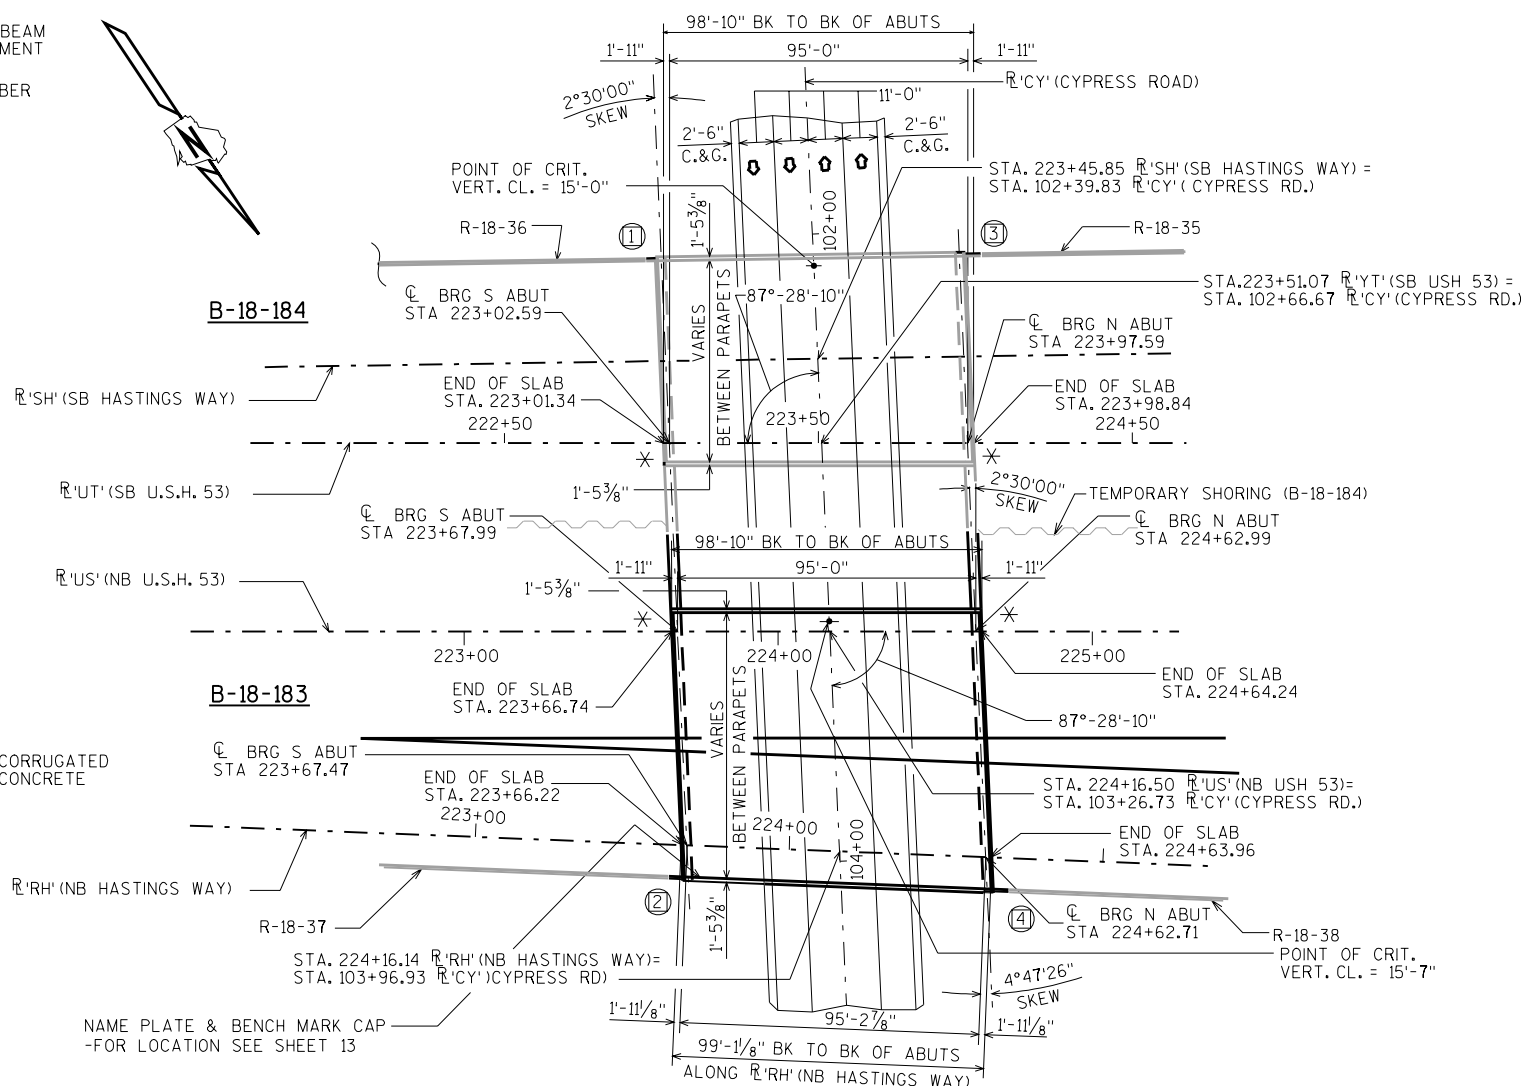


PLAN

SINGLE SPAN - 45" PRESTRESSED GIRDERS

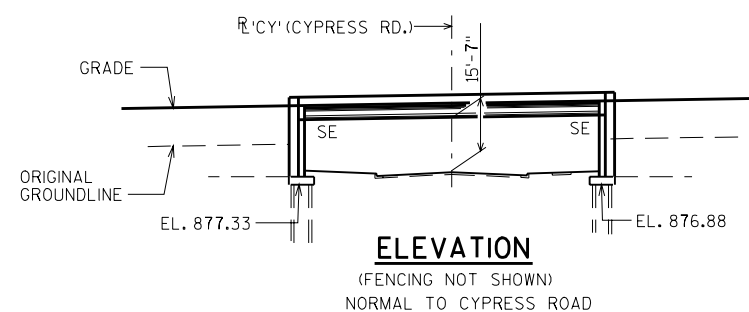

ELEVATION

(FENCING NOT SHOWN)
NORMAL TO CYPRESS ROAD

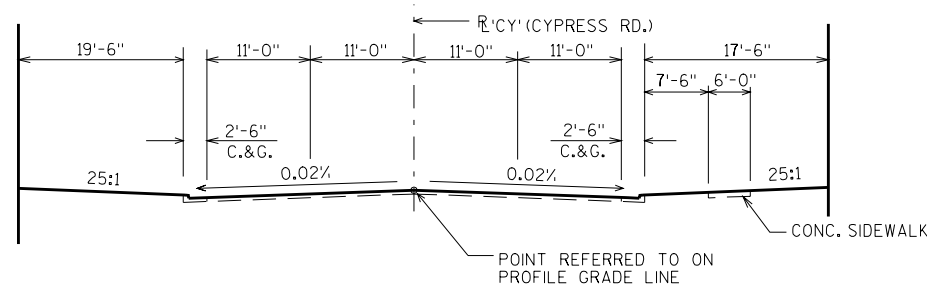


TYPICAL SECTION THRU CYPRESS ROAD

LIST OF DRAWINGS

1. GENERAL PLAN
2. CROSS SECTION & QUANTITIES
3. SUBSURFACE EXPLORATION
4. SOUTH ABUTMENT
5. S. ABUT. DETAILS
6. NORTH ABUTMENT
7. N. ABUT. DETAILS
8. WEST SUPERSTRUCTURE
9. EAST SUPERSTRUCTURE
10. SUPERSTRUCTURE DETAILS
11. 45" PRESTRESSED GIRDER DETAILS
12. STEEL DIAPHRAGM
13. SLOPED FACE PARAPET LF
14. FENCING DETAILS

BRIDGE OFFICE CONTACT = BILL DREHER (608) 261-8205

NO.	DATE	REVISION	BY



Plans Prepared By **WISDOT**
BUREAU OF STRUCTURES
Tim Hubbard


APPROVED **3-2-2004**
CHIEF STRUCTURAL DESIGN ENGINEER DATE

STRUCTURE B-18-183	
NB USH 53/HASTINGS WAY OVER CYPRESS RD	
COUNTY EAU CLAIRE	TOWN/CITY/VILLAGE EAU CLAIRE
DESIGN SPEC. AASHTO STD. SPEC. 2002	LOAD HS-20 CONST. SPEC. 2003
DESIGNED BY WCD	DESIGN CK'D. MGW
DRAWN BY JHG	PLANS CK'D. Budd
GENERAL PLAN	
SHEET 1 OF 14	

FILE= 01-183GP.DGN
SCALE = 30

I.D. 1190-00-05H

DATE: 2/12/04

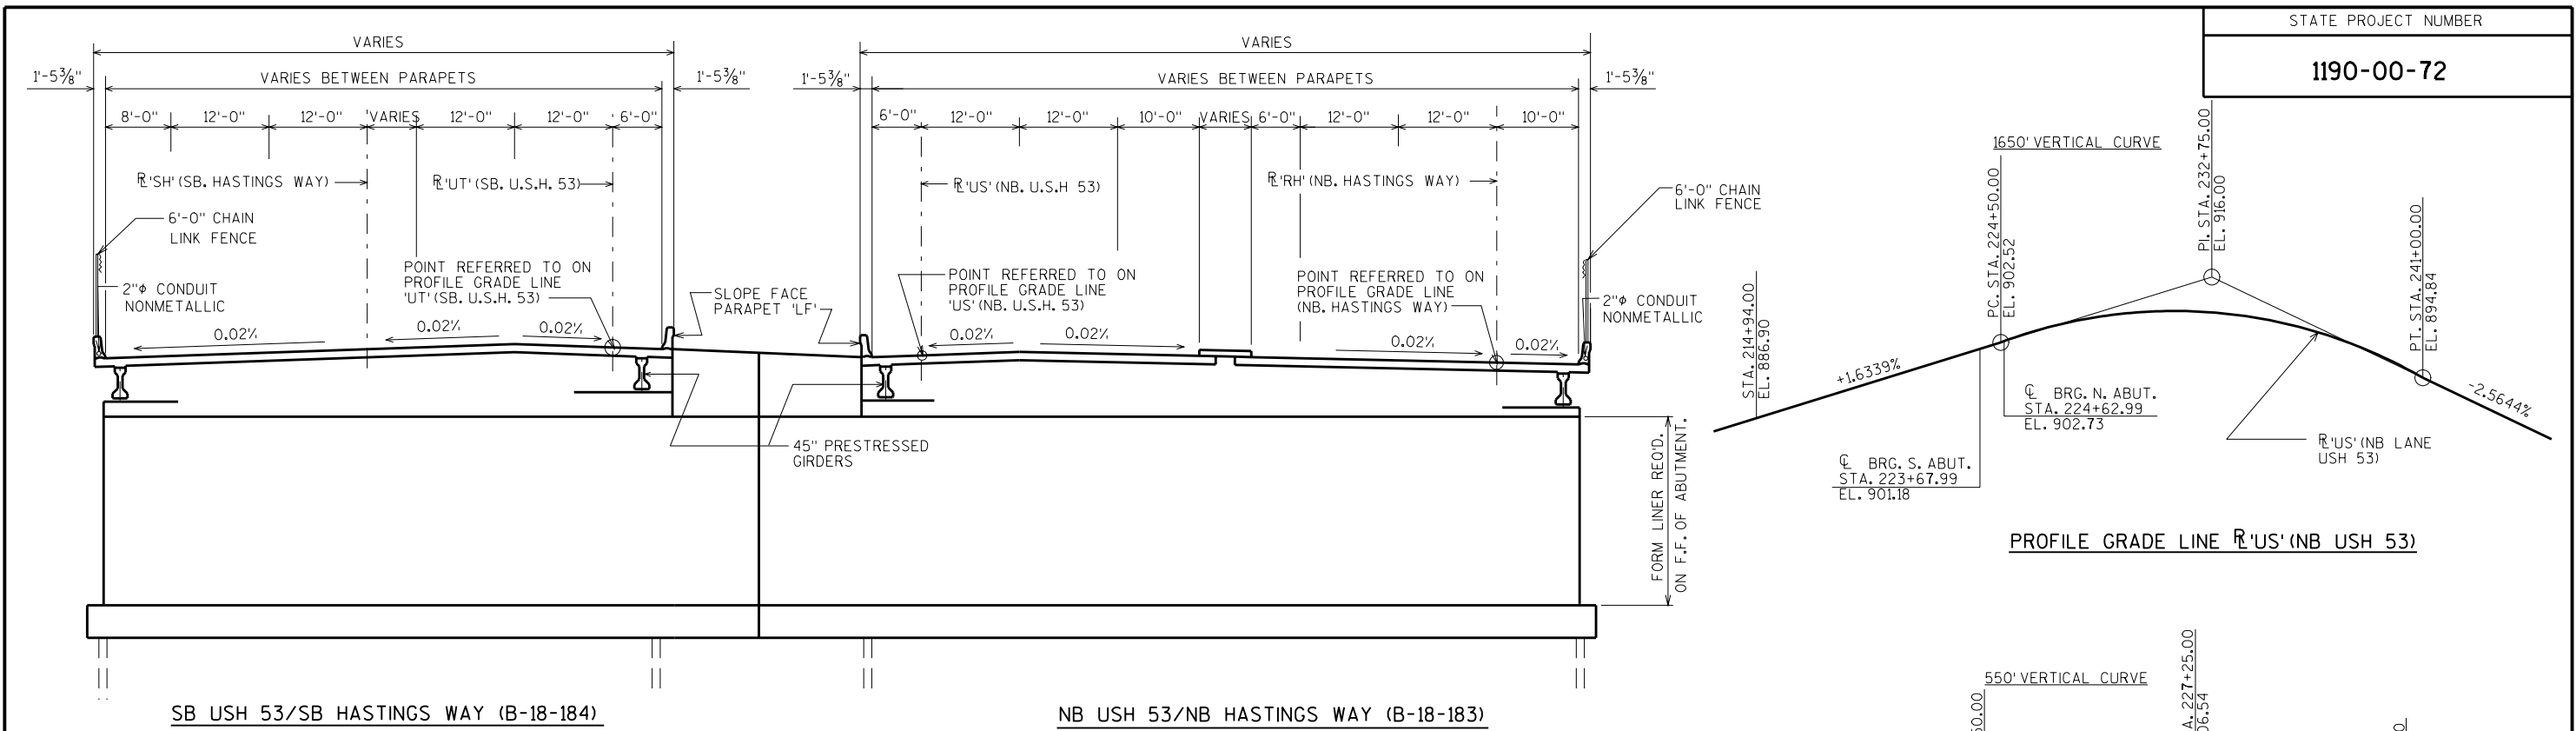

CROSS SECTION THRU ROADWAY LOOKING NORTH

TOTAL ESTIMATED QUANTITIES

BID ITEMS	UNIT	SUPER.	SOUTH ABUT.	NORTH ABUT.	TOTALS
MASONRY ANCHORS TYPE L NO. 5 BARS	EACH	132	—	—	132
EXCAVATION FOR STRUCTURES BRIDGES B-18-183	LS	—	—	—	1
BACKFILL STRUCTURE	CY	—	1830	2240	4070
CONCRETE MASONRY BRIDGES	CY	350	406	448	1204
PROTECTIVE SURFACE TREATMENT	SY	1020	—	—	1020
BAR STEEL REINFORCEMENT HS BRIDGES	LB	—	24970	25830	50800
BAR STEEL REINFORCEMENT HS COATED BRIDGES	LB.	49930	4880	4700	59510
BEARING PADS ELASTOMERIC NON-LAMINATED	EACH	32	—	—	32
PRESTRESSED GIRDER TYPE I 45-INCH	LF	1540	—	—	1540
STEEL DIAPHRAGMS B-18-183	EACH	28	—	—	28
GEOTEXTILE FABRIC TYPE DF - SCHEDULE A	SY	—	92	95	187
RUBBERIZED MEMBRANE WATERPROOFING	SY	—	22	23	45
PIPE UNDERDRAIN 6-INCH	LF	—	110	113	223
PIPE UNDERDRAIN UNPERFORATED 6-INCH	LF	—	20	20	40
QMP CONCRETE STRUCTURES 5 CYLINDER	CY	350	406	448	1204
INCENTIVE STRENGTH CONCRETE STRUCTURES	DOL	3500	4060	4480	12040
ANCHOR ASSEMBLIES FOR STEEL PLATE BEAM GUARD	EACH	—	—	—	2
ARCHITECTURAL SURFACE TREATMENT	SF	—	1740	2080	3820
CONDUIT RIGID NONMETALLIC SCHEDULE 40 2-INCH	LF	110	—	—	110
PILING CIP CONCRETE DELIVERED AND DRIVEN 10 3/4-INCH	LF	—	8000	7380	15380
CONCRETE STAINING B-18-183	LS	—	—	—	1
FENCE CHAIN LINK VINYL COATED 6-FT.	LF	107	—	—	107
NON-BID ITEMS					
FILLER	SIZE	—	—	—	1" 1/2" & 3/4"

GENERAL NOTES

DRAWINGS SHALL NOT BE SCALED.

BAR STEEL REINFORCEMENT SHALL BE EMBEDDED 2" CLEAR UNLESS OTHERWISE SHOWN OR NOTED.

ELASTOMERIC BEARING PADS NEED NOT BE INDIVIDUALLY MOLDED PROVIDED THE CUT EDGES ARE SMOOTH AND TRUE.

AT THE BACKFACE OF ABUTMENT ALL VOLUME WHICH CANNOT BE IN PLACE BEFORE ABUTMENT CONSTRUCTION AND NOT OCCUPIED BY THE NEW STRUCTURE SHALL BE BACKFILLED WITH STRUCTURE BACKFILL.

THE FIRST OR FIRST TWO DIGITS OF THE BAR MARK SIGNIFIES THE BAR SIZE.

FORMLINER ON ABUTMENT BODY TO BE 2" BROKEN ROCK RIB.

THE FOLLOWING COMPONENTS SHALL BE STAINED LIGHT GRAY (FEDERAL STANDARD COLOR NO. 36622) IN ACCORDANCE WITH THE SPECIAL PROVISIONS:

- THE UNDERSIDE OF THE DECK OVERHANGS TO THE EXTERIOR GIRDERS.
- THE EDGES OF THE DECK.
- THE BACK FACES OF THE PARAPETS.
- ALL EXPOSED VERTICAL SURFACES OF THE ABUTMENTS TO 1'-0" BELOW FINISHED GROUNDLINE.
- ALL EXPOSED VERTICAL SURFACES OF THE ABUTMENT DIAPHRAGMS EXCEPT BETWEEN GIRDERS.

THE FOLLOWING COMPONENTS SHALL BE STAINED DARK GRAY (FEDERAL STANDARD COLOR NO. 26293) IN ACCORDANCE WITH THE SPECIAL PROVISIONS:

- THE OUTSIDE FACE AND UNDERSIDE OF THE BOTTOM FLANGE OF THE EXTERIOR GIRDERS.


THE VINYL COATED CHAIN LINK FENCE SHALL BE BLACK.

PROTECTIVE SURFACE TREATMENT SHALL BE APPLIED TO THE TOP SURFACE OF THE DECK AND THE INSIDE FACE AND TOP OF PARAPETS.

PROFILE GRADE LINE R'CY' (CYPRESS ROAD)

NO.	DATE	REVISION	BY
STATE OF WISCONSIN DEPARTMENT OF TRANSPORTATION STRUCTURES DESIGN SECTION			
STRUCTURE B-18-183			
CONST. SPEC.	2003	DRAWN BY JHG	PLANS CK'D. Budd
CROSS SECTION & QUANTITIES		SHEET 2	

USH 53 OVER CYPRESS ROAD
EAU CLAIRE BYPASS, EAU CLAIRE COUNTY

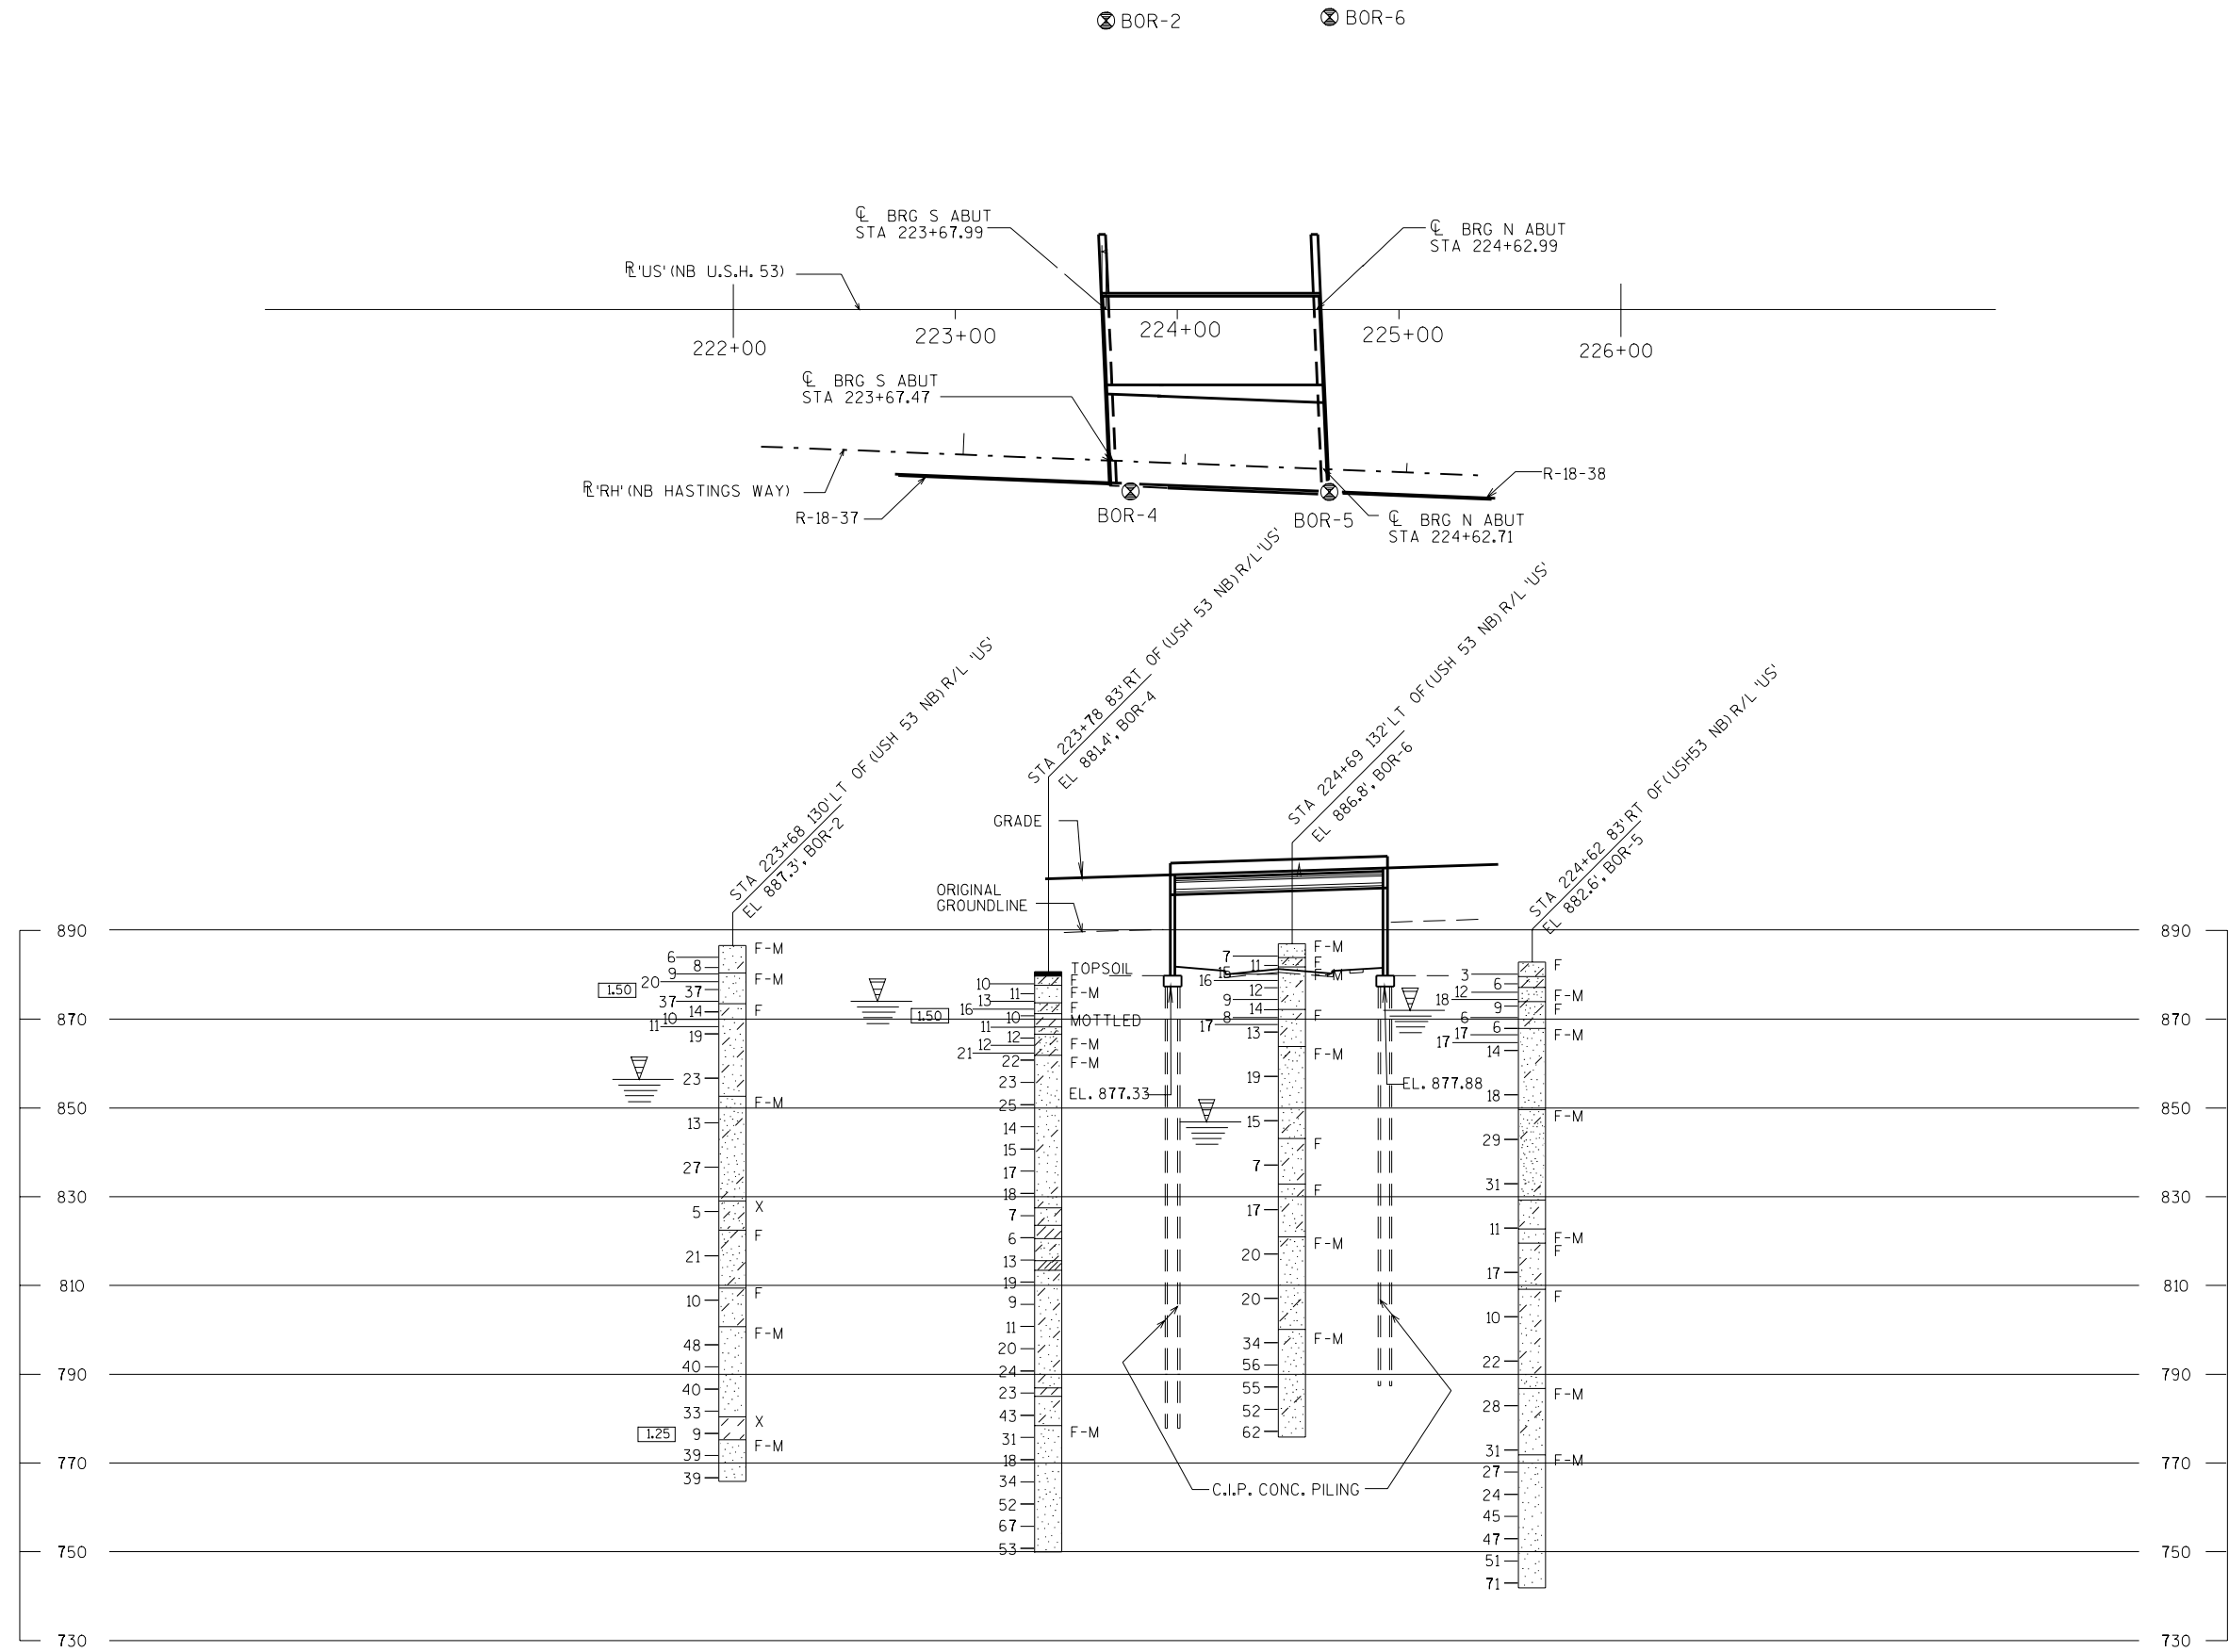

STATE PROJECT NUMBER

1190-00-72

ABBREVIATIONS

F— FINE M— MEDIUM C— COARSE
WS— WEATHERED SO— SOUND

MATERIAL SYMBOLS

TOPSOIL SILT SANDSTONE
SAND PEAT LIMESTONE
GRAVEL CLAY IGNEOUS ROCK

LEGEND OF PROBING

PROBING NO.
STA.
ELEVATION
7 AVERAGE BLOWS PER FOOT
95/6=95 BLOWS FOR 6" PENETRATION
PROBING TAKEN WITH A 350# WT. FALLING 18" ON A 2" O.D. POINT.
REFUSAL 95/6

LEGEND OF BORING




BORING NO.
STA.
ELEV.
UNCONFINED STRENGTH → 7.7
BLOWS PER FT. USING 140# WT. FALLING 30"
WASH SAMPLE
SHELBY TUBE — S.T.
GROUND WATER ELEVATION
NO GROUND WATER OBSERVED ABOVE THIS ELEVATION
SANDY GRAVEL
F. BOULDERS OR COBBLES
SAND
SILTY CLAY
SO LIMESTONE

UNLESS OTHERWISE SPECIFIED, THE BLOWS PER FOOT AT THE LOCATIONS INDICATED ARE BASED ON DRIVING A 2" O.D. X 1.4" I.D. SPLIT SPOON SAMPLER WITH A 140# HAMMER HAVING A FREE FALL OF 30". THE BLOW COUNT IS TAKEN IN UNDISTURBED SOIL IMMEDIATELY BELOW A CAGED OR OPEN HOLE ELIMINATING SIDE FRICTION ON THE DRIVE PIPE.


SUBSURFACE EXPLORATION FOR FOUNDATION DESIGN AND BIDDERS INFORMATION

TO OBTAIN RELATIVE DATA CONCERNING THE CHARACTER OF MATERIAL IN AND UPON WHICH THE FOUNDATION MIGHT BE BUILT, BORINGS AND/OR SOUNDINGS WERE MADE AT POINTS APPROXIMATELY AS INDICATED ON THIS DRAWING. THE DATA PRESENTED HEREIN REPRESENTS THE FINDINGS OF THE SUBSURFACE EXPLORATIONS MADE. HOWEVER, BECAUSE THE DEPTHS INVESTIGATED ARE LIMITED AND THE AREA OF THE BORINGS AND/OR SOUNDINGS IS VERY SMALL IN RELATION TO THE ENTIRE AREA, THE WISCONSIN DEPARTMENT OF TRANSPORTATION DOES NOT WARRANT CONDITIONS BELOW THE DEPTHS INVESTIGATED OR THAT THE CLASSIFICATION OF MATERIAL ENCOUNTERED IN THESE INVESTIGATIONS IS NECESSARILY TYPICAL OF THE ENTIRE SITE.

NO.	DATE	REVISION	BY
STATE OF WISCONSIN DEPARTMENT OF TRANSPORTATION STRUCTURES DESIGN SECTION			
STRUCTURE B-18-183			
CONST. SPEC.	2003	DRAWN BY JHG	PLANS CK'D. Budd
SUBSURFACE EXPLORATION		SHEET 3	

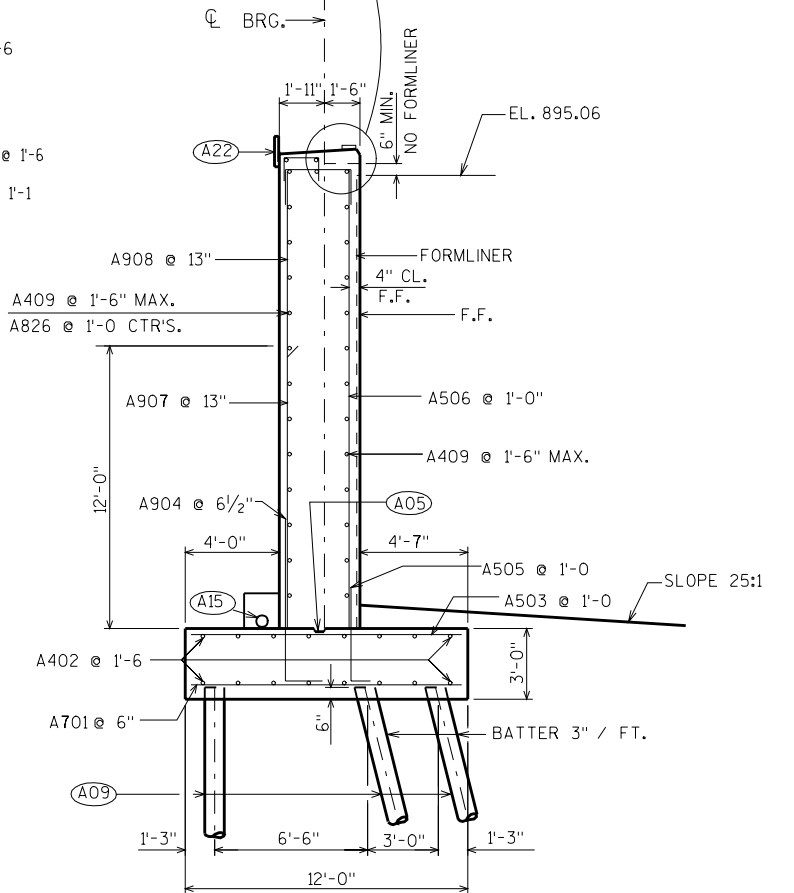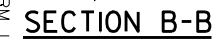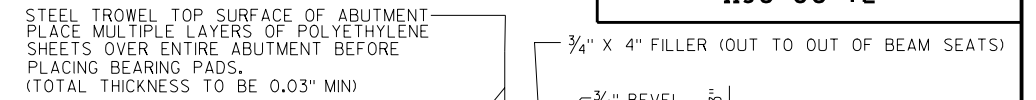

TYPICAL SECTION THRU ABUT. BODY


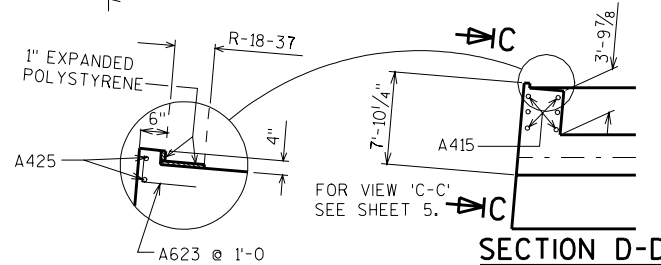


SECTION D-D

- (A04) VERT. CONSTRUCTION JOINT: KEYWAY FORMED BY A BEVELED 2 x 8. (3/4" "V" GROOVE ABOVE FORMLINER OR ABOVE EL.895.06 @ THE FRONT FACE) (R.M.W. @ BACKFACE).
- (A05) CONSTRUCTION JOINT IN FTG: KEYWAY FORMED BY A BEVELED 2 x 8.
- (A09) SUPPORT ABUTMENT ON 10 3/4" DIA. CAST-IN-PLACE CONCRETE PILING, ESTIMATED 100'-0" LONG, AND DRIVEN TO A MIN. BRG. VALUE OF 55 TONS PER PILE.
- (A15) PIPE UNDERDRAINS, 6 INCH. SLOPE 0.5% MIN. TO DRAIN, ENCLOSED IN 1'-6" X 1'-6" AREA OF SIZE 1 COARSE AGGREGATE (INCLUDED IN UNDERDRAIN BID ITEM) WRAPPED IN GEOTEXTILE FABRIC, TYPE DF, WITH 1'-6" OVERLAP.
- (A16) PIPE UNDERDRAIN, 6 INCH, UNPERFORATED. TO SUITABLE DRAINAGE.
- (A21) 3/4" CORK UP VERT. FACES OF BEAM SEATS.
- (A22) 18" (RMW) RUBBERIZED MEMBRANE WATERPROOFING SEAL ALL HORIZ. & VERT. JOINTS AT BACKFACE.
- (A20) 1/2" FILLER :SEAL EXPOSED HORIZ. & VERT. SURFACES OF 1/2" FILLER WITH NON-STAINING GRAY NON-BITUMINOUS JOINT SEALER. (1" DEEP AND HOLD 1/8" BELOW SURFACE OF CONCRETE).

NOTE: ABUTMENTS SHALL NOT BE BACKFILLED UNTIL
CONCRETE IN THE SUPERSTRUCTURE HAS BEEN
POURED AND CURED.


NO.	DATE	REVISION	BY
STATE OF WISCONSIN DEPARTMENT OF TRANSPORTATION STRUCTURES DESIGN SECTION			
STRUCTURE B-18-183			
CONST. SPEC.	2003	DRAWN BY	PLANS CK'D.
		JHG	Budd
SOUTH ABUTMENT		SHEET 4	

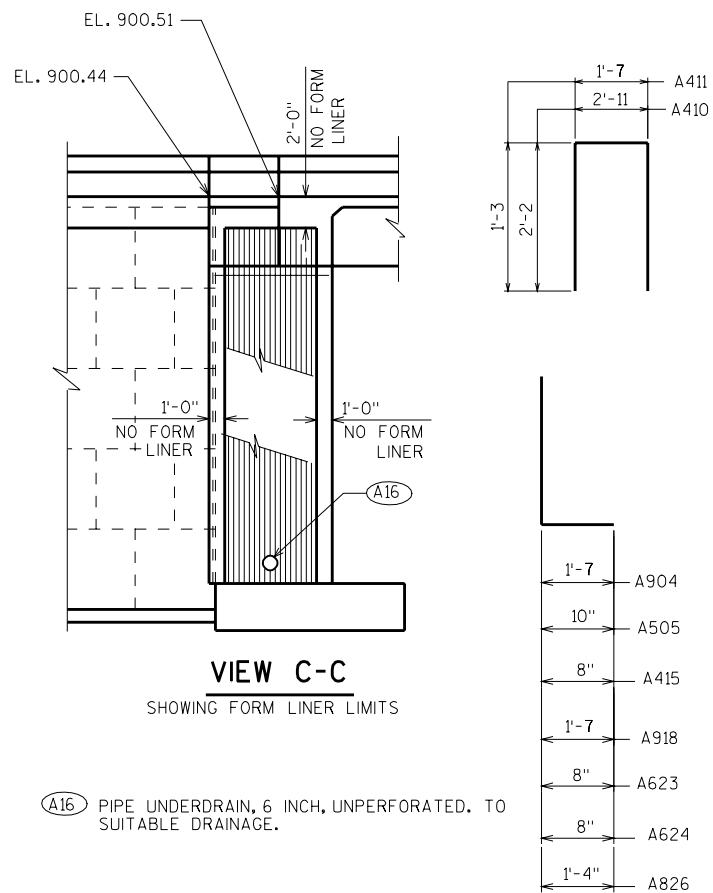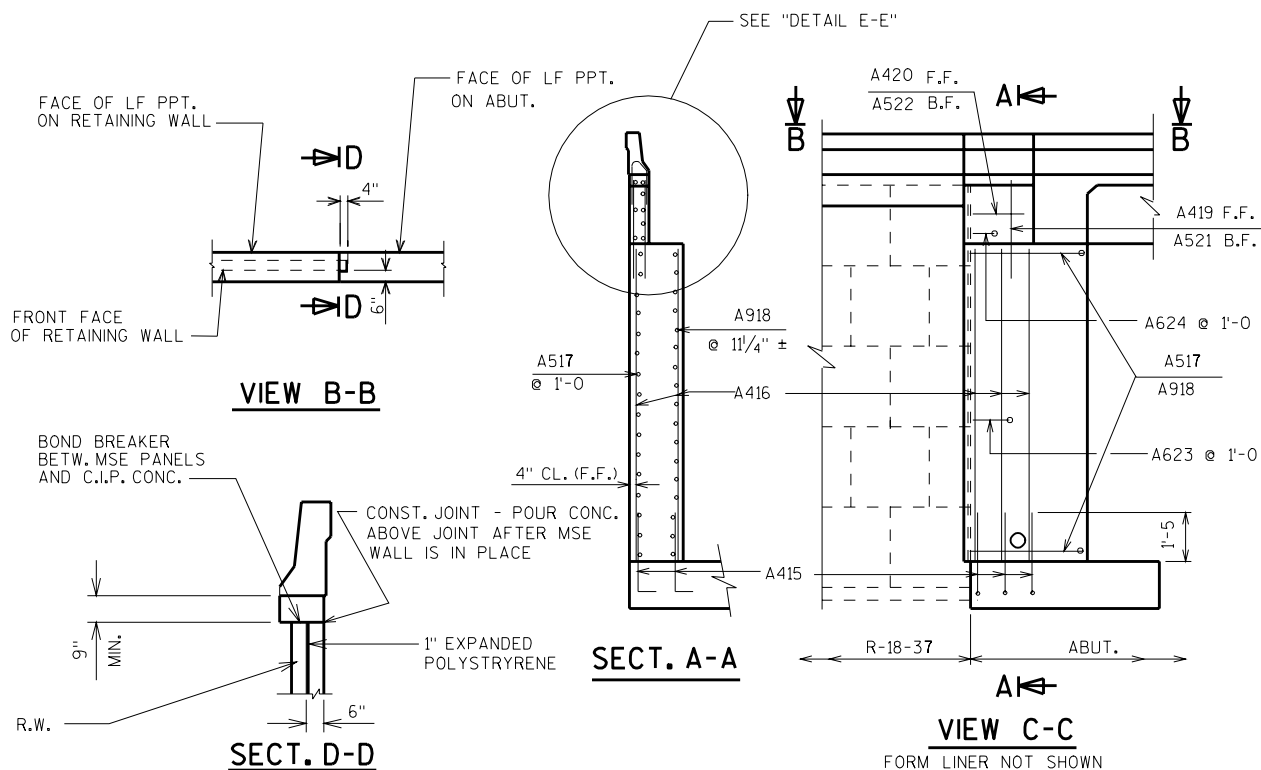


BILL OF BARS

NOTE: THE FIRST OR FIRST TWO DIGITS OF THE BAR MARK SIGNIFIES THE BAR SIZE.


BAR MARK	COAT	NO. REQ'D.	LENGTH	BENT	BAR SERIES	LOCATION
A701		226	11-8			FOOTING
A402		54	38-5			FOOTING
A503		113	11-8			FOOTING
A904		207	8-4	X		FOOTING DOWEL B.F.
A505		113	4-10	X		FOOTING DOWEL F.F.
A506	X	87	15-0			VERT. F.F.
A907		103	12-0			VERT. B.F.
A908		80	15-3			VERT. B.F.
A409	X	81	38-5			HORIZ. F.F. & B.F.
A410	X	76	7-1	X		TOP
A411		59	3-11	X		TOP
A912		24	20-6			VERT. B.F. WEST SIDE
A513	X	26	20-6			VERT. F.F. WEST SIDE
A414	X	9	25-5			HORIZ. F.F. & B.F. WEST SIDE
A415		6	4-4	X		FOOTING EAST SIDE WALL WING 2
A416		6	15-3			EAST SIDE-WALL VERT. F.F. & B.F. WING 2
A517		16	7-0			EAST SIDE-WALL HORIZ. F.F. WING 2
A918		17	8-4	X		EAST SIDE-WALL HORIZ. B.F. WING 2
A419	X	4	5-9			EAST SIDE-WALL VERT. F.F. WING 2
A420	X	3	3-7			EAST SIDE-WALL HORIZ. F.F. WING 2
A521	X	5	6-0			EAST SIDE-WALL VERT. B.F. WING 2
A522	X	5	3-7			EAST SIDE-WALL HORIZ. B.F.
A623	X	16	3-8	X		EAST SIDE-WALL
A624	X	4	1-5	X		EAST SIDE-WALL
A425	X	2	19-4			EAST SIDE-WALL
A826		16	9-1	X		BODY B.F. @ WING 2

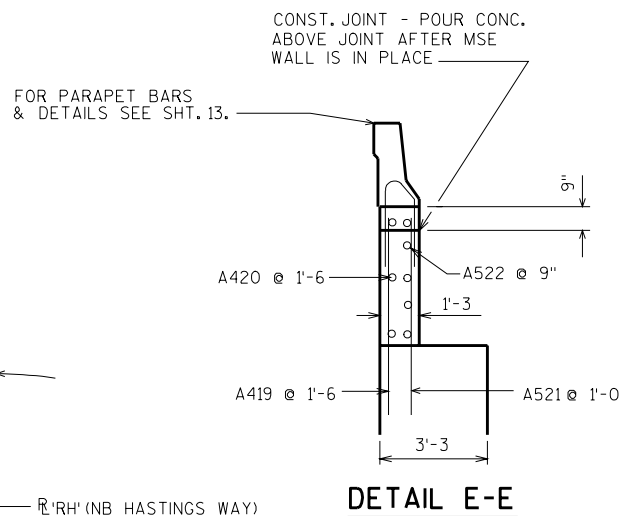

* PLACE OPT. FTG. JOINT TO CL. PILES BY 9" MIN.

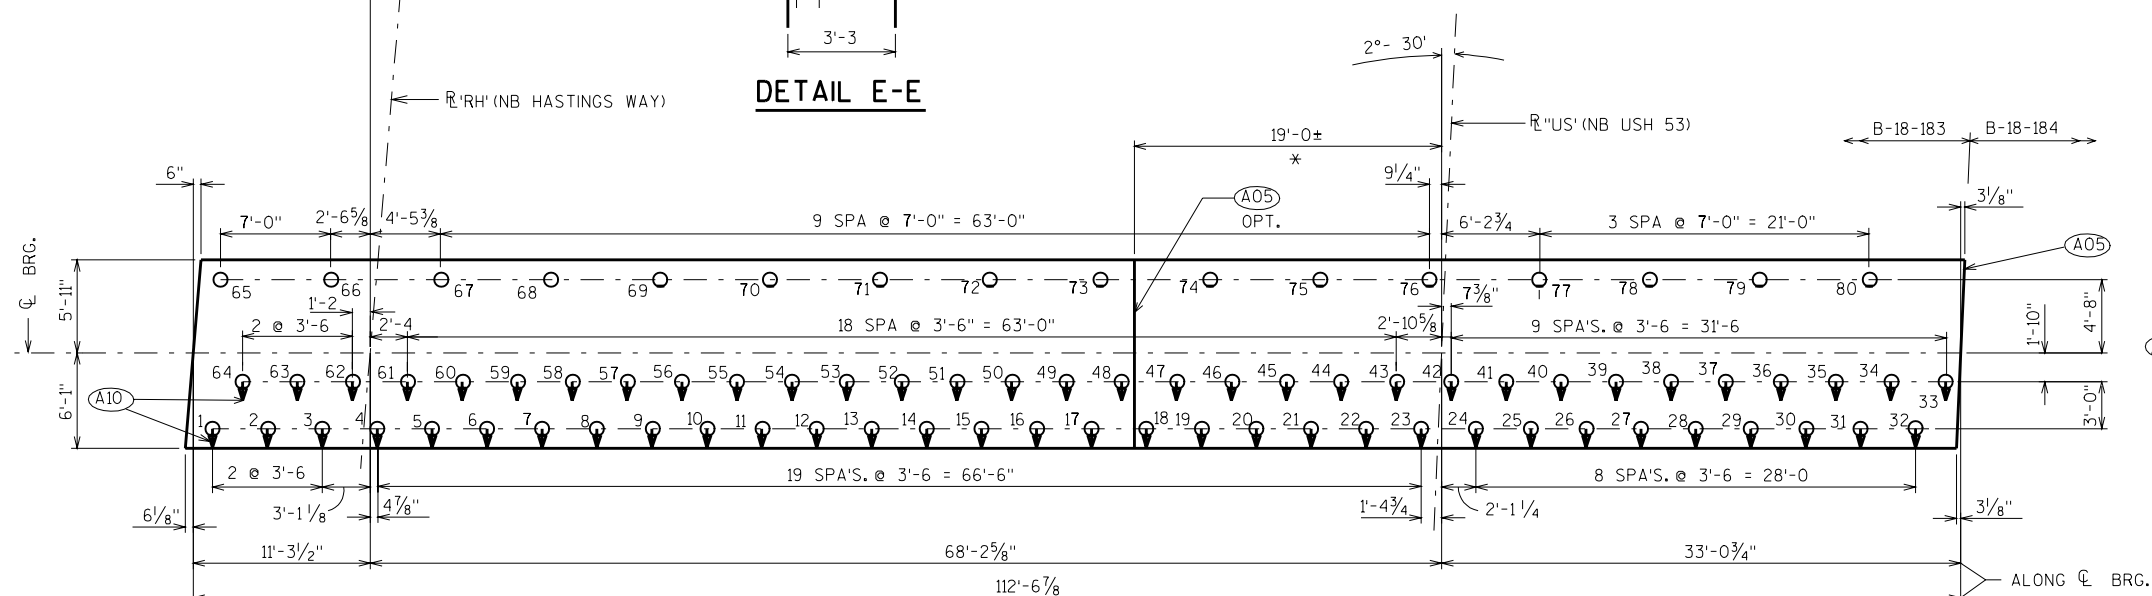

PILE PLAN

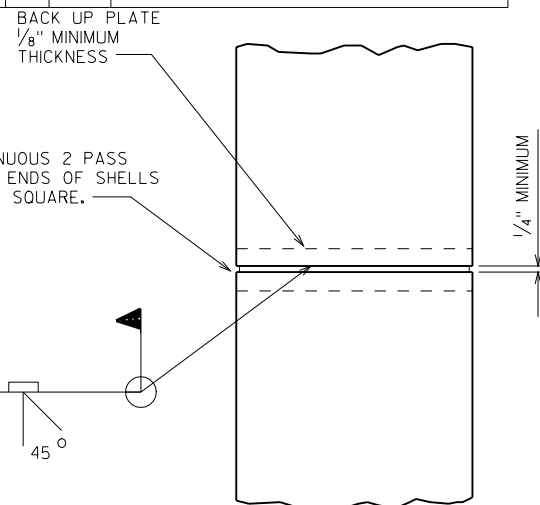


PILE SPLICE DETAIL

A05 CONSTRUCTION JOINT IN FTG: KEYWAY FORMED BY A BEVELED 2 x 8.

NO.	DATE	REVISION	BY
STATE OF WISCONSIN DEPARTMENT OF TRANSPORTATION STRUCTURES DESIGN SECTION			
STRUCTURE B-18-183			
CONST. SPEC.	2003	DRAWN BY	JHG
PLANS CK'D.	Budd	SHEET 5	
S. ABUT. DETAILS			



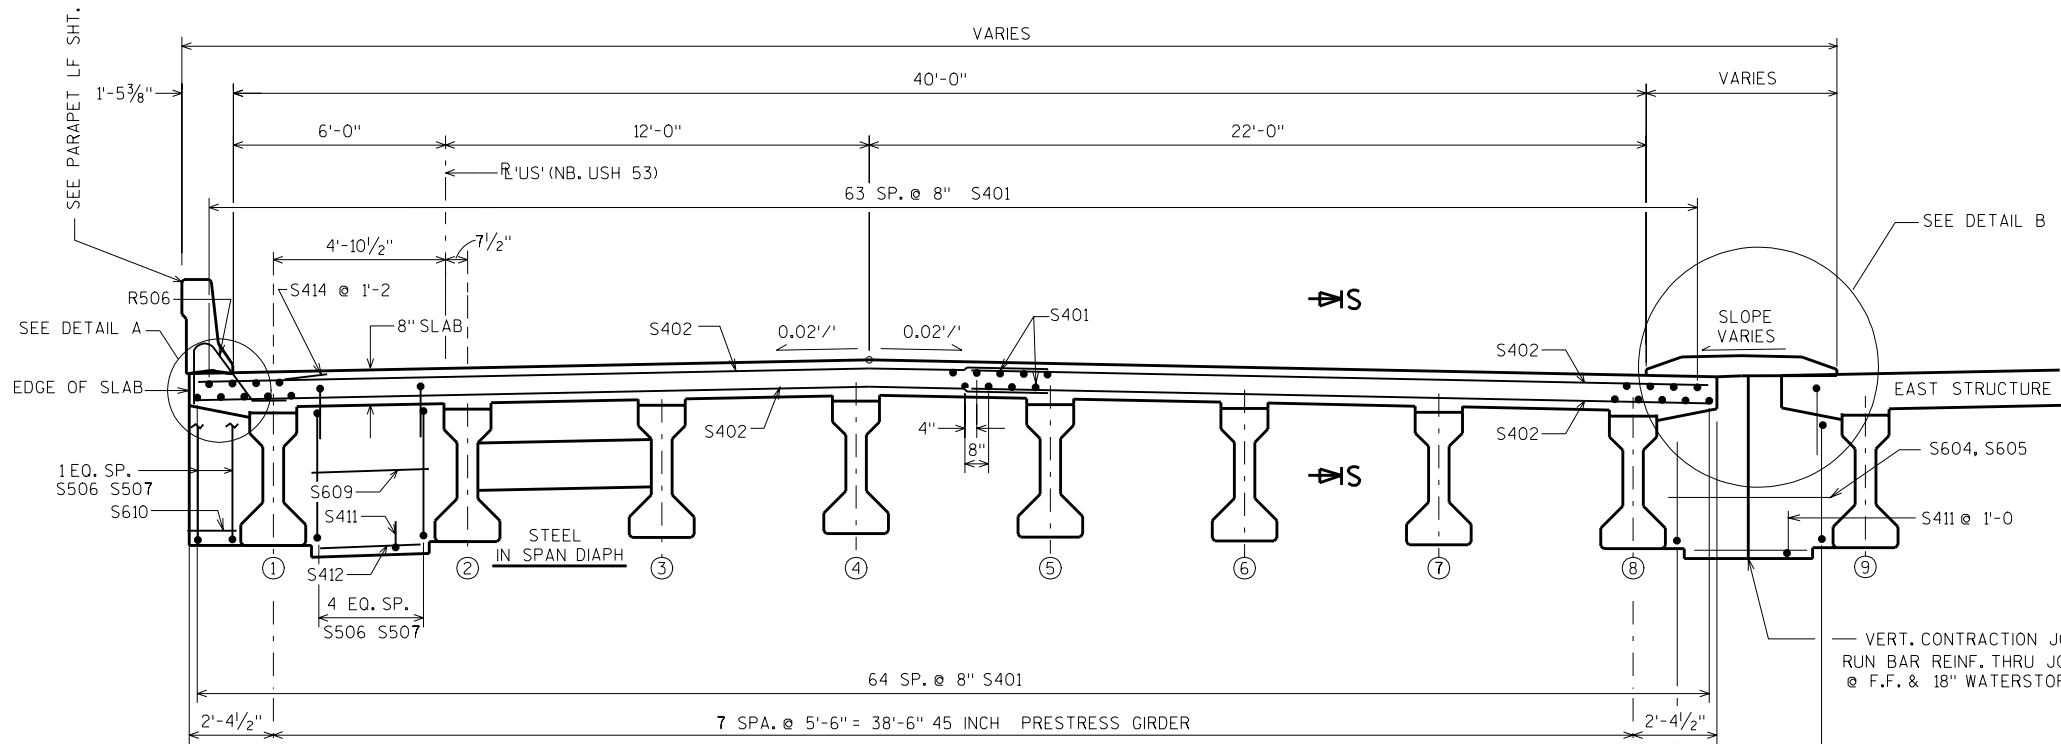


CROSS SECTION THRU ROADWAY
(LOOKING NORTH)


S414 @ 1'-2 BUNDLE TO EVERY OTHER TOP S402 BAR

3/4" CONTINUOUS DRIP GROOVE (TYP.) TERMINATE 2'-0" FROM FACE OF ABUTS.

DETAIL A

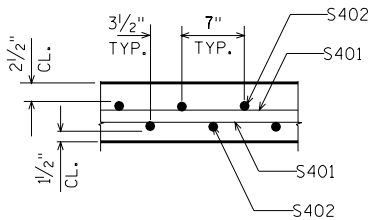


SECTION S-S

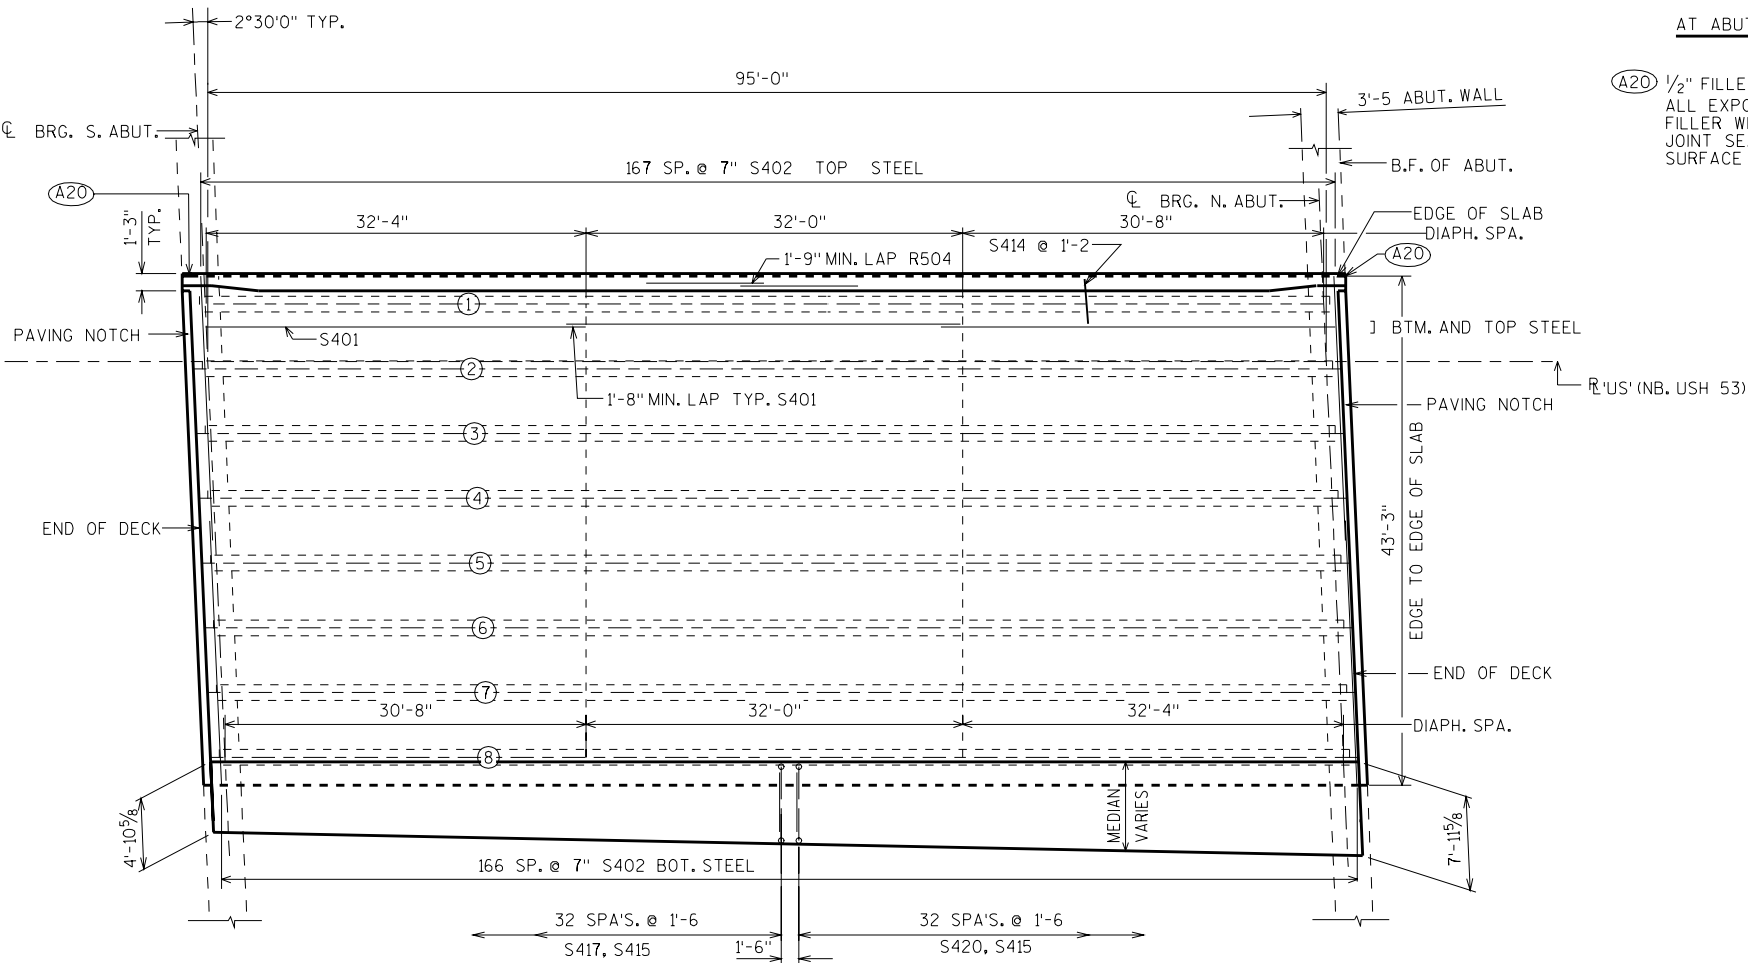

PLAN



(A20) 1/2" FILLER FROM BEAM SEAT TO TOP OF SLAB. SEAL ALL EXPOSED HORIZ. & VERT. SURFACES OF 1/2" FILLER WITH NON-STAINING GRAY NON-BITUMINOUS JOINT SEALER. (1" DEEP AND HOLD 1/8" BELOW SURFACE OF CONCRETE).

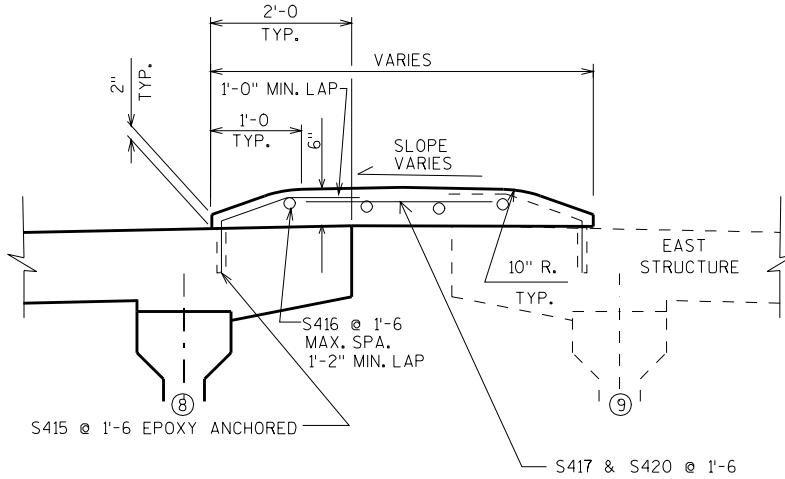

DETAIL B


NO.	DATE	REVISION	BY
STATE OF WISCONSIN DEPARTMENT OF TRANSPORTATION STRUCTURES DESIGN SECTION			
STRUCTURE B-18-183			
CONST. SPEC.	2003	DRAWN BY CMPT	PLANS CK'D. Budd
WEST SUPERSTRUCTURE			SHEET 8

STATE PROJECT NUMBER	SHEET NO.
1190-00-72	8.

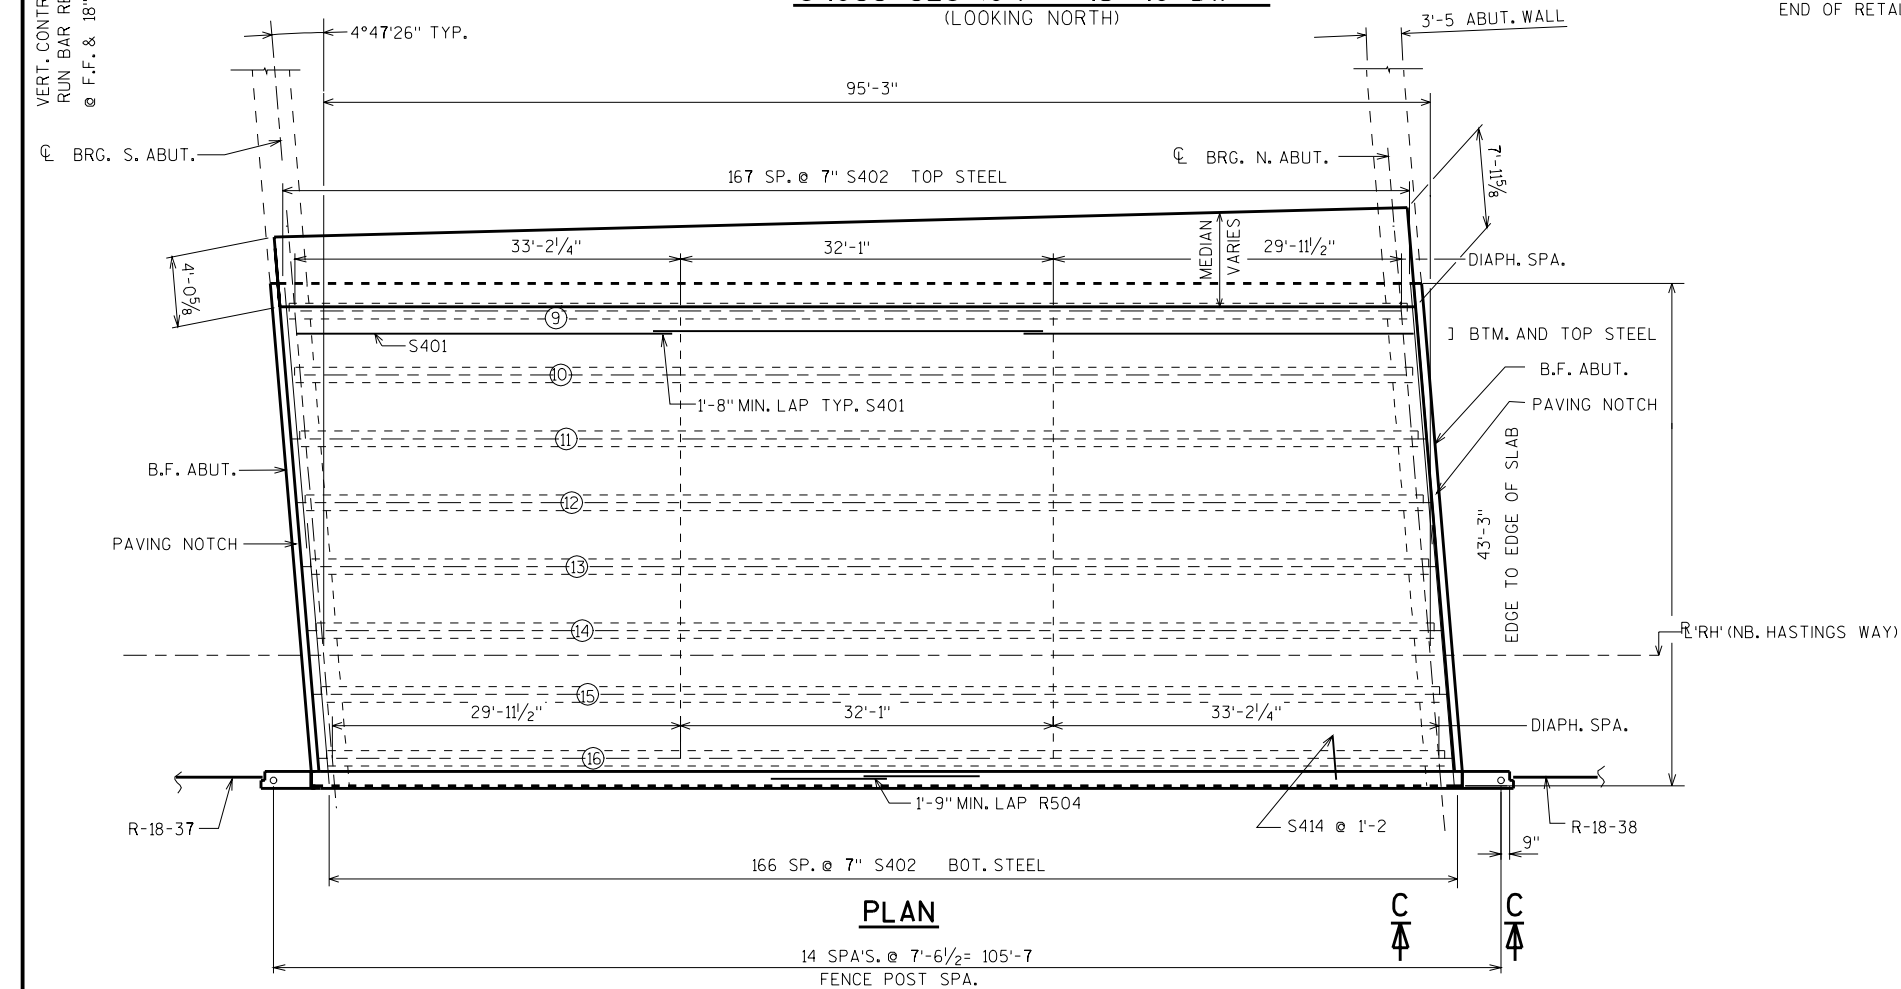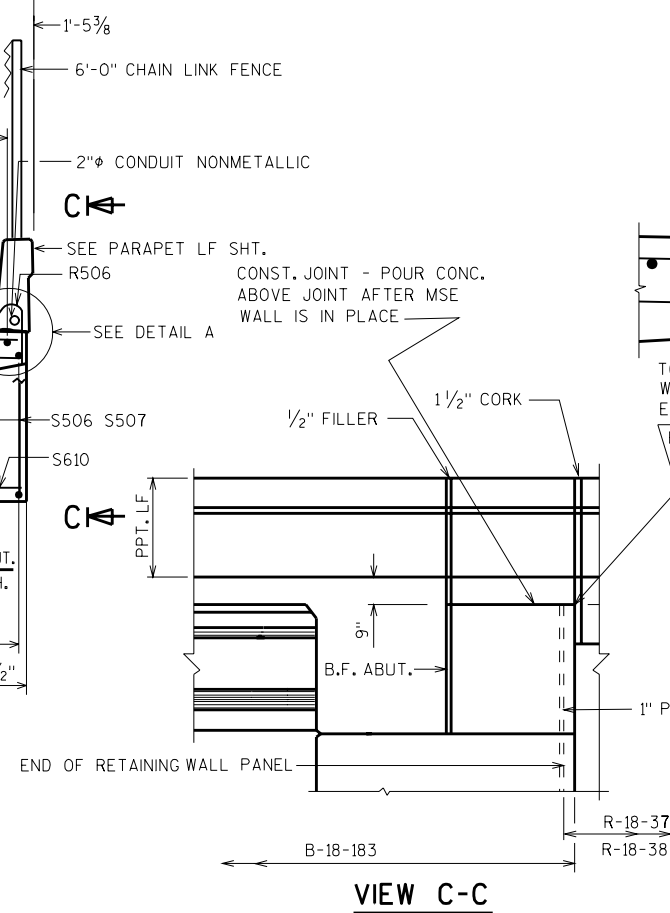

NO.	DATE	REVISION	BY
STATE OF WISCONSIN DEPARTMENT OF TRANSPORTATION STRUCTURES DESIGN SECTION			
STRUCTURE		B-18-183	
CONST. SPEC.	2003	DRAWN BY CMPT/JHG	PLANS CK'D. Budd
EAST SUPERSTRUCTURE		SHEET 9	

09-183SUP1E.DGN

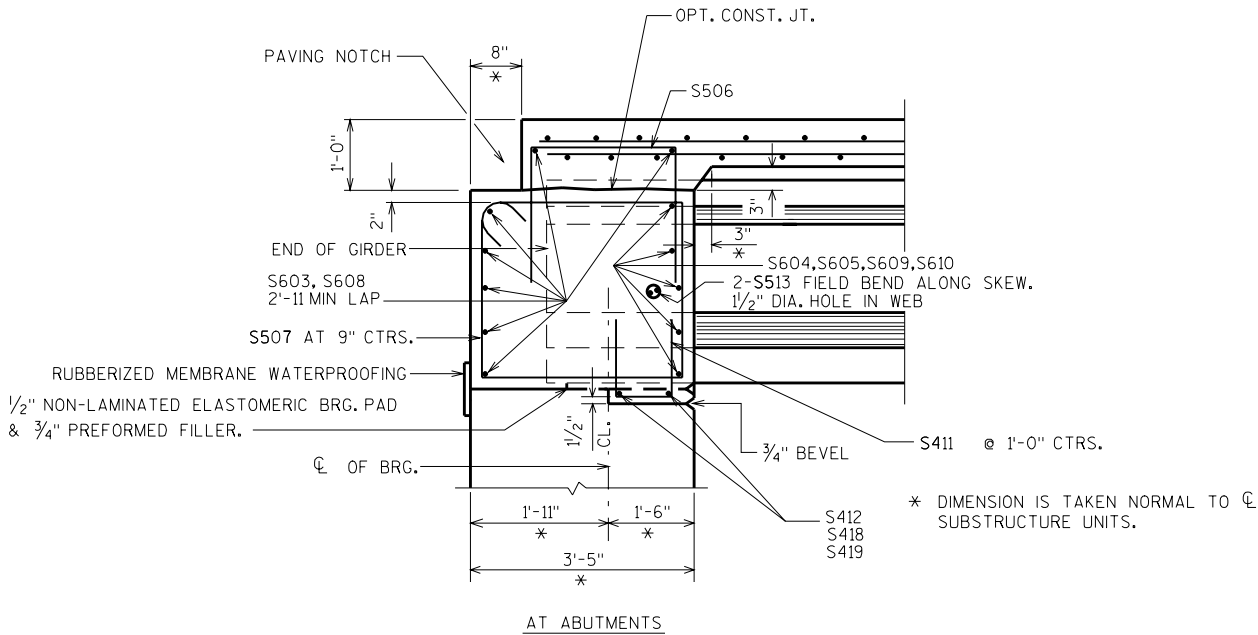


PART LONGIT. SECTION

BILL OF BARS


BAR MARK	COAT	NO. REQ'D.	LENGTH	BENT	BUNDLE	LOCATION
S401	X	774	33'-6"			LONGITUDINAL TOP & BOTTOM
S402	X	1340	22'-4"			TRANSVERSE
S603	X	21	32'-4"			ABUT. DIAPH. NO.
S604	X	5	6'-6"			ABUT. DIAPH. NO.-GIR 8-9
S605	X	5	2'-8"			ABUT. DIAPH. SO.-GIR 8-9
S506	X	161	6'-1"	X		ABUT. DIAPHRAGM SO.
S507	X	161	13'-8"	X		ABUT. DIAPHRAGM
S608	X	21	30'-10"			ABUT. DIAPHRAGM
S609	X	140	3'-4"			ABUT. DIAPHRAGM
S610	X	20	1'-2"			ABUT. DIAPHRAGM
S411	X	92	3'-6"	X		ABUT. DIAPHRAGM
S412	X	56	2'-4"			ABUT. DIAPHRAGM
S513	X	64	6'-0"			ABUT. DIAPHRAGM SYM @ CL GIR.
S414	X	168	4'-3"		X	TOP TRANSVERSE
Δ S415	X	132	3'-3"	X		MEDIAN TRANSVERSE
S416	X	12	33'-3"			MEDIAN LONGIT.
S417	X	33	2'-0"			MEDIAN TRANSVERSE
S418	X	2	1'-8"			ABUT. DIAPHRAGM S.A. GIR'S. 8-9
S419	X	2	5'-6"			ABUT. DIAPHRAGM N.A. GIR'S. 8-9
S420	X	33	4'-0"			MEDIAN TRANS.

Δ CONCRETE MASONRY ANCHORS, TYPE L, NO. 4 BARS. EMBED 5" INTO EXIST. CONCRETE. EPOXY ANCHORED.

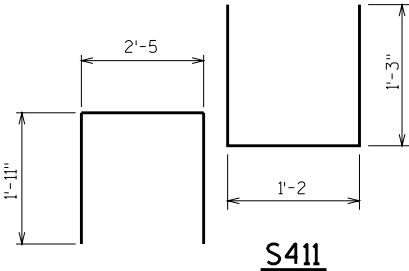


S506

S411

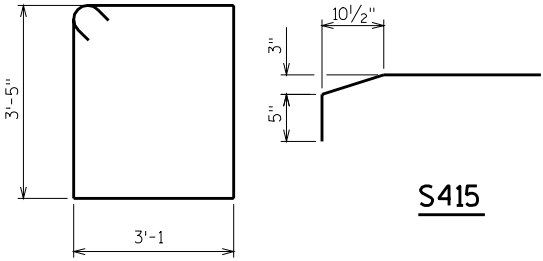

S415


S507

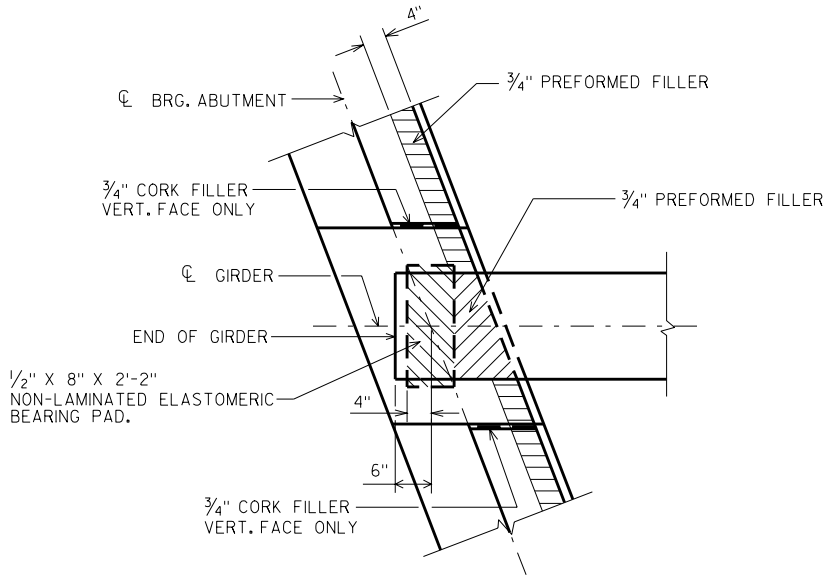

BEARING PAD DETAIL


TOP OF DECK ELEVATIONS

	S. ABUT.	1/8	2/8	3/8	4/8	5/8	6/8	7/8	N. ABUT.
GIR. 1	901.08	901.27	901.47	901.66	901.86	902.05	902.24	902.44	902.63
GIR. 2	901.19	901.39	901.58	901.78	901.97	902.16	902.36	902.55	902.74
GIR. 3	901.31	901.50	901.70	901.89	902.08	902.28	902.47	902.66	902.86
GIR. 4	901.42	901.62	901.81	902.00	902.20	902.39	902.58	902.78	902.97
GIR. 5	901.33	901.52	901.72	901.91	902.11	902.30	902.49	902.69	902.88
GIR. 6	901.22	901.42	901.61	901.81	902.00	902.19	902.39	902.58	902.77
GIR. 7	901.12	901.31	901.51	901.70	901.89	902.09	902.28	902.48	902.67
GIR. 8	901.01	901.21	901.40	901.59	901.79	901.98	902.18	902.37	902.56
GIR. 9	901.27	901.47	901.66	901.86	902.05	902.24	902.44	902.63	902.82
GIR. 10	901.17	901.37	901.56	901.75	901.95	902.14	902.33	902.53	902.72
GIR. 11	901.07	901.26	901.46	901.65	901.84	902.04	902.23	902.42	902.61
GIR. 12	900.97	901.16	901.35	901.55	901.74	901.94	902.13	902.32	902.51
GIR. 13	900.86	901.06	901.25	901.44	901.64	901.83	902.03	902.22	902.41
GIR. 14	900.76	900.96	901.15	901.34	901.54	901.73	901.92	902.12	902.30
GIR. 15	900.66	900.85	901.05	901.24	901.43	901.63	901.82	902.02	902.20
GIR. 16	900.56	900.75	900.94	901.14	901.33	901.52	901.72	901.91	902.10

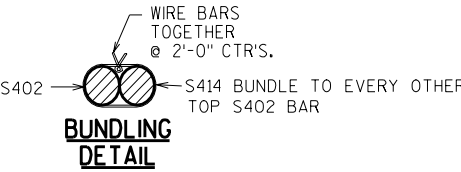


NO.	DATE	REVISION	BY
STATE OF WISCONSIN DEPARTMENT OF TRANSPORTATION STRUCTURES DESIGN SECTION			
STRUCTURE		B-18-183	
CONST. SPEC.	2003	DRAWN BY JHG	PLANS CK'D. Budd
SUPERSTRUCTURE DETAILS		SHEET 10	


WELDED WIRE FABRIC SHALL CONFORM TO THE REQUIREMENTS OF ASTM A497.

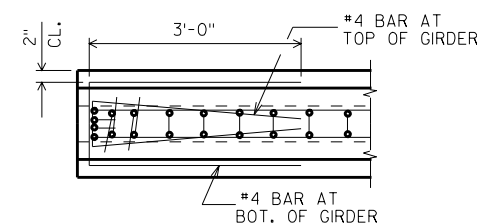

TOP VIEW OF GIRDER ENDS

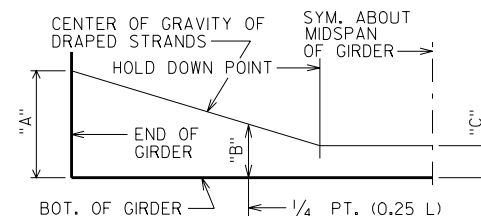


DRAPED STRAND PROFILE

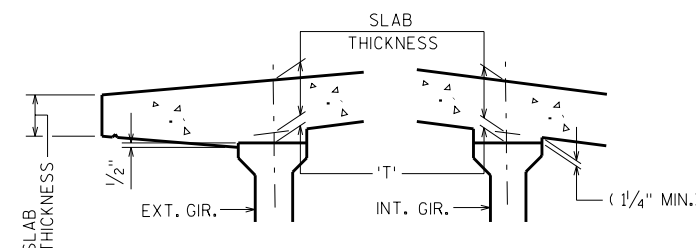


SLAB HAUNCH DETAIL

TOP OF DECK ELEV. AT FINAL GRADE
- TOP OF GIRDER ELEVATION
+ DEAD LOAD DEFLECTION
- SLAB THICKNESS

= HAUNCH HEIGHT 'T'

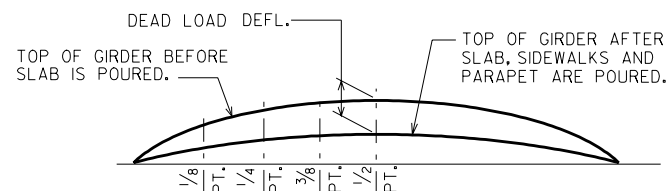


DEAD LOAD DEFLECTION DIAGRAM

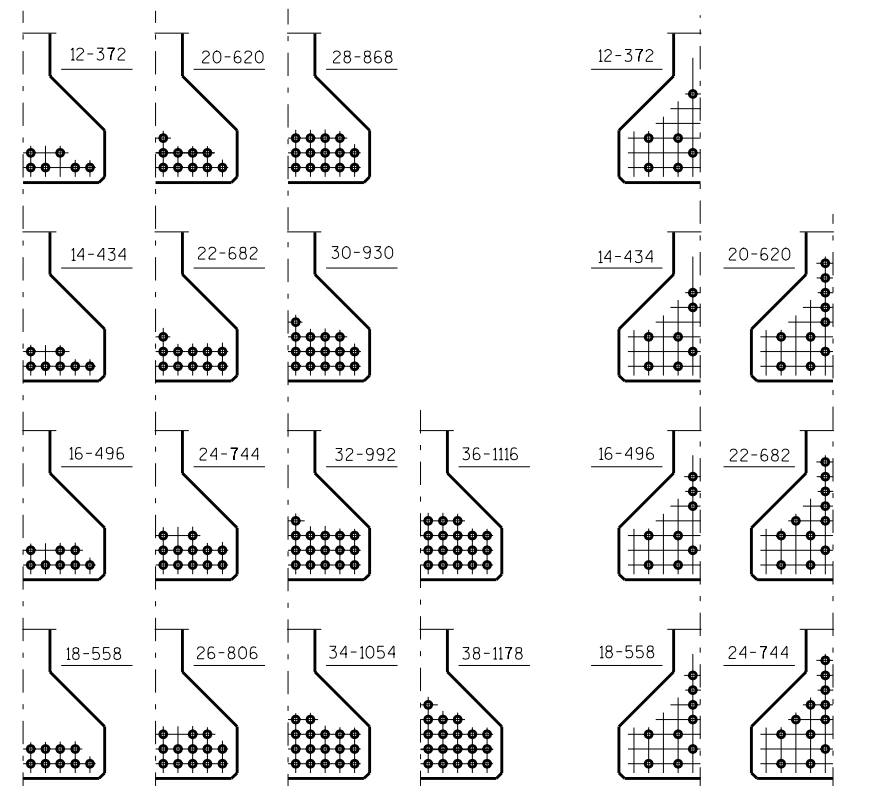

DRAPED PATTERN

UNDRAPED PATTERN

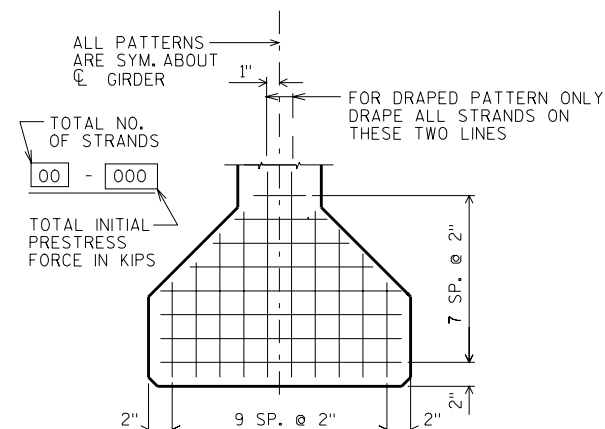

TYP. STRAND PATTERN

* MINIMUM CYLINDER STRENGTH OF CONCRETE @ TIME OF TRANSFER OF PRESTRESS FORCE.

[illegible]

NO.	DATE	REVISION	BY
STATE OF WISCONSIN DEPARTMENT OF TRANSPORTATION STRUCTURES DESIGN SECTION			
STRUCTURE		B-18-183	
CONST. SPEC.	2003	DRAWN BY JHG	PLANS C'K'D. Budd
45" PRESTRESSED GIRDER DETAILS		SHEET 11	

NOTES


ALL DIAPHRAGM MATERIAL NOT EMBEDDED IN THE CONCRETE GIRDER SHALL BE PAID FOR AT THE UNIT PRICE BID FOR "STEEL DIAPHRAGM", STRUCTURE, EACH.

EACH DIAPHRAGM BETWEEN GIRDERS SHALL CONSTITUTE ONE UNIT.

ALL DIAPHRAGM STRUCTURAL STEEL SHALL BE ASTM A709 GRADE 36. ALL BOLTS, NUTS AND WASHERS SHALL BE ASTM A325 TYPE 1.


ALL DIAPHRAGM STRUCTURAL STEEL SHOWN SHALL BE HOT-DIPPED GALVANIZED. ALL BOLTS, NUTS AND WASHERS SHALL BE HOT-DIPPED GALVANIZED IN ACCORDANCE WITH ASTM A153 CLASS C. GALVANIZED NUTS SHALL BE TAPPED OVERSIZE IN ACCORDANCE WITH THE REQUIREMENTS OF ASTM A563 AND SHALL MEET THE REQUIREMENTS OF SUPPLEMENTARY REQUIREMENT S1 OF ASTM A563, LUBRICANT AND TEST FOR COATED NUTS.

TABLE				
GIRDER HEIGHT	DIM. "A"	DIM. "B"	DIM. "L"	* DIM. "X"
28"	1'-0 7/8"	5 7/8"	9 1/2"	2 1/4"
36"	1'-2 7/8"	9 7/8"	1'-1 1/2"	3 1/4"
45"	1'-5 3/8"	1'-1 7/8"	1'-5 1/2"	2 1/4"
54"	1'-7 7/8"	1'-5 7/8"	1'-9 1/2"	4 1/4"
54W"	1'-9 1/8"	1'-5 7/8"	1'-9 1/2"	4 1/4"

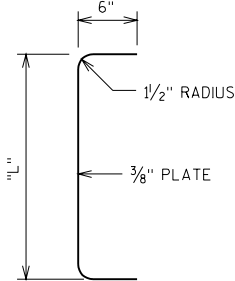


SECTION THRU ALTERNATE DIAPHRAGM


*DIM "X" = 2 1/2" FOR ALTERNATE PLATE DIAPHRAGM

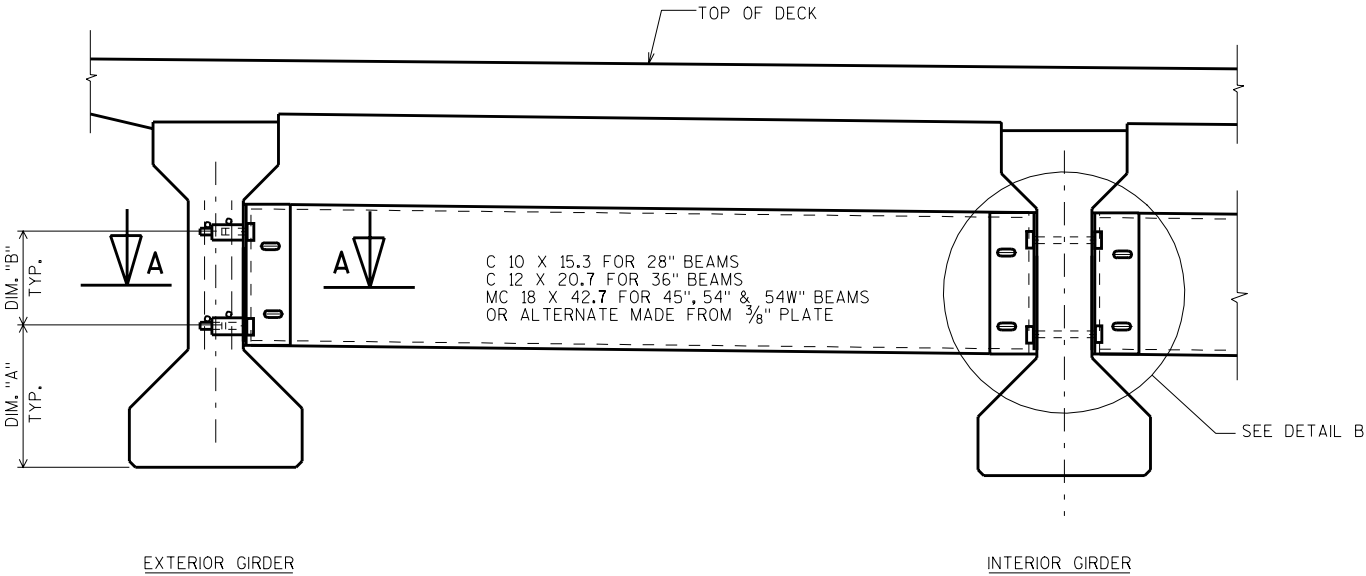

PART TRANSVERSE SECTION AT DIAPHRAGM

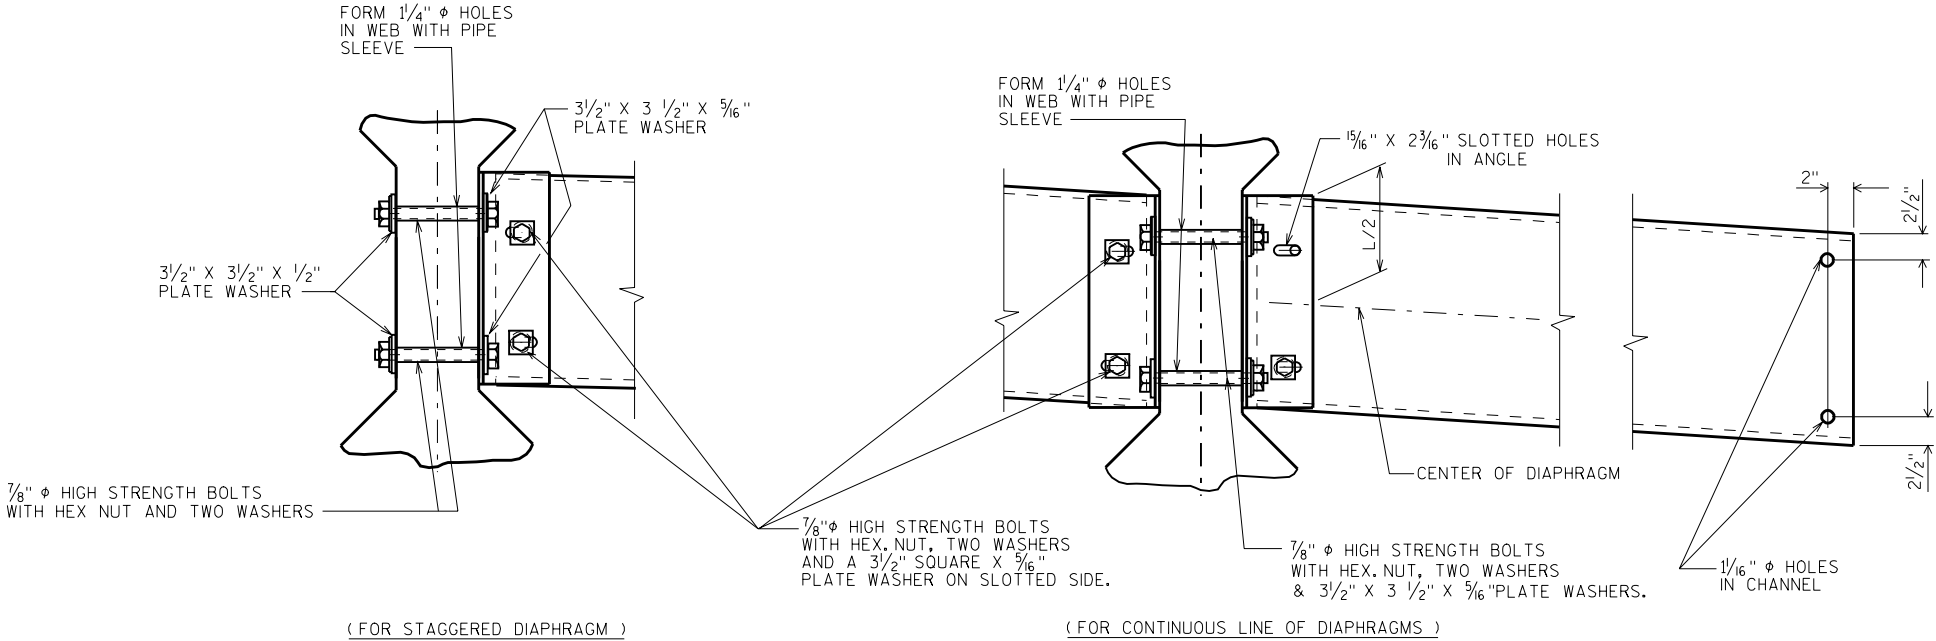


DETAIL B

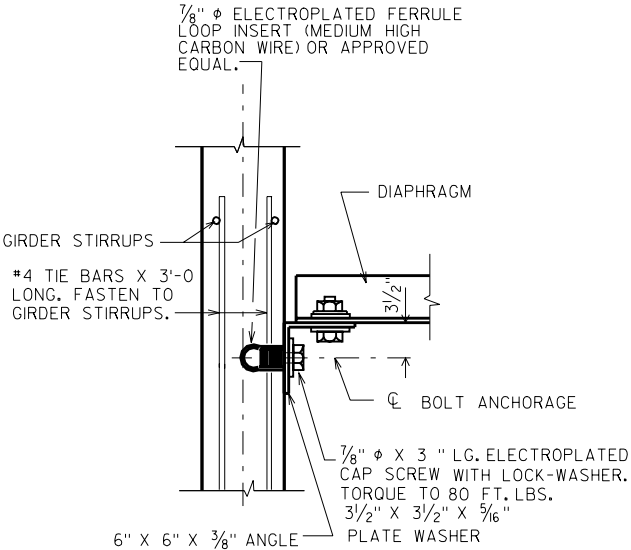

SECT. A-A




(FOR EXTERIOR ATTACHMENT)

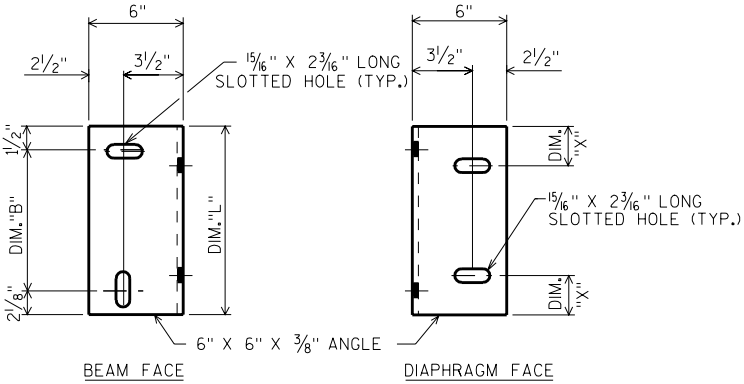


DIAPHRAGM SUPPORT

NO.	DATE	REVISION		BY
STATE OF WISCONSIN DEPARTMENT OF TRANSPORTATION STRUCTURES DESIGN SECTION				
STRUCTURE		B-18-183		
CONST. SPEC.	2003	DRAWN BY	JHG	PLANS CK'D. Budd
STEEL DIAPHRAGM			SHEET 12	

BAR MARK	COAT	NO. REQ'D.	LENGTH	BENT	LOCATION
R501	X	28	4-5	X	WEST PARAPET VERT.
R502	X	16	2-4	X	WEST PARAPET VERT.
R503	X	2	34-0	X	WEST PARAPET VERT.
R504	X	28	34-0		E. & W. PPT'S. HORIZ.
R505	X	412	4-10	X	E. & W. PPT'S. VERT.
R506	X	277	4-2	X	E. & W. PPT'S. VERT.
R507	X	16	4-8	X	WINGS 2 & 4 PPT'S.
R508	X	10	4-0		WINGS 2 & 4 PPT'S.

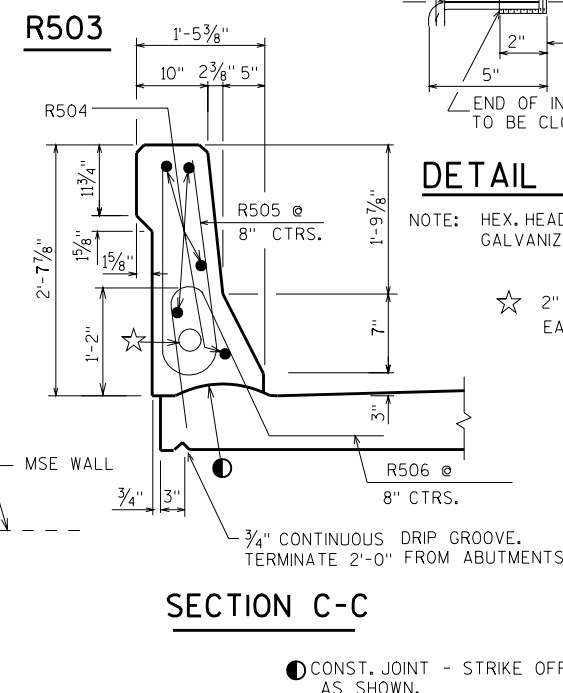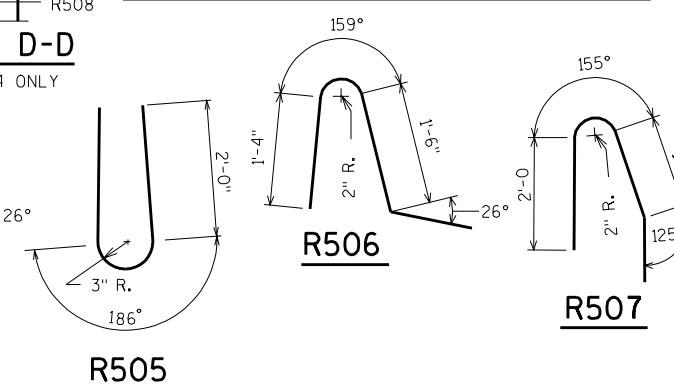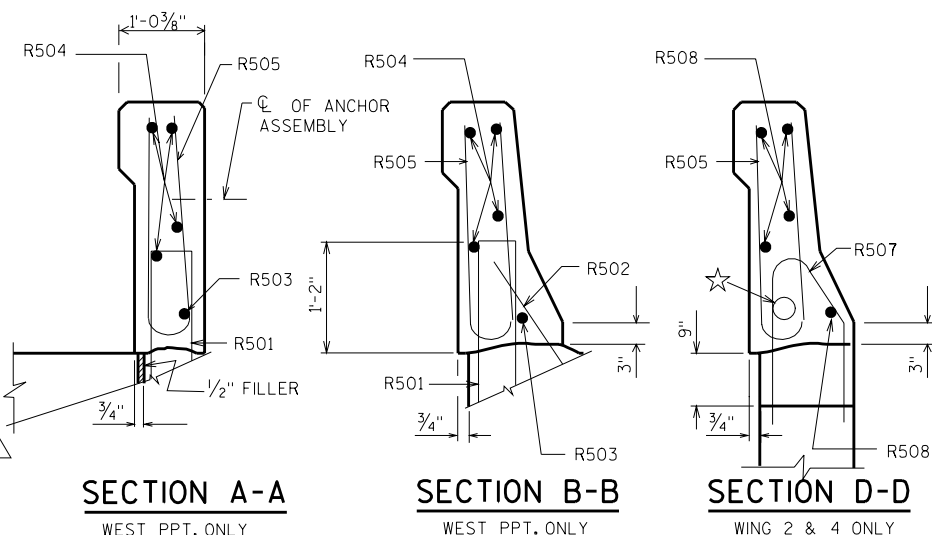

THREADED INSERTS FOR $\frac{7}{8}$ " ϕ X 2" LONG GALVANIZED HEX. HEAD CAP SCREWS, CAP SCREWS TO BE THREADED A MIN. OF $1\frac{1}{8}$ " AND SHALL BE SUPPLIED, INCLUDING WASHERS, WITH ASSEMBLY. INSERTS TO BE THREADED A MINIMUM OF $1\frac{3}{4}$ "

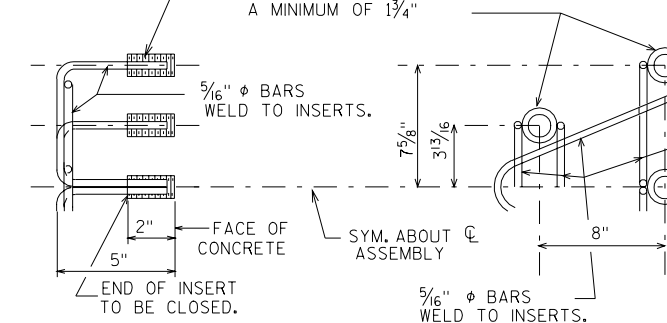

NOTE: HEX. HEAD CAP SCREWS & WASHERS TO BE GALVANIZED IN ACCORDANCE WITH AASHTO M232 CLASS C.

☆ 2" ϕ NON-METALLIC CONDUIT
EAST SIDE ONLY

NO.	DATE	REVISION			B
STATE OF WISCONSIN DEPARTMENT OF TRANSPORTATION STRUCTURES DESIGN SECTION					
STRUCTURE B-18-183					
CONST. SPEC.	2003	DRAWN BY	JHG	PLANS CK'D.	Blue
SLOPED FACE PARAPET LF				SHEET 13	

GENERAL NOTES

THE COLOR OF THE VINYL COATED CHAIN LINK FENCE SHALL BE BLACK.

POSTS ARE TO BE SET VERTICAL.

KNUCKLE TOP AND BOTTOM OF 2" MESH CHAIN LINK FENCING.

ALL FENCING COMPONENTS SHALL BE GALVANIZED STEEL OR APPROVED ALTERNATE LISTED BELOW.

ALL RAILS, POSTS AND SLEEVES ARE STANDARD WEIGHT PIPE, SCHEDULE 40.

PLACE ALL NUTS ON OUTSIDE OF FENCE.




TOP RAIL SHALL BE CONTINUOUS OVER INTERIOR POSTS. MINIMUM LENGTH OF TOP RAIL BETWEEN SPLICES SHALL BE 20'-0". PLACE TOP RAIL SPLICES NEAR 1/4 POINTS OF POST SPACING. NO. 9 GAGE TIES AT 9" SPACING REQ'D. ON RAILS & POSTS WITHOUT STRETCHER BARS.

ALTERNATE FENCING MATERIALS ARE ALUMINUM, ALUMINUM COATED STEEL, AND APPROVED COLOR COATING SYSTEMS. IF ALTERNATE MATERIALS ARE USED FOR POSTS & RAILS, THESE ELEMENTS SHOULD BE DESIGNED.

* ALTERNATE BOULEVARD 2-WAY CLAMP MAY BE USED WHEN THE POST IS EITHER BOLTED TO THE 3/2" ϕ PIPE SLEEVE OR DIRECTLY WELDED TO THE BASE PLATE.

☆ 1/2" ϕ CONCRETE MASONRY ANCHOR, TYPE "S", 6" EMBEDMENT (EPOXY ANCHORED) MIN. PULLOUT OF 10 KIPS, THREADED LENGTH OF ANCHOR, WASHER, AND NUT SHALL BE GALVANIZED.

▲ 1/2" DIA. X 6 7/8" LONG GALVANIZED HEX BOLT WITH NUT & WASHER. TYPE S, 1/2" ϕ CONCRETE MASONRY ANCHORS MAY BE SUBSTITUTED FOR 1/2" ϕ BOLTS. ANCHOR PLATE NOT REQUIRED WHEN TYPE S ANCHORS ARE USED. SEE ☆ IN "GENERAL NOTES".

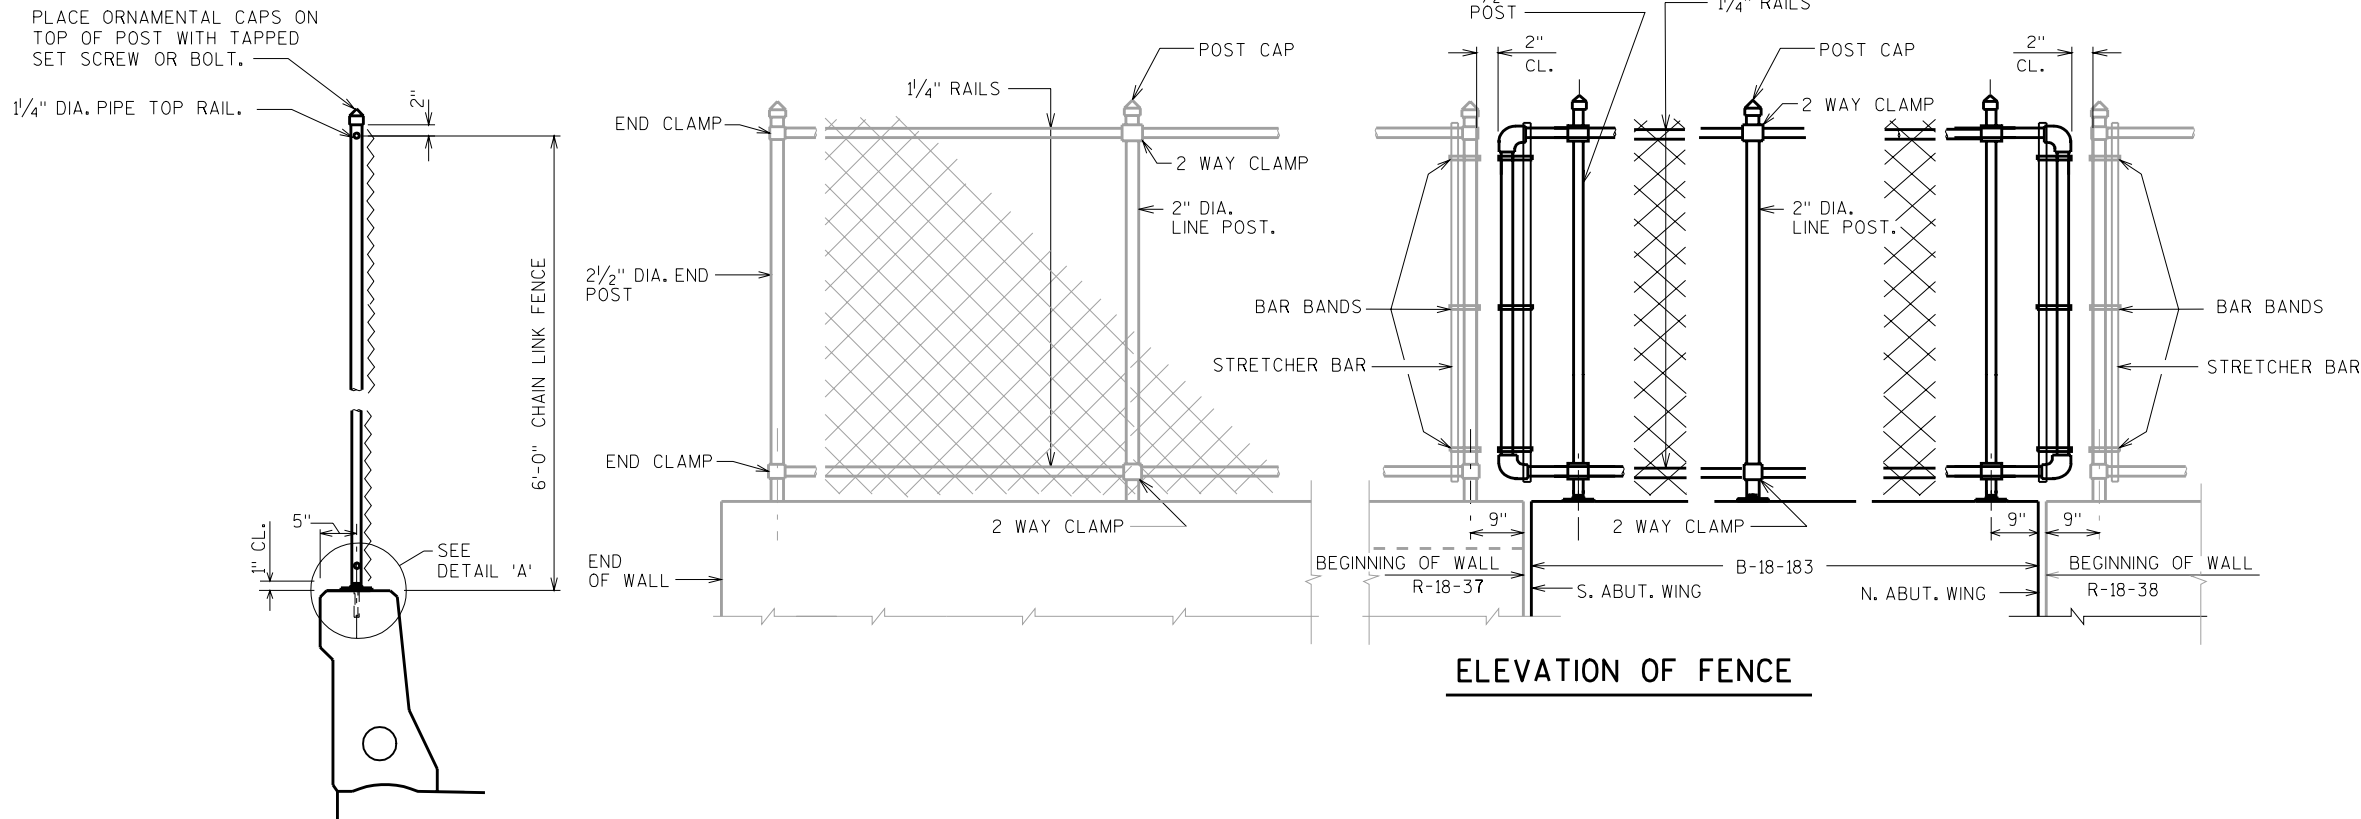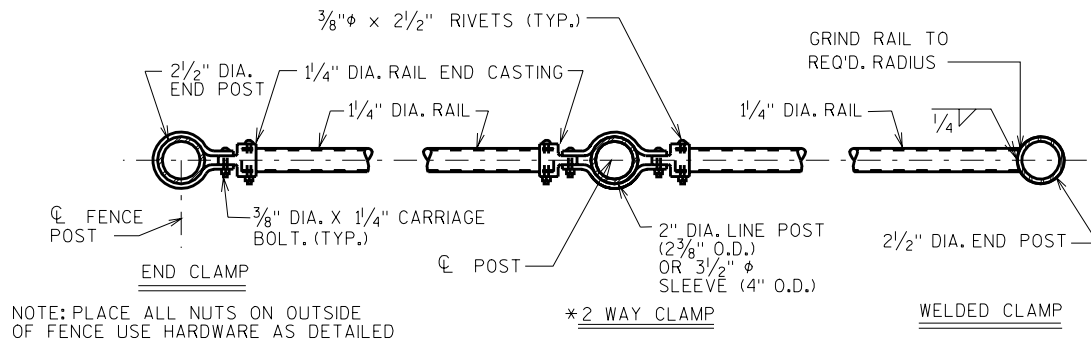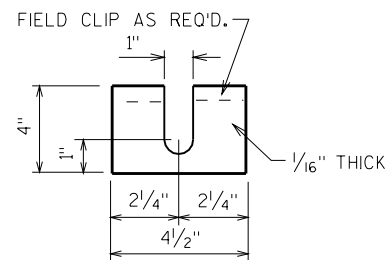**SECTION THRU FENCE****ELEVATION OF FENCE****PLAN OF RAILING****POST SHIM DETAILS**

SHIMS REQUIRED ONLY WHEN POSTS ARE WELDED TO BASE PLATES. PROVIDE 4 SHIMS PER POST.

DRILL 3/16" DIA. DRAIN HOLE PARALLEL TO ROADWAY IMMEDIATELY ABOVE GROUT IN POST. SLEEVE LOCATIONS ONLY.

FILL PIPE SLEEVE AND BEVEL AWAY FROM POST WITH NON-SHRINK GROUT AFTER SETTING POST.


3/8" DIA. CARRIAGE BOLT WITH LOCKING NUT. (TO BE SUPPLIED WITH ASSEMBLY)

BOTTOM OF MESH FENCING.

TOP OF CONCRETE


3 1/2" DIA. SLEEVE

BASE PLATE 3/4" X 5" X 8". SEAL BETWEEN BASE PLATE & TOP OF CONCRETE WITH NON-STAINING GRAY NON-BITUMINOUS JOINT SEALER

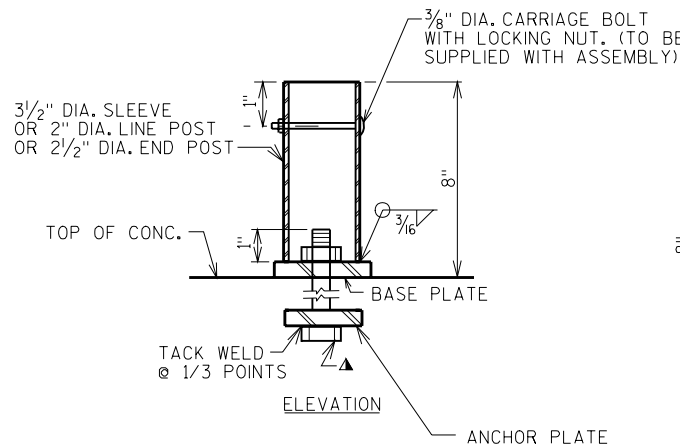DETAIL A**POST ATTACHMENT**

UNIT SHALL BE GALV. AFTER FABRICATION

NOTE: IN LIEU OF USING THE 3 1/2" ϕ SLEEVE, THE 2" ϕ OR 2 1/2" ϕ FENCE POST MAY BE WELDED TO THE BASE PLATE.

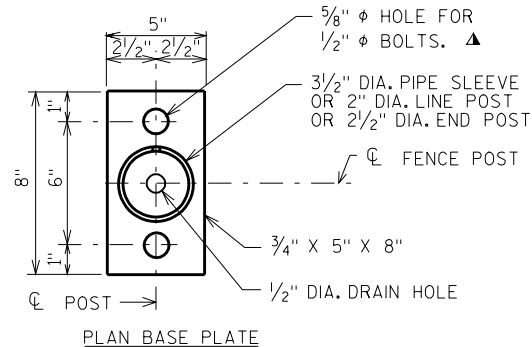**PLAN BASE PLATE**

NO.	DATE	REVISION	BY
STATE OF WISCONSIN DEPARTMENT OF TRANSPORTATION STRUCTURES DESIGN SECTION			
STRUCTURE B-18-183			
CONST. SPEC.	2003	DRAWN BY JHG	PLANS CK'D. Budd
FENCING DETAILS		SHEET 14	