

REHABILITATION STRUCTURE SURVEY REPORT

DT1696 6/2012

Wisconsin Department of Transportation

- ☒ **Grade Separation**
☐ **Stream Crossing**
☐ **Culvert**
☐ **Railroad**
☐ **Retaining Wall**
☐ **Noise Barrier**
☐ **Sign Structure**
☐ **Other:** _____

For guidance see: http://dotnet/dtid_bos/extranet/structures/reports-checklists.htm

Design Project ID 1190-02-34	Construction Project ID 1190-02-64	Highway (Project Name) EAU CLAIRE - CHIPPEWA FALLS		
Final Plan Due Date 05/01/2018	Preliminary Plan Due Date 05/01/2018	<input type="checkbox"/> Town <input type="checkbox"/> Village <input checked="" type="checkbox"/> City EAU CLAIRE		
PS&E Date 08/01/2018	Letting Date 02/12/2019	County EAU CLAIRE		
Structure Number B-18-184		Section 27	Town 27N	Range 09W
Station 223+01.34 - 223+98.84	Latitude: 444703.22 Longitude: 912655.68	<input checked="" type="checkbox"/> YES <input type="checkbox"/> NO Structure Located on National Highway System		
For Survey and CADD Files Horizontal Coordinate System: Vertical Datum:		Traffic Forecast Data		
Feature On USH 53 SB		Design Year 2008	Average Daily Traffic (ADT) 18800	Roadway Design Speed 70 MPH
Feature Under CYPRESS RD		Feature Under		Functional Class Principal Arterial
Region Contact: Adam Hetrick (Area Code) Telephone Number(s): 715-836-2855 Email: adam.hetrick@dot.wi.gov		Consultant Contact: (Area Code) Telephone Number(s): Email:		

Work To Be Performed

Field Information Required Item Number (see Pages 2-4)

- ☐ A. Structural Repair 1-3, 22
☒ B. Overlay 1-3, 10-22, 26-28, 32, 34
 ☐ Concrete Overlay ☐ Asphalt Overlay
 ☐ Polymer Modified Asphalt Overlay ☒ Thin Bonded Polymer Overlay
 ☐ Other: _____
☐ C. New Bearings 3, 8, 9, 22
☐ D. New Railings 15-17, 20-23
☐ E. Curb and Sidewalk Repair 2, 3, 16, 22, 23
☐ F. Abutment Repair 2, 3, 12, 16
☐ G. Pier Repair 2, 3, 12, 16
☐ H. New Deck 1-6, 9, 10, 13-28, 32-34
☐ I. Widening 1-28, 30, 32-35
☐ J. Joint Repair 2, 3, 8, 16, 19, 22
☐ K. Surface Repair 2, 3, 22
☐ L. Raising Bridge 3, 6, 9, 16, 20-24
☐ M. Slope Stabilization 1-3, 30
☐ N. Scour Repair 1, 2 or 3, 16, 19, 21, 27, 29, 31-35
☐ O. Painting 16, 22, 24
☐ P. Other: _____

Field Information Required

If no structure number exists provide the following: Small County Map on which the location of proposed structure is shown in red and any highway relocation in green. In addition, provide Location Map of scale not less than 1" = 2000' showing the structure location and number.

- ☒ 1. Most recent inspection report, brief history of bridge construction date, and description of repairs with dates.
- ☒ 2. Outline deficient areas on existing structure plan or drawing.
- ☒ 3. Photographs of details requiring repairs or modifications, such as: bearings, x-frames, joints, etc. Photograph all deficient areas. Clearly label all photographs.
- ☐ 4. Provide proposed typical section for roadway and structure showing dimensions and cross slopes.
- ☐ 5. Survey beam seat or girder elevations at both sides of bridge at all substructure units.
- ☐ 6. Provide cross-section elevations at 10 foot intervals extending across the structure and a minimum of 100 feet beyond each end. Sections should be normal to centerline and show elevations at centerline roadway and gutter line. Take elevations along joints and at floor drains.
- ☐ 7. Show and identify starting stationing on bridge.
- ☐ 8. Record measurement, temperature of the structure, and date taken for each of the following:
 - (a) Joint opening measured normal to joint at centerline of roadway and both curb lines.
 - (b) Clearance between girder ends at piers.
 - (c) Distance from front face of abutment backwall to closest point of girder end measured parallel to girder.
 - (d) Temperature of structure determined by averaging top and under deck (if accessible) readings.
- ☐ 9. Fixed and expansion bearings - condition and orientation.
- ☒ 10. Number and width of proposed pours including construction staging sequence.
- ☒ 11. Location of existing construction joints in the deck.
- ☒ 12. Estimated Quantities:

Preparation, Decks, Type 1	Sq. Yd. <u>0</u>	
Preparation, Decks, Type 2	Sq. Yd. <u>0</u>	
Full Depth Deck Repair	Sq. Yd. <u>0</u>	Galvanic Anodes? <u>NO</u>
Concrete Surface Repair Superstructure	Sq. Ft. <u>0</u>	Galvanic Anodes? <u>NO</u>
Concrete Surface Repair Substructure	Sq. Ft. <u>0</u>	Galvanic Anodes? <u>NO</u>
Curb Repair	LF. <u>0</u>	Galvanic Anodes? <u>NO</u>

☒ 13. Sufficiency number: 94.7 (obtain from HSI Bridge Inventory System)

☒ 14. Appraisal and Condition Rating

	Deck Condition	Superstructure Condition	Substructure Condition	Load Capacity Appraisal	Structural EVAL Appraisal
Current	8	8	8	5	8

☒ 15. Load Ratings

	Inventory	Operational
Current Calculated Date: 07/11/2013	HS25	HS53
After Completed by Bridge Designer		

- ☒ 16. Utilities on/near Structure. (WisDOT policy is to avoid placing utilities on the structure.)

☒ Yes ☐ No

Type	Owner and Contact Information	Size	Opening at Abutment	Weight	Pressure

- ☒ 17. Is existing bridge railing deficient?

☐ Yes ☒ No If Yes – Replacement Rail Type:

- ☐ 18. Drains to be:

☐ Raised ☐ Closed ☐ Downspouted ☐ New

- ☒ 19. Traffic maintained on bridge during work?

☒ Yes ☐ No If Yes – Include sketches

- ☒ 20. Will guard rail be attached?

☐ Yes ☒ No If Yes – Which corners? Existing guardrail to remain at the NE and SE corners.

- ☒ 21. Will work to be performed eliminate all deficiencies?

☒ Yes ☐ No If No – Explain:

- ☒ 22. Hazardous waste (asbestos) to be removed?

☐ Yes ☒ No If Yes – Explain:

- ☐ 23. Wing location(s) for surface drain anchors:

- ☒ 24. Painting?

☐ Yes ☒ No If Yes – Explain on Page 4

(all, part, railing, color system, containment, bid items)

- ☐ 25. Desired roadway width: (new deck / widening) _____ Ft.

Desired sidewalk clear width: Left: _____ Ft. Right: _____ Ft.

- ☒ 26. Maximum increase in grade line elevation 3/8 In.

- ☐ 27. Benchmark description to be shown

- ☒ 28. Desired final cross slopes on bridge 0.02 Ft./Ft.

- ☐ 29. Underwater Inspection Report including:

- Streambed Cross Section With Pier, Footing and Seal Elevations
- Pier Elevation Drawings
- Pier Layout
- Hydrographic Survey

- ☐ 30. Slope stabilization, provide:

Type: _____ Quantity: _____ CY.

Slope: _____ Ft./Ft. Fill: _____ CY.

- ☐ 31. Preliminary layout of grout bags or proposed scour repair.

C.I.P. Articulated Mats (for Scour) _____ CY.

Grout Bags (for Scour) _____ CY.

Heavy Riprap _____ CY.

Extra Heavy Riprap _____ CY.

- ☒ 32. Report submitted with Preliminary Plan requires **no** CADD file submittal (*See ESubmittal instructions*).
- ☐ 33. Report submitted for development of Preliminary Plan to structure design engineer requires CADD file (if available) submittal and Report submittal to Soils Engineer if project involves foundation modifications.
- ☐ 34. Coordinate with structure design engineer **before** going into the field if existing structure has no available plans, if staged construction is planned, or if there are adjoining/adjacent structures that will remain in place.
- ☐ 35. If project involves substructure widening coordinate with structure and/or hydraulic design engineer to determine if information on the separation and/or stream crossing SSR will be required.


Additional Information

Elaborate on other concerns such as: DNR, Local, Utility Conflicts, Aesthetics, Railing Type and Staged Construction.

Please be as detailed and specific as possible.

- 1.) Structure built in 2005. No repairs since construction. See attached Bridge Inspection Report.
- 2.) Deficient areas to be determined in the field by the engineer. See attached Bridge Inspection Report. A Polymer Overlay is proposed because of deficiency over the entire structure due to poor bridge deck surface. The deck has a few hairline transverse/diagonal cracks. The northwest approach shoulder is settling. The southwest corner of the deck is buckling upward.
- 3.) See attached photographs.
- 10.) This work will be constructed half at a time under traffic using single lane closures during non-peak hours with night work. Nighttime ramp closures are anticipated at some structures. All lanes and ramps will be opened to traffic daily.
- 11.) See asbuilt plans.
- 16.) Conduit for lighting is attached to the North abutment. No conflicts anticipated.
- 19.) This work will be constructed half at a time under traffic using single lane closures during non-peak hours with night work. Nighttime ramp closures are anticipated at some structures. All lanes and ramps will be opened to traffic daily.
- 22.) See attached Asbestos Inspection Report. No asbestos-containing material was found.
- 27.) To be determined.
- 32.) See preliminary plans.

CDR Map

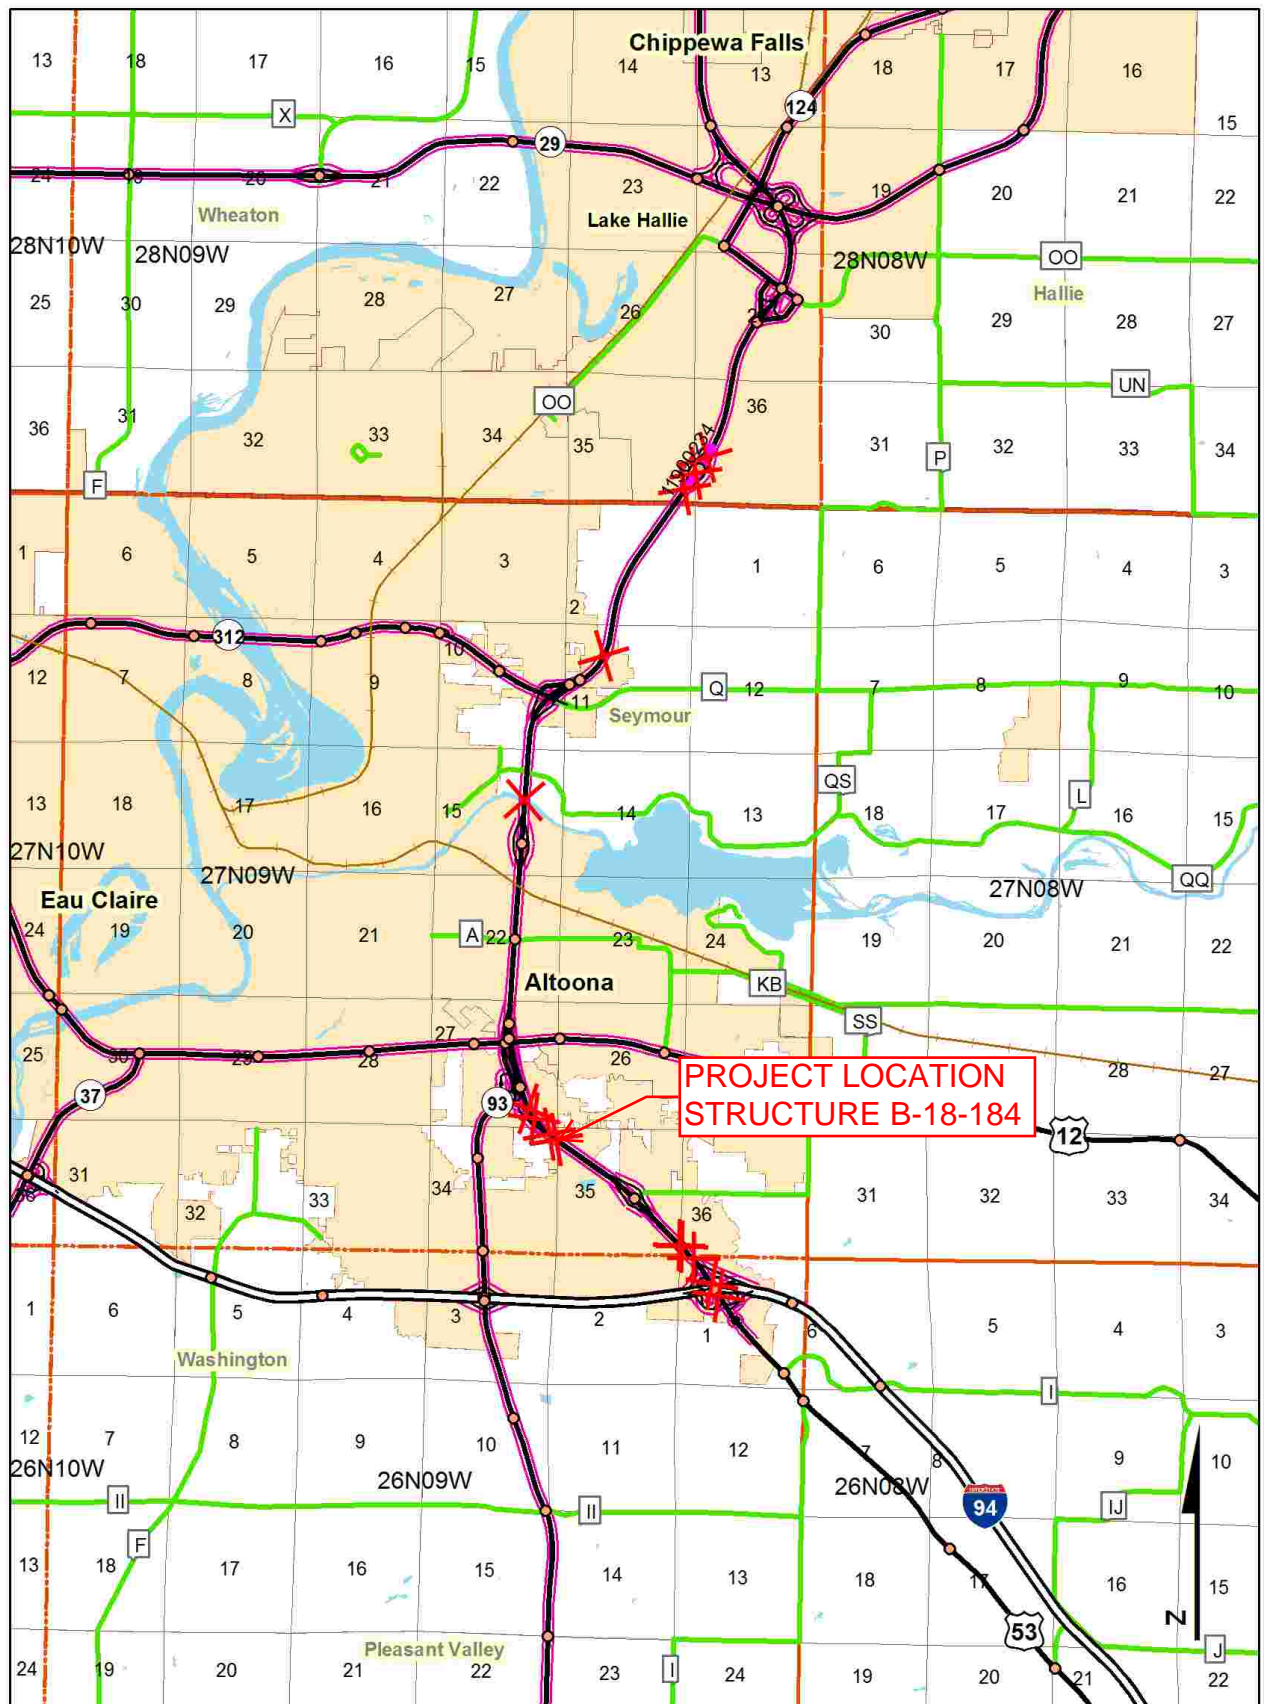


1190-02-64

EAU CLAIRE / CHIPPEWA



Section No. 1	Title
Section No. 2	Typical Sections and Details
Section No. 3	Estimate of Quantities
Section No. 3	Miscellaneous Quantities
Section No. 4	Right of Way Plat
Section No. 5	Plan and Profile
Section No. 6	Standard Detail Drawings
Section No. 7	Sign Plates
Section No. 8	Structure Plans
Section No. 9	Computer Earthwork Data
Section No. 9	Cross Sections

TOTAL SHEETS =

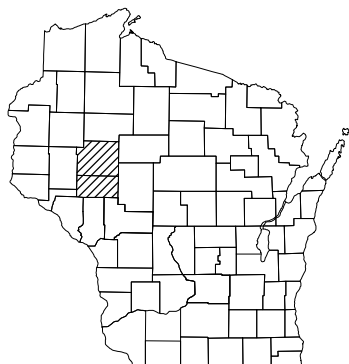

A.A.D.T.	=
A.A.D.T.	=
D.H.V.	=
D.D.	=
T.	=
DESIGN SPEED	=
ESALS	=

 

PLAN
CORPORATE LIMITS
PROPERTY LINE
LOT LINE
LIMITED HIGHWAY EASEMENT
EXISTING RIGHT OF WAY
PROPOSED OR NEW R/W LINE

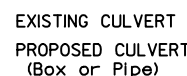

PROFILE
 GRADE LINE
 ORIGINAL GROUND
 MARSH OR ROCK PROFILE
 (To be noted as such)
 SPECIAL DITCH

 GRADE ELEVATION

  CULVERT (Profile View)
 UTILITIES
 ELECTRIC
 FIBER OPTIC
 GAS
 SANITARY SEWER
 STORM SEWER
 TELEPHONE
 WATER
 UTILITY PEDESTAL
 POWER POLE
 TELEPHONE POLE

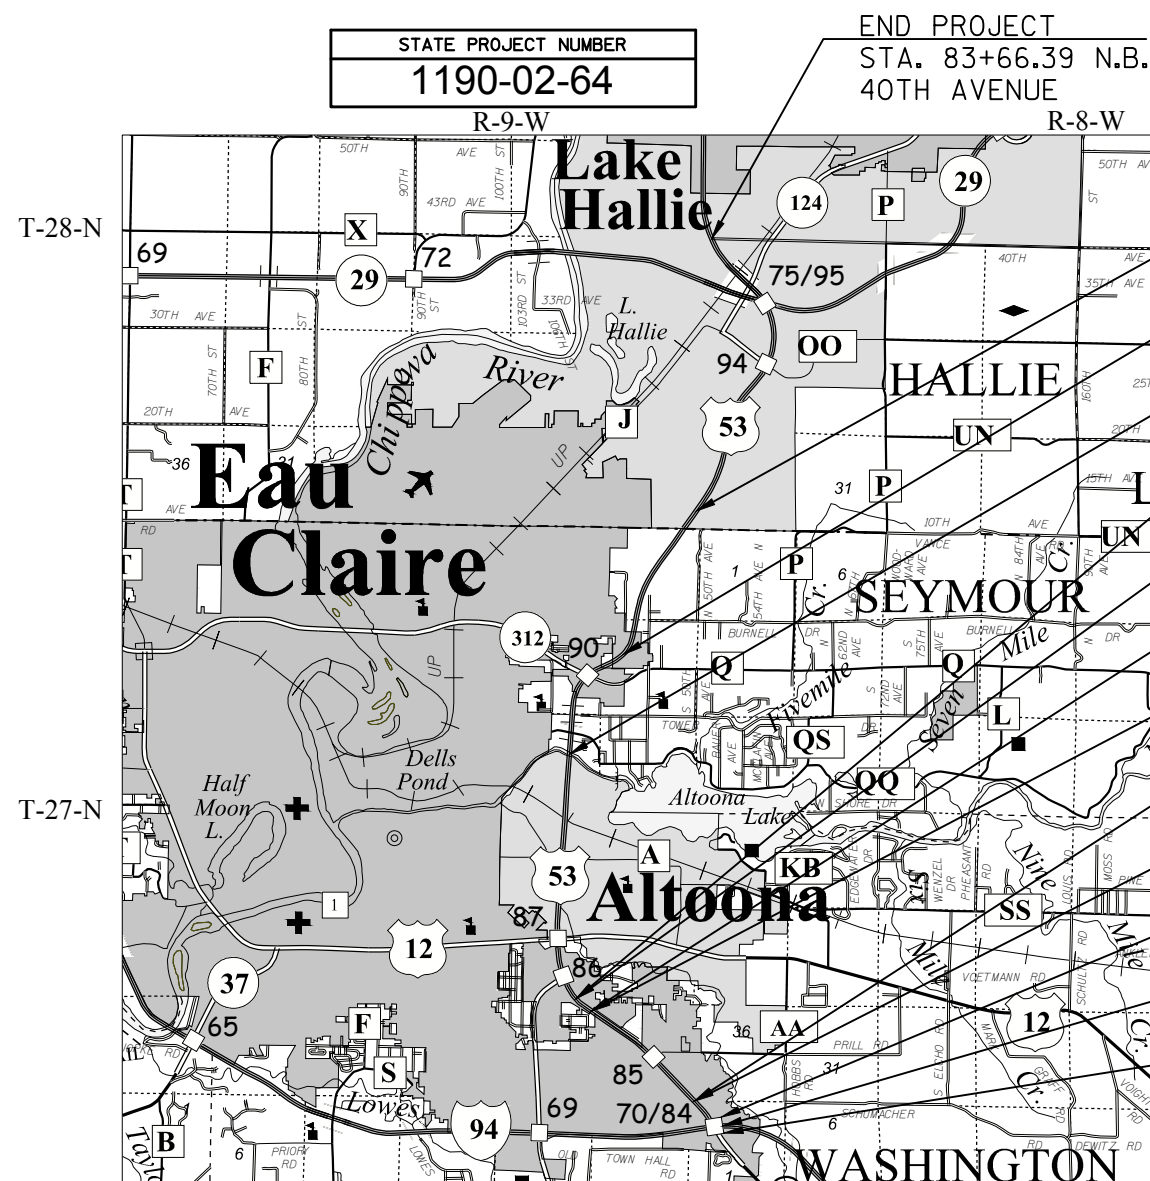

SCALE 0 2 MILES

TOTAL NET LENGTH OF CENTERLINE = 11.26 MILES

HORIZONTAL POSITIONS SHOWN ON THIS PLAN ARE WISCONSIN COUNTY COORDINATES, EAU CLAIRE COUNTY, NAD83 (1991), IN U.S. SURVEY FEET. VALUES ARE GRID COORDINATES, GRID BEARINGS, AND GRID DISTANCES. GRID DISTANCES MAY BE USED AS GROUND DISTANCES.

STATE PROJECT	FEDERAL PROJECT	
	PROJECT	CONTRACT
1190-02-64		

STATE OF WISCONSIN DEPARTMENT OF TRANSPORTATION	
PREPARED BY	
Surveyor	_____ WISDOT _____
Designer	_____ ADAM HETRICK _____
Project Manager	_____ DAVID KOEPP _____
Regional Examiner	_____ REGIONAL EXAMINER _____
Regional Supervisor	_____ TMOYTHY MASON _____
APPROVED FOR THE DEPARTMENT	
DATE: _____	_____ (Signature)



route: 053S county: EAU CLAIRE date: 08/14/2013 plm: 138.713

Lat: 44.78469488 Long: -91.44952059 Elev: 810.91 ft.

\\doteauplog1p\photolog\Rg5\053S_R5_2013\Front\Dir_140\F_14099.jpg

Copyright 2015 Mandli Communications, Inc.



route: 053S county: EAU CLAIRE date: 08/14/2013 plm: 138.723

Lat: 44.78461515 Long: -91.4493518 Elev: 810.37 ft.

\\doteauplog1p\photolog\Rg5\053S_R5_2013\Front\Dir_141\F_14100.jpg

Copyright 2015 Mandli Communications, Inc.



route: 053S county: EAU CLAIRE date: 08/14/2013 plm: 138.733

Lat: 44.78453485 Long: -91.44918334 Elev: 809.64 ft.

\\doteauplog1p\photolog\Rg5\053S_R5_2013\Front\Dir_141\F_14101.jpg

Copyright 2015 Mandli Communications, Inc.



route: 053S county: EAU CLAIRE date: 08/14/2013 plm: 138.743

Lat: 44.78445467 Long: -91.44901293 Elev: 809.05 ft.

\\doteauplog1p\photolog\Rg5\053S_R5_2013\Front\Dir_141\F_14102.jpg

Copyright 2015 Mandli Communications, Inc.



route: 053S county: EAU CLAIRE date: 08/14/2013 plm: 138.753

Lat: 44.78437393 Long: -91.44884324 Elev: 808.25 ft.

\\doteauplog1p\photolog\Rg5\053S_R5_2013\Front\Dir_141\F_14103.jpg

Copyright 2015 Mandli Communications, Inc.



route: 053S county: EAU CLAIRE date: 08/14/2013 plm: 138.763

Lat: 44.78429363 Long: -91.44867335 Elev: 807.39 ft.

\\doteauplog1p\photolog\Rg5\053S_R5_2013\Front\Dir_141\F_14104.jpg

Copyright 2015 Mandli Communications, Inc.



STATE OF WISCONSIN
DEPARTMENT OF TRANSPORTATION

Inspection Report for B-18-184

USH 53 SB HASTINGS WAY over CYPRESS RD
Jul 14, 2015



Type	Prior	Frequency (mos)	Performed
Routine	07-14-15	24	X
SI&A	07-11-13	48	

Latitude	44°47'03.22"N	Owner	STATE HIGHWAY DEPT
Longitude	91°26'55.68"W	Maintainer	STATE HIGHWAY DEPT

Time Log

Team members

Hours	Minutes	
1	59	

	Name	Number	Signature	Date
Inspector	Frueh, Rick J	1003	Completed by HSI System Account(HSI)	
Reviewer				

BRIDGE INSPECTION REPORT
Wisconsin Department of Transportation
DT2007 2003 s.84.17 Wis. Stats.

page 2

Identification & Location

Feature On: USH 53 SB HASTINGS WAY	Section Town Range: S27 T27N R09W	Structure Number: B-18-184
Feature Under: CYPRESS RD	County: EAU CLAIRE(18)	
Location AT CYPRESS RD	Municipality: CITY-EAU CLAIRE(18221)	Structure Name:

Geometry

measurements in feet, except where noted

Approach Roadway Width: 68	Bridge Roadway Width: 64.9	Total Length: 98.8
Approach Pavement Width: 54	Deck Width: 67.8	Deck Area (sq ft): 6698

Traffic

	Lanes	ADT	ADT year	Traffic Pattern
On	4	1500	2003	ONE WAY TRAFFIC
Under	4	100	2003	TWO WAY TRAFFIC

Capacity

Load Rating

Inventory rating: HS25	Overburden depth (in): 0.0	Last rating date:	Controlling: INTERIOR DECK GIRDER Positive Moment
Operating rating: HS53	Deck surface material: CONCRETE	Re-rate for capacity (Y/N):	Control location: SPAN 1
Posting:	Re-rate notes:		

Hydraulic

Classification

Scour Critical Code(113): (N) NO WATERWAY	Q100 (ft3/sec): 0	
High water elevation (ft): 0.0	Velocity (ft/sec): 0.0	Sufficiency #: 94.7

Span(s)

Span #	Material	Configuration	Depth (in)	Length (ft)	Main
1	PREST CONCRETE	DECK GIRDER	45	95.0	Y

Expansion joint(s)

Temperature:

File:	New:
-------	------

Vertical Clearance

	Measurement file (ft)	File Date	Measurement new (ft)
Highway Minimum Under Cardinal	15.0	17-Nov-2005	
Highway Minimum Under Non-Cardinal	15.0	17-Nov-2004	
Highway Minimum On			
Railroad Minimum Under			

BRIDGE INSPECTION REPORT
Wisconsin Department of Transportation
DT2007 2003 s.84.17 Wis. Stats.

page 3

Structure No.: **B-18-184**

Elements

Chk	Element	Defect	Description	UOM	Total	Quantity in Condition State			
						1	2	3	4
X	12		Reinforced Concrete Deck	SF	6,800	6,786	14	0	0
		1130	Cracking (RC) Few hairline diagonal cracks	SF		69	14	0	0
		8000	Wearing Surface (Bare)	SF	6,800	6,682	118	0	0
		3220	Crack (Wearing Surface) Few hairline Transverse/diagonal cracks.	SF		214	118	0	0
		8522	Coated Reinforcing	SF	6,800	0	0	0	0
X	109		Prestressed Concrete Open Girder	LF	1,056	1,056	0	0	0
			11 Girders.						
X	215		Reinforced Concrete Abutment	LF	175	156	13	6	0
			Electric lights on north abutment. Decorative face on both abutments.						
		1080	Delamination - Spall - Patched Area 1 ft X 1 ft spall at southeast joint with wing wall but no expose rebar. 1 ft X 2 ft spall at southeast joint with wing wall with expose rebar.	LF		0	0	3	0
		1130	Cracking (RC) 11 hairline vertical/mapping cracks in south abutment. 5 hairline vertical cracks in north abutment.	LF		0	13	3	0
X	331		Reinforced Concrete Bridge Rail	LF	200	171	20	9	0
			Safety chain link fence on west concrete parapet.						
		1130	Cracking (RC) Few hairline vertical cracks.	LF		0	20	9	0
X	8400		Integral Wingwall	EA	4	4	0	0	0
		8902	Wingwall Movement There no wing walls on this bridge, there are retaining walls. Northwest and Southwest roadway and parapet has settled at the retaining wall.	EA		0	0	0	0

BRIDGE INSPECTION REPORT
Wisconsin Department of Transportation
DT2007 2003 s.84.17 Wis. Stats.

page 4

Structure No.: **B-18-184**

Assessments

Chk	Element	Defect	Description	UOM	Total	Quantity in Condition State			
						1	2	3	4
X	9009		Sidewalk Under bridge on south side.	EA	1	1	0	0	0
X	9011		Utilities Conduit for lighting is attached to the North abutment.	EA	1	1	0	0	0
X	9167		Steel Diaphragm	EA	20	20	0	0	0
X	9322		Approach Roadway - Concrete (non-structural) Northwest approach shoulder is settling.	EA	2	1	1	0	0
X	9337		Protective Screening Mounted on top of east concrete parapet railing.	EA	1	1	0	0	0

NBI Ratings

	File	New
Deck	8	8
Superstructure	8	8
Substructure	8	8
Culvert	N	N
Channel	N	N
Waterway	N	N

Structure Specific Notes

Inspection Specific Notes

Inspector Site-Specific Safety Considerations

Structure Inspection Procedures

Special Requirements

	Chk	Comments
Traffic Control		
ReachAll Vehicle		
Access Equipment		
Other		

Construction History

Year	Work Performed	FOS id
2005	NEW STRUCTURE	1190-00-72

Maintenance Items History

Item	Recommended by	Status	Status change	Year completed
------	----------------	--------	---------------	----------------

BRIDGE INSPECTION REPORT
Wisconsin Department of Transportation
DT2007 2003 s.84.17 Wis. Stats.

page 5

Structure No.: **B-18-184**

Maintenance Items

Item	Priority	Recommended by	Status	Status change
------	----------	----------------	--------	---------------



708 Heartland Trail, Suite 3000
Madison, WI 53717

608.826.3600 PHONE
608.826.3941 FAX

www.TRCSolutions.com

Bridge Asbestos Inspection Report

WisDOT Project ID: 1190-02-34

Structure Number: B-18-0183, B-18-0184

Structure Name: USH 53 over Cypress Road

City/County: City of Eau Claire, Eau Claire County

Lat/Long Coordinates: 444704.31/ 912653.17, 444703.22/ 912655.68

TRC Project Number: 235777.0000.0000

Date Inspected: October 14, 2015

Inspected By/License Number: John Roelke, All-119523

Findings:

The inspection to identify and collect samples of potential asbestos-containing material (ACM) was completed following WisDOT standard sampling procedure for bridge inspections found in FDM 21-35-45.

None of the materials that were identified as potentially ACM and sampled tested positive for asbestos. The overlay on the bridges can proceed as planned. Standard Special Provision (STSP) 107-125 should be included in the specifications.

Sample Number	Sample Description	Sample Location	Analytical Results and Method	Friable/ Non-friable or No ACM	Quantity of ACM Material
B-18-0183					
1	Paint	Fence	PLM, non-detect	No ACM	0
2	Paint	Fence	PLM, non-detect	No ACM	
3	Paint	Fence	PLM, non-detect	No ACM	
4	Caulk	Around fence attachment plate	PLM, non-detect	No ACM	0
5	Caulk	Around fence attachment plate	PLM, non-detect	No ACM	
6	Caulk	Around fence attachment plate	PLM, non-detect	No ACM	

Sample Number	Sample Description	Sample Location	Analytical Results and Method	Friable/ Non-friable or No ACM	Quantity of ACM Material
7	Caulk	Abutment joint	PLM, non-detect	No ACM	0
8	Caulk	Abutment joint	PLM, non-detect	No ACM	
9	Caulk	Abutment joint	PLM, non-detect	No ACM	
B-18-0184					
1	Paint	Fence	PLM, non-detect	No ACM	0
2	Paint	Fence	PLM, non-detect	No ACM	
3	Paint	Fence	PLM, non-detect	No ACM	
4	Caulk	Around fence attachment plate	PLM, non-detect	No ACM	0
5	Caulk	Around fence attachment plate	PLM, non-detect	No ACM	
6	Caulk	Around fence attachment plate	PLM, non-detect	No ACM	
7	Caulk	Abutment joint	PLM, non-detect	No ACM	0
8	Caulk	Abutment joint	PLM, non-detect	No ACM	
9	Caulk	Abutment joint	PLM, non-detect	No ACM	

If you have any questions, please contact me, at (608) 826-3628.

TRC Environmental Corporation



Daniel Haak
Project Manager



John Roelke
Asbestos Inspector


Attachments: Location Map, Photos, and Laboratory Reports

Report Distribution:

Recipient	Electronic (PDF) Copy	Paper Copy
BTS-ESS sharlene.tebeest@dot.wi.gov	X (via email)	X
REC amy.adrihan@dot.wi.gov ; nicholasA.schaff@dot.wi.gov	X (via email)	
Project Manager david.koepp@dot.wi.gov	X (via email)	
Other		

\\NTAPB-MADISON\MSN-VOL6\-\WPMSN\PJT2\235777\0000\1190-02-34_B-18-0183 AND B-18-0184 USH 53 OVER CYPRESS ROAD, EAU CLAIRE



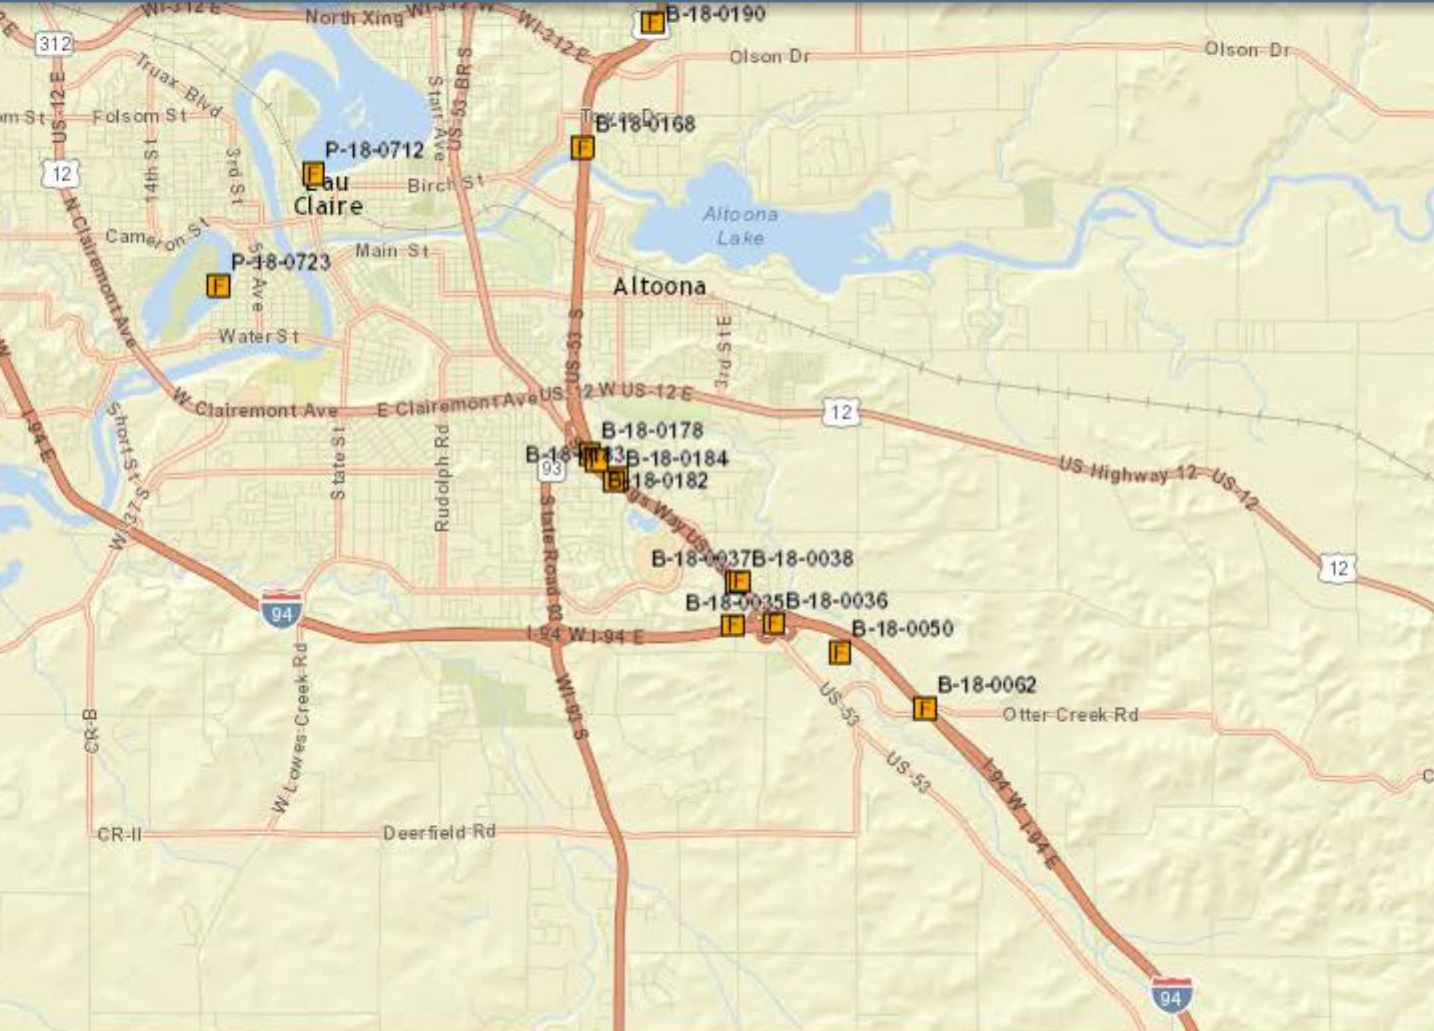

B-18-0183



Paint on fence



Caulk around fence attachment plate



Caulk in abutment joint

B-18-0184



Paint on fence



Caulk around fence attachment plate



Caulk in abutment joint



BULK ASBESTOS ANALYSIS REPORT

CLIENT: Wisconsin Department of Transportation

Lab Log #: 0047028
Project #: 235777.0000.0000
Date Received: 10/16/2015
Date Analyzed: 10/19/2015

Site: DOT Bridge Inspection, B-18-183

POLARIZED LIGHT MICROSCOPY by EPA 600/R-93/116

Sample No.	Color	Homogenous	Multi-Layered	Layer No.	Other Matrix Materials	Asbestos %	Asbestos Type
B-18-183 (1)	Black	Yes	No	--	---	ND	None
B-18-183 (2)	Black	Yes	No	--	---	ND	None
B-18-183 (3)	Black	Yes	No	--	---	ND	None
B-18-183 (4)	Grey	Yes	No	--	---	ND	None
B-18-183 (5)	Grey	Yes	No	--	---	ND	None
B-18-183 (6)	Grey	Yes	No	--	---	ND	None
B-18-183 (7)	Grey	Yes	No	--	---	ND	None
B-18-183 (8)	Grey	Yes	No	--	---	ND	None
B-18-183 (9)	Grey	Yes	No	--	---	ND	None

TRC LABORATORY ASBESTOS ANALYTICAL ACCREDITATIONS

NVLAP Lab Code 101424-0
RI #AAL-007 TX #300354
CO# AL-15020

AIHA-LAP,LLC #100122 CT #PH-0426
VT #AL014538 LA#05011 VA #3333 000283
PHIL# 461 PA#68-03387

ME LA-0075, LB-0071 MA #AA000052 NY #10980 WV# LT000411
AZ #A20944 HI #L-09-004 NJ #CT004 CA #2907

POLARIZED LIGHT MICROSCOPY by EPA 600/R-93/116

Sample No.	Color	Homogenous	Multi-Layered	Layer No.	Other Matrix Materials	Asbestos %	Asbestos Type
------------	-------	------------	---------------	-----------	------------------------	------------	---------------

Reporting limit- asbestos present at 1%

ND - asbestos was not detected

Trace - asbestos was observed at level of less than 1%

NA/PS - Not Analyzed / Positive Stop

SNA- Sample Not Analyzed- See Chain of Custody for details

Note: Polarized-light microscopy is not consistently reliable in detecting asbestos in floor coverings and similar non-friable organically bound materials. In those cases, EPA recommends, and certain states (e.g. NY) require, that negative results be confirmed by quantitative transmission electron microscopy.

The Laboratory at TRC follows the EPA's Interim Method for the Determination of Asbestos in Bulk Insulation (1982), and the EPA recommended Method for the Determination of Asbestos in Bulk Building Materials (EPA/600/R-93/116), July 1993, R.L. Perkins and B.W. Harvey which utilizes polarized light microscopy (PLM). Our analysts have completed an accredited course in asbestos identification. TRC's Laboratory is accredited under the National Voluntary Laboratory Accreditation Program (NVLAP), for Bulk Asbestos Fiber Analysis, NVLAP Code 18/A01, effective through June 30, 2016. TRC is an American Industrial Hygiene Association (AIHA) accredited lab for PLM effective through October 1, 2016. Asbestos content is determined by visual estimate unless otherwise indicated. Quality Control is performed in-house on at least 10% of samples and the QC data related to the samples is available upon written request from the client.

This report shall not be reproduced, except in full, without the written approval of TRC. This report must not be used by the client to claim product endorsement by NVLAP or any agency of the U.S. Government. This report relates only to the items tested.

Analyzed by: <u>K. Williamson</u>	Reviewed by: <u>Aud. Park</u>	Date Issued
Kathleen Williamson, Laboratory Manager	Amanda Parkins, Approved Signatory	10/19/2015

TRC LABORATORY ASBESTOS ANALYTICAL ACCREDITATIONS

NVLAP Lab Code 101424-0	AIHA-LAP.LLC #100122	CT #PH-0426	ME LA-0075, LB-0071	MA #AA000052	NY #10980	WV# LT000411
RI #AAL-007	TX #300354	VT #AL014538	LA#05011	VA #3333 000283	AZ #A20944	HI #L-09-004
CO# AL-15020	PHIL# 461	PA#68-03387				NJ #CT004
						CA #2907



BULK ASBESTOS ANALYSIS REPORT

CLIENT: Wisconsin Department of Transportation

Lab Log #: 0047033
Project #: 235777.0000.0000
Date Received: 10/16/2015
Date Analyzed: 10/19/2015

Site: DOT Bridge Inspection, B-18-184

POLARIZED LIGHT MICROSCOPY by EPA 600/R-93/116

Sample No.	Color	Homogenous	Multi-Layered	Layer No.	Other Matrix Materials	Asbestos %	Asbestos Type
B-18-184 (1)	Black	Yes	No	--	---	ND	None
B-18-184 (2)	Black	Yes	No	--	---	ND	None
B-18-184 (3)	Black	Yes	No	--	---	ND	None
B-18-184 (4)	Black	Yes	No	--	---	ND	None
B-18-184 (5)	Black	Yes	No	--	---	ND	None
B-18-184 (6)	Black	Yes	No	--	---	ND	None
B-18-184 (7)	Grey	Yes	No	--	---	ND	None
B-18-184 (8)	Grey	Yes	No	--	---	ND	None
B-18-184 (9)	Grey	Yes	No	--	---	ND	None

TRC LABORATORY ASBESTOS ANALYTICAL ACCREDITATIONS

NVLAP Lab Code 101424-0
RI #AAL-007 TX #300354
CO# AL-15020

AIHA-LAP, LLC #100122 CT #PH-0426
VT #AL014538 LA#05011 VA #3333 000283
PHIL# 461 PA#68-03387

ME LA-0075, LB-0071 MA #AA000052 NY #10980 WV# LT000411
AZ #A20944 HI #L-09-004 NJ #CT004 CA #2907



POLARIZED LIGHT MICROSCOPY by EPA 600/R-93/116

Sample No.	Color	Homogenous	Multi-Layered	Layer No.	Other Matrix Materials	Asbestos %	Asbestos Type
------------	-------	------------	---------------	-----------	------------------------	------------	---------------

Reporting limit- asbestos present at 1%

ND - asbestos was not detected

Trace - asbestos was observed at level of less than 1%

NA/PS - Not Analyzed / Positive Stop

SNA- Sample Not Analyzed- See Chain of Custody for details

Note: Polarized-light microscopy is not consistently reliable in detecting asbestos in floor coverings and similar non-friable organically bound materials. In those cases, EPA recommends, and certain states (e.g. NY) require, that negative results be confirmed by quantitative transmission electron microscopy.

The Laboratory at TRC follows the EPA's Interim Method for the Determination of Asbestos in Bulk Insulation (1982), and the EPA recommended Method for the Determination of Asbestos in Bulk Building Materials (EPA/600/R-93/116), July 1993, R.L. Perkins and B.W. Harvey which utilizes polarized light microscopy (PLM). Our analysts have completed an accredited course in asbestos identification. TRC's Laboratory is accredited under the National Voluntary Laboratory Accreditation Program (NVLAP), for Bulk Asbestos Fiber Analysis, NVLAP Code 18/A01, effective through June 30, 2016. TRC is an American Industrial Hygiene Association (AIHA) accredited lab for PLM effective through October 1, 2016. Asbestos content is determined by visual estimate unless otherwise indicated. Quality Control is performed in-house on at least 10% of samples and the QC data related to the samples is available upon written request from the client.

This report shall not be reproduced, except in full, without the written approval of TRC. This report must not be used by the client to claim product endorsement by NVLAP or any agency of the U.S. Government. This report relates only to the items tested.

Analyzed by: K. Williamson

Kathleen Williamson, Laboratory Manager

Reviewed by: Aud. Parkins

Amanda Parkins, Approved Signatory

Date Issued

10/21/2015

TRC LABORATORY ASBESTOS ANALYTICAL ACCREDITATIONS

NVLAP Lab Code 101424-0	AIHA-LAP,LLC #100122	CT #PH-0426	ME LA-0075, LB-0071	MA #AA000052	NY #10980	WV# LT000411
RI #AAL-007	TX #300354	VT #AL014538	LA#05011	VA #3333 000283	AZ #A20944	HI #L-09-004
CO# AL-15020	PHIL# 461	PA#68-03387			NJ #CT004	CA #2907

* PROVIDE FOR THREE BEAM
GUARD RAIL ATTACHMENT

○ INDICATES WING NUMBER

STATE PROJECT NUMBER

1190-00-72

DESIGN DATA

LIVE LOAD:

DESIGN RATING; HS-20
INVENTORY RATING; HS-24
OPERATIONAL RATING; HS-55
MAXIMUM STANDARD PERMIT VEHICLE LOAD = 250 KIPS.

STRUCTURE IS DESIGNED FOR A FUTURE WEARING
SURFACE OF 20 POUNDS PER SQUARE FOOT.

ULTIMATE DESIGN STRESSES:

CONCRETE MASONRY SLAB — $f'_c = 4,000$ P.S.I. ALL OTHER — $f'_c = 3,500$ P.S.I.
BAR STEEL REINFORCEMENT, GRADE 60 — $f_y = 60,000$ P.S.I.
45" PRESTRESSED GIRDERS, CONCRETE MASONRY — $f'_c = 6,000$ P.S.I.
STRANDS- $\frac{1}{2}$ " ϕ WITH ULTIMATE TENSILE STRENGTH OF 270,000 P.S.I.

FOUNDATION DATA

ABUTMENTS TO BE SUPPORTED ON $10\frac{3}{4}$ " ϕ CAST-IN-PLACE CONC. PILING
DRIVEN TO A MINIMUM BEARING VALUE OF 55 TONS PER PILE.
ESTIMATED 100'-0" LG. @ S. ABUT. & 90'-0" LG. @ N. ABUT.


TRAFFIC VOLUME

USH 53/HASTINGS WAY

A.D.T.=13,000 (2024)
R.D.S.=70 M.P.H.


CYPRESS ROAD

A.D.T.=25,750 (2024)
R.D.S.=40 M.P.H.

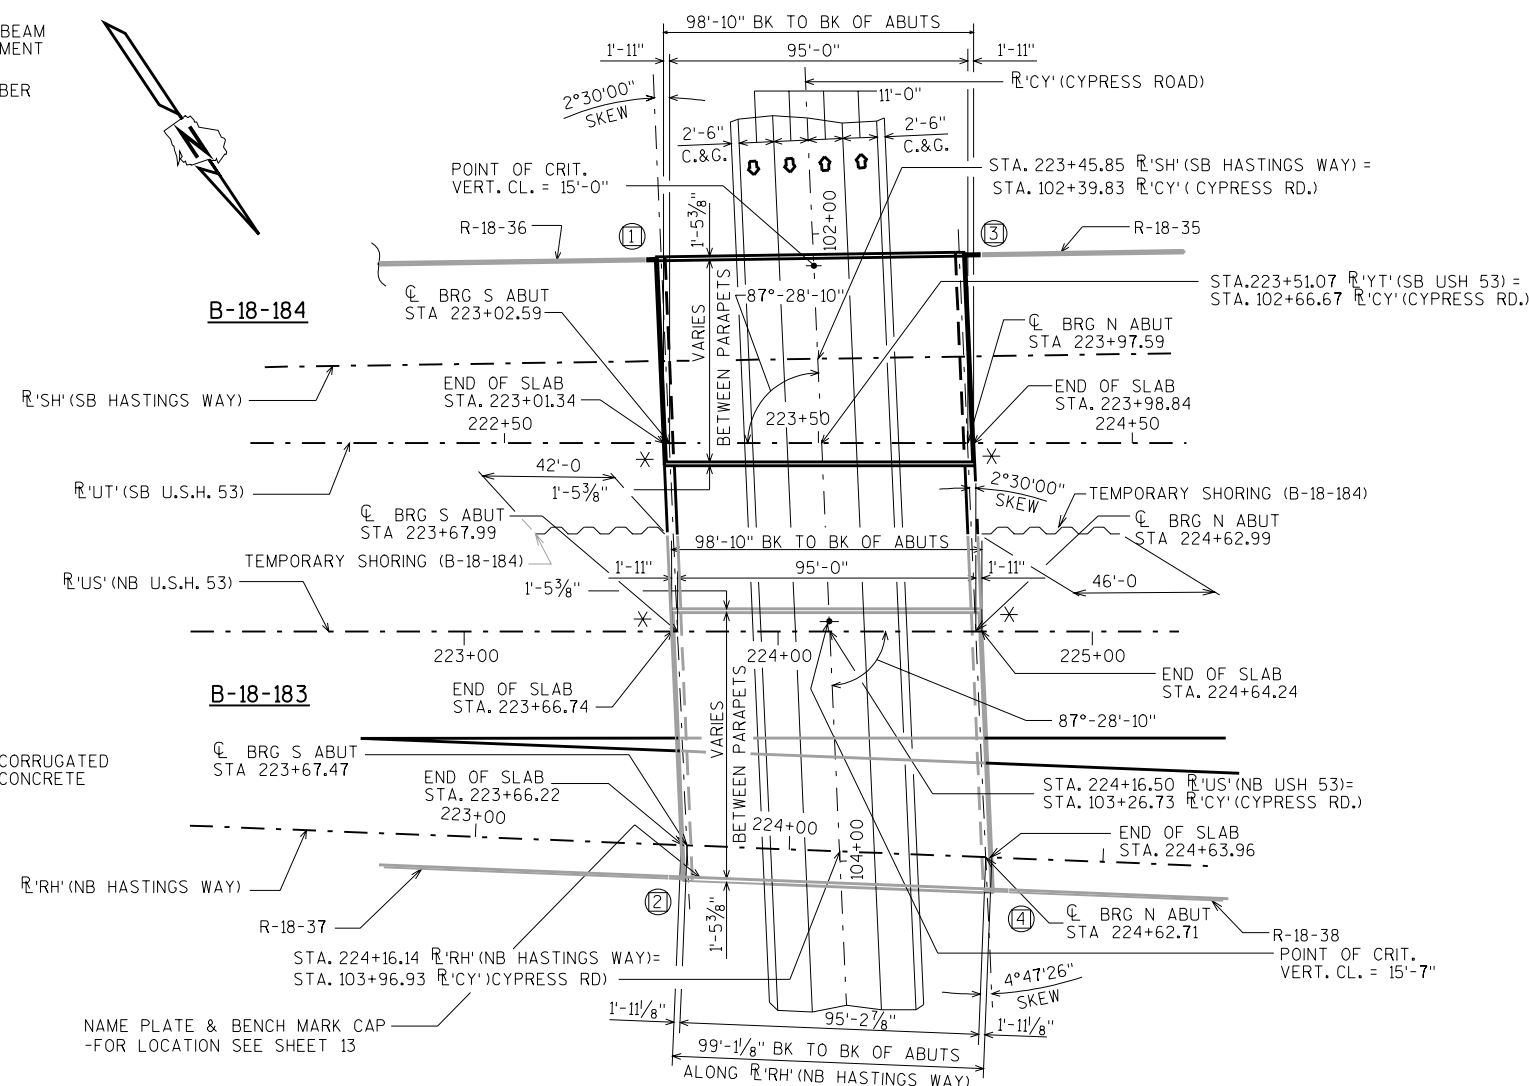


PLAN

SINGLE SPAN - 45" PRESTRESSED GIRDERS

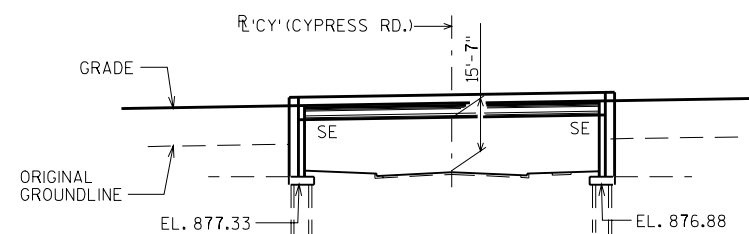

ELEVATION

(FENCING NOT SHOWN)
NORMAL TO CYPRESS ROAD

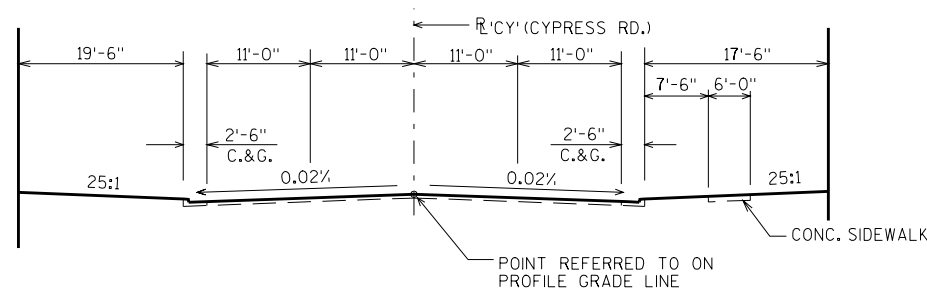


TYPICAL SECTION THRU CYPRESS ROAD

LIST OF DRAWINGS

1. GENERAL PLAN
2. CROSS SECTION & QUANTITIES
3. SUBSURFACE EXPLORATION
4. SOUTH ABUTMENT
5. S. ABUT. DETAILS
6. NORTH ABUTMENT
7. N. ABUT. DETAILS
8. SUPERSTRUCTURE
9. SUPERSTRUCTURE DETAILS
10. 45" PRESTRESSED GIRDER DETAILS
11. STEEL DIAPHRAGM
12. SLOPED FACE PARAPET LF
13. FENCING DETAILS

BRIDGE OFFICE CONTACT = BILL DREHER (608) 261-8205


NO.	DATE	REVISION	BY

	Plans Prepared By	WISDOT
	BUREAU OF STRUCTURES	
APPROVED	CHIEF STRUCTURAL DESIGN ENGINEER	3-2-2004
STRUCTURE B-18-184		
SB USH 53/HASTINGS WAY OVER CYPRESS RD		
COUNTY	EAU CLAIRE	TOWN/CITY/VILLAGE
DESIGN SPEC.	AASHTO STD. SPEC. 2002	LOAD HS-20 CONST. SPEC. 2003
DESIGNED BY	WCD	DRAWN BY JHG
GENERAL PLAN		SHEET 1 OF 13

I.D. 1190-00-05H

DATE: 2/17/04

FILE= 01-184GP.DGN
SCALE = 30

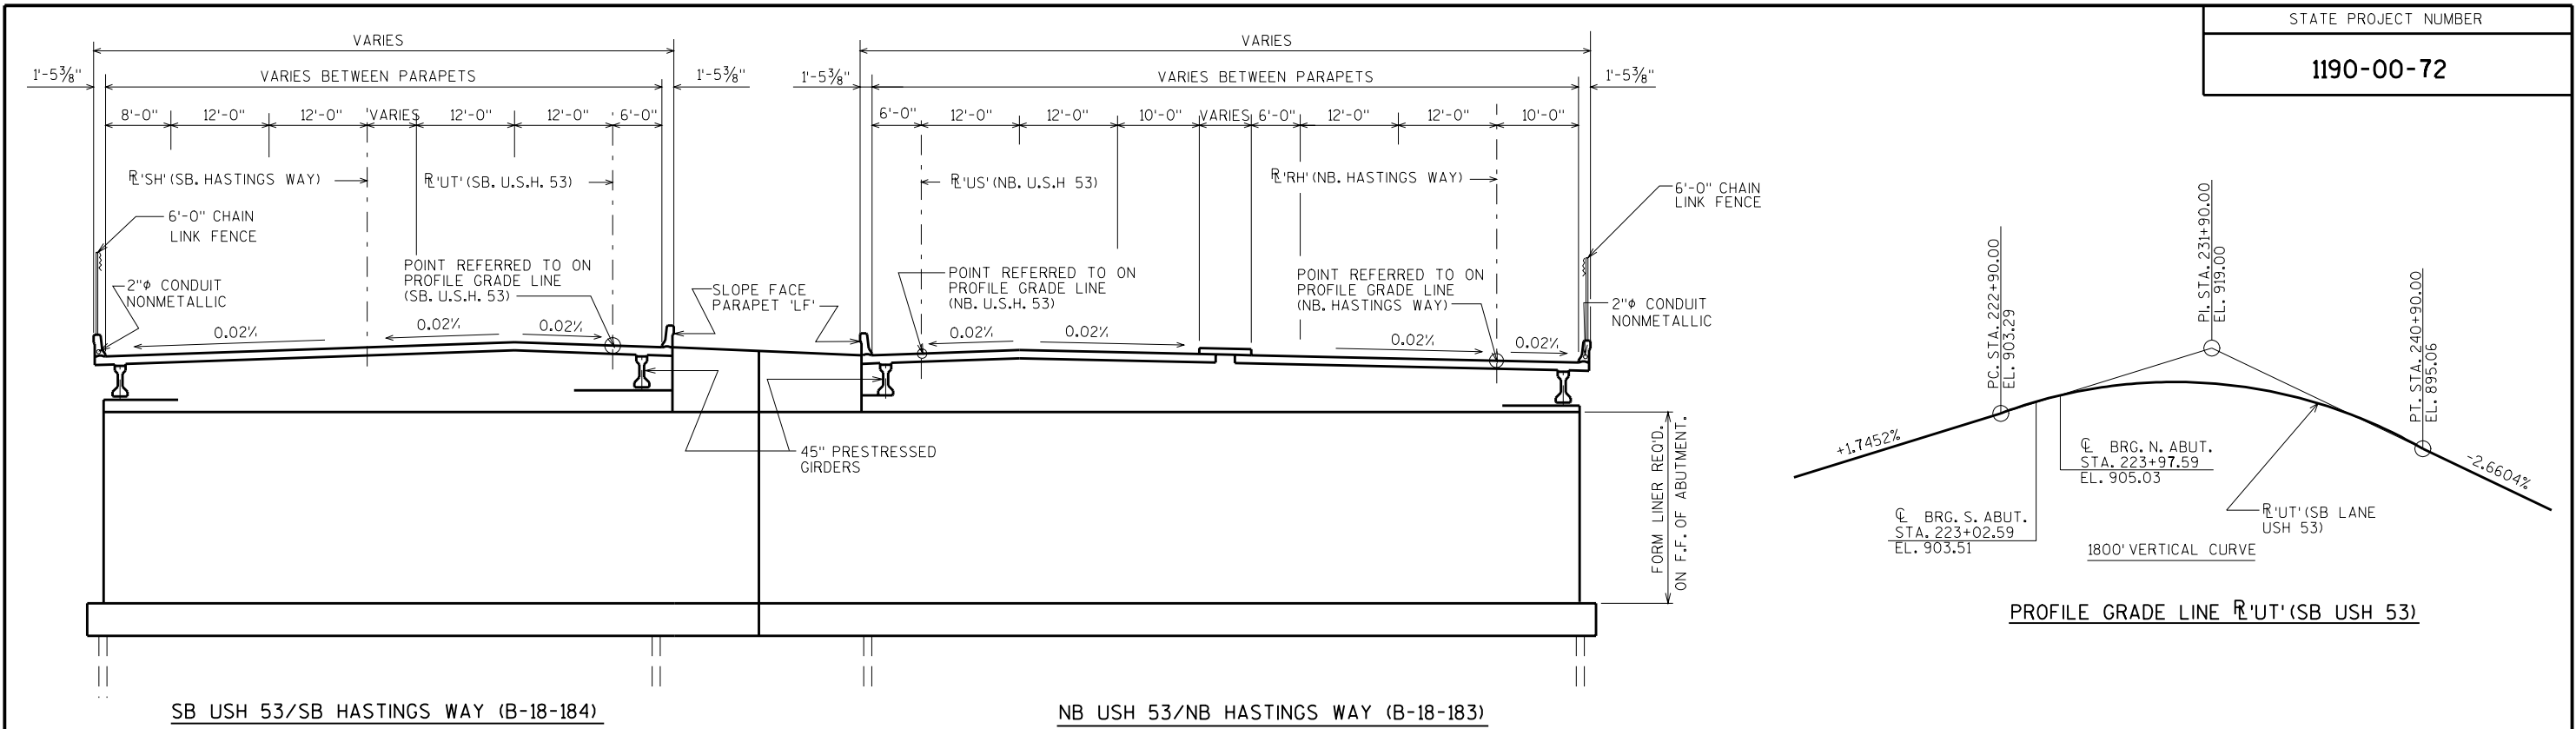

CROSS SECTION THRU ROADWAY LOOKING NORTH

TOTAL ESTIMATED QUANTITIES

BID ITEMS	UNIT	SUPER.	SOUTH ABUT.	NORTH ABUT.	TOTALS
CONDUIT RIGID NONMETALLIC SCHEDULE 40 2-INCH	LF	110	—	—	110
EXCAVATION FOR STRUCTURES BRIDGES B-18-184	L.S.	—	—	—	1
BACKFILL STRUCTURE	C.Y.	—	1730	2020	3750
CONCRETE MASONRY BRIDGES	C.Y.	258	336	365	959
PROTECTIVE SURFACE TREATMENT	S.Y.	785	—	—	758
BAR STEEL REINFORCEMENT HS BRIDGES	LB.	—	20720	21730	42450
BAR STEEL REINFORCEMENT HS COATED BRIDGES	LB.	45710	4070	4290	54070
BEARING PADS ELASTOMERIC NON-LAMINATED	EACH	22	—	—	22
PRESTRESSED GIRDER TYPE I 45-INCH	L.F.	1056	—	—	1056
STEEL DIAPHRAGMS B-18-184	EACH	20	—	—	20
GEOTEXTILE FABRIC TYPE DF - SCHEDULE A	S.Y.	—	70	70	140
RUBBERIZED MEMBRANE WATERPROOFING	S.Y.	—	22	23	45
PIPE UNDERDRAIN 6-INCH	L.F.	—	85	85	170
PIPE UNDERDRAIN UNPERFORATED 6-INCH	L.F.	—	20	20	40
QMP CONCRETE STRUCTURES 5 CYLINDER	C.Y.	258	336	365	959
INCENTIVE STRENGTH CONCRETE STRUCTURES	DOL.	2580	3360	3650	9590
ANCHOR ASSEMBLIES FOR STEEL PLATE BEAM GUARD	EACH	—	—	—	2
ARCHITECTURAL SURFACE TREATMENT	S.F.	—	1376	1580	2956
PILING CIP CONCRETE DELIVERED AND DRIVEN 10¾-INCH	L.F.	—	4960	4960	9920
CONCRETE STAINING B-18-184	LS	—	—	—	1
FENCE CHAIN LINK 6-FT.	L.F.	107	—	—	107
SHORING TEMPORARY	S.F.	—	395	480	875
NON-BID ITEMS					
FILLER	SIZE	—	—	—	1" 1/2" & ¾"

GENERAL NOTES

DRAWINGS SHALL NOT BE SCALED.

BAR STEEL REINFORCEMENT SHALL BE EMBEDDED 2" CLEAR UNLESS OTHERWISE SHOWN OR NOTED.

ELASTOMERIC BEARING PADS NEED NOT BE INDIVIDUALLY MOLDED PROVIDED THE CUT EDGES ARE SMOOTH AND TRUE.

AT THE BACKFACE OF ABUTMENT ALL VOLUME WHICH CANNOT BE IN PLACE BEFORE ABUTMENT CONSTRUCTION AND NOT OCCUPIED BY THE NEW STRUCTURE SHALL BE BACKFILLED WITH STRUCTURE BACKFILL.

THE FIRST OR FIRST TWO DIGITS OF THE BAR MARK SIGNIFIES THE BAR SIZE.

FORMLINER ON ABUTMENT BODY TO BE 2" BROKEN ROCK RIB.

THE FOLLOWING COMPONENTS SHALL BE STAINED LIGHT GRAY (FEDERAL STANDARD COLOR NO. 36622) IN ACCORDANCE WITH THE SPECIAL PROVISIONS:


- THE UNDERSIDE OF THE DECK OVERHANGS TO THE EXTERIOR GIRDERS.
- THE EDGES OF THE DECK.
- THE BACK FACES OF THE PARAPETS.
- ALL EXPOSED VERTICAL SURFACES OF THE ABUTMENTS TO 1'-0" BELOW FINISHED GROUNDLINE.
- ALL EXPOSED VERTICAL SURFACES OF THE ABUTMENT DIAPHRAGMS EXCEPT BETWEEN GIRDERS.

THE FOLLOWING COMPONENTS SHALL BE STAINED DARK GRAY (FEDERAL STANDARD COLOR NO. 26293) IN ACCORDANCE WITH THE SPECIAL PROVISIONS:

- THE OUTSIDE FACE AND UNDERSIDE OF THE BOTTOM FLANGE OF THE EXTERIOR GIRDERS.


THE VINYL COATED CHAIN LINK FENCE SHALL BE BLACK.

PROTECTIVE SURFACE TREATMENT SHALL BE APPLIED TO THE TOP SURFACE OF THE DECK AND THE INSIDE FACE AND TOP OF PARAPETS.

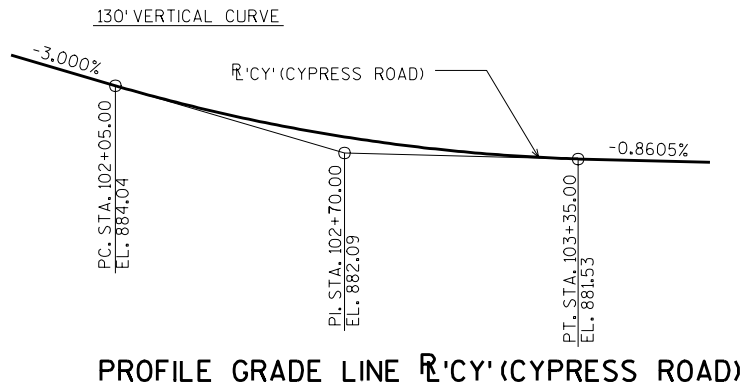

NO.	DATE	REVISION	BY
STATE OF WISCONSIN DEPARTMENT OF TRANSPORTATION STRUCTURES DESIGN SECTION			
STRUCTURE B-18-184			
CONST. SPEC.	2003	DRAWN BY	JHG
PLANS CK'D.	Budd	SHEET 2	
CROSS SECTION & QUANTITIES			

USH 53 OVER CYPRESS ROAD
EAU CLAIRE BYPASS, EAU CLAIRE COUNTY

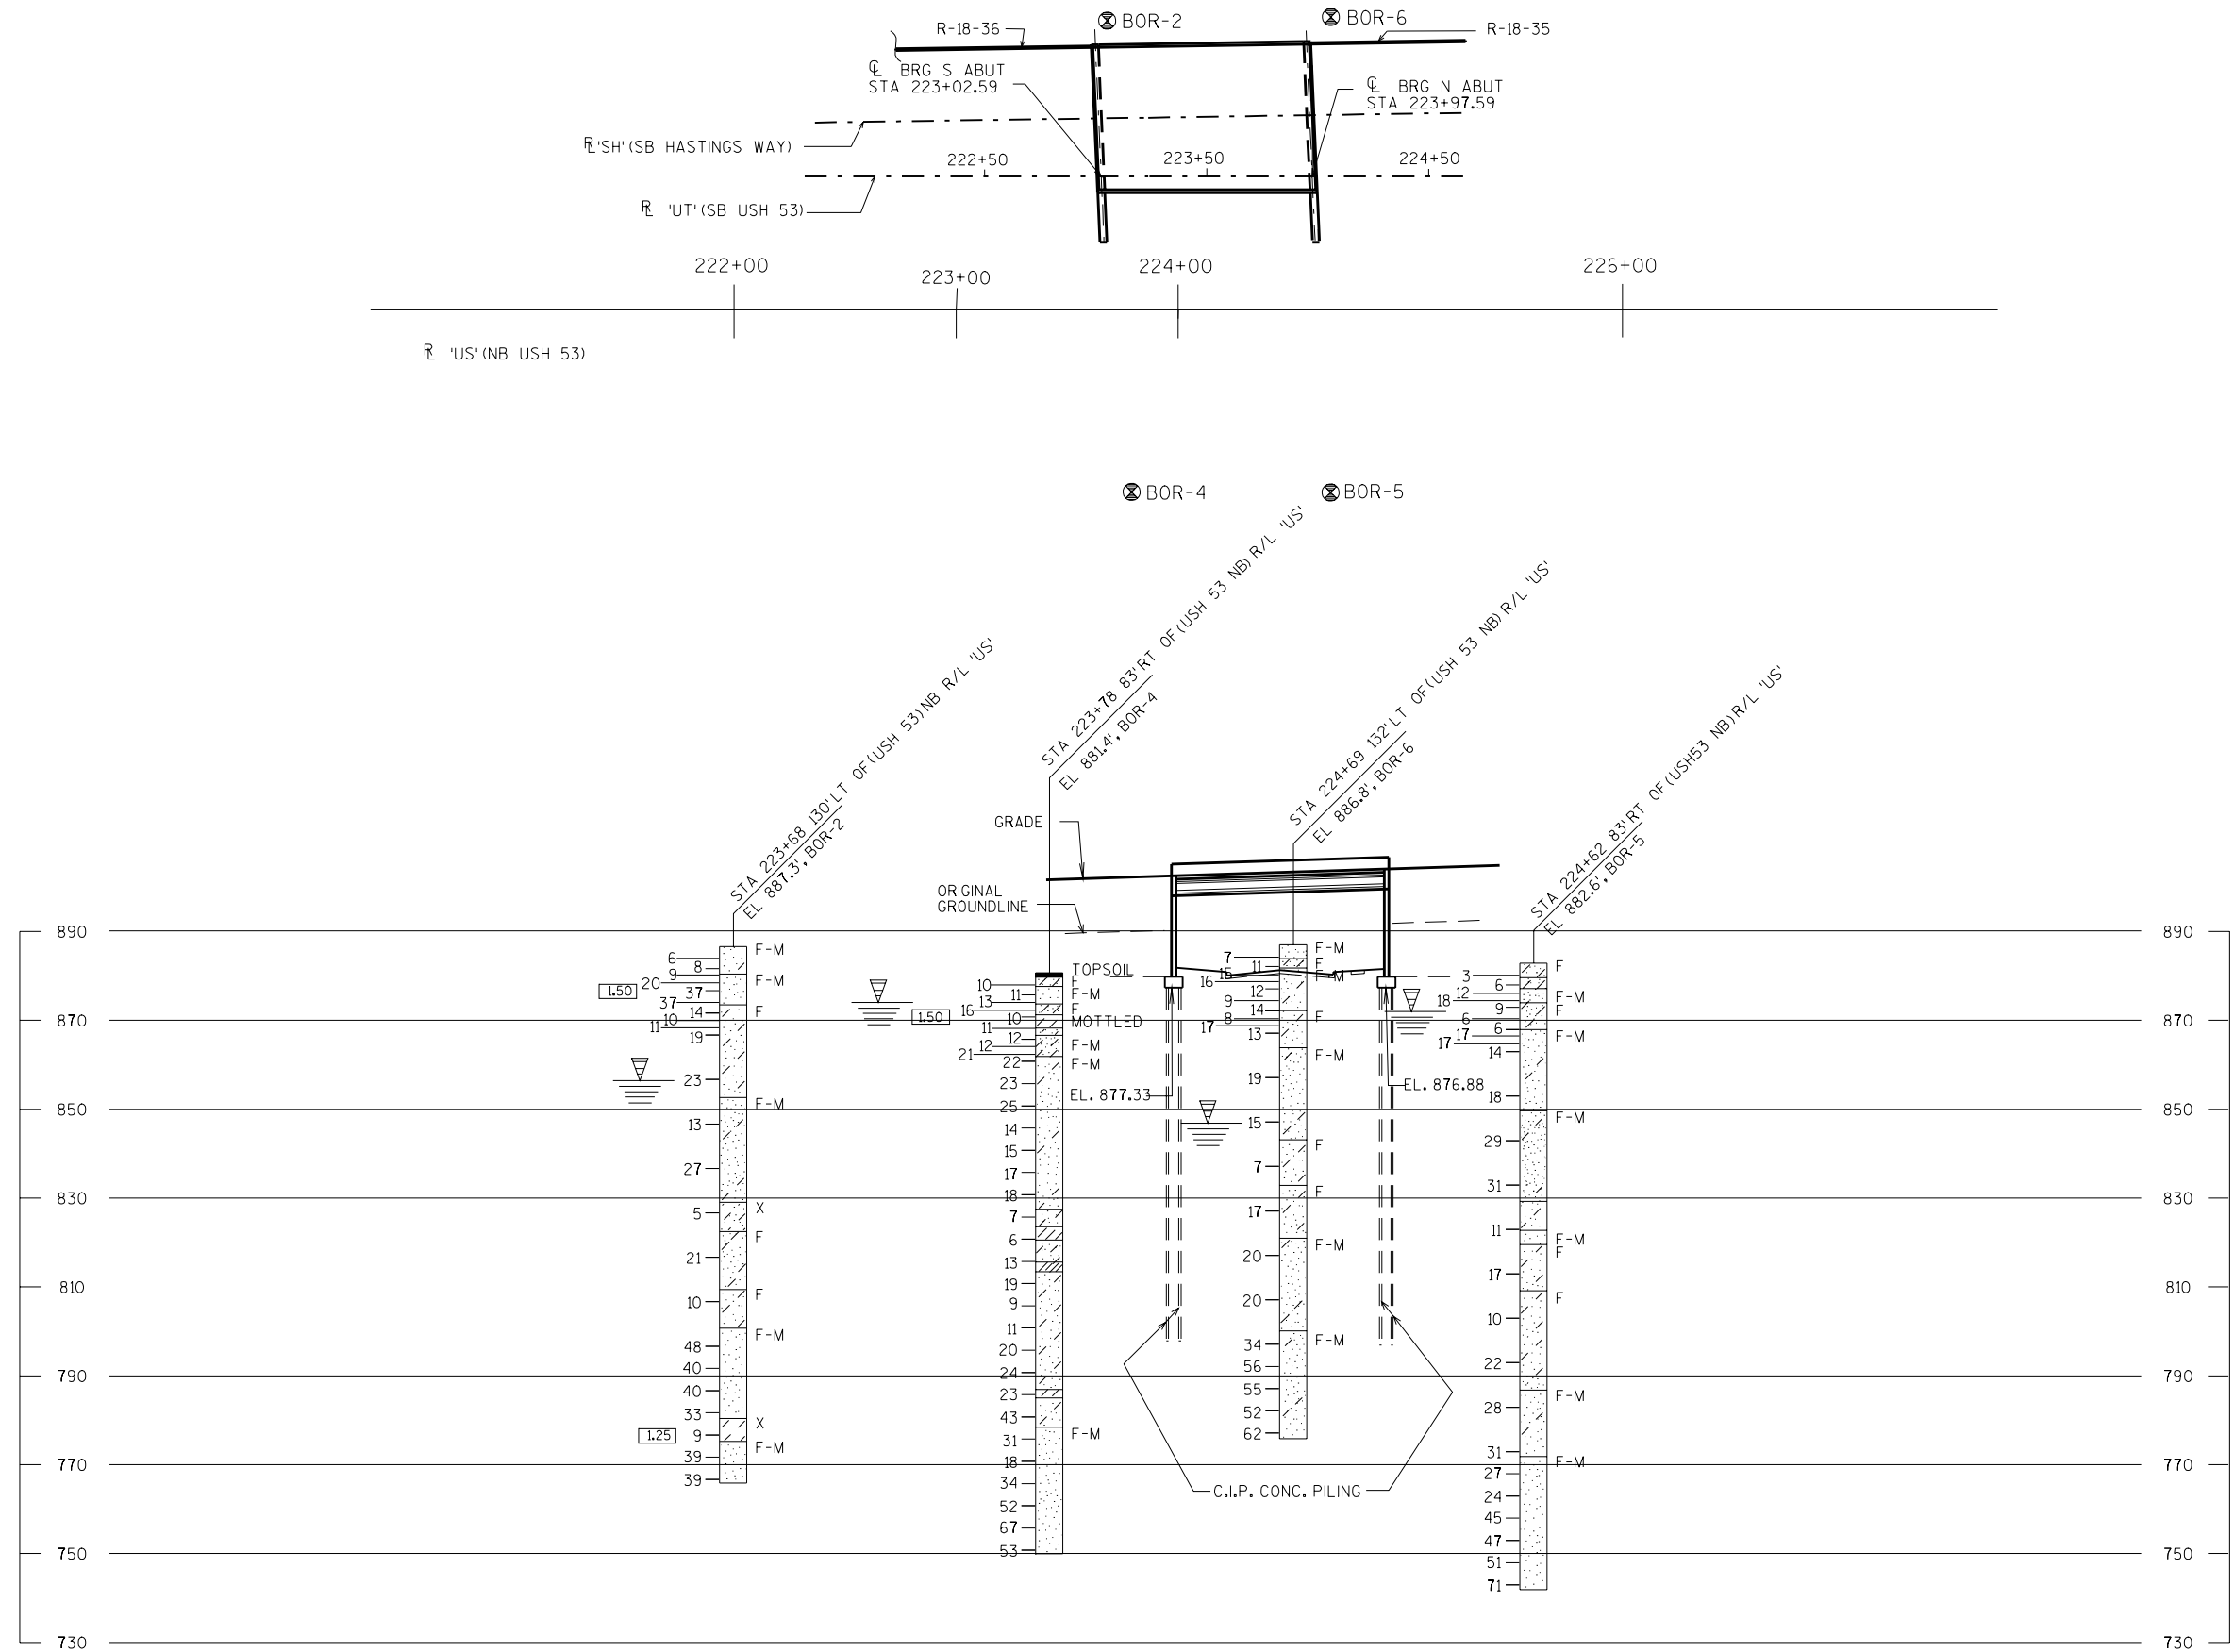

STATE PROJECT NUMBER

1190-00-72

ABBREVIATIONS

F — FINE M — MEDIUM C — COARSE
WS — WEATHERED SO — SOUND

MATERIAL SYMBOLS

TOPSOIL SILT SANDSTONE
SAND PEAT LIMESTONE
GRAVEL CLAY IGNEOUS ROCK

LEGEND OF PROBING

PROBING NO.
STA.
ELEVATION
7 AVERAGE BLOWS PER FOOT
REFUSAL 95/6

95/6=95 BLOWS FOR 6" PENETRATION
PROBING TAKEN WITH A 350# WT. FALLING 18" ON A 2" O.D. POINT.

LEGEND OF BORING

BORING NO.
STA.
ELEV.
UNCONFINED STRENGTH → 7.7
BLOWS PER FT. USING 140# WT. FALLING 30" → 7
WASH SAMPLE
SHELBY TUBE — S.T.
GROUND WATER ELEVATION
NO GROUND WATER OBSERVED ABOVE THIS ELEVATION

SANDY GRAVEL
F. BOULDERS OR COBBLES
SAND
SILTY CLAY
SO
LIMESTONE


UNLESS OTHERWISE SPECIFIED, THE BLOWS PER FOOT AT THE LOCATIONS INDICATED ARE BASED ON DRIVING A 2" O.D. X 1.4" I.D. SPLIT SPOON SAMPLER WITH A 140# HAMMER HAVING A FREE FALL OF 30". THE BLOW COUNT IS TAKEN IN UNDISTURBED SOIL IMMEDIATELY BELOW A CAGED OR OPEN HOLE ELIMINATING SIDE FRICTION ON THE DRIVE PIPE.

SUBSURFACE EXPLORATION FOR FOUNDATION DESIGN AND BIDDERS INFORMATION

TO OBTAIN RELATIVE DATA CONCERNING THE CHARACTER OF MATERIAL IN AND UPON WHICH THE FOUNDATION MIGHT BE BUILT, BORINGS AND/OR SOUNDINGS WERE MADE AT POINTS APPROXIMATELY AS INDICATED ON THIS DRAWING. THE DATA PRESENTED HEREIN REPRESENTS THE FINDINGS OF THE SUBSURFACE EXPLORATIONS MADE. HOWEVER, BECAUSE THE DEPTHS INVESTIGATED ARE LIMITED AND THE AREA OF THE BORINGS AND/OR SOUNDINGS IS VERY SMALL IN RELATION TO THE ENTIRE AREA, THE WISCONSIN DEPARTMENT OF TRANSPORTATION DOES NOT WARRANT CONDITIONS BELOW THE DEPTHS INVESTIGATED OR THAT THE CLASSIFICATION OF MATERIAL ENCOUNTERED IN THESE INVESTIGATIONS IS NECESSARILY TYPICAL OF THE ENTIRE SITE.

NO.	DATE	REVISION	BY
STATE OF WISCONSIN DEPARTMENT OF TRANSPORTATION STRUCTURES DESIGN SECTION			
STRUCTURE B-18-184			
CONST. SPEC.	2003	DRAWN BY JHG	PLANS CK'D. Budd
SUBSURFACE EXPLORATION		SHEET 3	



8
FILE= 03-184SOILS.DGN
SCALE = 40

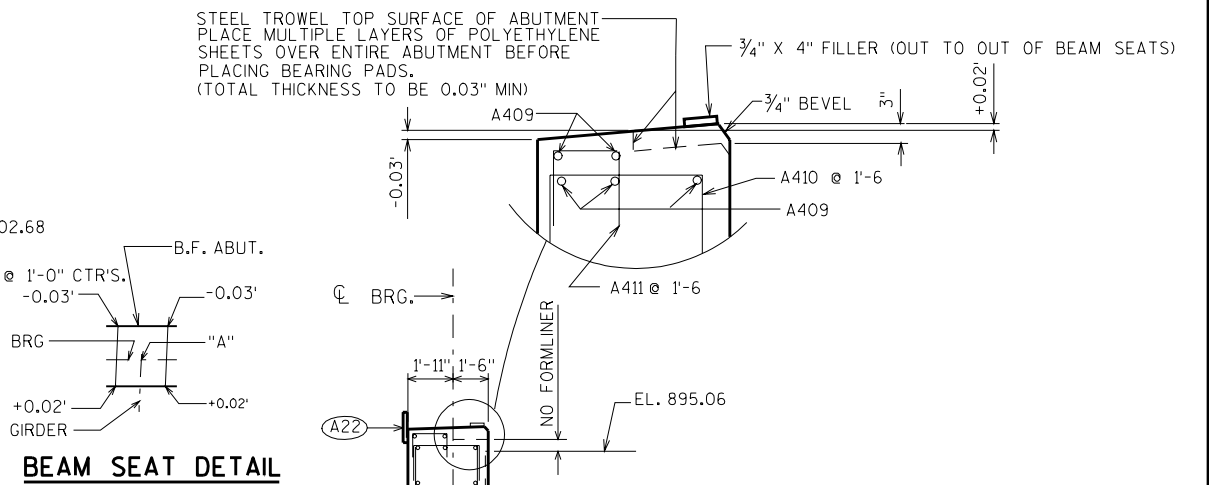

Technical drawing of a bridge abutment cross-section. The drawing shows a vertical wall on the left and a sloped abutment on the right. Reinforcement bars are labeled with callouts: A908 @ 13", A409 @ 1'-6" MAX., A826 @ 1'-0" CTR'S., A907 @ 13", A904 @ 6 1/2", A15, A402 @ 1'-6", A701 @ 6", A09, A506 @ 1'-0", A409 @ 1'-6" MAX., A05, A505 @ 1'-0", A503 @ 1'-0", and FORMLINER. Dimensions are given in feet and inches: 12'-0" (total height), 4'-0" (height of lower section), 4'-7" (height of upper section), 3'-0" (height of batter section), 1'-3" (width of base), 6'-6" (width of base), 3'-0" (width of batter section), and 1'-3" (width of base). A slope of 25:1 is indicated for the right side. A note at the bottom right states: "NOTE: ABUTMENTS SHALL BE CONCRETE IN THE FIELD AND CULVERTS SHALL BE CAST-IN-PLACE CONCRETE." A scale of 1" = 1'-0" is provided at the bottom left.

- (A04) VERT. CONSTRUCTION JOINT IN KEYWAY FORMED BY A BEVELED 2×8 . (3/4" "V" GROOVE ABOVE FORMLINER @ THE FRONT FACE) (R.M.W. @ BACKFACE).
- (A05) CONSTRUCTION JOINT IN FTG: KEYWAY FORMED BY A BEVELED 2×8 .
- (A09) SUPPORT ABUTMENT ON $10\frac{3}{4}$ " DIA. CAST-IN-PLACE CONCRETE PILING, ESTIMATED 80'-0" LONG, AND DRIVEN TO A MIN. BRG. VALUE OF 55 TONS PER PILE.
- (A15) PIPE UNDERDRAINS, 6 INCH. SLOPE 0.5% MIN. TO DRAIN. ENCLOSED IN 1'-6" X 1'-6" AREA OF SIZE 1 COARSE AGGREGATE (INCLUDED IN UNDERDRAIN BID ITEM) WRAPPED IN GEOTEXTILE FABRIC, TYPE DF, WITH 1'-6" OVERLAP.
- (A16) PIPE UNDERDRAIN, 6 INCH. UNPERFORATED. TO SUITABLE DRAINAGE.
- (A21) 3/4" CORK UP VERT. FACES OF BEAM SEATS.
- (A22) 18" (RMW) RUBBERIZED MEMBRANE WATERPROOFING SEAL ALL HORIZ. & VERT. JOINTS AT BACKFACE.
- (A20) 1/2" FILLER :SEAL EXPOSED HORIZ. & VERT. SURFACES OF 1/2" FILLER WITH NON-STAINING GRAY NON-BITUMINOUS JOINT SEALER. (1" DEEP AND HOLD 1/8" BELOW SURFACE OF CONCRETE).

NO.	DATE	REVISION	BY
STATE OF WISCONSIN DEPARTMENT OF TRANSPORTATION STRUCTURES DESIGN SECTION			
STRUCTURE B-18-184			
CONST. SPEC.	2003	DRAWN BY	JHG PLANS CK'D. Budd
SOUTH ABUTMENT		SHEET 4	

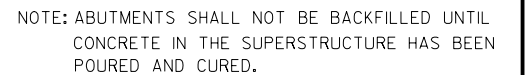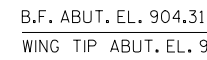

(A04) VERT. CONSTRUCTION JOINT IN KEYWAY FORMED BY A BEVELED 2×8 . (3/4" "V" GROOVE ABOVE FORMLINER @ THE FRONT FACE) (R.M.W. @ BACKFACE).

(A05) CONSTRUCTION JOINT IN FTG: KEYWAY FORMED BY A BEVELED 2×8 .

(A09) SUPPORT ABUTMENT ON $10\frac{3}{4}$ " DIA. CAST-IN-PLACE CONCRETE PILING, ESTIMATED 80'-0" LONG, AND DRIVEN TO A MIN. BRG. VALUE OF 55 TONS PER PILE.

(A15) PIPE UNDERDRAINS, 6 INCH. SLOPE 0.5% MIN. TO DRAIN, ENCLOSED IN 1'-6" X 1'-6" AREA OF SIZE 1 COARSE AGGREGATE (INCLUDED IN UNDERDRAIN BID ITEM) WRAPPED IN GEOTEXTILE FABRIC, TYPE DF, WITH 1'-6" OVERLAP.

(A16) PIPE UNDERDRAIN, 6 INCH, NONPERFORATED. TO SUITABLE DRAINAGE.

(A21) 3/4" CORK UP VERT. FACES OF BEAM SEATS.



(A22) 18" (RMW) RUBBERIZED MEMBRANE WATERPROOFING SEAL ALL HORIZ. & VERT. JOINTS AT BACKFACE.

(A20) 1/2" FILLER :SEAL EXPOSED HORIZ. & VERT. SURFACES
1/2" FILLER WITH NON-STAINING GRAY NON-BITUMINOUS JOINT SEALER. (1" DEEP AND HOLD 1/8" BELOW SURFACE OF CONCRETE).


SCALE = 8


NOTE: THE FIRST OR FIRST TWO DIGITS OF THE
BAR MARK SIGNIFIES THE BAR SIZE.

BAR MARK	COAT	NO. REQ'D.	LENGTH	BENT	BAR SERIES	LOCATION
B701		176	11-8			FOOTING
B402		48	30-7			FOOTING
B503		88	11-8			FOOTING
B904		162	8-4	X		FOOTING DOWEL B.F.
B505		89	4-10	X		FOOTING DOWEL F.F.
B506	X	70	19-2			VERT. F.F.
B907		81	12-0			VERT. B.F.
B908		63	19-6			VERT. B.F.
B409	X	87	30-7			HORIZ. F.F. & B.F.
B410	X	59	7-0	X		TOP
B411		46	3-11	X		TOP
B912		19	23-10			VERT. B.F. EAST SIDE
B513	X	21	23-10			VERT. F.F. EAST SIDE
B414	X	8	21-0			HORIZ. F.F. & B.F. EAST SIDE
B415		6	4-4	X		FOOTING EAST SIDE WALL WING
B416		6	19-6			EAST SIDE-WALL VERT. F.F. & B.F. WING
B517		20	7-1			EAST SIDE-WALL HORIZ. F.F. WING
B918		20	8-4			EAST SIDE-WALL HORIZ. B.F. WING
B419	X	4	5-9			EAST SIDE-WALL VERT. F.F. WING
B420	X	3	3-6			EAST SIDE-WALL HORIZ. F.F. WING
B521	X	4	6-0			EAST SIDE-WALL VERT. B.F. WING
B522	X	5	3-6			EAST SIDE-WALL HORIZ. B.F. WING
B623	X	20	3-5			EAST SIDE-WALL
B624	X	5	1-5	X		EAST SIDE-WALL
B425	X	2	23-9			EAST SIDE-WALL
B826		20	9-1	X		BODY B.F. @ WING 3

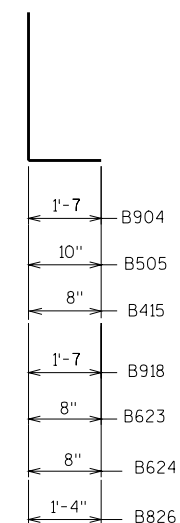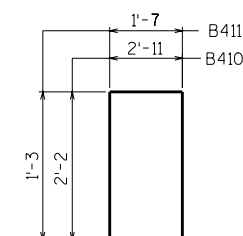


NO.	DATE	REVISION			BY
STATE OF WISCONSIN DEPARTMENT OF TRANSPORTATION STRUCTURES DESIGN SECTION					
STRUCTURE B-18-184					
CONST. SPEC.	2003	DRAWN BY	JHG	PLANS CK'D.	Bud
N. ABUT. DETAILS			SHEET 7		

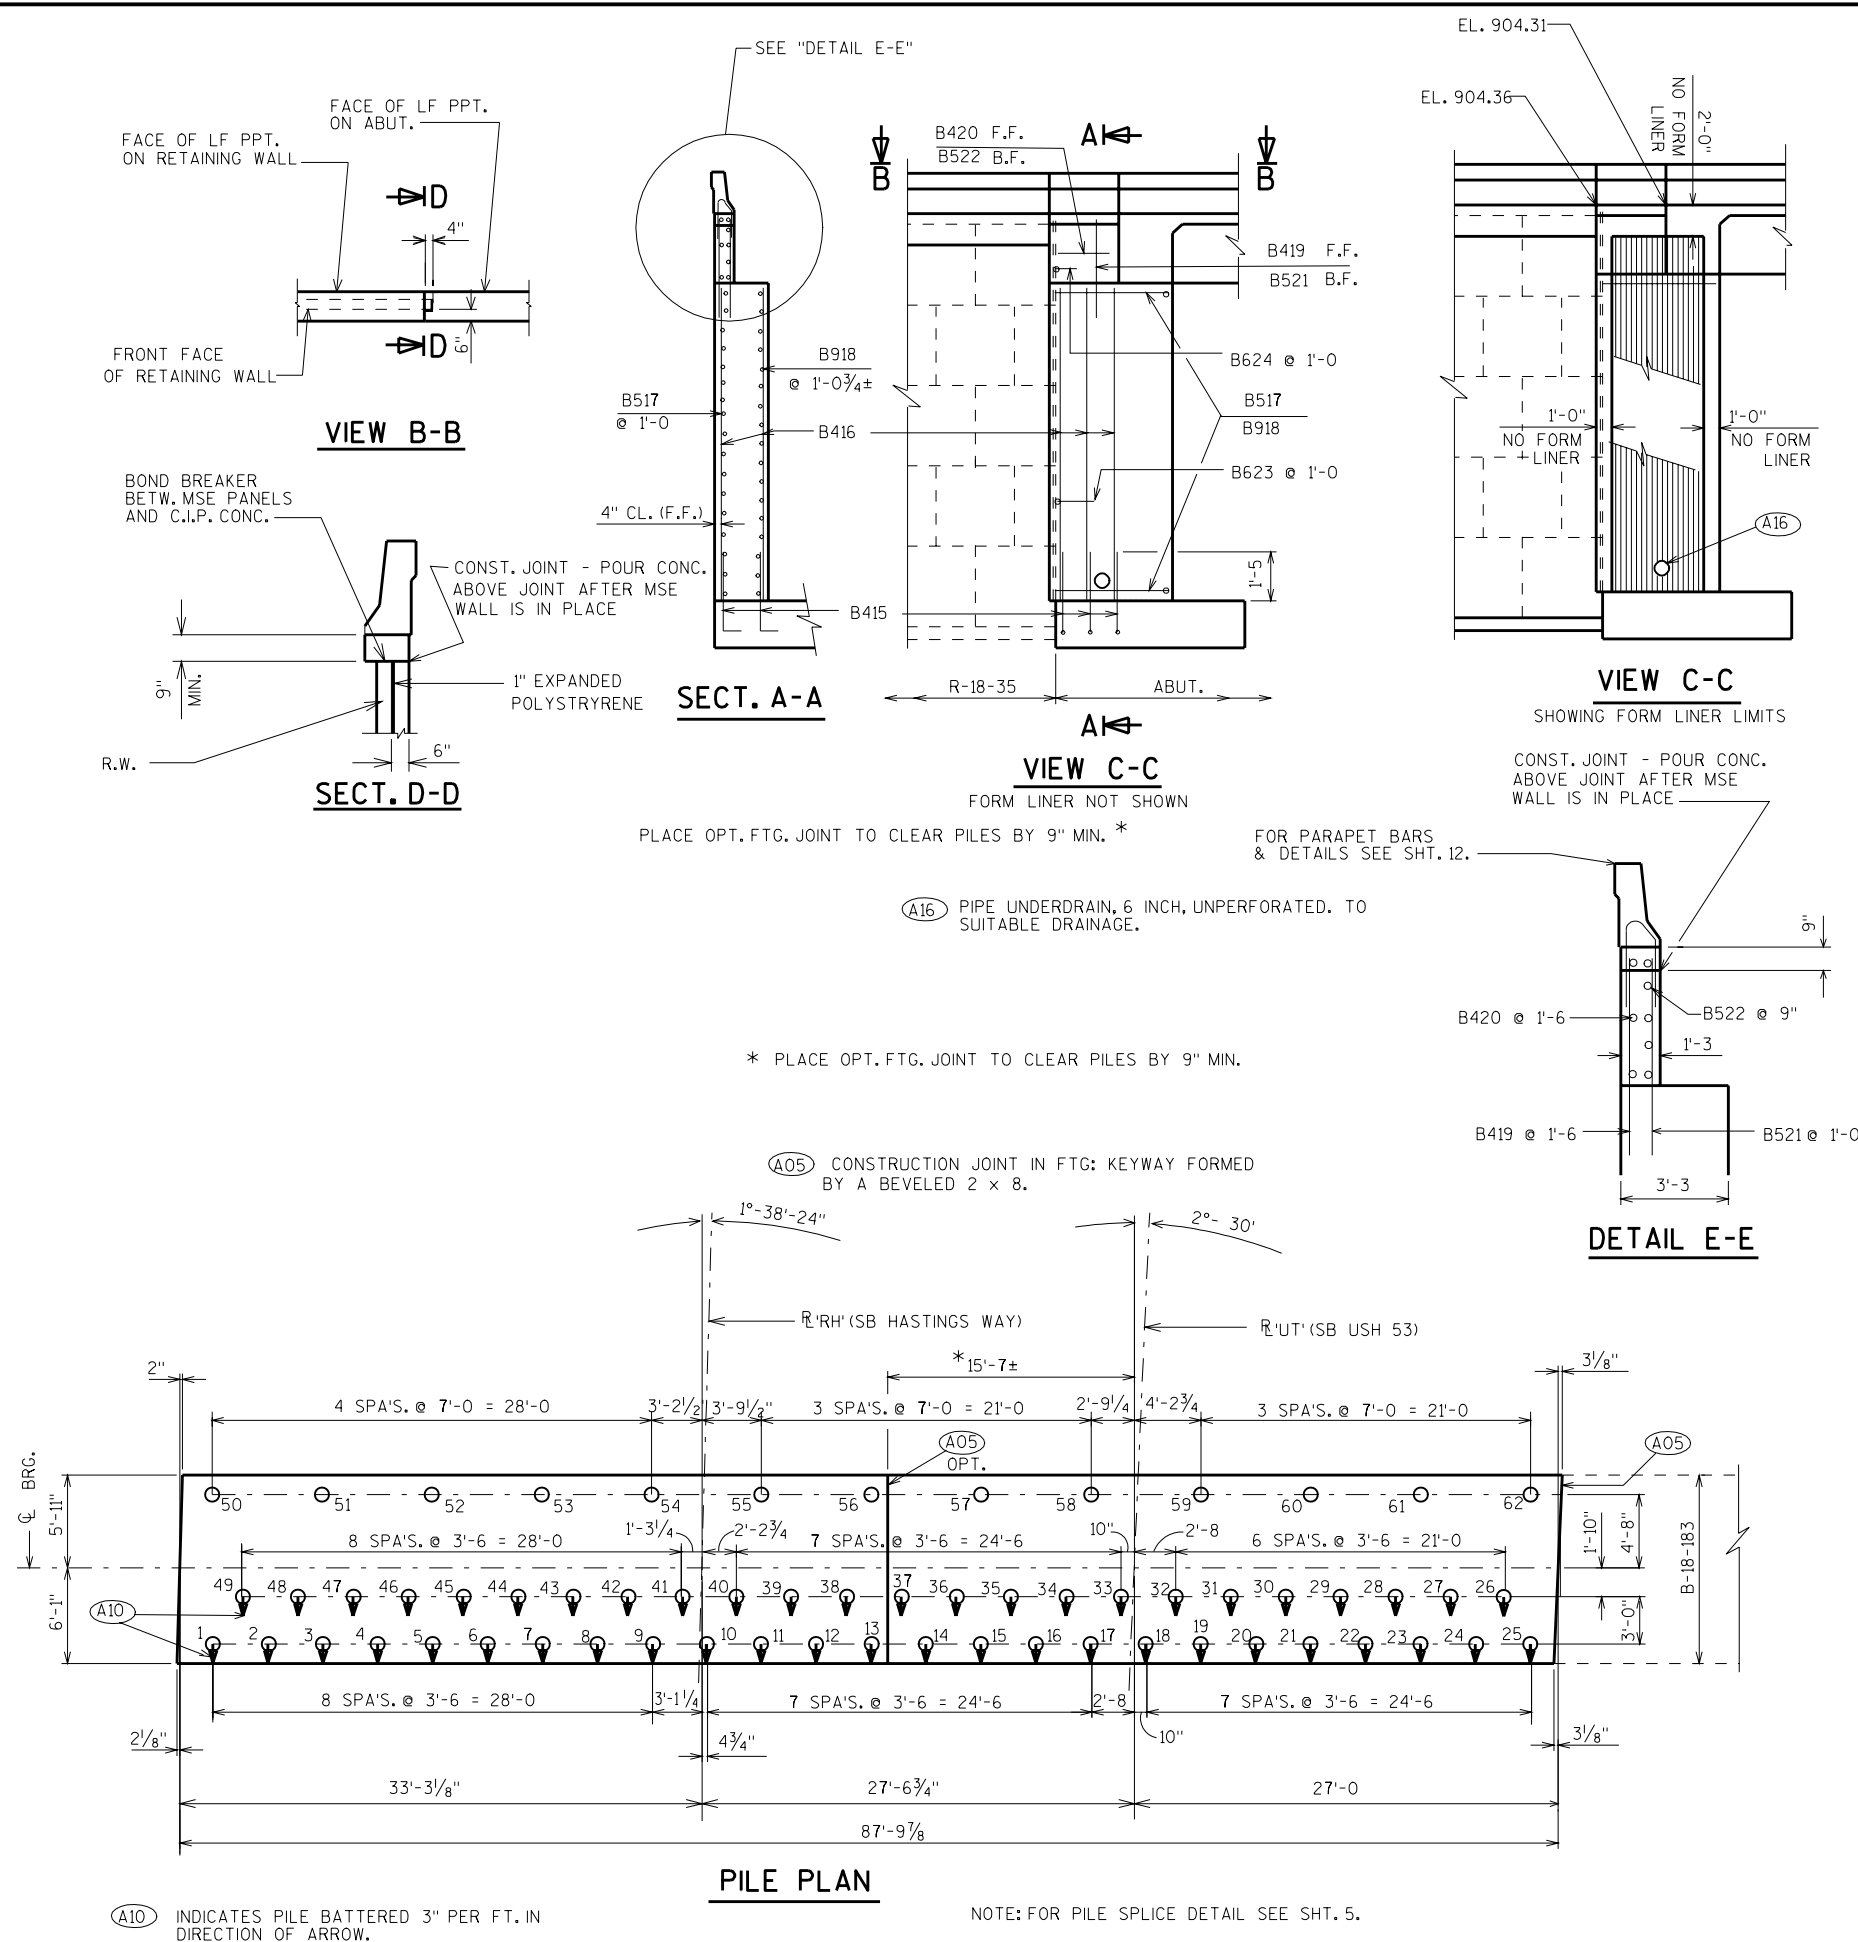


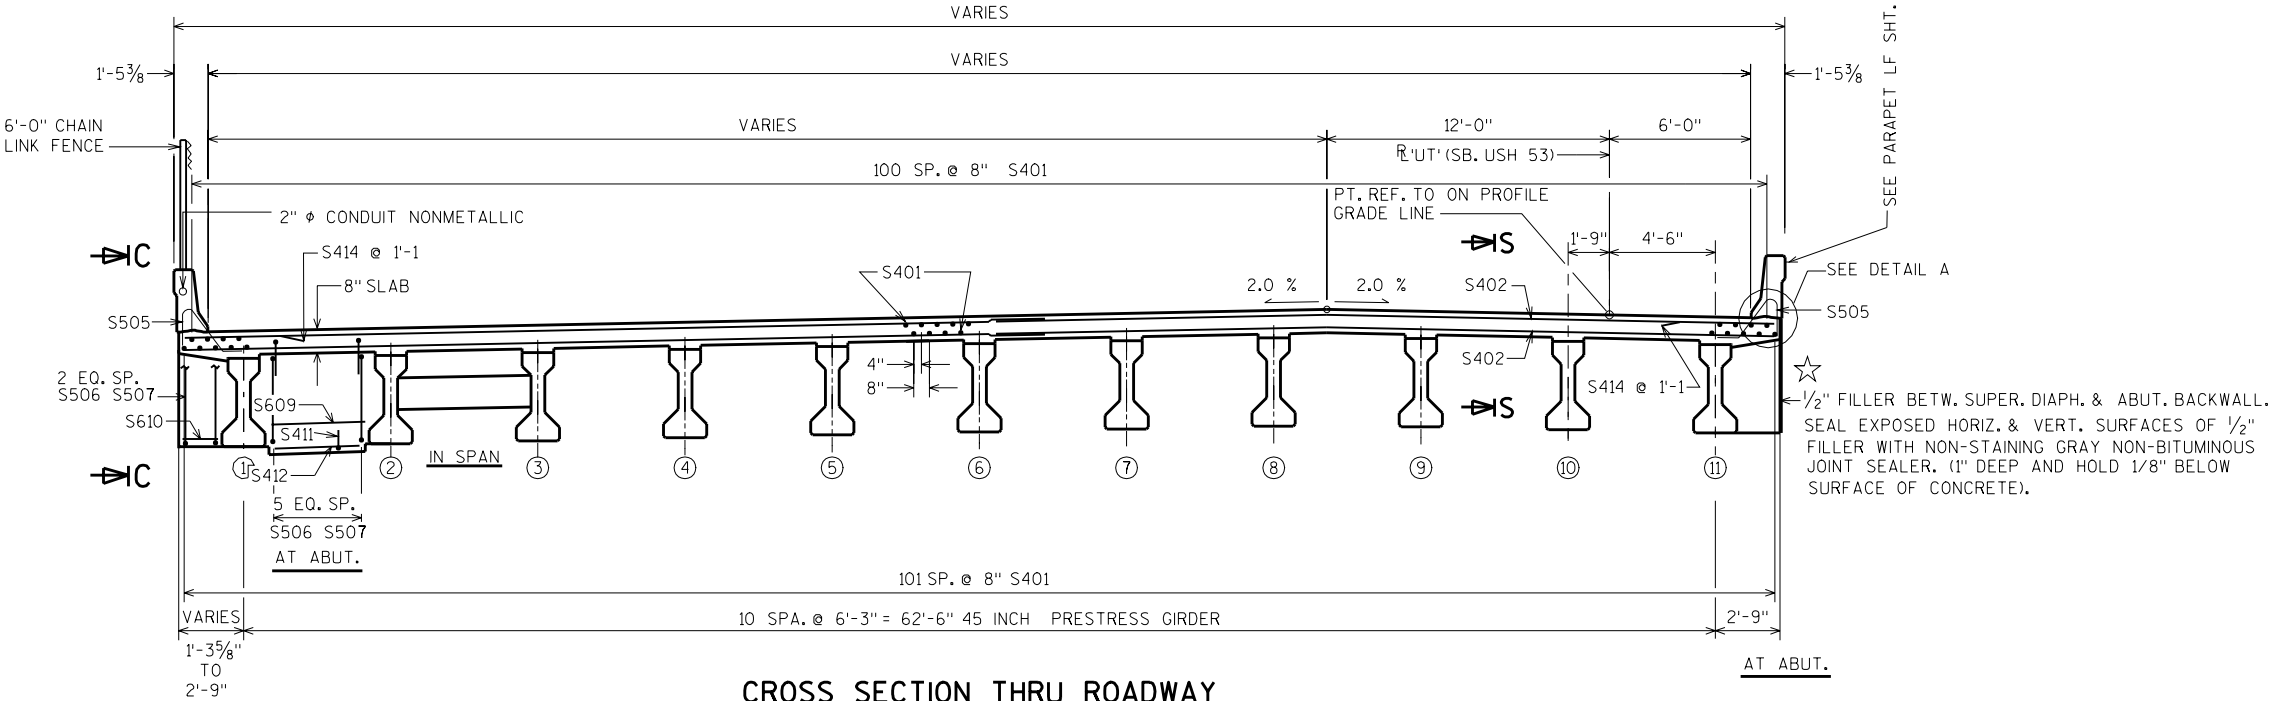


CROSS SECTION THRU ROADWAY
(LOOKING NORTH)

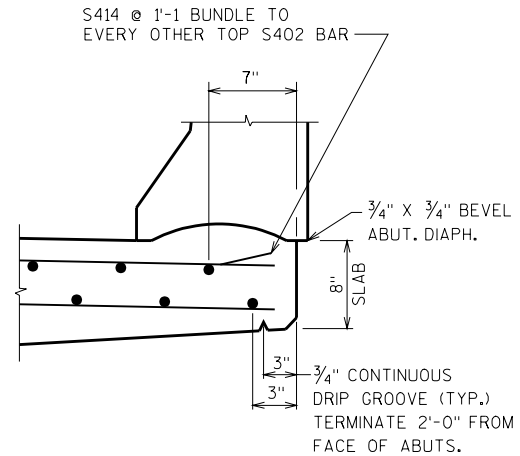


DETAIL A

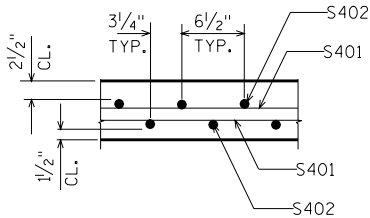

SECTION S-S

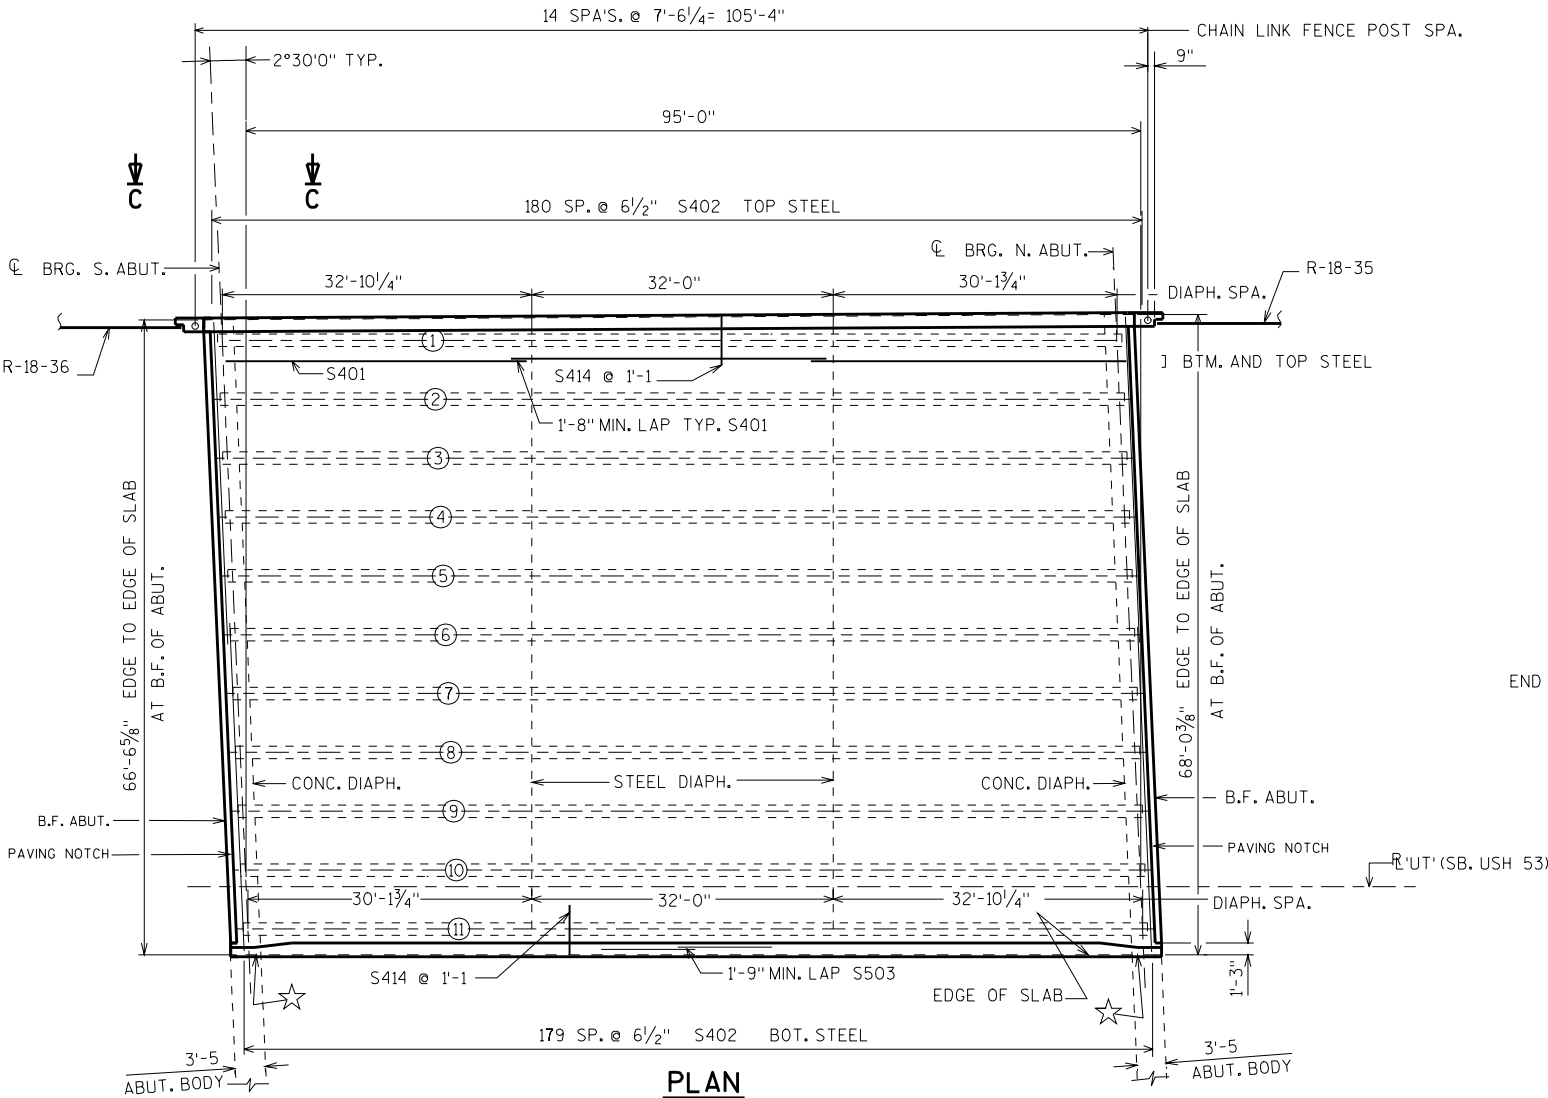


PLAN

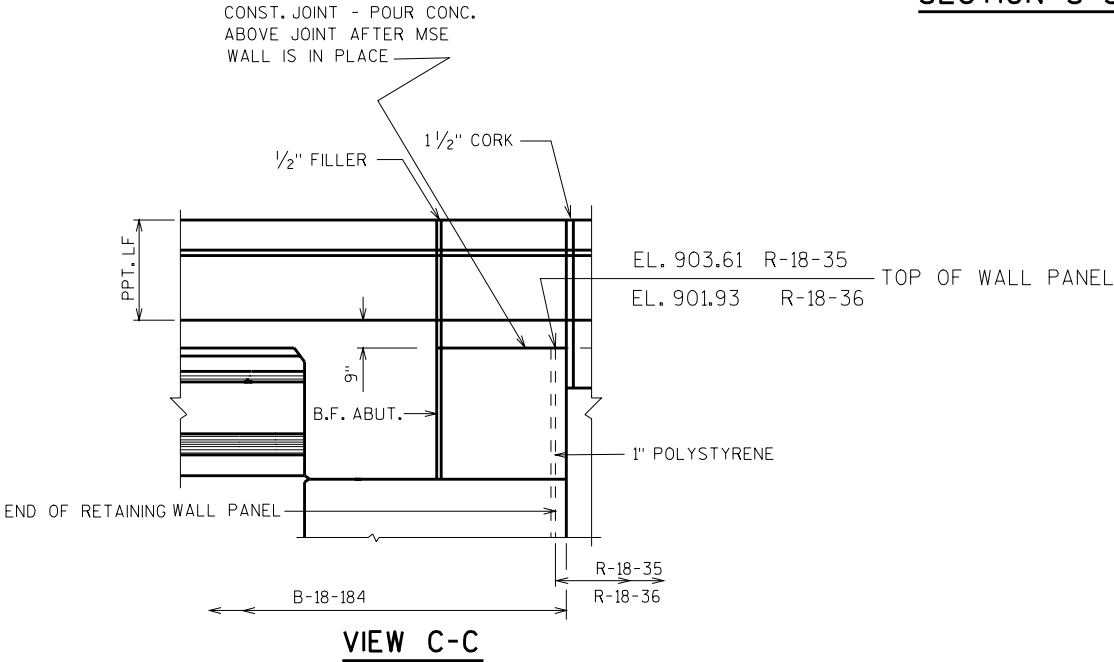


NO.	DATE	REVISION	BY
STATE OF WISCONSIN DEPARTMENT OF TRANSPORTATION STRUCTURES DESIGN SECTION			
STRUCTURE B-18-184			
CONST. SPEC.	2003	DRAWN BY JHG	PLANS CK'D. Budd
SUPERSTRUCTURE		SHEET 8	

BILL OF BARS


BAR MARK	COAT	NO. REQ'D.	LENGTH	BEND	BUNDLE	LOCATION
S401	X	609	33'-6"			LONGITUDINAL TOP & BOTTOM
S402	X	722	34'-8"		X	TRANSVERSE TOP & BOTTOM
S503	X	28	34'-0"			PARAPET LF HORIZ.
S504	X	309	4'-10"	X		PARAPET LF VERT.
S505	X	277	4'-5"	X		PARAPET LF VERT.
S506	X	132	6'-0	X		ABUT. DIAPHRAGM
S507	X	132	13'-8	X		ABUT. DIAPHRAGM
S608	X	28	35'-4"			ABUT. DIAPHRAGM
S609	X	100	4'-1"			ABUT. DIAPHRAGM
S610	X	15	1'-6"			ABUT. DIAPHRAGM @ SE, NE & NW COR'S.
S411	X	80	3'-6	X		ABUT. DIAPHRAGM
S412	X	40	3'-1"			ABUT. DIAPHRAGM
S513	X	44	6'-0"			ABUT. DIAPHRAGM SYM. ABOUT CL GIR.
S414	X	182	4'-3"		X	TOP TRANSVERSE

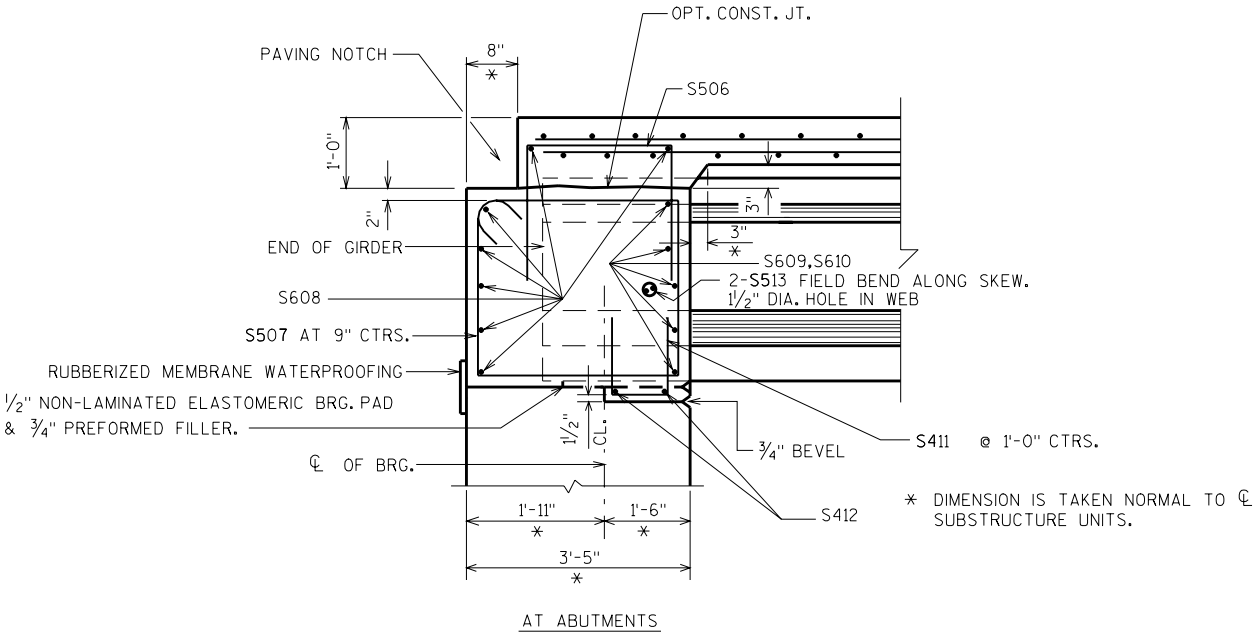


PART LONGIT. SECTION

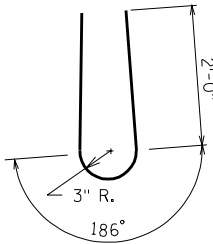

S504

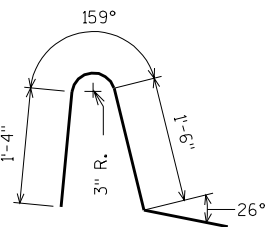


S505


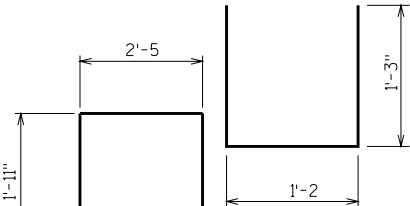


S506

S411

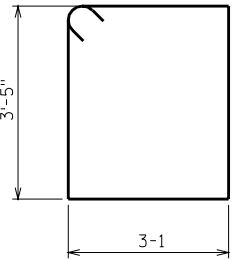

S507

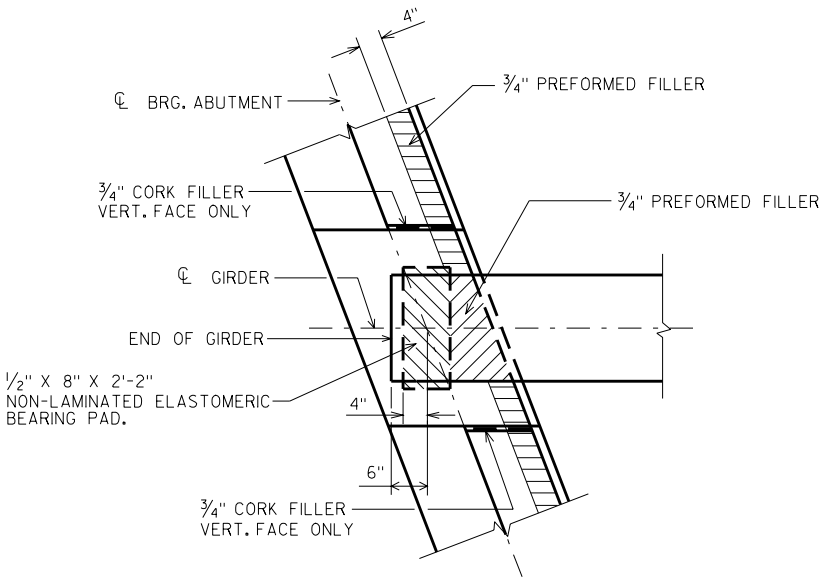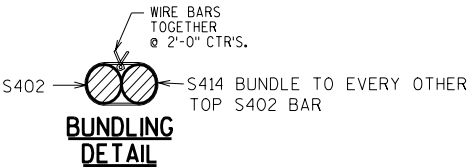


BEARING PAD DETAIL

TOP OF DECK ELEVATIONS


	S. ABUT.	1/8	2/8	3/8	4/8	5/8	6/8	7/8	N. ABUT.
GIR. 1	902.79	902.99	903.19	903.38	903.58	903.77	903.95	904.13	904.31
GIR. 2	902.92	903.12	903.32	903.51	903.71	903.90	904.08	904.26	904.44
GIR. 3	903.05	903.25	903.45	903.64	903.84	904.02	904.21	904.39	904.57
GIR. 4	903.18	903.38	903.58	903.77	903.96	904.15	904.34	904.52	904.70
GIR. 5	903.31	903.51	903.71	903.90	904.10	904.28	904.47	904.65	904.83
GIR. 6	903.44	903.64	903.84	904.03	904.22	904.41	904.60	904.78	904.96
GIR. 7	903.57	903.77	903.97	904.16	904.35	904.54	904.73	904.91	905.09
GIR. 8	903.70	903.90	904.10	904.29	904.48	904.67	904.86	905.04	905.22
GIR. 9	903.66	903.87	904.06	904.26	904.45	904.64	904.82	905.01	905.18
GIR. 10	903.54	903.75	903.94	904.14	904.33	904.52	904.70	904.88	905.06
GIR. 11	903.42	903.63	903.82	904.02	904.21	904.40	904.58	904.76	904.94

NO.	DATE	REVISION	BY
STATE OF WISCONSIN DEPARTMENT OF TRANSPORTATION STRUCTURES DESIGN SECTION			
STRUCTURE		B-18-184	
CONST. SPEC.	2003	DRAWN BY JHG	PLANS CK'D. Budd
SUPERSTRUCTURE DETAILS		SHEET 9	


WELDED WIRE FABRIC SHALL CONFORM TO THE REQUIREMENTS OF ASTM A497.

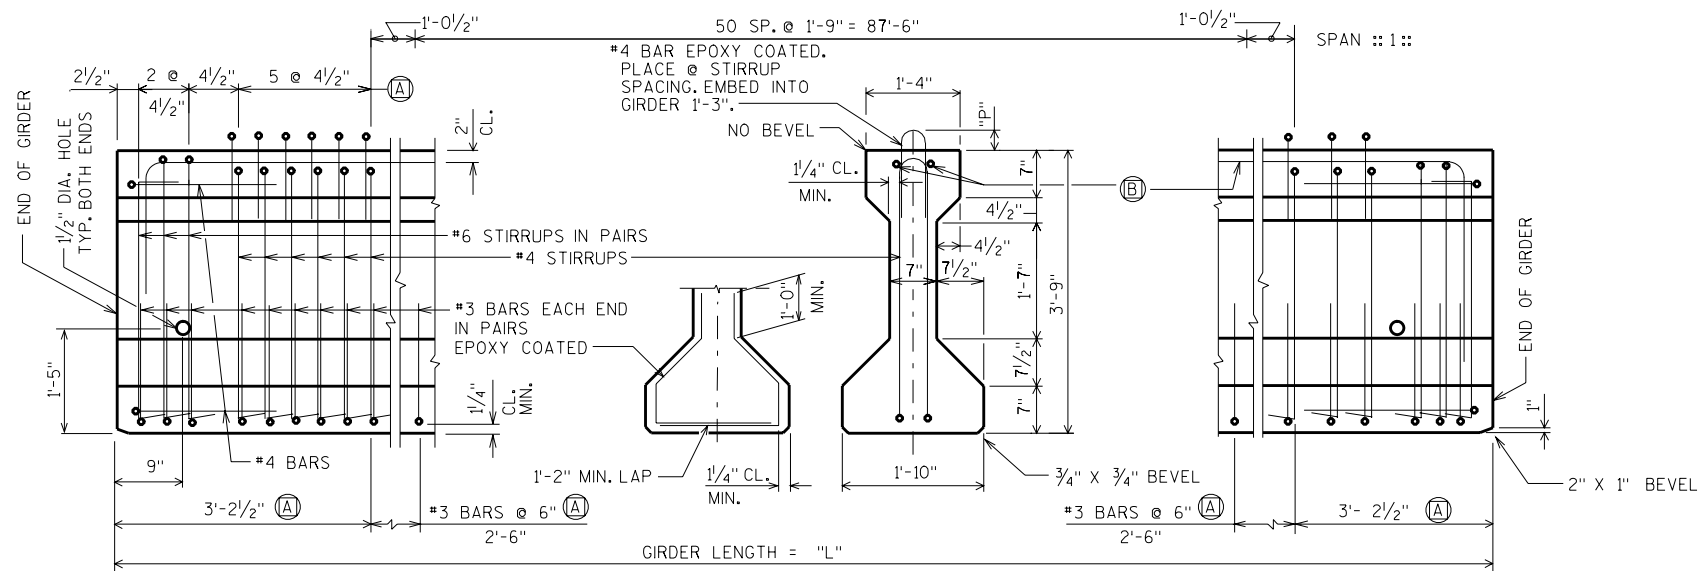


2-BARS BEND DOWN 16 BAR DIA. AT ENDS
(SPAN 1) 2 #4, 1'-11" MIN. LAP

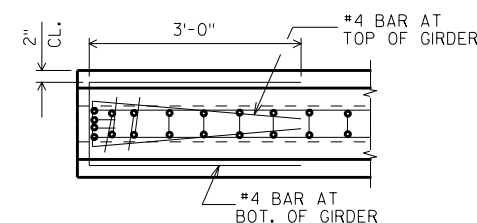


TOP VIEW OF GIRDER ENDS

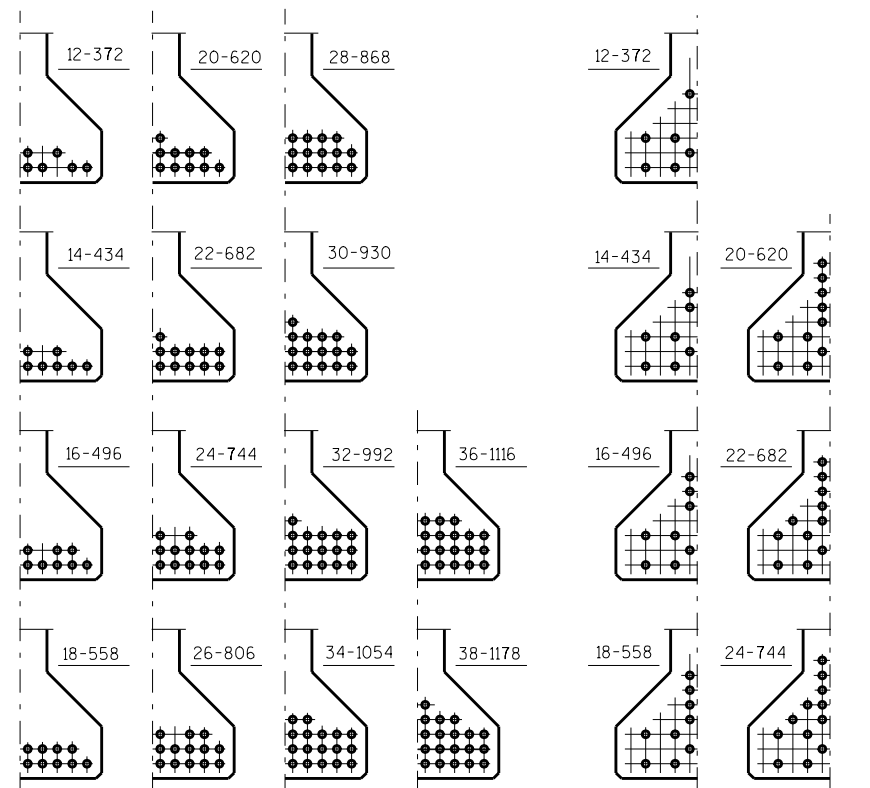


UNDRAPED PATTERN

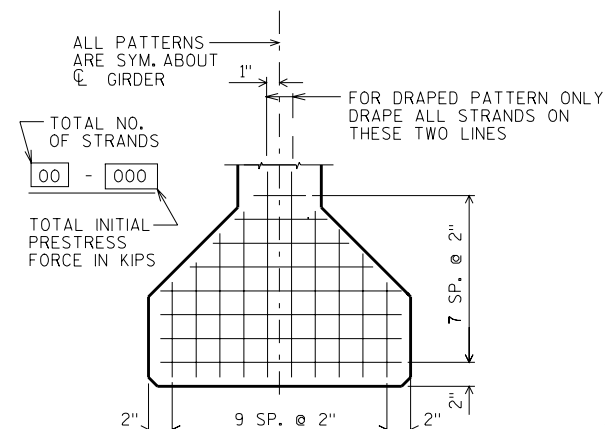


TYP. STRAND PATTERN

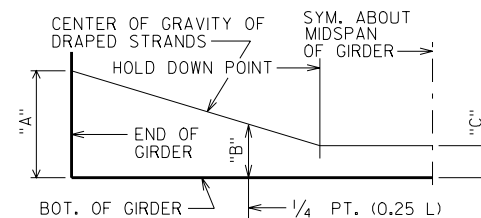

DRAPED STRAND PROFILE

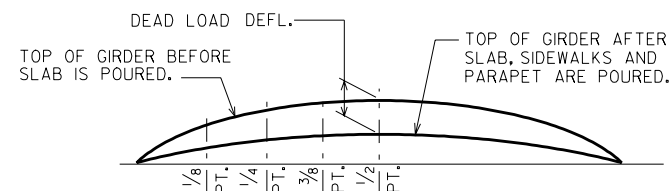

DEAD LOAD DEFLECTION DIAGRAM

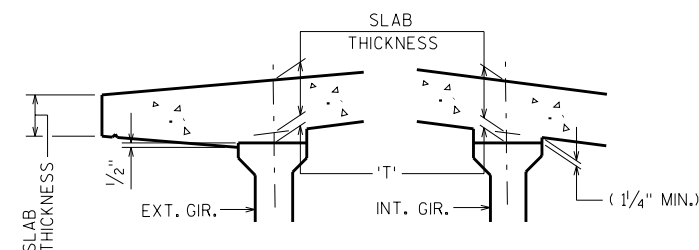

SLAB HAUNCH DETAIL

TO DETERMINE 'T', ELEV. OF TOP OF GIR'S. AT $\frac{1}{4}$ OF SUBSTRUCTURE UNITS
& AT $\frac{1}{8}$ POINTS OF EACH SPAN SHALL BE TAKEN. THEN FOLLOW THIS
PROCESS:

TOP OF DECK ELEV. AT FINAL GRADE
- TOP OF GIRDER ELEVATION
+ DEAD LOAD DEFLECTION
- SLAB THICKNESS

= HAUNCH HEIGHT 'T'

LV = 12345 8

8

FILE= 10-184GIR.DGN
SCALE = 2.66

* MINIMUM CYLINDER STRENGTH OF CONCRETE @ TIME OF TRANSFER OF PRESTRESS FORCE.

[illegible]

NO.	DATE	REVISION	BY
STATE OF WISCONSIN DEPARTMENT OF TRANSPORTATION STRUCTURES DESIGN SECTION			
STRUCTURE		B-18-184	
CONST. SPEC.	2003	DRAWN BY JHG	PLANS CK'D. Bud
45" PRESTRESSED		SHEET 10	
GIRDER DETAILS			

WED SEP 11 10:03:11 2002*

NOTES


ALL DIAPHRAGM MATERIAL NOT EMBEDDED IN THE CONCRETE GIRDER SHALL BE PAID FOR AT THE UNIT PRICE BID FOR "STEEL DIAPHRAGM", STRUCTURE, EACH.

EACH DIAPHRAGM BETWEEN GIRDERS SHALL CONSTITUTE ONE UNIT.

ALL DIAPHRAGM STRUCTURAL STEEL SHALL BE ASTM A709 GRADE 36. ALL BOLTS, NUTS AND WASHERS SHALL BE ASTM A325 TYPE 1.


ALL DIAPHRAGM STRUCTURAL STEEL SHOWN SHALL BE HOT-DIPPED GALVANIZED. ALL BOLTS, NUTS AND WASHERS SHALL BE HOT-DIPPED GALVANIZED IN ACCORDANCE WITH ASTM A153 CLASS C. GALVANIZED NUTS SHALL BE TAPPED OVERSIZE IN ACCORDANCE WITH THE REQUIREMENTS OF ASTM A563 AND SHALL MEET THE REQUIREMENTS OF SUPPLEMENTARY REQUIREMENT S1 OF ASTM A563, LUBRICANT AND TEST FOR COATED NUTS.

TABLE				
GIRDER HEIGHT	DIM. "A"	DIM. "B"	DIM. "L"	* DIM. "X"
28"	1'-0 7/8"	5 7/8"	9 1/2"	2 1/4"
36"	1'-2 7/8"	9 7/8"	1'-1 1/2"	3 1/4"
45"	1'-5 3/8"	1'-1 7/8"	1'-5 1/2"	2 1/4"
54"	1'-7 7/8"	1'-5 7/8"	1'-9 1/2"	4 1/4"
54W"	1'-9 1/8"	1'-5 7/8"	1'-9 1/2"	4 1/4"

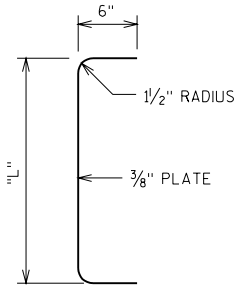


SECTION THRU ALTERNATE DIAPHRAGM


*DIM "X" = 2 1/2" FOR ALTERNATE PLATE DIAPHRAGM

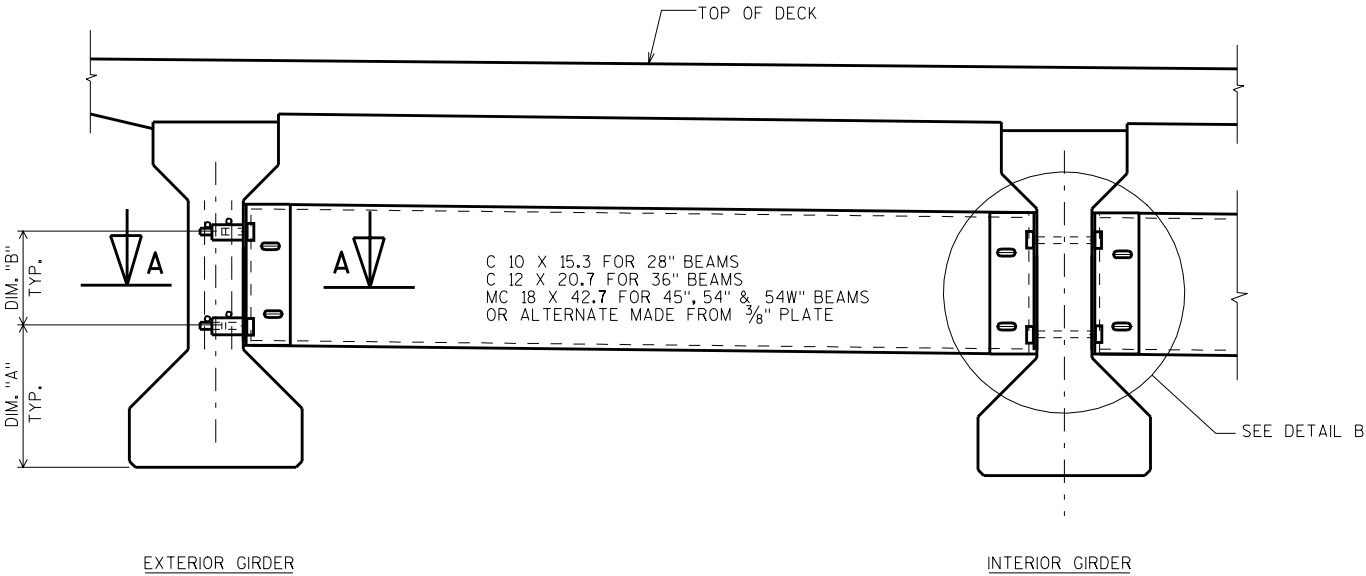

PART TRANSVERSE SECTION AT DIAPHRAGM

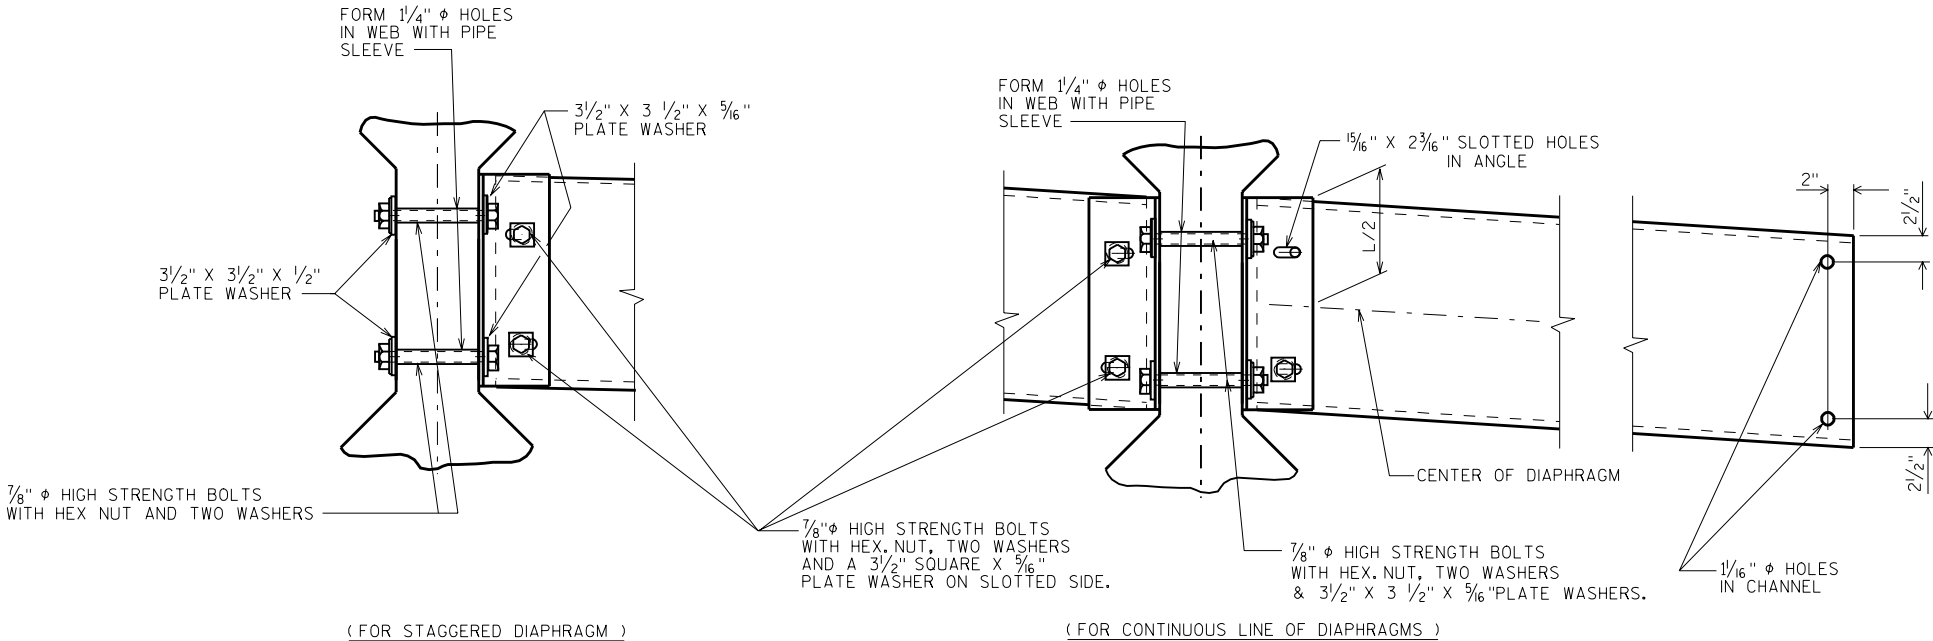


DETAIL B

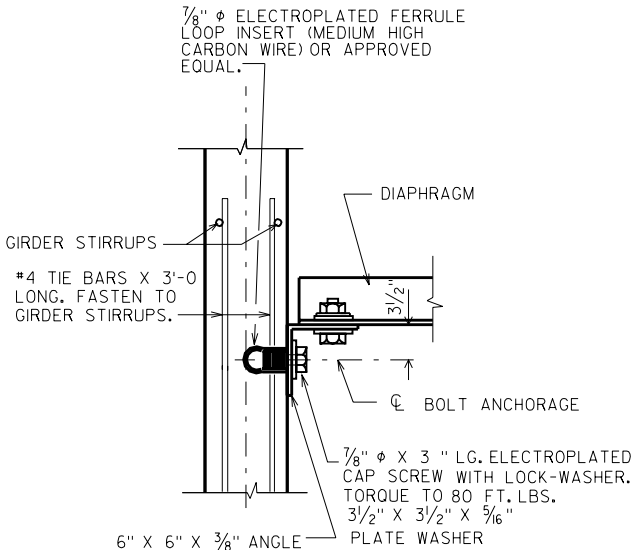

SECT. A-A

(FOR EXTERIOR ATTACHMENT)





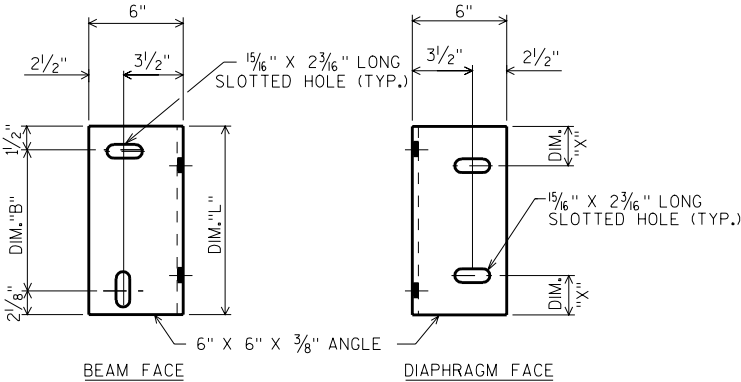


DIAPHRAGM SUPPORT


NO.	DATE	REVISION	BY
STATE OF WISCONSIN DEPARTMENT OF TRANSPORTATION STRUCTURES DESIGN SECTION			
STRUCTURE		B-18-184	
CONST. SPEC.	2003	DRAWN BY JHG	PLANS CK'D. Budd
STEEL DIAPHRAGM		SHEET 11	

BILL OF BARS




BAR MARK	COAT	NO. REQ'D.	LENGTH	BENT	LOCATION
R501	X	28	4-5	X	EAST PARAPET VERT.
R502	X	16	2-4	X	EAST PARAPET VERT.
R503	X	2	34-0	X	EAST PARAPET VERT.
R504	X	28	34-0		E. & W. PPT'S. HORIZ.
R505	X	412	4-10	X	E. & W. PPT'S. VERT.
R506	X	277	4-2	X	E. & W. PPT'S. VERT.
R507	X	16	4-8	X	WINGS 1 & 3 PPT'S.
R508	X	10	4-0		WINGS 1 & 3 PPT'S.

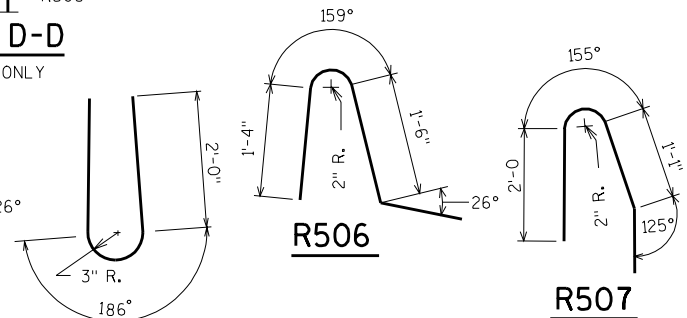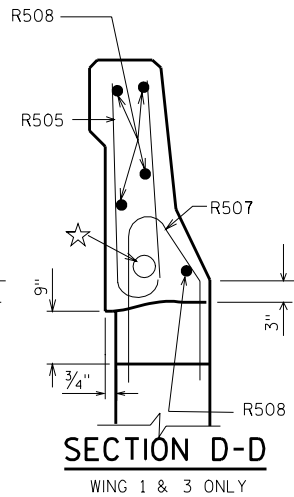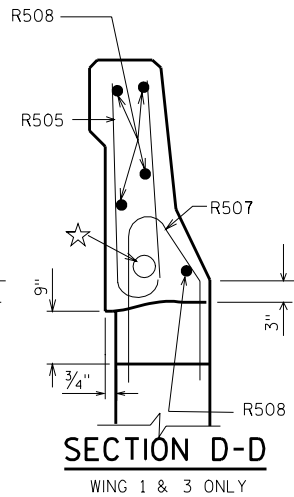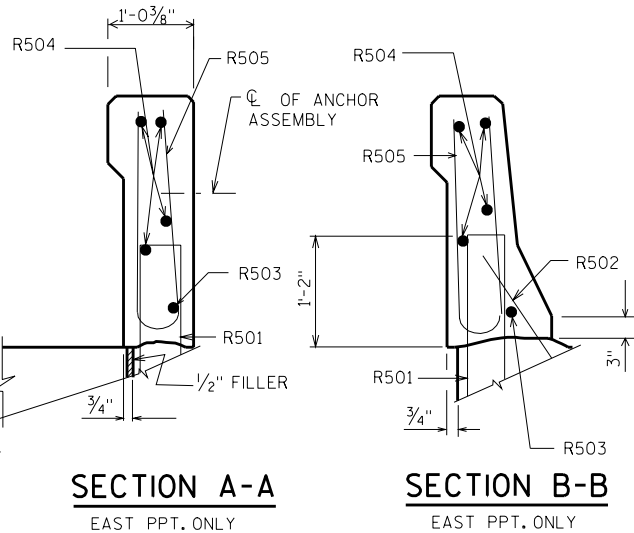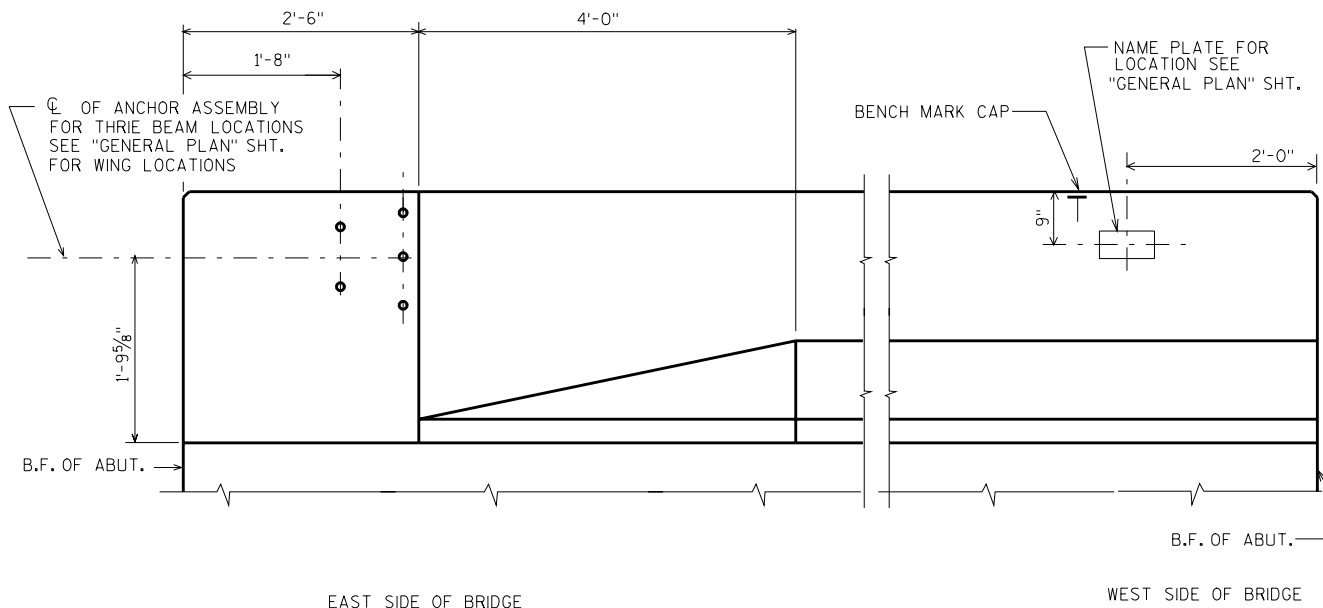

THREADED INSERTS FOR 7/8" ϕ X 2" LONG GALVANIZED HEX. HEAD CAP SCREWS. CAP SCREWS TO BE THREADED A MIN. OF 1 7/8" AND SHALL BE SUPPLIED, INCLUDING WASHERS, WITH ASSEMBLY. INSERTS TO BE THREADED A MINIMUM OF 1 3/4"

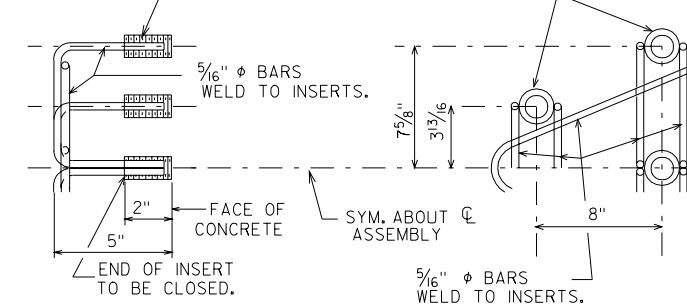

NOTE: HEX. HEAD CAP SCREWS & WASHERS TO BE GALVANIZED IN ACCORDANCE WITH AASHTO M232 CLASS C.
★ 2" ϕ NON-METALLIC CONDUIT WEST SIDE ONLY

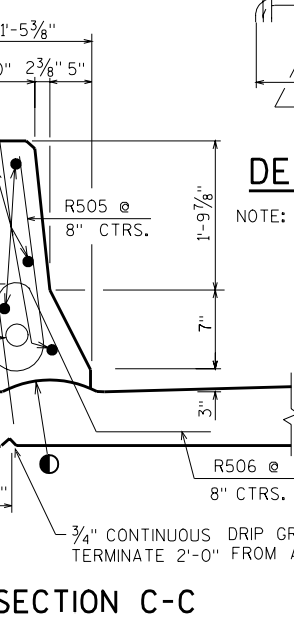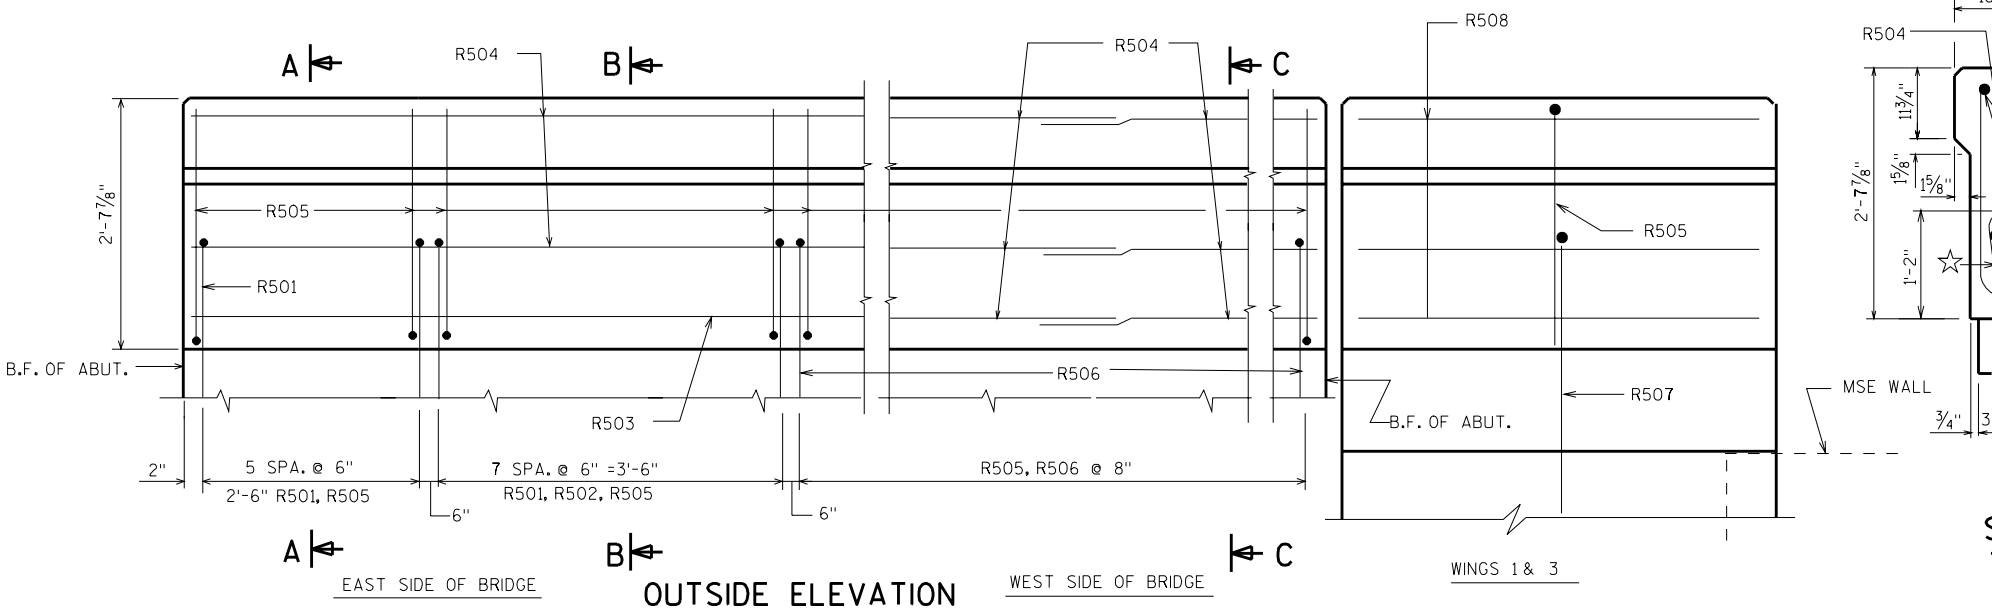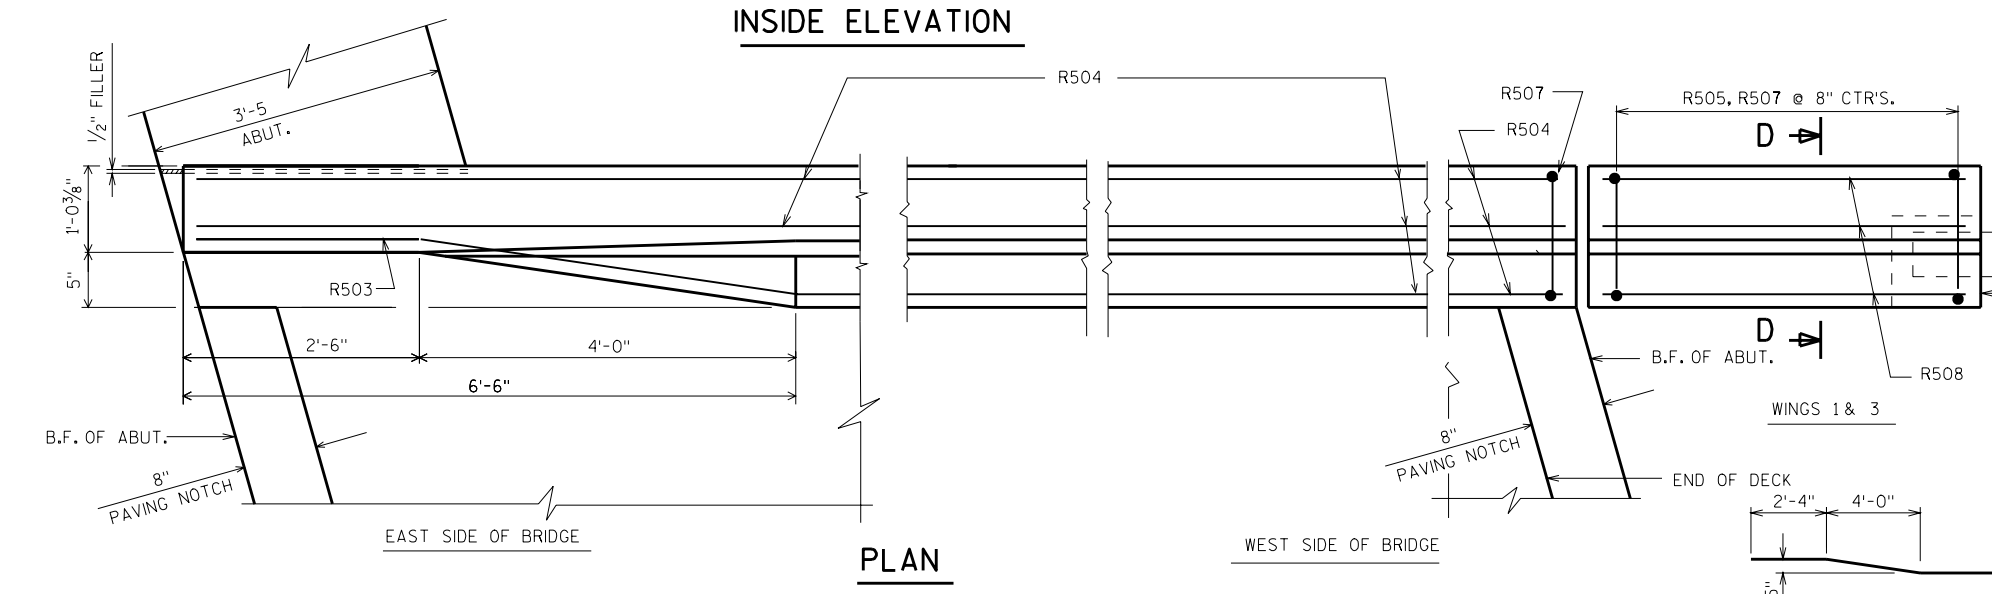

DETAIL OF ANCHOR ASSEMBLY

NOTE: HEX. HEAD CAP SCREWS & WASHERS TO BE GALVANIZED IN ACCORDANCE WITH AASHTO M232 CLASS C.
★ 2" ϕ NON-METALLIC CONDUIT WEST SIDE ONLY

NO.	DATE	REVISION	BY
STATE OF WISCONSIN DEPARTMENT OF TRANSPORTATION STRUCTURES DESIGN SECTION			
STRUCTURE B-18-184			
CONST. SPEC.	2003	DRAWN BY JHG	PLANS CK'D. Budd
SLOPED FACE PARAPET LF		SHEET 12	

CONST. JOINT - STRIKE OFF AS SHOWN.

GENERAL NOTES

THE COLOR OF THE VINYL COATED CHAIN LINK FENCING SHALL BE BLACK.
POSTS ARE TO BE SET VERTICAL.

KNUCKLE TOP AND BOTTOM OF 2" MESH CHAIN LINK FENCING.
ALL FENCING COMPONENTS SHALL BE GALVANIZED STEEL OR APPROVED ALTERNATE LISTED BELOW.
ALL RAILS, POSTS AND SLEEVES ARE STANDARD WEIGHT PIPE, SCHEDULE 40.
PLACE ALL NUTS ON OUTSIDE OF FENCE.


TOP RAIL SHALL BE CONTINUOUS OVER INTERIOR POSTS. MINIMUM LENGTH OF TOP RAIL BETWEEN SPLICES SHALL BE 20'-0". PLACE TOP RAIL SPLICES NEAR 1/4 POINTS OF POST SPACING. NO. 9 GAGE TIES AT 9" SPACING REQ'D. ON RAILS & POSTS WITHOUT STRETCHER BARS.

ALTERNATE FENCING MATERIALS ARE ALUMINUM, ALUMINUM COATED STEEL, AND APPROVED COLOR COATING SYSTEMS. IF ALTERNATE MATERIALS ARE USED FOR POSTS & RAILS, THESE ELEMENTS SHOULD BE DESIGNED.


* ALTERNATE BOULEVARD 2-WAY CLAMP MAY BE USED WHEN THE POST IS EITHER BOLTED TO THE 3/2" DIA. PIPE SLEEVE OR DIRECTLY WELDED TO THE BASE PLATE.

☆ 1/2" DIA. CONCRETE MASONRY ANCHOR, TYPE "S", 6" EMBEDMENT (EPOXY ANCHORED) MIN. PULLOUT OF 10 KIPS, THREADED LENGTH OF ANCHOR, WASHER, AND NUT SHALL BE GALVANIZED.


▲ 1/2" DIA. X 6 7/8" LONG GALVANIZED HEX BOLT WITH NUT & WASHER. TYPE S, 1/2" DIA. CONCRETE MASONRY ANCHORS MAY BE SUBSTITUTED FOR 1/2" DIA. BOLTS. ANCHOR PLATE NOT REQUIRED WHEN TYPE S ANCHORS ARE USED. SEE ☆ IN "GENERAL NOTES".

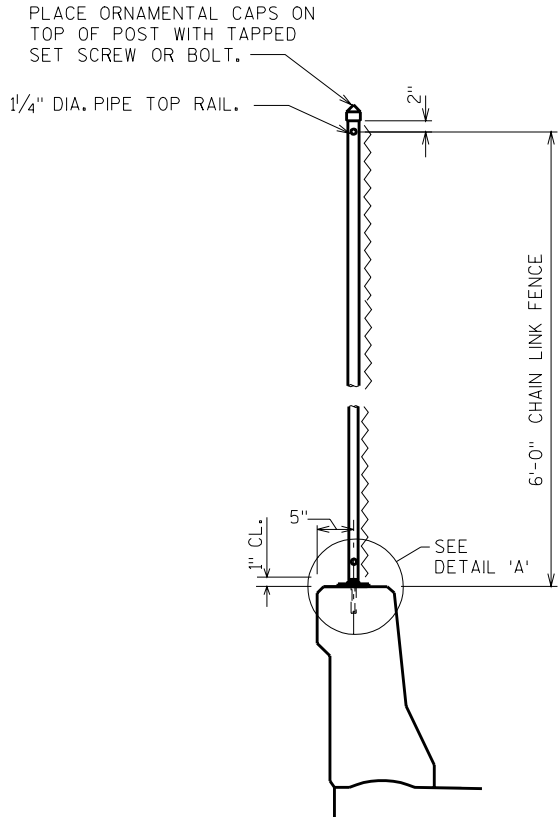

SECTION THRU WALL, COPING, & FENCE

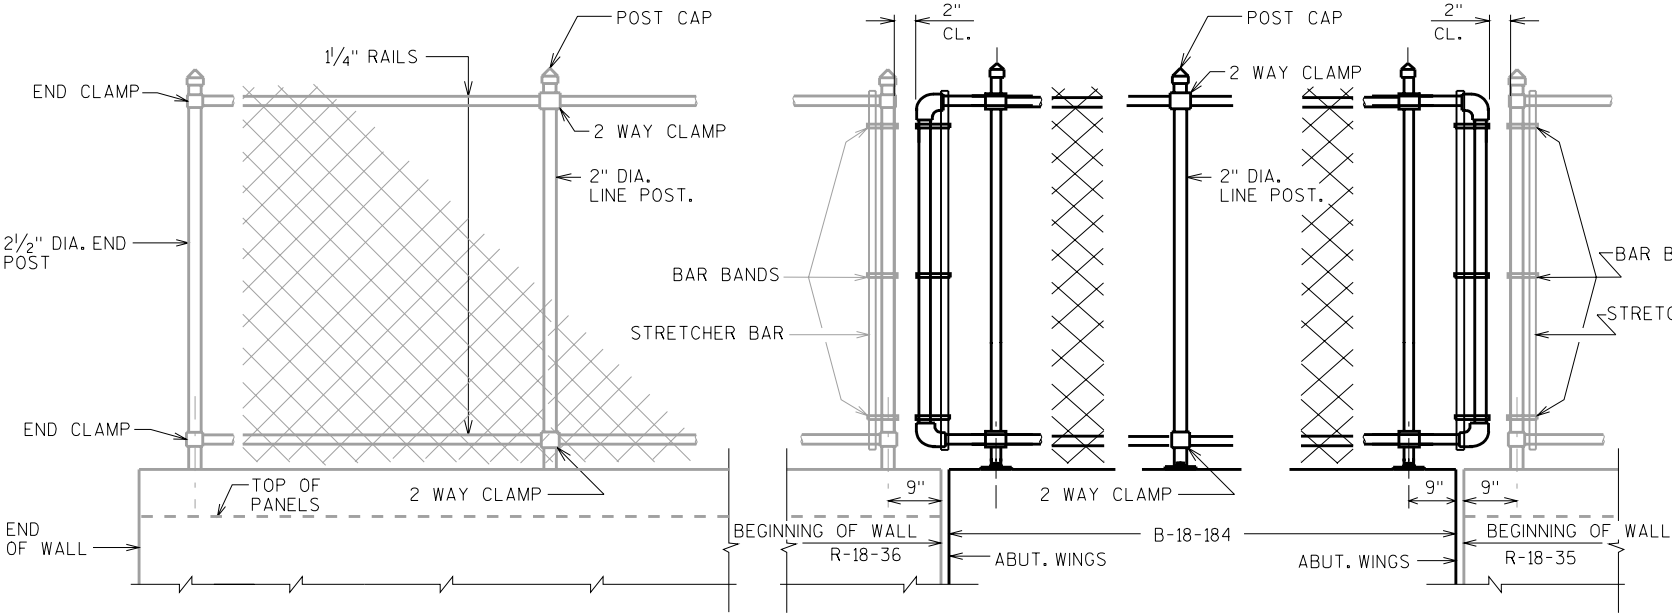


ELEVATION OF & FENCE

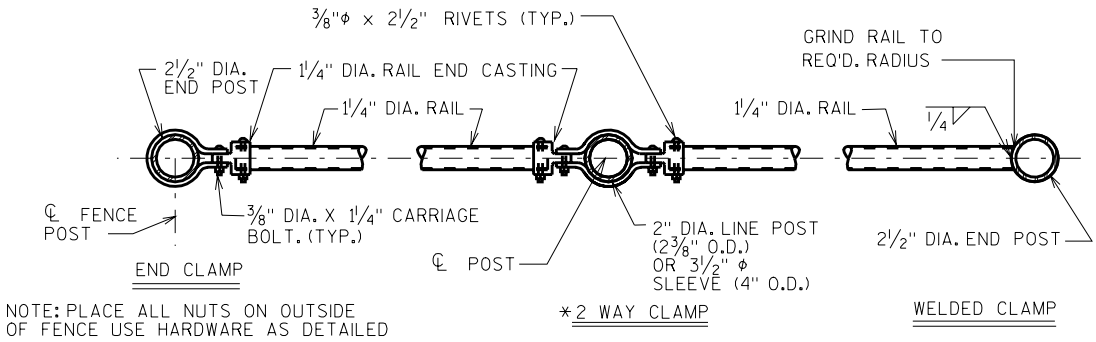


NOTE: PLACE ALL NUTS ON OUTSIDE OF FENCE USE HARDWARE AS DETAILED

PLAN OF RAILING

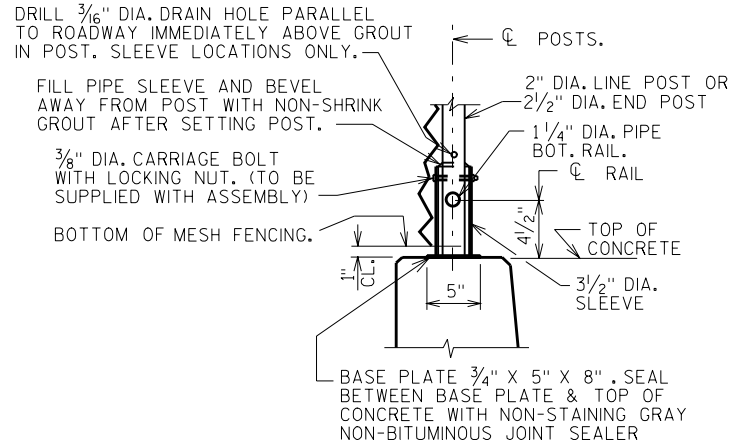


DETAIL A

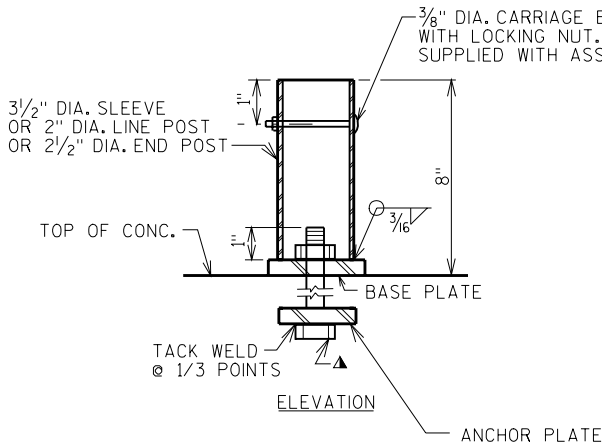


POST ATTACHMENT

UNIT SHALL BE GALV. AFTER FABRICATION


NOTE: IN LIEU OF USING THE 3/2" DIA. SLEEVE, THE 2" DIA. OR 2 1/2" DIA. FENCE POST MAY BE WELDED TO THE BASE PLATE.

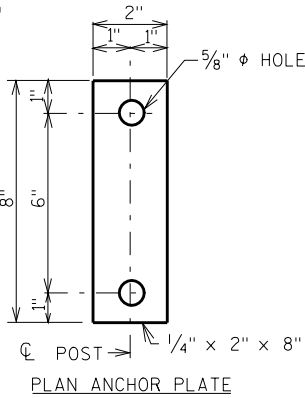

PLAN ANCHOR PLATE

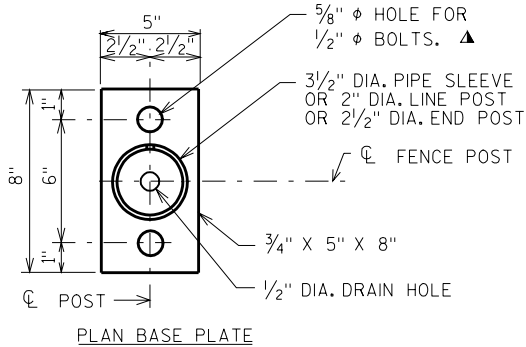

PLAN BASE PLATE

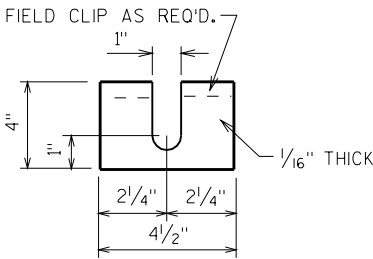

POST SHIM DETAILS

SHIMS REQUIRED ONLY WHEN POSTS ARE WELDED TO BASE PLATES. PROVIDE 4 SHIMS PER POST.

NO.	DATE	REVISION	BY
STATE OF WISCONSIN DEPARTMENT OF TRANSPORTATION STRUCTURES DESIGN SECTION			
STRUCTURE B-18-184			
CONST. SPEC.	2003	DRAWN BY JHG	PLANS CK'D. Budd
FENCING DETAILS		SHEET 13	