

REHABILITATION STRUCTURE SURVEY REPORT

DT1696 6/2012

Wisconsin Department of Transportation

- ☒ **Grade Separation**
☐ **Stream Crossing**
☐ **Culvert**
☐ **Railroad**
☐ **Retaining Wall**
☐ **Noise Barrier**
☐ **Sign Structure**
☐ **Other:** _____

For guidance see: http://dotnet/dtdi_bos/extranet/structures/reports-checklists.htm

Design Project ID 1190-02-34	Construction Project ID 1190-02-64	Highway (Project Name) EAU CLAIRE - CHIPPEWA FALLS		
Final Plan Due Date 05/01/2018	Preliminary Plan Due Date 05/01/2018	<input checked="" type="checkbox"/> Town <input type="checkbox"/> Village <input type="checkbox"/> City SEYMOUR		
PS&E Date 08/01/2018	Letting Date 02/12/2019	County EAU CLAIRE		
Structure Number B-18-190		Section 11	Town 27N	Range 09W
Station 11+35.52 - 14+02.07	Latitude: 445023.83 Longitude: 912631.51	<input checked="" type="checkbox"/> YES <input type="checkbox"/> NO Structure Located on National Highway System		
For Survey and CADD Files Horizontal Coordinate System: Vertical Datum:		Traffic Forecast Data		
Feature On LASALLE STREET		Design Year 2004	Average Daily Traffic (ADT) 3700	Roadway Design Speed 40 MPH
Feature Under USH 53		Feature Under 2014	36300	70 MPH
Region Contact: Adam Hetrick (Area Code) Telephone Number(s): 715-836-2855 Email: adam.hetrick@dot.wi.gov		Consultant Contact: (Area Code) Telephone Number(s): Email:		
		Functional Class Collector		
		Principal Arterial		

Work To Be Performed

Field Information Required Item Number (see Pages 2-4)

- ☐ A. Structural Repair 1-3, 22
☒ B. Overlay 1-3, 10-22, 26-28, 32, 34
 ☐ Concrete Overlay ☐ Asphalt Overlay
 ☐ Polymer Modified Asphalt Overlay ☒ Thin Bonded Polymer Overlay
 ☐ Other: _____
☐ C. New Bearings 3, 8, 9, 22
☐ D. New Railings 15-17, 20-23
☒ E. Curb and Sidewalk Repair 2, 3, 16, 22, 23
☐ F. Abutment Repair 2, 3, 12, 16
☐ G. Pier Repair 2, 3, 12, 16
☐ H. New Deck 1-6, 9, 10, 13-28, 32-34
☐ I. Widening 1-28, 30, 32-35
☐ J. Joint Repair 2, 3, 8, 16, 19, 22
☐ K. Surface Repair 2, 3, 22
☐ L. Raising Bridge 3, 6, 9, 16, 20-24
☐ M. Slope Stabilization 1-3, 30
☐ N. Scour Repair 1, 2 or 3, 16, 19, 21, 27, 29, 31-35
☐ O. Painting 16, 22, 24
☐ P. Other: _____

Field Information Required

If no structure number exists provide the following: Small County Map on which the location of proposed structure is shown in red and any highway relocation in green. In addition, provide Location Map of scale not less than 1" = 2000' showing the structure location and number.

- ☒ 1. Most recent inspection report, brief history of bridge construction date, and description of repairs with dates.
- ☒ 2. Outline deficient areas on existing structure plan or drawing.
- ☒ 3. Photographs of details requiring repairs or modifications, such as: bearings, x-frames, joints, etc. Photograph all deficient areas. Clearly label all photographs.
- ☐ 4. Provide proposed typical section for roadway and structure showing dimensions and cross slopes.
- ☐ 5. Survey beam seat or girder elevations at both sides of bridge at all substructure units.
- ☐ 6. Provide cross-section elevations at 10 foot intervals extending across the structure and a minimum of 100 feet beyond each end. Sections should be normal to centerline and show elevations at centerline roadway and gutter line. Take elevations along joints and at floor drains.
- ☐ 7. Show and identify starting stationing on bridge.
- ☐ 8. Record measurement, temperature of the structure, and date taken for each of the following:
 - (a) Joint opening measured normal to joint at centerline of roadway and both curb lines.
 - (b) Clearance between girder ends at piers.
 - (c) Distance from front face of abutment backwall to closest point of girder end measured parallel to girder.
 - (d) Temperature of structure determined by averaging top and under deck (if accessible) readings.
- ☐ 9. Fixed and expansion bearings - condition and orientation.
- ☒ 10. Number and width of proposed pours including construction staging sequence.
- ☒ 11. Location of existing construction joints in the deck.
- ☒ 12. Estimated Quantities:

Preparation, Decks, Type 1	Sq. Yd. <u>0</u>	
Preparation, Decks, Type 2	Sq. Yd. <u>0</u>	
Full Depth Deck Repair	Sq. Yd. <u>0</u>	Galvanic Anodes? <u>NO</u>
Concrete Surface Repair Superstructure	Sq. Ft. <u>0</u>	Galvanic Anodes? <u>NO</u>
Concrete Surface Repair Substructure	Sq. Ft. <u>0</u>	Galvanic Anodes? <u>NO</u>
Curb Repair	LF. <u>0</u>	Galvanic Anodes? <u>NO</u>

☒ 13. Sufficiency number: 93.5 (obtain from HSI Bridge Inventory System)

☒ 14. Appraisal and Condition Rating

	Deck Condition	Superstructure Condition	Substructure Condition	Load Capacity Appraisal	Structural EVAL Appraisal
Current	6	7	7	5	7

☒ 15. Load Ratings

	Inventory	Operational
Current Calculated Date: 6/10/2013	HS19	HS37
After Completed by Bridge Designer		

- ☒ 16. Utilities on/near Structure. (WisDOT policy is to avoid placing utilities on the structure.)

☐ Yes ☒ No

Type	Owner and Contact Information	Size	Opening at Abutment	Weight	Pressure

- ☒ 17. Is existing bridge railing deficient?

☐ Yes ☒ No If Yes – Replacement Rail Type:

- ☒ 18. Drains to be:

☐ Raised ☐ Closed ☐ Downspouted ☐ New

- ☒ 19. Traffic maintained on bridge during work?

☒ Yes ☐ No If Yes – Include sketches

- ☒ 20. Will guard rail be attached?

☐ Yes ☒ No If Yes – Which corners? Existing guardrail to remain at all corners.

- ☒ 21. Will work to be performed eliminate all deficiencies?

☒ Yes ☐ No If No – Explain:

- ☒ 22. Hazardous waste (asbestos) to be removed?

☐ Yes ☒ No If Yes – Explain:

- ☒ 23. Wing location(s) for surface drain anchors: NE and NW

- ☒ 24. Painting?

☐ Yes ☒ No If Yes – Explain on Page 4

(all, part, railing, color system, containment, bid items)

- ☐ 25. Desired roadway width: (new deck / widening) _____ Ft.

Desired sidewalk clear width: Left: _____ Ft. Right: _____ Ft.

- ☒ 26. Maximum increase in grade line elevation 3/8 In.

- ☒ 27. Benchmark description to be shown

- ☒ 28. Desired final cross slopes on bridge 0.02 Ft./Ft.

- ☐ 29. Underwater Inspection Report including:

- Streambed Cross Section With Pier, Footing and Seal Elevations
- Pier Elevation Drawings
- Pier Layout
- Hydrographic Survey

- ☐ 30. Slope stabilization, provide:

Type: _____ Quantity: _____ CY.

Slope: _____ Ft./Ft. Fill: _____ CY.

- ☐ 31. Preliminary layout of grout bags or proposed scour repair.

C.I.P. Articulated Mats (for Scour) _____ CY.

Grout Bags (for Scour) _____ CY.

Heavy Riprap _____ CY.

Extra Heavy Riprap _____ CY.

- ☒ 32. Report submitted with Preliminary Plan requires **no** CADD file submittal (*See ESubmittal instructions*).
- ☐ 33. Report submitted for development of Preliminary Plan to structure design engineer requires CADD file (if available) submittal and Report submittal to Soils Engineer if project involves foundation modifications.
- ☐ 34. Coordinate with structure design engineer **before** going into the field if existing structure has no available plans, if staged construction is planned, or if there are adjoining/adjacent structures that will remain in place.
- ☐ 35. If project involves substructure widening coordinate with structure and/or hydraulic design engineer to determine if information on the separation and/or stream crossing SSR will be required.


Additional Information

Elaborate on other concerns such as: DNR, Local, Utility Conflicts, Aesthetics, Railing Type and Staged Construction.

Please be as detailed and specific as possible.

- 1.) Structure built in 2003. No repairs since construction. See attached Bridge Inspection Report.
- 2.) Deficient areas to be determined in the field by the engineer. See attached Bridge Inspection Report. A Polymer Overlay is proposed because of deficiency over the entire structure due to poor bridge deck surface. The deck has a few longitudinal/diagonal cracks at the deck ends. The deck has numerous hairline transverse cracks especially on both sides of the piers and some of the cracks are leaching. The deck has negative moment cracks – the top of the deck is really cracked with a lot of alligator cracks. The deck was partially epoxy crack filled in 2006. The deck has diagonal cracks at all corners. Both of the roadway approaches to the bridge have settled approximately 3.5 inches and both were wedged in 2006. Approaches to the sidewalk on the bridge have settled approximately 3.5 inches.
- 3.) See attached photographs.
- 10.) This work will be constructed half at a time under traffic using single lane closures during non-peak hours with night work. All lanes will be opened to traffic daily.
- 11.) See asbuilt plans.
- 16.) No utilities on or near structure. No conflicts anticipated.
- 18.) Existing drains on the bridge deck to remain.
- 19.) This work will be constructed half at a time under traffic using single lane closures during non-peak hours with night work. Nighttime ramp closures are anticipated at some structures. All lanes and ramps will be opened to traffic daily.
- 22.) See attached Asbestos Inspection Report. No asbestos-containing material was found.
- 27.) To be determined.
- 32.) See preliminary plans.

CDR Map

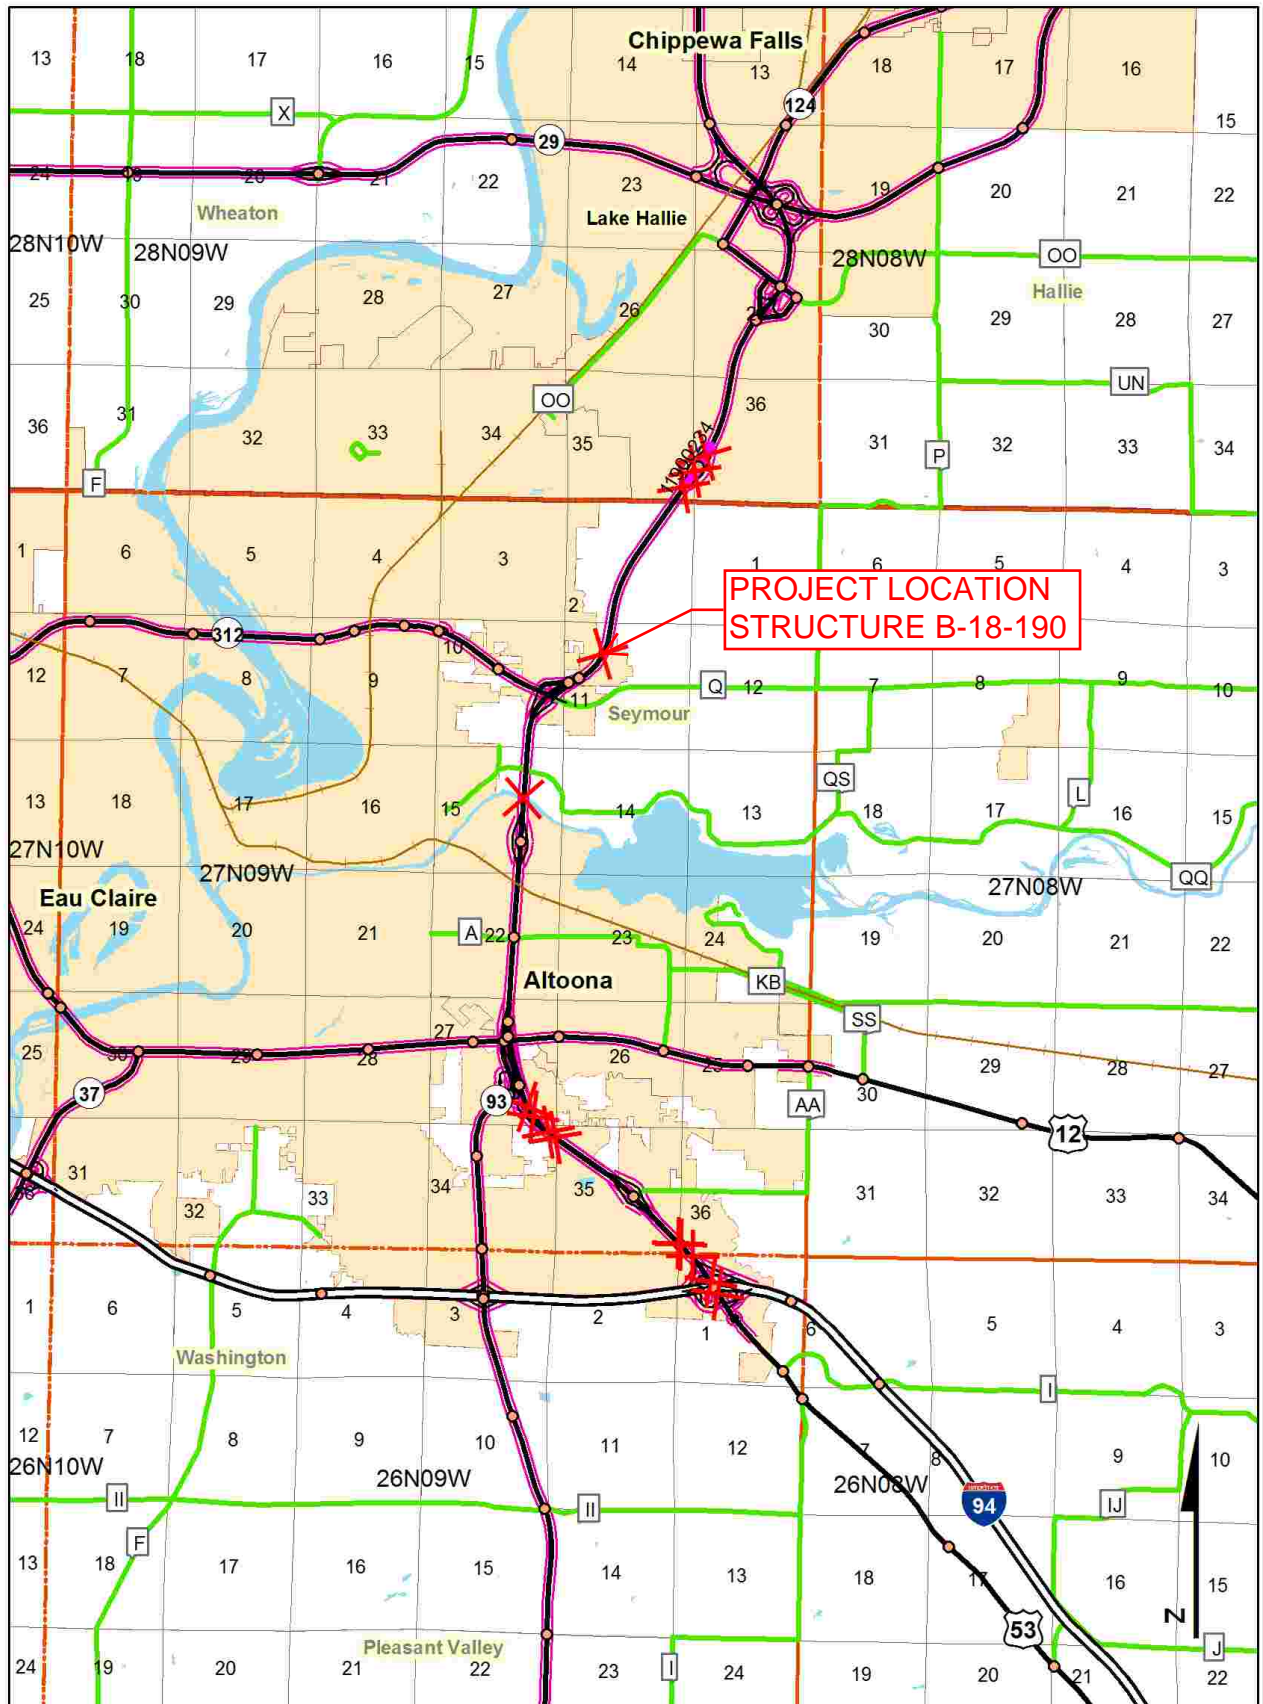

1190-02-64

EAU CLAIRE / CHIPPEWA

Section No. 1	Title
Section No. 2	Typical Sections and Details
Section No. 3	Estimate of Quantities
Section No. 3	Miscellaneous Quantities
Section No. 4	Right of Way Plat
Section No. 5	Plan and Profile
Section No. 6	Standard Detail Drawings
Section No. 7	Sign Plates
Section No. 8	Structure Plans
Section No. 9	Computer Earthwork Data
Section No. 9	Cross Sections

A.A.D.T.	=
A.A.D.T.	=
D.H.V.	=
D.D.	=
T.	=
DESIGN SPEED	=
FSALS	=

PLAN
CORPORATE LIMITS
PROPERTY LINE
LOT LINE
LIMITED HIGHWAY EASEMENT
EXISTING RIGHT OF WAY
PROPOSED OR NEW R/W LINE

SLOPE INTERCEPT
 REFERENCE LINE
 EXISTING CULVERT
 PROPOSED CULVERT
 (Box or Pipe)
 COMBUSTIBLE FLUIDS


MARSH AREA 

WOODED OR SHRUB AREA 

PROFILE
 GRADE LINE
 ORIGINAL GROUND
 MARSH OR ROCK PROFILE
 (To be noted as such)
 SPECIAL DITCH

 GRADE ELEVATION


 CULVERT (Profile View)
 UTILITIES
 ELECTRIC
 FIBER OPTIC
 GAS
 SANITARY SEWER
 STORM SEWER
 TELEPHONE
 WATER
 UTILITY PEDESTAL
 POWER POLE
 TELEPHONE POLE



 ROCK

 LABEL

 95.36



 E

 FO


 G


 SAN

 SS

 T

 W






PLAN OF PROPOSED IMPROVEMENT

EAU CLAIRE - CHIPPEWA FALLS

IH 94 TO 40TH AVENUE (11 BRIDGES)

USH 53

EAU CLAIRE AND CHIPPEWA COUNTIES

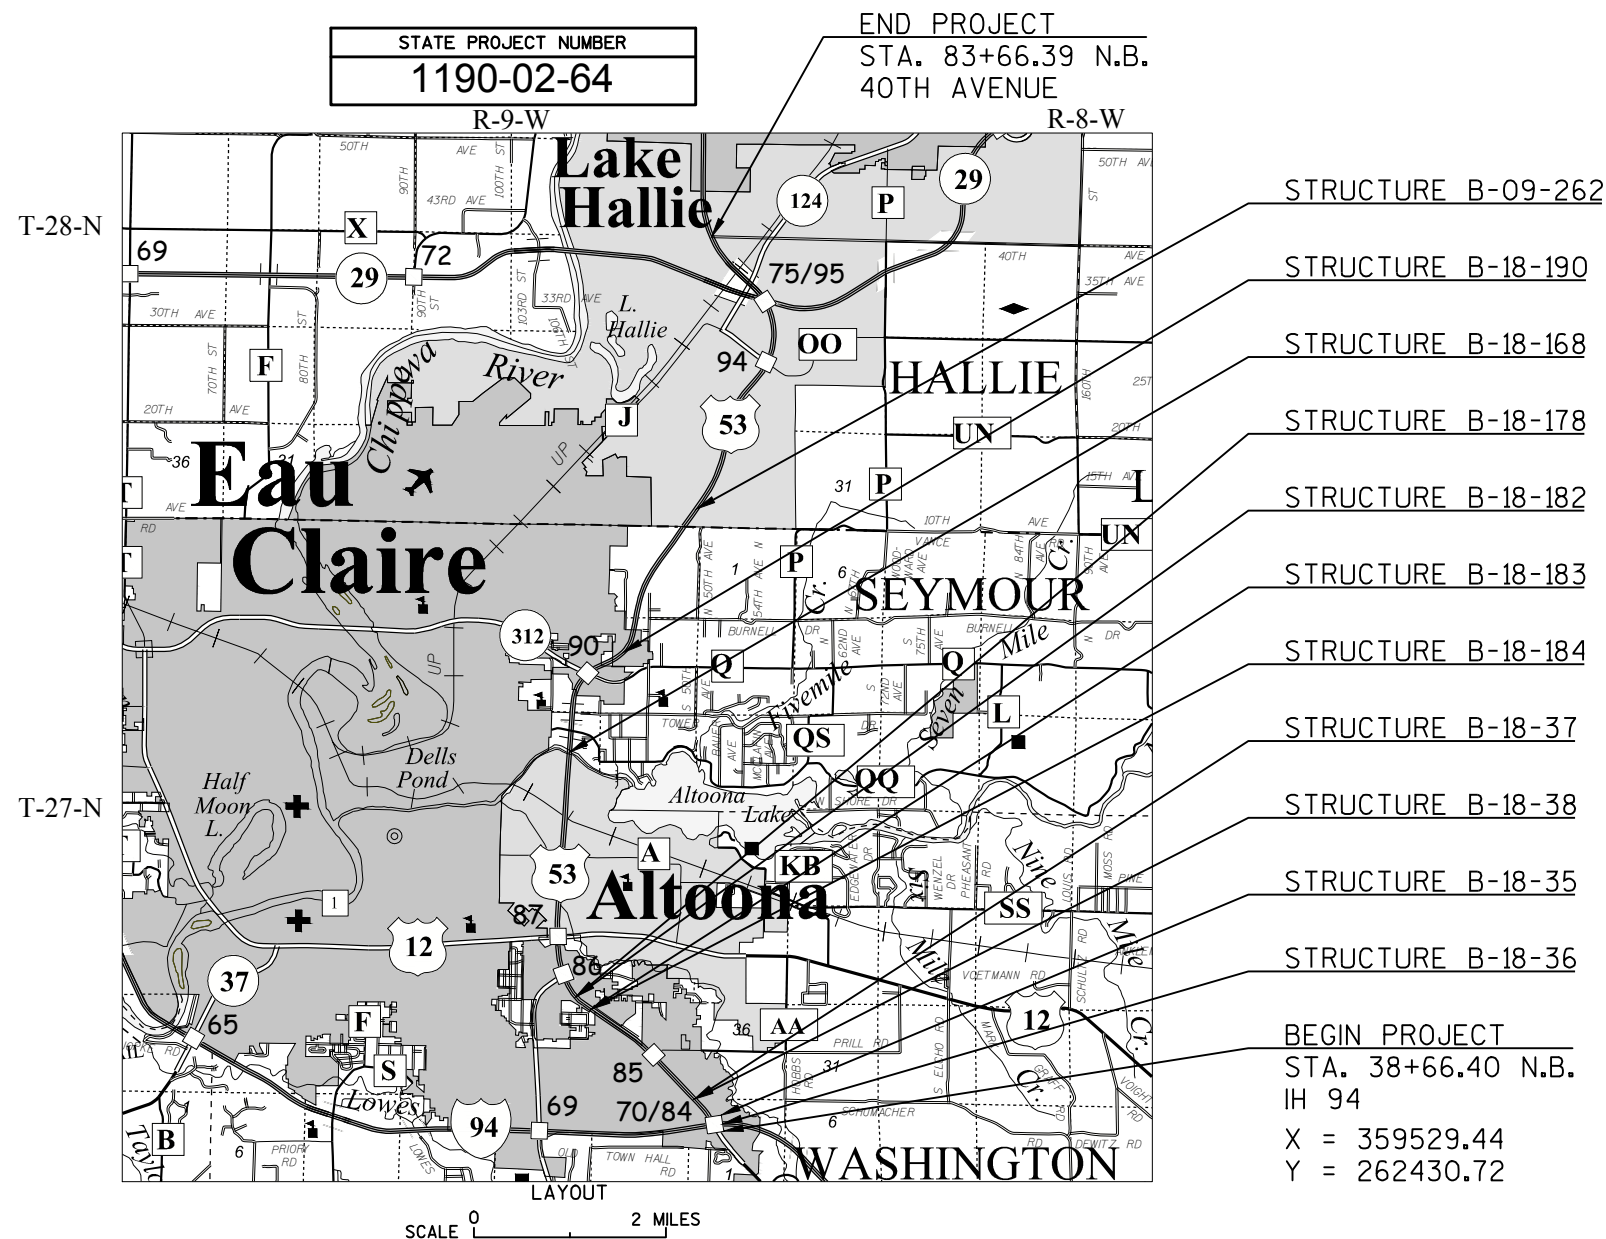

HORIZONTAL POSITIONS SHOWN ON THIS PLAN ARE WISCONSIN COUNTY COORDINATES, EAU CLAIRE COUNTY, NAD83 (1991), IN U.S. SURVEY FEET. VALUES ARE GRID COORDINATES, GRID BEARINGS, AND GRID DISTANCES. GRID DISTANCES MAY BE USED AS GROUND DISTANCES.

STATE PROJECT	FEDERAL PROJECT	
	PROJECT	CONTRACT
1190-02-64		

STATE OF WISCONSIN DEPARTMENT OF TRANSPORTATION	
PREPARED BY	
Surveyor	WISDOT
Designer	ADAM HETRICK
Project Manager	DAVID KOEPP
Regional Examiner	REGIONAL EXAMINER
Regional Supervisor	TIMOTHY MASON
APPROVED FOR THE DEPARTMENT	
DATE:	(Signature)

4429 La Salle St



Exit Street View

2



© 2015 Google
© 2015 Google

Google earth

44°50'23.88" N 91°26'32.38" W elev 970 ft eye alt 970 ft

[Report a problem](#)

Exit Street View

Google earth

44°50'23.29" N 91°26'27.90" W elev 969 ft eye alt 964 ft

[Report a problem](#)

4202 La Salle St



Exit Street View

2



© 2015 Google
© 2015 Google

Google earth

44°50'23.77" N 91°26'29.88" W elev 936 ft eye alt 948 ft

[Report a problem](#)

4204 La Salle St



Exit Street View

2



© 2015 Google
© 2015 Google

Google earth

44°50'23.77" N 91°26'28.86" W elev 926 ft eye alt 937 ft

[Report a problem](#)

4206 La Salle St



Exit Street View

2




© 2015 Google
© 2015 Google

Google earth

44°50'23.66" N 91°26'27.39" W elev 933 ft eye alt 944 ft

[Report a problem](#)

4210 La Salle St

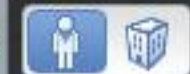

Exit Street View



[Report a problem](#)

© 2015 Google
© 2015 Google

Google earth

44°50'23.75" N 91°26'27.13" W elev 943 ft eye alt 951 ft



© 2015 Google

© 2015 Google

Google earth

4208 La Salle St



Exit Street View



© 2015 Google

© 2015 Google

Google earth

44°50'23.68" N 91°26'27.77" W elev 945 ft eye alt 954 ft

[Report a problem](#)

4206 La Salle St



Exit Street View



© 2015 Google

© 2015 Google

Google earth

44°50'23.90" N 91°26'30.11" W elev 929 ft eye alt 937 ft

[Report a problem](#)



© 2015 Google

© 2015 Google

Google earth



route: 053N county: EAU CLAIRE date: 08/13/2013 plm: 068.697

Lat: 44.83786227 Long: -91.44337121 Elev: 828.06 ft.

\\doteauplog1p\photolog\Rg5\053N_R5_2013\Front\Dir_071\F_07172.jpg

Copyright 2015 Mandli Communications, Inc.



route: 053N county: EAU CLAIRE date: 08/13/2013 plm: 068.807

Lat: 44.83909623 Long: -91.44196077 Elev: 831.38 ft.

\\doteauplog1p\photolog\Rg5\053N_R5_2013\Front\Dir_071\F_07183.jpg

Copyright 2015 Mandli Communications, Inc.



route: 053S county: EAU CLAIRE date: 08/14/2013 plm: 134.373

Lat: 44.84224729 Long: -91.44093668 Elev: 834.19 ft.

\\doteauplog1p\photolog\Rg5\053S_R5_2013\Front\Dir_136\F_13665.jpg

Copyright 2015 Mandli Communications, Inc.



route: 053S county: EAU CLAIRE date: 08/14/2013 plm: 134.473

Lat: 44.84082334 Long: -91.44130824 Elev: 827.55 ft.

\\doteauplog1p\photolog\Rg5\053S_R5_2013\Front\Dir_136\F_13675.jpg

Copyright 2015 Mandli Communications, Inc.



STATE OF WISCONSIN
DEPARTMENT OF TRANSPORTATION

Inspection Report for
B-18-190

LASALLE ST over USH 53
Jul 10, 2015

Type	Prior	Frequency (mos)	Performed
Routine	07-10-15	24	X
SI&A	07-20-11	48	X

Latitude	44°50'23.83"N	Owner	STATE HIGHWAY DEPT
Longitude	91°26'31.51"W	Maintainer	STATE HIGHWAY DEPT

Time Log

Team members

Hours	Minutes	
1	21	

	Name	Number	Signature	Date
Inspector	Frueh, Rick J	1003		
Reviewer			Completed by HSI System Account(HSI)	

BRIDGE INSPECTION REPORT
Wisconsin Department of Transportation
DT2007 2003 s.84.17 Wis. Stats.

page 2

Identification & Location

Feature On: LASALLE ST	Section Town Range: S11 T27N R09W	Structure Number: B-18-190
Feature Under: USH 53	County: EAU CLAIRE(18)	
Location AT USH 53	Municipality: TOWN-SEYMOUR(18020)	Structure Name:

Geometry

measurements in feet, except where noted

Approach Roadway Width: 33	Bridge Roadway Width: 31.8	Total Length: 265.7
Approach Pavement Width: 29	Deck Width: 40.4	Deck Area (sq ft): 10734

Traffic

	Lanes	ADT	ADT year	Traffic Pattern
On	2	3700	2004	TWO WAY TRAFFIC
Under	2	35600	2013	NO TRAFFIC

Capacity

Load Rating

Inventory rating: HS19	Overburden depth (in): 0.0	Last rating date: 06-10-03	Controlling: INTERIOR DECK GIRDER Fatigue
Operating rating: HS37	Deck surface material: CONCRETE	Re-rate for capacity (Y/N):	Control location: SPAN 1
Posting:	Re-rate notes:		

Hydraulic

Classification

Scour Critical Code(113): (N) NO WATERWAY	Q100 (ft3/sec): 0	
High water elevation (ft): 0.0	Velocity (ft/sec): 0.0	Sufficiency #: 93.5

Span(s)

Span #	Material	Configuration	Depth (in)	Length (ft)	Main
1	CONT PREST CONC	DECK GIRDER	70	137.8	Y
2	CONT PREST CONC	DECK GIRDER	70	124.7	

Expansion joint(s)

Temperature:

File:	New:
-------	------

Vertical Clearance

	Measurement file (ft)	File Date	Measurement new (ft)
Highway Minimum Under Cardinal	16.4	10-Dec-2002	
Highway Minimum Under Non-Cardinal	24.61	10-Dec-2002	
Highway Minimum On			
Railroad Minimum Under			

BRIDGE INSPECTION REPORT
Wisconsin Department of Transportation
DT2007 2003 s.84.17 Wis. Stats.

page 3

Structure No.: **B-18-190**

Elements

Chk	Element	Defect	Description	UOM	Total	Quantity in Condition State			
						1	2	3	4
X	12		Reinforced Concrete Deck	SF	10,784	10,000	784	0	0
		1130	Cracking (RC) Few longitudinal/diagonal cracks at deck ends. Numerous hairline transverse cracks especially on both sides of piers and some of the cracks are leaching.	SF		0	784	0	0
		8000	Wearing Surface (Bare)	SF	10,784	10,229	555	0	0
		3210	Debonding/Spall/Patched Area/Pothole	SF		0	0	0	0
		3220	Crack (Wearing Surface) Top of deck is really cracked with a lot of alligator cracks. Partially epoxy crack filled in 06. Few longitudinal/diagonal cracks at deck ends. Numerous hairline transverse cracks in pier area.	SF		2,111	555	0	0
		8522	Coated Reinforcing ok - neg moment cracks - top is really cracked with a lot of alligator cracks. Partially epoxy crack filled in 06. Few longitudinal cracks at deck ends. Diagonal cracks at all corners.	SF	10,784	0	0	0	0
X	109		Prestressed Concrete Open Girder 5 - 70 inch girders.	LF	1,323	1,323	0	0	0
X	205		Reinforced Concrete Column ok	EA	3	3	0	0	0
X	215		Reinforced Concrete Abutment Water felt stained at front face and under parapet joints.	LF	82	73	7	2	0
		1080	Delamination - Spall - Patched Area	LF		0	0	0	0
		1130	Cracking (RC) 6 hairline vertical cracks at west abutment. 3 hairline vertical cracks in east abutment.	LF		0	7	2	0
X	234		Reinforced Concrete Cap	LF	40	37	3	0	0
		1130	Cracking (RC) 1 vertical crack below girder 2. 2 hairline vertical cracks below girder 4.	LF		0	3	0	0
X	331		Reinforced Concrete Bridge Rail Railing on top of parapet, cracks at neg moment area. Sheared bolt at thrie beam attachment at southeast corner.	LF	532	432	100	0	0
		1130	Cracking (RC) Hairline vertical cracks (approx 5FT spacing).	LF		36	100	0	0
X	8400		Integral Wingwall	EA	4	3	1	0	0
		8902	Wingwall Movement Southeast wing is tipped outward about 1 inch. (2011-2013-2015)	EA		0	1	0	0
		8903	Wingwall Deterioration.	EA		0	0	0	0

BRIDGE INSPECTION REPORT
Wisconsin Department of Transportation
DT2007 2003 s.84.17 Wis. Stats.

page 4

Structure No.: **B-18-190**

Assessments

Chk	Element	Defect	Description	UOM	Total	Quantity in Condition State			
						1	2	3	4
X	9004		Drainage - Deck Inlets at NW and NE.	EA	2	2	0	0	0
X	9009		Sidewalk On north side of bridge. Few hairline transverse cracks. Approaches to sidewalk have settled approx 3.5 inches (2011). Sidewalk approaches have AC wedges.	EA	1	0	1	0	0
X	9030		Signs - Object Markers 4 markers	EA	4	4	0	0	0
X	9043		Slope Protection- Crushed Aggregate with Bit. Added slope paving beside abutment at SE corner to repair washout.	EA	2	2	0	0	0
X	9167		Steel Diaphragm ok	EA	16	16	0	0	0
X	9168		Concrete Diaphragm Over pier.	EA	4	4	0	0	0
X	9323		Approach Roadway - Asphalt Both approaches have settled (approx 3.5IN). Both have been wedged in 2006.	EA	2	2	0	0	0

NBI Ratings

	File	New
Deck	6	6
Superstructure	7	7
Substructure	7	7
Culvert	N	N
Channel	N	N
Waterway	N	N

Structure Specific Notes

Inspection Specific Notes

new bridge in 2003.
Possible epoxy overlay.

Inspector Site-Specific Safety Considerations

Structure Inspection Procedures

Walk around.

Special Requirements

	Chk	Comments
Traffic Control		
ReachAll Vehicle		
Access Equipment		
Other		

BRIDGE INSPECTION REPORT
Wisconsin Department of Transportation
DT2007 2003 s.84.17 Wis. Stats.

page 5

Structure No.: **B-18-190**

Construction History

Year	Work Performed	FOS id
2003	NEW STRUCTURE	1190-00-82

Maintenance Items History

Item	Recommended by	Status	Status change	Year completed
------	----------------	--------	---------------	----------------

Maintenance Items

Item	Priority	Recommended by	Status	Status change
IMP-Thin Epoxy Overlay	MEDIUM	Frueh, Rick J (1003)	COMPLETE	08/09/15
Consider possible epoxy over lay.				

STRUCTURE INVENTORY AND APPRAISAL FIELD REVIEW FORM

B-18-190
LASALLE ST over USH 53

LOCATION

(3) Municipality:
(16) Latitude(° ' "):
(17) Longitude(° ' "):

TOWN-SEYMOUR(18020)
44°50'23.83"N
91°26'31.51"W

TRAFFIC SERVICE

(28A) Lanes On:
(28B) Lanes Under:
(102) Traffic Pattern On:
(102) Traffic Pattern Under:
(19) Detour Length(mi):

2
2
-NO TRAFFIC -ONE WAY TRAFFIC <input checked="" type="checkbox"/> -TWO WAY TRAFFIC
<input checked="" type="checkbox"/> -NO TRAFFIC -ONE WAY TRAFFIC -TWO WAY TRAFFIC
1

GEOMETRY

(49) Structure Length(ft):
(50) Sidewalk Width(ft):
(50) Curb Width(ft):
(52) Culvert Barrel Length(ft):
(34) Skew:

(51) Bridge Roadway(ft):
(52) Deck(ft):
(32) Approach Roadway(ft):

(47) Minimum Horizontal(ft):
(55) Minimum Right Lateral(ft):
(55) Minimum Left Lateral(ft):

265.7	
Left: 5.9	Right: 0.0
Angle(°): 17	Direction: -RIGHT FORWARD <input checked="" type="checkbox"/> -LEFT FORWARD
Cardinal Width	Non-Cardinal Width
31.8	31.8
40.4	40.4
33	0
Cardinal Under Clearance	Non-Cardinal Under Clearance
88.25	85.5
30.75	19.5
32.5	33.0

RAILING APPRAISAL

(36A) Bridge Rail Adequacy:
(36B) Transition Adequacy:
(36C) Approach Guardrail Adequacy:
(36D) Guardrail Termination Adequacy:
Outer Rail:

-SUB-STANDARD <input checked="" type="checkbox"/> -STANDARD -NOT APPLICABLE		
-SUB-STANDARD <input checked="" type="checkbox"/> -STANDARD -NOT APPLICABLE		
-SUB-STANDARD <input checked="" type="checkbox"/> -STANDARD -NOT APPLICABLE		
<input checked="" type="checkbox"/> -SUB-STANDARD -STANDARD -NOT APPLICABLE		
Left	Right	Type
		TYPE F (TWO SQUARE TUBES) - STEEL(8)
		TYPE F (3 SQUARE TUBES) - STEEL(65)
		TYPE F (4 SQUARE TUBES) - STEEL(72)
		TYPE M-STEEL 3 SQUARE TUBES(93)
X	X	SLOPED FACE PARAPET LF(91)
		SLOPED FACE PARAPET HF(92)
		VERTICAL FACE PARAPET TYPE A(74)
		TYPE W-THRIE BEAM(79)
		TYPE H ON VERTICAL PARAPET(80)
		TIMBER(38)
		OTHER(99) (Please specify)

Transition Type:

	CONT GUARD RAIL
	NO APP GRDRL
	NO ATTACHMENT
5	22 MM(7/8") BOLT (Please enter quantity)
	25 MM(1") BOLT (Please enter quantity)
	OTHER (Please specify)

Guardrail Termination Type:

	(01) ENERGY ABSORBING TERMINAL/EAT
	(02) TURN DOWN
X	(99) OTHER (Please specify)

ROADWAY ALIGNMENT APPRAISAL

(72) Approach Alignment Appraisal:

	(3) INTOLERABLE- Horizontal or Vertical curvature requires a substantial reduction in vehicle operating speed
	(6) FAIR- Horizontal or Vertical curvature requires a very minor speed reduction
X	(8) GOOD- No speed reduction required

Wisconsin Dept. of Transportation
Structure Inventory Data

Bridge B180190

Structure No.: B180190	Municipality: TOWN- SEYMOUR (18020)	Section:	Town:	Range:	Maintenance Agency: STATE HIGHWAY DEPT	Owner: STATE HIGHWAY DEPT
Replaced Structure No.:	Historical Sig.: 5	Latitude: 445023. 83	Longitude: 912631.51	County: EAU CLAIRE (18)	District: 6	

ABUTMENT DATA (CARDINAL)

1. Abutment Type: SILL/SEMI EXP/RECT
2. Pile Type: STEEL
3. Pile Size: 254 OR 273 MM (10 OR 10-3/4")
4. Slope Protection Type: STAB CR STONE
5. Rdwy. Width: 31.8 ft
6. Deck Width: 40.4 ft
7. Wing Type: PARALLEL TO ROADWAY

ABUTMENT DATA (NON-CARDINAL)

1. Abutment Type: SILL/SEMI EXP/RECT
2. Pile Type: STEEL
3. Pile Size: 305 MM (12")
4. Slope Protection Type: STAB CR STONE
5. Rdwy. Width: 31.8 ft
6. Deck Width: 40.4 ft
7. Wing Type: PARALLEL TO ROADWAY

GEOMETRIC DATA

1. Structure Length: 265.7 ft (Back to Back Abuts. Along Rdwy. Centerline)
2. No. Lanes On: 2
3. L. Sdk. Width On: 5.9 ft
4. R. Sdk. Width On: 0.0 ft
5. Median Type:
6. Median Width: 0.0 ft
7. Skew Angle: 17 Deg.
8. Direction Skew Angle: LEFT
9. Horizontal Curve: 5728.35 Radius, ft
10. Dir.-Hor. Curve: LEFT
11. Girder Spacing: 6.6 ft
12. Height: 70.0 ft (Top Pier Footing to Top Deck or Streambed Elev. to Top Deck)
13. NBI Bridge Length Met: true

APPROACH DATA

1. Appr. Pavement Width: 29 ft
2. Rt. Shoulder Width: 4 ft
3. Lt. Shoulder Width: 0 ft
4. Total Width (Sum Above): 33 ft
5. Guardrail Termination: 0
6. Guardrail Adequacy: 1
7. Railing Attachment Type: 5 - 22 MM (7/8") BOLTS
8. Railing Design Year: 1965 AASHO
9. Left Outer Railing Type: SLOPED FACE PARAPET LF (91)
10. Right Outer Railing Type: SLOPED FACE PARAPET LF (91)
11. Left Inner Railing Type:
12. Right Inner Railing Type:

CAPACITY DATA

1. Design MS: HS20
2. Inventory MS: HS22.2
3. Operating MS: HS40
4. Max. Veh. Wt.: 250 kips
5. Load Rating Basis.: LFR
6. Load Governing Member: DECK GIRDER
7. Deck Composition:
8a. Deck Membrane:
8b. Deck Surface: CONCRETE

HYDRAULIC DATA

1. Design Flood Frequency: 0 yrs
2. Design Discharge: 0 cu-ft/s
3. Max. Velocity: 0.0 ft/s
4. Drainage Area: 0.0 sq. ft
5. High Water Elev.: 0.0 ft
6. Scour Critical Code: N
7. Scour Calculated?: false

STRUCTURE SERVICE DATA

1. Hwy. On Detour Length: 1 ft
2. Type Service On: HIGHWAY
3. Type Service Under: HIGHWAY

APPRAISAL UPDATE

1. Load Capacity: 5-LEGAL LOAD STRESS NOT EXCEEDED
2. Geom. On: 4-COND AT TOL LIMIT-NO REPAIRS
3. Geom. Under: 5-COND ADEQUATE-NO REPAIRS
4. Appr. Align: 8-COND EQUAL DESIRABLE CRITERIA
5. Horiz. Align:
6. Vert. Align:

PLANNING DATA

1. Functional Classification: LOCAL-URBAN (19)
2. ADT: 3700
3. ADT-Year: 2004
4. Truck ADT %: 0
5. Future ADT: 4100
6. Future ADT-Year: 2024

CONDITION DATA

Deck: 6	SuperStructure: 7	SubStructure: 7	Channel: N
Culvert: N	Waterway: N		

Bridge B180190

CONSTRUCTION DATE

Project ID	Construction Contractor	Construction Designer	Construction Year	Plans Reel Number	Letting Date	Survey Received	Work Performed
1190-00-82	HOFFMAN CONST.	ROMENESKO ENGINEERING	2003	PLAN	10-Jun-2003	07-Oct-2002	NEW STRUCTURE

CLEARANCE DATE

Clearance Lane Number	Minimum Vertical	Minimum Vertical Date	Minimum Horizontal Distance	Right Minimum Lateral
	24.61	10-Dec-2002	85.5	19.5
	16.4	10-Dec-2002	88.25	30.75

Left Minimum Lateral	Railroad Right Minimum Lateral	Railroad Left Minimum Lateral	Railroad Vertical Distance	Railroad Horizontal Distance
33.0				
32.5				

ROUTE DATE

Number	Direction	Type	Structure Route On / Under	Structure Route Cardinal / NonCardinal
	E		O	C
053	N		U	C
053	S		U	N

Number	Structure Route Location	Highway Feature Name	Structure Route Local System	Highway Feature Designation
	AT USH 53	LASALLE ST	LRD	MAINLINE
053	AT LASALLE ST	USH 53	USH	MAINLINE
053	AT LASALLE ST	USH 53	USH	MAINLINE

Number	Structure Route Primary Flag	Designed National Network Flag	Structure Defense Highway Designation	Highway On Inventory Route
	Y	N	0	NON
053	Y	N	0	NHS
053	N	N	0	NHS

PIER DATE

Number	Pier Type	Piling Type	Piling Size	Pier Skew Angle	Direction of Skew
1	ROUND COL BENT				

SPAN DATE

Number	Type	Length	Configuration	Material	Girder or Truss Height	Girder or Truss Spacing
1		137.8	DECK GIRDER	CONT PREST CONC	70.0	6.6
2		124.7	DECK GIRDER	CONT PREST CONC	70.0	6.6

EXPANSIONJOINT DATE

Number	Location	Type	Inactive Date



708 Heartland Trail, Suite 3000
Madison, WI 53717

608.826.3600 PHONE
608.826.3941 FAX

www.TRCSolutions.com

Bridge Asbestos Inspection Report

WisDOT Project ID: 1190-02-34

Structure Number: B-18-0168, B-18-0190

Structure Name: USH 53 SB over Eau Claire River, La Salle Street over USH 53

City/County: City of Altoona, Town of Seymour, Eau Claire County

Lat/Long Coordinates: 444929.4/ 912715.1, 445023.83/ 912631.51

TRC Project Number: 235777.0000.0000

Date Inspected: October 14, 2015

Inspected By/License Number: John Roelke, All-119523

Findings:

The inspection to identify and collect samples of potential asbestos-containing material (ACM) was completed following WisDOT standard sampling procedure for bridge inspections found in FDM 21-35-45.


None of the materials that were identified as potentially ACM and sampled tested positive for asbestos. The overlay on the bridges can proceed as planned. Standard Special Provision (STSP) 107-125 should be included in the specifications.

Sample Number	Sample Description	Sample Location	Analytical Results and Method	Friable/ Non-friable or No ACM	Quantity of ACM Material
B-18-0168					
1	Caulk	Abutment joint	PLM, non-detect	No ACM	0
2	Caulk	Abutment joint	PLM, non-detect	No ACM	
3	Caulk	Abutment joint	PLM, non-detect	No ACM	
4	Brown paint	Girder	PLM, non-detect	No ACM	0
5	Brown paint	Girder	PLM, non-detect	No ACM	
6	Brown paint	Girder	PLM, non-detect	No ACM	
7	White paint	Girder	PLM, non-detect	No ACM	0
8	White paint	Girder	PLM, non-detect	No ACM	
9	White paint	Girder	PLM, non-detect	No ACM	

Sample Number	Sample Description	Sample Location	Analytical Results and Method	Friable/ Non-friable or No ACM	Quantity of ACM Material
B-18-0190					
1	Paint	Pedestrian fence	PLM, non-detect	No ACM	0
2	Paint	Pedestrian fence	PLM, non-detect	No ACM	
3	Paint	Pedestrian fence	PLM, non-detect	No ACM	
4	Caulk	Around fence attachment plate	PLM, non-detect	No ACM	0
5	Caulk	Around fence attachment plate	PLM, non-detect	No ACM	
6	Caulk	Around fence attachment plate	PLM, non-detect	No ACM	
7	Caulk	Around bolts in fence attachment plate	PLM, non-detect	No ACM	0
8	Caulk	Around bolts in fence attachment plate	PLM, non-detect	No ACM	
9	Caulk	Around bolts in fence attachment plate	PLM, non-detect	No ACM	
10	Caulk	Abutment joint	PLM, non-detect	No ACM	0
11	Caulk	Abutment joint	PLM, non-detect	No ACM	
12	Caulk	Abutment joint	PLM, non-detect	No ACM	
13	Caulk	Parapet expansion joint	PLM, non-detect	No ACM	0
14	Caulk	Parapet expansion joint	PLM, non-detect	No ACM	
15	Caulk	Parapet expansion joint	PLM, non-detect	No ACM	

If you have any questions, please contact me, at (608) 826-3628.

TRC Environmental Corporation

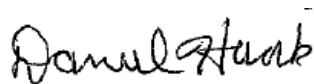

Daniel Haak
Project Manager



John Roelke
Asbestos Inspector

Attachments: Location Map, Photos, and Laboratory Reports


\\NTAPB-MADISON\MSN-VOL6\-\WPMSN\PJT2\235777\0000\1190-02-34_B-18-0168 USH 53 SB OVER EAU CLAIRE RIVER B-18-0190 LA SALLE ST OVER



Report Distribution:

Recipient	Electronic (PDF) Copy	Paper Copy
BTS-ESS sharlene.tebeest@dot.wi.gov	X (via email)	X
REC amy.adrihan@dot.wi.gov ; nicholasA.schaff@dot.wi.gov	X (via email)	
Project Manager david.koepp@dot.wi.gov	X (via email)	
Other		



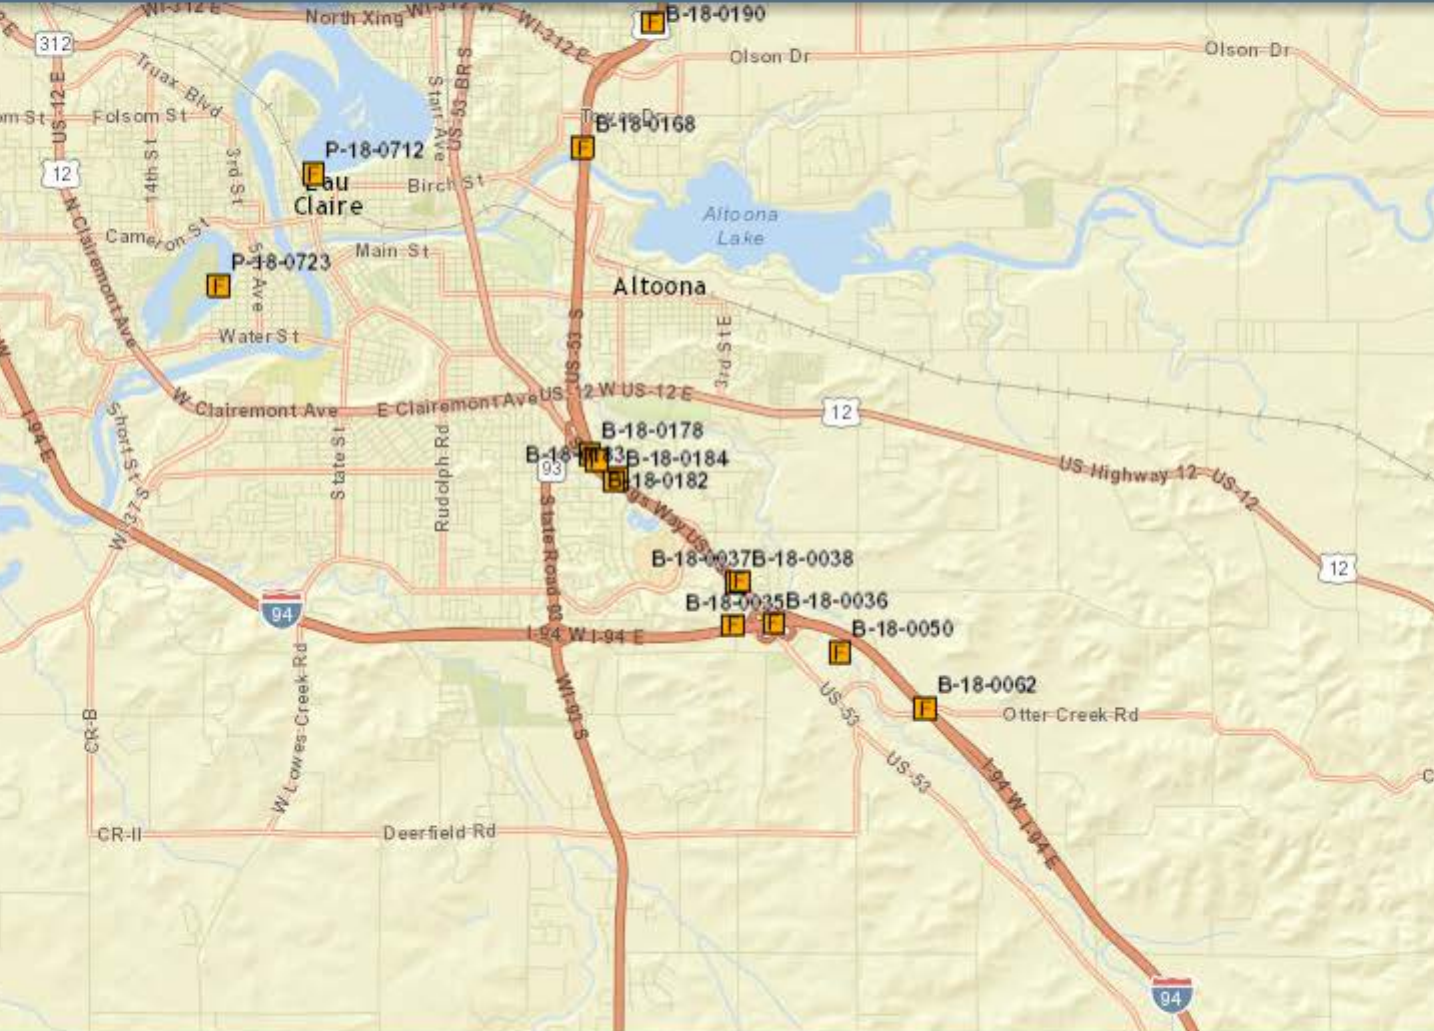

B-18-0168



Caulk in abutment joint





White graffiti paint on girder



Brown graffiti paint on girder

B-18-0190



Paint on fence



Caulk around fence attachment plate



Caulk around bolts in attachment plate



Caulk in abutment joint



Caulk in parapet expansion joint

BULK ASBESTOS ANALYSIS REPORT

CLIENT: Wisconsin Department of Transportation

Lab Log #: 0047027
Project #: 235777.0000.0000
Date Received: 10/16/2015
Date Analyzed: 10/19/2015

Site: DOT Bridge Inspection, B-18-168

POLARIZED LIGHT MICROSCOPY by EPA 600/R-93/116

Sample No.	Color	Homogenous	Multi-Layered	Layer No.	Other Matrix Materials	Asbestos %	Asbestos Type
B-18-168 (1)	Grey	Yes	No	--	---	ND	None
B-18-168 (2)	Grey	Yes	No	--	---	ND	None
B-18-168 (3)	Grey	Yes	No	--	---	ND	None
B-18-168 (4)	Brown	Yes	No	--	---	ND	None
B-18-168 (5)	Brown	Yes	No	--	---	ND	None
B-18-168 (6)	Brown	Yes	No	--	---	ND	None
B-18-168 (7)	White	Yes	No	--	---	ND	None
B-18-168 (8)	White	Yes	No	--	---	ND	None
B-18-168 (9)	White	Yes	No	--	---	ND	None

TRC LABORATORY ASBESTOS ANALYTICAL ACCREDITATIONS

NVLAP Lab Code 101424-0
RI #AAL-007 TX #300354
CO# AL-15020

AIHA-LAP,LLC #100122 CT #PH-0426
VT #AL014538 LA#05011 VA #3333 000283
PHIL# 461 PA#68-03387

ME LA-0075, LB-0071 MA #AA000052 NY #10980 WV# LT000411
AZ #A20944 HI #L-09-004 NJ #CT004 CA #2907

POLARIZED LIGHT MICROSCOPY by EPA 600/R-93/116

Sample No.	Color	Homogenous	Multi-Layered	Layer No.	Other Matrix Materials	Asbestos %	Asbestos Type
------------	-------	------------	---------------	-----------	------------------------	------------	---------------

Reporting limit- asbestos present at 1%

ND - asbestos was not detected

Trace - asbestos was observed at level of less than 1%

NA/PS - Not Analyzed / Positive Stop

SNA- Sample Not Analyzed- See Chain of Custody for details

Note: Polarized-light microscopy is not consistently reliable in detecting asbestos in floor coverings and similar non-friable organically bound materials. In those cases, EPA recommends, and certain states (e.g. NY) require, that negative results be confirmed by quantitative transmission electron microscopy.

The Laboratory at TRC follows the EPA's Interim Method for the Determination of Asbestos in Bulk Insulation (1982), and the EPA recommended Method for the Determination of Asbestos in Bulk Building Materials (EPA/600/R-93/116), July 1993, R.L. Perkins and B.W. Harvey which utilizes polarized light microscopy (PLM). Our analysts have completed an accredited course in asbestos identification. TRC's Laboratory is accredited under the National Voluntary Laboratory Accreditation Program (NVLAP), for Bulk Asbestos Fiber Analysis, NVLAP Code 18/A01, effective through June 30, 2016. TRC is an American Industrial Hygiene Association (AIHA) accredited lab for PLM effective through October 1, 2016. Asbestos content is determined by visual estimate unless otherwise indicated. Quality Control is performed in-house on at least 10% of samples and the QC data related to the samples is available upon written request from the client.


This report shall not be reproduced, except in full, without the written approval of TRC. This report must not be used by the client to claim product endorsement by NVLAP or any agency of the U.S. Government. This report relates only to the items tested.

Analyzed by:



Kathleen Williamson, Laboratory Manager

Reviewed by:

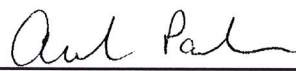

Amanda Parkins, Approved Signatory

Date Issued

10/19/2015

TRC LABORATORY ASBESTOS ANALYTICAL ACCREDITATIONS

NVLAP Lab Code 101424-0
RI #AAL-007 TX #300354
CO# AL-15020

AIHA-LAP.LLC #100122 CT #PH-0426
VT #AL014538 LA#05011 VA #3333 000283
PHIL# 461 PA#68-03387

ME LA-0075, LB-0071 MA #AA000052
AZ #A20944 HI #L-09-004

NY #10980 WV# LT000411
NJ #CT004 CA #2907



BULK ASBESTOS ANALYSIS REPORT

CLIENT: Wisconsin Department of Transportation

Lab Log #: 0047038
Project #: 235777.0000.0000
Date Received: 10/16/2015
Date Analyzed: 10/20/2015

Site: DOT Bridge Inspection, B-18-190

POLARIZED LIGHT MICROSCOPY by EPA 600/R-93/116

Sample No.	Color	Homogenous	Multi-Layered	Layer No.	Other Matrix Materials	Asbestos %	Asbestos Type
B-18-190 (1)	Black	Yes	No	--	---	ND	None
B-18-190 (2)	Black	Yes	No	--	---	ND	None
B-18-190 (3)	Black	Yes	No	--	---	ND	None
B-18-190 (4)	Grey	Yes	No	--	---	ND	None
B-18-190 (5)	Grey	Yes	No	--	---	ND	None
B-18-190 (6)	Grey	Yes	No	--	---	ND	None
B-18-190 (7)	Grey	Yes	No	--	---	ND	None
B-18-190 (8)	Grey	Yes	No	--	---	ND	None
B-18-190 (9)	Grey	Yes	No	--	---	ND	None
B-18-190 (10)	Grey	Yes	No	--	---	ND	None
B-18-190 (11)	Grey	Yes	No	--	---	ND	None
B-18-190 (12)	Grey	Yes	No	--	---	ND	None
B-18-190 (13)	Grey	Yes	No	--	---	ND	None
B-18-190 (14)	Grey	Yes	No	--	---	ND	None
B-18-190 (15)	Grey	Yes	No	--	---	ND	None

TRC LABORATORY ASBESTOS ANALYTICAL ACCREDITATIONS

NVLAP Lab Code 101424-0
RI #AAL-007 TX #300354
CO# AL-15020

AIHA-LAP,LLC #100122 CT #PH-0426
VT #AL014538 LA#05011 VA #3333 000283
PHIL# 461 PA#68-03387

ME LA-0075, LB-0071 MA #AA000052 NY #10980 WV# LT000411
AZ #A20944 HI #L-09-004 NJ #CT004 CA #2907



POLARIZED LIGHT MICROSCOPY by EPA 600/R-93/116

Sample No.	Color	Homogenous	Multi-Layered	Layer No.	Other Matrix Materials	Asbestos %	Asbestos Type
------------	-------	------------	---------------	-----------	------------------------	------------	---------------

Reporting limit- asbestos present at 1%

ND - asbestos was not detected

Trace - asbestos was observed at level of less than 1%

NA/PS - Not Analyzed / Positive Stop

SNA- Sample Not Analyzed- See Chain of Custody for details

Note: Polarized-light microscopy is not consistently reliable in detecting asbestos in floor coverings and similar non-friable organically bound materials. In those cases, EPA recommends, and certain states (e.g. NY) require, that negative results be confirmed by quantitative transmission electron microscopy.

The Laboratory at TRC follows the EPA's Interim Method for the Determination of Asbestos in Bulk Insulation (1982), and the EPA recommended Method for the Determination of Asbestos in Bulk Building Materials (EPA/600/R-93/116), July 1993, R.L. Perkins and B.W. Harvey which utilizes polarized light microscopy (PLM). Our analysts have completed an accredited course in asbestos identification. TRC's Laboratory is accredited under the National Voluntary Laboratory Accreditation Program (NVLAP), for Bulk Asbestos Fiber Analysis, NVLAP Code 18/A01, effective through June 30, 2016. TRC is an American Industrial Hygiene Association (AIHA) accredited lab for PLM effective through October 1, 2016. Asbestos content is determined by visual estimate unless otherwise indicated. Quality Control is performed in-house on at least 10% of samples and the QC data related to the samples is available upon written request from the client.

This report shall not be reproduced, except in full, without the written approval of TRC. This report must not be used by the client to claim product endorsement by NVLAP or any agency of the U.S. Government. This report relates only to the items tested.

Analyzed by: K. Williamson

Kathleen Williamson, Laboratory Manager

Reviewed by: Aud. Park

Amanda Parkins, Approved Signatory

Date Issued

10/21/2015

TRC LABORATORY ASBESTOS ANALYTICAL ACCREDITATIONS

NVLAP Lab Code 101424-0
RI #AAL-007 TX #300354
CO# AL-15020

AIHA-LAP,LLC #100122 CT #PH-0426
VT #AL014538 LA#05011 VA #3333 000283
PHIL# 461 PA#68-03387

ME LA-0075, LB-0071 MA #AA000052 NY #10980 WV# LT000411
AZ #A20944 HI #L-09-004 NJ #CT004 CA #2907

Jun 03
ORDER OF SHEETS

Sheet No. 1 Title
Sheet No. Typical Sections and Details
(includes erosion control plans)
Sheet No. Estimate of Quantities
Sheet No. Miscellaneous Quantities
Sheet No. Right of Way Plat
Sheet No. Plan and Profile
Sheet No. Standard Detail Drawings
Sheet No. Sign Plates
Sheet No. Structure Plans
Sheet No. Computer Earthwork Data
Sheet No. Cross Sections

TOTAL SHEETS = 858

STATE OF WISCONSIN
DEPARTMENT OF TRANSPORTATION
PLAN OF PROPOSED IMPROVEMENT
EAU CLAIRE - CHIPPEWA FALLS ROAD
(NORTH CROSSING TO LASALLE ST.) (LASALLE ST. TO U.S.H. 53)
U.S.H. 53 U.S.H. 53
EAU CLAIRE COUNTY EAU CLAIRE COUNTY

MAY 08 2003

STATE PROJECT	FEDERAL PROJECT	
	PROJECT	CONTRACT
1190-00-82	HHP 2003493	1
8610-00-72	STP 2003490	1

PROJECT ID: 1190-00-82
WITH: 8610-00-72

DESIGN ID: 1190-00-00-00
WITH: 8610-00-02

COUNTY: EAU CLAIRE




DESIGN DESIGNATION



A.D.T. (2004) = 23,200
A.D.T. (2024) = 31,100
D.H.V. (2024) = 3,565
D. = 50/60
T. = 7.7
DESIGN SPEED = 70 MPH
ESALS = 6,321,800

CONVENTIONAL SYMBOLS

COUNTY LINE
CORPORATE LIMITS
PROPERTY LINE
LOT LINE
LIMITED EASEMENT
EXISTING RIGHT OF WAY
PROPOSED OR NEW R/W LINE
SURVEY LINE
SLOPE INTERCEPT
ORIGINAL GROUND
MARSH OR ROCK PROFILE
(To be noted as such)
MARSH AREA
WOODED OR SHRUB AREA

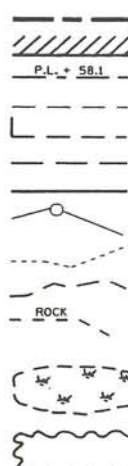

COMBUSTIBLE FLUIDS
UNDERGROUND UTILITIES
GAS
ELECTRIC
TELEPHONE OR TELEGRAPH
COMMUNICATIONS LINE
SERVICE PEDESTAL
POWER POLE
TELEPHONE POLE
RAILROAD
SANITARY SEWER
STORM SEWER
WATER
EXISTING CULVERT
PROPOSED CULVERT
(Box or Pipe)
CULVERT (Profile View)

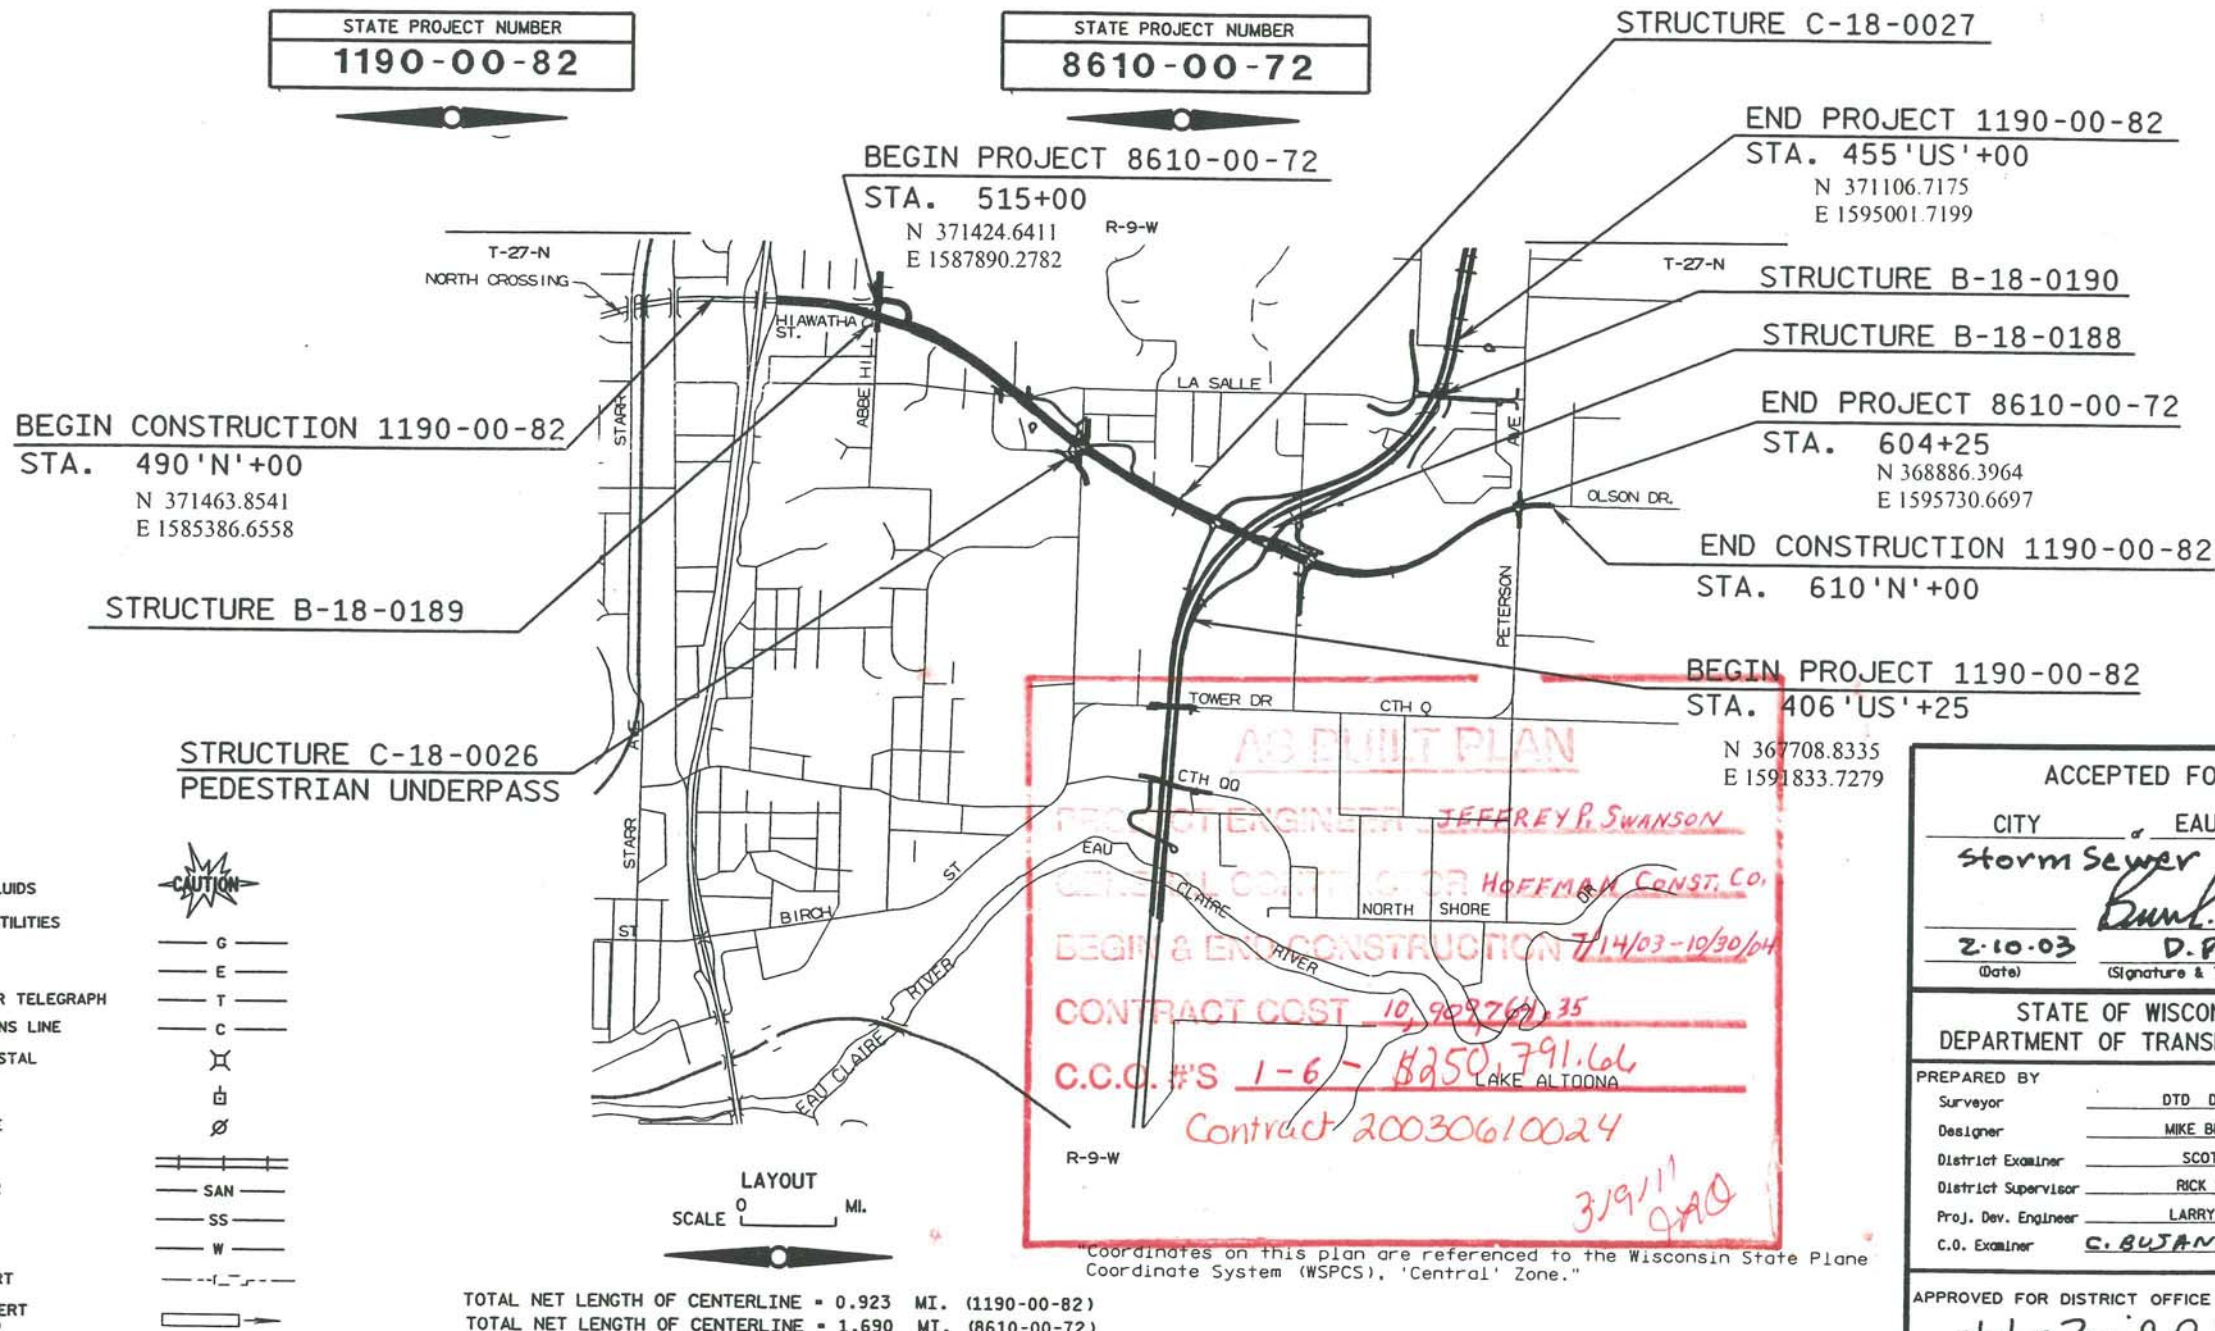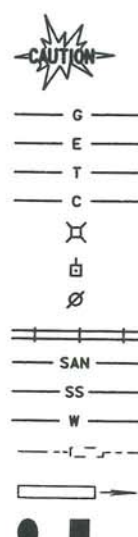

TOTAL NET LENGTH OF CENTERLINE = 0.923 MI. (1190-00-82)
TOTAL NET LENGTH OF CENTERLINE = 1.690 MI. (8610-00-72)

Coordinates on this plan are referenced to the Wisconsin State Plane Coordinate System (WSPCS), 'Central' Zone.

ACCEPTED FOR

CITY EAU CLAIRE

Storm Sewer




2-10-03
(Date)

STATE OF WISCONSIN
DEPARTMENT OF TRANSPORTATION

PREPARED BY
Surveyor DTD DIST. 6
Designer MIKE BERTHOLD
District Examiner SCOTT IVES
District Supervisor RICK SHERMO
Proj. Dev. Engineer LARRY JONES
C.O. Examiner C. BUJANOWSKI

APPROVED FOR DISTRICT OFFICE

DATE 2/7/03
(Signature)

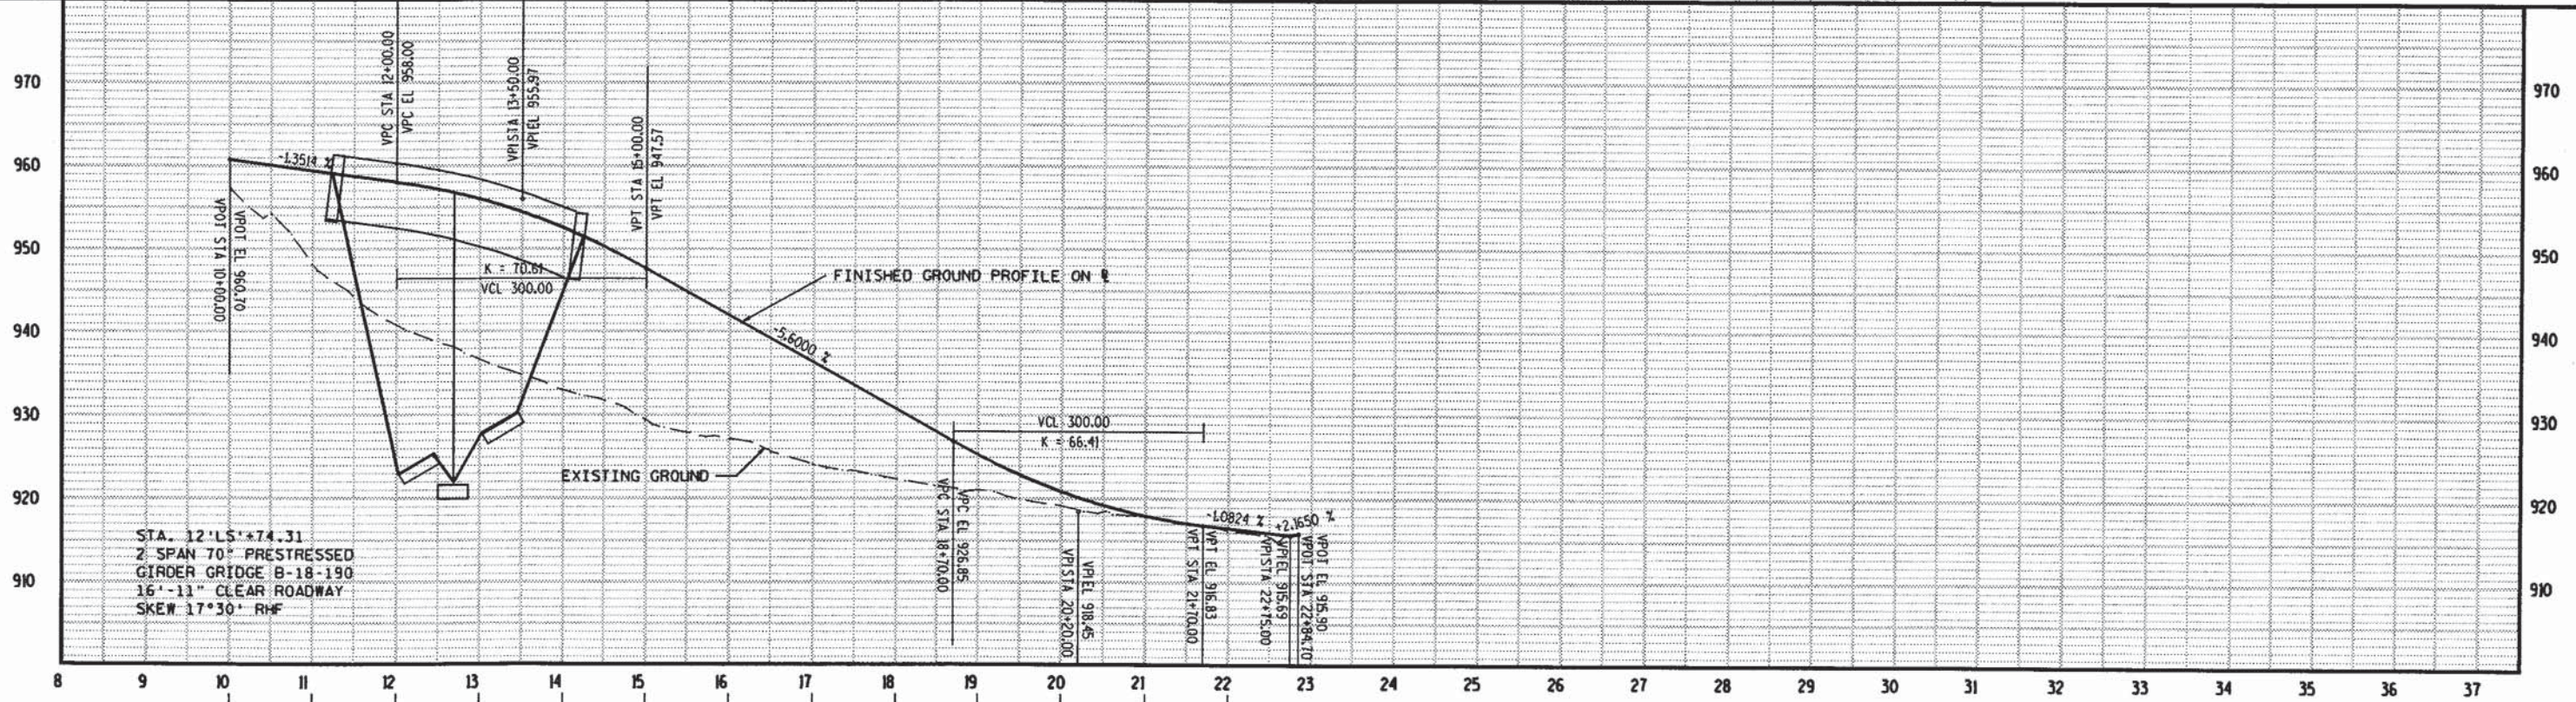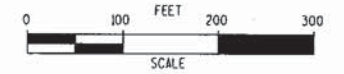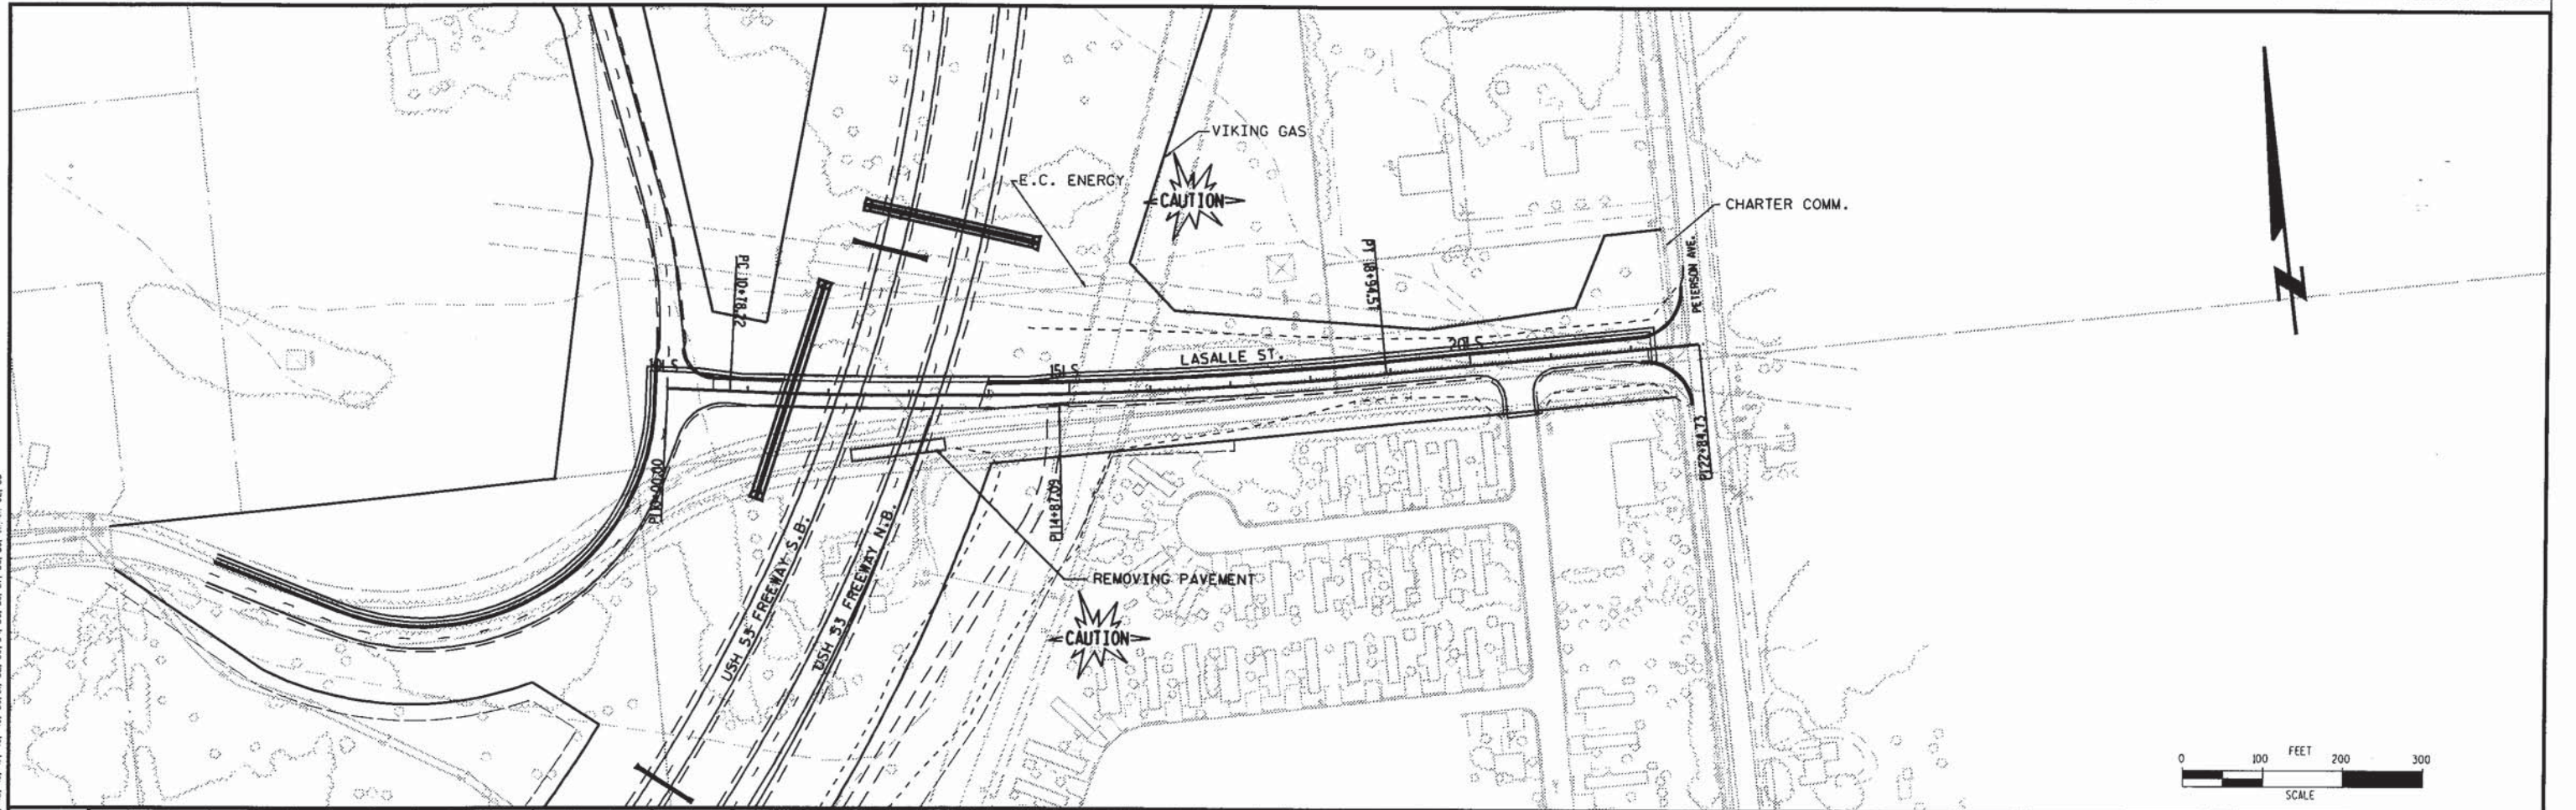

STATE PROJECT NO: 1190-00-82

HWY: U.S.H. 53 FREEWAY

COUNTY: EAU CLAIRE

PLAN & PROFILE: LASALLE STREET - 'LS' LINE

SHEET NO: 338

E

FILE NAME: \\EAU31ZP1\caddproj\microstation\Projects\d6_11900006\d6_119000062800P5831B0

PLOT DATE: 09-APR-2003 15:16

ORIG DATE:

PLOT NAME:

ORIGINATOR:

PLOT SCALE:

2.006061:1.000000


MSDOT/CADD SHEET 42

CURVE DATA

LA SALLE STREET
 P.I. STA. = 14+87.09
 Δ = 08°09'48"
 R = 5729.58'
 T = 408.86'
 L = 816.34'
 E = 14.57'

CURVE DATA

USH 53 NORTH BOUND
 P.I. STA. = 442+38.40
 Δ = 57°50'31"
 R = 2291.83'
 T = 1266.25'
 L = 2313.67'
 E = 326.54'
 S.E. = 5.9%

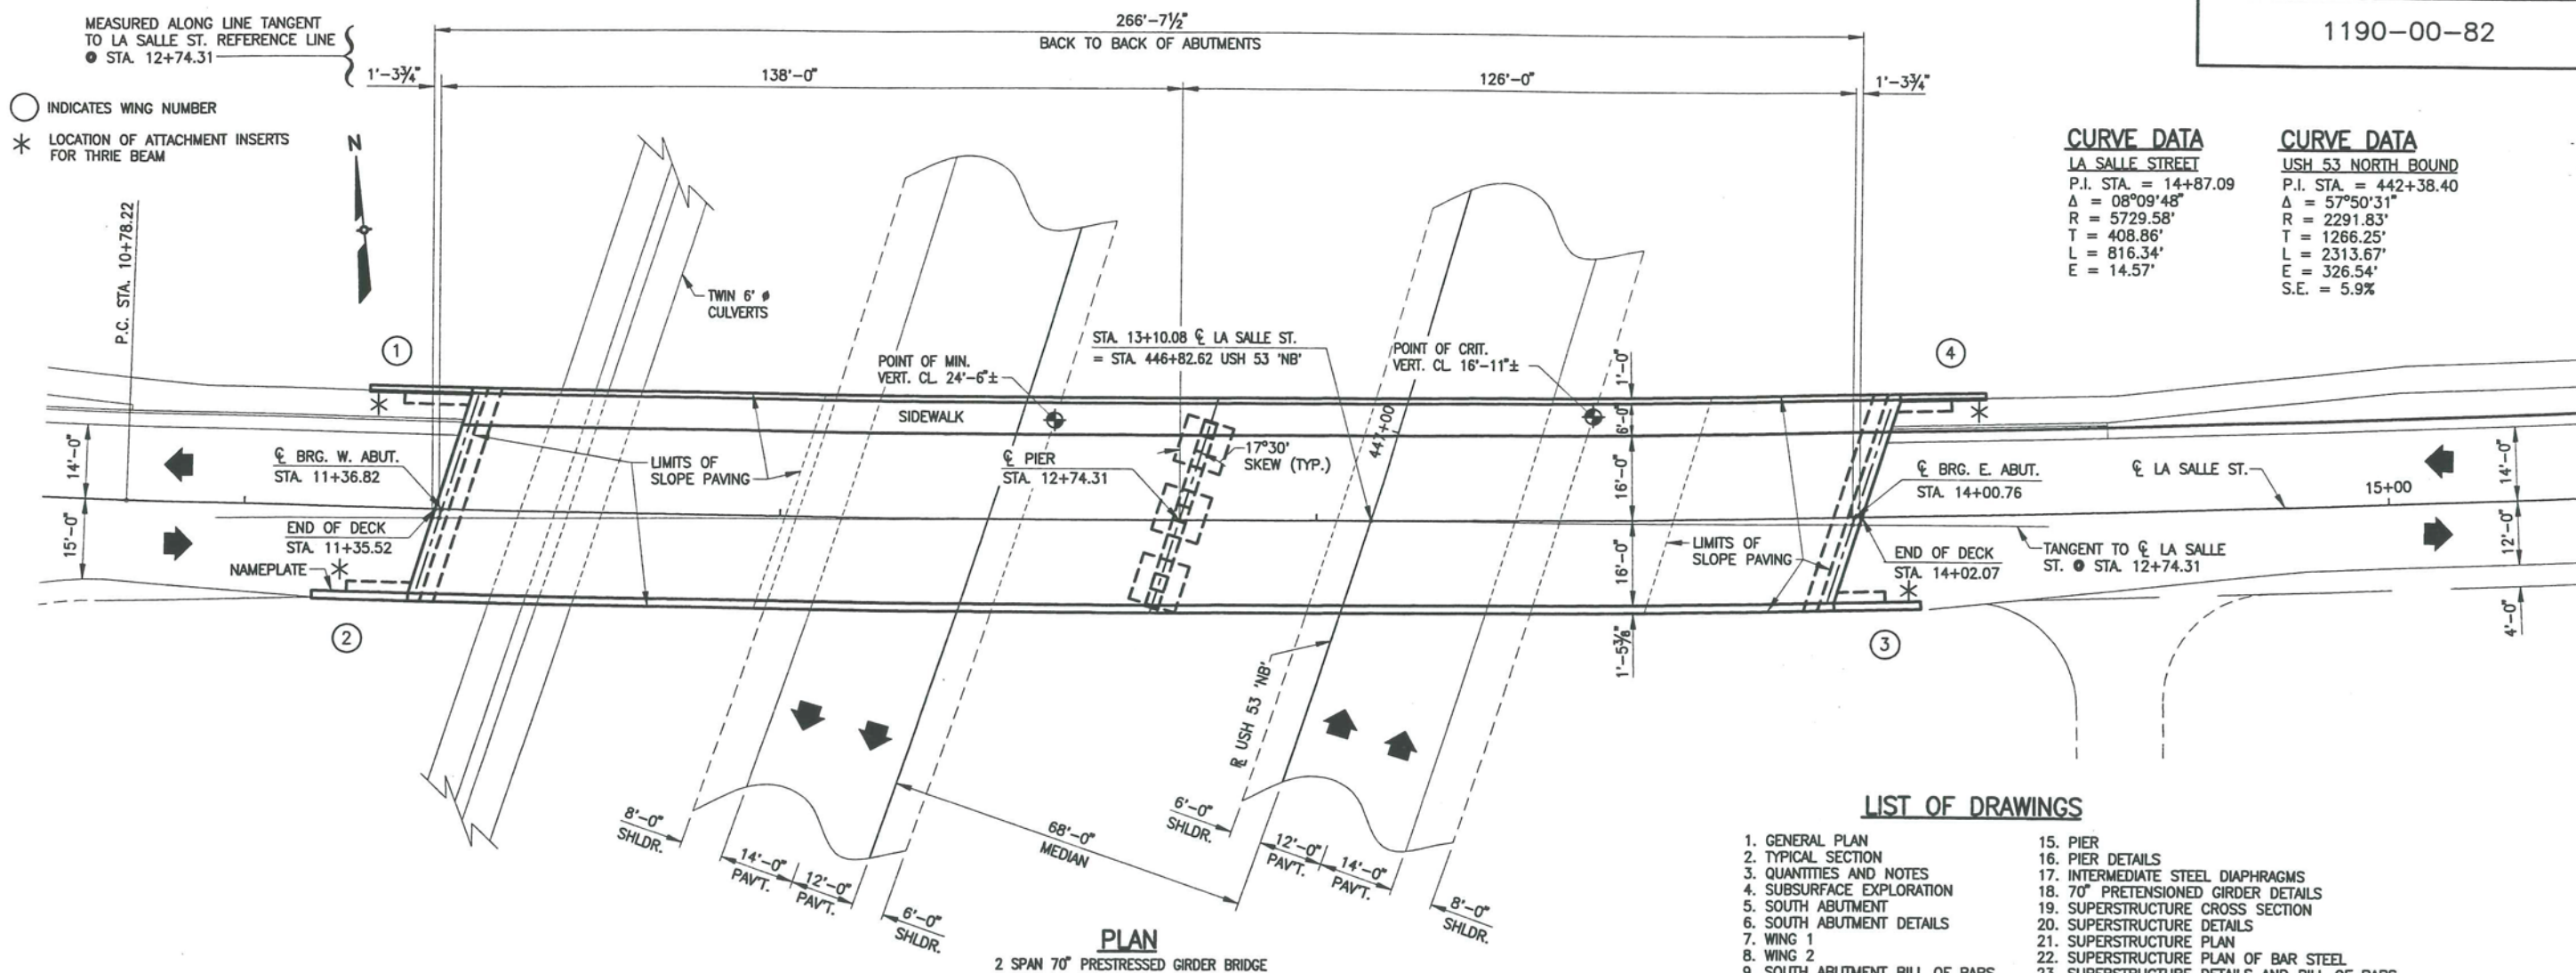


PLAN
 2 SPAN 70' PRESTRESSED GIRDER BRIDGE

LIST OF DRAWINGS


1. GENERAL PLAN
2. TYPICAL SECTION
3. QUANTITIES AND NOTES
4. SUBSURFACE EXPLORATION
5. SOUTH ABUTMENT
6. SOUTH ABUTMENT DETAILS
7. WING 1
8. WING 2
9. SOUTH ABUTMENT BILL OF BARS
10. NORTH ABUTMENT
11. NORTH ABUTMENT DETAILS
12. WING 3
13. WING 3
14. NORTH ABUTMENT BILL OF BARS
15. PIER
16. PIER DETAILS
17. INTERMEDIATE STEEL DIAPHRAGMS
18. 70' PRETENSIONED GIRDER DETAILS
19. SUPERSTRUCTURE CROSS SECTION
20. SUPERSTRUCTURE DETAILS
21. SUPERSTRUCTURE PLAN
22. SUPERSTRUCTURE PLAN OF BAR STEEL
23. SUPERSTRUCTURE DETAILS AND BILL OF BARS
24. SLOPED FACE PARAPET "LF" (SOUTH SIDE)
25. VERTICAL FACE PARAPET "A" (NORTH FACE)
26. TUBULAR RAILING, SPECIAL

BRIDGE OFFICE CONTACT:
 GERRY ANDERSON
 (608) 266-8488

ROMENESKO ENGINEERING, LLC
 213 JACKSON STREET
 SAUK CITY, WI 53583
 (608) 644-1502


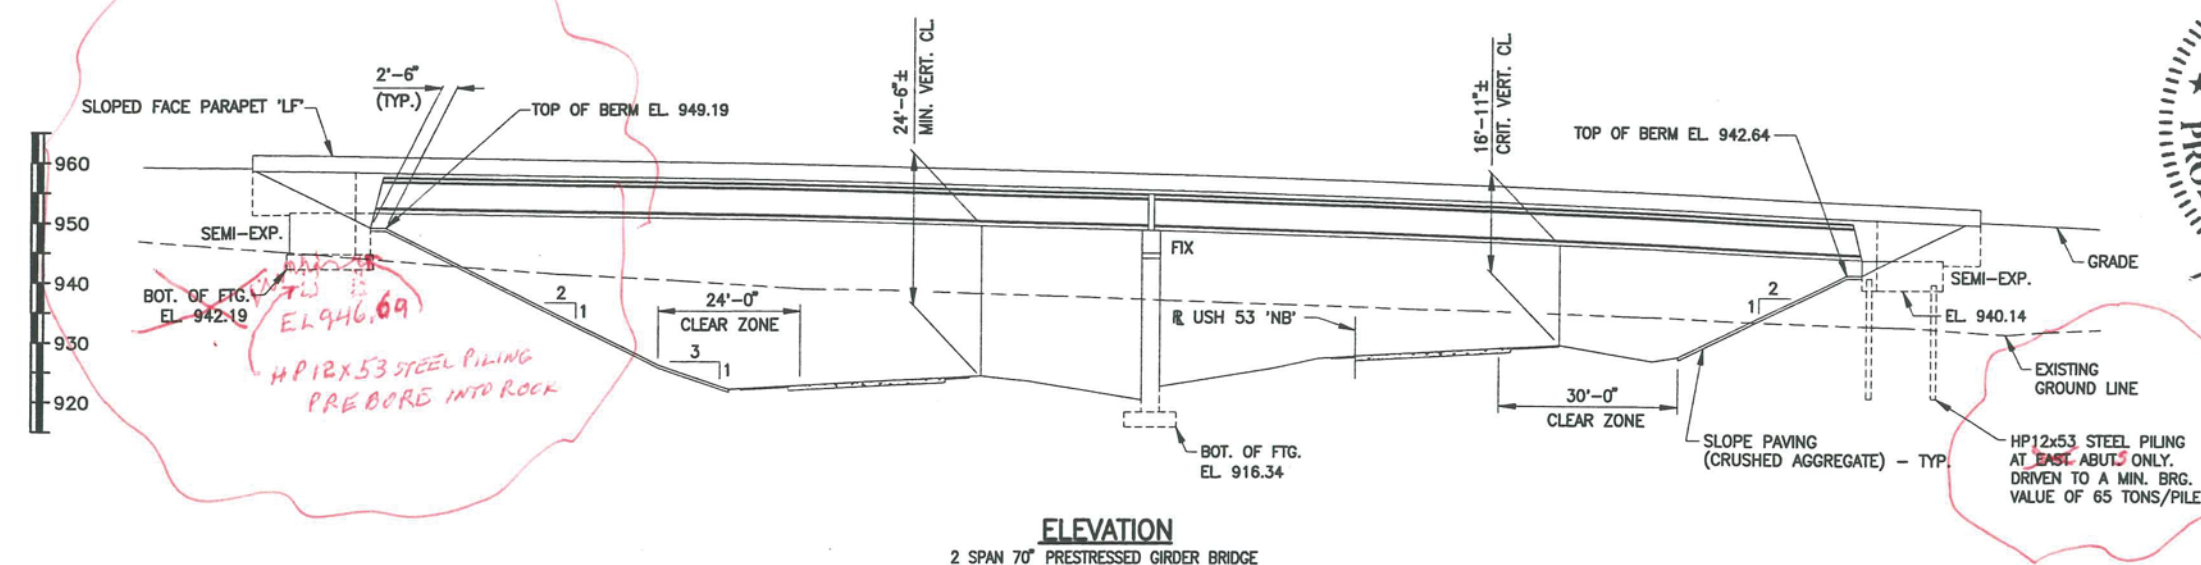


ELEVATION
 2 SPAN 70' PRESTRESSED GIRDER BRIDGE

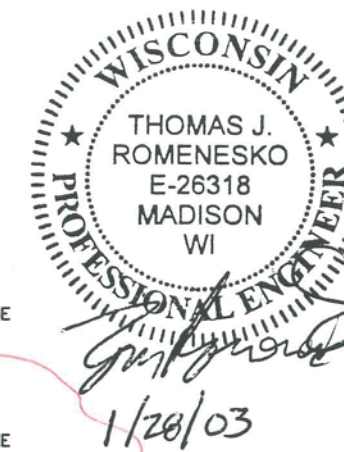

No.	Date	Revision	By
ROMENESKO ENGINEERING, LLC			
STATE OF WISCONSIN DEPARTMENT OF TRANSPORTATION			
STRUCTURE B-18-190			
LA SALLE ST. OVER USH 53			
County	EAU CLAIRE	Town	SEYMOUR
Design Spec.	A.A.S.H.T.O. 1996	Load	HS20
Design By	T.J.R.	Design Checked	V.A.R.
Drawn By	T.L.	Plans Checked	T.J.R.
Approved		State Bridge Engineer	
DATE		03/26/03	
GENERAL PLAN			
SHEET 1 OF 26			
DATE: DECEMBER 2002			

1190-00-82

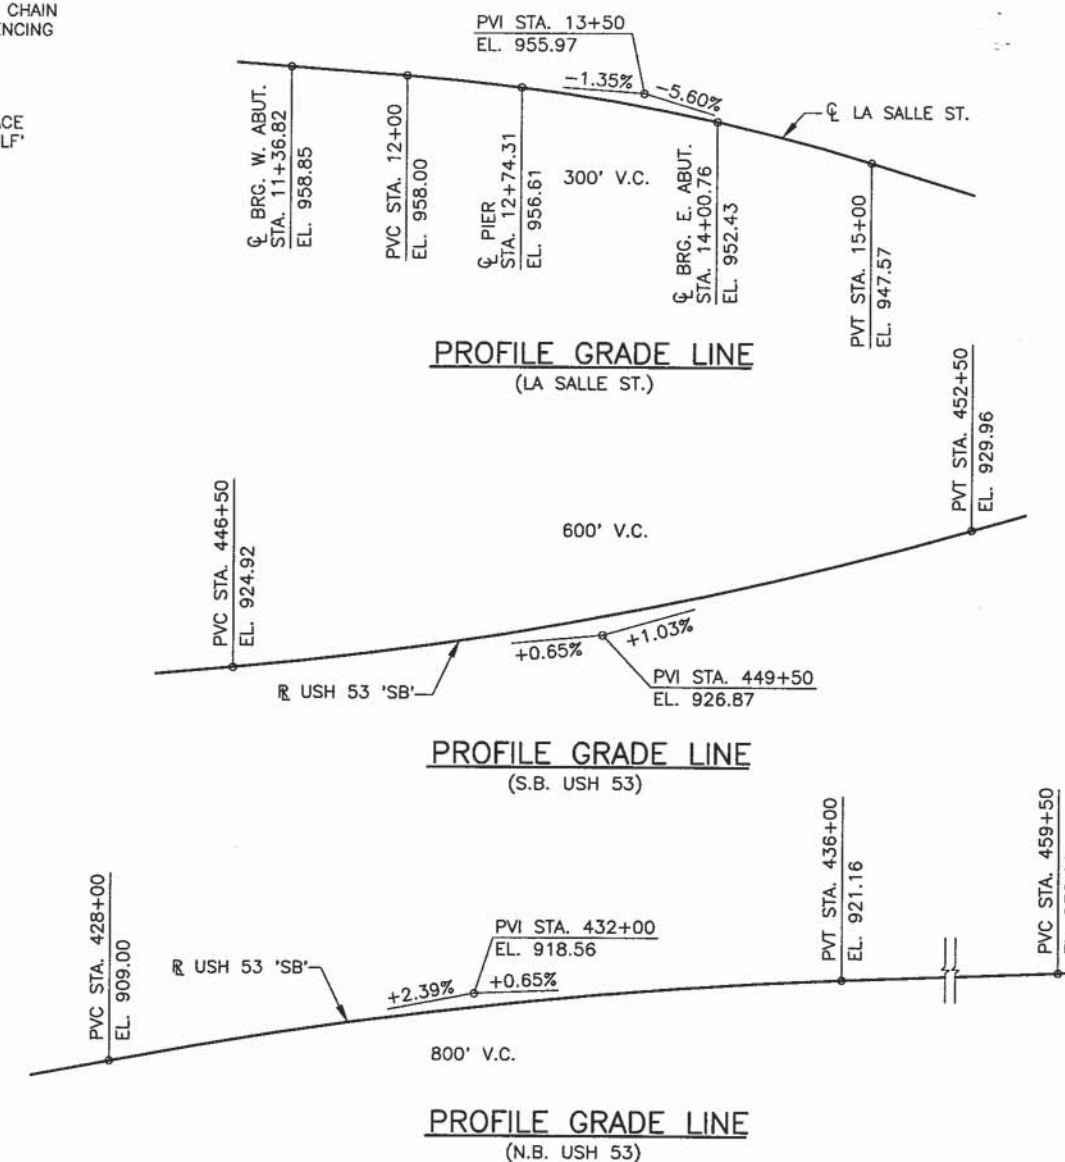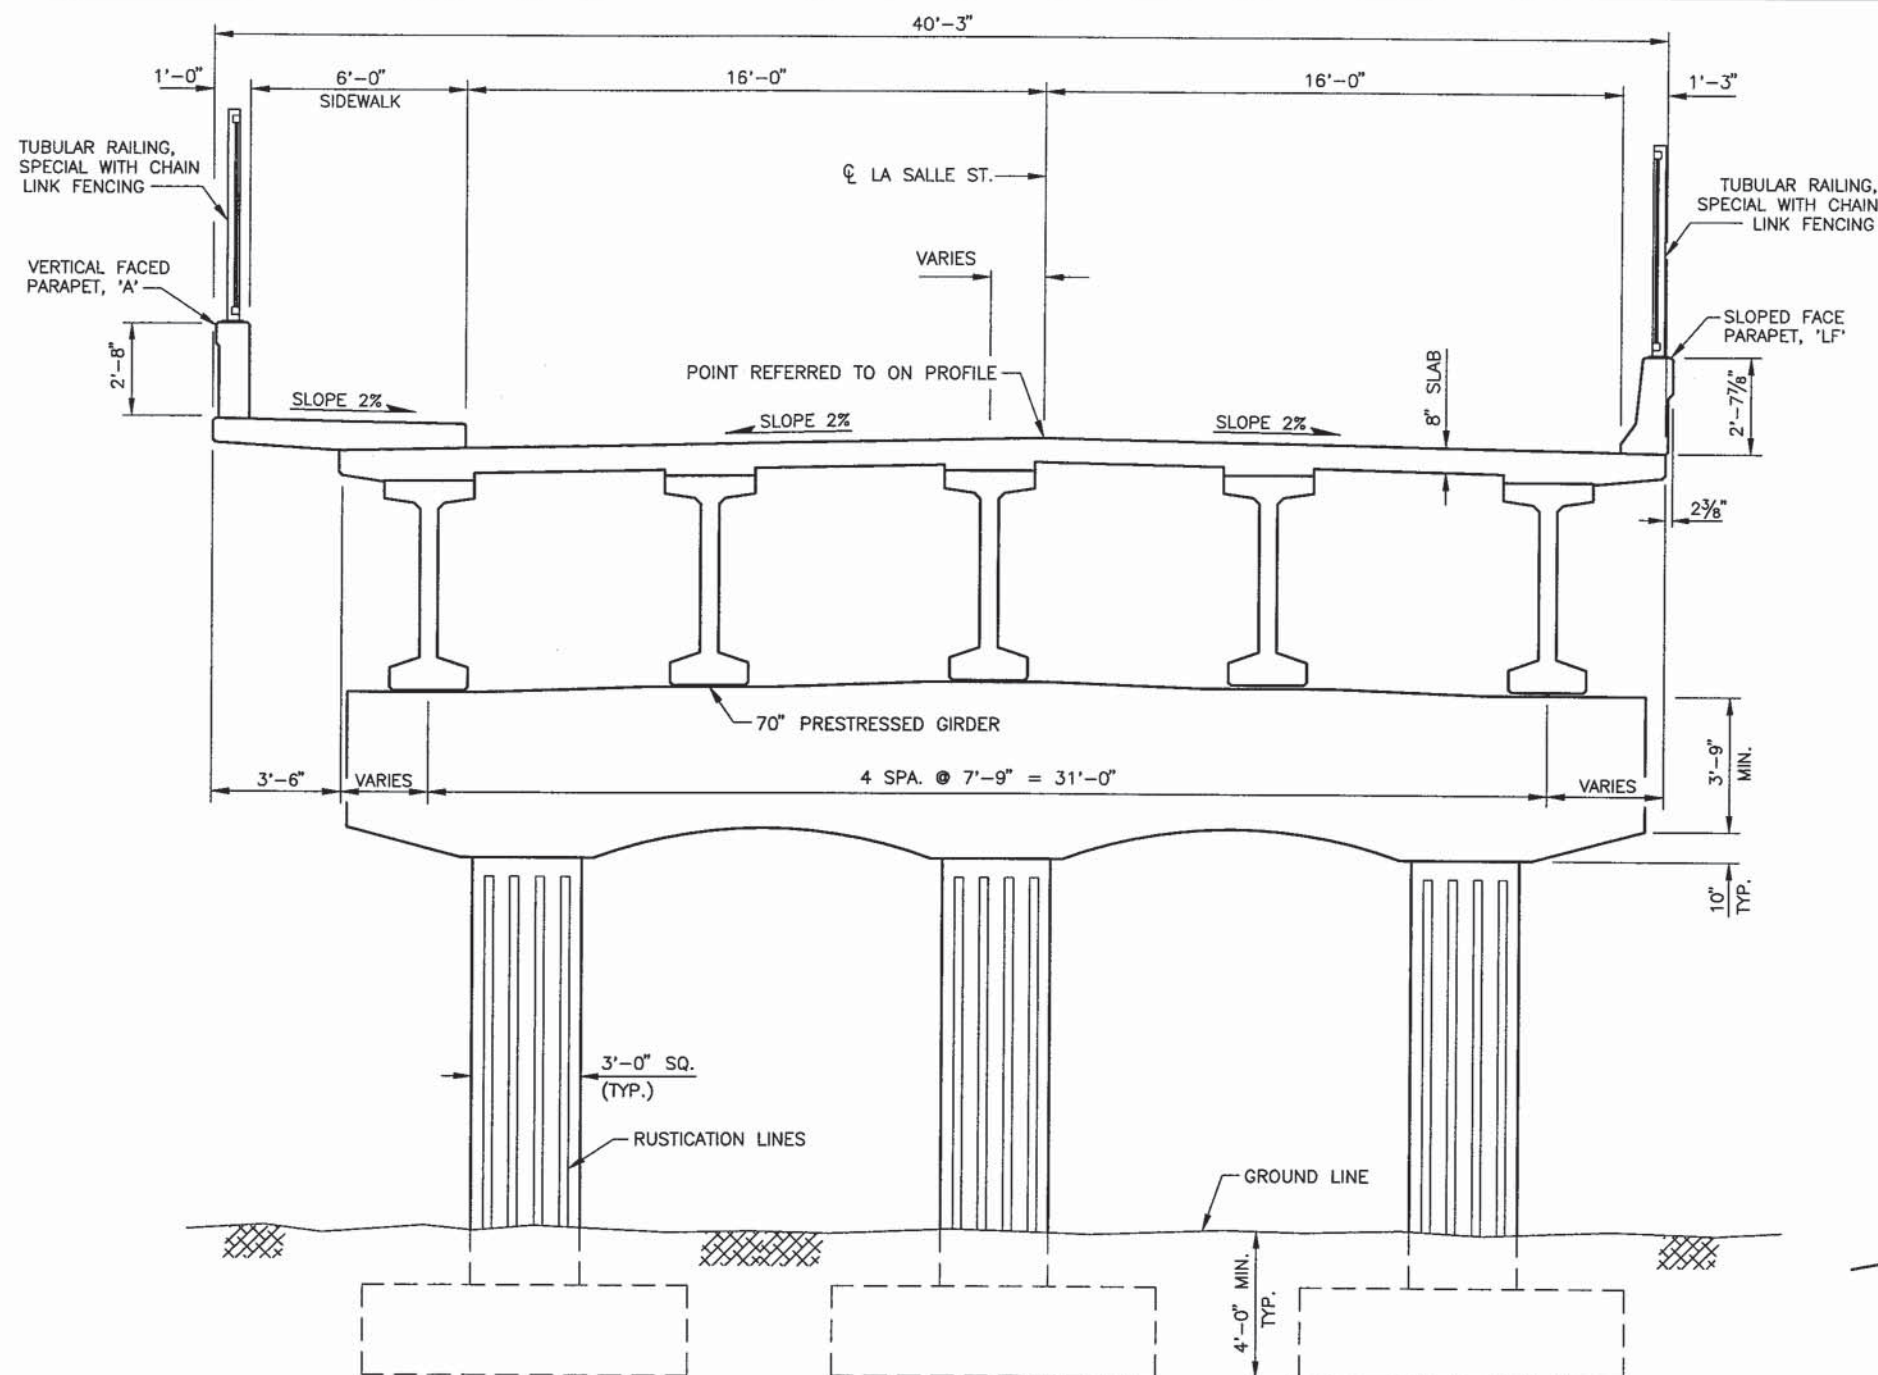

LA SALLE TYPICAL BRIDGE SECTION

DESIGN DATA

STRUCTURE IS DESIGNED FOR A FUTURE WEARING SURFACE
20 PSF.

LIVE LOAD:

DESIGN RATING ————— HS20
INVENTORY RATING ————— HS23
OPERATING RATING ————— HS40
MAX. STD. PERMIT VEHICLE LOAD = 250 KIPS

ULTIMATE DESIGN STRESSES:

CONCRETE MASONRY SLAB ————— $f'_c = 4,000$ psi
ALL OTHER ————— $f'_c = 3,500$ psi

HIGH STRENGTH BAR

STEEL REINFORCEMENT ————— $f_y = 60,000$ psi

70" PRETENSIONED GIRDERS

CONCRETE MASONRY ————— 8,000 psi
STRANDS — 1/2" OR 0.6" DIA. WITH AN
ULTIMATE TENSILE STRENGTH OF 270,000 psi

FOUNDATION DATA:

WEST ABUTMENT TO BE SUPPORTED ON
SPREAD FOOTINGS ON SANDSTONE
BEDROCK AT A MINIMUM BEARING
CAPACITY OF 7.5 TONS PER SQUARE FOOT.

PIER TO BE SUPPORTED ON
SPREAD FOOTINGS ON SANDSTONE
BEDROCK AT A MINIMUM BEARING
CAPACITY OF 7.5 TONS PER SQUARE FOOT.

EAST ABUTMENT TO BE SUPPORTED ON
HP12x53 STEEL PILING EST. 20' LG.,
DRIVEN TO A MIN. BRG. VALUE OF
65 TONS PER PILE (TYP.)

TRAFFIC DATA:

LA SALLE STREET

ADT = 4,100 (2024)
RDS = 40

USH 53

ADT = 32,750 (2024)
RDS = 70

No.	Date.	Revision	By
STATE OF WISCONSIN DEPARTMENT OF TRANSPORTATION DIVISION OF HIGHWAYS			
STRUCTURE B-18-190			
Const. Spec.	WIS. '99	Drawn By	Plans Checked
		TL	TR
TYPICAL SECTION			SHEET 2 OF 26
			548

ABBREVIATIONS

F— Fine
Ws— Weathered
M— Medium
C— Coarse
So— Sound

MATERIAL SYMBOLS

Topsoil Silt Sandstone
Sand Peat Limestone
Gravel Clay Igneous Rock

LEGEND OF PROBING

Probing No.
Sta.
Elevation

95/6 = 95 Blows for 6"
Penetration
Probing taken with a
350 Lb. Wt.
Falling 18" on a 2"
O.D. Point

7 Average
Blows Per Foot

Refusal 95/6

LEGEND OF BORING

Unconfined Strength → 7.7
Blows Per Foot Using 140 Lb. Wt. Falling 30"
Wash Sample
Shelby Tube — S.T.
Ground Water Elevation
No Ground Water Observed Above This Elevation

Elev.

Boring No., Elev. Sta. & Offset


Sandy Gravel
F.
Boulders or Cobbles
Sand
Silty Clay
So
Limestone

Unless otherwise specified, the blows per foot at the locations indicated are based on driving a 2" O.D. x 1.4" I.D. split spoon sampler with a 140 lb. hammer having a free fall of 30". The blow count is taken in undisturbed soil immediately below a cased or open hole eliminating side friction on the drive pipe.


SUBSURFACE EXPLORATION FOR FOUNDATION DESIGN AND BIDDERS INFORMATION

To obtain relative data concerning the character of material in and upon which the foundation might be built, borings and/or soundings were made at points approximately as indicated on this drawing. The data presented herein represents the findings of the subsurface explorations made. However, because the depths investigated are limited and the area of the borings and/or soundings is very small in relation to the entire area, the Division of Highways does not warrant conditions below the depths investigated or that the classification of material encountered in these investigations is necessarily typical of the entire site.

No.	Date	Revision	By
STATE OF WISCONSIN DEPARTMENT OF TRANSPORTATION			
STRUCTURE B-18-190			
Const. Spec.	WIS. 1996	Drawn By T.L.	Plans Checked T.R.
SUBSURFACE EXPLORATION			SHEET 4 OF 26
			550

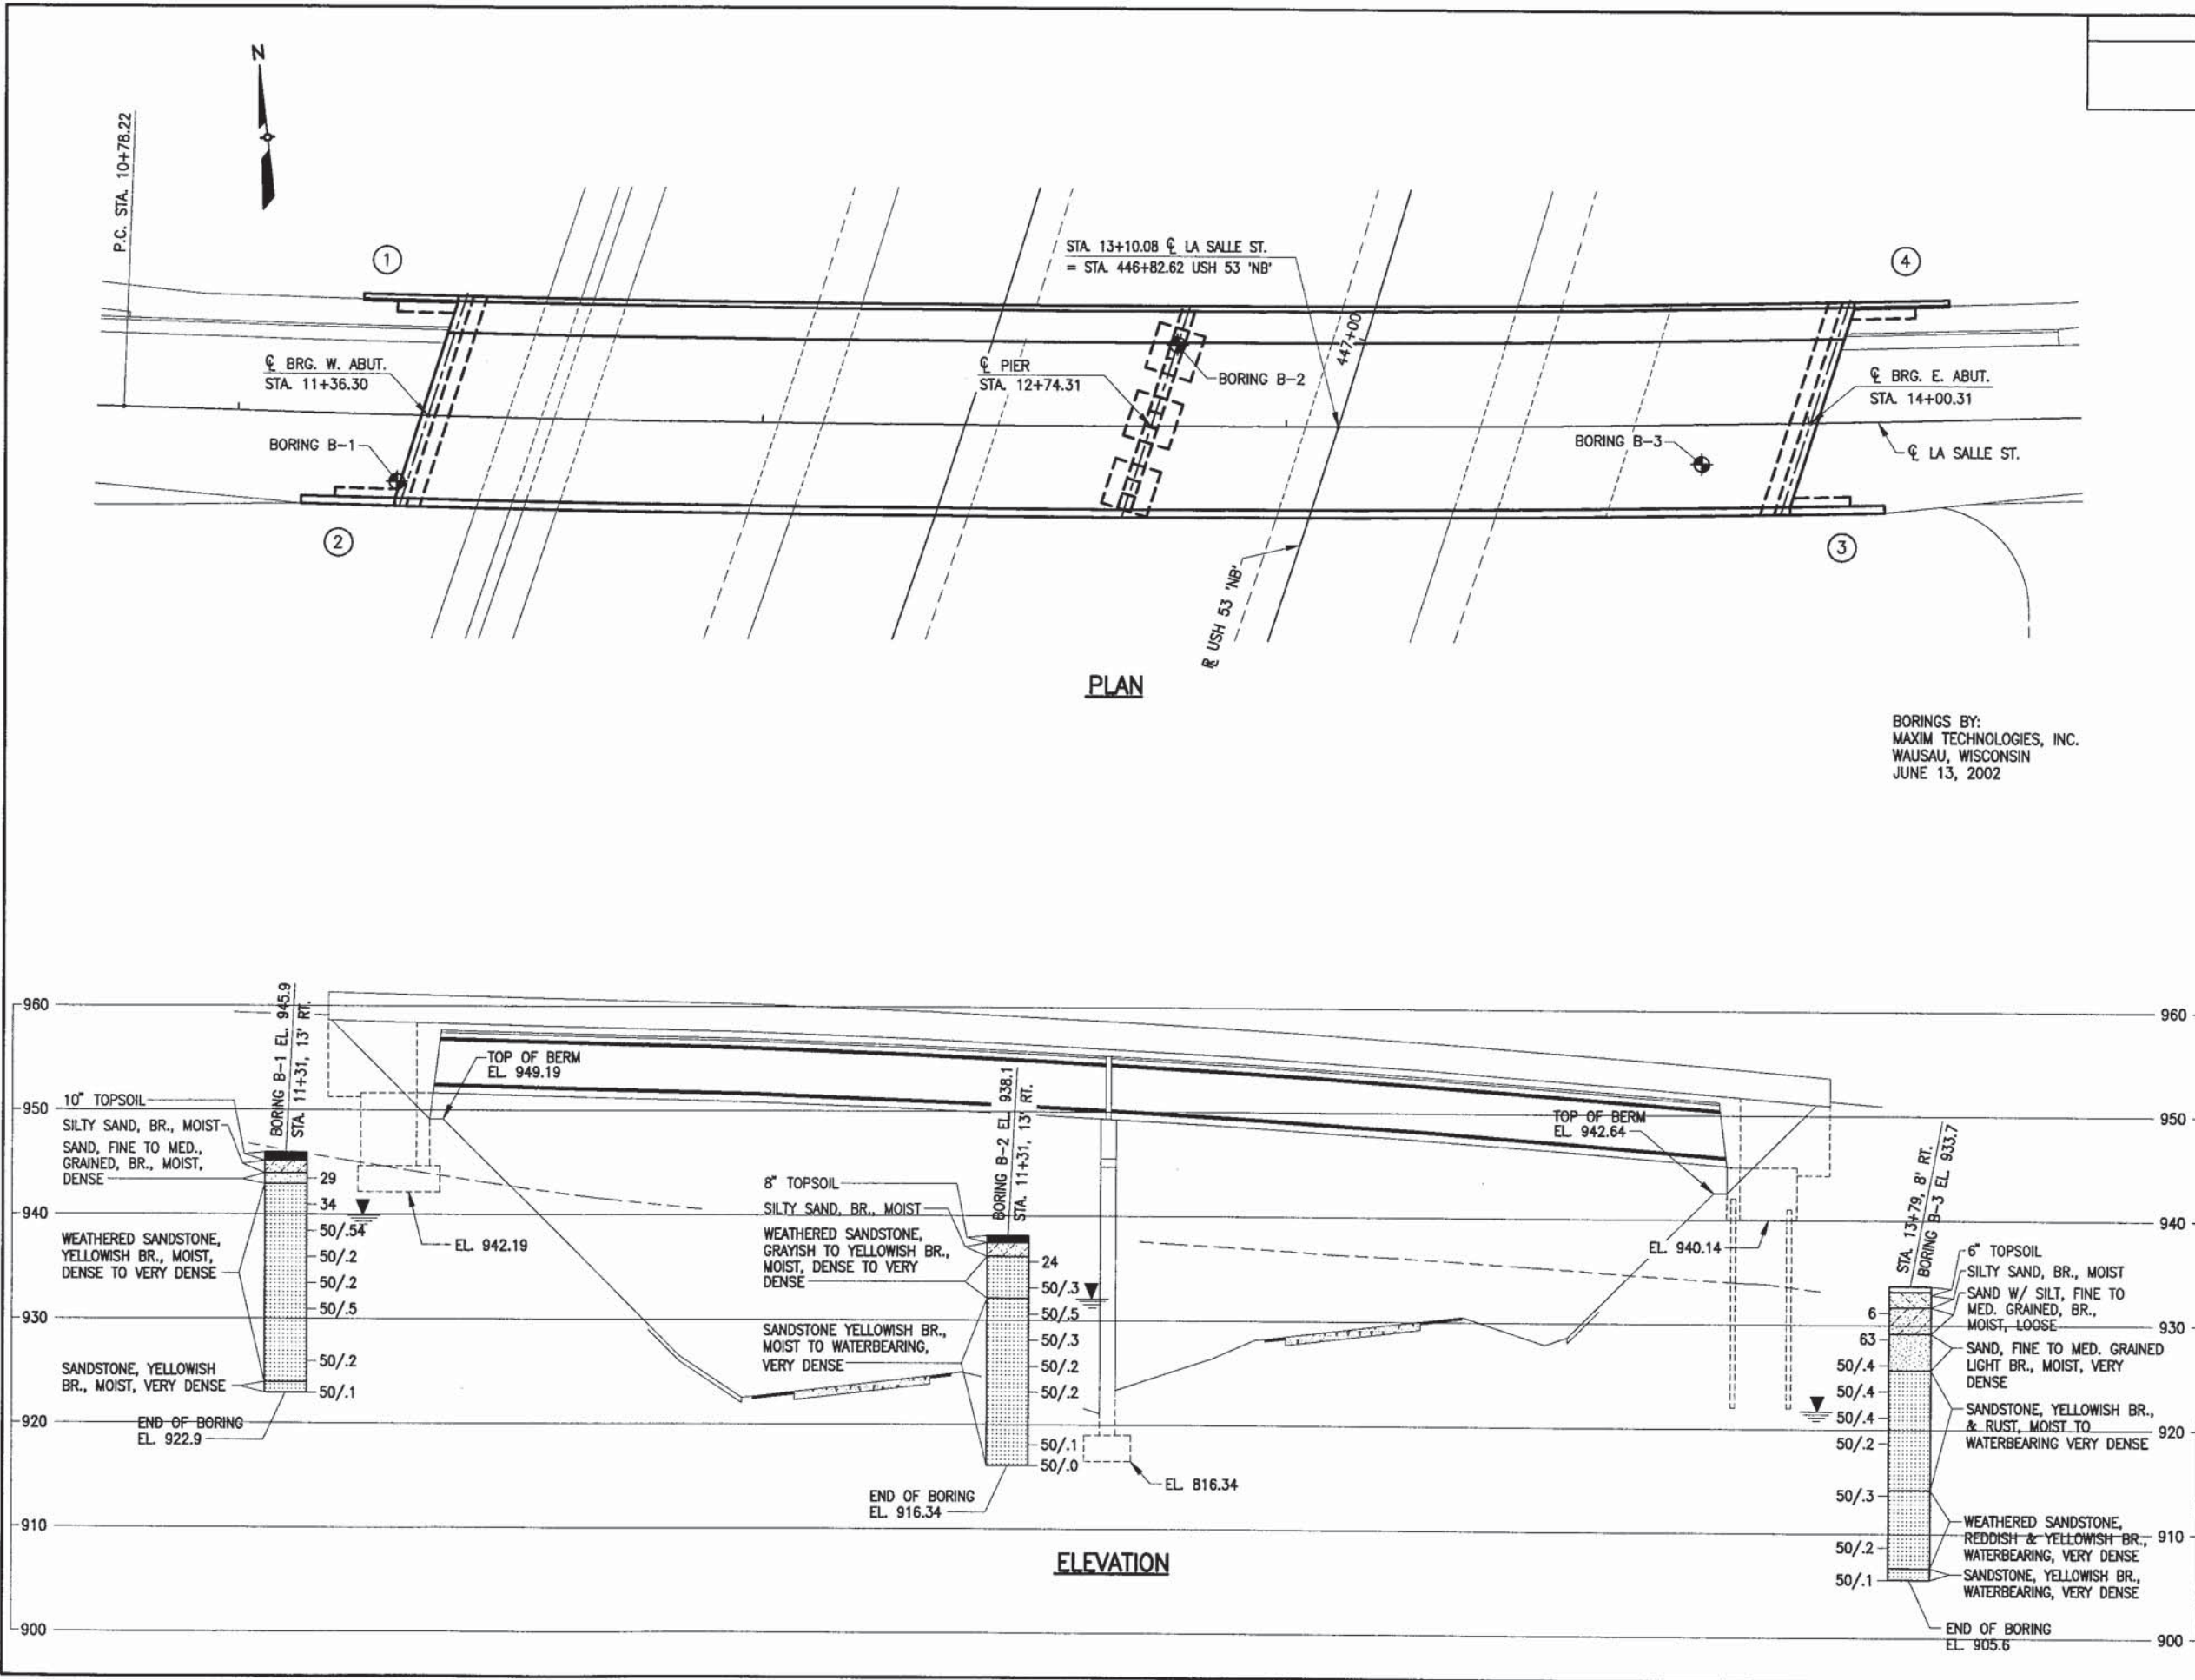

BORINGS BY:
MAXIM TECHNOLOGIES, INC.
WAUSAU, WISCONSIN
JUNE 13, 2002

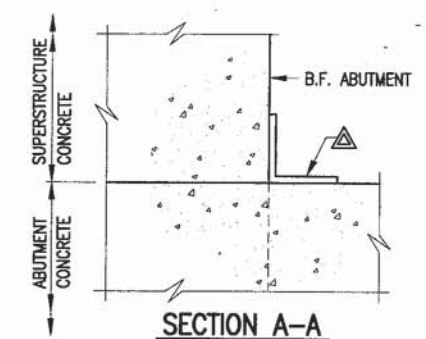

LEGEND


- * DIMENSIONS AND ELEVATIONS ARE GIVEN AT THE TOP OF CONCRETE AT THE ϕ OF BEARING.
- ** DIMENSIONS ARE GIVEN AT THE B.F. OF ABUTMENT. FOR WING DETAILS AND ELEVATIONS, SEE SHEETS 7 & 8.
- ▲ 1/2" FILLER TO EXTEND AS SHOWN. SEAL ALL EXPOSED HORIZONTAL AND VERTICAL SURFACES OF FILLER WITH NON-STAINING GRAY NON-BITUMINOUS JOINT SEALER, (1" DEEP AND HOLD 1/8" BELOW SURFACE OF CONCRETE.)
- ▲ 18" RUBBERIZED MEMBRANE WATERPROOFING - TO EXTEND HORIZONTAL BETWEEN INSIDE FACE OF WINGS AND VERTICAL FROM TOP OF BODY TO TOP OF WINGS.
- ★ 3/4" CORK FILLER ON VERTICAL FACES ONLY.
- STEEL TROWEL TOP SURFACE OF ABUTMENT. PLACE MULTIPLE LAYERS OF POLYETHYLENE SHEETS OVER ENTIRE ABUTMENT TOP BEFORE PLACING BEARING PADS AND/OR SUPERSTRUCTURE. TOTAL THICKNESS OF SHEETS SHALL BE AT LEAST 0.03".
- ▲ PLACE BOTTOM HALF OF RUBBERIZED MEMBRANE WATERPROOFING HORIZONTAL IN THIS AREA. SEE SECTION A-A ON THIS SHEET.
- VERTICAL CONSTRUCTION JOINT KEYWAY FORMED BY A SURFACED, BEVELED 2" x 8". BEVEL EXPOSED EDGES 3/4".
- (X) INDICATES WING NUMBER

FOOTING NOTE



ABUTMENTS TO BE SUPPORTED ON SPREAD FOOTING ON BEDROCK AT A MINIMUM BEARING CAPACITY OF 7.5 TONS PER SQUARE FOOT.

MINIMUM BAR LAPS
#6 = 2'-11"

No.	Date.	Revision	By
STATE OF WISCONSIN DEPARTMENT OF TRANSPORTATION			
STRUCTURE B-18-190			
Const. Spec.	WIS. '99	Drawn By TL	Plans Checked TR
WEST ABUTMENT			SHEET 5 OF 26
			55L

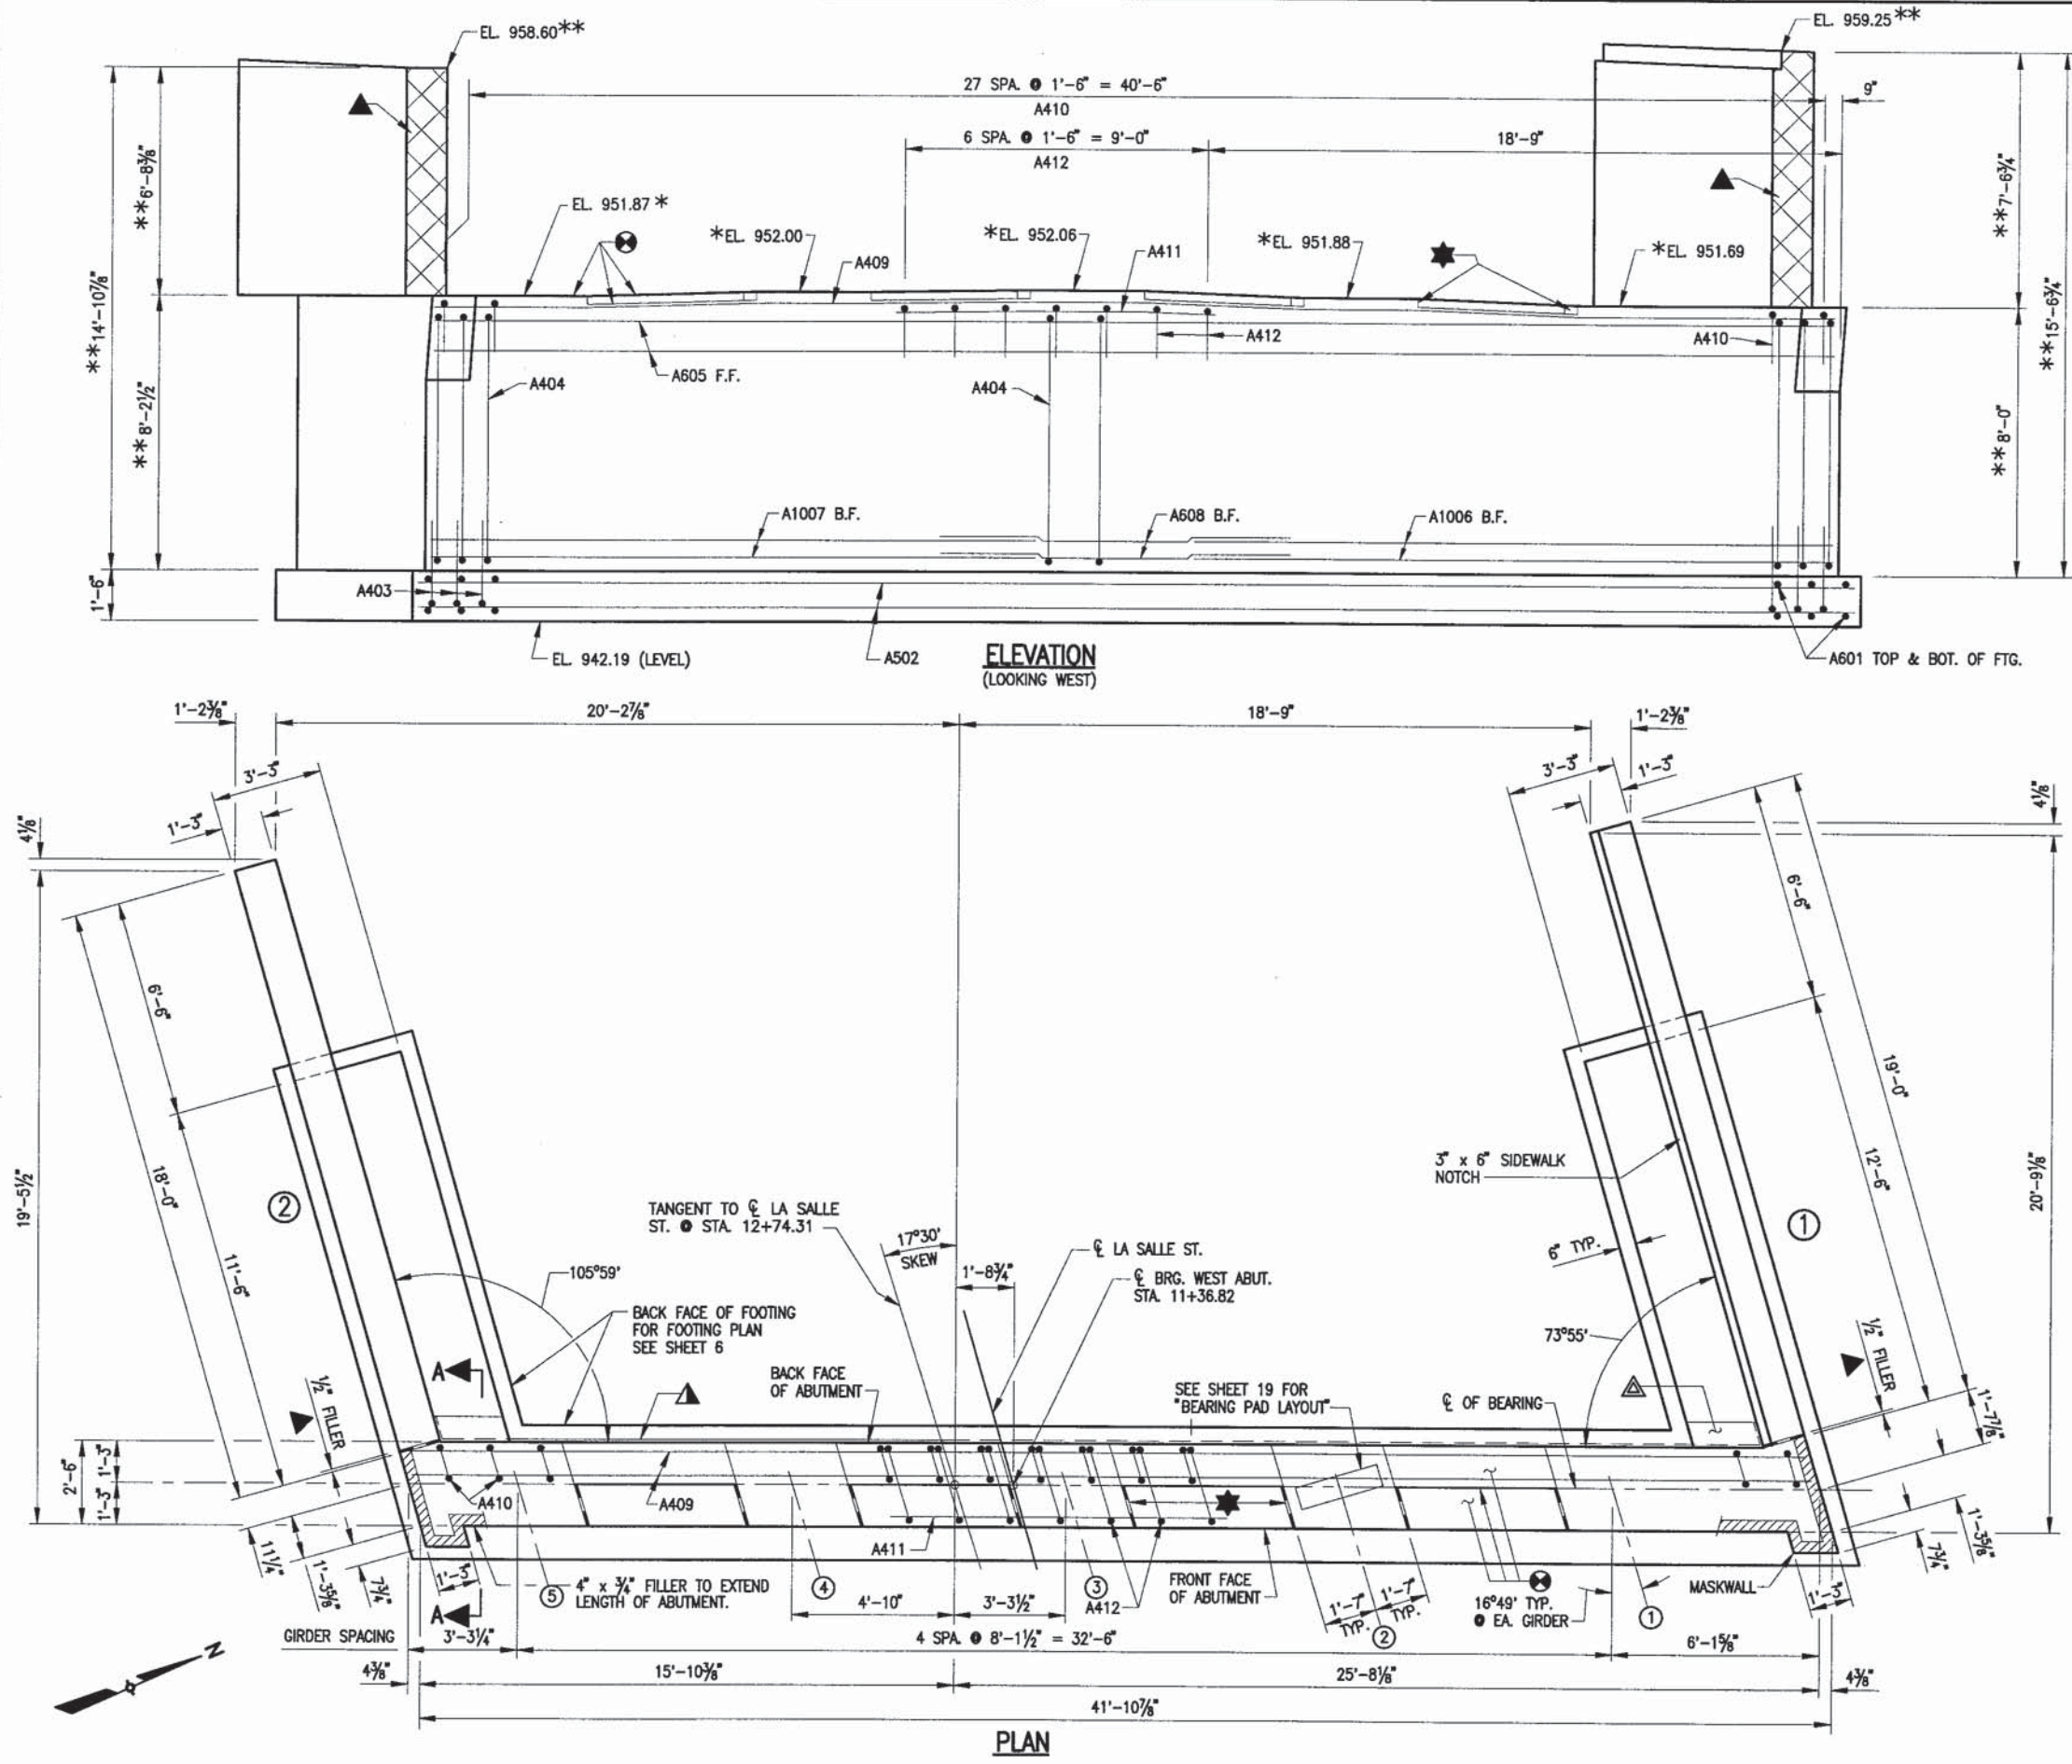

STATE PROJECT NUMBER	SHEET NO
1190-00-82	

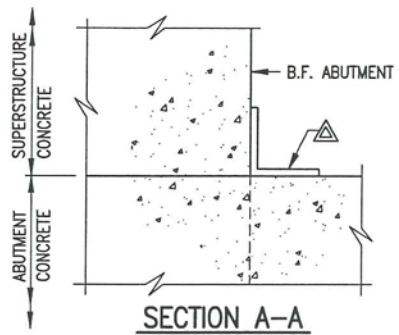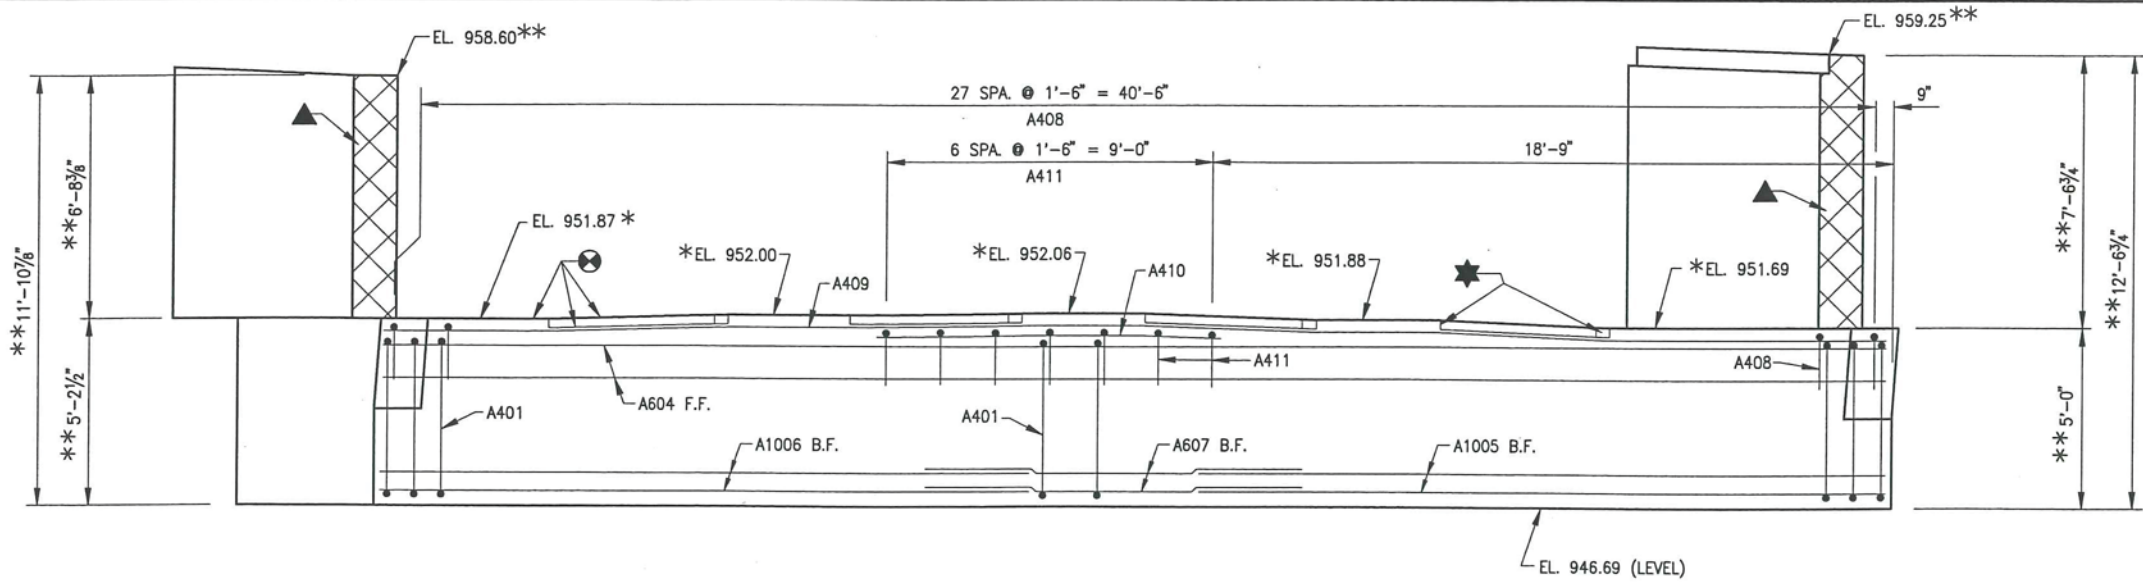


LEGEND

- * DIMENSIONS AND ELEVATIONS ARE GIVEN AT THE TOP OF CONCRETE AT THE ϕ OF BEARING.
- ** DIMENSIONS ARE GIVEN AT THE B.F. OF ABUTMENT. FOR WING DETAILS AND ELEVATIONS, SEE SHEETS 7 & 8.
- ▲ 1/2" FILLER TO EXTEND AS SHOWN. SEAL ALL EXPOSED HORIZONTAL AND VERTICAL SURFACES OF FILLER WITH NON-STAINING GRAY NON-BITUMINOUS JOINT SEALER, (1" DEEP AND HOLD 1/8" BELOW SURFACE OF CONCRETE.)
- ▲ 18" RUBBERIZED MEMBRANE WATERPROOFING - TO EXTEND HORIZONTAL BETWEEN INSIDE FACE OF WINGS AND VERTICAL FROM TOP OF BODY TO TOP OF WINGS.
- ★ 3/4" CORK FILLER ON VERTICAL FACES ONLY.
- ⊗ STEEL TROWEL TOP SURFACE OF ABUTMENT. PLACE MULTIPLE LAYERS OF POLYETHYLENE SHEETS OVER ENTIRE ABUTMENT TOP BEFORE PLACING BEARING PADS AND/OR SUPERSTRUCTURE. TOTAL THICKNESS OF SHEETS SHALL BE AT LEAST 0.03".
- ▲ PLACE BOTTOM HALF OF RUBBERIZED MEMBRANE WATERPROOFING HORIZONTAL IN THIS AREA. SEE SECTION A-A ON THIS SHEET.
- VERTICAL CONSTRUCTION JOINT KEYWAY FORMED BY A SURFACED, BEVELED 2' x 8". BEVEL EXPOSED EDGES 3/4".
- ⊗ INDICATES WING NUMBER.


PILE NOTE

WEST ABUTMENT TO BE SUPPORTED ON HP 12 x 53 STEEL PILING. PREBORE PILES TO ELEV. 932.2, THEN DRIVE PILES TO A MINIMUM BEARING VALUE OF 67 TONS PER PILE AND FILL VOID AROUND PILE WITH CONCRETE MASONRY. FOR PILE SPLICE DETAILS AND PILE LAYOUT, SEE SHEET 6.

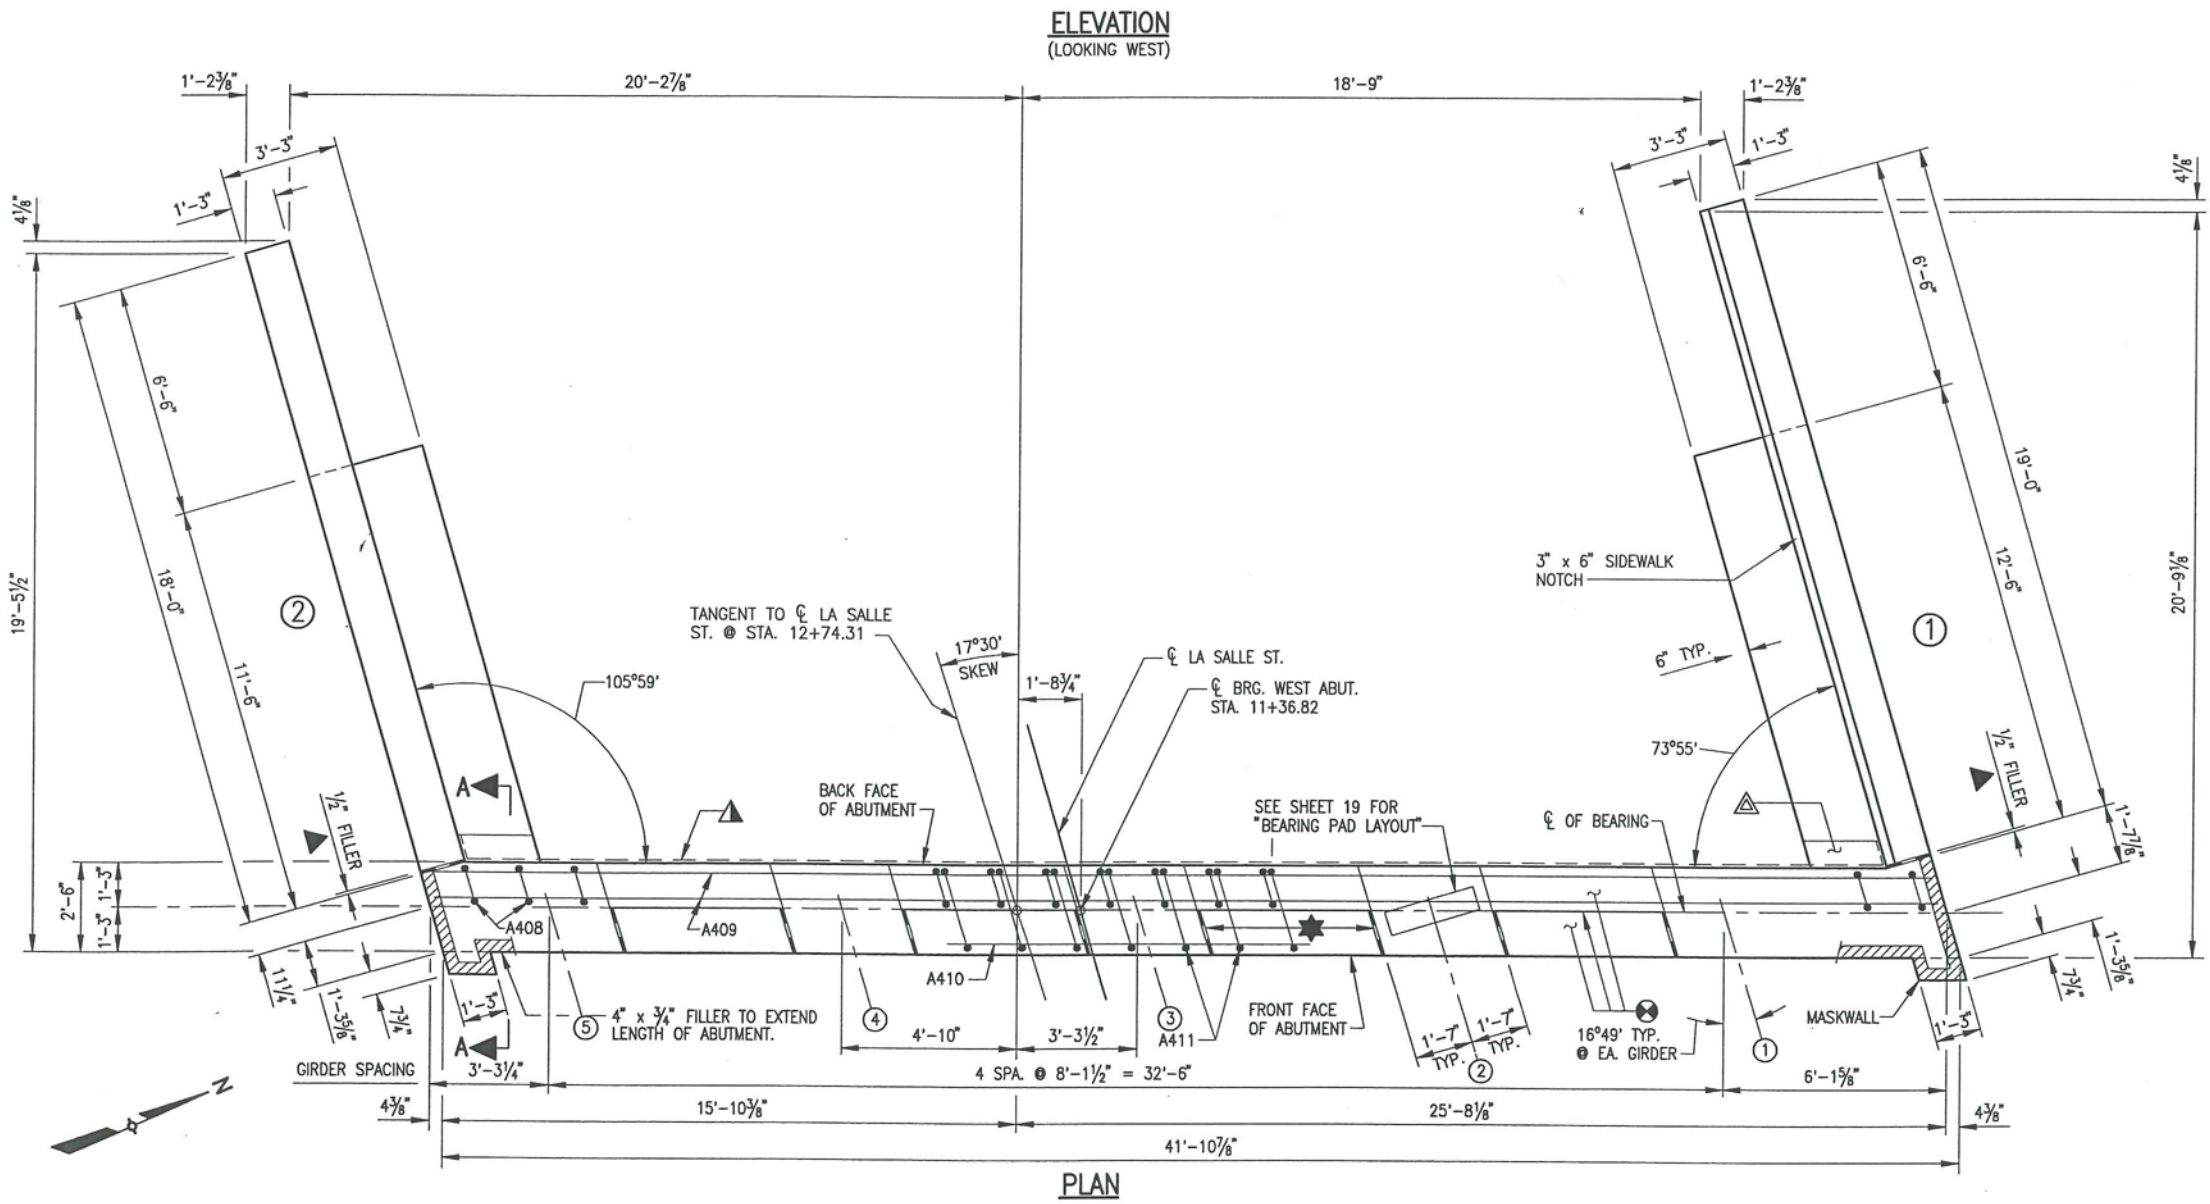


MINIMUM BAR LAPS
#6 = 2'-11"


No.	Date.	Revision	By
STATE OF WISCONSIN DEPARTMENT OF TRANSPORTATION			
STRUCTURE B-18-190			
Const. Spec.	WIS. '99	Drawn By TL	Plans Checked TR
WEST ABUTMENT			SHEET 5 OF 26
			551A

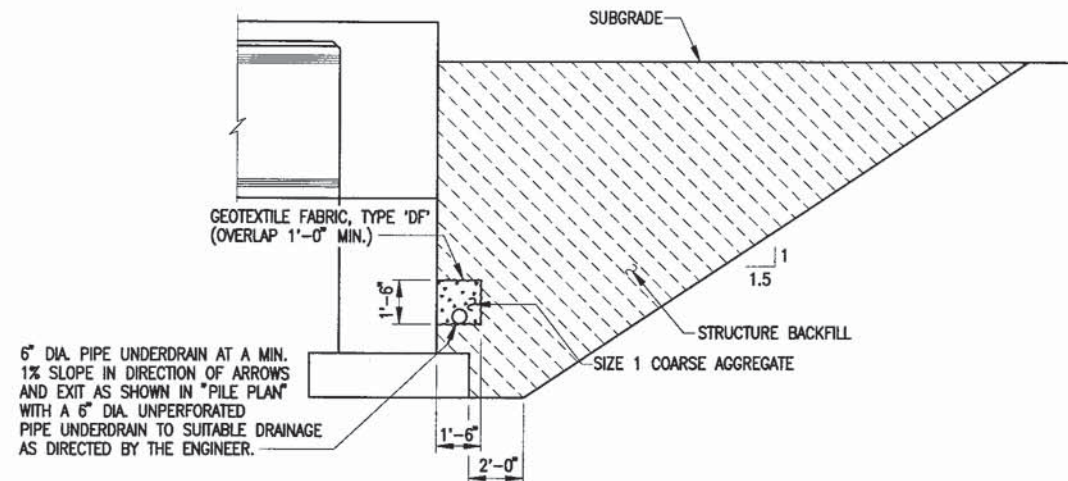


PIPE UNDERDRAIN AND BACKFILL DETAILS

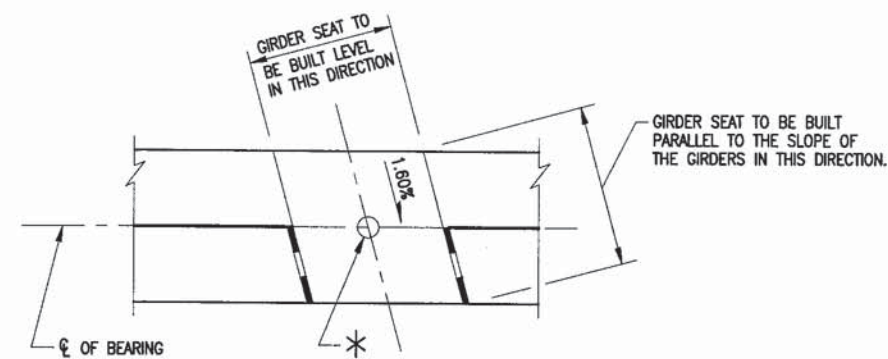

PLAN
GIRDER SEAT DETAIL

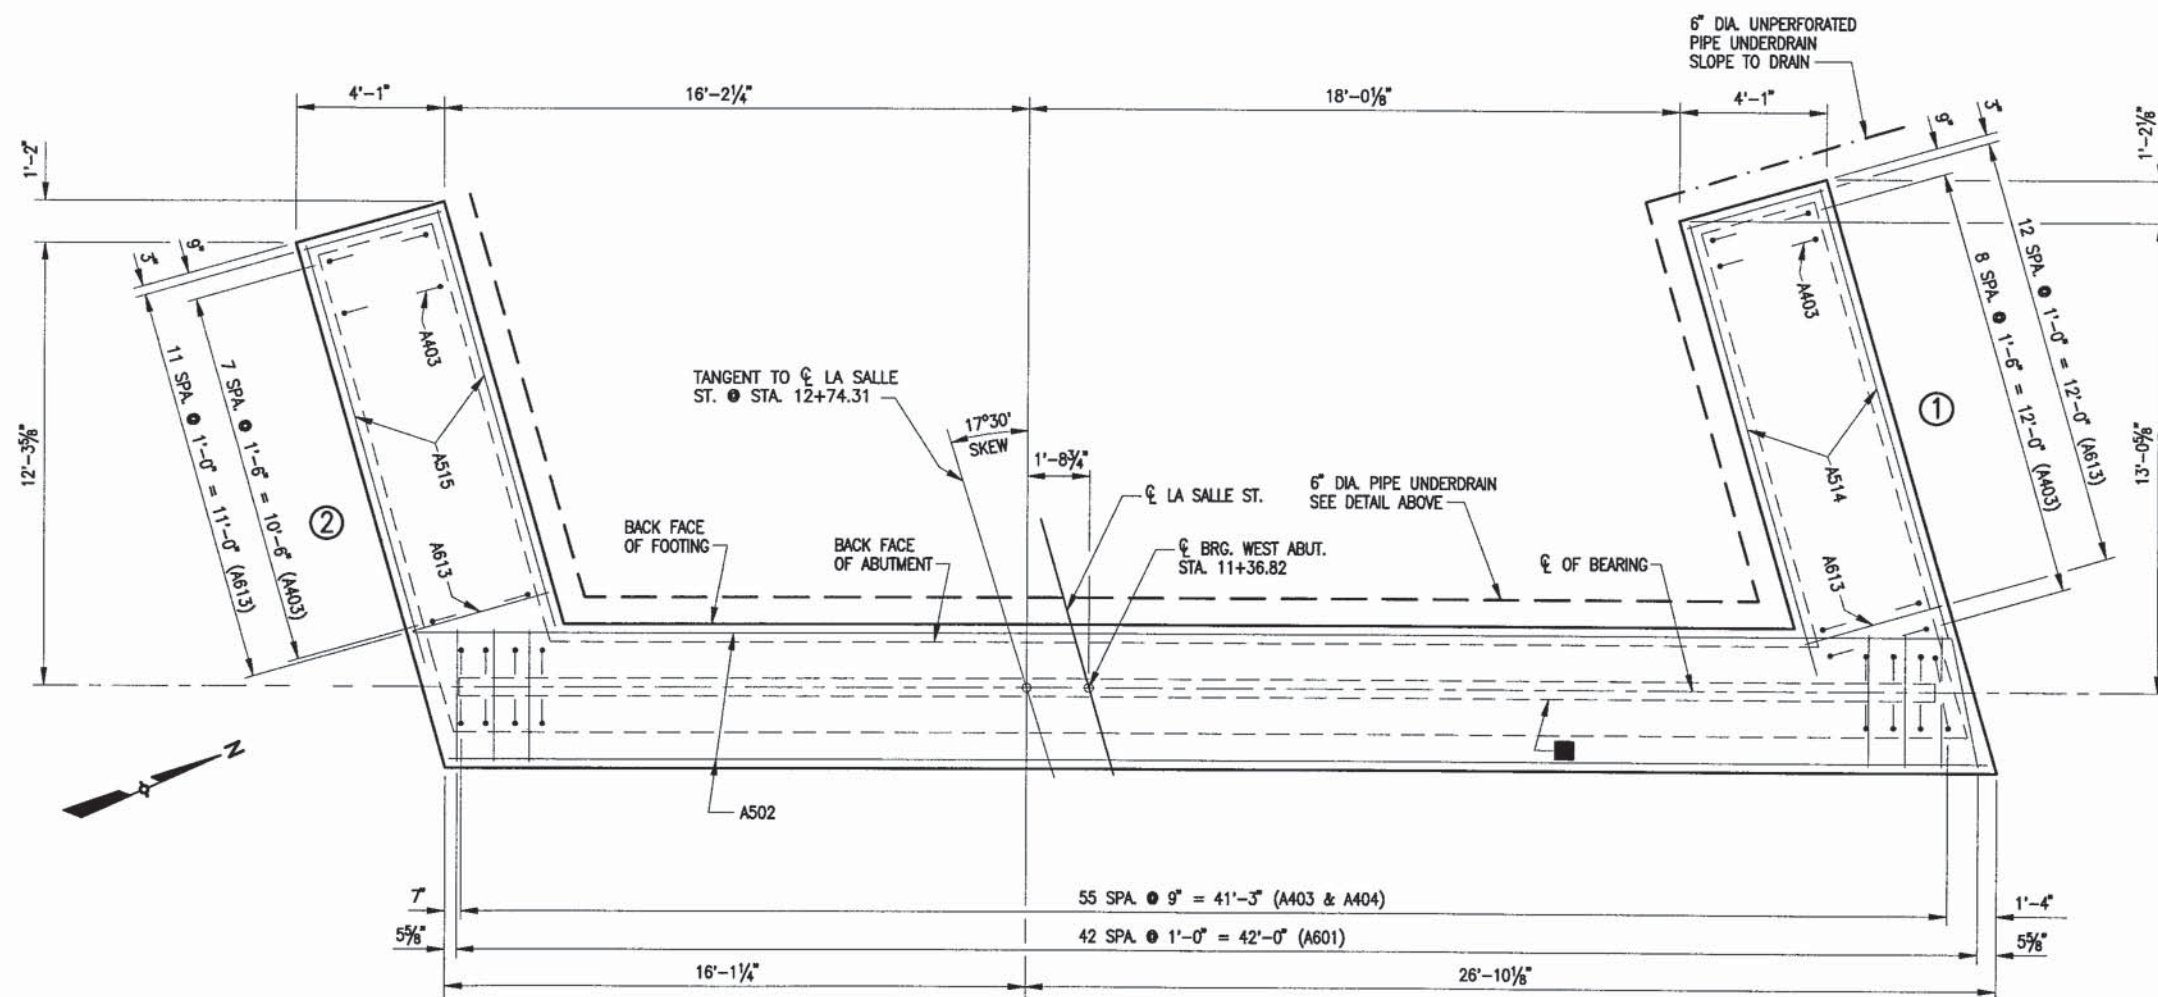

FOOTING PLAN

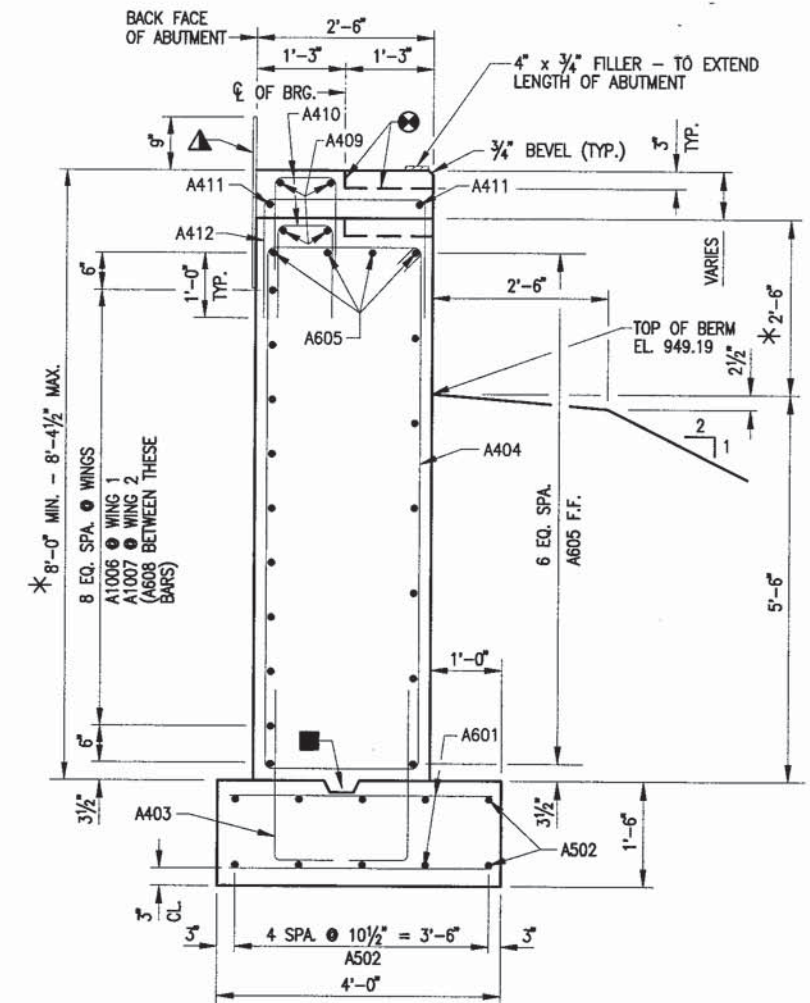


SECTION THRU ABUT. BODY

LEGEND


* (X) ▲ ● FOR SYMBOL DESCRIPTIONS, SEE SHEET 5.

■ CONSTRUCTION JOINT FORMED BY A SURFACED, BEVELED 2' X 6". TERMINATE 6" FROM END OF ABUTMENT BODY.


No.	Date.	Revision	By
STATE OF WISCONSIN DEPARTMENT OF TRANSPORTATION			
STRUCTURE B-18-190			
Const. Spec.	WIS. '99	Drawn By	TL Plans Checked TR
WEST ABUTMENT DETAILS		SHEET 6 OF 26 552	

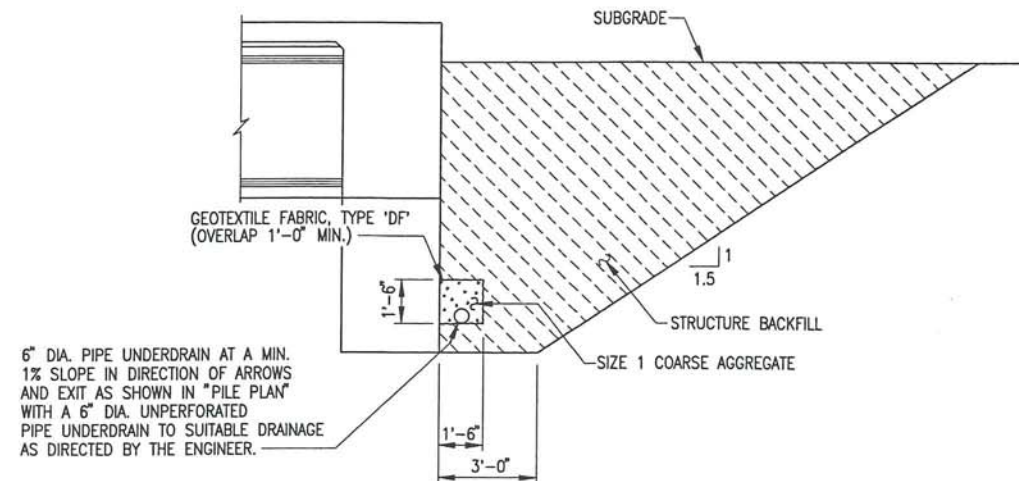


PIPE UNDERDRAIN AND BACKFILL DETAILS

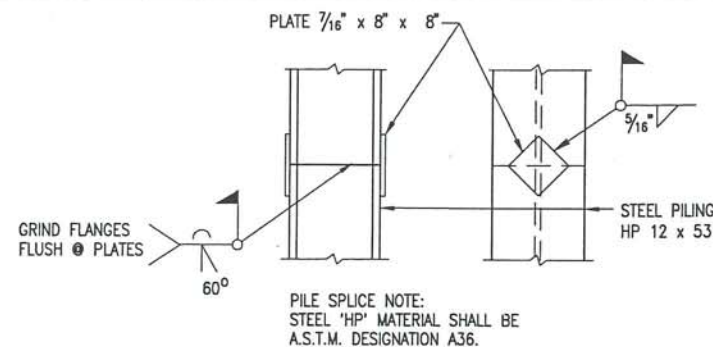

PILE SPLICE DETAIL

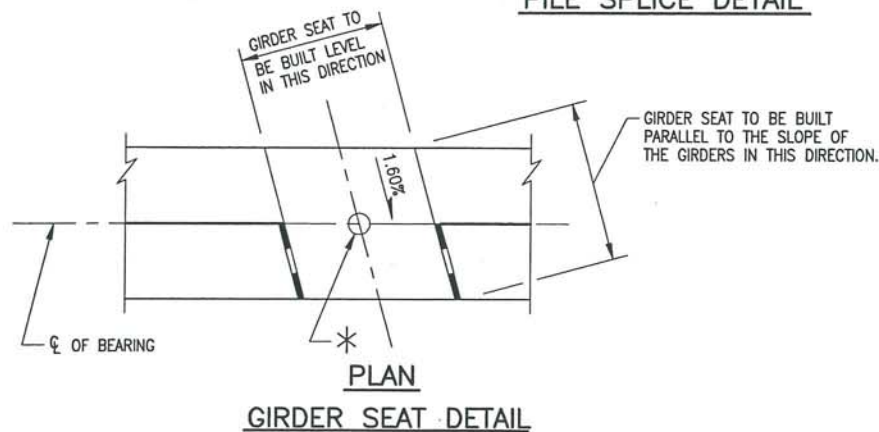


GIRDER SEAT DETAIL

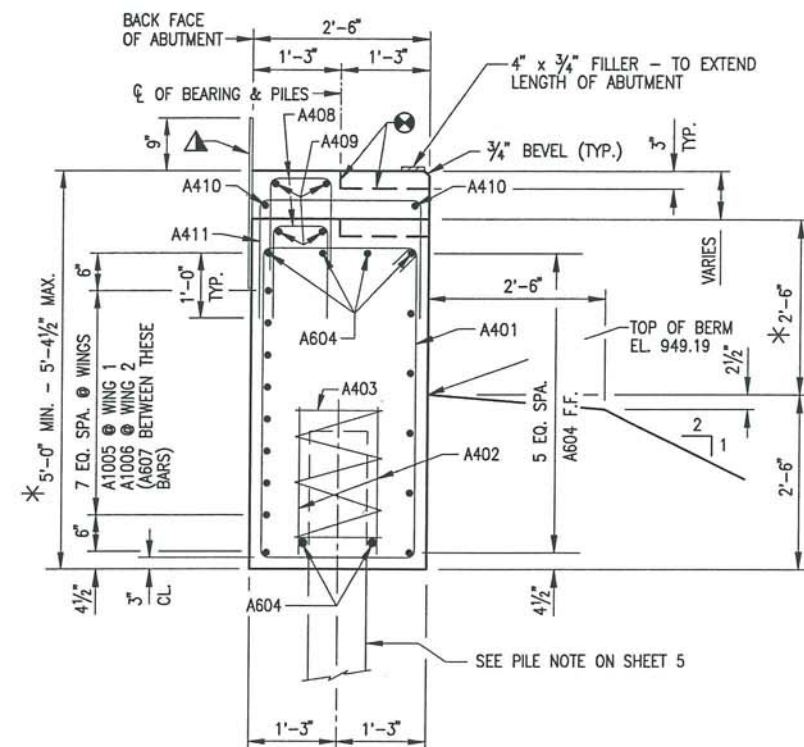

SECTION THRU ABUT. BODY

LEGEND


- * (X) (A) (B) FOR SYMBOL DESCRIPTIONS, SEE SHEET 5.
- CONSTRUCTION JOINT FORMED BY A SURFACED, BEVELED 2' X 6". TERMINATE 6" FROM END OF ABUTMENT BODY.

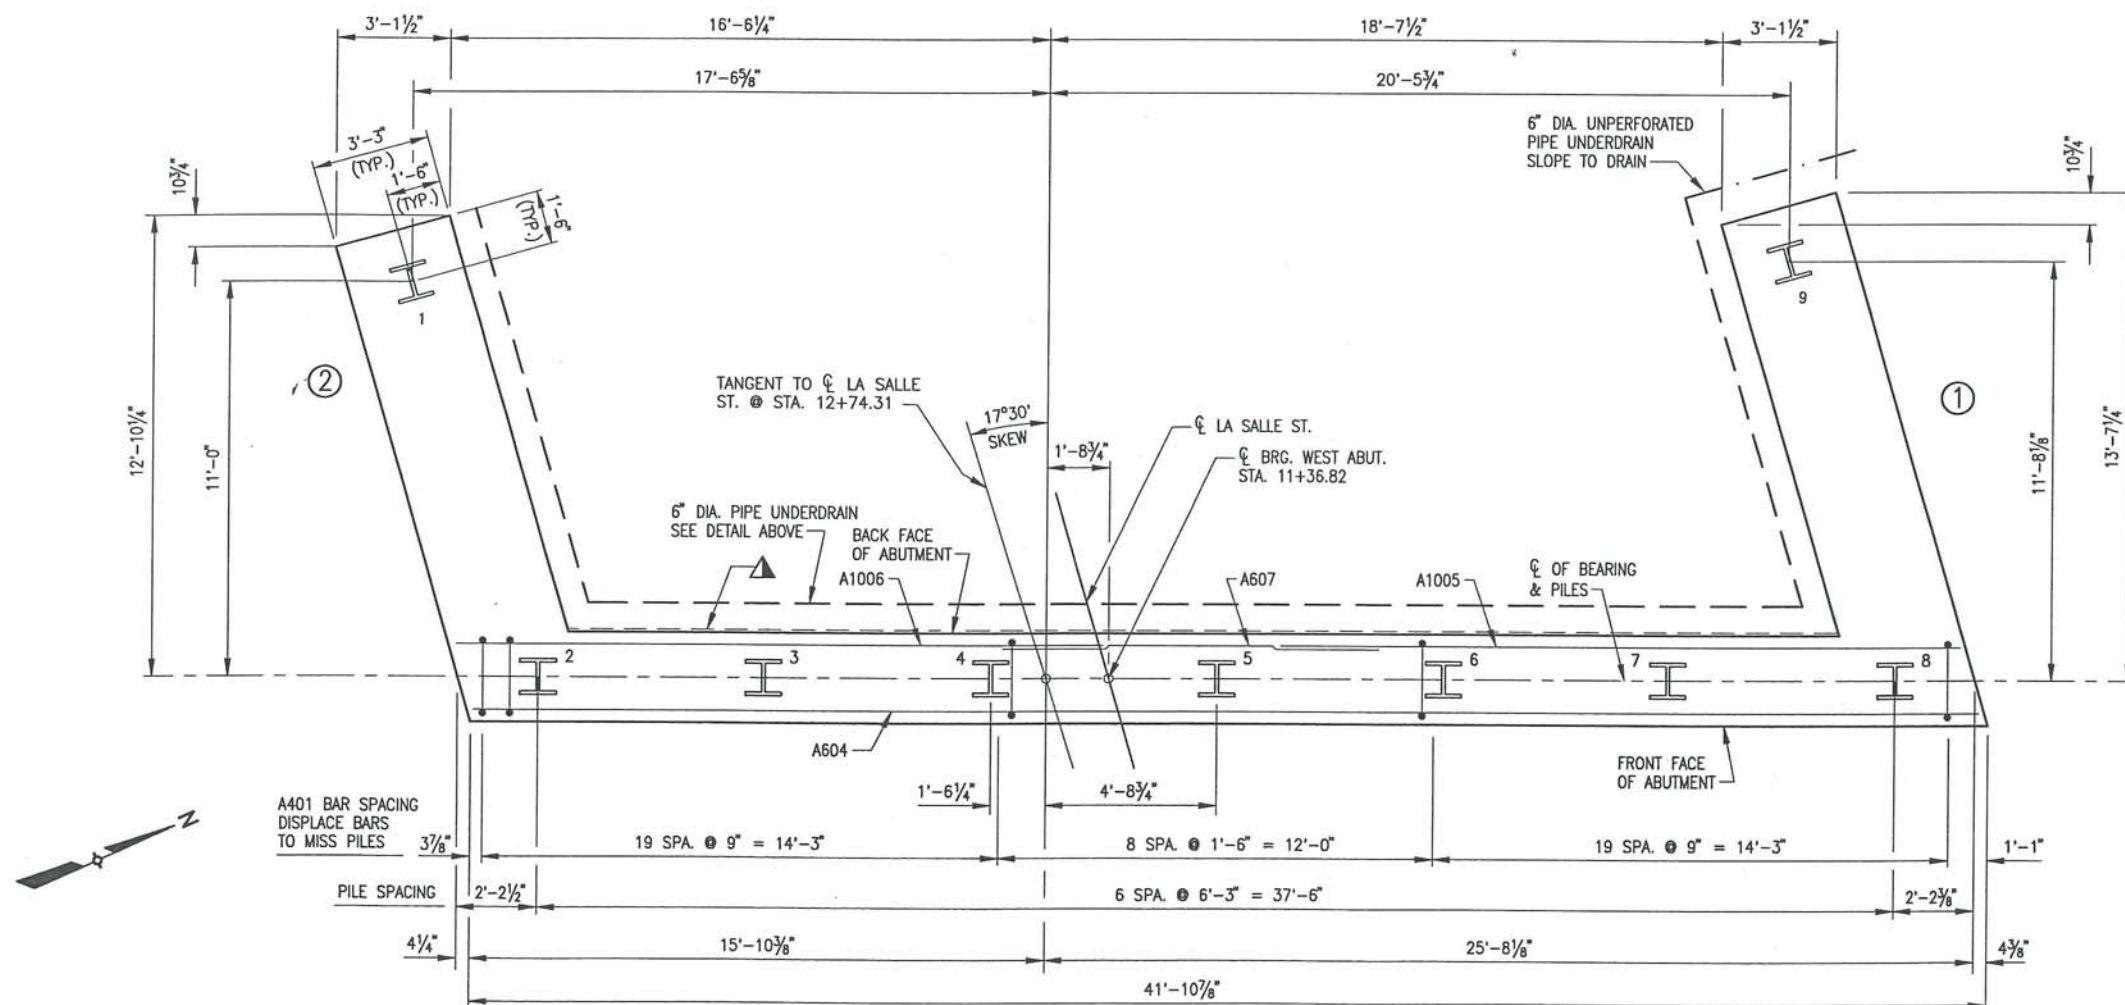


PILE PLAN

No.	Date.	Revision	By
STATE OF WISCONSIN DEPARTMENT OF TRANSPORTATION			
STRUCTURE B-18-190			
Const. Spec.	WIS. '99	Drawn By TL	Plans Checked TR
WEST ABUTMENT DETAILS			SHEET 6 OF 26
			552A

1190-00-82

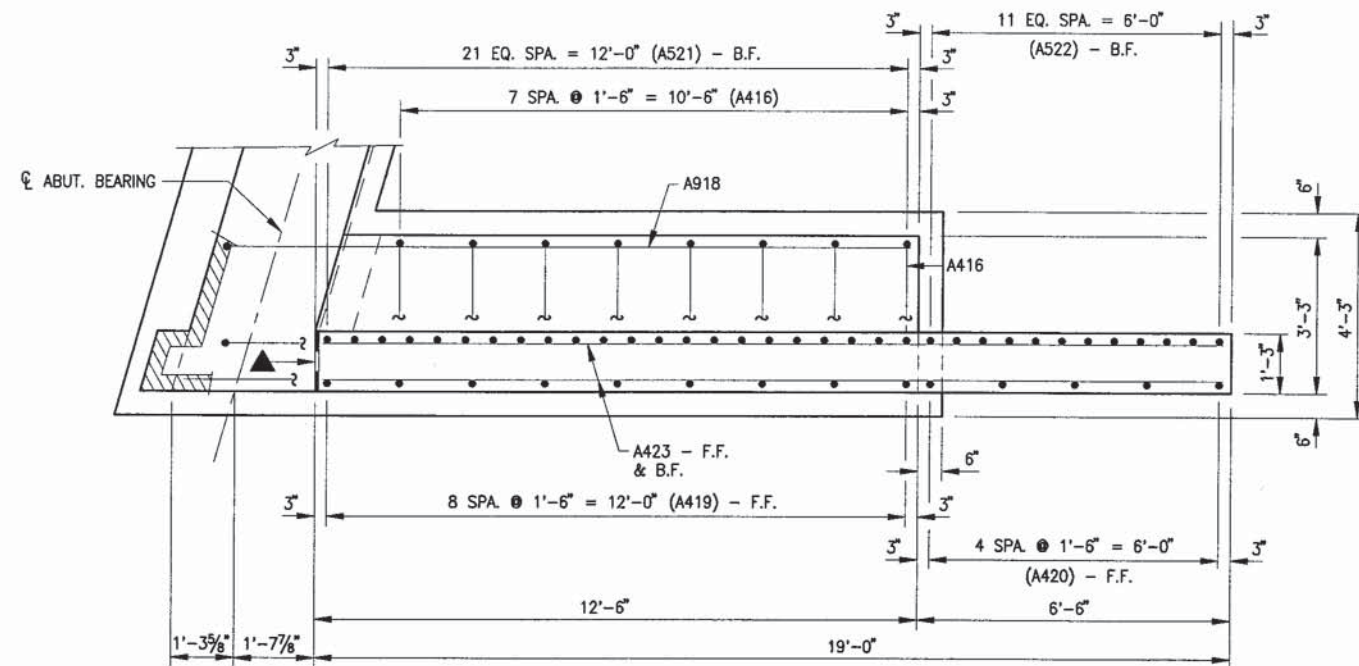

PLAN - WING 1

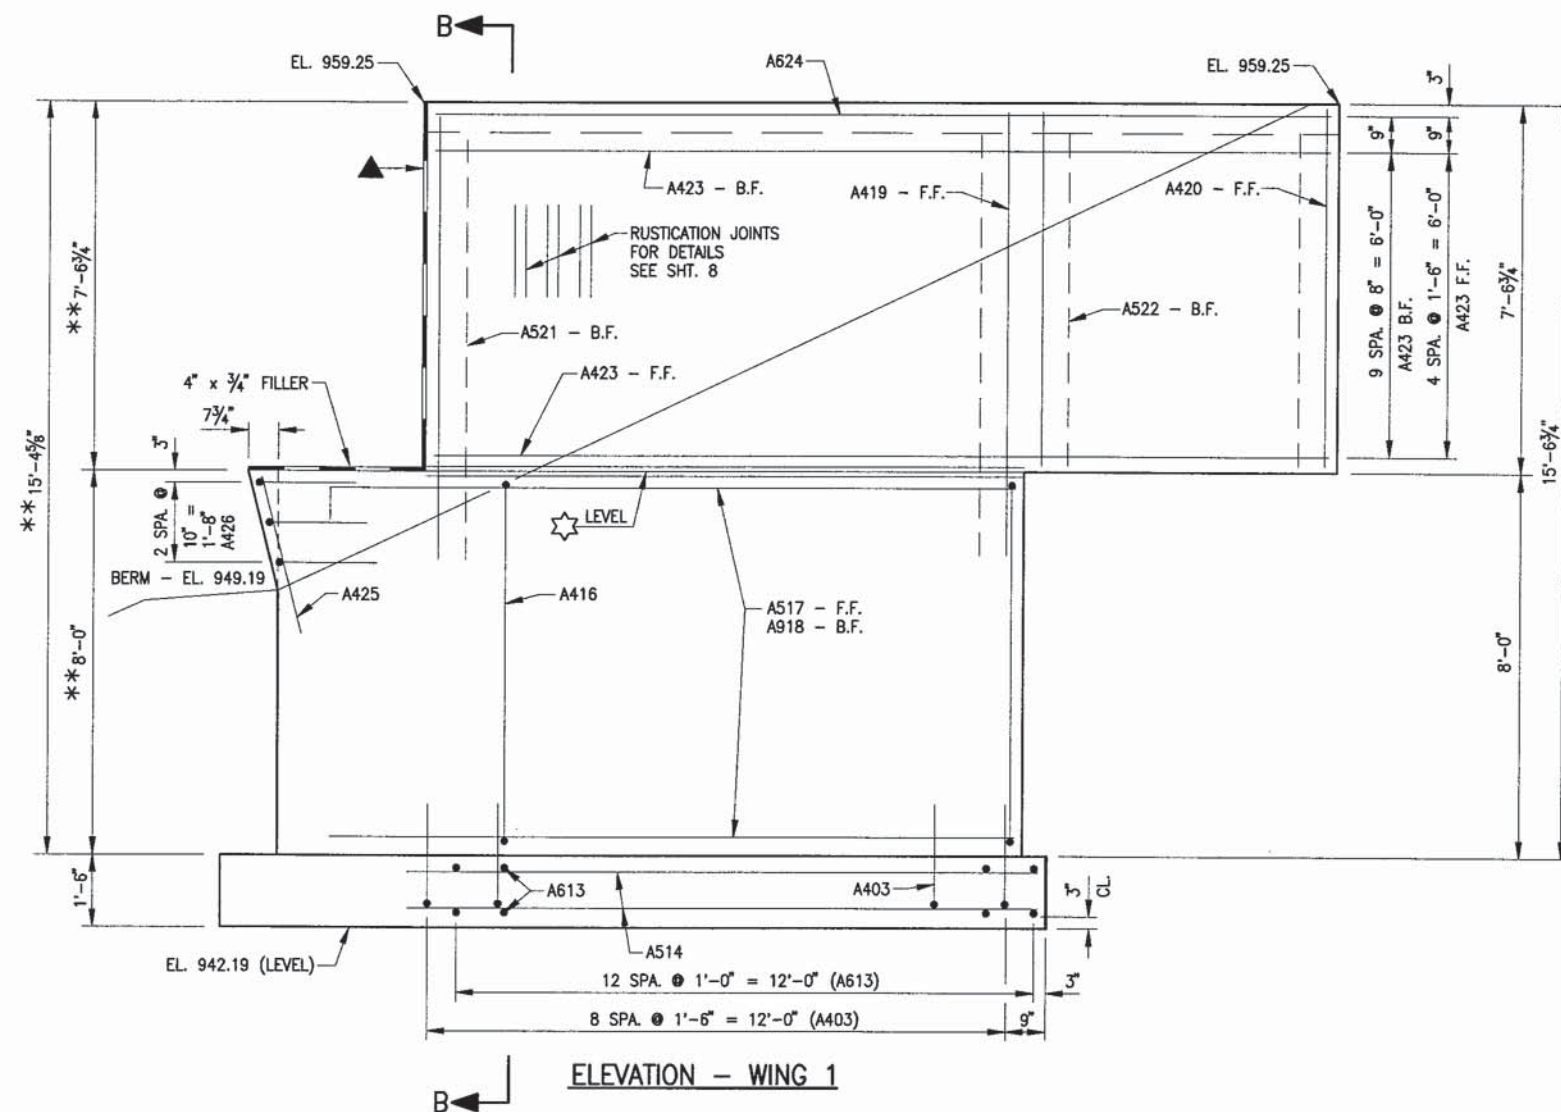

ELEVATION - WING 1


LEGEND

☆ OPTIONAL KEYED CONSTRUCTION JOINT FORMED BY A SURFACED, BEVELED 2" x 6" AND A 3/4" V-GROOVE ON FRONT FACE OF WINGWALL. V-GROOVE SHALL BE OMITTED IF CONSTRUCTION JOINT IS NOT USED.

** DIMENSIONS ARE GIVEN AT THE B.F. OF ABUTMENT.


▲ 1/2" FILLER TO EXTEND AS SHOWN. SEAL ALL EXPOSED HORIZONTAL AND VERTICAL SURFACES OF FILLER WITH NON-STAINING GRAY NON-BITUMINOUS JOINT SEALER, (1" DEEP AND HOLD 1/8" BELOW SURFACE OF CONCRETE.)

■ CONSTRUCTION JOINT FORMED BY A SURFACED, BEVELED 2" x 6". TERMINATE 6" FROM END OF WING.

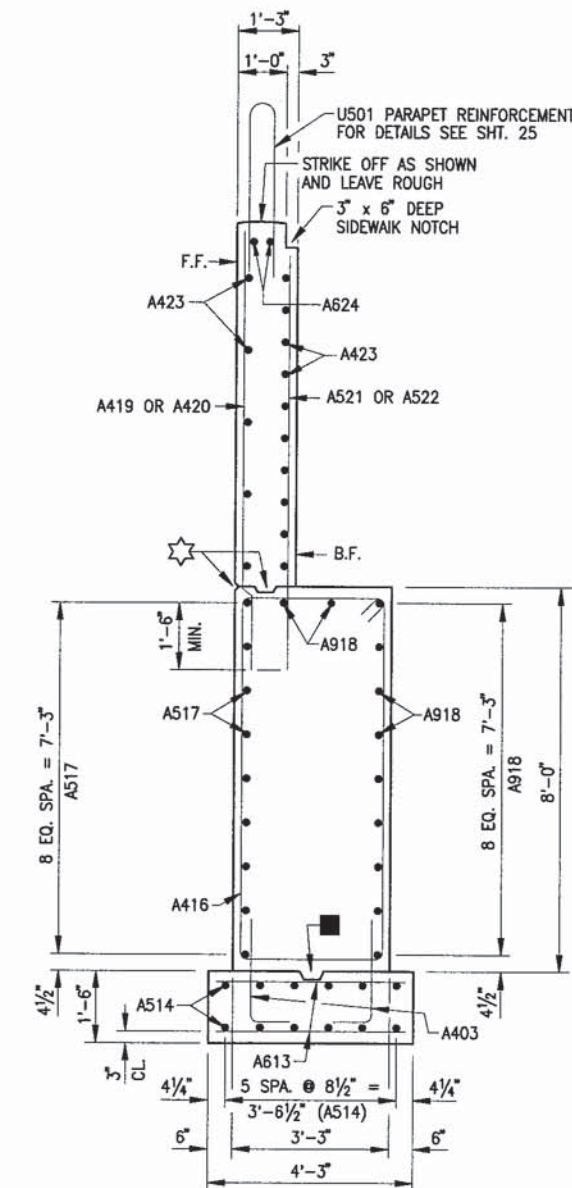


SECTION B-B

No.	Date.	Revision	By
STATE OF WISCONSIN DEPARTMENT OF TRANSPORTATION			
STRUCTURE B-18-190			
Const. Spec.	WIS. '99	Drawn By TL	Plans Checked TR
WING 1			SHEET 7 OF 26
			553

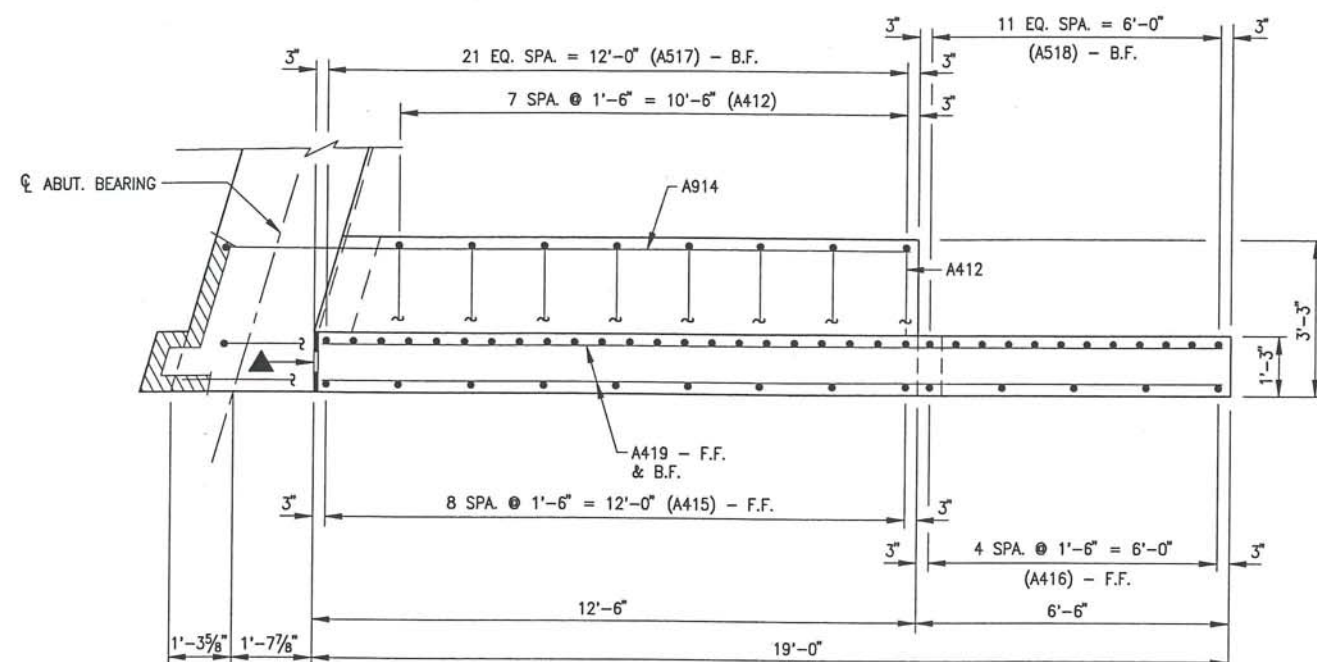

PLAN - WING 1

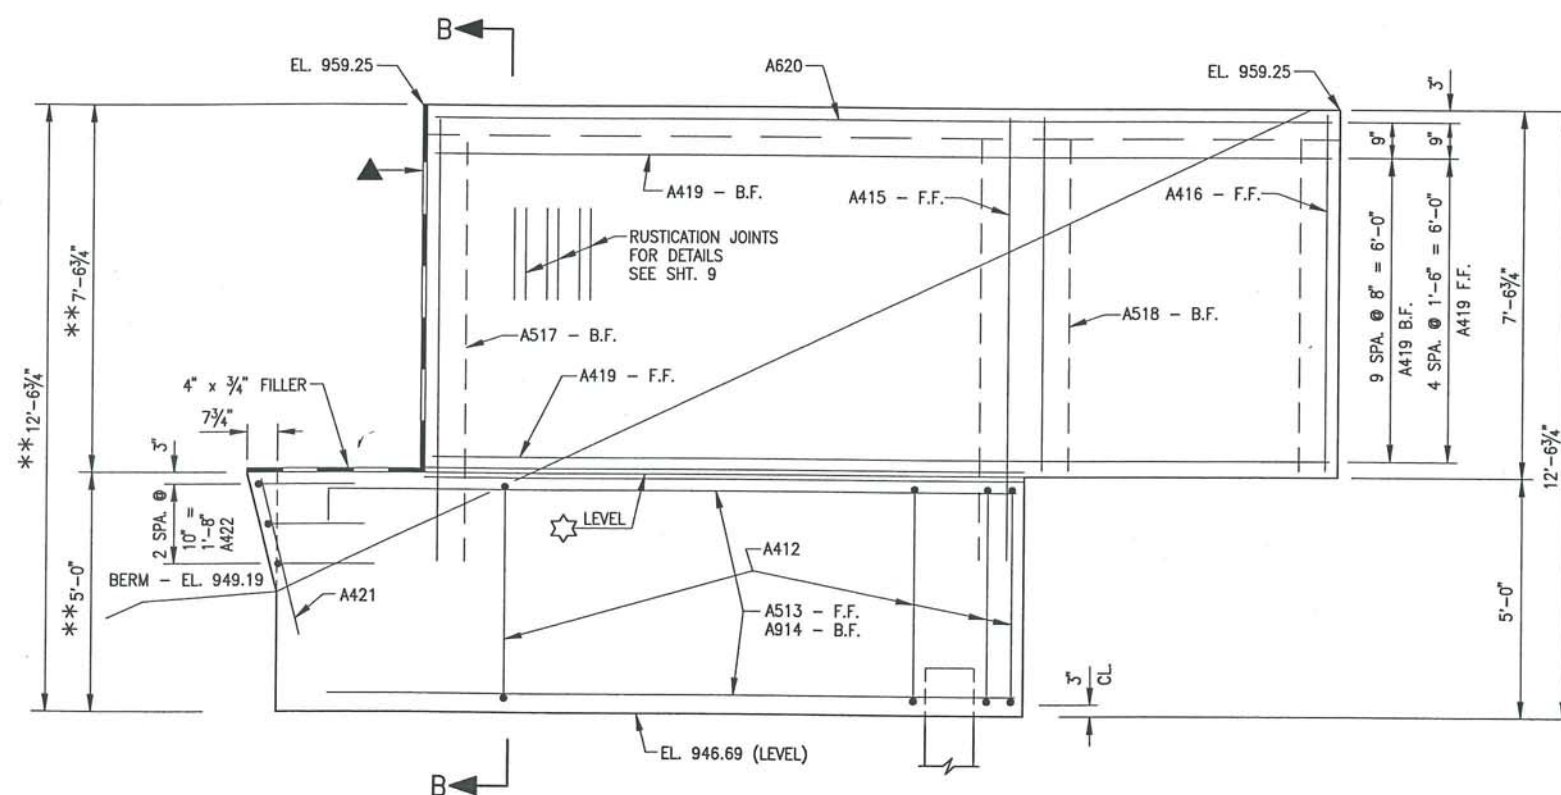

ELEVATION - WING 1


LEGEND

★ OPTIONAL KEYED CONSTRUCTION JOINT FORMED BY A SURFACED, BEVELED 2" x 6" AND A 3/4" V-GROOVE ON FRONT FACE OF WINGWALL. V-GROOVE SHALL BE OMITTED IF CONSTRUCTION JOINT IS NOT USED.

** DIMENSIONS ARE GIVEN AT THE B.F. OF ABUTMENT.


▲ 1/2" FILLER TO EXTEND AS SHOWN. SEAL ALL EXPOSED HORIZONTAL AND VERTICAL SURFACES OF FILLER WITH NON-STAINING GRAY NON-BITUMINOUS JOINT SEALER, (1" DEEP AND HOLD 1/8" BELOW SURFACE OF CONCRETE.)

■ CONSTRUCTION JOINT FORMED BY A SURFACED, BEVELED 2" x 6". TERMINATE 6" FROM END OF WING.

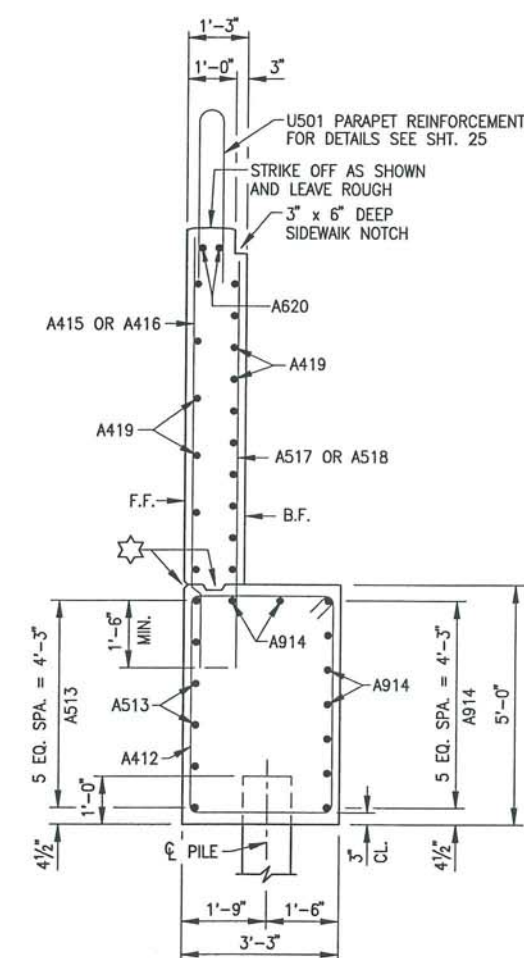


SECTION B-B


No.	Date.	Revision	By
STATE OF WISCONSIN DEPARTMENT OF TRANSPORTATION			
STRUCTURE B-18-190			
Const. Spec.	WIS. '99	Drawn By	Plans Checked
WING 1		SHEET 7 OF 26	
		559A	

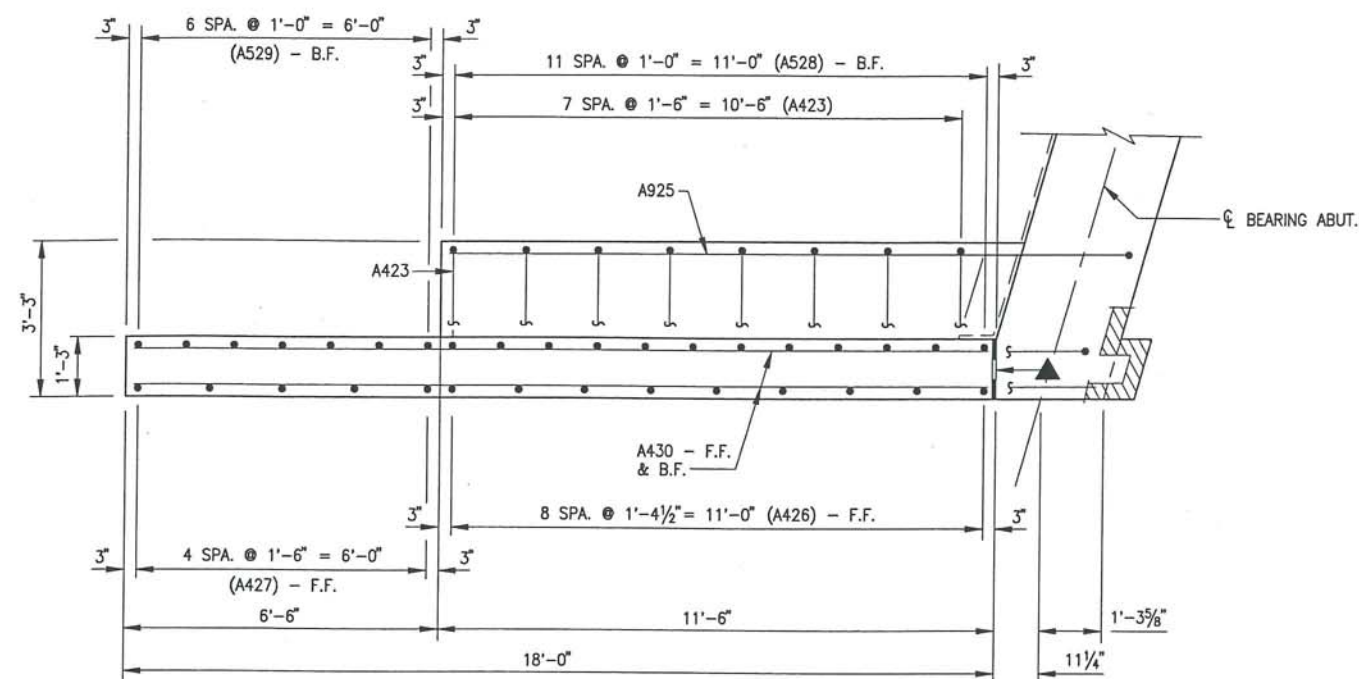

PLAN - WING 2

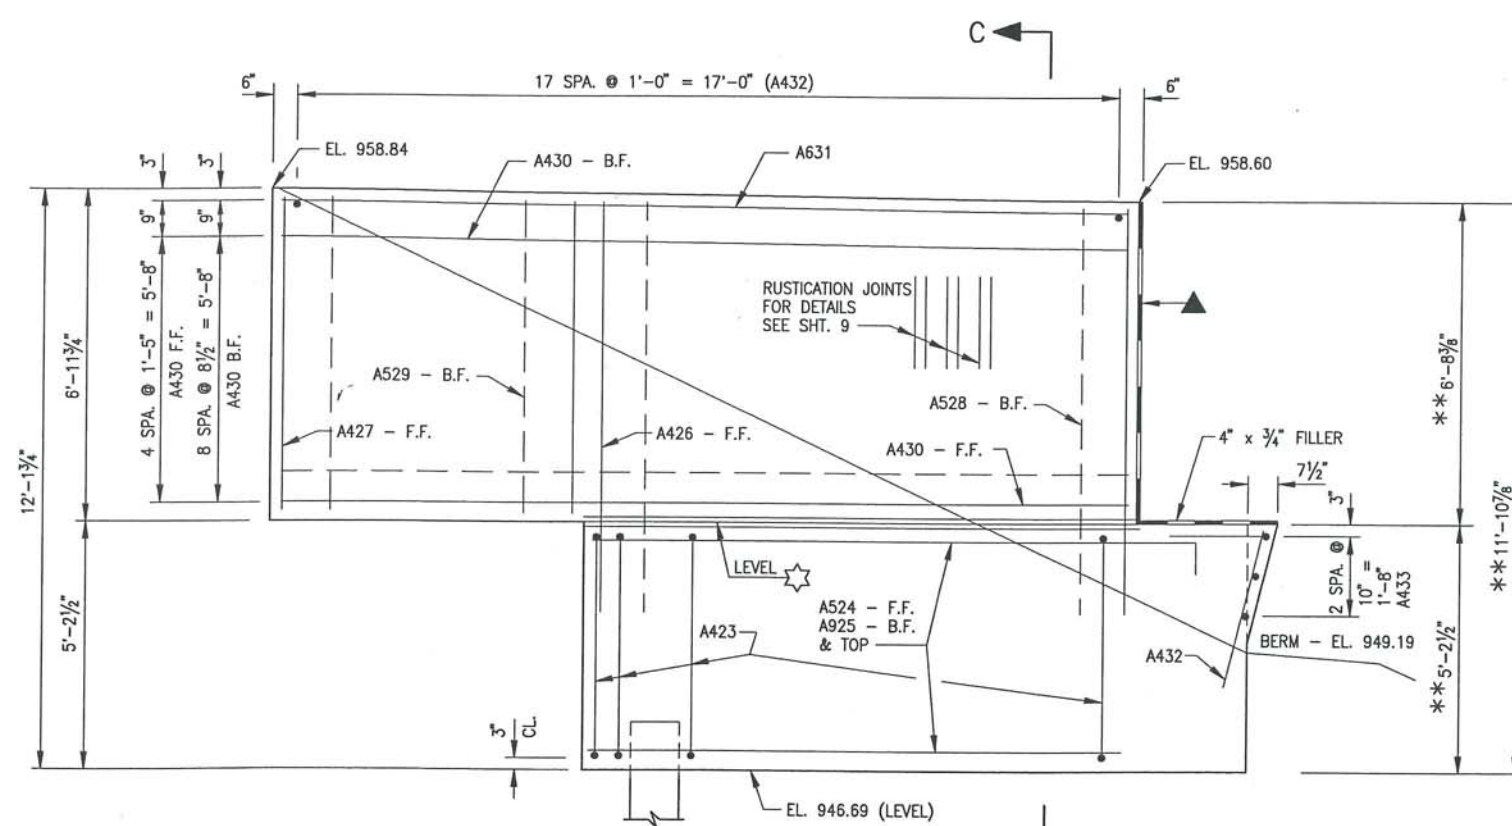

ELEVATION - WING 2

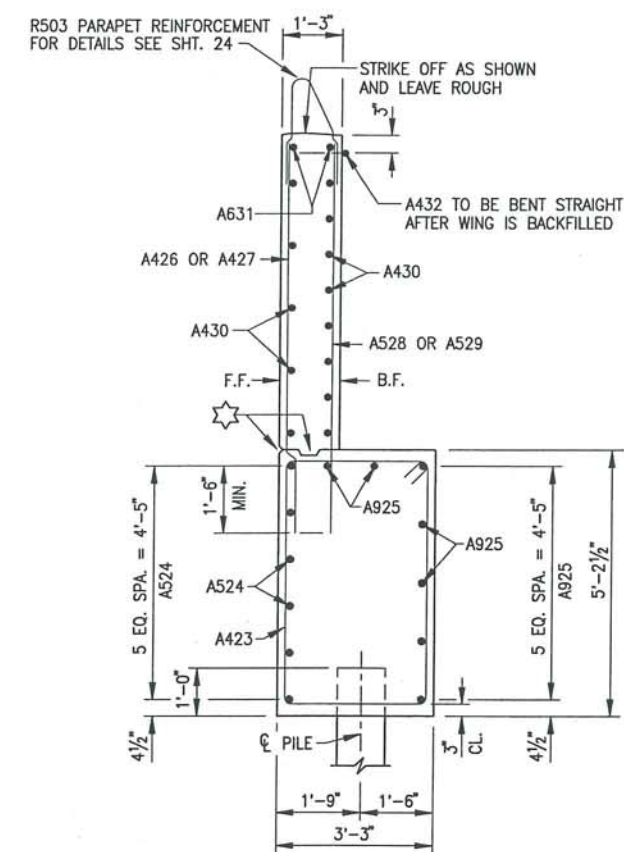

SECTION B-B

LEGEND


★ OPTIONAL KEYED CONSTRUCTION JOINT FORMED BY A SURFACED, BEVELED 2" x 6" AND A 3/4" V-GROOVE ON FRONT FACE OF WINGWALL. V-GROOVE SHALL BE OMITTED IF CONSTRUCTION JOINT IS NOT USED.

** DIMENSIONS ARE GIVEN AT THE B.F. OF ABUTMENT.

▲ 1/2" FILLER TO EXTEND AS SHOWN. SEAL ALL EXPOSED HORIZONTAL AND VERTICAL SURFACES OF FILLER WITH NON-STAINING GRAY NON-BITUMINOUS JOINT SEALER, (1" DEEP AND HOLD 1/8" BELOW SURFACE OF CONCRETE.)

■ CONSTRUCTION JOINT FORMED BY A A SURFACED, BEVELED
2' X 6". TERMINATE 6" FROM END OF WING.

No.	Date.	Revision	By
STATE OF WISCONSIN DEPARTMENT OF TRANSPORTATION			
STRUCTURE B-18-190			
Const. Spec.	WIS. '99	Drawn By	Plans Checked
		TL	TR
WING 2		SHEET 8 OF 26	
		554 A	

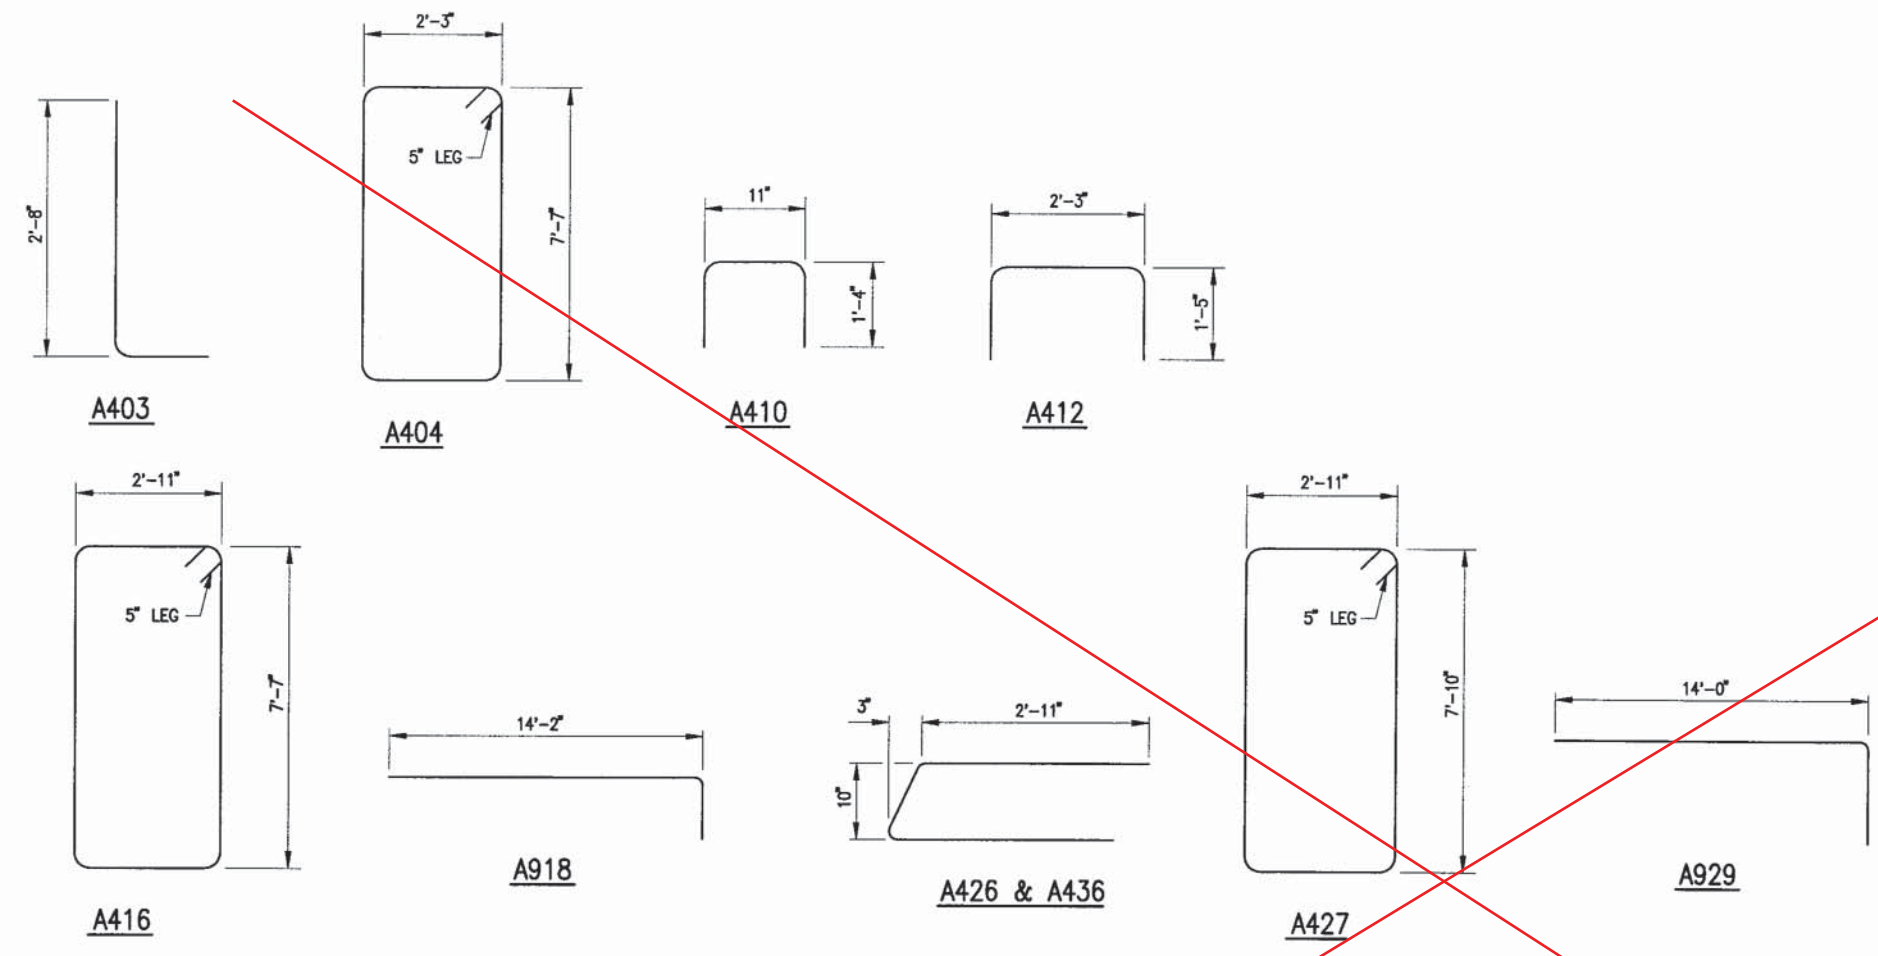


BILL OF BARS


DIMENSIONS IN BENDING DETAILS ARE OUT TO OUT OF BAR.

MARK	NO. REQ'D.	LENGTH	BEND	LOCATION	
A601	86	3'-8"		SPREAD FTG. @ ABUT. - TOP & BOT.	TRANSV.
A502	10	42'-7"		SPREAD FTG. @ ABUT. - TOP & BOT.	LONGIT.
A403	148	3'-7"	X	SPREAD FTG. - DOWELS - F.F. & B.F.	VERT.
A404	56	20'-3"	X	ABUT. BODY - STIRRUPS	VERT.
A605	10	41'-6"		ABUT. BODY	HORIZ.
A1006	10	19'-0"		ABUT. BODY - B.F.	HORIZ.
A1007	10	18'-0"		ABUT. BODY - B.F.	HORIZ.
A608	10	10'-5"		ABUT. BODY - B.F.	HORIZ.
A409	2	41'-6"		ABUT. BODY - TOP	HORIZ.
A410	28	3'-5"	X	ABUT. BODY - TOP - B.F. ALL GIRDERS	VERT.
A411	2	10'-0"		ABUT. BODY - TOP	HORIZ.
A412	7	4'-11"	X	ABUT. BODY - TOP - AT GIRDER 3	VERT.
A613	50	3'-11"		SPREAD FTG. @ WINGS 1 & 2 - TOP & BOT.	TRANSV.
A514	12	13'-6"		SPREAD FTG. @ WING 1 - TOP & BOT.	LONGIT.
A515	12	12'-6"		SPREAD FTG. @ WING 2 - TOP & BOT.	LONGIT.
A416	8	21'-7"	X	WING 1 - STIRRUPS	VERT.
A517	9	15'-0"		WING 1 - F.F.	HORIZ.
A918	11	15'-6"	X	WING 1 - B.F.	HORIZ.
A419	9	9'-3"		WING 1 - F.F.	VERT.
A420	5	7'-3"		WING 1 - F.F.	VERT.
A521	22	8'-9"		WING 1 - B.F.	VERT.
A522	12	6'-9"		WING 1 - B.F.	VERT.
A423	15	18'-8"		WING 1 - F.F. & B.F.	HORIZ.
A425	2	3'-6"		WING 1 - @ MASKWALL	VERT.
A426	3	6'-6"	X	WING 1 - @ MASKWALL	HORIZ.
A427	8	22'-1"	X	WING 2 - STIRRUPS	VERT.
A528	9	13'-4"		WING 2 - F.F.	HORIZ.
A929	11	15'-4"	X	WING 2 - B.F.	HORIZ.
A430	9	8'-6"		WING 2 - F.F.	VERT.
A431	5	6'-6"		WING 2 - F.F.	VERT.
A532	12	8'-6"		WING 2 - B.F.	VERT.
A533	7	6'-6"		WING 2 - B.F.	VERT.
A434	14	17'-8"		WING 2 - F.F. & B.F.	HORIZ.
A435	2	3'-6"		WING 2 - @ MASKWALL	VERT.
A436	3	6'-1"	X	WING 2 - @ MASKWALL	HORIZ.
EPOXY COATED BARS					
A624	2	18'-8"		WING 1 - TOP	HORIZ.
A437	18	2'-0"	X	WING 2 - DOWEL	HORIZ.
A638	2	17'-8"		WING 2 - TOP	HORIZ.

● FIELD BEND TO FOLLOW TOP SLOPE OF ABUTMENT.

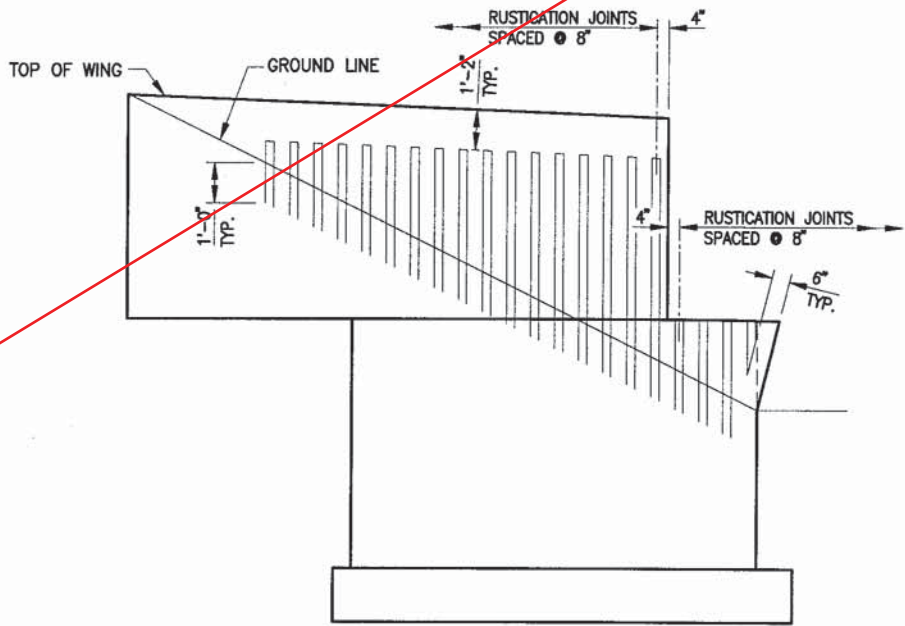


ELEVATION OF RUSTICATION JOINTS

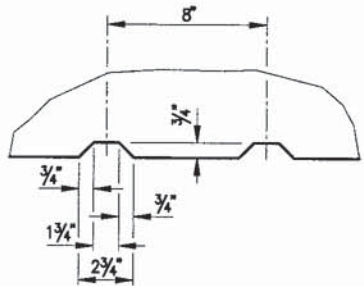


RUSTICATION JOINT DETAILS
(VERTICAL JOINTS ONLY)
(INCIDENTAL TO "CONCRETE MASONRY BRIDGES")


1190-00-82

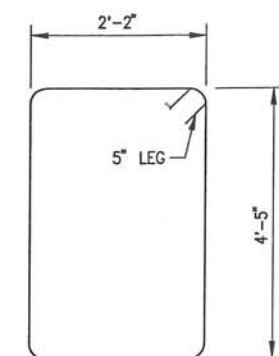


A401

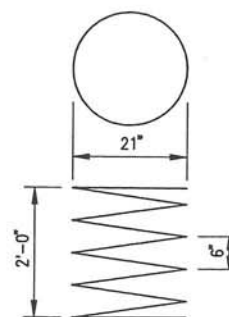


A403

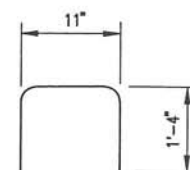


A408

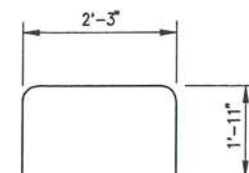


A411

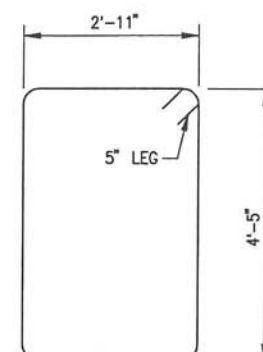


A412

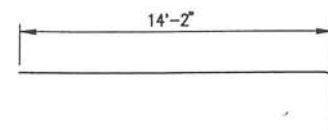


A914

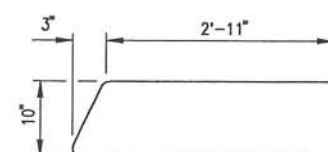

A422 & A433

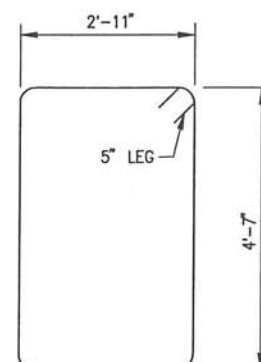


A423

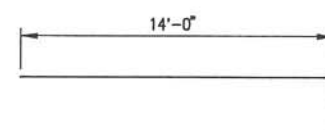


A925



A432

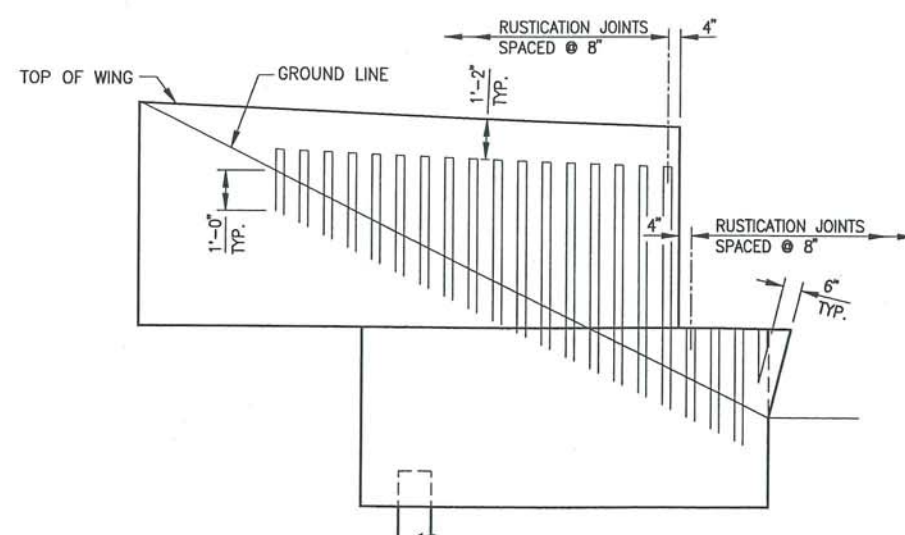

ELEVATION OF RUSTICATION JOINTS

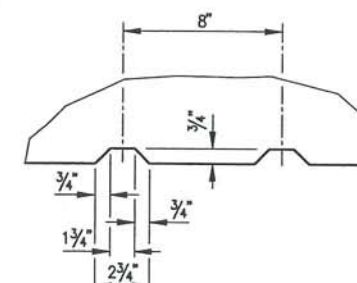

RUSTICATION JOINT DETAILS
(VERTICAL JOINTS ONLY)
(INCIDENTAL TO "CONCRETE MASONRY BRIDGES")


BILL OF BARS

DIMENSIONS IN BENDING DETAILS ARE OUT TO OUT OF BAR.


MARK	NO. REQ'D.	LENGTH	BENT	LOCATION	
A401	47	13'-9"	X	ABUT. BODY - STIRRUPS	VERT.
A402	14	2'-3"		ABUT. BODY - 2 @ EA. PILE	VERT.
A403	7	28'-0"	X	ABUT. BODY - @ EA. PILE	HORIZ
A604	11	41'-6"		ABUT. BODY	HORIZ
A1005	9	19'-0"		ABUT. BODY - B.F.	HORIZ
A1006	9	18'-0"		ABUT. BODY - B.F.	HORIZ
A607	9	10'-4"		ABUT. BODY - B.F.	HORIZ
A408	28	3'-5"	X	ABUT. BODY - TOP - B.F. ALL GIRDERS	VERT
A409	2	41'-6"		ABUT. BODY - TOP	HORIZ
A410	2	10'-0"		ABUT. BODY - TOP	HORIZ
A411	7	5'-11"	X	ABUT. BODY - TOP - BETWEEN GIRDERS 2 & 4	VERT.
A412	8	15'-3"	X	WING 1 - STIRRUPS	VERT.
A513	6	15'-0"		WING 1 - F.F.	HORIZ
A914	8	15'-6"	X	WING 1 - B.F.	HORIZ
A415	9	9'-3"		WING 1 - F.F.	VERT.
A416	5	7'-3"		WING 1 - F.F.	VERT.
A517	22	8'-9"		WING 1 - B.F.	VERT.
A518	12	6'-9"		WING 1 - B.F.	VERT.
A419	15	18'-8"		WING 1 - F.F. & B.F.	HORIZ
A421	2	3'-6"		WING 1 - @ MASKWALL	VERT.
A422	3	6'-6"	X	WING 1 - @ MASKWALL	HORIZ
A423	8	15'-7"	X	WING 2 - STIRRUPS	VERT.
A524	6	13'-4"		WING 2 - F.F.	HORIZ
A925	8	15'-4"	X	WING 2 - B.F.	HORIZ
A426	9	8'-6"		WING 2 - F.F.	VERT.
A427	5	6'-7"		WING 2 - F.F.	VERT.
A528	12	8'-6"		WING 2 - B.F.	VERT.
A529	7	6'-7"		WING 2 - B.F.	VERT.
A430	14	17'-8"		WING 2 - F.F. & B.F.	HORIZ
A432	2	3'-6"		WING 2 - @ MASKWALL	VERT.
A433	3	6'-6"	X	WING 2 - @ MASKWALL	HORIZ
EPOXY COATED BARS					
A620	2	18'-8"		WING 1 - TOP	HORIZ
A631	2	17'-8"		WING 2 - TOP	HORIZ
A432	18	2'-0"	X	WING 2 - DOWEL	HORIZ

● FIELD BEND TO FOLLOW TOP SLOPE OF ABUTMENT.


No.	Date.	Revision		By
STATE OF WISCONSIN DEPARTMENT OF TRANSPORTATION				
STRUCTURE B-18-190				
Const. Spec.	WIS. '99	Drawn By	TL	Plans Checked TR
WEST ABUTMENT BILL OF BARS			SHEET 9 OF 26 <i>555A</i>	

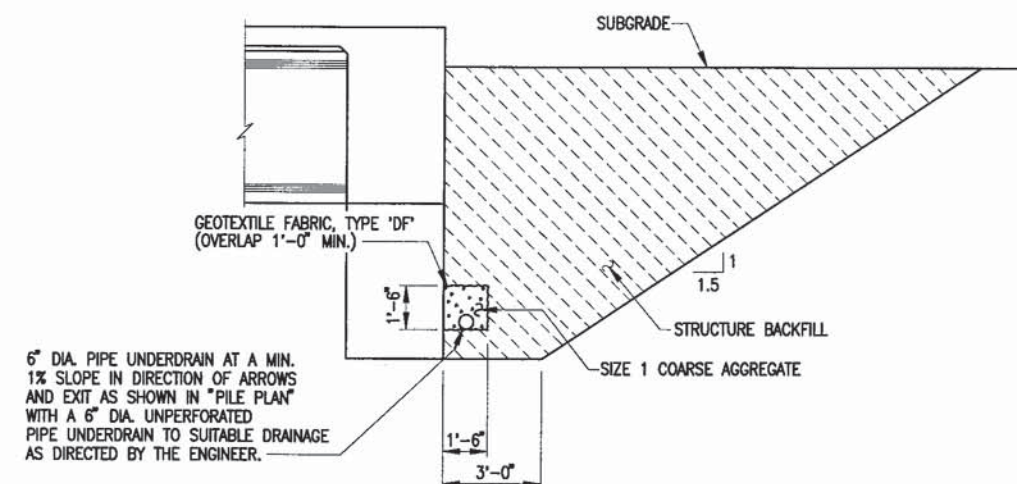


PIPE UNDERDRAIN AND BACKFILL DETAILS

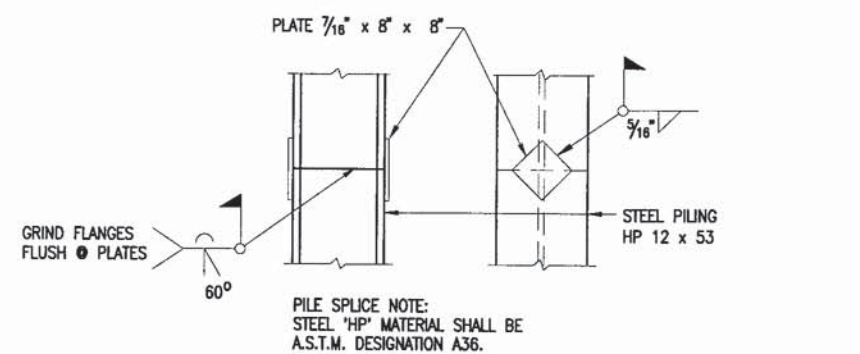


PILE SPLICE DETAIL

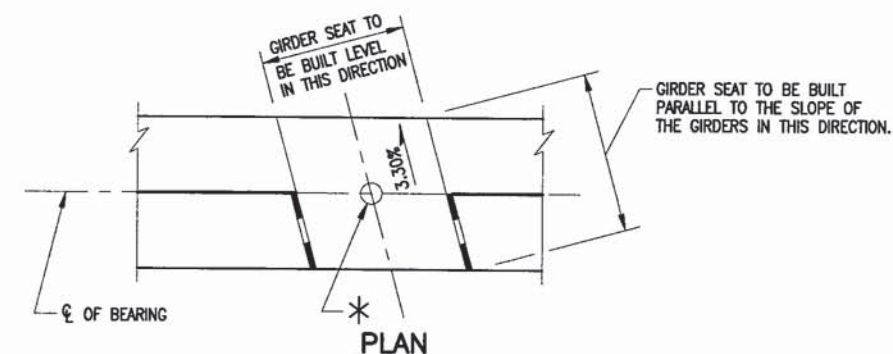

GIRDER SEAT DETAIL

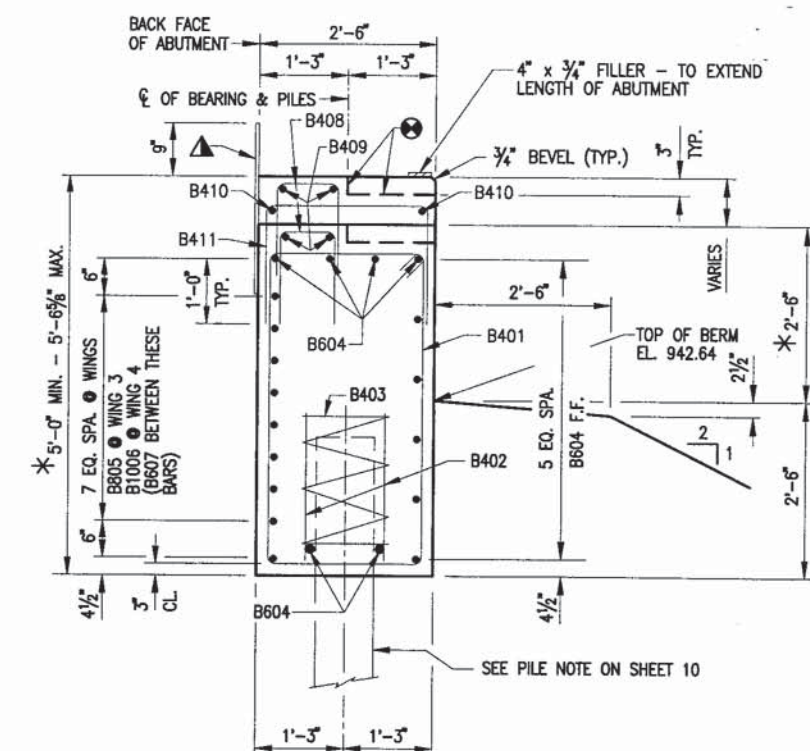

SECTION THRU ABUT. BODY

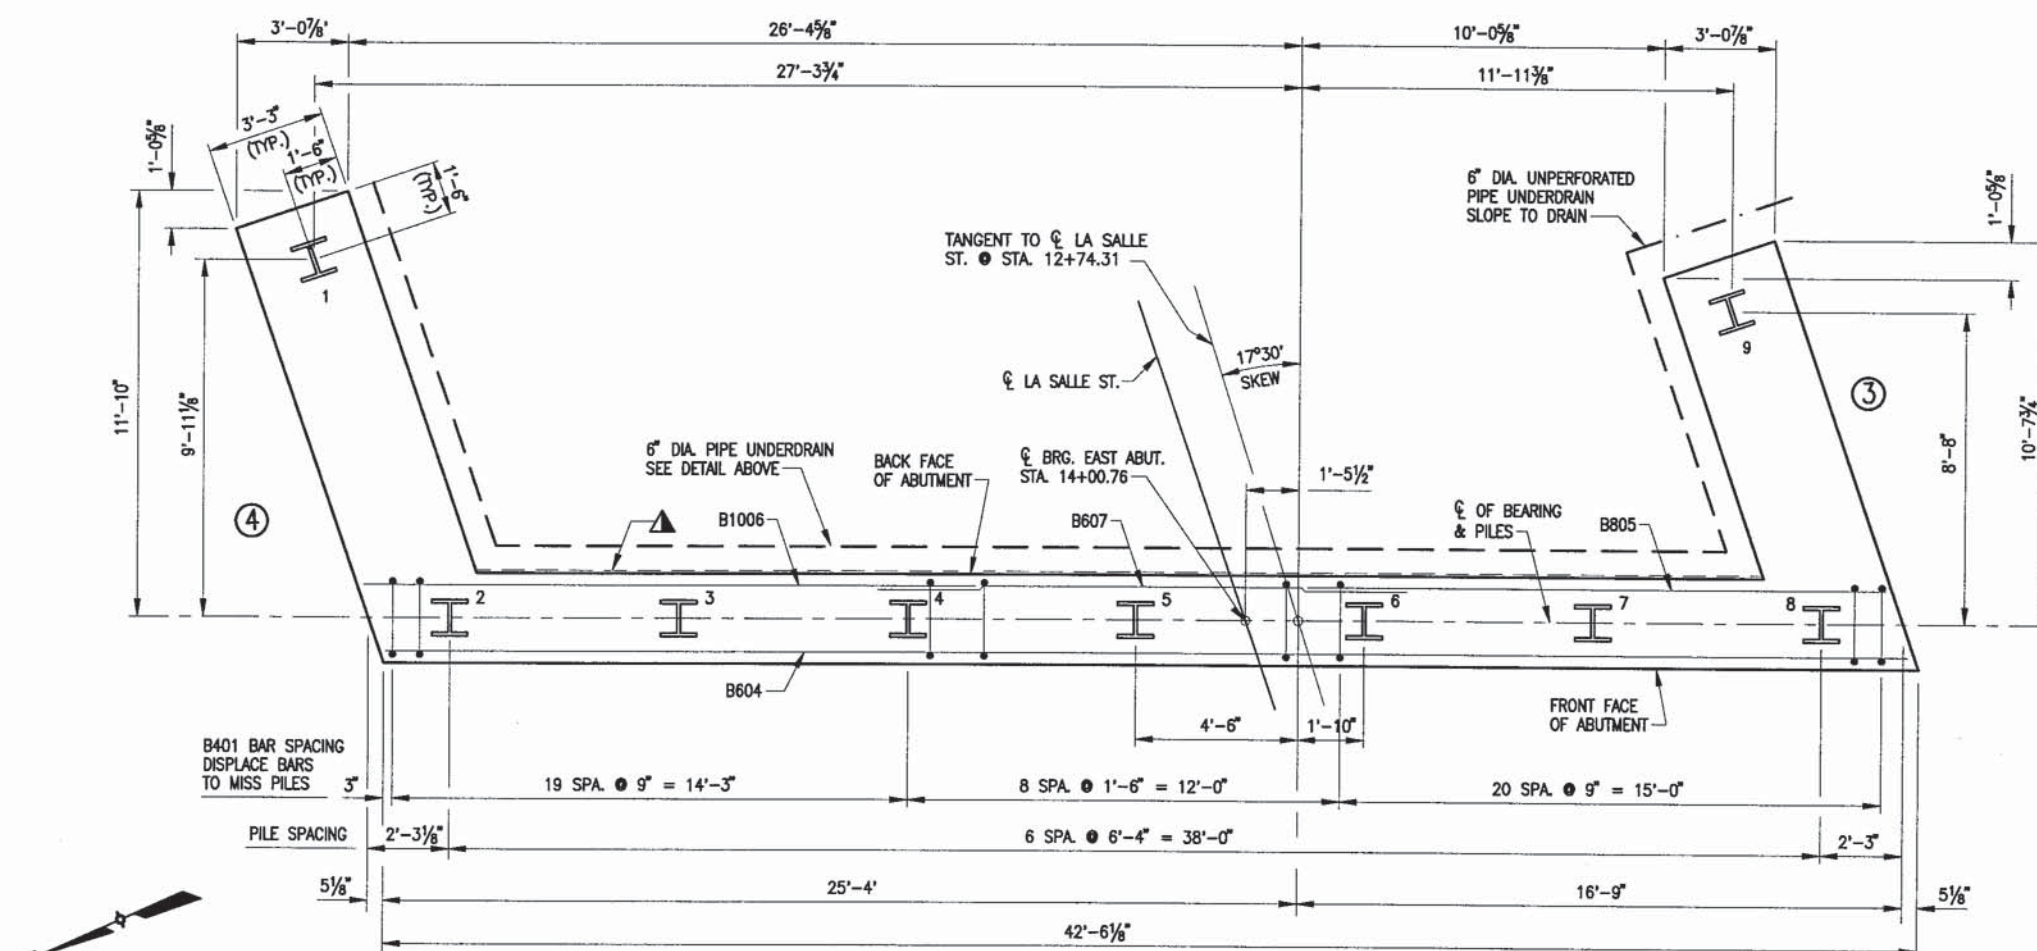


PILE PLAN

LEGEND


* (X) ▲ ● FOR SYMBOL DESCRIPTIONS, SEE SHEET 10.

No.	Date.	Revision		By
STATE OF WISCONSIN DEPARTMENT OF TRANSPORTATION				
STRUCTURE B-18-190				
Const. Spec.	WIS. '99	Drawn By	TL	Plans Checked TR
EAST ABUTMENT DETAILS			SHEET 11 OF 26	
			557	


1190-00-82

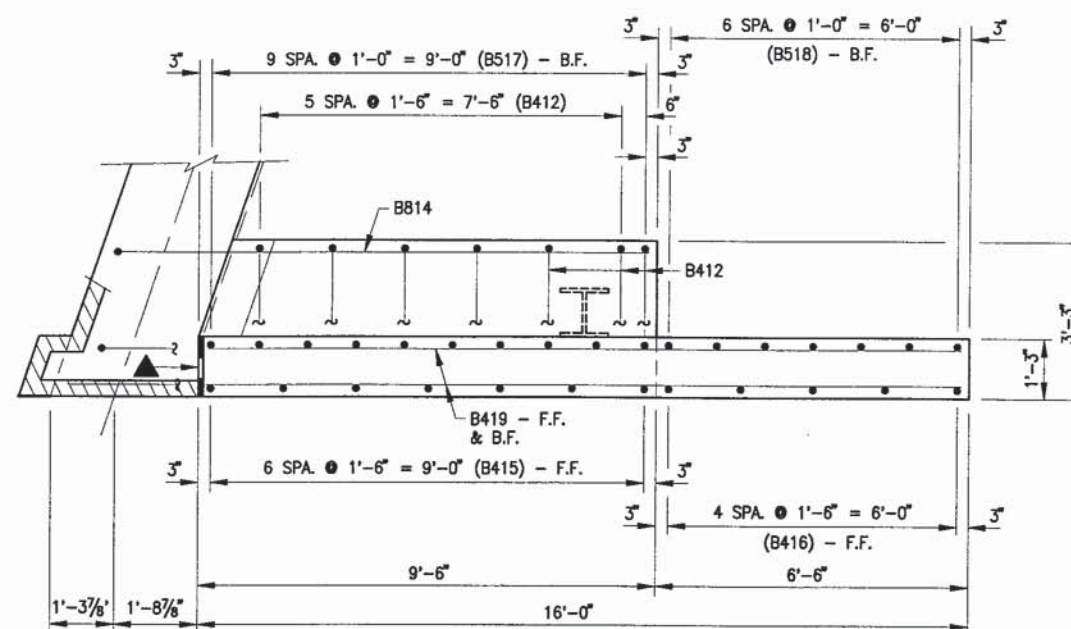

PLAN - WING 3

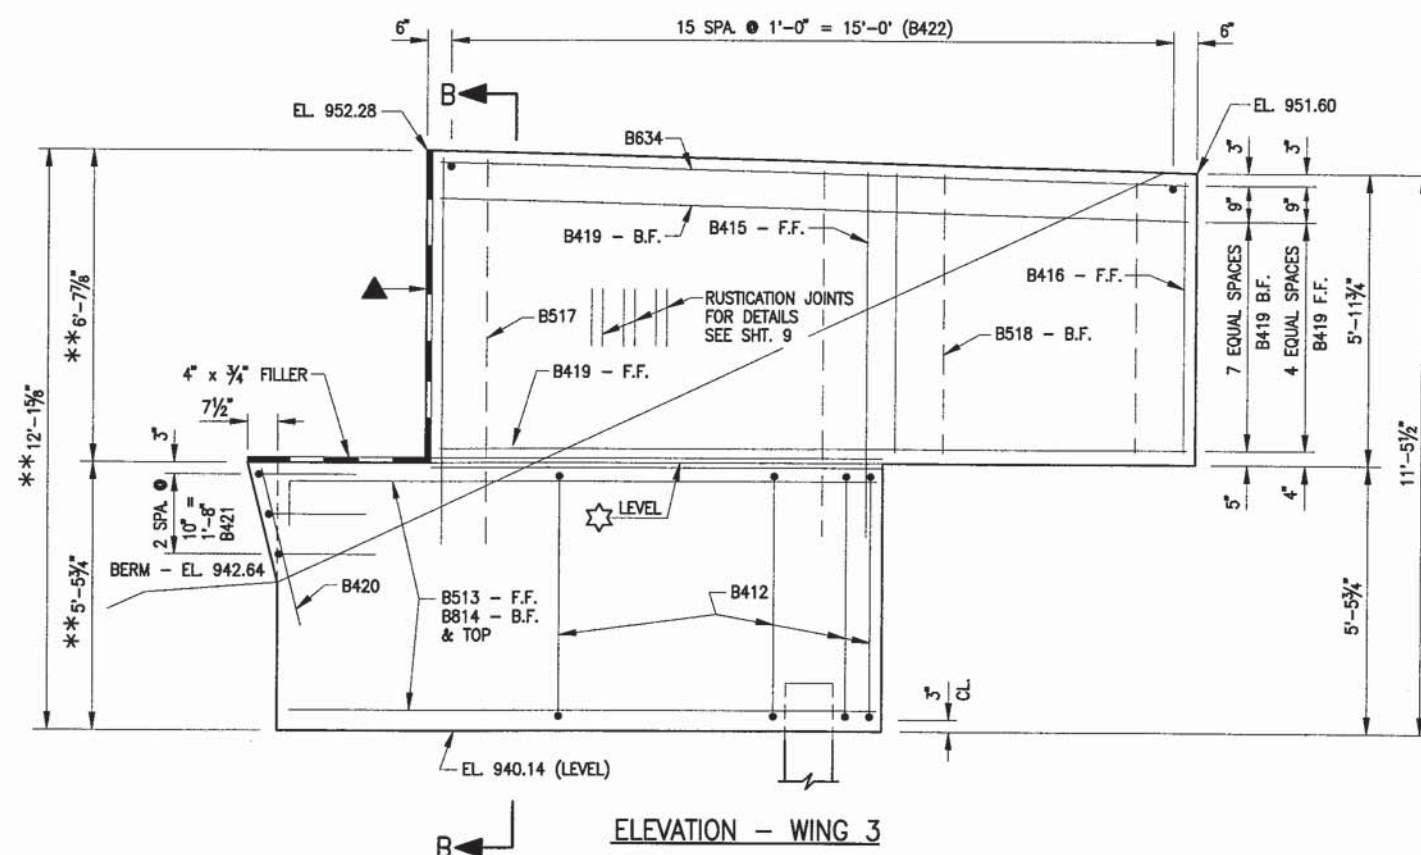

ELEVATION - WING 3

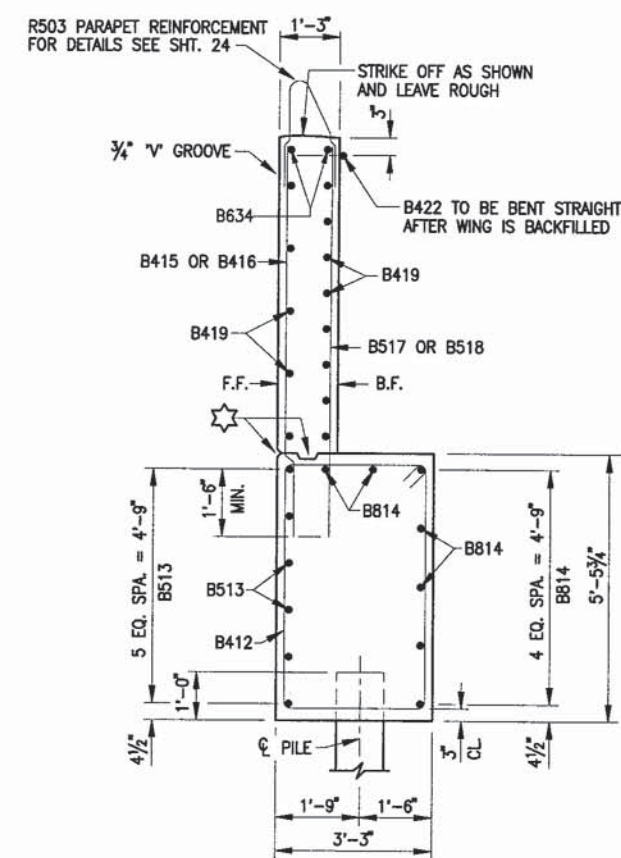


SECTION B-B


LEGEND

- ☆ OPTIONAL KEYED CONSTRUCTION JOINT FORMED BY A SURFACED, BEVELED 2" x 6" AND A 3/4" V-GROOVE ON FRONT FACE OF WINGWALL. V-GROOVE SHALL BE OMITTED IF CONSTRUCTION JOINT IS NOT USED.
- ** DIMENSIONS ARE GIVEN AT THE B.F. OF ABUTMENT.
- ▲ 1/2" FILLER TO EXTEND AS SHOWN. SEAL ALL EXPOSED HORIZONTAL AND VERTICAL SURFACES OF FILLER WITH NON-STAINING GRAY NON-BITUMINOUS JOINT SEALER, (1" DEEP AND HOLD 1/8" BELOW SURFACE OF CONCRETE.)

No.	Date.	Revision		By
STATE OF WISCONSIN DEPARTMENT OF TRANSPORTATION				
STRUCTURE B-18-190				
Const. Spec.	WIS. '99	Drawn By	TL	Plans Checked TR
WING 3			SHEET 12 OF 26	
			558	

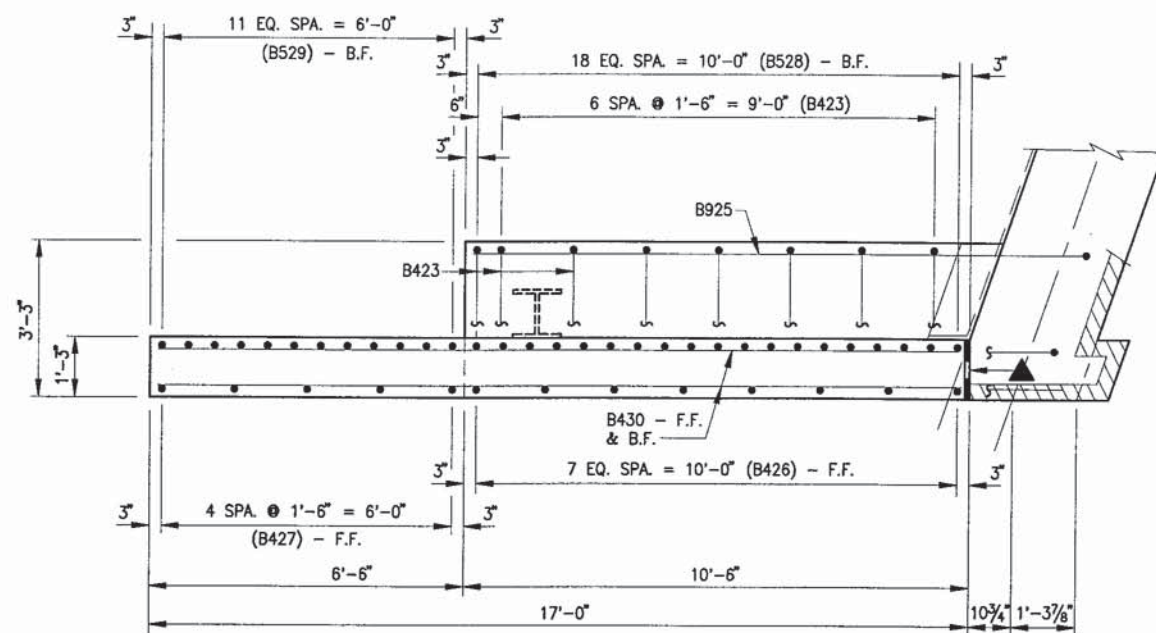

PLAN - WING 4

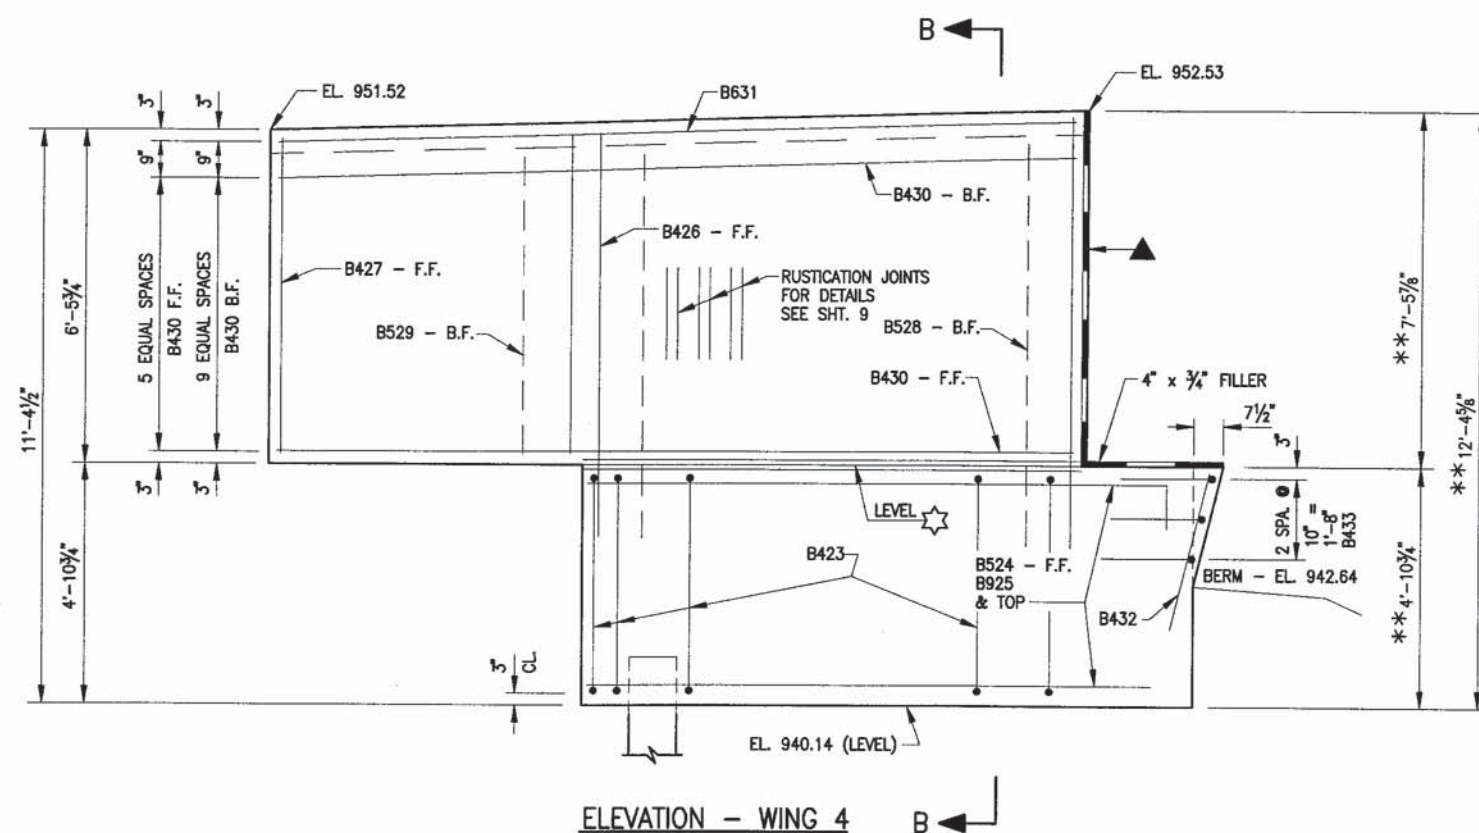


ELEVATION - WING 4

LEGEND

★ OPTIONAL KEYED CONSTRUCTION JOINT FORMED BY A SURFACED, BEVELED 2" x 6" AND A 3/4" V-GROOVE ON FRONT FACE OF WINGWALL. V-GROOVE SHALL BE OMITTED IF CONSTRUCTION JOINT IS NOT USED.


** DIMENSIONS ARE GIVEN AT THE B.F. OF ABUTMENT.

▲ 1/2" FILLER TO EXTEND AS SHOWN. SEAL ALL EXPOSED HORIZONTAL AND VERTICAL SURFACES OF FILLER WITH NON-STAINING GRAY NON-BITUMINOUS JOINT SEALER, (1" DEEP AND HOLD 1/8" BELOW SURFACE OF CONCRETE.)

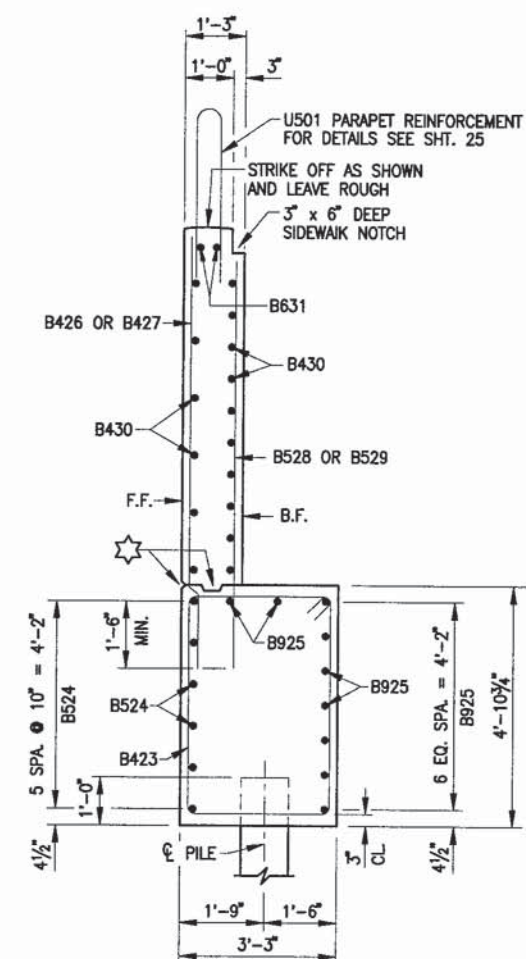

SECTION B-B

No.	Date.	Revision	By
STATE OF WISCONSIN DEPARTMENT OF TRANSPORTATION			
STRUCTURE B-18-190			
Const. Spec.	WIS. '99	Drawn By	Plans Checked
		TL	TR
WING 4		SHEET 13 OF 26	
		559	

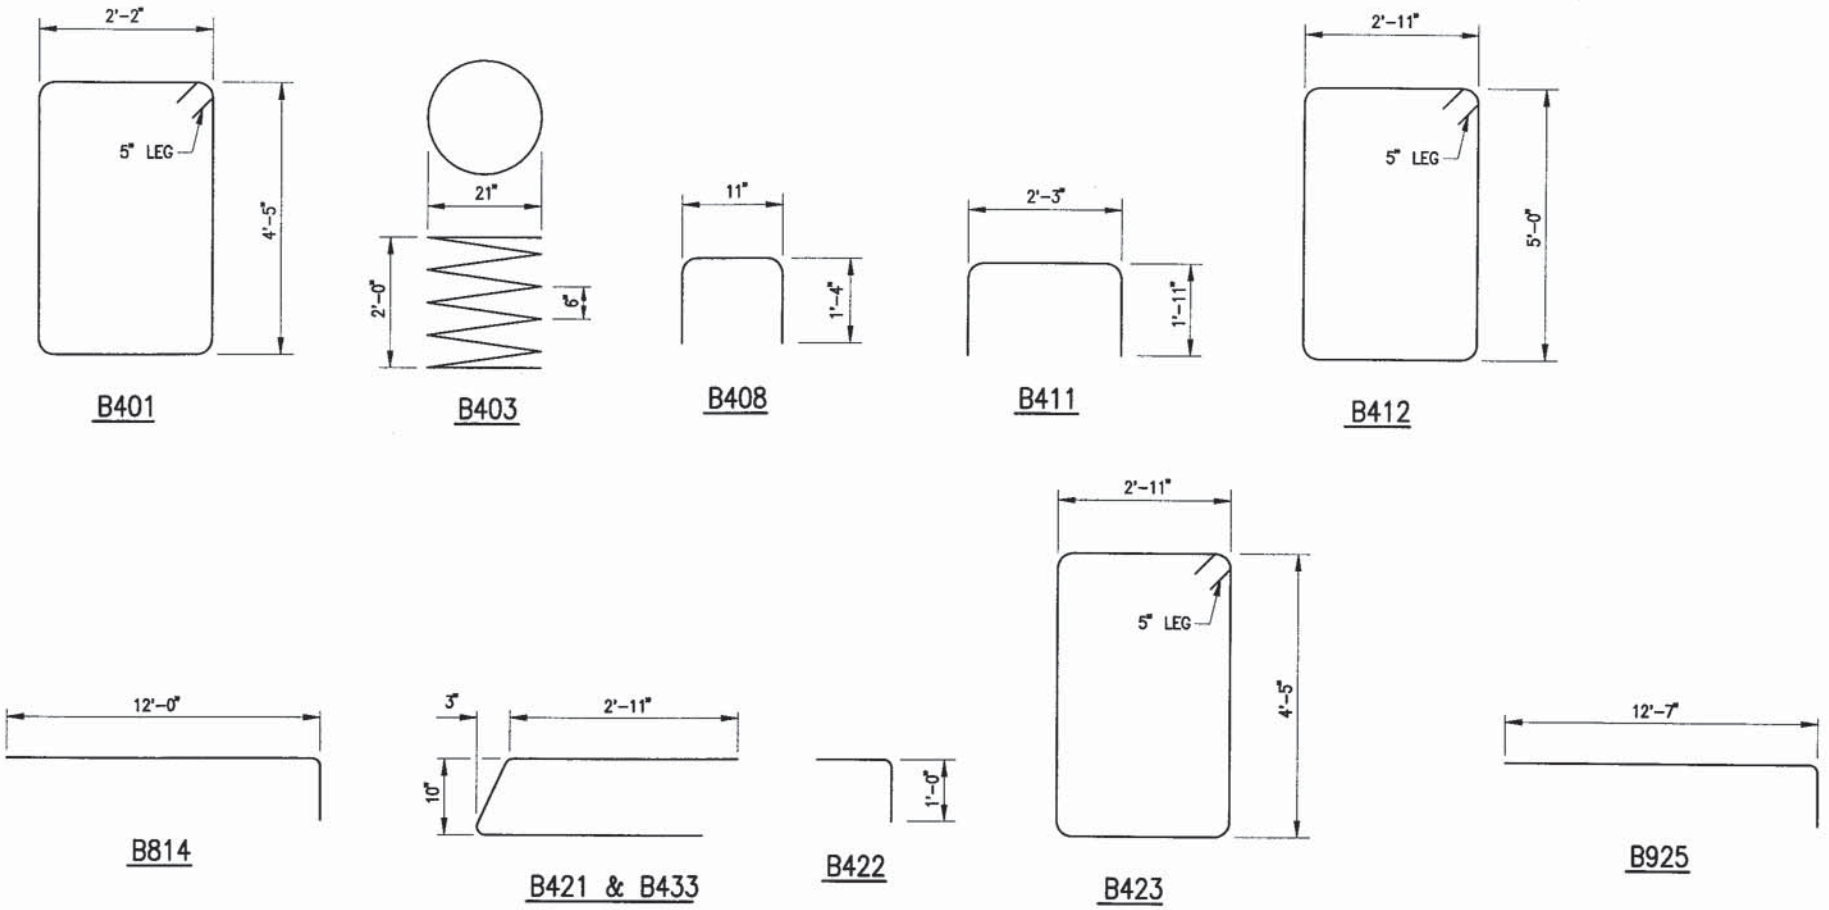




BILL OF BARS

DIMENSIONS IN BENDING DETAILS ARE OUT TO OUT OF BAR.

MARK	NO. REQ'D.	LENGTH	BENT	LOCATION	
B401	48	13'-9"	X	ABUT. BODY - STIRRUPS	VERT.
B402	14	2'-3"		ABUT. BODY - 2 @ EA. PILE	VERT.
B403	7	28'-0"	X	ABUT. BODY - @ EA. PILE	HORIZ.
B604	11	42'-1"		ABUT. BODY	HORIZ.
B805	9	16'-0"		ABUT. BODY - B.F.	HORIZ.
B1006	9	17'-0"		ABUT. BODY - B.F.	HORIZ.
B607	9	14'-11"		ABUT. BODY - B.F.	HORIZ.
B408	29	3'-5"	X	ABUT. BODY - TOP - B.F. ALL GIRDERS	VERT.
B409	2	42'-1'		ABUT. BODY - TOP	HORIZ.
B410	2	26'-0"		ABUT. BODY - TOP	HORIZ.
B411	18	5'-11"	X	ABUT. BODY - TOP - BETWEEN GIRDERS 2 & 5	VERT.
B412	7	16'-5"	X	WING 3 - STIRRUPS	VERT.
B513	6	12'-0"		WING 3 - F.F.	HORIZ.
B814	7	13'-2"	X	WING 3 - B.F.	HORIZ.
B415	7	8'-0"		WING 3 - F.F.	VERT.
B416	5	5'-7"		WING 3 - F.F.	VERT.
B517	10	8'-0"		WING 3 - B.F.	VERT.
B518	7	5'-7"		WING 3 - B.F.	VERT.
B419	13	15'-8"		WING 3 - F.F. & B.F.	HORIZ.
B420	2	3'-6"		WING 3 - @ MASKWALL	VERT.
B421	3	6'-6"	X	WING 3 - @ MASKWALL	HORIZ.
B423	8	15'-7"	X	WING 4 - STIRRUPS	VERT.
B524	6	12'-3"		WING 4 - F.F.	HORIZ.
B925	9	13'-11"	X	WING 4 - B.F.	HORIZ.
B426	8	8'-9"		WING 4 - F.F.	VERT.
B427	5	6'-1"		WING 4 - F.F.	VERT.
B528	19	8'-3"		WING 4 - B.F.	VERT.
B529	12	5'-7"		WING 4 - B.F.	VERT.
B430	16	16'-8"		WING 4 - F.F. & B.F.	HORIZ.
B432	2	3'-6"		WING 4 - @ MASKWALL	VERT.
B433	3	6'-6"	X	WING 4 - @ MASKWALL	HORIZ.
EPOXY COATED BARS					
B631	2	16'-8"		WING 4 - TOP	HORIZ.
B422	16	2'-0"	X	WING 3 - DOWEL	HORIZ.
B634	2	15'-8"		WING 3 - TOP	

● FIELD BEND TO FOLLOW TOP SLOPE OF ABUTMENT.

No.	Date.	Revision	By
STATE OF WISCONSIN DEPARTMENT OF TRANSPORTATION			
STRUCTURE B-18-190			
Const. Spec.	WIS. '99	Drawn By TL	Plans Checked TR
EAST ABUTMENT BILL OF BARS			SHEET 14 OF 26 560

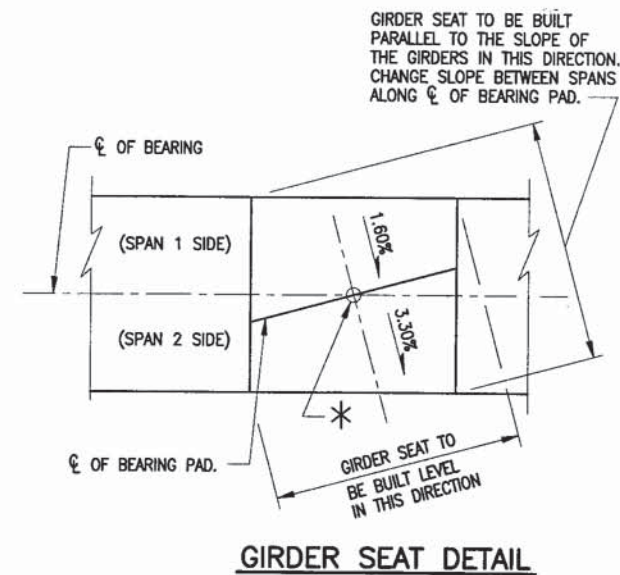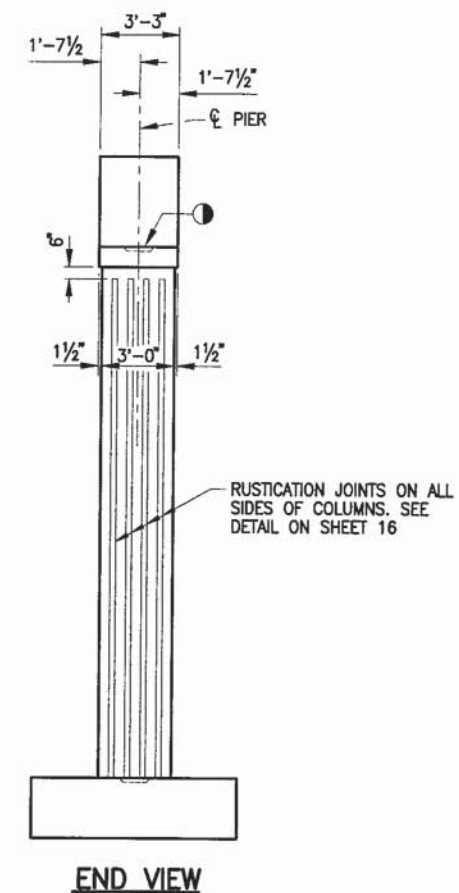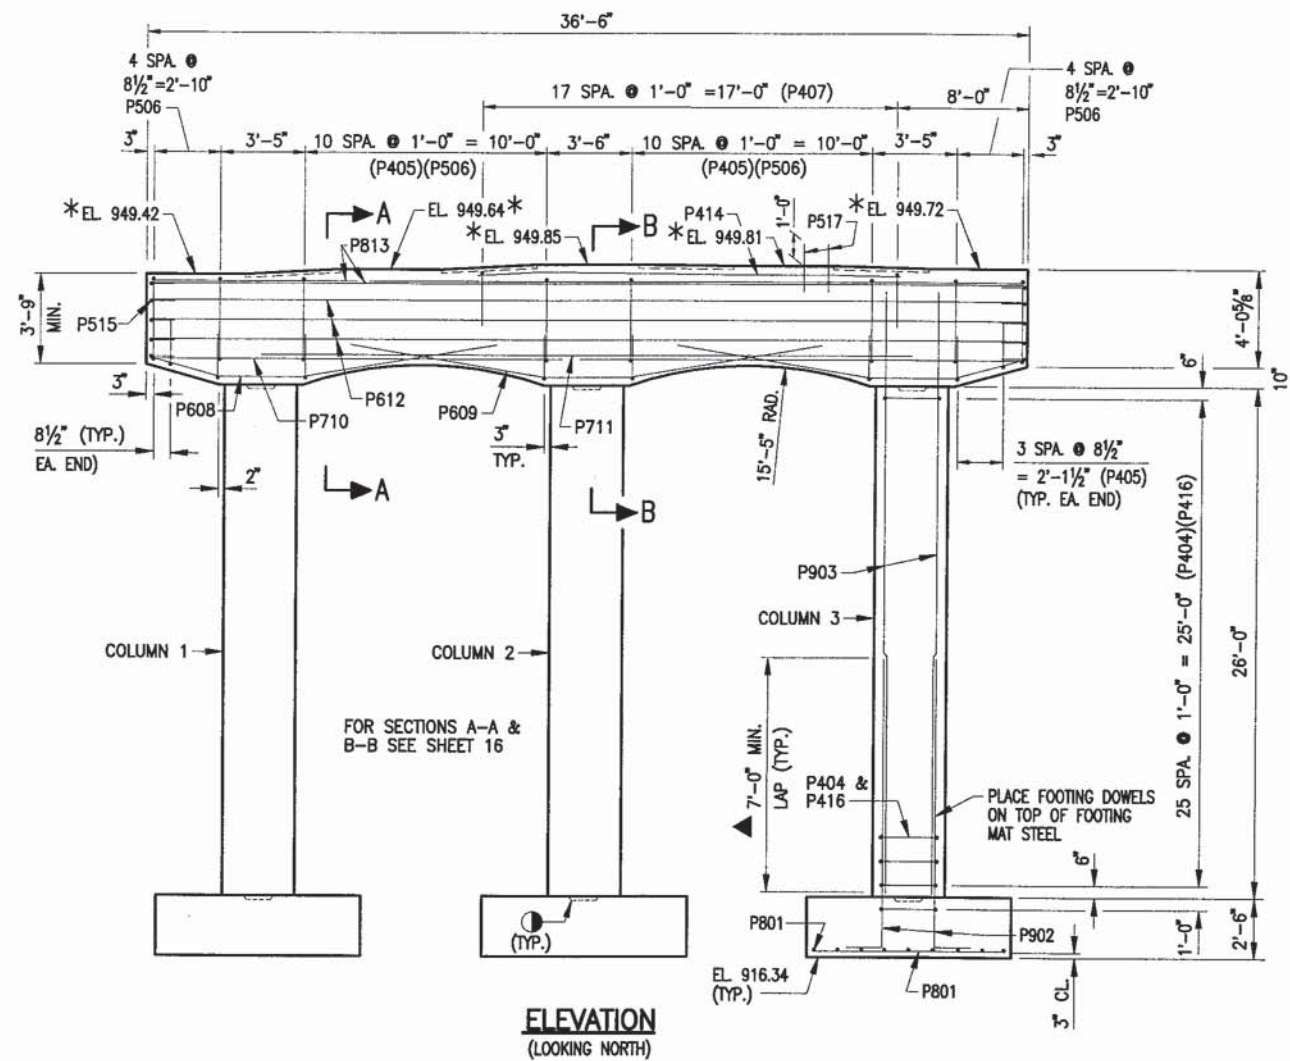


- LEGEND**
- * ELEVATIONS ARE GIVEN AT THE TOP OF CONCRETE AT THE ϕ OF PIER.
 - KEYED CONSTRUCTION JOINT FORMED BY A BEVELED 2" X 6".
 - 1'-3" X 1'-3" X 2" CONSTRUCTION JOINT FORMED BY A BEVELED KEYWAY, TYPICAL ALL COLUMNS AND FOOTINGS.
 - ▲ P902 BAR PROVIDED WITH 3'-0" EXTRA LENGTH FOR FOOTING ELEVATION ADJUSTMENT. ADDITIONAL P404 & P416 BARS ALSO PROVIDED. FOOTING CAN BE LOWERED A MAXIMUM OF 3'-0" WITHOUT A RE-DESIGN.

FOOTING NOTE

PIER TO BE SUPPORTED ON SPREAD FOOTINGS ON SANDSTONE BEDROCK AT A MINIMUM BEARING CAPACITY OF 7.5 TONS PER SQUARE FOOT.

NOTE:
P517 BARS MAY BE PLACED AFTER CONCRETE IS POURED, BUT BEFORE THE INITIAL SET HAS TAKEN PLACE. SEE SHEET 16 FOR CAP AND FOOTING DETAILS.

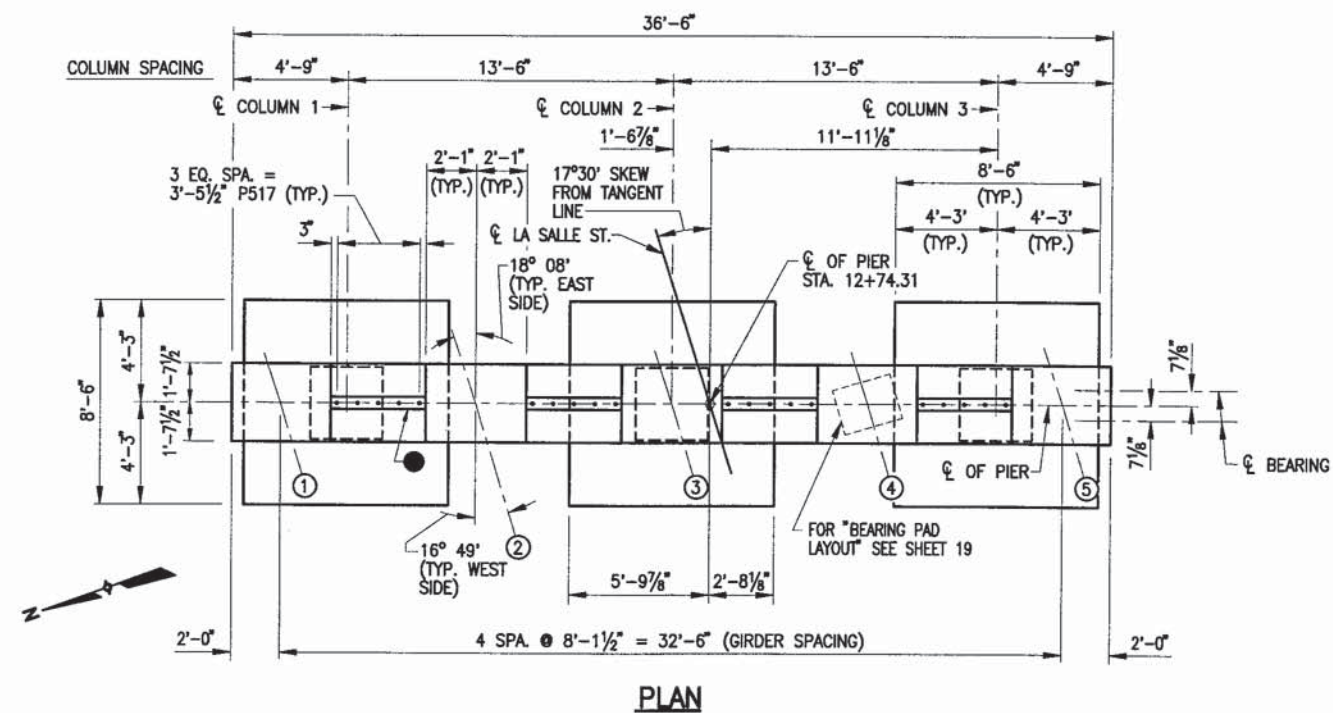


No.	Date.	Revision	By
STATE OF WISCONSIN DEPARTMENT OF TRANSPORTATION			
STRUCTURE B-18-190			
Const. Spec.	WIS. '99	Drawn By TL	Plans Checked TR
PIER			SHEET 15 OF 26
			561


BILL OF BARS

DIMENSIONS IN BENDING DETAILS ARE OUT TO OUT OF BAR.


MARK	NO. REQ'D.	LENGTH	BENT	COATED	LOCATION
P901	54	8'-2"			FOOTING
P902	48	13'-10"	X	X	FOOTING & COLUMN
P903	48	29'-6"	X	X	COLUMN
P404	180	8'-1"	X	X	COLUMN - STIRRUPS
P405	30	7'-2"	X	X	CAP - BOTTOM - STIRRUPS
P506	64	11'-0"	X	X	CAP - STIRRUPS
P407	18	8'-2"	X	X	CAP - TOP - STIRRUPS
P608	8	12'-8"	X	X	CAP - BOTTOM
P609	4	15'-11"	X	X	CAP - BOTTOM
P710	4	36'-2"		X	CAP - BOTTOM
P711	4	27'-0"		X	CAP - BOTTOM
P612	6	36'-2"		X	CAP
P813	12	36'-2"		X	CAP - TOP
P414	4	17'-6"		X	CAP - TOP
P515	10	4'-7"	X	X	CAP - END
P416	90	10'-5"	X	X	COLUMN - STIRRUPS
P517	20	2'-0"		X	CAP - TOP DOWELS

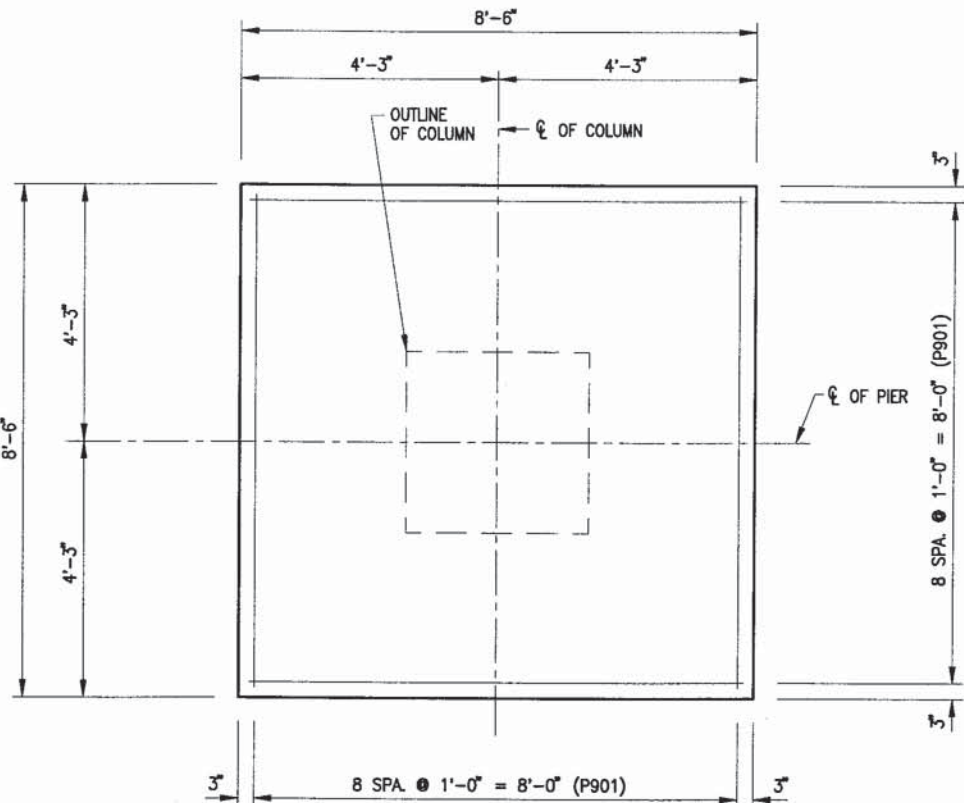

FOOTING PLAN

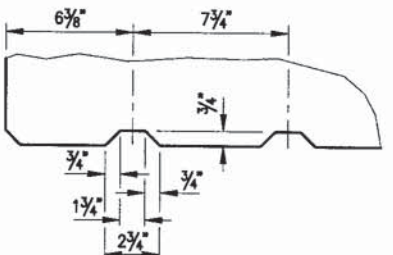


RUSTICATION JOINT DETAILS

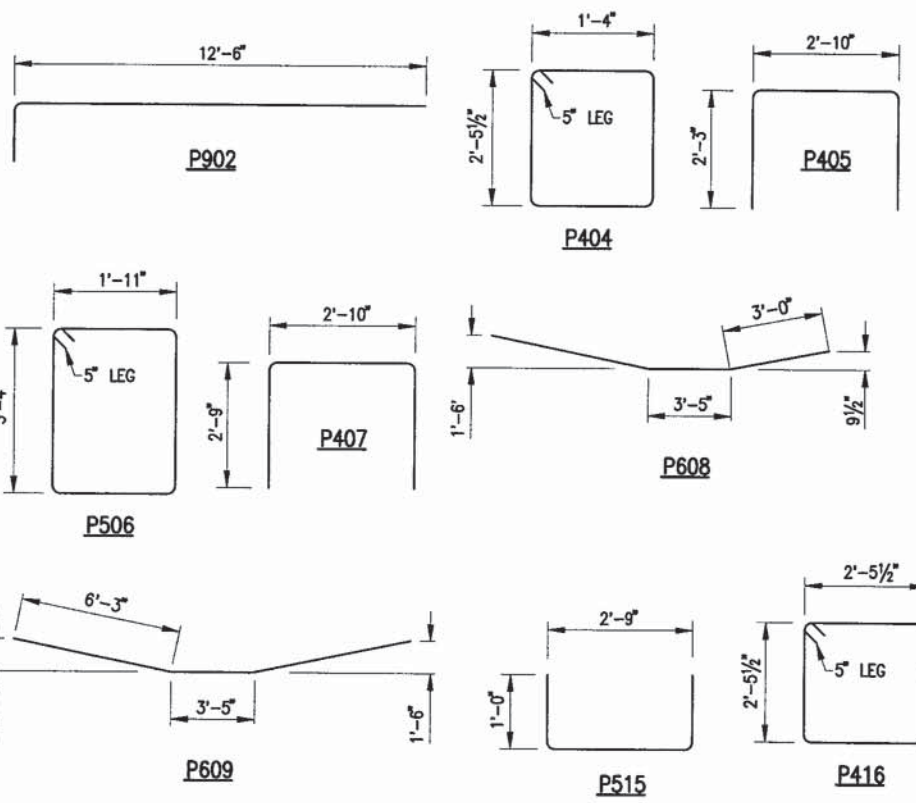


LEGEND

KEYED CONSTRUCTION JOINT FORMED BY A BEVELED 2' x 6'

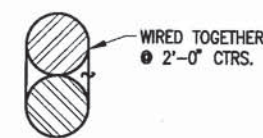


BUNDLING DETAIL

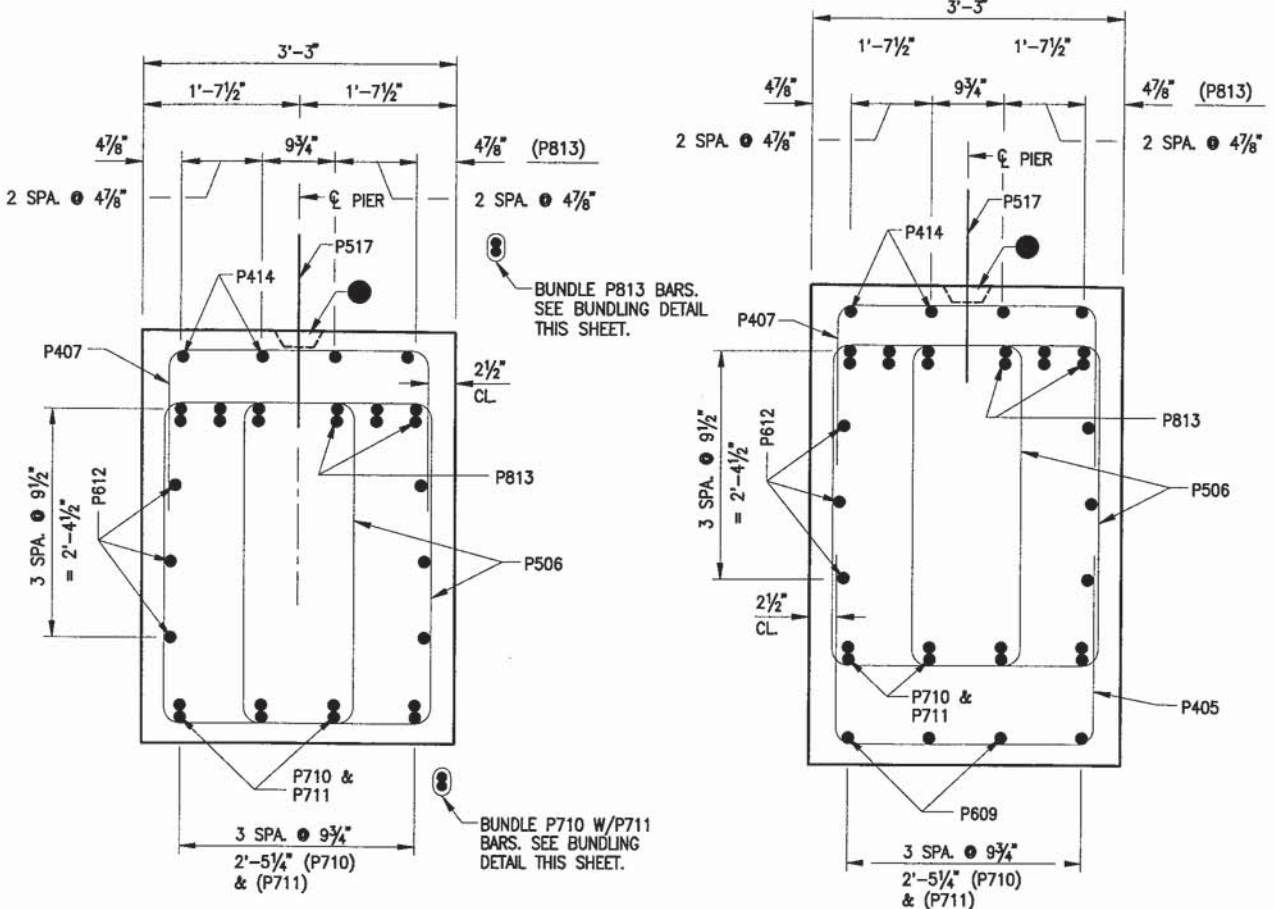


SECTION A-A

SECTION B-B

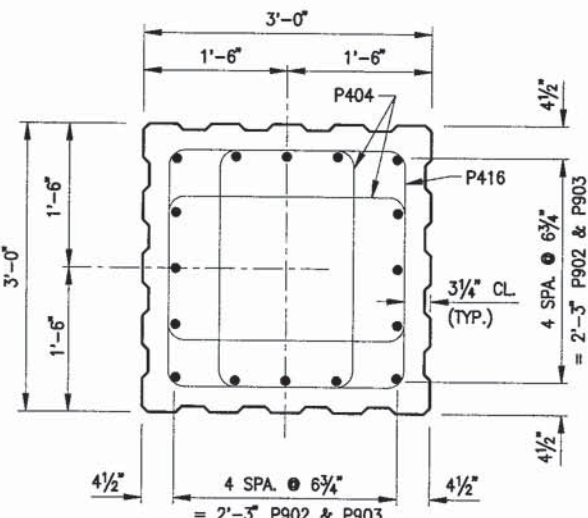


TYPICAL COLUMN SECTION


No.	Date.	Revision	By
STATE OF WISCONSIN DEPARTMENT OF TRANSPORTATION			
STRUCTURE B-18-190			
Const. Spec.	WIS. '99	Drawn By TL	Plans Checked TR
PIER DETAILS			SHEET 16 OF 26
			562

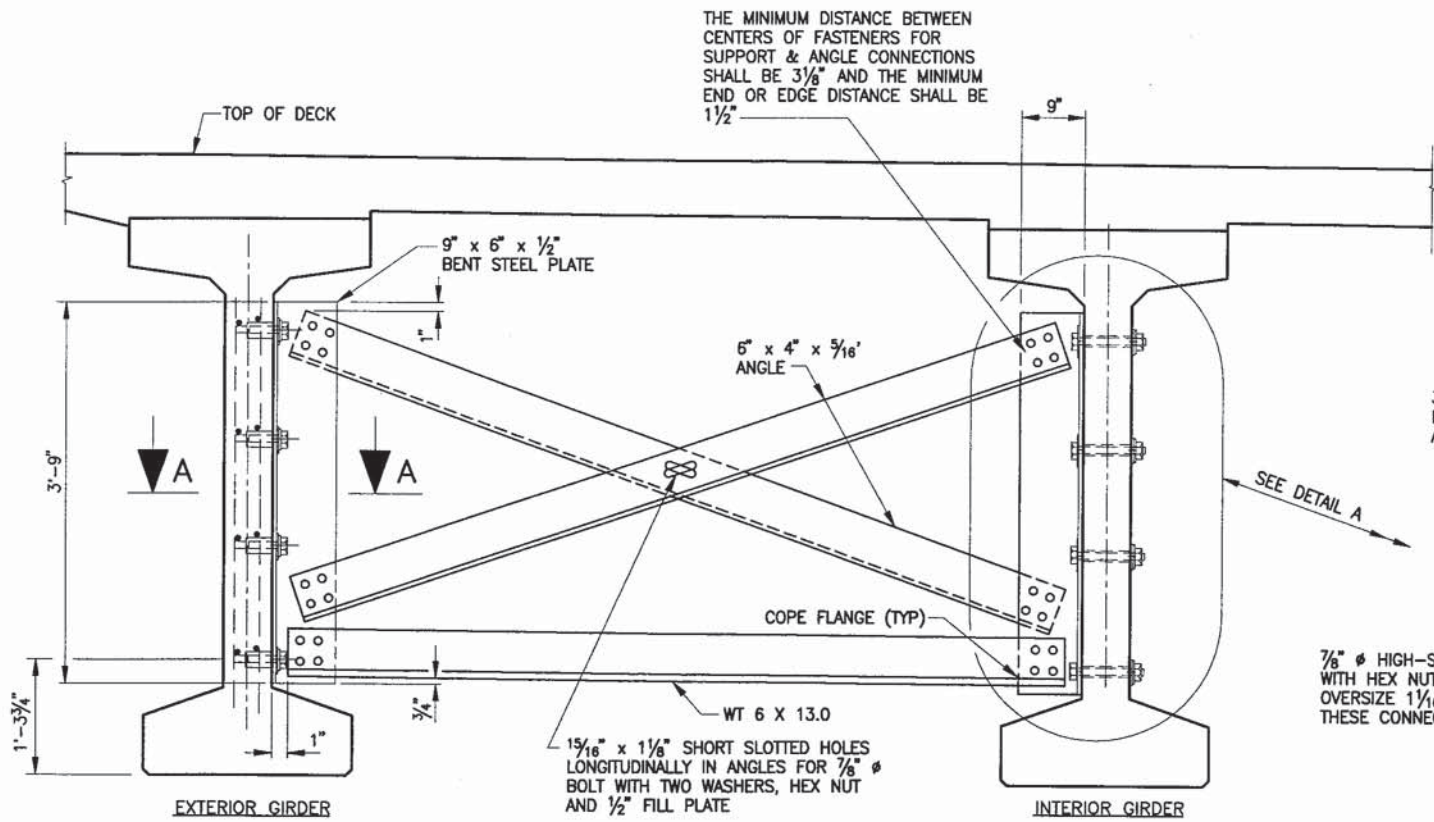

PART TRANSVERSE SECTION AT DIAPHRAGM

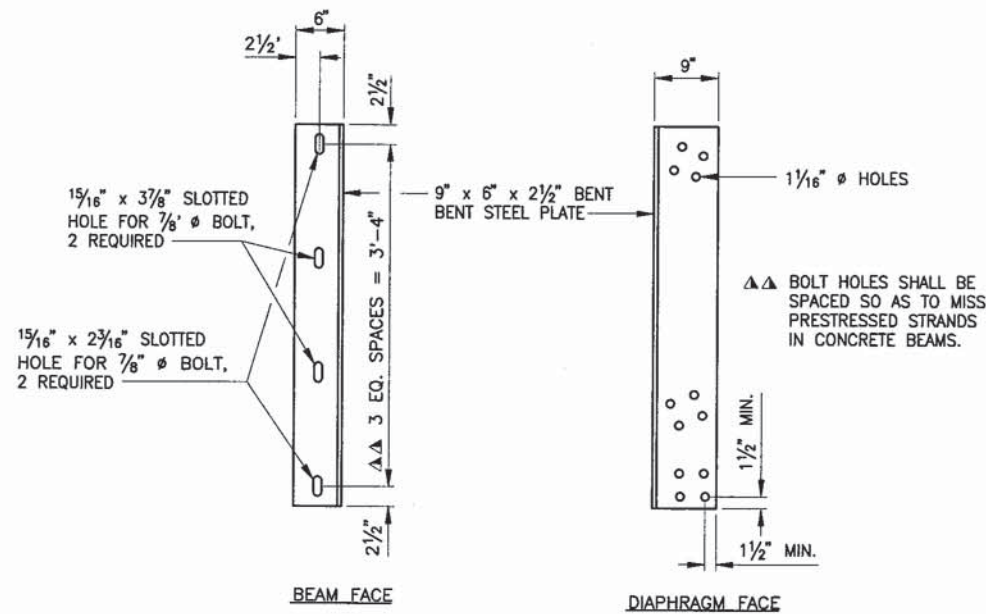

DIAPHRAGM SUPPORT

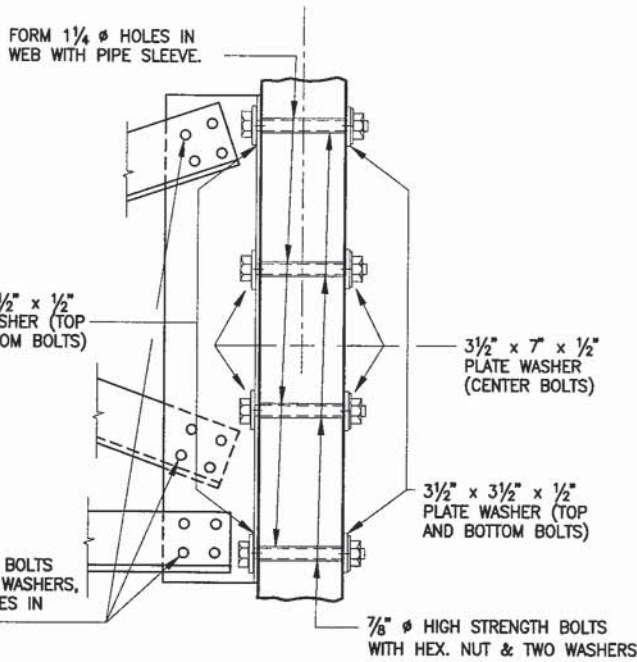

DETAIL A


NOTES

ALL DIAPHRAGM MATERIAL NOT EMBEDDED IN THE CONCRETE GIRDER SHALL BE PAID FOR AT THE UNIT PRICE BID FOR "STEEL DIAPHRAGM, STRUCTURE B-18-190", EACH.

EACH DIAPHRAGM BETWEEN GIRDERS SHALL CONSTITUTE ONE UNIT.

ALL DIAPHRAGM STRUCTURAL STEEL SHALL BE ASTM A709 GRADE 36. ALL BOLTS, NUTS AND WASHERS SHALL BE ASTM A325 TYPE 1.


ALL DIAPHRAGM STRUCTURAL STEEL SHOWN SHALL BE HOT-DIPPED GALVANIZED. ALL BOLTS, NUTS AND WASHERS SHALL BE HOT-DIPPED GALVANIZED IN ACCORDANCE WITH ASTM A153 CLASS C. GALVANIZED NUTS SHALL BE TAPPED OVERSIZE IN ACCORDANCE WITH THE REQUIREMENTS OF ASTM A563 AND SHALL MEET THE REQUIREMENTS OF SUPPLEMENTARY REQUIREMENT S1 OF ASTM A563, LUBRICANT AND TEST FOR COATED NUTS.

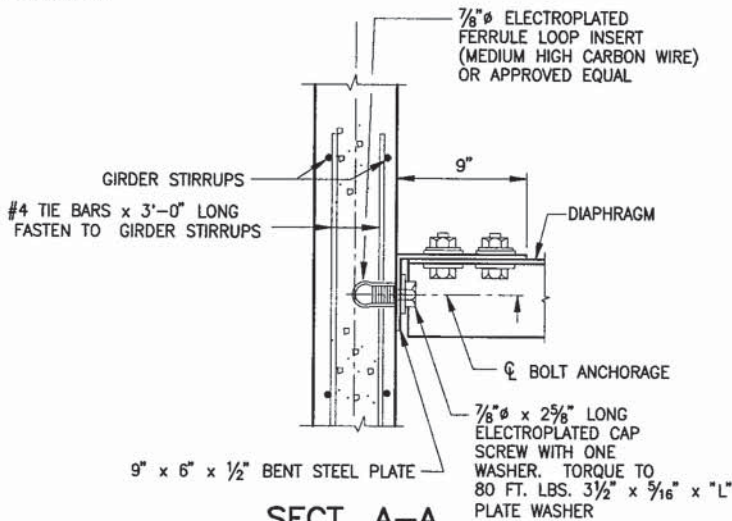

**SECT. A-A
(FOR EXTERIOR ATTACHMENT)**

"L" = 3 1/2'; TOP & BOTTOM BOLTS
"L" = 7'; CENTER BOLTS


No.	Date.	Revision	By
STATE OF WISCONSIN DEPARTMENT OF TRANSPORTATION			
STRUCTURE B-18-190			
Const. Spec.	WIS. '99	Drawn By TL	Plans Checked TR
INTERMEDIATE STEEL DIAPHRAGMS			SHEET 17 OF 26 563

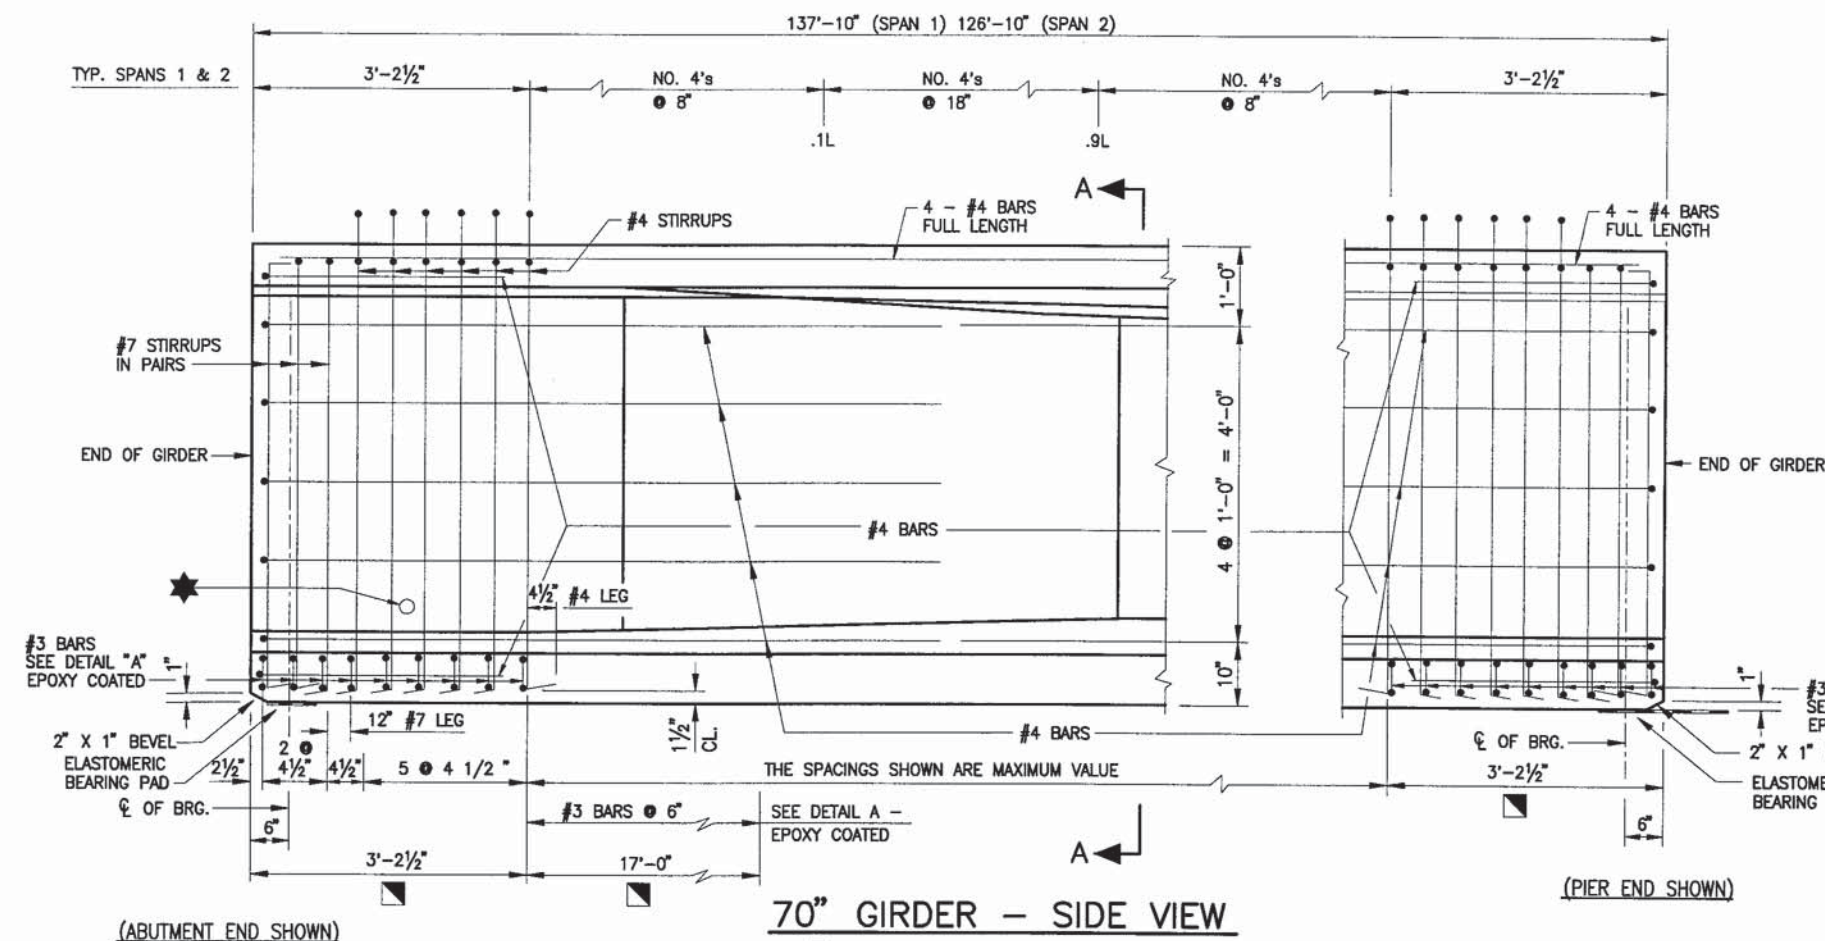


70" GIRDER - SIDE VIEW

DETAIL TYPICAL EACH END.


1 1/2" DIA. HOLE IN WEB FOR 2 S515 BARS, (TYPICAL AT ABUTMENTS) FIELD BEND ALONG SKEW

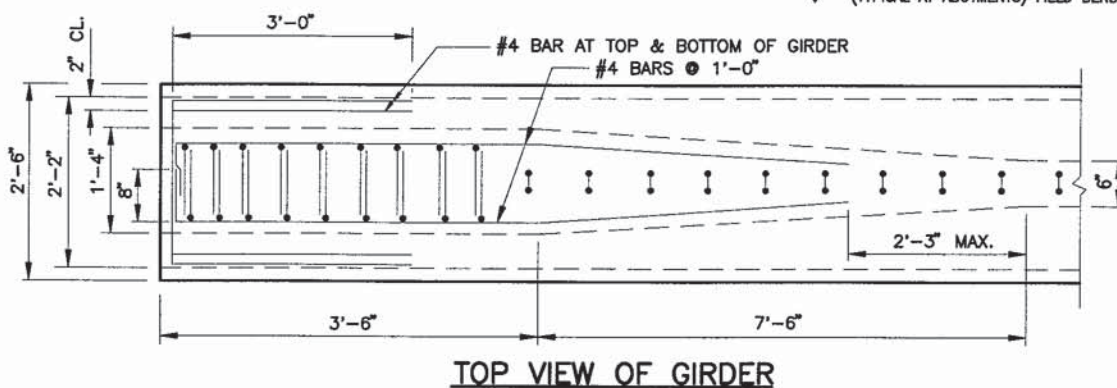

TOP VIEW OF GIRDER

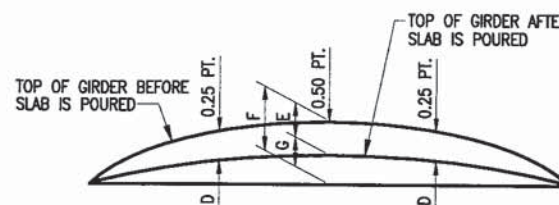

DEAD LOAD DEFLECTION DIAGRAM

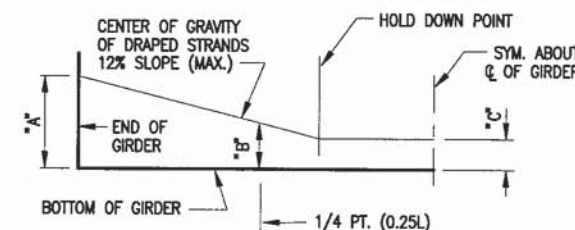


DRAPED STRAND PROFILE


GIRDER DATA		LOW RELAXATION	
GIRDER LENGTH "L" REQUIRED		SPAN 1	SPAN 2
f'ci (psi) *		137'-10"	126'-10"
DRAPED STRANDS	DRAPED PATTERN	6200	4800
	SPREAD PATTERN	N/A	N/A
	DIMENSION "A"	65	65
	DIMENSION "B" (MINIMUM)	20	20
DEFLECTION DATA **	DIMENSION "B" (MAXIMUM)	23	23
	DIMENSION "C"	5	5
	DIMENSION "D"	1 1/8"	1 1/8"
CAMBER DATA	DIMENSION "E"	2 3/8"	1 3/8"
	PRESTRESSED CAMBER "F"	4 3/8"	2 3/8"
	RESIDUAL CAMBER "G"	2"	1"

* MINIMUM CYLINDER STRENGTH OF CONCRETE AT THE TIME OF TRANSFER OF PRESTRESS FORCE.


** DATA SHOWN IS THEORETICAL AND MAY VARY WITH CONCRETE STRENGTH, VARIABLE PRESTRESS CONDITIONS AND PRESTRESS LOSSES.

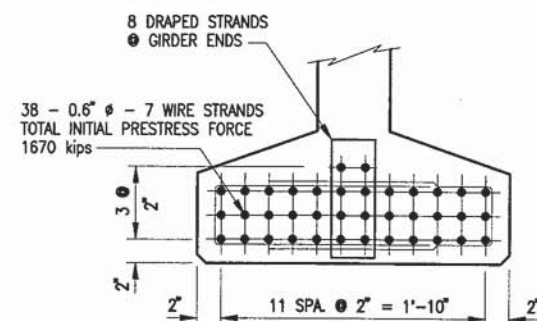


DRAPED STRAND PATTERN (SPAN 1)

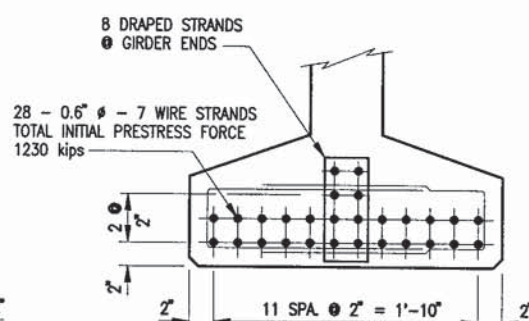


DRAPED STRAND PATTERN (SPAN 2)

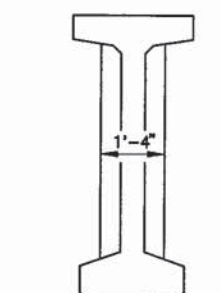


SECTION A-A

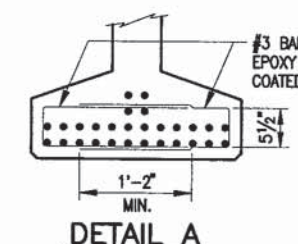

DETAIL A

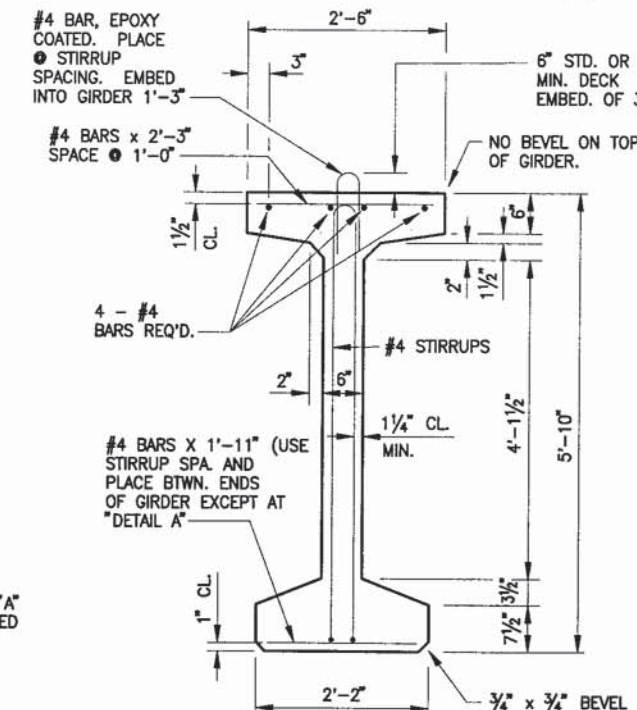

SECTION THRU GIRDER

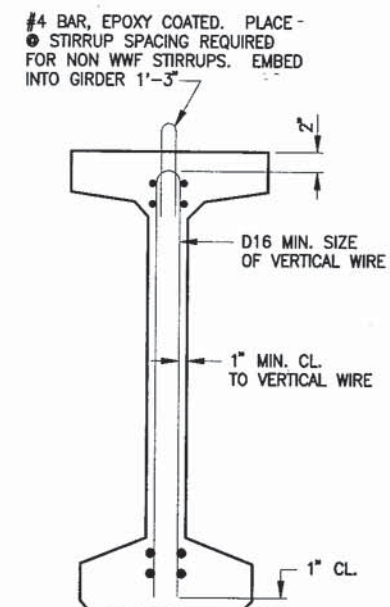

SECTION THRU GIRDER SHOWING WELDED WIRE FABRIC (WWF) STIRRUPS

GIRDER NOTES

TOP OF GIRDERS TO BE ROUGH FLOATED AND BROOMED TRANSVERSELY FOR BONDING TO THE SLAB, EXCEPT THE OUTSIDE 2" OF GIRDER, WHICH SHALL BE TROWEL FINISHED.

THE GIRDER MANUFACTURER SHALL PROVIDE A SUITABLE LIFTING DEVICE FOR HANDLING AND ERECTING THE GIRDERS. THE DETAILS OF THE LIFTING DEVICE USED SHALL BE SUBMITTED FOR APPROVAL.

ALL GIRDERS SHALL BE CAST FULL LENGTH AS SHOWN.

BEND EACH END OF NO. 4 STIRRUPS 4 1/2" AND NO. 7 STIRRUPS 12".

PRESTRESSING STRANDS SHALL BE 0.6" # 7 WIRE LOW-RELAXATION STRANDS WITH AN ULTIMATE STRENGTH OF 270,000 psi AND SHALL BE FLUSH WITH THE ENDS OF THE GIRDER.

ENDS OF STRANDS SHALL BE PAINTED WITH NON-STAINING GRAY NON-BITUMINOUS JOINT SEALER. (THIS APPLIES ONLY TO THOSE ENDS OF GIRDER THAT ARE FINALLY EXPOSED.)

SPACING SHOWN FOR #4 STIRRUPS IS FOR GRADE 60 REINFORCEMENT. IF THE FABRICATOR WANTS TO BUILD A BAR STEEL CAGE BY WELDING LONGITUDINAL REINFORCEMENT TO THE #4 STIRRUPS, 2 OPTIONS ARE AVAILABLE:



1. USE ASTM A706, GRADE 60 REINFORCEMENT AND THE STIRRUP SPACING AS SHOWN ON THE PLANS.

2. USE ASTM A615, GRADE 40 REINFORCEMENT AND A MODIFIED STIRRUP SPACING SUBMITTED TO AND APPROVED BY THE STRUCTURES DEVELOPMENT SECTION.

AN ALTERNATE EQUIVALENT OF WELDED WIRE FABRIC (WWF) MAY BE SUBSTITUTED FOR THE STIRRUP REINFORCEMENT SHOWN, UPON APPROVAL OF THE STRUCTURES DEVELOPMENT SECTION (608) 266-8494. WELDED WIRE FABRIC SHALL CONFORM TO THE REQUIREMENTS OF ASTM A497.

IF THE CONTRACTOR USES THE BOTTOM FLANGE TO SUPPORT CONSTRUCTION FORMS, THE CONTRACTOR SHALL SUBMIT FALSEWORK PLANS FOR APPROVAL BY THE STRUCTURES DESIGN SECTION.

No.	Date.	Revision	By
STATE OF WISCONSIN DEPARTMENT OF TRANSPORTATION			
STRUCTURE B-18-190			
Const. Spec.	WS. '99	Drawn By TL	Plans Checked TR
70" PRETENSIONED GIRDER DETAILS			SHEET 18 OF 26
			564

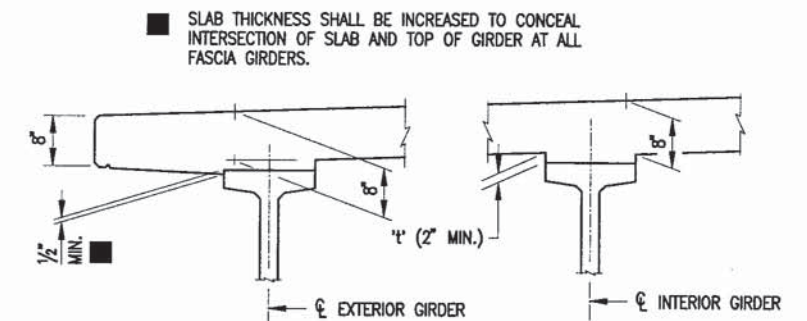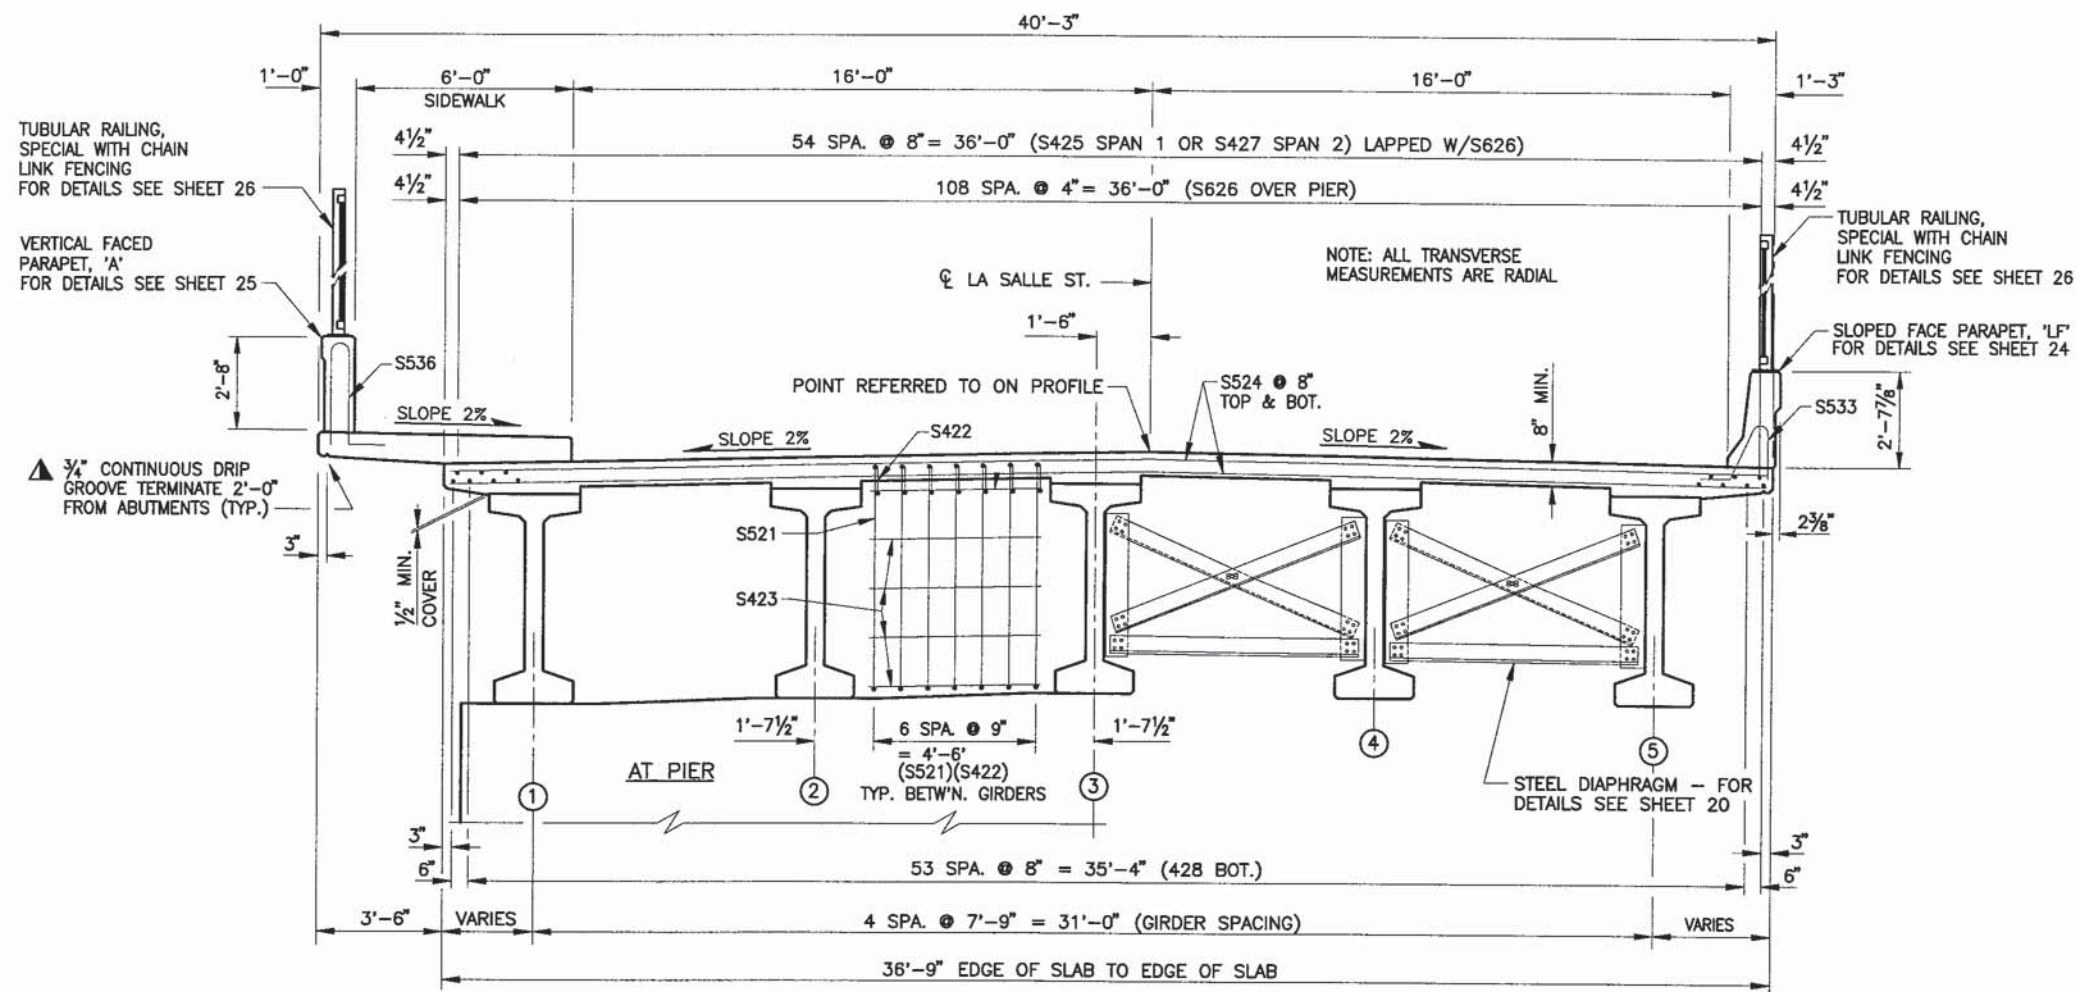


SLAB HAUNCH DETAIL

IF THE 2" MINIMUM HAUNCH HEIGHT 'h' CANNOT BE MAINTAINED, THE GRADE LINE MAY BE REVISED BY THE ENGINEER AT THE OPTION OF THE CONTRACTOR. THE PLAN SLAB THICKNESS SHALL BE HELD. TO DETERMINE 'h', ELEV. OF TOP OF GIRDERS AT C OF SUBSTRUCTURE UNITS & AT 0.1 POINTS OF EACH SPAN SHALL BE TAKEN. THEN FOLLOW THIS PROCESS:


TOP OF DECK ELEV. AT FINAL GRADE
- TOP OF GIRDER ELEVATION
+ DEAD LOAD DEFLECTION
- SLAB THICKNESS
= HAUNCH HEIGHT 'h'

TYPICAL CROSS SECTION THRU DECK (LOOKING EAST)

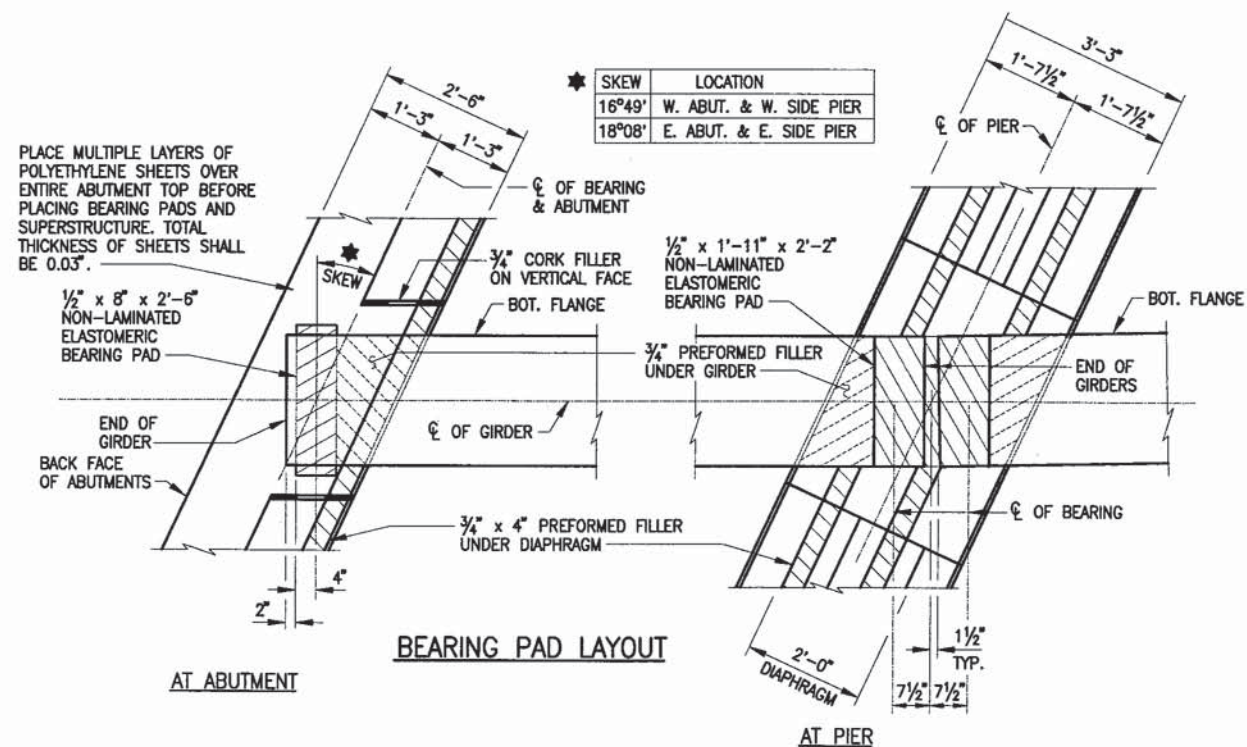


LEGEND


- END 2'-0" AWAY FROM FACE OF ABUTMENT.
- HORIZONTAL CONSTRUCTION JOINT - STRIKE OFF AS SHOWN AND LEAVE ROUGH.

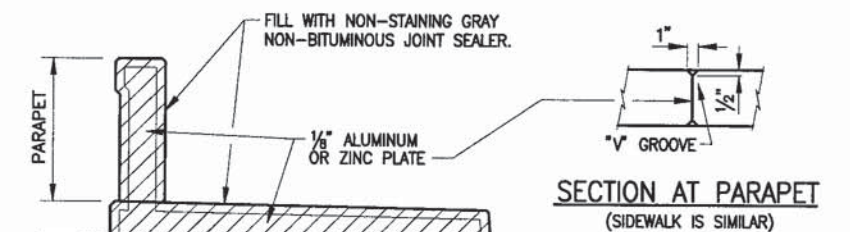

DEFLECTION JOINT DETAIL (PLACE DEFLECTION JOINT OVER PIER)

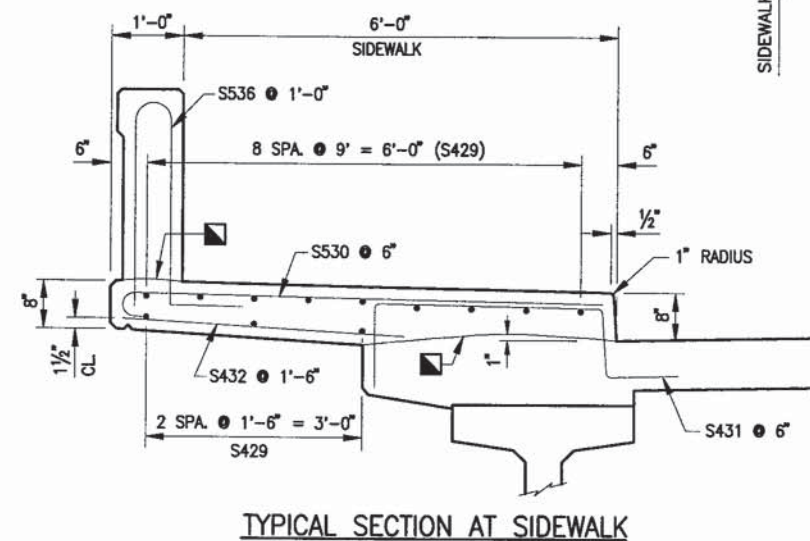



No.	Date.	Revision	By
STATE OF WISCONSIN DEPARTMENT OF TRANSPORTATION DIVISION OF HIGHWAYS			
STRUCTURE B-18-190			
Const. Spec.	WIS. '99	Drawn By	TL
		Plans Checked	TR
SUPERSTRUCTURE CROSS SECTION			SHEET 19 OF 26
			565

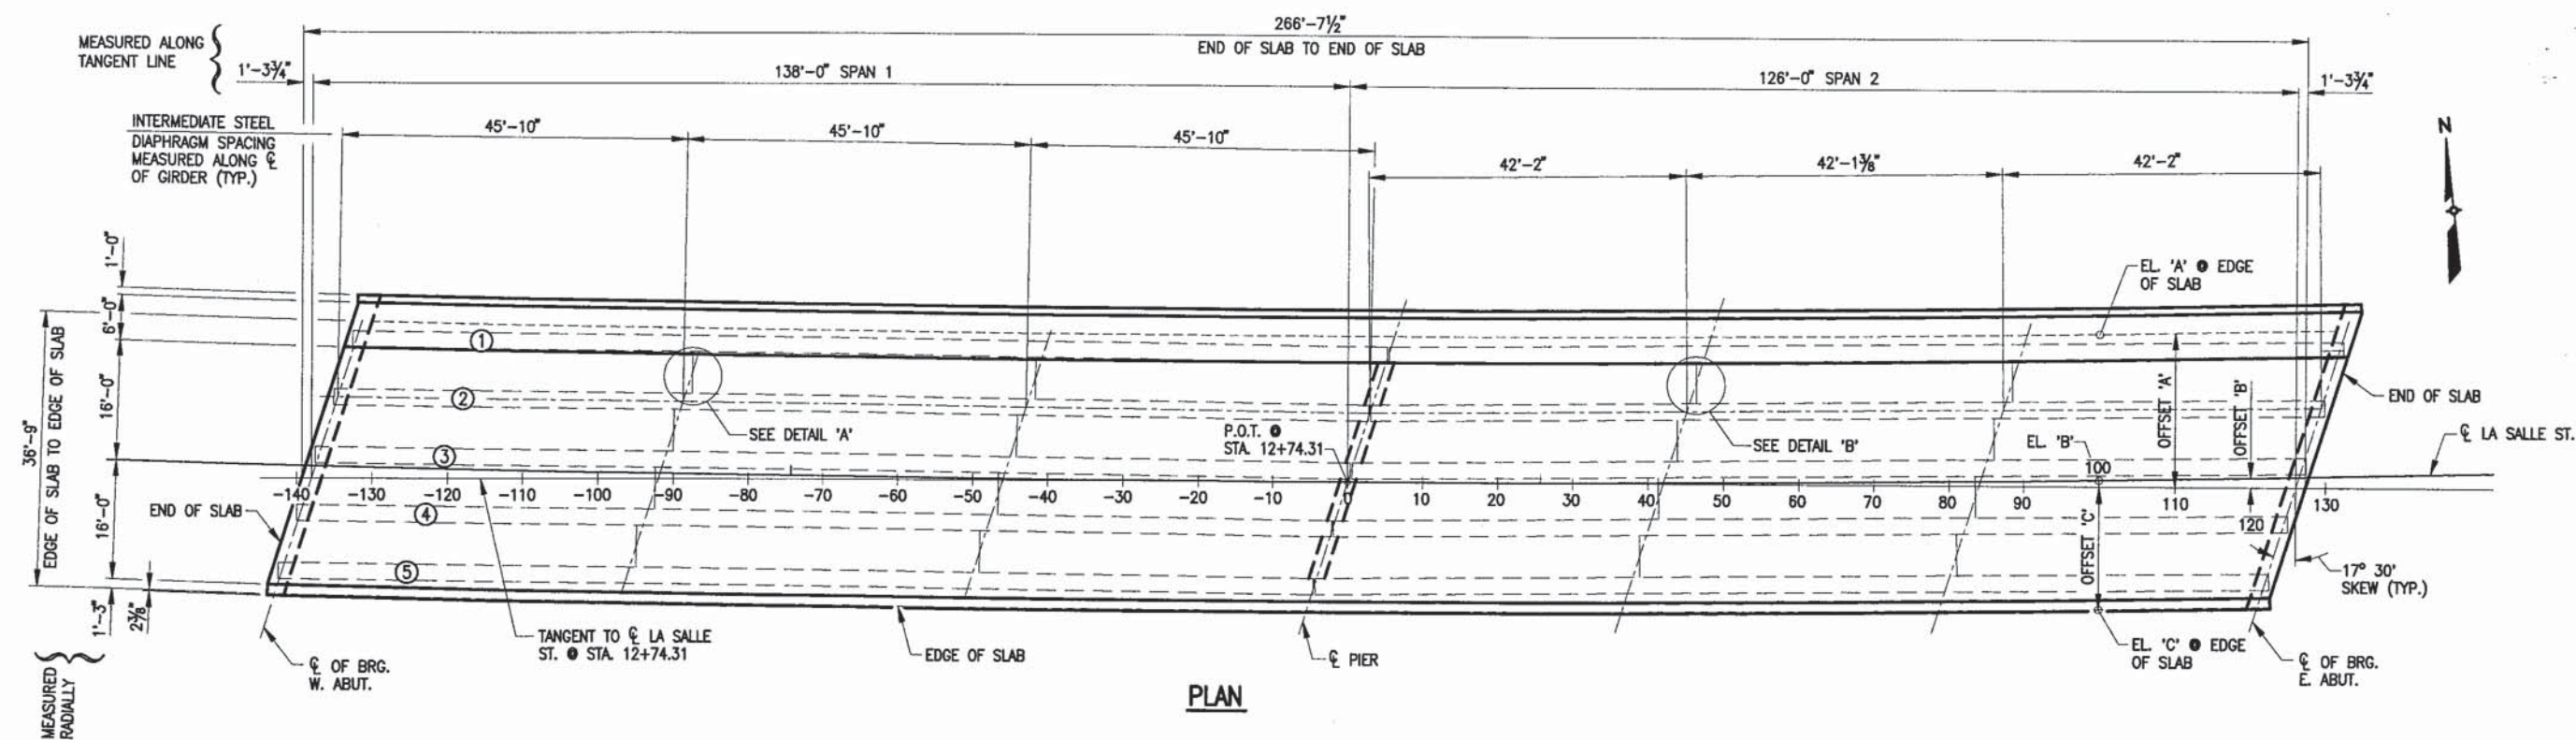

OFFSET & ELEVATION TABLE

DISTANCE	-140	-130	-120	-110	-100	-90	-80	-70	-60	-50	-40	-30	-20	-10
OFFSET 'A'	---	20'-11 3/4"	20'-9 1/8"	20'-6 3/4"	20'-4 1/2"	20'-2 1/2"	20'-0 3/4"	19'-11 1/8"	19'-9 3/4"	19'-8 5/8"	19'-7 5/8"	19'-7"	19'-6 3/8"	19'-6 1/8"
EL. 'A'	---	958.36	958.23	958.09	957.96	957.82	957.69	957.55	957.40	957.24	957.06	956.87	956.66	956.44
OFFSET 'B'	---	1'-5 3/4"	1'-3 3/8"	1'-0 5/8"	10 1/2"	8 1/2"	6 3/4"	5 1/8"	3 3/4"	2 5/8"	1 5/8"	7/8"	3/8"	1/8"
EL. 'B'	---	958.75	958.61	958.48	958.34	958.21	958.07	957.94	957.79	957.62	957.45	957.26	957.05	956.83
OFFSET 'C'	15'-6 1/2"	15'-9 5/8"	16'-0"	16'-2 3/8"	16'-4 1/2"	16'-6 1/2"	16'-8 3/8"	16'-9 5/8"	16'-11 1/4"	17'-0 3/8"	17'-1 1/8"	17'-2"	17'-2 5/8"	17'-2 3/8"
EL. 'C'	958.53	958.40	958.26	958.13	957.99	957.86	957.72	957.59	957.44	957.28	957.10	956.91	956.71	956.49


DISTANCE	0	10	20	30	40	50	60	70	80	90	100	110	120	130
OFFSET 'A'	19'-6"	19'-6 1/8"	19'-6 3/8"	19'-7"	19'-7 5/8"	19'-8 5/8"	19'-9 3/4"	19'-11 1/8"	20'-0 3/4"	20'-2 1/2"	20'-4 1/2"	20'-6 3/4"	20'-9 1/8"	20'-11 3/4"
EL. 'A'	956.21	955.96	955.70	955.42	955.13	954.83	954.51	954.17	953.83	953.46	953.09	952.70	952.29	951.87
OFFSET 'B'	0	1/8"	3/8"	7/8"	1 5/8"	2 5/8"	3 3/4"	5 1/8"	6 3/4"	8 1/2"	10 1/2"	1'-0 5/8"	1'-3 3/8"	---
EL. 'B'	956.60	956.35	956.09	955.82	955.53	955.22	954.90	954.57	954.23	953.86	953.49	953.10	952.70	---
OFFSET 'C'	17'-5"	17'-2 3/8"	17'-2 5/8"	17'-2"	17'-1 5/8"	17'-0 3/8"	16'-11 1/4"	16'-9 5/8"	16'-8 3/8"	16'-6 1/2"	16'-4 1/2"	16'-2 3/8"	16'-0"	---
EL. 'C'	956.26	956.01	955.75	955.47	955.18	954.88	954.56	954.23	953.89	953.53	953.16	952.77	952.37	---

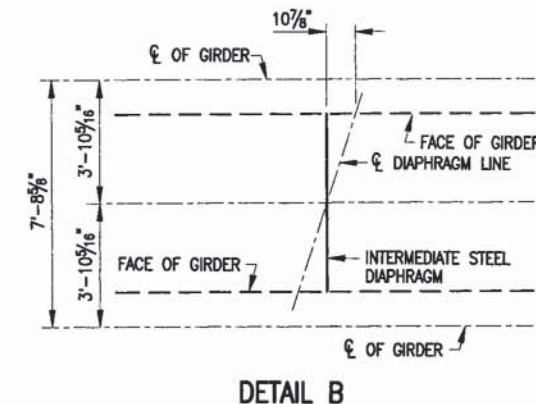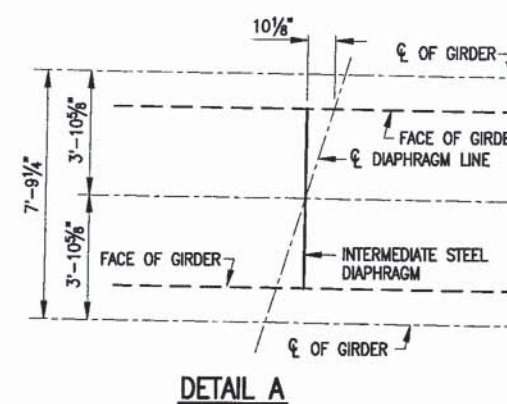

TOP OF DECK ELEVATIONS

	ϕ OF BRG. W. ABUT.	0.1 PT.	0.2 PT.	0.3 PT.	0.4 PT.	0.5 PT.	0.6 PT.	0.7 PT.	0.8 PT.	0.9 PT.	ϕ OF PIER	0.1 PT.	0.2 PT.	0.3 PT.	0.4 PT.	0.5 PT.	0.6 PT.	0.7 PT.	0.8 PT.	0.9 PT.	ϕ OF BRG. E. ABUT.
GIRDER 1	958.44	958.25	958.06	957.87	957.69	957.49	957.27	957.03	956.75	956.45	956.13	955.80	955.45	955.08	954.68	954.27	953.83	953.37	952.91	952.45	951.85
GIRDER 2	958.63	958.43	958.25	958.06	957.87	957.68	957.47	957.23	956.96	956.66	956.34	956.02	955.68	955.31	954.92	954.51	954.07	953.62	953.14	952.64	952.11
GIRDER 3	958.81	958.62	958.44	958.25	958.06	957.87	957.66	957.43	957.16	956.87	956.56	956.24	955.90	955.53	955.15	954.75	954.32	953.88	953.41	952.91	952.39
GIRDER 4	958.75	958.56	958.38	958.20	958.01	957.83	957.62	957.39	957.13	956.84	956.52	956.21	955.88	955.53	955.15	954.75	954.32	953.88	953.41	952.91	952.39
GIRDER 5	958.62	958.44	958.26	958.07	957.89	957.70	957.50	957.27	957.02	956.74	956.43	956.12	955.79	955.44	955.07	954.68	954.26	953.81	953.35	952.86	952.35

No.	Date.	Revision	By
STATE OF WISCONSIN DEPARTMENT OF TRANSPORTATION			
STRUCTURE B-18-190			
Const. Spec.	WIS. '99	Drawn By TL	Plans Checked TR
SUPERSTRUCTURE PLAN			SHEET 21 OF 26 567

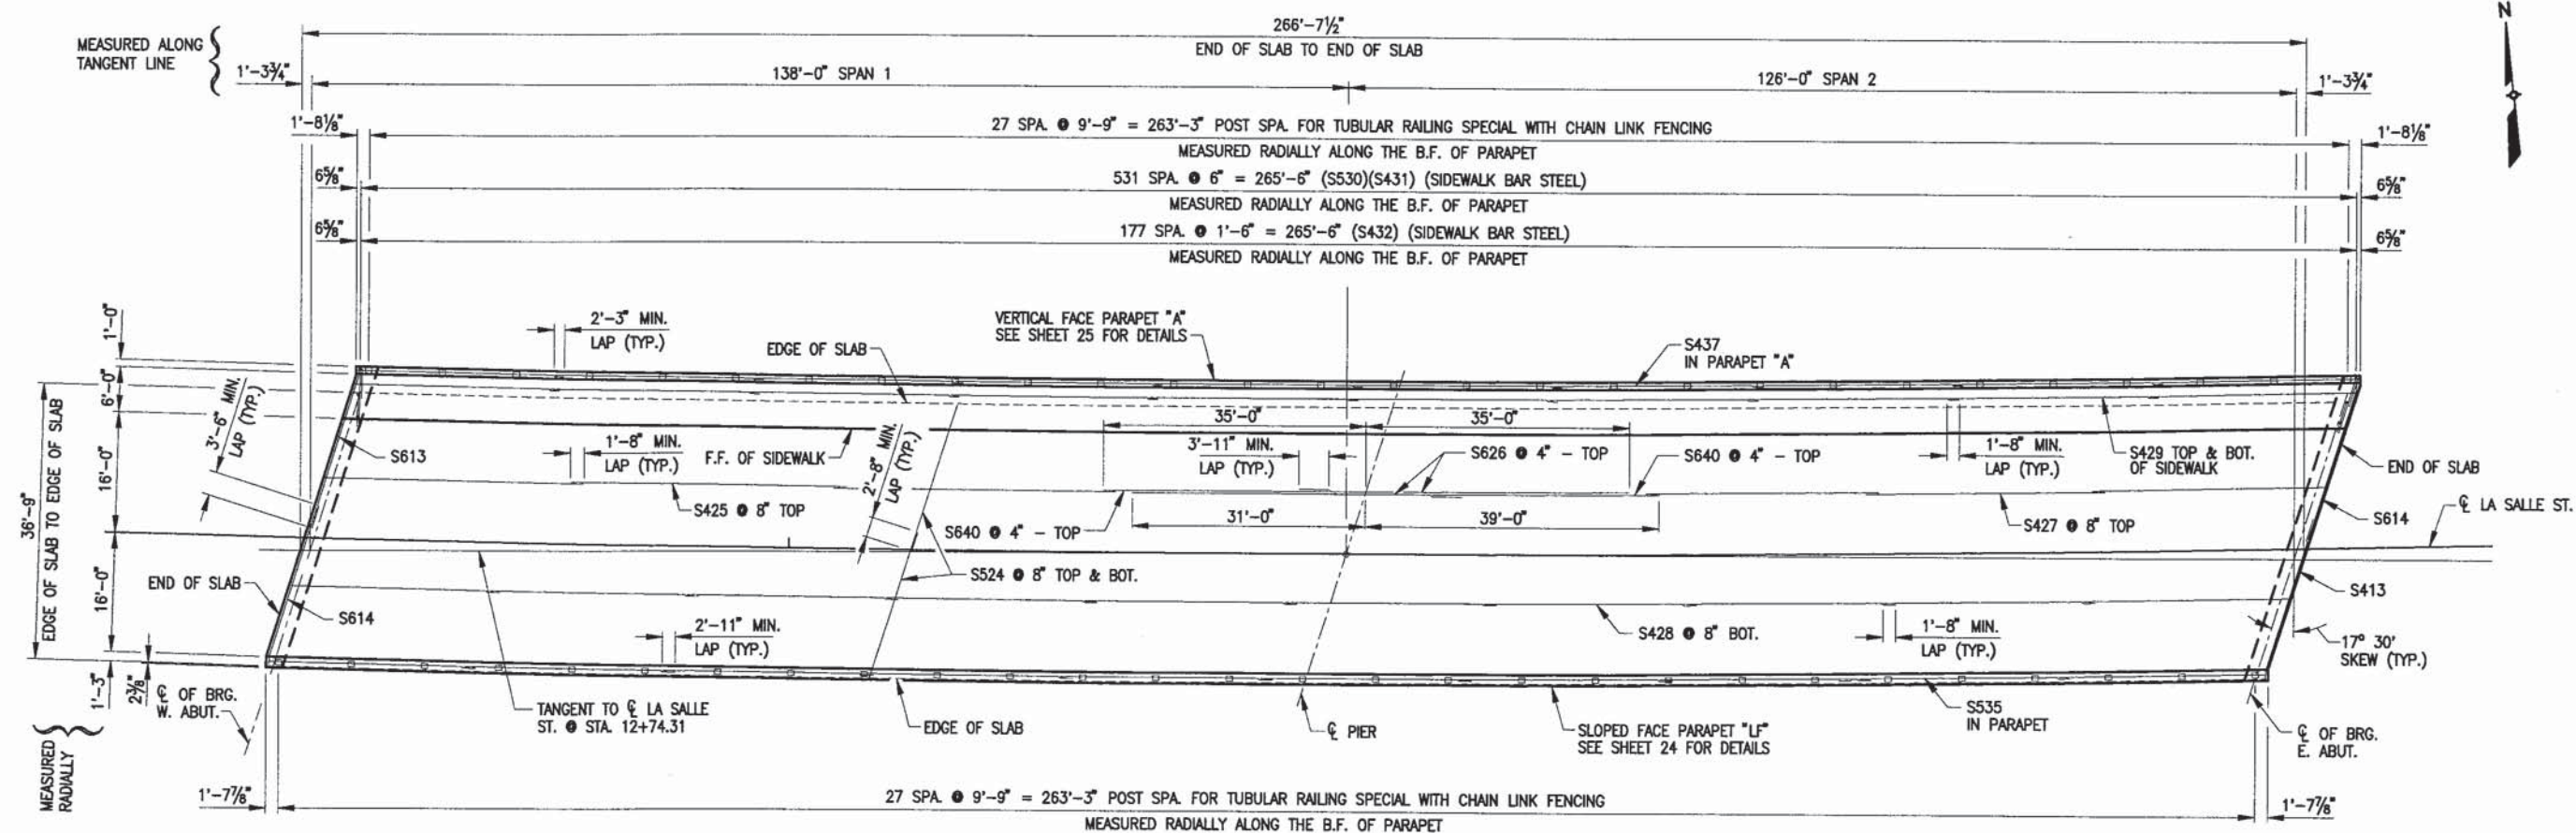

PLAN

NOTES


1. ALL TRANSVERSE BAR STEEL REINFORCEMENT SHALL BE PLACED ALONG THE SKEW.
2. THE BOTTOM TRANSVERSE BAR STEEL REINFORCEMENT SHALL BE SUPPORTED BY CONTINUOUS BAR CHAIRS WITH A CENTER TO CENTER SPACING NOT TO EXCEED 4'-0". ONE LINE OF CONTINUOUS BAR CHAIRS SHALL BE PLACED NEAR EACH EDGE OF SLAB TO SUPPORT THE ENDS OF THE BOTTOM TRANSVERSE BAR STEEL.
3. THE TOP LONGITUDINAL BAR STEEL REINFORCEMENT SHALL BE SUPPORTED BY CONTINUOUS BAR CHAIRS IN TRANSVERSE DIRECTION ON 4'-0" CENTERS.

No.	Date.	Revision	By
STATE OF WISCONSIN DEPARTMENT OF TRANSPORTATION			
STRUCTURE B-18-190			
Const. Spec.	WIS. '99	Drawn By TL	Plans Checked TR
SUPERSTRUCTURE PLAN OFF BAR STEEL			SHEET 22 OF 26 568


BILL OF BARS

DIMENSIONS IN BENDING DETAILS ARE OUT TO OUT OF BAR.
ALL REINFORCEMENT BARS IN THIS BILL SHALL BE EPOXY COATED.


MARK	NO. REQ'D.	LENGTH	BENT	BAR SERIES	LOCATION
S401	40	3'-3"	X		DIAPHRAGM @ ABUTMENTS VERT.
S402	16	4'-5"			DIAPHRAGM @ ABUTMENTS BETWEEN GIRDERS HORIZ.
S503	62	17'-7"	X		DIAPHRAGM @ ABUTMENTS - STIRRUPS VERT.
S504	6	19'-1'	X		DIAPHRAGM @ ABUTMENTS - STIRRUPS - @ WINGS 1 & 4 VERT.
S505	1	19'-4"	X		DIAPHRAGM @ S. ABUTMENT - STIRRUPS - @ WING 1 VERT.
S506	1	19'-8"	X		DIAPHRAGM @ S. ABUTMENT - STIRRUPS - @ WING 1 VERT.
S507	1	17'-4"	X		DIAPHRAGM @ S. ABUTMENT - STIRRUPS - @ WING 2 VERT.
S508	1	17'-0"	X		DIAPHRAGM @ S. ABUTMENT - STIRRUPS - @ WING 2 VERT.
S509	1	17'-10"	X		DIAPHRAGM @ N. ABUTMENT - STIRRUPS - @ WING 3 VERT.
S510	1	18'-4"	X		DIAPHRAGM @ N. ABUTMENT - STIRRUPS - @ WING 3 VERT.
S511	1	19'-0"	X		DIAPHRAGM @ N. ABUTMENT - STIRRUPS - @ WING 4 VERT.
S512	1	18'-5"	X		DIAPHRAGM @ N. ABUTMENT - STIRRUPS - @ WING 4 VERT.
S613	18	22'-7"	X		DIAPHRAGM @ ABUTMENTS - WINGS 1 & 3 - B.F. HORIZ.
S614	18	22'-7"	X		DIAPHRAGM @ ABUTMENTS - WINGS 2 & 4 - B.F. HORIZ.
S615	7	4'-6"			DIAPHRAGM @ S. ABUTMENT - WING 1 - F.F. HORIZ.
S616	7	1'-7"			DIAPHRAGM @ S. ABUTMENT - WING 2 - F.F. HORIZ.
S617	7	1'-10"			DIAPHRAGM @ N. ABUTMENT - WING 3 - F.F. HORIZ.
S618	7	4'-9"			DIAPHRAGM @ N. ABUTMENT - WING 4 - F.F. HORIZ.
S619	56	5'-2"			DIAPHRAGM @ ABUTMENTS - BETWEEN GIRDERS - F.F. HORIZ.
S520	20	6'-0"			DIAPHRAGM @ ABUTMENTS - 2 @ EA. GIRDER - SYM. ABOUT C. HORIZ.
S521	28	15'-5"	X		DIAPHRAGM @ PIER VERT.
S422	28	10'-7"	X		DIAPHRAGM @ PIER LONGIT.
S423	56	5'-2"			DIAPHRAGM @ PIER - BETWEEN GIRDERS HORIZ.
S524	799	20'-9"			SLAB - TOP & BOT. TRANSV.
S425	165	36'-3"			SLAB - TOP - SPAN 1 LONGIT.
S626	109	44'-0"			SLAB - TOP OVER PIER LONGIT.
S427	165	31'-3"			SLAB - TOP - SPAN 2 LONGIT.
S428	560	28'-2"			SLAB - BOT. LONGIT.
S429	120	28'-2"			SIDEWALK - TOP & BOT. LONGIT.
S530	532	7'-0"	X		SIDEWALK TRANSV.
S431	532	6'-0"	X		SIDEWALK TRANSV.
S432	178	4'-6"			SIDEWALK TRANSV.
S533	400	4'-8"	X		"LF" PARAPETS SOUTH SIDE VERT.
S634	400	4'-10"	X		"LF" PARAPETS SOUTH SIDE VERT.
S535	50	28'-3"			"LF" PARAPETS SOUTH SIDE HORIZ.
S536	267	7'-4"	X		"A" PARAPET NORTH SIDE VERT.
S437	60	28'-8"			"A" PARAPET NORTH SIDE HORIZ.
S438	24	6'-9"	X		DIAPHRAGM @ MASKWALLS HORIZ.
S439	16	6'-2"			DIAPHRAGM @ MASKWALLS VERT.
S640	109	30'-0"			SLAB - TOP OVER PIER LONGIT.

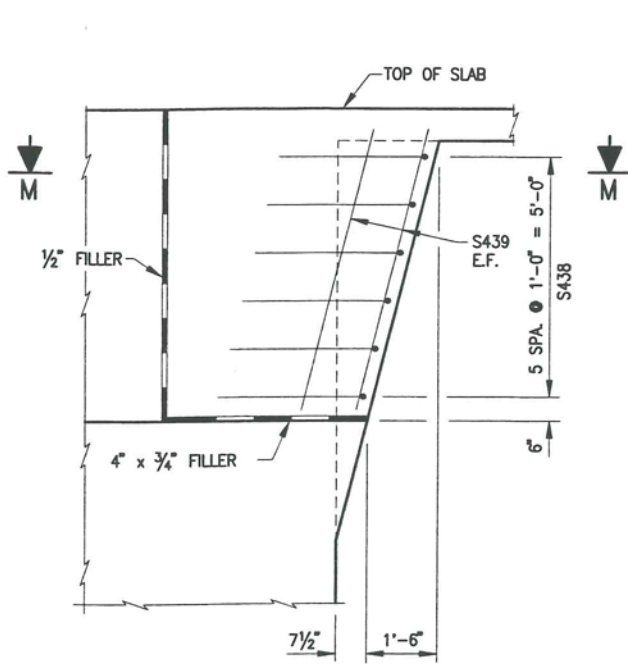


MASKWALL SECTION

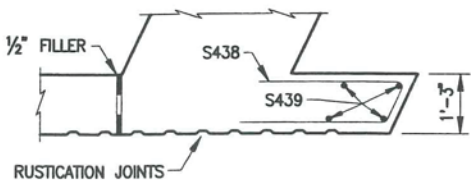

SECTION M-M

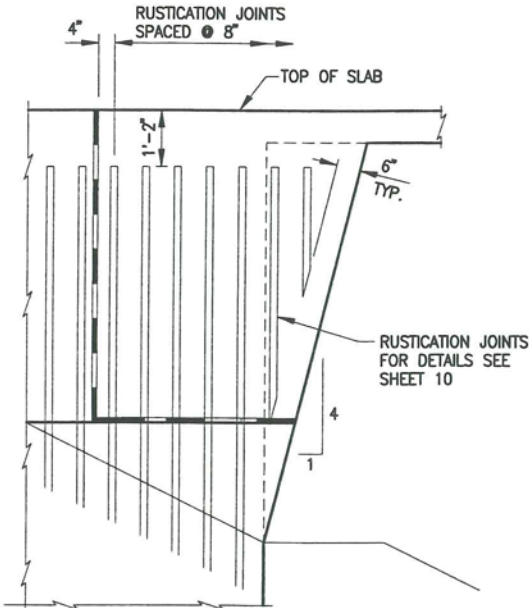


MASKWALL RUSTICATION JOINT DETAILS
(INCIDENTAL TO "CONCRETE MASONRY, BRIDGES)

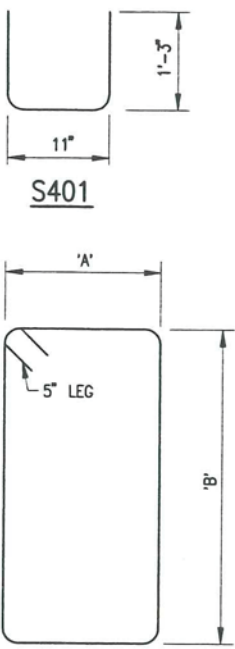


S401

BAR NO.	DIM. 'A'	DIM. 'B'
S503	2'-3"	6'-4"
S504	2'-3"	7'-1"
S505	2'-4 1/2"	7'-1"
S506	2'-6 1/2"	7'-1"
S507	2'-1 1/2"	6'-4"
S508	1'-11 1/2"	6'-4"
S509	2'-4 1/2"	6'-4"
S510	2'-7 1/2"	6'-4"
S511	2'-2 1/2"	7'-1"
S512	1'-11"	7'-1"


S503 THRU S512

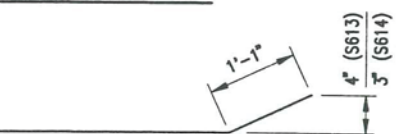


S613 & S614

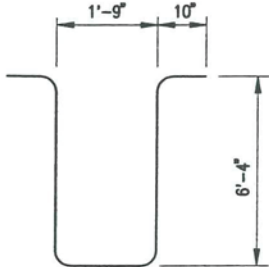


S521

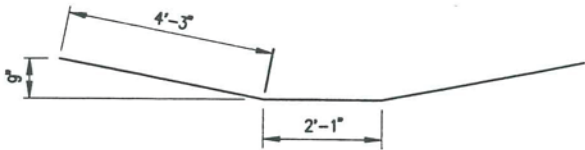


S422

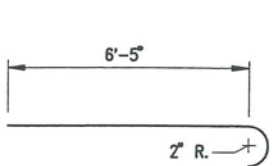


S530

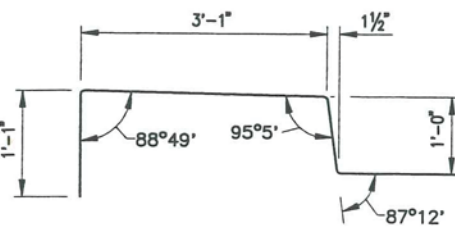


S431

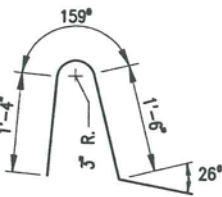


S533

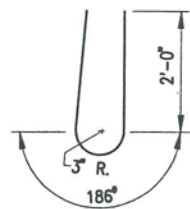

S534

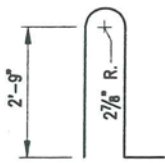

S536

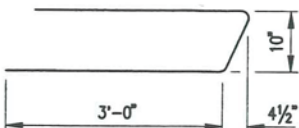

S438


No.	Date.	Revision	By
STATE OF WISCONSIN DEPARTMENT OF TRANSPORTATION			
STRUCTURE B-18-190			
Const. Spec.	WIS. '99	Drawn By TL	Plans Checked TR
SUPERSTRUCTURE DETAILS & BILL OF BARS			SHEET 23 OF 26 969

1190-00-82


BILL OF BARS

DIMENSIONS IN BENDING DETAILS ARE OUT TO OUT OF BAR.
ALL REINFORCEMENT BARS IN THIS BILL SHALL BE EPOXY COATED.


MARK	NO. REQ'D.	LENGTH	BENT	BAR SERIES	LOCATION
R501	28	4'-7"	X		PARAPET - WINGS 2 & 3
R502	16	3'-2"	X		PARAPET - WINGS 2 & 3
R503	31	4'-8"	X		PARAPET - WINGS 2 & 3
R504	59	4'-10"	X		PARAPET - WINGS 2 & 3
R505	4	17'-8"			PARAPET - WING 2
R506	4	15'-8"			PARAPET - WING 3
R507	1	17'-8"	X		PARAPET - WING 2
R508	1	15'-8"	X		PARAPET - WING 3

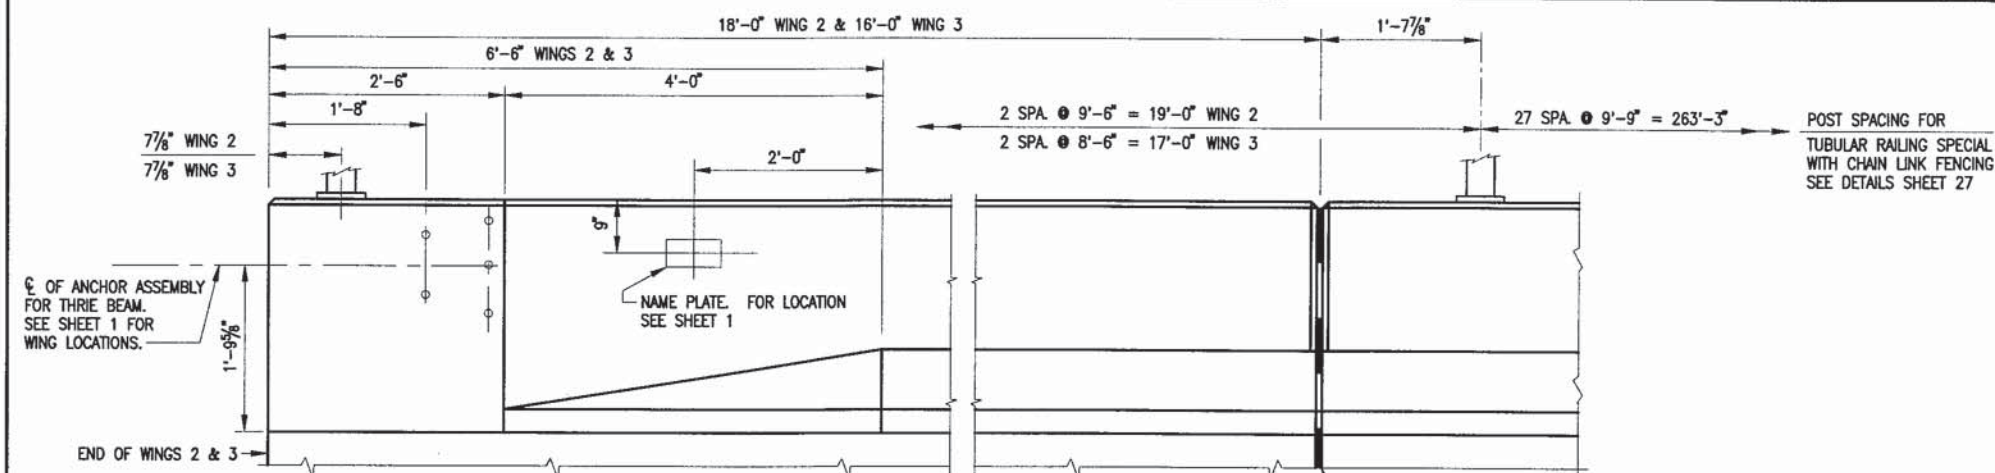


INSIDE ELEVATION

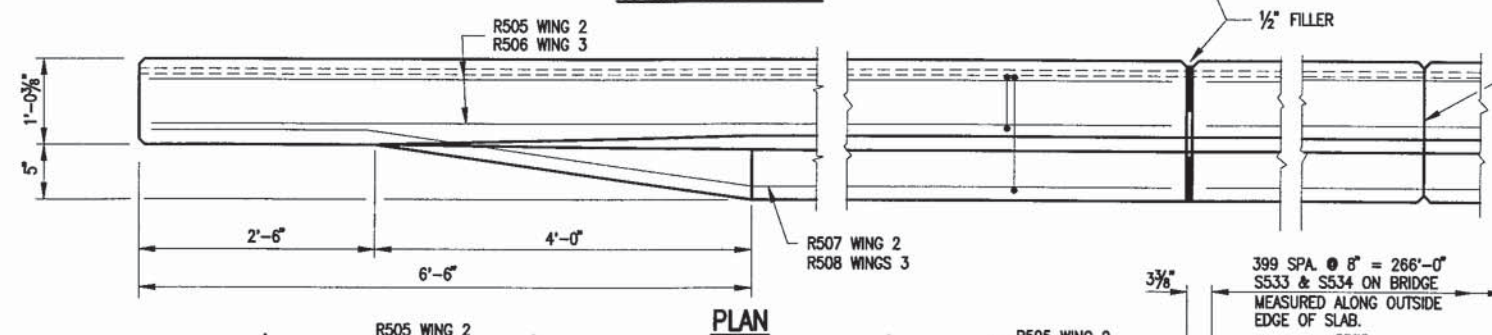


PLAN

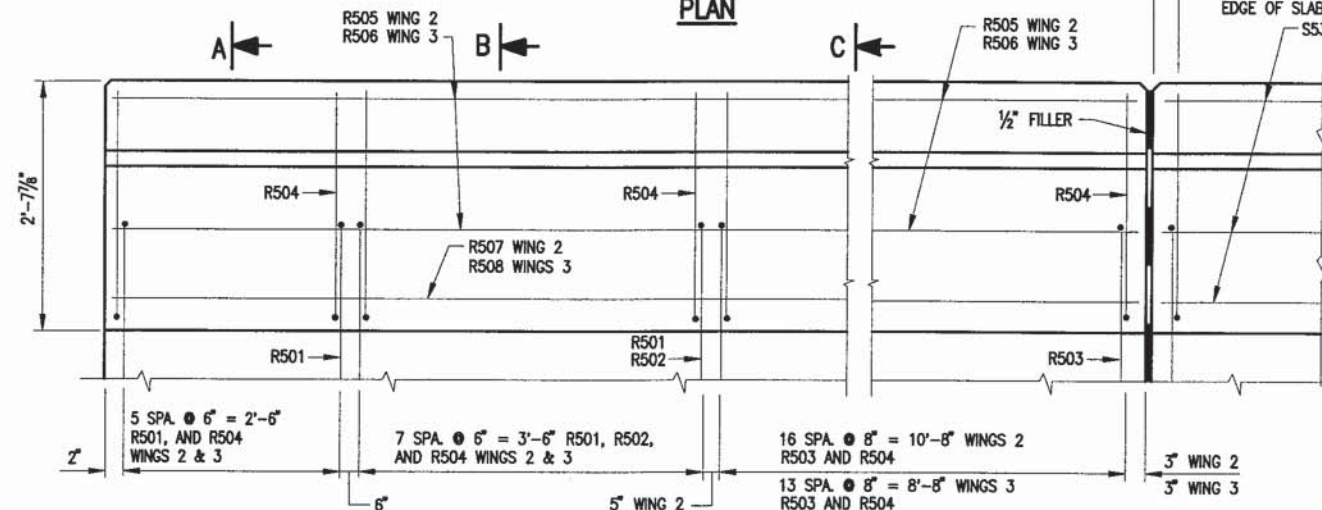


OUTSIDE ELEVATION

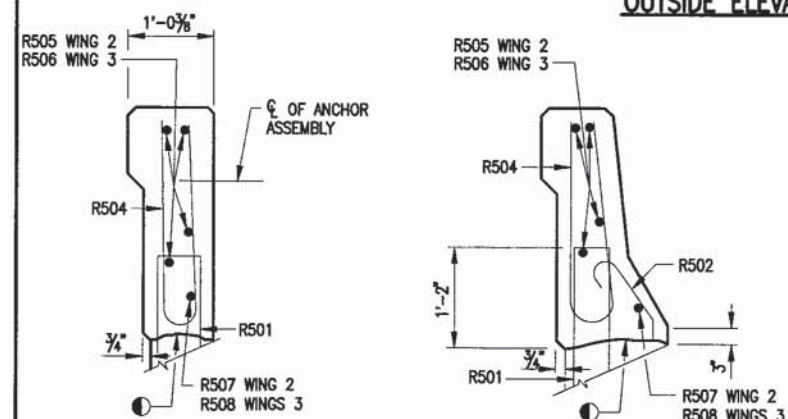


SECTION A

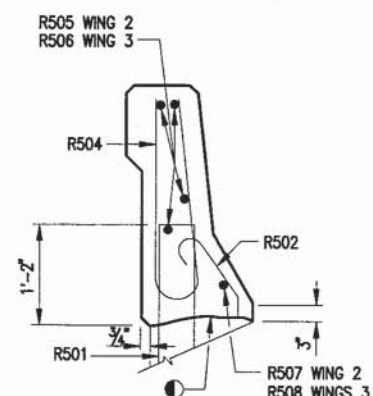



SECTION B

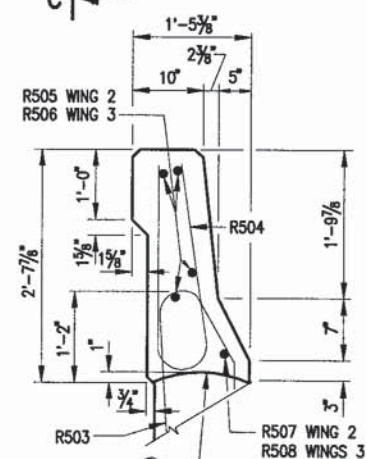

SECTION C

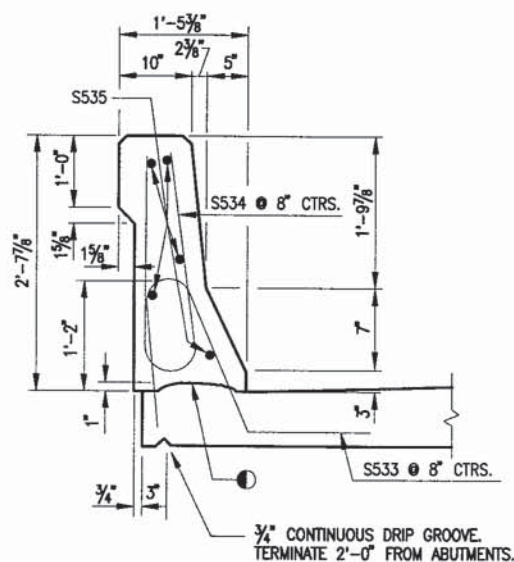

SECTION THRU PARAPET ON BRIDGE

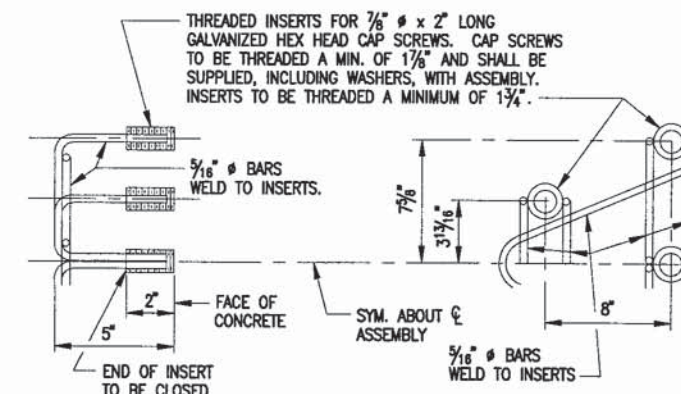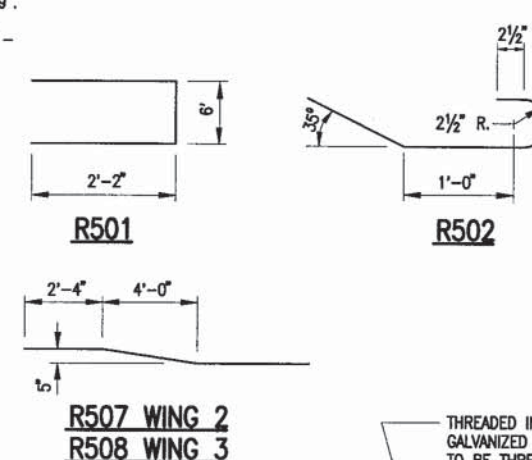

DETAIL OF ANCHOR ASSEMBLY

NOTE: HEX. HEAD CAP SCREWS & WASHERS TO BE GALVANIZED IN ACCORDANCE WITH AASHTO M232 CLASS C. SEE SHEET 1 FOR LOCATION

CONST. JOINT - STRIKE OFF AS SHOWN & FINISH WITH A WOODEN TROWEL.

No.	Date	Revision	By
STATE OF WISCONSIN DEPARTMENT OF TRANSPORTATION			
STRUCTURE B-18-190			
Const. Spec.	WIS. '99	Drawn By TL	Plans Checked TR
SLOPED FACE PARAPET "LF" (SOUTH SIDE)			SHEET 24 OF 26
			570

