

REHABILITATION STRUCTURE SURVEY REPORT

DT1696 6/2012

Wisconsin Department of Transportation

- ☒ **Grade Separation**
☐ **Stream Crossing**
☐ **Culvert**
☐ **Railroad**
☐ **Retaining Wall**
☐ **Noise Barrier**
☐ **Sign Structure**
☐ **Other:** _____

For guidance see: http://dotnet/dtdi_bos/extranet/structures/reports-checklists.htm

Design Project ID 1190-02-34	Construction Project ID 1190-02-64	Highway (Project Name) EAU CLAIRE - CHIPPEWA FALLS														
Final Plan Due Date 05/01/2018	Preliminary Plan Due Date 05/01/2018	<input checked="" type="checkbox"/> Town <input type="checkbox"/> Village <input type="checkbox"/> City WASHINGTON														
PS&E Date 08/01/2018	Letting Date 02/12/2019	County EAU CLAIRE														
Structure Number B-18-36		Section 01	Town 26N	Range 09W												
Station 38+66.40 - 41+42.82	Latitude: 444600.9 Longitude: 912516.85	<input checked="" type="checkbox"/> YES <input type="checkbox"/> NO Structure Located on National Highway System														
For Survey and CADD Files Horizontal Coordinate System: Vertical Datum:		Traffic Forecast Data <table border="1"> <thead> <tr> <th>Design Year</th> <th>Average Daily Traffic (ADT)</th> <th>Roadway Design Speed</th> <th>Functional Class</th> </tr> </thead> <tbody> <tr> <td>Feature On 2014</td> <td>14200</td> <td>70 MPH</td> <td>Principal Arterial</td> </tr> <tr> <td>Feature Under 2009</td> <td>20900</td> <td>70 MPH</td> <td>Interstate-Rural</td> </tr> </tbody> </table>			Design Year	Average Daily Traffic (ADT)	Roadway Design Speed	Functional Class	Feature On 2014	14200	70 MPH	Principal Arterial	Feature Under 2009	20900	70 MPH	Interstate-Rural
Design Year	Average Daily Traffic (ADT)	Roadway Design Speed	Functional Class													
Feature On 2014	14200	70 MPH	Principal Arterial													
Feature Under 2009	20900	70 MPH	Interstate-Rural													
Feature On USH 53 NB																
Feature Under IH 94																
Region Contact: Adam Hetrick (Area Code) Telephone Number(s): 715-836-2855 Email: adam.hetrick@dot.wi.gov		Consultant Contact: (Area Code) Telephone Number(s): Email:														

Work To Be Performed

Field Information Required Item Number (see Pages 2-4)

- ☐ A. Structural Repair 1-3, 22
☒ B. Overlay 1-3, 10-22, 26-28, 32, 34
 ☐ Concrete Overlay ☐ Asphalt Overlay
 ☐ Polymer Modified Asphalt Overlay ☒ Thin Bonded Polymer Overlay
 ☐ Other: _____
☐ C. New Bearings 3, 8, 9, 22
☐ D. New Railings 15-17, 20-23
☐ E. Curb and Sidewalk Repair 2, 3, 16, 22, 23
☐ F. Abutment Repair 2, 3, 12, 16
☐ G. Pier Repair 2, 3, 12, 16
☐ H. New Deck 1-6, 9, 10, 13-28, 32-34
☐ I. Widening 1-28, 30, 32-35
☐ J. Joint Repair 2, 3, 8, 16, 19, 22
☐ K. Surface Repair 2, 3, 22
☐ L. Raising Bridge 3, 6, 9, 16, 20-24
☐ M. Slope Stabilization 1-3, 30
☐ N. Scour Repair 1, 2 or 3, 16, 19, 21, 27, 29, 31-35
☐ O. Painting 16, 22, 24
☐ P. Other: _____

Field Information Required

If no structure number exists provide the following: Small County Map on which the location of proposed structure is shown in red and any highway relocation in green. In addition, provide Location Map of scale not less than 1" = 2000' showing the structure location and number.

- ☒ 1. Most recent inspection report, brief history of bridge construction date, and description of repairs with dates.
- ☒ 2. Outline deficient areas on existing structure plan or drawing.
- ☒ 3. Photographs of details requiring repairs or modifications, such as: bearings, x-frames, joints, etc. Photograph all deficient areas. Clearly label all photographs.
- ☐ 4. Provide proposed typical section for roadway and structure showing dimensions and cross slopes.
- ☐ 5. Survey beam seat or girder elevations at both sides of bridge at all substructure units.
- ☐ 6. Provide cross-section elevations at 10 foot intervals extending across the structure and a minimum of 100 feet beyond each end. Sections should be normal to centerline and show elevations at centerline roadway and gutter line. Take elevations along joints and at floor drains.
- ☐ 7. Show and identify starting stationing on bridge.
- ☐ 8. Record measurement, temperature of the structure, and date taken for each of the following:
 - (a) Joint opening measured normal to joint at centerline of roadway and both curb lines.
 - (b) Clearance between girder ends at piers.
 - (c) Distance from front face of abutment backwall to closest point of girder end measured parallel to girder.
 - (d) Temperature of structure determined by averaging top and under deck (if accessible) readings.
- ☒ 9. Fixed and expansion bearings - condition and orientation.
- ☒ 10. Number and width of proposed pours including construction staging sequence.
- ☒ 11. Location of existing construction joints in the deck.
- ☒ 12. Estimated Quantities:

Preparation, Decks, Type 1	Sq. Yd. <u>0</u>	
Preparation, Decks, Type 2	Sq. Yd. <u>0</u>	
Full Depth Deck Repair	Sq. Yd. <u>0</u>	Galvanic Anodes? <u>NO</u>
Concrete Surface Repair Superstructure	Sq. Ft. <u>0</u>	Galvanic Anodes? <u>NO</u>
Concrete Surface Repair Substructure	Sq. Ft. <u>0</u>	Galvanic Anodes? <u>NO</u>
Curb Repair	LF. <u>0</u>	Galvanic Anodes? <u>NO</u>

☒ 13. Sufficiency number: 61.1 (obtain from HSI Bridge Inventory System)

☒ 14. Appraisal and Condition Rating

	Deck Condition	Superstructure Condition	Substructure Condition	Load Capacity Appraisal	Structural EVAL Appraisal
Current	7	5	7	5	5

☒ 15. Load Ratings

	Inventory	Operational
Current Calculated Date: 07/02/2013	HS14	HS24
After Completed by Bridge Designer		

- ☒ 16. Utilities on/near Structure. (WisDOT policy is to avoid placing utilities on the structure.)

☐ Yes ☒ No

Type	Owner and Contact Information	Size	Opening at Abutment	Weight	Pressure

- ☒ 17. Is existing bridge railing deficient?

☐ Yes ☒ No If Yes – Replacement Rail Type:

- ☐ 18. Drains to be:

☐ Raised ☐ Closed ☐ Downspouted ☐ New

- ☒ 19. Traffic maintained on bridge during work?

☒ Yes ☐ No If Yes – Include sketches

- ☒ 20. Will guard rail be attached?

☐ Yes ☒ No If Yes – Which corners? Existing guardrail to remain at the SE and SW corners.

- ☒ 21. Will work to be performed eliminate all deficiencies?

☒ Yes ☐ No If No – Explain:

- ☒ 22. Hazardous waste (asbestos) to be removed?

☐ Yes ☒ No If Yes – Explain:

- ☐ 23. Wing location(s) for surface drain anchors:

- ☒ 24. Painting?

☐ Yes ☒ No If Yes – Explain on Page 4

(all, part, railing, color system, containment, bid items)

- ☐ 25. Desired roadway width: (new deck / widening) _____ Ft.

Desired sidewalk clear width: Left: _____ Ft. Right: _____ Ft.

- ☒ 26. Maximum increase in grade line elevation 3/8 In.

- ☒ 27. Benchmark description to be shown

- ☒ 28. Desired final cross slopes on bridge 0.02 Ft./Ft.

- ☐ 29. Underwater Inspection Report including:

- Streambed Cross Section With Pier, Footing and Seal Elevations
- Pier Elevation Drawings
- Pier Layout
- Hydrographic Survey

- ☐ 30. Slope stabilization, provide:

Type: _____ Quantity: _____ CY.

Slope: _____ Ft./Ft. Fill: _____ CY.

- ☐ 31. Preliminary layout of grout bags or proposed scour repair.

C.I.P. Articulated Mats (for Scour) _____ CY.

Grout Bags (for Scour) _____ CY.

Heavy Riprap _____ CY.

Extra Heavy Riprap _____ CY.

- ☒ 32. Report submitted with Preliminary Plan requires **no** CADD file submittal (*See ESubmittal instructions*).
- ☐ 33. Report submitted for development of Preliminary Plan to structure design engineer requires CADD file (if available) submittal and Report submittal to Soils Engineer if project involves foundation modifications.
- ☐ 34. Coordinate with structure design engineer **before** going into the field if existing structure has no available plans, if staged construction is planned, or if there are adjoining/adjacent structures that will remain in place.
- ☐ 35. If project involves substructure widening coordinate with structure and/or hydraulic design engineer to determine if information on the separation and/or stream crossing SSR will be required.


Additional Information

Elaborate on other concerns such as: DNR, Local, Utility Conflicts, Aesthetics, Railing Type and Staged Construction.

Please be as detailed and specific as possible.

- 1.) Structure built in 1966. Concrete Masonry Deck Overlay was completed in 1987. Steel Deck Girders were painted in 1990. Pedestrian Fence was added in 1996. Bridge Deck was replaced and widened in 2011. The Steel Deck Girders are scheduled to be painted in 2016. See attached Bridge Inspection Report.
- 2.) Deficient areas to be determined in the field by the engineer. See attached Bridge Inspection Report. A Polymer Overlay is proposed because of deficiency over the entire structure due to poor bridge deck surface. The deck has multiple transverse and longitudinal cracks with efflorescence.
- 3.) See attached photographs.
- 9.) Strip Seal Expansion Joints at the North Abutment and South Abutment.
- 10.) This work will be constructed half at a time under traffic using single lane closures during non-peak hours with night work. Nighttime ramp closures are anticipated at some structures. All lanes and ramps will be opened to traffic daily.
- 11.) See asbuilt plans.
- 16.) No utilities on or near structure. No conflicts anticipated.
- 19.) This work will be constructed half at a time under traffic using single lane closures during non-peak hours with night work. Nighttime ramp closures are anticipated at some structures. All lanes and ramps will be opened to traffic daily.
- 22.) See attached Asbestos Inspection Report. No asbestos-containing material was found.
- 27.) To be determined.
- 32.) See preliminary plans.


CDR Map

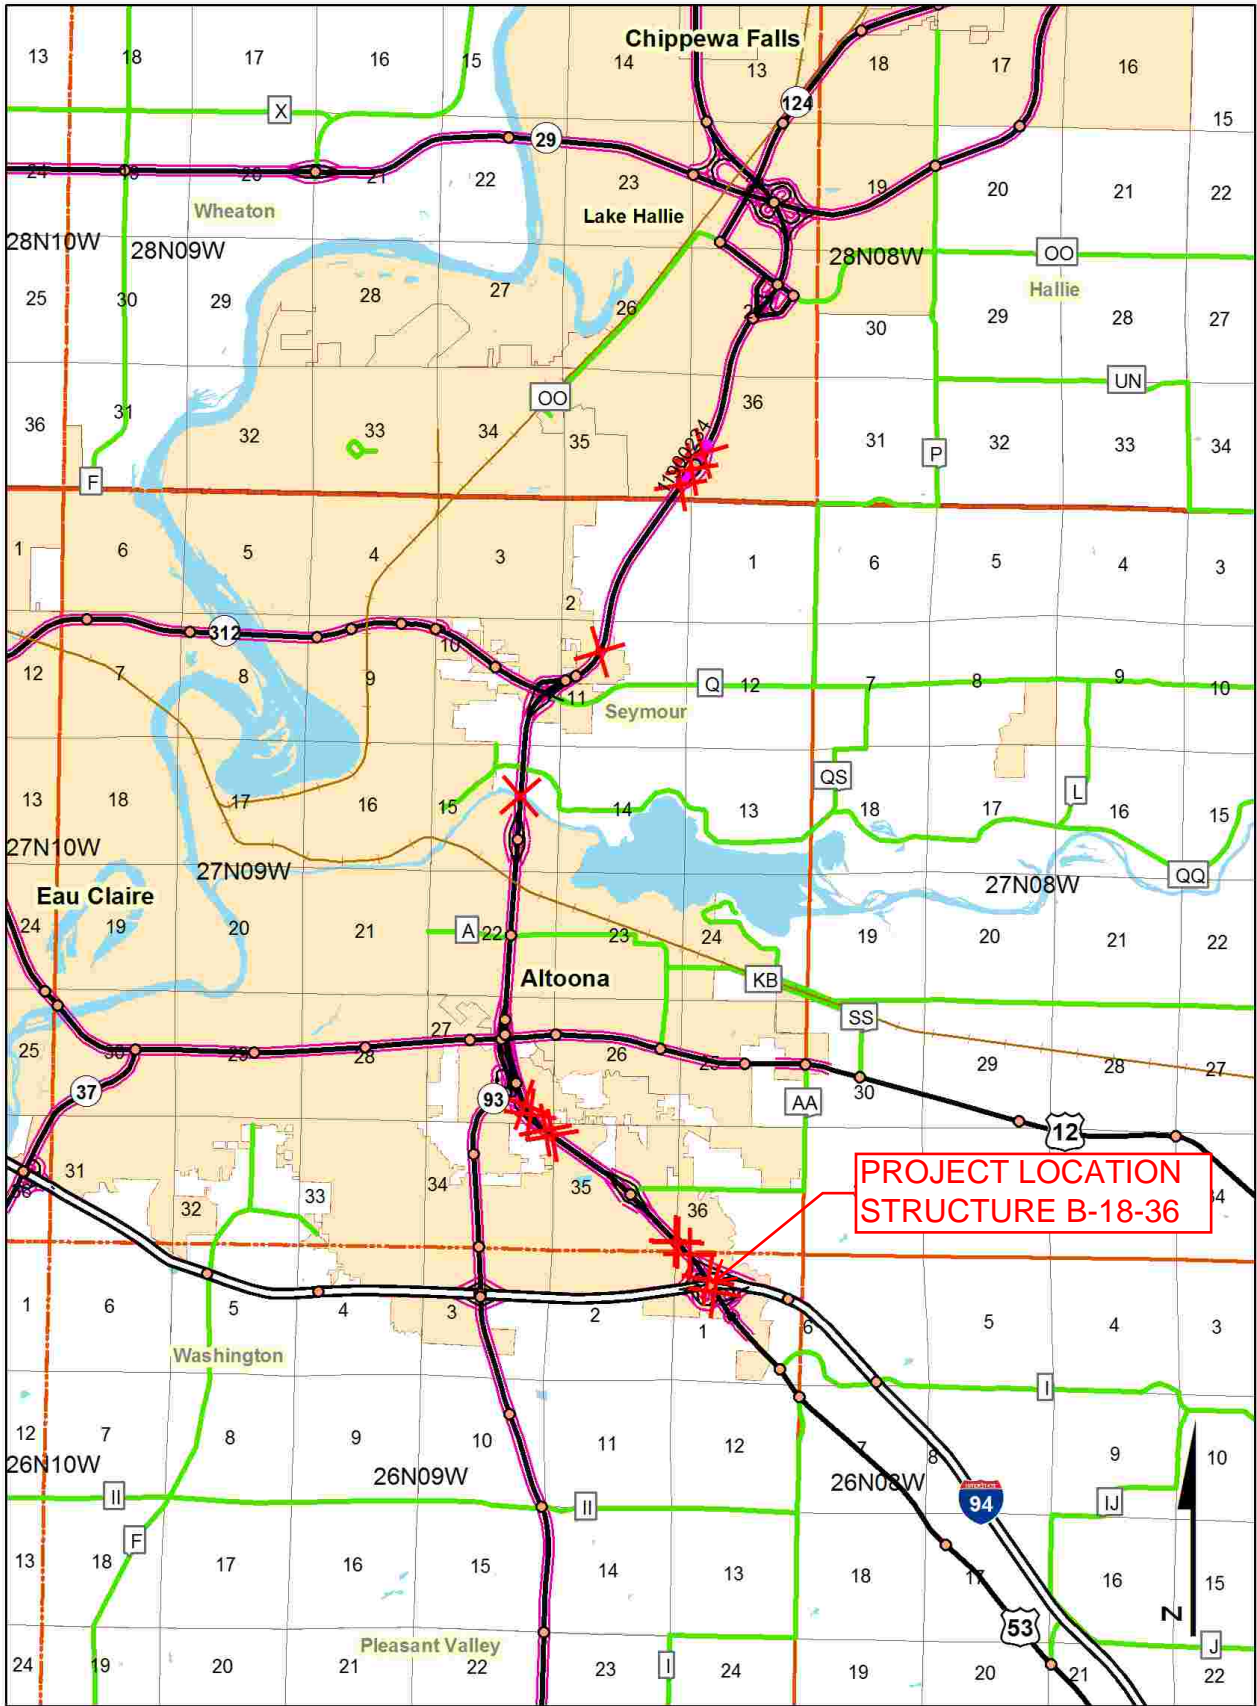

1190-02-64

EAU CLAIRE / CHIPPEWA

TOTAL SHEETS =

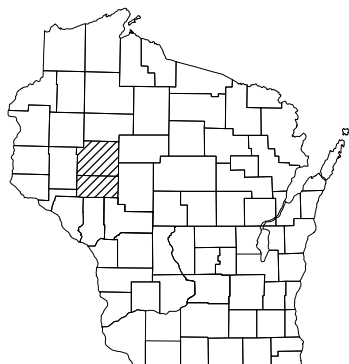

A.A.D.T.	=
A.A.D.T.	=
D.H.V.	=
D.D.	=
T.	=
DESIGN SPEED	=
ESALS	=


 
PLAN
CORPORATE LIMITS
PROPERTY LINE
LOT LINE
LIMITED HIGHWAY EASEMENT
EXISTING RIGHT OF WAY
PROPOSED OR NEW R/W LINE



PROFILE
 GRADE LINE
 ORIGINAL GROUND
 MARSH OR ROCK PROFILE
 (To be noted as such)
 SPECIAL DITCH

 GRADE ELEVATION

 CULVERT (Profile View)
 UTILITIES
 ELECTRIC
 FIBER OPTIC
 GAS
 SANITARY SEWER
 STORM SEWER
 TELEPHONE
 WATER
 UTILITY PEDESTAL
 POWER POLE
 TELEPHONE POLE

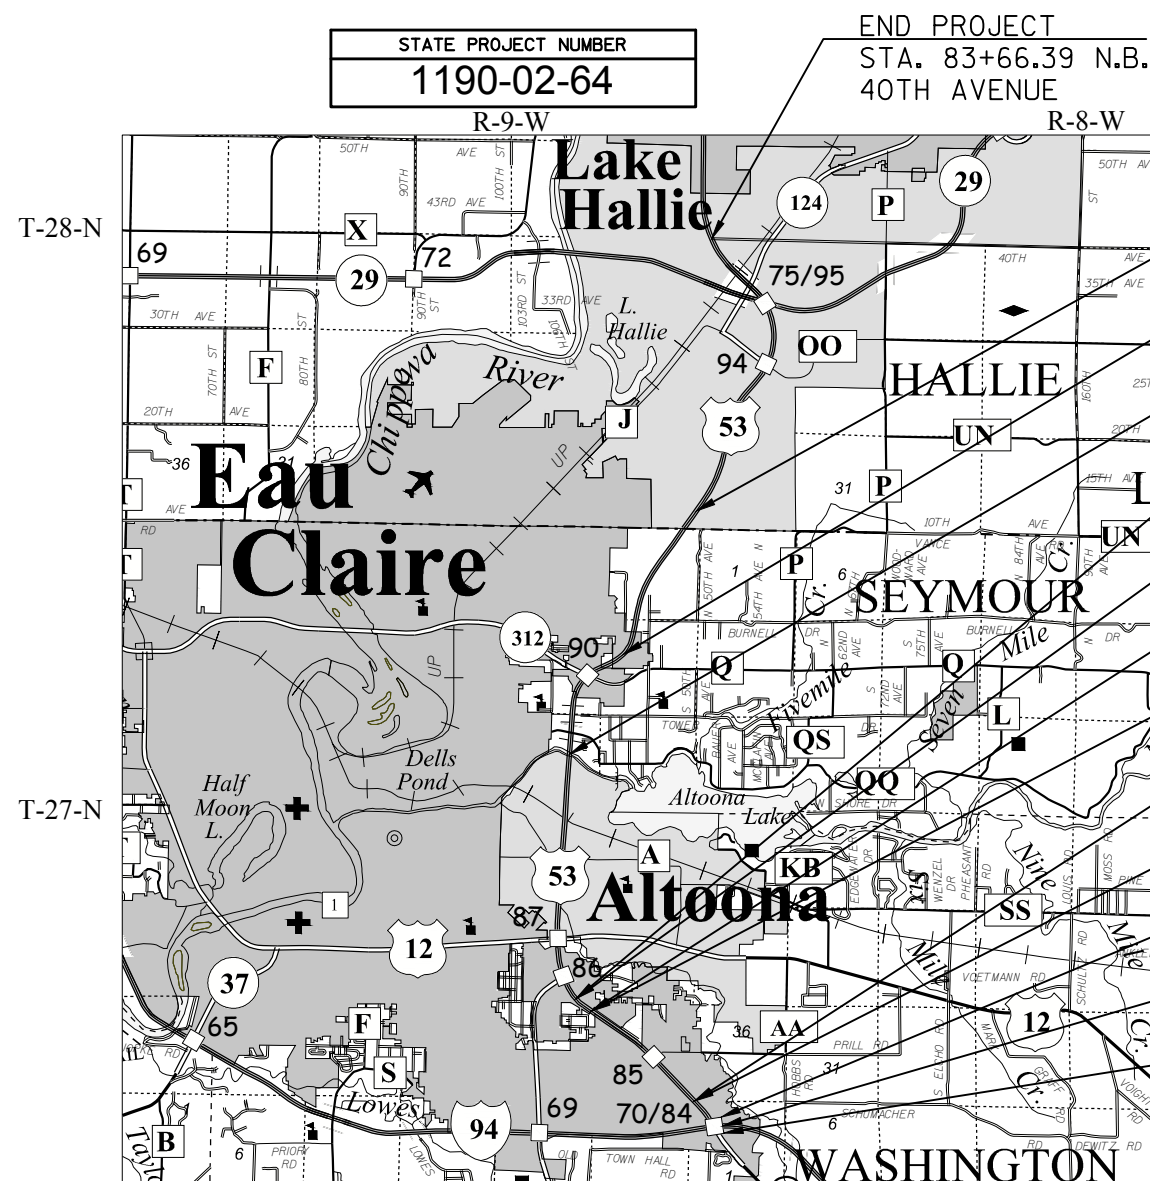

TOTAL NET LENGTH OF CENTERLINE = 11.26 MILES

HORIZONTAL POSITIONS SHOWN ON THIS PLAN ARE WISCONSIN COUNTY COORDINATES, EAU CLAIRE COUNTY, NAD83 (1991), IN U.S. SURVEY FEET. VALUES ARE GRID COORDINATES, GRID BEARINGS, AND GRID DISTANCES. GRID DISTANCES MAY BE USED AS GROUND DISTANCES.

STATE PROJECT	FEDERAL PROJECT	
	PROJECT	CONTRACT
1190-02-64		

STATE OF WISCONSIN DEPARTMENT OF TRANSPORTATION	
PREPARED BY	
Surveyor	_____ WISDOT _____
Designer	_____ ADAM HETRICK _____
Project Manager	_____ DAVID KOEPP _____
Regional Examiner	_____ REGIONAL EXAMINER _____
Regional Supervisor	_____ TMOYTHY MASON _____
APPROVED FOR THE DEPARTMENT	
DATE: _____	_____ (Signature)



route: 053N county: EAU CLAIRE date: 08/13/2013 plm: 062.827

Lat: 44.7665968 Long: -91.42129139 Elev: 825.11 ft.

\\doteauplog1p\photolog\Rg5\053N_R5_2013\Front\Dir_065\F_06585.jpg

Copyright 2015 Mandli Communications, Inc.



route: 053N county: EAU CLAIRE date: 08/13/2013 plm: 062.837

Lat: 44.76671868 Long: -91.42140103 Elev: 825.52 ft.

\\doteauplog1p\photolog\Rg5\053N_R5_2013\Front\Dir_065\F_06586.jpg

Copyright 2015 Mandli Communications, Inc.



route: 053N county: EAU CLAIRE date: 08/13/2013 plm: 062.847

Lat: 44.76684036 Long: -91.42151017 Elev: 826.12 ft.

\\doteauplog1p\photolog\Rg5\053N_R5_2013\Front\Dir_065\F_06587.jpg

Copyright 2015 Mandli Communications, Inc.



route: 053N county: EAU CLAIRE date: 08/13/2013 plm: 062.857

Lat: 44.76696246 Long: -91.42161901 Elev: 826.05 ft.

\\doteauplog1p\photolog\Rg5\053N_R5_2013\Front\Dir_065\F_06588.jpg

Copyright 2015 Mandli Communications, Inc.



route: 053N county: EAU CLAIRE date: 08/13/2013 plm: 062.867

Lat: 44.76708465 Long: -91.42172745 Elev: 826.23 ft.

\\doteauplog1p\photolog\Rg5\053N_R5_2013\Front\Dir_065\F_06589.jpg

Copyright 2015 Mandli Communications, Inc.



route: 053N county: EAU CLAIRE date: 08/13/2013 plm: 062.877

Lat: 44.76720799 Long: -91.421837 Elev: 826.43 ft.

\\doteauplog1p\photolog\Rg5\053N_R5_2013\Front\Dir_065\F_06590.jpg

Copyright 2015 Mandli Communications, Inc.



route: 053N county: EAU CLAIRE date: 08/13/2013 plm: 062.887

Lat: 44.76732949 Long: -91.4219454 Elev: 826.35 ft.

\\doteauplog1p\photolog\Rg5\053N_R5_2013\Front\Dir_065\F_06591.jpg

Copyright 2015 Mandli Communications, Inc.



route: 053N county: EAU CLAIRE date: 08/13/2013 plm: 062.897

Lat: 44.76745092 Long: -91.42205473 Elev: 826.48 ft.

\\doteauplog1p\photolog\Rg5\053N_R5_2013\Front\Dir_065\F_06592.jpg

Copyright 2015 Mandli Communications, Inc.



Google earth





Google earth





**STATE OF WISCONSIN
DEPARTMENT OF TRANSPORTATION**

**Inspection Report for
B-18-036**

**USH 53 NB over IH 94
Jul 28, 2015**



Type	Prior	Frequency (mos)	Performed
Routine	07-28-15	24	X
In-Depth	03-10-10	72	
Interim	03-10-08	0	
SI&A	07-02-13	48	

Latitude 44°46'00.90"N
Longitude 91°25'16.85"W

Owner STATE HIGHWAY DEPT
Maintainer STATE HIGHWAY DEPT

Time Log

Team members

Hours 1	Minutes 30	WJK
------------	---------------	-----

	Name	Number	Signature	Date
Inspector	Kovaleski, William J	8007	Completed by Bill(dotwjk)	
Reviewer				

BRIDGE INSPECTION REPORT
Wisconsin Department of Transportation
DT2007 2003 s.84.17 Wis. Stats.

page 2

Identification & Location

Feature On: USH 53 NB	Section Town Range: S01 T26N R09W	Structure Number: B-18-036
Feature Under: IH 94	County: EAU CLAIRE(18)	
Location 0.2M N JCT CTH II	Municipality: TOWN-WASHINGTON(18024)	Structure Name:

Geometry

measurements in feet, except where noted

Approach Roadway Width: 47	Bridge Roadway Width: 43.1	Total Length: 276.4
Approach Pavement Width: 36	Deck Width: 45.5	Deck Area (sq ft): 12797

Traffic

	Lanes	ADT	ADT year	Traffic Pattern
On	3	14200	2014	ONE WAY TRAFFIC
Under	6	26220	2003	TWO WAY TRAFFIC

Capacity

Load Rating

Inventory rating: HS14	Overburden depth (in):	Last rating date:	Controlling: INTERIOR DECK GIRDER Moment
Operating rating: HS24	Deck surface material: CONCRETE	Re-rate for capacity (Y/N):	Control location: 4.5 SPAN 2, 42.4
Posting:	Re-rate notes:		

Hydraulic

Classification

Scour Critical Code(113): (N) NO WATERWAY	Q100 (ft3/sec): 0	
High water elevation (ft): 0.0	Velocity (ft/sec): 0.0	Sufficiency #: 61.1

Span(s)

Span #	Material	Configuration	Depth (in)	Length (ft)	Main
1	CONT STEEL	DECK GIRDER		43.0	
2	CONT STEEL	DECK GIRDER		95.0	Y
3	CONT STEEL	DECK GIRDER		95.0	
4	CONT STEEL	DECK GIRDER		39.0	

Expansion joint(s)

Temperature:

File:	New:
-------	------

Vertical Clearance

	Measurement file (ft)	File Date	Measurement new (ft)
Highway Minimum Under Cardinal	16.92		
Highway Minimum Under Non-Cardinal	16.42		
Highway Minimum On			
Railroad Minimum Under			

BRIDGE INSPECTION REPORT
Wisconsin Department of Transportation
DT2007 2003 s.84.17 Wis. Stats.

page 3

Structure No.: **B-18-036**

Elements

Chk	Element	Defect	Description	UOM	Total	Quantity in Condition State			
						1	2	3	4
X	12		Reinforced Concrete Deck	SF	12,649	11,974	675	0	0
			Re-decked and widened in 2011.						
		1130	Cracking (RC) Spans 1, 2, 4: very few hrlin transverse cracks. Span 3: Multiple transverse cracks w/ lt/med efflorescence.	SF		0	675	0	0
		8000	Wearing Surface (Bare) Re-decked and widened in 2011.	SF	11,958	10,087	1,720	151	0
		3220	Crack (Wearing Surface) CS3 transverse cracks - 1 @ Pier 1 - full width, 2 @ Pier 2 - full and 1/2 width, 2 @ Pier 3 - each 1/2 width. 1 CS3 tr 20ft of fine/hrlne map cracking at Pier 1 & 2.	SF		0	1,720	151	0
	8522		Coated Reinforcing Re-decked and widened in 2011.	SF	12,649	0	0	0	0
X	107		Steel Open Girder	LF	1,652	457	265	930	0
			7 steel haunched girders at varied spacing. Girders, Painted June 1990. Girder 6 replaced in 2011. Girders appear straight and plumb.						
		1000	Corrosion 5 Original Girders - Spn 1 & 4: < 2% web freckle rust, 10-20% flange edges rust. Spn 2 & 3: 60-80% web freckle rust w/ some flaking, 90% flange rust w/ some hvy flaking. 1 New Girder primed (no top coat) w/ with local areas of spot rusting (edges btm flng).	LF		0	265	930	0
		8516	Painted Steel Girders = 15,900sf, Struts & X brc = 3,400. Original 5 painted June 1990. New G6 primed (no top coat).	SF	19,300	3,570	4,270	2,850	8,610
		3440	Effectiveness (Steel Protective Coatings) 5 Original Girders - Spn 1 & 4: < 2% web freckle rust, 10-20% flange edges rust. Spn 2 & 3: 60-80% web freckle rust w/ some flaking, 90% flange rust w/ some hvy flaking. 1 New Girder primed (no top coat) w/ with local areas of spot rusting (edges btm flng).	SF		0	4,270	2,850	8,610
X	205		Reinforced Concrete Column	EA	9	9	0	0	0
			Fiber wrapped in 2011. Loss of wrap at top of columns of Pier 2.						
X	215		Reinforced Concrete Abutment	LF	100	39	60	1	0
			Surface repairs & backwall top 2011. Approx. 4ft added on east end of South.						
		1080	Delamination - Spall - Patched Area North: 1ft edge spall under G6 w/ map cracking. Patches - at G2, G3, G4 and G5 and locations btwn each girders G1 & G5. 3 - 3in x 6in spalls w/ staining (rebar close to surface) @ G2. South: 2ft patch under G4. Lt delam/spall staining under G3.	LF		0	50	1	0
		1130	Cracking (RC) North: Few fine/hrlne transverse cracks in abut & bkwall. South: 2ft map cracking on east end. Few fine vertical cracks.	LF		0	10	0	0
		6000	Scour NE - horiz. face scaling near brng.	LF		0	2	0	0
X	234		Reinforced Concrete Cap	LF	149	149	0	0	0
			Fiber wrapped in 2011. Loss of wrap at top of columns of Pier 2 w/ some staining.						
X	300		Strip Seal Expansion Joint	LF	100	90	10	0	0
			New in 2011. 2013 @ 85 degrees - N=0.16, S=0.13						
		2360	Adjacent Deck or Header Damage Few vert cracks in paving block.	LF		0	10	0	0

BRIDGE INSPECTION REPORT
Wisconsin Department of Transportation
DT2007 2003 s.84.17 Wis. Stats.

page 4

Structure No.: **B-18-036**

X	311		Moveable Bearing	EA	24	0	24	0	0
			At both abutments and piers 1 and 3. Sandblasted in 2011. G3 brg south abut nuts loose.						
		1000	Corrosion	EA		0	24	0	0
			Lt to hvy rust.						
X	313		Fixed Bearing	EA	6	0	6	0	0
			Pier 2.						
		1000	Corrosion	EA		0	6	0	0
			Light to hvy surface rust.						
X	331		Reinforced Concrete Bridge Rail	LF	546	0	546	0	0
			New "LF" Parapets in 2011.						
		1130	Cracking (RC)	LF		0	546	0	0
			Hrline vert cracks at 6-10ft spacing. Surface map cracking on all.						
X	8400		Integral Wingwall	EA	4	2	2	0	0
			New wings in 2011.						
		8903	Wingwall Deterioration.	EA		0	2	0	0
			Surface map cracking on NE & NW.						

Assessments

Chk	Element	Defect	Description	UOM	Total	Quantity in Condition State			
						1	2	3	4
X	9001		Drainage - Approach	EA	4	4	0	0	0
			NE & SE C & G, NW & SW asphlt/grvl shldr						
X	9030		Signs - Object Markers	EA	4	4	0	0	0
			2 south end.						
X	9043		Slope Protection- Crushed Aggregate with Bit.	EA	2	2	0	0	0
			Sprayed in 2011. Rocks tightly adhered. Light vegetation at edges of both slopes - heavier on south.						
X	9167		Steel Diaphragm	EA	64	0	50	14	0
			Light to hvy rust on all - worst over driving lanes. Note: original connection needs grinding where cut on G5.						
X	9322		Approach Roadway - Concrete (non-structural)	EA	2	2	0	0	0
			New in 2011.						

NBI Ratings

	File	New
Deck	9	7
Superstructure	6	5
Substructure	7	7
Culvert	N	N
Channel	N	N
Waterway	N	N

BRIDGE INSPECTION REPORT
Wisconsin Department of Transportation
DT2007 2003 s.84.17 Wis. Stats.

page 5

Structure No.: **B-18-036**

Structure Specific Notes

Proposed to be painted in 2016/17.
OLD: less than 2 % delam 1998-chained---Full depth at pier 1 and 3.

Inspection Specific Notes

OLD: Re-decked & widened in 2011. Significant lifting of girder ends at abutments. Working with Central Office to minimize movement.
Girders to be repainted 2015.

Inspector Site-Specific Safety Considerations

Structure Inspection Procedures

Walk-thru visible.
OLD: CONCRETE OVERLAY 110000

Special Requirements

	Chk	Comments
Traffic Control		
Access Equipment		
Other		

Construction History

Year	Work Performed	FOS id
9999	NOT BUILT	1022-00-10
2011	NEW DECK	1022-00-78
1996	ADD PED FENCING	1020-06-72
1990	PAINTING	
1987	OVERLAY - CONCRETE	0018-74-10
1966	NEW STRUCTURE	

Maintenance Items History

Item	Recommended by	Status	Status change	Year completed
------	----------------	--------	---------------	----------------

Maintenance Items

Item	Priority	Recommended by	Status	Status change
------	----------	----------------	--------	---------------

Routine
Document Comment/Description

N abut



Routine
Document Comment/Description

S abut



Routine
Document Comment/Description

Pier 2 - west column





**STATE OF WISCONSIN
DEPARTMENT OF TRANSPORTATION**

**Inspection Report for
B-18-036**

**USH 53 NB over IH 94
Aug 27,2015**



Type	Prior	Frequency (mos)	Performed
Routine	08-27-15	24	X
In-Depth	03-10-10	72	
Interim	03-10-08	0	
SI&A	07-02-13	48	X

Latitude 44°46'00.90"N
Longitude 91°25'16.85"W

Owner STATE HIGHWAY DEPT
Maintainer STATE HIGHWAY DEPT

Time Log

Team members

Hours 0	Minutes 55	
------------	---------------	--

	Name	Number	Signature	Date
Inspector	Balsiger, Lee	6011	Completed by HSI System Account(HSI)	
Reviewer				

BRIDGE INSPECTION REPORT
Wisconsin Department of Transportation
DT2007 2003 s.84.17 Wis. Stats.

page 2

Identification & Location

Feature On: USH 53 NB	Section Town Range: S01 T26N R09W	Structure Number: B-18-036
Feature Under: IH 94	County: EAU CLAIRE(18)	
Location 0.2M N JCT CTH II	Municipality: TOWN-WASHINGTON(18024)	Structure Name:

Geometry

measurements in feet, except where noted

Approach Roadway Width: 47	Bridge Roadway Width: 43.1	Total Length: 276.4
Approach Pavement Width: 36	Deck Width: 45.5	Deck Area (sq ft): 12797

Traffic

	Lanes	ADT	ADT year	Traffic Pattern
On	3	14200	2014	ONE WAY TRAFFIC
Under	6	20900	2009	TWO WAY TRAFFIC

Capacity

Load Rating

Inventory rating: HS14	Overburden depth (in):	Last rating date:	Controlling: INTERIOR DECK GIRDER Moment
Operating rating: HS24	Deck surface material: CONCRETE	Re-rate for capacity (Y/N):	Control location: 4.5 SPAN 2, 42.4
Posting:	Re-rate notes:		

Hydraulic

Classification

Scour Critical Code(113): (N) NO WATERWAY	Q100 (ft3/sec): 0	
High water elevation (ft): 0.0	Velocity (ft/sec): 0.0	Sufficiency #: 61.1

Span(s)

Span #	Material	Configuration	Depth (in)	Length (ft)	Main
1	CONT STEEL	DECK GIRDER		43.0	
2	CONT STEEL	DECK GIRDER		95.0	Y
3	CONT STEEL	DECK GIRDER		95.0	
4	CONT STEEL	DECK GIRDER		39.0	

Expansion joint(s)

Temperature:

File:	New:
-------	------

Vertical Clearance

	Measurement file (ft)	File Date	Measurement new (ft)
Highway Minimum Under Cardinal	16.92		
Highway Minimum Under Non-Cardinal	16.42		
Highway Minimum On			
Railroad Minimum Under			

BRIDGE INSPECTION REPORT
Wisconsin Department of Transportation
DT2007 2003 s.84.17 Wis. Stats.

page 3

Structure No.: **B-18-036**

Elements

Chk	Element	Defect	Description	UOM	Total	Quantity in Condition State			
						1	2	3	4
X	12		Reinforced Concrete Deck	SF	12,649	11,974	675	0	0
			Re-decked and widened in 2011.						
		1130	Cracking (RC) Spans 1 and 4: Few hrlin transverse cracks. Span 2 and 3: Multiple transverse cracks w/ lt/med efflorescence.	SF		0	675	0	0
		8000	Wearing Surface (Bare) Re-decked and widened in 2011.	SF	11,958	10,087	1,720	151	0
		3220	Crack (Wearing Surface) CS3 transverse cracks - 1 @ Pier 1 - full width, 2 @ Pier 2 - full and 1/2 width, 2 @ Pier 3 - each 1/2 width. 1 CS3 tr 20ft of fine/hrline map cracking at Pier 1 & 2.	SF		0	1,720	151	0
	8522		Coated Reinforcing Re-decked and widened in 2011.	SF	12,649	0	0	0	0
X	107		Steel Open Girder	LF	1,652	457	265	930	0
			7 steel haunched girders at varied spacing. Girders, Painted June 1990. Girder 6 replaced in 2011. Girders appear straight and plumb.						
		1000	Corrosion 5 Original Girders - Spn 1 & 4: < 2% web freckle rust, 10-20% flange edges rust. Spn 2 & 3: 60-80% web freckle rust w/ some flaking, 90% flange rust w/ some hvy flaking. 1 New Girder primed (no top coat) w/ with local areas of spot rusting (edges btm flng).	LF		0	265	930	0
		8516	Painted Steel Girders = 15,900sf, Struts & X brc = 3,400. Original 5 painted June 1990. New G6 primed (no top coat).	SF	19,300	3,570	4,270	2,850	8,610
		3440	Effectiveness (Steel Protective Coatings) 5 Original Girders - Spn 1 & 4: < 2% web freckle rust, 10-20% flange edges rust. Spn 2 & 3: 60-80% web freckle rust w/ some flaking, 90% flange rust w/ some hvy flaking. 1 New Girder primed (no top coat) w/ with local areas of spot rusting (edges btm flng).	SF		0	4,270	2,850	8,610
X	205		Reinforced Concrete Column Fiber wrapped in 2011. Loss of protective coating on wrap at top of columns of Pier 2.	EA	9	9	0	0	0
X	215		Reinforced Concrete Abutment	LF	100	39	60	1	0
			Surface repairs & backwall top 2011. Approx. 4ft added on east end of South.						
		1080	Delamination - Spall - Patched Area North: 1ft edge spall under G6 w/ map cracking. Patches - at G2, G3, G4 and G5 and locations btwn each girders G1 & G5. 3 - 3in x 6in spalls w/ staining (rebar close to surface) @ G2. South: 2ft patch under G4. Lt delam/spall staining under G3.	LF		0	50	1	0
		1130	Cracking (RC) North: Few fine/hrline transverse cracks in abut & bkwall. South: 2ft map cracking on east end. Few fine vertical cracks.	LF		0	10	0	0
		6000	Scour NE - horiz. face scaling near brng.	LF		0	2	0	0
X	234		Reinforced Concrete Cap Fiber wrapped in 2011. Loss of wrap at top of columns of Pier 2 w/ some staining.	LF	149	149	0	0	0
X	300		Strip Seal Expansion Joint	LF	100	90	10	0	0
			New in 2011. 2013 @ 85 degrees - N=0.16, S=0.13						
	2360		Adjacent Deck or Header Damage Few vert cracks in paving block.	LF		0	10	0	0

BRIDGE INSPECTION REPORT
Wisconsin Department of Transportation
DT2007 2003 s.84.17 Wis. Stats.

page 4

Structure No.: **B-18-036**

X	311		Moveable Bearing At both abutments and piers 1 and 3. Sandblasted in 2011. G3 brg south about nuts loose. Tiedowns on both abutments for G1, G3, G4, and G6.	EA	24	0	24	0	0
		1000	Corrosion Lt to hvy rust.	EA		0	24	0	0
X	313		Fixed Bearing Pier 2.	EA	6	0	6	0	0
		1000	Corrosion Light to hvy surface rust.	EA		0	6	0	0
X	331		Reinforced Concrete Bridge Rail New "LF" Parapets in 2011.	LF	546	0	546	0	0
		1130	Cracking (RC) Hrline vert cracks at 6-10ft spacing. Surface map cracking on all.	LF		0	546	0	0
X	8400		Integral Wingwall New wings in 2011.	EA	4	2	2	0	0
		8903	Wingwall Deterioration. Surface map cracking on NE & NW.	EA		0	2	0	0

Assessments

Chk	Element	Defect	Description	UOM	Total	Quantity in Condition State			
						1	2	3	4
X	9001		Drainage - Approach NE & SE C & G.	EA	2	2	0	0	0
X	9030		Signs - Object Markers 2 south end.	EA	2	2	0	0	0
X	9043		Slope Protection- Crushed Aggregate with Bit. Sprayed in 2011. Rocks tightly adhered. Light vegetation at edges of both slopes - heavier on south.	EA	2	2	0	0	0
X	9167		Steel Diaphragm Light to hvy rust on all - worst over driving lanes. Note: original connection needs grinding where cut on G5.	EA	64	0	50	14	0
X	9322		Approach Roadway - Concrete (non-structural) New in 2011.	EA	2	2	0	0	0

NBI Ratings

	File	New
Deck	7	7
Superstructure	5	5
Substructure	7	7
Culvert	N	N
Channel	N	N
Waterway	N	N

BRIDGE INSPECTION REPORT
Wisconsin Department of Transportation
DT2007 2003 s.84.17 Wis. Stats.

page 5

Structure No.: **B-18-036**

Structure Specific Notes

Proposed to be painted in 2016/17.
 OLD: less than 2 % delam 1998-chained---Full depth at pier 1 and 3.

Inspection Specific Notes

OLD: Re-decked & widened in 2011. Significant lifting of girder ends at abutments. Working with Central Office to minimize movement.
 Girders to be repainted 2015.

Inspector Site-Specific Safety Considerations

Structure Inspection Procedures

Walk-thru visible.
 OLD: CONCRETE OVERLAY 110000

Special Requirements

	Chk	Comments
Traffic Control		
ReachAll Vehicle		
Access Equipment		
Other		

Construction History

Year	Work Performed	FOS id
9999	NOT BUILT	1022-00-10
2011	NEW DECK	1022-00-78
1996	ADD PED FENCING	1020-06-72
1990	PAINTING	
1987	OVERLAY - CONCRETE	0018-74-10
1966	NEW STRUCTURE	

Maintenance Items History

Item Recommended by Status Status change Year completed

Maintenance Items

Item	Priority	Recommended by	Status	Status change
Misc - Cut Brush	MEDIUM	Balsiger, Lee (6011)	IDENTIFIED	08/27/15
Cut brush and spray weeds on slope protection				

Routine
Document Comment/Description

N abut



Routine
Document Comment/Description

S abut



Routine
Document Comment/Description

Pier 2 - west column



STRUCTURE INVENTORY AND APPRAISAL FIELD REVIEW FORM

B-18-036
USH 53 NB over IH 94

LOCATION

(3) Municipality:
 (16) Latitude(° ' "):
 (17) Longitude(° ' "):

TOWN-WASHINGTON(18024)
44°46'00.90"N
91°25'16.85"W

TRAFFIC SERVICE

(28A) Lanes On:
 (28B) Lanes Under:
 (102) Traffic Pattern On:
 (102) Traffic Pattern Under:
 (19) Detour Length(mi):

3
6
-NO TRAFFIC <input checked="" type="checkbox"/> -ONE WAY TRAFFIC -TWO WAY TRAFFIC
-NO TRAFFIC -ONE WAY TRAFFIC <input checked="" type="checkbox"/> -TWO WAY TRAFFIC
0

GEOMETRY

(49) Structure Length(ft):
 (50) Sidewalk Width(ft):
 (50) Curb Width(ft):
 (52) Culvert Barrel Length(ft):
 (34) Skew:
 (51) Bridge Roadway(ft):
 (52) Deck(ft):
 (32) Approach Roadway(ft):
 (47) Minimum Horizontal(ft):
 (55) Minimum Right Lateral(ft):
 (55) Minimum Left Lateral(ft):

276.4	
Left: 0.0	Right: 0.0
5.0	
Angle(°): 25	Direction: -RIGHT FORWARD <input checked="" type="checkbox"/> -LEFT FORWARD
Cardinal Width	Non-Cardinal Width
43.1	45.1
45.5	47.1
47	0
Cardinal Under Clearance	Non-Cardinal Under Clearance
41.25	41.25
11.25	11.25
7.0	7.0

RAILING APPRAISAL

(36A) Bridge Rail Adequacy:
 (36B) Transition Adequacy:
 (36C) Approach Guardrail Adequacy:
 (36D) Guardrail Termination Adequacy:
 Outer Rail:

-SUB-STANDARD <input checked="" type="checkbox"/> -STANDARD -NOT APPLICABLE		
-SUB-STANDARD <input checked="" type="checkbox"/> -STANDARD -NOT APPLICABLE		
-SUB-STANDARD <input checked="" type="checkbox"/> -STANDARD -NOT APPLICABLE		
-SUB-STANDARD <input checked="" type="checkbox"/> -STANDARD -NOT APPLICABLE		
Left	Right	Type
		TYPE F (TWO SQUARE TUBES) - STEEL(8)
		TYPE F (3 SQUARE TUBES) - STEEL(65)
		TYPE F (4 SQUARE TUBES) - STEEL(72)
		TYPE M-STEEL 3 SQUARE TUBES(93)
X	X	SLOPED FACE PARAPET LF(91)
		SLOPED FACE PARAPET HF(92)
		VERTICAL FACE PARAPET TYPE A(74)
		TYPE W-THRIE BEAM(79)
		TYPE H ON VERTICAL PARAPET(80)
		TIMBER(38)
		OTHER(99) (Please specify)

Transition Type:

	CONT GUARD RAIL
	NO APP GRDRL
	NO ATTACHMENT
5	22 MM(7/8") BOLT (Please enter quantity)
	25 MM(1") BOLT (Please enter quantity)
	OTHER (Please specify)

Guardrail Termination Type:

X	(01) ENERGY ABSORBING TERMINAL/EAT
	(02) TURN DOWN
	(99) OTHER (Please specify)

ROADWAY ALIGNMENT APPRAISAL

(72) Approach Alignment Appraisal:

	(3) INTOLERABLE- Horizontal or Vertical curvature requires a substantial reduction in vehicle operating speed
	(6) FAIR- Horizontal or Vertical curvature requires a very minor speed reduction
X	(8) GOOD- No speed reduction required



708 Heartland Trail, Suite 3000
Madison, WI 53717

608.826.3600 PHONE
608.826.3941 FAX

www.TRCSolutions.com

Bridge Asbestos Inspection Report

WisDOT Project ID: 1190-02-34

Structure Number: B-18-0035, B-18-0036

Structure Name: USH 53 over IH 94

City/County: Town of Washington, Eau Claire County

Lat/Long Coordinates: 444600.0/ 912542.0, 444600.9/ 912516.85

TRC Project Number: 235777.0000.0000

Date Inspected: October 14, 2015

Inspected By/License Number: John Roelke, All-119523

Findings:


The inspection to identify and collect samples of potential asbestos-containing material (ACM) was completed following WisDOT standard sampling procedure for bridge inspections found in FDM 21-35-45.

None of the materials that were identified as potentially ACM and sampled tested positive for asbestos. The overlay on the bridges can proceed as planned. Standard Special Provision (STSP) 107-125 should be included in the specifications.

Sample Number	Sample Description	Sample Location	Analytical Results and Method	Friable/ Non-friable or No ACM	Quantity of ACM Material
B-18-0035					
1	Paint	Girder	PLM, non-detect	No ACM	0
2	Paint	Girder	PLM, non-detect	No ACM	
3	Paint	Girder	PLM, non-detect	No ACM	
B-18-0036					
1	Paint	Girder	PLM, non-detect	No ACM	0
2	Paint	Girder	PLM, non-detect	No ACM	
3	Paint	Girder	PLM, non-detect	No ACM	

If you have any questions, please contact me, at (608) 826-3628.

TRC Environmental Corporation

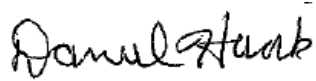

Daniel Haak
Project Manager




John Roelke
Asbestos Inspector

Attachments: Location Map, Photos, and Laboratory Reports

Report Distribution:

Recipient	Electronic (PDF) Copy	Paper Copy
BTS-ESS sharlene.tebeest@dot.wi.gov	X (via email)	X
REC amy.adrihan@dot.wi.gov ; nicholasA.schaff@dot.wi.gov	X (via email)	
Project Manager david.koepp@dot.wi.gov	X (via email)	
Other		



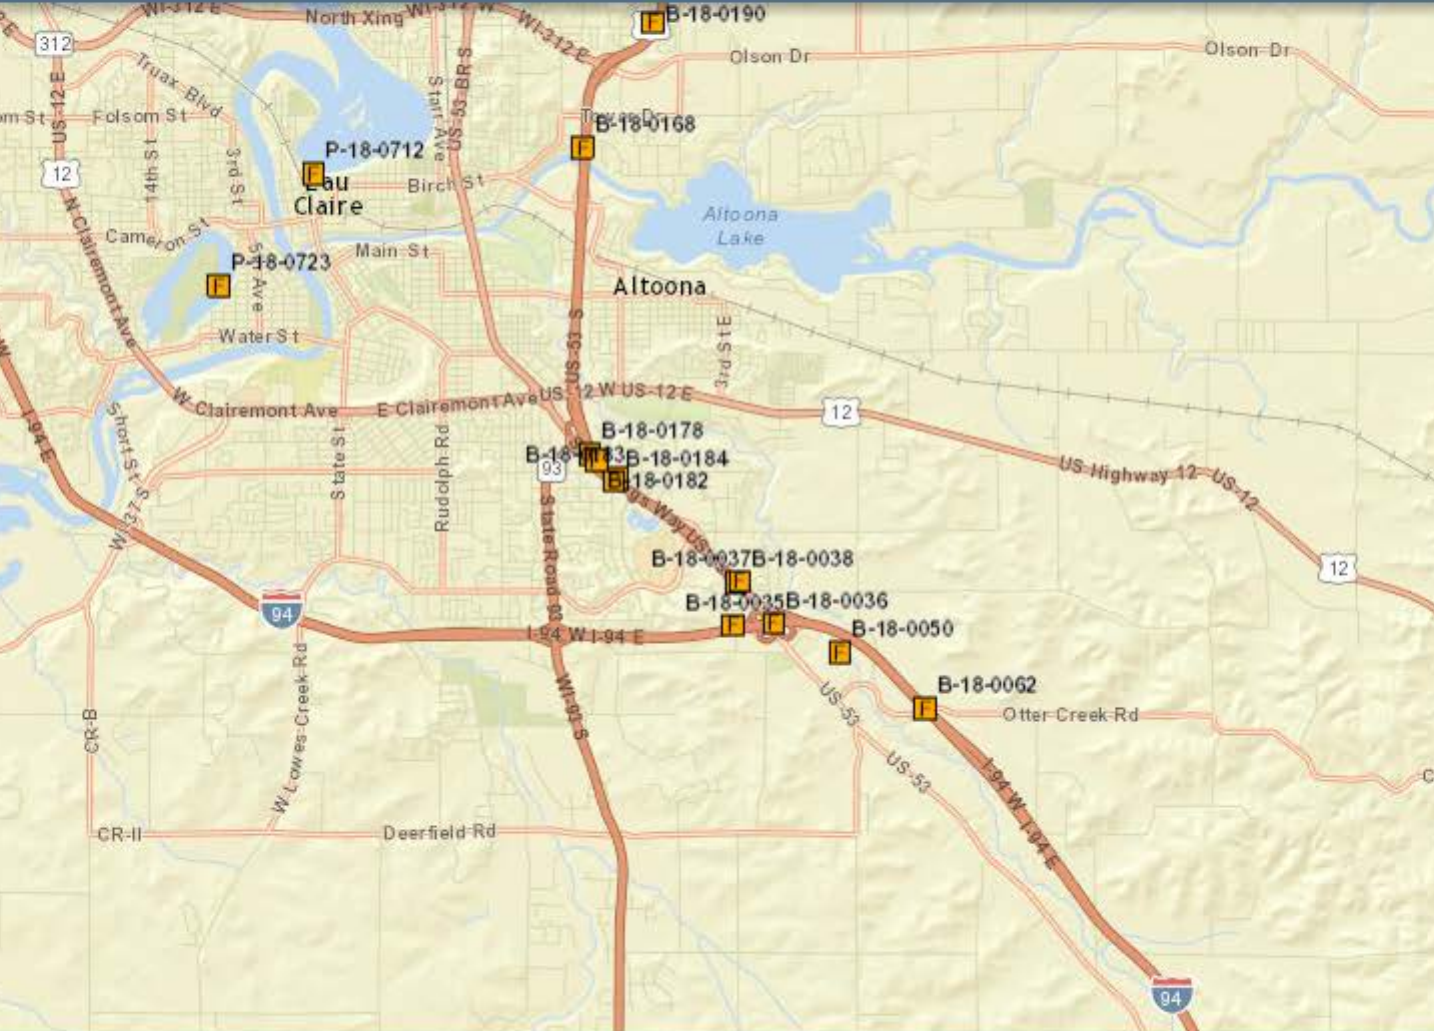

B-18-0035



Paint on girder

B-18-0036



Paint on girder



BULK ASBESTOS ANALYSIS REPORT

CLIENT: Wisconsin Department of Transportation

Lab Log #: 0047023
Project #: 235777.0000.0000
Date Received: 10/16/2015
Date Analyzed: 10/19/2015

Site: DOT Bridge Inspection, B-18-35

POLARIZED LIGHT MICROSCOPY by EPA 600/R-93/116

Sample No.	Color	Homogenous	Multi-Layered	Layer No.	Other Matrix Materials	Asbestos %	Asbestos Type
B-18-35 (1)	Grey	Yes	No	--	---	ND	None
B-18-35 (2)	Grey	Yes	No	--	---	ND	None
B-18-35 (3)	Grey	Yes	No	--	---	ND	None

Reporting limit- asbestos present at 1%

ND - asbestos was not detected

Trace - asbestos was observed at level of less than 1%

NA/PS - Not Analyzed / Positive Stop

SNA- Sample Not Analyzed- See Chain of Custody for details

Note: Polarized-light microscopy is not consistently reliable in detecting asbestos in floor coverings and similar non-friable organically bound materials. In those cases, EPA recommends, and certain states (e.g. NY) require, that negative results be confirmed by quantitative transmission electron microscopy.

The Laboratory at TRC follows the EPA's Interim Method for the Determination of Asbestos in Bulk Insulation (1982), and the EPA recommended Method for the Determination of Asbestos in Bulk Building Materials (EPA/600/R-93/116), July 1993, R.L. Perkins and B.W. Harvey which utilizes polarized light microscopy (PLM). Our analysts have completed an accredited course in asbestos identification. TRC's Laboratory is accredited under the National Voluntary Laboratory Accreditation Program (NVLAP), for Bulk Asbestos Fiber Analysis, NVLAP Code 18/A01, effective through June 30, 2016. TRC is an American Industrial Hygiene Association (AIHA) accredited lab for PLM effective through October 1, 2016. Asbestos content is determined by visual estimate unless otherwise indicated. Quality Control is performed in-house on at least 10% of samples and the QC data related to the samples is available upon written request from the client.

This report shall not be reproduced, except in full, without the written approval of TRC. This report must not be used by the client to claim product endorsement by NVLAP or any agency of the U.S. Government. This report relates only to the items tested.

Analyzed by: K. Williamson
Kathleen Williamson, Laboratory Manager

Reviewed by: Aud. Parks
Amanda Parkins, Approved Signatory

Date Issued
10/19/2015

TRC LABORATORY ASBESTOS ANALYTICAL ACCREDITATIONS

NVLAP Lab Code 101424-0
RI #AAL-007 TX #300354
CO# AL-15020

AIHA-LAP,LLC #100122 CT #PH-0426
VT #AL014538 LA#05011 VA #3333 000283
PHIL# 461 PA#68-03387

ME LA-0075, LB-0071
AZ #A20944

MA #AA000052
HI #L-09-004

NY #10980 WV# LT000411
NJ #CT004 CA #2907



BULK ASBESTOS ANALYSIS REPORT

CLIENT: Wisconsin Department of Transportation

Lab Log #: 0047029
Project #: 235777.0000.0000
Date Received: 10/16/2015
Date Analyzed: 10/19/2015

Site: DOT Bridge Inspection, B-18-36

POLARIZED LIGHT MICROSCOPY by EPA 600/R-93/116

Sample No.	Color	Homogenous	Multi-Layered	Layer No.	Other Matrix Materials	Asbestos %	Asbestos Type
B-18-36 (1)	Grey	Yes	No	--	---	ND	None
B-18-36 (2)	Grey	Yes	No	--	---	ND	None
B-18-36 (3)	Grey	Yes	No	--	---	ND	None

Reporting limit- asbestos present at 1%

ND - asbestos was not detected

Trace - asbestos was observed at level of less than 1%

NA/PS - Not Analyzed / Positive Stop

SNA- Sample Not Analyzed- See Chain of Custody for details

Note: Polarized-light microscopy is not consistently reliable in detecting asbestos in floor coverings and similar non-friable organically bound materials. In those cases, EPA recommends, and certain states (e.g. NY) require, that negative results be confirmed by quantitative transmission electron microscopy.


The Laboratory at TRC follows the EPA's Interim Method for the Determination of Asbestos in Bulk Insulation (1982), and the EPA recommended Method for the Determination of Asbestos in Bulk Building Materials (EPA/600/R-93/116), July 1993, R.L. Perkins and B.W. Harvey which utilizes polarized light microscopy (PLM). Our analysts have completed an accredited course in asbestos identification. TRC's Laboratory is accredited under the National Voluntary Laboratory Accreditation Program (NVLAP), for Bulk Asbestos Fiber Analysis, NVLAP Code 18/A01, effective through June 30, 2016. TRC is an American Industrial Hygiene Association (AIHA) accredited lab for PLM effective through October 1, 2016. Asbestos content is determined by visual estimate unless otherwise indicated. Quality Control is performed in-house on at least 10% of samples and the QC data related to the samples is available upon written request from the client.


This report shall not be reproduced, except in full, without the written approval of TRC. This report must not be used by the client to claim product endorsement by NVLAP or any agency of the U.S. Government. This report relates only to the items tested.

Analyzed by: K. Williamson Reviewed by: Aud. Parks Date Issued: 10/21/2015
Kathleen Williamson, Laboratory Manager Amanda Parkins, Approved Signatory

TRC LABORATORY ASBESTOS ANALYTICAL ACCREDITATIONS

NVLAP Lab Code 101424-0 AIHA-LAP.LLC #100122 CT #PH-0426 ME LA-0075, LB-0071 MA #AA000052 NY #10980 WV# LT000411
RI #AAL-007 TX #300354 VT #AL014538 LA#05011 VA #3333 000283 AZ #A20944 HI #L-09-004 NJ #CT004 CA #2907
CO# AL-15020 PHIL# 461 PA#68-03387

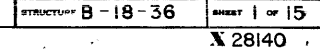

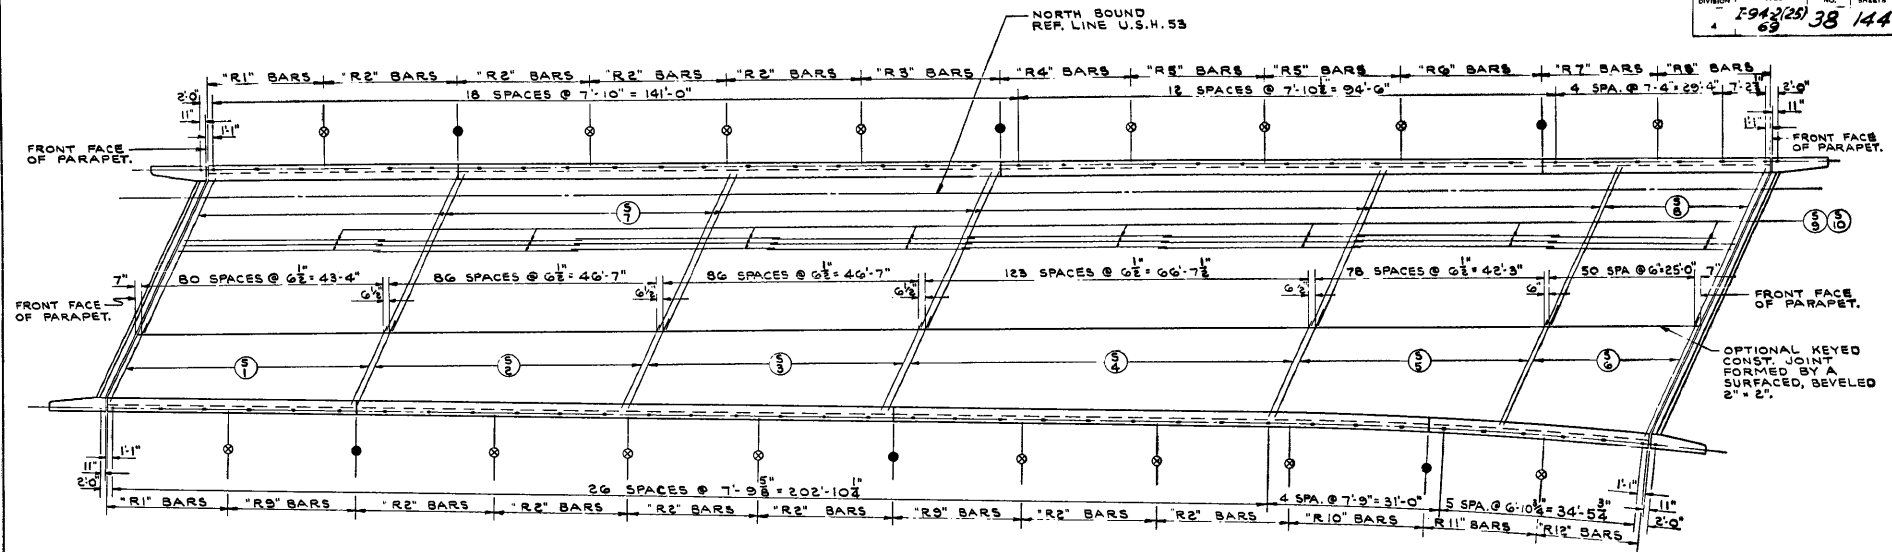

FLOOR PLAN

BILL OF BARS

120,150#

DIMENSIONS IN BENDING DETAILS ARE OUT TO OUT.


POUR MARK NO.	SIZE	LENGTH	SPACING	LOCATION	DET.
51 161	6	16'-0"	6 1/2"	FLOOR TRANS. - TOP & BOTTOM	
52 173	6	17'-0"	6 1/2"	" " " " " "	
53 173	6	18'-0"	6 1/2"	" " " " " "	
54 247	6	19'-0"	6 1/2"	" " " " " "	
55 157	6	21'-0"	6 1/2"	" " " " " "	
56 101	6	23'-0"	6"	" " " " " "	
57 911	6	30'-0"	6 1/2"	" " " " " "	
58 101	6	30'-0"	6"	" " " " " "	
59 320	5	35'-0"	11 1/2"	FLOOR LONG. - TOP	
60 480	5	35'-0"	6 1/2"	" " " " - BOTTOM	
61 36	5	15'-0"	SHOWN	" " " " - SYM ABOUT C OF PIER	
62 542	6	2'-0"	1'-0"	CURB TRANS.	A
63 542	5	4'-3"	1'-0"	" " " "	B
64 20	6	22'-0"	SHOWN	" " LONG. - SPAN 1	
65 60	6	32'-0"	SHOWN	" " " " SPANS 2 & 3	
66 20	6	20'-0"	SHOWN	" " " " SPAN 4	
67 542	5	5'-0"	1'-0"	" " & RAIL PARAPET	C
68 66	5	2'-0"	1'-0"	DIAPHRAGM AT ABUTMENTS	
69 5	4	8'-0"	SHOWN	" " SOUTH ABUT.	D
70 5	4	9'-3"	SHOWN	" " NORTH "	

POUR MARK NO.	SIZE	LENGTH	SPACING	LOCATION	DET.
R1 8	5	20'-0"	SHOWN	RAIL PARAPET	
R2 40	5	23'-0"	"	"	
R3 4	5	24'-0"	"	"	
R4 4	5	22'-3"	"	"	
R5 8	5	23'-3"	"	"	
R6 4	5	24'-9"	"	"	
R7 4	5	20'-3"	"	"	
R8 4	5	18'-9"	"	"	
R9 8	5	22'-9"	"	"	
R10 4	5	23'-6"	"	"	
R11 4	5	20'-0"	"	"	
R12 4	5	17'-9"	"	"	


- INDICATES DEFLECTION JOINT IN RAILING PARAPET AND CURBS.
- ⊗ INDICATES DEFLECTION JOINT IN RAILING PARAPET ONLY.

NOTE: RAIL POST SPACING IS MEASURED ALONG C OF RAIL PARAPET.
WEST RAILING MEASURED ALONG N.B. REF. LINE U.S.H. 53.
EAST RAILING MEASURED ALONG N.E. LOOP REF. LINE.


* 11" = 1" = 1'-8 1/2" TOP & BOTTOM AT SPlice #1 & #4 ONLY. PLACE ON SIDE AWAY FROM PIER #1 ON SPlice #1. PLACE ON SIDE AWAY FROM PIER #3 ON SPlice #4.

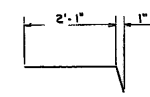


DETAIL A

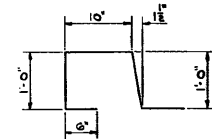


DETAIL B

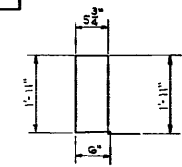


DETAIL C

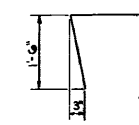

DETAIL D

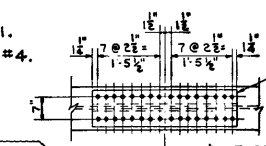

FILL PLATE 11" x 1/2" x 1'-8 1/2" TOP & BOTTOM SPlice #2 ONLY.

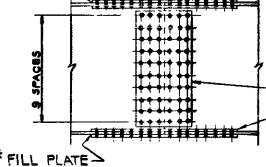

* FILL PLATE

FIELD SPlice DETAILS


ALL SPlices SIMILAR.
ALL SPlice MATERIAL SHALL CONFORM TO A.S.T.M. A36.


NOTE: C OF SPlice TO BE C OF WEB.

NOTE: ALL FIELD SPlice CONNECTIONS SHALL BE MADE WITH 3/4" HIGH TENSILE STRENGTH BOLTS OR 3/4" RIVETS.

REVISION	STATE HIGHWAY COMMISSION OF WISCONSIN
	SUPERSTRUCTURE
DESIGNED BY: A.A.S. & G. [Signature]	DATE: 12-27-68
CHECKED BY: P.R.W. [Signature]	DATE: 12-27-68
STRUCTURE: B-18-36	SHEET: 3 OF 15

 
128142



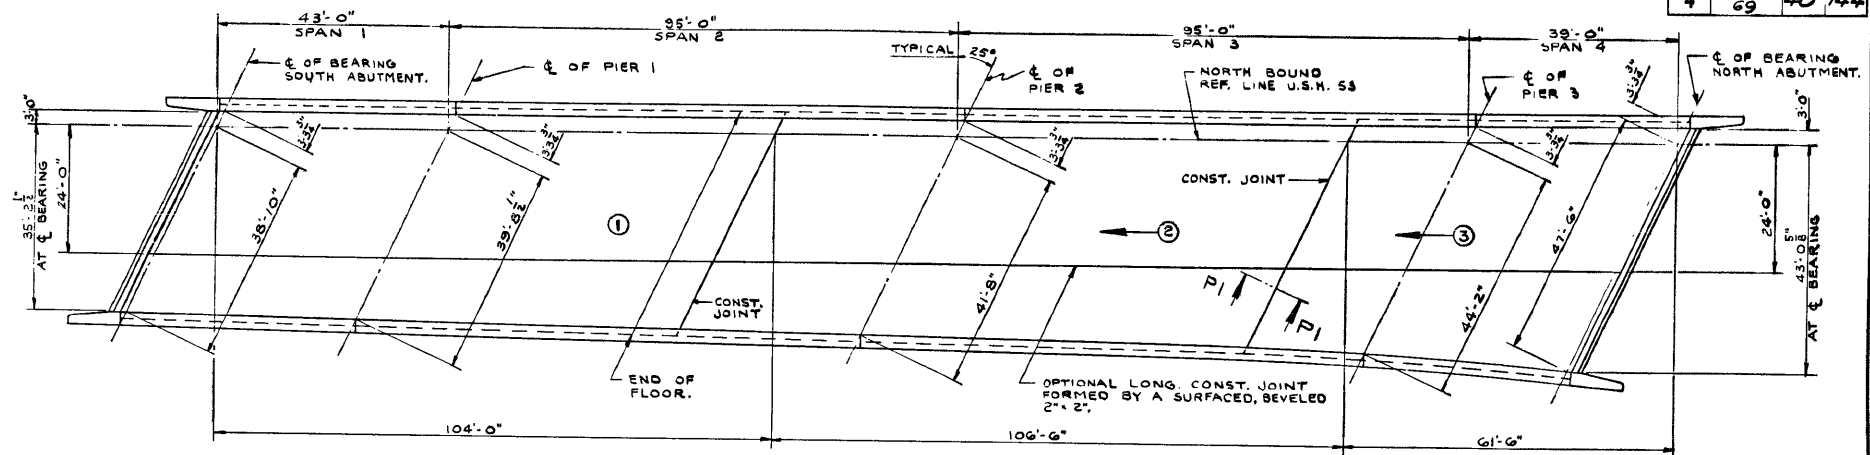

LOCATION	A	B	C	D	E	F	G	H	J
GIRDER 1	0	1 1/8"	1 1/8"	3 3/4"	4 1/8"	5 1/8"	7 3/8"	8 1/4"	9 3/4"
GIRDER 2	0	1 3/8"	1 1/8"	3 1/4"	4 3/8"	5 3/8"	7 5/8"	8 1/8"	9 5/8"
GIRDER 3	0	1 3/8"	1 3/8"	3 1/4"	4 1/8"	5 3/8"	7 1/2"	8"	9 1/8"
GIRDER 4	0	1 3/8"	1 3/8"	3 1/4"	4 1/8"	5 3/8"	7 3/8"	7 7/8"	9 1/8"
GIRDER 5	0	1 3/8"	1 3/8"	3 1/4"	4 1/8"	5 3/8"	7 3/8"	7 7/8"	9 1/8"
GIRDER 6	1"	2 3/8"	2 3/8"	4 1/8"	5"	5 1/8"	2 3/8"	2"	0

POURING DIAGRAM

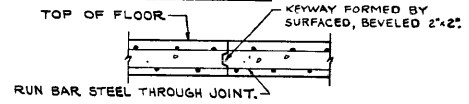


SECTION P1


TWO OR MORE POURS MAY BE COMBINED AND TRANSVERSE CONSTRUCTION JOINTS OMITTED IF THE POUR FOR AN ENTIRE SPAN OR THE PORTION OF A SPAN TO A CONSTRUCTION JOINT CAN BE COMPLETED WITHIN FOUR HOURS AFTER CONCRETE OVER THE ADJACENT PIER IS PLACED.

DIRECTION OF POUR MAY BE REVERSED IF PORTION OF POUR FROM THE PIER CAN BE COMPLETED IN A FOUR HOUR PERIOD.

② INDICATES POUR NUMBER AND DIRECTION.

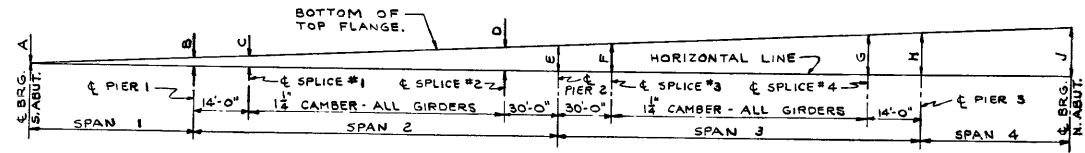


BLOCKING DIAGRAM

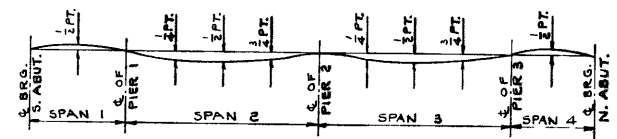

DEFLECTION DIAGRAM

DEAD LOAD DEFLECTIONS

POINT	SPAN 1	SPAN 2	SPAN 3	SPAN 4
TOTAL D.L.	-1 1/8"	3/8"	1 1/8"	1 1/8"
CONCRETE ONLY	-1 1/8"	3/8"	1"	1 1/8"

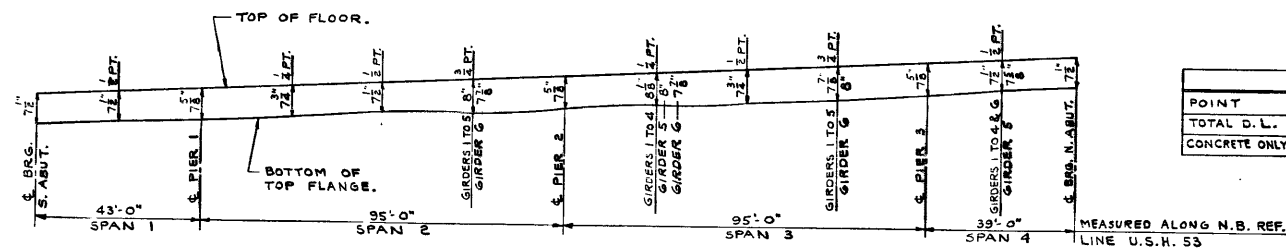


FORMING DIAGRAM

SLAB THICKNESS FIGURES SHOWN ARE THEORETICAL AND ARE SUBJECT TO CORRECTION TO MEET VARIABLE FIELD CONDITIONS.


REVISION	STATE HIGHWAY COMMISSION OF WISCONSIN
DATE	1969
DESIGN	1969
DATE	1969
STRUCTURE	B-18-36
SHEET	5 OF 15

EXPLANATION ONLY AT SOUTH AND NORTH ABUTMENTS, FOR DETAILS SEE X2814-G.

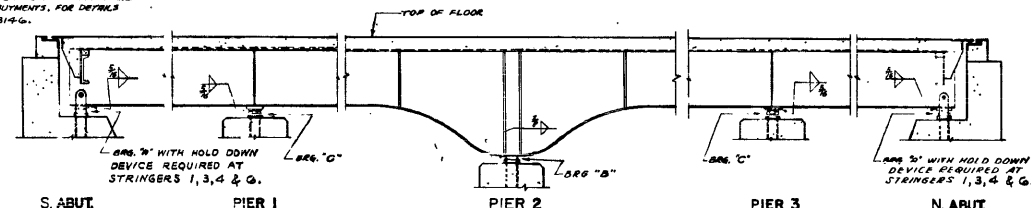


LONGITUDINAL SECTION


NOTE: PLACE 1/2" BEARING AND SAME SIZE AT ANCHORAGE PLATE UNDER EACH BEARING.

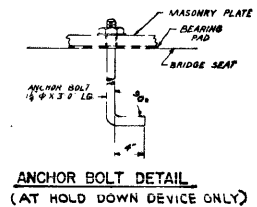

ANCHOR BOLT DETAIL (AT HOLD DOWN DEVICE ONLY)

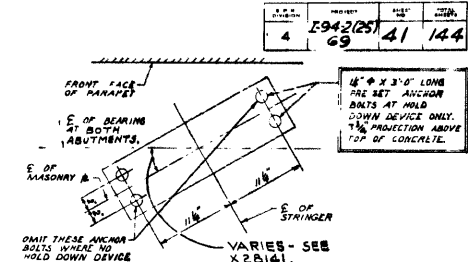


PRE-SET ANCHOR BOLT PLAN AT HOLD DOWN DEVICE

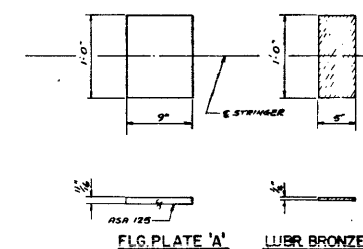


FLG. PLATE 'A'

LUBR. BRONZE PL. 'A'

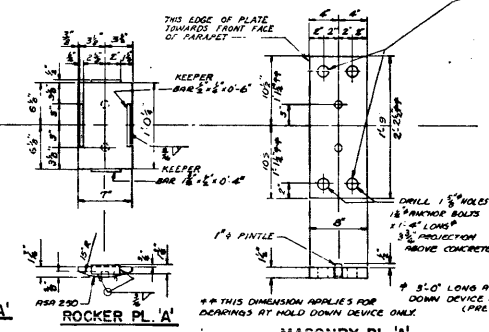

ROCKER PL. 'A'


MASONRY PL. 'A'

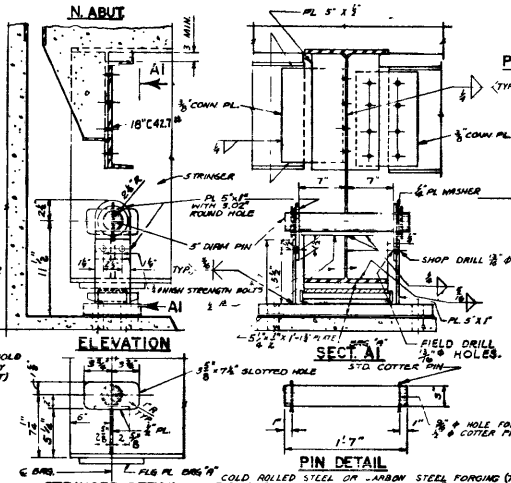

STRINGER DETAIL


HOLD DOWN DEVICE DETAIL

PIN DETAIL

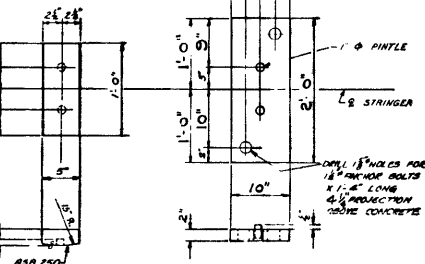

ROCKER PL. 'B'


MASONRY PL. 'B'

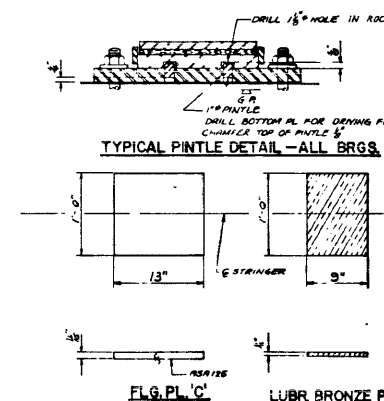

TYPICAL PINTLE DETAIL - ALL BRGS.

FLG. PL. 'C'

LUBR. BRONZE PL. 'C'

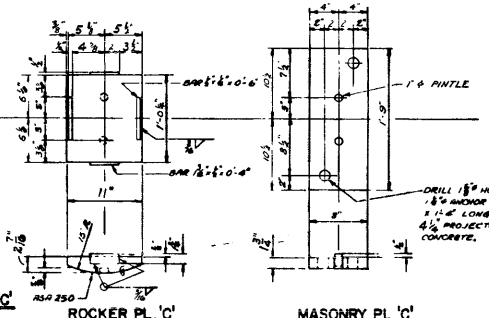

ROCKER PL. 'C'

MASONRY PL. 'C'

BEARING NOTES

ALL STRUCTURAL STEEL BEARING PLATES SHALL BE FLAT ROLLED STEEL PLATES WITH ALL SURFACES SMOOTH AND FREE FROM WARP AND ALL EDGES SMOOTH, STRAIGHT, AND VERTICAL. ALL PLATE CUTS SHALL BE MACHINE OR MACHINE FLAME CUTS. ALL SURFACES MARKED 3 SHALL BE MACHINE FINISHED. ANCHOR BOLTS SHALL BE THREADED 3". PROVIDE ONE STANDARD WROUGHT WASHER AND ONE HEX NUT PER BOLT. ALL MATERIAL EXCEPT ANCHOR BOLTS, NUTS, AND WASHERS AND PINS SHALL BE MADE 1242 STEEL WITH A CORROSION RESISTANCE OF 4 OR MORE TIMES THAT OF A36 STEEL. THE TOP 4% OF ANCHOR BOLTS, WASHERS & NUTS SHALL BE GALVANIZED. FINISH FLG. PLATE OF BRG. 'A' & 'C' IN DIRECTION OF MOVEMENT. LUBRICATE TOP SURFACE OF BRONZE PLATES ONLY. ALL MATERIAL IN BEARINGS EXCLUDING BRONZE PLATES AND BEARING PADS SHALL BE PAID FOR AT UNIT PRICE BID FOR STRUCTURAL LOW ALLOY STEEL.




REV. NO.	STATE HIGHWAY COMMISSION OF WISCONSIN
1	LONG. SECTION & BEARINGS
DESIGNER: R. J. G. B. C. (1000-1100-516) WPP/1963	
DRAWN: J. J. G. B. C. (1000-1100-516) WPP/1963	
STRUCTURE: B-18-36	SHEET: 6 OF 15

X28145



STATE	DIVISION	PROJECT	SHEET NUMBER	TOTAL SHEETS
WISCONSIN	194325	42	144	

LEGEND

1. ST. OF WF 30" RDWY. WIDTH.
2. 2" x 4" x 1/2" RDWY. WIDTH.
3. BAR 2" x 1/2" RDWY. WIDTH. WELD TO L#2 WITH 2 LINES OF 1/2" FILLET WELD.
4. 5" FABRICATE FROM 1/2" WELDED PLATE. WELD TO STEM & FLANGE OF S.T. #1 WITH 1/2" FILLET WELD NEAR SIDE & FAR SIDE.
5. 6" MIN. LAMINATED & SLOTTED SHIM.
6. 7" DRILL HOLES IN STRINGER FLANGE IN FIELD FOR 4" x 6" EJECTION BOLTS.
7. 8" BOLT WITH SQ NUT @ 2'-0" CTRS. TACK WELD TO NUT TO L#2. OREGASE FOR EASY REMOVAL. 1 1/2" x 1 1/2" SLOTTED HOLE IN ST #1. LONG DIMENSION OF SLOTTED HOLE TO BE PARALLEL TO RDWY.
8. 9. APPLY 1/2" COAT OF BITUMASTIC TO THIS SURFACE. AFTER CONCRETE HAS SET FILL HOLES WITH HOT POURED ELASTIC TYPE JOINT SEALER.
9. 10. 1/2" VENT HOLES @ 2'-0" CTRS.
10. 11. 1/2" BENT BAR @ 0'-0" ALTERNATE CTRS. BETWEEN STRINGERS. WELD TO ST #1. (BAR 1'-3" LONG.)
11. 12. 1/2" BENT BAR @ 1'-0" CTRS. WELD TO L#2. (BAR 2'-0" LONG.)
12. 13. 1/2" x 2 1/2" x 1/2" x 0'-3" APPROX 30" CTRS WELD TO L#2.
13. 14. 1/2" BOLT & NUT. TACK WELD NUT TO L#2. 9" LONG.
14. 15. 1/2" BOLT. SAME AS BOLT #14 EXCEPT FOR LENGTH.
15. 16. 1/2" x 13 1/2" x 1/2" BEND DOWN FACE OF CURB AS SHOWN. FIELD WELD TO ST #1. WELD TO R#25 AS SHOWN.
16. 17. 1/2" x 9 1/2" x 1/2" BEND DOWN FLUSH WITH FACE OF CURB AS SHOWN. WELD TO R#22 AS SHOWN.
17. 18. 1/2" x 2 1/2" x 1/2" BEND DOWN FLUSH WITH FACE OF CURB AS SHOWN. WELD TO R#17 WITH 1 LINE OF 1/2" FILLET WELD. FIELD WELD TO BAR #14.
18. 19. 1/2" BENT BAR. 1'-6" LONG. WELD TO R#17 & R#22 AND R#5. #16 & #23 WITH 1/2" FILLET WELD. ALL AROUND.
19. 20. 1/2" x 1 1/2" x 1/2" x 0'-3" PROVIDE 1/2" HOLE IN 2 1/2" LEG FOR BOLT #21. WELD TO R#17.
20. 21. 1/2" BOLT. 1'-7" LONG & NUT. TACK WELD NUT TO L#20.
21. 22. 1/2" x 6" x 1/2" CUT TO CURB LIMITS AS SHOWN.
22. 23. 1/2" x 8" x 1/2" CUT TO CURB LIMITS AS SHOWN. FIELD WELD TO R#24.
23. 24. 1/2" x 3/8" R. CUT TO CURB LIMITS AS SHOWN. SHOP WELD TO ST. #1 AND SUPPORT #25. 2 1/2" x 3/8" x 1'-0" L. WELD TO R#5. #16 & #17.
24. 25. BLOCK & BOLT FOR SHIPMENT WITH PIPE SLEEVE AND 1/2" BOLT. PROVIDE 3/4" x 1/2" HOLES IN L#2 & STEM OF ST. #1 AT 3'-0" CTRS. FOR 1/2" BOLT.
25. AFTER CONCRETE HAS SET THE JOINT OPENING SHALL BE THOROUGHLY CLEANED.
26. NO PAINT SHALL BE APPLIED TO EXPANSION JOINT EXCEPT AS NOTED. AFTER CONCRETE HAS SET REMOVE BOLTS #8 & #15 AND FILL HOLES WITH HOT POURED ELASTIC TYPE JOINT SEALER.
27. EXPANSION JOINT TO BE BUILT TO CONFORM TO RDWY. CROWN, GRADE & CURB SLOPE RESPECTIVELY.
28. ALL ITEMS MARKED # SHALL BE MADE OF A242 STEEL WITH A CORROSIVE RESISTANCE OF 4 OR MORE TIMES THAT OF A36 STEEL.
29. 1/2" x 1/2" HOLE IN BAR #3 AND L#2.
30. ALL MATERIAL IN EXPANSION JOINT SHALL BE PAID FOR AS LOW ALLOY STEEL.
31. ONE FIELD SPICE SHALL BE PERMITTED.
32. *** PROVIDE 1/2" HOLE IN 2 1/2" LEG FOR BOLT #14.

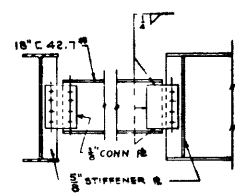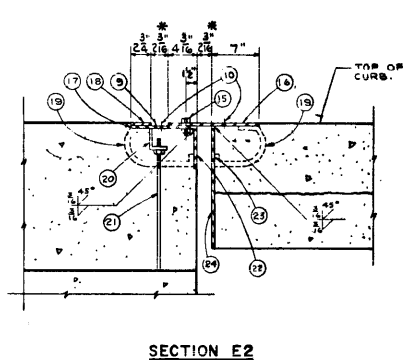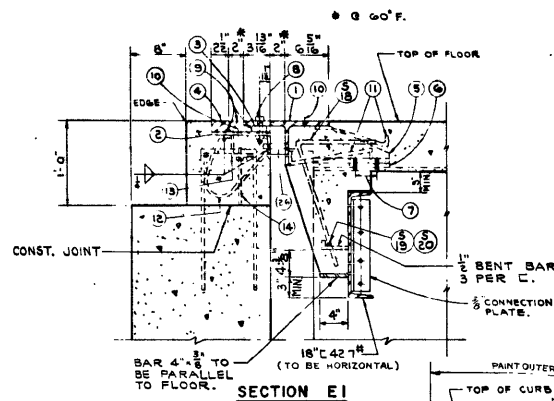


TYPICAL DIAPHRAGM DETAIL
NOTE: FOR DIAPHRAGM DETAIL AT HOLD DOWN DEVICES ON NORTH AND SOUTH ABUTMENTS SEE X28145.

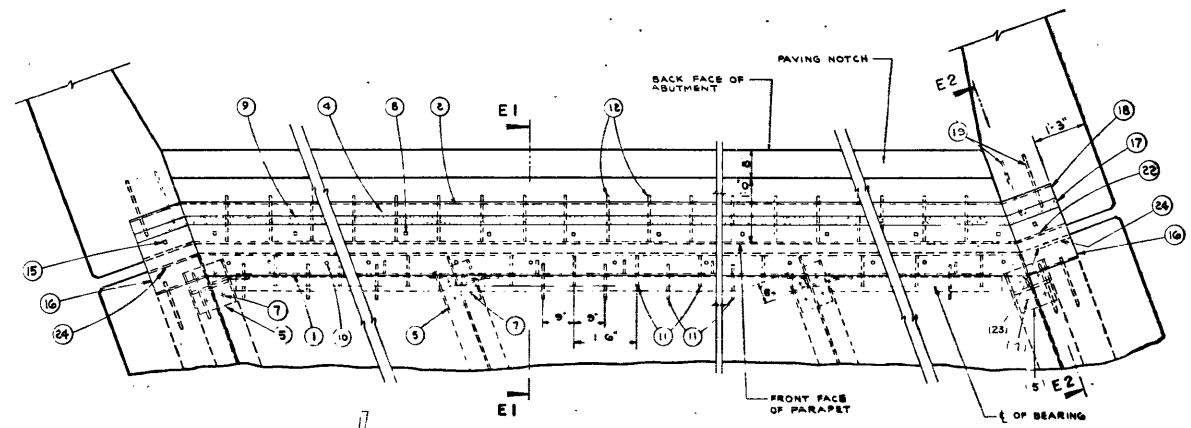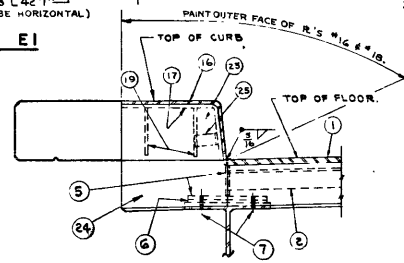


STATE	DIVISION	PROJECT	SHEET NUMBER	TOTAL SHEETS
WISCONSIN	194325	42	144	


STRUCTURE B-18-36 SHEET 7 OF 15

X28146

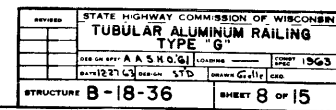


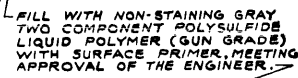


SECTION THRU CURB

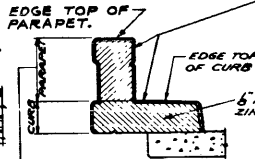

SECTION A

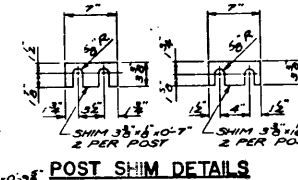


END PLATE SHIM DETAILS

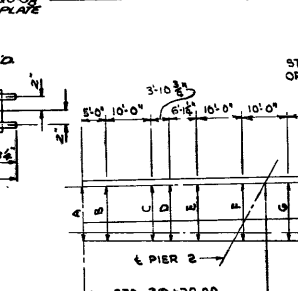


AT POSTS

POST SHIM DETAILS

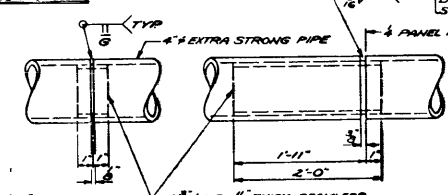


MECHANICAL TUBING

<u>SHOP RAIL</u>	<u>FIELD ERECTION</u>
<u>SPLICE DETAIL</u>	<u>JOINT DETAIL</u>

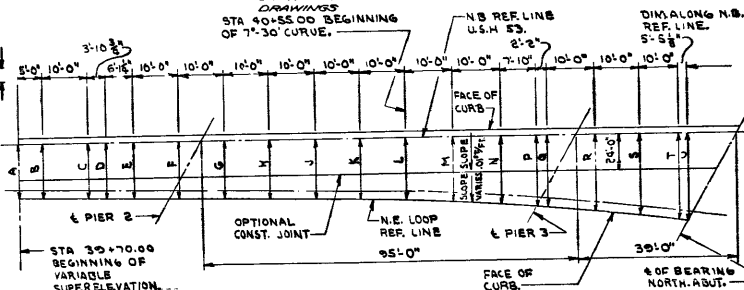

SUPERSTRUCTURE LAYOUT

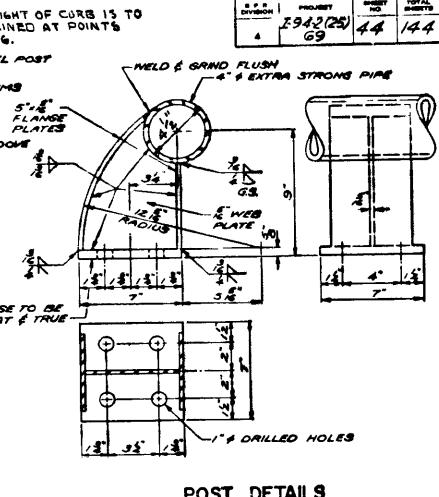

POST DETAILS

1. STEEL RAIL POSTS SHALL BE SET NORMAL TO GRADE.
RAILING SHALL BE FABRICATED IN 2 & 3
RAIL LENGTHS.
3. STEEL SHIMS SHALL BE USED UNDER POSTS AND
UNDER END PLATES WHERE REQUIRED FOR ALIGNMENT.
SHIMS SHALL BE CUT TO THE REQUIRED LENGTH AND
CONTINUOUSLY FROM END TO END THEY SHALL BE
SEPARATED AT THE DEFLECTED PLATE CUT AS SHOWN IN
SECTION A BY SHAVED AREA. IF CONSTRUCTION JOINTS
ARE NECESSARY, CURVED SHIMS SHALL BE USED. BOTH
JOINTS ON ONE SIDE OF JOINT SHALL BE COATED WITH
BITUMINOUS PAINT AND PLATE SEPARATORS MAY
BE USED.
4. THE FOLLOWING MATERIALS SHALL BE USED:
RAILING SHALL BE 4" EXTRA STRONG PIPE
CONFORMING TO ASTM A 133.
SLEEVES SHALL BE 3/8" OD X 1/4" THICK SEAMLESS
MECHANICAL TUBING MADE OF STEEL WITH A MINIMUM
TENSILE STRENGTH OF 60,000 PSI, YIELD STRENGTH OF
A MINIMUM ELONGATION OF 10%.
POSTS SHALL BE FABRICATED FROM MATERIAL
CONFORMING TO ASTM A 36.
ANCHOR BOLTS TO BE MADE FROM MATERIAL
CONFORMING TO ASTM A 307.
6. END PLATES SHALL BE PLACED BETWEEN SHIMS
WITH LEAD WOOL.
7. ALIGNMENT ENTIRE RAILING AFTER FABRICATION
W/OUT SLASHES, SHIMS AND TOP 3/4" OF

TABLE OF OFFSETS & ELEVATIONS			
DIM.	OFFSET	ELEVATION OF CENTERLINE	ELEVATION OF EAST CURB
A	37'-4.28"	922.60	922.60
B	37'-6"	922.69	922.55
C	38'-0.4"	922.60	922.40
D	37'-10"	922.70	922.55
E	37'-10.5"	922.76	922.63
F	38'-0.3"	922.70	922.38
G	38'-3"	922.76	922.71
H	38'-1.7"	922.76	922.24
M	38'-1.7"	922.62	922.18

REVISED

STATE HIGHWAY COMMISSION OF WISCONSIN



TUBULAR STEEL RAILING

TYPE 10

DESIGN SPEC AARH.Q.51 LOADING _____ DESIGN SPEC 1965
DATE 12 27 63 DESIGN STD. DRAWN Gelle GRD.

STRUCTURE B-18-36








REVISED	STATE HIGHWAY COMMISSION OF WISCONSIN	
	SOUTH ABUTMENT	
DESIGNER SPEC. <u>AASHTO</u>	LOADING <u>WS 20</u>	DATE <u>12/81</u>
DATE <u>12/27/63</u> DESIGNER <u>J.B.</u>	TRAFFIC <u>Gravel</u>	BY <u>RLP</u>
STRUCTURE <u>B-18-36</u>	SHEET <u>10</u> OF <u>15</u>	

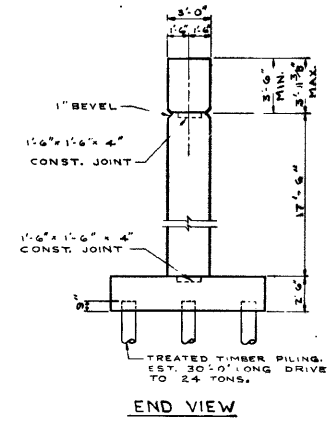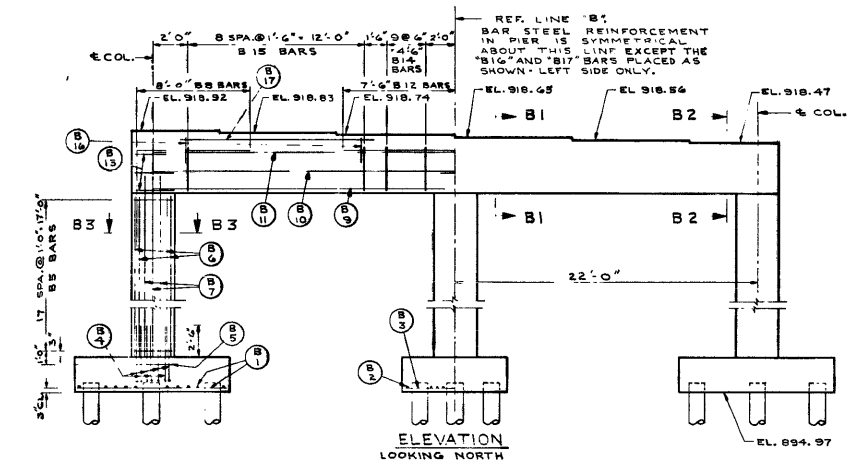

BILL OF BARS 9,540 #

DIMENSIONS IN BENDING DETAILS ARE OUT TO OUT.

BAR MARK	NO	SIZE	LENGTH	SPACING	LOCATION	FT
B1	40	3	10'-6"		FOOTINGS - EXT.	
B2	8	3	9'-6"		" " INT.	
B3	11	5	7'-0"		" " "	
B4	36	4	5'-0"		DOVELS	A
B5	3	4	9'-6"	1'-0"	HOOPS	B
B6	54	4	9'-6"	1'-0"	HOOPS - COLUMNS	B
B7	18	10	11'-3"	SHOWN	COLUMNS	
B8	8	10	20'-0"		" " "	
B9	20	9	20'-0"		CAP & EXT. COLUMNS	B
B10	4	4	20'-3"		SIDES	
B11	4	10	40'-0"		TOP	
B12	8	10	15'-0"		CENTER	
B13	6	5	10'-9"		ENDS	
B14	40	4	11'-9"		STIRRUPS	C
B15	18	4	12'-9"		" " "	D
B16	3	4	5'-9"		LEFT HALF - STIRRUPS	E
B17	2	4	13'-0"		" " TOP	F

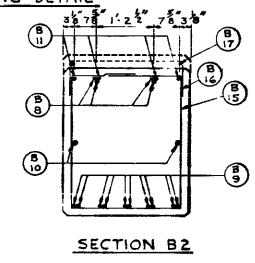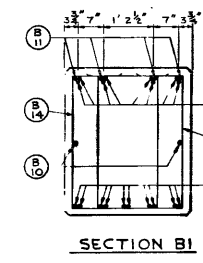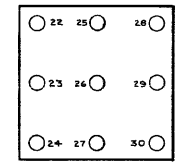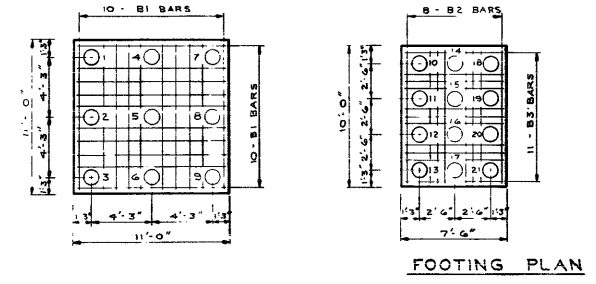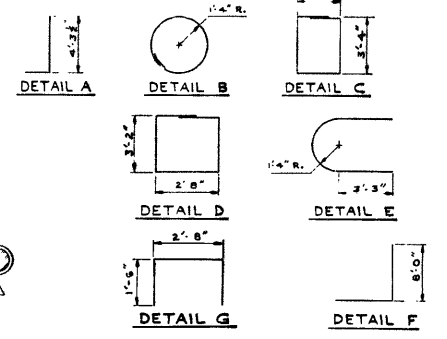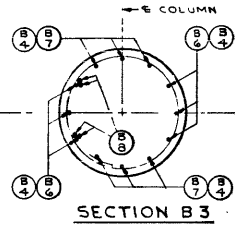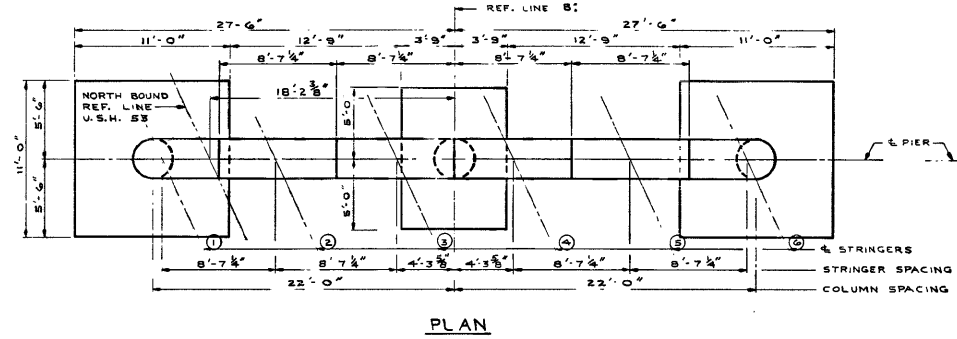

CONCRETE MASONRY

CAP	19.2 C.Y.
COLUMNS	13.7 C.Y.
FOOTINGS	28.7 C.Y.
TOTAL	61.6 C.Y.

STATE HIGHWAY COMMISSION OF WISCONSIN


PIER 1

DESIGN BY: A. A. S. H. O. & S. L. O. & S. L. O. 1943


BY: 12-27-63 DESIGN: J. B. CHECK: J. D. T. RLP

STRUCTURE: B 18 36 SHEET 11 OF 15


POUR	MARK	NO	SIZE	LENGTH	SPACING	LOCATION	P
FOOTINGS	C1	20	8	9'-6"	SHOWN	FOOTING - EXT.	
	C2	22	8	8'-0"	"	" - "	
	C3	22	9	9'-6"	"	" - INT.	
	C4	36	10	5'-0"	"	DOWELS	
	C5	3	4	9'-0"	1'-0"	HOOPS	
COLUMNS & CAP	C5	45	4	9'-6"	1'-0"	COLUMNS - HOOPS	
	C6	18	10	14'-9"	SHOWN	" - VERT.	
	C7	18	10	17'-6"	"	" - "	
	C8	8	11	16'-0"	"	" - CAP	
	C9	20	10	22'-0"	"	CAP - BOTTOM	
	C10	7	4	21'-0"	"	" - SIDES	
	C11	4	11	41'-0"	"	" - TOP	
	C12	8	11	15'-0"	"	" - CENTER	
	C13	6	5	11'-9"	"	" - ENDS	
	C14	36	5	13'-0"	"	" - STIRRUPS	
	C15	20	5	14'-0"	"	" - "	
	C16	10	5	5'-9"	"	" - LEFT SIDE - STIRRUPS	
C17	2	4	14'-6"	"	" - "		

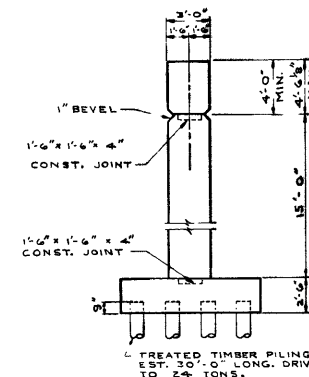


END VIEW

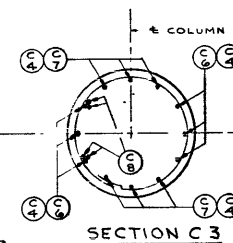


SECTION C 3

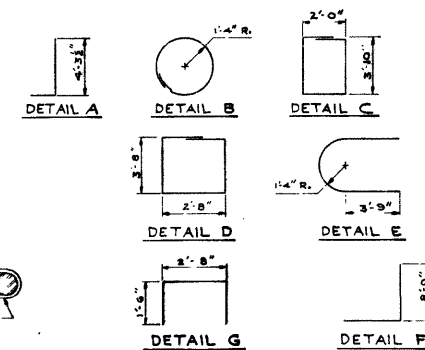



BUNDLING DETAIL

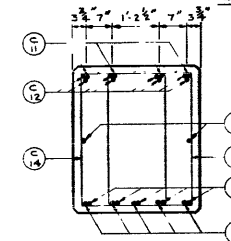

SECTION C1


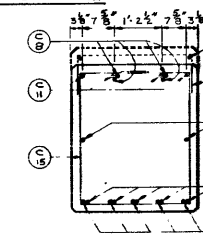


SECTION C 2

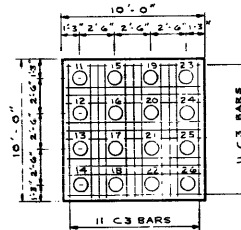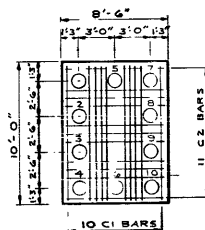

FOOTING PLAN

27	31	33
<input type="radio"/>	<input type="radio"/>	<input type="radio"/>
28		34
<input type="radio"/>		<input type="radio"/>
29		35
<input type="radio"/>		<input type="radio"/>
30	32	36
<input type="radio"/>	<input type="radio"/>	<input type="radio"/>





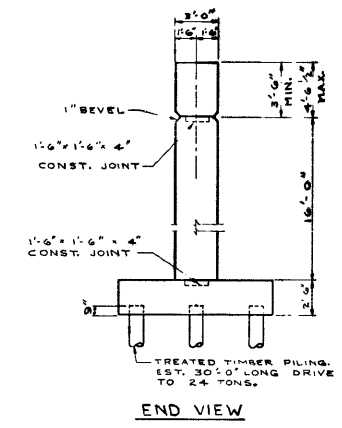
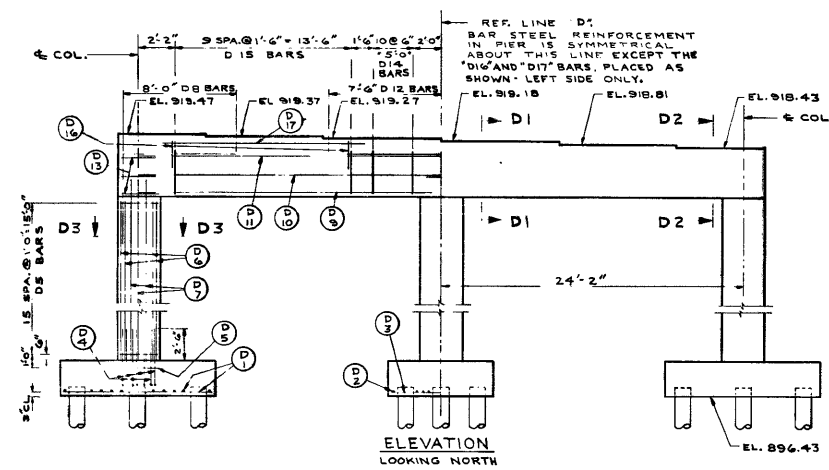


BILL OF BARS

10,750

DIMENSIONS IN BENDING DETAILS ARE OUT TO OUT.

FOUR MARK	NO	SIZE	LENGTH	SPACING	LOCATION	REQ	
FOOTINGS	D1	10	3	10'-6"	SHO. 1	FOOTINGS KEY	
	D2	8	3	9'-6"	"	"	
	D3	11	3	7'-0"	"	"	
	D4	36	10	5'-0"	"	DOWELS	A
	D5	3	4	9'-6"	1'-0"	HOOPS	B
COLUMNS & CAP	D1	48	4	9'-6"	1'-0"	HOOPS - COLUMNS	H
	D2	18	10	15'-9"	SHOWN	COLUMNS	
	D7	18	10	18'-6"	"	"	
	D8	8	11	14'-0"	"	CAP & EXT. COLUMNS	H
	D9	20	10	22'-0"	"	" - BOTTOMS	
	D10	4	4	22'-0"	"	" - SIDES	
	D11	4	11	43'-0"	"	" - TOP	
	D12	8	11	15'-0"	"	" - CENTER	
	D13	4	4	12'-3"	"	" - ENDS	E
	D14	4	4	13'-3"	"	" - STIRRUPS	C
	D15	20	5	13'-0"	"	"	D
	D16	10	5	7'-0"	"	" - LEFT HALF - STIRRUPS	G
	D17	2	4	14'-6"	"	"	

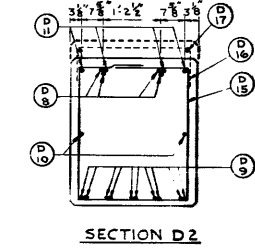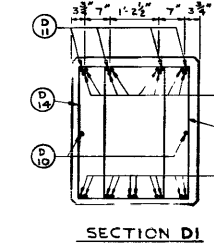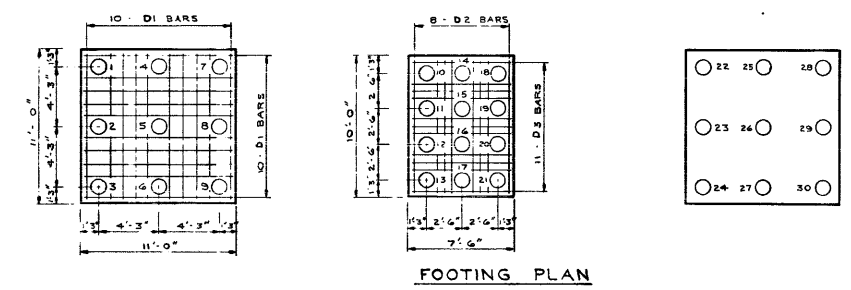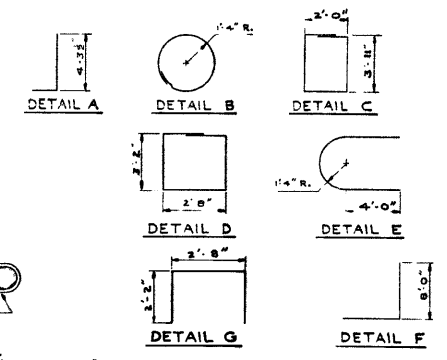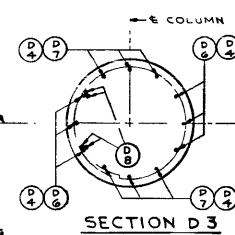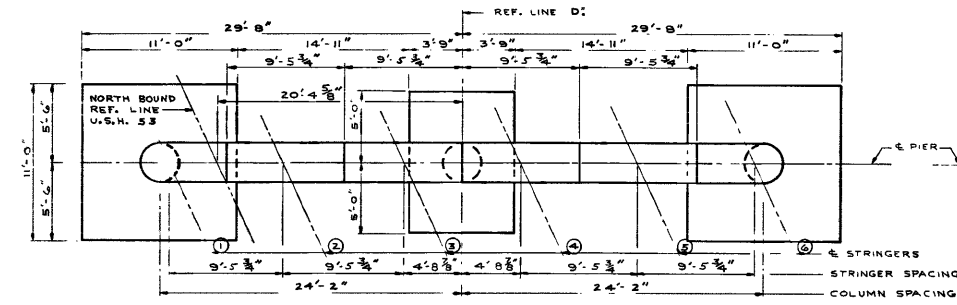

CONCRETE MASONRY

CAP	23.5 C.Y.
COLUMNS	12.6 C.Y.
FOOTINGS	28.7 C.Y.
TOTAL	64.8 C.Y.



STATE HIGHWAY COMMISSION OF WISCONSIN
PIER 3
DESIGNED BY A. A. SHOEN (20-516) 1963
CHIEF ENGINEER J. B. JENSEN (J.D.T.) L.L.P.
STRUCTURE **B 18 36** SHEET **13 OF 15**

BILL OF BARS


DIMENSIONS IN BENDING DETAILS ARE OUT TO OUT.

BAR MARK	NO	SIZE	LENGTH	SPA NO	LOCATION	DET
E1	48	4	13-0	AP 2-0	BODY	A
E2	8	4	18-0	SHOWN	"	"
E3	6	4	18-0	SHOWN	"	"
E4	35	5	0-0	1-0	BACK WALL - VERT.	C
E5	6	4	28-0	SHOWN	"	"
E6	11	5	5-0	1-0	PAVING NOTCH - VERT.	C
E7	16	4	7-0	SHOWN	"	"
E8	18	4	11-0	1-0	WINGS - HORIZ. F.F. B.F.	B
E9	19	4	11-0	1-0	"	"
E10	16	4	11-0	1-0	WING 2 - VERT.	"
E11	6	4	6-0	1-0	WING 1 - " B.F.	"
E12	7	4	13-0	1-0	" " F.F.	"
E13	7	4	5-0	1-0	" " B.F.	"
E14	10	5	6-0	1-0	RAILING PARAPET	C
E15	8	5	5-3	SHOWN	"	"
E16	30	4	3-3	SHOWN	GRID	B
E17	15	4	2-0	"	"	"

** THE 2-0" SPA. MAY BE ALTERED TO MISS PLIES

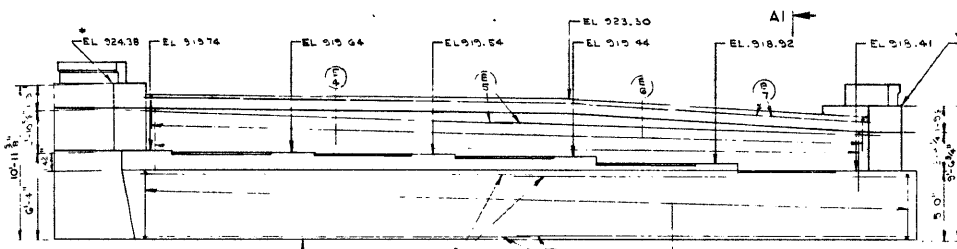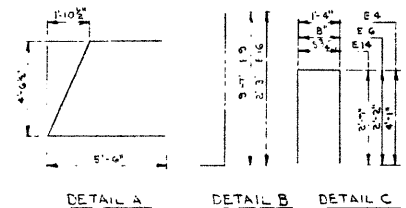


ELEVATION

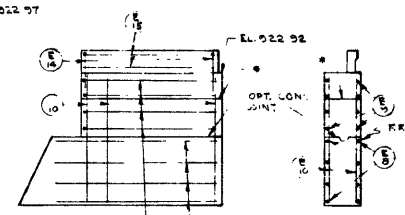


END VIEW-WING 2

SECTION A2

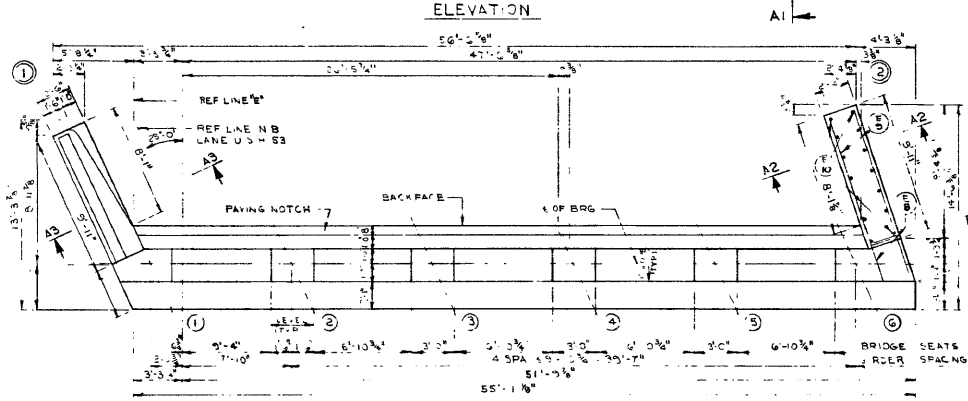


PLAN

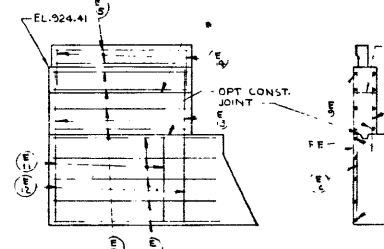


END VIEW-WING 1

SECTION A3

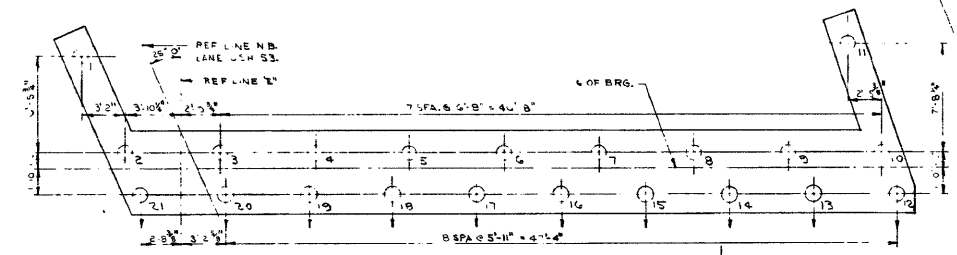


PILE PLAN

INDICATES BATTERED PILE BATTER 3/4% IN DIRECTION SHOWN

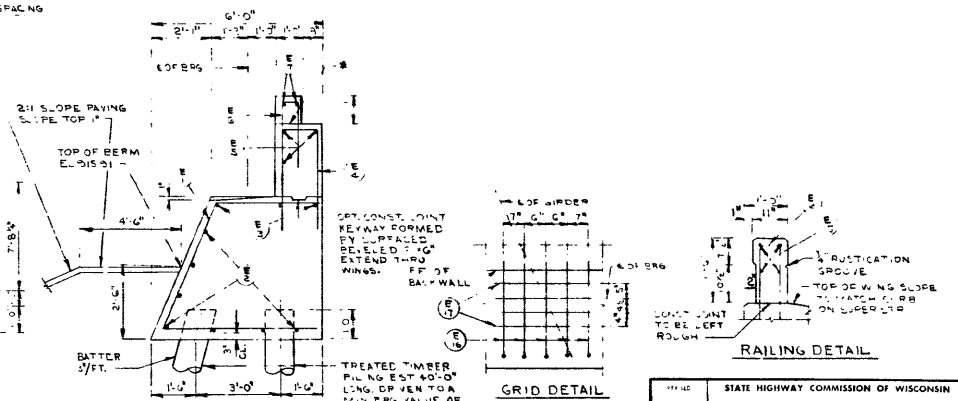

NOTES: FILL TO EL 918.92 BEFORE DRIVING PILING. UPPER LIMIT OF EXCAVATION FOR STRUCTURES SHALL NOT EXCEED THIS EL.

STATE HIGHWAY COMMISSION OF WISCONSIN
NORTH ABUTMENT
DESIGN SHEET A 1/2 H 0 W 1 LOADING H 2 1/2" H 1/2" (1/2")
DATE: 2-1-73 DESIGN: J.B. DRAWING: J.B. RLP
STRUCTURE: B-18-36 SHEET 14 OF 15

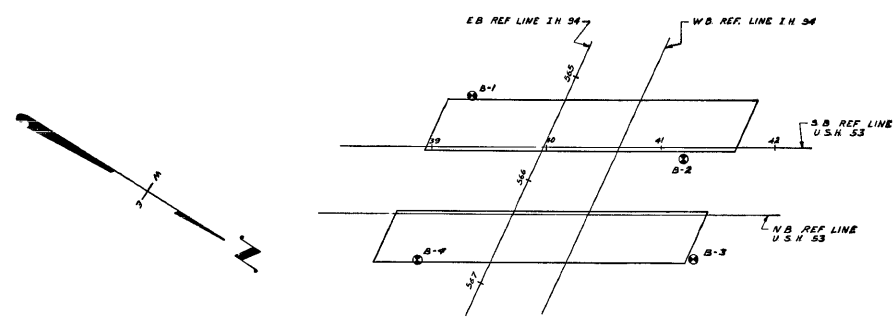

SUBSURFACE EXPLORATION FOR FOUNDATION DESIGN.

FOR THE DESIGN OF THE STRUCTURE FOUNDATION, TO OBTAIN RELATIVE DATA CONCERNING THE CHARACTER OF MATERIAL IN AND UPON WHICH THE FOUNDATION MIGHT BE BUILT, BORINGS AND/OR SOUNDINGS WERE MADE AT POINTS APPROXIMATELY AS INDICATED ON THIS DRAWING WITH THE LOG OF SUCH EXPLORATION DATA AS INTERPRETED FOR SUCH DESIGN PURPOSE AS SHOWN. THE EXPLORATIONS WERE MADE BY ORDINARY AND CONVENTIONAL METHODS AND CARE DEEMED ADEQUATE FOR SUCH PURPOSE. HOWEVER, SINCE IT IS A MATTER OF COMMON KNOWLEDGE THAT THE EXACT CHARACTER OF ANY MATERIAL AND ITS REACTION IS DIFFICULT TO DETERMINE FROM SUCH SUBSURFACE EXPLORATION AND THAT THE KIND AND CHARACTER OF MATERIAL AT THE SITE WHERE THE FOUNDATIONS ARE BUILT MAY VARY SUBSTANTIALLY FROM THAT INDICATED BY THE LOG THEY ARE MADE AVAILABLE TO THE BIDDERS SIMPLY FOR WHAT THEY ARE WORTH, WITHOUT ANY WARRANTY, EXPRESSED OR IMPLIED THAT THE MATERIAL TO BE ENCOUNTERED IN BUILDING THE FOUNDATION WILL CONFORM THEREWITH. IF THE LOG IS USED BY THE CONTRACTOR OR IN MAKING HIS BID, IT IS HEREBY EXPRESSLY STIPULATED THAT THE COMMISSION ACCEPTS NO RESPONSIBILITY FOR SAID USE.

UNLESS OTHERWISE SPECIFIED THE BLOWS PER FOOT AT THE LOCATIONS INDICATED ARE BASED ON DRIVING A 2" O.D. X 1.4" I.D. SPLIT SPOON SAMPLER WITH A 140 LB. HAMMER HAVING A FREE FALL OF 30 INCHES. THE BLOW COUNT IS TAKEN IN UNDISTURBED SOIL IMMEDIATELY BELOW A CASED OR OPEN HOLE ELIMINATING SIDE FRICTION ON THE DRIVE PIPE.

BORING #1		BORING #2		BORING #4		BORING #5		LEGEND OF BORING OPERATIONS	
DEPTH (FEET)	DESCRIPTION	DEPTH (FEET)	DESCRIPTION	DEPTH (FEET)	DESCRIPTION	DEPTH (FEET)	DESCRIPTION	BORING NO.	DESCRIPTION OF MATERIAL
310	SANDY TOPSOIL	310	SANDY TOPSOIL	310	SANDY TOPSOIL	310	SANDY TOPSOIL	1	GROUND ELEV
300	LOOSE BR FINE SAND & SILT	300	LOOSE BR FINE SAND	300	FINE BR SAND TR SILT	300	LOOSE-FIRM BR FINE-MED SAND, TR SILT	2	LOCATION OF BLOW COUNT
290	FIRM BR FINE SAND TR SILT	290	FIRM BR FINE SAND	290	SOME SILT, LOOSE BR FINE SAND, TR SILT	290	DENSE BR FINE-MED SAND	3	MATERIAL CHANGE
280	LOOSE BR SILT, TR FINE SAND	280	LOOSE BR FINE SAND	280	FIRM BR FINE-MED SAND	280	LOOSE-FIRM BR LAYERS OF SILT & FINE SAND	4	WH NO GROUND WATER ABOVE INDICATED ELEV
270	LOOSE BR SILT SEAMS OF FINE SAND	270	LOOSE BR FINE SAND	270	LOOSE BR FINE SAND, TR SILT	270	FIRM BR SILT, SOME FINE SAND		
260	DENSE VERY DENSE FINE BR SAND, TR SILT	260	LOOSE BR SILT, TR SAND	260	LOOSE BR SILT SOME FINE SAND	260	FIRM BR SILT, TR FINE SAND		
250		250	LOOSE GRAY SILT TR SAND	250	VERY LOOSE BR SILT TR SAND	250	FIRM BR SILT SOME FINE SAND		
		240	FIRM BR FINE SAND SEAMS OF SILT	240	FIRM GRAY SILT LAYERS FINE-MED SAND	240	VERY DENSE BR FINE-MED SAND, TR SILT		
		230	DENSE BR FINE SAND TR SILT	230	VERY DENSE BR FINE-MED SAND, TR SILT	230	VERY DENSE BR FINE-MED SAND, TR SILT		
		220	DENSE BR FINE SAND TR SILT	220	GROUND WATER ELEV 220.3 (7 DAY READING)	220	VERY DENSE BR FINE-MED SAND, TR SILT		
		210	HOLE FILLED			210			

★ 1/4" SAW CUT-SEE DETAIL SHEET 2.

BENCH MARK

KEEL MARK S.E. CORNER
OF SIGN BASE SOUTH OF I 94
WEST OF U.S.H. 53.
EL. 922.92.

STATE PROJECT NUMBER

0018-79-10

SHEET NO.

B.0

GENERAL NOTES

DRAWINGS ARE NOT TO SCALE.
CONTRACTOR SHALL VERIFY DIMENSIONS
IN THE FIELD.

TOTAL ESTIMATED QUANTITIES


	B-18-35	B-18-36
CONCRETE MASONRY, OVERLAY	91 C.Y.	110 C.Y.
DECK CLEANING	1157 S.Y.	1294 S.Y.
DECK PREPARATION	93 S.Y.	155 S.Y.
EPoxy CRACK SEALING	244 L.F.	272 L.F.
EXPANSION DEVICE	1 L.S.	1 L.S.
PROTECTIVE SURFACE TREATMENT	53 GAL.	60 GAL.
HIGH STRENGTH BAR STEEL REINF.	180 LB.	200 LB.
STRUCTURAL CARBON STEEL	1160 LB.	1270 LB.
JOINT REPAIR	10 S.Y.	11 S.Y.

DESIGN DATA

LIVE LOAD:	B-18-35	B-18-36
INVENTORY RATING	H19	H19
OPERATING RATING	HS24	HS25
ALLOWABLE DESIGN STRESSES:		
CONCRETE MASONRY	F'c = 4,000 psi	

LIST OF DRAWINGS

- OVERLAY — X72482
- DETAILS — X72483
- EXPANSION DEVICE AT ABUTMENTS — X72484

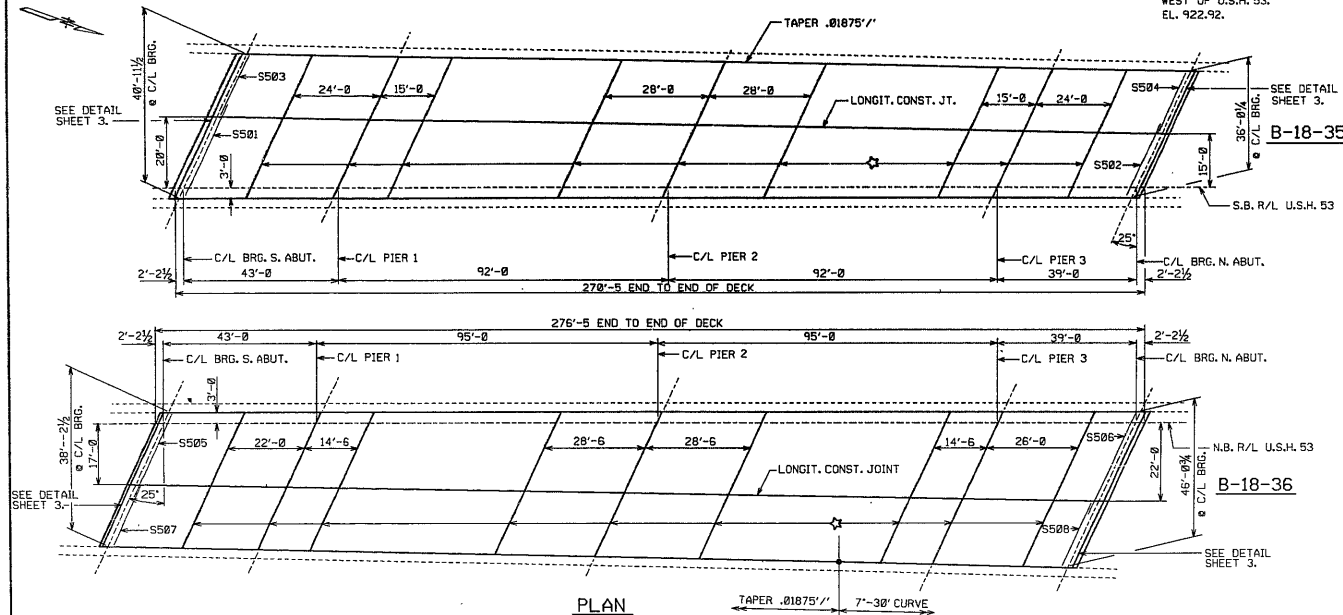

PLAN

END OF DECK S. ABUT.
STA. 38+94.12
EL. 923.95

TOP OF OVERLAY
R/L S.B.L. U.S.H. 53

AVG. OVERLAY THICKNESS = 2 1/4"
PROPOSED GRADE LINE
B-18-35

END OF DECK N. ABUT.
STA. 41+64.54
EL. 924.79

NOTE: VARIATIONS TO THE NEW GRADE
LINE OVER 1/4" MUST BE SUBMITTED
FOR REVIEW BY THE BRIDGE OFFICE

END OF DECK S. ABUT.
STA. 38+66.29
EL. 923.84


AVG. OVERLAY THICKNESS = 2 3/8"
PROPOSED GRADE LINE
B-18-36

TOP OF OVERLAY
R/L N.B.L. U.S.H. 53


END OF DECK N. ABUT.
STA. 41+42.71
EL. 923.80

NO.	DATE	REVISION	BY
STATE OF WISCONSIN DEPARTMENT OF TRANSPORTATION DIVISION OF HIGHWAYS			
STRUCTURE B-18-35/36			
U.S.H. 53 OVER I 94			
COUNTY	EAU CLAIRE	TOWN/ENCLAVE	WASHINGTON
DESIGN SPEC.	AASHTO '83	LOAD	CONSTR. 1981
DESIGNED BY	KAB	DRAWN BY	DB
PLANS	CK'D.	PLANS	CK'D.
APPROVED	Shirley J. Smith	DATE	3-29-00
CHIEF BRIDGE ENGINEER		DATE	
OVERLAY			SHEET 1 OF 3
			X 72482


B-18-35

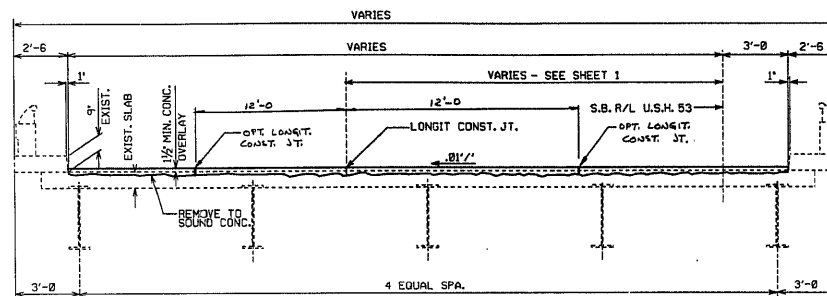

CROSS SECTION THRU RDWY.-B-18-35
(LOOKING NORTH)

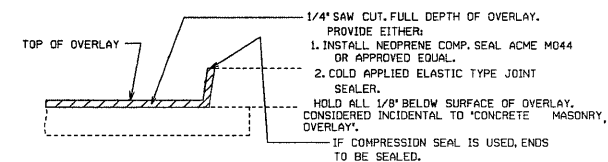


SAW CUT DETAIL

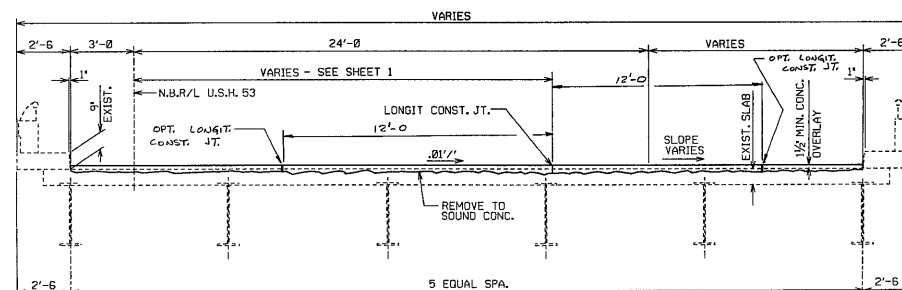

CROSS SECTION THRU RDWY.-B-18-36
(LOOKING NORTH)

NO.	DATE	REVISION	BY
STATE OF WISCONSIN DEPARTMENT OF TRANSPORTATION DIVISION OF HIGHWAYS			
STRUCTURE B-18-35/36			
CONST. SPEC.	1981	DRAWN BY DB	PLANS C.R.D. BW
DETAILS			SHEET 2 OF 3
			X 72483

B-18-35

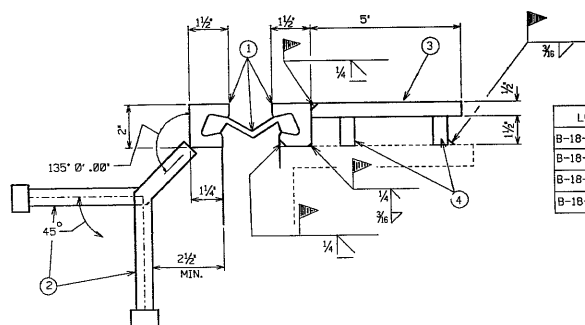

JOINT SECTION

LOCATION	'A'	'B'	'C'
B-18-35-S. ABUT.	25°-00'	23°-56'	45°-2½'
B-18-35-N. ABUT.	23°-56'	25°-00'	39°-9'
B-18-36-S. ABUT.	23°-56'	25°-00'	42°-2'
B-18-36-N. ABUT.	25°-00'	18°-53'	50°-11¼'

TEMPERATURE TABLE

TEMP.	JOINT OPENING
90°	1½"
80°	1½"
70°	1¾"
60°	1¾"
50°	1¾"
40°	1¾"
30°	2"

TEMP.=SHADED UNDERSIDE
DECK TEMP. (F°)


SEAL NOTES

FIELD SPlice DETAILS at LONGIT. CONST. JT.
SHALL BE SUBMITTED FOR APPROVAL. NO SPLICING
OF NEOPRENE SEAL PERMITTED.
SAND BLAST CLEAN STEEL EXTRUSIONS PRIOR TO COATING
WITH LUBRICANT ADHESIVE FOR NEOPRENE SEAL.
STRIP SEAL EXPANSION JOINT ASSEMBLY, INCLUDING ANCHOR
STUDS AND HARDWARE, WILL BE PAID FOR AT THE LUMP SUM
PRICE BID FOR "EXPANSION DEVICE."
NO.3 & NO.4 SHALL BE "STRUCTURAL CARBON STEEL."

BILL OF BARS

NOTE: THE FIRST OR FIRST TWO DIGITS
OF A BAR MARK SIGNIFIES THE
BAR SIZE.

BAR MARK	Coat	NO. REOD	LENGTH	SOFT	CUT. DIAG.	BUN- DLE	LOCATION
S501		2	27-3				PAVING BLOCK-B18-35-S.A.
S502		2	21-6				PAVING BLOCK-B18-35-N.A.
S503		2	19-5				PAVING BLOCK-B18-35-S.A.
S504		2	19-7				PAVING BLOCK-B18-35-N.A.
S505		2	23-11				PAVING BLOCK-B18-36-S.A.
S506		2	29-5				PAVING BLOCK-B18-36-N.A.
S507		2	19-9				PAVING BLOCK-B18-36-S.A.
S508		2	22-11				PAVING BLOCK-B18-36-N.A.

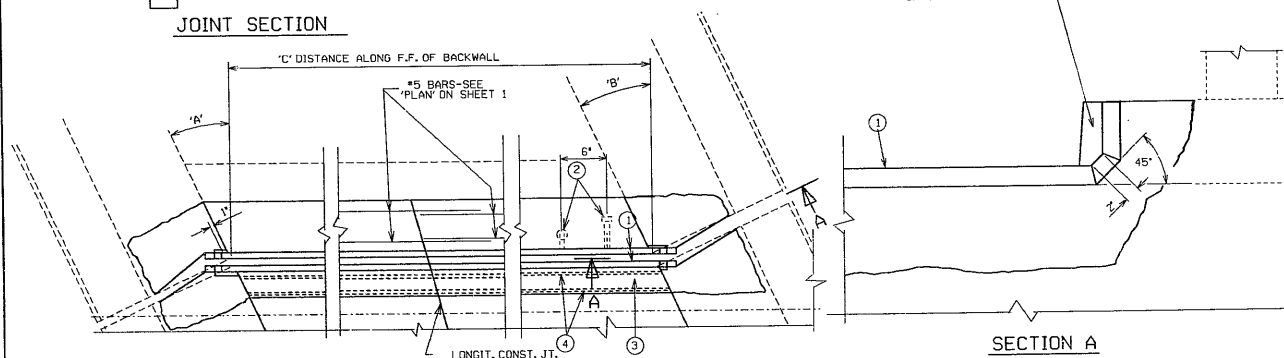


PLAN OF PROPOSED JOINT

SECTION A

NO.	DATE	REVISION			BY
STATE OF WISCONSIN DEPARTMENT OF TRANSPORTATION DIVISION OF HIGHWAYS					
STRUCTURE B-18-35/36					
CONST. SPEC.	1981	DRAWN BY	DB	PLANS C'D.	BW
EXPANSION DEVICE AT ABUTS.				SHEET 3 OF 3 X 72484	

B-18-35

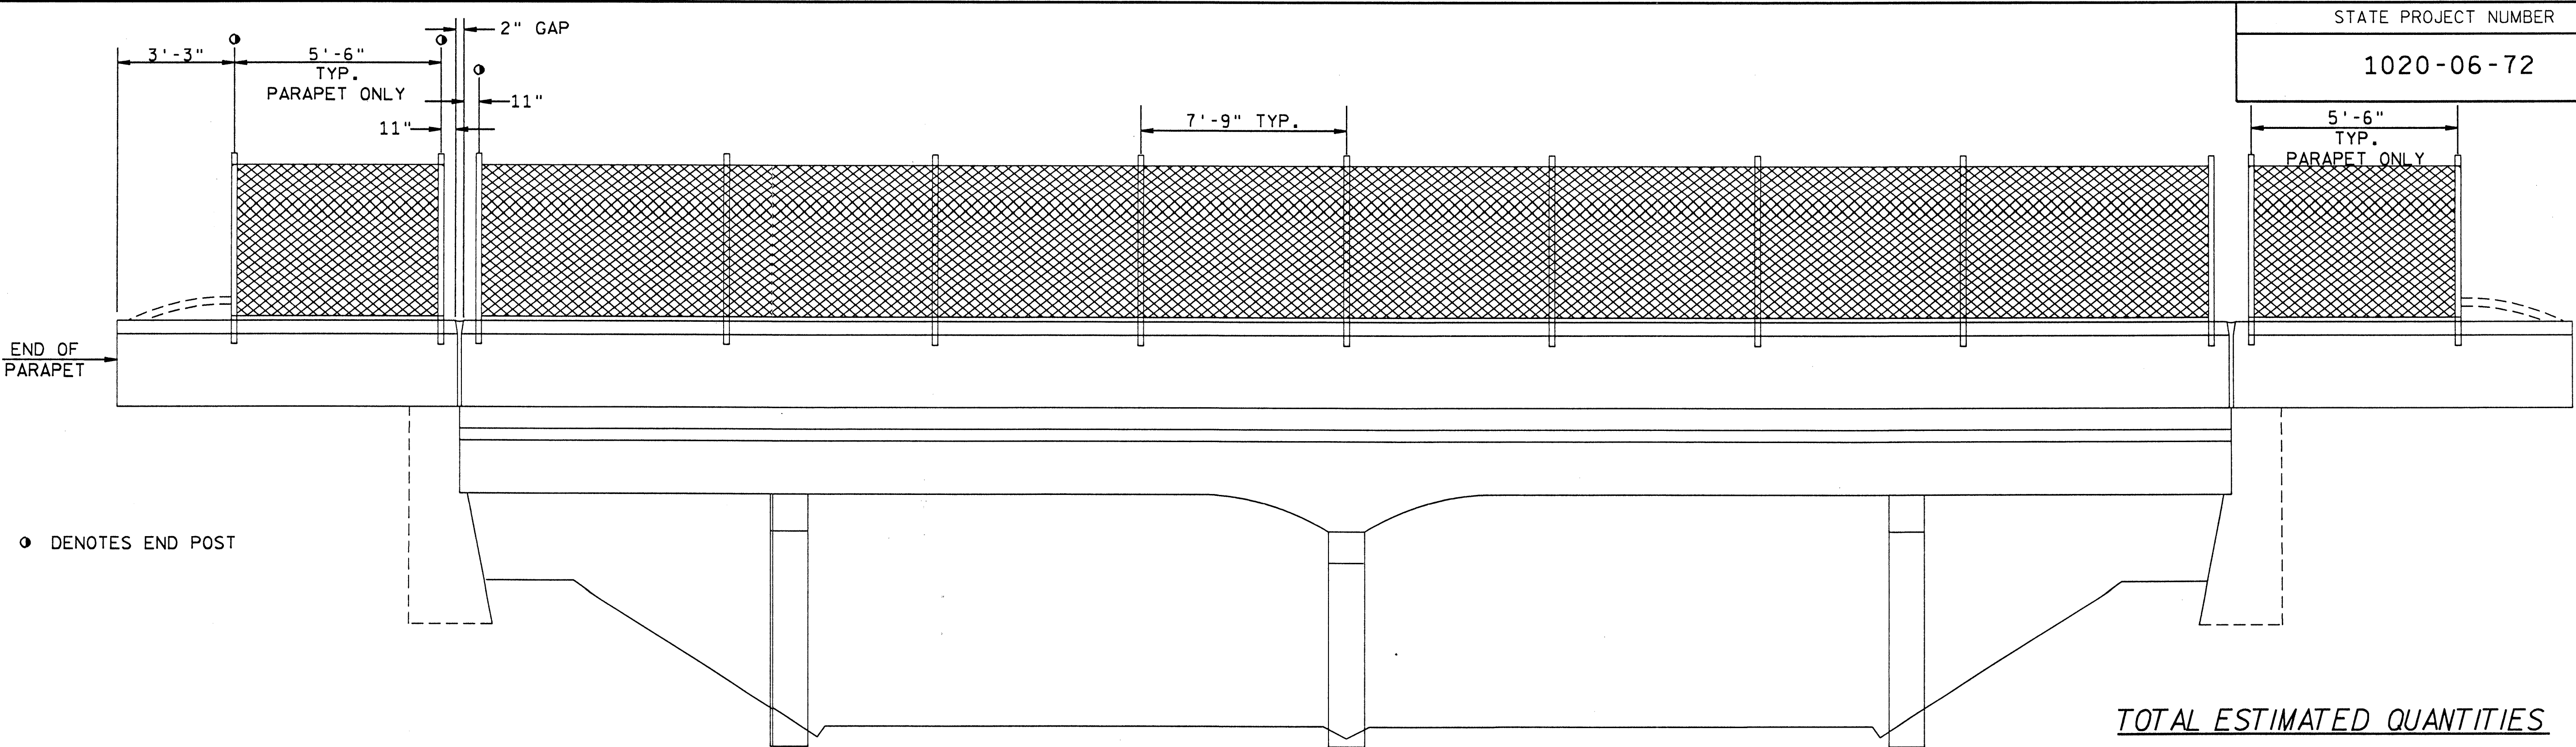


● DENOTES END POST

ELEVATION

TOTAL ESTIMATED QUANTITIES

BID ITEM	B-18-35	B-18-36
CHAIN LINK FENCE, 8 FT.	549	549
CONC. MASONRY ANCHORS, TYPE S, 3/4-IN.	160	160

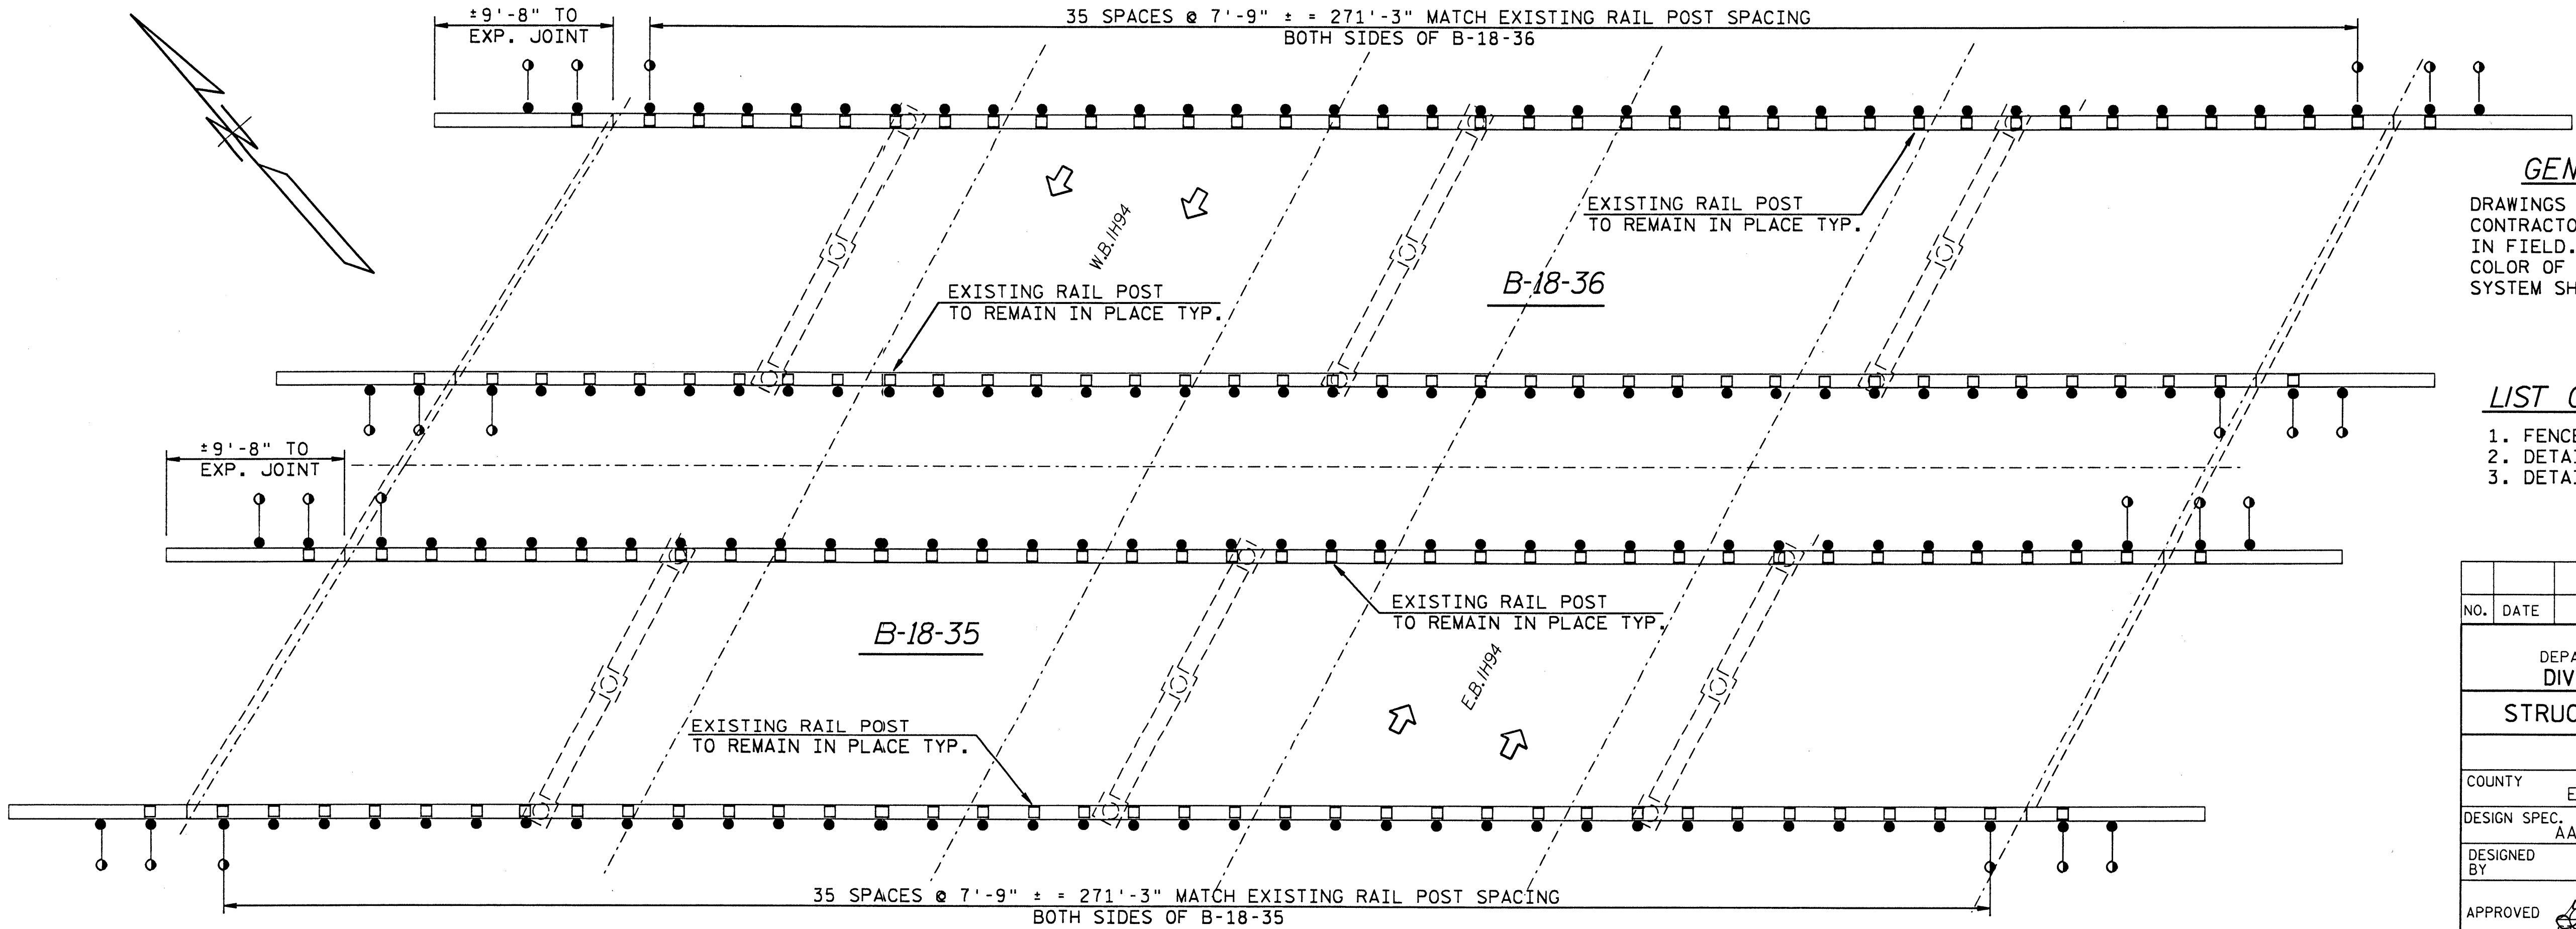


PLAN

GENERAL NOTES

DRAWINGS SHALL NOT BE SCALED.
CONTRACTOR SHALL VERIFY DIMENSIONS
IN FIELD.
COLOR OF VINYL COATED FENCING
SYSTEM SHALL BE BLACK.


LIST OF DRAWINGS

1. FENCE DETAILS
2. DETAILS
3. DETAILS

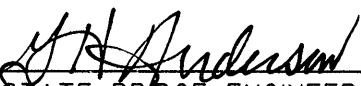NO.	DATE	REVISION	BY
STATE OF WISCONSIN DEPARTMENT OF TRANSPORTATION DIVISION OF HIGHWAYS			
STRUCTURE B-18-35/36			
U.S.H. 53 OVER I.H. 94			
COUNTY	EAU CLAIRE	TOWN/CITY/VILLAGE WASHINGTON	
DESIGN SPEC.	AASHTO 1990	LOAD ———	CONST. SPEC. 1989
DESIGNED BY	DESIGN CK'D.	DRAWN BY DIST. 6	PLANS CK'D.
APPROVED	 STATE BRIDGE ENGINEER		12-21-95 DATE
OVERPASS FENCE DETAILS		SHEET 1 OF 3	
		DATE: 6-23-94	

D6_10200601:OVERDET.DGN
PENS:IP-PENWTS
3-29-95 AJE


PAGE 2

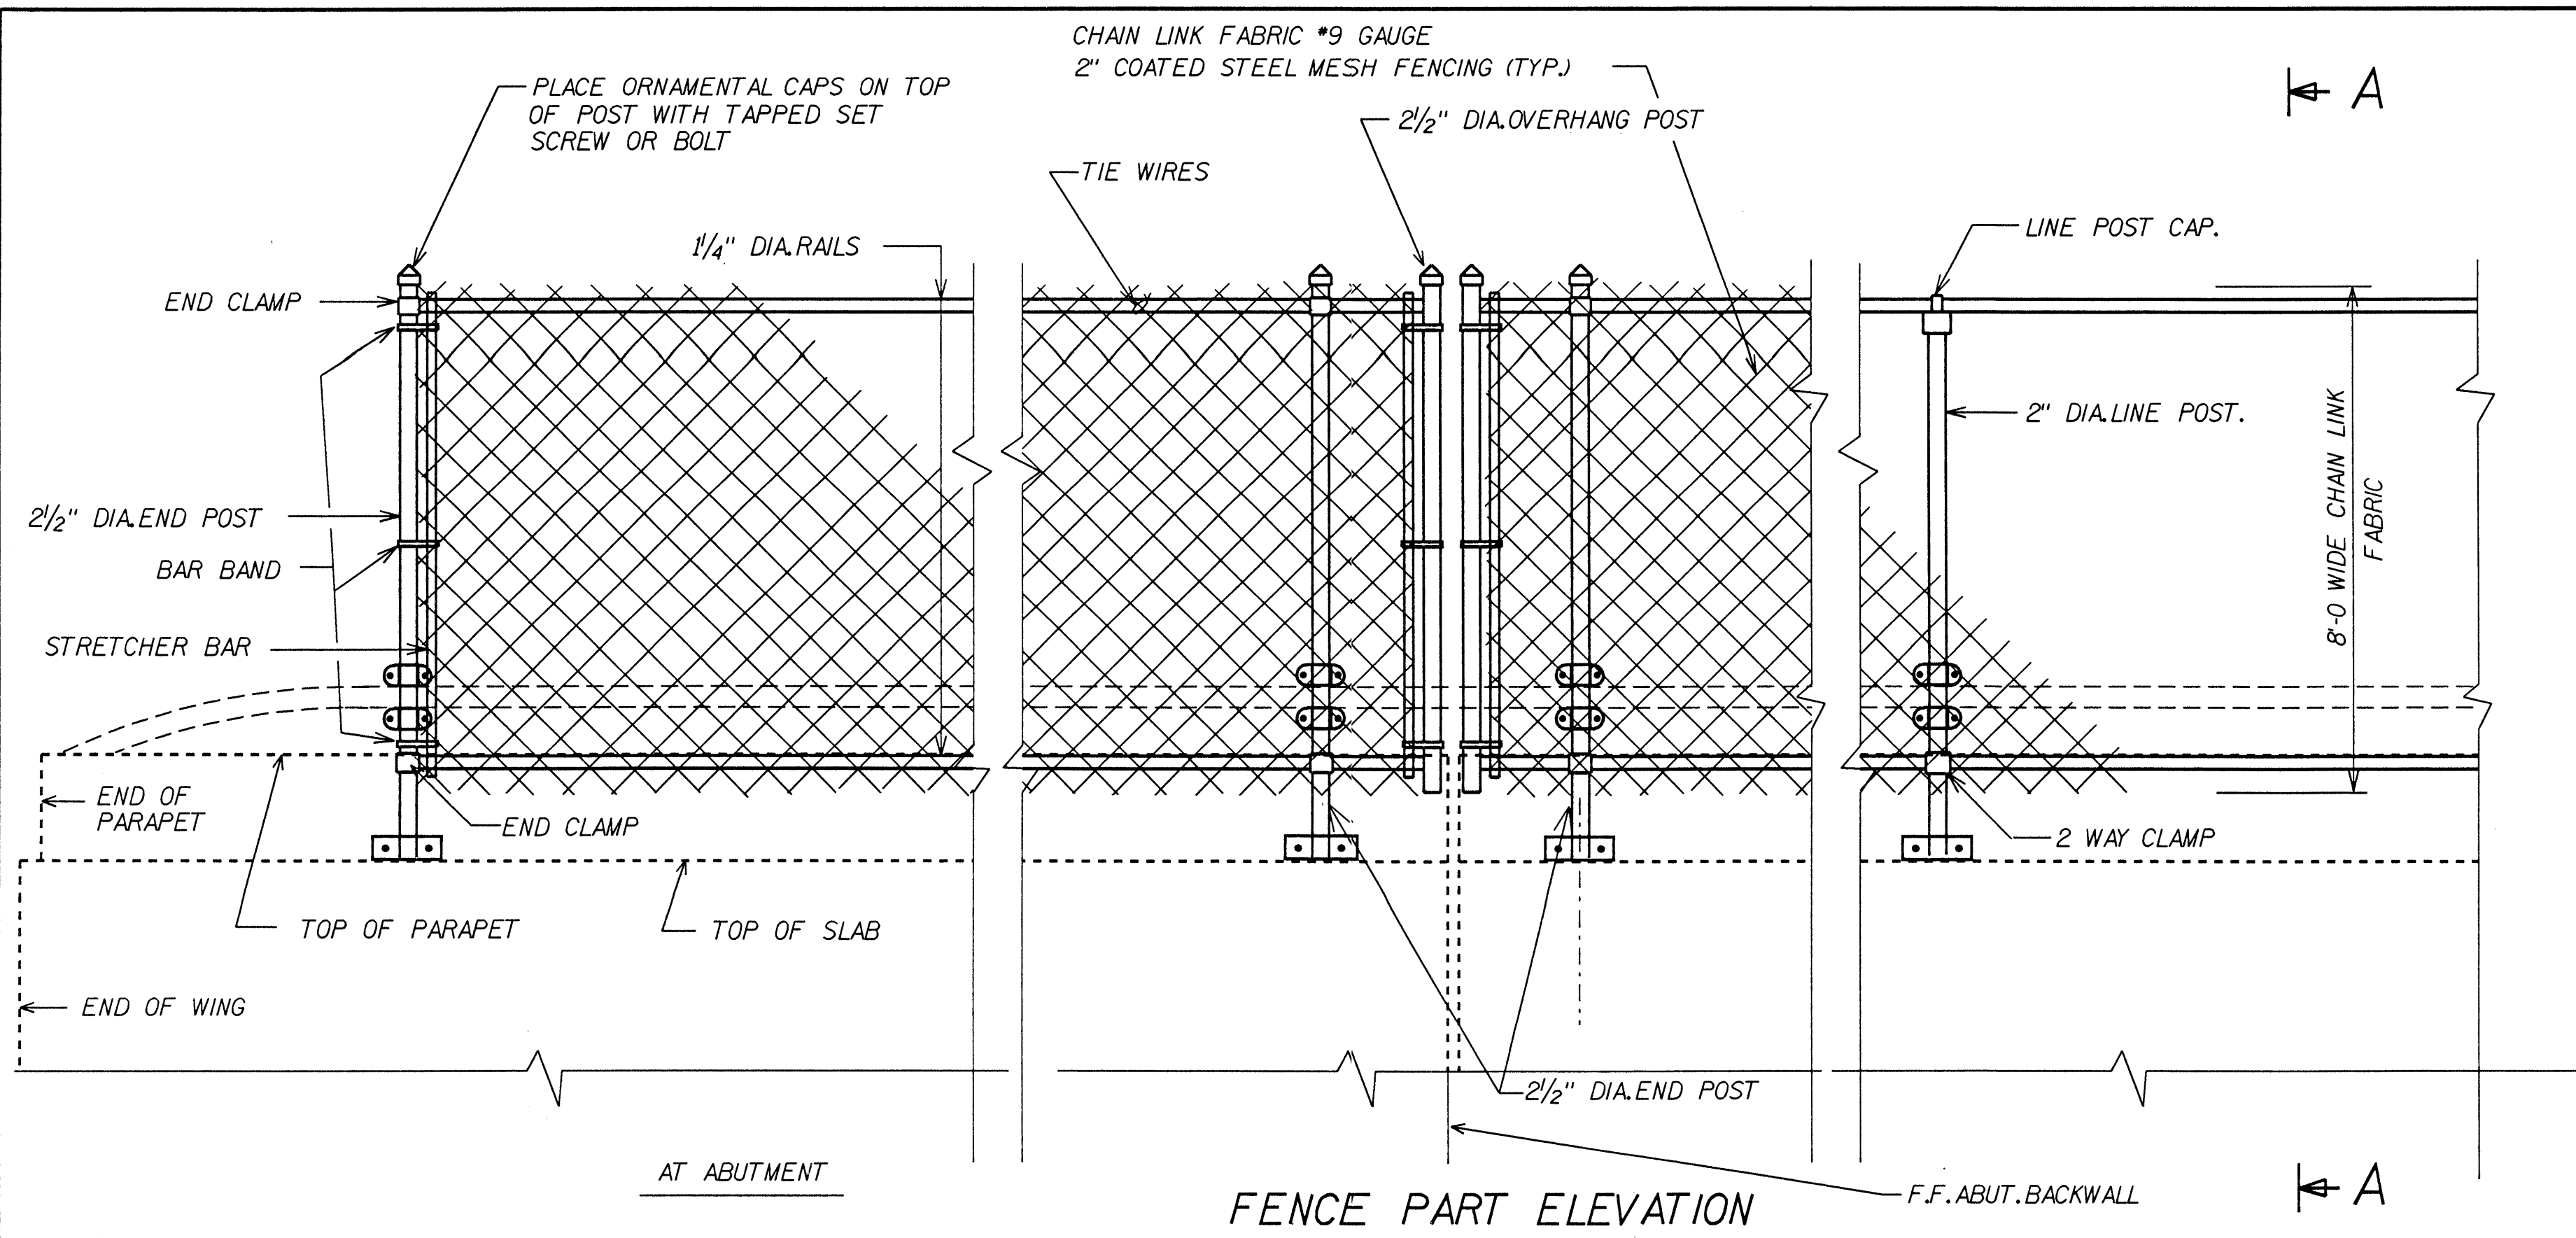


FENCE PART ELEVATION

FENCING NOTES


ALL RAILS AND POSTS ARE STANDARD GALVANIZED STEEL PIPE.
ALL POSTS SHALL BE SET VERTICAL.
KNUCKLE TOP AND BOTTOM OF 2" MESH CHAIN LINK FENCING.
ALL FENCING BAR BANDS, STRETCHER BARS, & CLAMPS ARE TO BE GALVANIZED STEEL (GRADE 1) & COLOR COATED TO MATCH FENCE.
CHAIN LINK FENCE SHALL CONFORM TO THE REQUIREMENTS OF A.A.S.H.T.O.M-181 TYPE IV, CLASS B ANY SPECIFICATION IN 616.2.3 THAT CONFLICTS WITH A.A.S.H.T.O.M-181 SHALL NOT APPLY. FENCE MATERIAL SHALL BE COATED BLACK.

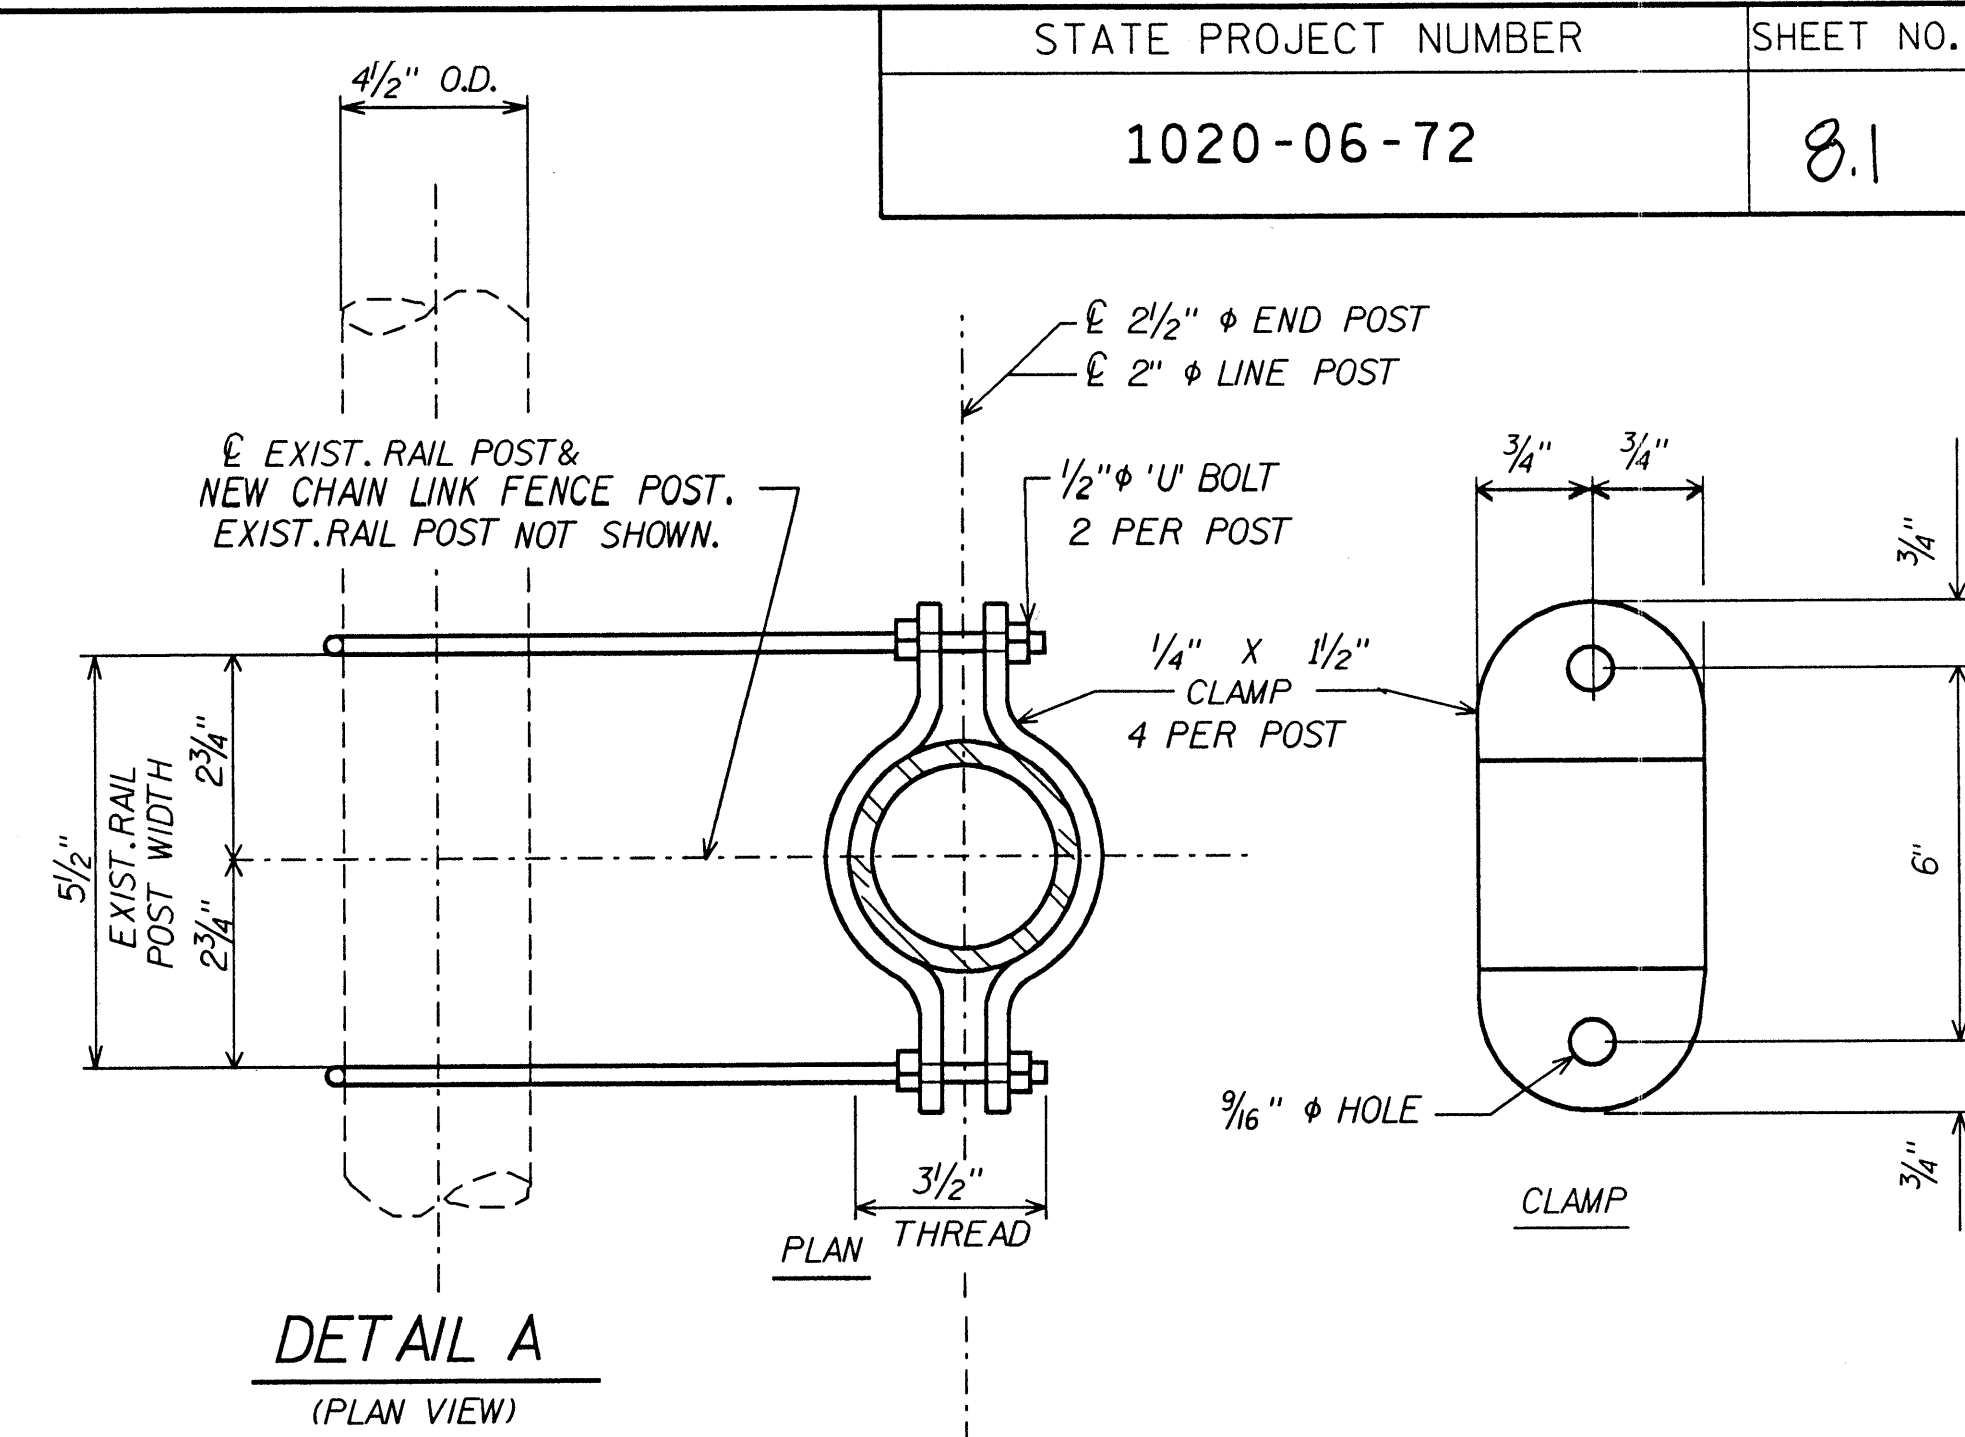


DETAIL A
(PLAN VIEW)

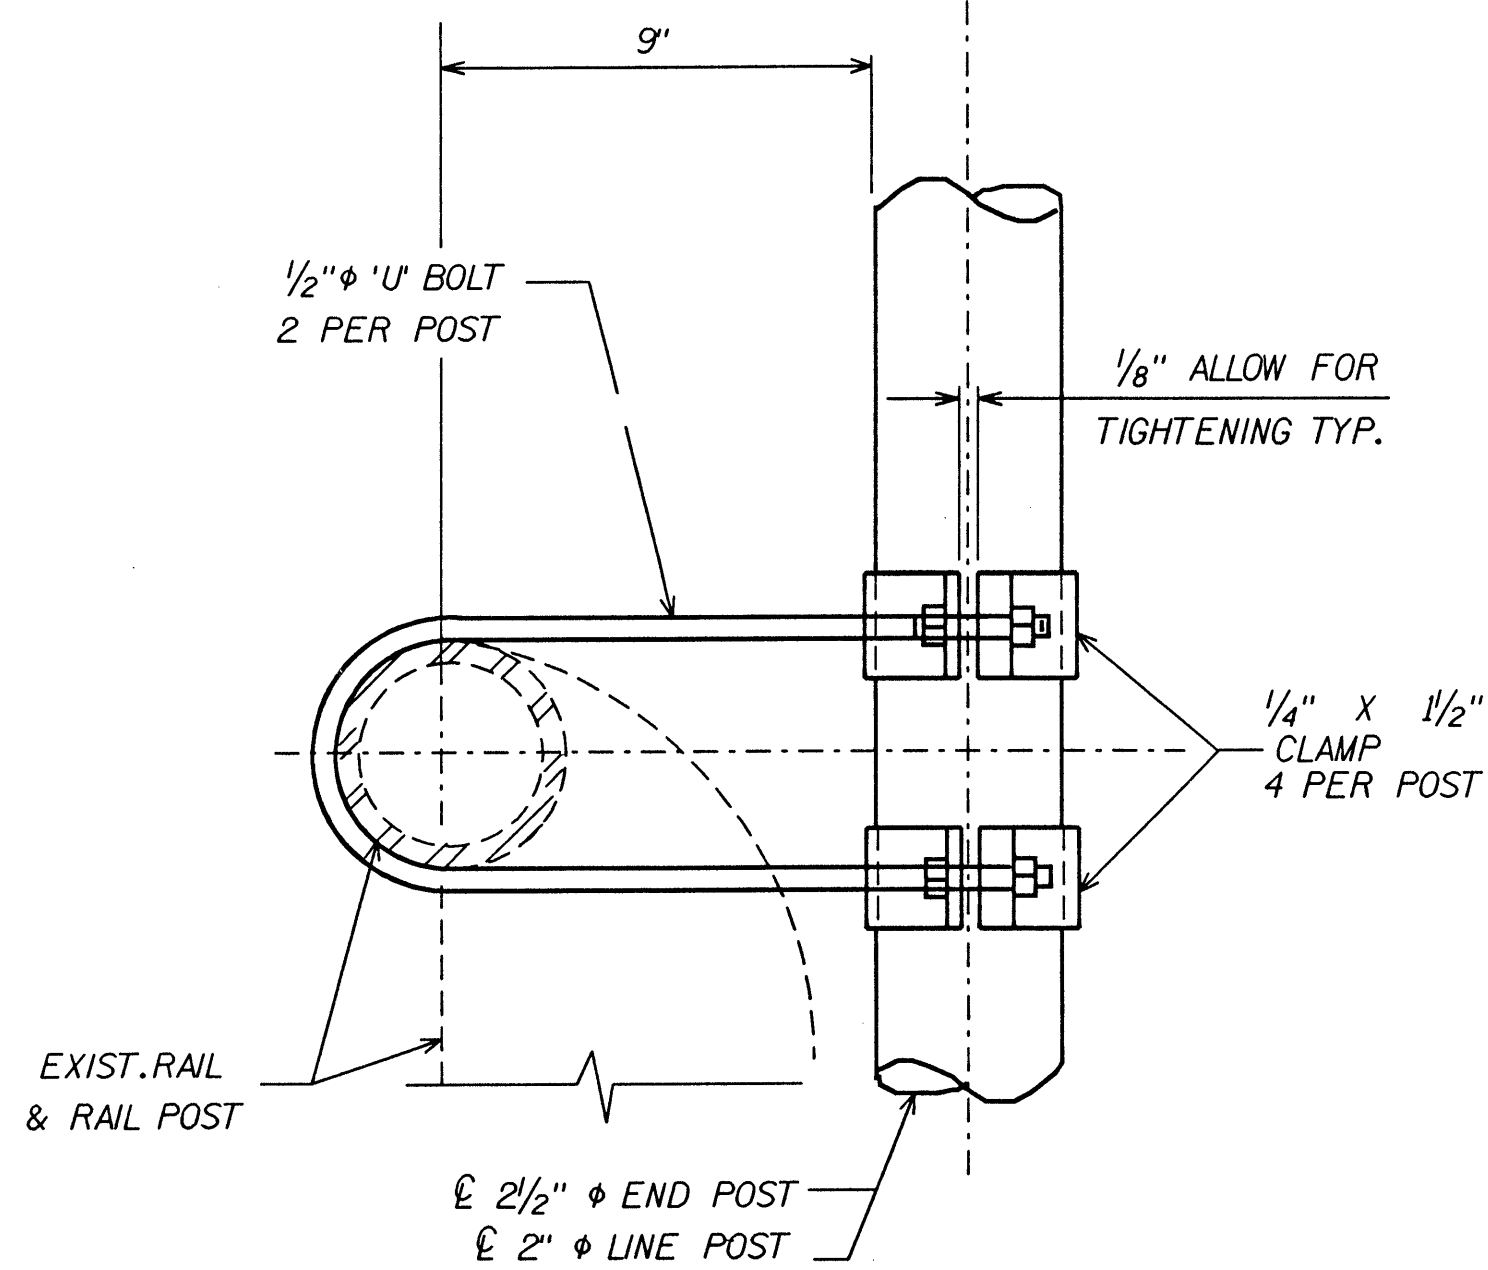

ELEVATION AT CLAMP CONN.

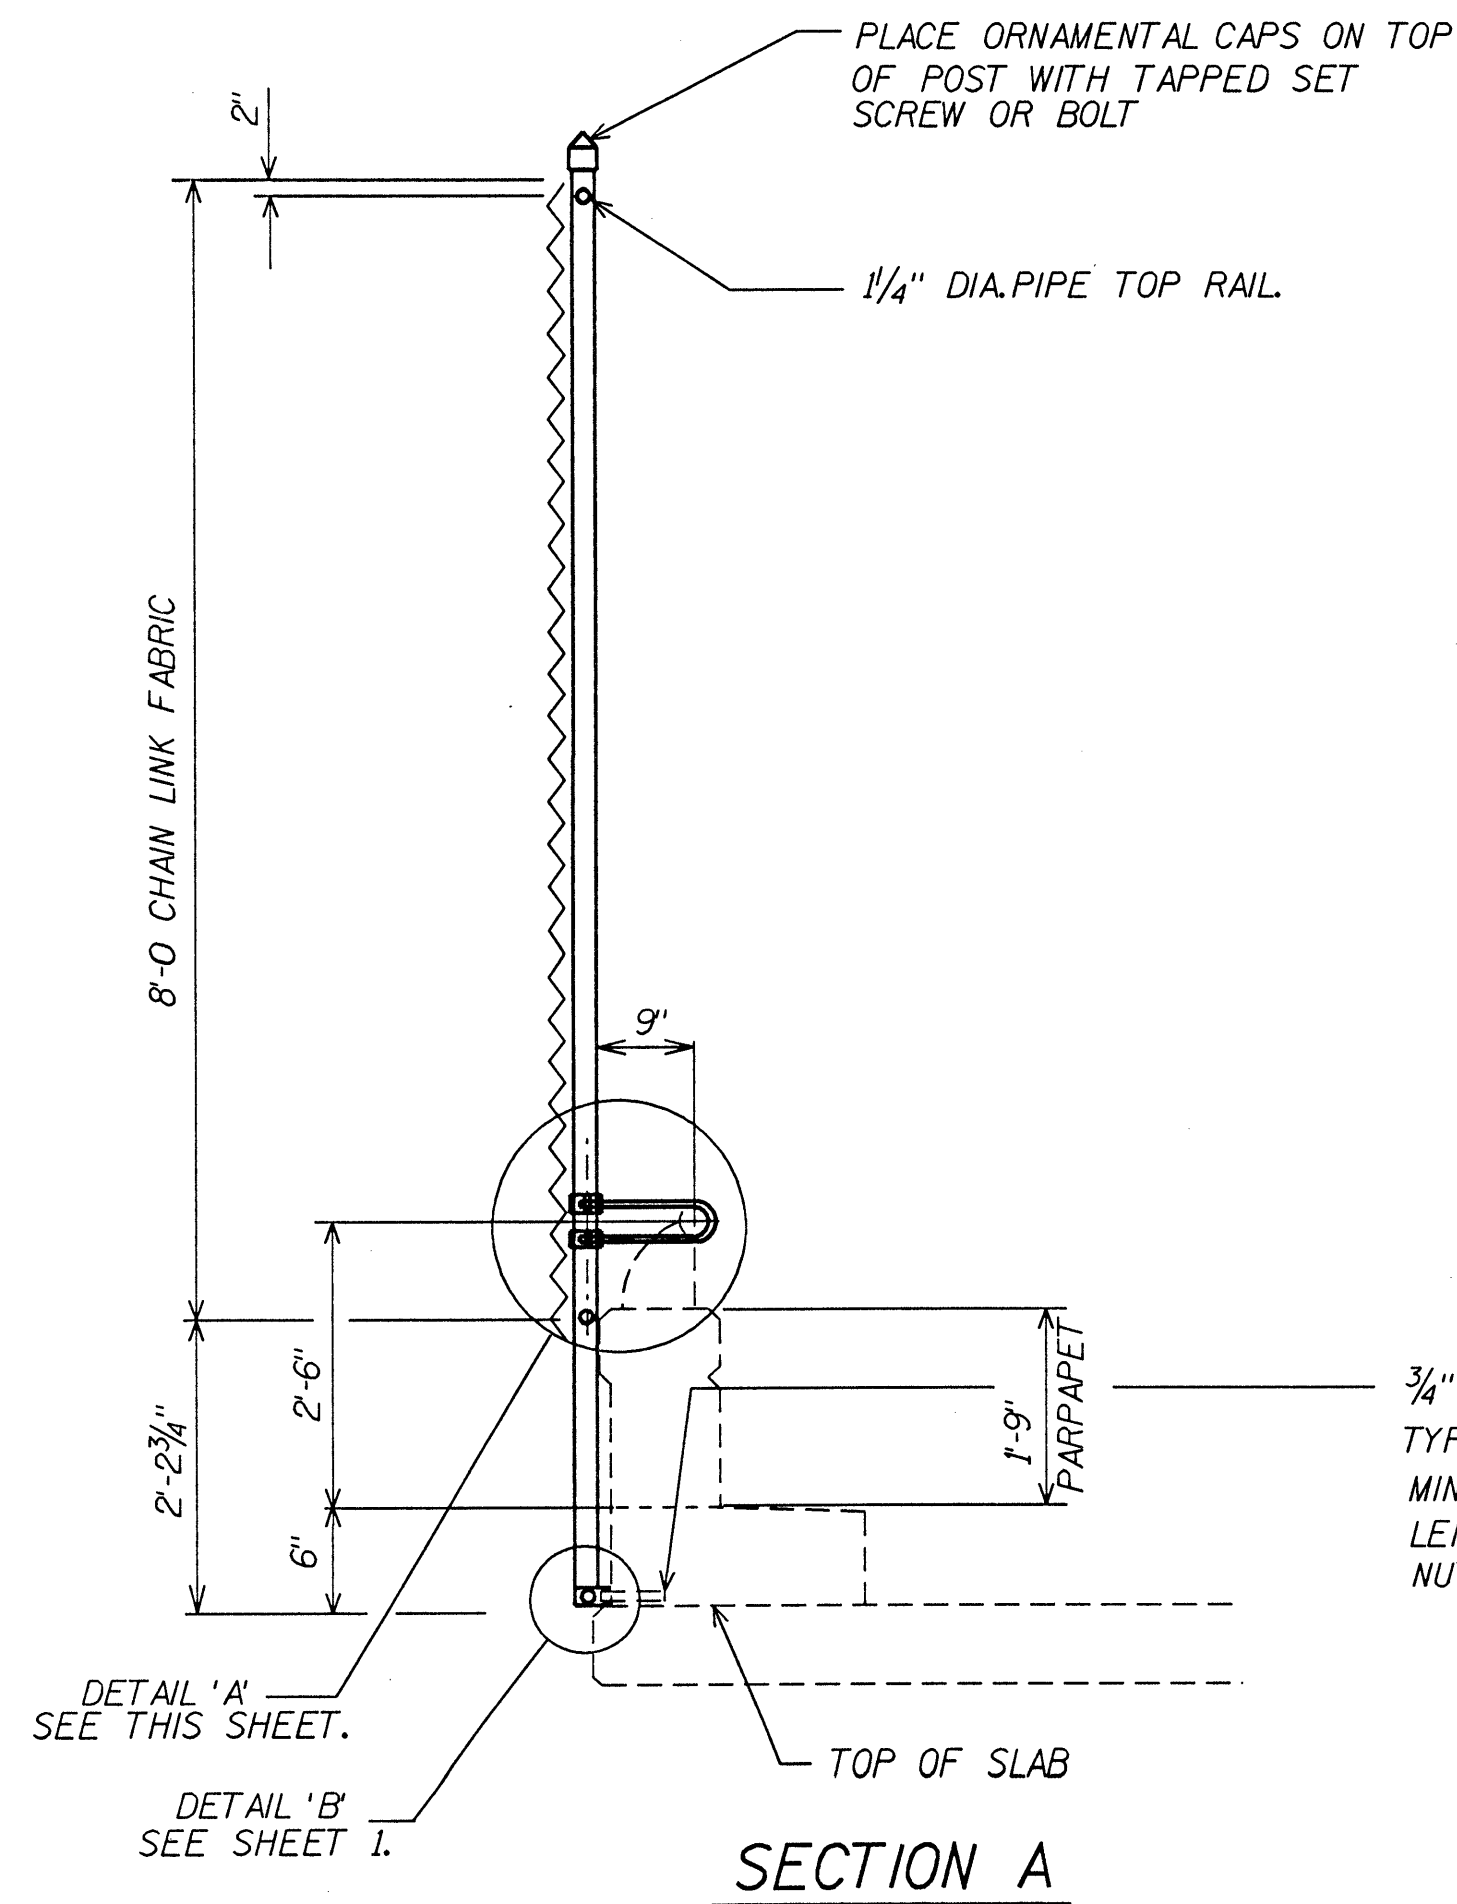

SECTION A

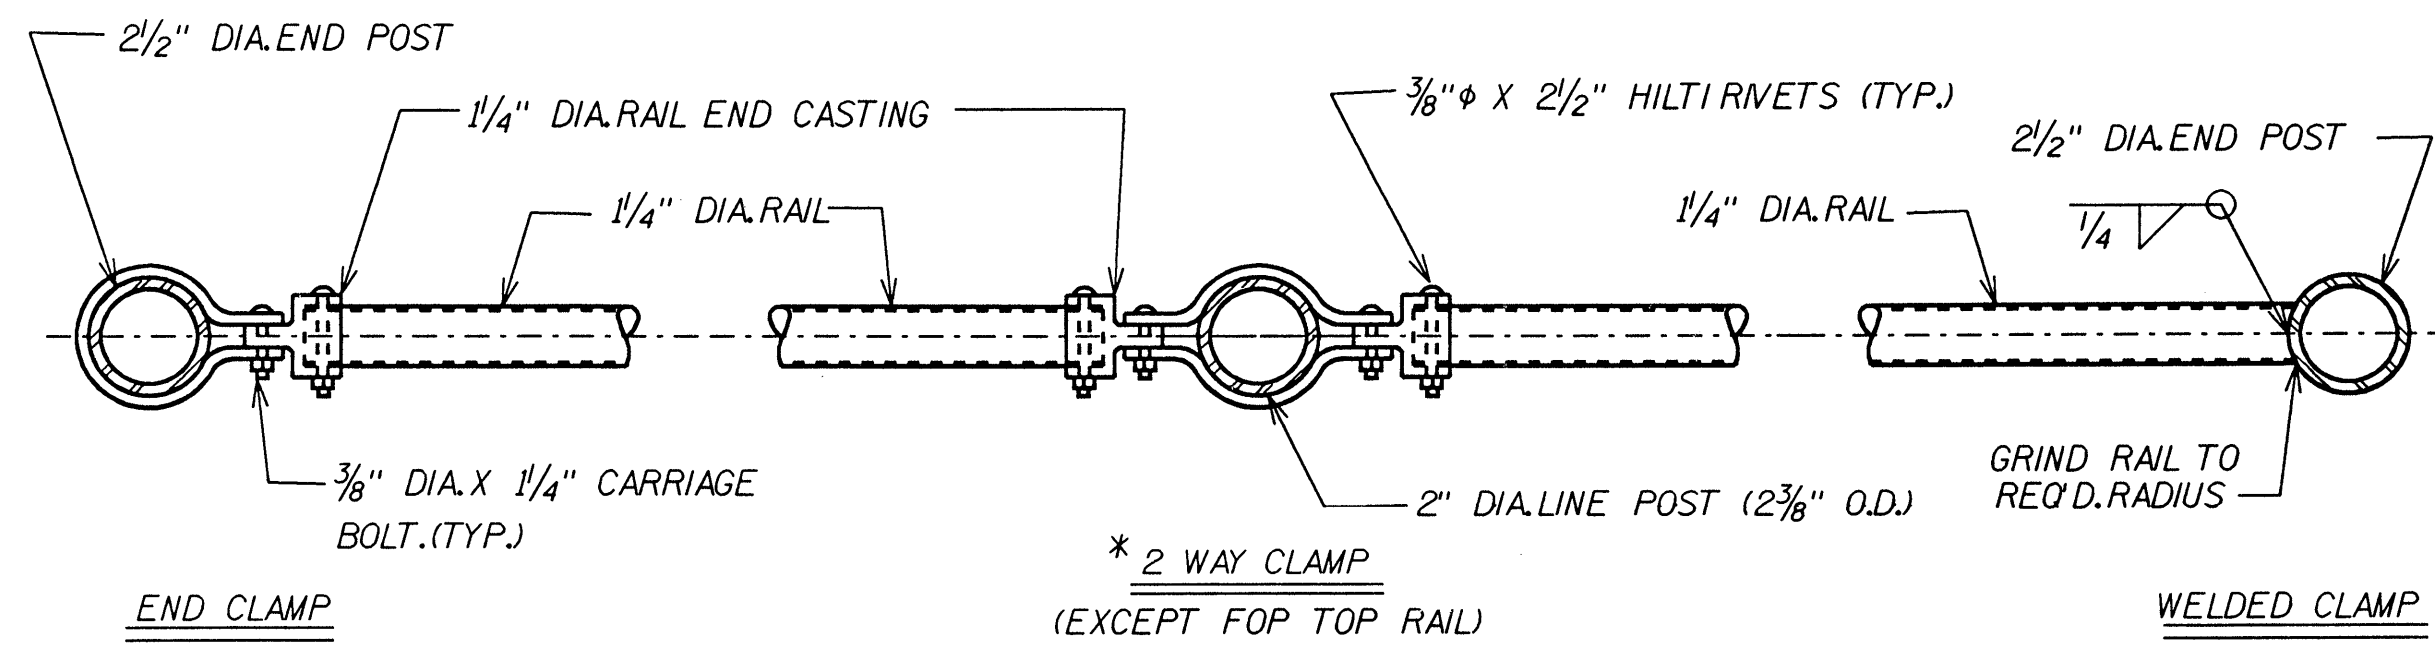

PLAN OF RAILING








NOTE: PLACE ALL NUTS ON OUTSIDE OF FENCE

* ALTERNATE BOULEVARD 2-WAY CLAMP MAY BE USED.

NO.	DATE	REVISION	BY
		STATE OF WISCONSIN DEPARTMENT OF TRANSPORTATION DIVISION OF HIGHWAYS	
		STRUCTURE B-18-35/ 36	
CONST. SPEC.	1989	DRAWN BY BUDD	PLANS CKD. DRG
OVERPASS FENCE DETAILS			SHEET 2 OF 3

REVISED 6/23/94 - DIST. 6 - LJH

42CHAIN.DGN AS-5.33333

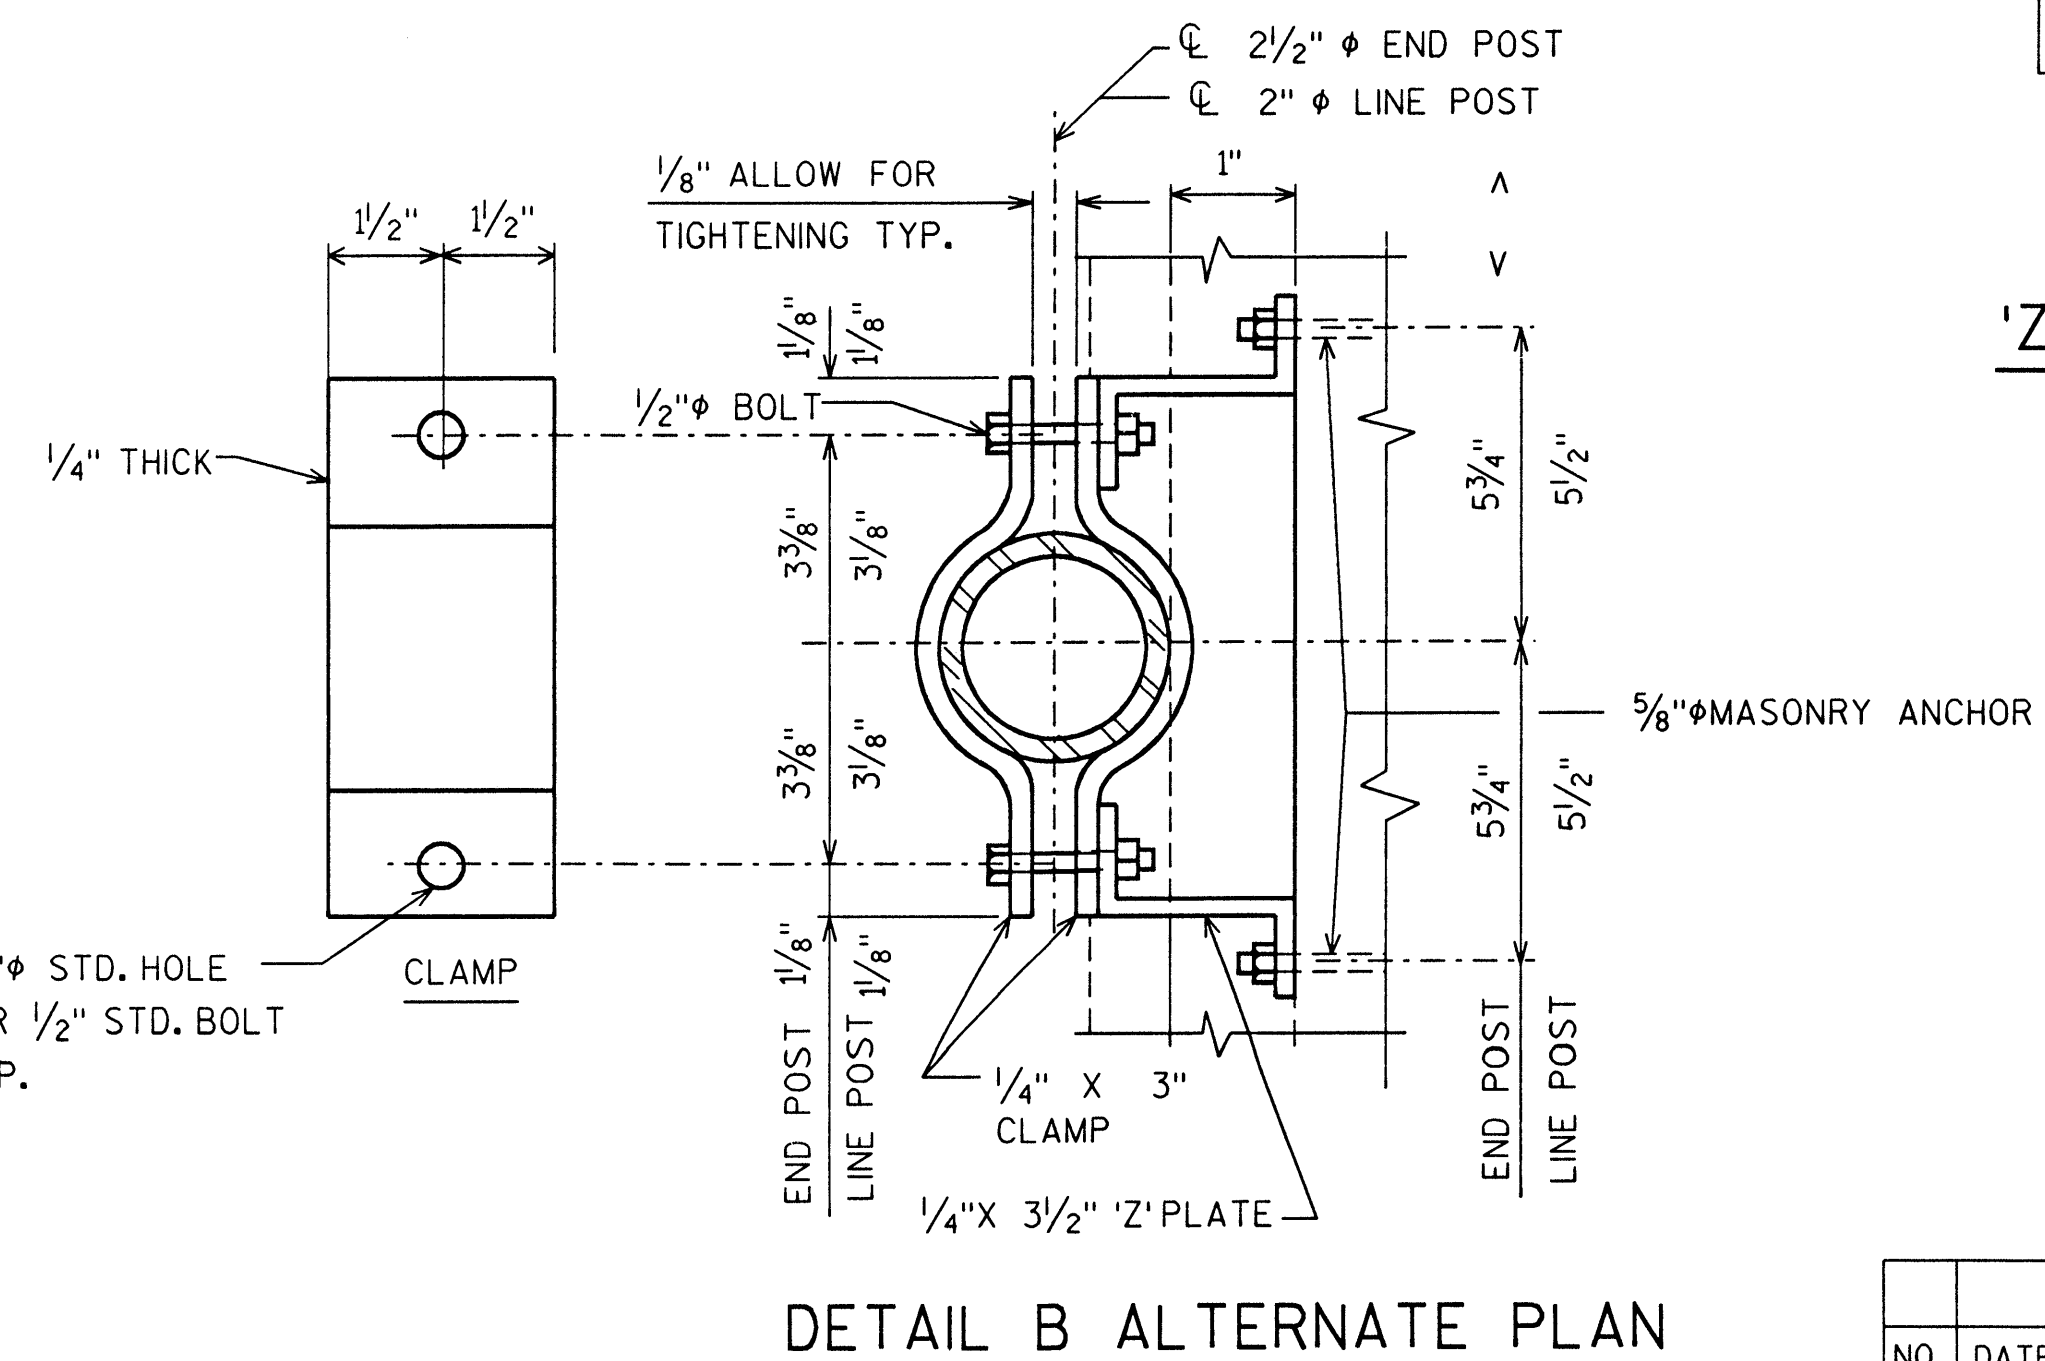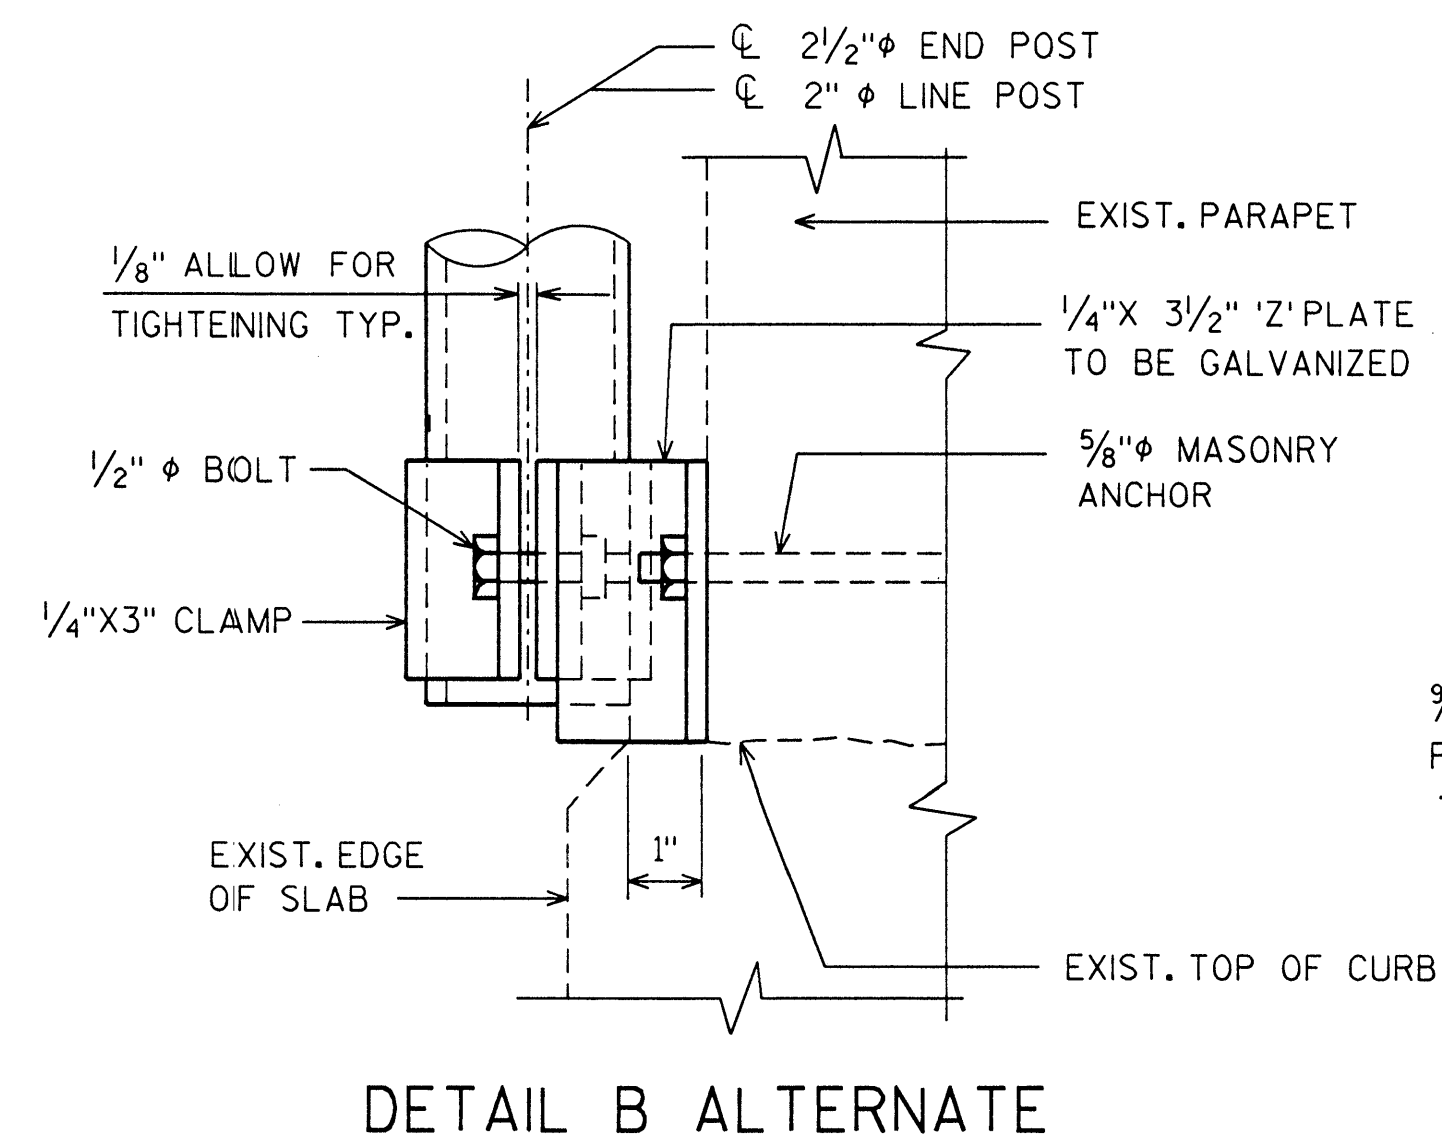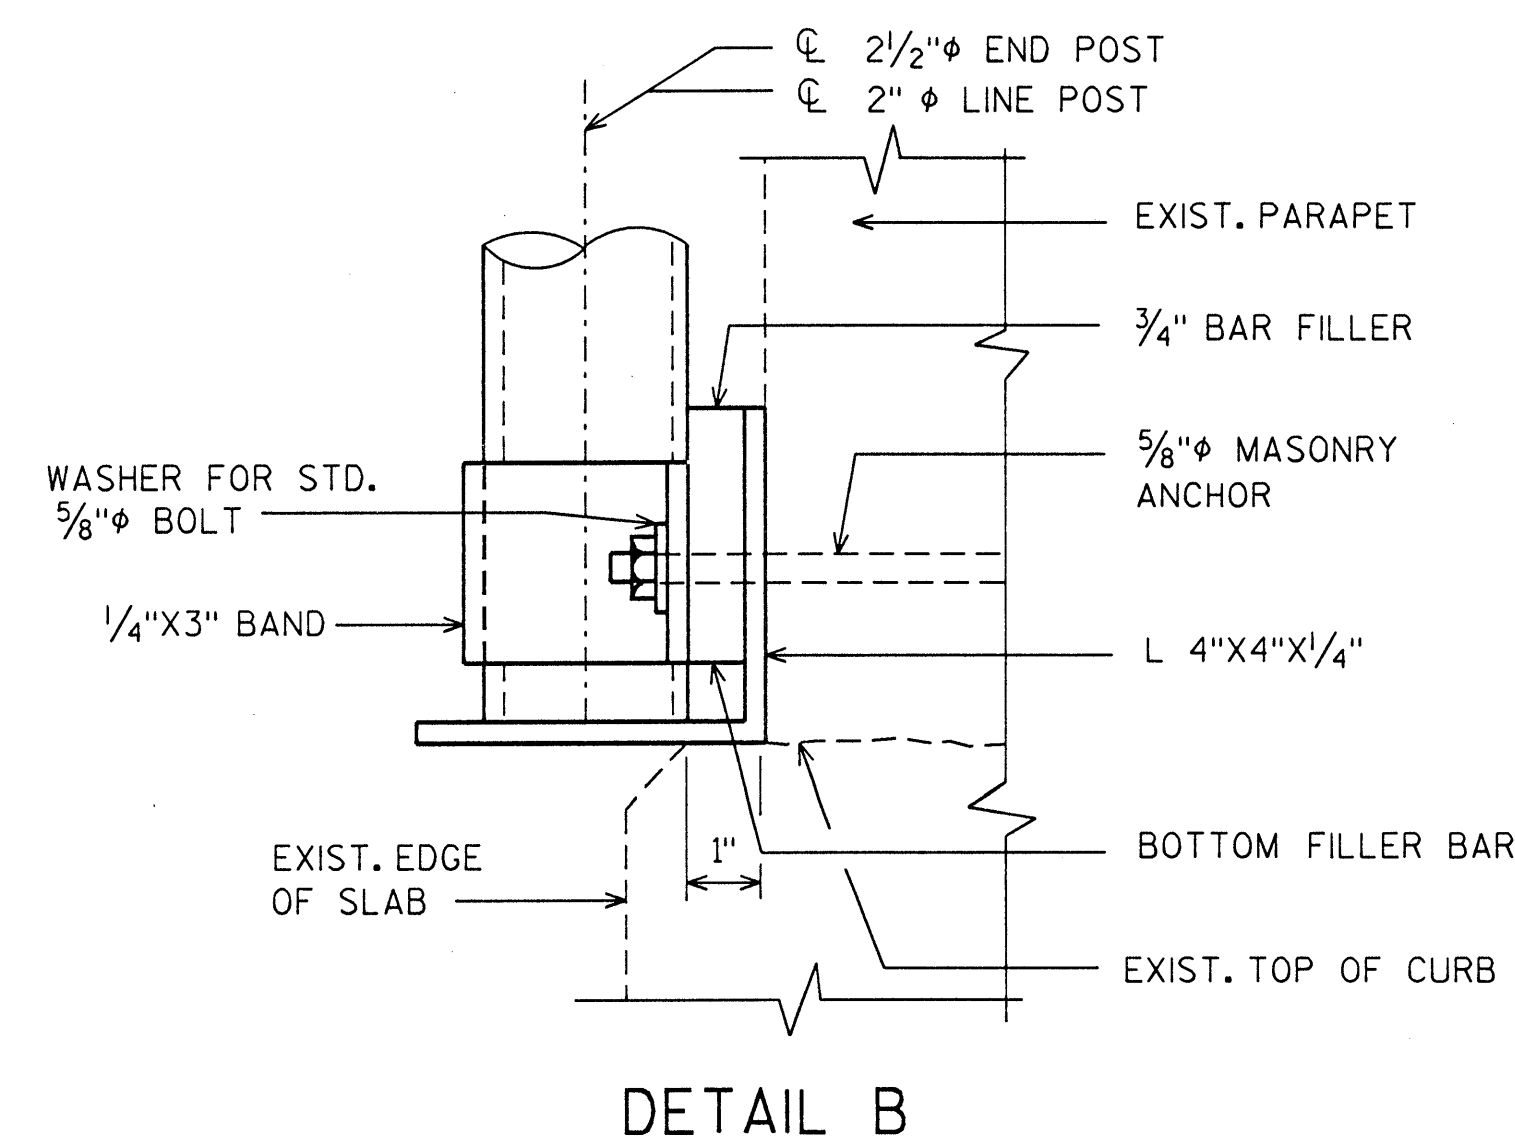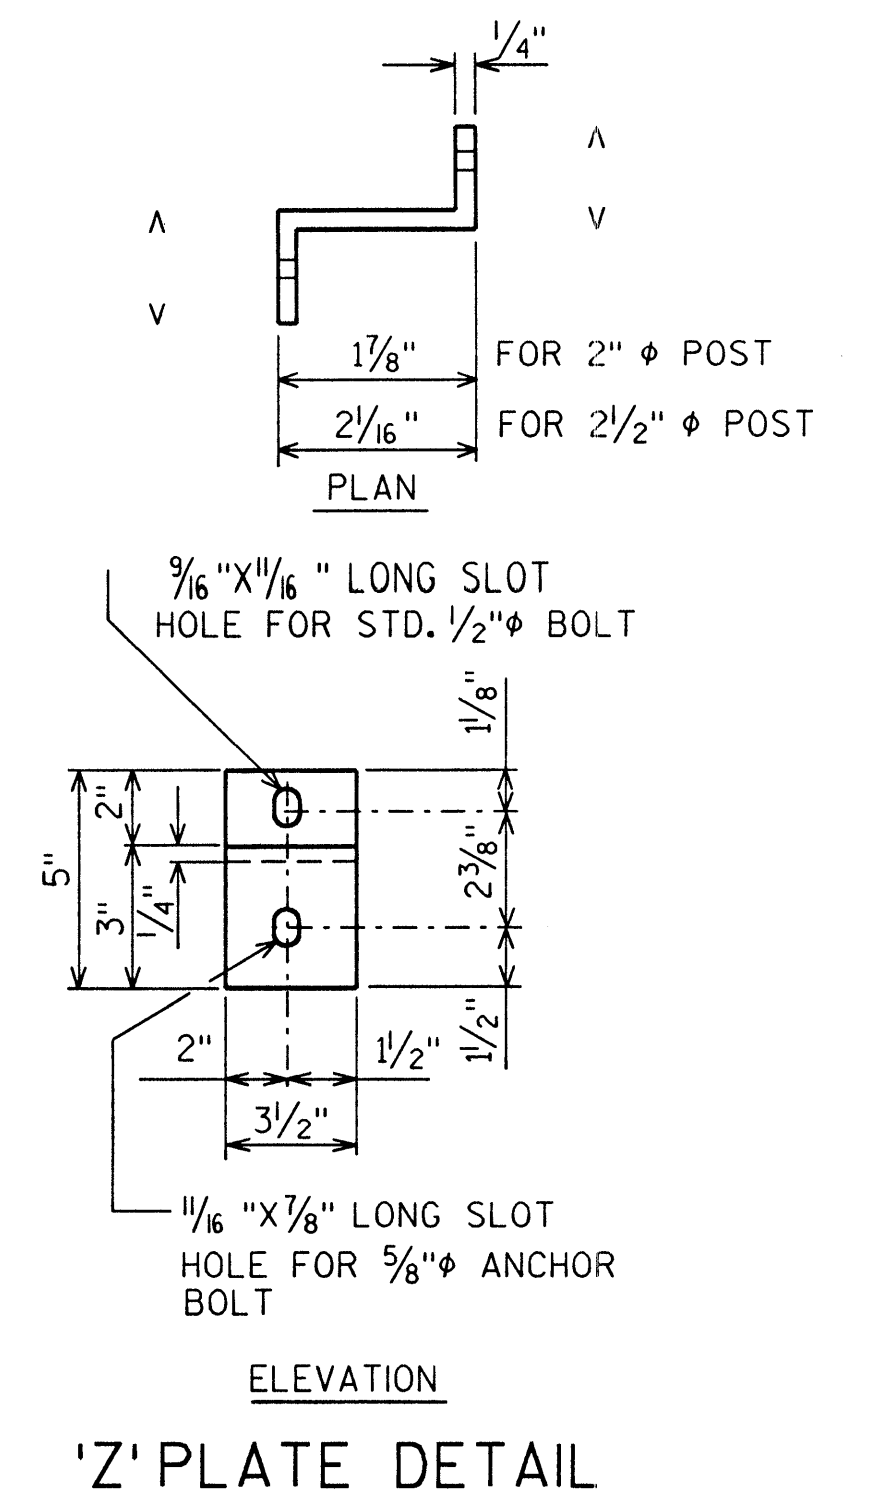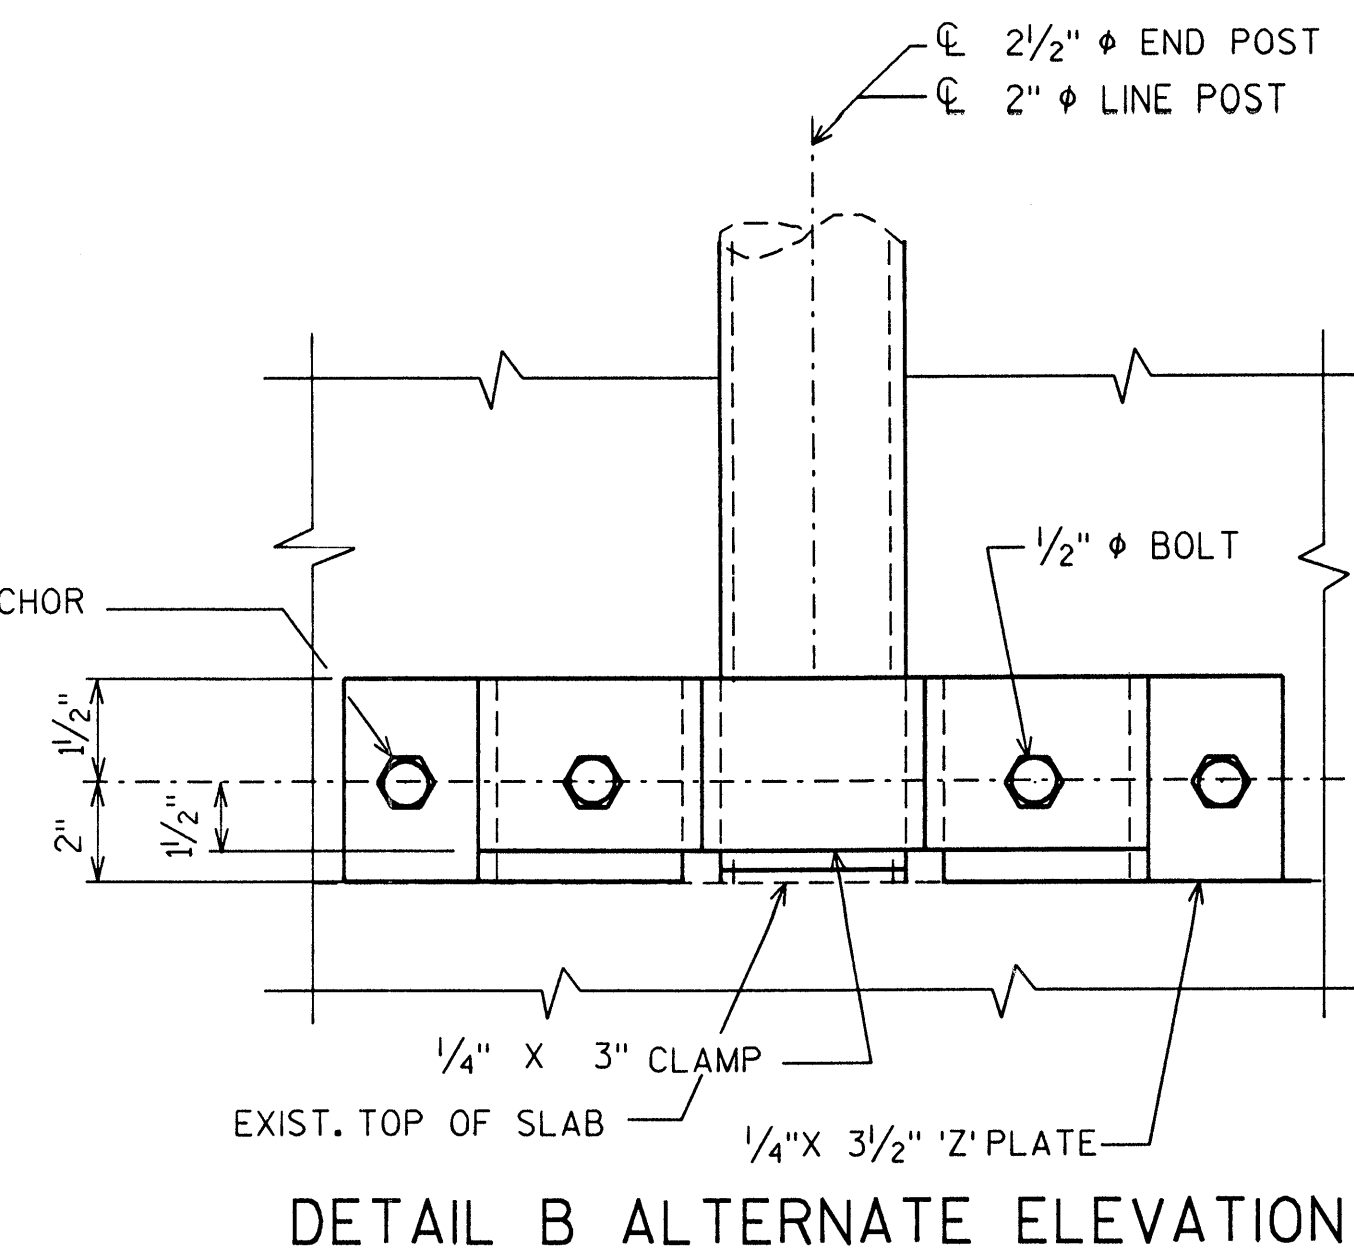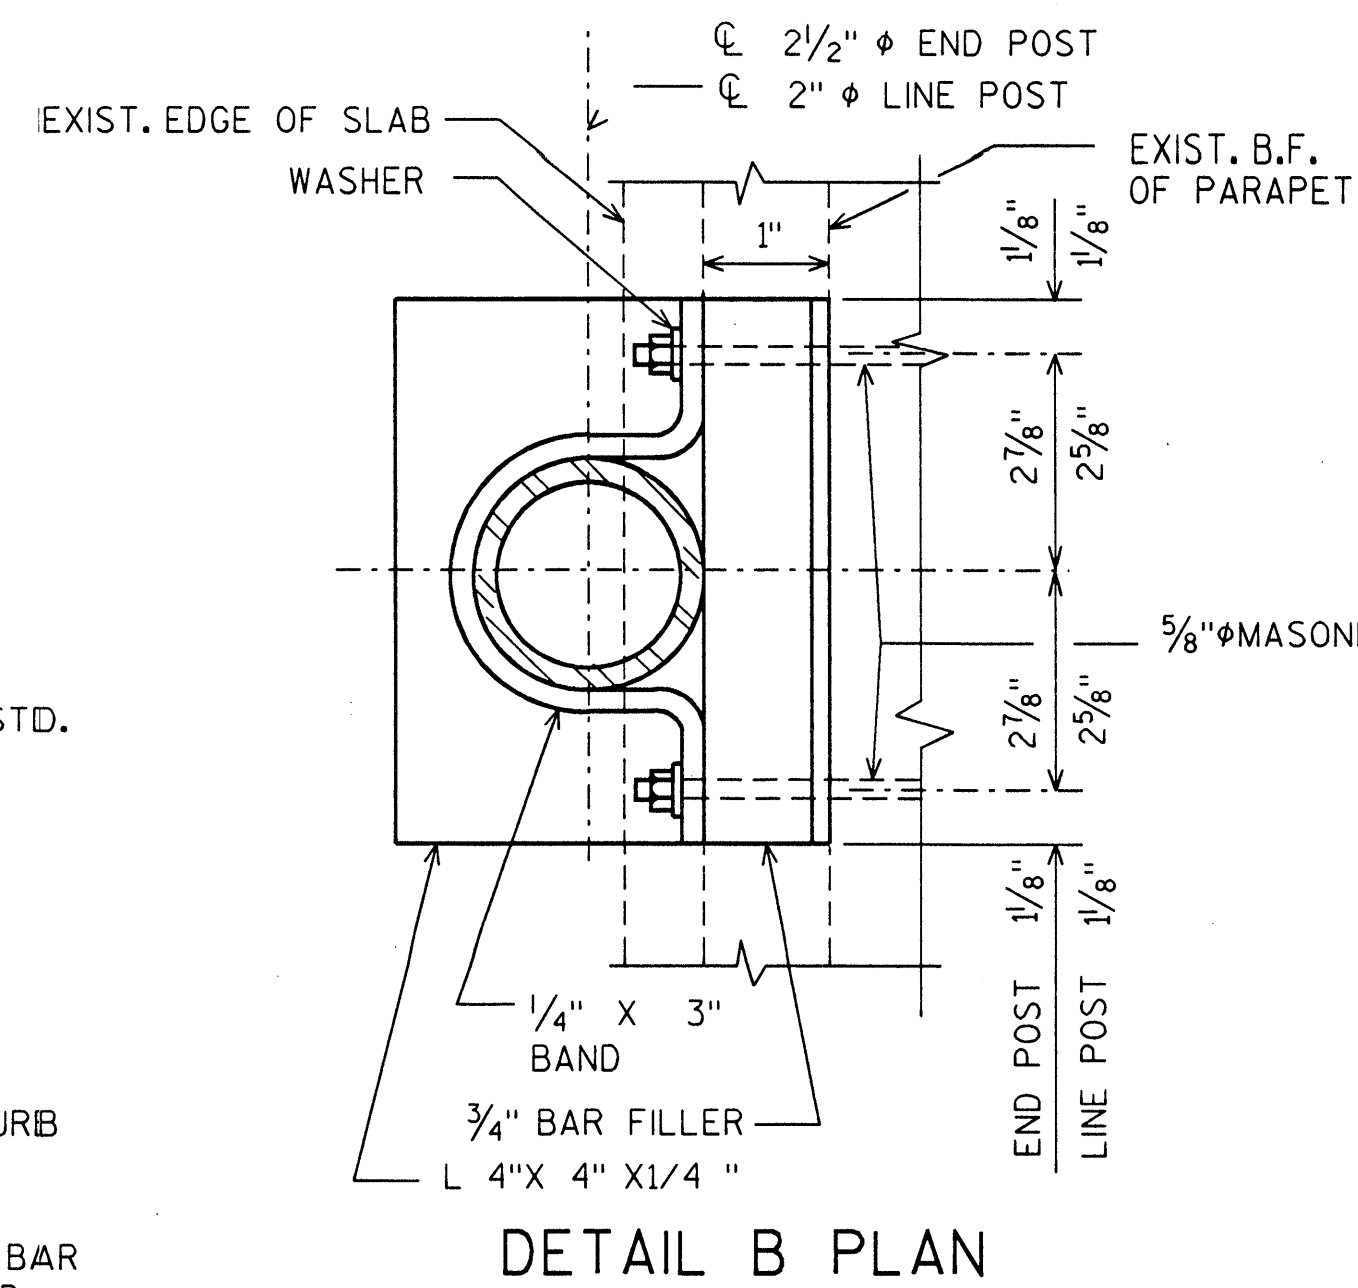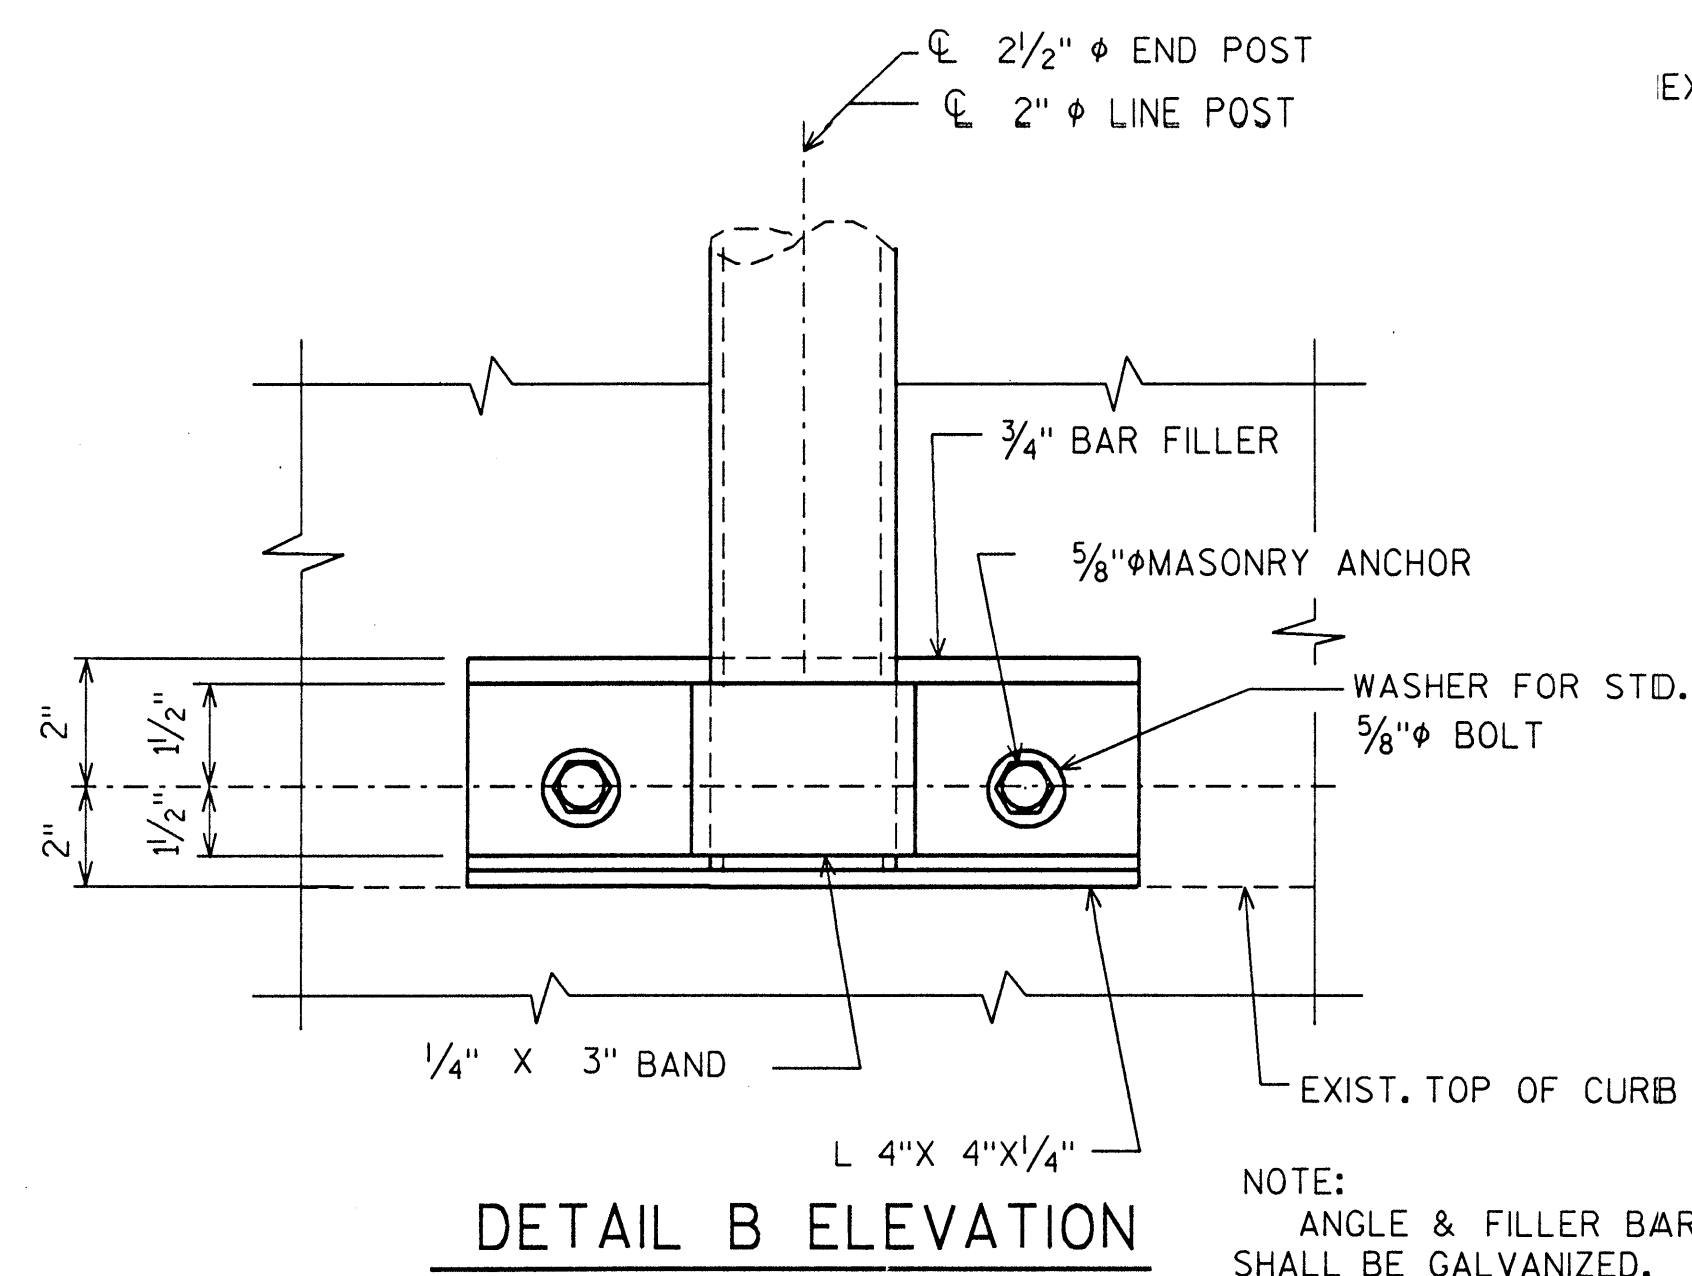

STATE OF WISCONSIN
DEPARTMENT OF TRANSPORTATION

PLAN OF PROPOSED IMPROVEMENT

EAU CLAIRE - OSSEO ROAD
USH 53 SOUTH BOUND B-18-0035 USH 53 NORTH BOUND B-18-0036
USH 53 USH 53
EAU CLAIRE COUNTY EAU CLAIRE COUNTY

STATE PROJECT	FEDERAL PROJECT	
	PROJECT	CONTRACT
1022-00-78	WISC 2010692	1
1022-01-73	WISC 2010693	1

AS-BUILT PLAN

PROJECT ENGINEER: BRIAN DANIELSEN, P.E.
QUEST CIVIL ENGINEERS

PRIME CONTRACTOR: ZENITH TECH INC.

BEGIN CONSTRUCTION: 9/7/10

END CONSTRUCTION: 12/9/11

FINAL CONTRACT COST: \$3,868,486.25

CONTRACT MOD #S: 14 - \$355,578.18


CONTRACT ID: 20100713017

3/10/14

ORDER OF SHEETS

Section No.	Title
1	Typical Sections and Details
2	Estimate of Quantities
3	Miscellaneous Quantities
4	Right-of-Way Plot
5	Plan and Profile
6	Standard Detail Drawings
7	Sign Plates
8	Structure Plans
9	Computer Earthwork Data
9	Cross Sections

TOTAL SHEETS = 242

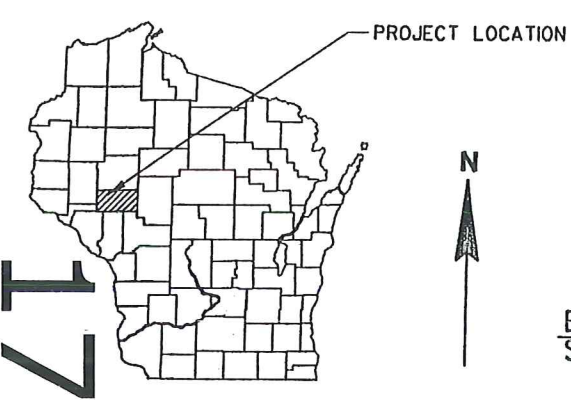

STATE PROJECT NUMBER
1022-00-78

STATE PROJECT NUMBER
1022-01-73

END PROJECT 1022-00-78
STA 41+00.00

END PROJECT 1022-01-73
STA 43+70.00

STRUCTURE B-18-35 SB
STA 38+00 SB

STRUCTURE B-18-36 NB
STA 40+00 NB

BEGIN PROJECT 1022-00-78
STA 33+75.00
Y = 262226.368
X = 359571.148


BEGIN PROJECT 1022-01-73
STA 36+40.00
Y = 262233.524
X = 359637.700

DESIGN DESIGNATION (USH 53) (I-94)

A.A.D.T. 2008	= 22,900	25,350
A.A.D.T. 2031	= 31,400	39,300
D.H.V.	= N/A	N/A
D.D.	= 58/42	58/42
T.	= 5.4%	N/A
DESIGN SPEED	= 60 M.P.H.	70 M.P.H.
ESALS	= N/A	N/A

CONVENTIONAL SYMBOLS

COUNTY LINE	--- --	COMBUSTIBLE FLUIDS	☠
CORPORATE LIMITS	--- --	UNDERGROUND UTILITIES	---
PROPERTY LINE	--- --	GAS	--- G ---
LOT LINE	--- --	ELECTRIC	--- E ---
LIMITED EASEMENT	--- --	TELEPHONE OR TELEGRAPH	--- T ---
EARTHWORK BALANCE POINT	⊙	TV/CABLE	--- TV ---
EXISTING RIGHT OF WAY	---	SERVICE PEDESTAL	⊕
PROPOSED OR NEW R/W LINE	---	POWER POLE	⊞
SURVEY LINE	---	TELEPHONE POLE	⊞
SLOPE INTERCEPT	---	RAILROAD	==
ORIGINAL GROUND	---	SANITARY SEWER	--- SAN ---
MARSH OR ROCK PROFILE (To be noted as such)	---	STORM SEWER	--- SS ---
MARSH AREA	---	WATER	--- W ---
WOODED AREA	---	EXISTING CULVERT	---
		PROPOSED CULVERT (Box or Pipe)	---
		CULVERT (Profile View)	---

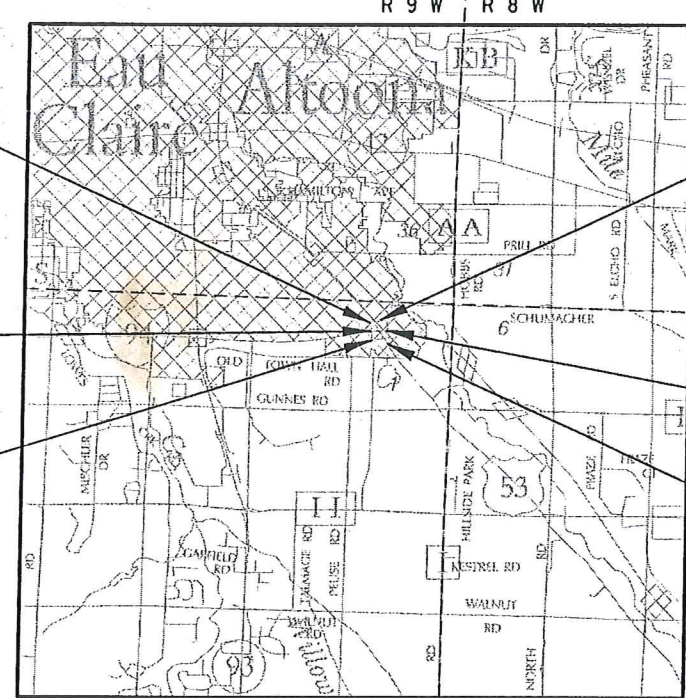

LAYOUT
SCALE 0 1 MI.

TOTAL NET LENGTH OF CENTERLINE = 0.14 MI. 1022-00-78
0.14 MI. 1022-01-73

Coordinates on this plan are referenced to the Wisconsin County
Coordinate System (WCCS), Eau Claire County.

ORIGINAL PLANS PREPARED BY:



SEH
1/27/2010
GREGORY L. WEYANDT
32570
CHIPPEWA FALLS, WI

STATE OF WISCONSIN
DEPARTMENT OF TRANSPORTATION

PREPARED BY

Surveyor	SEH
Designer	SEH
Project Manager	STACEY RUSCH
District Examiner	DANIEL OJIBWAY
District Supervisor	RICHARD SHERMO
C.O. Examiner	JANE ENGBRETSSEN

APPROVED FOR DISTRICT OFFICE
DATE: 1/28/10 *[Signature]*
(Signature)

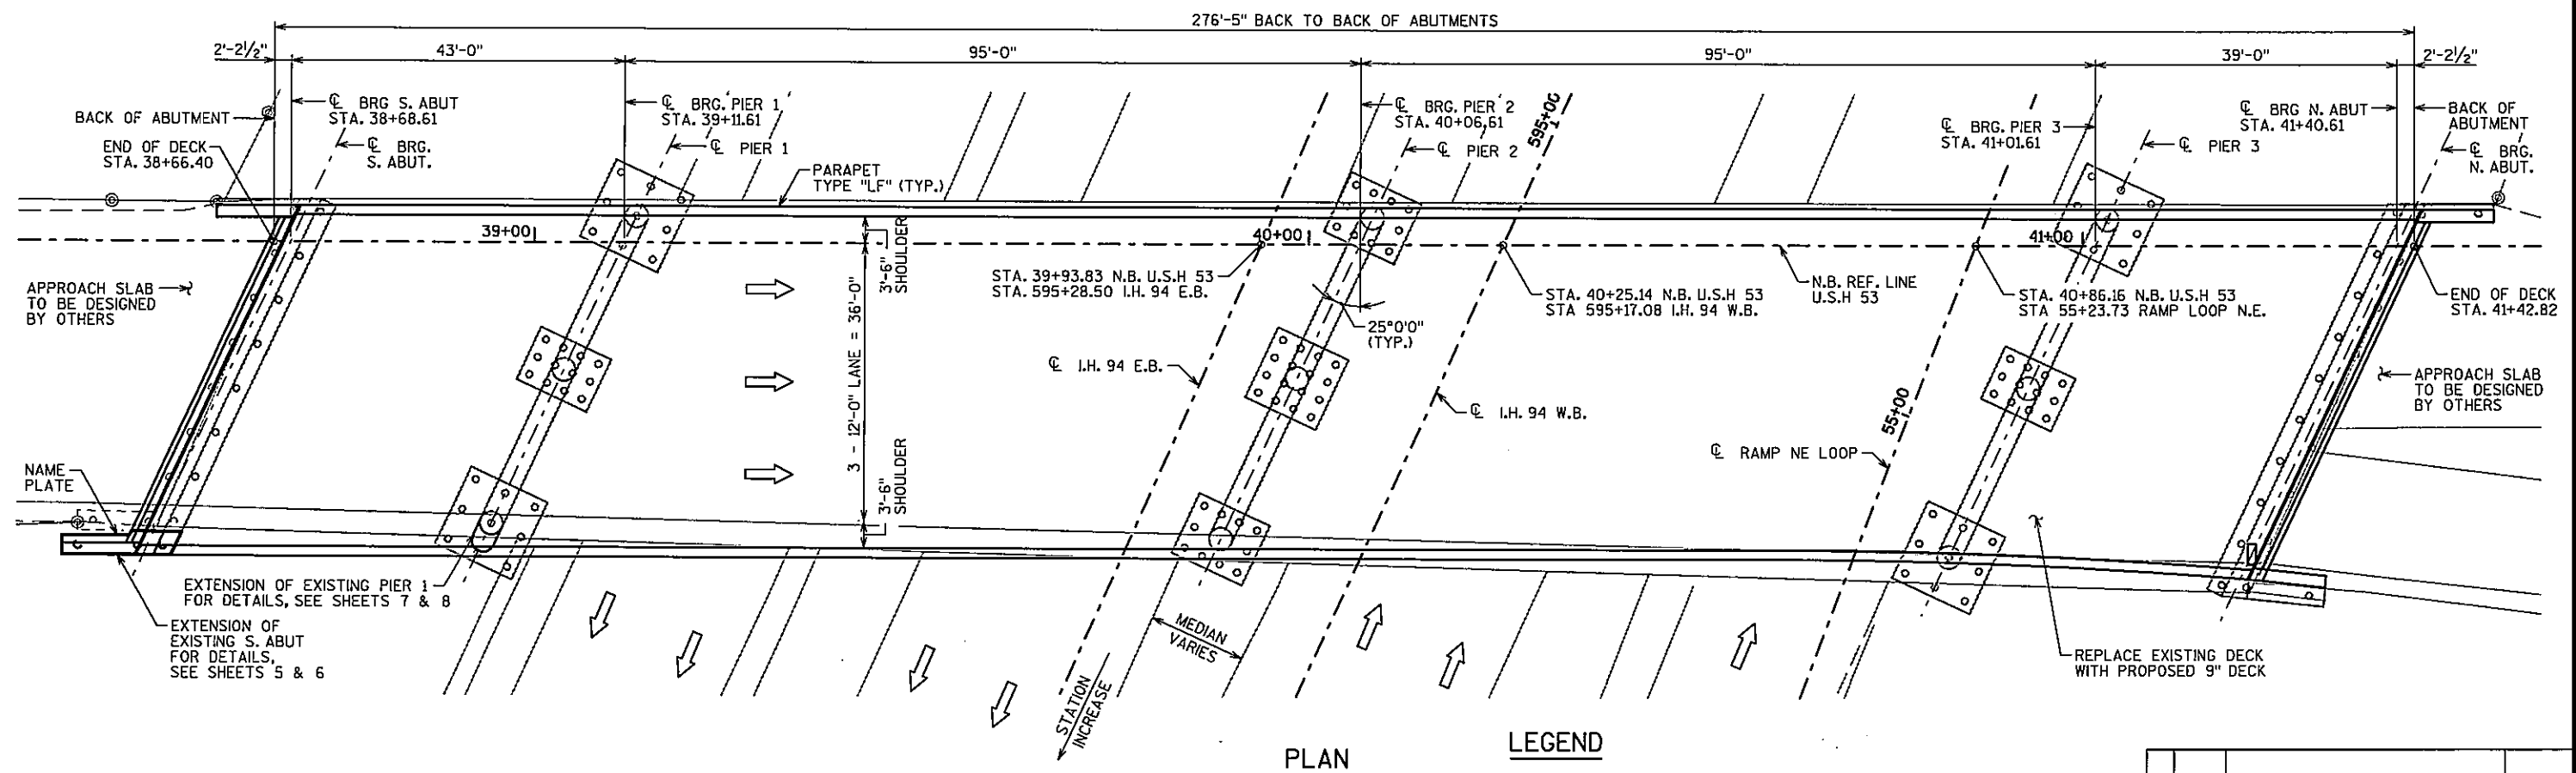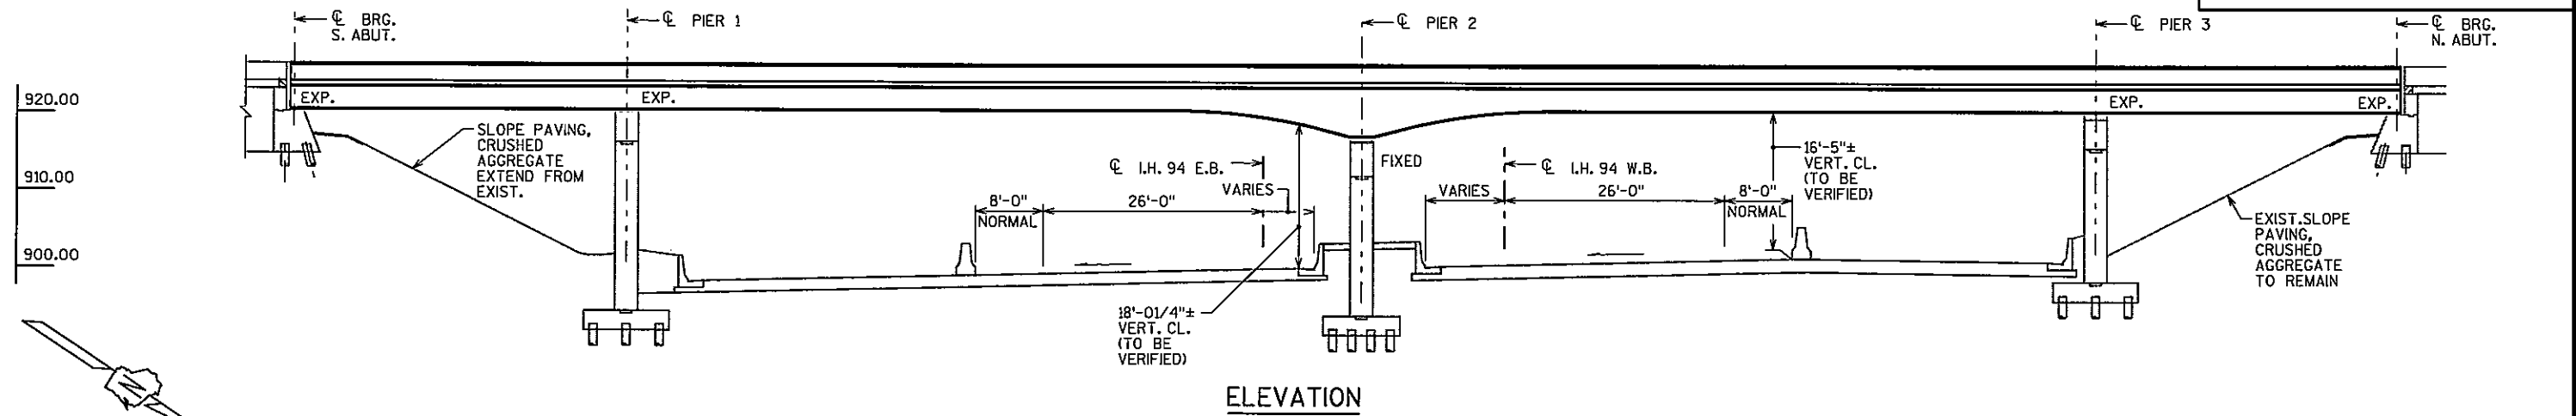


LEGEND

- EXISTING TO REMAIN
 --- EXISTING TO BE REMOVED
 --- PROPOSED

INDEX OF SHEETS

1. GENERAL PLAN & ELEVATION
2. TYPICAL SECTION, DESIGN DATA & QUANTITIES
3. CROSS SECTIONS AT PIER 2
4. SUBSURFACE EXPLORATION
5. SOUTH ABUTMENT 1
6. SOUTH ABUTMENT 2
7. PIER 1-1
8. PIER 1-2
9. PIER 2
10. PIER 3
11. NORTH ABUTMENT 1
12. NORTH ABUTMENT 2
13. DECK REINFORCING PLAN
14. DECK REINFORCING SCHEDULE
15. BLOCKING & SLAB HAUNCH DETAILS
16. FRAMING PLAN
17. GIRDER ELEVATION
18. STEEL DETAILS 1
19. STEEL DETAILS 2
20. BEARING DETAILS
21. HOLD DOWN DEVICE
22. STRIP SEAL EXPANSION JOINT DETAIL
23. STRIP SEAL COVER PLATE DETAILS
24. RAILING DETAILS

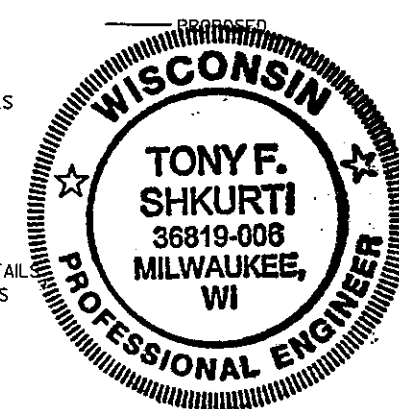

STRUCTURES DESIGN CONTACTS
 BRIDGE OFFICE:
 MICHAEL WILLIAMS (608) 266-5089
 CONSULTANT:
 TONY SHKURTI (312) 930-9119

[Signature]
 1/28/2010

HNTB
 HNTB CORPORATION
 31 NORTH CANAL STREET
 SUITE 1250
 CHICAGO, IL 60606
 (312) 930-9119

NO.	DATE	REVISION	BY
Plans Prepared For WISDOT BUREAU OF STRUCTURES			
APPROVED <i>William C. Dreher</i>		DATE 4/21/10	
CHIEF STRUCTURAL DESIGN ENGINEER			
B-18-36			
USH 53 OVER IH-94			
COUNTY	EAU CLAIRE	TOWN/CITY/VILLAGE	EAU CLAIRE
DESIGN SPEC.	AASHTO STD SPEC. 2002	LOAD	CONST. SPEC. 2010
DESIGNED BY	MX	DESIGN CK'D.	KG
DRAWN BY	LK	PLANS CK'D.	SL
GENERAL PLAN AND ELEVATION			SHEET 1 OF 24
			JAN-28-2010

\\ahw00\projects\50206\CADD\tds\new 36\50206_B1836_2typsection.dgn
28-JAN-2010 07:53
PLOTTED BY: Italina

8

STATE PROJECT NUMBER

1022-01-73

GENERAL NOTES

DRAWINGS SHALL NOT BE SCALED. DIMENSIONS SHOWN ARE BASED ON THE ORIGINAL STRUCTURE PLANS.

BAR STEEL REINFORCEMENT SHALL BE EMBEDDED 2" CLEAR UNLESS OTHERWISE SHOWN OR NOTED.

ALL FIELD CONNECTIONS SHALL BE MADE WITH 3/4" DIAMETER FRICTION TYPE HIGH-TENSILE STRENGTH BOLTS UNLESS OTHERWISE SHOWN OR NOTED.

ALL STATIONS AND ALL ELEVATIONS ARE IN FEET.

ALL REINFORCING BARS ARE ENGLISH AND THE FIRST DIGITS OF BAR MARK SIGNIFY THE BAR SIZE.

THE EXISTING GROUNDLINE SHALL BE THE UPPER LIMITS OF EXCAVATION FOR STRUCTURES.

THE FINISHED GRADED SECTION SHALL BE THE UPPER LIMITS OF EXCAVATION FOR STRUCTURES.

THE UPPER LIMITS OF EXCAVATION FOR STRUCTURES FOR THE ABUTMENTS SHALL BE THE BOTTOM OF SLOPE PROTECTION.


AT ABUTMENTS ALL SPACES EXCAVATED AND NOT OCCUPIED BY THE NEW STRUCTURE SHALL BE BACKFILLED WITH GRANULAR BACKFILL.

USE EXISTING BAR STEEL REINFORCING WHERE SHOWN AND EXTEND INTO NEW WORK. EXTEND BARS TO PROVIDE A MINIMUM LAP LENGTH OF 2'-0" UNLESS OTHERWISE NOTED

EXPANSION JOINT ASSEMBLY, INCLUDING ANCHOR STUDS AND HARDWARE SHALL BE PAID FOR IN THE LUMP SUM PRICE BID AS "EXPANSION DEVICE".


CLEAN AND FILL EXISTING LONGITUDINAL AND TRANSVERSE CRACKS WITH PENETRATING EPOXY AS DIRECTED BY THE FIELD ENGINEER.

APPLY PROTECTIVE SURFACE TREATMENT TO THE NEW DECK AND TOP & INSIDE FACES OF THE NEW PARAPETS.

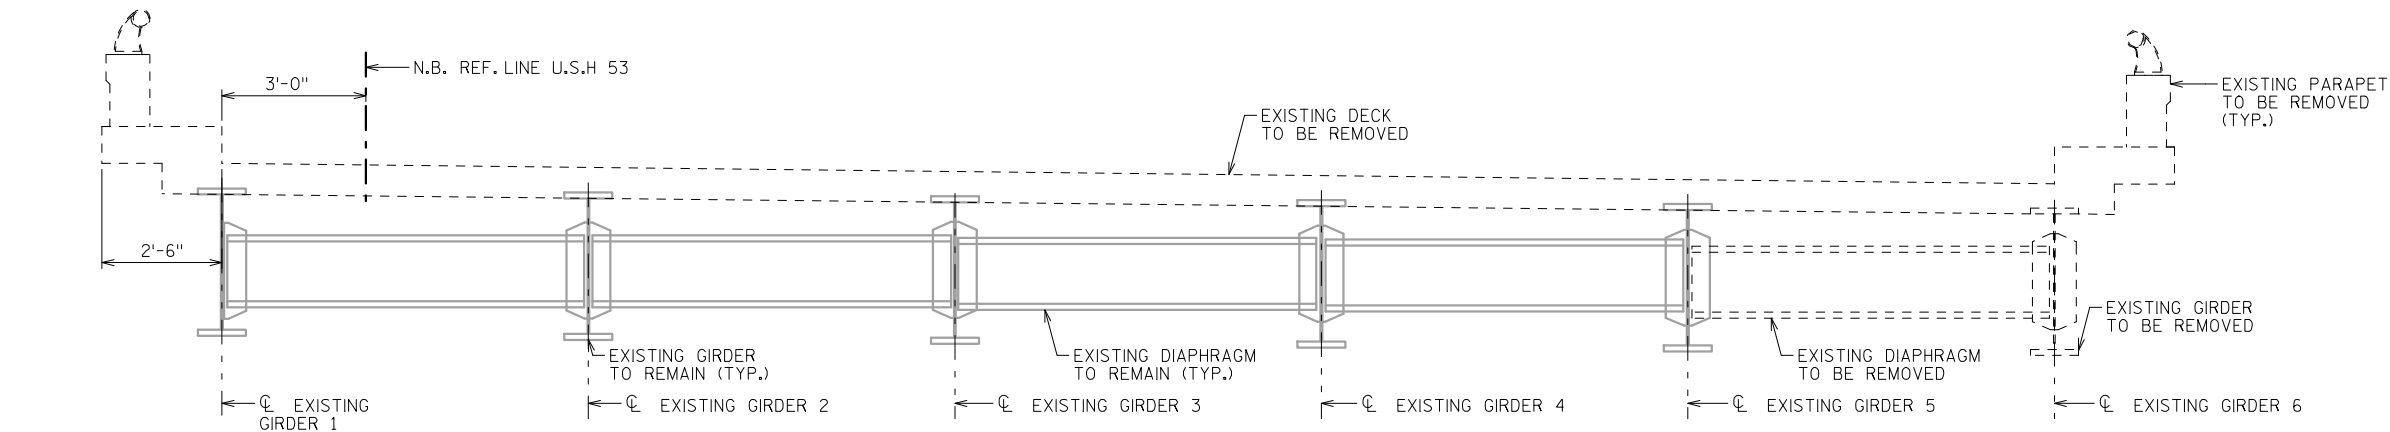

TYPICAL CROSS SECTION THRU ROADWAY

(EXISTING, LOOKING UPSTATION)

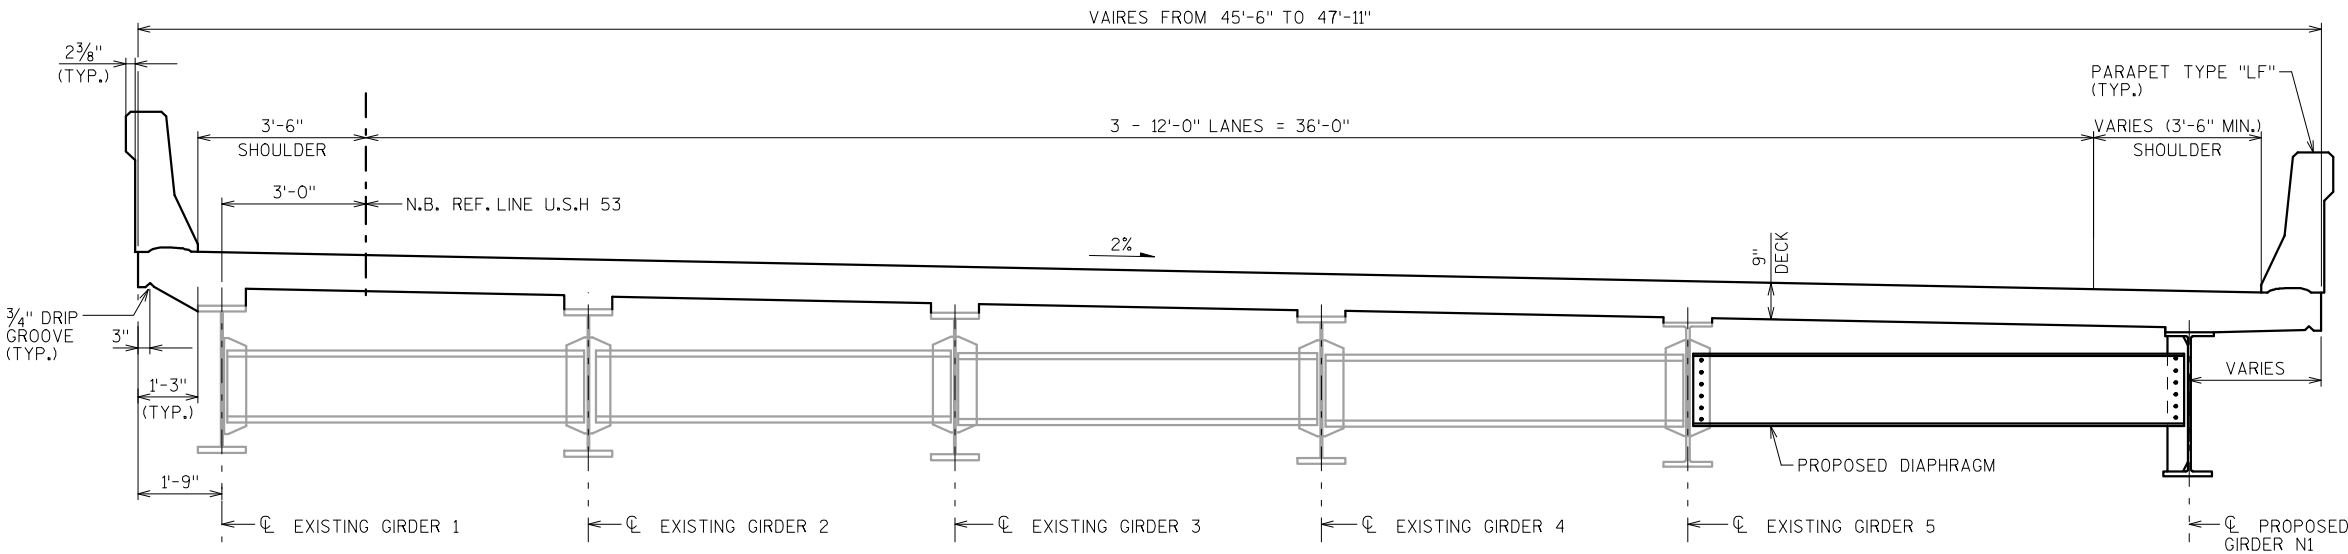

TYPICAL CROSS SECTION THRU ROADWAY

(PROPOSED, LOOKING UPSTATION)

ESTIMATE OF QUANTITIES

BID ITEMS	UNIT	SUPER.	S. ABUT.	PIER 1	PIER 2	PIER 3	N. ABUT.	TOTAL
REMOVING OLD STRUCTURE (STA 39+93.83)	LS							1
EXCAVATION FOR STRUCTURES BRIDGES (B-18-36)	LS							1
BACKFILL STRUCTURE	CY		2					2
CONCRETE MASONRY BRIDGES	CY	442	27	6			25	500
EXPANSION DEVICE (B-18-36)	LS							1
PROTECTIVE SURFACE TREATMENT	SY	1,536	7				7	1550
MASONRY ANCHORS TYPE L NO.4 BARS	EACH		31	105		14	67	217
MASONRY ANCHORS TYPE L NO.5 BARS	EACH		8	11				19
MASONRY ANCHORS TYPE L NO.7 BARS	EACH		8					8
BAR STEEL REINFORCEMENT HS BRIDGES	LB		360					360
BAR STEEL REINFORCEMENT HS COATED BRIDGES	LB	99,850	2,310	1,370		30	2,590	106150
STRUCTURAL STEEL HS	LB	66,900						66900
STRUCTURAL STEEL CARBON	LB	6,980						6980
WELDED STUD SHEAR CONNECTOR 7/8X6-INCH	EACH	2,100						2100
BEARING ASSEMBLIES FIXED (B-18-36)	EACH				1			1
BEARING ASSEMBLIES EXPANSION (B-18-36)	EACH		1	1		1	1	4
CONCRETE SURFACE REPAIR	SF		25	30	12	20	25	112
PILING CIP CONCRETE DELIVERED AND DRIVEN 10 3/4 X 0.219-INCH	LF		150					150
RUBBERIZED MEMBRANE WATERPROOFING	SY		28				26	54
PAINTING INORGANIC ZINC RICH PRIMER (B-18-36)	LS							1
SLOPE PAVING, CRUSHED AGGREGATE	SY		22					22
ANCHOR ASSEMBLIES FOR STEEL PLATE BEAM GUARD	EACH		2				2	4
FIBER WRAP PIER REINFORCING (B-18-36)	LS							1
PREPARATION AND COATING OF TOP FLANGES (B-18-36)	LS							1
EPOXY CRACK SEALING	LF		10				10	20

SPECIFICATIONS

- AASHTO STANDARD SPECIFICATIONS FOR HIGHWAY BRIDGES, SEVENTEENTH EDITION, 2002.
- LATEST EDITION OF WISCONSIN BRIDGE MANUAL, WISCONSIN DEPARTMENT OF TRANSPORTATION.
- WISCONSIN DEPARTMENT OF TRANSPORTATION STANDARD SPECIFICATIONS FOR HIGHWAY AND STRUCTURE CONSTRUCTION 2010 EDITION.

DESIGN DATA

LIVE LOAD = HS-25
INVENTORY RATING = HS-15.6
OPERATIONAL RATING = HS-26
ULTIMATE DESIGN STRESSES:
SLAB & PARAPET: F'C=4000 PSI
ALL OTHERS: F'C=3500 PSI
HIGH STRENGTH BAR STEEL REINFORCEMENT (GRADE 60): FY=60,000 PSI
HIGH STRENGTH STRUCTURE STEEL ASTM A 709 GRADE 50: FY=50,000 PSI
STRUCTURAL CARBON STEEL ASTM A709 GRADE 36: FY=36,000 PSI
HIGH STRENGTH BOLT: ASTM A325 TYPE 1

FOUNDATION DATA

THE EXTENSION OF ABUTMENT TO BE SUPPORTED ON 10 3/4-IN DIAMETER CAST-IN-PLACE PILES DRIVEN TO A CAPACITY OF 20 TONS/PILE WITH ESTIMATED PILE LENGTH OF 50 FEET.

LEGEND


- EXISTING TO REMAIN
- - - EXISTING TO BE REMOVED
— PROPOSED

NO.	DATE	REVISION	BY
STATE OF WISCONSIN DEPARTMENT OF TRANSPORTATION STRUCTURES DESIGN SECTION			
STRUCTURE B-18-36			
2010	DRAWN BY	MMK	PLANS CK'D. SL
TYPICAL SECTION, DESIGN DATA & QUANTITIES			SHEET 2 OF 24
			JAN-28-2010

HNTB


SCALE =

8

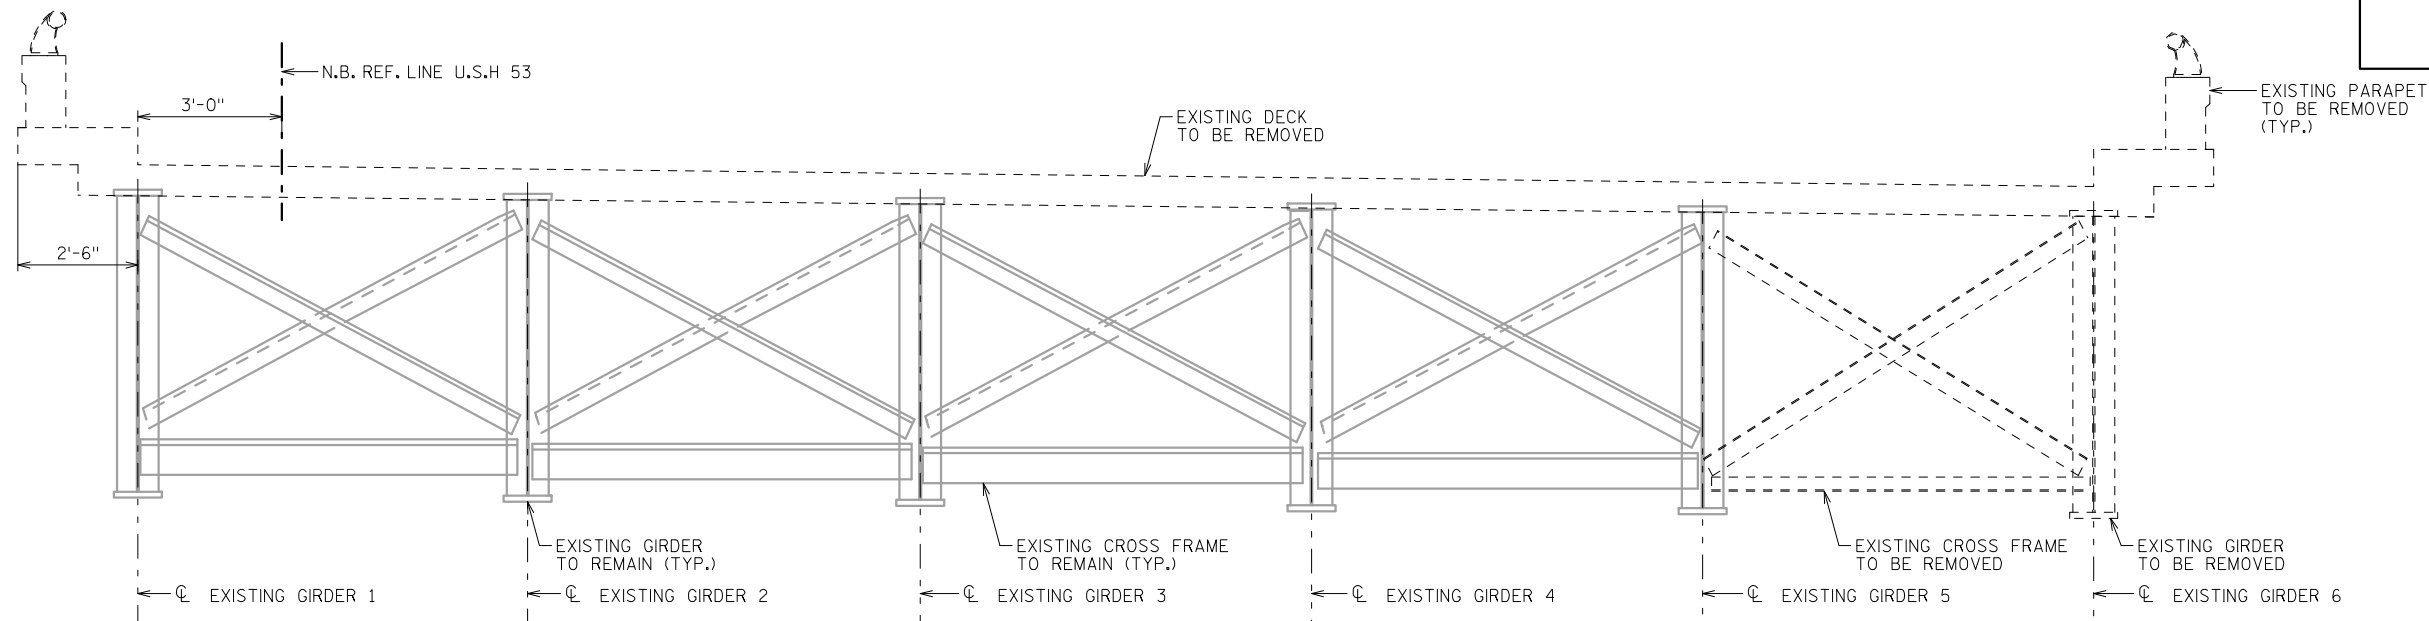

CROSS SECTION THRU ROADWAY AT PIER 2

(EXISTING, LOOKING UPSTATION)

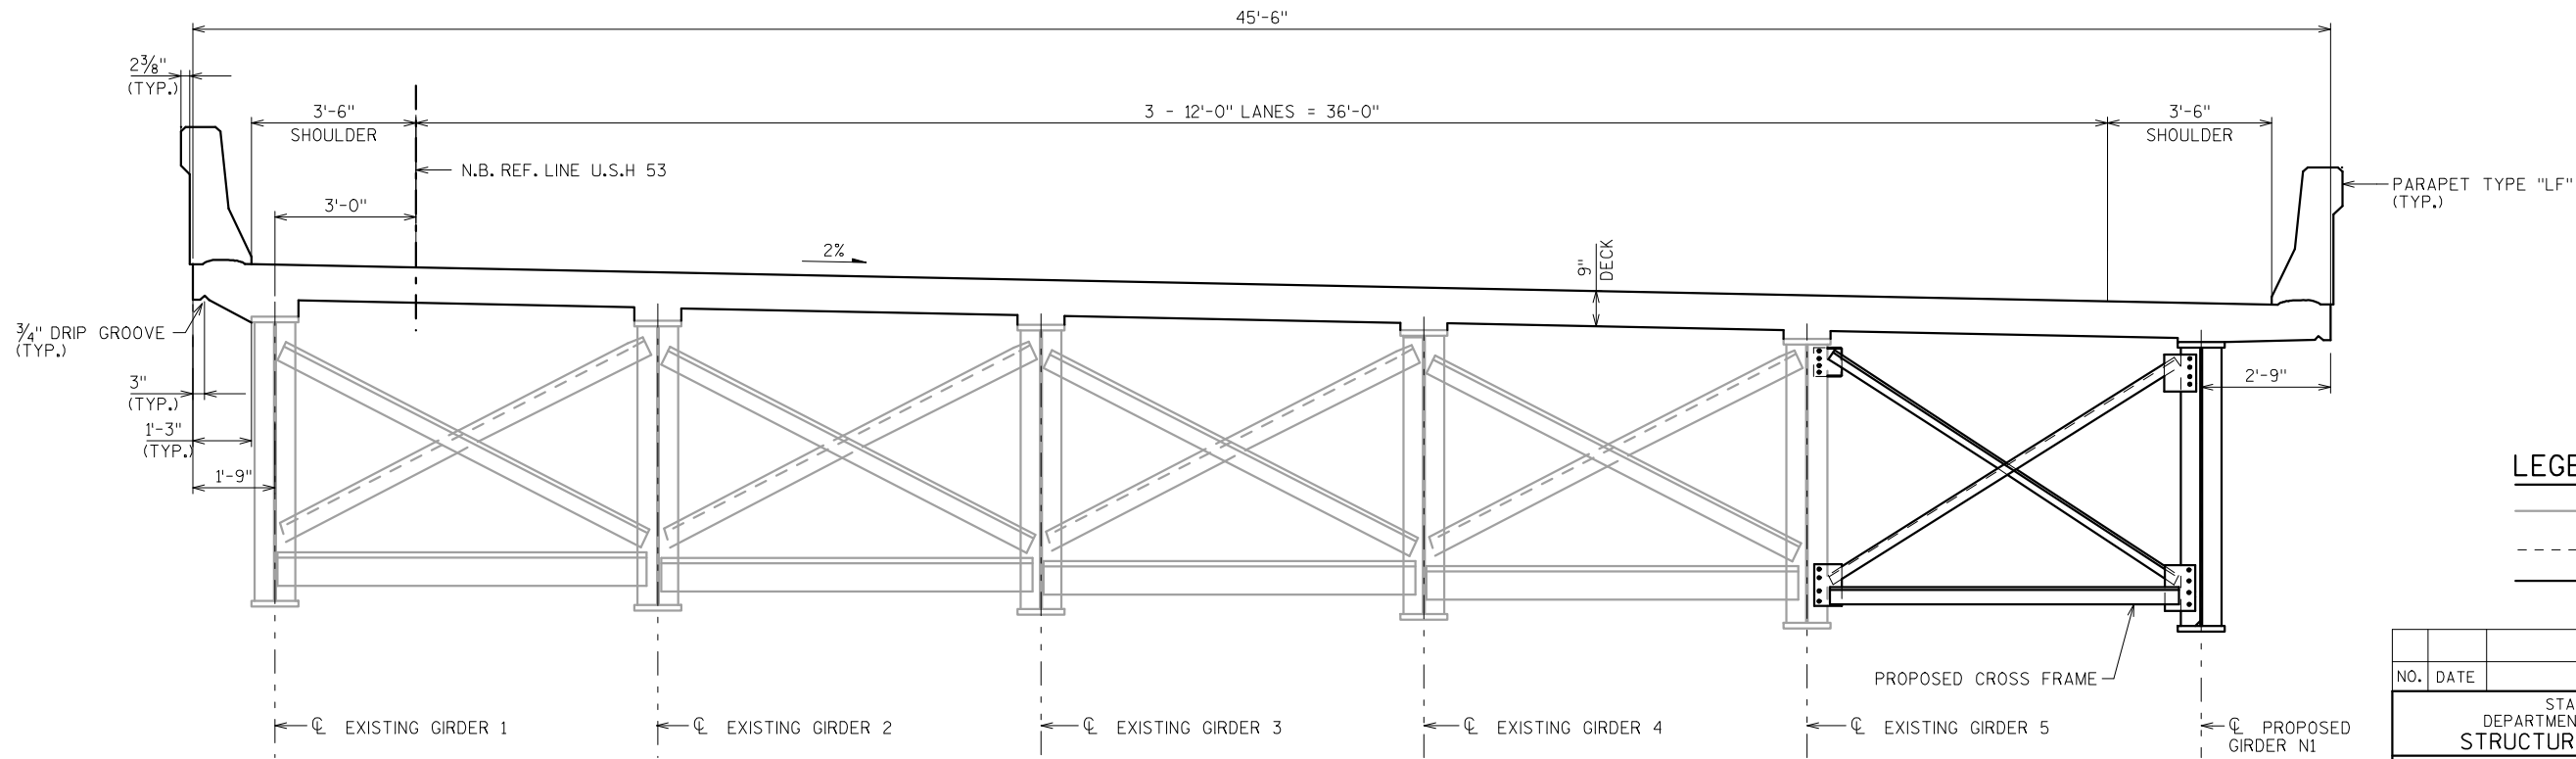

CROSS SECTION THRU ROADWAY AT PIER 2

(PROPOSED, LOOKING UPSTATION)

LEGEND

- EXISTING TO REMAIN
- - - EXISTING TO BE REMOVED
- PROPOSED


NO.	DATE	REVISION	BY
STATE OF WISCONSIN DEPARTMENT OF TRANSPORTATION STRUCTURES DESIGN SECTION			
STRUCTURE B-18-36			
2010	DRAWN BY	MMK	PLANS CK'D. MX
CROSS SECTION AT PIER 2			SHEET 3 OF 24
			JAN-28-2010

HNTB

\\ohiaw00\projects\50206\CADD\cds\new 36\50206_B1836_3crosssection\pier2.dgn
28-JAN-2010 07:53
PLOTTED BY: Italina

\\ohiaw00\projects\50206\CADD\ods\new 36\50206_B1836_4subexpl.dgn
28-JAN-2010 07:53
PLOTTED BY:

8

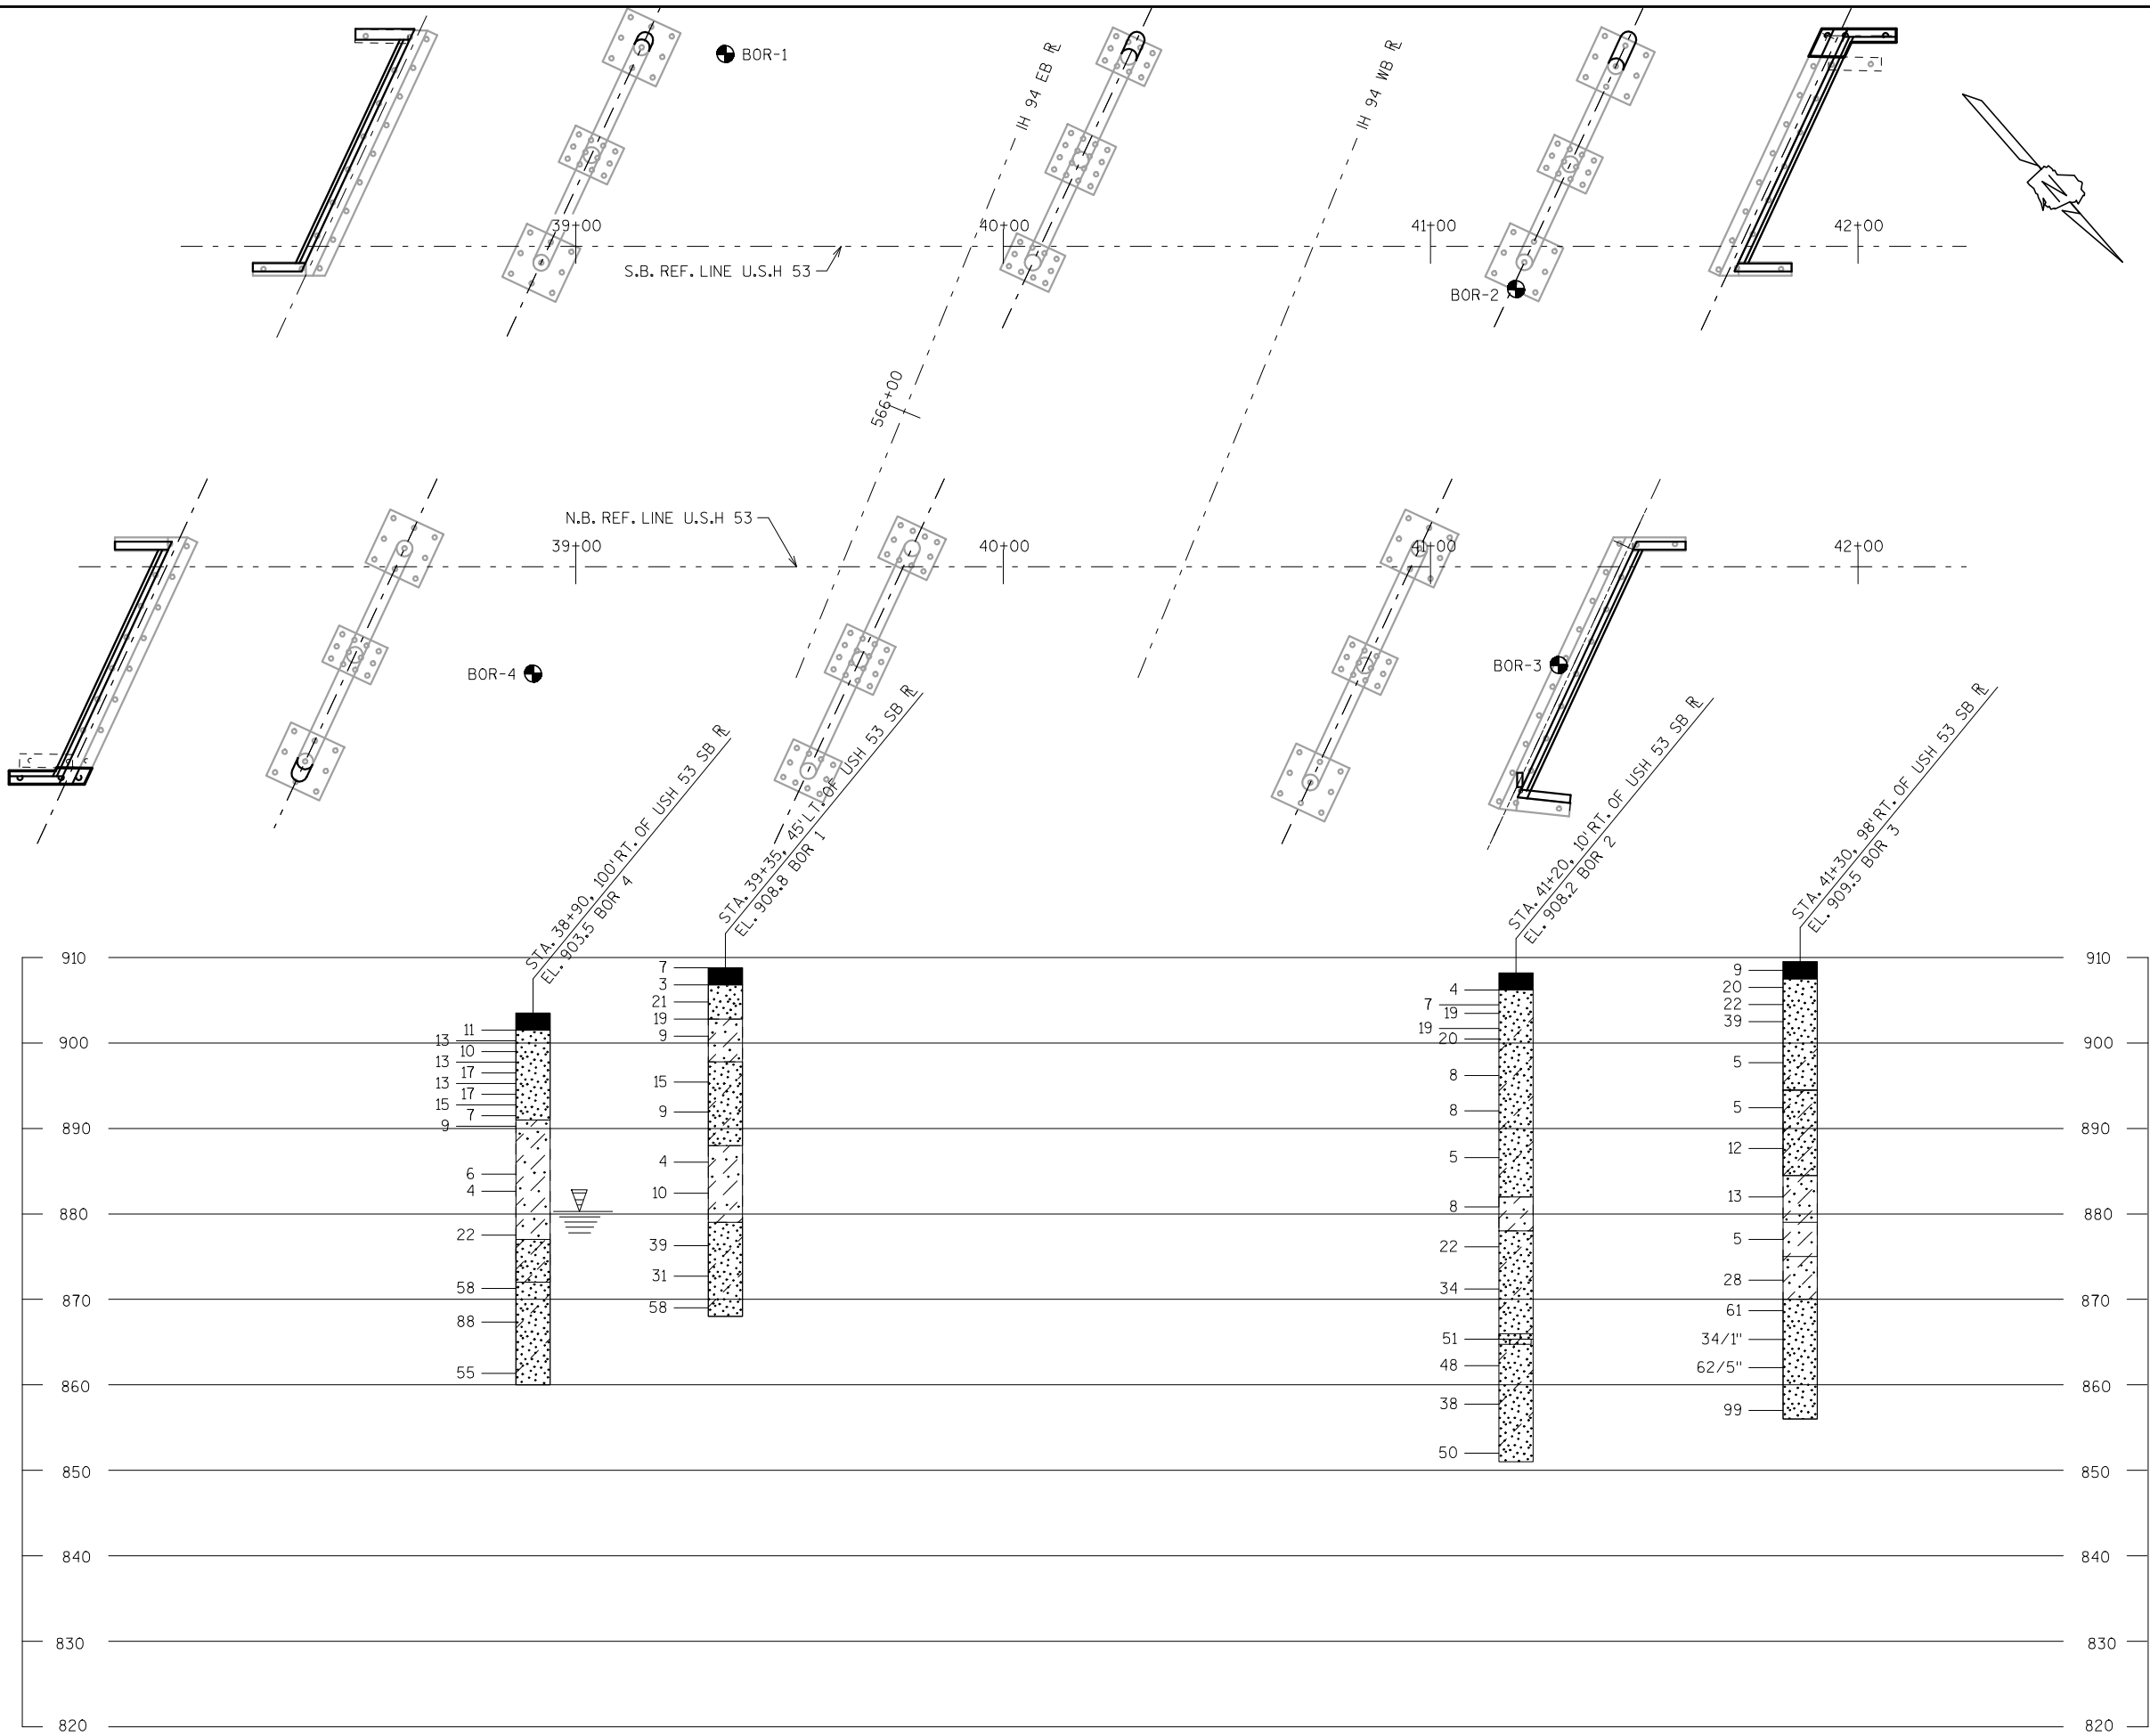

STATE PROJECT NUMBER

1022-01-73

ABBREVIATIONS

F— FINE M— MEDIUM C— COARSE
WS— WEATHERED SO— SOUND

MATERIAL SYMBOLS

TOPSOIL SILT SANDSTONE
SAND PEAT LIMESTONE
GRAVEL CLAY IGNEOUS ROCK

LEGEND OF PROBING

PROBING NO.
STA.
ELEVATION
95/6=95 BLOWS FOR 6"
PENETRATION
PROBING TAKEN WITH
A 350# WT.
FALLING 18" ON A 2"
O.D. POINT.
7 AVERAGE BLOWS PER FOOT
REFUSAL 95/6

LEGEND OF BORING

BORING NO.
STA.
ELEV.
UNCONFINED
STRENGTH → 7.7
BLOWS PER FT.
USING 140# WT.
FALLING 30"
WASH SAMPLE
SHELBY TUBE — S.T.
GROUND WATER
ELEVATION
NO GROUND WATER
OBSERVED ABOVE
THIS ELEVATION
SANDY GRAVEL
F.
BOULDERS OR
COBBLES
SAND
SILTY CLAY
SO
LIMESTONE

UNLESS OTHERWISE SPECIFIED, THE BLOWS PER FOOT AT THE LOCATIONS INDICATED ARE BASED ON DRIVING A 2" O.D. X 1.4" I.D. SPLIT SPOON SAMPLER WITH A 140# HAMMER HAVING A FREE FALL OF 30". THE BLOW COUNT IS TAKEN IN UNDISTURBED SOIL IMMEDIATELY BELOW A CASED OR OPEN HOLE ELIMINATING SIDE FRICTION ON THE DRIVE PIPE.

SUBSURFACE EXPLORATION FOR FOUNDATION
DESIGN AND BIDDERS INFORMATION

TO OBTAIN RELATIVE DATA CONCERNING THE CHARACTER OF MATERIAL IN AND UPON WHICH THE FOUNDATION MIGHT BE BUILT, BORINGS AND/OR SOUNDINGS WERE MADE AT POINTS APPROXIMATELY AS INDICATED ON THIS DRAWING. THE DATA PRESENTED HEREIN REPRESENTS THE FINDINGS OF THE SUBSURFACE EXPLORATIONS MADE. HOWEVER, BECAUSE THE DEPTHS INVESTIGATED ARE LIMITED AND THE AREA OF THE BORINGS AND/OR SOUNDINGS IS VERY SMALL IN RELATION TO THE ENTIRE AREA, THE WISCONSIN DEPARTMENT OF TRANSPORTATION DOES NOT WARRANT CONDITIONS BELOW THE DEPTHS INVESTIGATED OR THAT THE CLASSIFICATION OF MATERIAL ENCOUNTERED IN THESE INVESTIGATIONS IS NECESSARILY TYPICAL OF THE ENTIRE SITE.

NO. DATE REVISION BY

STATE OF WISCONSIN
DEPARTMENT OF TRANSPORTATION
STRUCTURES DESIGN SECTION

STRUCTURE B-18-36

CONST. 2010 DRAWN BY PR PLANS CK'D.

SUBSURFACE
EXPLORATION


SHEET 4 OF 26

JAN-28-2010


SCALE =

8

GIRDER	ELEV.
N1	918.72

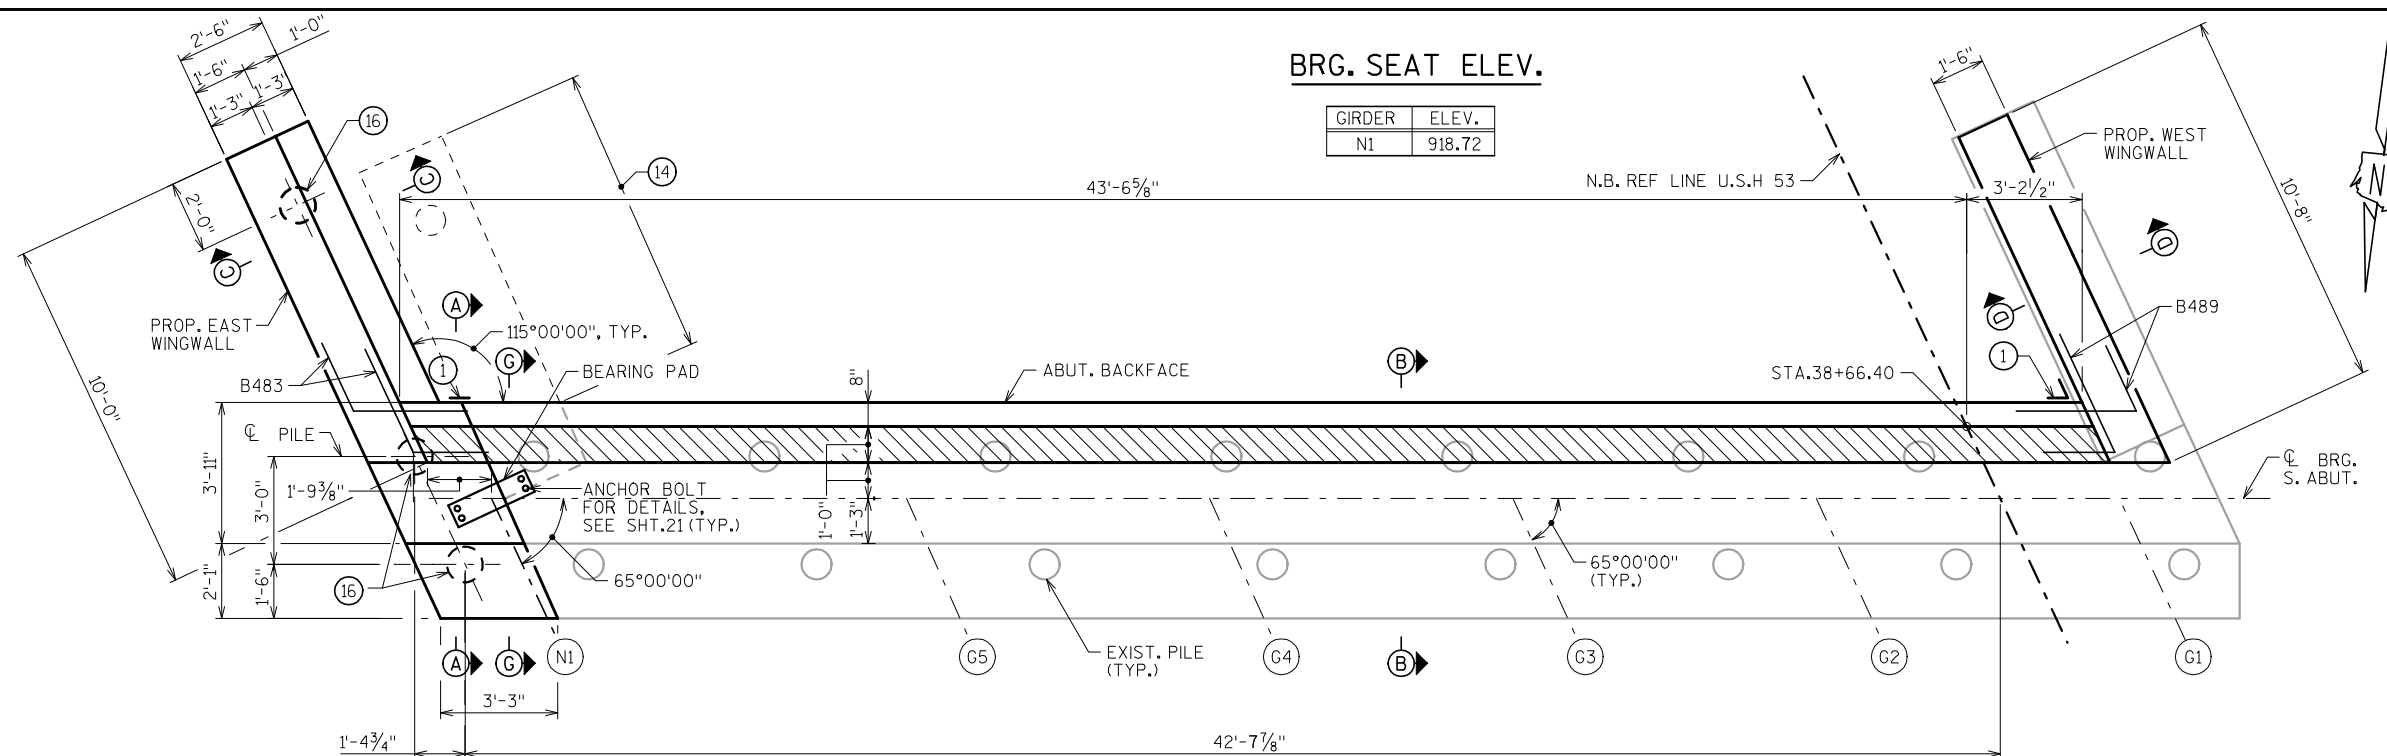



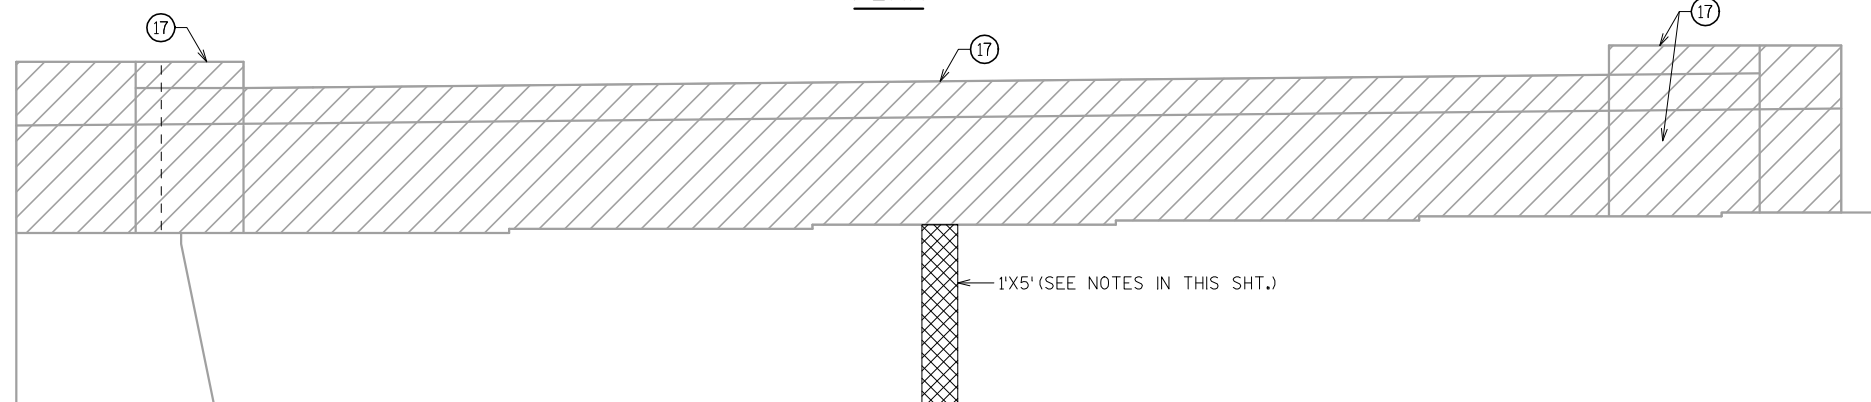


PLAN



EXISTING ELEVATION

LEGEND

-  EXISTING TO REMAIN
 PROPOSED
 EXISTING TO REMOVE
 CONCRETE SURFACE REPAIR

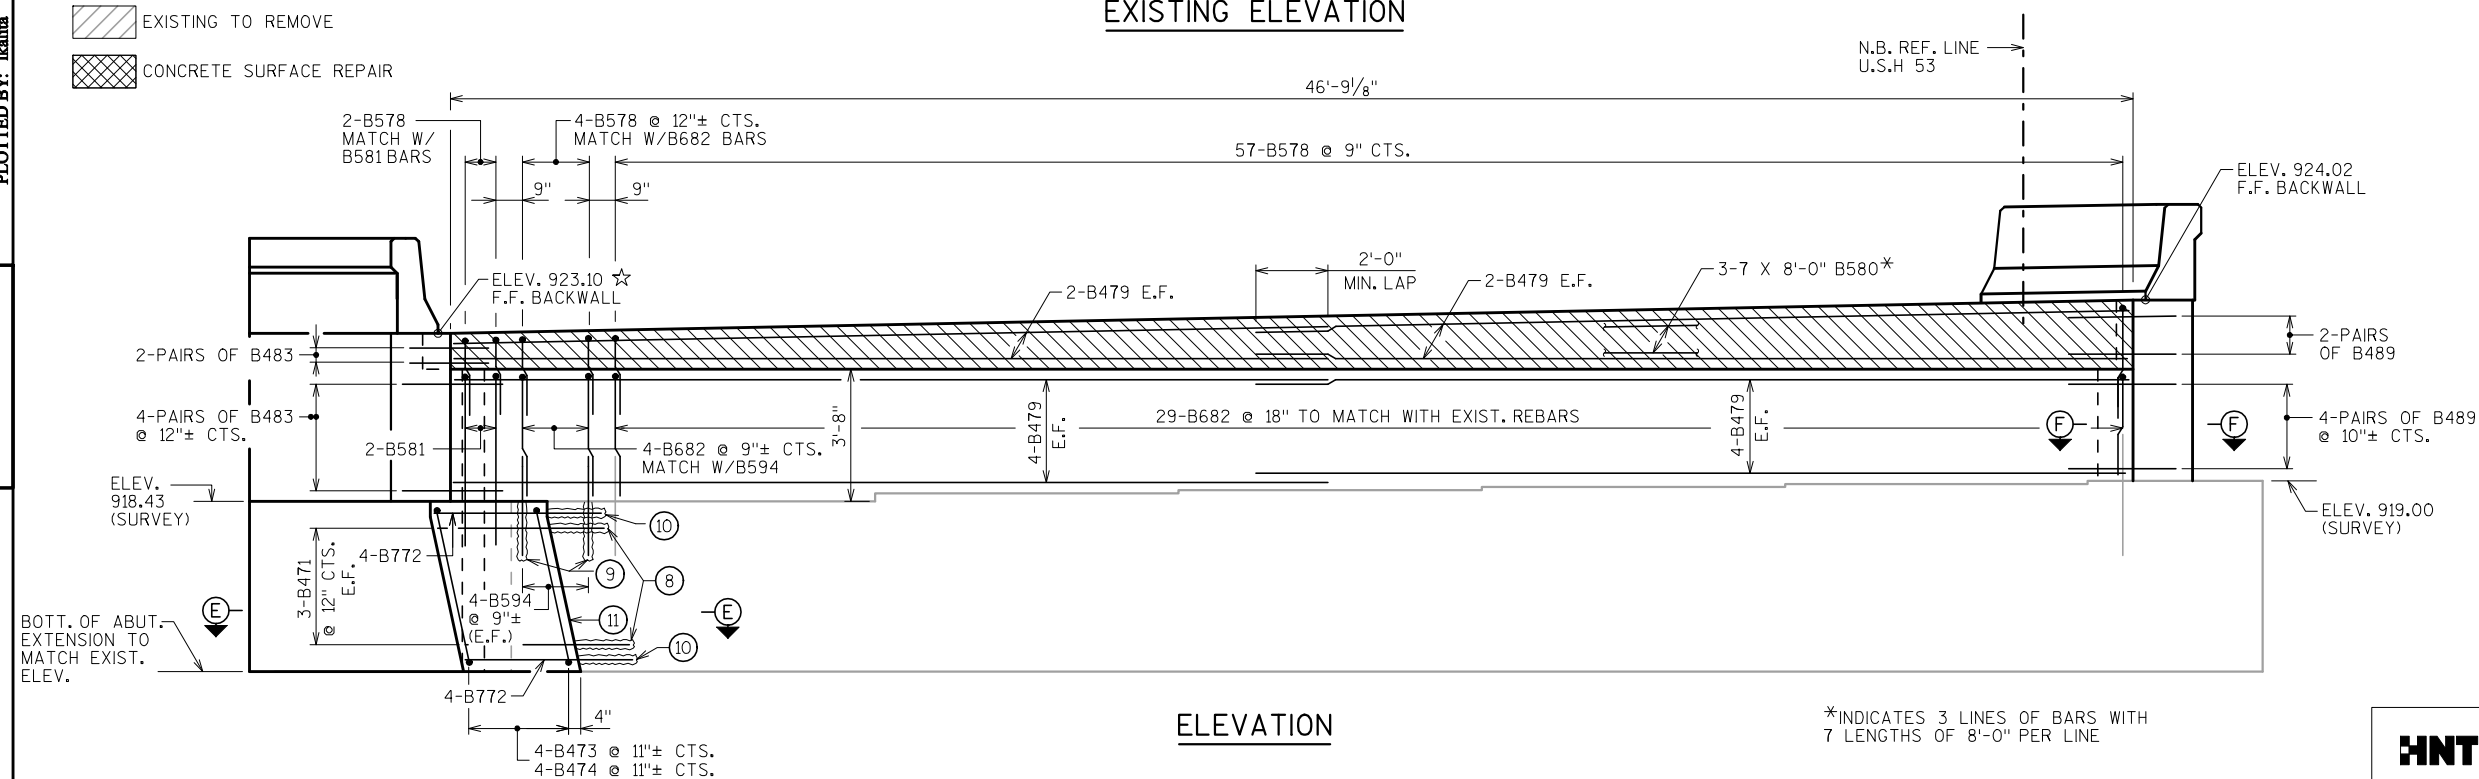

ELEVATION

*INDICATES 3 LINES OF BARS WITH
7 LENGTHS OF 8'-0" PER LINE

NOTES:

WORK THIS SHEET WITH SHEET 6, 11 & 12.

FOR SECT. A-A, SECT. B-B, SECT. C-C, SECT. D-D, SECT.
E-E, SECT. F-F AND SECT. G-G, SEE SHEET 6.


- ① 18" RUBBERIZED MEMBRANE WATERPROOFING. SEAL ALL HORIZ & VERT JTS ON BACK FACE ABOVE FOOTING
- ② OPTIONAL CONST JT: KEYWAY FORMED BY A BEVELED 2 X 6
- ⑧ CONCRETE MASONRY ANCHOR, TYPE L, NO. 4 BAR, EMBED 1'-0".
- ⑨ CONCRETE MASONRY ANCHOR, TYPE L, NO. 5 BAR, EMBED 1'-0".
- ⑩ CONCRETE MASONRY ANCHOR, TYPE L, NO. 7 BAR, EMBED 1'-8".
- ⑪ ROUGHEN SURFACE OF EXISTING CONCRETE 1/4" DEEP MIN. ALL AREAS OF NEW TO EXISTING CONCRETE CONTACT.
- ⑫ PRESERVE AND INCORPORATE EXISTING REBARS. IF AN EXISTING REBAR IS DAMAGED, REPLACE WITH A NEW BAR TO MATCH THE EXISTING.
- ⑭ REMOVE EXIST. WINGWALLS A MIN. OF 2'-0" BELOW FINISHED GRADE.
- ⑮ PROPOSED PILE. SEE "FOUNDATION NOTES" ON SHT. 2.
- ⑰ REMOVE EXIST. BACKWALL & WINGWALL, PRESERVE AND INCORPORATE EXIST. REBARS FOR NEW BACKWALL. CUT EXIST. REBARS ON THE WINGWALL.
- ☆ ELEV. AT F.F. ABUT. BACKWALL AND GUTTER LINE.

THE AMOUNT OF CONCRETE SURFACE REPAIRS SHOWN IS ONLY AN ESTIMATE BASED ON 2008 FIELD INSPECTION, AND IS SHOWN FOR BIDDING PURPOSE ONLY. THE CONTRACTOR SHALL VERIFY THE EXTENT OF THESE REPAIRS IN AGREEMENT WITH THE ENGINEER.

THE AMOUNT OF EPOXY CRACKING SEALING IS NOT SHOWN AND WILL BE REQUIRED AS DIRECTED BY THE ENGINEER.

SOUTH ABUTMENT BILL OF BARS

BAR MARK	COATED	NO. REQ'D	LENGTH	BENT	BAR SERIES	LOCATION
B471		6	4'-0"			ABUTMENT CAP EXTENSION HORIZ.
B772		8	4'-8"			ABUTMENT CAP EXTENSION HORIZ.
B473		4	12'-7"	X		ABUTMENT CAP EXTENSION VERT.
B474		4	12'-2"	X		ABUTMENT CAP EXTENSION VERT.
B475		20	6'-6"	X		EAST WINGWALL CAP VERT.
B476		10	3'-8"	X		EAST WINGWALL CAP VERT.
B477		12	1'-3"			EAST WINGWALL CAP HORIZ.
B578	X	63	7'-2"	X		BACKWALL & PAVING BLOCK HORIZ.
B479	X	24	24'-6"			PAVING BLOCK HORIZ.
B580	X	21	8'-0"			PAVING BLOCK HORIZ.
B581	X	2	1'-10"	X		BACKWALL VERT.
B682	X	33	7'-2"	X		BACKWALL VERT.
B483	X	12	5'-3"	X		EAST WINGWALL, BACKWALL HORIZ.
B484	X	23	2'-10"	X		EAST & WEST WINGWALL VERT.
B485	X	23	6'-5"			EAST WINGWALL VERT.
B487	X	5	9'-6"			EAST WINGWALL HORIZ.
B488	X	5	9'-0"			EAST WINGWALL HORIZ.
B489	X	12	5'-4"	X		WEST WINGWALL, BACKWALL HORIZ.
B490	X	25	5'-10"			WEST WINGWALL VERT.
B492	X	6	9'-8"			WEST WINGWALL HORIZ.
B493	X	6	10'-2"			WEST WINGWALL HORIZ.
B594	X	8	3'-2"			BACKWALL VERT.

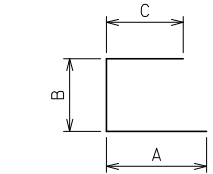

MARK	A	B	C
B474	4'-8"	4'-6"	3'-0"
B476	0'-10"	2'-0"	0'-10"
B578	3'-3"	0'-8"	3'-3"
B581	5'-3"	1'-4"	5'-3"
B682	2'-11"	1'-4"	2'-11"
B484	0'-10"	1'-2"	0'-10"

B474, B476, B578, B581, B682 & B484

NOTES:

WORK THIS SHEET WITH SHEET 5.

UNDER THE BID ITEMS "MASONRY ANCHORS TYPE L", ANCHORED REINFORCING STEEL SHALL BE PAID FOR SEPARATELY AS PROVIDED IN SECTION 505 OF THE STANDARD SPECIFICATIONS FOR BAR STEEL REINFORCEMENT.

** SET WITH EXPANSION JOINT PLATE, FOR MORE INFORMATION, SEE SHTS. 5 & 22.


LEGEND

- EXISTING TO REMAIN
- PROPOSED


HNTB

NO.	DATE	REVISION	BY
STATE OF WISCONSIN DEPARTMENT OF TRANSPORTATION STRUCTURES DESIGN SECTION			
STRUCTURE B-18-36			
2010	DRAWN BY	LK	PLANS CK'D. MX
SOUTH ABUTMENT 2			SHEET 6 OF 24
			JAN-28-2010


SCALE =

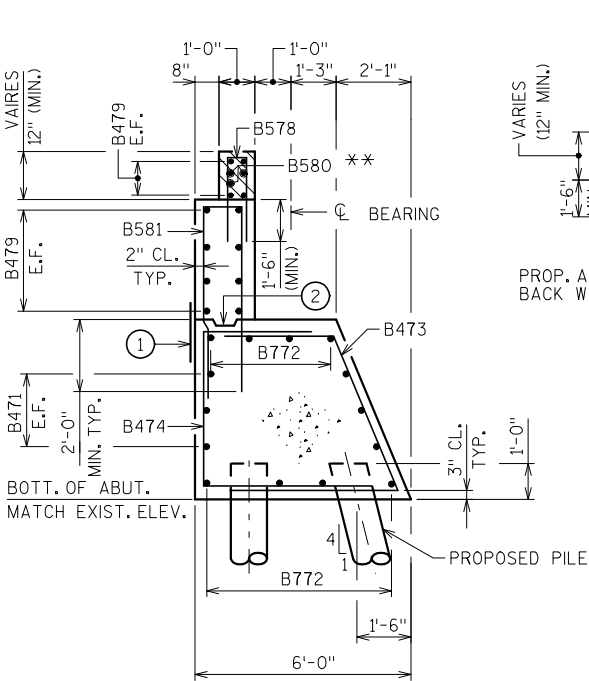


SECTION A-A

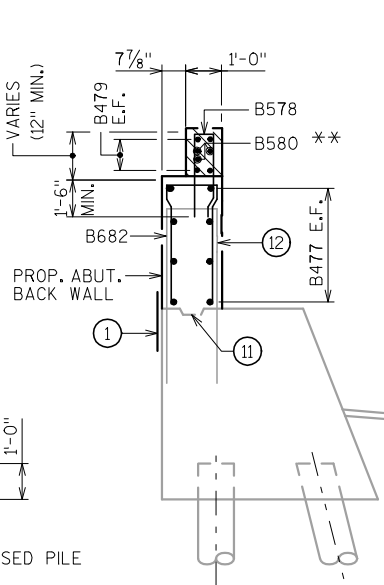


SECTION B-B

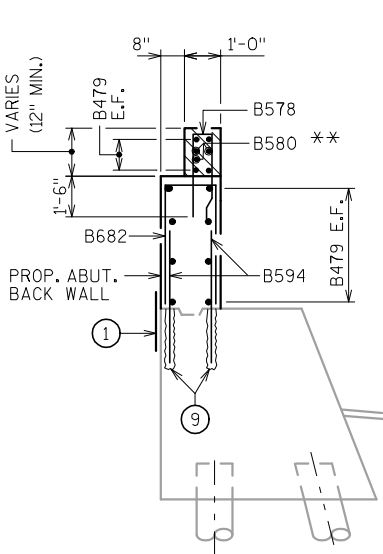


SECTION G-G

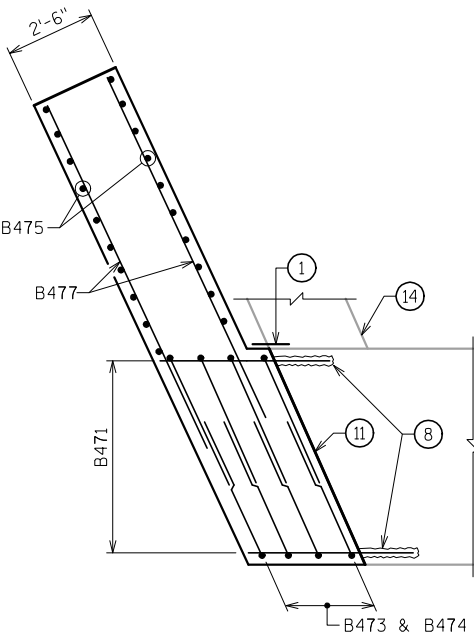


SECTION E-E

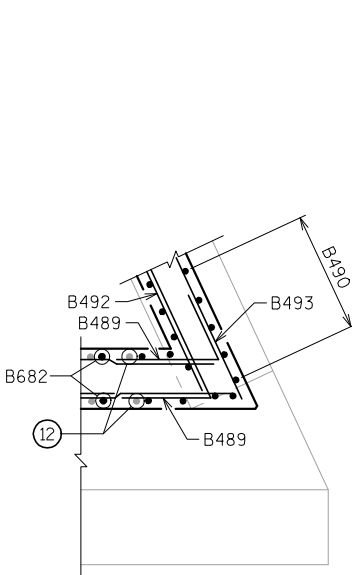


SECTION F-F

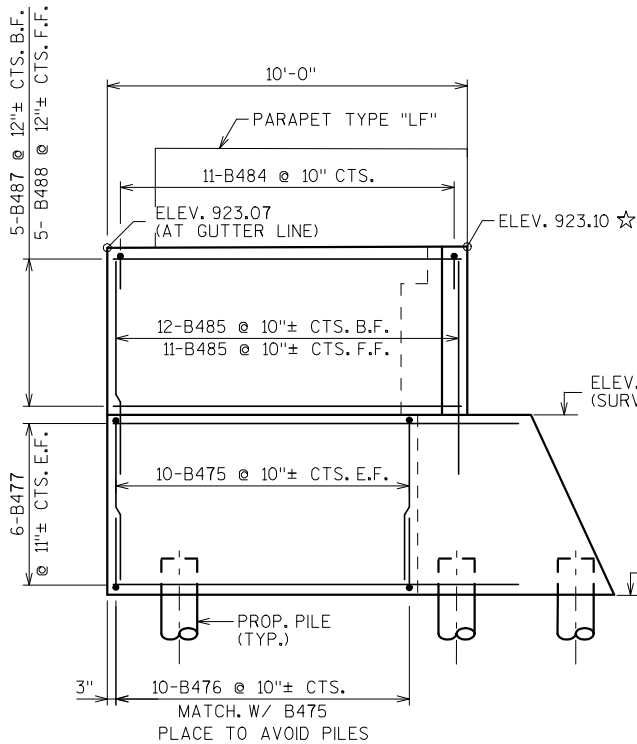


EAST WINGWALL

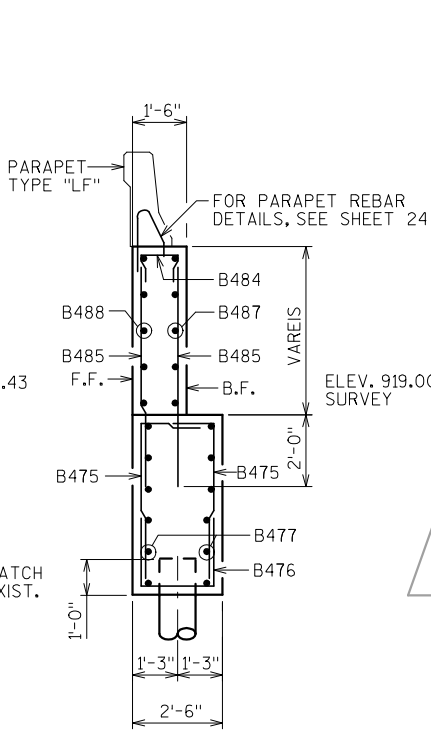


SECTION C-C

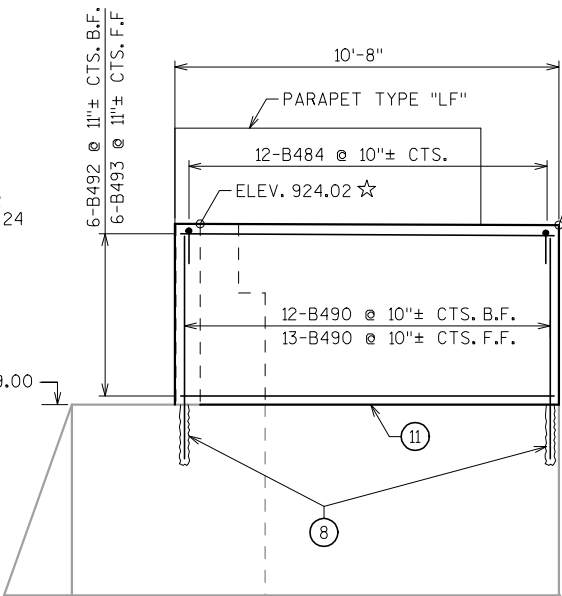


WEST WINGWALL

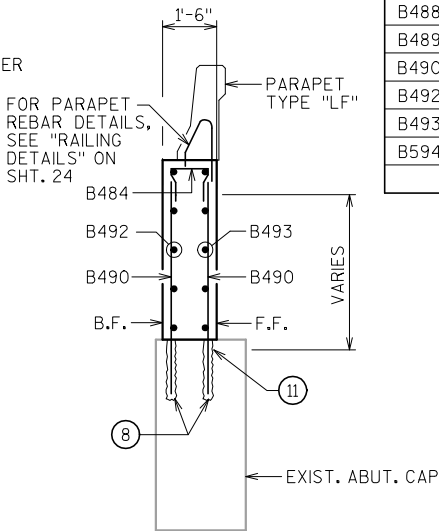


SECTION D-D

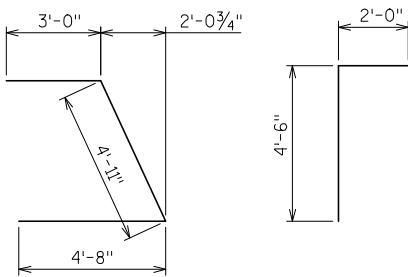

B473

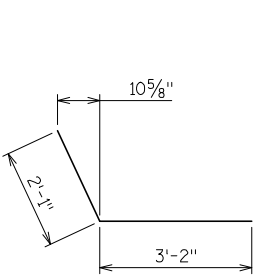

B475

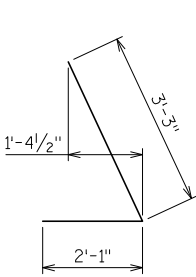

B483



B489



(LOOKING UPSTATION)
(FIBER WRAP PIER REINFORCING LIMITS ARE NOT SHOWN FOR CLARITY)




VIEW A-A


BEARING SEAT ELEVATION

LOCATION	BEARING SEAT ELEVATION
GIRDER N1	918.74

1. FOR REPAIR OF PIER CAP AND COLUMNS, REMOVE AND/OR REPAIR ALL UNSOUND CONCRETE. THE AMOUNT OF REPAIRS SHOWN IS ONLY AN ESTIMATE BASED ON 2008 FIELD INSPECTION, AND IS SHOWN FOR BIDDING PURPOSE ONLY. THE CONTRACTOR SHALL VERIFY THE EXTENT OF THESE REPAIRS IN AGREEMENT WITH THE ENGINEER.
2. WRAP THE COLUMNS AND PIER CAP WITH FIBER WRAP PIER REINFORCING AS SHOWN ON THE PLANS AND ACCORDING TO SPECIAL PROVISION SPV.0165.01. THE AREA TO BE WRAPPED IS 944 S.F. AND SHALL BE VERIFIED IN THE FIELD IN AGREEMENT WITH THE ENGINEER.
3. THE WORK DESCRIBED ABOVE SHALL BE COMPLETED WITHOUT ANY DAYTIME LANE CLOSURES ON I.H. 94 BEL

——— EXISTING TO REMAIN
 - - - - EXISTING TO BE REMOVED
 ——— PROPOSED

 CONCRETE REPAIR


 FIBER WRAP PIER REINFORCING




PLAN

\\ohiaw00\projects\50206\CADD\cds\new 36\50206_B1836_8\pier1-2.dgn
28-JAN-2010 07:53
PLOTTED BY: Italina


8

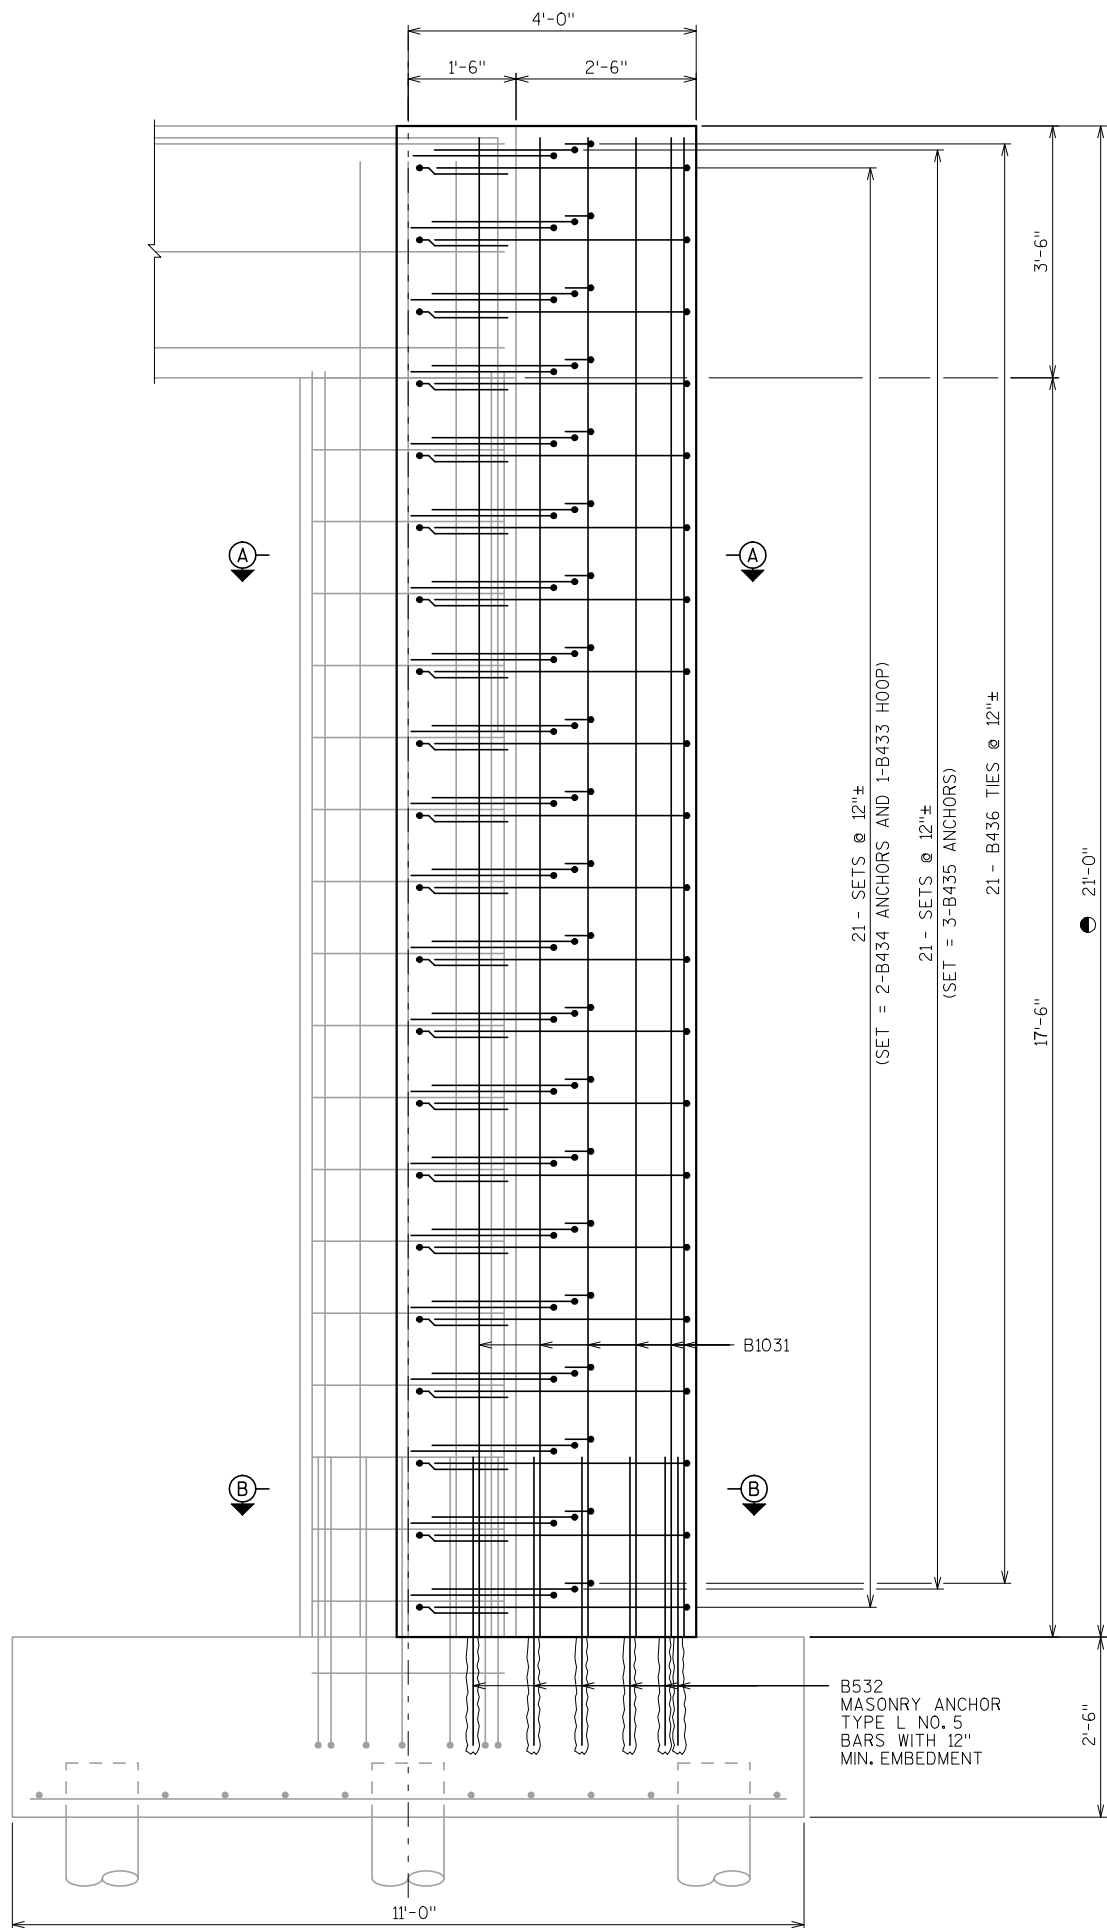


PROPOSED PARTIAL ELEVATION

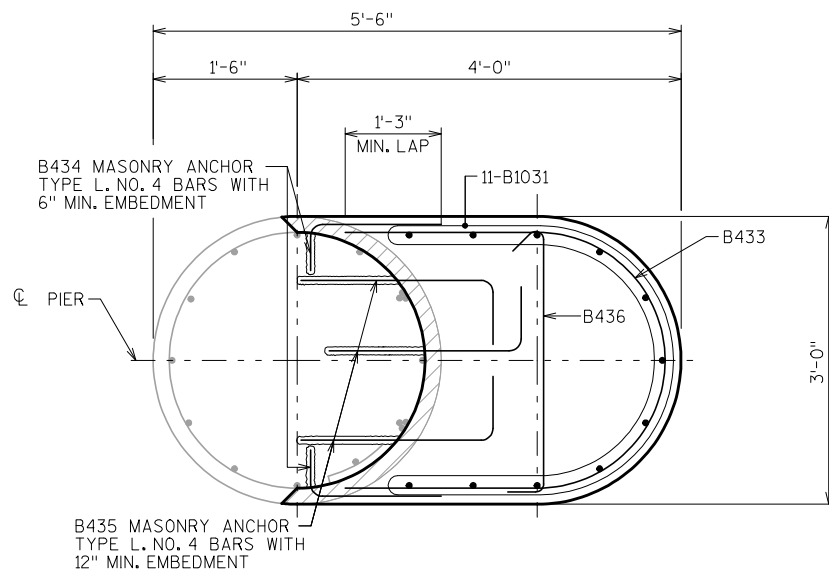

SECTION A-A

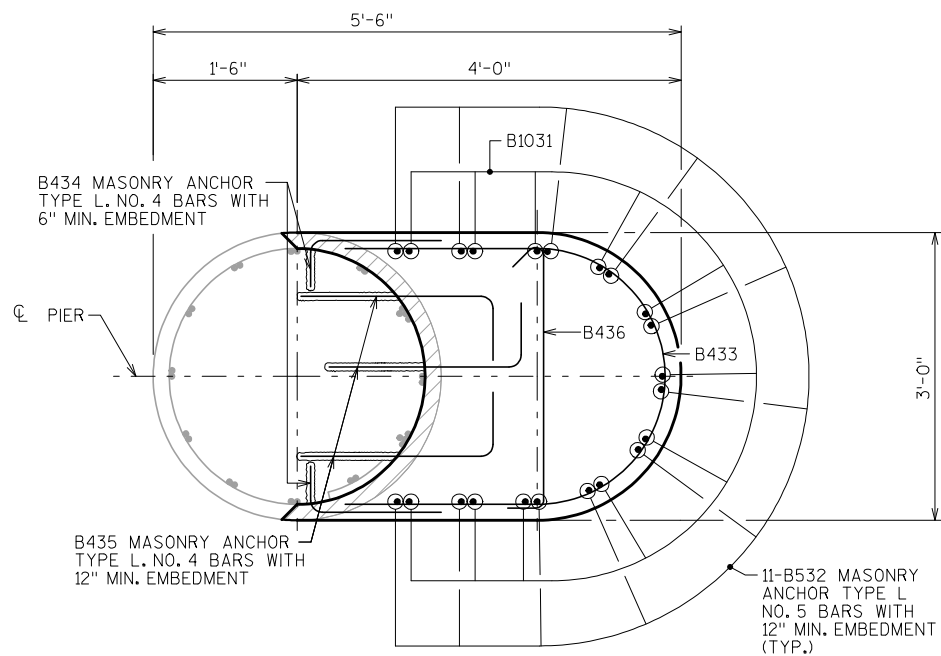

SECTION B-B

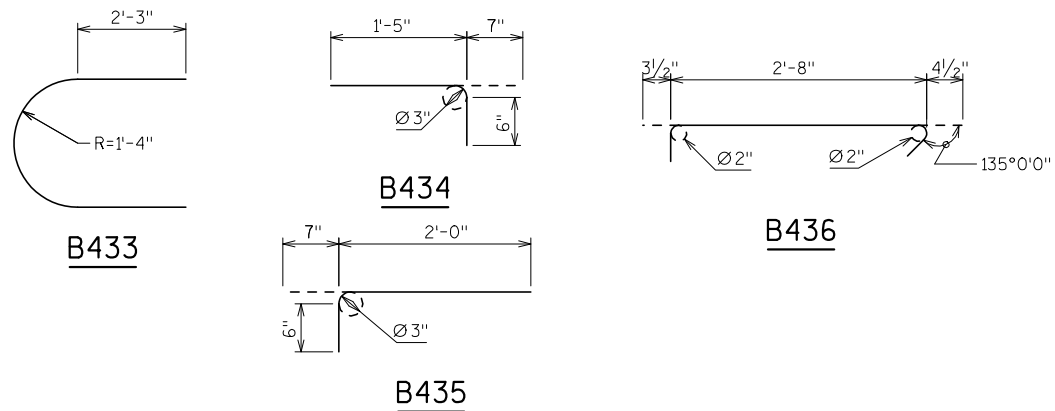

STATE PROJECT NUMBER

1022-01-73

BILL OF BARS

BAR MARK	COATED	NO. REQ'D	LENGTH	BENT	BAR SERIES	LOCATION
B1031	X	11	20'-9"			PIER 1 VERTICAL
B532	X	11	4'-0"			PIER 1 VERTICAL
B433	X	21	8'-9"	X		PIER 1 HOOP
B434	X	42	2'-0"	X		PIER 1 HORIZONTAL
B435	X	63	2'-7"	X		PIER 1 HORIZONTAL
B436	X	21	3'-4"	X		PIER 1 HORIZONTAL TIES

NOTES

PROVIDE A 2" MIN. CLEARANCE FOR REINFORCEMENT UNLESS OTHERWISE NOTED

- DIMENSIONS SHALL BE VERIFIED BY CONTRACTOR IN THE FIELD PRIOR TO ORDERING OF STEEL REINFORCEMENT

ROUGHEN SURFACE OF EXISTING CONCRETE 1/4" DEEP MIN. ALL AREA OF NEW TO EXISTING

LEGEND


- EXISTING TO REMAIN
- EXISTING TO BE REMOVED
- PROPOSED

NO.	DATE	REVISION	BY
STATE OF WISCONSIN DEPARTMENT OF TRANSPORTATION STRUCTURES DESIGN SECTION			
STRUCTURE B-18-36			
2010	DRAWN BY	IS	PLANS CK'D. SL
PIER 1 - 2			SHEET 8 OF 24
			JAN-28-2010

HNTB


SCALE =

8

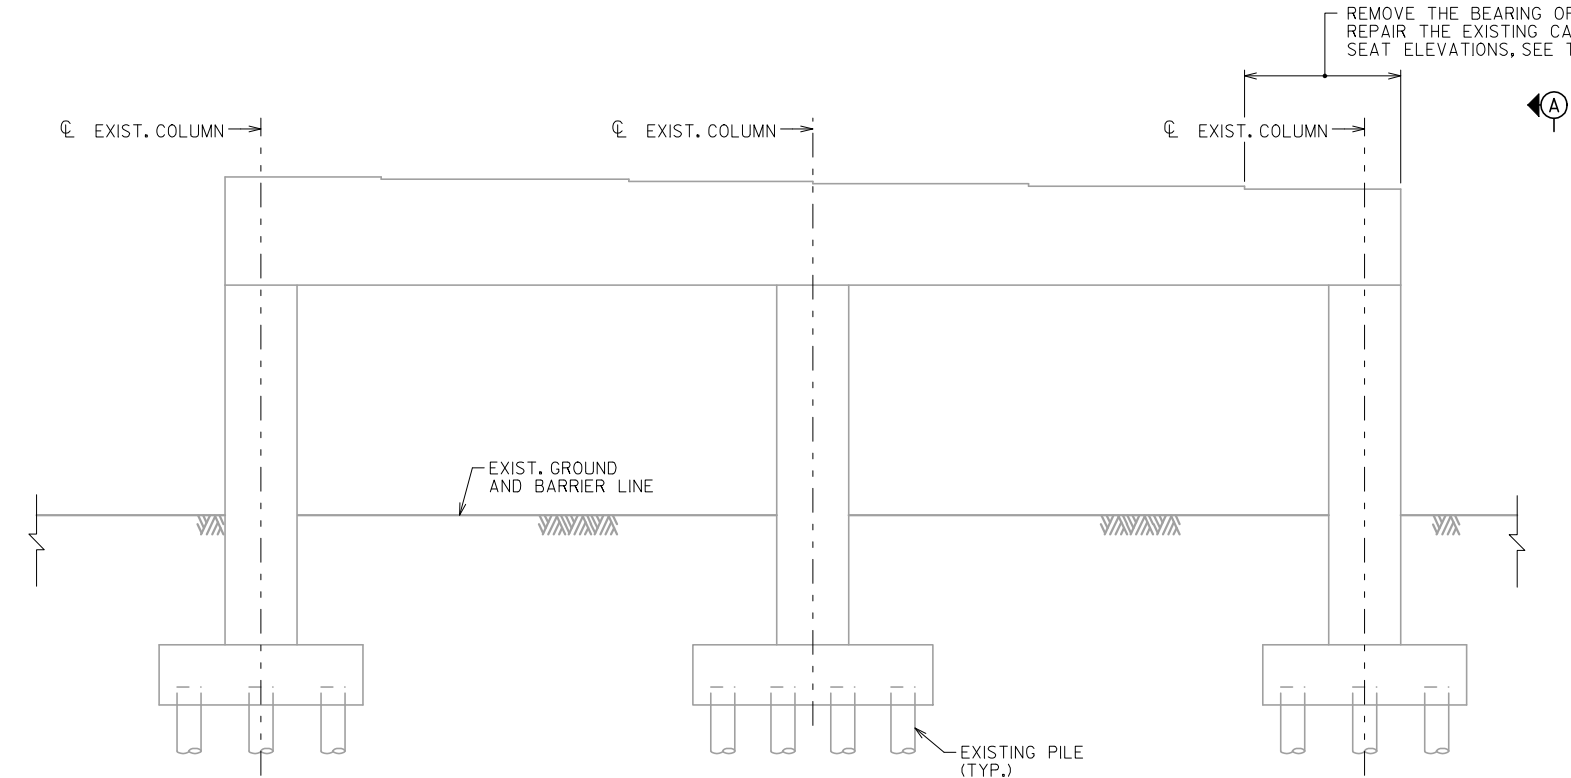

ELEVATION

(LOOKING UPSTATION)
(FIBER WRAP PIER REINFORCING LIMITS ARE NOT SHOWN FOR CLARITY)

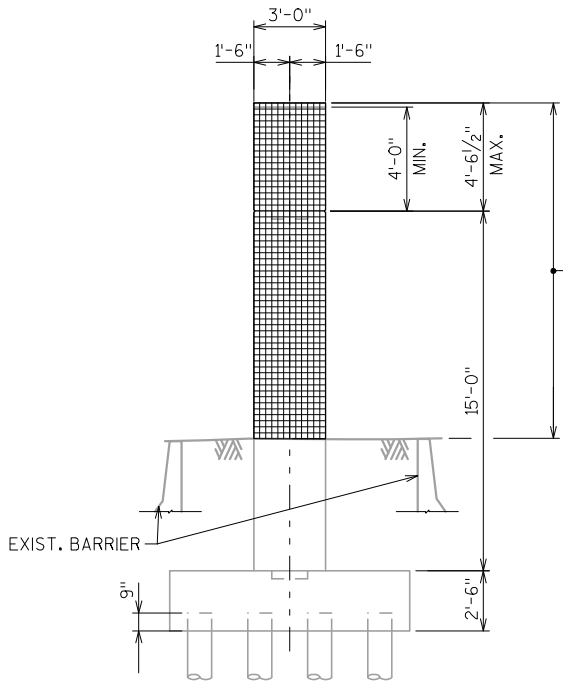

VIEW A-A

LIMITS OF FIBER WRAP PIER REINFORCING.
APPLY ABOVE EXISTING GROUND LINE AROUND ALL COLUMNS
AND PIER CAP WITH THE EXCEPTION OF PIER CAP TOP FACE.

BEARING SEAT ELEVATION


LOCATION	BEARING SEAT ELEVATION
GIRDER N1	915.76

NOTES:

- FOR REPAIR OF PIER CAP AND COLUMNS, REMOVE AND/OR REPAIR ALL UNSOUND CONCRETE. THE AMOUNT OF REPAIRS SHOWN IS ONLY AN ESTIMATE BASED ON 2008 FIELD INSPECTION, AND IS SHOWN FOR BIDDING PURPOSE ONLY. THE CONTRACTOR SHALL VERIFY THE EXTENT OF THESE REPAIRS IN AGREEMENT WITH THE ENGINEER.
- WRAP THE COLUMNS AND PIER CAP WITH FIBER WRAP PIER REINFORCING AS SHOWN ON THE PLANS AND ACCORDING TO SPECIAL PROVISION SPV.0165.01. THE AREA TO BE WRAPPED IS 820 S.F. AND SHALL BE VERIFIED IN THE FIELD IN AGREEMENT WITH THE ENGINEER.
- THE WORK DESCRIBED ABOVE SHALL BE COMPLETED WITHOUT ANY DAYTIME LANE CLOSURES ON I.H. 94 BELOW.

LEGEND

- EXISTING TO REMAIN
- EXISTING TO BE REMOVED
- PROPOSED
- ▒ FIBER WRAP PIER REINFORCING

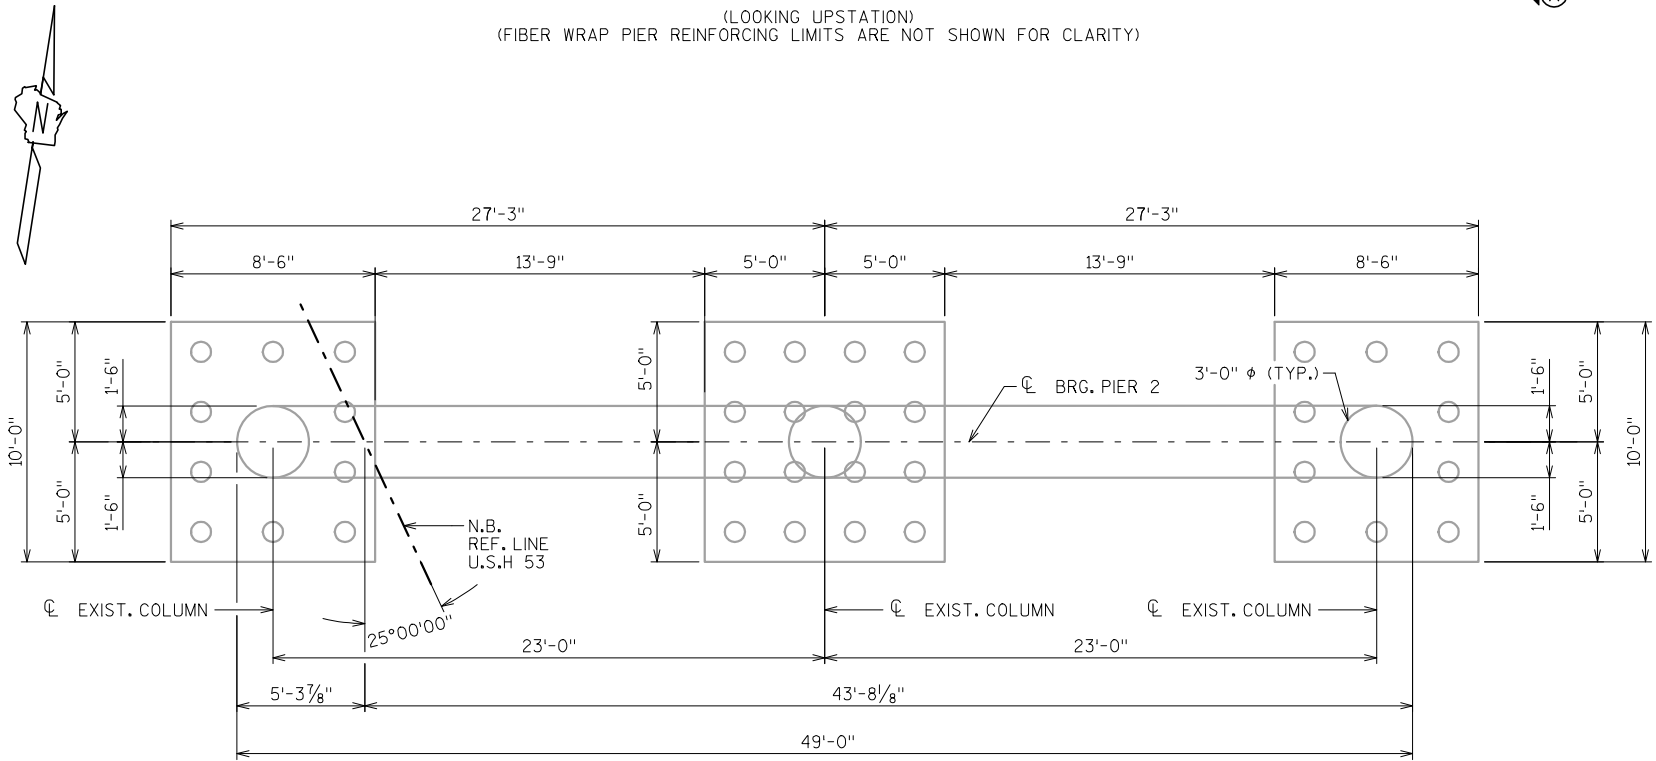

PLAN

NO.	DATE	REVISION	BY
STATE OF WISCONSIN DEPARTMENT OF TRANSPORTATION STRUCTURES DESIGN SECTION			
STRUCTURE B-18-36			
2010	DRAWN BY	IS	PLANS CK'D. SL
PIER 2			SHEET 9 OF 24
			JAN-28-2010

HNTB


PIER 2

JAN-28-2010

SCALE =


\\ohiaw00\projects\50206\CADD\tds\new 36\50206_B1836_10pier3.dgn
28-JAN-2010 07:53
PLOTTED BY: Ikalina

8


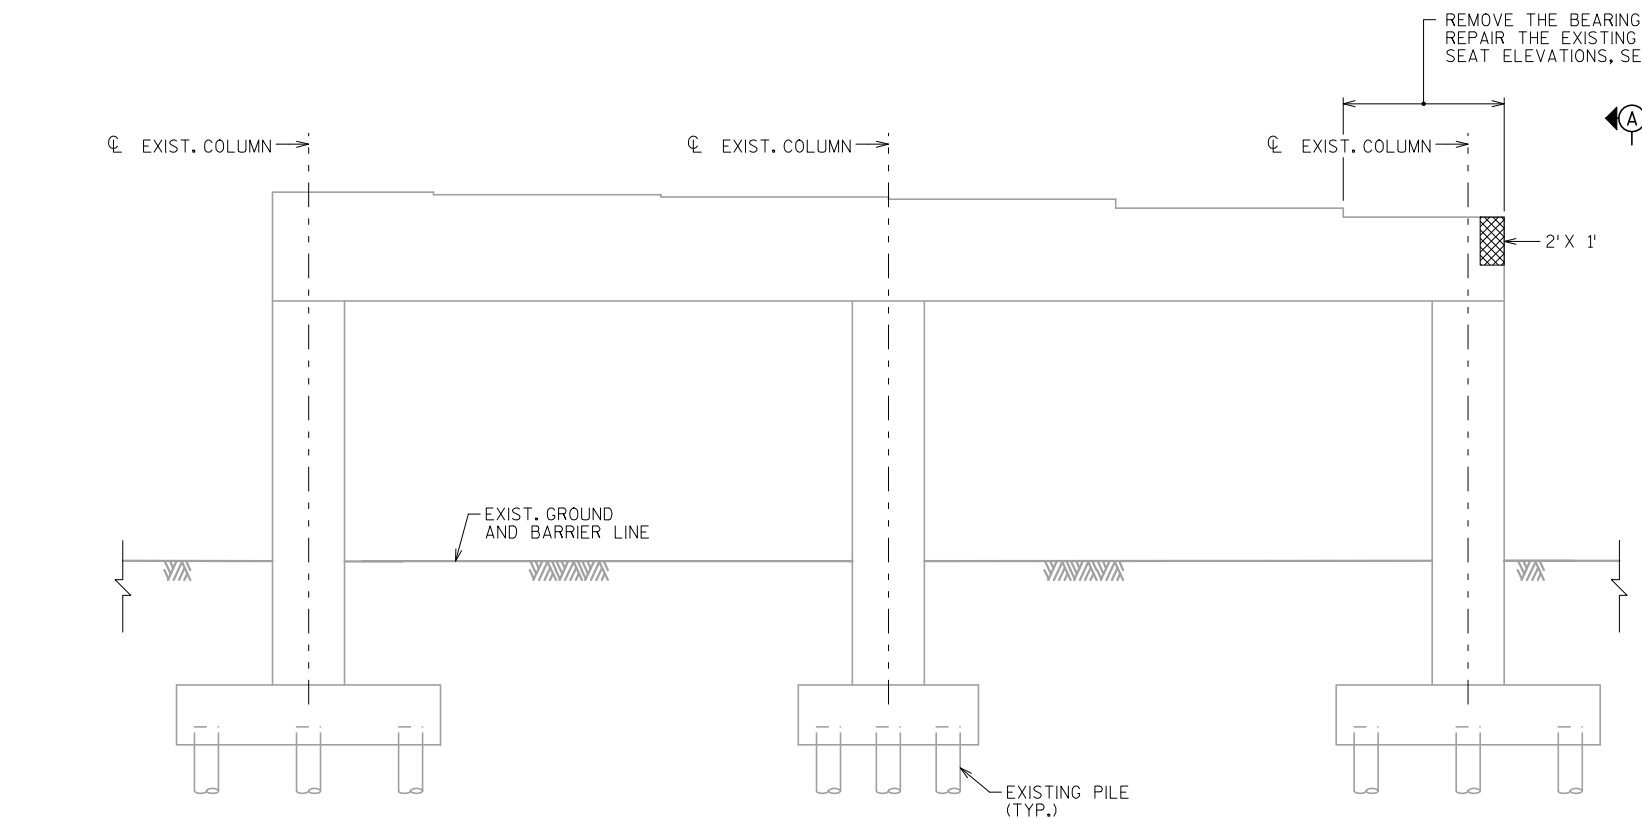


ELEVATION


(LOOKING UPSTATION)
(FIBER WRAP PIER REINFORCING LIMITS ARE NOT SHOWN FOR CLARITY)

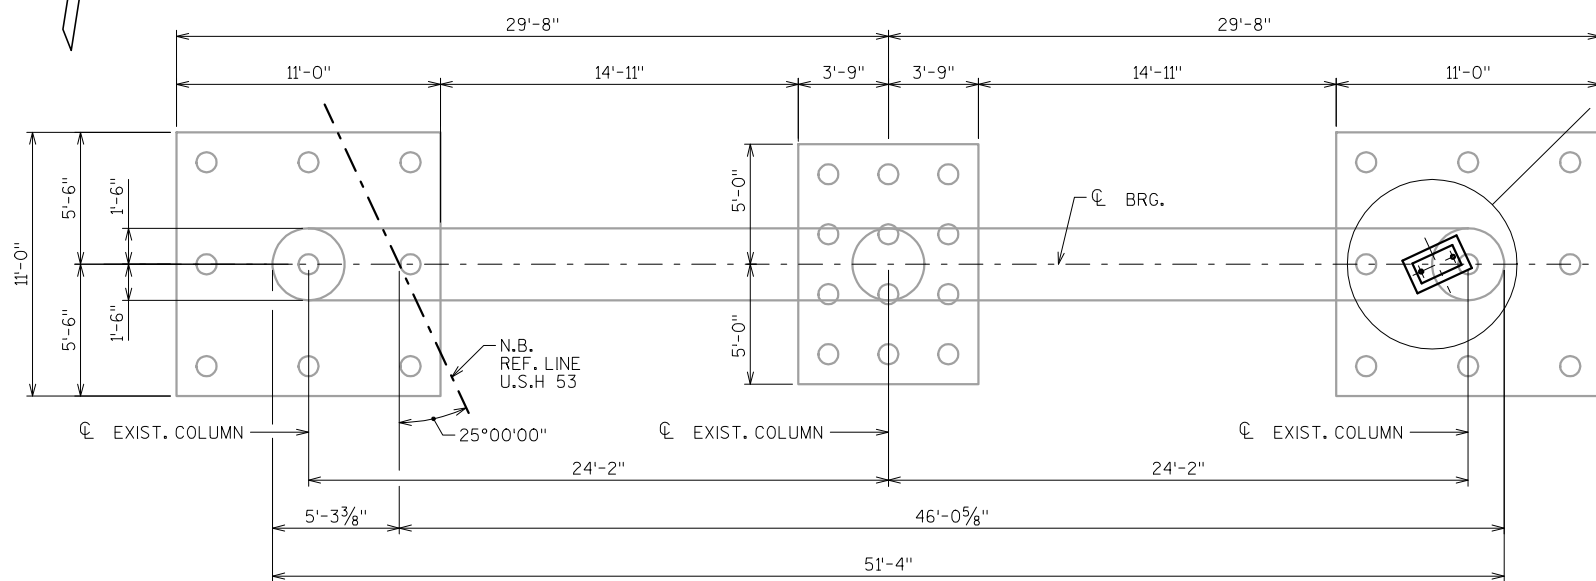


PLAN

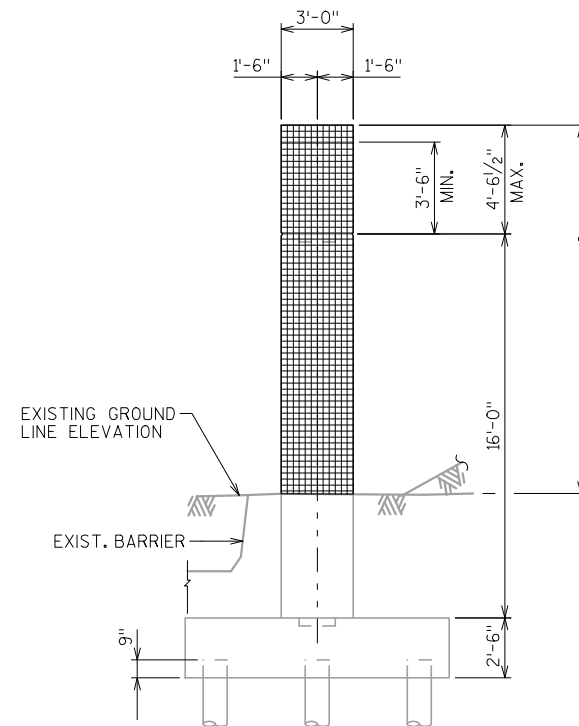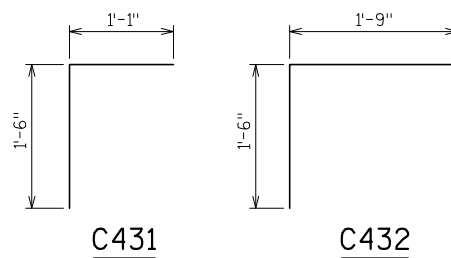


VIEW A-A

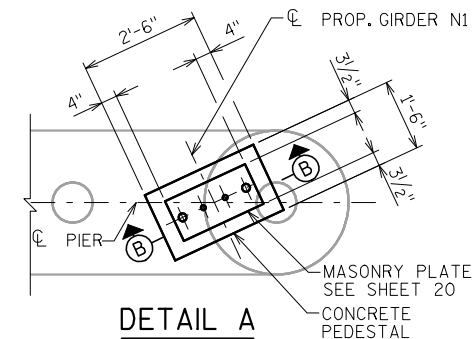

DETAIL A

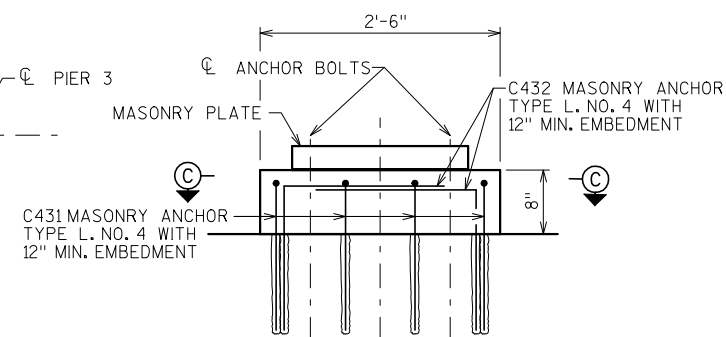

SECTION B-B

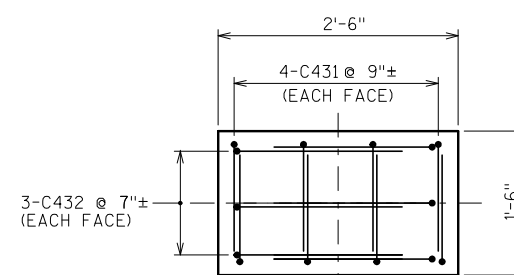

SECTION C-C

STATE PROJECT NUMBER

1022-01-73

BILL OF BARS

BAR MARK	COATED	NO. REQ'D	LENGTH	BENT BAR SERIES	LOCATION
C431	X	8	2'-7"	X	PIER 3 PEDESTAL
C432	X	6	3'-3"	X	PIER 3 PEDESTAL

BEARING SEAT ELEVATION

LOCATION	BEARING SEAT ELEVATION
GIRDER N1	919.27

NOTES:

- FOR REPAIR OF PIER CAP AND COLUMNS, REMOVE AND/OR REPAIR ALL UNSOUND CONCRETE. THE AMOUNT OF REPAIRS SHOWN IS ONLY AN ESTIMATE BASED ON 2008 FIELD INSPECTION, AND IS SHOWN FOR BIDDING PURPOSE ONLY. THE CONTRACTOR SHALL VERIFY THE EXTENT OF THESE REPAIRS IN AGREEMENT WITH THE ENGINEER.
- WRAP THE COLUMNS AND PIER CAP WITH FIBER WRAP PIER REINFORCING AS SHOWN ON THE PLANS AND ACCORDING TO SPECIAL PROVISION SPV.0165.01. THE AREA TO BE WRAPPED IS 893 S.F. AND SHALL BE VERIFIED IN THE FIELD IN AGREEMENT WITH THE ENGINEER.
- THE WORK DESCRIBED ABOVE SHALL BE COMPLETED WITHOUT ANY DAYTIME LANE CLOSURES ON I.H. 94 BELOW.
- PROVIDE A 2" MIN. CLEARANCE FOR REINFORCEMENT UNLESS OTHERWISE NOTED.

LEGEND

- EXISTING TO REMAIN
- EXISTING TO BE REMOVED
- PROPOSED
- CONCRETE REPAIR
- FIBER WRAP PIER REINFORCING

NO.	DATE	REVISION	BY
STATE OF WISCONSIN DEPARTMENT OF TRANSPORTATION STRUCTURES DESIGN SECTION			
STRUCTURE B-18-36			
2010	DRAWN BY	IS	PLANS CK'D. SL
PIER 3			SHEET 10 OF 24
			JAN-28-2010


HNTB

SCALE =

8

\\chiw00\projects\50206\CADD\ods\new 36\50206_B1836_11abut1.dgn
28-JAN-2010 07:54
PLOTTED BY: Italina

8


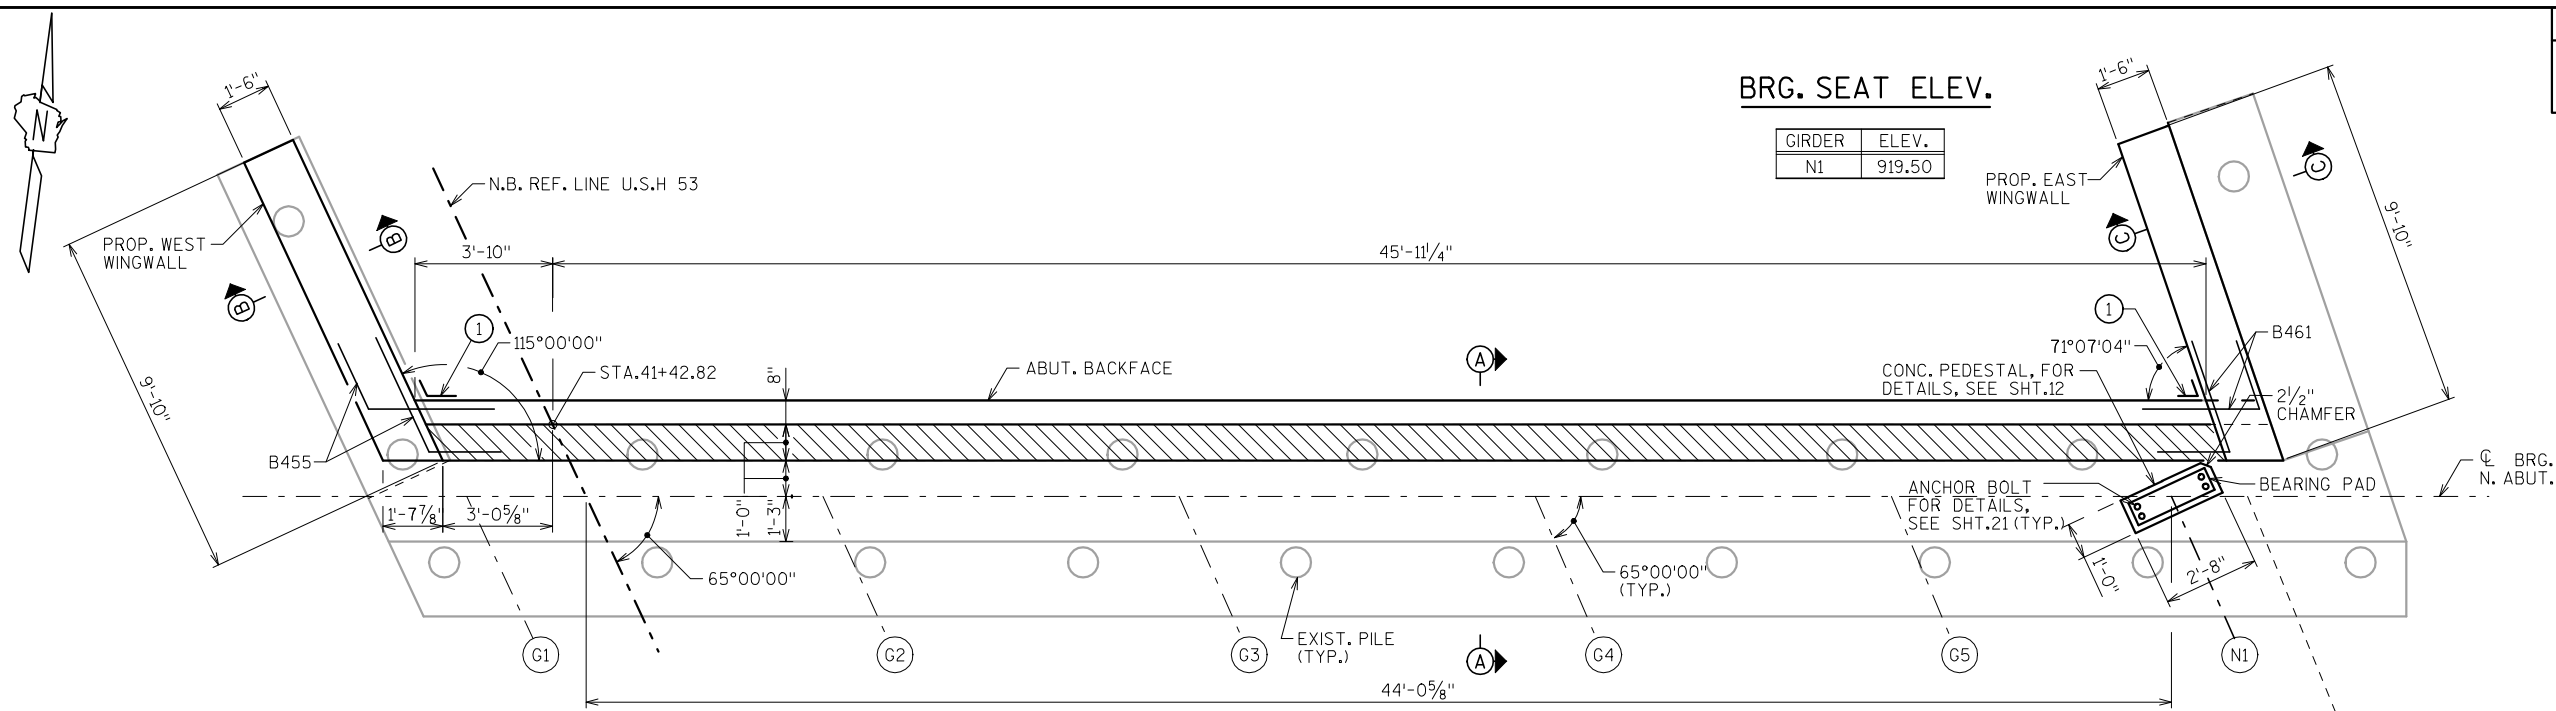


NOTES:

WORK THIS SHEET WITH SHEETS 5, 6 & 12.
FOR SECTION A-A THRU, F-F, SEE SHEET 12.

LEGEND

- EXISTING TO REMAIN
- PROPOSED
- EXISTING TO REMOVE
- CONCRETE SURFACE REPAIR

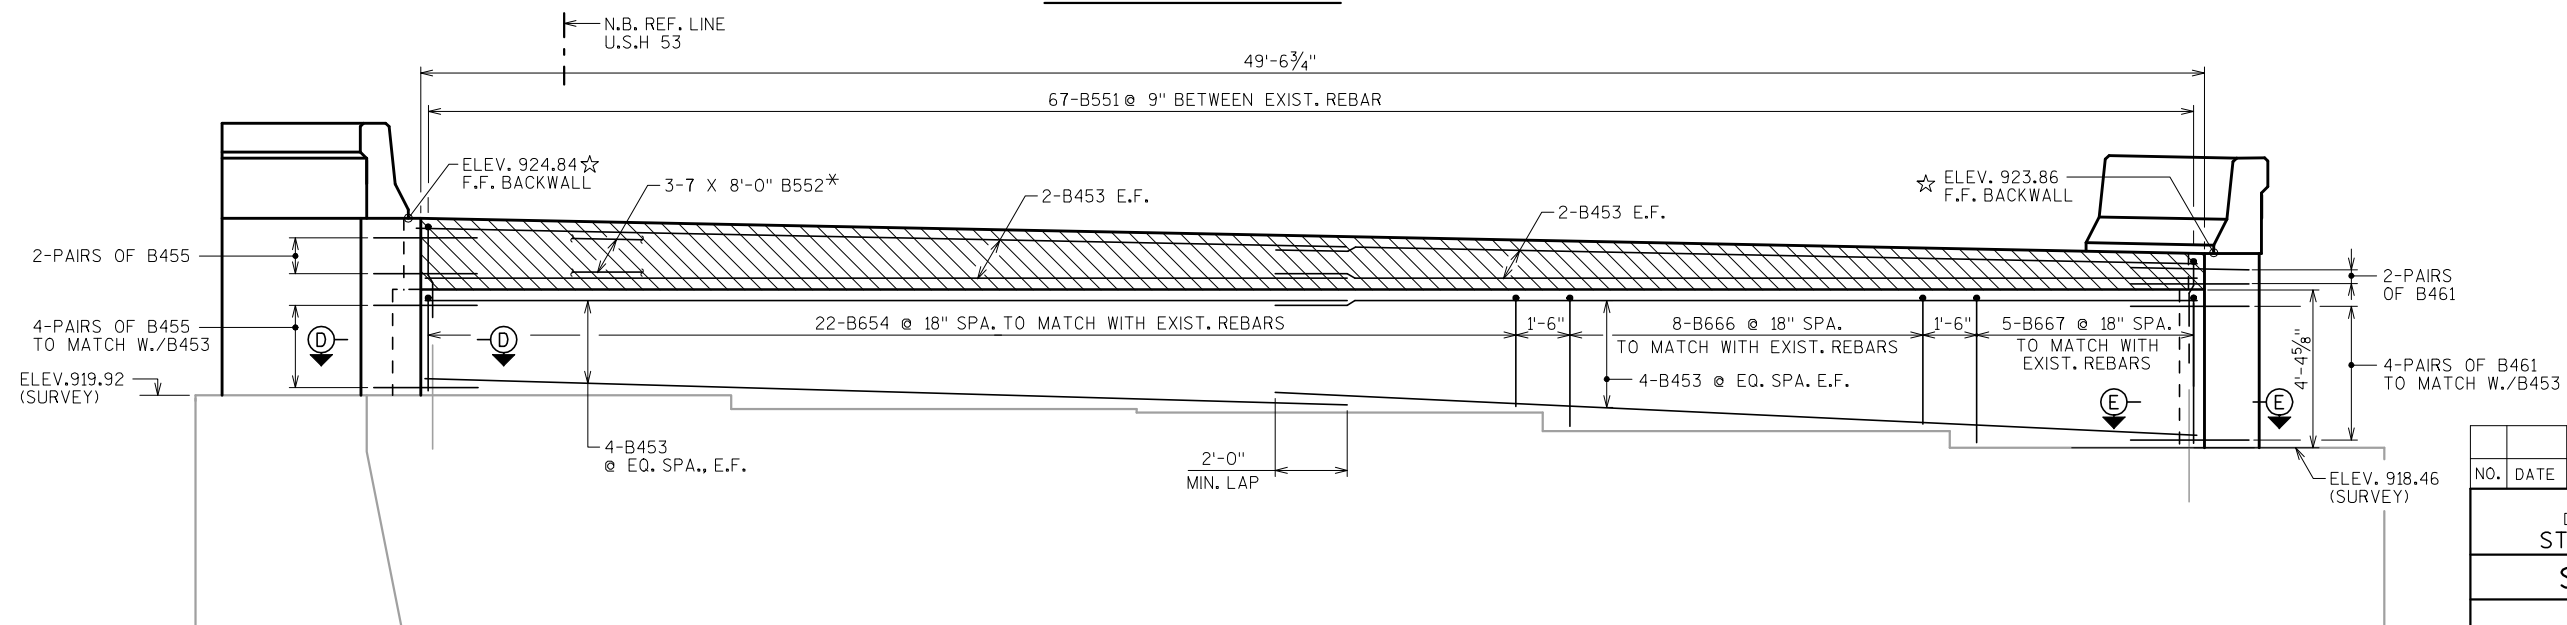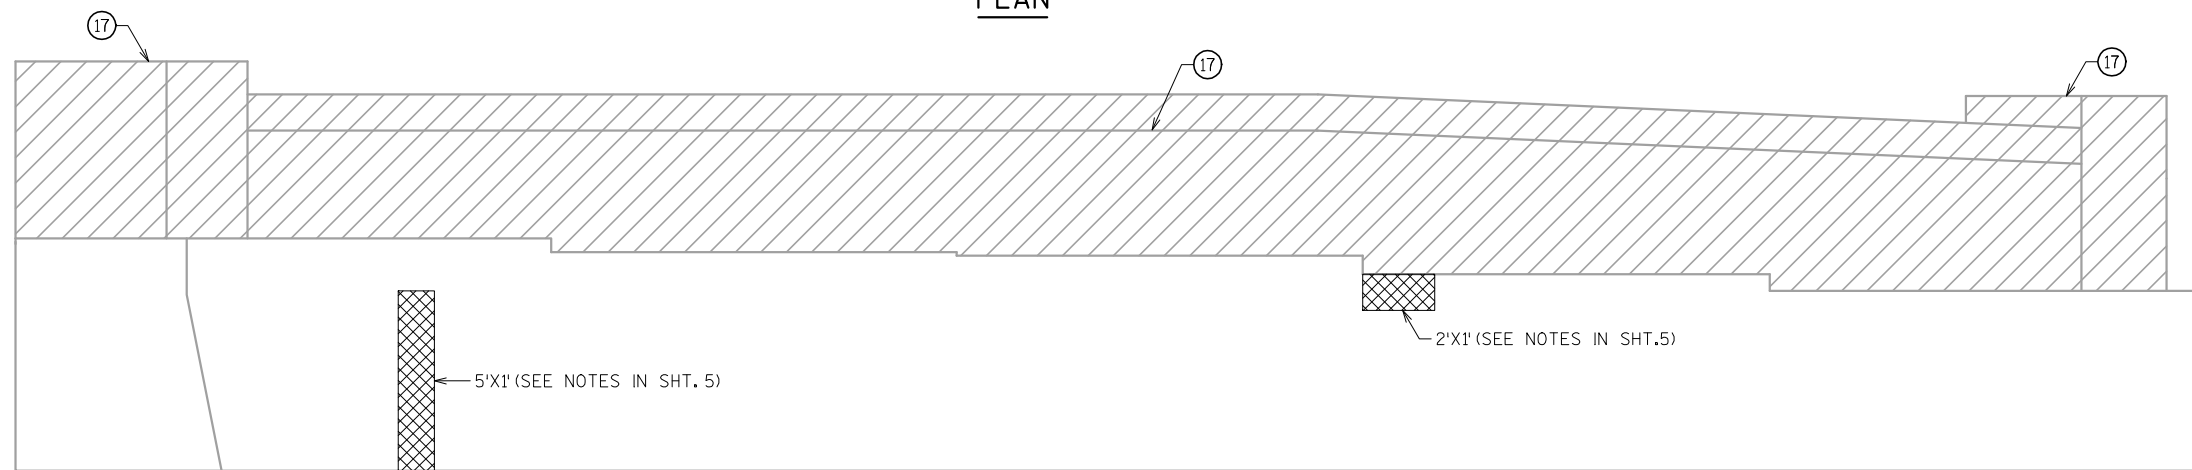

*INDICATES 3 LINES OF BARS WITH 7 LENGTHS OF 8'-0" PER LINE

HNTB


NO.	DATE	REVISION	BY
STATE OF WISCONSIN DEPARTMENT OF TRANSPORTATION STRUCTURES DESIGN SECTION			
STRUCTURE B-18-36			
2010	DRAWN BY	LK	PLANS CK'D. MX
NORTH ABUTMENT 1			SHEET 11 OF 24
			JAN-28-2010

SCALE =


8

\\ohw00\projects\50206\CADD\ods\new 36\50206_B1836_12abut2.dgn
28-JAN-2010 07:54
PLOTTED BY: Ikalina


8

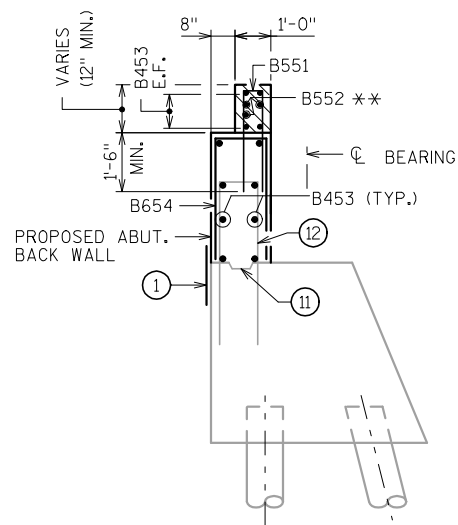

SECTION A-A

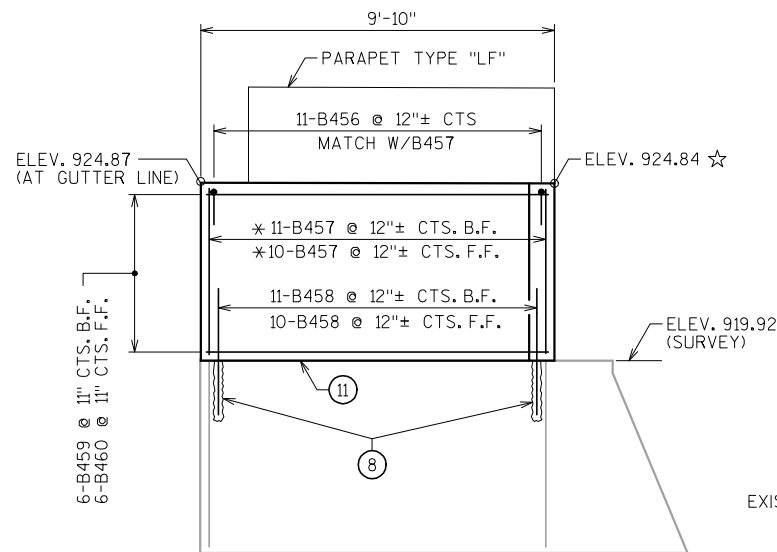


WEST WINGWALL

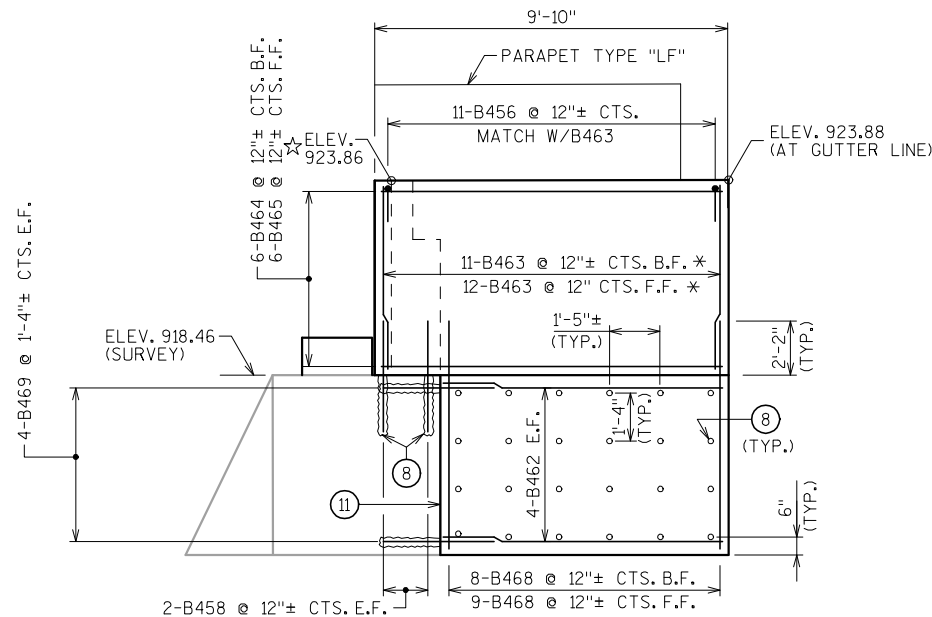


EAST WINGWALL


(EXIST. ABUT. CAP NOT SHOWN FOR CLARITY)

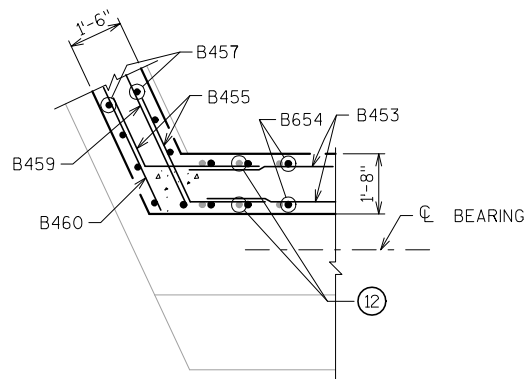


SECTION D-D

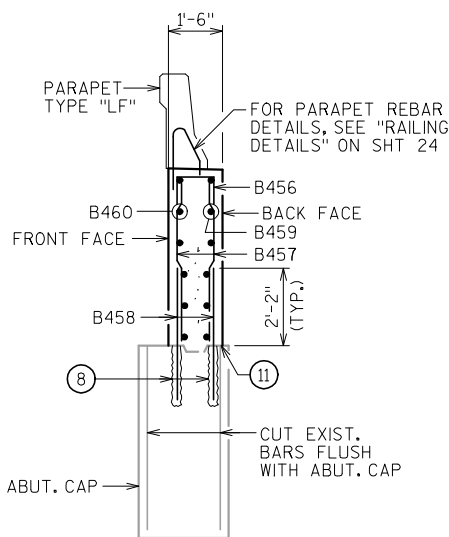


SECTION B-B

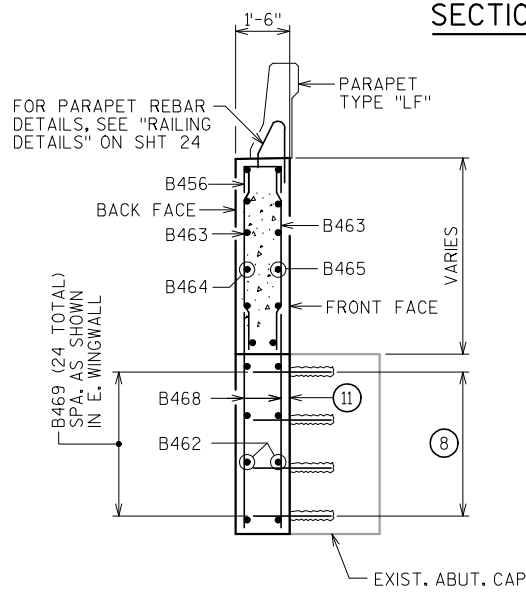


SECTION C-C

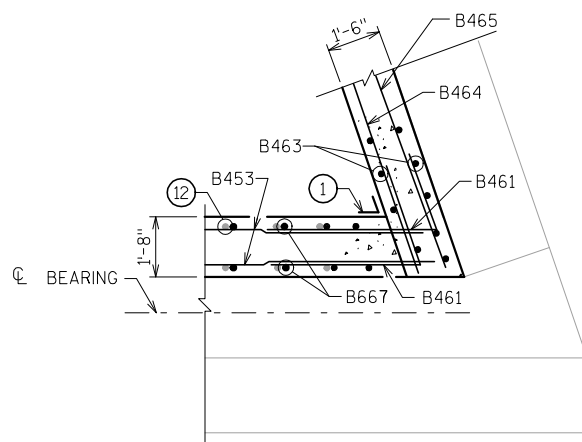


SECTION E-E

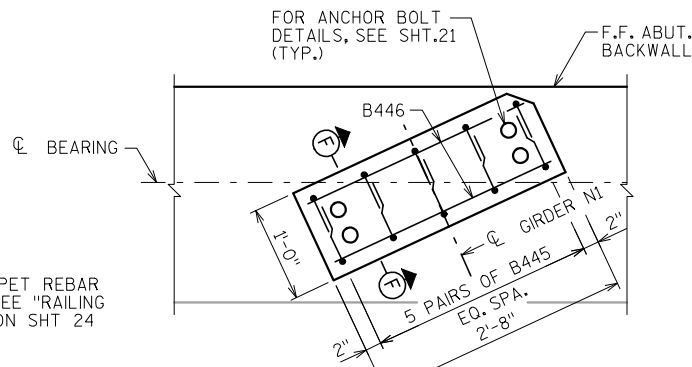


PLAN - PEDESTAL

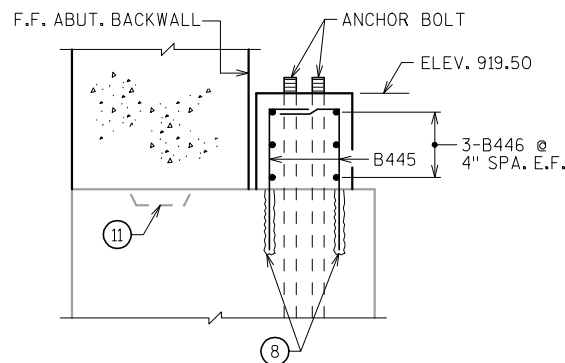


SECTION F-F

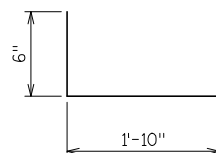

B445

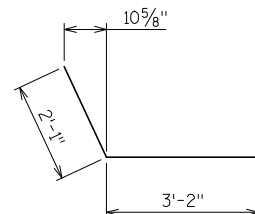


B455

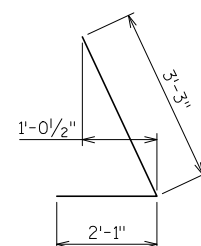

B461

B551, B654, B456,
B666 & B667

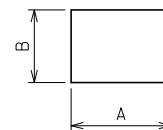

MARK	A	B
B551	3'-4"	0'-8"
B654	2'-9"	1'-4"
B456	0'-10"	1'-2"
B666	3'-9"	1'-4"
B667	4'-2"	1'-4"

NOTES:

WORK THIS SHEET WITH SHEETS 5 & 11.

UNDER THE BID ITEMS "MASONRY ANCHORS TYPE L", ANCHORED REINFORCING STEEL SHALL BE PAID FOR SEPARATELY AS PROVIDED IN SECTION 505 OF THE STANDARD SPECIFICATIONS FOR BAR STEEL REINFORCEMENT.

LEGEND

— EXISTING TO REMAIN
— PROPOSED

* TO MATCH WITH B458 & B468

** SET WITH EXPANSION JOINT ANCHOR PLATE. FOR MORE DETAILS, SEE SHTS. 5 & 22.

NO.	DATE	REVISION	BY
STATE OF WISCONSIN DEPARTMENT OF TRANSPORTATION STRUCTURES DESIGN SECTION			
STRUCTURE B-18-36			
2010	DRAWN BY	LK	PLANS CK'D. MX
NORTH ABUTMENT 2		SHEET 12 OF 24	
		JAN-28-2010	

HNTB

SCALE =

8

STATE PROJECT NUMBER


1022-01-73

NORTH ABUTMENT BILL OF BARS


BAR MARK	COATED	NO. REQ'D	LENGTH	BENT	BAR SERIES	LOCATION
B445	X	10	2'-4"	X		PEDESTAL VERT.
B446	X	6	2'-4"	X		PEDESTAL HORIZ.
B551	X	67	7'-4"	X		PAVING BLOCK VERT.
B552	X	21	8'-0"			PAVING BLOCK HORIZ.
B453	X	24	25'-9"			BACKWALL & PAVING BLOCK HORIZ.
B654	X	22	6'-10"	X		BACKWALL VERT.
B455	X	12	5'-3"	X		WINGWALL, BACKWALL & PAVING BLOCK HORIZ.
B456	X	22	2'-10"	X		WINGWALL VERT.
B457	X	21	4'-9"			WEST WINGWALL VERT.
B458	X	25	3'-2"			WINGWALL VERT.
B459	X	6	9'-4"			WEST WINGWALL HORIZ.
B460	X	6	8'-10"			WEST WINGWALL HORIZ.
B461	X	12	5'-4"	X		EAST WINGWALL, BACKWALL & PAVING BLOCK HORIZ.
B462		8	7'-2"			EAST WINGWALL HORIZ.
B463	X	23	5'-2"			EAST WINGWALL VERT.
B464	X	6	9'-0"			EAST WINGWALL HORIZ.
B465	X	6	9'-5"			EAST WINGWALL HORIZ.
B666	X	8	8'-10"	X		BACKWALL VERT.
B667	X	5	9'-8"	X		BACKWALL VERT.
B468	X	17	6'-11"			EAST WINGWALL VERT.
B469	X	32	2'-3"			EAST WINGWALL HORIZ.

\\chaw00\projects\50206\CADD\tds\new 36\50206_B1836_13deck.dgn
28-JAN-2010 07:54
PLOTTED BY: Italina


8

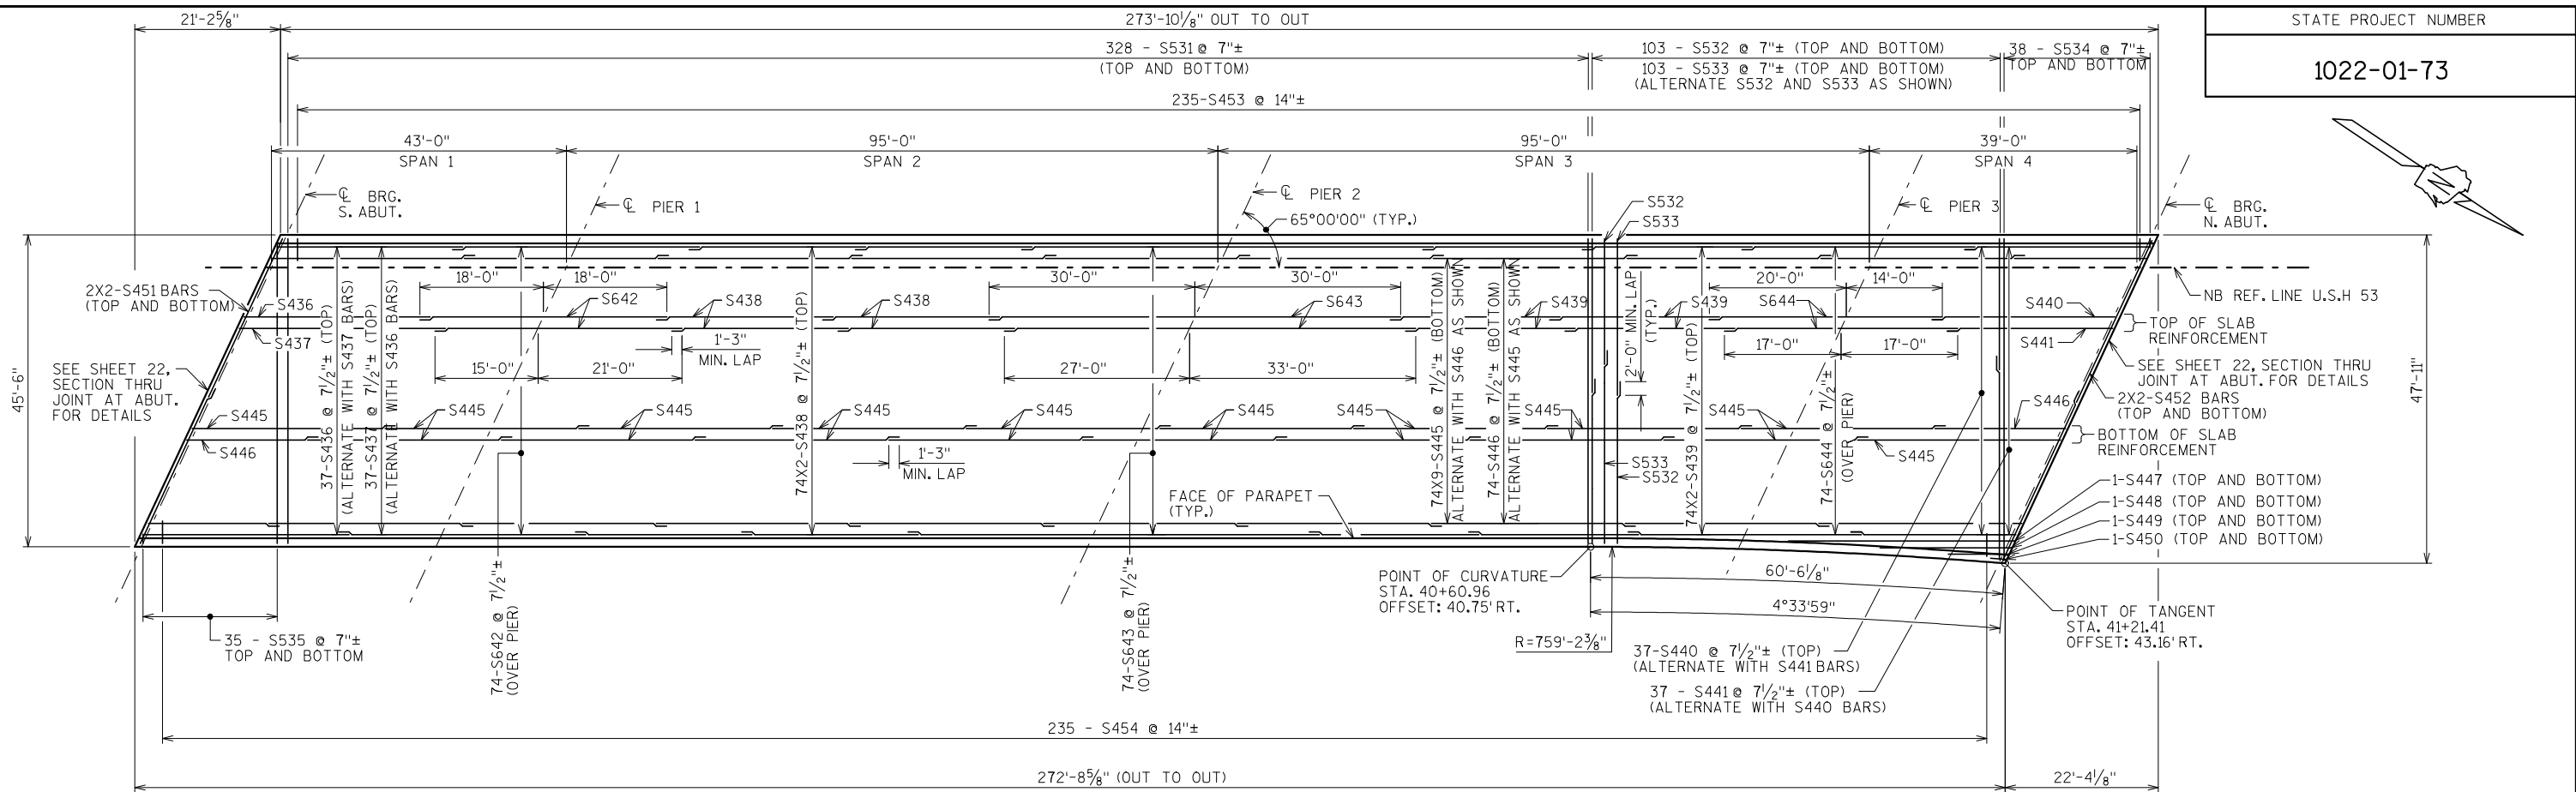

SLAB PLAN

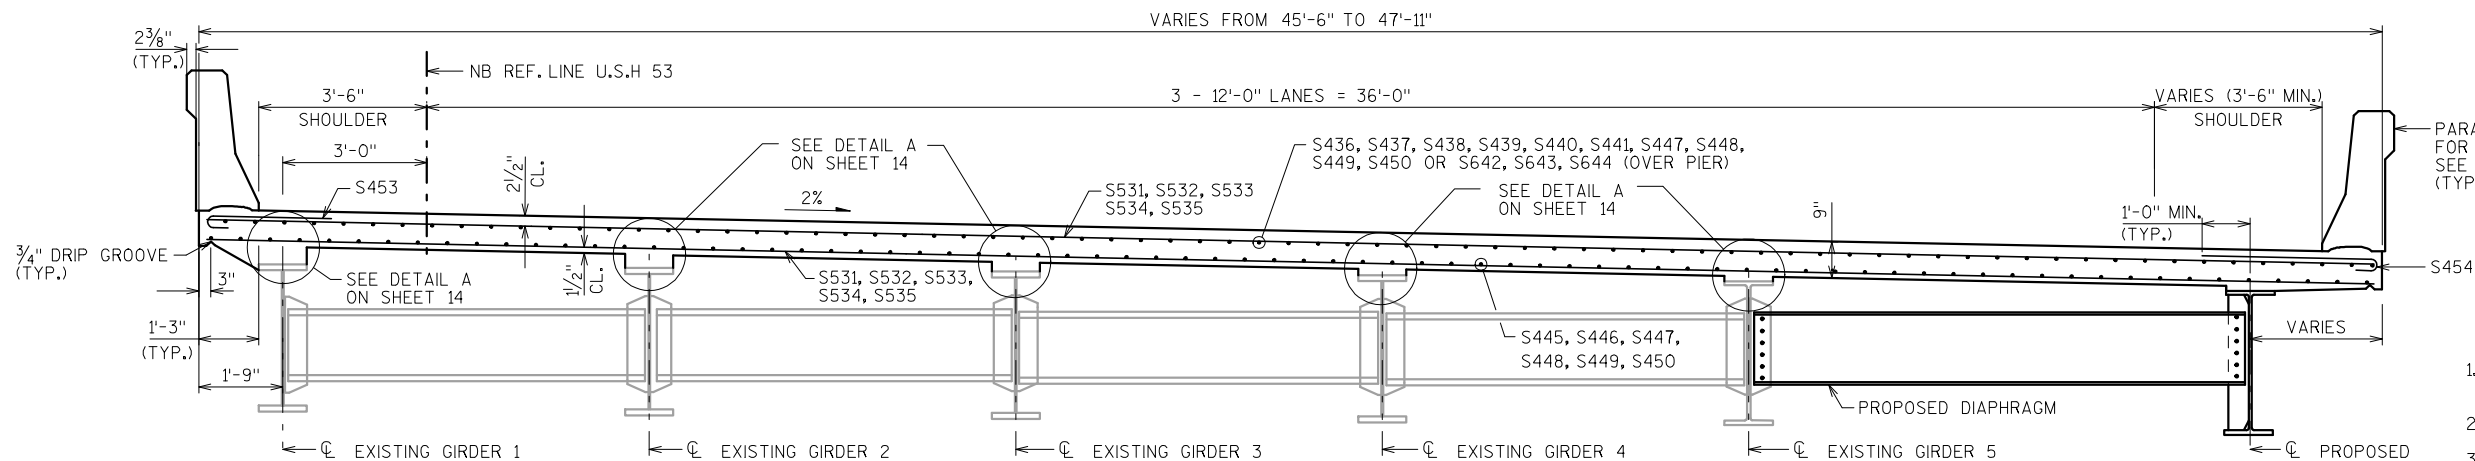

TYPICAL CROSS SECTION THRU ROADWAY (PROPOSED, LOOKING UPSTATION)

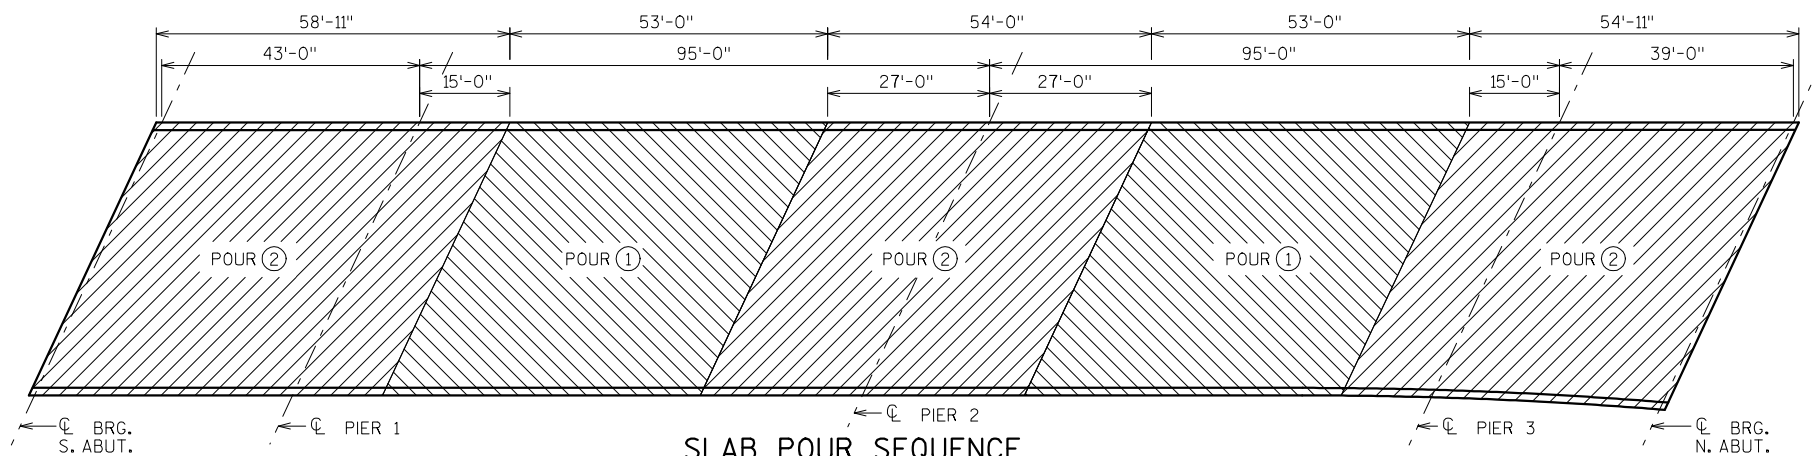

SLAB POUR SEQUENCE

SLAB POUR NOTES:

1. THE RATE OF PLACING CONCRETE SHALL EQUAL OR EXCEED HALF SPAN LENGTH PER HOUR BUT NEED NOT EXCEED 100 CU. YDS. PER HOUR.
2. TRANSVERSE CONSTRUCTION JOINTS, EXCEPT THOSE ADJACENT TO IN SPAN HINGES MAY BE OMITTED WITH THE APPROVAL OF THE STRUCTURES DESIGN SECTION.
3. TWO OR MORE ALTERNATE POURS MAY BE PLACED ON THE SAME DAY.
4. THE CONTRACTOR MAY SUBMIT AN ALTERNATE POURING SEQUENCE SUBJECT TO THE APPROVAL OF THE STRUCTURES DESIGN SECTION.

NOTES:

1. PROVIDE A 2" MIN. CLEARANCE FOR REINFORCEMENT UNLESS OTHERWISE NOTED
2. SEE SHEET 24 FOR PARAPET REINFORCEMENT
3. BARS INDICATED THUS "74 X 8 - MARK @ 7/2\" ±" INDICATES 74 LINES OF BARS WITH 8 LENGTHS PER LINE

LEGEND

- EXISTING TO REMAIN
- - - EXISTING TO BE REMOVED
- PROPOSED

NO.	DATE	REVISION	BY
STATE OF WISCONSIN DEPARTMENT OF TRANSPORTATION STRUCTURES DESIGN SECTION			
STRUCTURE B-18-36			
2010	DRAWN BY	IS	PLANS CK'D. SL
DECK REINFORCING PLAN			SHEET 13 OF 24
			JAN-28-2010

HNTB


SCALE =

8


STATE PROJECT NUMBER

1022-01-73


\\ohiaw00\projects\50206\CADD\ods\new 36\50206_B1836_14deckreinforcingschedule.dgn
28-JAN-2010 07:54
PLOTTED BY: Italina

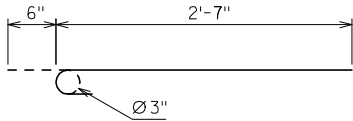


S453

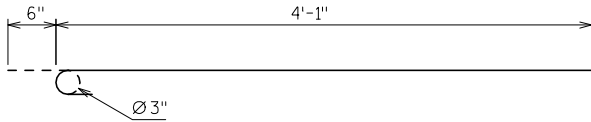


S454

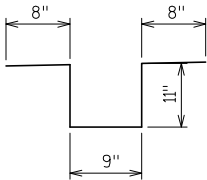

S456

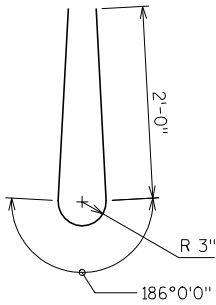

S558

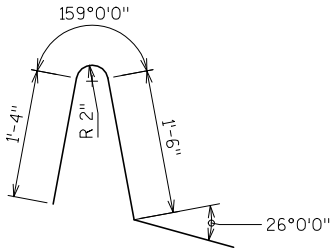


S559

BAR SERIES TABLE

BAR MARK	NO. REQ'D	LENGTH
S534	2 SERIES OF 38	1'-6" TO 47'-6"
S535	2 SERIES OF 35	1'-6" TO 43'-11"

BUNDLE AND TAG EACH SERIES SEPARATELY.

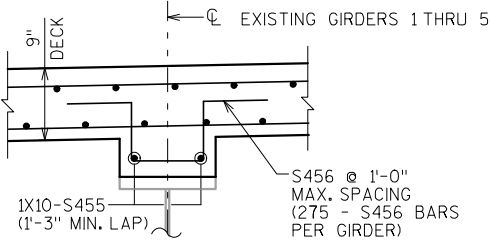

DETAIL A

BILL OF BARS

BAR MARK	COATED	NO. REQ'D	LENGTH	BENT	BAR SERIES	LOCATION
S531	X	656	45'-2"			DECK TRANS.
S532	X	206	30'-0"			DECK TRANS.
S533	X	206	20'-0"			DECK TRANS.
S534	X	76	24'-6"		▲	DECK TRANS.
S535	X	70	22'-9"		▲	DECK TRANS.
S436	X	37	27'-4"			DECK LONG. (TOP)
S437	X	37	30'-4"			DECK LONG. (TOP)
S438	X	148	25'-9"			DECK LONG. (TOP)
S439	X	148	24'-9"			DECK LONG. (TOP)
S440	X	37	27'-4"			DECK LONG. (TOP)
S441	X	37	24'-4"			DECK LONG. (TOP)
S642	X	74	36'-0"			DECK LONG. (OVER PIER 1)
S643	X	74	60'-0"			DECK LONG. (OVER PIER 2)
S644	X	74	34'-0"			DECK LONG. (OVER PIER 3)
S445	X	666	29'-9"			DECK LONG. (BOTTOM)
S446	X	74	19'-3"			DECK LONG. (BOTTOM)
S447	X	2	33'-0"			DECK LONG. (TOP & BOTTOM)
S448	X	2	19'-2"			DECK LONG. (TOP & BOTTOM)
S449	X	2	8'-9"			DECK LONG. (TOP & BOTTOM)
S450	X	2	2'-0"			DECK LONG. (TOP & BOTTOM)
S451	X	8	25'-6"			DECK ALONG E.J. (TOP & BOTTOM)
S452	X	8	27'-0"			DECK ALONG E.J. (TOP & BOTTOM)
S453	X	235	3'-1"	X		DECK OVERHANG (TOP)
S454	X	235	4'-7"	X		DECK OVERHANG (TOP)
S455	X	100	28'-9"			DECK HAUNCH LONG.
S456	X	1375	3'-11"	X		DECK HAUNCH TRANS.
S557	X	50	56'-9"			PARAPET HORIZONTAL
S558	X	822	4'-10"	X		PARAPET VERTICAL
S559	X	822	4'-9"	X		PARAPET VERTICAL

▲ LENGTH SHOWN FOR BAR IS AN AVERAGE LENGTH AND SHOULD ONLY BE USED FOR BAR WEIGHT CALCULATIONS, SEE BAR SERIES TABLE FOR ACTUAL LENGTHS.

NO.	DATE	REVISION	BY
STATE OF WISCONSIN DEPARTMENT OF TRANSPORTATION STRUCTURES DESIGN SECTION			
STRUCTURE B-18-36			
2010	DRAWN BY	IS	PLANS CK'D. SL
DECK REINFORCING SCHEDULE			SHEET 14 OF 24
			JAN-28-2010

HNTB

SCALE =

\\chiw00\projects\50206\CADD\ods\new 36\50206_B1836_15blocking&slabhaunch.dgn
28-JAN-2010 07:54
PLOTTED BY: Italina

8

ELEVATIONS AT TOP OF DECK (T.D.) & TOP OF STEEL (T.S.)

GIRDER	℄	BRG. S	ABUT.	0.1 SPAN	0.2 SPAN	0.3 SPAN	0.4 SPAN	0.5 SPAN	0.6 SPAN	0.7 SPAN	0.8 SPAN	0.9 SPAN	℄	PIER 1	0.1 SPAN	℄	SPLICE	0.2 SPAN	0.3 SPAN	0.4 SPAN	0.5 SPAN	0.6 SPAN	℄	SPLICE 1	0.7 SPAN	0.8 SPAN	0.9 SPAN	℄	PIER 2
N1	T.D.		923.13	923.15	923.16	923.17	923.18	923.20	923.21	923.22	923.24	923.25	923.26	923.29				923.32	923.35	923.38	923.40	923.43	923.46	923.46	923.49	923.52	923.55		
	T.S.		922.22										922.35										922.51					922.62	
G1	T.D.		924.01	924.02	924.04	924.05	924.06	924.07	924.09	924.10	924.11	924.13	924.14	924.17			924.18	924.20	924.22	924.25	924.28	924.31	924.33	924.34	924.37	924.40	924.42		
	T.S.																												
G2	T.D.		923.85	923.86	923.87	923.88	923.90	923.91	923.92	923.93	923.95	923.96	923.97	924.00			924.01	924.03	924.06	924.08	924.11	924.14	924.16	924.17	924.19	924.22	924.25		
	T.S.																												
G3	T.D.		923.68	923.70	923.71	923.72	923.73	923.74	923.76	923.77	923.78	923.79	923.81	923.83			923.85	923.86	923.89	923.91	923.94	923.97	923.99	923.99	924.02	924.05	924.08		
	T.S.																												
G4	T.D.		923.52	923.53	923.54	923.56	923.57	923.58	923.59	923.60	923.61	923.63	923.64	923.66			923.68	923.69	923.72	923.74	923.77	923.80	923.82	923.82	923.85	923.87	923.90		
	T.S.																												
G5	T.D.		923.36	923.37	923.38	923.39	923.40	923.41	923.43	923.44	923.45	923.46	923.47	923.50			923.51	923.52	923.55	923.57	923.60	923.62	923.65	923.65	923.68	923.70	923.73		
	T.S.																												

GIRDER		0.1 SPAN	0.2 SPAN	0.3 SPAN	℄ SPLICE 2	0.4 SPAN	0.5 SPAN	0.6 SPAN	0.7 SPAN	0.8 SPAN	℄ SPLICE	0.9 SPAN	℄ PIER 3	0.1 SPAN	0.2 SPAN	0.3 SPAN	0.4 SPAN	0.5 SPAN	0.6 SPAN	0.7 SPAN	0.8 SPAN	0.9 SPAN	℄ BRG. N. ABUT
N1	T.D.	923.58	923.60	923.63	923.64	923.66	923.69	923.71	923.74	923.76		923.79	923.81	923.82	923.83	923.84	923.85	923.86	923.87	923.88	923.89	923.90	923.91
	T.S.				922.63								922.88										922.99
G1	T.D.	924.45	924.48	924.51	924.52	924.54	924.57	924.60	924.62	924.65	924.67	924.68	924.71	924.72	924.73	924.74	924.76	924.77	924.78	924.79	924.80	924.81	924.83
	T.S.																						
G2	T.D.	924.28	924.31	924.33	924.34	924.36	924.39	924.42	924.44	924.47	924.49	924.50	924.53	924.54	924.55	924.56	924.57	924.58	924.59	924.60	924.61	924.62	924.63
	T.S.																						
G3	T.D.	924.10	924.13	924.16	924.16	924.18	924.21	924.24	924.26	924.29	924.30	924.32	924.34	924.35	924.36	924.37	924.38	924.39	924.40	924.41	924.42	924.43	924.44
	T.S.																						
G4	T.D.	923.93	923.95	923.98	923.98	924.01	924.03	924.06	924.08	924.11	924.12	924.14	924.16	924.17	924.18	924.19	924.19	924.20	924.21	924.22	924.23	924.24	924.25
	T.S.																						
G5	T.D.	923.75	923.78	923.80	923.81	923.83	923.85	923.88	923.90	923.93	923.94	923.95	923.97	923.98	923.99	924.00	924.01	924.02	924.02	924.03	924.04	924.05	924.06
	T.S.																						

DEAD LOAD DEFLECTION FOR EXISTING GIRDERS G1, G2, G3, G4 & G5


	SPAN 1			SPAN 2			SPAN 3			SPAN 4		
POINT	0.25L	0.5L	0.75L	0.25L	0.5L	0.75L	0.25L	0.5L	0.75L	0.25L	0.5L	0.75L
CONC. DEFLECTION	0"	-0⅛"	0"	0⅞"	1⅛"	0⅜"	0⅝"	1¼"	1"	0"	-0⅛"	0"
TOTAL DEFLECTION	0"	-0⅛"	0"	1"	1¼"	0⅜"	0⅝"	1⅝"	1⅛"	0"	-0⅛"	0"

DEAD LOAD DEFLECTION FOR PROPOSED GIRDER N1


	SPAN 1			SPAN 2			SPAN 3			SPAN 4		
POINT	0.25L	0.5L	0.75L	0.25L	0.5L	0.75L	0.25L	0.5L	0.75L	0.25L	0.5L	0.75L
CONC. DEFLECTION	0	0	-0⅛"	0⅝"	0⅞"	0⅜"	0⅜"	0⅞"	0⅝"	-0⅛"	0	0
TOTAL DEFLECTION	0	0	-0⅛"	0¾"	1"	0⅜"	0½"	1⅛"	0¾"	-0⅛"	-0⅛"	0

BLOCKING TABLE


	A	B	C	D	E	F	G
PROPOSED GIRDER N1	0"	1⅝"	4⅛"	4⅞"	5¾"	8"	9⅜"

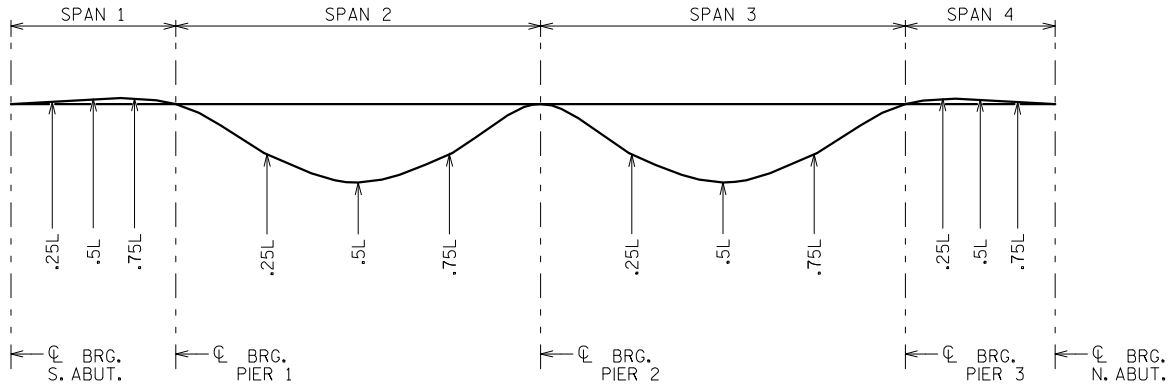

DEFLECTION DIAGRAM

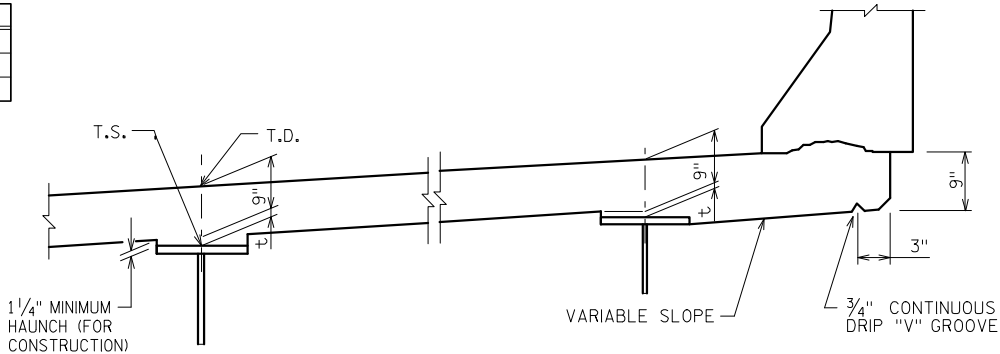

SECTION THRU SLAB

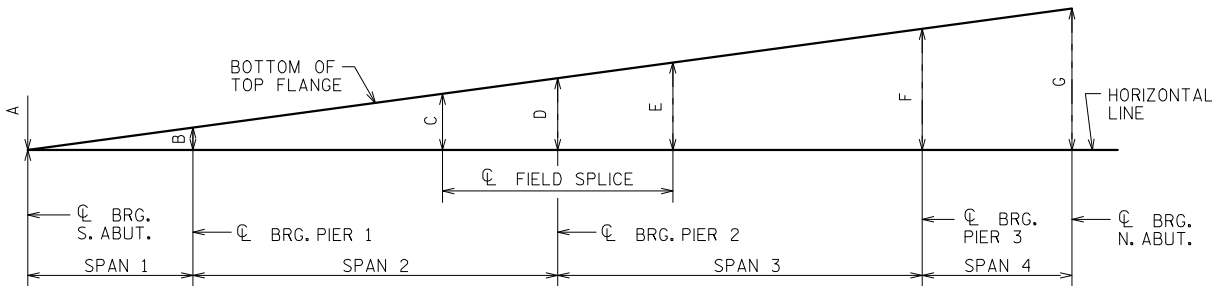

BLOCKING DIAGRAM

NOTES:

℄ = HAUNCH HEIGHT AT CENTERLINE OF GIRDER.

CONCRETE DEFLECTION INCLUDE CONCRETE SLAB, HAUNCH AND BARRIERS.
"+" INDICATES DOWNWARD DEFLECTION.

TOTAL DEFLECTION INCLUDES CONCRETE DEFLECTION PLUS DEFLECTION
DUE TO SELF WEIGHT OF STEEL.

THE MINIMUM HAUNCH (AT EDGE OF GIRDER FLANGE) ALLOWED IN CONSTRUCTION
IS 1/4".

IF 1/4" MINIMUM HAUNCH HEIGHT AT EDGE OF GIRDER CANNOT BE MAINTAINED,
THE GRADE LINE MAY BE REVISED BY THE ENGINEER AT THE OPTION OF THE
CONTRACTOR. THE PLAN SLAB THICKNESS SHALL BE HELD. NOTIFY THE
STRUCTURES SECTION IF THE GRADE LINE IS RAISED FROM THE PLAN PROFILE
BY MORE THAN 1/2".

TO DETERMINE "T": AFTER ALL STRUCTURAL STEEL HAS BEEN ERECTED.
ELEVATIONS OF THE TOP FLANGES, TOP OF SPLICE PLATES, OR TOP OF COVER
PLATES, WHICHEVER APPLIES, SHALL BE TAKEN AT CENTERLINE OF BEARINGS,
CENTERLINE OF FIELD SPLICES, AND AT 0.1 POINTS.

- TOP OF DECK ELEV. AT FINAL GRADE.
- TOP OF STEEL ELEV. AFTER PLACEMENT.
- + CONC. ONLY DEFLECTION; DOWNWARD DEFLECTION
IS ADDED, UPWARD DEFLECTION IS SUBTRACTED.
- SLAB THICKNESS ('T')
- = "℄" VALUE FOR SETTING HAUNCH.


STATE PROJECT NUMBER

1022-01-73


NO.	DATE	REVISION	BY
STATE OF WISCONSIN DEPARTMENT OF TRANSPORTATION STRUCTURES DESIGN SECTION			
STRUCTURE B-18-36			
2010	DRAWN BY	MMK	PLANS CK'D. MX
BLOCKING & SLAB HAUNCH DETAILS			SHEET 15 OF 24
			JAN-28-2010

HNTB

SCALE =

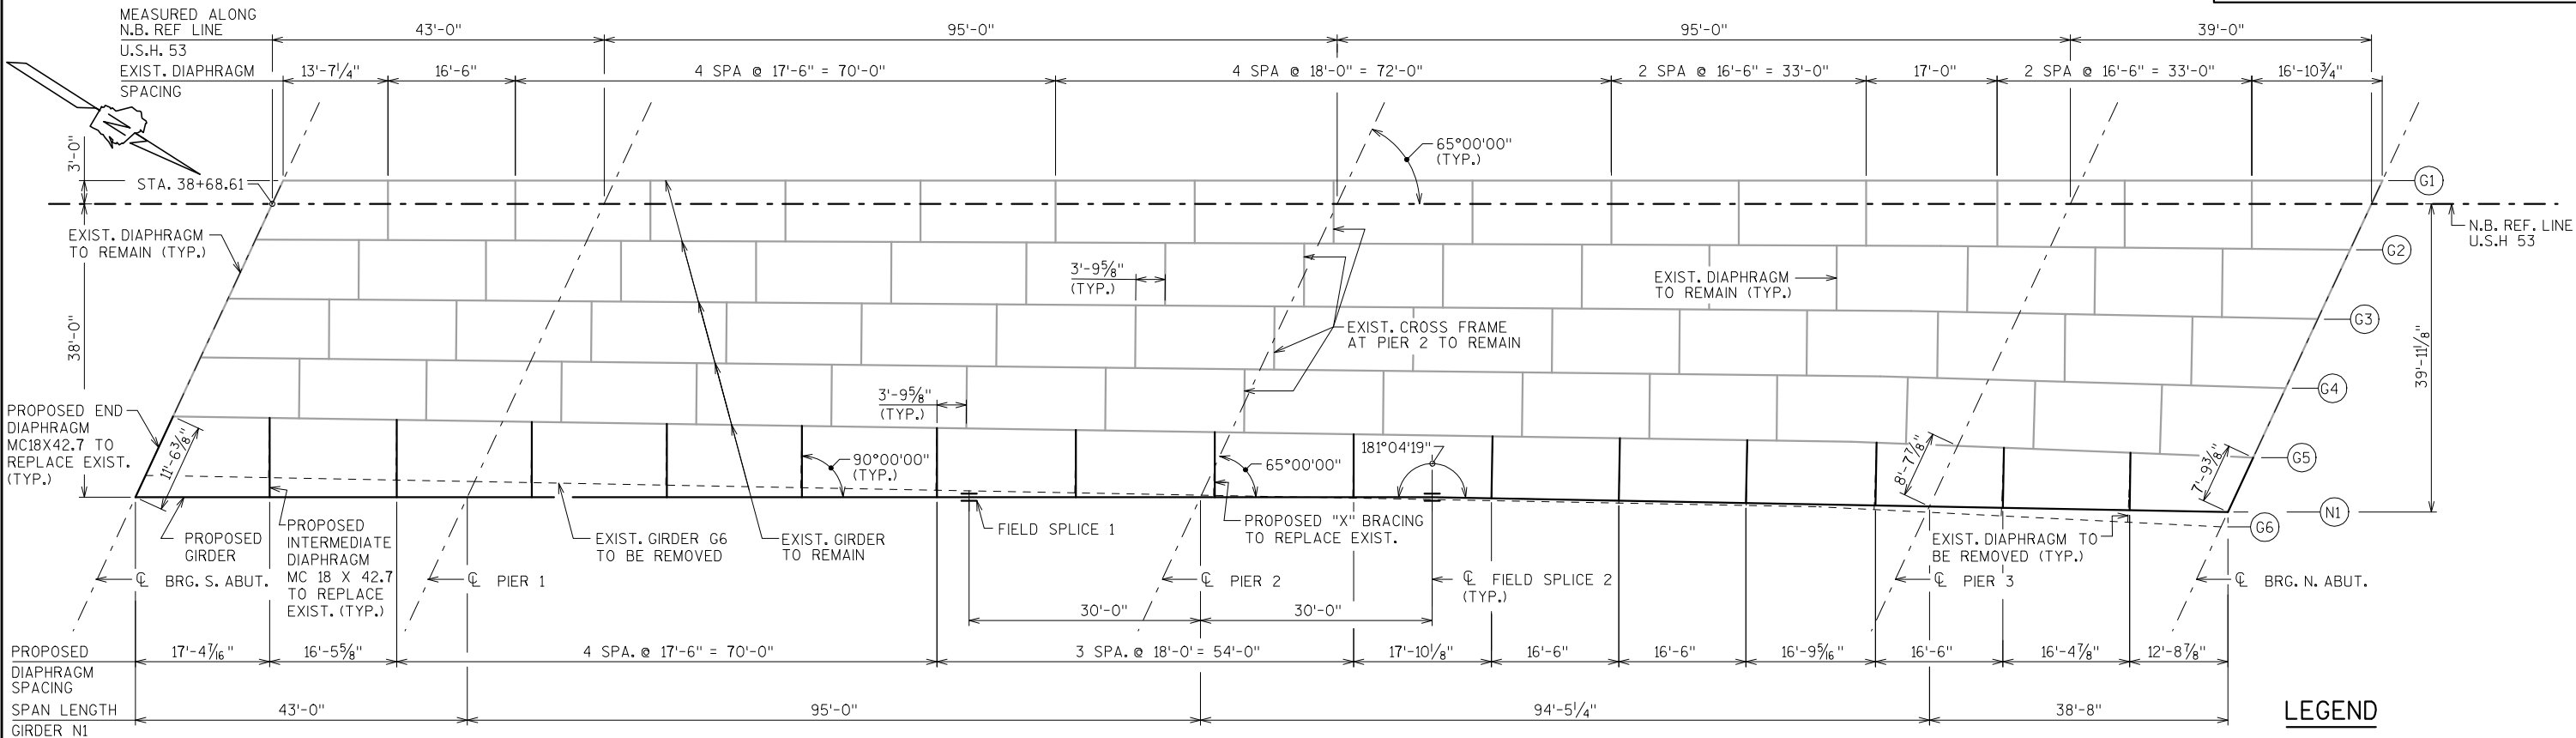

FRAMING PLAN

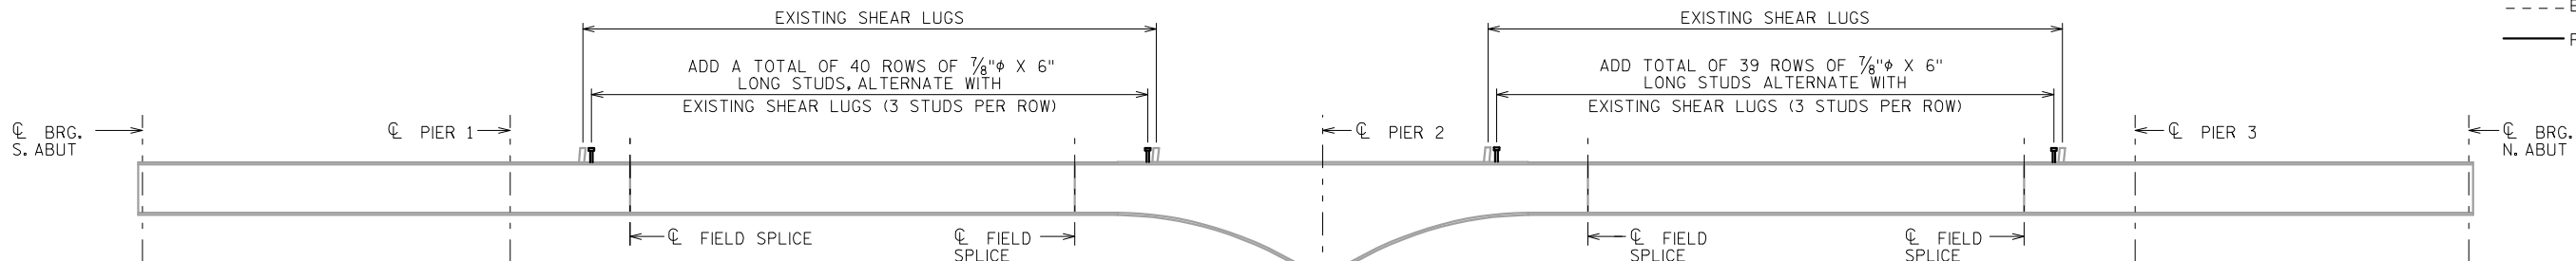

ADDITIONAL SHEAR CONNECTORS

(EXIST. GIRDERS G1, G2, G3, G4 & G5)

NOTES:

ALL DIMENSIONS TO BE VERIFIED BY CONTRACTOR IN THE FIELD BEFORE PREPARING STEEL SHOP DRAWINGS.

ALL STRUCTURAL STEEL FOR GIRDERS, FIELD SPLICE PLATES AND BEARING PLATES SHALL BE HIGH STRENGTH STRUCTURAL STEEL, ASTM A709-GRADE 50.

ALL THE STEEL FOR DIAPHRAGMS, CROSS FRAMES, INTERMEDIATE STIFFENERS AND CONNECTING PLATES SHALL BE ASTM A709 GRADE 36.

ALL BOLTED CONNECTIONS FOR FIELD SPLICE SHALL BE FRICTION TYPE USING $\frac{7}{8}$ " ϕ HIGH STRENGTH BOLTS (A.S.T.M. A325). ALL OTHER BOLTED CONNECTIONS SHOULD BE FRICTION TYPE USING $\frac{3}{4}$ " ϕ HIGH STRENGTH BOLTS (A.S.T.M. A325).


ALL NEW STRUCTURAL STEEL SHOULD BE PAINTED WITH INORGANIC ZINC RICH PRIMER ONLY.

CONNECTION PLATES AND INTERMEDIATE STIFFENERS SHALL BE PLACED NORMAL TO THE TOP FLANGE OF THE GIRDER.

ALL DIMENSIONS ARE MEASURED ALONG A HORIZONTAL PLANE. LONGITUDINAL AND TRANSVERSE GRADE EFFECTS ARE NOT INCLUDED IN DIMENSIONS. THE NOTE ALSO APPLIES TO ALL DIMENSIONS AND PLATE LENGTHS GIVEN ON THE GIRDER ELEVATION.

PRIOR TO STEEL BLAST, ALL FLAME CUT EDGES OF PLATES THAT ARE TO BE PAINTED SHALL BE GROUND OR PLANED TO REMOVE THE HARDENED SURFACE CAUSED BY THE FLAME.

FIELD REPAIR OF PAINT AT EXISTING STEEL MEMBERS WITHIN 1'-0" OF PROPOSED CONNECTIONS SHALL BE INCLUDED IN THE BID ITEM, "PAINTING INORGANIC ZINC RICH PRIMER".

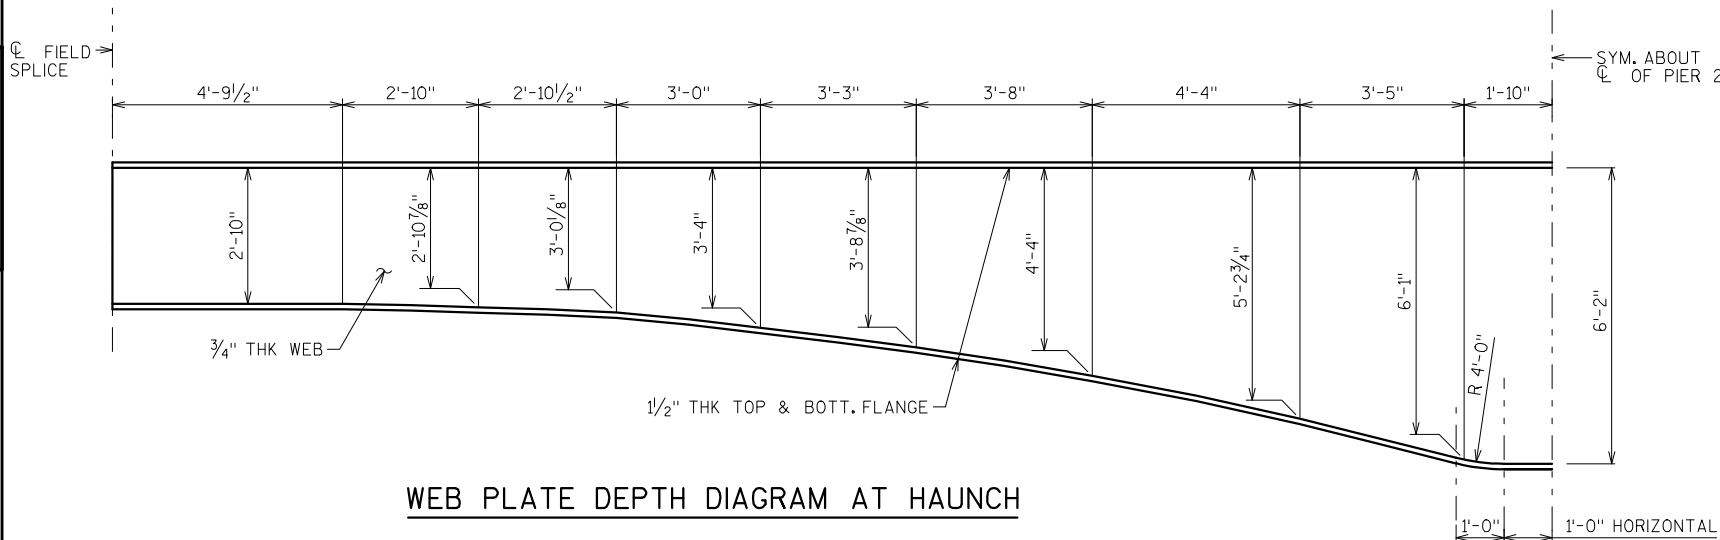

WEB PLATE DEPTH DIAGRAM AT HAUNCH

NO.	DATE	REVISION	BY
STATE OF WISCONSIN DEPARTMENT OF TRANSPORTATION STRUCTURES DESIGN SECTION			
STRUCTURE B-18-36			
2010	DRAWN BY	MMK	PLANS CK'D. MX
FRAMING PLAN			SHEET 16 OF 24
			JAN-28-2010


HNTB

FRAMING PLAN

SHEET 16 OF 24

JAN-28-2010

SCALE =

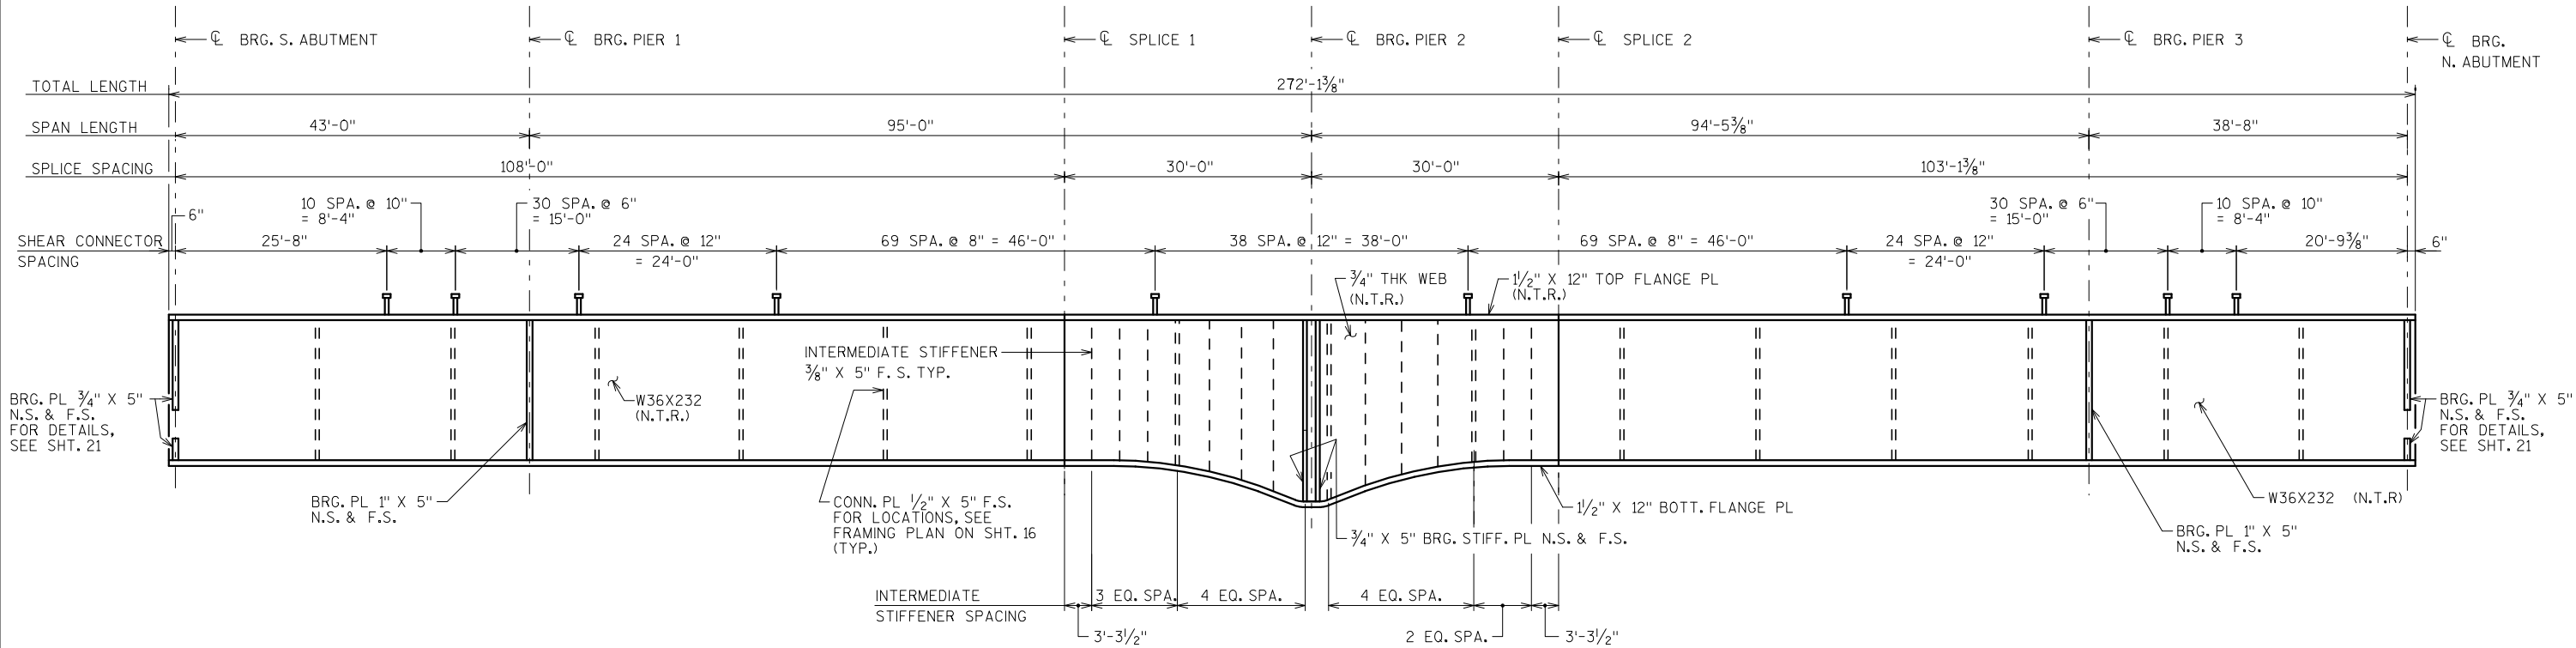

GIRDER N1 ELEVATION

NOTES:

N.T.R. DENOTES STEEL THAT SHALL CONFORM TO SUPPLEMENTAL REQUIREMENTS FOR NOTCH TOUGHNESS (ZONE 2).

\\ohiaw00\projects\50206\CADD\ods\new 36\50206_B1836_17\girder1.dgn
28-JAN-2010 07:54
PLOTTED BY: lkalina

NO.	DATE	REVISION	BY
STATE OF WISCONSIN DEPARTMENT OF TRANSPORTATION STRUCTURES DESIGN SECTION			
STRUCTURE B-18-36			
2010	DRAWN BY	MMK	PLANS CK'D. MX
GIRDER ELEVATION			SHEET 17 OF 24
			JAN-28-2010

TABLE "A"

SIZE	MAX. LENGTH OF MEMBER	WELD LENGTH	NO. OF 3/4" Ø BOLTS	WEIGHT PER FT.
L 3 1/2 X 3 1/2 X 5/16	21'-6"	9"	4	7.2*

TABLE "B"

SIZE	MAX. LENGTH OF MEMBER	WELD SIZE	WELD LENGTH	NO. OF 3/4" Ø BOLTS	WEIGHT PER FT.
L 5 X 5 X 5/16	11'-6"	1/4"	11"	4	10.3*

NOTES:

- ALL BOLTED CONNECTIONS SHALL BE FRICTION TYPE USING 3/4" Ø HIGH STRENGTH BOLTS (A.S.T.M. A325) WITH DOUBLE WASHERS. U.N.O.
- DIAPHRAGMS OR LOWER CROSS FRAME MEMBERS THAT ARE LEVEL SHALL BE PLACED 4" ABOVE THE TOP OF THE HIGHER BOTTOM FLANGE OF ADJACENT GIRDERS.
- HOLES IN CROSS FRAME CONNECTIONS MAY BE OVERSIZED @ 15/16" DIA. IN 1 PLY.
- DIAPHRAGMS OR LOWER CROSS FRAME MEMBERS ARE SLOPED WHEN DIFFERENCE IN ADJACENT BOTTOM FLANGE ELEVATIONS EXCEEDS 6".


* TABLE OF FILLET WELD SIZES

MATERIAL THICKNESS OF THICKER PART JOINED.	MIN. SIZE OF FILLET WELD
TO 1/2" INCLUSIVE	3/16"
OVER 1/2" TO 3/4"	1/4"
OVER 3/4" TO 1 1/2"	Δ 5/16"
OVER 1 1/2" TO 2 1/4"	Δ 3/8"
OVER 2 1/4" TO 6"	Δ 1/2"


† EXCEPT THAT THE WELD SIZE SHALL NOT EXCEED THE THICKNESS OF THE THINNER PART JOINED.

Δ MIN. PASS SIZE IS 5/16"

"X" BRACING AT PIER 2
(LOOKING UPSTATION)

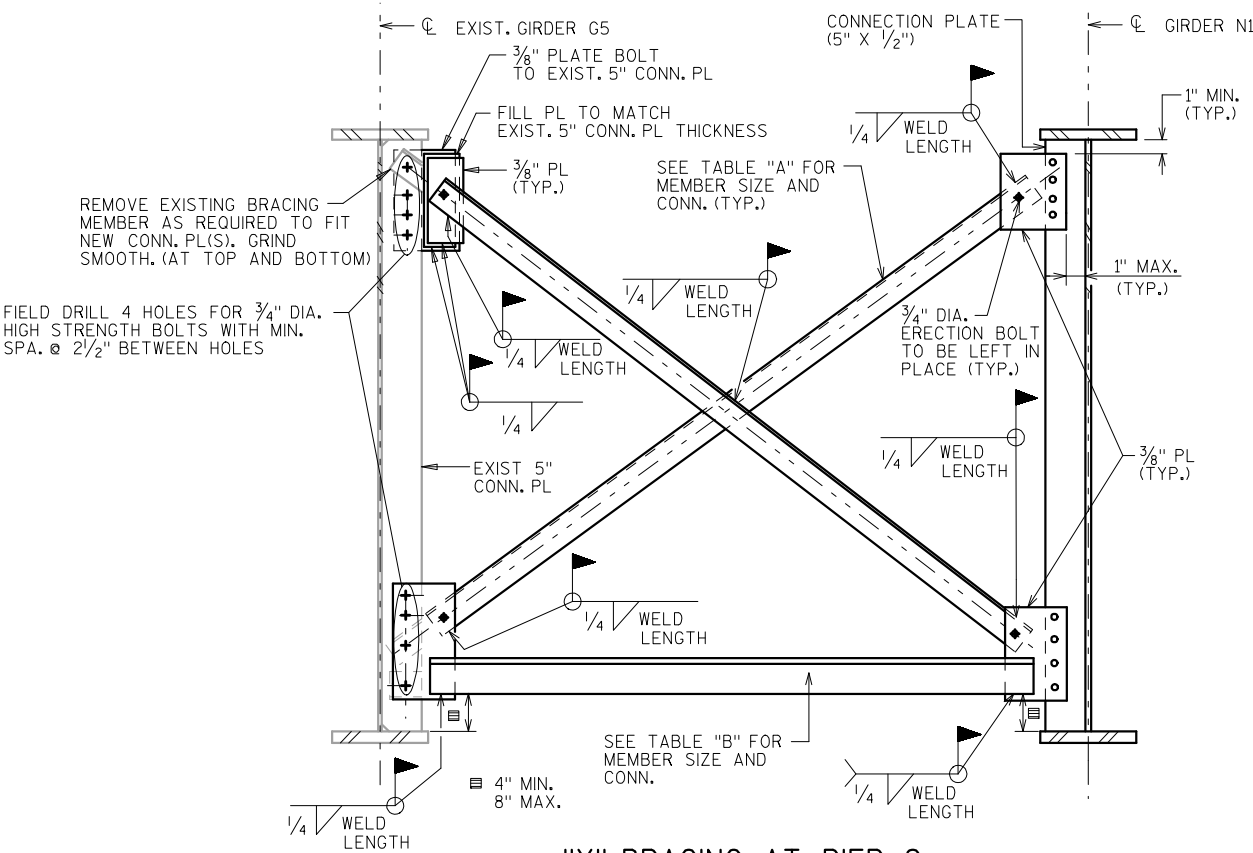


ELEVATION

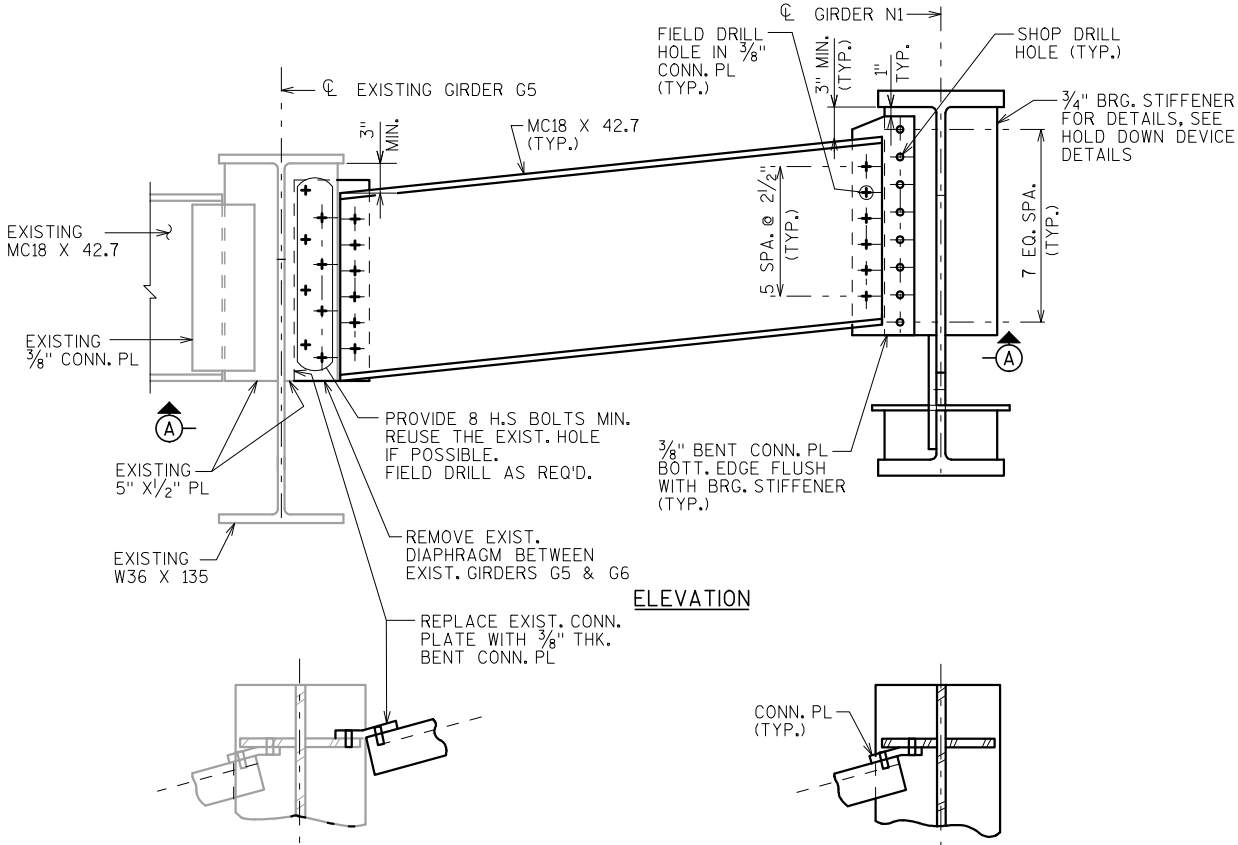

SECTION A-A

END DIAPHRAGM CONNECTION

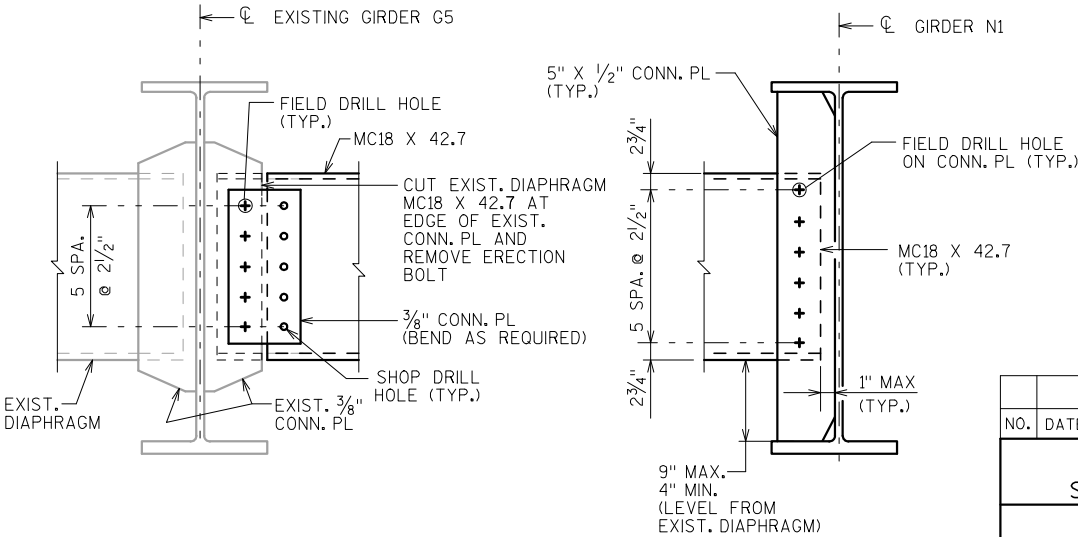

INTERMEDIATE DIAPHRAGM

LEGEND


- EXISTING TO REMAIN
- PROPOSED
- + FIELD DRILL
- SHOP DRILL

NO.	DATE	REVISION	BY
STATE OF WISCONSIN DEPARTMENT OF TRANSPORTATION STRUCTURES DESIGN SECTION			
STRUCTURE B-18-36			
2010	DRAWN BY	MMK	PLANS CK'D. MX
STEEL DETAILS I			SHEET 18 OF 24
			JAN-28-2010

HNTB

\\ohiaw00\projects\50206\CADD\ods\new 36\50206_B1836_19steel\det_2.dgn
28-JAN-2010 07:54
PLOTTED BY: Ikalina


8

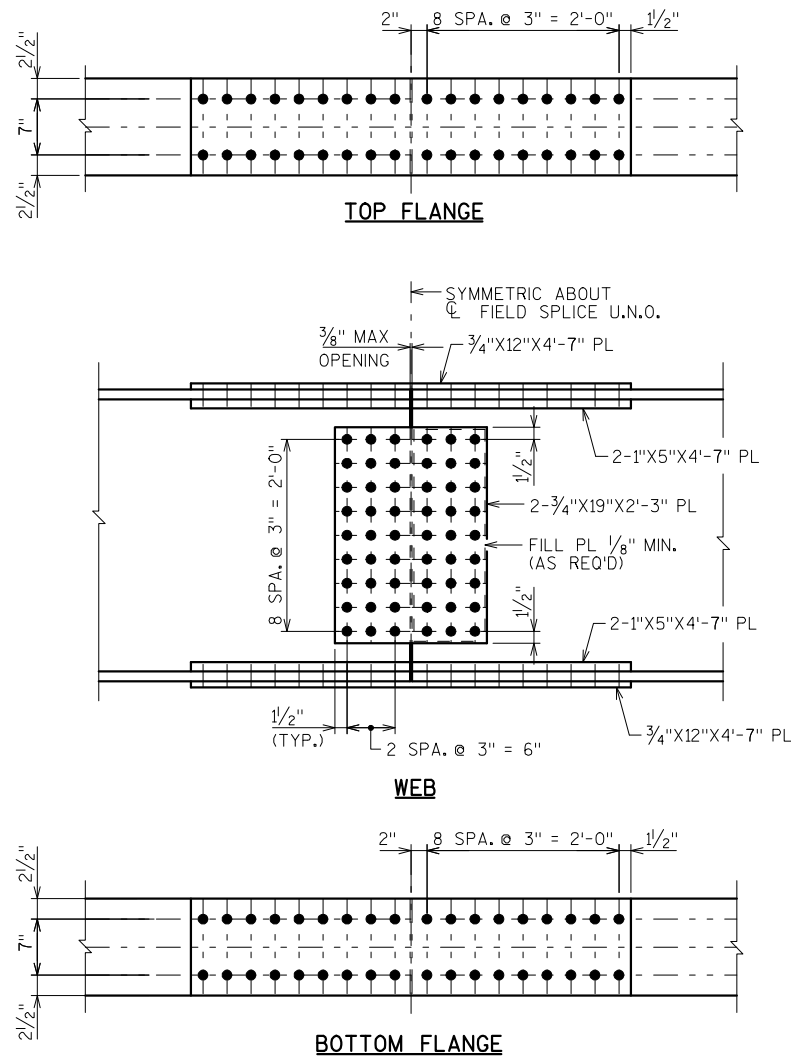

FIELD SPLICE DETAILS


(ALL THE BOLTS IN FIELD SPLICE TO BE 7/8" DIA. ASTM A325 H.S. BOLT)
(FOR GIRDER KINK ANGLE AT FIELD SPLICE 2, SEE FRAMING PLAN)

NOTE: USE THREE FIELD WELDED
7/8" DIA. X 6" LONG \odot STUDS EQUALLY
SPACED WITH A MIN. OF 1 1/2" CL. FROM THE
FLANGE EDGE. STUDS SHALL NOT BE PLACED
OVER FIELD SPLICE PLATES.

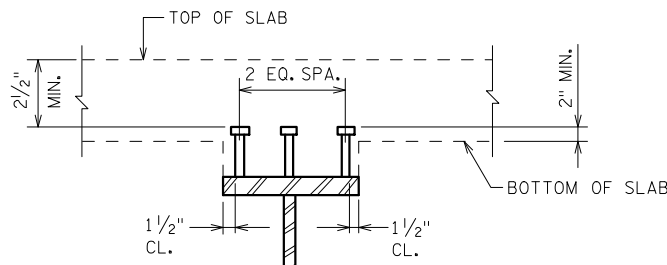


\odot USE DIFFERENT LENGTH STUDS IF 2 1/2" MIN.
CLEARANCE OR 2" EXTENSION CRITERIA IS VIOLATED.


SHEAR CONN. DETAILS

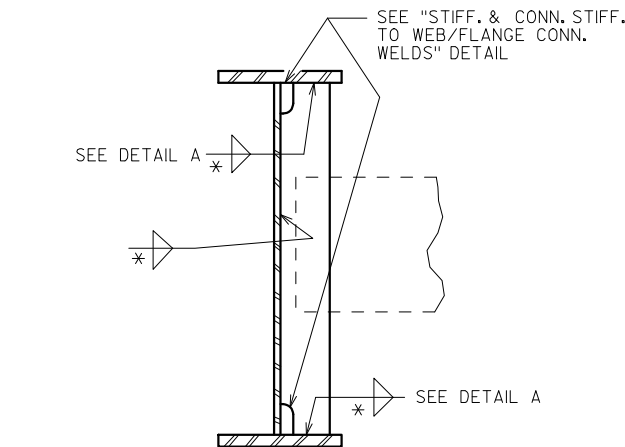


CONNECTION STIFF. DETAILS

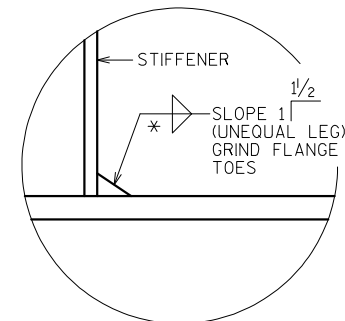

DETAIL A
CONNECTION STIFFENER
DETAIL @ FLANGE

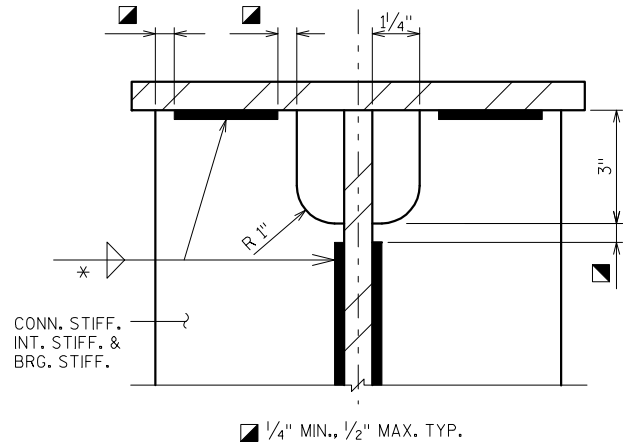

STIFF. & CONN. STIFF. TO WEB/FLANGE CONN. WELDS

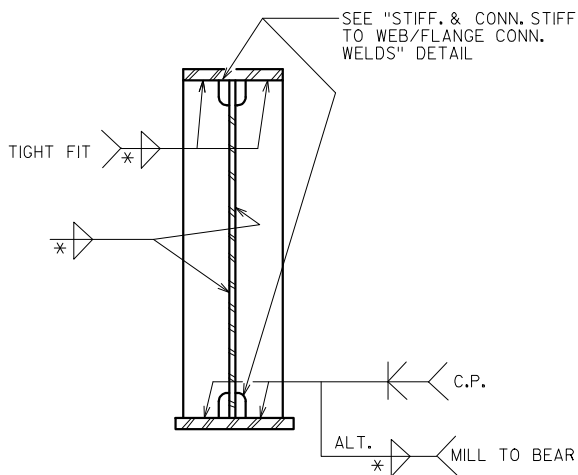

BRG. STIFF. DETAILS TYP. AT ABUTMENT & PIER

STATE PROJECT NUMBER

1022-01-73

NOTES:

WORK THIS SHEET WITH SHEETS 16, 17 & 18.

NO.	DATE	REVISION	BY
STATE OF WISCONSIN DEPARTMENT OF TRANSPORTATION STRUCTURES DESIGN SECTION			
STRUCTURE B-18-36			
2010	DRAWN BY	MMK	PLANS CK'D. MX
STEEL DETAILS 2			SHEET 19 OF 24
			JAN-28-2010

HNTB

SCALE =

\\ohw00\projects\50206\CADD\ods\new 36\50206_B1836_20bearing.dgn
28-JAN-2010 07:54
PLOTTED BY: Italina

8


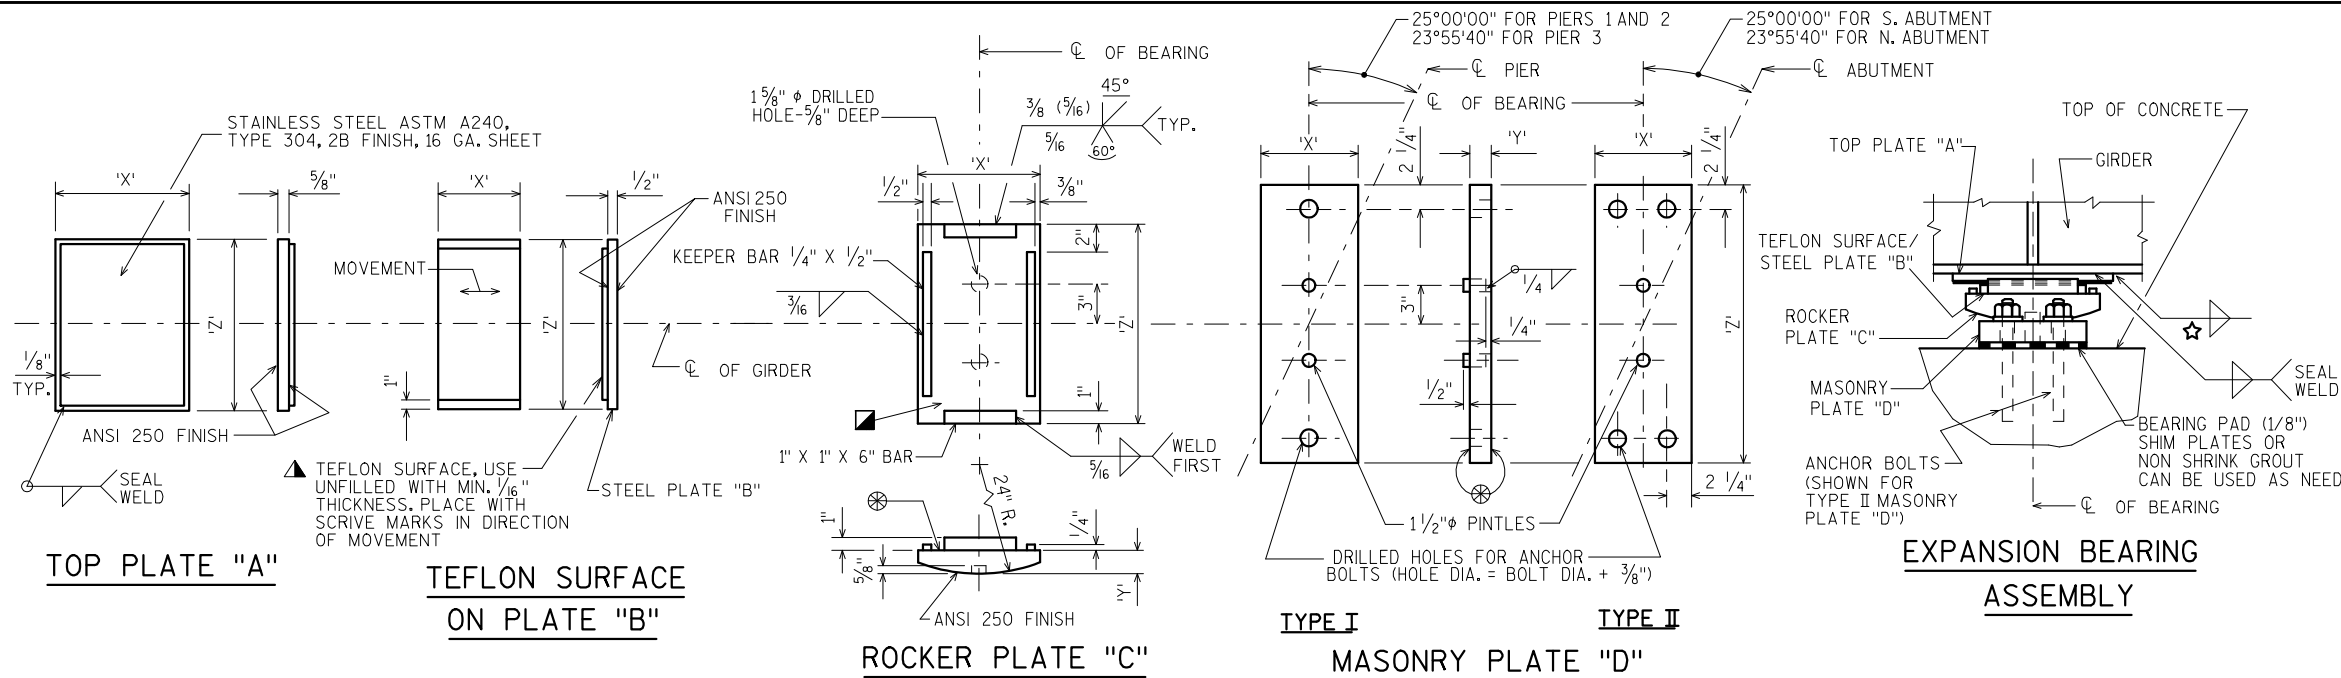


	PLATE "A"		PLATE "B"		PLATE "C"			PLATE "D"			PLATE "D" TYPE	ANCHOR BOLT SIZE	NO. OF BRG'S REQ'D.	HEIGHT (FEET)	LOCATION
	'X'	'Z'	'X'	'Z'	'X'	'Y'	'Z'	'X'	'Y'	'Z'					
EXPANSION BEARING	11"	1'-0"	7"	1'-0"	9"	1 5/16"	1'-2 1/4"	8"	1 1/2"	2'-4"	II	*	1	0.401	SOUTH ABUTMENT
	11"	1'-0"	7"	1'-0"	9"	1 5/16"	1'-2 1/4"	8"	1 1/2"	2'-4"	II	*	1	0.401	NORTH ABUTMENT
	1'-3"	1'-0"	11"	1'-0"	1'-11"	2 7/8"	1'-2 1/4"	11"	2"	1'-10"	I	**	1	0.521	PIER 1
	1'-3"	1'-0"	11"	1'-0"	1'-11"	2 7/8"	1'-2 1/4"	11"	2"	1'-10"	I	**	1	0.521	PIER 3
FIXED BEARING						2 3/8"	1'-2"	1'-1"	2 7/8"	1'-11"	I	**	1	0.448	PIER 2

- * BEARING ASSEMBLY FOR GIRDERS SET ON EXISTING CONCRETE WILL HAVE 1/8" X 3'-0" LONG ANCHOR BOLTS, FULLY THREADED. BEARING ASSEMBLY FOR GIRDERS SET ON PROPOSED CONCRETE ADDITION WILL HAVE 1/4" X 3'-0" LONG PRESET ANCHOR BOLTS, THREADED 3". (SEE DETAILS ON SHEET 21)
- ** BEARING ASSEMBLY FOR GIRDERS SET ON EXISTING CONCRETE WILL HAVE 1/8" X 1'-10" LONG ANCHOR BOLTS, FULLY THREADED. BEARING ASSEMBLY FOR GIRDERS SET ON PROPOSED CONCRETE ADDITION WILL HAVE 1/4" X 1'-5" LONG PRESET ANCHOR BOLTS, THREADED 3".

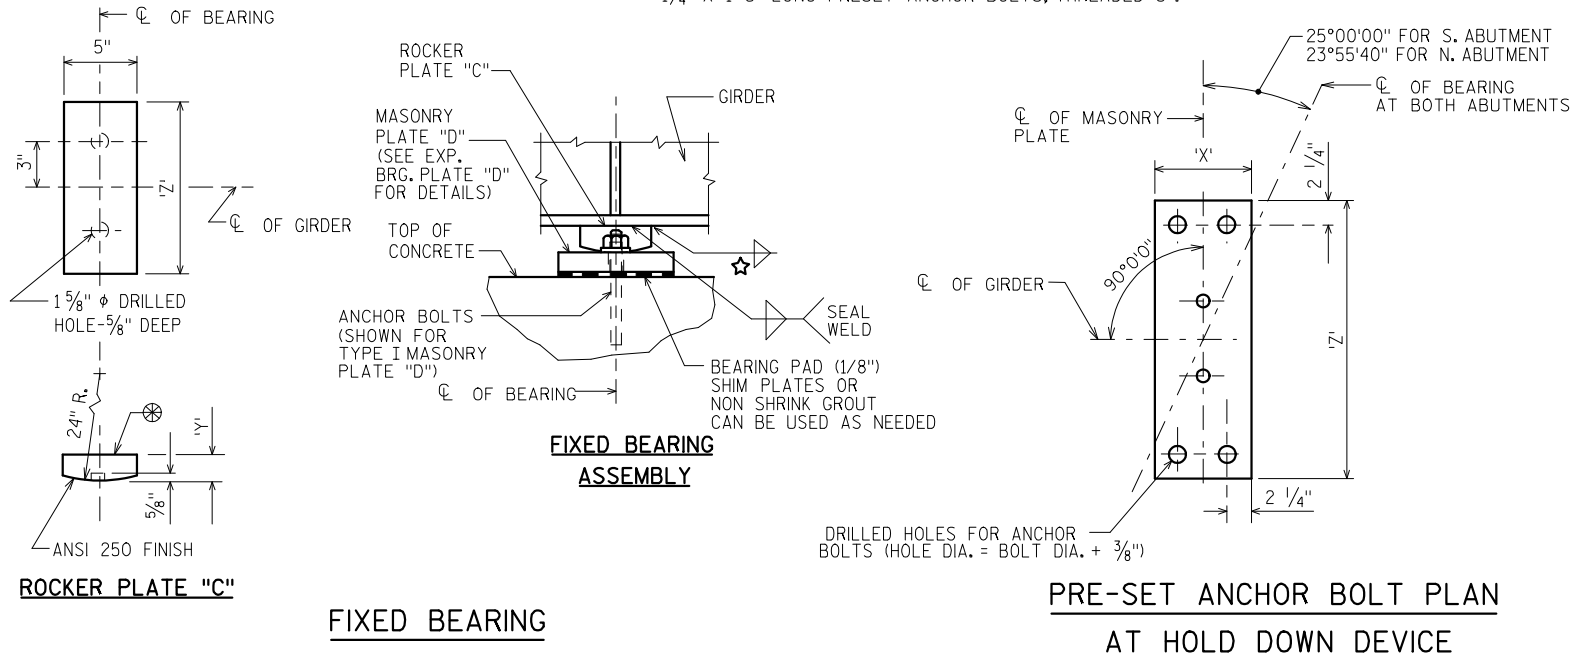

NOTES:

ALL BEARINGS ARE SYMMETRICAL ABOUT CL OF GIRDER AND CL OF BEARING.

ALL STRUCTURAL STEEL BEARING PLATES SHALL BE FLAT ROLLED STEEL PLATES WITH ALL SURFACES SMOOTH AND FREE FROM WARP AND ALL EDGES SMOOTH, STRAIGHT AND VERTICAL.

ALL PLATE CUTS SHALL BE MACHINE OR MACHINE FLAME CUTS.

ALL FINISHED SURFACES SHALL BE MACHINE FINISHED BY AN AUTOMATIC PROCESS.

CHAMFER ANCHOR BOLTS PRIOR TO THREADING.

ANCHOR BOLTS SET ON EXISTING CONCRETE SHALL BE FULLY THREADED. ANCHOR BOLTS PRESET ON PROPOSED ABUT./PIER ADDITIONS SHALL BE THREADED 3". PROVIDE ONE STANDARD WROUGHT WASHER AND ONE HEX NUT PER BOLT. PROJECT ANCHOR BOLTS, MASONRY PLATE "D" THICKNESS + 2 1/4", ABOVE TOP OF CONCRETE.

CHAMFER TOP OF PINTLES 1/8". DRILL HOLES FOR ALL PINTLES IN MASONRY PLATE "D" FOR A DRIVING FIT.

ALL MATERIAL IN BEARINGS, INCLUDING SHIM PLATES, BUT EXCLUDING ANCHOR BOLTS, STAINLESS STEEL SHEET, TEFLON SURFACE, PINTLES, NUTS AND WASHERS SHALL CONFORM TO ASTM A709 GRADE 50W.

STEEL PINTLES SHALL CONFORM TO ASTM A449 OR MATERIAL OF EQUIVALENT YIELD STRENGTH AND ELONGATION.

ANCHOR BOLTS, NUTS AND WASHERS SHALL CONFORM TO ASTM A709 GRADE 36, OR MATERIAL OF EQUIVALENT YIELD STRENGTH AND ELONGATION.

PROVIDE 1/8" THICK BEARING PAD THE SAME SIZE AS MASONRY PLATE "D" FOR EACH BEARING.

ALL MATERIAL IN BEARINGS, INCLUDING SHIM PLATES AND BEARING PADS, SHALL BE PAID FOR AT THE UNIT PRICE BID FOR "BEARING ASSEMBLIES EXPANSION" OR "BEARING ASSEMBLIES FIXED" EACH.

ANCHOR BOLTS, NUTS AND WASHERS SHALL BE GALVANIZED IN ACCORDANCE WITH ASTM A153, CLASS C.

FIXED BEARINGS:
ROCKER PLATE "C" SHALL BE SHOP PAINTED WITH A WELDABLE PRIMER.
MASONRY PLATE "D" SHALL BE GALVANIZED.

EXPANSION BEARINGS:
TOP PLATE "A" AND STEEL PLATE "B" SHALL BE SHOP PAINTED. USE A WELDABLE PRIMER ON TOP PLATE "A".
ROCKER PLATE "C" AND MASONRY PLATE "D" SHALL BE GALVANIZED. DO NOT PAINT STAINLESS STEEL OR TEFLON SURFACES.

⊗ FINISH THESE SURFACES TO ANSI250 IF 'Y' DIMENSION IS GREATER THAN 2".

▣ PROVIDE A METHOD FOR HANDLING ROCKER PLATE "C" DURING GALVANIZING.

▲ BOND STEEL PLATE "B" AND TEFLON WITH ADHESIVE MATERIAL MEETING FEDERAL SPECIFICATION MMM-A-134, FEP FILM OR EQUAL.

TABLE OF FILLET WELD SIZES

MATERIAL THICKNESS OF THICKER PART JOINED.	MIN. SIZE OF FILLET WELD
TO 1/2" INCLUSIVE	3/16"
OVER 1/2" TO 3/4"	1/4"
OVER 3/4" TO 1 1/2"	△ 5/16"
OVER 1 1/2" TO 2 1/4"	△ 3/8"
OVER 2 1/4" TO 6"	△ 1/2"

± EXCEPT THAT THE WELD SIZE SHALL NOT EXCEED THE THICKNESS OF THE THINNER PART JOINED.

△ MIN. PASS SIZE IS 5/16"

HNTB

NO.	DATE	REVISION	BY
STATE OF WISCONSIN DEPARTMENT OF TRANSPORTATION STRUCTURES DESIGN SECTION			
STRUCTURE B-18-36			
2010	DRAWN BY	IS	PLANS CK'D. SL
BEARING DETAILS			SHEET 20 OF 24
			JAN-28-2010

SCALE =

8

NOTES:

ALL BEARINGS ARE SYMMETRICAL ABOUT ϕ OF GIRDER AND ϕ OF BEARING.

ALL STRUCTURAL STEEL PLATES SHALL BE FLAT ROLLED STEEL PLATES WITH ALL SURFACES SMOOTH AND FREE FROM WARP AND ALL EDGES SMOOTH, STRAIGHT AND VERTICAL.

ALL PLATE CUTS SHALL BE MACHINE OR MACHINE FLAME CUTS.

CHAMFER TOP OF ANCHOR BOLTS PRIOR TO THREADING.

ANCHOR BOLTS SHALL BE 1/8" DIAMETER X 3'-0" LONG AND FULLY THREADED AT EXISTING ABUTMENT LOCATION.

ANCHOR BOLTS SET ON PROPOSED CONCRETE ADDITION SHALL BE THREADED 3". PROVIDE ONE STANDARD WROUGHT WASHER AND ONE HEX NUT PER BOLT.

ANCHOR BOLTS, NUTS AND WASHERS SHALL BE GALVANIZED IN ACCORDANCE WITH ASTM A153, CLASS C.

THE MATERIAL FOR THE HOLD-DOWN PLATES SHALL CONFORM TO ASTM A709 GRADE 50W.

ALL MATERIAL WELDED TO THE GIRDERS, WHICH INCLUDES BEARING STIFFENERS, STIFFENER PLATE, AND PIN BEARING PLATE, SHALL MATCH THE STEEL REQUIREMENTS OF THE WEB AT THAT LOCATION.

ANCHOR BOLTS, NUTS AND WASHERS SHALL CONFORM TO ASTM A709 GRADE 36 OR MATERIAL OF EQUIVALENT YIELD STRENGTH AND ELONGATION.

PROVIDE 1/8" THICK BEARING PAD THE SAME SIZE AS PLATE "D" FOR EACH BEARING.

ALL MATERIAL IN HOLD DOWN DEVICES, WHICH INCLUDES HOLD-DOWN PLATES, HIGH TENSILE STRENGTH BOLTS, PINS AND ANCHOR BOLTS, SHALL BE INCLUDED IN THE UNIT PRICE BID FOR "BEARING ASSEMBLIES EXPANSION".

ALL MATERIAL WELDED TO THE GIRDERS, WHICH INCLUDES BEARING STIFFENERS, STIFFENER PLATE, AND PIN BEARING PLATE, SHALL BE INCLUDED IN THE BID ITEM USED FOR THE STEEL GIRDER QUANTITIES.

- PROJECT ANCHOR BOLTS, PLATE "D" THICKNESS + 2 1/4", ABOVE TOP OF CONCRETE
- SEE SHEET 19 FOR WELD DETAILS SHOWING BEARING STIFFENER CONNECTION TO WEB AND FLANGE.


☆ TABLE OF FILLET WELD SIZES

MATERIAL THICKNESS OF THICKER PART JOINED.	MIN. SIZE OF FILLET WELD
TO 1/2" INCLUSIVE	3/16"
OVER 1/2" TO 3/4"	1/4"
OVER 3/4" TO 1 1/2"	Δ 5/16"
OVER 1 1/2" TO 2 1/4"	Δ 3/8"
OVER 2 1/4" TO 6"	Δ 1/2"


Δ EXCEPT THAT THE WELD SIZE SHALL NOT EXCEED THE THICKNESS OF THE THINNER PART JOINED.
Δ MIN. PASS SIZE IS 5/16"

NO.	DATE	REVISION	BY
STATE OF WISCONSIN DEPARTMENT OF TRANSPORTATION STRUCTURES DESIGN SECTION			
STRUCTURE B-18-36			
2010	DRAWN BY	IS	PLANS SL
HOLD DOWN DEVICE			SHEET 21 OF 24
			JAN-28-2010

HNTB

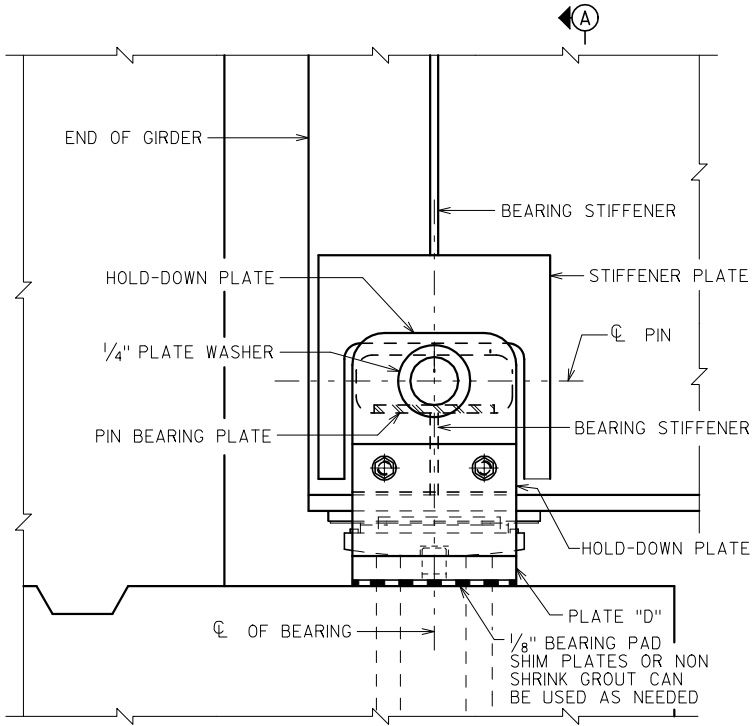


ELEVATION

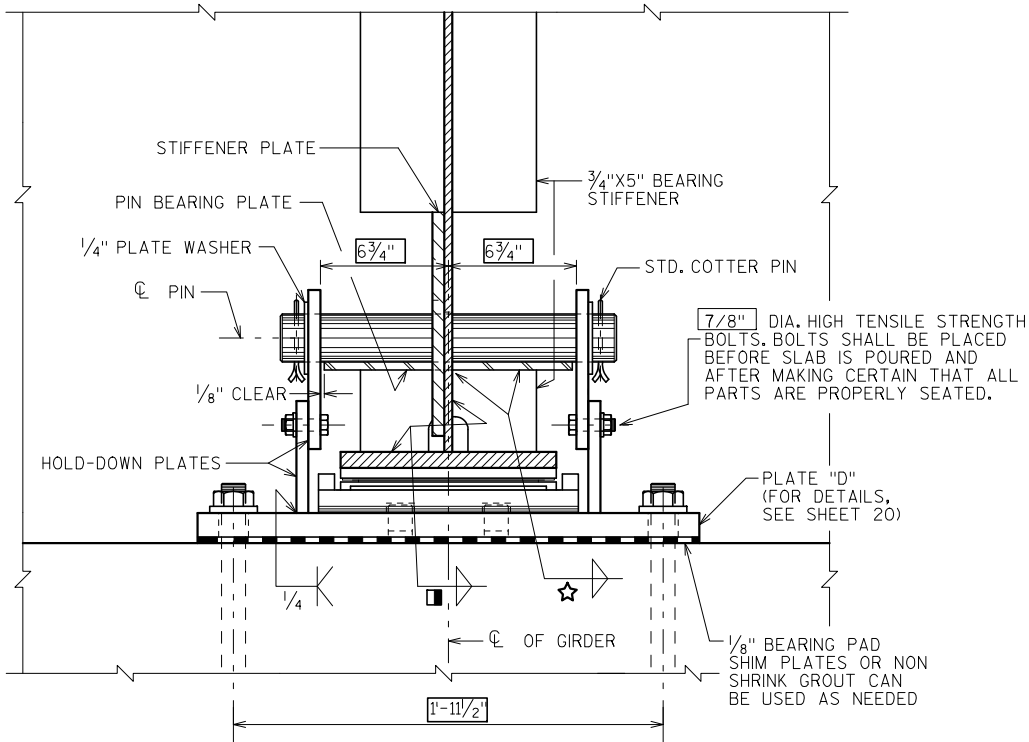


SECTION A-A


PERMANENT HOLD DOWN DEVICE

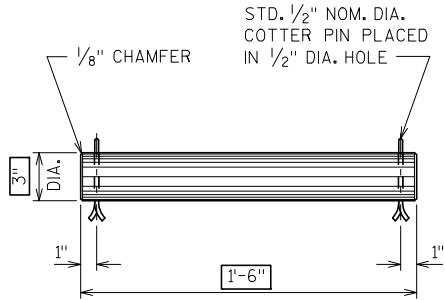


PIN DETAIL
COLD ROLLED STEEL OR CARBON STEEL FORGING.

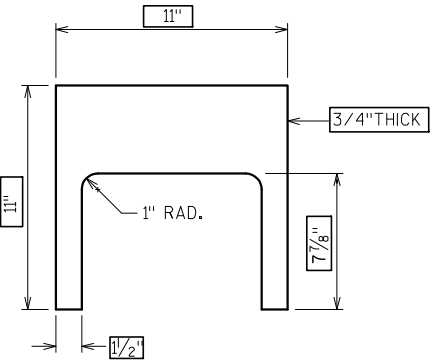


STIFFENER PLATE

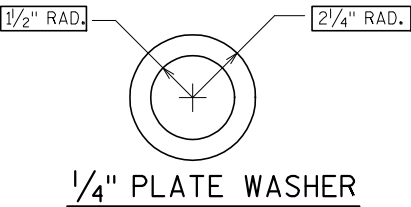


1/4" PLATE WASHER

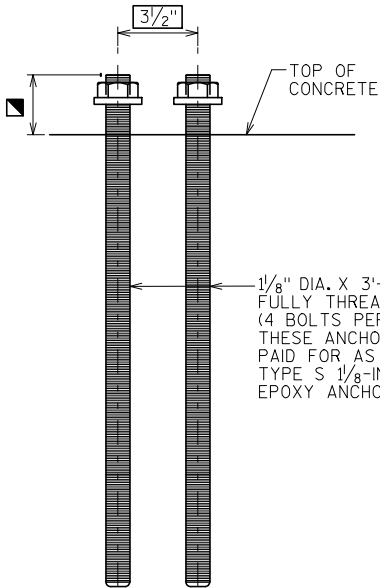


ANCHOR BOLT DETAIL
(AT EXISTING ABUTMENT LOCATION)

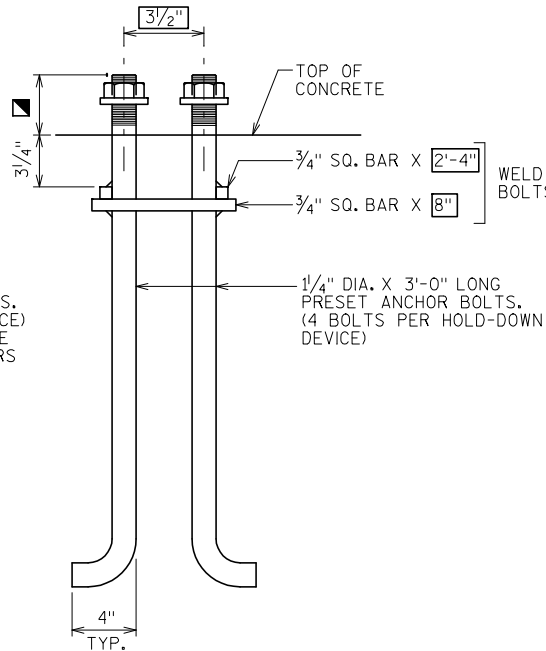

ANCHOR BOLT DETAIL
(AT PROP. EXTENSION OF ABUTMENT LOCATION)

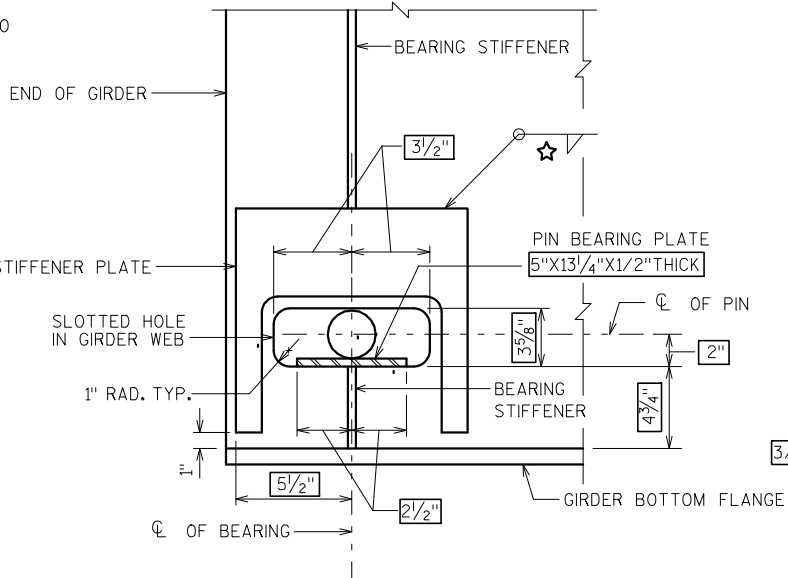

GIRDER DETAIL

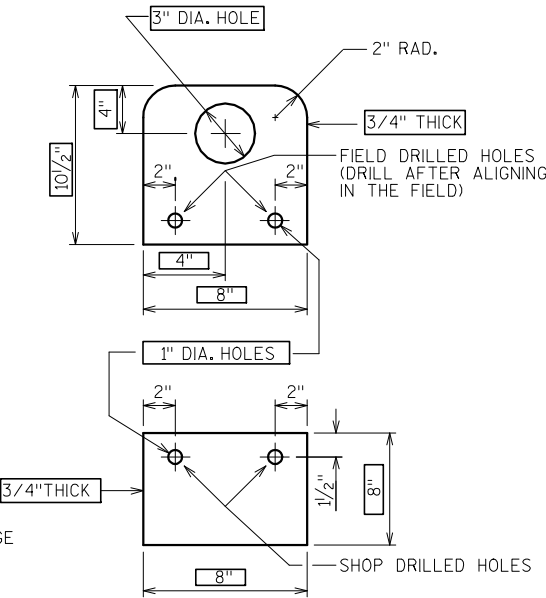

HOLD-DOWN PLATES

LEGEND

- 1. NEOPRENE STRIP SEAL (4 - INCH) & STEEL EXTRUSIONS.
- 2. STUDS $\frac{5}{8}$ " ϕ X $6\frac{3}{8}$ " LONG AT 6" ALTERNATE CENTERS. WELD TO EXTRUSIONS & BEND AS SHOWN AFTER WELDING.
- 2A. $\frac{1}{2}$ " THICK ANCHOR PLATE WITH $\frac{5}{8}$ " ϕ ROD (OR ALTERNATE STRIP SEAL ANCHOR). WELD ROD TO ANCHOR PLATE, WELD ANCHOR PLATE TO #1AT 1'-6" CENTERS BETWEEN GIRDERS.
- 3. $\frac{3}{4}$ " ϕ THREADED ROD WITH 2 NUTS AND PLATE WASHERS. WELD THREADED ROD TO TOP FLANGE OR ATTACH BY BOLTING THRU FLANGE. ON ABUTMENT SIDE GROUT THREADED ROD INTO FIELD DRILLED HOLES IN ABUTMENT BACKWALL AS SHOWN.
- 4. $\frac{3}{4}$ " ϕ THREADED ROD WITH NUT. TACK WELD NUT TO NO. 5.
- 5. FABRICATE SUPPORT FROM 3" X $\frac{1}{2}$ " BAR AS SHOWN OR EQUIVALENT, ONE PER GIRDER PER SIDE, FIELD OR SHOP WELD TO NO. 1. IF FIELD WELDED, COVER WELDED AREAS WITH EPOXY-COATING MATERIAL. PROVIDE $1\frac{1}{2}$ " ϕ HOLE FOR NO. 3 & 1" ϕ HOLE FOR NO. 4.
- 6. GALVANIZED PLATE $\frac{3}{8}$ " X LIMITS SHOWN WITH HOLES FOR #7. BEND AS SHOWN.
- 7. $\frac{3}{4}$ " ϕ X $1\frac{1}{2}$ " STAINLESS STEEL SOCKET FLAT HEAD SCREWS WITH ANTI-SEIZE LUBRICANT. RECESS $\frac{1}{16}$ " BELOW PLATE SURFACE.
- 8. $\frac{3}{4}$ " ϕ X 4" GALVANIZED HEX HEAD BOLT. BEND 45°.
- 9. $\frac{3}{4}$ " ϕ X $2\frac{1}{4}$ " GALVANIZED THREADED COUPLING.
- 10. 1" X 5" SLOTTED CSK. HOLE FOR #7. SLOT PARALLEL TO DIRECTION OF MOVEMENT.

NOTES:

ONE FIELD SPLICE PERMITTED IN STEEL EXTRUSIONS, IF USED, DETAILS SHALL BE SUBMITTED FOR APPROVAL. NO SPLICING PERMITTED IN NEOPRENE STRIP SEAL.


AFTER FABRICATION, BUT BEFORE SHIPMENT, STRAIGHTEN STEEL EXTRUSIONS SUCH THAT THEY SHALL BE FREE FROM WARP, TWIST & SWEEP.

FABRICATOR SHALL PROVIDE MEANS OF KEEPING GALVANIZED EXTRUSIONS CLEAN & SMOOTH DURING SHIPMENT AND PRIOR TO APPLYING LUBRICANT ADHESIVE FOR NEOPRENE GLAND INSTALLATION.


SANDBLAST PLATES & EXTRUSIONS AFTER FABRICATION IN ACCORDANCE WITH SSPC SP. #6 "COMMERCIAL BLAST CLEANING". AFTER BLAST CLEANING THE PLATES & EXTRUSIONS SHALL BE HOT DIPPED GALVANIZED.

ANCHOR SYSTEM #8 & #9 SHALL CONFORM TO ASTM A307 & SHALL BE GALVANIZED IN ACCORDANCE WITH ASTM A153 CLASS C & D.


STRIP SEAL EXPANSION JOINT ASSEMBLY, INCLUDING ANCHOR STUDS & HARDWARE WILL BE PAID FOR AT THE LUMP SUM PRICE BID FOR "EXPANSION DEVICE".

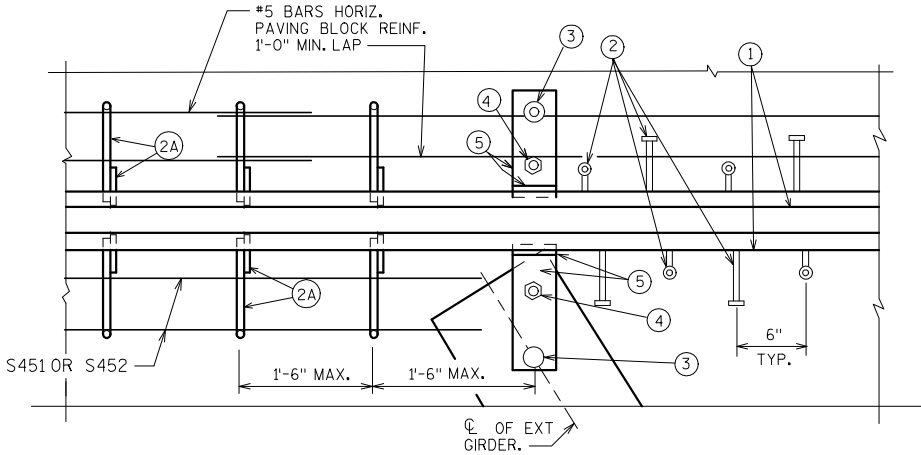


PART PLAN

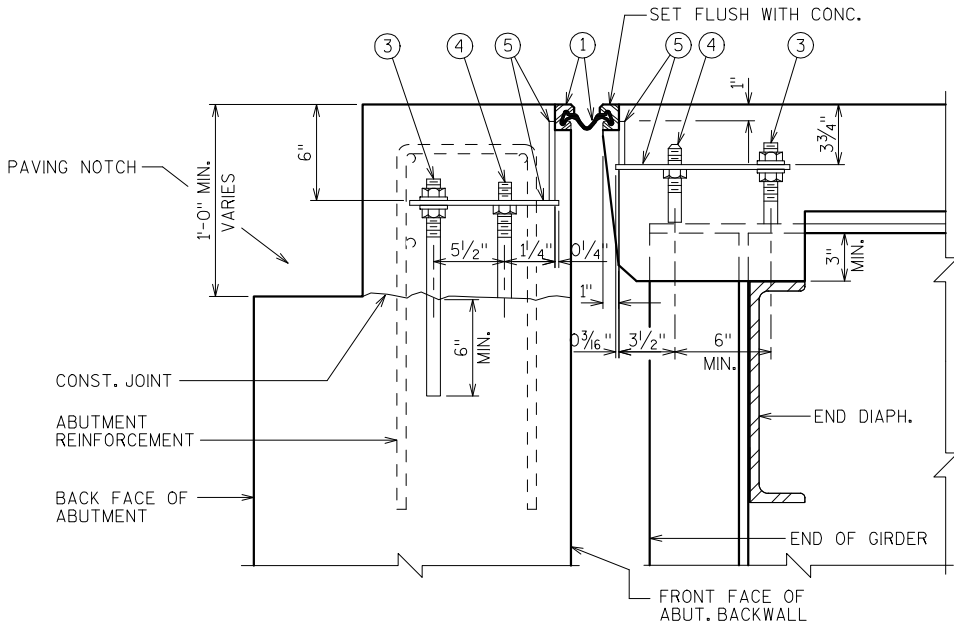


SECTION THRU JOINT AT ABUTMENT
NORMAL TO CL SUBSTRUCTURE

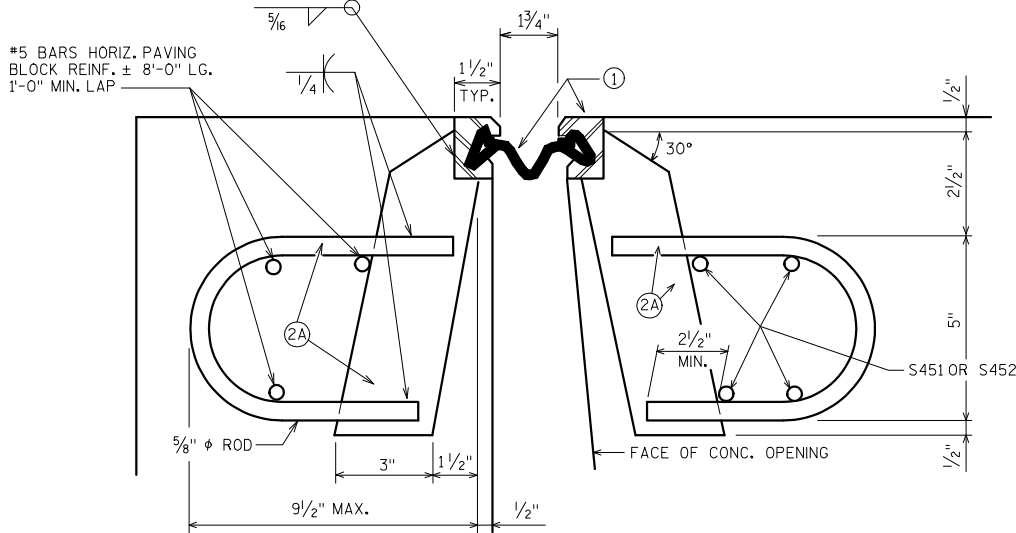

SECTION THRU JOINT
ROADWAY TRAFFIC AREA BETWEEN EXTERIOR GIRDERS.

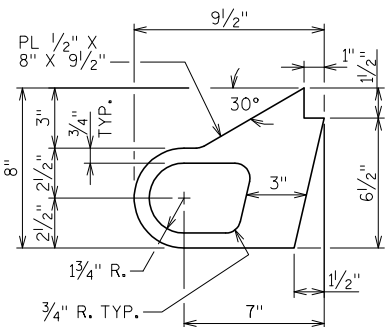

ALTERNATE STRIP SEAL ANCHOR

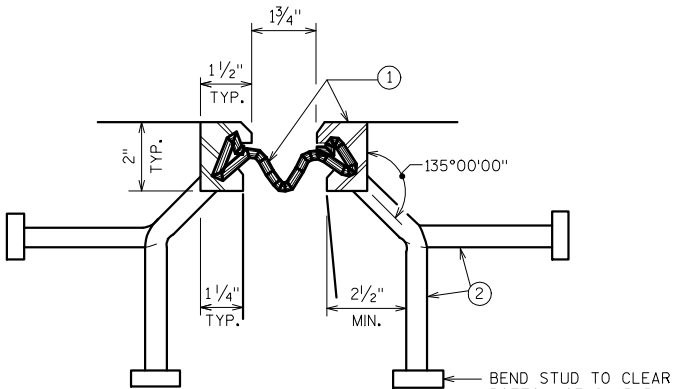


SECTION THRU JOINT
EXTERIOR GIRDER TO EDGE OF SLAB & AT PARAPETS, MEDIANS & SIDEWALKS

\\ohiaw00\projects\50206\CADD\caddnew 36\50206_B1836_22expansion.dgn
28-JAN-2010 07:55
PLOTTED BY: Ikalina


NO.	DATE	REVISION	BY
STATE OF WISCONSIN DEPARTMENT OF TRANSPORTATION STRUCTURES DESIGN SECTION			
STRUCTURE B-18-36			
2010	DRAWN BY	IS	PLANS SL
STRIP SEAL EXPANSION JOINT DETAILS		SHEET 22 OF 24 JAN-28-2010	

\\ohiaw00\projects\50206\CADD\ods\new 36\50206_B1836_23Seal_cover_PL.dgn
28-JAN-2010 07:55
PLOTTED BY: Ikalia


8

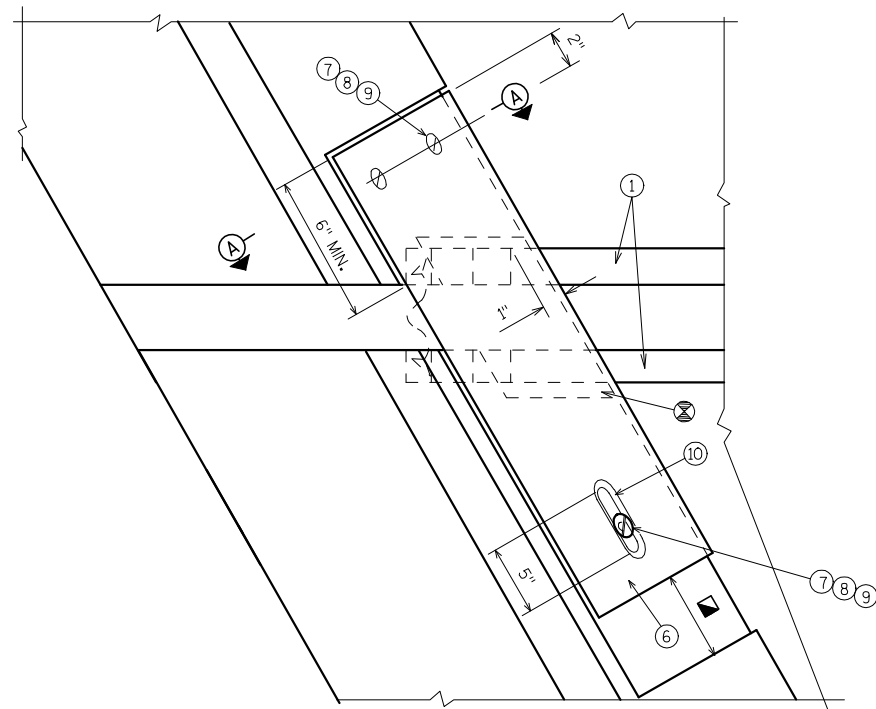


PLAN

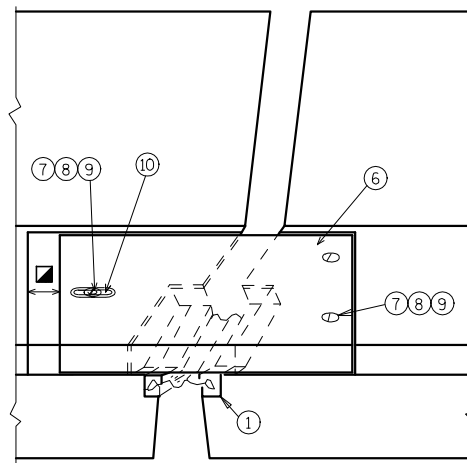

VIEW OF PARAPET PLATES
FROM ROADWAY

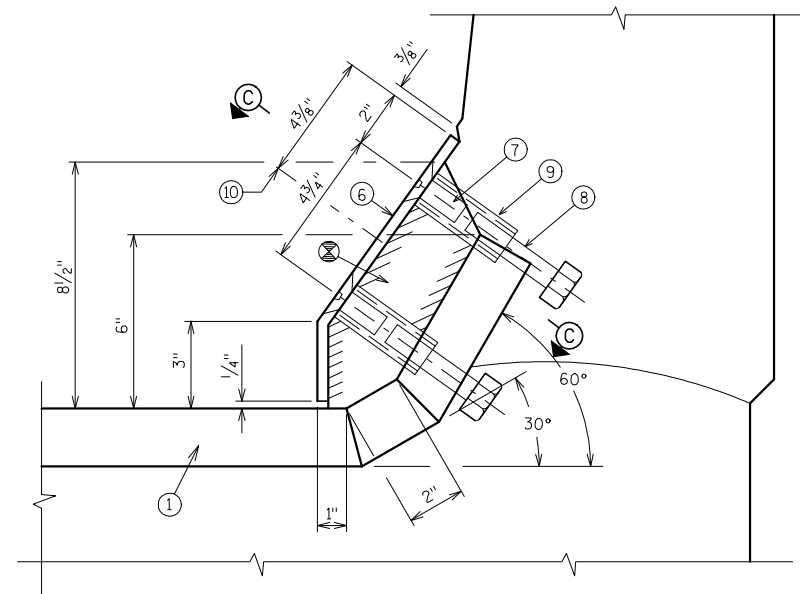

SECTION A-A

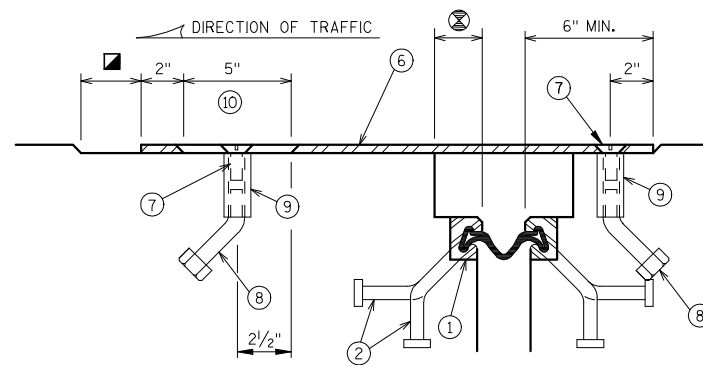

SECTION C-C

NOTE:

WORK THIS SHEET WITH SHEET 22.

- ⊗ BLOCK OUT CONCRETE 2" EACH SIDE FOR JOINT OPENING
- ▣ JOINT OPENING DIM. ALONG SKEW PLUS 1/2"

HNTB


NO.	DATE	REVISION	BY
STATE OF WISCONSIN DEPARTMENT OF TRANSPORTATION STRUCTURES DESIGN SECTION			
STRUCTURE B-18-36			
2010	DRAWN BY	IS	PLANS CK'D. SL
STRIP SEAL COVER PLATE DETAILS			SHEET 23 OF 24 JAN-28-2010

SCALE =


8

FOR ABUTMENT PARAPETS


BAR MARK	COAT	SOUTH ABUT.	NORTH ABUT.	LENGTH	BENT	BAR SERIES	LOCATION
R531	X	28	28	4'-7"	X		PARAPET VERT.
R532	X	16	16	2'-4"	X		PARAPET VERT.
R533	X	6	6	4'-7"	X		PARAPET VERT.
R534	X	8	8	8'-4"			PARAPET HORIZ.
R535	X	34	34	4'-10"	X		PARAPET VERT.
R536	X	2	2	8'-4"	X		PARAPET HORIZ.

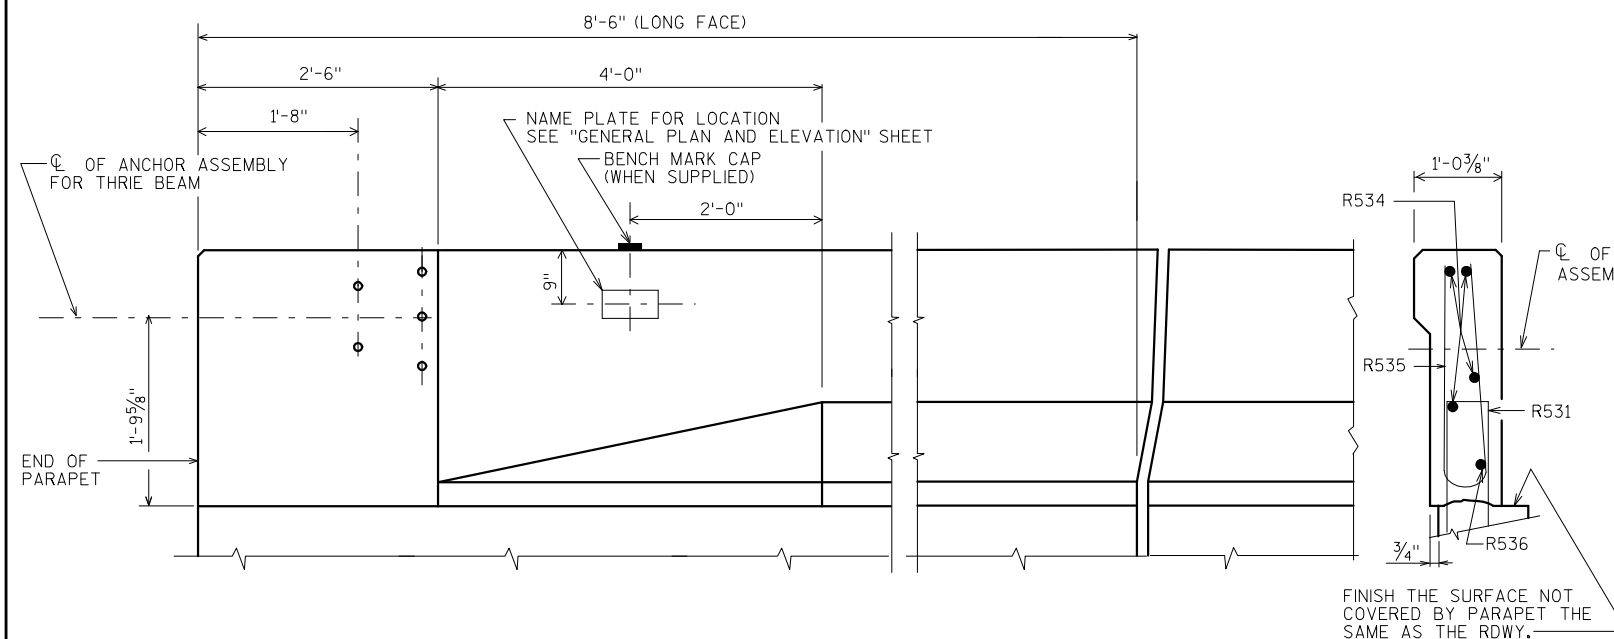


INSIDE ELEVATION

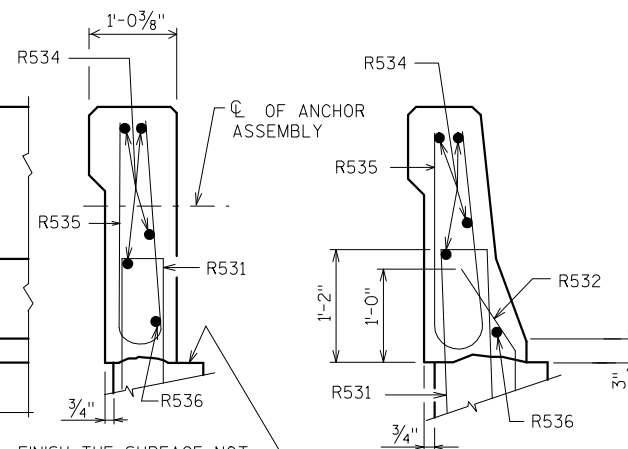


SECTION A

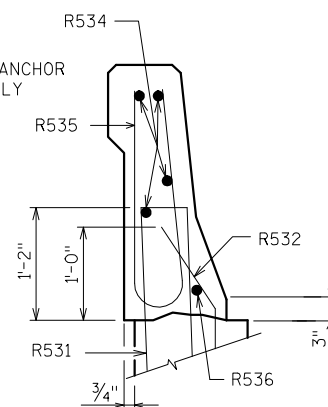

SECTION B

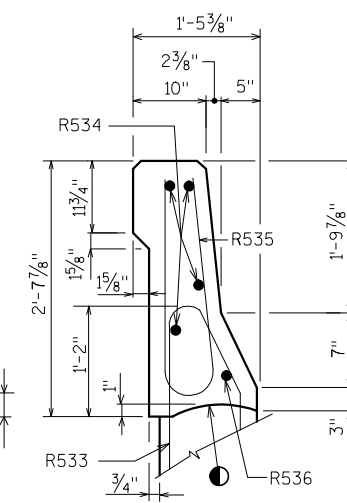


SECTION C

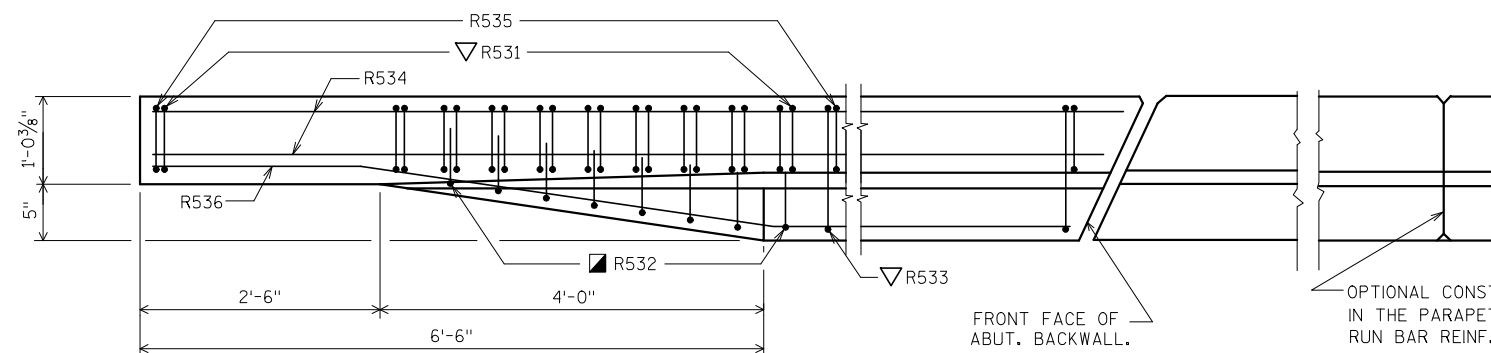


PLAN


OPTIONAL CONSTRUCTION JOINTS
IN THE PARAPETS MAY BE USED.
RUN BAR REINF. THRU THE JOINT.
LAP LONGIT. BARS A MIN. OF 1'-9".
MIN. JOINT SPACING OF 80'-0".
DEFINE CONST. JOINT
WITH A $\frac{3}{4}$ " 'V' GROOVE.

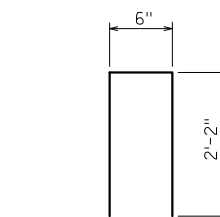


R531

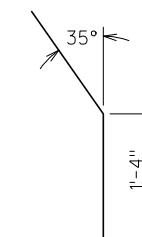


R532

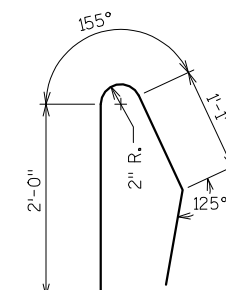

R533

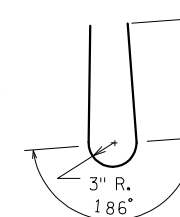


R535

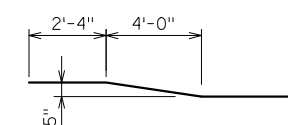

R536

— THREADED INSERTS FOR $\frac{7}{8}" \phi \times 2"$ LONG GALVANIZED HEX HEAD CAP SCREWS. CAP SCREWS TO BE THREADED A MIN. OF $\frac{1}{8}"$ AND SHALL BE SUPPLIED, INCLUDING WASHERS, WITH ASSEMBLY. INSERTS TO BE THREADED A MINIMUM OF $\frac{1}{4}"$.

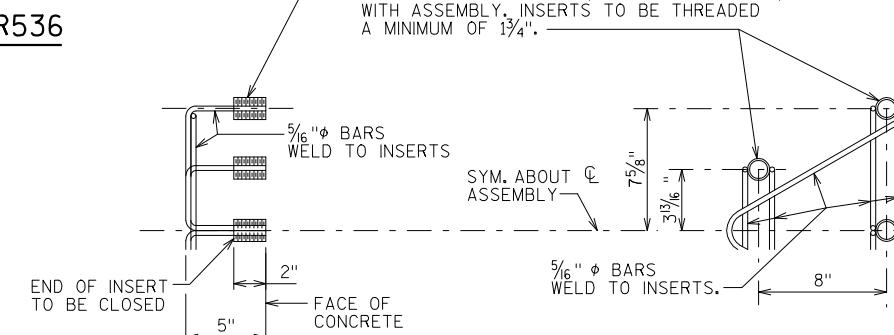

DETAIL OF ANCHOR ASSEMBLY

NOTE: HEX HEAD CAP SCREWS & WASHERS TO BE GALVANIZED IN ACCORDANCE WITH AASHTO M232 CLASS C.


ASSEMBLY SHALL BE BID ITEM "ANCHOR
ASSEMBLIES FOR STEEL PLATE BEAM
GUARD", EACH.

● CONST. JOINT - STRIKE OFF AS SHOWN.

■ R532 BARS MAY BE PLACED AFTER CONCRETE IS POURED BUT BEFORE INITIAL SET HAS TAKEN PLACE. USE CARE TO PLACE R532 BARS CORRECTLY ALONG TRANSITION OF PARAPET.


▽ R531 AND R533 BARS TO BE TIED TO WING STEEL BEFORE WING IS POURED.

NO.	DATE	REVISION		BY
STATE OF WISCONSIN DEPARTMENT OF TRANSPORTATION STRUCTURES DESIGN SECTION				
STRUCTURE B-18-36				
2010		DRAWN BY	IS	PLANS CK'D. SL
RAILING DETAILS			SHEET 24 OF 2	
			JAN-28-2010	

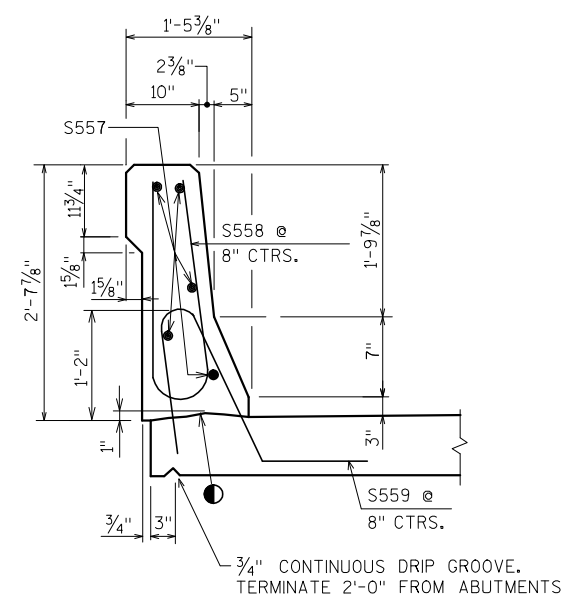

SECTION THRU PARAPET ON BRIDGE

(FOR BAR DETAILS AND BILL OF BARS SEE SHEET 14)

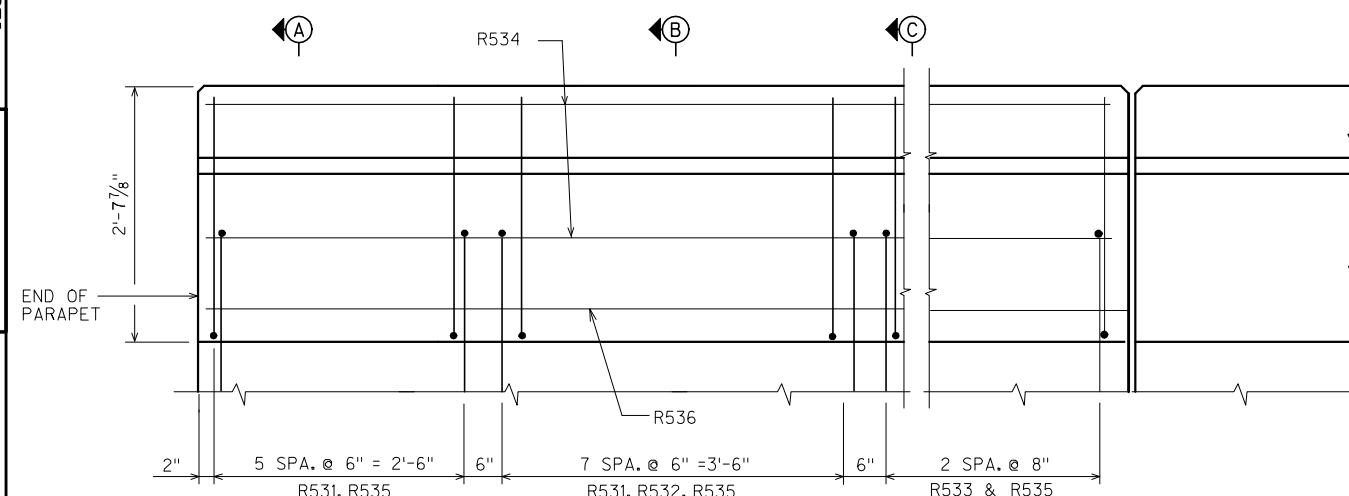


OUTSIDE ELEVATION

BILL OF BARS


NOTE: THE FIRST OR FIRST TWO DIGITS OF THE BAR MARK SIGNIFIES THE BAR SIZE.

BAR MARK	COAT	NO. REQ'D.	LENGTH	BENT	BAR SERIES	LOCATION
B578	X	17	7'-2"	X		PAVING BLOCK VERT.
B682	X	7	7'-2"	X		BACKWALL VERT.
B695	X	80	5'-0"			MASONRY ANCHORS


SPECIAL NOTE: USE THE FOLLOWING BARS FROM ORIGINAL PLANS: B578, B479, B580, B682, IN ADDITION TO THE BARS LISTED HERE, IN ORDER TO REINFORCE THE ABUTMENT BACKWALL AND PAVING BLOCK.

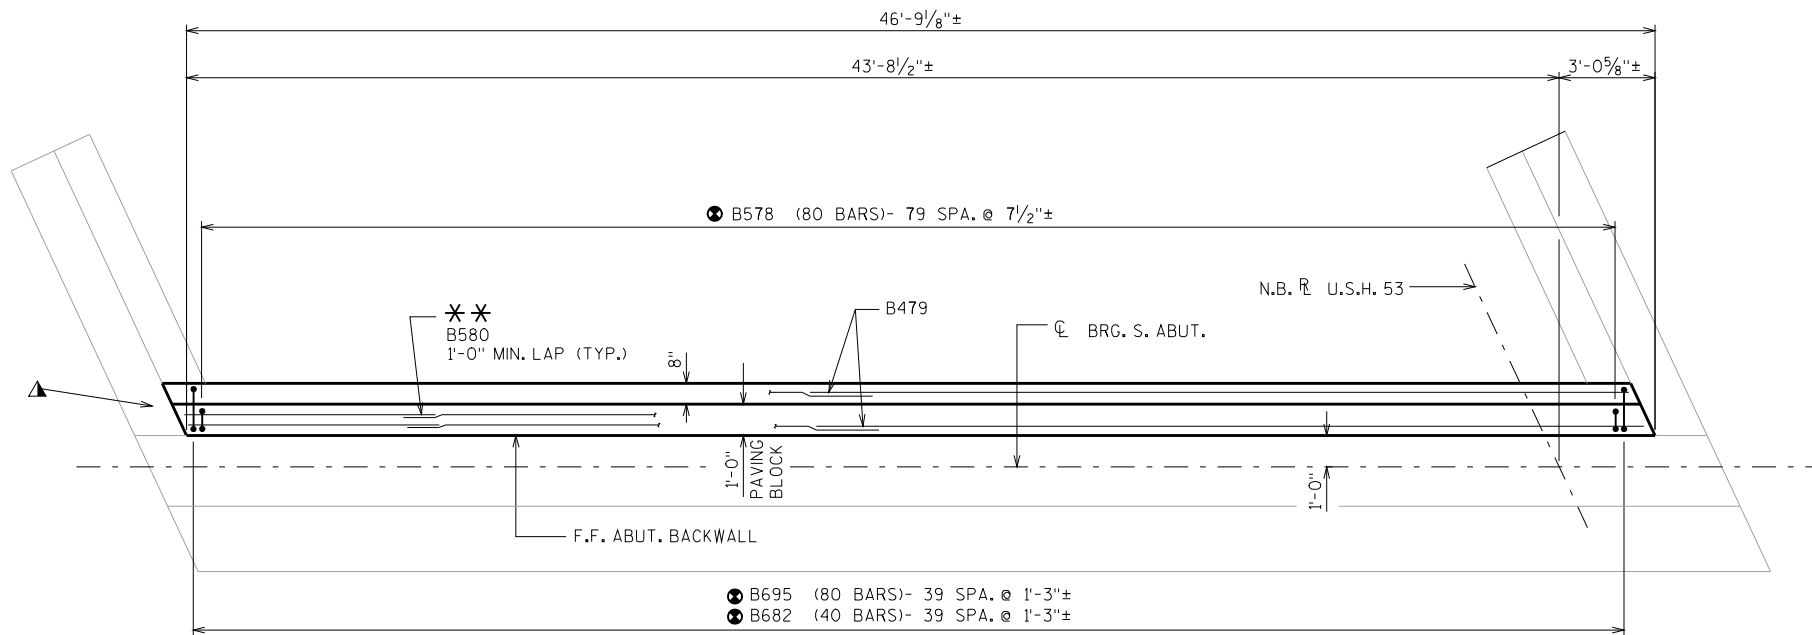

PLAN

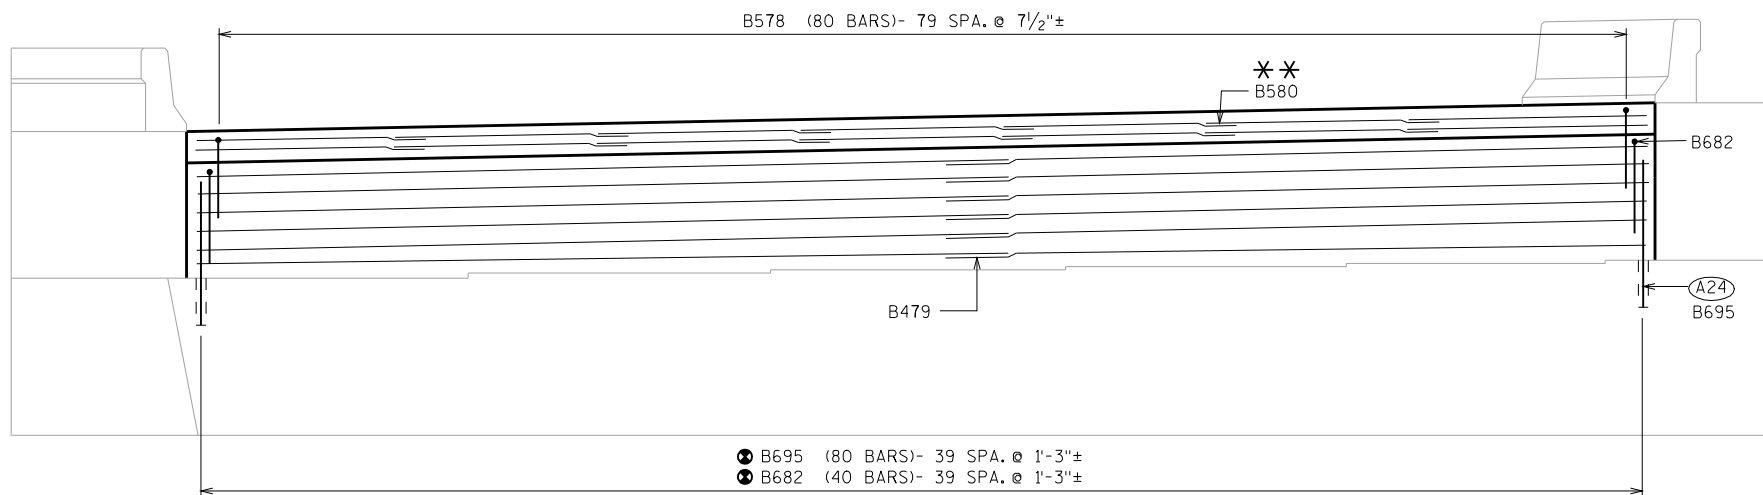

ELEVATION

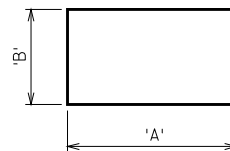


MARK	A	B
B578	3'-3"	0'-8"
B682	2'-11"	1'-4"

LIST OF DRAWINGS

6A. REVISED SOUTH ABUTMENT DETAILS
12A. REVISED NORTH ABUTMENT DETAILS

STRUCTURE DESIGN CONTACT:

KENT BAHLER (608) 266-8490
WARNER RISSER (608) 266-5081

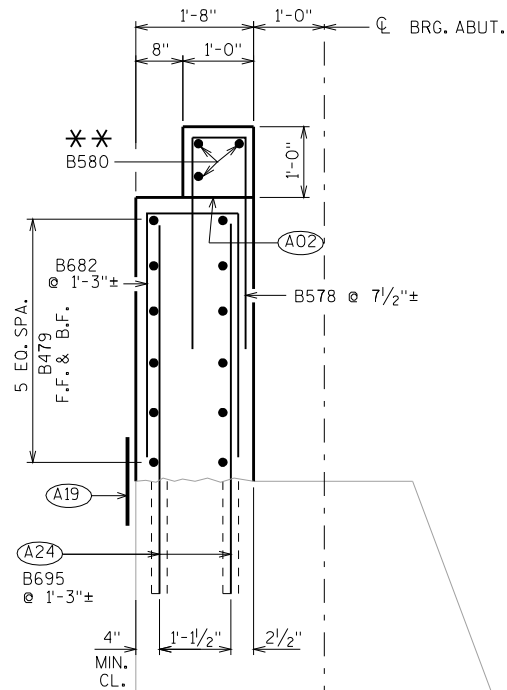

SECT. THRU ABUT.

DRAWINGS SHALL NOT BE SCALED.
BAR STEEL REINFORCEMENT SHALL BE
EMBEDDED 2" CLEAR UNLESS OTHERWISE NOTED.

NOTE: SEE ORIGINAL PLANS FOR TIE-IN REINFORCEMENT
BARS B483 & B489, WINGWALL TO BACKWALL.

SET WITH EXPANSION JOINT ANCHOR PLATE.
FOR MORE DETAILS, SEE HNTB PLAN SET.


FOR ELEVATIONS REFER TO HNTB PLAN SET.

FAN BARS B578, B682, AND B695, AS NEEDED
AT ENDS OF ABUTMENT.

CONSTRUCTION JOINT: POUR CONCRETE ABOVE
THIS JOINT AFTER SUPERSTRUCTURE CONCRETE
IS IN PLACE. STRIKE OFF AND LEAVE ROUGH.

18" (RMW) RUBBERIZED MEMBRANE WATERPROOFING
SEAL ALL HORIZ. & VERT. JOINTS AT BACKFACE.

B695 MASONRY ANCHORS TYPE L NO. 6 BARS,
EMBED 1'-6" INTO EXIST. CONCRETE.
EPOXY ANCHORED.


NO.	DATE	REVISION	BY
 Plans Prepared By WISDOT BUREAU OF STRUCTURES			
ACCEPTED _____ CHIEF STRUCTURES DESIGN ENGINEER DATE			
STRUCTURE B-18-36			
USH 53 OVER IH-94			
COUNTY	EAU CLAIRE	TOWN/CITY/VILLAGE	EAU CLAIRE
DESIGN SPEC. AASHTO LRFD DESIGN SPEC. 5th EDITION			
DESIGNED BY	DESIGN CK'D.	DRAWN BY	PLANS CK'D.
		WWR	DDS
REVISED SOUTH ABUTMENT BACKWALL DETAILS			SHEET 6A OF 24

BILL OF BARS

NOTE: THE FIRST OR FIRST TWO DIGITS OF THE BAR MARK SIGNIFIES THE BAR SIZE.

BAR MARK	COAT	NO. REQ'D.	LENGTH	BENT	BAR SERIES	LOCATION
B551	X	15	7'-4"	X		PAVING BLOCK VERT.
B654	X	5	6'-10"	X		BACKWALL VERT.
B666	X	1	8'-10"			BACKWALL VERT.
B670	X	82	5'-3"	X		MASONRY ANCHORS

SPECIAL NOTE: USE THE FOLLOWING BARS FROM ORIGINAL PLANS: B551, B552, B453, B654, B666, B667, IN ADDITION TO THE BARS LISTED HERE, IN ORDER TO REINFORCE THE ABUTMENT BACKWALL AND PAVING BLOCK.



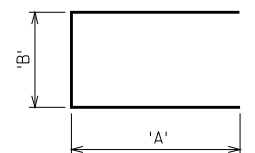


MARK	A	B
B551	3'-4"	0'-8"
B654	2'-9"	1'-4"
B666	3'-9"	1'-4"

PLAN

ELEVATION

SECT. THRU ABUT.

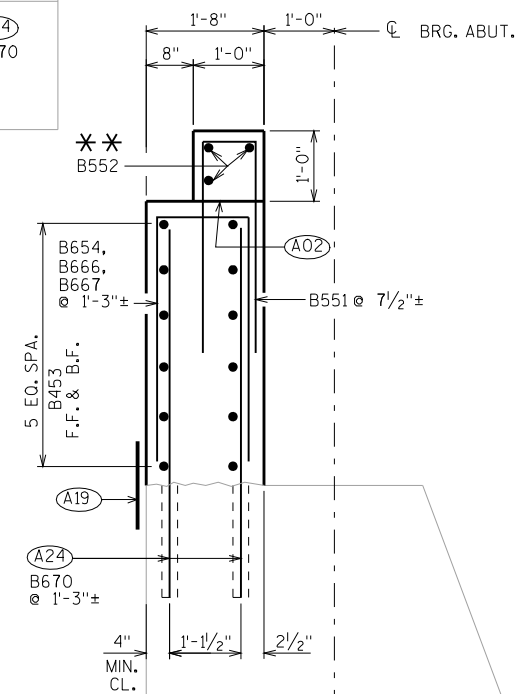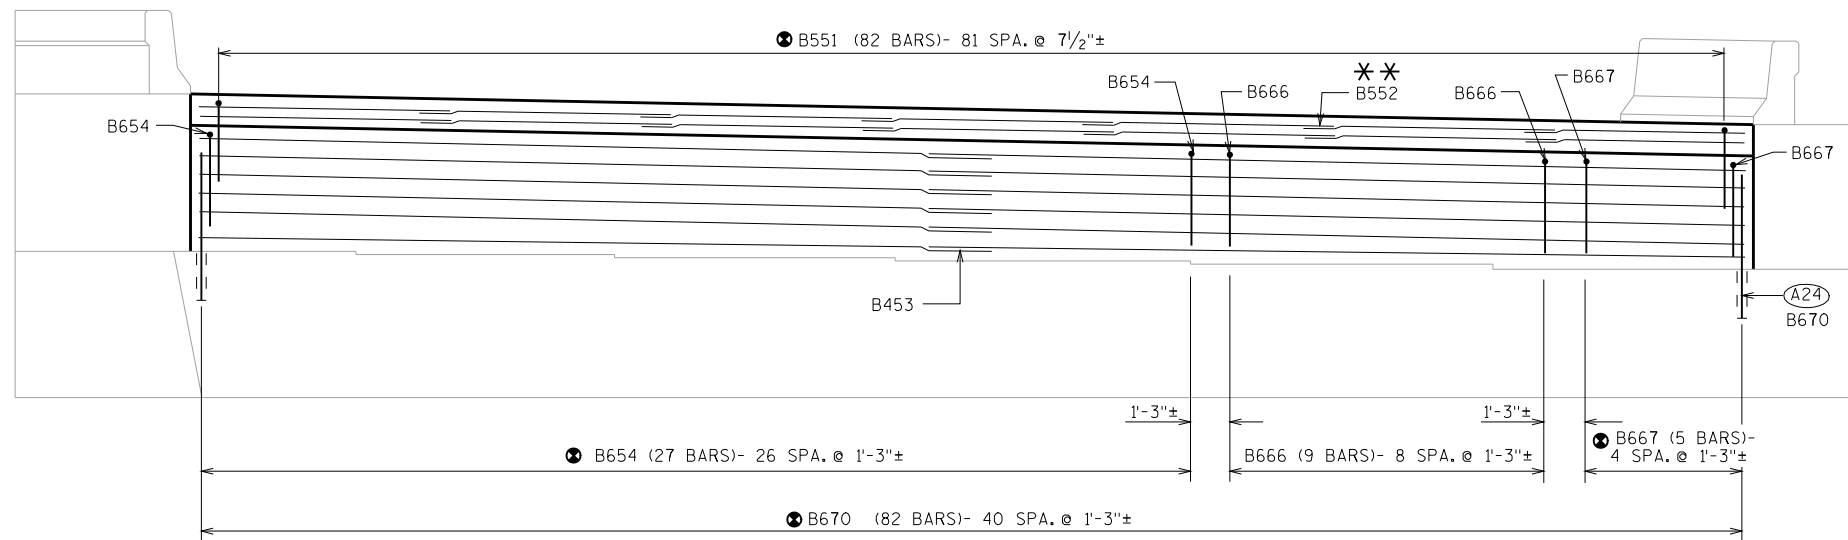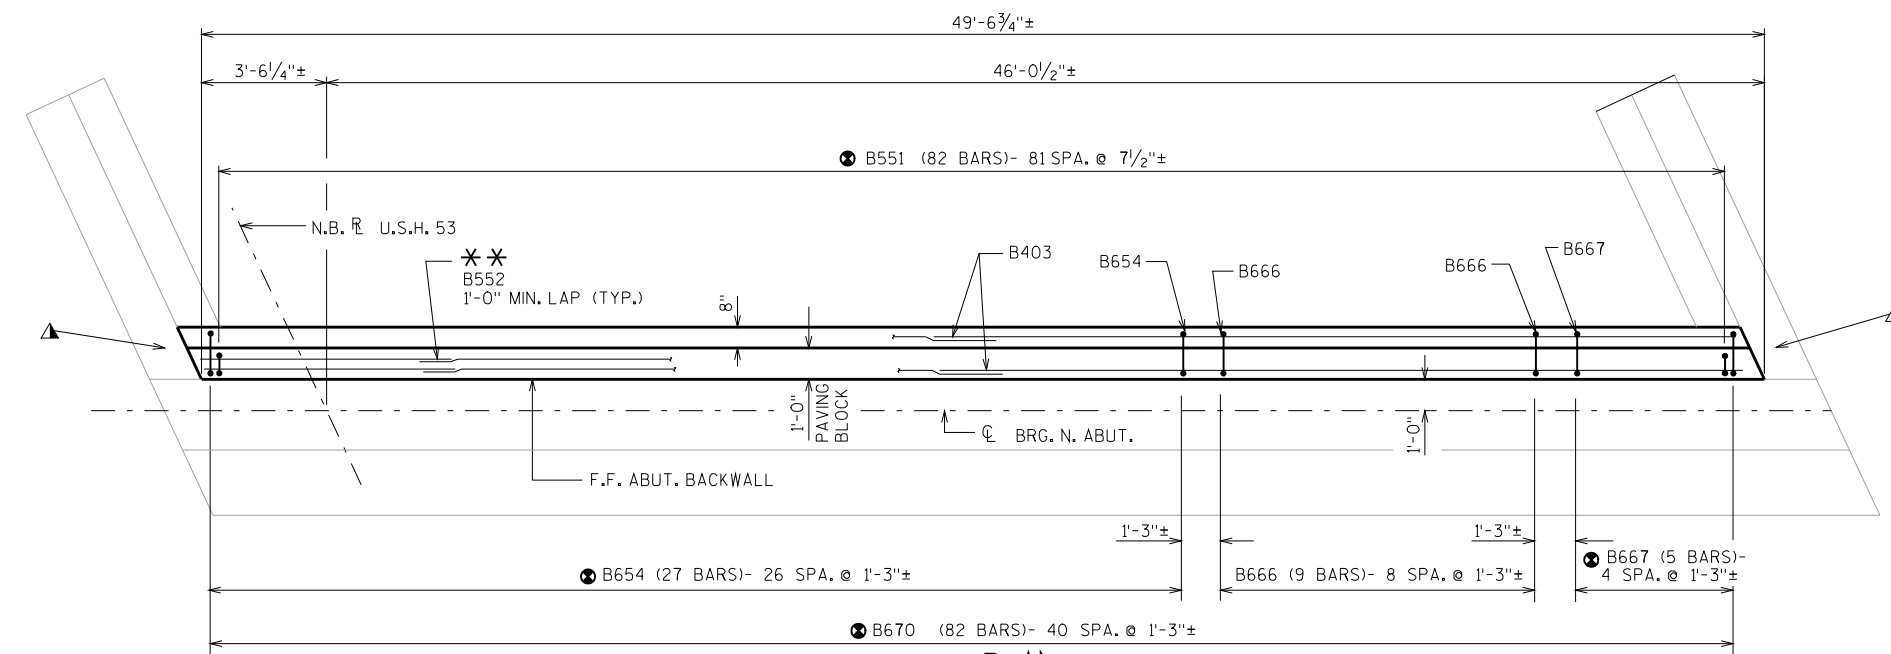

NOTE: SEE ORIGINAL PLANS FOR TIE-IN REINFORCEMENT BARS B455 & B461, WINGWALL TO BACKWALL.

SET WITH EXPANSION JOINT ANCHOR PLATE. FOR MORE DETAILS, SEE HNTB PLAN SET.

FOR ELEVATIONS REFER TO HNTB PLAN SET.

FAN BARS B551, B654, AND B670 AS NEEDED AT ENDS OF ABUTMENT.

CONSTRUCTION JOINT: POUR CONCRETE ABOVE THIS JOINT AFTER SUPERSTRUCTURE CONCRETE IS IN PLACE. STRIKE OFF AND LEAVE ROUGH.

18" (RMW) RUBBERIZED MEMBRANE WATERPROOFING SEAL ALL HORIZ. & VERT. JOINTS AT BACKFACE.

B670 MASONRY ANCHORS TYPE L NO.6 BARS, EMBED 1'-6" INTO EXIST. CONCRETE. EPOXY ANCHORED.

NO.	DATE	REVISION	BY
STATE OF WISCONSIN DEPARTMENT OF TRANSPORTATION STRUCTURES DESIGN SECTION			
STRUCTURE B-18-36			
DRAWN BY		WWR	PLANS CK'D. DDS
REVISED NORTH ABUTMENT BACKWALL DETAILS			SHEET 12A