


AS-BUILT PLAN

SUPERVISOR: DAVID OSTROWSKI PE
 PROJECT MANAGER: PHILIP KEPPERS PE
 PROJECT LEADER: BRIAN MATTSON
 PRIME CONTRACTOR: MCCABE CONSTRUCTION
 SUB CONTRACTORS: NORTHWOODS PAVING
 GREG WECK SURVEY
 MATTISON CONTRACTORS
 WORK STARTED: JULY 10, 2016
 WORK COMPLETE: SEPTEMBER 28, 2016

1560-04-72
 BAYFIELD
 DRUMMOND - USH 2
 TWENTY MILE CREEK CLVT: C-04-0001
 EMERGENCY FLOOD REPAIR

FINAL CONTRACTS COSTS: \$527,252.90
 CONTRACT MODS: #1 \$93,099.15 #2 \$33,065.75, Total: \$126,164.90
 CONTRACT ID: EM1560-04-72

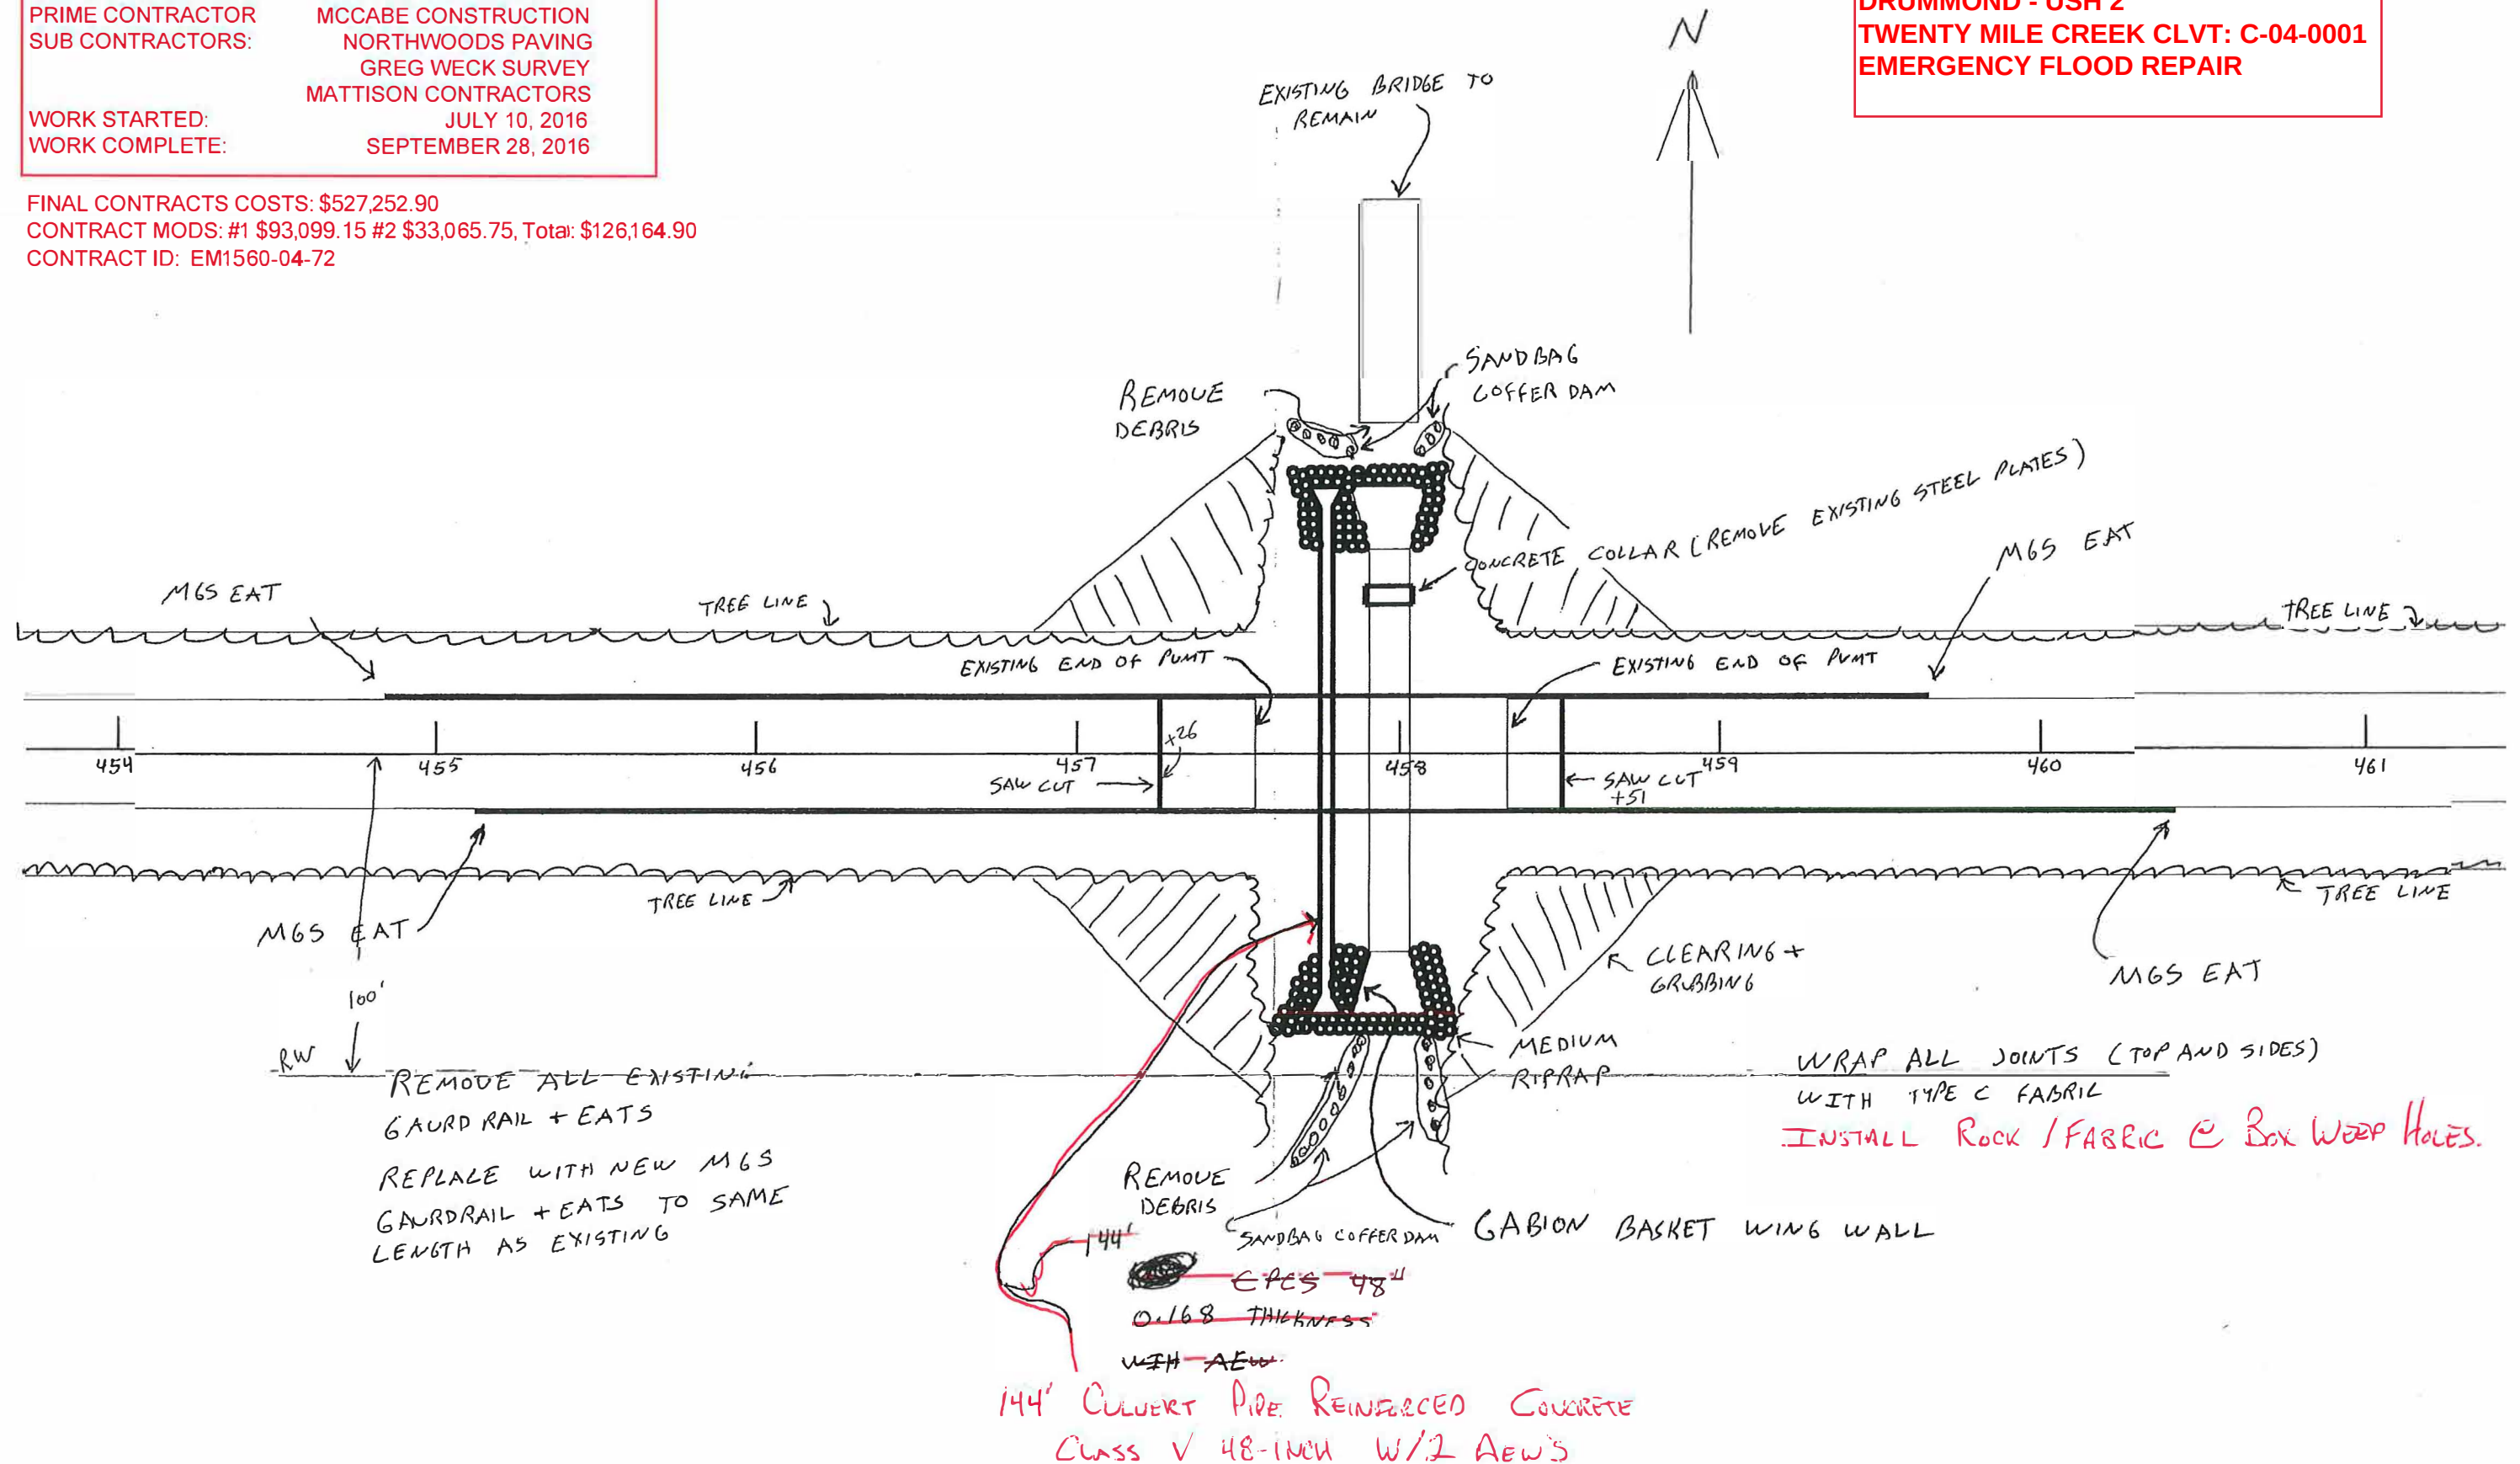

LOOKING NORTH

PROFILE IS NOT EXAGGERATED

