


AS-BUILT

Nov 05
INDEX OF SHEETS

| | |
|-------------|------------------------------|
| Sheet No. 1 | Title |
| Sheet No. | Typical Sections and Details |
| Sheet No. | Estimate of Quantities |
| Sheet No. | Miscellaneous Quantities |
| Sheet No. | Right of Way Plot |
| Sheet No. | Plan and Profile |
| Sheet No. | Standard Detail Drawings |
| Sheet No. | Sign Plates |
| Sheet No. | Structure Plans |
| Sheet No. | Computer Earthwork Data |
| Sheet No. | Cross Sections |

TOTAL SHEETS = 38

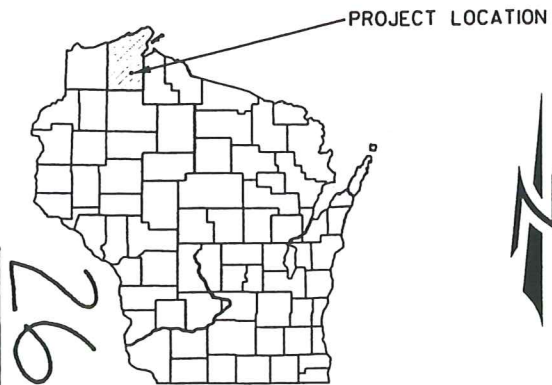


DESIGN DESIGNATION

| | | |
|---------------|---|---------|
| A.D.T. (2002) | = | 2525 |
| A.D.T. (2022) | = | 3350 |
| D.H.V. (2022) | = | 8.2% |
| D. | = | 60-40 |
| T. % ADT | = | 11.3% |
| DESIGN SPEED | = | 55 MPH |
| ESALS | = | 854,100 |

CONVENTIONAL SYMBOLS


| | |
|--|--|
| COUNTY LINE | |
| CORPORATE LIMITS | |
| PROPERTY LINE | |
| LOT LINE | |
| LIMITED EASEMENT | |
| EXISTING RIGHT OF WAY | |
| PROPOSED OR NEW R/W LINE | |
| SURVEY LINE | |
| SLOPE INTERCEPT | |
| ORIGINAL GROUND | |
| MARSH OR ROCK PROFILE (To be noted as such) | |
| MARSH AREA | |
| WOODED OR SHRUB AREA | |

| | |
|-----------------------------------|--|
| COMBUSTIBLE FLUIDS | |
| UNDERGROUND UTILITIES | |
| GAS | |
| ELECTRIC | |
| TELEPHONE OR TELEGRAPH | |
| COMMUNICATIONS LINE | |
| SERVICE PEDESTAL | |
| POWER POLE | |
| TELEPHONE POLE | |
| RAILROAD | |
| SANITARY SEWER | |
| STORM SEWER | |
| WATER | |
| EXISTING CULVERT | |
| PROPOSED CULVERT (Box or Pipe) | |
| CULVERT (Profile View) | |

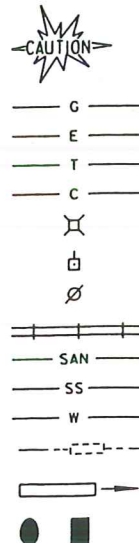

LAYOUT
SCALE 0 1 MI.

TOTAL NET LENGTH OF CENTERLINE = 8.774 MI.

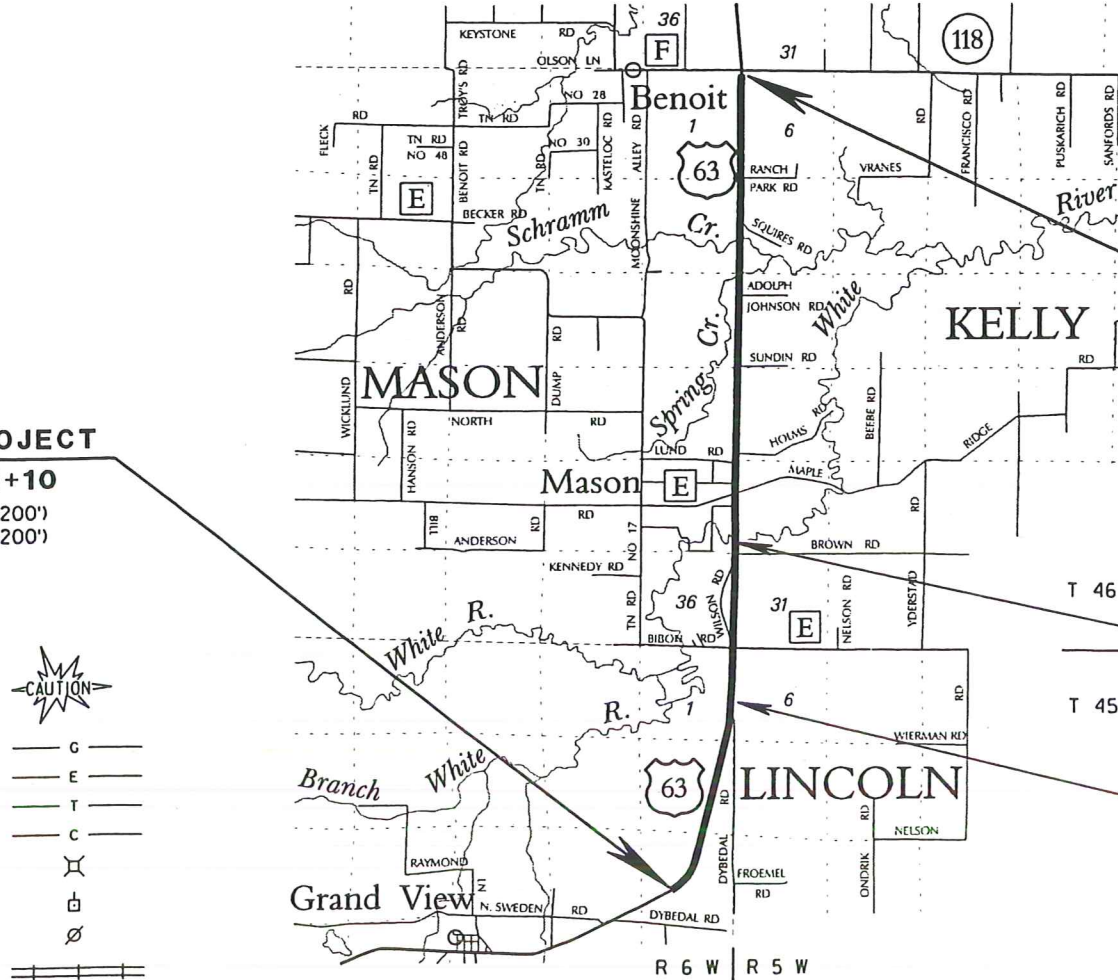

BEGIN PROJECT
STA. 1030+10
Y = 443000 (±200')
X = 1731300 (±200')

END PROJECT
STA. 1494+75

EXCEPTION TO NET &
STA 1231+68.67 TO
STA 1232+58.33

EXCEPTION TO NET &
STA 1139+76.50 TO
STA 1140+23.38

Coordinates are scaled from U.S.G.S. Topographic
Maps (Mason and Grand View), Wisconsin Quadrangle,
for identification only.

STATE OF WISCONSIN
DEPARTMENT OF TRANSPORTATION
PLAN OF PROPOSED IMPROVEMENT
GRAND VIEW - STH 118
USH 63
BAYFIELD COUNTY

| STATE PROJECT | FEDERAL PROJECT | |
|---------------|-----------------|----------|
| | PROJECT | CONTRACT |
| 1560-20-71 | STP 2005558 | 1 |
| | | |
| | | |
| | | |

1560-20-71
USH 63
Grandview - STH 118
Northwoods Plaving
Ralph Meir.

Bayfield County

Start Date: 5/15/06
Completion Date: 11/2/06
Final Contract Cost:
\$1,876,558

Prime Contractor: Northwoods Plaving
Sub Contractors: Century Fence
Chippewa Conc. Services
Fahnes Asph. Sealers
Mattison Contractors
Pitlik & Wick
Roffers Const.
Safemark

ORIGINAL PLANS PREPARED BY
NORTHERN WISCONSIN-
BASED ENGINEERS, INC.




2/4/04
(Date) Heather Harrington
(Signature)

STATE OF WISCONSIN
DEPARTMENT OF TRANSPORTATION

| | |
|---------------------|---------------------|
| PREPARED BY | |
| Surveyor | NWBE |
| Designer | NWBE |
| Project Manager | HEATHER HARRINGTON |
| District Examiner | CHRISTINE KOSKI |
| District Supervisor | LANCE BURGER |
| C.O. Examiner | Jane Englebrechtson |


APPROVED FOR DISTRICT OFFICE
DATE: 5-3-05 Cindy Stumstad
(Signature)

E

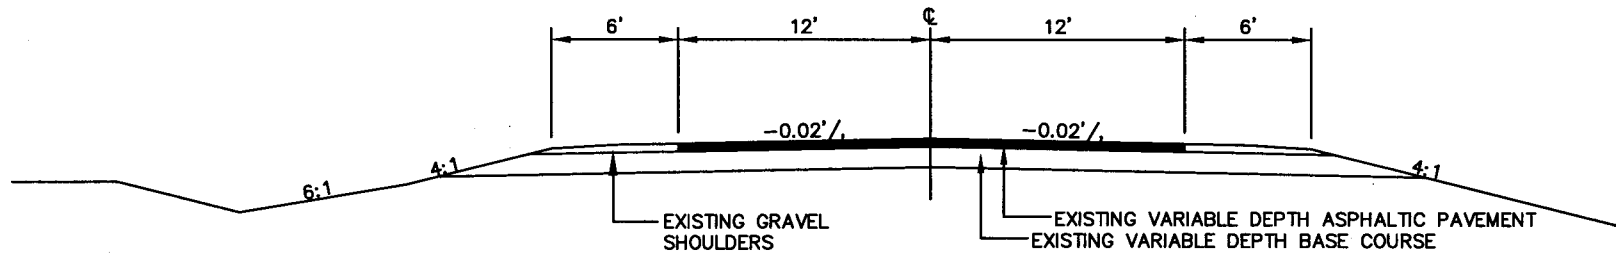

TYPICAL EXISTING SECTION

STA 1030+10 - STA 1139+76.5

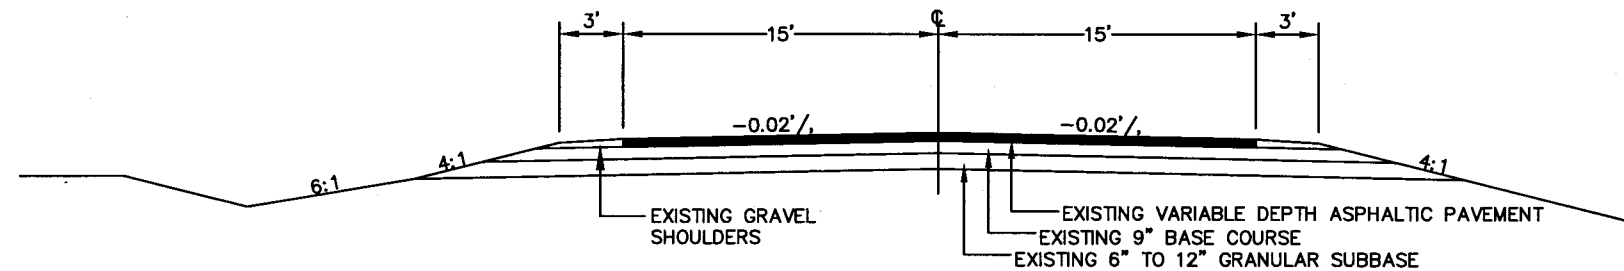

TYPICAL EXISTING SECTION

STA 1140+23.38 - STA 1231+68.67
STA 1232+58.33 - STA 1494+75

STANDARD DETAIL DRAWINGS

| | |
|--------------|---|
| 8D1-13 | CONCRETE CURB, CONCRETE CURB AND GUTTER AND PAVEMENT TIES |
| 8E8-3 | TYPICAL INSTALLATIONS OF EROSION BALES/TEMPORARY DITCH CHECKS |
| 8E9-5 | SILT FENCE |
| 8F4-5 | JOINT TIES FOR CONCRETE PIPE |
| 14B15-4a&b | STEEL PLATE BEAM GUARD, CLASS "A" INSTALLATION AND ELEMENTS |
| 14B18-4a | STEEL PLATE BEAM GUARD, CLASS "A", (AT BRIDGES, OBSTACLES AND SIDEROADS/DRIVEWAYS) |
| 14B20-6a | STEEL THRIE BEAM STRUCTURE APPROACH |
| 14B20-6c | STEEL THRIE BEAM STRUCTURE APPROACH, CONNECTION TO SLOPED END PARAPETS |
| 14B20-7d | STEEL THRIE BEAM STRUCTURE APPROACH, CONNECTION TO BRIDGE RAILING TYPES "F" AND "W" |
| 14B24-4a,b&c | STEEL PLATE BEAM GUARD ENERGY ABSORBING TERMINAL |
| 15A3-1 | MARKER POST, FLEXIBLE, FOR CULVERT END |
| 15C4-1 | TRAFFIC CONTROL, ADVANCE WARNING SIGNS, 45 MPH OR GREATER |
| 15C8-9a | TWO-WAY UNDIVIDED ROAD OPEN TO TRAFFIC |
| 15C8-9b | PAVEMENT MARKING (MAINLINE) |
| 15C12-2 | PAVEMENT MARKING (INTERSECTIONS) |
| 15D28-1 | TRAFFIC CONTROL FOR LANE CLOSURE (SUITABLE FOR MOVING OPERATIONS) |
| | TRAFFIC CONTROL WORK ON SHOULDER OR PARKING LANE, UNDIVIDED ROADWAY |

GENERAL NOTES

ELEVATIONS SHOWN ON THIS PLAN ARE REFERENCED TO AN ASSUMED VERTICAL DATUM.

RESTORE SIDEROAD INTERSECTIONS AND PRIVATE ENTRANCES TO EXISTING SURFACE CONDITIONS UNLESS SHOWN OTHERWISE.

WHEN THE QUANTITY OF BASE AGGREGATE DENSE IS MEASURED BY THE TON, THE THICKNESS OF THE LAYER SHOWN ON THE PLAN IS APPROXIMATE, AND THE ACTUAL THICKNESS WILL DEPEND ON THE DISTRIBUTION OF THE MATERIAL AS DIRECTED BY THE ENGINEER.

TACK COAT HAS BEEN ESTIMATED AT AN APPLICATION RATE OF 0.025 GALLONS PER SQUARE YARD, AND SHALL BE PLACED BETWEEN LAYERS OF HMA PAVEMENT TYPE E-1 AND ON THE EXISTING ASPHALTIC SURFACE.

DISTURBED AREAS WITHIN THE RIGHT-OF-WAY, EXCEPT THE AREAS WITHIN THE FINISHED SHOULDER POINTS, SHALL BE FERTILIZED, SEEDED, AND MULCHED.

THE LOCATIONS OF EXISTING AND PROPOSED UTILITY INSTALLATIONS AS SHOWN ON THE PLANS ARE APPROXIMATE. THERE MAY BE OTHER UTILITY INSTALLATIONS WITHIN THE PROJECT AREA THAT ARE NOT SHOWN. THE CONTRACTOR SHALL COORDINATE CONSTRUCTION ACTIVITIES WITH A CALL TO DIGGER'S HOTLINE AND/OR A DIRECT CALL TO THE UTILITIES WHICH HAVE FACILITIES IN THE AREA. NOT ALL UTILITIES ARE MEMBERS OF DIGGER'S HOTLINE.

3-1/2" HMA PAVEMENT TYPE E-1, SHALL BE PLACED IN 2 LAYERS OF SURFACE MATERIAL (12.5mm NOMINAL) AT 1-3/4" EACH. IN SHOULDER PAVING ONLY AREAS, 3" HMA PAVEMENT TYPE E-1, SHALL BE PLACED IN ONE LAYER OF SURFACE MATERIAL.

IN BEAM GUARD AREAS, EXTEND PAVED SHOULDER OUT TO BEAM GUARD FACE.

DEPARTMENT OF NATURAL RESOURCES

NORTHERN REGION HEADQUARTERS
810 WEST MAPLE STREET
SPOONER, WI 54801
ATTN: BILL CLARK
(715) 635-4226

COUNTY SURVEYOR

BOB MICK
78215 STATE HWY B
WASHBURN, WI 54891
(715) 373-5022

DESIGN CONTACT

NWBE, INC.
10597N KANSAS AVENUE
HAYWARD, WI 54843
ATTN: HEATHER HARRINGTON
(715) 634-4334

UTILITIES

D:\Diggershotline.jpg

DIGGER'S HOTLINE
1-800-242-8511
TDD 1-800-542-2289
CALL 3 WORK DAYS
BEFORE YOU DIG


BAYFIELD ELECTRIC COOPERATIVE
P.O. BOX 68
IRON RIVER, WI 54847
ATTN: PHILIP BEEKSMA
(715) 372-4287

XCEL ENERGY - DISTRIBUTION
100 BARSTOW STREET
P.O. BOX 8
EAU CLAIRE, WI 54702-0008
ATTN: BILL TEETERS
(715) 836-1195

XCEL ENERGY - TRANSMISSION
100 BARSTOW STREET
P.O. BOX 8
EAU CLAIRE, WI 54702-0008
ATTN: PAM TAYLOR
(715) 839-1306


CHEQUAMEGON TELEPHONE CO-OP, INC.
BOX 67
CABLE, WI 54821
ATTN: JOE LABEREE
(715) 798-3303

CENTURYTEL OF NORTHWEST WISCONSIN
P.O. BOX 78
425 ELLINGSON AVENUE
HAWKINS, WI 54530
ATTN: PETE FILIPIAC
(715) 585-6388

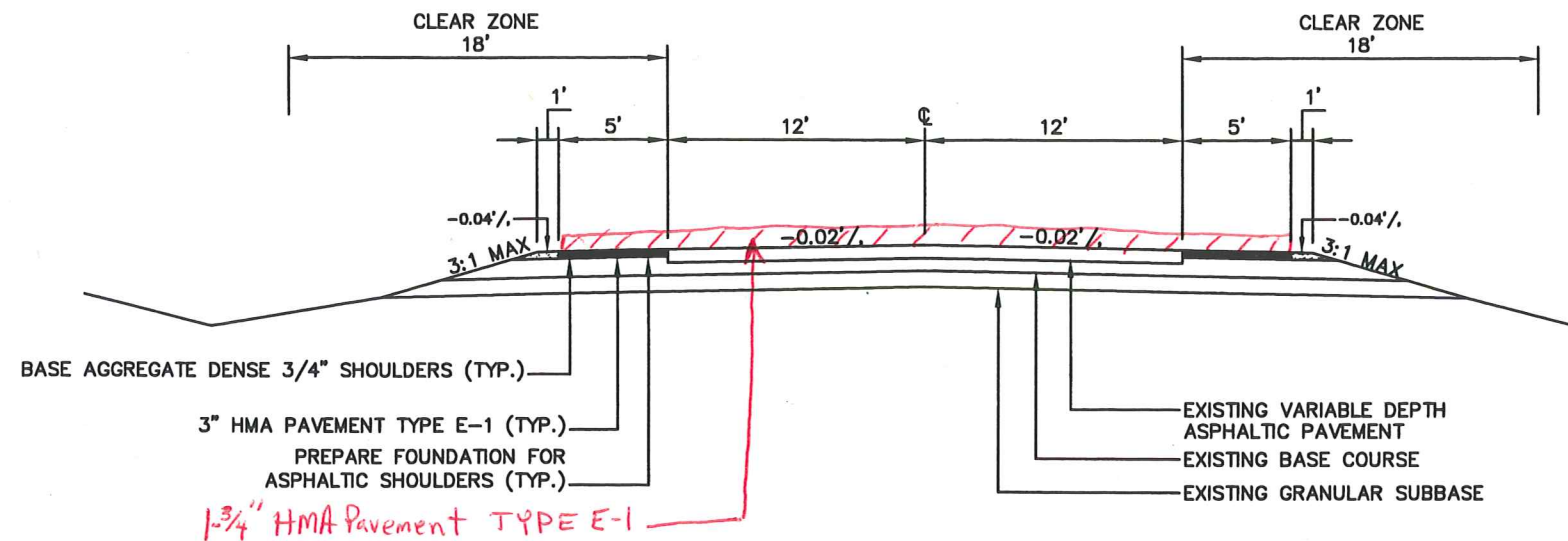


TYPICAL FINISHED SECTION


STA 1030+10 - STA 1139+76.5

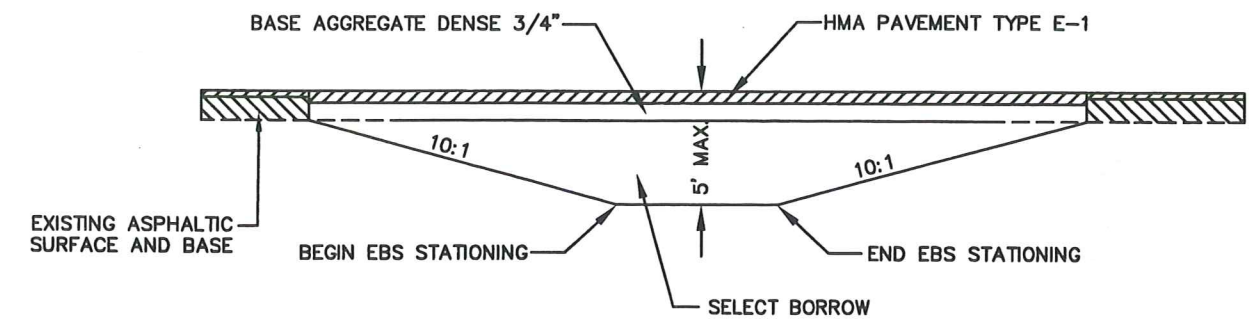

TRANSITIONS AT EBS LIMITS

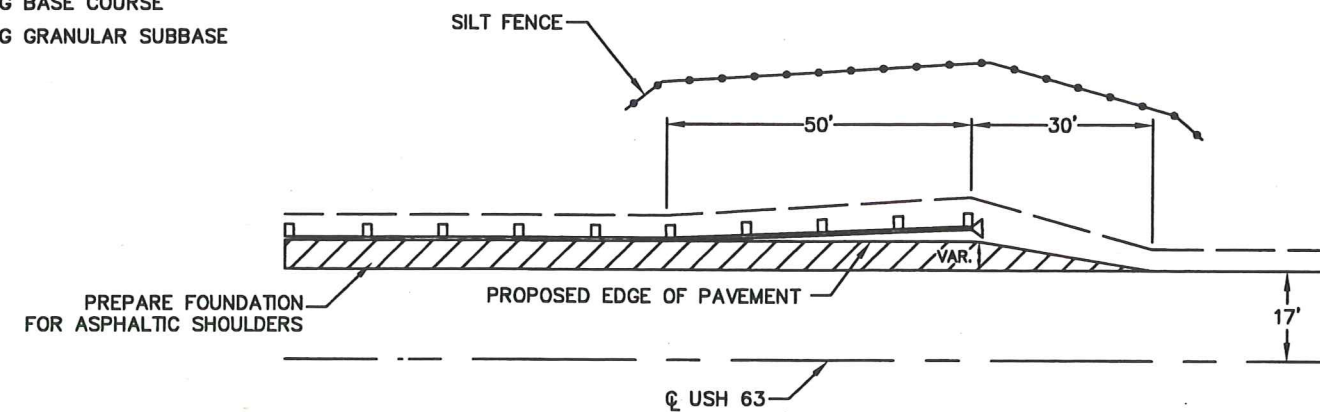


BEAM GUARD TERMINAL DETAIL

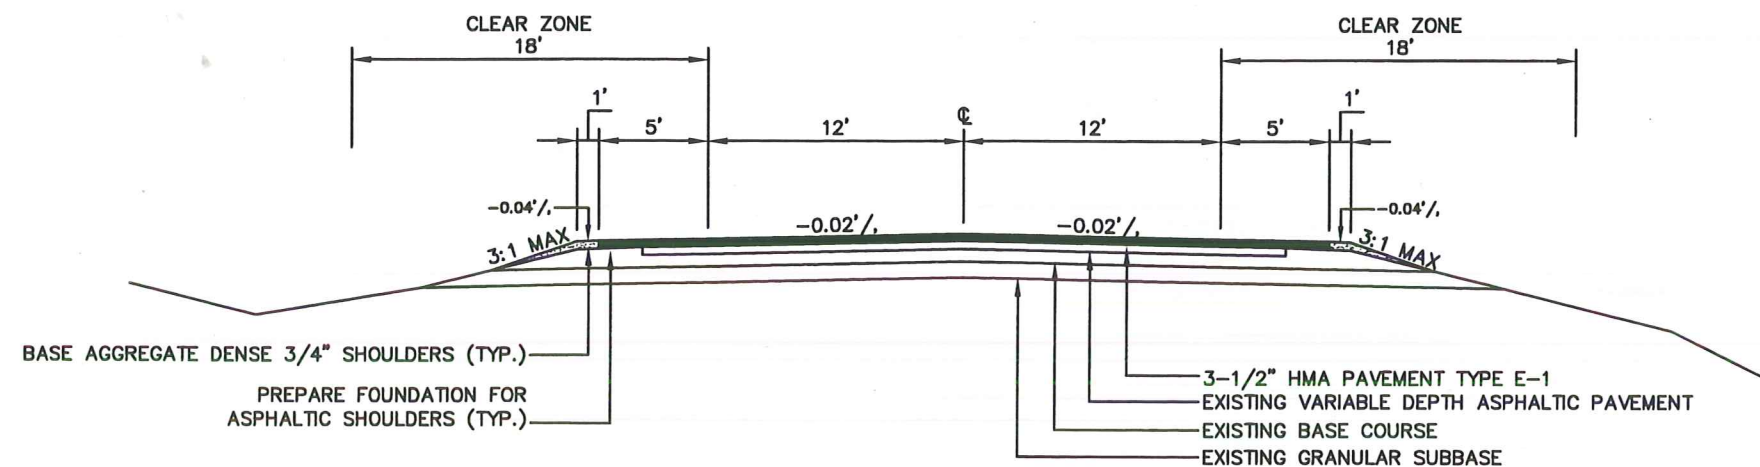


TYPICAL FINISHED SECTION

STA 1140+23.38 - STA 1231+68.67
STA 1232+58.33 - STA 1494+75

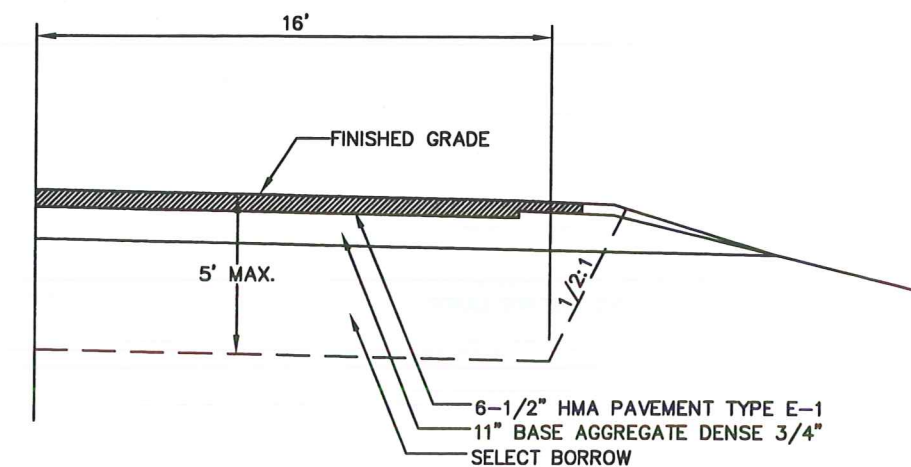

TYPICAL EBS HALF SECTION

STA 1216+60 - 1219+55
STA 1235+50 - 1239+00
STA 1225+23 - 1226+73

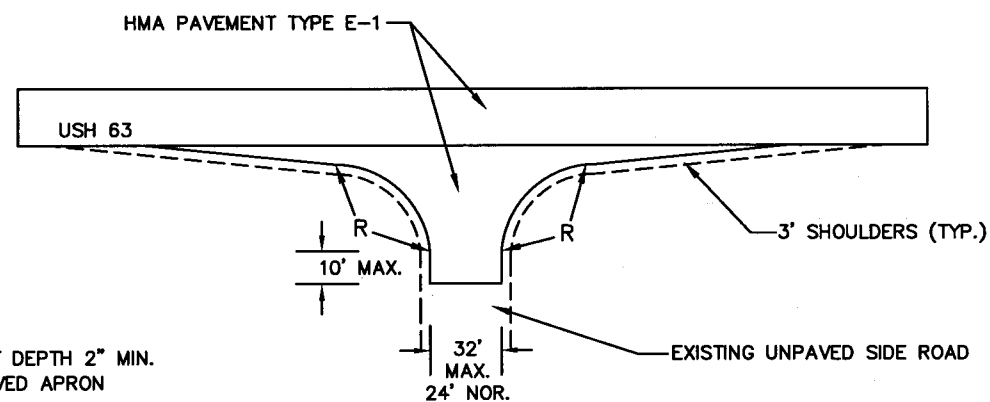


NOTE

SIDEROAD PAVEMENT DEPTH 2" MIN.
MATCH EXISTING PAVED APRON

PAVING DETAIL

SIDEROADS WITH EXISTING UNPAVED SURFACE

| | |
|---------------------|--------------------|
| BIBON RD (RT) | SUNDIN RD (RT) |
| WILSON RD (LT & RT) | A JOHNSON RD (RT) |
| BROWN RD (RT) | SQUIRES RD (RT) |
| MAPLE RIDGE RD (RT) | RANCH PARK RD (RT) |
| HOLMS RD (RT) | |

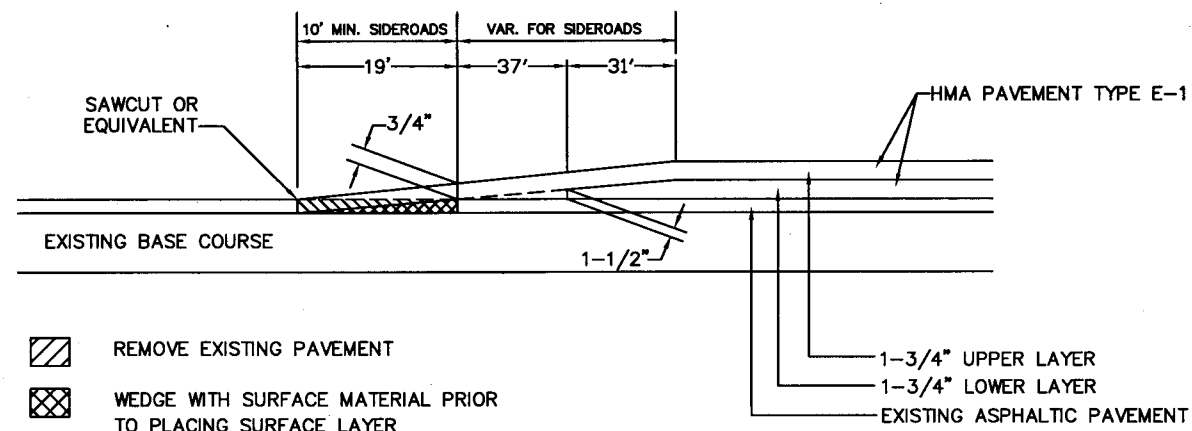


- REMOVE EXISTING PAVEMENT
- WEDGE WITH SURFACE MATERIAL PRIOR TO PLACING SURFACE LAYER


1-3/4" UPPER LAYER
1-3/4" LOWER LAYER
EXISTING ASPHALTIC PAVEMENT

DETAIL OF BUTT JOINT

| | |
|----------------|-----------------|
| STA 1140+23.38 | STA 1494+75 |
| STA 1231+68.67 | CTH E (LT & RT) |
| STA 1232+58.33 | |

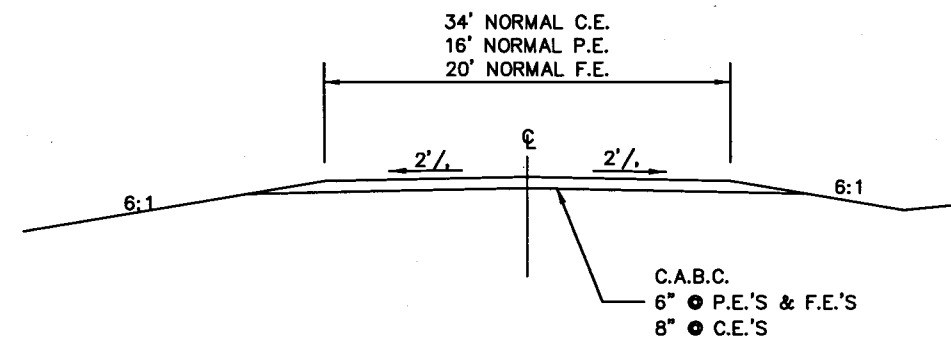

TYPICAL SECTION FOR BASE
AGGREGATE ENTRANCES

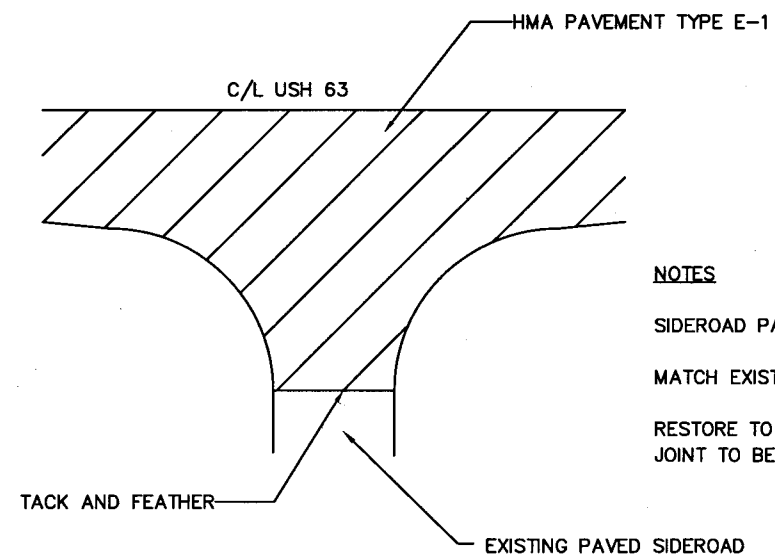

NOTES

SIDEROAD PAVEMENT DEPTH 2" MIN.
MATCH EXISTING PAVED SURFACE RADII AND TAPERS
RESTORE TO RADIUS POINT (EXACT LOCATION OF FEATHER JOINT TO BE DETERMINED BY THE ENGINEER IN THE FIELD)

PAVING DETAIL
SIDEROADS WITH EXISTING PAVED SURFACE
LUND RD (LT)

SYMBOLS


WORK AREA

FLAGGER, EQUIPPED WITH STOP/SLOW PADDLE FASTENED ON SUPPORT STAFF

SIGN ON PORTABLE OR PERMANENT SUPPORT

TRAFFIC CONTROL DRUM

TYPE III BARRICADE

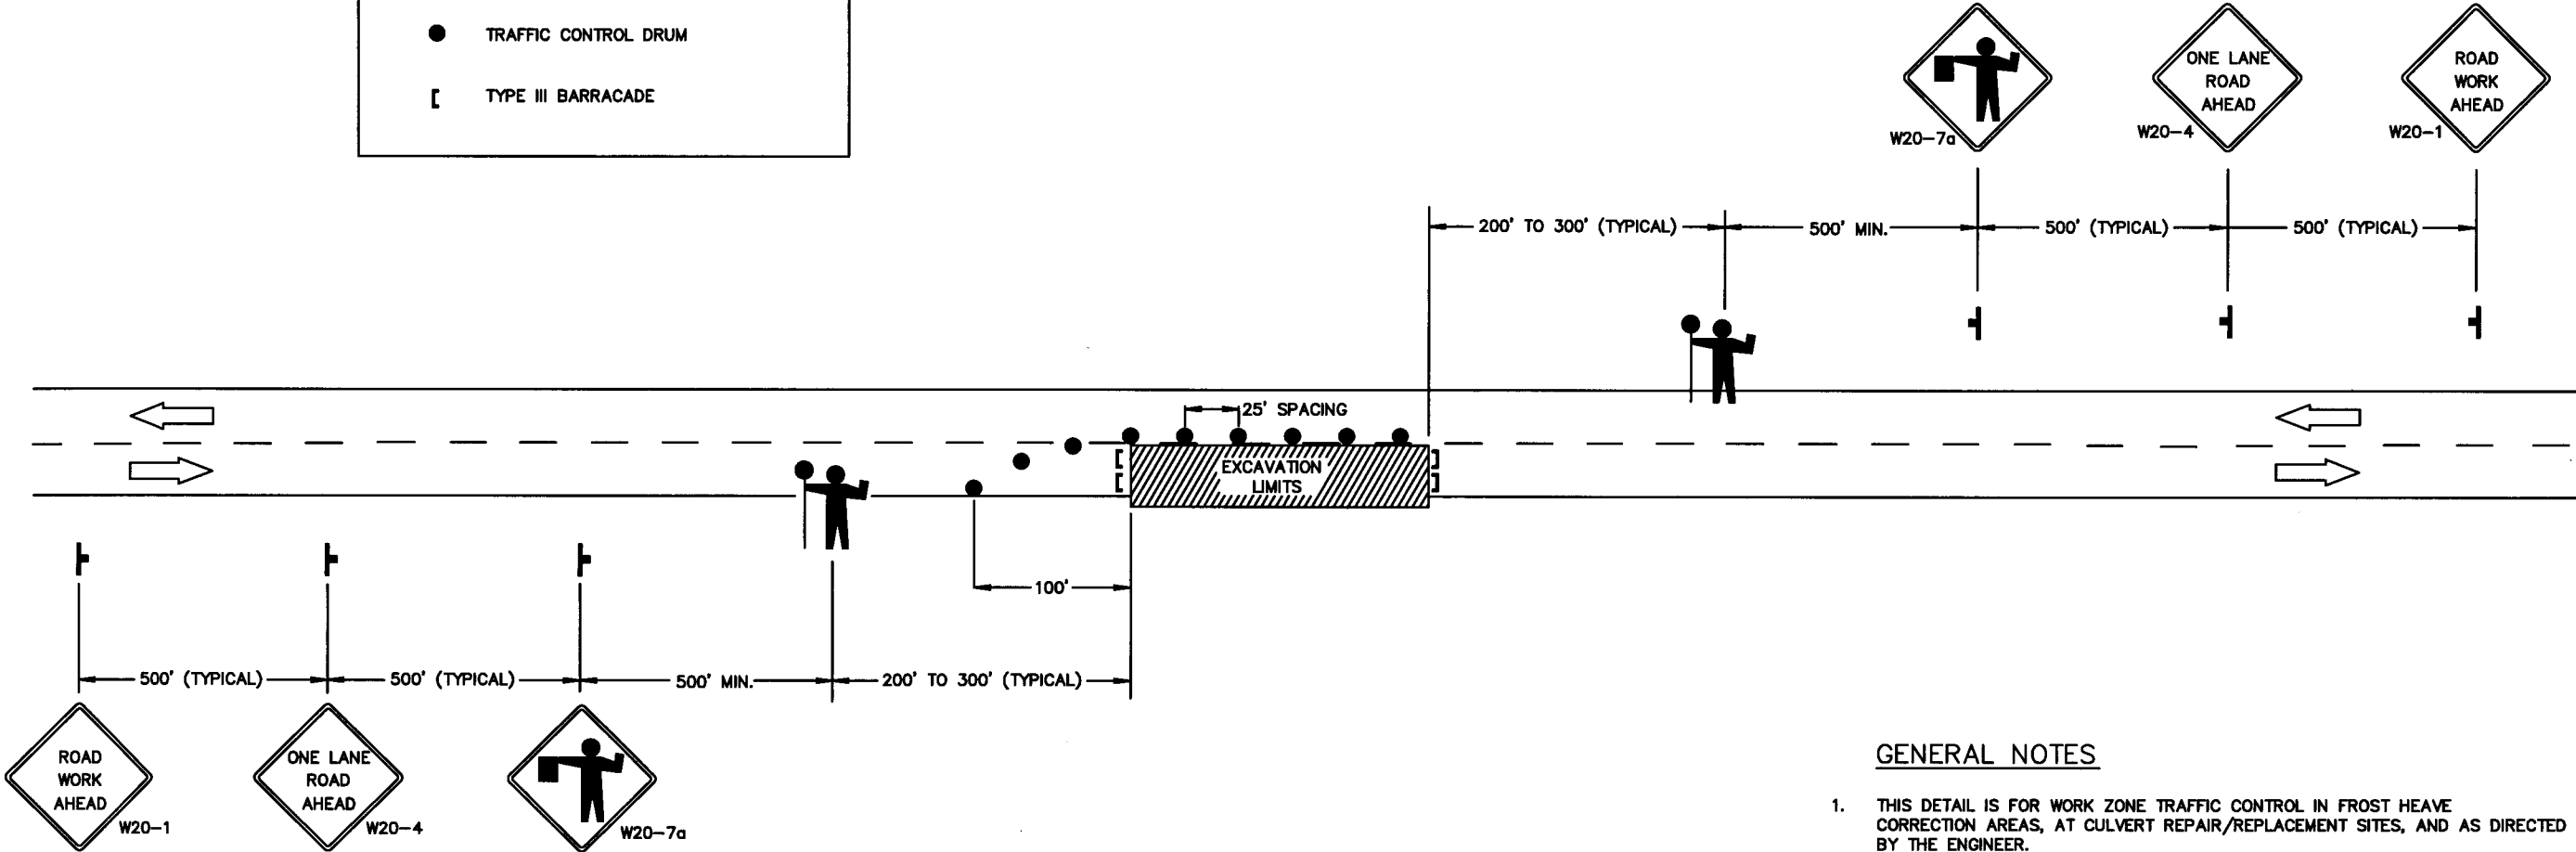

GENERAL NOTES

- THIS DETAIL IS FOR WORK ZONE TRAFFIC CONTROL IN FROST HEAVE CORRECTION AREAS, AT CULVERT REPAIR/REPLACEMENT SITES, AND AS DIRECTED BY THE ENGINEER.
- DETAILS OF TRAFFIC CONTROL DEVICES AND INSTALLATIONS NOT SHOWN ON THIS DRAWING SHALL CONFORM TO THE PERTINENT REQUIREMENTS OF THE STANDARD SPECIFICATIONS, THE SPECIAL PROVISIONS, AND THE MANUAL ON UNIFORM TRAFFIC CONTROL DEVICES.
- THE EXACT NUMBER, LOCATION AND SPACING OF ALL SIGNS AND DEVICES (AND THE LOCATION OF ALL FLAGGERS) SHALL BE ADJUSTED TO FIT FIELD CONDITIONS AS DIRECTED BY THE ENGINEER.
- FLAGGERS SHALL BE IN SIGHT OF EACH OTHER OR IN DIRECT COMMUNICATION AT ALL TIMES. THEY SHALL BE EQUIPPED WITH STOP/SLOW PADDLES FASTENED ON SUPPORT STAFFS. WHEN THE FLAGGING OPERATION IS NOT IN EFFECT, THE "FLAGGER AHEAD", THE "ROAD WORK AHEAD" AND THE ONE LANE ROAD AHEAD" SIGNS SHALL BE COVERED OR REMOVED AND THE HIGHWAY RESTORED TO NORMAL OPERATION.
- ALL SIGNS ARE 48" X 48" UNLESS OTHERWISE NOTED.
- SEE S.D.D. FOR MOVING OPERATION WORK ZONE TRAFFIC CONTROL.



DATE 01AUG05

E S T I M A T E O F Q U A N T I T I E S

| LINE | | | | | 1560-20-71 |
|--------|------------|--|------|------------|------------|
| NUMBER | ITEM | ITEM DESCRIPTION | UNIT | TOTAL | QUANTITY |
| 0010 | 204.0115 | REMOVING ASPHALTIC SURFACE BUTT JOINTS | SY | 318.000 | 318.000 |
| 0020 | 204.0150 | REMOVING CURB & GUTTER | LF | 90.000 | 90.000 |
| 0030 | 204.0165 | REMOVING GUARDRAIL | LF | 632.000 | 632.000 |
| 0040 | 205.0100 | EXCAVATION COMMON | CY | 4,350.000 | 4,350.000 |
| 0050 | 205.9005.S | GRADING SHAPING & FINISHING FOR BEAM GUARD TERMINALS & ANCHORAGES | EACH | 8.000 | 8.000 |
| 0060 | 208.1100 | SELECT BORROW | CY | 3,629.000 | 3,629.000 |
| 0070 | 211.0100 | PREPARE FOUNDATION FOR ASPHALTIC PAVING (PROJECT) 01. 1560-20-71 | LS | 1.000 | 1.000 |
| 0080 | 211.0400 | PREPARE FOUNDATION FOR ASPHALTIC SHOULDERS | STA | 930.000 | 930.000 |
| 0090 | 213.0100 | FINISHING ROADWAY (PROJECT) 01. 1560-20-71 | EACH | 1.000 | 1.000 |
| 0100 | 301.0100.S | QMP BASE AGGREGATE | TON | 10,513.000 | 10,513.000 |
| 0110 | 305.0110 | BASE AGGREGATE DENSE 3/4-INCH | TON | 10,513.000 | 10,513.000 |
| 0120 | 455.0105 | ASPHALTIC MATERIAL PG58-28 | TON | 1,720.000 | 1,720.000 |
| 0130 | 455.0605 | TACK COAT | GAL | 6,355.000 | 6,355.000 |
| 0140 | 460.1101 | HMA PAVEMENT TYPE E-1 | TON | 28,661.000 | 28,661.000 |
| 0150 | 460.2000 | INCENTIVE DENSITY HMA PAVEMENT | DOL | 18,470.000 | 18,470.000 |
| 0160 | 460.2500.S | QMP HMA PAVEMENT NUCLEAR DENSITY | TON | 28,661.000 | 28,661.000 |
| 0170 | 460.3000 | QMP HMA MIXTURE | TON | 28,661.000 | 28,661.000 |
| 0180 | 465.0120 | ASPHALTIC SURFACE DRIVEWAYS AND FIELD ENTRANCES | TON | 6.000 | 6.000 |
| 0190 | 520.7000 | CLEANING CULVERT PIPES | EACH | 9.000 | 9.000 |
| 0200 | 601.0558 | CONCRETE CURB & GUTTER 6-INCH MOUNTABLE 36-INCH TYPE D | LF | 90.000 | 90.000 |
| 0210 | 614.0200 | STEEL THRIE BEAM STRUCTURE APPROACH | LF | 264.000 | 264.000 |
| 0220 | 614.0305 | STEEL PLATE BEAM GUARD CLASS A | LF | 150.000 | 150.000 |
| 0230 | 614.0370 | STEEL PLATE BEAM GUARD ENERGY ABSORBING TERMINAL | EACH | 8.000 | 8.000 |
| 0240 | 614.0620.S | MARKER POSTS CULVERT END FLEXIBLE | EACH | 30.000 | 30.000 |
| 0250 | 618.0100 | MAINTENANCE AND REPAIR OF HAUL ROADS (PROJECT) 01. 1560-20-71 | EACH | 1.000 | 1.000 |
| 0260 | 619.1000 | MOBILIZATION | EACH | 1.000 | 1.000 |
| 0270 | 628.1105 | EROSION BALES DELIVERED | EACH | 20.000 | 20.000 |
| 0280 | 628.1110 | EROSION BALES INSTALLED | EACH | 20.000 | 20.000 |
| 0290 | 628.1505 | SILT FENCE DELIVERED | LF | 800.000 | 800.000 |
| 0300 | 628.1510 | SILT FENCE INSTALLED | LF | 800.000 | 800.000 |
| 0310 | 628.1520 | SILT FENCE MAINTENANCE | LF | 800.000 | 800.000 |
| 0320 | 628.1905 | MOBILIZATIONS EROSION CONTROL | EACH | 1.000 | 1.000 |
| 0330 | 628.1910 | MOBILIZATIONS EMERGENCY EROSION CONTROL | EACH | 1.000 | 1.000 |
| 0340 | 628.2010 | EROSION MAT DELIVERED CLASS I TYPE B | SY | 328.000 | 328.000 |
| 0350 | 628.3010 | EROSION MAT INSTALLED CLASS I TYPE B | SY | 328.000 | 328.000 |
| 0360 | 642.5000 | FIELD OFFICE TYPE B (PROJECT) 01. 1560-20-71 | EACH | 1.000 | 1.000 |
| 0370 | 643.0100 | TRAFFIC CONTROL (PROJECT) 01. 1560-20-71 | EACH | 1.000 | 1.000 |
| 0380 | 646.0106 | PAVEMENT MARKING EPOXY 4-INCH | LF | 92,930.000 | 92,930.000 |
| 0390 | 646.0406 | PAVEMENT MARKING SAME DAY EPOXY 4-INCH | LF | 33,673.000 | 33,673.000 |
| 0400 | 648.0100 | LOCATING NO-PASSING ZONES | MI | 6.700 | 6.700 |
| 0410 | 649.0100 | TEMPORARY PAVEMENT MARKING 4-INCH | LF | 25,568.000 | 25,568.000 |
| 0420 | 690.0100 | SAWING EXISTING PAVEMENT | LF | 105.000 | 105.000 |
| 0430 | ASP.1TOA | ON-THE-JOB TRAINING APPRENTICE AT \$5. 00/HR | HRS | 150.000 | 150.000 |
| 0440 | ASP.1TOG | ON-THE-JOB TRAINING GRADUATE AT \$5.00/HR | HRS | 400.000 | 400.000 |
| 0450 | SPV.0060 | SPECIAL 01. RESETTING CULVERT ENDS | EACH | 2.000 | 2.000 |

| | | | | | | | | | | | | | | | | |
|--|--|---|---|--|---|---|--|--|---|--|---|---|--|--|---|----------------------|
| ASPHALT ITEMS | | | | | | EXCAVATION COMMON | | | EROSION BALES | | | | | | | |
| | | HMA PAVEMENT TYPE E-1 | ASPHALTIC MATERIAL PG58-28 | ASPHALTIC SURFACE DRIVEWAYS AND F.E. | TACK COAT GAL. | <u>STATION - STATION</u> 1216+20 - 1219+95 1235+10 - 1239+40 | | <u>LOCATION</u> MAINLINE EBS MAINLINE EBS | <u>C.Y.</u> 2010 2340 | <u>LOCATION</u> UNDISTRIBUTED | | DELIVERED <u>EACH</u> 20 | INSTALLED <u>EACH</u> 20 | | | |
| <u>STATION - STATION</u> 1140+23 - 1231+69 1232+58 - 1494+75 1030+10 - 1139+77 1140+23 - 1231+69 1232+58 - 1494+75 1216+20 - 1219+95 1235+10 - 1239+40 1138+56 - 1141+44 1230+48 - 1233+79 1170+58 1259+62 1277+03 1172+08 1175+33 1224+68 1226+40 1259+62 1282+28 1347+28 1370+78 1411+28 1436+18 1440+43 1491+45 - 1494+75 | | <u>TON</u> 4695 13458 2011 1955 5608 234 268 18 26 74 74 22 14 37 31 23 23 11 11 11 16 7 --- 34 | <u>TON</u> 282 808 121 117 336 14 16 1 2 4 4 1 1 2 2 1 1 1 1 1 1 1 2 | <u>TON</u> --- 6 --- | <u>GAL.</u> 1219 3496 --- 407 1165 --- --- 2 3 12 12 3 2 5 4 3 3 2 2 1 2 1 9 | TOTAL: | | | 4350 | SILT FENCE | | | | | | |
| | | | | | | SELECT BORROW | | | | | | | | | | |
| <u>STATION - STATION</u> 1216+20 - 1219+95 1235+10 - 1239+40 | | <u>LOCATION</u> MAINLINE EBS MAINLINE EBS | | <u>C.Y.</u> 1669 1960 | | <u>STATION - STATION</u> 1216+20 - 1219+95 1235+10 - 1239+40 | | <u>LOCATION</u> MAINLINE EBS MAINLINE EBS | <u>C.Y.</u> 1669 1960 | <u>STATION - STATION</u> 1138+17 - 1139+17 1138+54 - 1139+54 1140+46 - 1141+46 1140+84 - 1141+84 1230+09 - 1231+09 1230+46 - 1231+46 1232+81 - 1233+81 1233+19 - 1234+19 | | <u>LOCATION</u> RT LT RT LT RT LT RT LT | DELIVERED <u>L.F.</u> 100 100 100 100 100 100 100 100 | INSTALLED <u>L.F.</u> 100 100 100 100 100 100 100 100 | MAINTEN. <u>L.F.</u> 100 100 100 100 100 100 100 100 | |
| TOTAL: | | | | | | TOTAL: | | 3629 | | TOTAL: | | 800 | 800 | 800 | | |
| | | | | | | STEEL THRIE BEAM STRUCTURE APPROACH | | | EROSION MAT CLASS I TYPE B | | | | | | | |
| <u>STATION - STATION</u> 1139+44 - 1139+77 1139+44 - 1139+77 1140+23 - 1140+56 1140+23 - 1140+56 1231+36 - 1231+69 1231+36 - 1231+69 1232+58 - 1232+91 1232+58 - 1232+91 | | <u>LOCATION</u> LT RT LT RT LT RT LT RT | | <u>L.F.</u> 33 33 33 33 33 33 33 33 | | <u>STATION - STATION</u> 1139+44 - 1139+77 1139+44 - 1139+77 1140+23 - 1140+56 1140+23 - 1140+56 1231+36 - 1231+69 1231+36 - 1231+69 1232+58 - 1232+91 1232+58 - 1232+91 | | <u>LOCATION</u> LT RT LT RT LT RT LT RT | <u>L.F.</u> 33 33 33 33 33 33 33 33 | <u>STATION - STATION</u> 1137+57 - 1139+07 1138+94 - 1139+44 1140+56 - 1141+06 1140+94 - 1141+44 1230+49 - 1230+99 1230+86 - 1231+36 1232+91 - 1233+41 1233+29 - 1233+79 | | <u>LOCATION</u> RT LT RT LT RT LT RT LT | DELIVERED <u>S.Y.</u> 41 41 41 41 41 41 41 41 | INSTALLED <u>S.Y.</u> 41 41 41 41 41 41 41 41 | | |
| TOTAL: | | | | | | TOTAL: | | 264 | | TOTAL: | | 328 | 328 | | | |
| REMOVING ASPHALTIC SURFACE BUTT JOINTS | | | | | | REMOVING GUARDRAIL | | | PAVEMENT MARKING EPOXY 4-INCH | | | | | | | |
| <u>STATION - STATION</u> 1140+23 - 1140+42 1231+50 - 1231+69 1232+58 - 1232+77 1494+56 - 1494+75 CTH E CTH E | | <u>LOCATION</u> MAINLINE MAINLINE MAINLINE MAINLINE RT LT | <u>S.Y.</u> 63 63 63 63 33 33 | <u>STATION - STATION</u> 1138+98 - 1139+77 1140+23 - 1141+02 1230+90 - 1231+69 1232+58 - 1233+37 | | <u>LOCATION</u> LT & RT LT & RT LT & RT LT & RT | <u>L.F.</u> 158 158 158 158 | <u>STATION - STATION</u> 1139+06.5 - 1139+44 1140+56 - 1140+93.5 1230+98.5 - 1231+36 1232+91 - 1233+28.5 | | <u>LOCATION</u> RT LT RT LT | <u>L.F.</u> 37.5 37.5 37.5 37.5 | <u>STATION - STATION</u> 1030+10 - 1494+75 | | <u>TYPE</u> WHITE EDGELINE | <u>L.F.</u> 92930 | |
| TOTAL: | | 318 | TOTAL: | | 632 | TOTAL: | | 150 | PAVEMENT MARKING SAME DAY EPOXY 4-INCH | | | | | | | |
| | | | | | | | | | | <u>STATION - STATION</u> 1030+10 - 1494+75 | | | | | <u>TYPE</u> YELLOW CL | <u>L.F.</u> 33673 |
| PREPARE FOUNDATION FOR ASPHALTIC SHOULDERS | | | | BASE AGGREGATE DENSE 3/4-INCH | | STEEL PLATE BEAM GUARD ENERGY ABSORBING TERMINAL | | | | TEMPORARY PAVEMENT MARKING 4-INCH | | | | | | |
| <u>STATION - STATION</u> 1030+10 - 1139+77 1030+10 - 1139+77 1140+23 - 1231+69 1140+23 - 1231+69 1232+58 - 1494+75 1232+58 - 1494+75 | | <u>LOCATION</u> LT RT LT RT LT RT | <u>STA.</u> 110 110 92 92 263 263 | <u>STATION - STATION</u> 1216+20 - 1219+95 1235+10 - 1239+40 1030+10 - 1139+77 1030+10 - 1139+77 1140+23 - 1231+69 1140+23 - 1231+69 1140+23 - 1231+69 1232+58 - 1494+75 1232+58 - 1494+75 SIDEROADS, UNPAVED P.E.'s, UNPAVED BEAM GUARD TERMINALS | | <u>LOCATION</u> MAINLINE EBS MAINLINE EBS SHOULDER, LT SHOULDER, RT SHOULDER, LT SHOULDER, RT SHOULDER, RT SHOULDER, LT SHOULDER, RT SHOULDER, RT SHOULDER, RT SHOULDER, RT SHOULDER, RT | <u>TON</u> 915 1048 962 962 802 802 802 2302 2302 45 225 148 | <u>STATION</u> 1138+56.5 1138+94 1141+06 1141+43.5 1230+48.5 1230+86 1233+41 1233+78.5 | | <u>LOCATION</u> RT LT RT LT RT LT RT LT | <u>EACH</u> 1 1 1 1 1 1 1 1 | <u>STATION - STATION</u> 1030+10 - 1494+75 | | <u>TYPE</u> YELLOW CL | <u>L.F.</u> 25568 | |
| TOTAL: | | 930 | TOTAL: | | 10513 | TOTAL: | | 8 | LOCATING NO-PASSING ZONES | | | | | | | |
| | | | | | | | | | | <u>STATION - STATION</u> 1030+10 - 1494+75 | | | | | <u>LOCATION</u> MAINLINE | <u>MILES</u> 6.7 |
| STATE PROJECT NUMBER: 1560-20-71 | | | | HWY: USH 63 | | COUNTY: BAYFIELD | | | MISCELLANEOUS QUANTITIES | | | | SHEET NO: 7 | | E | |

| | | | | | | | | | | | |
|--|-----------------|-------------|--------------------------|-----------------|-------------|--|-----------------|-------------|-----------------------------------|-----------------|-------------|
| CONCRETE CURB & GUTTER 6-INCH MOUNTABLE 36-INCH TYPE D | | | CLEANING CULVERT PIPES | | | RESETTING CULVERT ENDS | | | MARKER POSTS CULVERT END FLEXIBLE | | |
| <u>STATION - STATION</u> | <u>LOCATION</u> | <u>L.F.</u> | <u>STATION</u> | <u>LOCATION</u> | <u>EACH</u> | <u>STATION</u> | <u>LOCATION</u> | <u>EACH</u> | <u>STATION</u> | <u>LOCATION</u> | <u>EACH</u> |
| 1258+84 - 1259+34 | CTH E, LT | 90 | 1095+03 | MAINLINE | 1 | 1326+95 | LT | 1 | 1034+00 | LT & RT | 2 |
| REMOVING CURB AND GUTTER | | | 1113+95 | MAINLINE | 1 | 1326+95 | RT | 1 | 1095+03 | LT & RT | 2 |
| | | | 1114+00 | MAINLINE | 1 | TOTAL: 2 | | | 1113+95 | RT | 1 |
| | | | 1114+05 | MAINLINE | 1 | JOINT TIES REQUIRED: 2 AT EACH SECTION JOINT AND 2 AT EACH ENDWALL. JOINT TIES ARE CONSIDERED INCIDENTAL TO THE PAY ITEM. | | | 1114+15 | LT | 1 |
| | | | 1114+10 | MAINLINE | 1 | | | | 1206+35 | LT & RT | 2 |
| | | | 1114+15 | MAINLINE | 1 | | | | 1218+30 | LT & RT | 2 |
| | | | 1218+30 | MAINLINE | 1 | | | | 1251+48 | LT & RT | 2 |
| | | | 1251+48 | MAINLINE | 1 | | | | 1326+95 | LT & RT | 2 |
| | | | 1477+65 | MAINLINE | 1 | 1344+24 | LT & RT | 2 | 1361+60 | LT & RT | 2 |
| | | | TOTAL: 9 | | | 1375+60 | LT & RT | 2 | 1383+46 | LT & RT | 2 |
| | | | | | | 1433+55 | LT & RT | 2 | 1444+00 | LT & RT | 2 |
| | | | | | 1459+50 | LT & RT | 2 | 1477+65 | LT & RT | 2 | |
| | | | | | | | | TOTAL: 30 | | | |
| GRADING SHAPING AND FINISHING FOR BEAM GUARD TERMINALS AND ANCHORAGES | | | SAWING EXISTING PAVEMENT | | | SALVAGED TOPSOIL, FERTILIZER, SEEDING, MULCHING, EXCAVATION COMMON AND FILL FOR BEAM GUARD TERMINALS (FOR INFORMATION ONLY) | | | | | |
| <u>STATION - STATION</u> | <u>LOCATION</u> | <u>EACH</u> | <u>STATION</u> | <u>LOCATION</u> | <u>L.F.</u> | | | | | | |
| 1138+26.5 - 1139+06.5 | RT | 1 | 1170+58 | CTH E, RT | 30 | | | | | | |
| 1138+64 - 1139+44 | LT | 1 | 1259+62 | CTH E, LT | 30 | | | | | | |
| 1140+56 - 1141+36 | RT | 1 | 1494+75 | MAINLINE | 45 | | | | | | |
| 1140+93.5 - 1141+73.5 | LT | 1 | TOTAL: 105 | | | | | | | | |
| 1230+18.5 - 1230+98.5 | RT | 1 | | | | | | | | | |
| 1230+56 - 1231+36 | LT | 1 | | | | | | | | | |
| 1232+91 - 1233+71 | RT | 1 | | | | | | | | | |
| 1233+28.5 - 1234+08.5 | LT | 1 | | | | | | | | | |
| TOTAL: 8 | | | | | | | | | | | |
| | | | | | | | | | | | |
| | | | | | | | | | | | |
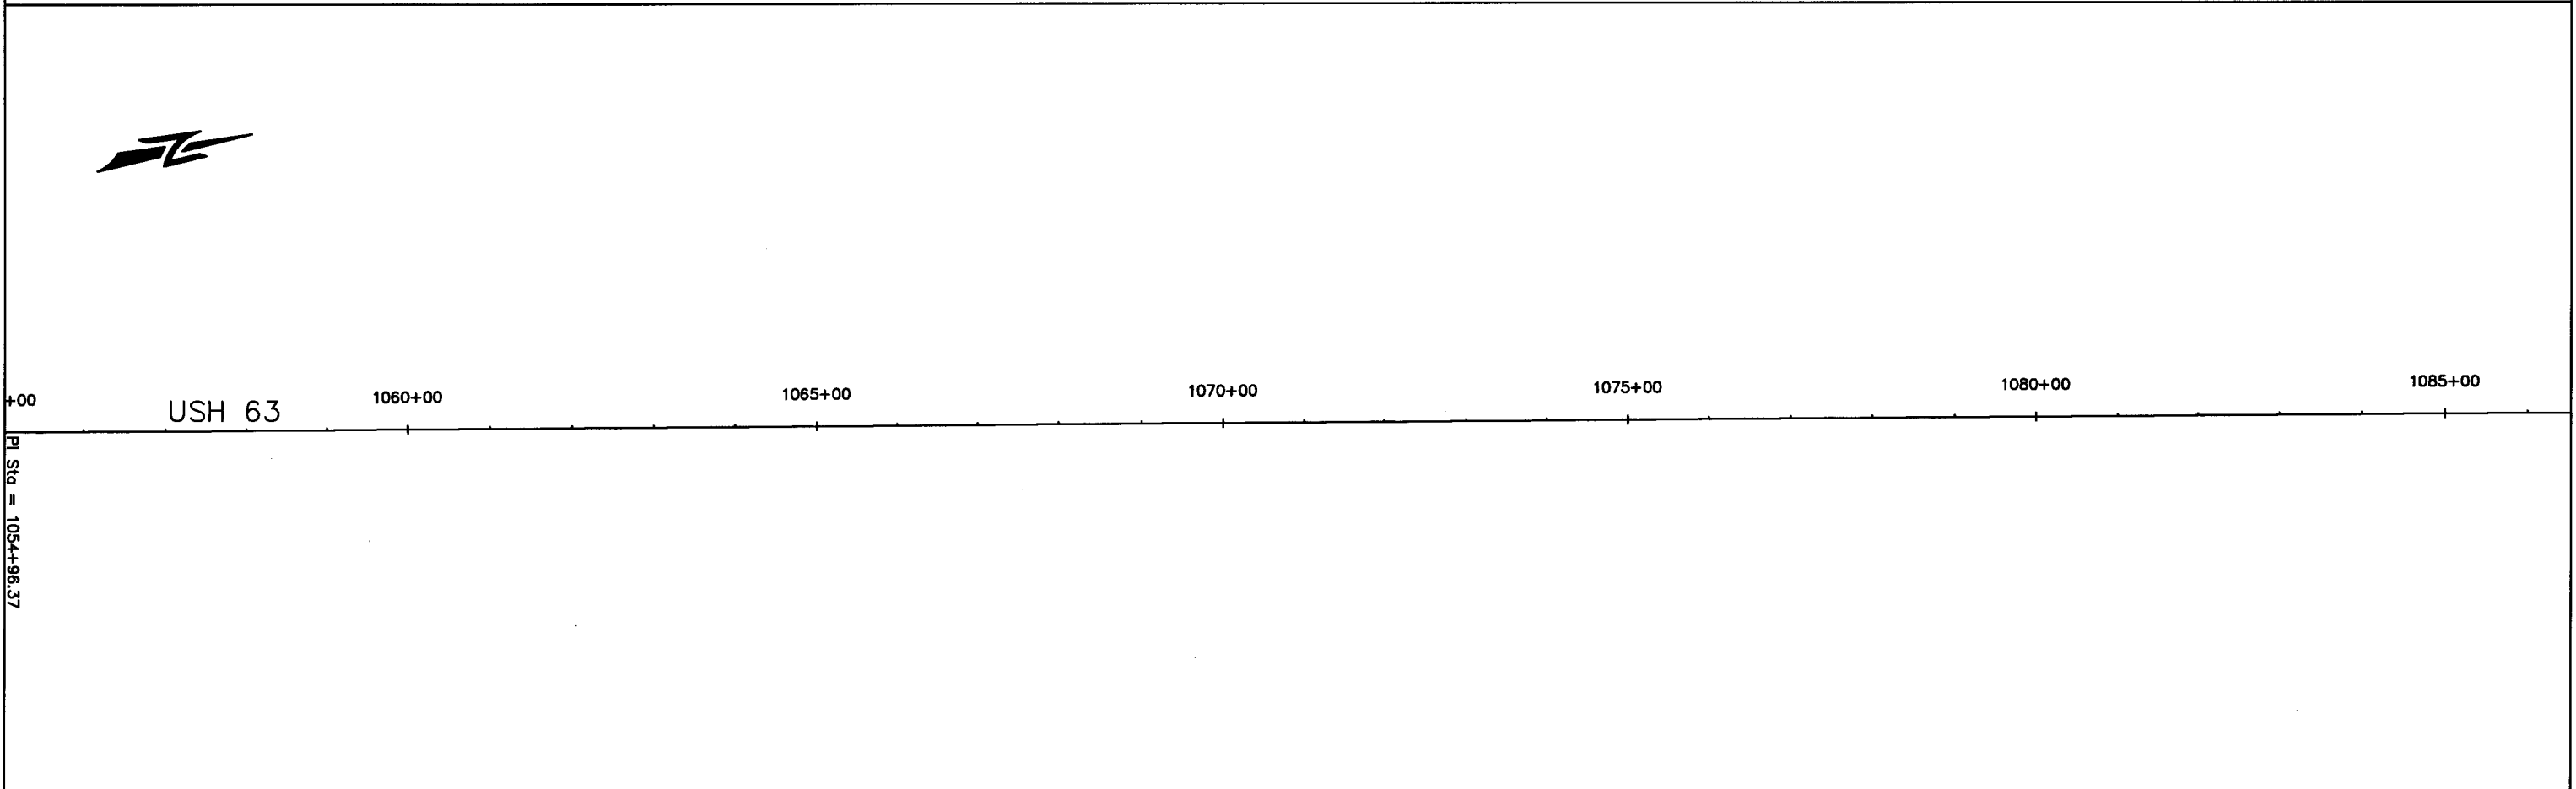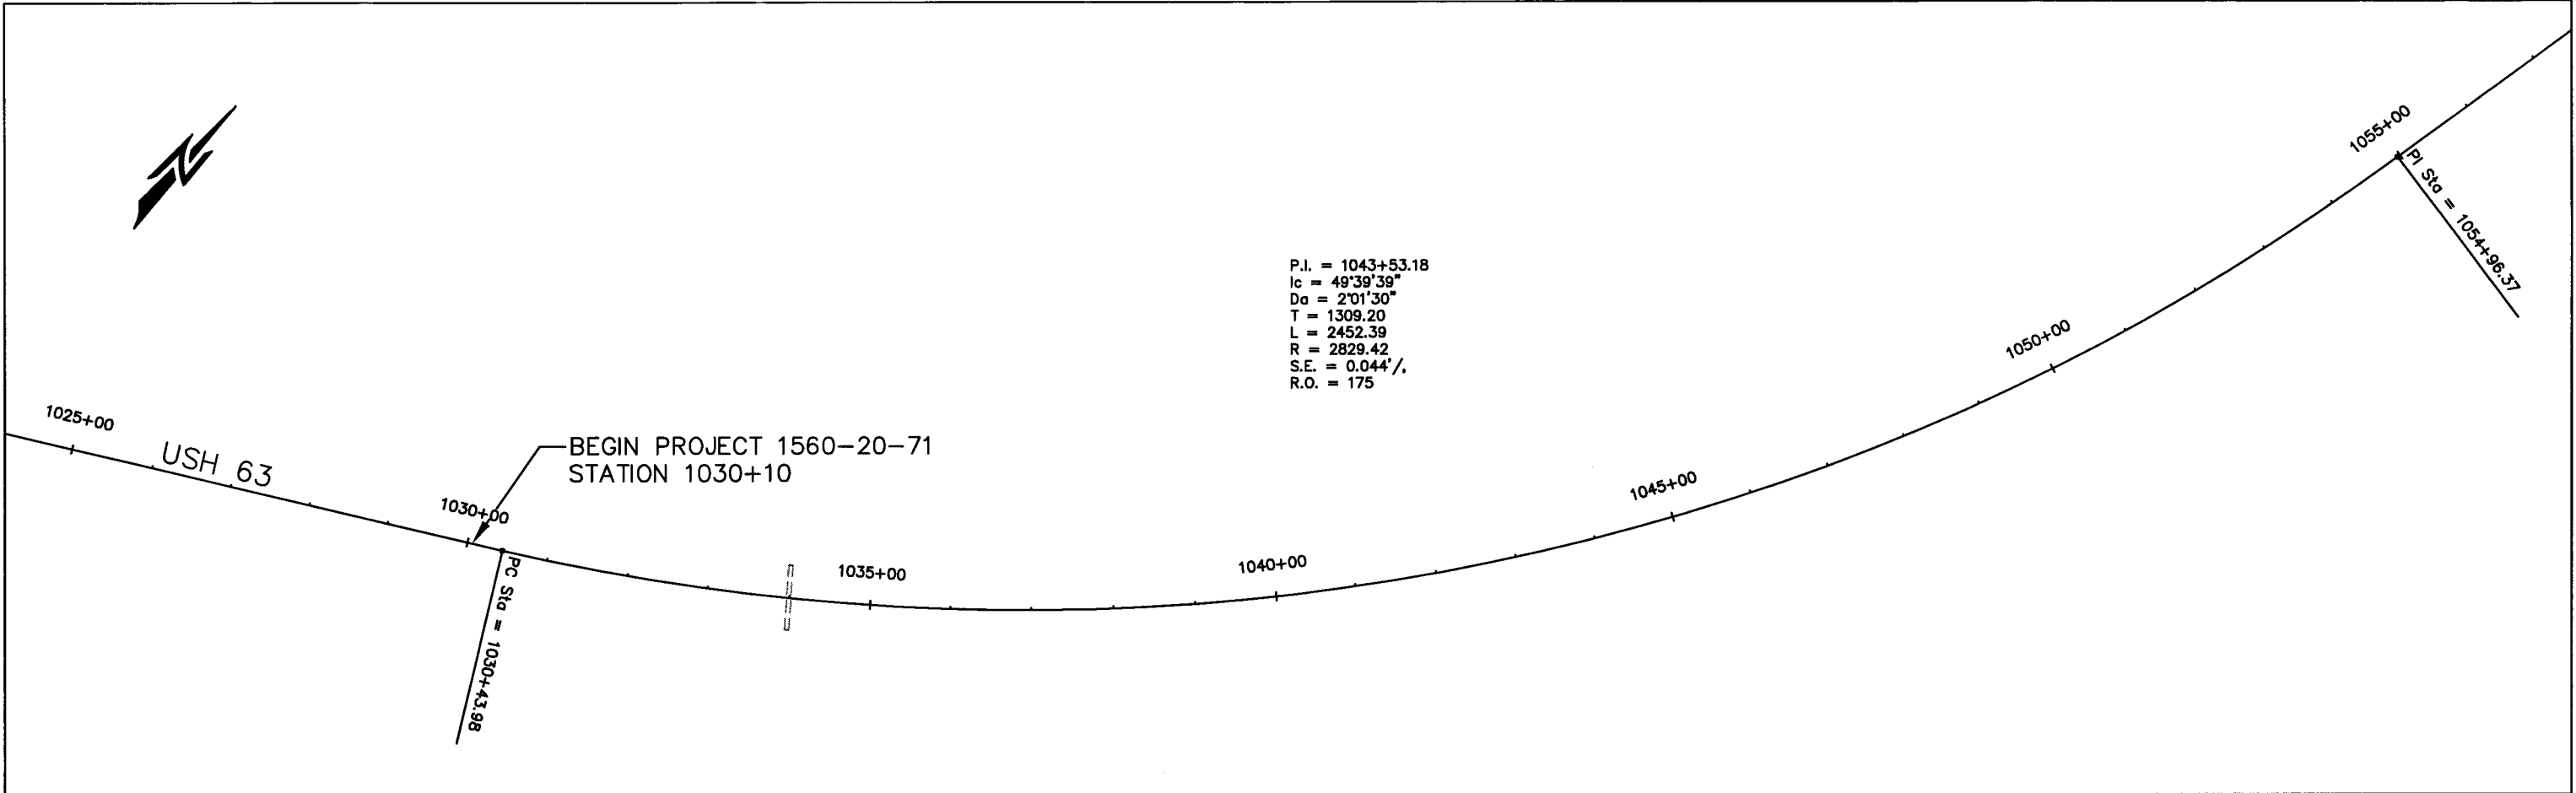



STA 1095+03
CLEAN CULVERT PIPE

Lined existing 24" x 66' CP


STA 1113+95
CLEAN CULVERT PIPE

STA 1114+00
CLEAN CULVERT PIPE

STA 1114+05
CLEAN CULVERT PIPE

STA 1114+10
CLEAN CULVERT PIPE

STA 1114+15
CLEAN CULVERT PIPE

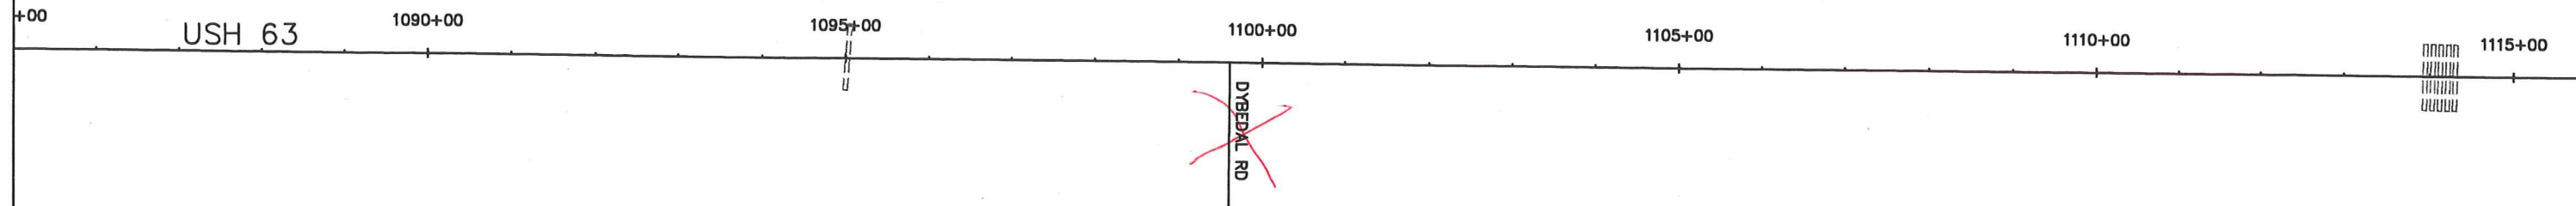


P.I. = 1129+64.95
Ic = 11'49'28"
Da = 2'00'00"
T = 296.66
L = 591.22
R = 2864.79
S.E. = 0.045%
R.O. = 175

STA 1138+98 - STA 1139+77 LT
REMOVING GUARDRAIL

STA 1138+94 - STA 1139+77 LT
STEEL THRIE BEAM STRUCTURE APPROACH, AND
STEEL PLATE BEAM GUARD ENERGY ABSORBING
TERMINAL REQUIRED.

STA 1140+23 - STA 1141+02 LT
REMOVING GUARDRAIL

STA 1140+23 - STA 1141+43.5 LT
STEEL THRIE BEAM STRUCTURE APPROACH,
STEEL PLATE BEAM GUARD CLASS A, AND
STEEL PLATE BEAM GUARD ENERGY ABSORBING
TERMINAL REQUIRED.


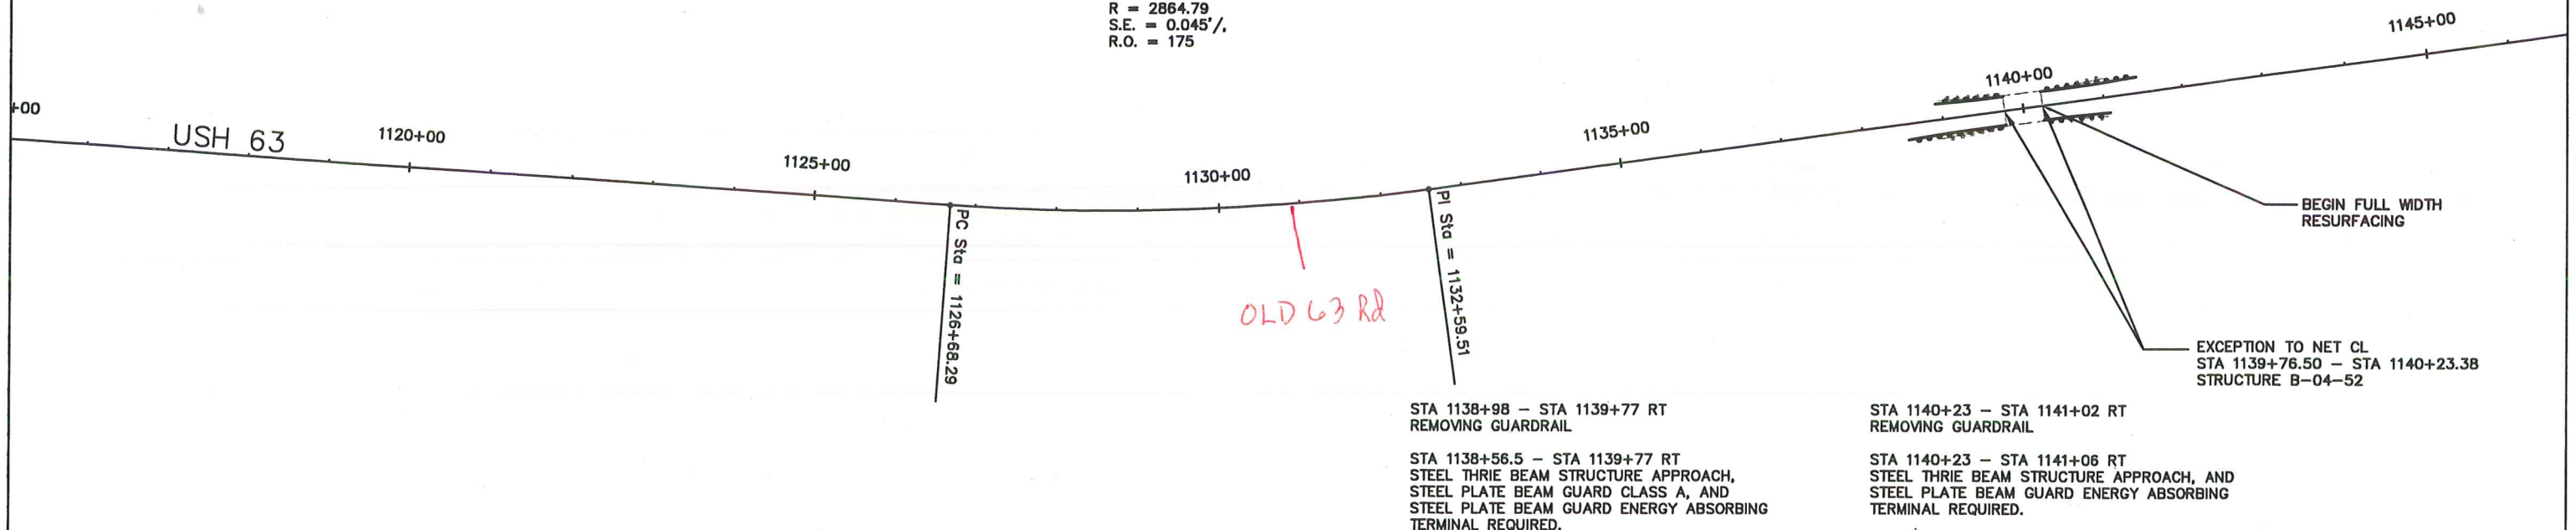



STA 1138+98 - STA 1139+77 RT
REMOVING GUARDRAIL



STA 1138+56.5 - STA 1139+77 RT
STEEL THRIE BEAM STRUCTURE APPROACH,
STEEL PLATE BEAM GUARD CLASS A, AND
STEEL PLATE BEAM GUARD ENERGY ABSORBING
TERMINAL REQUIRED.

STA 1140+23 - STA 1141+02 RT
REMOVING GUARDRAIL

STA 1140+23 - STA 1141+06 RT
STEEL THRIE BEAM STRUCTURE APPROACH, AND
STEEL PLATE BEAM GUARD ENERGY ABSORBING
TERMINAL REQUIRED.

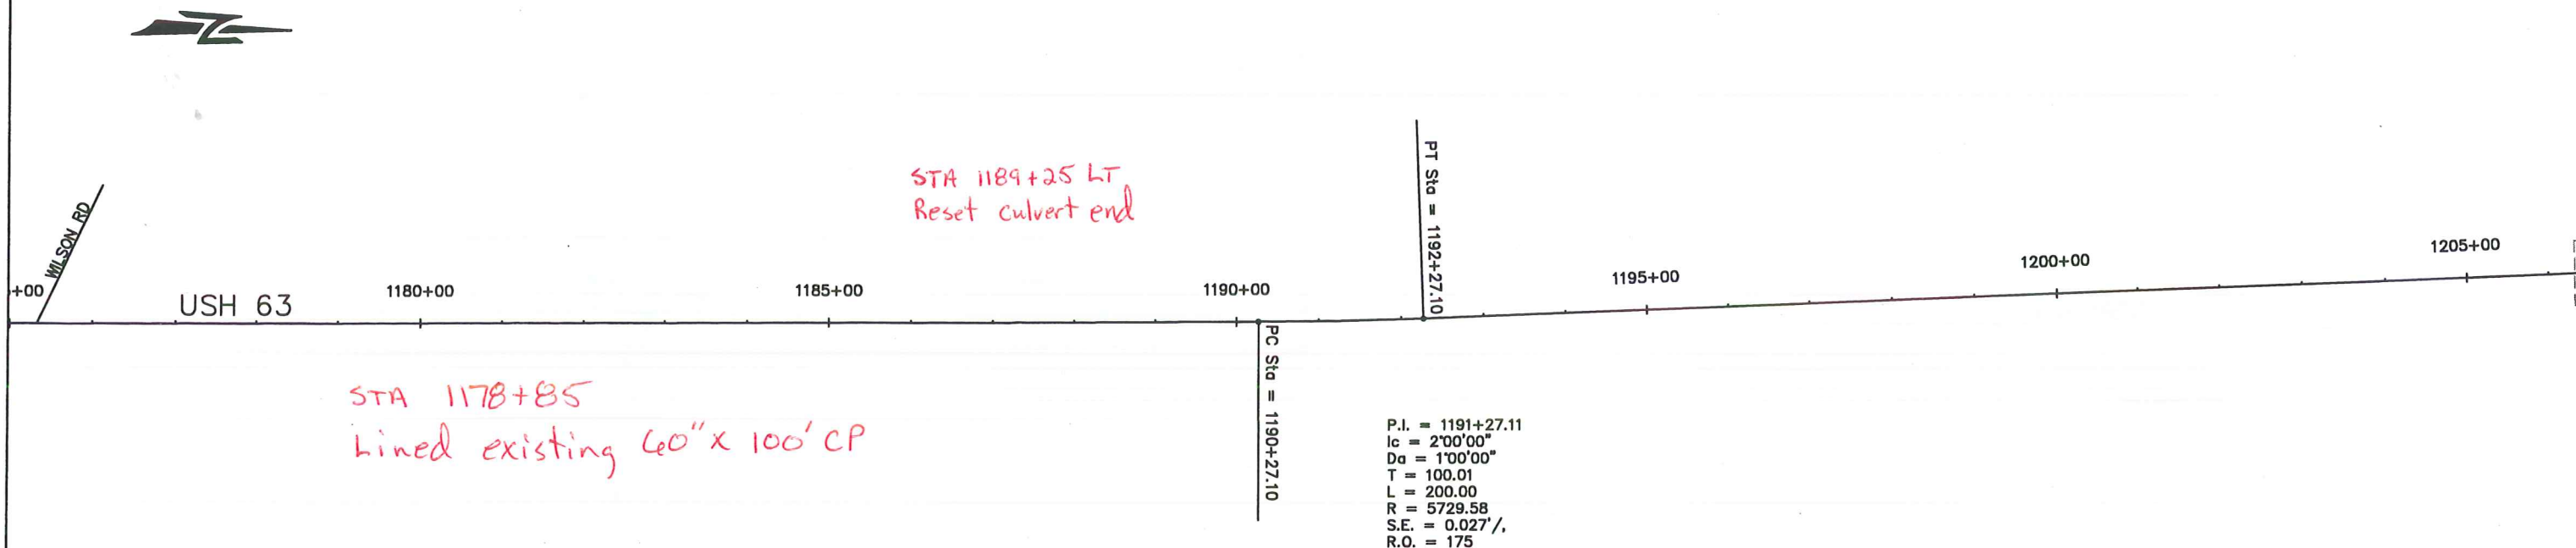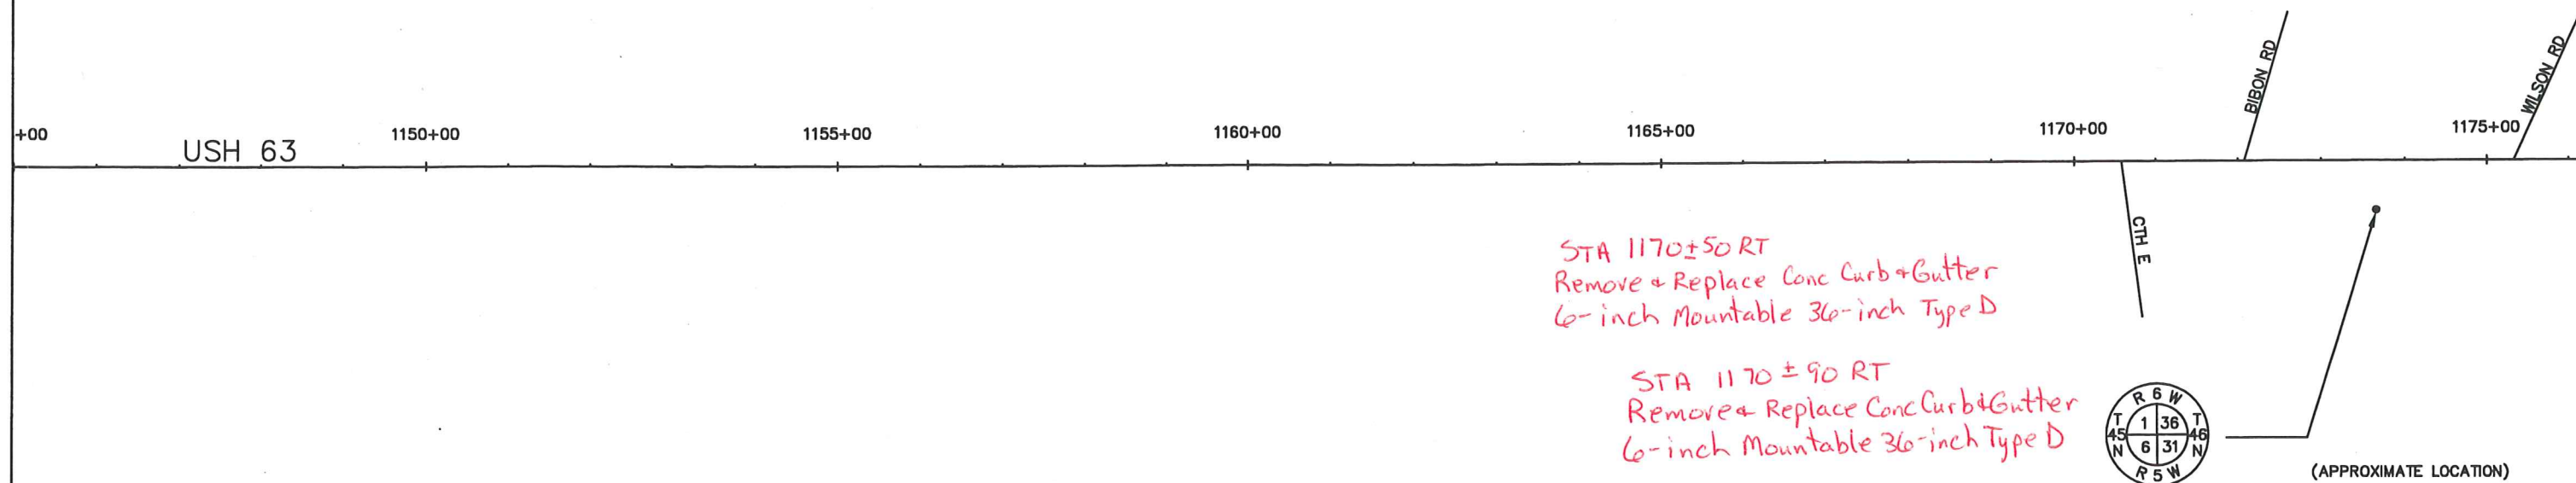

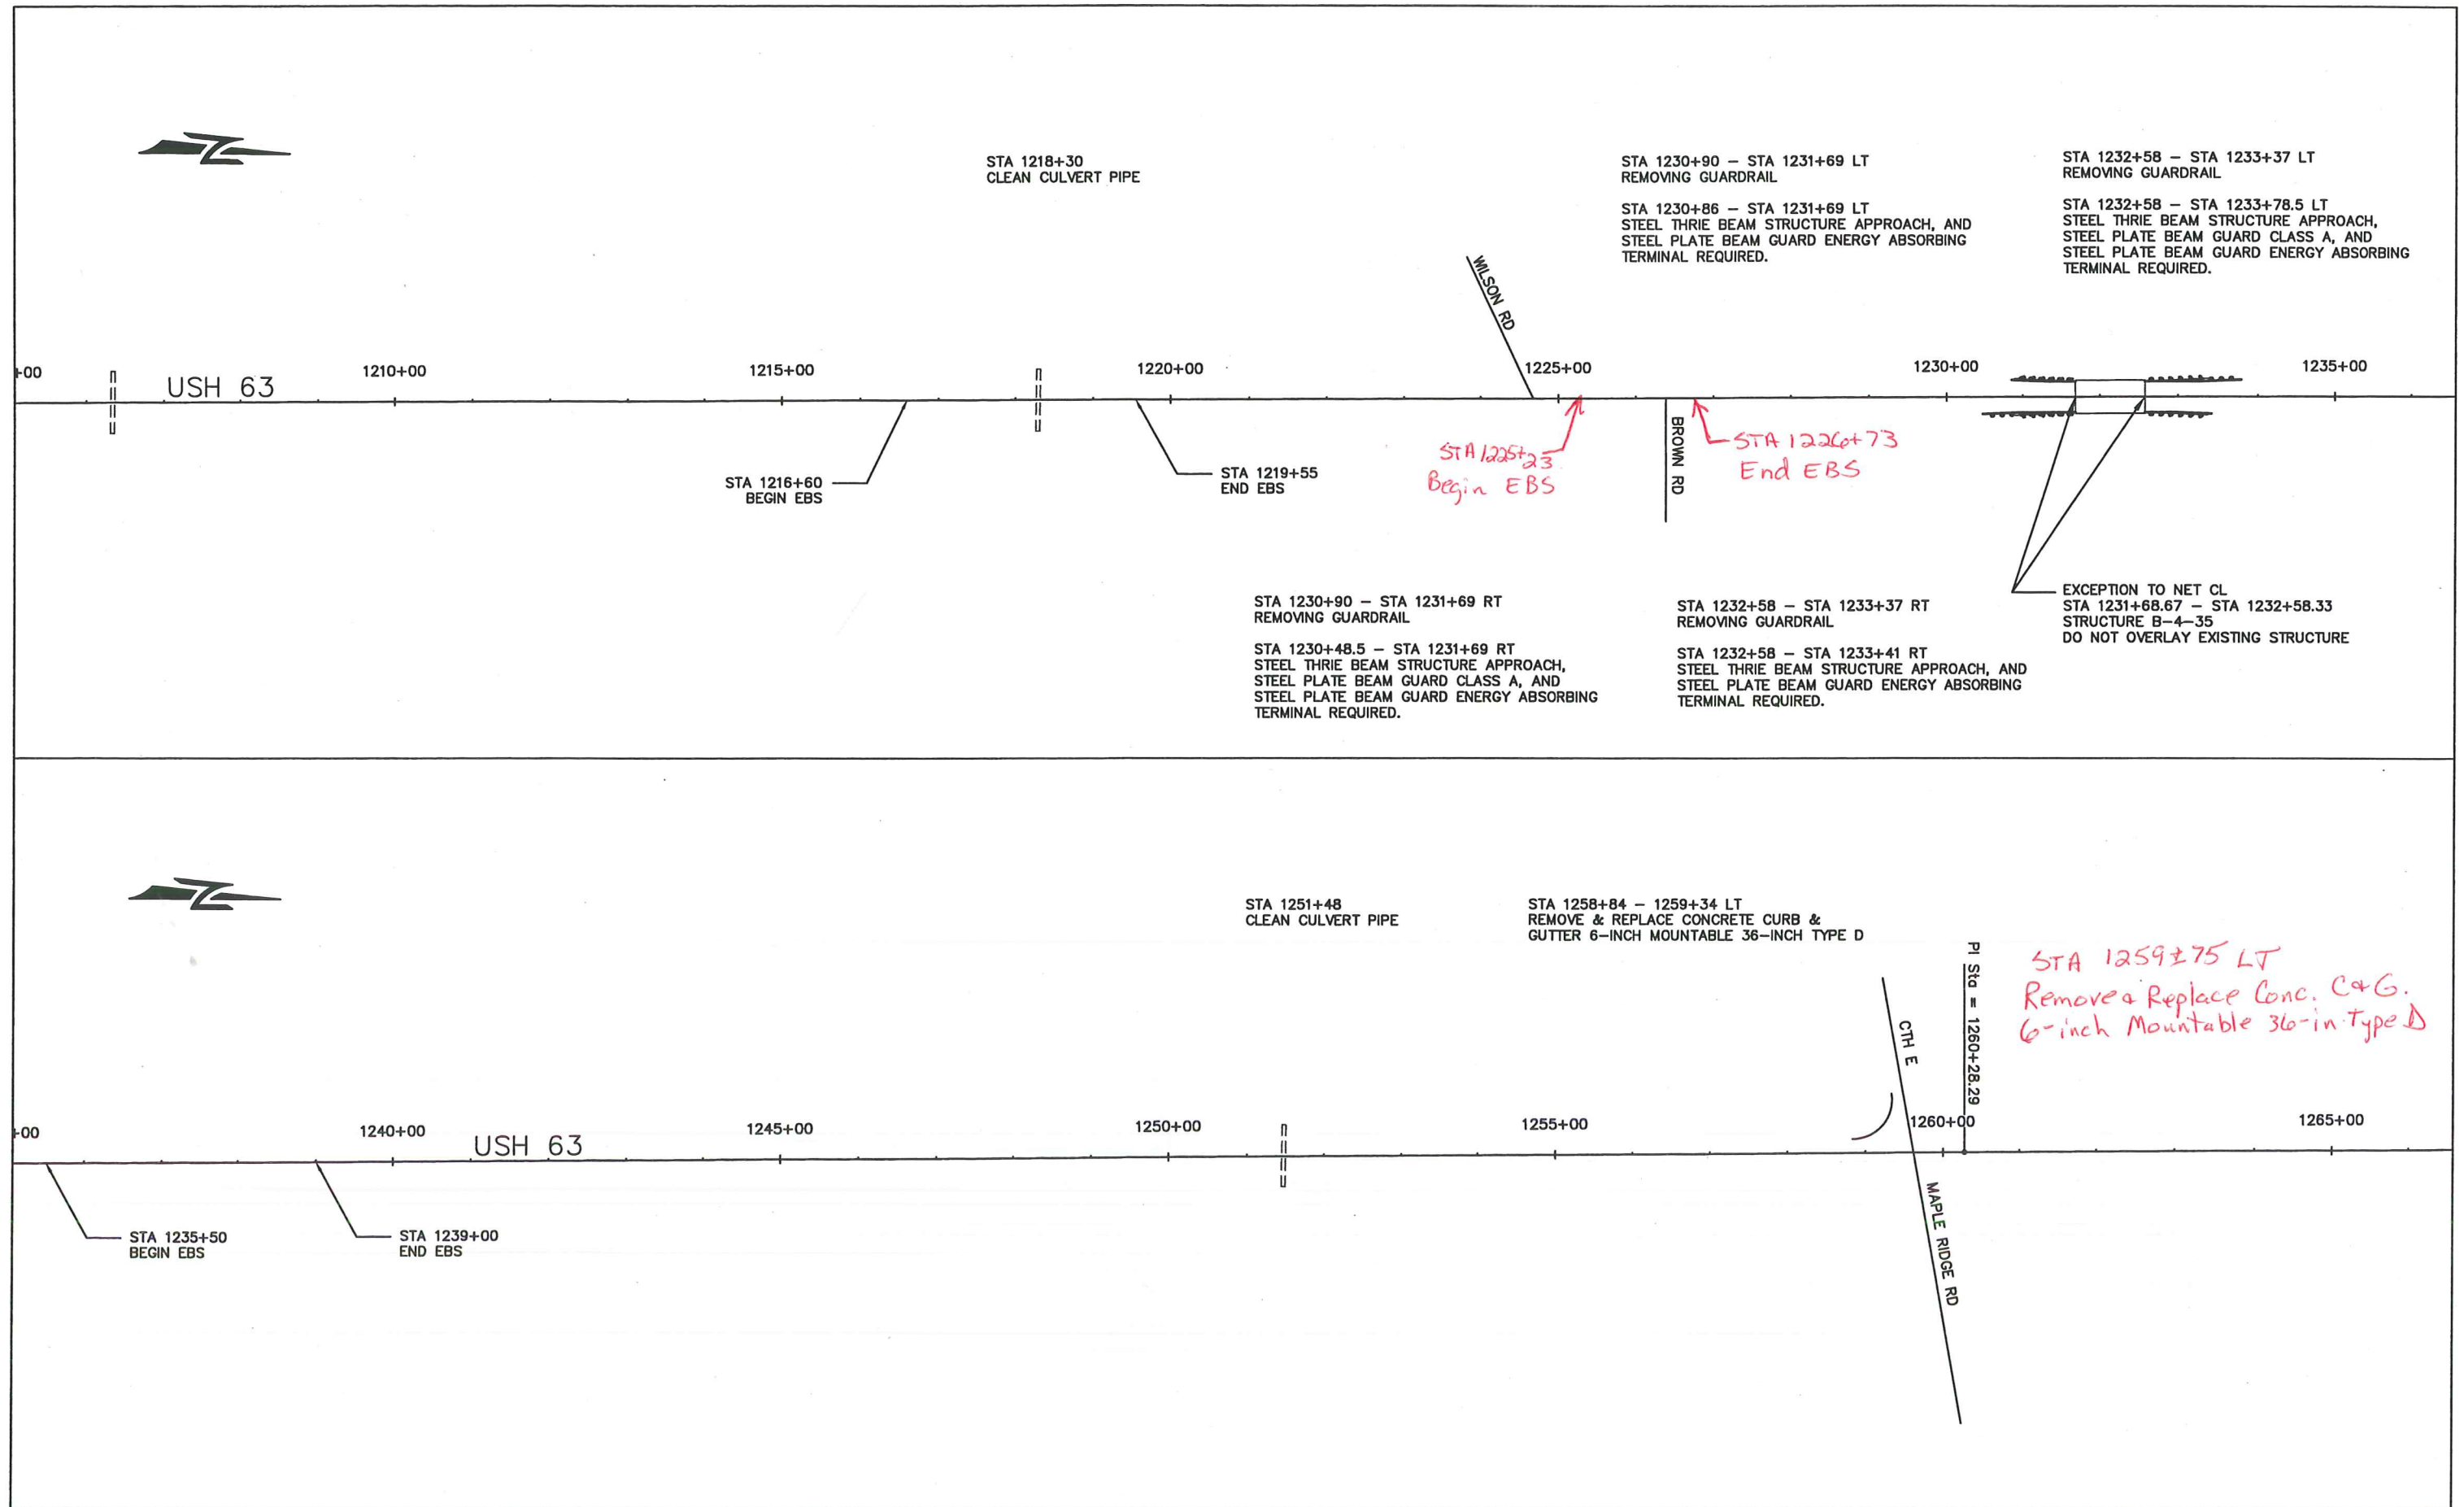

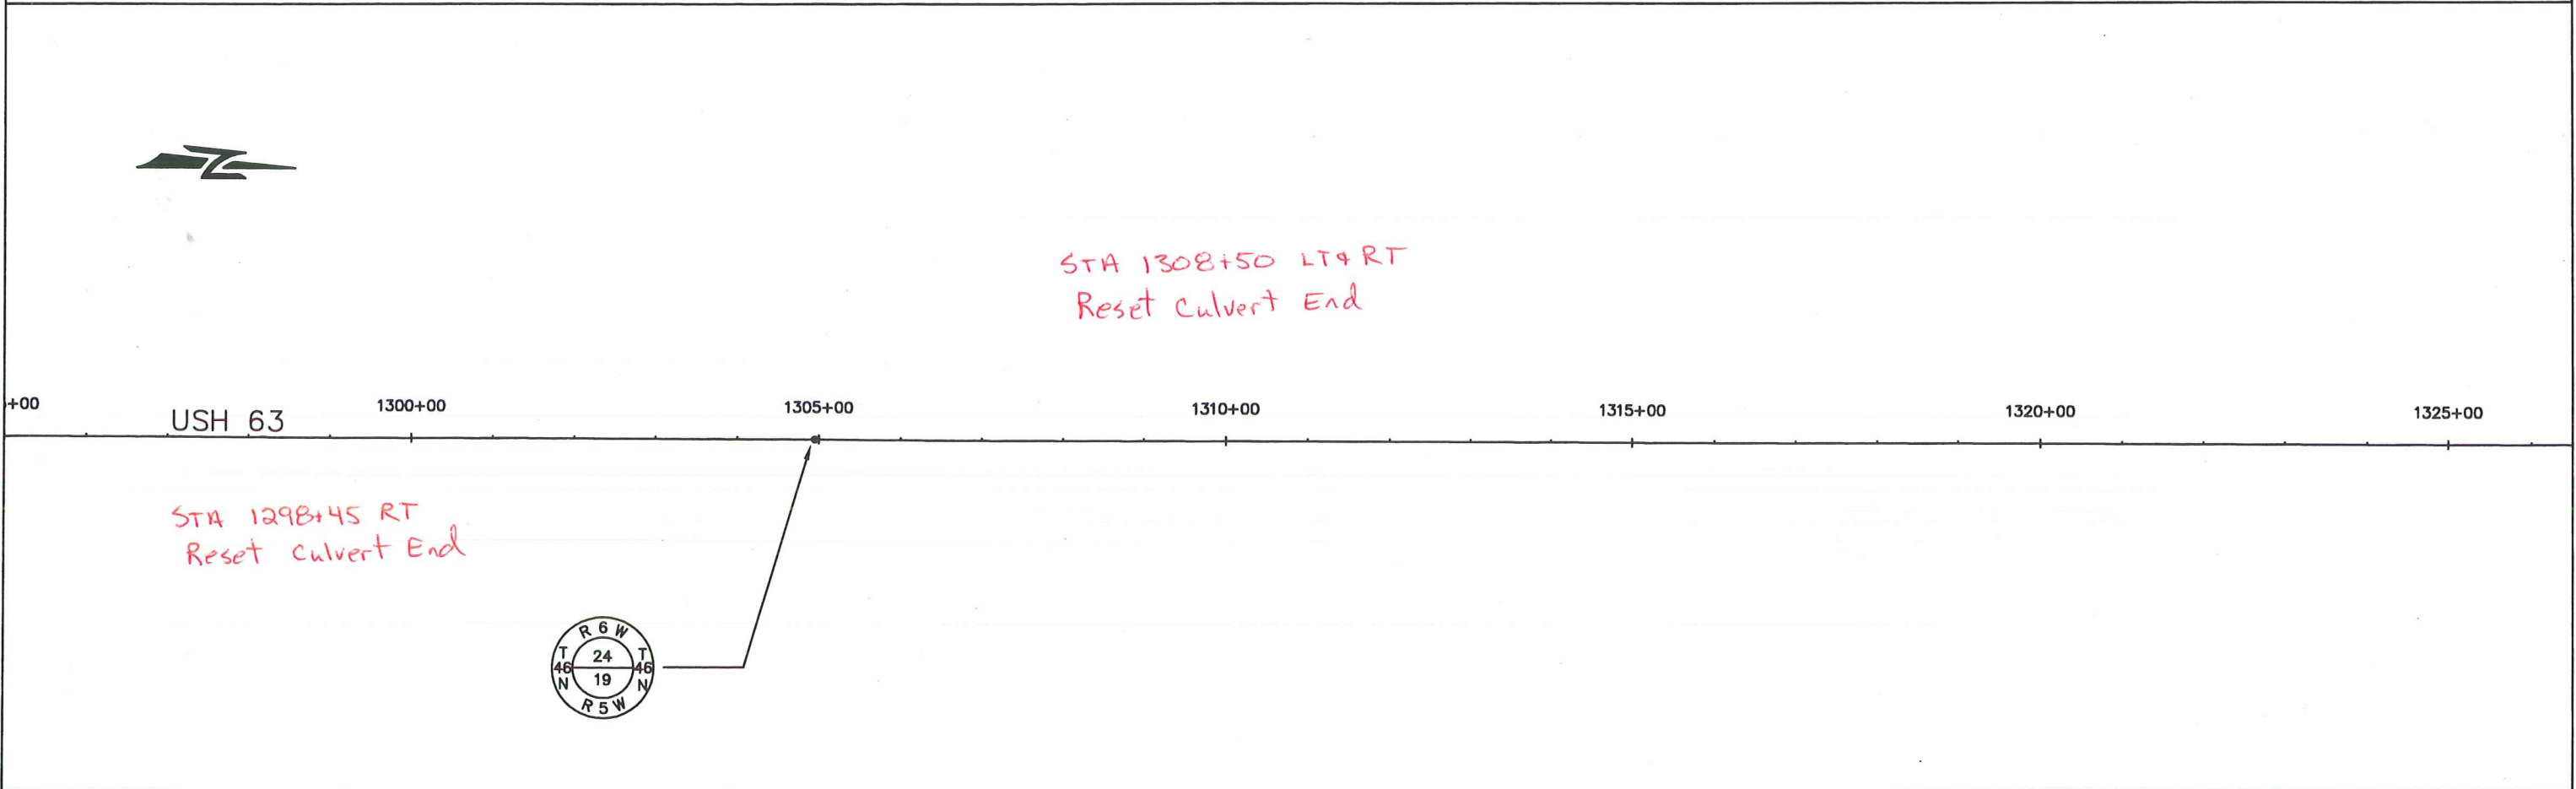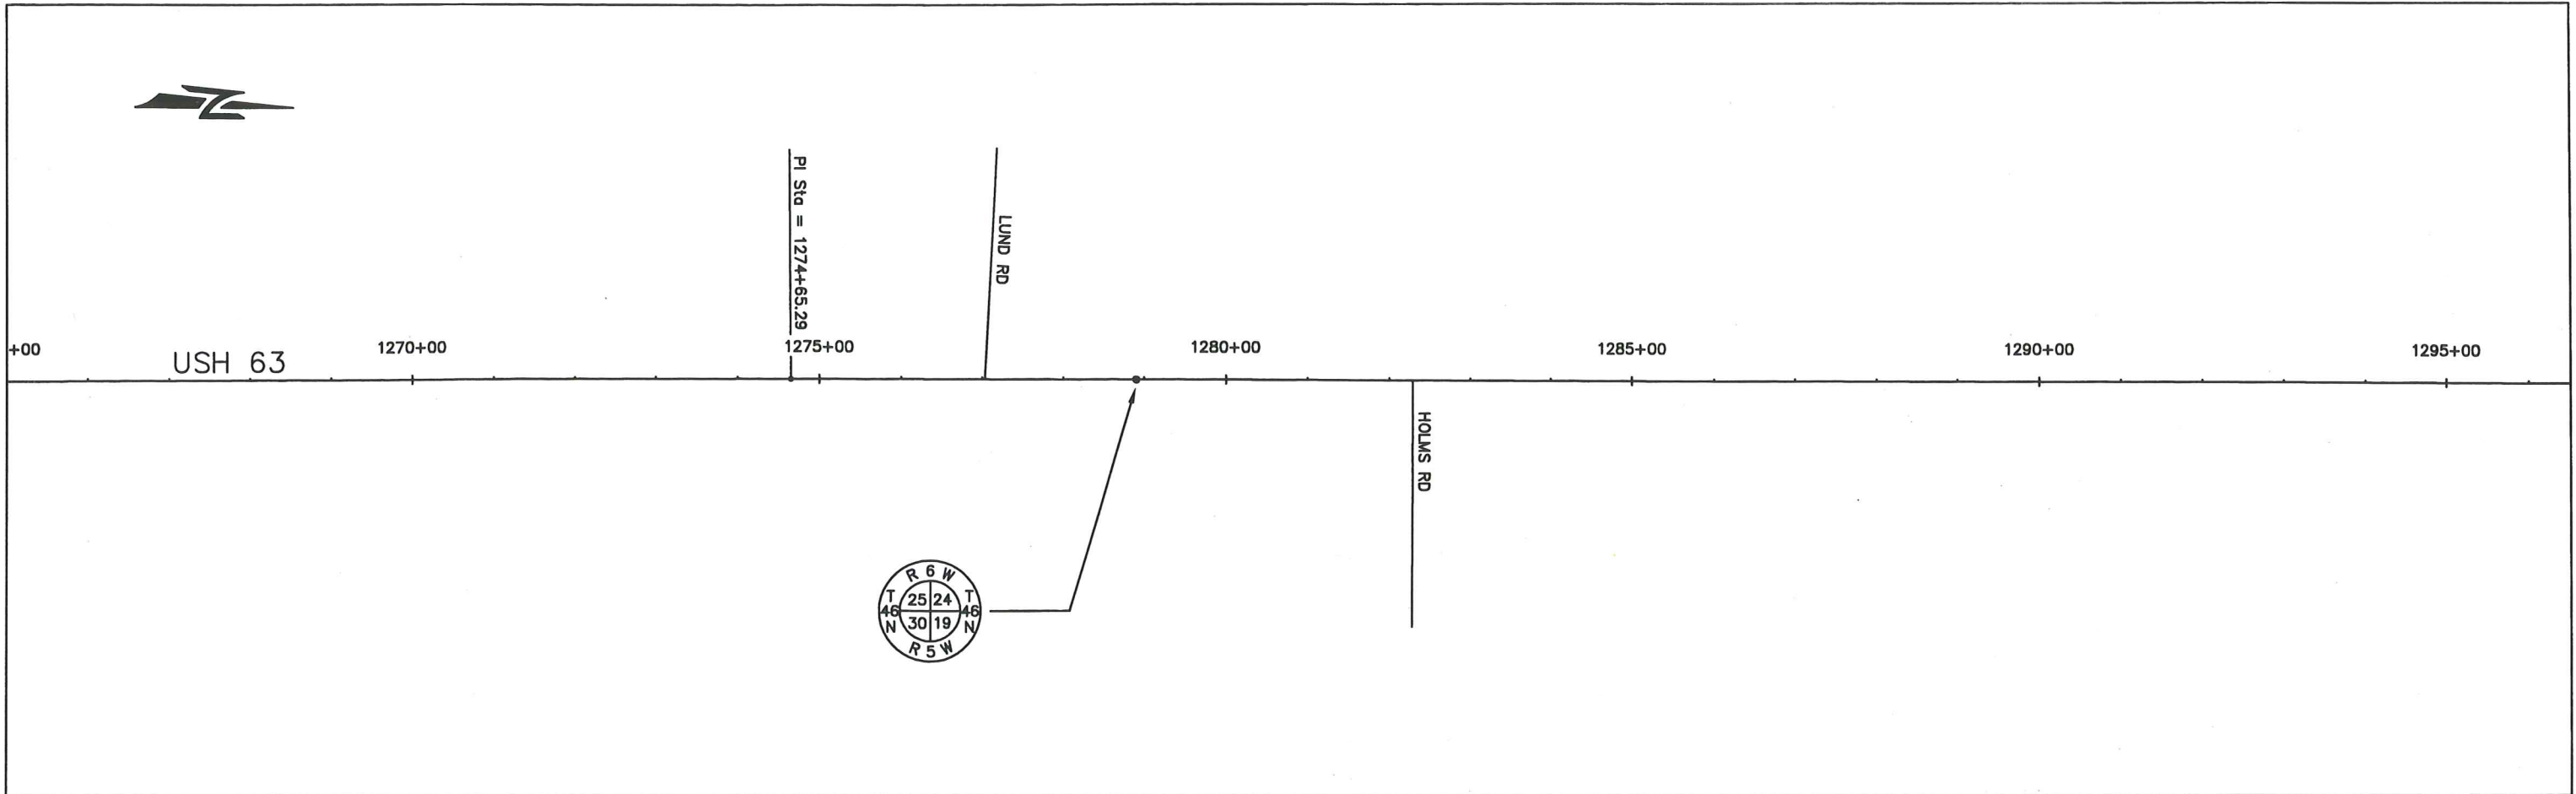



STA 1326+95 ~~LT~~ & RT
RESETTING CULVERT ENDS

PI Sta = 1331+28.29

USH 63

MORRIS RD

STA 1344+20 LT+RT
Reset Culvert End



SUNDIN RD



USH 63

STA 1361+45 RT
Reset Culvert End

ADOLPH JOHNSON RD

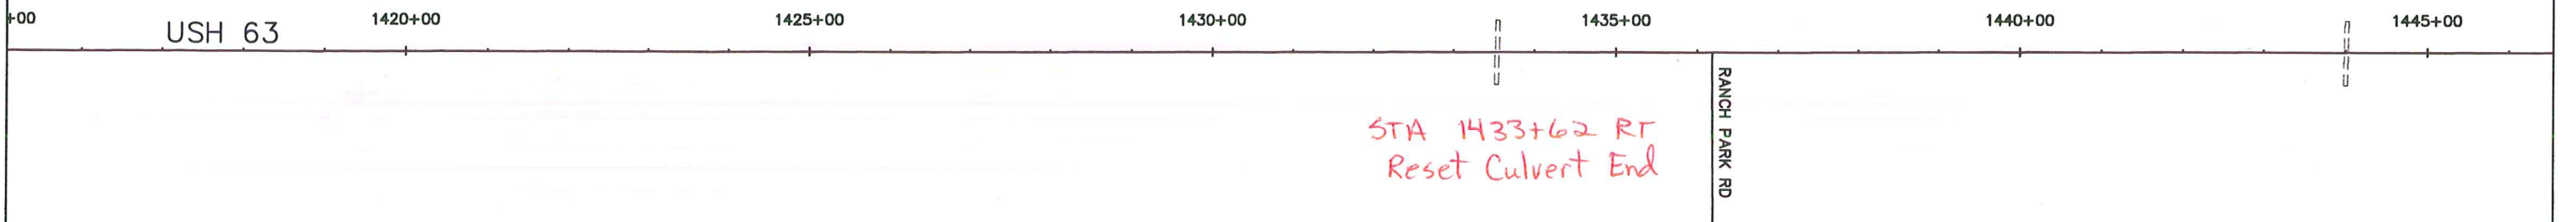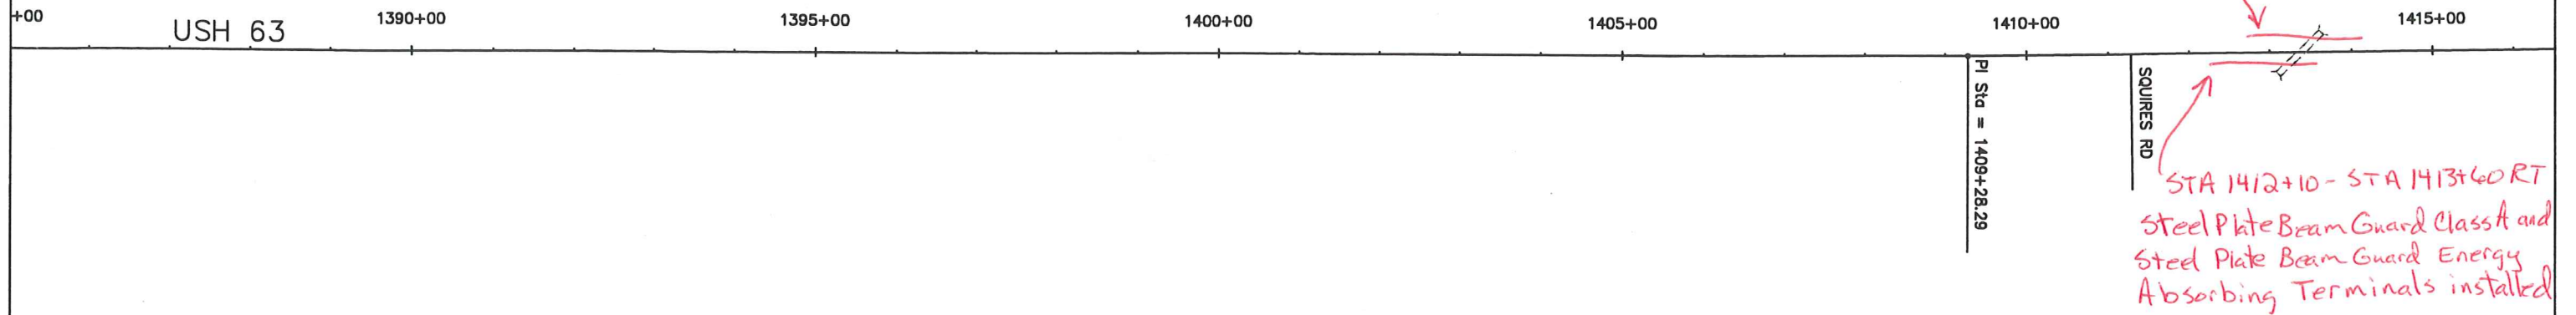



+00 USH 63 1450+00 1455+00 1460+00 1465+00 1470+00 1475+00

STA 1460+41 RT
Reset Culvert End



STA 1477+65
CLEAN CULVERT PIPE

+00 1480+00 USH 63 1485+00 1490+00 1495+00 1500+00

P.I. = 1497+15.50
Ic = 5'15"30"
Da = 0'30"00"
T = 526.20
L = 1051.67
R = 11459.16
S.E. = 0.020'/%
R.O. = 175

PC Sta = 1491+89.30

STA 1496±0 LT
Remove & Replace Conc. C+G
6-inch mountable 36-in Type D

STA 1496±50 LT
Remove & Replace Conc. C+G
6-inch Mountable 36-in Type D

PT Sta = 1502+40.96


STA 1496±0 RT
Remove & Replace Conc C+G
6-inch Mountable 36-in Type D

STA 1496±50 RT
Remove & Replace Conc C+G
6-inch Mountable 36-in Type D


END PROJECT 1560-20-71
STATION 1494+75

1497±25


STH 118 INTERSECTION
Removed existing 24" CP
Installed 1-24" x 110' CP and 2 AEWs

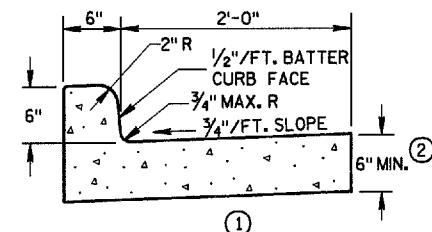


TYPES A & D

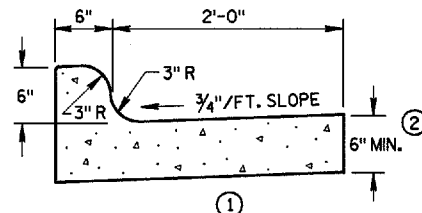



TYPES K & L

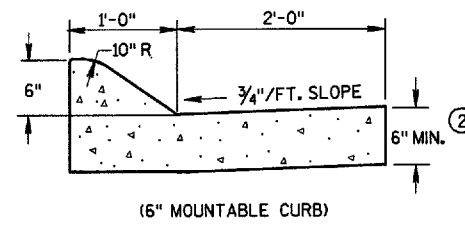

(6" MOUNTABLE CURB)

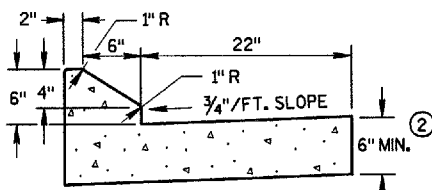


TYPES G & J

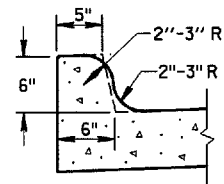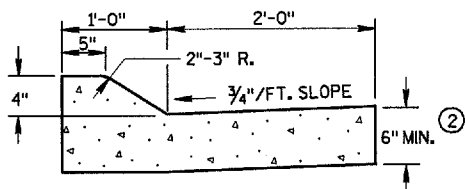OPTIONAL CURB SHAPE
FOR TYPES K & L

(4" MOUNTABLE CURB)


TYPES A & D
CONCRETE CURB & GUTTER 36"

CONCRETE CURB & GUTTER 30"

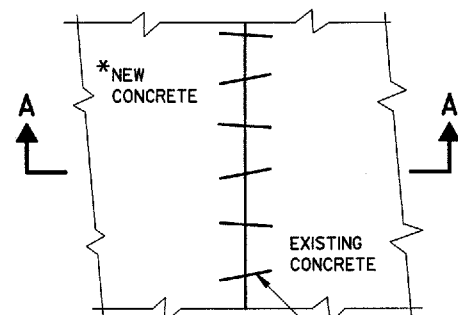

PLAN VIEW



*NEW CURB & GUTTER,
SURFACE DRAINS,
CONCRETE PAVEMENT
OR OTHER NEW CONCRETE.

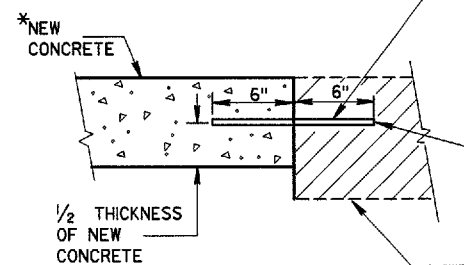SECTION A-A
PAVEMENT TIES



NO. 6 X 12" DEF. BARS
SPACED 3'-0" C-C,
INSTALLED ON 6:1 SKEW
HORIZONTALLY. DIRECTION
OF SKEW ALTERNATING AFTER
EVERY ONE OR TWO BARS.

THE HOLE FOR THE BAR SHALL
BE DRILLED TO A DEPTH OF
7" AND TO SUCH A DIAMETER
AS TO PROVIDE A TIGHT
DRIVEN FIT

EXISTING
CONCRETE

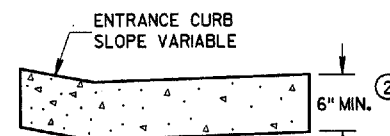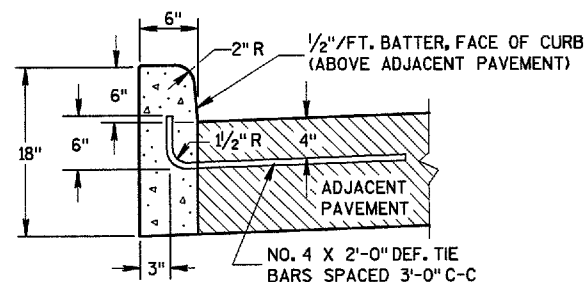DRIVEWAY ENTRANCE CURB
(WHEN DIRECTED BY THE ENGINEER)

TYPES A & D

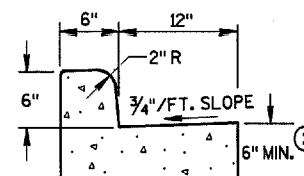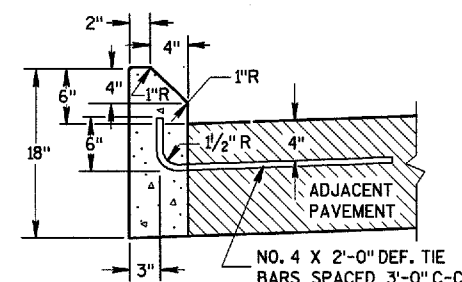TYPES A & D
CONCRETE CURB & GUTTER 18"

TYPES G & J

CONCRETE CURB

GENERAL NOTES

DETAILS OF CONSTRUCTION, MATERIALS AND WORKMANSHIP NOT SHOWN ON THIS DRAWING SHALL CONFORM TO THE PERTINENT REQUIREMENTS OF THE CONTRACT.


PAVEMENT TIES AND TIE BARS SHALL BE EPOXY COATED IN CONFORMANCE WITH SUBSECTION 505.2.6.2 OF THE STANDARD SPECIFICATIONS.

INTEGRAL CURB & GUTTER SHALL CONFORM TO THE DETAILS SHOWN FOR CONCRETE CURB & GUTTER INCLUDING THE TRANSVERSE GUTTER SLOPE. A LONGITUDINAL CONSTRUCTION JOINT IS NOT REQUIRED WITH INTEGRAL CURB AND GUTTER.



WHERE THE TRANSVERSE JOINTS IN THE PAVEMENT ARE REQUIRED TO BE SEALED, THE JOINTS IN THE INTEGRAL CURB AND GUTTER SHALL BE SEALED TO THE FACE OF CURB WITH THE SAME TYPE OF SEALANT. THE COST OF FURNISHING AND INSTALLING THIS SEALANT SHALL BE INCIDENTAL TO THE ITEM CONCRETE CURB AND GUTTER.

UNLESS OTHERWISE SHOWN ON THE TYPICAL CROSS SECTIONS, THE BASE COURSE AND UNCLASSIFIED EXCAVATION LIMITS ARE 2'-0" BEHIND THE BACK OF CURBS.

- ① TIE BARS ARE REQUIRED FOR CURB AND GUTTER TYPES A, G AND K.
- ② THE BOTTOM OF CURB AND GUTTER MAY BE CONSTRUCTED EITHER LEVEL OR PARALLEL TO THE SLOPE OF THE SUBGRADE OR BASE COURSE PROVIDED A 6" MINIMUM GUTTER THICKNESS IS MAINTAINED.
- ③ WHEN REVERSE SLOPE GUTTER IS REQUIRED, THE LOCATION(S) WILL BE SHOWN ELSEWHERE IN THE PLAN.

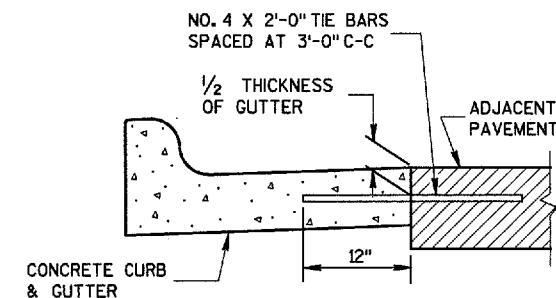

TYPICAL TIE BAR LOCATION

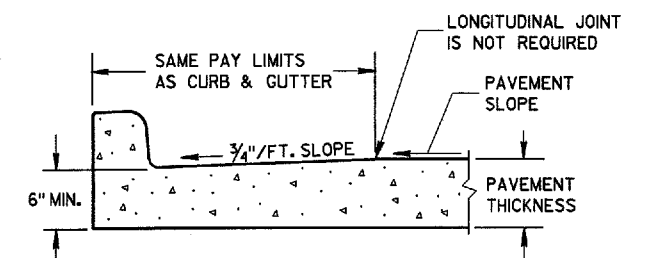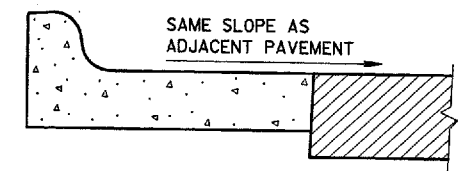PARTIAL SECTION OF PAVEMENT
WITH INTEGRAL CURB & GUTTERREVERSE SLOPE GUTTER
(TYPICAL FOR ALL CURB & GUTTER TYPES)

CONCRETE CURB, CONCRETE
CURB & GUTTER AND
PAVEMENT TIES

STATE OF WISCONSIN
DEPARTMENT OF TRANSPORTATION


APPROVED

04/16/99
DATE

FWHA


Ray J. Thompson
CHIEF ROADWAY DEVELOPMENT ENGINEER

WOOD STAKES (2 PER BALE)
NOMINAL 2" X 2" X 30" MIN.
LENGTH OR EQUIVALENT

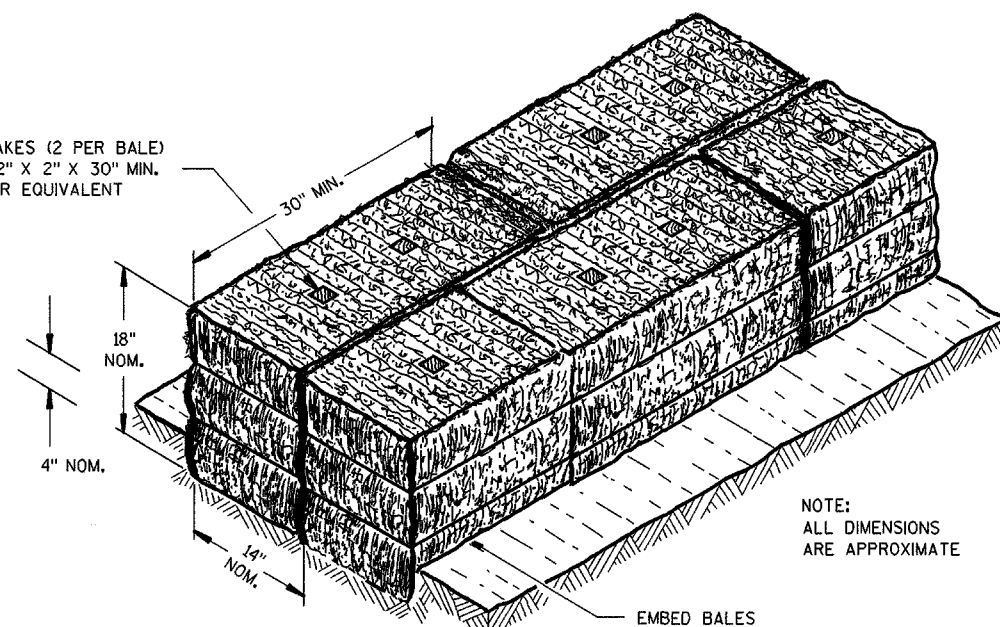


NOTE:
ALL DIMENSIONS
ARE APPROXIMATE

SECTION A-A

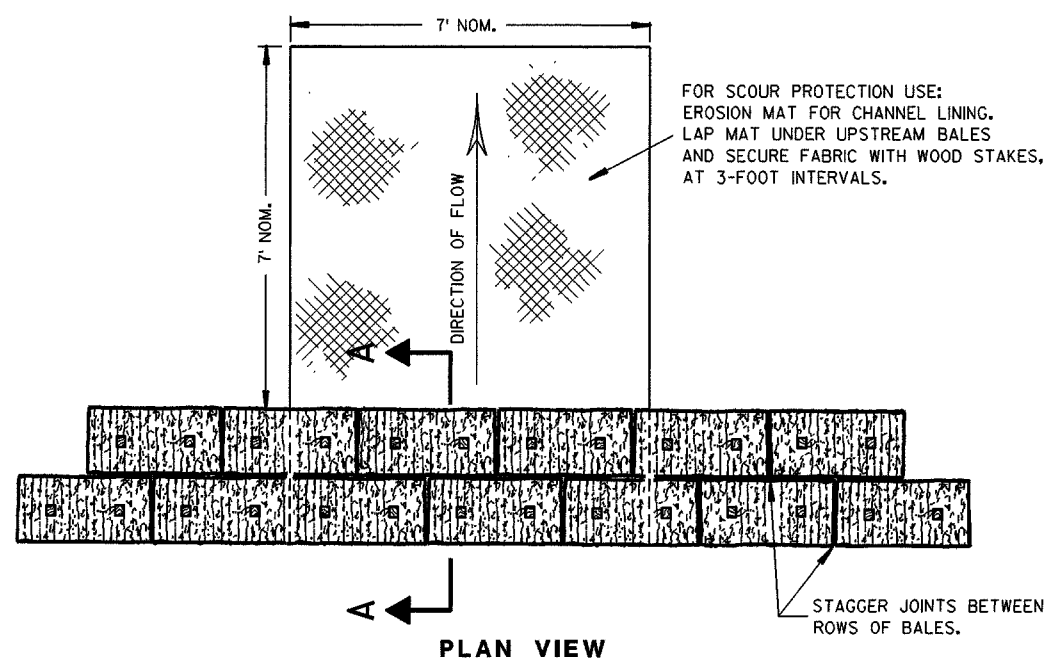

PLAN VIEW

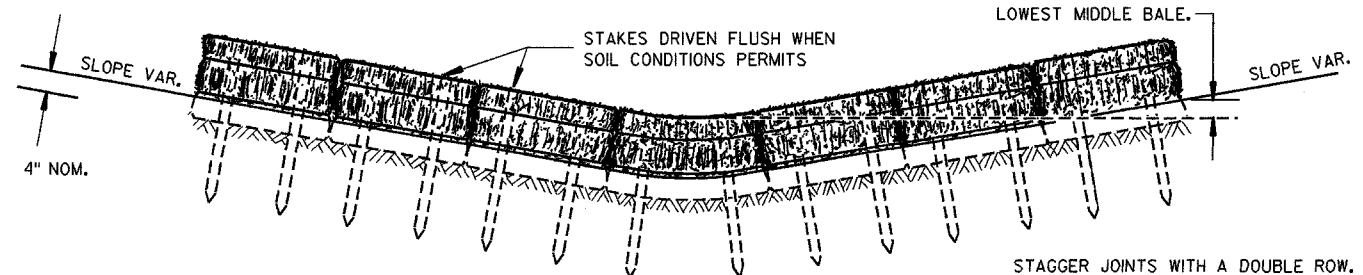


FRONT ELEVATION

TEMPORARY DITCH CHECK USING EROSION BALES ①

GENERAL NOTES


DETAILS OF CONSTRUCTION, MATERIALS AND WORKMANSHIP NOT SHOWN ON THIS DRAWING SHALL CONFORM TO THE PERTINENT REQUIREMENTS OF THE STANDARD SPECIFICATIONS AND THE APPLICABLE SPECIAL PROVISIONS.

- ① TEMPORARY DITCH CHECKS EITHER EROSION BALES OR MANUFACTURED SHALL BE PAID FOR UNDER THE BID ITEM OF TEMPORARY DITCH CHECK. THE DEPARTMENT WILL NOT PAY FOR TEMPORARY DITCH CHECKS CONSTRUCTED OF A SINGLE ROW OF EROSION BALES.

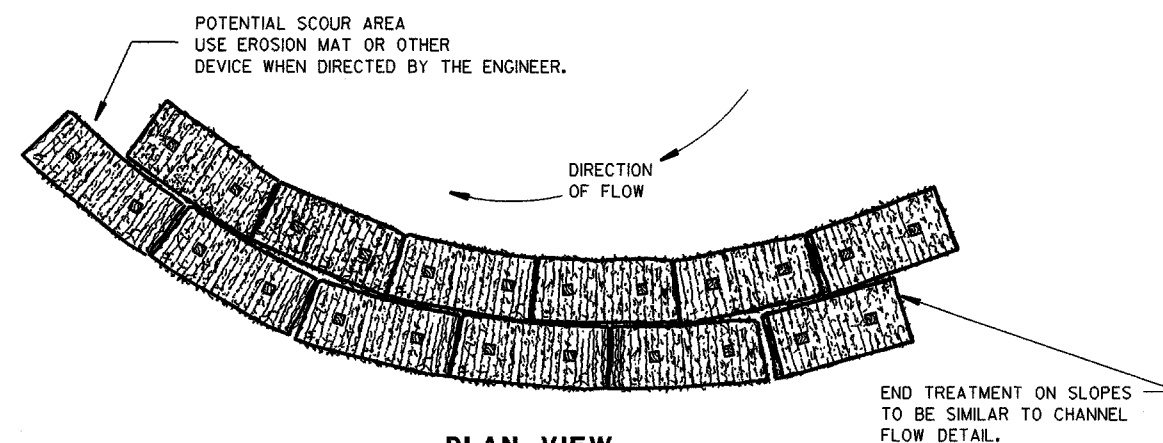


PLAN VIEW

WHEN ALTERING THE DIRECTION OF FLOW

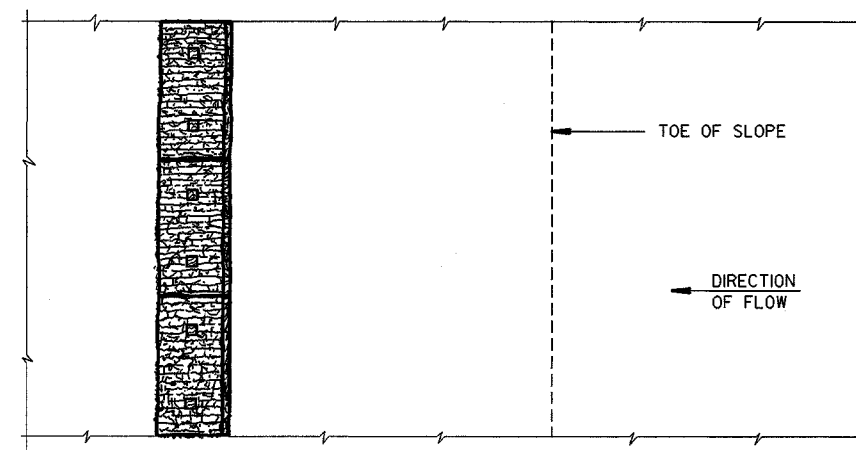

PLAN VIEW

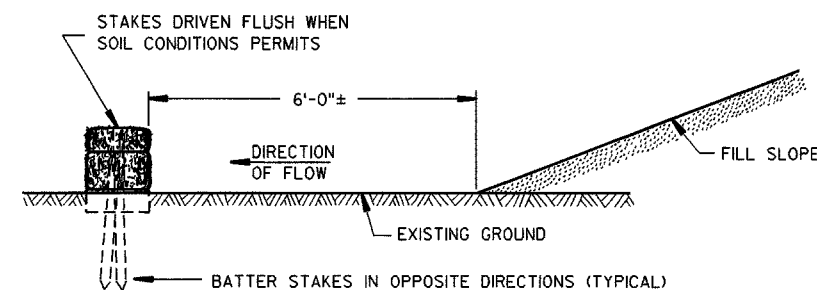

FRONT ELEVATION

WHEN EXISTING GROUND SLOPES AWAY FROM FILL SLOPE

EROSION BALES FOR SHEET FLOW

TYPICAL INSTALLATIONS OF EROSION BALES / TEMPORARY DITCH CHECKS


STATE OF WISCONSIN
DEPARTMENT OF TRANSPORTATION

APPROVED


6/4/02
DATE

FHWA

CHIEF ROADWAY DEVELOPMENT ENGINEER

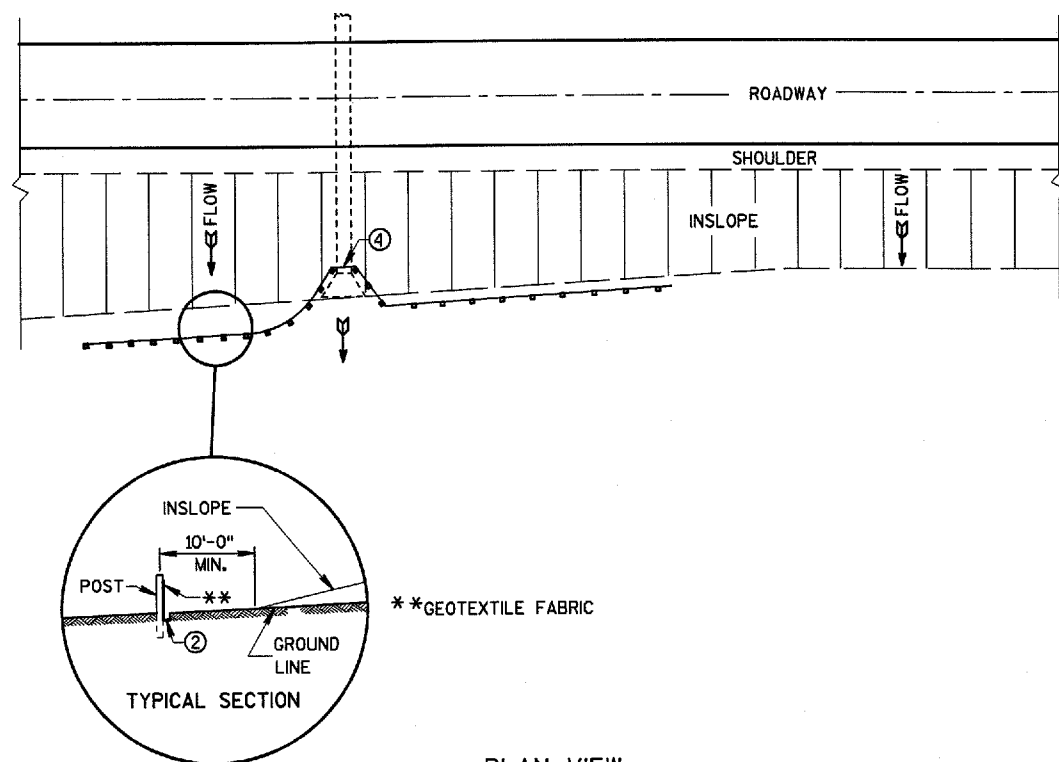

PLAN VIEW
TYPICAL APPLICATION OF SILT FENCE

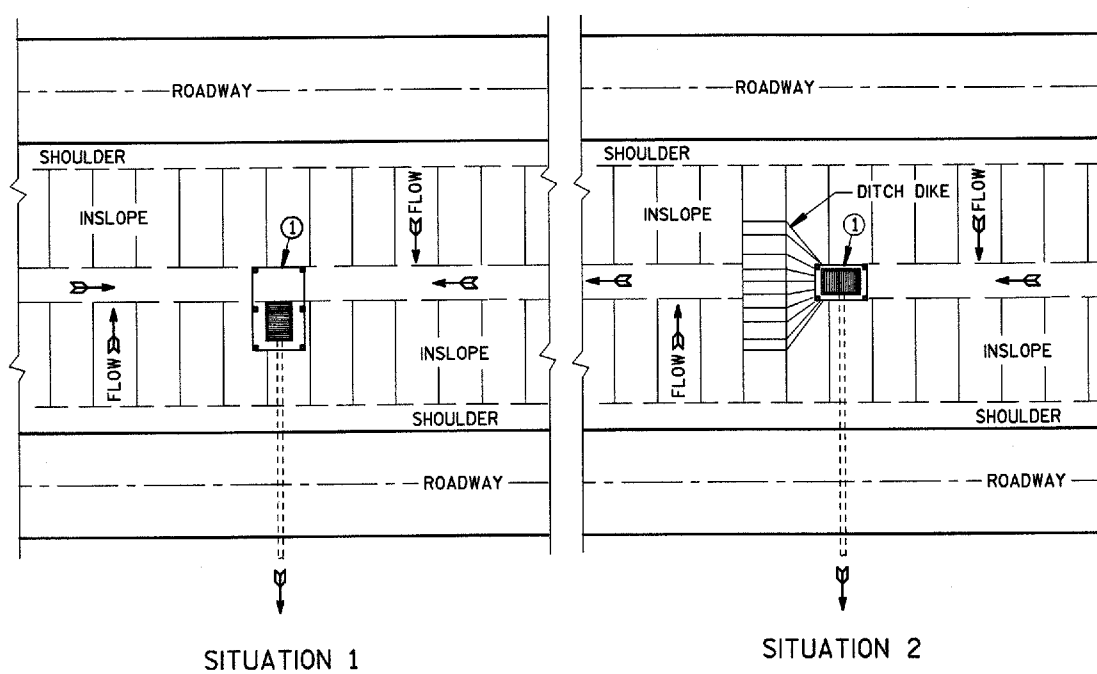


PLAN VIEW
SILT FENCE AT MEDIAN SURFACE DRAINS


GENERAL NOTES

DETAILS OF CONSTRUCTION NOT SHOWN ON THIS DRAWING SHALL CONFORM TO THE PERTINENT REQUIREMENTS OF THE STANDARD SPECIFICATIONS AND APPLICABLE SPECIAL PROVISIONS.


- ① HORIZONTAL BRACE REQUIRED WITH 2" X 4" WOODEN FRAME OR EQUIVALENT AT TOP OF POSTS.
- ② TRENCH SHALL BE A MINIMUM OF 4" WIDE & 6" DEEP TO BURY AND ANCHOR THE GEOTEXTILE FABRIC. FOLD MATERIAL TO FIT TRENCH AND BACKFILL & COMPACT TRENCH WITH EXCAVATED SOIL.
- ③ WOOD POSTS SHALL BE A MINIMUM SIZE OF 1 1/8" X 1 1/8" OF OAK OR HICKORY.
- ④ SILT FENCE TO EXTEND ACROSS THE TOP OF THE PIPE.

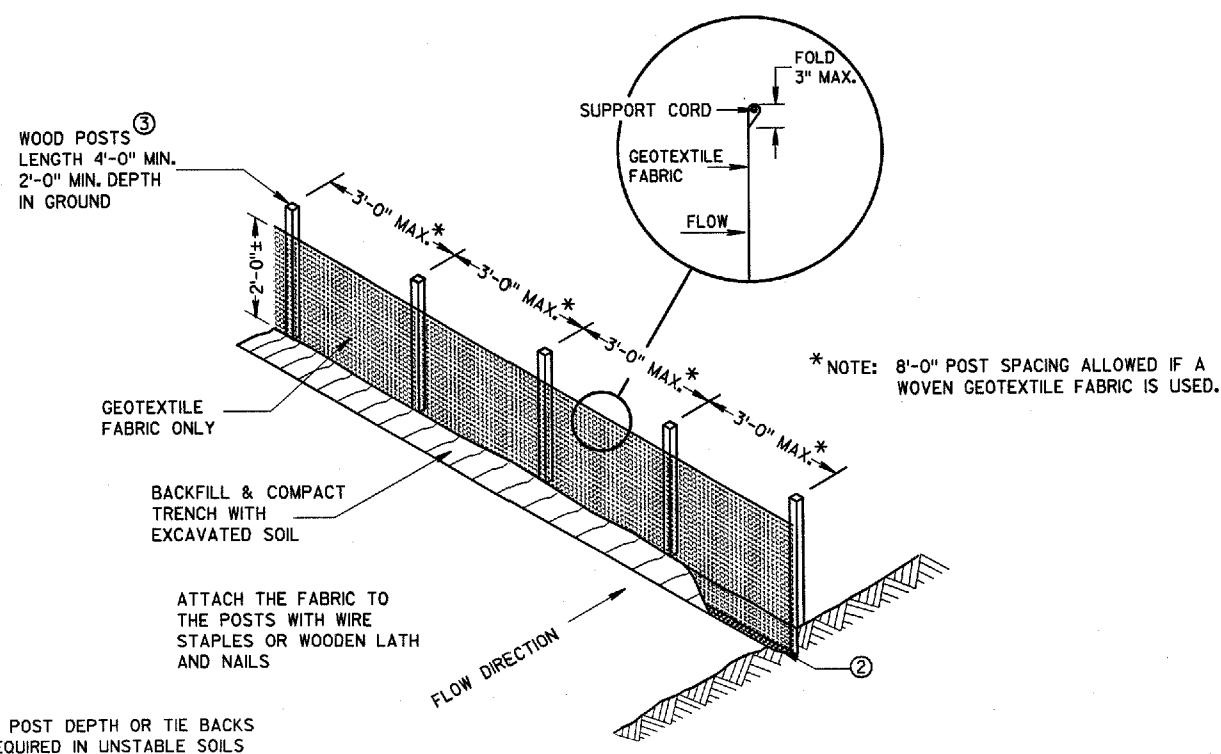

SILT FENCE

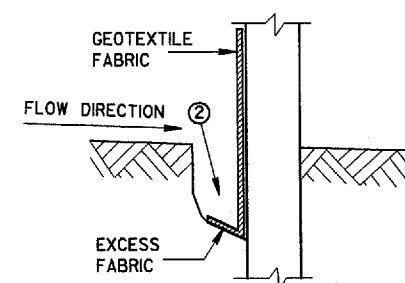

TRENCH DETAIL

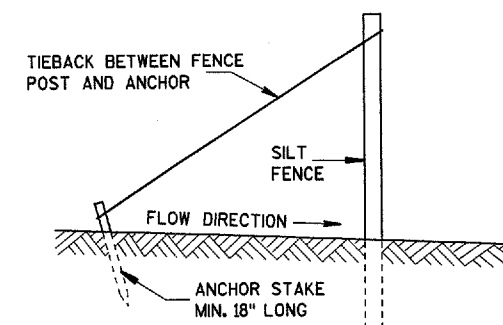


SILT FENCE TIE BACK
(WHEN REQUIRED BY THE ENGINEER)

NOTE: ADDITIONAL POST DEPTH OR TIE BACKS MAY BE REQUIRED IN UNSTABLE SOILS


SILT FENCE

STATE OF WISCONSIN
DEPARTMENT OF TRANSPORTATION

APPROVED *[Signature]*
DATE 03/06/00
DATE 03/06/00
CHIEF ROADWAY DEVELOPMENT ENGINEER
FHWA

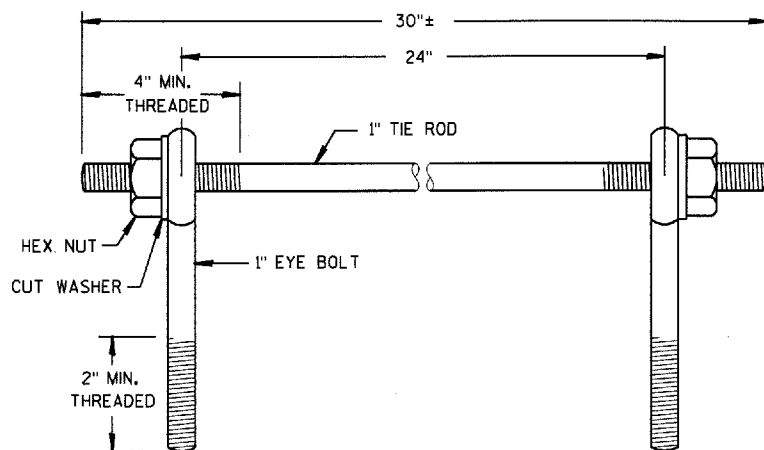

EYE BOLTS AND TIE ROD

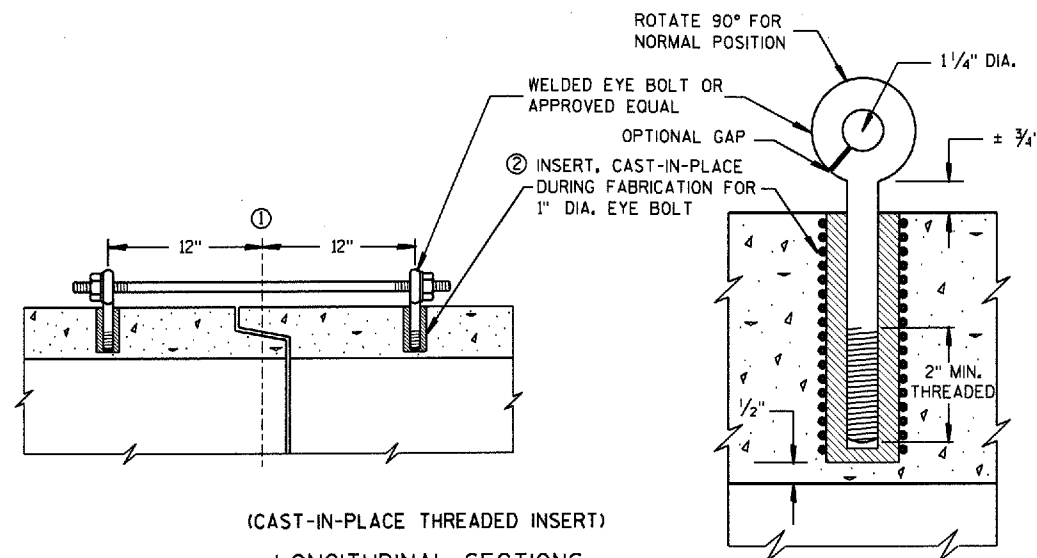

(CAST-IN-PLACE THREADED INSERT)
LONGITUDINAL SECTIONS


GENERAL NOTES

CONCRETE CULVERT PIPE SHALL BE TIED TOGETHER IN THE MANNER ILLUSTRATED BY THIS DETAIL AT LOCATIONS DESIGNATED ON THE PLAN. THE CONTRACTOR MAY USE EITHER ALTERNATE 1, 2 OR 3 FOR DRAINAGE STRUCTURES. ONLY ALTERNATE 1 AND 3 MAY BE USED FOR CATTLE PASSES. UNLESS OTHERWISE STATED IN THE CONTRACT THE MATERIALS, FABRICATION AND WORK NECESSARY TO TIE CULVERT PIPE AS INDICATED ON THE PLANS AND BY THIS DETAIL WILL BE CONSIDERED INCIDENTAL TO CULVERT PIPE, REINFORCED CONCRETE CULVERT PIPE, OR REINFORCED CONCRETE PIPE CATTLE PASS.


DETAILED DRAWINGS FOR PROPOSED ALTERNATE DESIGNS FOR JOINT TIES SHALL BE SUBMITTED TO THE ENGINEER FOR APPROVAL.

- ① ϕ OF TONGUE AND GROOVE OR BELL AND SPIGOT JOINTS.
- ② THE INSIDE OF THE THREADED INSERTS SHALL BE CLEAN TO ALLOW THE INSERTION OF THREADED EYE BOLTS.
- ③ HOLES SHALL BE CAST-IN-PLACE OR DRILLED 12" FROM ϕ OF TONGUE AND GROOVE.
- ④ BOLT PROJECTION INSIDE OF PIPE SHALL NOT EXCEED 2".
- ⑤ ROD DIAMETER + 1 INCH.
- ⑥ LENGTH ADEQUATE TO EXTEND TO WITHIN $\frac{1}{2}$ INCH OF THE INNER SURFACE OF THE PIPE.

EYE BOLT AND TIE ROD ASSEMBLY (ALTERNATE NO. 1)

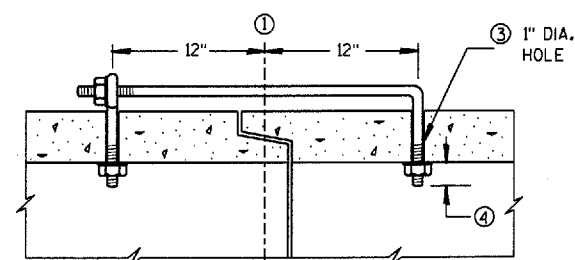

(TONGUE & GROOVE PIPE)

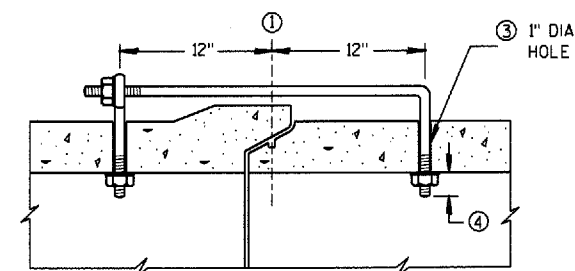

(MODIFIED BELL PIPE)
LONGITUDINAL SECTION


EYE BOLT DIMENSION TABLE

| PIPE SIZE | L = LENGTH | |
|------------|----------------------|--------------------|
| | TONGUE & GROOVE PIPE | MODIFIED BELL PIPE |
| 18" TO 24" | 4 $\frac{1}{2}$ " | 6 $\frac{1}{4}$ " |
| 30" | 5" | 7" |
| 36" | 5 $\frac{1}{2}$ " | 7" |
| 42" | 6" | |
| 48" | 6 $\frac{1}{2}$ " | |
| 60" | 7 $\frac{1}{2}$ " | |
| 66" | 8" | |


ADJUSTABLE TIE ROD TABLE

| PIPE DIAMETER | TIE ROD DIAMETER | D | L ₁ | N |
|---------------|------------------|---------------|----------------|----------------|
| 12-60 | $\frac{5}{8}$ | $\frac{5}{8}$ | 5 | $\frac{1}{2}$ |
| 66-84 | $\frac{3}{4}$ | $\frac{3}{4}$ | 5 | $\frac{1}{2}$ |
| 90-108 | 1 | 1 | 7 | $1\frac{1}{8}$ |

DIMENSIONS SHOWN ARE IN INCHES

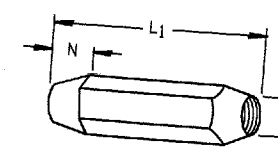


TAPERED

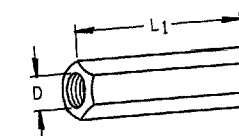

PLAIN


RIGHT AND LEFT THREADS

SLEEVE NUTS

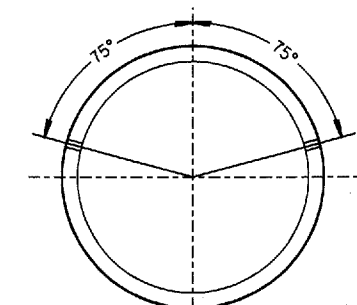


PLACEMENT OF (2) CAST-IN-PLACE INSERTS OR HOLES DURING FABRICATION FOR PIPE SECTIONS REQUIRING TIE RODS

TRANSVERSE SECTION

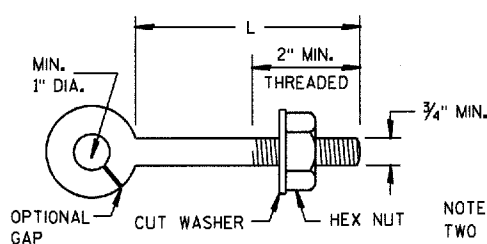

EYE BOLT


NOTE:
TWO EYE BOLTS MAY BE USED WITH A 30" LONG THREADED ROD IN LIEU OF THE 90° BENT TIE ROD.

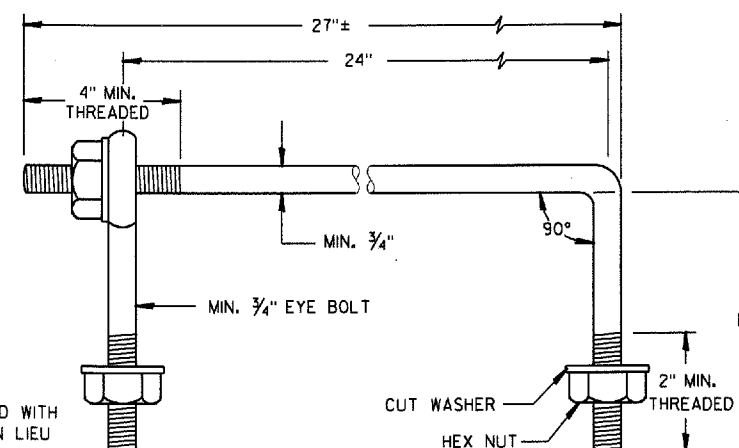

EYE BOLT AND TIE ROD

(JOINT TIES FOR 18" TO 66" DIA. CONCRETE PIPE)

EYE BOLT AND TIE ROD ASSEMBLY (ALTERNATE NO. 2)

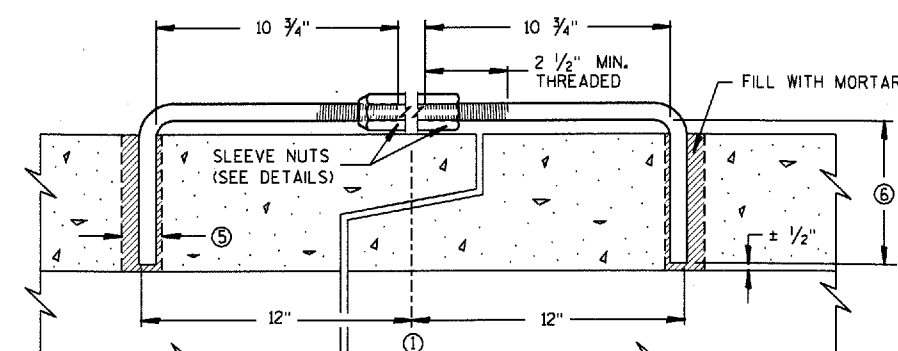

LONGITUDINAL SECTION

(JOINT TIES FOR 12" TO 108" DIA. CONCRETE PIPE)

ADJUSTABLE TIE ROD (ALTERNATE NO. 3)

JOINT TIES FOR CONCRETE PIPE

STATE OF WISCONSIN
DEPARTMENT OF TRANSPORTATION

APPROVED

9/19/92

DATE


FHWA

STATE DESIGN ENGINEER FOR HWYS


GENERAL NOTES

DETAILS OF CONSTRUCTION, MATERIALS AND WORKMANSHIP NOT SHOWN ON THIS DRAWING SHALL CONFORM TO THE PERTINENT REQUIREMENTS OF THE STANDARD SPECIFICATIONS, AND THE APPLICABLE SPECIAL PROVISIONS.

- ① W6 X 9 OR W6 X 8.5 STEEL POSTS AND NOTCHED PLASTIC BLOCKOUTS ARE ACCEPTABLE ALTERNATIVES FOR 6" X 8" WOOD POSTS WITH WOOD OR PLASTIC BLOCKOUTS. USE APPROVED NOTCHED PLASTIC BLOCKOUTS WITH STEEL POSTS.
DO NOT MIX STEEL POSTS AND WOOD POSTS IN A SINGLE INSTALLATION.
 - ② USE STRUCTURAL STEEL POSTS CONFORMING TO AASHTO M183. GALVANIZE ACCORDING TO AASHTO M 11L EITHER SET THE POSTS IN DRILLED HOLES OR DRIVE TO GRADE. REMOVE MUSHROOMING CAUSED BY DRIVING AND REPAIR DAMAGED SPALTER COATING ON GALVANIZED POSTS.
 - ③ INSTALL STEEL POSTS WITH HOLES ON APPROACHING TRAFFIC SIDE.
 - ④ USE EITHER WOOD OR APPROVED PLASTIC BLOCKOUTS ON WOOD POSTS.
 - ⑤ WHEN SPECIFIED IN THE PLANS, THE 2-FOOT MINIMUM TO HINGE POINT MAY BE REDUCED OR ELIMINATED IF EXISTING CONDITIONS DO NOT PERMIT THE DESIRABLE EARTHWORK.
INCREASE POST LENGTH TO PROVIDE A MINIMUM EMBEDMENT OF 3'-6" IF THE SHOULDER HINGE POINT IS LOCATED IN FRONT OF THE POST.
 - ⑥ IF ROCK IS ENCOUNTERED DURING EXCAVATION, THE ENGINEER MAY APPROVE USING A 12 INCH DIAMETER POST HOLE EXTENDING 20 INCHES DEEP INTO THE ROCK. PLACE GRANULAR MATERIAL IN THE BOTTOM OF THE HOLE APPROXIMATELY 2 1/2 INCHES DEEP. CUT THE POSTS TO LENGTH AND PLACE IN THE HOLE. BACKFILL WITH MATERIAL EXCAVATED FROM THE HOLE AND COMPACT ADEQUATELY.
- INSTALL BEAM GUARD SECTIONS AND ALL NECESSARY HARDWARE ACCORDING TO THE APPLICABLE PLAN AND CURRENT STANDARD AND SUPPLEMENTAL SPECIFICATIONS.
- ALL DIMENSIONS ARE SUBJECT TO MANUFACTURER'S TOLERANCES EXCEPT WHERE ALLOWABLE TOLERANCES ARE SHOWN.

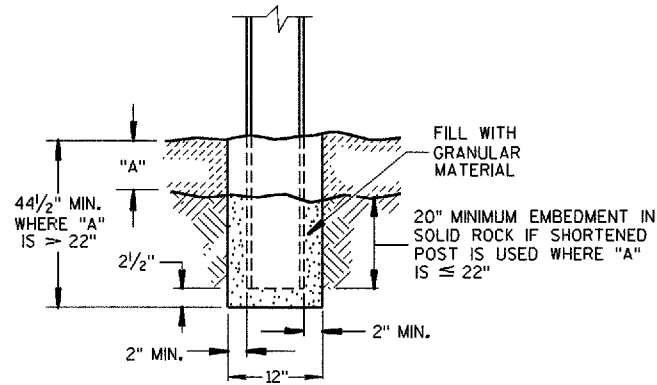


END VIEW
SETTING STEEL OR WOOD POST IN ROCK ⑥

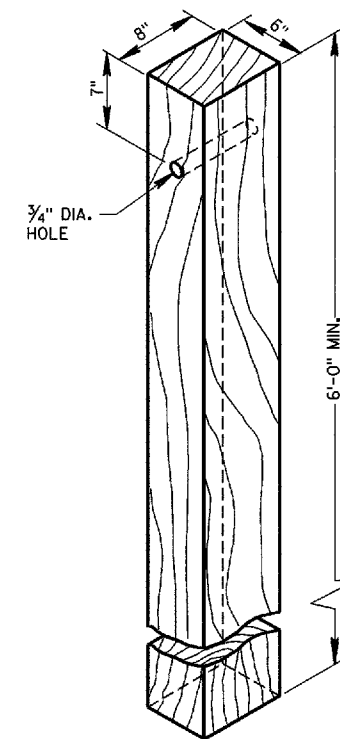


WOOD POST
(6" X 8") NOMINAL


OPTIONAL 1 3/16" DIA.
HOLE FOR HANDLING
DURING GALVANIZING.
(ONE PERMITTED)

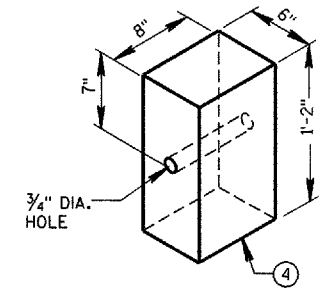


WOOD OR PLASTIC
BLOCKOUT FOR WOOD POSTS

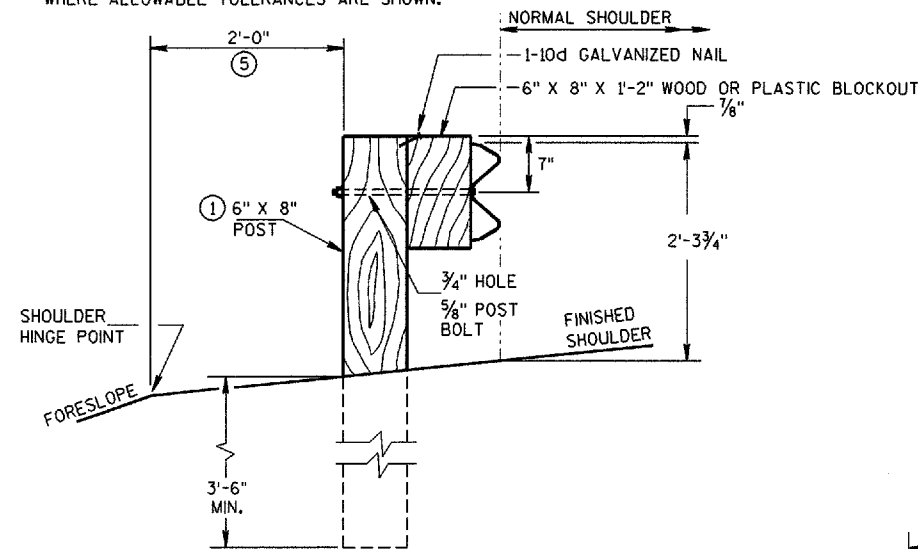


END VIEW
LOCATED ALONG A ROADWAY SHOULDER

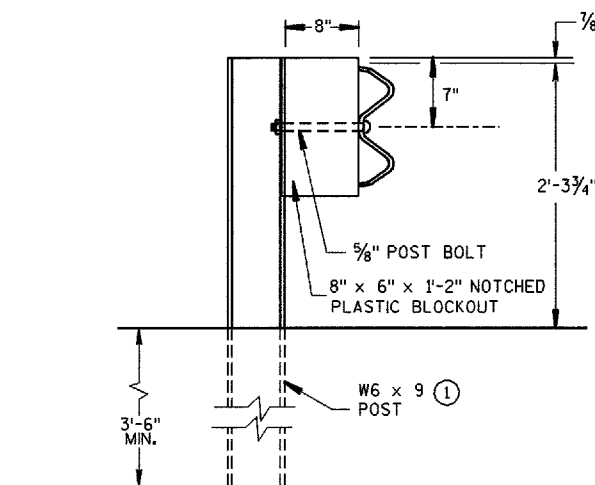


END VIEW
STEEL POST & NOTCHED
PLASTIC BLOCKOUT ALTERNATIVE

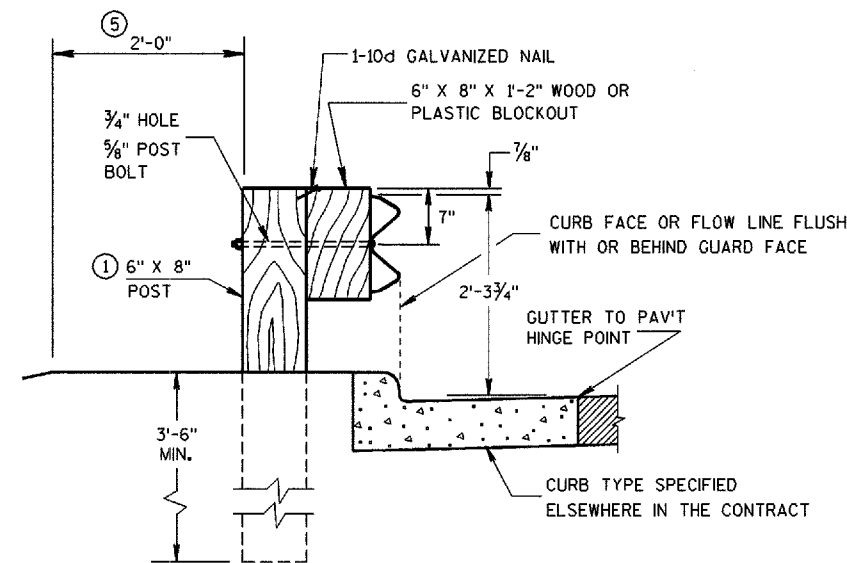


END VIEW
LOCATED ALONG A CURBED ROADWAY

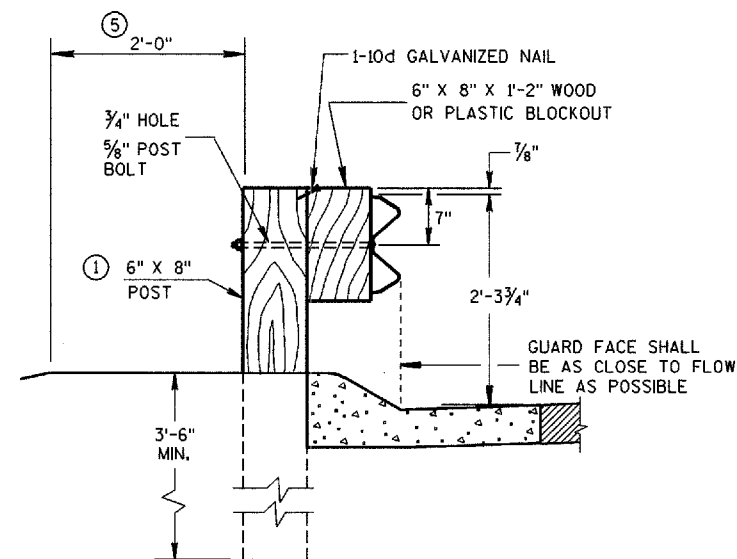


END VIEW
LOCATED ALONG A
MOUNTABLE CURBED ROADWAY

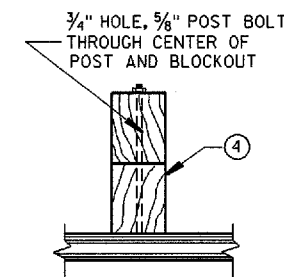

PLAN VIEW
WOOD POST,
BLOCKOUT & BEAM

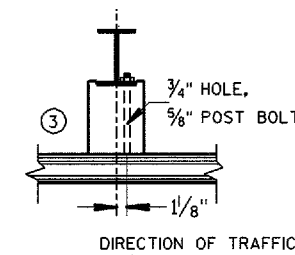


PLAN VIEW
STEEL POST, NOTCHED
PLASTIC BLOCKOUT & BEAM

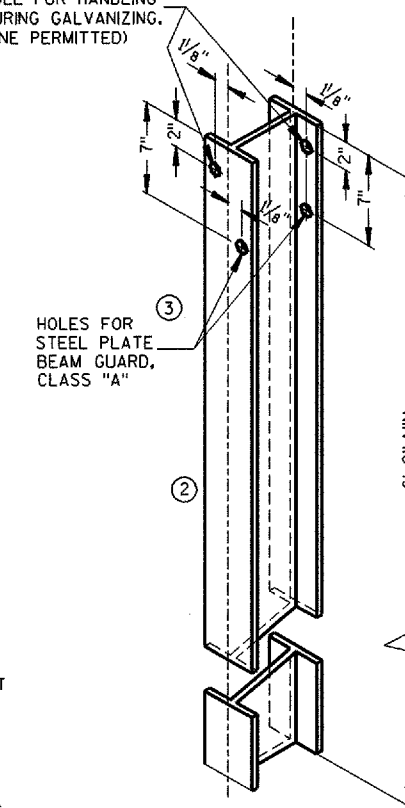

STEEL POST &
HOLE PUNCHING DETAIL
(W6 X 9) ①


ALL HOLES 1 3/16" DIAMETER EXCEPT AS NOTED

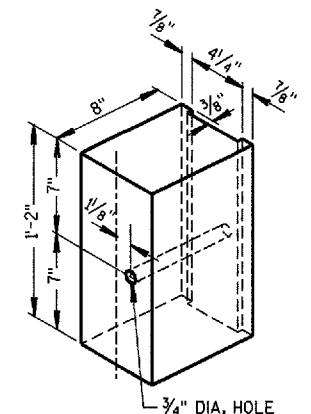




NOTCHED PLASTIC BLOCKOUT
FOR STEEL POSTS

STEEL PLATE BEAM GUARD,
CLASS 'A'
INSTALLATION & ELEMENTS

STATE OF WISCONSIN
DEPARTMENT OF TRANSPORTATION

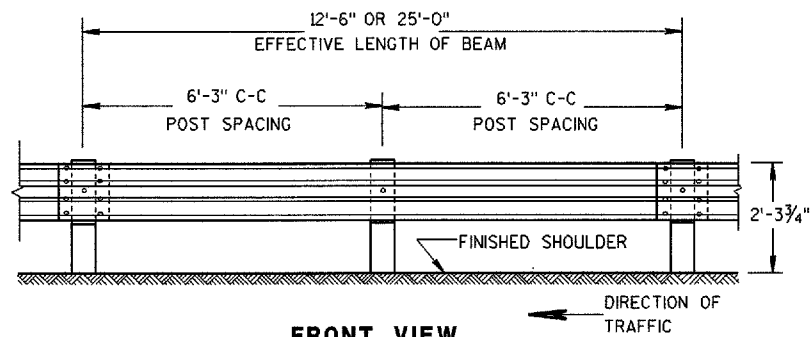



**PLAN VIEW
BEAM LAPPING DETAIL**

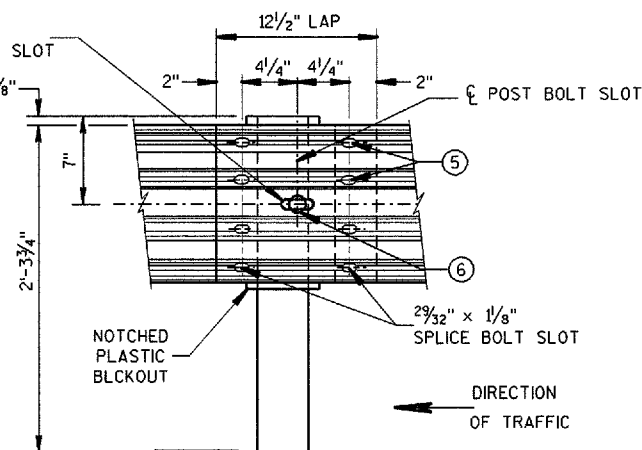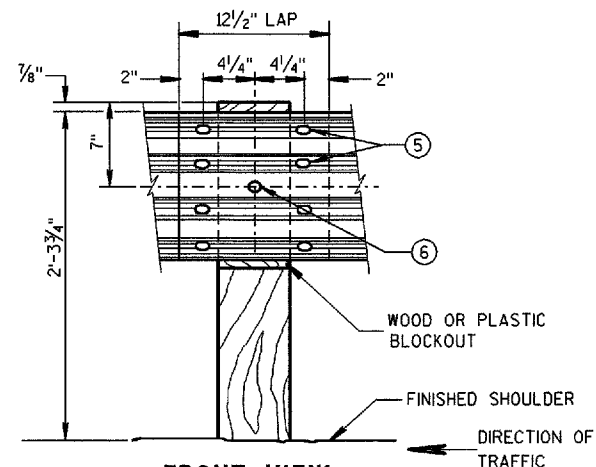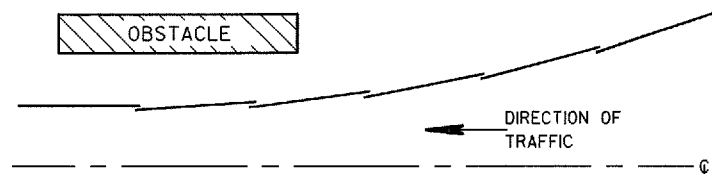

TYPICAL SPLICING DETAILS OF STEEL PLATE BEAM GUARD



REFLECTOR SPACING^②

| | BEAM GUARD LENGTH | REFLECTOR SPACING | NO. SURFACES REFLECTORIZED | MIN. NO. REFLECTORS |
|-----------------|-------------------|-------------------|----------------------------|---------------------|
| ONE WAY TRAFFIC | < 200' | 50' C-C | 1 | 3 |
| | > 200' | 100' C-C | 1 | 3 |
| TWO WAY TRAFFIC | < 200' | 25' C-C | 1 ③ | 6 |
| | > 200' | 50' C-C | 1 | 6 |
| TWO WAY TRAFFIC | < 200' | 50' C-C | 2 ④ | 3 |
| | > 200' | 100' C-C | 2 | 3 |

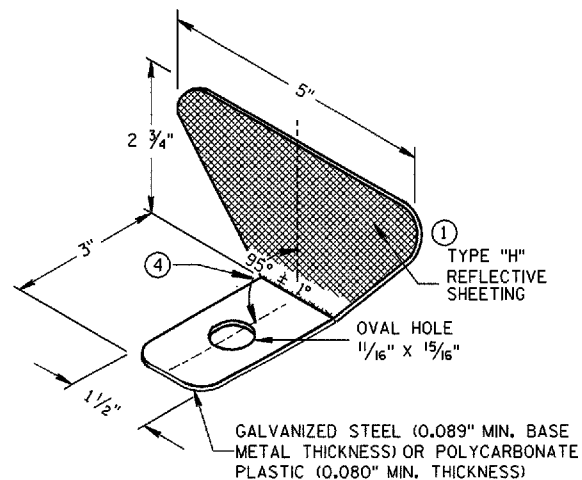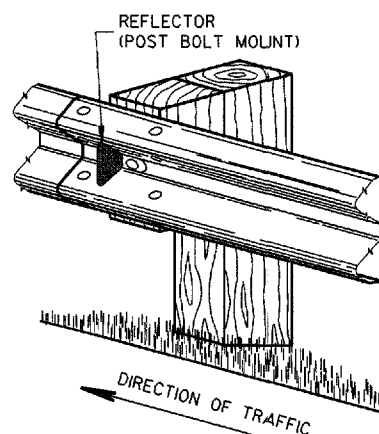


GENERAL NOTES

- ① PROVIDE TYPE "H" SILVER REFLECTIVE SHEETING ON ALL REFLECTORS EXCEPT THOSE LOCATED ALONG THE LEFT EDGE OF ONE-WAY ROADWAYS, WHICH SHALL BE PROVIDED WITH TYPE "H" YELLOW REFLECTIVE SHEETING.
- ② DO NOT INSTALL REFLECTORS ON THE FIRST 50 FEET OF THE APPROACH END OF THE ENERGY ABSORBING TERMINAL.
- ③ REVERSE EVERY OTHER REFLECTOR FOR 2-WAY VISIBILITY. THE CONTRACTOR MAY FURNISH TWO-SIDED REFLECTORS IN LIEU OF ONE-SIDED REFLECTORS.
- ④ PROVIDE AN ANGLE OF BEND OF 90° ± 1° FOR TWO-SIDED REFLECTORS.
- ⑤ 8 - 5/8" φ X 1 1/4" BUTTON HEAD BOLTS WITH OVAL SHOULDERS & RECESS NUTS.
- ⑥ 5/8" φ X 1'-6" BUTTON HEAD BOLT AND AND RECESS NUT WITH ROUND WASHER UNDER NUT.

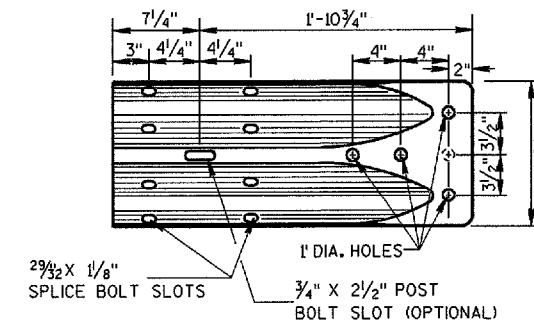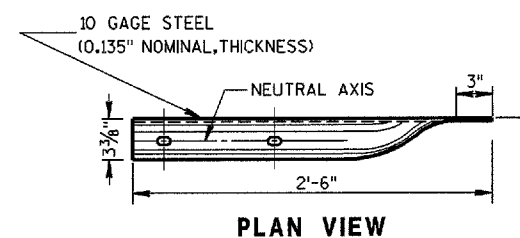

W BEAM TERMINAL CONNECTOR


(USE ONLY ON THE TRAFFIC EXIT END OF ONE WAY BRIDGES)

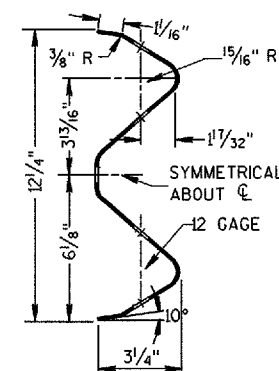


STEEL PLATE BEAM GUARD, CLASS 'A', INSTALLATION & ELEMENTS

STATE OF WISCONSIN
DEPARTMENT OF TRANSPORTATION


APPROVED
12/08/00
DATE
John Haverburg
CHIEF ROADWAY DEVELOPMENT ENGINEER
FHWA

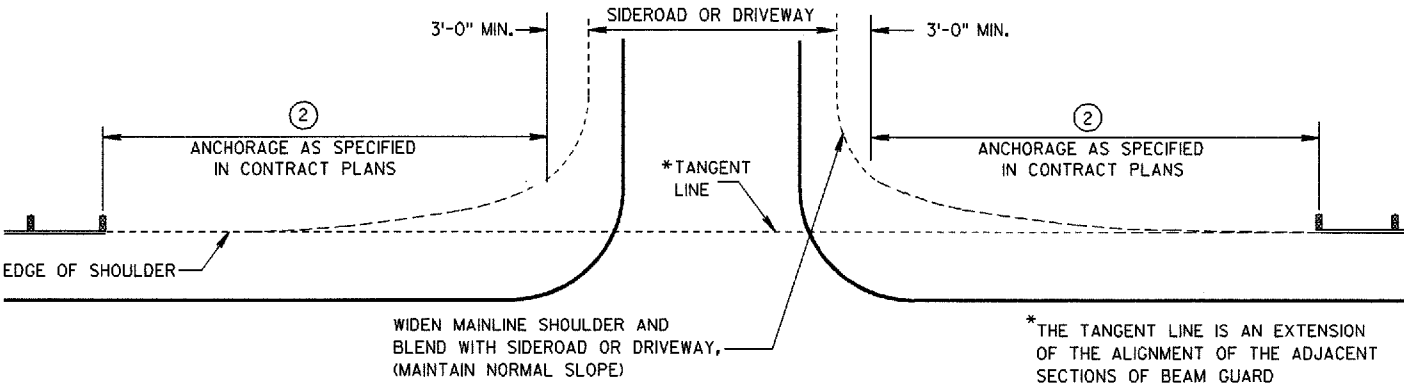


BEAM GUARD AT SIDEROADS OR DRIVEWAYS

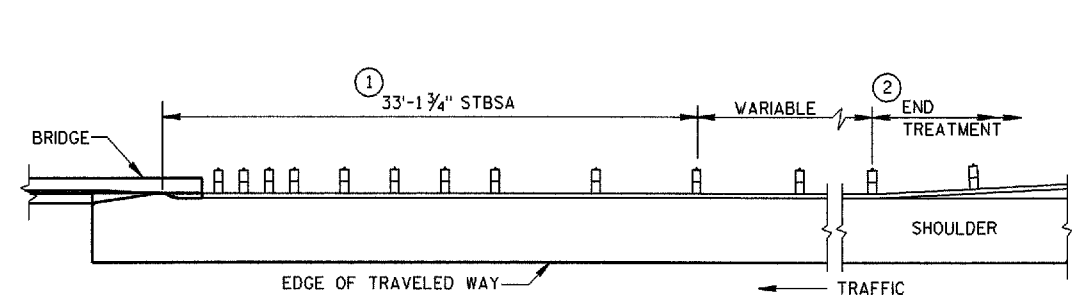


BEAM GUARD AT FULL WIDTH BRIDGES

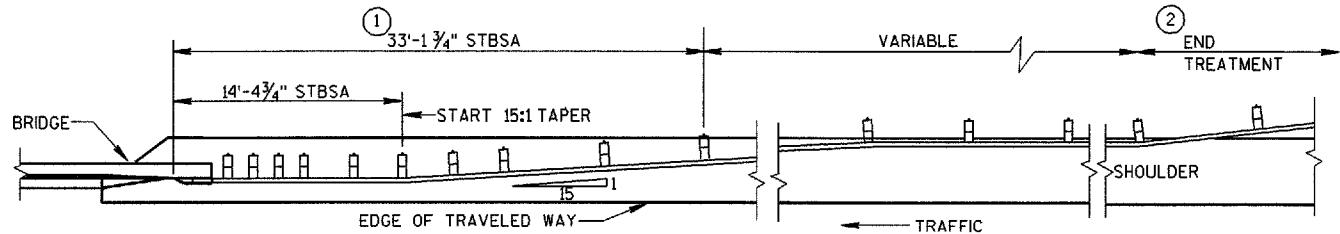

BEAM GUARD AT NARROW BRIDGES
(FLARED TO SHOULDER EDGE, THEN PARALLEL TO ROADWAY)

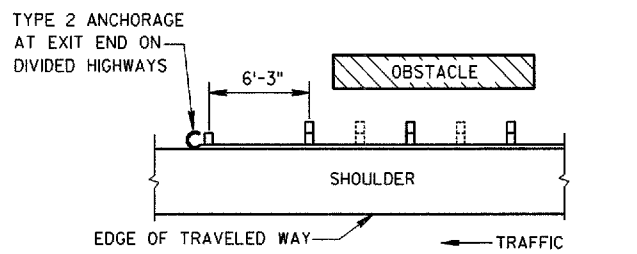

BEAM GUARD AT OBSTACLES
EXIT END - ONE WAY TRAFFIC

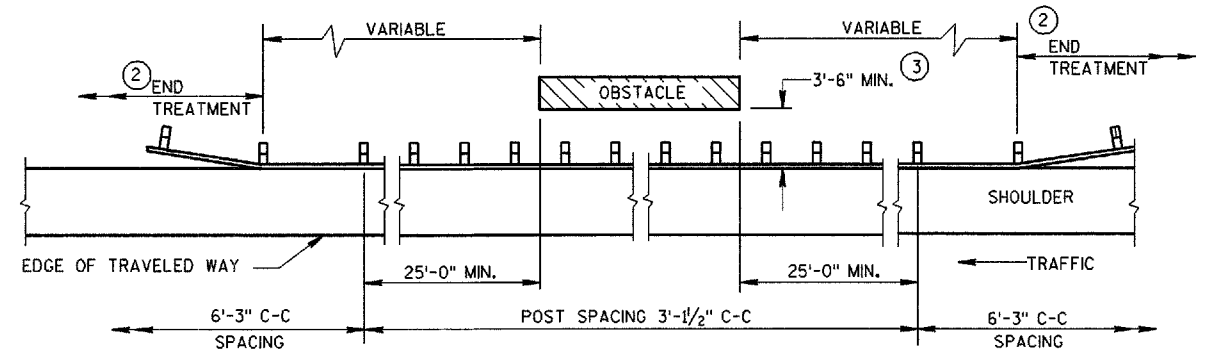

BEAM GUARD AT OSBSTACLES - TWO WAY TRAFFIC
(RAIL TO OBSTACLE CLEARANCE 3'-6" TO 4'-6")

GENERAL NOTES

DETAILS OF CONSTRUCTION, MATERIALS AND WORKMANSHIP NOT SHOWN ON THIS DRAWING SHALL CONFORM TO THE PERTINENT REQUIREMENTS OF THE STANDARD SPECIFICATIONS AND THE APPLICABLE SPECIAL PROVISIONS.

W6 X 9 OR W6 X 8.5 STEEL POSTS WITH NOTCHED PLASTIC BLOCKOUTS ARE ACCEPTABLE ALTERNATIVES FOR 6" X 8" WOOD POSTS WITH WOOD OR PLASTIC BLOCKOUTS. USE APPROVED NOTCHED PLASTIC BLOCKOUTS WITH STEEL POSTS.

THE LOCATIONS AND LENGTHS OF BEAM GUARD ARE SHOWN ELSEWHERE IN THE PLAN.

- ① USE STEEL THRIE BEAM STRUCTURAL APPROACH (STBSA).
- ② USE AN APPROVED END TREATMENT FOR THE TRAFFIC APPROACH SIDE OF BRIDGE/OBSTACLES. USE TYPE 2 ANCHORAGE ONLY AT THE DOWNSTREAM ENDS OF BEAM GUARD LOCATED ALONG ROADWAYS WITH ONE WAY TRAFFIC.

③ DESIGN DEFLECTION OF W-BEAM BARRIER SYSYTEM

| LATERAL DISTANCE TO FIXED OBJECT | POST SPACING |
|----------------------------------|--------------|
| 3'-6" TO 4'-6" | 3' - 1 1/2" |
| 4'-6" AND OVER | 6' - 3" |

S.D.D. 14 B 18-4a



STEEL PLATE BEAM GUARD, CLASS 'A'
(AT BRIDGES, OBSTACLES AND SIDEROADS/DRIVEWAYS)

STATE OF WISCONSIN
DEPARTMENT OF TRANSPORTATION


APPROVED
12/08/00
DATE

John Haverberg
CHIEF ROADWAY DEVELOPMENT ENGINEER


FHWA

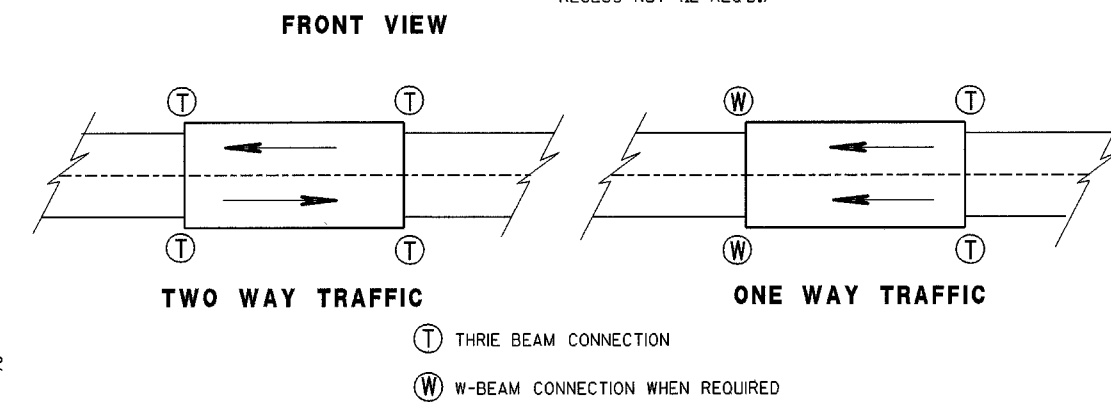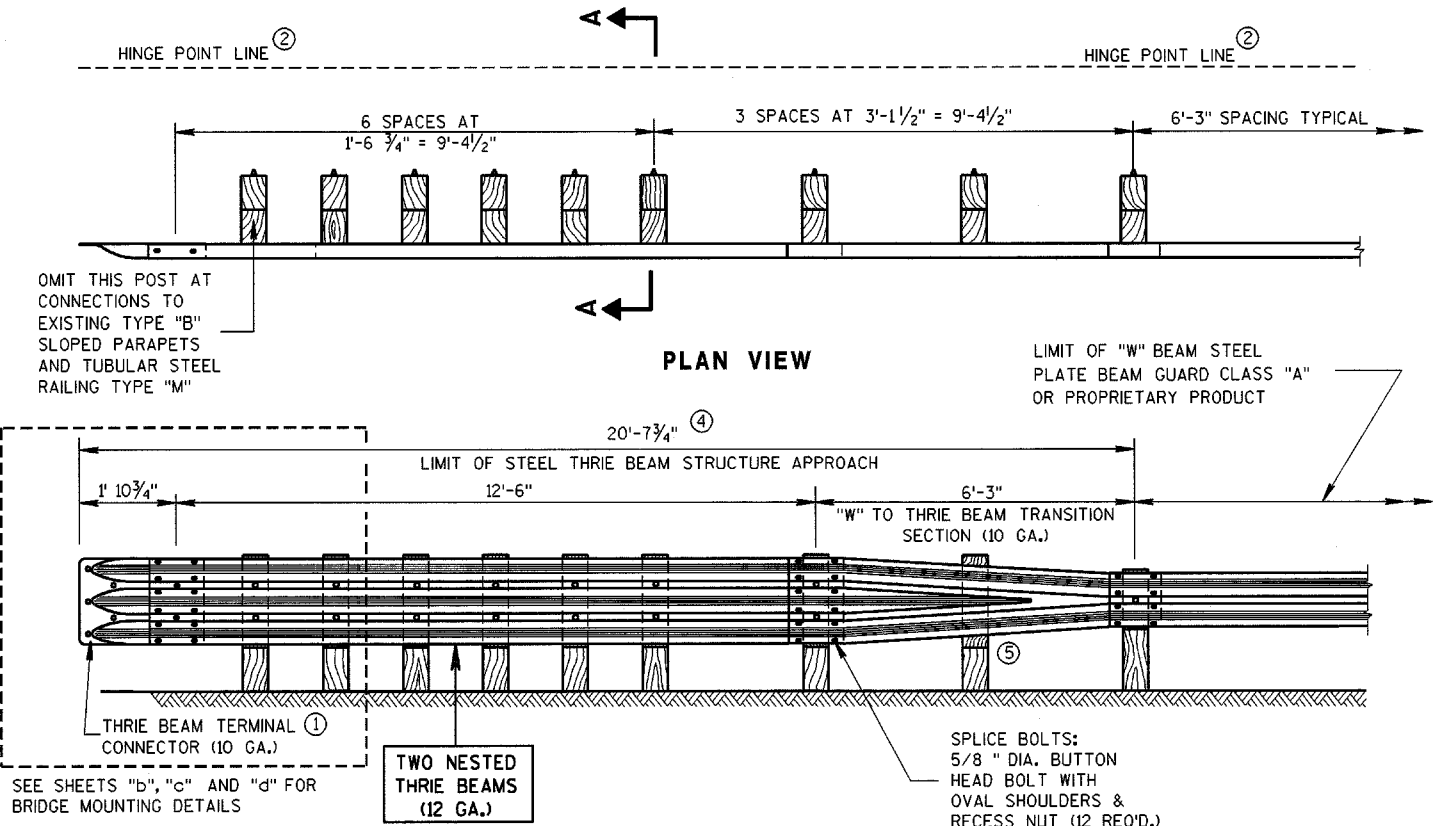


TYPICAL LOCATIONS OF THRIE BEAM AND W-BEAM CONNECTIONS TO BRIDGE

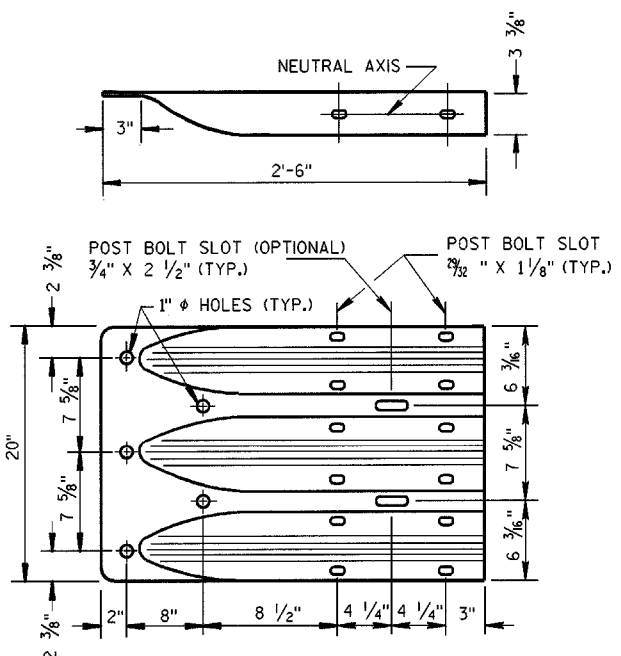


THRIE BEAM TERMINAL CONNECTOR

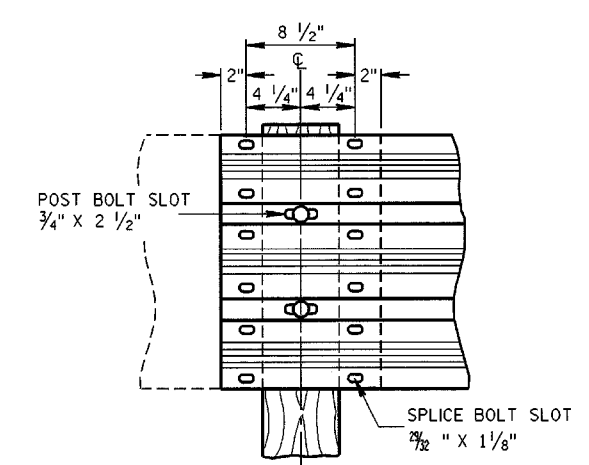

THRIE BEAM SPLICE

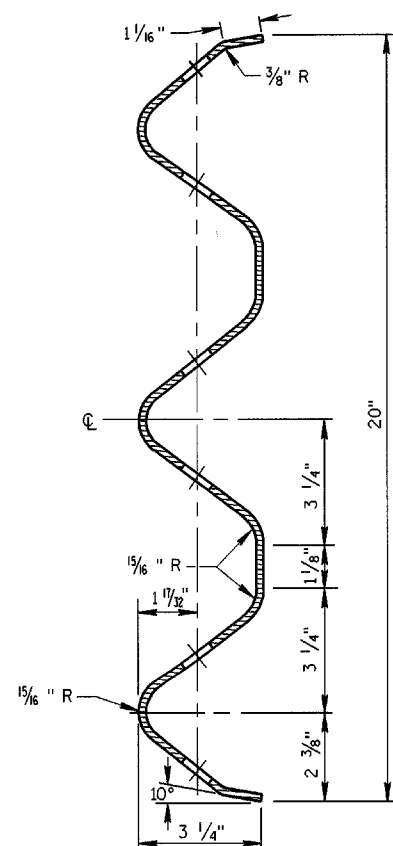

SECTION THRU THRIE BEAM RAIL ELEMENT

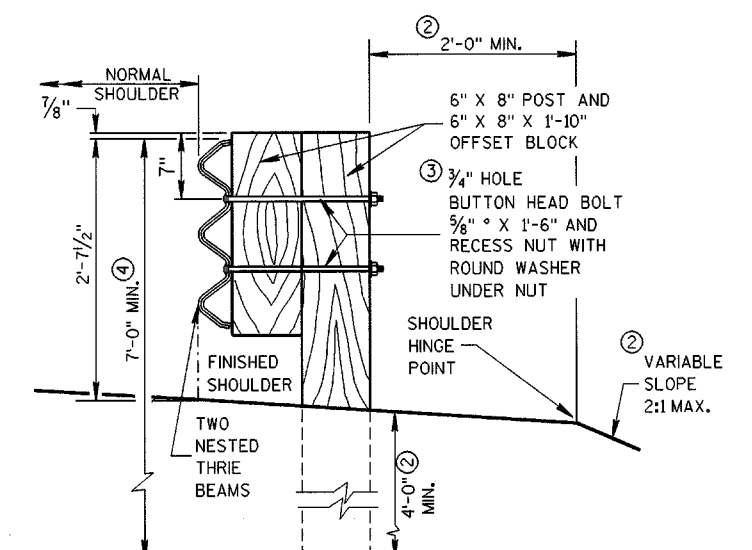

SECTION A-A

GENERAL NOTES

DETAILS OF CONSTRUCTION, MATERIALS AND WORKMANSHIP NOT SHOWN ON THIS DRAWING SHALL CONFORM TO THE PERTINENT REQUIREMENTS OF THE STANDARD SPECIFICATIONS AND THE APPLICABLE SPECIAL PROVISIONS.

FURNISH AND CONSTRUCT THRIE BEAM STRUCTURAL APPROACH ACCORDING TO THE REQUIREMENTS OF SECTION 614 OF THE STANDARD SPECIFICATIONS. THRIE BEAM SECTIONS SHALL CONFORM TO THE REQUIREMENTS OF AASHTO DESIGNATION M180, CLASS "A", TYPE 2.


BOLT THE THRIE BEAM TO ALL POSTS AND BLOCKOUTS. DRILL OR PUNCH BOLT HOLES IN THE BEAM IF THE POST SPACING IS LESS THAN 6'-3".

DO NOT USE STEEL POSTS AND NOTCHED PLASTIC BLOCKOUTS IN THE STEEL THRIE BEAM STRUCTURAL APPROACH AND THE TRANSITION SECTION OF STEEL PLATE BEAM GUARD, CLASS "A" INSTALLATIONS.

IF ROCK IS ENCOUNTERED DURING EXCAVATION, THE ENGINEER MAY APPROVE USING A 12 INCH DIAMETER POST HOLE EXTENDING 20 INCHES DEEP INTO THE ROCK. PLACE GRANULAR MATERIAL IN THE BOTTOM OF THE HOLE APPROXIMATELY 2 1/2 INCHES DEEP. CUT THE POSTS TO LENGTH AND PLACE IN THE HOLE. BACKFILL WITH MATERIAL EXCAVATED FROM THE HOLE AND COMPACT ADEQUATELY, (SEE SDD 14 B 15-4a).

- ① BRIDGE RAILING TYPE "W" DOES NOT REQUIRE A TERMINAL CONNECTOR.
- ② MINIMUM EMBEDMENT SHALL BE 4'-0". WHERE EXISTING CONDITIONS DO NOT PERMIT THE APPROPRIATE EARTHWORK SHOWN ON THE PLAN TYPICAL SECTIONS OR DETAILS, THE ENGINEER MAY ALLOW THE REDUCTION OR ELIMINATION OF THE 2 FOOT DISTANCE TO THE HINGE POINT. OTHERWISE BUILD AS THE PLAN SHOWS OR AS THE ENGINEER DIRECTS. IF THE 2 FOOT DISTANCE TO THE HINGE POINT IS REDUCED OR ELIMINATED, INCREASE THE POST EMBEDMENT DEPTH TO 4'-6" OR MORE.
- ③ BOLTS SHALL CONFORM TO THE REQUIREMENTS OF ASTM F-1554, GRADE 55. NUTS SHALL CONFORM TO THE REQUIREMENTS OF ASTM A-563 DH.
- ④ ALL WOOD POSTS MUST BE 6" X 8" AND AT LEAST 7'-0" LONG.
- ⑤ DO NOT ATTACH POST IN "W" TO THRIE BEAM TRANSITION SECTION.

| | |
|--|--|
| STEEL THRIE BEAM STRUCTURE APPROACH | |
| STATE OF WISCONSIN DEPARTMENT OF TRANSPORTATION | |

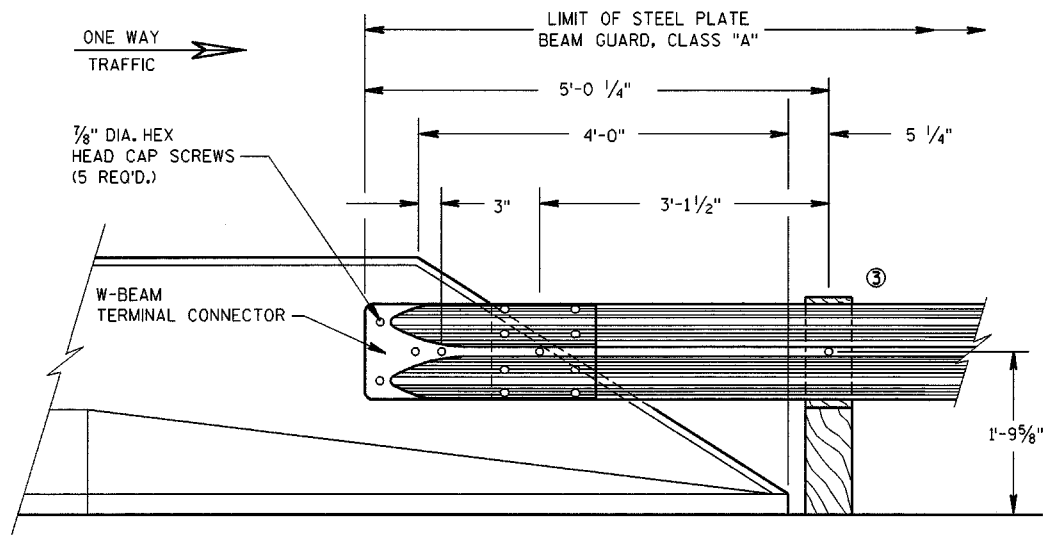

FRONT VIEW
W BEAM CONNECTION TO
PARAPETS WITH SLOPED ENDS
(USE ONLY AT TRAFFIC EXIT END OF ONE WAY BRIDGE)

GENERAL NOTES

THESE ARE TYPICAL CONNECTION DETAILS. ADJUST THE POSITION OF CONNECTIONS TO EXISTING BRIDGES TO FIT THE ACTUAL BRIDGE AND SITE DIMENSIONS.


BOLTS, PLATES, NUTS AND WASHERS SHALL CONFORM TO THE REQUIREMENTS OF ASTM SPECIFICATION A 325, AND BE GALVANIZED IN ACCORDANCE WITH ASTM A 153.

① INCLUDE THE PAYMENT FOR DRILLING BOLT HOLES THROUGH THE PARAPET, AND THE BACKUP PLATE AND ALL BOLTS, NUTS AND WASHERS IN THE ITEM "STEEL THRIE BEAM STRUCTURAL APPROACH".


② EACH BOLT AT THE BACK FACE OF THE PARAPET REQUIRES A HARDENED ROUND STEEL WASHER WITH A 2 1/4" O.D. X 5/32" THICK.

③ W6 X 9 OR W6 X 8.5 STEEL POSTS AND NOTCHED PLASTIC BLOCKOUTS ARE ACCEPTABLE ALTERNATIVES FOR 6" X 8" WOOD POST WITH WOOD OR PLASTIC BLOCKOUTS. USE APPROVED NOTCHED PLASTIC BLOCKOUTS WITH STEEL POSTS.

DO NOT USE STEEL POSTS AND NOTCHED PLASTIC BLOCKOUTS IN THE STEEL THRIE BEAM STRUCTURAL APPROACH AND THE TRANSITION SECTION OF STEEL PLATE BEAM GUARD, CLASS "A" INSTALLATIONS.

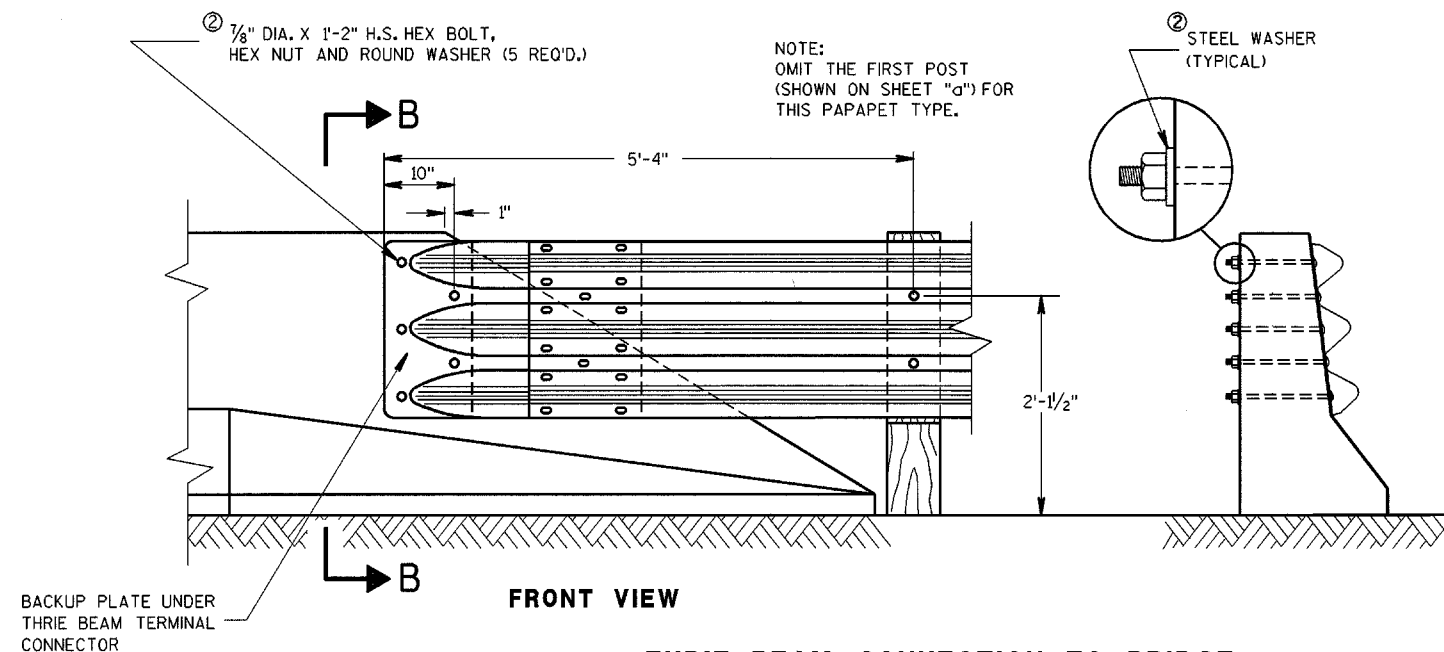

FRONT VIEW
THRIE BEAM CONNECTION TO BRIDGE
PARAPETS WITH SLOPED ENDS

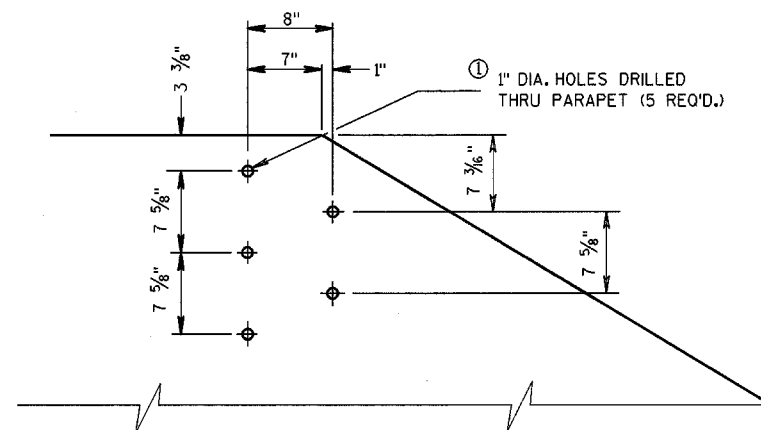

DRILL HOLE LOCATION AND PATTERN
FOR THRIE BEAM CONNECTION

STEEL THRIE BEAM STRUCTURE
APPROACH, CONNECTION TO
SLOPED END PARAPETS


STATE OF WISCONSIN
DEPARTMENT OF TRANSPORTATION

APPROVED


7/12/04
 DATE

FHWA



CHIEF ROADSIDE DEVELOPMENT ENGINEER

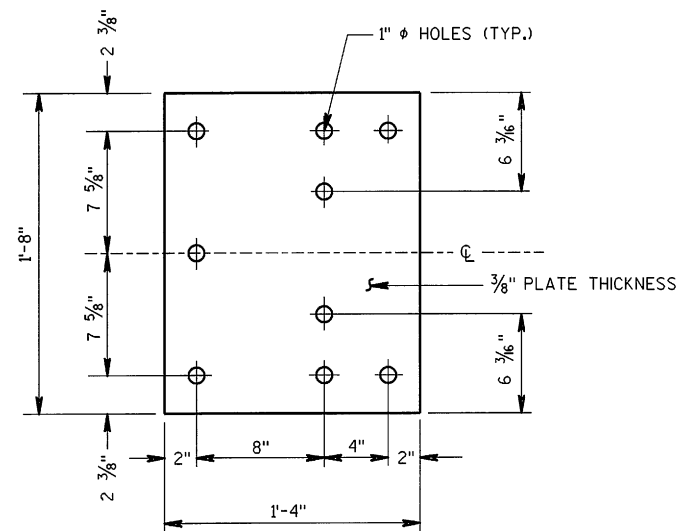


BACK-UP PLATE DETAIL

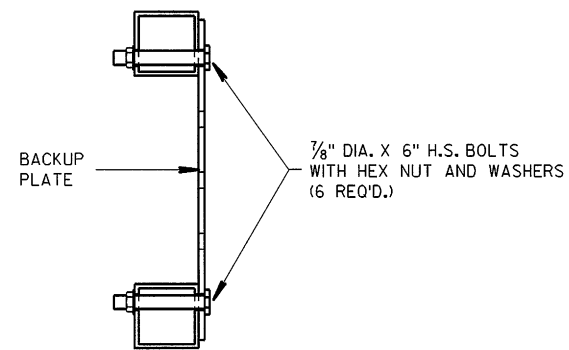

SECTION A-A

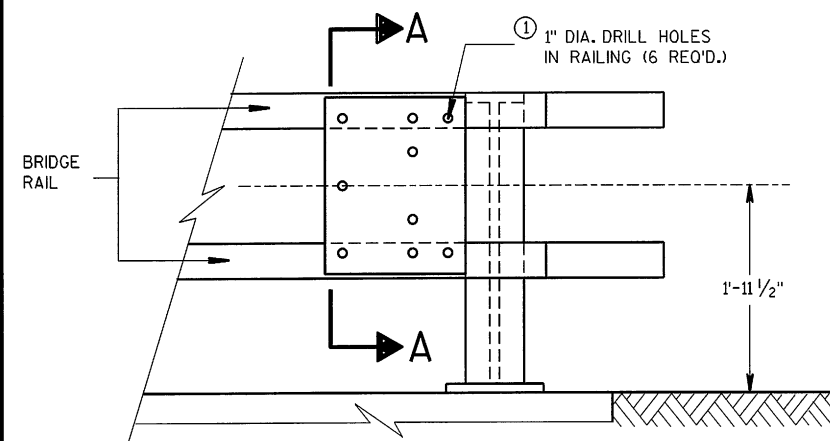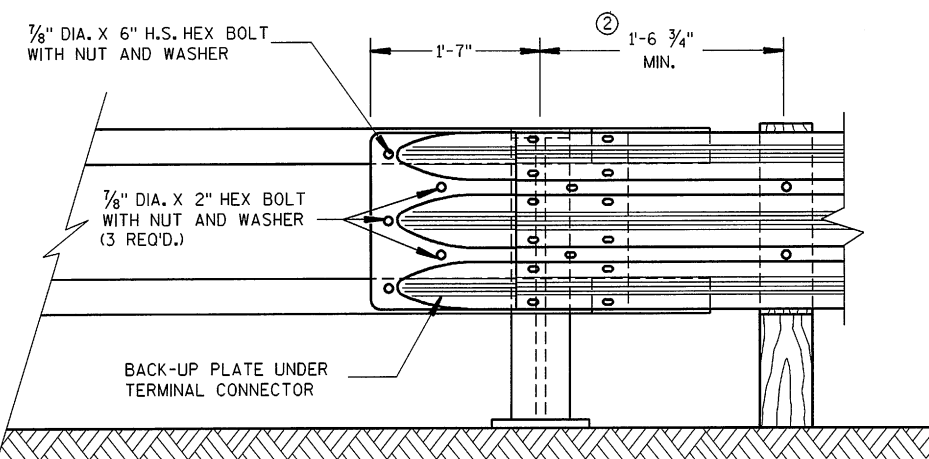BACK-UP PLATE MOUNTING
ONTO BRIDGE RAILING

FRONT VIEW

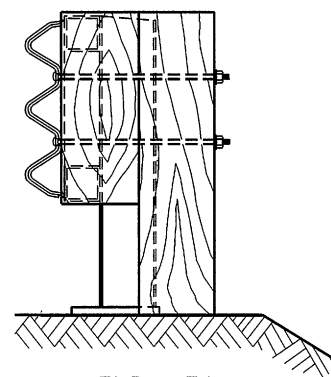
THRIE BEAM CONNECTION TO
TUBULAR RAILING TYPE "F"

END VIEW

GENERAL NOTES

BOLTS, PLATES, NUTS AND WASHERS SHALL CONFORM TO THE REQUIREMENTS OF ASTM SPECIFICATION A 325 AND BE GALVANIZED IN ACCORDANCE WITH ASTM A 153.

- ① INCLUDE THE PAYMENT FOR DRILLING HOLES IN RAILING IN THE ITEM "STEEL THRIE BEAM STRUCTURE APPROACH".
- ② VARY THIS DIMENSION DEPENDING ON ABUTMENT TYPE, WINGWALL DETAILS, AND ANGLE OF SKEW. PLACE THE FIRST WOOD POST OFF THE BRIDGE SHALL AS CLOSE AS FEASIBLE TO THE STEEL END POST.

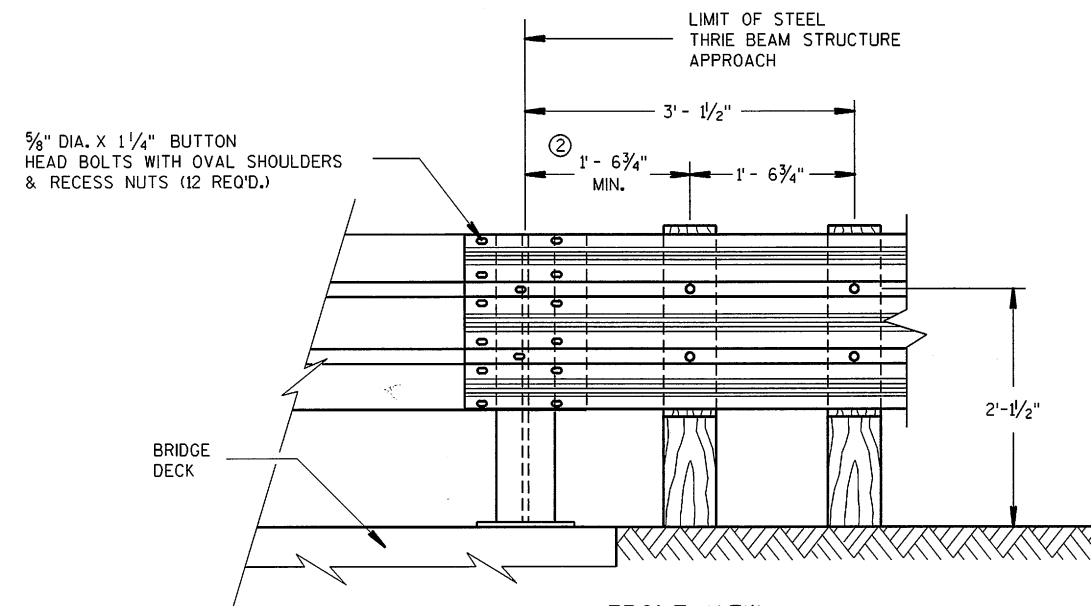FRONT VIEW
THRIE BEAM CONNECTION TO
STEEL RAILING TYPE "W"

STEEL THRIE BEAM STRUCTURE
APPROACH, CONNECTION TO BRIDGE
RAILING TYPES "F" AND "W"

STATE OF WISCONSIN
DEPARTMENT OF TRANSPORTATION

APPROVED

08/19/04

DATE

FHWA



CHIEF ROADWAY DEVELOPMENT ENGINEER

BILL OF MATERIALS


| NOTE NO. | QTY. | DESCRIPTION |
|----------|------|--|
| ① | 4 | WOOD BREAKAWAY TERMINAL POST: 5 1/2" X 7 1/2" X 3'-9" |
| ② | 4 | STEEL TUBE: TS 8" X 6" X 0.188", 4'-6" LONG |
| ③ | 4 | SOIL PLATE: 2'-0" X 1'-6" X 1/4" |
| ④ | 4 | WOOD BREAKAWAY CRT POST: 6" X 8" X 6'-0" |
| ⑤ | 6 | WOOD OFFSET BLOCKS: 6' X 8" X 1'-2" |
| ⑥ | 1 | PIPE SLEEVE: 2" X 5 1/2" STANDARD PIPE |
| ⑦ | 1 | BEARING PLATE |
| ⑧ | 1 | BCT CABLE ASSEMBLY |
| ⑨ | 1 | CABLE ANCHOR BOX |
| ⑩ | 1 | STRUT & YOKE |
| ⑪ | 1 | STEEL PLATE BEAM, END PANEL 12 GA. 13'-6 1/2" LONG FOR SKT-350, ET-2000 AND ET-2000 PLUS |
| ⑫ | 3 | STEEL PLATE BEAM: 12 GA. 13'-6 1/2" |
| ⑬ | 1 | ET-2000/ET-2000 PLUS GUARDRAIL EXTRUDER OR SKT-350 IMPACT HEAD: AS FURNISHED BY MANUFACTURER |
| ⑭ | 1 | REFLECTIVE SHEETING: 18" X 18" |

GENERAL NOTES


- (A) USE 3:1 OR FLATTER SLOPE FOR INSTALLATION ON EXISTING HIGHWAYS.
- (B) DO NOT ATTACH GUARDRAIL TO POST BLOCKS AT POSTS NO. 3, 5 & 7.
- (C) AFTER FINAL ASSEMBLY, RECHECK CABLE TO BE SURE IT IS TAUT AND HAS NOT RELAXED.
- STEEL POSTS SHALL NOT BE ALLOWED FOR USE WITH ENERGY ABSORBING TERMINALS.
- DO NOT INSTALL REFLECTORS ON THE FIRST 50 FEET OF THE APPROACH END OF THE ENERGY ABSORBING TERMINAL.
- * DO NOT ATTACH BLOCKOUTS TO POSTS 1 AND 2.

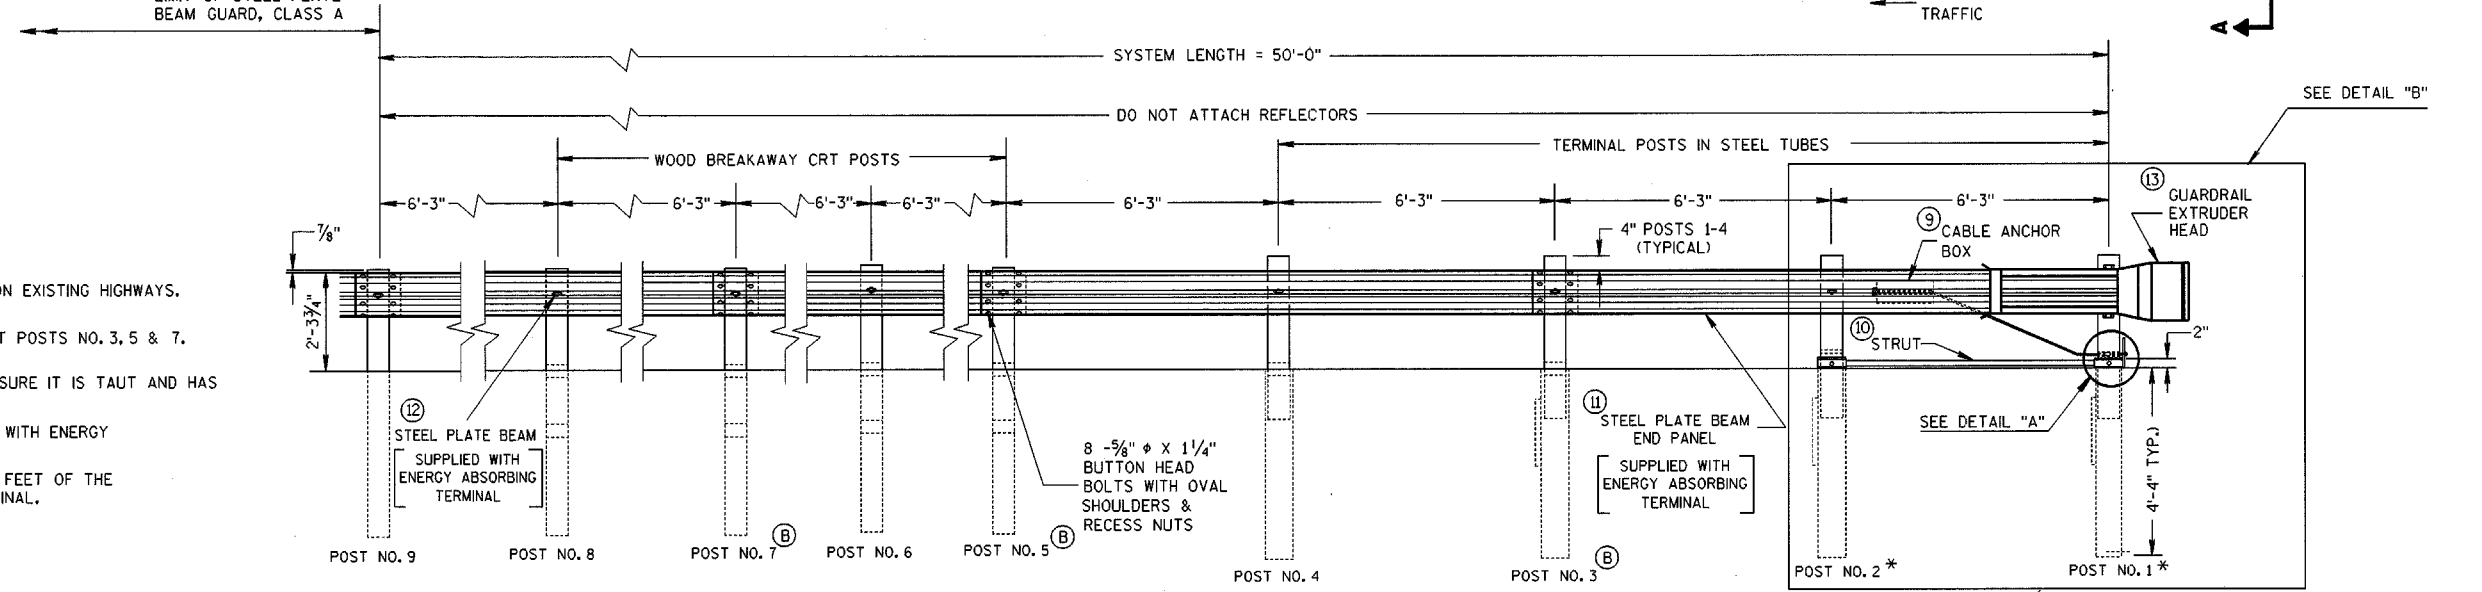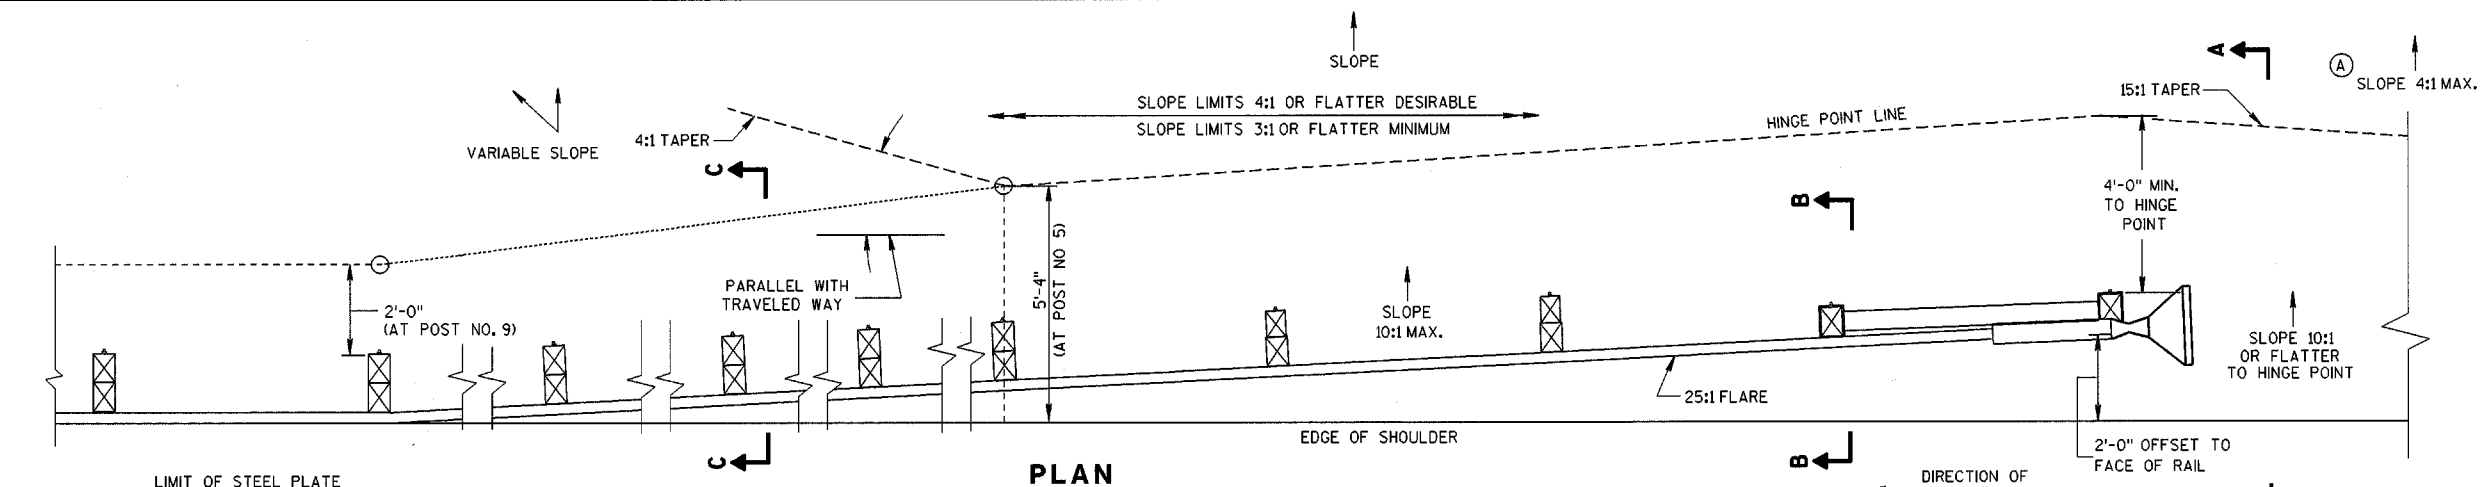


ELEVATION

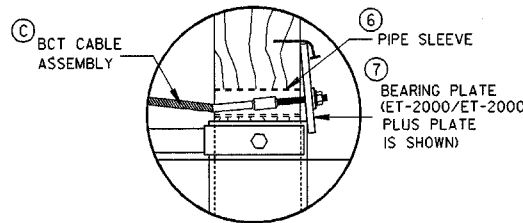

DETAIL "A"

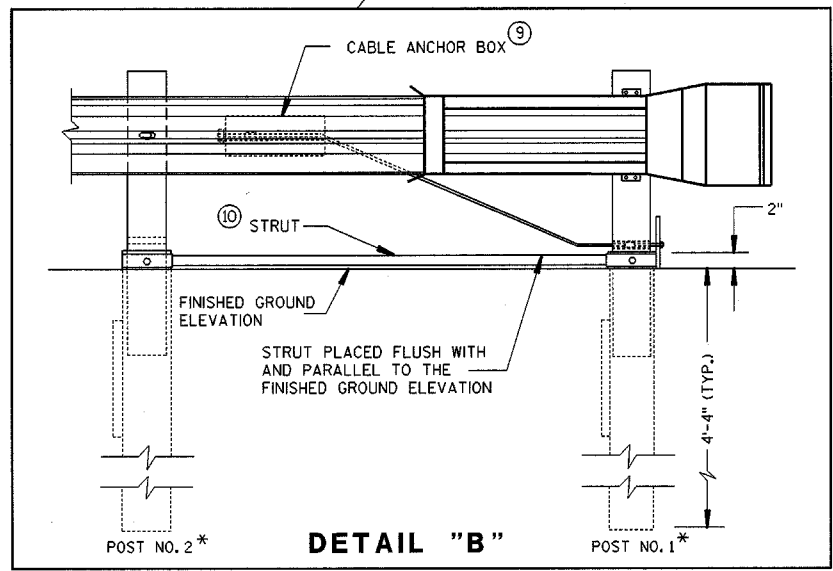


DETAIL "B"

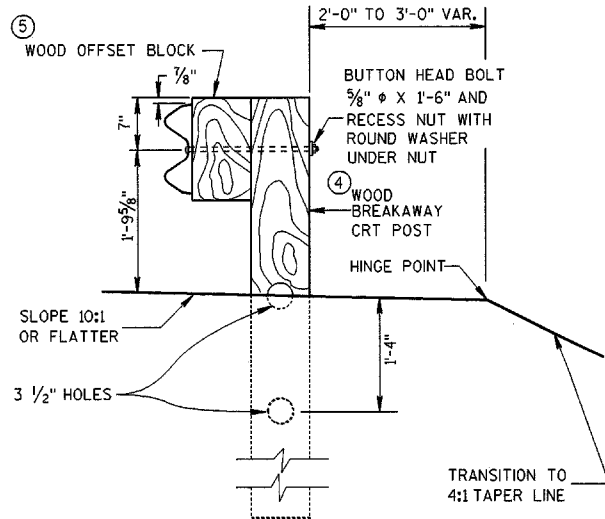


SECTION C-C

TYPICAL AT POST NOS. 4, 6, 8

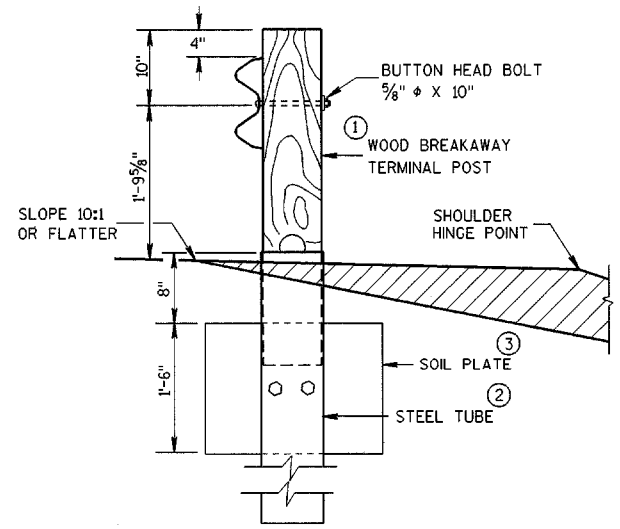

SECTION B-B

TYPICAL AT POST NO. 2*

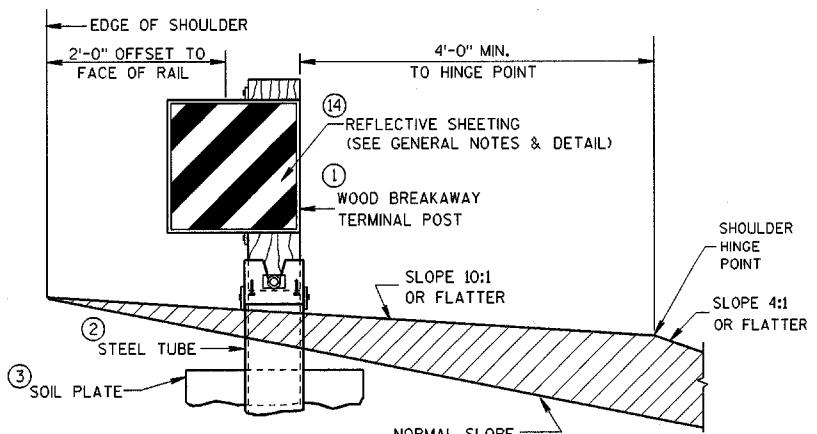


SECTION A-A


TYPICAL AT POST NO. 1*

**STEEL PLATE BEAM GUARD
ENERGY ABSORBING TERMINAL**


STATE OF WISCONSIN
DEPARTMENT OF TRANSPORTATION

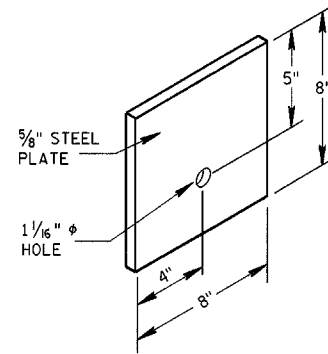

STEEL BEARING PLATE (SKT-350)

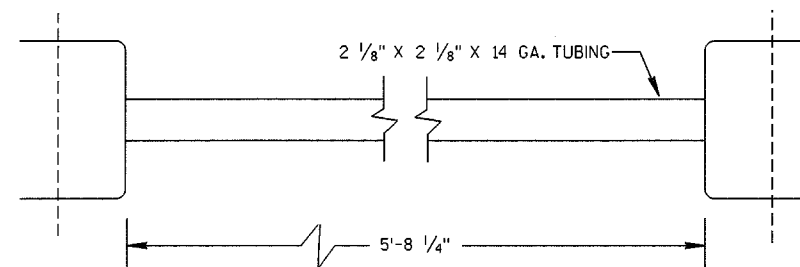


STRUT DETAIL (SKT-350)

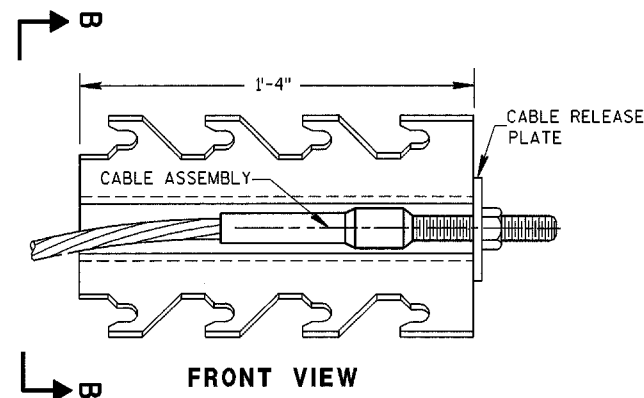


CABLE ANCHOR BOX (SKT-350)


(SKT-350)

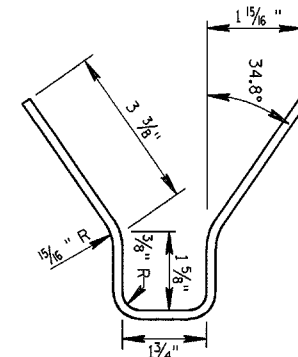


SECTION B-B

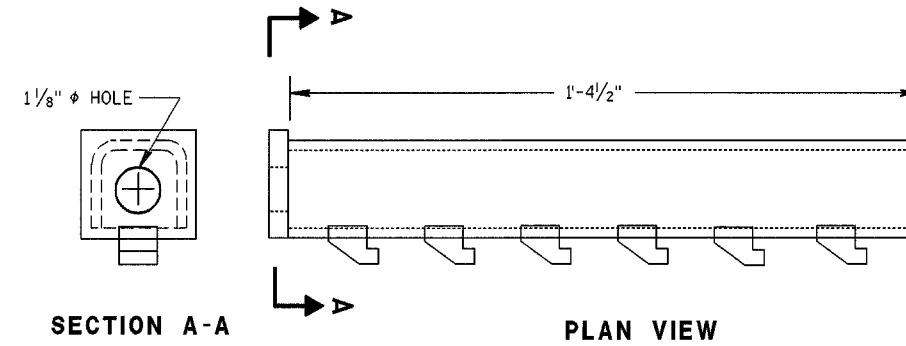


CABLE ANCHOR BOX (ET-2000/ET-2000 PLUS)

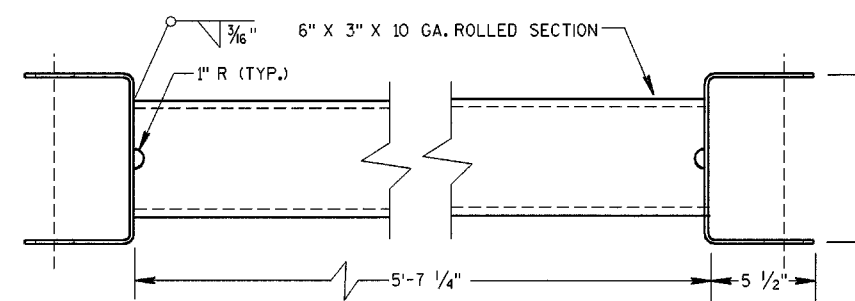

STRUT DETAIL (ET-2000/ET-2000 PLUS)

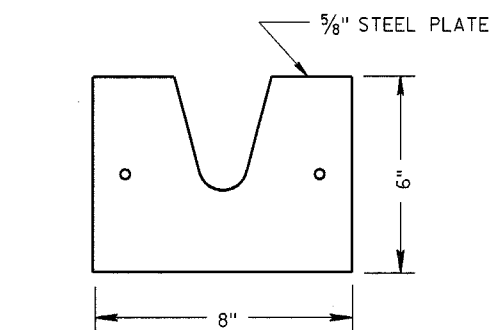


**STEEL BEARING PLATE
(ET-2000/ET-2000 PLUS)**

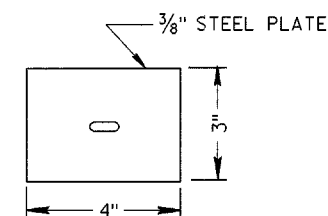

**BEARING PLATE WASHER
(ET-2000/ET-2000 PLUS)**


(ET-2000/ET-2000 PLUS)

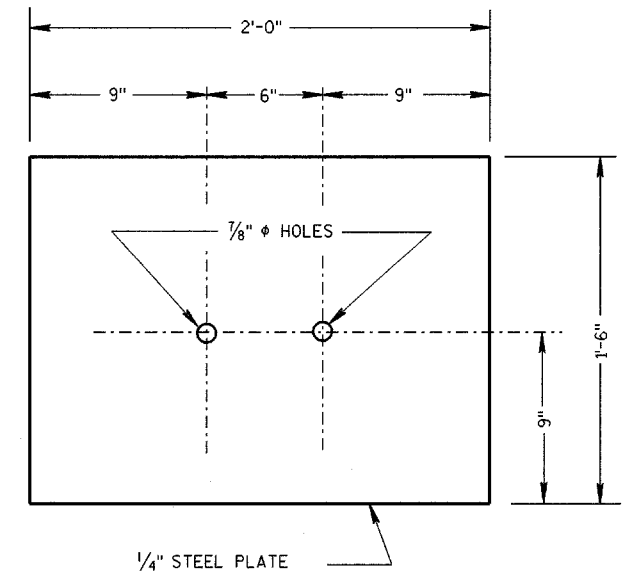

**SOIL PLATE
(SKT-350, ET-2000/ET-2000 PLUS)**


**STEEL PLATE BEAM GUARD
ENERGY ABSORBING TERMINAL**

**STATE OF WISCONSIN
DEPARTMENT OF TRANSPORTATION**

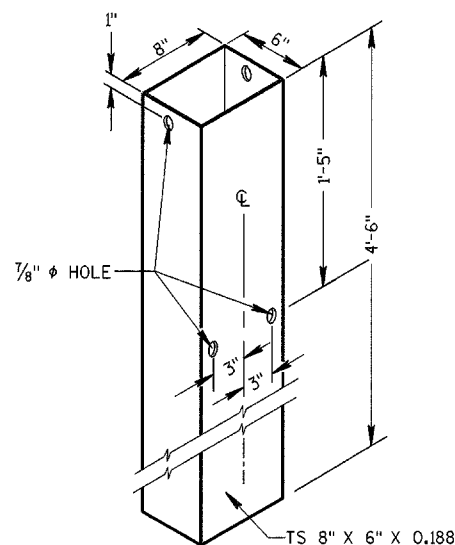


STEEL TUBE

(POSTS NO. 1-4)
THE STEEL TUBE SHALL CONFORM
TO REQUIREMENTS OF ASTM A500

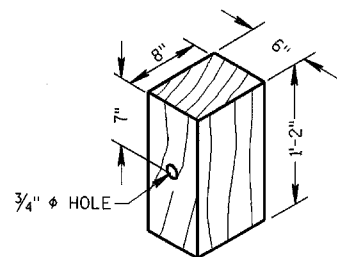


WOOD OFFSET BLOCK

REQ'D. AT ALL POSTS EXCEPT POST NO'S 1 & 2

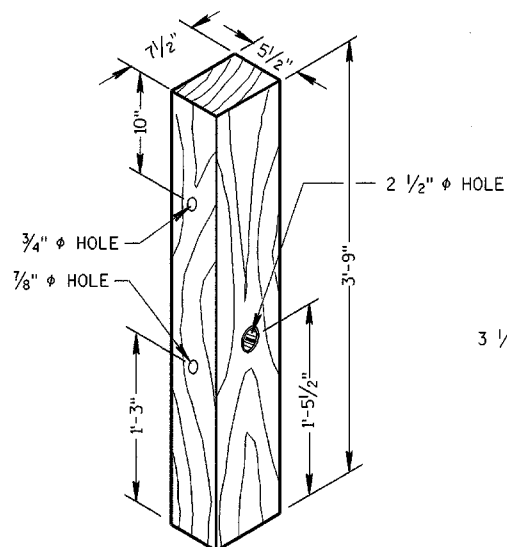

TERMINAL POST


(POSTS NO. 1-4)

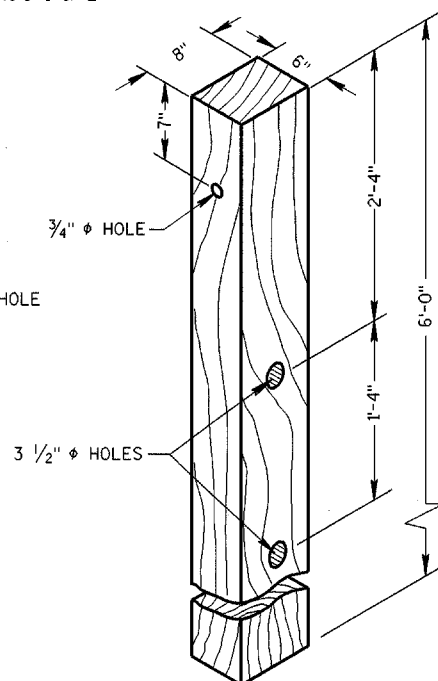

CRT POST


(POSTS NO'S 5-8)

WOOD BREAKAWAY POSTS

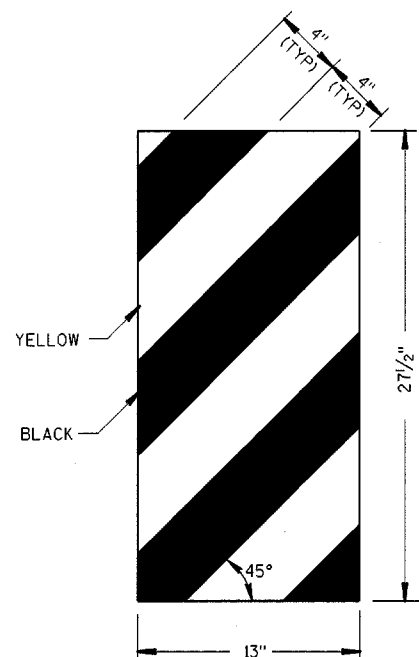

ET-2000 PLUS ONLY

REFLECTIVE SHEETING DETAILS

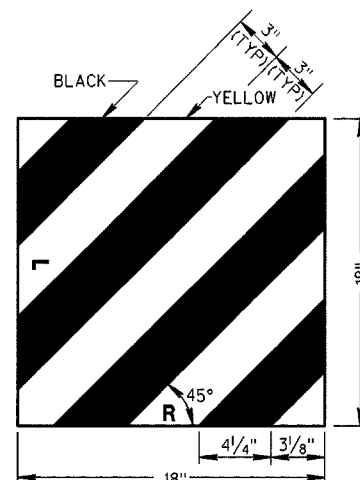

ET-2000 AND SKT-350

GENERAL NOTES

DETAILS OF CONSTRUCTION, MATERIALS AND WORKMANSHIP NOT SHOWN ON THIS DRAWING SHALL CONFORM TO THE PERTINENT REQUIREMENTS OF THE STANDARD SPECIFICATIONS, APPLICABLE SPECIAL PROVISIONS AND MANUFACTURERS INSTRUCTIONS.

STEEL PLATE BEAM GUARD ENERGY ABSORBING TERMINAL SHALL BE EITHER THE EXTRUDER TERMINAL (ET-2000), OR THE SEQUENTIAL KINKING TERMINAL (SKT-350). THE CONTRACTOR SHALL NOT INTERMIX PROPRIETARY PRODUCT MATERIALS.

STEEL PLATE BEAM GUARD, ENERGY ABSORBING TERMINAL SHALL BE PAID FOR AT THE CONTRACT UNIT PRICE EACH, WHICH SHALL INCLUDE HARDWARE, STEEL PLATE BEAM GUARD, POSTS, REFLECTIVE SHEETING AND INSTALLATION AS SHOWN.

REFLECTIVE SHEETING - SHALL CONFORM TO ASTM SPECIFICATION D4956-94, REFLECTIVE SHEETING TYPE III, BACKING CLASS 4, PERFORMANCE REQUIREMENT TYPE III. THE MESSAGE AND LINES SHALL BE APPLIED TO THE SIGNS BY THE SILK SCREEN STENCIL PROCESS USING A BLACK OR DARK STENCIL PASTE AS A TYPE APPROVED BY THE MANUFACTURER OF THE FACE MATERIAL TO WHICH IT IS TO BE APPLIED. MESSAGE UNITS CUT FROM NONREFLECTIVE SHEETING AND APPLIED TO THE SIGN FACE ARE NOT ACCEPTABLE. AFTER THE APPROACH END OF THE STEEL PLATE BEAM GUARD INSTALLATION IS COMPLETE, CLEAN THE AREA WHERE THE REFLECTIVE SHEETING WILL BE APPLIED IN ACCORDANCE WITH THE MANUFACTURERS RECOMMENDATION. ONCE CLEAN, APPLY REFLECTIVE SHEETING DIRECTLY TO THE STEEL PLATE BEAM GUARD AS SHOWN. THE CONTRACTOR SHALL TURN OVER THE MANUFACTURERS WARRANTY FOR THE REFLECTIVE SHEETING TO THE DEPARTMENT FOR POTENTIAL DEALING WITH THE MANUFACTURER. PAYMENT OF REFLECTIVE SHEETING IS INCIDENTAL TO STEEL PLATE BEAM GUARD, ENERGY ABSORBING TERMINAL.

WHEN ROCK IS ENCOUNTERED DURING EXCAVATION, A 12 INCH DIA. POST HOLE EXTENDING 20 INCHES DEEP INTO THE ROCK MAY BE USED IF APPROVED BY THE ENGINEER. GRANULAR MATERIAL SHALL BE PLACED IN THE BOTTOM OF THE HOLE APPROXIMATELY 2 1/2" INCHES DEEP TO PROVIDE DRAINAGE. THE SOIL TUBES SHALL BE FIELD CUT TO LENGTH, PLACED IN THE HOLE AND BACKFILLED WITH ADEQUATELY COMPACTED MATERIAL EXCAVATED FROM THE HOLE.


STEEL PLATE BEAM GUARD
ENERGY ABSORBING TERMINAL

STATE OF WISCONSIN
DEPARTMENT OF TRANSPORTATION




APPROVED
6/25/03
DATE

CHIEF ROADWAY DEVELOPMENT ENGINEER

FHWA

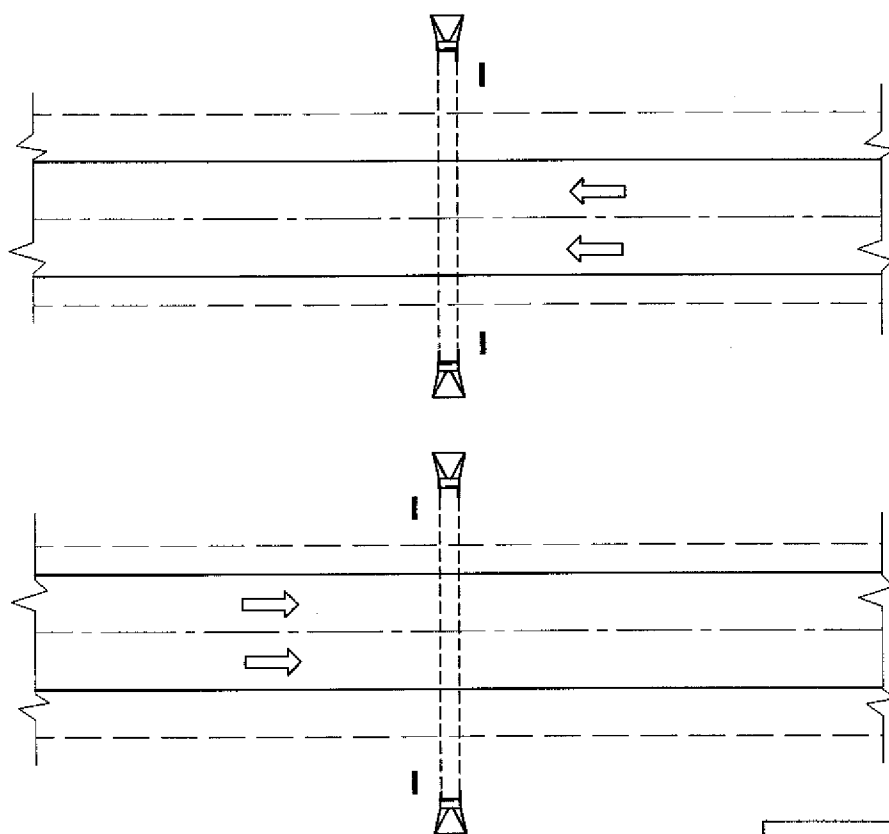


PLAN VIEW
DIVIDED HIGHWAY

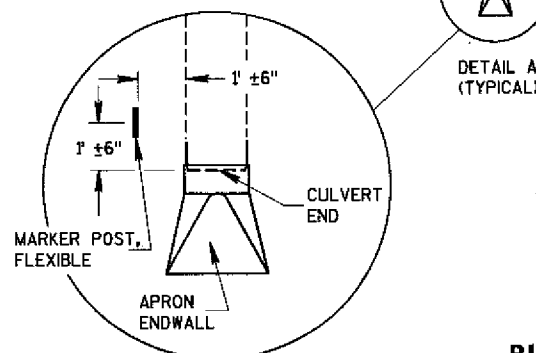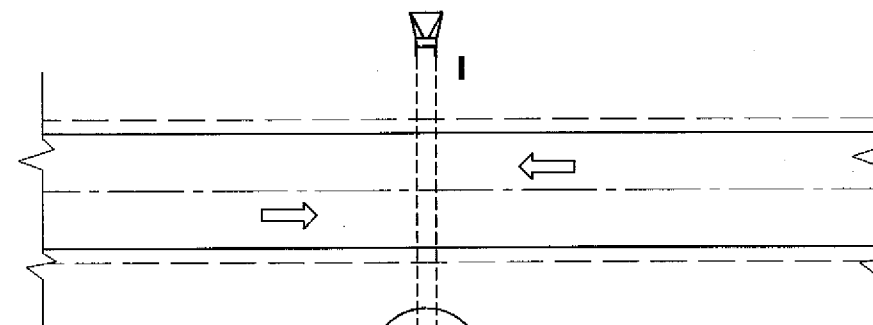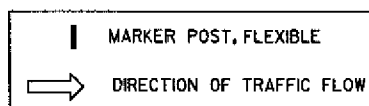


DETAIL A
(TYPICAL)

PLAN VIEW
UNDIVIDED HIGHWAY

FLEXIBLE MARKER POST LOCATION

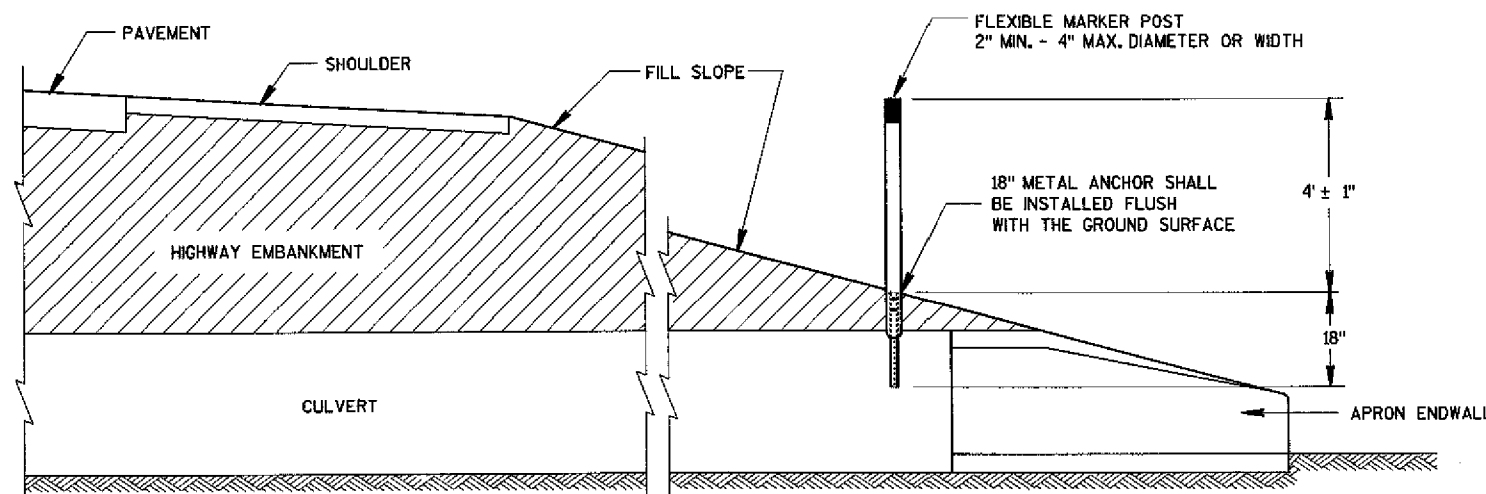


CROSS SECTION
FLEXIBLE MARKER POST

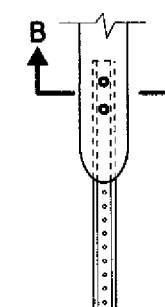


FRONT VIEW
CURVED MARKER



SIDE VIEW
CURVED MARKER

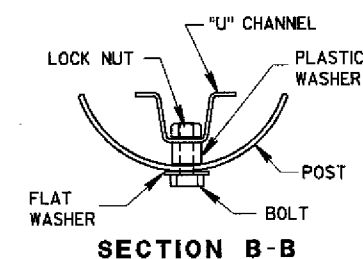


SECTION B-B

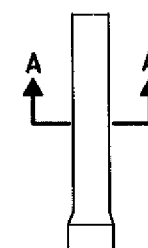

FRONT VIEW
ROUND MARKER



SIDE VIEW
ROUND MARKER

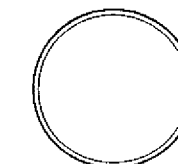


SECTION A-A


FLEXIBLE MARKER POST ANCHORS

GENERAL NOTES

DETAILS OF CONSTRUCTION, MATERIALS AND WORKMANSHIP NOT SHOWN ON THIS DRAWING SHALL CONFORM TO THE PERTINENT REQUIREMENTS OF THE STANDARD SPECIFICATIONS AND THE APPLICABLE SPECIAL PROVISIONS.

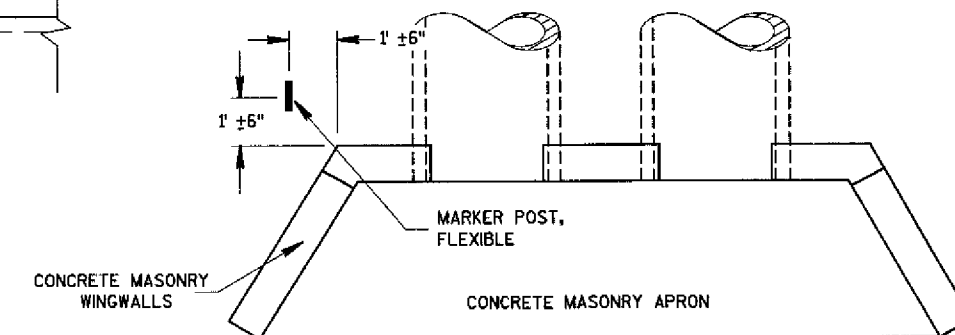

PLAN VIEW
CONCRETE MASONRY ENDWALLS FOR
CULVERT PIPE AND PIPE ARCH

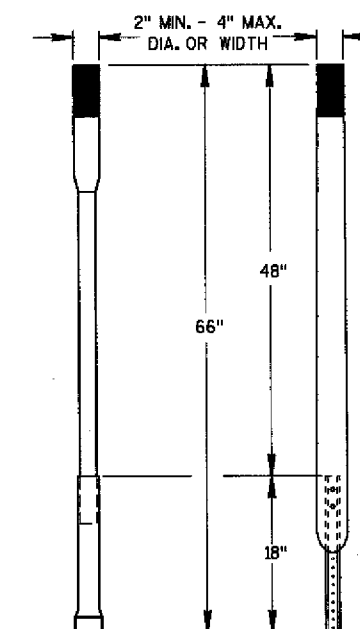

ALTERNATE 1 ALTERNATE 2
FLEXIBLE MARKER POST

MARKER POST, FLEXIBLE,
FOR CULVERT END

STATE OF WISCONSIN
DEPARTMENT OF TRANSPORTATION


APPROVED
10/01/96
DATE


Paul J. Henderson
CHIEF ROADWAY DEVELOPMENT ENGINEER


FHWA

TWO-LANE ROADWAY

SYMBOLS


 WORK AREA

 FLAGGER, EQUIPPED WITH STOP/SLOW PADDLE FASTENED ON SUPPORT STAFF

 SIGN ON PORTABLE OR PERMANENT SUPPORT



USE OF THE "BE PREPARED TO STOP" SIGN IS OPTIONAL. WHEN USED, THIS SIGN SHALL BE LOCATED BETWEEN THE W20-7a AND W20-4 SIGNS. A 500' TYPICAL SPACING SHALL BE PROVIDED BETWEEN THE SIGNS.

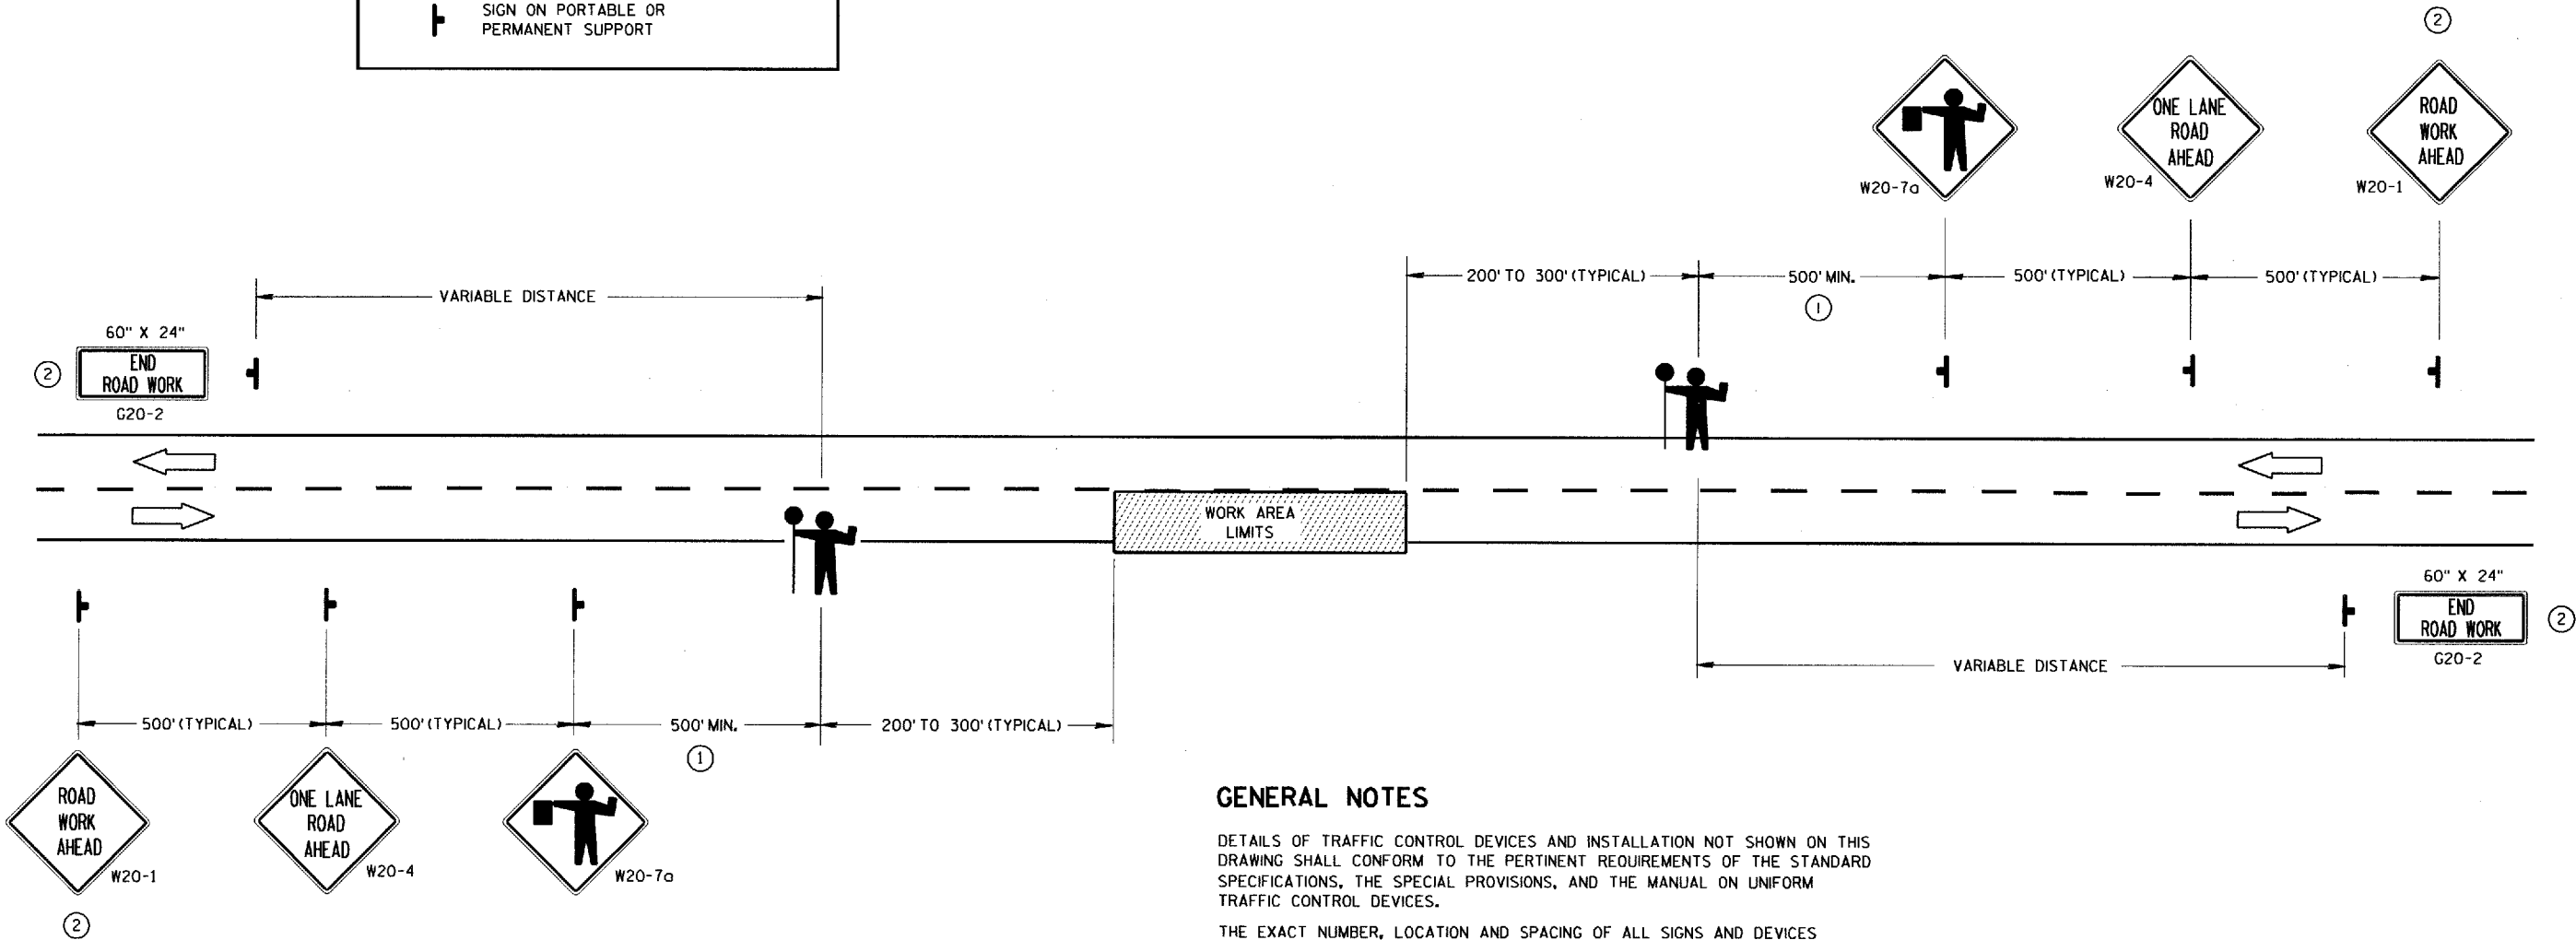

- ① FOR A MOVING WORK OPERATION, SIGNING FOR BOTH DIRECTIONS SHALL BE REESTABLISHED (AS SIMULTANEOUSLY AS PRACTICAL) AT APPROXIMATELY 3500 FOOT INTERVALS IN THE MOVING WORK OPERATION OR AS DIRECTED BY THE ENGINEER.
- ② SIGN NOT REQUIRED IF FLAGGING OPERATION OCCURS WITHIN A SIGNED ROAD WORK ZONE AREA.

GENERAL NOTES

DETAILS OF TRAFFIC CONTROL DEVICES AND INSTALLATION NOT SHOWN ON THIS DRAWING SHALL CONFORM TO THE PERTINENT REQUIREMENTS OF THE STANDARD SPECIFICATIONS, THE SPECIAL PROVISIONS, AND THE MANUAL ON UNIFORM TRAFFIC CONTROL DEVICES.

THE EXACT NUMBER, LOCATION AND SPACING OF ALL SIGNS AND DEVICES (AND THE LOCATION OF ALL FLAGGERS) SHALL BE ADJUSTED TO FIT FIELD CONDITIONS AS DIRECTED BY THE ENGINEER.

THE FIRST ADVANCE WARNING SIGN SHOULD TYPICALLY BE LOCATED IN ADVANCE OF THE ANTICIPATED TRAFFIC BACKUP OR QUEUE.

WHEN A SIDE ROAD OR RAMP INTERSECTS THE FACILITY ON WHICH THE WORK IS BEING PERFORMED, ADDITIONAL TRAFFIC CONTROLS SHALL BE PROVIDED AS SPECIFIED IN THE PLANS AND/OR THE SPECIAL PROVISIONS OR AS DIRECTED BY THE ENGINEER.

FLAGGERS SHALL BE IN SIGHT OF EACH OTHER OR IN DIRECT COMMUNICATION AT ALL TIMES. THEY SHALL BE EQUIPPED WITH STOP/SLOW PADDLES FASTENED ON SUPPORT STAFFS. WHEN THE FLAGGING OPERATION IS NOT IN EFFECT, THE "FLAGGER AHEAD", THE "ROAD WORK AHEAD" AND THE ONE LANE ROAD AHEAD" SIGNS SHALL BE COVERED OR REMOVED AND THE HIGHWAY RESTORED TO NORMAL OPERATION.


ALL SIGNS ARE 48" X 48" UNLESS OTHERWISE NOTED.

TRAFFIC CONTROL FOR LANE CLOSURE (SUITABLE FOR MOVING OPERATIONS)

STATE OF WISCONSIN
DEPARTMENT OF TRANSPORTATION

APPROVED
DATE 2/17/94
STATE TRAFFIC ENGINEER FOR HWYS

FHWA

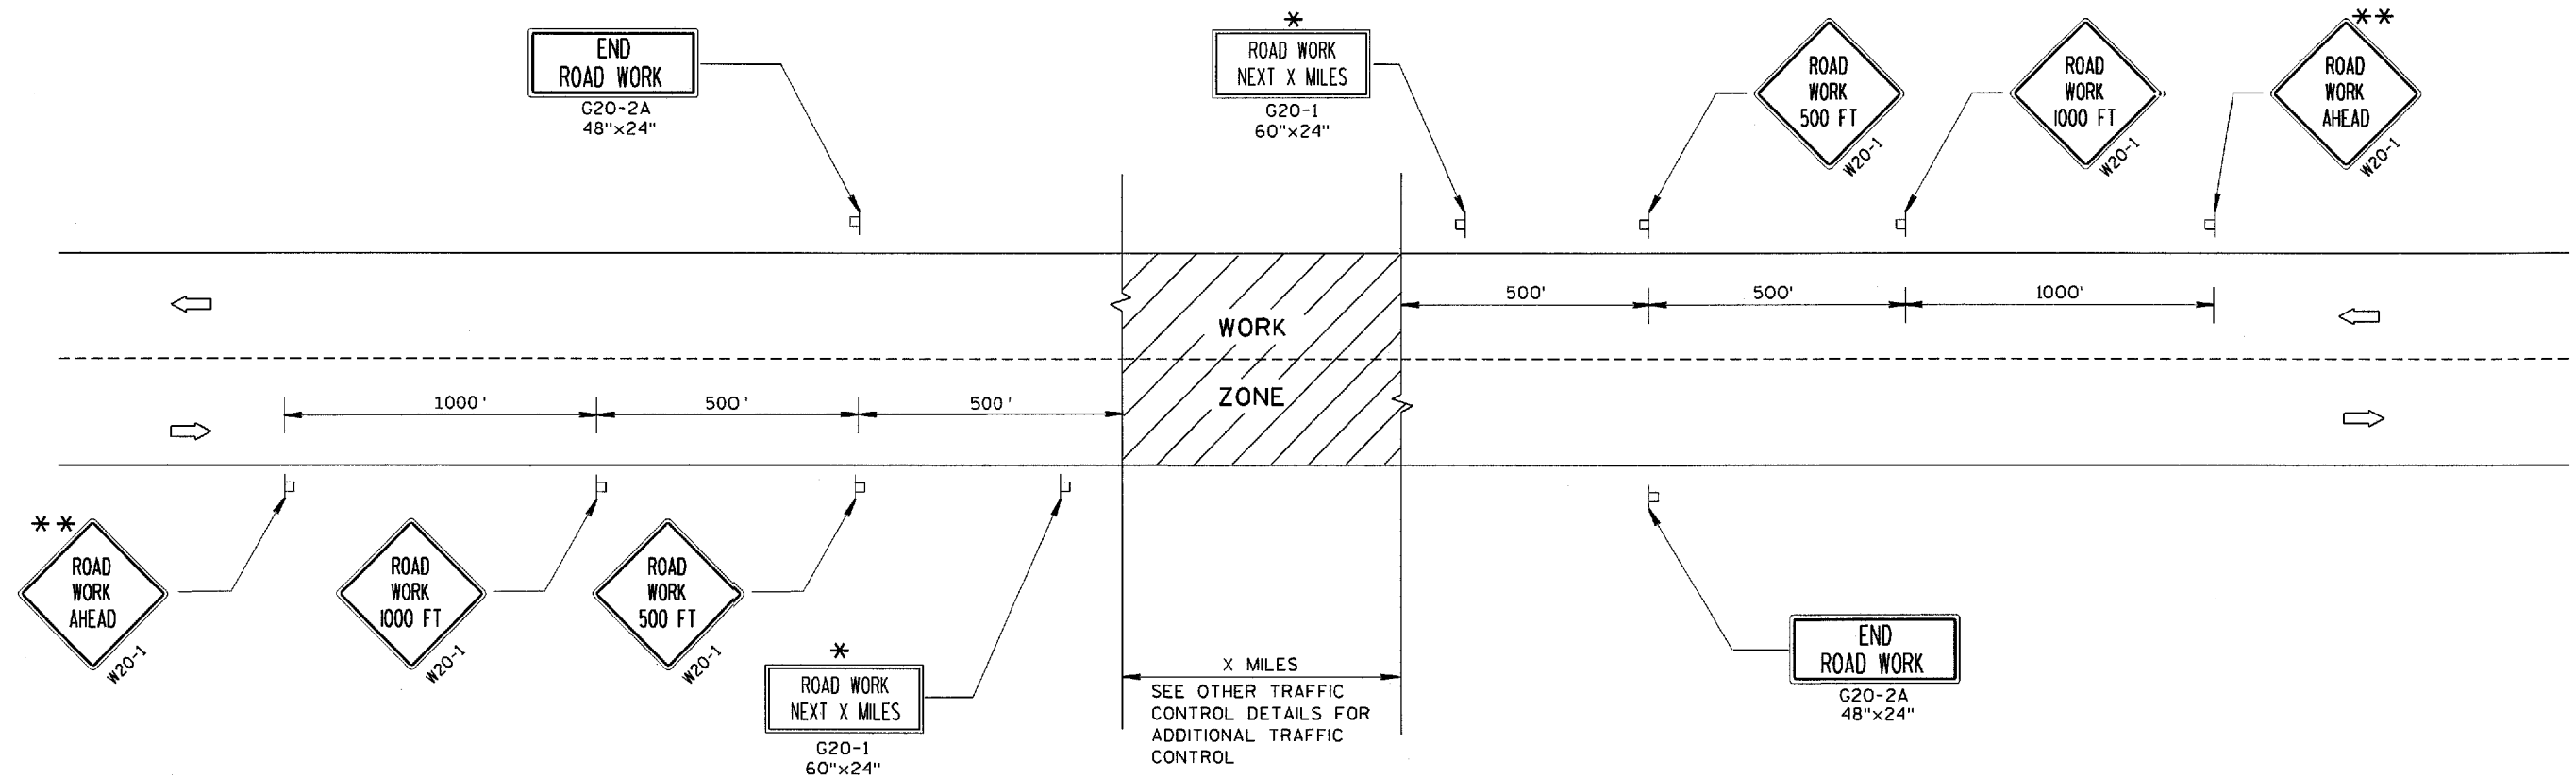

TYPICAL SIDEROAD APPROACH WARNING SIGN DETAIL

GENERAL NOTES

THE EXACT NUMBER, LOCATION, AND SPACING OF ALL SIGNS AND DEVICES SHALL BE ADJUSTED TO FIT FIELD CONDITIONS.

THE SPACING BETWEEN TRAFFIC CONTROL SIGNS SHOULD BE ADJUSTED TO NOT CONFLICT WITH AND SHOULD PROVIDE A MINIMUM OF 200 FEET (500 FEET DESIRABLE) CLEARANCE TO EXISTING SIGNS THAT WILL REMAIN IN PLACE.


ALL SIGNS ARE 48"x48" UNLESS OTHERWISE NOTED.

SIGNS THAT WILL BE IN PLACE LESS THAN 7 CONTINUOUS DAYS AND NIGHTS MAY BE MOUNTED ON PORTABLE SUPPORTS.

IF A "STOP" SIGN MUST BE REMOVED FOR A WORK OPERATION, A TEMPORARY "STOP" SIGN SHALL BE PLACED PRIOR TO THE SIGN REMOVAL, OR A FLAGGER SHALL BE PROVIDED UNTIL THE SIGN IS RE-ESTABLISHED.

* OMIT G20-1 SIGNS IF LENGTH OF WORK AREA IS 2 MILES OR LESS.


** PLACE ADDITIONAL W20-1 "ROAD WORK AHEAD" SIGN IF WORK AREA WITHIN THE PROJECT IS SEPARATED BY MORE THAN 2 MILES FROM PREVIOUS WORK AREA OR SIGNING.

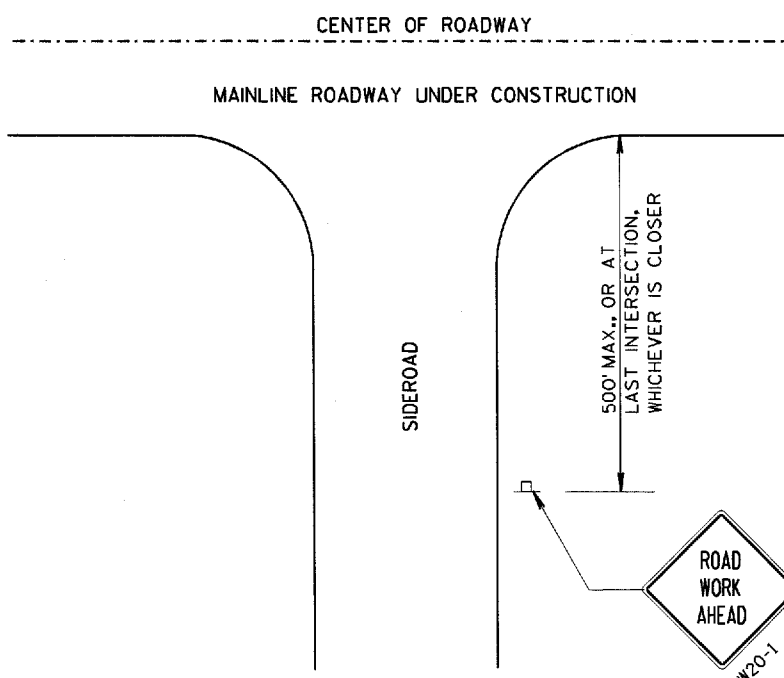


LEGEND

- ⊞ POST MOUNTED SIGN
- ➡ DIRECTION OF TRAFFIC FLOW

| | |
|---|--|
| TRAFFIC CONTROL, ADVANCE WARNING SIGNS 45 M.P.H. OR GREATER TWO-WAY UNDIVIDED ROAD OPEN TO TRAFFIC | |
| STATE OF WISCONSIN DEPARTMENT OF TRANSPORTATION | |
| APPROVED 5/23/00 DATE | Christa J. Spang CHIEF SIGNS AND MARKING ENGINEER |
| FHWA | |

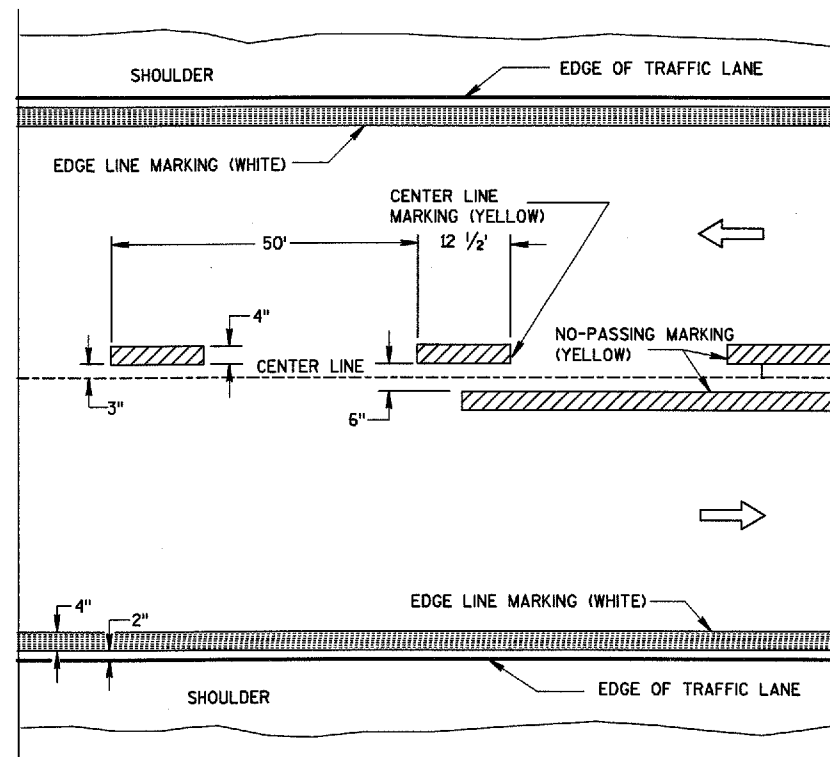


TWO WAY TRAFFIC

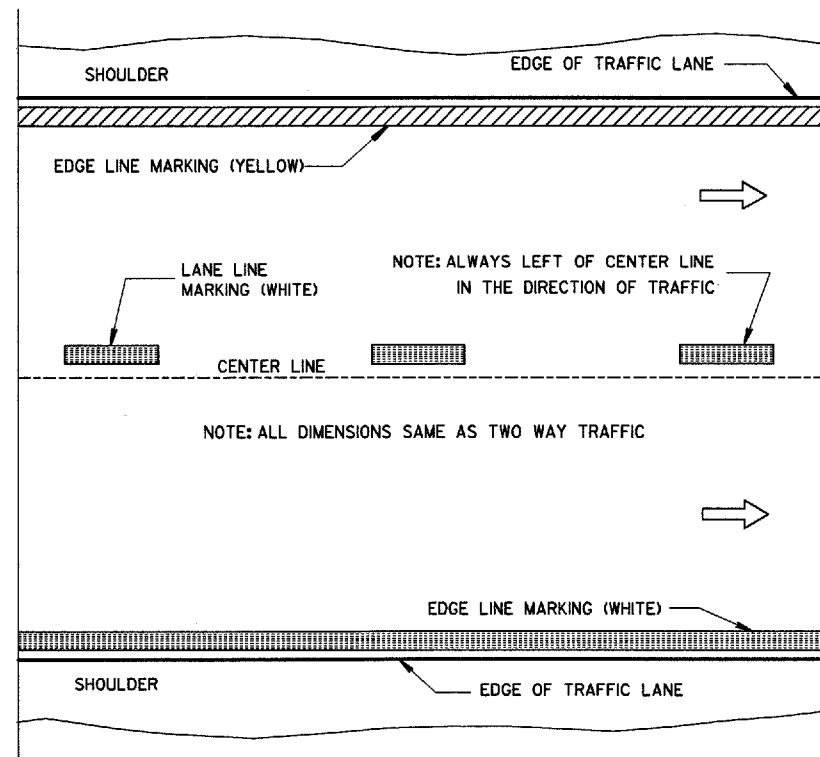


ONE WAY TRAFFIC

PERMANENT PAVEMENT MARKING

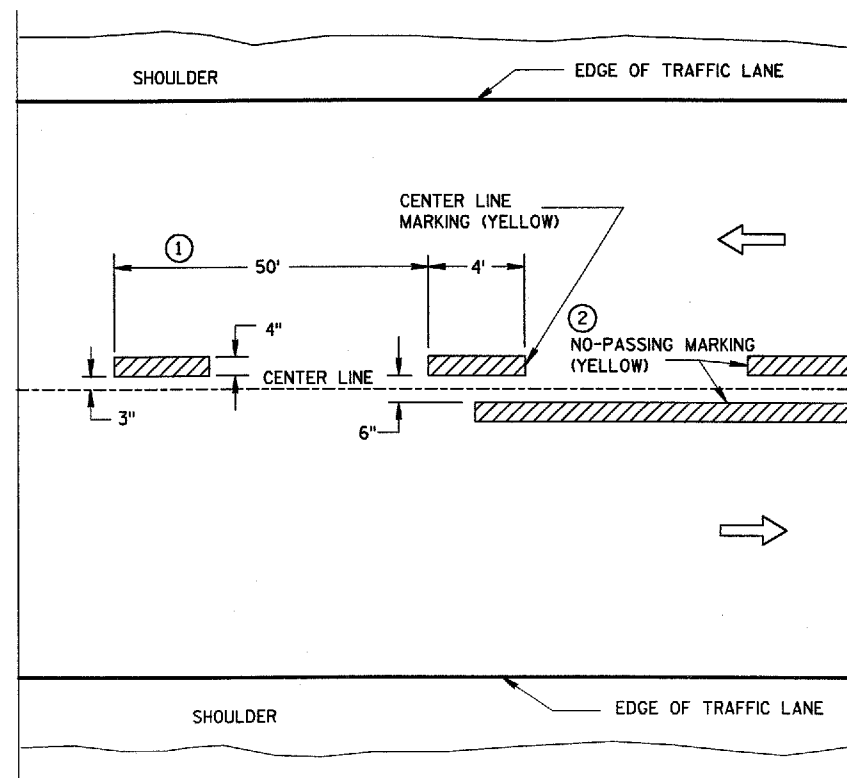

TWO WAY TRAFFIC

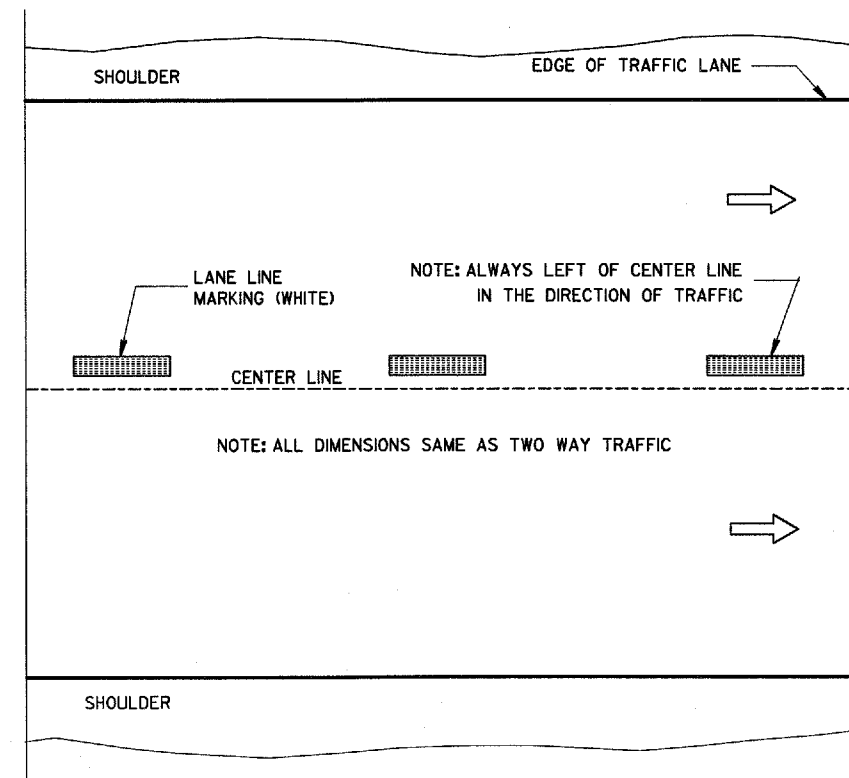

ONE WAY TRAFFIC

TEMPORARY (INTERMEDIATE) PAVEMENT MARKING (SHOWS CYCLE FOR TEMPORARY CENTER LINE OR TEMPORARY LANE LINE MARKING)

GENERAL NOTES

DETAILS OF CONSTRUCTION NOT SHOWN ON THIS DRAWING SHALL CONFORM TO STANDARD SPECIFICATIONS AND SPECIAL PROVISIONS.

- ① HALF CYCLE LENGTHS (25'±) WITH 2' MINIMUM STRIPE LENGTHS SHALL BE PROVIDED ON ROADWAYS (INCLUDING TEMPORARY TRAVELED WAYS) WITH REVERSE CURVATURE, CURVATURE OF OVER 5 DEGREES OR WHEN DIRECTED BY THE ENGINEER TO MARK UNUSUAL ALIGNMENT OF THE TRAVELED WAY.
- ② NO PASSING ZONE TEMPORARY PAVEMENT MARKING IS REQUIRED TO BE PLACED, WHERE APPROPRIATE, ALONG WITH CENTERLINE TEMPORARY PAVEMENT MARKING WHEN A SAME DAY PERMANENT PAVEMENT MARKING ITEM IS INCLUDED IN THE CONTRACT.

NOTE

ARROW SYMBOL (→) SHOWS DIRECTION OF TRAVEL

PAVEMENT MARKING
(MAINLINE)

STATE OF WISCONSIN
DEPARTMENT OF TRANSPORTATION

APPROVED

2-17-00
DATE


FHWA


CHIEF SIGNS AND MARKING ENGINEER

NOTES



EDGE LINES SHALL BE OMITTED THROUGH INTERSECTIONS. EDGE LINES SHALL BE CONTINUED THROUGH DRIVEWAYS.

- ① WHEN DISTANCE "A" IS LESS THAN 250 FEET, OMIT LANE LINE.
- ② WHEN DISTANCE "B" IS LESS THAN 100 FEET, OMIT CHANNELIZING LANE LINE.
- ③ ALTERNATIVE MARKING SHALL BE PROVIDED WHEN SPECIFIED IN THE CONTRACT. TYPICAL SITUATIONS WHERE THIS MARKING MAY BE REQUIRED ARE WHERE THE INTERSECTION IS ON A SHARP HORIZONTAL CURVE OR CREST VERTICAL CURVE IN AN UNLIGHTED AREA SUCH THAT THE EDGE LINE MAY BE MISLEADING TO THE MOTORIST OR DISAPPEAR FROM SIGHT.
- ④ LOCATE THE EDGE LINE ALONG THE TAPER WHERE "W" IS 10' OR MORE.
- ⑤ THE EDGE LINE IN THE TAPER AREAS OF THE BYPASS LANE AND THE BYPASS LANE SHALL BE LOCATED 1-FOOT FROM EDGE OF PAVEMENT TO THE OUTSIDE EDGE OF EDGE LINE.
- ⑥ BARRIER LINE ENDS AT SIDE ROAD PAVEMENT/SURFACE EDGE EXTENSION.

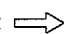
ARROW SYMBOL () SHOWS DIRECTION OF TRAVEL

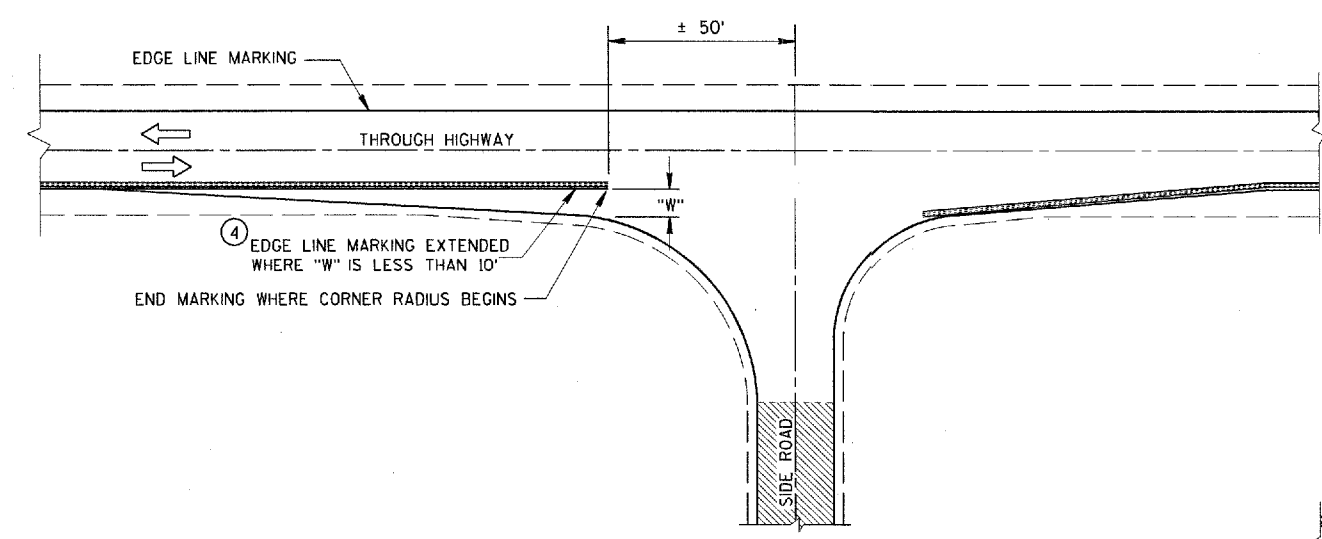


MINOR INTERSECTION WITHOUT CURBS

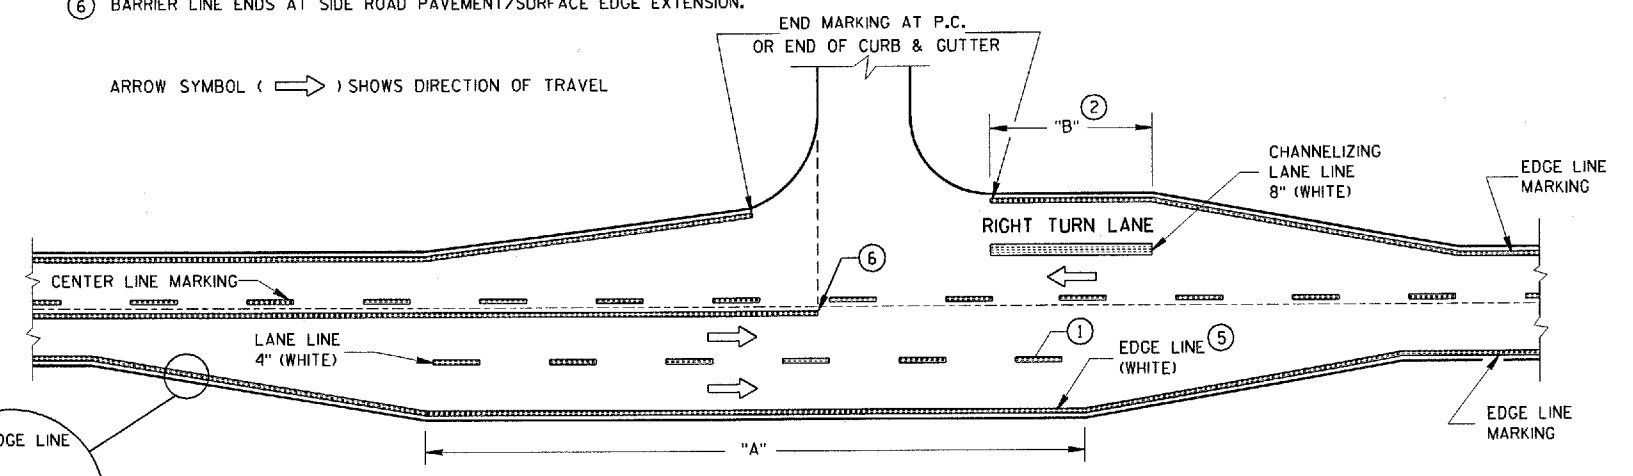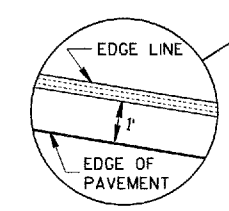

MAJOR INTERSECTIONS
(INTERSECTION WITH FULL RIGHT TURN LANE OR BYPASS LANES)

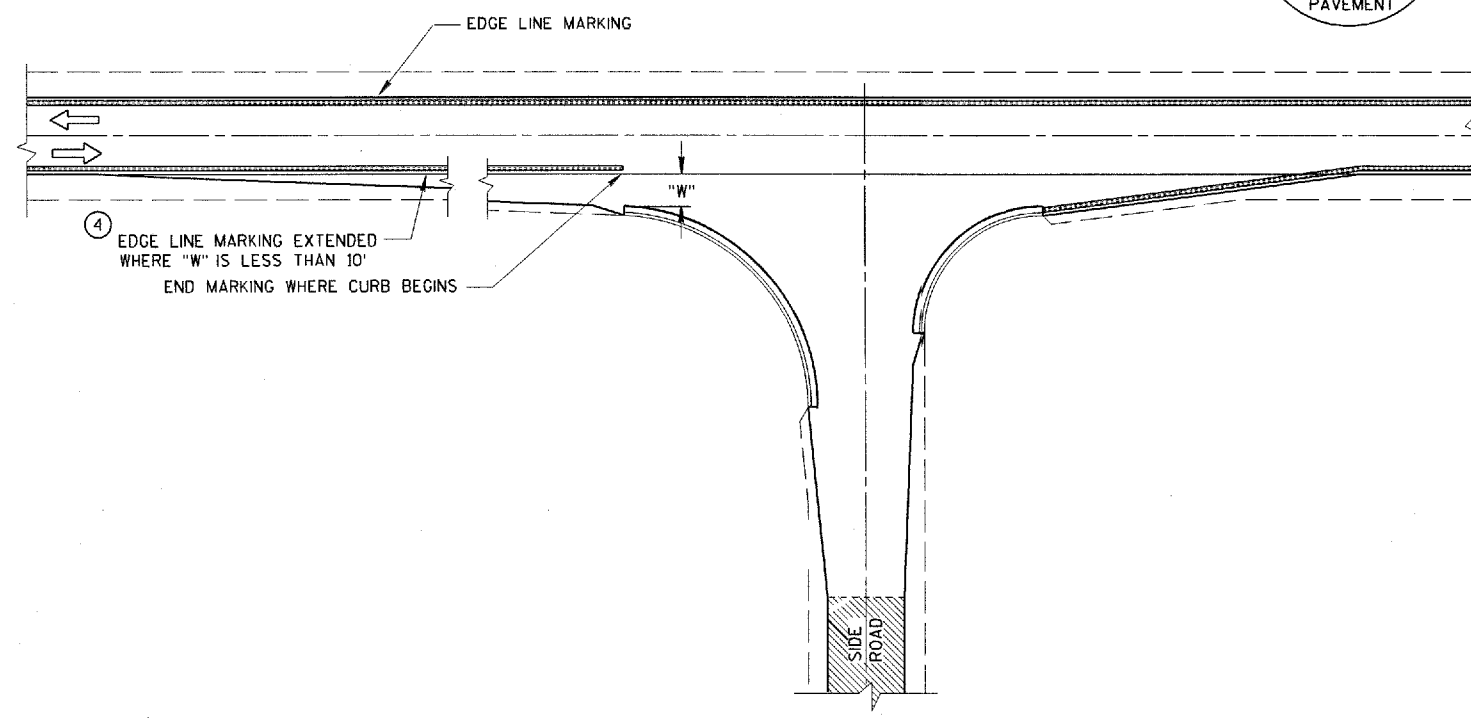

MINOR INTERSECTION WITH CURBS
(TYPICAL MARKING)

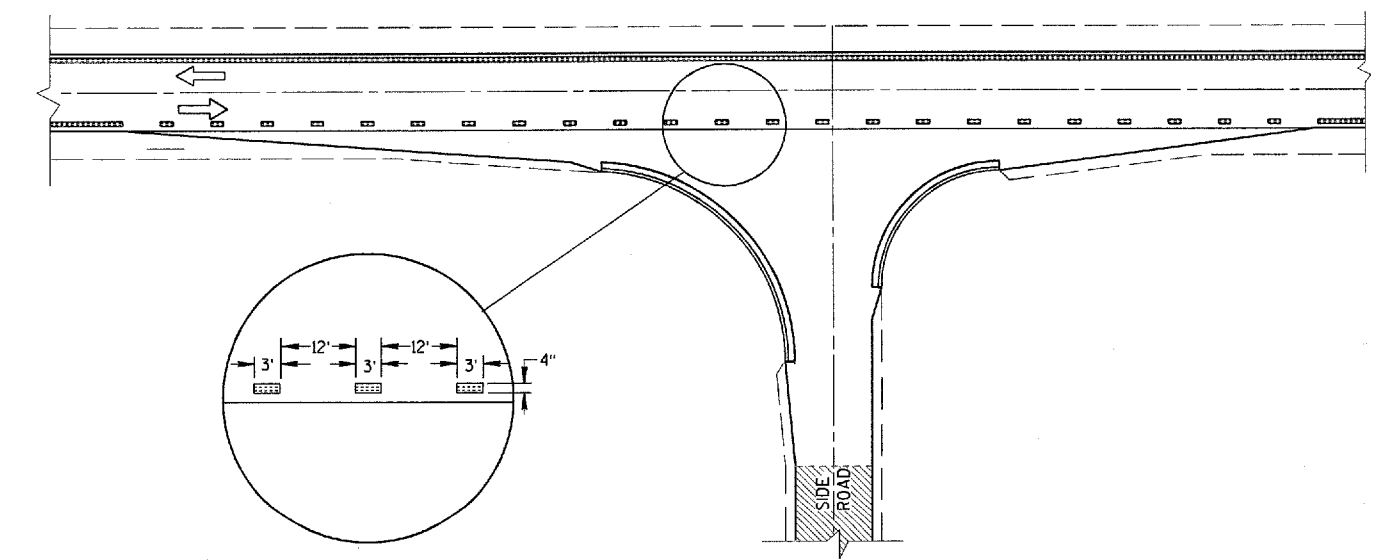

MINOR INTERSECTION WITH CURBS
③ (FOR SPECIAL CONDITIONS AS SPECIFIED)

PAVEMENT MARKING
(INTERSECTIONS)

STATE OF WISCONSIN
DEPARTMENT OF TRANSPORTATION

GENERAL NOTES

THE EXACT NUMBER, LOCATION AND SPACING OF ALL SIGNS AND DEVICES SHALL BE ADJUSTED TO FIT FIELD CONDITIONS AS APPROVED BY THE ENGINEER.

ALL SIGNS ARE 48" X 48" UNLESS OTHERWISE NOTED. IF NECESSARY DUE TO SPACE CONSTRAINTS IN URBAN AREAS, 36" X 36" SIGNS MAY BE USED IF APPROVED BY DISTRICT TRAFFIC UNIT.

"W0" SIGNS ARE THE SAME AS "W" SIGNS EXCEPT THE BACKGROUND IS ORANGE.

SIGNS THAT WILL BE IN PLACE LESS THAN 7 CONTINUOUS DAYS AND NIGHTS MAY BE MOUNTED ON PORTABLE SUPPORTS.

ANY SIGNS TEMPORARY OR EXISTING, WHICH CONFLICT WITH TRAFFIC CONTROL "IN USE" SHALL BE REMOVED OR COVERED AS NEEDED AND AS APPROVED BY THE ENGINEER.

W20-1 AND G20-2A SIGNS ARE NOT REQUIRED IF THE WORK AREA IS WITHIN A LARGER WORK ZONE WHERE THESE SIGNS ARE ALREADY PRESENT. G20-2A SIGNS MAY ALSO BE OMITTED IF DURATION OF WORK IS LESS THAN 7 CONTINUOUS DAYS AND NIGHTS.


CHANNELIZING DEVICES PLACED ADJACENT TO THE WORK AREA SHALL BE PULLED BACK FROM THE TRAVEL LANE WHEN WORK IS NOT IN PROGRESS.

TABLE A

| | | SHOULDER TAPER LENGTH (FEET) | | | | BUFFER SPACE (FEET) |
|----|---|------------------------------|-----|-----|-----|---------------------|
| | | 4 | 6 | 8 | 10 | |
| 30 | W | 20 | 30 | 40 | 50 | 85 |
| 35 | W | 30 | 45 | 55 | 70 | 120 |
| 40 | W | 40 | 55 | 75 | 90 | 170 |
| 45 | W | 60 | 90 | 120 | 150 | 220 |
| 50 | W | 70 | 100 | 135 | 170 | 280 |
| 55 | W | 75 | 110 | 150 | 185 | 335 |

W = SHOULDER WIDTH (FEET)
S = NON-CONSTRUCTION SPEED LIMIT (MPH)

SHOULDER TAPER LENGTH
= $\frac{WS}{3}$ AT 45 MPH OR GREATER
= $\frac{WS^2}{180}$ AT 40 MPH OR LESS

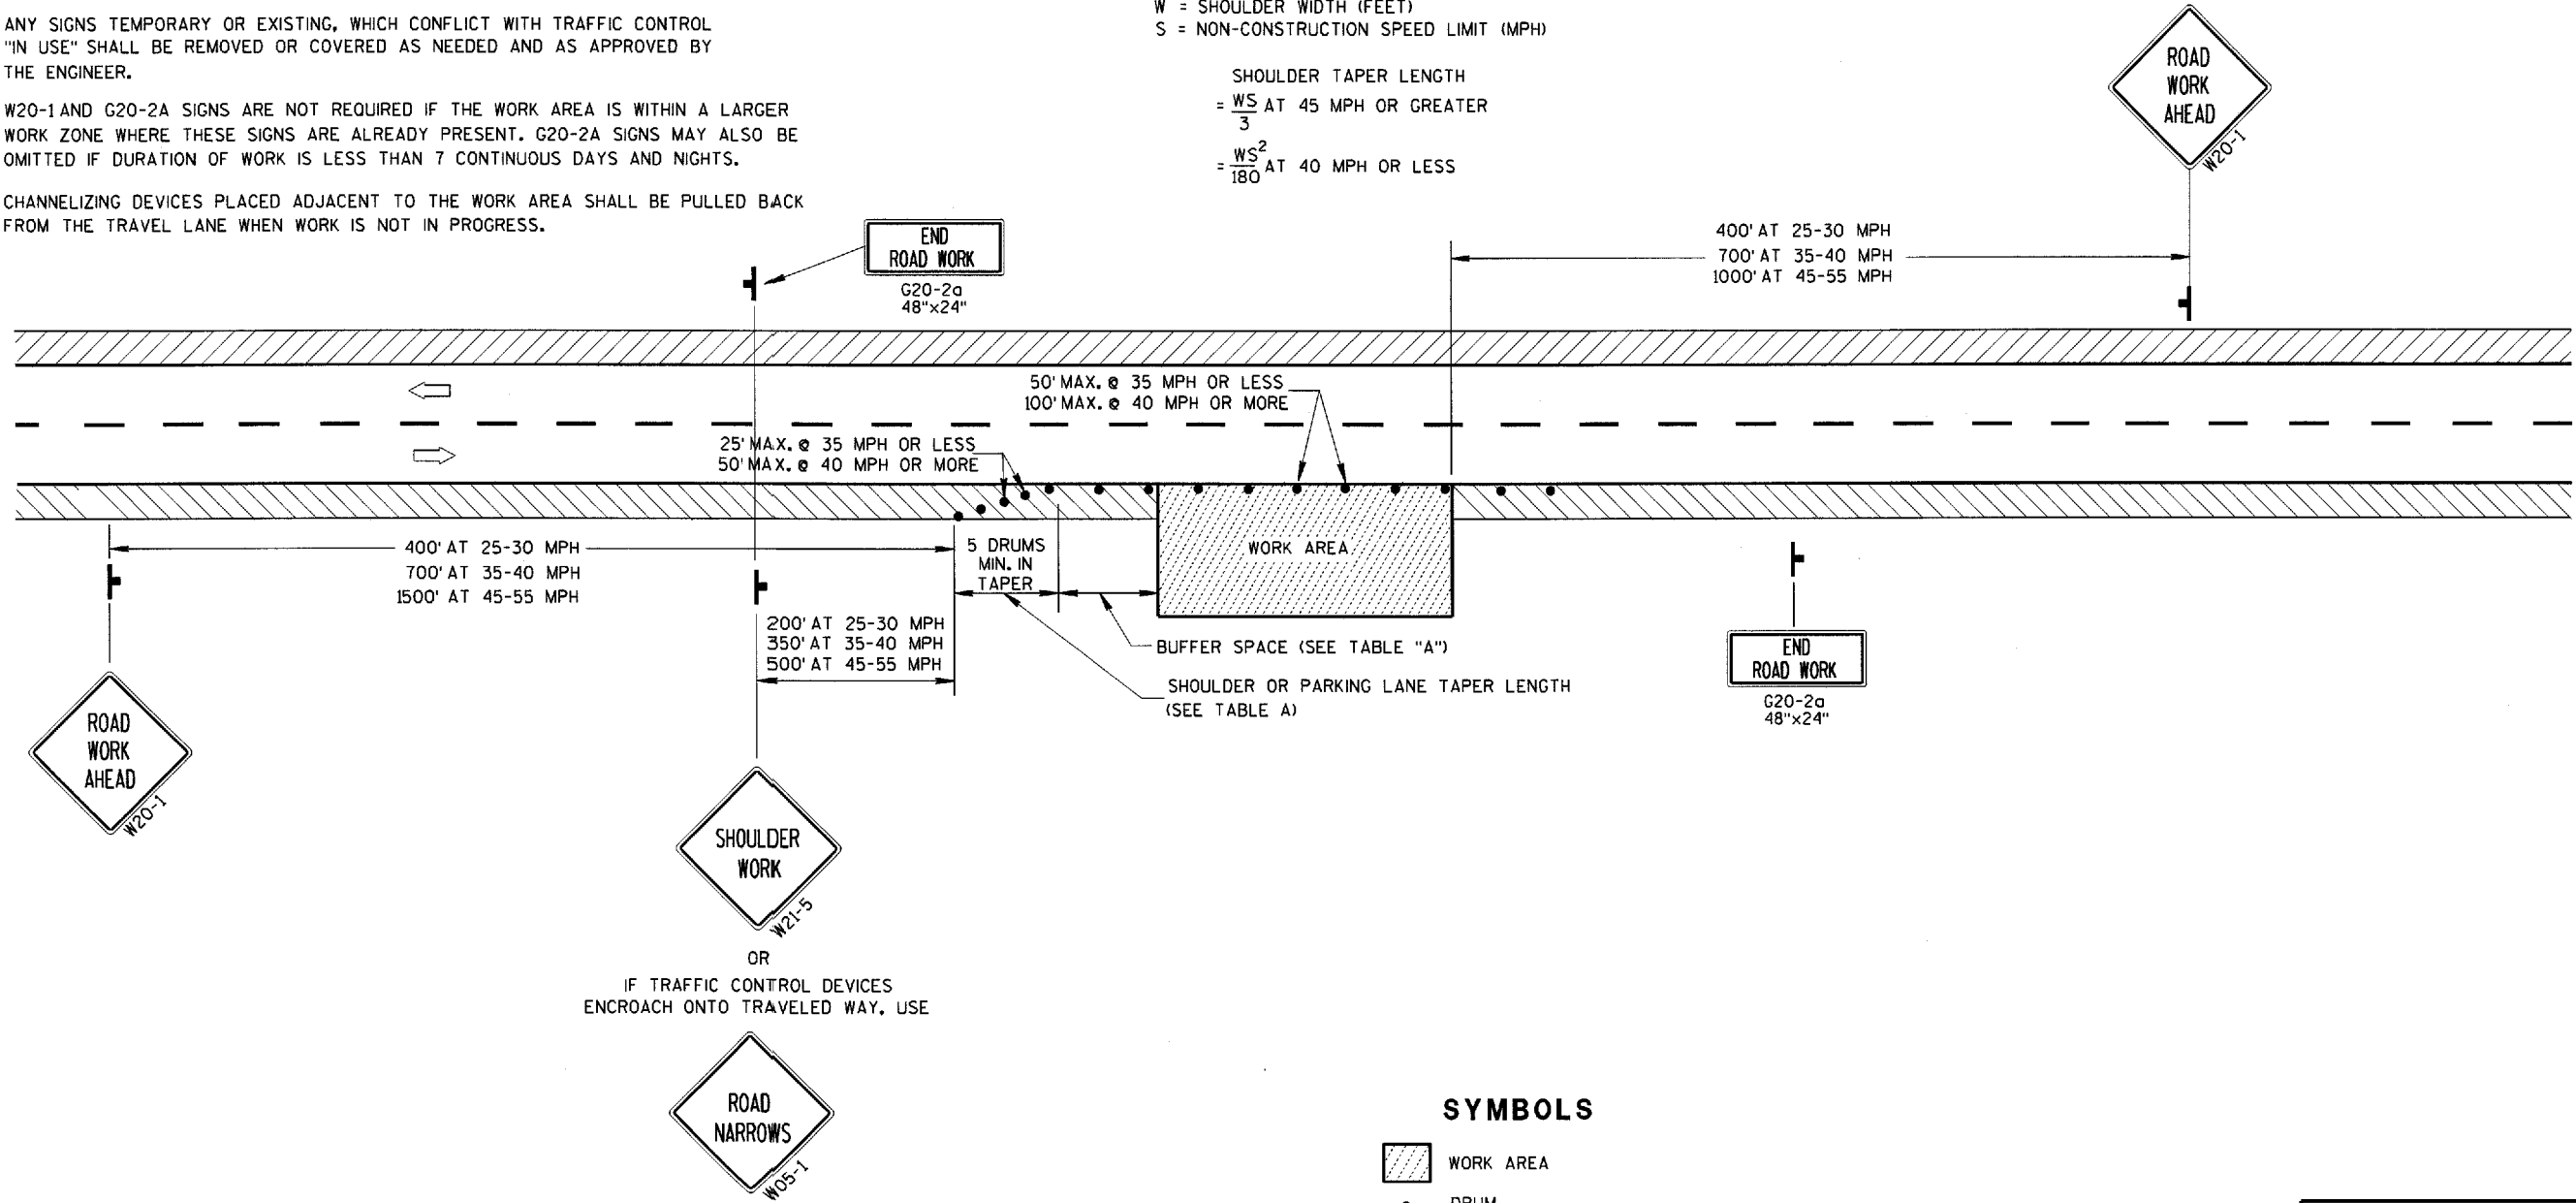

SYMBOLS

- WORK AREA
- DRUM
- POST MOUNTED SIGN
- DIRECTION OF TRAFFIC FLOW

| | |
|---|--|
| TRAFFIC CONTROL, WORK ON SHOULDER OR PARKING LANE, UNDIVIDED ROADWAY | |
| STATE OF WISCONSIN DEPARTMENT OF TRANSPORTATION | |
| APPROVED 5/23/00 DATE | CHIEF SIGNS AND MARKING ENGINEER FHWA |

USH 63 EARTHWORK VOLUMES AT BEAMGUARD TERMINALS

| STATION | END AREA CUT (S.F.) | END AREA FILL (S.F.) | COMMON C.Y. | FILL C.Y. | FILL (EXP. 30%) C.Y. |
|---------------|------------------------|-------------------------|----------------|--------------|----------------------------|
| Bibon Creek | | | | | |
| 1138+26.5, RT | 0 | 0 | 0 | 0 | --- |
| 1138+56.5, RT | 12.9 | 0 | 7.2 | 0 | --- |
| 1139+06.5, RT | 0 | 0 | 11.9 | 0 | --- |
| 1138+64, LT | 0 | 0 | 0 | 0 | --- |
| 1138+94, LT | 15.2 | 0 | 8.4 | 0 | --- |
| 1139+44, LT | 0 | 0 | 14.1 | 0 | --- |
| 1140+56, RT | 0 | 0 | 0 | 0 | --- |
| 1141+06, RT | 10.5 | 0 | 9.7 | 0 | --- |
| 1141+36, RT | 0 | 0 | 5.8 | 0 | --- |
| 1140+93.5, LT | 0 | 0 | 0 | 0 | --- |
| 1141+43.5, LT | 10.5 | 0 | 9.7 | 0 | --- |
| 1141+73.5, LT | 0 | 0 | 5.8 | 0 | --- |
| White River | | | | | |
| 1230+18.5, RT | 0 | 0 | 0 | 0 | --- |
| 1230+48.5, RT | 8.1 | 1.5 | 4.5 | 0.8 | 1 |
| 1230+98.5, RT | 0 | 0 | 7.5 | 1.4 | 1.8 |
| 1230+56, LT | 0 | 0 | 0 | 0 | --- |
| 1230+86, LT | 8.7 | 20.1 | 4.8 | 11.2 | 14.6 |
| 1231+36, LT | 0 | 0 | 8.1 | 18.6 | 24.2 |
| 1232+91, RT | 0 | 0 | 0 | 0 | --- |
| 1233+41, RT | 6.7 | 8.4 | 7.8 | 5.4 | 7 |
| 1233+71, RT | 0 | 0 | 4.4 | 3 | 3.9 |
| 1233+28.5, LT | 0 | 0 | 0 | 0 | --- |
| 1233+78.5, LT | 8.6 | 11.2 | 8.0 | 10.4 | 13.5 |
| 1234+08.5, LT | 0 | 0 | 4.5 | 6.2 | 8.1 |
| TOTALS: | | | 122 | 57 | 74 |

