


"AS BUILT"

7/19

Index of Sheets

Sheet No.	1	Title
Sheet No.	2	Typical Cross Sections
Sheet No.	3	Estimate of Quantities
Sheet No.	3A	Miscellaneous Quantities
Sheet No.	-	Right of Way Plat
Sheet No.	5	5.4 Plan and Profile
Sheet No.	6	6.5 Standard Details
Sheet No.	-	Structure Plans
Sheet No.	-	Computer Earthwork Data
Sheet No.	9	9.14 Cross Sections

TOTAL SHEETS = 30

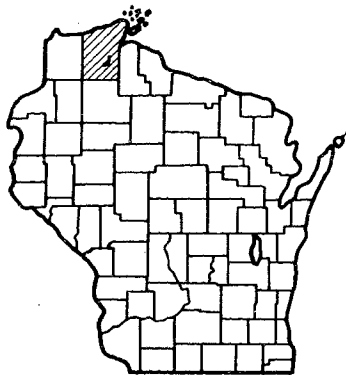

Design Designation

A.D.T. (1980)	= 1240
A.D.T. (2000)	= 1990
D.H.V.	= 292
D.	= 65%
T.	= 10.6%

Conventional Signs

County Line	---
Township or Range Line	----
Section Line	-----
New Right of Way Line	-----
Present Right of Way Line	-----
Wire Fence	-----
Corporate or City Limits	-----
Property Line	-----
Traveled Way or P.E.	-----
Railroads	-----
Base or Survey Line	-----
Caution Symbol (combustible fluids under pressure)	-----

Culverts in Place	-----
Culverts Required	-----
Drop Inlet	-----
Power Pole	-----
Telephone or Telegraph Pole	-----
Right of Way Markers	-----
Reference Stake for Hubs Only	-----
Marsh	-----
Hedge	-----
Trees	-----
Ground Elevation	-----
Grade Elevation	-----

STATE OF WISCONSIN DEPARTMENT OF TRANSPORTATION

PLAN AND PROFILE OF PROPOSED


GRANDVIEW — MASON ROAD

U.S.H. 63
BAYFIELD COUNTY

STATE PROJECT NUMBER
1564-5-71

Plan 1 in. = 100 ft.
Profile Hor. 1 in. = 100 ft. Vert. 1 in. = 10 ft.
Cross Sections Hor. 1 in. = 5' Vert. 1 in. = 5'

GN

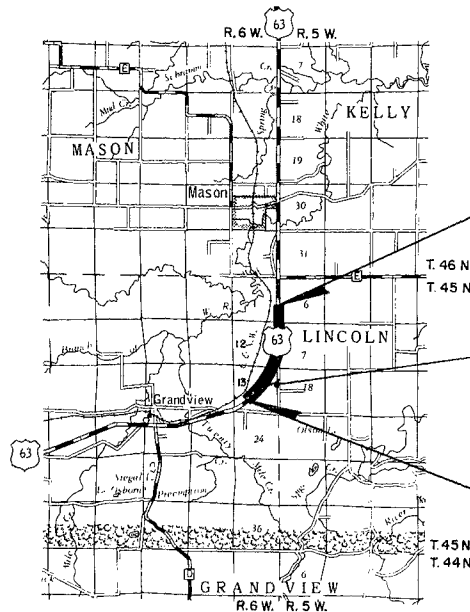

END PROJECT 1564-5-71
STA. 645+68
N. 453,200 (±200')
E. 1,734,800 (±200')
APPROX. 1800' N. & 200' W. OF THE SE. COR.
OF SEC. 1, T. 45 N., R. 6 W.

EQUATION
STA. 559+16.40 =
STA. 560+85.22

BEGIN PROJECT 1564-5-71
STA. 534+00
N. 443,000 (±200')
E. 1,731,300 (±200')
APPROX. 1600' N. & 1400' E. OF THE SW. COR.
OF SEC. 13, T. 45 N., R. 6 W.

Layout
Scale 0 1 2 MI.

Total Net Length of Centerline = 2.083 Mi. RURAL


NOTE:
ALL COORDINATES SHOWN ARE SCALED FROM
U.S.G.S. QUADRANGLE MAP MASON, WISC. AND
GRANDVIEW, WISC. FOR IDENTIFICATION ONLY.

STATE PROJECT	FEDERAL PROJECT	
	PROJECT	CONTRACT
1564-5-71	F 011(7)	1

STATE OF WISCONSIN DEPARTMENT OF TRANSPORTATION	
SURVEYOR <u>R.O.L.</u>	DISTRICT CHECKER <u>L.L.H.</u>
DESIGNER <u>R.H.W.</u>	C.O. CHECKER <u>J.R.T.</u>
DISTRICT SUPERVISOR <u>G.L.M.</u>	C.O. COORDINATOR <u>J.W.</u>
Approved: DATE <u>9-13-79</u> <u>Donald H. Fonglen</u> DISTRICT TRANSPORTATION DIRECTOR	
Approved: DATE <u>10-16-79</u> <u>D. Strand</u> CHIEF DESIGN ENGINEER	
Approved: DATE <u>10/17/79</u> <u>E.J. Byrkit</u> DIRECTOR OF DEVELOPMENT	
U.S. DEPARTMENT OF TRANSPORTATION FEDERAL HIGHWAY ADMINISTRATION REGION 5 WISCONSIN DIVISION	
Approved: DATE _____ DIVISION ENGINEER	

STATE PROJECT NUMBER	SHEET NO.
1564 - 5 - 71	2
TYPICAL SECTIONS & DETAILS FOR USH 63	


RI 11/15/79

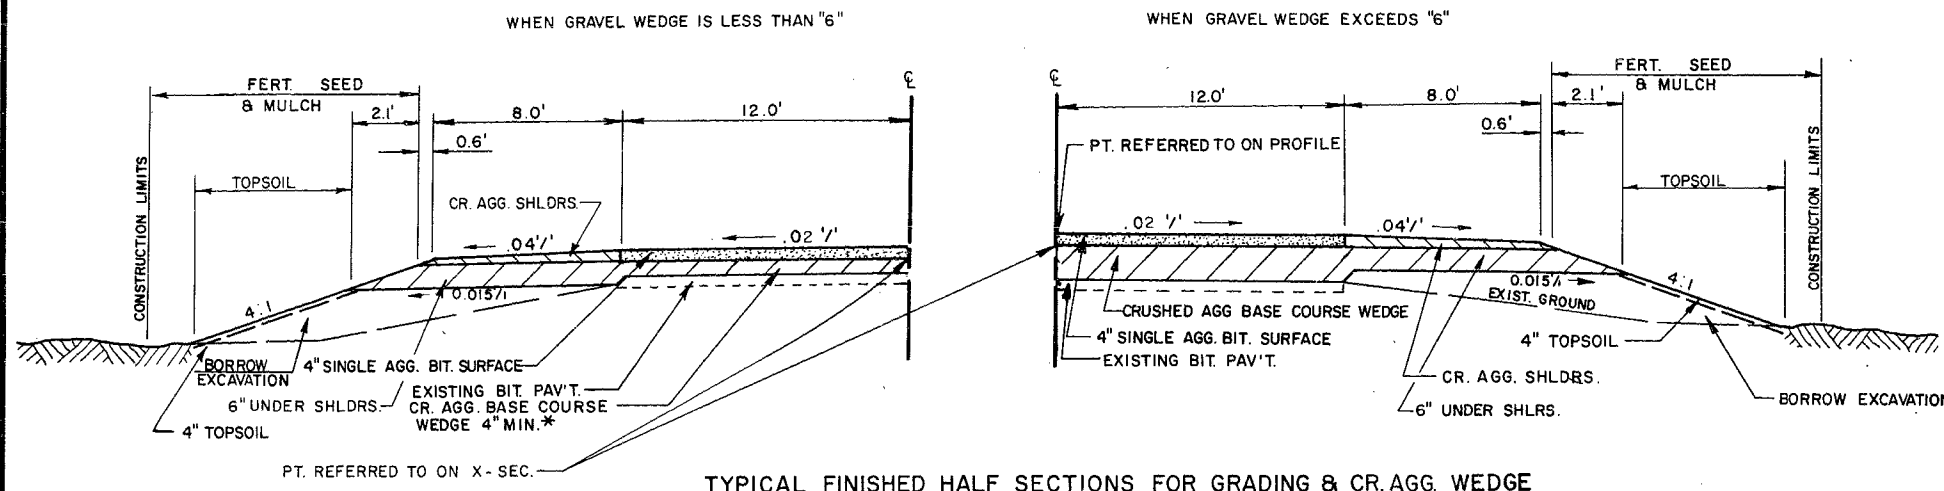

TYPICAL FINISHED HALF SECTIONS FOR GRADING & CR.agg. WEDGE


* SEE GRAVEL WEDGE DETAIL WHEN 4" OF CRUSHED AGGREGATE BASE COURSE CAN NOT BE MAINTAINED

STA. 573+00 - 582+00
583+00 - 593+00
608+00 - 625+00
638+00 - 645+68

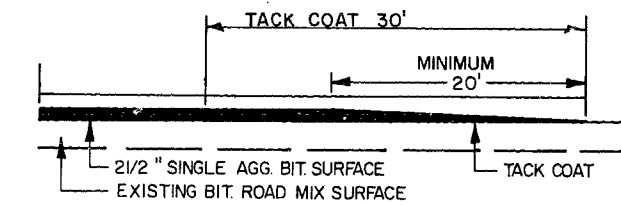

FEATHERING DETAIL

STA. 534+00
645+68

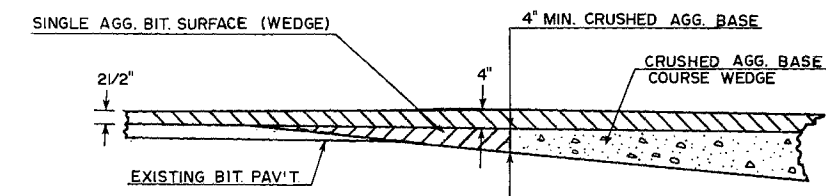

CR.agg. WEDGE DETAIL

GENERAL NOTES

WHEN THE QUANTITY OF THE ITEMS OF BASE OR SURFACE COURSE IS MEASURED FOR PAYMENT BY THE TON THE DEPTH OR THICKNESS OF THE COURSE SHOWN ON THE PLANS IS APPROXIMATE AND THE ACTUAL THICKNESS WILL DEPEND ON THE DISTRIBUTION OF THE MATERIAL AS DIRECTED BY THE ENGINEER.

ALL DISTURBED AREA WITHIN THE RIGHT OF WAY, EXCLUDING THE PAVED SURFACE AND THE SHOULDERS SHALL BE FERTILIZED, SEED AND MULCHED.

SALVAGED TOPSOIL OR TOPSOIL SHALL BE PLACED ON SLOPES FROM SUBGRADE SHOULDER TO SLOPE INTERCEPT, TO AN APPROXIMATE THICKNESS OF 4 INCHES AT THE TIME OF PLACEMENT.

FILL SLOPES SHALL BE ROUNDED 5 FEET BEYOND THE SLOPE INTERCEPT OR TO THE RIGHT OF WAY LIMITS, WHICHEVER COMES FIRST.

UNDERCUT SHALL ONLY BE MADE AT LOCATIONS APPROVED AND STAKED BY THE ENGINEER.

UNLESS OTHERWISE SHOWN, ALL INTERSECTIONS SHALL BE TYPE "C".

SIDE ROAD AND PRIVATE ENTRANCE FILL SLOPES SHALL BE 4:1 OR FLATTER FOR A DISTANCE OF 35 FEET FROM EDGE OF PAVEMENT OF THE MAIN ROADWAY IF R/W PERMITS.


THE EXACT LOCATIONS & LIMITS FOR NEW DRIVEWAYS SHALL BE DETERMINED BY THE ENGINEER IN THE FIELD.

SEED MIXTURE NO. 1 APPLIED AT THE RATE OF 11/2 POUNDS PER 1000 SQUARE FEET WAS USED IN COMPUTING QUANTITIES.

TACK COATING SHALL BE CONSIDERED INCIDENTAL TO THE ITEM OF SINGLE AGGREGATE BITUMINOUS SURFACE.


STANDARD DETAIL DRAWINGS

TYPICAL INSTALLATION OF EROSION BALES.....8E8-1
APRON ENDWALLS FOR CULVERT PIPE AND ARCH PIPE.....8F1-8
LAYOUT DETAIL FOR GRADE AT SIDE ROAD INTERSECTIONS.....9A1-3
CLASS "A" STEEL PLATE BEAM GUARD AND STEEL PLATE
BEAM GUARD MEDIAN.....14B2-4a&b
CONSTRUCTION BARRICADES AND STANDARD SIGNS.....15C1-5

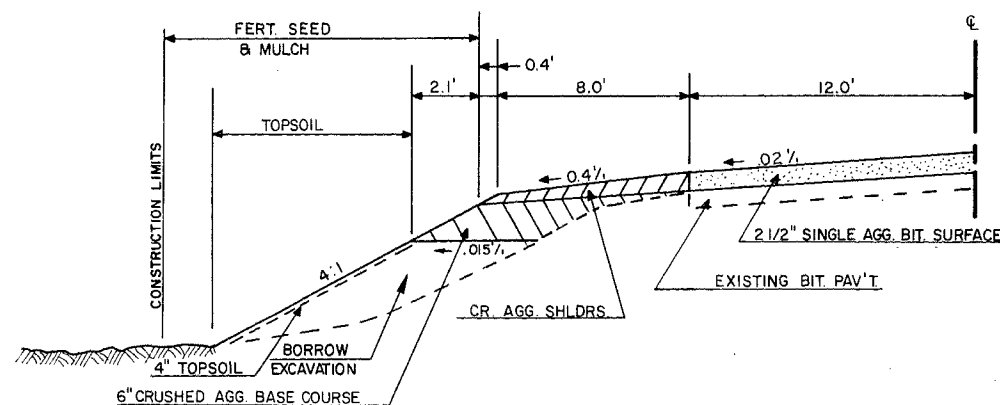


TYPICAL FINISHED HALF SECTION FOR RESURFACING

STA. 534+00 - 573+00
582+00 - 583+00
593+00 - 608+00
625+00 - 638+00

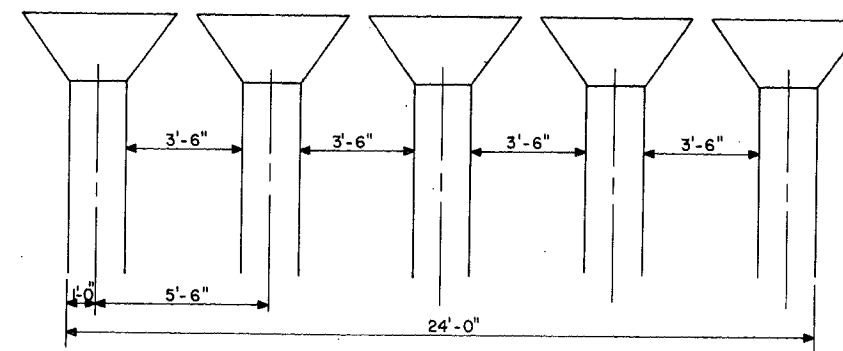

SPACING DETAIL FOR 24" X 18" CMPA

STA. 620+00

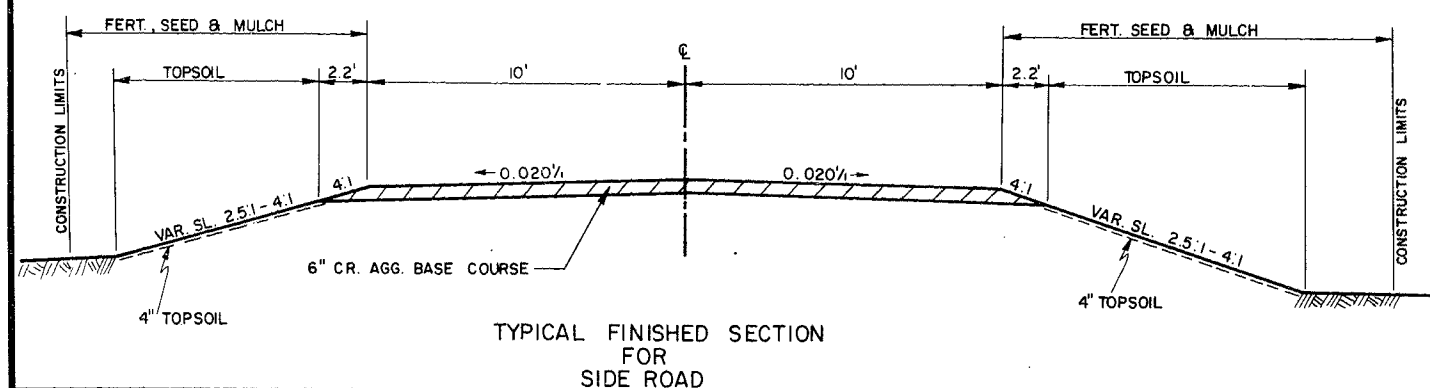

TYPICAL FINISHED SECTION FOR SIDE ROAD

11/19

DETAIL SUMMARY OF MISCELLANEOUS QUANTITIES

STATE PROJECT NUMBER

SHEET NO.

1564 -5- 71

3A

CLEARING

STATION	TO	STATION	STA.
534+00		554+00	20
562+00		645+67	83
PROJECT TOTAL			103

ANCHORAGE FOR STEEL PLATE BEAM GUARD

STATION	LOCATION	EACH
644+41.5	LT.	1
644+41.5	RT.	1
PROJECT TOTAL		2

CROSS DRAINS

STATION	LOCATION	DIA. IN.	LENGTH L.F.	TYPE	RCCP CLASS	THICKNESS STEEL ALUM.	A.E.W. EACH
538+16	€	24	64	CP	III	0.064 0.075	2
600+94	€	24	64	CP	III	0.064 0.075	2
620+00	€	24X18	5 PIPES - 64 EACH	PA	III	0.064 0.075	10

SALVAGED GUARD FENCE STEEL BEAM

STATION	TO	STATION	L.F.
644+41.5		645+68.5 LT.	127
644+41.5		645+68.5 RT.	127
PROJECT TOTAL			254

UNCLASSIFIED EXCAVATION

STATION	TO	STATION	C.Y.
573+00		645+68	50
PROJECT TOTAL			50

SINGLE AGGREGATE BITUMINOUS SURFACE

STATION	TO	STATION	TONS
534+00		559+16	369
534+00		559+16	923
560+85		573+00	179
560+85		573+00	446
573+00		574+00	30
573+00		582+00	528
582+00		583+00	15
582+00		583+00	37
583+00		593+00	587
591+50		592+50	30
593+00		608+00	220
593+00		608+00	550
608+00		609+00	30
608+00		625+00	997
624+00		625+00	30
625+00		638+00	191
625+00		638+00	477
635+00		639+00	30
638+00		645+68	451
645+00		645+68	30
S.R. RT.		640+50	40
PROJECT TOTAL			6190

CRUSHED AGGREGATE BASE COURSE

STATION	TO	STATION	LOCATION	TONS
534+00		573+00	UNDER SHLDS	2144
534+00		573+00	SHLDS	1183
573+00		582+00	UNDER SHLDS	700
573+00		582+00	WEDGING	1550
573+00		582+00	SHLDS	263
582+00		583+00	UNDER SHLDS	46
582+00		583+00	SHLDS	24
583+00		593+00	UNDER SHLDS	778
583+00		593+00	WEDGING	1686
583+00		593+00	SHLDS	292
593+00		608+00	UNDER SHLDS	737
593+00		608+00	SHLDS	360
608+00		625+00	UNDER SHLDS	1323
608+00		625+00	WEDGING	2493
608+00		625+00	SHLDS	497
625+00		638+00	UNDER SHLDS	447
625+00		638+00	SHLDS	351
638+00		645+00	UNDER SHLDS	599
638+00		645+00	WEDGING	800
638+00		645+00	SHLDS	223
S.R. RT.		STA. 640+50		42
P.E.'S.				25
PROJECT TOTAL				16,563

STEEL PLATE BEAM GUARD CLASS A

STATION	LOCATION	L.F.
644+41.5	LT.	2
644+41.5	RT.	2
PROJECT TOTAL		4*

*USED TO ATTACH SALVAGED
GUARD FENCE, STEEL BEAM
TO NEW ANCHORAGES

BASE PATCHING

STATION	S.Y.
538+16	27
600+94	27
PROJECT TOTAL	54

SEEDING

LOCATION	LB.
ROADWAY	558
BORROW PIT	59
PROJECT TOTAL	617

FERTILIZER

LOCATION	CWT.
ROADWAY	26.0
BORROW PIT	5.4
PROJECT TOTAL	31.4

SOODING

STATION	S.Y.
UNDISTRIBUTED	25
PROJECT TOTAL	
	25

EROSION BALES

STATION	EACH
UNDISTRIBUTED	25
PROJECT TOTAL	25

CALCIUM FLORIDE SURFACE TREATMENT

STATION	TO	STATION	TONS
573+00		582+00	3.5
583+00		593+00	4.0
608+00		625+00	6.5
638+00		645+00	3.5
PROJECT TOTAL			17.5



ORIGIN OF LEVELS
PERMANENT BENCH MARK M42, LINE 1
NATIONAL GEODETIC SURVEY
ELEV 908.538

PJ=547.47522 BK=
 647.7602 AHD
 AL=49.39.39 LT
 DL=2.1.30
 TL=0309.20
 BL=245.39
 EL=288.21
 RL=2829.42
 SE=0.047%




BENCH MARKS			
NO.	STATION	DESCRIPTION	ELEV.
2	560+70	8" POPLAR 75 RT	916.68
3	583+95	8" POPLAR 40 LT	915.34

STATE PROJECT NUMBER	SHEET NO.
1564 - 5 - 71	5.1

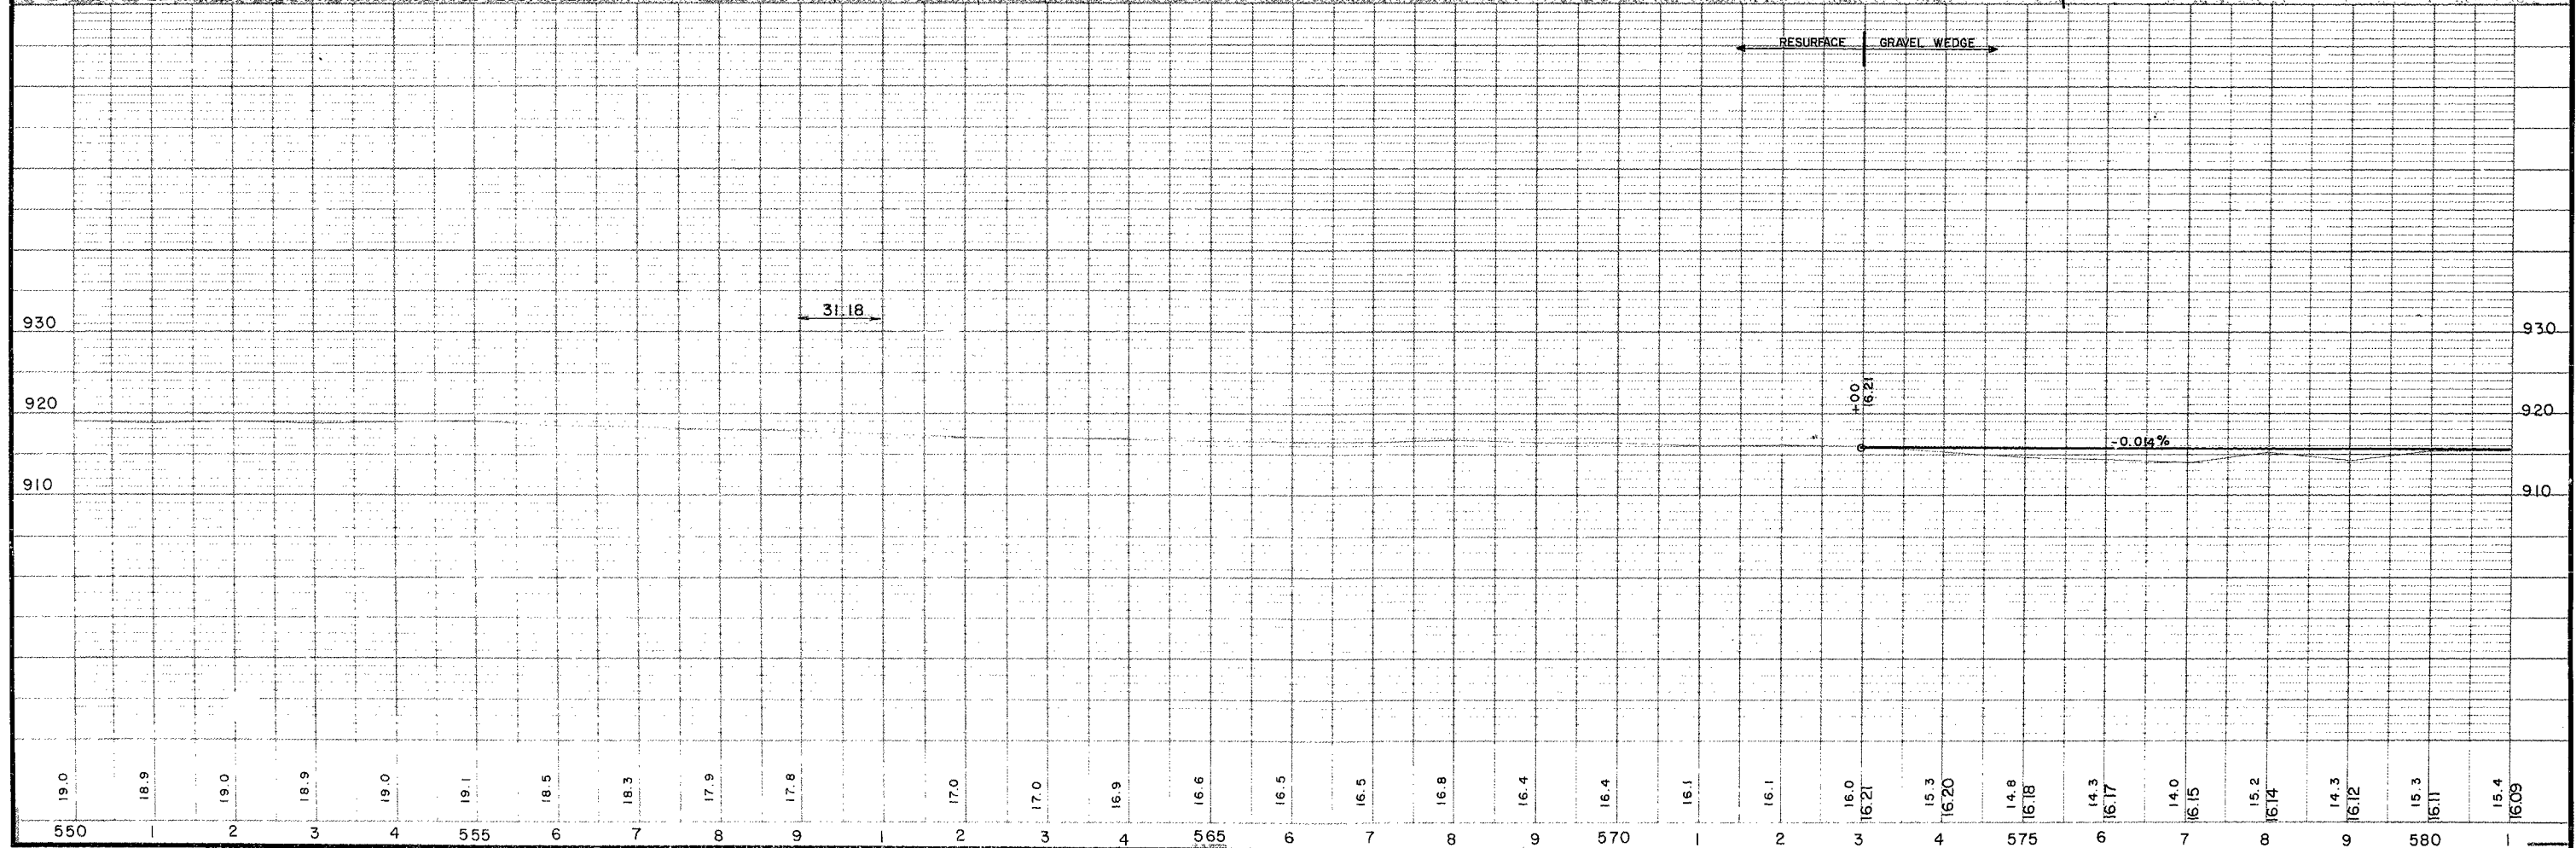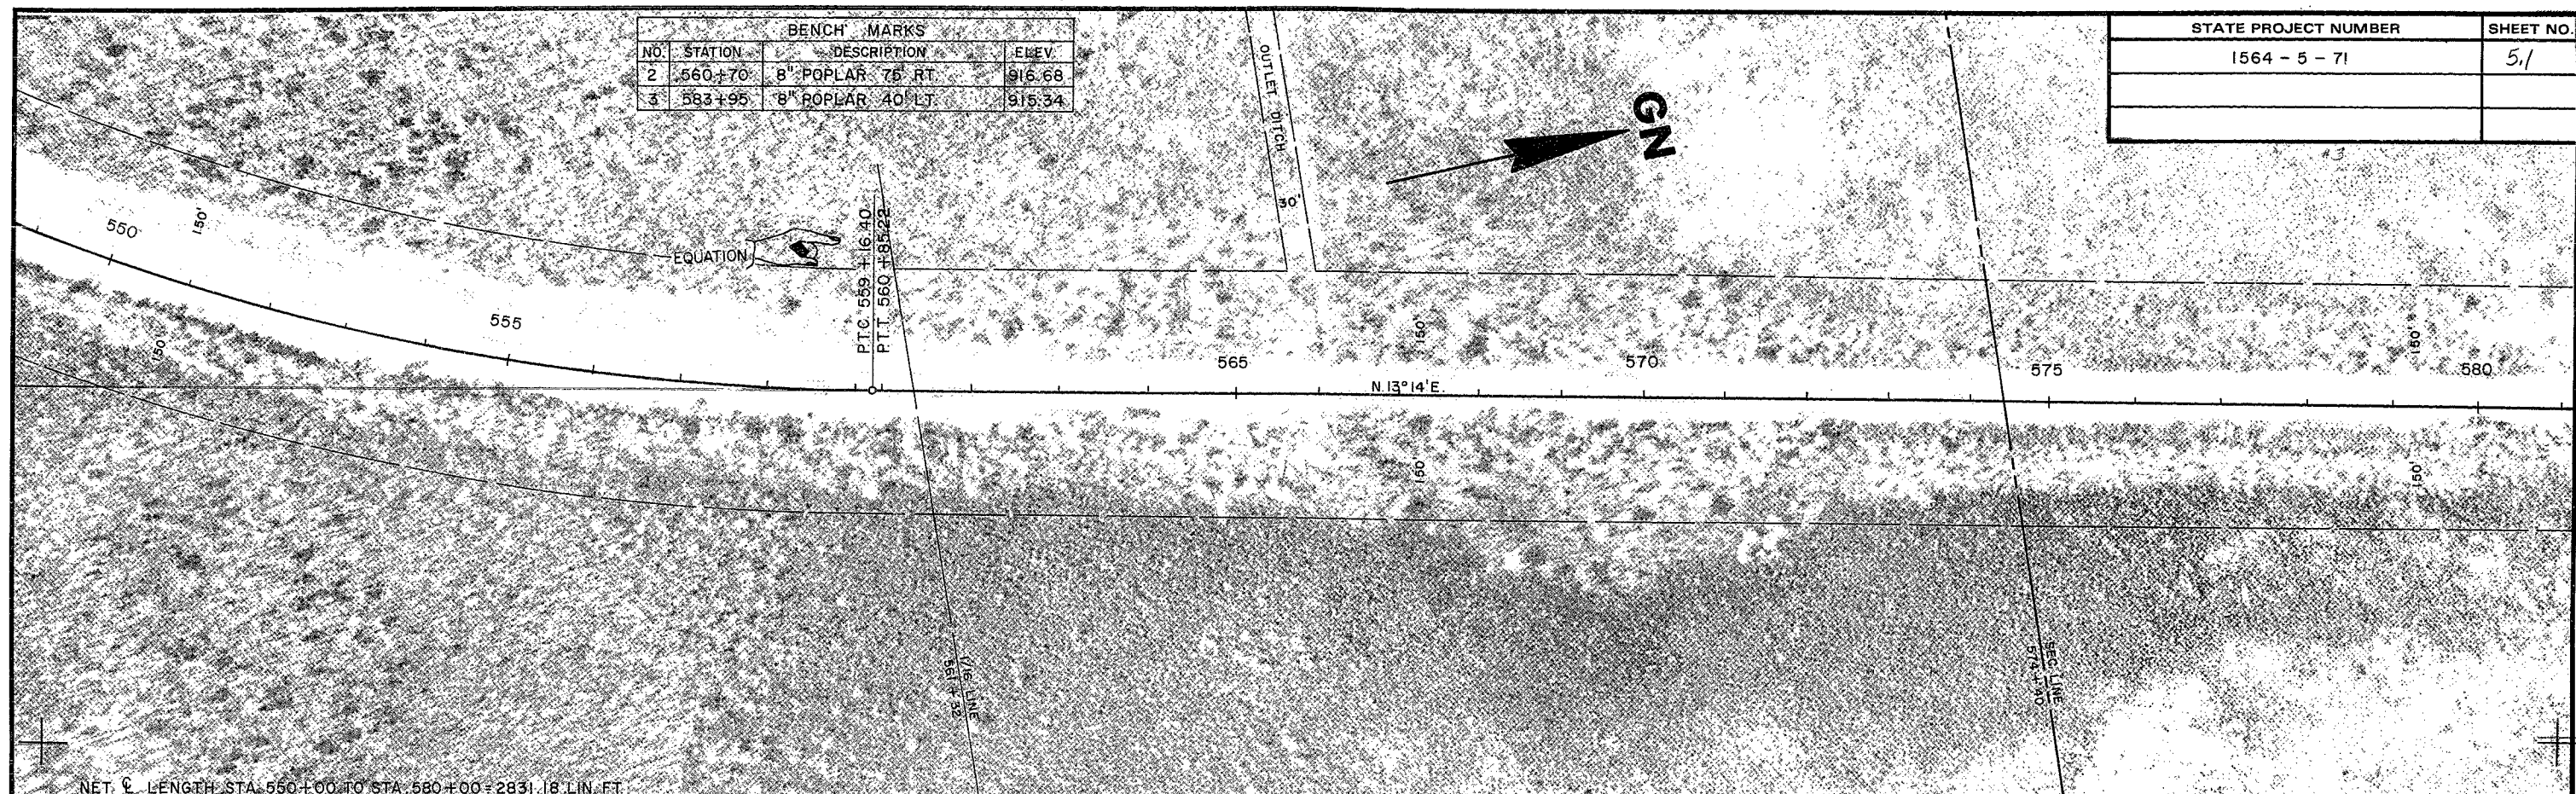



BENCH MARKS			
NO.	STATION	DESCRIPTION	ELEV.
3	583+95	8" POPLAR 40' LT.	915.34
4	600+10	6" POPLAR 40' LT.	910.04

STATE PROJECT NUMBER	SHEET NO.
1564 - 5 - 71	52

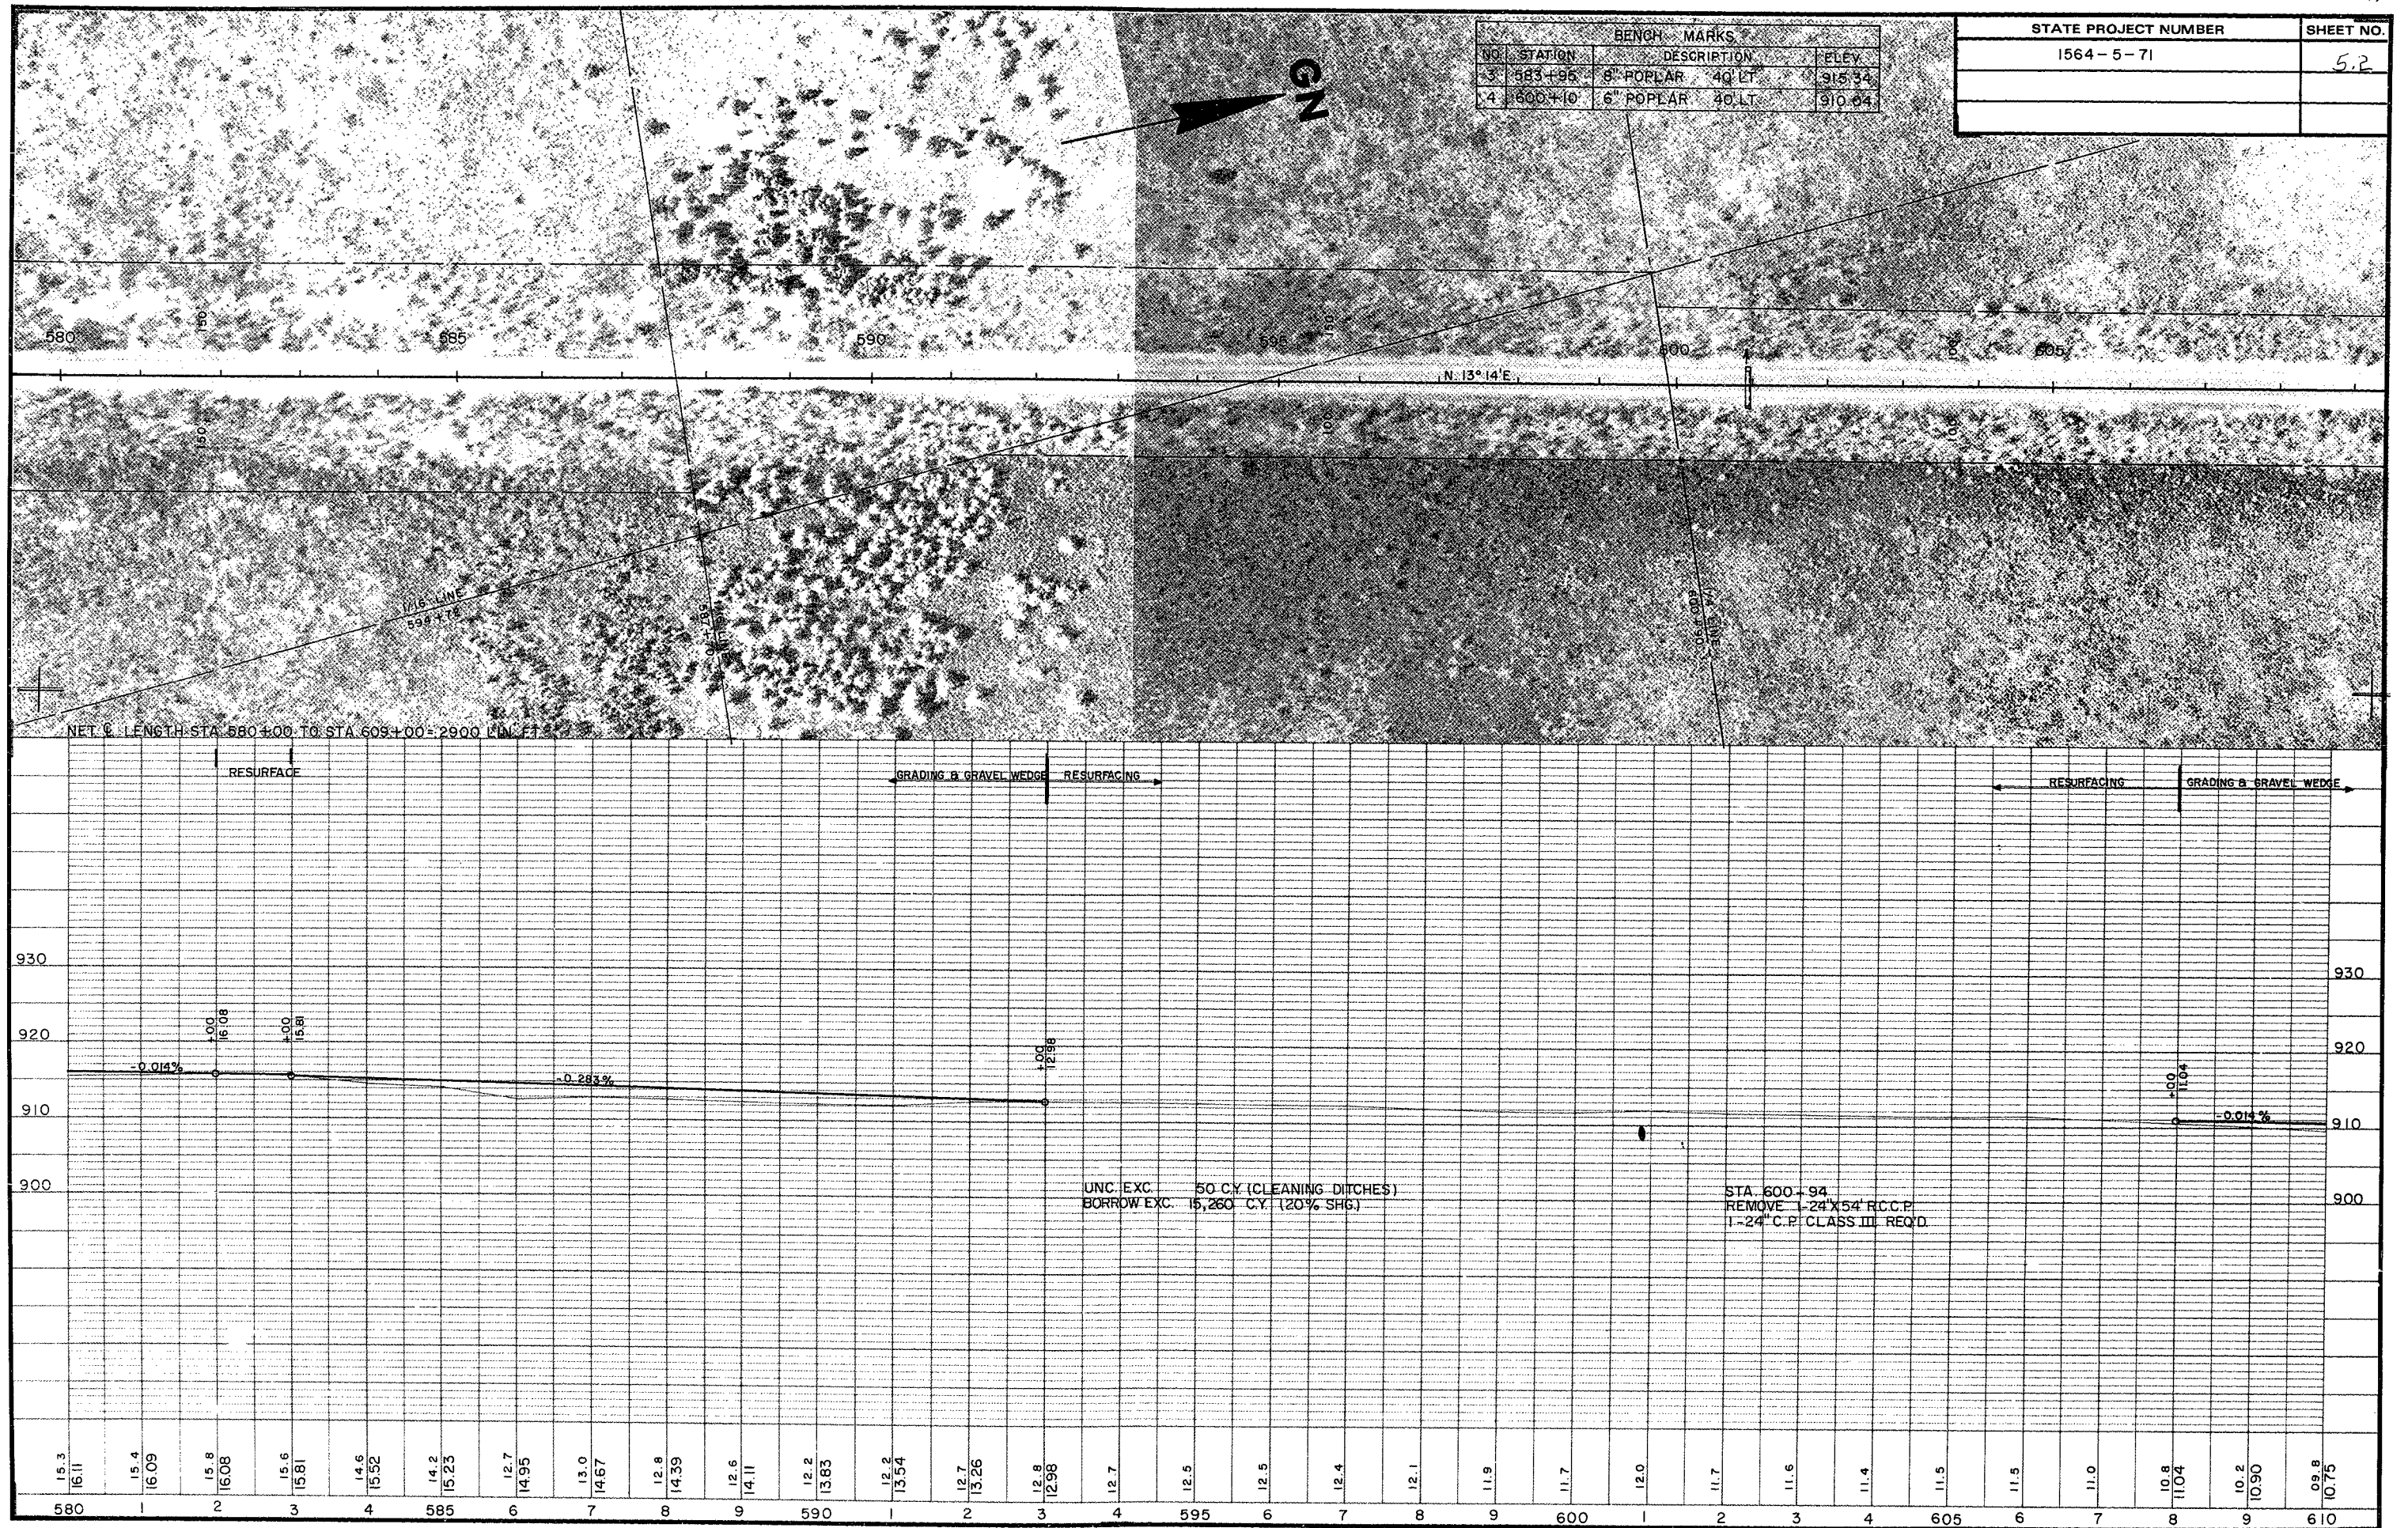



BENCH MARKS			
NO.	STATION	DESCRIPTION	ELEV.
5	617+65	10' POPLAR 80' RT.	908.04
6	630+00	6' POPLAR 40' LT.	906.81

STATE PROJECT NUMBER	SHEET NO.
1564 - 5 - 71	5.3

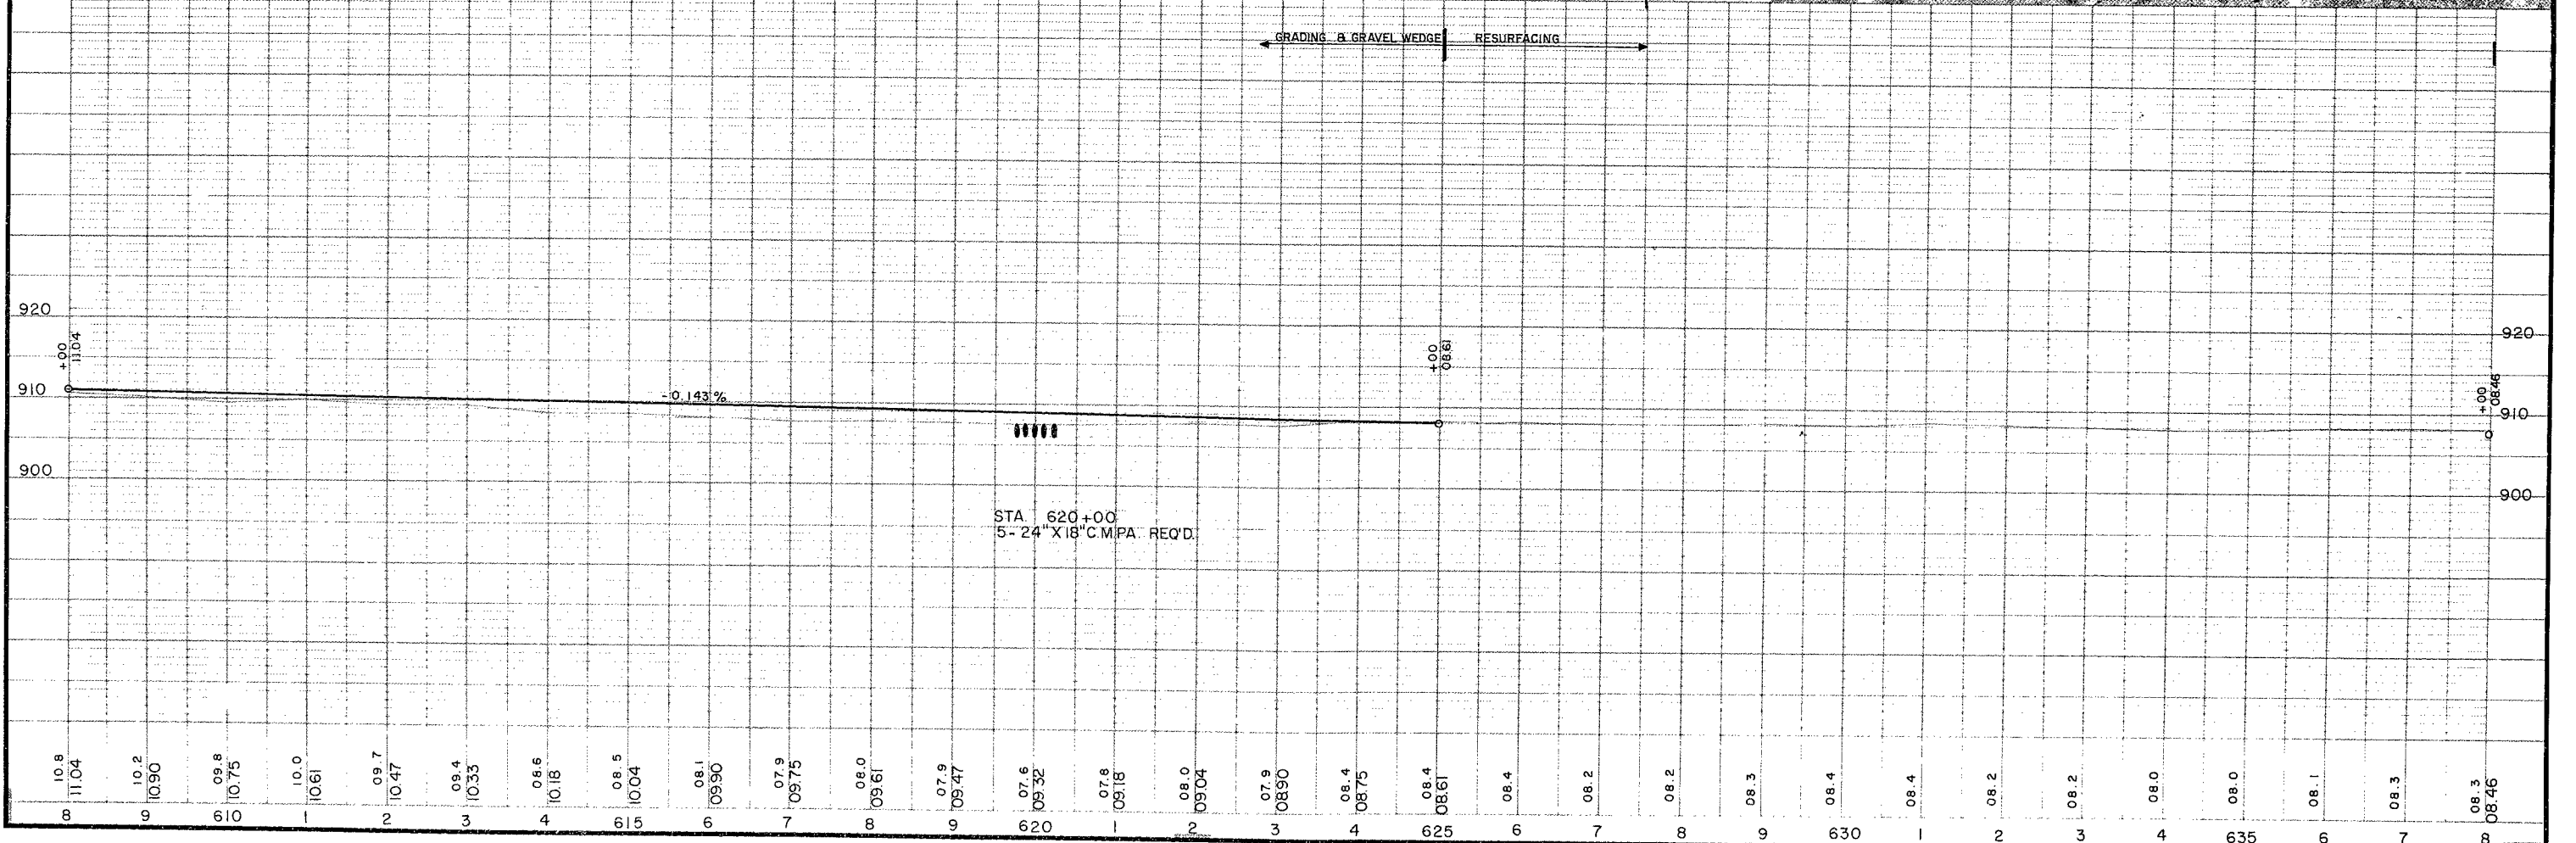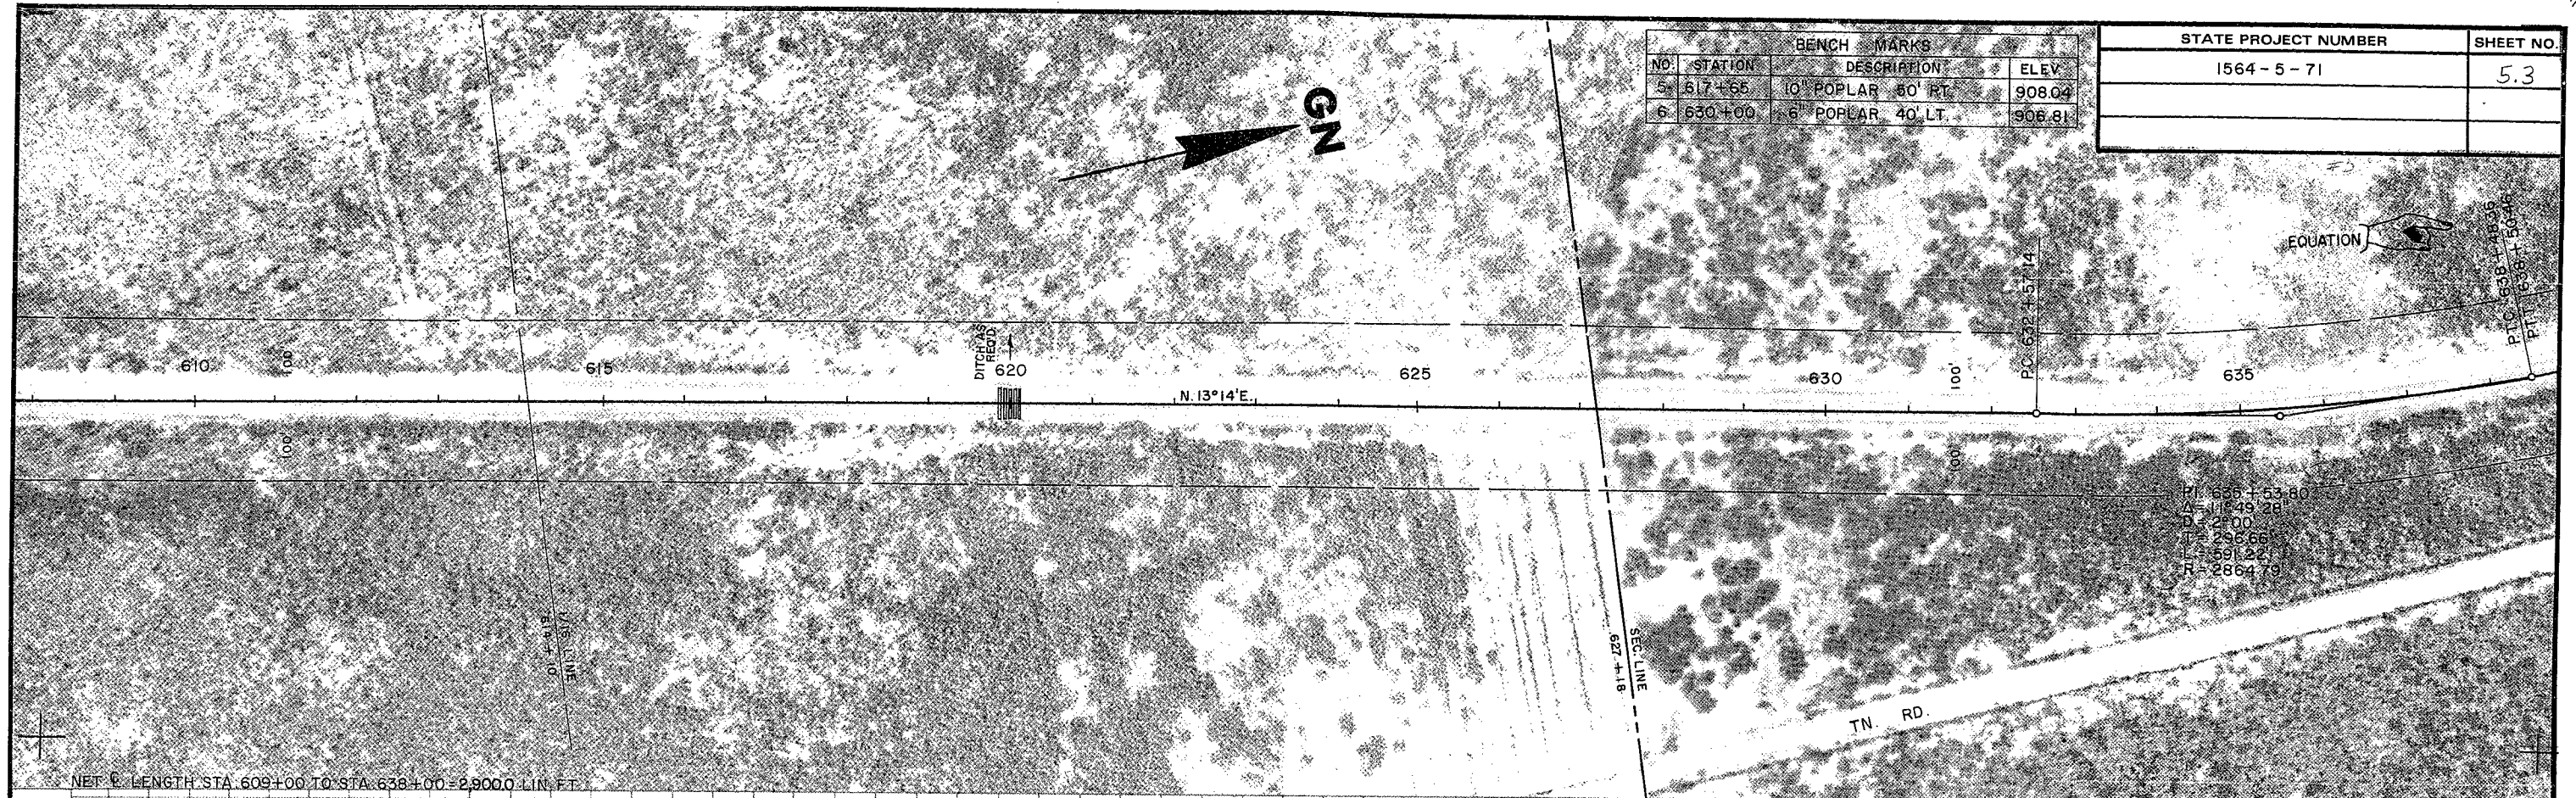


BENCH MARKS			
NO.	STATION	DESCRIPTION	ELEV.
74	645+68	SE COR 53R CURB STA 648+68	909.92


STATE PROJECT NUMBER	SHEET NO.
1564 - 5 - 71	5.4

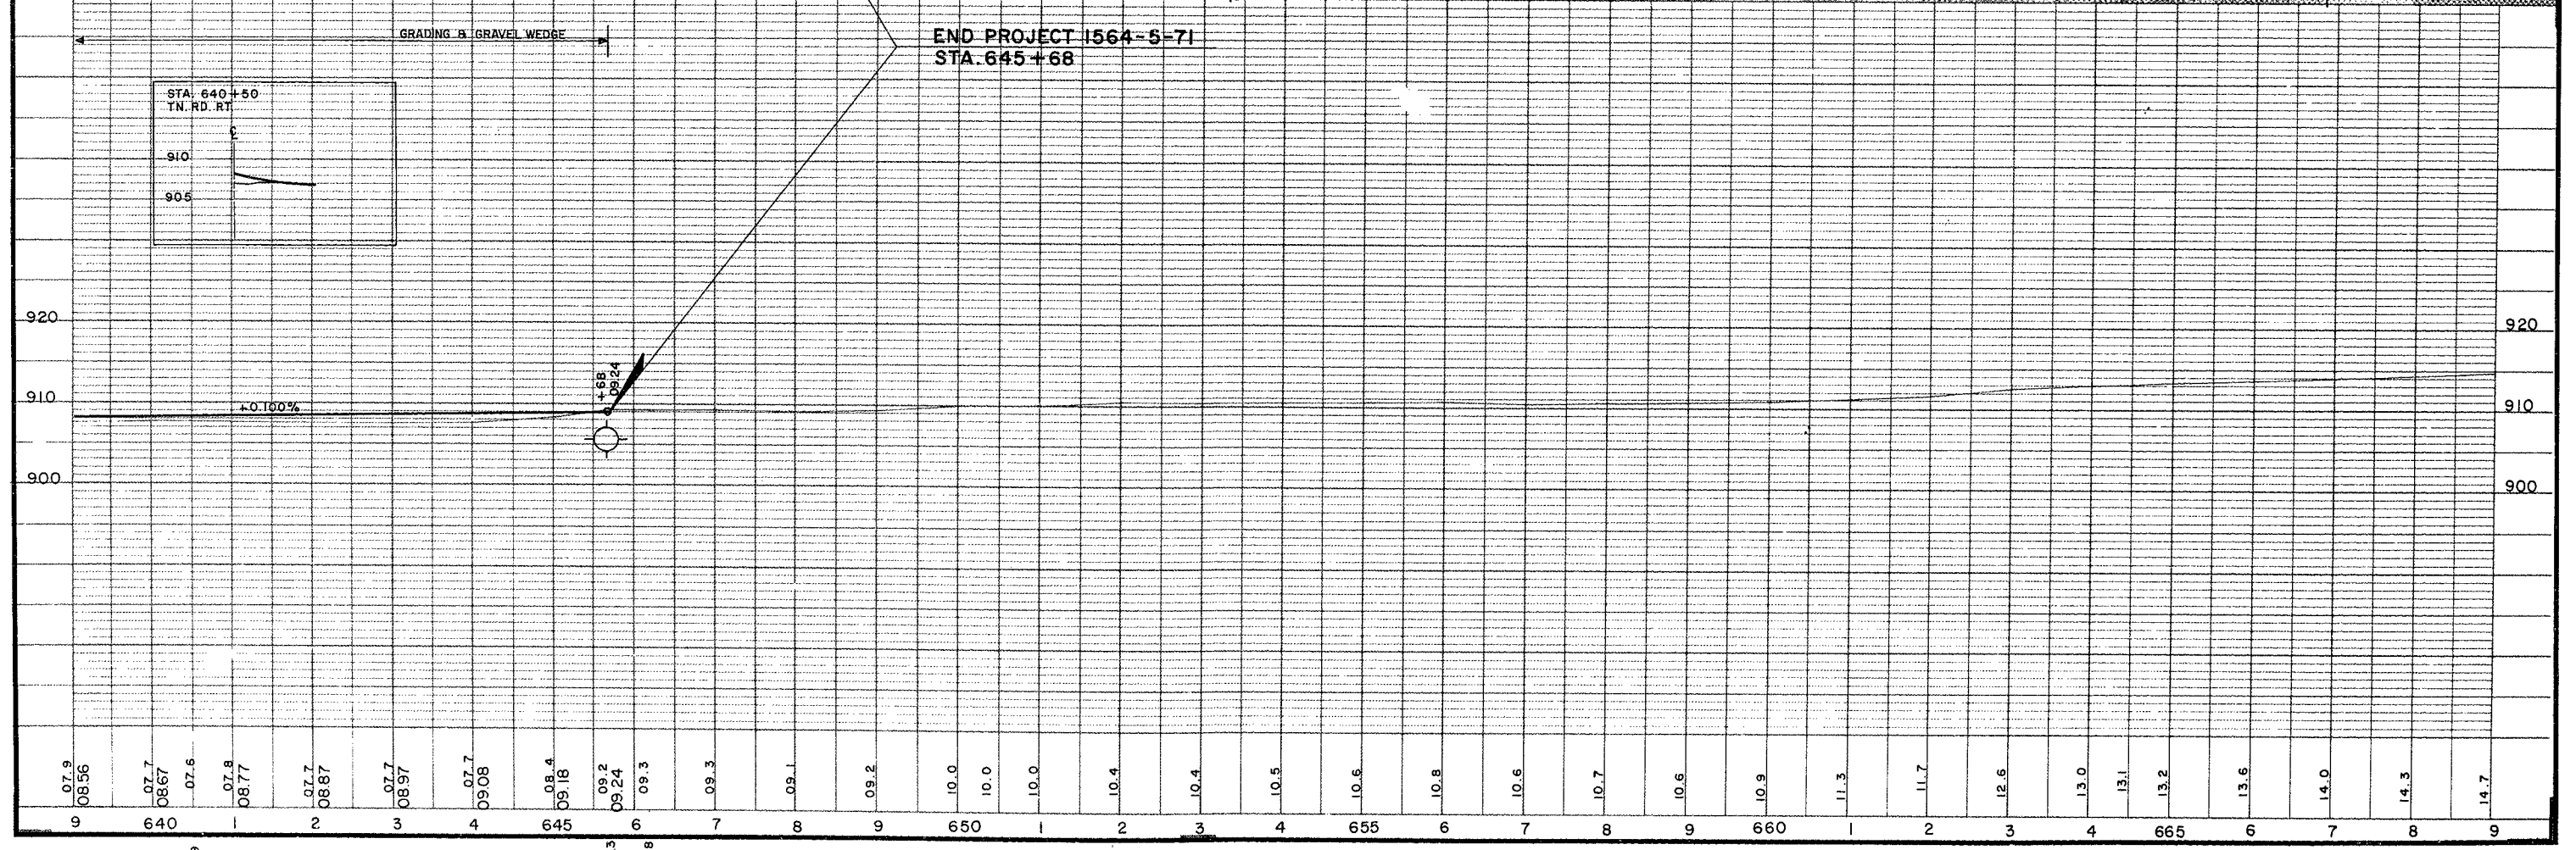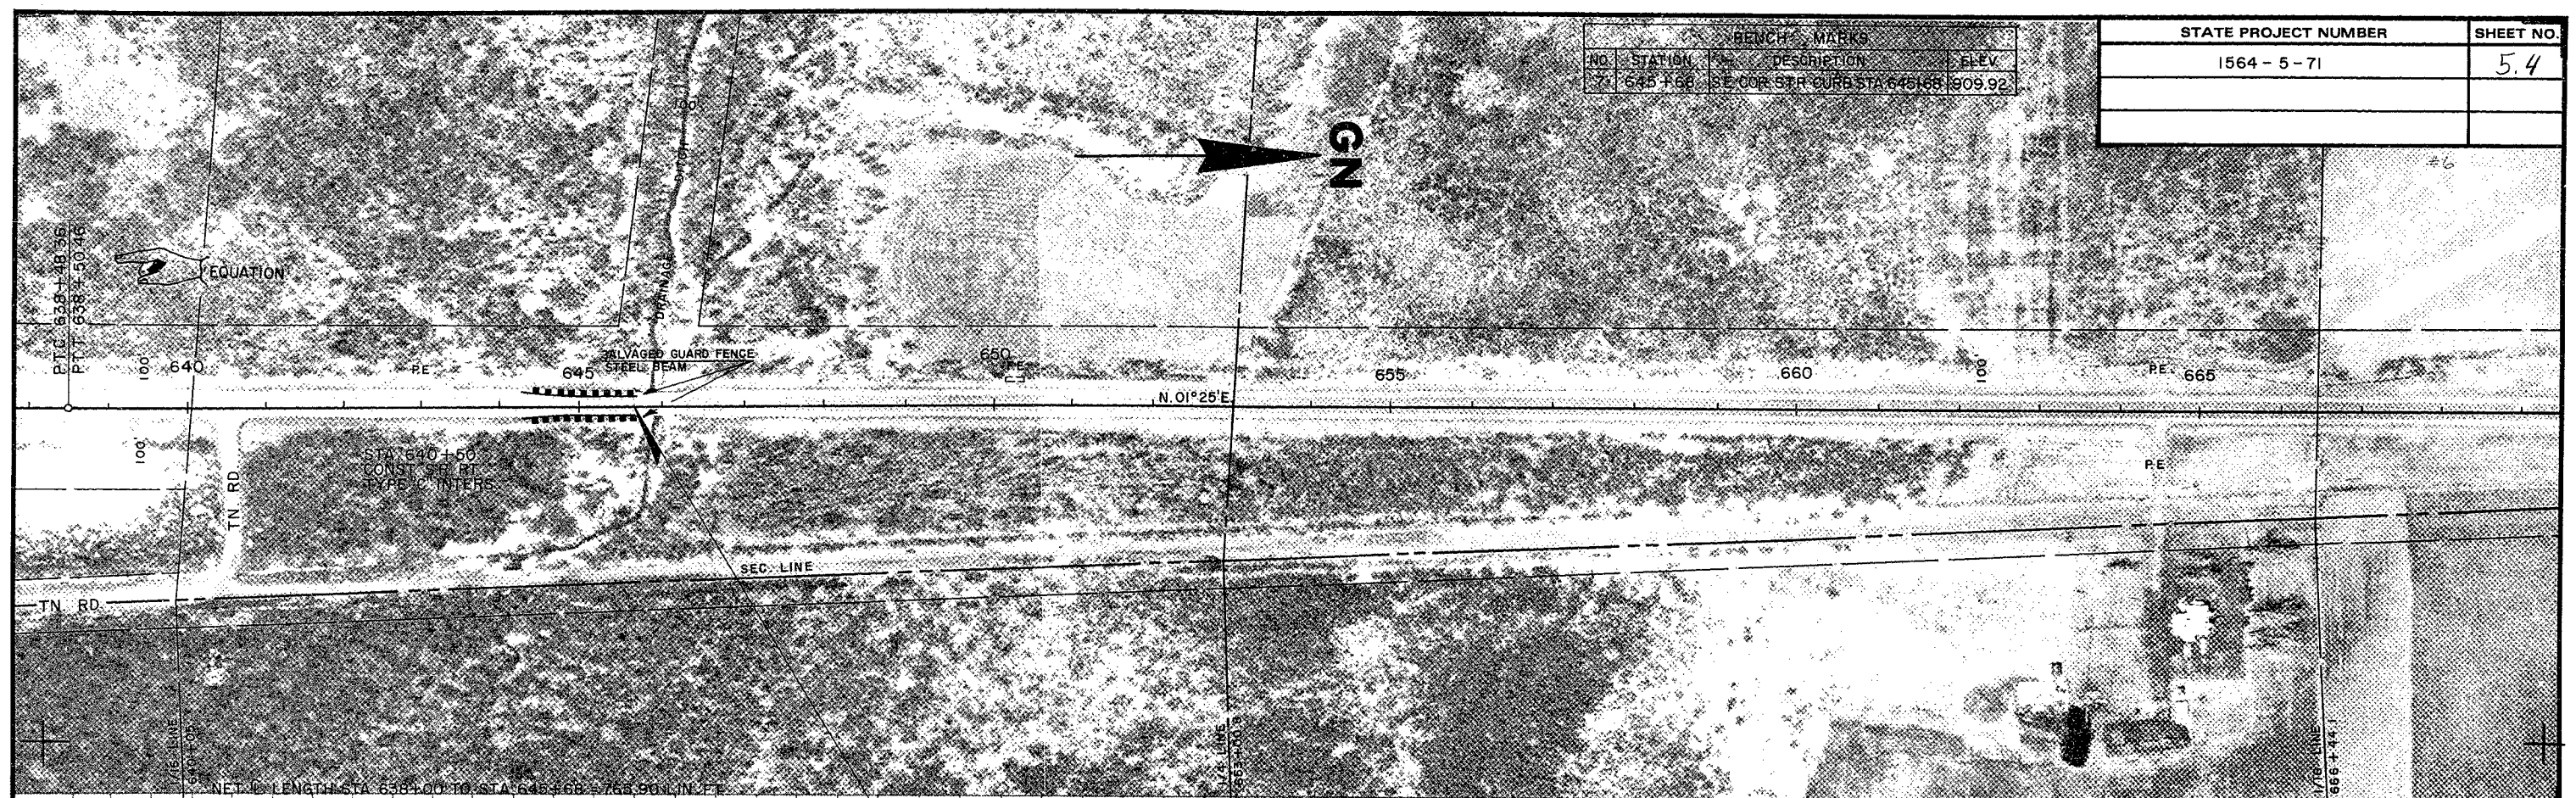


																														5.4	Catalog No. 2150-D142
																														5.4	Catalog No. 2150-D142

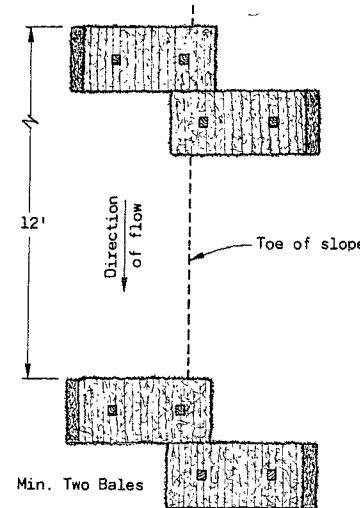


PLAN VIEW

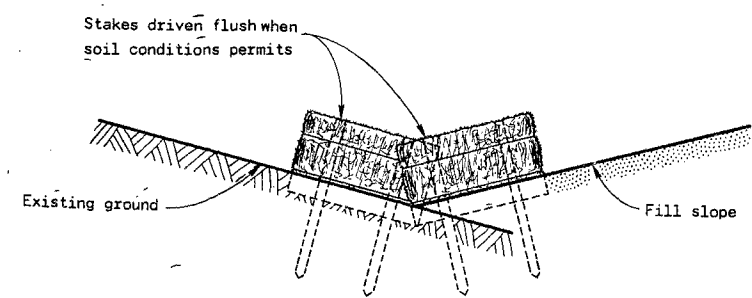


FRONT ELEVATION
WHEN EXISTING GROUND
SLOPES TOWARD FILL SLOPE

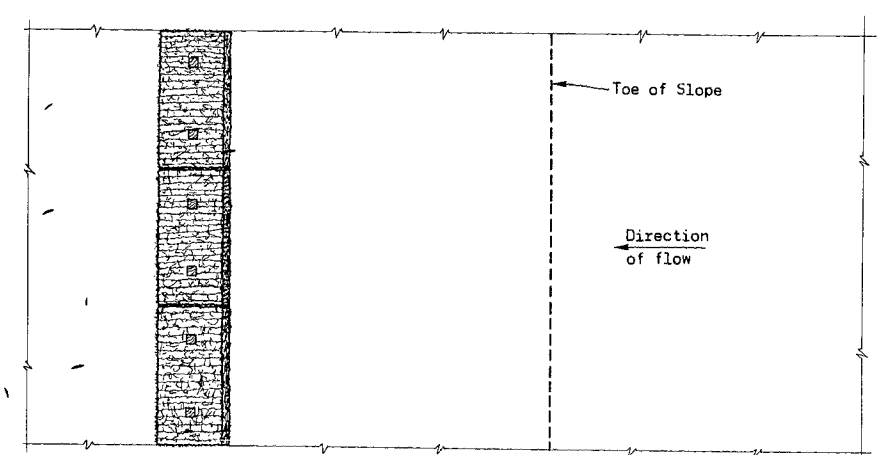


PLAN VIEW

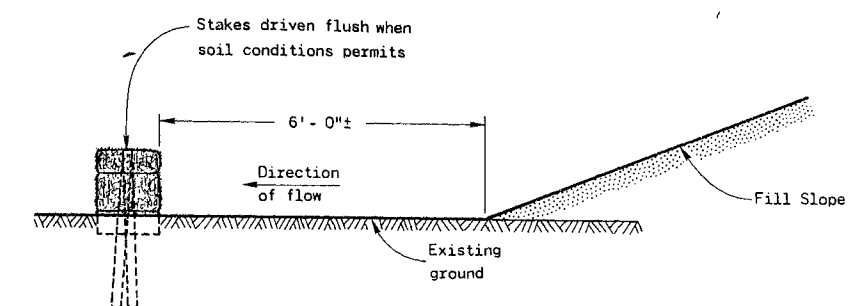


FRONT ELEVATION
EROSION BALES AT TOE OF SLOPE
WHEN EXISTING GROUND SLOPES AWAY FROM FILL SLOPE

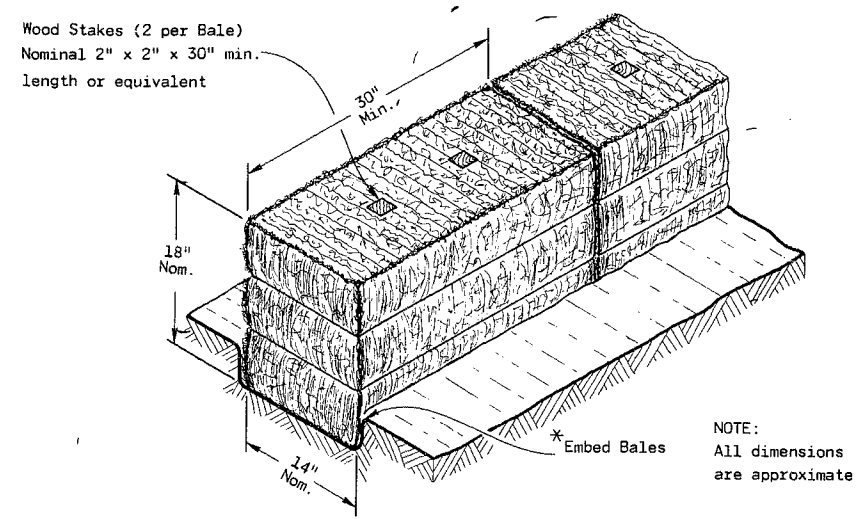

DETAIL OF EROSION BALE INSTALLATION

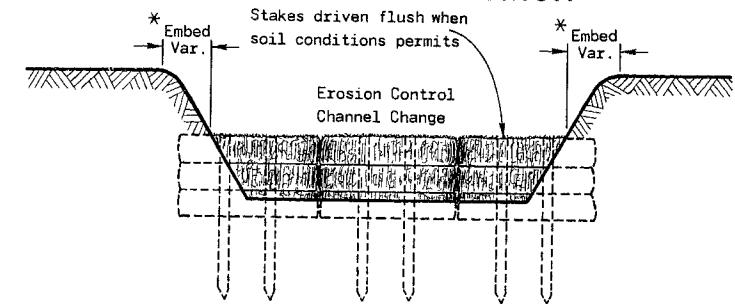


EROSION CONTROL CHANNEL CHANGE

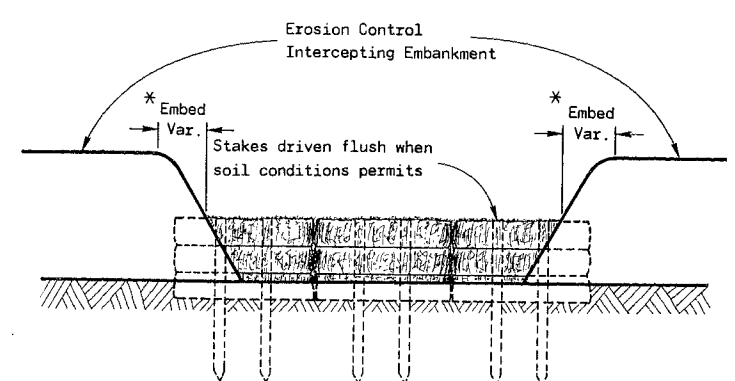

EROSION CONTROL INTERCEPTING EMBANKMENT



PLAN VIEW

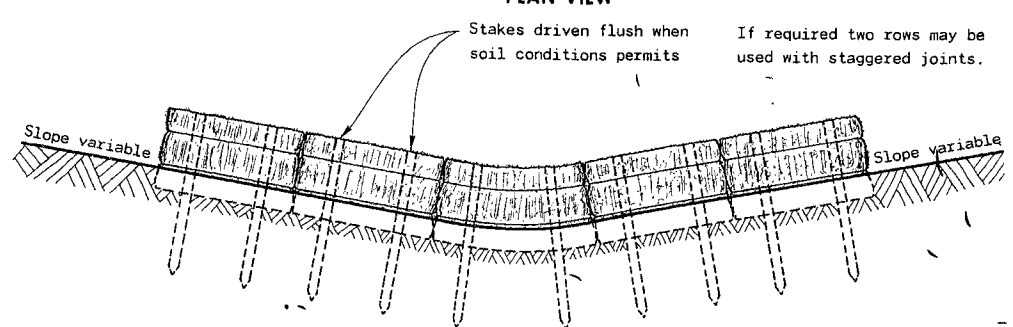

FRONT ELEVATION
EROSION BALES ACROSS DITCH BOTTOM

GENERAL NOTES


Details of construction, materials and workmanship not shown on this drawing shall conform to the pertinent requirements of the Standard Specifications and the applicable Special Provisions.

Bales shall be placed end to end or overlapping at right angles to the direction of flow and far enough up the sides of the ditch to prevent eroding around ends.


Bales shall be placed with twine or tie wires parallel to the ground.

Stakes to be battered in opposite directions.

* As determined by the Engineer.

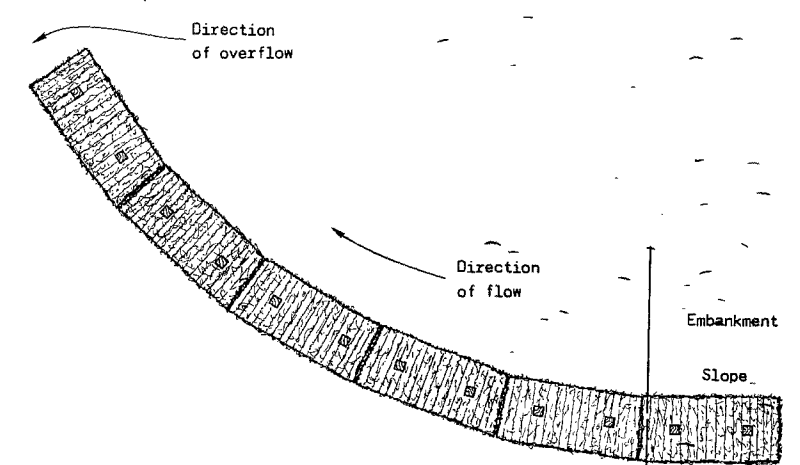

PLAN VIEW

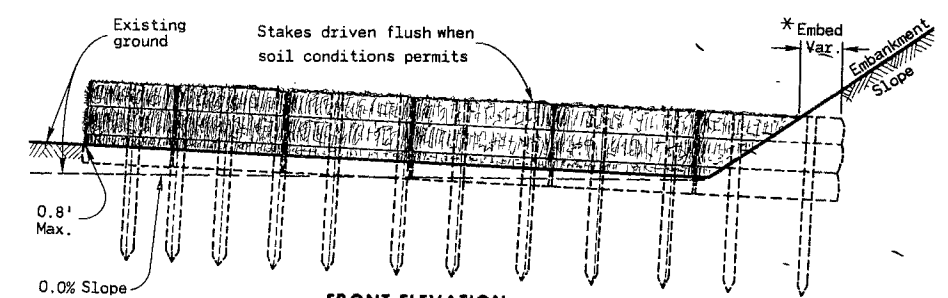

FRONT ELEVATION

EROSION BALES AT TOE OF SLOPE

TYPICAL INSTALLATIONS OF EROSION BALES








State of Wisconsin
Department of Transportation
Division of Highways

RECOMMENDED FOR APPROVAL:
10/14/75
DATE


J. C. Hennrich
CHIEF OF FACILITIES DEVELOPMENT

APPROVED
10/16/75
DATE


W. J. Sieder
STATE HIGHWAY ENGINEER

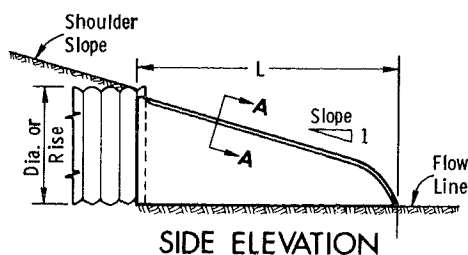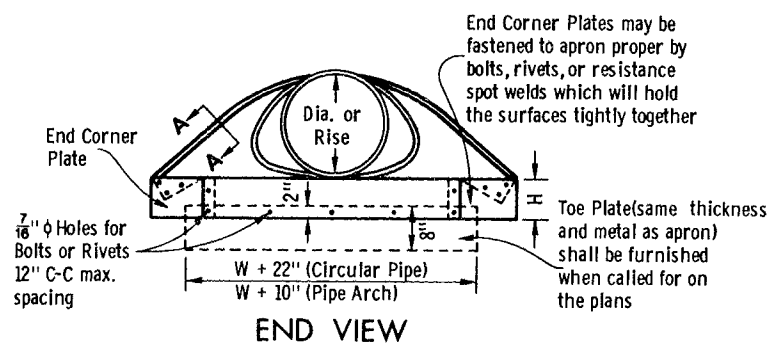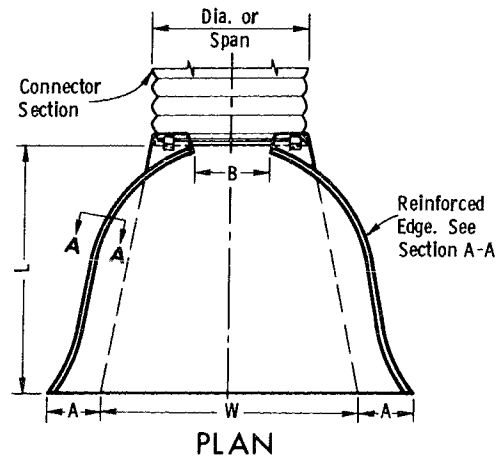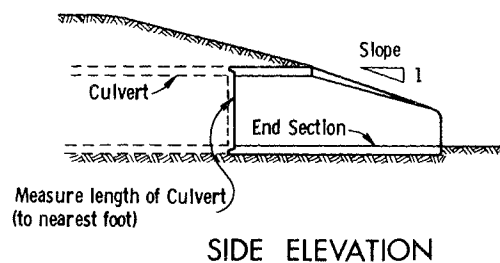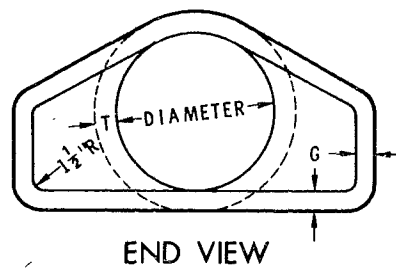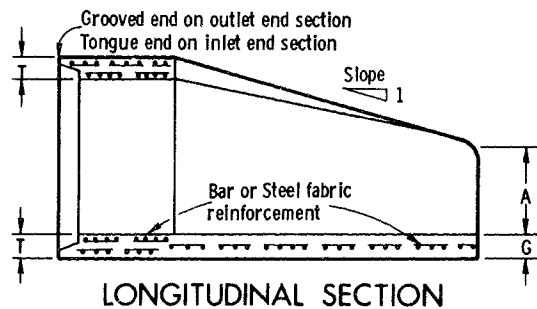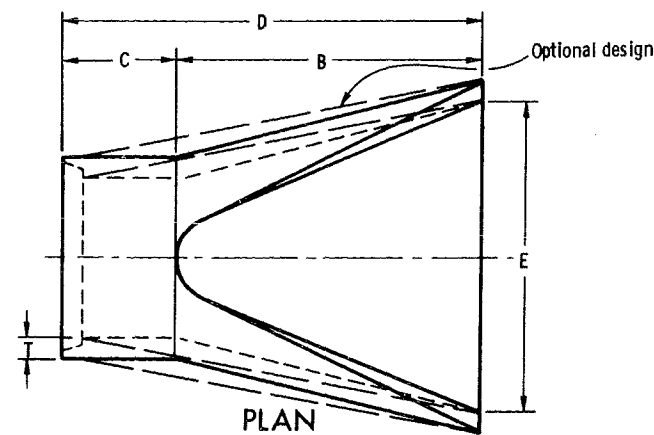


1" Wide, 12 Ga. galvanized (0.109" thick) strap with standard 6" x 1/2" band bolt and nut

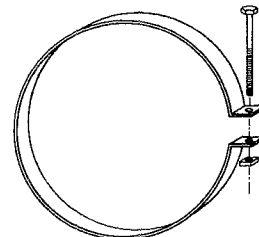


Alternate for Type 1 Connection
END SECTION CONNECTOR STRAP

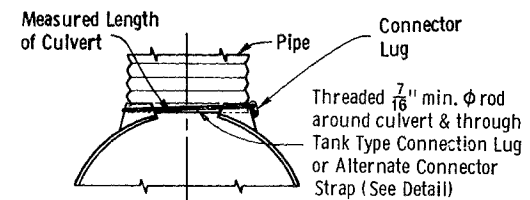


TYPE 1
For 12" thru 24" only (Circular Pipe)

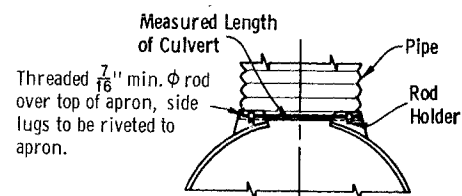


TYPE 2
For 30" and 36" only (Circular Pipe)
For 17" X 13" thru 57" X 38" only (Pipe Arch)

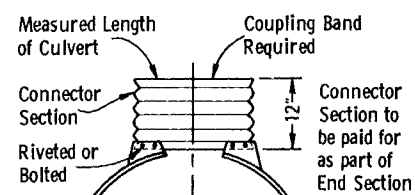

For 42" thru 84" only (Circular Pipe)
For 64" X 43" & 71" X 47" (Pipe Arch)

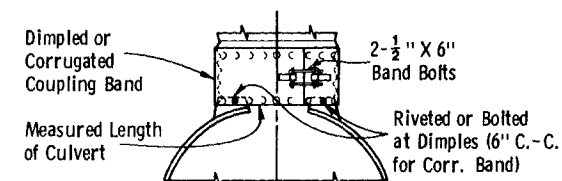

TYPE 5
Alternate for
All sizes Corrugated Circular Pipe and Pipe Arch

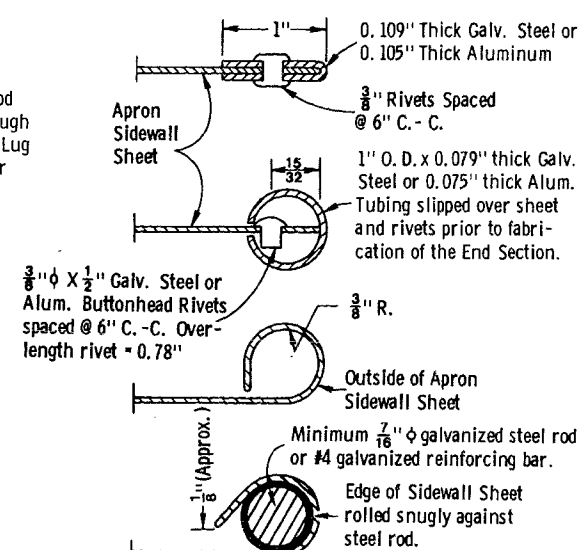

SECTION A-A

GENERAL NOTES

Details of construction, materials, and workmanship not shown on this drawing shall conform to the pertinent requirements of the Standard Specifications and the applicable Special Provisions.

Variations of the dimensions and designs shown hereon will be permitted providing equivalent capacity and structural integrity are attained, and prior approval of the Engineer is obtained.

Concrete culvert endwalls may not be used with galvanized steel or aluminum culvert pipe or vice versa.

Galvanized steel or aluminum endwalls shall normally be installed on culvert pipe of the same metal. The use of galvanized steel endwalls on aluminum pipes is permitted, provided the two metals at the joint interface are kept separated by a suitable insulating material approximately 1/16" thick or greater. Such material would be an asphalt impregnated fabric, a sheet plastic, a rubber gasket or other nondegradable material of substantial strength.

When two or more pipe arches with apron endwalls are to be laid adjacent to each other, they shall be separated by the following amount.

Pipes: Total width of apron endwall less the diameter of pipe plus 6 inches.

Pipe Arches: Total width of apron endwall less the span dimension of the pipe arch plus 6 inches.

DIA.	APPROX. WEIGHT/SECTION	T	A	B	C	D	E	G	APPROX. SLOPE
12"	530	2"	4"	24"	48 7/8"	72 7/8"	24"	2"	3 to 1
15"	740	2 1/4"	6"	27"	46"	73"	30"	2 1/4"	
18"	990	2 1/2"	9"	27"	46"	73"	36"	2 1/2"	
21"	1,280	2 3/4"	9"	36"	37 1/2"	73 1/2"	42"	2 3/4"	
24"	1,520	3"	9 1/2"	43 1/2"	30"	73 1/2"	48"	3"	
27"	1,930	3 1/4"	10 1/2"	49 1/2"	24"	73 1/2"	54"	3 1/4"	
30"	2,190	3 1/2"	12"	54"	19 3/4"	73 3/4"	60"	3 1/2"	
36"	4,100	4"	15"	63"	34 3/4"	97 3/4"	72"	4"	
42"	5,380	4 1/2"	21"	63"	35"	98"	78"	4 1/2"	
48"	6,550	5"	24"	72"	26"	98"	84"	5"	3 to 1
54"	8,040	5 1/2"	27"	65"	33 1/4" - 35"	98 1/4" - 100"	90"	5"	2 5/8 to 1
60"	8,730	6"	30"	60"	39"	99"	96"	5"	2 to 1
66"	10,630	6 1/2"	30"	72"	72" - 78"	21" - 27"	102"	5 1/2"	
72"	12,520	7"	36"	78"	21"	108"	108"	6"	
78"	14,430	7 1/2"	42"	78"	21"	99"	114"	6 1/2"	2 to 1
84"	18,160	8"	48"	90"	21"	111 1/2"	120"	6 1/2"	1 1/2 to 1

** Minimum
* Maximum

REINFORCED CONCRETE APRON ENDWALLS

D PIPE DIAM.	MIN. METAL THICKNESS	MIN. ALUM.	DIMENSIONS					APPROX. SLOPE
			A ± 1"	B MAX.	H ± 1"	L ± 1 1/2"	W ± 2"	
12"	0.064	0.060	6"	6"	6"	21"	24"	2 1/2 to 1
15"			7"	8"		26"	30"	
18"			8"	10"		31"	36"	
21"		0.060	9"	12"		36"	42"	
24"	0.064	0.075	10"	13"	6"	41"	48"	
30"	0.079	0.075	12"	16"	8"	51"	60"	
36"	0.079	0.105	14"	19"	9"	60"	72"	
42"	0.109		16"	22"	11"	69"	84"	2 1/2 to 1
48"			18"	27"	12"	78"	90"	2 1/4 to 1
54"		0.105	30"			84"	102"	2 to 1
60"		NA	33"			87"	114"	1 3/4 to 1
66"			36"			87"	120"	1 1/2 to 1
72"			39"			87"	126"	1 1/3 to 1
78"			42"			87"	132"	1 1/4 to 1
84"	0.109	NA	45"	45"	12"	87"	138"	1 1/8 to 1

NOTE: All splices to be lap riveted or bolted

METAL OR ALUMINUM APRON
ENDWALLS FOR CIRCULAR PIPES

PIPE - ARCH DIMENSIONS SPAN	RISE	MIN. METAL THICK.	DIMENSIONS					APPROX. SLOPE
			A ± 1"	B MAX.	H ± 1"	L ± 1 1/2"	W ± 2"	
17"	13"	0.064	7"	9"	6"	19"	30"	2 1/2 to 1
21"	15"		7"	10"		23"	36"	
24"	18"		8"	12"		28"	42"	
28"	20"	0.064	9"	14"		32"	48"	
35"	24"	0.079	10"	16"	6"	39"	60"	
42"	29"	0.079	12"	18"	8"	46"	75"	
49"	33"	0.109	13"	21"	9"	53"	85"	
57"	38"		18"	26"	12"	63"	90"	2 1/2 to 1
64"	43"		18"	30"	12"	70"	102"	2 1/4 to 1
71"	47"		18"	33"	12"	77"	114"	2 1/4 to 1
77"	52"		18"	36"	12"	77"	126"	2 to 1
83"	57"	0.109	18"	39"	12"	77"	138"	2 to 1

NOTE: All splices to be lap riveted or bolted

METAL APRON ENDWALLS
FOR PIPE ARCHES

CONNECTION DETAILS

CIRCULAR PIPE

For Circumferentially Corrugated Pipe use Endwall Connection Details 1, 2, 3, or 5 as applicable.

For Helically Corrugated Pipe use Endwall Connection Details 1, 2 or 5.

For Helically Corrugated Pipes with two Circumferential Corrugations at each end use Endwall Connection Details 1, 2, or 3

PIPE ARCH


Use Endwall Connection Details 2, 3, or 5 as applicable.

APRON ENDWALLS FOR CULVERT PIPE AND PIPE ARCH

State of Wisconsin
Department of Transportation
Division of Highways

APPROVED
7-14-78
DATE
APPROVED
7-17-78
DATE
LHW

John J. Bader
SUPERVISING DEVELOPMENT ENGINEER
D. J. Standa
CHIEF OF PROJECTS DEVELOPMENT

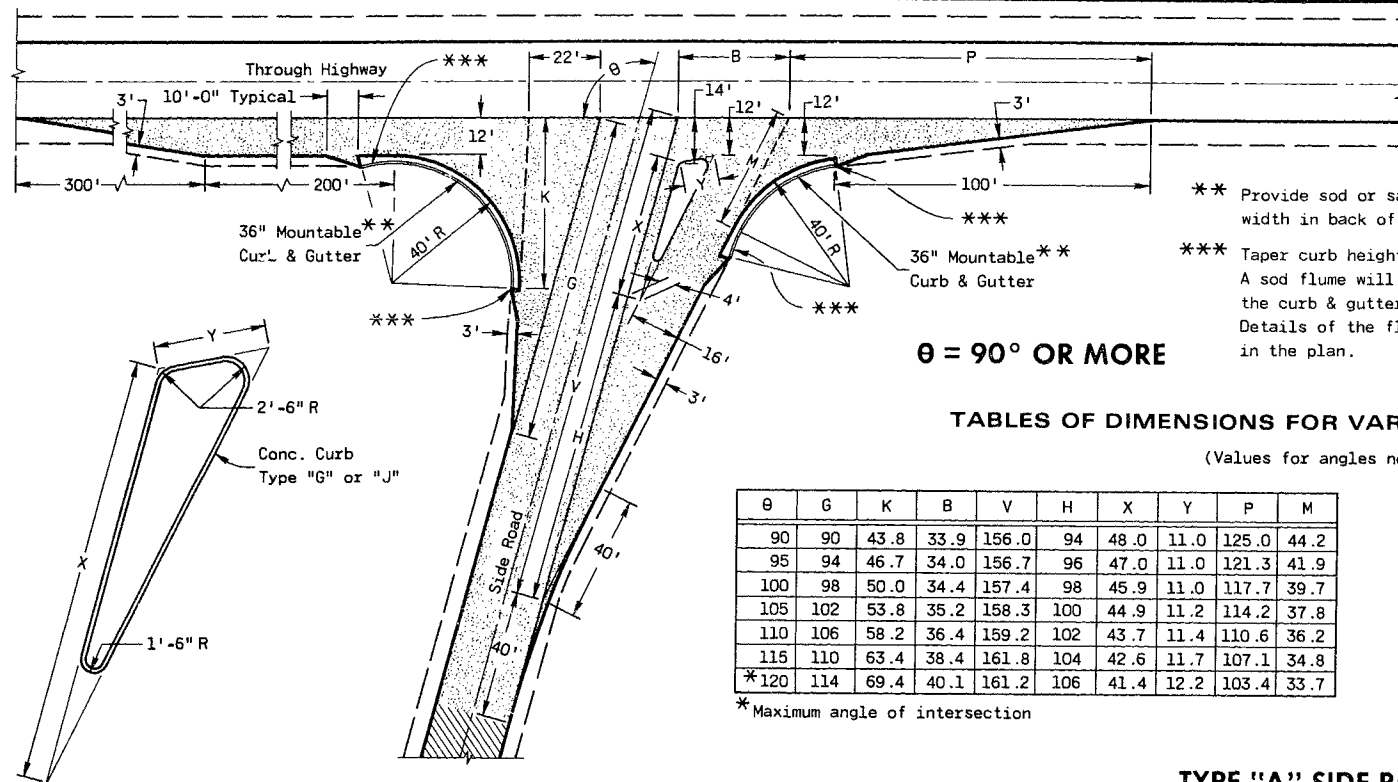

*** Provide sod or salvaged topsoil & seed to a 3'-0" width in back of curb & gutter sections.

*** Taper curb height 0" to 6" in 10'-0". A sod flume will be required at discharge end of the curb & gutter. Details of the flume(s) will be shown elsewhere in the plan.


$\theta = 90^\circ$ OR MORE

TABLES OF DIMENSIONS FOR VARIABLE SIDE ROAD INTERSECTION ANGLES

(Values for angles not shown shall be interpolated)

θ	G	K	B	V	H	X	Y	P	M
90	90	43.8	33.9	156.0	94	48.0	11.0	125.0	44.2
95	94	46.7	34.0	156.7	96	47.0	11.0	121.3	41.9
100	98	50.0	34.4	157.4	98	45.9	11.0	117.7	39.7
105	102	53.8	35.2	158.3	100	44.9	11.2	114.2	37.8
110	106	58.2	36.4	159.2	102	43.7	11.4	110.6	36.2
115	110	63.4	38.4	161.8	104	42.6	11.7	107.1	34.8
*120	114	69.4	40.1	161.2	106	41.4	12.2	103.4	33.7

* Maximum angle of intersection

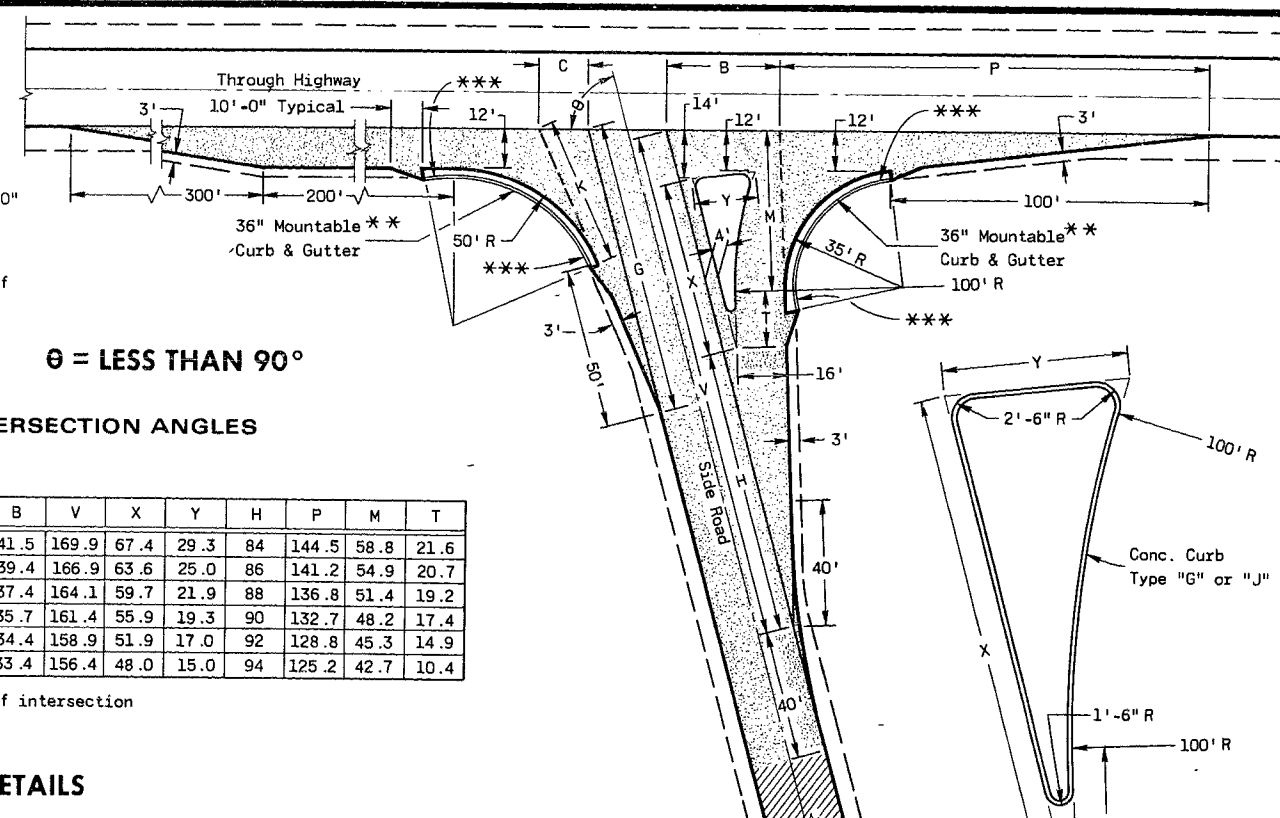


$\theta = \text{LESS THAN } 90^\circ$

θ	C	G	K	B	V	X	Y	H	P	M	T
*60	19.7	76.3	38.6	41.5	169.9	67.4	29.3	84	144.5	58.8	21.6
65	17.8	82.6	40.6	39.4	166.9	63.6	25.0	86	141.2	54.9	20.7
70	15.8	87.2	43.1	37.4	164.1	59.7	21.9	88	136.8	51.4	19.2
75	15.7	90.9	45.6	35.7	161.4	55.9	19.3	90	132.7	48.2	17.4
80	15.9	94.9	48.3	34.4	158.9	51.9	17.0	92	128.8	45.3	14.9
85	16.2	99.3	51.4	33.4	156.4	48.0	15.0	94	125.2	42.7	10.4

* Desirable minimum angle of intersection

TYPE "A" SIDE ROAD INTERSECTION DETAILS

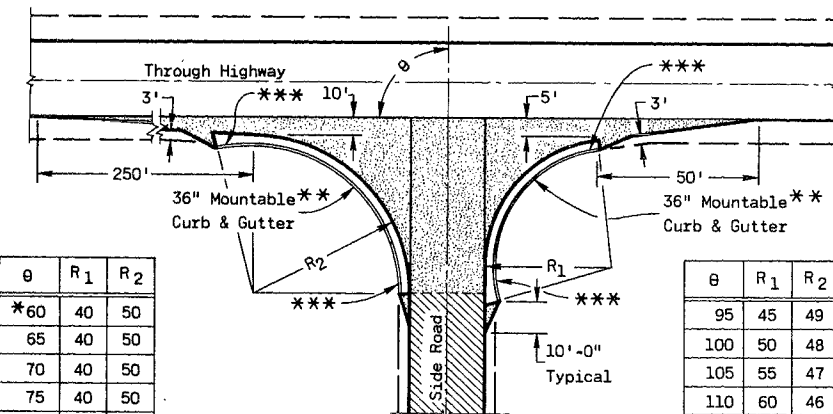


θ	R ₁	R ₂
*60	40	50
65	40	50
70	40	50
75	40	50
80	40	50
85	40	50
90	40	50

* Min. Angle of Intersection

θ	R ₁	R ₂
95	45	49
100	50	48
105	55	47
110	60	46
115	65	45
*120	70	44


* Max. Angle of Intersection

TYPE "B" SIDE ROAD INTERSECTION DETAILS

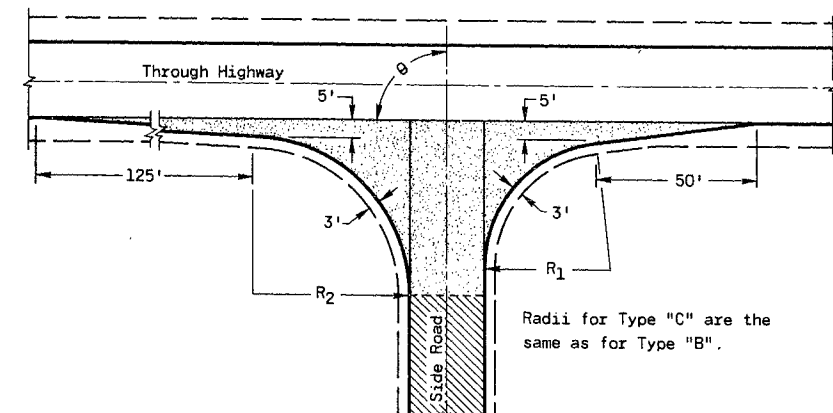

Radii for Type "C" are the same as for Type "B".

TYPE "C" SIDE ROAD INTERSECTION DETAILS

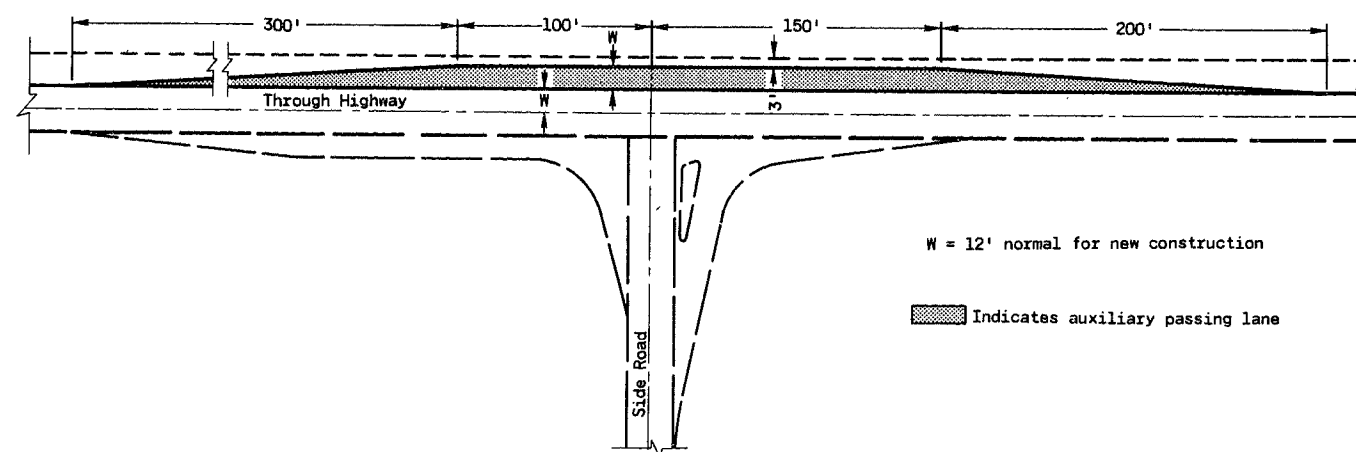


W = 12' normal for new construction

Indicates auxiliary passing lane


PASSING LANE DETAIL

"H" = 6" Max. and 4" Min. and shall be 6" unless otherwise shown on the plans.

"H₁" = Same as adjacent pavement thickness for rigid pavement and 12" for non-rigid pavement (Tie Bars omitted).

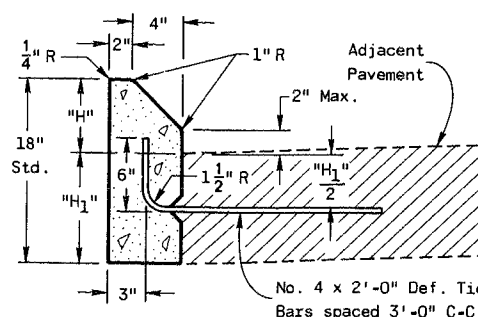

TYPE "G" (INCLUDING TIE BARS) TYPE "J" (EXCLUDING TIE BARS) MOUNTABLE CONCRETE CURB

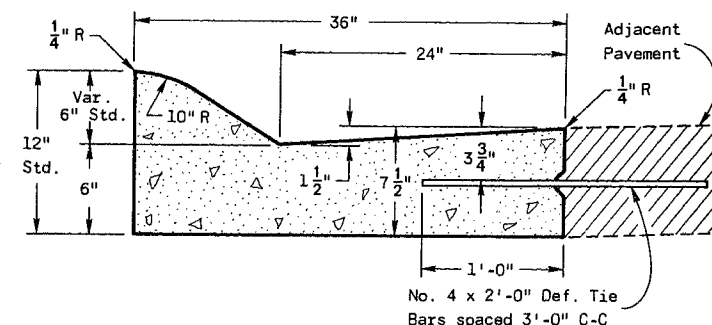

TYPE "A" (INCLUDING TIE BARS) TYPE "D" (EXCLUDING TIE BARS) MOUNTABLE CONCRETE CURB & GUTTER 36"

GENERAL NOTES

Designs may be used interchangeably in combination or separately for any one complete intersection depending upon intersection angle and surfacing of each approach roadway.

Details on this drawing are for minimum design only, and not applicable to special conditions, as shown elsewhere on the plans.

SIDE ROAD SURFACING NOTE

If the side road is not presently paved, pavement shall be placed to the limits shown. In the case where the construction limits are beyond the paving limits, gravel or crushed stone surfacing shall be placed between the paving limits and construction limits.

If the side road is presently paved, new pavement shall be placed to the limits of design as shown and beyond, if necessary, to meet existing pavement.

If the side road is the construction project, the intersection surfacing shall be the same as for the project.

New Pavement
Existing Surface

LAYOUT DETAILS FOR AT-GRADE SIDE ROAD INTERSECTIONS

State of Wisconsin
Department of Transportation
Division of Highways

RECOMMENDED FOR APPROVAL

9-10-76

DATE

APPROVED


9-10-76

DATE


D. J. Stank
CHIEF OF FACILITIES DEVELOPMENT

W. J. Fisher
STATE HIGHWAY ENGINEER

S. D. D. 9A1-3

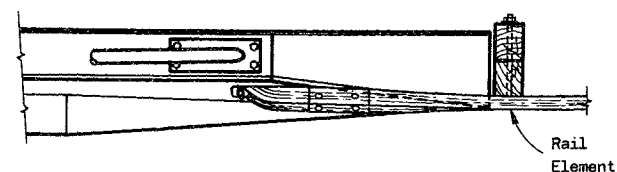


PLAN VIEW

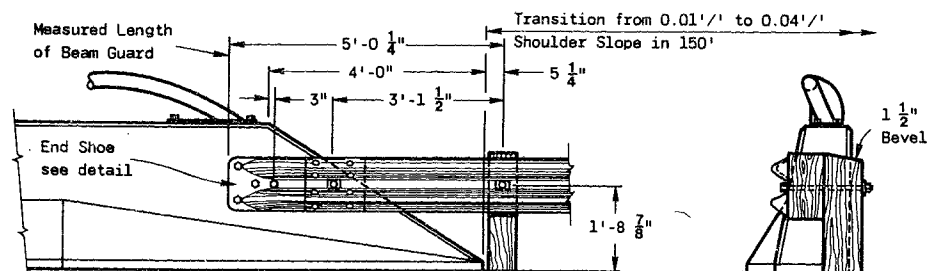


FRONT ELEVATION

END ELEVATION

STRUCTURE MOUNTING DETAIL
SLOPING TYPE PAPAPET WALL

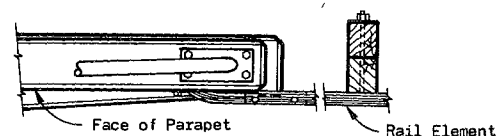


PLAN VIEW

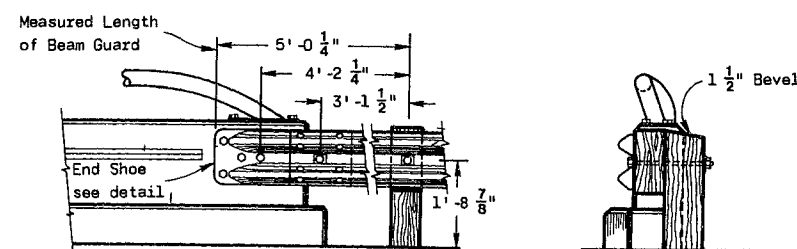


FRONT ELEVATION

END ELEVATION

STRUCTURE MOUNTING DETAIL
VERTICAL TYPE PAPAPET WALL

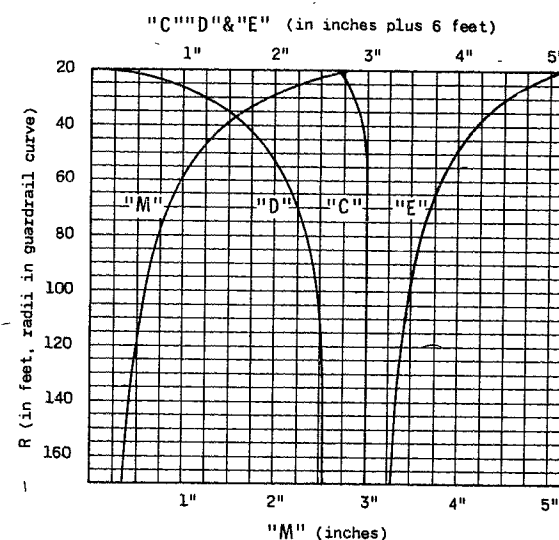

CURVE DATA FOR POST SPACING AND BEAM CURVING

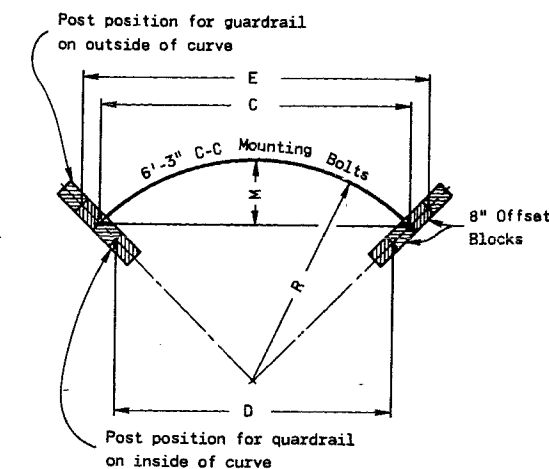

CHORD LENGTHS FOR POST SPACING AND
MIDDLE ORDINATES FOR BEAM CURVING

GENERAL NOTES

Details of construction, materials and workmanship not shown on this drawing shall conform to the pertinent requirements of the Standard Specifications and the applicable Special Provisions.

The exact location of the beginning and end of each Guardrail installation shall be as shown on the plans or as directed by the Engineer.

Square anchor alternates will be permitted. Square anchors shall be a minimum of 24 inches x 24 inches.


The shoulder widening to accommodate the anchored end of the guardrail shall be accomplished at the rate of widening not to exceed 15 to 1.

Upon approval of the Engineer, the 6 foot anchor offset may be reduced to nothing for replacement installations where existing conditions will not permit the desirable offset. However, when no offset greater than or equal to 3 feet can be provided, the minimum length of guardrail in advance of an obstacle (obstacle to anchor) shall be 150 feet.


The minimum clearance from the front face of guardrail to obstacle shall be 3 feet unless otherwise shown on contract plans. When clearance is less than 3 feet post spacing shall be reduced to 3 feet - 1 1/2 inches C.C.

The "Post Footing Details At Piers" shall be used when guardrail posts are over structure footings and less than 3 feet - 6 inches of earth is provided over the top of the footing.

NOTE:
THIS STANDARD DETAIL DRAWING CONSISTS OF TWO PLATES, AND BOTH PLATES ARE REQUIRED WHEN THIS STANDARD IS CALLED FOR IN THE PLANS.

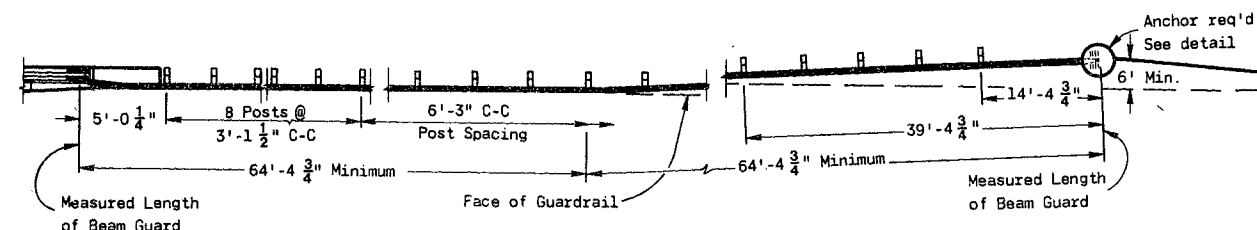


PLAN VIEW

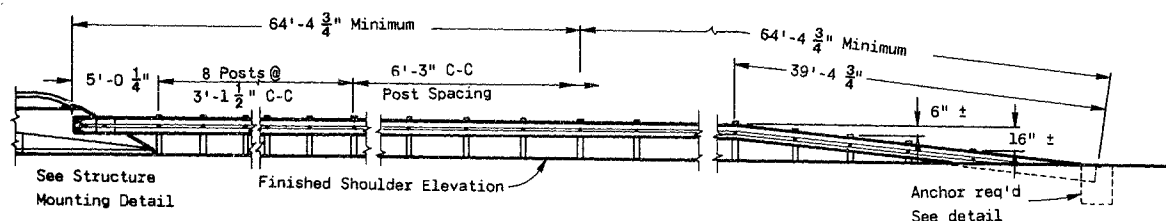


FRONT ELEVATION

TYPICAL INSTALLATION AT STRUCTURES

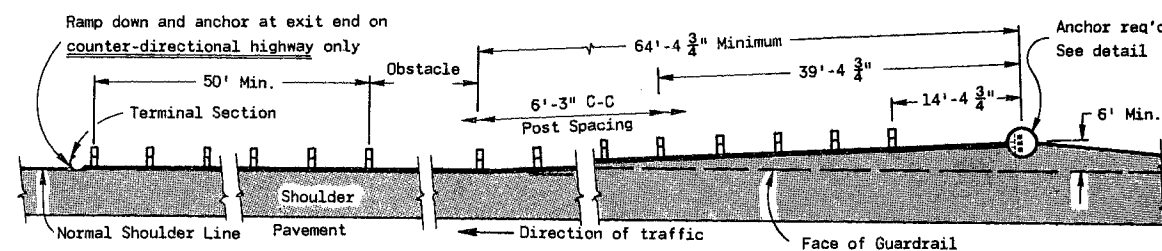

PLAN VIEW

TYPICAL INSTALLATION AT
LOCATIONS OTHER THAN STRUCTURES

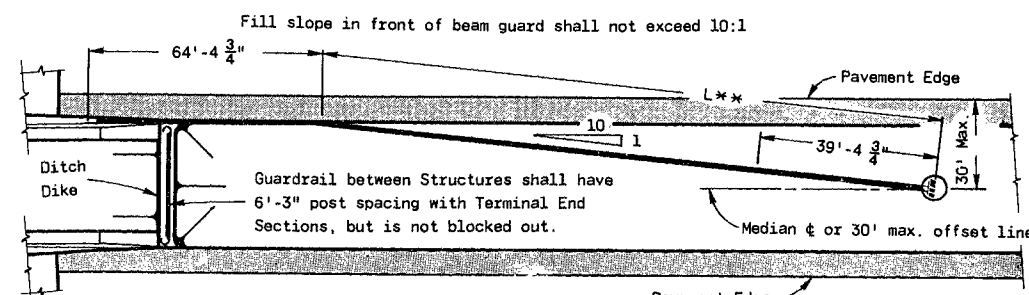

PLAN VIEW


MEDIAN PROTECTION

** Variable based on Median width or 30' max. offset


TABLE OF BARRICADE CHARACTERISTICS

BARRICADE TYPE	I	II	III
Height	3' Minimum		5' Minimum
* Rail Width	8" Minimum to 12" Maximum		
Rail Length	2' Minimum to variable Maximum		
** Stripe Width	6" at 45° Angle		
Stripe Colors	Reflectorized Orange & White		


* Nominal dimensions when barricade is constructed of lumber.
 ** May be 4" for rail lengths less than 3'.

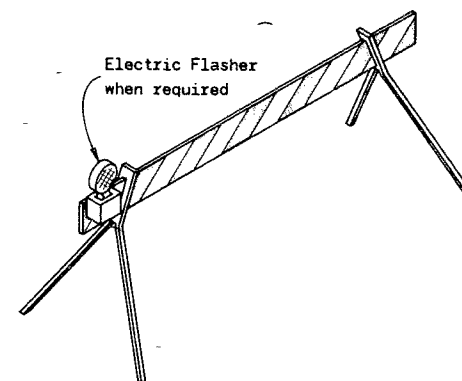

TYPICAL TYPE I BARRICADE

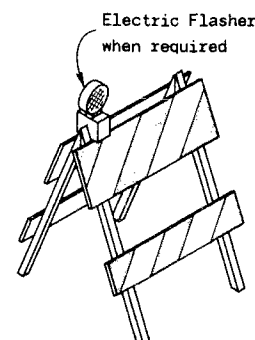


TYPICAL TYPE II BARRICADE

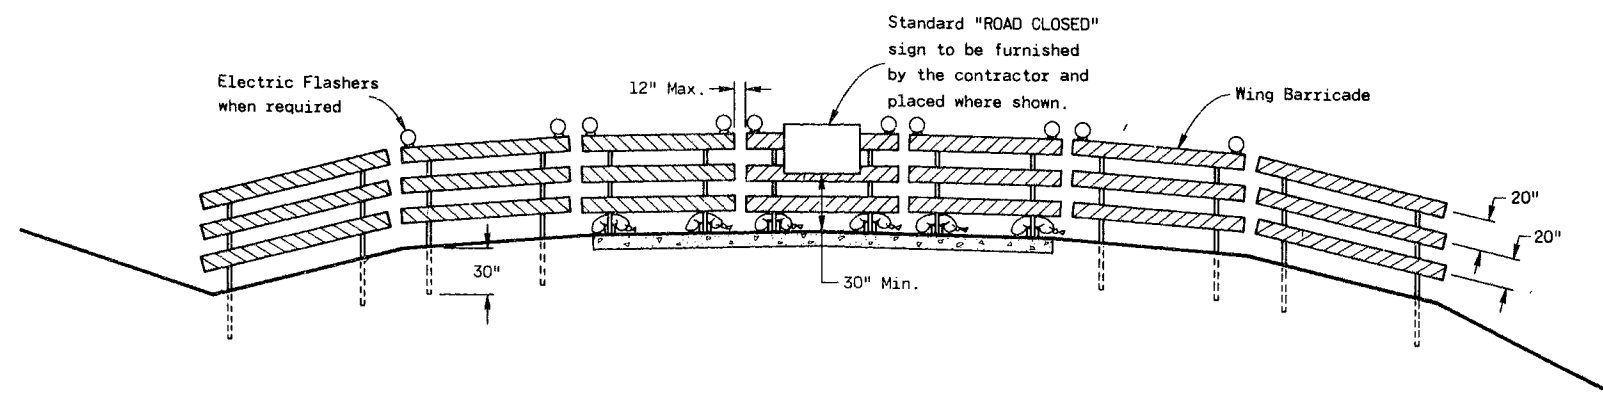

TYPICAL INSTALLATION SHOWING TYPE III BARRICADE

CONSTRUCTION BARRICADES

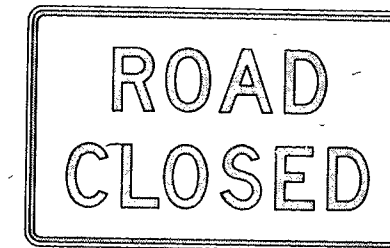

R11-2

48" x 30"

Black Lettering on Reflective
 White Background
 Letter Series "D"
 Letter height 8"



W20-3

48" x 48"

Black Lettering on Reflective
 Orange Background
 Letter Series "D"
 Letter height 7"

STANDARD SIGNS-TYPE II

GENERAL NOTES

The contractor shall furnish, erect and maintain Barricades and Signs. Details regarding location, spacing, dimensions, fabrication, material, sign lettering, lighting devices and color of Barricades and Signs shall conform to this drawing, the Wisconsin Manual on Uniform Traffic Control Devices, the Standard Specifications, Special Provisions and/or plans.

Type III Barricades and Signs shall be erected at the termini of projects and at other road or street locations where it is necessary to control or eliminate public access to the construction area.

Type I and II Barricades shall be used on projects when traffic is to be maintained through the construction area.

The actual field location of barricade installations and advance signs shall be as directed by the Engineer.

Each barricade shall have the name and telephone number of a person responsible for 24 hour emergency service printed in letters at least 3/4 inch in height.

CONSTRUCTION BARRICADES & STANDARD SIGNS


State of Wisconsin
 Department of Transportation
 Division of Highways

APPROVED
 10-1-76
 DATE

D. J. Standa
 CHIEF OF FACILITIES DEVELOPMENT

APPROVED
 10-1-76
 DATE


H. J. Siddle
 STATE HIGHWAY ENGINEER

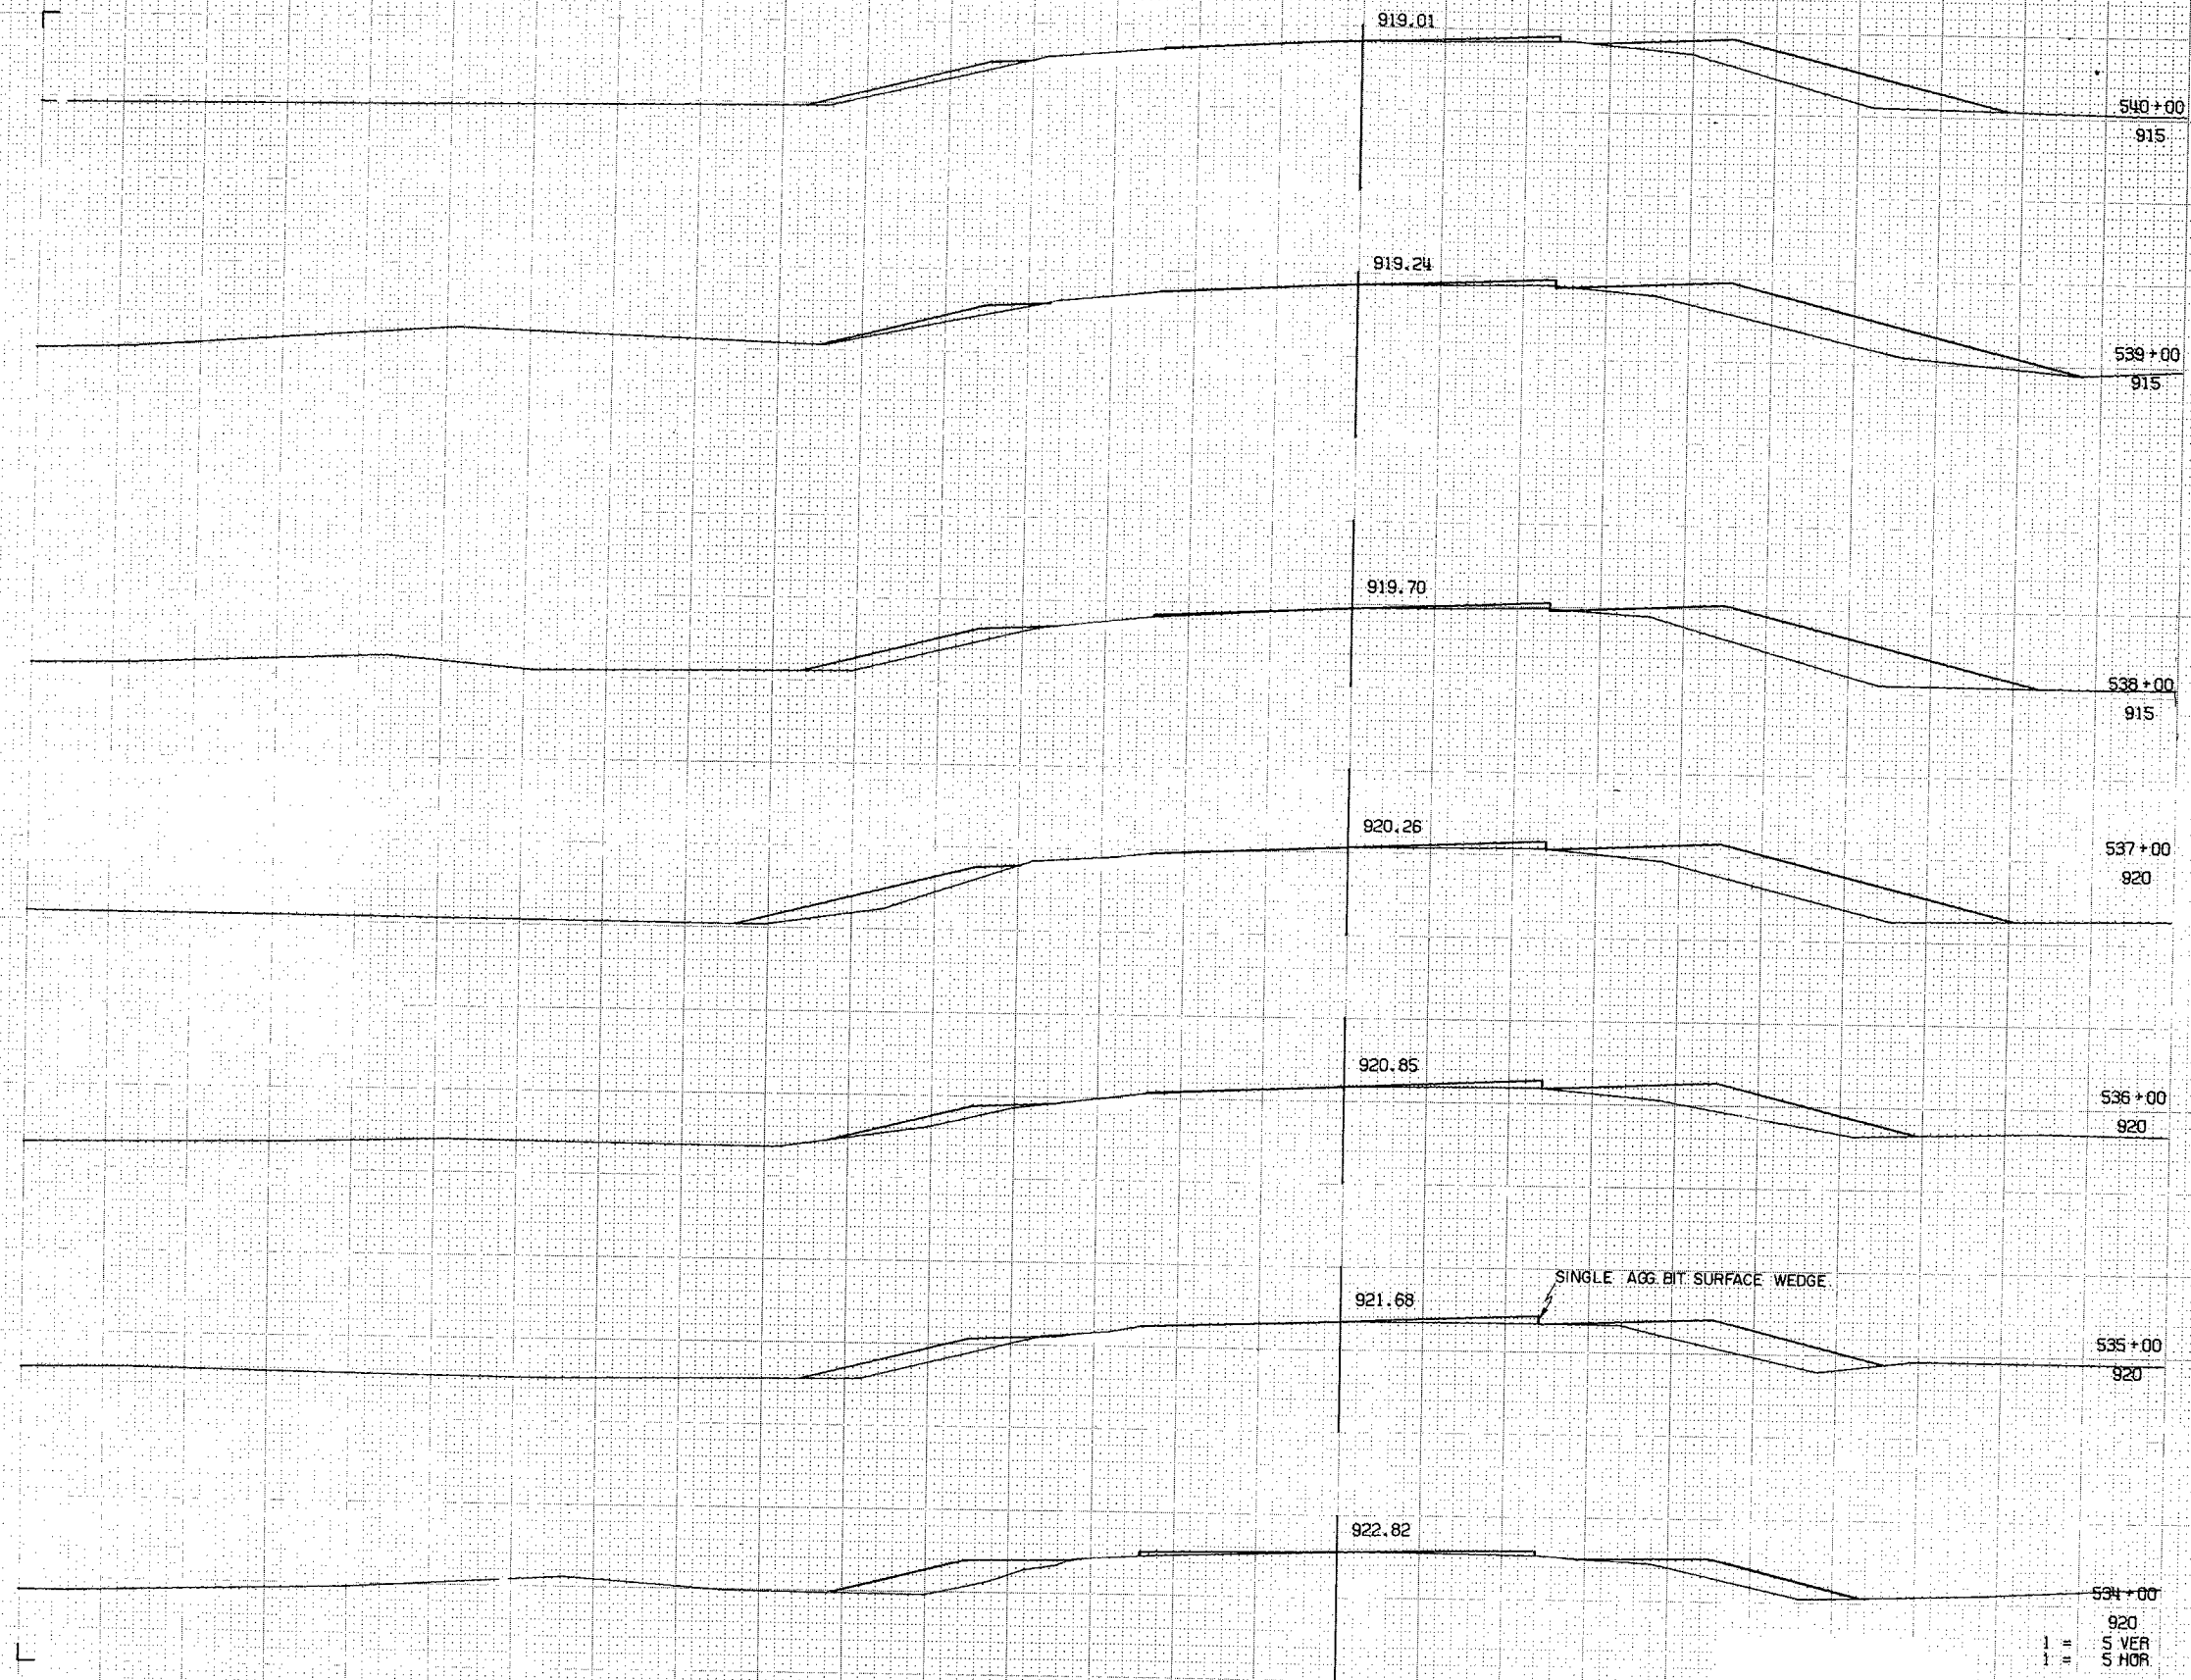

STATE PROJECT NUMBER				SHEET NUMBER
1564-5-71				9
STATION	DISTANCE	YARDAGE		
		EXCAVATION		FILL
534				
535				109
536				13
537				52
538				91
539				172
540				43


1 = 920
1 = 5 VER
1 = 5 HOR
8 1564050013

2/1/71

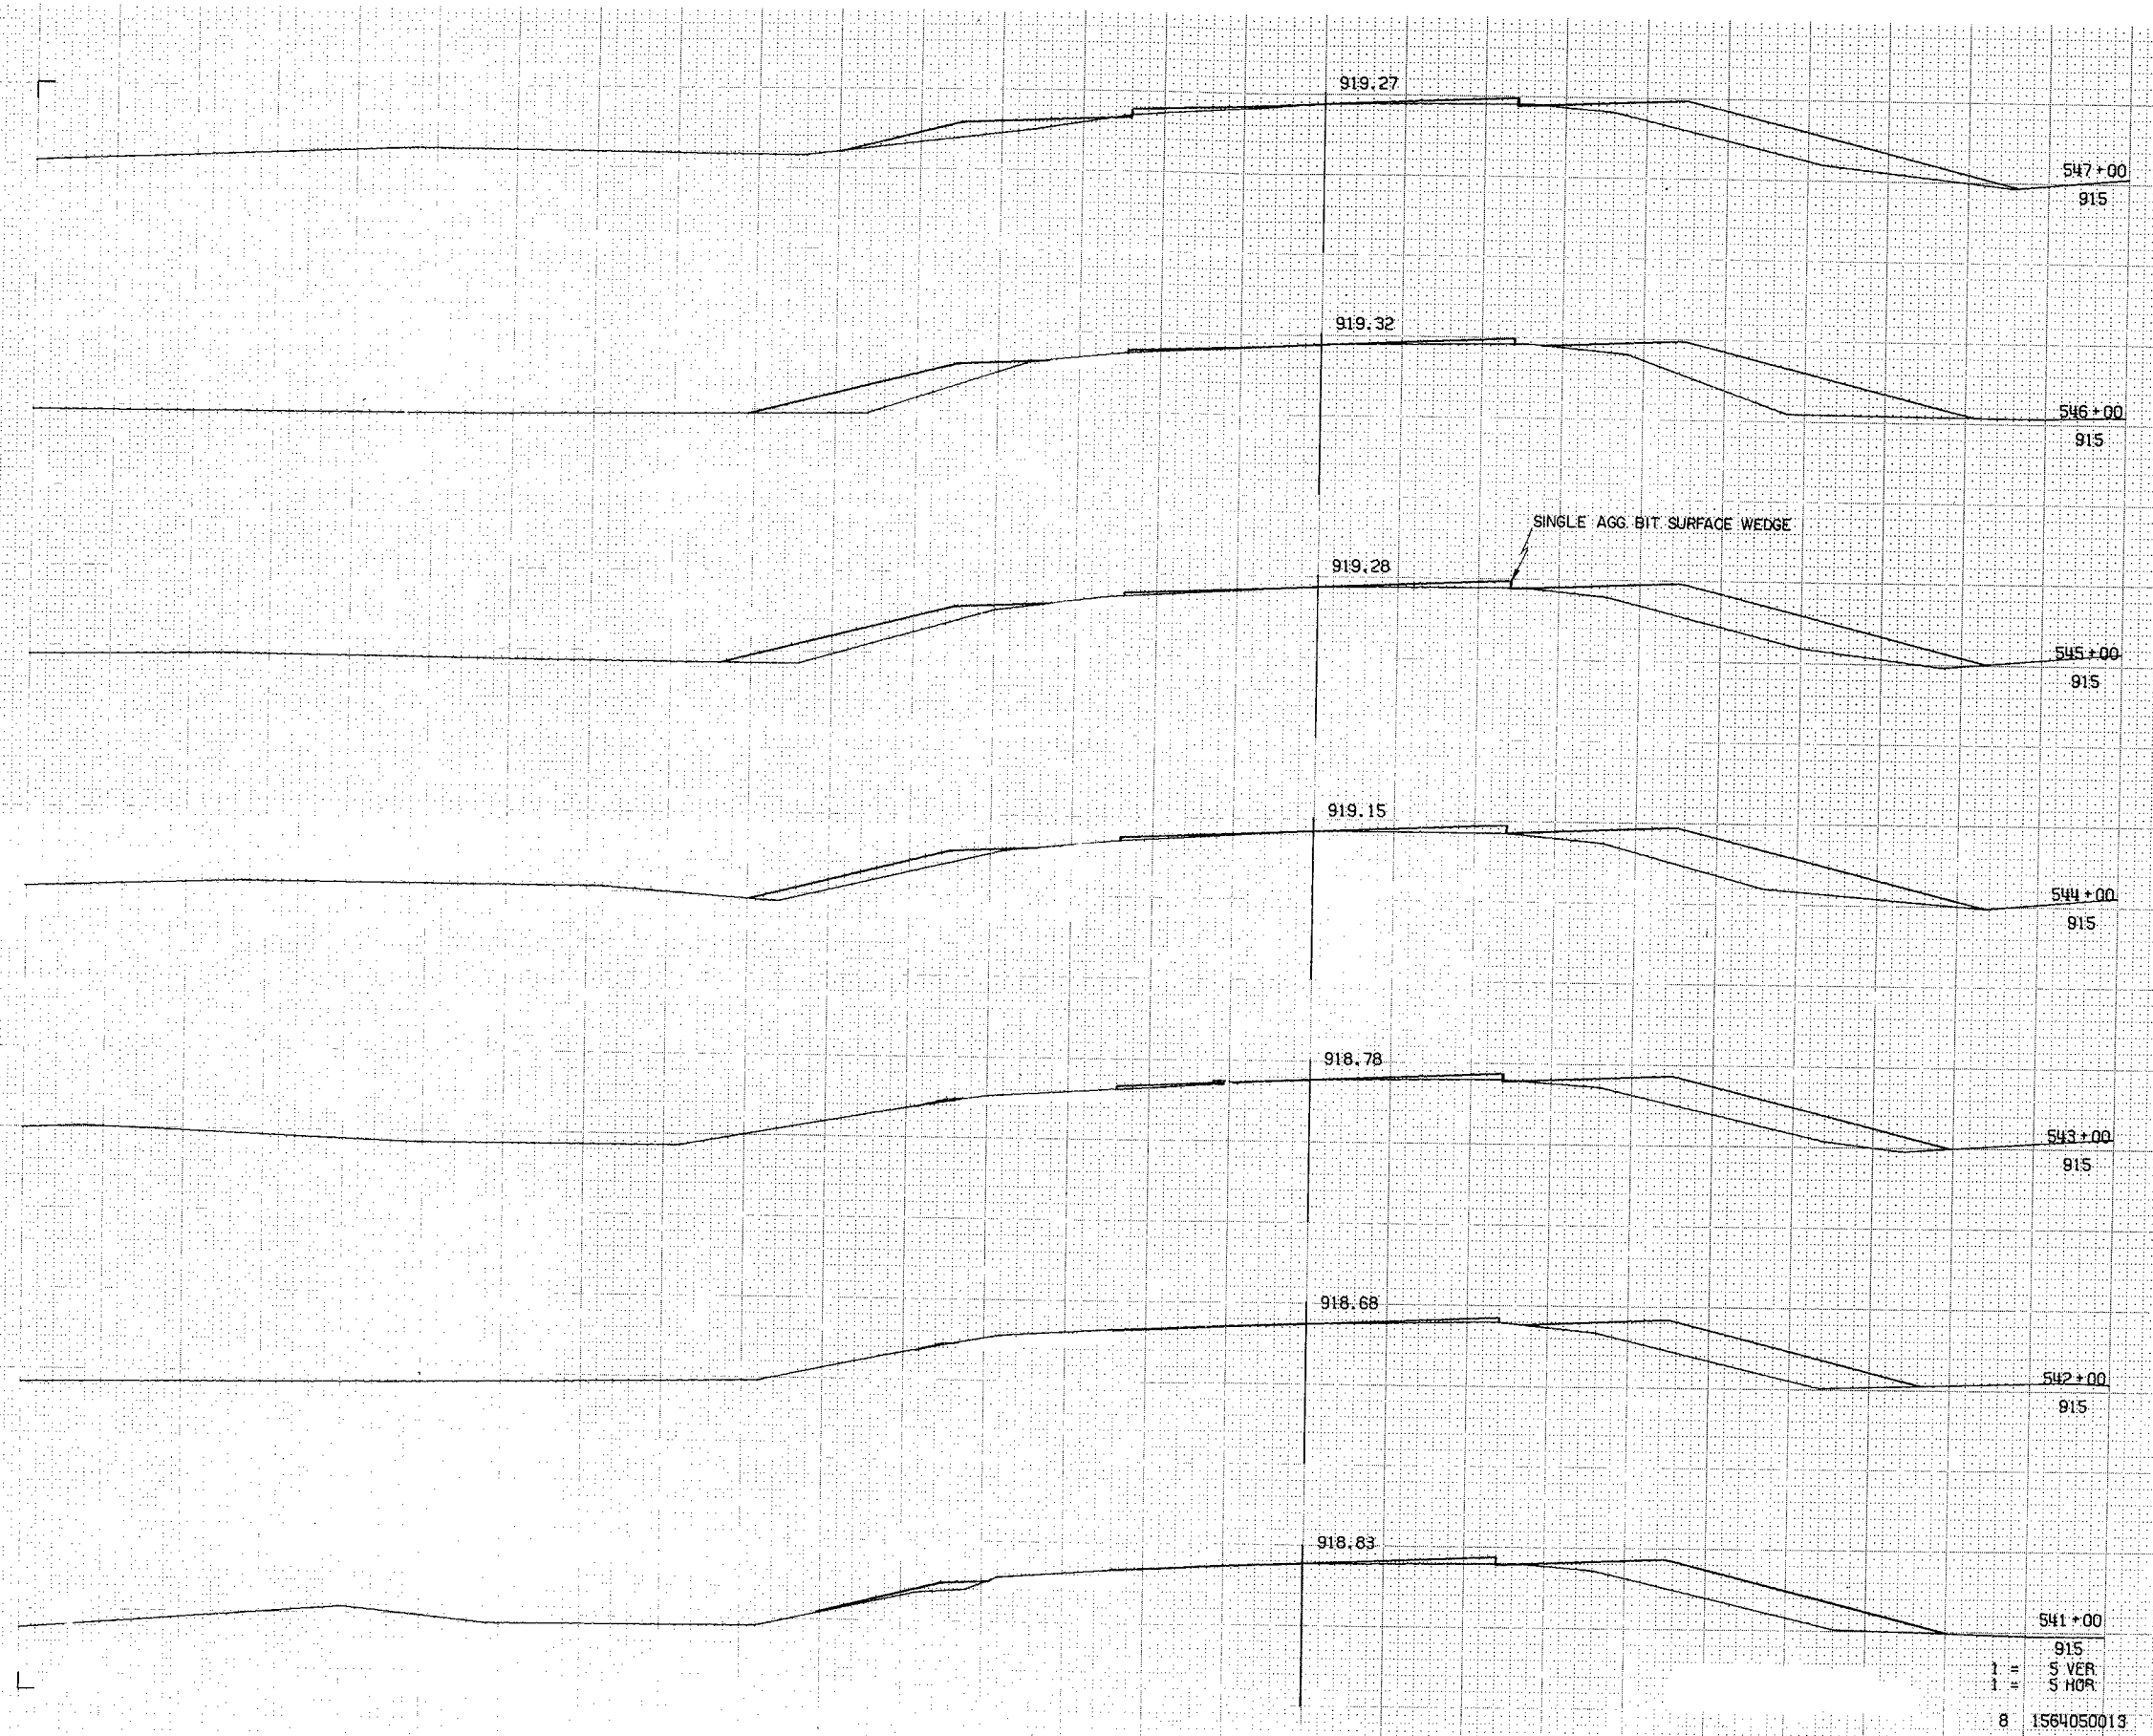


STATE PROJECT NUMBER					SHEET NUMBER
1564 - 5-71					91
STATION	DISTANCE	YARDAGE			FILL
		EXCAVATION			
540					128
541					122
542					122
543					157
544					200
545					217
546					198
547					

1" = 5' VER.
1" = 8' HOR.
8 1564050013

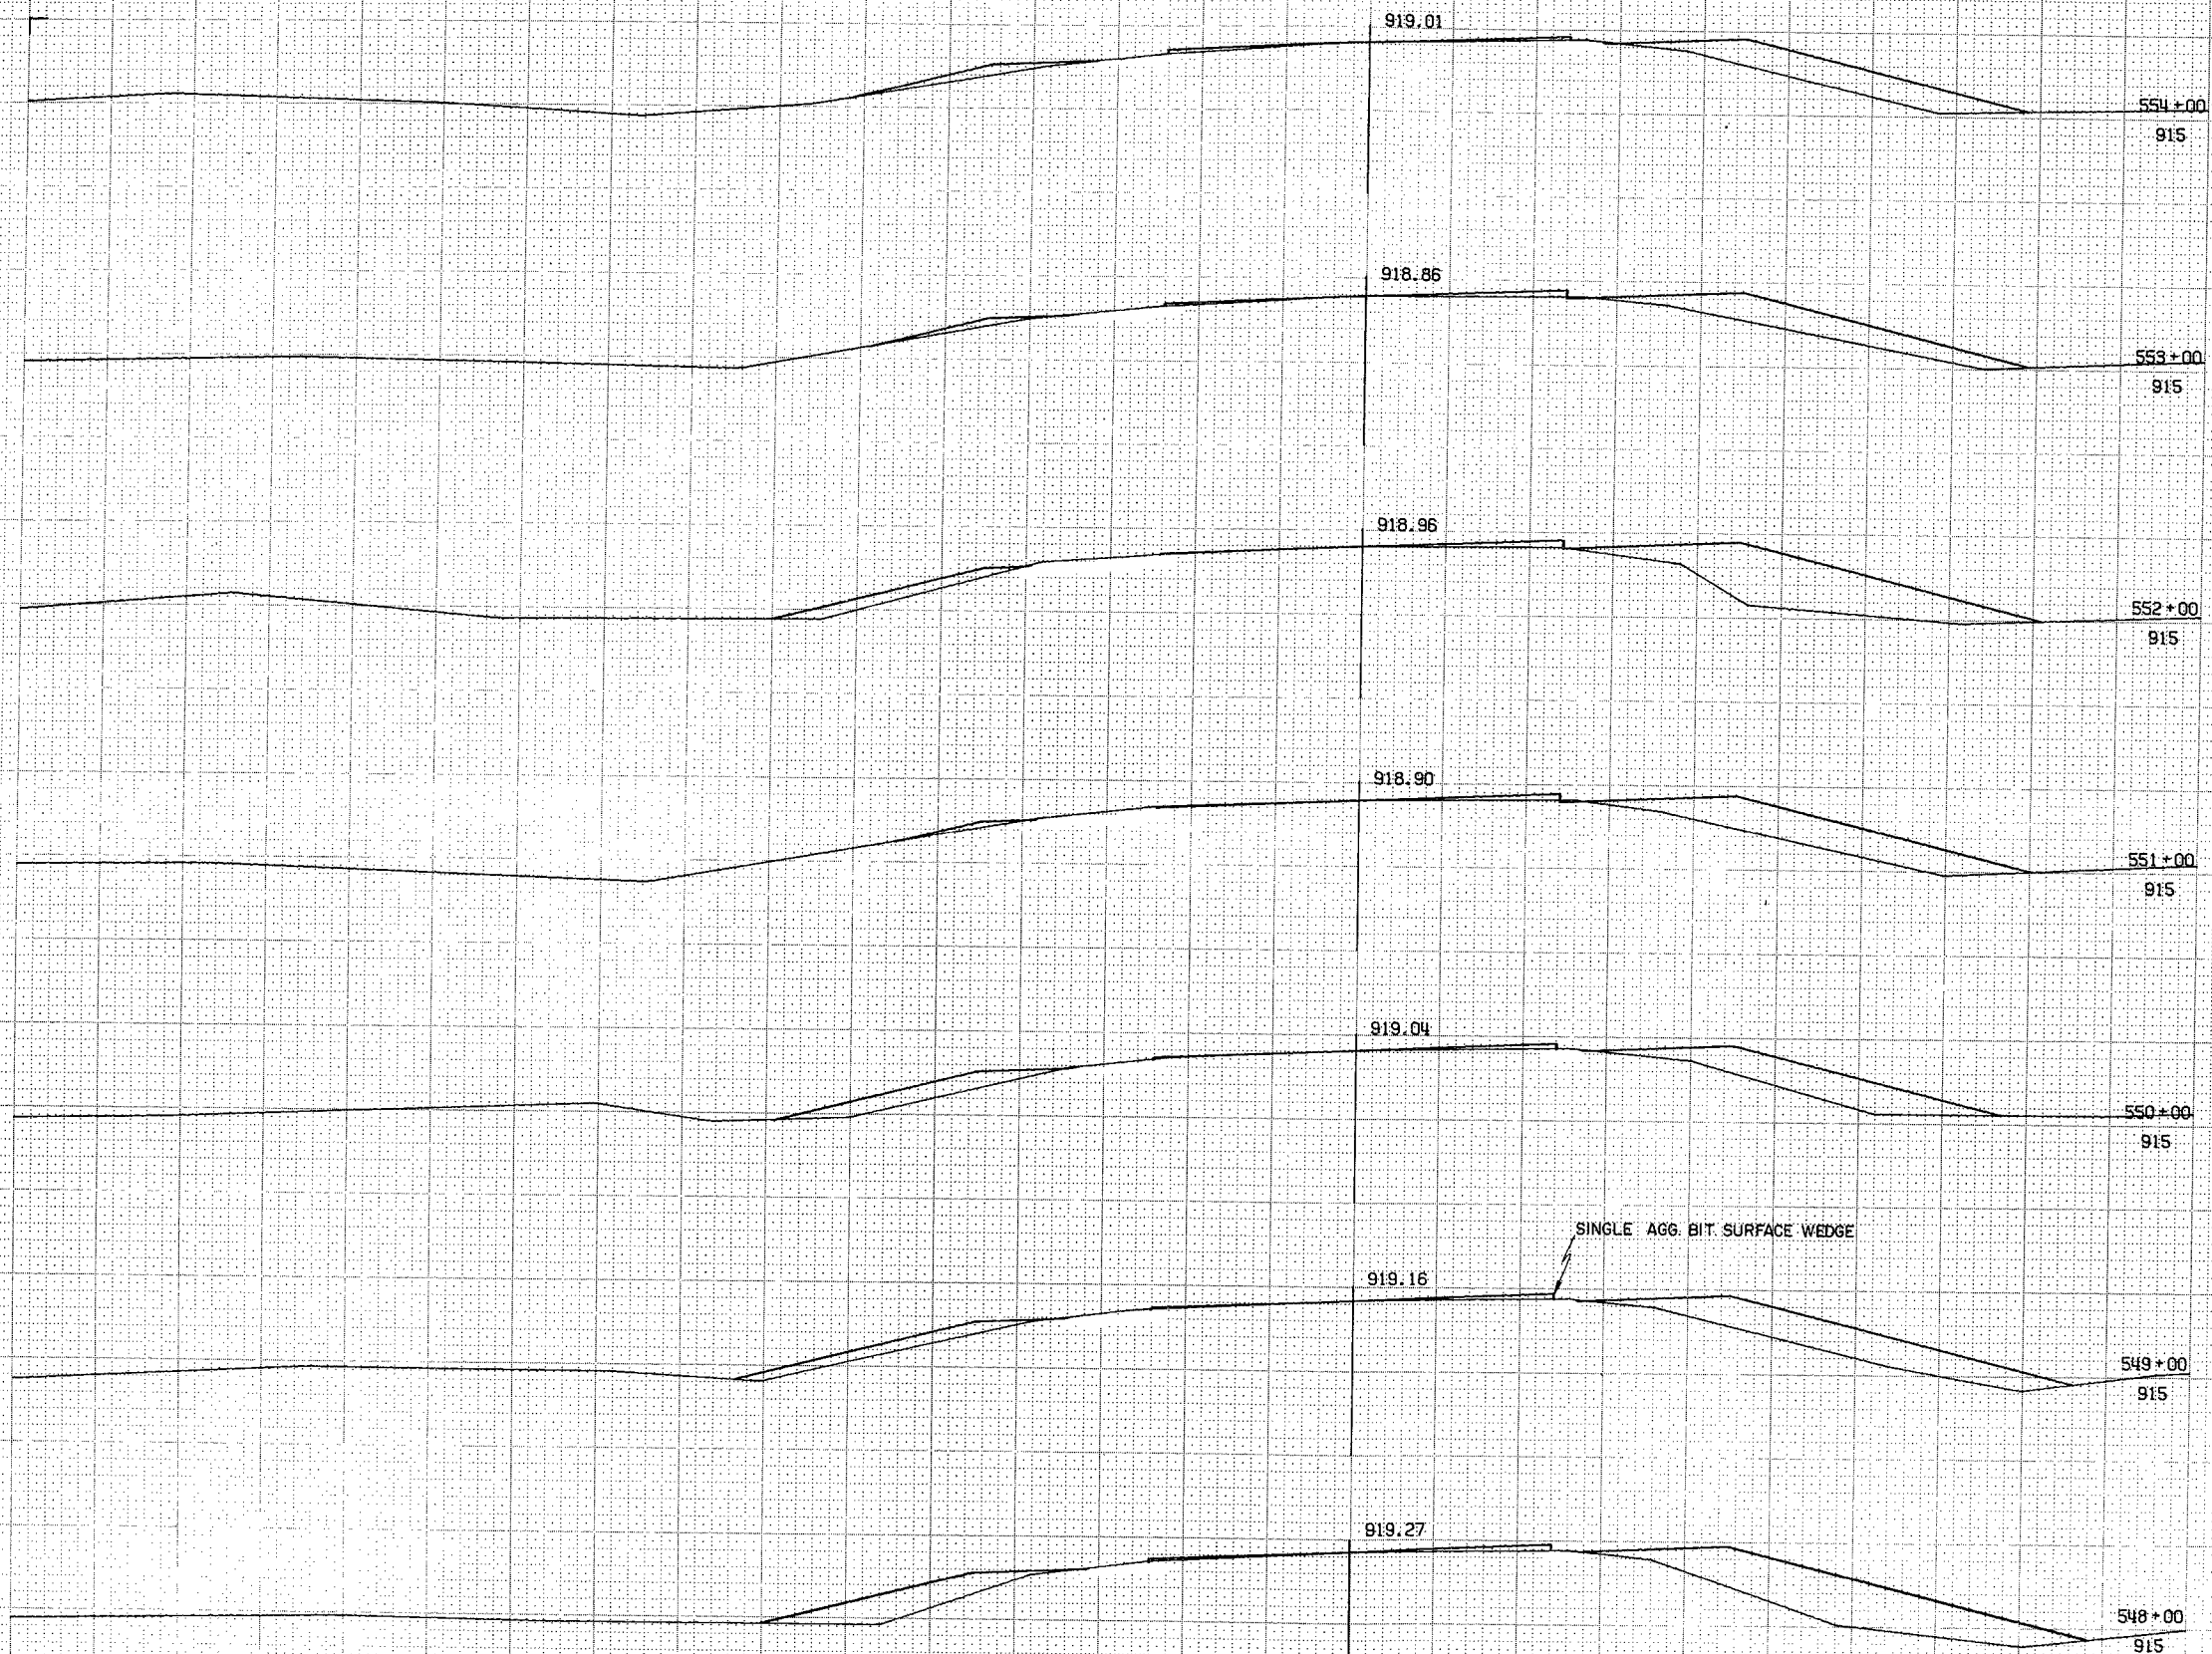


STATE PROJECT NUMBER					SHEET NUMBER
1564-5-71					92
STATION	DISTANCE	YARDAGE			
		EXCAVATION			FILL
547					
548					222
549					224
550					165
551					144
552					178
553					167
554					120

1 = 5 VER
1 = 5 HOR
8 1564050013

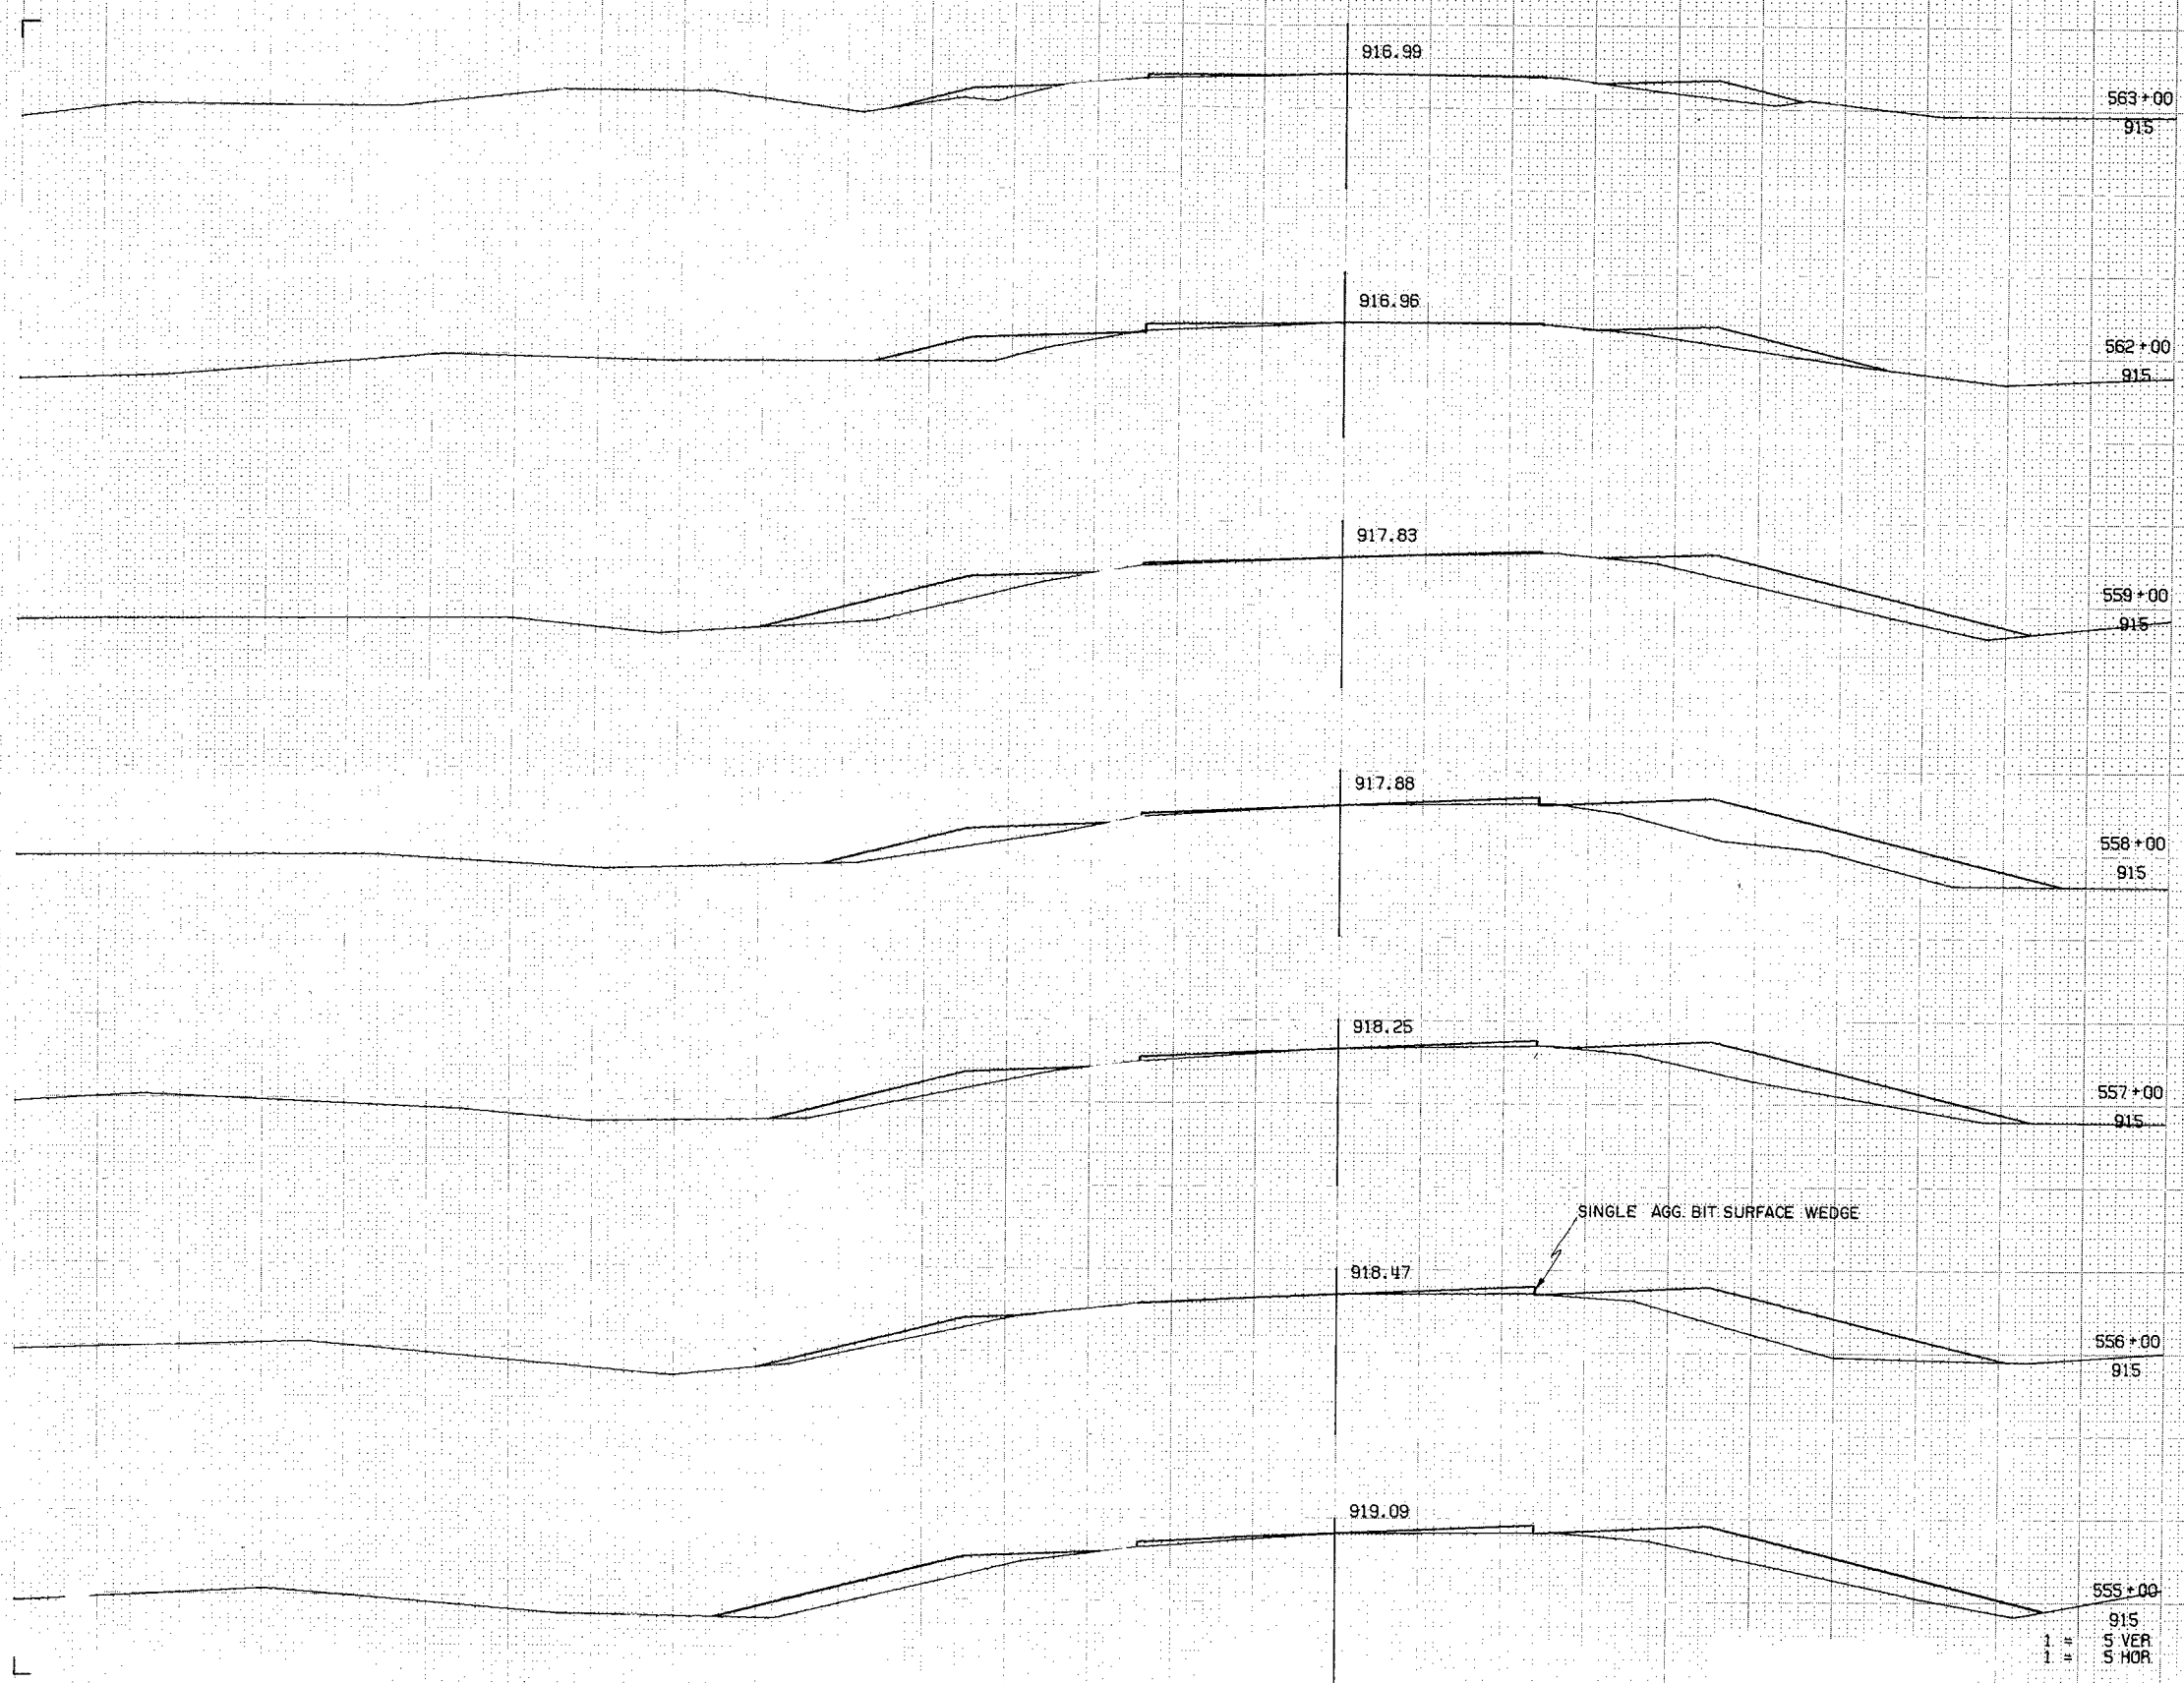

STATE PROJECT NUMBER					SHEET NUMBER
1564 - 5 - 71					93
STATION	DISTANCE	YARDAGE			
		EXCAVATION			FILL
554					159
555					180
556					165
557					183
558					181
559					163
EQUATION					69
562					
563					


1 =
1 =
8 1564050013

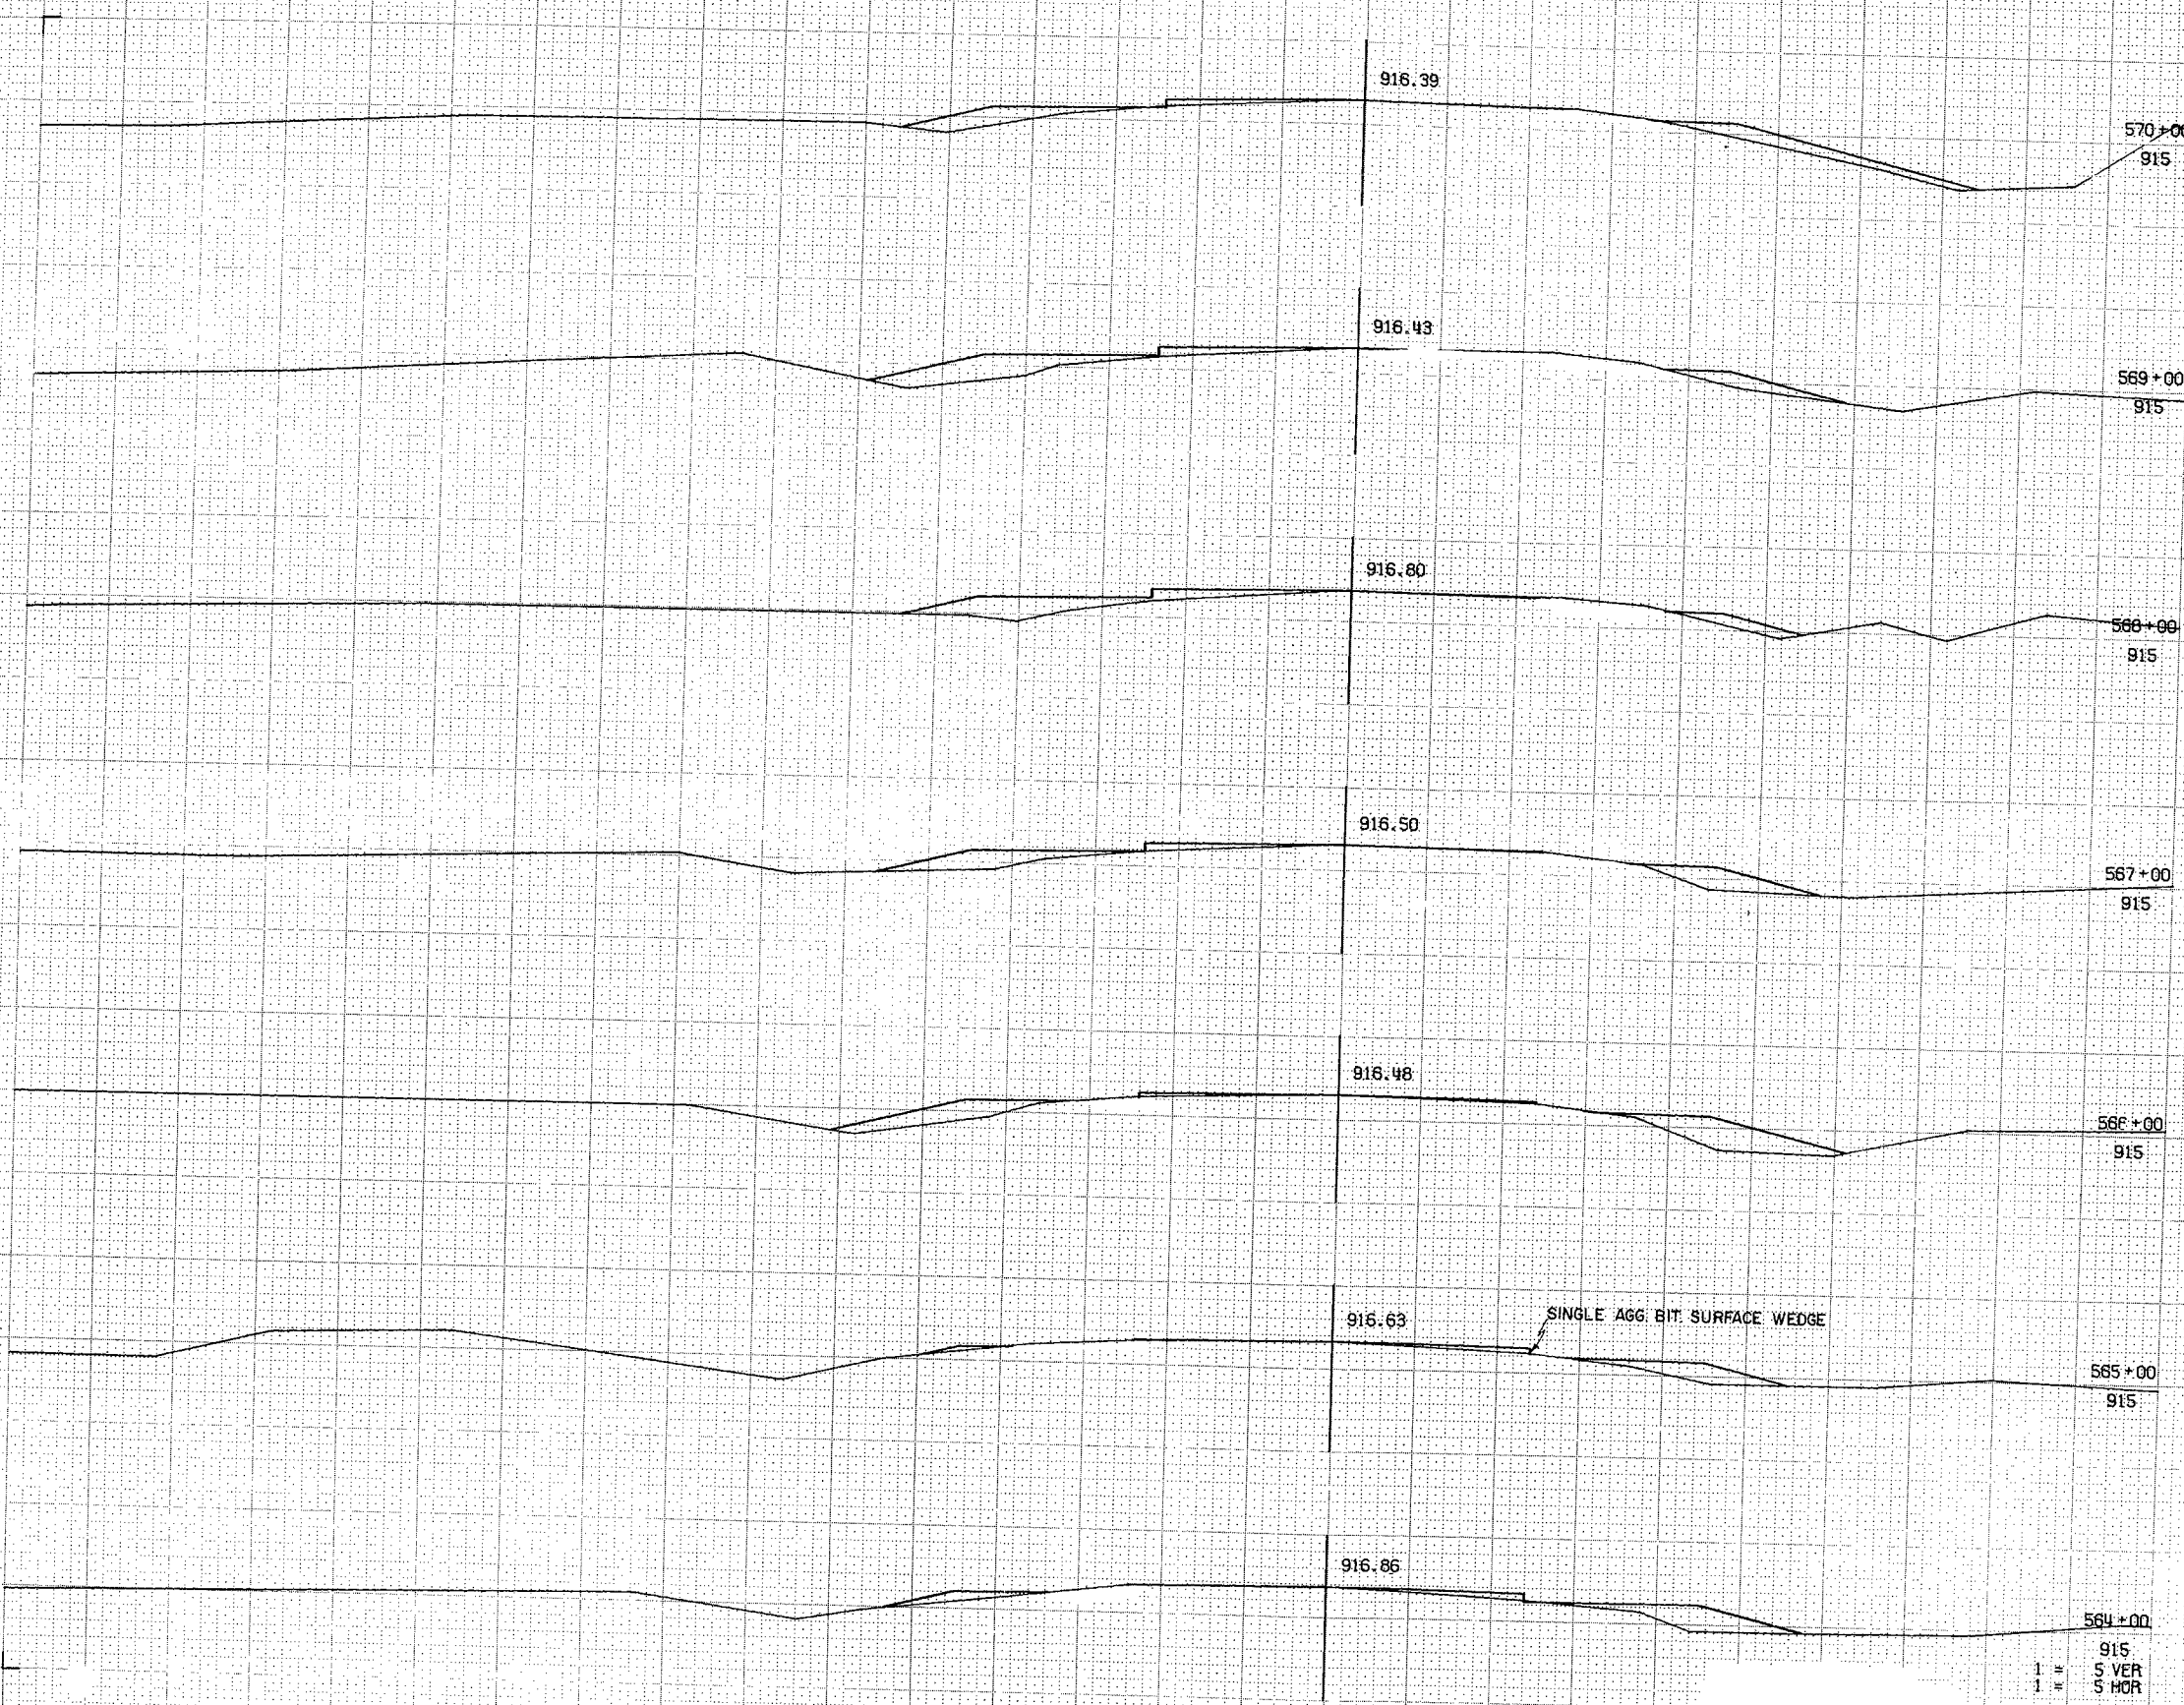

STATE PROJECT NUMBER				SHEET NUMBER
1564-5-71				94
STATION	DISTANCE	YARDAGE		FILL
		EXCAVATION		
563				52
564				46
565				67
566				85
567				74
568				80
569				80
570				


1" = 10' VERT
 1" = 10' HOR
 8 1564050013

5/13

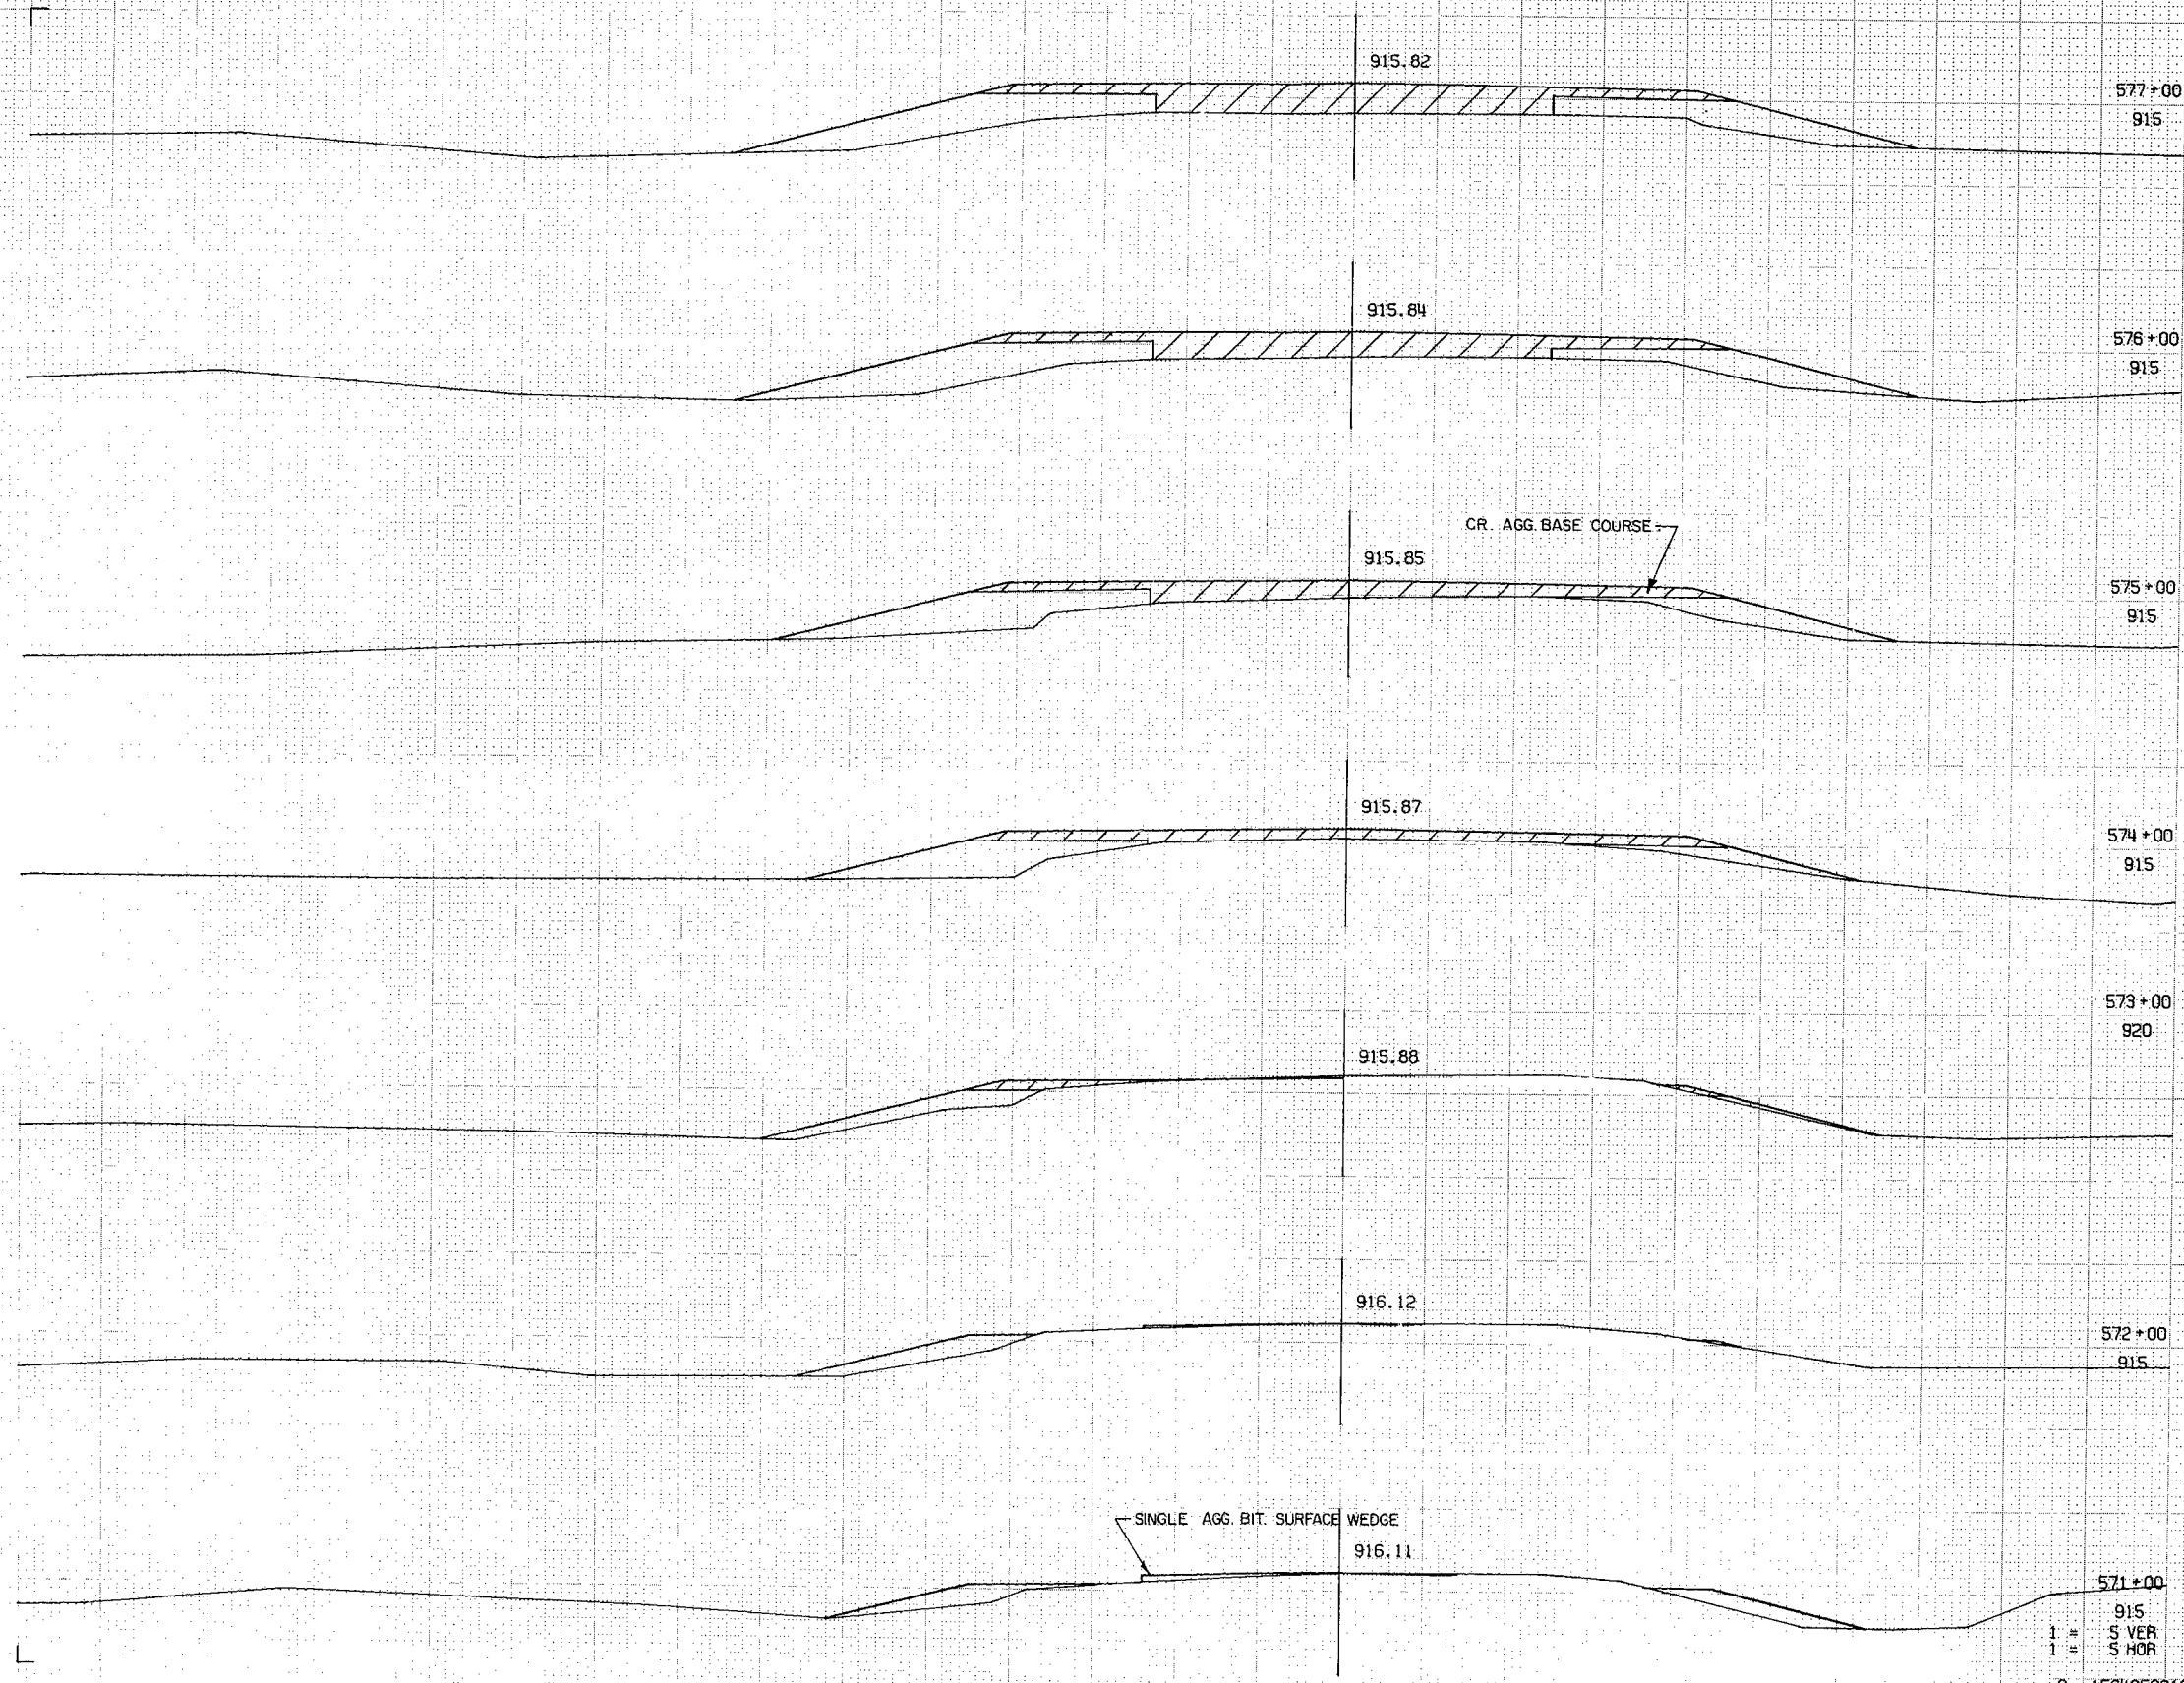

STATE PROJECT NUMBER					SHEET NUMBER
1564-5-71					95
STATION	DISTANCE	YARDAGE			FILL
		EXCAVATION			
570					72
571					57
572					57
573					106
574					148
575					200
576					230
577					


571+00
915
1" = 5' VERT
1" = 10' HOR
8 1564050013

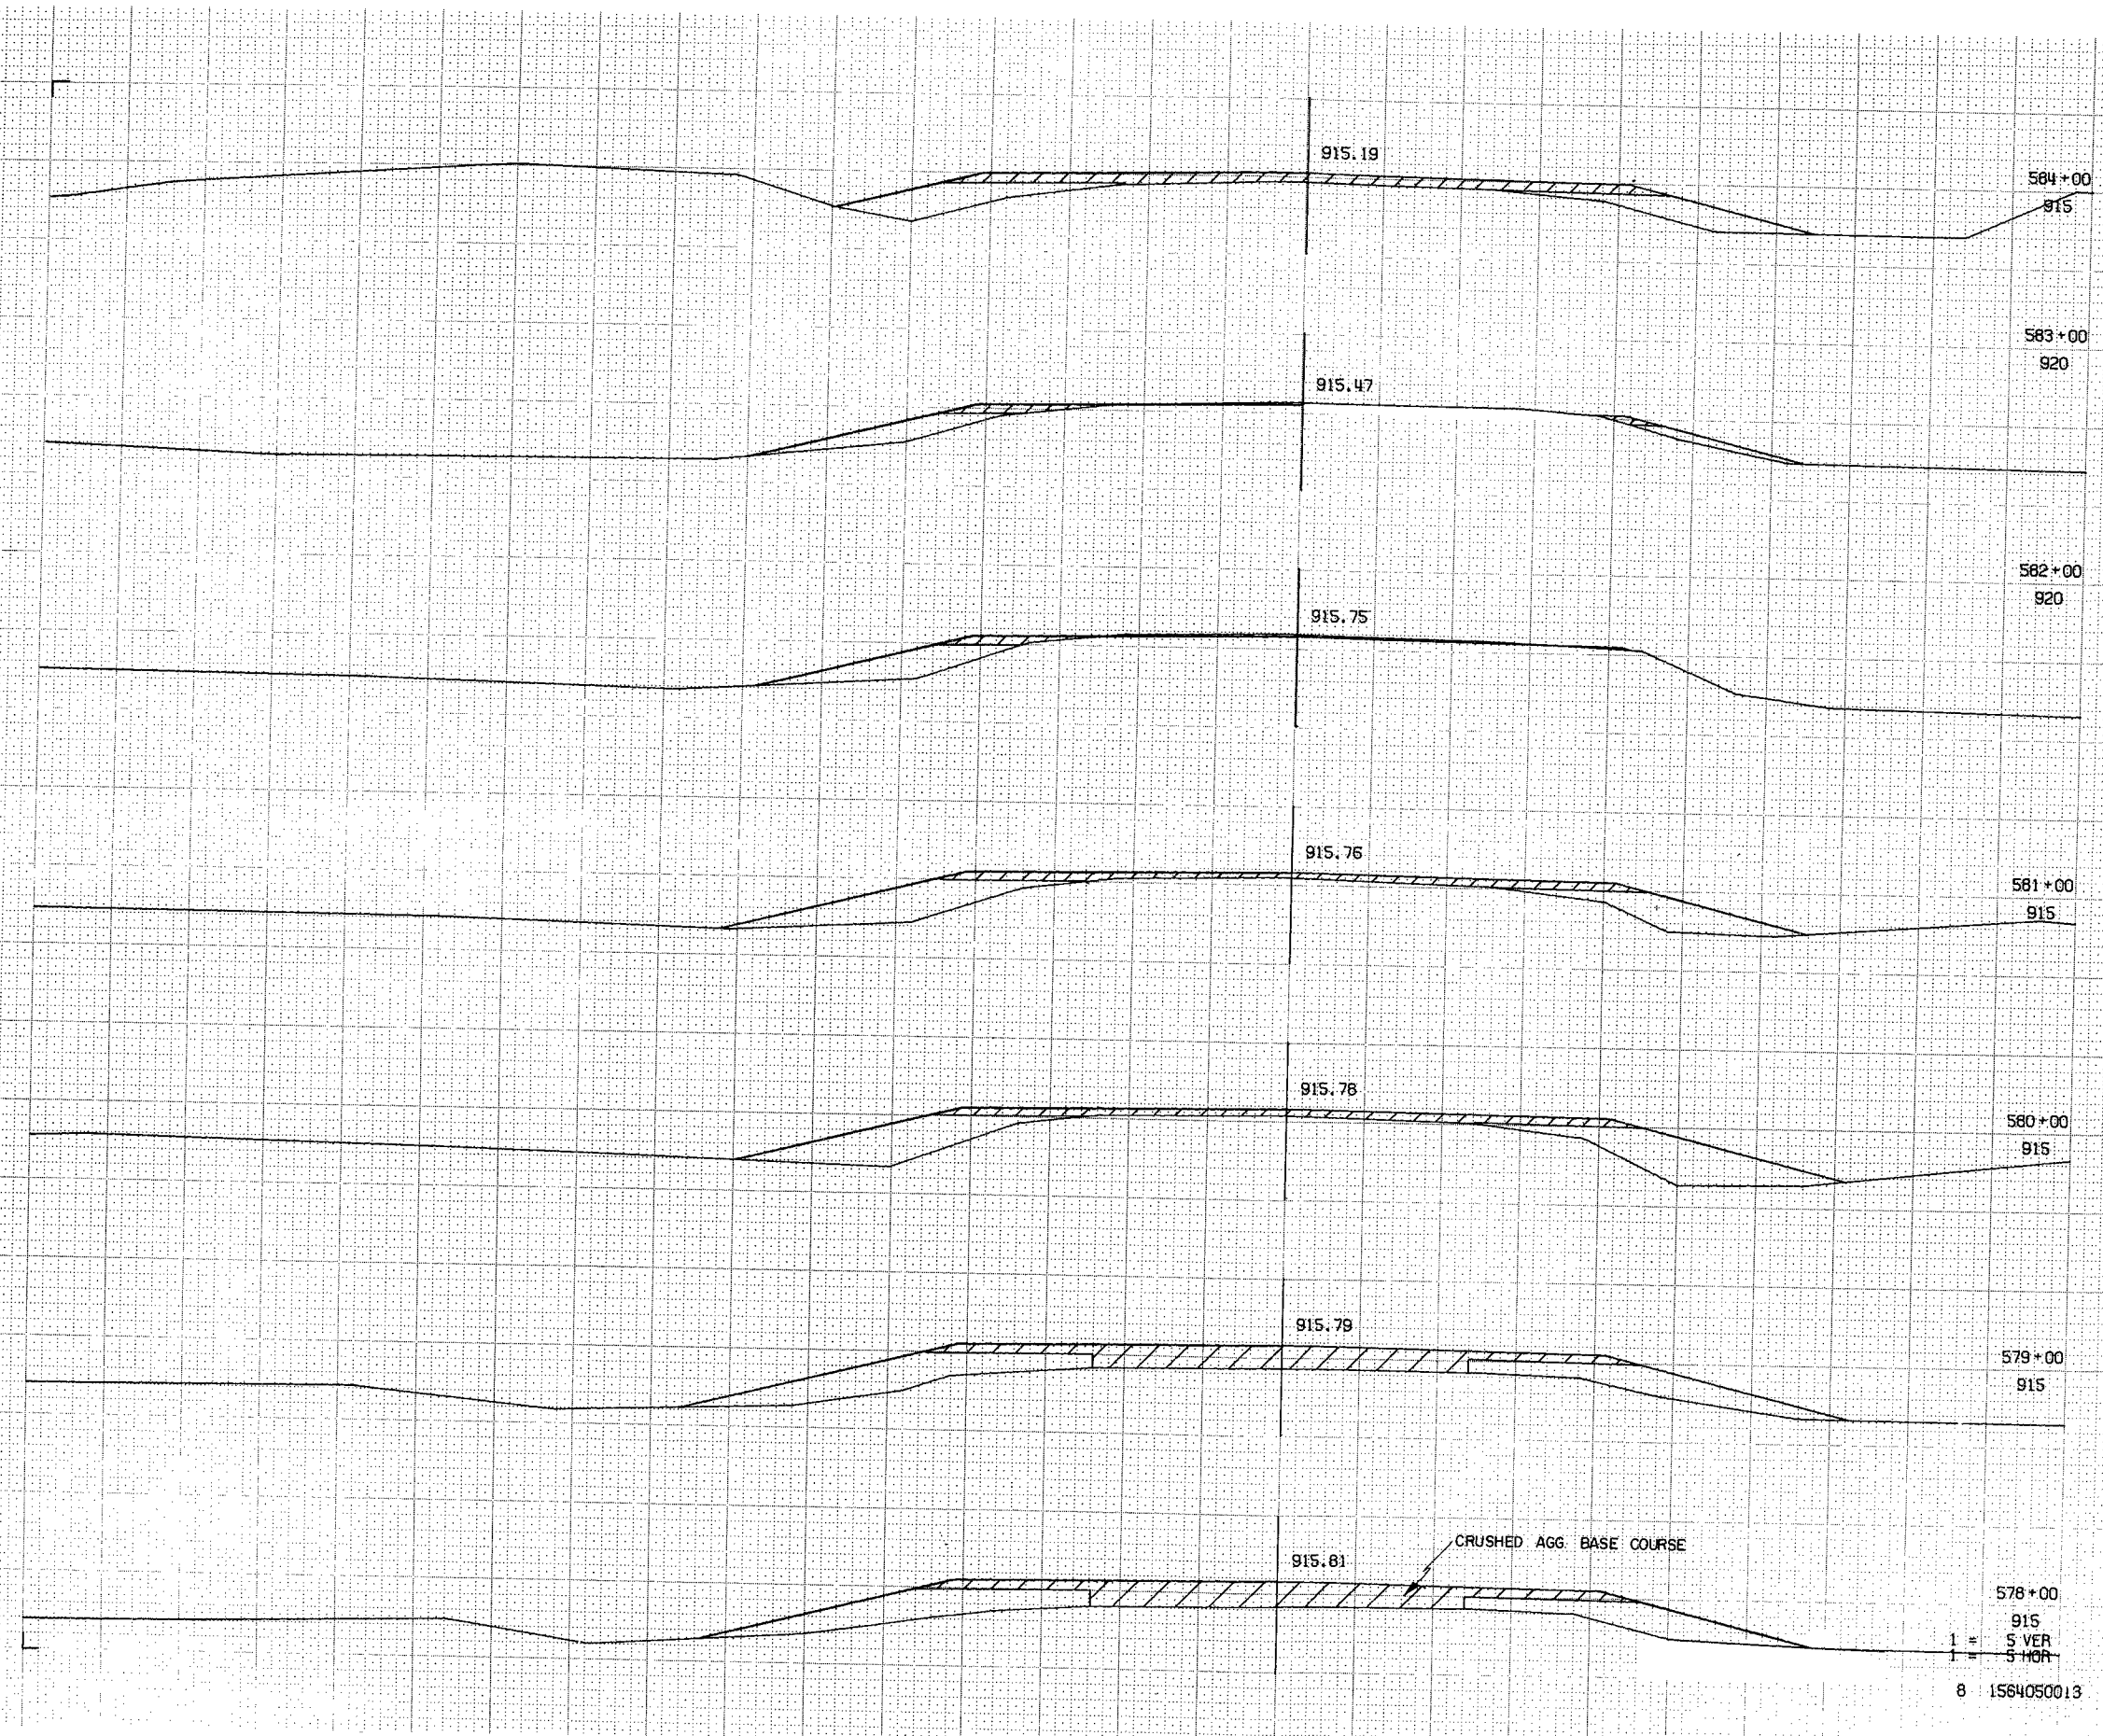

STATE PROJECT NUMBER				SHEET NUMBER
1564 - 5 - 71				96
STATION	DISTANCE	YARDAGE		
		EXCAVATION		FILL
577				221
578				219
579				230
580				200
581				105
582				60
583				91
584				

578+00
915
1 = 5 VER
1 = 5 HOR
8 1564050013

8/12

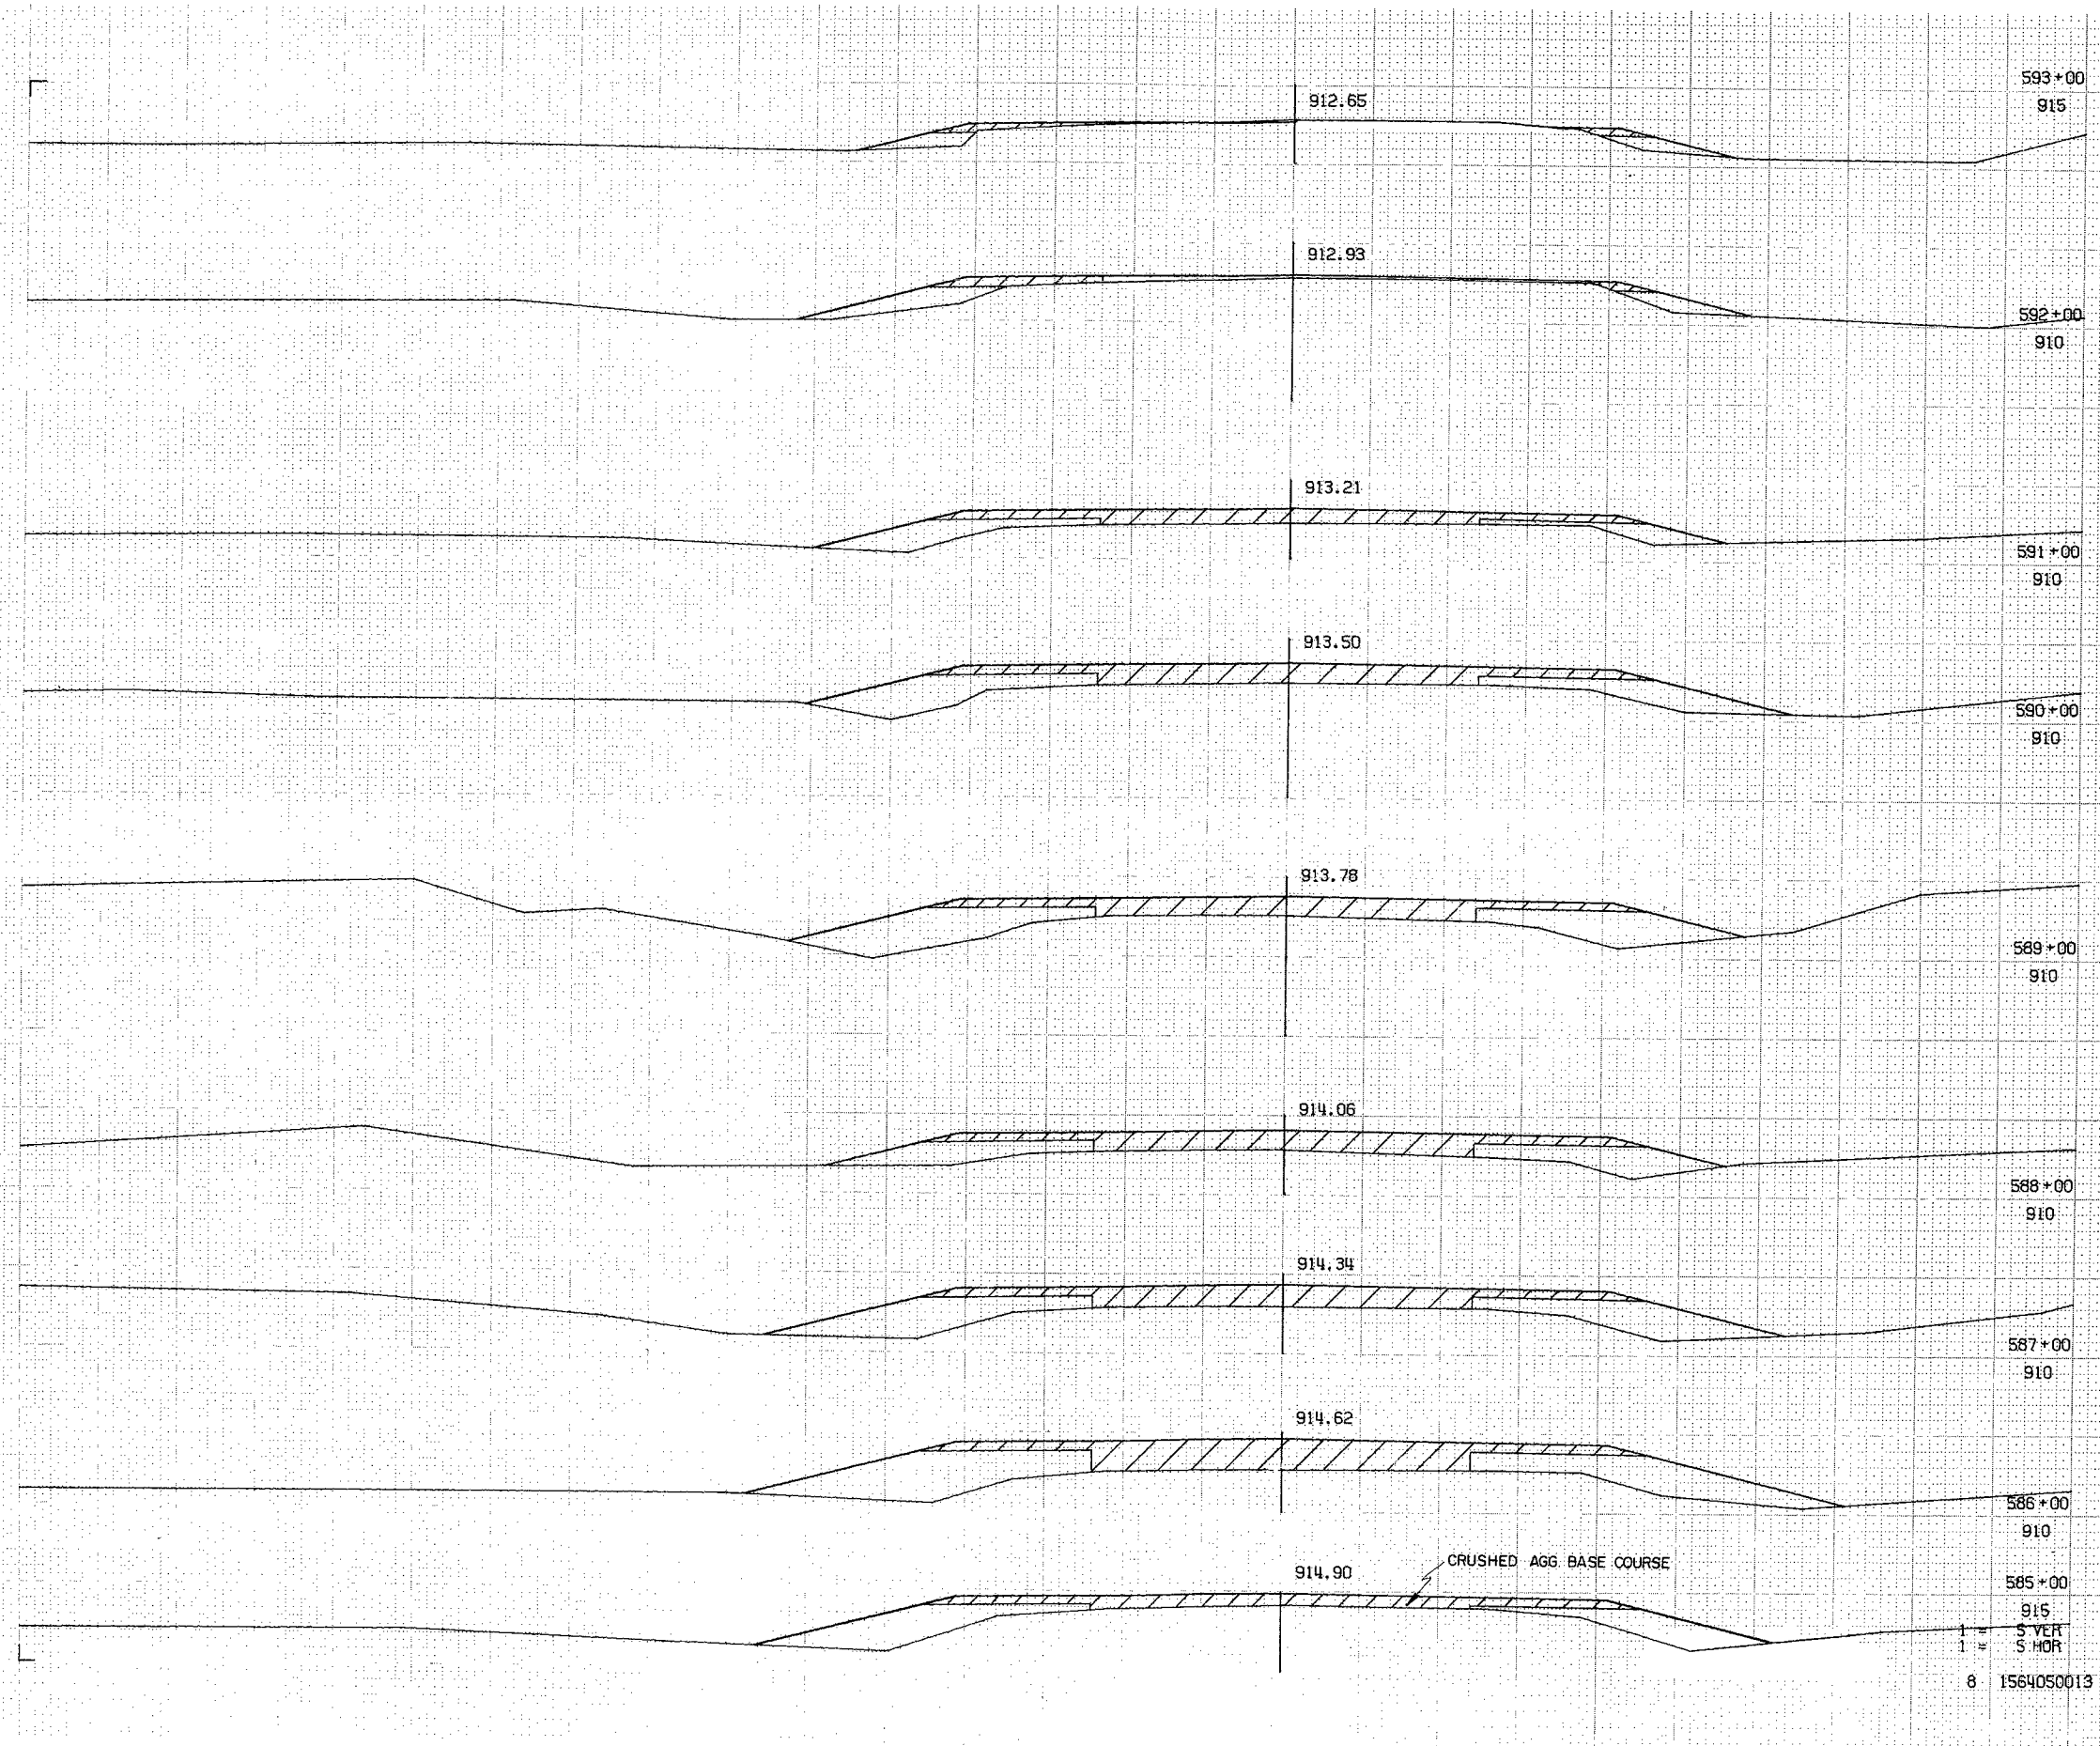

STATE PROJECT NUMBER					SHEET NUMBER
1564-5-71					9.7
STATION	DISTANCE	YARDAGE			
		EXCAVATION			FILL
584					
585					146
586					214
587					236
588					163
589					165
590					180
591					123
592					67
593					41

STATE PROJECT NUMBER	SHEET NUMBER
1564- 5 - 71	98

STATION	DISTANCE	YARDAGE			
		EXCAVATION			FILL
593					43
594					43
595					52
596					61
597					57
598					39
599					44
600					

911.70

600+00

910

911.69

599+00

910

912.08

598+00

910

912.35

597+00

910

912.47

596+00

910

912.46

595+00

910

SINGLE AGG. BIT. SURFACE WEDGE


912.65

594+00

910


1 1/2" S VER
1 1/2" S HOR

8 1564050013

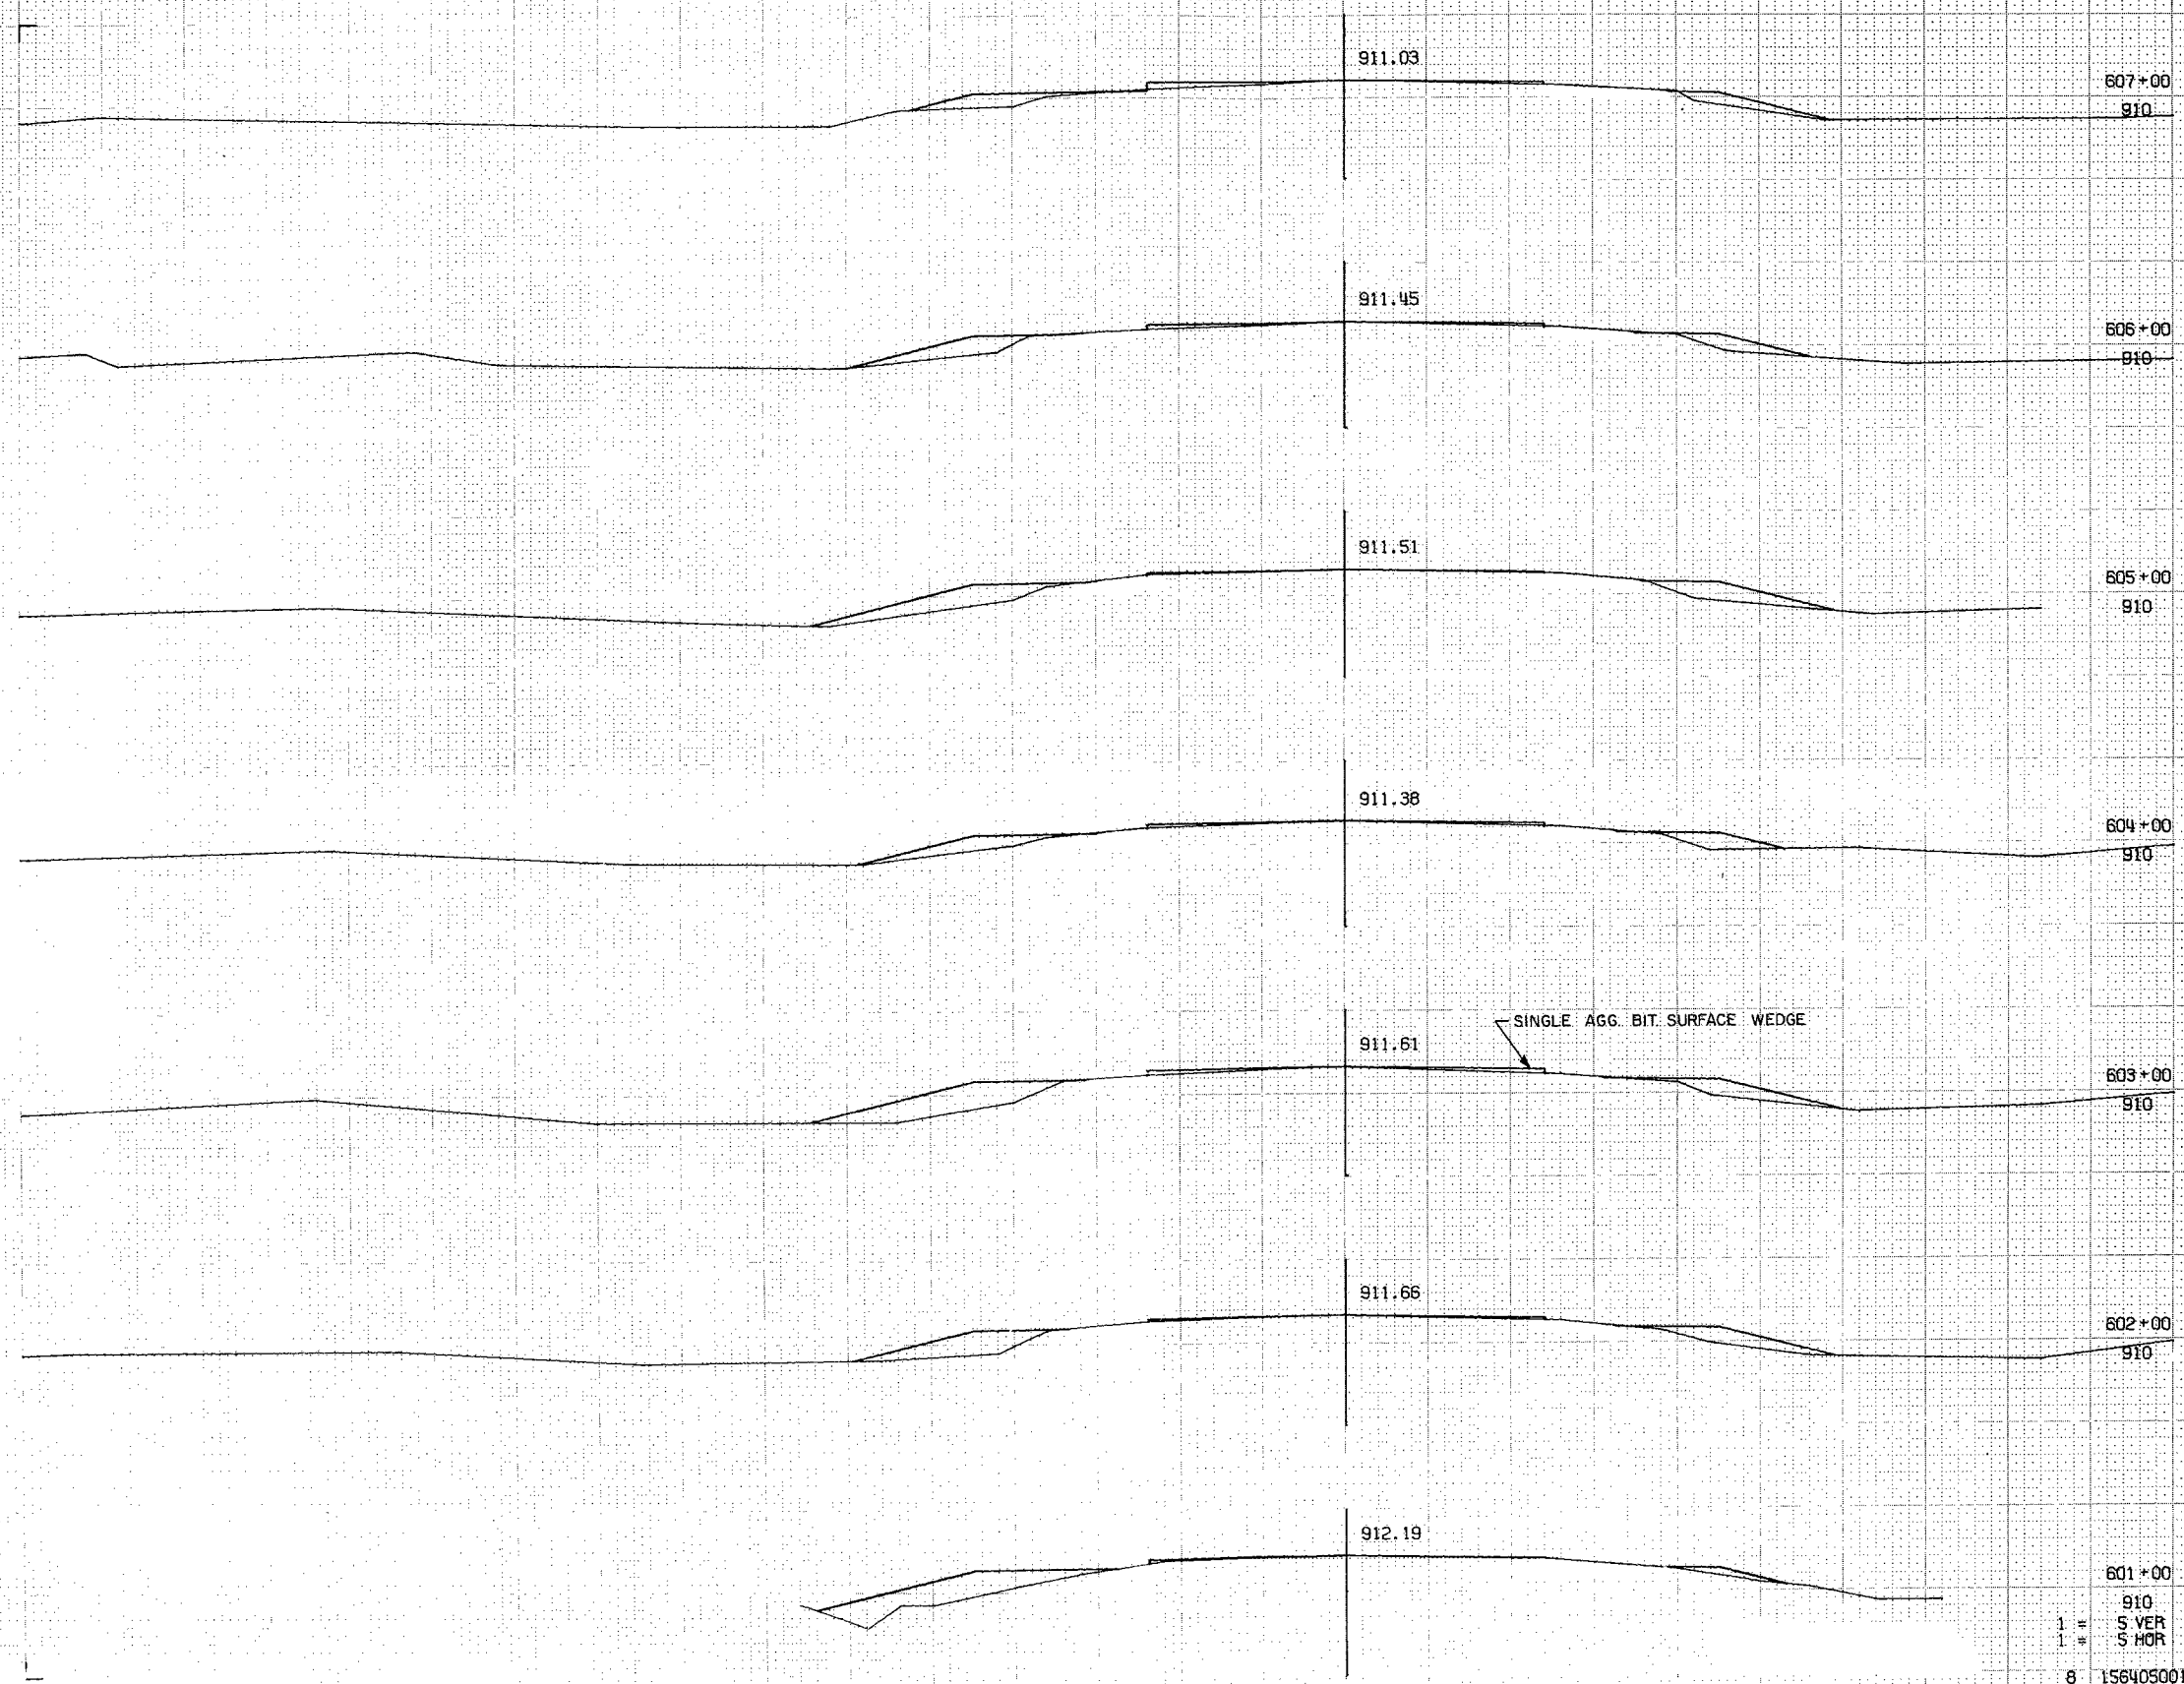


STATE PROJECT NUMBER					SHEET NUMBER
1564-5-71					9.9
STATION	DISTANCE	YARDAGE			
		EXCAVATION			FILL
600					61
601					67
602					80
603					70
604					61
605					63
606					50
607					

1" = 10' VERT
1" = 100' HOR
8 1564050013

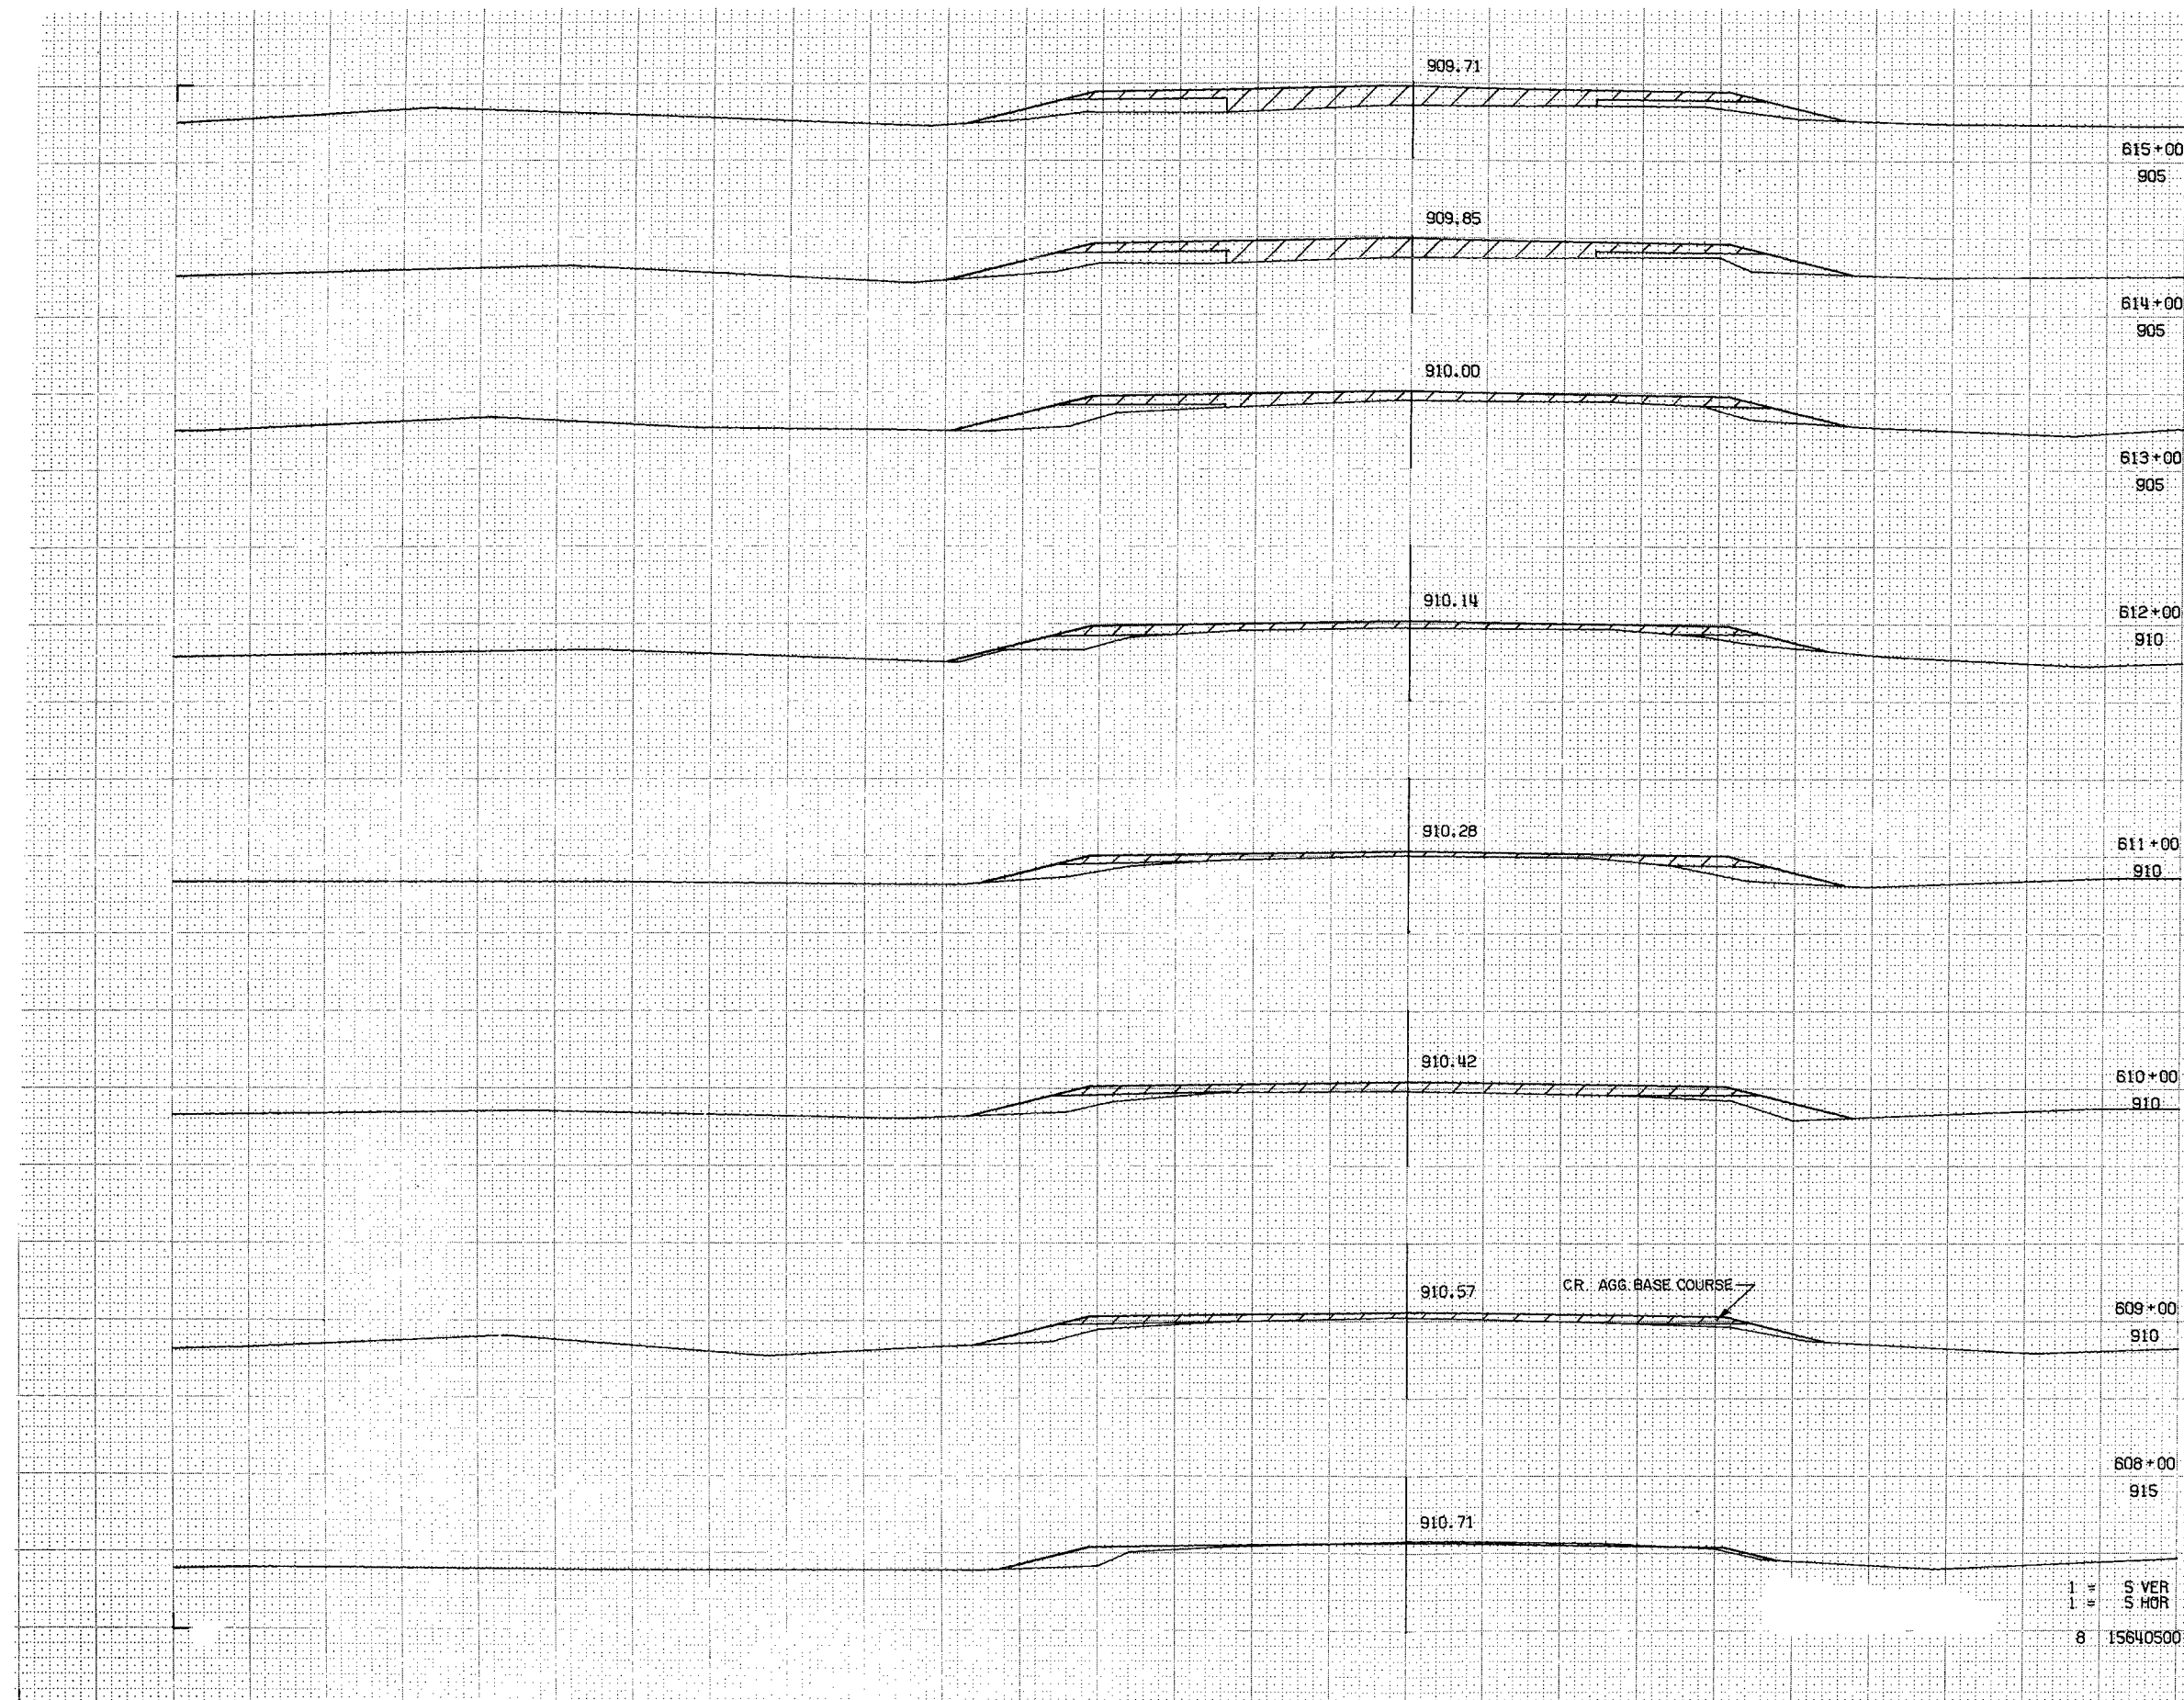

STATE PROJECT NUMBER				SHEET NUMBER
1564-5-71				9/10
STATION	DISTANCE	YARDAGE		
		EXCAVATION		FILL
607				39
608				30
609				45
610				50
611				39
612				54
613				80
614				85
615				

8 1564050013

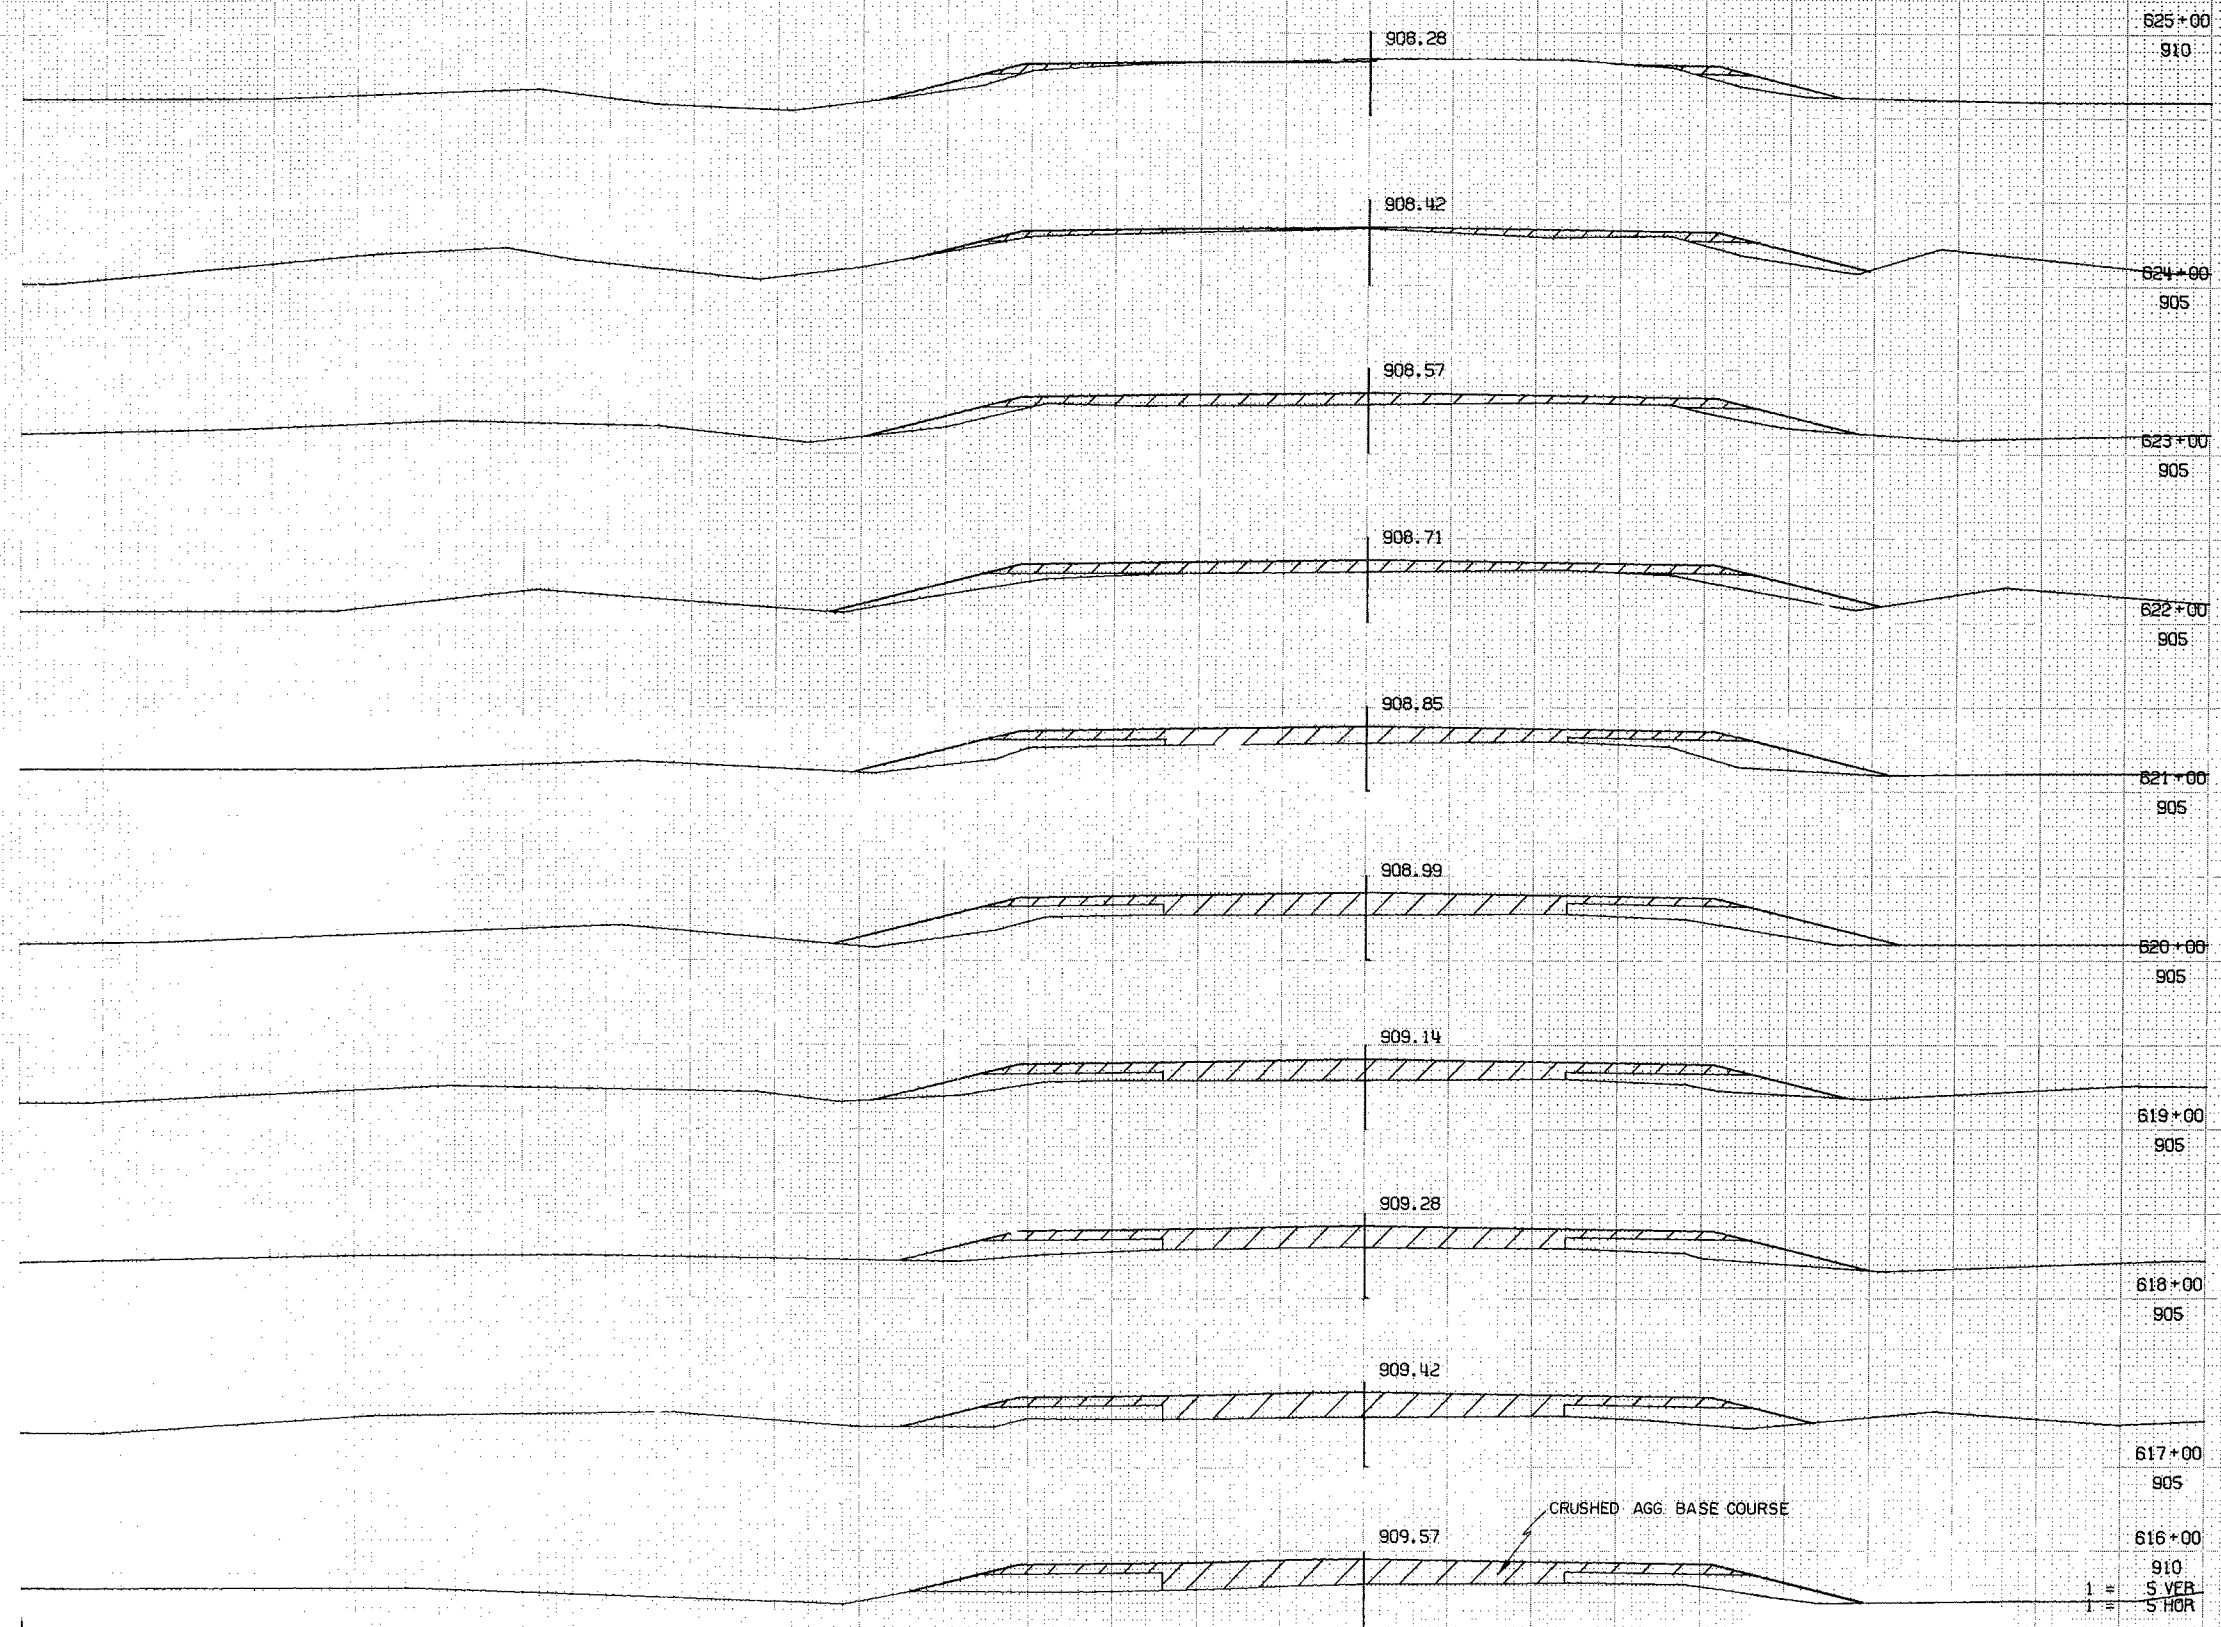

STATE PROJECT NUMBER
1564-B-71


SHEET NUMBER
9 //

STATION	DISTANCE	YARDAGE				FILL
		EXCAVATION				
615						90
616						96
617						96
618						88
619						0.1
620						1.1
621						80
622						48
623						24
624						20
625						


8 1564050013

STATE PROJECT NUMBER	SHEET NUMBER
1564- 5 - 71	9.12

STATION	DISTANCE	YARDAGE					FILL
		EXCAVATION					
625							59
626							59
627							39
628							28
629							41
630							72
631							91
632							119
633							113
634							

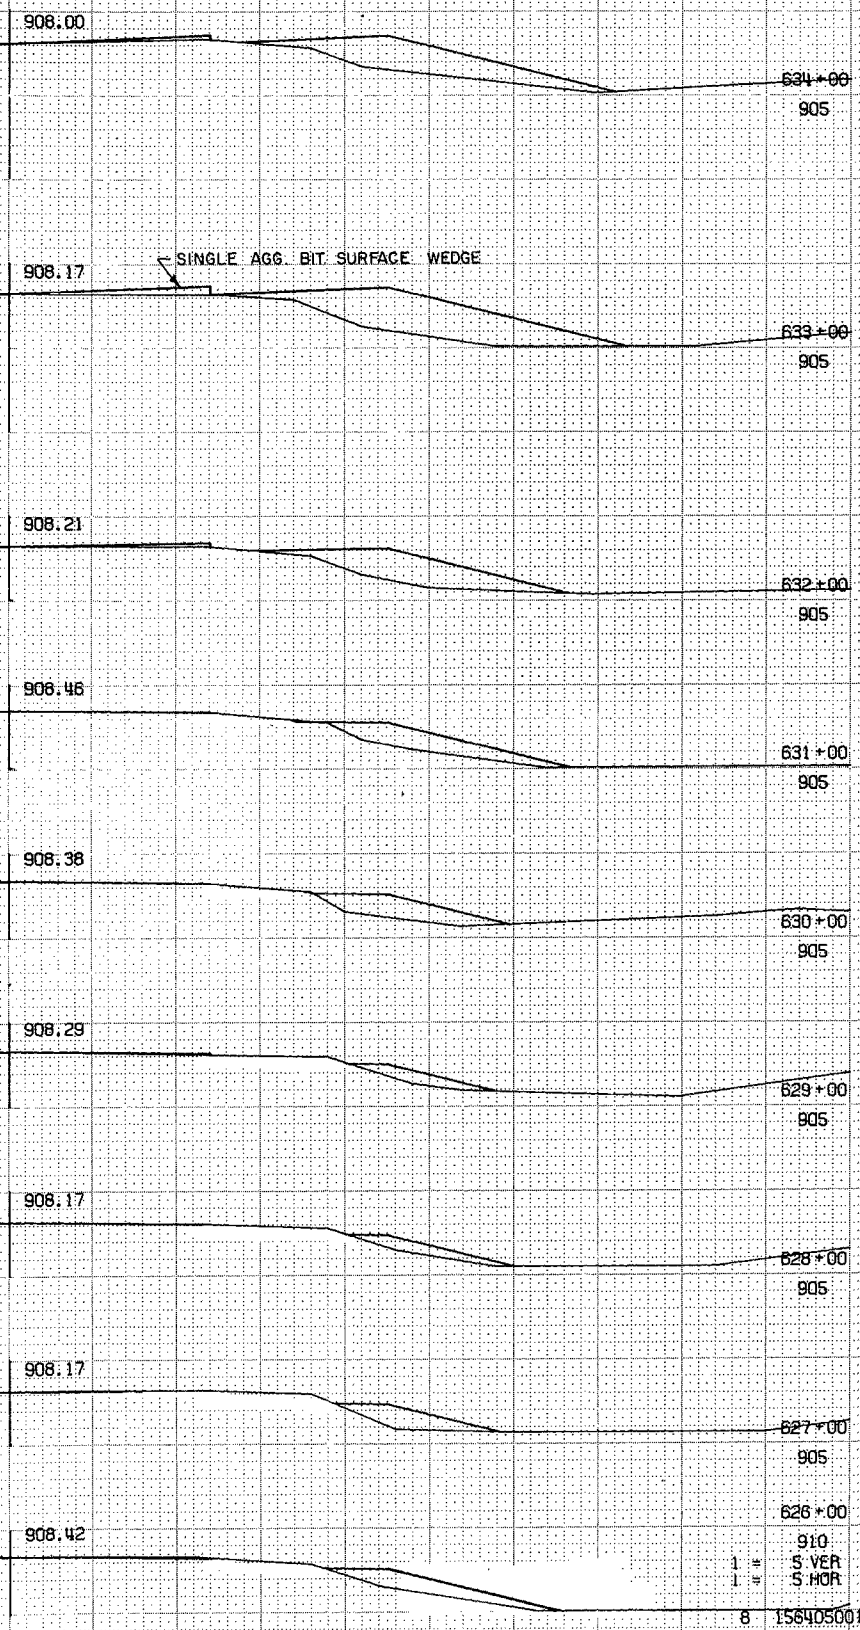

STATE PROJECT NUMBER					SHEET NUMBER
1564-5-71					9/13
STATION	DISTANCE	YARDAGE			FILL
		EXCAVATION			
634					85
635					94
636					128
637					158
638					163
639					146
640					

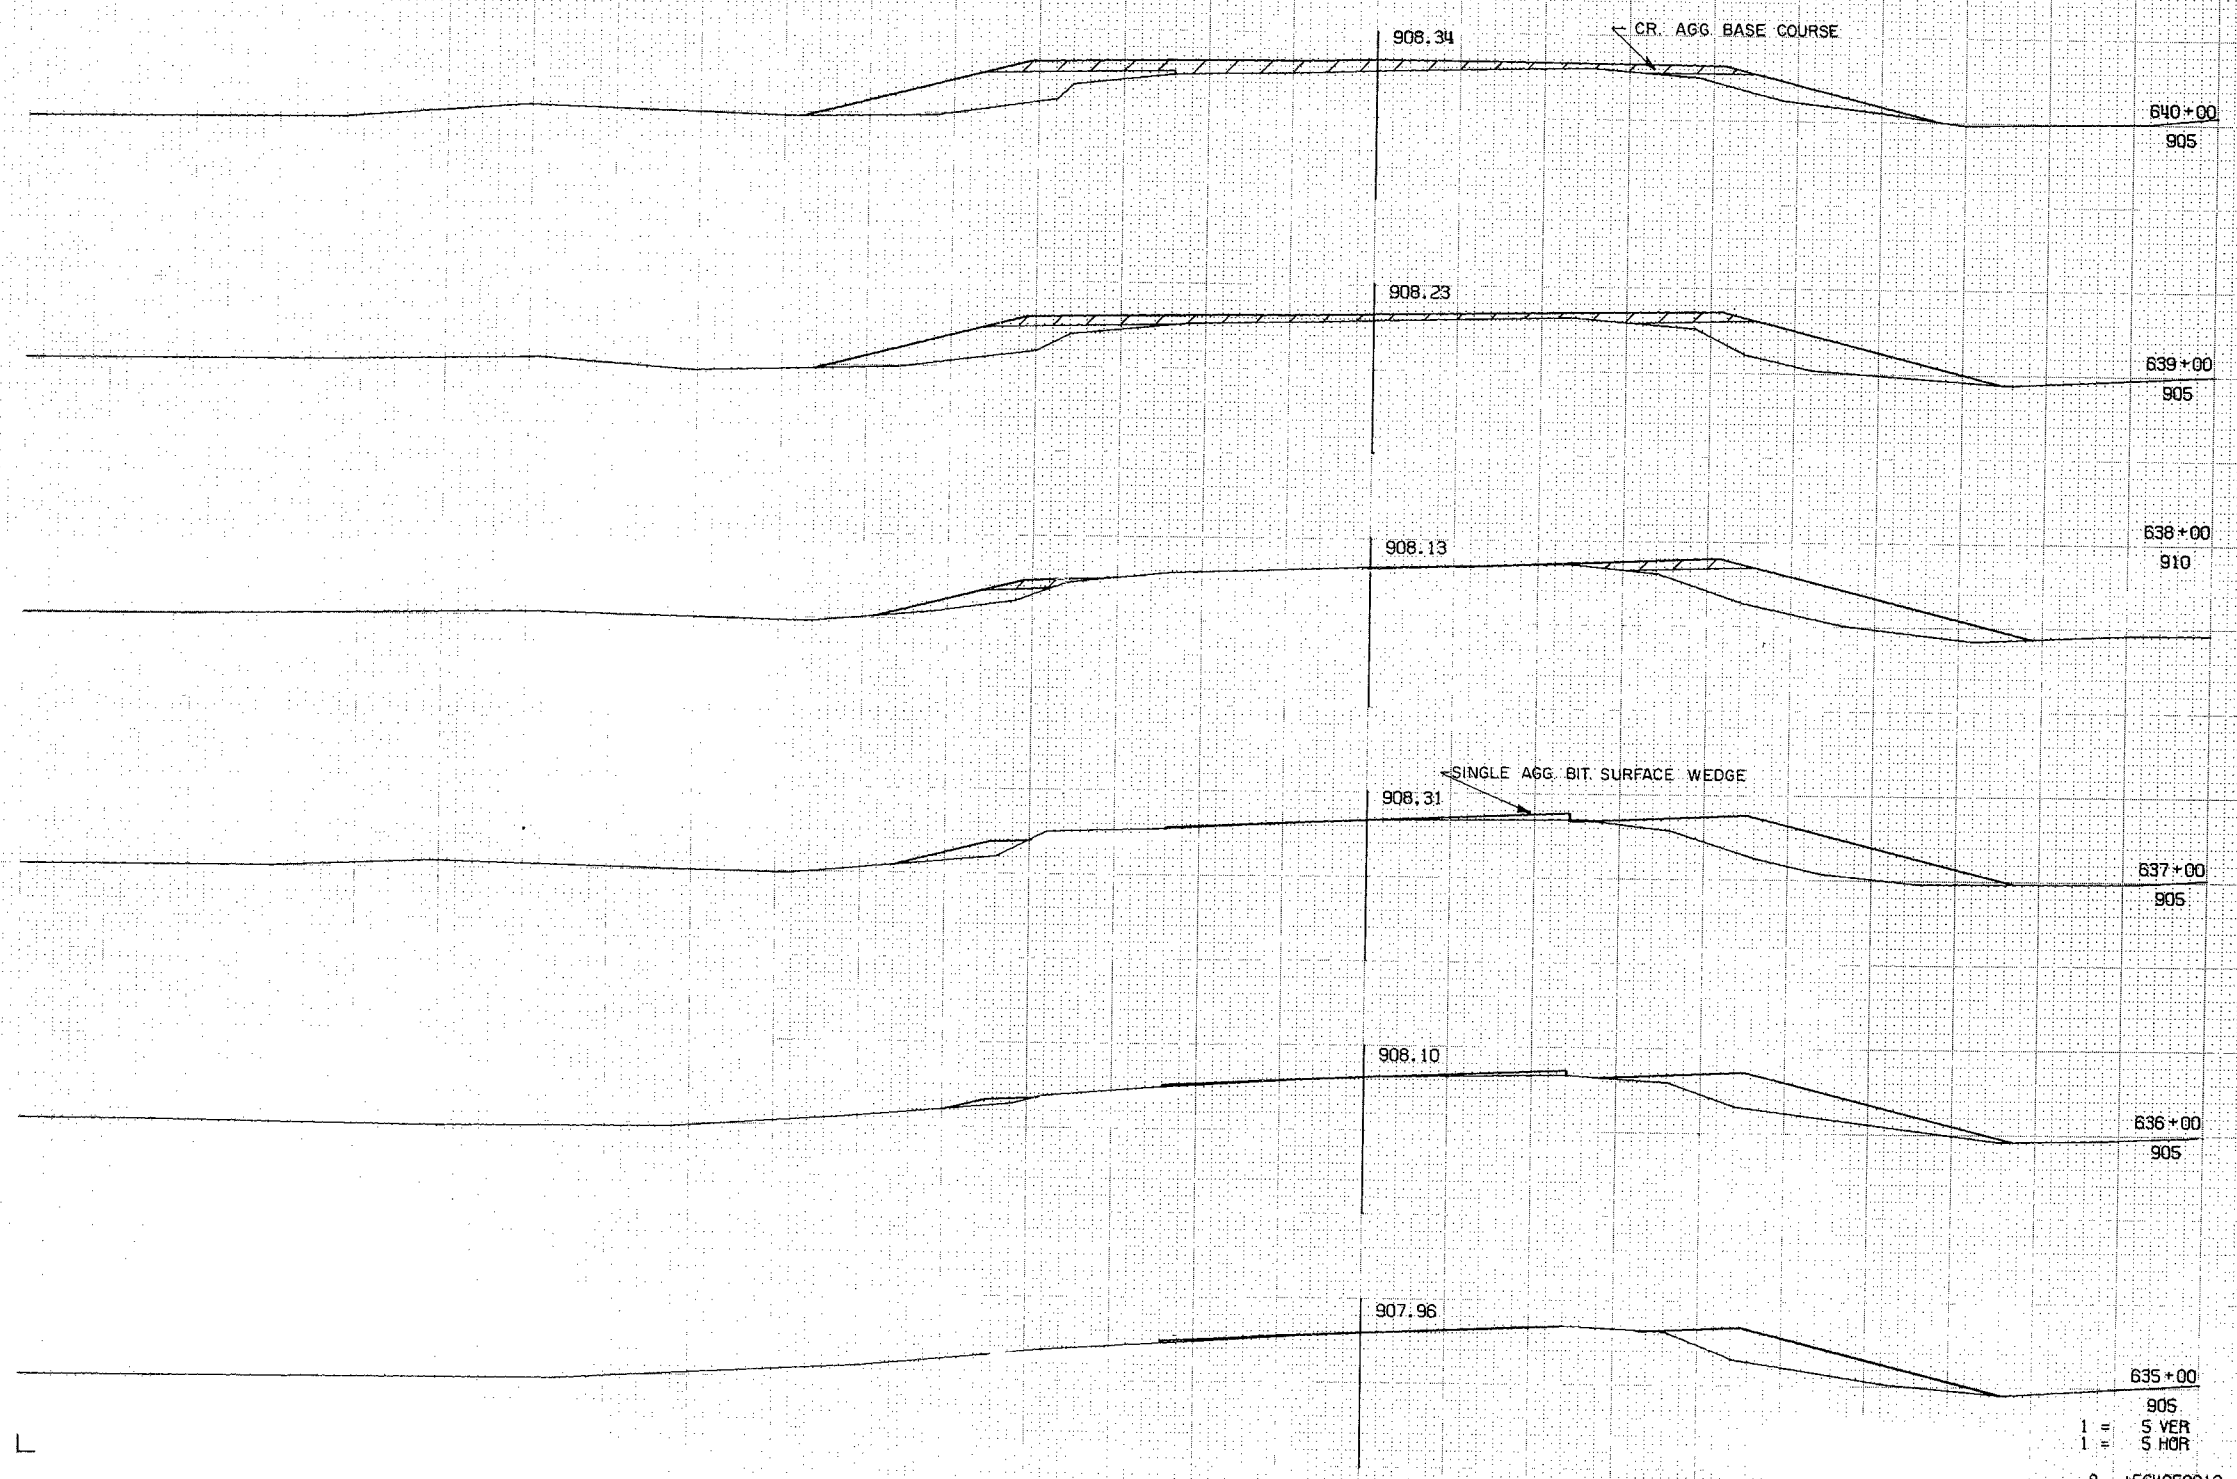


1 = 5' VER
1 = 5' HOR

8 1564050013

STATE PROJECT NUMBER	SHEET NUMBER
1564-5-71	9/14

STATION	DISTANCE	YARDAGE	
		EXCAVATION	FILL
640			74
641			159
642			189
643			208
644			308
645			237
+67			

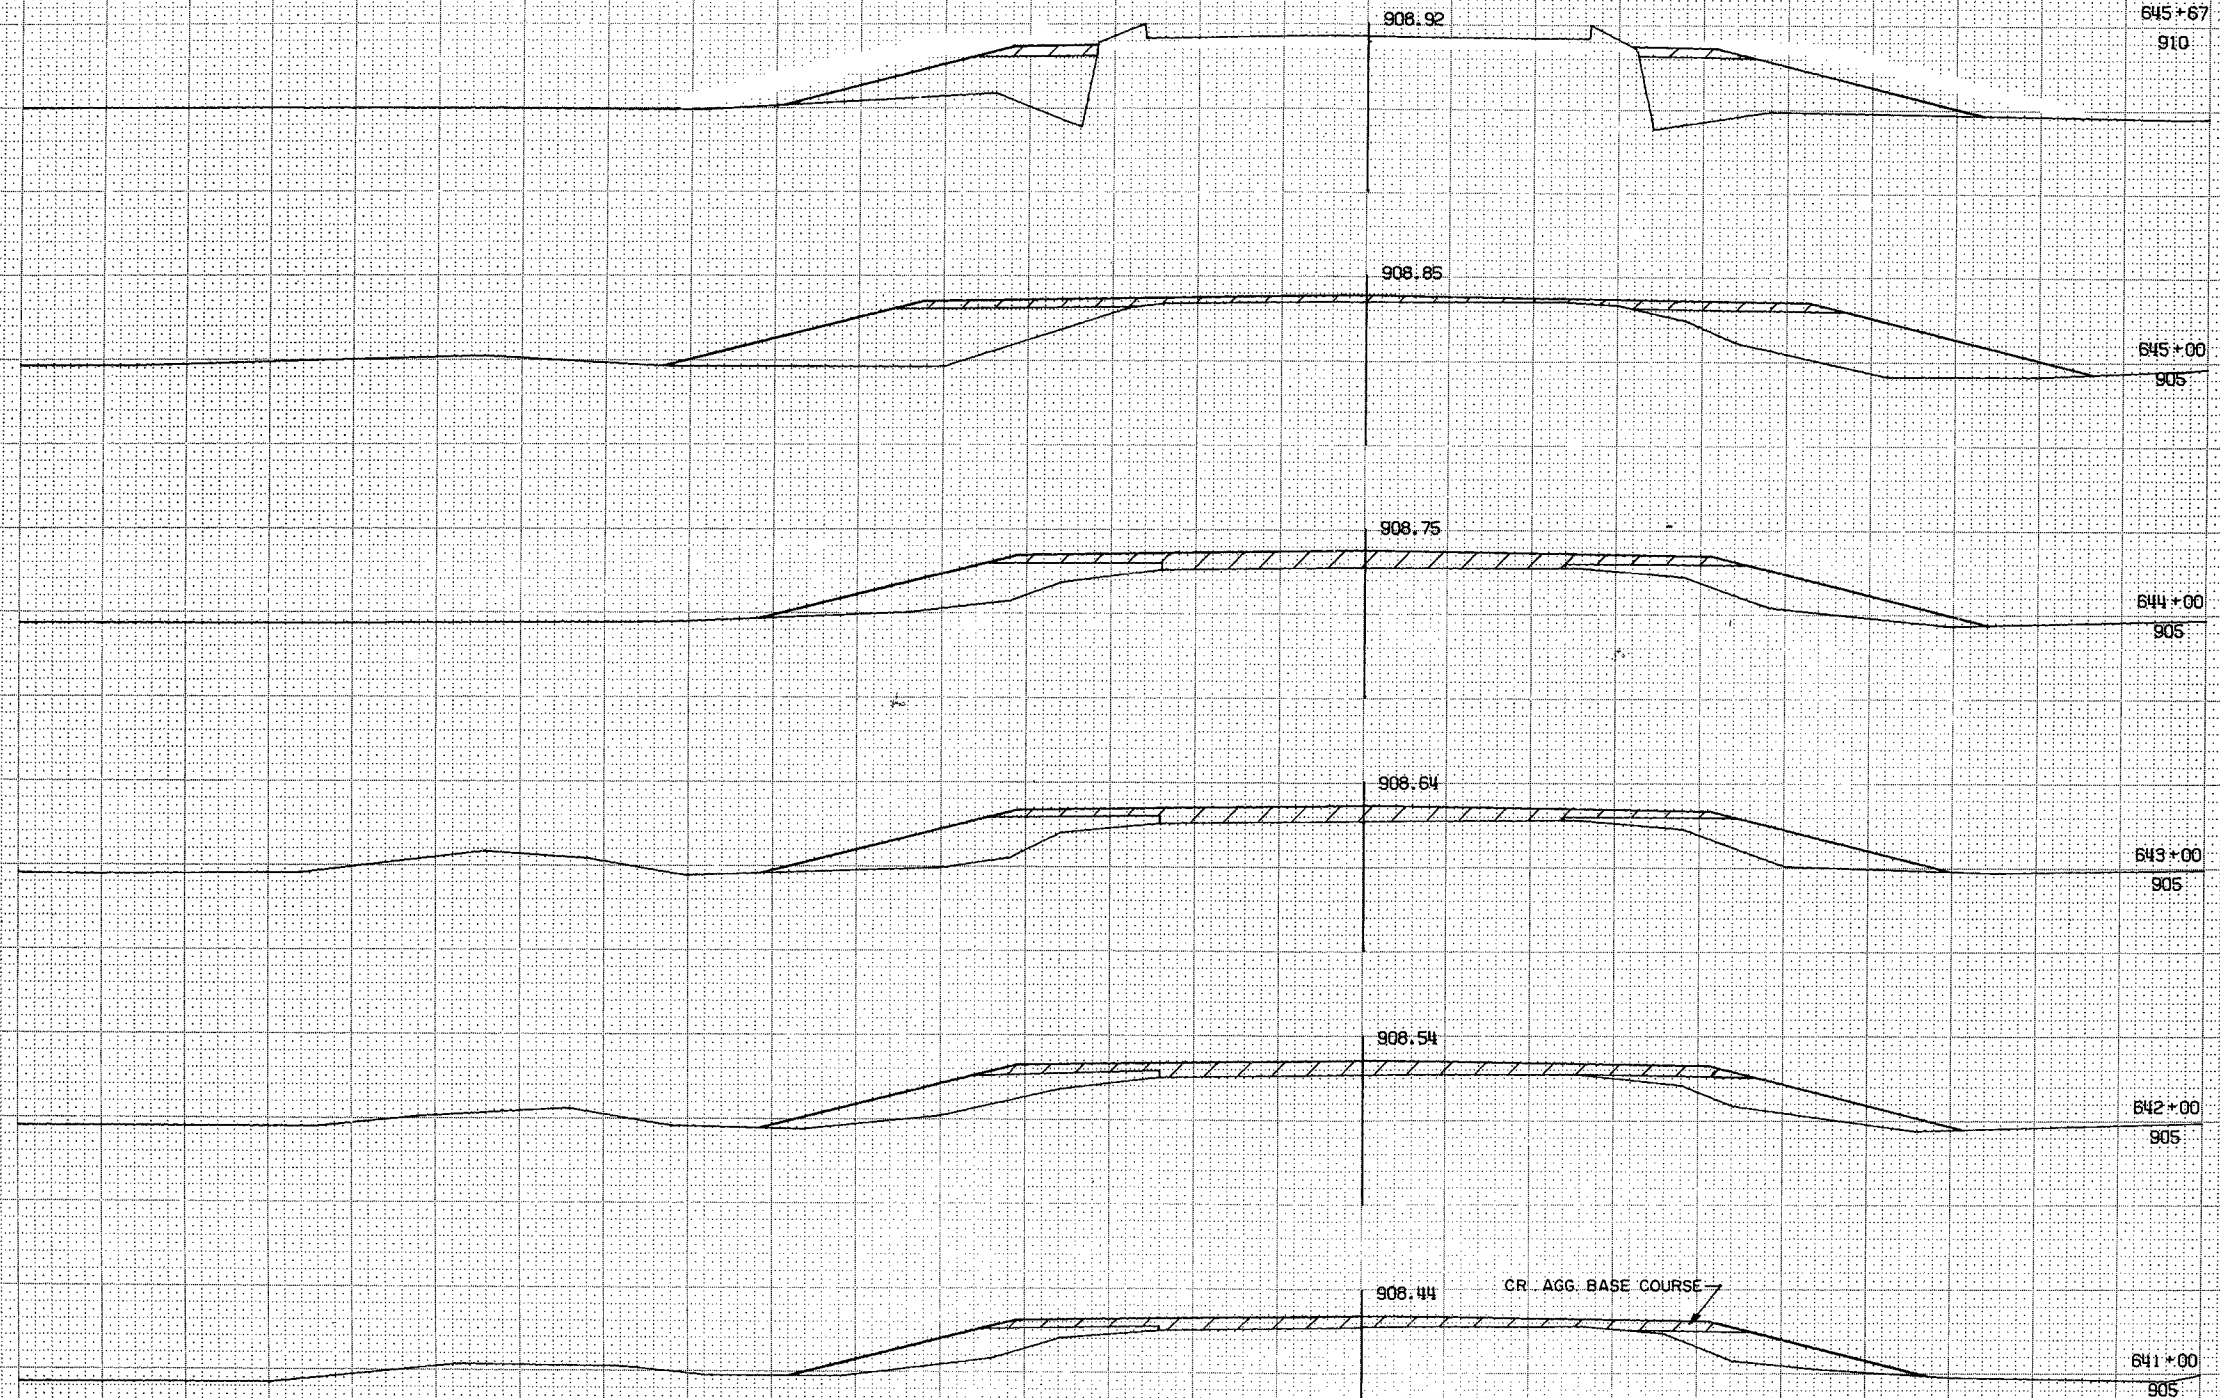

1" = 5' VER
1" = 5' HOR

8 1564050013