


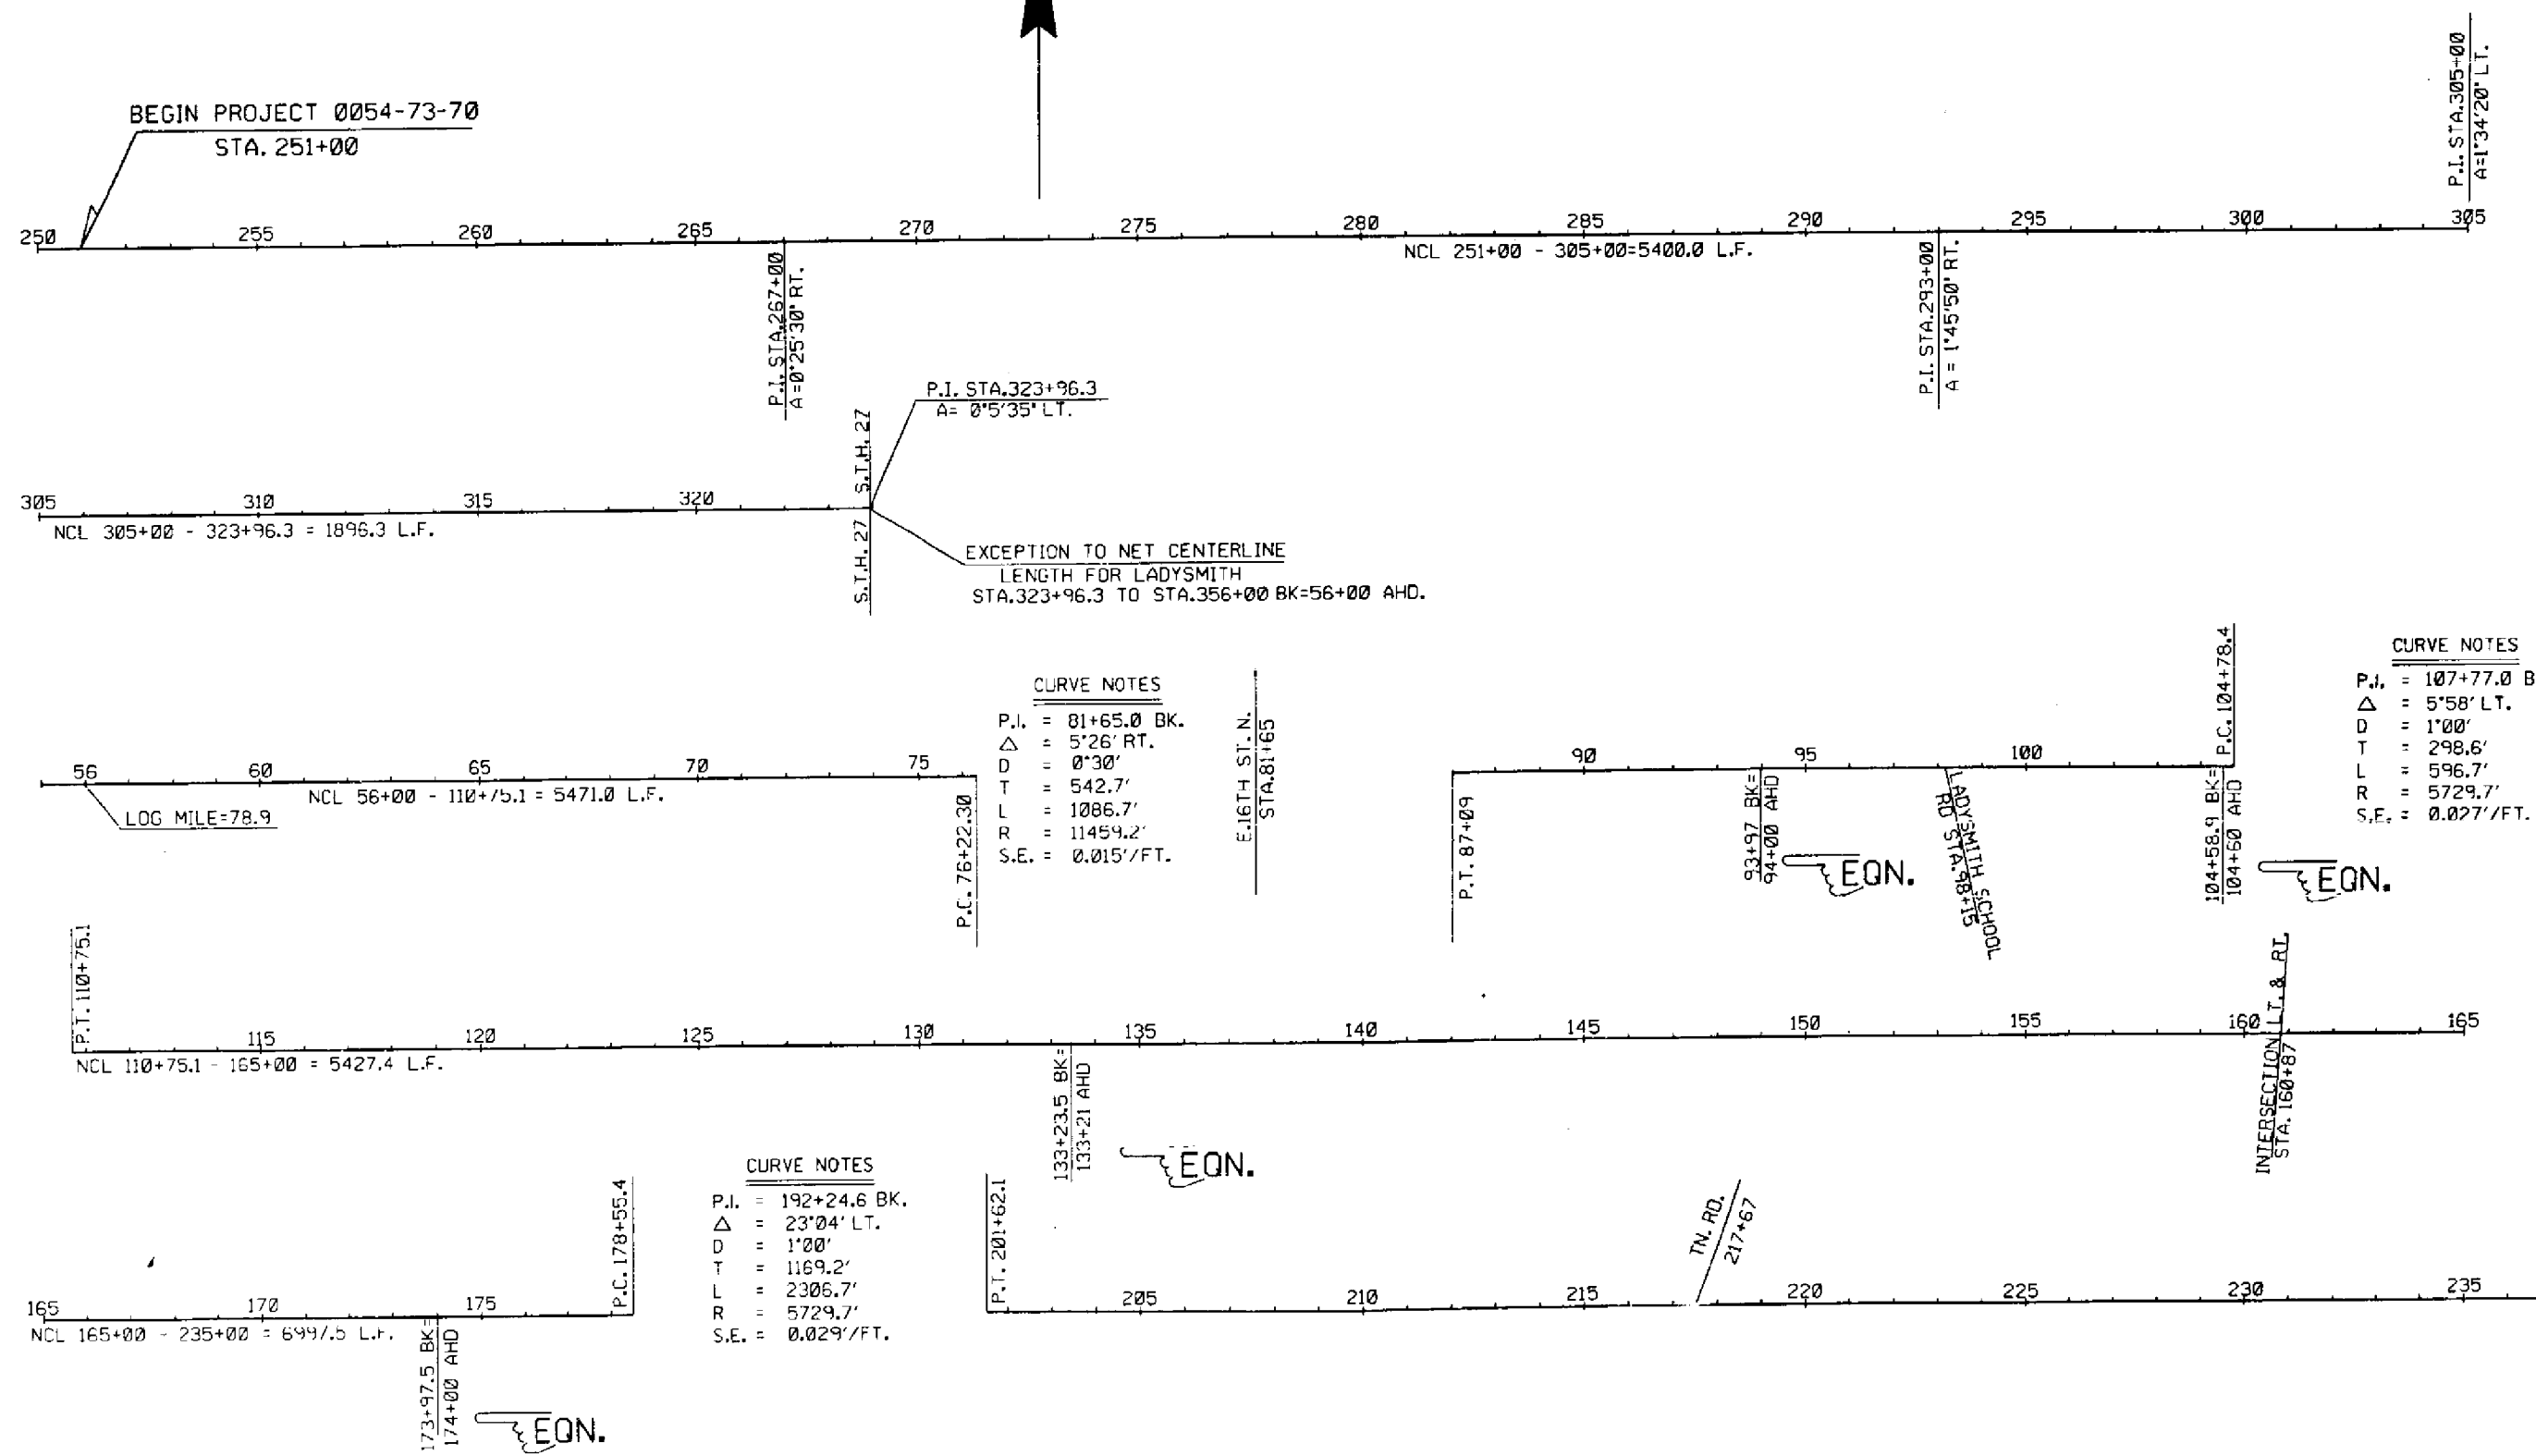


CURVE NOTES
P.I. = 81+65.0 BK.
 Δ = 5°26' RT.
D = 0°30'
T = 542.7'
L = 1086.7'
R = 11459.2'
S.E. = 0.015'/FT.


CURVE NOTES
P.I. = 107+77.0 BK
 Δ = 5°58' LT.
D = 1°00'
T = 298.6'
L = 596.7'
R = 5729.7'
S.E. = 0.027'/FT.

CURVE NOTES
P.I. = 192+24.6 BK.
 Δ = 23°04' LT.
D = 1°00'
T = 1169.2'
L = 2306.7'
R = 5729.7'
S.E. = 0.029'/FT.

11.2, 13.5, 15.8, 2897.7, 2899.9, 2902.2, 2904.5, 3097.7, 3099.9, 3102.2, 3104.5, 3297.7, 3299.9, 3302.2, 3304.5, 3306.8, 3309.1, 3311.4, 3313.

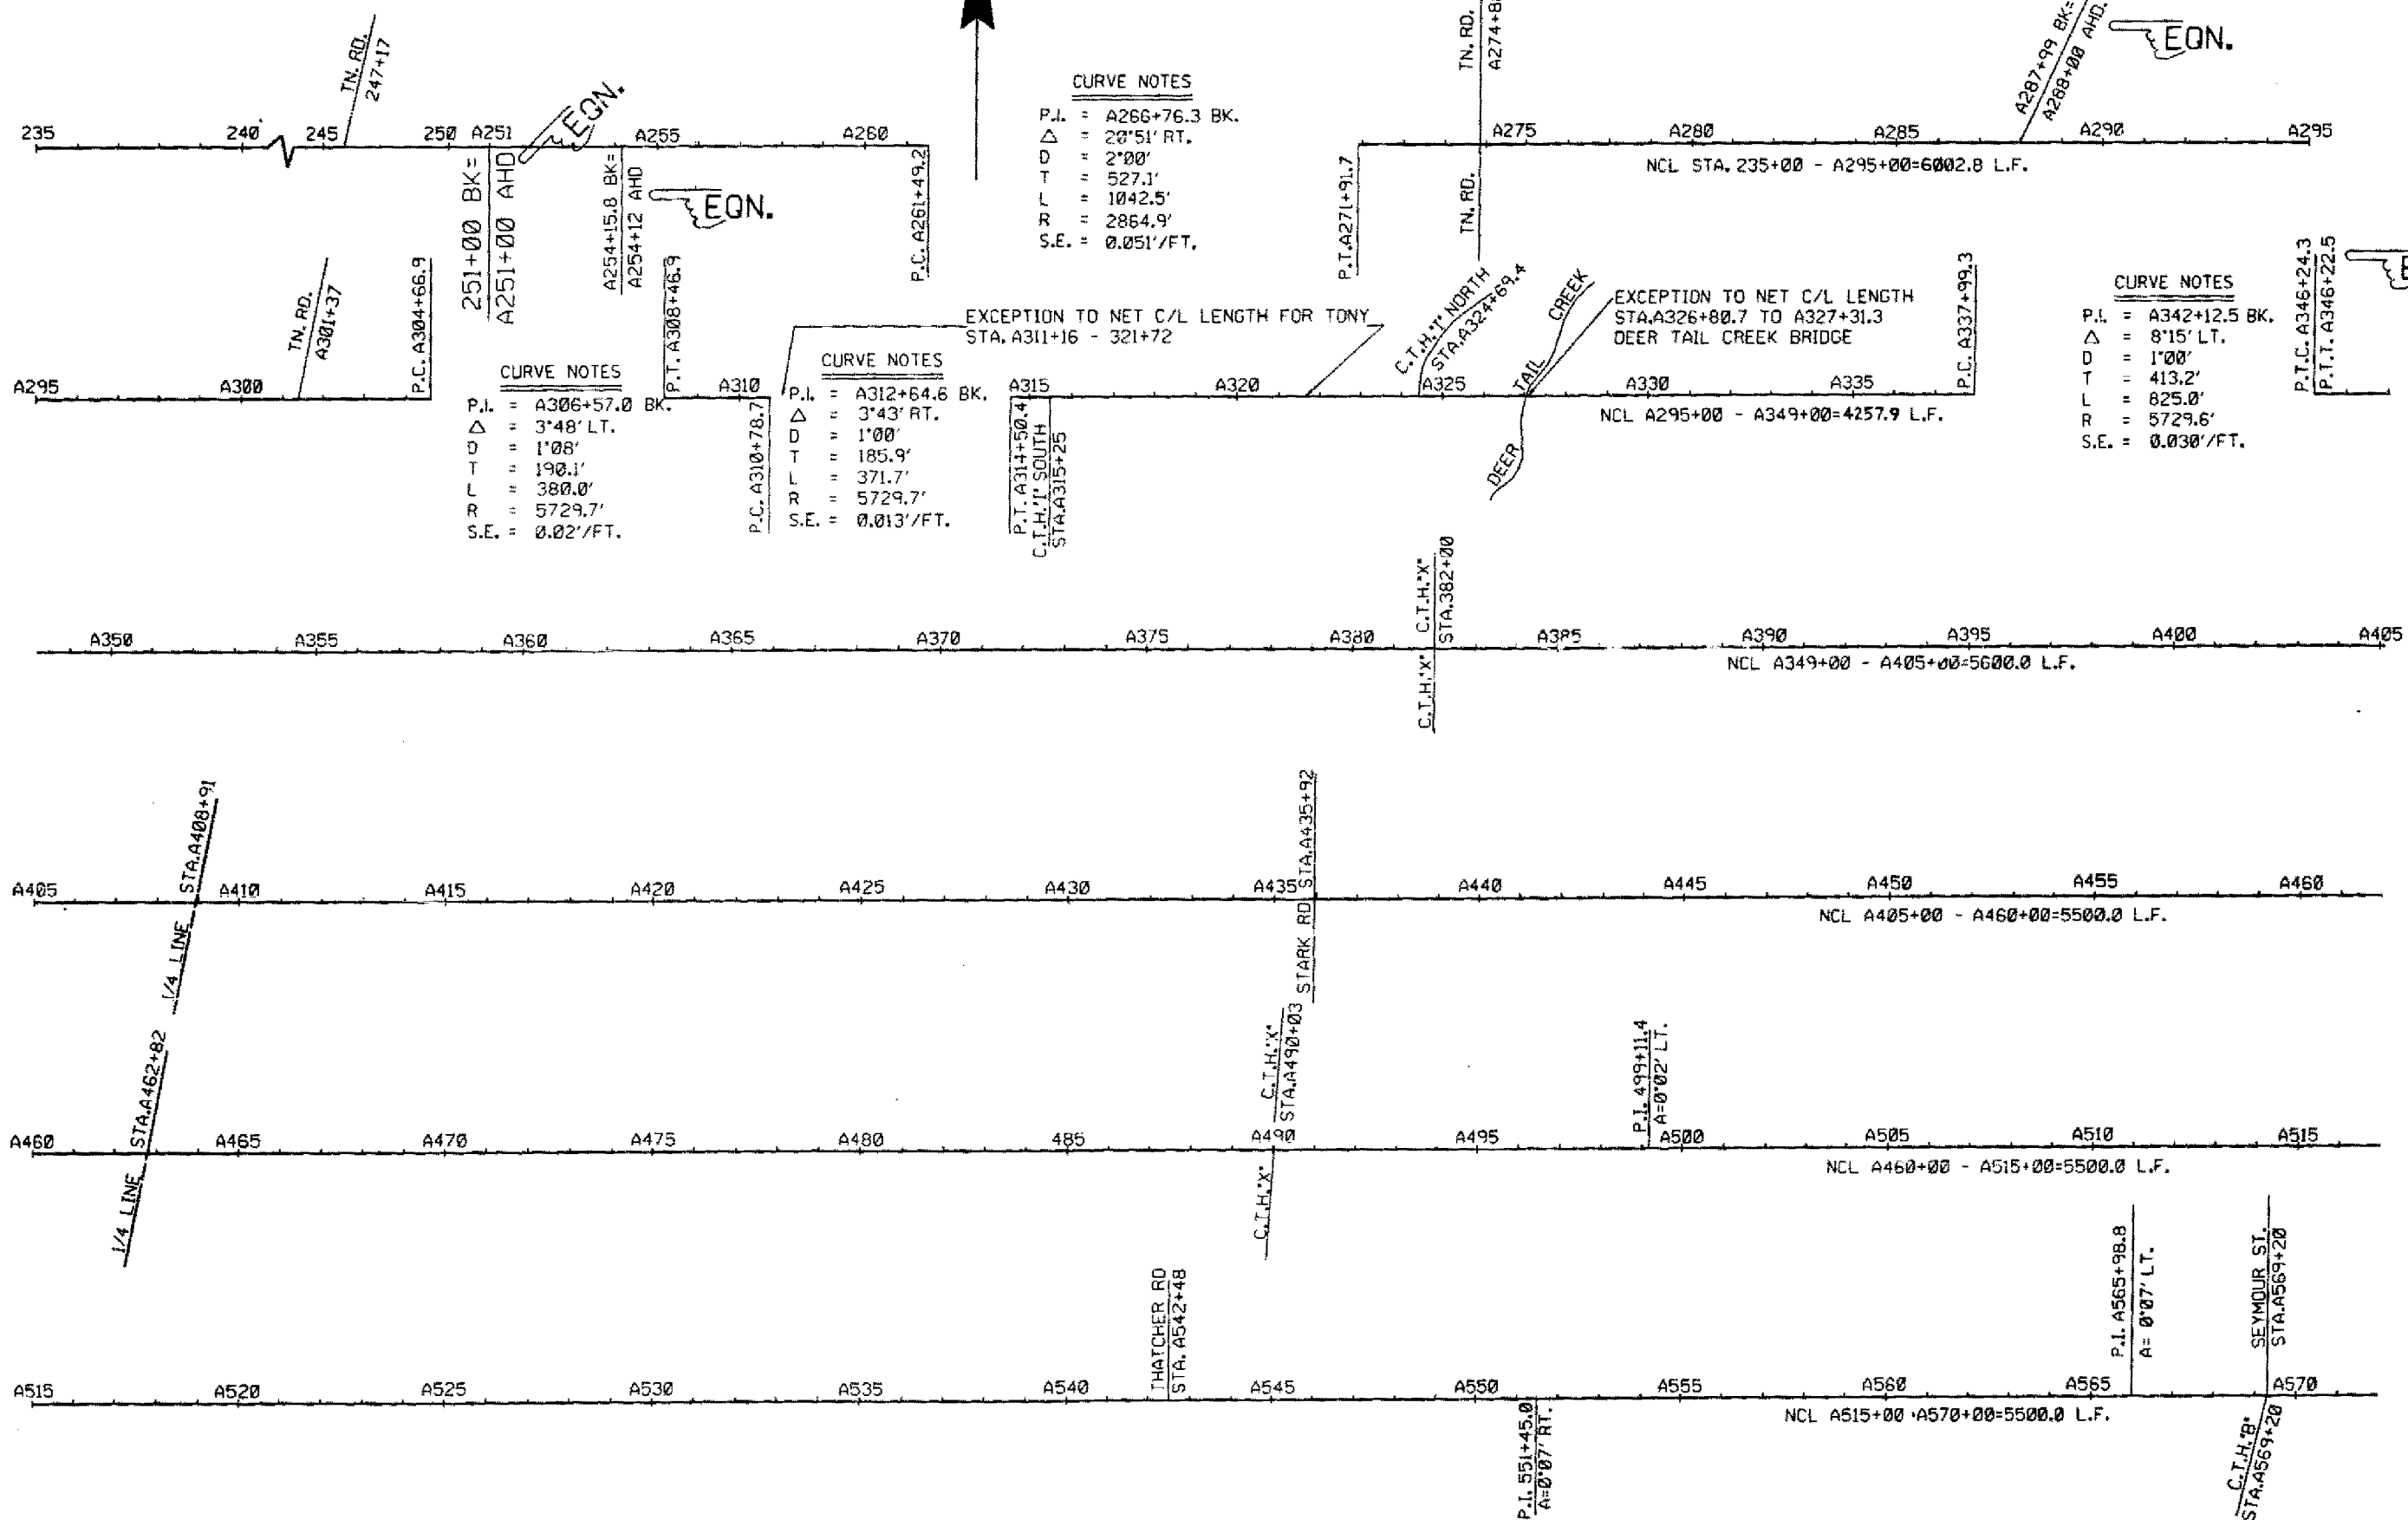

LEVELS ON - 1, 2, 3, 62, 63

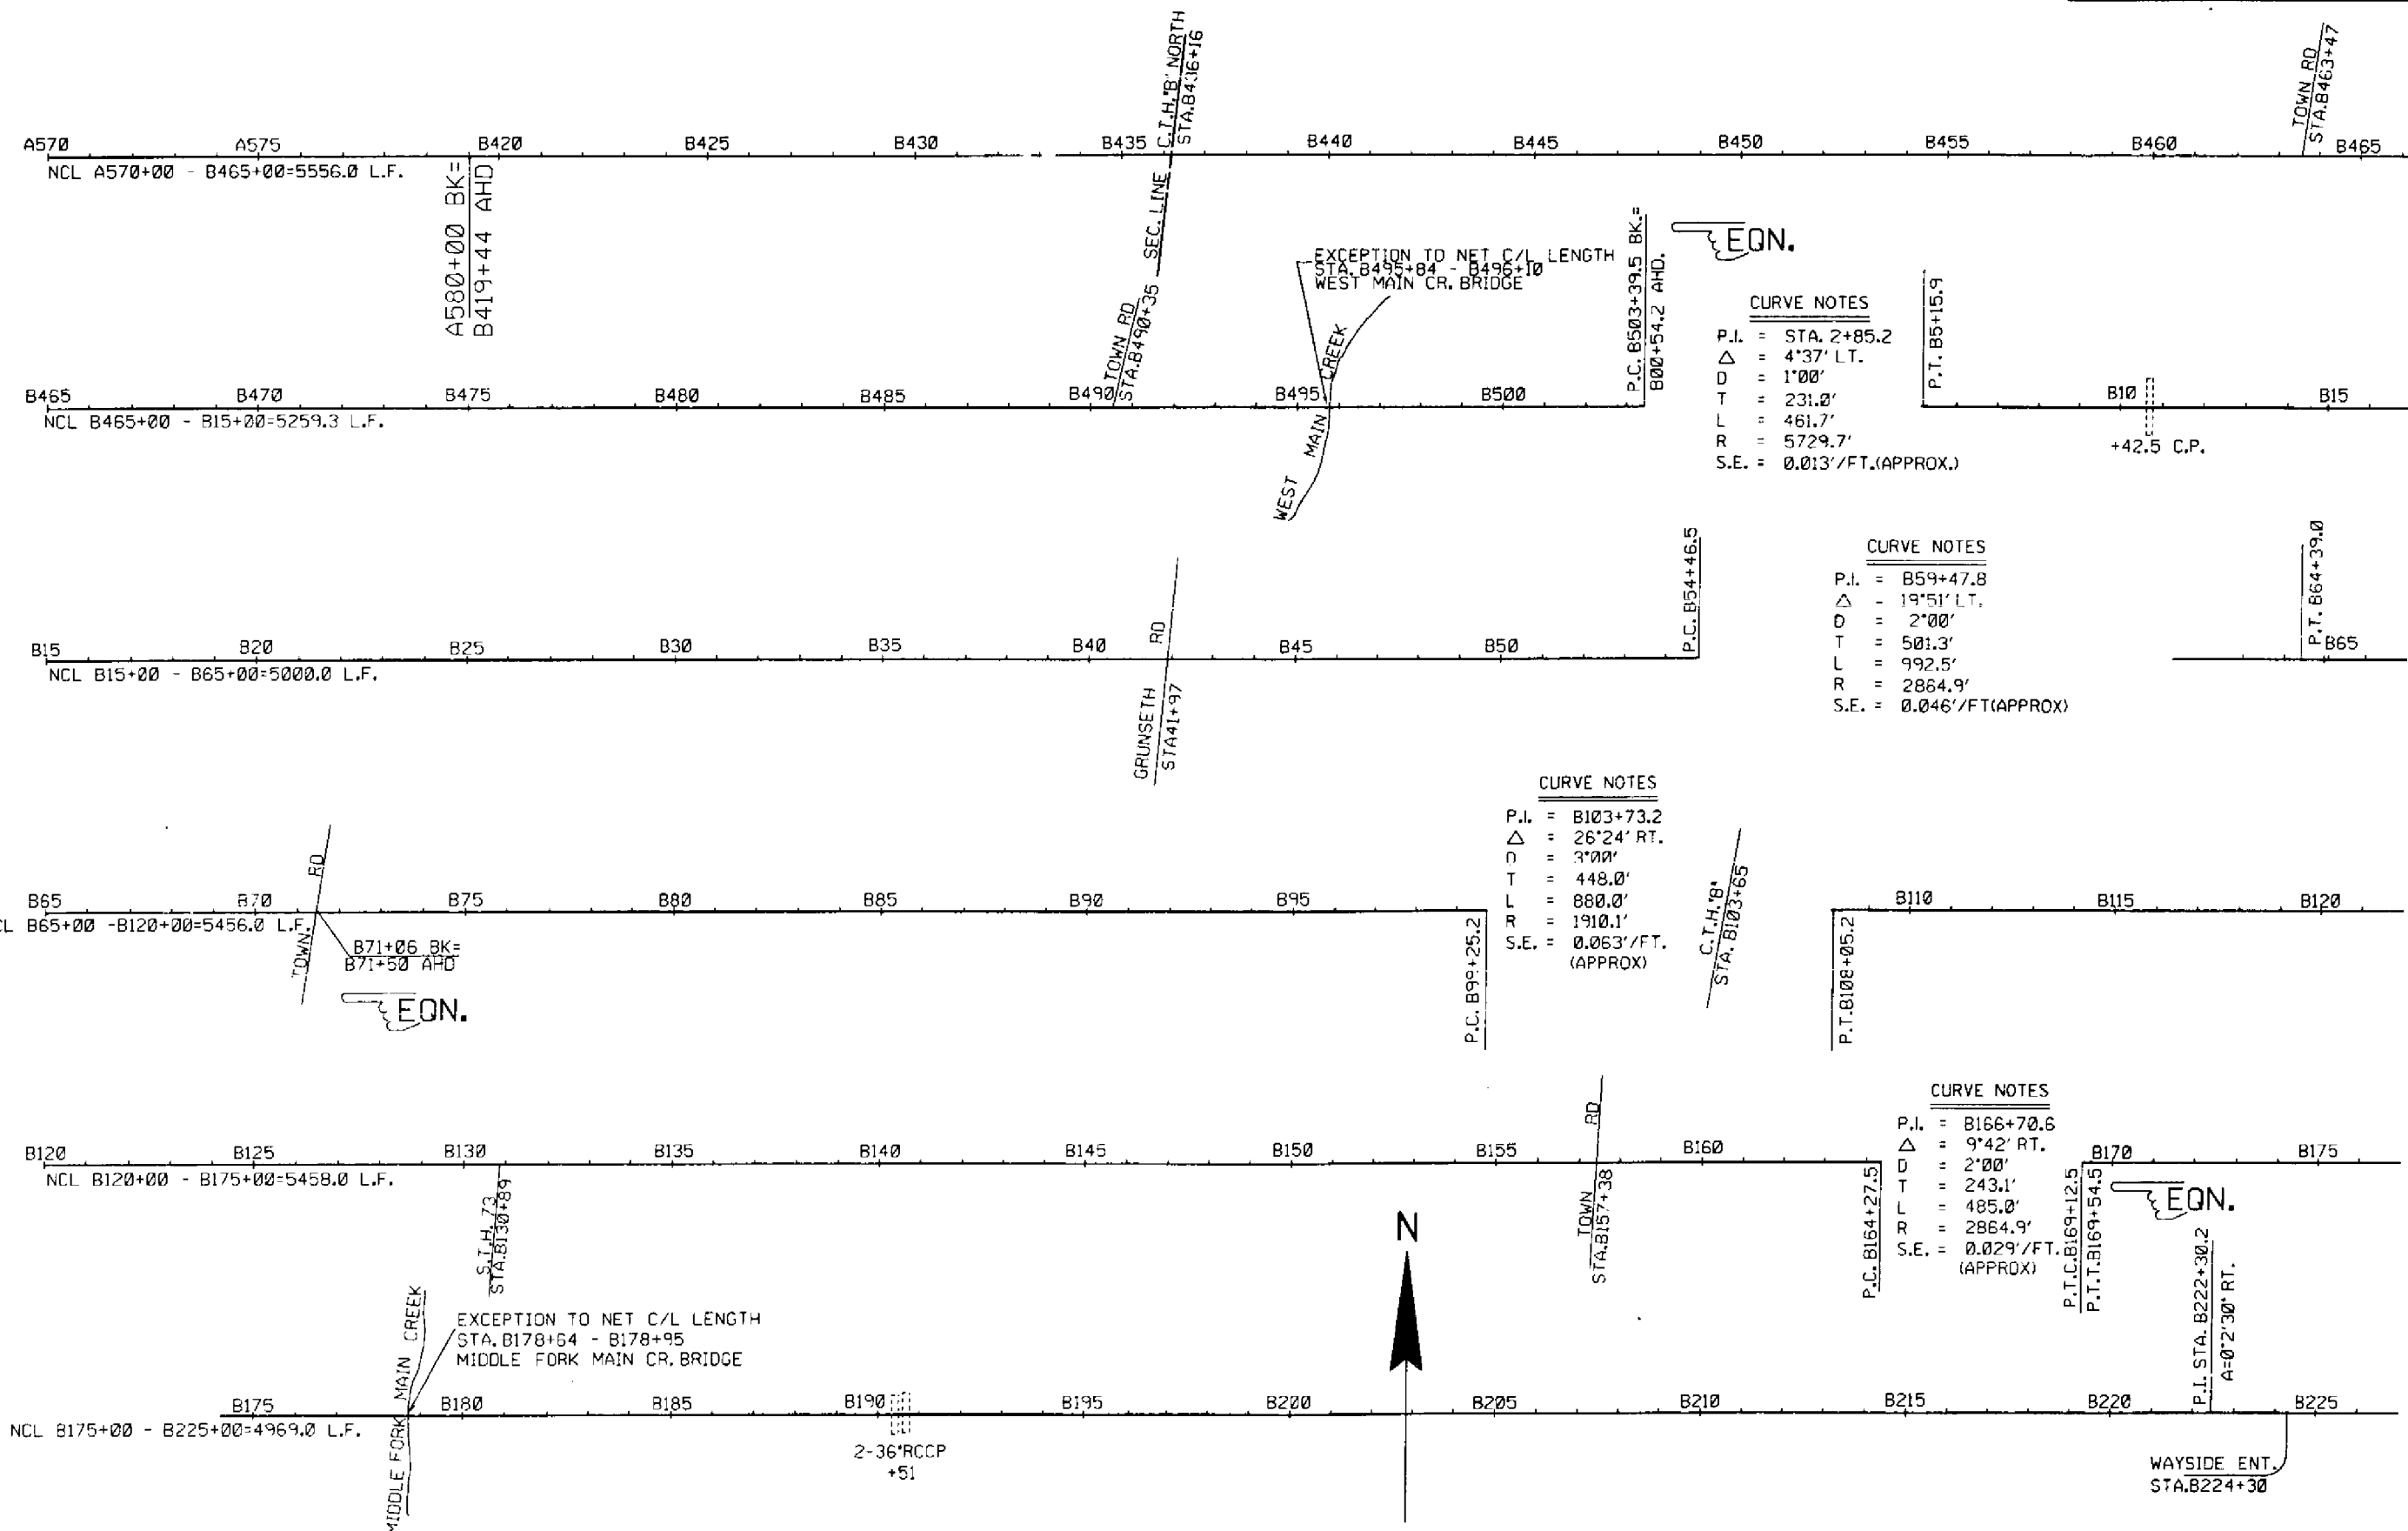

CURVE NOTES

P.I. = STA. 2+85.2
 Δ = 4°37' LT.
D = 1°00'
T = 231.0'
L = 461.7'
R = 5729.7'
S.E. = 0.013'/FT. (APPROX.)

CURVE NOTES

P.I. = B59+47.8
 Δ = 19°51' LT.
D = 2°00'
T = 501.3'
L = 992.5'
R = 2864.9'
S.E. = 0.046'/FT. (APPROX.)


CURVE NOTES

P.I. = B103+73.2
 Δ = 26°24' RT.
D = 3°00'
T = 448.0'
L = 880.0'
R = 1910.1'
S.E. = 0.063'/FT. (APPROX.)

CURVE NOTES

P.I. = B166+70.6
 Δ = 9°42' RT.
D = 2°00'
T = 243.1'
L = 485.0'
R = 2864.9'
S.E. = 0.029'/FT. (APPROX.)

LEVELS (M) = 102.3, 4, 5, 6, 62, 63

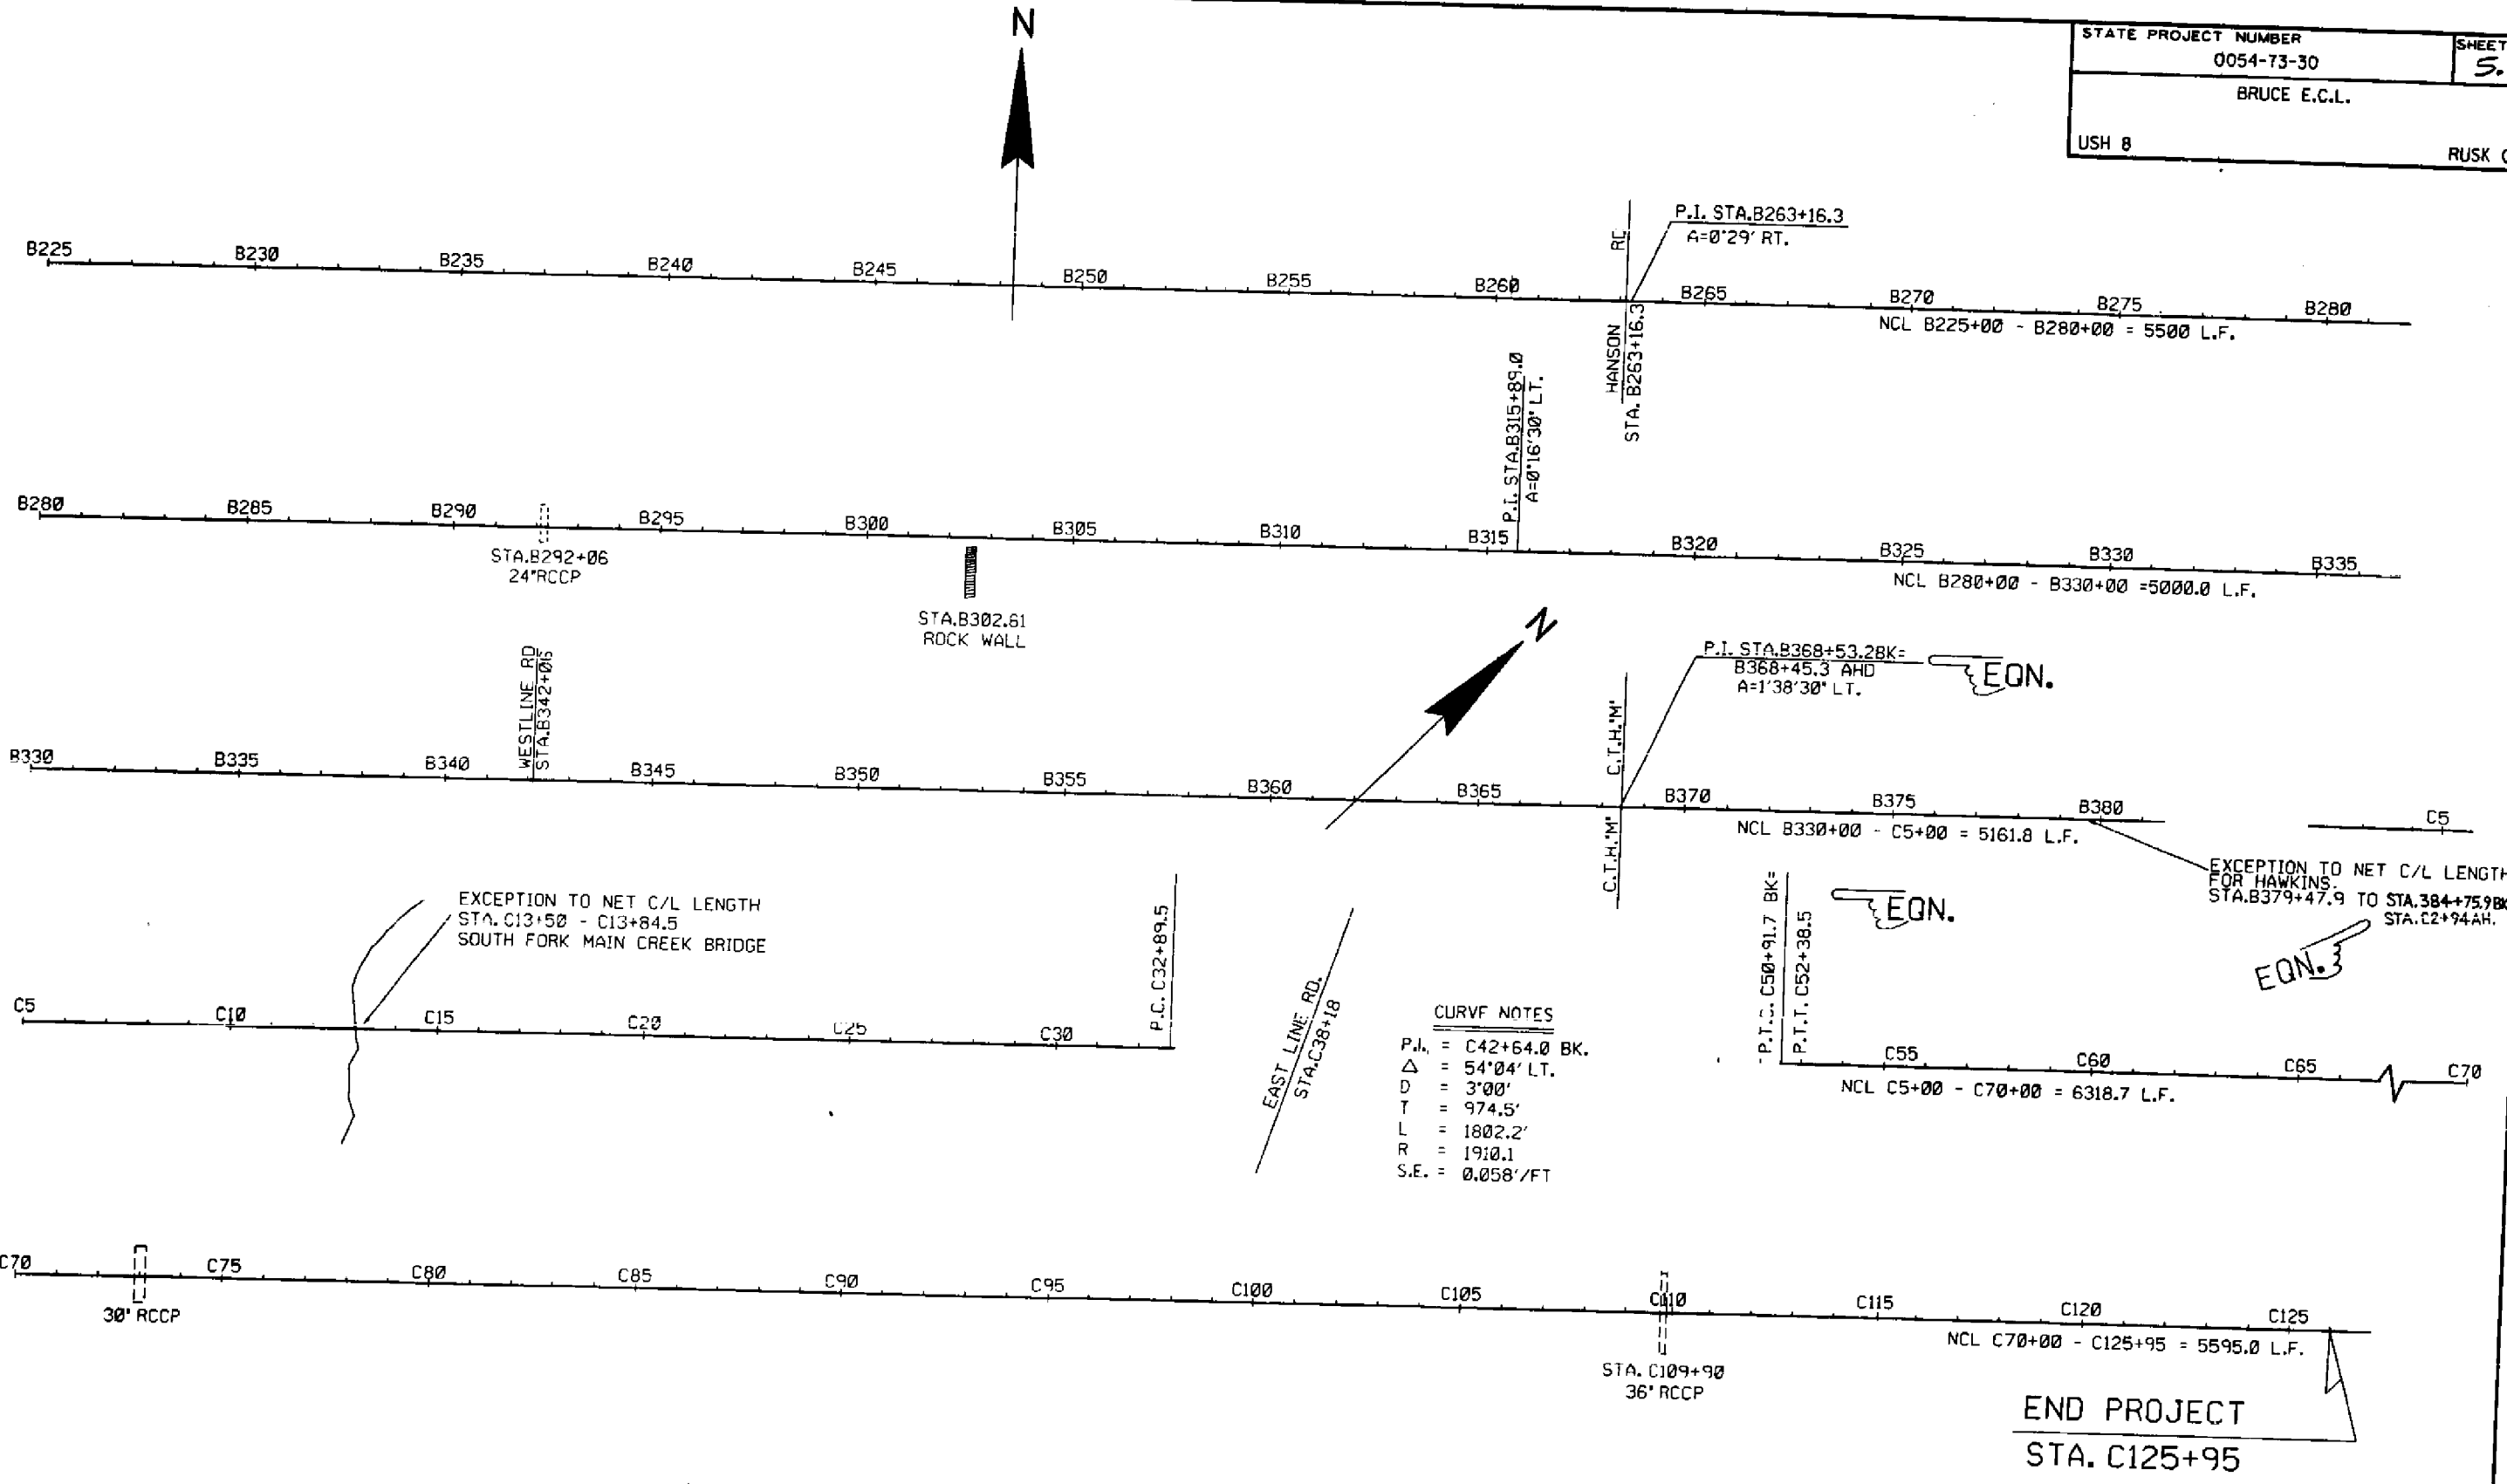

LEVELS ON = 1, 2, 3, 62, 63