

AS BUILT

INDEX OF SHEETS

Sheet No. 1	Title
Sheet No. 2-2.2	Typical Sections and Details
Sheet No. 3	Estimate of Quantities
Sheet No. 2	Miscellaneous Quantities
Sheet No. —	Right of Way Plat
Sheet No. 5-5.3	Plan and Profile
Sheet No. 6	Standard Detail Drawings
Sheet No. —	Sign Plates
Sheet No. —	Structure Plans
Sheet No. —	Computer Earthwork Data
Sheet No. —	Cross Sections

TOTAL SHEETS = 10

STATE OF WISCONSIN DEPARTMENT OF TRANSPORTATION

PLAN OF PROPOSED IMPROVEMENT


BRUCE - EAST COUNTY LINE ROAD

U.S.H. 8

RUSK COUNTY

STATE PROJECT NUMBER
0054-73-70

STATE PROJECT	FEDERAL PROJECT	
	PROJECT	CONTRACT
0054-73-70	—	—

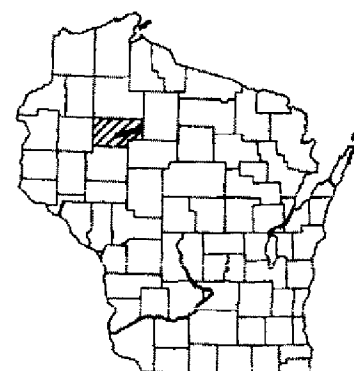


DESIGN DESIGNATION

A.D.T. 1985	= 2300 AVG.
A.D.T.	=
D.M.V.	=
D.	=
T.	=
V.	=

CONVENTIONAL SIGNS

COUNTY LINE	— — — — —
CORPORATE LIMITS	=====
PROPERTY LINE	-----
LOT LINE	-----
LIMITED HIGHWAY EASEMENT	-----
EXISTING RIGHT OF WAY	-----
NEW RIGHT OF WAY	=====
REFERENCE LINE	-----
SLOPE INTERCEPT	-----
ORIGINAL GROUND	-----
MARSH OR ROCK PROFILE	-----
CULVERT IN PLACE	-----
CULVERT REQUIRED	-----
CULVERT REQUIRED (Profile)	-----

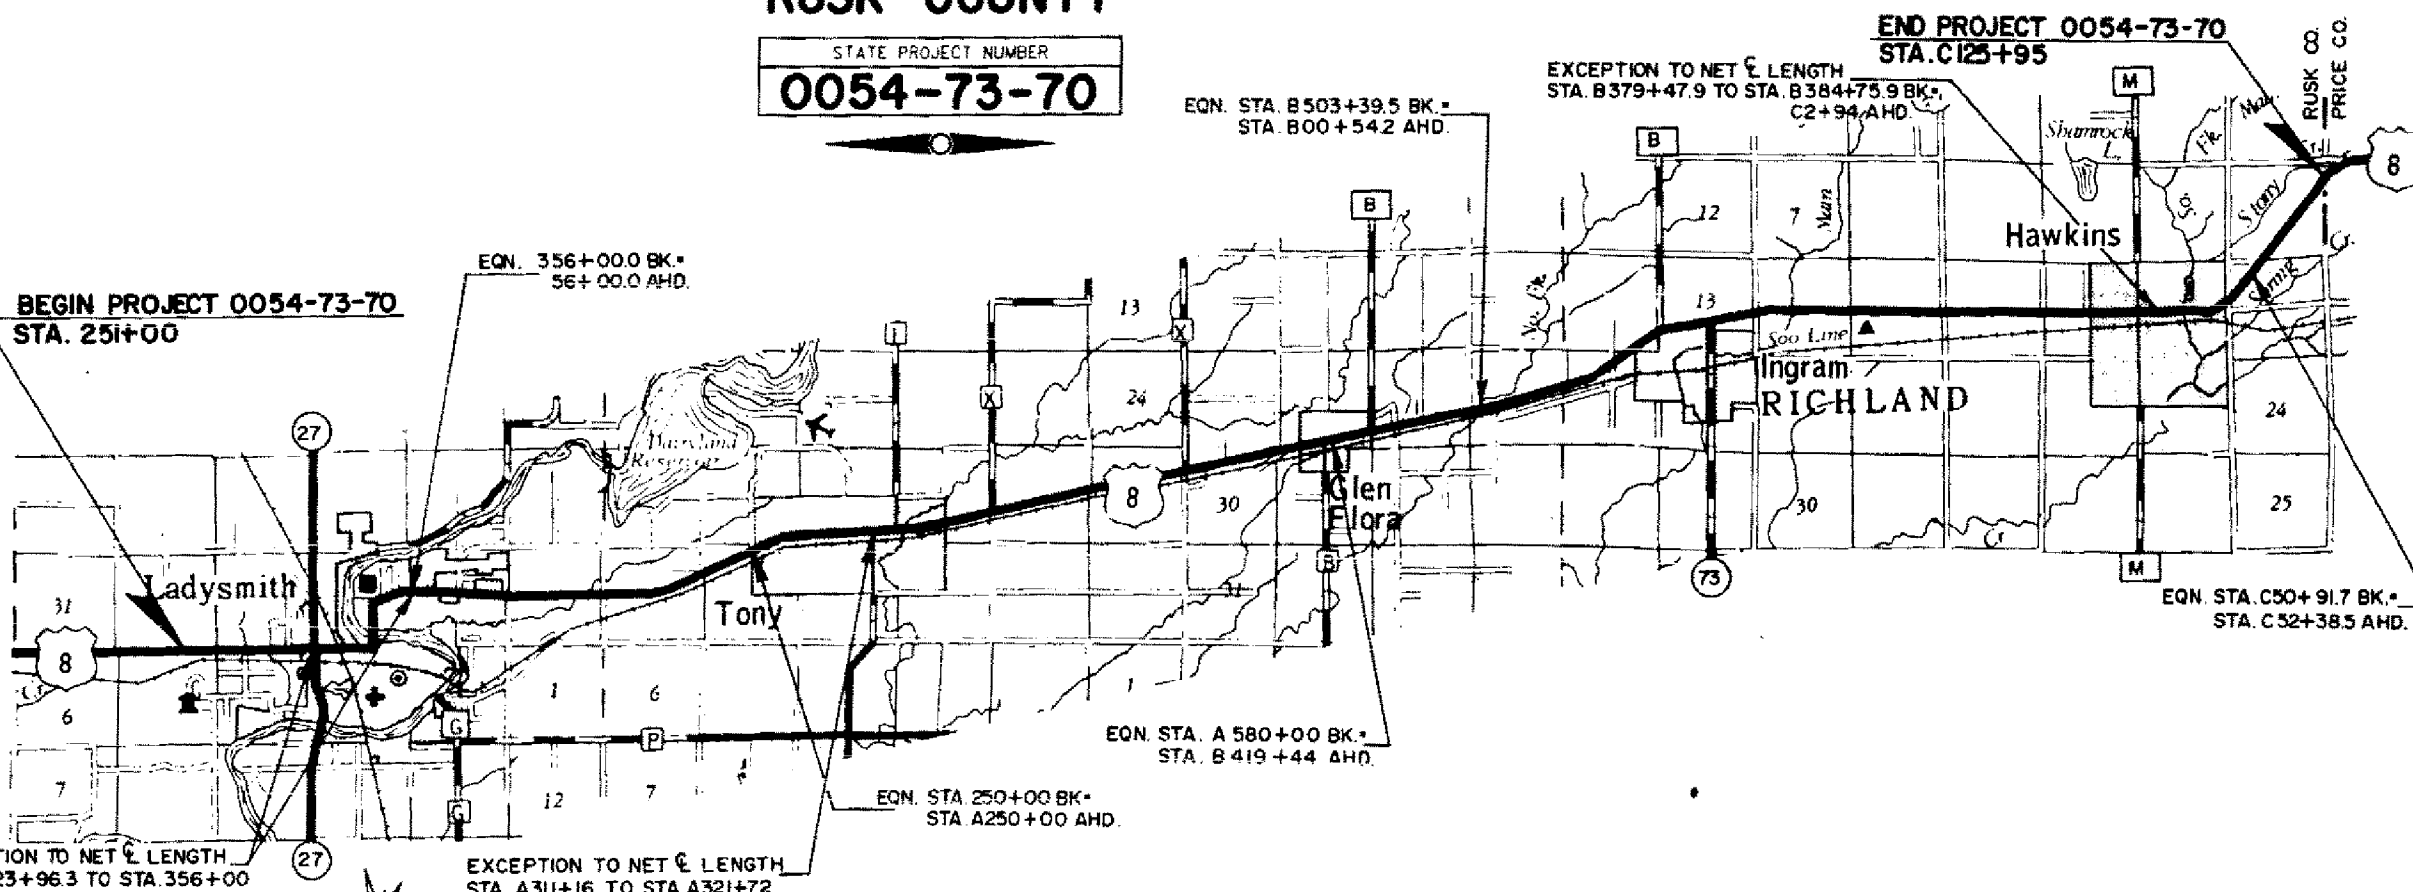

EXCEPTION TO NET LENGTH
STA. 323+96.3 TO STA. 356+00

EXCEPTION TO NET LENGTH
STA. A311+16 TO STA. A321+72

LAYOUT
SCALE 0 1 MI.

TOTAL NET LENGTH OF CENTERLINE = 22.126 MI.

STATE OF WISCONSIN DEPARTMENT OF TRANSPORTATION	
Surveyor GAG	District Checker RLL
Designer W.D.G.	C.O. Checker NRA
District Supervisor W.J.G.	C.O. Coordinator
APPROVED:	
DATE: 3/6/87	Del R. Langhin DISTRICT TRANSPORTATION DIRECTOR (ACTING)
DATE: 3-20-87	J. Shober STATE MAINTENANCE ENGINEER FOR HWYS.
DATE: 3-30-87	Michael Jackson DIRECTOR OF ENGINEERING OPERATIONS