

STATE PROJECT NUMBER


SWEET PLUM

4	
---	--

SHEET TOTAL

380

1

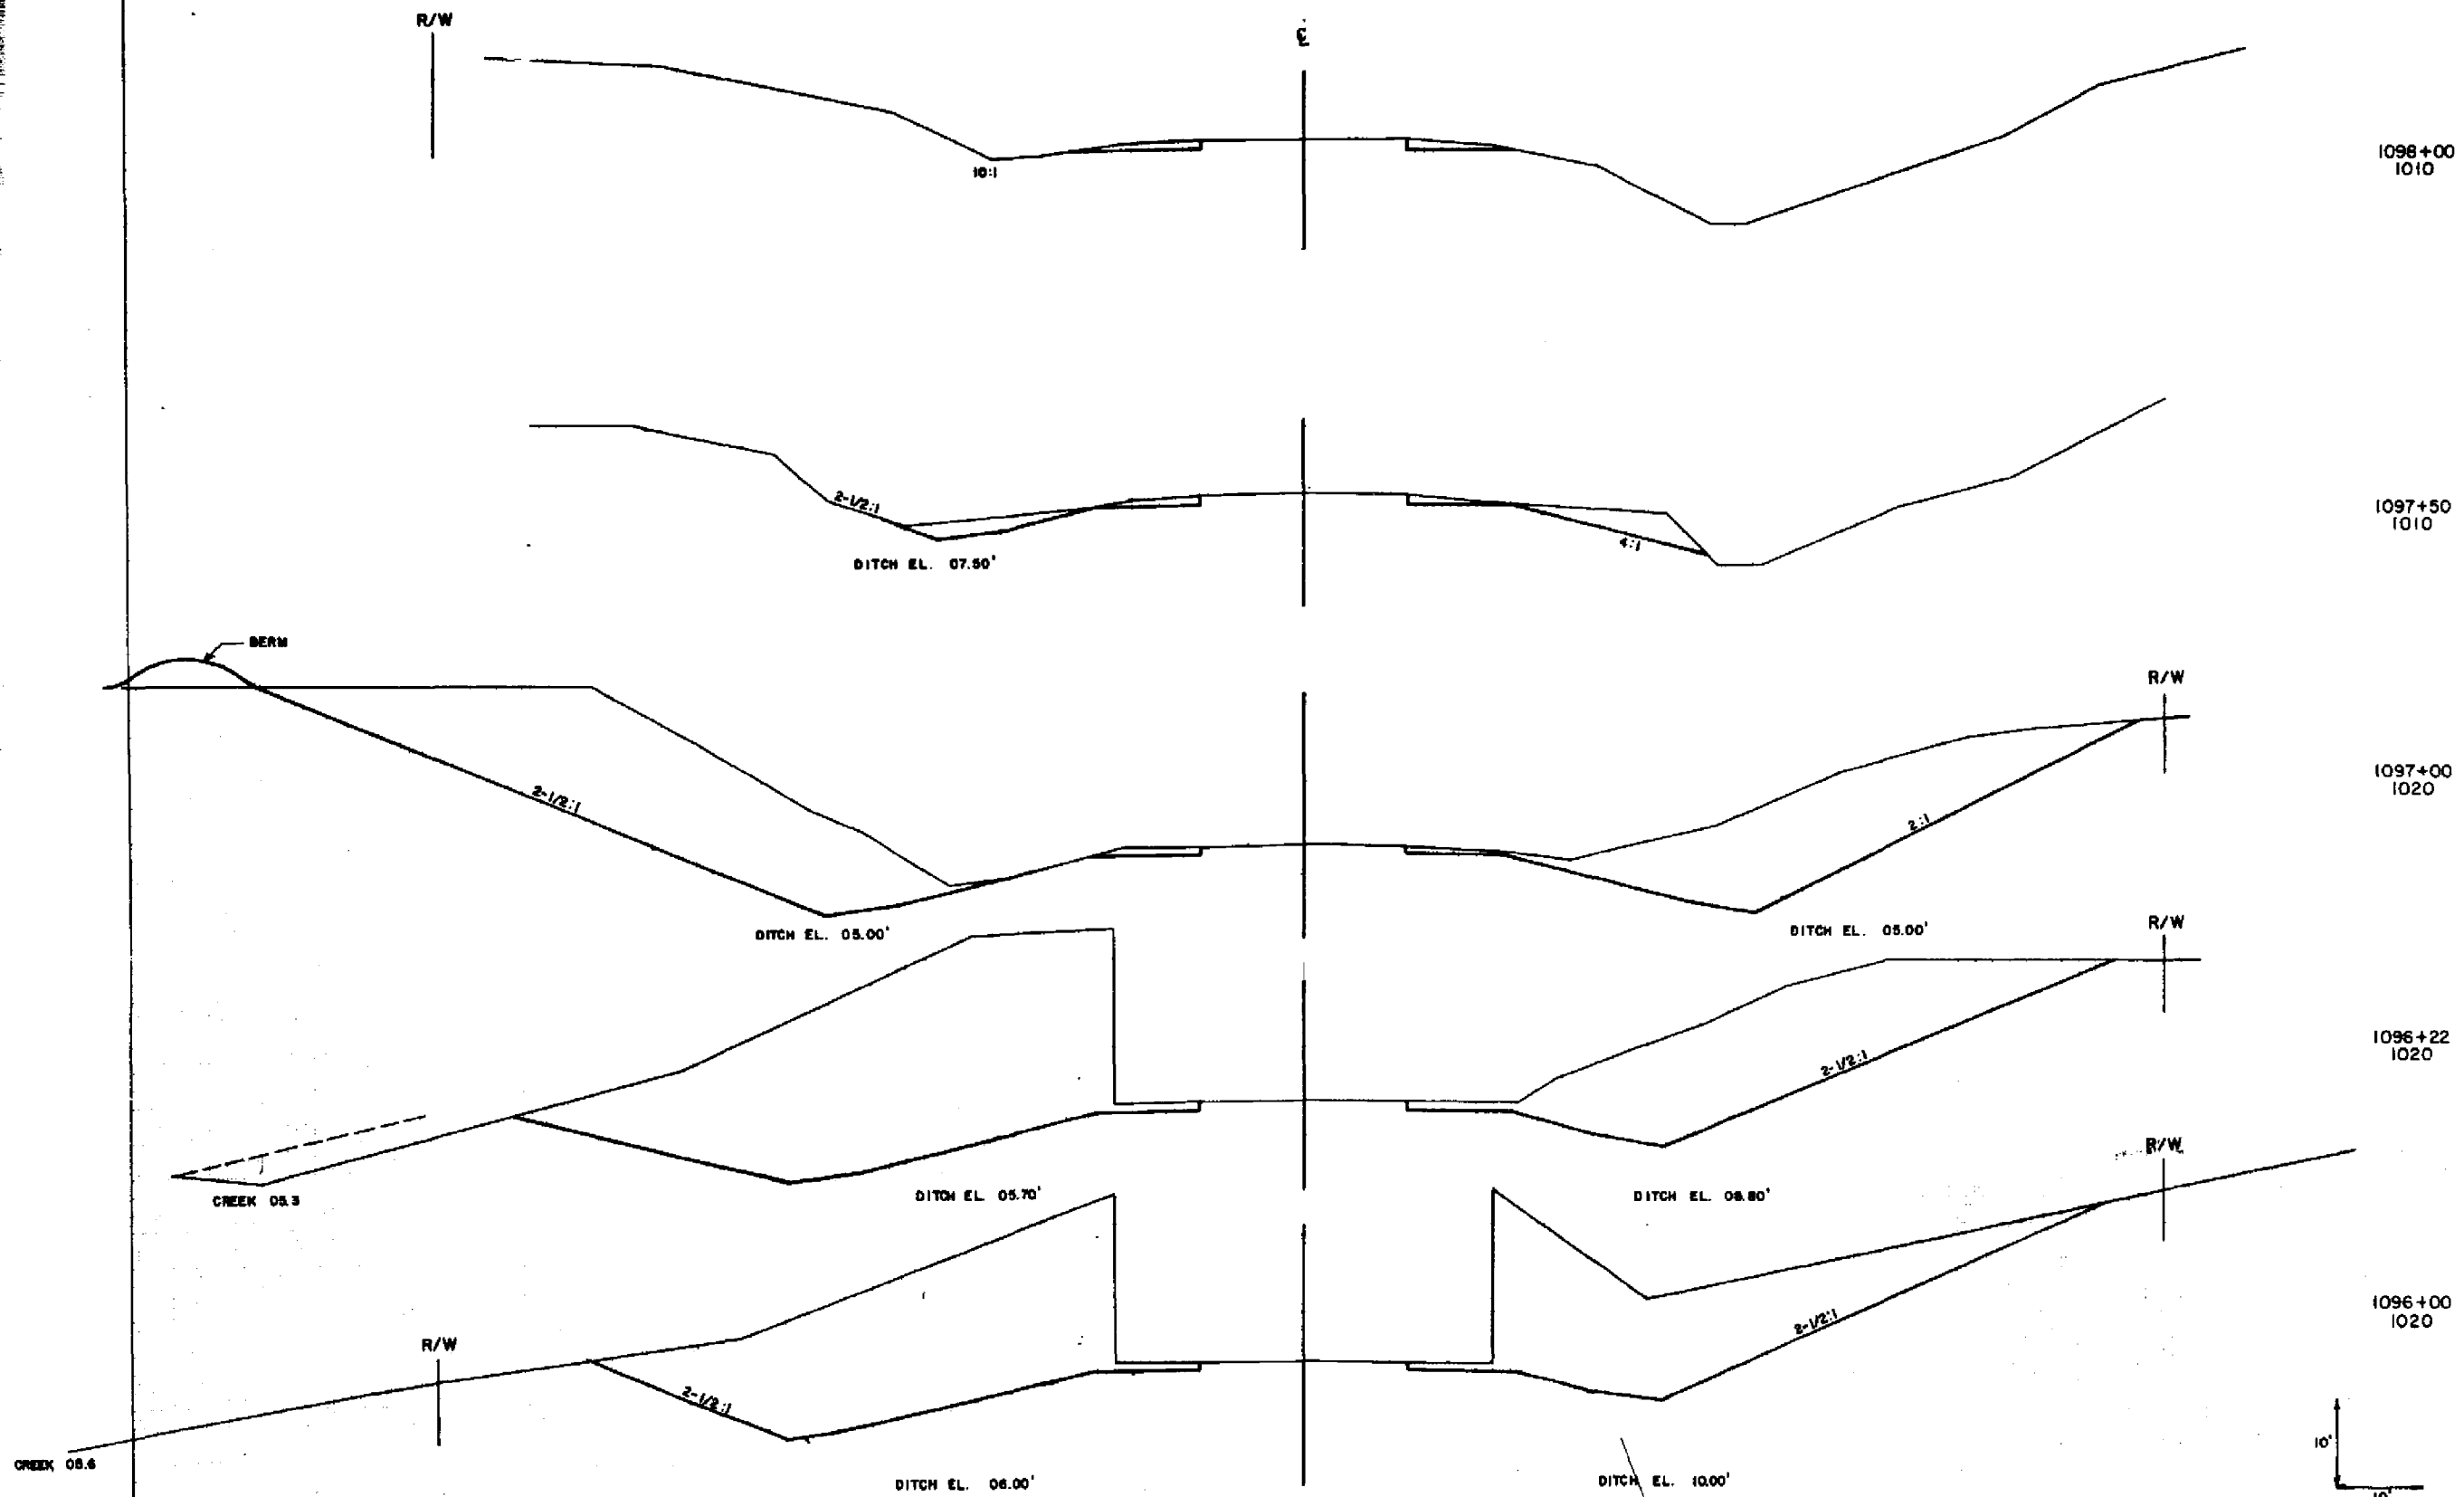

1098+00
1010

1097+50
1010

1097+00
1020

1096+22
1020

1096+00
1020

SHEET TOTAL

1

SWEET
THE MOTHER


9.4

9.4

1298+00
1010


+

91

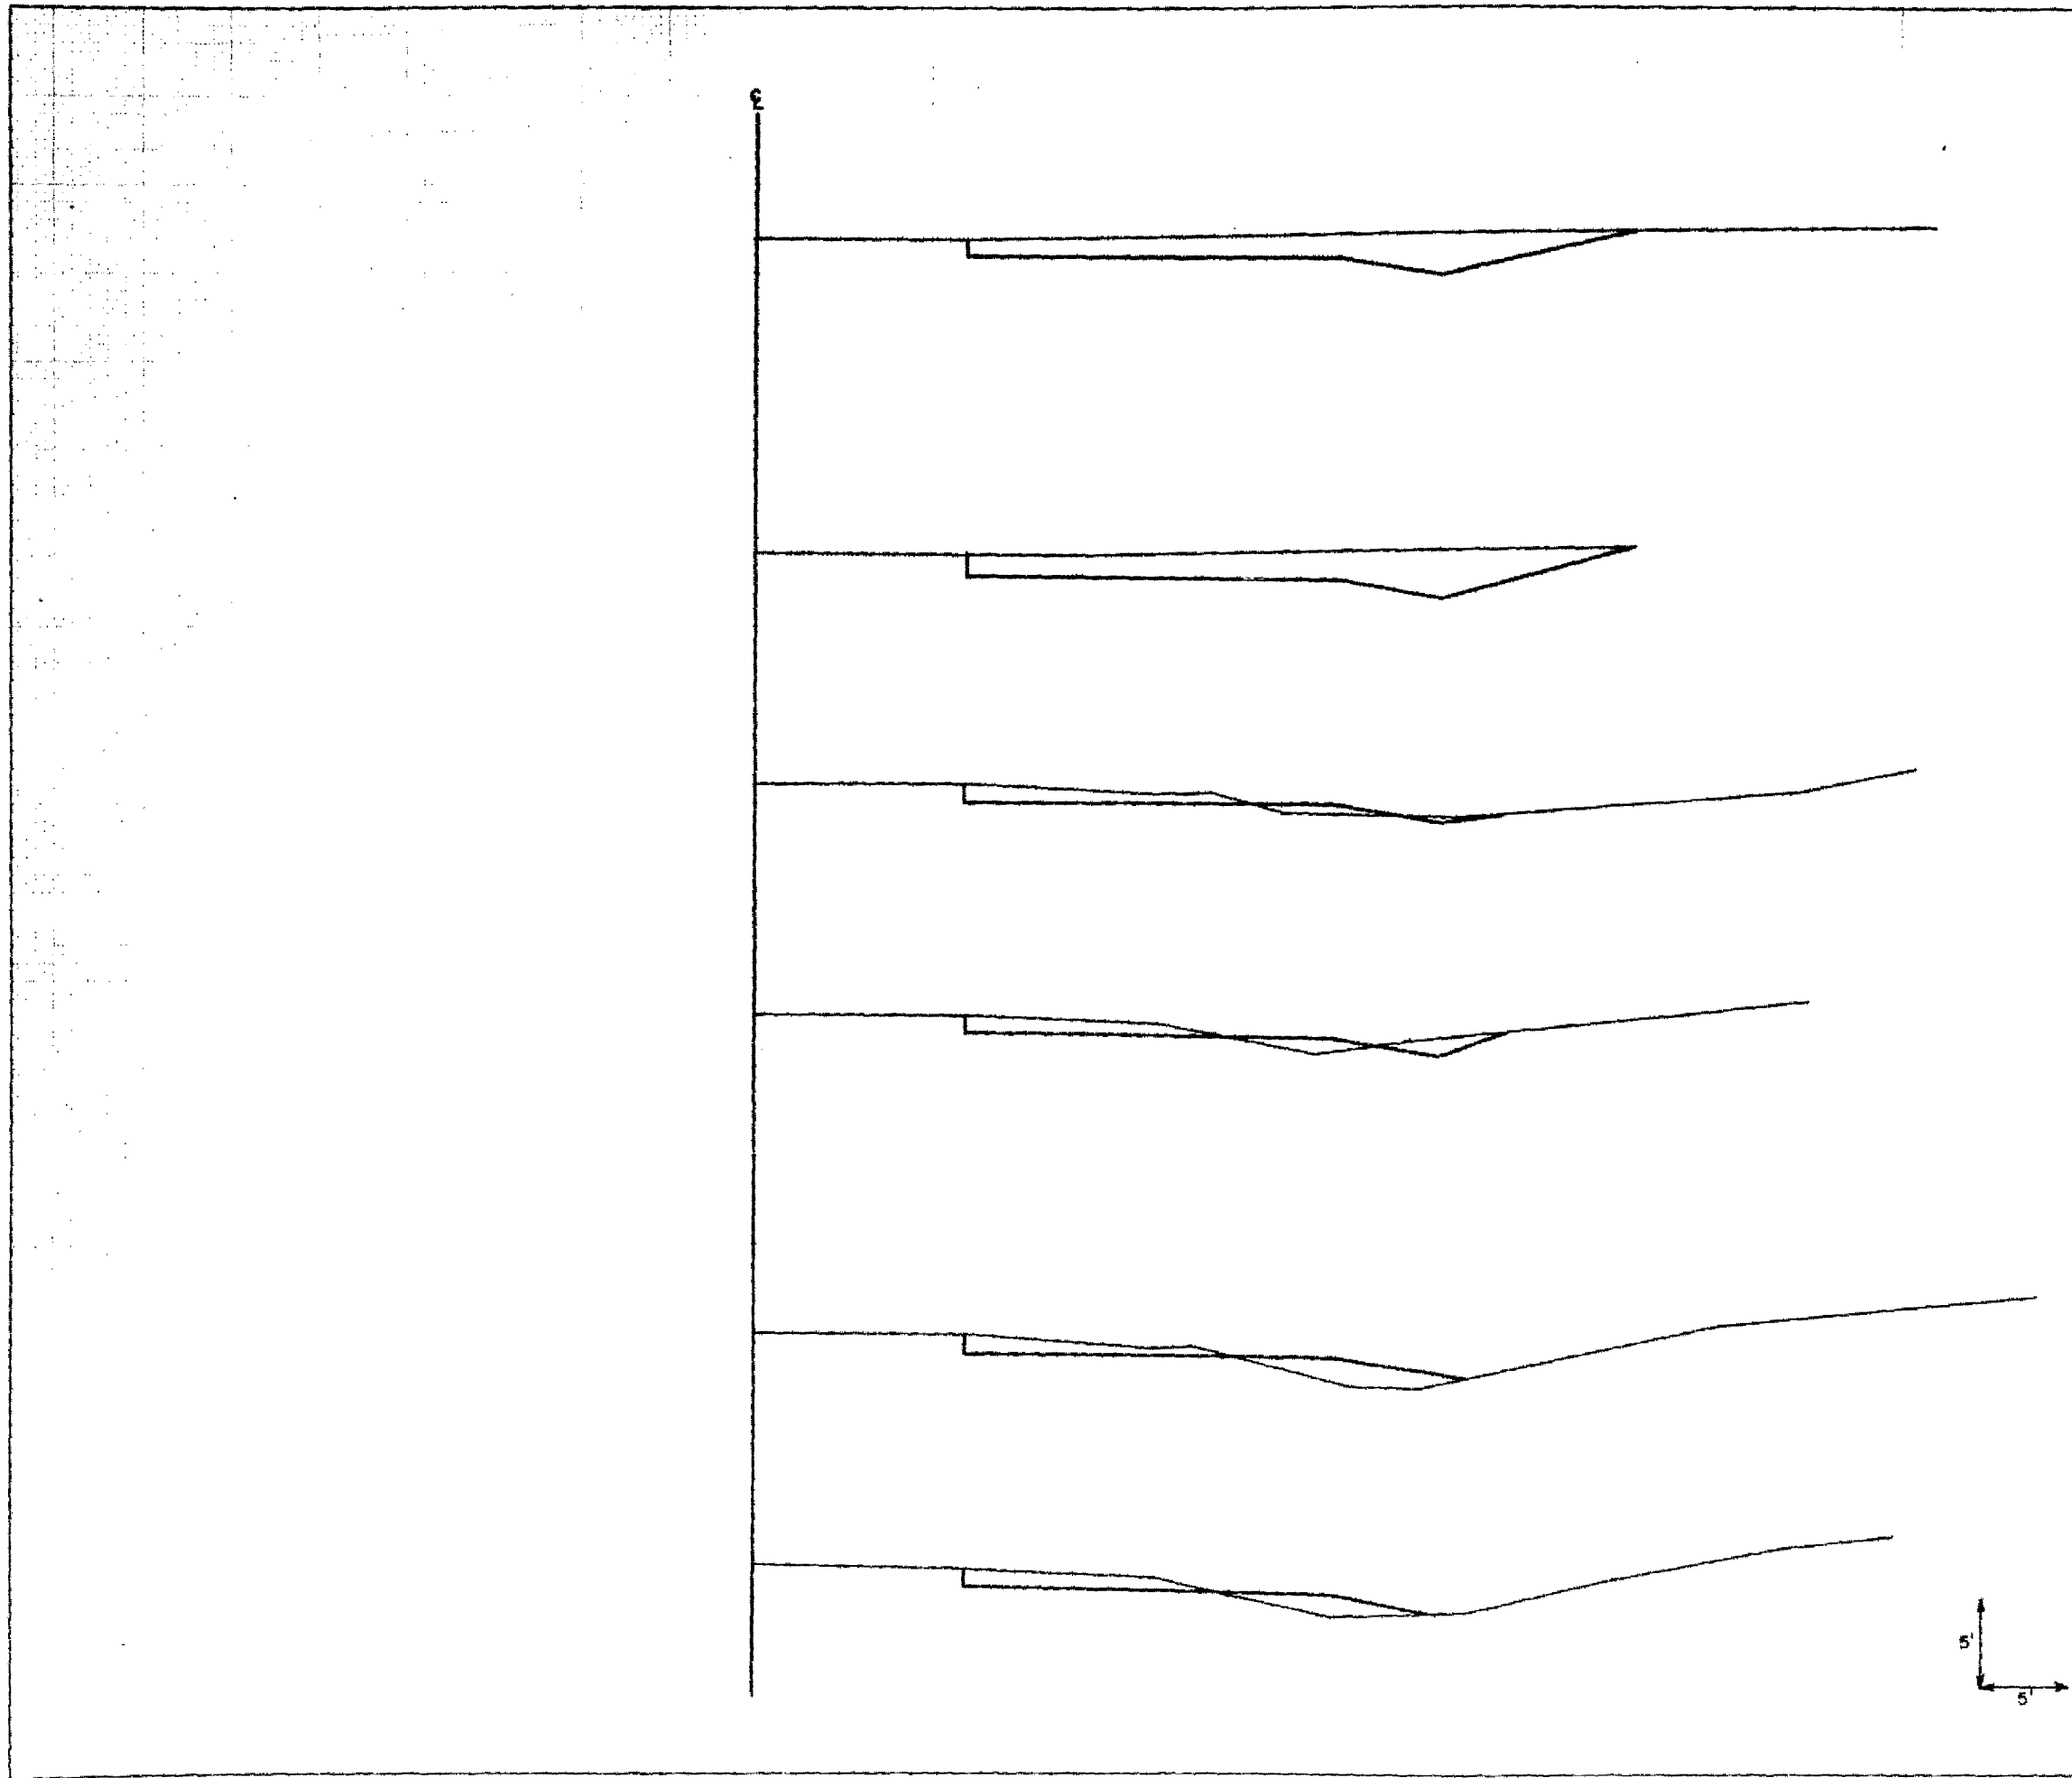

STATE PROJECT NUMBER				SHEET NUMBER
1180-03-71				9.5
STATION	DISTANCE	YARDAGE		
		EXCAVATION		FILL
		UNCL.		
1301		14		7
+50				
1302		25		24

STATE PROJECT NUMBER	SHEET NUMBER
1180-03-71	9.6

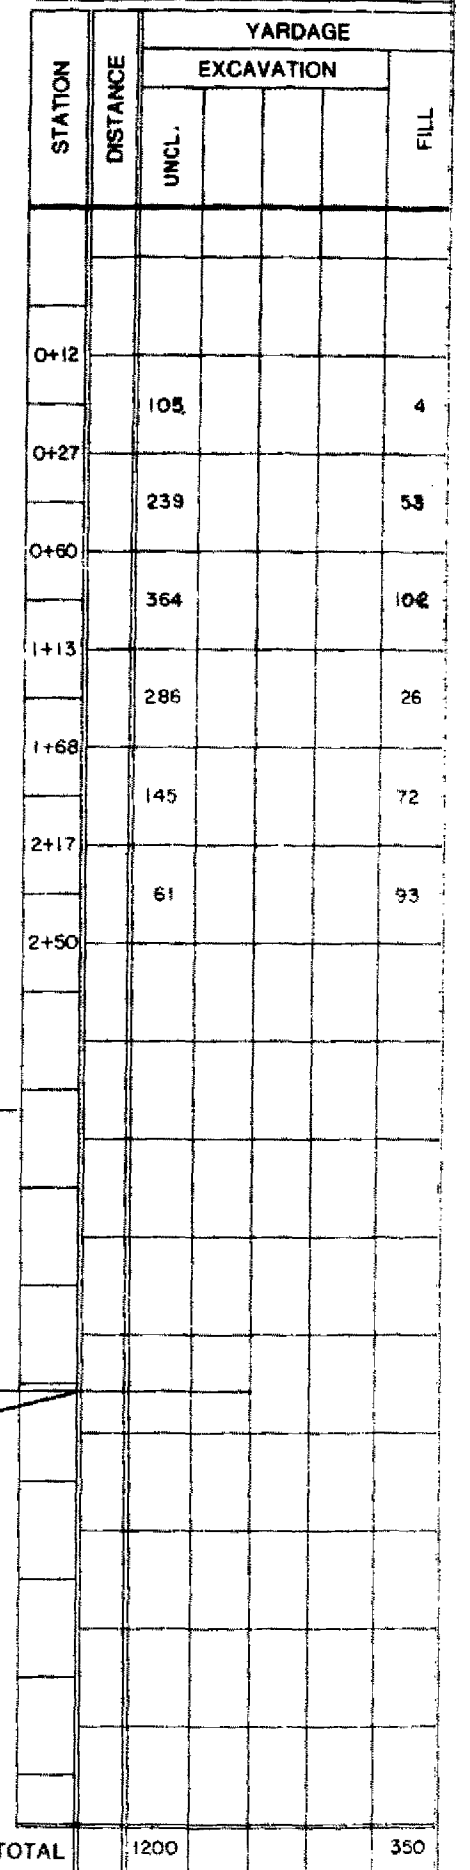


350

S.R. LT.
STA. 1488+00

STATE PROJECT NUMBER

1000-50-72

9.7

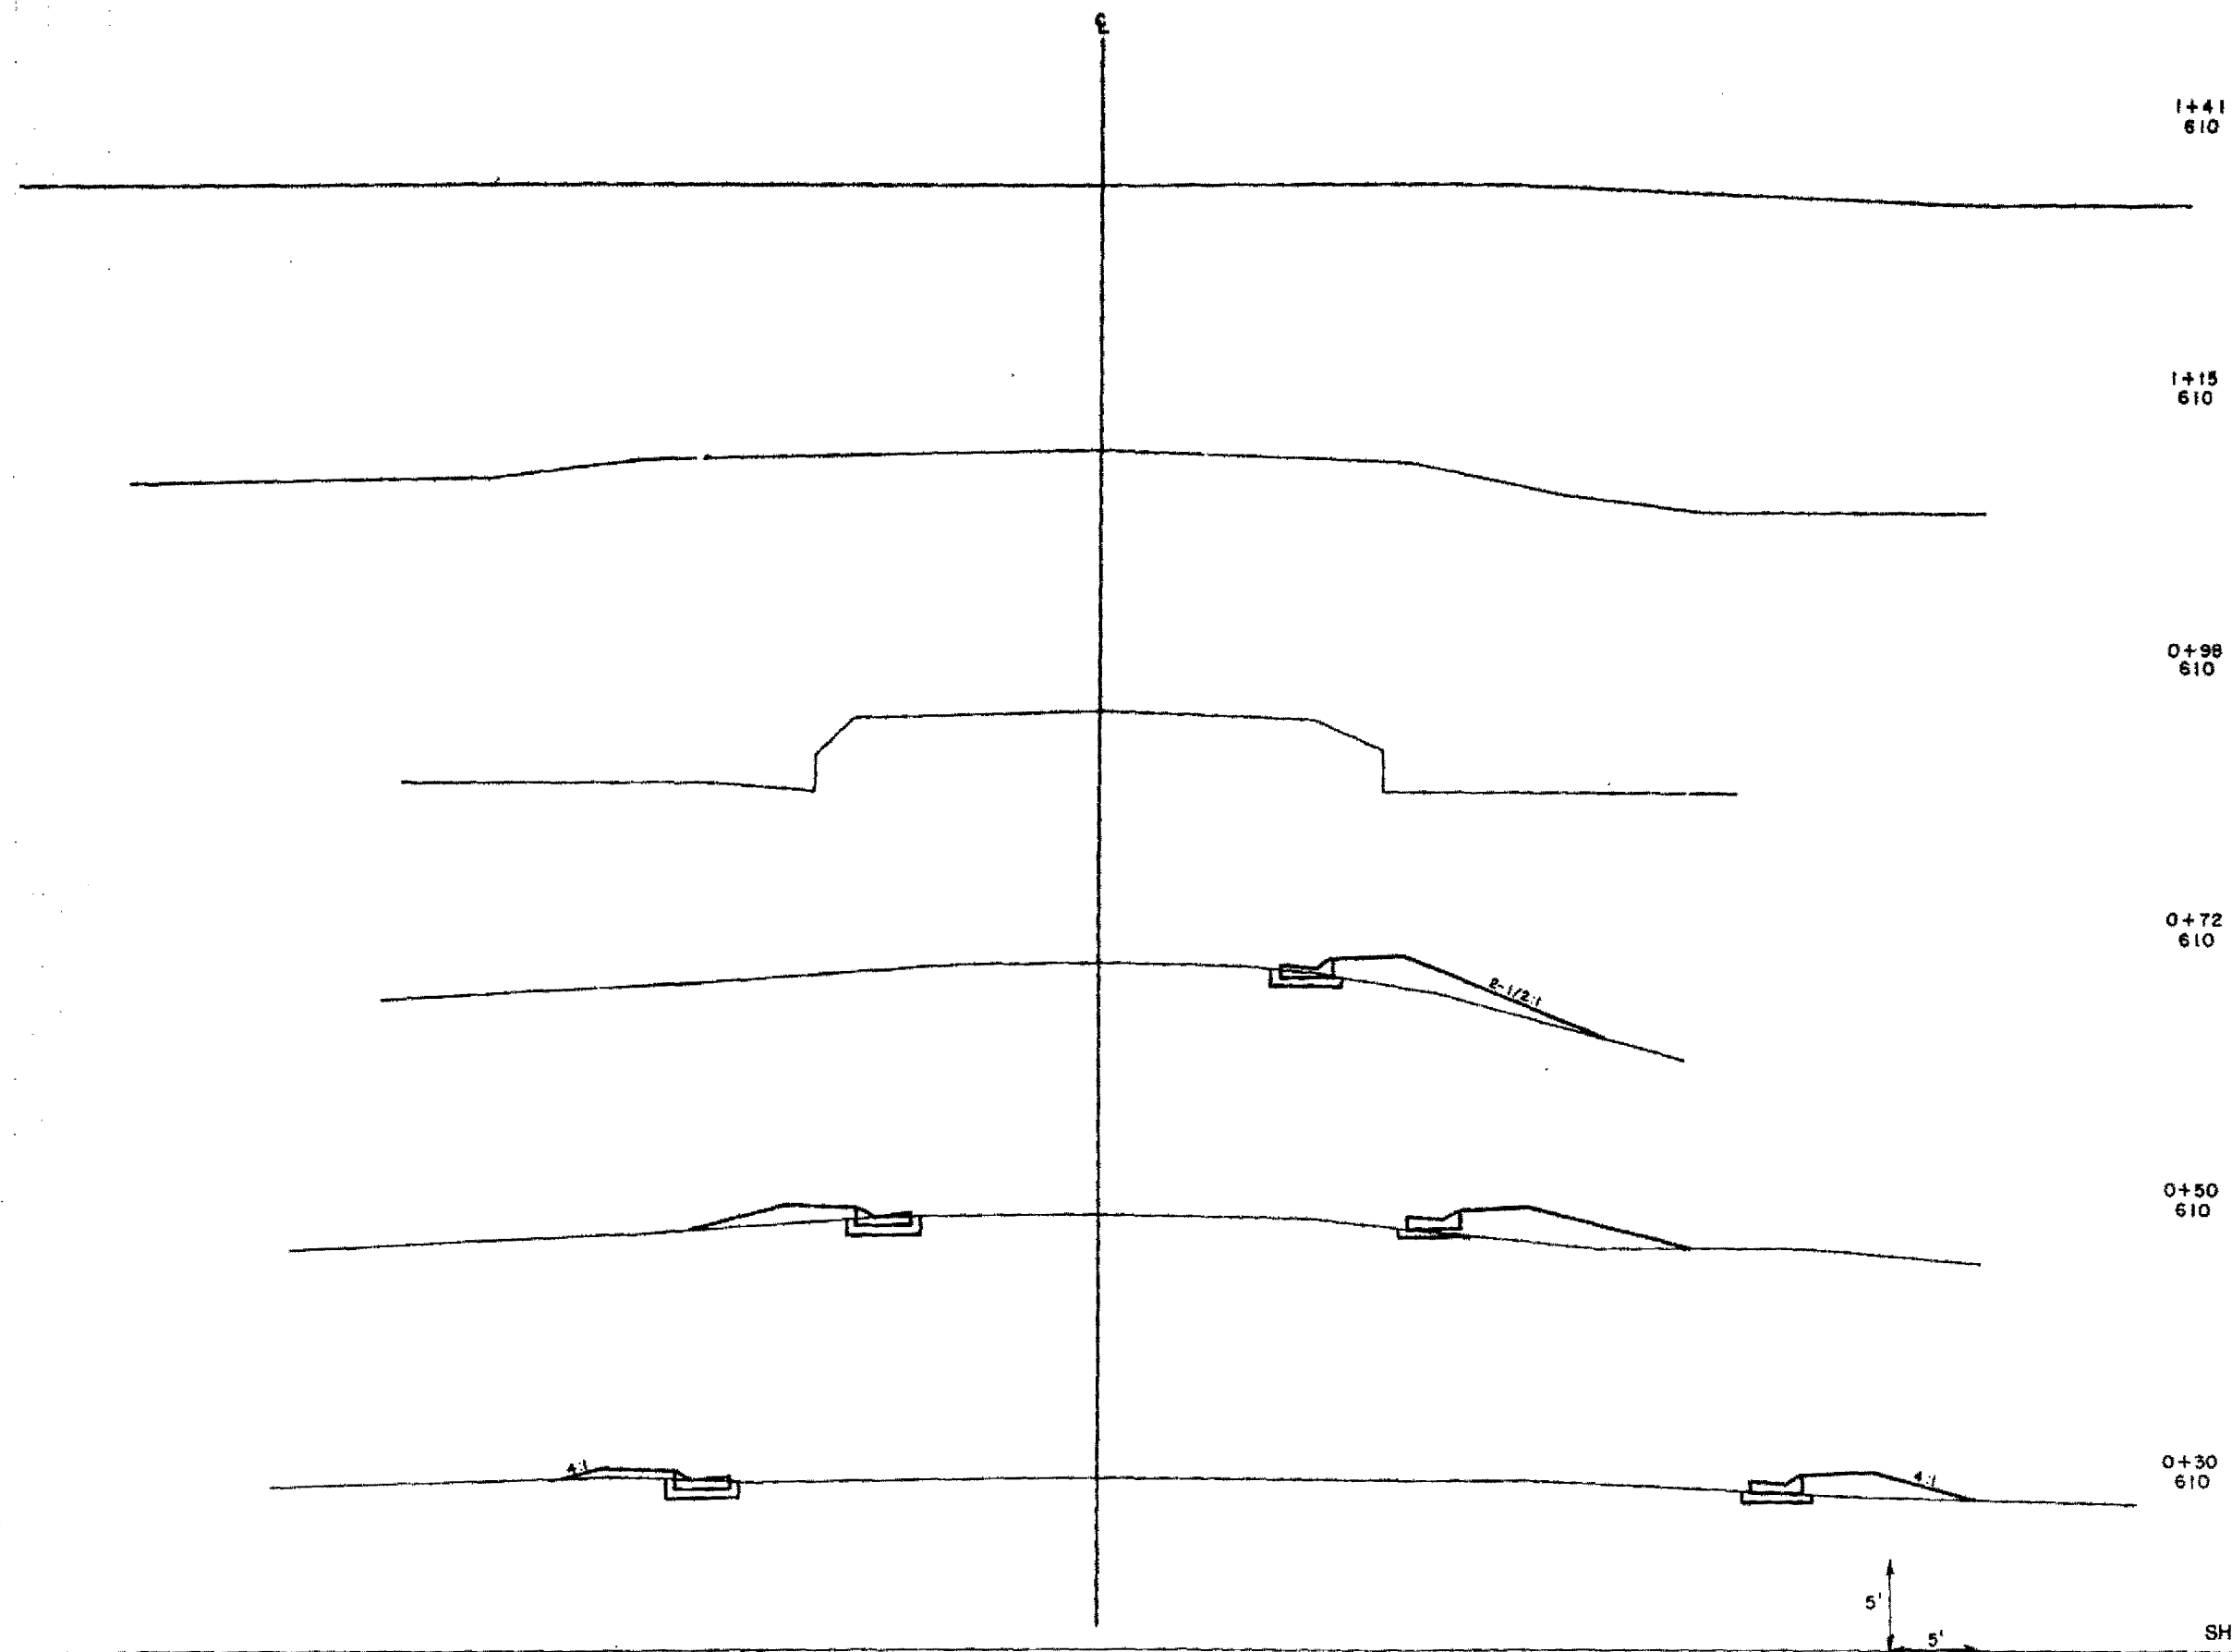

STATION	DISTANCE	YARDAGE			
		EXCAVATION			FILL
		UNCL.			
0 + 00		3			5
0 + 30		3			12
0 + 50		3			18
0 + 72		1			7
0 + 98		0			0
1 + 15		0			0
1 + 41					
TOTAL		10			42