

AS BUILT

Index of Sheets

Sheet No.	1	Title
Sheet No.	2 - 2.4	Typical Sections and Details
Sheet No.	3 - 3.1	Estimate of Quantities
Sheet No.	3A	Miscellaneous Quantities
Sheet No.	—	Right of Way Plat
Sheet No.	5 - 5.4	Plan and Profile
Sheet No.	6 - 6.5	Standard Detail Drawings
Sheet No.	—	Standard Sign Plates
Sheet No.	—	Structure Plans
Sheet No.	—	Computer Earthwork Data
Sheet No.	9 - 9.7	Cross Sections

TOTAL SHEETS = 28

STATE OF WISCONSIN
DEPARTMENT OF TRANSPORTATION

PLAN OF PROPOSED IMPROVEMENT

C.T.H. "E" - S.T.H. 13 ROAD HAZARD ELIMINATION, DISTRICT 8
(INO - ASHLAND JCT.) (U.S.H. 2 & S.T.H. 13 INTER.)

U.S.H. 2


U.S.H. 2

BAYFIELD COUNTY

BAYFIELD COUNTY

STATE PROJECT NUMBER
1180-3-71

STATE PROJECT NUMBER
1000-50-72

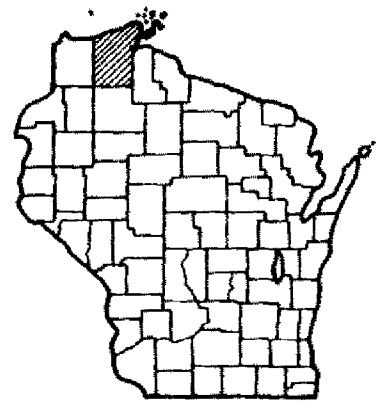


Design Designation


A.D.T. (1984)	= 4000
A.D.T. (2004)	= 6600
D.H.V.	= 976
D.	= 60-40
T.	= 10%
V.	= 55MPH.

Conventional Signs

County Line	=====	Caution Symbol (Combustible fluids under pressure)	
Township or Range Line	-----	Railroads	
Section Line	-----	Fence	
Corporate or City Limits	=====	Culverts in Place	
Property line	-----	Culverts Required	
Lot Line	-----	Power Pole	
Existing Right of Way Line	-----	Telephone or Telegraph Pole	
New Right of Way Line	-----	Right of Way Markers	
Base or Survey Line	-----	Marsh	
Slope Intercept	-----	Wooded Area	
Existing Roadway or Private Entrance	-----	Grade Elevation	

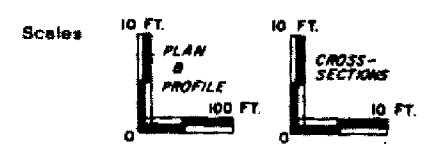


BEGIN PROJECT 1180-03-71
STA. 823 + 50
N. 499,800 (±200')
E. 1703,400 (±200')

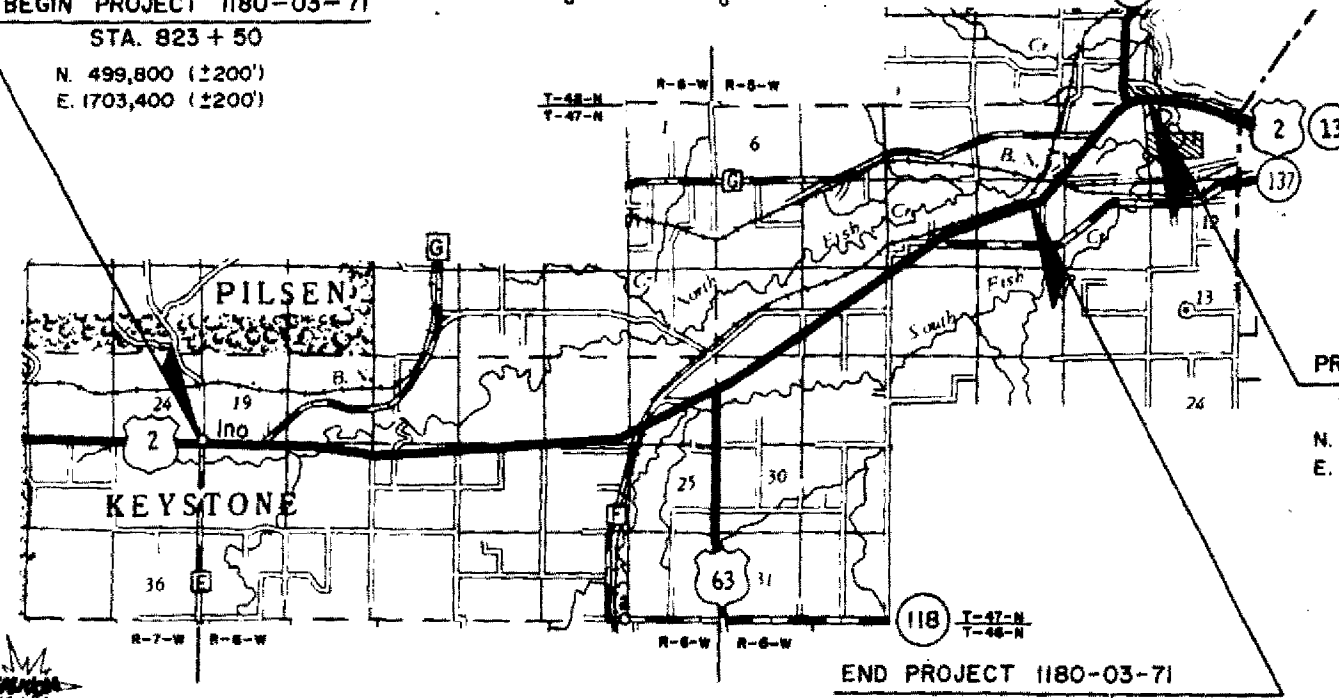

PROJECT 1000-50-72
STA. 1466 + 00
N. 520,000 (±200')
E. 1,761,300 (±200')

END PROJECT 1180-03-71
STA. 1366 + 88

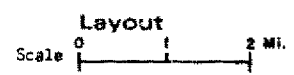

Total Net Length of Centerline = 10.291 Mi. RURAL

NOTE: COORDINATES SCALED FROM U.S.G.S. TOPOGRAPHIC MAPS, INO AND ASHLAND WEST, WISCONSIN, QUADRANGLES FOR IDENTIFICATION ONLY.

STATE OF WISCONSIN DEPARTMENT OF TRANSPORTATION	
Surveyor <u>R.L.</u>	District Checker <u>R.A.B.</u>
Designer <u>G.A.W.</u>	C. O. Checker <u>7/2/82</u>
District Supervisor <u>G.L.M.</u>	C. O. Coordinator <u>[Signature]</u>
Approved: _____ Date <u>9/22/82</u> <u>Donald H. Berglund</u> District Transportation Director	
Approved: _____ Date <u>11-5-82</u> <u>[Signature]</u> Chief Design Engineer	
Approved: _____ Date <u>11/5/82</u> <u>[Signature]</u> Director of Development	
U. S. DEPARTMENT OF TRANSPORTATION FEDERAL HIGHWAY ADMINISTRATION REGION 5 WISCONSIN DIVISION	
Approved: _____ Date _____ Division Administrator	