


TYPICAL SECTIONS


GENERAL NOTES

1. TOPSOIL SHALL BE PLACED AS SHOWN ON THE PLANS TO AN APPROXIMATE DEPTH OF 4-INCHES AT THE TIME OF PLACEMENT.
2. MULCH ALL TOPSOILED SLOPES STEEPER THAN 4:1.
3. ALL DISTURBED AREAS WITHIN THE RIGHT OF WAY, EXCLUSIVE OF THE ROADBED, SHALL BE SEEDED AND FERTILIZED.
4. ALL INTERSECTIONS SHALL BE TYPE "C" UNLESS OTHERWISE NOTED.
5. CUT AND FILL SLOPES SHALL BE ROUNDED 5 FEET BEYOND THE SLOPE INTERCEPT OR TO THE RIGHT OF WAY LIMITS WHICHEVER COMES FIRST.
6. UNDERCUTS SHALL ONLY BE MADE AT LOCATIONS APPROVED AND STAKED BY THE ENGINEER.
7. NO TREES ARE TO BE REMOVED WITHOUT APPROVAL OF THE ENGINEER.
8. SEED QUANTITIES ARE BASED ON SEED MIXTURE NO. 1.
9. AT SIDE ROADS WHERE BITUMINOUS SURFACE TAPERS DOWN TO MEET THE EXISTING PAVEMENT, THE CONTRACTOR SHALL LAY A TACK COAT IN THE LAST 20 FEET OF THE TAPERS TO HOLD THE MAT IN PLACE, THE COST OF THE TACK COAT SHALL BE INCIDENTAL TO RECYCLED BITUMINOUS SURFACE.
10. UNLESS OTHERWISE SHOWN IN THE PLAN, SIDEROADS SHALL BE PAVED WITH 2" RECYCLED BITUMINOUS SURFACE TO THE BACK RADIUS POINT.
11. THE LOCATION OF EXISTING AND PROPOSED UTILITY INSTALLATIONS AS SHOWN ON THE PLANS ARE APPROXIMATE. THERE MAY BE OTHER UTILITY INSTALLATIONS WITHIN THE PROJECT AREA THAT ARE NOT SHOWN.
12. WHEN THE QUANTITY OF THE ITEMS OF BASE OR SURFACE COURSE IS MEASURED FOR PAYMENT BY THE TON, THE DEPTH OR THICKNESS OF THE COURSE SHOWN ON THE PLANS IS APPROXIMATE AND ACTUAL THICKNESS WILL DEPEND ON THE DISTRIBUTION OF THE MATERIAL AS DIRECTED BY THE ENGINEER.
13. THE REMOVAL OF PIPE CULVERTS SHALL BE INCIDENTAL TO THE ITEM OF BASE PATCHING, CULVERTS.


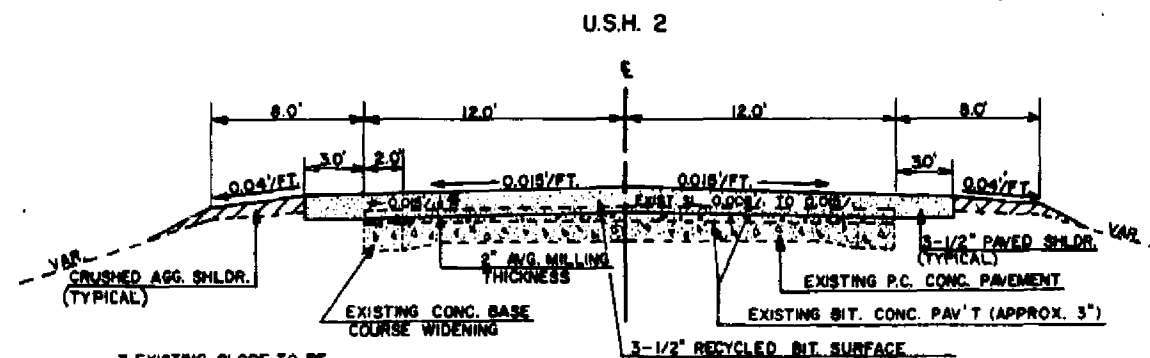


TYPICAL FINISHED TANGENT SECTION


USE AT STA. 823+50 - 826+00
 826+00 - 828+00 **
 828+00 - 830+00 **
 830+00 - 832+00 **
 1822+00 - 1824+00 **
 1824+00 - 1

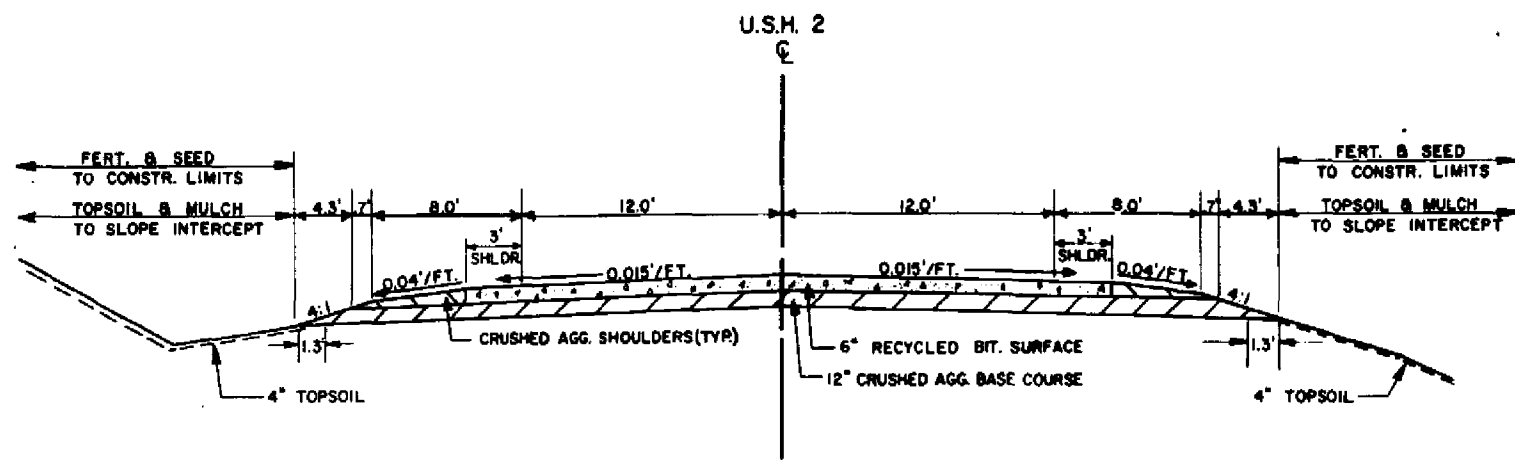


TYPICAL FINISHED SECTION
 USE AT STA. 892+00 TO 894+00
 886+20 TO 887+70

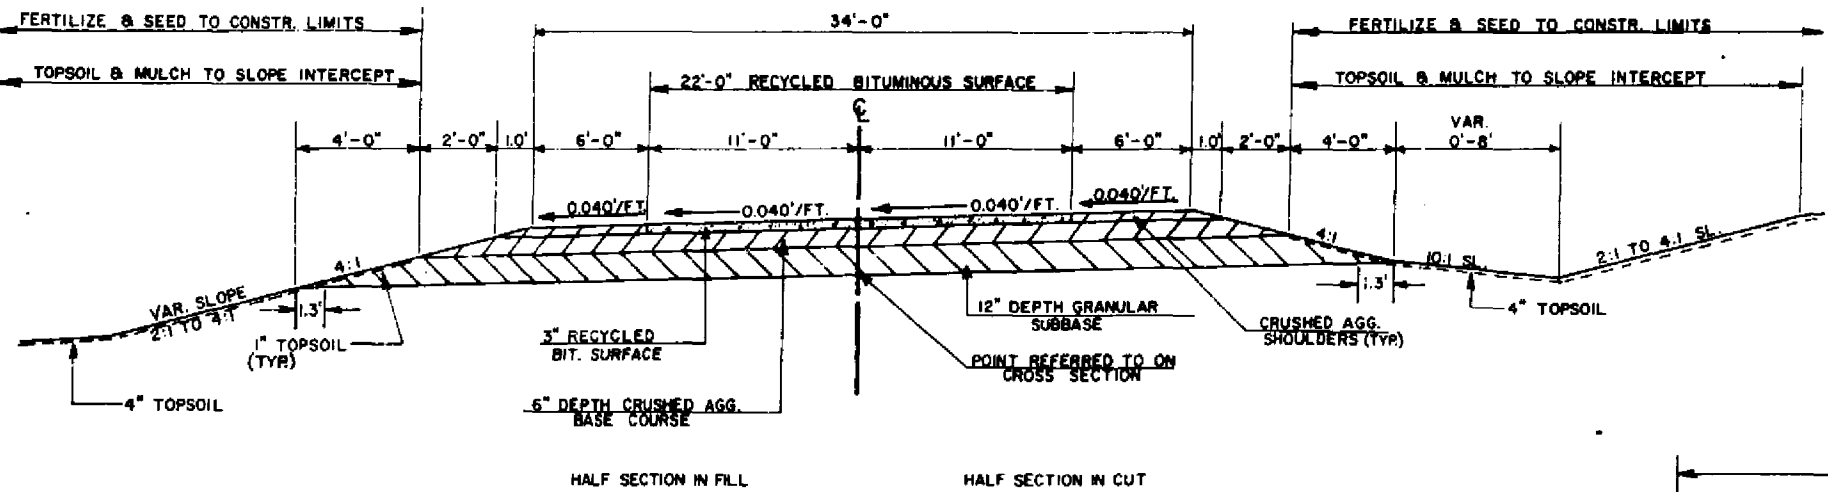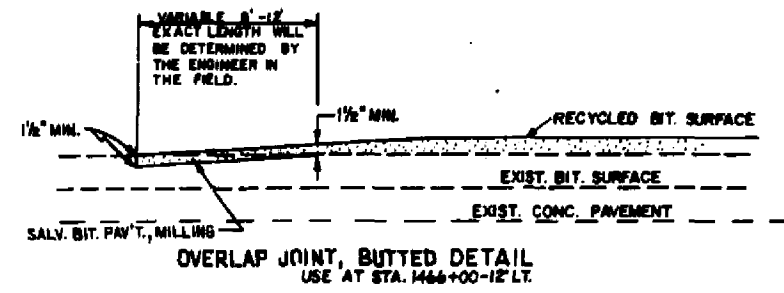


TYPICAL FOR SUPERELEVATED SECTION
 USE: S.T.H. "137" STA. 1304 + 08 RT.
 C.T.H. "6" STA. 863 + 53 LT.

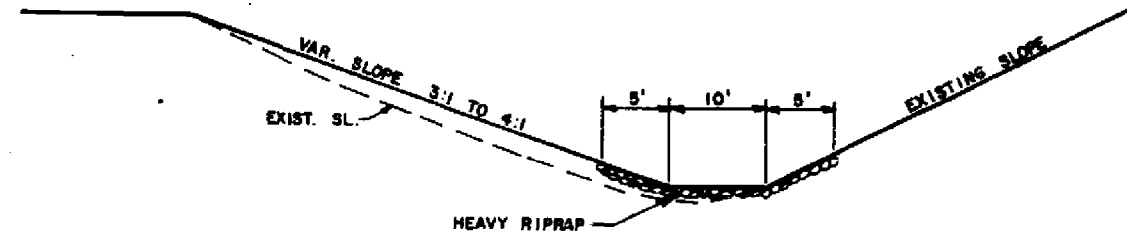


SLOPE CORRECTION AND DITCH TREATMENT
 USE AT STATION 1119+20 - 1121+77

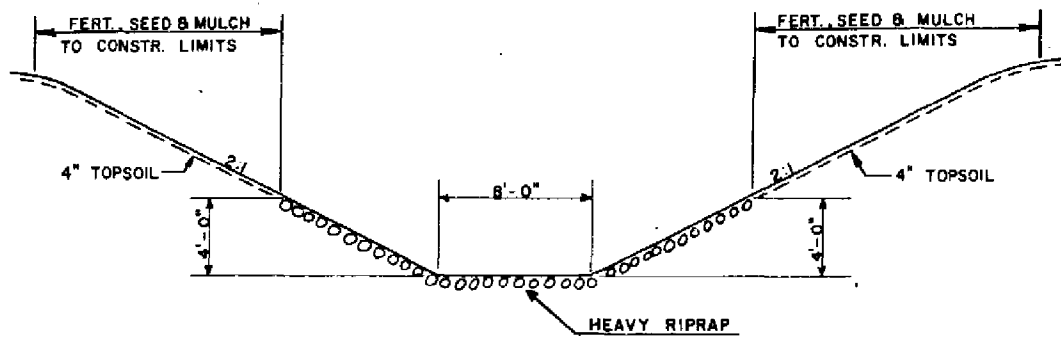


DRAINAGE DITCH
 USE STA. 1096 + 20 LT. TO 1097 + 0 LT.

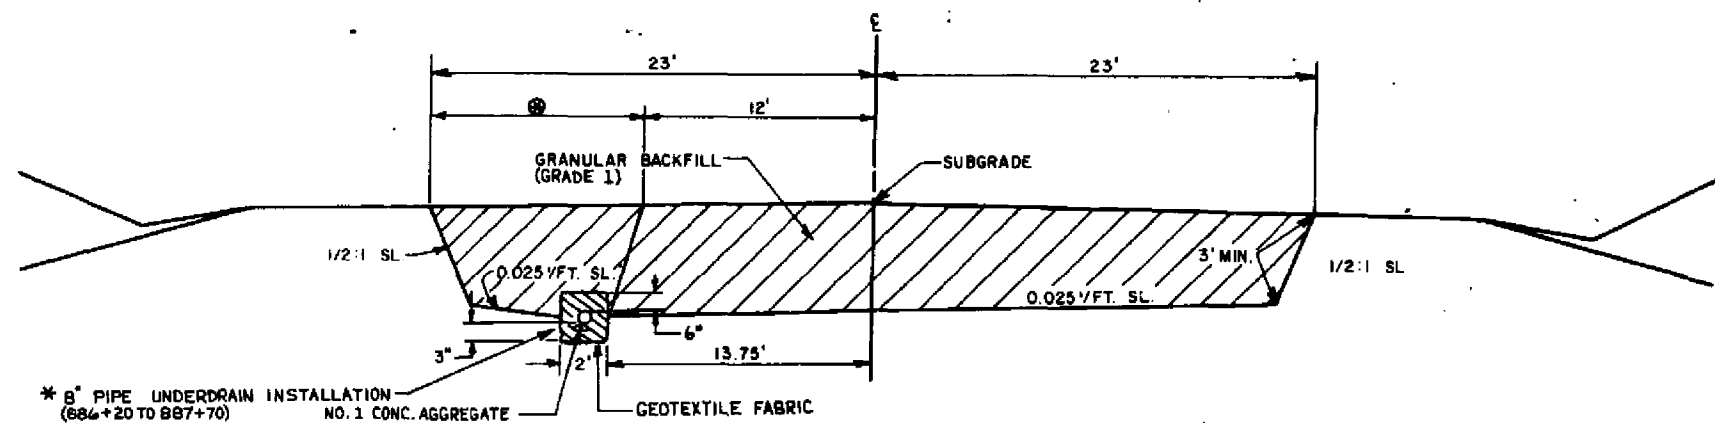


UNDERCUT SECTION WITH UNDERDRAINS
 FULL WIDTH - STA. 886+20 TO STA. 887+70
 LEFT ONLY - STA. 892+00 TO STA. 894+00
 892+17 - 893+82

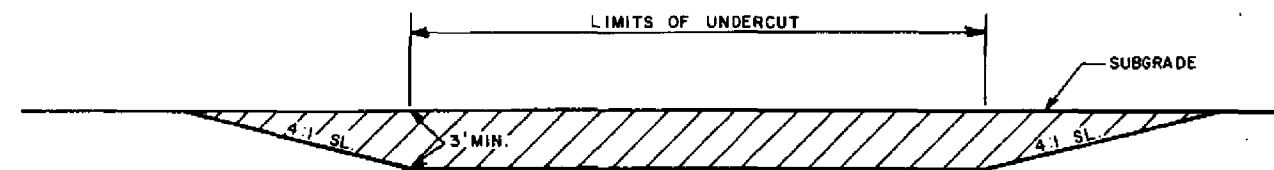


LONGITUDINAL SECTION FOR UNDERCUTS
 USE AT STA. 886+20 - 887+70
 892+00 - 894+00 (LEFT ONLY)

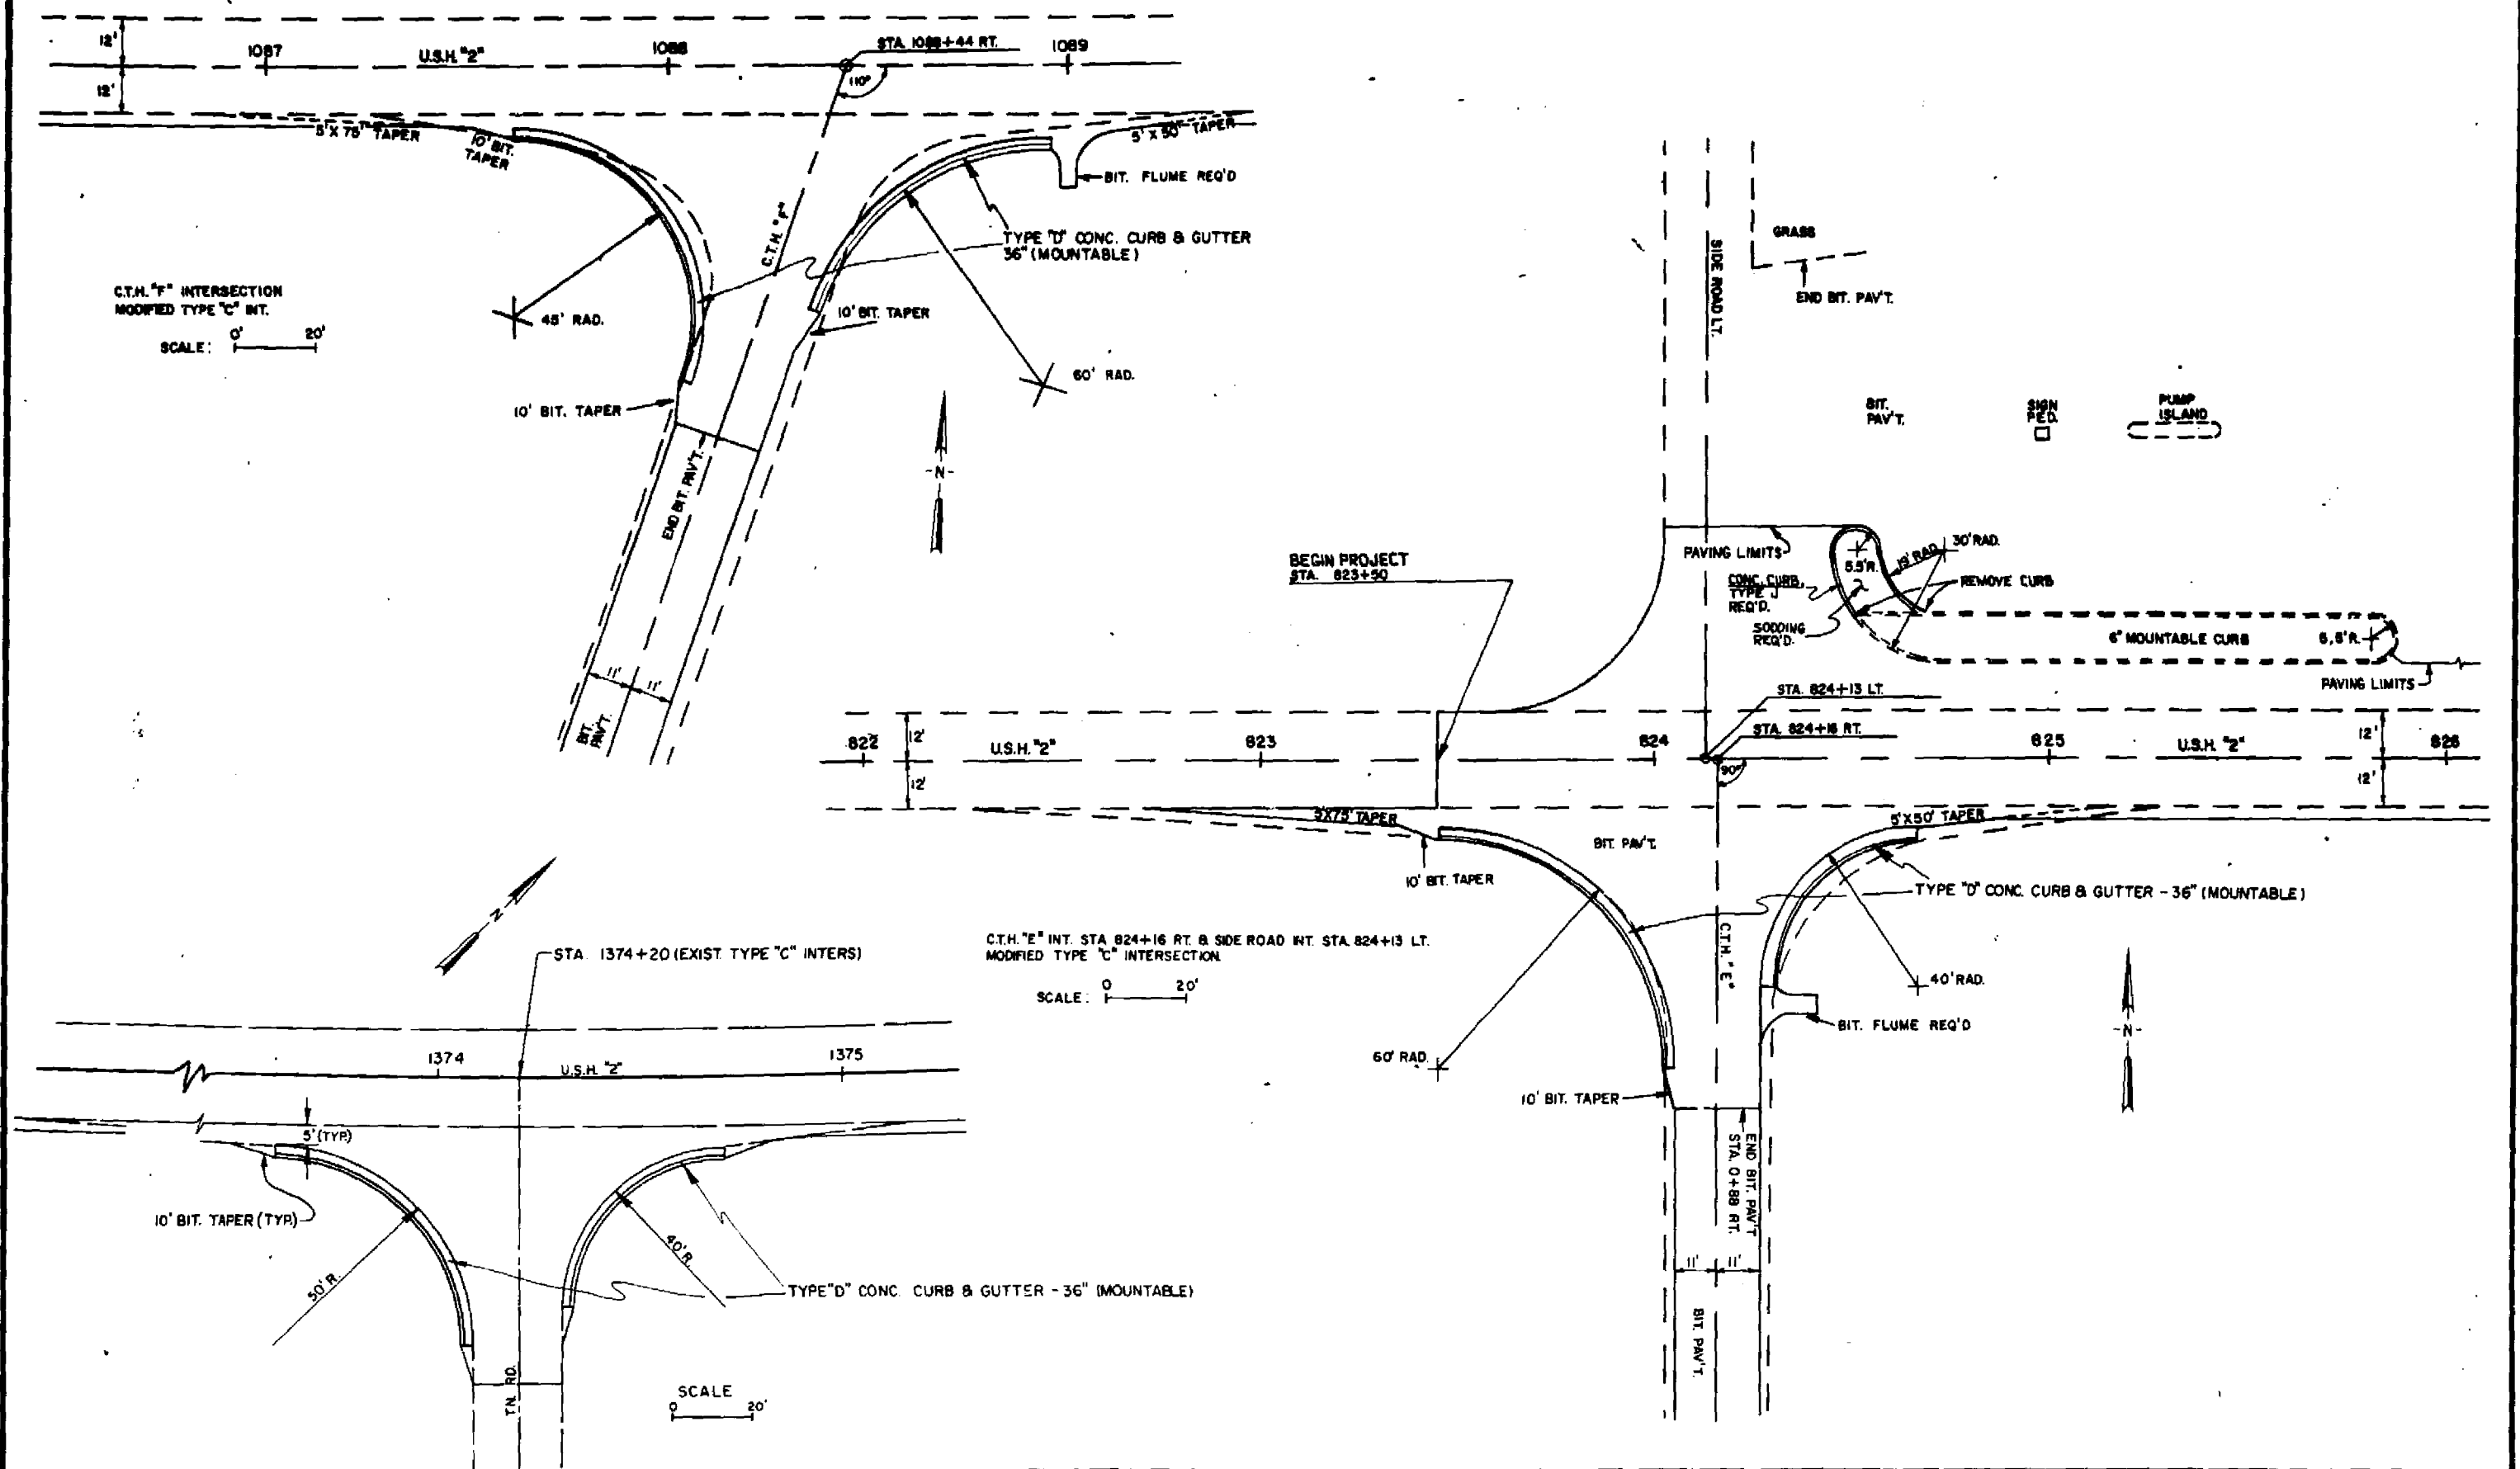

INTERSECTION DETAILS

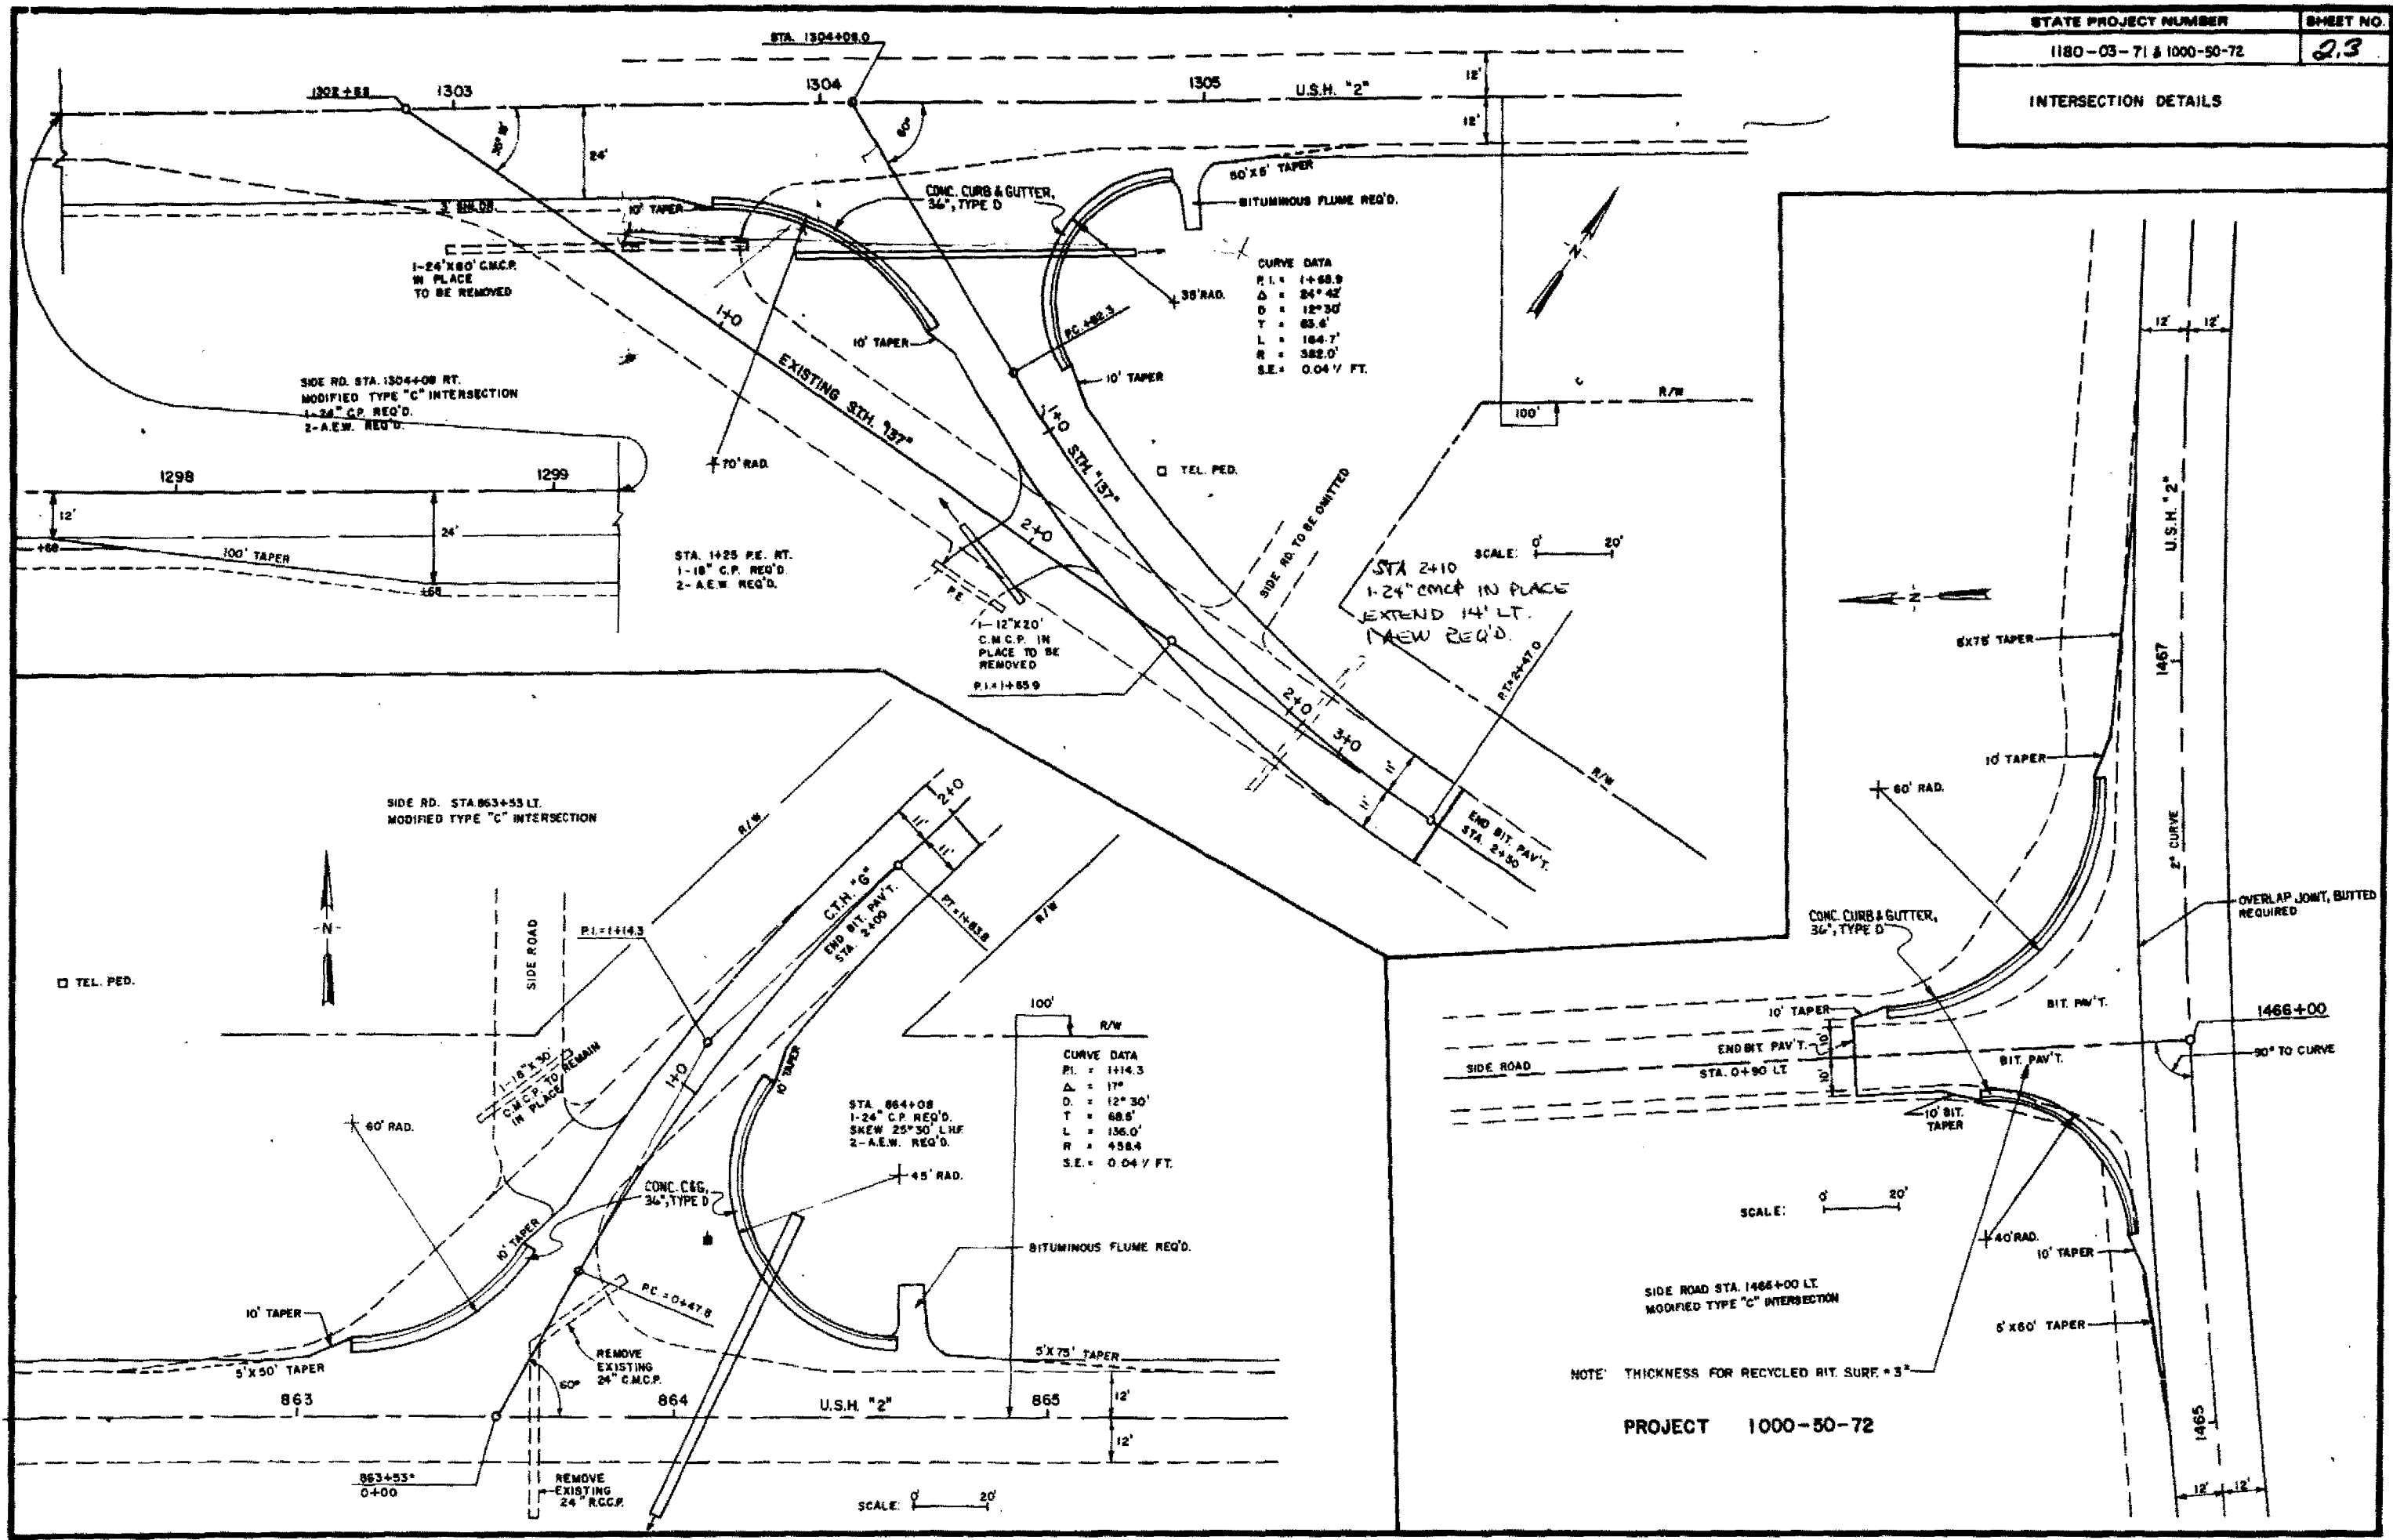


STATE PROJECT NUMBER	SHEET NO.
1180-05-71 & 1000-50-72	2.4
TRAFFIC CONTROL	

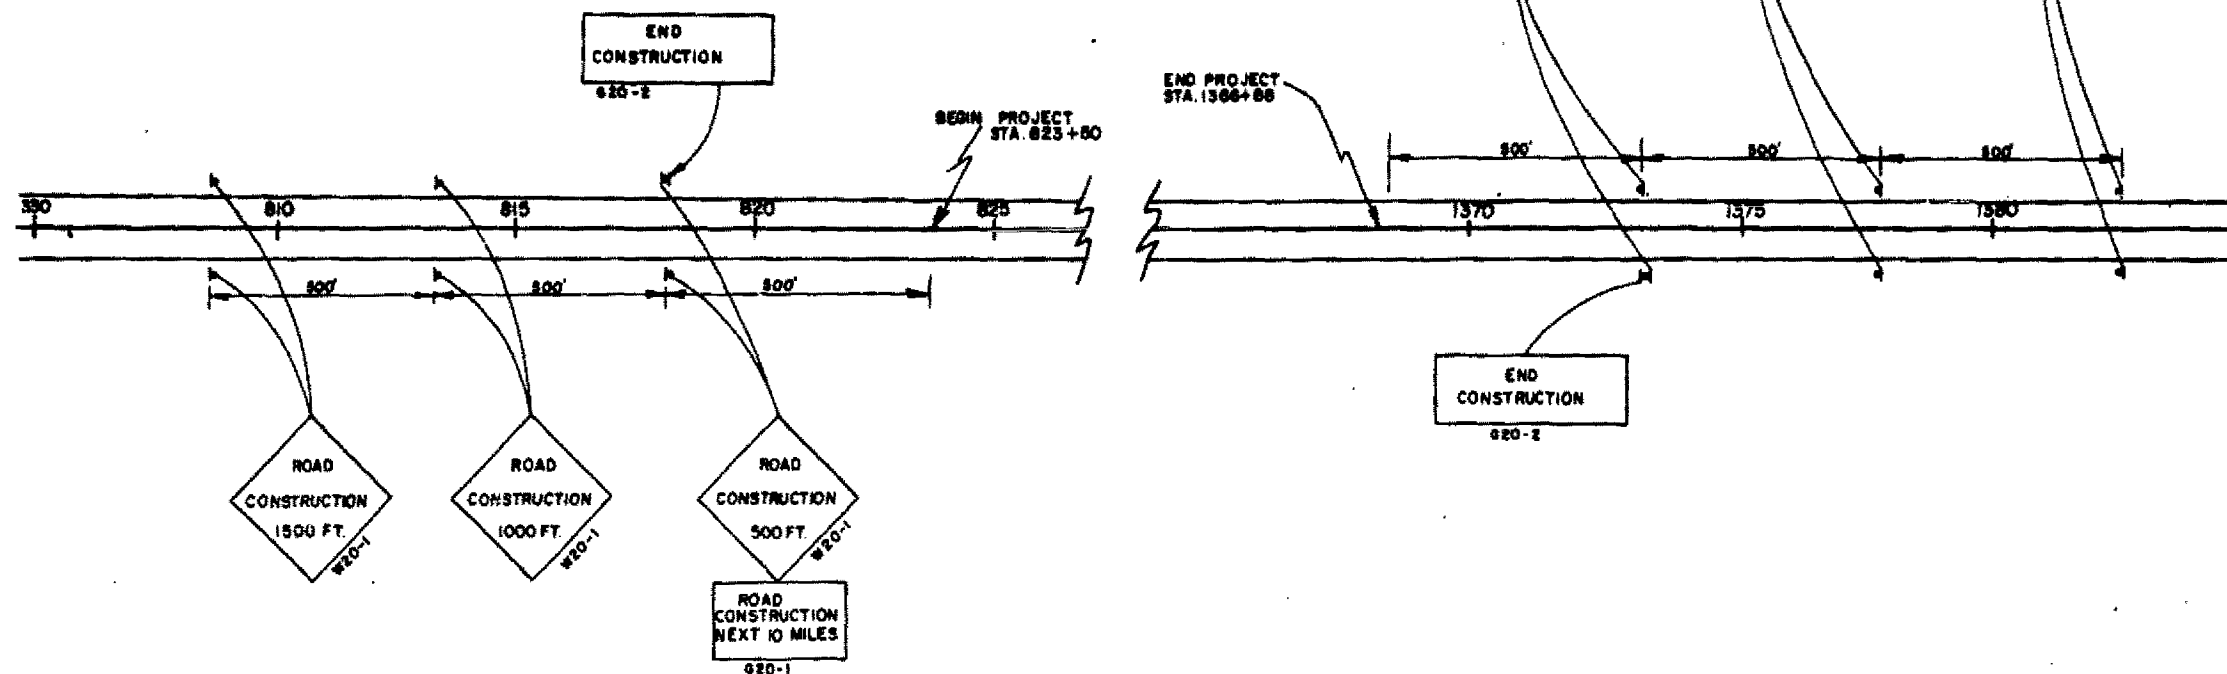

SIGN NUMBER	SIZE
W20-1	48"X48"
W20-4	48"X48"
W20-7A	48"X48"
W08-9	36"X36"
G20-1	60"X36"
G20-2	60"X24"
W013-1	24"X24"

**DETAIL OF TRAFFIC CONTROL FOR MOVING WORK AREAS
AND HAZARD ELIMINATION STA. 1486+00**

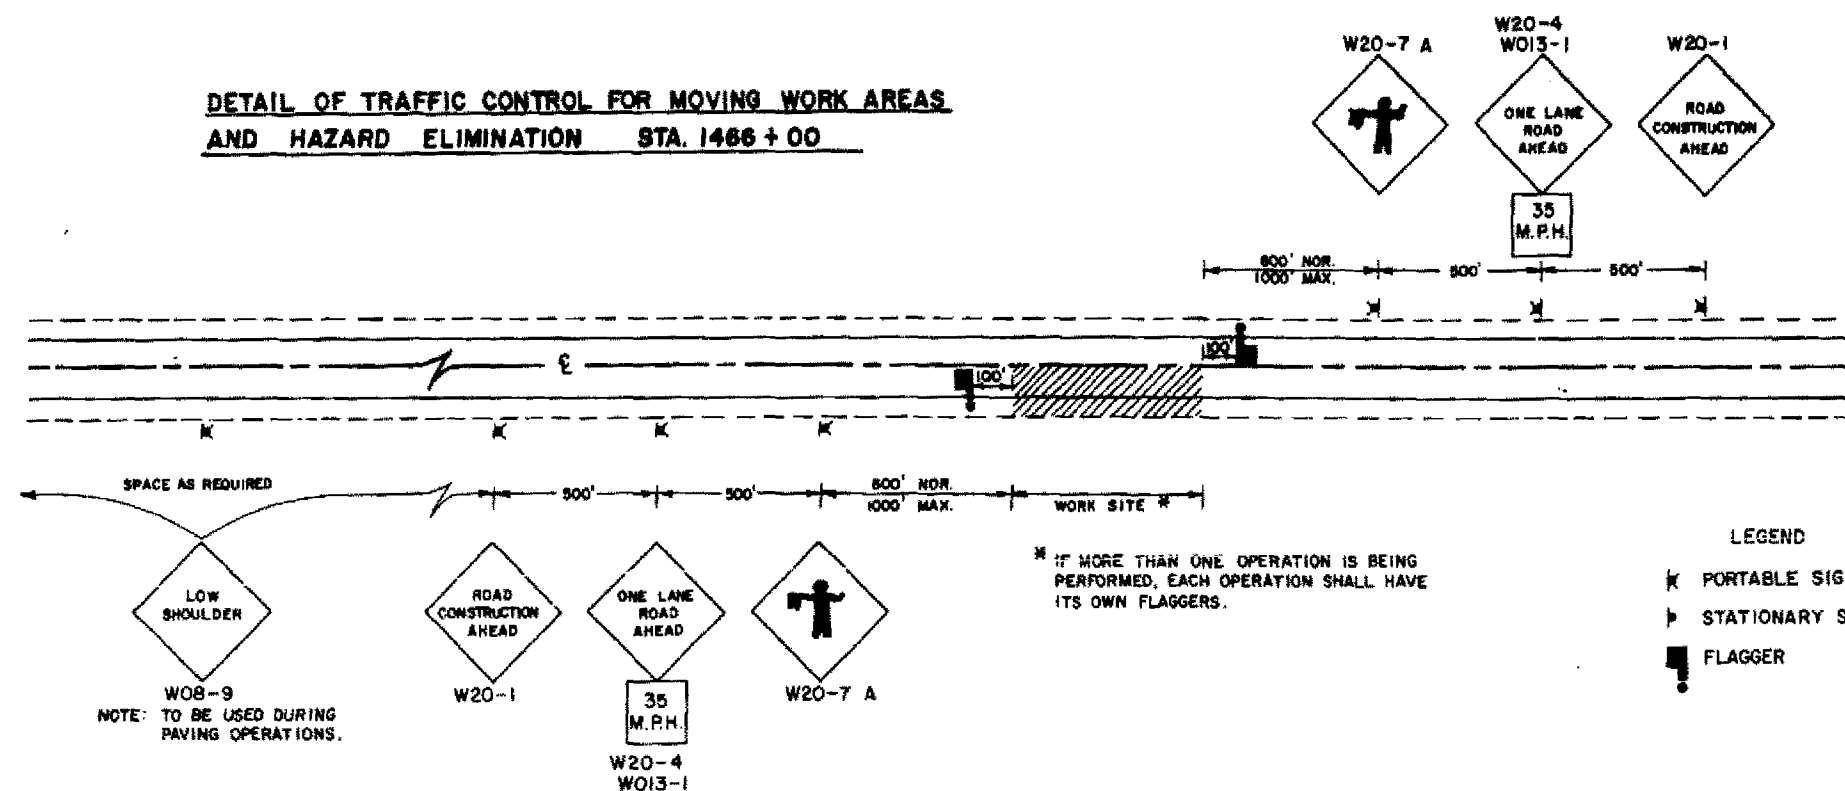

NOTE: SIGN LAYOUTS SHALL BE IN ACCORDANCE WITH THE FEDERAL HIGHWAY ADMINISTRATION MANUAL OF STANDARD HIGHWAY SIGNS UNLESS OTHERWISE NOTED.

"W0" SIGNS ARE THE SAME AS "W" EXCEPT BACKGROUND IS ORANGE.

ALL ITEMS ON THIS SHEET TO BE PAID FOR UNDER THE ITEM "TRAFFIC CONTROL".