


FILE NAME: PROJECTS DB 11801700.DGN CTHF OVERLIDGN
LEVELS ON = 1, 2, 3, 62, 63

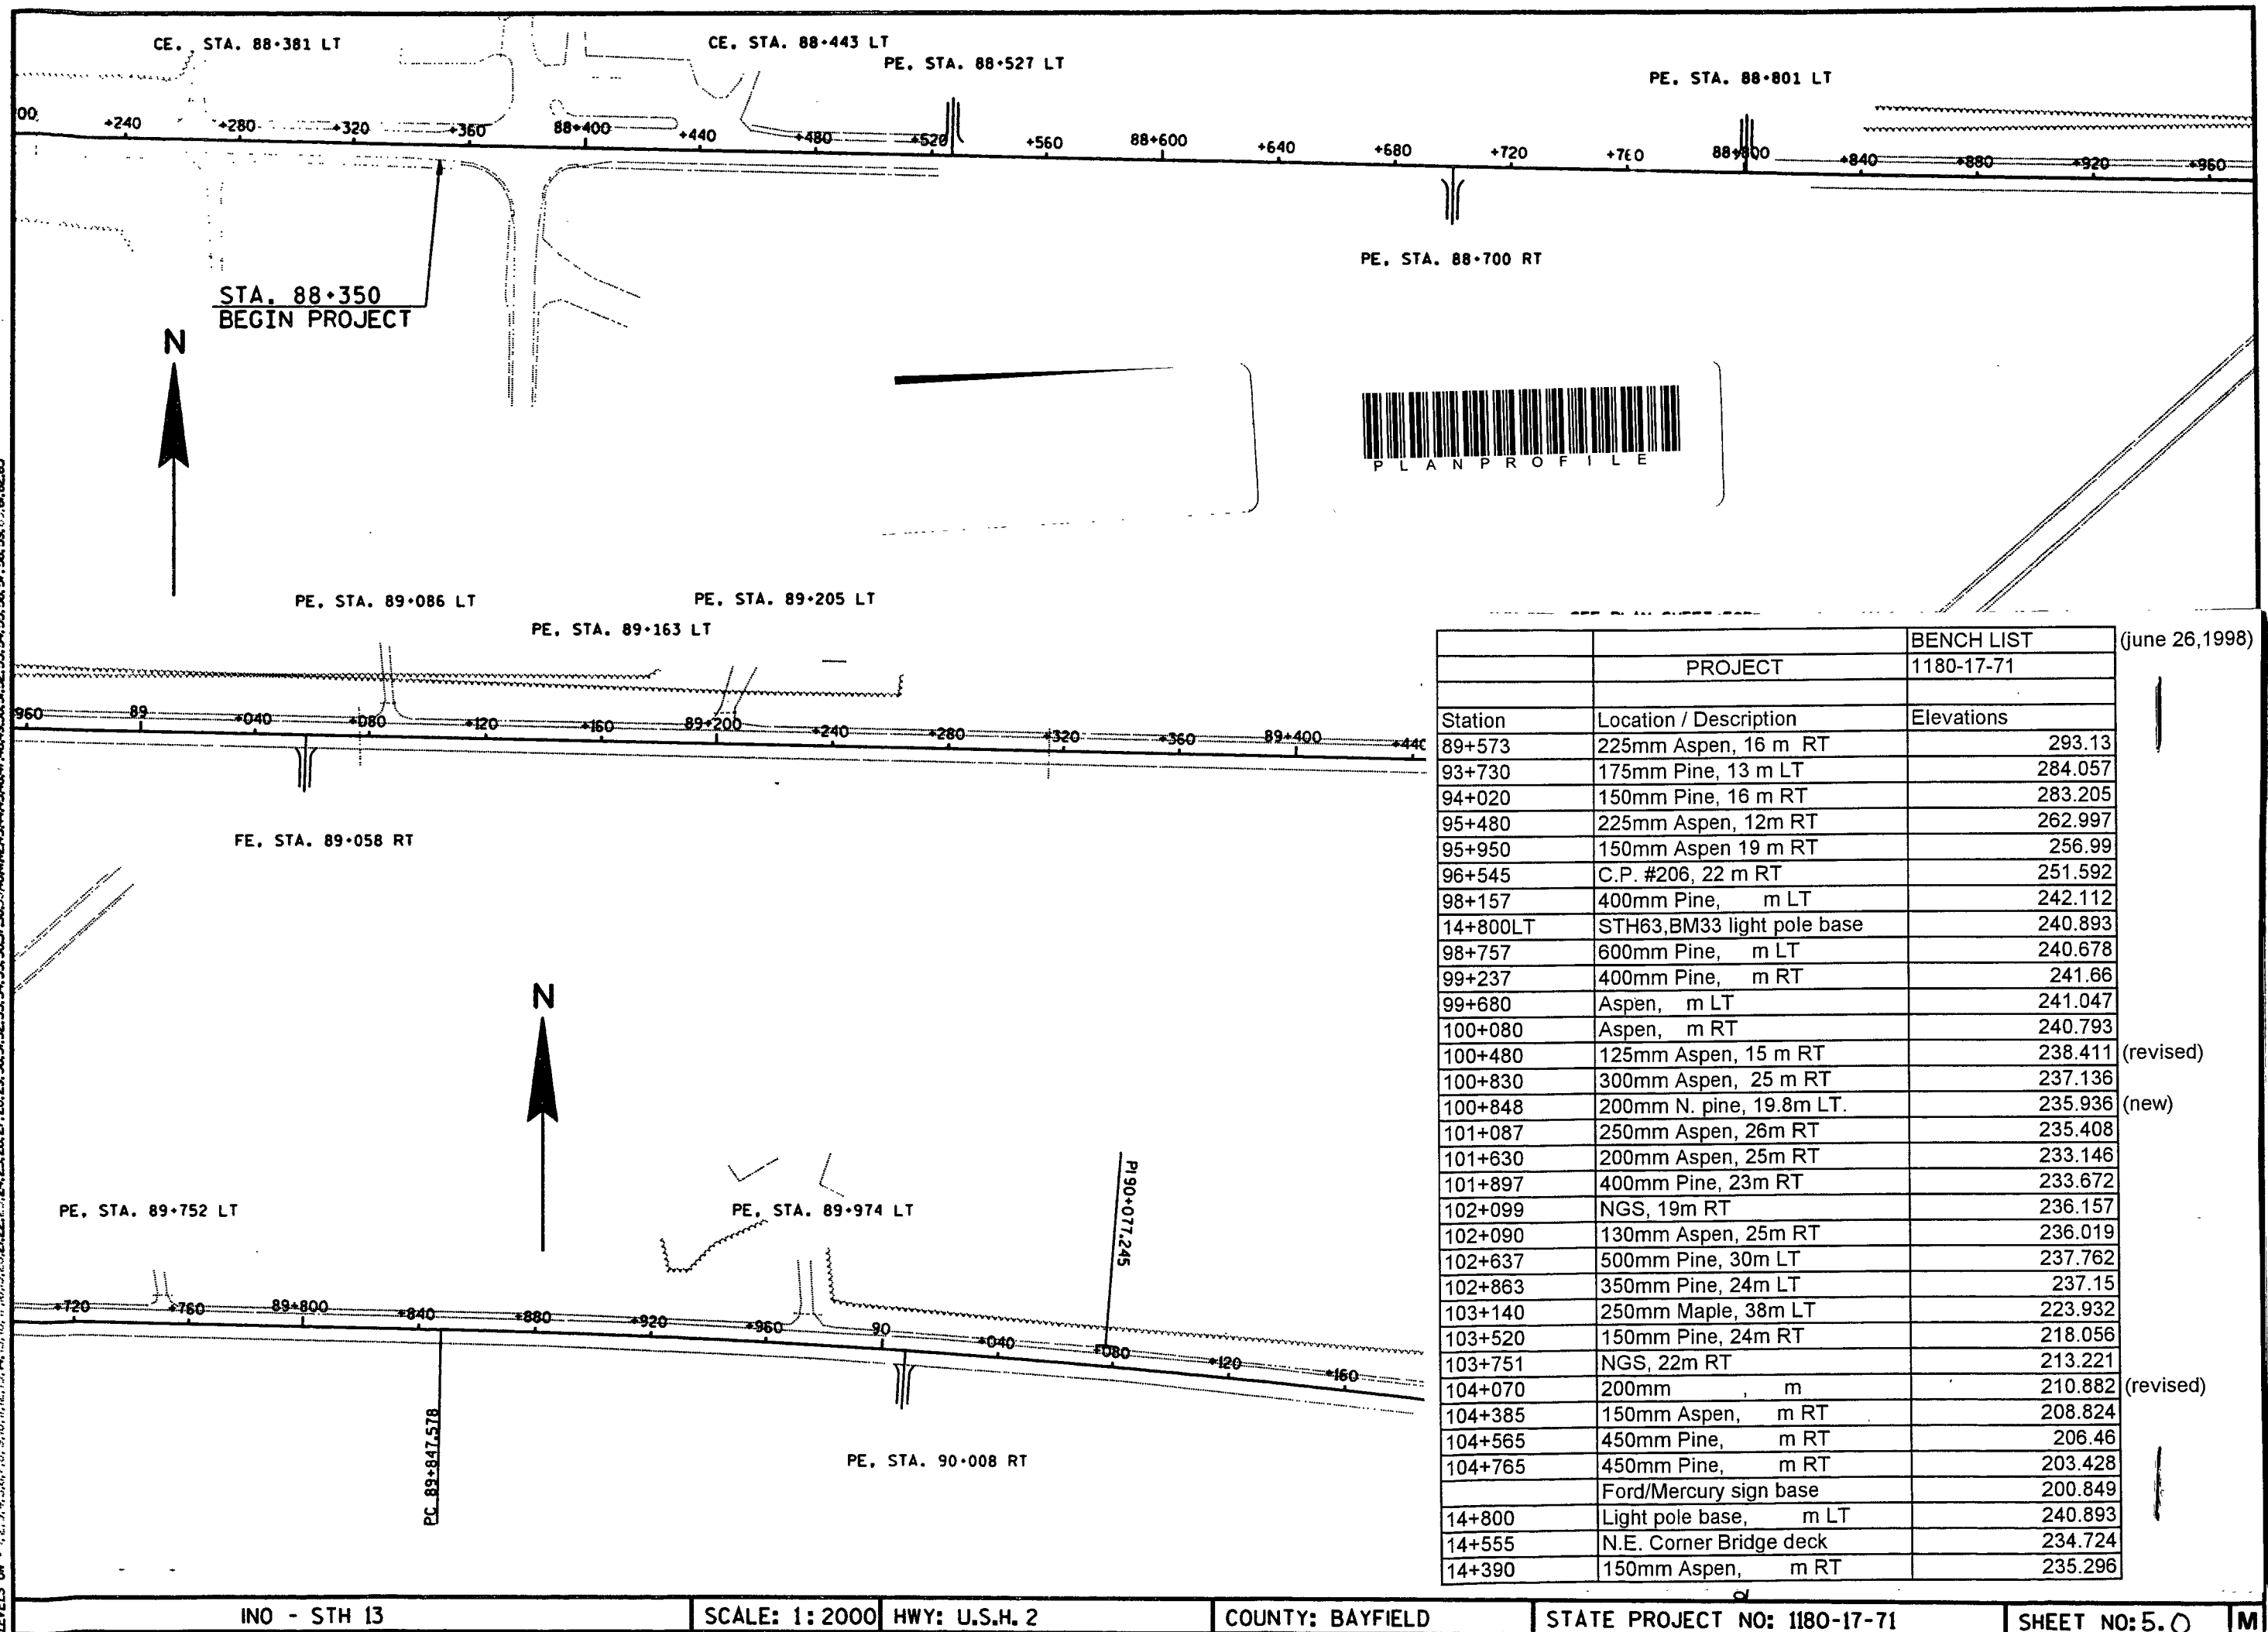

		BENCH LIST
PROJECT		1180-17-71
Station	Location / Description	Elevations
89+573	225mm Aspen, 16 m RT	293.13
93+730	175mm Pine, 13 m LT	284.057
94+020	150mm Pine, 16 m RT	283.205
95+480	225mm Aspen, 12m RT	262.997
95+950	150mm Aspen 19 m RT	256.99
96+545	C.P. #206, 22 m RT	251.592
98+157	400mm Pine, m LT	242.112
14+800LT	STH63, BM33 light pole base	240.893
98+757	600mm Pine, m LT	240.678
99+237	400mm Pine, m RT	241.66
99+680	Aspen, m LT	241.047
100+080	Aspen, m RT	240.793
100+480	125mm Aspen, 15 m RT	238.411
100+830	300mm Aspen, 25 m RT	237.136
100+848	200mm N. pine, 19.8m LT.	235.936
101+087	250mm Aspen, 26m RT	235.408
101+630	200mm Aspen, 25m RT	233.146
101+897	400mm Pine, 23m RT	233.672
102+099	NGS, 19m RT	236.157
102+090	130mm Aspen, 25m RT	236.019
102+637	500mm Pine, 30m LT	237.762
102+863	350mm Pine, 24m LT	237.15
103+140	250mm Maple, 38m LT	223.932
103+520	150mm Pine, 24m RT	218.056
103+751	NGS, 22m RT	213.221
104+070	200mm m	210.882
104+385	150mm Aspen, m RT	208.824
104+565	450mm Pine, m RT	206.46
104+765	450mm Pine, m RT	203.428
	Ford/Mercury sign base	200.849
14+800	Light pole base, m LT	240.893
14+555	N.E. Corner Bridge deck	234.724
14+390	150mm Aspen, m RT	235.296

(june 26, 1998)

(revised)

(new)

(revised)

BENCHMARKS			
NO.	STATION	DESCRIPTION	ELEVATION
185	89+550.000	0.20 m ASPEN 17.0 m RT	293.465
186	89+843.000	0.20 m ASPEN 14.32 m RT	296.107

SEE PG 50



3.0 m WIDE PAVED SHOULDER
TAPER 89+360 (3.9 m RT) TO 89+400.5 (6.6 m RT)
STA 89+360 TO BYPASS LANE
SEE TYPICAL SECTIONS

BEGIN TAPER - BYPASS LANE
3.9 m RT (EDGE OF TRAVELED WAY)
STA 89+483.3

BEGIN TAPER - BYPASS LANE
7.5 m RT (EDGE OF TRAVELED WAY)
STA 89+620.5

PE. STA. 89+752 LT

PE. STA. 89+974 LT

END TAPER - BYPASS LANE
7.5 m RT (EDGE OF TRAVELED WAY)
STA 89+544.3

STA 89+590 RT - EXTEND EXISTING PIPE
1-5.3 x 600 mm DEEP RED C.P.
1-CONCRETE COLLAR, 1-AEW
1.9 m³ RIP RAP
30° LHF EXTENDED 4.1 m RT.


END TAPER - BYPASS LANE
3.9 m RT (EDGE OF TRAVELED WAY)
STA 89+711.9

CURVE DATA	
PI	= 90+077.245
N	= 152298.598
E	= 511331.014
Δ	= 7°07'46.3" (RT)
T	= 229.667
L	= 458.742
E	= 7.147
R	= 3686.642
SE	= NC

PLOT SCALE: 1" = 100'

REV. DATE:

FILE NAME: D8 1180100 DGN PLANS.DGN
LEVELS ON: 1, 2, 3, 62, 63

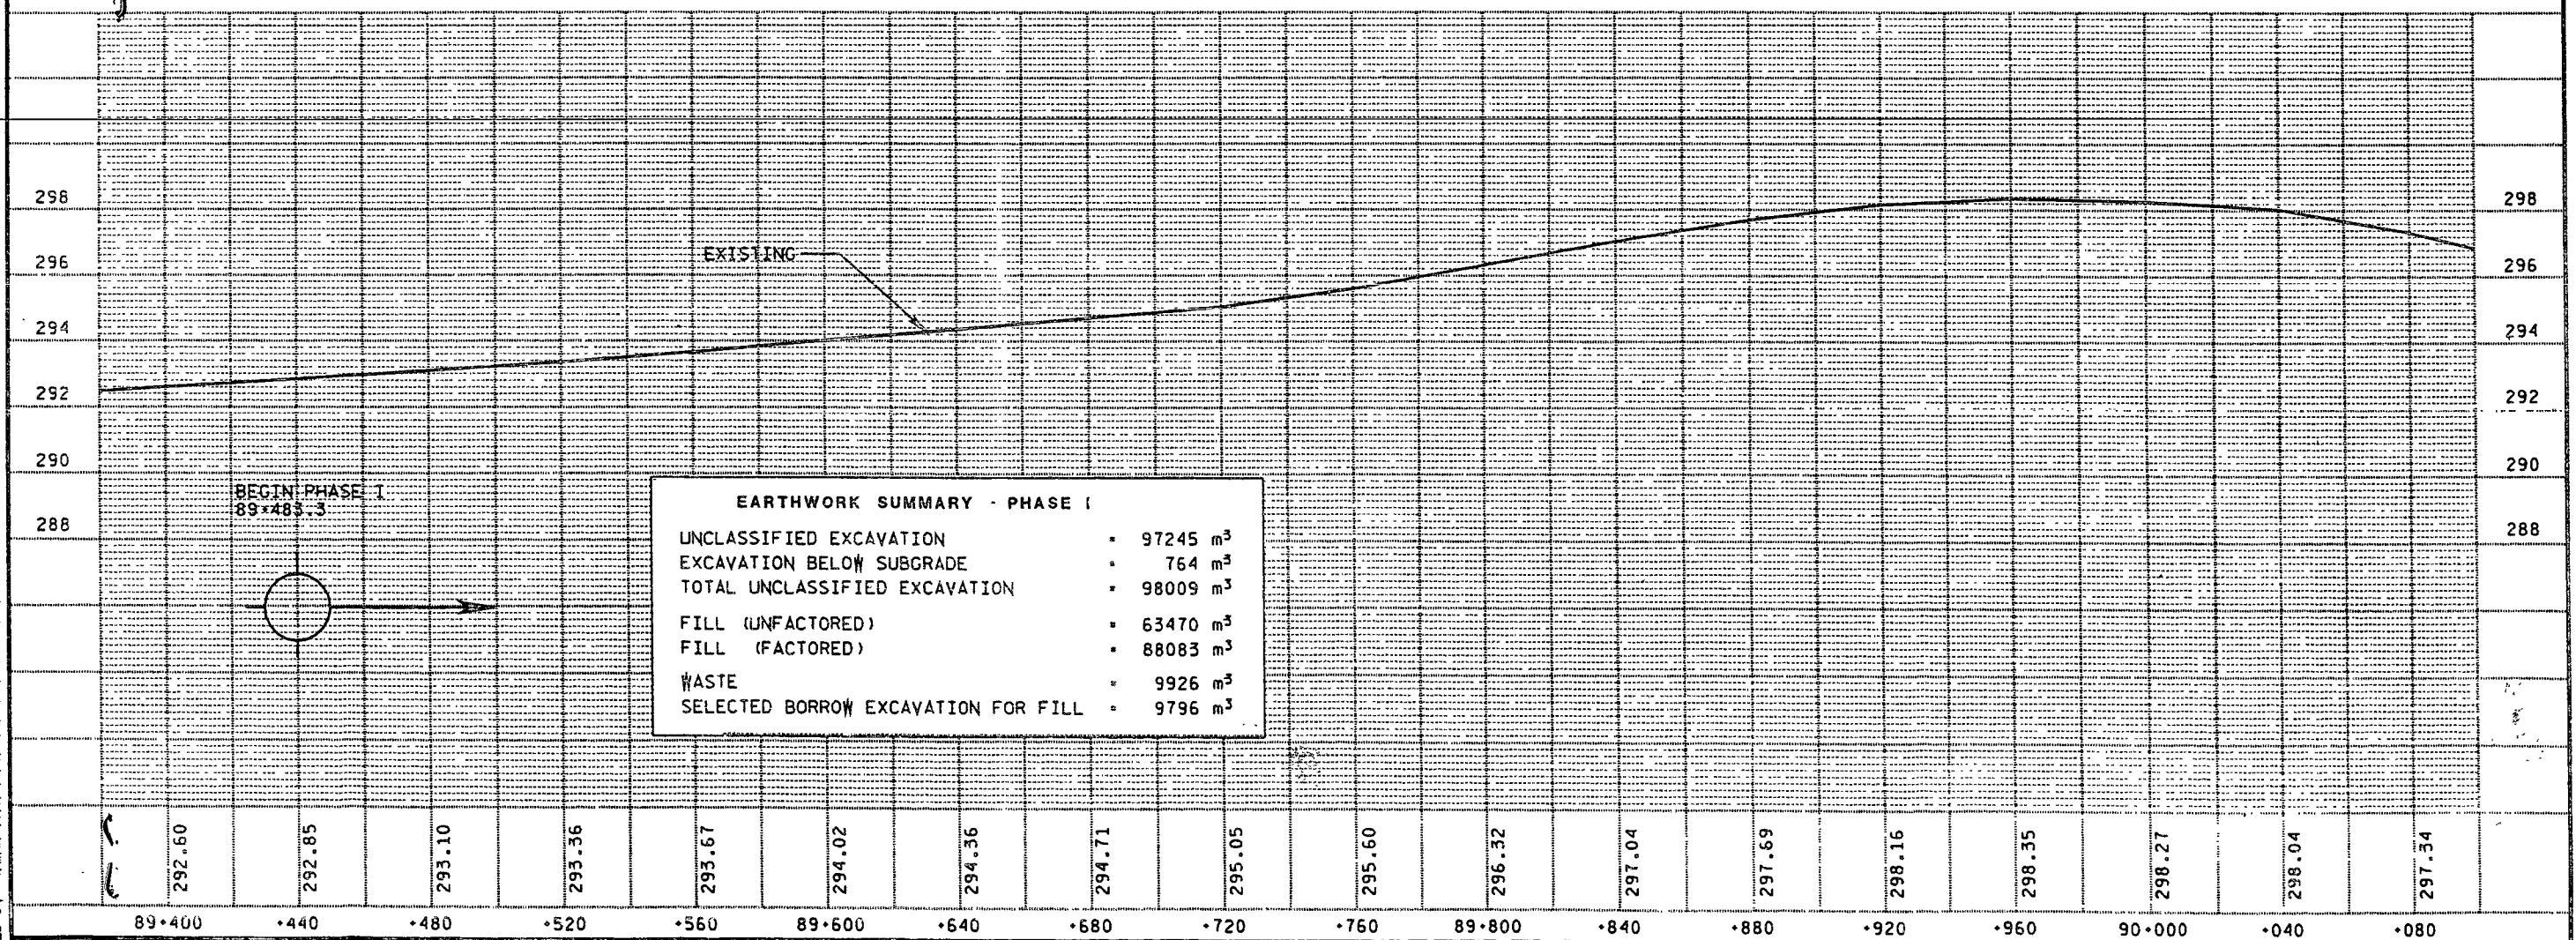

INO - STH 13

SCALE: 1:2000 HWY: U.S.H. 2

COUNTY: BAYFIELD

STATE PROJECT NO: 1180-17-71

SHEET NO: 5.1

M

WISDOT: MSHT46

PE. STA. 90+603 LT

CURVE DATA	
PI	= 91+706.152
N	= 152060.441
E	= 512943.016
Δ	= 11°40'11.0" (LT)
T	= 177.770
L	= 354.310
E	= 9.060
R	= 1739.582
SE	= 0.028
RO	= 56 m

U.S.H. 2 STA. 91+590.78 = SR
STA. 3+000.00 (TOMICH ROAD)

PE. STA. 91+520 LT

PE. STA. 91+886 RT

PE. STA. 91+947 RT

PE. STA. 91+778 RT

PE. STA. 92+389 LT

U.S.H. 2 STA. 92+003.30 = SR
STA. 5+000.00 (NORDIN ROAD)

PE. STA. 92+250 RT

PE. STA. 91+947 RT

PE. STA. 91+886 RT

SCALE: 1:2000 HWY: U.S.H. 2

COUNTY: BAYFIELD

STATE PROJECT NO: 1180-17-71

SHEET NO-5 ?

INO - STH 13



FILE NAME: PROJECTS DB 1180100 DON CTFM OVERLIDON
LEVELS ON = 1, 2, 3, 62, 63

REV. DATE:

FILE NAMES: PROJECTS DB 11801700 DGN CTHF OVERLIDGN
LEVELS ON - 1, 2, 3, 62, 63



PE. STA. 92+948 LT
PE. STA. 92+996 LT

640 +680 +720 +760 92+800 +840 +880 +920 +960 93 +040 +080 +120 +160 93+200 +240 +280 +320 +360 93+40



PE. STA. 93+484 RT

93+400 +440 +480 +520 +560 93+600 +640 +680 +720 +760 93+800

INO - STH 13

SCALE: 1:2000 HWY: U.S.H. 2

COUNTY: BAYFIELD

STATE PROJECT NO: 1180-17-71

SHEET NO: 5.3

M

WI-DOT: MSHT20

FILE NAME: PROJECTS 08 11801700 DON CTHF PL2.DGN
LEVELS ON - 1, 2, 3, 62, 63



STA 94+008 RT - EXTEND EXISTING PIPE
1-12.2m x 600mm RCCP REQ'D
1-CONCRETE COLLAR, 1-AEW
MITER PIPE EXTENSION AT 45 DEGREES

BENCHMARKS			
NO.	STATION	DESCRIPTION	ELEVATION
198	93+775.000	0.2 m STUMP, 12.8 m RT	285.152
3864	94+012.000	GPS 3864, 8m LT	281.460

SEE PG 5.0

PLACE RUMBLE STRIP ON TAPER LT
ST 94+120 TO STA 94+340

U.S.H. 2 STA. 94+014.23 - SR
STA. 12+000.00 (KINNY ROAD)

WIDE PAVED SHOULDER TAPER
STA 94+934 TO 94+984
(0.9m to 3.0m)

CONSTRUCT PE
STA. 94+312 LT

BEGIN PASSING LANE TAPER
STA. 94+120.00 3.6 m LT

CONSTRUCT PE
STA. 94+312 LT

END PASSING LANE TAPER
STA. 94+340.00 7.2 m LT

CONSTRUCT PE
STA. 94+503 LT

EXTEND WIDE PAVED SHOULDER
TO PASSING LANE TAPER
STATION 94+250, 6.6MLT

CONSTRUCT PE
STA. 93+879 LT

VISION TRIANGLE
STA. 93+830.23
3.6 m RT & U.S.H. 2

CLEAR AND GRUB
VISION TRIANGLE
TO EXISTING ROW

VISION TRIANGLE
STA. 12+961.00
& KINNY ROAD

CLEAR AND GRUB
VISION TRIANGLE
TO EXISTING ROW

VISION TRIANGLE
STA. 94+198.23
3.6 m RT & U.S.H. 2

STA 94+236 LT - EXTEND EXISTING PIPE
1-2.5m x 750mm RCCP REQ'D
1-CONCRETE COLLAR, 1-AEW
2.5 m³ RIP RAP

7.3m STA 94+486 LT - EXTEND EXISTING PIPE
1-10.2m x 900mm RCCP REQ'D
1-CONCRETE COLLAR, 1-AEW
3.1 m³ RIP RAP

* PASSING LANE TAPERS ARE
EDGE OF TRAVELED WAY

CONSTRUCT MODIFIED TYPE B1
INTERSECTION (SEE DETAIL)

CAUTION UTILITIES IN AREA

STA 94+008
EXTENDED 600mm 10.3m RT

STA 94+055
EXTENDED EXIST. RCCP (600mm) 2.4m LT

EXISTING

PLOT NAME:

REV. DATE:

DATE:

ORIGINATOR:


FILE NAME: PROJECTS DB 118100 DGN CTHF PL3.DGN
LEVELS ON: 1, 2, 3, 62, 63




13.4m
14.8m
STA 94+820 LT- EXTEND EXISTING CULVERT
1- ~~14.7~~ x 900 mm RCCP REQ'D
REMOVE 7.2 m (6 SECTIONS) OF EXISTING
1-CONCRETE COLLAR, 1-AEW
3.8 m³ RIP RAP
STA 95+175 LT- EXTEND EXISTING CULVERT
1- ~~14.7~~ x 1050 mm RCCP REQ'D
REMOVE 3.6 m (3 SECTIONS) OF EXISTING
1-CONCRETE COLLAR, 1-AEW
3.1 m³ RIP RAP

BENCHMARKS			
NO.	STATION	DESCRIPTION	ELEVATION
3865	94+632.000	GPS 3865, 8.6 m RT	273.707
202	94+972.000	NGS B213, 36.88 m RT	269.984
203	95+248.000	0.3 m W.PINE, 13.1 m RT	267.757

SEE PG 5.0

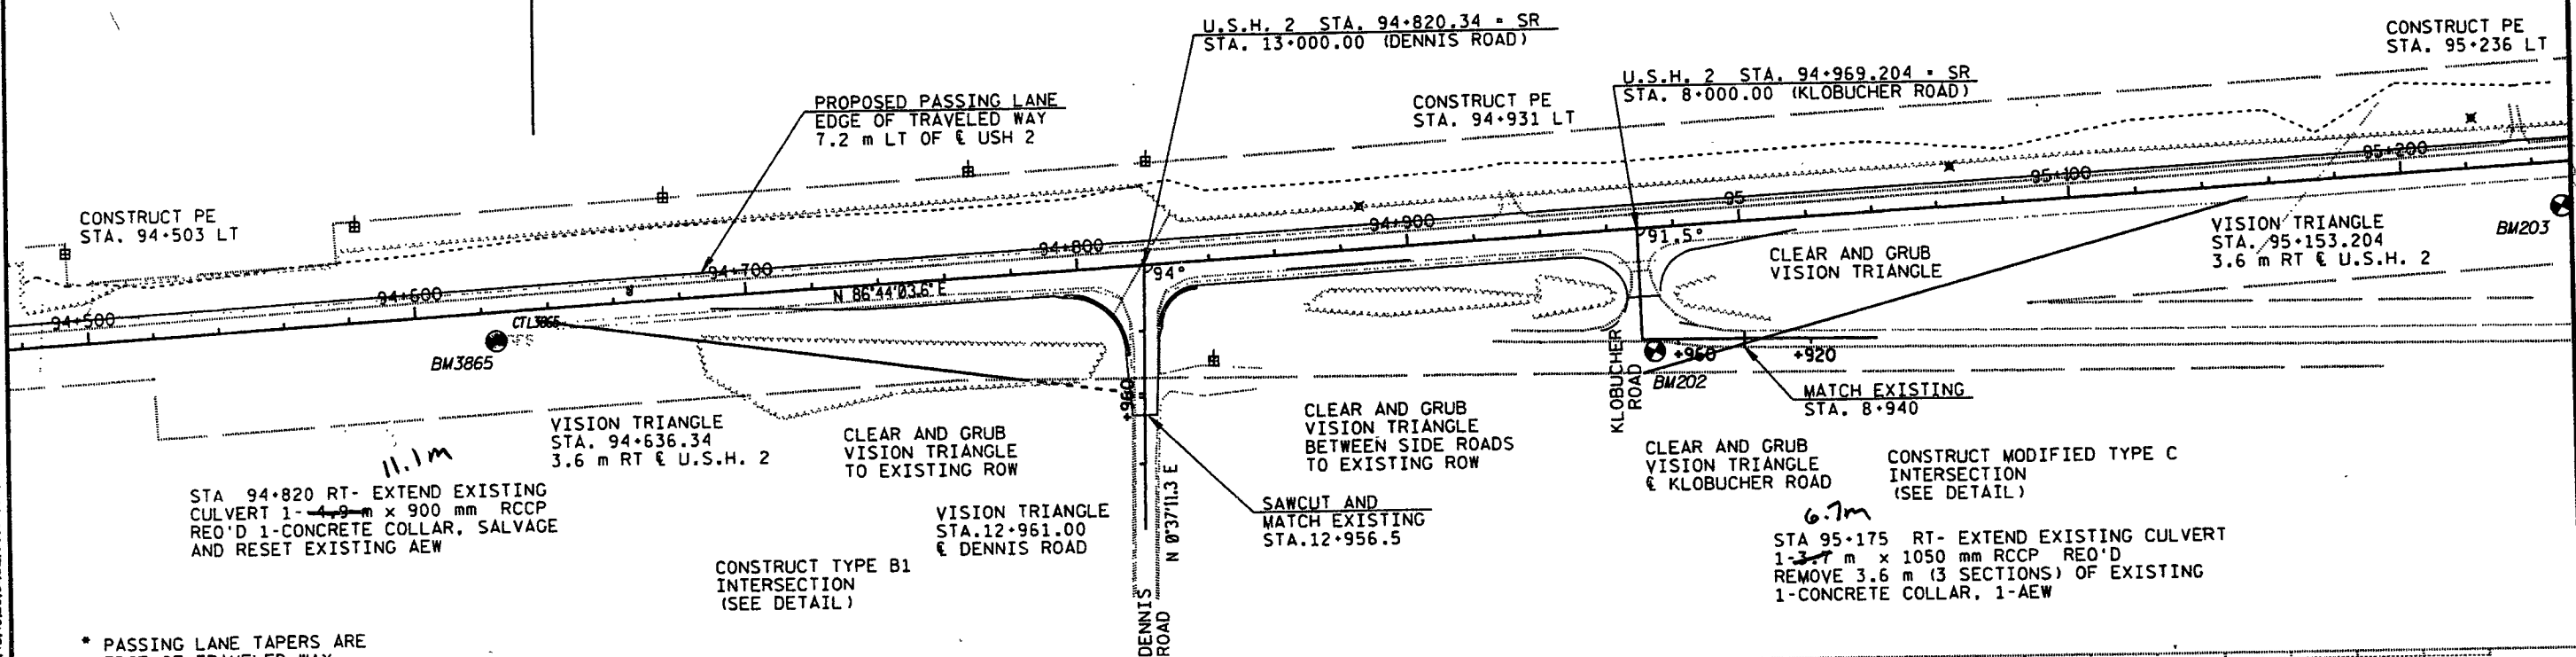

* PASSING LANE TAPERS ARE
EDGE OF TRAVELED WAY

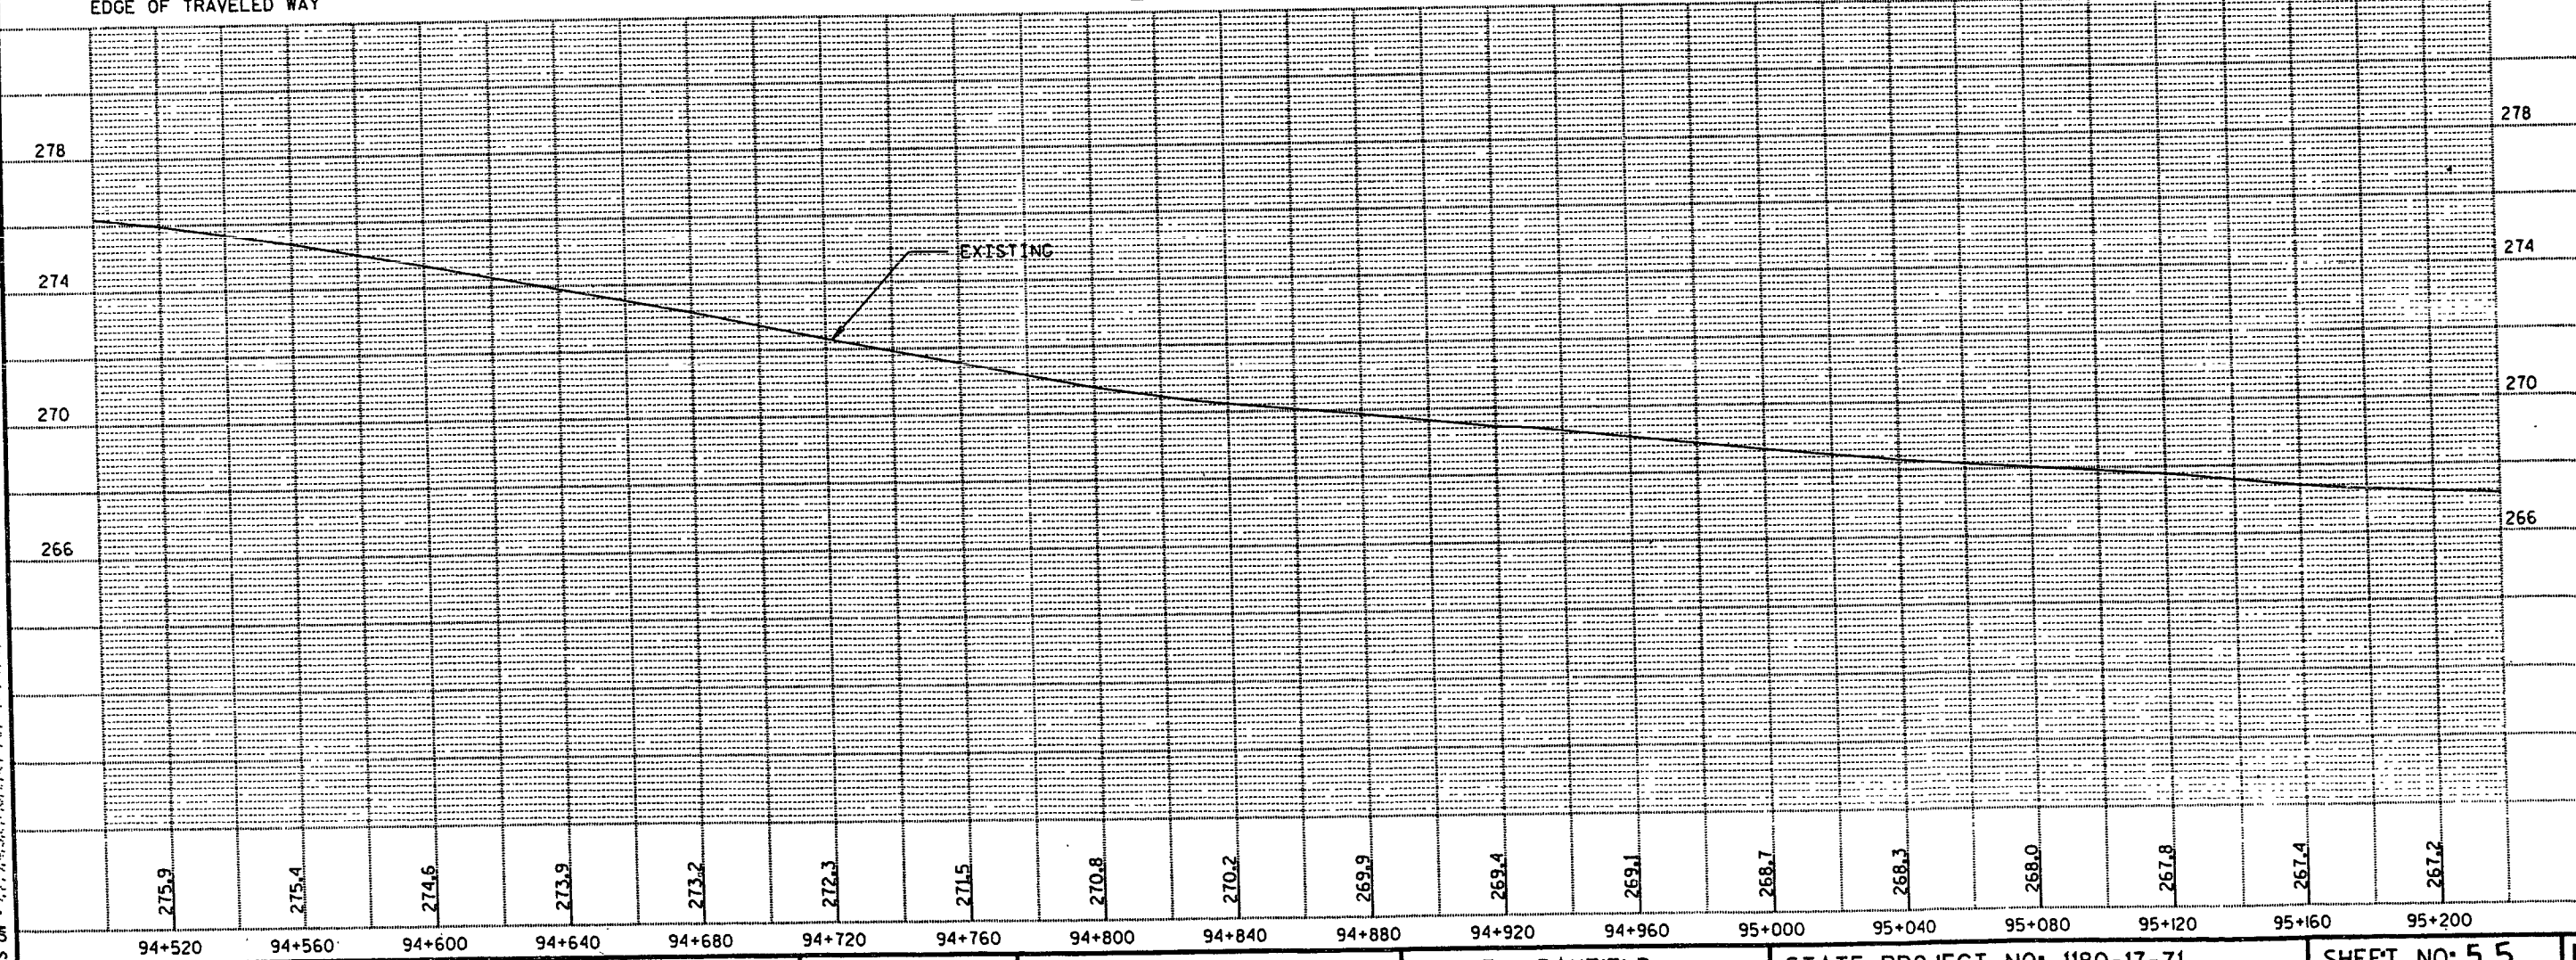

INO - STH 13

SCALE: 1: 2000 HWY: U.S.H. 2

COUNTY: BAYFIELD

STATE PROJECT NO: 1180-17-71

SHEET NO: 5.5


M

FILE NAME: PROJECTS DB 11801700 DGN CTMF PL4.DGN
LEVELS ON: 1, 2, 3, 62, 63




BENCHMARKS			
NO.	STATION	DESCRIPTION	ELEVATION
203	95+248.000	0.3 m W.PINE, 13.1 m RT	267.757
204	95+511.000	0.2 m ASPEN, 17.68 m RT	260.793
205	95+950.000	0.15 m ASH, 19.2 m RT	256.990

SEE PG 5.0

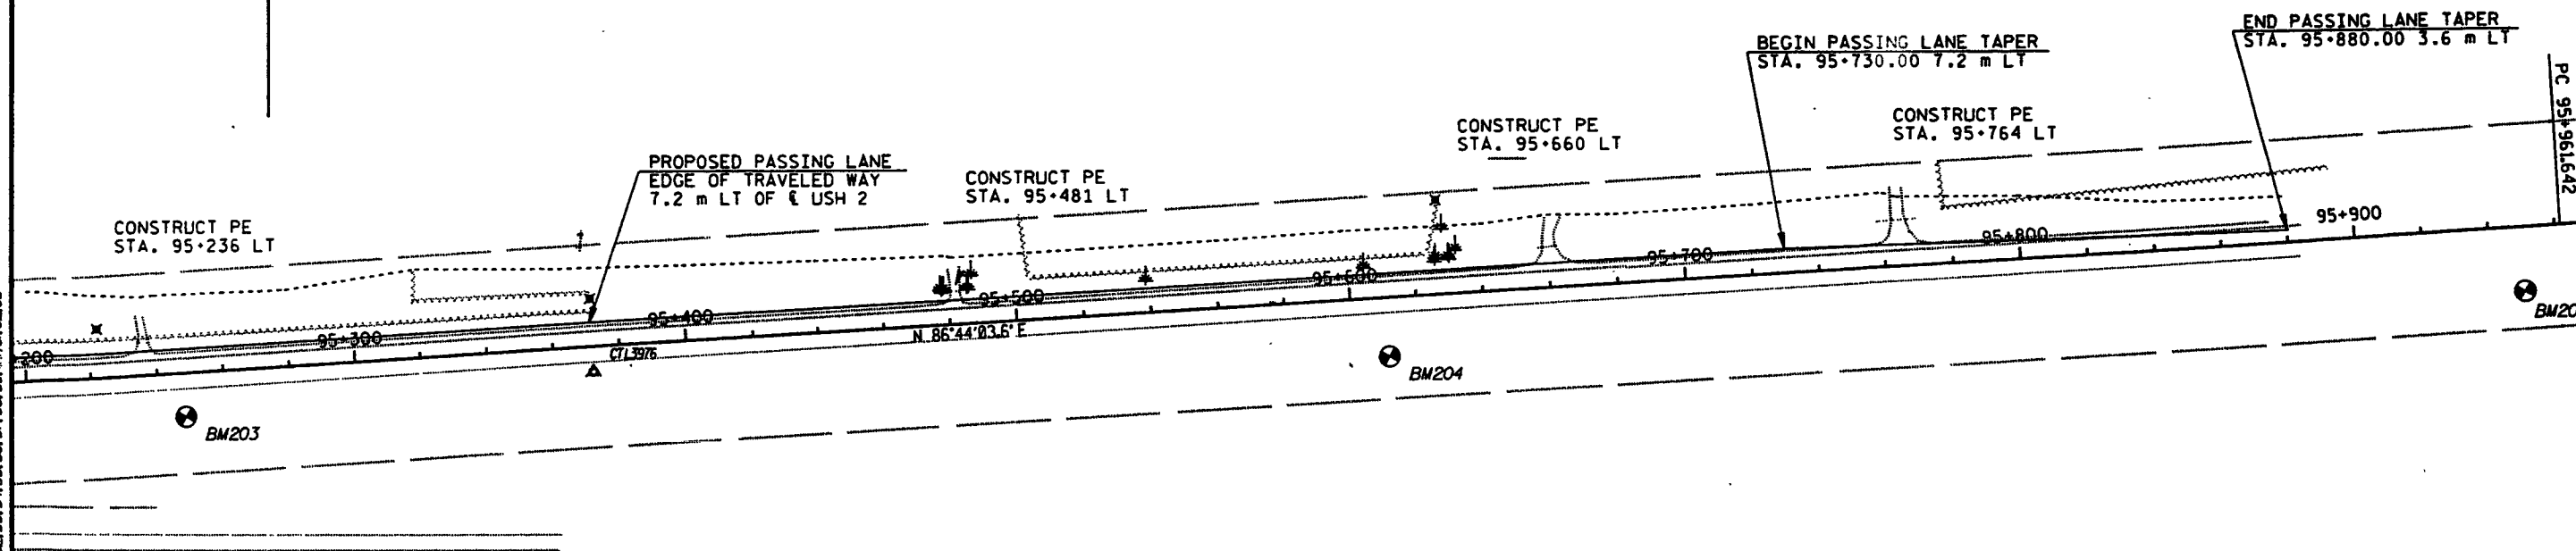

* PASSING LANE TAPERS ARE
EDGE OF TRAVELED WAY

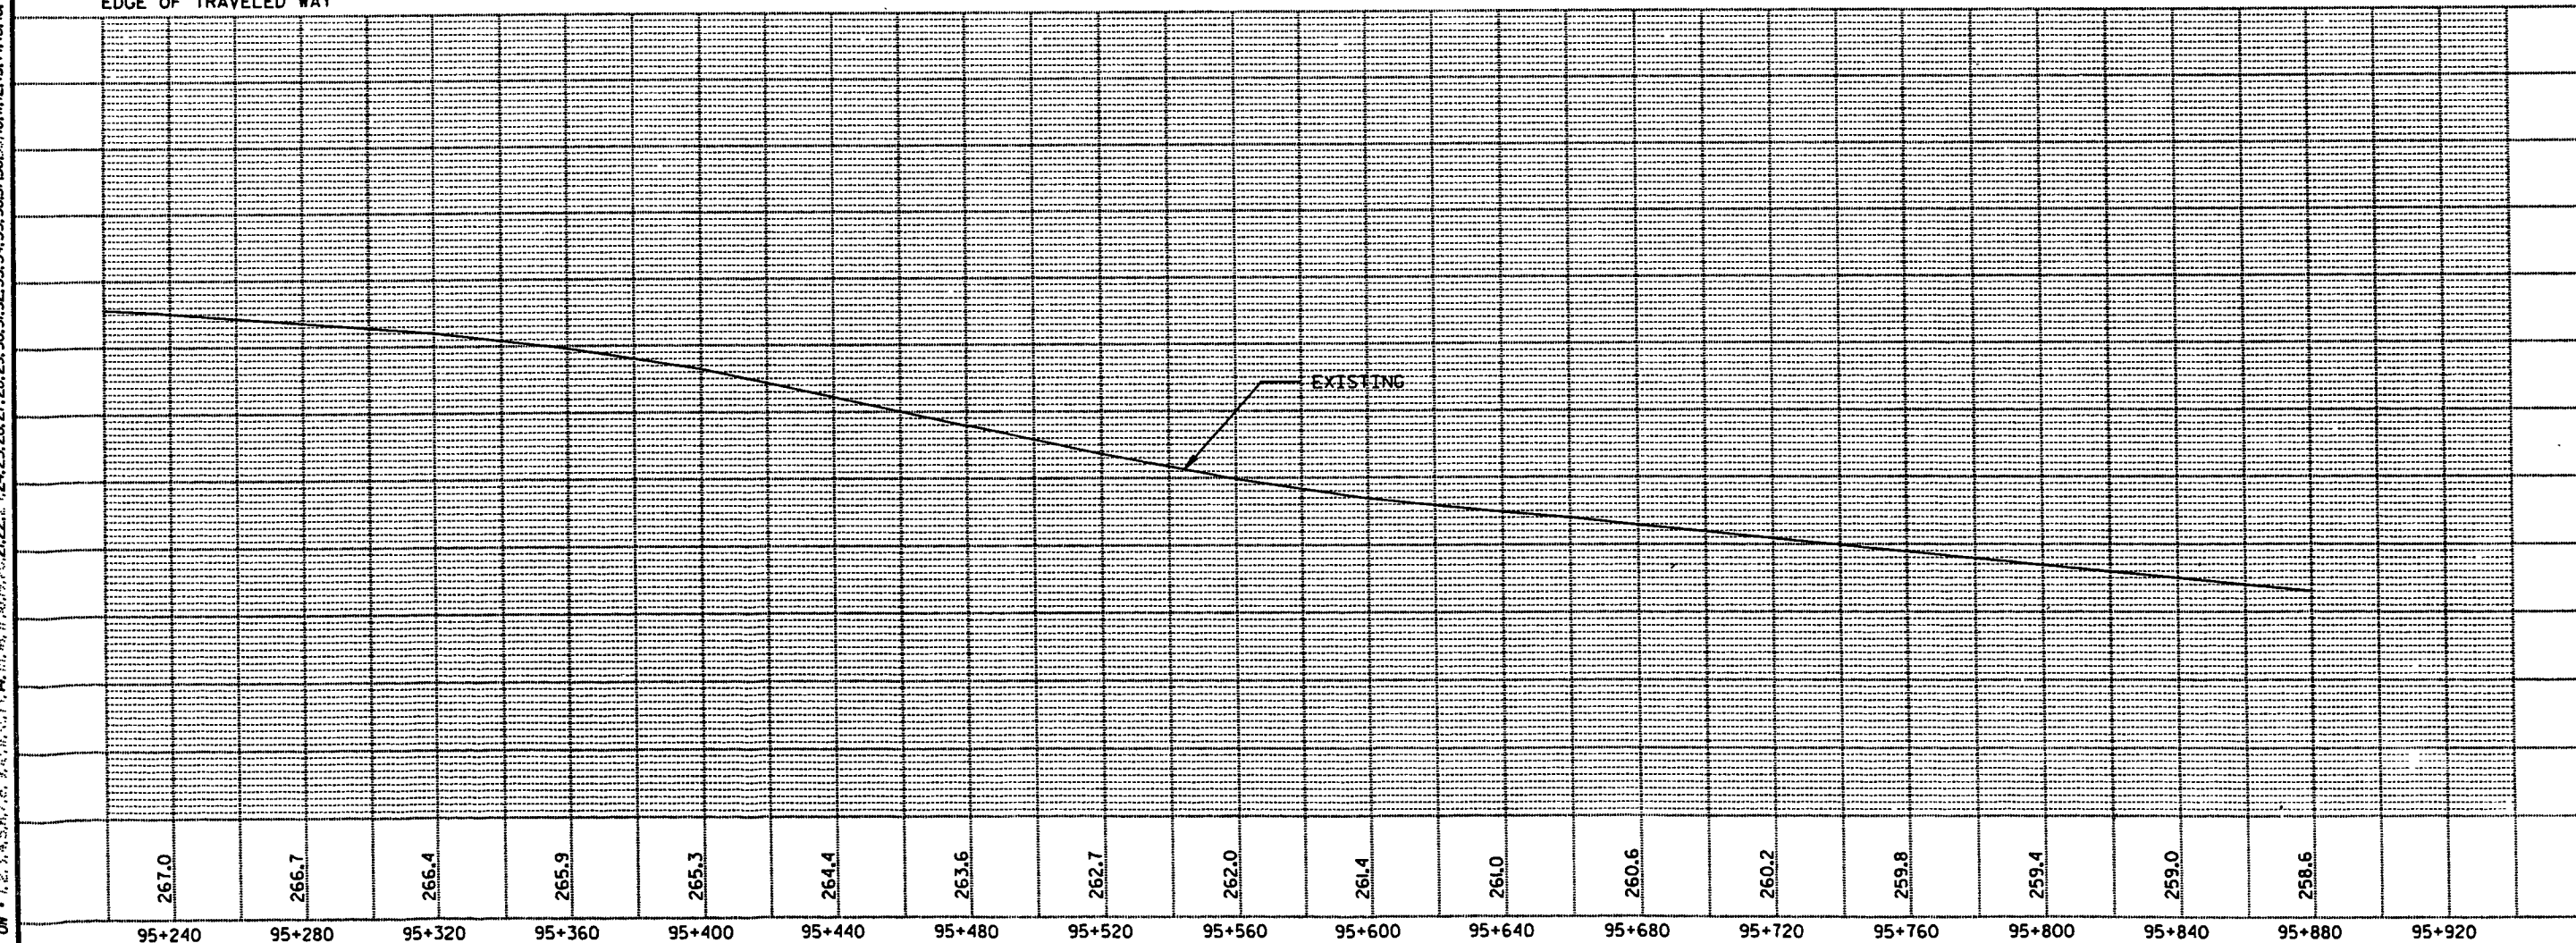

INO - STH 13

SCALE: 1:2000 HWY: U.S.H. 2

COUNTY: BAYFIELD

STATE PROJECT NO: 1180-17-71

SHEET NO: 5.6

M

WISDOT: MSH/26

CURVE DATA	
PI	= 96+196.158
E	= 517426.958
N	= 152316.287
Δ	= 22°53'28.4" (LT)
T	= 234.516
L	= 462.777
E	= 23.502
R	= 1158.311
SE	= 0.038
RO	= 56 m

CONSTRUCT BOX CULVERT EXTENSION
STA. 96+376.00
SEE DETAIL SHEET

CONSTRUCT TYPE "B1"
INTERSECTION
(SEE DETAIL)

VISION TRIANGLE
STA. 30+039.00
@ JANECEK ROAD

VISION TRIANGLE
STA. 96+620.59
3.6 m LT @ U.S.H. 2

VISION TRIANGLE
STA. 96+252.59
3.6 m LT @ U.S.H. 2

CLEAR AND GRUB
VISION TRIANGLE

CONSTRUCT PE
STA. 96+351 LT

CLEAR AND GRUB
VISION TRIANGLE

VISION TRIANGLE
STA. 96+620.59
3.6 m RT @ U.S.H. 2

U.S.H. 2 STA. 96+436.59 = SR
STA. 30+000.00 (CTH F)

CLEAR AND GRUB
VISION TRIANGLE

VISION TRIANGLE
STA. 29+962.00
@ CTH "F"


CONSTRUCT TYPE "B1"
INTERSECTION
(SEE DETAIL)

SAWCUT AND
MATCH EXISTING
STA. 29+900

BENCHMARKS			
NO.	STATION	DESCRIPTION	ELEVATION
205	95+950.100	0.15 m ASH, 19.2 m RT	256.990
206	96+545.700	NGS C213, 21.64 m LT	251.592


SEE PG 5.0

* PASSING LANE TAPERS ARE
EDGE OF TRAVELED WAY

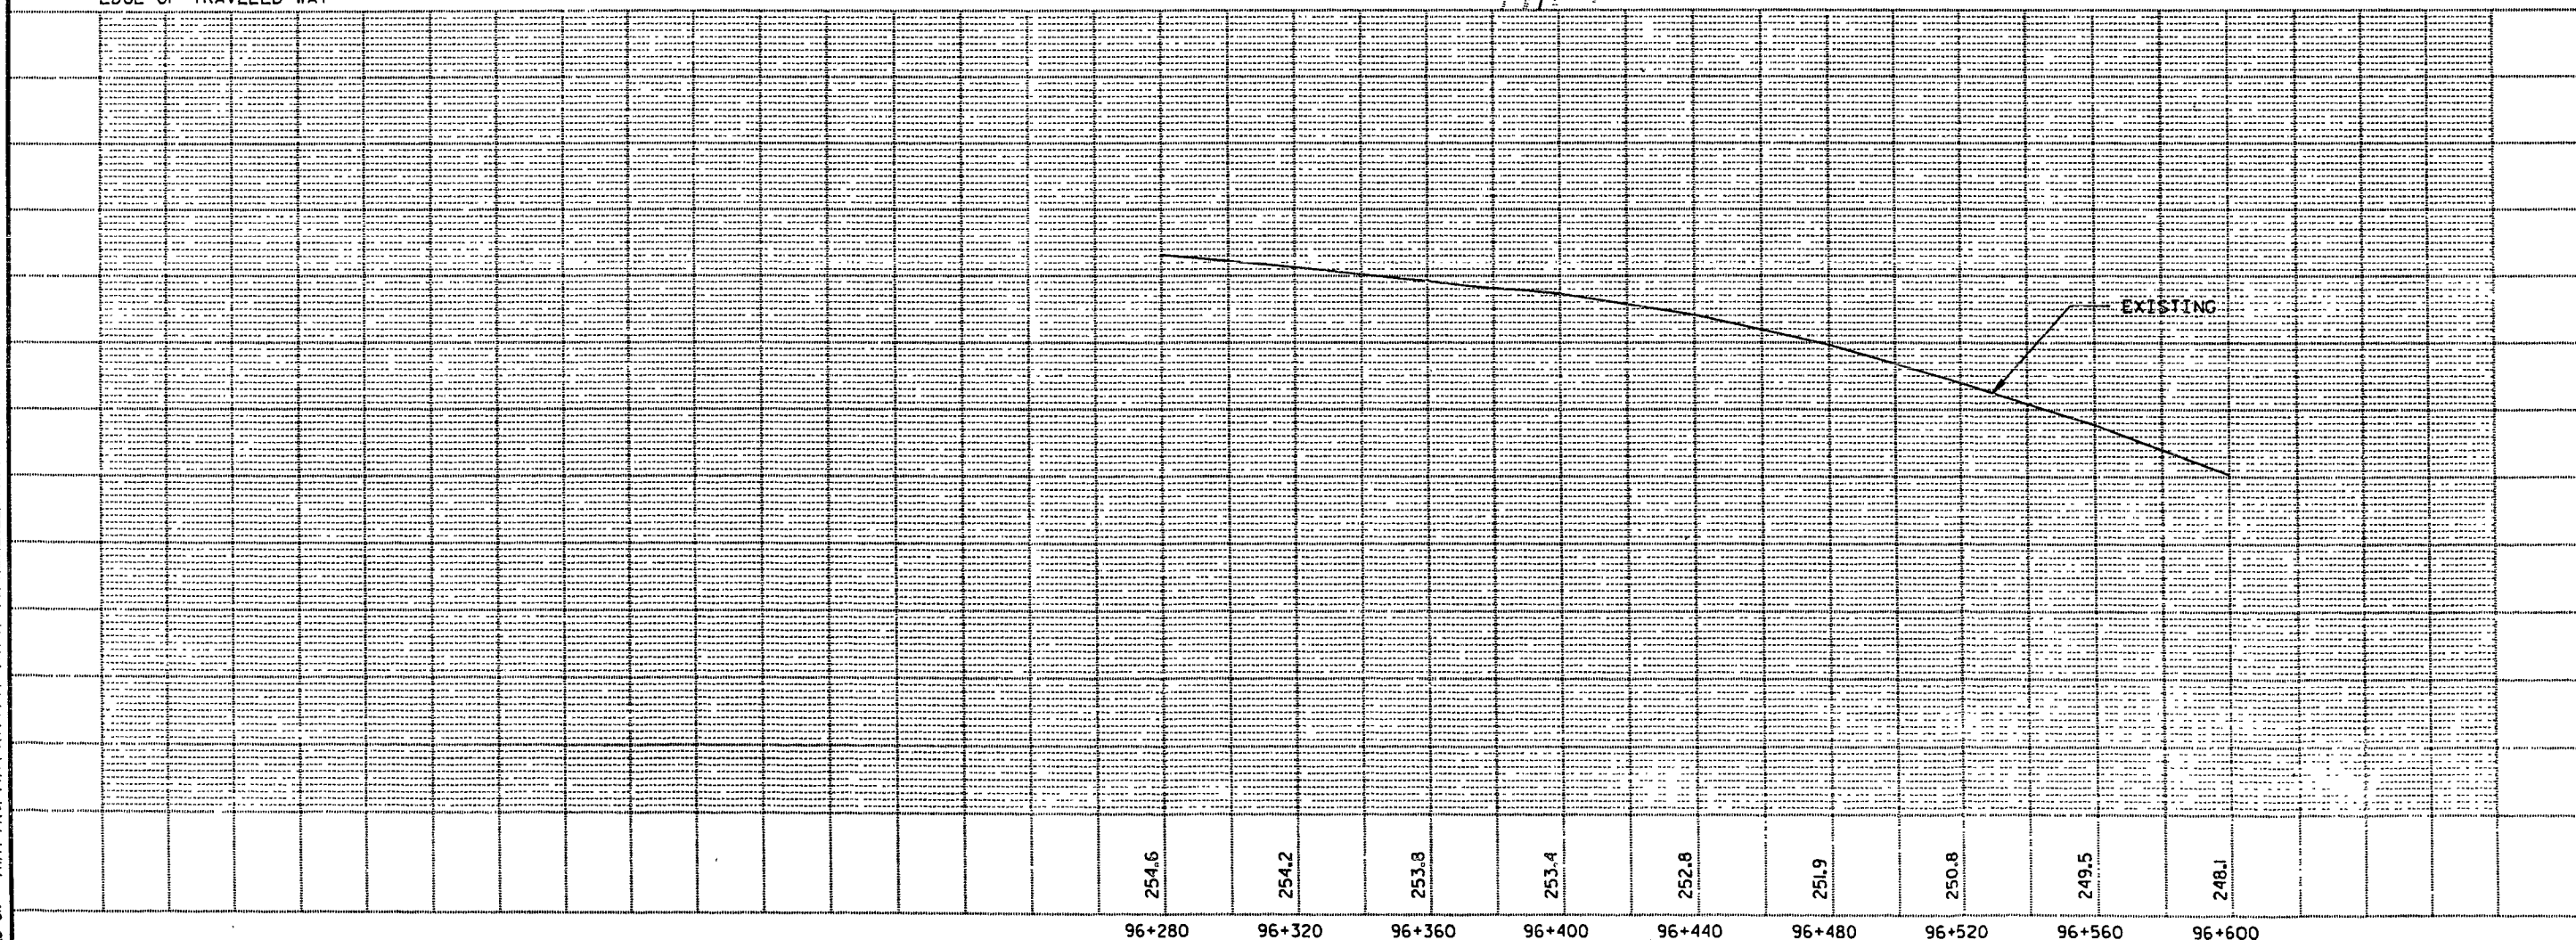

FILE NAME: PROJECTS DB 180100 DGN CTH FLS.DGN
LEVELS ON: 1, 2, 3, 62, 63

FILE NAME: PROJECTS DB 11801700 DGN CTHF OVERLDDN
LEVELS ON - 1, 2, 3, 62, 63

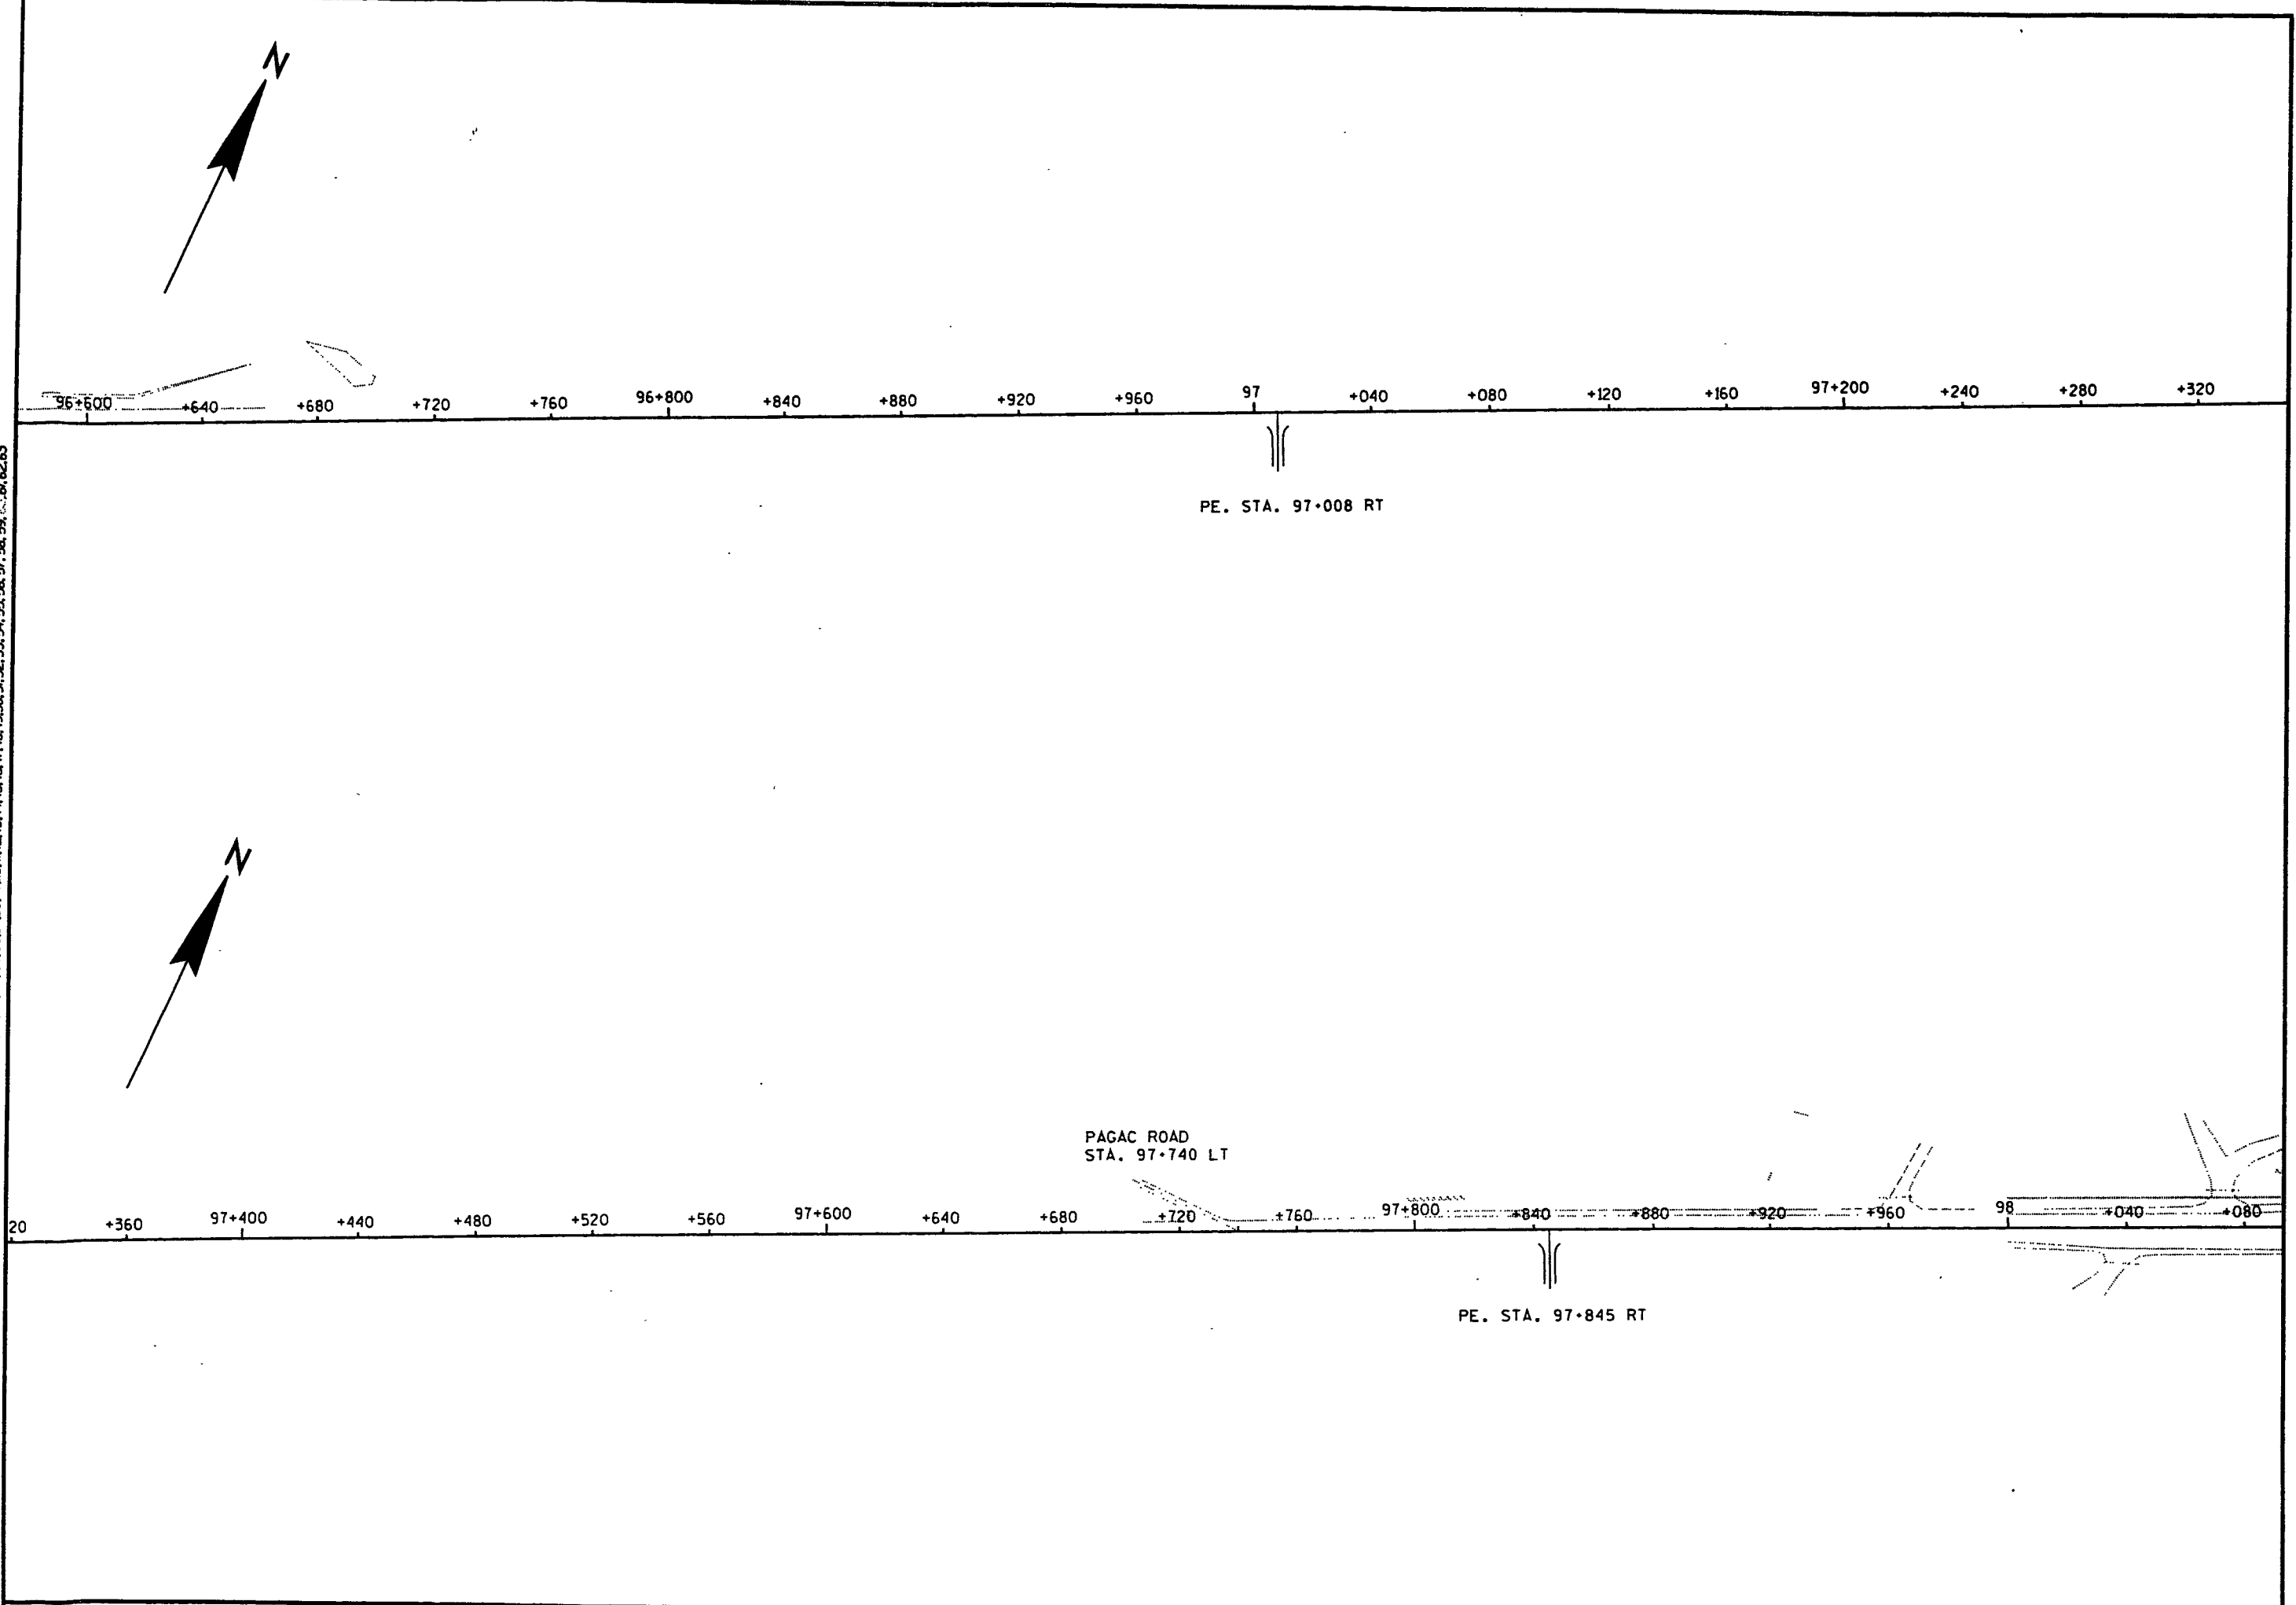

INO - STH 13

SCALE: 1:2000 HWY: U.S.H. 2


COUNTY: BAYFIELD

STATE PROJECT NO: 1180-17-71

SHEET NO: 5.8


1M

FILE NAME: PROJECTS DB 11801700 DON STH137 PLD ON
LEVELS ON 1, 2, 3, 62, 63

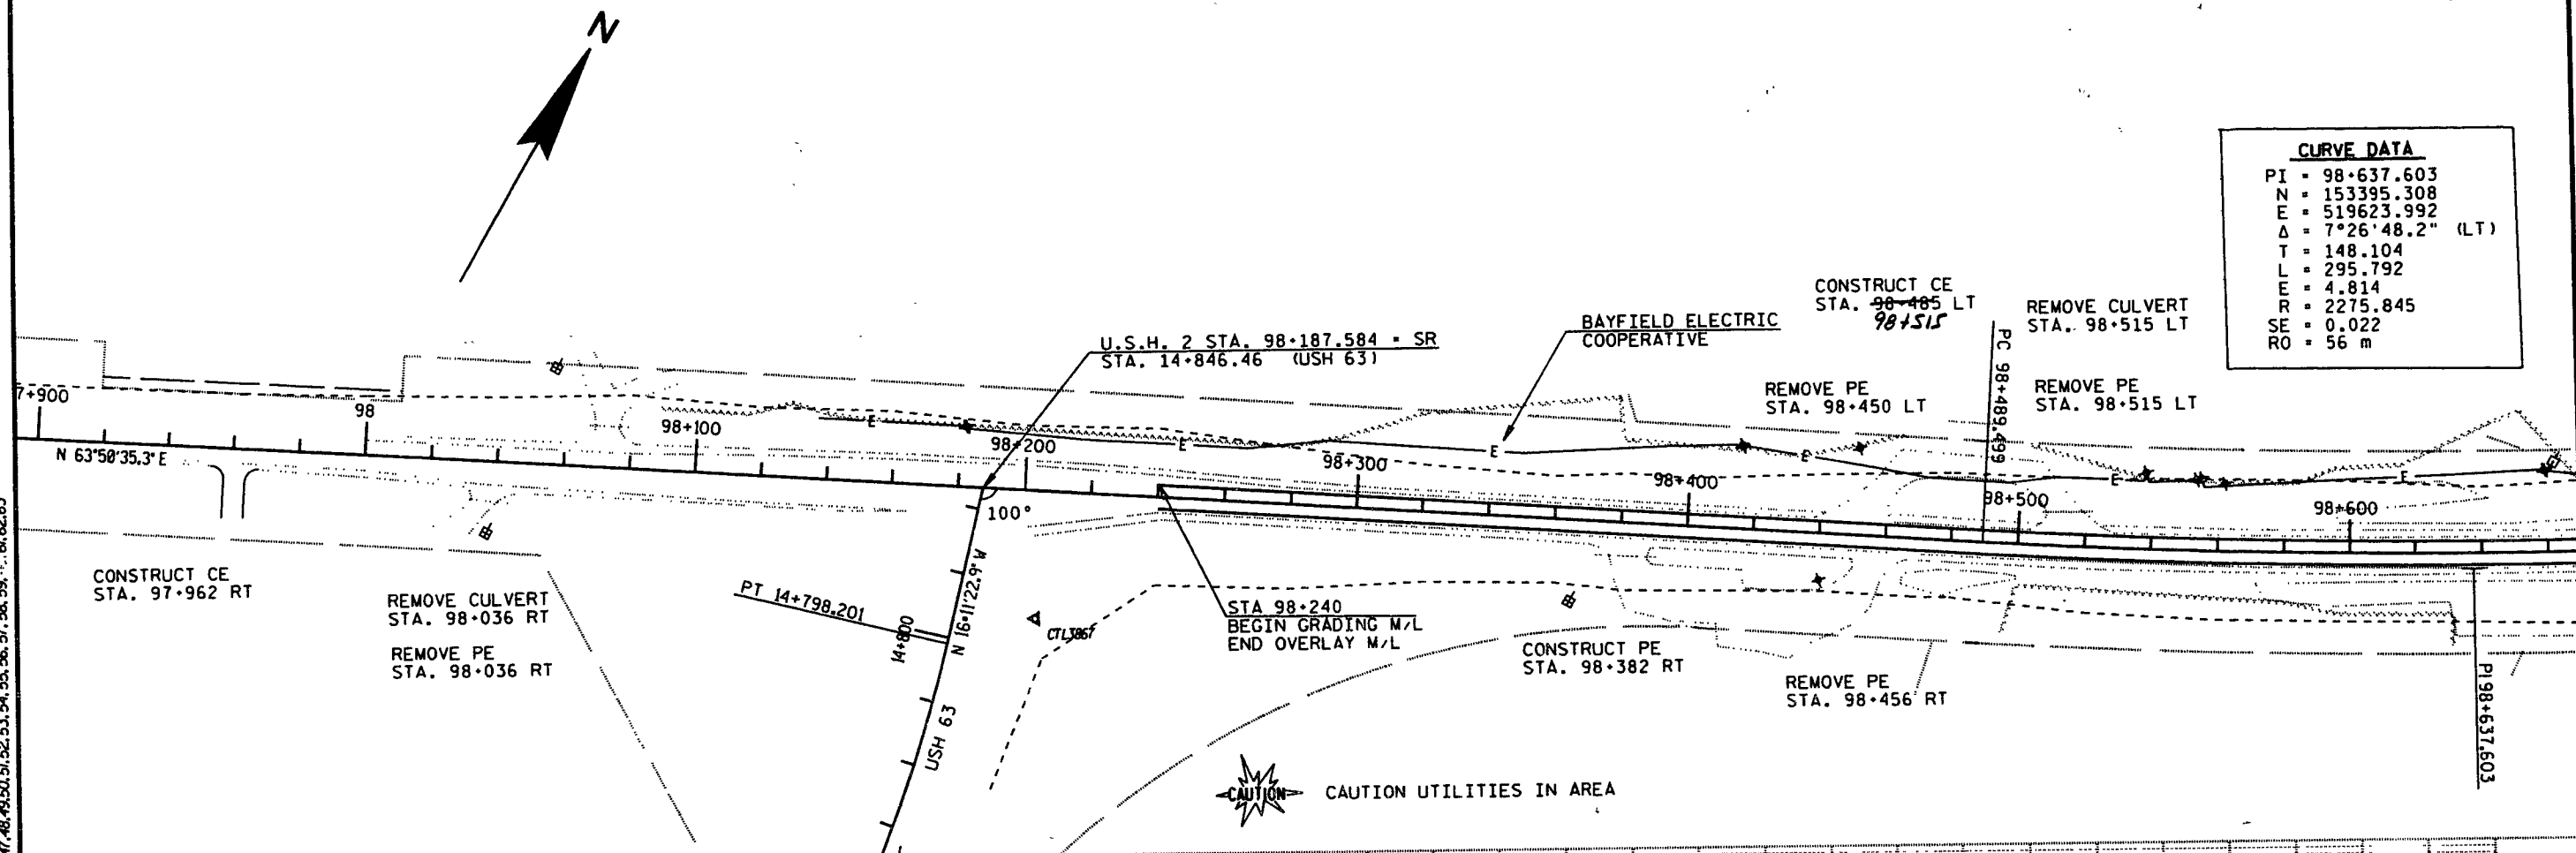

CURVE DATA	
PI	= 98+637.603
N	= 153395.308
E	= 519623.992
Δ	= 7°26'48.2" (LT)
T	= 148.104
L	= 295.792
E	= 4.814
R	= 2275.845
SE	= 0.022
RO	= 56 m




EARTHWORK SUMMARY - PHASE III	
UNCLASSIFIED EXCAVATION	= 9520 m ³
EXCAVATION BELOW SUBGRADE	= 2820 m ³
TOTAL UNCLASSIFIED EXCAVATION	= 12340 m ³
WASTE	= 12340 m ³
SELECTED BORROW EXCAVATION FOR FILL	= 4107 m ³

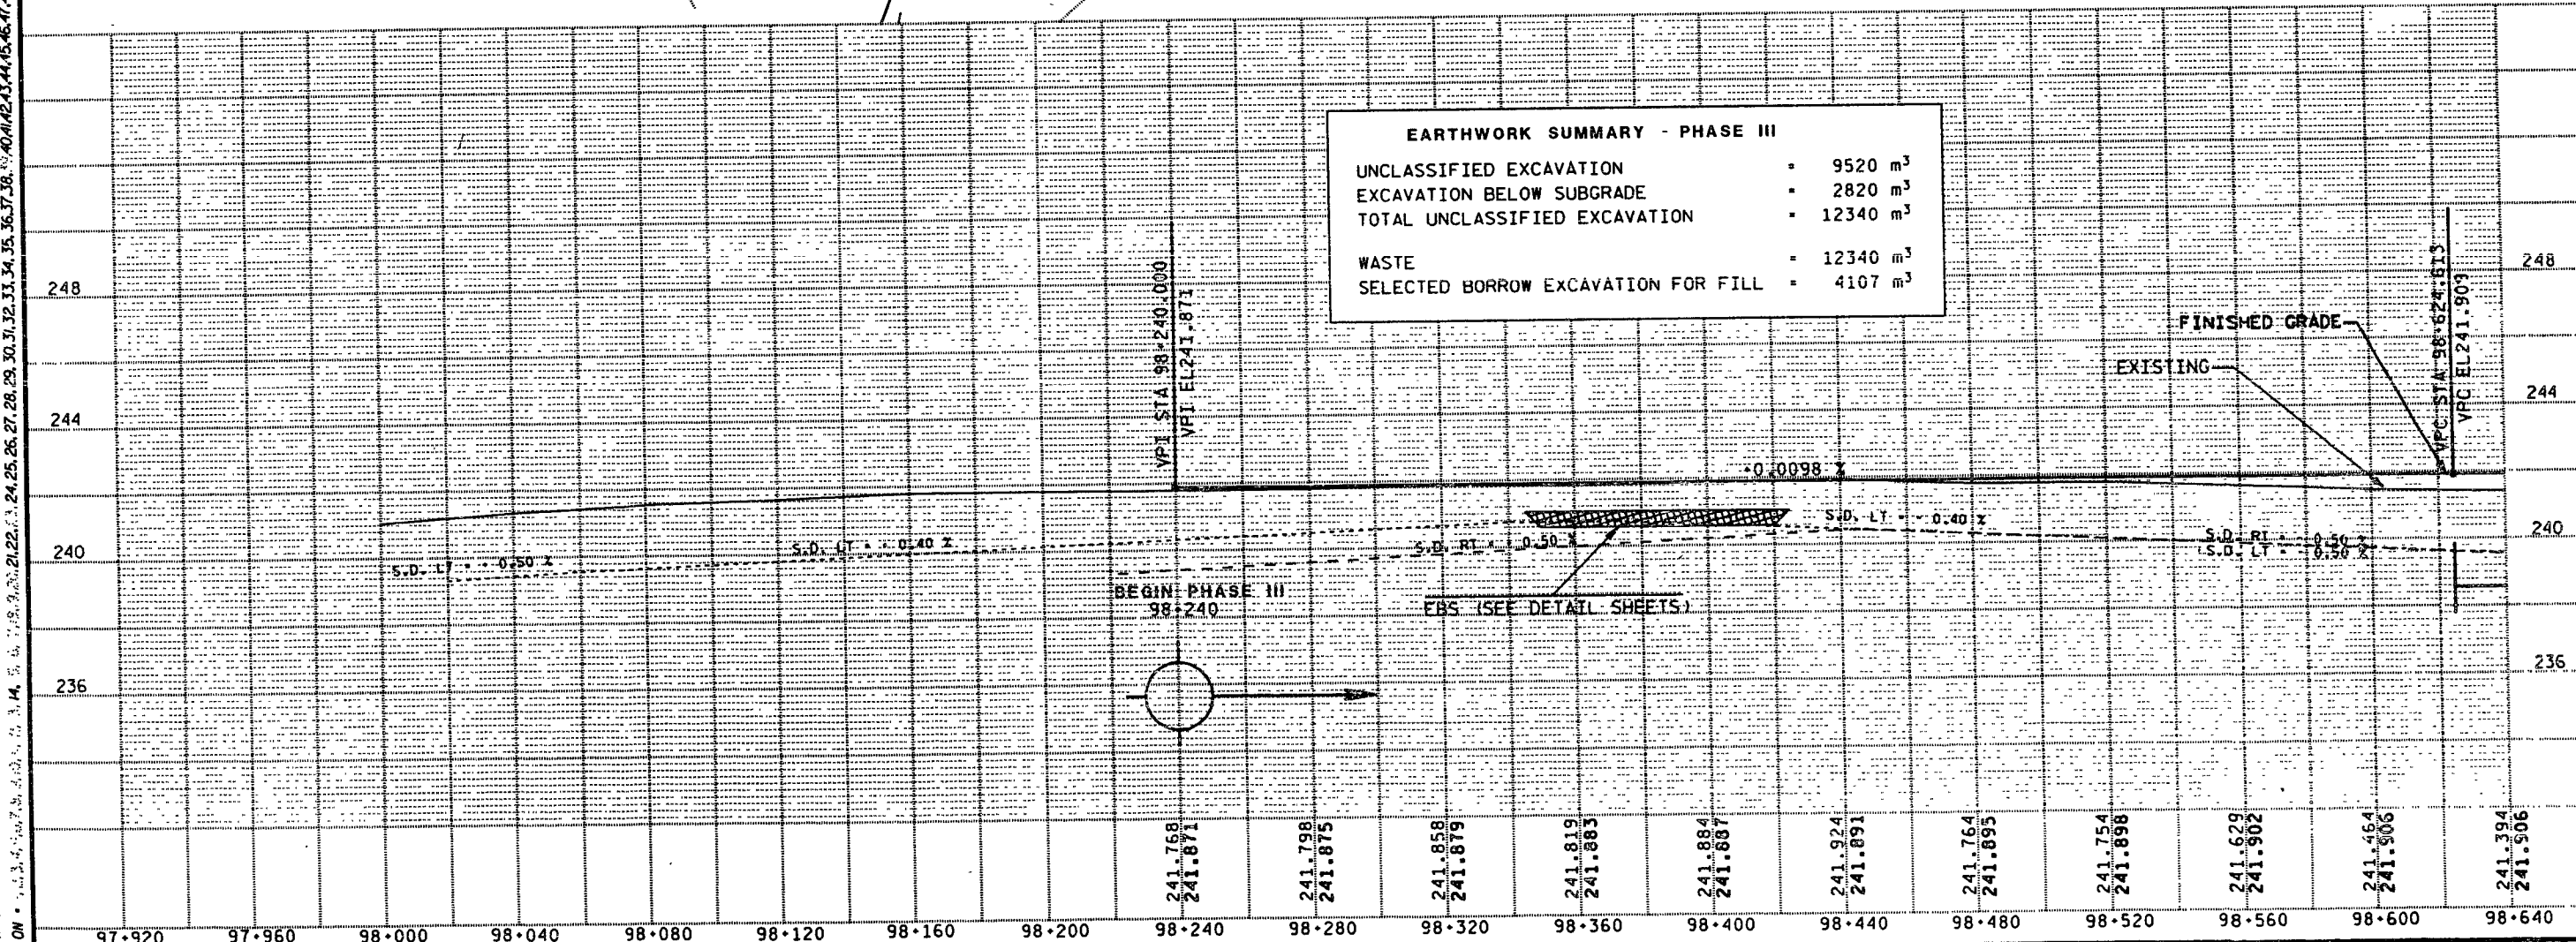

FILE NAME: PROJECTS DB 11801700 DON STH137 P2.DGN
LEVELS ON - 1, 2, 3, 62, 63

CURVE DATA

PI = 98+637.603
N = 153395.308
E = 519623.992
Δ = 7°26'48.2" (RT)
T = 148.104
L = 295.792
E = 4.814
R = 2275.845
SE = 0.022
RO = 56 m

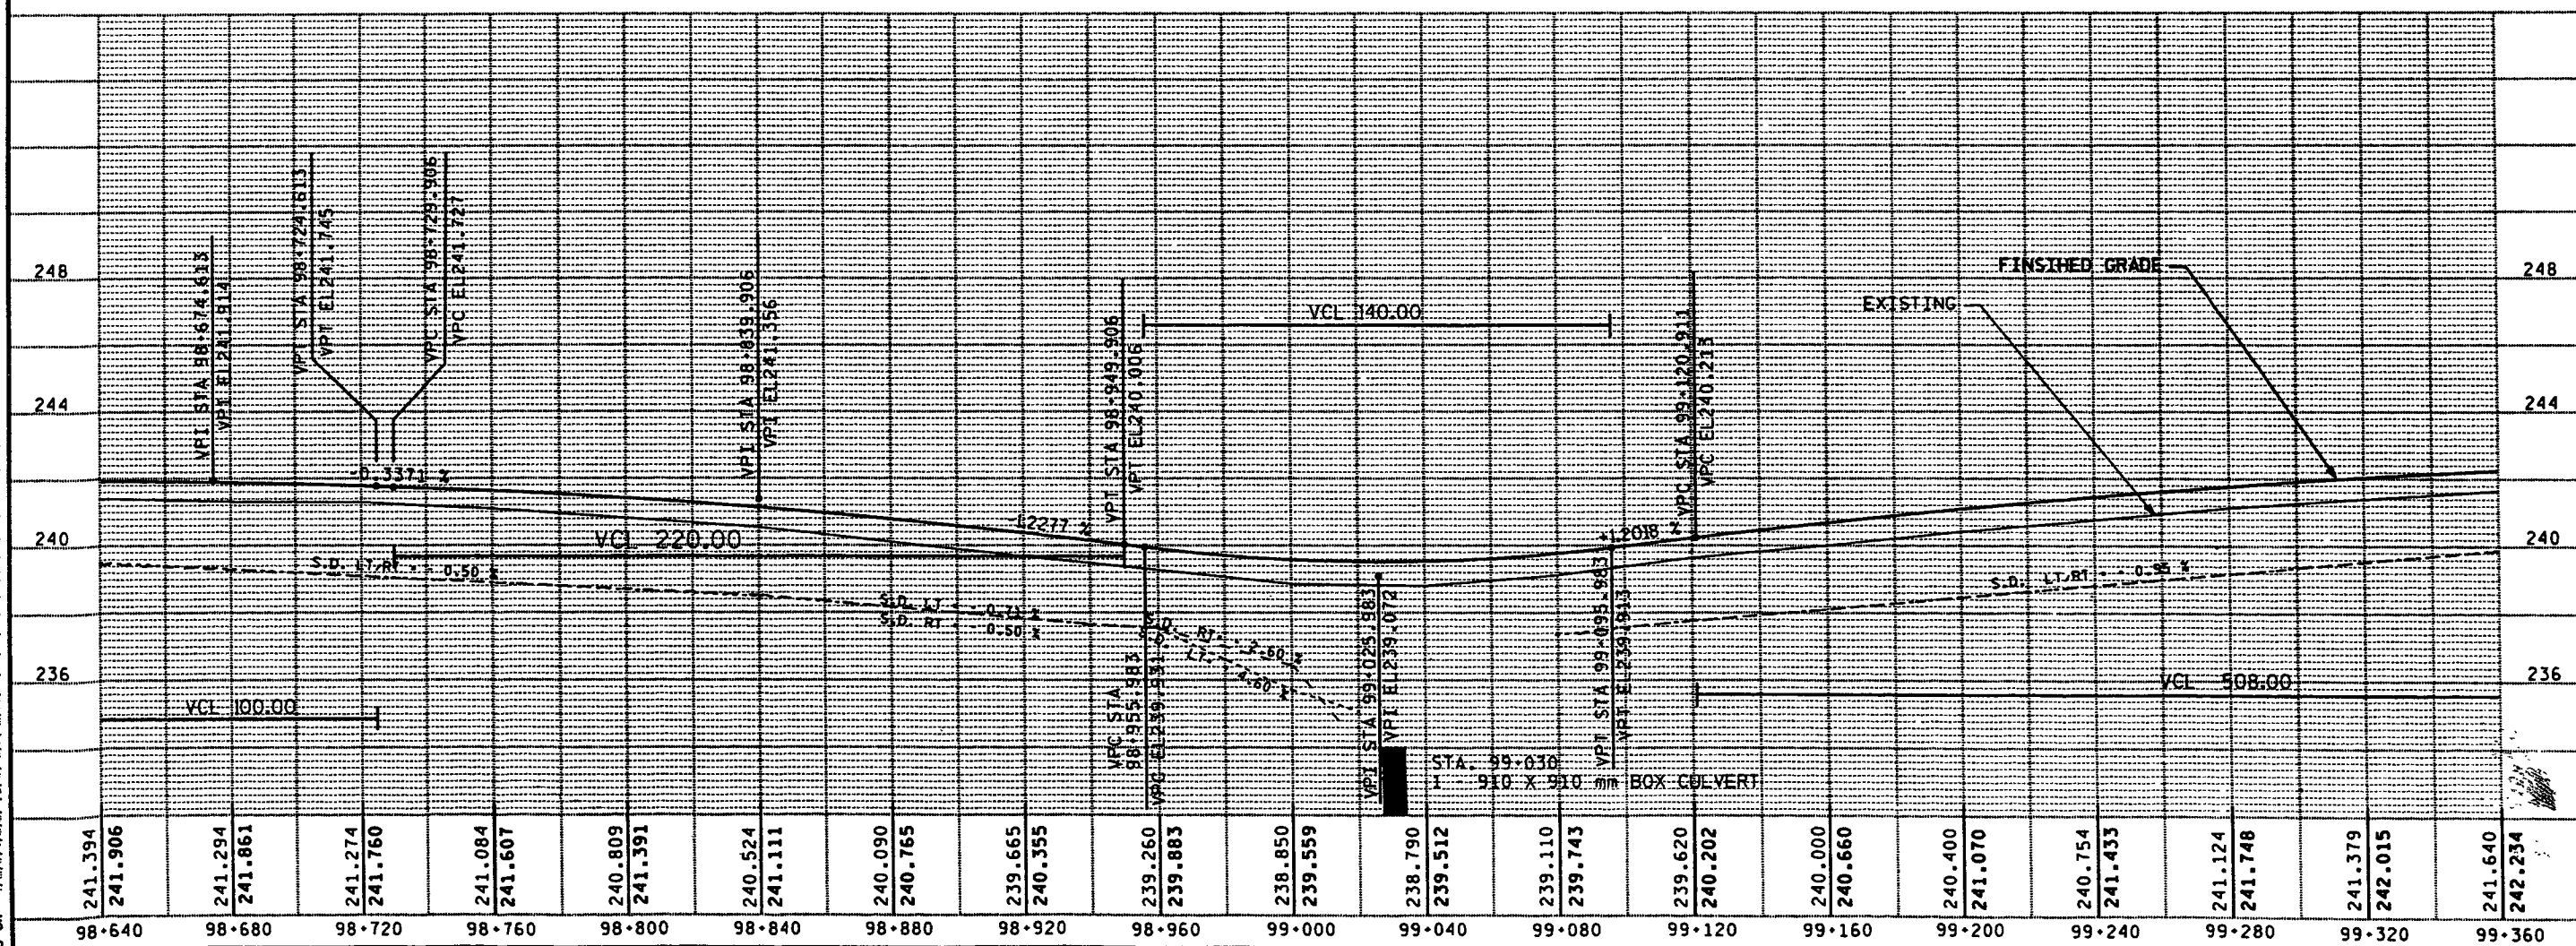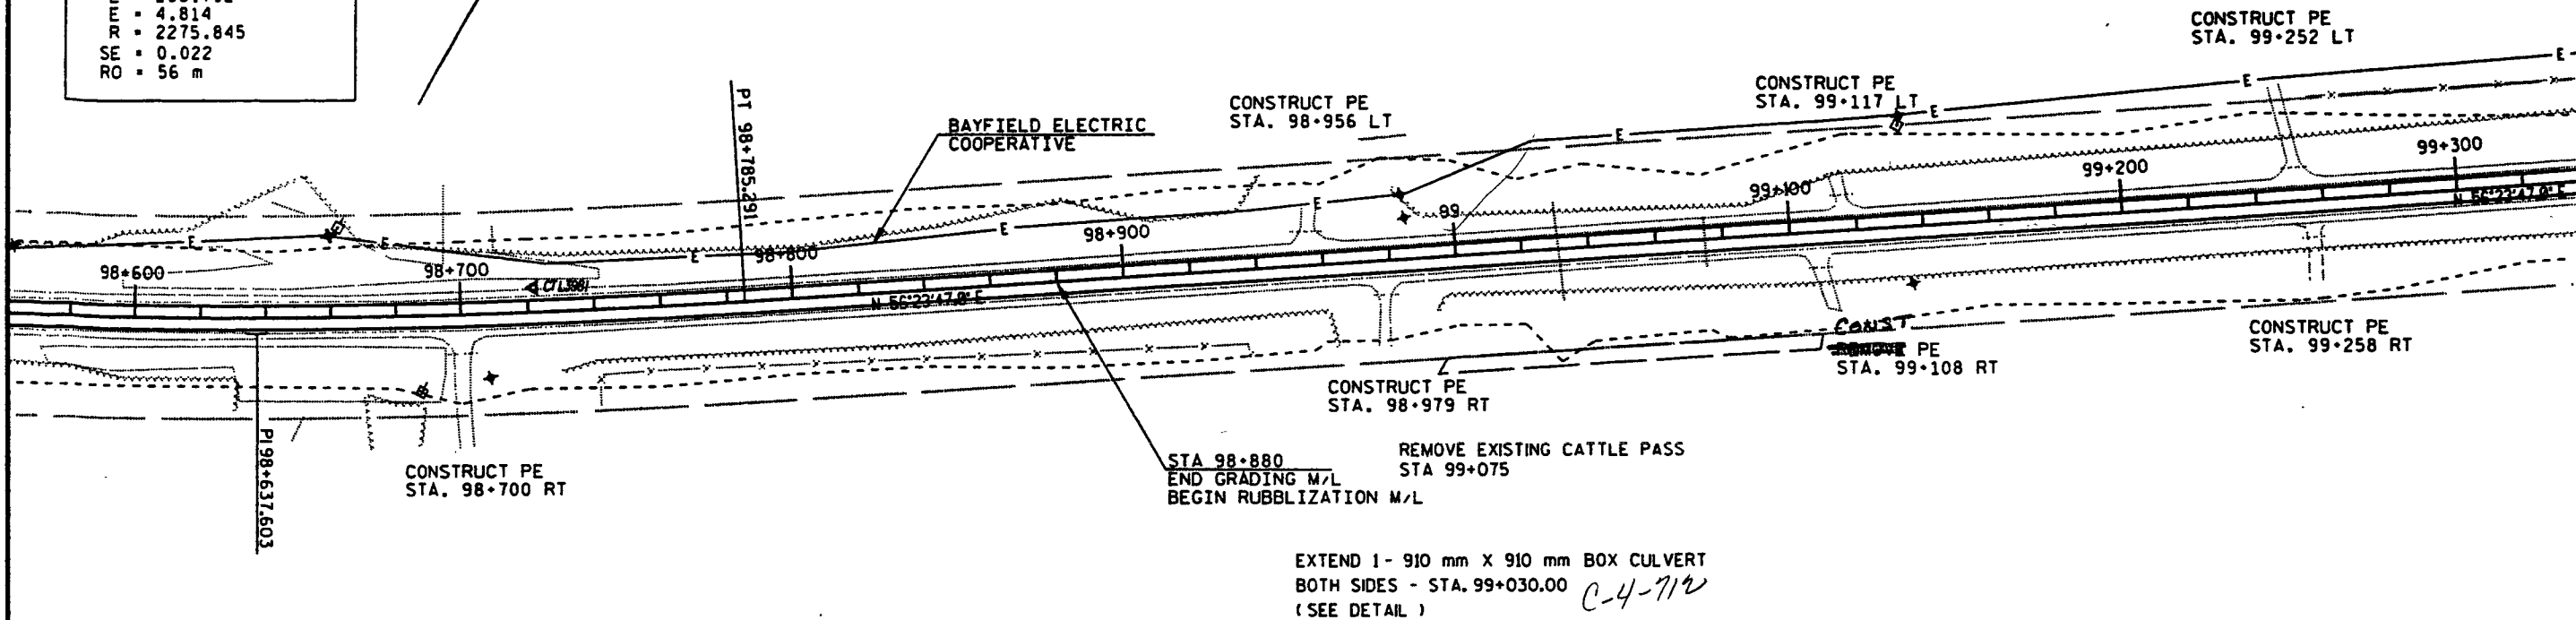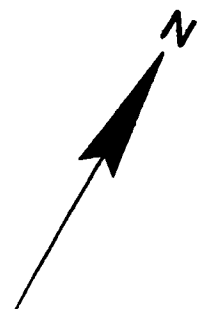

INO - STH 13

SCALE: 1:2000 HWY: U.S.H. 2

COUNTY: BAYFIELD


STATE PROJECT NO: 1180-17-71

SHEET NO: 5.10

M

REV. DATE:

FILE NAME: PROJECTS DB 11801700 DON STH137 P3.DGN
LEVELS ON: 11801700 DON STH137 P3.DGN

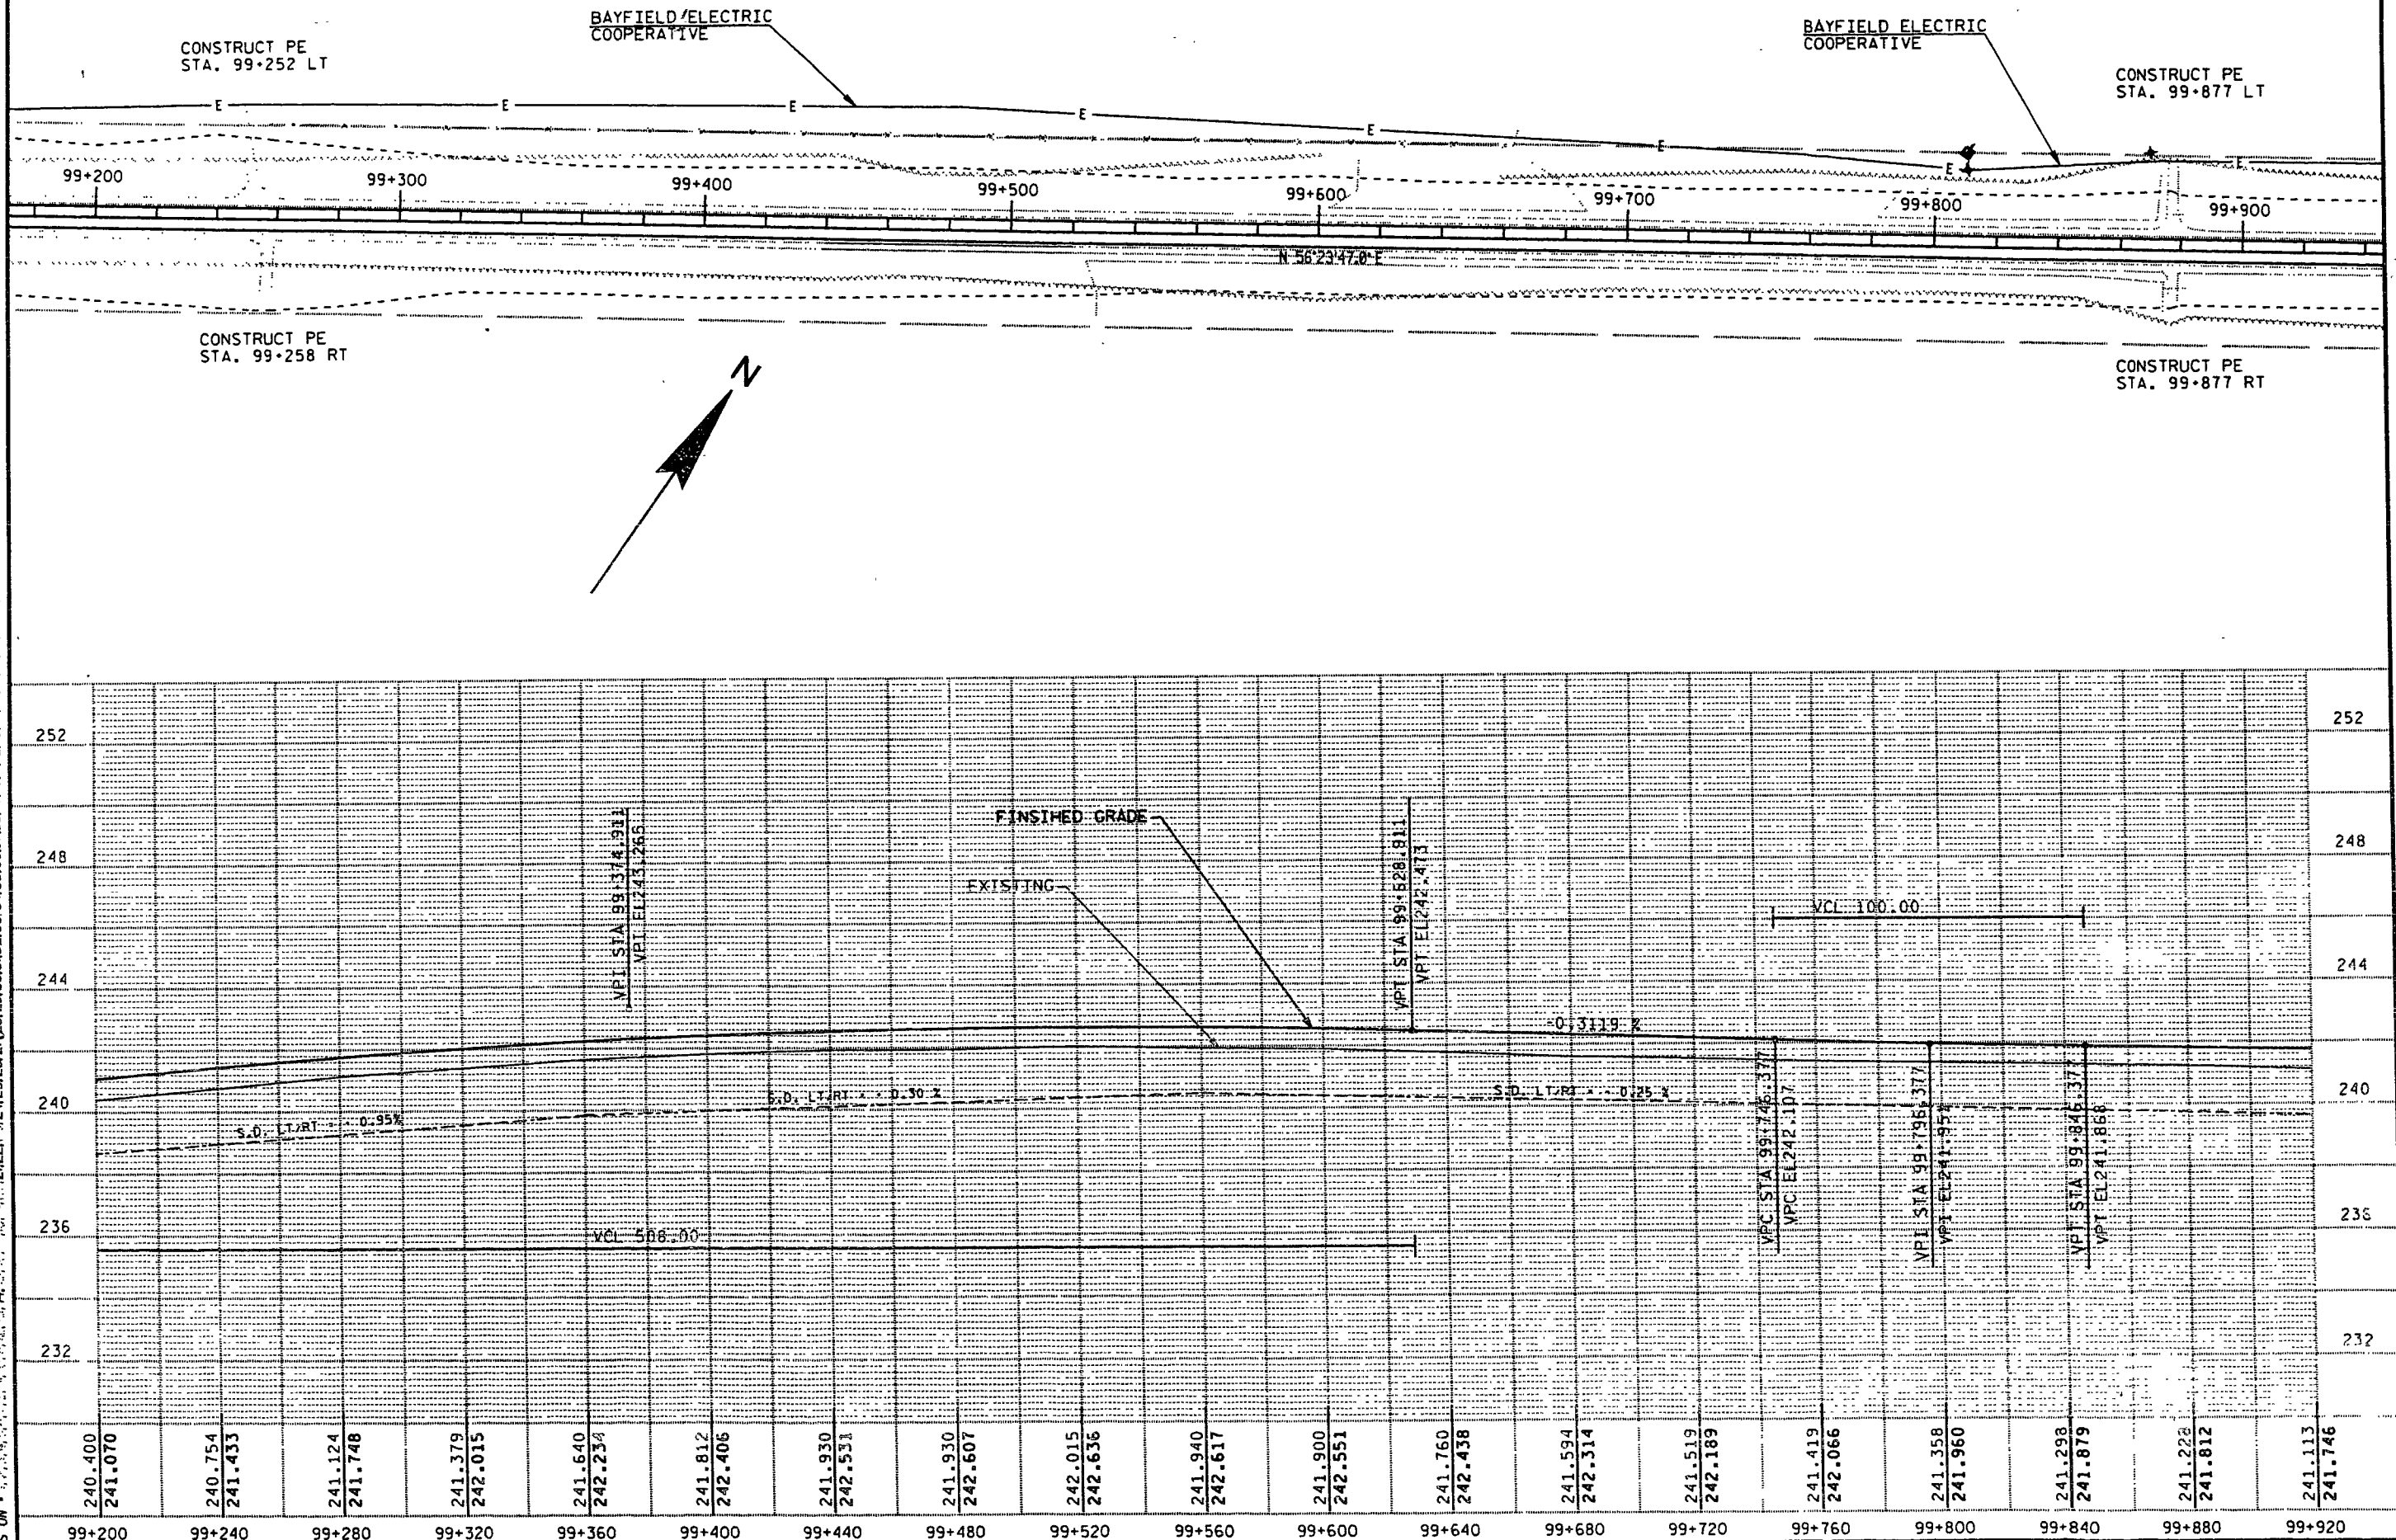


INO - STH 13

SCALE: 1:2000 HWY: U.S.H. 2

COUNTY: BAYFIELD

STATE PROJECT NO: 1180-17-71

SHEET NO: 5.11

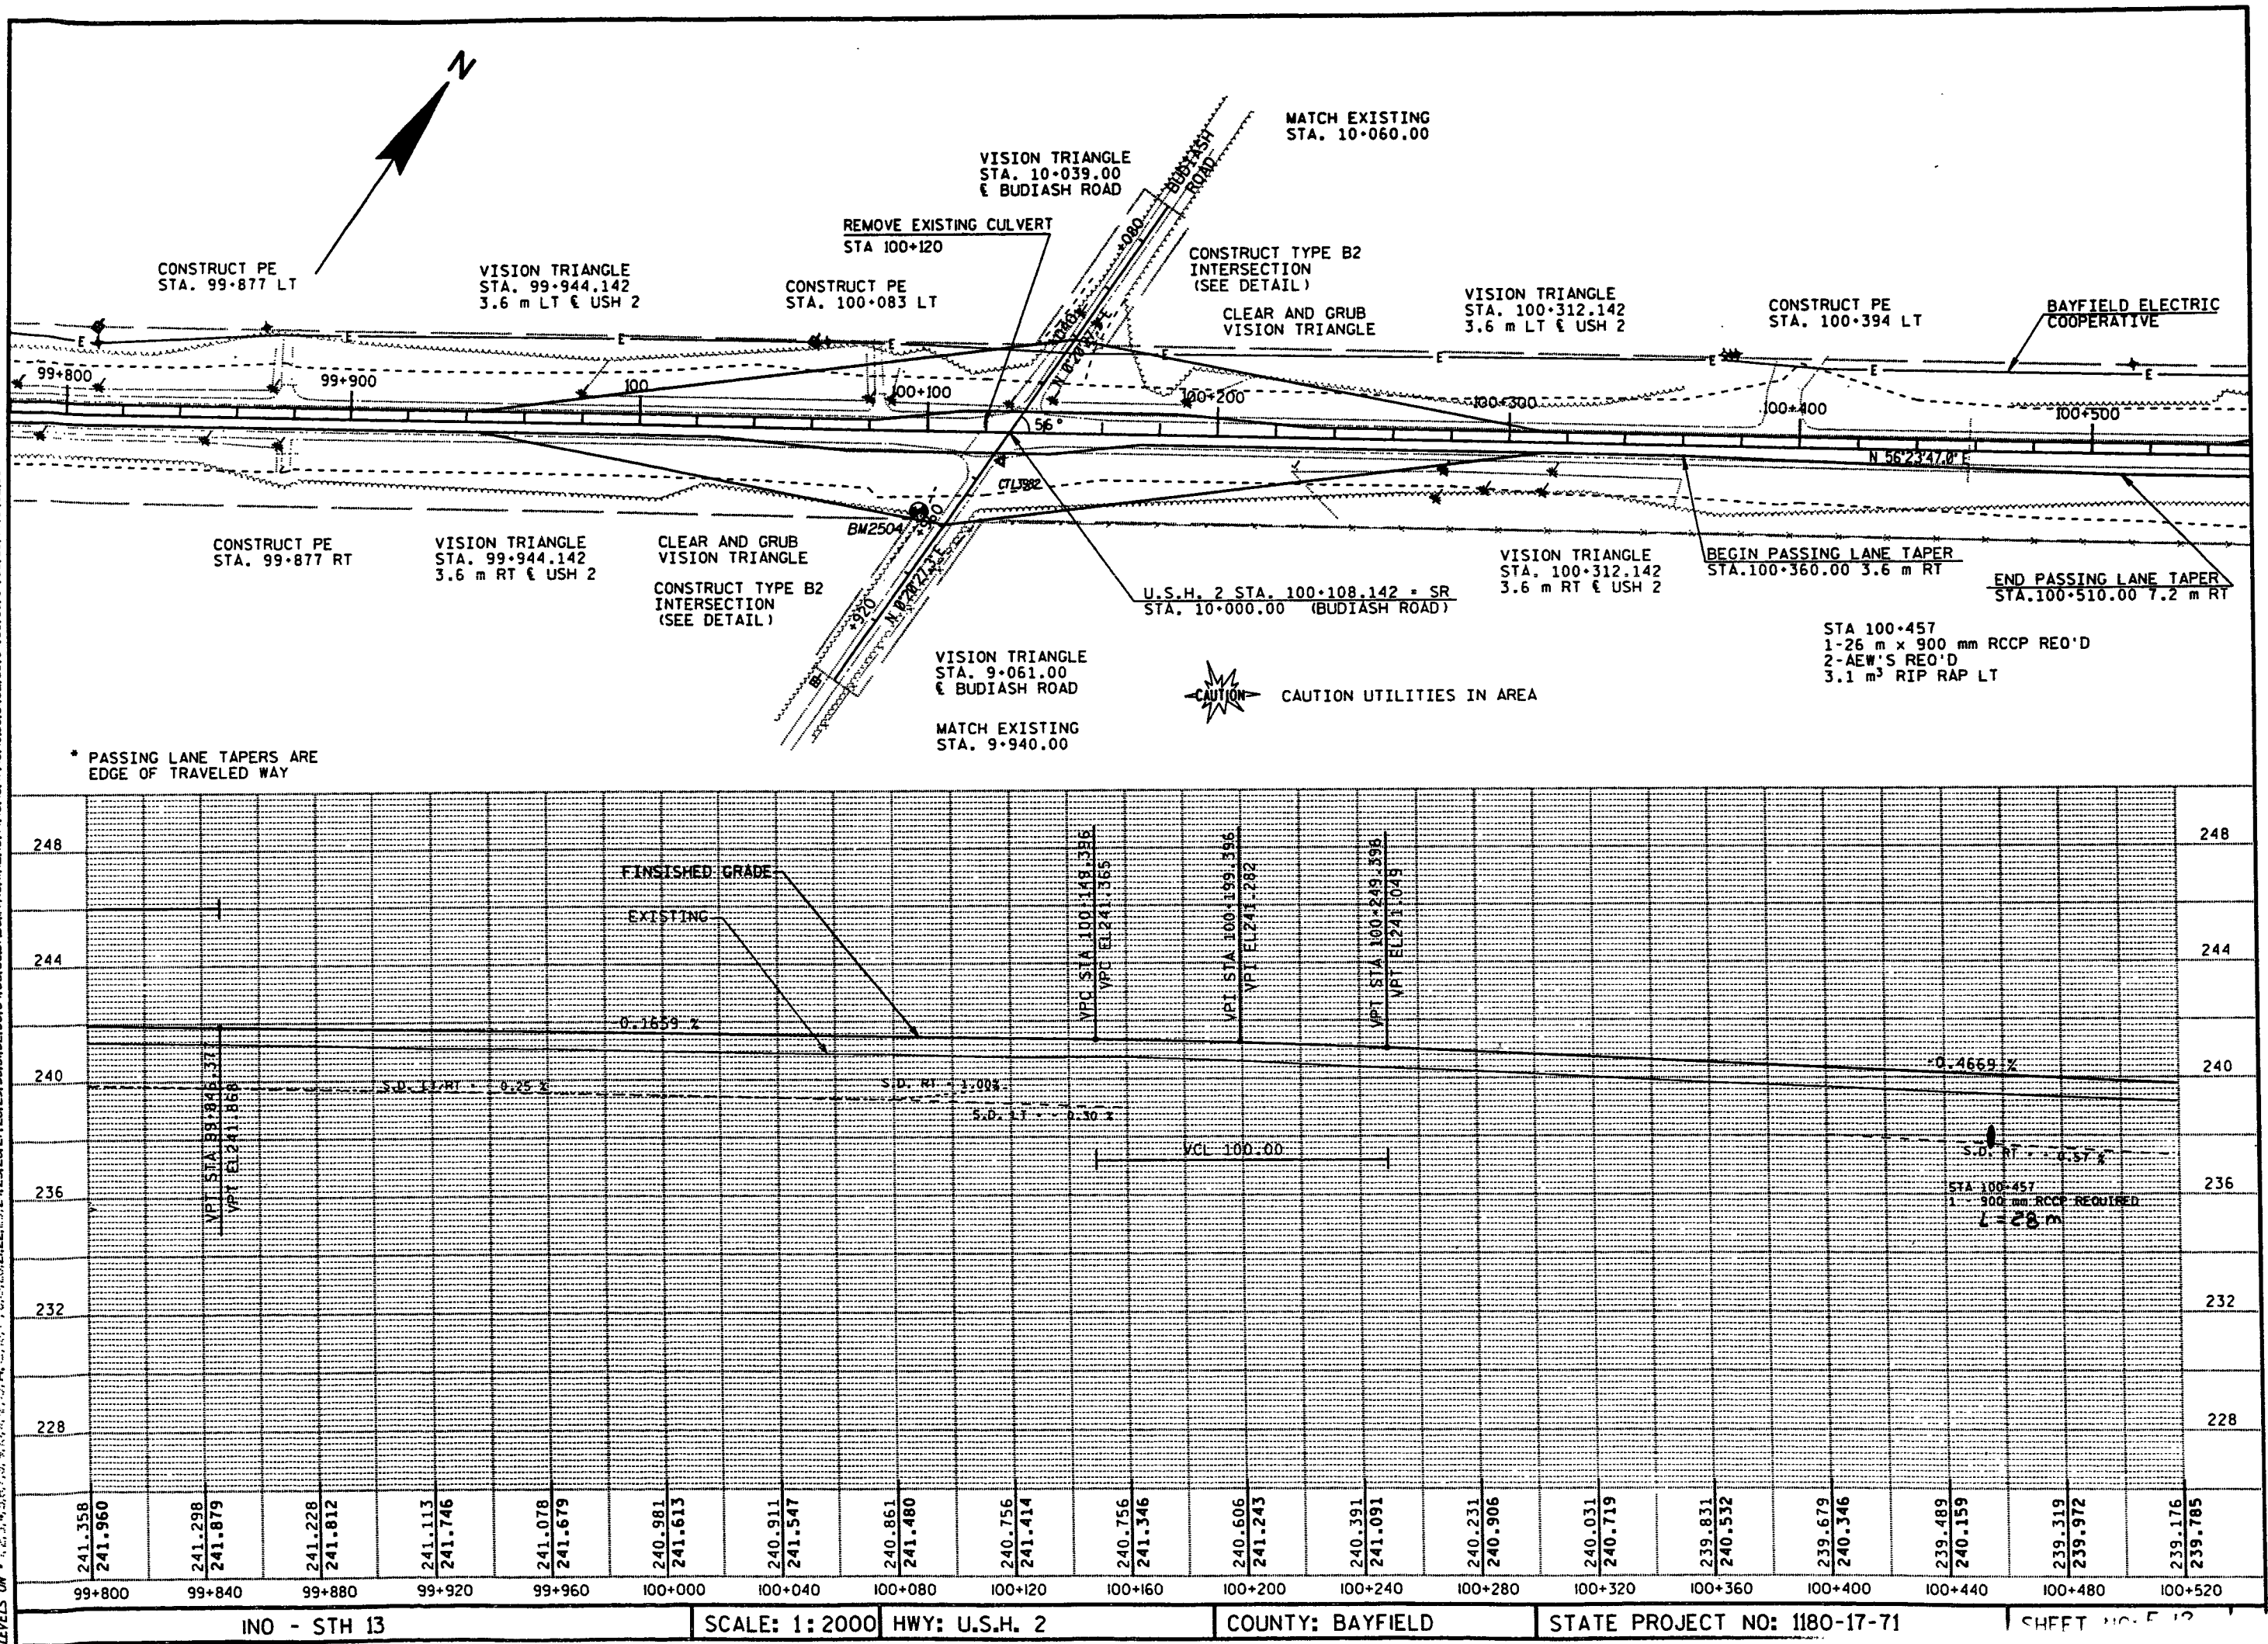

BENCHMARKS			
NO.	STATION	DESCRIPTION	ELEVATION
217	100+453.739	0.25 m ASPEN, 21.263 m RT	238.305
218	100+848.534	0.51 m N.PINE, 19.882 m RT	235.936

SEE PG 5.0

MATCH EXISTING
19+854.00

VISION TRIANGLE
STA. 19+961.00
E OLD USH 2

CURVE DATA

PI = 19+937.557
N = 154611.924
E = 521328.289
Δ = 55°44'13.6" (RT)
T = 47.589
L = 87.552
E = 11.807
R = 90.000
SE = NC

CURVE DATA

PI = 30+069.996
N = 154605.954
E = 521572.384
Δ = 55°34'04.0" (LT)
T = 47.419
L = 87.286
E = 11.728
R = 90.000
SE = NC

CONSTRUCT PE
STA. 19+955 LT

CONSTRUCT TYPE B2
INTERSECTION
(SEE DETAIL)

VISION TRIANGLE
STA. 100+546.00
3.6 m LT & USH 2

CONSTRUCT PE
STA. 100+394 LT

BAYFIELD ELECTRIC
COOPERATIVE

CLEAR AND GRUB
VISION TRIANGLE
TO ROW

REMOVE PE
STA. 100+716 LT


OBLITERATE
EXISTING ROAD

REMOVE EXISTING CULVERT
CLEAR AND GRUB
VISION TRIANGLE

VISION TRIANGLE
STA. 100+914.00
3.6 m LT & USH 2

STA 100+965
1-27.9 m x 600 mm RCCP REQ'D
2-AEW'S REQ'D
1.9 m³ RIP RAP LT

CONSTRUCT PE
STA. 101+116 LT

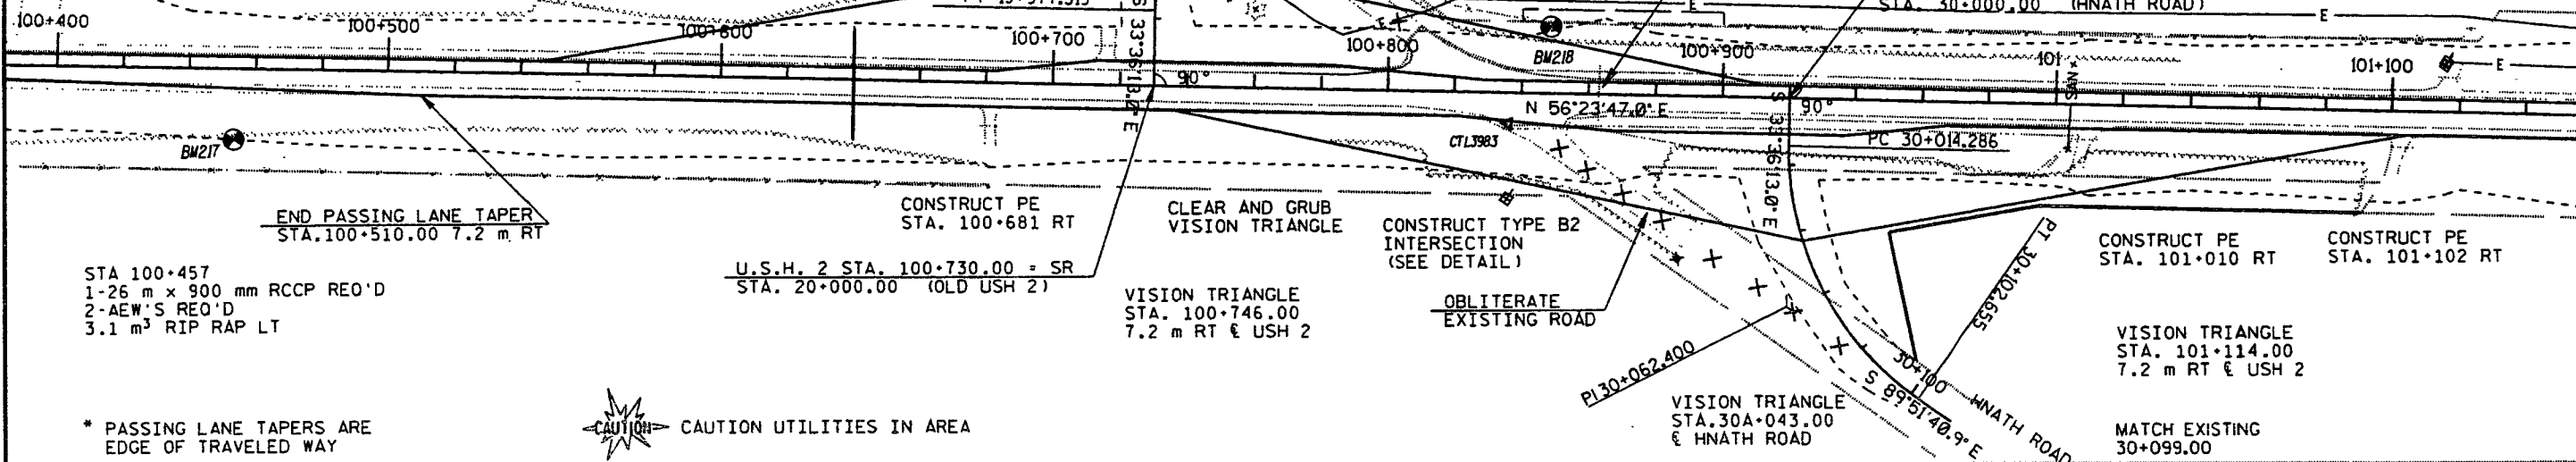

STA 100+457
1-26 m x 900 mm RCCP REQ'D
2-AEW'S REQ'D
3.1 m³ RIP RAP LT

END PASSING LANE TAPER
STA. 100+510.00 7.2 m RT

CONSTRUCT PE
STA. 100+681 RT

U.S.H. 2 STA. 100+730.00 = SR
STA. 20+000.00 (OLD USH 2)

VISION TRIANGLE
STA. 100+746.00
7.2 m RT & USH 2

CONSTRUCT TYPE B2
INTERSECTION
(SEE DETAIL)

OBLITERATE
EXISTING ROAD

CONSTRUCT PE
STA. 101+010 RT


CONSTRUCT PE
STA. 101+102 RT

VISION TRIANGLE
STA. 101+114.00
7.2 m RT & USH 2

MATCH EXISTING
30+099.00

* PASSING LANE TAPERS ARE
EDGE OF TRAVELED WAY

CAUTION UTILITIES IN AREA

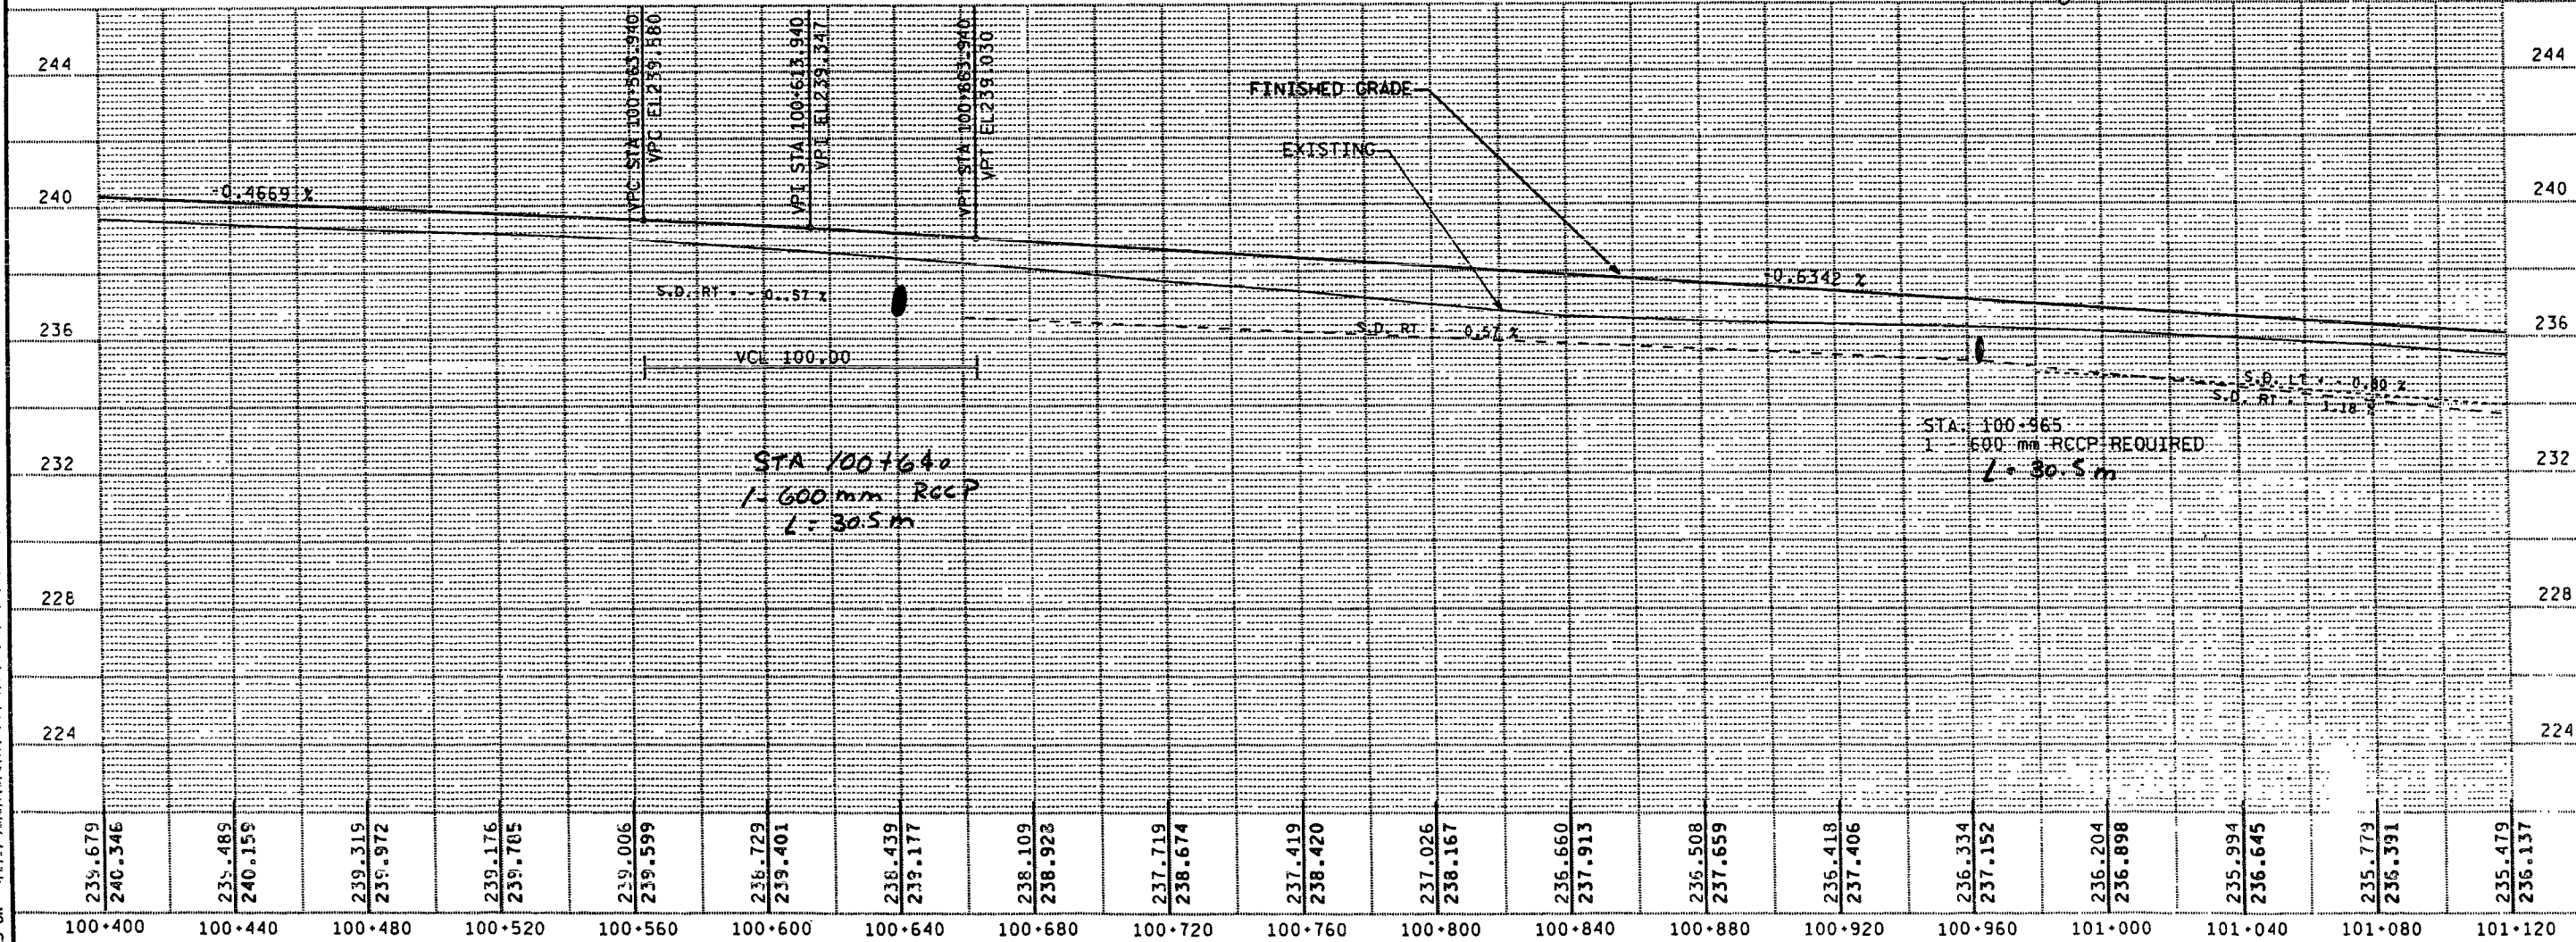

STA 100+640
1-600 mm RCCP
L = 30.5 m

STA. 100+965
1-600 mm RCCP REQUIRED
L = 30.5 m

FILE NAME: PROJECTS DB 11801700 DON STH137 P5.DGN
LEVELS ON: 1, 2, 3, 62, 63

INO - STH 13

SCALE: 1:2000 HWY: U.S.H. 2

COUNTY: BAYFIELD



STATE PROJECT NO: 1180-17-71

SHEET NO: 5 13

FILE NAME: PROJECTS DB 11801700 DGN STH137 P6.DGN
LEVELS ON: 1, 2, 3, 62, 63

BENCHMARKS			
NO.	STATION	DESCRIPTION	ELEVATION
219	101+217.958	0.25 m W.Pine, 14.075 m LT.	234.038
220	101+572.872	0.30 m N.Pine, 19.097 m LT.	232.651

SEE PG 5.0

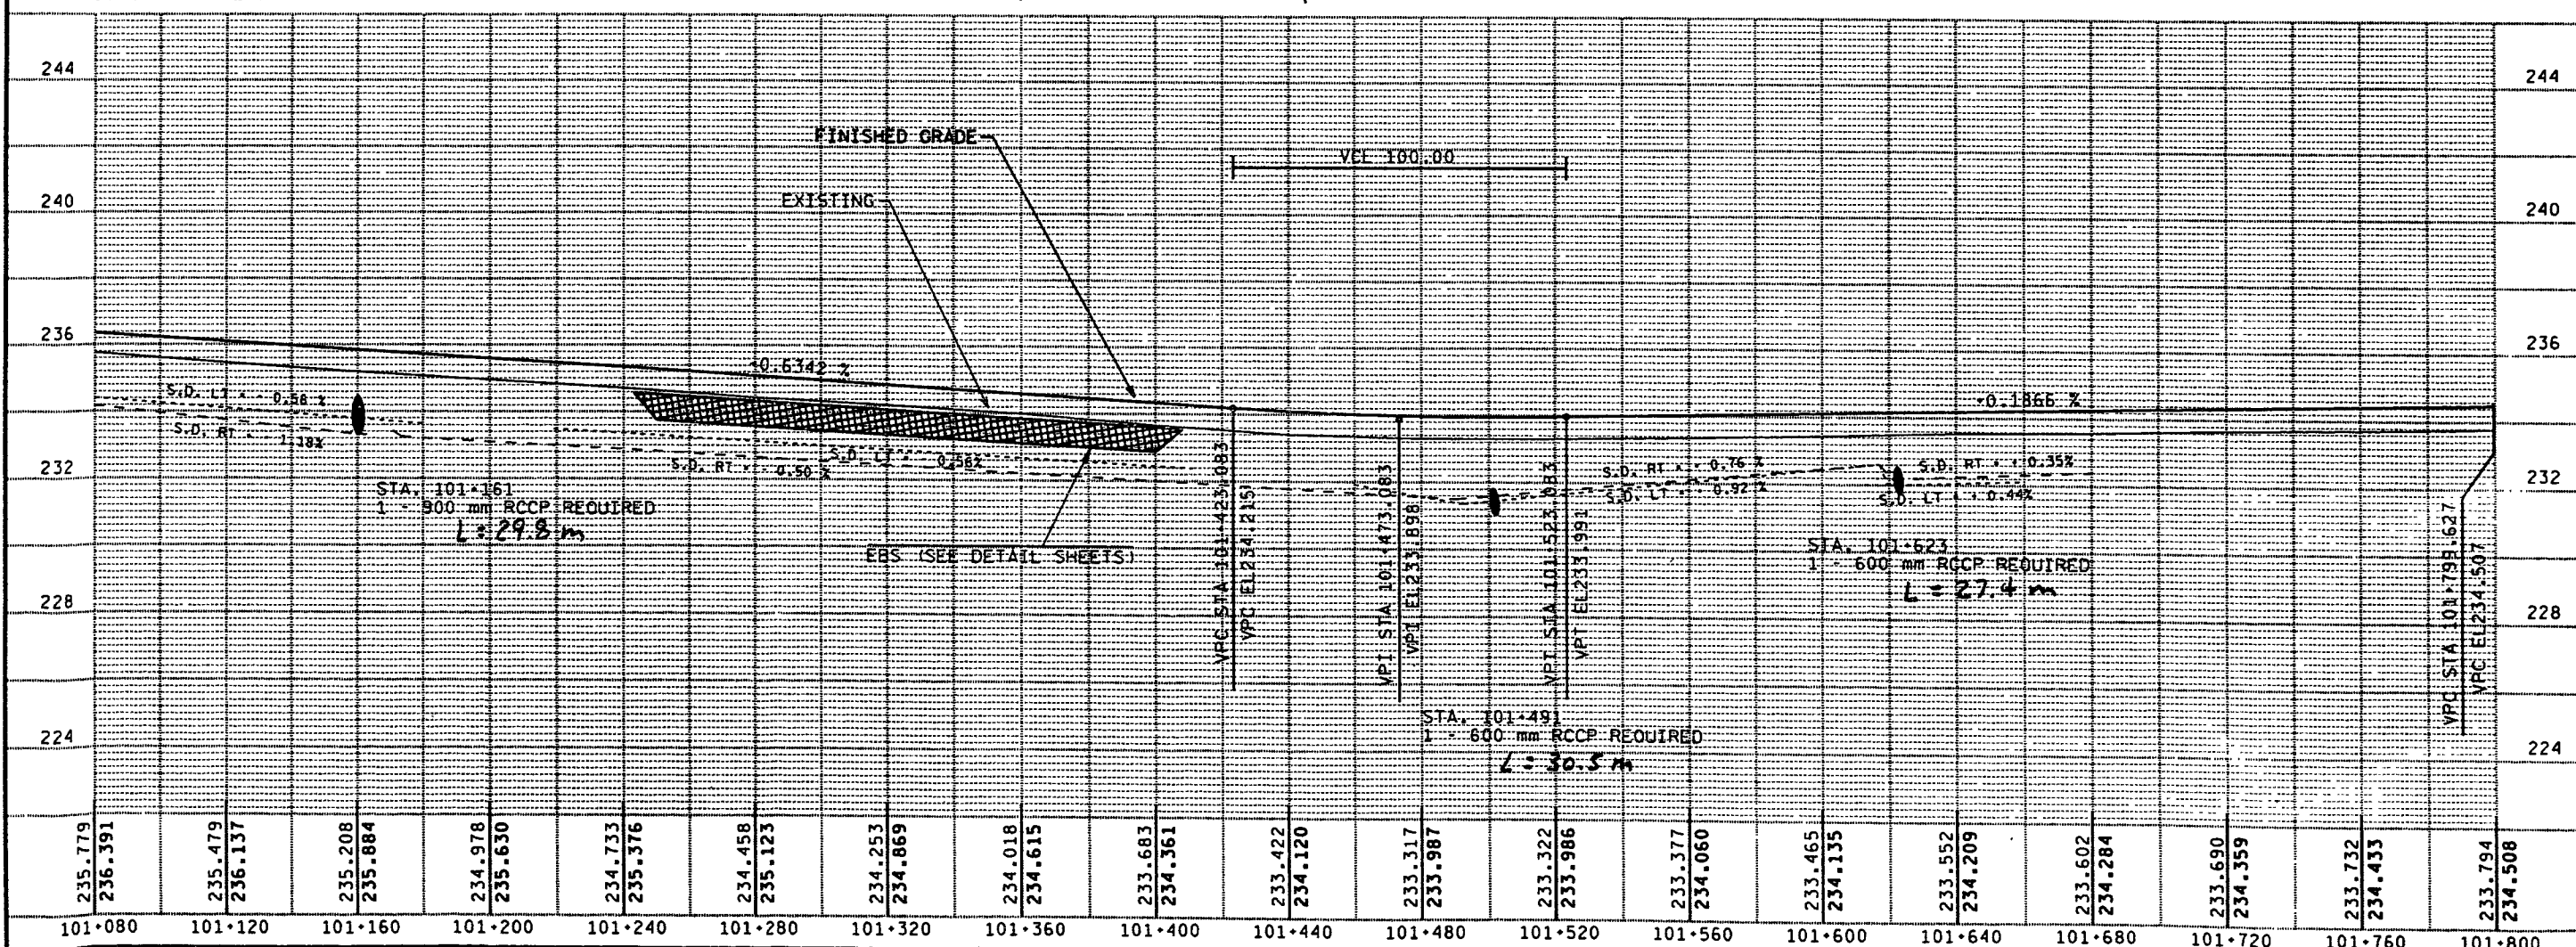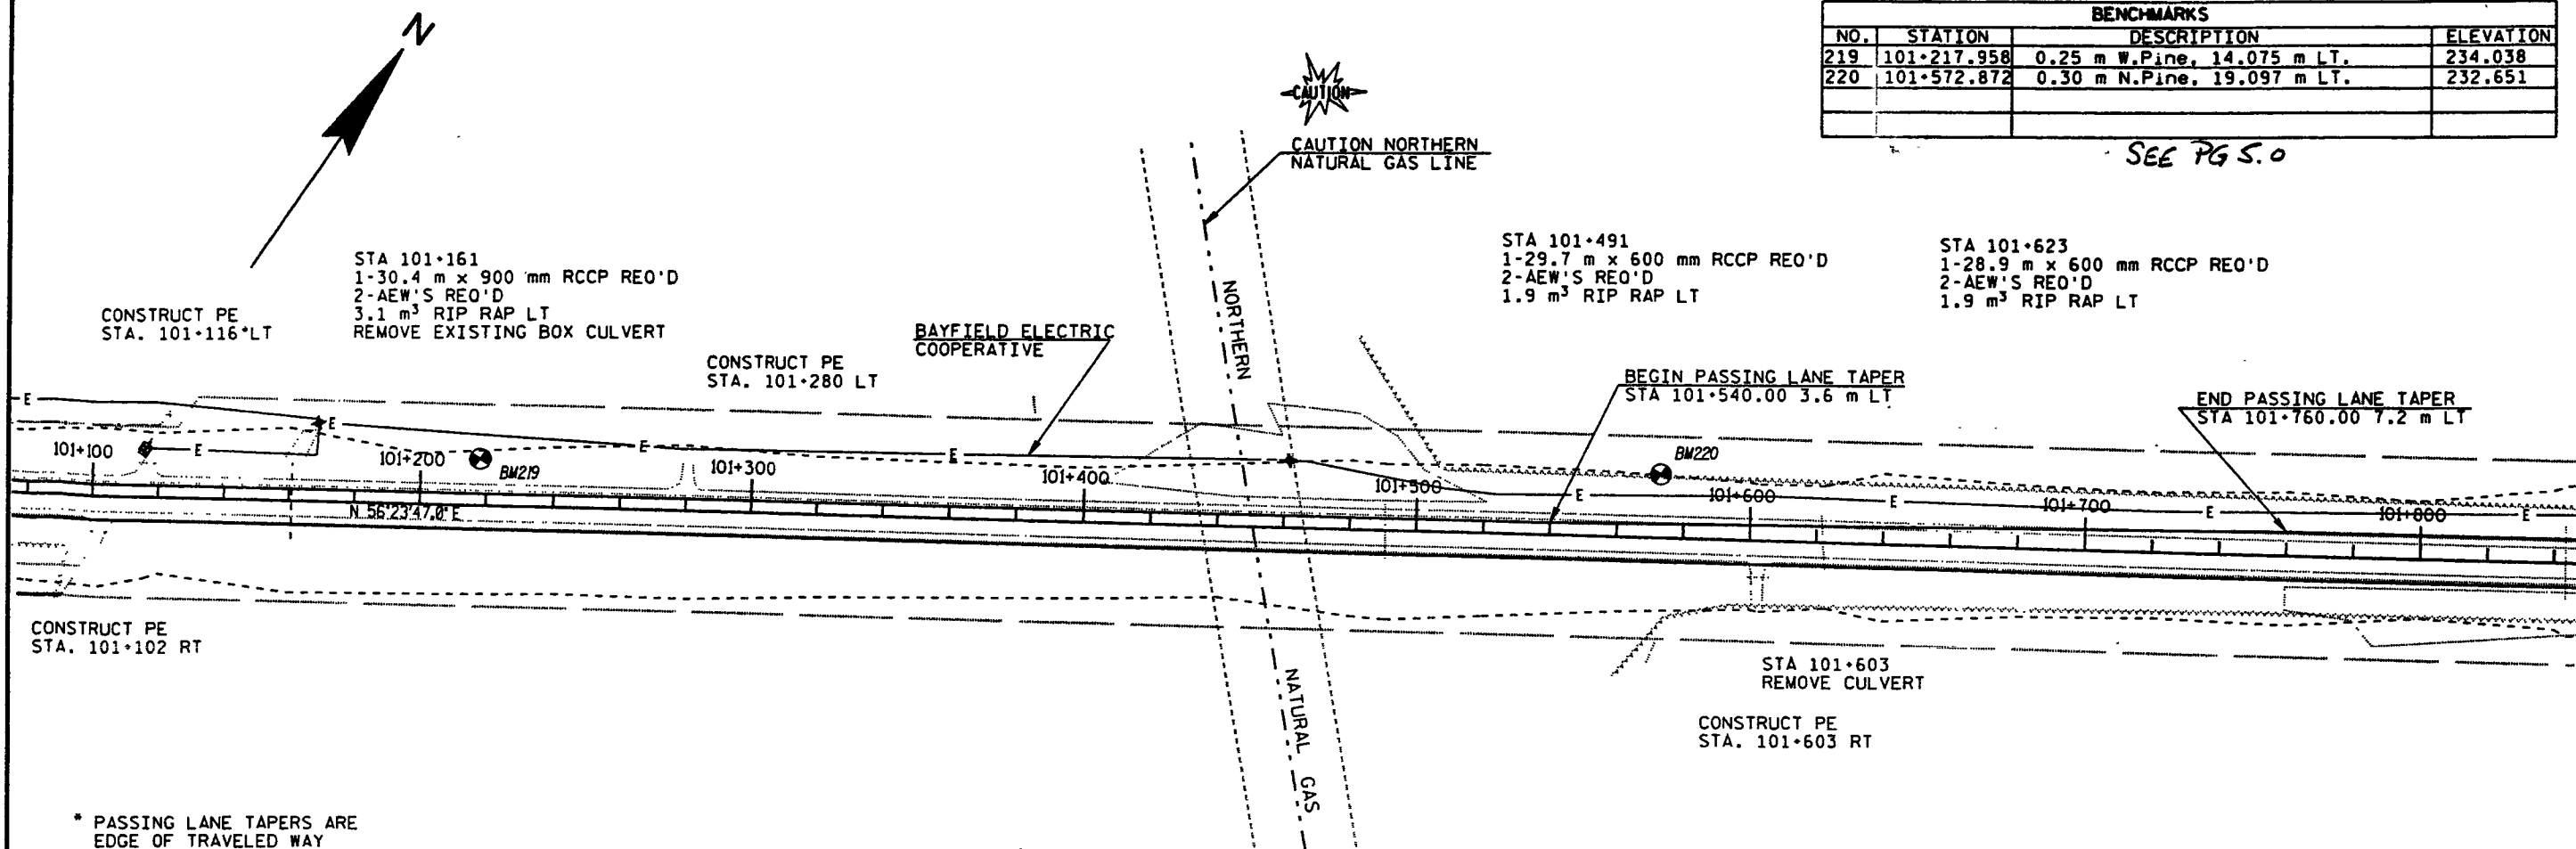

INO - STH 13

SCALE: 1:2000 HWY: U.S.H. 2


COUNTY: BAYFIELD

STATE PROJECT NO: 1180-17-71


SHEET NO: 5.14

BENCHMARKS			
NO.	STATION	DESCRIPTION	ELEVATION
221	101+894.449	0.46 m WHITE PINE, 17.063 m RT	233.680
222	102+099.144	NGS E-213 MONUMENT, 19.215 m RT	236.157
223	102+480.288	0.25 m ASPEN 14.609 m RT	236.488

SEE PG 5.0

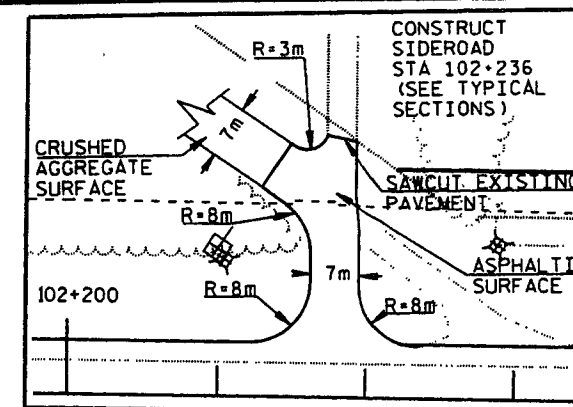

FILE NAME: PROJECTS DB 1801700 DON STH137 P7.DGN
LEVELS ON: 101+800, 101+840, 101+880, 101+920, 101+960, 102+000, 102+040, 102+080, 102+120, 102+160, 102+200, 102+240, 102+280, 102+320, 102+360, 102+400, 102+440, 102+480, 102+520

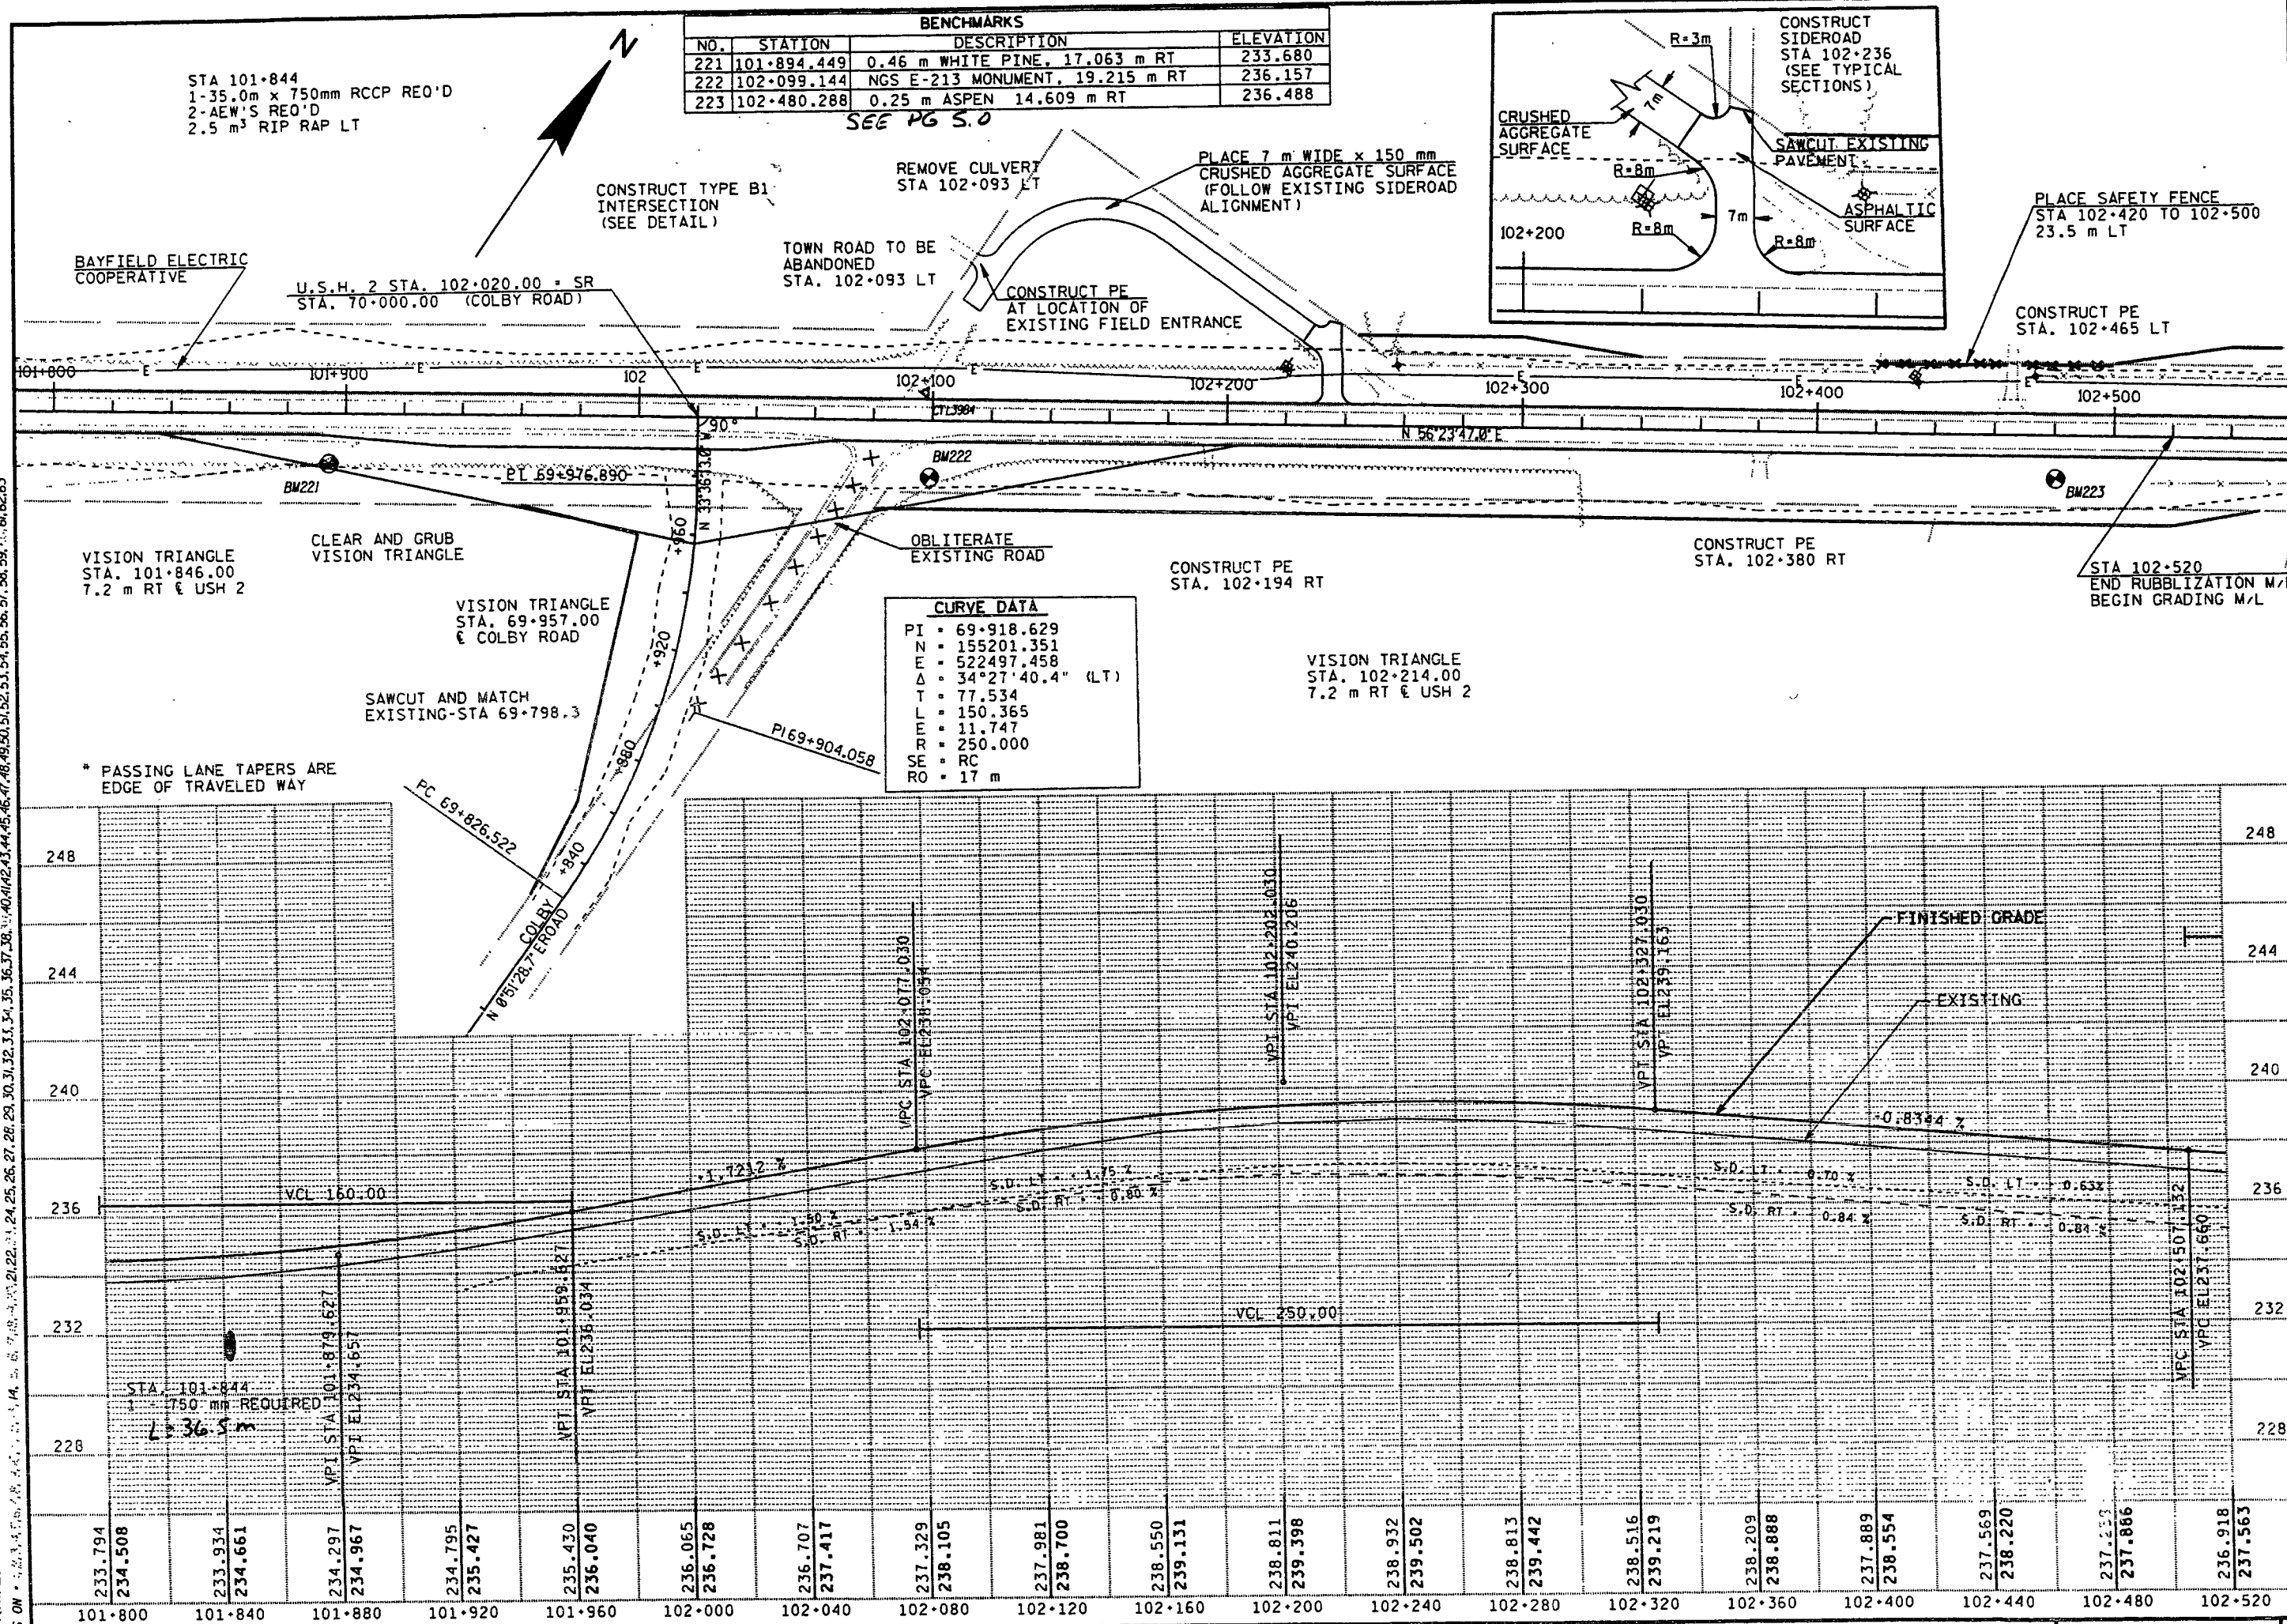

INO - STH 13

SCALE: 1:2000 HWY: U.S.H. 2


COUNTY: BAYFIELD

STATE PROJECT NO: 1180-17-71

SHEET NO: 5.15

M

FILE NAME: PROJ TS DB 1801700 DGN STH137 PB.DGN
LEVELS ON = 1.0, 1.5, 2.0, 29.0, 30.0, 31.0, 62.0, 63.0

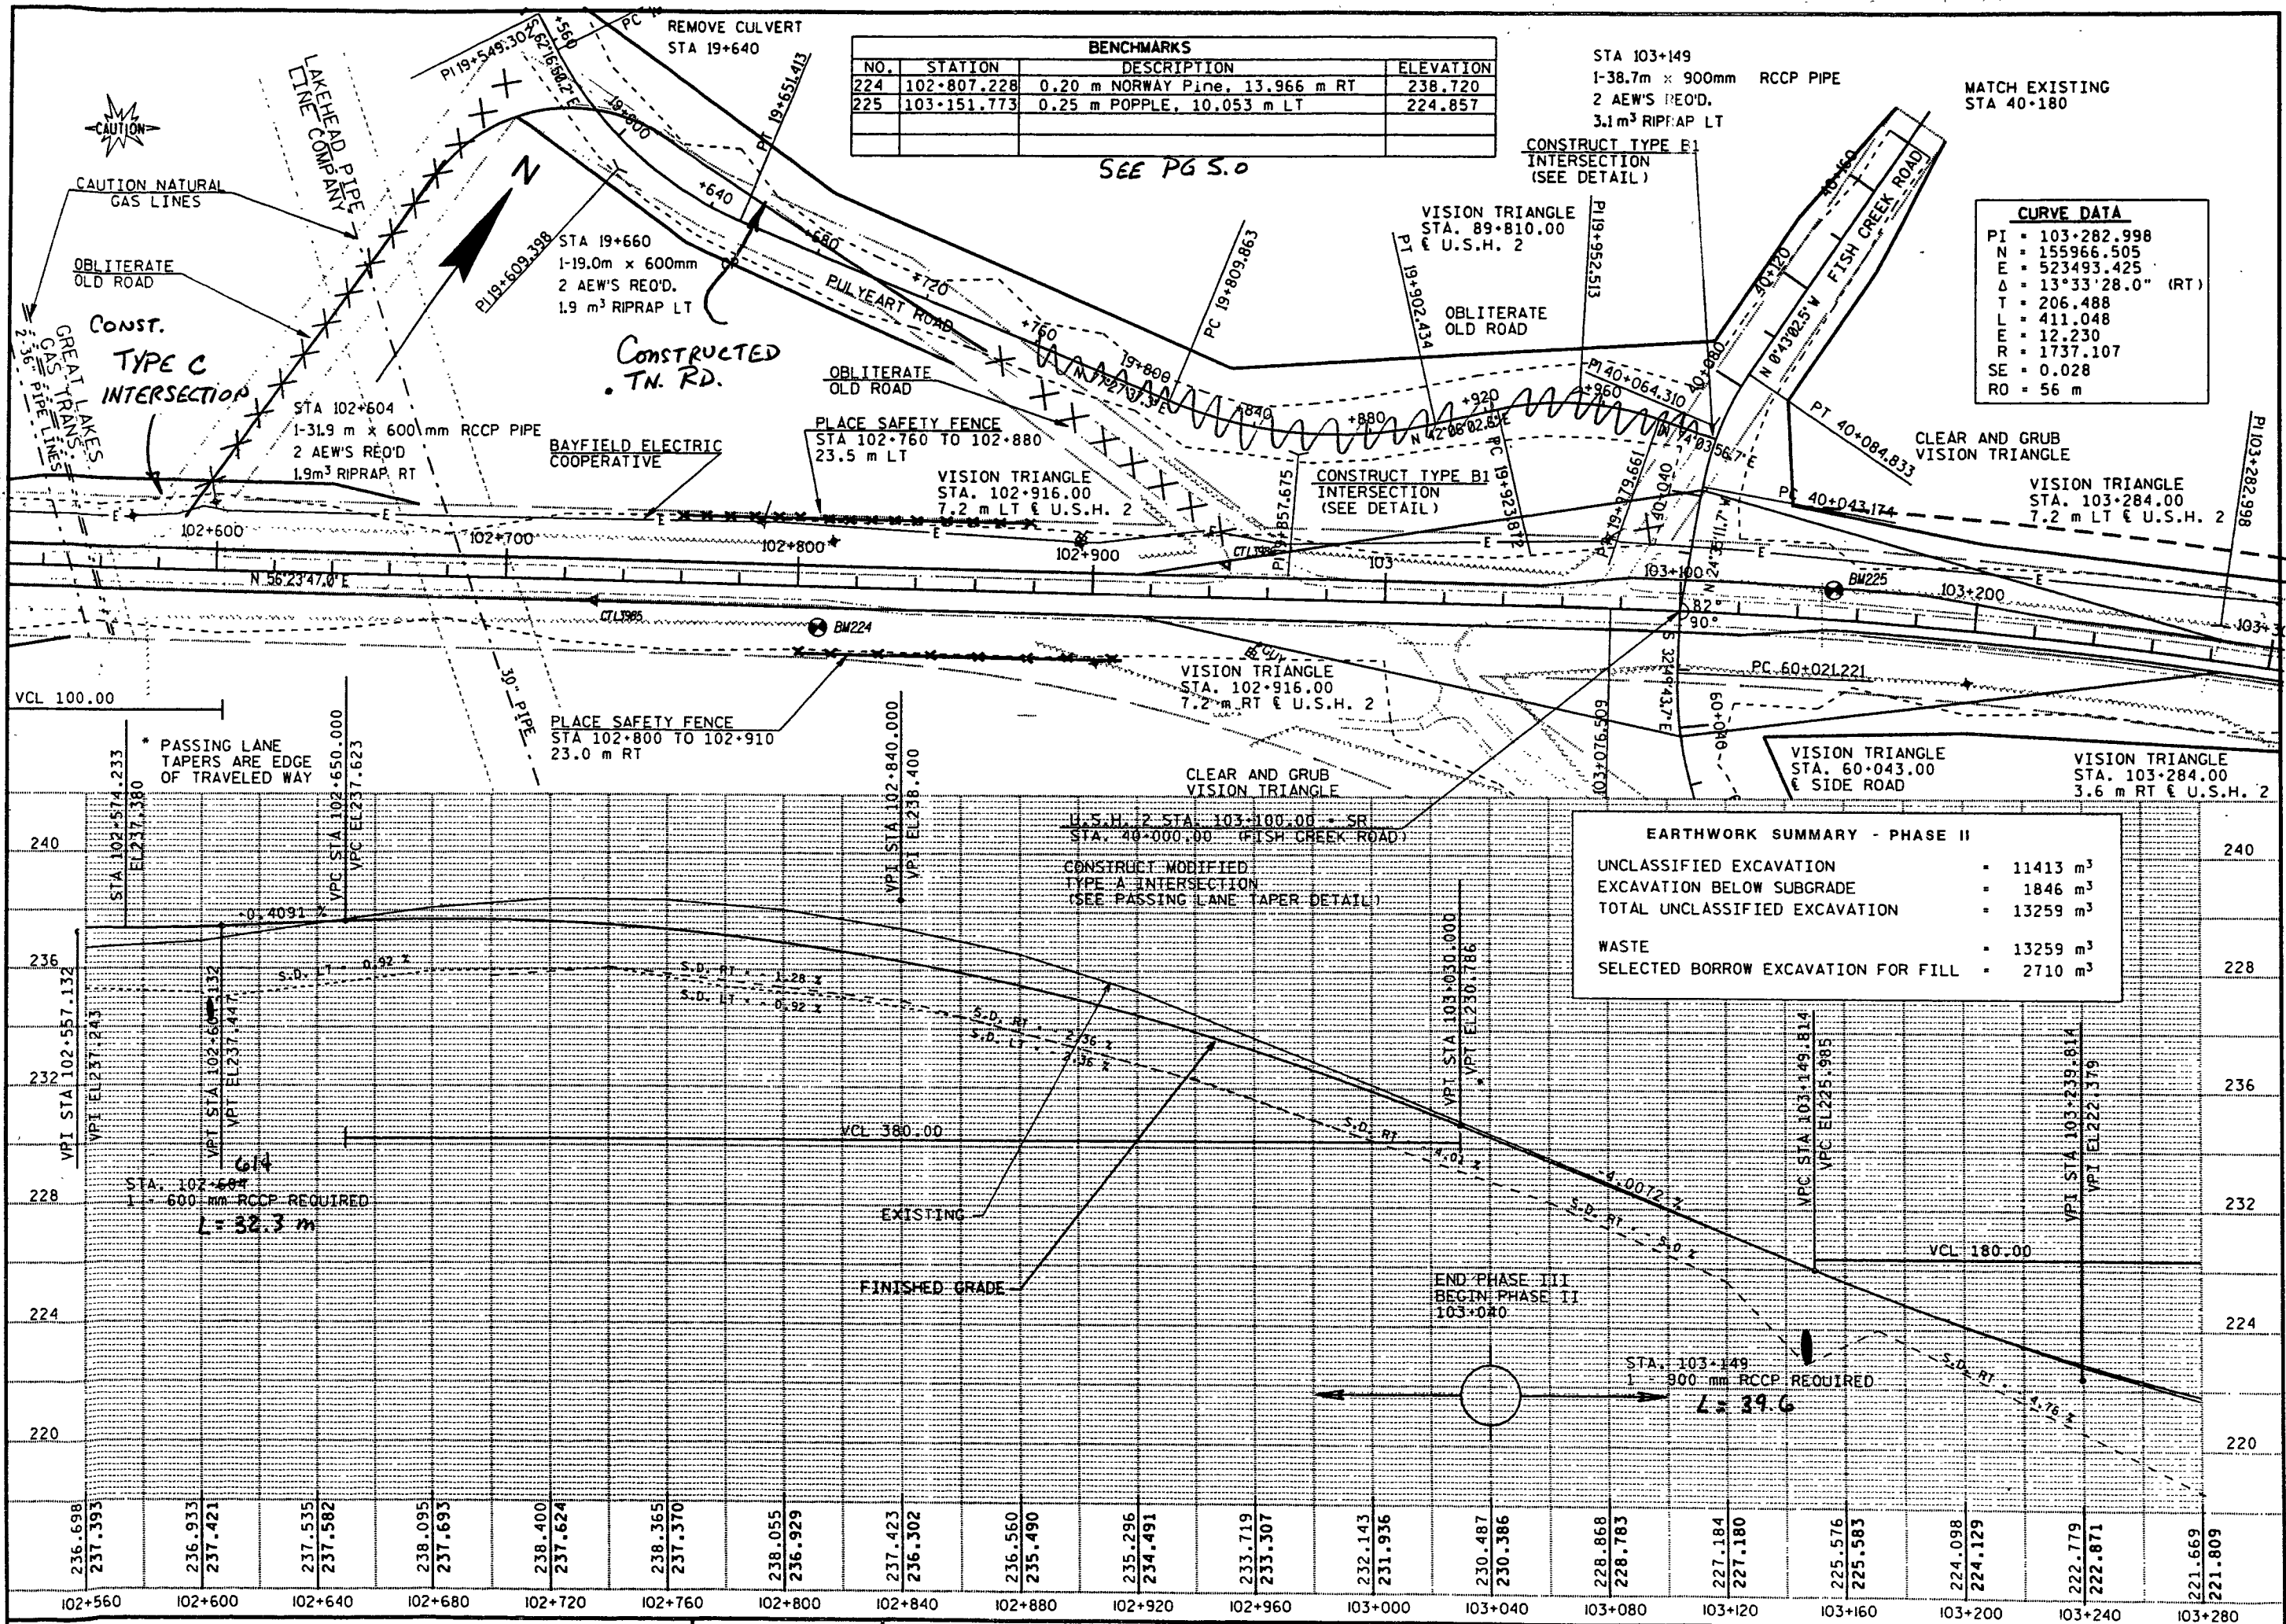

BENCHMARKS			
NO.	STATION	DESCRIPTION	ELEVATION
224	102+807.228	0.20 m NORWAY Pine, 13.966 m RT	238.720
225	103+151.773	0.25 m POPPLE, 10.053 m LT	224.857

CURVE DATA	
PI	103+282.998
N	155966.505
E	523493.425
Δ	13°33'28.0" (RT)
T	206.488
L	411.048
E	12.230
R	1737.107
SE	0.028
RO	56 m

STA 103+149
1-38.7m x 900mm RCCP PIPE
2 AEW'S REQ'D.
3.1m³ RIPRAP LT

CONSTRUCT TYPE B1
INTERSECTION
(SEE DETAIL)

VISION TRIANGLE
STA. 89+810.00
U.S.H. 2

CONSTRUCT TYPE B1
INTERSECTION
(SEE DETAIL)

CONSTRUCT MODIFIED
TYPE A INTERSECTION
(SEE PASSING LANE TAPER DETAIL)

EARTHWORK SUMMARY - PHASE II	
UNCLASSIFIED EXCAVATION	11413 m³
EXCAVATION BELOW SUBGRADE	1846 m³
TOTAL UNCLASSIFIED EXCAVATION	13259 m³
WASTE	13259 m³
SELECTED BORROW EXCAVATION FOR FILL	2710 m³

PI = 103.282.998
N = 155966.505
E = 523493.425
 $\Delta = 13^{\circ}33'28.0''$ (RT)
T = 206.488
L = 411.048
E = 12.230
R = 1737.107
SE = 0.028
R0 = 56 m

STA. 103+282.00
1 - 38.3 x 600 mm RCCP PIPE
2 AEW'S REQ'D
3.1 m³ RIP RAP LT

STA. 103+399.00
1 - 42.9 x 600 mm RCCP PIPE
2 AEW'S REQ'D
1.9 m³ RIP RAP LT


STA. 103+643.00
1 - 27.2 x 600 mm RCCP PIPE
2 AEW'S REQ'D
1.9 m³ RIP RAP LT

STA. 103+776.00
1- 23.3 x 600 mm RCCP PIPE
2 AEW'S REQ'D
1.9 m³ RIP RAP LT


STA. 103+867.00
1- 22.5 m x 900 mm RCCP PIPE
2 AEW'S REQ'D
3.1m³ RIP RAP LT

BENCHMARKS			
NO.	STATION	DESCRIPTION	ELEVATION
479	103-527.323	BM 226: 0.26 m N.PINE 13.585 m RT	217.151
485	103-751.343	BM 227:NGS F-213 22.315 m RT	213.221

SEE PG 5.0

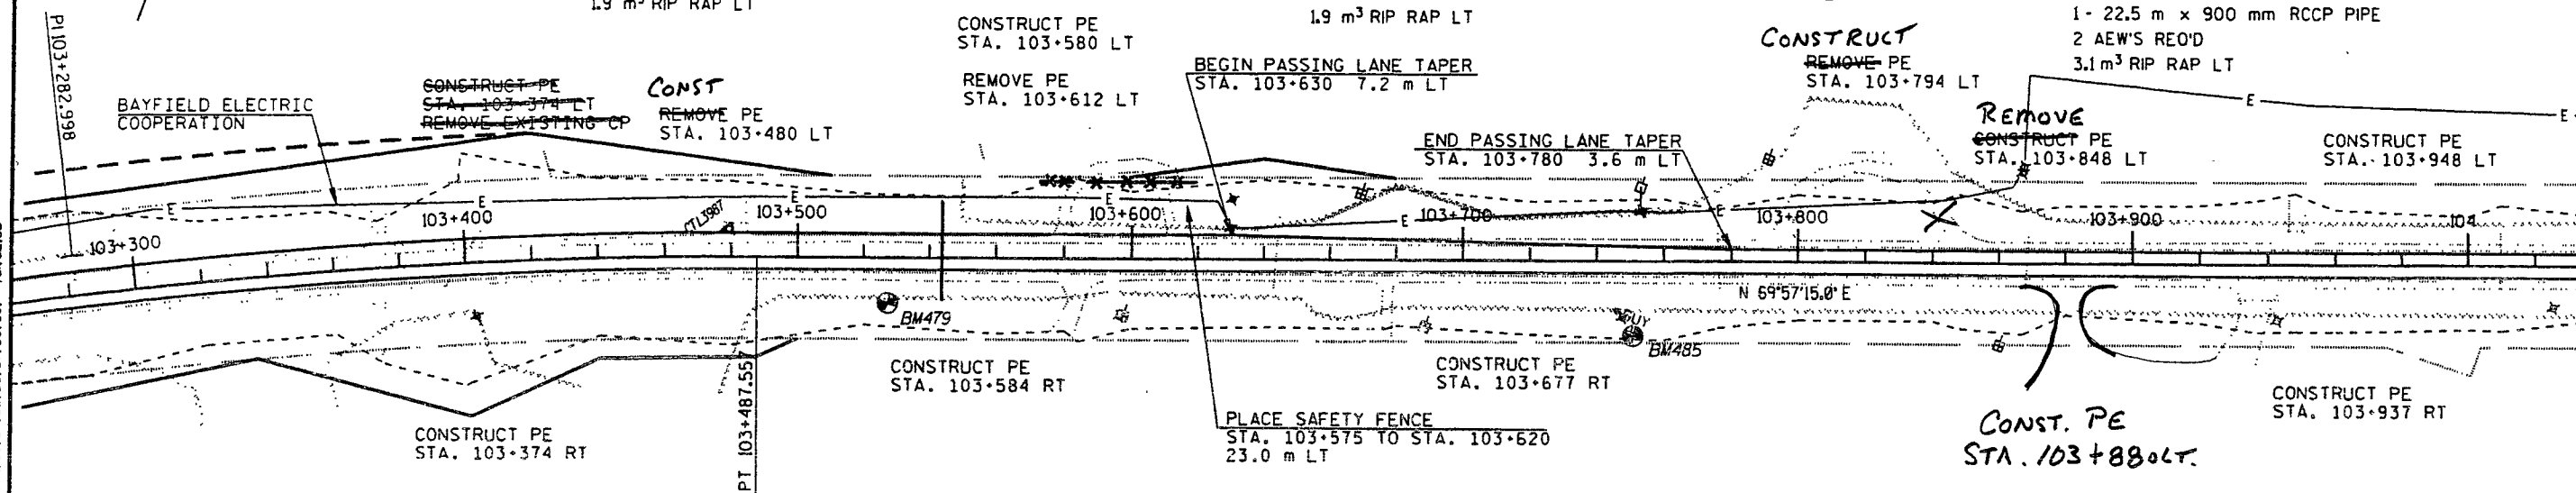

* PASSING LANE TAPERS ARE
EDGE OF TRAVELED WAY

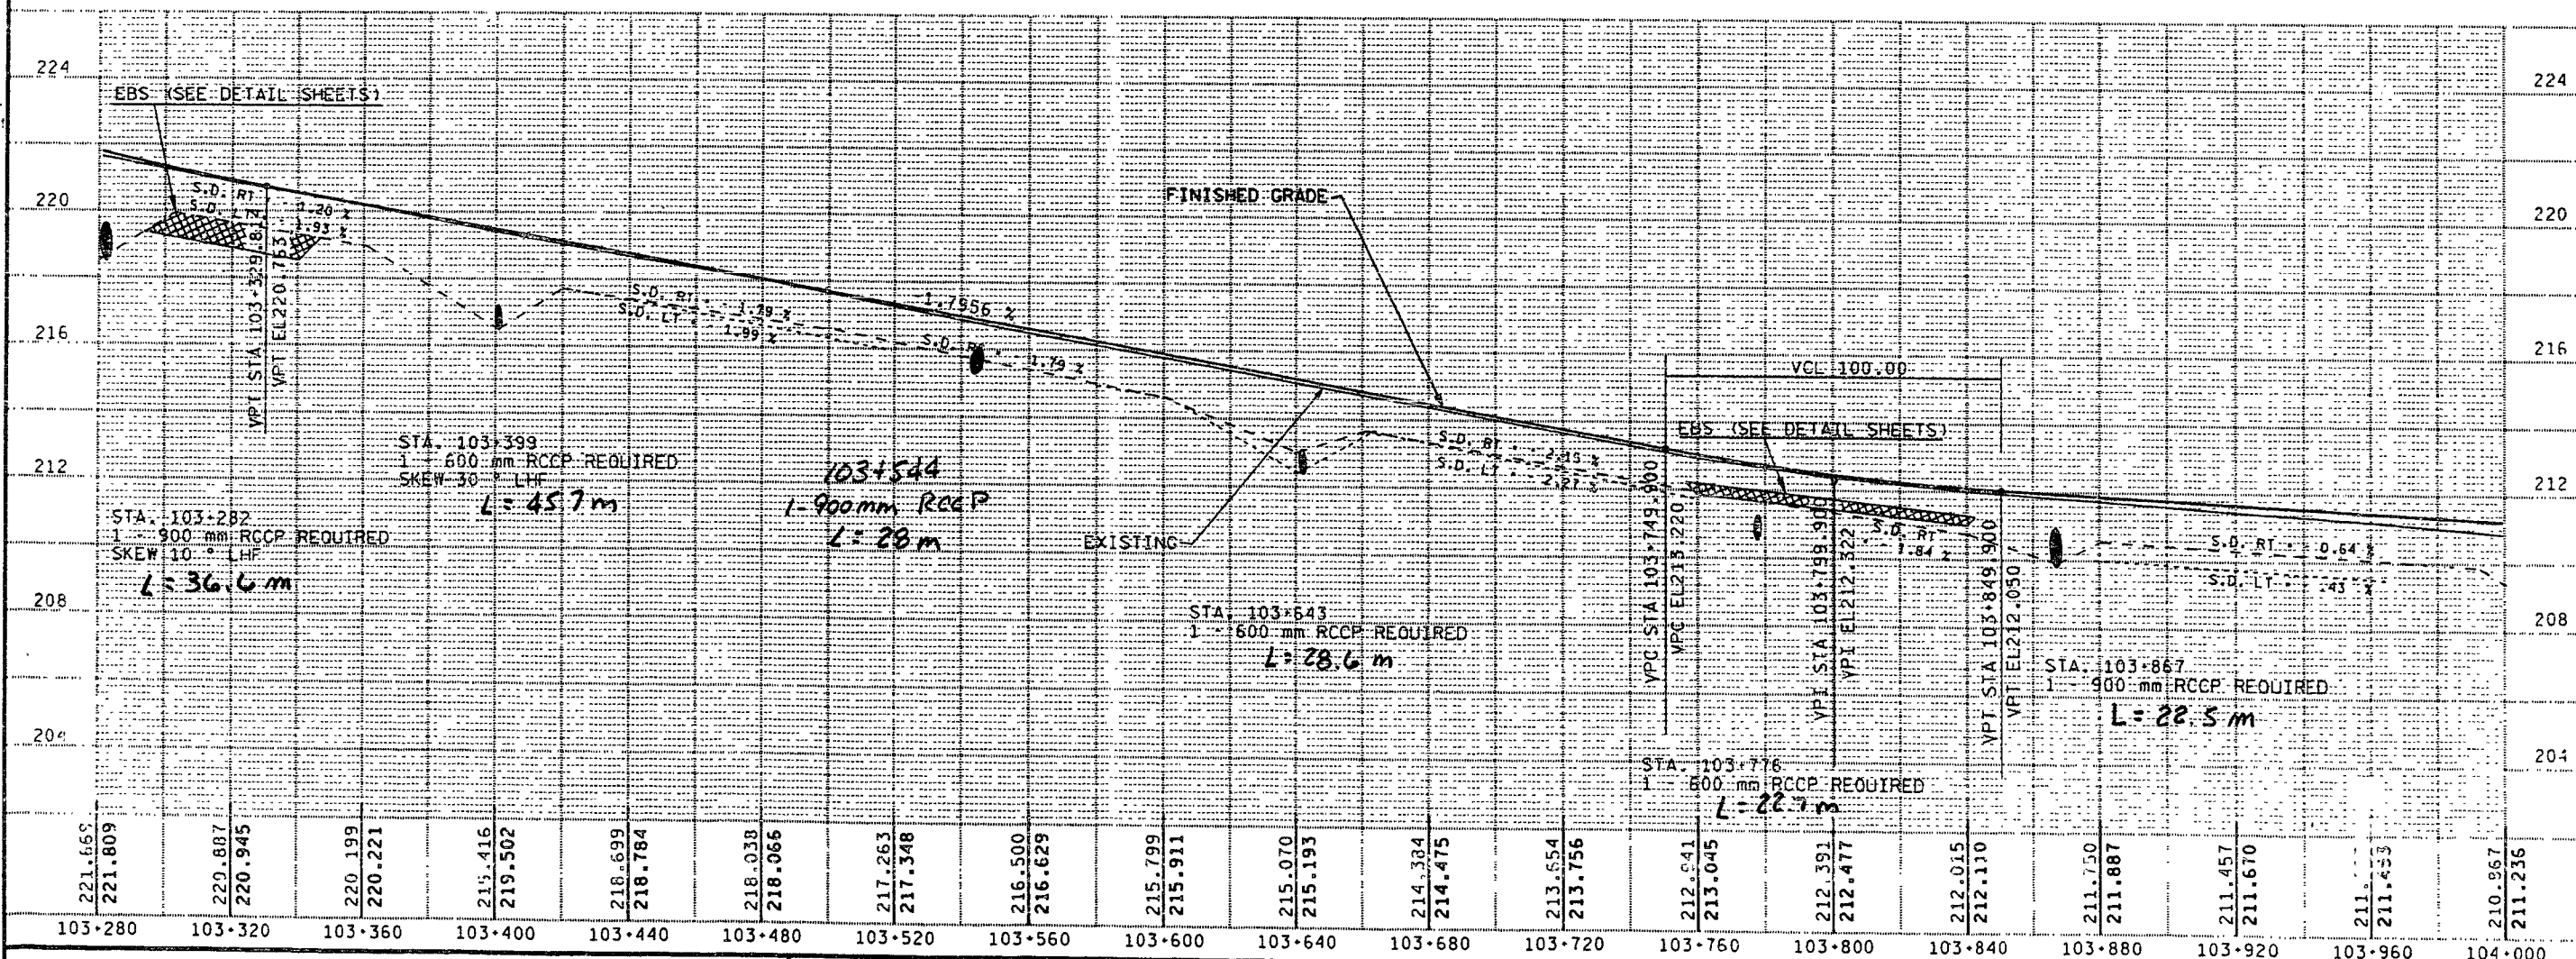

INO - STH 13

SCALE: 1:2000 HWY: U.S.H. 2


COUNTY: BAYFIELD

STATE PROJECT NO: 1180-17-71

SHEET NO: 5.17	M
----------------	---

WLRDOT: MSHTA

FILE NAME: PROJECTS DB 1181700 DGN STH137 P10.DGN
LEVELS ON: 1181700.DGN, 1181700.P10, 1181700.P11, 1181700.P12, 1181700.P62, 1181700.P63

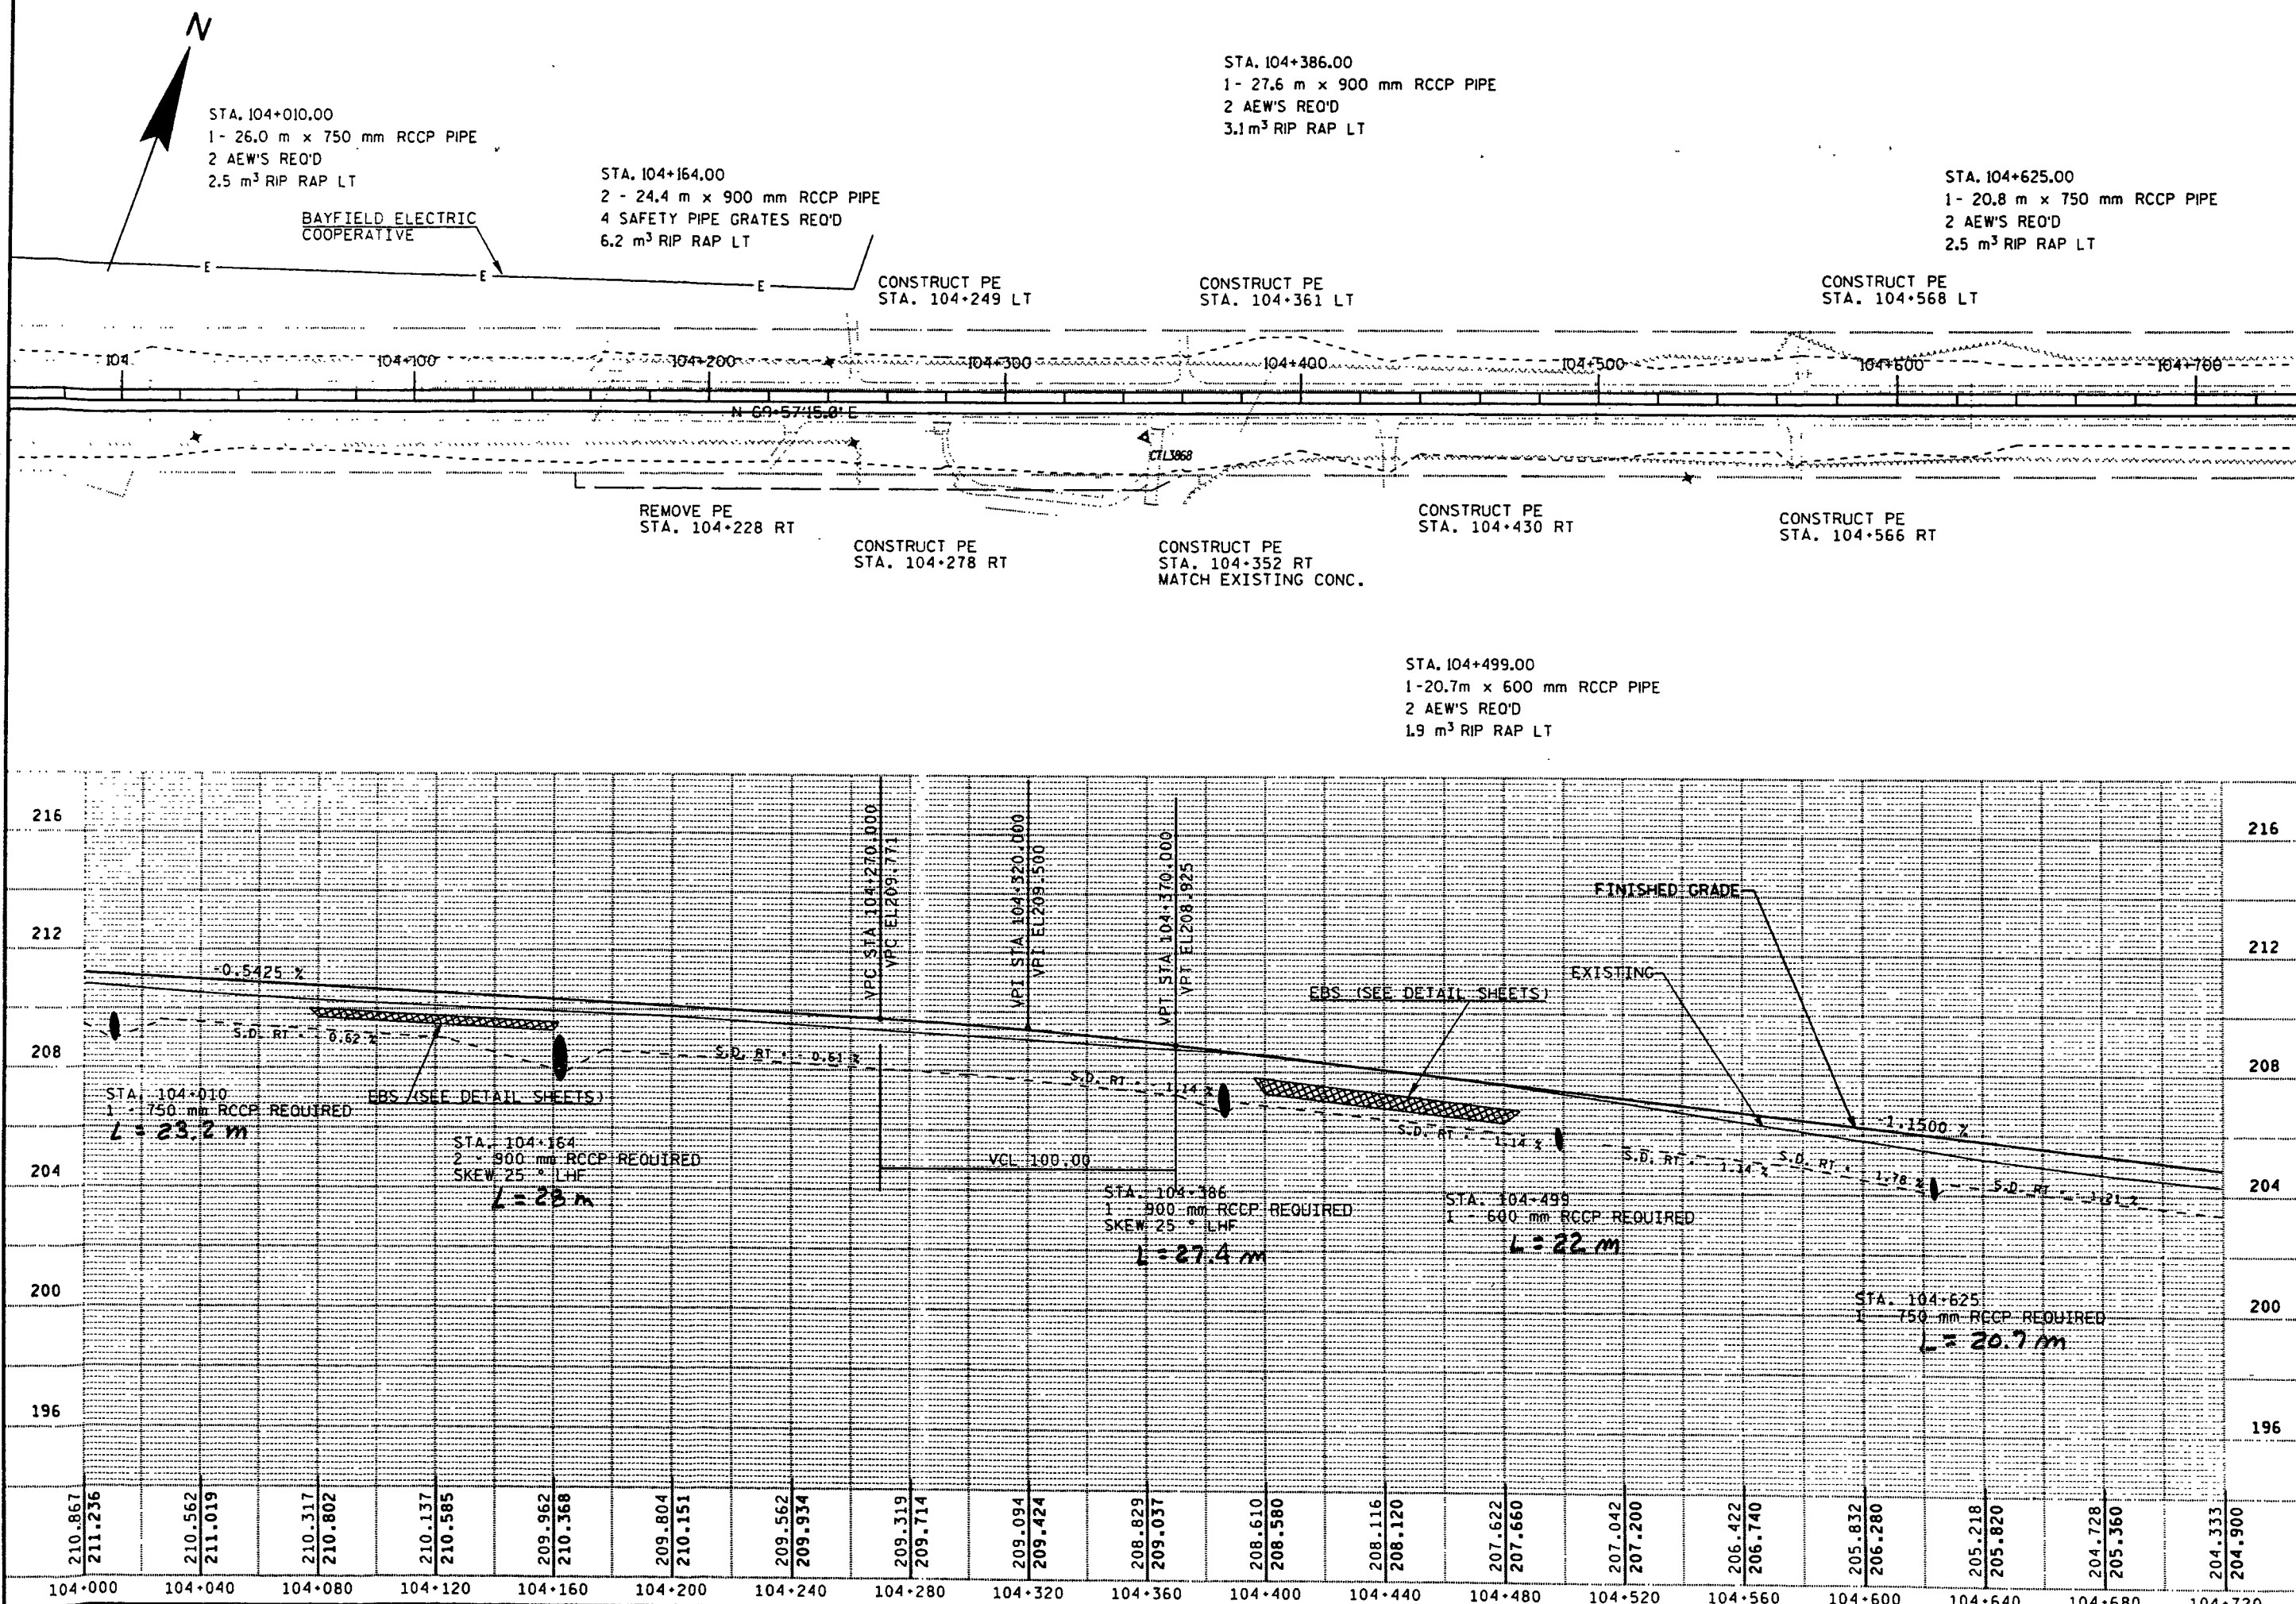

INO - STH 13

SCALE: 1:2000 HWY: U.S.H. 2

COUNTY: BAYFIELD

STATE PROJECT NO: 1180-17-71

SHEET NO: 5.18

M

WISDOT: MSH46



CURVE DATA	
PI	= 105+393.017
N	= 156690.421
E	= 525477.429
Δ	= 34°58'01.8" (LT)
T	= 411.863
L	= 797.999
E	= 63.331
R	= 1307.570
SE	= 0.035
RO	= 56 m

STA. 104+907
1- 32.0 m x 900 mm RCCP PIPE
2 AEW'S REQ'D
3.1 m³ RIP RAP

CONSTRUCT PE
STA. 105+201 LT

END BY-PASS LANE
TAPER 105+156.4
7.5 m LT

BEGIN BY-PASS LANE
TAPER 105+253.7
7.5 m LT

END BY-PASS LANE
TAPER 105+314.7
3.6 m LT

BEGIN BY-PASS LANE
TAPER 105+086.1
3.6 m LT

CONSTRUCT PE
STA. 104+848 LT

CONSTRUCT PE
STA. 104+959 LT

STA. 104+920
END GRADING M/L


BEGIN 2.4 m WIDE
PAVED SHOULDER OVERLAY
LT/RT

VISION TRIANGLE
STA. 105+023.00
3.6 m RT & USH 2

BEGIN 3.0 m WIDE
PAVED SHOULDER OVERLAY
105+220 RT AND
105+267.78 LT

EXPERIMENTAL FARM ROAD

* PASSING LANE TAPERS ARE
EDGE OF TRAVELED WAY

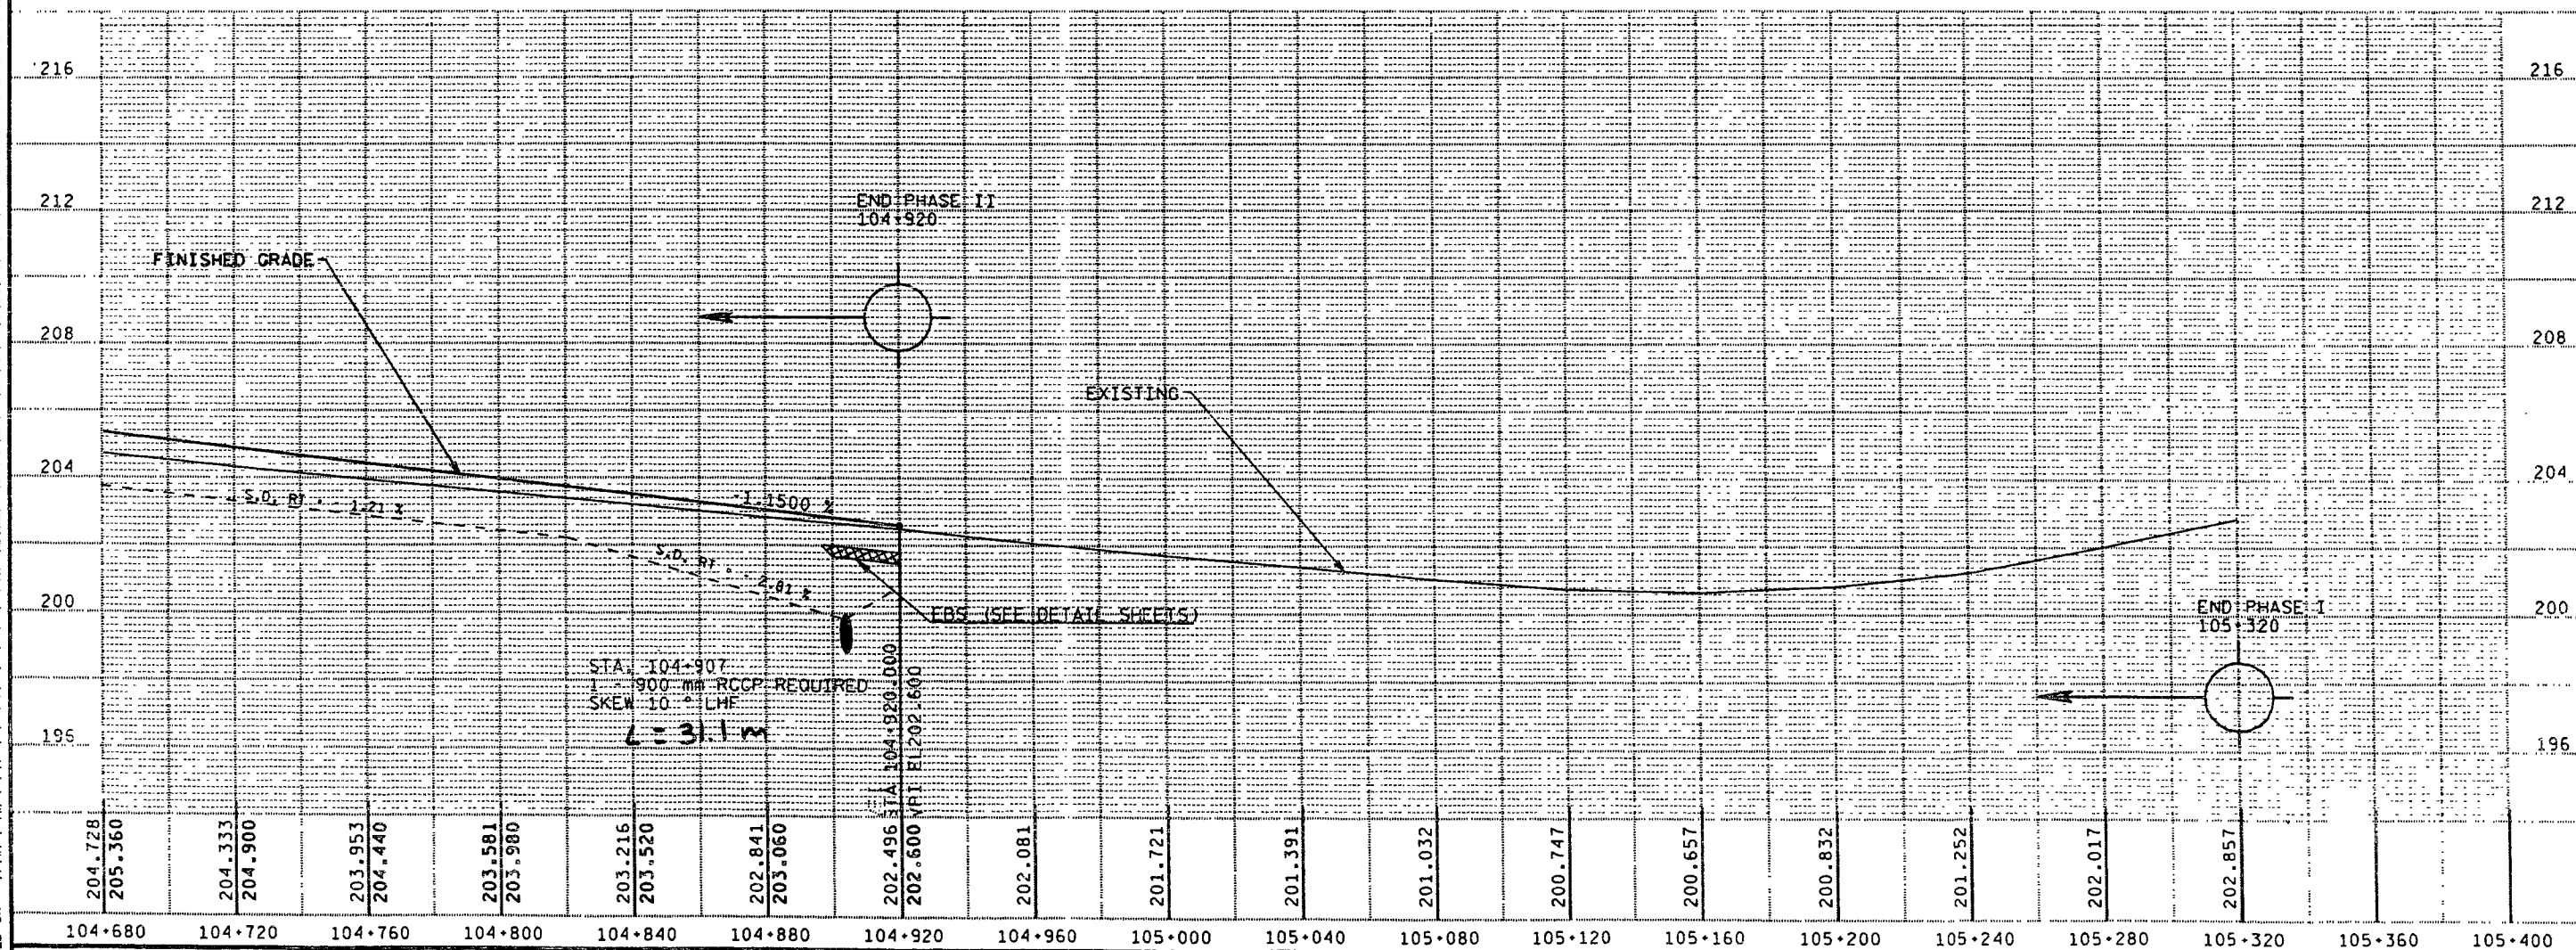

FILE NAME: PROJECTS DB 11801700 DGN STH137 PILDON
LEVELS ON: 11801700.DGN, 11801700.PLT, 11801700.PDF, 11801700.PSD, 11801700.TIF, 11801700.XPS, 11801700.ZIP, 11801700.1, 11801700.2, 11801700.3, 11801700.4, 11801700.5, 11801700.6, 11801700.7, 11801700.8, 11801700.9, 11801700.10, 11801700.11, 11801700.12, 11801700.99, 11801700.100

INO - STH 13

SCALE: 1:2000 HWY: U.S.H. 2

COUNTY: BAYFIELD


STATE PROJECT NO: 1180-17-71

SHEET NO: 5.19

M

WISDOT: MSHT46

FILE NAME: E:\CIS-D8-11801700-DGN-SI137.P13.DGN
LEVELS ON: 1, 2, 3, 62, 63

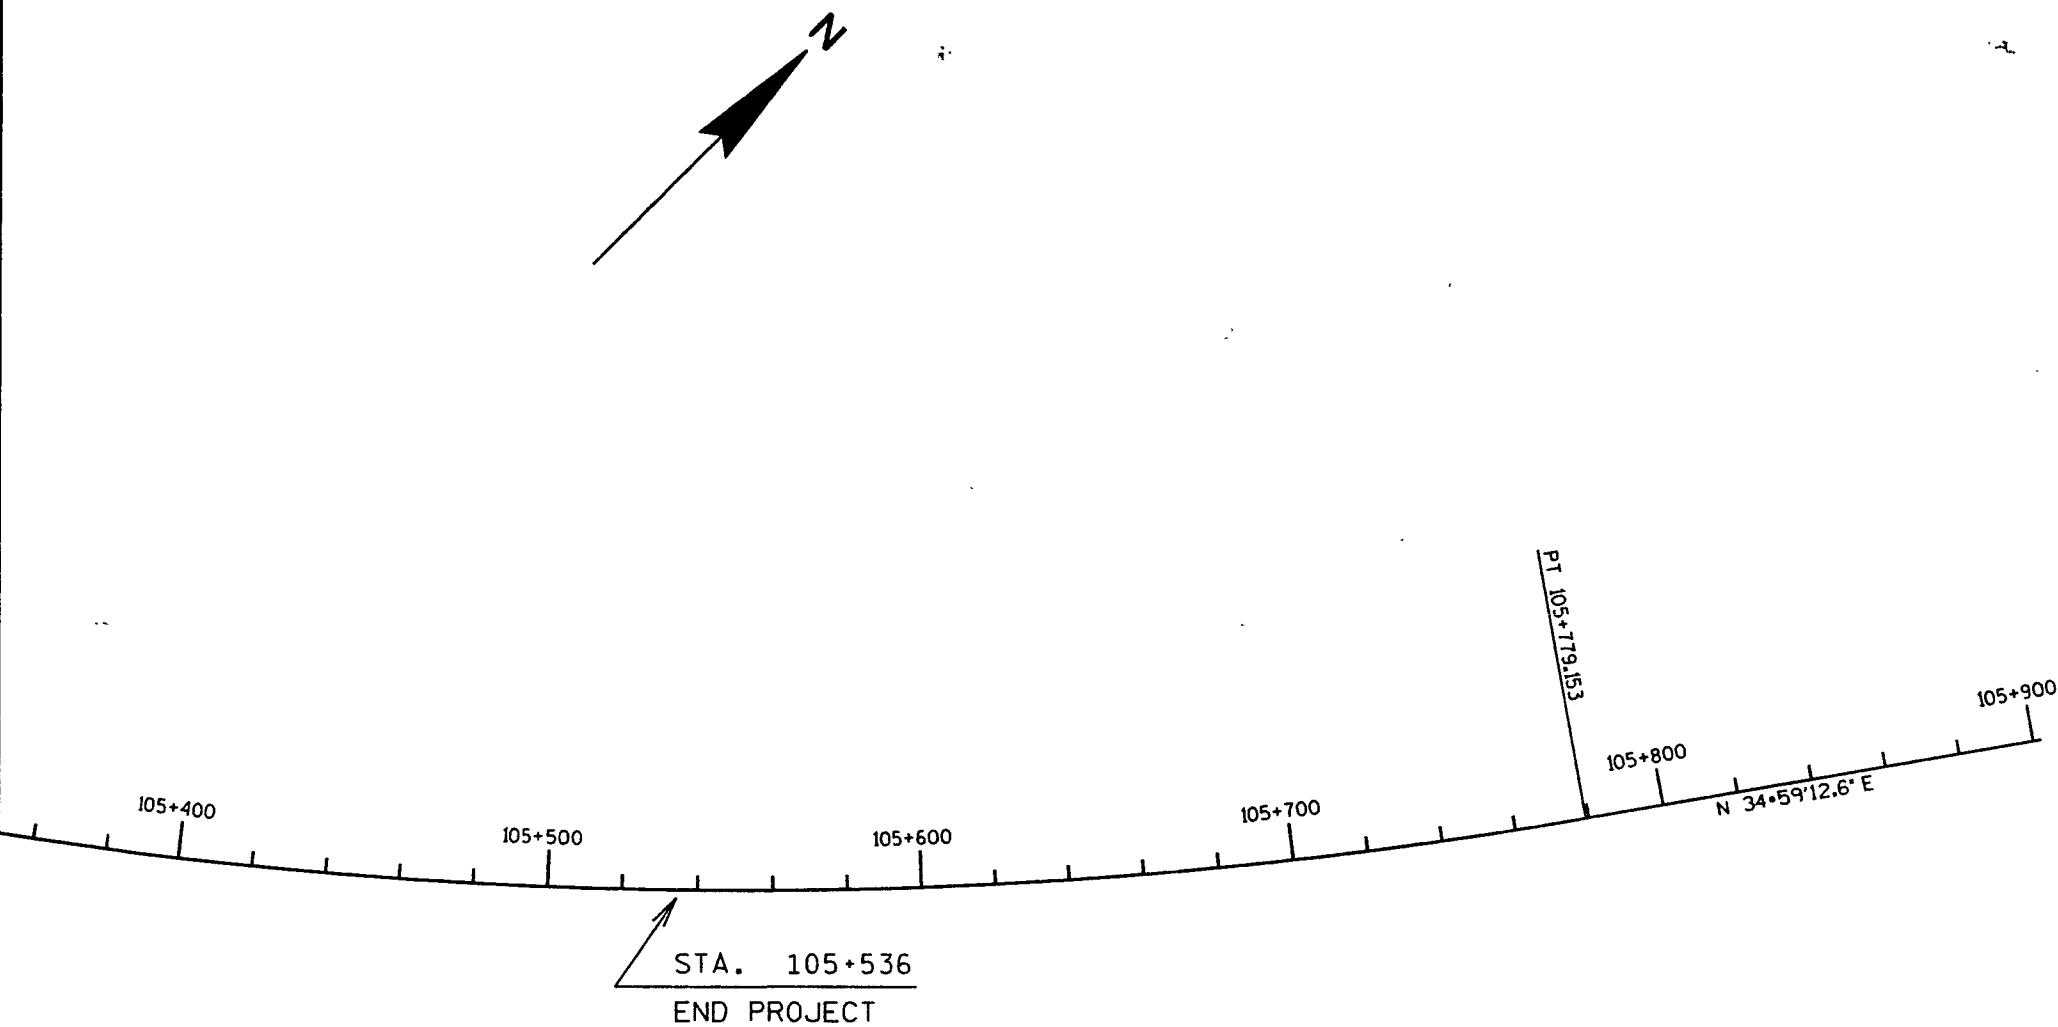

CURVE DATA	
PI	= 105+393.017
N	= 156690.421
E	= 525477.429
Δ	= 34°58'01.8" (LT)
T	= 411.863
L	= 797.999
E	= 63.331
R	= 1307.570
SE	= 0.035
RO	= 56 m

INO - 13

SCALE: 1:

HWY: U.S.H.2

COUNTY: BAYFIELD


STATE PROJECT NO: 1180-17-71

SHEET NO: 5.20

M

WISDOT: MSHT20
7-1-2000

CURVE DATA	
PI	= 19+857.675
N	= 155834.089
E	= 523204.721
Δ	= 35°21'34.7" (LT)
T	= 47.813
L	= 92.571
E	= 7.436
RR	= 150.000
SE	= 0.03
RO	= 17 m

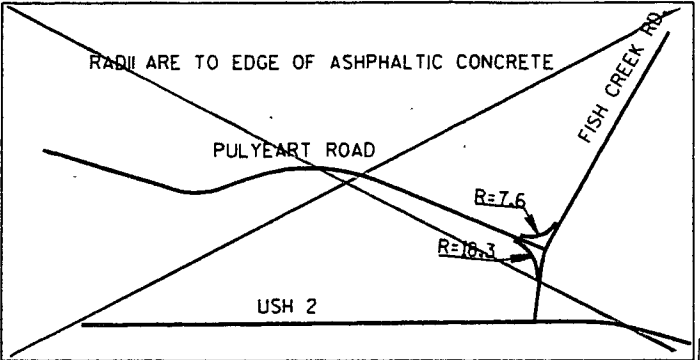

BENCHMARKS			
NO.	STATION	DESCRIPTION	ELEVATION
224	102+807.228	0.20m N.PINE, 13.966 m RT	238.720
225	103+151.773	0.25m POPPLE, 10.053 m LT	224.857

CURVE DATA	
PI	= 19+952.513
N	= 155906.722
E	= 523270.351
Δ	= 31°57'54.1" (RT)
T	= 28.642
L	= 55.789
E	= 4.021
RR	= 100.000
SE	= 0.03
RO	= 17 m

CURVE DATA	
PI	= 40+064.310
N	= 155923.572
E	= 523314.339
Δ	= 23°52'09.2" (RT)
T	= 21.136
L	= 41.660
E	= 2.209
RR	= 100.000
SE	= NC
RO	= 17 m

CURVE DATA	
PI	= 19+609.398
N	= 155779.359
E	= 522958.655
Δ	= 40°15'32.5" (LT)
T	= 45.817
L	= 87.832
E	= 8.132
RR	= 125.000
SE	= NC
RO	= 17 m


STA 102+604
1-31.9 m x 600 mm RCCP PIPE
2 AEW'S REQ'D
1.9m³ RIPRAP RT

STA 19+660
1-19.0m x 600mm CP
2 AEW'S REQ'D
1.9 m³ RIPRAP LT

STA 103+149
1-38.7m x 900mm RCCP PIPE
2 AEW'S REQ'D
3.1m³ RIPRAP LT

CONST.
TYPE 'C'
INTERSECTION

CONST.
TN. RD

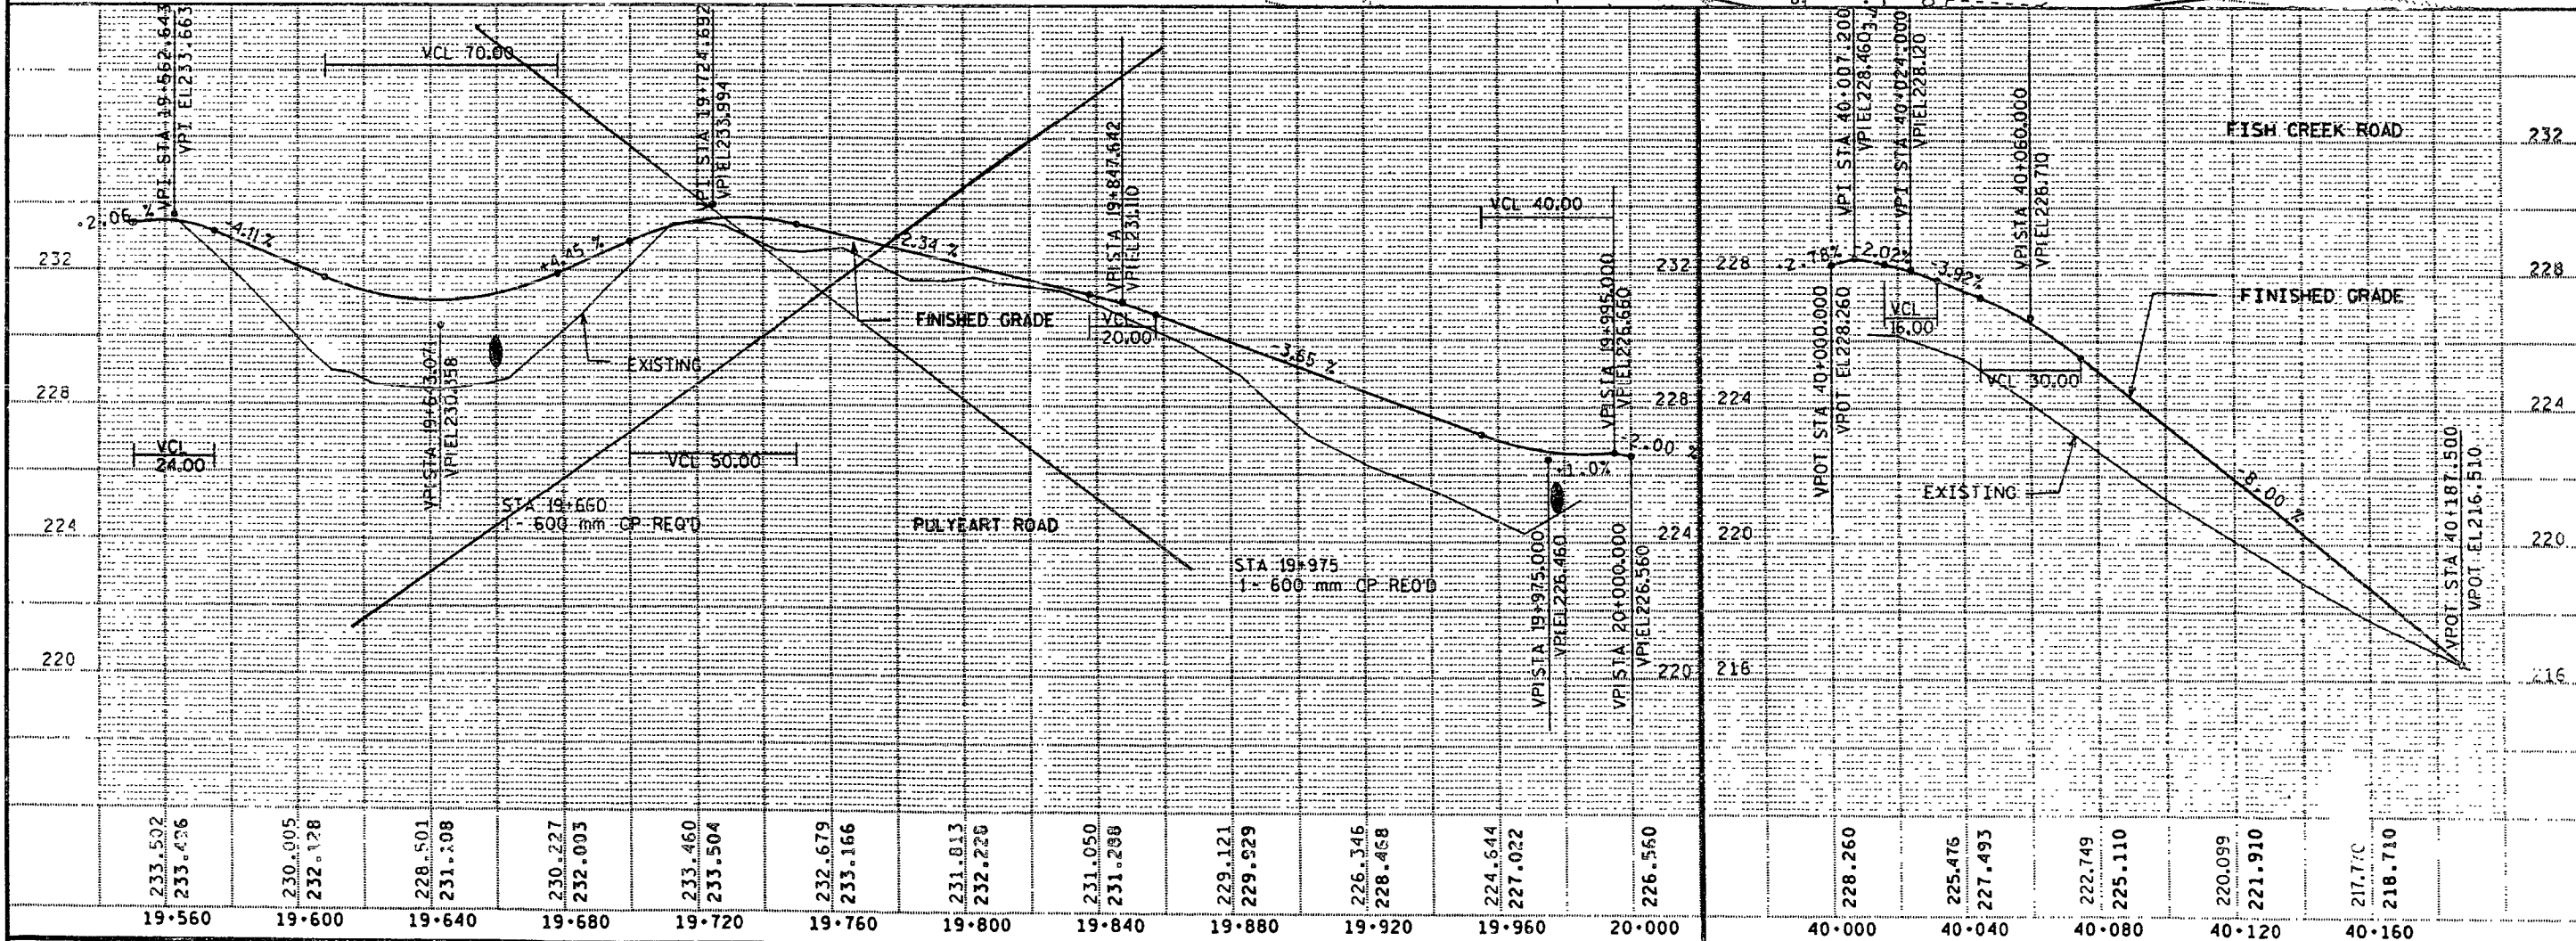

FILE NAME: PROJECT'S DB 11801700 DON STH137 PILDON
LEVELS ON: 11801700 DON STH137 PILDON
24.25.26.27.28.29.30.31.32.33.34.35.36.37.38.40.41.42.43.44.45.46.47.48.49.50.51.52.53.54.55.56.57.58.59.60.61.62.63

FILE NAME: PROJECTS DB 11801700 S.R. STH37 P14.DGN
LEVELS ON: 1, 2, 3, 62, 63



SIDE ROAD PROFILES

SCALE: 1:

HWY: U.S.H. 2

COUNTY: BAYFIELD

STATE PROJECT NO: 1180-17-71

SHEET NO: 5.23



FILE NAME: PROJECTS DB 11801700 S.R. ST137 P14.DGN
LEVELS ON: 1, 2, 3, 62, 63

