


SURVEY	PLOTTED	
NOTE BOOK	TEMPLATE	
	AREAS	
	AREAS CHECKED	


SURVEY	PLOTTED	
NOTE BOOK	TEMPLATE	
NO.	AREAS	
	AREAS CHECKED	

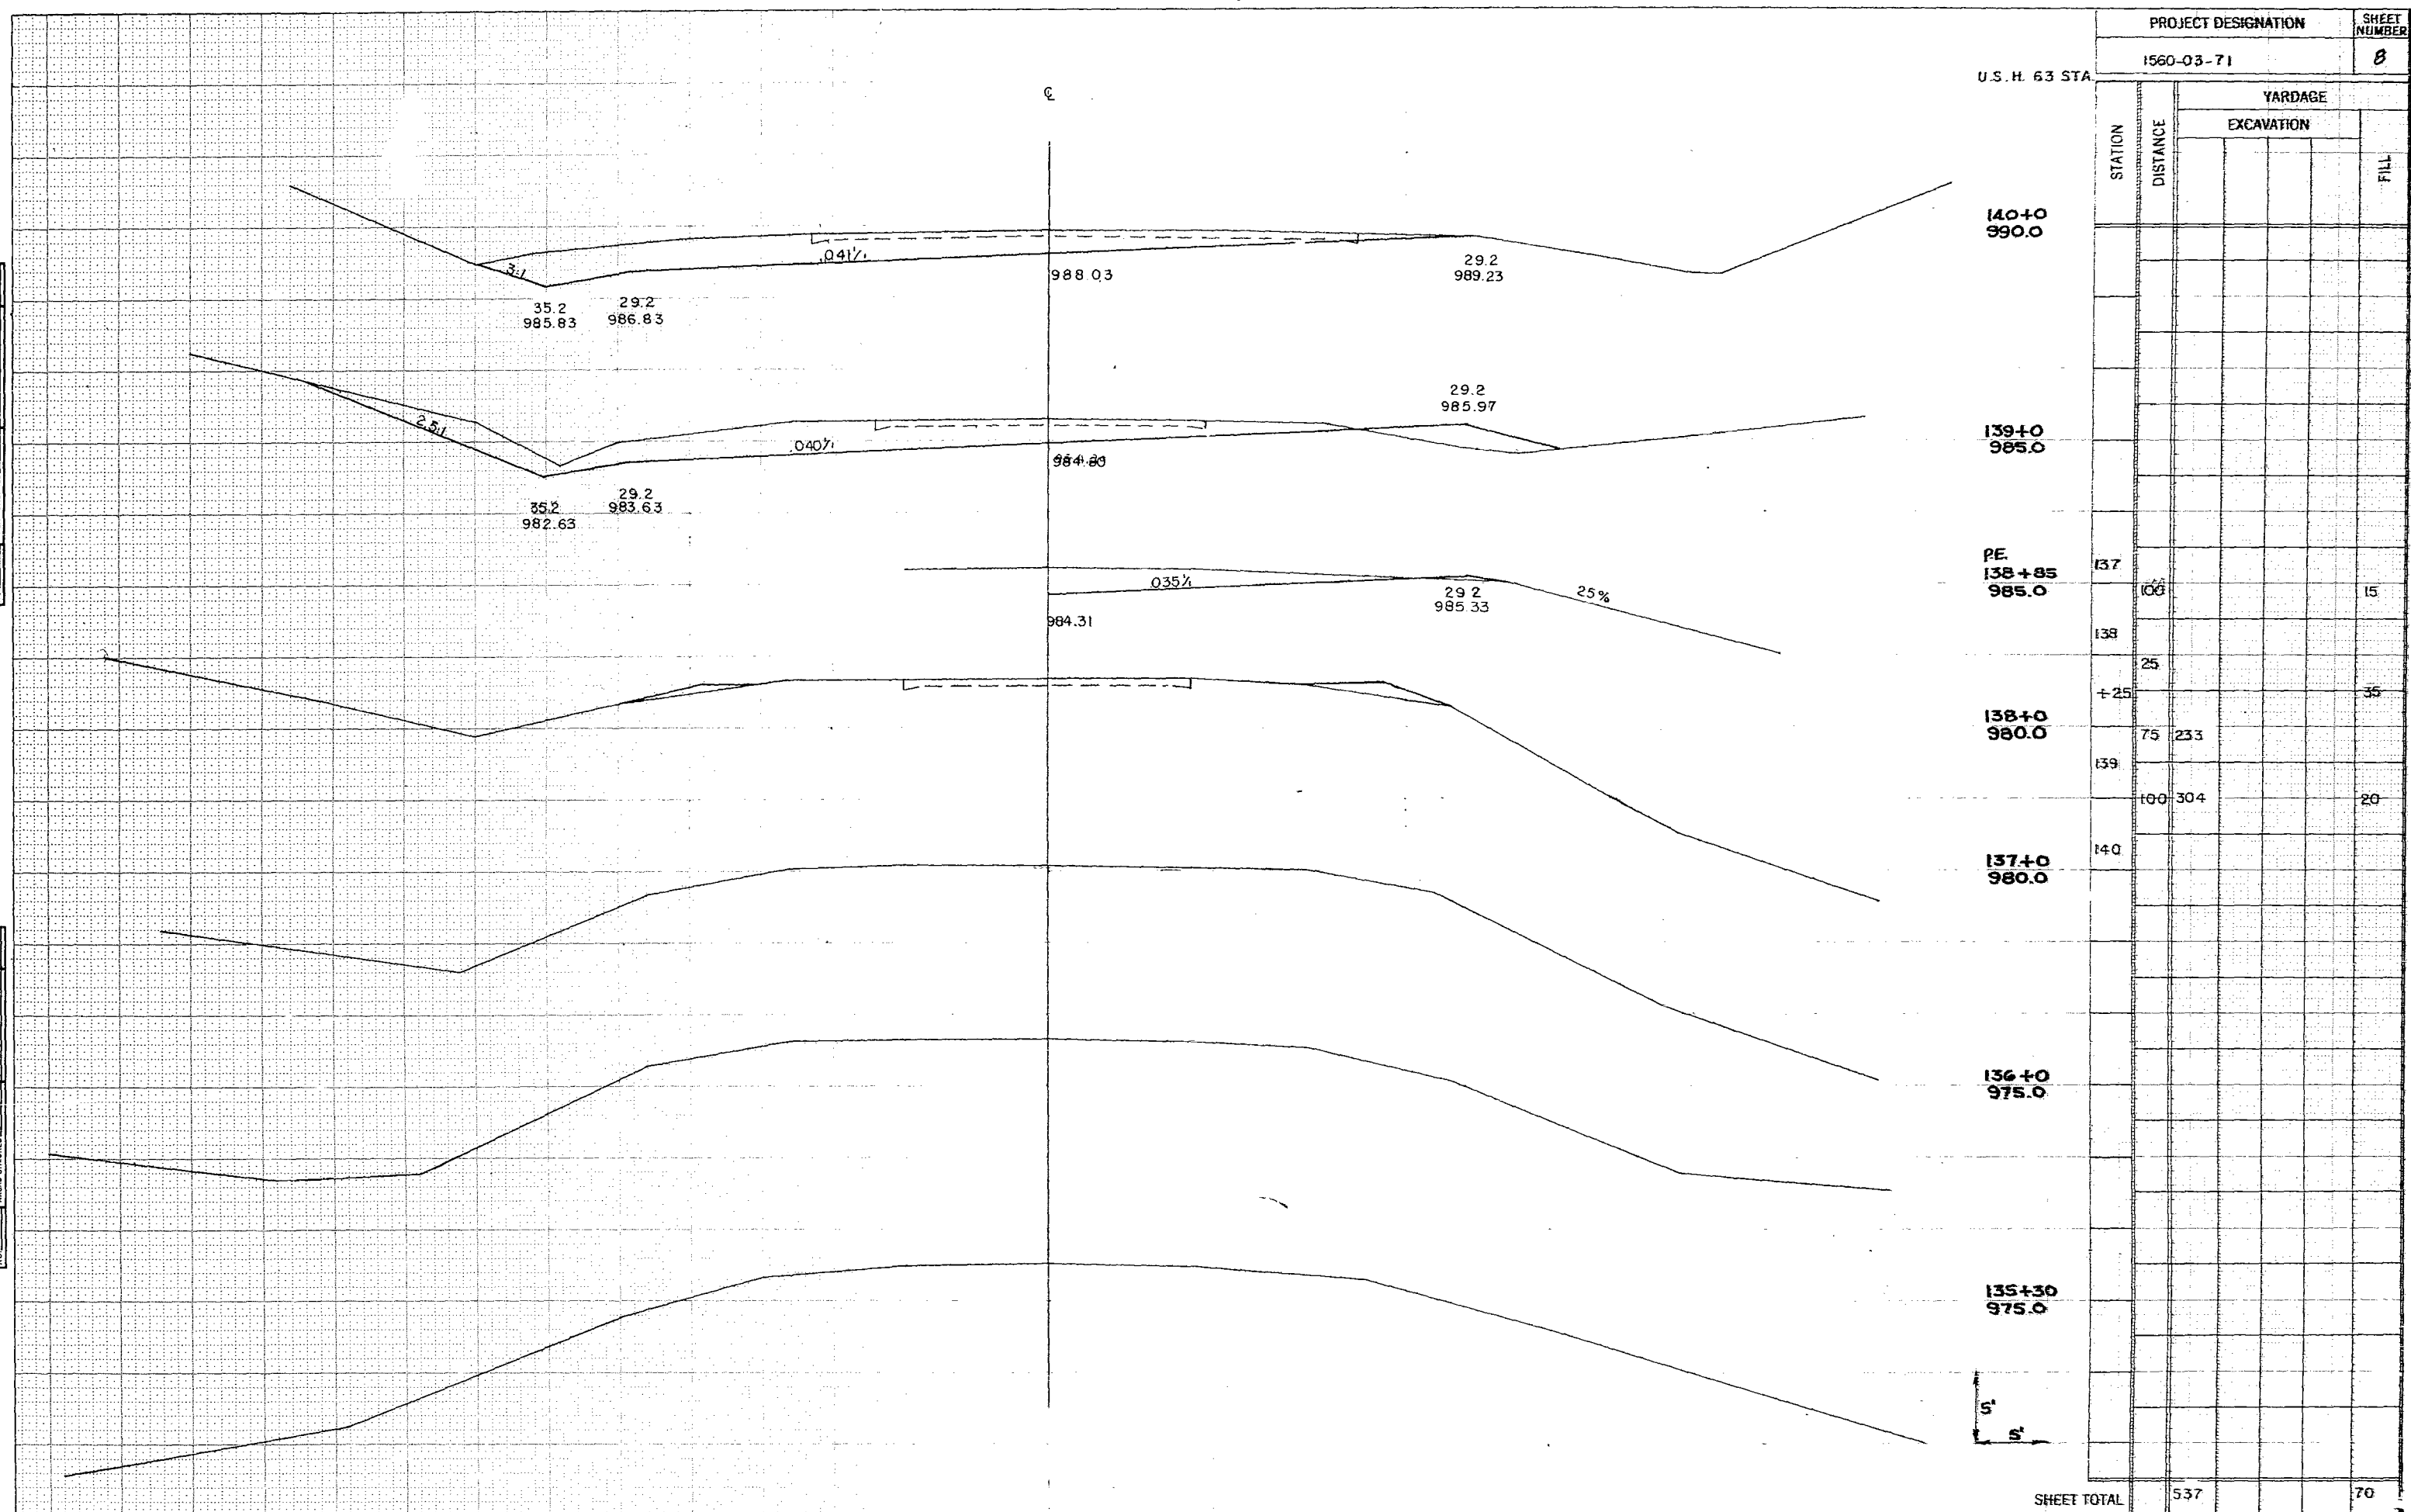


FINAL SURVEY	NO.	SHEET	DATE
			BY
			SURVEYED
			PLOTTED
NOTE BOOK		AREA CHECKED	

ORIGINAL SURVEY	NO.	SHEET	DATE
			BY
			SURVEYED
			PLOTTED
NOTE BOOK		AREA CHECKED	

PROJECT DESIGNATION	SHEET NUMBER
1560-03-71	8.1

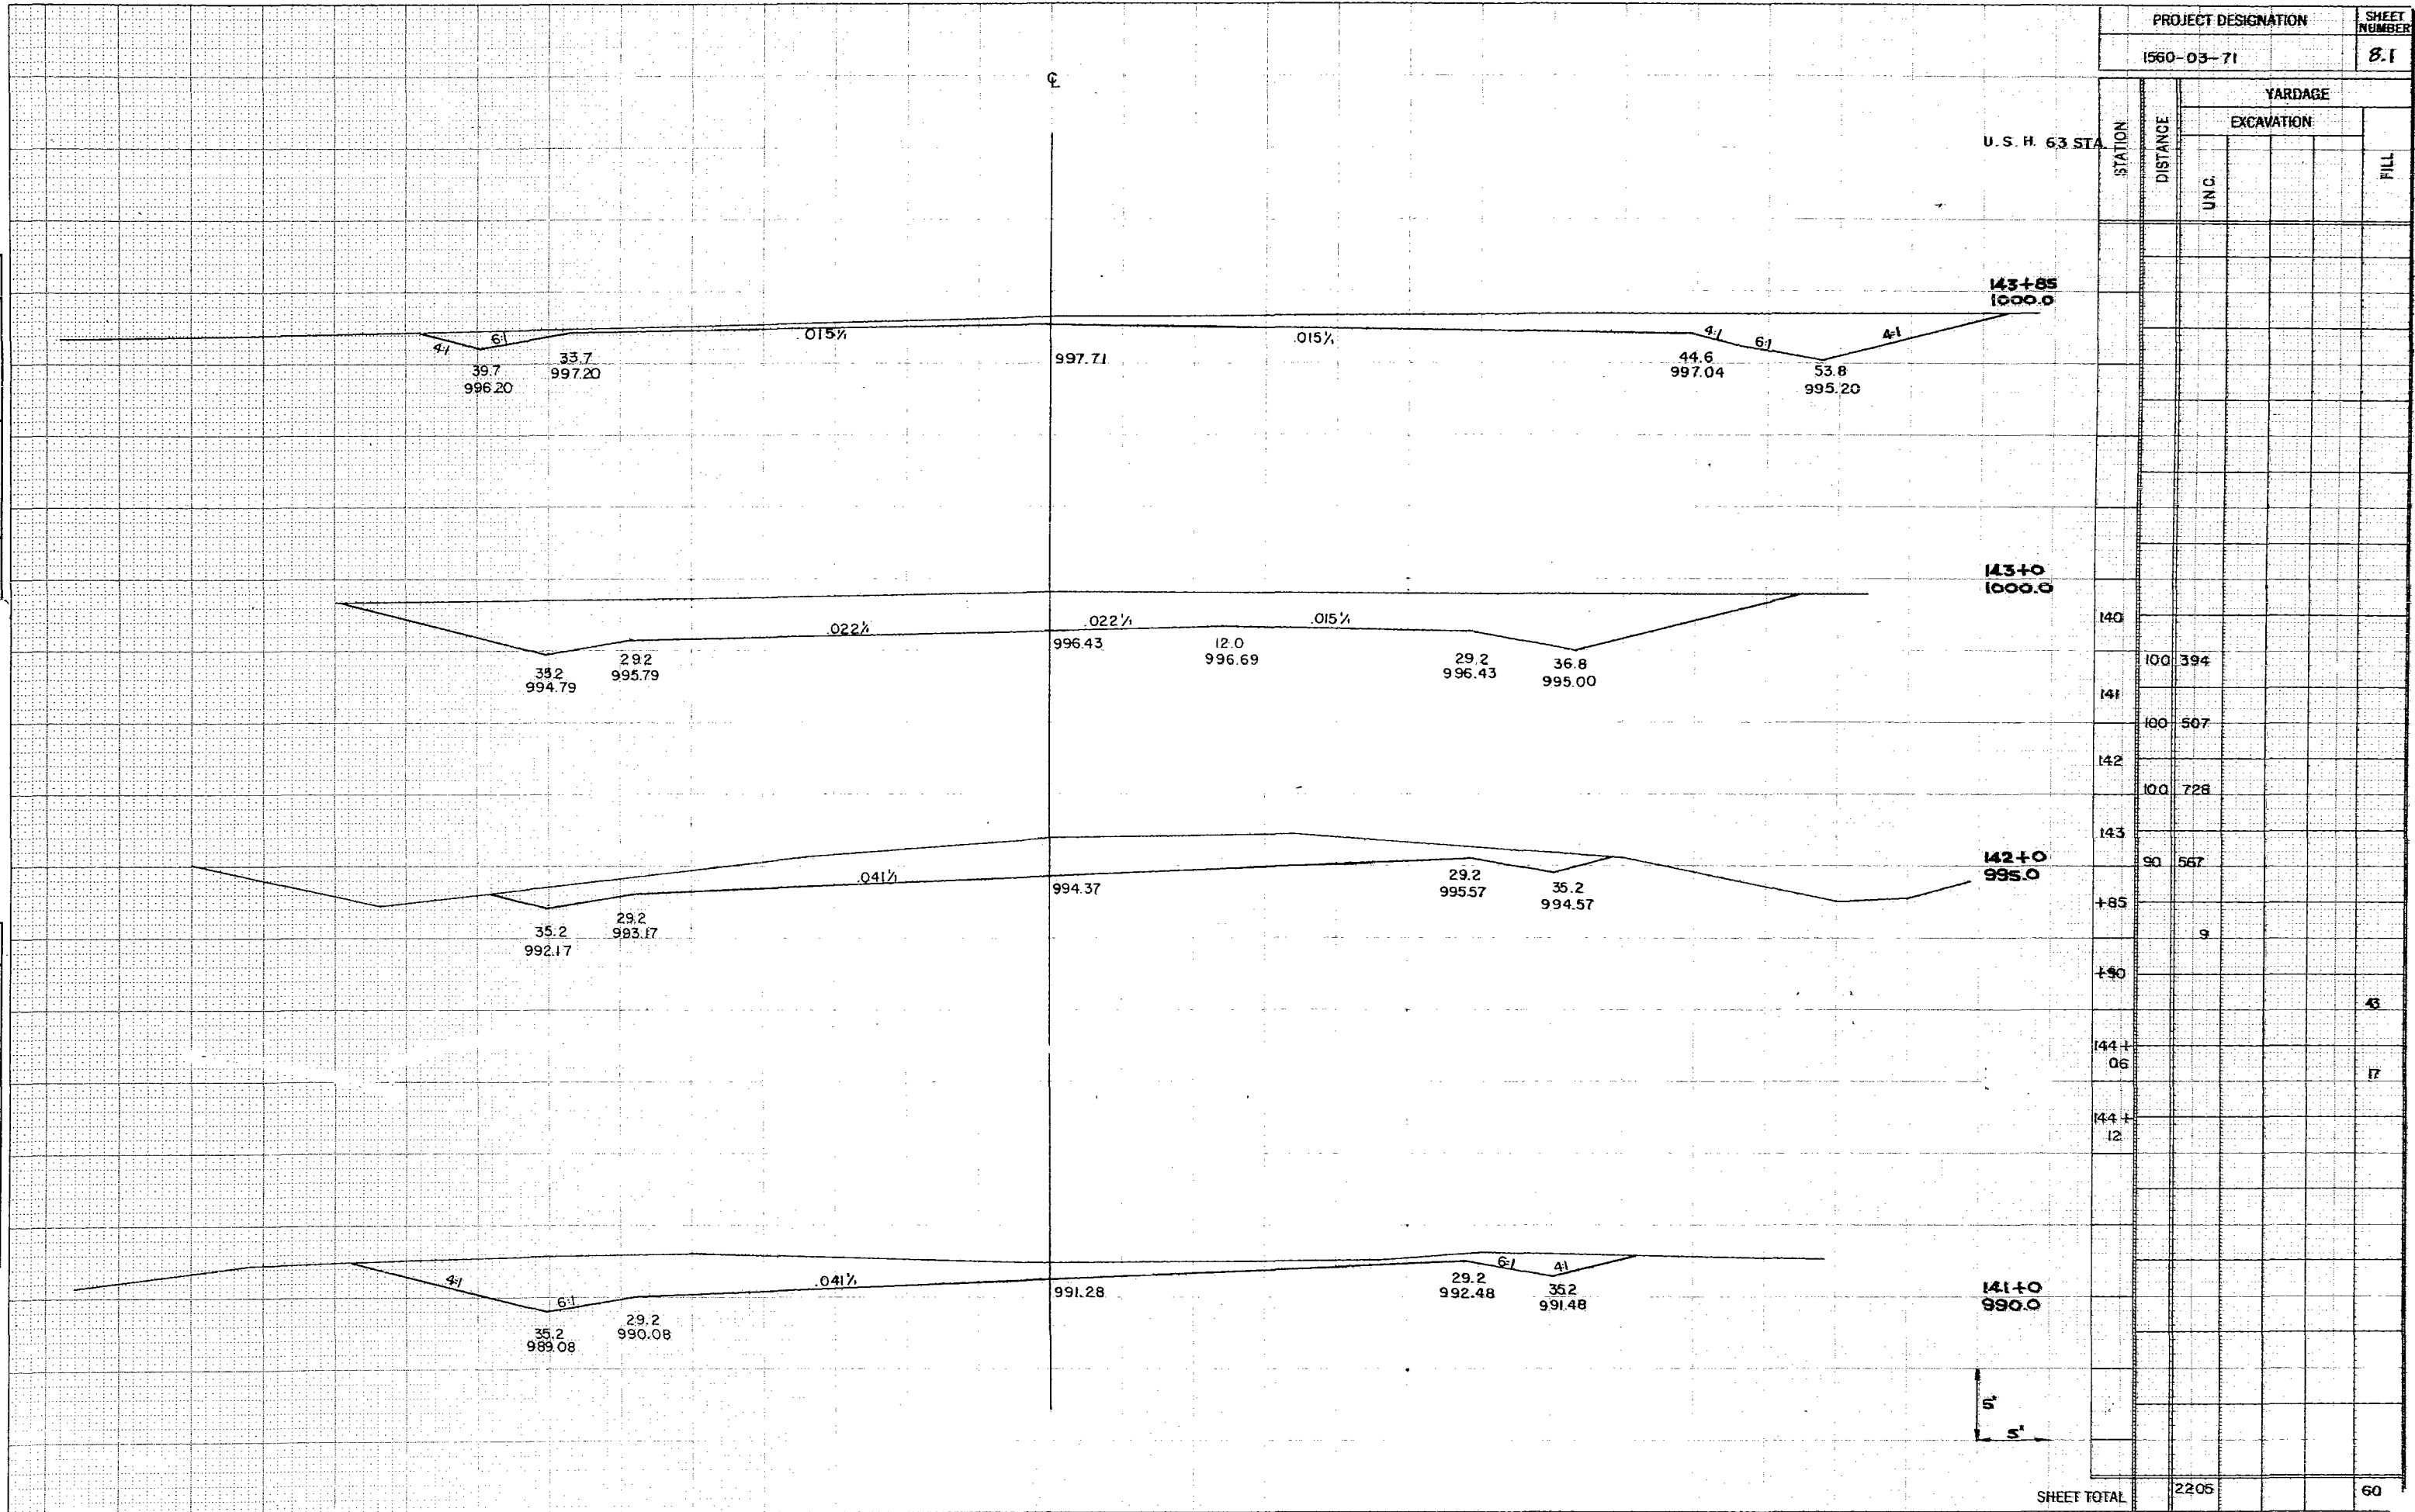

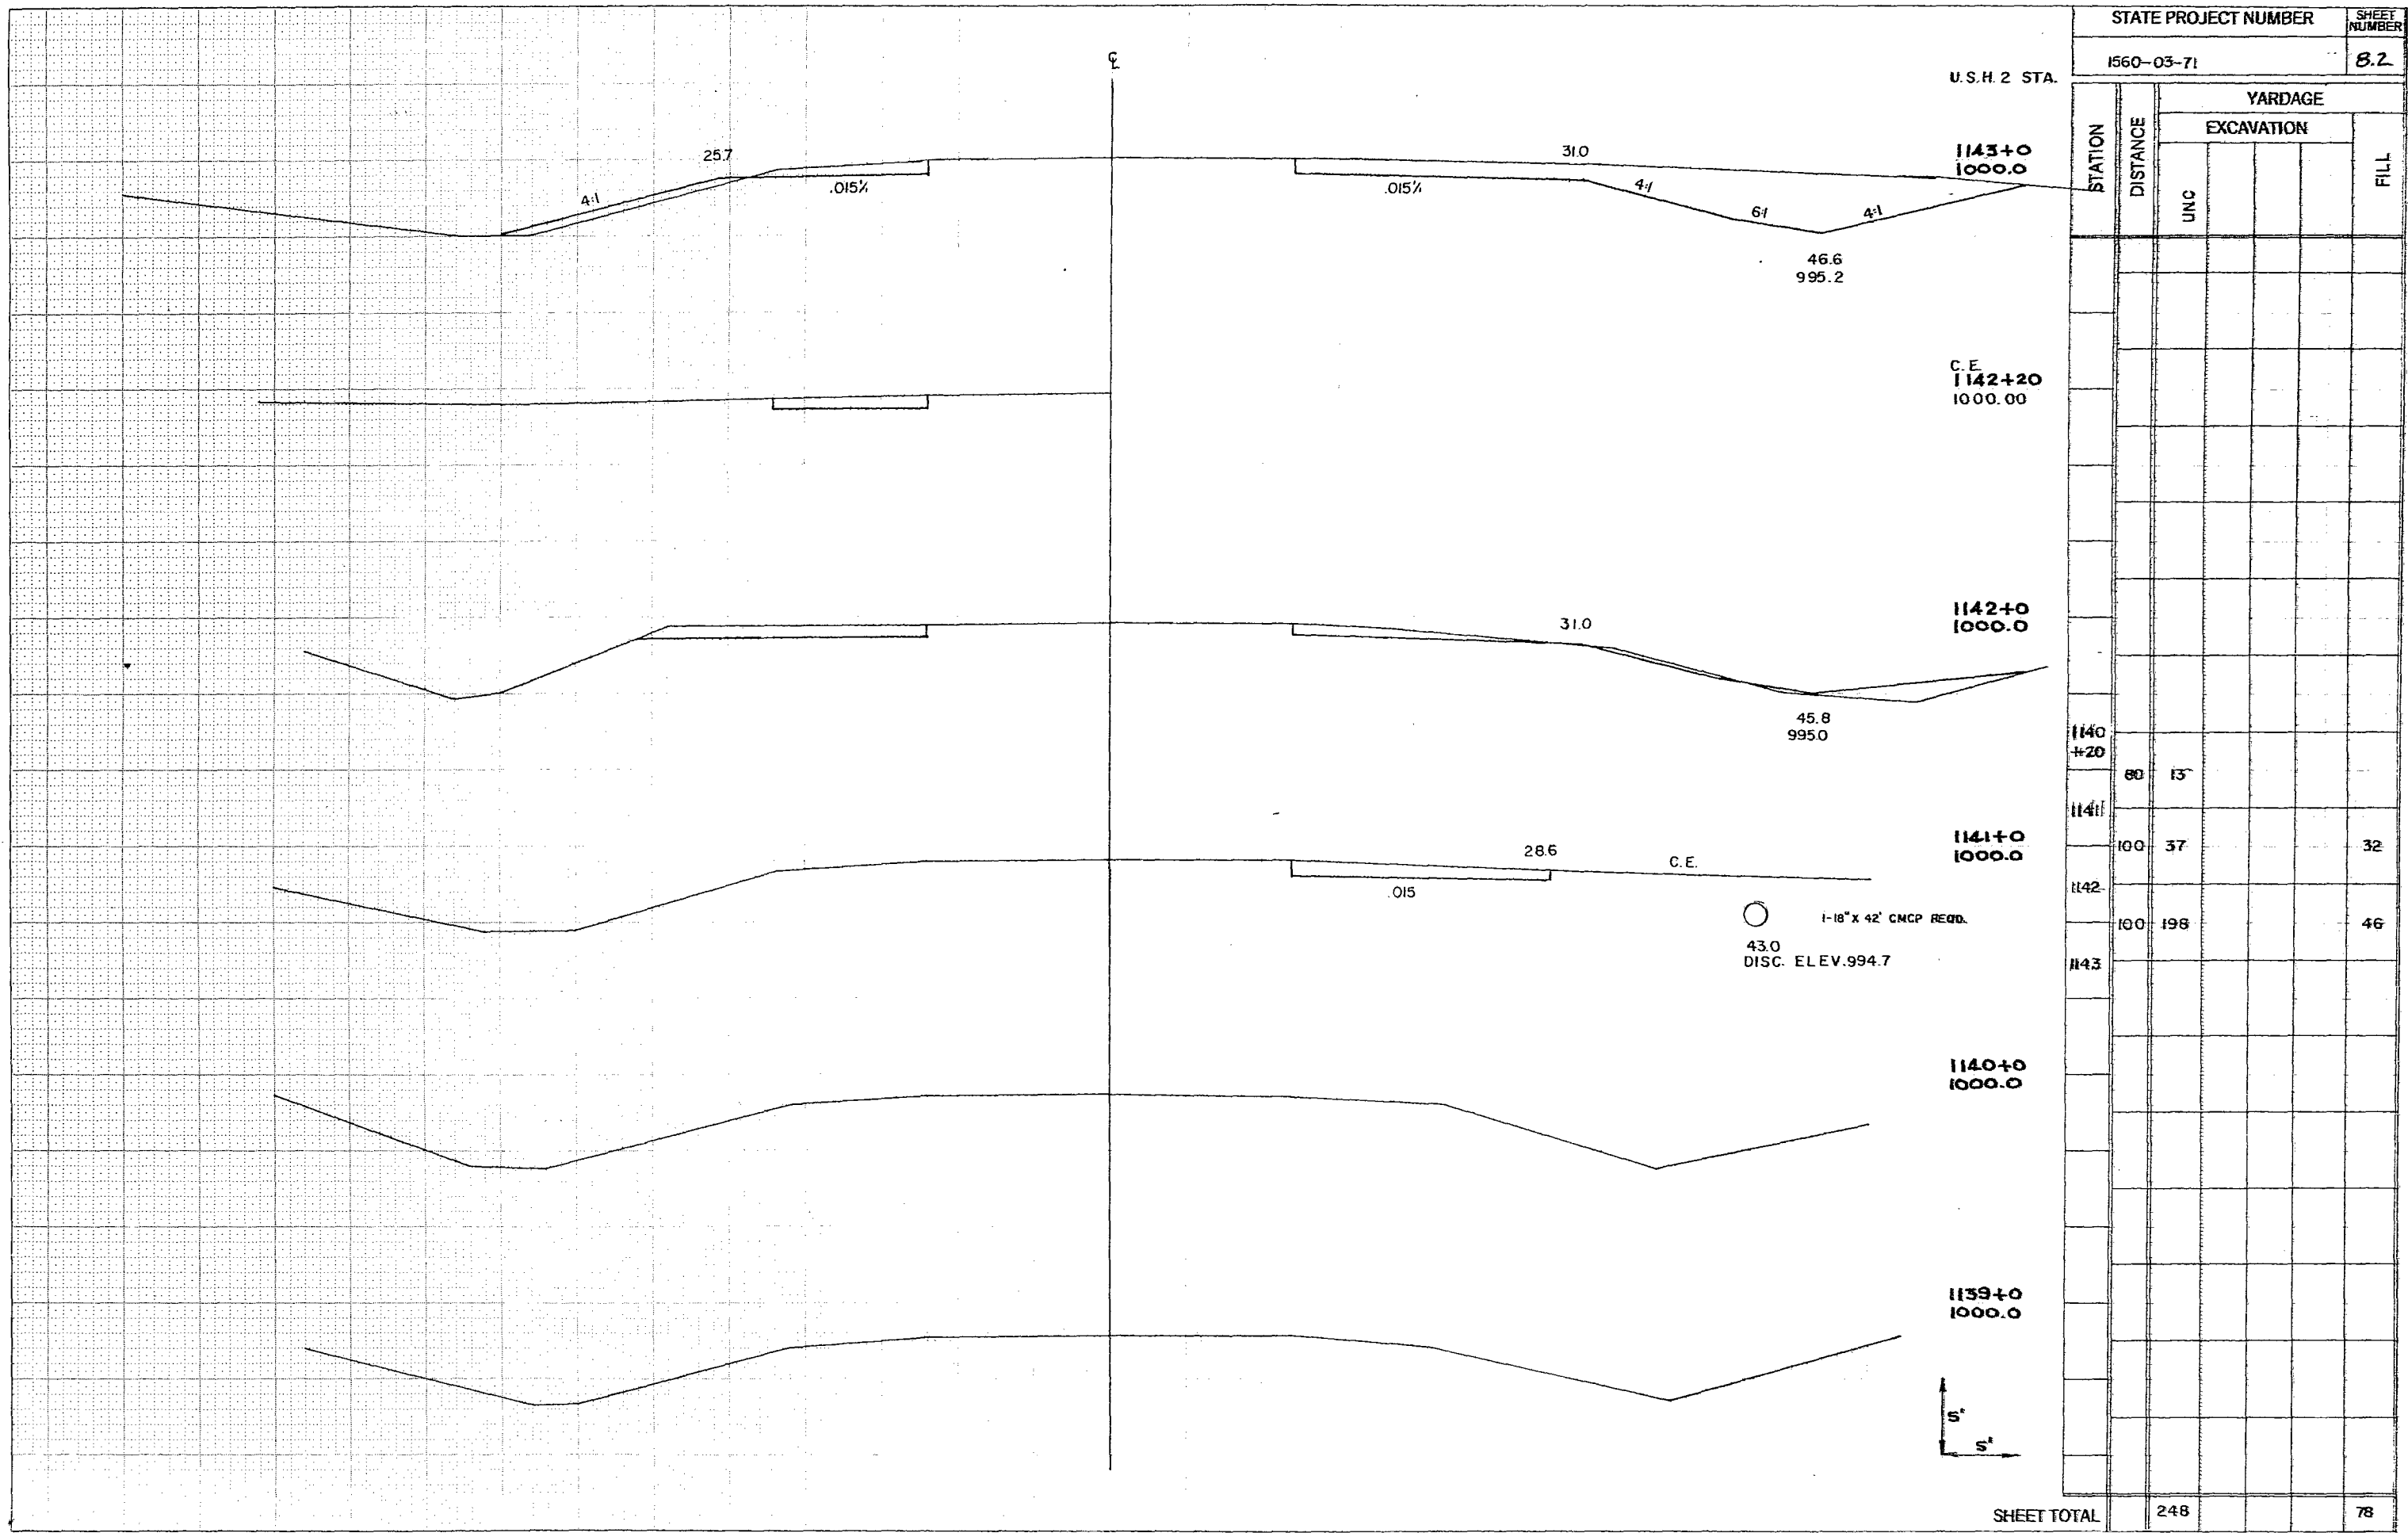

STATE PROJECT NUMBER					SHEET NUMBER
1560-03-71					8.2
STATION	DISTANCE	YARDAGE			
		EXCAVATION			FILL
		UNC			
1140+20	80	15			
1141					
	100	37			32
1142					
	100	198			46
1143					
TOTAL		248			78

