


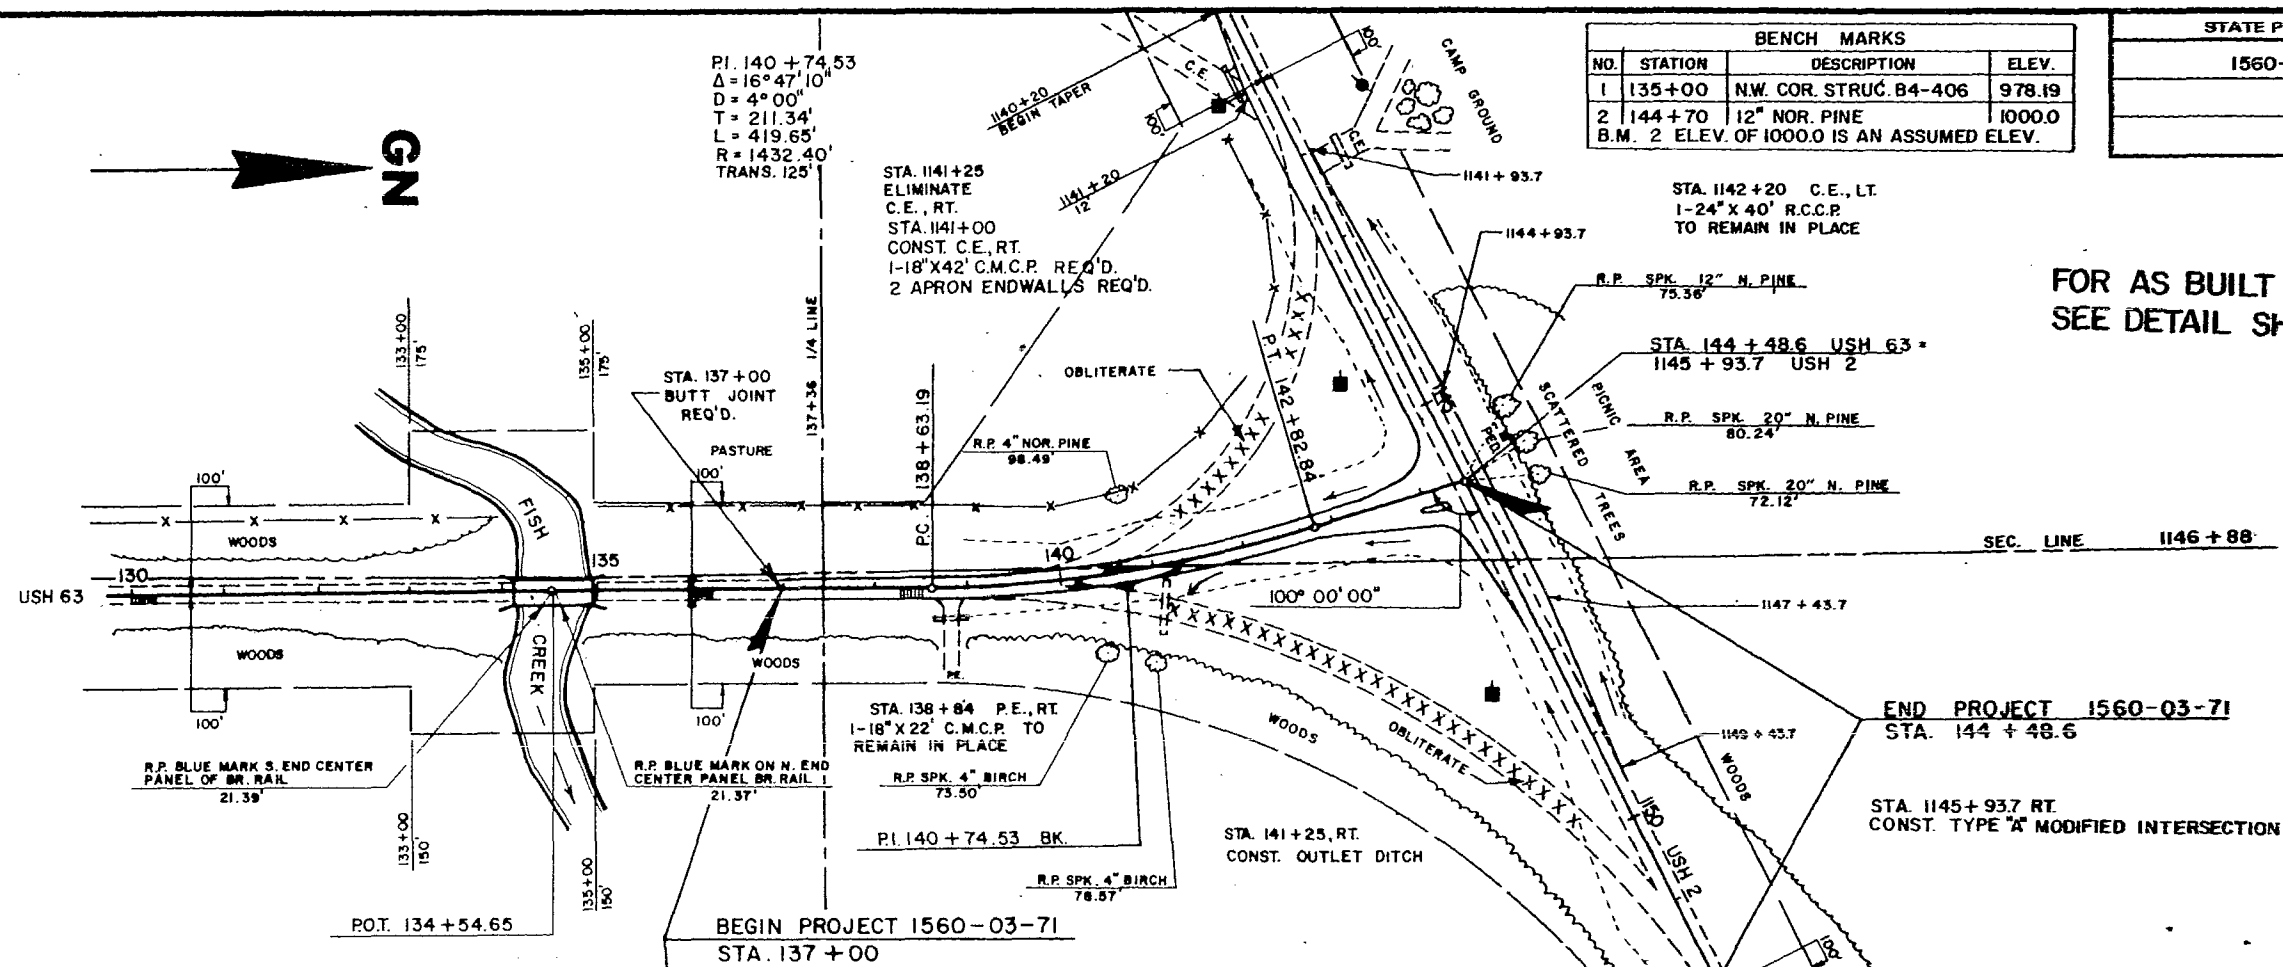

FOR AS BUILT INFORMATION
 SEE DETAIL SHEET 2.2

BENCH MARKS			
NO.	STATION	DESCRIPTION	ELEV.
1	135+00	N.W. COR. STRUC. B4-406	978.19
2	144+70	12" NOR. PINE	1000.0
B.M. 2 ELEV. OF 1000.0 IS AN ASSUMED ELEV.			

STATE PROJECT NUMBER		SHEET NO.
1560-03-71		5

NET LENGTH STA. 137+00 TO STA. 144+48.6 = 748.6 L.F.

