



STATE PROJECT NUMBER	SHEET NO.
1560-03-71	2
TYPICAL SECTIONS	
USH 2 & USH 63 INTER.	

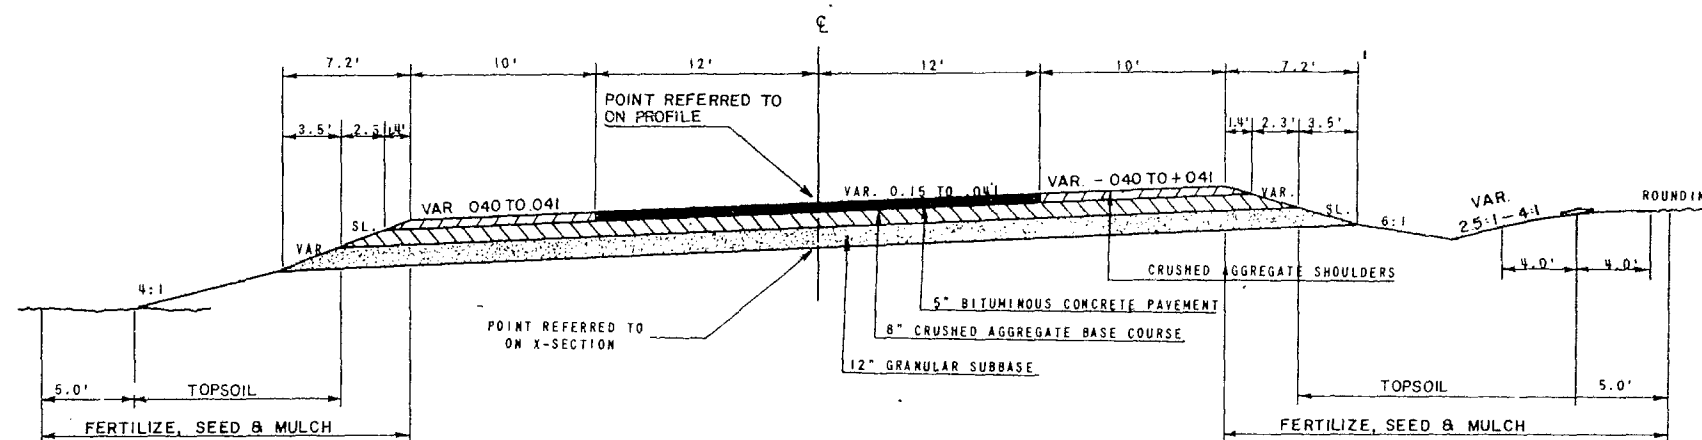


TYPICAL FINISHED SUPERELEVATED SECTION

STA 138+25 - 144+24.6

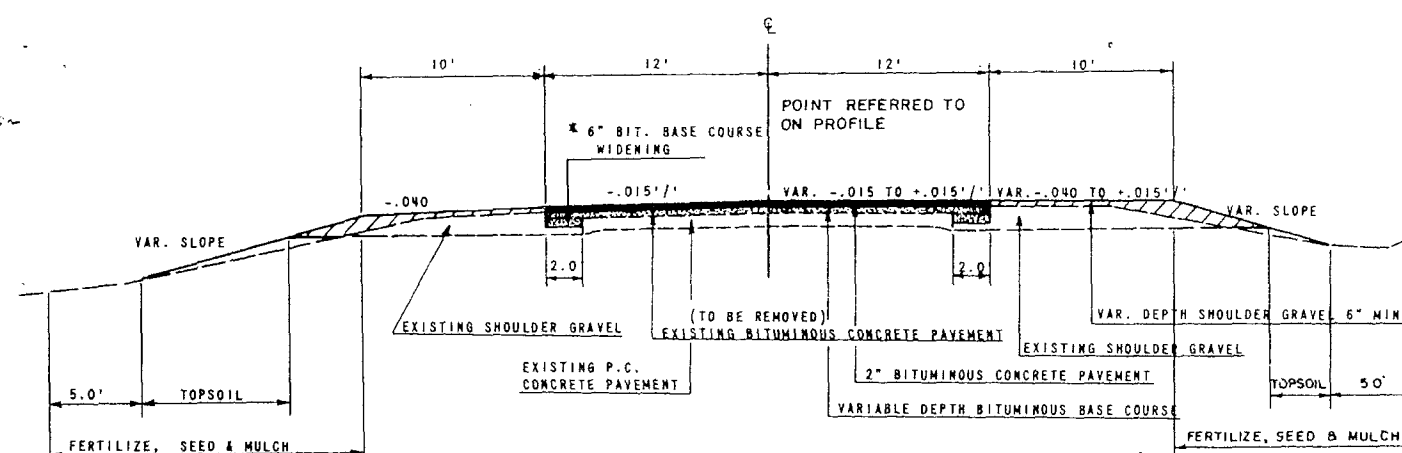

TYPICAL FINISHED RESURFACED SUPERELEVATED SECTION

STA 137+00 - 138+25
BUTT JOINT REQUIRED AT STA. 137+00

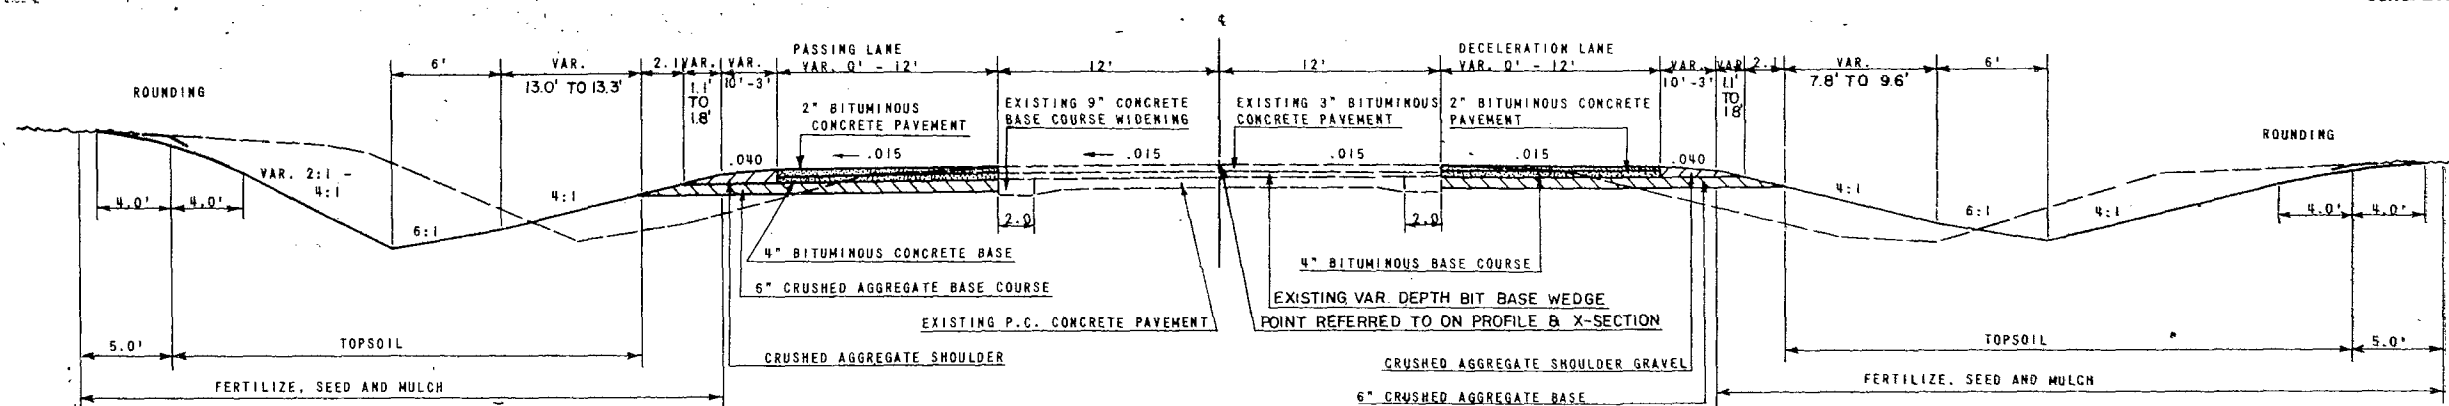

TYPICAL FINISHED SECTION

STA. 1141+93.7 - 1145+00 LT.
1140+20.0 - 1145+00 RT.

GENERAL NOTES

CONSTRUCTION DETAILS NOT SPECIFICALLY SHOWN SHALL CONFORM TO THE PERTINENT REQUIREMENTS OF THE STANDARD SPECIFICATIONS, THE SPECIAL PROVISIONS AND THE STANDARD DETAIL DRAWINGS.

WHEN THE QUANTITY OF THE ITEM OF BASE OR SURFACE COURSE IS MEASURED FOR PAYMENT BY THE TON OR CUBIC YARD, THE DEPTH OR THICKNESS WILL DEPEND ON THE DISTRIBUTION OF THE MATERIAL AS DIRECTED BY THE ENGINEER.

ALL DISTURBED AREAS WITHIN THE RIGHT OF WAY SHALL BE TOPSOILED TO THE SLOPE INTERCEPT POINT AT A 4" DEPTH. THE GRANULAR SUBBASE SLOPES SHALL BE TOPSOILED TO A 1" DEPTH. ALL DISTURBED AREAS WITHIN THE RIGHT OF WAY LIMITS SHALL BE FERTILIZED, SEEDING AND MULCHED.

UNDERCUTS SHALL ONLY BE MADE AT LOCATIONS APPROVED AND STAKED BY THE ENGINEER, AND THE UNDERCUT MATERIAL PLACED IN THE OLD ROAD OBLITERATION AREA.

CUT AND FILL SLOPES SHALL BE ROUNDED 5 FEET BEYOND THE SLOPE INTERCEPT POINT.


UTILITY OWNERS ARE:

WISCONSIN TELEPHONE COMPANY
334 SOUTH DEXEY STREET
EAU CLAIRE, WIS. 54701
715-835-6786

BAYFIELD ELECTRIC COOP
IRON RIVER, WIS. 54847
715-372-4287


STANDARD DETAIL DRAWINGS

CONCRETE CURB, GUTTER, COMBINATION CURB AND GUTTER	801-2
SODDED BACKSLOPE FLUME AND INTERCEPTING EMBANKMENT	805-1
TYPICAL INSTALLATION OF EROSION BALES	808-1
APRON ENDWALLS FOR CULVERT PIPE AND PIPE ARCH	801-6
TRAFFIC SIGNAL AND TRAFFIC COUNTER DETAILS	903-2
CONSTRUCTION BARRICADES AND STANDARD SIGNS	1501-4
METAL CONDUIT	902-1
CONCRETE PAVEMENT REINFORCEMENT	1301-2

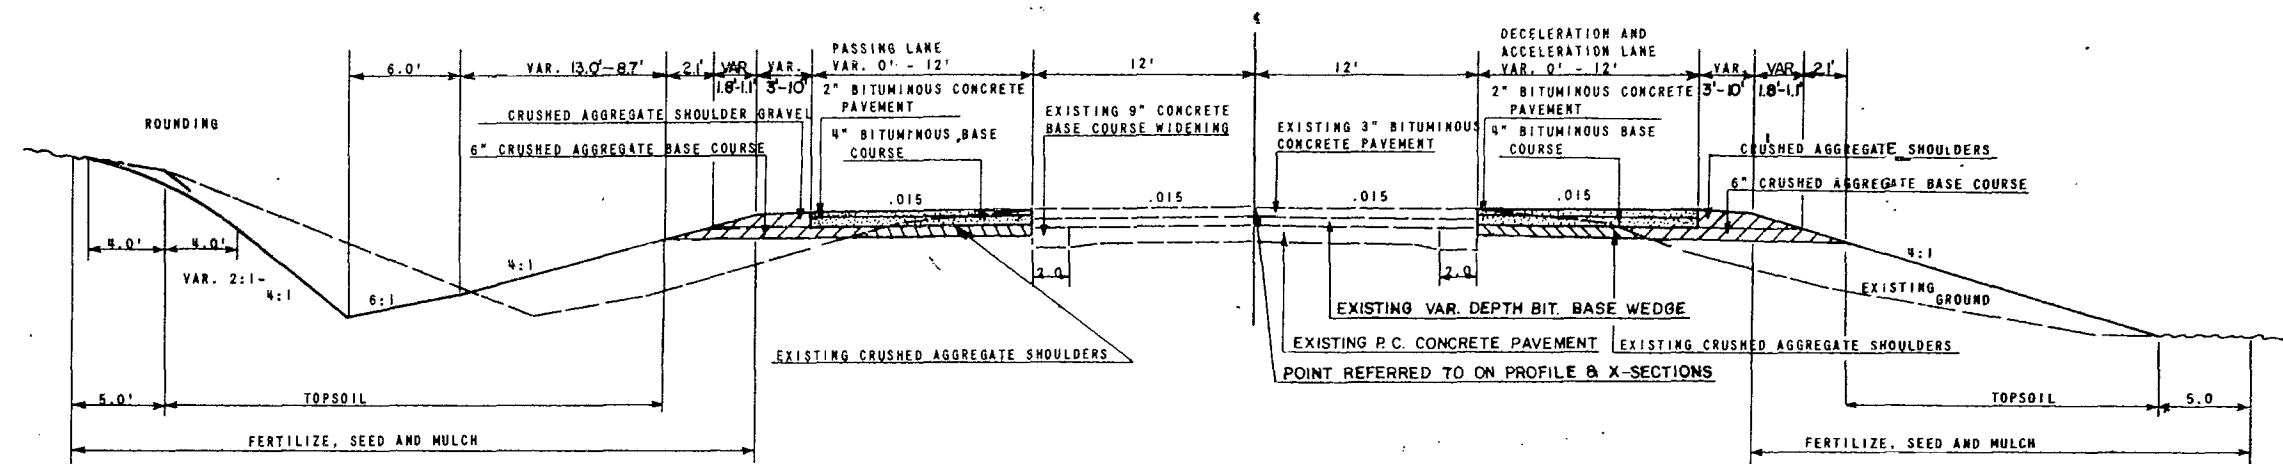


TYPICAL FINISHED SECTION

STA. 1145+00 - 1149+43.7 LT.
1145+00 - 1147+55.7 RT.

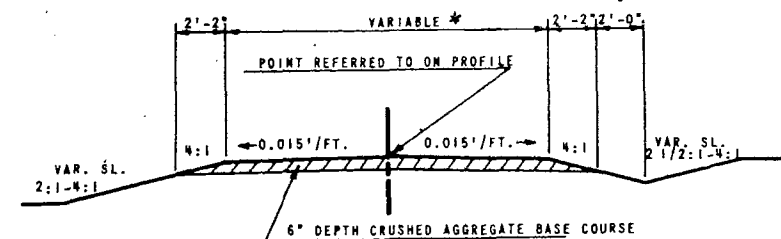

HALF SECTION IN FILL HALF SECTION IN CUT
TYPICAL SECTION FOR COMMERCIAL OR PRIVATE
ENTRANCES

*WIDTH OF PRIVATE ENTRANCES 16'MIN - 24'MAX.
WIDTH OF COMMERCIAL ENTRANCES 35'MAX.
PIPE LENGTHS FOR PRIVATE ENTRANCES BASED ON 16'TOP
PIPE LENGTHS FOR COMMERCIAL ENTRANCES BASED ON 30'TOP

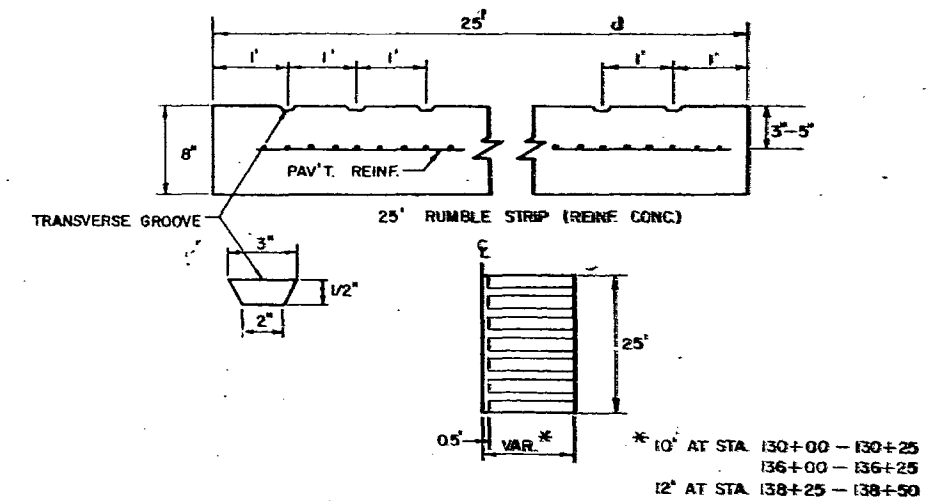

RUMBLE STRIP DETAIL

