

BEGIN PROJECT
1580-15-71

EXISTING TYPE
"C" INTERSECTION

SEE INTERSECTION DETAIL


1-155
2-910mm x 19.50m
RCCP



EXISTING TYPE
"C" INTERSECTION

P.I. 1-986.595
△ 0°05' RT.

2-302
1-610mm x 17.07m
RCCP

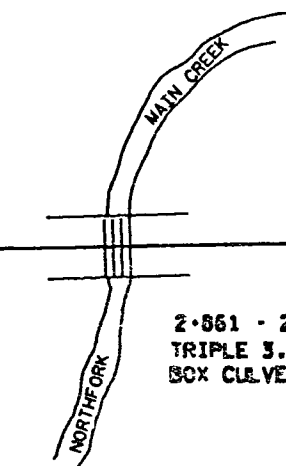

2-861 - 2-872
TRIPLE 3.66m x 2.13m
BOX CULVERT

P.C. 3-095.915
TOWN RD.
3-108.96

P.I. 3-166.323 BK.
3-166.232 A.O.
△ = 4°37' LT.
T = 70.409m
L = 140.726m
RAD = 1746.413m
S.E. 2.9%

3-403
1-610mm x 24.38m
RCCP



FILE NAME: 08 15801500/mbp0101.dgn
LEVELS ON - 1, 2, 3, 62, 63

GLEN FLORA - E.C.L.

SCALE: 1:1


HWY: U.S.H. 8

COUNTY: RUSK


STATE PROJECT NO: 1580-15-71

SHEET NO: .50 M

FILE NAME: 08 15801500/mbp/08-09-11
LEVELS ON - 1, 2, 3, 62, 63

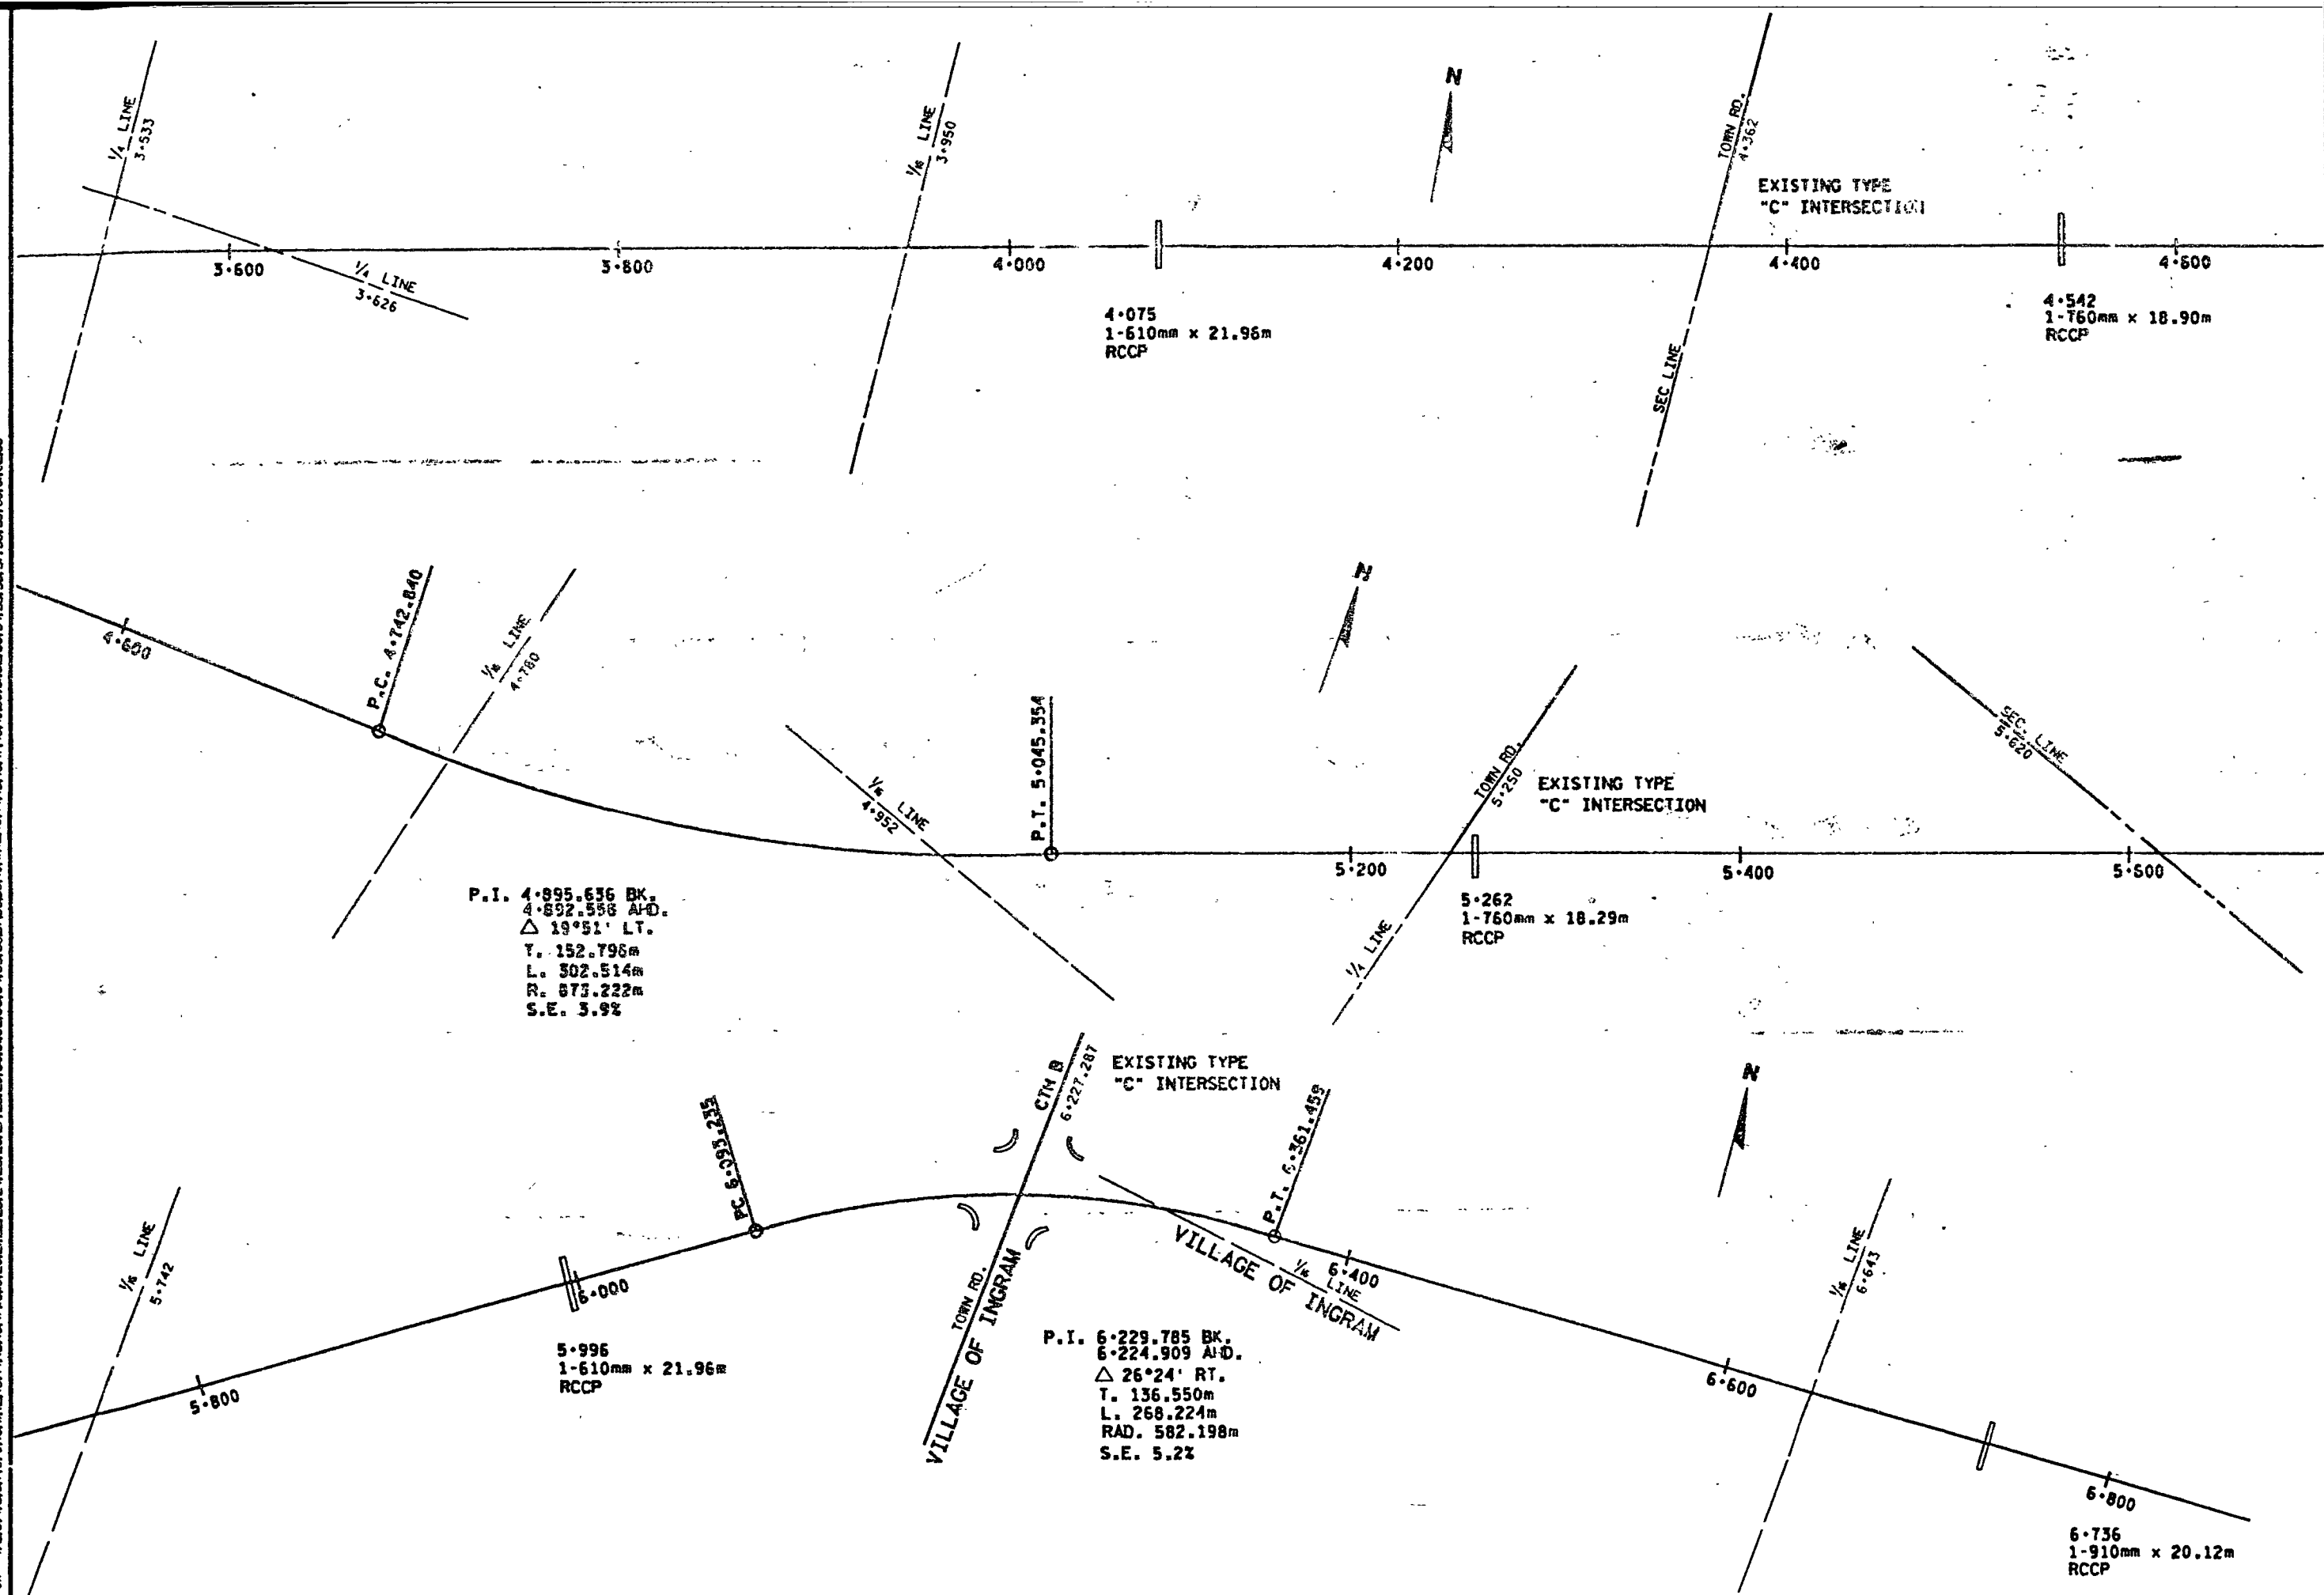

FILE NAME: 158015000/mbplan.dgn
 LEVELS ON - 1, 2, 3, 62, 63

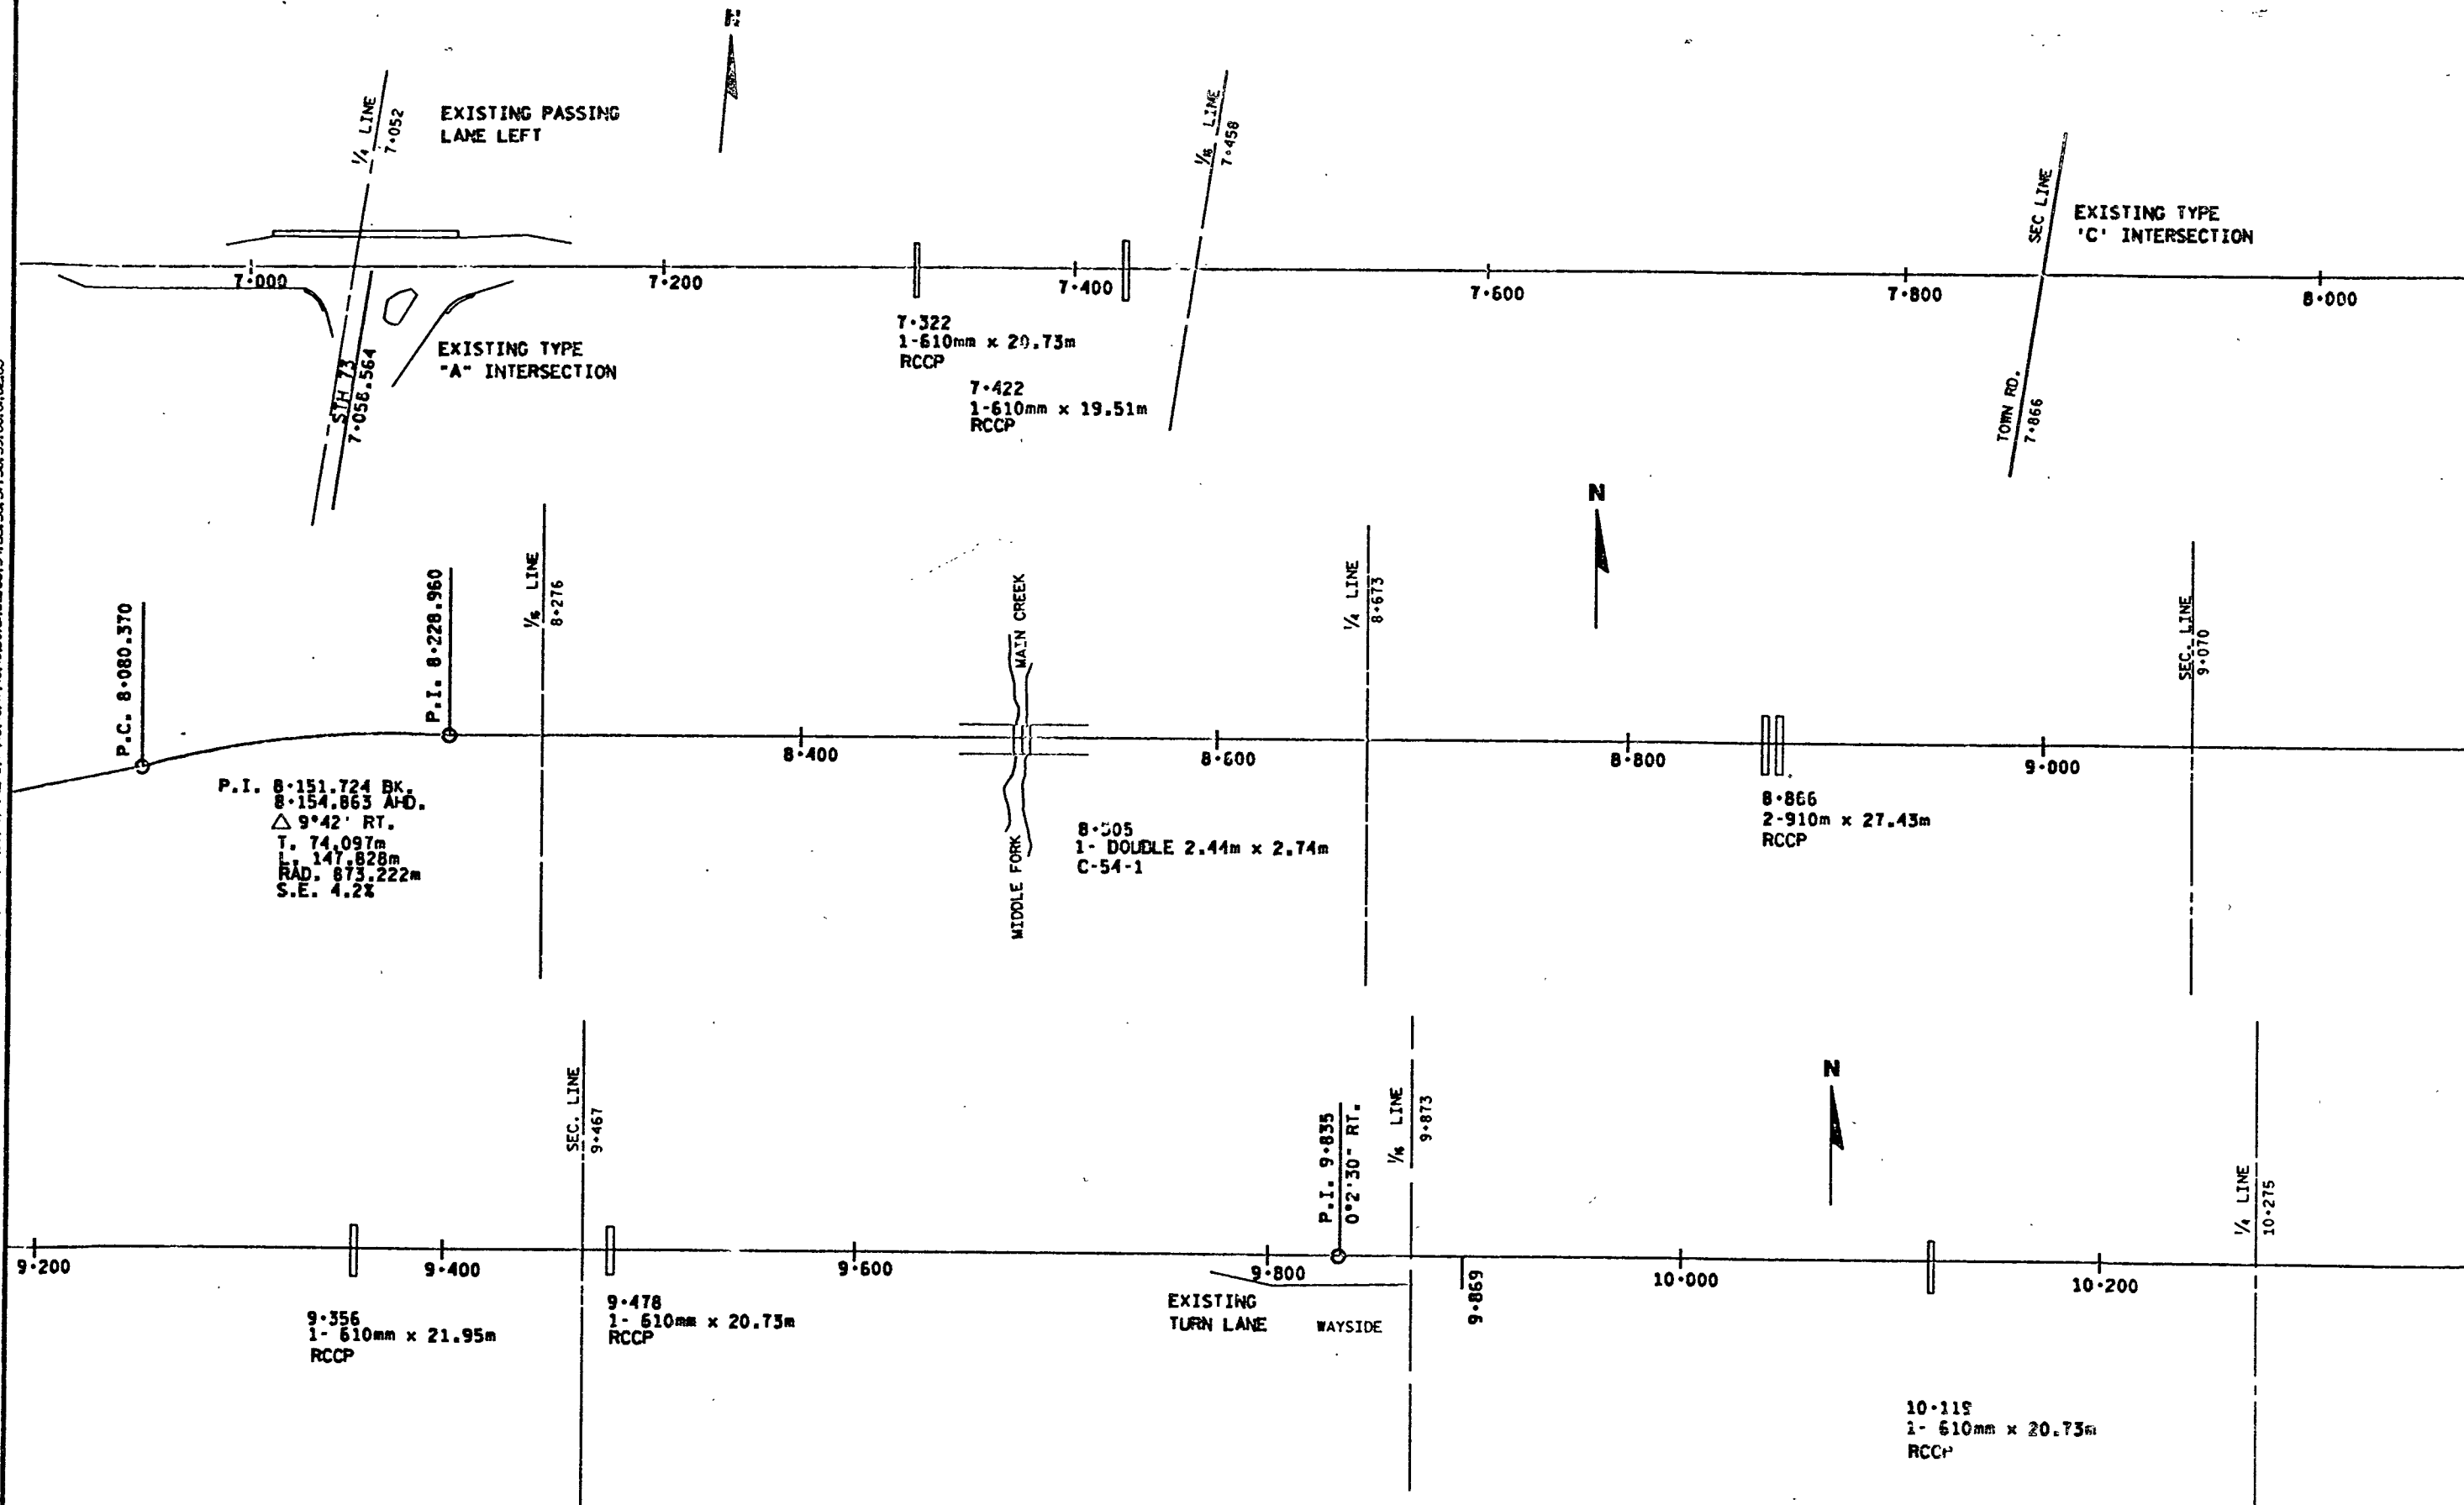

GLEN FLORA - E.C.L.

SCALE: 1:1


HWY: U.S.H. 8

COUNTY: RUSK


STATE PROJECT NO: 1580-15-71

SHEET NO: . 5.2 M

LEVELS ON - 1, 2, 3, 62, 63

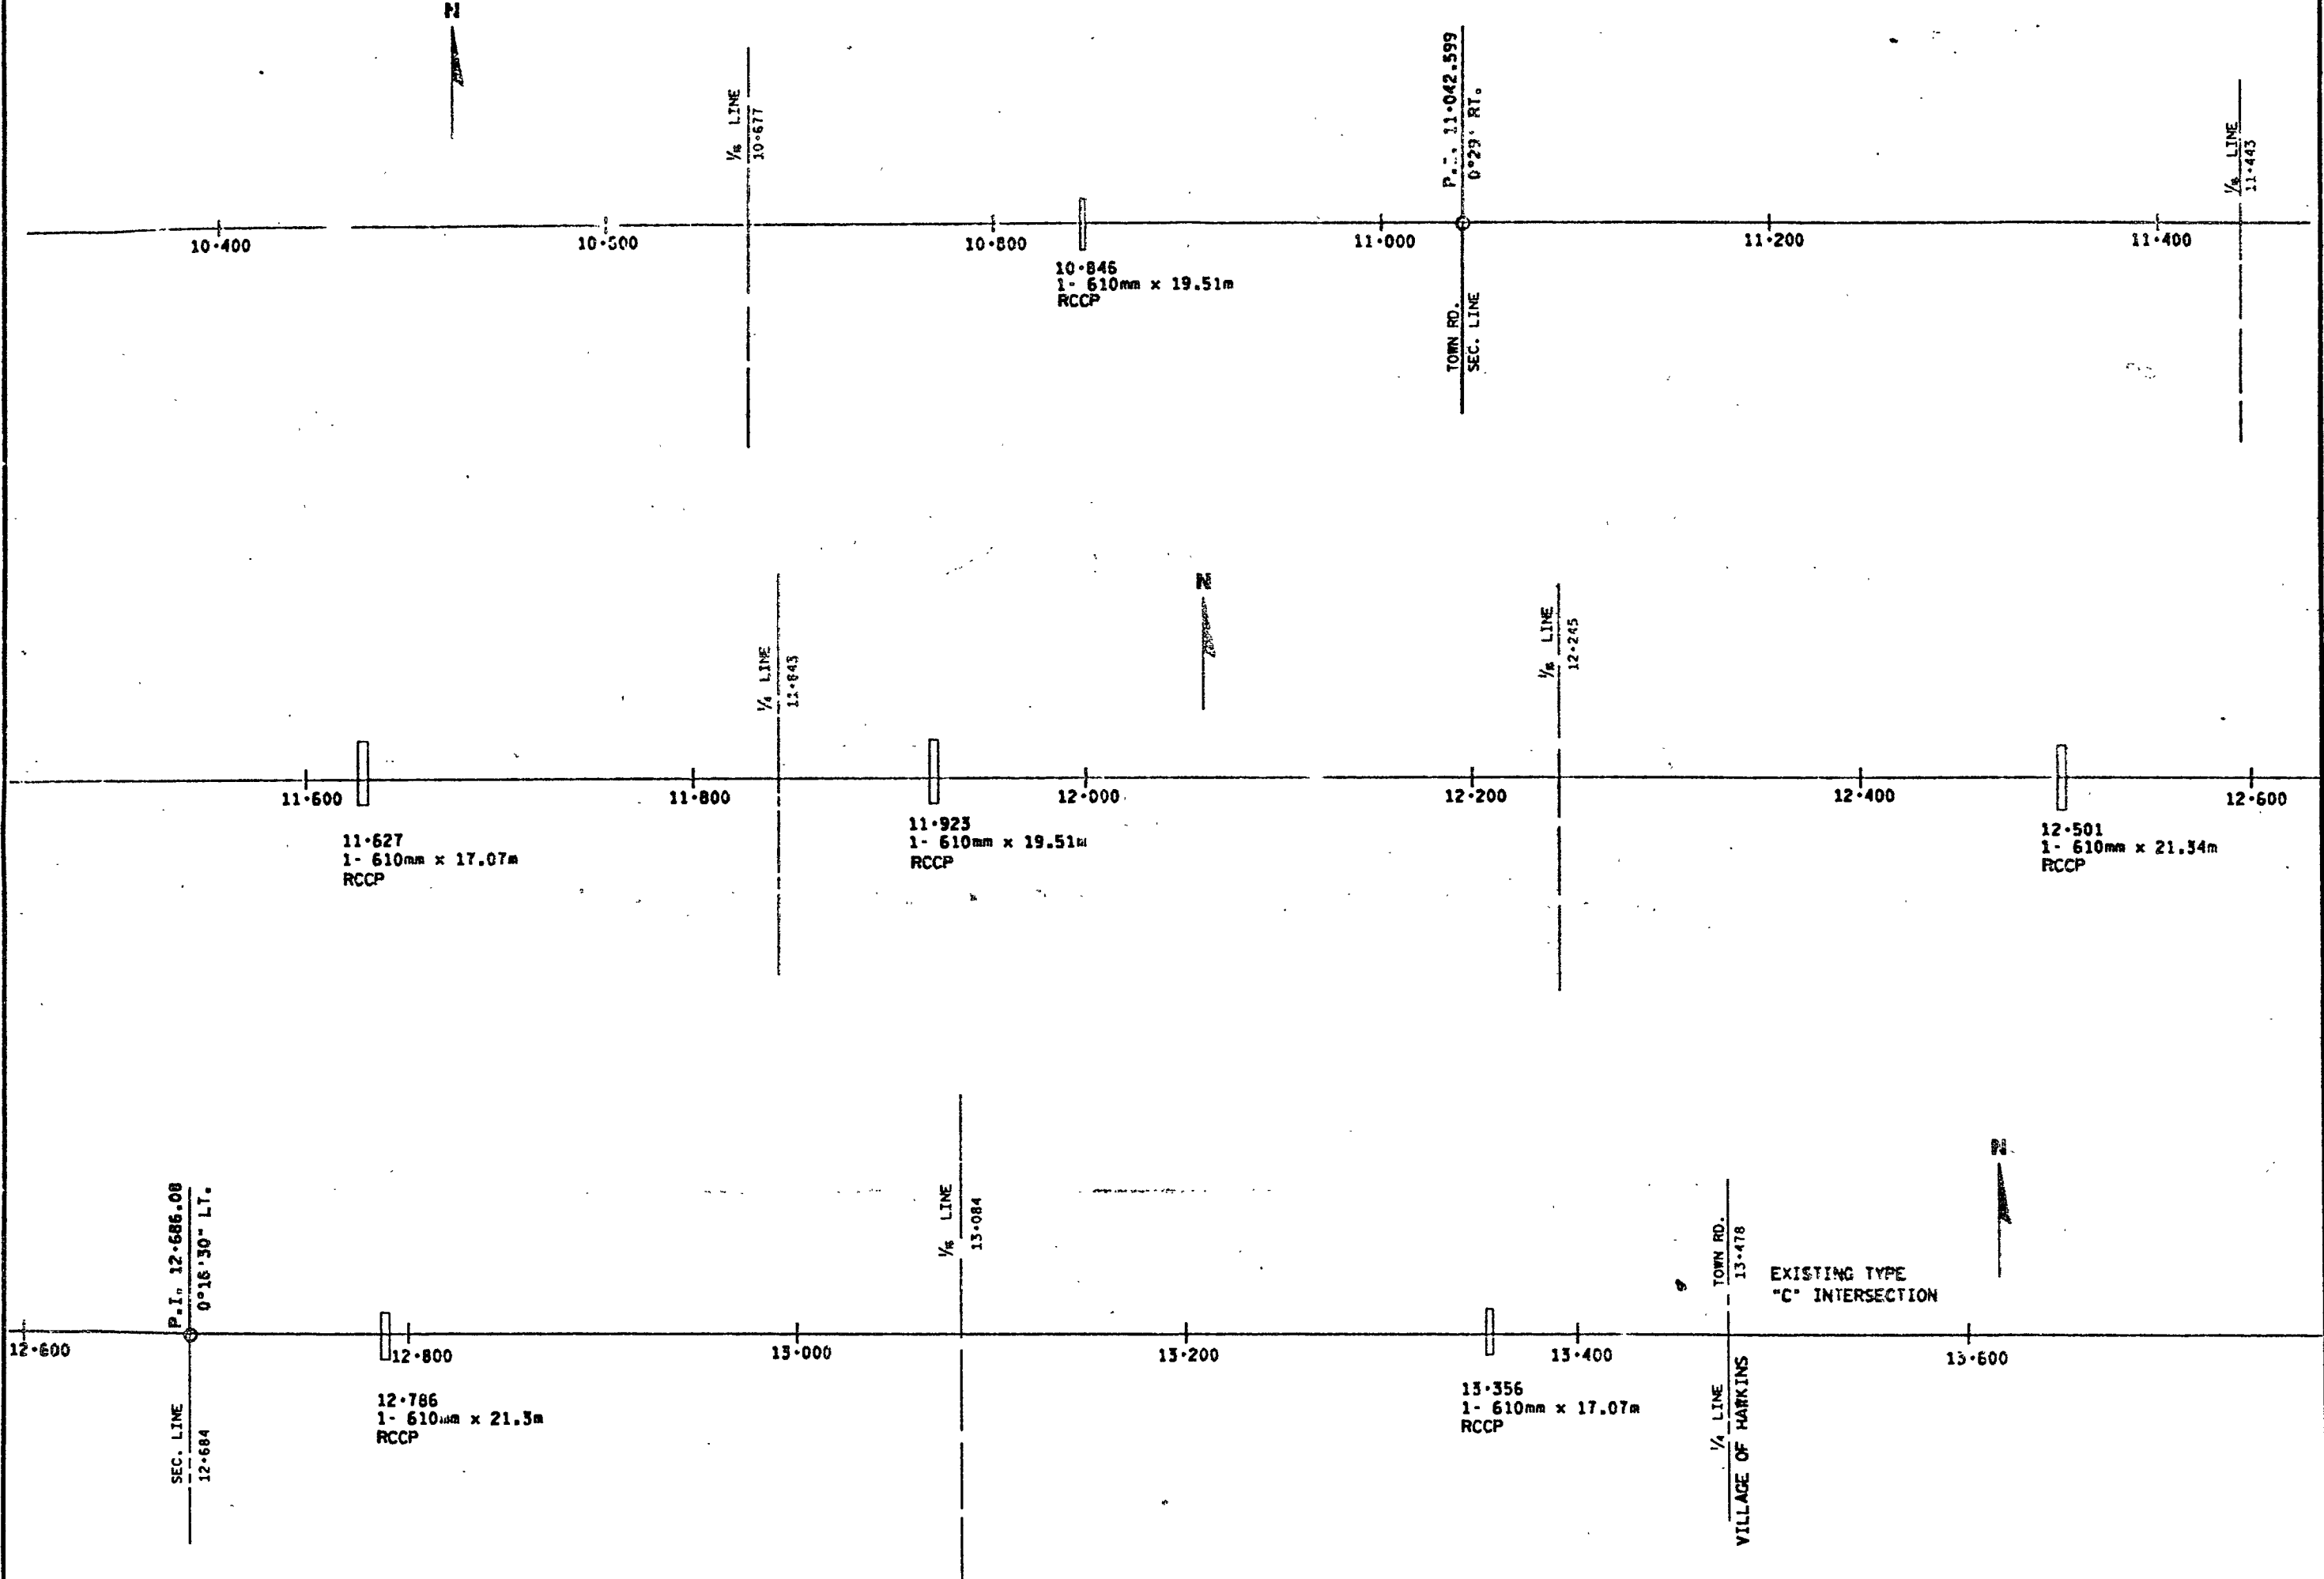

FILE NAME: DB 15801500/mbien.dgn
LEVELS ON - 1,2,3,4,5,6,7,8,9,10,11,12,13,14,15,16,17,18,19,20,21,22,23,24,25,26,27,28,29,30,31,32,33,34,35,36,37,38,39,40,41,42,43,44,45,46,47,48,49,50,51,52,53,54,55,56,57,58,59,60,61,62,63

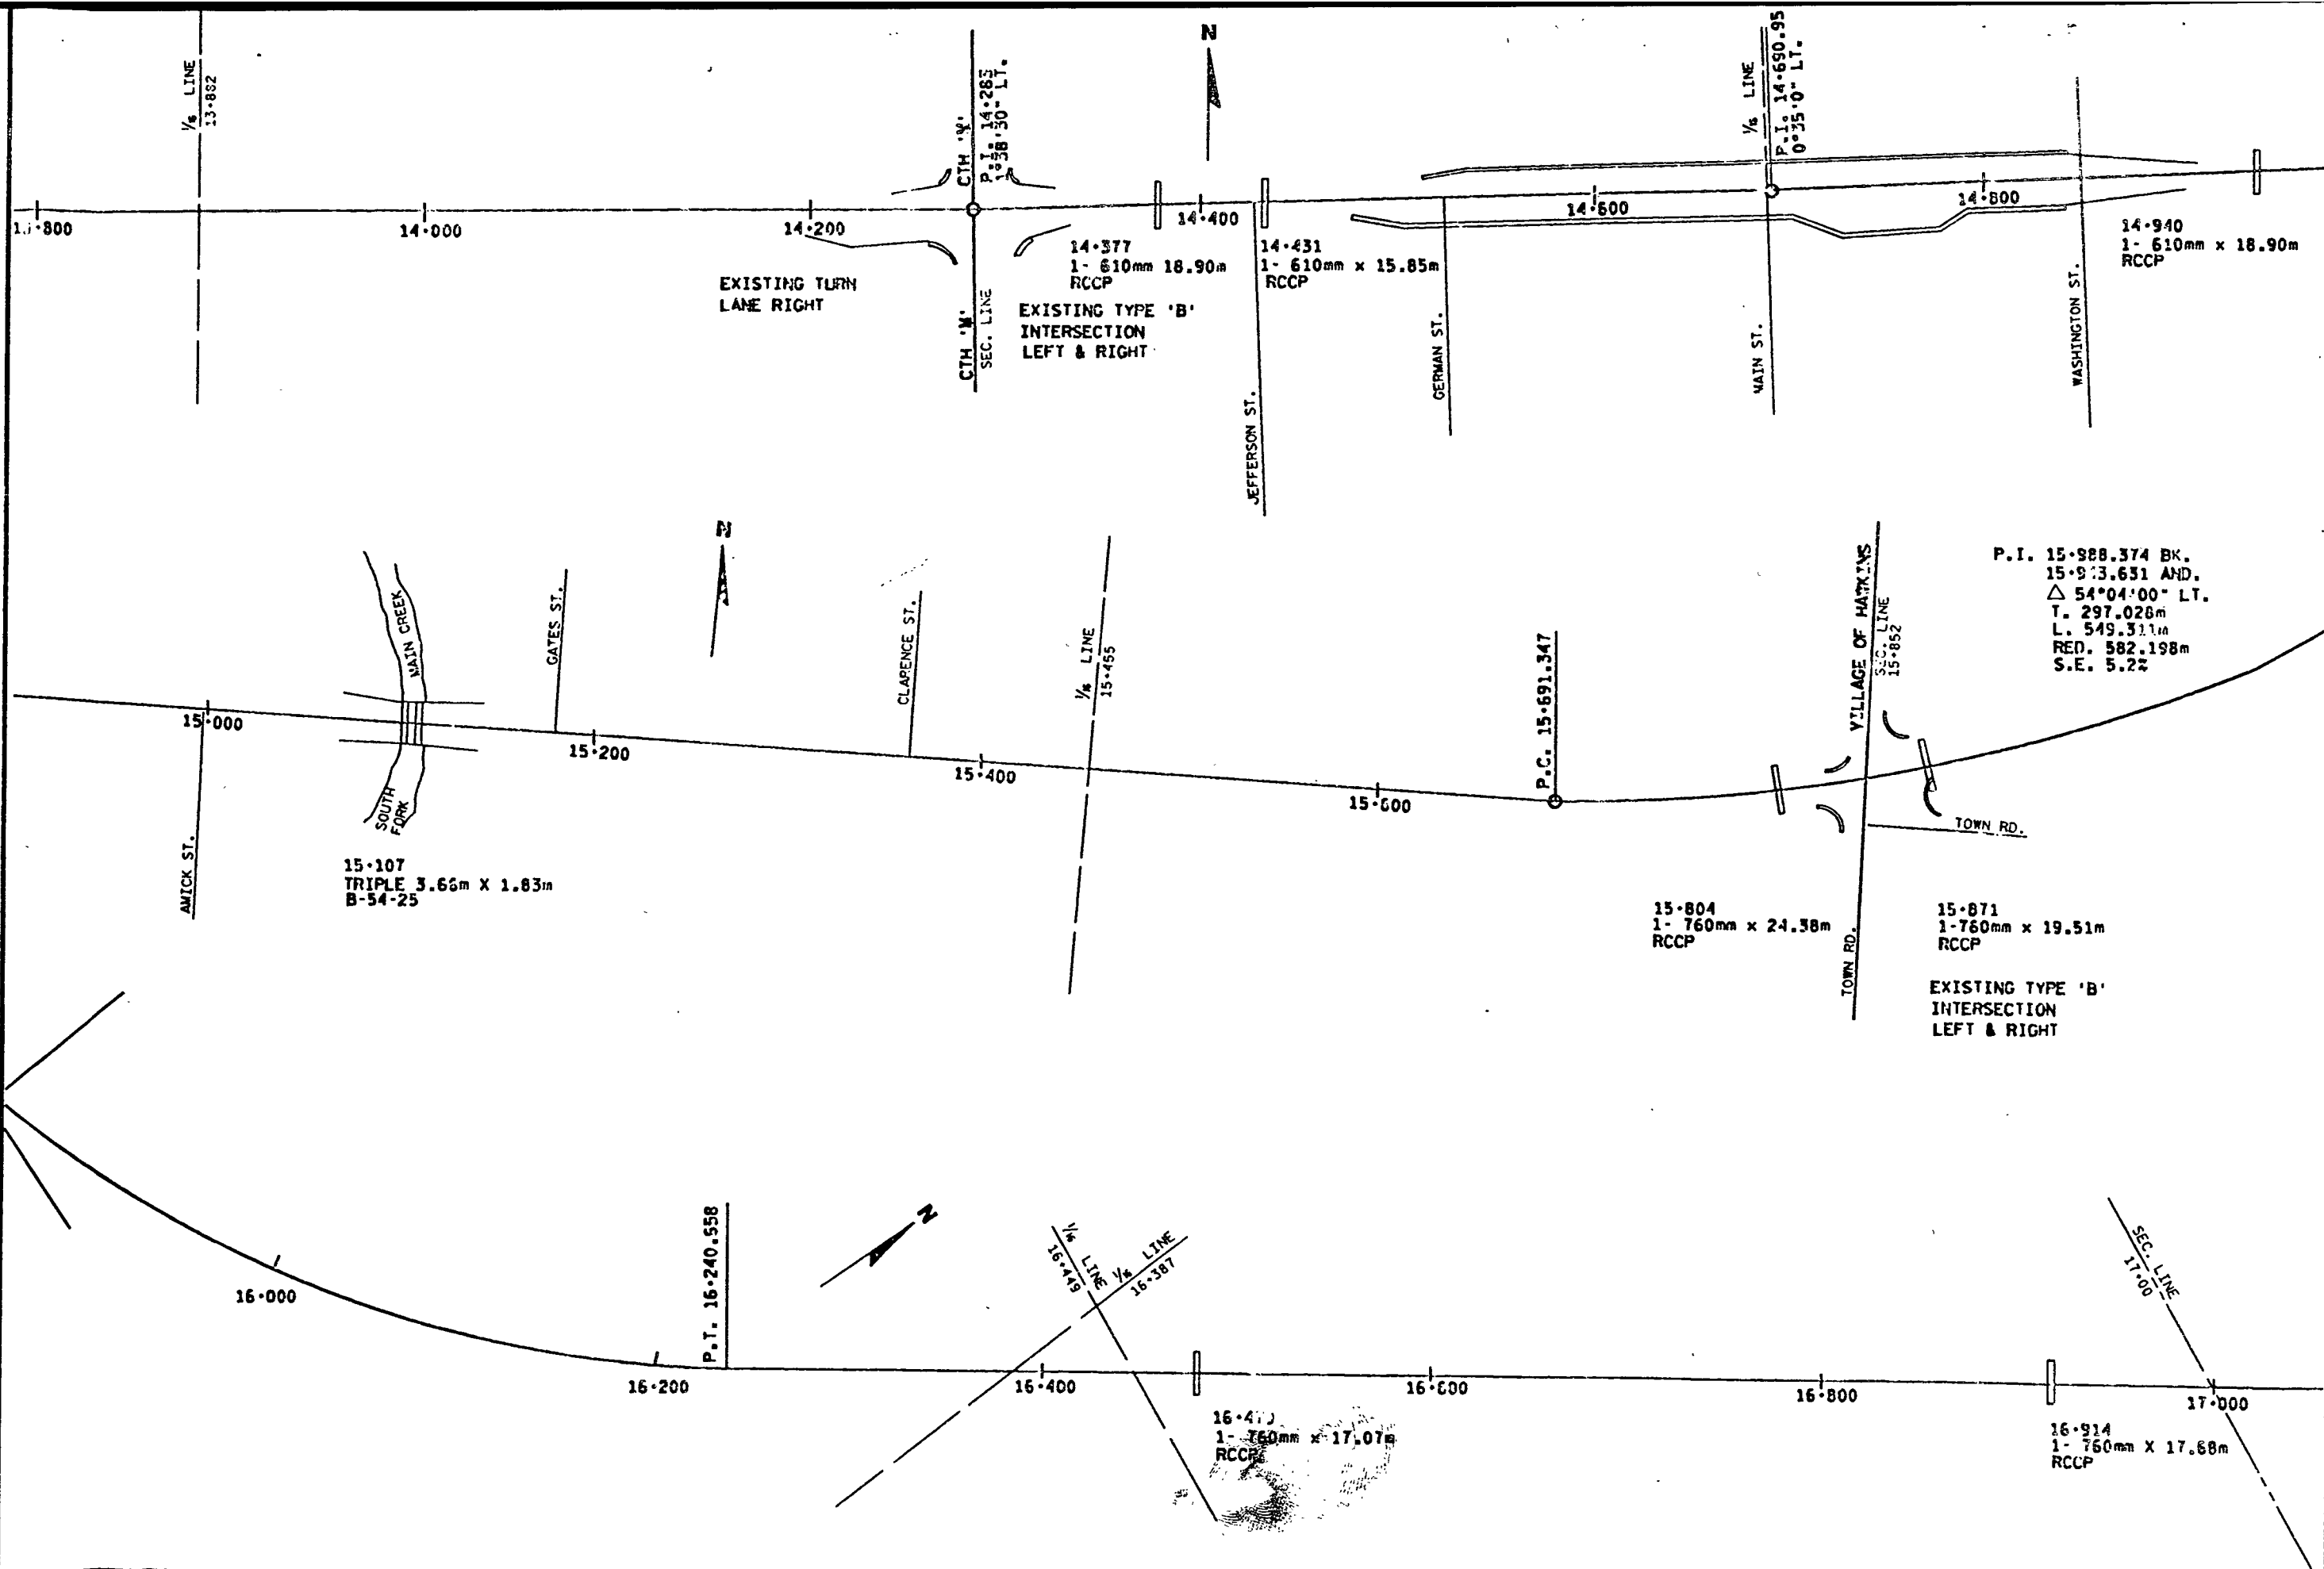

GLEN FLORA - E.C.L.

SCALE: 1:1

HWY: U.S.H. 8

COUNTY: RUSK

STATE PROJECT NO: 1580-15-71

SHEET NO: .5.4 M

LEVELS ON - 1, 2, 3, 62, 63

