

Sheet No. 1 Title
 Sheet No. 2-2.6 Typical Sections and Details
 Sheet No. Estimate of Quantities
 Sheet No. 3A-3B Miscellaneous Quantities
 Sheet No. Right of Way Plat
 Sheet No. 5-5.5 Plan and Profile
 Sheet No. 6-6.6 Standard Detail Drawings
 Sheet No. Sign Plates
 Sheet No. Structure Plans
 Sheet No. Computer Earthwork Data
 Sheet No. Cross Sections

TOTAL SHEETS = 23

CONTRACTOR

MONARCH PAVING CO.

SUB-CONTRACTORS

MIRRA'S TREE SERVICE

CENTURY FENCE

RENT-A-FLASH OF WISCONSIN INC.

TIME INC.

ELVORD TRUCKING INC.

TWIN LAKES TRANSIT LTD.

DEPARTMENT OF TRANSPORTATION

GLEN FLORA - E.C.L.

U.S.H. 8

RUSK COUNTY

STATE PROJECT NUMBER

1580-15-71

PROJECT ENGINEER: QUENTIN MARTIN
 PROJECT DIARY: 97-06
 PROJECT PERSONNEL INFO LOCATED IN 97-06


METRIC PROJECT

START OF CONTRACT TIME AUG. 4, 1997
 CONSTRUCTION WORK STARTED AUG. 4, 1997
 CONSTRUCTION WORK COMPLETED SEPT. 25, 1997
 CONTRACT TIME STOPPED SEPT. 26, 1997

END PROJECT
 STA. 18+470.88



N

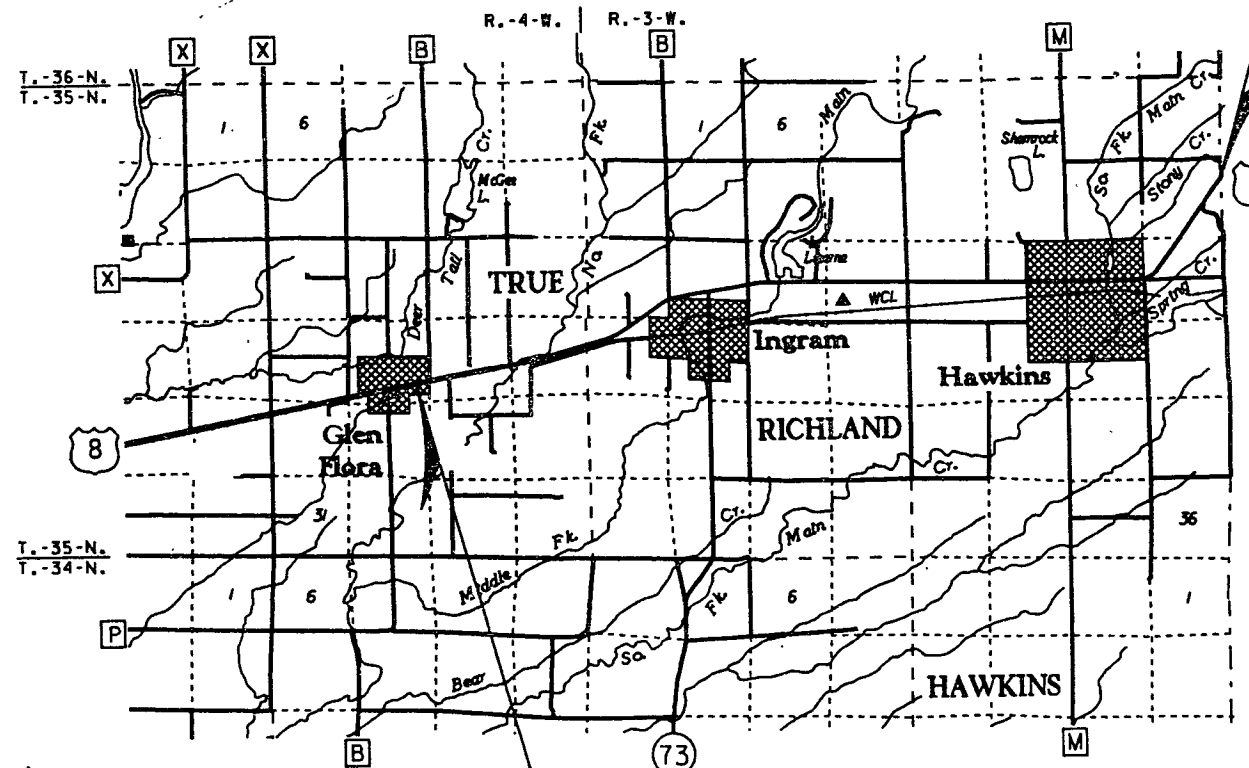

DESIGN DESIGNATION


A.D.T. 1997 = 2800
 A.D.T. 2017 = 3800
 D.H.V. =
 D. = 60/40
 T. = 11.9%
 DESIGN SPEED = 86.4KPH
 ESALS = 1233.700

CONVENTIONAL SYMBOLS

COUNTY LINE
 CORPORATE LIMITS
 PROPERTY LINE
 LOT LINE
 LIMITED EASEMENT
 EXISTING RIGHT OF WAY
 PROPOSED OR NEW R/W LINE
 SURVEY LINE
 SLOPE INTERCEPT
 ORIGINAL GROUND
 MARSH OR ROCK PROFILE
 EXISTING CULVERT
 PROPOSED CULVERT (Box or Pipe)
 CULVERT (Profile View)

COMBUSTIBLE FLUIDS

UNDERGROUND UTILITIES
 GAS
 ELECTRIC
 TELEPHONE OR TELEGRAPH
 SERVICE PEDESTAL
 CABLE MARKER
 POWER POLE
 TELEPHONE POLE
 RAILROAD
 MARSH AREA
 WOODED OR SHRUB AREA

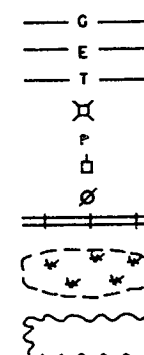

BEGIN PROJECT
 STA. 0+643.33

LAYOUT
 SCALE 0 1 2 km

TOTAL NET LENGTH OF CENTERLINE = 17.82 km

Village
 OF HAWKINS

APPROVED BY:

DATE: 9-7-97 *Al Stand*
 (Chairman)

Village
 OF GLEN FLORA

APPROVED BY:

DATE: 4-10-98 *John Fry*
 (Chairman)

STATE OF WISCONSIN
 DEPARTMENT OF TRANSPORTATION

PREPARED BY

Surveyor
 Designer: JOHN J. FRY
 District Examiner: CHARLES L. SMITH
 District Supervisor: JAMES A. RAUSCH
 Proj. Dev. Engineer: JAMES D. WHALEN
 C. O. Examiner: Dale E. Marg

APPROVED FOR DISTRICT OFFICE

DATE: 9-17-96 *Paul P. P.*
 (Signature)

AUTHORIZED FOR CENTRAL OFFICE DESIGN

DATE: 1-15-97 *J. Whalen*
 (Signature)

PLOT NAME: TITLE
 RUSK COUNTY

REV. DATE:

1580-15-71
 (1580-15-00)

ORIGINATOR: DISTRICT 8
 MARCH 97

FILE NAME: DB 15801500-MTYP.DGN