

PROPOSED HIGHWAY IMPROVEMENT NOTICE

DT1077 10/2005 (Trans. 220 WI Admin. Code)

Wisconsin Department of Transportation

Pursuant to s.84.063 Wisconsin Statutes, this notice advises that the Wisconsin Department of Transportation is planning the improvement identified below.

To Jamey Oldeen Charter Communications - Communication Line 2304 S Main St Rice Lake, WI 54868	From Susan Heller Division Of Transportation System Development Northwest Region Superior Office 1701 N 4th St Superior, WI 54880
Improvement Project ID 1560-31-71	County Washburn
Highway Route or Name USH 63	
Improvement Limits Cumberland - Spooner Road Woodyard Road To CTH B (East)	
General Description of Work to be Done Recondition, mill and overlay, add passing lane, recondition existing passing lane, add third lane.Culverts, beamguard and road sign replacement. Curb & gutter, storm sewer added.Intersection improvement.	
Utility Coordination Desired Completion Date 2013	Anticipated Year of Improvement Construction 2015

Transportation Region Name Northwest Region Superior Office	<i>Susan Heller</i> (Region or Consultant Representative Signature)	June 7, 2010 (Date)
Consultant Name	Utility Coordinator (Title)	

NOTICE ACKNOWLEDGEMENT

Return this form within 7 days of receipt to address shown above

Receipt of the above notice is acknowledged.

- ☐ We have no utility facilities in the vicinity of the improvement
- ☐ We have utility facilities in the improvement vicinity and within 100 feet of the above notification date as required by s.84.063(2)(b) Wis. Stats.
- ☒ We have utility facilities in the improvement vicinity; their description and general location are identified below.
(Attach additional sheets if necessary.)



TOM HAASE
Project Coordinator
CONSTRUCTION
tel: 715•234•5341 ext 252
2304 S. Main Street fax: 715•234•8537
Rice Lake, WI cell: 715•829-0171 370-1661
54868 tom.haase@chartercom.com
thomas

Utility Name Charter Communications	<i>Tom Haase</i> (Utility Representative Signature)	6/14/10 (Date)
Utility Representative Name – Please Print <i>TOM HAASE</i>	<i>CONSTRUCTION COORDINATOR</i> (Title)	

NC 6-16-10



UNDERGROUND FIBER OPTIC CABLE

ROUTE SYMBOLS		QTY.	ROUTE SYMBOLS		QTY.	ROUTE SYMBOLS		QTY.	FOOTAGE	SIZE	CABLE DESCRIPTION	UNIT PRICE	DESIGN SYMBOLS		NODE / AMP / LE DATA		NOTATIONS		REVISIONS		BASE		FIELD	SYSTEM NAME:		
L.D. LONG DROP	0	0	⊙ PUSH POLE	0	0	⊙ AER. SINGLE DWELL. ACT./POT.	0/0	0	0	0	STRAHD	0	⊙ 2 PORT TAP	0	1	1	1	1	1	1	1	1	1	1	1	1
EXISTING ANCHOR	0	0	✕ POWER POLE	0	0	⊙ AER. COMMERCIAL UNITS	0	0	0	0	0	0	⊙ 4 PORT TAP	0	2	2	2	2	2	2	2	2	2	2	2	2
SET ANCHOR	0	0	○ PHONE POLE	0	0	⊙ AER. MULTI-DWELLING UNITS	0	0	0	0	0	0	⊙ 8 PORT TAP	0	3	3	3	3	3	3	3	3	3	3	3	3
SIDEWALK GUY	0	0	⊙ JOINT USE POLE	0	0	○ U-G SINGLE DWELL. ACT./POT.	0/0	0	0	0	U-G	0	⊙ 3 WAY SPLIT	0	4	4	4	4	4	4	4	4	4	4	4	4
SIDEWALK SET GUY	0	0	⊙ CATV SET POLE	0	0	⊙ U-G COMMERCIAL UNITS	0	0	0	0	2750'	0	⊙ 1/2" SPLIT	0	5	5	5	5	5	5	5	5	5	5	5	5
POLE TO POLE GUY	0	0	⊙ TRANS. POLE	0	0	⊙ U-G MULTI-DWELLING UNITS	0	0	0	0	TOTAL	0	⊙ 1/4" SPLIT	0	6	6	6	6	6	6	6	6	6	6	6	6
OVERHEAD GUY	0	0	○ CONC./METAL POLE	0	0	⊙ MOTEL UNITS	0	0	0	0	3050'	0	⊙ 1/8" SPLIT	0	7	7	7	7	7	7	7	7	7	7	7	7
RISE	0	0	○ PEDESTAL	0	0	⊙ 1" U-G BORE	300'	3	0	0	RG-6	0	⊙ 1/16" SPLIT	0	8	8	8	8	8	8	8	8	8	8	8	8


SCALE: 0 100'

SYSTEM NAME: SHELL LAKE TO BARRONETTE IC, WISCONSIN

W11608-1105 W11508-1106 W11608-1107

W11607-1105 W11507-1106 W11607-1107

W11606-1105 W11506-1106 W11606-1107

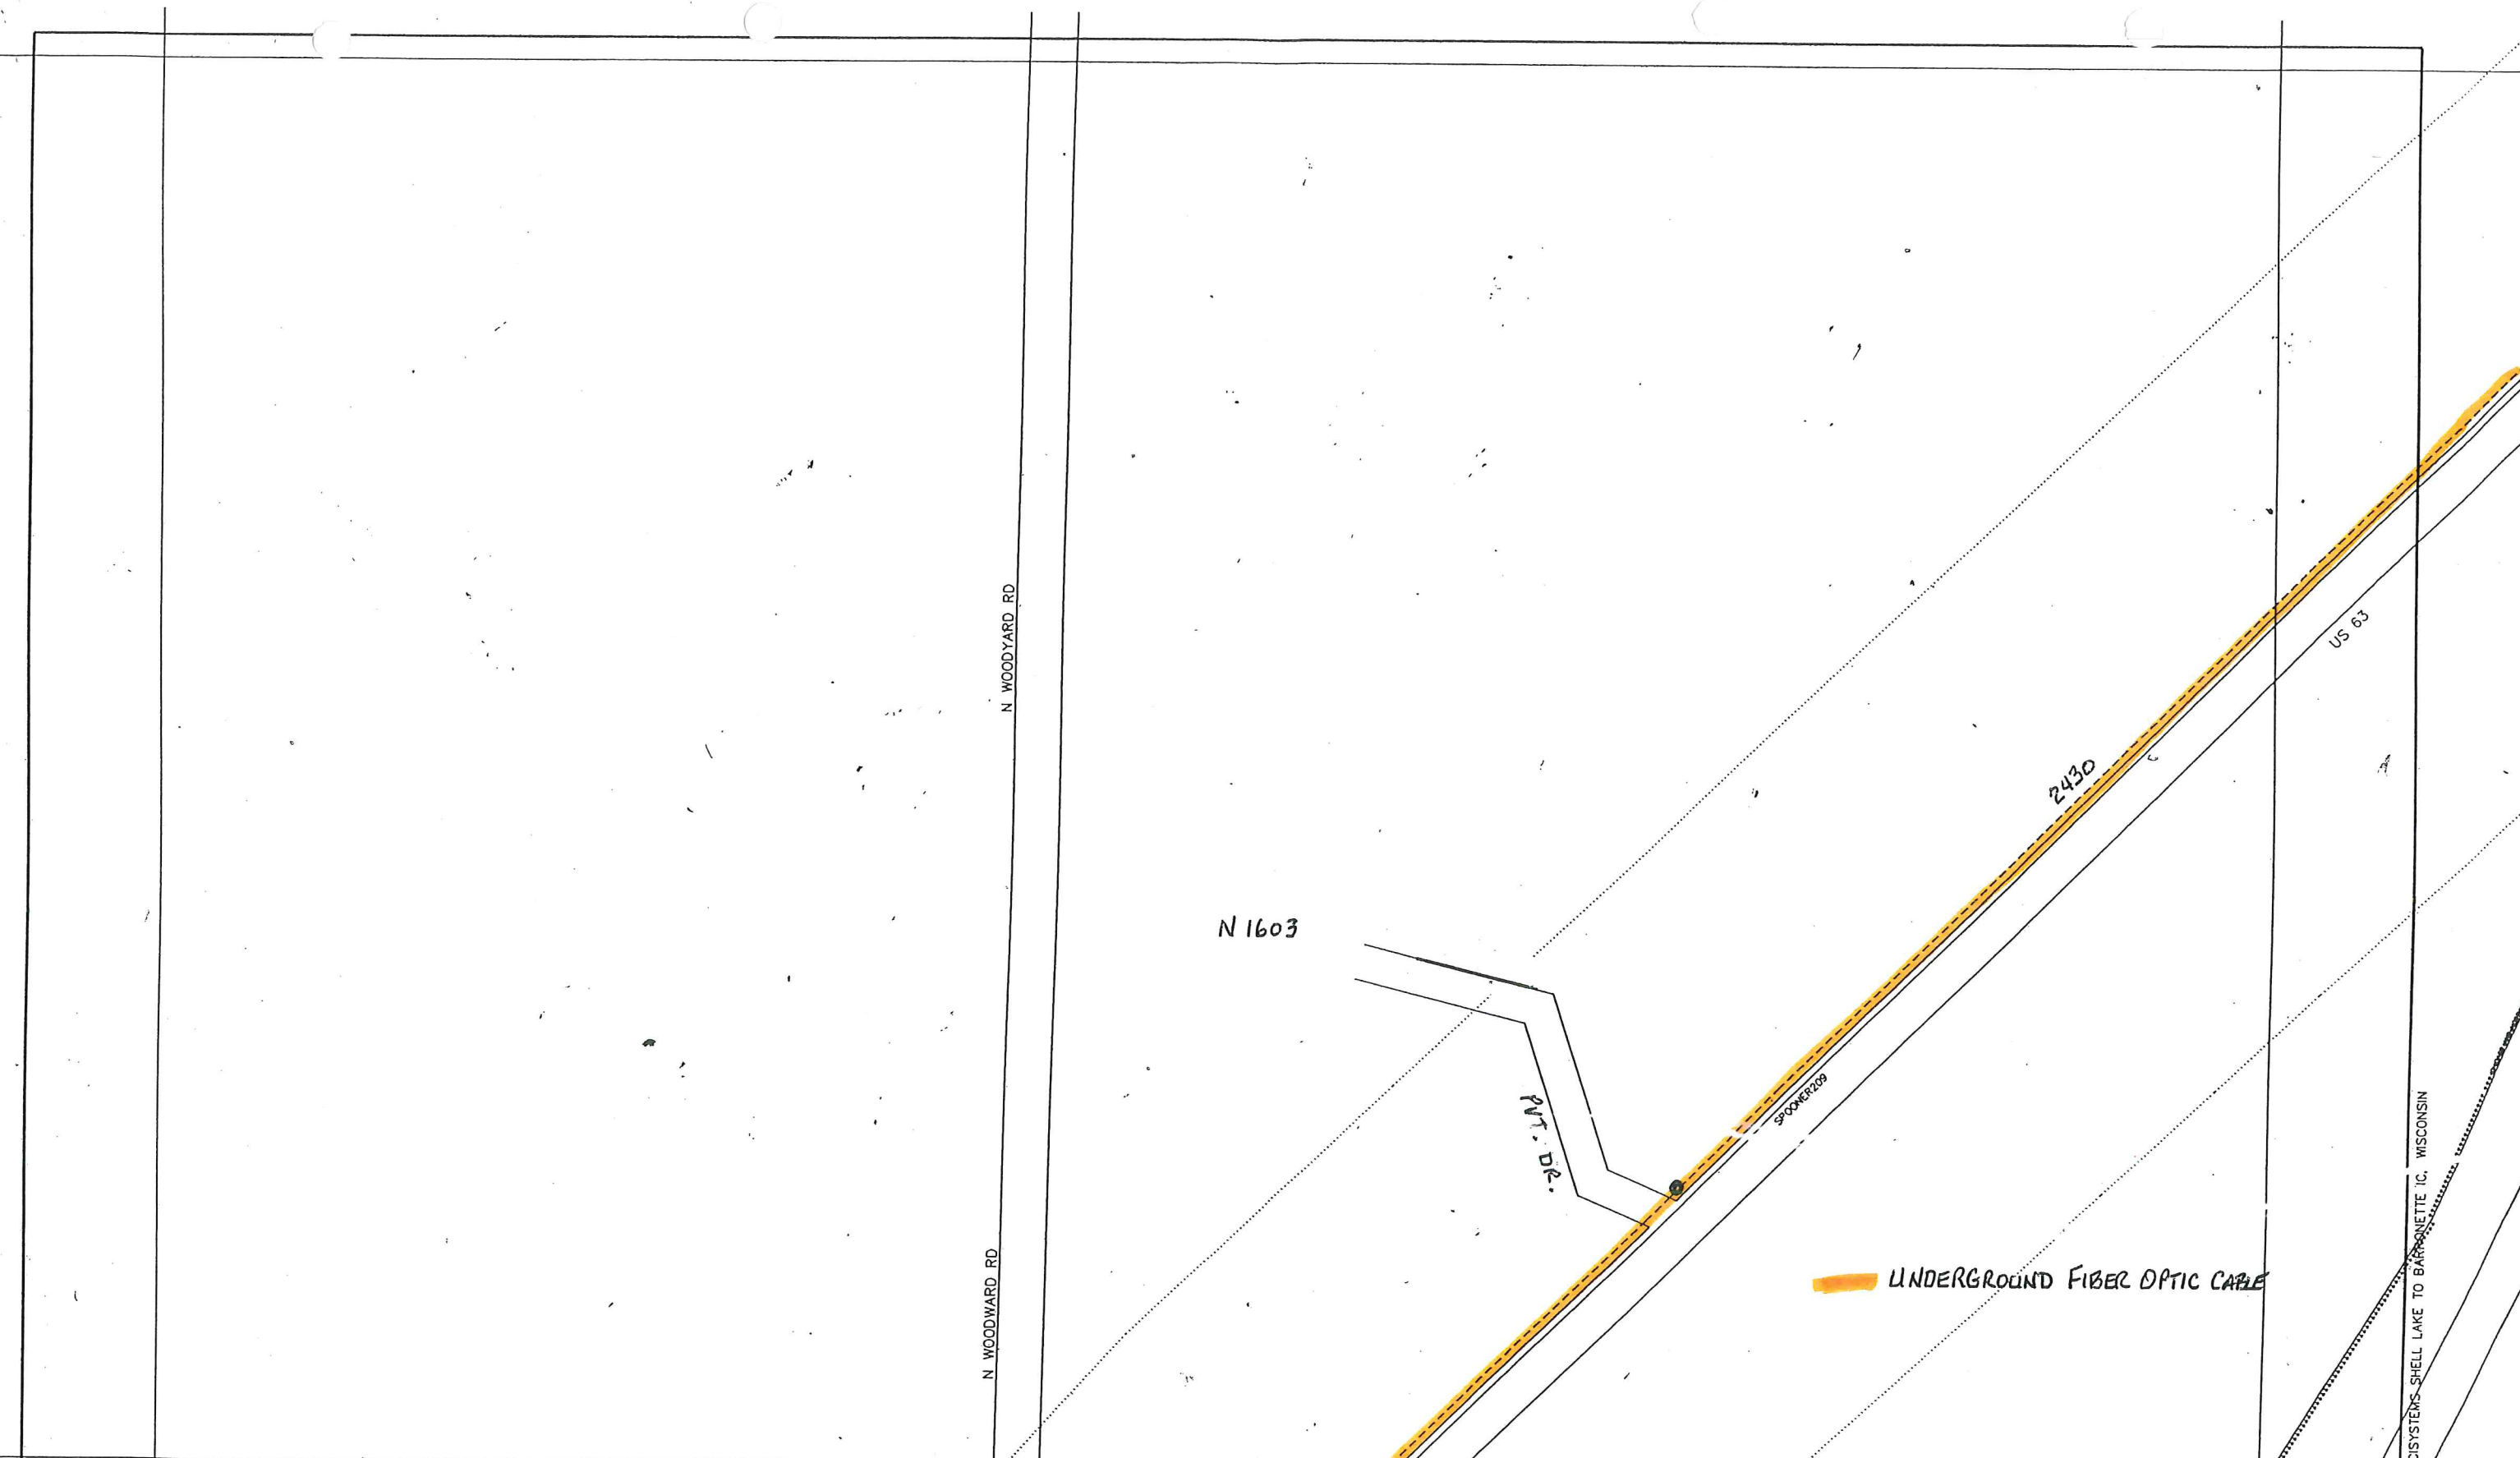



ROUTE SYMBOLS	QTY.	ROUTE SYMBOLS	QTY.	ROUTE SYMBOLS	QTY.	FOOTAGE	SIZE	CABLE DESCRIPTION	REMARKS
L.D. LONG DROP	0	⊙ PUSH POLE	0	○ AER. SINGLE DWELL. ACT./POT.	0/0	0'	10"	1000	
→ EXISTING ANCHOR	0	✕ POWER POLE	0	▽ AER. COMMERCIAL UNITS	0	0'	10"	1000	
→ SET ANCHOR	0	○ PHONE POLE	0	□ AER. MULTI-DWELLING UNITS	0	0'	10"	1000	
→ SIDEWALK GUY	0	⊙ JOINT USE POLE	0	○ U-G SINGLE DWELL. ACT./POT.	0/0	0'	10"	1000	
→ SIDEWALK SET GUY	0	● CATV SET POLE	0	▽ U-G COMMERCIAL UNITS	0	0'	10"	1000	
→ POLE TO POLE GUY	0	⊗ TRANS. POLE	0	□ U-G MULTI-DWELLING UNITS	0	0'	10"	1000	
→ OVERHEAD GUY	0	○ CONC./METAL POLE	0	□ HOTEL UNITS	0	0'	10"	1000	
→ RISER	0	□ PEDESTAL	0	✕ U-G BORE	0	0'	10"	1000	

DESIGN SYMBOLS	NOTES
2-PORT MAP	2-PORT MAP
4-PORT MAP	4-PORT MAP
8-PORT MAP	8-PORT MAP
16-PORT MAP	16-PORT MAP
162259276829213363391778010288128-PORT MAP	162259276829213363391778010288128-PORT MAP
324518553658426726783556020576256-PORT MAP	324518553658426726783556020576256-PORT MAP
649037107316853453567112041152512-PORT MAP	649037107316853453567112041152512-PORT MAP
1298074214633706907134224082305024-PORT MAP	1298074214633706907134224082305024-PORT MAP
2596148429267413814268448164610048-PORT MAP	2596148429267413814268448164610048-PORT MAP
5192296858534827628536896329220096-PORT MAP	5192296858534827628536896329220096-PORT MAP
10384593717069655257073792658440192-PORT MAP	10384593717069655257073792658440192-PORT MAP
20769187434139310514147585316880384-PORT MAP	20769187434139310514147585316880384-PORT MAP
41538374868278621028295170633760768-PORT MAP	41538374868278621028295170633760768-PORT MAP
83076749736557242056590341267521536-PORT MAP	83076749736557242056590341267521536-PORT MAP
166153499473114484113180682535042816-PORT MAP	166153499473114484113180682535042816-PORT MAP
332306998946228968226361365070085632-PORT MAP	332306998946228968226361365070085632-PORT MAP
664613997892457936452722730140171264-PORT MAP	664613997892457936452722730140171264-PORT MAP
1329227995784915872905445460280342528-PORT MAP	1329227995784915872905445460280342528-PORT MAP
17422457186352049329346254736965055830016-PORT MAP	17422457186352049329346254736965055830016-PORT MAP
34844914372704098658692509473930111660032-PORT MAP	34844914372704098658692509473930111660032-PORT MAP
69689828745408197317385018947860223320064-PORT MAP	69689828745408197317385018947860223320064-PORT MAP
139379657490816394634770037895720446640128-PORT MAP	139379657490816394634770037895720446640128-PORT MAP
278759314981632789269540075791440893280256-PORT MAP	278759314981632789269540075791440893280256-PORT MAP
557518629963265578539080151582881786560512-PORT MAP	557518629963265578539080151582881786560512-PORT MAP
1115037259926531157078160303165763573121024-PORT MAP	1115037259926531157078160303165763573121024-PORT MAP
2230074519853062314156320606331527146242048-PORT MAP	2230074519853062314156320606331527146242048-PORT MAP
4460149039706124628312641212663054292484096-PORT MAP	4460149039706124628312641212663054292484096-PORT MAP
8920298079412249256625282425326108584968192-PORT MAP	8920298079412249256625282425326108584968192-PORT MAP
17840596158824498513250564850652217169936384-PORT MAP	17840596158824498513250564850652217169936384-PORT MAP
356811923176489970265011297013044343987328-PORT MAP	356811923176489970265011297013044343987328-PORT MAP
713623846352979940530022594026088687974656-PORT MAP	713623846352979940530022594026088687974656-PORT MAP
1427247692705959881060045188052177375949312-PORT MAP	1427247692705959881060045188052177375949312-PORT MAP
2854495385411919762120090376104354751898624-PORT MAP	2854495385411919762120090376104354751898624-PORT MAP
570899077082383952424018075220870950379728-PORT MAP	570899077082383952424018075220870950379728-PORT MAP
1141798154164767904848036150441741907559456-PORT MAP	1141798154164767904848036150441741907559456-PORT MAP
2283596308329535809696072300883483815118912-PORT MAP	2283596308329535809696072300883483815118912-PORT MAP
4567192616659071619392144601766967630237824-PORT MAP	4567192616659071619392144601766967630237824-PORT MAP
9134385233318143238784289203533935260475648-PORT MAP	9134385233318143238784289203533935260475648-PORT MAP
18268770466636286477568578407067870520951296-PORT MAP	18268770466636286477568578407067870520951296-PORT MAP
36537540933272572955137156814135741041902592-PORT MAP	36537540933272572955137156814135741041902592-PORT MAP
73075081866545145910274313628271482083805184-PORT MAP	73075081866545145910274313628271482083805184-PORT MAP
146150163733090291820548627256542961667610368-PORT MAP	146150163733090291820548627256542961667610368-PORT MAP
292300327466180583641097254513085923335220736-PORT MAP	292300327466180583641097254513085923335220736-PORT MAP
584600654932361167282194509026171846710441472-PORT MAP	584600654932361167282194509026171846710441472-PORT MAP
1169201309864722334564389018052343693420882944-PORT MAP	1169201309864722334564389018052343693420882944-PORT MAP
2338402619729444669128778036104687386841765888-PORT MAP	233840261972944466912877803610468738684176



5/11/2010 11:23:13 AM CCISYSTEMS SHELL LAKE TO BARRONETTE IC, WISCONSIN

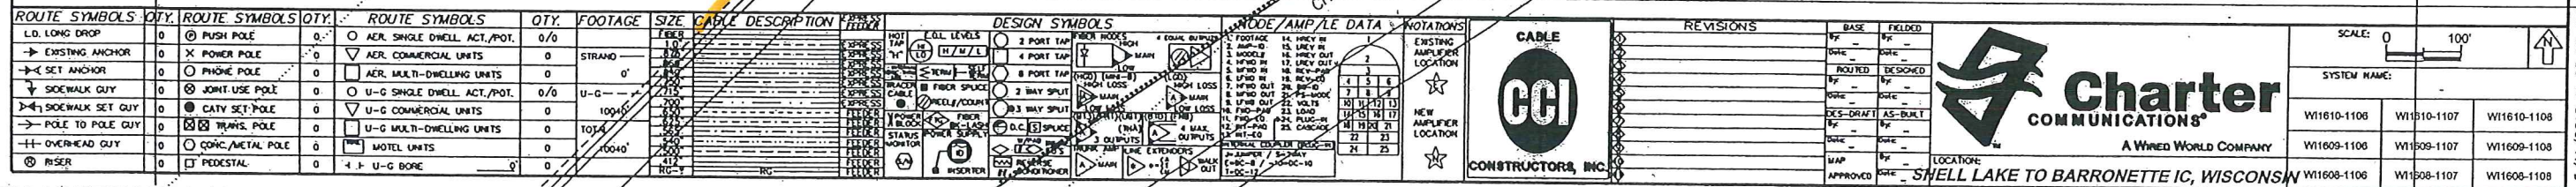

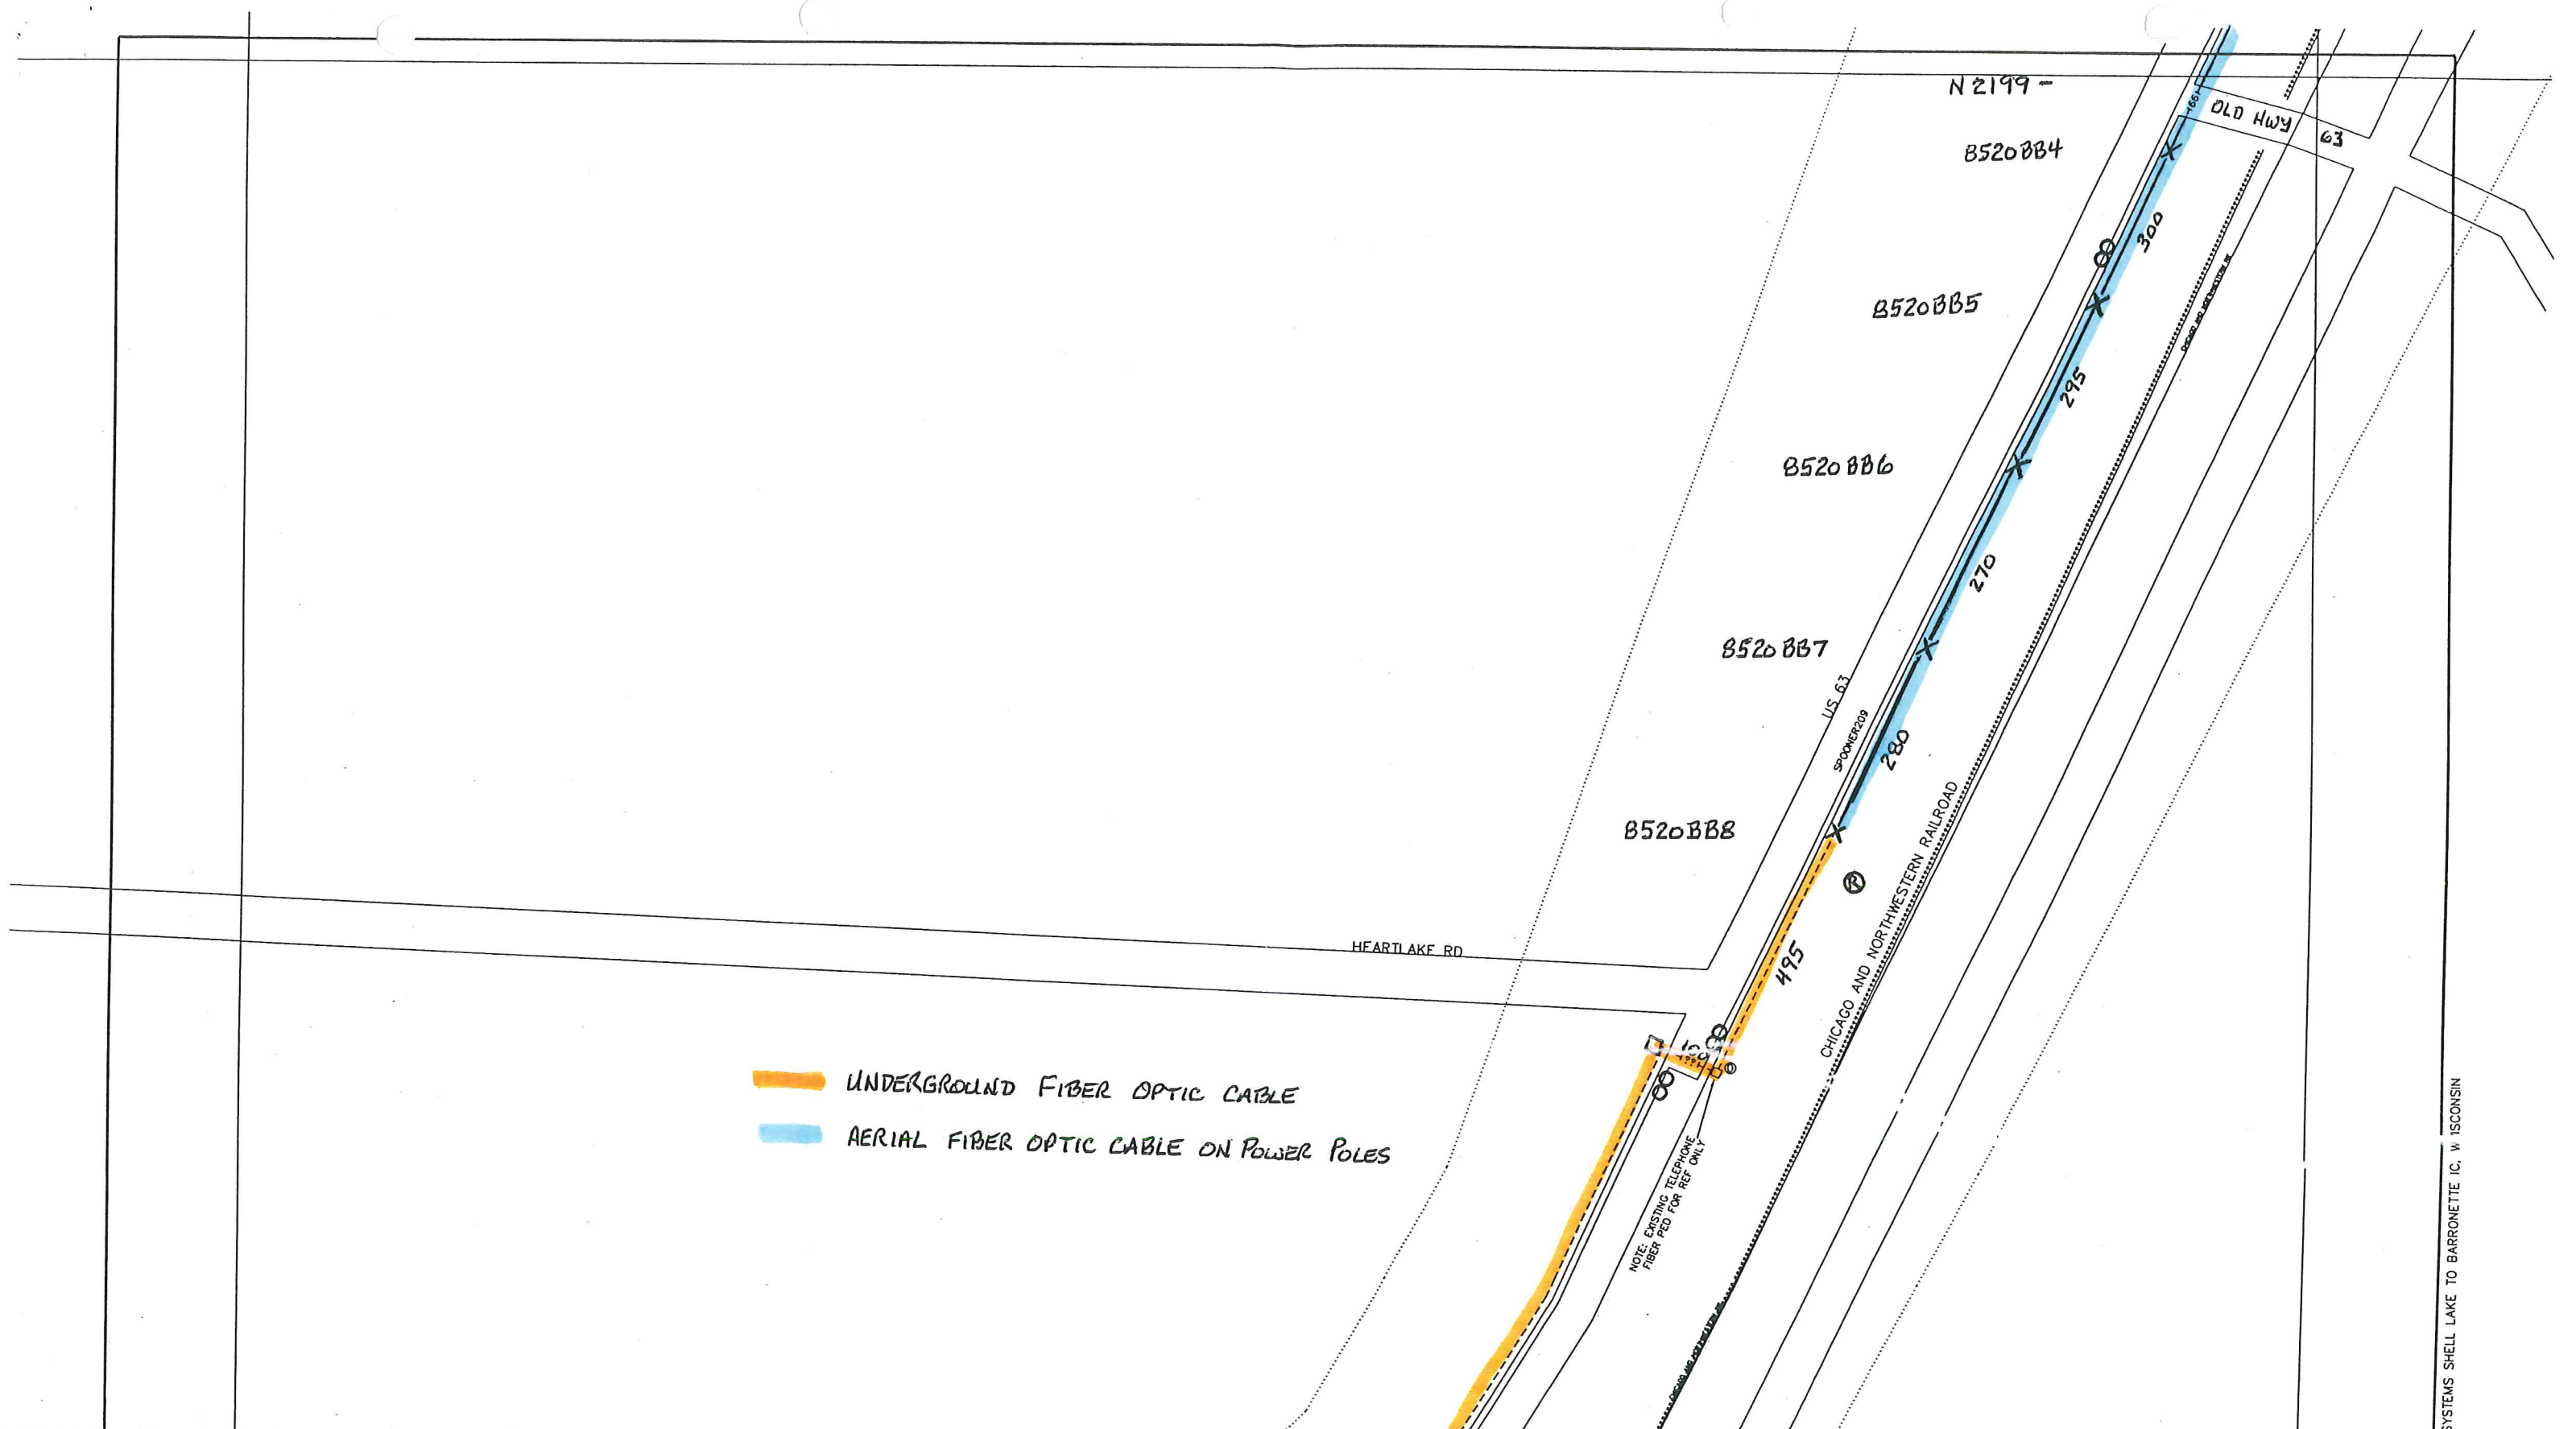

UNDERGROUND FIBER OPTIC CABLE
AERIAL FIBER OPTIC CABLE ON POWER POLES

ROUTE SYMBOLS		QTY.	ROUTE SYMBOLS		QTY.	ROUTE SYMBOLS		QTY.	ROUTE SYMBOLS		QTY.	FOOTAGE	SIZE	CABLE DESCRIPTION	FEEDER	DESIGN SYMBOLS	NOTES/AMP/LE DATA	NOTATIONS	REVISIONS	BASE	FIELD	SCALE	SYSTEM NAME	LOCATION
L.O. LONG DROP	0	0	PUSH POLE	0	0	AER. SINGLE DWELL. ACT./POT.	0/0	0	STRAND	0	0	0	1/2"	10	10	10	10	10	10	10	10	10	10	10
EXISTING ANCHOR	0	0	POWER POLE	0	0	AER. COMMERCIAL UNITS	0	0	0	0	0	0	1/2"	10	10	10	10	10	10	10	10	10	10	10
SET ANCHOR	0	0	PHONE POLE	0	0	AER. MULTI-DWELLING UNITS	0	0	0	0	0	0	1/2"	10	10	10	10	10	10	10	10	10	10	10
SOEWALK GUY	0	0	JOINT USE POLE	0	0	U-G SINGLE DWELL. ACT./POT.	0/0	0	U-G	0	0	0	1/2"	10	10	10	10	10	10	10	10	10	10	10
SOEWALK SET GUY	0	0	CATV SET POLE	0	0	U-G COMMERCIAL UNITS	0	0	0	0	0	0	1/2"	10	10	10	10	10	10	10	10	10	10	10
POLE TO POLE GUY	0	0	TRANS. POLE	0	0	U-G MULTI-DWELLING UNITS	0	0	0	0	0	0	1/2"	10	10	10	10	10	10	10	10	10	10	10
OVERHEAD GUY	0	0	CONC./METAL POLE	0	0	MOTEL UNITS	0	0	0	0	0	0	1/2"	10	10	10	10	10	10	10	10	10	10	10
RISE	0	0	PEDESTAL	1	1	U-G BORE	66	2	0	0	0	0	1/2"	10	10	10	10	10	10	10	10	10	10	10

CCCI

CONSTRUCTORS, INC.

Charter COMMUNICATIONS


A WIRED WORLD COMPANY

SCALE: 0 100'

SYSTEM NAME:

W11612-1107	W11612-1108	W11612-1109
W11611-1107	W11611-1108	W11611-1109
W11610-1107	W11610-1108	W11610-1109

LOCATION: SHELL LAKE TO BARRONETTE IC, WISCONSIN

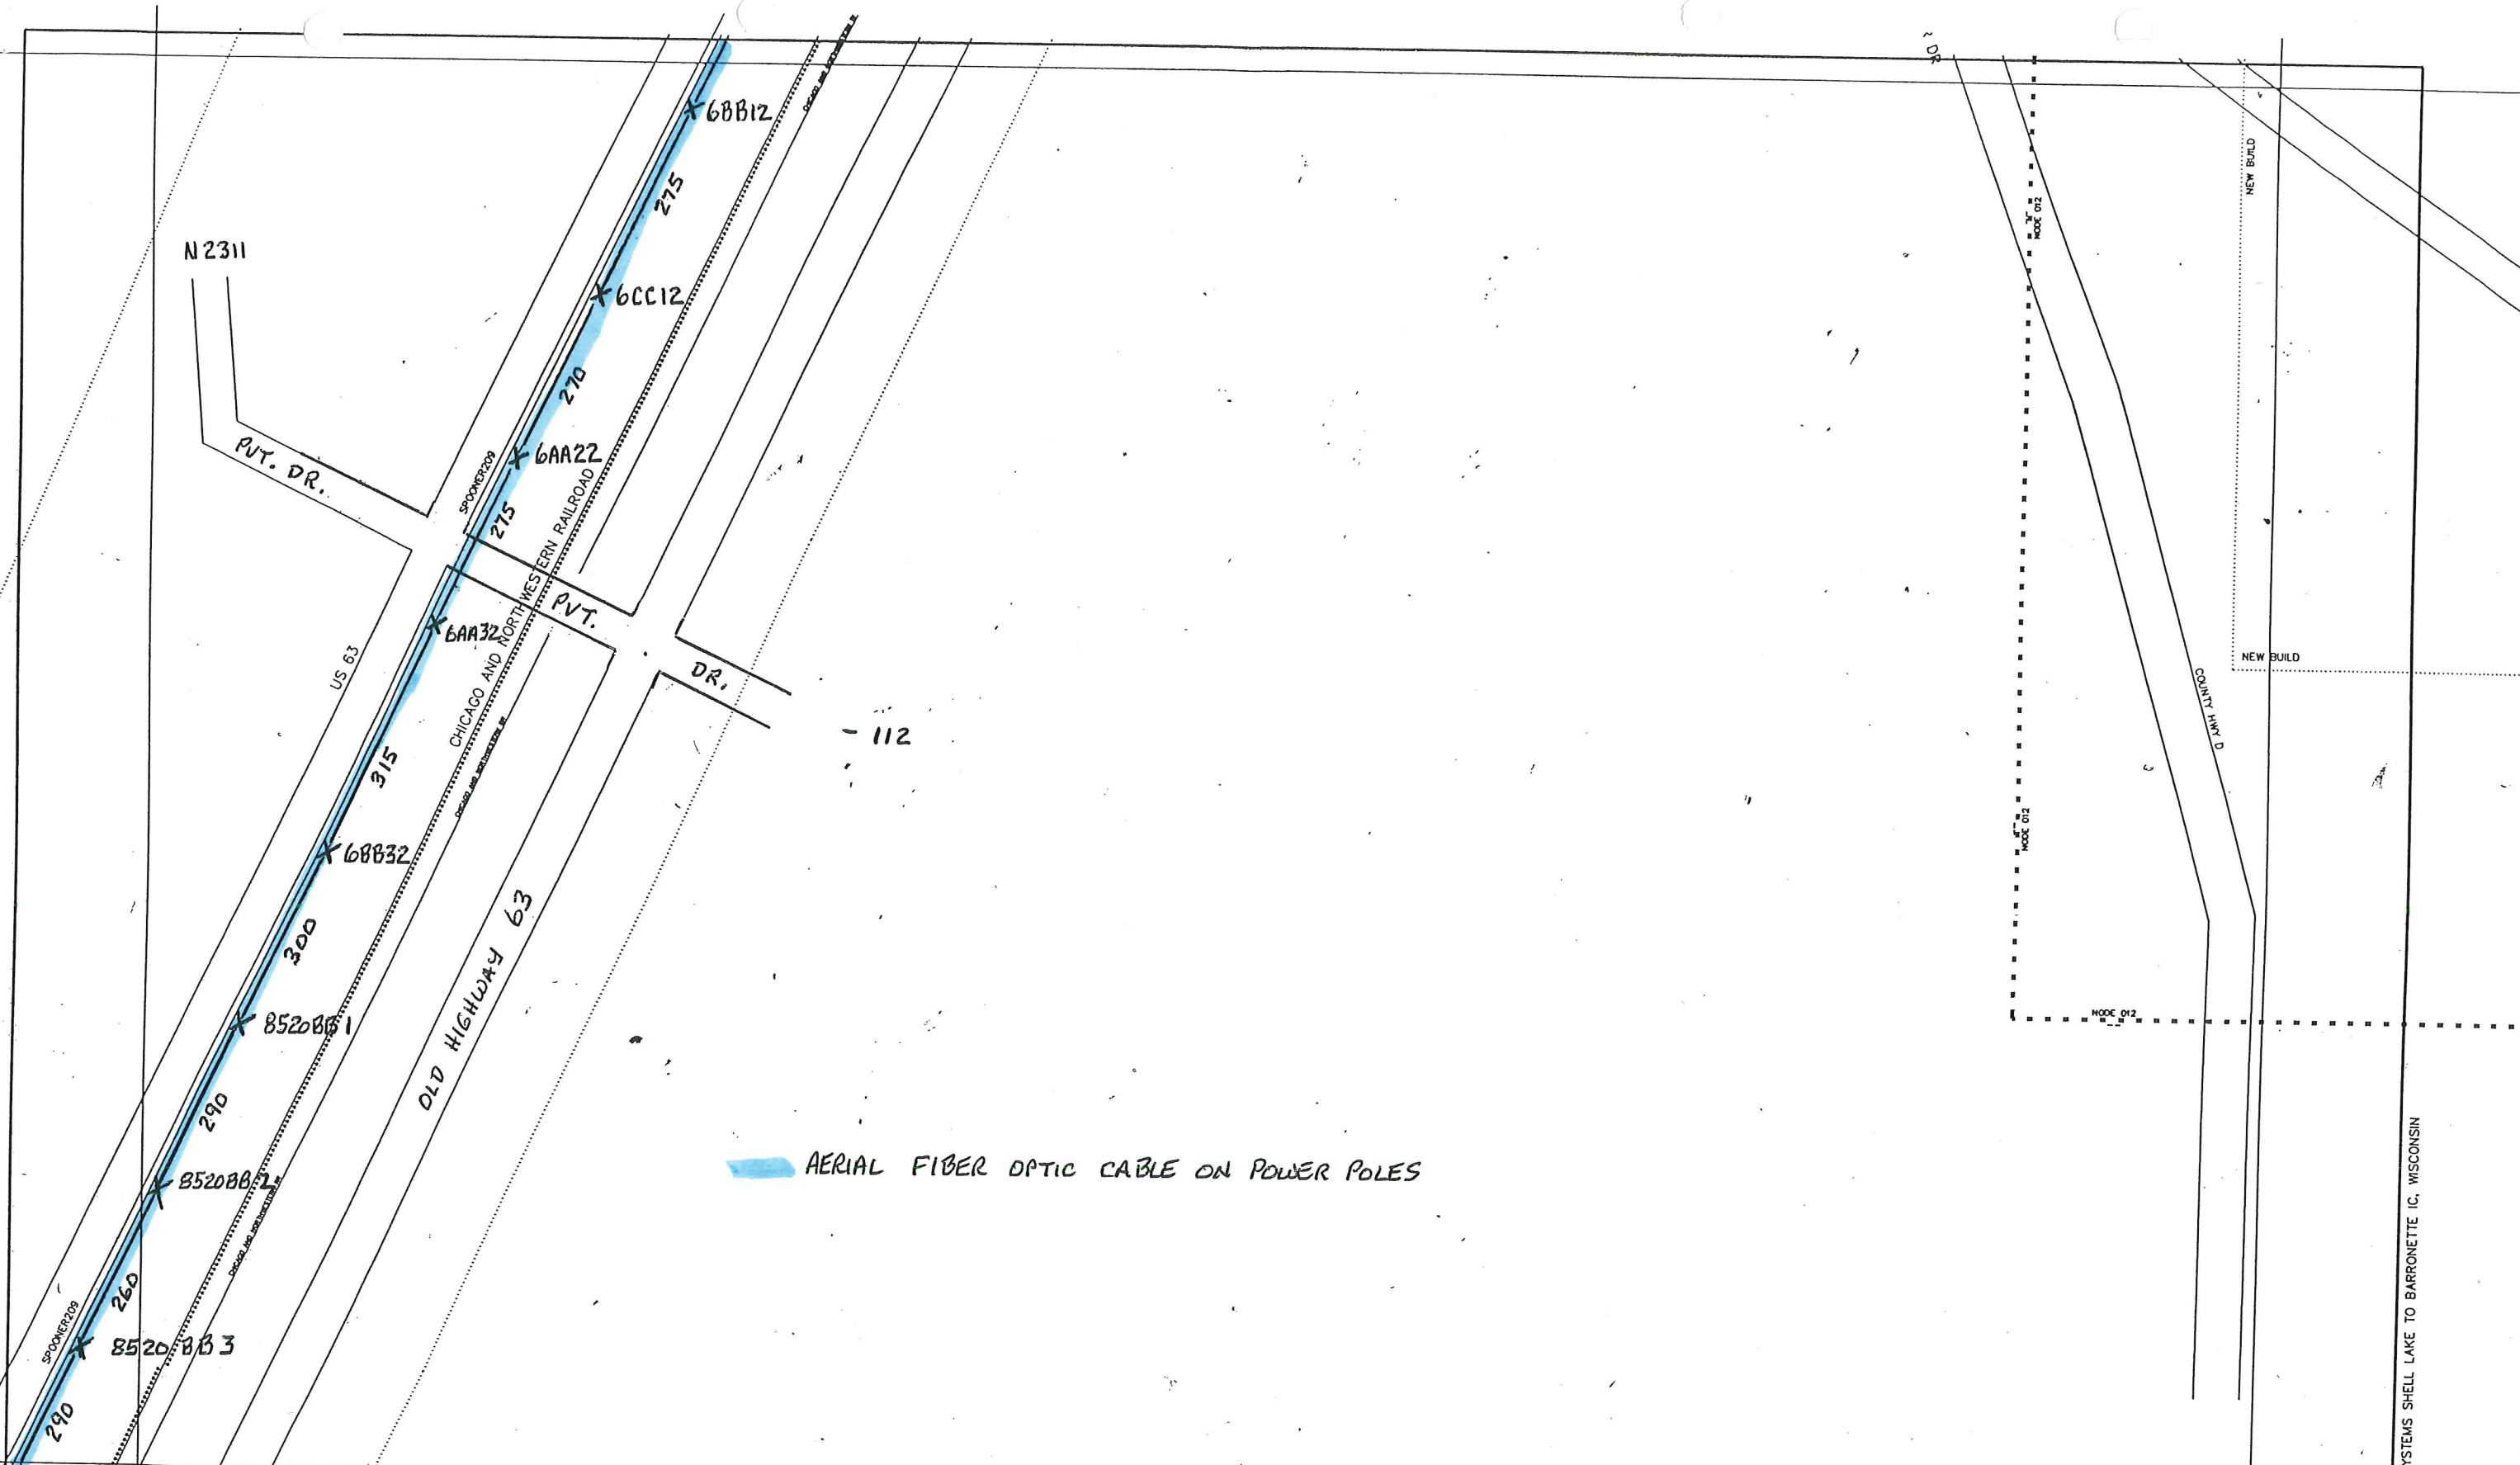

AERIAL FIBER OPTIC CABLE ON POWER POLES


ROUTE SYMBOLS	QTY.	ROUTE SYMBOLS	QTY.	ROUTE SYMBOLS	QTY.	FOOTAGE	SIZE	CABLE DESCRIPTION
LO. LONG DROP	0	⊙ PUSH POLE	0	⊙ AER. SINGLE DWELL. ACT./POT.	0/0	STRAND	1/0	
→ EXISTING ANCHOR	0	⊗ POWER POLE	0	▽ AER. COMMERCIAL UNITS	0			
→ SET ANCHOR	0	⊙ PHONE POLE	0	□ AER. MULTI-DWELLING UNITS	0	0'		
↘ SIDEWALK GUY	0	⊙ JOINT USE POLE	0	□ U-G SINGLE DWELL. ACT./POT.	0/0	U-G		
↘ SIDEWALK SET GUY	0	⊙ CATV SET POLE	0	▽ U-G COMMERCIAL UNITS	0	4025'		
→ POLE TO POLE GUY	0	⊗ TRANS. POLE	0	□ U-G MULTI-DWELLING UNITS	0	TOTAL		
++ OVERHEAD GUY	0	⊙ CONC./METAL POLE	0	⊞ MOTEL UNITS	0	4025'		
⊕ RISER	0	⊙ PEDESTAL	0	1 + U-G BORE	0	0		


DESIGN SYMBOLS	NOTES
2 PORT TAP	
4 PORT TAP	
8 PORT TAP	
2 WAY SPLIT	
3 WAY SPLIT	
D.C. S. SPLIT	
U/G BORE	
REVERSE CONNECTION	

NOTES
1. FOOTAGE
2. AMP-B
3. WOODS
4. WFO IN
5. WFO OUT
6. WFO IN
7. WFO OUT
708.

UNDERGROUND FIBER OPTIC CABLE

ROUTE SYMBOLS	QTY.	ROUTE SYMBOLS	QTY.	ROUTE SYMBOLS	QTY.	FOOTAGE	SIZE	CABLE DESCRIPTION	DESIGN SYMBOLS	NOTATIONS	REVISIONS	BASE	FIELD	SCALE: 0 100'	SYSTEM NAME:	W11615-1108	W11615-1109	W11615-1110
L.D. LONG DROP	0	⊙ PUSH POLE	0	○ AER. SINGLE DWELL. ACT./POT.	0/0	0/0	18"		2 PORT TAP	1	05/08/09 03-01-10 MAP	BY: -	DATE: -					
EXISTING ANCHOR	0	✕ POWER POLE	0	▽ AER. COMMERCIAL UNITS	3	STRAND	18"		4 PORT TAP	2	UPDATES SLOTT RELJ	DATE: -	DATE: -					
SET ANCHOR	1	○ PHONE POLE	0	□ AER. MULTI-DWELLING UNITS	0	998'	18"		8 PORT TAP	3		ROUTED	DESIGNED					
SIDEWALK GUY	0	⊗ JOINT USE POLE	1	○ U-G SINGLE DWELL. ACT./POT.	1/1	U-G	18"		2 WAY SPLIT	4		DATE: -	DATE: -					
SIDEWALK SET GUY	0	● CATV SET POLE	0	▽ U-G COMMERCIAL UNITS	0	3091'	18"		3 WAY SPLIT	5		DATE: -	DATE: -					
POLE TO POLE GUY	0	⊗ TRANS. POLE	3	□ U-G MULTI-DWELLING UNITS	0	TOTAL	18"		D.C. SPLIT	6		DES-DRAFT	AS-BUILT					
OVERHEAD GUY	0	○ CONC./METAL POLE	0	□ MOTEL UNITS	0	4984'	18"		W/200 BLK	7		DATE: -	DATE: -					
RISER	2	□ PEDESTAL	5	1 + U-G BORE	45'	1	18"		COAX REVERSE	8		MAP	BY: -					
									CONDITIONER	9		APPROVED	DATE: -					

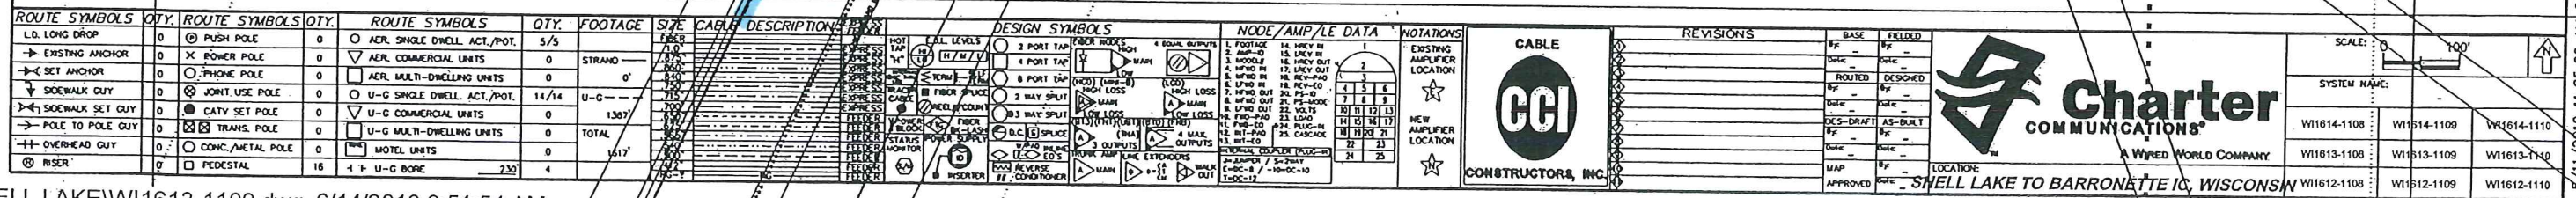

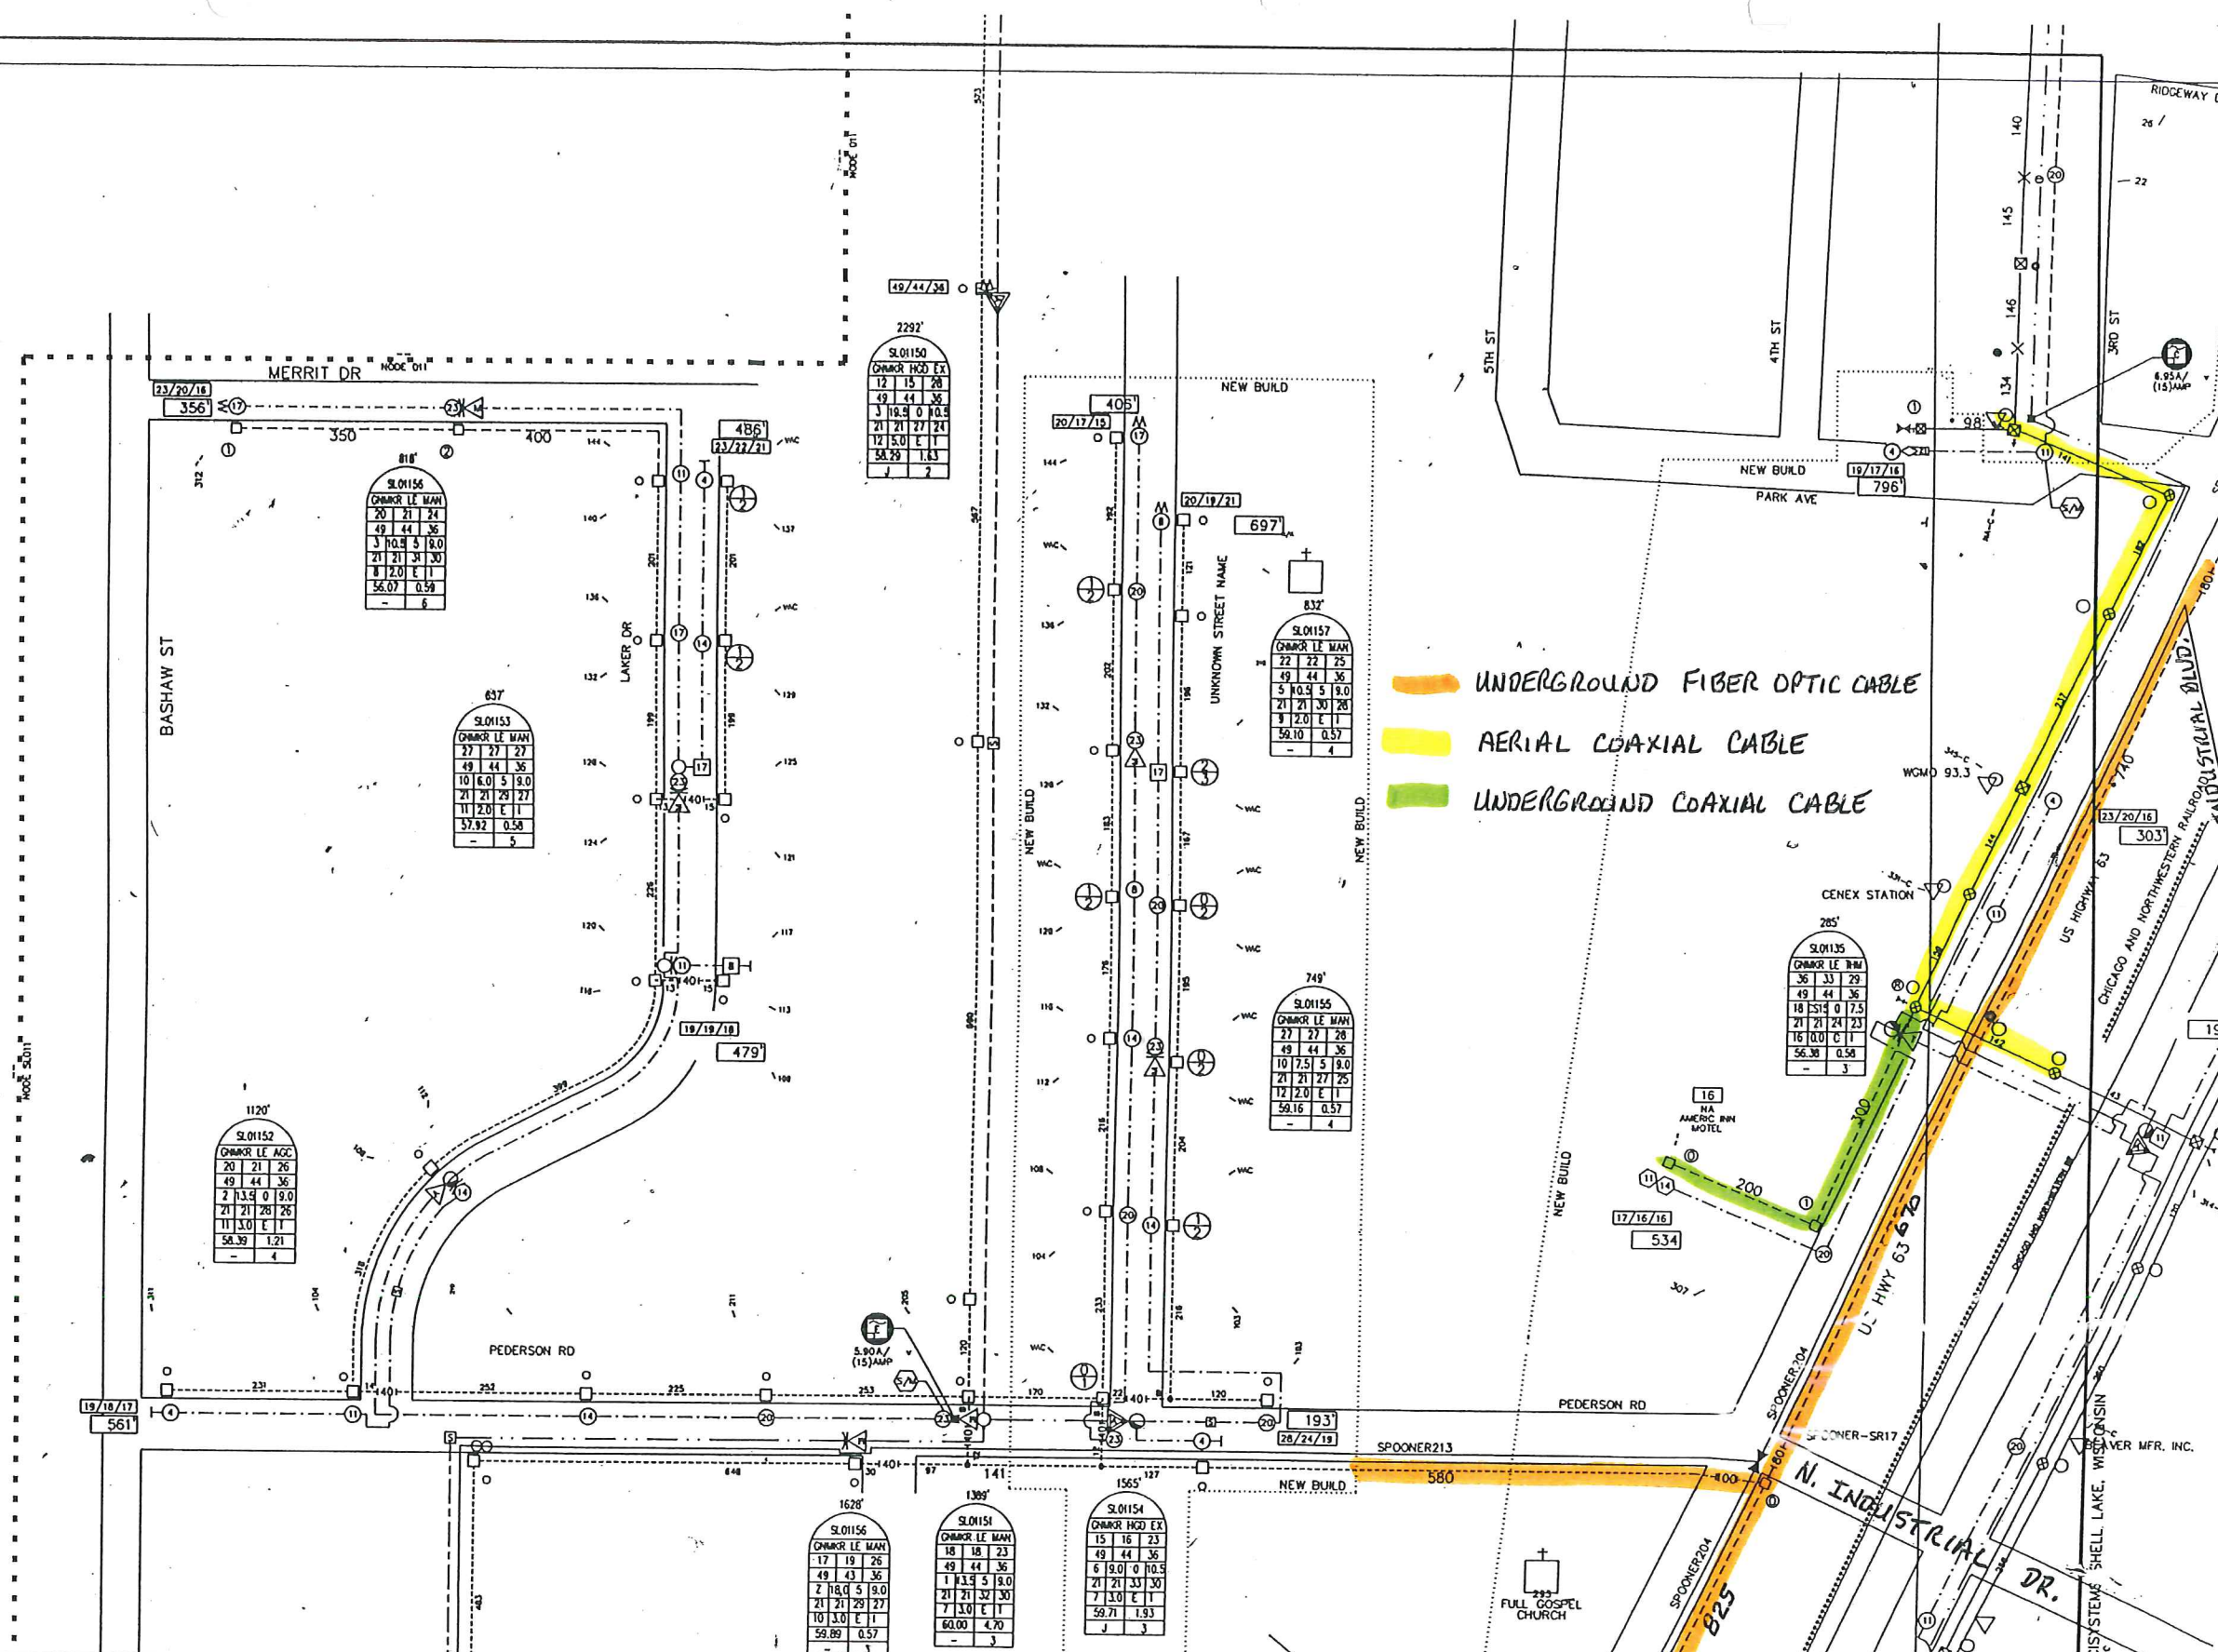

ROUTE SYMBOLS	QTY.	ROUTE SYMBOLS	QTY.	ROUTE SYMBOLS	QTY.	FOOTAGE	SIZE	CABLE DESCRIPTION	DESIGN SYMBOLS	NOTES	REVISIONS	DATE	BY	CHKD	APPD
LD LONG DROP	0	⊙ PUSH POLE	0	△ AER. SINGLE DWELL. ACT./POT.	40/51	1	STRAND	1.0	1.0	1.0	1.0	1.0	1.0	1.0	1.0
→ EXISTING ANCHOR	0	⊗ POWER POLE	0	□ AER. MULTI-DWELLING UNITS	0	1	0'	1.0	1.0	1.0	1.0	1.0	1.0	1.0	1.0
→ SET ANCHOR	3	⊙ PHONE POLE	0	○ U-G SINGLE DWELL. ACT./POT.	4/4	1	U-G	1.0	1.0	1.0	1.0	1.0	1.0	1.0	1.0
→ SIDEWALK GUY	0	⊙ JOINT USE POLE	1	▽ U-G MULTI-DWELLING UNITS	0	2574'	TOTAL	1.0	1.0	1.0	1.0	1.0	1.0	1.0	1.0
→ POLE TO POLE GUY	0	⊙ CATY SET POLE	0	□ U-G MULTI-DWELLING UNITS	0	3059'	TOTAL	1.0	1.0	1.0	1.0	1.0	1.0	1.0	1.0
→ OVERHEAD GUY	0	⊙ CONC./METAL POLE	0	□ MOTEL UNITS	0	450'	9	1.0	1.0	1.0	1.0	1.0	1.0	1.0	1.0
→ RISER	1	⊙ PEDESTAL	39	□ U-G BORE	0	450'	9	1.0	1.0	1.0	1.0	1.0	1.0	1.0	1.0

SCALE: 0 100'

SYSTEM NAME: W1616-1109


W1616-1109 W1616-1109 W1616-1110

W1616-1109 W1616-1109 W1616-1110

W1616-1109 W1616-1109 W1616-1110

5/11/2010 11:26:02 AM

CCS STEVE SHELL LAKE, WISCONSIN

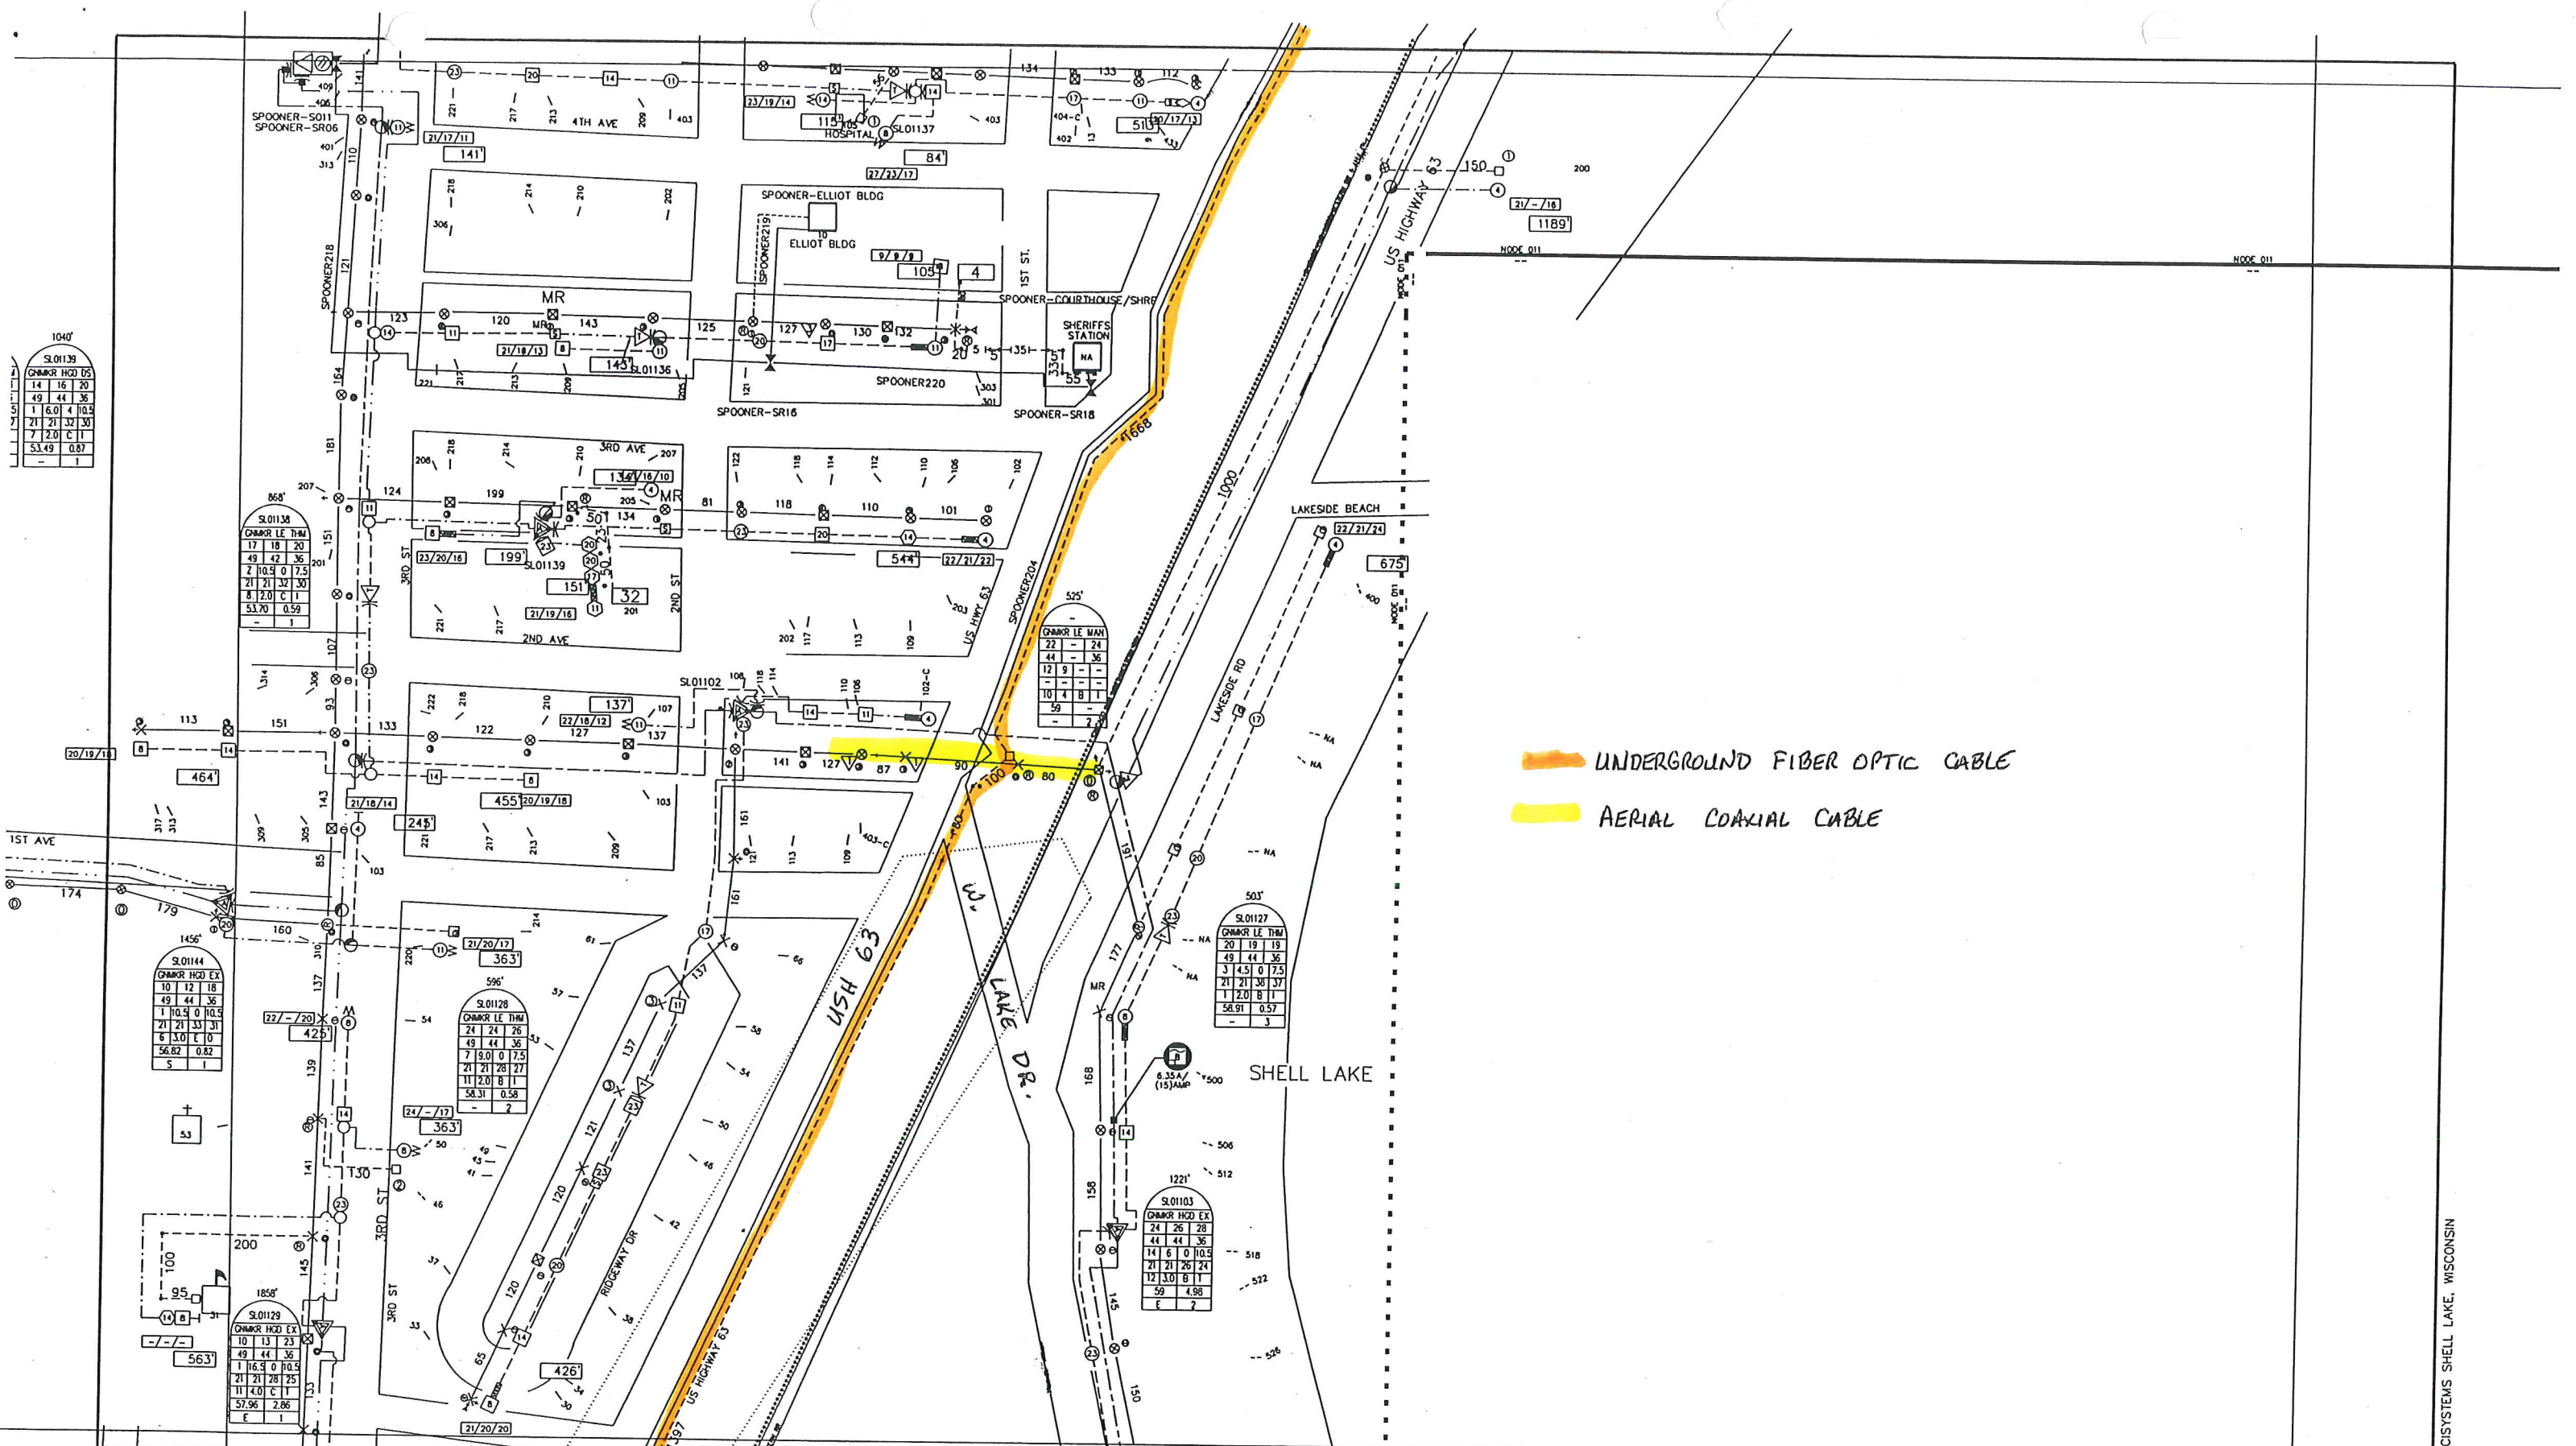

UNDERGROUND FIBER OPTIC CABLE
AERIAL COAXIAL CABLE

ROUTE SYMBOLS		QTY.	ROUTE SYMBOLS		QTY.	ROUTE SYMBOLS		QTY.	ROUTE SYMBOLS		QTY.
L.D. LONG DROP		0	X PUSH POLE		0	O AER. SINGLE DWELL. ACT./POT.		0	O AER. SINGLE DWELL. ACT./POT.		0
EXISTING ANCHOR		11	X POWER POLE		5	V AER. COMMERCIAL UNITS		5	V AER. COMMERCIAL UNITS		5
SET ANCHOR		2	O PHONE POLE		1	U-G MULTI-DWELLING UNITS		36	U-G MULTI-DWELLING UNITS		36
SIDEWALK GUY		0	JOINT USE POLE		0	U-G SINGLE DWELL. ACT./POT.		12/12	U-G SINGLE DWELL. ACT./POT.		12/12
SIDEWALK SET GUY		0	CATV SET POLE		0	V U-G COMMERCIAL UNITS		0	V U-G COMMERCIAL UNITS		0
POLE TO POLE GUY		0	TRANS. POLE		14	U-G MULTI-DWELLING UNITS		0	U-G MULTI-DWELLING UNITS		0
OVERHEAD GUY		0	CONC. METAL POLE		0	MOTEL UNITS		0	MOTEL UNITS		0
USER		10	PEDESTAL		8	+ U-G BORE		40	+ U-G BORE		40

DESIGN SYMBOLS		NODE/AMP/LE DATA	
EOL LEVELS		1. FOOTAGE	
2 PORT TAP		2. AMP/LE	
4 PORT TAP		3. WIRE IN	
8 PORT TAP		4. WIRE OUT	
2 WAY SPLIT		5. WIRE IN	
3 WAY SPLIT		6. WIRE OUT	
D.C. SPLIT		7. WIRE IN	
D.C. SPLIT		8. WIRE OUT	
D.C. SPLIT		9. WIRE IN	
D.C. SPLIT		10. WIRE OUT	
D.C. SPLIT		11. WIRE IN	
D.C. SPLIT		12. WIRE OUT	
D.C. SPLIT		13. WIRE IN	
D.C. SPLIT		14. WIRE OUT	
D.C. SPLIT		15. WIRE IN	
D.C. SPLIT		16. WIRE OUT	
D.C. SPLIT		17. WIRE IN	
D.C. SPLIT		18. WIRE OUT	
D.C. SPLIT		19. WIRE IN	
D.C. SPLIT		20. WIRE OUT	
D.C. SPLIT		21. WIRE IN	
D.C. SPLIT		22. WIRE OUT	
D.C. SPLIT		23. WIRE IN	
D.C. SPLIT		24. WIRE OUT	
D.C. SPLIT		25. WIRE IN	
D.C. SPLIT		26. WIRE OUT	
D.C. SPLIT		27. WIRE IN	
D.C. SPLIT		28. WIRE OUT	
D.C. SPLIT		29. WIRE IN	
D.C. SPLIT		30. WIRE OUT	
D.C. SPLIT		31. WIRE IN	
D.C. SPLIT		32. WIRE OUT	
D.C. SPLIT		33. WIRE IN	
D.C. SPLIT		34. WIRE OUT	
D.C. SPLIT		35. WIRE IN	
D.C. SPLIT		36. WIRE OUT	
D.C. SPLIT		37. WIRE IN	
D.C. SPLIT		38. WIRE OUT	
D.C. SPLIT		39. WIRE IN	
D.C. SPLIT		40. WIRE OUT	
D.C. SPLIT		41. WIRE IN	
D.C. SPLIT		42. WIRE OUT	
D.C. SPLIT		43. WIRE IN	
D.C. SPLIT		44. WIRE OUT	
D.C. SPLIT		45. WIRE IN	
D.C. SPLIT		46. WIRE OUT	
D.C. SPLIT		47. WIRE IN	
D.C. SPLIT		48. WIRE OUT	
D.C. SPLIT		49. WIRE IN	
D.C. SPLIT		50. WIRE OUT	
D.C. SPLIT		51. WIRE IN	
D.C. SPLIT		52. WIRE OUT	
D.C. SPLIT		53. WIRE IN	
D.C. SPLIT		54. WIRE OUT	
D.C. SPLIT		55. WIRE IN	
D.C. SPLIT		56. WIRE OUT	
D.C. SPLIT		57. WIRE IN	
D.C. SPLIT		58. WIRE OUT	
