


ORDER OF SHEETS

Section No. 1	Title
Section No. 2	Typical Sections and Details
Section No. 3	Estimate of Quantities
Section No. 3	Miscellaneous Quantities
Section No. 4	Right of Way Plat
Section No. 5	Plan and Profile
Section No. 6	Standard Detail Drawings
Section No. 7	Sign Plates
Section No. 8	Structure Plans
Section No. 9	Computer Earthwork Data
Section No. 9	Cross Sections

TOTAL SHEETS = 388

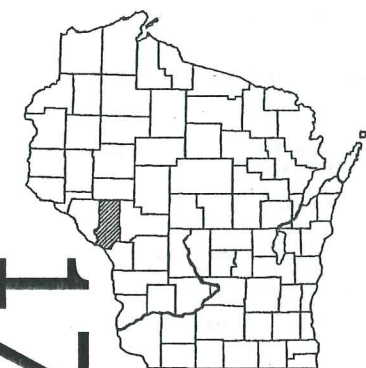

DESIGN DESIGNATION

A.A.D.T. (2008)	=	7750
A.A.D.T. (2028)	=	9850
D.H.V. (2028)	=	956
D.D.	=	60-40
T.	=	9.7%
DESIGN SPEED	=	30-60 MPH
ESALS	=	3,409,100

CONVENTIONAL SYMBOLS

PLAN	
CORPORATE LIMITS	////
PROPERTY LINE	---
LOT LINE	- - - -
LIMITED HIGHWAY EASEMENT	L---
EXISTING RIGHT OF WAY	---
PROPOSED OR NEW R/W LINE	---
SLOPE INTERCEPT	- - - -
REFERENCE LINE	---
EXISTING CULVERT	- - - -
PROPOSED CULVERT (Box or Pipe)	---
COMBUSTIBLE FLUIDS	CAUTION

MARSH AREA
WISC 2010749
WISC 2010748

WOODED OR SHRUB AREA

PROFILE	
GRADE LINE	---
ORIGINAL GROUND	---
MARSH OR ROCK PROFILE (To be noted as such)	---
SPECIAL DITCH	---
GRADE ELEVATION	95.36
CULVERT (Profile View)	□
UTILITIES	
ELECTRIC	— E —
FIBER OPTIC	— FO —
GAS	— G —
SANITARY SEWER	— SAN —
STORM SEWER	— SS —
TELEPHONE	— T —
WATER	— W —
UTILITY PEDESTAL	⊗
POWER POLE	⊕
TELEPHONE POLE	⊙

STATE OF WISCONSIN
DEPARTMENT OF TRANSPORTATION

PLAN OF PROPOSED IMPROVEMENT

MAIN STREET, CITY OF GALESVILLE

(RIDGE AVE. TO PRAIRIE RIDGE LANE)

(BEAVER CREEK BRIDGE: B-61-0203)

USH 53

USH 53

TREMPEALEAU COUNTY

TREMPEALEAU COUNTY

STATE PROJECT NUMBER
1633-04-74STATE PROJECT NUMBER
1633-04-76PROJECT SUPERVISOR: PAUL CONLIN
PROJECT ENGINEER: JOEL GOODENOUGH, KNIGHT
PROJECT MANAGER: WENDY MAYES

PRIME CONTRACTOR: ZENITH TECH INC.


CONSTRUCTION: APRIL 18, 2011

END CONSTRUCTION: OCTOBER 28, 2011

FINAL CONTRACT COST: \$4,530,369.33

CONTRACT MOD #S: 1-13 - \$223,682.53

CONTRACT ID: 20100810017

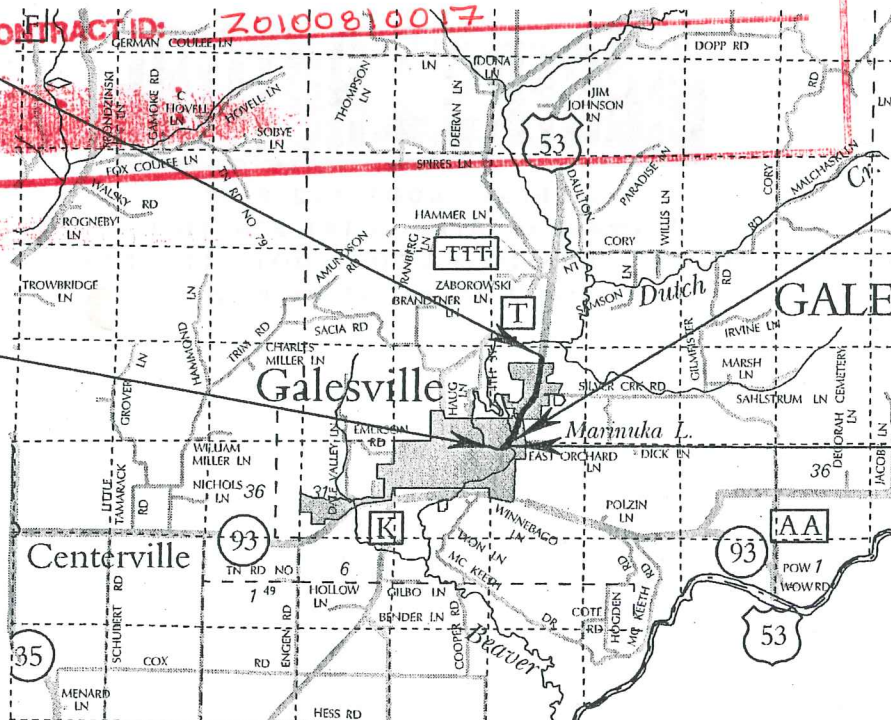END PROJECT 1633-04-74
STA. 619'A'+52END PROJECT 1633-04-76
STA. 564'A'+31BEGIN PROJECT 1633-04-74
STA. 558'A'+97
Y=336269.96
X=847647.11BEGIN PROJECT 1633-04-76
B-61-0203
STA. 561'A'+75
Y=336506.87
X=847785.20LAYOUT
SCALE 0 1 MI.TOTAL NET LENGTH OF CENTERLINE (PROJECT 1633-04-74) = 1.098 MI.
TOTAL NET LENGTH OF CENTERLINE (PROJECT 1633-04-76) = 0.006 MI.
TOTAL NET LENGTH OF CENTERLINE (CONTRACT) = 1.104 MI."Coordinates on this plan are referenced to the Wisconsin County
Coordinate System (WCCS), Trempealeau County."

STATE PROJECT

1633-04-74

1633-04-76

FEDERAL PROJECT

PROJECT

WISC 2010748

WISC 2010749


CONTRACT

1

1

ACCEPTED FOR

City of Galesville

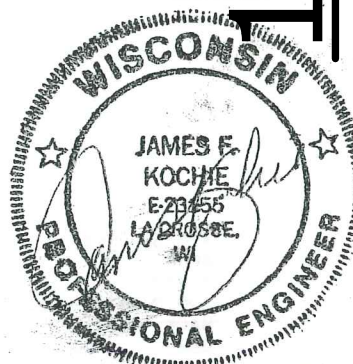4/29/10
(Date) MAYOR
(Title)WATER & SANITARY SEWER
DESIGN PREPARED BYDAVY
ENGINEERING

SEAL ONLY APPLIES TO SHEETS PREPARED BY CONSULTANT



STATE OF WISCONSIN
DEPARTMENT OF TRANSPORTATION

PREPARED BY



Surveyor	NW REGION
Designer	ADAM SARAUER
Project Manager	STACEY RUSCH
Regional Examiner	DAN OJBWAY
Regional Supervisor	RICK SHERMO
C.O. Examiner	JANE ENGLEBRETTSEN

APPROVED FOR THE DEPARTMENT

DATE: 4/29/10
(Signature)

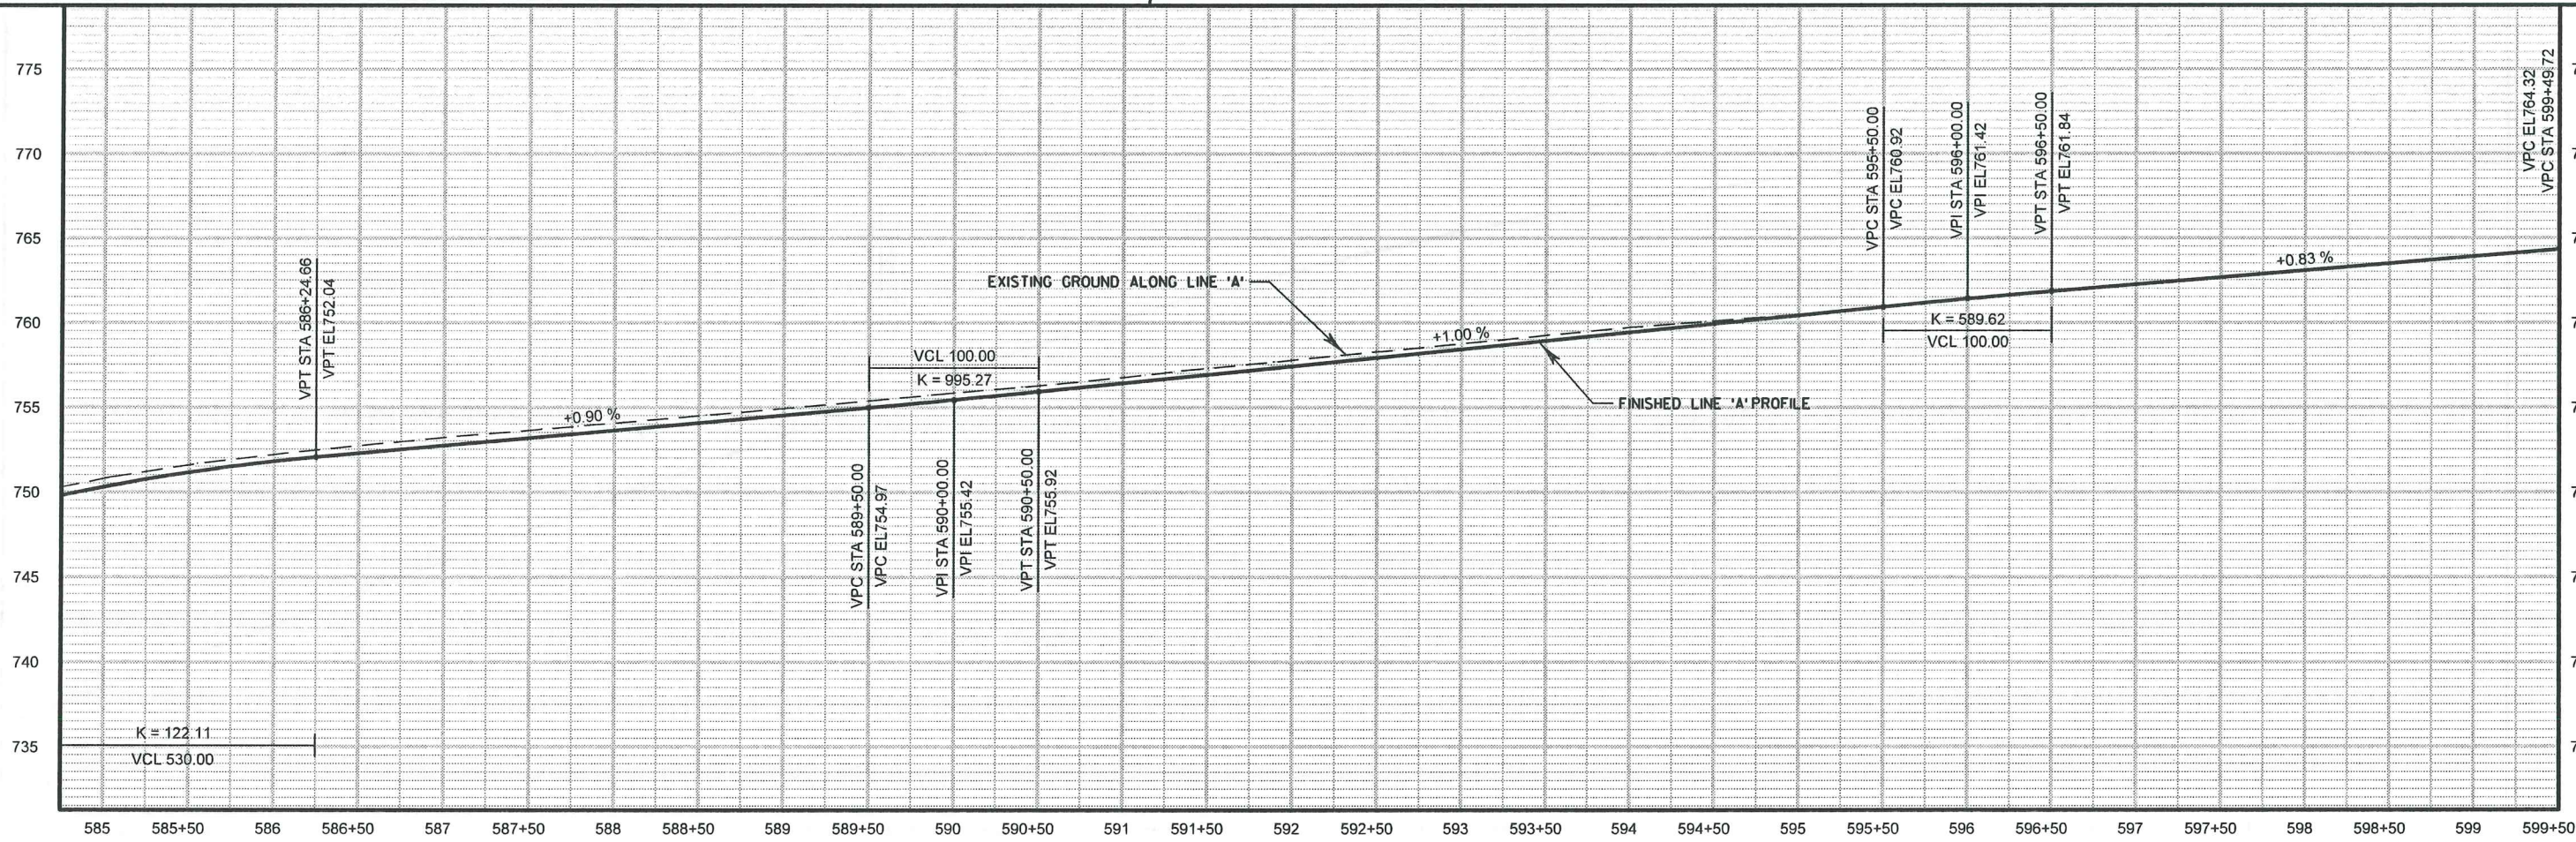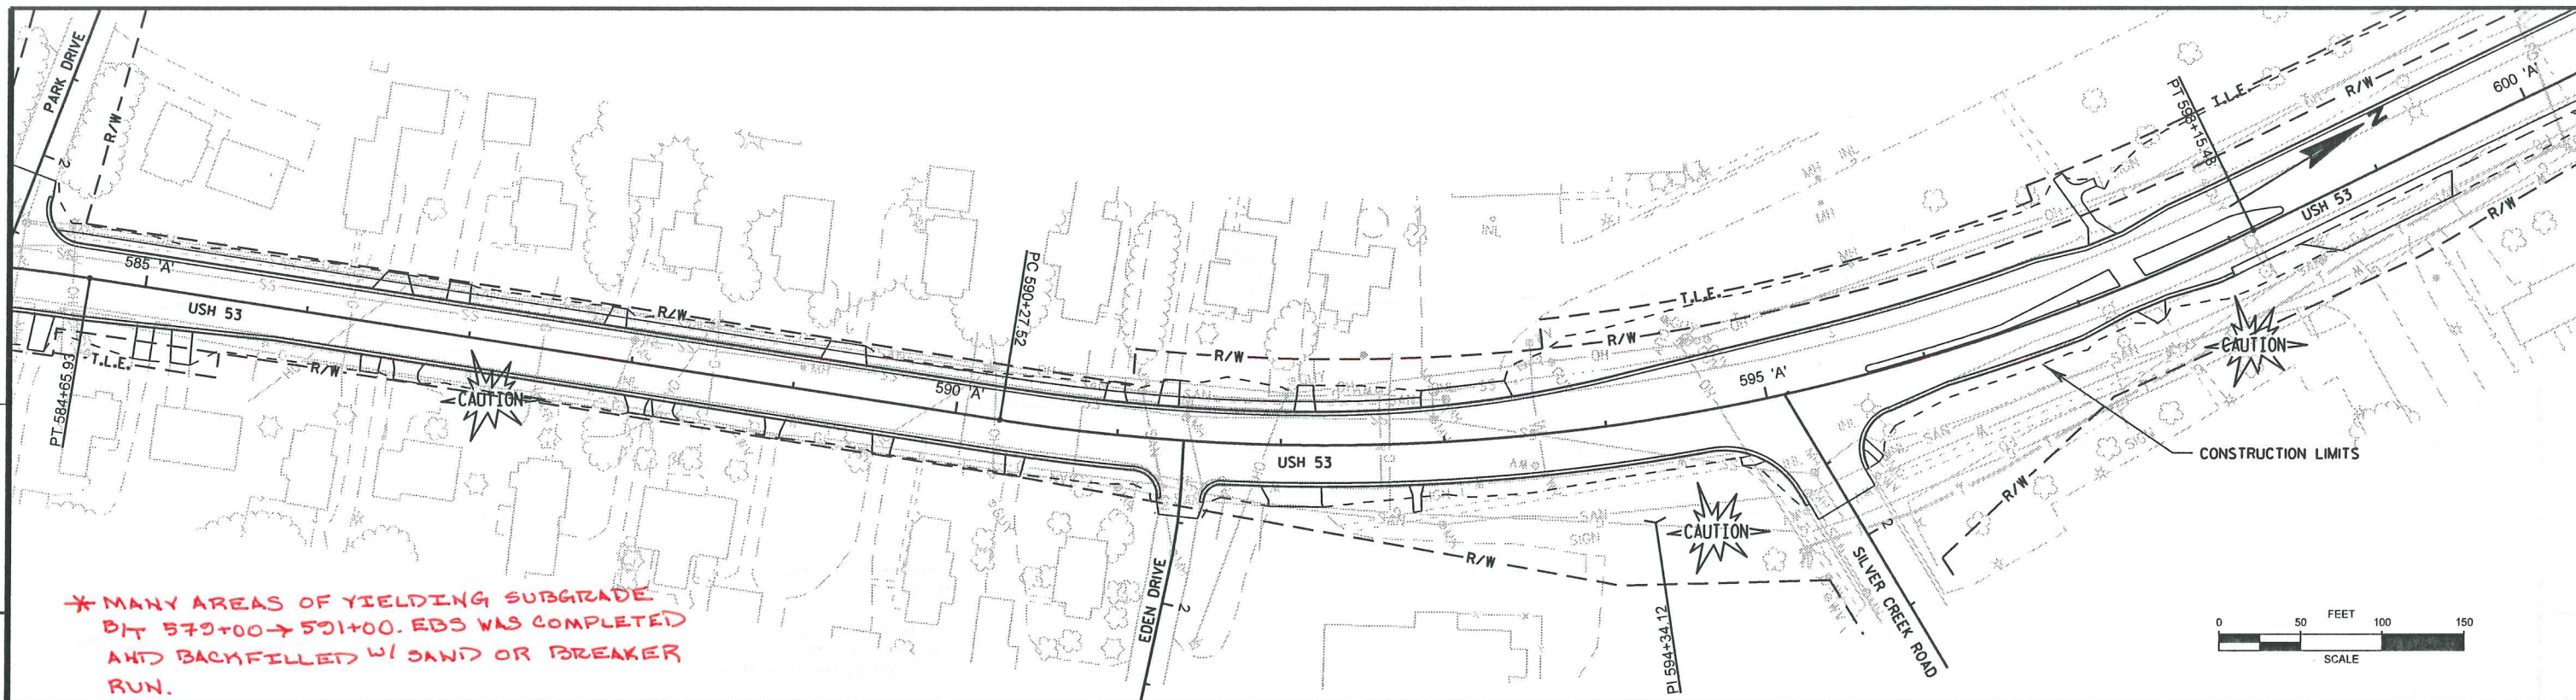

750.79	750.29	751.61	751.14	752.21	751.80	752.73	752.27	753.21	752.72	753.65	753.17	754.07	753.62	754.50	754.07	754.94	754.52	755.39	754.97	755.85	755.43	756.28	755.92	756.77	756.42	757.30	756.92	757.79	757.42	758.28	757.92	758.76	758.42	759.25	758.92	759.72	759.42	760.10	759.92	760.48	760.42	760.89	760.92	761.36	761.40	761.78	761.84	762.26	762.25	762.69	762.67	763.08	763.08	763.49	763.50	763.91	763.91	764.31	764.33
--------	--------	
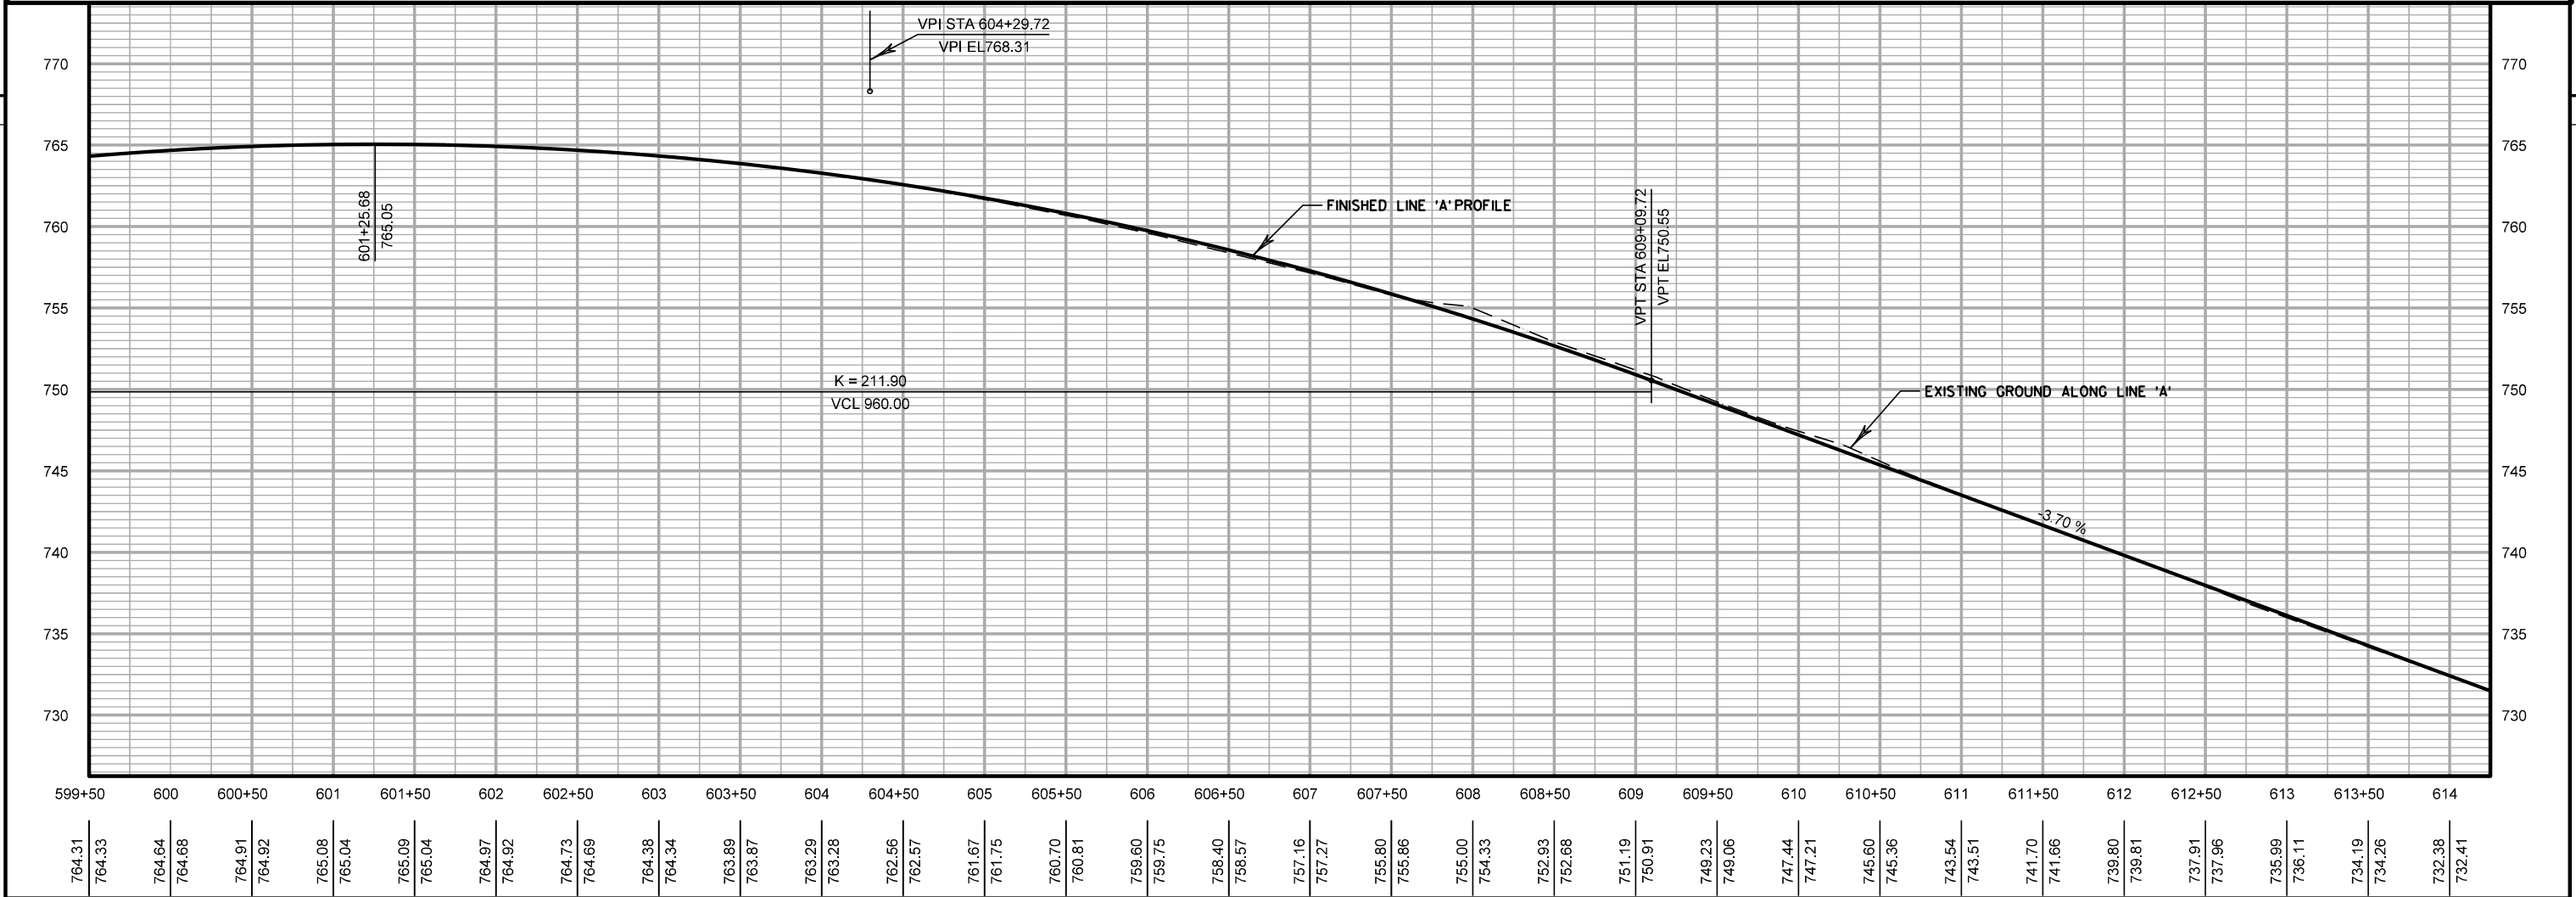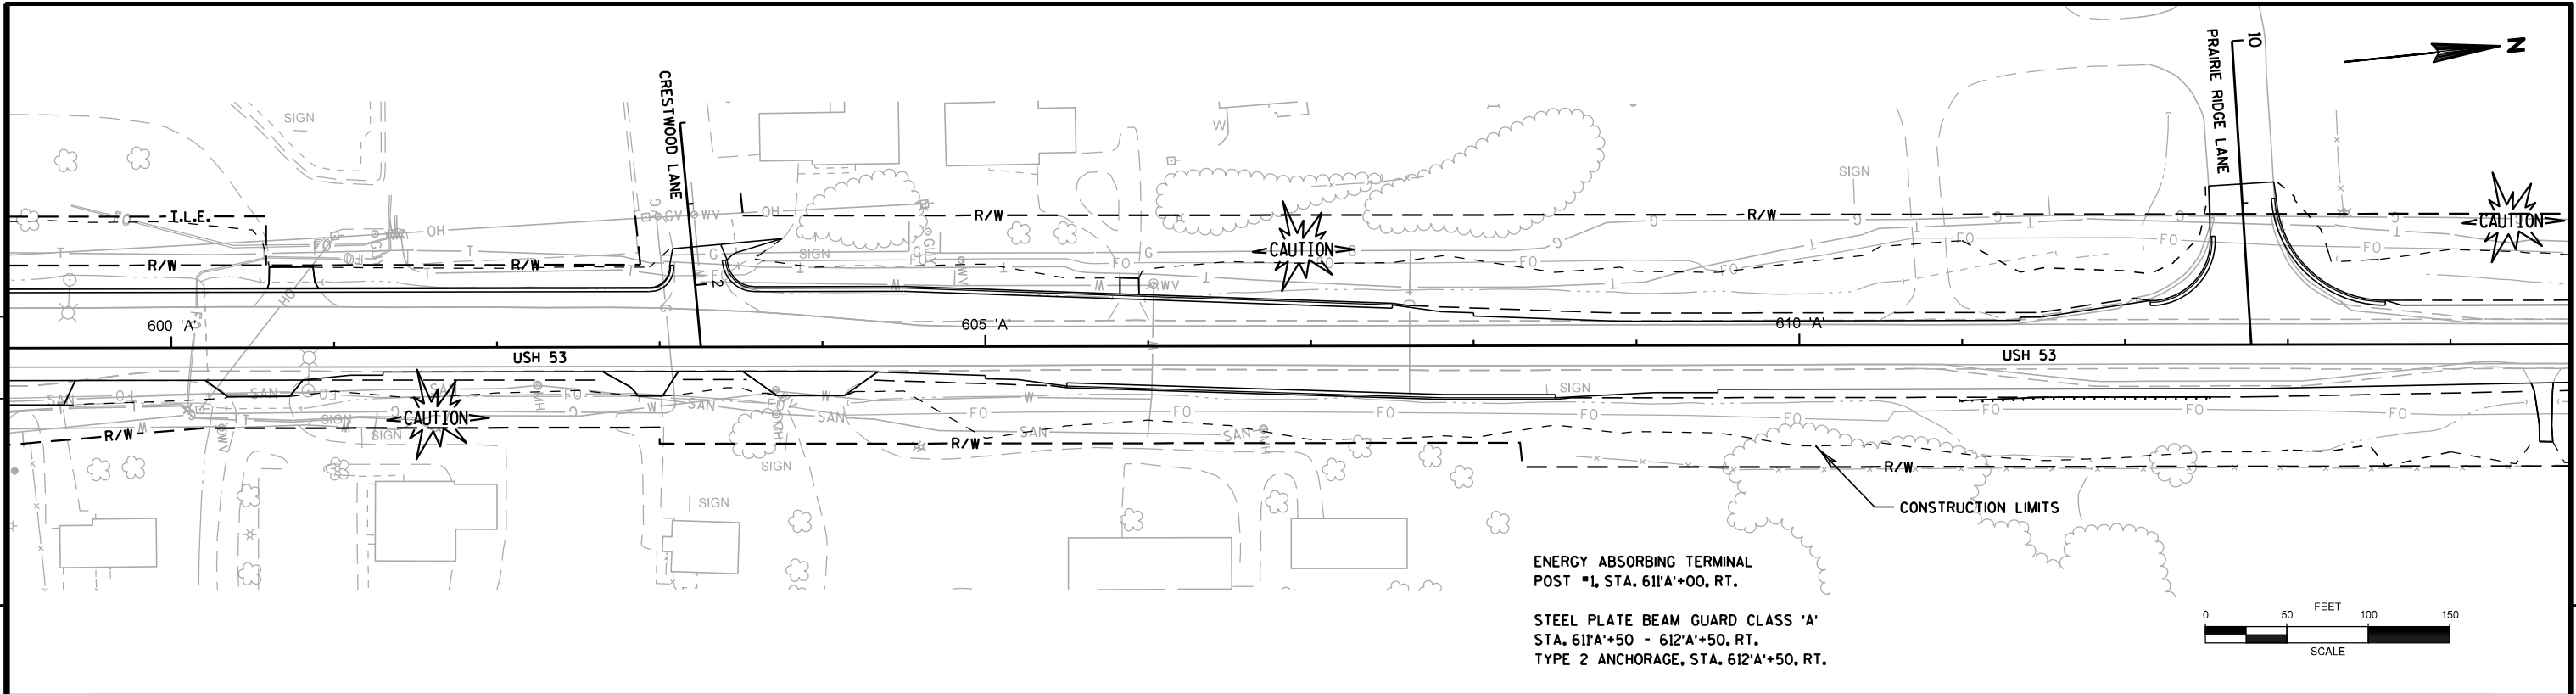

* NOTE: PROFILE GRADE ADJUSTED
BT 614+00 → 620+00 TO MATCH
EXISTING PAV'T. ORIGINAL SURVEY
NOT CORRECT.

C.E. REMOVED TO R/W



30' C.E. BUILT
CABC

END PROJECT 1633-04-74
STA. 619+52 620+00



USH 53



CONSTRUCTION LIMITS

PI 1+00.00

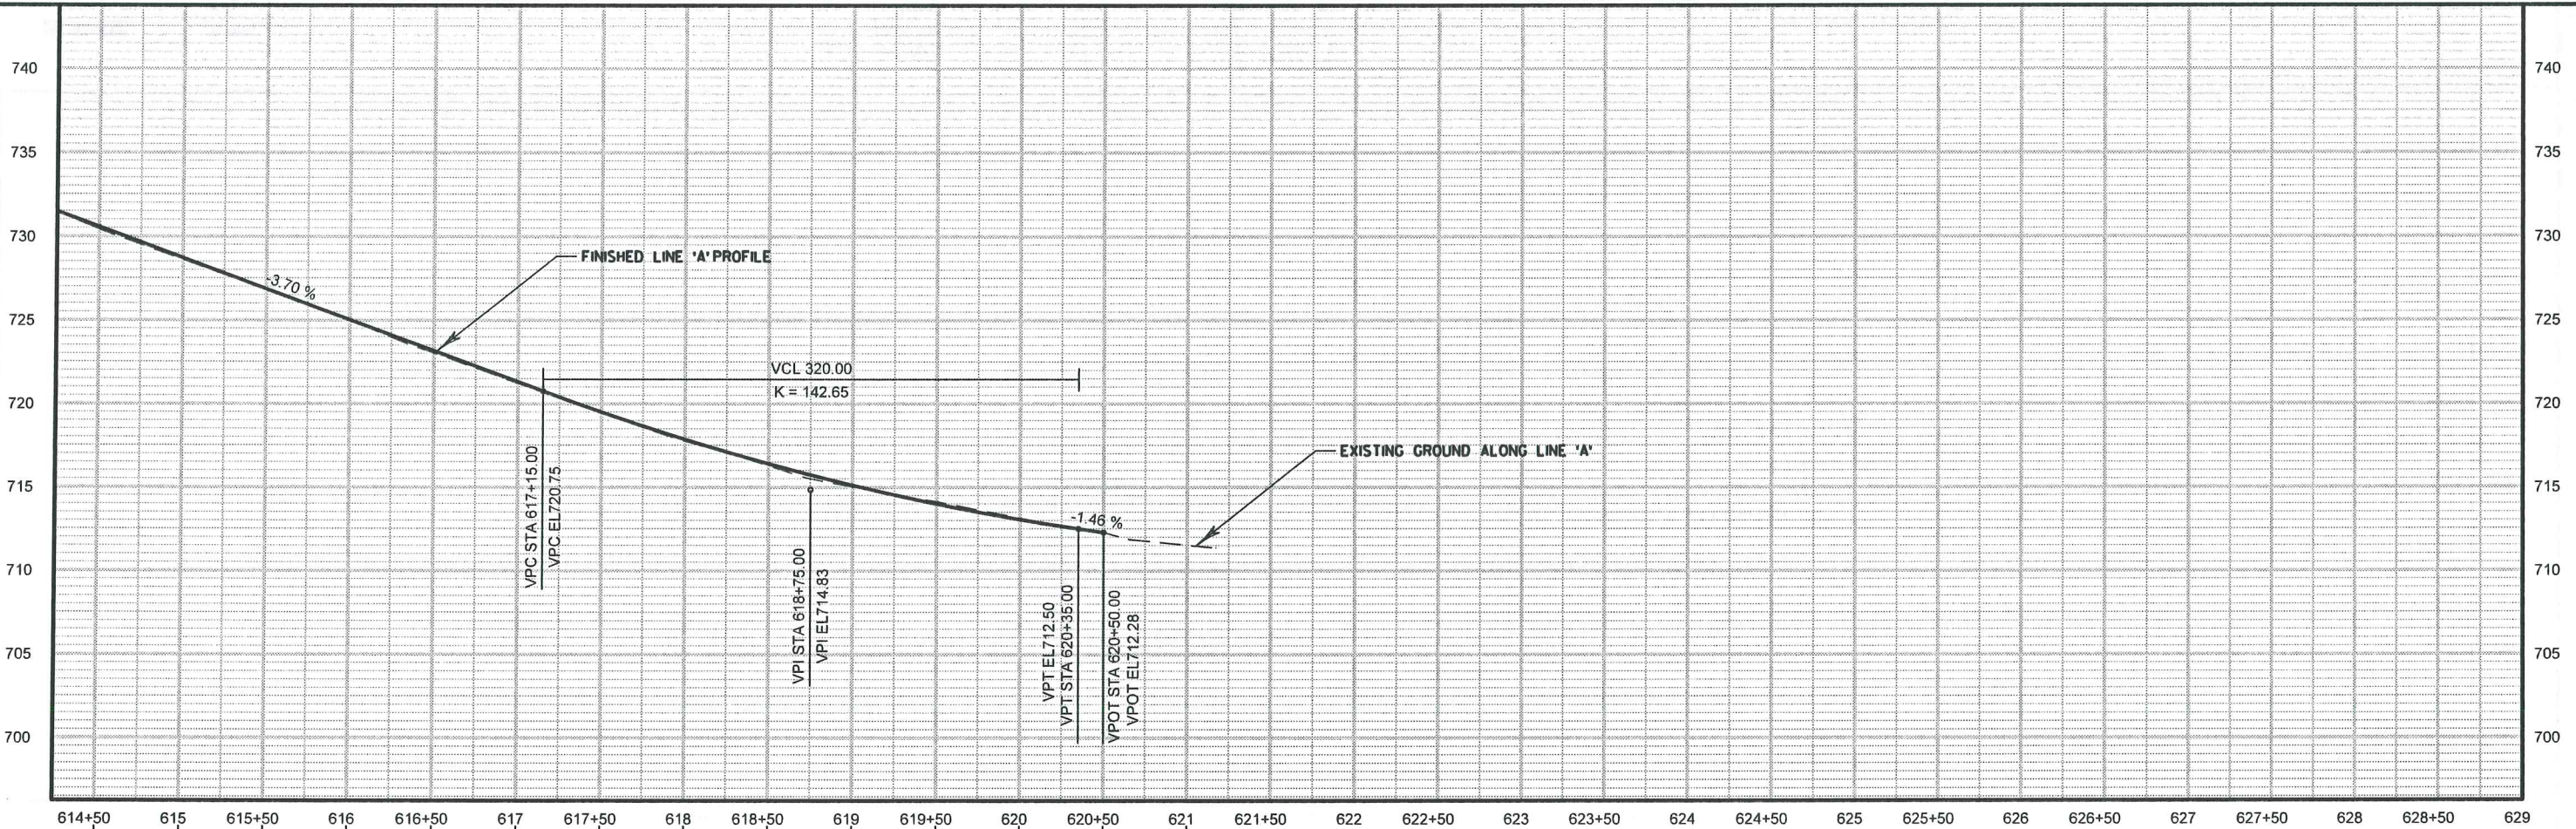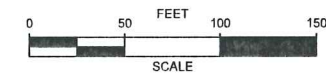



614+50	615	615+50	616	616+50	617	617+50	618	618+50	619	619+50	620	620+50	621	621+50	622	622+50	623	623+50	624	624+50	625	625+50	626	626+50	627	627+50	628	628+50	629	
730.42	730.66	728.62	728.71	726.82	726.86	724.98	725.01	723.03	723.16	721.21	721.31	719.44	719.50	717.77	717.86	716.28	716.39	715.02	715.10	714.13	713.99	713.15	713.05	712.28	712.28	711.54				

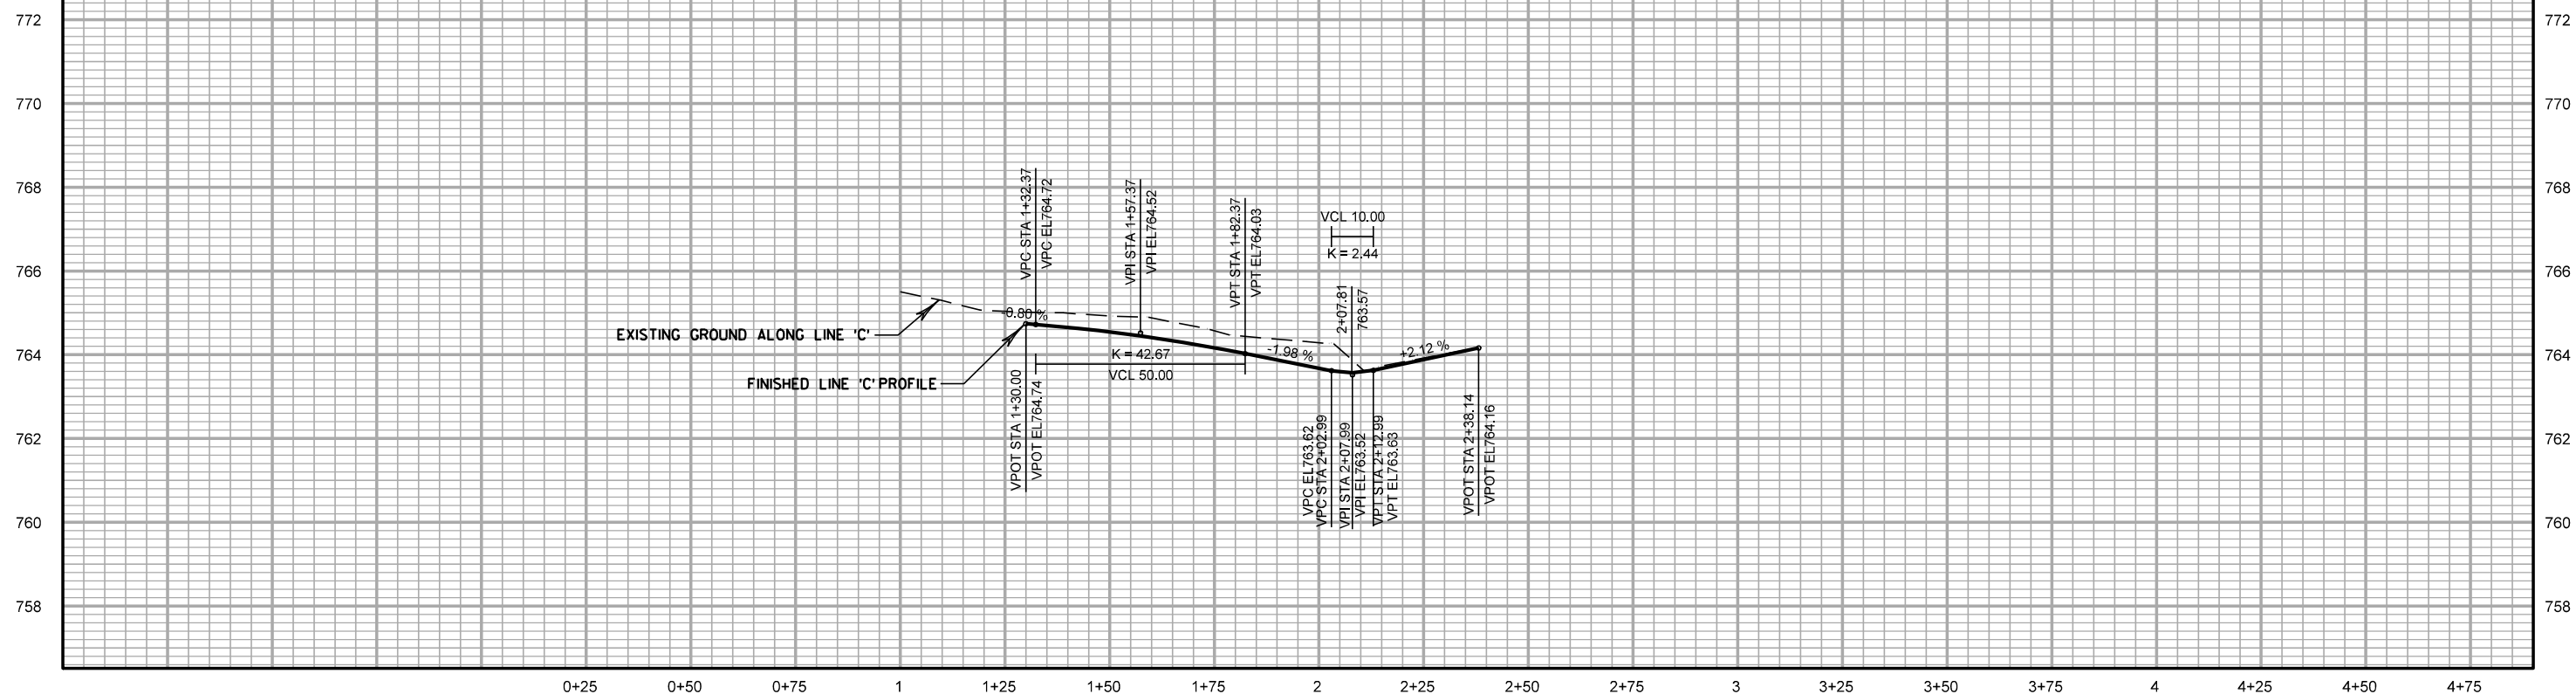
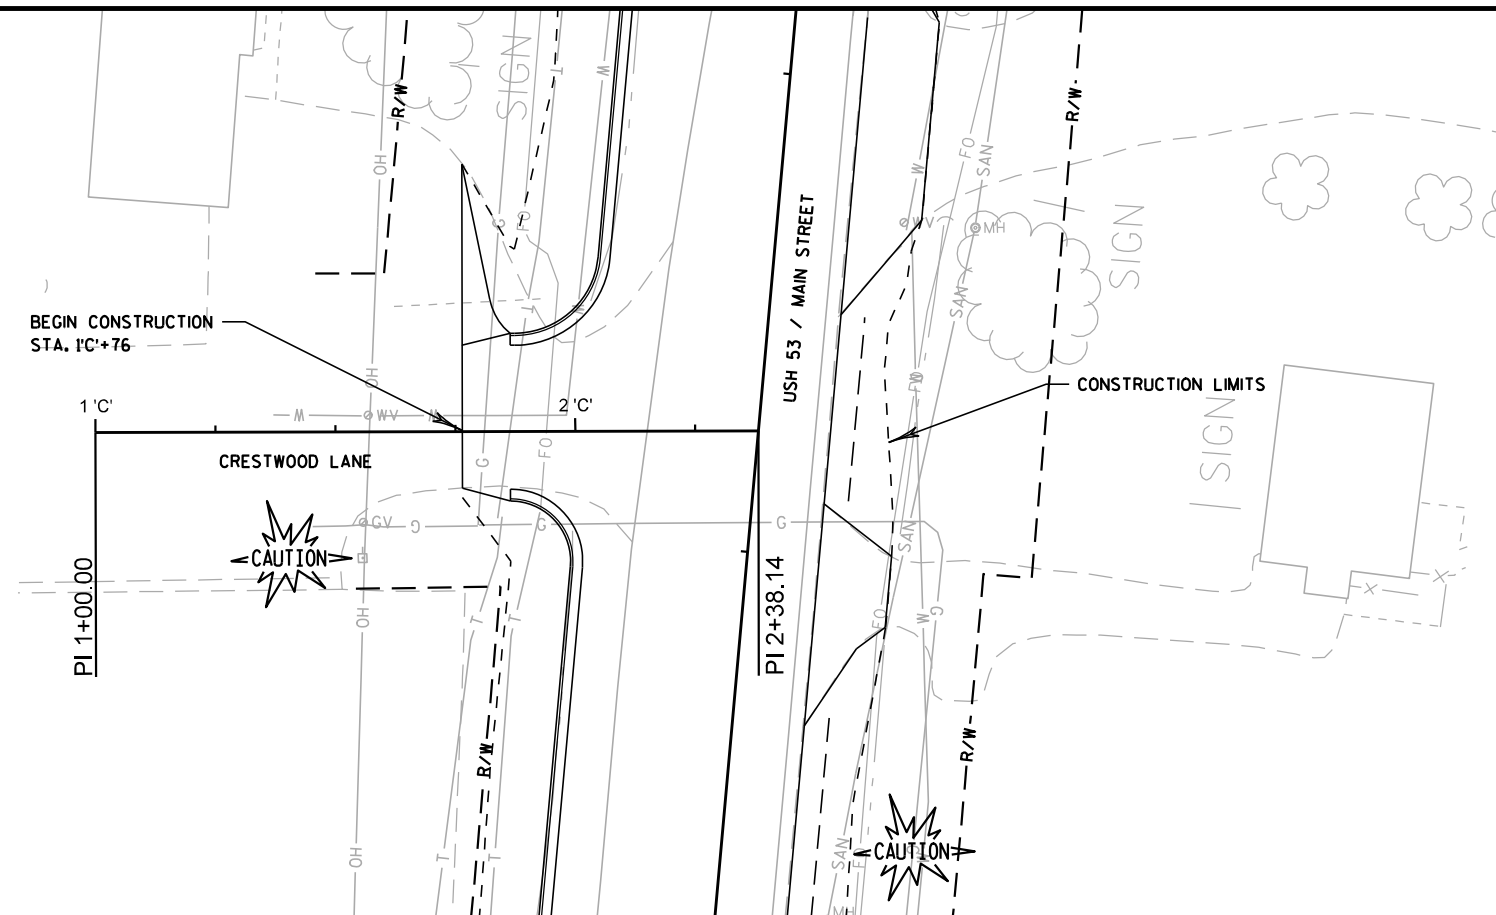


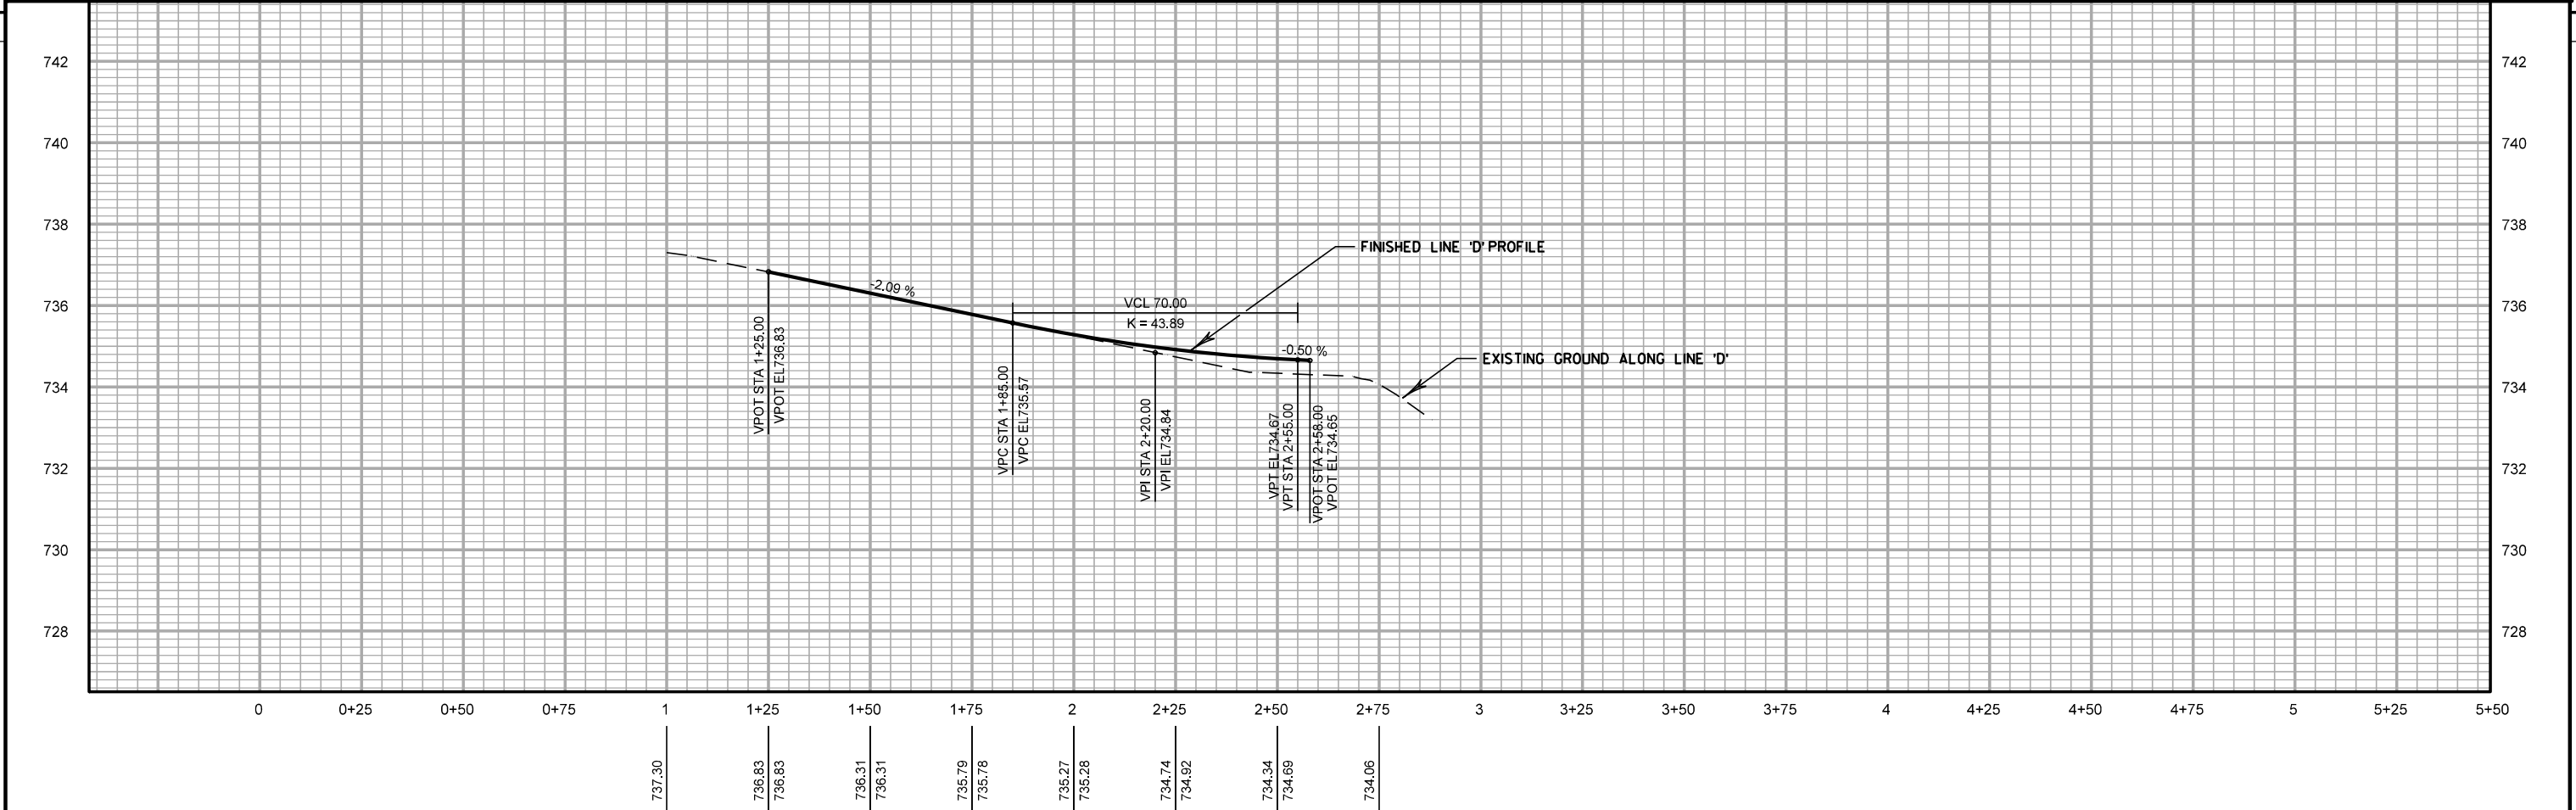
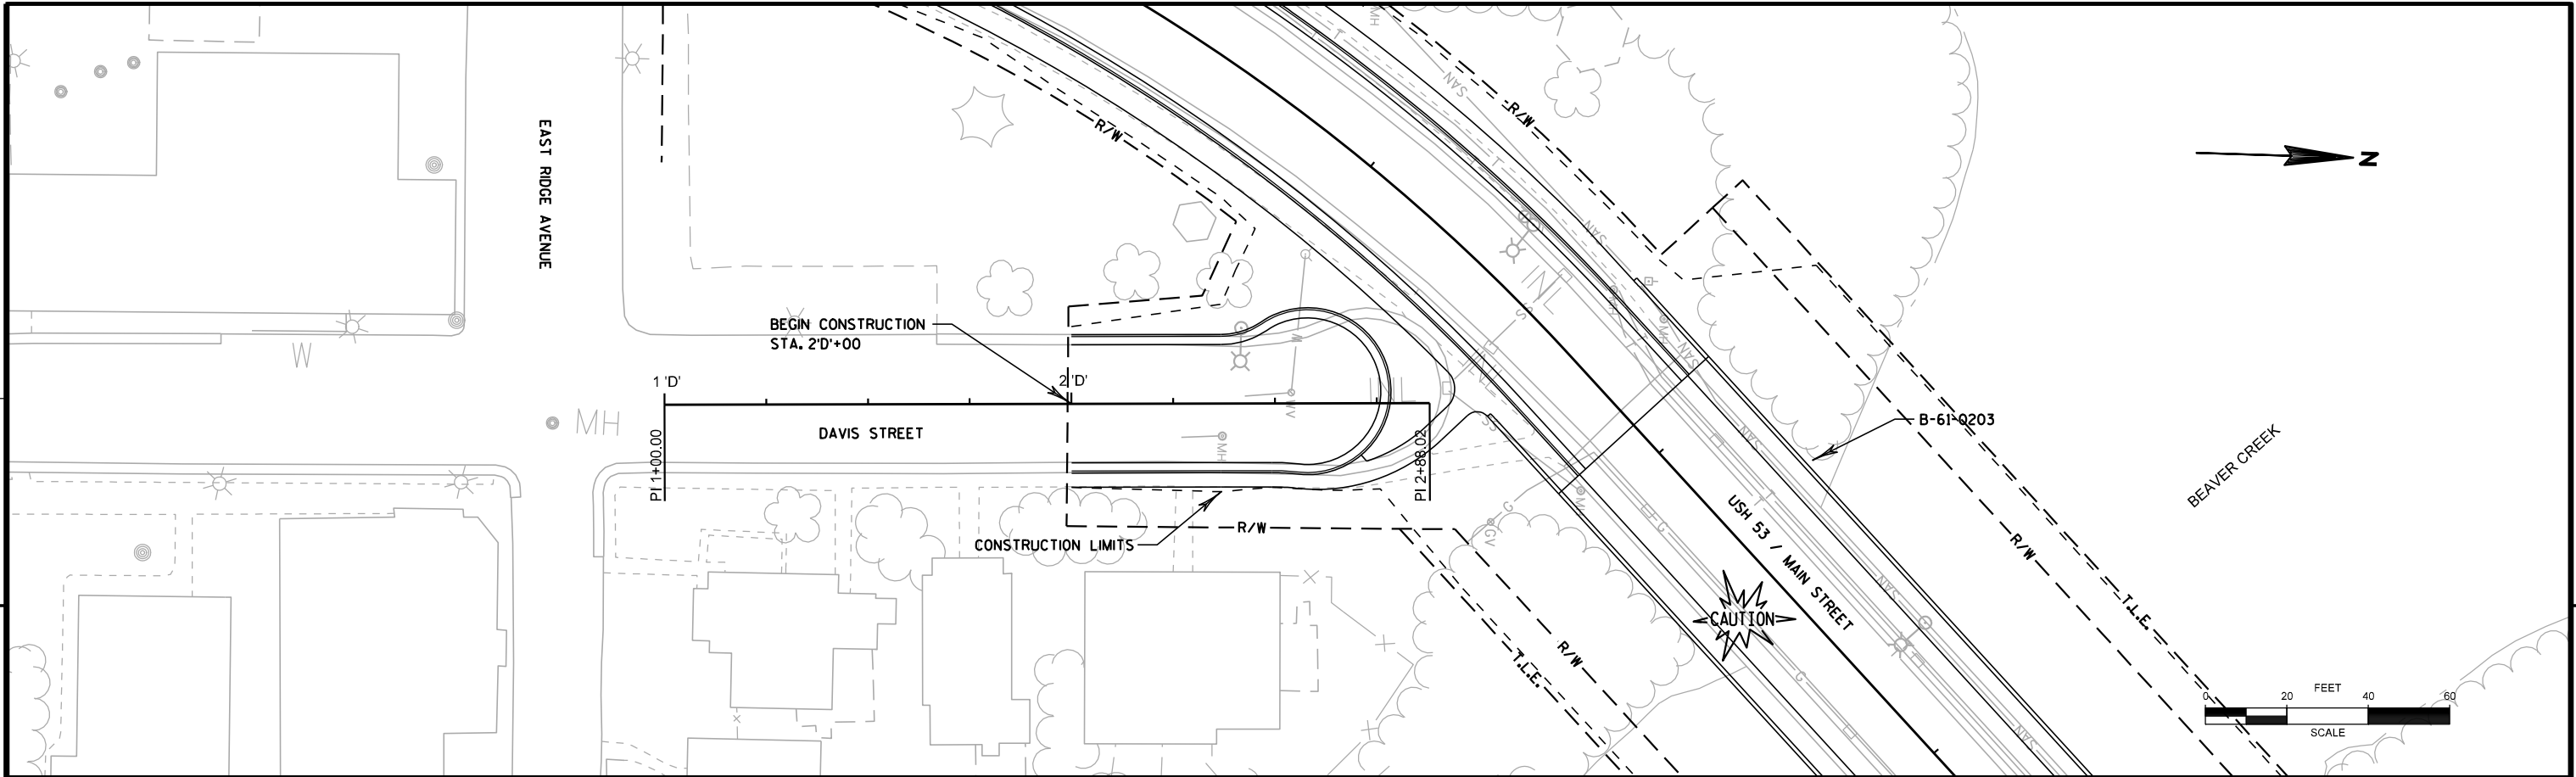




STATE PROJECT NO: 1633-04-74	HWY: USH 53	COUNTY: TREMPPEALEAU	PLAN & PROFILE	LINE 'D' (DAVIS STREET)	SHEET NO:	E
------------------------------	-------------	----------------------	----------------	-------------------------	-----------	---



FILE NAME : c:\User\s\PROJECTS\D6+GALES01\74_050150_pp.DGN PLOT DATE : 22-FEB-2010 10:24 PLOT BY : dataas PLOT NAME : PLOT SCALE : 2:1

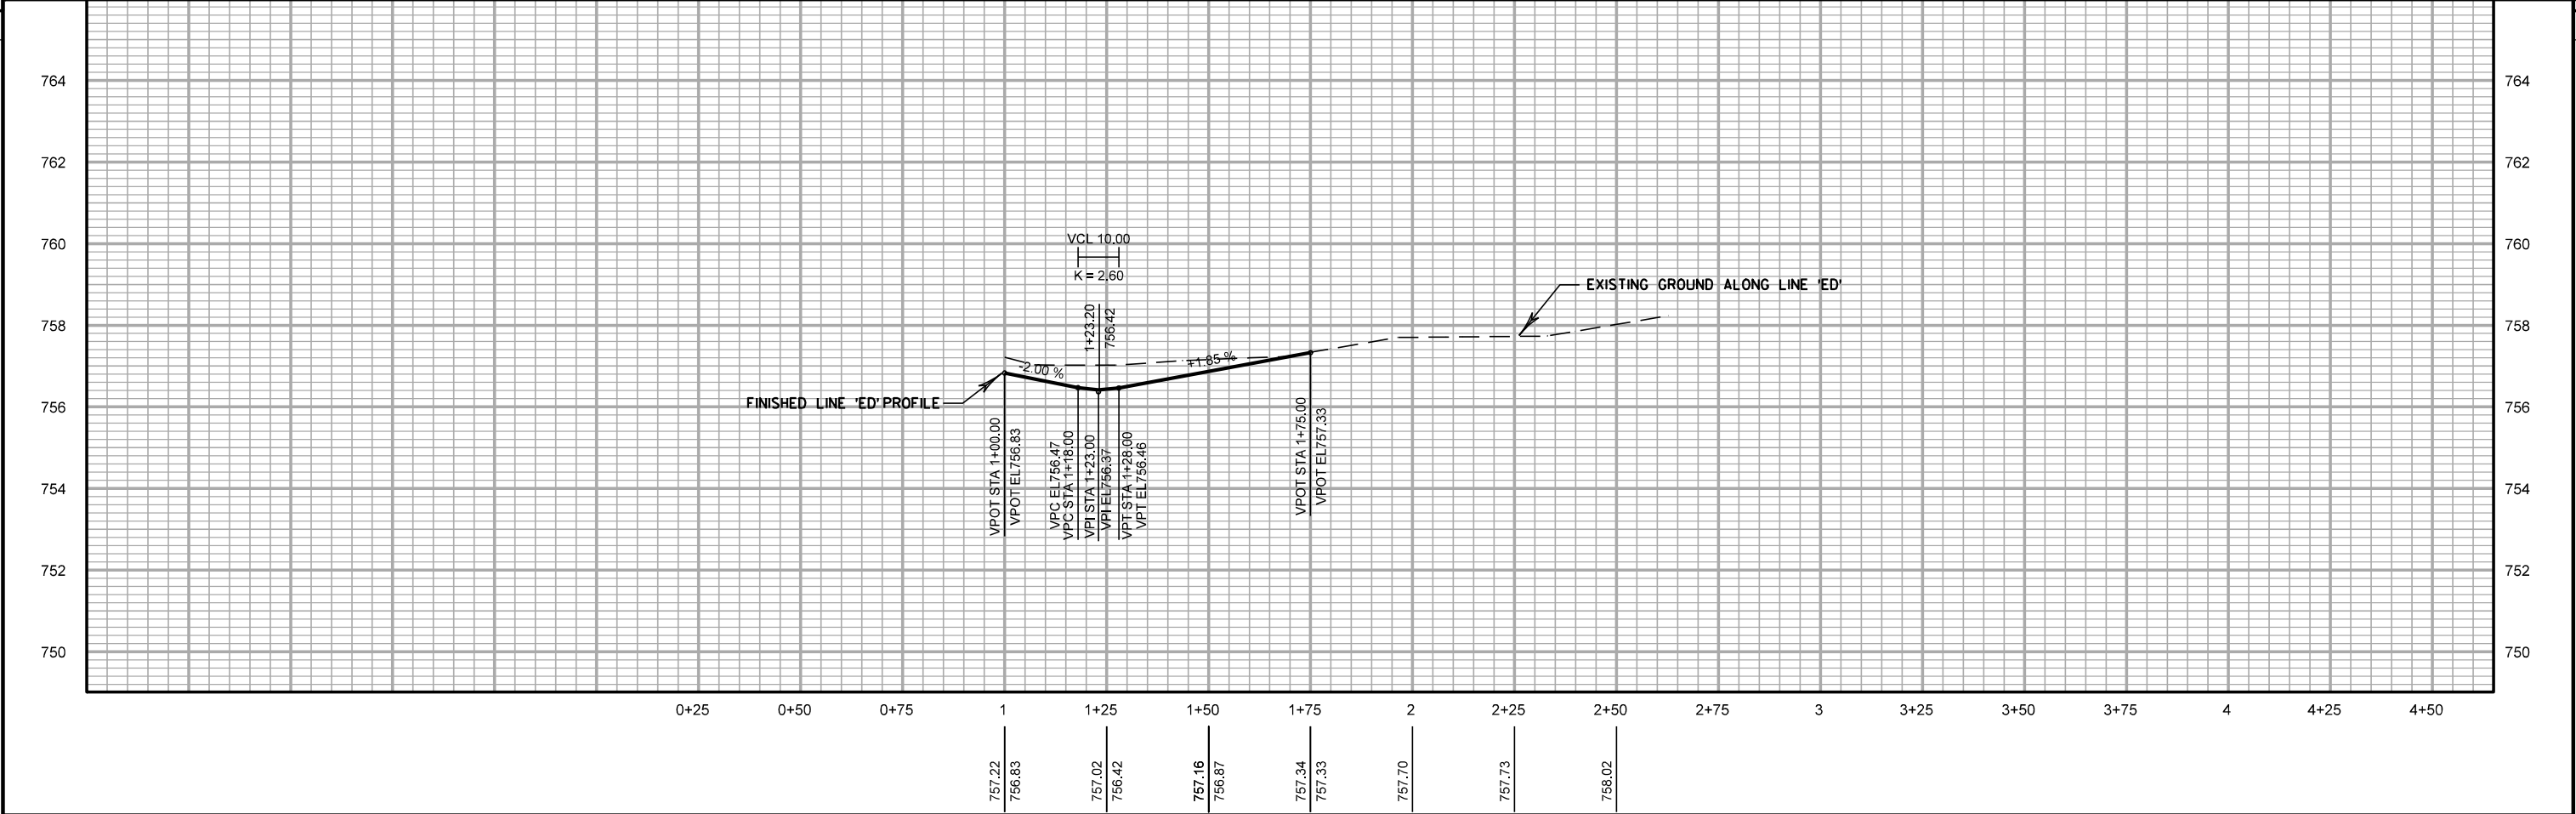
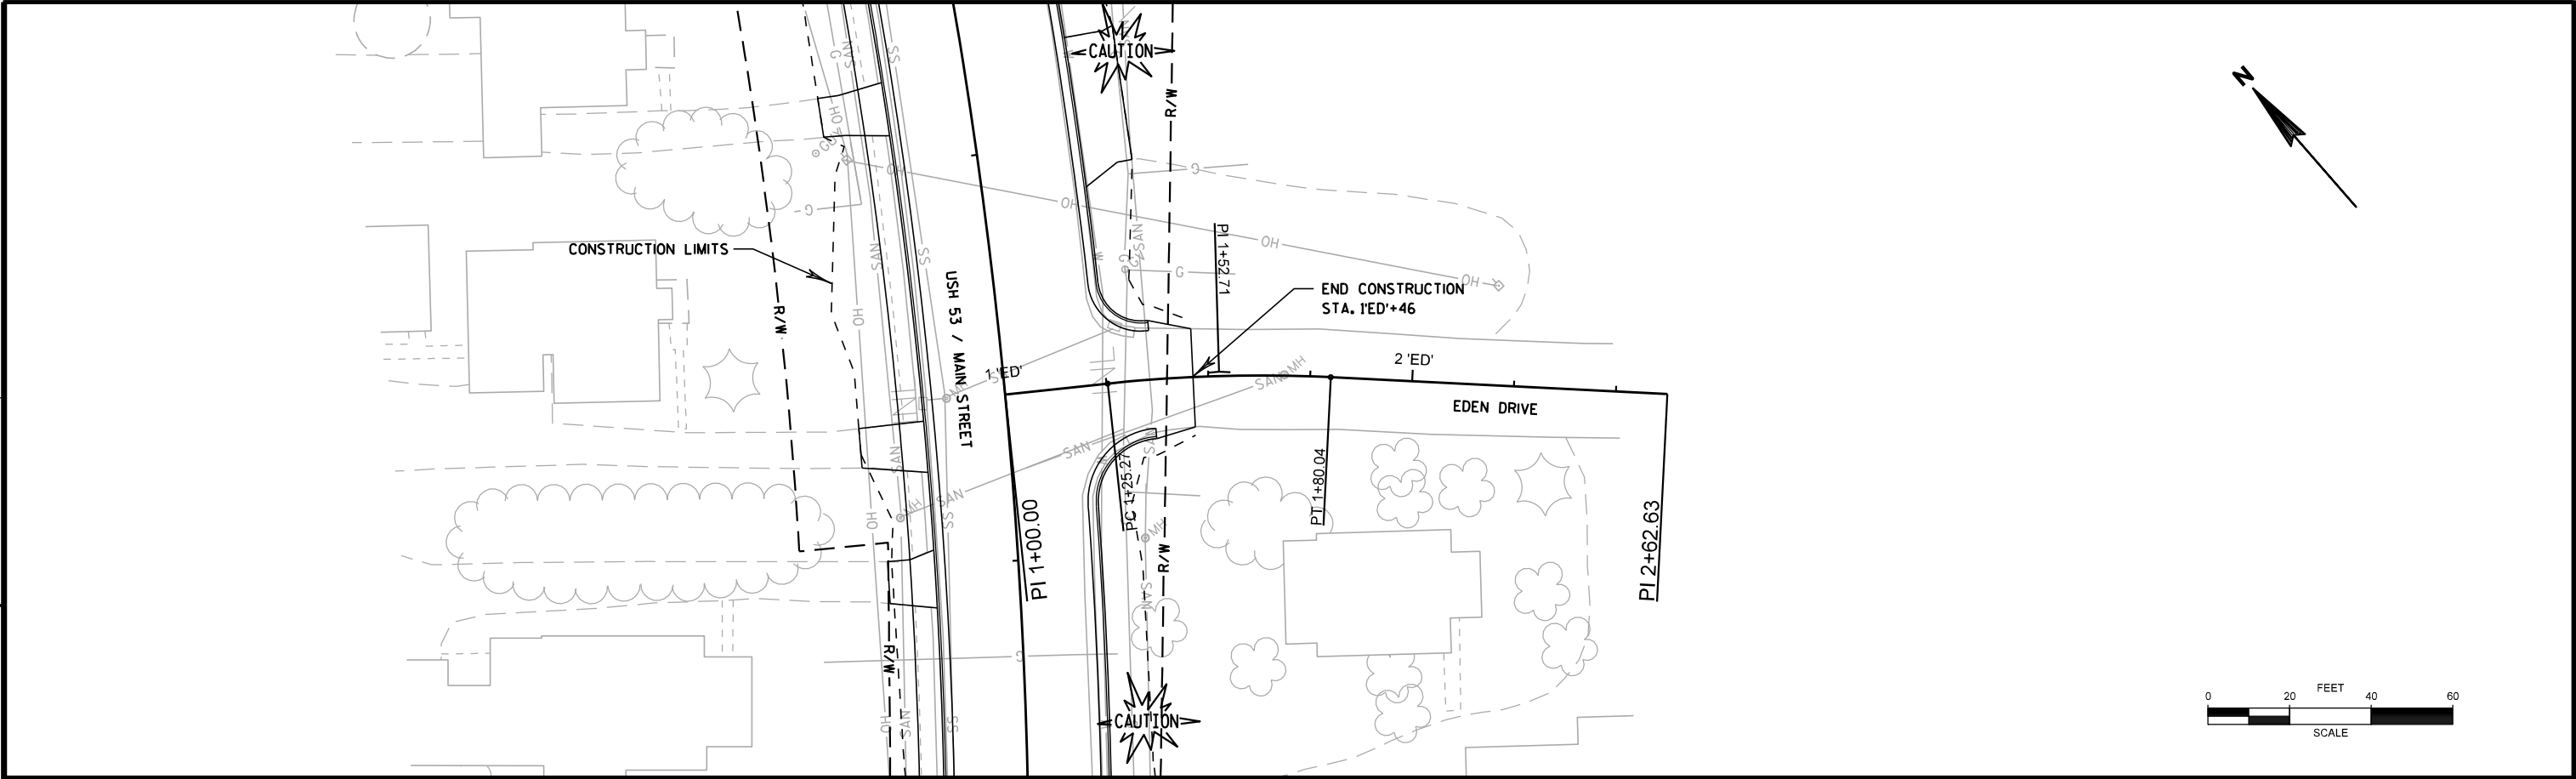


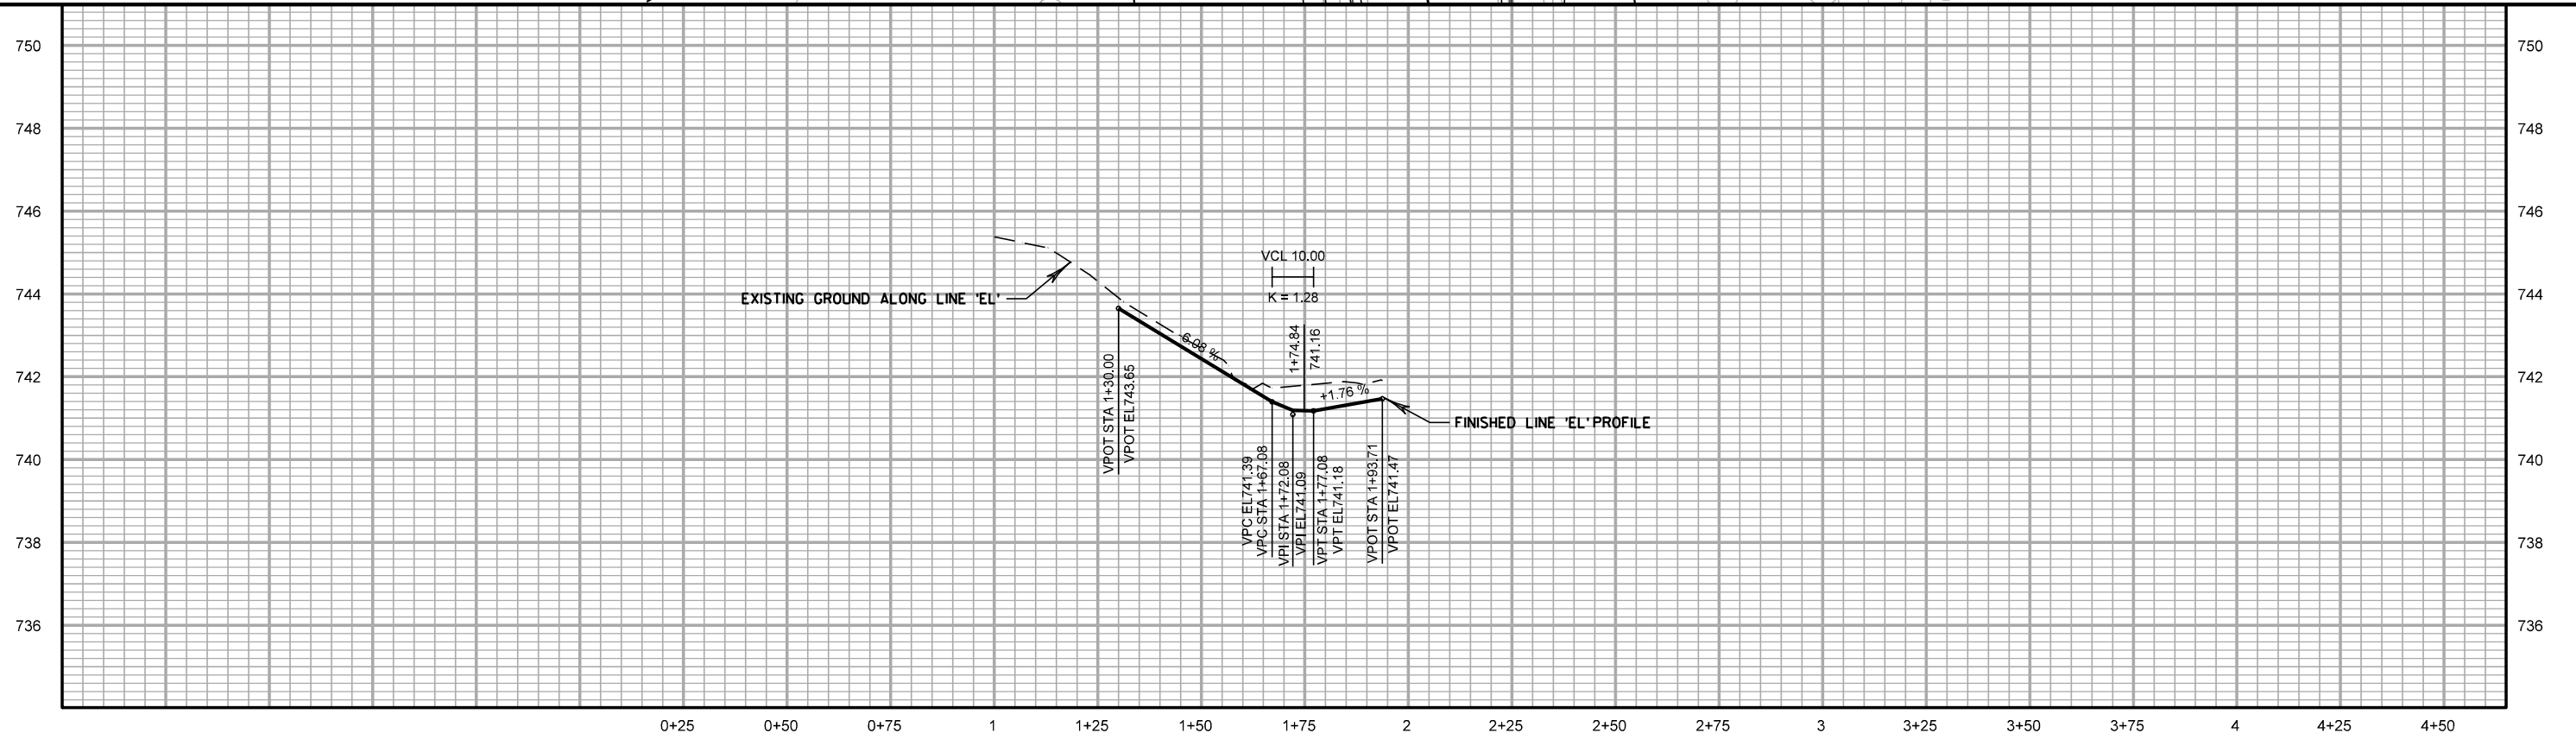
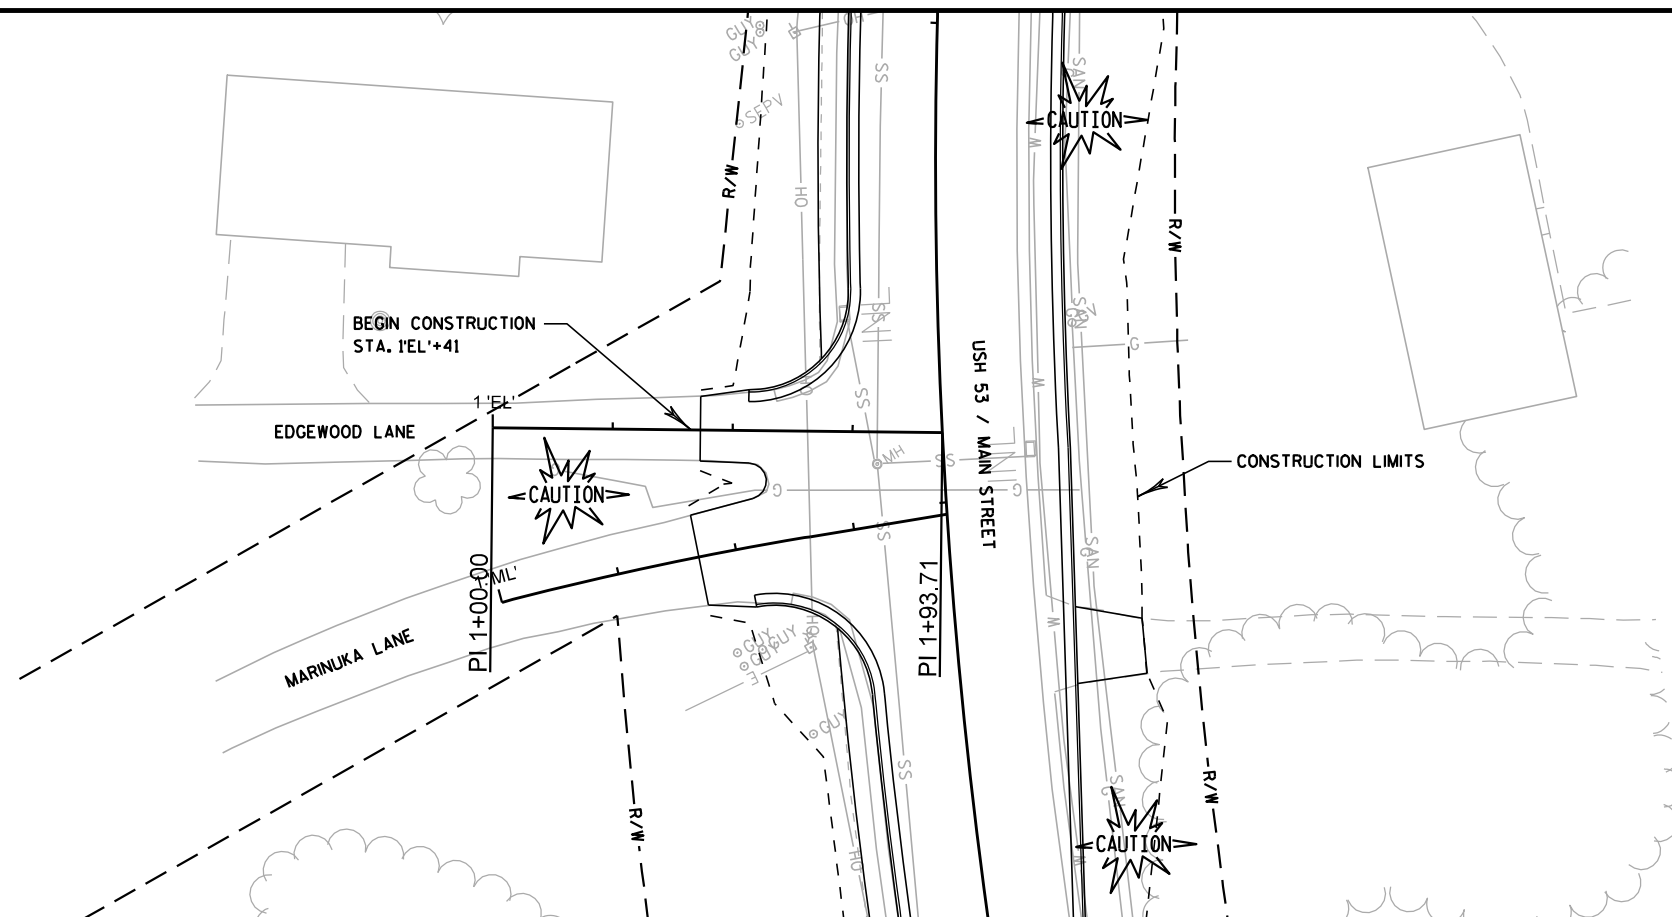



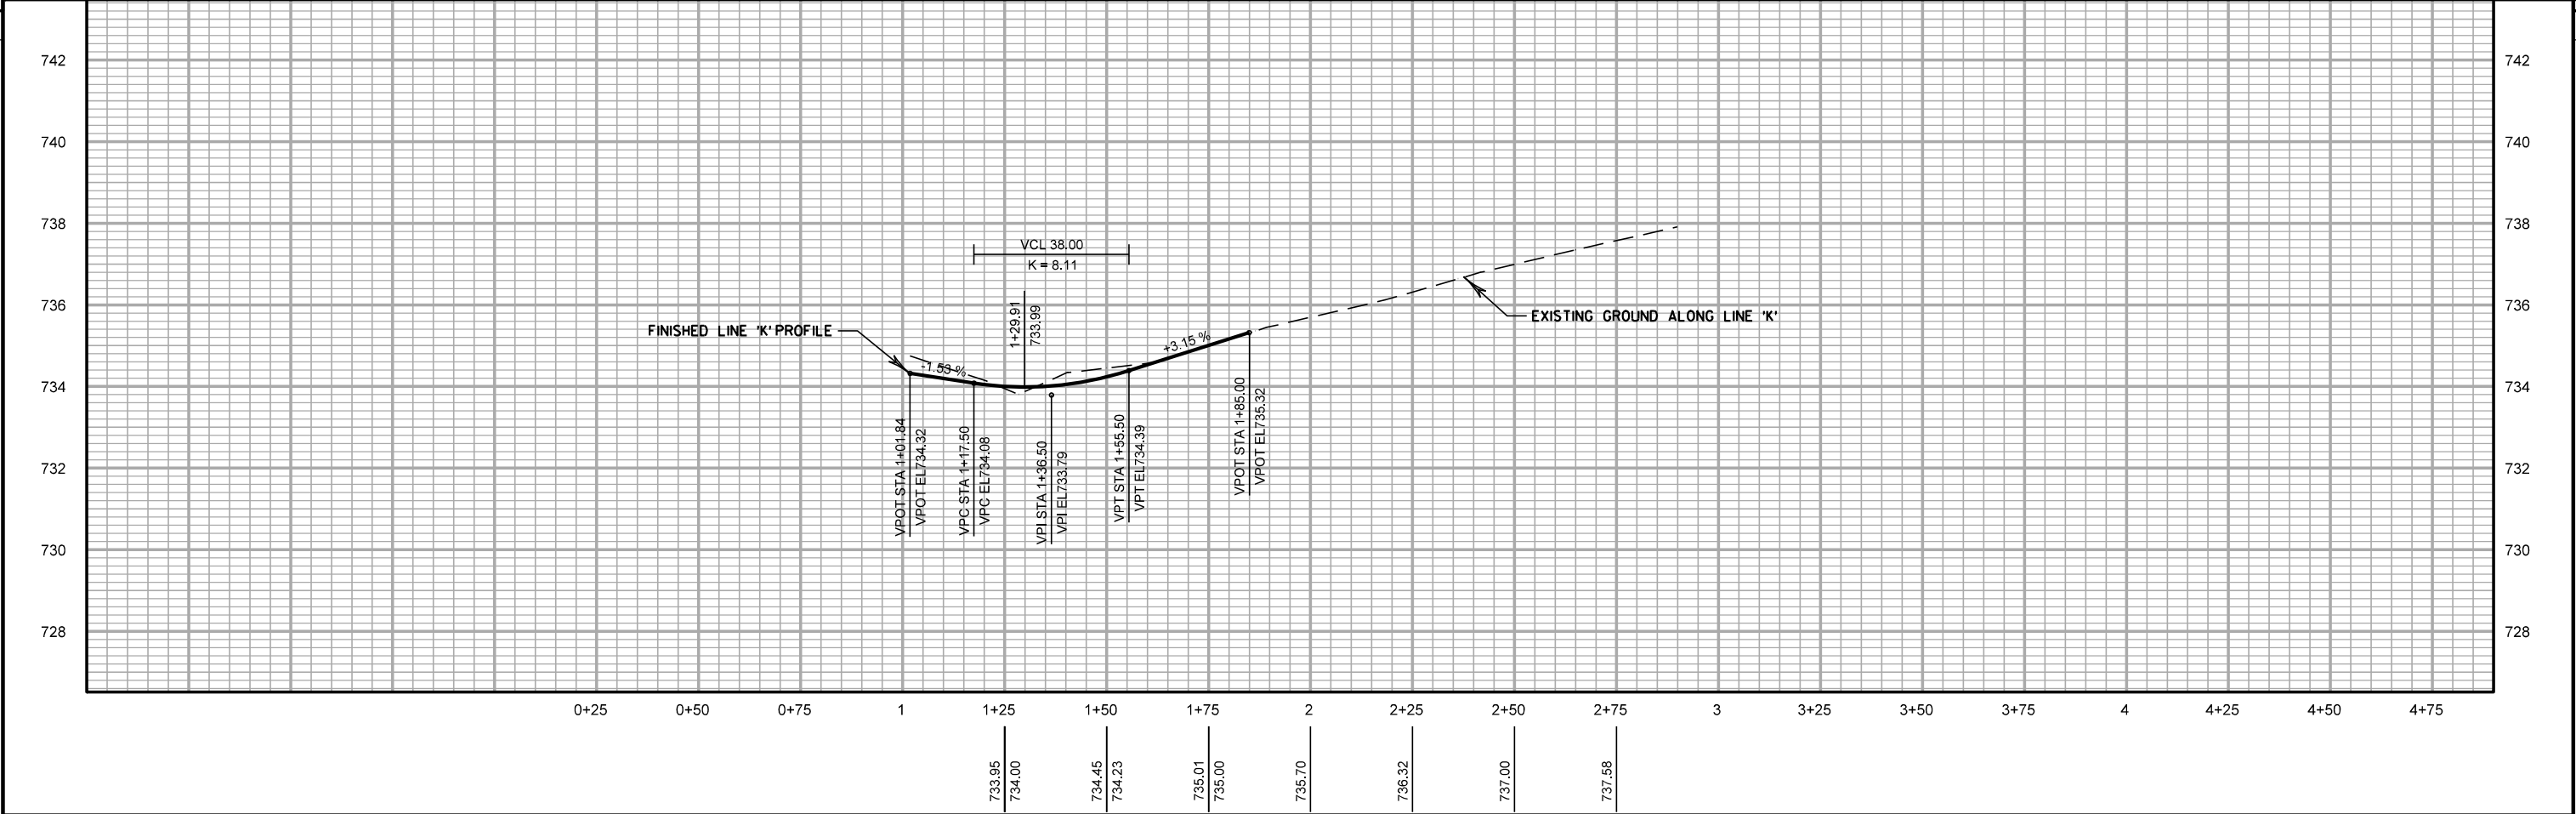
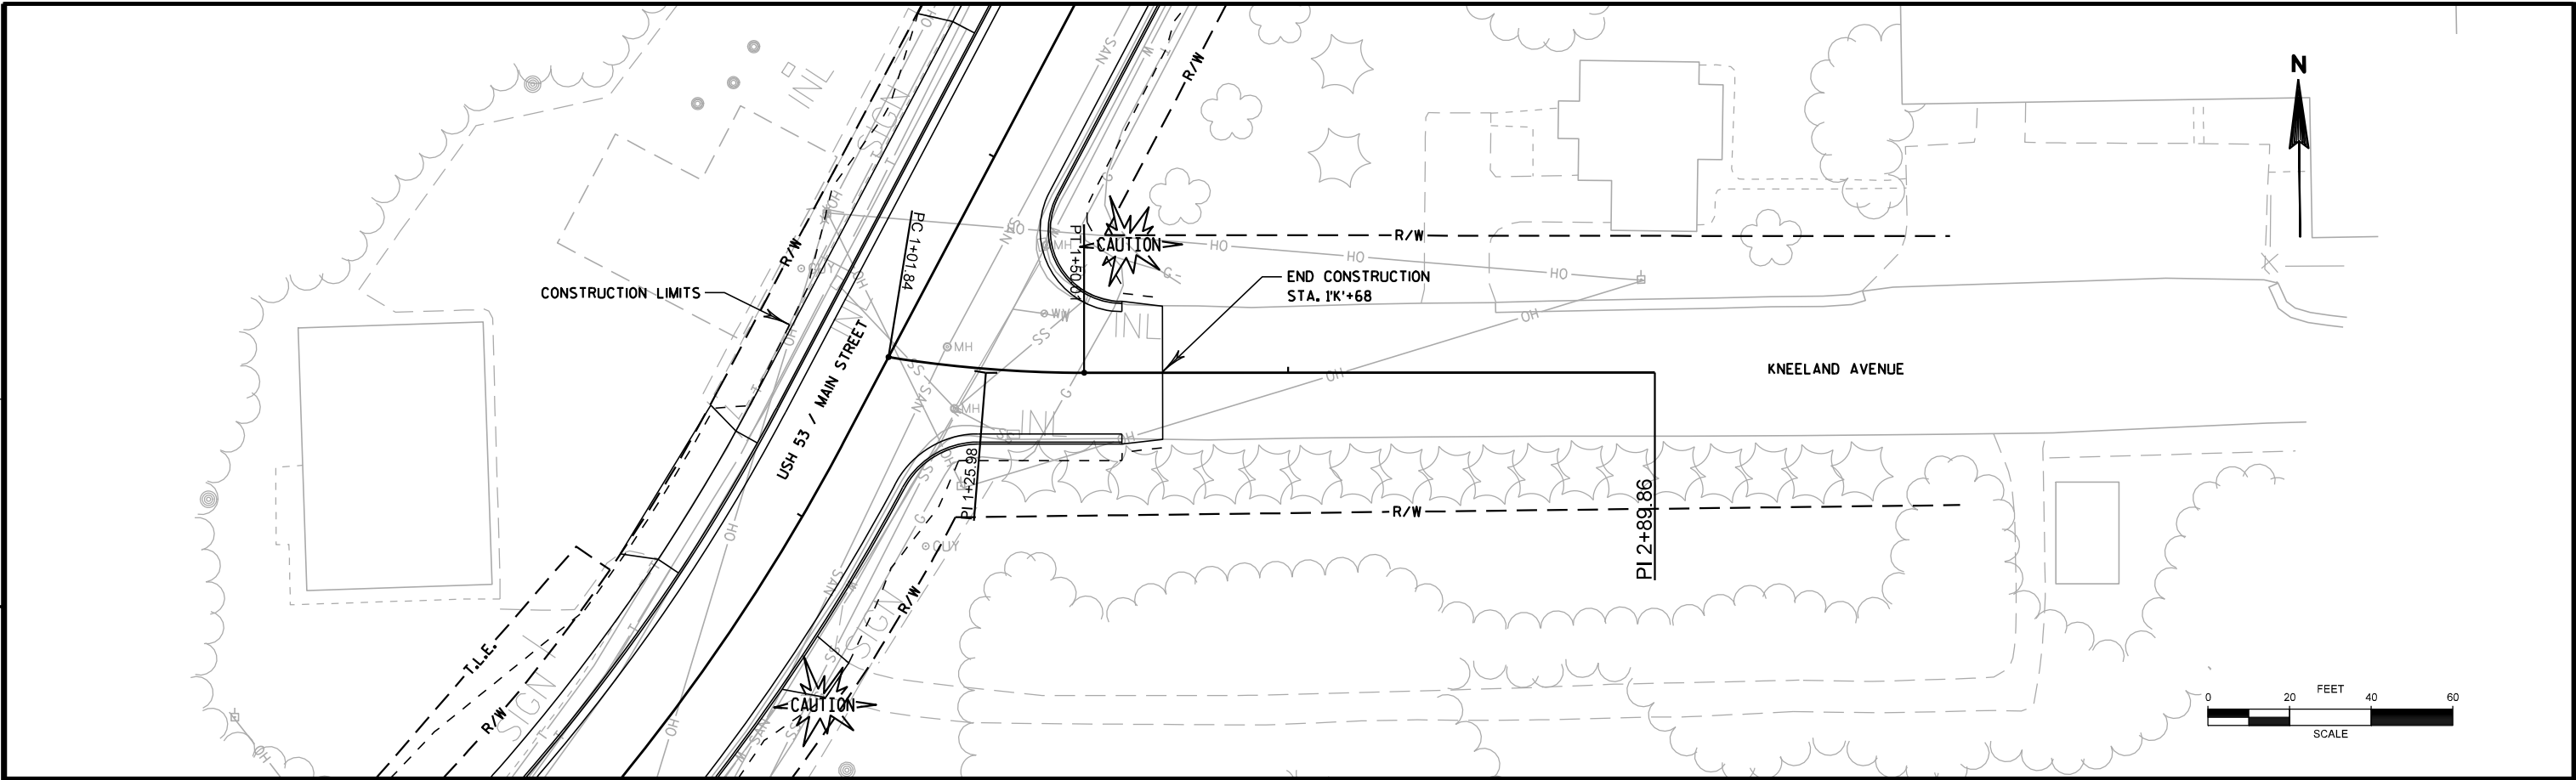


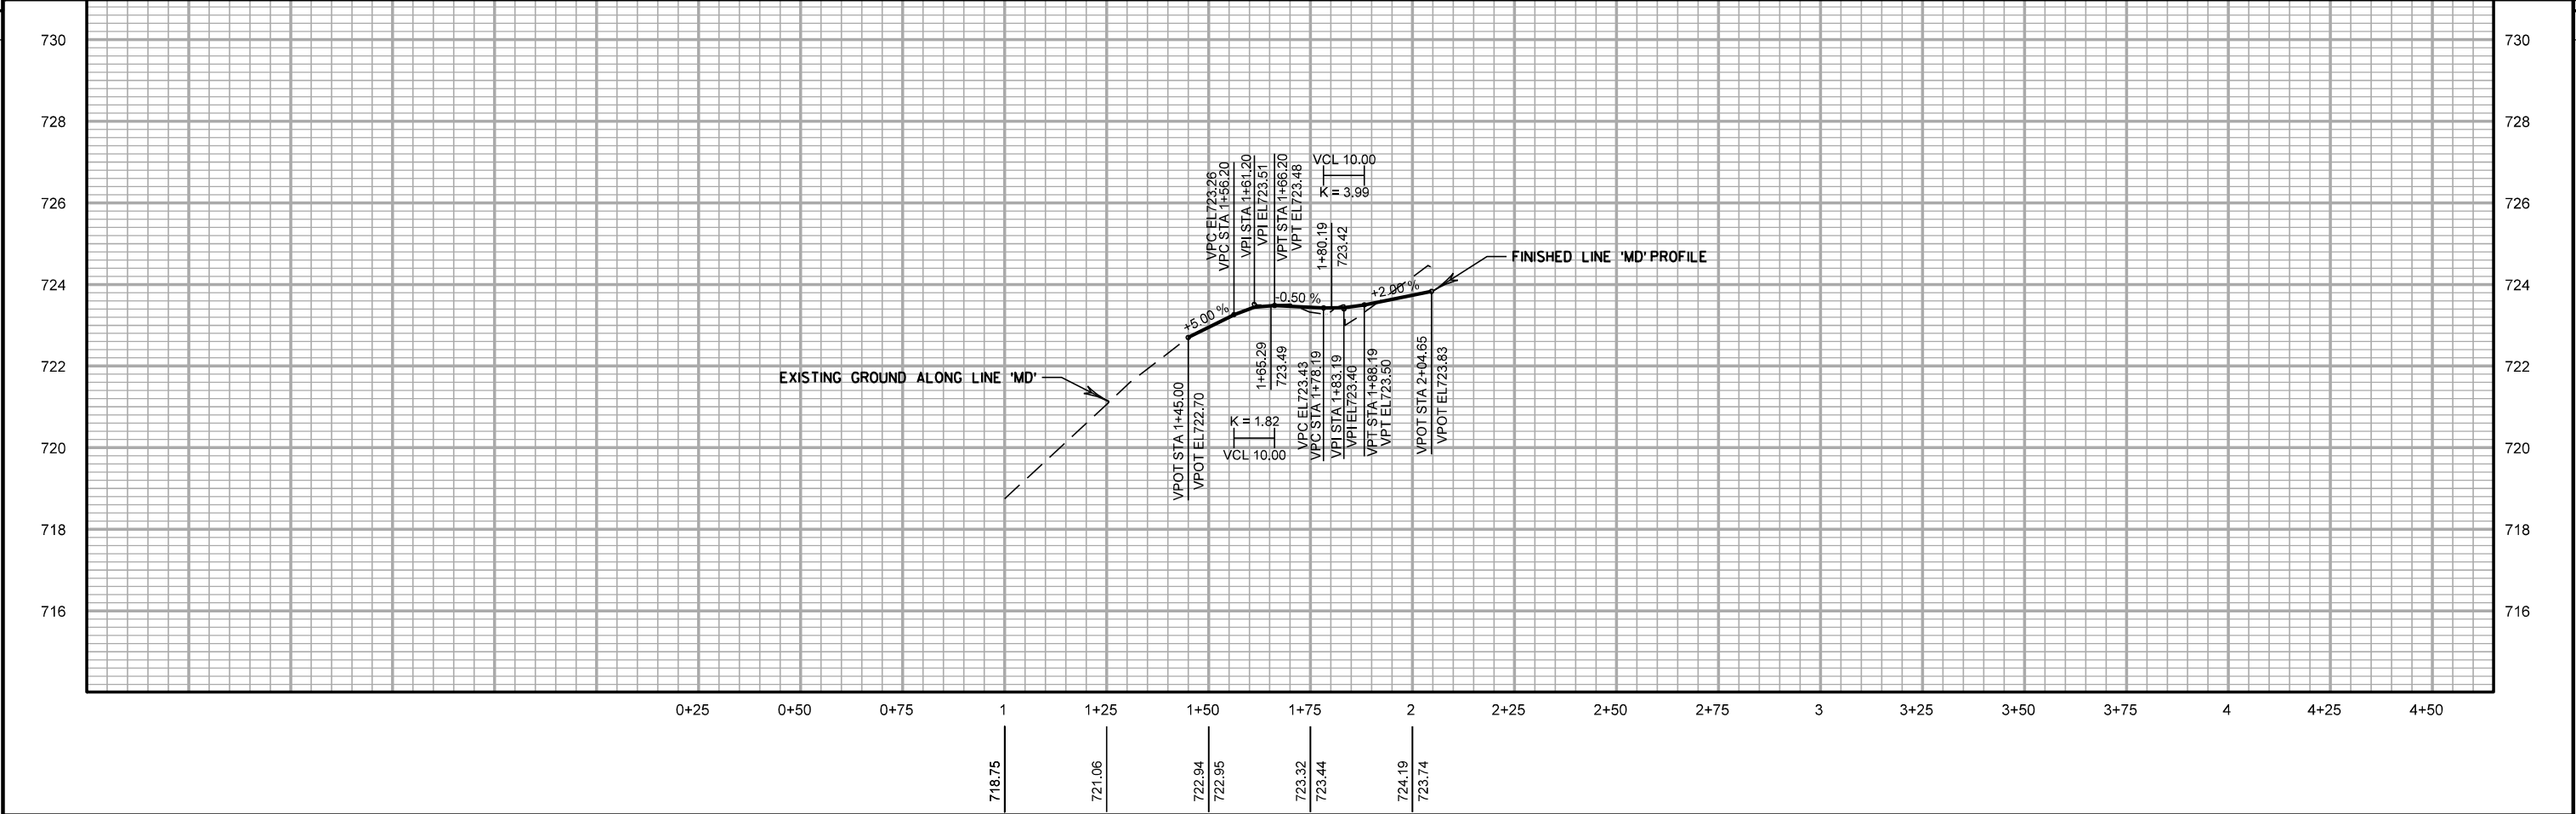
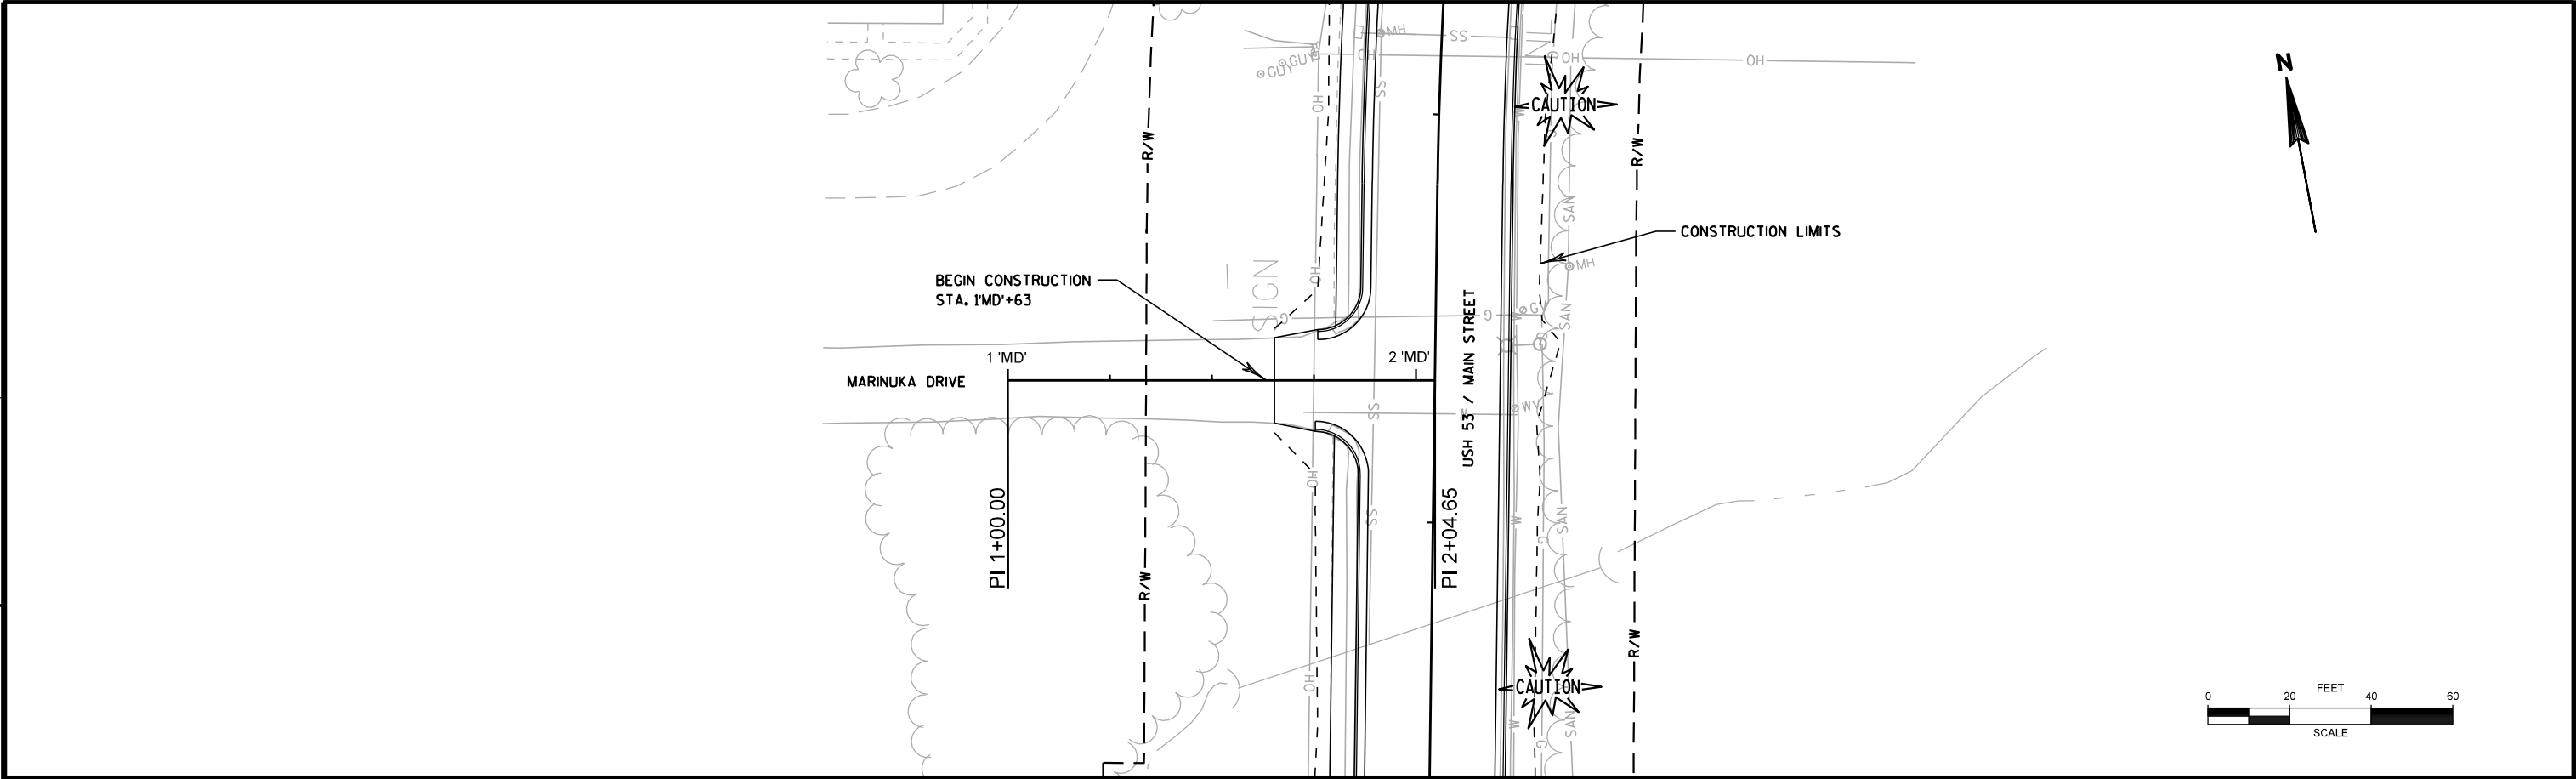


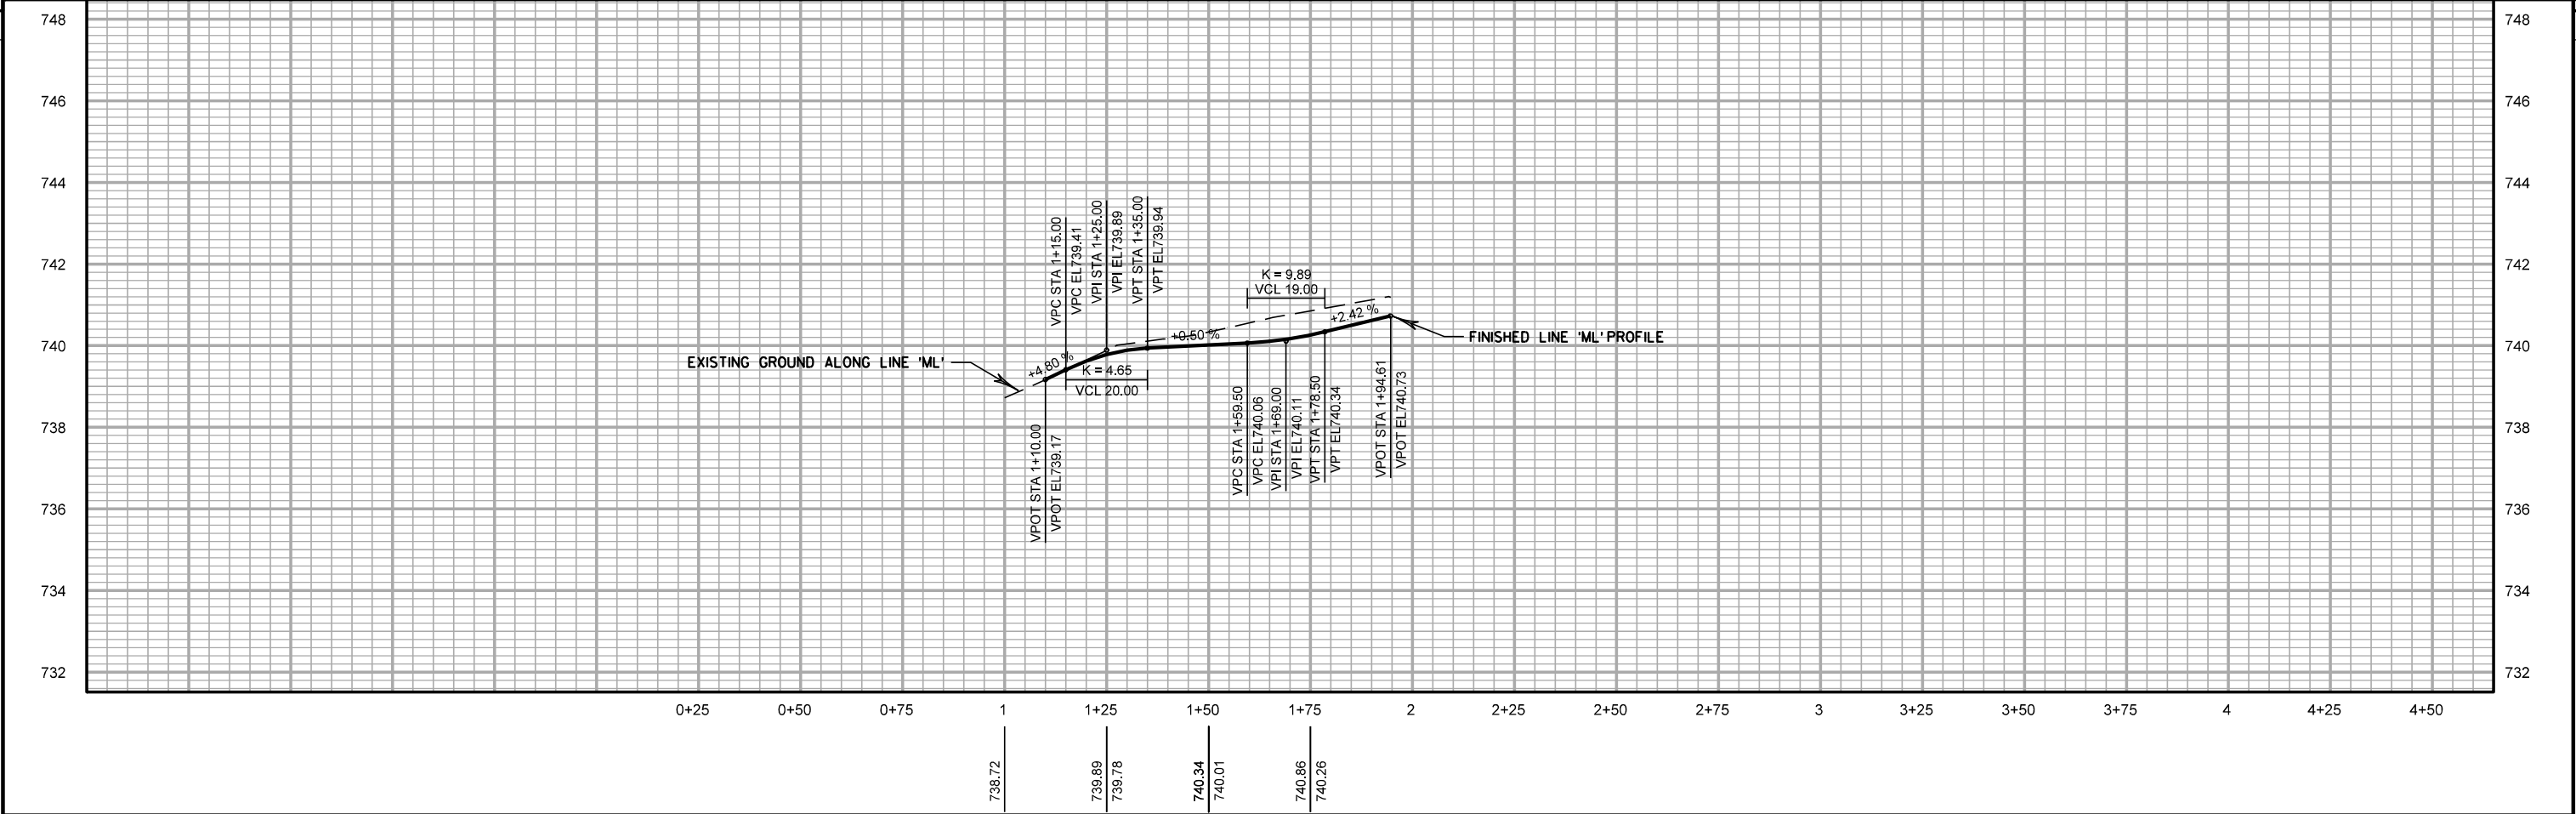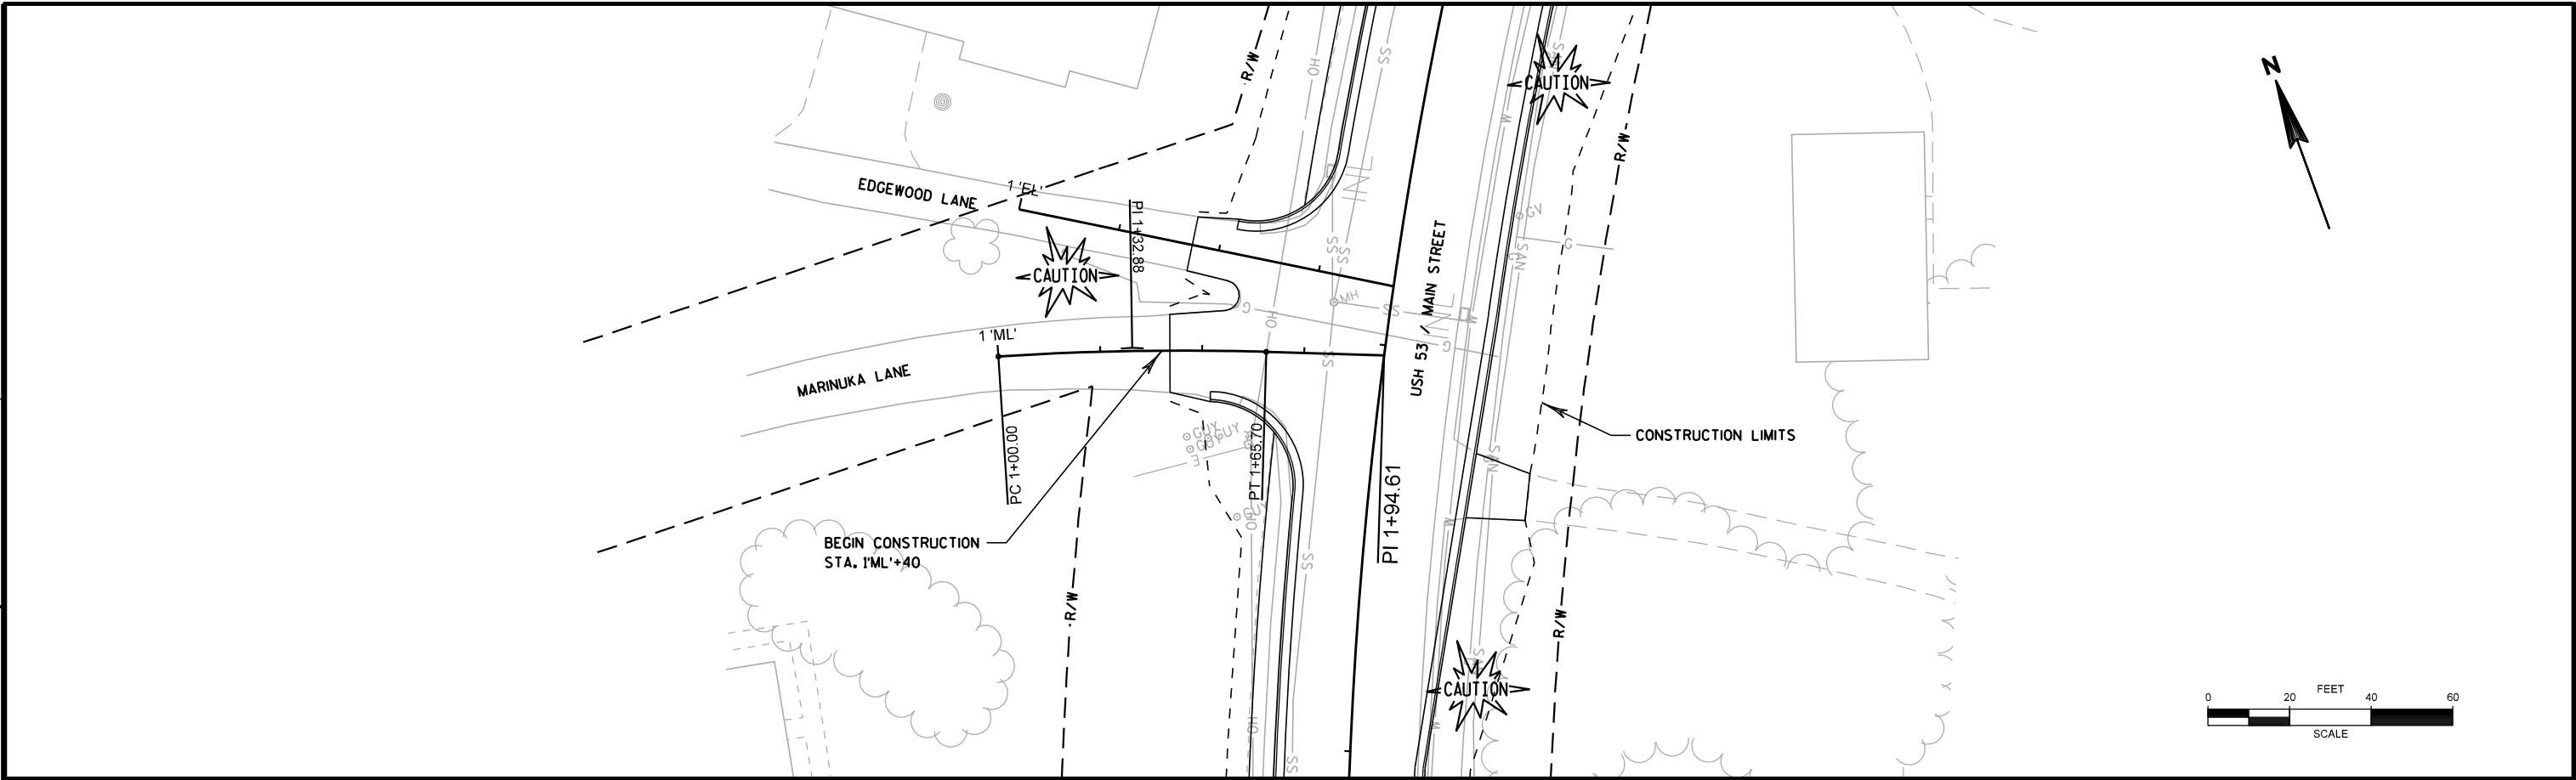

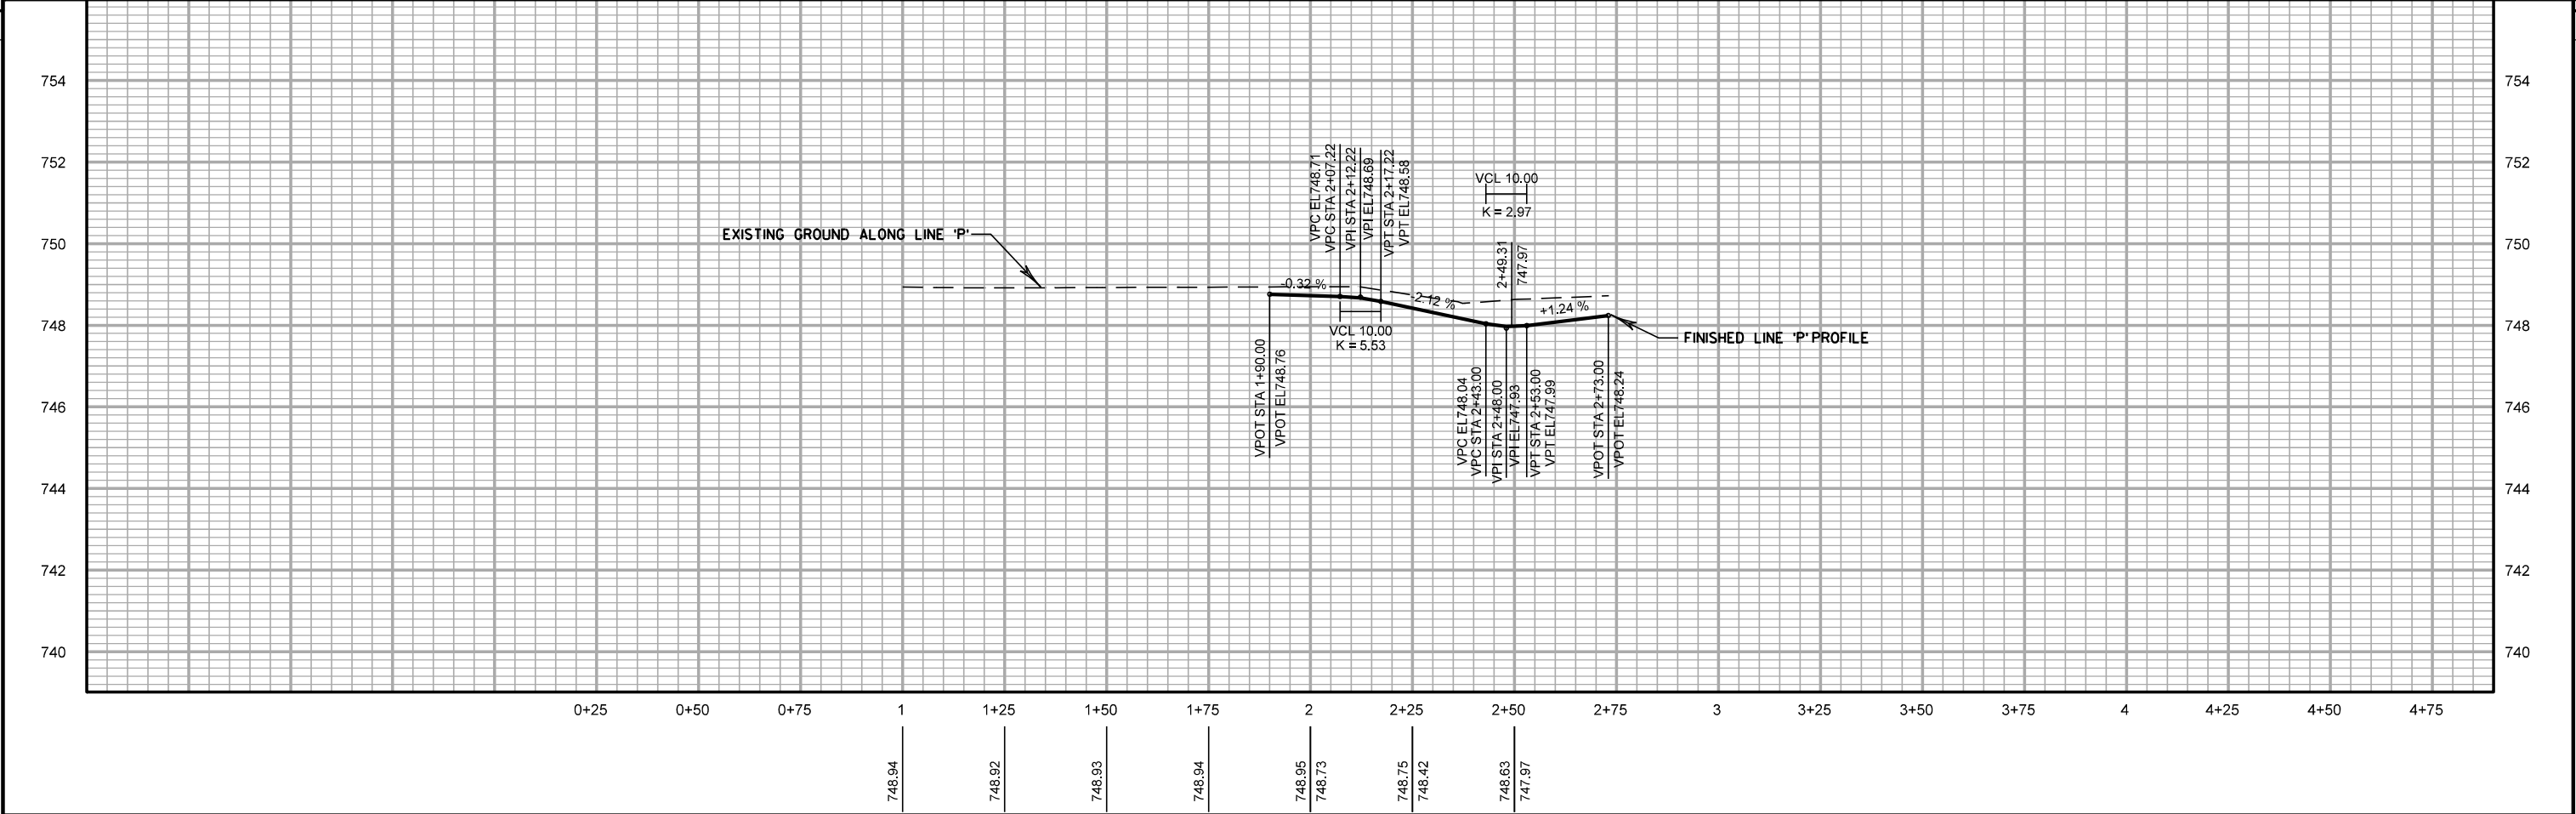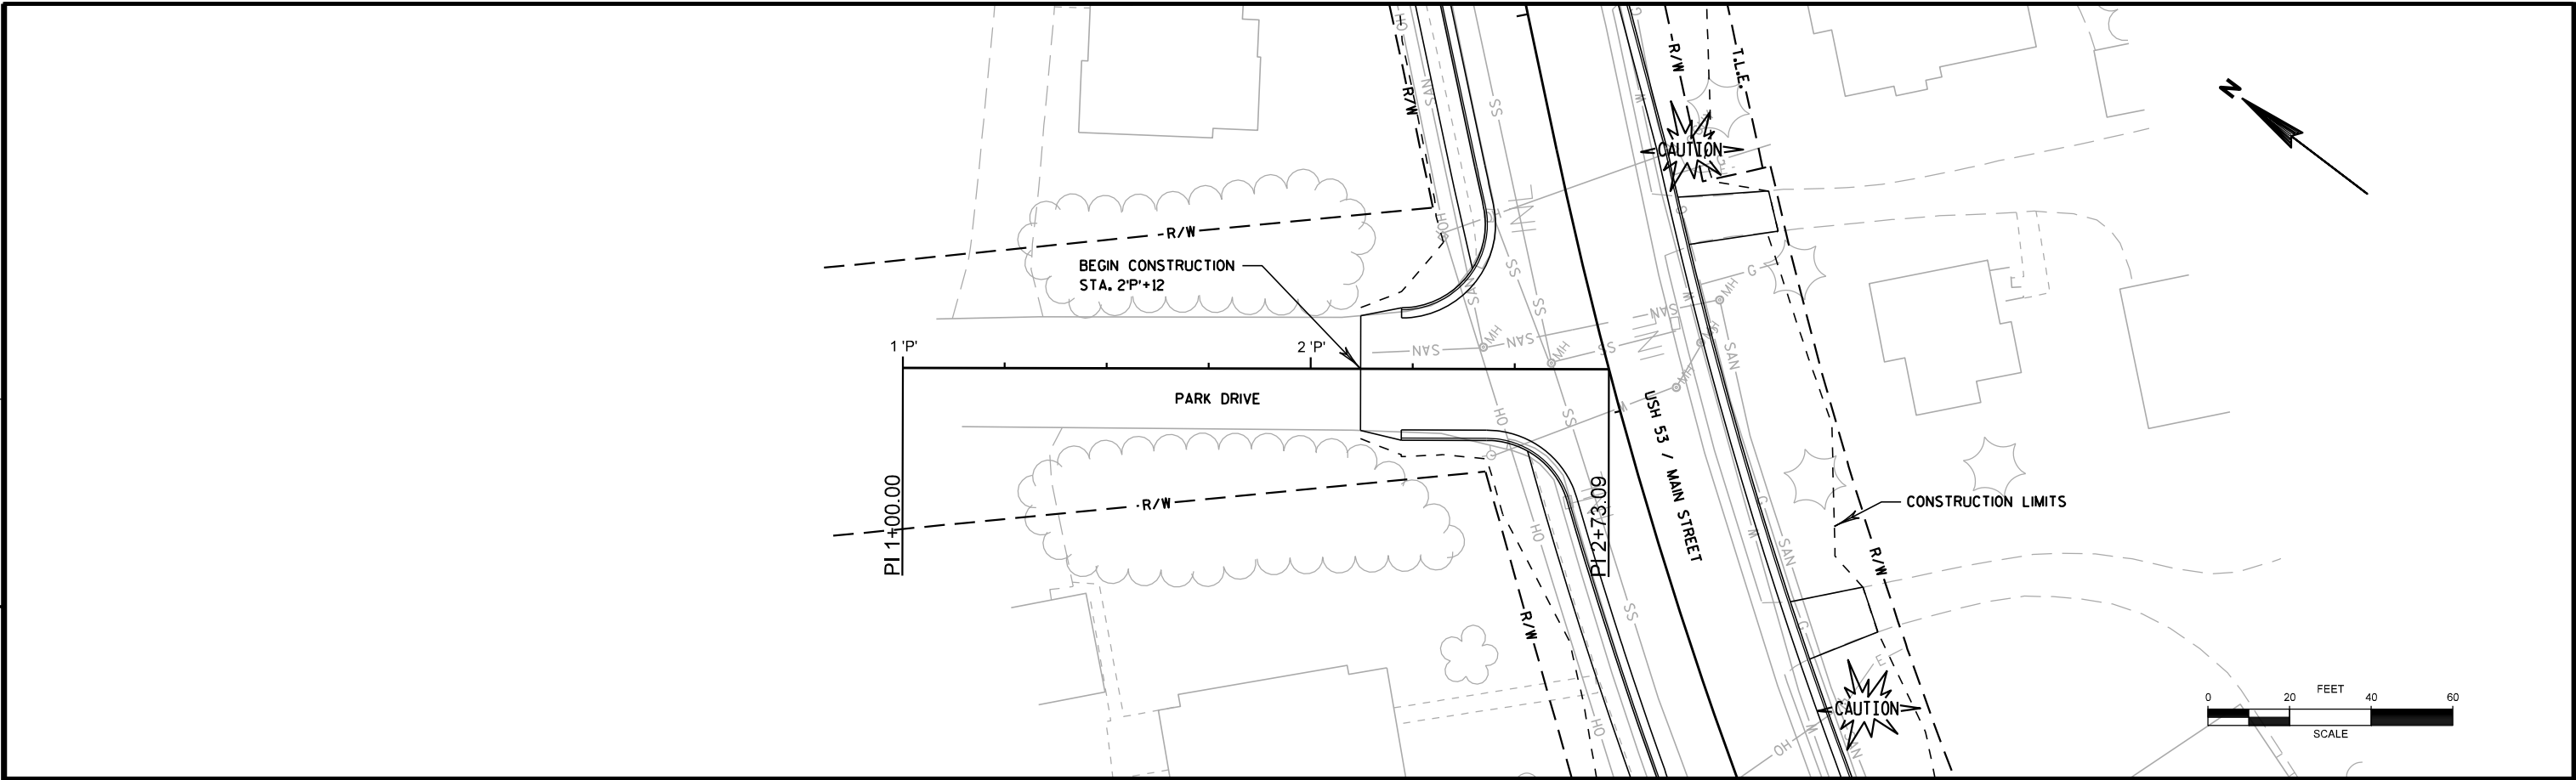

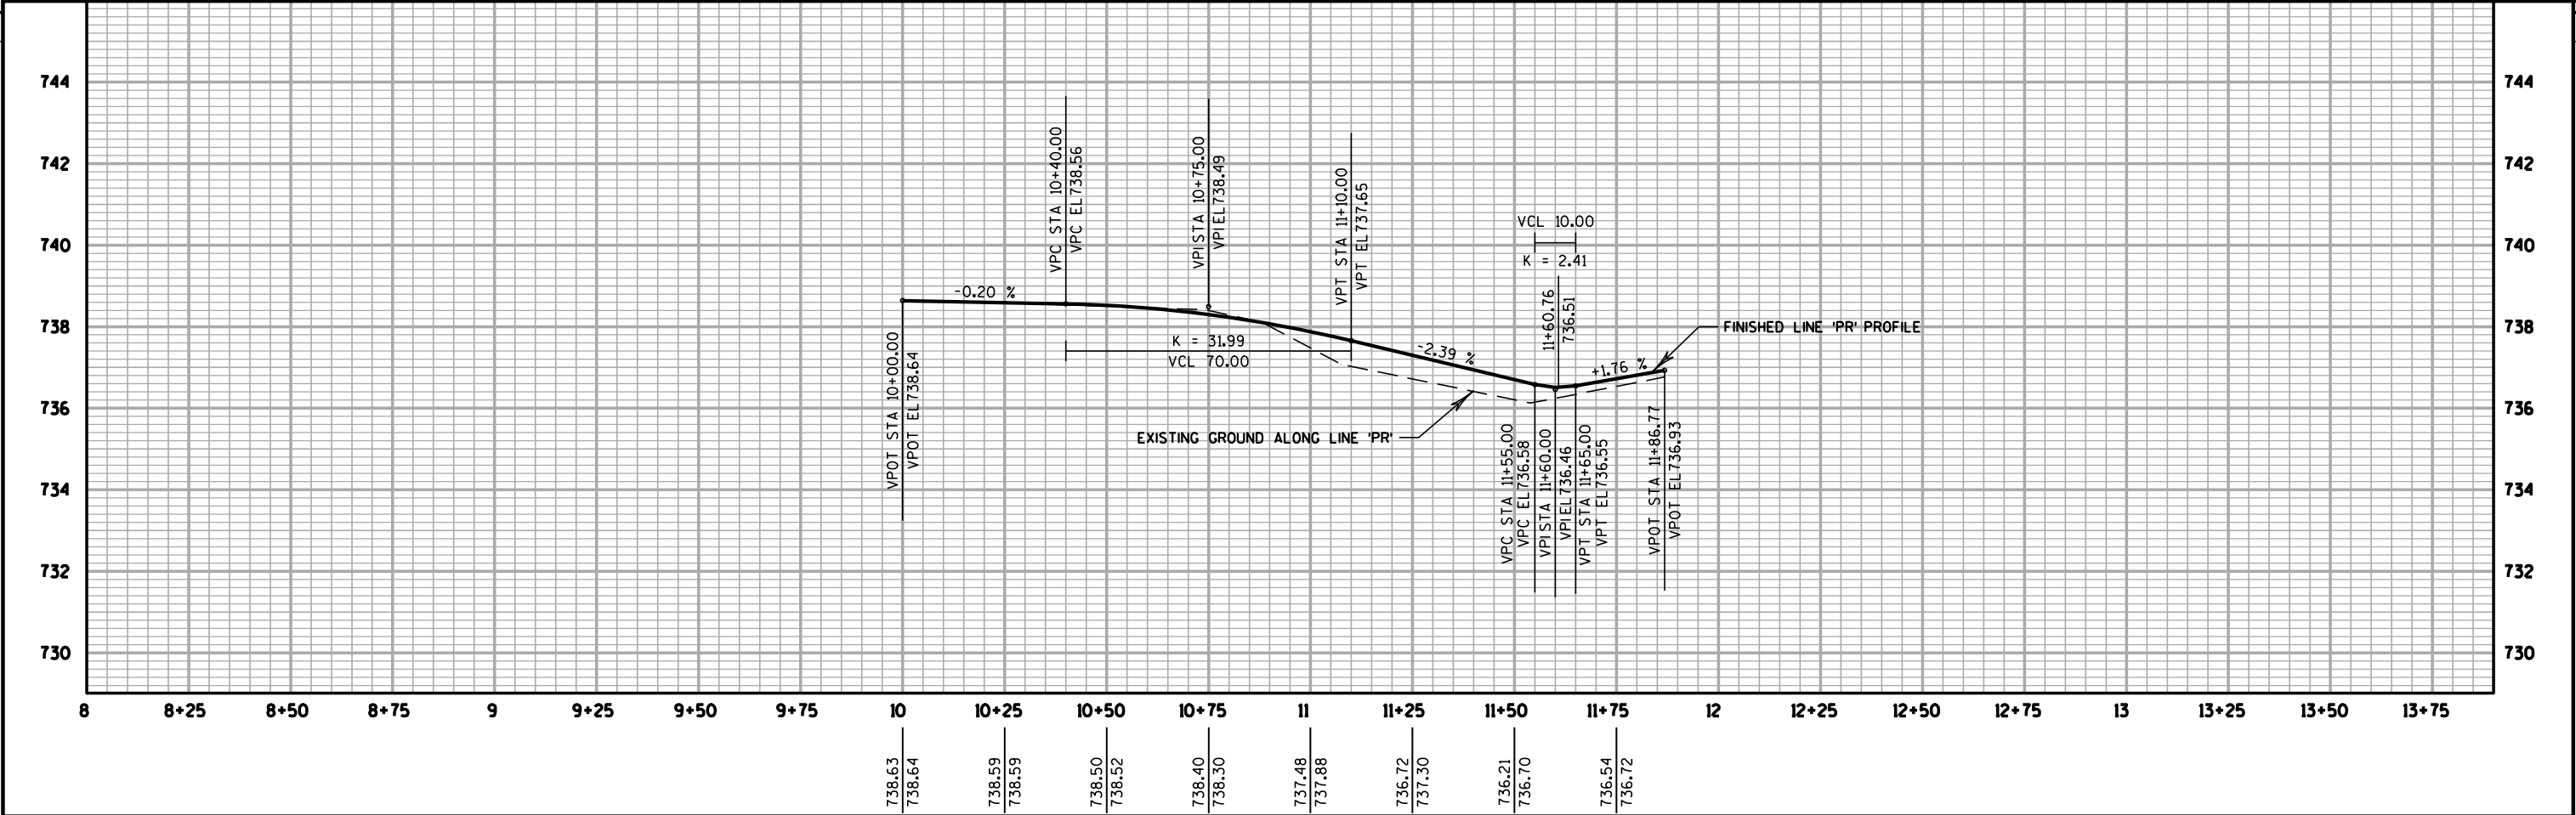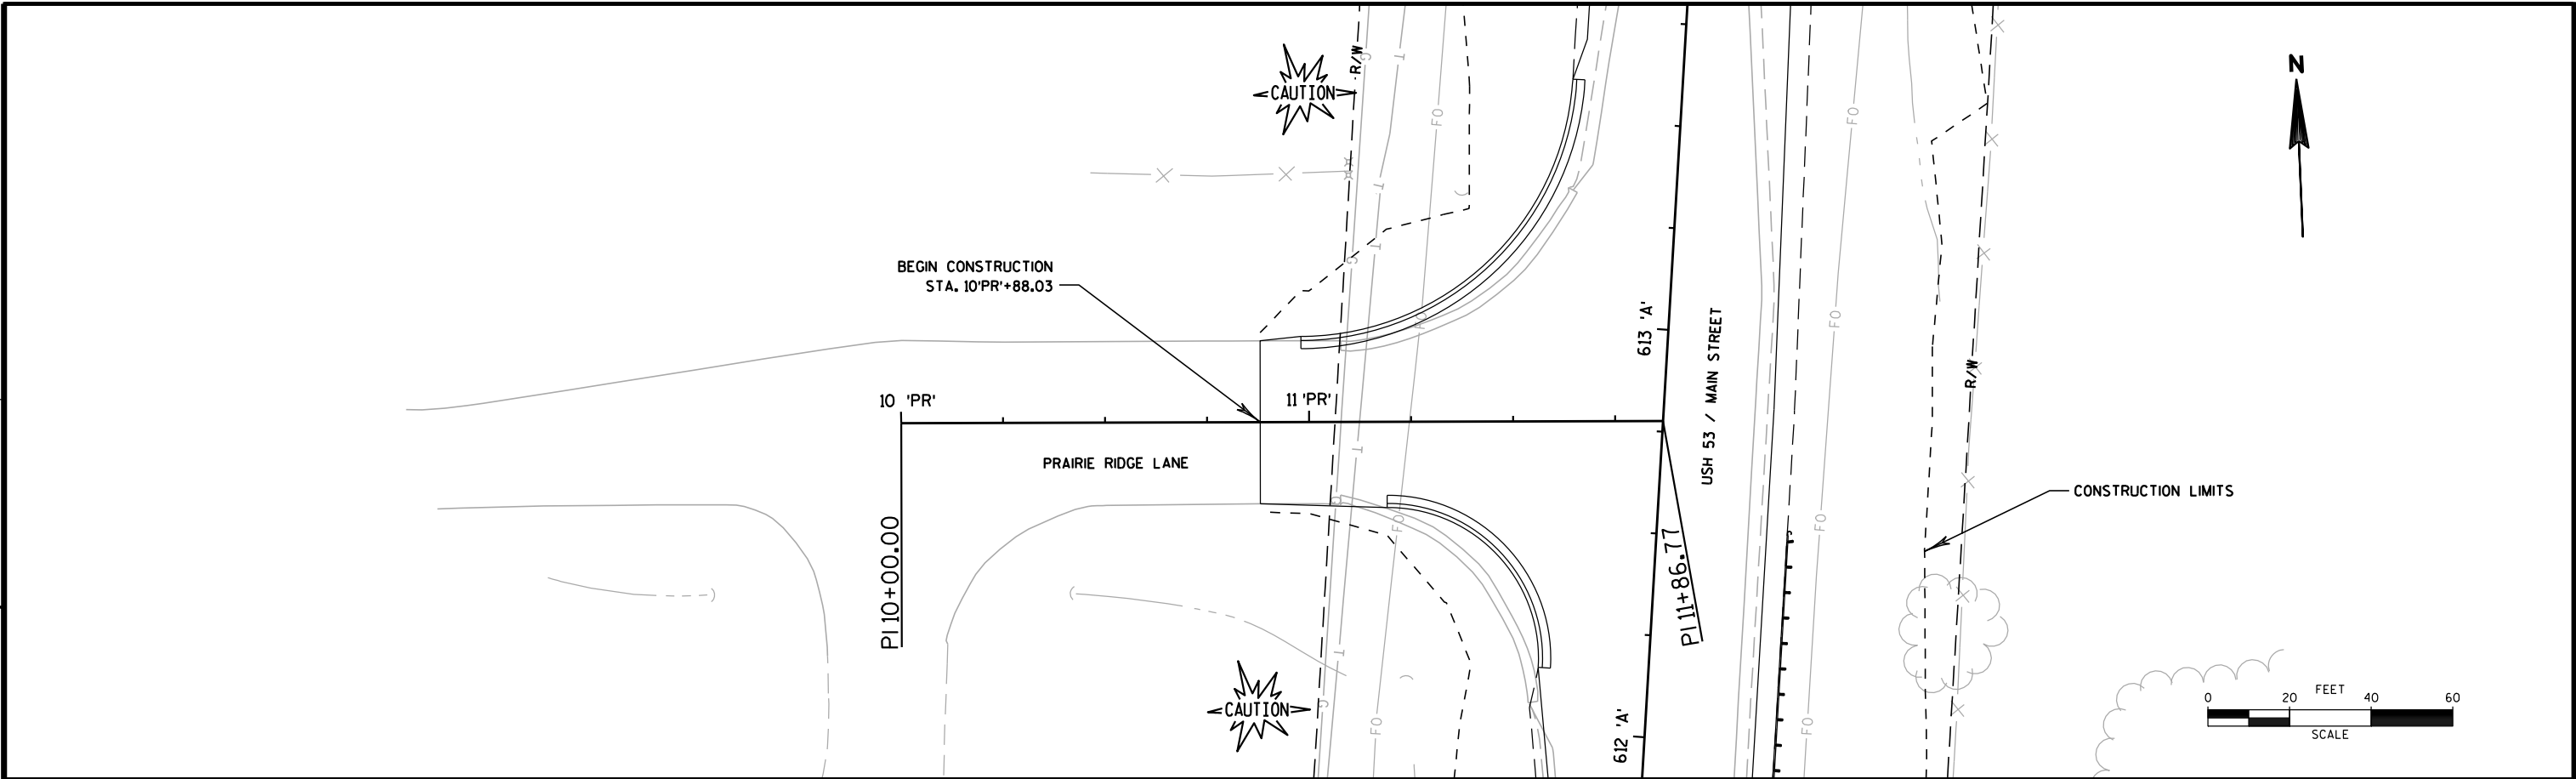

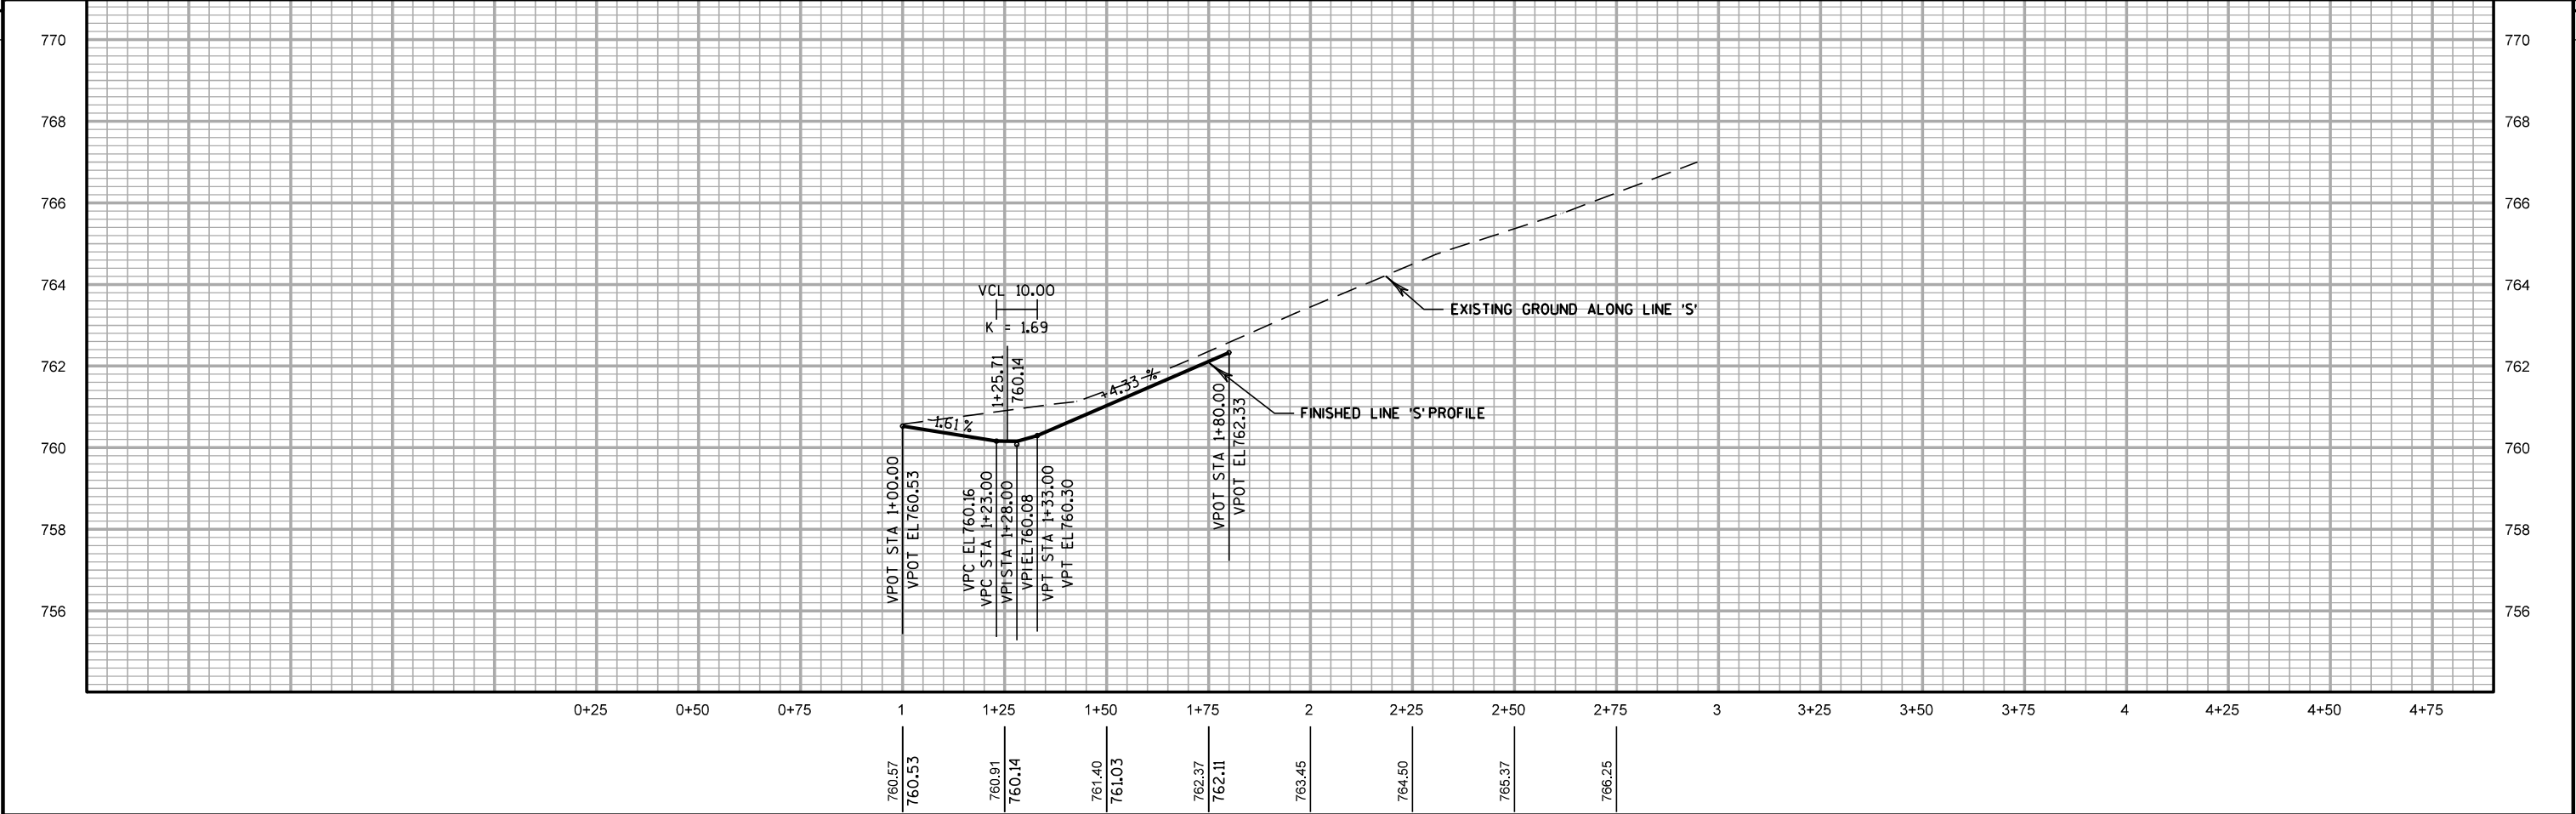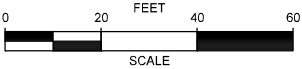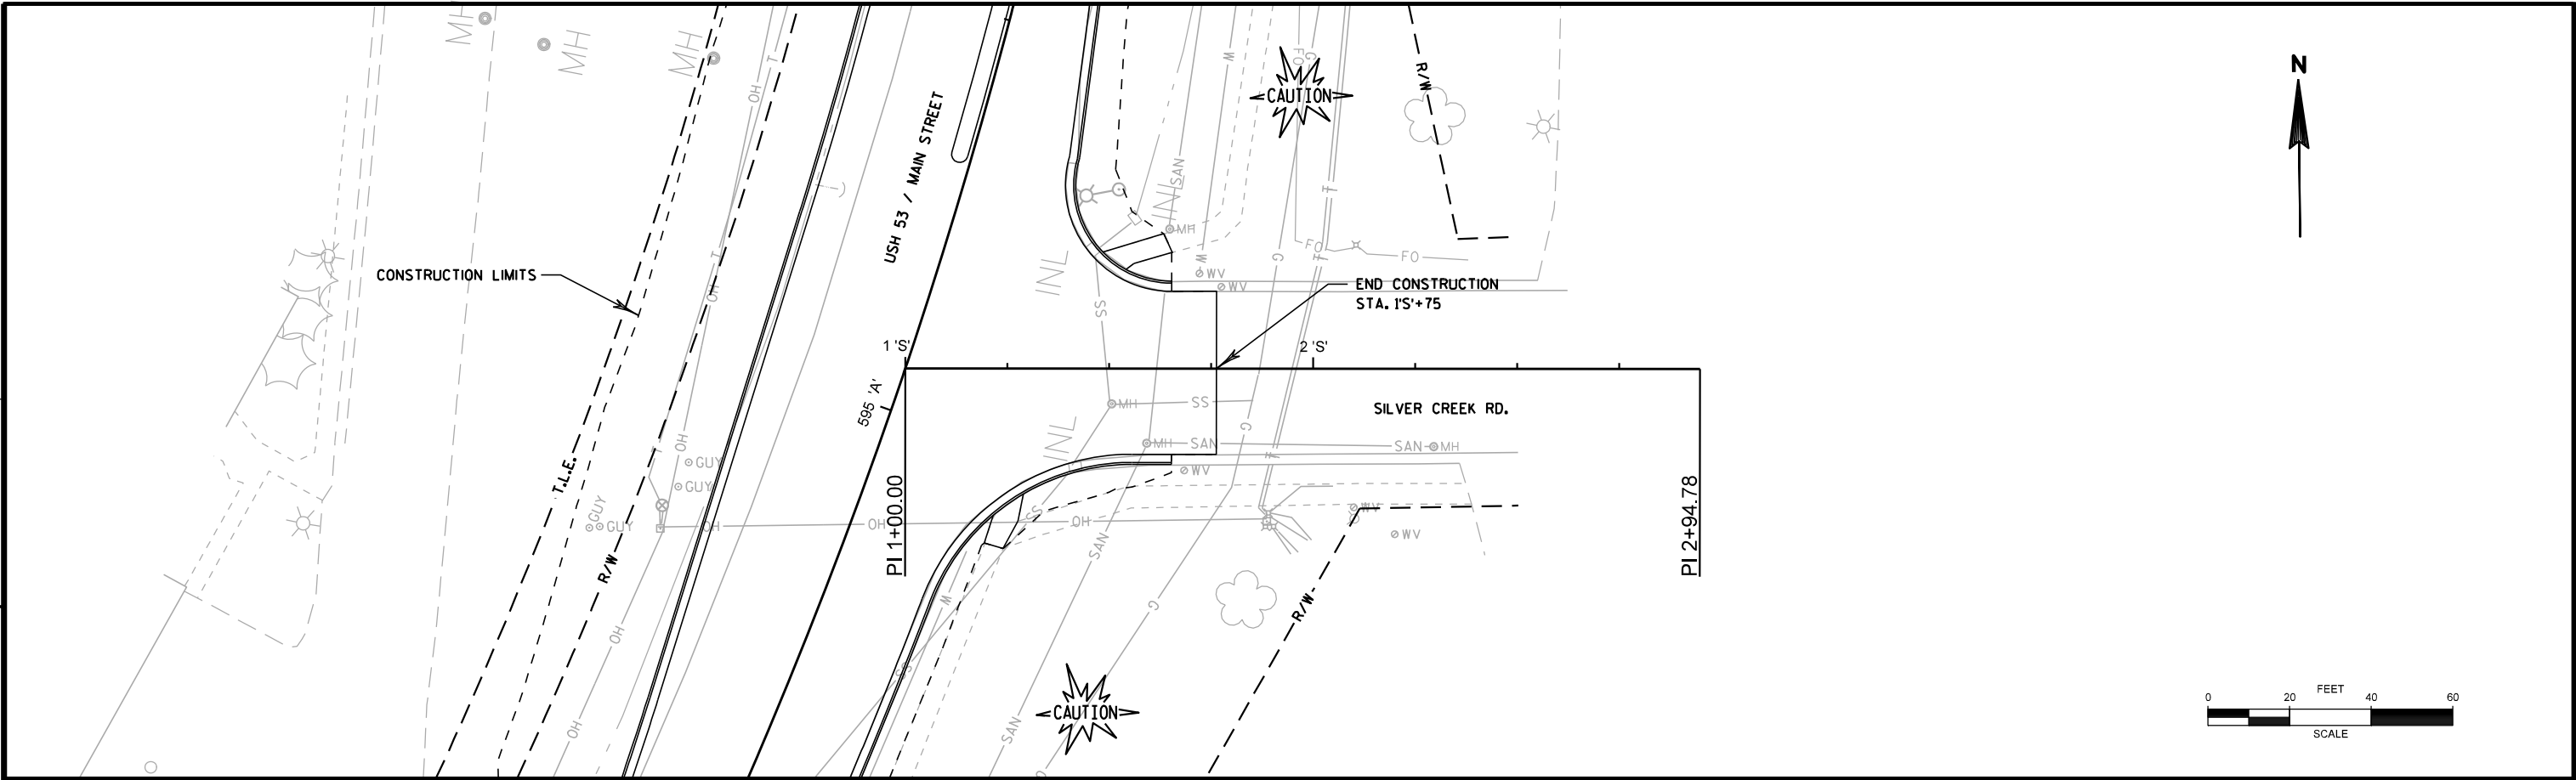

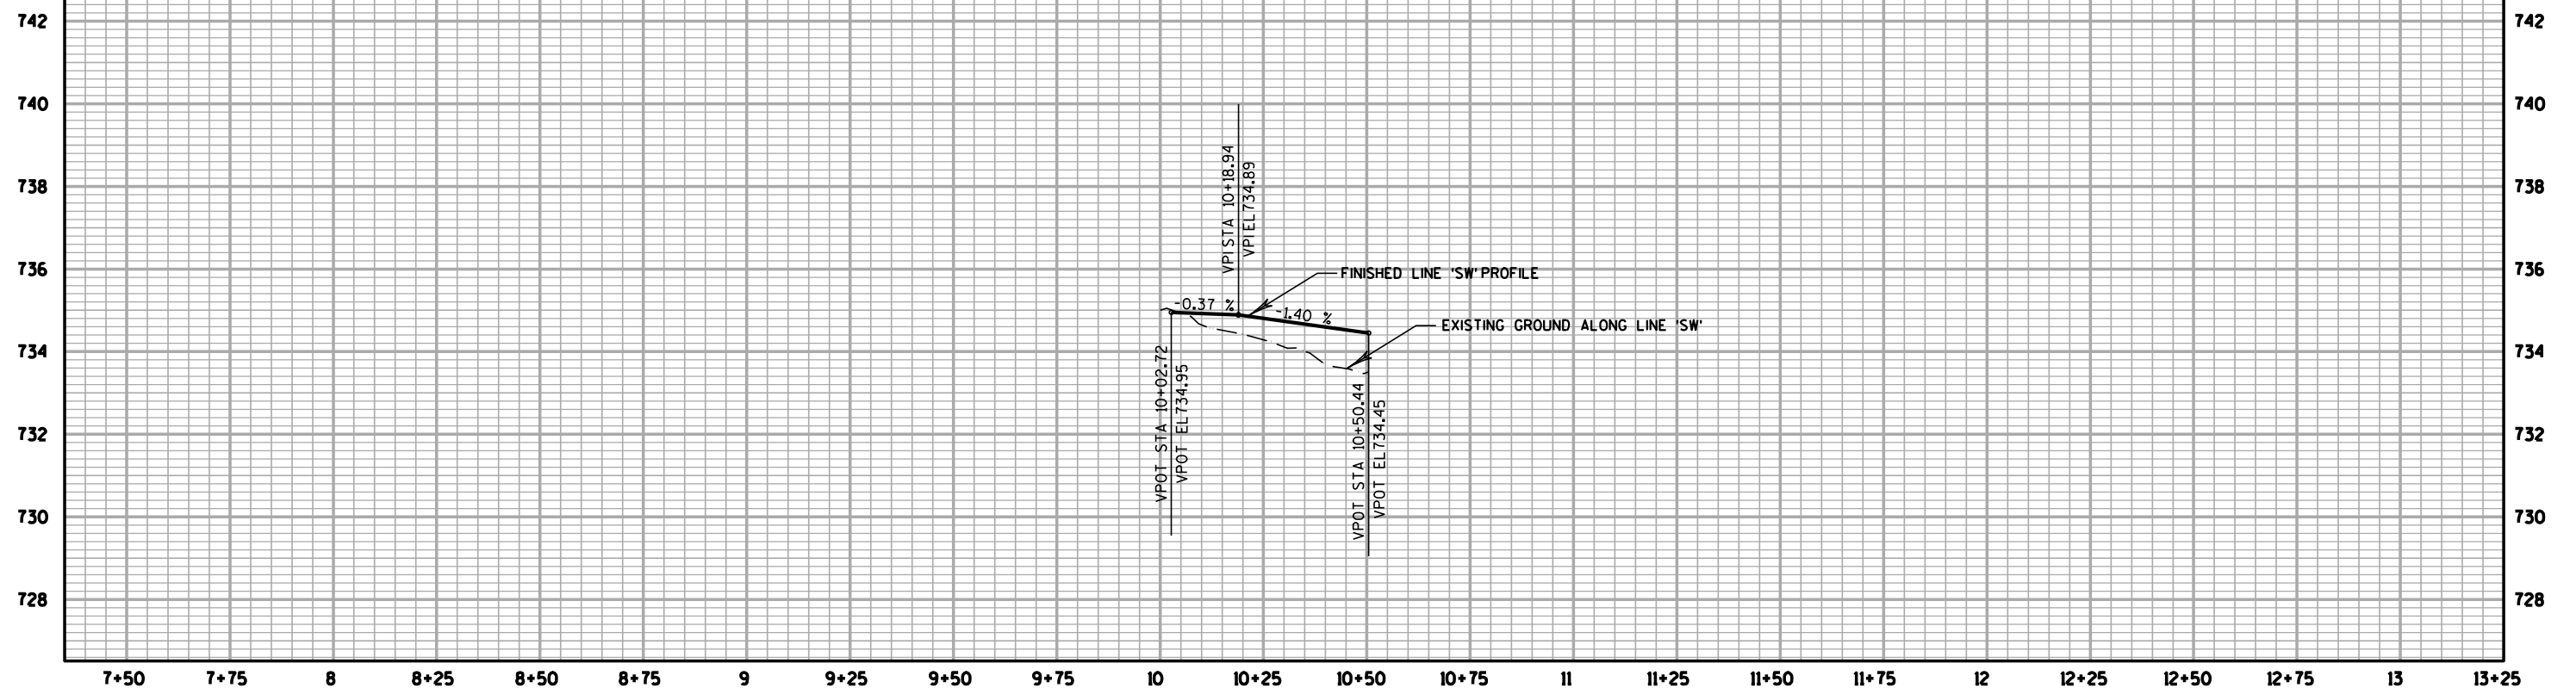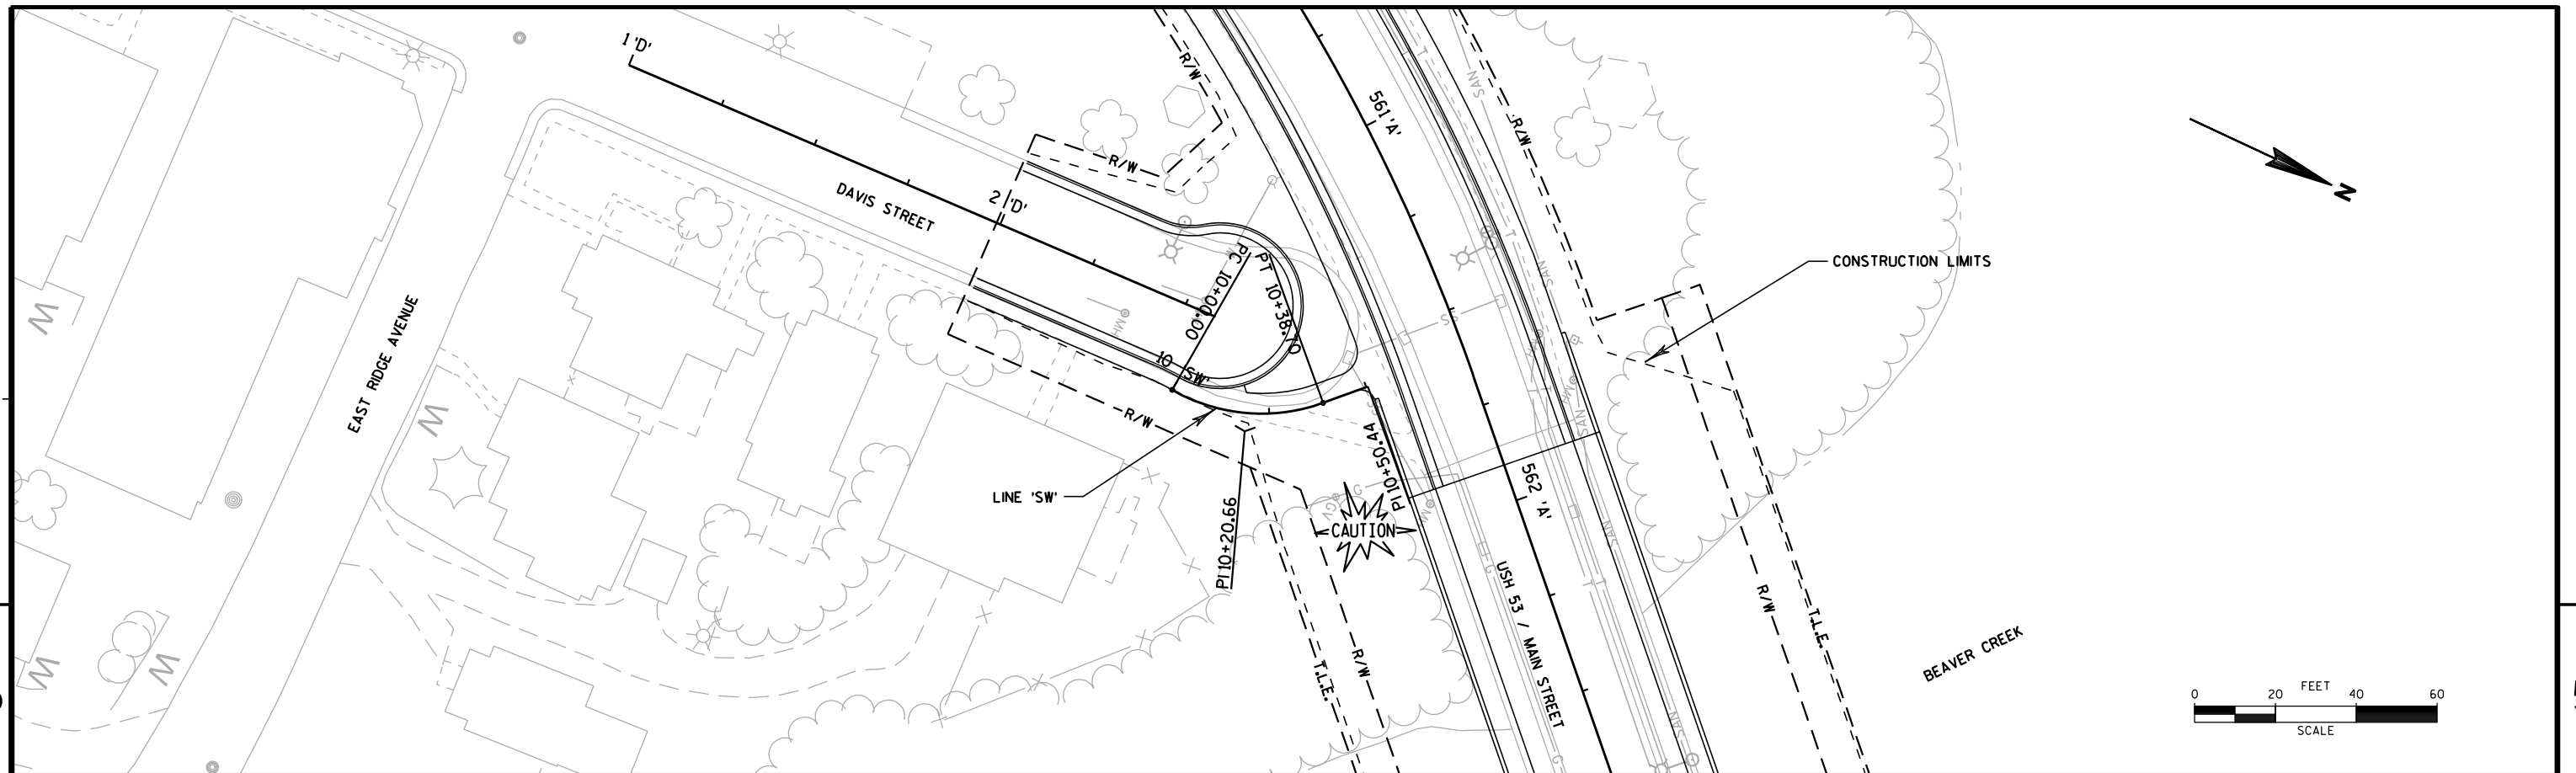

PROJECT NO: 1633-04-74

HWY: USH 53

FILE NAME : c:\Users\PROJECTS\PROJECTS\GALES01\74_050187_pp.DGN

