

EAU
PROJECT ID: 7125-04-74
WITH:

MAY 08
ORDER OF SHEETS

Section No. 1 Title
Section No. 2 Typical Sections and Details
Section No. 3 Estimate of Quantities
Section No. 3 Miscellaneous Quantities
Section No. 4 Right of Way Plat
Section No. 5 Plan and Profile
Section No. 6 Standard Detail Drawings
Section No. 7 Sign Plates
Section No. 8 ~~Structure Plans~~
Section No. 9 ~~Computer Earthwork Data~~
Section No. 9 ~~Cross Sections~~

TOTAL SHEETS = 86

STATE OF WISCONSIN
DEPARTMENT OF TRANSPORTATION

PLAN OF PROPOSED IMPROVEMENT

MONDOVI - EAU CLAIRE

USH 10 TO NORTH COUNTY LINE


STH 37

BUFFALO COUNTY

Warranty Project
AS-BUILT PLAN

PROJECT ENGINEER: Chad Halama
PRIME CONTRACTOR: Cedar Corporation
BEGIN CONSTRUCTION: 7/21/2008
END CONSTRUCTION: 10/16/2008
FINAL CONTRACT COST: \$1,560,211.42
CONTRACT MOD #S: 1, 2, 3, 4, 5, 6 - \$121,833.56
CONTRACT ID: W121,833.56 20080513047

STATE PROJECT NUMBER
7125-04-74

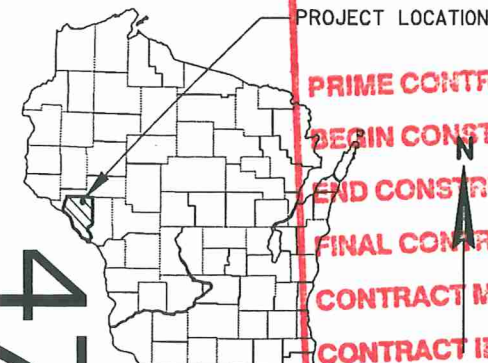

DESIGN DESIGNATION

A.D.T. 2001 = 3200
A.D.T. 2028 = 5600
D.H.V. = 320
D.D. = 62/38
T. = 10%
DESIGN SPEED = 55 MPH
ESALS = 1,500,000

CONVENTIONAL SYMBOLS

PLAN

CORPORATE LIMITS

PROPERTY LINE

LOT LINE

LIMITED HIGHWAY EASEMENT

EXISTING RIGHT OF WAY

PROPOSED OR NEW R/W LINE

SLOPE INTERCEPT

REFERENCE LINE

EXISTING CULVERT

PROPOSED CULVERT
(Box or Pipe)

COMBUSTIBLE FLUIDS

MARSH AREA

WOODED OR SHRUB AREA

PROFILE

GRADE LINE

ORIGINAL GROUND

MARSH OR ROCK PROFILE
(To be noted as such)

SPECIAL DITCH

GRADE ELEVATION

CULVERT (Profile View)

UTILITIES

ELECTRIC

FIBER OPTIC

GAS

SANITARY SEWER

STORM SEWER


TELEPHONE

WATER

UTILITY PEDESTAL

POWER POLE

TELEPHONE POLE

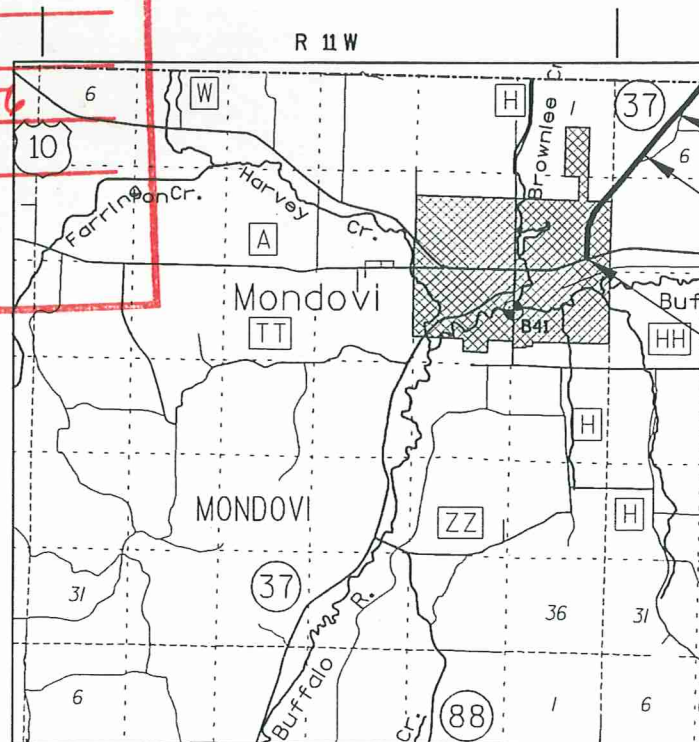

LAYOUT
SCALE 0 1 MI.

TOTAL NET LENGTH OF CENTERLINE = 2.187 MI. (RURAL)

END PROJECT
STA. 419+25.00
Y = 406,528.79
X = 618,161.11

EXCEPTION TO NET LENGTH OF C
STA. 397+91.69 TO STA. 398+42.87

EXCEPTION TO NET LENGTH OF C
STA. 364+21.91 TO STA. 364+99.19

BEGIN PROJECT
STA. 302+50.00
Y = 397,000.19
X = 611,971.78

ORIGIN OF DATUM

WDOT PLAQUE ON CURB SE CORNER OF STRUCTURE B-06-0041
OVER BUFFALO RIVER, EAU CLAIRE STREET, CITY OF MONDOVI
SEC. 13, T24N, R11W SET 1975, EL. 788.130

COORDINATES ON THIS PLAN ARE REFERENCED TO THE WISCONSIN
COUNTY COORDINATE SYSTEM (WCCS), BUFFALO COUNTY

STATE PROJECT	FEDERAL PROJECT	
	PROJECT	CONTRACT
7125-04-74	STP 2008281	1

ACCEPTED FOR

CITY MONDOVI

DATE 1/30/08 CITY ADMINISTRATOR

ORIGINAL PLANS PREPARED BY

FAA
CONSULTING ENGINEERS

WISCONSIN
MATTHEW J. GUNDRY
38517
EAU CLAIRE, WI
1-29-08
PROFESSIONAL ENGINEER

(Date)

(Signature)

STATE OF WISCONSIN
DEPARTMENT OF TRANSPORTATION

PREPARED BY

Surveyor FAA

Designer FAA

Project Manager WENDY MAVES, P.E.

Region Examiner

Region Supervisor PAUL CONLIN, P.E.

C.O. Examiner Carl W. Buganowski

APPROVED FOR DISTRICT OFFICE

DATE: 1/30/08 (Signature)