

PROJECT ENGINEER: JEFF REDDY (WISDOT)  
PROJECT STAFF: JOHN LEONHARD, TODD MUEHLER (KAPUR)

START DATE: 9/18/99 FINISH: 11/24/99  
ELECTRONIC DIARY

1999 10110  
PLOT DATE:  
PLOT SCALE: 201.35951711000000  
REV. DATE: 2/2/99  
454 Aug. 99  
1507  
1320-02-60  
ORIGINATOR: D2 JCT  
405040515.DGN  
FILE NAME:

INDEX OF SHEETS

- Sheet No. 1 Title  
Sheet No. 2.1-2.15 Typical Sections and Details  
Sheet No. 3.1-3.2 Estimate of Quantities  
Sheet No. 3A-3C Miscellaneous Quantities  
Sheet No. Right of Way Plot  
Sheet No. Plan and Profile  
Sheet No. 6.1-6.10 Standard Detail Drawings  
Sheet No. Sign Plates  
Sheet No. 8.1-8.5 Structure Plans  
Sheet No. Computer Earthwork Data  
Sheet No. Cross Sections

TOTAL SHEETS = 36




DESIGN DESIGNATION


- A.D.T. "  
A.D.T. "  
D.H.V. "  
D. "  
T. "  
DESIGN SPEED "  
ESALS "  
K "

CONVENTIONAL SIGNS

- COUNTY LINE  
CORPORATE LIMITS  
PROPERTY LINE  
LOT LINE  
LIMITED EASEMENT  
EXISTING RIGHT OF WAY  
PROPOSED OR NEW R/W LINE  
SURVEY LINE  
SLOPE INTERCEPT  
ORIGINAL GROUND  
MARSH OR ROCK PROFILE  
EXISTING CULVERT  
PROPOSED CULVERT (Box or Pipe)  
CULVERT (Profile View)

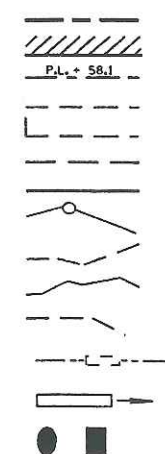

- COMBUSTIBLE FLUIDS  
UNDERGROUND UTILITIES  
GAS  
ELECTRIC  
TELEPHONE OR TELEGRAPH  
SERVICE PEDESTAL  
CABLE MARKER  
POWER POLE  
TELEPHONE POLE  
RAILROAD  
MARSH AREA  
WOODED OR SHRUB AREA

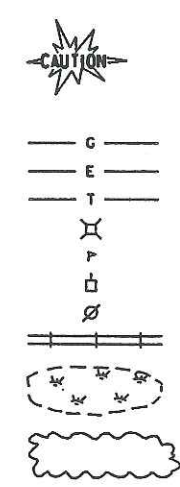

STATE OF WISCONSIN  
DEPARTMENT OF TRANSPORTATION

STATE HIGHWAY REHABILITATION - MAINTENANCE PROJECT

STRUCTURE MAINTENANCE REPAIRS

(STH 100 BRIDGE OVER MILWAUKEE RIVER & BRIDGE ON 107th STREET OVER STH 145)



STH 100 & 145

MILWAUKEE COUNTY

(B-40-504/505, 252)

STATE PROJECT NUMBER
2320-02-60

CONTRACTOR: ZENITH TECH, INC.  
REMOVALS  
CONCRETE MASONRY, OVERLAY  
JOINT REPAIR  
DECK CLEANING  
DECK PREPARATION  
CONCRETE CURB  
CONCRETE SIDEWALK

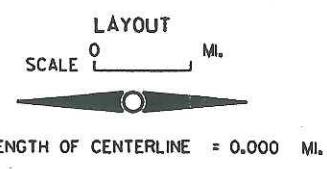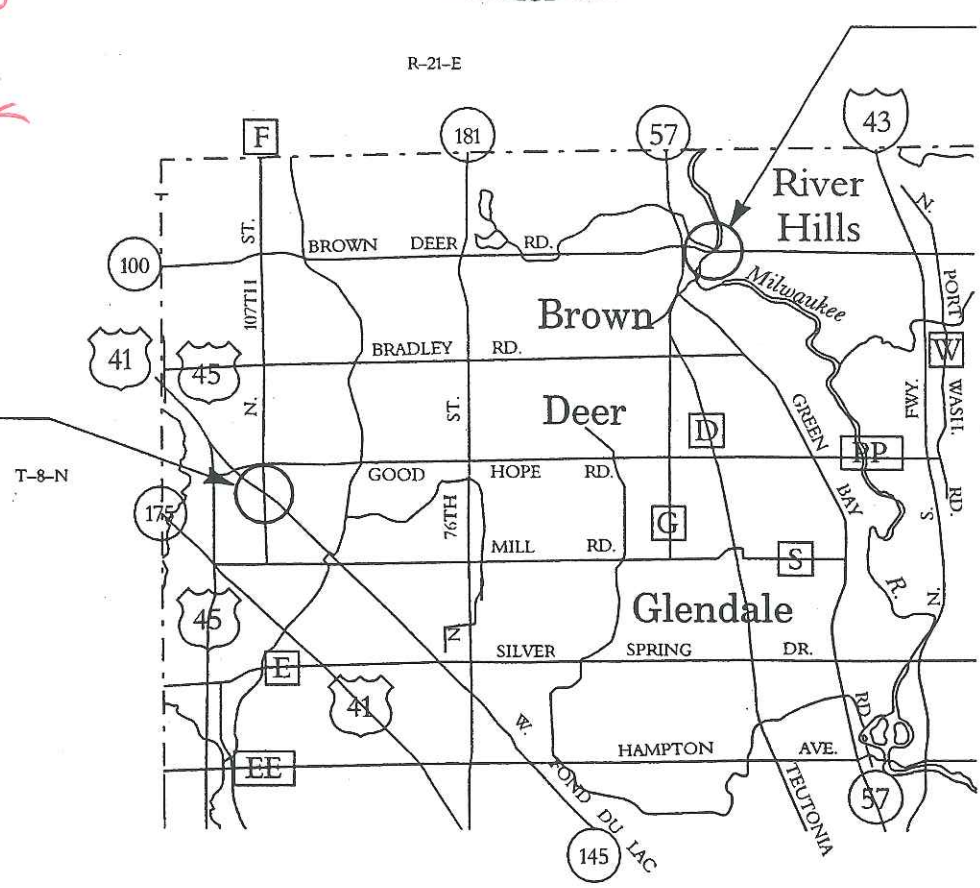

STATE PROJECT	FEDERAL PROJECT	
	PROJECT	CONTRACT
2320-02-60		

AS BUILT

SUBCONTRACTORS  
PAYNE & DOLAN  
ASPHALT  
D.A. DROST CONSTRUCTION  
PORTABLE CRASH CUSHIONS  
CON-COR COMPANY INC.  
SAWING PAVEMENT  
CENTURY FENCE  
PAVEMENT MARKING  
BARRICADE FLASHER  
TRAFFIC CONTROL

STATE OF WISCONSIN DEPARTMENT OF TRANSPORTATION	
PREPARED BY	
Surveyor	
Designer	JEFF LOWTHER
District Examiner	TODD BECKER
District Supervisor	JOHN OHMOEN
Proj. Dev. Engineer	
C.O. Examiner	M.A. MOHLMAN
APPROVED FOR DISTRICT OFFICE	
DATE: 3/29/99	Todd Becker (Signature)
AUTHORIZED FOR CENTRAL OFFICE DESIGN	
DATE: 6/14/99	Bruce Starnes (Signature)



GENERAL NOTES - ROADWAY

THE LOCATION OF EXISTING UTILITIES AS SHOWN ON THE PLAN ARE APPROXIMATE. THERE MAY BE OTHER UTILITY INSTALLATIONS WITHIN THE PROJECT AREA THAT ARE NOT SHOWN.

ALL PRIVATE UTILITIES ARE TO BE ADJUSTED BY THE UTILITY CONCERNED.

WHEN THE QUANTITY OF CONCRETE MASONRY, OVERLAY APPROACHES ARE MEASURED FOR PAYMENT BY THE CUBIC YARD, THE DEPTH OR THICKNESS OF THE PAVEMENT SHOWN ON THE PLANS IS APPROXIMATE, AND THE ACTUAL THICKNESS WILL DEPEND UPON THE DISTRIBUTION OF THE MATERIALS AS DIRECTED BY THE ENGINEER.

DISTANCES SHOWN ON THIS PLAN ARE GROUND DISTANCES.

STANDARD DETAIL DRAWINGS

SSD NUMBER	TITLE
8D 1-12	CONCRETE CURB, CONCRETE CURB AND GUTTER, AND PAVEMENT TIES
8M 2-4	INLETS, CATCH BASINS, AND INLETS COVERS
8M 4-4	INLETS AND INLET COVERS
14B 7-9a	TEMPORARY PRECAST CONCRETE BARRIER
15C 2-3	BARRICADES AND SIGNS FOR ROAD CLOSURES
15C 7-5a	PAVEMENT MARKING SYMBOLS
15C 8-8a	PAVEMENT MARKING (MAINLINE)
15C 8-8d	PAVEMENT MARKING (LEFT TURN LANE)
15D 3-1	TRAFFIC CONTROL, LANE CLOSURE, SPEEDS GREATER THAN 40 M.P.H.. WITH BARRIER
15C 6-4	SIGNING AND MARKING FOR TWO LANE BRIDGES

UTILITY CONTACT LIST

WISCONSIN ELECTRIC POWER COMPANY ATTN: MR. MICHAEL JAMES LEO SCHUELLER 231 W. MICHIGAN AVENUE A440 MILWAUKEE, WI 53201 PHONE: 414-224-2710 256-5511	VILLAGE OF BROWN DEER ATTN: MR. RICHARD HALFMAN 4800 W. GREEN BROOK DRIVE BROWN DEER, WI 53223 PHONE: 414-357-0141
WISCONSIN GAS COMPANY ATTN: MR. GREG NEVINSKI 5400 GREEN BAY AVENUE MILWAUKEE, WI 53209 PHONE: 414-540-5141 FAX: 414-228-1877	VILLAGE OF RIVER HILLS ATTN: MR. KURT FREDRICKSON 7650 N. PHEASANT LANE RIVER HILLS, WI 53217 PHONE: 414-352-0080
AMERITECH ATTN: MR. JAMES HADDEN 2005 PEWAUKEE ROAD WAUKESHA, WI 53188 PHONE: 414-896-7440 FAX: 414-896-7435	CITY OF MILWAUKEE ATTN: MR. MARIANO SCHIFALACQUA 841 N. BROADWAY RM 612 MILWAUKEE, WI 53202 PHONE: 414-286-2400
TIME WARNER CABLE ATTN: MR. DON DIETSCH 1610 N. 2ND STREET MILWAUKEE, WI 53212 PHONE: 414-227-4045	MILWAUKEE COUNTY HIGHWAY DEPT. ATTN: MR. CHET ZURAWIK 10190 WATERTOWN PLANK ROAD MILWAUKEE, WI 53226 PHONE: 414-257-6568

WisDOT TRAFFIC-LIGHTING  
ATTN: MR. CHARLES LANDEY  
2000 PEWAUKEE ROAD  
P.O. BOX 798  
WAUKESHA, WI 53187-0798  
PHONE: 414-521-5346

WDNR CONTACT  
  
WISCONSIN DEPARTMENT OF NATURAL RESOURCES  
ATTN: MR. VICTOR C. PAPPAS  
2300 MARTIN LUTHER KING JR. DRIVE  
MILWAUKEE, WI 53212  
PHONE: 414-225-2219




TO OBTAIN LOCATION OF  
PARTICIPANTS' UNDERGROUND  
FACILITIES BEFORE YOU  
DIG IN WISCONSIN

CALL DIGGERS HOTLINE

TOLL FREE 1-800-242-8511  
MILWAUKEE AREA (414) 259-1181  
TELEFAX 1-800-338-3860  
TDD (For hearing impaired) 1-800-542-2289

WIS. STATUTE 182.0175 (1974)  
REQUIRES MIN. OF 3 WORK DAYS  
NOTICE BEFORE YOU EXCAVATE.


\$PRNAME\$  
 PEN TABLE = \$plot72+LASER+S.  
 DATE OF PLOT: 2/23/99  
 DESIGN FILE = U:\TRROADS\46187\pl.dgn  
 DGN LEVELS ON = 1-63

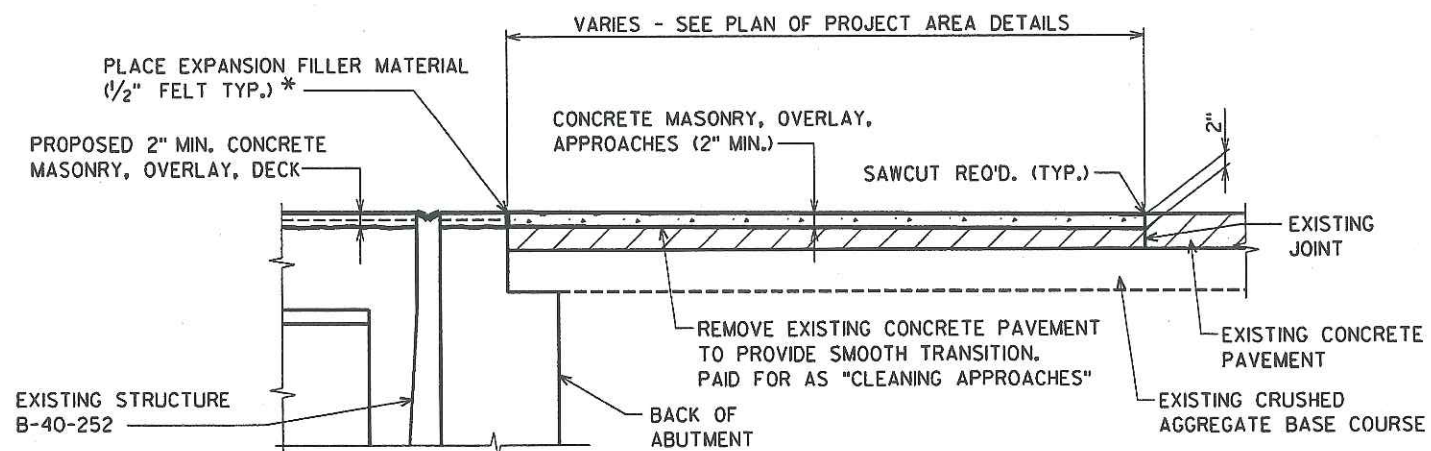

**CONCRETE MASONRY OVERLAY DETAIL**  
 (LOOKING EAST AT SOUTH APPROACH)

\* INCIDENTAL TO "CONCRETE MASONRY, OVERLAY, APPROACHES"

NOTE:  
 SAWCUT REQUIRED BETWEEN  
 STAGE CONSTRUCTION LIMITS  
 ALSO.

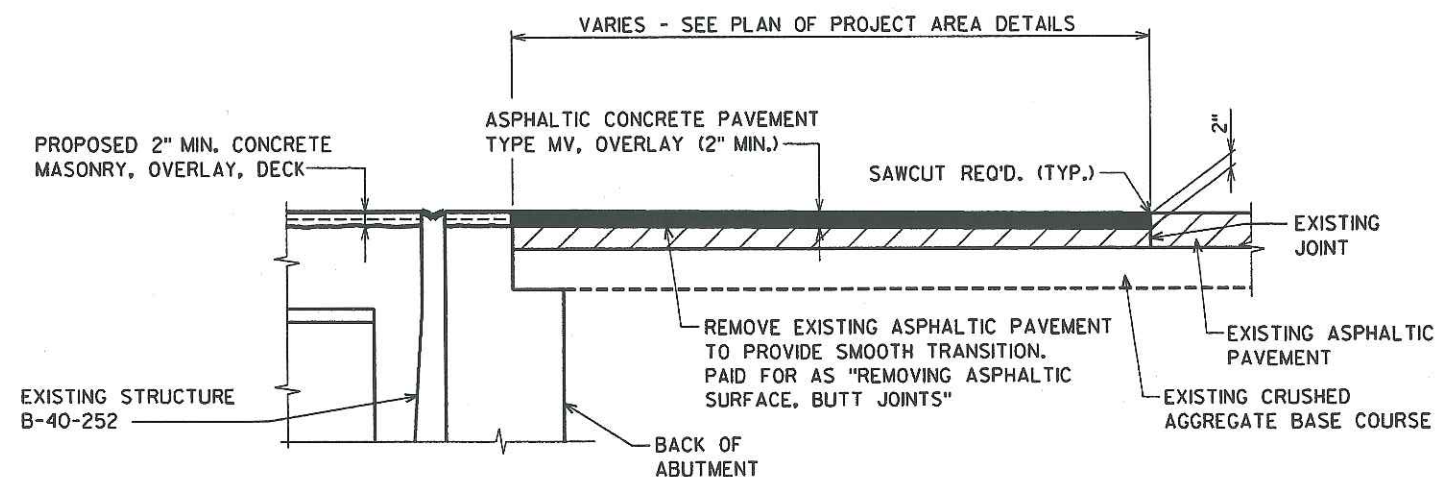

**ASPHALTIC OVERLAY DETAIL**  
 (LOOKING WEST AT NORTH APPROACH)

NOTE:  
 SAWCUT REQUIRED BETWEEN  
 STAGE CONSTRUCTION LIMITS  
 ALSO.

## GENERAL NOTES

THE LOCATION OF EXISTING UTILITY INSTALLATIONS AS SHOWN ON THE PLANS ARE APPROXIMATE. THERE MAY BE OTHER UTILITY INSTALLATIONS WITHIN THE PROJECT AREA THAT ARE NOT SHOWN.

WHEN THE QUANTITY OF CONCRETE MASONRY, OVERLAY, APPROACHES, IS MEASURED FOR PAYMENT BY THE CUBIC YARD, THE DEPTH OR THICKNESS OF THE PAVEMENT SHOWN ON THE PLANS IS APPROXIMATE, AND THE ACTUAL THICKNESS WILL DEPEND UPON THE DISTRIBUTION OF THE MATERIALS AS DIRECTED THE THE ENGINEER.


DISTANCES SHOWN ON THIS PLAN ARE GROUND DISTANCES.

ALL PRIVATE UTILITIES ARE TO BE ADJUSTED BY THE UTILITY CONCERNED.


TACK COAT HAS BEEN ESTIMATED AT AN APPLICATION RATE OF 0.025 GALLONS PER SQUARE YARD AND SHALL BE PLACED BETWEEN THE EXISTING ASPHALTIC PAVEMENT AND THE ASPHALTIC CONCRETE PAVEMENT, TYPE MV.

THE 2" ASPHALTIC CONCRETE PAVEMENT, TYPE MV, OVERLAY SHALL BE PLACED IN ONE LAYER.

TRANSVERSE JOINTS IN CONCRETE WALK SHALL BE CONSTRUCTED AT 5'-0" INTERVALS UNLESS OTHERWISE NOTED BY THE ENGINEER.

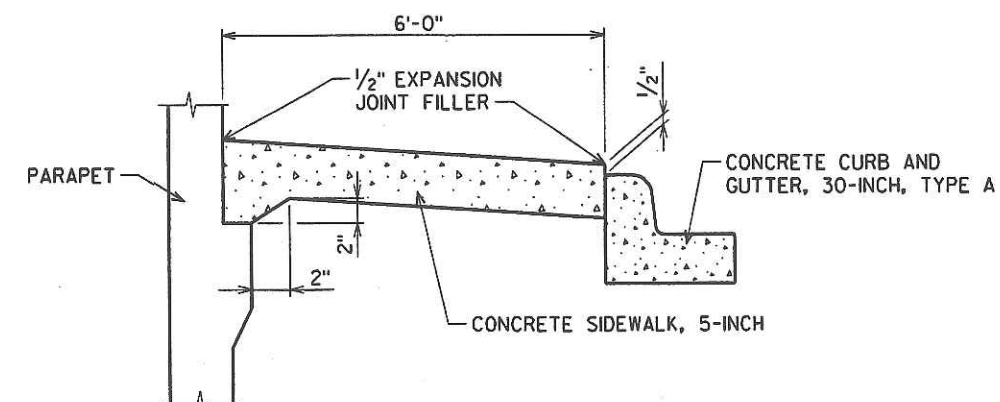

**SIDEWALK DETAIL AT WINGWALL**

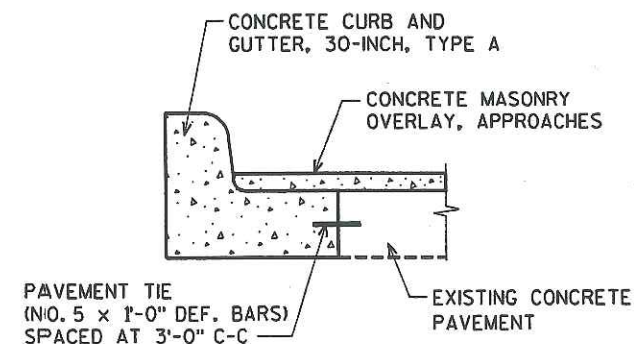


**CONCRETE CURB AND GUTTER REPLACEMENT**

STA. 111+45 TO STA. 111+50 RT.




\$PRNAME\$  
 PEN TABLE = \$plot72\$LASER+spc.tbl  
 DATE OF PLOT: 2/23/99  
 DESIGN FILE = U:\TRROADS\46187bpl.dgn  
 DGN LEVELS ON = 1-63

STATE PROJECT NUMBER 2320-02-60	SHEET NO. 2.3
DETAILS FOR	
S.T.H. 100	MILWAUKEE COUNTY

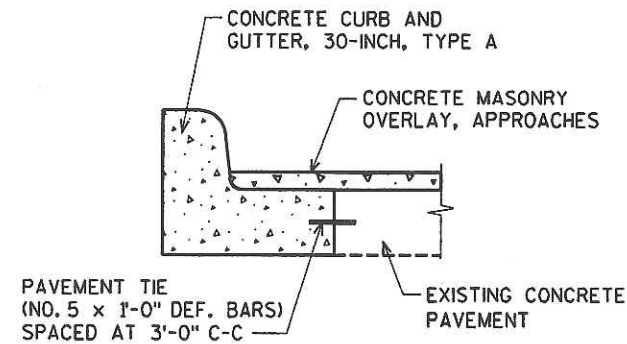

### CONCRETE CURB AND GUTTER REPLACEMENT

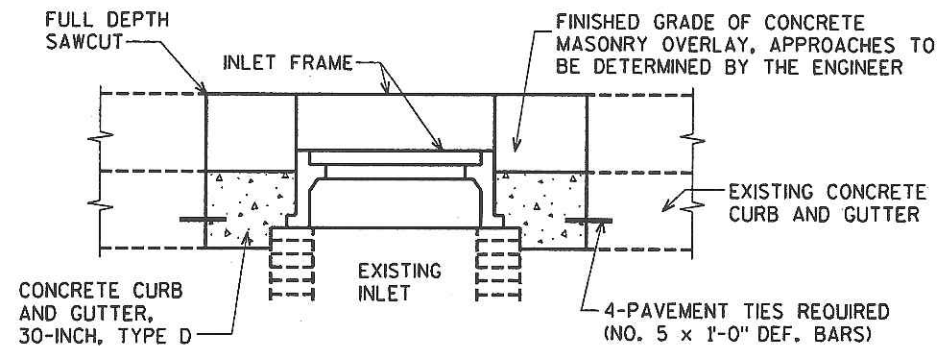

### ADJUSTING INLET COVERS


### GENERAL NOTES

THE LOCATION OF EXISTING UTILITY INSTALLATIONS AS SHOWN ON THE PLANS ARE APPROXIMATE. THERE MAY BE OTHER UTILITY INSTALLATIONS WITHIN THE PROJECT AREA THAT ARE NOT SHOWN.

WHEN THE QUANTITY OF CONCRETE MASONRY, OVERLAY, APPROACHES IS MEASURED FOR PAYMENT BY THE CUBIC YARD, THE DEPTH OR THICKNESS OF THE PAVEMENT SHOWN ON THE PLANS IS APPROXIMATE, AND THE ACTUAL THICKNESS WILL DEPEND UPON THE DISTRIBUTION OF THE MATERIALS AS DIRECTED BY THE ENGINEER.

DISTANCES SHOWN ON THIS PLAN ARE GROUND DISTANCES.

ALL PRIVATE UTILITIES ARE TO BE ADJUSTED BY THE UTILITY CONCERNED.

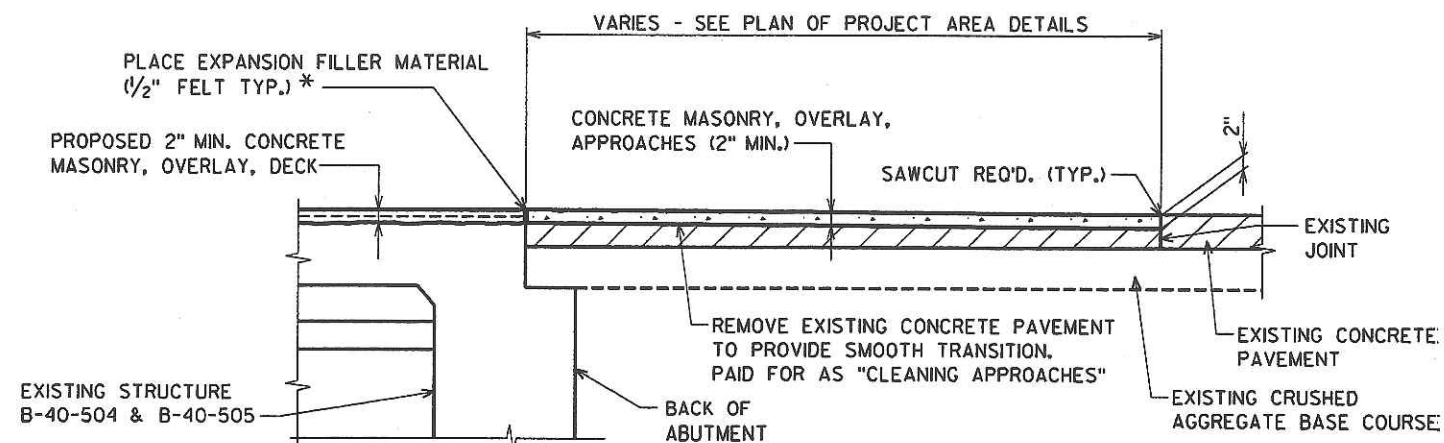

### CONCRETE MASONRY OVERLAY DETAIL (LOOKING NORTH AT EAST APPROACH; WEST APPROACH SIMILAR)

\* INCIDENTAL TO "CONCRETE MASONRY, OVERLAY, APPROACHES"


NOTE:  
 SAWCUT REQUIRED BETWEEN  
 STAGE CONSTRUCTION LIMITS  
 ALSO.



\$PRNAME\$  
PEN TABLE = #plot72+LASER+S  
DATE OF PLOT: 2/23/99  
DESIGN FILE = U:\TRROADS\46187pl.dgn  
DGN LEVELS ON = 1-63

BENCH MARKS			
NO.	STA.	DESCRIPTION	ELEV.
1	111+50	CHISELED SQUARE AT FACE OF CURB, 22 FT. RT.	100.00

STATE PROJECT NUMBER 2320-02-60	SHEET NO. 2.4
PLAN VIEW/PAVEMENT MARKINGS FOR	
NORTH 107TH ST.	MILWAUKEE COUNTY

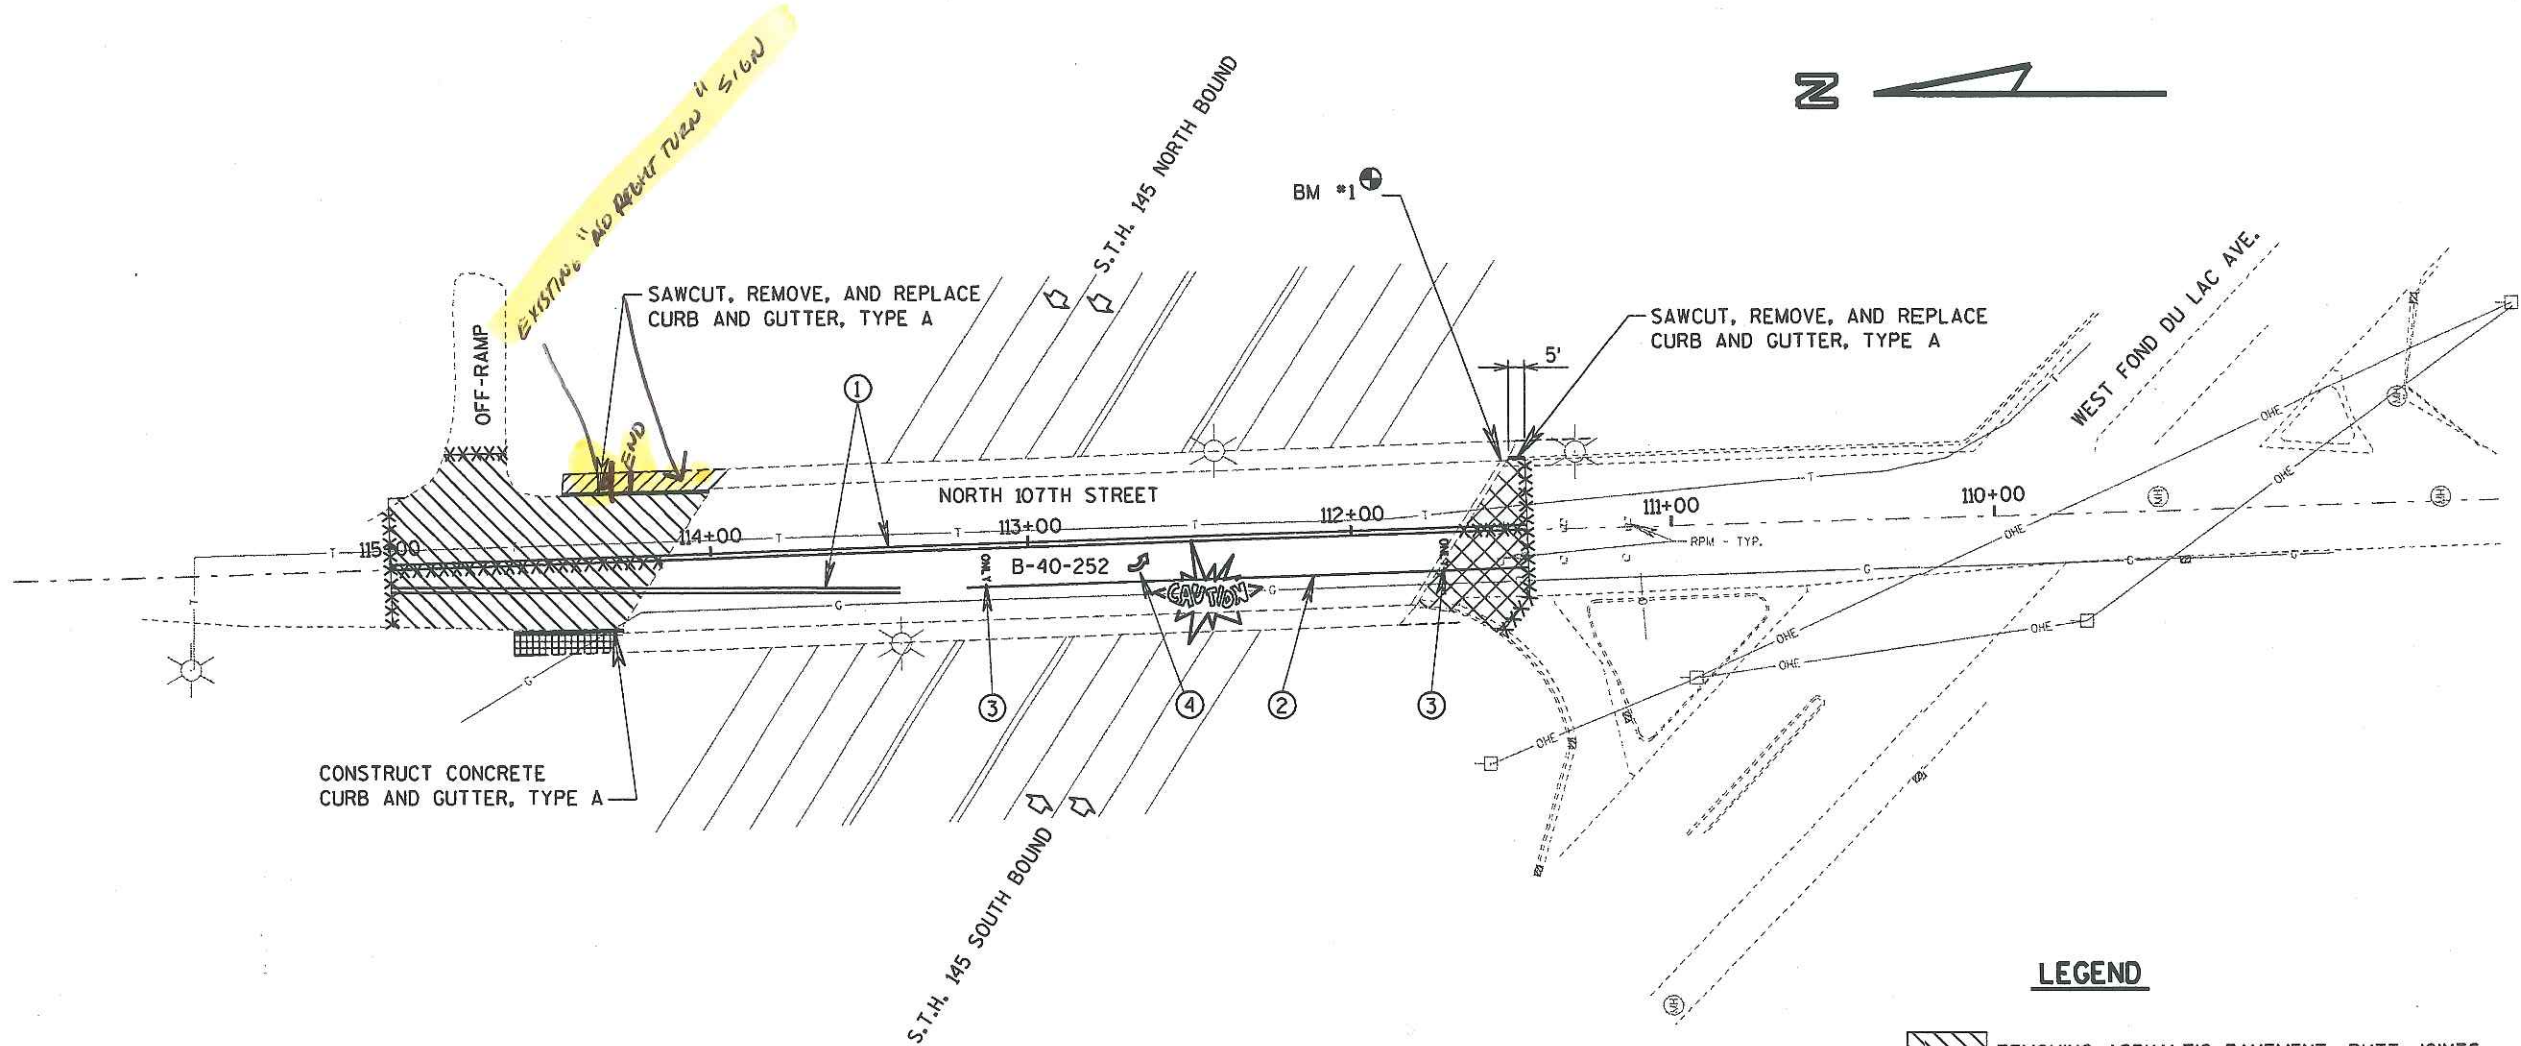

**CONVENTIONAL SIGNS**

UNDERGROUND GAS	— G —
UNDERGROUND TELEPHONE	— T —
OVERHEAD ELECTRIC	— OHE —
MANHOLE	(MH)
RAISED PAVEMENT MARKER (RPM)	u
INLET	□
LIGHT POLE	⊙
POWER POLE	⊠

**LEGEND**

	REMOVING ASPHALTIC PAVEMENT, BUTT JOINTS
	CONSTRUCT CONCRETE SIDEWALK
	REMOVE AND REPLACE CONCRETE SIDEWALK
	CLEANING APPROACHES


XXXXXX SAWING EXISTING PAVEMENT

- ① PAVEMENT MARKING, EPOXY, 4 INCHES (DOUBLE YELLOW CENTERLINE)
- ② PAVEMENT MARKING, CHANNELIZING, EPOXY, 8 INCHES (SOLID WHITE)
- ③ PAVEMENT MARKING, WORDS, EPOXY (ONLY)
- ④ PAVEMENT MARKING, ARROWS, TYPE 2, EPOXY

\$PRNAME\$  
PEN TABLE = C:\plot72\Laser\app.tbl  
DATE OF PLOT: 2/23/99  
DESIGN FILE = U:\trroads\46187bpl.dgn  
DGN LEVELS ON = 1-63

BENCH MARKS			
NO.	STA.	DESCRIPTION	ELEV.
1	518'W'+50	RAILROAD SPIKE IN POWER POLE, 45 FT. LT.	100.00

STATE PROJECT NUMBER 2320-02-60	SHEET NO. 25
PLAN VIEW/PAVEMENT MARKINGS FOR S.T.H. 100 MILWAUKEE CO	

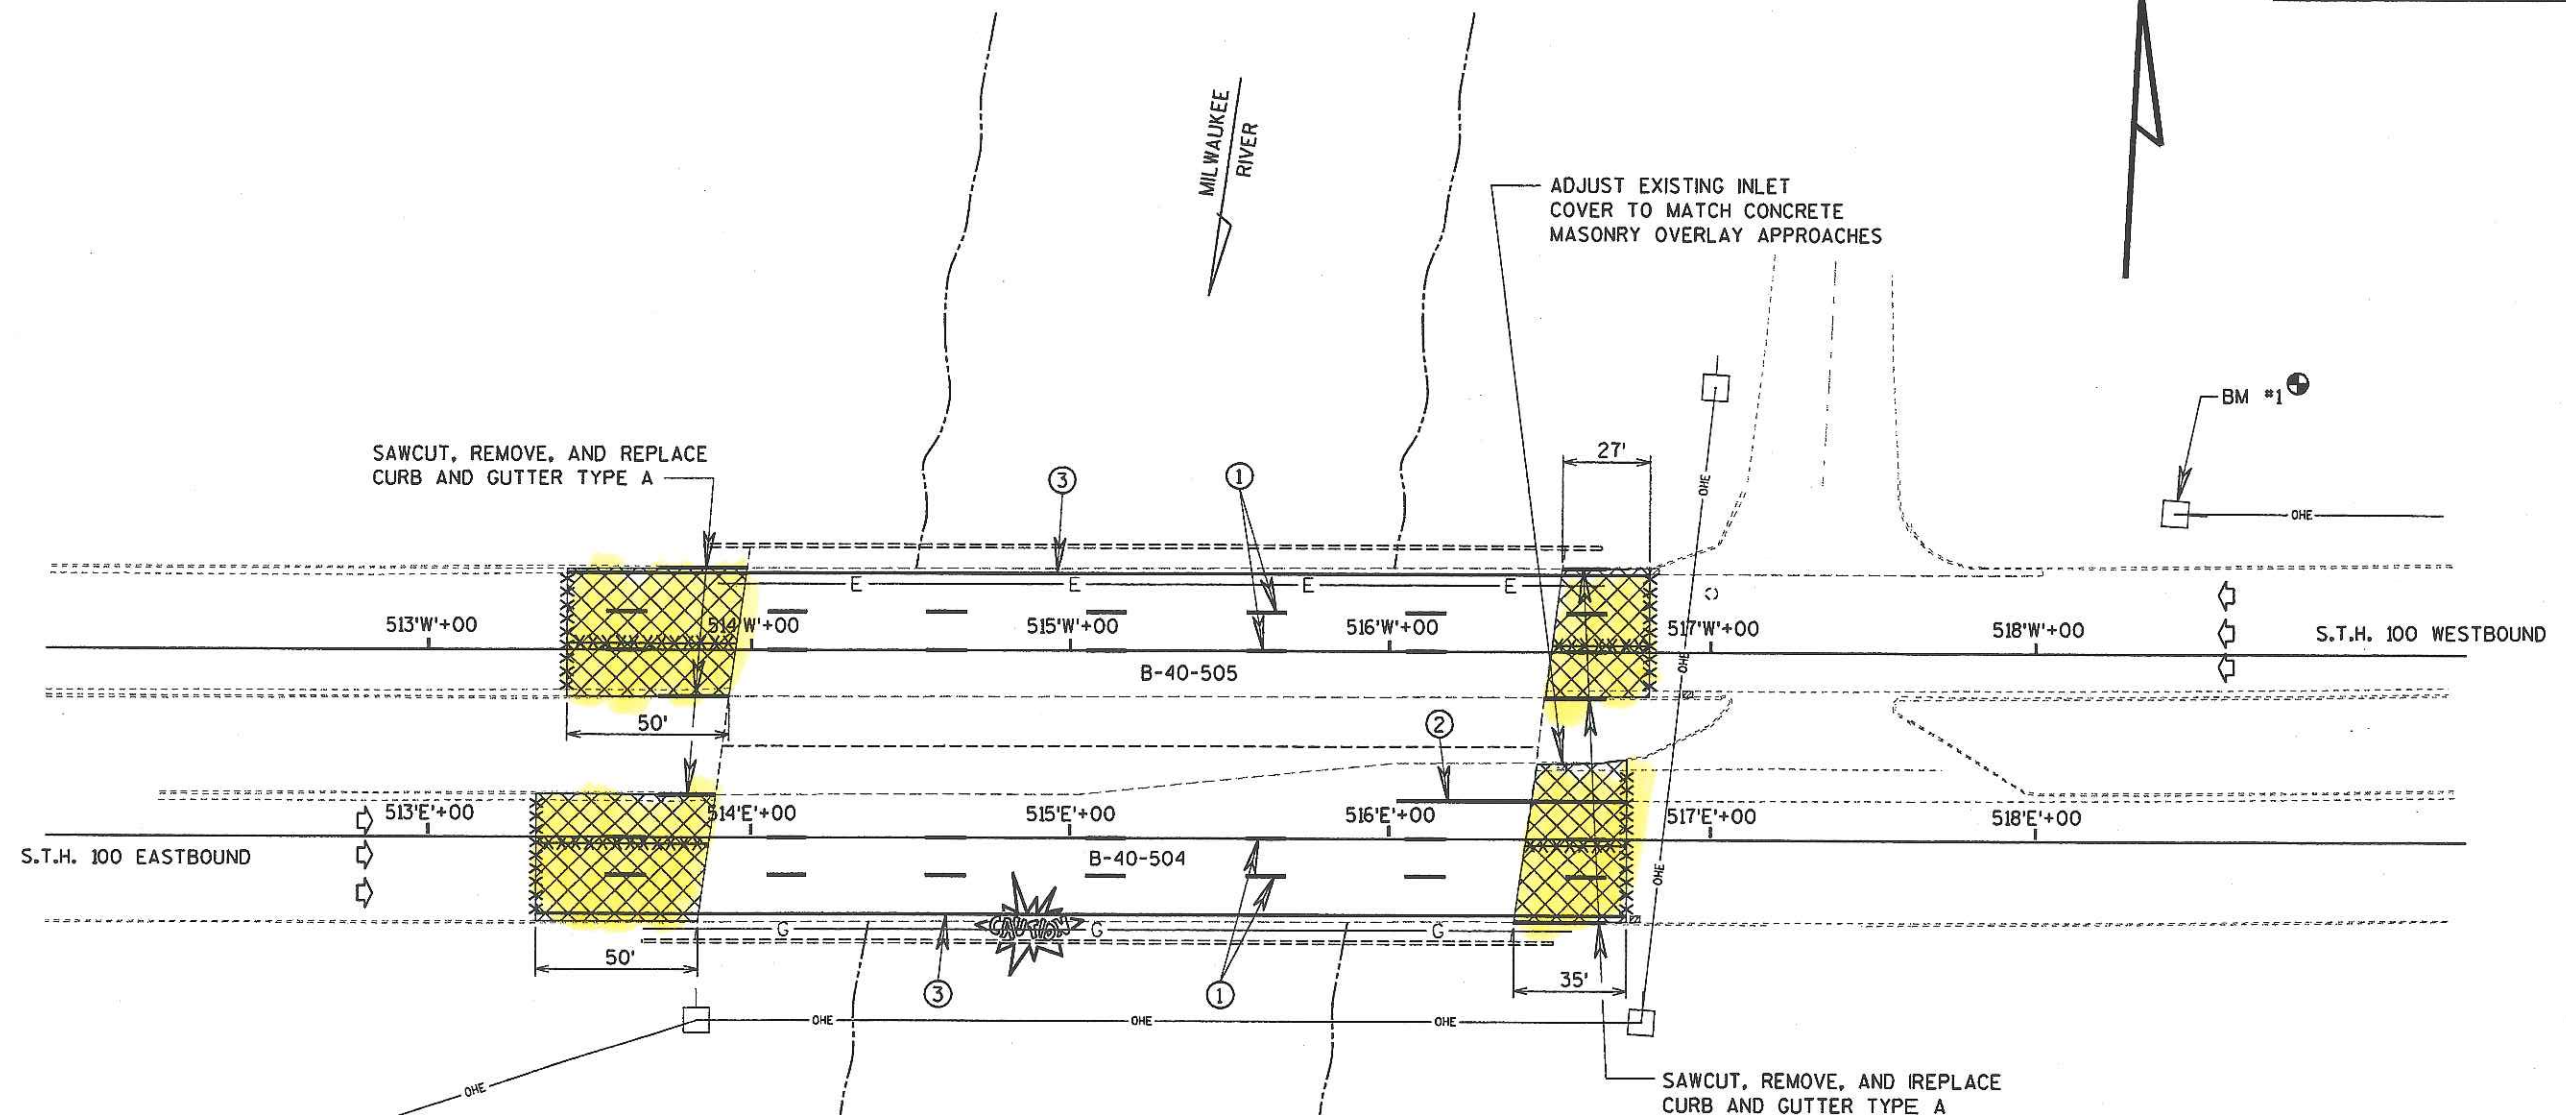

### CONVENTIONAL SIGNS

UNDERGROUND GAS	—G—
UNDERGROUND ELECTRIC	—E—
OVERHEAD ELECTRIC	—OHE—
INLET	□
POWER POLE	—□—

### LEGEND



EXISTING APPROACHES  
WERE ASPHALT. NEW  
APPROACHES WERE  
ALSO MADE ASPHALT

REMOVING ASPHALTIC SURFACE,  
BUT JUNCTS  
CLEANING, APPROACHES

XXXXXX SAWING EXISTING PAVEMENT

- 1 PAVEMENT MARKING, EPOXY, 4 INCHES (SKIP WHITE LANE LINE)
- 2 PAVEMENT MARKING, CHANNELIZING, EPOXY, 8 INCHES (SOLID WHITE)
- 3 PAVEMENT MARKING, EPOXY, 4 INCHES (SOLID WHITE EDGE LINE) (OFFSET 2' FROM FACE OF CURB OR MATCH EXISTING)



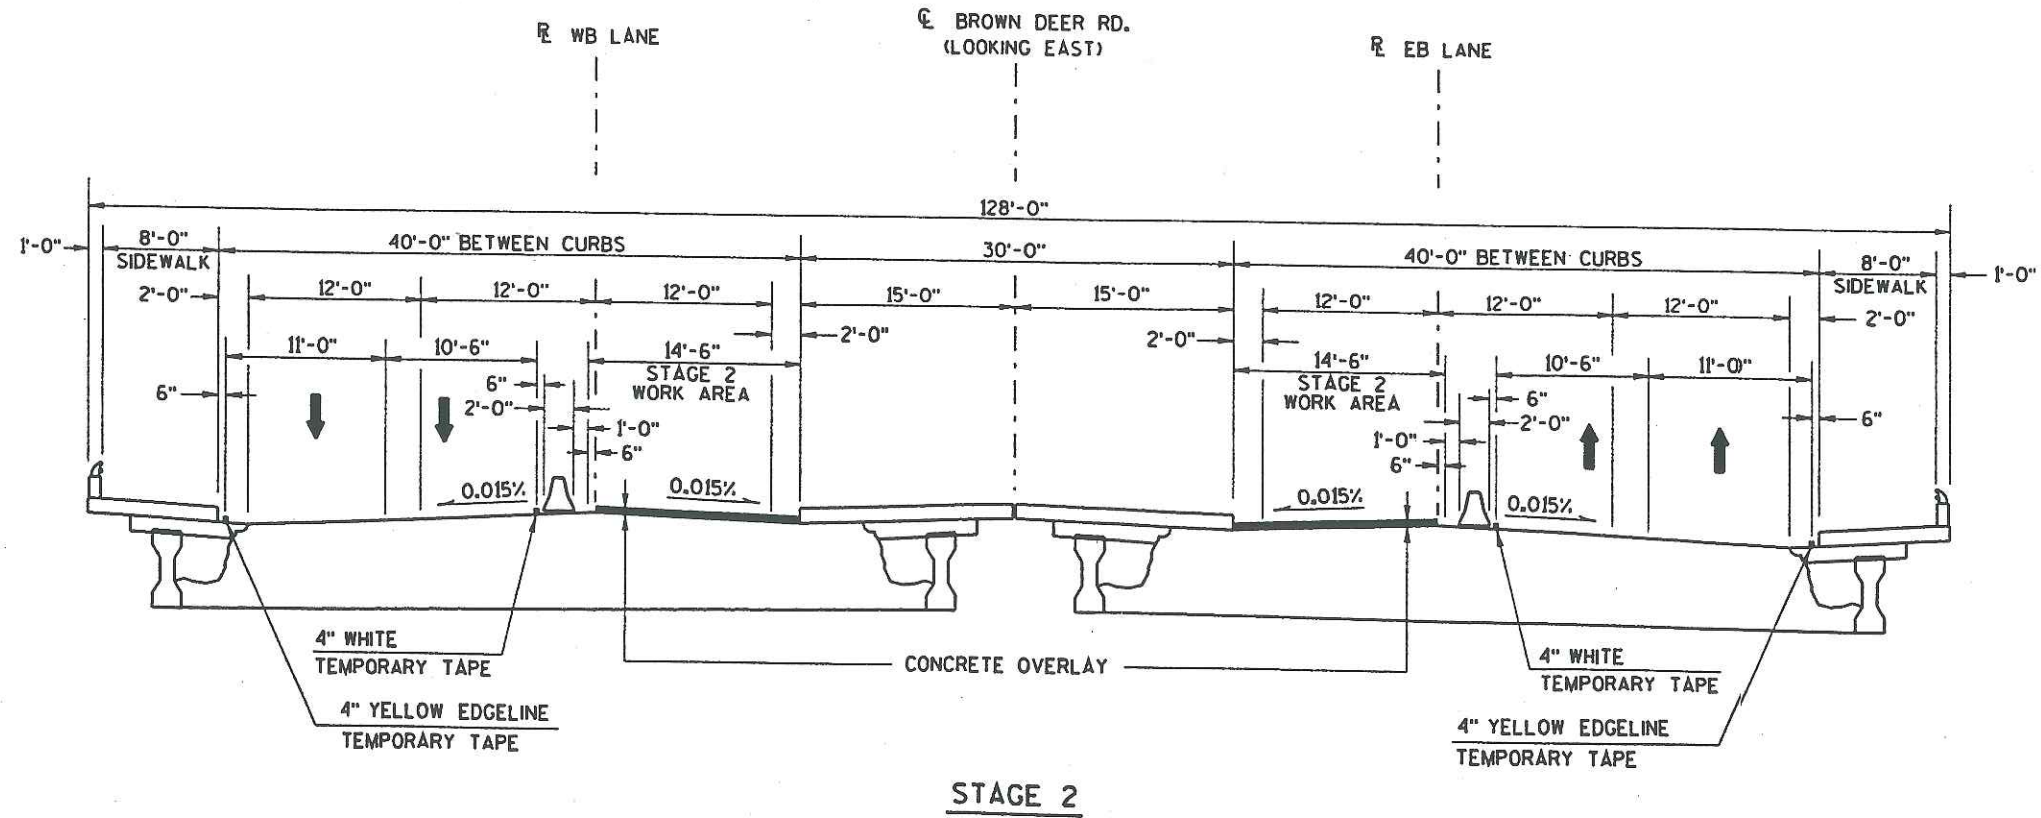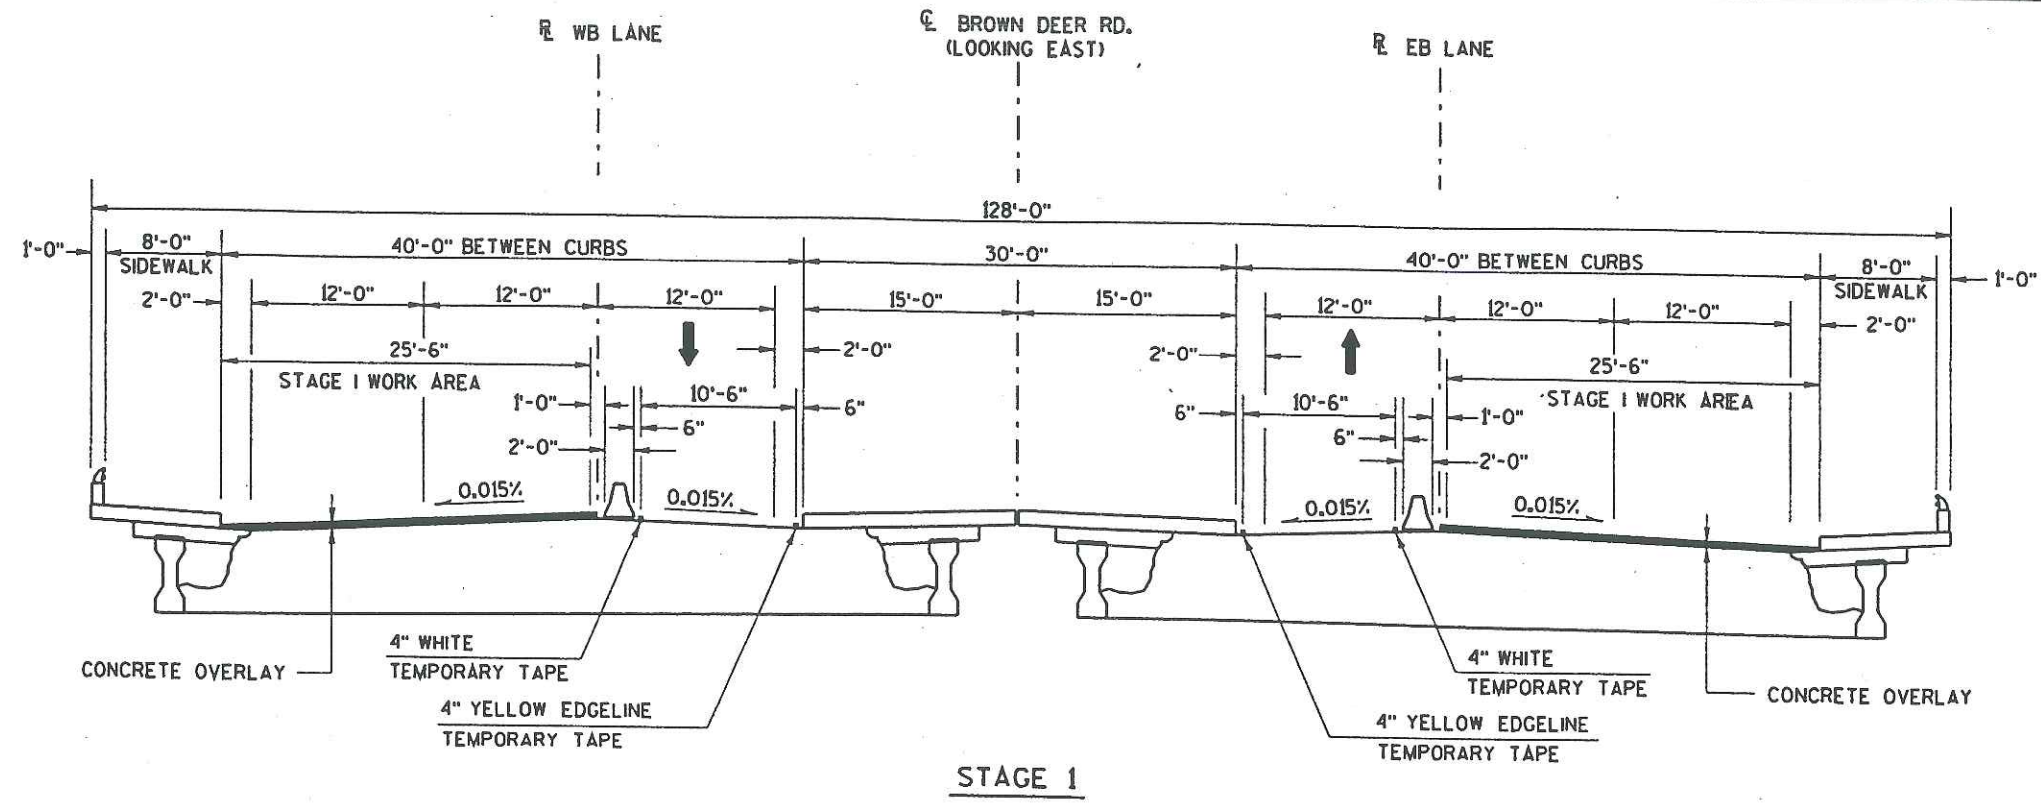



FILE NAME: D2 BR 40504051C504.DGN  
LEVELS ON - 1  
ORIGINATOR: D2 JCT  
REV. DATE: 2/2/99  
PLOT SCALE: 100.6757581:1.0000000  
PLOT DATE: 02-FEB-1999 15:04



### TRAFFIC CONTROL NOTES

THE EXACT NUMBER, LOCATION AND SPACING OF ALL SIGNS AND DEVICES SHALL BE ADJUSTED TO FIT FIELD CONDITIONS AS DIRECTED BY THE ENGINEER.

CHANNELIZING DEVICES PLACED ADJACENT TO WORK AREA SHALL BE PULLED BACK FROM TRAVEL LANE WHEN WORK IS NOT IN PROGRESS

FOR NIGHTTIME OPERATION ALL ADVANCE SIGNS PLACED ON PAVEMENT SHALL HAVE A TYPE "A" FLASHING LIGHT.

DURING HOURS OF DARKNESS, TYPE "C" (STEADY BURN) LIGHTS SHALL BE PROVIDED ON ALL CHANNELIZING DEVICES IN TAPERS, BARRICADES SHIELDING AN ISOLATED HAZARD, SHALL BE EQUIPPED WITH TYPE "A" (LOW-INTENSITY FLASHING) LIGHTS.

ALL SIGNS ARE 48" X 48" UNLESS OTHERWISE NOTED.


"WO" SIGNS ARE THE SAME AS "W" SIGNS EXCEPT THE BACKGROUND IS ORANGE.

STEADY BURN LIGHTS, WHERE USED, SHALL BE ONE-WAY/UNI-DIRECTIONAL WITH THE LIGHT SOURCE SHOWING ONLY TOWARD ADJACENT APPROACHING TRAFFIC. UNLESS THERE IS A CLEAR APPLICATION IN WHICH TWO-WAY LIGHTS WOULD LOGICALLY BENEFIT TRAFFIC CONTROL AND SAFETY.

IF LANE CLOSURE IS MORE THAN 1 MILE, PLACE A TYPE III BARRICADE APPROXIMATELY EVERY 1000' ACROSS THE CLOSED LANE TO HELP ENFORCE THE DRUM LINE.

CONSIDER GEOMETRICS WHEN LOCATING SIGNS AND ARROWBOARDS SO THE DRIVER HAS A CLEAR VIEW OF THE ARROWBOARD AND THE LANE CLOSURE DRUMS FOR A MINIMUM 1500' IN FRONT OF DRUMS.


STATE PROJECT NUMBER	2320-02-60	SHEET NO.	2.7
TRAFFIC CONTROL		STAGE I	
STH 100		MILWAUKEE COUN	

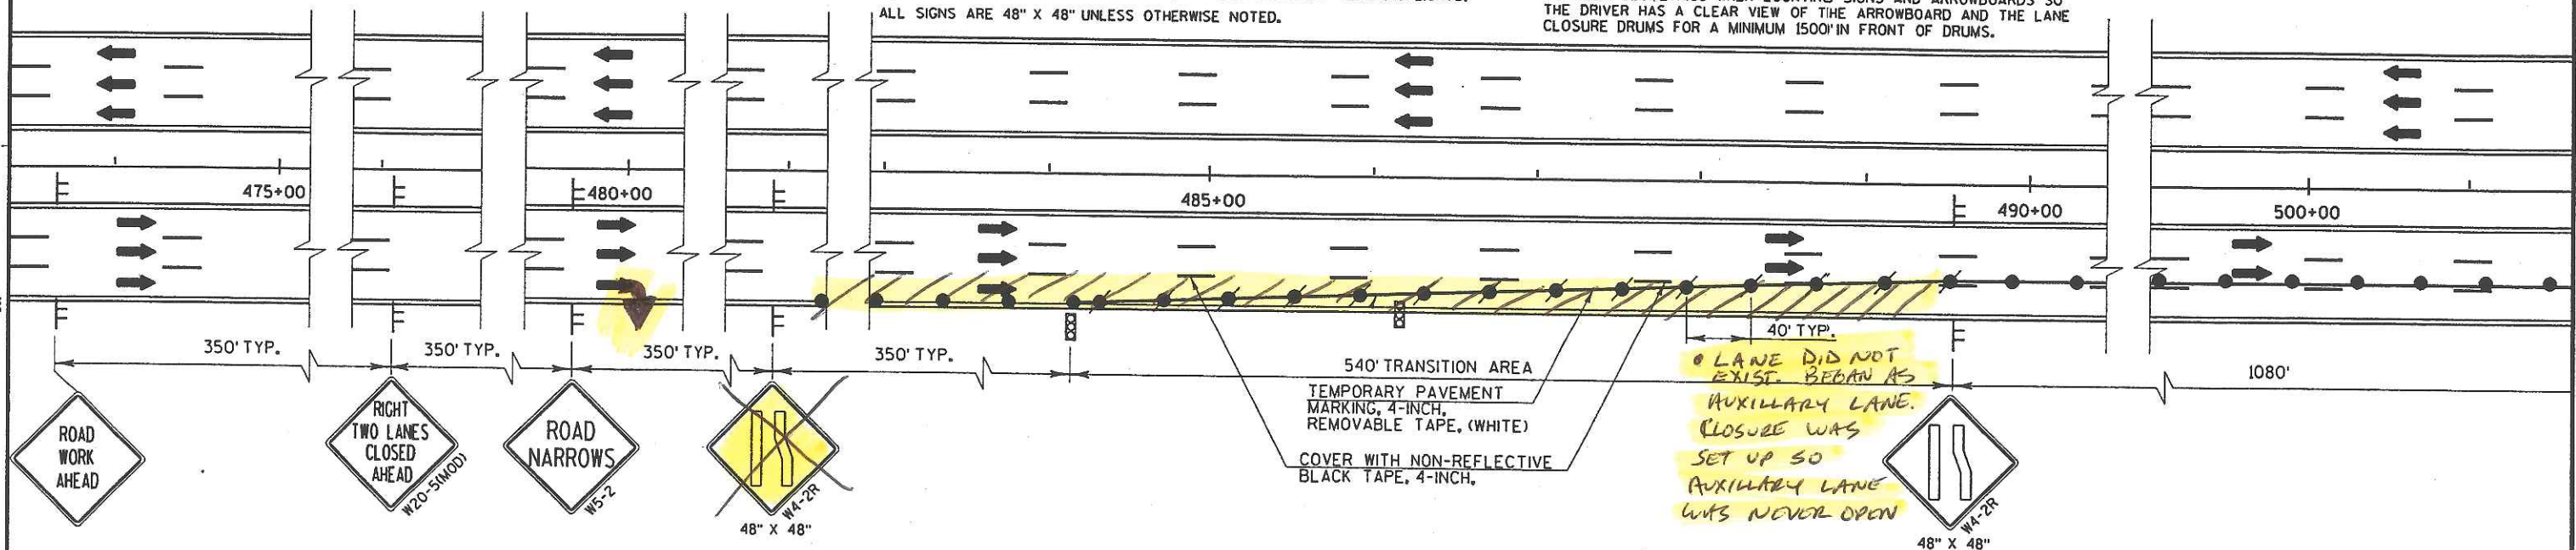

### TRAFFIC CONTROL LEGEND


- TRAFFIC CONTROL DRUM
- ⬢ TRAFFIC CONTROL DRUM WITH LIGHT
- ▨ WORK ZONE
- ▨ WORK ZONE
- ⊥ SIGN ON TEMPORARY SUPPORT
- ↑ TYPE III BARRICADE
- ⊠ FLASHING ARROW BOARD SIGN

END  
ROAD WORK  
G20-2A  
48" X 24"

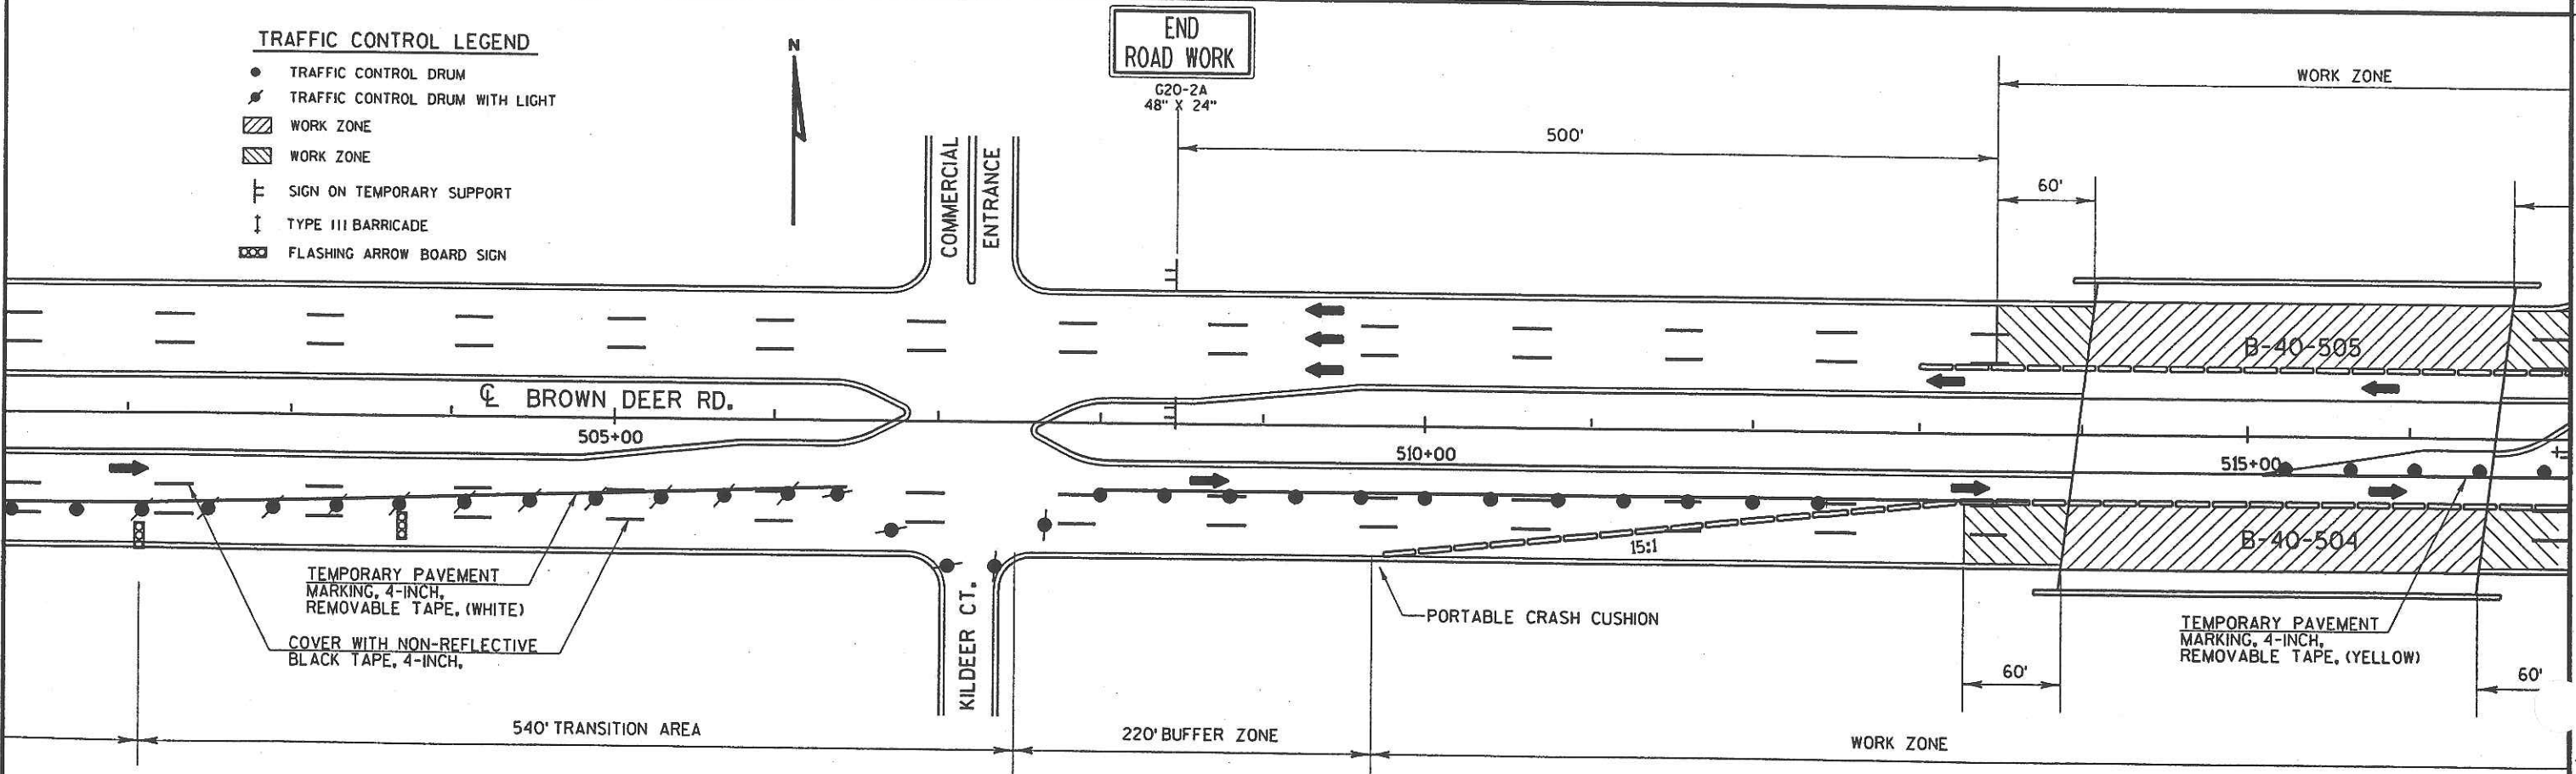



REV. DATE: 2/2/99 PLOT SCALE: 100:6797581:0000000 PLOT DATE: 0 -1999 10:18  
FILE NAME: 4050405:ITC504.DGN  
LEVELS ON: 1  
ORIGINATOR: D2 JCT

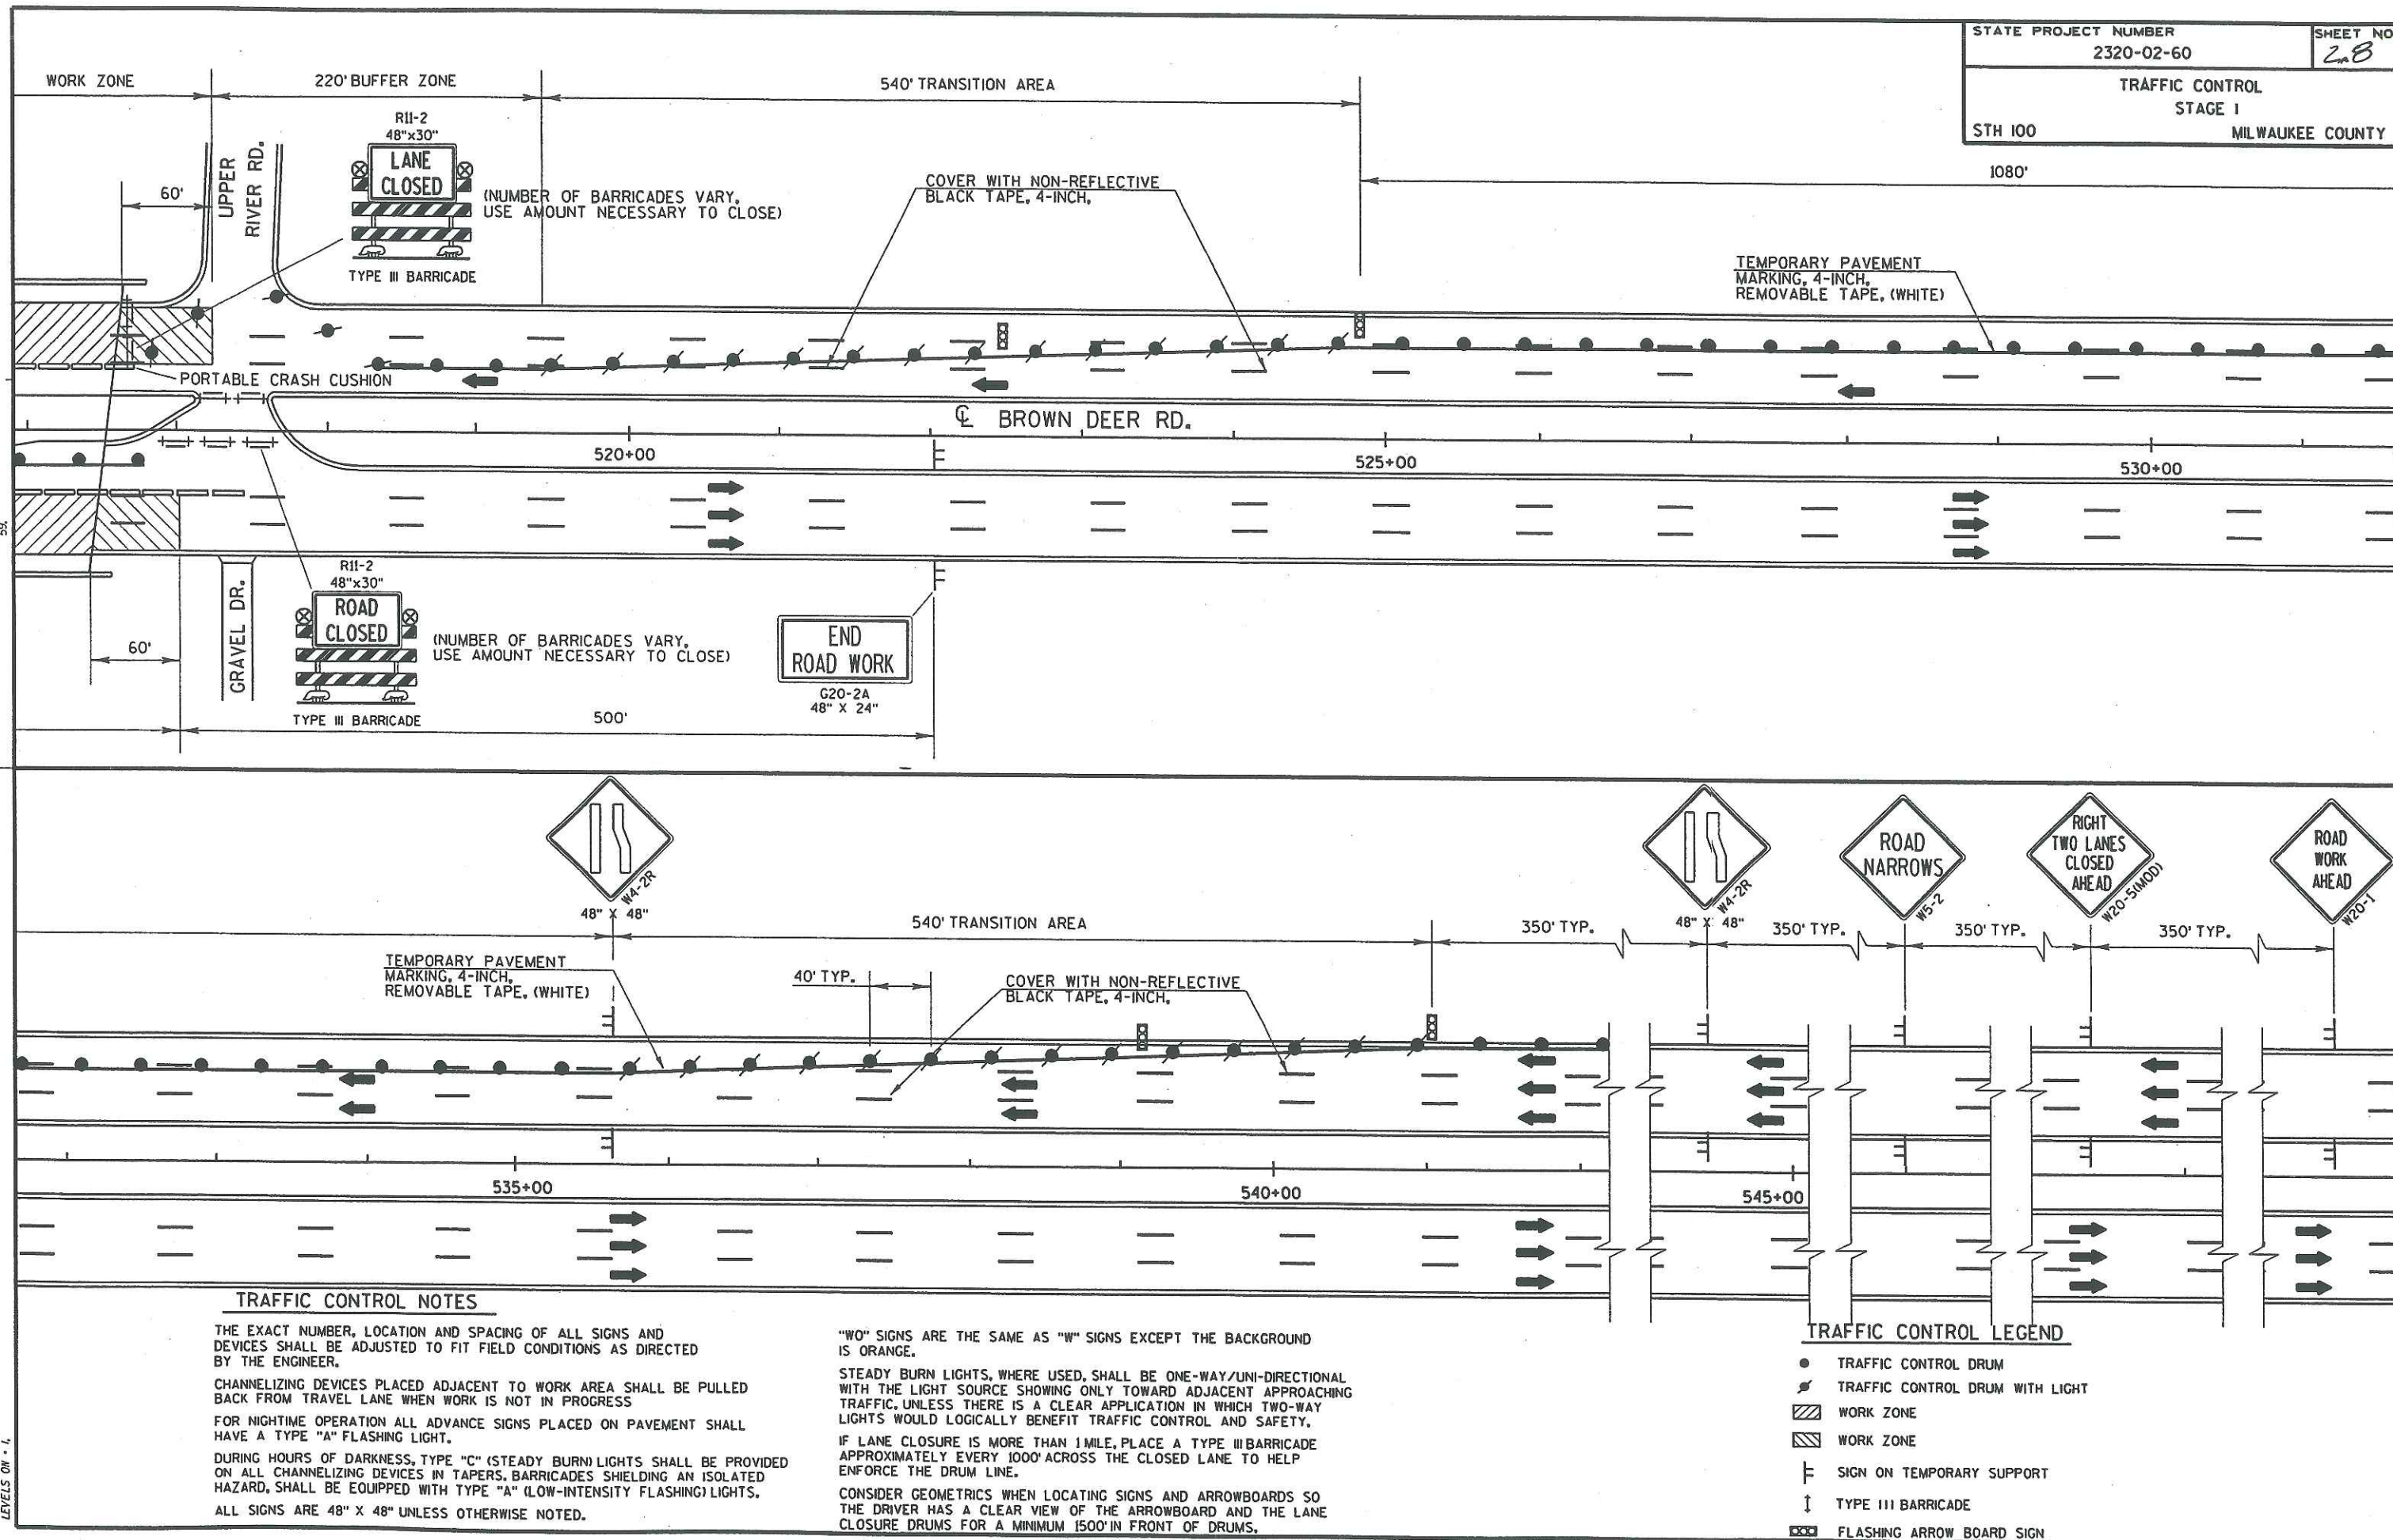



03-FEB-1999 10:19  
PLOT DATE:  
100.67975811.000000  
PLOT SCALE: 1  
REV. DATE: 2/2/99  
JCT  
ORIGINATOR: D2  
FILE NAME: D2 BR 40504051C504.DGN  
LEVELS 01 - 1

TRAFFIC CONTROL NOTES

THE EXACT NUMBER, LOCATION AND SPACING OF ALL SIGNS AND DEVICES SHALL BE ADJUSTED TO FIT FIELD CONDITIONS AS DIRECTED BY THE ENGINEER.

CHANNELIZING DEVICES PLACED ADJACENT TO WORK AREA SHALL BE PULLED BACK FROM TRAVEL LANE WHEN WORK IS NOT IN PROGRESS

FOR NIGHTTIME OPERATION ALL ADVANCE SIGNS PLACED ON PAVEMENT SHALL HAVE A TYPE "A" FLASHING LIGHT.

DURING HOURS OF DARKNESS, TYPE "C" (STEADY BURN) LIGHTS SHALL BE PROVIDED ON ALL CHANNELIZING DEVICES IN TAPERS, BARRICADES SHIELDING AN ISOLATED HAZARD, SHALL BE EQUIPPED WITH TYPE "A" (LOW-INTENSITY FLASHING) LIGHTS.

ALL SIGNS ARE 48" X 48" UNLESS OTHERWISE NOTED.


"WO" SIGNS ARE THE SAME AS "W" SIGNS EXCEPT THE BACKGROUND IS ORANGE.

STEADY BURN LIGHTS, WHERE USED, SHALL BE ONE-WAY/UNI-DIRECTIONAL WITH THE LIGHT SOURCE SHOWING ONLY TOWARD ADJACENT APPROACHING TRAFFIC, UNLESS THERE IS A CLEAR APPLICATION IN WHICH TWO-WAY LIGHTS WOULD LOGICALLY BENEFIT TRAFFIC CONTROL AND SAFETY.

IF LANE CLOSURE IS MORE THAN 1 MILE, PLACE A TYPE III BARRICADE APPROXIMATELY EVERY 1000' ACROSS THE CLOSED LANE TO HELP ENFORCE THE DRUM LINE.




CONSIDER GEOMETRICS WHEN LOCATING SIGNS AND ARROWBOARDS SO THE DRIVER HAS A CLEAR VIEW OF THE ARROWBOARD AND THE LANE CLOSURE DRUMS FOR A MINIMUM 1500' IN FRONT OF DRUMS.

STATE PROJECT NUMBER 2320-02-60	SHEET NO. 2.9
TRAFFIC CONTROL STAGE II	
STH 100 MILWAUKEE COUNT	

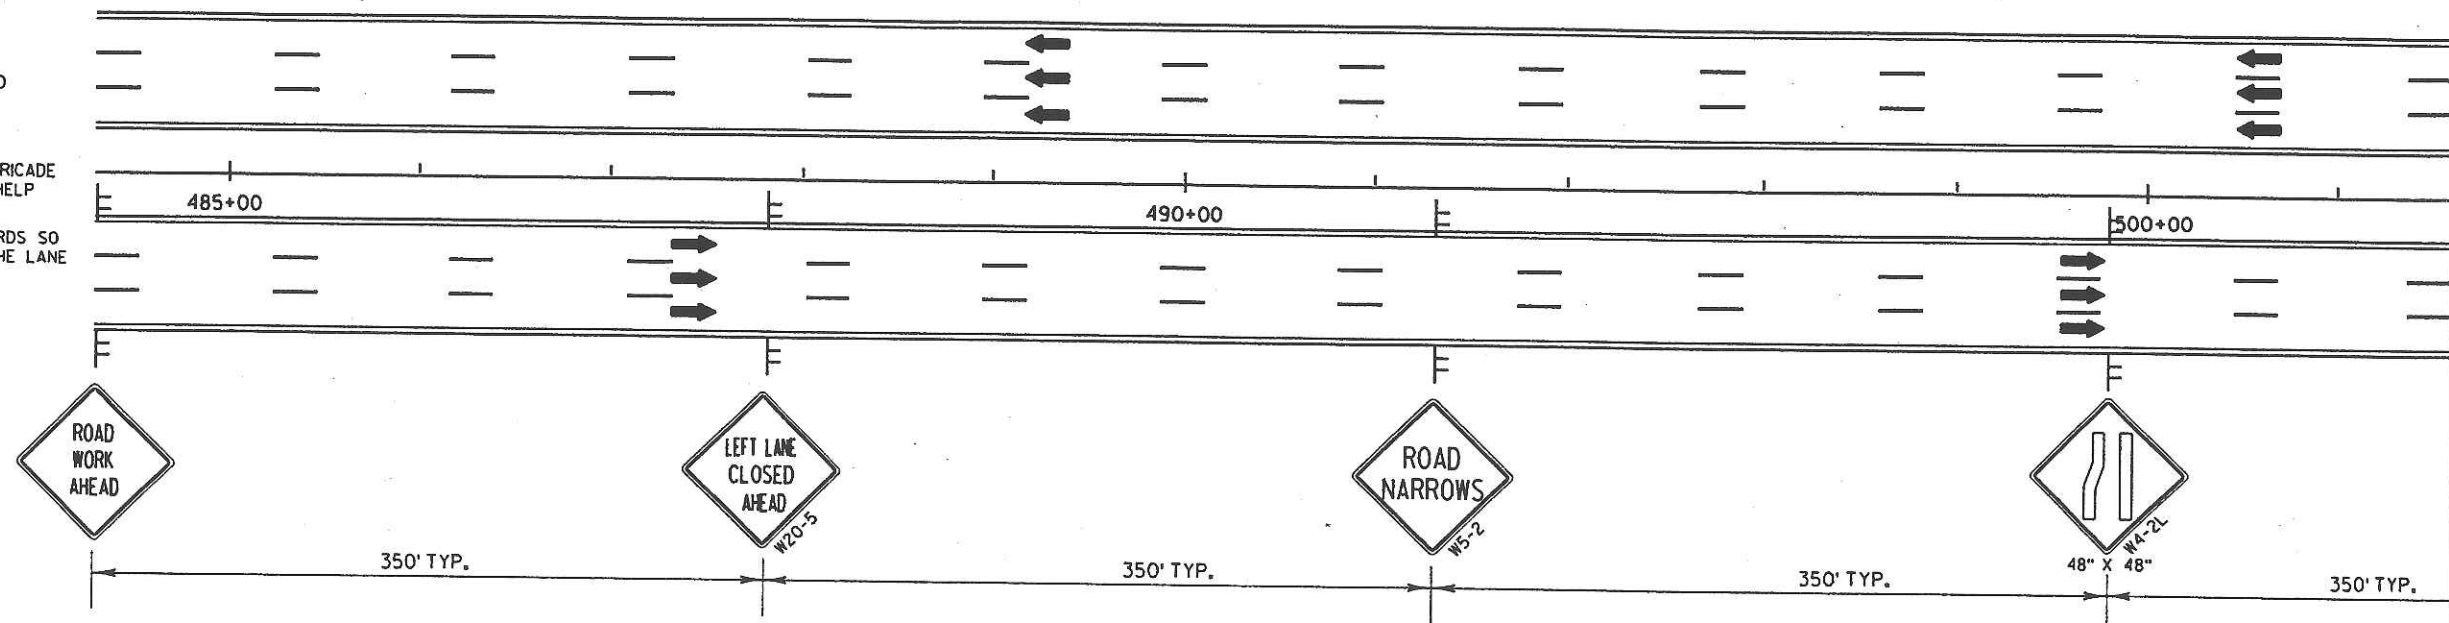

TRAFFIC CONTROL LEGEND

- TRAFFIC CONTROL DRUM
- ⬤ TRAFFIC CONTROL DRUM WITH LIGHT
- ▨ WORK ZONE
- ▨ WORK ZONE
- ⊥ SIGN ON TEMPORARY SUPPORT
- ⬇ TYPE III BARRICADE
- ⬢ FLASHING ARROW BOARD SIGN

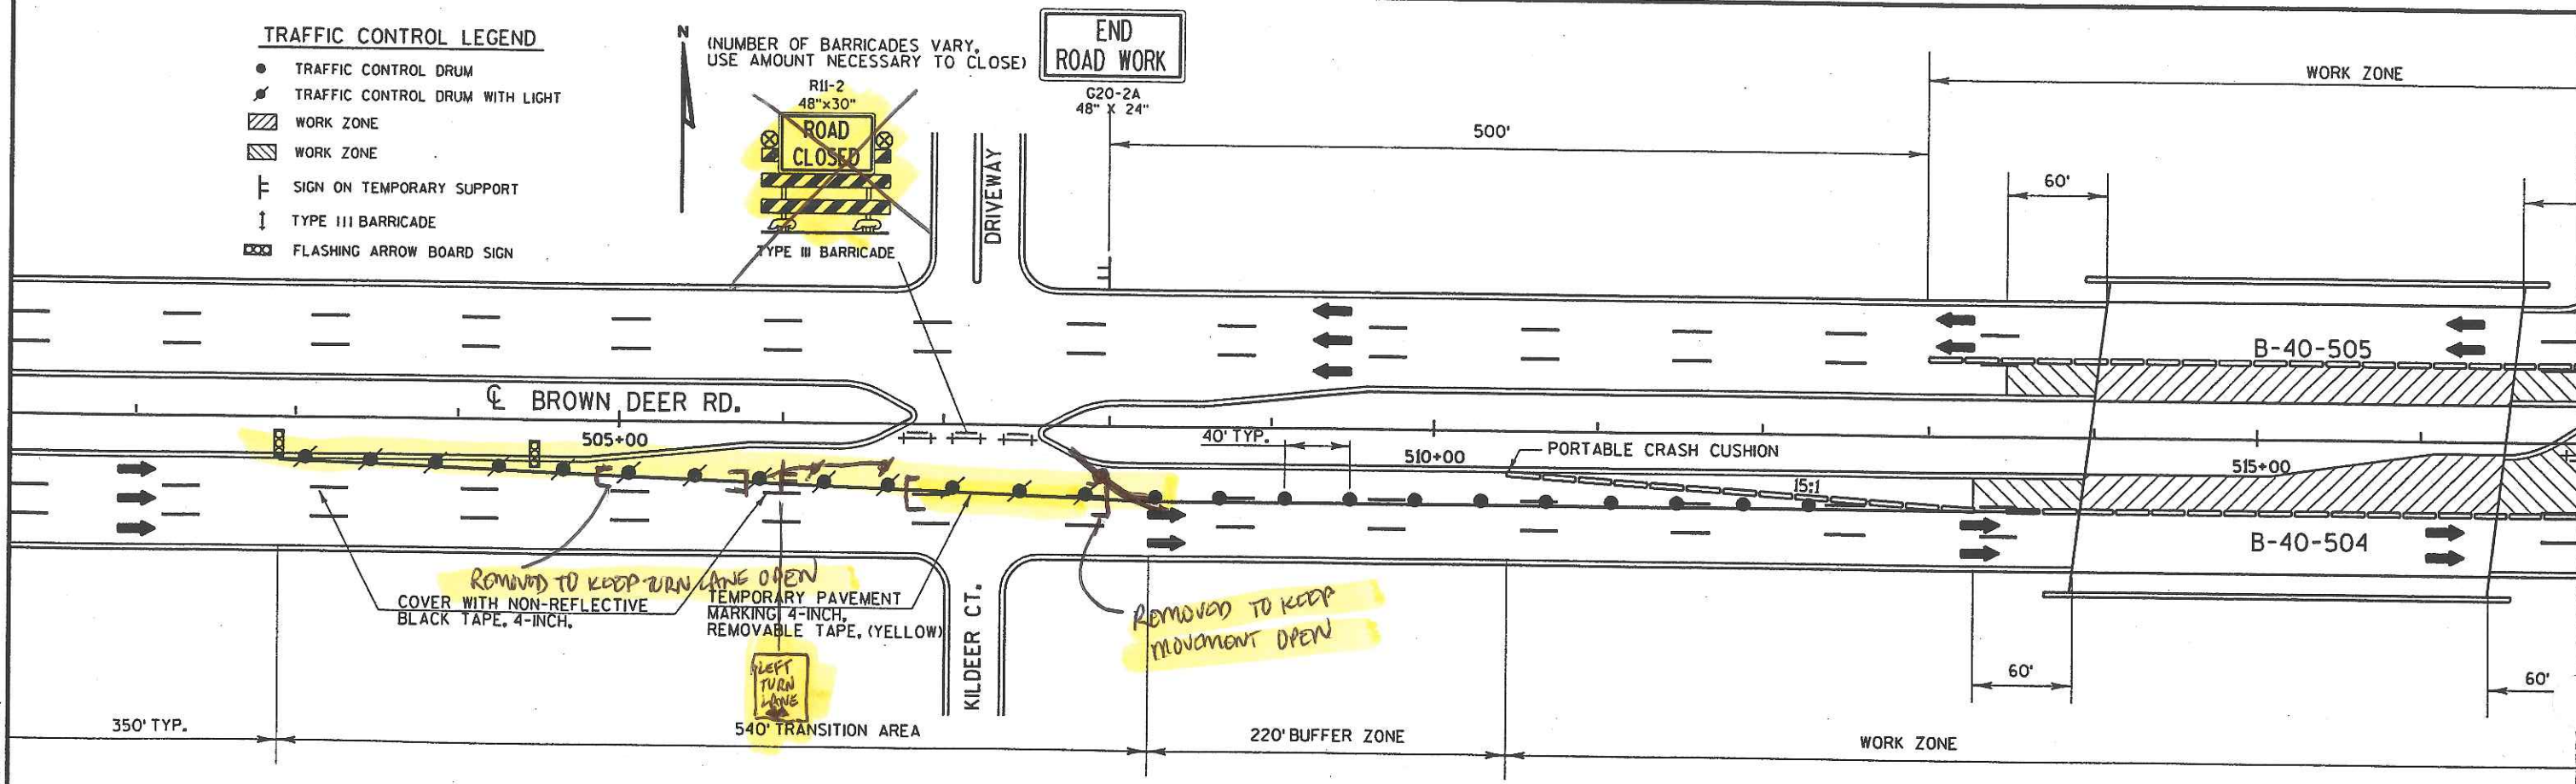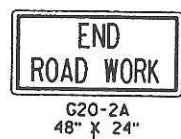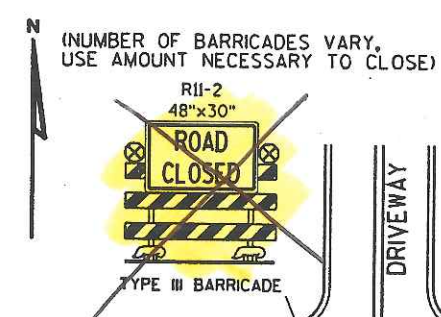





REV. DATE: 2/2/99 PLOT SCALE: 100.6797581:1.0000000 PLOT DATE: 01.1999 10:20

ORIGINATOR: D2 JCT

FILE NAME: I 405040517C504.DGN LEVELS ON - 1

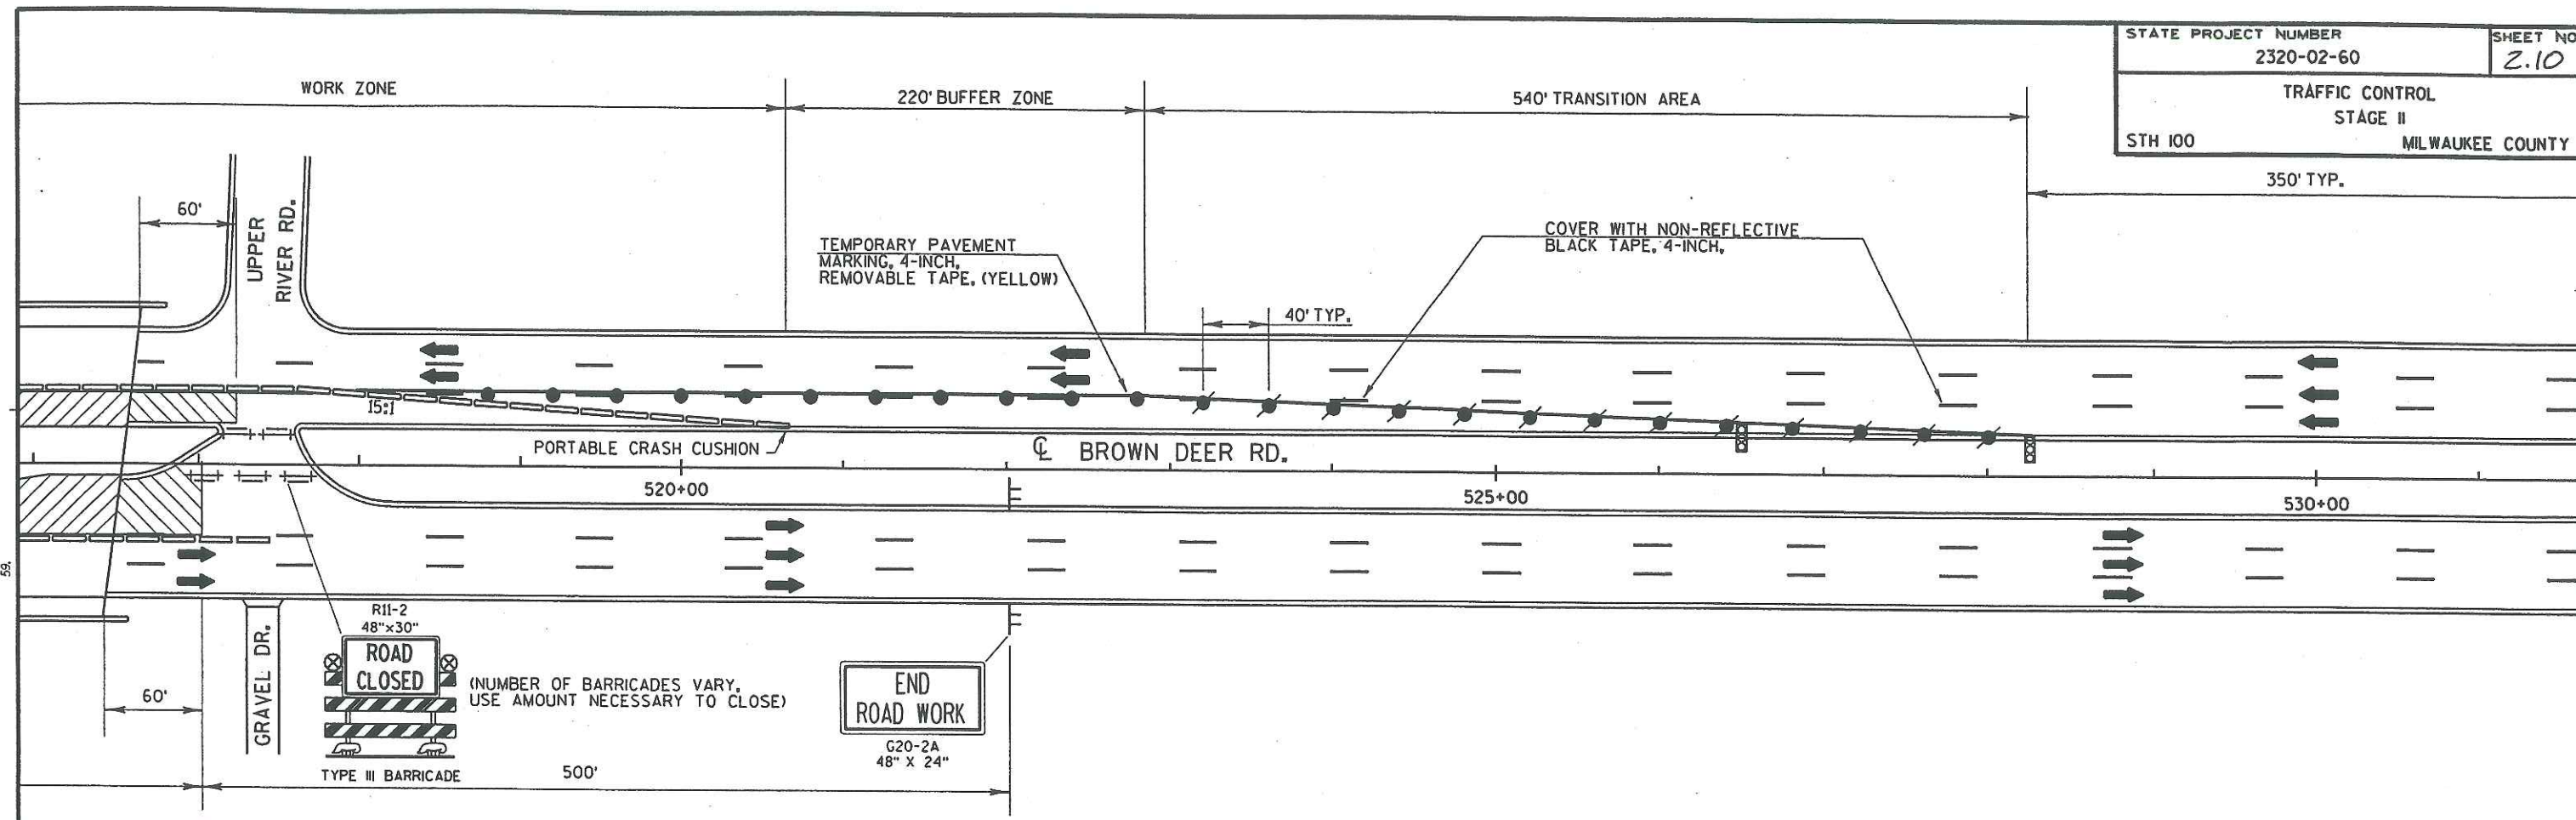

STATE PROJECT NUMBER	2320-02-60	SHEET NO.	2.10
TRAFFIC CONTROL			
STAGE II			
STH 100	MILWAUKEE COUNTY		

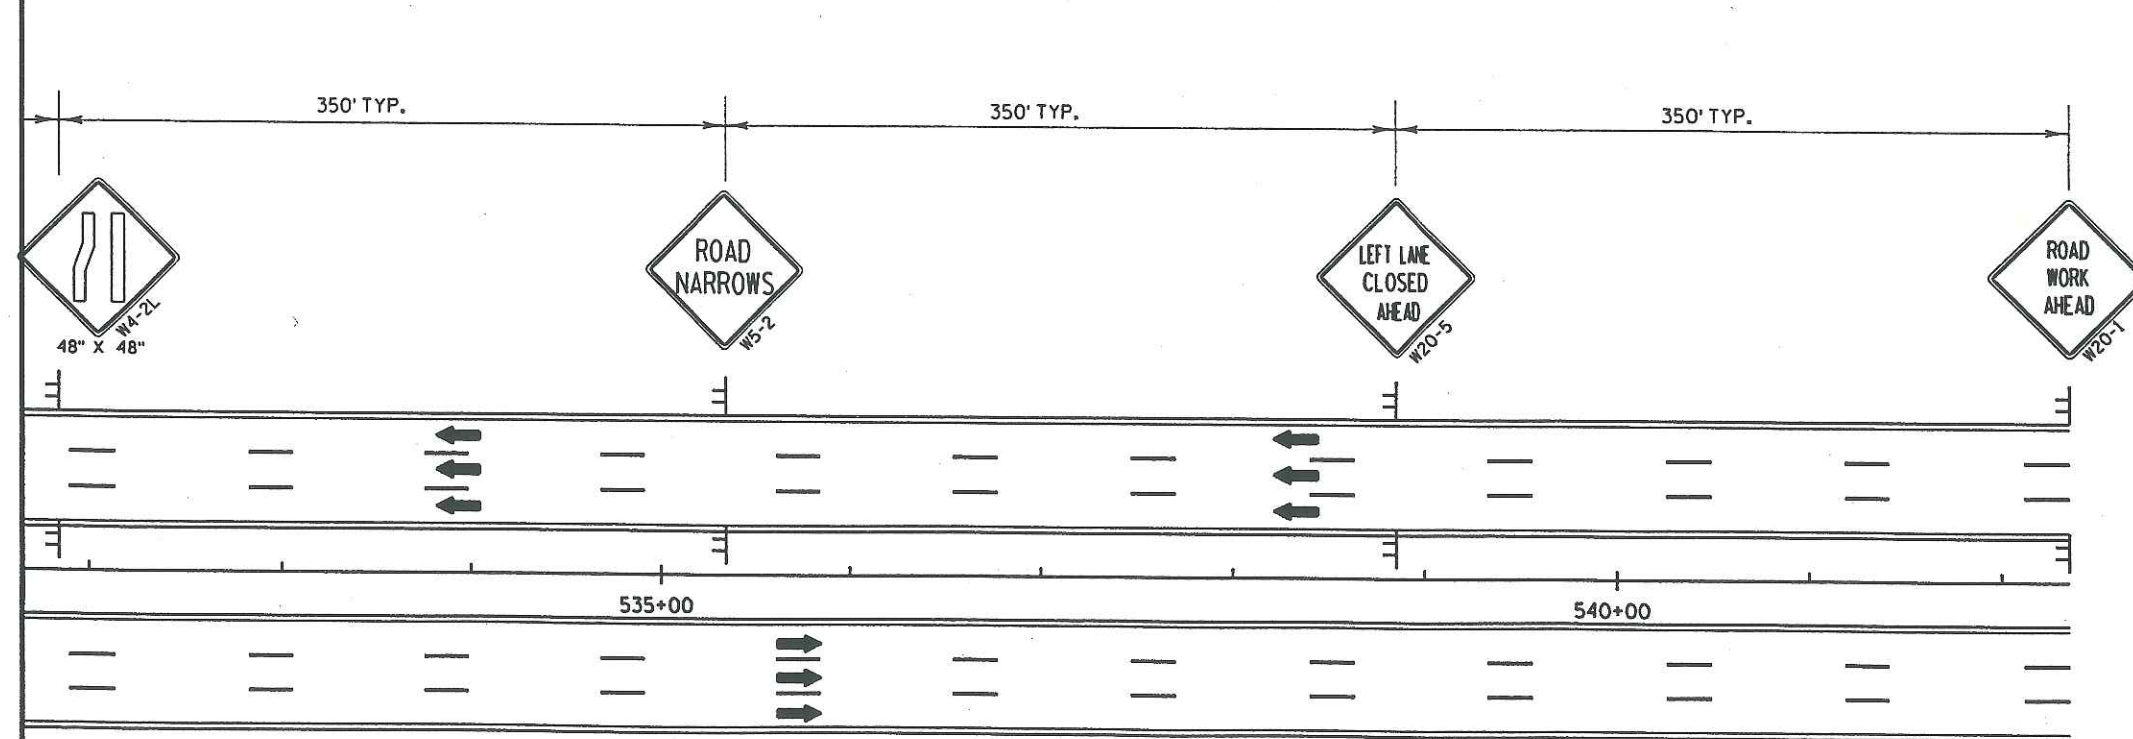

#### TRAFFIC CONTROL LEGEND

- TRAFFIC CONTROL DRUM
- ⚡ TRAFFIC CONTROL DRUM WITH LIGHT
- ▨ WORK ZONE
- ▨ WORK ZONE
- ⌄ SIGN ON TEMPORARY SUPPORT
- ⌄ TYPE III BARRICADE
- ⚡ FLASHING ARROW BOARD SIGN

#### TRAFFIC CONTROL NOTES

THE EXACT NUMBER, LOCATION AND SPACING OF ALL SIGNS AND DEVICES SHALL BE ADJUSTED TO FIT FIELD CONDITIONS AS DIRECTED BY THE ENGINEER.

CHANNELIZING DEVICES PLACED ADJACENT TO WORK AREA SHALL BE PULLED BACK FROM TRAVEL LANE WHEN WORK IS NOT IN PROGRESS.

FOR NIGHTTIME OPERATION ALL ADVANCE SIGNS PLACED ON PAVEMENT SHALL HAVE A TYPE "A" FLASHING LIGHT.

DURING HOURS OF DARKNESS, TYPE "C" (STEADY BURN) LIGHTS SHALL BE PROVIDED ON ALL CHANNELIZING DEVICES IN TAPERS, BARRICADES SHIELDING AN ISOLATED HAZARD, SHALL BE EQUIPPED WITH TYPE "A" (LOW-INTENSITY FLASHING) LIGHTS.

ALL SIGNS ARE 48" X 48" UNLESS OTHERWISE NOTED.

"WO" SIGNS ARE THE SAME AS "W" SIGNS EXCEPT THE BACKGROUND IS ORANGE.


STEADY BURN LIGHTS, WHERE USED, SHALL BE ONE-WAY/UNI-DIRECTIONAL WITH THE LIGHT SOURCE SHOWING ONLY TOWARD ADJACENT APPROACHING TRAFFIC, UNLESS THERE IS A CLEAR APPLICATION IN WHICH TWO-WAY LIGHTS WOULD LOGICALLY BENEFIT TRAFFIC CONTROL AND SAFETY.

IF LANE CLOSURE IS MORE THAN 1 MILE, PLACE A TYPE III BARRICADE APPROXIMATELY EVERY 1000' ACROSS THE CLOSED LANE TO HELP ENFORCE THE DRUM LINE.

CONSIDER GEOMETRICS WHEN LOCATING SIGNS AND ARROWBOARDS SO THE DRIVER HAS A CLEAR VIEW OF THE ARROWBOARD AND THE LANE CLOSURE DRUMS FOR A MINIMUM 1500' IN FRONT OF DRUMS.




LEVELS ON : 1, 2, 3, 62, 63

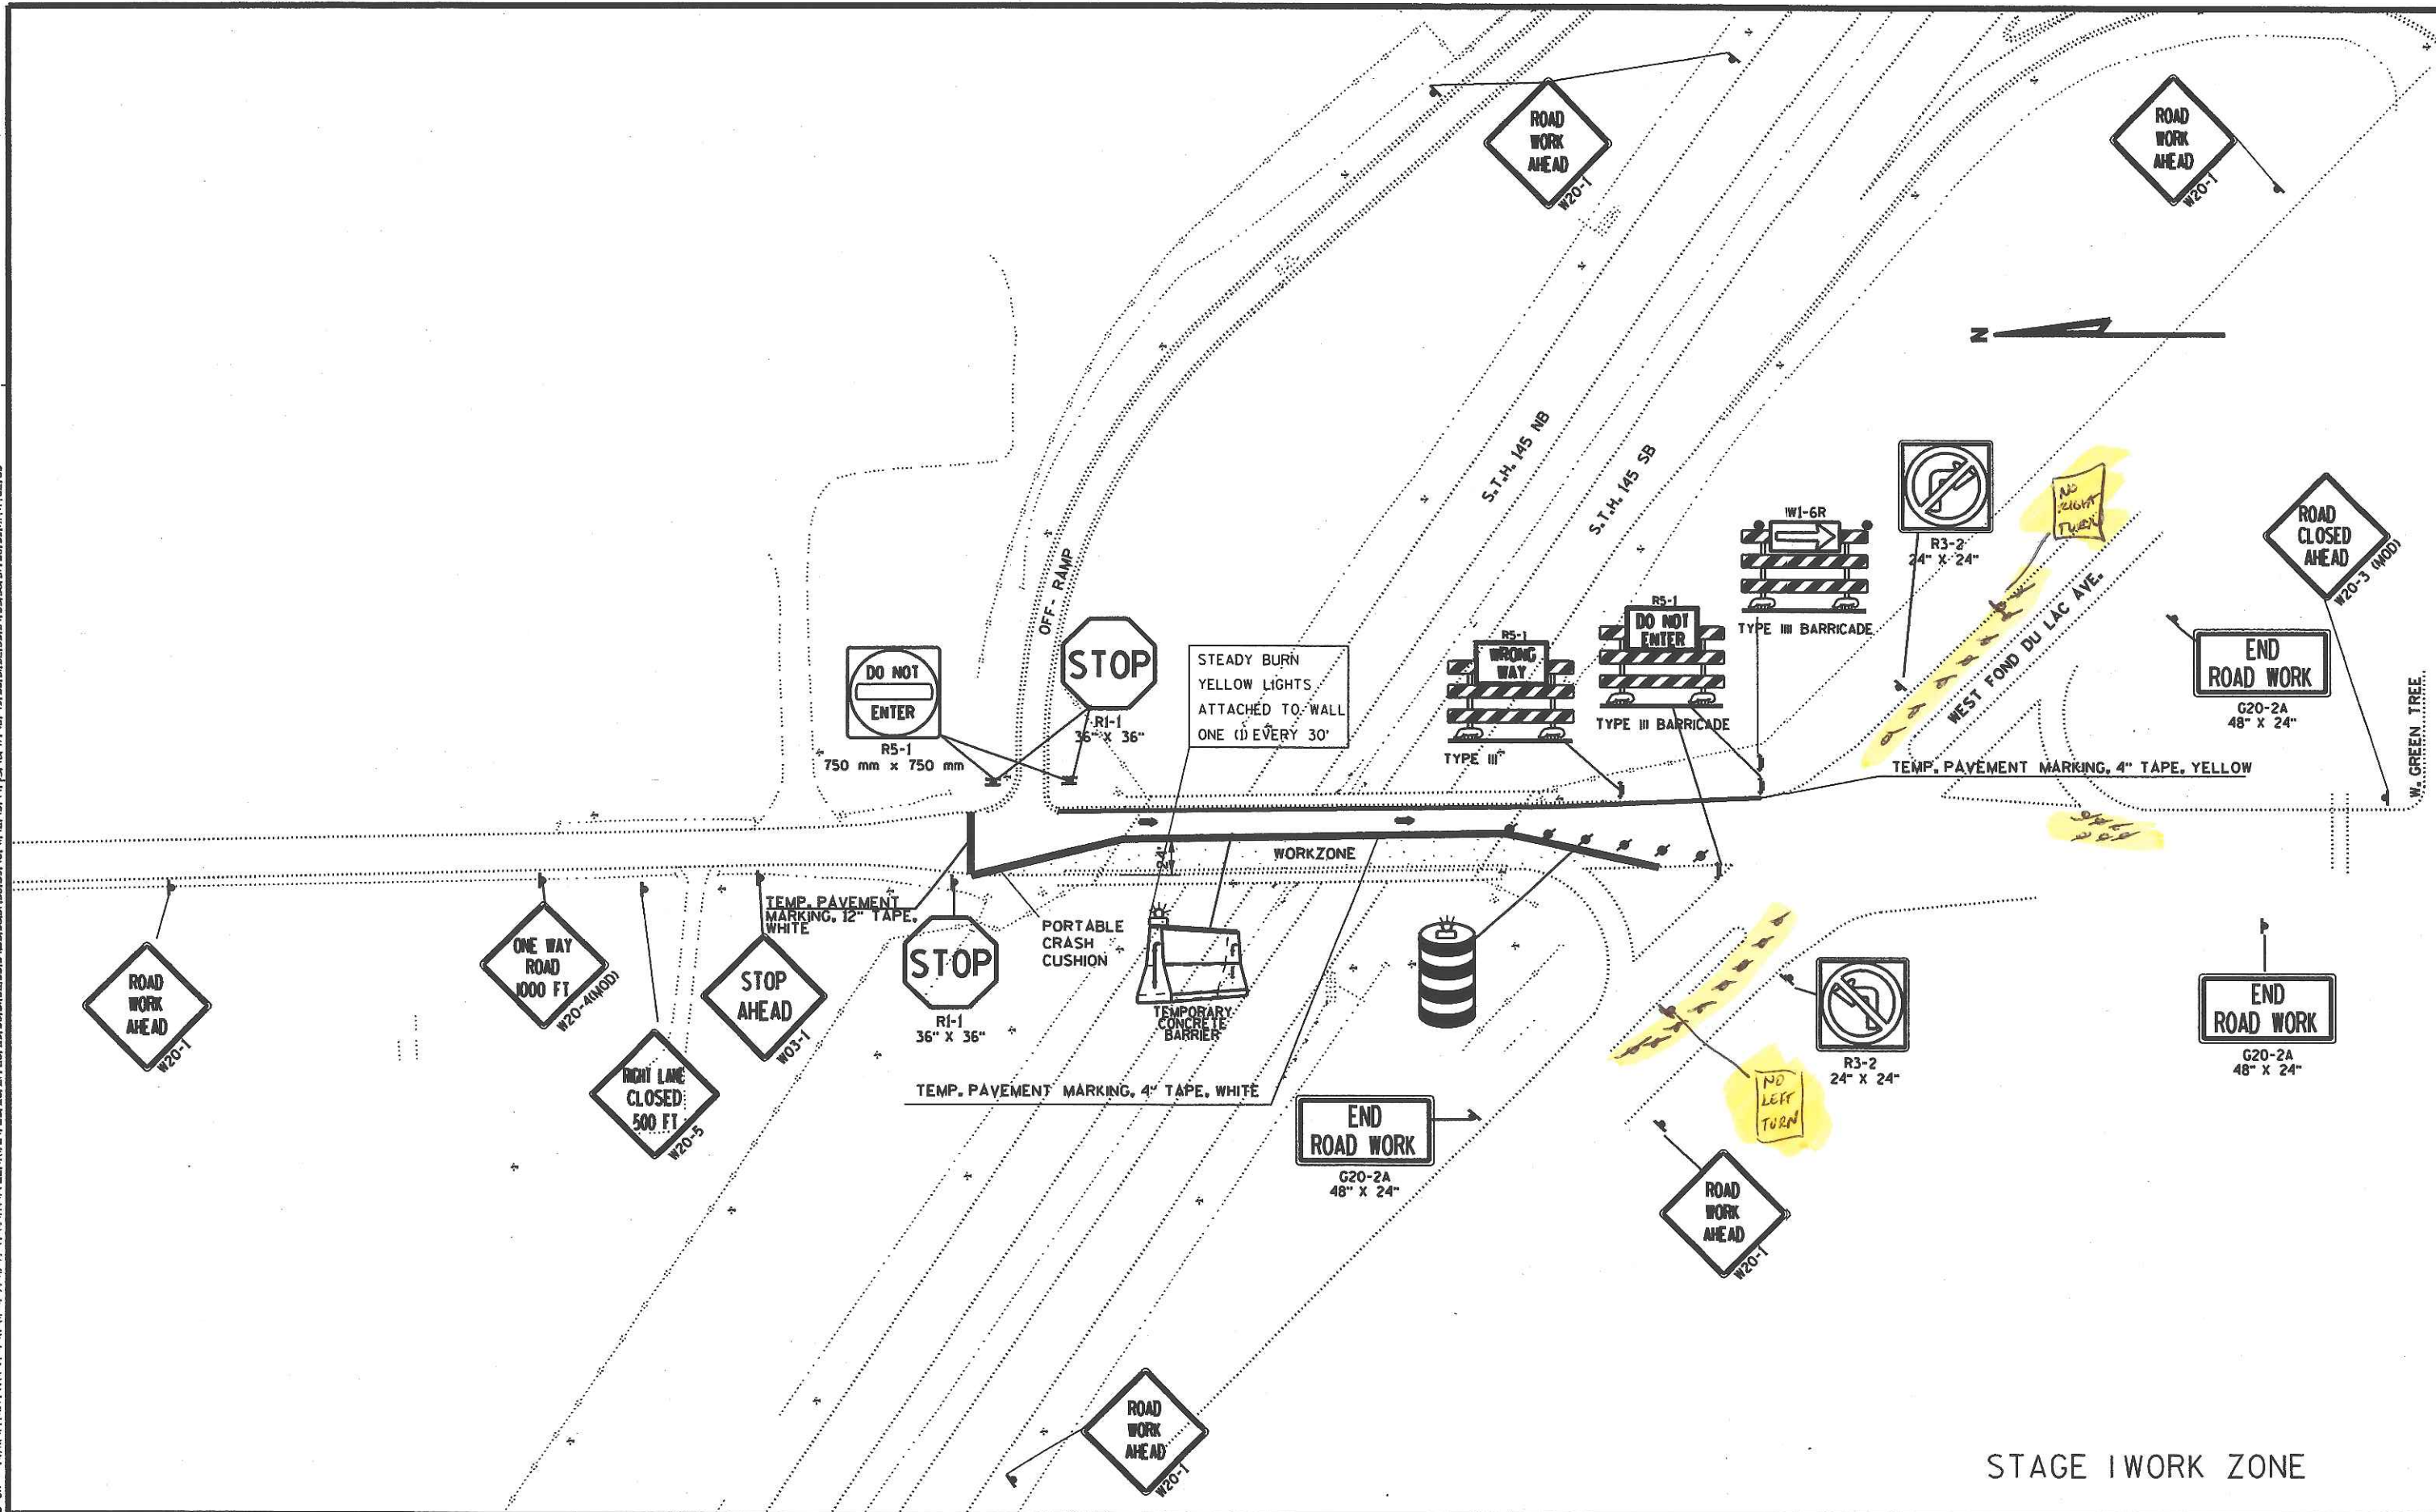



LEVELS ON : 62.63

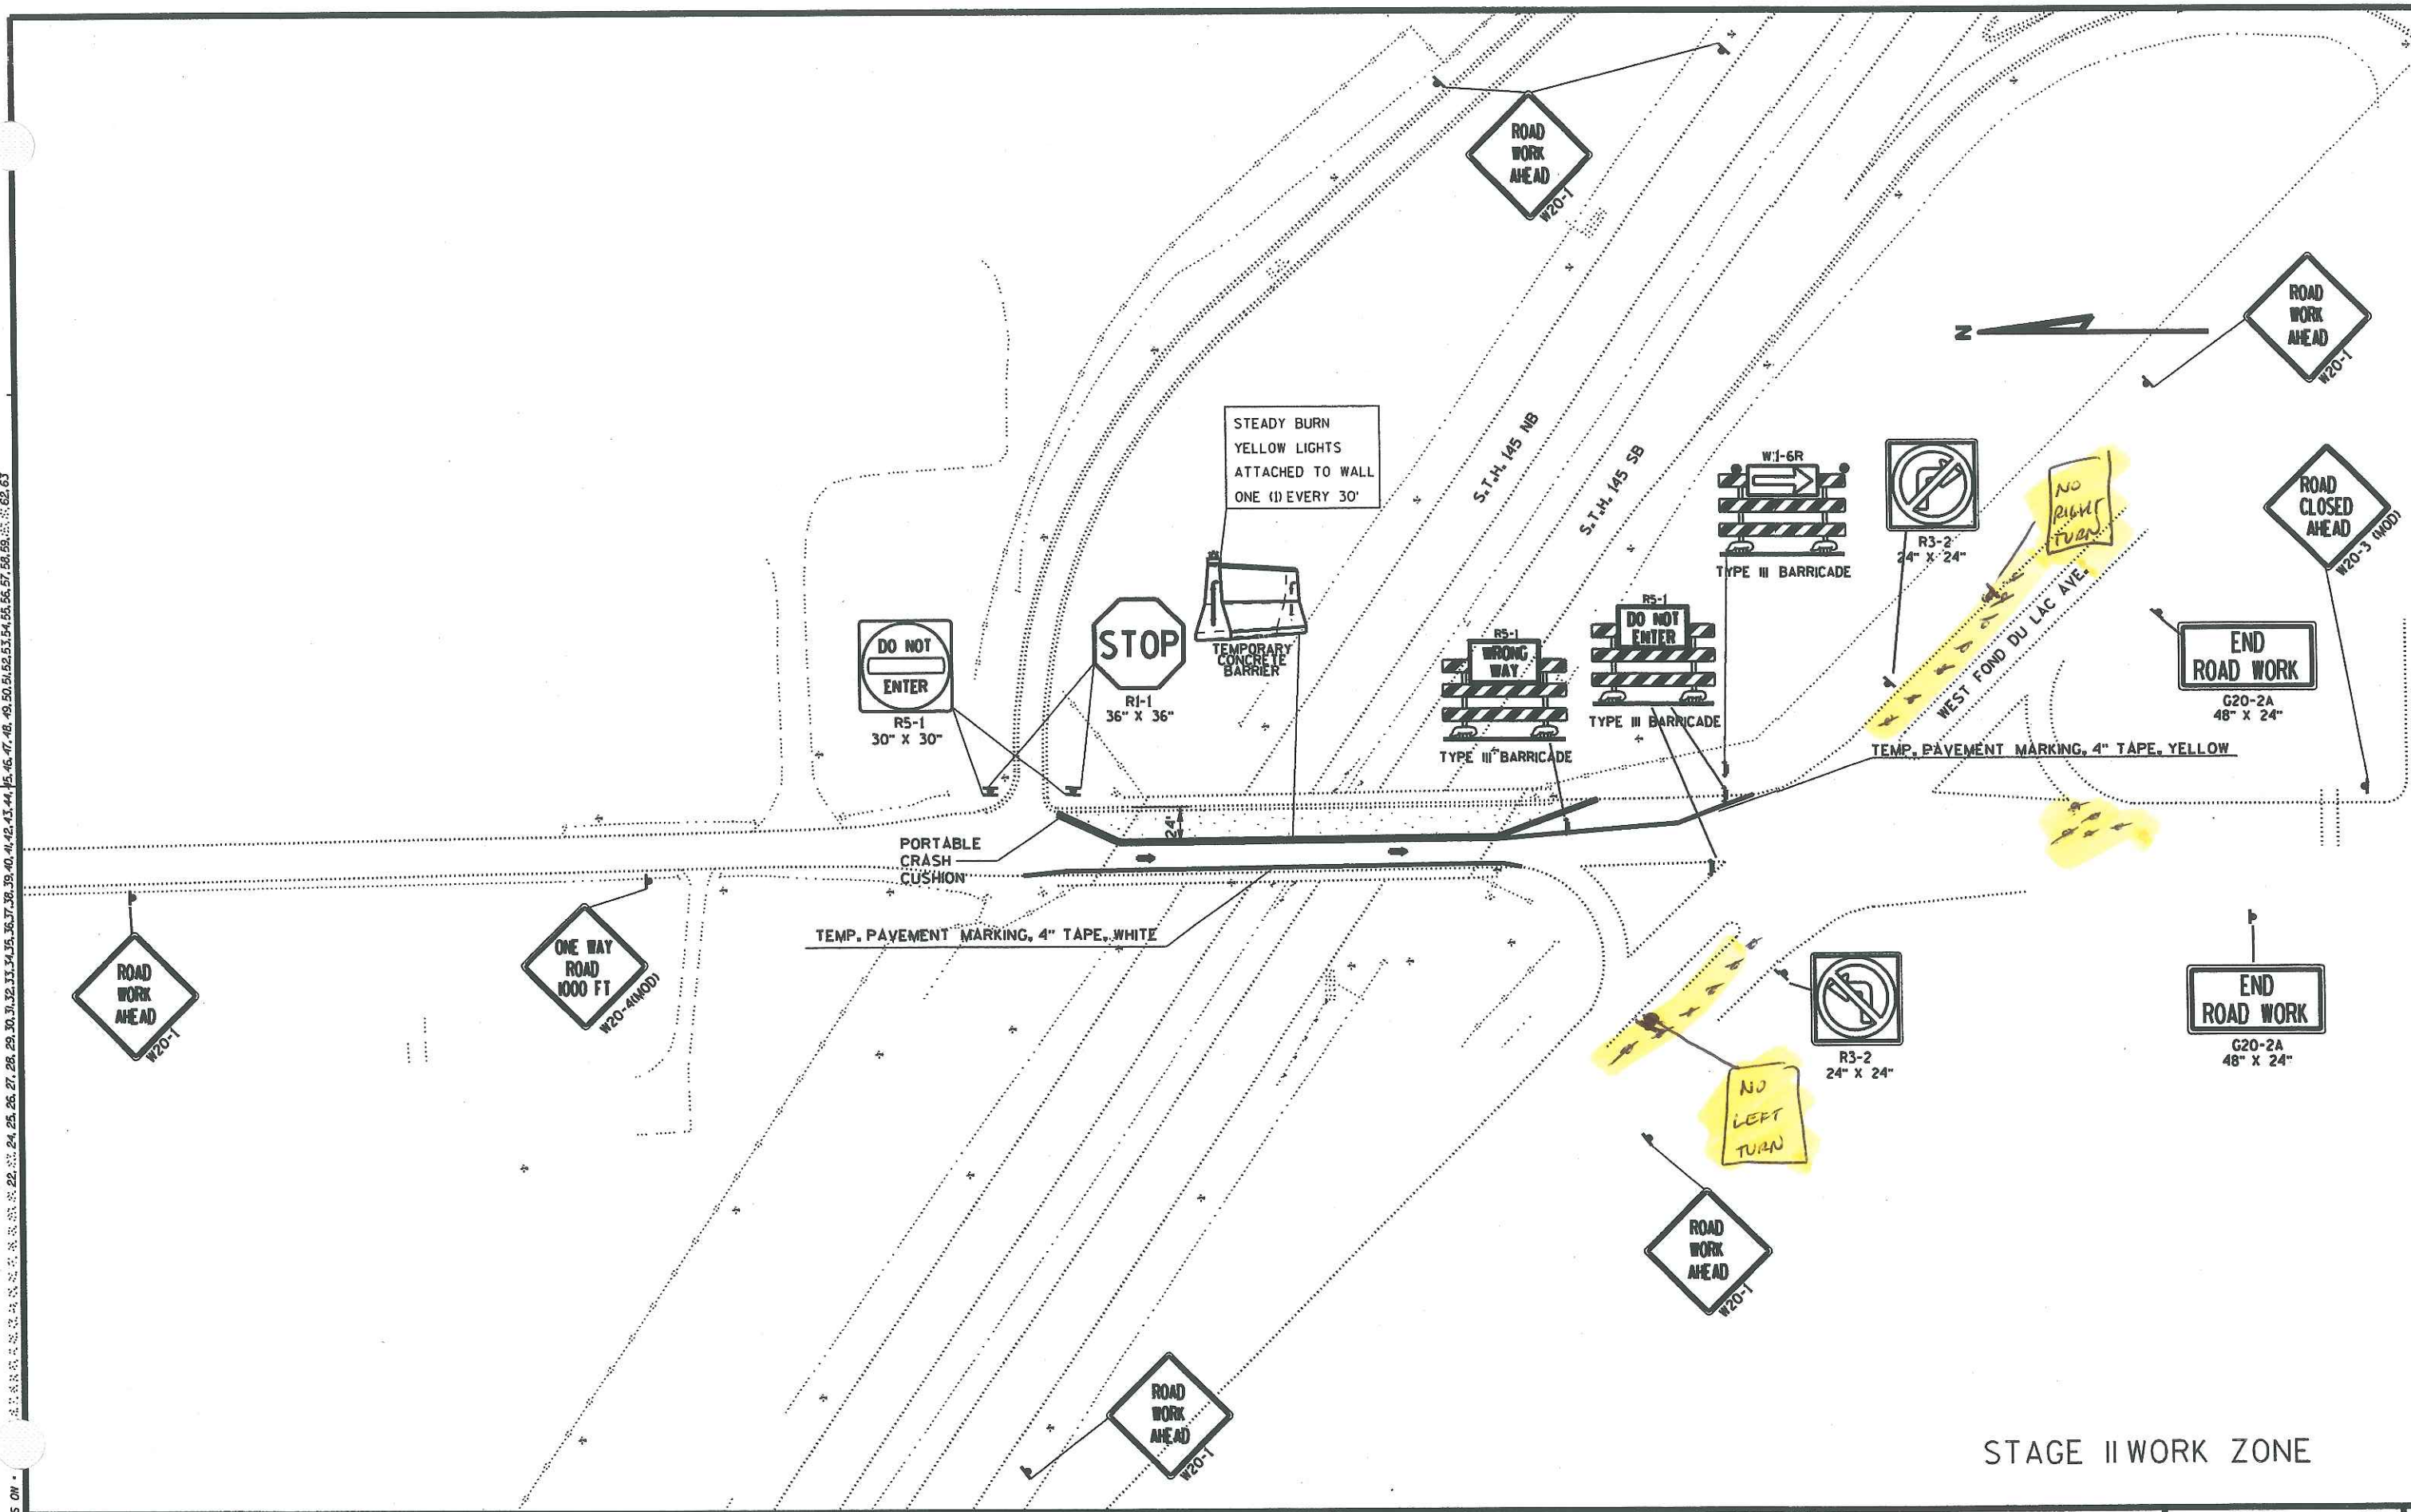

STAGE II WORK ZONE

STATE PROJECT NUMBER: 2320-02-60

HWY: STH 145

COUNTY: MILWAUKEE

TRAFFIC CONTROL

SCALE, FEET

SHEET NO: 212

FILE NAME : j:\projects\d2\_br\_4050405\tcs2.dgn

PLOT DATE: 01-JUL-1999 13:12

ORG DATE : FEB 19, 1999

PLOT NAME :


Originator : Dist

PLOT SCALE : 100.000000:1.000000

WISDOT/CADDs SHEET 42

FILE NAME: D2 BR 4050405:CTYP.DGN  
LEVELS ON: 1, 2, 3, 62, 63  
ORIGINATOR: D2 JCT  
REV. DATE: 1/22/99  
PLOT SCALE: 201.3595171:1000000  
PLOT DATE: 03-FEB-1999 09:06


### TYPICAL TWO-LANE CLOSURE (SHORT TERM-3 DAYS OR LESS)

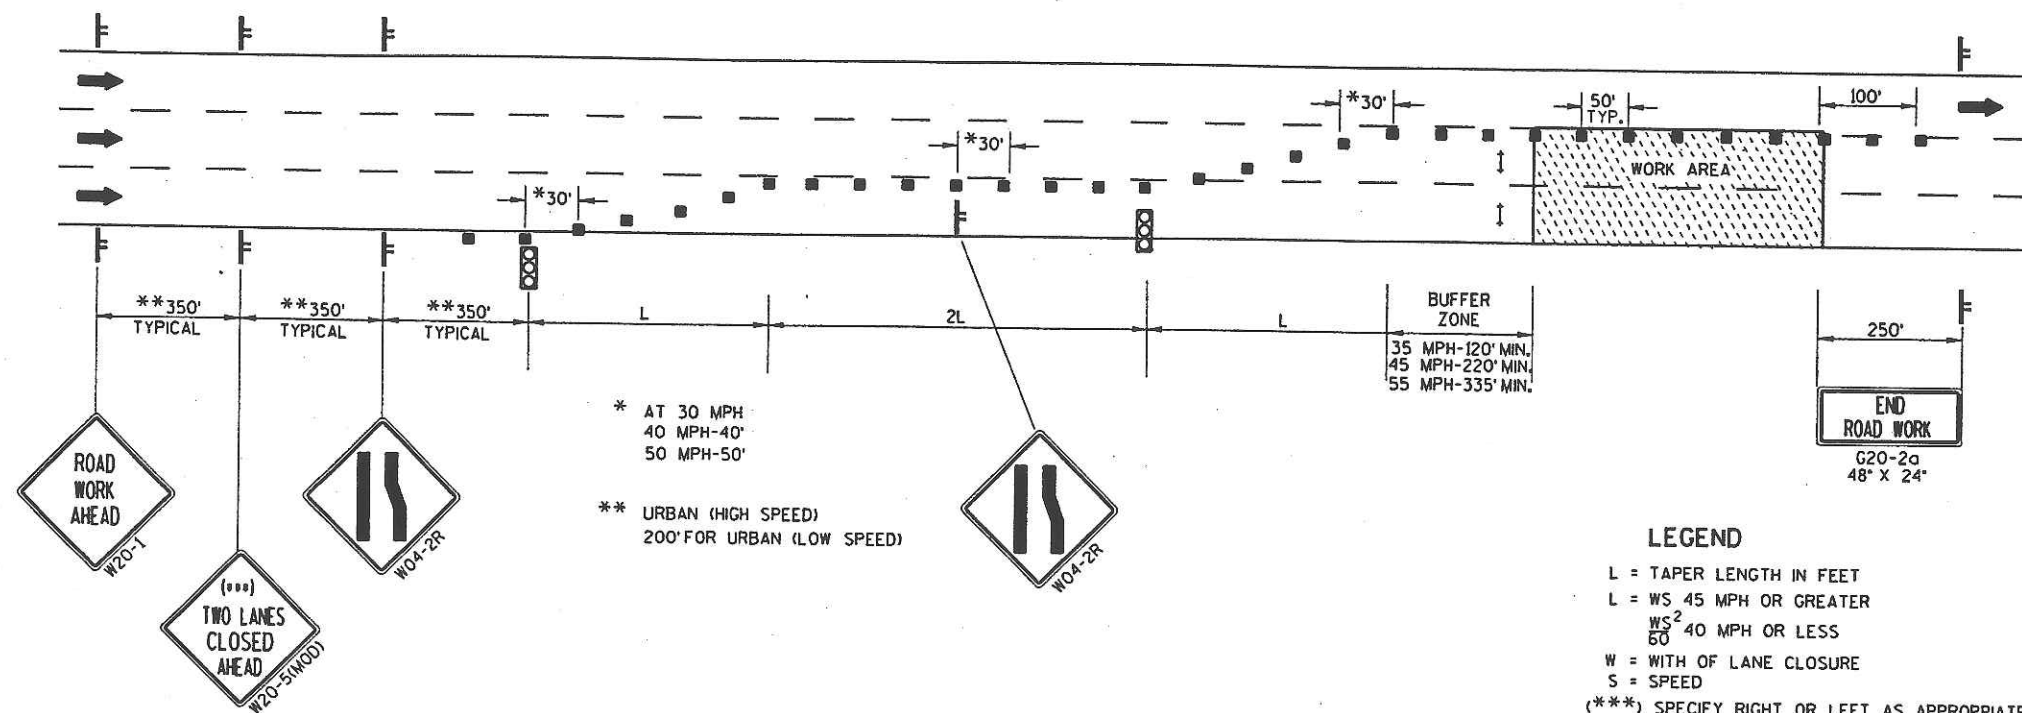

#### LEGEND

- L = TAPER LENGTH IN FEET
- L = WS 45 MPH OR GREATER  
WS<sup>2</sup> 40 MPH OR LESS
- W = WIDTH OF LANE CLOSURE
- S = SPEED
- (\*\*\*) SPECIFY RIGHT OR LEFT AS APPROPRIATE
- DRUM
- ⊥ SIGN ON TEMPORARY SUPPORT
- ⊞ ARROW BOARD
- ↑ BARRICADE TYPE III WITH 'A' WARNING LIGHTS

### TYPICAL ONE-LANE CLOSURE (SHORT TERM-3 DAYS OR LESS)

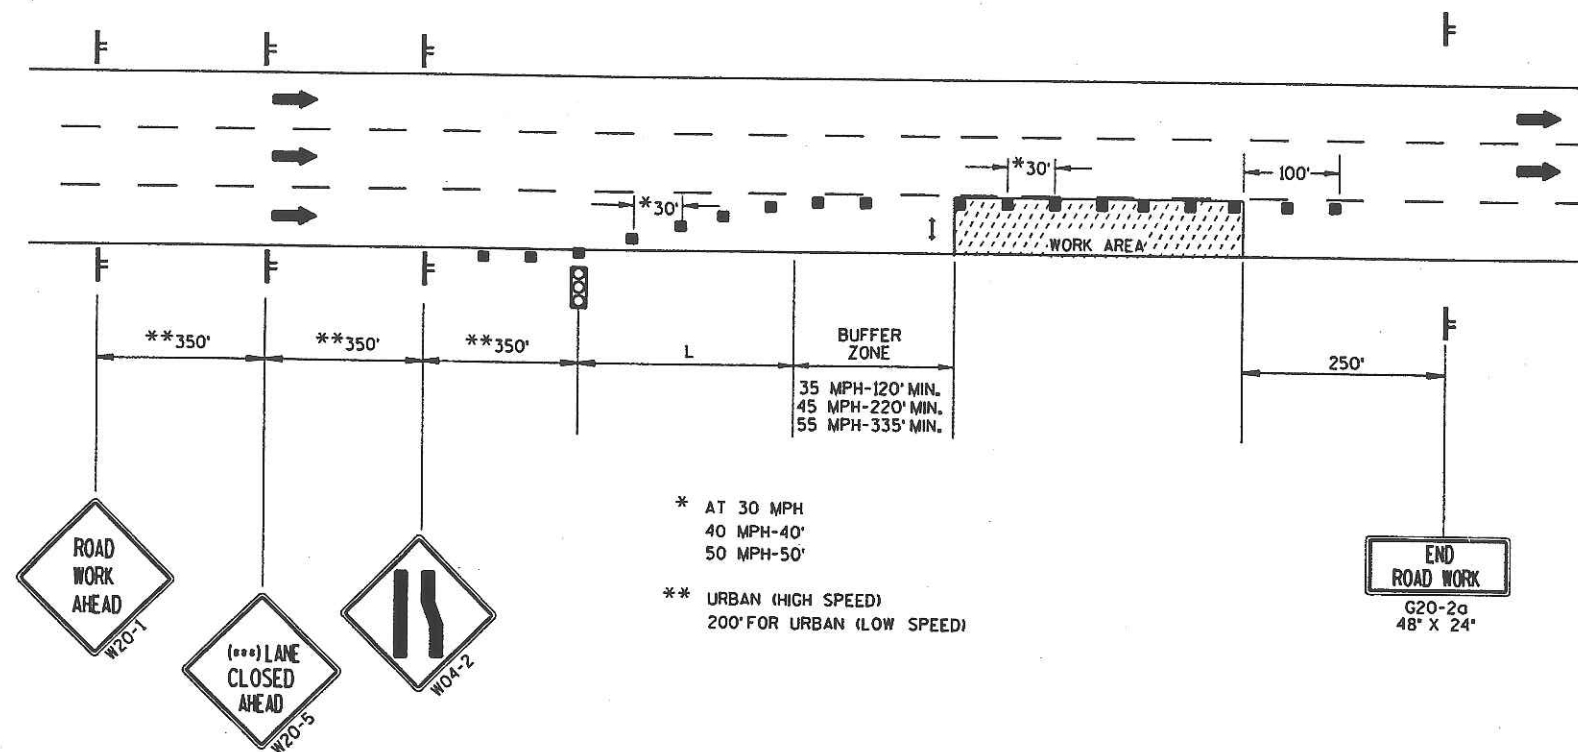

STATE PROJECT NUMBER 2320-02-60	SHEET NO. 2.13
TRAFFIC CONTROL FOR LANE CLOSURE NON - FREEWAY	
STH 100 & 145	MILWAUKEE COUNT

#### TRAFFIC CONTROL NOTES

THE EXACT NUMBER, LOCATION AND SPACING OF ALL SIGNS AND DEVICES SHALL BE ADJUSTED TO FIT FIELD CONDITIONS AS DIRECTED BY THE ENGINEER.

CHANNELIZING DEVICES PLACED ADJACENT TO WORK AREA SHALL BE PULLED BACK FROM TRAVEL LANE WHEN WORK IS NOT IN PROGRESS.

DURING HOURS OF DARKNESS, TYPE "C" (STEADY BURN) LIGHTS SHALL BE PROVIDED ON ALL CHANNELIZING DEVICES IN TAPERS. BARRICADES SHIELDING AN ISOLATED HAZARD, SHALL BE EQUIPPED WITH TYPE "A" (LOW-INTENSITY FLASHING) LIGHTS.


ALL SIGNS ARE 48" X 48" UNLESS OTHERWISE NOTED.

"WO" SIGNS ARE THE SAME AS "W" SIGNS EXCEPT THE BACKGROUND IS ORANGE.

STEADY BURN LIGHTS, WHERE USED, SHALL BE ONE-WAY / UNI-DIRECTIONAL WITH THE LIGHT SOURCE SHOWING ONLY TOWARD ADJACENT APPROACHING TRAFFIC, UNLESS THERE IS A CLEAR APPLICATION IN WHICH TWO-WAY LIGHTS WOULD LOGICALLY BENEFIT TRAFFIC CONTROL AND SAFETY.


IF LANE CLOSURE IS MORE THAN 1 MILE, PLACE A TYPE III BARRICADE APPROXIMATELY EVERY 1000' ACROSS THE CLOSED LANE TO HELP ENFORCE THE DRUM LINE.

CONSIDER GEOMETRICS WHEN LOCATING SIGNS AND ARROWBOARDS SO THE DRIVER HAS A CLEAR VIEW OF THE ARROWBOARD AND LANE CLOSURE DRUMS FOR A MINIMUM 1500' IN FRONT OF DRUMS.

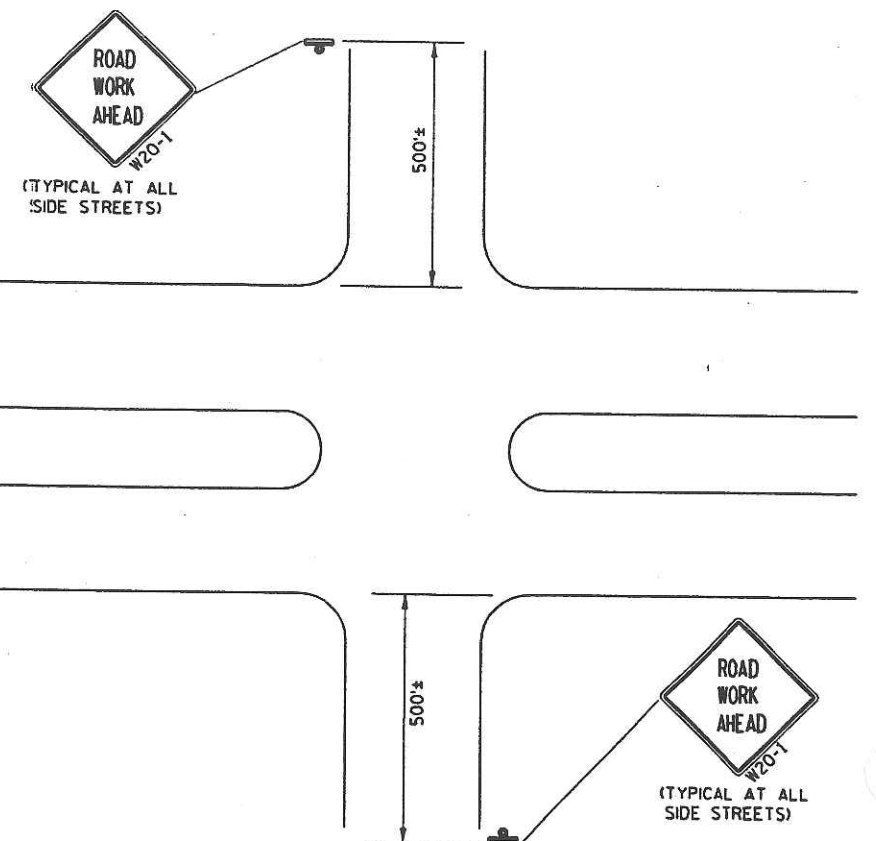



REV. DATE: 1/22/99 PLOT SCALE: 201.35951710000000 PLOT DATE: 1999 09104  
FILE NAME: R 40504051CTYP.DGN ORIGINATOR: D2 JCT  
LEVELS ON: 1, 2, 3, 62, 63

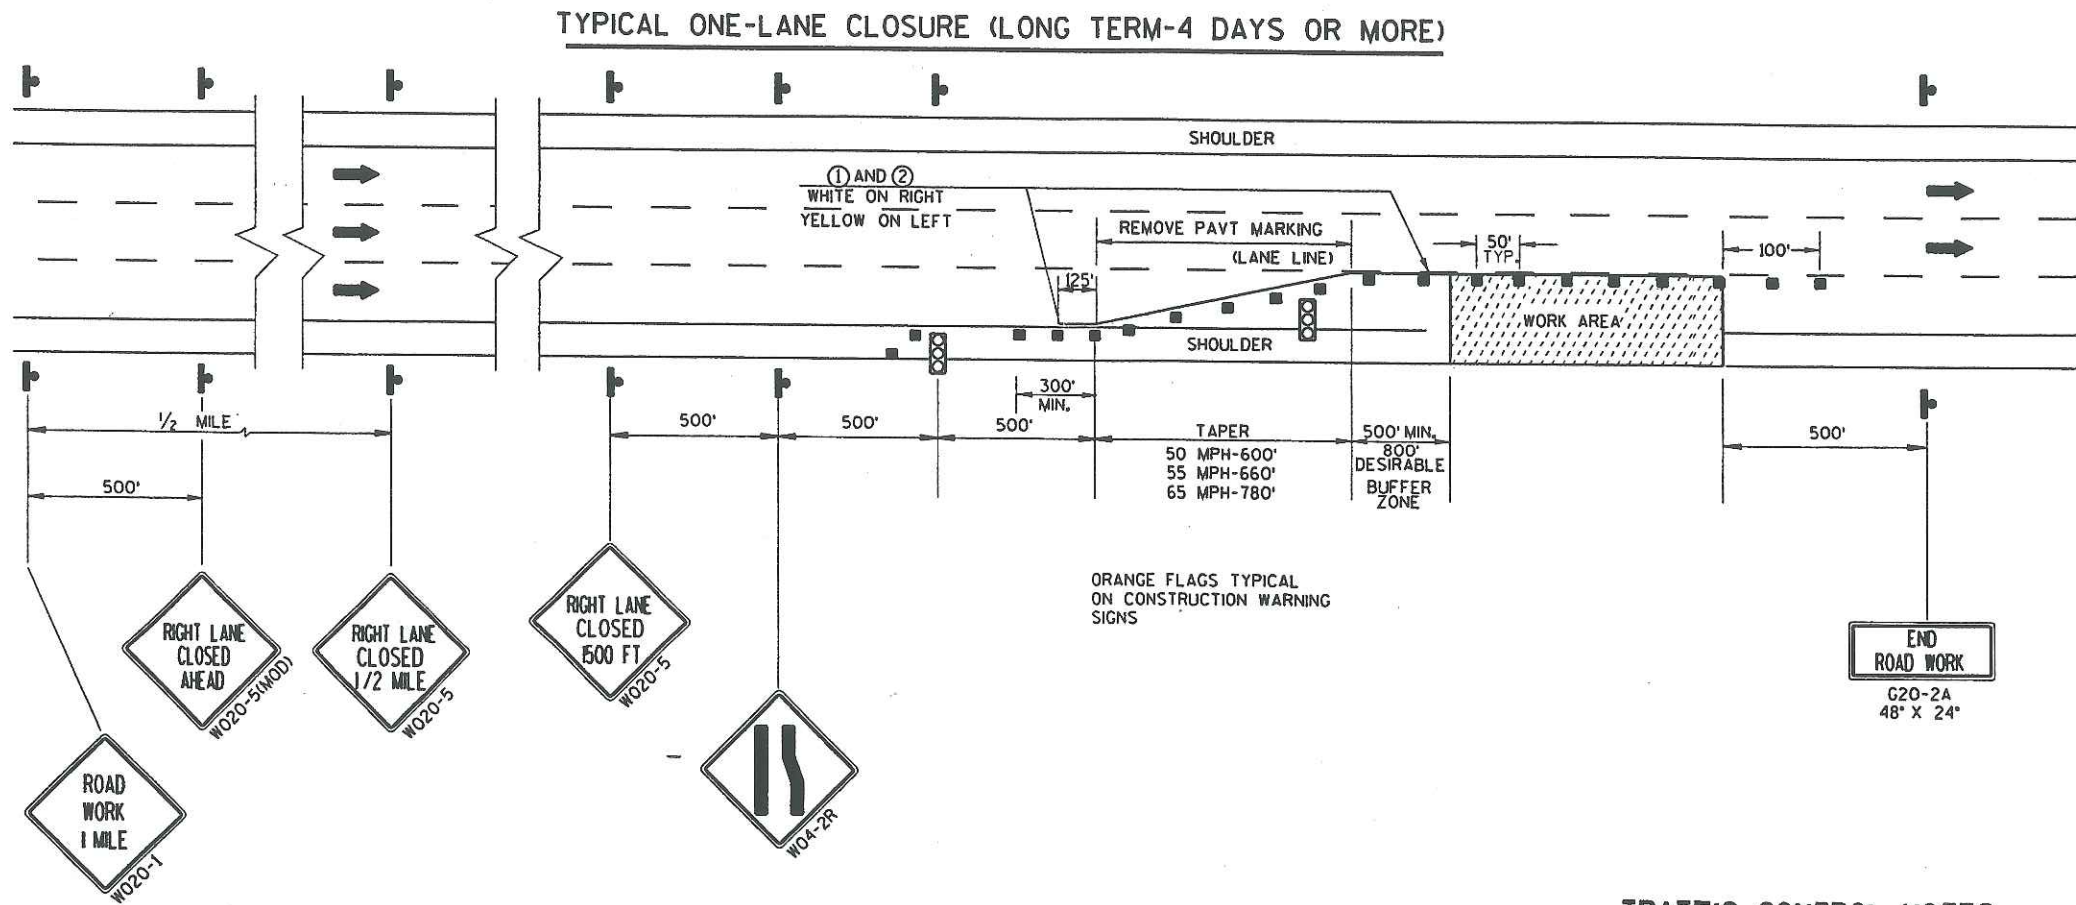

LEGEND

- DRUM
- ⊥ SIGN ON FIXED SUPPORT
- ⊥ SIGN ON TEMPORARY SUPPORT
- ⊥ ARROW BOARD

- ① TEMPORARY PAVEMENT MARKING, RAISED MARKERS, AT 25' SPACING, WHEN SPECIFIED IN MISCELLANEOUS QUANTITIES.
- ② TEMPORARY PAVEMENT MARKING, REMOVEABLE TAPE.

TRAFFIC CONTROL NOTES

RIGHT LANE CLOSURE SHOWN, LEFT LANE CLOSURE SIMILAR.

THE EXACT NUMBER, LOCATION AND SPACING OF ALL SIGNS AND DEVICES SHALL BE ADJUSTED TO FIT FIELD CONDITIONS AS DIRECTED BY THE ENGINEER.

FOR NIGHTTIME OPERATION ALL DRUMS IN TAPERS SHALL HAVE A WARNING LIGHT, TYPE C (STEADY BURN).

ALL SIGNS ARE 48" X 48" UNLESS OTHERWISE NOTED.

"WO" SIGNS ARE THE SAME AS "W" SIGNS EXCEPT THE BACKGROUND IS ORANGE.

WHEN A RAMP INTERSECTS THE FACILITY ON WHICH THE WORK IS BEING PERFORMED, ADDITIONAL TRAFFIC CONTROLS SHALL BE PROVIDED AS SPECIFIED IN THE PLANS AND/OR THE SPECIAL PROVISIONS OR AS DIRECTED BY THE ENGINEER.

ALL SHORT TERM LANE CLOSURE SIGNS SHALL BE REMOVED OR COVERED AND ALL ARROWBOARDS AND DEVICES REMOVED BEYOND THE SHOULDER WHEN THE WORK IS NOT IN PROGRESS AND THE LANE IS RESTORED TO A SAFE OPERATING CONDITION.

ALL WARNING SIGNS FOR LONG TERM OPERATIONS SHALL BE NON-FLUORESCENT DIAMOND (GRADE SHEETING, TYPE A LIGHTS AND FLAGS ARE NOT REQUIRED WHEN USING DIAMOND GRADE SHEETING.


IF LANE CLOSURE IS MORE THAN 1 MILE, PLACE A TYPE III BARRICADE APPROXIMATELY EVERY 1000' ACROSS THE CLOSED LANE TO HELP ENFORCE THE DRUM LINE.

CONSIDER GEOMETRICS WHEN LOCATING SIGNS AND ARROWBOARDS SO THE DRIVER HAS A CLEAR VIEW OF THE ARROWBOARD AND LANE CLOSURE DRUMS FOR A MINIMUM 1500' IN FRONT OF DRUMS.

REMOVE EXIST. PAV'T. MARKING  
FOR TAPER LENGTH

TEMPORARY PAVEMENT MARKING, REMOVEABLE  
TAPE, WHITE ON RIGHT YELLOW ON LEFT

REMOVE EXIST. PAV'T. MARKING  
FOR TAPER LENGTH

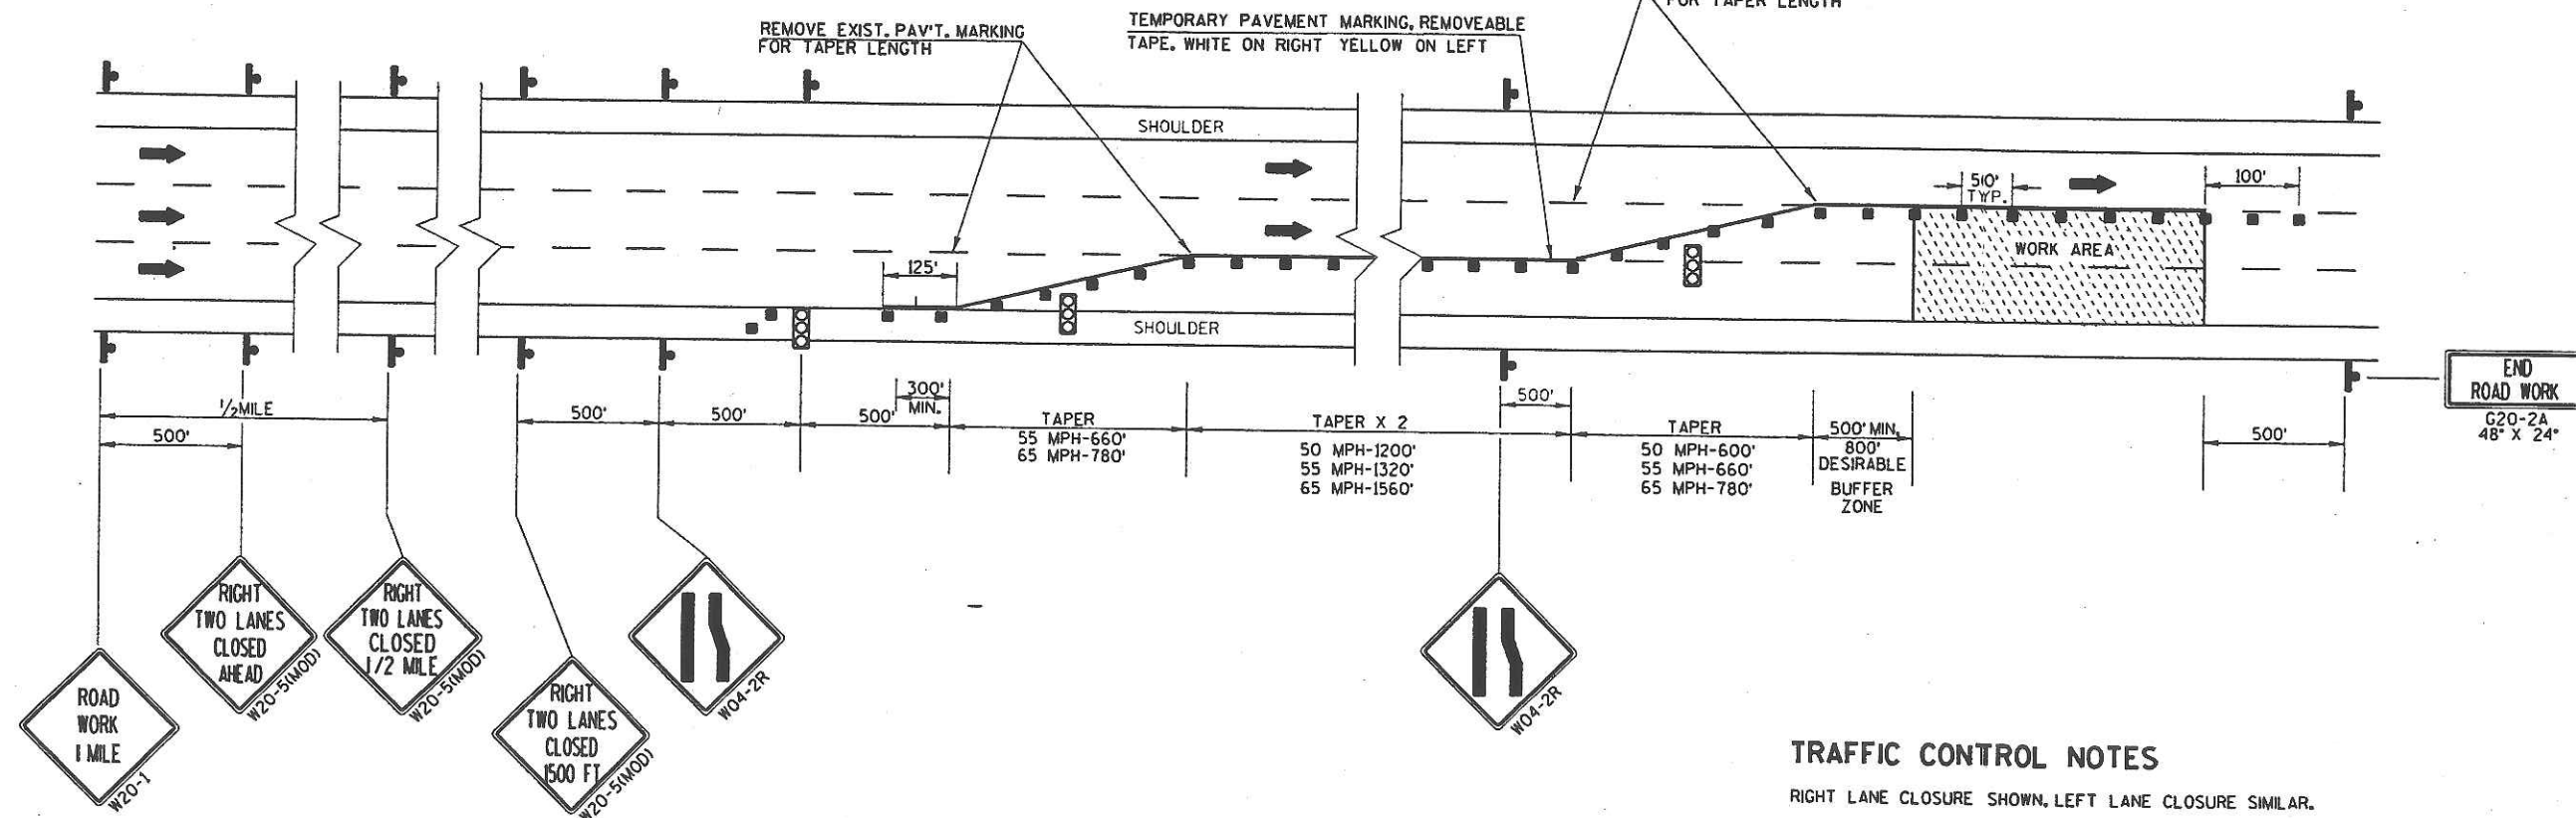

- DRUM
- ⊥ SIGN ON FIXED SUPPORT
- ⊥ SIGN ON TEMPORARY SUPPORT
- ⬆ ARROW BOARD

RIGHT LANE CLOSURE SHOWN, LEFT LANE CLOSURE SIMILAR.

THE EXACT NUMBER, LOCATION AND SPACING OF ALL SIGNS AND DEVICES SHALL BE ADJUSTED TO FIT FIELD CONDITIONS AS DIRECTED BY THE ENGINEER.

FOR NIGHTTIME OPERATION ALL DRUMS IN TAPERS SHALL HAVE A WARNING LIGHT, TYPE C (STEADY BURN).

ALL SIGNS ARE 48" X 48" UNLESS OTHERWISE NOTED.

"WO" SIGNS ARE THE SAME AS "W" SIGNS EXCEPT THE BACKGROUND IS ORANGE.

WHEN A RAMP INTERSECTS THE FACILITY ON WHICH THE WORK IS BEING PERFORMED, ADDITIONAL TRAFFIC CONTROLS SHALL BE PROVIDED AS SPECIFIED IN THE PLANS AND/OR THE SPECIAL PROVISIONS OR AS DIRECTED BY THE ENGINEER.

ALL SHORT TERM LANE CLOSURE SIGNS SHALL BE REMOVED OR COVERED AND ALL ARROWBOARDS AND DEVICES REMOVED BEYOND THE SHOULDER WHEN THE WORK IS NOT IN PROGRESS AND THE LANE IS RESTORED TO A SAFE OPERATING CONDITION.


ALL WARNING SIGNS FOR LONG TERM OPERATIONS SHALL BE NON-FLUORESCENT DIAMOND GRADE SHEETING. TYPE A LIGHTS AND FLAGS ARE NOT REQUIRED WHEN USING DIAMOND GRADE SHEETING.

IF LANE CLOSURE IS MORE THAN 1MILE, PLACE A TYPE III BARRICADE  
APPROXIMATELY EVERY 1000' ACROSS THE CLOSED LANE TO HELP ENFORCE  
THE DRUM LINE.

CONSIDER GEOMETRICS WHEN LOCATING SIGNS AND ARROWBOARDS SO THE DRIVER HAS A CLEAR VIEW OF THE ARROWBOARD AND LANE CLOSURE DRUMS FOR A MINIMUM 1500' IN FRONT OF DRUMS.



LINE NUMBER	ITEM	ITEM DESCRIPTION	UNIT	TOTAL	2320-02-60 QUANTITY
0010	20401	REMOVING PAVEMENT	S.Y.	325.00	325.00
0020	20405	REMOVING CURB AND GUTTER	L.F.	141.00	141.00
0030	20406	REMOVING CONCRETE SIDEWALK	S.Y.	30.00	30.00
0040	20419	REMOVING ASPHALTIC SURFACE, BUTT JOINTS	S.Y.	420.00	420.00
0050	21301	FINISHING ROADWAY	LS	1.00	1.00
0060	40204	ASPHALTIC MATERIAL FOR TACK COAT	GAL.	21.00	21.00
0070	40501	ASPHALTIC MATERIAL FOR PLANT MIXES	TON	7.00	7.00
0080	40713	ASPHALTIC CONCRETE PAVEMENT, TYPE MV	TON	103.00	103.00
0090	41653	PAVEMENT TIES	EACH	39.00	39.00
0100	50201	CONCRETE MASONRY, BRIDGES	C.Y.	18.00	18.00
0110	50232	EXPANSION DEVICE, STRUCTURE B-40-252	LS	1.00	1.00
0120	50265	PROTECTIVE SURFACE TREATMENT	S.Y.	3,567.00	3,567.00
0130	50511	COATED HIGH STRENGTH BAR STEEL REINFORCEMENT, BRIDGES	LB.	1,820.00	1,820.00
0140	50902	PREPARATION, APPROACHES	S.Y.	215.00	215.00
0150	50903	PREPARATION, DECKS, TYPE 1	S.Y.	730.00	730.00
0160	50904	PREPARATION, DECKS, TYPE 2	S.Y.	730.00	730.00
0170	50905	CLEANING, DECKS	S.Y.	3,567.00	3,567.00
0180	50906	CLEANING, APPROACHES	S.Y.	885.00	885.00
0190	50910	JOINT REPAIR	S.Y.	42.00	42.00
0200	50912	CURB REPAIR	L.F.	35.00	35.00
0210	50915	CONCRETE SURFACE REPAIR	S.F.	80.00	80.00
0220	50920	FULL DEPTH DECK REPAIR	S.Y.	70.00	70.00
0230	50925	CONCRETE MASONRY, OVERLAY, DECKS	C.Y.	268.00	268.00
0240	50926	CONCRETE MASONRY, OVERLAY, APPROACHES	C.Y.	53.00	53.00
0250	60123	CONCRETE CURB AND GUTTER, 30-INCH, TYPE A	L.F.	171.00	171.00
0260	60133	CONCRETE CURB AND GUTTER, 30-INCH, TYPE D	L.F.	171.00	171.00
0270	60205	CONCRETE SIDEWALK, 5-INCH	S.F.	456.00	456.00
0280	60305	TEMPORARY PRECAST CONCRETE BARRIER, CONTRACTOR FURNISHED AND DELIVERED	L.F.	1,820.00	1,820.00
0290	60308	TEMPORARY PRECAST CONCRETE BARRIER, CONTRACTOR FURNISHED, CONTRACTOR INSTALLED	L.F.	1,820.00	1,820.00
0300	61183	ADJUSTING INLET COVERS	EACH	1.00	1.00
0310	61425	PORTABLE CRASH CUSHIONS, DELIVERED	EACH	3.00	3.00
0320	61426	PORTABLE CRASH CUSHIONS, INSTALLED	EACH	6.00	6.00

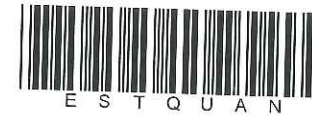



DATE 25JUN99

## ESTIMATE OF QUANTITIES

SHEET: 3.2

LINE NUMBER	ITEM	ITEM DESCRIPTION	UNIT	TOTAL	2320-02-60 QUANTITY
0330	61910	MOBILIZATION	LS	1.00	1.00
0340	64201	FIELD OFFICE, TYPE A	LS	1.00	1.00
0350	64301	TRAFFIC CONTROL	LS	1.00	1.00
0360	64310	TRAFFIC CONTROL, ARROW BOARDS	DAYS	172.00	172.00
0370	64313	TRAFFIC CONTROL, DRUMS	DAYS	6,628.00	6,628.00
0380	64318	TRAFFIC CONTROL, BARRICADES, TYPE III	DAYS	635.00	635.00
0390	64321	TRAFFIC CONTROL, WARNING LIGHTS, TYPE A	DAYS	892.00	892.00
0400	64323	TRAFFIC CONTROL, WARNING LIGHTS, TYPE C	DAYS	2,648.00	2,648.00
0410	64326	TRAFFIC CONTROL, SIGNS	DAYS	978.00	978.00
0420	64327	TRAFFIC CONTROL, SIGNS, FIXED MESSAGE	S.F.	488.00	488.00
0430	64334	TRAFFIC CONTROL, DETOUR	LS	1.00	1.00
0440	64602	PAVEMENT MARKING, 4-INCH, EPOXY	L.F.	2,050.00	2,050.00
0450	64618	PAVEMENT MARKING, CHANNELIZING, 8-INCH, EPOXY	L.F.	260.00	260.00
0460	64635	PAVEMENT MARKING, RAISED MARKERS	EACH	3.00	3.00
0470	64642	REMOVING PAVEMENT MARKINGS	L.F.	450.00	450.00
0480	64734	PAVEMENT MARKING, ARROWS, TYPE 2, EPOXY	EACH	1.00	1.00
0490	64758	PAVEMENT MARKING, WORDS, EPOXY	EACH	2.00	2.00
0500	64904	TEMPORARY PAVEMENT MARKING, 4-INCH, REMOVABLE TAPE	L.F.	12,074.00	12,074.00
0510	64910	TEMPORARY PAVEMENT MARKING, STOP LINE, 12-INCH, REMOVABLE TAPE	L.F.	44.00	44.00
0520	66501	SAWING EXISTING PAVEMENT	L.F.	569.00	569.00





\$PRNAME\$  
PEN TABLE = #plot72+LASER+s  
DATE OF PLOT: 2/23/99  
DESIGN FILE = U:\TRROADS\46187bpl.dgn  
DGN LEVELS ON = 1-63

ALL QUANTITIES ON THIS SHEET ARE CATEGORY 0010

STATE PROJECT NUMBER	SHEET NO.
2320-02-60	3A
QUANTITIES FOR	
S.T.H. 100	MILWAUKEE COUNTY

MISCELLANEOUS QUANTITIES

ITEM NO. 50906 CLEANING, APPROACHES*		
STAGE	LOCATION	S.Y.
1	EAST BOUND LANES - WEST APPROACH	150
1	EAST BOUND LANES - EAST APPROACH	100
1	WEST BOUND LANES - WEST APPROACH	155
1	WEST BOUND LANES - EAST APPROACH	85
2	EAST BOUND LANES - WEST APPROACH	85
2	EAST BOUND LANES - EAST APPROACH	80
2	WEST BOUND LANES - WEST APPROACH	80
2	WEST BOUND LANES - EAST APPROACH	50
TOTAL		785

ITEM NO. 61183 ADJUSTING INLET COVERS		
STAGE	LOCATION	EACH
2	EAST BOUND LANES - EAST APPROACH	1

ITEM NO. 50926 CONCRETE MASONRY, OVERLAY, APPROACHES*		
STAGE	LOCATION	C.Y.
1	EAST BOUND LANES - WEST APPROACH	9
1	EAST BOUND LANES - EAST APPROACH	6
1	WEST BOUND LANES - WEST APPROACH	9
1	WEST BOUND LANES - EAST APPROACH	5
2	EAST BOUND LANES - WEST APPROACH	5
2	EAST BOUND LANES - EAST APPROACH	5
2	WEST BOUND LANES - WEST APPROACH	5
2	WEST BOUND LANES - EAST APPROACH	3
TOTAL		47

ITEM NO. 66501 SAWING EXISTING PAVEMENT*			
STAGE	LOCATION	L.F.	REMARKS
1	EAST BOUND LANES - WEST APPROACH	80	CONCRETE
1	EAST BOUND LANES - EAST APPROACH	58	CONCRETE
1	WEST BOUND LANES - WEST APPROACH	78	CONCRETE
1	WEST BOUND LANES - EAST APPROACH	57	CONCRETE
2	EAST BOUND LANES - WEST APPROACH	14	CONCRETE
2	EAST BOUND LANES - EAST APPROACH	24	CONCRETE
2	WEST BOUND LANES - WEST APPROACH	14	CONCRETE
2	WEST BOUND LANES - EAST APPROACH	14	CONCRETE
TOTAL		339	

ITEM NO. 50902 PREPARATION, APPROACHES*		
STAGE	LOCATION	S.Y.
1	EAST BOUND LANES - WEST APPROACH	30
1	EAST BOUND LANES - EAST APPROACH	30
1	WEST BOUND LANES - WEST APPROACH	30
1	WEST BOUND LANES - EAST APPROACH	30
2	EAST BOUND LANES - WEST APPROACH	15
2	EAST BOUND LANES - EAST APPROACH	25
2	WEST BOUND LANES - WEST APPROACH	15
2	WEST BOUND LANES - EAST APPROACH	15
TOTAL		190

ITEM NO. 20405 REMOVING CURB AND GUTTER*		
STAGE	LOCATION	L.F.
1	EAST BOUND LANES - WEST APPROACH	20
1	WEST BOUND LANES - WEST APPROACH	20
1	WEST BOUND LANES - EAST APPROACH	10
2	EAST BOUND LANES - WEST APPROACH	10
2	WEST BOUND LANES - WEST APPROACH	20
2	WEST BOUND LANES - EAST APPROACH	10
TOTAL		90


ITEM NO. 64602			
PAVEMENT MARKING, 4-INCH, EPOXY *			
STA. - STA.	LOCATION	LANE LINES WHITE L.F.	EDGE LINES WHITE L.F.
513'E'+39 TO 516'E'+80	EAST BOUND LANES - 24 FT. RT.	---	341
513'E'+39 TO 516'E'+80	EAST BOUND LANES - 12 FT. RT.	90	---
513'E'+39 TO 516'E'+80	EAST BOUND LANES - CENTERLINE	90	---
513'W'+49 TO 516'W'+88	WEST BOUND LANES - CENTERLINE	90	---
513'W'+49 TO 516'W'+88	WEST BOUND LANES - 12 FT. LT.	90	---
513'W'+49 TO 516'W'+88	WEST BOUND LANES - 24 FT. LT.	---	339
SUB TOTAL		360	680
TOTAL		1040	

ITEM NO. 64618 PAVEMENT MARKING, CHANNELIZING, 8-INCH, EPOXY*		
STA. - STA.	LOCATION	L.F.
516'E'+00 TO 516'E'+80	EAST BOUND LANES - 12 FT. LT.	80

ITEM NO. 60123 CONCRETE CURB AND GUTTER, 30-INCH, TYPE A*		
STAGE	LOCATION	L.F.
1	EAST BOUND LANES - WEST APPROACH	20
1	WEST BOUND LANES - WEST APPROACH	20
1	WEST BOUND LANES - EAST APPROACH	10
2	EAST BOUND LANES - WEST APPROACH	10
2	WEST BOUND LANES - WEST APPROACH	20
2	WEST BOUND LANES - EAST APPROACH	10
TOTAL		90

ITEM NO. 20401 REMOVING PAVEMENT*		S.Y.
LOCATION		
UNDISTRIBUTED		195

ITEM NO. 41653 PAVEMENT TIES*		
STAGE	LOCATION	EACH
1	EAST BOUND LANES - WEST APPROACH	7
1	WEST BOUND LANES - WEST APPROACH	7
1	WEST BOUND LANES - EAST APPROACH	4
2	EAST BOUND LANES - WEST APPROACH	4
2	WEST BOUND LANES - WEST APPROACH	7
2	WEST BOUND LANES - EAST APPROACH	4
2	EAST BOUND LANES - EAST APPROACH	4
TOTAL		37

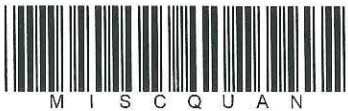

\* ADDITIONAL QUANTITIES SHOWN ELSEWHERE

\$PRNAME\$  
PEN TABLE = #plot72+LASER+Spp.tbl  
DATE OF PLOT: 2/23/99  
DESIGN FILE = U:\TRROADS\46187\dl.dgn  
DGN LEVELS ON = 1-63

ALL QUANTITIES ON THIS SHEET ARE CATEGORY 0010

STATE PROJECT NUMBER 2320-02-60	SHEET NO. 38
QUANTITIES FOR NORTH 107th ST. MILWAUKEE COUNTY	

MISCELLANEOUS QUANTITIES

ITEM NO. 20419 REMOVING ASPHALTIC SURFACE, BUTT JOINTS		
STAGE	LOCATION	S.Y.
1	STA. 114+14 TO STA. 115+00	195
2	STA. 114+14 TO STA. 115+00	225
	TOTAL	420

ITEM NO. 50906 CLEANING, APPROACHES*		
STAGE	LOCATION	S.Y.
1	STA. 111+45 TO STA. 111+65	69
2	STA. 111+45 TO STA. 111+65	31
	TOTAL	100

ITEM NO. 50902 PREPARATION, APPROACHES*		
STAGE	LOCATION	S.Y.
1	STA. 111+45 TO STA. 111+65	17
2	STA. 111+45 TO STA. 111+65	8
	TOTAL	25

ITEM NO. 20401 REMOVING PAVEMENT*		
LOCATION	S.Y.	
UNDISTRIBUTED	130	

ITEM NO. 50926 CONCRETE MASONRY, OVERLAY, APPROACHES*		
STAGE	LOCATION	C.Y.
1	STA. 111+45 TO STA. 111+65	4
2	STA. 111+45 TO STA. 111+65	2
	TOTAL	6

ITEM NO. 64602 PAVEMENT MARKING, 4-INCH, EPOXY*		
LOCATION	LANE LINES DOUBLE YELLOW	L.F.
STA. 111+45 TO STA. 115+00, CENTERLINE		710
STA. 113+50 TO STA. 115+00, 11 FT. LT.		300
	TOTAL	1010

ITEM NO. 64618 PAVEMENT MARKING, CHANNELIZING, 8-INCH, EPOXY*		
LOCATION	L.F.	
STA. 111+45 TO STA. 113+25, 11 FT. LT.	180	

ITEM NO. 64734 PAVEMENT MARKING, ARROWS, TYPE 2, EPOXY		
LOCATION	EACH	
STA. 112+75, 5.5 FT. LT.	1	

ITEM NO. 64758 PAVEMENT MARKING, WORDS, EPOXY		
LOCATION	EACH	
STA. 111+65, 5.5 FT. LT.	1	
STA. 113+25, 5.5 FT. LT.	1	
	TOTAL	2

ITEM NO. 66501 SAWING EXISTING PAVEMENT*			
STAGE	LOCATION	L.F.	REMARKS
1	STA. 111+45	38	CONCRETE
2	STA. 114+75, 30 FT. RT.	20	ASPHALT
1	STA. 115+00	22	ASPHALT
2	STA. 111+45	22	CONCRETE
2	STA. 115+00	22	ASPHALT
1	STA. 114+14 TO STA. 115+00 E	86	ASPHALT
1	STA. 111+45 TO STA. 111+65 E	20	CONCRETE
	TOTAL	230	

ITEM NO. 20405 REMOVING CURB AND GUTTER*		
STAGE	LOCATION	L.F.
2	STA. 111+45 TO STA. 111+50 RT.	5
2	STA. 113+99 TO STA. 114+45 RT.	46
	TOTAL	51

ITEM NO. 41653 PAVEMENT TIES*		
STAGE	LOCATION	EACH
2	STA. 111+45 TO STA. 111+50 RT.	2

ITEM NO. 40204 ASPHALTIC MATERIAL FOR TACK COAT		
STAGE	LOCATION	GAL.
1	STA. 114+14 TO STA. 115+00	10
2	STA. 114+14 TO STA. 115+00	11
	TOTAL	21

ITEM NO. 40501 ASPHALTIC MATERIAL FOR PLANT MIXES		
STAGE	LOCATION	TON
1	STA. 114+14 TO STA. 115+00	3
2	STA. 114+14 TO STA. 115+00	4
	TOTAL	7

ITEM NO. 40713 ASPHALTIC CONCRETE PAVEMENT, TYPE MV		
STAGE	LOCATION	TON
1	STA. 114+14 TO STA. 115+00	48
2	STA. 114+14 TO STA. 115+00	55
	TOTAL	103

ITEM NO. 64635 PAVEMENT MARKING, RAISED MARKERS		
LOCATION	EACH	REMARKS
STA. 111+50, 0.5 FT. RT.	1	YELLOW
STA. 111+50, 0.5 FT. LT.	1	YELLOW
STA. 111+50, 11 FT. LT.	1	WHITE
	TOTAL	3

ITEM NO. 60123 CONCRETE CURB AND GUTTER, 30-INCH, TYPE A*		
STAGE	LOCATION	L.F.
2	STA. 111+45 TO STA. 111+50 RT.	5
2	STA. 113+99 TO STA. 114+45 RT.	46
1	STA. 114+29 TO STA. 114+59 LT.	30
	TOTAL	81

ITEM NO. 60205 CONCRETE SIDEWALK, 5-INCH		
STAGE	LOCATION	S.F.
2	STA. 113+99 TO STA. 114+45	276
1	STA. 114+29 TO STA. 114+59	180
	TOTAL	456

ITEM NO. 20406 REMOVING CONCRETE SIDEWALK		
STAGE	LOCATION	S.Y.
2	STA. 113+99 TO STA. 114+45	30

\* ADDITIONAL QUANTITIES SHOWN ELSEWHERE



FILE NAME: D2 BR 405040510TY1M5.DGN  
LEVELS ON - 1, 2, 3, 62, 63  
ORIGINATOR: D2 JCT  
REV. DATE: 7/1/99 PLOT SCALE: 201.35951711000000 PLOT DATE: 01-JUL-1999 13:08


TRAFFIC CONTROL

STATE PROJECT NUMBER 2320-02-60	SHEET NO. 30
MISCELLANEOUS QUANTITIES	
STH 100 & I-45	MILWAUKEE COUNTY


ALL QUANTITIES ON THIS SHEET ARE CATEGORY 0010.

LOCATION	TRAFFIC CONTROL, ARROW BOARDS *64310 DAYS	TRAFFIC CONTROL, DRUMS *64313 DAYS	TRAFFIC CONTROL, BARRICADES, TYPE III *64318 DAYS	TRAFFIC CONTROL, WARNING LIGHTS, TYPE A *64321 DAYS	TRAFFIC CONTROL, WARNING LIGHTS, TYPE C *64323 DAYS	TRAFFIC CONTROL, SIGNS, CONTROL, FIXED MESSAGE *64326 DAYS	TRAFFIC CONTROL, SIGNS, FIXED MESSAGE *64327 FT2
STAGE 1							
EB BROWN DEER RD.	42	2464	84	168	784	280	0
WB BROWN DEER RD.	42	2464	140	280	784	308	0
STAGE 1 SUBTOTAL	84	4928	224	448	1568	588	0
STAGE 2							
EB BROWN DEER RD.	42	350	112	224	196	126	0
WB BROWN DEER RD.	42	350	147	196	196	23	0
STAGE 2 SUBTOTAL	84	700	259	420	392	149	0
STAGE 1 & 2							
N. 107TH STREET	4	280	140	0	560	193	488
NB & SB STH 145	0	720	12	24	128	48	0
SUBTOTAL	4	1000	152	24	688	241	488
PROJECT TOTALS	172	6628	635	892	2648	978	488


LOCATION	TEMPORARY PRECAST CONCRETE BARRIER CONTRACTOR FURNISHED & DELIVERED *60305 LF	TEMPORARY PRECAST CONCRETE BARRIER CONTRACTOR FURNISHED & INSTALLED *60308 LF	TEMPORARY PAVEMENT MARKING, 4-INCH, REMOVABLE TAPE (WHITE) *64904 L.F.	TEMPORARY PAVEMENT MARKING, 4-INCH, REMOVABLE TAPE (YELLOW) *64904 L.F.	TEMPORARY REMOVING PAVEMENT MARKINGS *64642 L.F.	TEMPORARY PAVEMENT MARKING STOP LINE 12-INCH REMOVABLE TAPE *64910 L.F.	PORTABLE CRASH CUSHION, DELIVERED *61425 EACH	PORTABLE CRASH CUSHION, INSTALLED *61426 EACH
STAGE 1								
NORTH 107TH STREET	510	510	250	450	0	44	1	1
EB BROWN DEER RD.	422	430	3487	0	150	0	1	1
WB BROWN DEER RD.	878	880	3578	0	150	0	1	1
STAGE 1 SUBTOTAL	1810	1820	7315	450	300	44	3	3
STAGE 2								
NORTH 107TH STREET	0	0	400	450	0	0	0	1
EB BROWN DEER RD.	0	0	0	1707	75	0	0	1
WB BROWN DEER RD.	0	0	0	1752	75	0	0	1
STAGE 2 SUBTOTAL	0	0	400	3909	150	0	0	3
PROJECT TOTAL	1810	1820	7715	4359	450	44	3	6

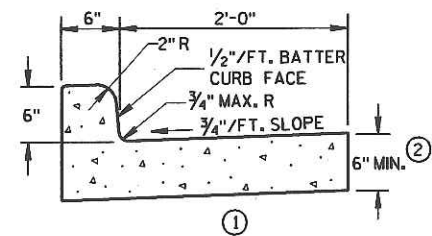


TYPES A & D

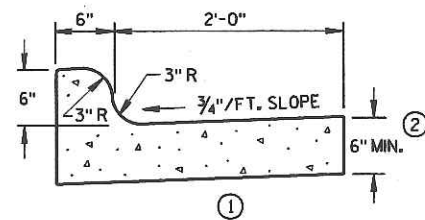


TYPES K & L

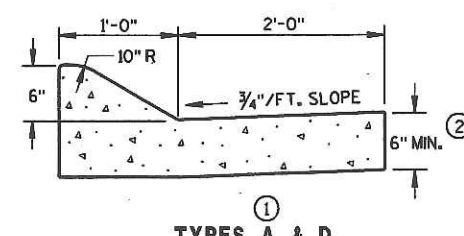


TYPES A & D  
CONCRETE CURB & GUTTER 36"

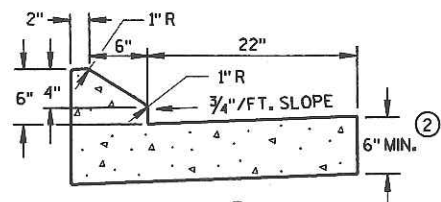

TYPES G & J

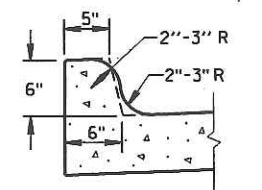


OPTIONAL CURB SHAPE  
FOR TYPES K & L

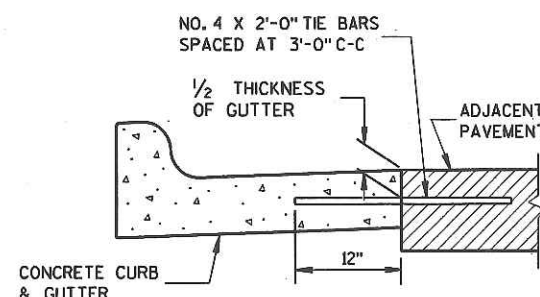


TYPICAL TIE BAR LOCATION

CONCRETE CURB & GUTTER 30"

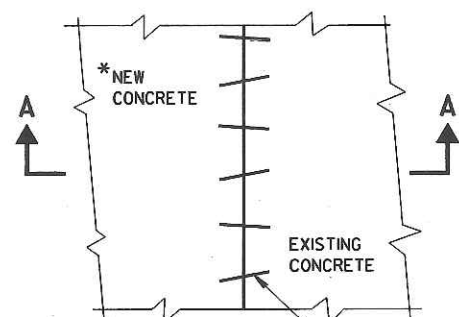

PLAN VIEW

\*NEW CURB & GUTTER,  
SURFACE DRAINS,  
CONCRETE PAVEMENT  
OR OTHER NEW CONCRETE.

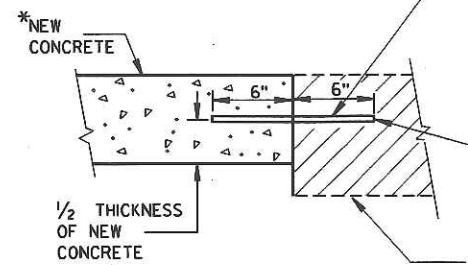


SECTION A-A  
PAVEMENT TIES


NO. 6 X 12" DEF. BARS  
SPACED 3'-0" C-C,  
INSTALLED ON 6:1 SKEW  
HORIZONTALLY. DIRECTION  
OF SKEW ALTERNATING AFTER  
EVERY ONE OR TWO BARS.

THE HOLE FOR THE BAR SHALL  
BE DRILLED TO A DEPTH OF  
7" AND TO SUCH A DIAMETER  
AS TO PROVIDE A TIGHT  
DRIVEN FIT


EXISTING  
CONCRETE

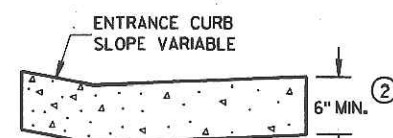


DRIVEWAY ENTRANCE CURB  
(WHEN DIRECTED BY THE ENGINEER)

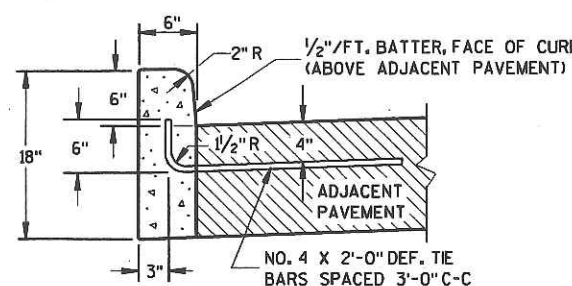

TYPES A & D

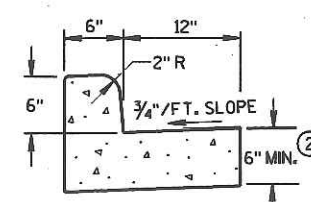

TYPES A & D  
CONCRETE CURB & GUTTER 18"

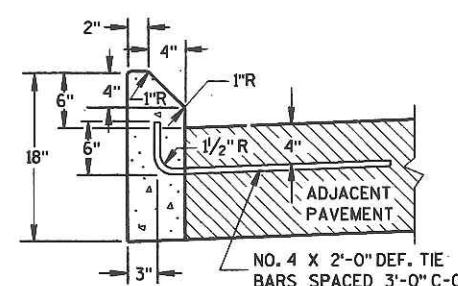

TYPES G & J

CONCRETE CURB

## GENERAL NOTES

DETAILS OF CONSTRUCTION, MATERIALS AND WORKMANSHIP NOT SHOWN ON THIS DRAWING SHALL CONFORM TO THE PERTINENT REQUIREMENTS OF THE CONTRACT.


PAVEMENT TIES AND TIE BARS SHALL BE EPOXY COATED IN CONFORMANCE WITH SUBSECTION 505.2.6.2 OF THE STANDARD SPECIFICATIONS.

INTEGRAL CURB & GUTTER SHALL CONFORM TO THE DETAILS SHOWN FOR CONCRETE CURB & GUTTER INCLUDING THE TRANSVERSE GUTTER SLOPE. A LONGITUDINAL CONSTRUCTION JOINT IS NOT REQUIRED WITH INTEGRAL CURB AND GUTTER.


WHERE THE TRANSVERSE JOINTS IN THE PAVEMENT ARE REQUIRED TO BE SEALED, THE JOINTS IN THE INTEGRAL CURB AND GUTTER SHALL BE SEALED TO THE FACE OF CURB WITH THE SAME TYPE OF SEALANT. THE COST OF FURNISHING AND INSTALLING THIS SEALANT SHALL BE INCIDENTAL TO THE ITEM CONCRETE CURB AND GUTTER.

UNLESS OTHERWISE SHOWN ON THE TYPICAL CROSS SECTIONS, THE BASE COURSE AND UNCLASSIFIED EXCAVATION LIMITS ARE 2'-0" BEHIND THE BACK OF CURBS.

- ① TIE BARS ARE REQUIRED FOR CURB AND GUTTER TYPES A, G AND K.
- ② THE BOTTOM OF CURB AND GUTTER MAY BE CONSTRUCTED EITHER LEVEL OR PARALLEL TO THE SLOPE OF THE SUBGRADE OR BASE COURSE PROVIDED A 6" MINIMUM GUTTER THICKNESS IS MAINTAINED.
- ③ WHEN REVERSE SLOPE GUTTER IS REQUIRED, THE LOCATION(S) WILL BE SHOWN ELSEWHERE IN THE PLAN.

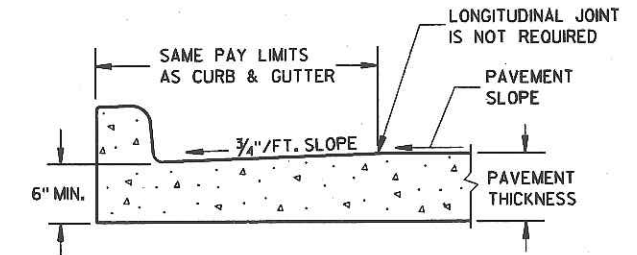

PARTIAL SECTION OF PAVEMENT  
WITH INTEGRAL CURB & GUTTER

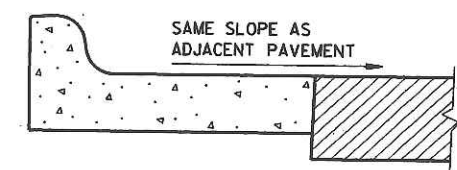

REVERSE SLOPE GUTTER  
(TYPICAL FOR ALL CURB & GUTTER TYPES)

CONCRETE CURB, CONCRETE  
CURB & GUTTER AND  
PAVEMENT TIES

STATE OF WISCONSIN  
DEPARTMENT OF TRANSPORTATION


APPROVED  
10/22/96  
DATE

FOR 2. Thompson  
CHIEF ROADWAY DEVELOPMENT ENGINEER

PHWA




## INLET COVERS

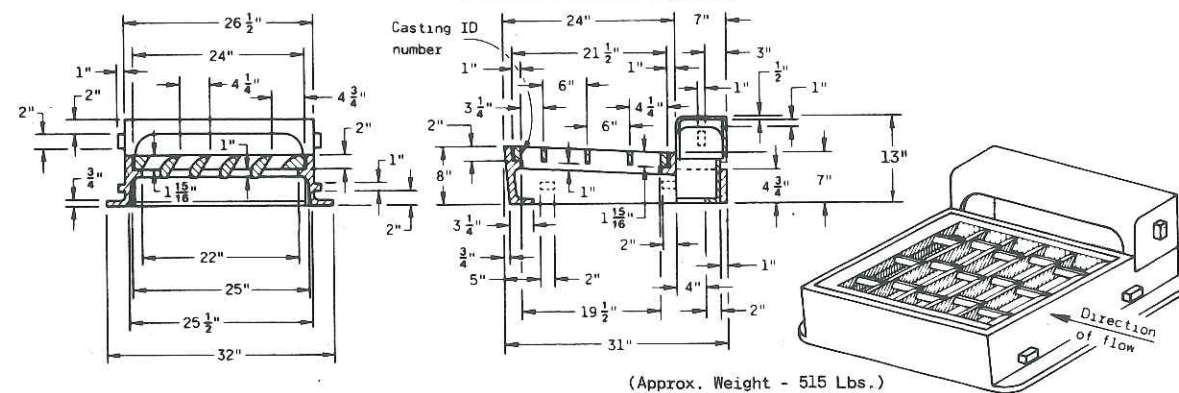


**TYPE "R"**  
SHOWING SPECIAL GRATE NO. 1  
(To be noted as R-1 in Drainage Table)


(Approx. Weight - 515 Lbs.)  
Frame.....245 Lbs.  
Curb.....120 Lbs.  
Grate.....150 Lbs.

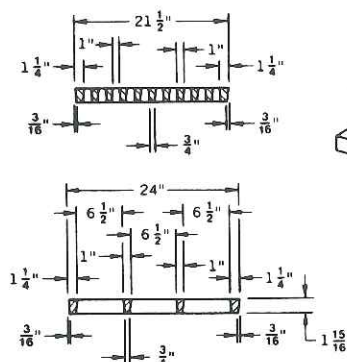


**GRATE FOR TYPE "R" INLET COVER**  
(Grate ..... 150 Lbs.)  
(To be used unless otherwise noted in Drainage Table)

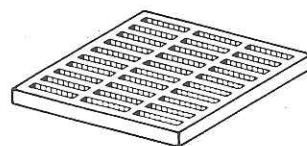

NOTE: Curb plug used in place of curb box in absence of conc. curb. Fill to top with concrete.

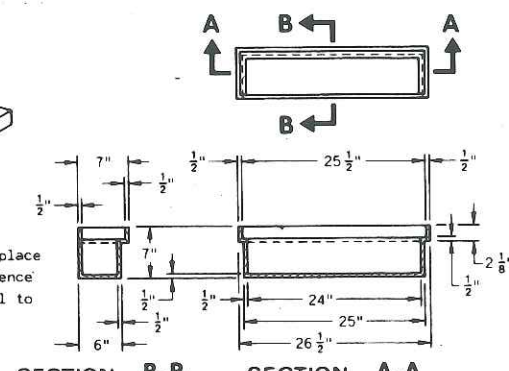


**SPECIAL CURB PLUG "P"**  
(Curb Plug ..... 85 Lbs.)  
(To be noted as R-P in Drainage Table)

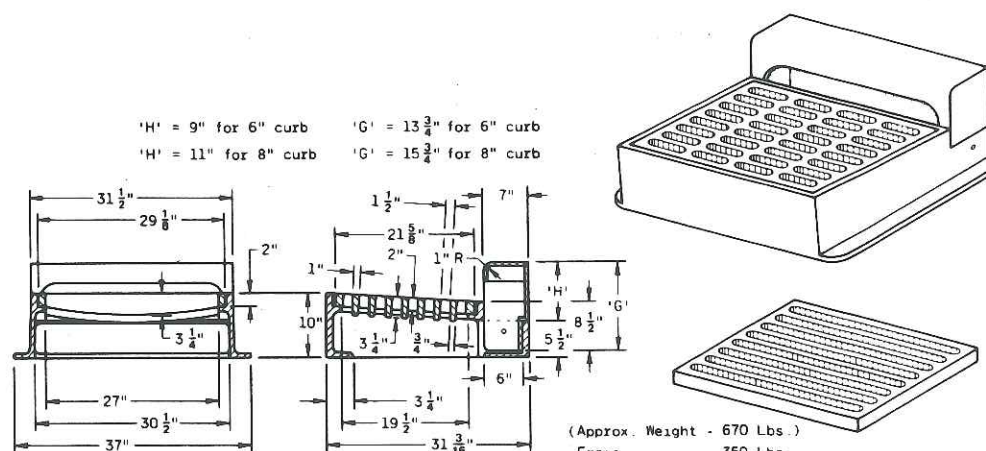

**TYPE "W"**

(Approx. Weight - 670 Lbs.)  
Frame ..... 350 Lbs.  
Curb box ..... 135 Lbs.  
Grate ..... 185 Lbs.

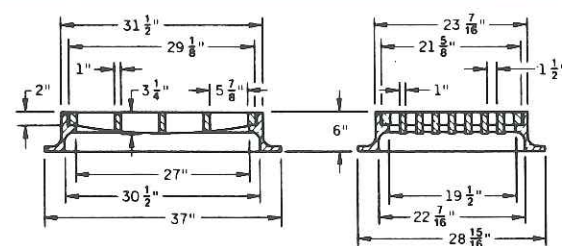


**TYPE "X"**


(Approx. Weight - 470 Lbs.)

**ALTERNATE GRATE**  
(For Expressway Ramps)


**TYPES "W" & "X"**

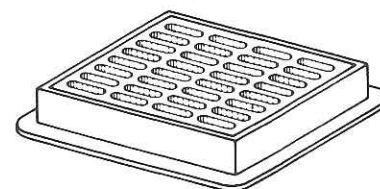

## INLETS & CATCH BASINS

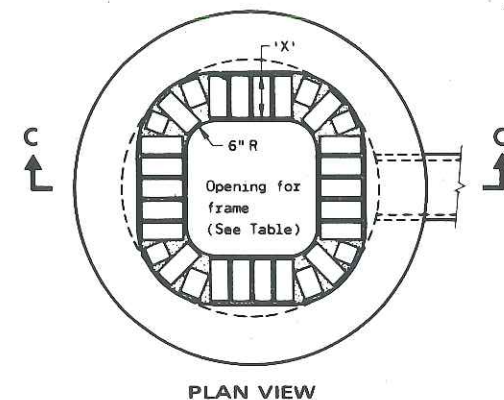


**PLAN VIEW**

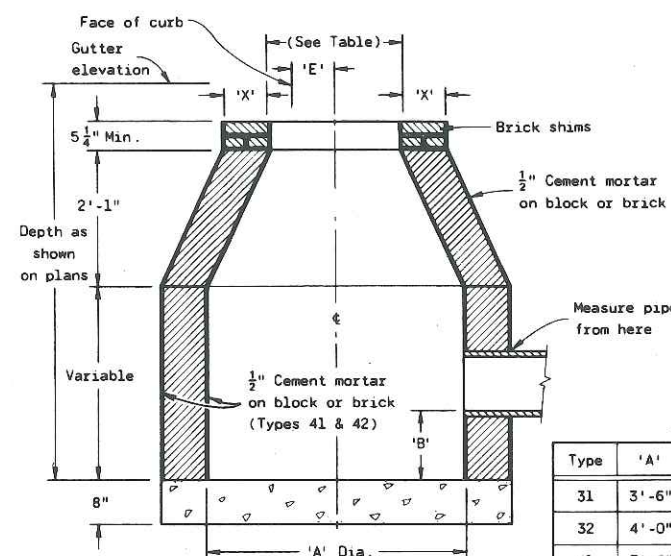


**SECTION C - C**  
**INLETS TYPE 31 & 32**  
**CATCH BASINS TYPE 41 & 42**

Type	'A'	'B'
31	3'-6"	0"
32	4'-0"	0"
41	3'-6"	1'-6"
42	4'-0"	1'-0"

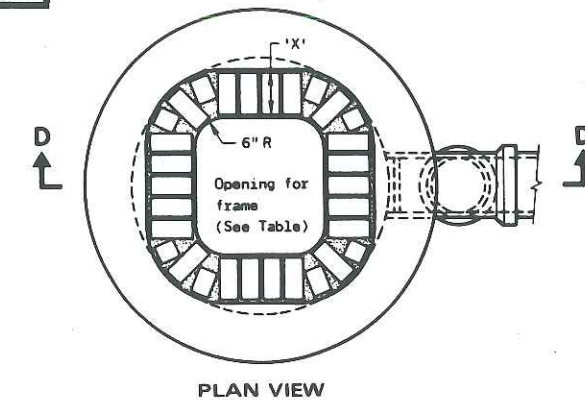

**PLAN VIEW**

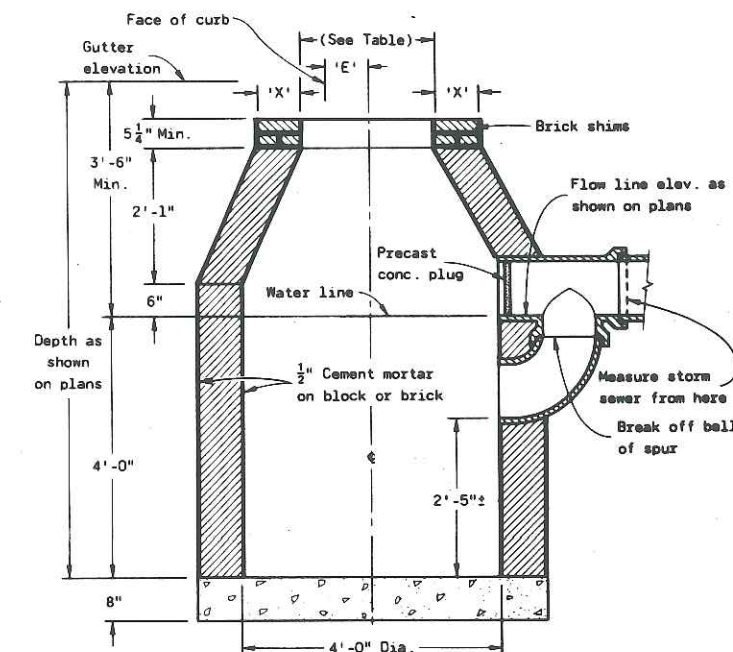

**SECTION D - D**  
**CATCH BASIN TYPE 43**

### GENERAL NOTES

Structure wall thickness 'X' to be 8" brick, 6" concrete block, 6" Grade A concrete or 5" precast reinforced concrete.

Structure footings are to be Grade A concrete to the thickness shown on the detail or 5" precast reinforced concrete.

Reinforcement for 5" precast reinforced concrete shall be 6" x 6" W16 x W16 welded steel wire fabric and shall be embedded 2" clear.

Precast inlet units and bases shall conform to the pertinent requirements of AASHTO Designation M 199.

Precast concrete flat slab tops may be used on the structures. The tops shall be installed on a bed of mortar.

Precast reinforced bases shall be placed on a bed of material at least 6" in depth, which meets the requirements for granular backfill. This bedding shall be compacted and provide uniform support for the entire area of the base.

Set frame elevation 0.03 ft. lower than elevation indicated on the plans.

### NOTES FOR CATCH BASIN TYPE "43"

1. Special tee branches having a spigot end spur shall be used for the overflow to the storm drain. Standard short radius elbows shall be used with the tee branch as shown.
2. A cement mortar disc shall be cemented into the opening at the inner face of the tee branch.

### INLETS, CATCH BASINS & INLET COVERS

STATE OF WISCONSIN  
DEPARTMENT OF TRANSPORTATION


APPROVED  
11-8-85  
DATE

STATE DESIGN ENGINEER FOR HWYS

FHWA




## INLETS

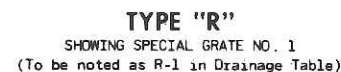

(Approx. Weight - 515 Lbs.)


Frame.....	245 Lbs.
Curb.....	120 Lbs.
Grate.....	150 Lbs.

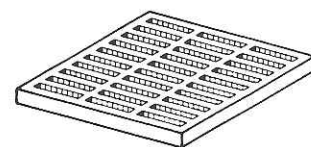


NOTE: Curb plug used in place of curb box in absence of conc. curb. Fill to top with concrete.




(Curb Plug ..... 85 Lbs.)  
(To be noted as R-P in Drainage Table)

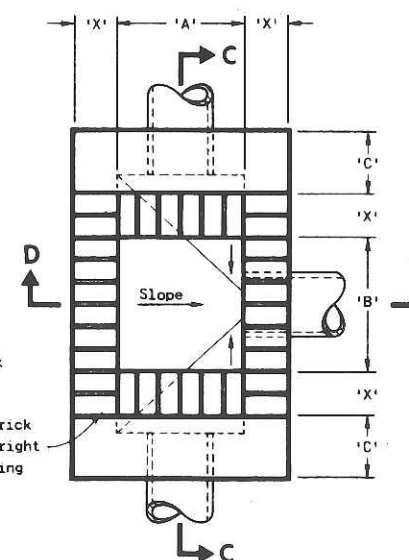

Inlet Type	'A'	'B'	'C'	'D' Min.	'E'	'F'	Cover Type
34	1'-8"	2'-6"	9"	3'-6"	4'-0"	2'-0"	"W", "X"
35	1'-8"	2'-6"	0"	2'-0"	2'-6"		"W", "X"
37	2'-0"	2'-1"	0"	2'-0"	2'-1"		"R"
38	1'-10"	1'-10"	1'-1"	3'-11"	4'-0"	2'-8"	"GM"
38-A	1'-6"	1'-10"	1'-1"	3'-11"	4'-0"	2'-8"	"GM-A"
39	1'-10"	1'-10"	0"	2'-0"	1'-10"		"GM"
39-A	1'-6"	1'-10"	0"	2'-0"	1'-10"		"GM-A"
40	2'-0"	2'-1"	11 1/2"	3'-6"	4'-0"	2'-0"	"R"

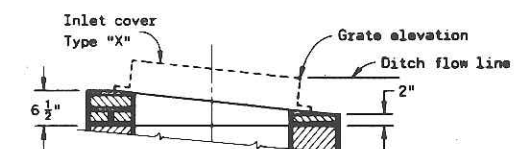

Alternate shimming for ditch inlets - flow in one direction. (Place cover level when inlet is at low point.)

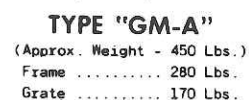

### INLETS TYPE 34, 35, 37, 38, 39 & 40

Structure wall thickness 'X' to be 8" brick, 6" concrete block,  
6" Grade A concrete or 5" precast reinforced concrete.

Structure footings are to be Grade A concrete of the thickness shown in the detail or 5" precast reinforced concrete.



Reinforcement for 5" precast reinforced concrete shall be 6" x 6" W16 x W16 welded steel wire fabric and shall be embedded 2" clear.

Precast inlet units and bases shall conform to the pertinent requirements of AASHTO Designation M 199.

Precast concrete flat slab tops may be used on the structures. The tops shall be installed on a bed of mortar.

Precast reinforced bases shall be placed on a bed of material at least 6" in depth, which meets the requirements for granular backfill. This bedding shall be compacted and provide uniform support for the entire area of the base.


Set frame elevation 0.03 ft. lower than elevation indicated on the plans.

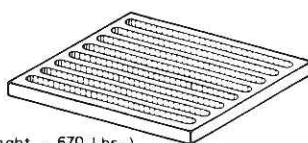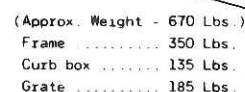

**ALTERNATE GRATE**  
(For Expressway Ramps)  
**TYPES "W" & "X"**



(Approx. Weight - 470 Lbs.)

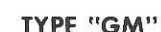



(Approx. Weight - 460 Lbs.)

Frame .....	290 Lbs.
Grate .....	170 Lbs.







DESCRIPTION	SIZE	NO. REQ'D	LENGTH
TOP CONNECTOR WIRE ROPE ①	1/2"	2	6' - 0"
BOTTOM CONN. WIRE ROPE ①	1/2"	2	6' - 0"
TOP CONNECTOR STEEL BAR	NO. 4	1	9' - 0"
BOTTOM CONN. STEEL BAR	NO. 4	1	9' - 0"
STEEL CONNECTING PIN	1 1/4" DIA.	1	2' - 6"
BOTTOM TIE BARS	NO. 4	5	1' - 8"
VERTICAL STEEL BAR	NO. 4	10	2' - 1"
HORIZONTAL STEEL BAR	NO. 5	4	9' - 4"

### BILL OF MATERIALS

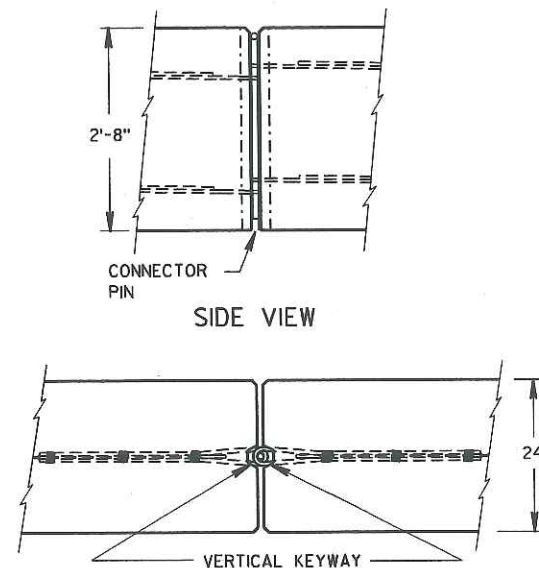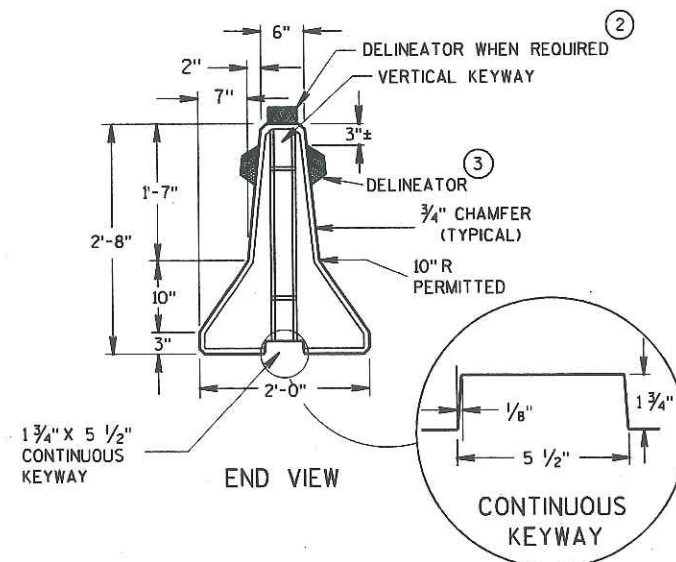

### PIN & LOOP CONNECTION DETAILS

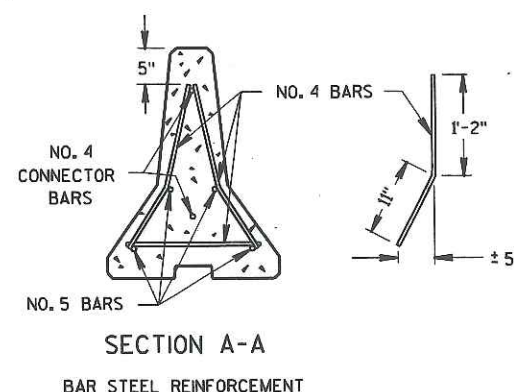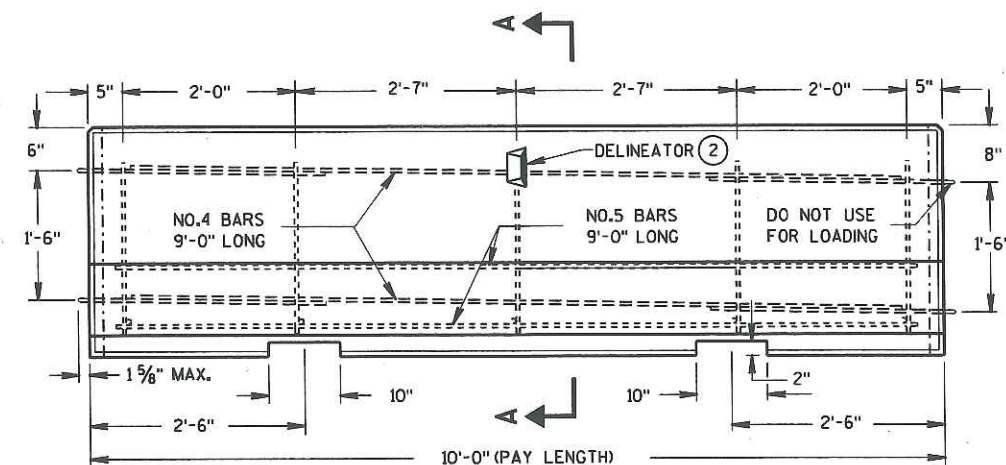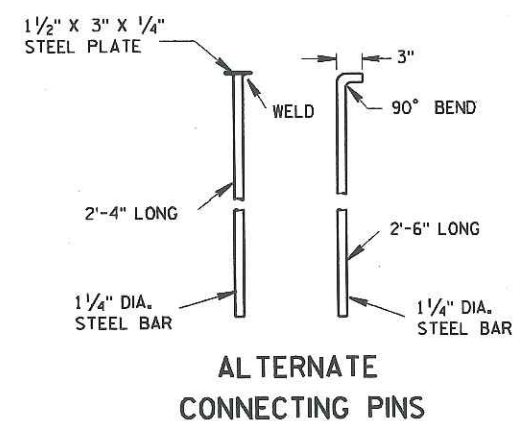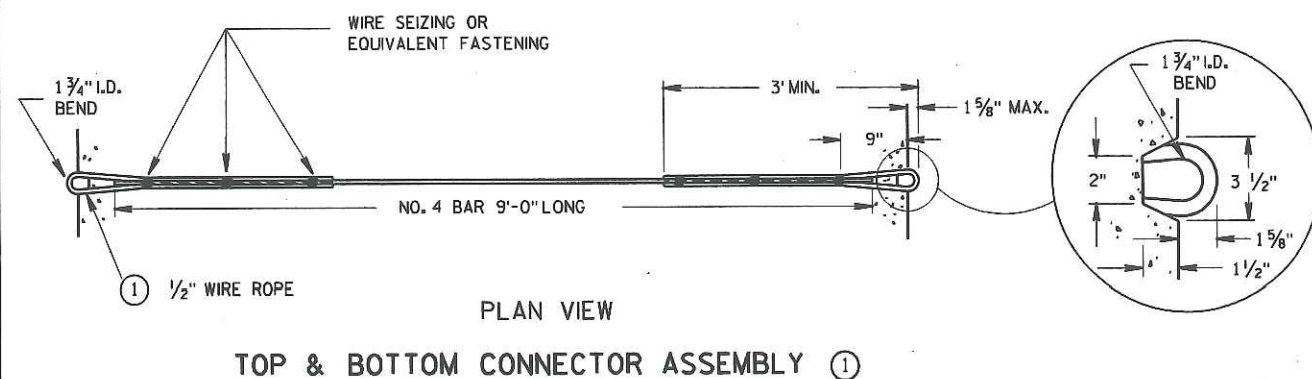

### GENERAL NOTES

DETAILS OF CONSTRUCTION, MATERIALS AND WORKMANSHIP NOT SHOWN ON THIS DRAWING SHALL CONFORM TO THE PERTINENT REQUIREMENTS OF THE STANDARD SPECIFICATIONS AND THE APPLICABLE SPECIAL PROVISIONS.

BARRIERS SHALL BE REINFORCED WITH EITHER BAR STEEL REINFORCEMENT AS DETAILED ON THIS DRAWING OR WELDED STEEL WIRE FABRIC ADEQUATE TO ASSURE SAFE HANDLING STRENGTH.

ALL STEEL REINFORCEMENT SHALL BE EMBEDDED 2 INCHES CLEAR UNLESS OTHERWISE SHOWN.


WIRE ROPE SHALL BE ZINC-COATED 6 X 19 CLASS 2 IWRC WITH A MINIMUM BREAKING STRENGTH OF 20,000 LBS., AND SHALL CONFORM TO FEDERAL SPECIFICATION RR-W-410. THE ZINC-COATING SHALL CONFORM TO TABLE II OF THE FEDERAL SPECIFICATIONS.

DELINATORS SHALL CONFORM TO SECTION 633 OF THE STANDARD SPECIFICATIONS EXCEPT THE SHAPE SHALL BE AS SHOWN ON THIS DRAWING. ALTERNATIVE SHAPES MAY BE USED WHEN APPROVED BY THE ENGINEER. CONCRETE SURFACE PREPARATION, ADHESIVE AND METHOD OF APPLICATION SHALL BE AS RECOMMENDED BY THE DELINATOR MANUFACTURER. THE COLOR OF REFLECTORS SHALL BE YELLOW WHEN LOCATED TO THE LEFT OF TRAFFIC AND WHITE WHEN LOCATED TO THE RIGHT OF TRAFFIC. MAXIMUM SPACING SHALL BE 20 FEET.

- ① CONNECTOR ASSEMBLIES MAY, AT THE CONTRACTORS OPTION, BE FORMED FROM A CONTINUOUS SECTION OF 1/2 INCH WIRE ROPE (16'-6" MIN. LENGTH). THE NO. 4 CONNECTOR STEEL BARS MAY THEN BE OMITTED.
- ② TOP MOUNTED DELINATORS SHALL BE PROVIDED IN ADDITION TO THE SIDE MOUNTED DELINATORS ON ALL BARRIER INSTALLATIONS LOCATED ON CURVED ALIGNMENT LONGER THAN 200 FEET.
- ③ BARRIERS USED TO SEPARATE OPPOSING TRAFFIC SHALL HAVE DELINATORS ON BOTH SIDES. TOP MOUNTED DELINATORS SHALL BE DOUBLE FACED FOR THIS CONDITION.


### ALTERNATE DESIGN

J-J HOOKS PORTABLE CONCRETE BARRIER BY EASI-SET INDUSTRIES MAY BE FURNISHED INSTEAD OF THE BARRIER DETAILED ON THIS DRAWING. CONTACT INFORMATION : EASISSET INDUSTRIES, P.O. BOX 300, MIDLAND, VIRGINIA 22728, TELEPHONE (703) 439-8911.

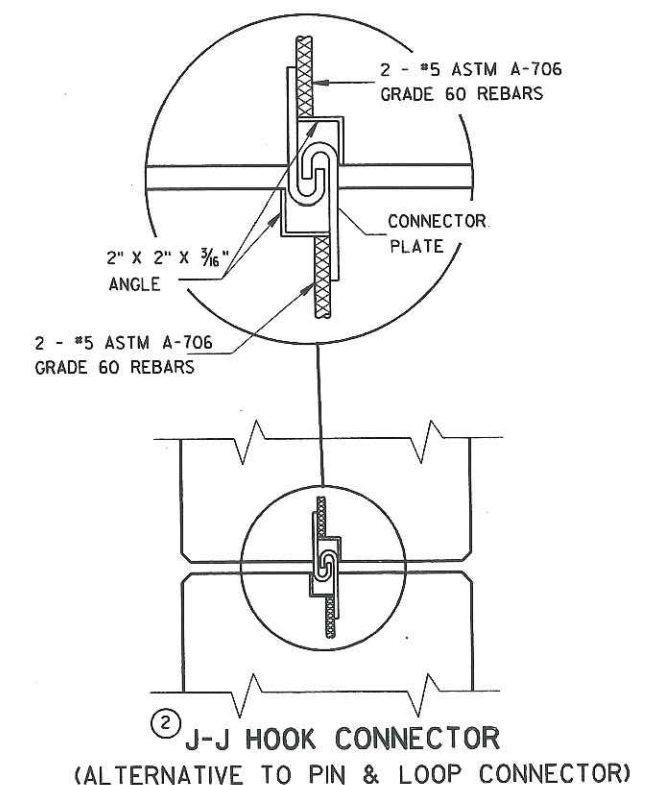


TEMPORARY PRECAST  
CONCRETE BARRIER


STATE OF WISCONSIN  
DEPARTMENT OF TRANSPORTATION

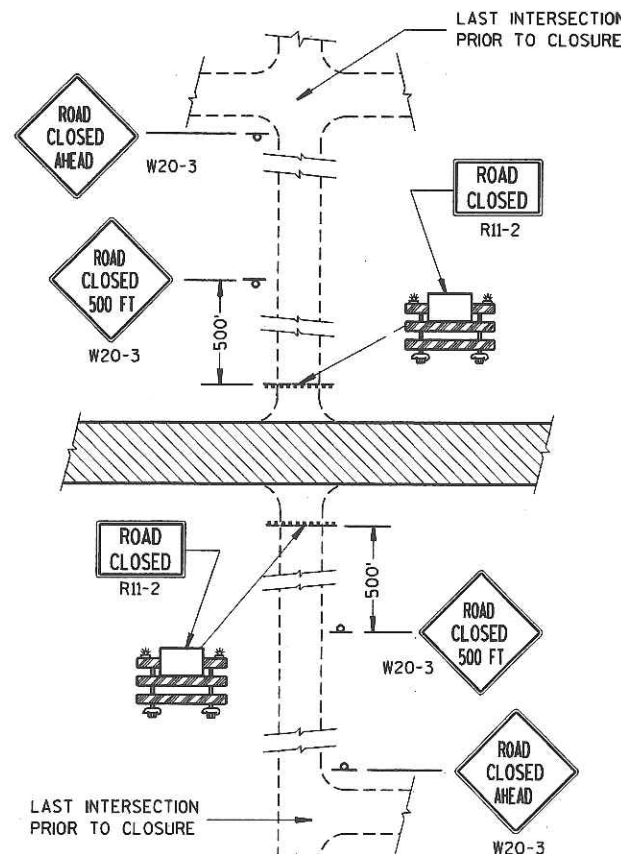

**DETAIL 1**  
(NO ACCESS TO PROJECT)

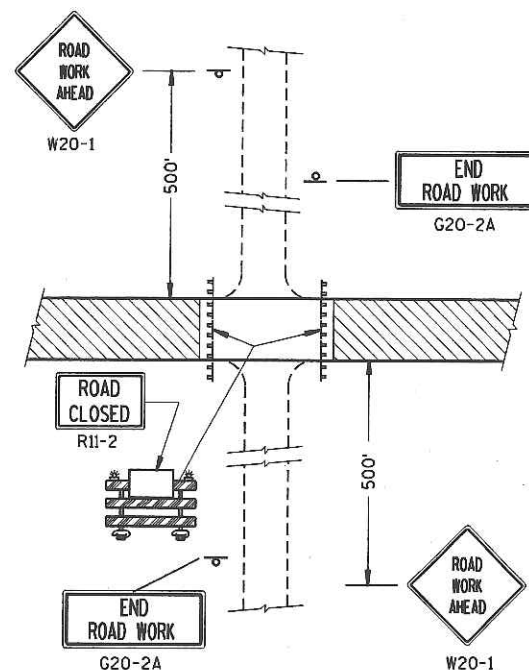


**DETAIL 2**  
(PUBLIC CROSS-TRAFFIC MAINTAINED,  
NO ACCESS TO PROJECT).

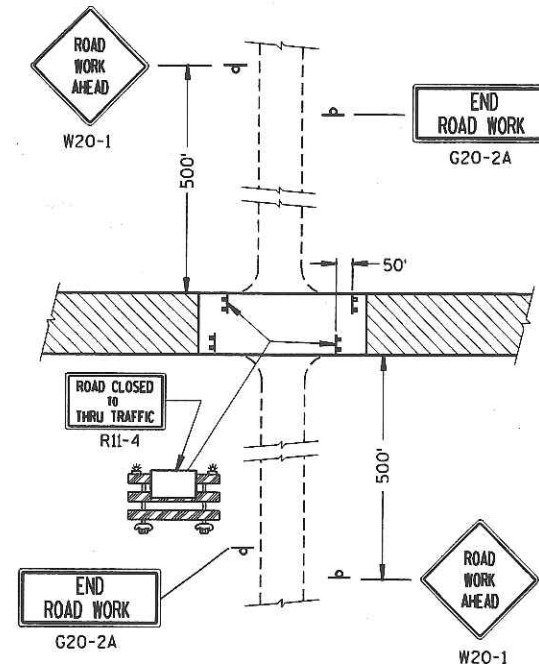


**DETAIL 3**  
(PUBLIC CROSS-TRAFFIC MAINTAINED, CONTRACTOR,  
LOCAL BUSINESS AND RESIDENT ACCESS).


## SIDEROAD CLOSURES

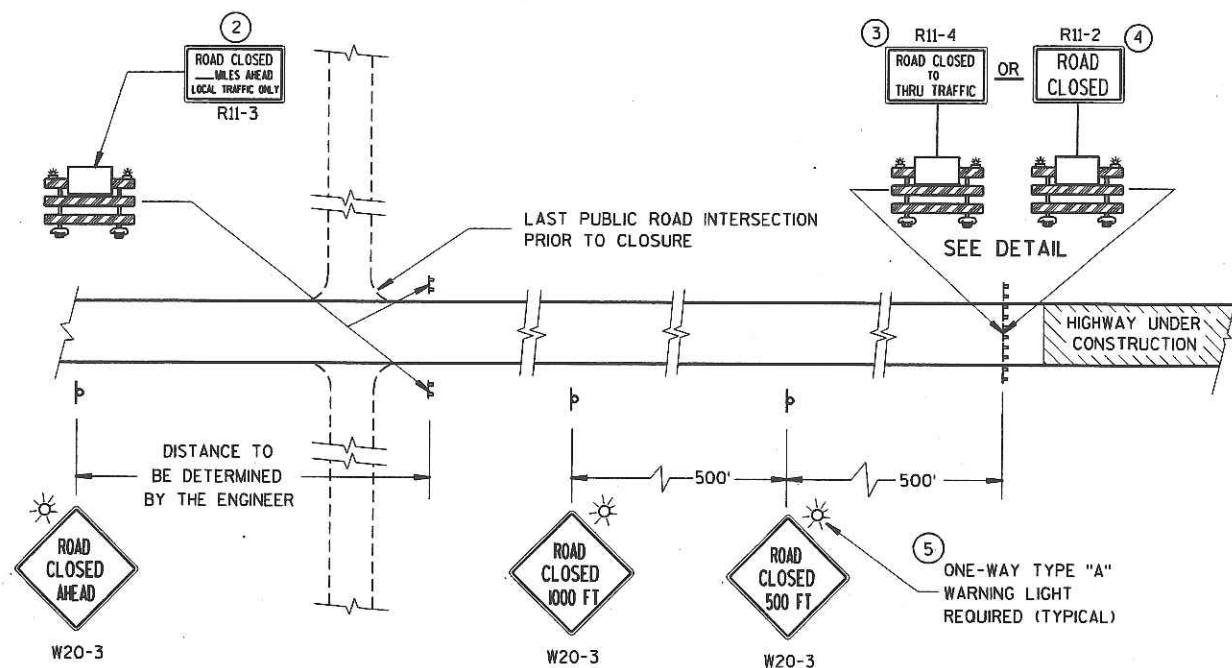

**MAINLINE CLOSURE**

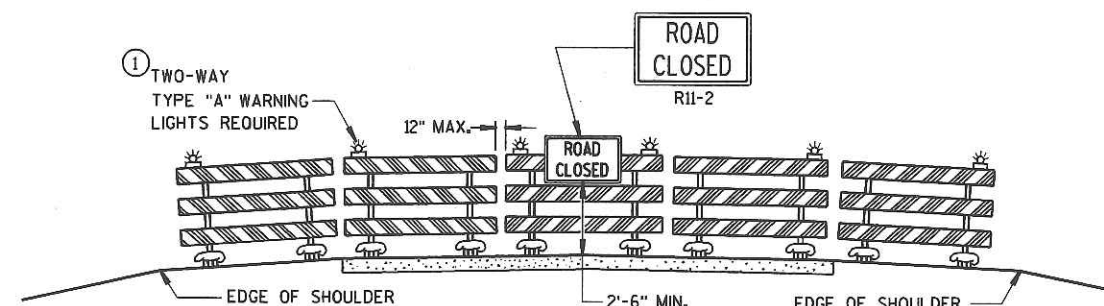

**ROAD CLOSURE BARRICADE DETAIL**

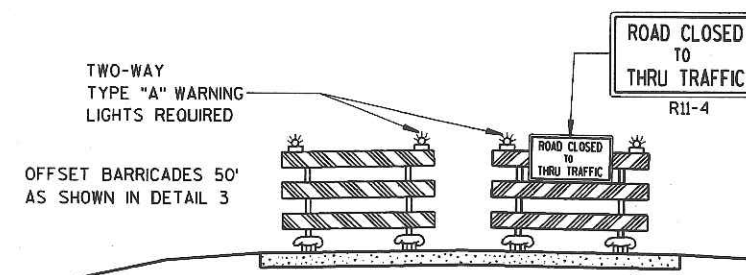

**LANE CLOSURE BARRICADE DETAIL**

## GENERAL NOTES

DETAILS OF TRAFFIC CONTROL DEVICES AND THEIR LOCATION NOT SHOWN ON THIS DRAWING SHALL CONFORM TO THE PERTINENT REQUIREMENTS OF THE WISCONSIN MANUAL OF TRAFFIC CONTROL DEVICES, THE PLANS, SPECIFICATIONS AND CONTRACT.

SIGN AND BARRICADE LOCATIONS MAY BE ADJUSTED IN THE FIELD AS DIRECTED BY THE ENGINEER. ANY EXISTING TRAFFIC SIGNS THAT CONFLICT WITH THIS WORK SHALL BE COVERED AS DIRECTED BY THE ENGINEER. ALL "STOP" OR OTHER REGULATORY SIGNS ON THE SIDE ROADS SHALL NOT BE DISTURBED, EXCEPT WHEN NECESSARY TO COMPLETE THE WORK. THE SIGNS MUST THEN BE IMMEDIATELY REESTABLISHED.

ALL TYPE III BARRICADES SHALL HAVE RAILS REFLECTORIZED ON BOTH FACES. STRIPES SHALL BE PROPERLY SLOPED DOWN TOWARD THE TRAFFIC SIDE OR AS SHOWN IN THE ROAD CLOSURE BARRICADE DETAIL FOR FULL ROAD CLOSURES. TYPE "A" LOW INTENSITY FLASHING WARNING LIGHTS SHALL BE VISIBLE ON BOTH SIDES OF THE BARRICADE.

THE ROAD CLOSED SIGN (R11-2), ROAD CLOSED \_\_\_\_\_ MILES AHEAD SIGN (R11-3) AND THE ROAD CLOSED TO THRU TRAFFIC SIGN (R11-4) SHALL BE ATTACHED ONLY TO THE TOP RAIL OF THE TYPE III BARRICADE. THE SIGNS SHALL NOT COVER MIDDLE RAIL.

TYPE "H" REFLECTIVE SHEETING SHALL BE USED ON ALL BARRICADES, TYPE I, II AND III, AND ON ALL R11-2, R11-3 AND R11-4 SIGNS.

ALL SIGNS SHALL BE 48" X 48" UNLESS OTHERWISE NOTED BELOW:

R11-2, "ROAD CLOSED" SIGNS SHALL BE 48" X 30".

R11-3, AND R11-4 SIGNS SHALL BE 60" X 30".

G20-2A SIGNS SHALL BE 48" X 24".

- 1 TWO WARNING LIGHTS SHALL BE PROVIDED ON THE CENTER BARRICADE AND AT LEAST ONE WARNING LIGHT SHALL BE PROVIDED ON EACH OF THE OTHER BARRICADES WITHIN THE ROADWAY LIMITS. SPACING OF THE WARNING LIGHTS SHALL BE UNIFORM TO THE EDGE OF ROADWAY AS SHOWN.
- 2 THESE SIGNS AND BARRICADES ARE NOT REQUIRED IF ROAD CLOSURE BEGINS AT INTERSECTION.
- 3 FOR ROAD CLOSURE WITH LOCAL ACCESS TO PROJECT, SEE LANE CLOSURE BARRICADE DETAIL.
- 4 FOR ROAD CLOSURE WITHOUT LOCAL ACCESS TO PROJECT, SEE ROAD CLOSURE BARRICADE DETAIL.
- 5 ONE-WAY LIGHTS SHALL BE PROVIDED ON ALL ADVANCE WARNING SIGNS. THE UNIT SHALL BE POSITIONED SUCH THAT THE LIGHT SOURCE IS OUTSIDE THE SIGN FACE AND AT THE TOP OF THE SIGN.

## LEGEND

- POST MOUNTED WARNING SIGN
- TYPE III BARRICADES WITH TYPE "H" REFLECTIVE SHEETING
- TYPE "A" LOW INTENSITY FLASHING WARNING LIGHT (FOR NIGHT USE)
- WORK AREA

## BARRICADES AND SIGNS FOR ROAD CLOSURES

STATE OF WISCONSIN  
DEPARTMENT OF TRANSPORTATION

APPROVED

8-10-95  
DATE

FHWA

for *Charles J. Spang*  
DIRECTOR, OFFICE OF TRAFFIC










## GENERAL NOTES


DETAILS OF INSTALLATION, MATERIALS AND WORKMANSHIP NOT SHOWN ON THIS DRAWING SHALL CONFORM TO THE PERTINENT REQUIREMENTS OF THE STANDARD SPECIFICATIONS AND APPLICABLE SPECIAL PROVISIONS.

ALL LETTERS AND SYMBOLS SHALL BE IN CONFORMANCE WITH REQUIREMENTS INCLUDED IN "STANDARD ALPHABETS FOR HIGHWAY SIGNS AND PAVEMENT MARKING" BY THE FEDERAL HIGHWAY ADMINISTRATION. ALL LETTERS, ARROWS AND SYMBOLS SHALL BE WHITE AND REFLECTORIZED.


A DETAILED DRAWING OF THE HANDICAPPED PARKING SYMBOL IS ILLUSTRATED IN THE "STANDARD HIGHWAY SIGNS MANUAL" BY THE FEDERAL HIGHWAY ADMINISTRATION.

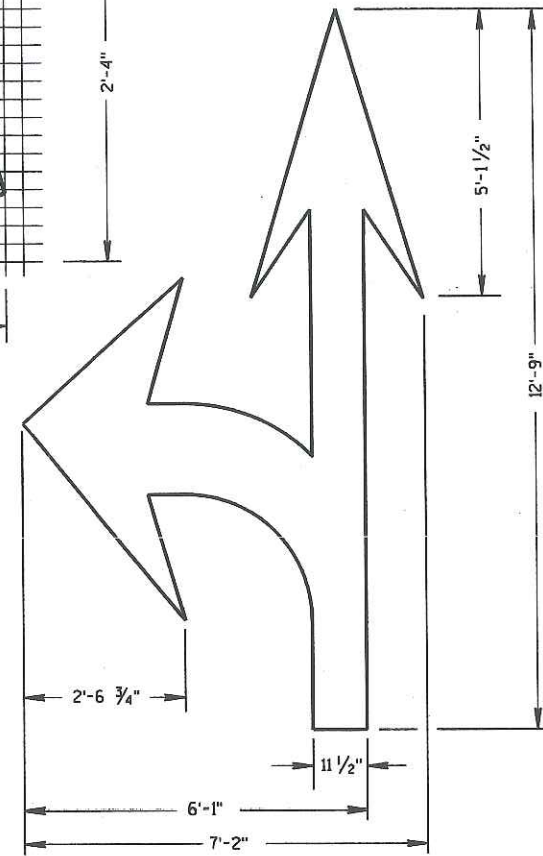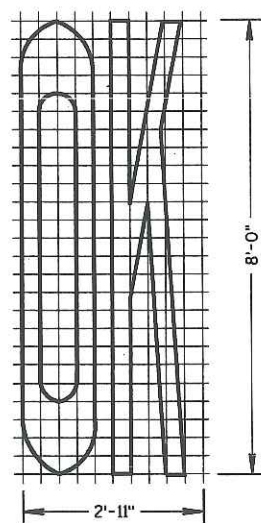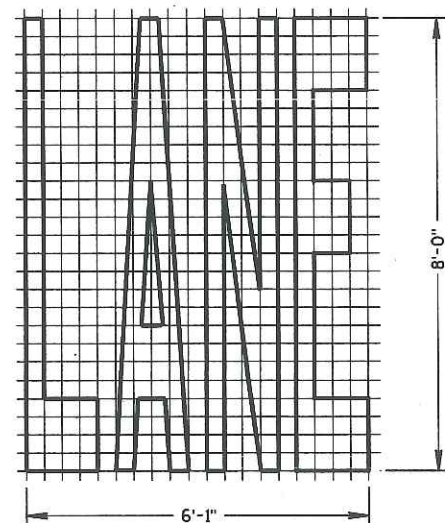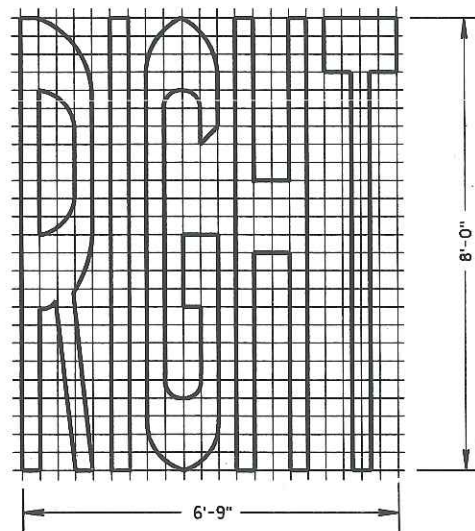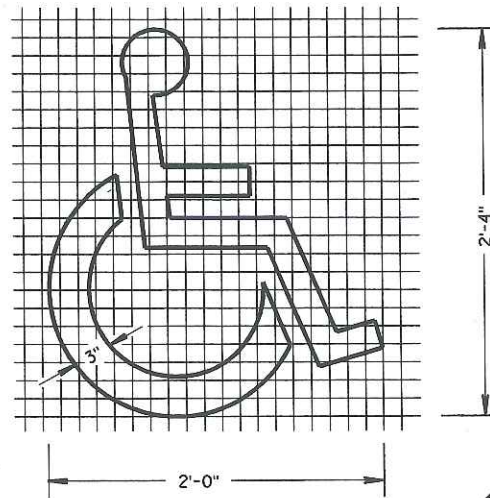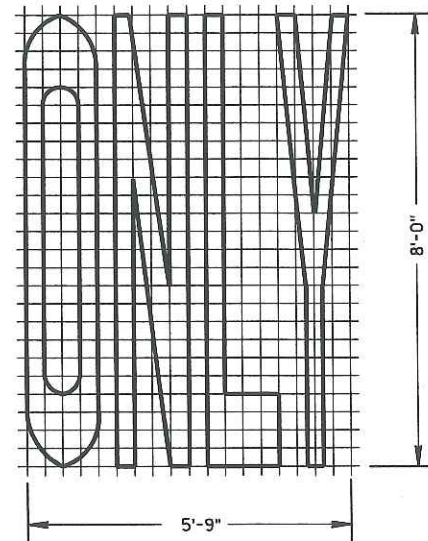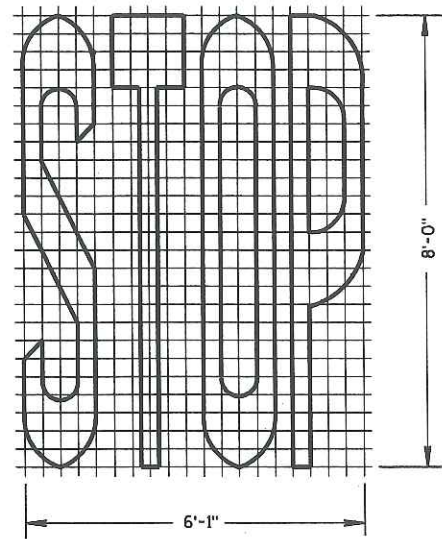




TYPE 3

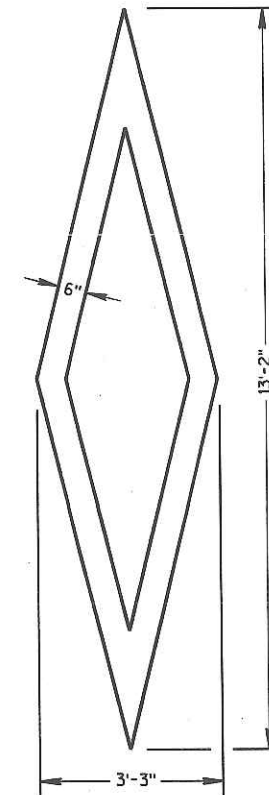


PREFERENTIAL  
LANE SYMBOL

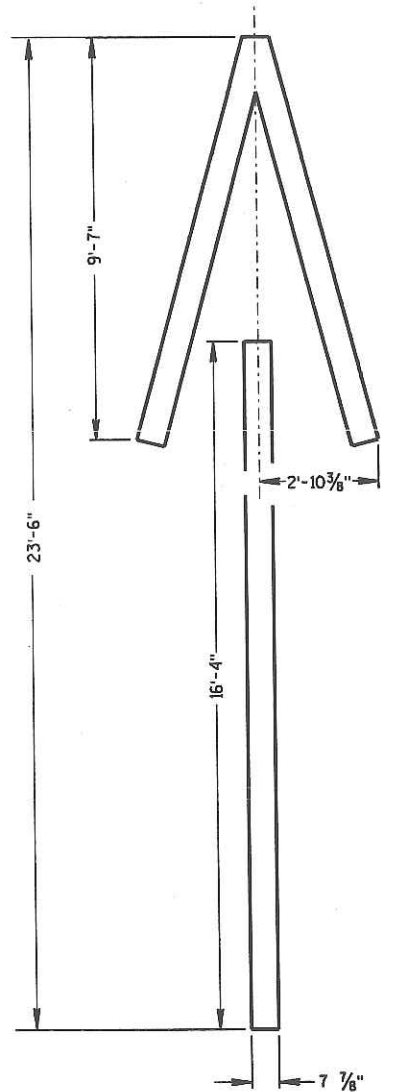

TYPE 4

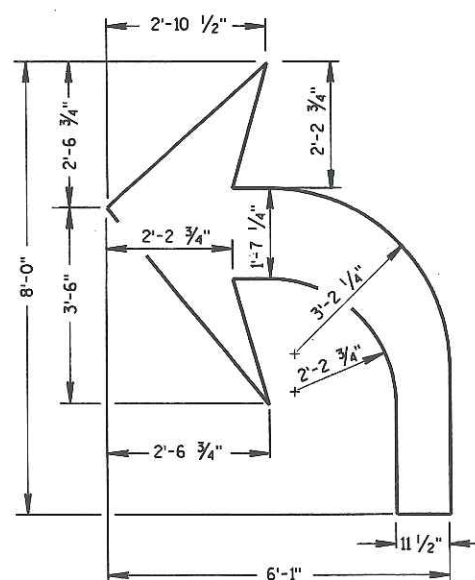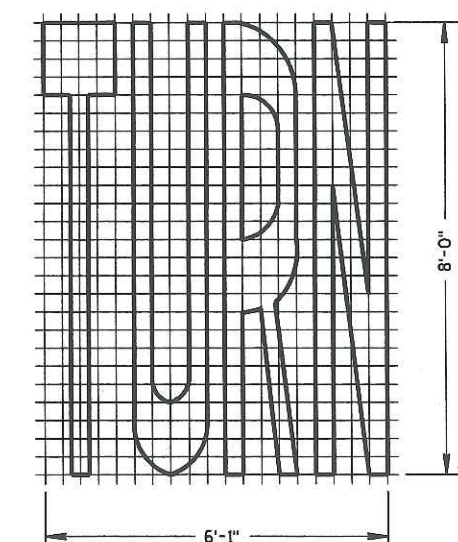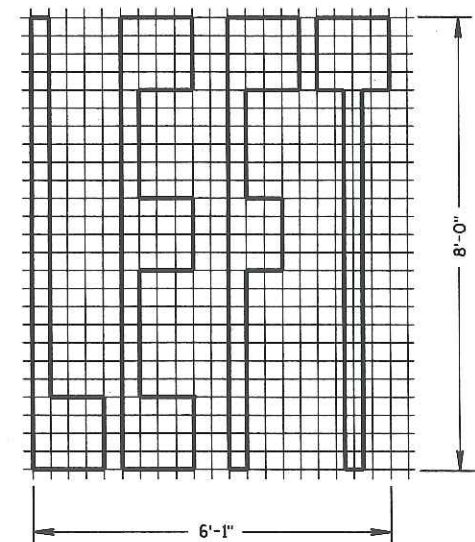

TYPE 2

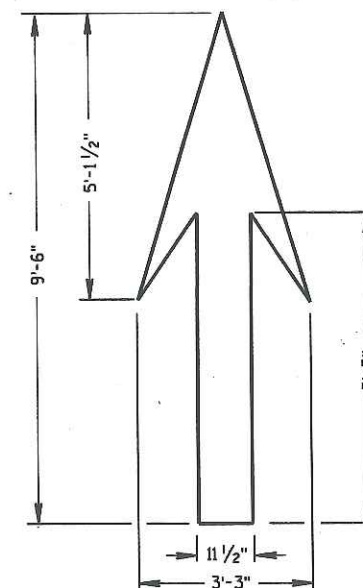

TYPE 1

## PAVEMENT MARKING SYMBOLS


STATE OF WISCONSIN  
DEPARTMENT OF TRANSPORTATION

APPROVED


7-28-95  
DATE

FHWA

*Chute J. Spang*  
for DIRECTOR, OFFICE OF TRAFFIC

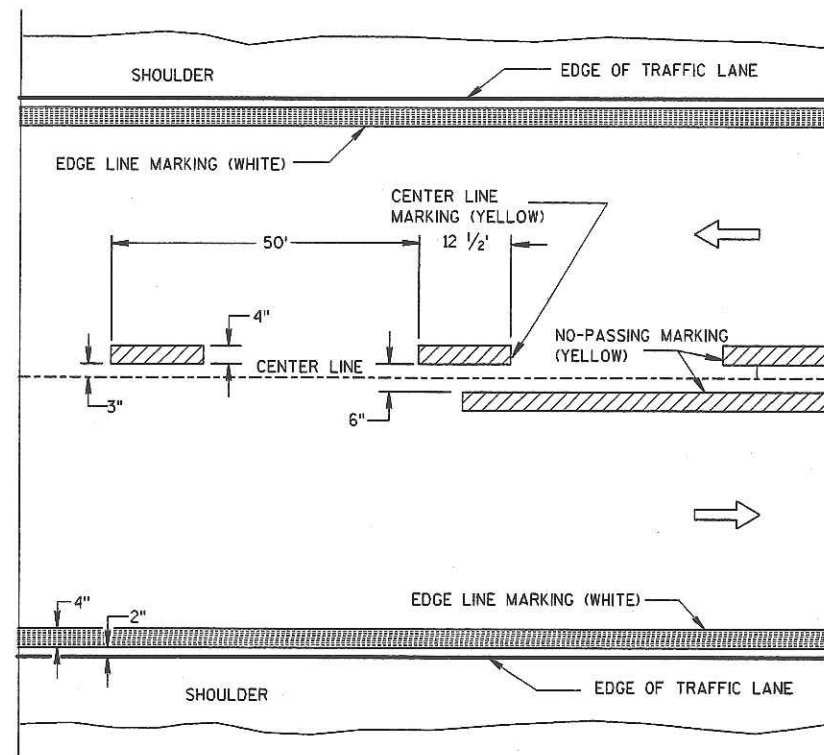


TWO WAY TRAFFIC

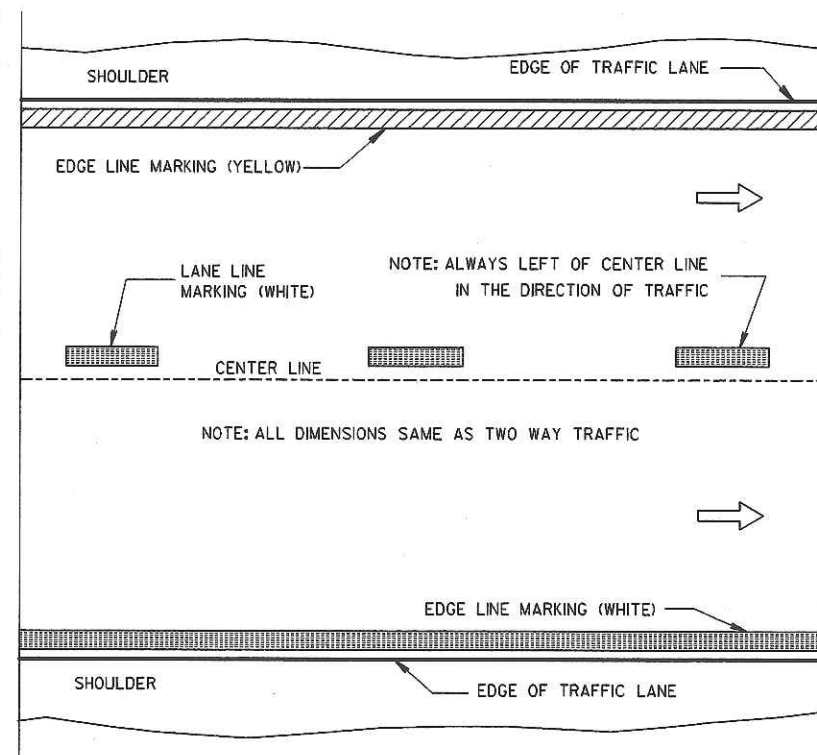


ONE WAY TRAFFIC

### PERMANENT PAVEMENT MARKING

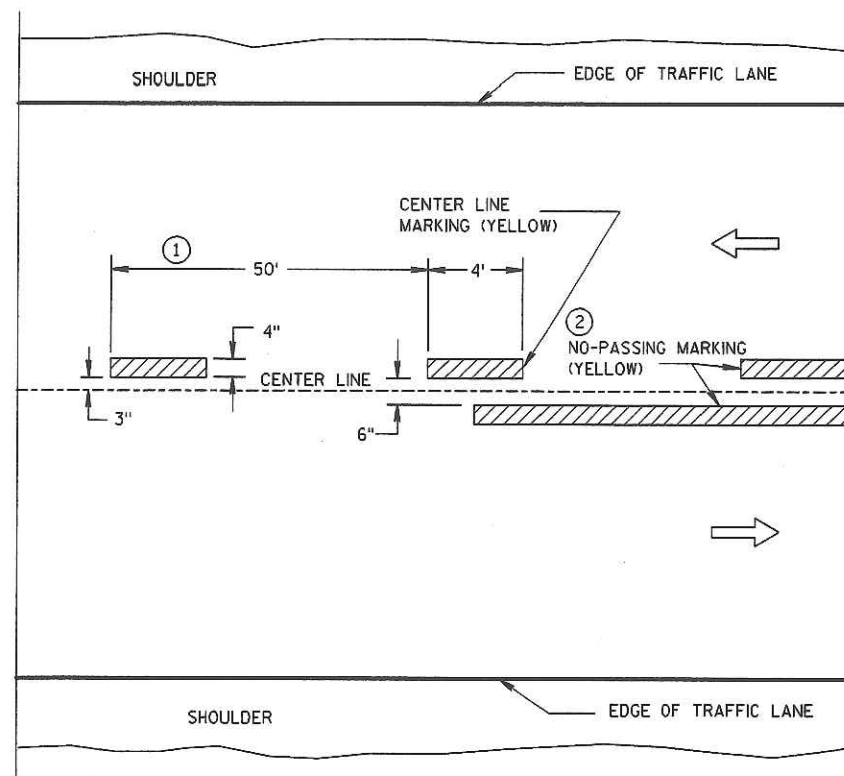

TWO WAY TRAFFIC

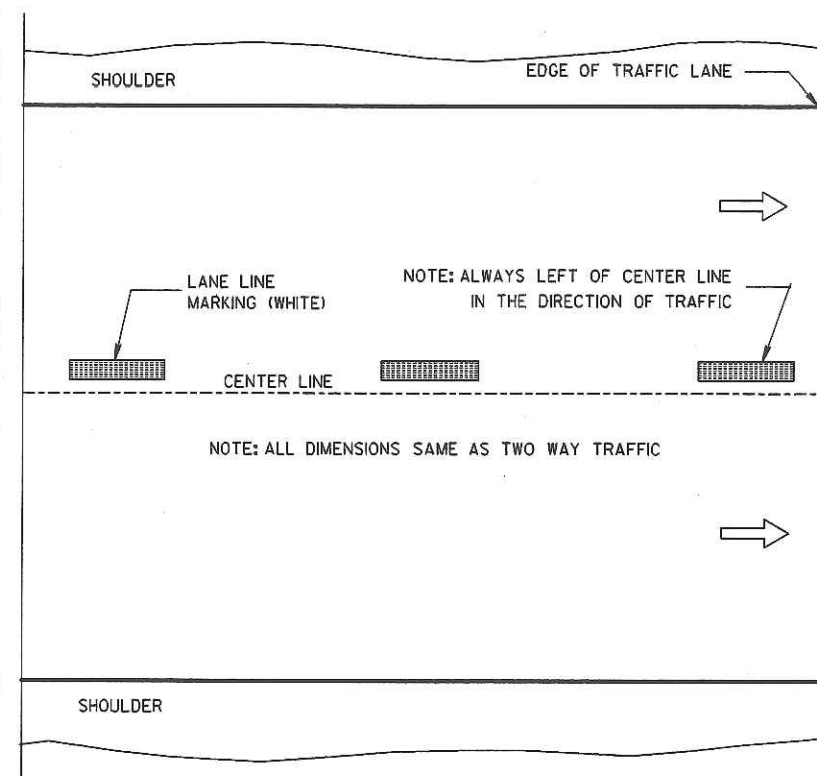

ONE WAY TRAFFIC

### TEMPORARY (INTERMEDIATE) PAVEMENT MARKING (SHOWS CYCLE FOR TEMPORARY CENTER LINE OR TEMPORARY LANE LINE MARKING)

### GENERAL NOTES

DETAILS OF CONSTRUCTION NOT SHOWN ON THIS DRAWING SHALL CONFORM TO STANDARD SPECIFICATIONS AND SPECIAL PROVISIONS.

- ① HALF CYCLE LENGTHS (25'±) WITH 2' MINIMUM STRIPE LENGTHS SHALL BE PROVIDED ON ROADWAYS (INCLUDING TEMPORARY TRAVELED WAYS) WITH REVERSE CURVATURE, CURVATURE OF OVER 5 DEGREES OR WHEN DIRECTED BY THE ENGINEER TO MARK UNUSUAL ALIGNMENT OF THE TRAVELED WAY.
- ② NO PASSING ZONE TEMPORARY PAVEMENT MARKING IS REQUIRED TO BE PLACED, WHERE APPROPRIATE, ALONG WITH CENTERLINE TEMPORARY PAVEMENT MARKING WHEN A SAME DAY PERMANENT PAVEMENT MARKING ITEM IS INCLUDED IN THE CONTRACT.

### NOTE

ARROW SYMBOL (→) SHOWS DIRECTION OF TRAVEL

PAVEMENT MARKING  
(MAINLINE)

STATE OF WISCONSIN  
DEPARTMENT OF TRANSPORTATION

APPROVED


4-10-98  
DATE

FHWA

Christa J. Spang  
CHIEF SIGNS AND MARKING ENGINEER




NOTE:  
ARROW SYMBOL (→)  
SHOWS DIRECTION OF TRAVEL

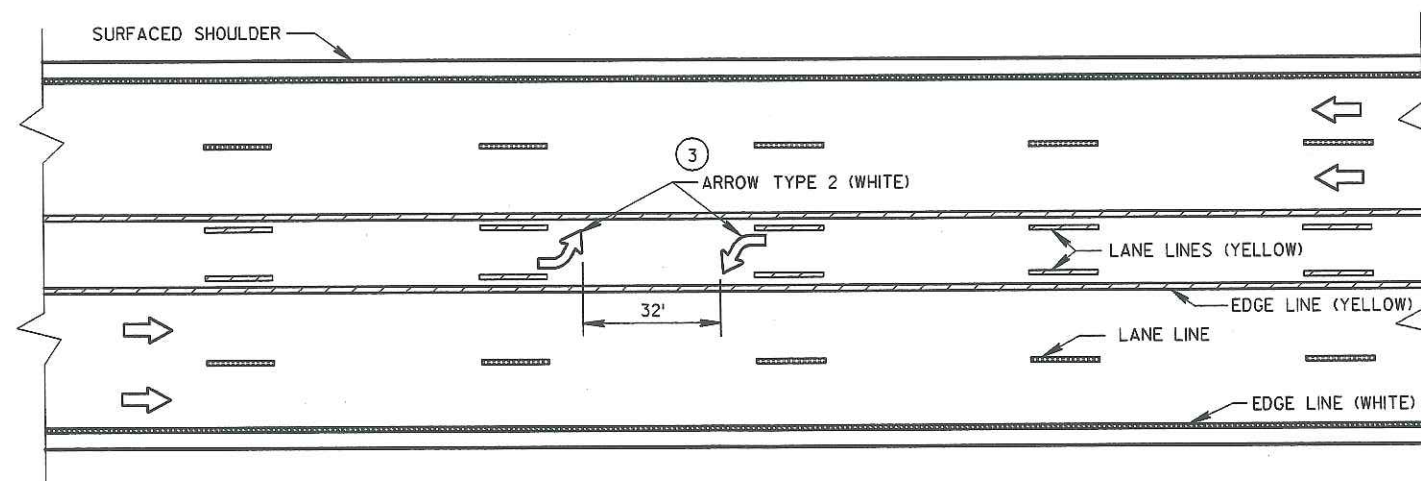

TWO WAY LEFT TURN LANE


NOTES:

- ① STOP BAR IS REQUIRED ONLY WHEN SPECIFIED IN THE CONTRACT.
- ② DISTANCE MAY BE ADJUSTED TO ACCOMMODATE SHORT LEFT TURN LANES, AS APPROVED BY THE ENGINEER.
- ③ A SET OF ARROWS IS REQUIRED EVERY 400' OR NEAR INTERSECTIONS OR DRIVEWAYS WITH TURNING TRAFFIC.

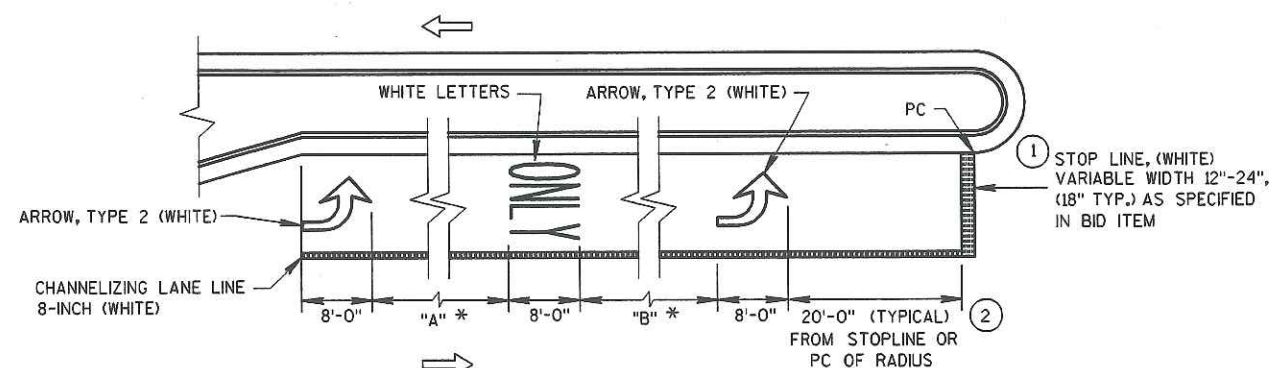


\*VARIABLE, 32' MIN.  
"A" = "B" (TYPICAL)

LEFT TURN LANE  
(LENGTH 108' TO 167')

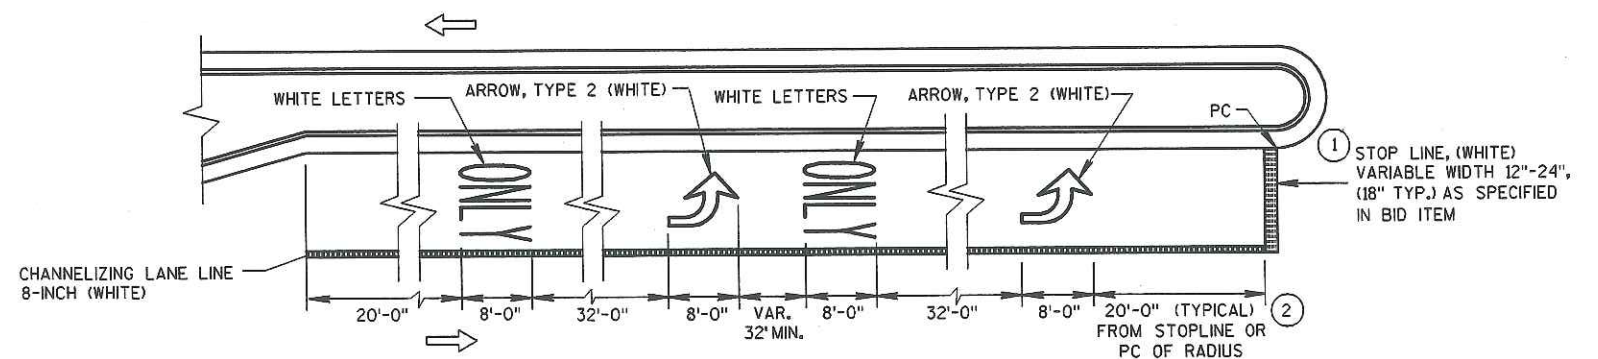

LEFT TURN LANE  
(LENGTH OVER 167')

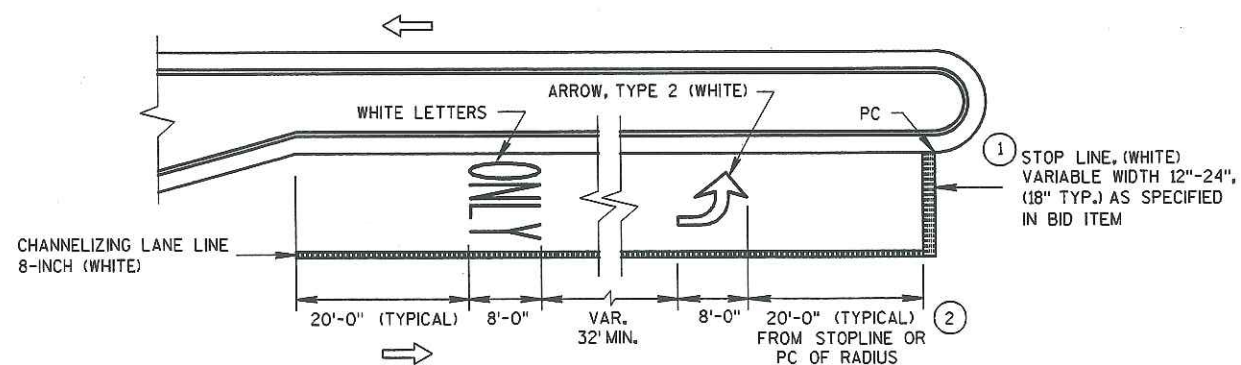


LEFT TURN LANE  
(LENGTH UNDER 108')

PAVEMENT MARKING  
(LEFT TURN LANE)

STATE OF WISCONSIN  
DEPARTMENT OF TRANSPORTATION

# LEGEND

- POST WITH ATTACHED SIGN
- DRUM WITH WARNING LIGHT (TYPE C)
- DRUM
- ARROW BOARD
- REMOVING PAVEMENT MARKING
- TEMPORARY PRECAST CONCRETE BARRIER
- DIRECTION OF TRAFFIC
- WORK ZONE

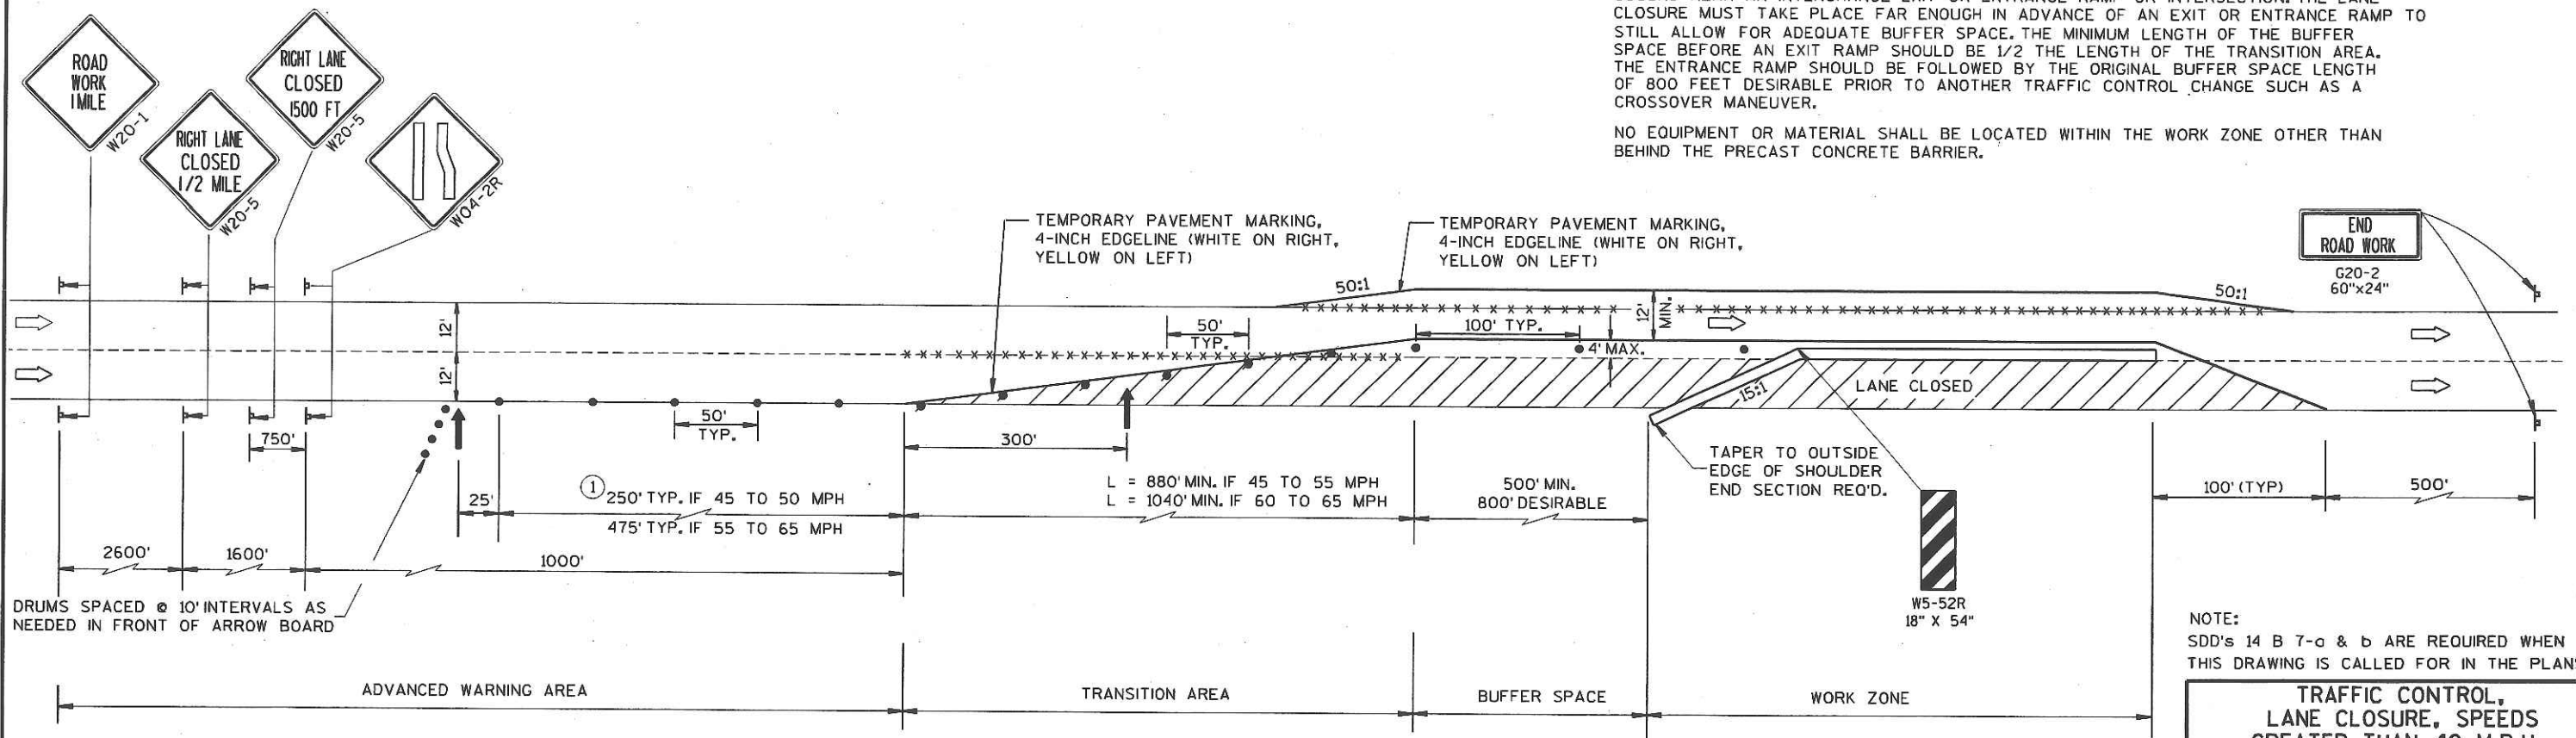

## GENERAL NOTES :

THIS LANE CLOSURE IS TYPICAL FOR CLOSING RIGHT LANE - REVERSE FOR CLOSING LEFT LANE.

THE EXACT NUMBER, LOCATION, AND SPACING OF ALL SIGNS AND DEVICES SHALL BE ADJUSTED TO FIT FIELD CONDITIONS AS APPROVED BY THE ENGINEER.

THE SPACING BETWEEN SIGNS SHOULD BE ADJUSTED TO NOT CONFLICT WITH AND TO PROVIDE A MINIMUM OF 200 FEET, (500 FEET DESIRABLE) CLEARANCE TO EXISTING SIGNS.

ALL SIGNS ARE 48"x48" UNLESS OTHERWISE NOTED.

"WO" IS THE SAME AS "W" EXCEPT THE BACKGROUND IS ORANGE.

ANY SIGNS TEMPORARY OR EXISTING, WHICH CONFLICT WITH TRAFFIC CONTROL "IN USE" SHALL BE REMOVED OR COVERED AS NEEDED AND AS APPROVED BY THE ENGINEER.

- CONSIDER ROADWAY GEOMETRICS WHEN LOCATING SIGNS AND ARROW BOARD SO THE DRIVER HAS A CLEAR VIEW OF THE ARROW BOARD AND LANE CLOSURE DRUMS FOR A MINIMUM 1500 FEET IN FRONT OF DRUMS.

FOR A LANE CLOSURE THAT IS IN PLACE LESS THAN 7 CONTINUOUS DAYS AND NIGHTS, THE ADVANCED WARNING SIGNS MAY BE MOUNTED ON PORTABLE SUPPORTS.

REMOVE PAVEMENT MARKINGS IF LANE CLOSURE IS TO BE IN PLACE FOR LONGER THAN 7 CONTINUOUS DAYS AND NIGHTS.

IF THE HORIZONTAL ALIGNMENT IS SUCH THAT A CURVE MAY REQUIRE ADDITIONAL DELINEATION, THE DEVICE SPACING MAY BE DECREASED TO 50 FEET.

ADJUSTMENTS IN BUFFER SPACE NEED TO BE INCORPORATED WHEN THE LANE CLOSURE OCCURS NEAR AN INTERCHANGE EXIT OR ENTRANCE RAMP OR INTERSECTION. THE LANE CLOSURE MUST TAKE PLACE FAR ENOUGH IN ADVANCE OF AN EXIT OR ENTRANCE RAMP TO STILL ALLOW FOR ADEQUATE BUFFER SPACE. THE MINIMUM LENGTH OF THE BUFFER SPACE BEFORE AN EXIT RAMP SHOULD BE 1/2 THE LENGTH OF THE TRANSITION AREA. THE ENTRANCE RAMP SHOULD BE FOLLOWED BY THE ORIGINAL BUFFER SPACE LENGTH OF 800 FEET DESIRABLE PRIOR TO ANOTHER TRAFFIC CONTROL CHANGE SUCH AS A CROSSOVER MANEUVER.

NO EQUIPMENT OR MATERIAL SHALL BE LOCATED WITHIN THE WORK ZONE OTHER THAN BEHIND THE PRECAST CONCRETE BARRIER.

NOTE:  
SDD's 14 B 7-a & b ARE REQUIRED WHEN THIS DRAWING IS CALLED FOR IN THE PLANS.

TRAFFIC CONTROL,  
LANE CLOSURE, SPEEDS  
GREATER THAN 40 M.P.H.  
WITH BARRIER

STATE OF WISCONSIN  
DEPARTMENT OF TRANSPORTATION

APPROVED  
1-14-94  
DATE  
CHESTER J. SPANG  
DIRECTOR, OFFICE OF TRAFFIC  
FHWA




## GENERAL NOTES

DETAILS OF TRAFFIC CONTROL DEVICES AND INSTALLATION NOT SHOWN ON THIS DRAWING SHALL CONFORM TO THE PERTINENT REQUIREMENTS OF THE STANDARD SPECIFICATIONS, THE SPECIAL PROVISIONS, AND THE MANUAL ON UNIFORM TRAFFIC CONTROL DEVICES.

PAVEMENT MARKING SHOWN ON THIS DRAWING IS NOT REQUIRED UNLESS OTHERWISE SPECIFIED IN THE CONTRACT. WHEN SPECIFIED, PAVEMENT MARKING SHALL CONFORM TO THIS DRAWING AND OTHER CONTRACT REQUIREMENTS.


- ① MINIMUM DISTANCE UNLESS OTHERWISE SHOWN ON THE PLAN.
- ② FACE OF OBJECT MARKERS W5-52R AND W5-52L SHALL BE COVERED WITH TYPE H REFLECTIVE SHEETING.
- ③ LOCATE OBJECT MARKER POST(S) BEHIND GUARDRAIL WHEN PRESENT.
- ④ OBJECT MARKERS (W5-53) SHALL BE LOCATED ALONG A LINE FLARED AWAY FROM THE BRIDGE CORNER TO DELINEATE THE NARROWING OF THE SHOULDER OR BERM.
- ⑤ A 10 FOOT DELINEATOR POST MAY BE USED INSTEAD OF A WOOD POST.
- ⑥ NON-BID ITEM. INCIDENTAL TO OTHER ITEMS.

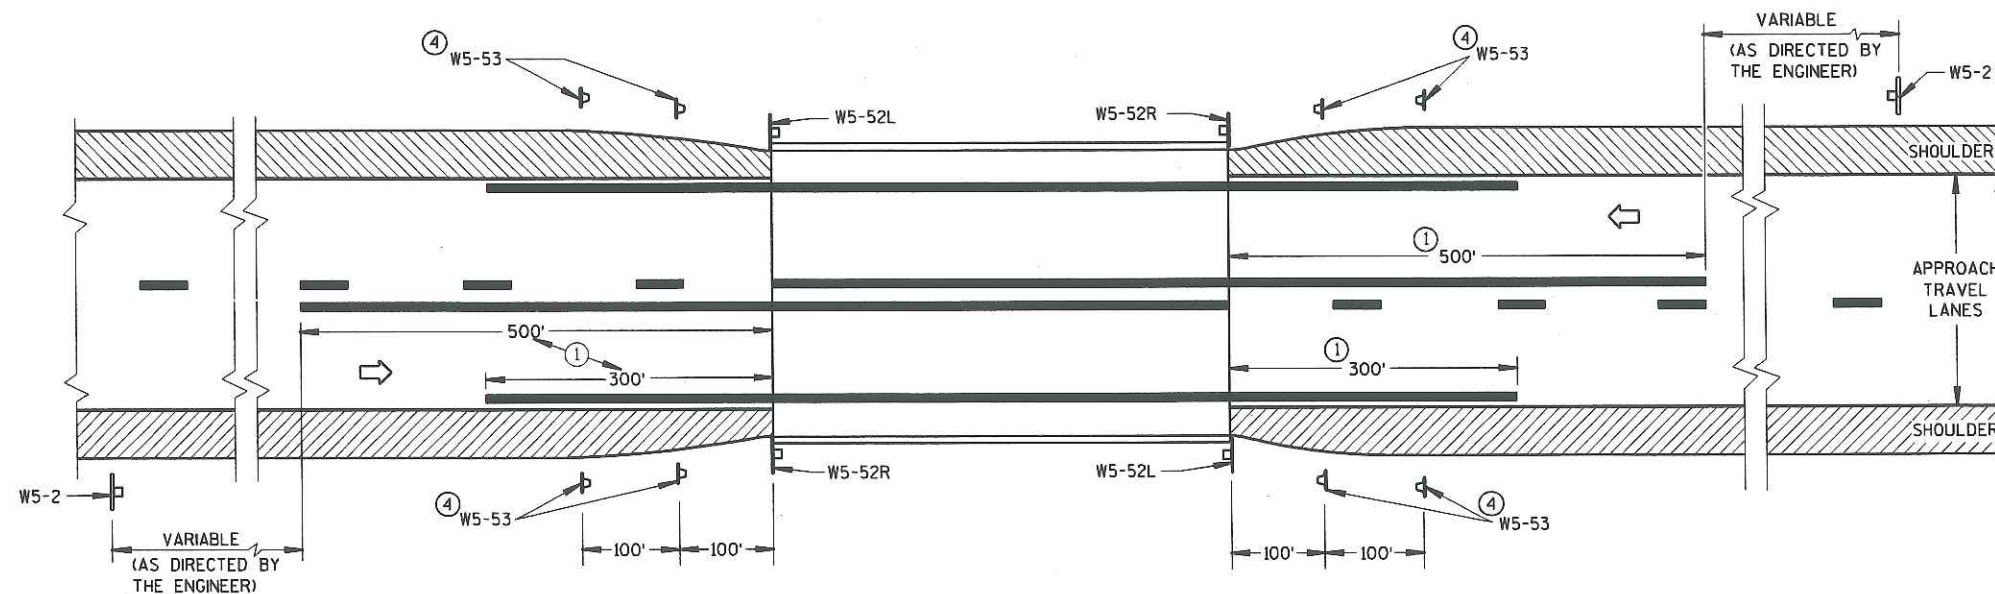

### SITUATION 1

WARRANTING CRITERION:



BRIDGE WIDTH IS AT LEAST 18 FEET BUT LESS THAN 24 FEET

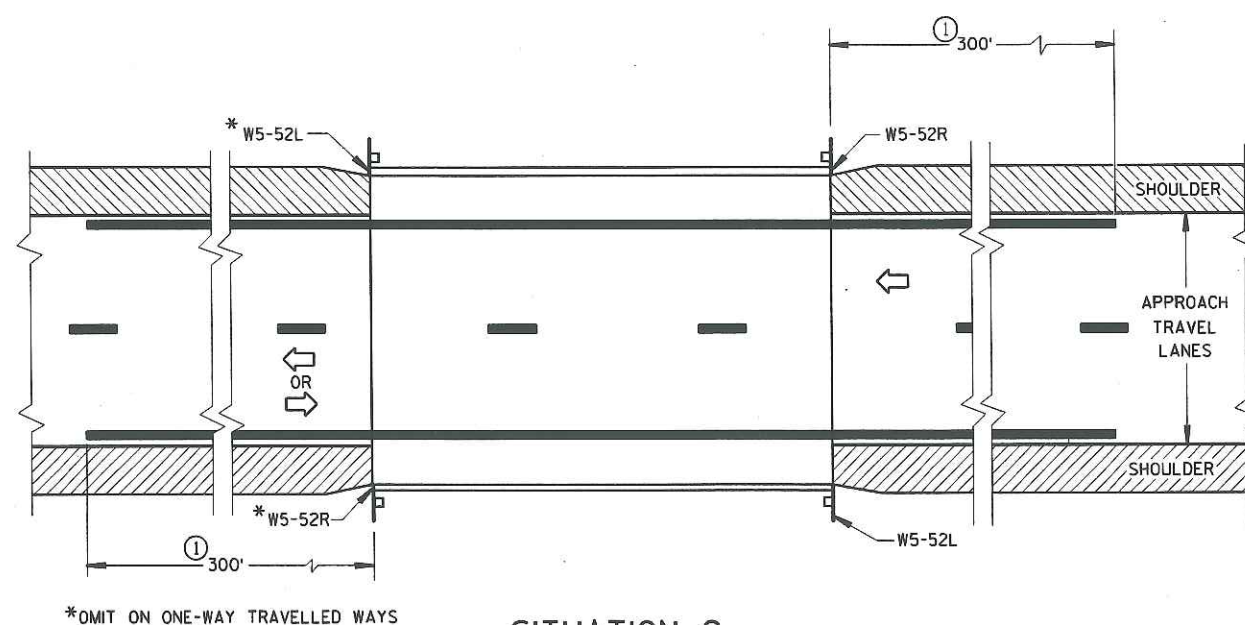


### SITUATION 2

WARRANTING CRITERIA:


1. BRIDGE WIDTH IS AT LEAST 24 FEET AND
2. BRIDGE IS LESS THAN 6 FEET WIDER (ON EACH SIDE) THAN APPROACH TRAVEL LANES.

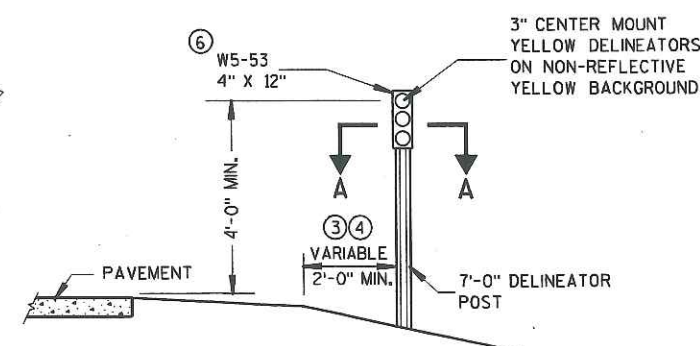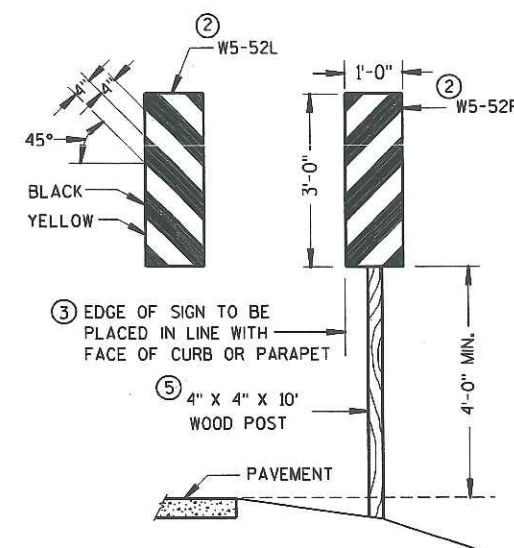

### OBJECT MARKER PLACEMENT

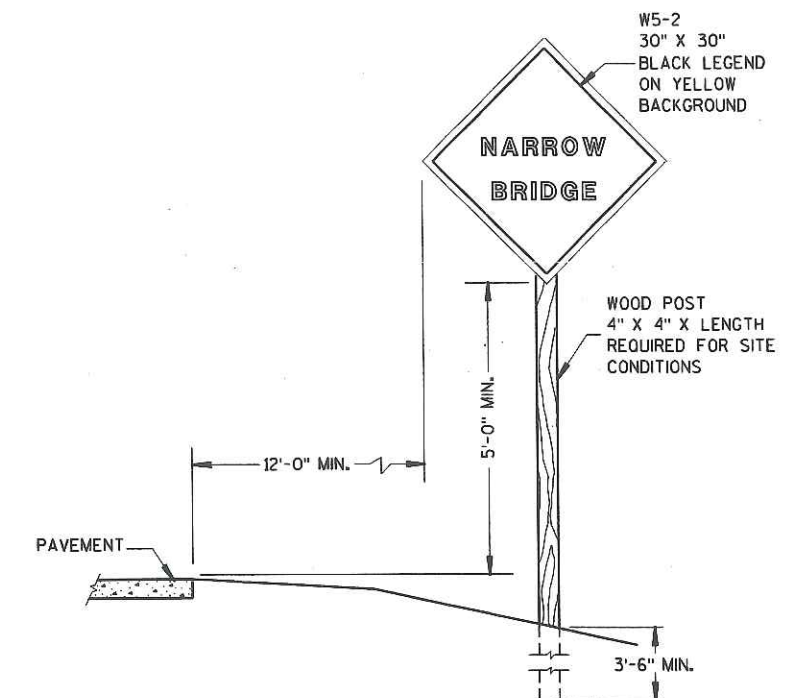

### SIGN PLACEMENT

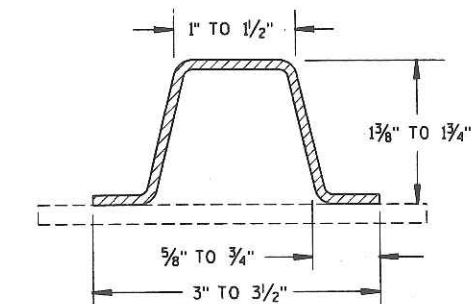

### SECTION A-A

(MINIMUM WEIGHT 1.9 LBS. PER FT. AFTER GALVANIZING)

### SIGNING & MARKING FOR TWO LANE BRIDGES


STATE OF WISCONSIN  
DEPARTMENT OF TRANSPORTATION

APPROVED

8-7-95  
DATE

Charles J. Spring  
DIRECTOR, OFFICE OF TRAFFIC

FHWA

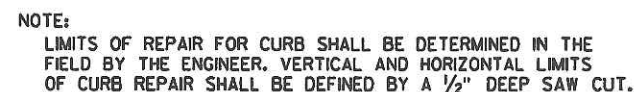

REMOVE SIDEWALK AND  
PARAPET AS REQUIRED  
TO INSTALL THE NEW  
EXPANSION DEVICE


1. GENERAL PLAN  
2. EXPANSION JOINT DETAIL  
3. EXPANSION JOINT DETAIL

<u>BID ITEM</u>	<u>AMOUNT</u>
CONCRETE MASONRY, OVERLAY, DECKS	102 C.Y.
CLEANING DECK	1190 S.Y.
PROTECTIVE SURFACE TREATMENT	1190 S.Y.
PREPARATION DECK, TYPE 1	250 S.Y.
PREPARATION DECK, TYPE 2	110 S.Y.
CURB REPAIR	25 L.F.
JOINT REPAIR	42 S.Y.
EXPANSION DEVICE, STRUCTURE B-40-252	1 L.S.
COATED HIGH STRENGTH BAR STEEL REINFORCEMENT BRIDGES	1820 LB.
CONCRETE MASONRY, BRIDGES	18 C.Y.
* CONCRETE SURFACE REPAIR	70 S.F.
FULL DEPTH DECK REPAIR	40 S.Y.

\* CONCRETE SURFACE REPAIR QUANTITY IS BASED ON 50 S.F. AT SOUTH ABUTMENT AND 20 S.F. UNDISTRIBUTED.


INVENTORY RATING: HS-22  
OPERATING RATING: HS-37  
MAX. STANDARD PERMIT VEHICLE LOAD: 210 KIPS

CONCRETE MASONRY	{	SLAB _____	$f'_c =$	4,000	p.s.i.
	{	ALL OTHER _____	$f'_a =$	3,500	p.s.i.
HIGH STRENGTH BAR STEEL REINFORCEMENT (GRADE 60)		_____	$f'_y =$	60,000	p.s.i.

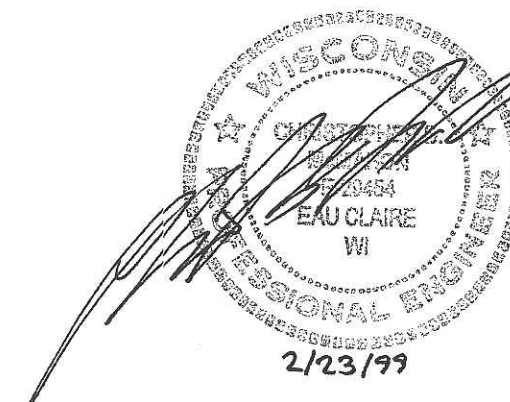

DISTRICT 2 BRIDGE MAINTENANCE OFFICE CONTACT:  
CHRIS WILLIAMS  
(414) 548-6711

CONSULTANT CONTACT:  
CHRIS McMAHON  
(715) 834-3161

No.	Date	Revision	By
PLANS PREPARED BY			
<b>AVRES</b> <b>ASSOCIATES</b>		Engineers/Architects Scientists/Surveyors 3433 Oakwood Hills Parkway Eau Claire, WI 54701	
STATE OF WISCONSIN			
DEPARTMENT OF TRANSPORTATION			
STRUCTURE		B-40-252	
107 STREET OVER S.T.H. 145			
County	MILWAUKEE	Source City/Allyage	MILWAUKEE
Design Spec.	A.A.S.H.T.O. '96	Load	HS-20 Const. Spec. 1996
Designed By	CBM	Checked	PWD
		Drawn By	GLD
		Plans Checked	CBM
Approved	 Chief Bridge Design Engineer		05-27-0 Date
GENERAL PLAN		SHEET 1 OF 3	
		DATE: FEB. 1999	



8.2

1. NEOPRENE STRIP SEAL & STEEL EXTRUSIONS BY D. S. BROWN SSA2-400A2, R. J. WATSON RJA-RJ400, WATSON-BOWMAN-ACME A-SE400 OR A-AS400. EXTRUSIONS TO BE A709 GRADE 250.
2. WELD  $\frac{5}{8}" \phi \times 6\frac{3}{8}"$  LONG AT 6" ALTERNATE CENTERS. STUDES TO STEEL EXTRUSIONS & BEND AS SHOWN AFTER WELDING.
- 2A.  $3" \times \frac{1}{2}"$  THICK ANCHOR PLATE WITH  $\frac{5}{8}" \phi$  ROD. WELD ROD TO ANCHOR PLATE. WELD ANCHOR PLATE TO NO. 1 @ 1'-6" CENTERS BETWEEN GIRDERS.
3.  $\frac{3}{4}" \phi$  THREADED ROD WITH 2 NUTS AND WASHERS. WELD THREADED ROD TO TOP FLANGE OR ATTACH BY BOLTING THRU FLANGE. ON ABUTMENT SIDE GROUT THREADED ROD INTO FIELD DRILLED HOLES IN ABUTMENT BACKWALL AS SHOWN.
4.  $\frac{3}{4}" \phi$  THREADED ROD WITH NUT. TACK WELD NUT TO NO. 5.
5. FABRICATE SUPPORT FROM  $3" \times \frac{1}{2}"$  BAR AS SHOWN OR EQUIVALENT, ONE PER GIRDER, PER SIDE. WELD TO NO. 1. PROVIDE  $1\frac{1}{2}" \phi$  HOLE FOR NO. 3 & 1"  $\phi$  HOLE FOR NO. 4.
6. GALVANIZED PLATE  $\frac{3}{8}" \times 1'-2" \times 2'-0"$  LONG WITH HOLES FOR NO. 7 & NO. 11. BEND AS SHOWN.
7.  $\frac{3}{4}" \phi \times 1\frac{1}{2}"$  STAINLESS STEEL FLAT HEAD MACHINE SCREWS. RECESS  $\frac{1}{16}"$  BELOW PLATE SURFACE.
8.  $\frac{3}{4}" \phi \times 4"$  GALVANIZED HEX HEAD BOLT. BEND 45°.
9.  $\frac{3}{4}" \phi \times 2\frac{1}{4}"$  GALVANIZED THREADED COUPLING.
10. GALVANIZED SIDEWALK PLATE  $\frac{3}{8}" \times 2'-0"$  WIDE x LIMITS SHOWN. BEND DOWN FACE OF SIDEWALK WITH HOLES FOR NO. 7.
11. 1" x 5" SLOTTED CSK. HOLE FOR NO. 7 PARALLEL TO DIRECTION OF MOVEMENT.

ONE FIELD SPLICE PERMITTED IN STEEL EXTRUSIONS. IF USED, DETAILS SHALL BE SUBMITTED FOR APPROVAL. NO SPLICING PERMITTED IN NEOPRENE STRIP SEAL.


STRIP SEAL EXPANSION JOINT ASSEMBLY, INCLUDING ANCHOR STUDS & HARDWARE WILL BE PAID FOR AT THE LUMP SUM PRICE BID FOR "EXPANSION DEVICE".



AFTER FABRICATION, BUT BEFORE SHIPMENT, STRAIGHTEN STEEL EXTRUSIONS SUCH THAT THEY SHALL BE FREE FROM WARP, TWIST AND SWEEP.

SANDBLAST PLATES & EXTRUSION AFTER FABRICATION IN ACCORDANCE WITH SSPC SP. NO. 6 "COMMERCIAL BLAST CLEANING". AFTER BLAST CLEANING THE PLATES & EXTRUSIONS SHALL BE HOT DIPPED GALVANIZED.

FABRICATOR SHALL PROVIDE MEANS OF KEEPING GALVANIZED EXTRUSIONS CLEAN AND SMOOTH DURING SHIPMENT AND PRIOR TO APPLYING LUBRICANT ADHESIVE FOR NEOPRENE GLAND INSTALLATION.


ANCHOR SYSTEM NO. 8 & NO. 9 SHALL CONFORM TO ASTM A307 & SHALL BE GALV. IN ACCORDANCE WITH ASTM A153 CLASS C & D. 124 MILS. MIN.

No.	Date	Revision	By
		PLANS PREPARED BY Engineers/Architects Scientists/Surveyors 3433 Oakwood Hills Parkway Eau Claire, WI 54701	
STATE OF WISCONSIN DEPARTMENT OF TRANSPORTATION			
STRUCTURE		B-40-252	
Const. Spec.	1996	Drawn By	G. L. O.
		Plans Checked	CBM
EXPANSION JOINT DETAILS		SHEET 2 OF 3	

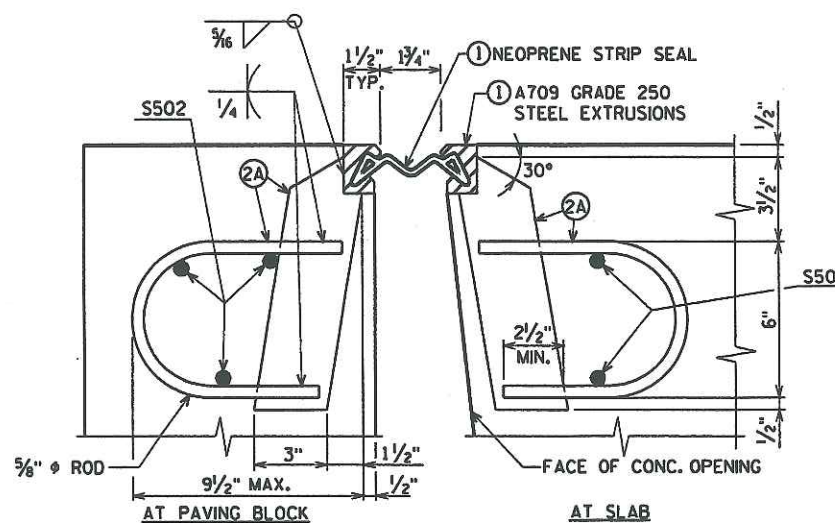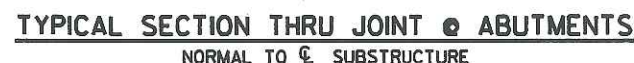

### SECTION THRU JOINT

ROADWAY TRAFFIC AREA BETWEEN EXTERIOR GIRDERS

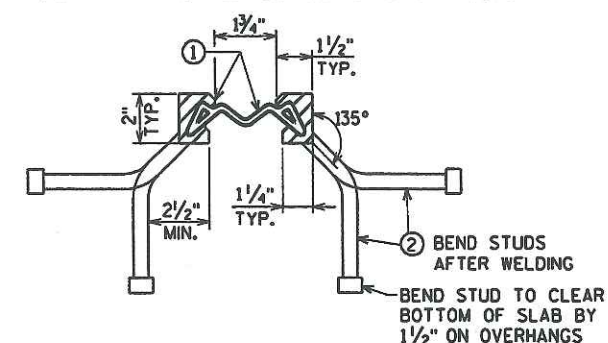


## SECTION THRU JOINT

EXTERIOR GIRDER TO EDGE OF SLAB & AT SIDEWALKS

[illegible]

BENDING DIMENSIONS ARE OUT TO OUT OF BARS.

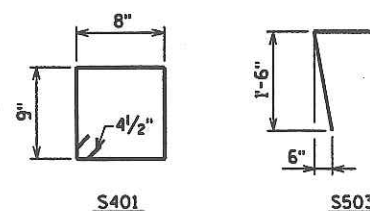

S401

S503

```
OPEN TABLE = #plot72+LASER+smb.r.t
DATE OF PLOT = 2/11/99
DESIGN FILE IS u:\trbrldge+460187x2.dgn
LOGN LEVELS ON = 1-63
```


## REFERENCE FILES

CHECKED BY: BY: DATE: DATE: DATE:




PEN TABLE = #plot72LASER&smb.r.tbl  
 DATE OF PLOT = 2/11/99  
 DESIGN FILE IS utstrbridge460187x2.dgn  
 DGN LEVELS ON = 1-63

STATE PROJECT NUMBER	SHEET NO.
2320-02-60	B3

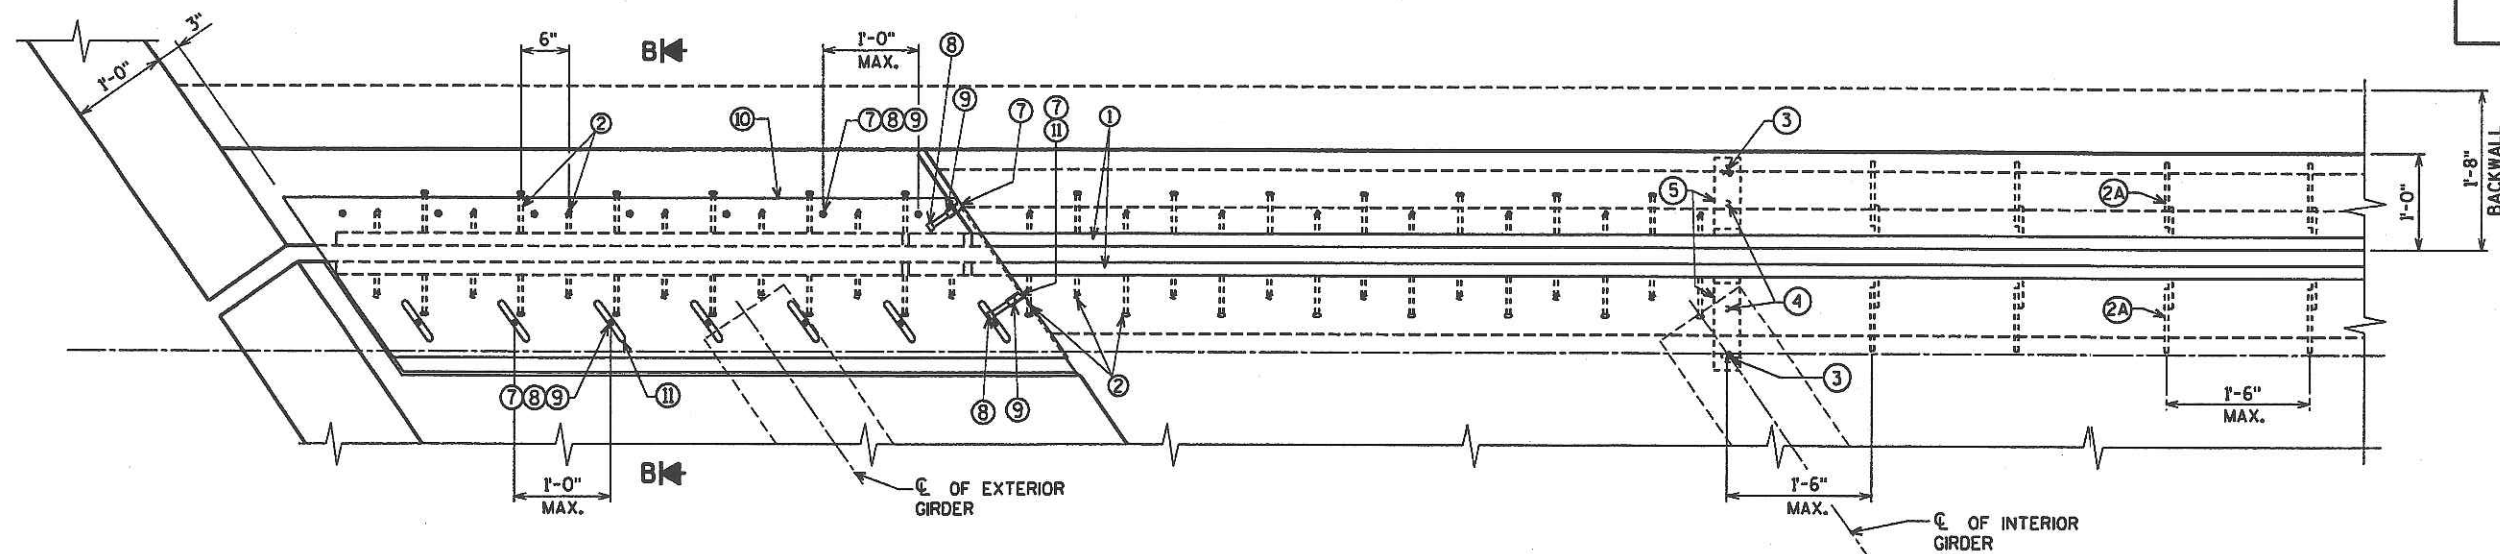


PART PLAN

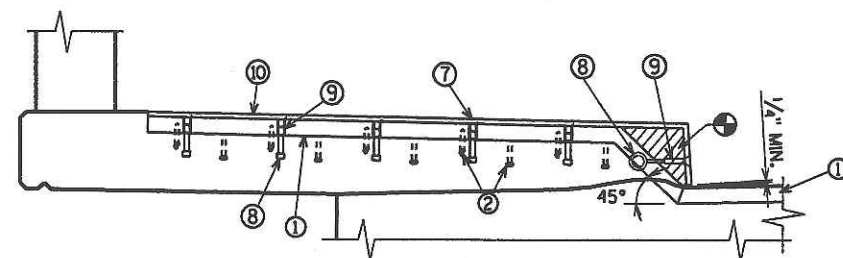


SECTION AT SIDEWALK

NOTE: COVER PLATE REQ'D. FOR ALL SIDEWALKS

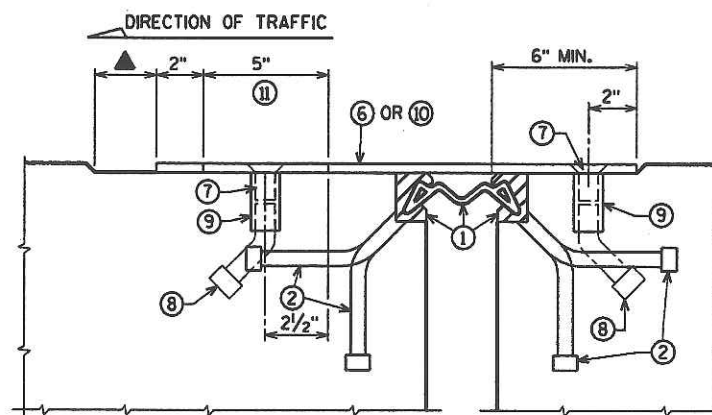


SECTION B-B

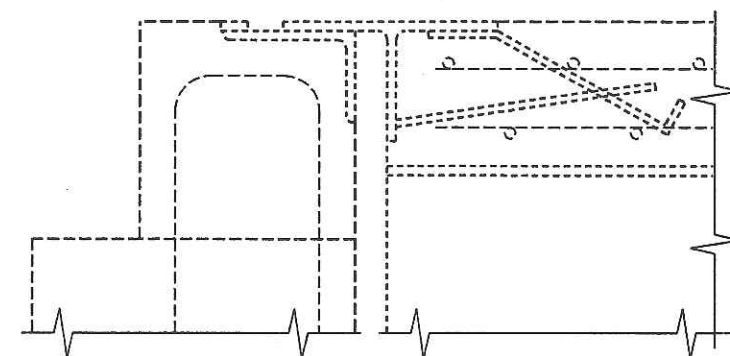

TYP. SECTION THRU EXISTING JOINT

- ▲ JOINT OPENING DIM. ALONG SKEW PLUS 1/2".
- ⊕ BLOCK OUT CONCRETE 2" EACH SIDE FOR JOINT OPENING.

WORK THIS SHEET WITH SHEET 2.

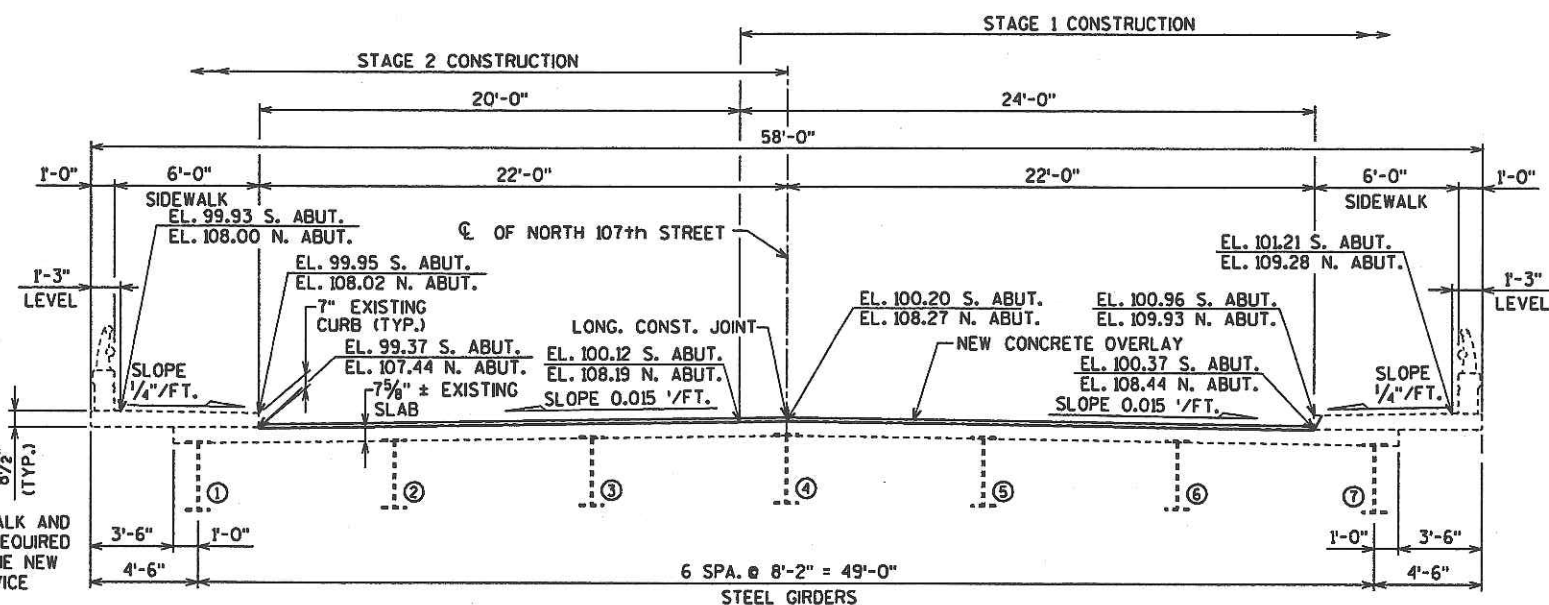

CROSS SECTION THRU EXISTING ROADWAY  
 (LOOKING SOUTH)

NOTE:  
 ALL ELEVATIONS TAKEN TO  
 ORIGINAL CONCRETE SURFACES.

No.	Date	Revision	By
PLANS PREPARED BY			
<b>AVRES ASSOCIATES</b> Engineers/Architects Scientists/Surveyors 3433 Oakwood Hills Parkway Eau Claire, WI 54701			
STATE OF WISCONSIN DEPARTMENT OF TRANSPORTATION			
STRUCTURE B-40-252			
Const. Spec.	1996	Drawn By	6.L.D.
		Plans Checked	C
EXPANSION JOINT DETAILS			SHEET 3 OF 3

REFERENCE FILES

DATE:

CHECKED BY:  
 BACK CHECKED BY:  
 CORRECTED BY:



PEN TABLE = #plot72+LASER+smbr.1  
DATE OF PLOT = 2/11/99  
DESIGN FILE IS u:\trbrldge+460187g4.dgn  
DGN LEVELS ON = 1-63

REFERENCE FILES

DATE:  
DATE:  
DATE:

BY:

CHECKED  
BACK C  
CORREC.

STATE PROJECT NUMBER SHEET NO.

2320-02-60

8.4

### GENERAL NOTES

DRAWINGS SHALL NOT BE SCALED.  
DIMENSIONS ARE BASED ON ORIGINAL PLANS THEREFORE THE CONTRACTOR SHALL VERIFY THEM IN THE FIELD BEFORE ACCEPTANCE.  
A MINIMUM OF 1 INCH OF CONCRETE SHALL BE REMOVED FROM THE ENTIRE BRIDGE DECK UNDER THE BID ITEM, "CLEANING DECK", BUT LESS THAN 1 1/2" MAXIMUM.  
ALL PREVIOUS PATCHES SHALL BE REMOVED UNDER THE BID ITEM "PREPARATION DECK".  
PROTECTIVE SURFACE TREATMENT SHALL BE 150 S.F. PER GALLON OR PER MANUFACTURER'S RECOMMENDATIONS.  
PREPARATION, DECKS, CONCRETE SURFACE REPAIR AND CURB REPAIR SHALL BE AS DETERMINED BY THE ENGINEER IN THE FIELD.

### TOTAL ESTIMATED QUANTITIES




BID ITEM	AMOUNT
CONCRETE MASONRY, OVERLAY, DECKS	87 C.Y.
CLEANING DECK	1,240 S.Y.
PROTECTIVE SURFACE TREATMENT	1,240 S.Y.
PREPARATION DECK, TYPE 1	250 S.Y.
PREPARATION DECK, TYPE 2	250 S.Y.
FULL DEPTH DECK REPAIR	15 S.Y.
CURB REPAIR	5 L.F.
CONCRETE SURFACE REPAIR	5 S.F.

### DESIGN DATA


LIVE LOAD:  
INVENTORY RATING: HS-25  
OPERATING RATING: HS-43  
MAX. STANDARD PERMIT VEHICLE LOAD: 210 KIPS

ULTIMATE DESIGN STRESSES:  
CONCRETE MASONRY { SLAB  $f'_c = 4,000$  p.s.i.  
ALL OTHER  $f'_c = 3,500$  p.s.i.  
HIGH STRENGTH BAR STEEL REINFORCEMENT (GRADE 60)  $f_y = 60,000$  p.s.i.


NOTE:  
LIMITS OF REPAIR FOR CURB SHALL BE DETERMINED IN THE FIELD BY THE ENGINEER. VERTICAL AND HORIZONTAL LIMITS OF CURB REPAIR SHALL BE DEFINED BY A 1/2" DEEP SAW CUT.

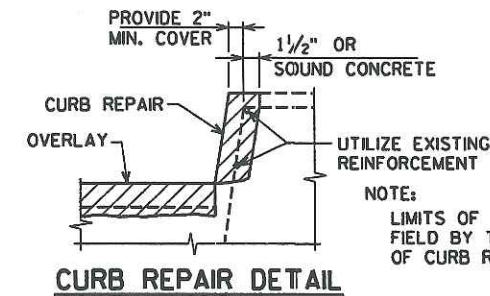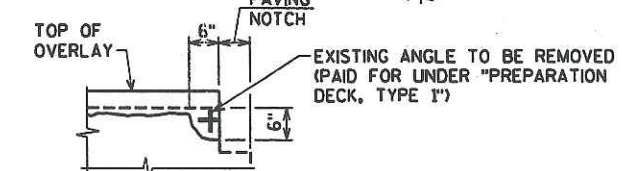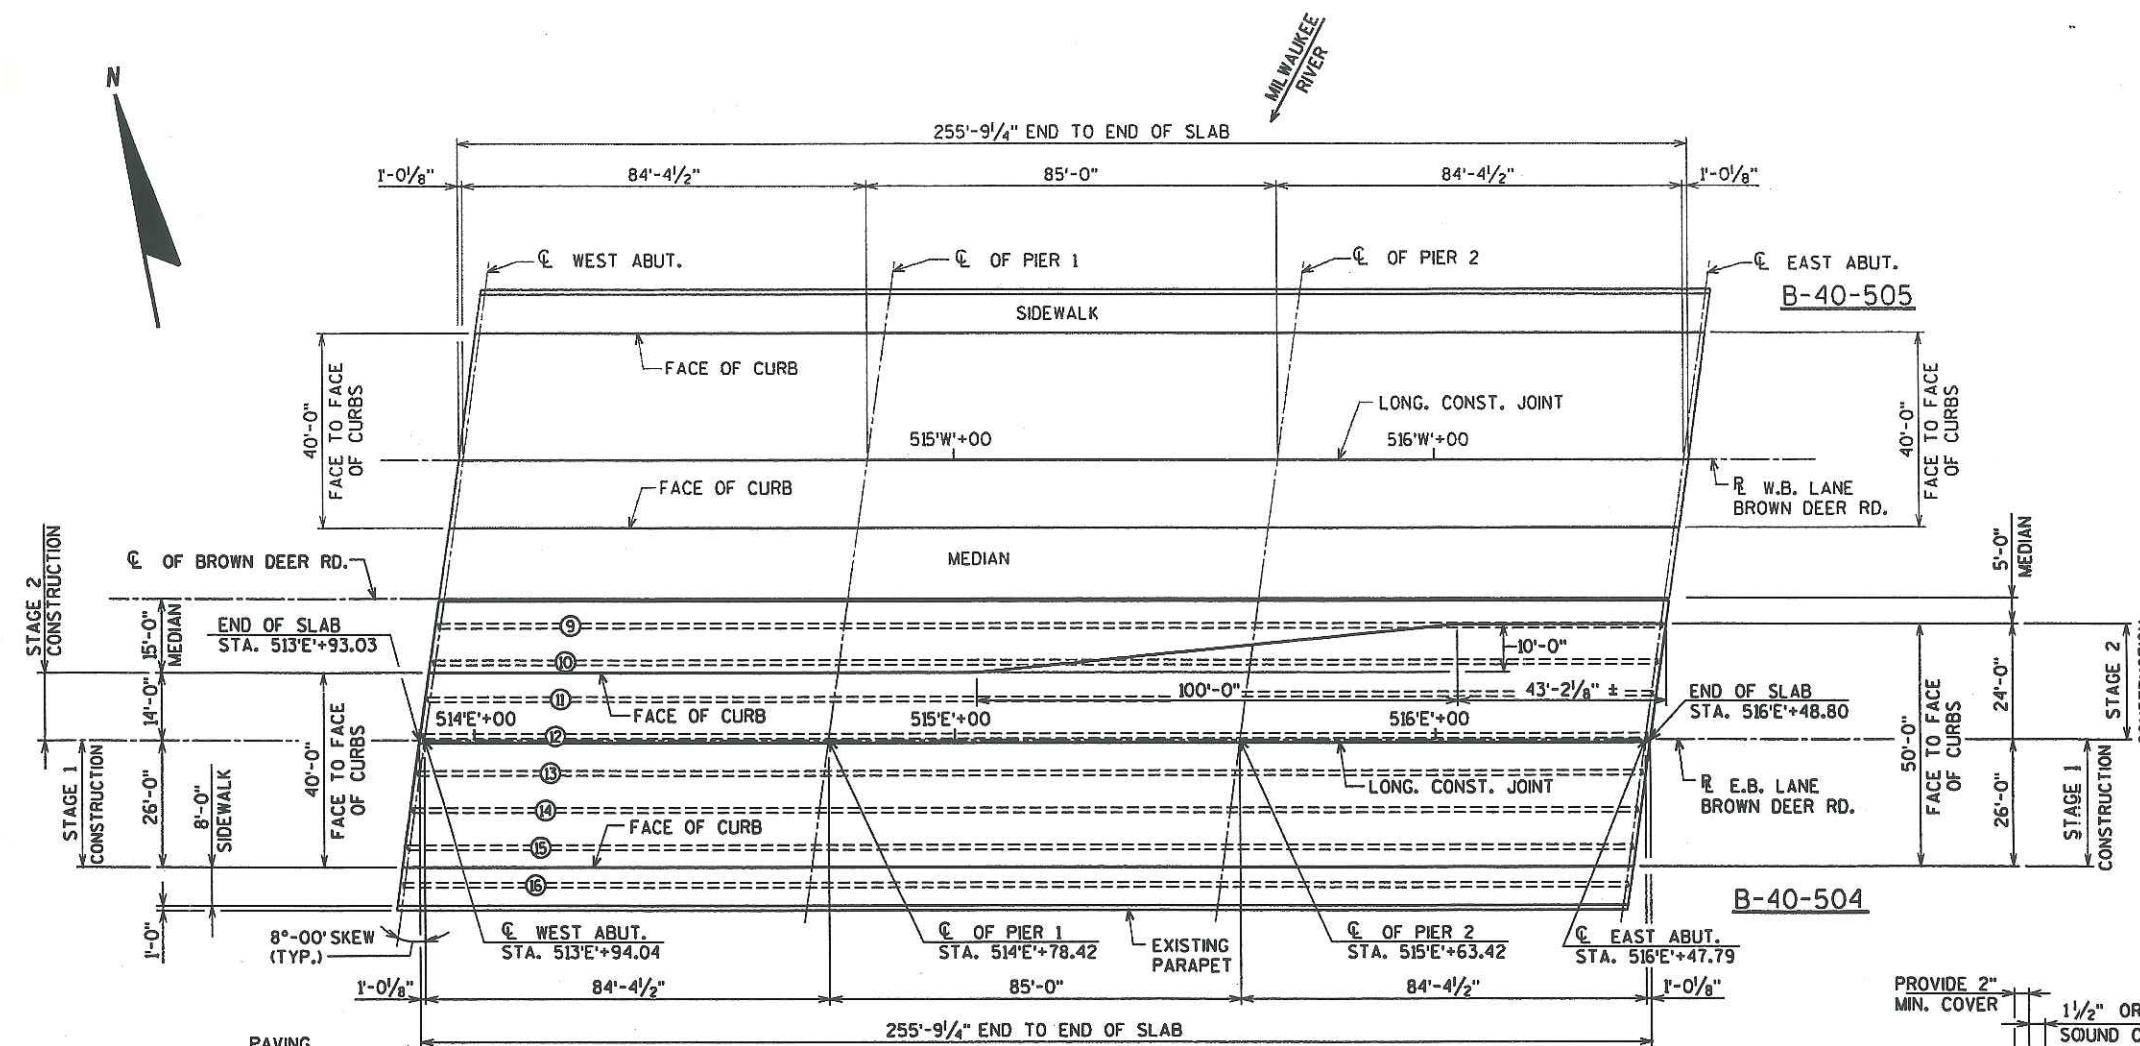

### SECTION AT END OF SLAB

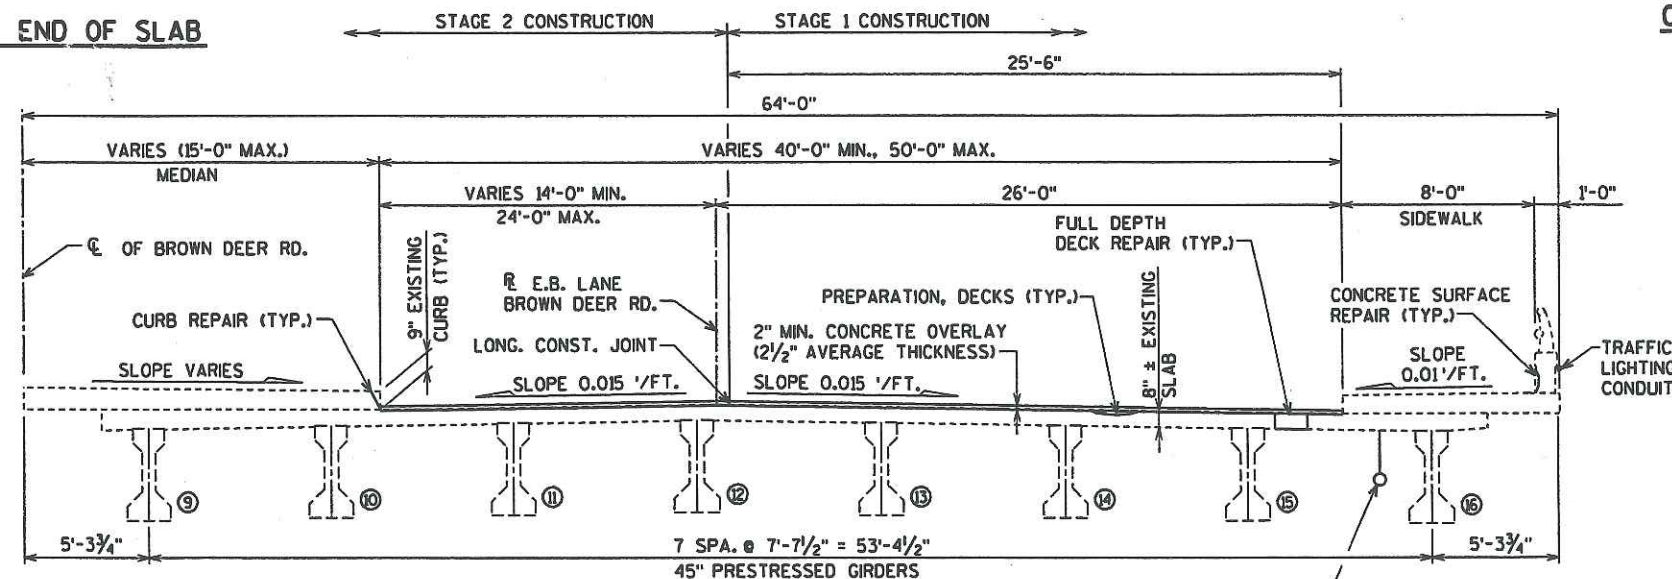

### CROSS SECTION THRU EXISTING ROADWAY (LOOKING EAST)

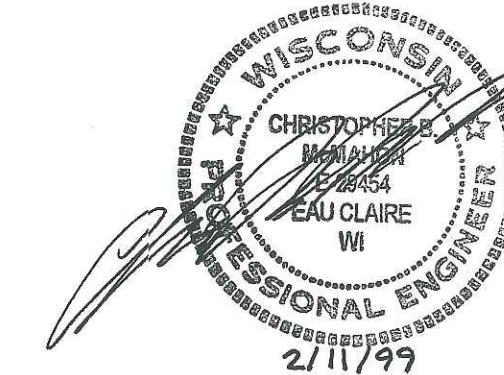

DISTRICT 2 BRIDGE MAINTENANCE OFFICE CONTACT:  
CHRIS WILLIAMS  
(414) 548-6711

CONSULTANT CONTACT:  
CHRIS MCMAHON  
(715) 834-3161

No.	Date	Revision	By
PLANS PREPARED BY <b>AVRES ASSOCIATES</b> Engineers/Architects Scientists/Surveyors 3433 Oakwood Hills Parkway Eau Claire, WI 54701			
STATE OF WISCONSIN DEPARTMENT OF TRANSPORTATION			
STRUCTURE B-40-504			
BROWN DEER RD. (S.T.H. 100) OVER MILWAUKEE RIVER			
County	MILWAUKEE	Supervisor/Village	RIVER HILLS
Design Spec.	A.A.S.H.T.O. '96	Load	HS-20
Design Spec.	Const. Spec. 1996	Const. Spec.	1996
Designed By	CBM	Design Checked	PWD
Drawn By	GLO/CLS	Plans Checked	CBM
Approved	[Signature] 05-27-99		Date
GENERAL PLAN			
SHEET 1 OF 1			
DATE: FEB. 1999			



