

DIST 2

Jun 04  
ORDER OF SHEETS

Section No. 1	Title
Section No. 2	Typical Sections and Details
Section No. 3	Estimate of Quantities
Section No. 3	Miscellaneous Quantities
Section No. 4	Right of Way Plat
Section No. 5	Plan and Profile
Section No. 6	Standard Detail Drawings
Section No. 7	Sign Plates
Section No. 8	Structure Plans
Section No. 9	Computer Earthwork Data
Section No. 9	Cross Sections

TOTAL SHEETS = 50



DESIGN DESIGNATION

A.D.T.	=	7,300	(2004)
A.D.T.	=	11,700	(2024)
D.H.V.	=	7.2%	
D.D.	=	62/38	
T.	=	9%	
DESIGN SPEED	=	60 MPH	
ESALS	=	5,389,371	

CONVENTIONAL SYMBOLS

PLAN	
CORPORATE LIMITS	
PROPERTY LINE	
LOT LINE	
LIMITED HIGHWAY EASEMENT	
EXISTING RIGHT OF WAY	
PROPOSED OR NEW R/W LINE	
SLOPE INTERCEPT	
REFERENCE LINE	
EXISTING CULVERT	
PROPOSED CULVERT (Box or Pipe)	
COMBUSTIBLE FLUIDS	
MARSH AREA	
WOODED OR SHRUB AREA	

PROFILE	
GRADE LINE	
ORIGINAL GROUND	
MARSH OR ROCK PROFILE (To be noted as such)	
SPECIAL DITCH	
GRADE ELEVATION	
CULVERT (Profile View)	
UTILITIES	
ELECTRIC	
FIBER OPTIC	
GAS	
SANITARY SEWER	
STORM SEWER	
TELEPHONE	
WATER	
UTILITY PEDESTAL	
POWER POLE	
TELEPHONE POLE	


ROCK	
LABEL	
95.36	
E	
FO	
G	
SAN	
SS	
T	
W	
X	
P	
T	

STATE OF WISCONSIN  
DEPARTMENT OF TRANSPORTATION

STATE HIGHWAY REHABILITATION - MAINTENANCE PROJECT

WATERFORD AVENUE  
SOUTH COUNTY LINE TO HENNEBERRY AVENUE  
STH 164  
WAUKESHA COUNTY

STATE PROJECT NUMBER  
2781-00-60

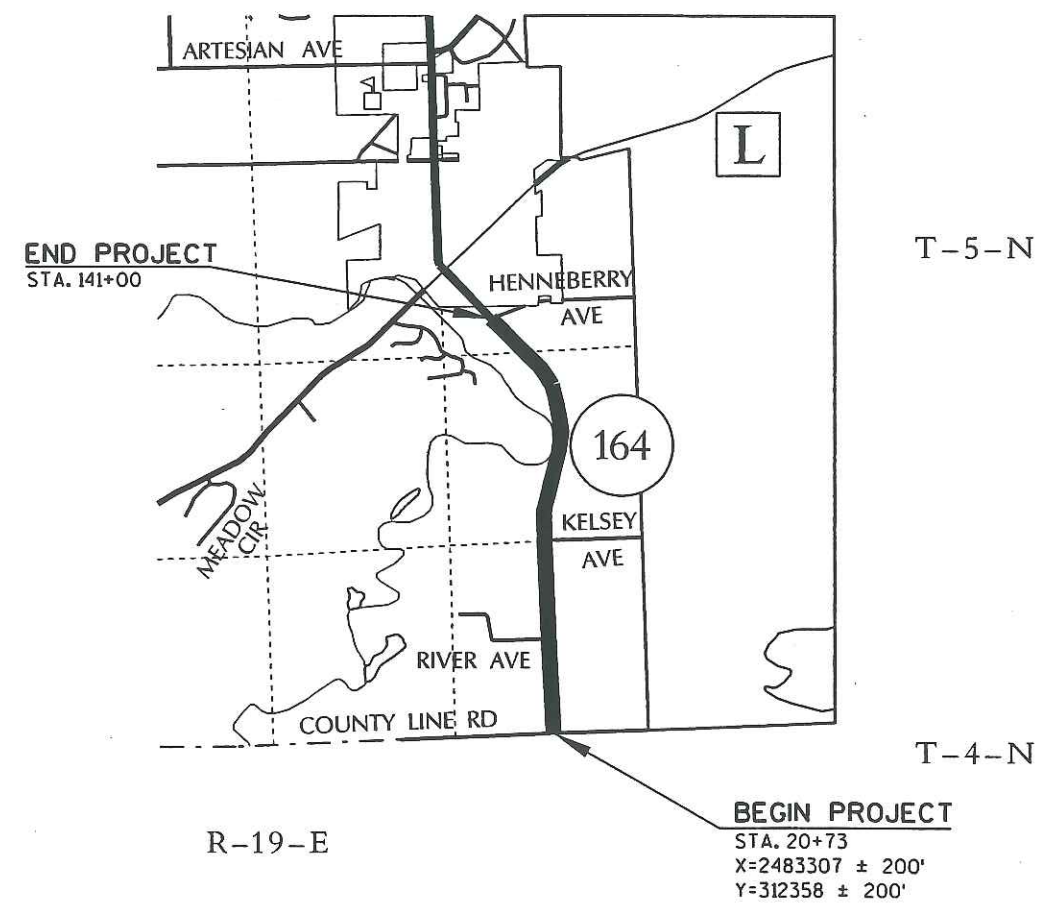

LAYOUT  
SCALE 0 0.5 MI.

TOTAL NET LENGTH OF CENTERLINE = 2.278 MI. RURAL

All coordinates on this plan are ground coordinates, (unless noted X, Y for grid) based on the Wisconsin State Plane Coordinate system (WSPCS) NAD 27 South Zone. To convert ground coordinates (N, E) to Grid Coordinates (X, Y), multiply ground coordinate by a combination factor of 0.999319 and add 2,000,000 to the X coordinate.  
\* Elevations show on this plan are referenced to the National Geodetic Vertical Datum of 1929 (NGVD 29)

STATE PROJECT	FEDERAL PROJECT	
	PROJECT	CONTRACT
2781-00-60		

AS-BUILT PLAN

Prime Contractor : Payne + Dolan, Inc.

Subcontractors : Century Fence  
Con - Cor  
Safemark  
The Kuehne Co.

Start Date : 7 Sep 04

Work Completed : 5 Oct 04

STATE OF WISCONSIN DEPARTMENT OF TRANSPORTATION	
PREPARED BY	
Surveyor	WAYNE HARTLING
Designer	SHARAD MOHOLKAR
Project Manager	SHARAD MOHOLKAR
District Examiner	PHIL BAIN
District Supervisor	DENNIS SKORY
C.O. Examiner	CARL BUJANOWSKI
APPROVED FOR DISTRICT OFFICE	
DATE: 3/22/04	Sharad Moholkar (Signature)

E



GENERAL NOTES

- 1. ITEMS SHOWN ON THE PLANS AND NOT INCLUDED IN THE ESTIMATE OF QUANTITIES ARE NOT PART OF THIS CONTRACT.
- 2. ASPHALTIC PRIVATE ENTRANCES SHALL BE SAW CUT AS REQUIRED TO PROVIDE A CLEAN BUTT JOINT.
- 3. MISCELLANEOUS REMOVAL ITEMS REQUIRING RESTORATION OF ASPHALTIC CONCRETE DRIVEWAYS OR SIDE STREETS SHALL BE REMOVED TO AN EXISTING JOINT OR SAWED AS DETERMINED BY THE FIELD ENGINEER.
- 4. THE CRUSHED AGGREGATE FOR SHOULDERS ADJACENT TO THE ASPHALTIC CONCRETE SHALL NOT BE PLACED UNTIL AFTER THE ASPHALTIC CONCRETE HAS BEEN PLACED.
- 5. PRIOR TO THE PLACEMENT OF STEEL PLATE BEAM GUARD, THE SHOULDERS SHALL BE IN PLACE, SHAPED AND COMPACTED UNLESS SHOWN OTHERWISE.
- 6. CONTRACTOR SHALL MAINTAIN ACCESS TO ALL DRIVEWAYS AT ALL TIMES.
- 7. THERE WILL BE 2 1/2 INCHES OF HMA PAVEMENT, TYPE E-10, OVERLAY.

STANDARD DETAIL DRAWINGS

08D4-3	CONCRETE SURFACE DRAIN & ASPHALTIC FLUME
8E8-3	TYPICAL INSTALLATIONS OF EROSION BALES/TEMPORARY DITCH CHECKS
8E9-5	SILT FENCE
14B15-4A, B	STEEL PLATE BEAM GUARD, CLASS "A" INSTALLATION & ELEMENTS
14B18-4A	STEEL PLATE BEAM GUARD, CLASS "A" (AT BRIDGES, OBSTACLES AND SIDEROADS/DRIVEWAYS)
14B24-4A	STEEL PLATE BEAM GUARD ENERGY ABSORBING TERMINAL
14B24-4B	STEEL PLATE BEAM GUARD ENERGY ABSORBING TERMINAL
14B24-4C	STEEL PLATE BEAM GUARD ENERGY ABSORBING TERMINAL
15C4-1	TRAFFIC CONTROL, ADVANCE WARNING SIGNS 45 M.P.H. OR GREATER TWO-WAY UNDIVIDED ROAD OPEN TO TRAFFIC
15C8-9A	PAVEMENT MARKING (MAINLINE)
15C8-9B	PAVEMENT MARKING (INTERSECTIONS)
15C12-2	TRAFFIC CONTROL FOR LANE CLOSURE (SUITABLE FOR MOVING OPERATIONS)

UTILITIES

MR. CARL LEMMER, PROJECT MANAGER  
WE ENERGIES (ELECTRIC)  
333 W EVERETT ST. - A279  
MILWAUKEE WI 53203  
PHONE: (262) 544-7248  
FAX: (262) 544-7341

MR. CARL LEMMER, PROJECT MANAGER  
WE ENERGIES (GAS)  
333 W EVERETT ST. - A279  
MILWAUKEE WI 53203  
PHONE: (262) 544-7248  
FAX: (262) 544-7341

MR. KEVIN ANDERSON, AREA MANAGER  
DESIGN ENGINEER, SBC  
2005 PEWAUKEE ROAD  
WAUKESHA, WI 53186  
PHONE: (262) 896-7440  
FAX: (262) 896-7435

OTHER CONTACT

WISCONSIN DEPARTMENT OF NATURAL RESOURCES  
ATTN: MAUREEN MILLMAN  
ENVIRONMENTAL COORDINATOR, SOUTHEAST REGION  
2300 N. MARTIN LUTHER KING DRIVE  
MILWAUKEE, WI 53212  
414-263-8613



Toll Free (800) 242-8511  
Milwaukee Area (414) 259-1181  
Hearing Impaired TDD (800) 542-2289  
[www.DiggersHotline.com](http://www.DiggersHotline.com)

STATE PROJECT NO: 2781-00-60


HWY: STH 164

COUNTY: WAUKESHA

GENERAL NOTES

SHEET NO: 2

E

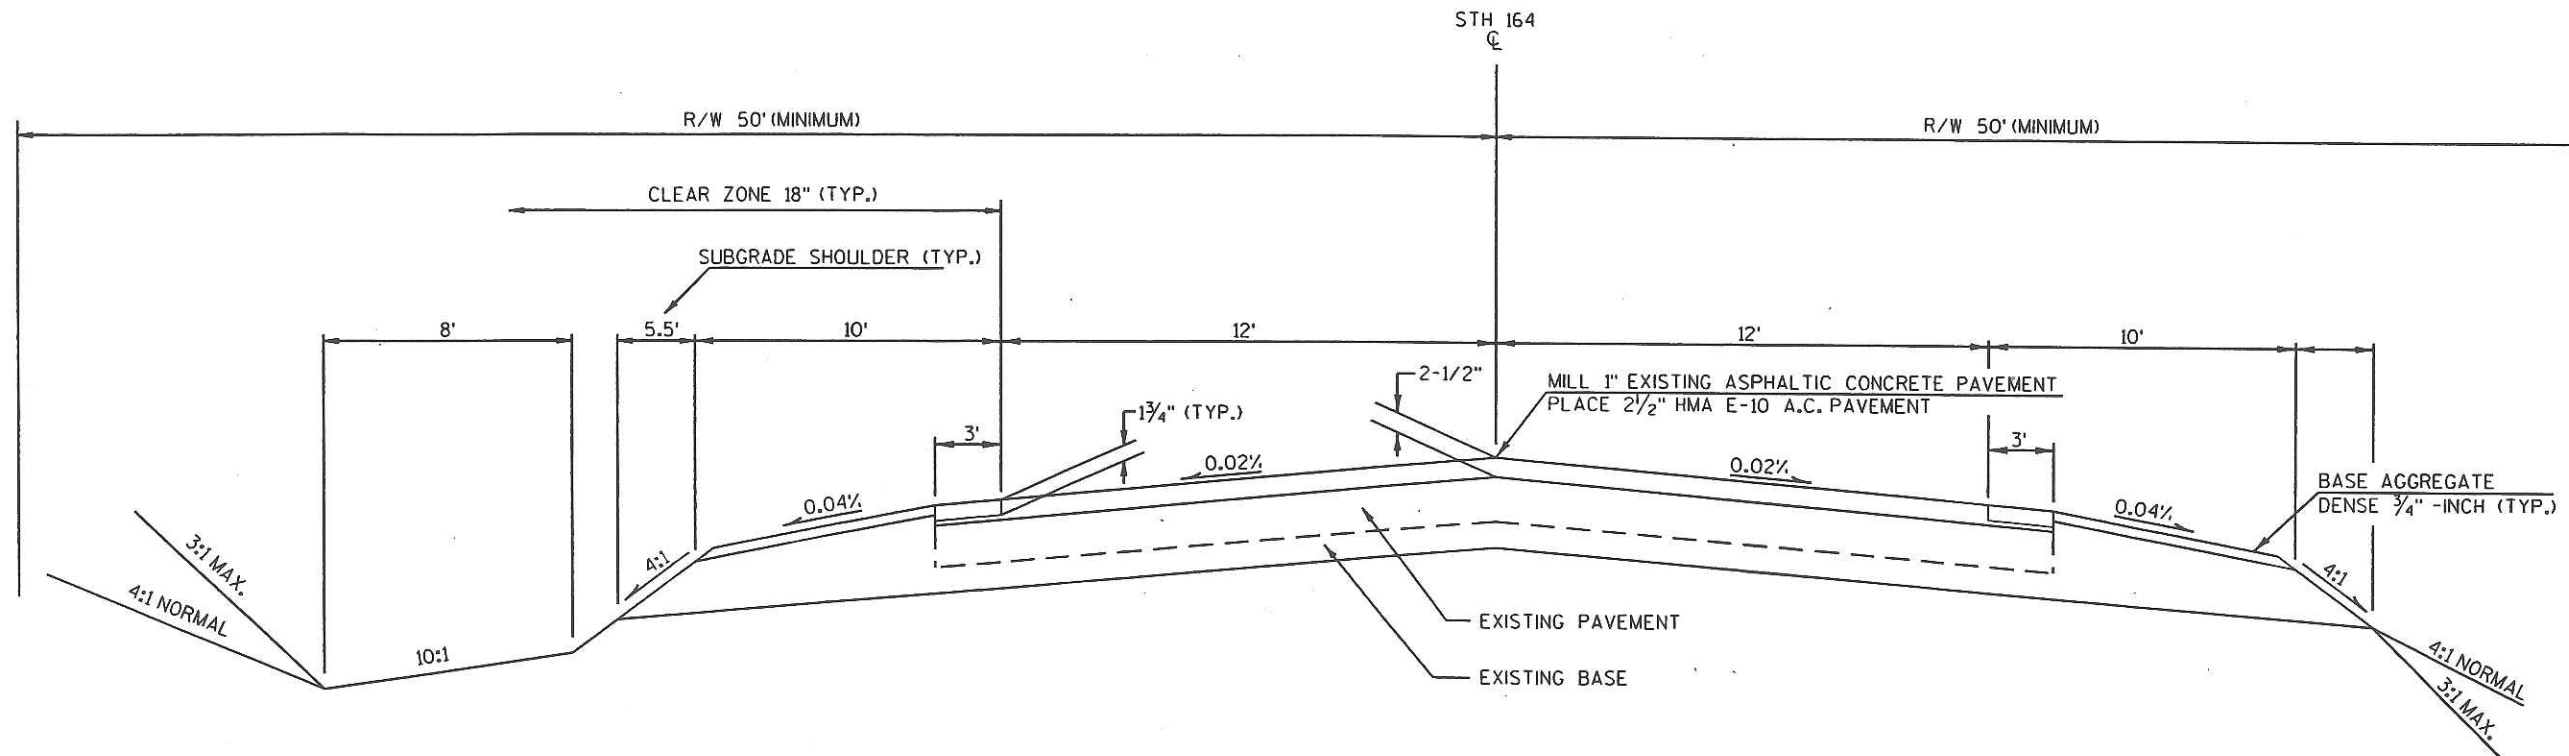

# TYPICAL SECTION STA. 20+73 TO STA. 141+00


## SUPER ELEVATED SECTION

THIS DATA IS FOR INFORMATIONAL PURPOSE ONLY, CONTRACTOR  
TO VERIFY AND MATCH EXISTING SUPER ELEVATION


PC STA. 75+73.75 TO PT STA. 86+33.38  
PC STA. 97+90.47 TO PT STA. 114+66.55  
PC STA. 114+66.65 TO PT 135+95.48

RATE OF SUPER ELEVATION  
0.04'/FT  
0.05'/FT  
0.04'/FT

SUBGRADE SHOULDER WIDTH  
7.3'  
7.7'  
7.3'

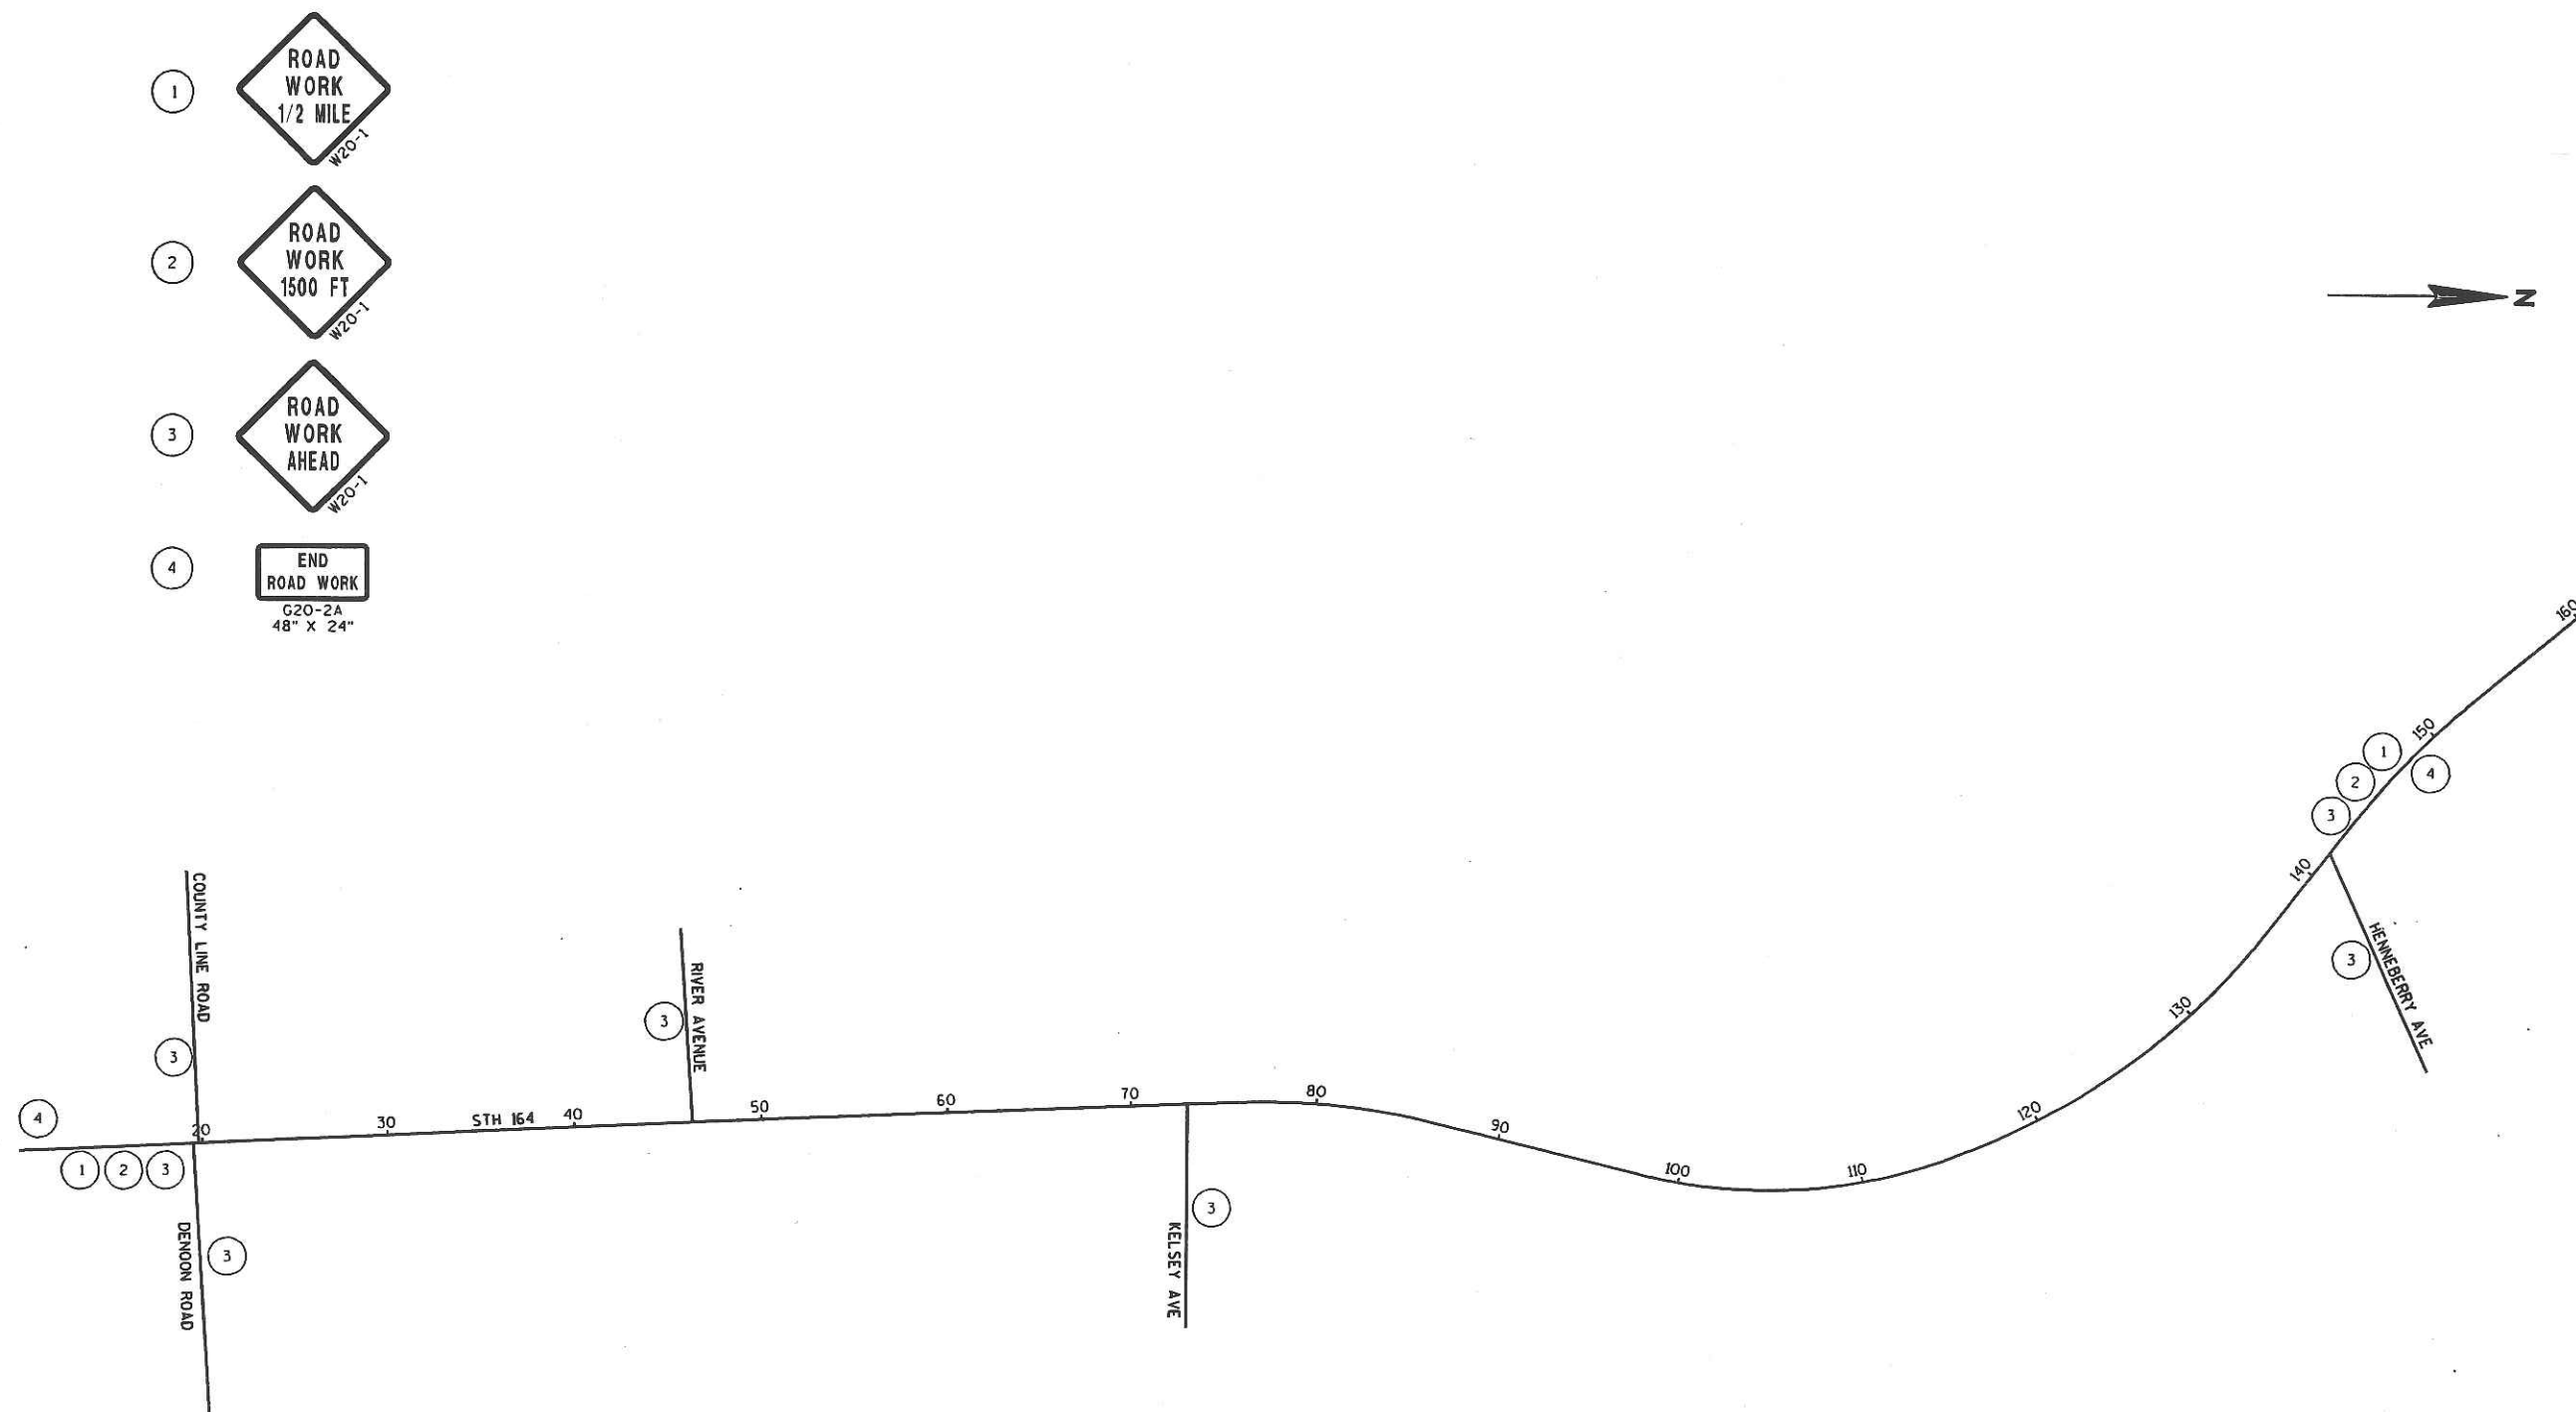




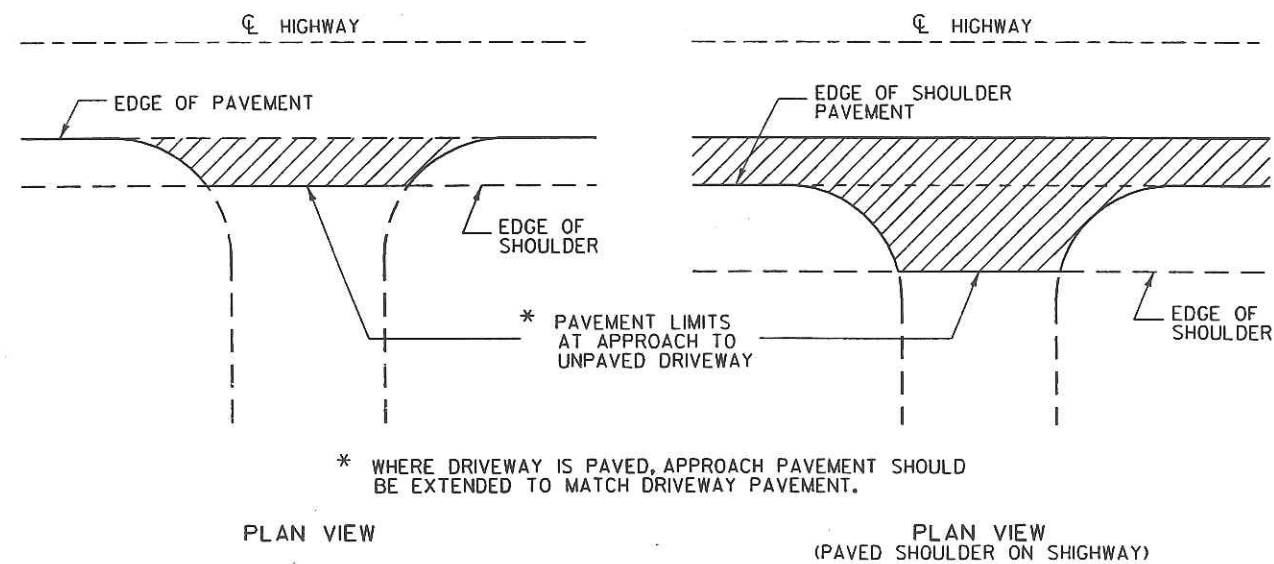

RURAL DRIVEWAY INTERSECTION DETAIL

2

2

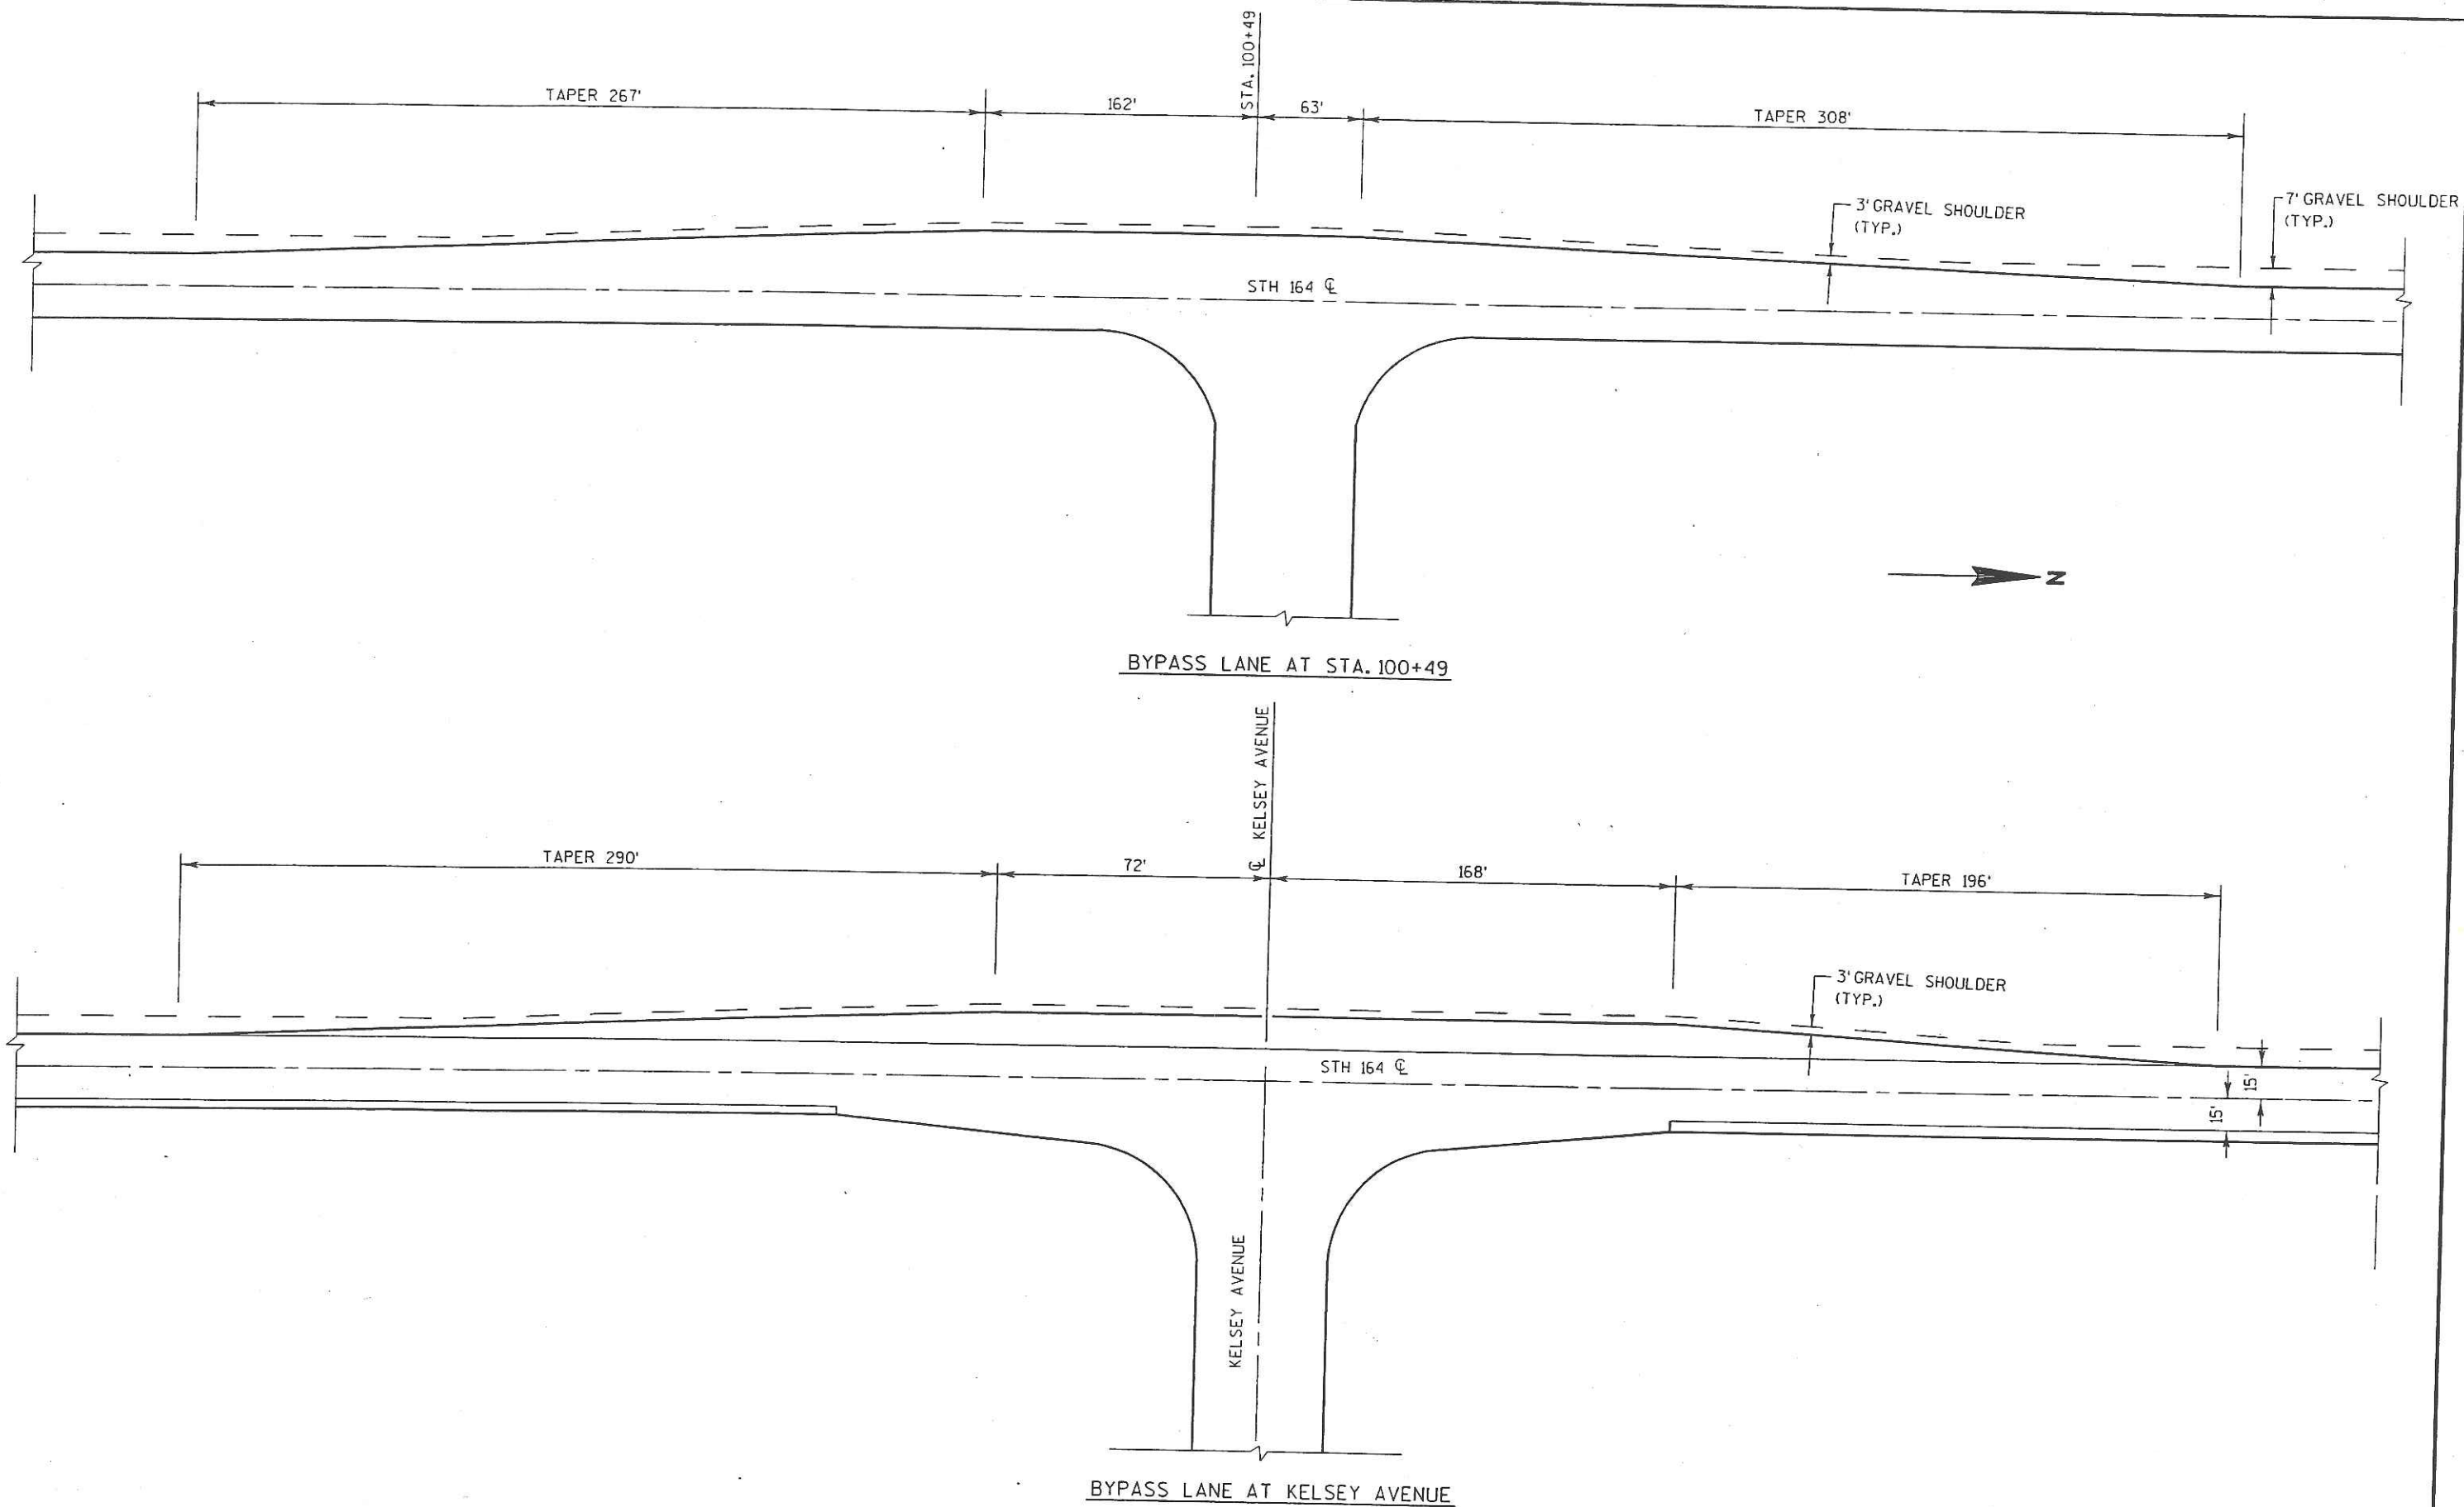

PROJECT NO: 2781-00-60

HWY: STH 164

COUNTY: WAUKESHA

BYPASS LANE

SHEET

E

FILE NAME : \\WKE31FP1\CADDs\projects\02-278100164\021001\_CD.dgn

PLOT DATE : 12-MAR-2004 13:22


PLOT BY : DOTR3H

PLOT NAME :

PLOT SCALE : 200:1


WISDOT/CADDs SHEET 42



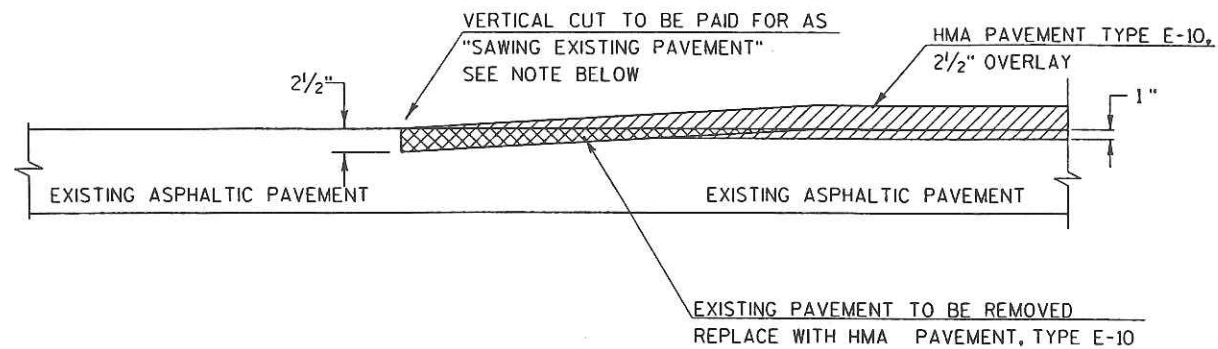


**NOTE:**  
THE PORTION OF THE JOINT THAT VARIES  
IN MILLED DEPTH FROM 1" TO 2 1/2" IS PAID  
FOR AS "REMOVING ASPHALTIC SURFACE,  
MILLING".

**MILLING DETAIL**  
FROM STA. 20+73 TO STA. 21+73  
FROM STA. 140+00 TO STA. 141+00

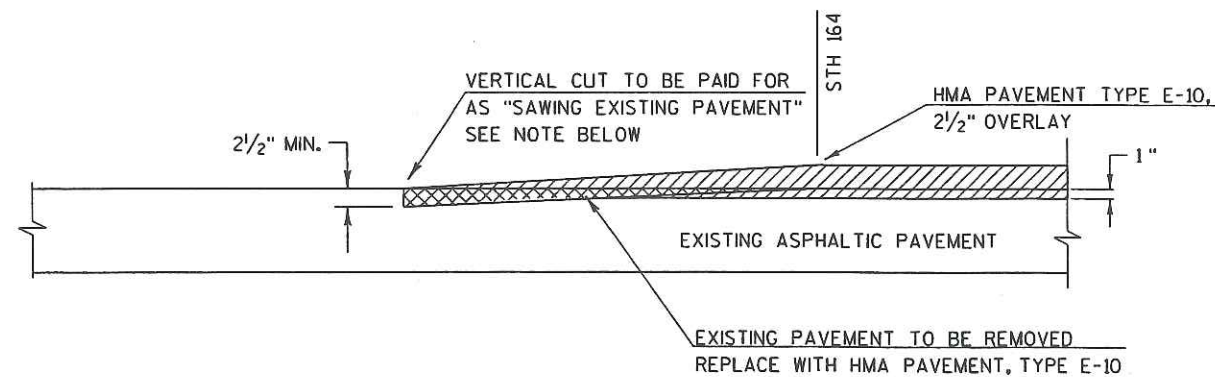


**NOTE:**  
THE PORTION OF THE JOINT THAT VARIES  
IN MILLED DEPTH FROM 1" TO 2 1/2" IS PAID  
FOR AS "REMOVING ASPHALTIC SURFACE,  
MILLING".

**MILLING DETAIL**  
AT RIVER AVENUE 35'  
AT KELSEY AVENUE 67'

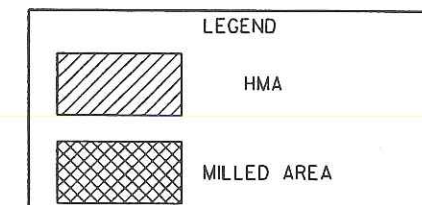


2

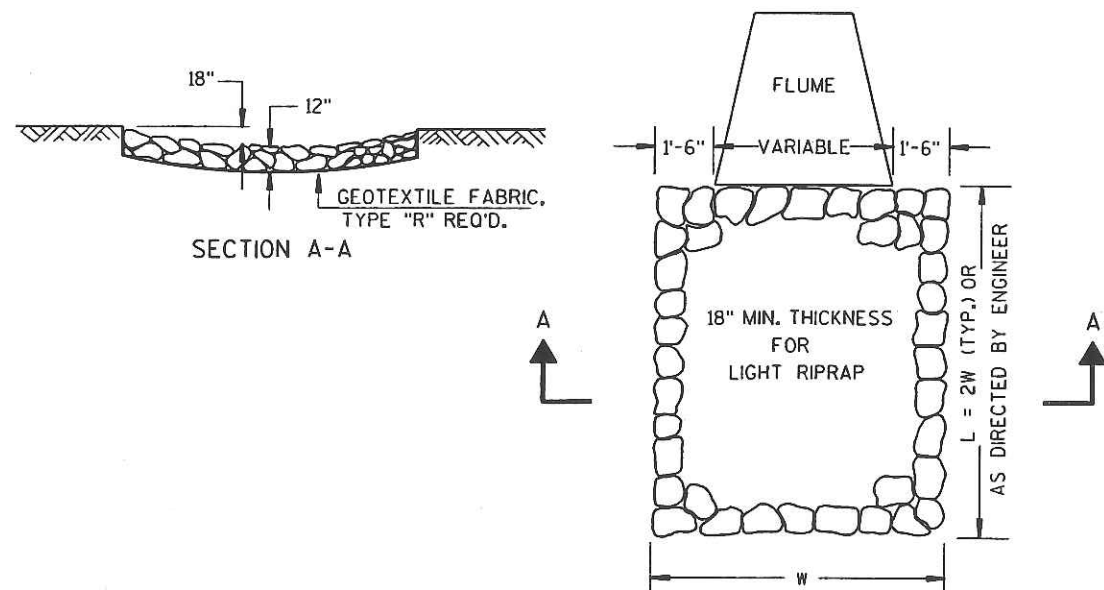

#### RIPRAP TREATMENT AT ASPHALTIC FLUMES



STA. 96+37, LT  
STA. 104+27, LT

2

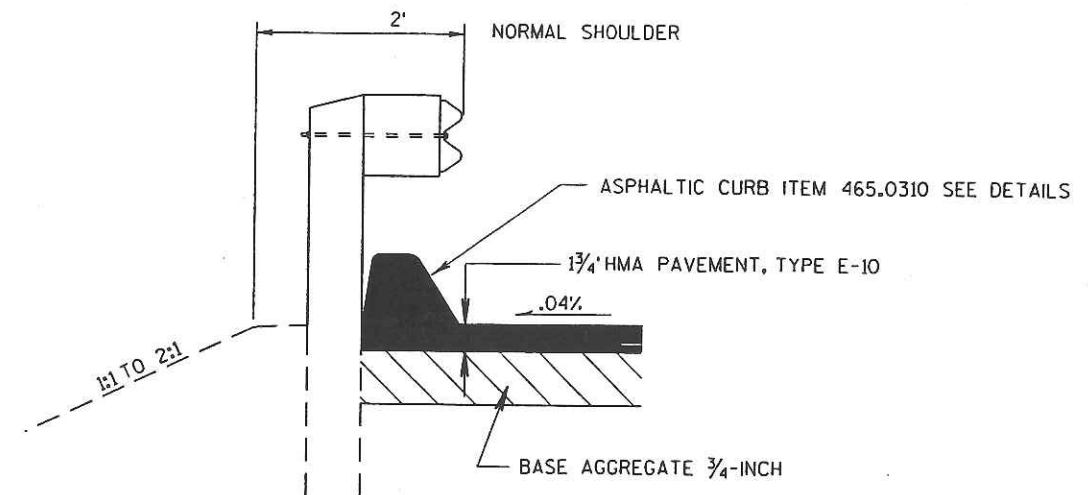

#### SHOULDER PAVING DETAIL AT GUARDRAIL

STA. 96+87 TO STA. 97+75 LT  
STA. 103+50 TO STA. 105+57 LT  
STA. 104+27 TO STA. 105+30 LT

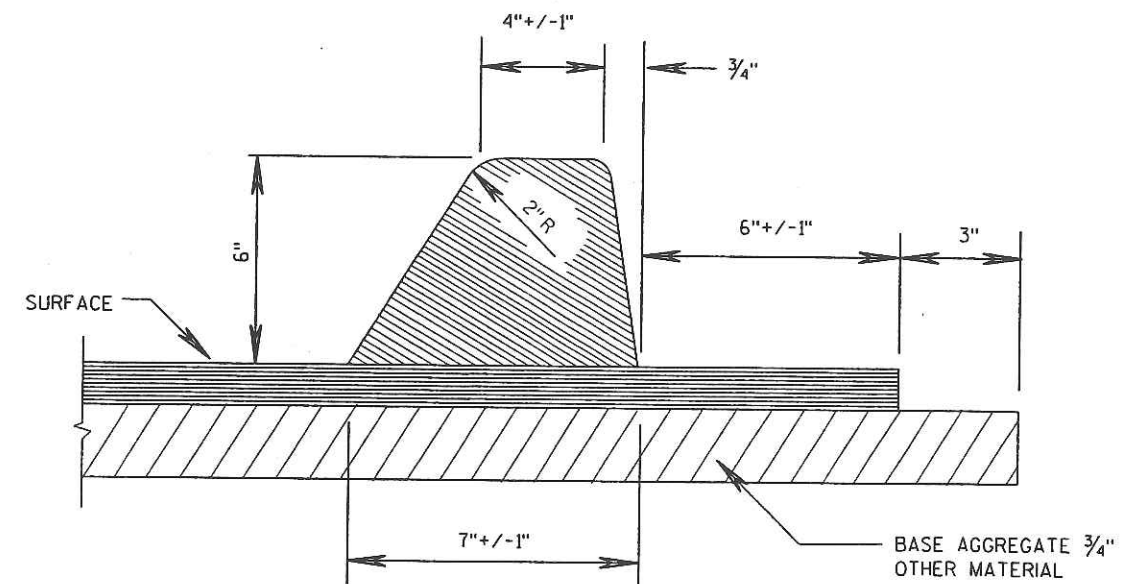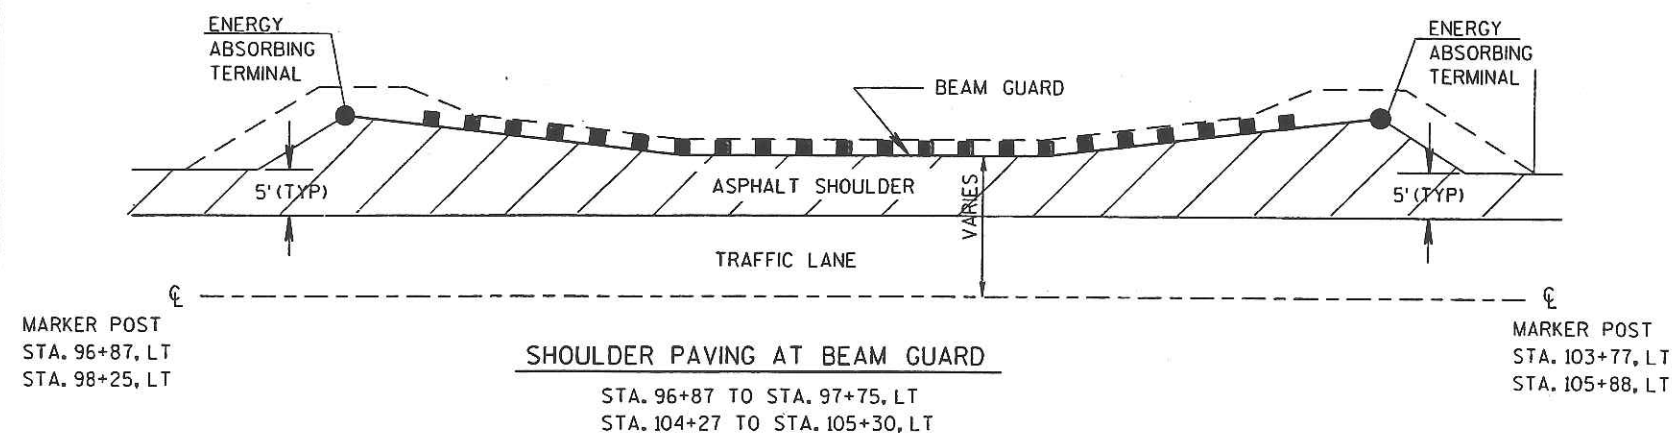









#### ASPHALTIC CURB DETAIL

STA. 96+87 TO STA. 97+75  
STA. 104+27 TO STA. 105+50, LT



### LEGEND

 EXISTING SIGN MOUNTED ON POST(S)  
 EXISTING SIGN MOUNTED ON BRIDGE OR SIGN BRIDGE  
 PROPOSED SIGN MOUNTED ON POST(S)  
 PROPOSED SIGN MOUNTED ON BRIDGE OR SIGN BRIDGE  
 DENOTES SIGN NUMBER  
 ESTR EXISTING SIGN TO REMAIN  
 (X) INDICATES SIGN SIZE  
 LOCAL STREET SIGN  
 GRAYSHADE REPRESENTS EXISTING TO BE REMOVED

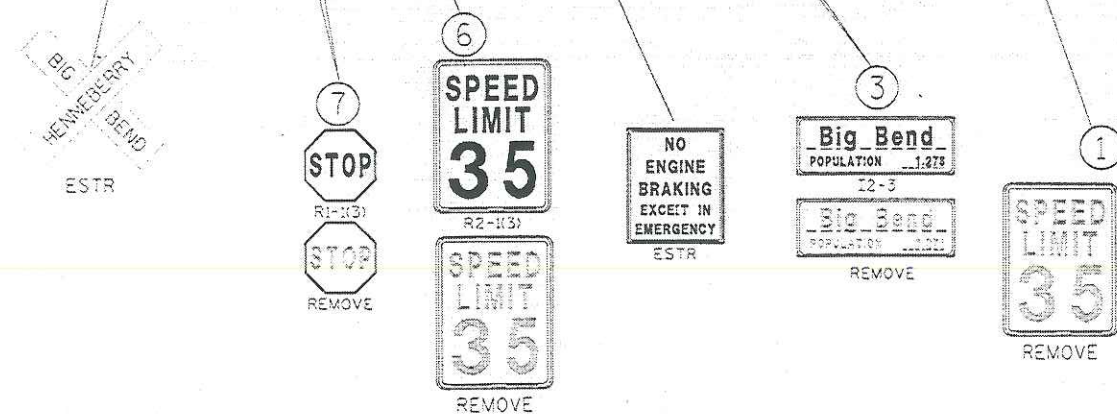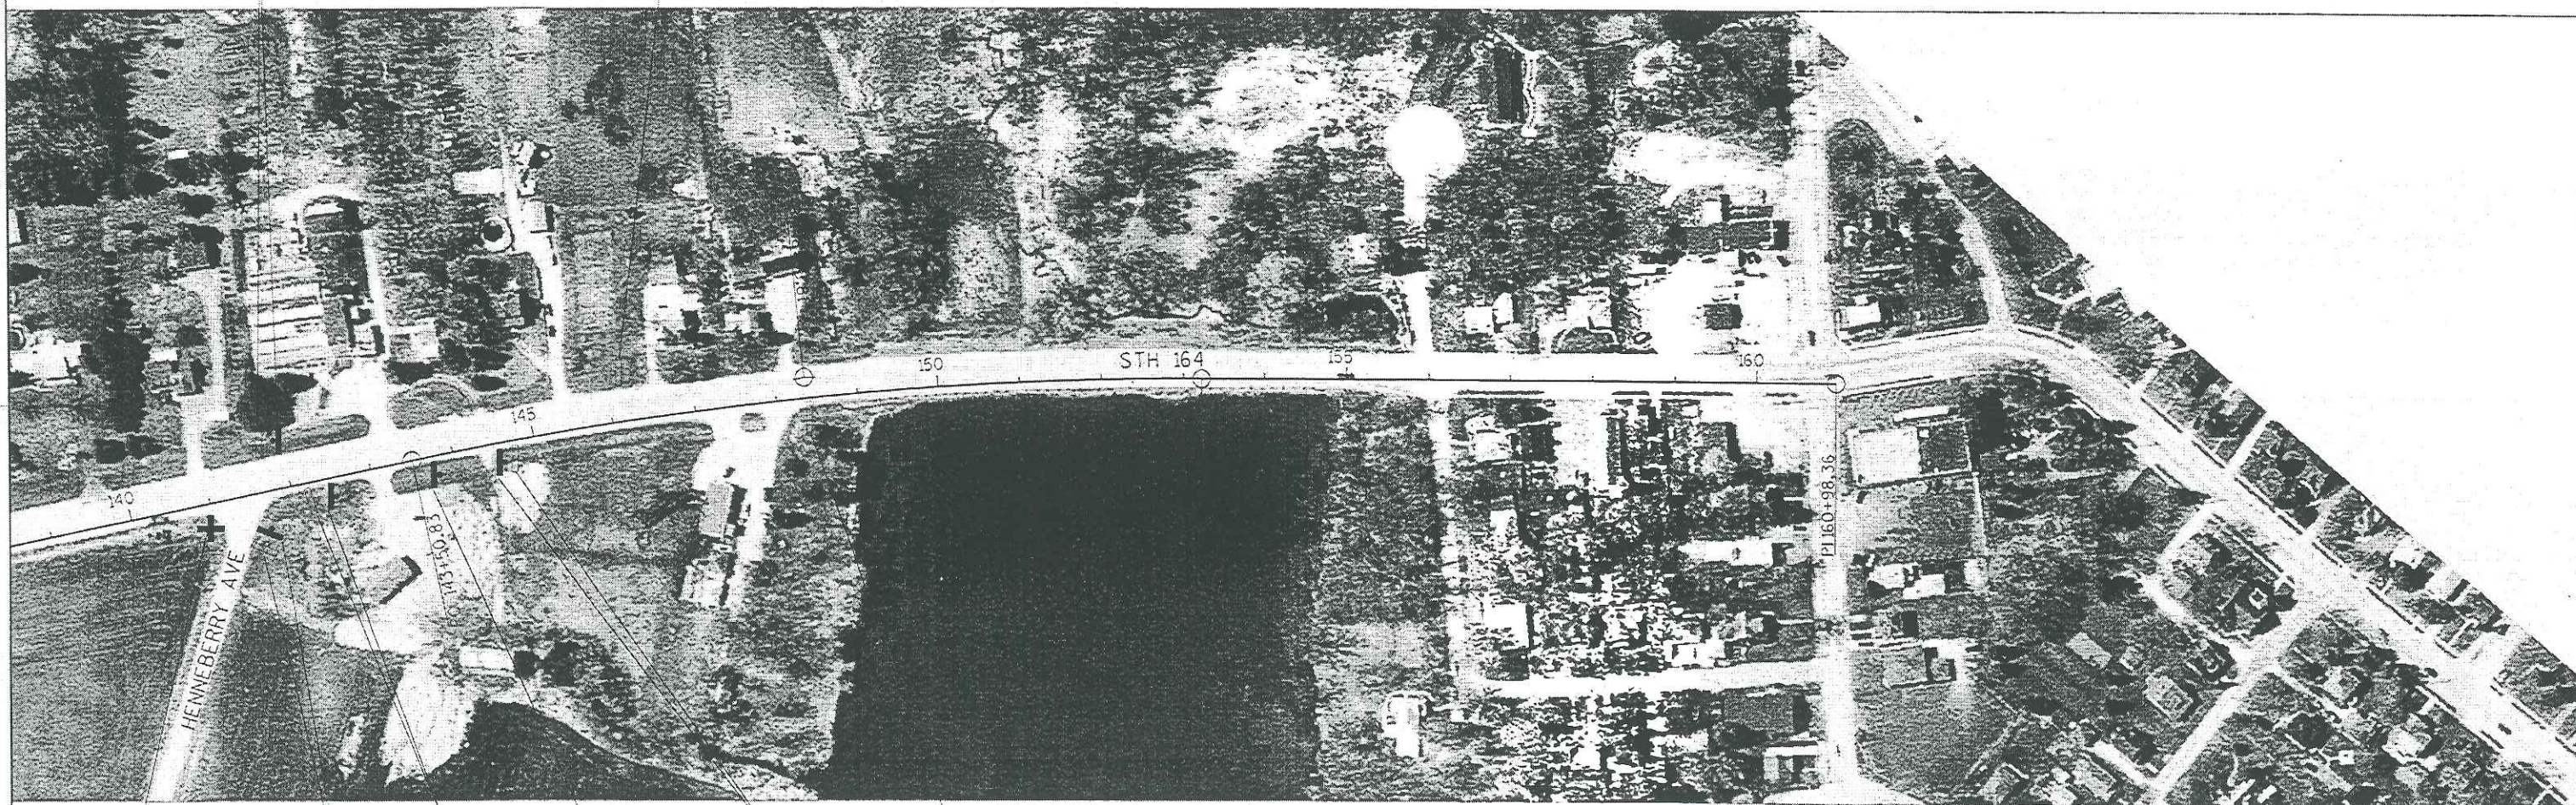



NOTE:

NO PASSING ZONE PERMANENT SIGNS SHALL  
BE LOCATED AFTER PASSING ZONES  
HAVE BEEN ESTABLISHED (SIGN #8, 9, 10, 13, 19)



LEGEND


- EXISTING SIGN MOUNTED ON POST(S)
- EXISTING SIGN MOUNTED ON BRIDGE OR SIGN BRIDGE
- PROPOSED SIGN MOUNTED ON POST(S)
- PROPOSED SIGN MOUNTED ON BRIDGE OR SIGN BRIDGE
- XX DENOTES SIGN NUMBER
- ESTR EXISTING SIGN TO REMAIN
- (X) INDICATES SIGN SIZE
- LOCAL STREET SIGN
- GRAYSHADE REPRESENTS EXISTING TO BE REMOVED

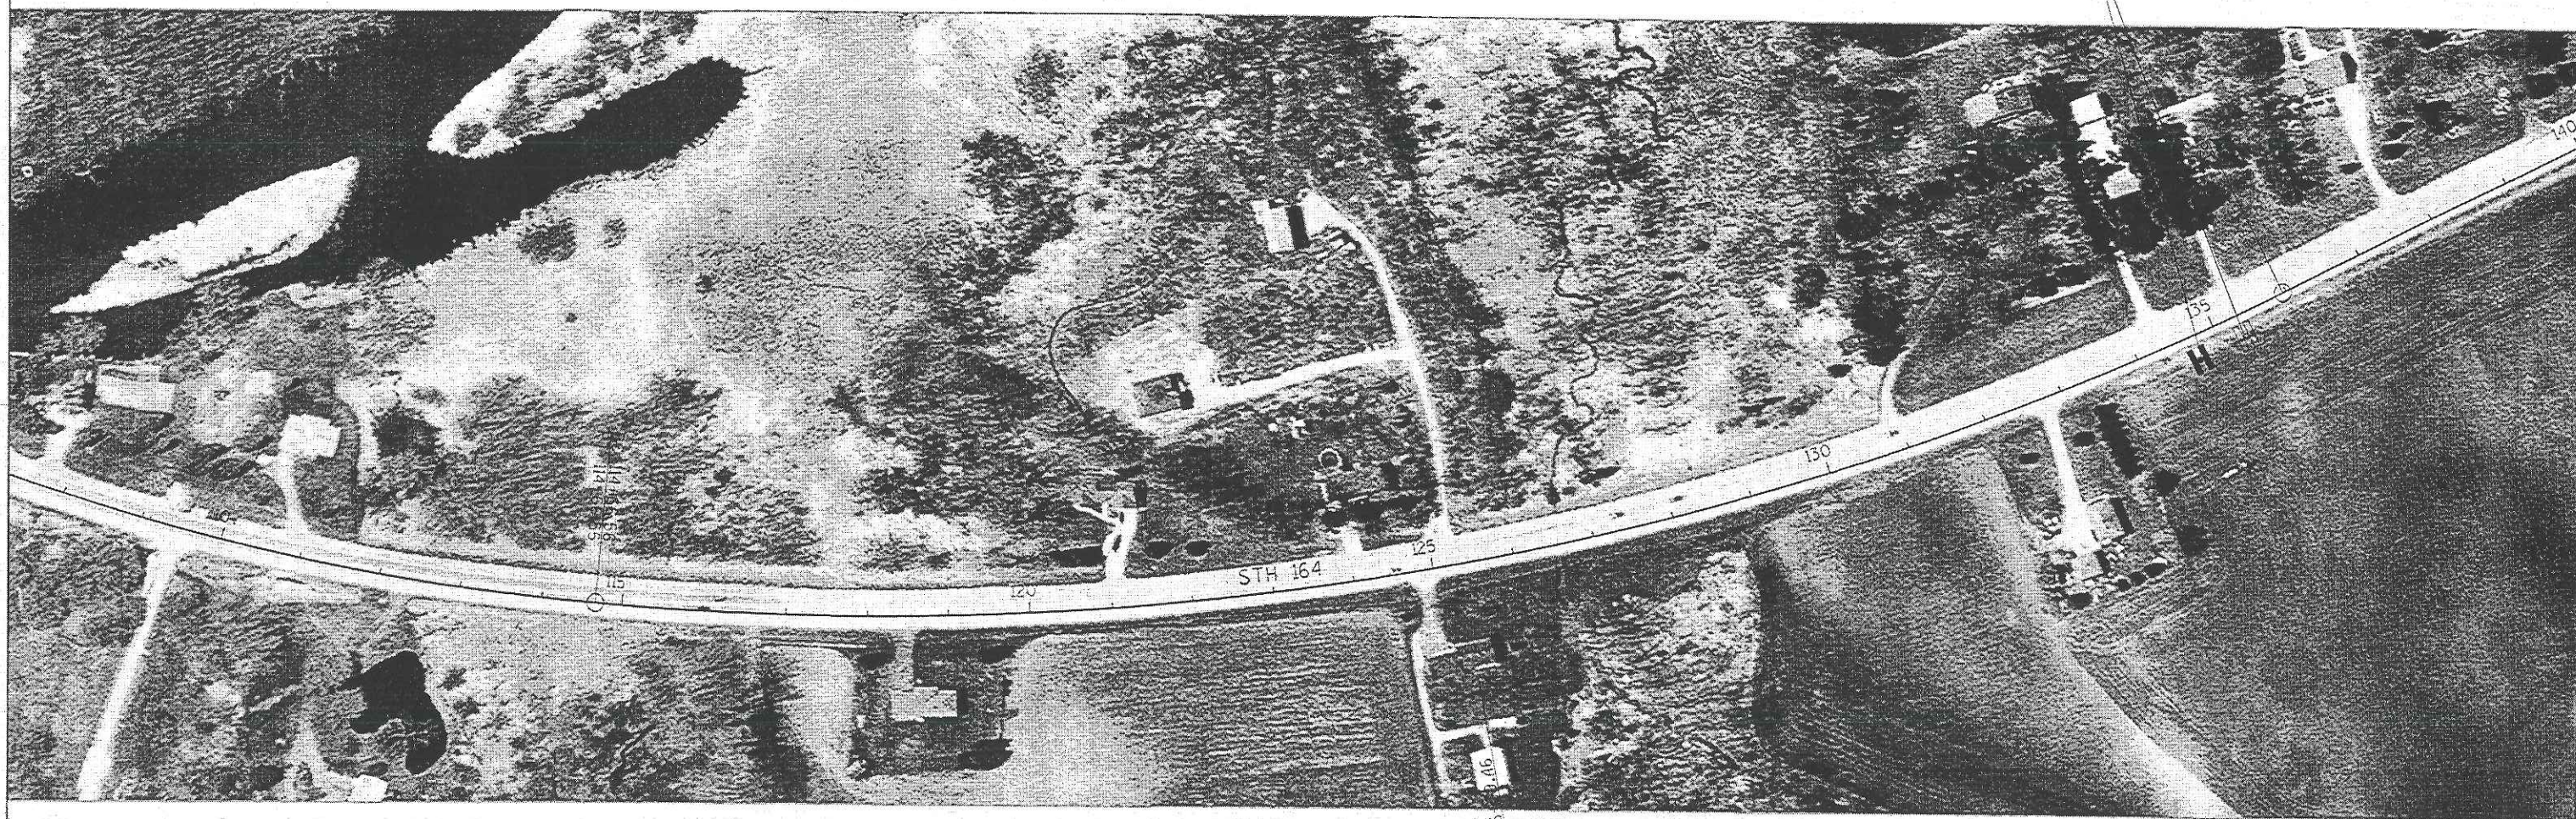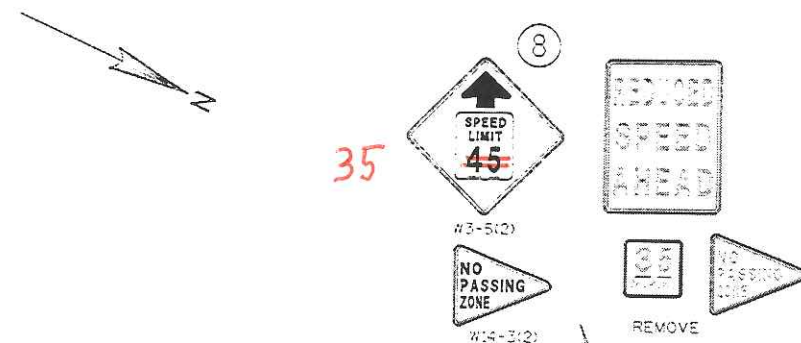



LEGEND

- EXISTING SIGN MOUNTED ON POST(S)
- EXISTING SIGN MOUNTED ON BRIDGE OR SIGN BRIDGE
- PROPOSED SIGN MOUNTED ON POST(S)
- PROPOSED SIGN MOUNTED ON BRIDGE OR SIGN BRIDGE
- DENOTES SIGN NUMBER
- ESTR EXISTING SIGN TO REMAIN
- (X) INDICATES SIGN SIZE
- LOCAL STREET SIGN
- GRAYSHADE REPRESENTS EXISTING TO BE REMOVED

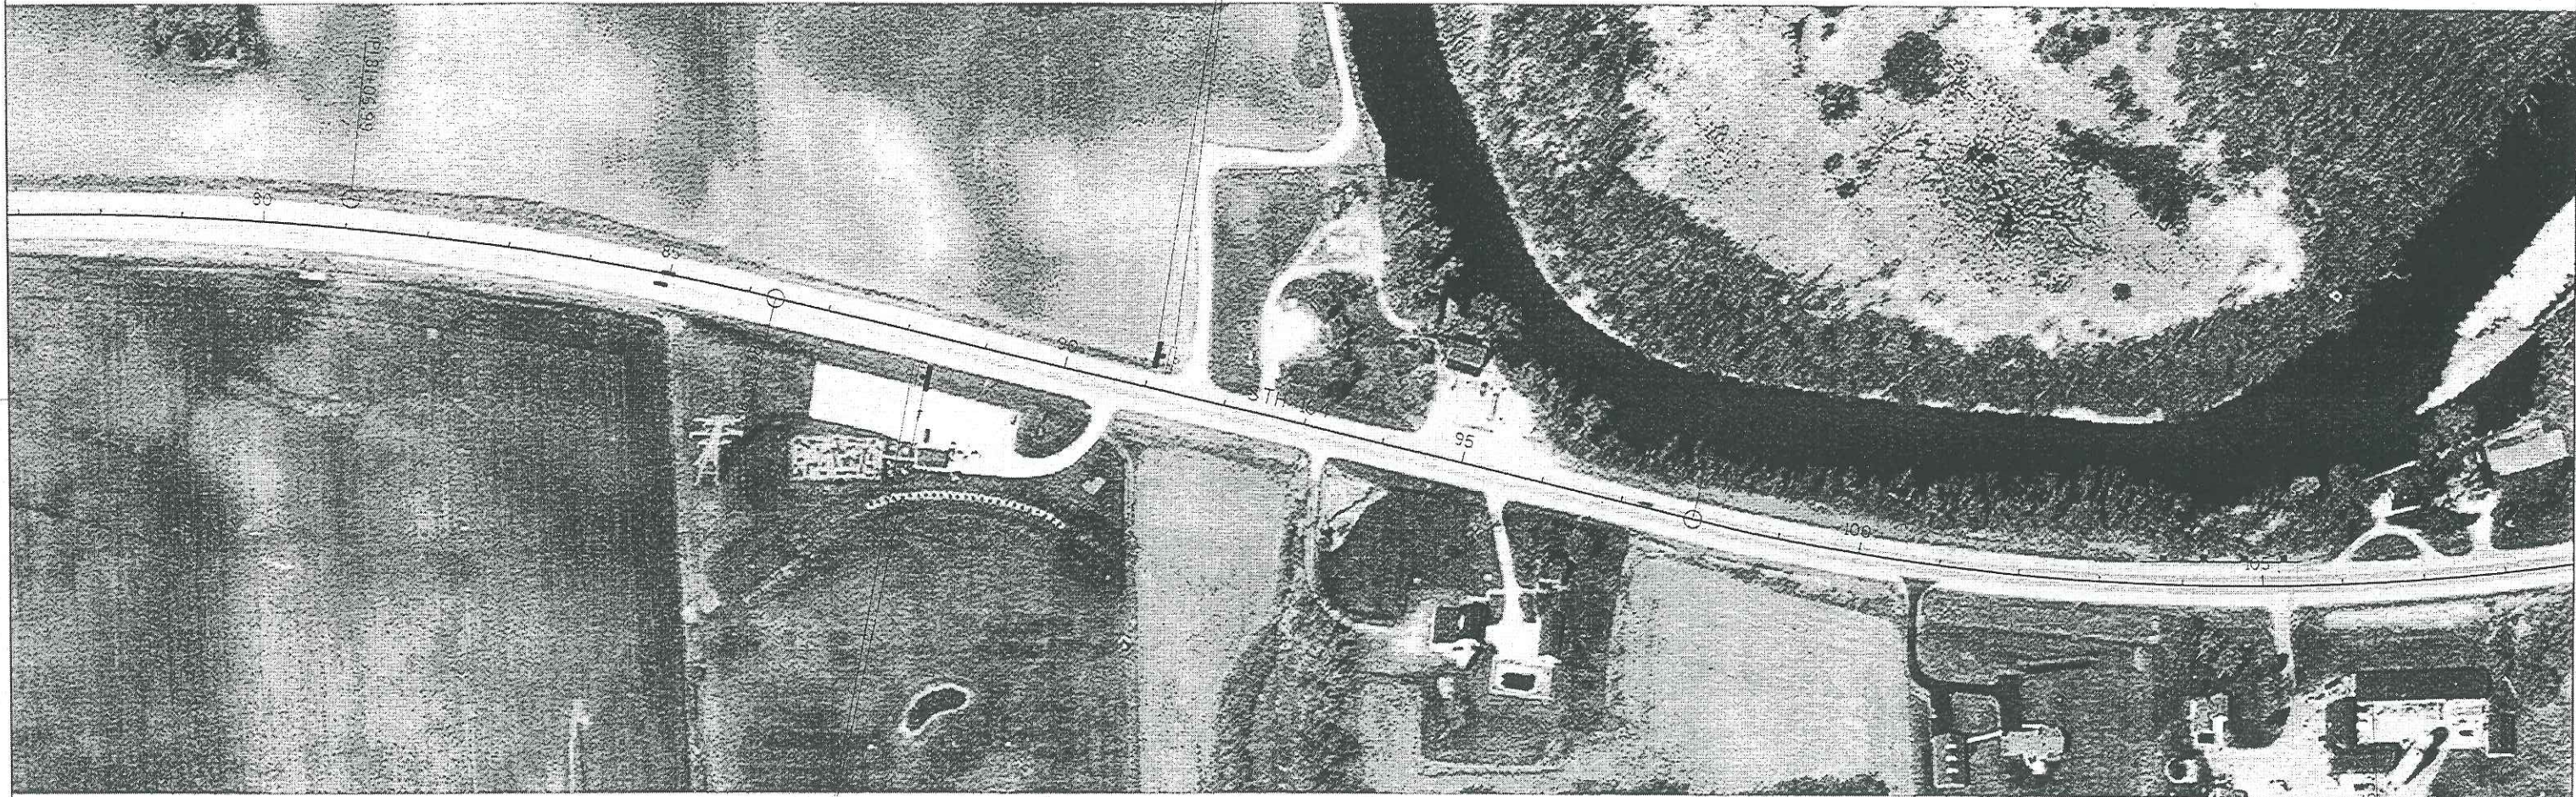




LEGEND

- EXISTING SIGN MOUNTED ON POST(S)
- EXISTING SIGN MOUNTED ON BRIDGE OR SIGN BRIDGE
- PROPOSED SIGN MOUNTED ON POST(S)
- PROPOSED SIGN MOUNTED ON BRIDGE OR SIGN BRIDGE
- (XX) DENOTES SIGN NUMBER
- ESTR EXISTING SIGN TO REMAIN
- (X) INDICATES SIGN SIZE
- LOCAL STREET SIGN
- GRAYSHADE REPRESENTS EXISTING TO BE REMOVED




NOTE:  
PUT IN LINE WITH ROADWAY

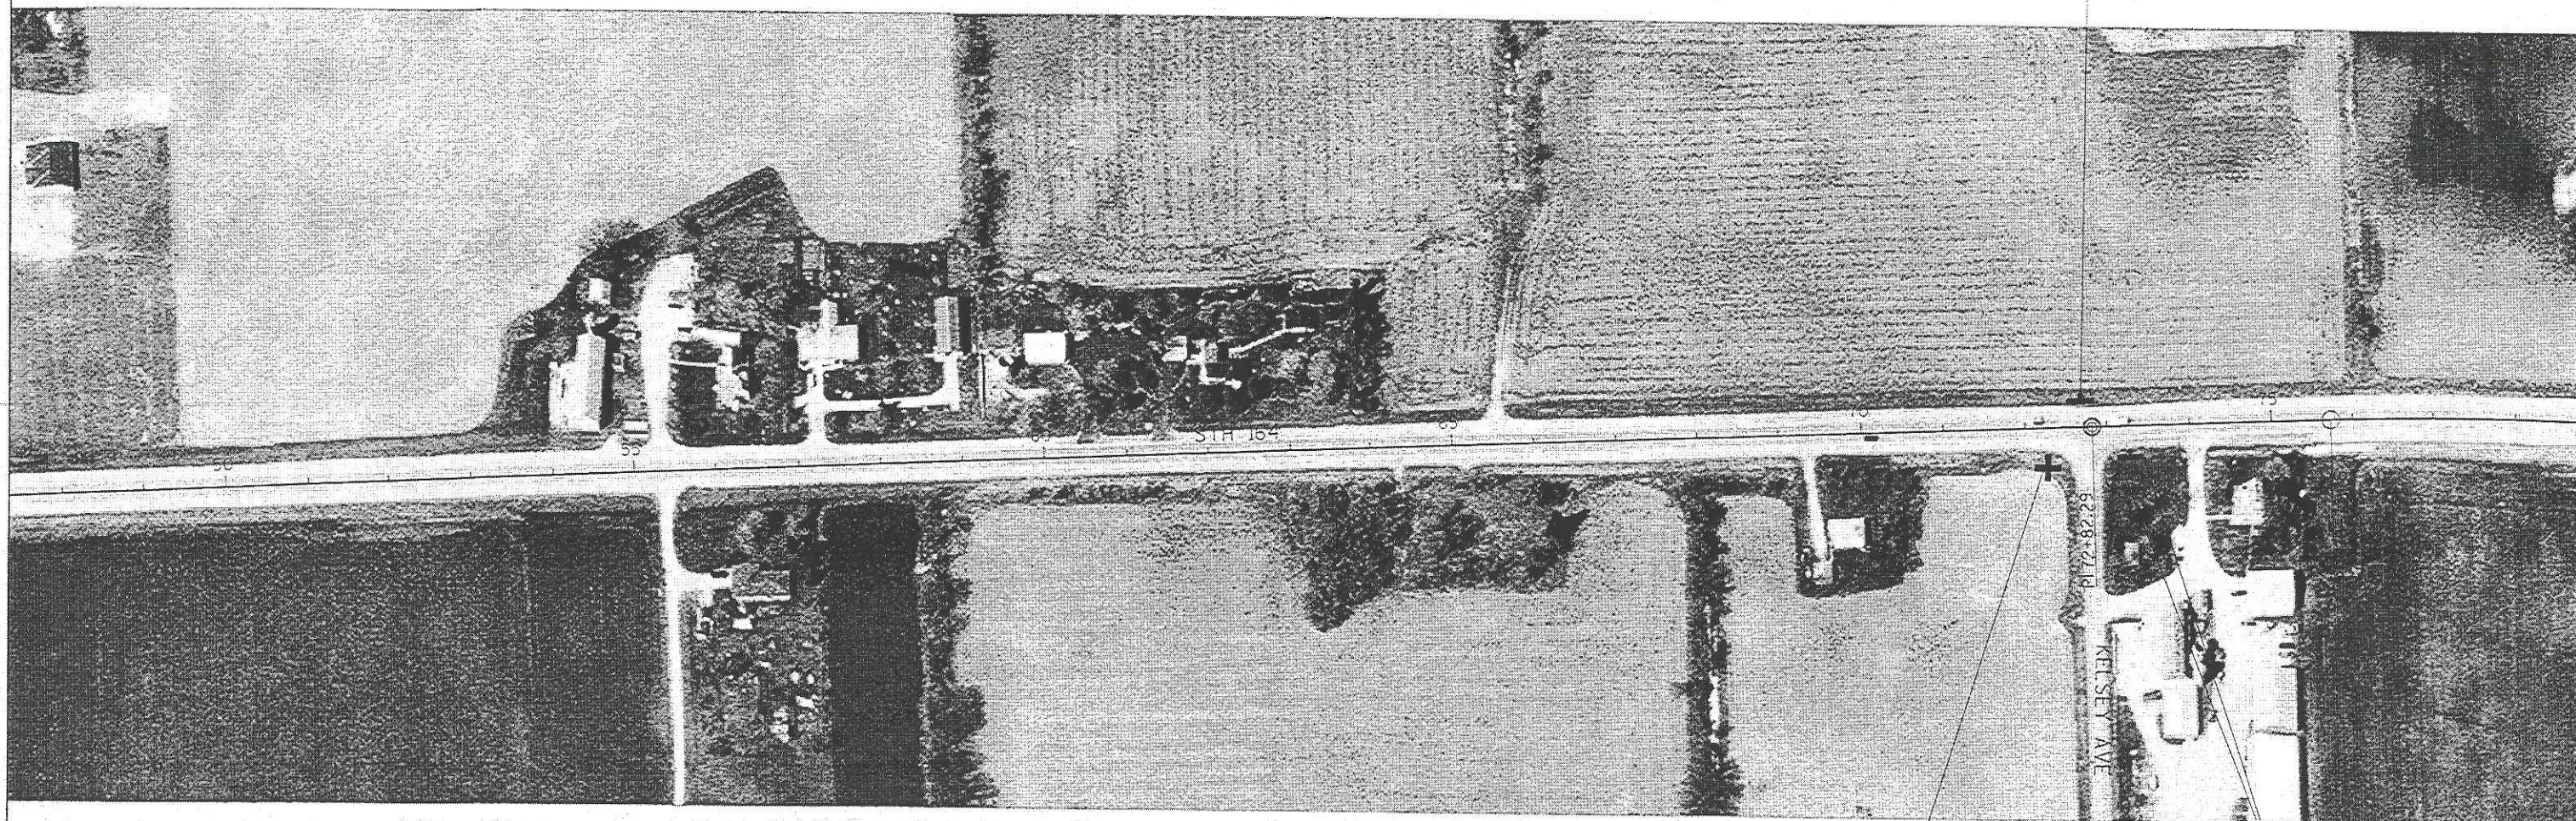

ESTR





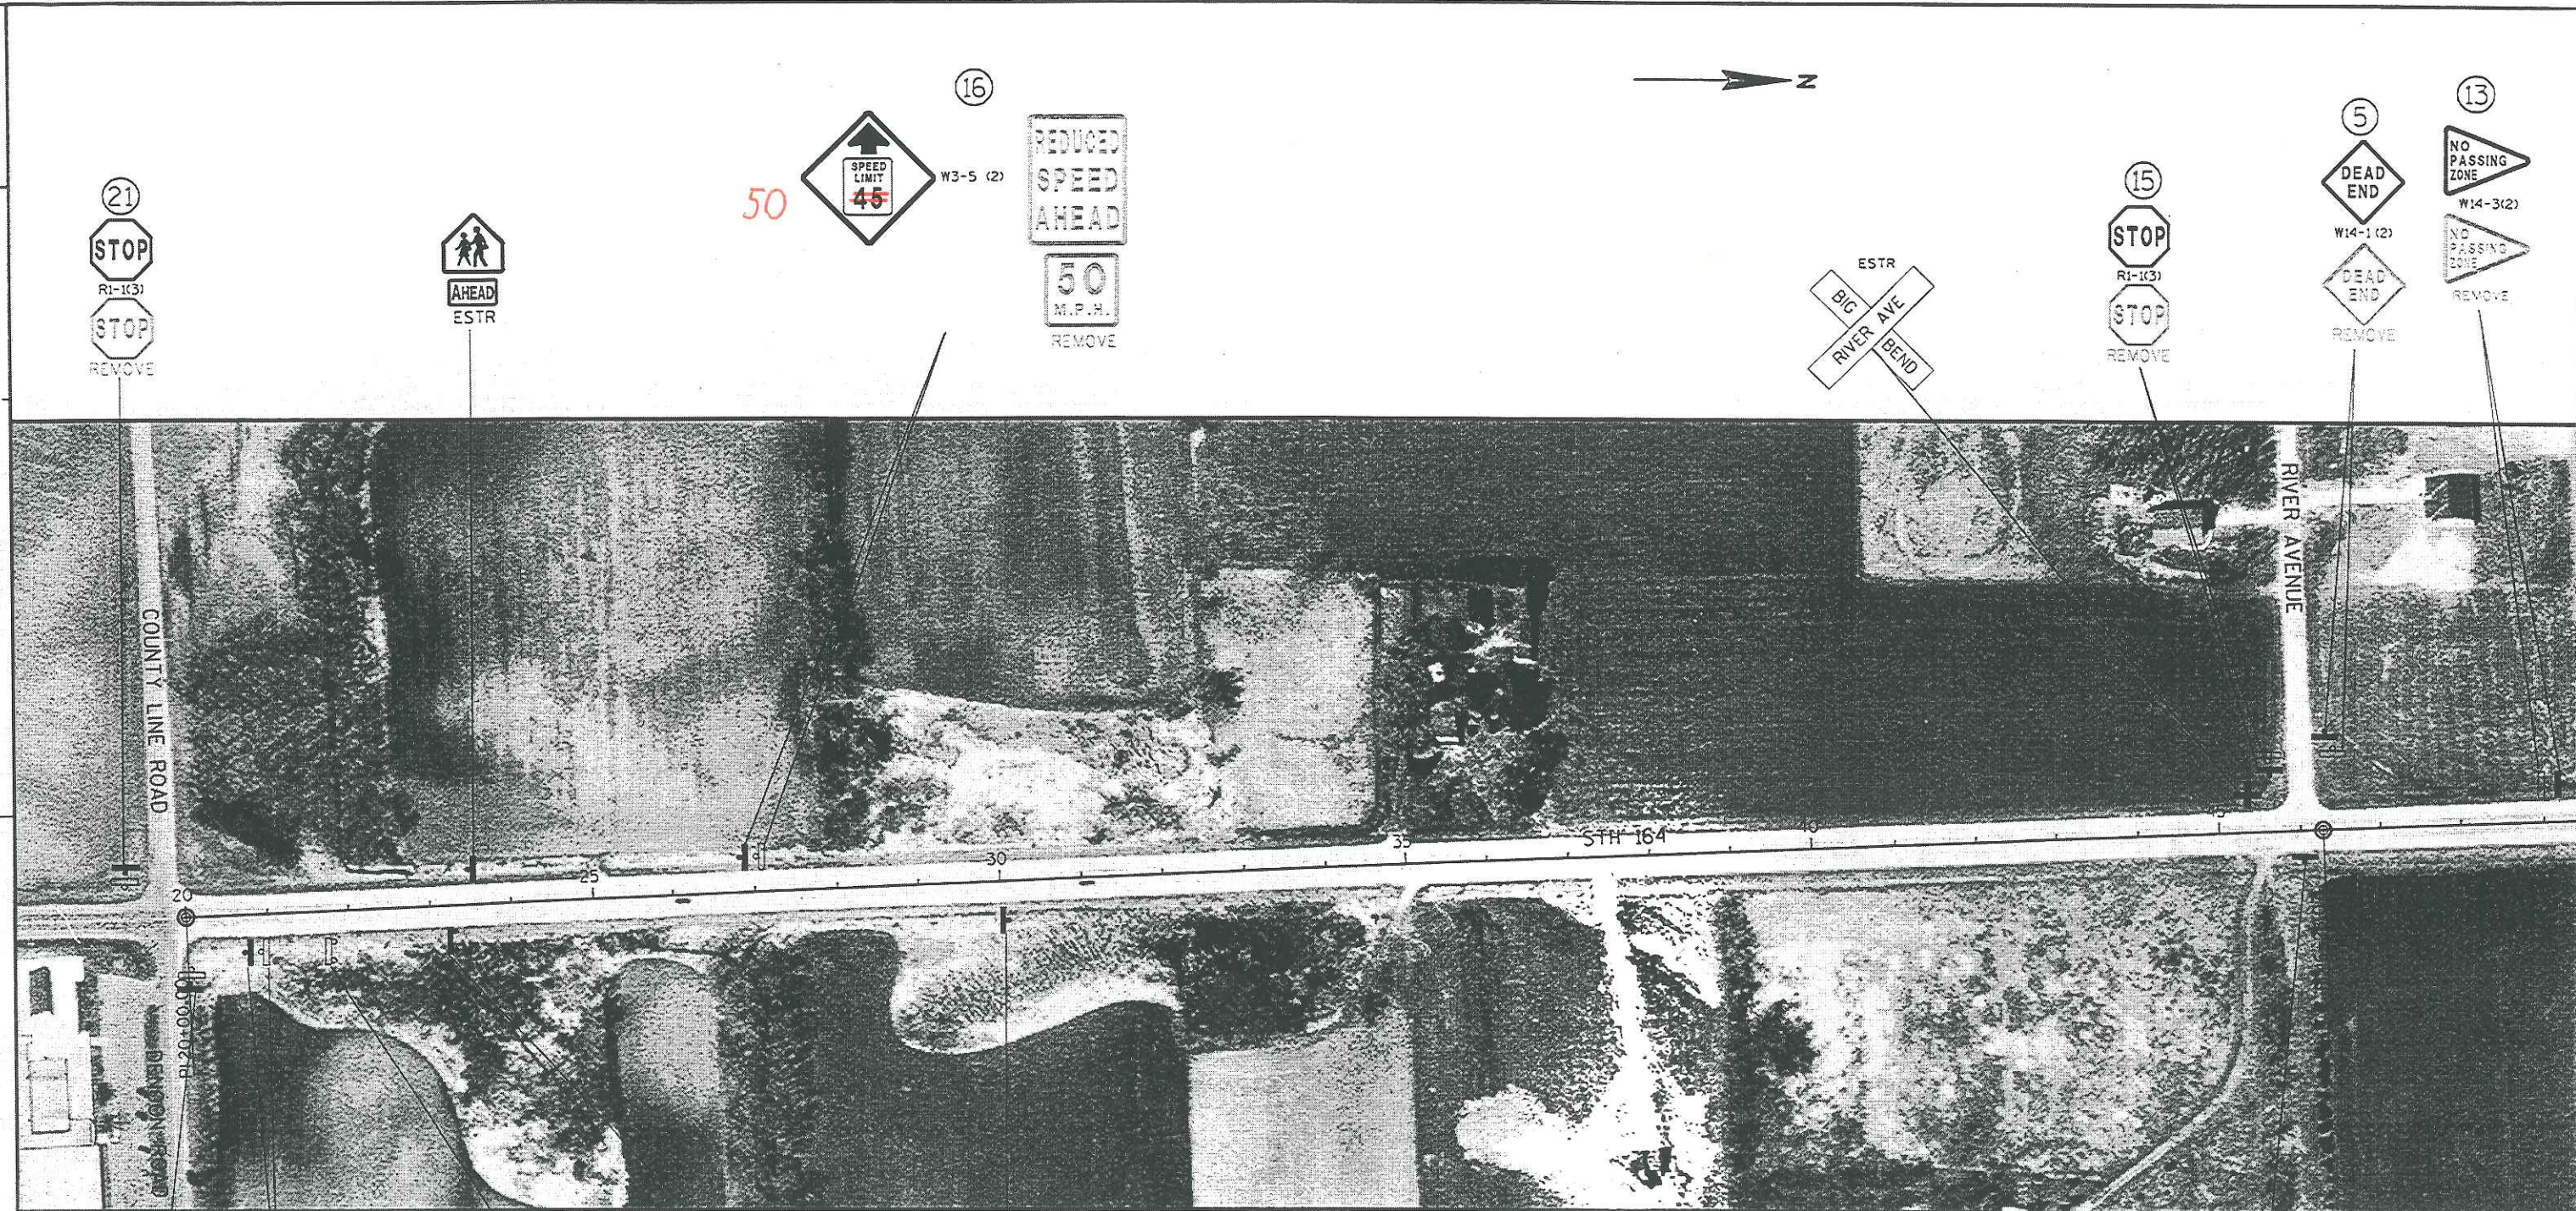

21  
STOP  
R1-1K3  
REMOVE

16  
50  
SPEED LIMIT 45  
W3-5 (2)  
REDUCED SPEED AHEAD  
50 M.P.H.  
REMOVE

15  
STOP  
R1-1K3  
REMOVE

5  
DEAD END  
W14-1 (2)  
REMOVE

13  
NO PASSING ZONE  
W14-3 (2)  
REMOVE

20  
STOP  
R1-1K3  
REMOVE

19  
NO PASSING ZONE  
W14-3 (2)  
REMOVE

18  
SPEED LIMIT 55  
NORTH 164  
Waukesha Co  
REMOVE

22  
Waukesha Co  
I2-2

17  
SPEED LIMIT 55  
R2-1K2


14  
W1-7 (2)

**LEGEND**

- EXISTING SIGN MOUNTED ON POST(S)
- EXISTING SIGN MOUNTED ON BRIDGE OR SIGN BRIDGE
- PROPOSED SIGN MOUNTED ON POST(S)
- PROPOSED SIGN MOUNTED ON BRIDGE OR SIGN BRIDGE
- XX DENOTES SIGN NUMBER
- ESTR EXISTING SIGN TO REMAIN
- (X) INDICATES SIGN SIZE
- LOCAL STREET SIGN
- GRAYSHADE REPRESENTS EXISTING TO BE REMOVED

NOTE:  
PUT IN LINE WITH ROADWAY



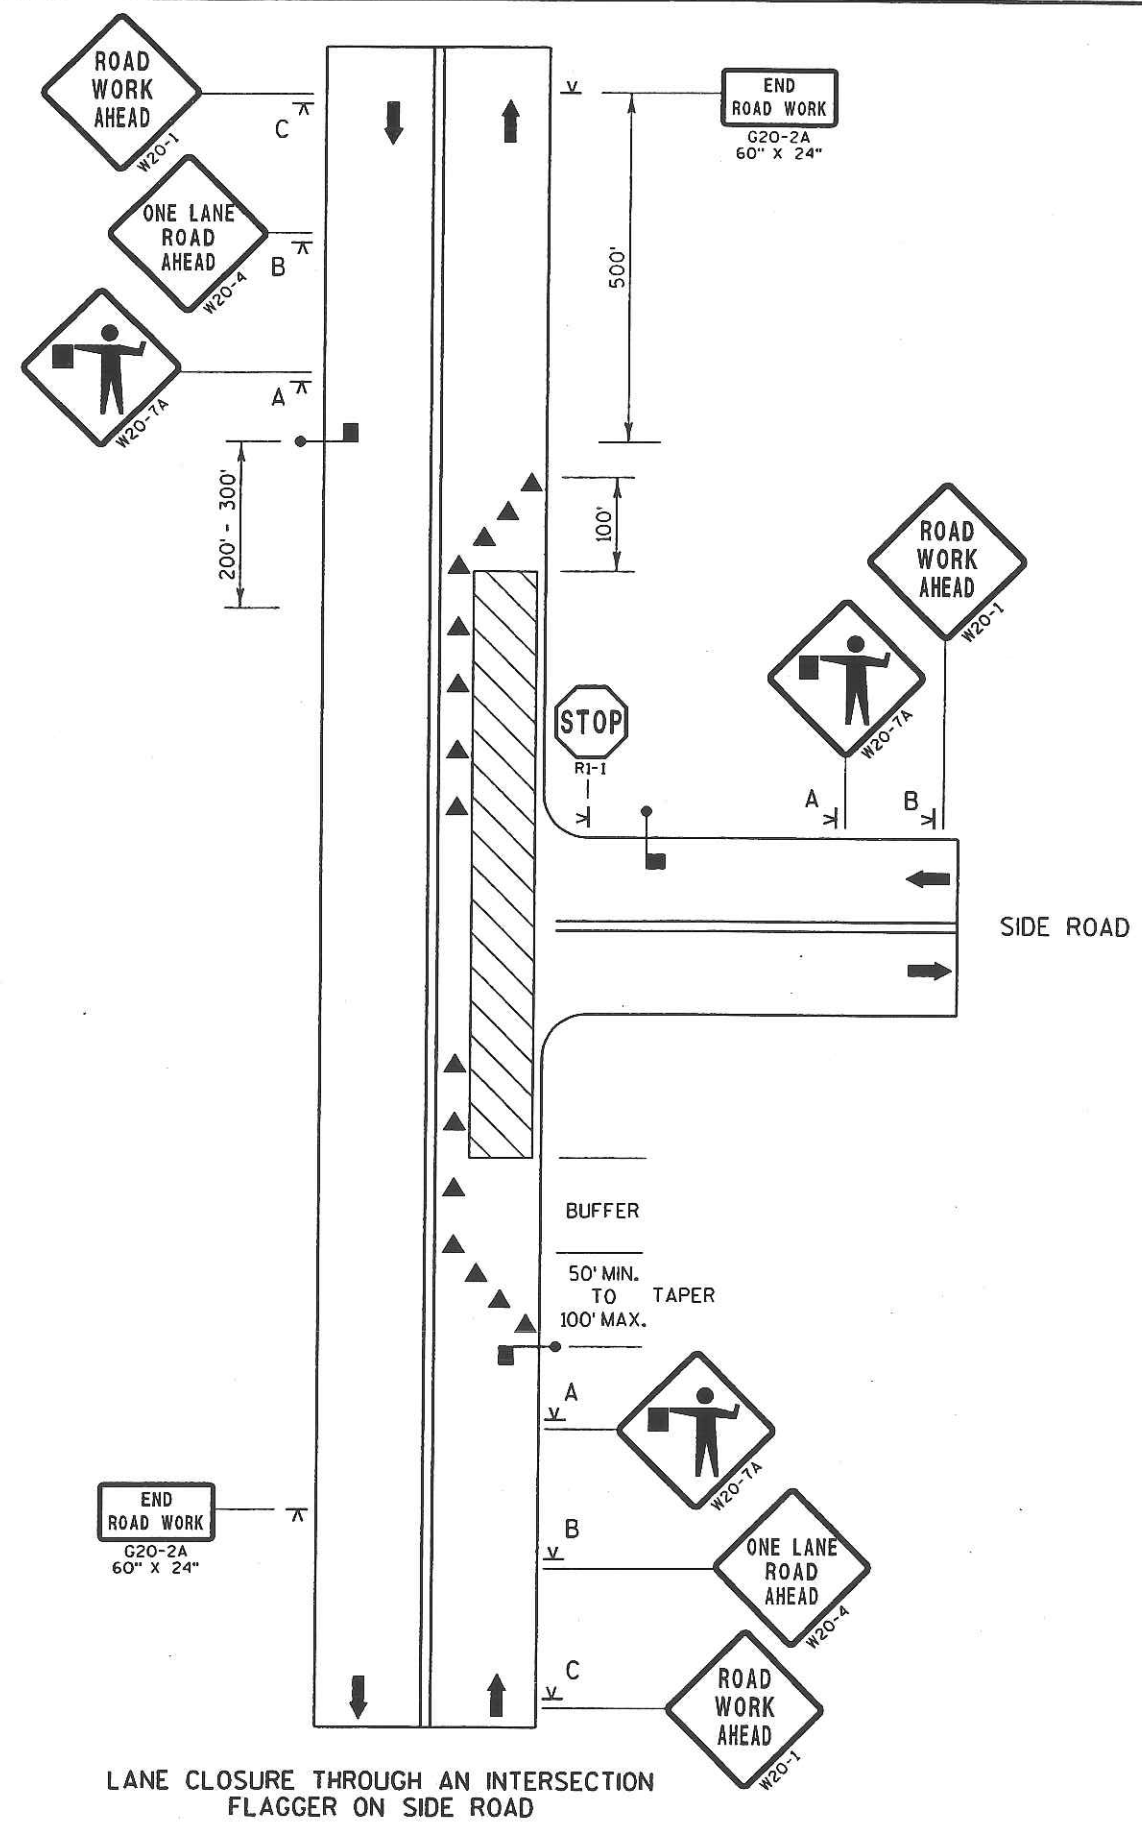

LEGEND

- ◀ CHANNELIZING DEVICE
- ⌞ PORTABLE SIGN SUPPORT
- ▨ WORK AREA
- ➡ TRAFFIC FLOW
- 🚧 FLAGGER

**BE PREPARED TO STOP**

USE OF THE "BE PREPARED TO STOP" SIGN IS OPTIONAL. WHEN USED, THIS SIGN SHALL BE LOCATED BETWEEN THE W20-7a AND W20-4 SIGNS. A 500' TYPICAL SPACING SHALL BE PROVIDED BETWEEN THE SIGNS.

SPEED LIMIT (MPH)	SIGN SPACING A, B, C (FT)	BUFFER (FT)
25	200	55
30	200	85
35	350	120
40	350	170
45	500	220
50	500	280
55	500	335

GENERAL NOTES

DETAILS OF TRAFFIC CONTROL DEVICES AND INSTALLATION NOT SHOWN ON THIS DRAWING SHALL CONFORM TO THE PERTINENT REQUIREMENTS OF THE STANDARD SPECIFICATION, THE SPECIAL PROVISIONS, AND THE MANUAL ON UNIFORM TRAFFIC CONTROL DEVICES.

THE EXACT NUMBER, LOCATION AND SPACING OF ALL SIGNS AND DEVICES (AND THE LOCATION OF ALL FLAGGERS) SHALL BE ADJUSTED TO FIT FIELD CONDITIONS AS DIRECTED BY THE ENGINEER.

THE FIRST ADVANCE WARNING SIGN SHOULD TYPICALLY BE LOCATED IN ADVANCE OF THE ANTICIPATED TRAFFIC BACKUP OR QUEUE.

FLAGGERS SHALL BE IN SIGHT OF EACH OTHER OR IN DIRECT COMMUNICATION AT ALL TIMES. THEY SHALL BE EQUIPPED WITH STOP/SLOW PADDLES FASTENED ON SUPPORT STAFFS. WHEN THE FLAGGING OPERATION IS NOT IN EFFECT, THE "FLAGGER AHEAD", THE "ROAD CONSTRUCTION AHEAD" AND THE ONE LANE ROAD AHEAD" SIGNS SHALL BE COVERED OR REMOVED AND THE HIGHWAY RESTORED TO NORMAL OPERATION.

ALL SIGNS ARE 48" X 48" UNLESS OTHERWISE NOTED.


NOTES

1. Depending on traffic conditions, consider additional traffic control on the side road approaches, such as flaggers and appropriate signs.

LANE CLOSURE THROUGH AN INTERSECTION  
FLAGGER ON SIDE ROAD



# LANE CLOSURE BEYOND AN INTERSECTION (Work Area on the Through Road)

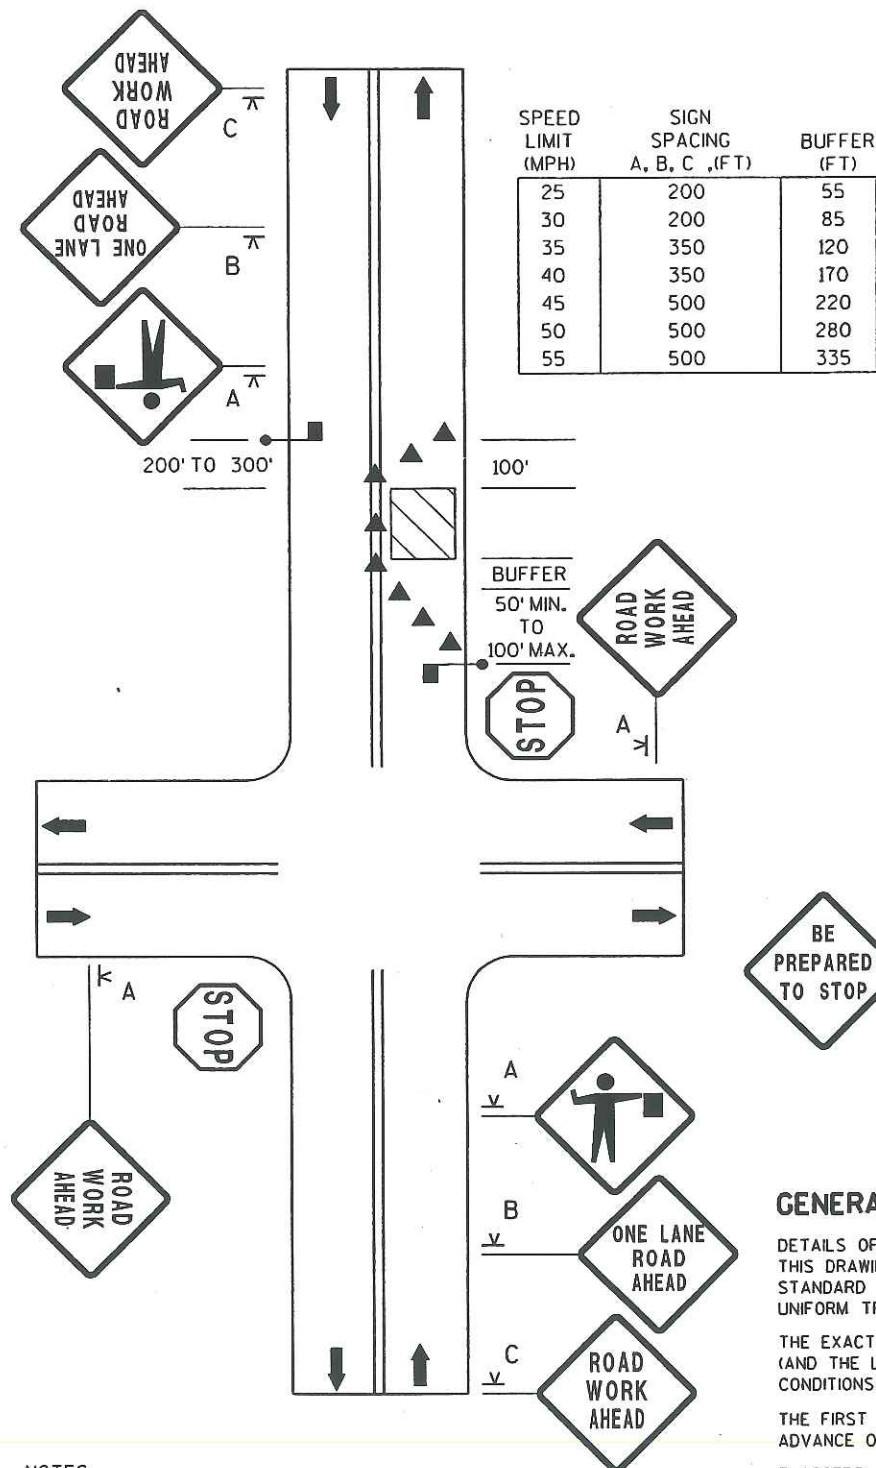

## LEGEND

- ◀ CHANNELIZING DEVICE
- ⌵ PORTABLE SIGN SUPPORT
- ▨ WORK AREA
- ➡ TRAFFIC FLOW
- 🚧 FLAGGER



USE OF THE "BE PREPARED TO STOP" SIGN IS OPTIONAL. WHEN USED, THIS SIGN SHALL BE LOCATED BETWEEN THE W20-7a AND W20-4 SIGNS. A 500' TYPICAL SPACING SHALL BE PROVIDED BETWEEN THE SIGNS.

## GENERAL NOTES

DETAILS OF TRAFFIC CONTROL DEVICES AND INSTALLATION NOT SHOWN ON THIS DRAWING SHALL CONFORM TO THE PERTINENT REQUIREMENTS OF THE STANDARD SPECIFICATION, THE SPECIAL PROVISIONS, AND THE MANUAL ON UNIFORM TRAFFIC CONTROL DEVICES.

THE EXACT NUMBER, LOCATION AND SPACING OF ALL SIGNS AND DEVICES (AND THE LOCATION OF ALL FLAGGERS) SHALL BE ADJUSTED TO FIT FIELD CONDITIONS AS DIRECTED BY THE ENGINEER.

THE FIRST ADVANCE WARNING SIGN SHOULD TYPICALLY BE LOCATED IN ADVANCE OF THE ANTICIPATED TRAFFIC BACKUP OR QUEUE.


FLAGGERS SHALL BE IN SIGHT OF EACH OTHER OR IN DIRECT COMMUNICATION AT ALL TIMES. THEY SHALL BE EQUIPPED WITH STOP/SLOW PADDLES FASTENED ON SUPPORT STAFFS. WHEN THE FLAGGING OPERATION IS NOT IN EFFECT, THE "FLAGGER AHEAD", THE "ROAD CONSTRUCTION AHEAD" AND THE ONE LANE ROAD AHEAD" SIGNS SHALL BE COVERED OR REMOVED AND THE HIGHWAY RESTORED TO NORMAL OPERATION.

ALL SIGNS ARE 48" X 48" UNLESS OTHERWISE NOTED.

## NOTES

- Depending on traffic conditions, consider additional traffic control, such as flaggers and appropriate signs.

# LANE CLOSURE BEYOND AN INTERSECTION (Work Area on Side Road)

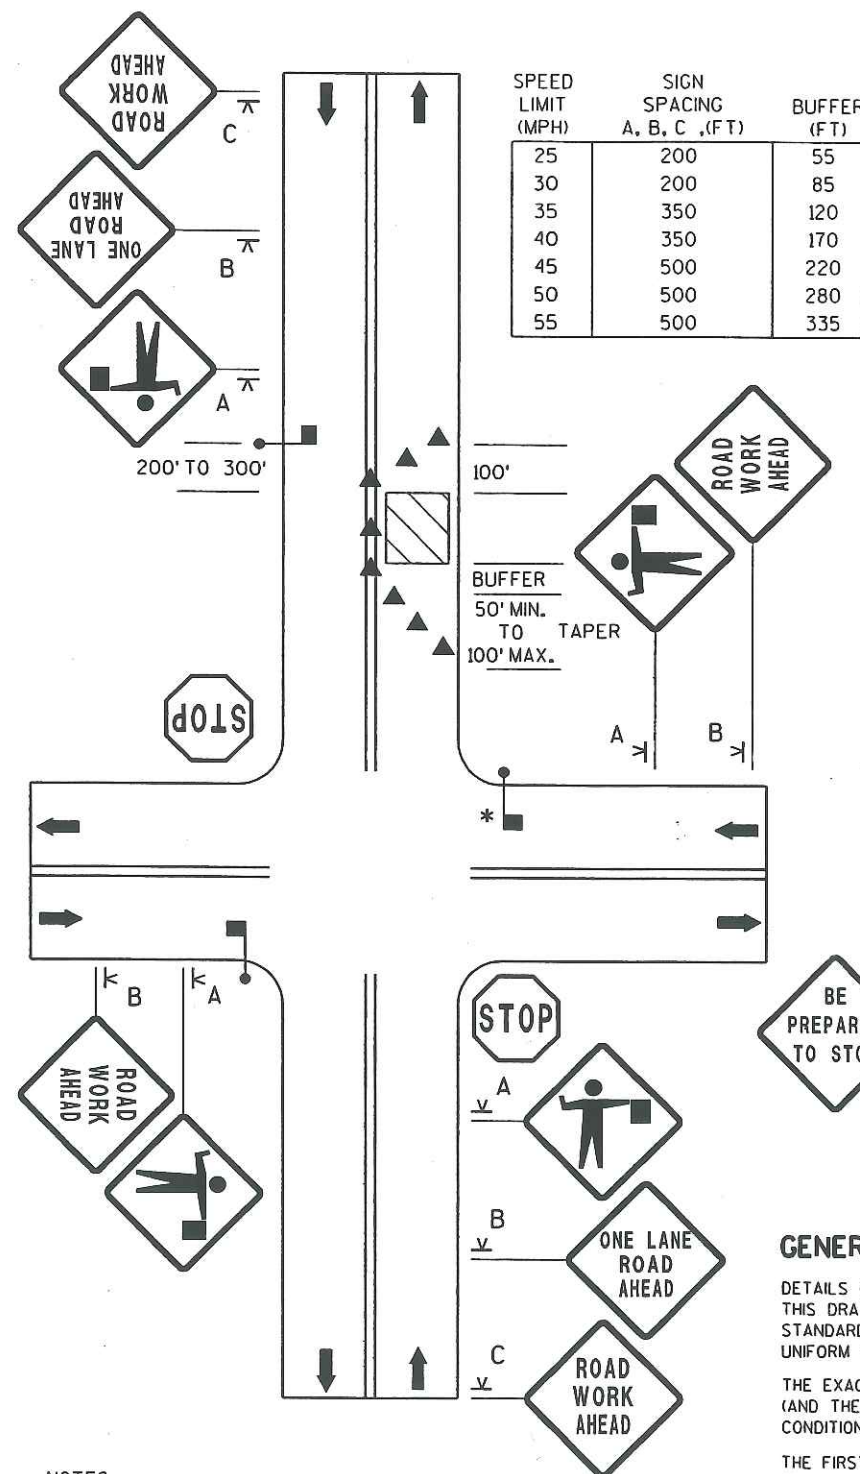

## LEGEND

- ◀ CHANNELIZING DEVICE
- ⌵ PORTABLE SIGN SUPPORT
- ▨ WORK AREA
- ➡ TRAFFIC FLOW
- 🚧 FLAGGER



USE OF THE "BE PREPARED TO STOP" SIGN IS OPTIONAL. WHEN USED, THIS SIGN SHALL BE LOCATED BETWEEN THE W20-7a AND W20-4 SIGNS. A 500' TYPICAL SPACING SHALL BE PROVIDED BETWEEN THE SIGNS.

## GENERAL NOTES

DETAILS OF TRAFFIC CONTROL DEVICES AND INSTALLATION NOT SHOWN ON THIS DRAWING SHALL CONFORM TO THE PERTINENT REQUIREMENTS OF THE STANDARD SPECIFICATION, THE SPECIAL PROVISIONS, AND THE MANUAL ON UNIFORM TRAFFIC CONTROL DEVICES.

THE EXACT NUMBER, LOCATION AND SPACING OF ALL SIGNS AND DEVICES (AND THE LOCATION OF ALL FLAGGERS) SHALL BE ADJUSTED TO FIT FIELD CONDITIONS AS DIRECTED BY THE ENGINEER.

THE FIRST ADVANCE WARNING SIGN SHOULD TYPICALLY BE LOCATED IN ADVANCE OF THE ANTICIPATED TRAFFIC BACKUP OR QUEUE.

FLAGGERS SHALL BE IN SIGHT OF EACH OTHER OR IN DIRECT COMMUNICATION AT ALL TIMES. THEY SHALL BE EQUIPPED WITH STOP/SLOW PADDLES FASTENED ON SUPPORT STAFFS. WHEN THE FLAGGING OPERATION IS NOT IN EFFECT, THE "FLAGGER AHEAD", THE "ROAD CONSTRUCTION AHEAD" AND THE ONE LANE ROAD AHEAD" SIGNS SHALL BE COVERED OR REMOVED AND THE HIGHWAY RESTORED TO NORMAL OPERATION.

ALL SIGNS ARE 48" X 48" UNLESS OTHERWISE NOTED.

## NOTES

- Depending on traffic conditions, consider additional traffic control, such as flaggers and appropriate signs.
- \* The middle flagger would normally be lead flagger and would coordinate the other flaggers.

## LANE CLOSURE

## BEYOND INTERSECTION FLAGGING

PROJECT NO: 2781-00-60

HWY: STH 164

COUNTY: WAUKESHA

SHEET 15

E



DATE 13APR04		ESTIMATE OF QUANTITIES			
LINE				2781-00-60	
NUMBER	ITEM	ITEM DESCRIPTION	UNIT	TOTAL	QUANTITY
0010	204.0125	REMOVING ASPHALTIC SURFACE MILLING	TON	2,340.000	2,340.000
0020	204.0165	REMOVING GUARDRAIL	LF	120.000	120.000
0030	205.9005.S	GRADING SHAPING & FINISHING FOR BEAM GUARD TERMINALS & ANCHORAGES	EACH	4.000	4.000
0040	213.0100	FINISHING ROADWAY (PROJECT) 01. 2781-00-60	EACH	1.000	1.000
0050	305.0110	BASE AGGREGATE DENSE 3/4-INCH	TON	810.000	810.000
0060	455.0105	ASPHALTIC MATERIAL PG58-28	TON	320.000	320.000
0070	455.0605	TACK COAT	GAL	1,070.000	1,070.000
0080	460.1110	HMA PAVEMENT TYPE E-10	TON	5,840.000	5,840.000
0090	460.2000	INCENTIVE DENSITY HMA PAVEMENT	DOL	3,740.000	3,740.000
0100	460.3000	QMP HMA MIXTURE	TON	5,840.000	5,840.000
0110	465.0310	ASPHALTIC CURB	LF	235.000	235.000
0120	465.0315	ASPHALTIC FLUMES	SY	32.000	32.000
0130	606.0100	RIPRAP LIGHT	CY	4.000	4.000
0140	614.0305	STEEL PLATE BEAM GUARD CLASS A	LF	88.000	88.000
0150	614.0370	STEEL PLATE BEAM GUARD ENERGY ABSORBING TERMINAL	EACH	4.000	4.000
0160	619.1000	MOBILIZATION	EACH	1.000	1.000
0170	625.0100	TOPSOIL	SY	300.000	300.000
0180	627.0200	MULCHING	SY	300.000	300.000
0190	628.1105	EROSION BALES DELIVERED	EACH	64.000	64.000
0200	628.1110	EROSION BALES INSTALLED	EACH	64.000	64.000
0210	628.1505	SILT FENCE DELIVERED	LF	480.000	480.000
0220	628.1510	SILT FENCE INSTALLED	LF	480.000	480.000
0230	628.1520	SILT FENCE MAINTENANCE	LF	480.000	480.000
0240	628.1905	MOBILIZATIONS EROSION CONTROL	EACH	1.000	1.000
0250	629.0210	FERTILIZER TYPE B	CWT	0.200	0.200
0260	630.0130	SEEDING MIXTURE NO. 30	LB	5.000	5.000
0270	634.0616	POSTS WOOD 4X6-INCH X 16-FT	EACH	21.000	21.000
0280	634.0618	POSTS WOOD 4X6-INCH X 18-FT	EACH	2.000	2.000
0290	637.0202	SIGNS REFLECTIVE TYPE II	SF	144.170	144.170
0300	638.2102	MOVING SIGNS TYPE II	EACH	1.000	1.000
0310	638.2602	REMOVING SIGNS TYPE II	EACH	24.000	24.000
0320	638.3000	REMOVING SMALL SIGN SUPPORTS	EACH	20.000	20.000
0330	642.5200	FIELD OFFICE TYPE C (PROJECT)	EACH	1.000	1.000
0340	643.0100	TRAFFIC CONTROL (PROJECT) 01. 2781-00-60	EACH	1.000	1.000
0350	643.0300	TRAFFIC CONTROL DRUMS	DAYS	600.000	600.000
0360	643.0900	TRAFFIC CONTROL SIGNS	DAYS	600.000	600.000
0370	645.0130	GEOTEXTILE FABRIC TYPE R	SY	16.000	16.000
0380	646.0106	PAVEMENT MARKING EPOXY 4-INCH	LF	10,990.000	10,990.000
0390	646.0226	PAVEMENT MARKING CHANNELIZING EPOXY 8-INCH	LF	300.000	300.000
0400	646.0403	PAVEMENT MARKING SAME DAY PAINT 4-INCH	LF	11,650.000	11,650.000
0410	646.0406	PAVEMENT MARKING SAME DAY EPOXY 4-INCH	LF	26,480.000	26,480.000
0420	648.0100	LOCATING NO-PASSING ZONES	MI	2.300	2.300
0430	690.0100	SAWING EXISTING PAVEMENT	LF	370.000	370.000
0440	SPV.0060	SPECIAL 01. MARKER POST FLEXIBLE FOR GUARD RAIL TERMINAL	EACH	4.000	4.000
0450	SPV.0170	SPECIAL 01. DITCHING AND SHAPING	STA	18.000	18.000

[illegible]

EROSION CONTROL AND LANDSCAPING ITEMS

	#606.0100 RIPRAP LIGHT	#645.0130 GEOFAB TYPE "R"	#625.0100 TOPSOIL	#627.0200 MULCH	#629.0205 FERTILIZER TYPE "B"	#630.0130 SEEDING MIX# 30	#628.1105 EROSION BLS INST	#628.1110 EROSION BLS INST	#628.1505 SILT FENCE DELIVERED SANDY	#628.1510 SILT FENCE INSTALLED	#628.1520 SILT FENCE MAINTENANCE
LOCATION	C.Y.	S.Y.	S.Y.	S.Y.	cwt	LB	EACH	EACH	LF	LF	LF
STA96+37 LT	2	8	--	--	--	--	--	--	240	240	240
STA104+27 LT	2	8	--	--	--	--	--	--	240	240	240
STA98+00 LT	--	--	300	300	0.2	5	--	--	--	--	--
STA27+00 LT	--	--	--	--	--	--	8	8	--	--	--
STA67+50 RT	--	--	--	--	--	--	8	8	--	--	--
STA70+25 RT	--	--	--	--	--	--	8	8	--	--	--
STA74+31 RT	--	--	--	--	--	--	8	8	--	--	--
STA75+20 RT	--	--	--	--	--	--	8	8	--	--	--
STA75+70 RT	--	--	--	--	--	--	8	8	--	--	--
STA76+50 RT	--	--	--	--	--	--	16	16	--	--	--
TOTALS	4	16	300	300	0.2	5	64	64	480	480	480



STH 164


WAUKESHA COUNTY  
PROJECT NO. 2781-00-60  
PERMANENT TYPE II SIGNING

CATEGORY : 010

6' MINIMUM MOUNTING HEIGHT  
MEASURED FROM RIGHT EDGELINE

SIGN NO.	SIGN CODE	DESCRIPTION	SIGN SIZE	SIGN SIZE W X H (IN)X(IN)	637.0202 SIGNS TYPE II REFLEC. SQ.FT.	638.2102 MOVING SIGNS TYPE II (EA)	638.2602 REMOVING SIGNS TYPE II (EA)	638.3000 REMOVING SMALL SIGN SUPPORTS (EA)	634.0616 POST WOOD 4"X 6"X16' (EA)	634.0618 POST WOOD 4"X 6"X18' (EA)	REMARKS
1	--	SPEED LIM. 35					1	1			
2	--	SPEED LIM. 35					1	1			
3	I2-3	BIG BEND, POP.. 1,278		72 X 24	12.00		1	1	2		
4	R2-1	SPEED LIM. 55	2	24 X 30	5.00		1	1	1		
5	W14-1	DEAD END	2	36 X 36	9.00		1	1	1		SEE SHEET 10F 5
6	R2-1	SPEED LIM. 35	2	24 X 30	5.00		1	1	1		
7	R1-1	STOP SIGN	3	36 X 36	7.46		1	1	1		
8	W3-5	SPEED REDUCTION (45)	2	36 X 36	9.00				1		
	W14-3	NO PASSING ZONE	2	48 X 36	6.00		1				
	--	REDUCE SPEED AHEAD					1	1			
	--	35 M.P.H.					1				
9	W14-3	NO PASSING ZONE	2	48 X 36	6.00		1	1	1		
10	W14-3	NO PASSING ZONE	2	48 X 36	6.00		1	1	1		
11	R1-1	STOP SIGN	3	36 X 36	7.46		1	1	1		
12	W1-7	DOUBLE NIGHT ARROW	2	48 X 24	8.00				1		NEW
13	W14-3	NO PASSING ZONE	2	48 X 36	6.00		1	1	1		
14	W1-7	DOUBLE NIGHT ARROW	2	48 X 24	8.00				1		NEW
15	R1-1	STOP SIGN	3	36 X 36	7.46		1	1	1		
16	W3-5	SPEED REDUCTION (45)	2	36 X 36	9.00				1		
	--	REDUCE SPEED AHEAD					1	1			
	--	55 M.P.H.					1				
17	R2-1	SPEED LIM. 55	2	24 X 30	5.00				1		
18	--	SPEED LIM 55					1				
	J4-1	NORTH / STH 64					1				
	--	WAUKESHA CO.					1	1			
19	W14-3	NO PASSING ZONE	2	48 X 36	6.00		1	1	1		
20	R1-1	STOP SIGN	3	36 X 36	7.46		1	1	1		
21	R1-1	STOP SIGN	3	36 X 36	7.46		1	1	1		
22	J4-1	NORTH									
	M3-1	STH 164									
	M1-6	WAUKESHA CO.		72 X 15	7.50				1	1	
	I2-2										
-	-	UNDISTRIBUTED	-	-	-	1	1	2	1	1	- - -
-	-	TOTALS	-	-	-	144.17	1	24	20	21	2



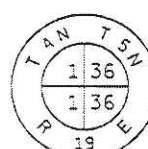


N = 312378.62  
E = 483339.88

BEGIN PROJECT 2781-00-60  
STA. 20+73

EROSION BALES REQUIRED  
DITCHING AND SHAPING REQUIRED  
FROM STA. 27+00 TO STA. 29+00, LT

N = 315004.39  
E = 483228.34

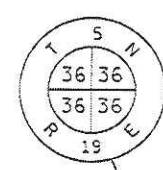

5

COUNTY LINE ROAD

DENIGON ROAD

RIVER AVENUE

5

STH 164




KRUEGER BROOK


LEGEND  
DRIVEWAY ENTRANCE

STA.46+00± PLACE A 4" RING OVER MONUMENT, RING TO BE FURNISHED BY D.O.T.



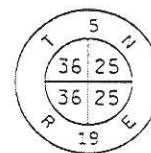

N= 317656.22  
E = 483115.61

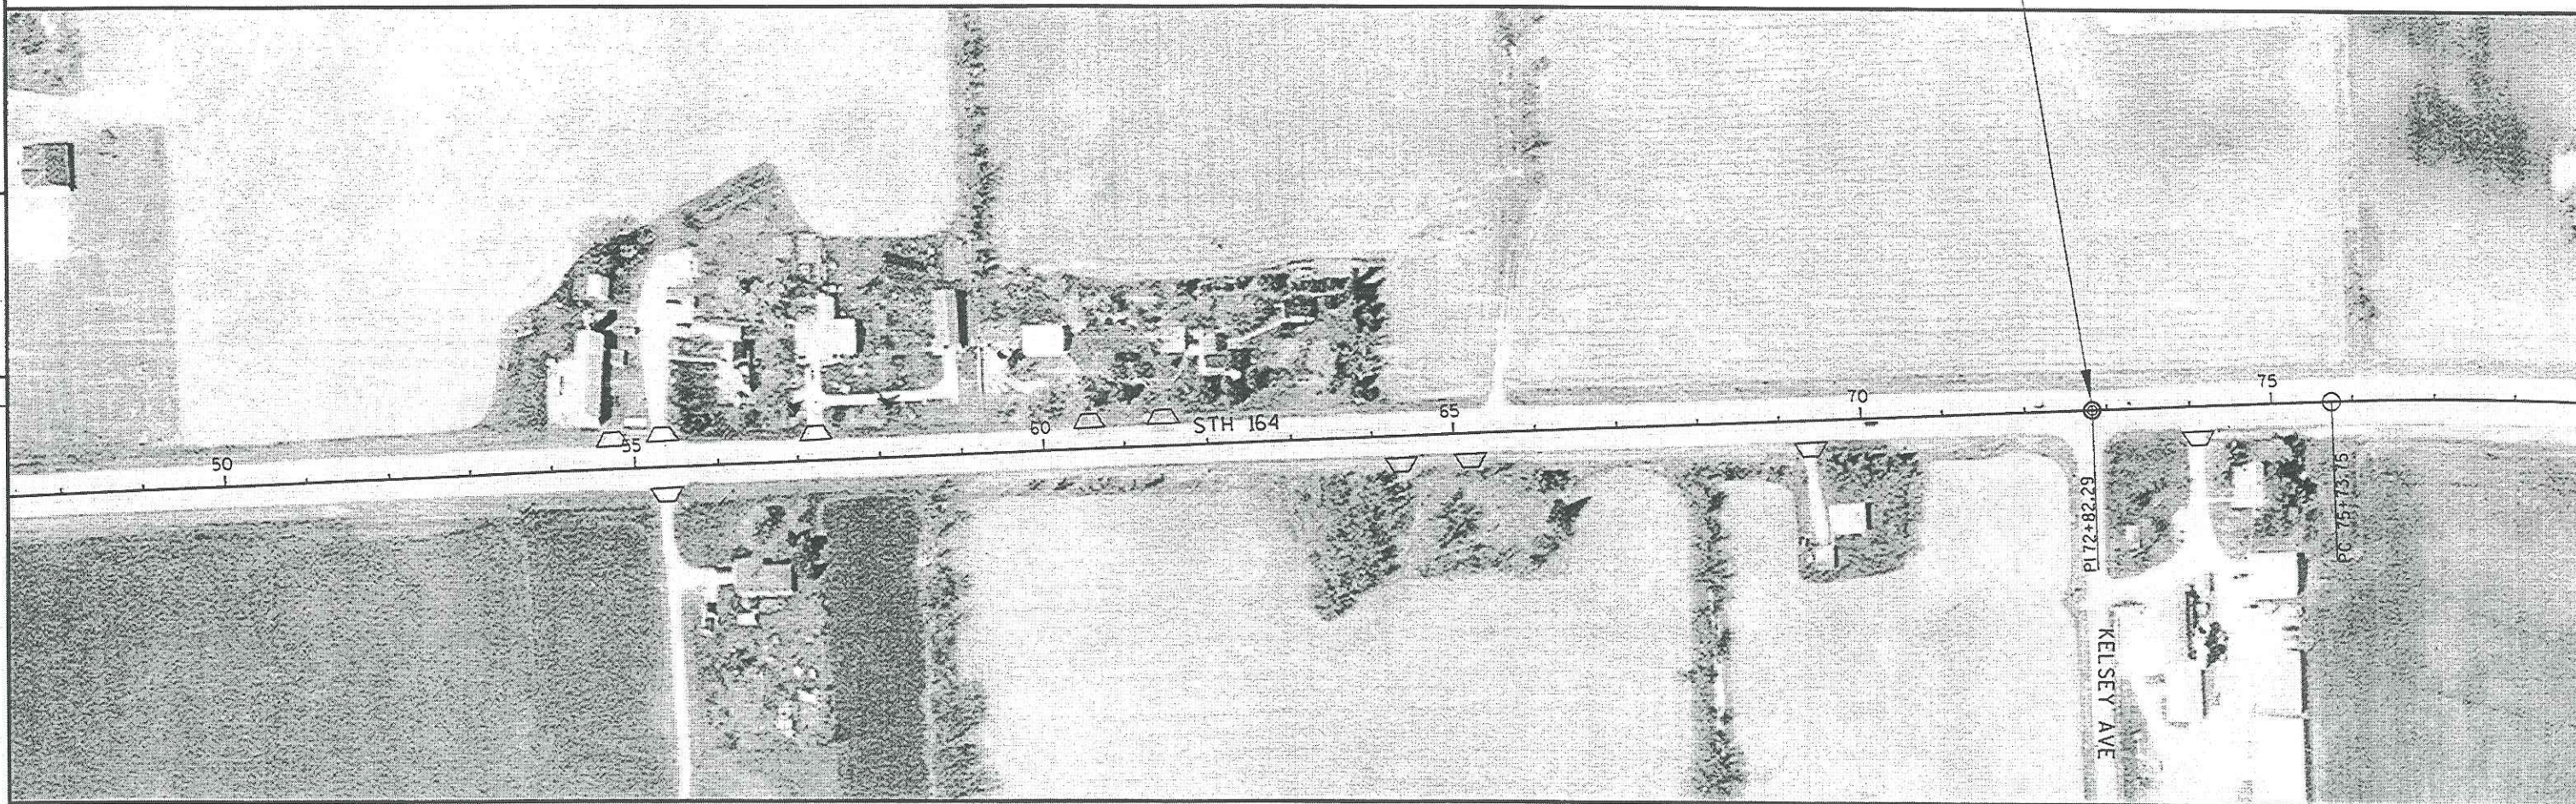

LEGEND

 DRIVEWAY ENTRANCE

DITCHING AND SHAPING REQUIRED  
FROM STA. 67+50 TO STA. 69+58, RT  
FROM STA. 70+25 TO STA. 74+00, RT  
FROM STA. 74+31 TO STA. 85+00

EROSION BALES REQUIRED

STA. 72+80± PLACE A 4" RING OVER MONUMENT, RING TO BE FURNISHED BY D.O.T.

PROJECT NO: 2781-00-60

HWY: STH 164

COUNTY: WAUKESHA

PLAN DETAIL

SHEET 21

E

FILE NAME : \\wke31fp1\cadds\projects\02\_278100164\021202.PD.dgn

PLOT DATE : 15-MAR-2004 16:02

PLOT BY : DOTMLL

PLOT NAME :

PLOT SCALE : 200:1

WISDOT/CADDs SHEET 44



STA. 97+75 TO STA. 98+25  
REQUIRED STEEL PLATE BEAM GUARD ENERGY ABSORBING TERMINALS

STA. 105+30 TO STA. 105+80, LT  
REMOVE GUARDRAIL  
REQUIRED STEEL PLATE BEAM GUARD ENERGY ABSORBING TERMINALS

STA. 97+75 TO STA. 98+25  
REQUIRED STEEL PLATE BEAM GUARD CLASS A

STA. 103+77 TO STA. 104+27, LT  
REQUIRED STEEL PLATE BEAM GUARD ENERGY ABSORBING TERMINALS

CURVE AT PISTA. 81+06.99  
PC STA. 75+73.75  
PT STA. 86+33.38  
SUPERELEVATION = 0.04%

STA. 96+37, LT  
REQUIRED MARKER POST

STA. 103+68 TO STA. 104+27, LT  
REMOVE GUARDRAIL

STA. 103+77, LT  
REQUIRED MARKER POST

STA. 105+80, LT  
REQUIRED MARKER POST



5

5

STH 164 90

PT 86+33.38

PT 91+06.99

PT 106+53.26

DITCHING AND SHAPING REQUIRED  
FROM STA. 74+31 TO STA. 85+00, RT  
EROSION BALES REQUIRED

STA. 96+37, LT  
REQUIRED ASPHALTIC FUME  
REQUIRED GEOTEXILE FABRIC TYPE R  
REQUIRED LIGHT RIPRAP

STA. 98+25,  
REQUIRED MARKER POST

STA. 96+37 TO STA. 96+87, LT  
REQUIRED STEEL PLATE BEAM GUARD ENERGY ABSORBING TERMINALS

STA. 104+27, LT  
REQUIRED ASPHALTIC FUME  
REQUIRED GEOTEXILE FABRIC TYPE R  
REQUIRED LIGHT RIPRAP

CURVE AT PISTA. 106+53.26  
PC STA. 97+90.47  
PT STA. 104+66.55  
SUPERELEVATION = 0.05%

LEGEND

DRIVEWAY ENTRANCE

STA. 96+87 TO STA. 97+75, LT  
REQUIRED SHOULDER PAVING AT BEAM GUARD  
REQUIRED ASPHALTIC CURB  
REQUIRED SILT FENCE

STA. 104+27 TO STA. 105+30, LT  
REQUIRED SHOULDER PAVING AT BEAM GUARD  
REQUIRED ASPHALTIC CURB  
REQUIRED SILT FENCE

PROJECT NO: 2781-00-60

HWY: STH 164

COUNTY: WAUKESHA

PLAN DETAIL

SHEET 22

E

FILE NAME : \\WKE31FP1\CADDs\projects\02\_278100164\021203\_PD.dgn

PLOT DATE : 16-MAR-2004 10:50

PLOT BY : D0TR3H

PLOT NAME :

PLOT SCALE : 200:1

WISDOT/CADDs SHEET 44





LEGEND

 DRIVEWAY ENTRANCE

PROJECT NO:2781-00-60

HWY:STH 164

COUNTY:WAUKESHA

PLAN DETAIL

SHEET 23

E

FILE NAME : \\WKE31FP1\CADD5\projects\02\_278100164\021204\_PD.dgn

PLOT DATE : 12-MAR-2004 09:15

PLOT BY : DQTR3H

PLOT NAME :


PLOT SCALE : 200.000232:1

WISDOT/CADD5 SHEET 44




5

5

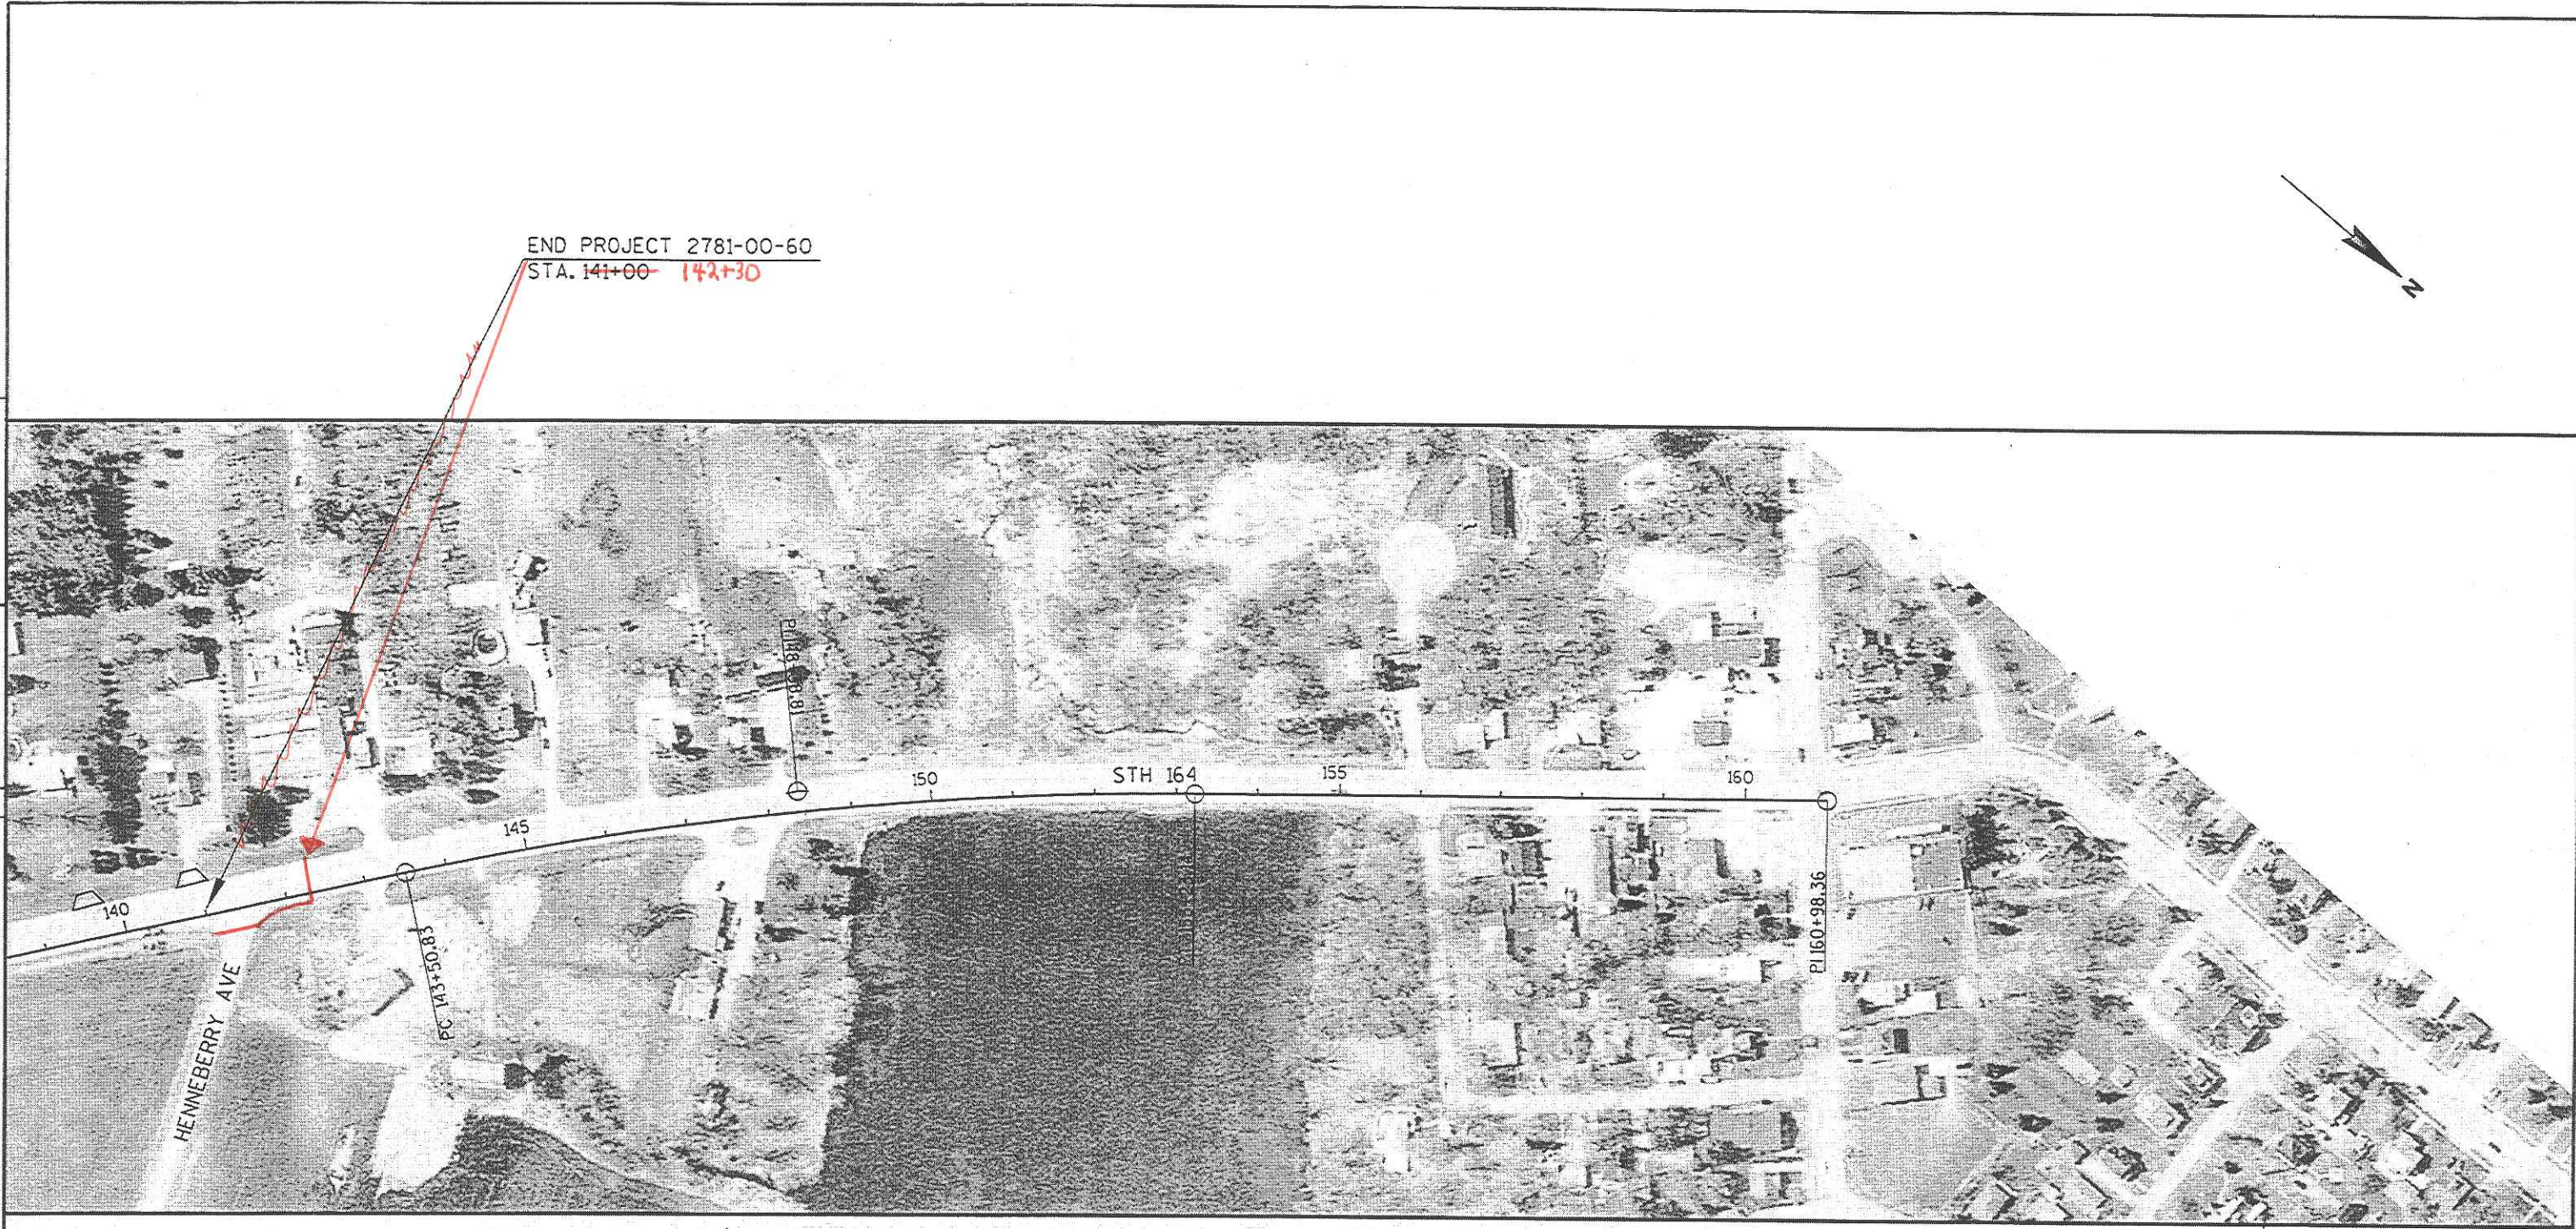


LEGEND  
◡ DRIVEWAY ENTRANCE



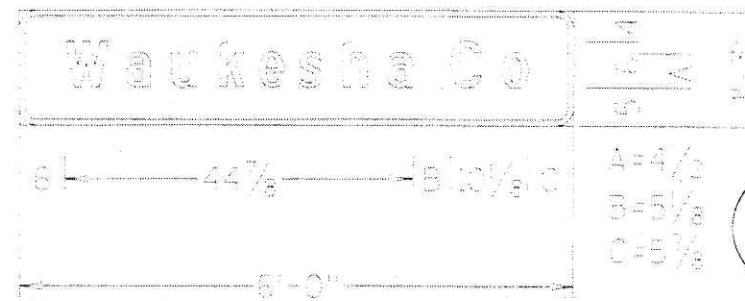

3/4" BORDER  
3/4" RADIUS  
2-2

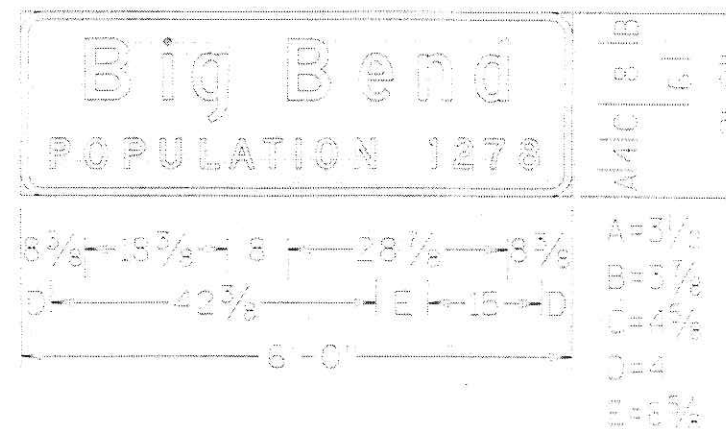

1" BORDER  
3" RADIUS  
12-3(MOB)

#### GENERAL NOTES:

1. DETAILS OF CONSTRUCTION, MATERIALS, AND WORKMANSHIP NOT SHOWN ON THIS DRAWING SHALL CONFORM TO THE PLATMENT REQUIREMENTS OF THE STANDARD SPECIFICATIONS, THE SPECIAL PROVISIONS, AND THE PLANS.
2. UNLESS OTHERWISE NOTED, ALL SIGNS SHOWN ON THIS SHEET ARE "SIGNS, TYPE 1".
3. UNLESS OTHERWISE NOTED, TYPE 1 SIGNS ON THIS SHEET SHALL HAVE "TYPE H REFLECTIVE SHEETING" AND, "TYPE H MESSAGE MATERIAL". TYPE 1 SIGNS SHALL BE TYPE H REFLECTIVE SHEETING.
4. UNLESS OTHERWISE NOTED, ALL SIGNS SHOWN ON THIS SHEET SHALL HAVE A GREEN BACKGROUND AND WHITE MESSAGE.
5. ALL UPPER CASE MESSAGE (EXCEPT ON SHIELDS OR WHERE OTHERWISE NOTED) SHALL BE "SERIES E, MODIFIED". ALL LOWERCASE MESSAGE WITH AN INITIAL UPPER CASE LETTER SHALL BE "SERIES E, MODIFIED".
6. UNLESS OTHERWISE NOTED, ALL SIGNS SHOWN ON THIS SHEET SHALL HAVE "TYPE A" OR "TYPE C" ARROWS AS SHOWN. SEE THE STANDARD SIGN PLATES FOR FURTHER DETAILS.
7. SEE THE STANDARD SIGN PLATES FOR FURTHER DETAILS ON ROUTE MARKER SHIELDS.
8. THE SIGN NUMBER IS DENOTED IN THE BLOCK NEAR EACH DETAIL.
9. DO NOT SCALE.

PROJECT NO: 2781-00-60

HWY: STH 164

COUNTY: WAUKESHA

SIGNING DETAIL - TYPE 1 SIGNS

SCALE: 0 1/2" = 1'

SHEET 25

E

FILE NAME: H:\PROJECTS\2781-00-60\2781-00-60.dwg

PLOT DATE: H:\PROJECTS\2781-00-60\2781-00-60.dwg PLOT BY: H:\PROJECTS\2781-00-60\2781-00-60.dwg PLOT NAME: 2781-00-60.dwg

PLOT SCALE: H:\PROJECTS\2781-00-60\2781-00-60.dwg WISDOT/CADD SHEET 47



INCREASE  $\phi$  FROM RIGHT ANGLE  
TO BEST FIT FIELD CONDITIONS

INCREASE  $\phi$  FROM RIGHT ANGLE  
TO BEST FIT FIELD CONDITIONS



DETAILS OF CONSTRUCTION, MATERIALS AND WORKMANSHIP NOT SHOWN ON THIS DRAWING SHALL CONFORM TO PERTINENT REQUIREMENTS OF THE STANDARD SPECIFICATIONS AND APPLICABLE SPECIAL PROVISIONS.

- ① JOINTS SHALL BE  $\frac{1}{8}$  TO  $\frac{1}{4}$  INCH WIDE BY  $1\frac{1}{2}$  INCHES DEEP AND SPACED AT UNIFORM INTERVALS OF APPROXIMATELY 4 FEET.
- ② GEOTEXTILE FABRIC TYPE "R" SHALL UNDERLAY THE FULL LENGTH AND WIDTH OF THE CONCRETE SURFACE DRAIN AND RIPRAP.
- ③ CONCRETE SURFACE DRAIN WITHOUT CURB AND GUTTER MAY BE USED ON BACKSLOPES WHEN SPECIFIED

INCREASE  $\phi$  FROM RIGHT ANGLE  
TO BEST FIT FIELD CONDITIONS




APPROVED  
10/23/89  
DATE

[Signature]  
STATE DESIGN ENGINEER FOR HWYS

FHWA




WOOD STAKES (2 PER BALE)  
NOMINAL 2" X 2" X 30" MIN.  
LENGTH OR EQUIVALENT

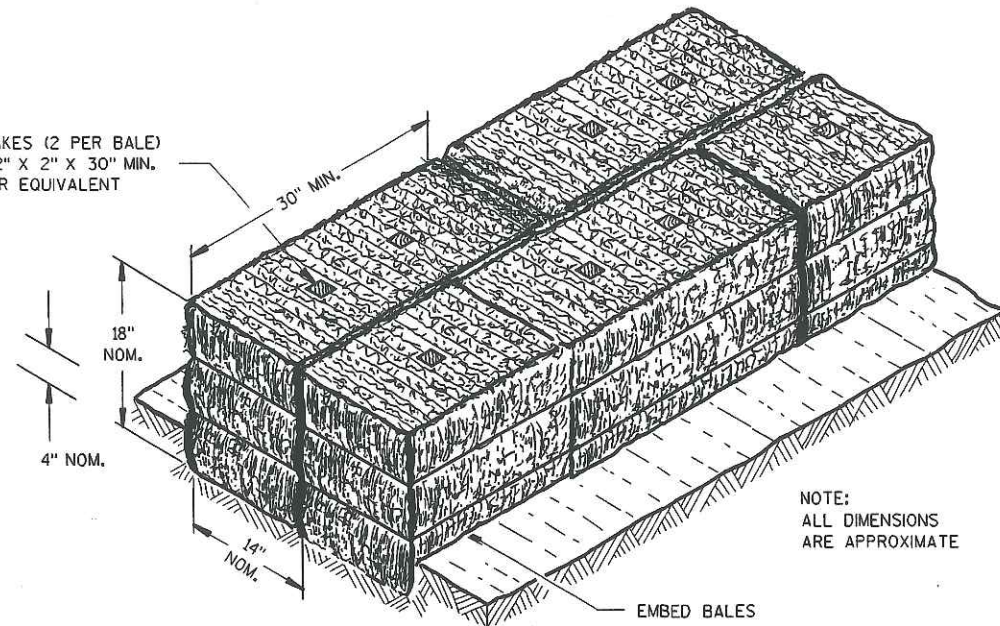


NOTE:  
ALL DIMENSIONS  
ARE APPROXIMATE

SECTION A-A

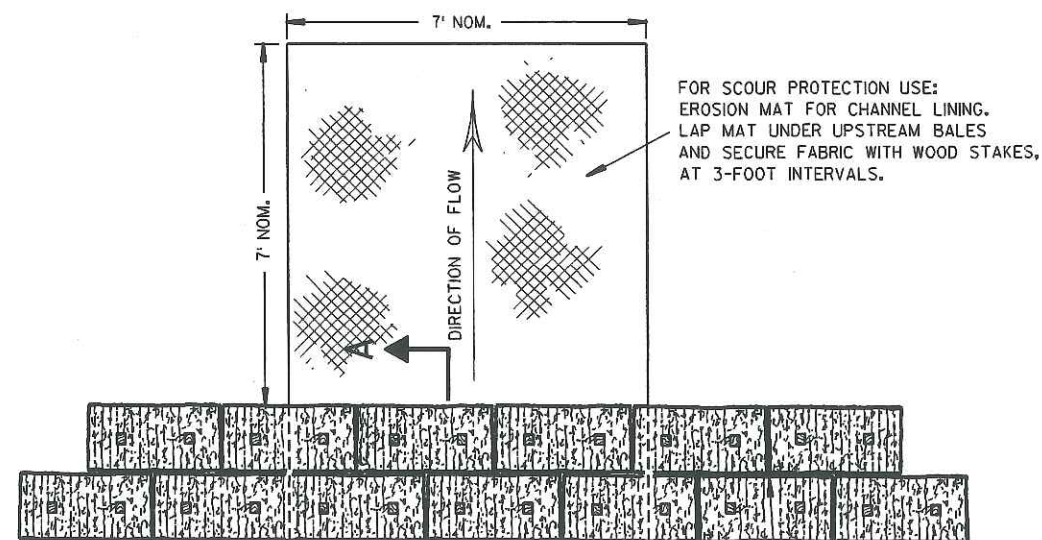

PLAN VIEW

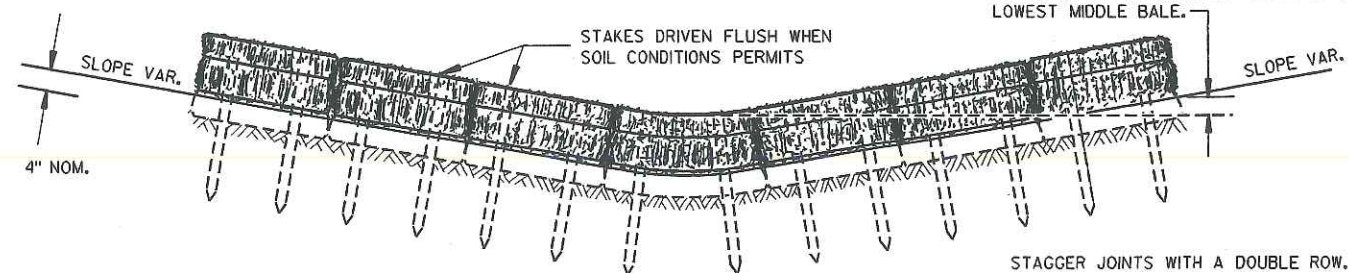


FRONT ELEVATION

TEMPORARY DITCH CHECK USING EROSION BALES ①

## GENERAL NOTES


DETAILS OF CONSTRUCTION, MATERIALS AND WORKMANSHIP NOT SHOWN ON THIS DRAWING SHALL CONFORM TO THE PERTINENT REQUIREMENTS OF THE STANDARD SPECIFICATIONS AND THE APPLICABLE SPECIAL PROVISIONS.

- ① TEMPORARY DITCH CHECKS EITHER EROSION BALES OR MANUFACTURED SHALL BE PAID FOR UNDER THE BID ITEM OF TEMPORARY DITCH CHECK. THE DEPARTMENT WILL NOT PAY FOR TEMPORARY DITCH CHECKS CONSTRUCTED OF A SINGLE ROW OF EROSION BALES.

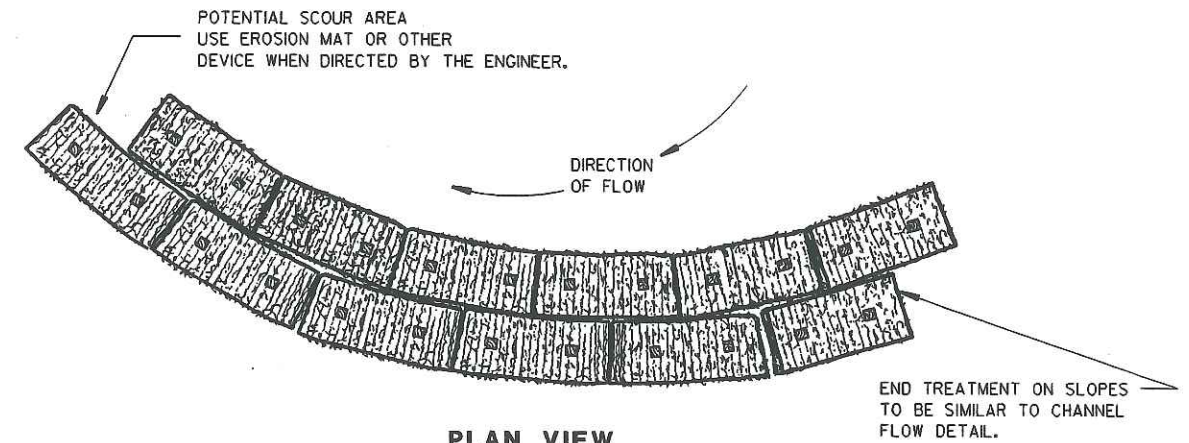


PLAN VIEW

WHEN ALTERING THE DIRECTION OF FLOW

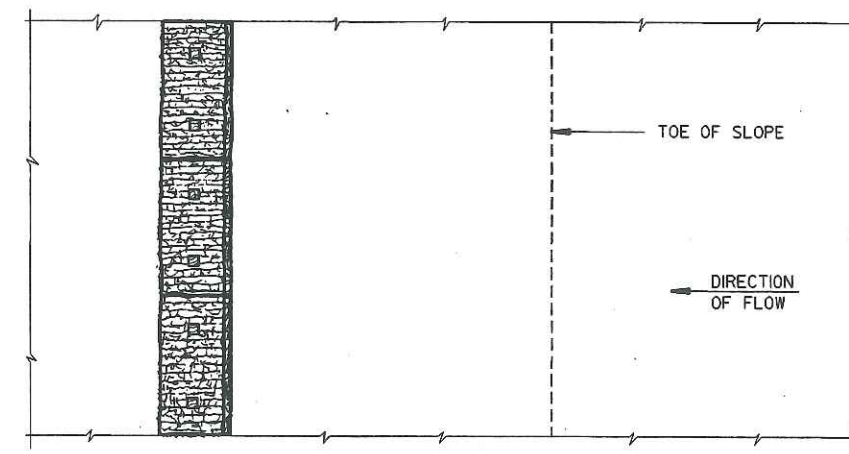

PLAN VIEW

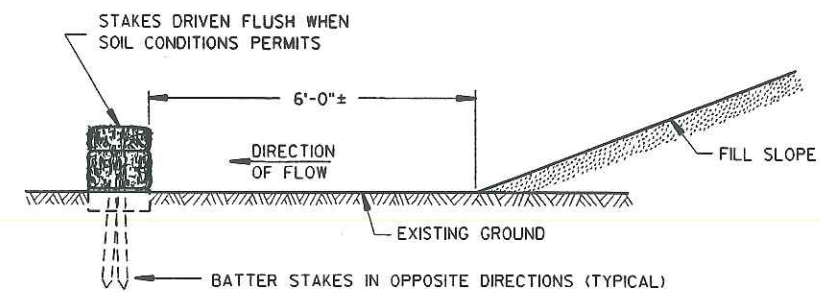

FRONT ELEVATION

WHEN EXISTING GROUND SLOPES AWAY FROM FILL SLOPE

EROSION BALES FOR SHEET FLOW

## TYPICAL INSTALLATIONS OF EROSION BALES / TEMPORARY DITCH CHECKS


STATE OF WISCONSIN  
DEPARTMENT OF TRANSPORTATION

APPROVED  
6/4/02  
DATE


CHIEF ROADWAY DEVELOPMENT ENGINEER

FHWA



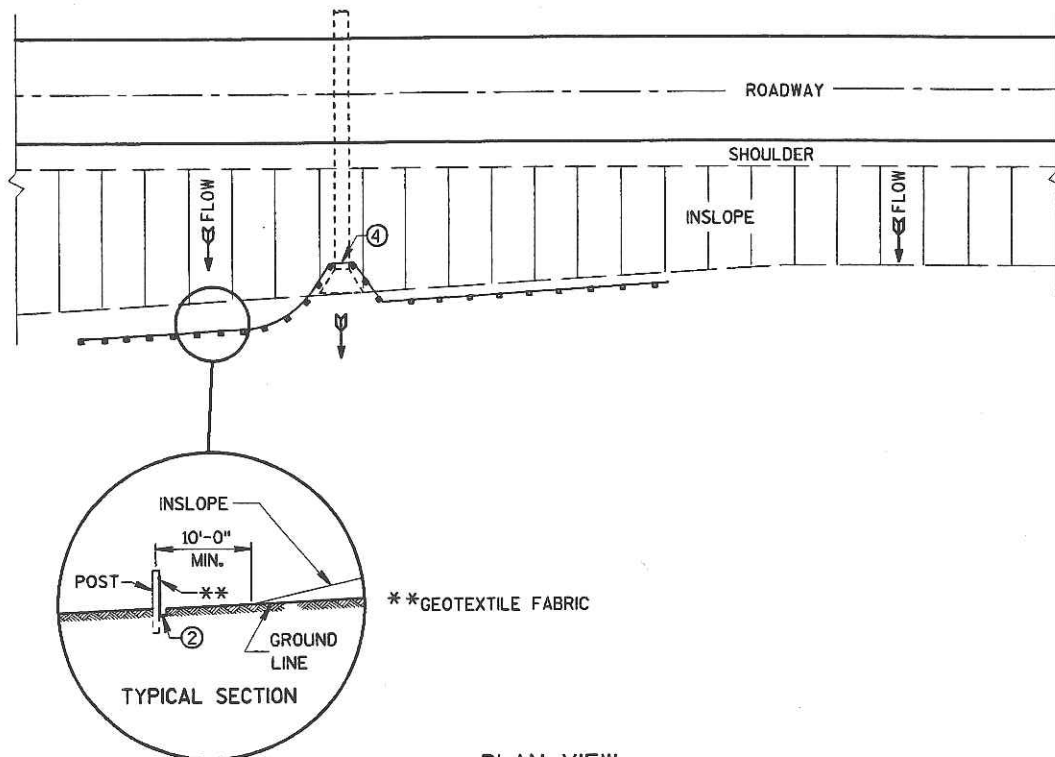

PLAN VIEW  
TYPICAL APPLICATION OF SILT FENCE

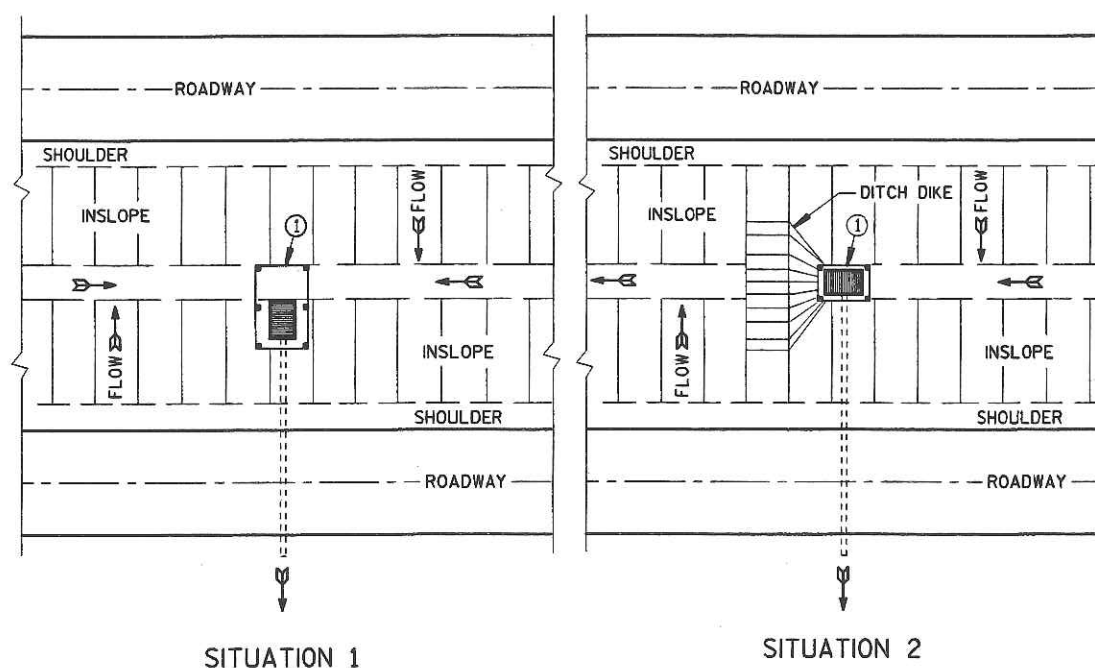


SITUATION 1  
SITUATION 2  
PLAN VIEW  
SILT FENCE AT MEDIAN SURFACE DRAINS

## GENERAL NOTES


DETAILS OF CONSTRUCTION NOT SHOWN ON THIS DRAWING SHALL CONFORM TO THE PERTINENT REQUIREMENTS OF THE STANDARD SPECIFICATIONS AND APPLICABLE SPECIAL PROVISIONS.

- ① HORIZONTAL BRACE REQUIRED WITH 2" X 4" WOODEN FRAME OR EQUIVALENT AT TOP OF POSTS.
- ② TRENCH SHALL BE A MINIMUM OF 4" WIDE & 6" DEEP TO BURY AND ANCHOR THE GEOTEXTILE FABRIC. FOLD MATERIAL TO FIT TRENCH AND BACKFILL & COMPACT TRENCH WITH EXCAVATED SOIL.
- ③ WOOD POSTS SHALL BE A MINIMUM SIZE OF 1 1/8" X 1 1/8" OF OAK OR HICKORY.
- ④ SILT FENCE TO EXTEND ACROSS THE TOP OF THE PIPE.

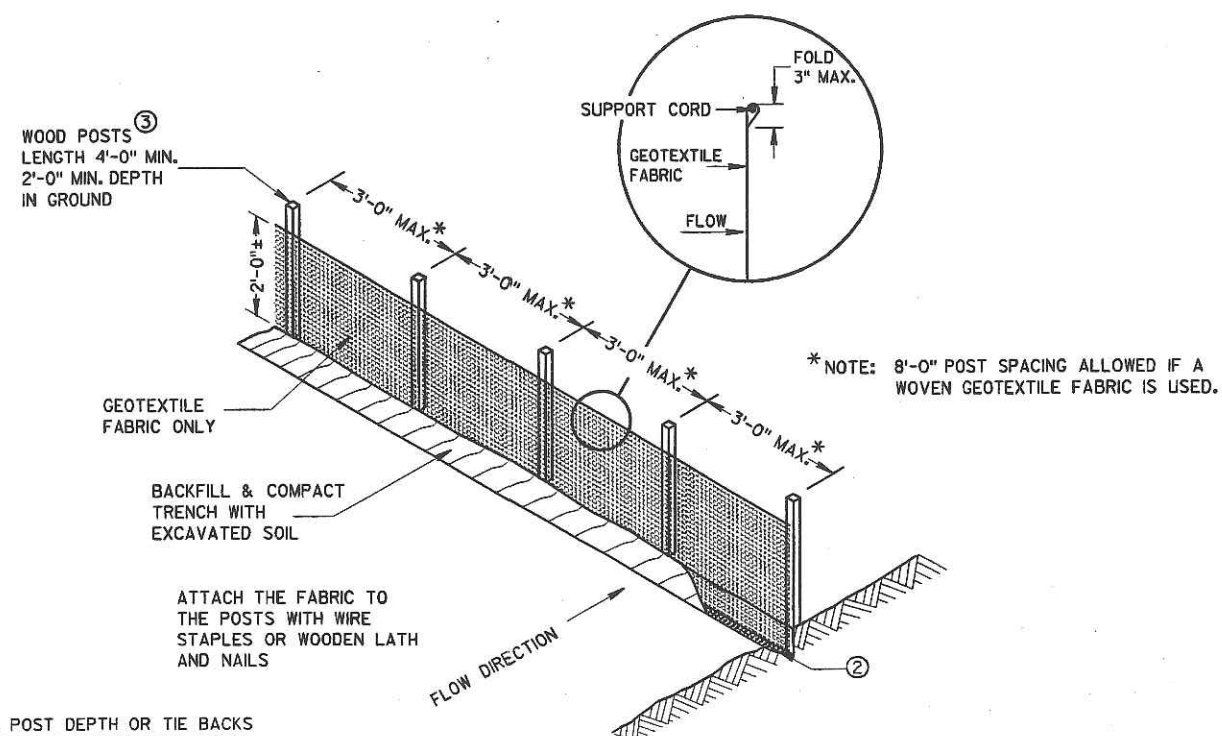


NOTE: ADDITIONAL POST DEPTH OR TIE BACKS MAY BE REQUIRED IN UNSTABLE SOILS

SILT FENCE

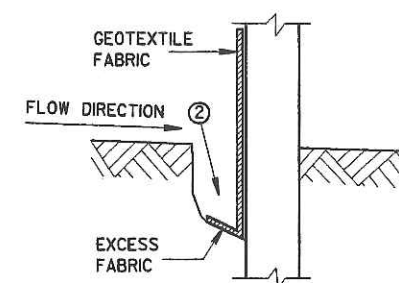

TRENCH DETAIL

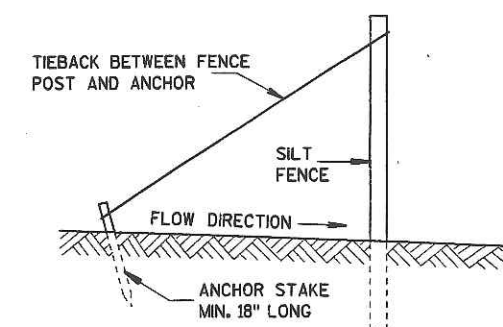

SILT FENCE TIE BACK  
(WHEN REQUIRED BY THE ENGINEER)

## SILT FENCE

STATE OF WISCONSIN  
DEPARTMENT OF TRANSPORTATION

APPROVED *[Signature]*  
DATE 03/06/00  
DATE CHIEF ROADWAY DEVELOPMENT ENGINEER  
FHWA



# GENERAL NOTES

DETAILS OF CONSTRUCTION, MATERIALS AND WORKMANSHIP NOT SHOWN ON THIS DRAWING SHALL CONFORM TO THE PERTINENT REQUIREMENTS OF THE STANDARD SPECIFICATIONS, AND THE APPLICABLE SPECIAL PROVISIONS.


- W6 X 9 OR W6 X 8.5 STEEL POSTS AND NOTCHED PLASTIC BLOCKOUTS ARE ACCEPTABLE ALTERNATIVES FOR 6" X 8" WOOD POSTS WITH WOOD OR PLASTIC BLOCKOUTS. USE APPROVED NOTCHED PLASTIC BLOCKOUTS WITH STEEL POSTS. DO NOT MIX STEEL POSTS AND WOOD POSTS IN A SINGLE INSTALLATION.
- USE STRUCTURAL STEEL POSTS CONFORMING TO AASHTO M183. GALVANIZE ACCORDING TO AASHTO M 111. EITHER SET THE POSTS IN DRILLED HOLES OR DRIVE TO GRADE. REMOVE MUSHROOMING CAUSED BY DRIVING AND REPAIR DAMAGED SPECTER COATING ON GALVANIZED POSTS.
- INSTALL STEEL POSTS WITH HOLES ON APPROACHING TRAFFIC SIDE.
- USE EITHER WOOD OR APPROVED PLASTIC BLOCKOUTS ON WOOD POSTS.
- WHEN SPECIFIED IN THE PLANS, THE 2-FOOT MINIMUM TO HINGE POINT MAY BE REDUCED OR ELIMINATED IF EXISTING CONDITIONS DO NOT PERMIT THE DESIRABLE EARTHWORK.

INCREASE POST LENGTH TO PROVIDE A MINIMUM EMBEDMENT OF 3'-6" IF THE SHOULDER HINGE POINT IS LOCATED IN FRONT OF THE POST.


- IF ROCK IS ENCOUNTERED DURING EXCAVATION, THE ENGINEER MAY APPROVE USING A 12 INCH DIAMETER POST HOLE EXTENDING 20 INCHES DEEP INTO THE ROCK. PLACE GRANULAR MATERIAL IN THE BOTTOM OF THE HOLE APPROXIMATELY 2 1/2 INCHES DEEP. CUT THE POSTS TO LENGTH AND PLACE IN THE HOLE. BACKFILL WITH MATERIAL EXCAVATED FROM THE HOLE AND COMPACT ADEQUATELY.

INSTALL BEAM GUARD SECTIONS AND ALL NECESSARY HARDWARE ACCORDING TO THE APPLICABLE PLAN AND CURRENT STANDARD AND SUPPLEMENTAL SPECIFICATIONS.


ALL DIMENSIONS ARE SUBJECT TO MANUFACTURER'S TOLERANCES EXCEPT WHERE ALLOWABLE TOLERANCES ARE SHOWN.

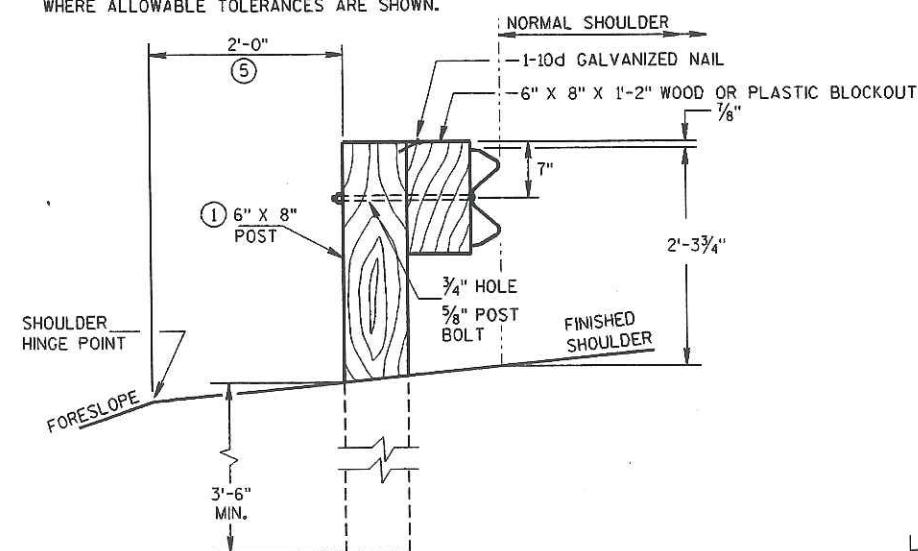


END VIEW  
LOCATED ALONG A ROADWAY SHOULDER

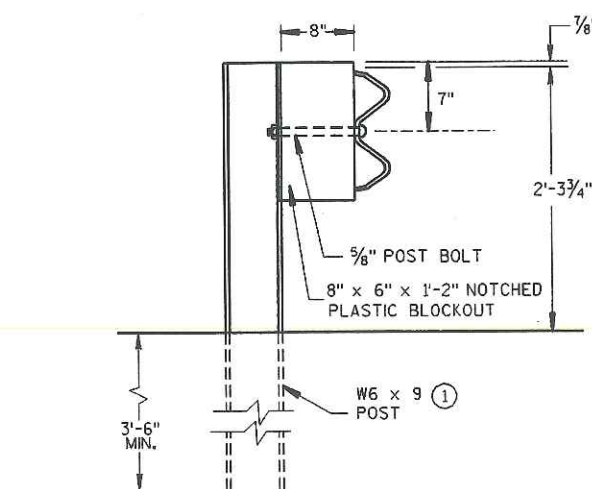


END VIEW  
STEEL POST & NOTCHED  
PLASTIC BLOCKOUT ALTERNATIVE

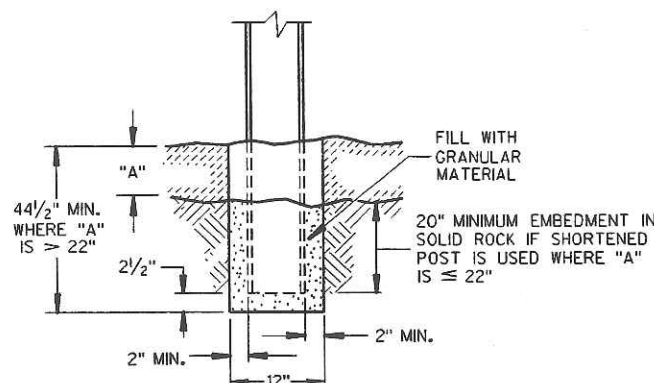


END VIEW  
SETTING STEEL OR WOOD POST IN ROCK

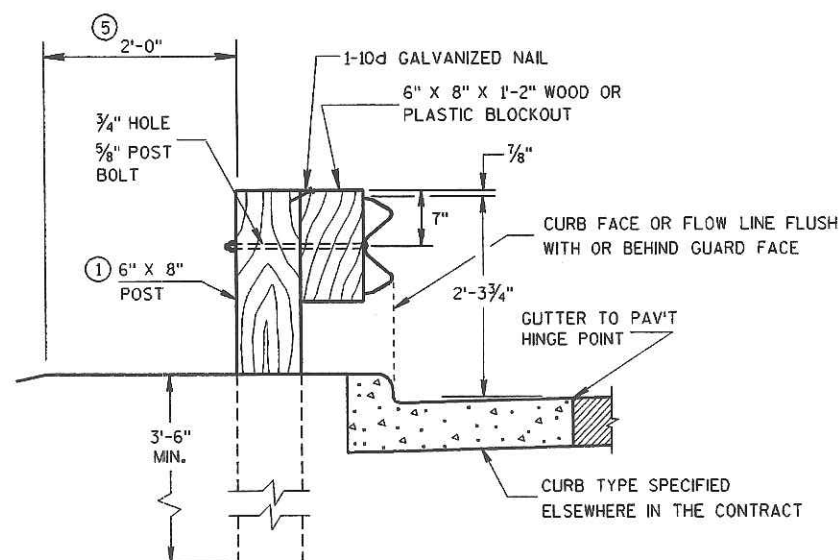


END VIEW  
LOCATED ALONG A CURBED ROADWAY

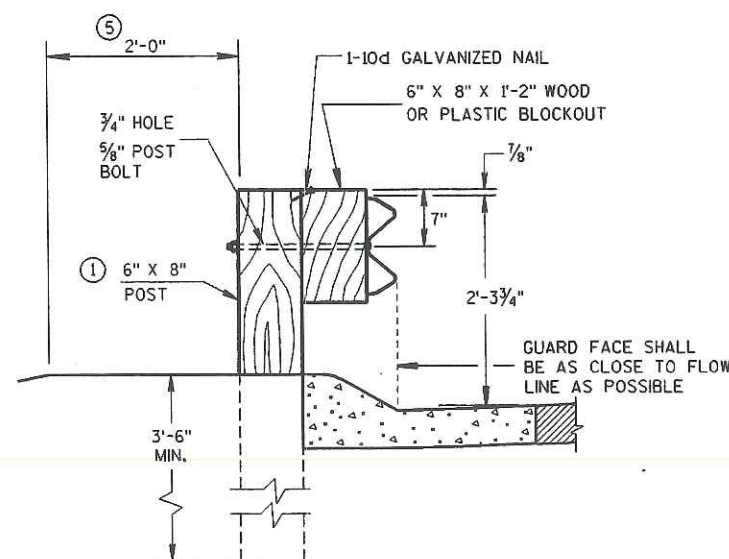


END VIEW  
LOCATED ALONG A  
MOUNTABLE CURBED ROADWAY

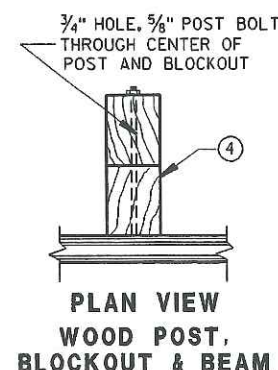

PLAN VIEW  
WOOD POST,  
BLOCKOUT & BEAM

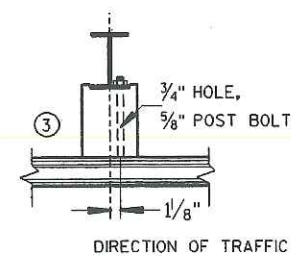


PLAN VIEW  
STEEL POST, NOTCHED  
PLASTIC BLOCKOUT & BEAM

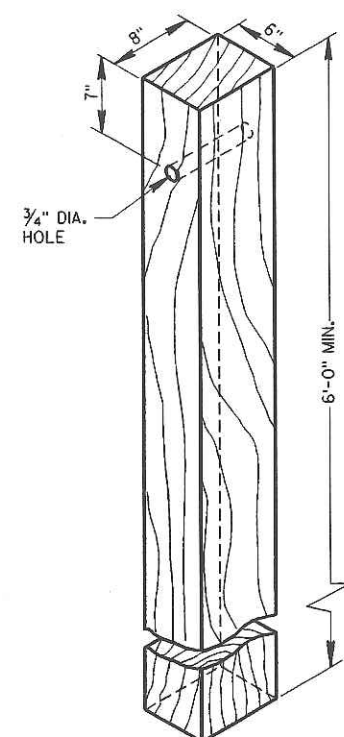


WOOD POST  
(6" X 8") NOMINAL

OPTIONAL 1 3/16" DIA.  
HOLE FOR HANDLING  
DURING GALVANIZING.  
(ONE PERMITTED)

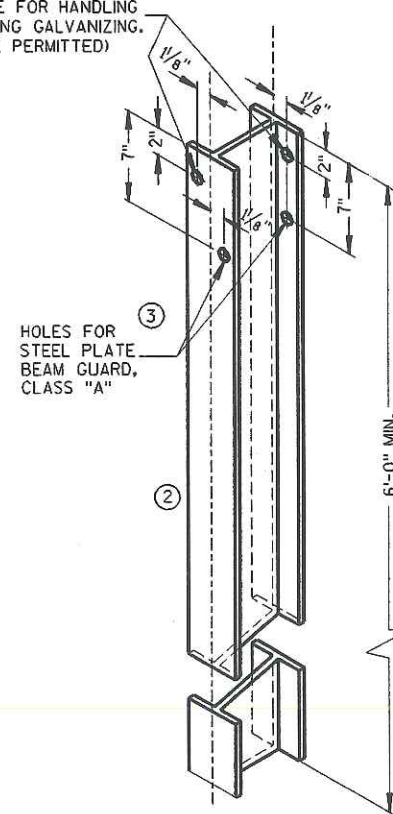


STEEL POST &  
HOLE PUNCHING DETAIL  
(W6 X 9)

ALL HOLES 1 3/16" DIAMETER EXCEPT AS NOTED

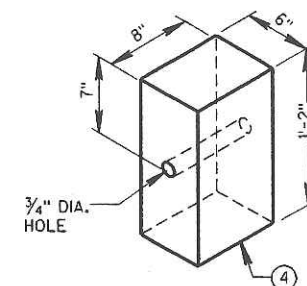

WOOD OR PLASTIC  
BLOCKOUT FOR WOOD POSTS




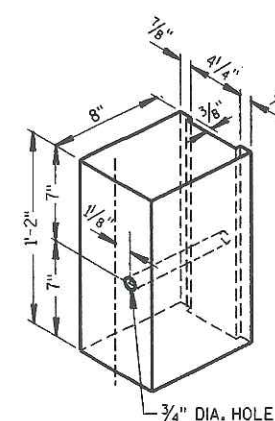


NOTCHED PLASTIC BLOCKOUT  
FOR STEEL POSTS

STEEL PLATE BEAM GUARD,  
CLASS "A"  
INSTALLATION & ELEMENTS

STATE OF WISCONSIN  
DEPARTMENT OF TRANSPORTATION







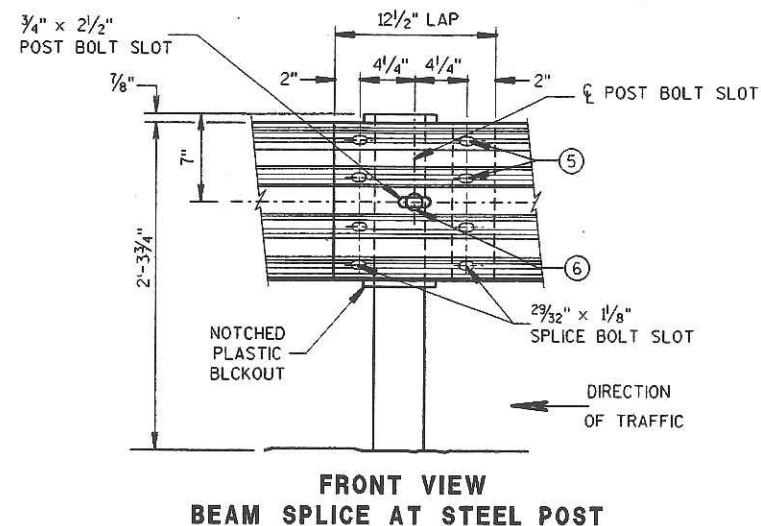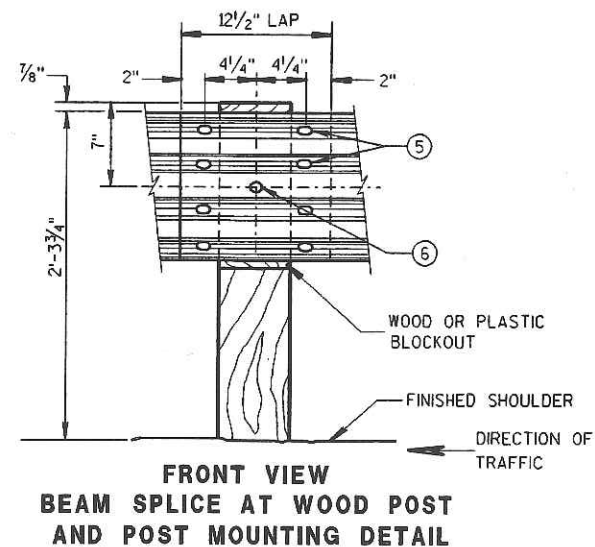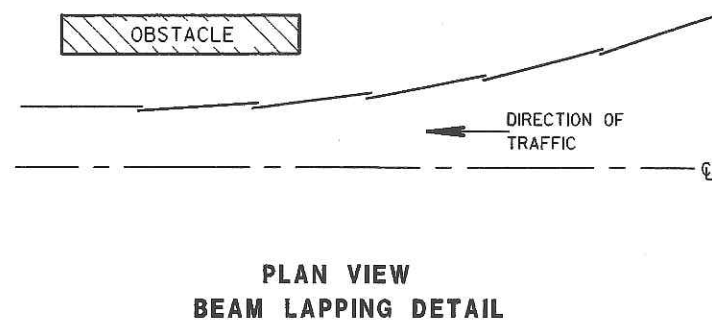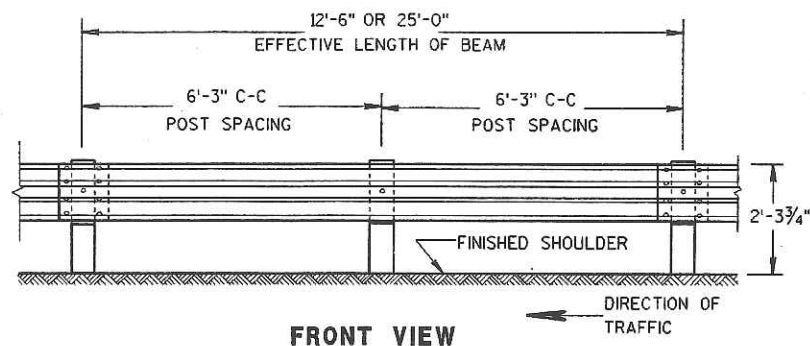

### TYPICAL SPLICING DETAILS OF STEEL PLATE BEAM GUARD


**REFLECTOR SPACING** ②

	BEAM GUARD LENGTH	REFLECTOR SPACING	NO. SURFACES REFLECTORIZED	MIN. NO. REFLECTORS
ONE WAY TRAFFIC	< 200'	50' C-C	1	3
	> 200'	100' C-C	1	
TWO WAY TRAFFIC	< 200'	25' C-C	1 ③	6
	> 200'	50' C-C	1	
TWO WAY TRAFFIC	< 200'	50' C-C	2 ④	3
	> 200'	100' C-C	2	

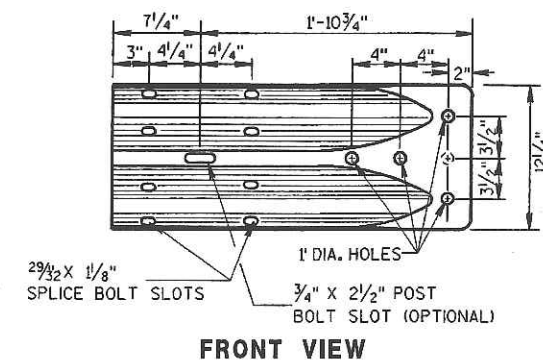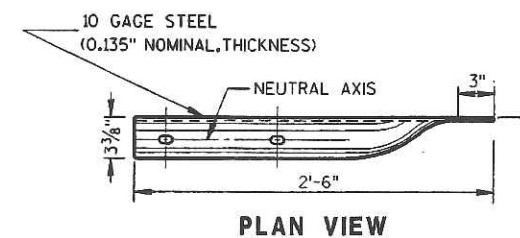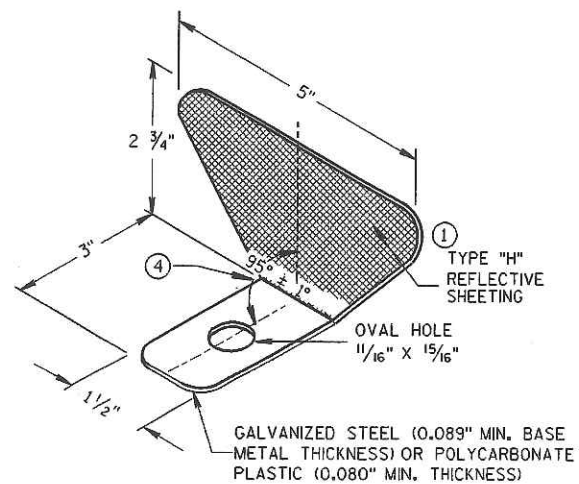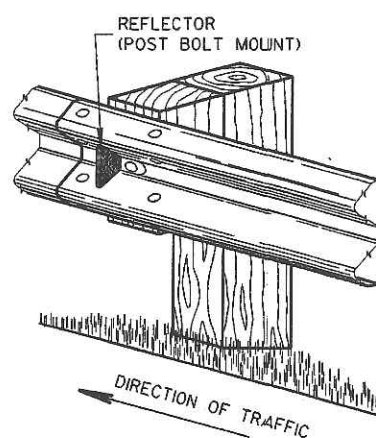

### W BEAM TERMINAL CONNECTOR

(USE ONLY ON THE TRAFFIC EXIT END OF ONE WAY BRIDGES)

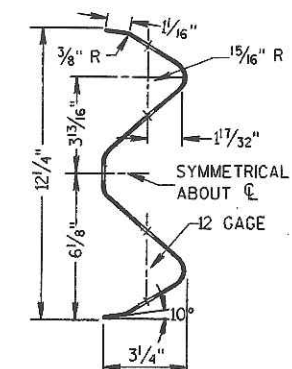


### SECTION THRU W BEAM

### STEEL PLATE BEAM GUARD, CLASS 'A', INSTALLATION & ELEMENTS


STATE OF WISCONSIN  
DEPARTMENT OF TRANSPORTATION

APPROVED  
12/08/00  
DATE  
John Haverburg  
CHIEF ROADWAY DEVELOPMENT ENGINEER  
FHWA




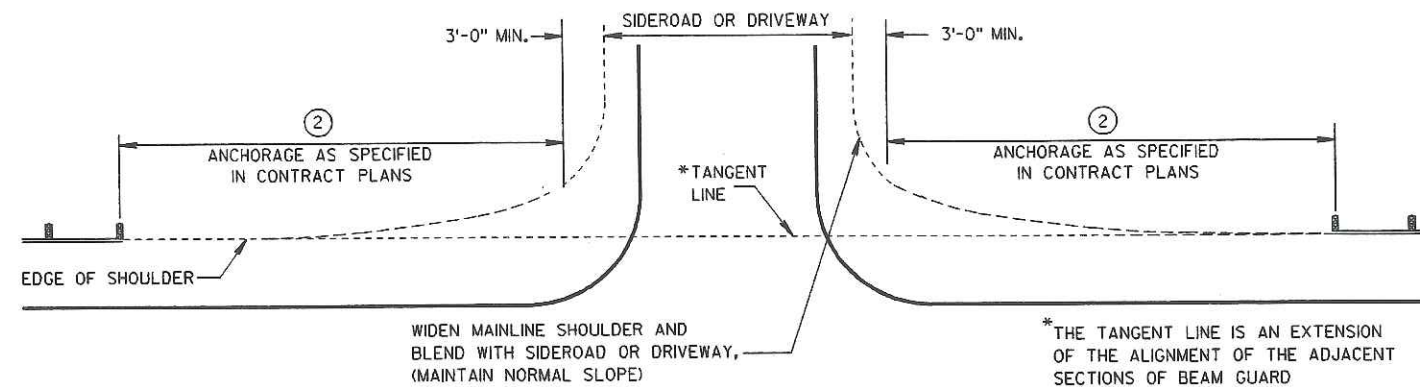


**BEAM GUARD AT SIDEROADS OR DRIVEWAYS**

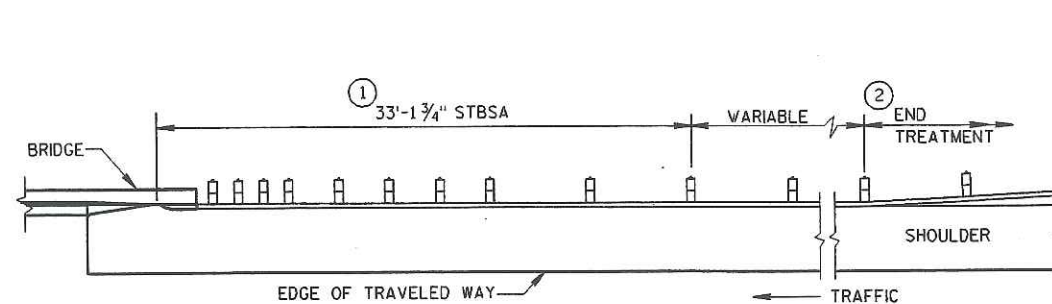

**BEAM GUARD AT FULL WIDTH BRIDGES**

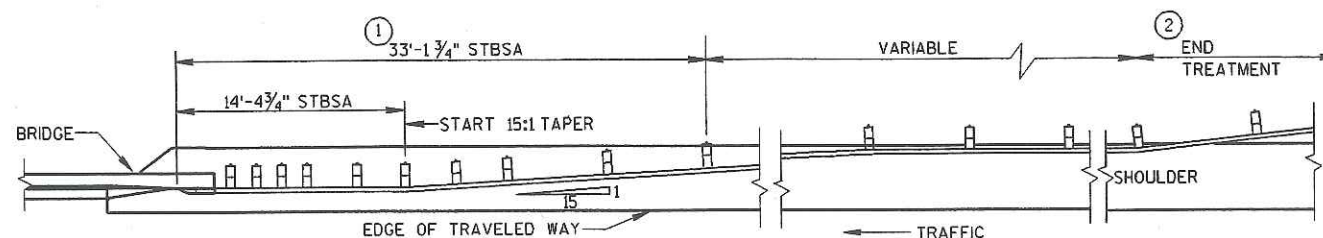

**BEAM GUARD AT NARROW BRIDGES**  
(FLARED TO SHOULDER EDGE, THEN PARALLEL TO ROADWAY)

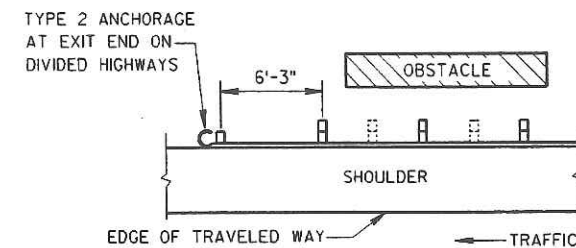

**BEAM GUARD AT OBSTACLES**  
**EXIT END - ONE WAY TRAFFIC**

**GENERAL NOTES**

DETAILS OF CONSTRUCTION, MATERIALS AND WORKMANSHIP NOT SHOWN ON THIS DRAWING SHALL CONFORM TO THE PERTINENT REQUIREMENTS OF THE STANDARD SPECIFICATIONS AND THE APPLICABLE SPECIAL PROVISIONS.


W6 X 9 OR W6 X 8.5 STEEL POSTS WITH NOTCHED PLASTIC BLOCKOUTS ARE ACCEPTABLE ALTERNATIVES FOR 6" X 8" WOOD POSTS WITH WOOD OR PLASTIC BLOCKOUTS. USE APPROVED NOTCHED PLASTIC BLOCKOUTS WITH STEEL POSTS.

THE LOCATIONS AND LENGTHS OF BEAM GUARD ARE SHOWN ELSEWHERE IN THE PLAN.

- ① USE STEEL THRIE BEAM STRUCTURAL APPROACH (STBSA).
- ② USE AN APPROVED END TREATMENT FOR THE TRAFFIC APPROACH SIDE OF BRIDGE/OBSTACLES. USE TYPE 2 ANCHORAGE ONLY AT THE DOWNSTREAM ENDS OF BEAM GUARD LOCATED ALONG ROADWAYS WITH ONE WAY TRAFFIC.

**③ DESIGN DEFLECTION OF W-BEAM BARRIER SYSTEM**

LATERAL DISTANCE TO FIXED OBJECT	POST SPACING
3'-6" TO 4'-6"	3' - 1 1/2"
4'-6" AND OVER	6' - 3"

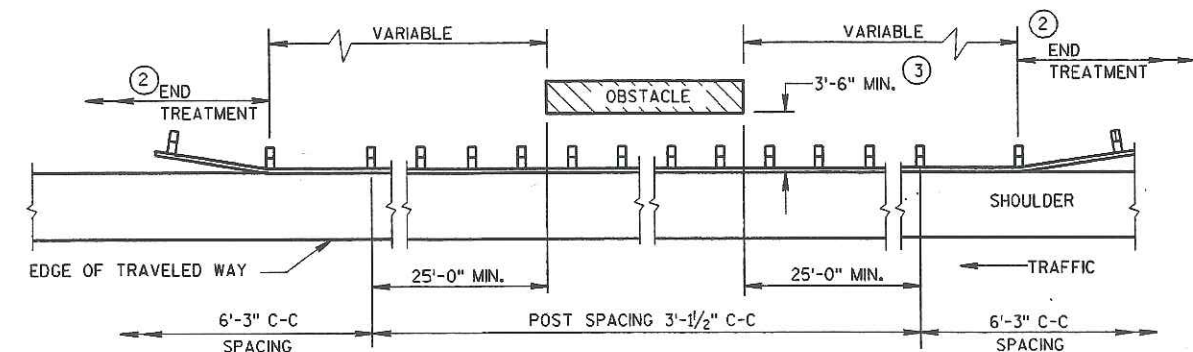

**BEAM GUARD AT OSBSTACLES - TWO WAY TRAFFIC**  
(RAIL TO OBSTACLE CLEARANCE 3'-6" TO 4'-6")

**STEEL PLATE BEAM GUARD,**  
**CLASS "A"**  
(AT BRIDGES, OBSTACLES  
AND SIDEROADS/DRIVEWAYS)

STATE OF WISCONSIN  
DEPARTMENT OF TRANSPORTATION

APPROVED  
12/08/00  
DATE

*John Haverberg*  
CHIEF ROADWAY DEVELOPMENT ENGINEER

FHWA





# BILL OF MATERIALS


NOTE NO.	QTY.	DESCRIPTION
①	4	WOOD BREAKAWAY TERMINAL POST: 5 1/2" X 7 1/2" X 3'-9"
②	4	STEEL TUBE: TS 8" X 6" X 0.188", 4'-6" LONG
③	4	SOIL PLATE: 2'-0" X 1'-6" X 1/4"
④	4	WOOD BREAKAWAY CRT POST: 6" X 8" X 6'-0"
⑤	6	WOOD OFFSET BLOCKS: 6' X 8" X 1'-2"
⑥	1	PIPE SLEEVE: 2" X 5 1/2" STANDARD PIPE
⑦	1	BEARING PLATE
⑧	1	BCT CABLE ASSEMBLY
⑨	1	CABLE ANCHOR BOX
⑩	1	STRUT & YOKE
⑪	1	STEEL PLATE BEAM, END PANEL 12 GA. 13'-6 1/2" LONG FOR SKT-350, ET-2000 AND ET-2000 PLUS
⑫	3	STEEL PLATE BEAM: 12 GA. 13'-6 1/2"
⑬	1	ET-2000/ET-2000 PLUS GUARDRAIL EXTRUDER OR SKT-350 IMPACT HEAD: AS FURNISHED BY MANUFACTURER
⑭	1	REFLECTIVE SHEETING: 18" X 18"

## GENERAL NOTES


- (A) USE 3:1 OR FLATTER SLOPE FOR INSTALLATION ON EXISTING HIGHWAYS.
  - (B) DO NOT ATTACH GUARDRAIL TO POST BLOCKS AT POSTS NO. 3, 5 & 7.
  - (C) AFTER FINAL ASSEMBLY, RECHECK CABLE TO BE SURE IT IS TAUT AND HAS NOT RELAXED.
- STEEL POSTS SHALL NOT BE ALLOWED FOR USE WITH ENERGY ABSORBING TERMINALS.
- DO NOT INSTALL REFLECTORS ON THE FIRST 50 FEET OF THE APPROACH END OF THE ENERGY ABSORBING TERMINAL.
- \* DO NOT ATTACH BLOCKOUTS TO POSTS 1 AND 2.

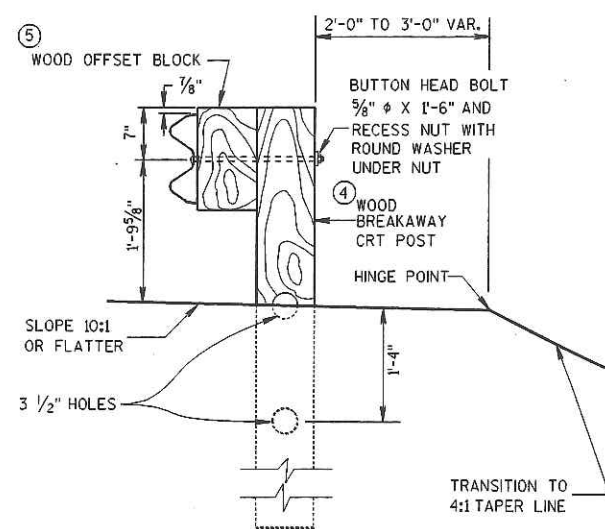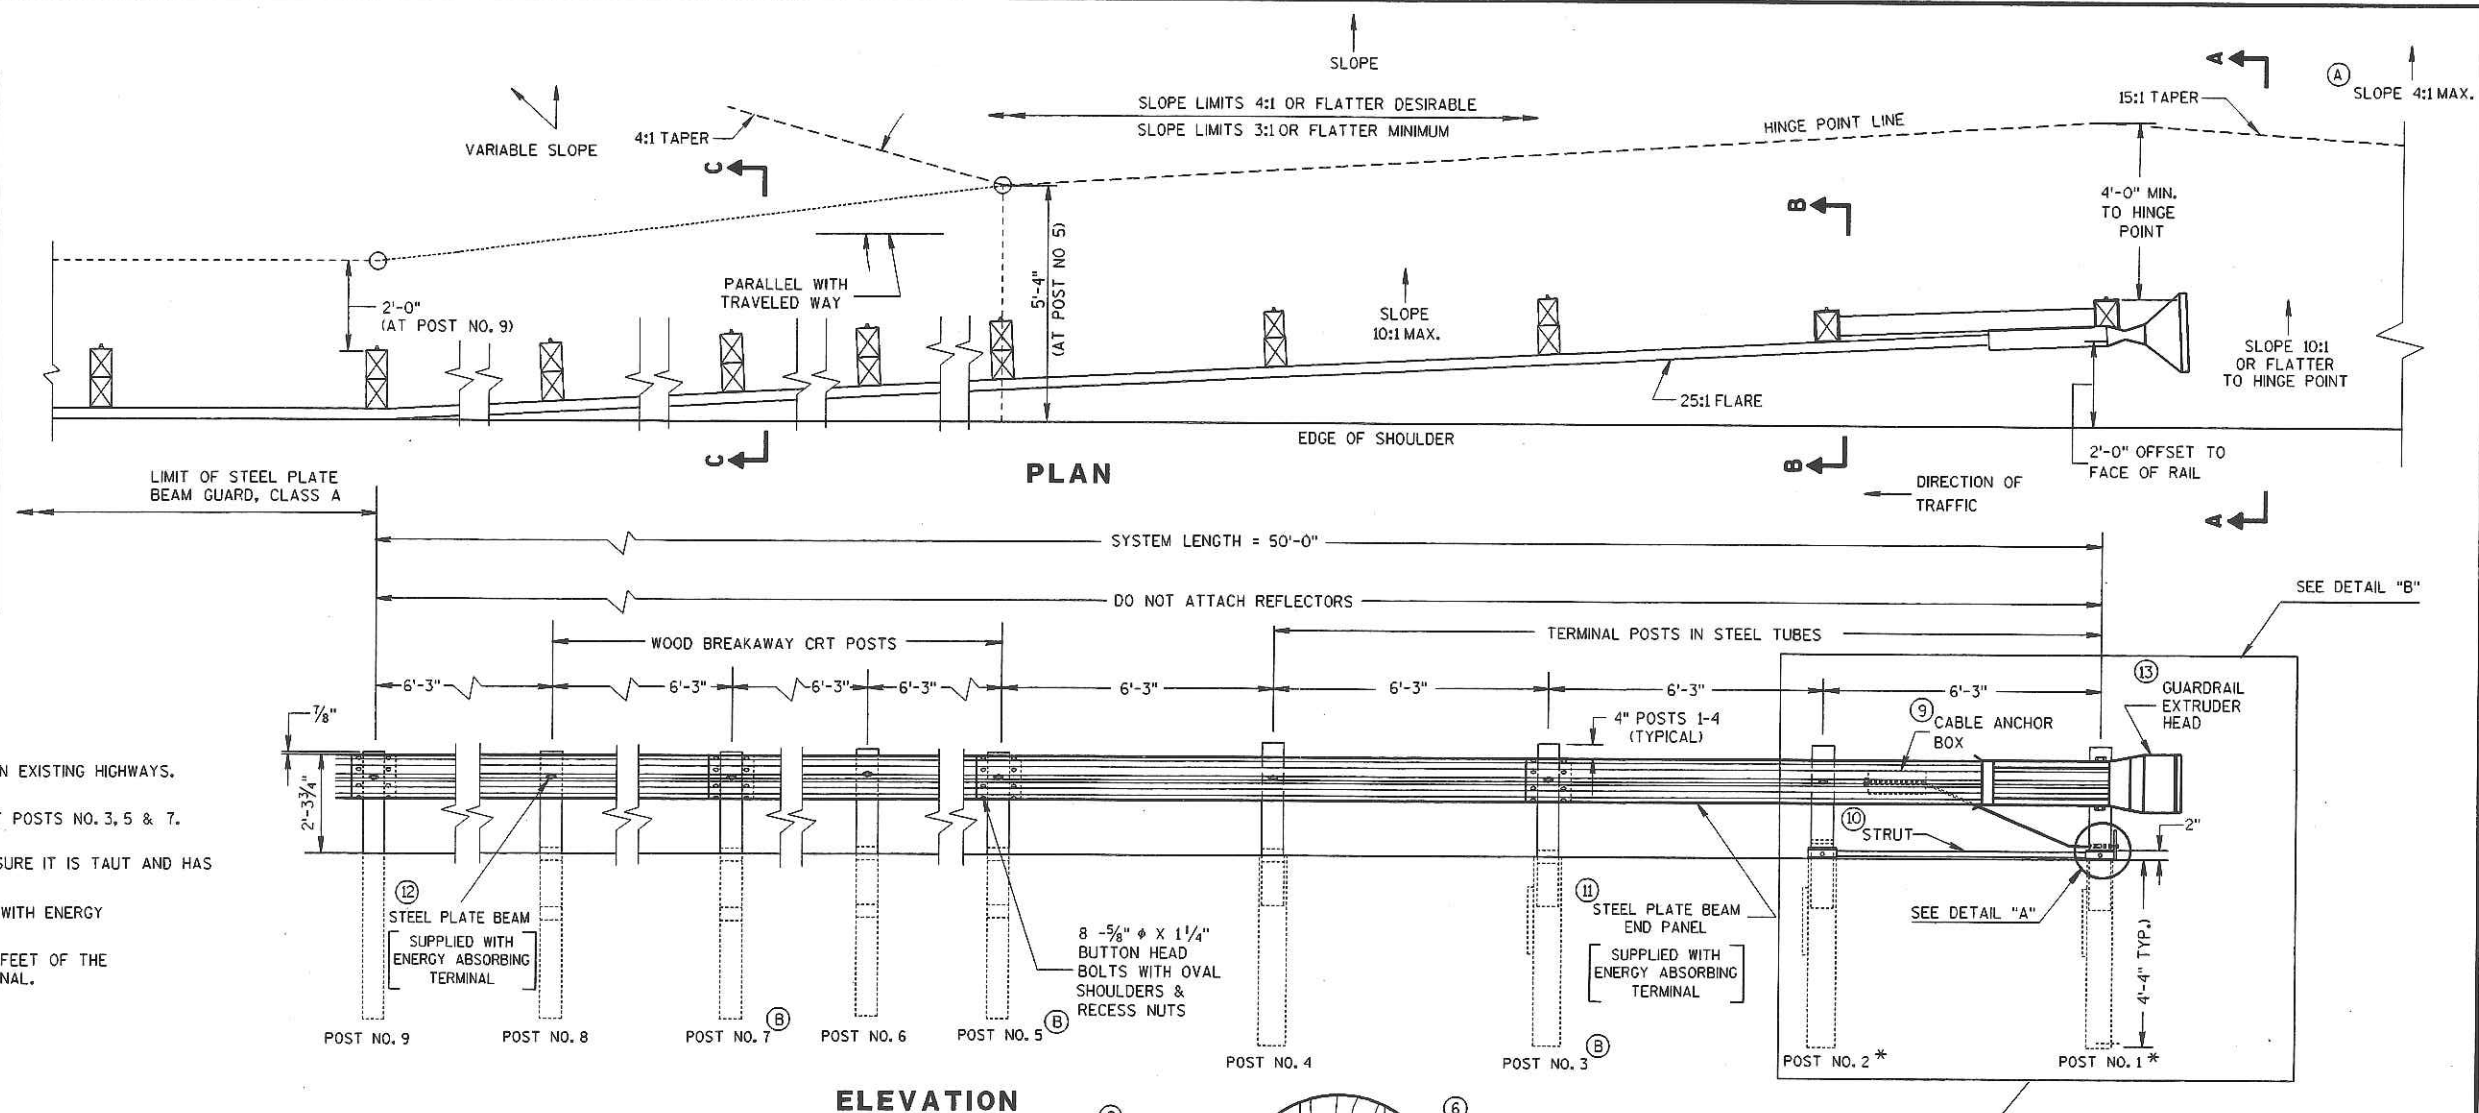


SECTION C-C  
TYPICAL AT POST NOS. 4, 6, 8

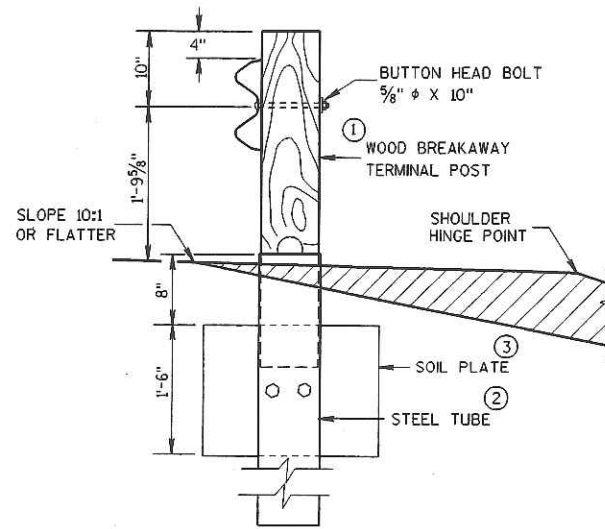


SECTION B-B  
TYPICAL AT POST NO. 2\*

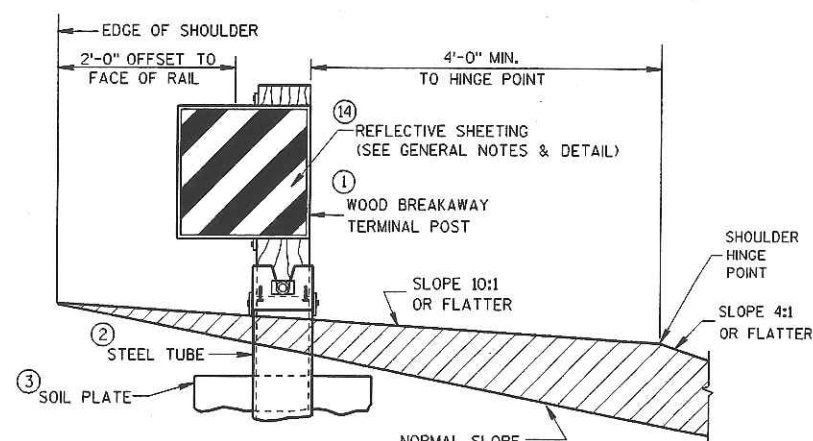

SECTION A-A  
TYPICAL AT POST NO. 1\*

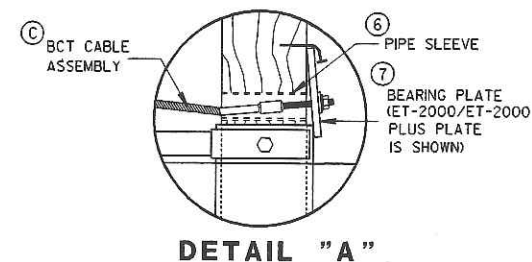

DETAIL "A"

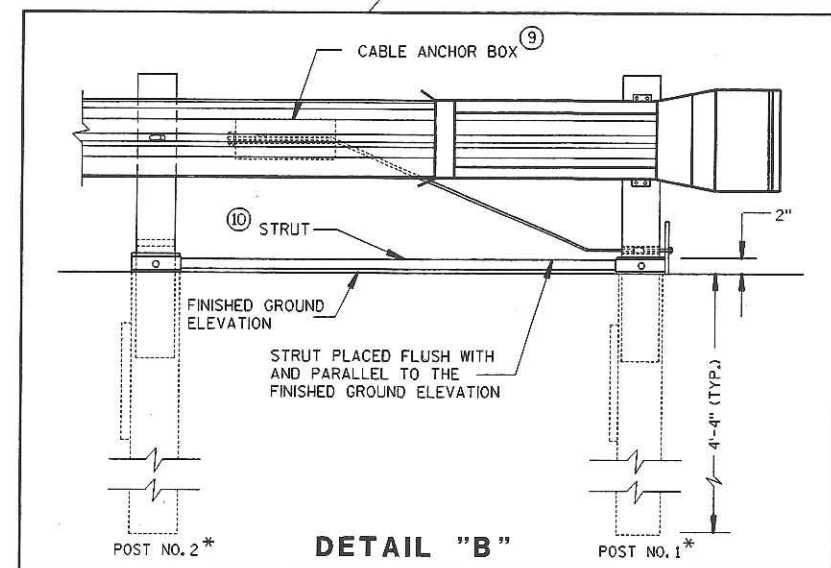


DETAIL "B"


STEEL PLATE BEAM GUARD  
ENERGY ABSORBING TERMINAL

STATE OF WISCONSIN  
DEPARTMENT OF TRANSPORTATION




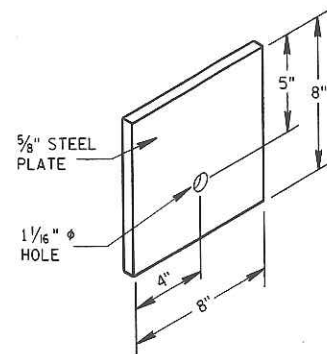

**STEEL BEARING PLATE (SKT-350)**

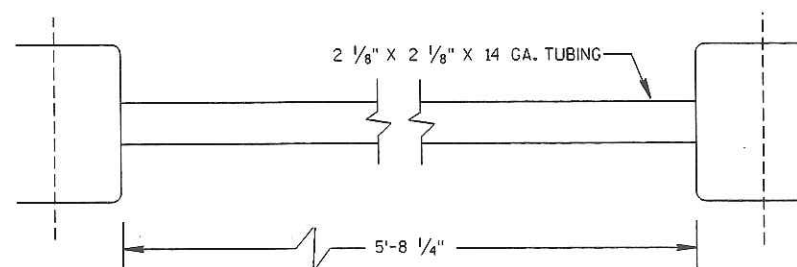


**STRUT DETAIL (SKT-350)**

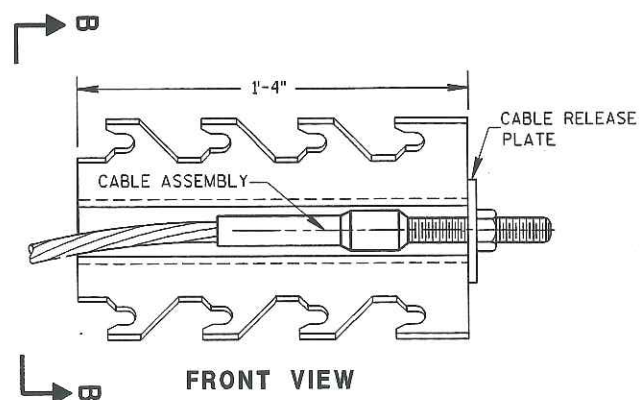


**CABLE ANCHOR BOX (SKT-350)**


**(SKT-350)**

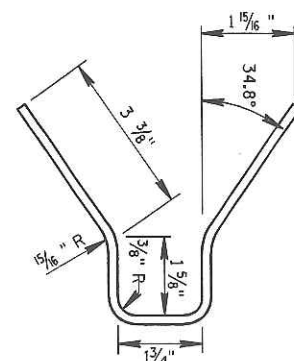


**SECTION B-B**

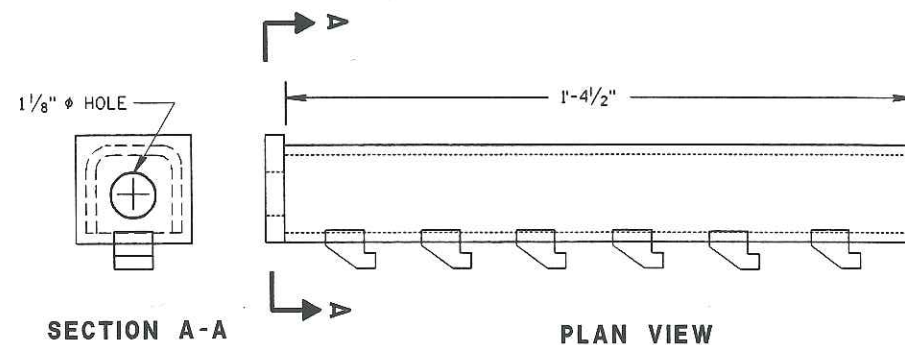


**CABLE ANCHOR BOX (ET-2000/ET-2000 PLUS)**

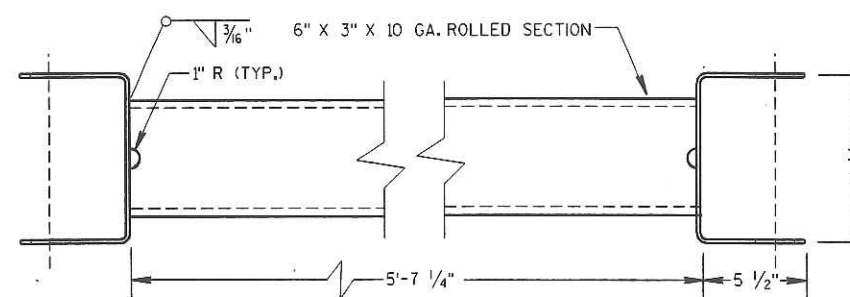

**STRUT DETAIL (ET-2000/ET-2000 PLUS)**

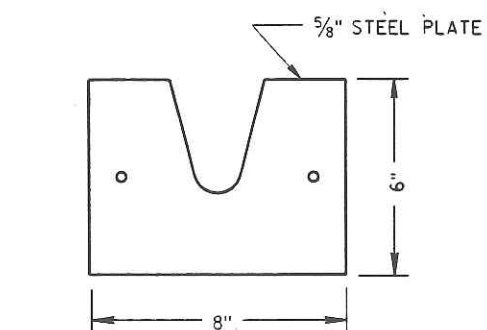


**STEEL BEARING PLATE  
(ET-2000/ET-2000 PLUS)**

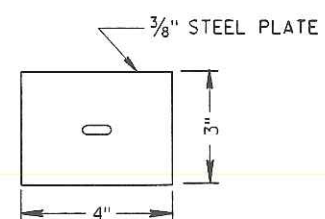

**BEARING PLATE WASHER  
(ET-2000/ET-2000 PLUS)**

**(ET-2000/ET-2000 PLUS)**

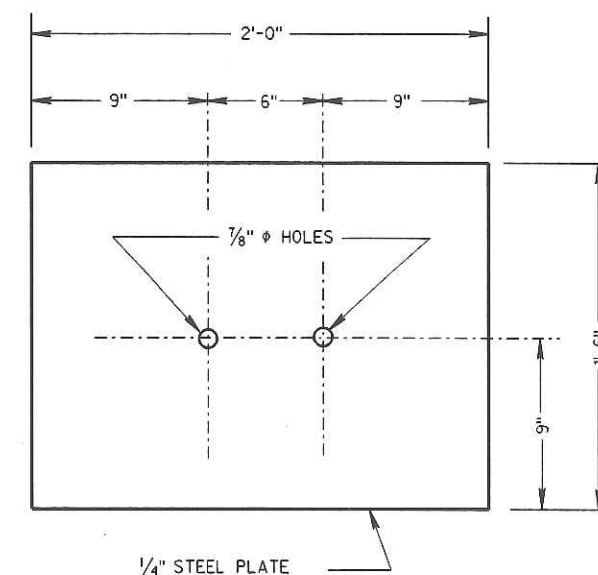


**SOIL PLATE  
(SKT-350, ET-2000/ET-2000 PLUS)**

**STEEL PLATE BEAM GUARD  
ENERGY ABSORBING TERMINAL**

**STATE OF WISCONSIN  
DEPARTMENT OF TRANSPORTATION**




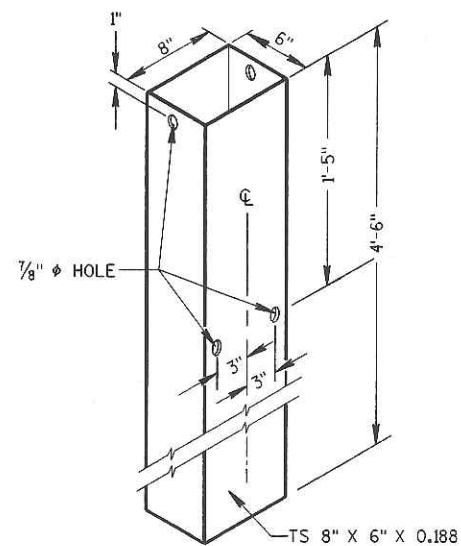

### STEEL TUBE


(POSTS NO. 1-4)

THE STEEL TUBE SHALL CONFORM TO REQUIREMENTS OF ASTM A500

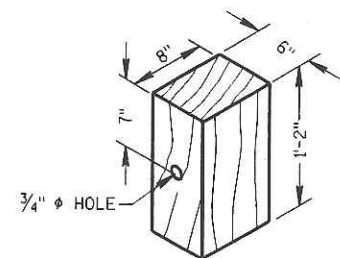


### WOOD OFFSET BLOCK

REQ'D. AT ALL POSTS EXCEPT POST NO'S 1 & 2

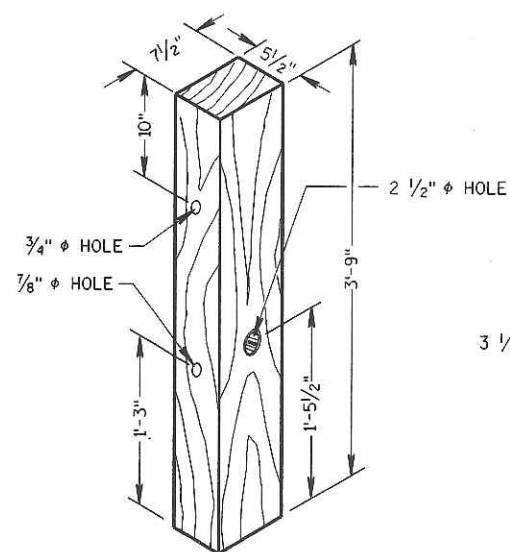

### TERMINAL POST


(POSTS NO. 1-4)

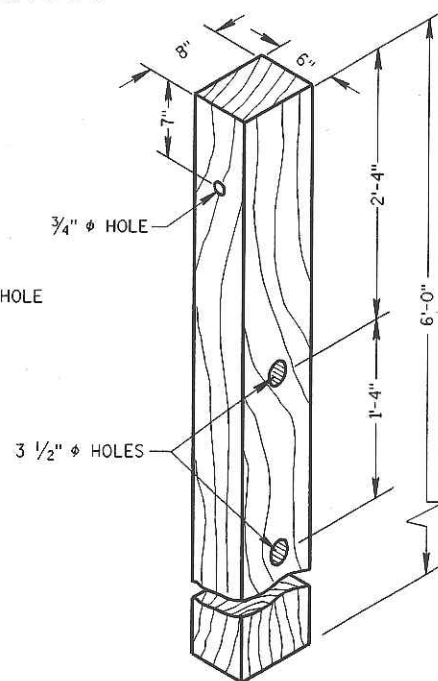

### CRT POST


(POSTS NO'S 5-8)

### WOOD BREAKAWAY POSTS

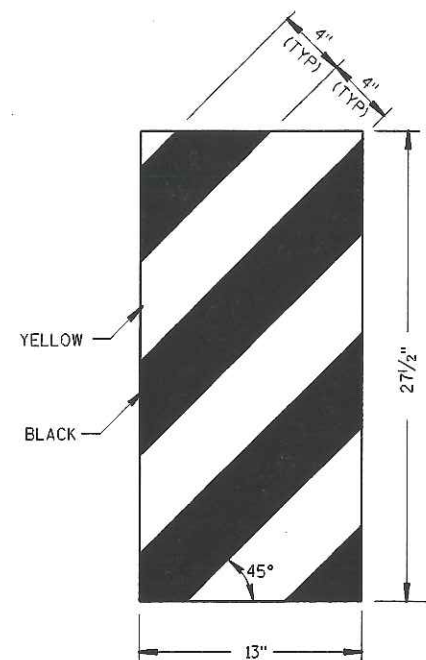

### ET-2000 PLUS ONLY

REFLECTIVE SHEETING DETAILS

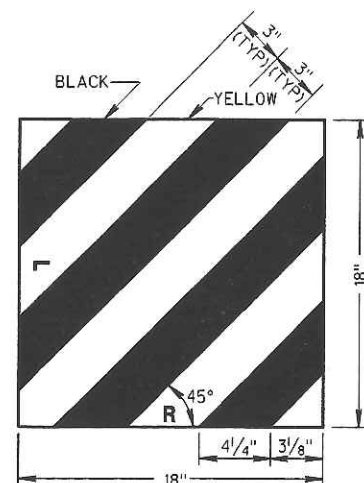

### ET-2000 AND SKT-350

REFLECTIVE SHEETING DETAILS

### GENERAL NOTES

DETAILS OF CONSTRUCTION, MATERIALS AND WORKMANSHIP NOT SHOWN ON THIS DRAWING SHALL CONFORM TO THE PERTINENT REQUIREMENTS OF THE STANDARD SPECIFICATIONS, APPLICABLE SPECIAL PROVISIONS AND MANUFACTURERS INSTRUCTIONS.

STEEL PLATE BEAM GUARD ENERGY ABSORBING TERMINAL SHALL BE EITHER THE EXTRUDER TERMINAL (ET-2000), OR THE SEQUENTIAL KINKING TERMINAL (SKT-350). THE CONTRACTOR SHALL NOT INTERMIX PROPRIETARY PRODUCT MATERIALS.

STEEL PLATE BEAM GUARD, ENERGY ABSORBING TERMINAL SHALL BE PAID FOR AT THE CONTRACT UNIT PRICE EACH, WHICH SHALL INCLUDE HARDWARE, STEEL PLATE BEAM GUARD, POSTS, REFLECTIVE SHEETING AND INSTALLATION AS SHOWN.

REFLECTIVE SHEETING - SHALL CONFORM TO ASTM SPECIFICATION D4956-94, REFLECTIVE SHEETING TYPE III, BACKING CLASS 4, PERFORMANCE REQUIREMENT TYPE III. THE MESSAGE AND LINES SHALL BE APPLIED TO THE SIGNS BY THE SILK SCREEN STENCIL PROCESS USING A BLACK OR DARK STENCIL PASTE AS A TYPE APPROVED BY THE MANUFACTURER OF THE FACE MATERIAL TO WHICH IT IS TO BE APPLIED. MESSAGE UNITS CUT FROM NONREFLECTIVE SHEETING AND APPLIED TO THE SIGN FACE ARE NOT ACCEPTABLE. AFTER THE APPROACH END OF THE STEEL PLATE BEAM GUARD INSTALLATION IS COMPLETE, CLEAN THE AREA WHERE THE REFLECTIVE SHEETING WILL BE APPLIED IN ACCORDANCE WITH THE MANUFACTURERS RECOMMENDATION. ONCE CLEAN, APPLY REFLECTIVE SHEETING DIRECTLY TO THE STEEL PLATE BEAM GUARD AS SHOWN. THE CONTRACTOR SHALL TURN OVER THE MANUFACTURERS WARRANTY FOR THE REFLECTIVE SHEETING TO THE DEPARTMENT FOR POTENTIAL DEALING WITH THE MANUFACTURER. PAYMENT OF REFLECTIVE SHEETING IS INCIDENTAL TO STEEL PLATE BEAM GUARD, ENERGY ABSORBING TERMINAL.

WHEN ROCK IS ENCOUNTERED DURING EXCAVATION, A 12 INCH DIA. POST HOLE EXTENDING 20 INCHES DEEP INTO THE ROCK MAY BE USED IF APPROVED BY THE ENGINEER. GRANULAR MATERIAL SHALL BE PLACED IN THE BOTTOM OF THE HOLE APPROXIMATELY 2 1/2 INCHES DEEP TO PROVIDE DRAINAGE. THE SOIL TUBES SHALL BE FIELD CUT TO LENGTH, PLACED IN THE HOLE AND BACKFILLED WITH ADEQUATELY COMPACTED MATERIAL EXCAVATED FROM THE HOLE.

STEEL PLATE BEAM GUARD  
ENERGY ABSORBING TERMINAL


STATE OF WISCONSIN  
DEPARTMENT OF TRANSPORTATION


APPROVED  
6/25/03  
DATE  
CHIEF ROADWAY DEVELOPMENT ENGINEER  
FHWA




TWO-LANE ROADWAY

**SYMBOLS**


 WORK AREA

 FLAGGER, EQUIPPED WITH STOP/SLOW PADDLE FASTENED ON SUPPORT STAFF

 SIGN ON PORTABLE OR PERMANENT SUPPORT



USE OF THE "BE PREPARED TO STOP" SIGN IS OPTIONAL. WHEN USED, THIS SIGN SHALL BE LOCATED BETWEEN THE W20-7a AND W20-4 SIGNS. A 500' TYPICAL SPACING SHALL BE PROVIDED BETWEEN THE SIGNS.

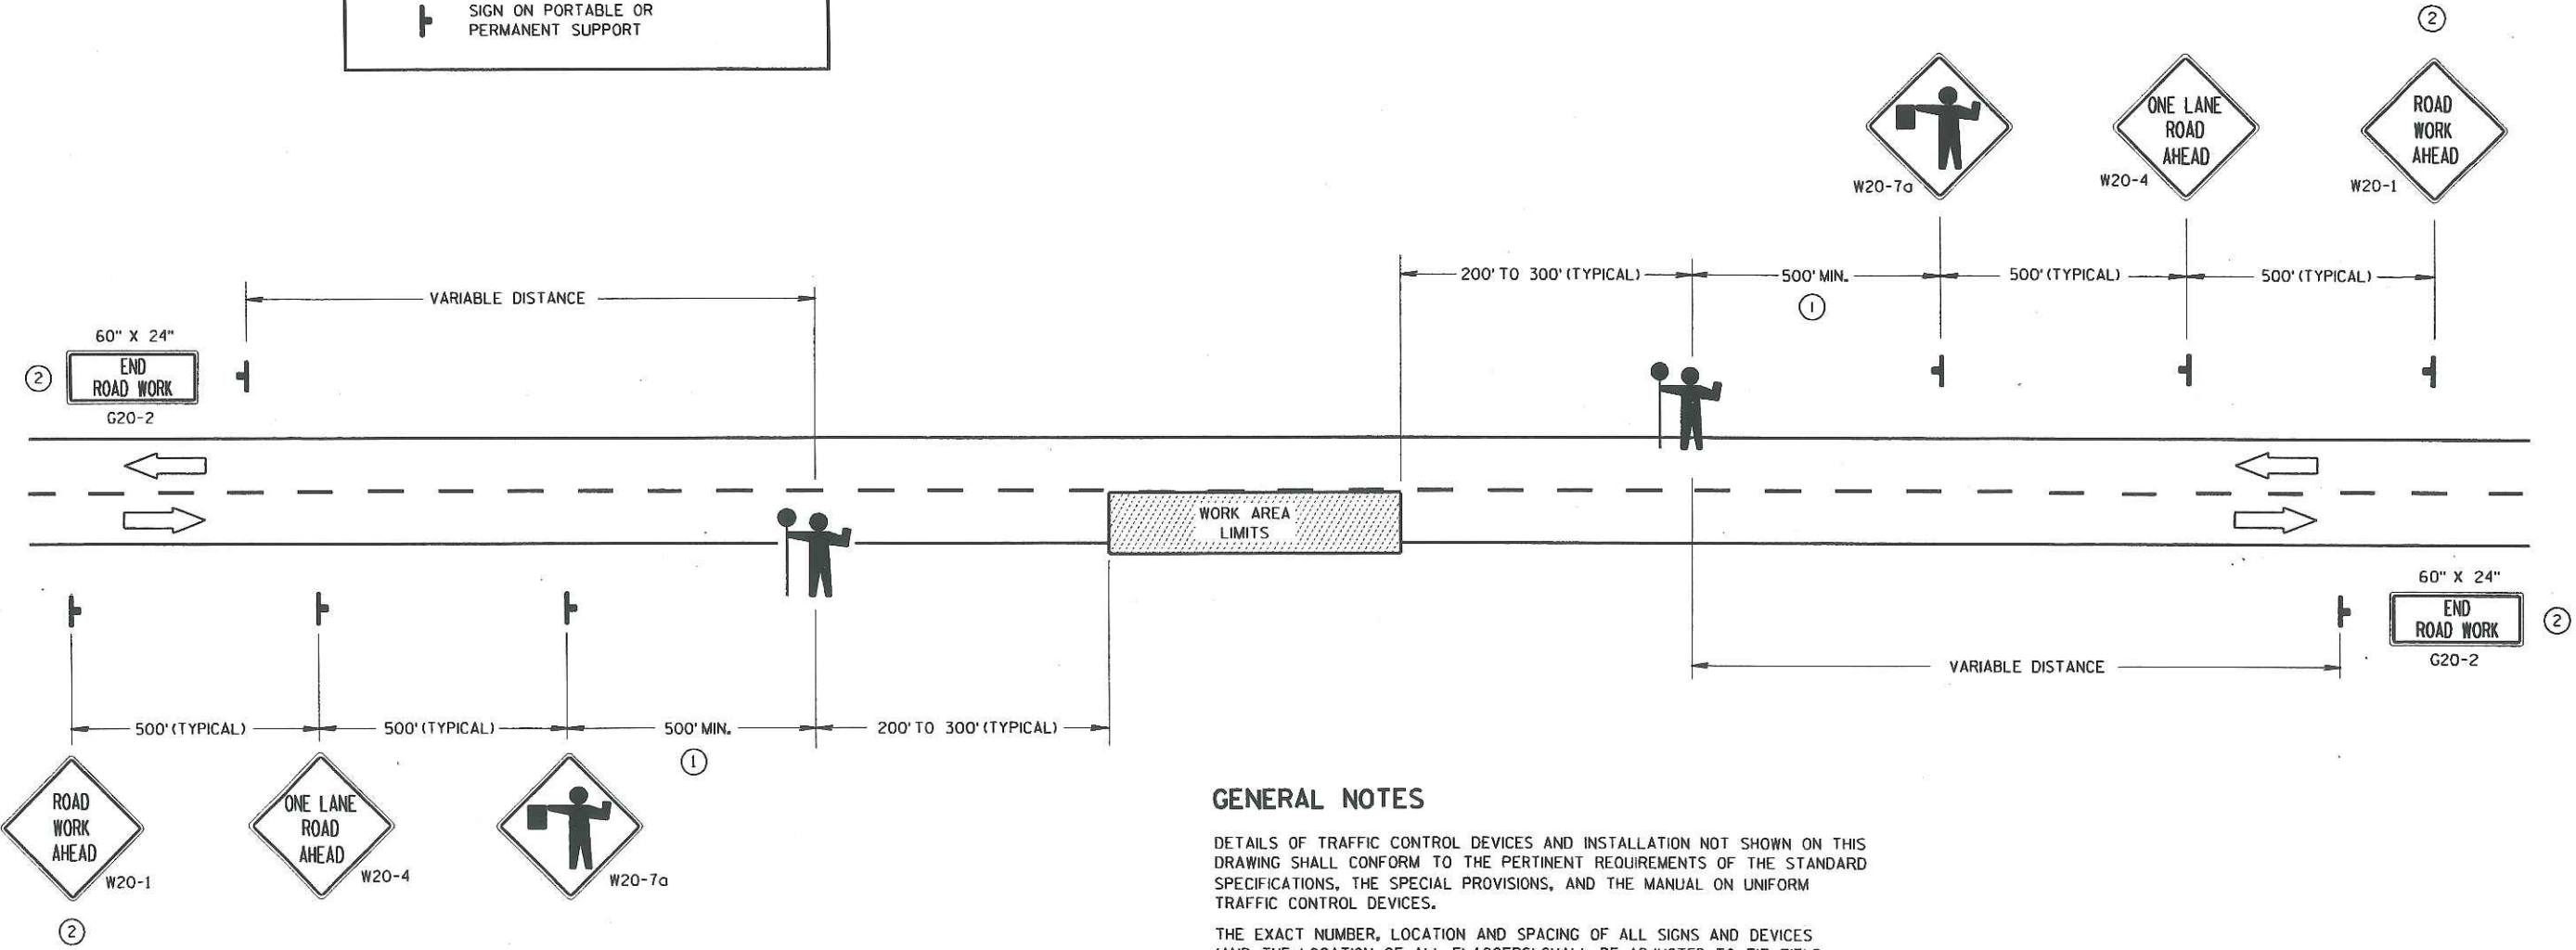

**GENERAL NOTES**

DETAILS OF TRAFFIC CONTROL DEVICES AND INSTALLATION NOT SHOWN ON THIS DRAWING SHALL CONFORM TO THE PERTINENT REQUIREMENTS OF THE STANDARD SPECIFICATIONS, THE SPECIAL PROVISIONS, AND THE MANUAL ON UNIFORM TRAFFIC CONTROL DEVICES.

THE EXACT NUMBER, LOCATION AND SPACING OF ALL SIGNS AND DEVICES (AND THE LOCATION OF ALL FLAGGERS) SHALL BE ADJUSTED TO FIT FIELD CONDITIONS AS DIRECTED BY THE ENGINEER.

THE FIRST ADVANCE WARNING SIGN SHOULD TYPICALLY BE LOCATED IN ADVANCE OF THE ANTICIPATED TRAFFIC BACKUP OR QUEUE.

WHEN A SIDE ROAD OR RAMP INTERSECTS THE FACILITY ON WHICH THE WORK IS BEING PERFORMED, ADDITIONAL TRAFFIC CONTROLS SHALL BE PROVIDED AS SPECIFIED IN THE PLANS AND/OR THE SPECIAL PROVISIONS OR AS DIRECTED BY THE ENGINEER.

FLAGGERS SHALL BE IN SIGHT OF EACH OTHER OR IN DIRECT COMMUNICATION AT ALL TIMES. THEY SHALL BE EQUIPPED WITH STOP/SLOW PADDLES FASTENED ON SUPPORT STAFFS. WHEN THE FLAGGING OPERATION IS NOT IN EFFECT, THE "FLAGGER AHEAD", THE "ROAD WORK AHEAD" AND THE ONE LANE ROAD AHEAD" SIGNS SHALL BE COVERED OR REMOVED AND THE HIGHWAY RESTORED TO NORMAL OPERATION.

ALL SIGNS ARE 48" X 48" UNLESS OTHERWISE NOTED.

- ① FOR A MOVING WORK OPERATION, SIGNING FOR BOTH DIRECTIONS SHALL BE REESTABLISHED (AS SIMULTANEOUSLY AS PRACTICAL) AT APPROXIMATELY 3500 FOOT INTERVALS IN THE MOVING WORK OPERATION OR AS DIRECTED BY THE ENGINEER.
- ② SIGN NOT REQUIRED IF FLAGGING OPERATION OCCURS WITHIN A SIGNED ROAD WORK ZONE AREA.


**TRAFFIC CONTROL FOR LANE CLOSURE (SUITABLE FOR MOVING OPERATIONS)**

STATE OF WISCONSIN  
DEPARTMENT OF TRANSPORTATION

APPROVED  
DATE 2/17/94  
STATE TRAFFIC ENGINEER FOR HWYS

FHWA



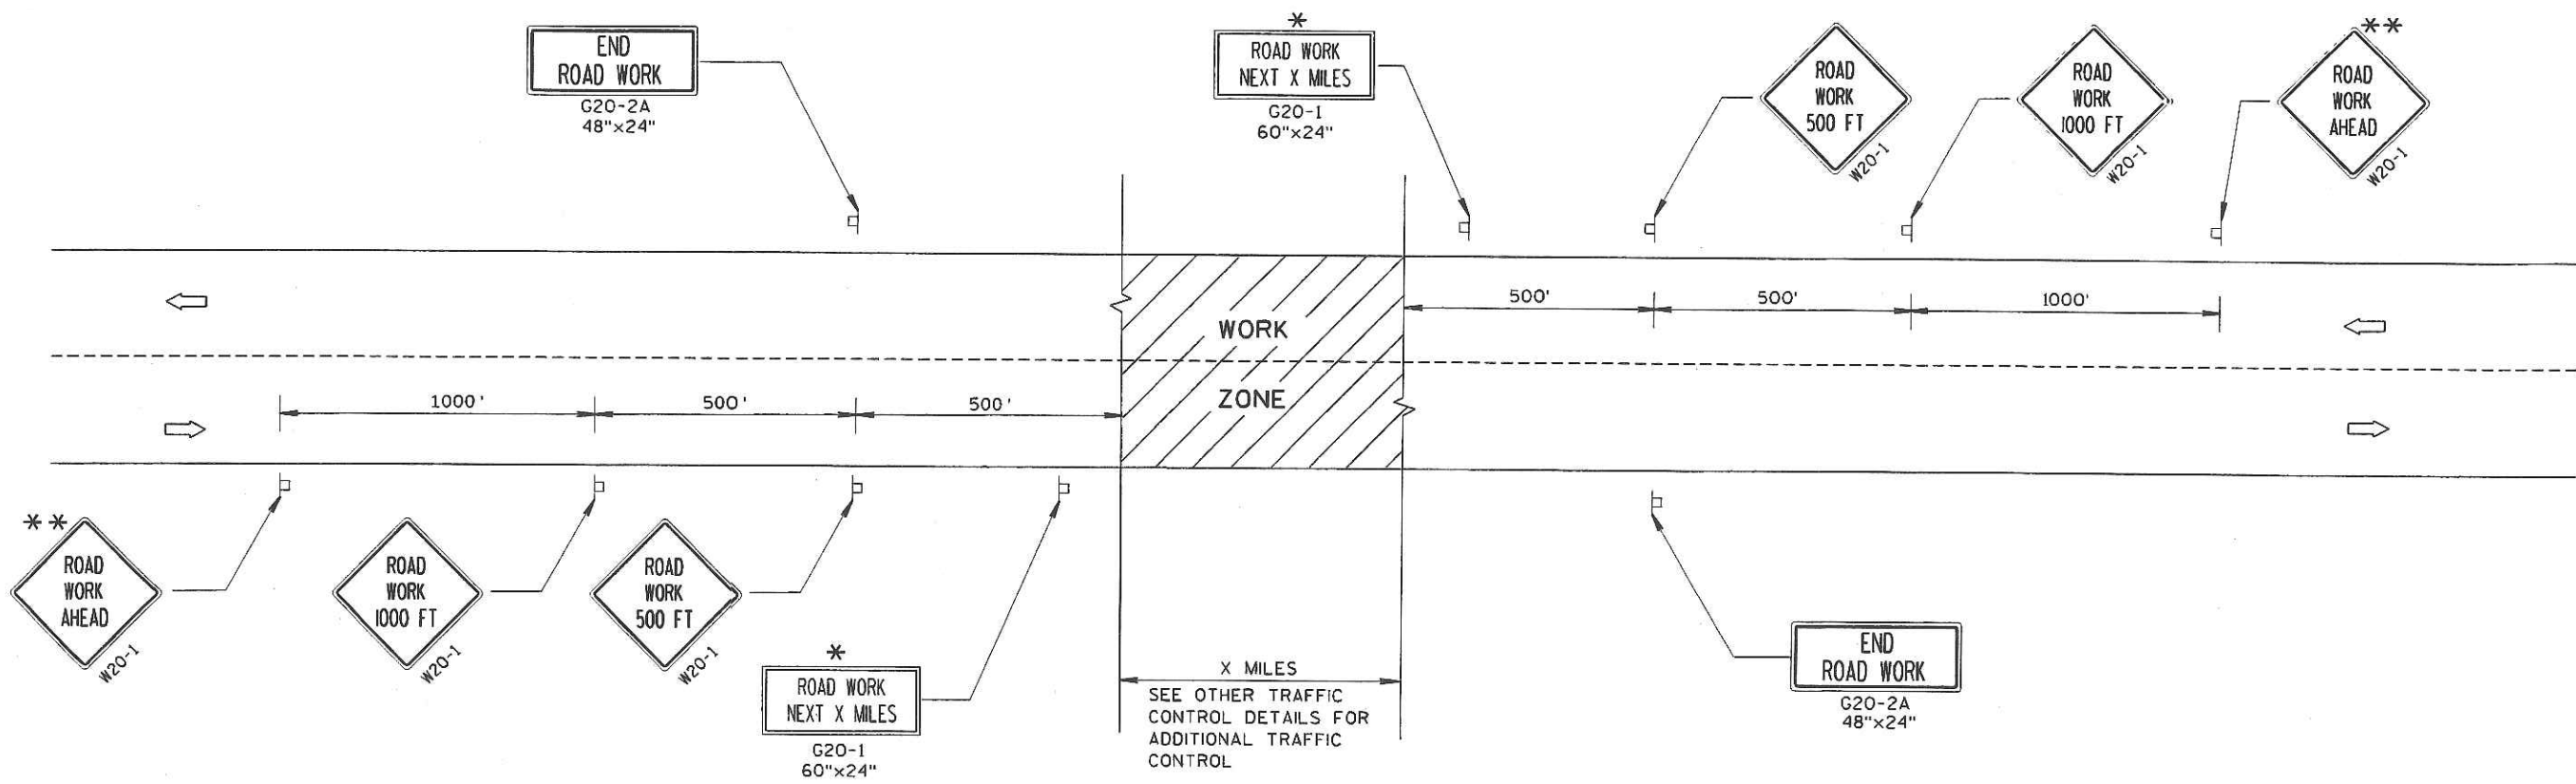

TYPICAL SIDEROAD APPROACH WARNING SIGN DETAIL

GENERAL NOTES

THE EXACT NUMBER, LOCATION, AND SPACING OF ALL SIGNS AND DEVICES SHALL BE ADJUSTED TO FIT FIELD CONDITIONS.


THE SPACING BETWEEN TRAFFIC CONTROL SIGNS SHOULD BE ADJUSTED TO NOT CONFLICT WITH AND SHOULD PROVIDE A MINIMUM OF 200 FEET (500 FEET DESIRABLE) CLEARANCE TO EXISTING SIGNS THAT WILL REMAIN IN PLACE.

ALL SIGNS ARE 48"x48" UNLESS OTHERWISE NOTED.

SIGNS THAT WILL BE IN PLACE LESS THAN 7 CONTINUOUS DAYS AND NIGHTS MAY BE MOUNTED ON PORTABLE SUPPORTS.

IF A "STOP" SIGN MUST BE REMOVED FOR A WORK OPERATION, A TEMPORARY "STOP" SIGN SHALL BE PLACED PRIOR TO THE SIGN REMOVAL, OR A FLAGGER SHALL BE PROVIDED UNTIL THE SIGN IS RE-ESTABLISHED.

- \* OMIT G20-1 SIGNS IF LENGTH OF WORK AREA IS 2 MILES OR LESS.
- \*\* PLACE ADDITIONAL W20-1 "ROAD WORK AHEAD" SIGN IF WORK AREA WITHIN THE PROJECT IS SEPARATED BY MORE THAN 2 MILES FROM PREVIOUS WORK AREA OR SIGNING.

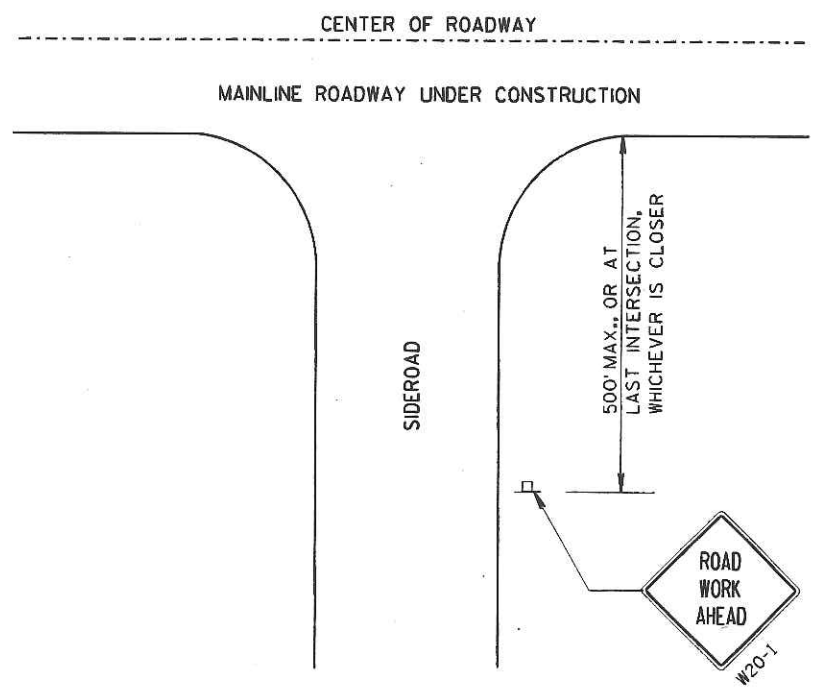


LEGEND


- POST MOUNTED SIGN
- ➡ DIRECTION OF TRAFFIC FLOW

TRAFFIC CONTROL, ADVANCE WARNING SIGNS 45 M.P.H. OR GREATER TWO-WAY UNDIVIDED ROAD OPEN TO TRAFFIC	
STATE OF WISCONSIN DEPARTMENT OF TRANSPORTATION	
APPROVED 5/23/00 DATE	<i>Chester J. Spang</i> CHIEF SIGNS AND MARKING ENGINEER
FHWA	



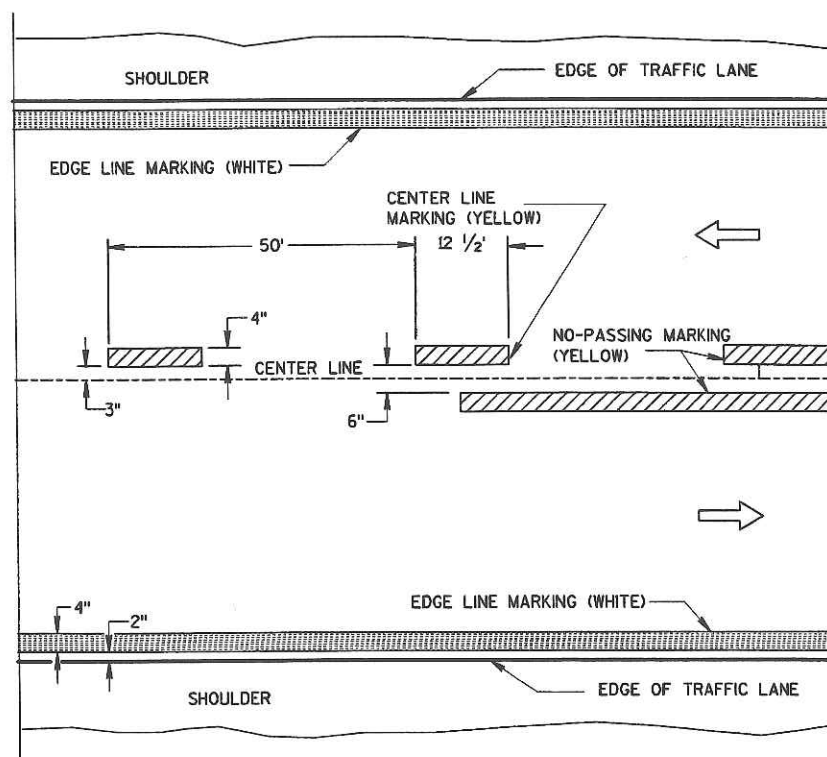


TWO WAY TRAFFIC

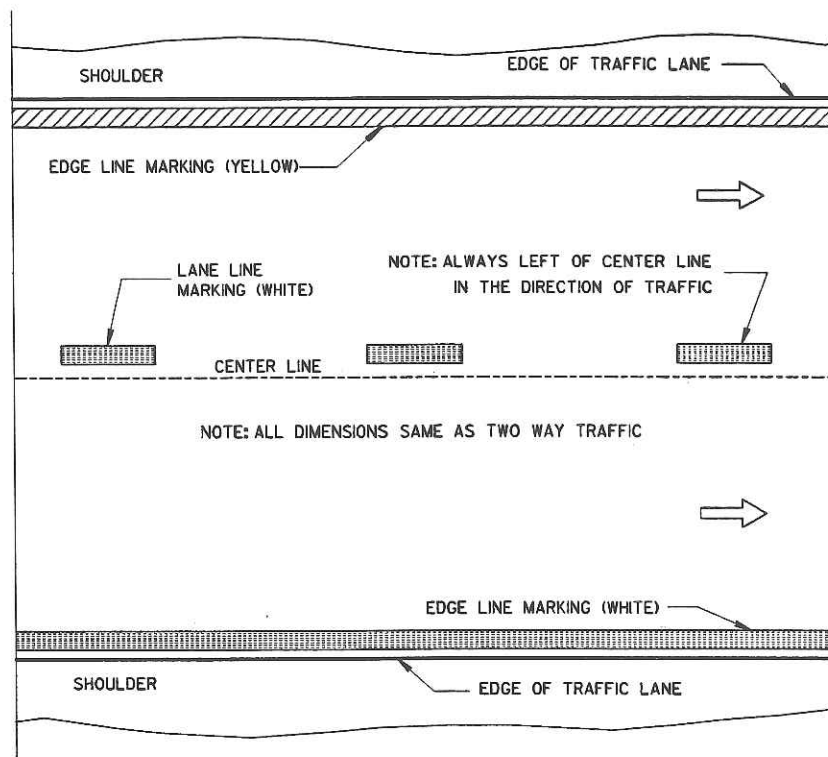


ONE WAY TRAFFIC

### PERMANENT PAVEMENT MARKING

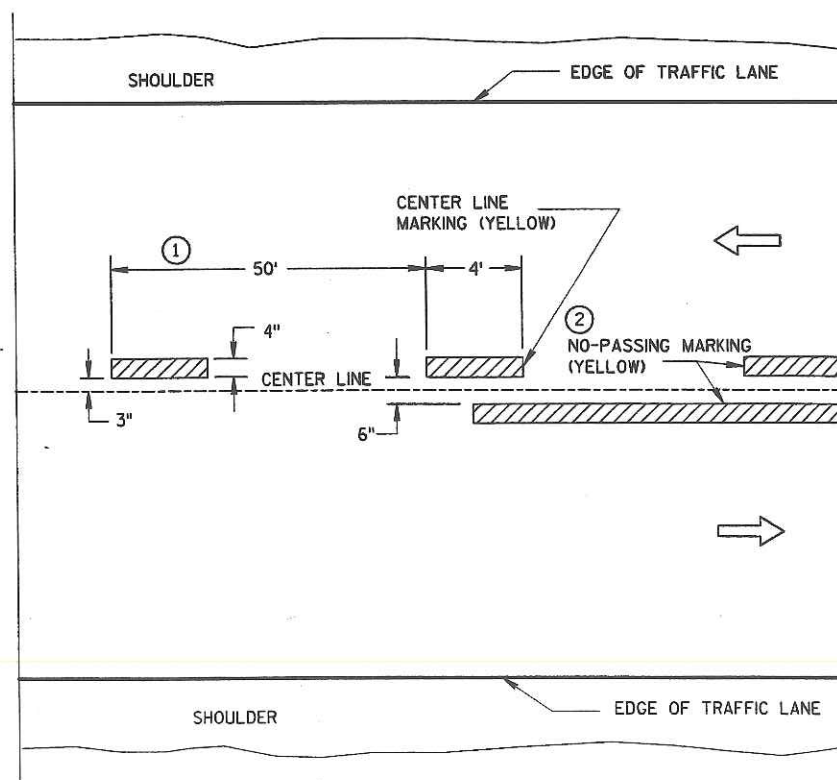

TWO WAY TRAFFIC

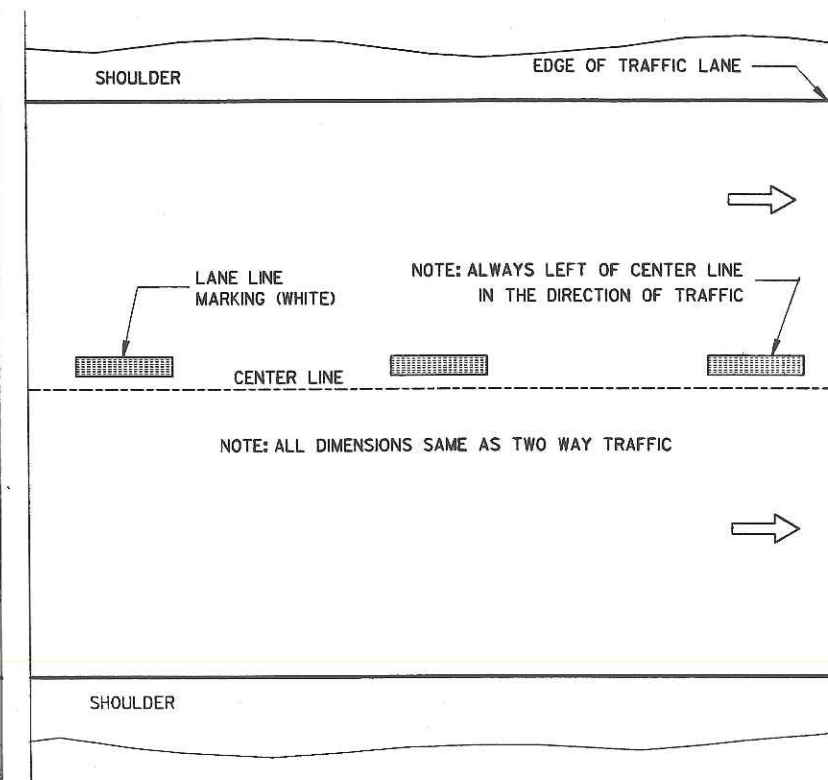

ONE WAY TRAFFIC

### TEMPORARY (INTERMEDIATE) PAVEMENT MARKING (SHOWS CYCLE FOR TEMPORARY CENTER LINE OR TEMPORARY LANE LINE MARKING)

### GENERAL NOTES

DETAILS OF CONSTRUCTION NOT SHOWN ON THIS DRAWING SHALL CONFORM TO STANDARD SPECIFICATIONS AND SPECIAL PROVISIONS.

- ① HALF CYCLE LENGTHS (25') WITH 2' MINIMUM STRIPE LENGTHS SHALL BE PROVIDED ON ROADWAYS (INCLUDING TEMPORARY TRAVELED WAYS) WITH REVERSE CURVATURE, CURVATURE OF OVER 5 DEGREES OR WHEN DIRECTED BY THE ENGINEER TO MARK UNUSUAL ALIGNMENT OF THE TRAVELED WAY.
- ② NO PASSING ZONE TEMPORARY PAVEMENT MARKING IS REQUIRED TO BE PLACED, WHERE APPROPRIATE, ALONG WITH CENTERLINE TEMPORARY PAVEMENT MARKING WHEN A SAME DAY PERMANENT PAVEMENT MARKING ITEM IS INCLUDED IN THE CONTRACT.

### NOTE

ARROW SYMBOL (→) SHOWS DIRECTION OF TRAVEL

PAVEMENT MARKING  
(MAINLINE)

STATE OF WISCONSIN  
DEPARTMENT OF TRANSPORTATION

APPROVED

2-17-00  
DATE

FHWA

Christy J. Spang  
CHIEF SIGNS AND MARKING ENGINEER




NOTES


EDGE LINES SHALL BE OMITTED THROUGH INTERSECTIONS. EDGE LINES SHALL BE CONTINUED THROUGH DRIVEWAYS.

- ① WHEN DISTANCE "A" IS LESS THAN 250 FEET, OMIT LANE LINE.
- ② WHEN DISTANCE "B" IS LESS THAN 100 FEET, OMIT CHANNELIZING LANE LINE.
- ③ ALTERNATIVE MARKING SHALL BE PROVIDED WHEN SPECIFIED IN THE CONTRACT. TYPICAL SITUATIONS WHERE THIS MARKING MAY BE REQUIRED ARE WHERE THE INTERSECTION IS ON A SHARP HORIZONTAL CURVE OR CREST VERTICAL CURVE IN AN UNLIGHTED AREA SUCH THAT THE EDGE LINE MAY BE MISLEADING TO THE MOTORIST OR DISAPPEAR FROM SIGHT.
- ④ LOCATE THE EDGE LINE ALONG THE TAPER WHERE "W" IS 10' OR MORE.
- ⑤ THE EDGE LINE IN THE TAPER AREAS OF THE BYPASS LANE AND THE BYPASS LANE SHALL BE LOCATED 1-FOOT FROM EDGE OF PAVEMENT TO THE OUTSIDE EDGE OF EDGE LINE.
- ⑥ BARRIER LINE ENDS AT SIDE ROAD PAVEMENT/SURFACE EDGE EXTENSION.


ARROW SYMBOL (  $\Rightarrow$  ) SHOWS DIRECTION OF TRAVEL

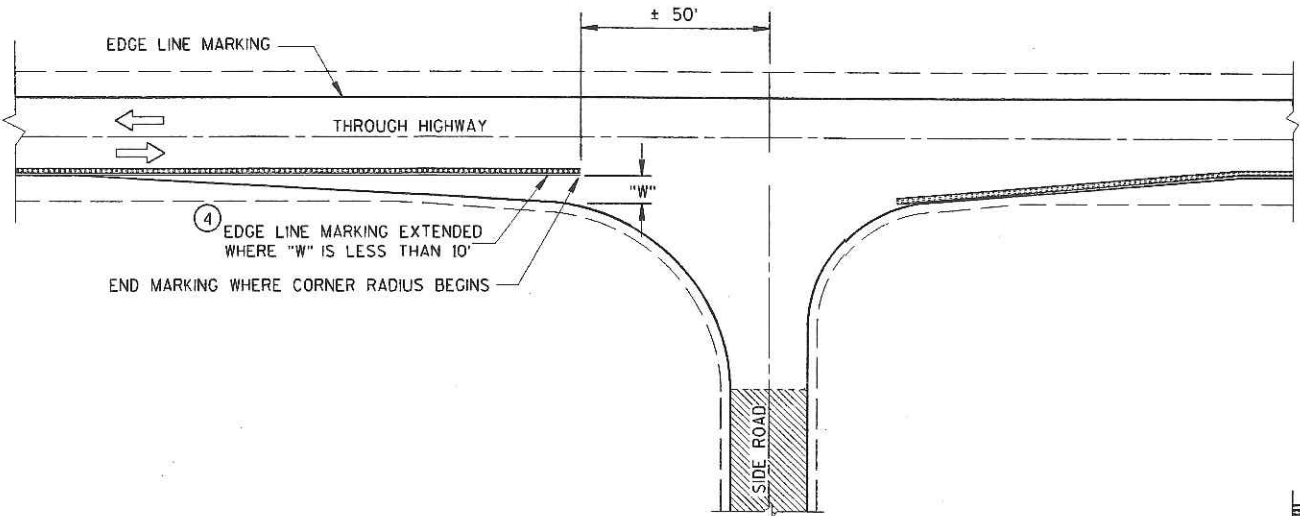


MINOR INTERSECTION WITHOUT CURBS

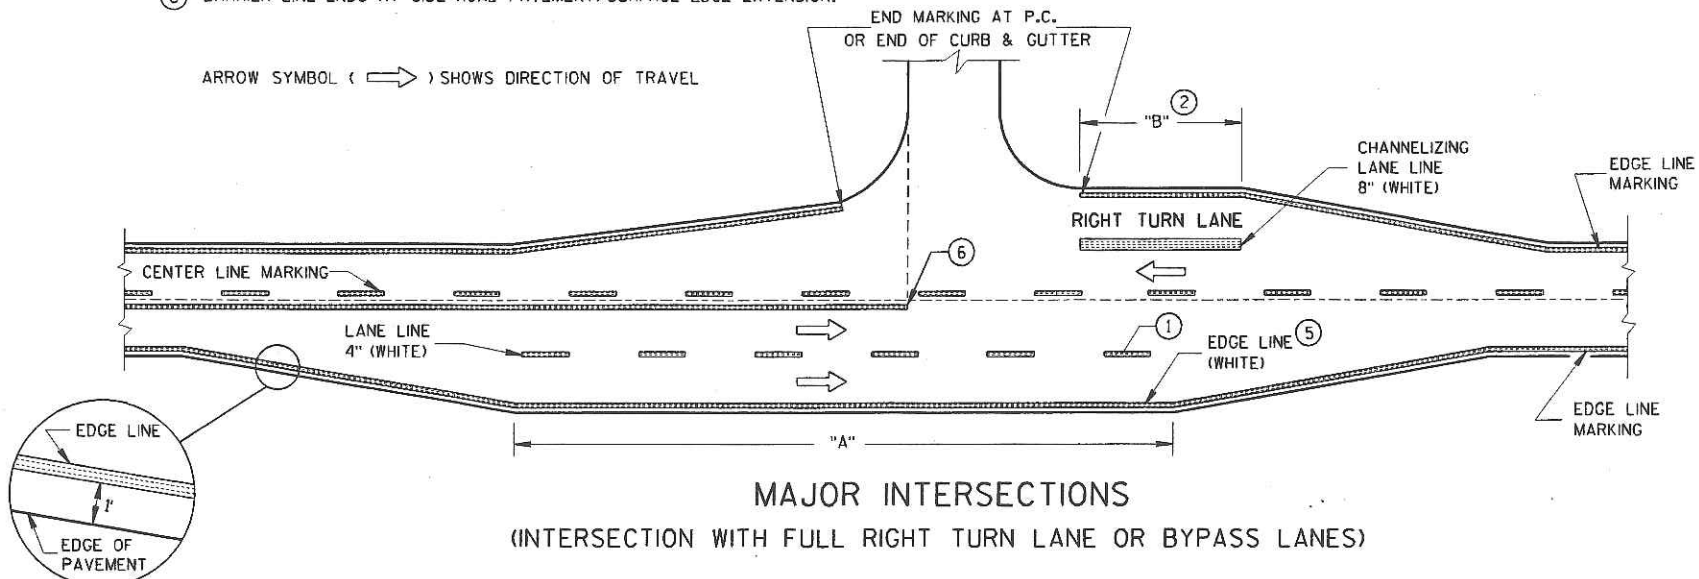

MAJOR INTERSECTIONS  
(INTERSECTION WITH FULL RIGHT TURN LANE OR BYPASS LANES)

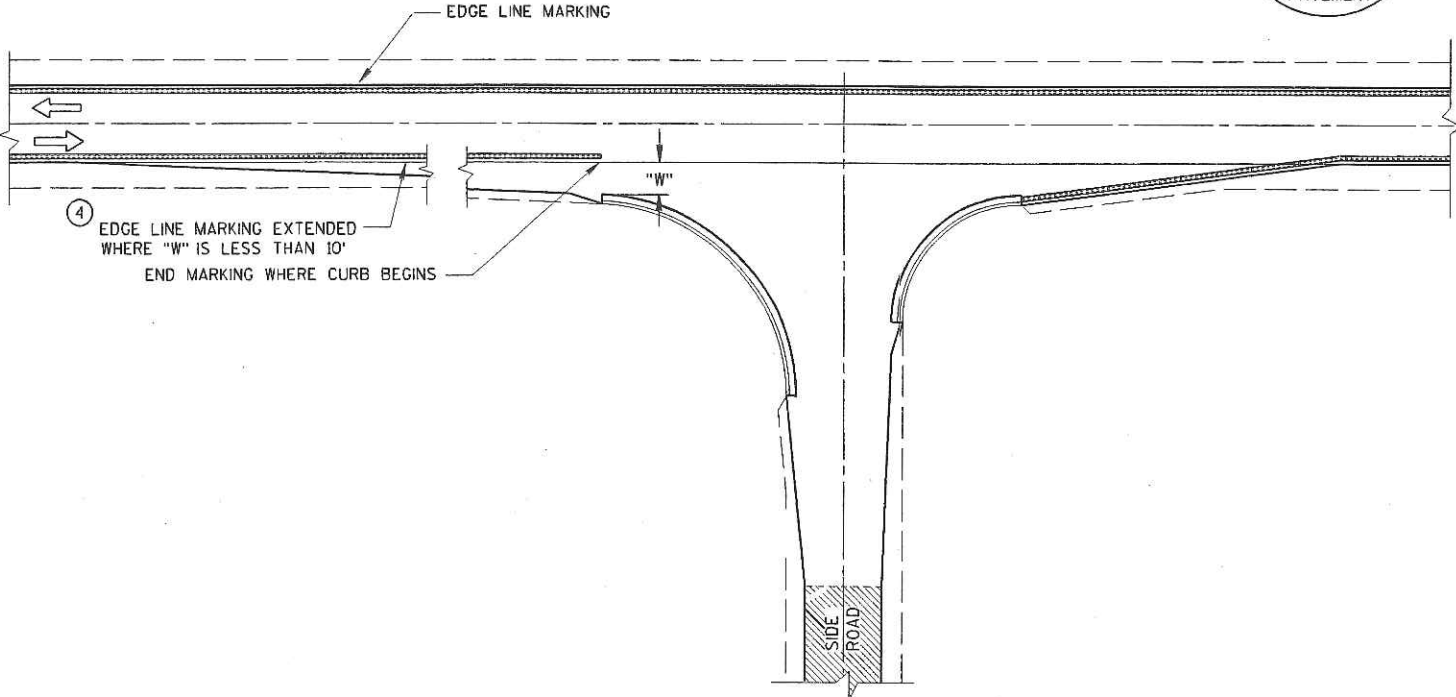

MINOR INTERSECTION WITH CURBS  
(TYPICAL MARKING)

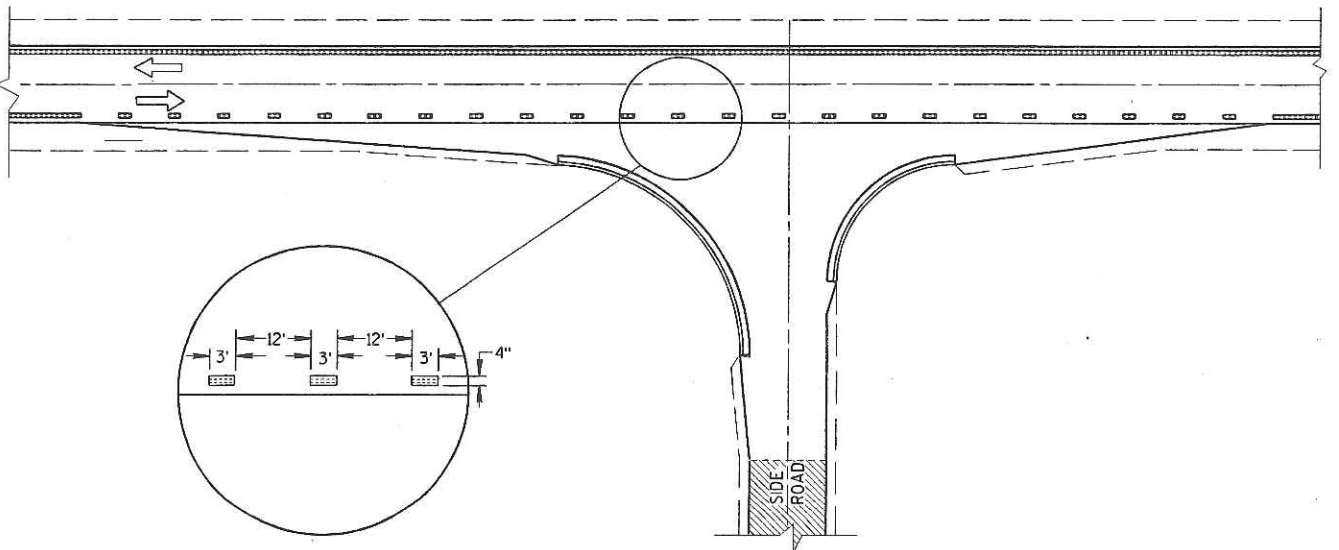

MINOR INTERSECTION WITH CURBS  
③ (FOR SPECIAL CONDITIONS AS SPECIFIED)

PAVEMENT MARKING (INTERSECTIONS)
STATE OF WISCONSIN DEPARTMENT OF TRANSPORTATION




57.55.59.61.62.63

LEVELS ON - 2.3.5.6


## TYPICAL ASSEMBLIES



J1-1

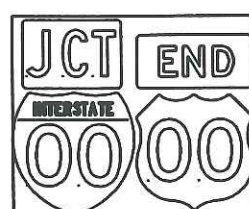


J1-2

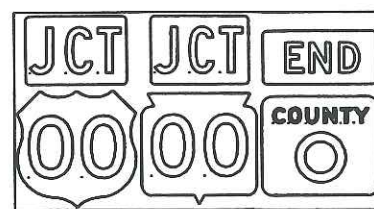


J1-3




J2-1

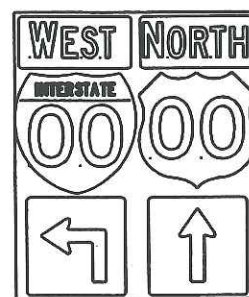


J2-2

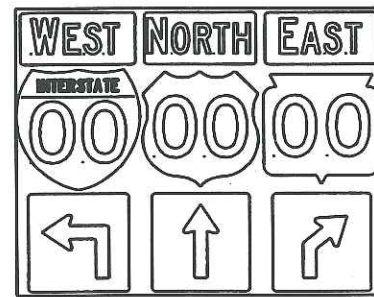


J2-3

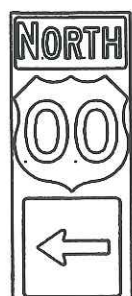

J3-1

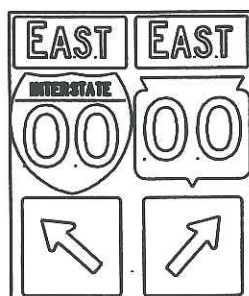


J3-2

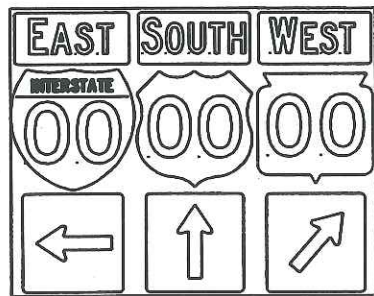


J3-3



J4-1

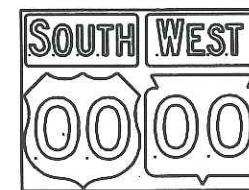

J4-2

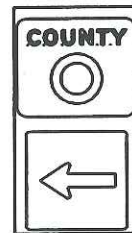

J13-1



J12-1



J32-1



J33-1



J23-1




J22-1





JV

[blue background with interstate]

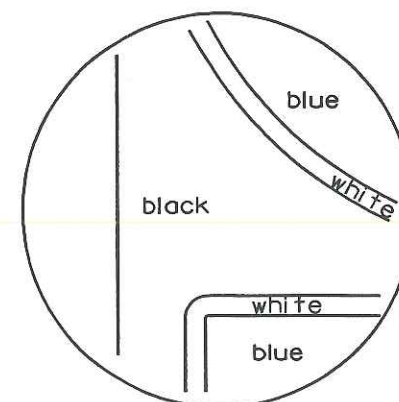

## NOTES

1. Signs are Type II - Type H Reflective - reference WIS DOT Standard Specification for HIGHWAY and STRUCTURE CONSTRUCTION latest edition.
2. Color:  
Background - Black Non-reflective  
Message - see Note 5
3. Message Series - See Note 5
4. Corners shall be square since base material is plywood.
5. The colors and message spacing on each marker shall be according to the applicable route marker panel specifications.
6. Certain marker heads require the component pieces to be the same color. As an example, all the components used with an MI-1 interstate marker shall be blue.

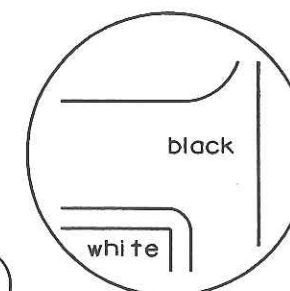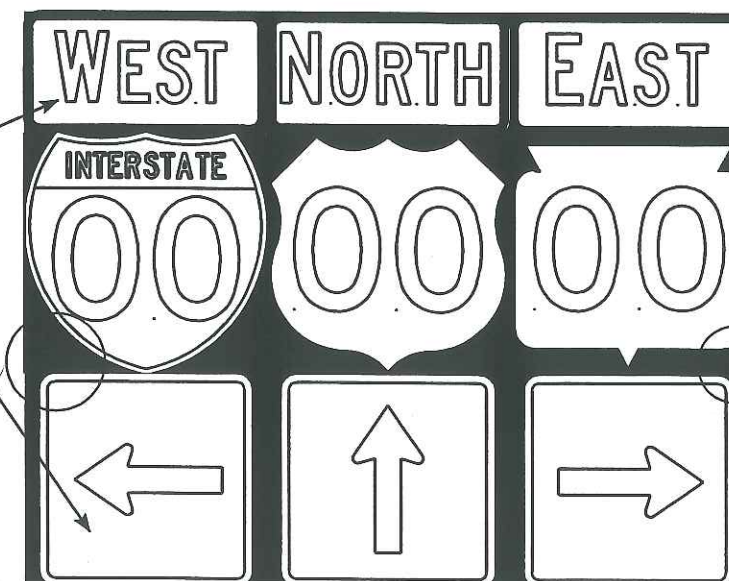

[black background]

## ROUTE MARKERS & COMPONENTS IN TYPICAL ASSEMBLIES

WISCONSIN DEPT OF TRANSPORTATION

APPROVED *Matthew R. Rauch*  
for State Traffic Engineer

DATE 10/17/02 PLATE NO. A2-1S.3

STATE PROJECT NUMBER:

FILE NAME : C:\Users\Projects\tr\_std\plate\A21S.DGN

PLOT DATE : 09-APR-2004 09:02

PLOT BY : DOTDZK

PLOT NAME :

ORG DATE : 10/17/02

Originator : DON KLUEVER

SHEET NO: 39

E


WISDOT/CADDs SHEET 42





# URBAN AREA

# RURAL AREA (See Note 2)


# GENERAL NOTES

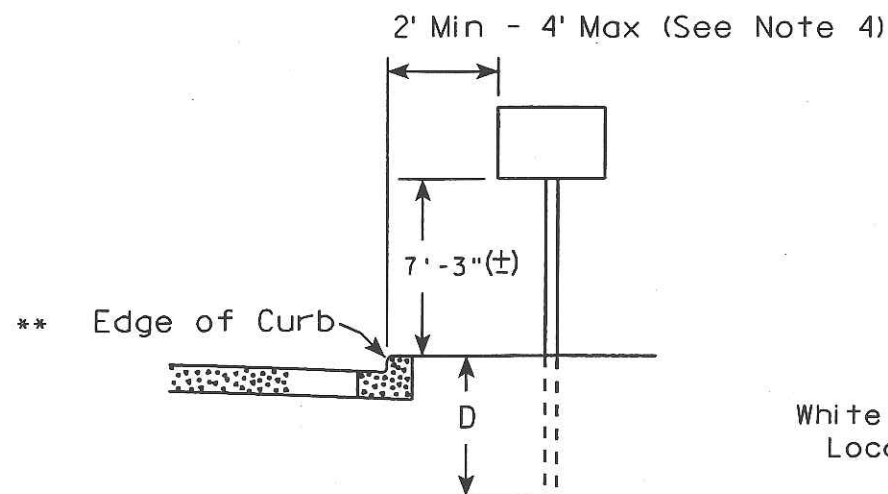

White Edgeline Location

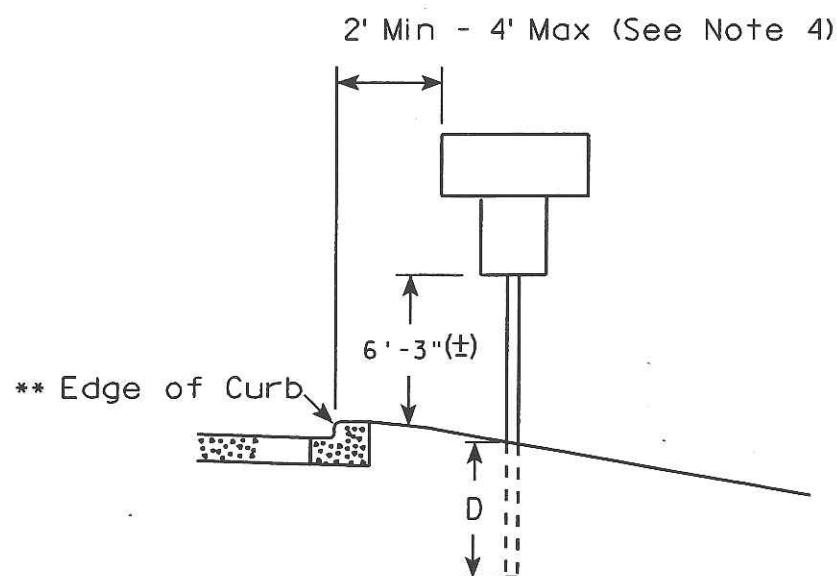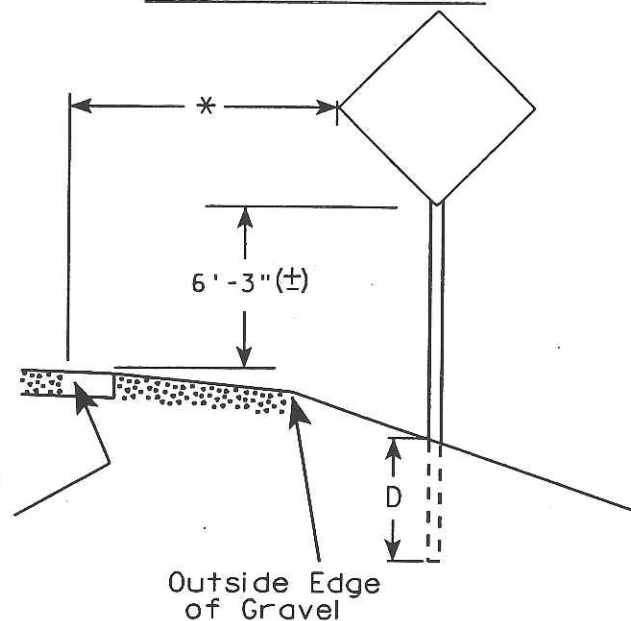

White Edgeline Location

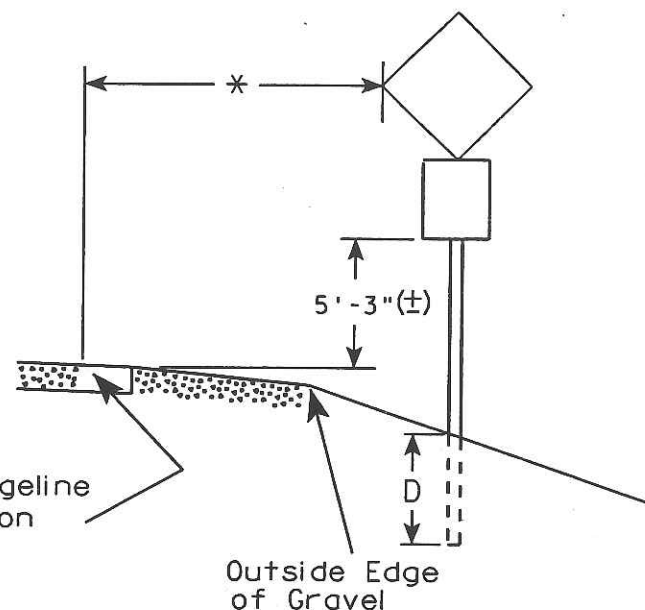

1. Signs wider than 4 feet or larger than 20 sq. ft. shall be mounted on multiple posts. Refer to plate A4-4.
2. For expressways and freeways, mounting height is 7'-3" ( $\pm$ ) or 6'-3" ( $\pm$ ) depending upon existence of a sub-sign.
3. Minimum mounting height for J assemblies (A4-5) is 7'-3" ( $\pm$ ) or 6'-3" ( $\pm$ ) per urban or rural detail respectively.
4. Minimum mounting height for signs mounted on traffic signal poles is 5'-3" ( $\pm$ ).
5. Offset distance shall be consistent with existing signs or consistent throughout length of project.
6. The ( $\pm$ ) tolerance for mounting height is 3 inches.

## POST EMBEDMENT DEPTH

Area of Sign Installation ( Sq. Ft. )	D ( Min )
20 or Less	4'
Greater than 20	5'

\*\* The existence of curb and gutter does not in itself mandate the vertical clearance illustrated. That height is typically where there is sidewalk adjacent to the roadway or parking is permitted. This same criteria applies to mountable curb as well and measurement shall be taken from flow line.

\* 6 feet from edge of a paved shoulder or 12 feet from the edge of pavement (edge line location) or 2 feet from outside edge of gravel, whichever is greater unless directed by project engineer.

TYPICAL INSTALLATION  
OF PERMANENT TYPE II  
SIGNS ON SINGLE POSTS

WISCONSIN DEPT OF TRANSPORTATION

APPROVED *Matthew R. Rauch*  
for State Traffic Engineer

DATE 2/20/03 PLATE NO. A4-3.12

STATE PROJECT NUMBER:

HWY:

COUNTY:

SHEET NO: 40 E

FILE NAME : C:\Users\Projects\tr\_stdplate\A43.DGN

PLOT DATE : 09-APR-2004 09:02

PLOT BY : DOTDZK

PLOT NAME :

REV DATE : 12/20/02

Originator : Sandy Anderson

PLOT SCALE : 101.940000:1.000000






WISDOT/CADDs SHEET 42



# URBAN AREA

# RURAL AREA (See Note 3)

# GENERAL NOTES

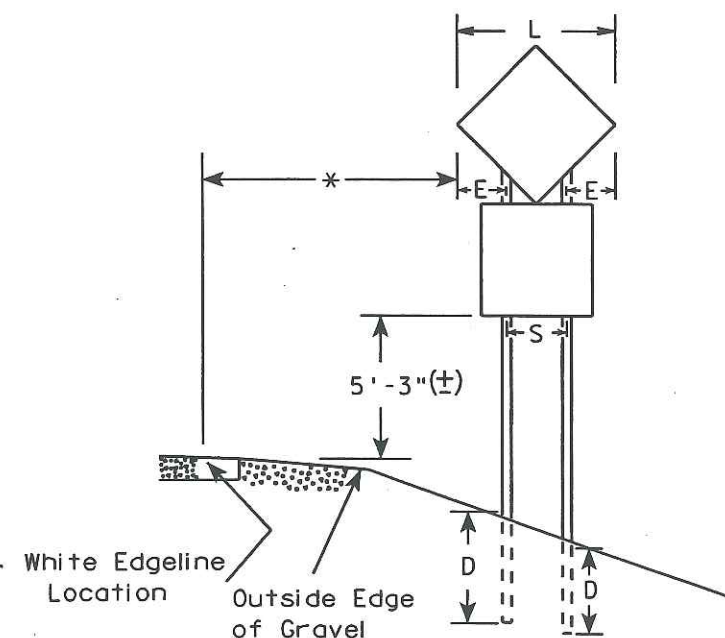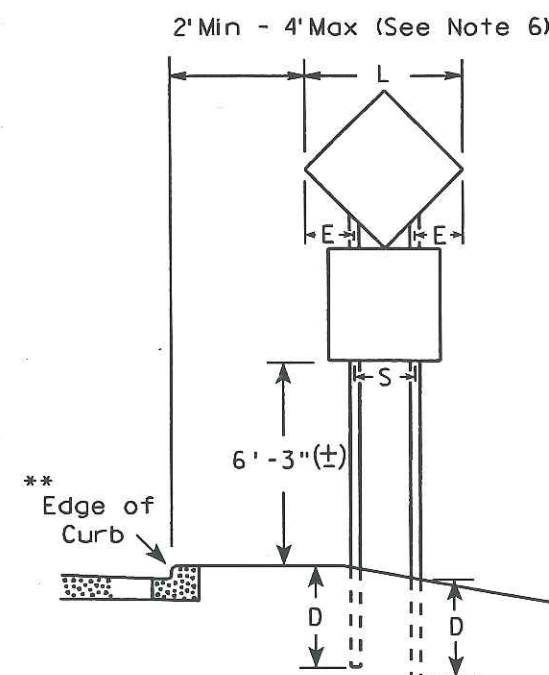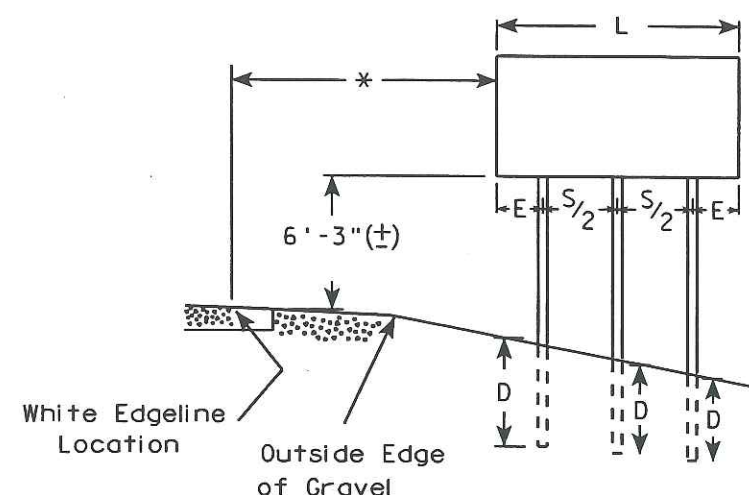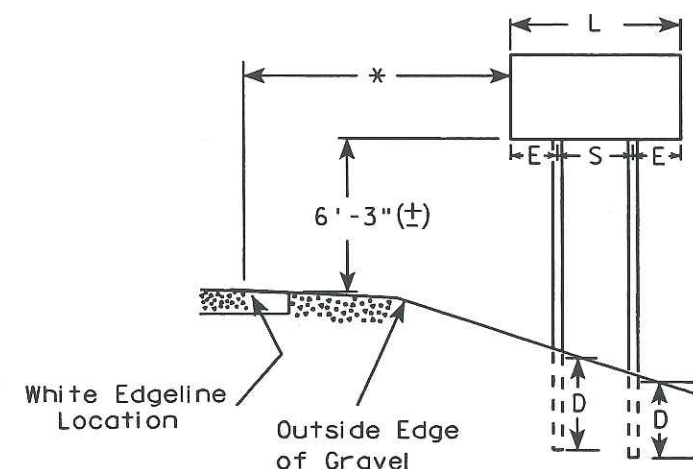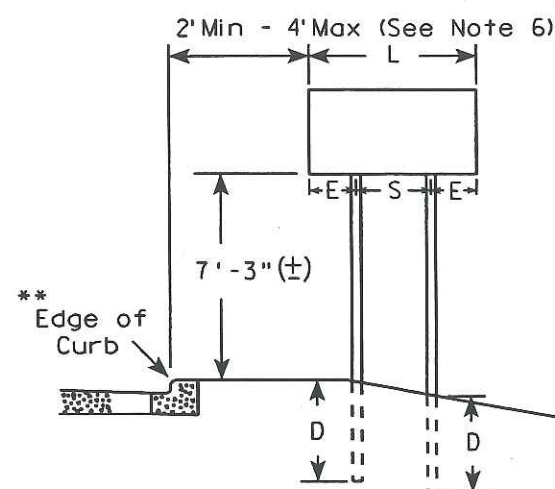

1. For 3 post installations, spacing is  $S/2$  and  $S$  must be greater than 7'-0".
2. For 4 post installations, spacing is  $S/3$  and  $S$  must be greater than 10'-6".
3. For expressways and freeways, mounting height is 7'-3" (±) or 6'-3" (±) depending upon existence of sub-sign.
4. The (±) tolerance for mounting height is 3 inches.
5. Minimum mounting height for J assemblies (A4-5) is 7'-3" (±) or 6'-3" (±) per urban or rural detail respectively.
6. Offset distance shall be consistent with existing signs or consistent throughout length of project.

\* 6 feet from edge of a paved shoulder or 12 feet from the edge of pavement (edge line location) or 2 feet from outside edge of gravel, whichever is greater unless directed by project engineer.

\*\* The existence of curb and gutter does not in itself mandate the vertical clearance illustrated. That height is typically where there is sidewalk adjacent to the roadway or parking is permitted. This same criteria applies to mountable curb as well and measurement shall be from the flow line.

## DIAMOND SHAPED SIGNS

L	S	E
Less than 60"	20"	$L/2 - 10$
60"--72"	32"	$L/2 - 16$
Greater than 72"	$3 L/5$	$L/5$

## SIGN SHAPE OTHER THAN DIAMOND (Two Post Installations)

L	S	E
Less than 60"	L-24"	12"
60" or more	$3 L/5$	$L/5$

## POST EMBEDMENT DEPTH

Area of Sign Installation ( Sq. Ft. )	D ( Min )
20 or Less	4'
Greater than 20	5'

## TYPICAL INSTALLATION OF TYPE II SIGNS ON MULTIPLE POSTS

WISCONSIN DEPT OF TRANSPORTATION  
APPROVED *Matthew R. Rauch*  
For State Traffic Engineer  
DATE 2/20/03 PLATE NO. A4-4.7

STATE PROJECT NUMBER:


HWY:

COUNTY:

SHEET NO: 41

E



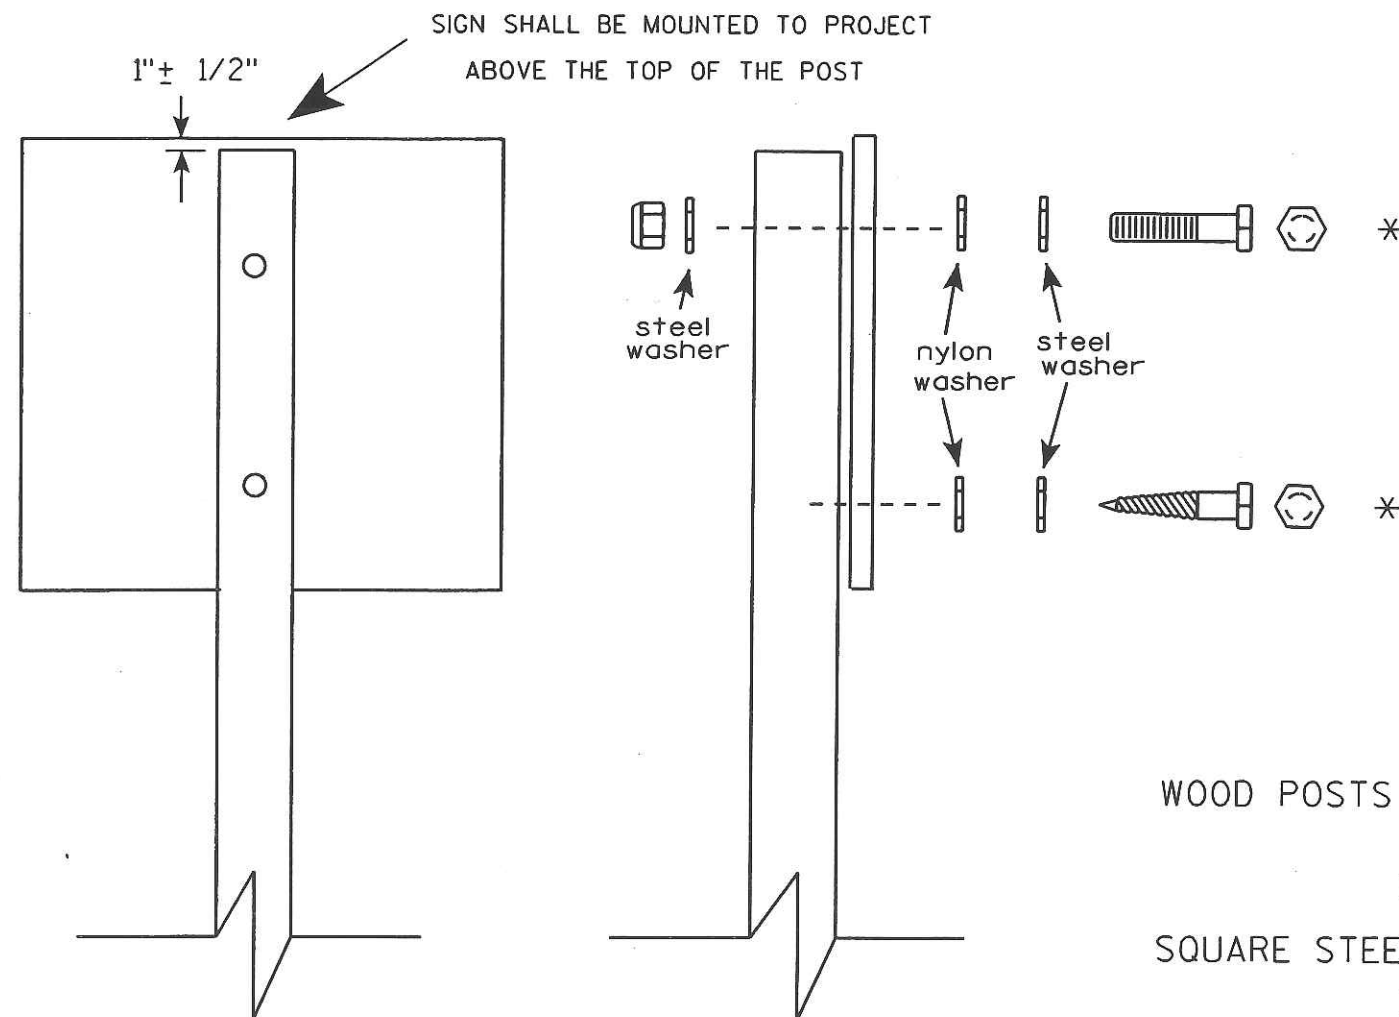

Nuts, bolts and lags used for mounting signs shall have hexagonal heads and shall be either :

- Hot dip or mechanically galvanized in accordance with ASTM Designation: A 153, Class D, or
- Cadmium plated in accordance with ASTM Designation : B 766 TYPE 3, Class 12, or
- Electro-galvanized in accordance with ASTM Designation : B 633, TYPE III, SC 3.

Threads on bolts and nuts shall be manufactured with sufficient allowance for the cadmium plate or galvanized coating to permit the nuts to run freely on the bolts.

WOOD POSTS (4" x 4" or 4" x 6")

LAG SCREWS -  $\frac{3}{8}$ " X 3"

MACHINE BOLTS -  $\frac{5}{16}$ " X 6-1/2" or 7" Length w/ nuts


SQUARE STEEL POSTS (2" x 2" )

MACHINE BOLTS -  $\frac{3}{8}$ " X 3-1/4" Length w/ nuts

WASHERS (ALL POSTS) -

1-1/4" O.D. X  $\frac{3}{8}$ " I.D. X  $\frac{1}{16}$ " STEEL

1-1/4" O.D. X  $\frac{3}{8}$ " I.D. X .080 NYLON for all Type H signs.

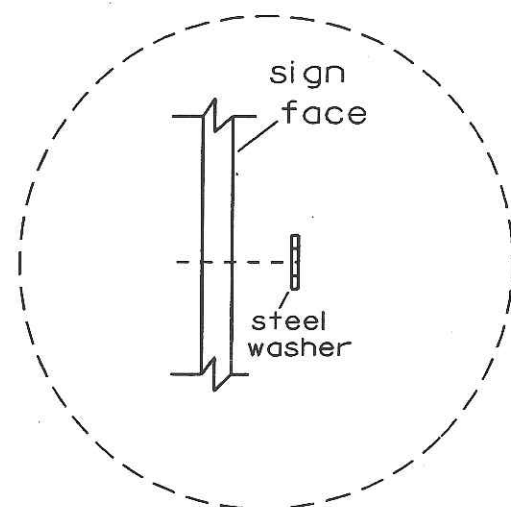

Washer Placement when Sign Has Other Than Type H or Type F Face

- \* Two different fastening systems are shown for illustration purposes. On any individual sign, either one or the other system shall be used. Actual number of fasteners per sign varies with the sign area, but normally there are two. For a single post installation, all signs 9 sq. ft. or larger require the use of 3 fasteners.

## ATTACHMENT OF SIGNS TO POSTS

WISCONSIN DEPT OF TRANSPORTATION

APPROVED

*Chester J. Spang*  
for State Traffic Engineer

DATE 4/03/02

PLATE NO. A4-8.5

STATE PROJECT NUMBER:

PLOT DATE : 09-APR-2004 09:04

PLOT BY : D0TDZK

ORG DATE : 4/03/02

Originator : DON KLUEVER

SHEET NO: 42 E

WISDOT/CADDs SHEET 42




57.56.59 61.62.63

18.

10.

LEVELS ON - 2, 3, 4, 5, 6

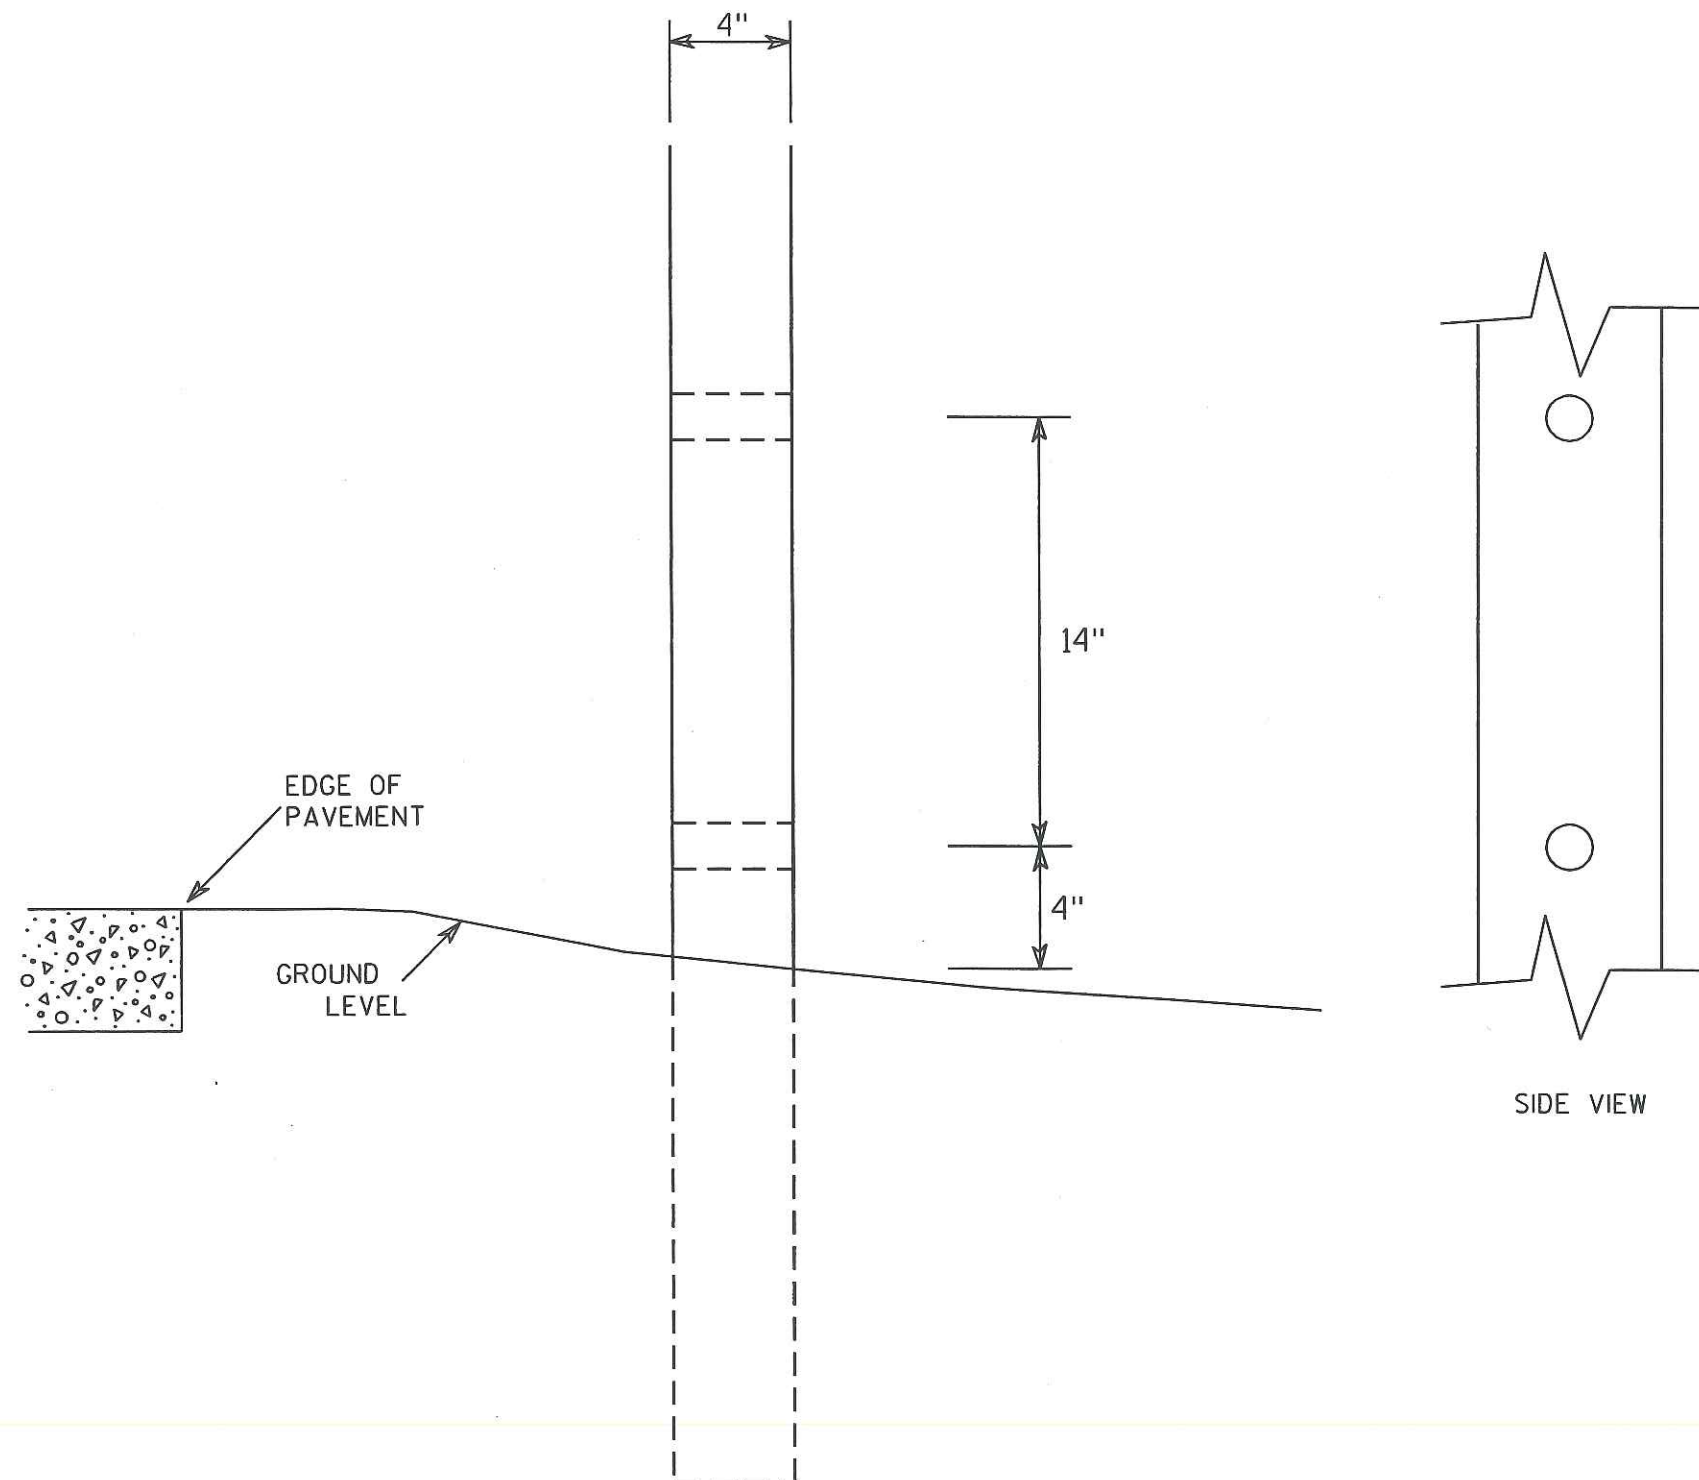

### GENERAL NOTES

1. All 4 x 6 Wood Posts shall be modified by having two 1 1/2" diameter holes drilled perpendicular to the roadway centerline.

### 4 X 6 WOOD POST MODIFICATIONS

WISCONSIN DEPT OF TRANSPORTATION

APPROVED

*Chester J. Spang*  
for State Traffic Engineer

DATE 3/27/97

PLATE NO. A4-11.2

STATE PROJECT NUMBER:

FILE NAME : C:\Users\Projects\tr\_stdplate\A411.DGN

PLOT DATE : 09-APR-2004 09:04

PLOT BY : DOTDZK

ORG DATE : 3/27/97


Originator : DON KLUEVER

SHEET NO: 43 E

WISDOT/CADDs SHEET 42



58.59.00.61.62.63

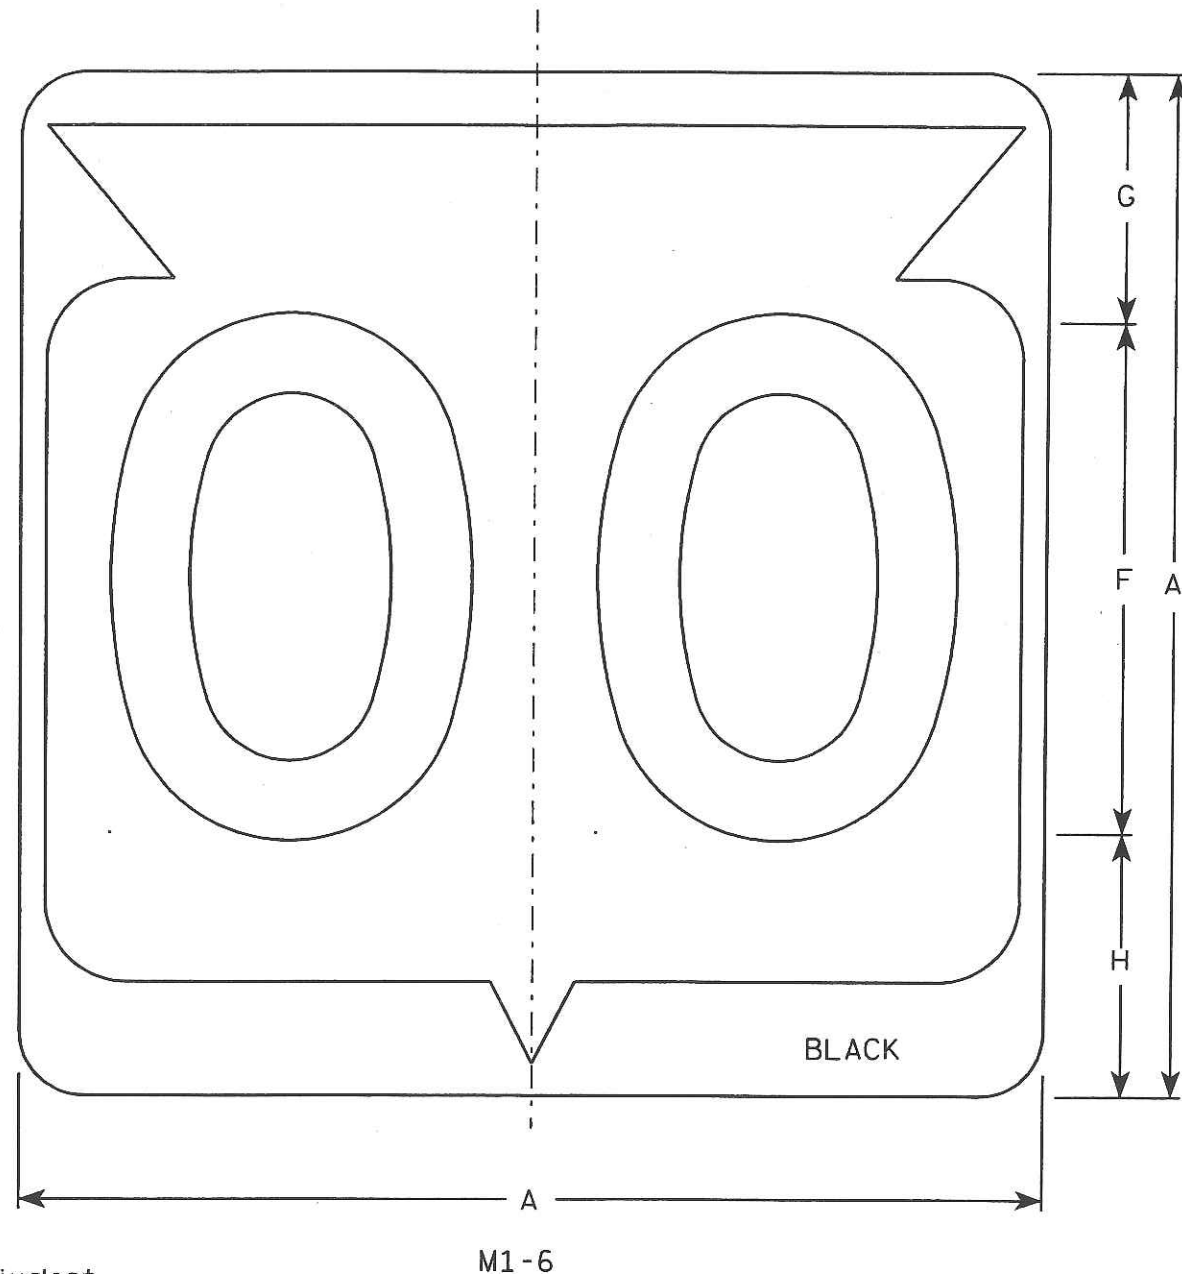

M1-6

Metric equivalent  
for this sign is:

SIZE	
1	
2	600 mm X 600 mm
3	900 mm X 900 mm
4	900 mm X 900 mm
5	900 mm X 900 mm

SIZE	A	B	C	D	E	F	G	H	I	J	K	L	M	N	O	P	Q	R	S	T	U	V	W	X	Y	Z	Area sq. ft.	Area sq2
1																												
2	24		1 1/2			12	5 1/2	6 1/2	10 1/4	2 1/2	8 7/8	11 1/2	1	1 7/8	11 1/4	21 7/8											4.0	.36
3	36		2 1/4			18	8 3/4	9 1/4	15 3/8	5 3/8	12 5/8	17 1/8	1 1/2	2 7/8	16 7/8	33											9.0	.81
4	36		2 1/4			18	8 3/4	9 1/4	15 3/8	5 3/8	12 5/8	17 1/8	1 1/2	2 7/8	16 7/8	33											9.0	.81
5	36		2 1/4			18	8 3/4	9 1/4	15 3/8	5 3/8	12 5/8	17 1/8	1 1/2	2 7/8	16 7/8	33											9.0	.81

STATE PROJECT NUMBER:

FILE NAME : C:\Users\Projects\tr\_std\plate\M16.DGN

PLOT DATE : 09-APR-2004 09:05

ORG DATE : 1980


Originator : Sandy Anderson

SHEET NO: 44 E

WISDOT/CADDs SHEET 42

## NOTES

1. Sign is Type II - See Note 6 - reference  
WIS DOT Standard Specification for HIGHWAY  
and STRUCTURE CONSTRUCTION latest edition.
2. Color:  
Background - White & Black - See Note 6  
Message - Black
3. Message Series - See note 5
4. Corners may be square or rounded when base  
material is plywood but borders shall be rounded  
as shown. When base material is metal, the  
corners and borders shall be rounded.
5. Substitute appropriate Series numerals and  
adjust spacing as per plate A10-1.
6. Permanent Signs  
Background - Type H Reflective  
Detour or temporary Signs  
Background - Reflective

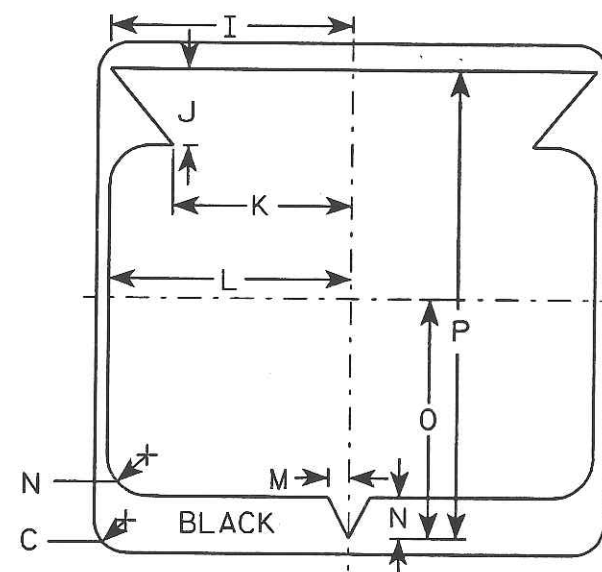

STATE ROUTE MARKER  
M1-6 FOR ASSEMBLIES

WISCONSIN DEPT OF TRANSPORTATION


APPROVED

*Chester J. Spang*  
for State Traffic Engineer


DATE 3/20/02

PLATE NO. M1-6.9



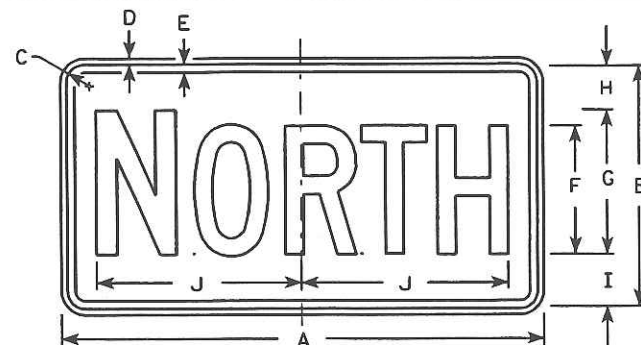


M3-1  
MK3-1  
M03-1

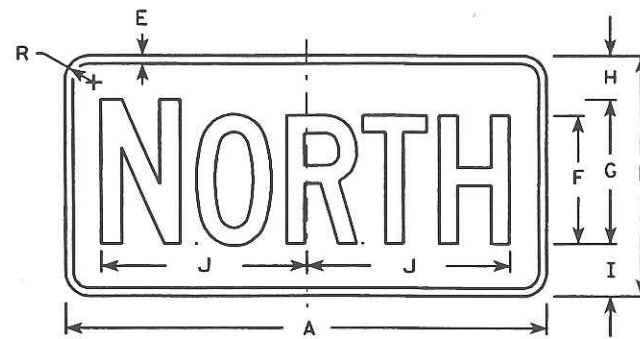


MB3-1  
MG3-1  
MM3-1\*  
MN3-1




M3-2  
MK3-2  
M03-2

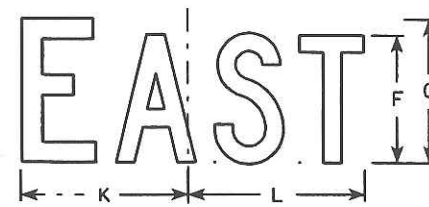

MB3-2  
MG3-2  
MM3-2\*  
MN3-2

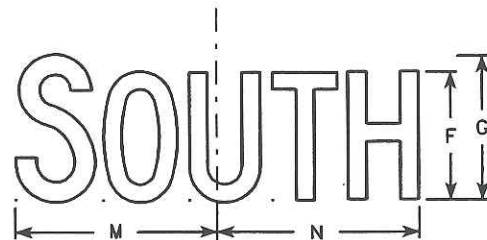


M3-3  
MK3-3  
M03-3

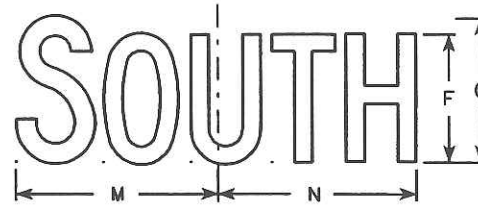

MB3-3  
MG3-3  
MM3-3\*  
MN3-3



M3-4  
MK3-4  
M03-4

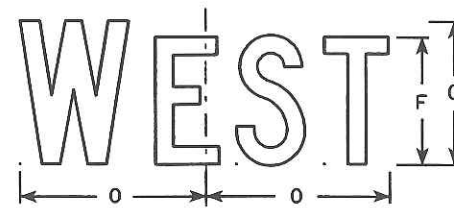

MB3-4  
MG3-4  
MM3-4\*  
MN3-4

Metric equivalent  
for this sign is:

SIZE	
1	
2	600 mm X 300 mm
3	750 mm X 375 mm
4	750 mm X 375 mm
5	750 mm X 375 mm

SIZE	A	B	C	D	E	F	G	H	I	J	K	L	M	N	O	P	Q	R	S	T	U	V	W	X	Y	Z	Area sq. ft.	Area m <sup>2</sup>
1																												
2	24	12	1 1/8	3/8	1/2	6	7	2 1/4	2 3/4	10 1/4	7 7/8	8 3/8	10 1/4	9 3/4	8 3/4			1 1/2									2.00	0.18
3	30	15	1 1/8	3/8	1/2	8	9	2 3/4	3 1/4	12 3/4	10 3/8	11 1/8	12 5/8	12 1/2	11 5/8			1 1/2									3.13	0.28
4	30	15	1 1/8	3/8	1/2	8	9	2 3/4	3 1/4	12 3/4	10 3/8	11 1/8	12 5/8	12 1/2	11 5/8			1 1/2									3.13	0.28
5	30	15	1 1/8	3/8	1/2	8	9	2 3/4	3 1/4	12 3/4	10 3/8	11 1/8	12 5/8	12 1/2	11 5/8			1 1/2									3.13	0.28

STATE PROJECT NUMBER:

FILE NAME : C:\Users\Projects\tr\_stdplate\M31.DGN

PLOT DATE : 09-APR-2004 09:06

ORG DATE : 1980

Originator : Sandy Anderson

## NOTES

- All Signs Type II - See Note 5 - reference WIS DOT Standard Specification for HIGHWAY and STRUCTURE CONSTRUCTION latest edition.
- Color:
  - Background - See note 5
  - Message - See note 5
- Message Series - C
- Corners may be square or rounded when base material is plywood but borders shall be rounded as shown. When base material is metal, the corners and borders shall be rounded.
- M3-1 thru M3-4 Background - White - Type H Reflective  
(Detour or temporary signs - Reflective)  
Message - Black  
MB3-1 thru MB3-4 Background - Blue  
Message - White - Type H Reflective  
(Detour or temporary signs - Reflective)  
MG3-1 thru MG3-4 Background - Green  
Message - White - Type H Reflective  
MK3-1 thru MK3-4 Background - Green  
Message - White - Type H Reflective  
MM3-1 thru MM3-4 Background - White - Type H Reflective  
Message - Green  
MN3-1 thru MN3-4 Background - Brown  
Message - White - Type H Reflective  
M03-1 thru M03-4 Background - Orange - Reflective  
Message - Black
- Border shall be omitted on MM series.
- Note the first letter of each direction is larger than the remainder of the message.

\* See Note 6

STANDARD SIGNS  
M3-1 thru M3-4  
SERIES

WISCONSIN DEPT OF TRANSPORTATION

APPROVED

*Chester J. Spang*  
for State Traffic Engineer


DATE 3/20/02

PLATE NO. M3-1.10

SHEET NO: 45

E



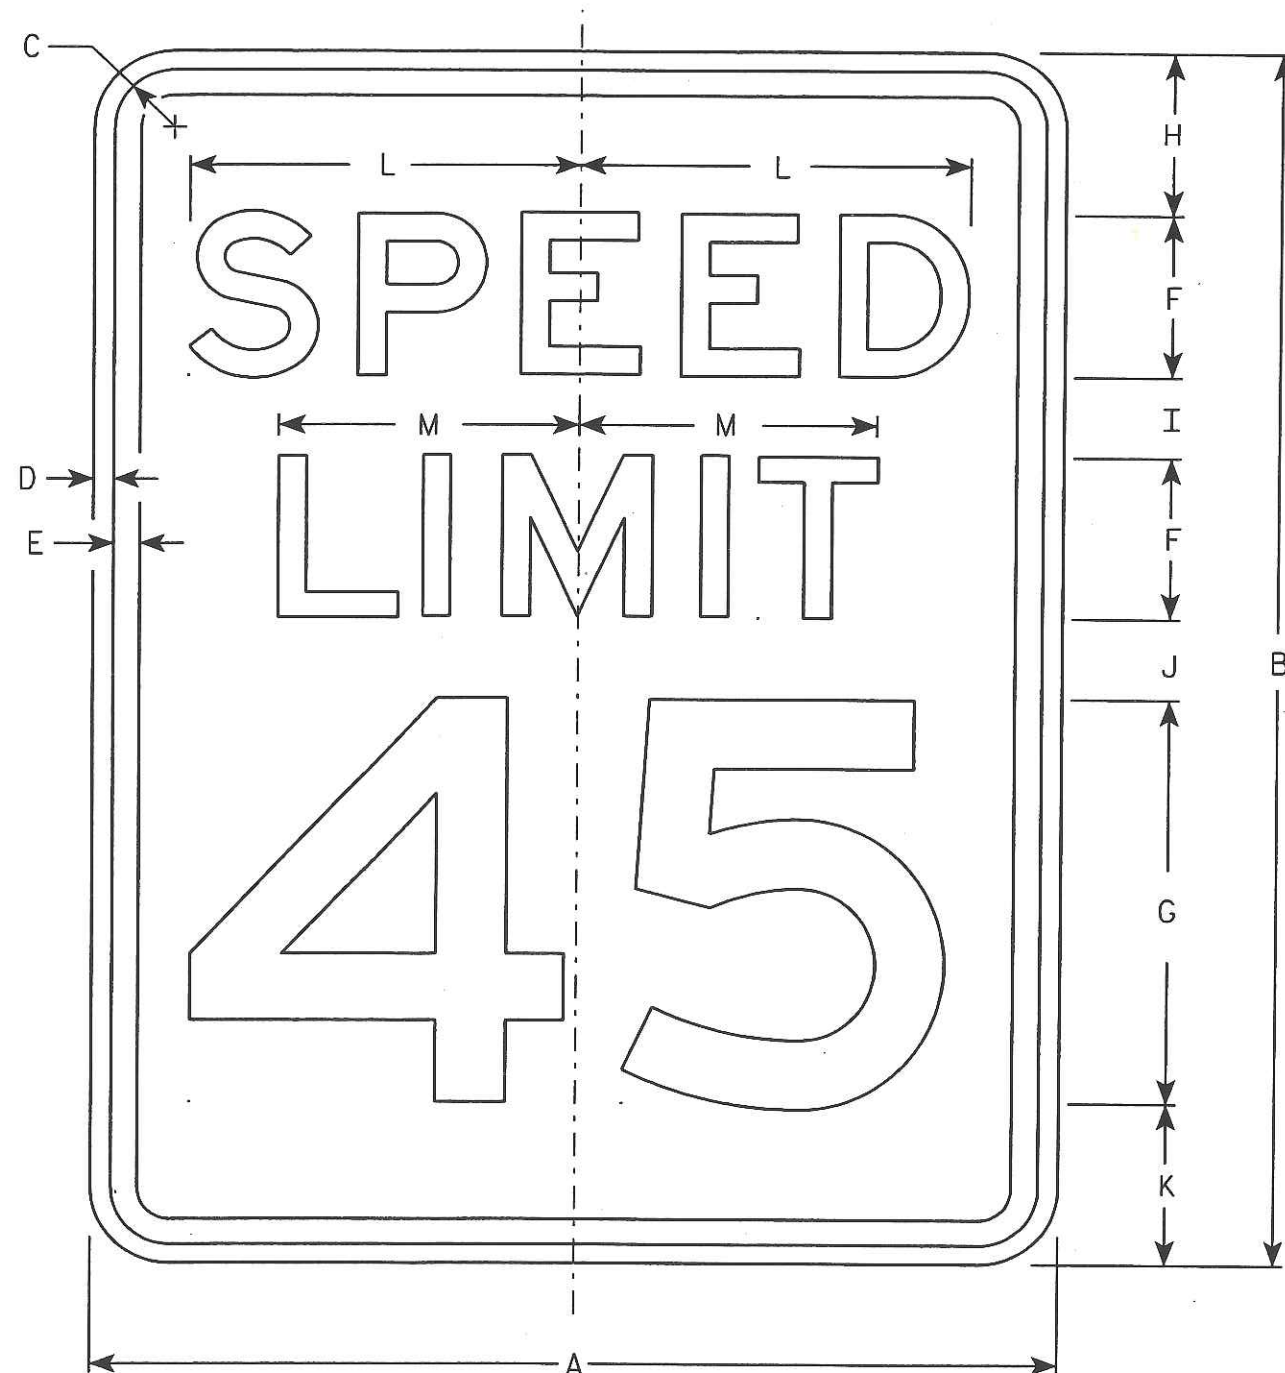

# NOTES

1. Sign is Type II - Type H Reflective - reference WIS DOT Standard Specification for HIGHWAY and STRUCTURE CONSTRUCTION latest edition.
2. Color:  
Background - White  
Message - Black
3. Message Series - E
4. Corners may be square or rounded when base material is plywood but borders shall be rounded as shown. When base material is metal, the corners and borders shall be rounded.
5. Substitute appropriate numerals and optically adjust spacing to achieve proper balance.

Metric equivalent  
for this sign is:

SIZE	
1	450 mm X 600 mm
2	600 mm X 750 mm
3	900 mm X 1200 mm
4	900 mm X 1200 mm
5	1200 mm X 1500 mm

SIZE	A	B	C	D	E	F	G	H	I	J	K	L	M	N	O	P	Q	R	S	T	U	V	W	X	Y	Z	Area sq. ft.	Area sq. m.
1	18	24	1 1/8	3/8	1/2	3	8	3	2	2	3	7 1/4	5 1/2														3.0	.28
2	24	30	1 1/8	3/8	1/2	4	10	3	2 1/4	3 3/8	3 3/8	9 5/8	7 3/8														5.0	.46
3	36	48	1 3/8	1/2	5/8	6	14	6	5	5	6	14 3/8	11														12.0	1.11
4	36	48	1 3/8	1/2	5/8	6	14	6	5	5	6	14 3/8	11														12.0	1.11
5	48	60	2 1/4	3/4	1	8	20	6	4 1/2	6 3/4	6 3/4	19 1/4	14 5/8														20.0	1.86

## STANDARD SIGN R2-1

WISCONSIN DEPT OF TRANSPORTATION

APPROVED

*Charles J. Spang*  
for State Traffic Engineer

DATE 2/01/02

PLATE NO. R2-1.11

STATE PROJECT NUMBER:

SHEET NO: 16

E

FILE NAME : C:\Users\Projects\tr\_stdplate\R21.DGN


PLOT DATE : 09-APR-2004 09:06

ORG DATE : 6/4/97

Originator : Don Kluever

WISDOT/CADDs SHEET 42



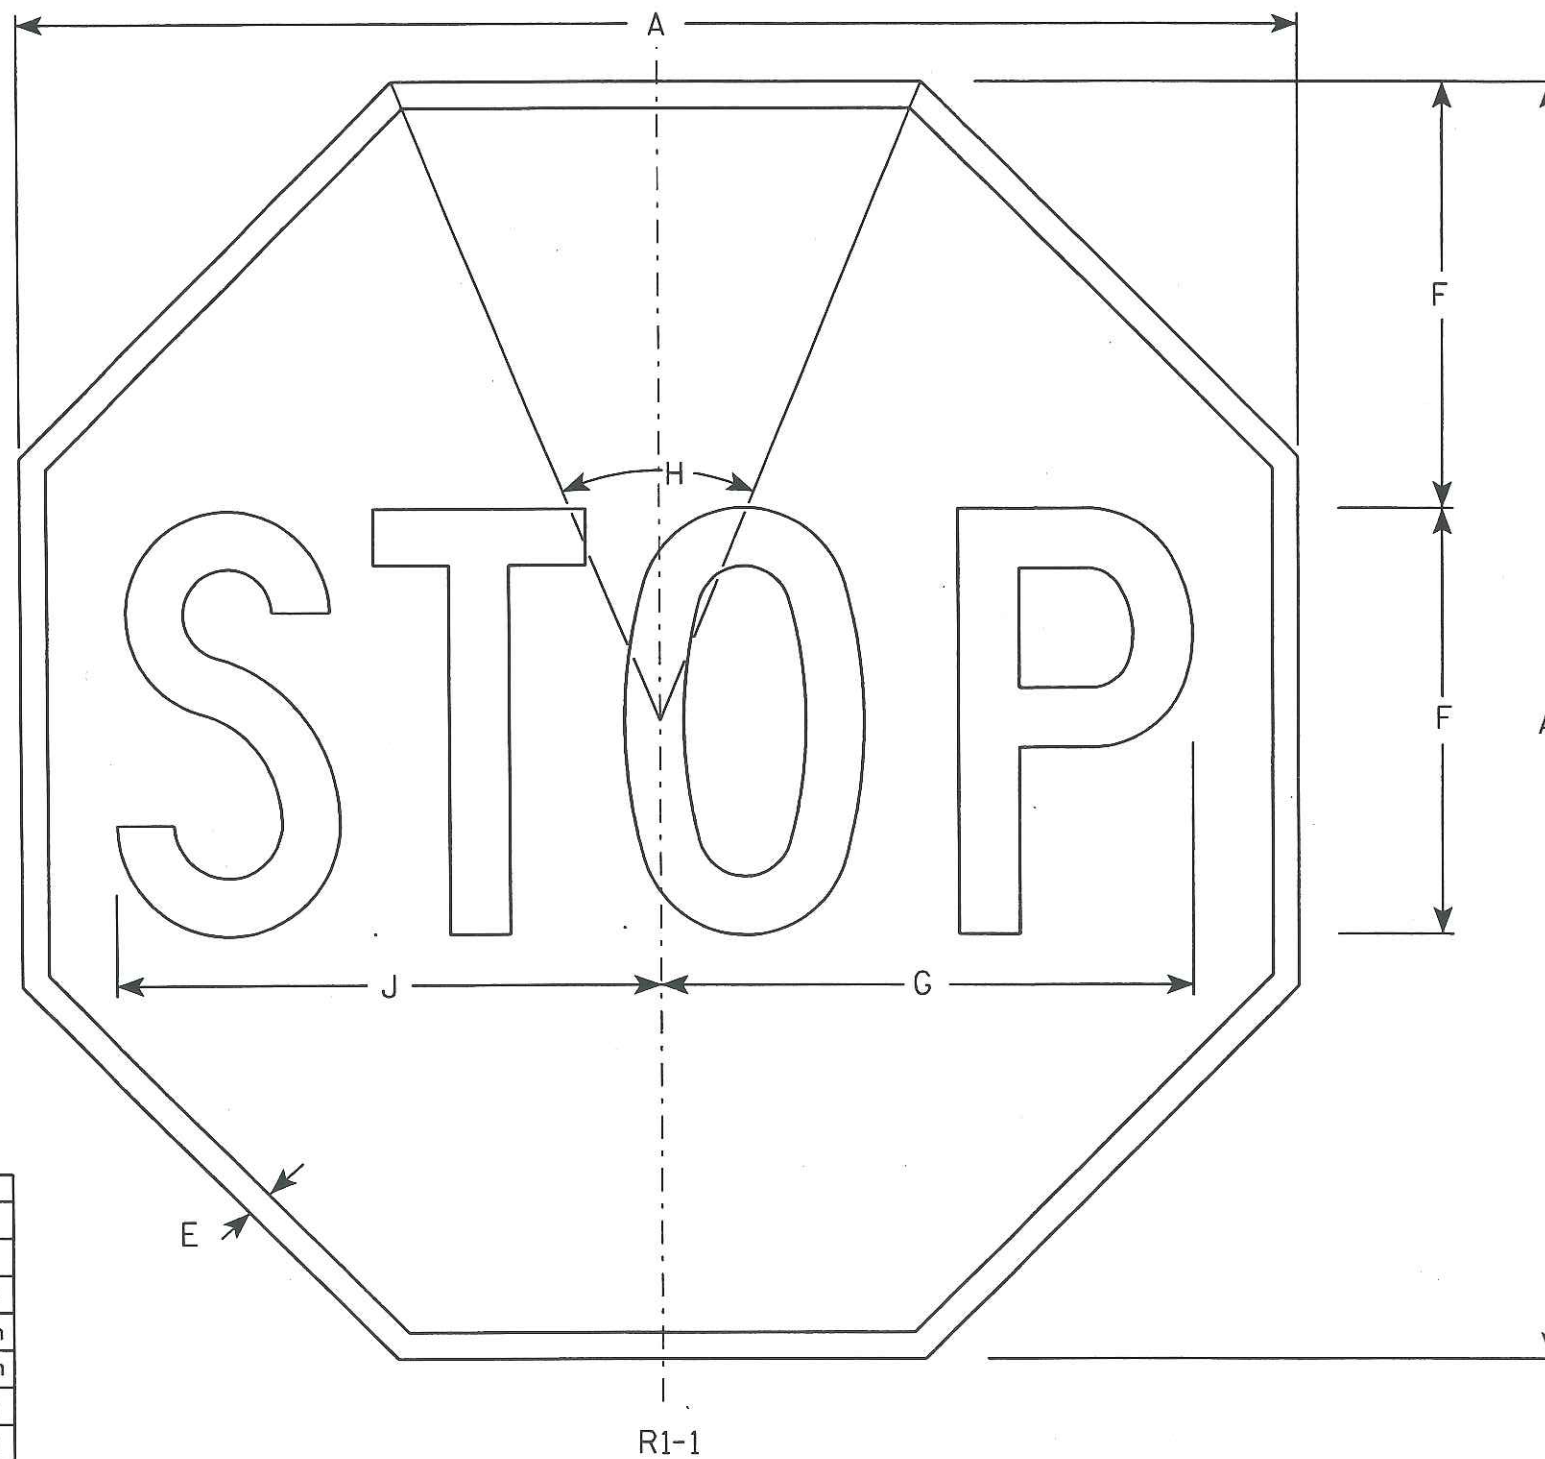

Metric equivalent  
for this sign is:

SIZE	
1	600 mm X 600 mm
2	750 mm X 750 mm
3	900 mm X 900 mm
4	1200 mm X 1200 mm
5	1200 mm X 1200 mm
6	450 mm X 450 mm
7	300 mm X 300 mm

SIZE	A	B	C	D	E	F	G	H	I	J	K	L	M	N	O	P	Q	R	S	T	U	V	W	X	Y	Z	Area sq. ft.	Area sq. m.
1	24				$\frac{3}{8}$	8	10	45°		10 $\frac{1}{4}$																	3.31	0.31
2	30				$\frac{5}{8}$	10	12 $\frac{1}{2}$	45°		12 $\frac{3}{4}$																	5.18	0.48
3	36				$\frac{3}{4}$	12	15	45°		15 $\frac{3}{8}$																	7.46	0.69
4	48				1	16	20	45°		20 $\frac{1}{2}$																	13.25	1.23
5	48				1	16	20	45°		20 $\frac{1}{2}$																	13.25	1.23
6	18				$\frac{3}{8}$	6	7 $\frac{3}{4}$	45°		7 $\frac{3}{4}$																	1.86	0.17
7	12				$\frac{1}{4}$	4	5	45°		5 $\frac{1}{8}$																	0.78	0.07

### NOTES

- Sign is Type II - Type H Reflective - reference WIS DOT Standard Specification for HIGHWAY and STRUCTURE CONSTRUCTION latest edition.
- Color:  
Background - Red  
Message - White
- Message Series - C

### STANDARD SIGN R1-1

WISCONSIN DEPT OF TRANSPORTATION

APPROVED

*Chester J. Spang*  
for State Traffic Engineer

DATE 10/15/98

PLATE NO. R1-1.11

STATE PROJECT NUMBER:

HWY:


COUNTY:

SHEET NO: 47 E



# NOTES

1. Sign is Type II - Type H Reflective - reference WIS DOT Standard Specification for HIGHWAY and STRUCTURE CONSTRUCTION latest edition.
2. Color:  
Background - Yellow  
Message - Black
3. Message Series - See note 5
4. Corners and borders shall be rounded on all base materials for this sign.
5. Lines 1 and 2 are Series D.  
Line 3 is series C.

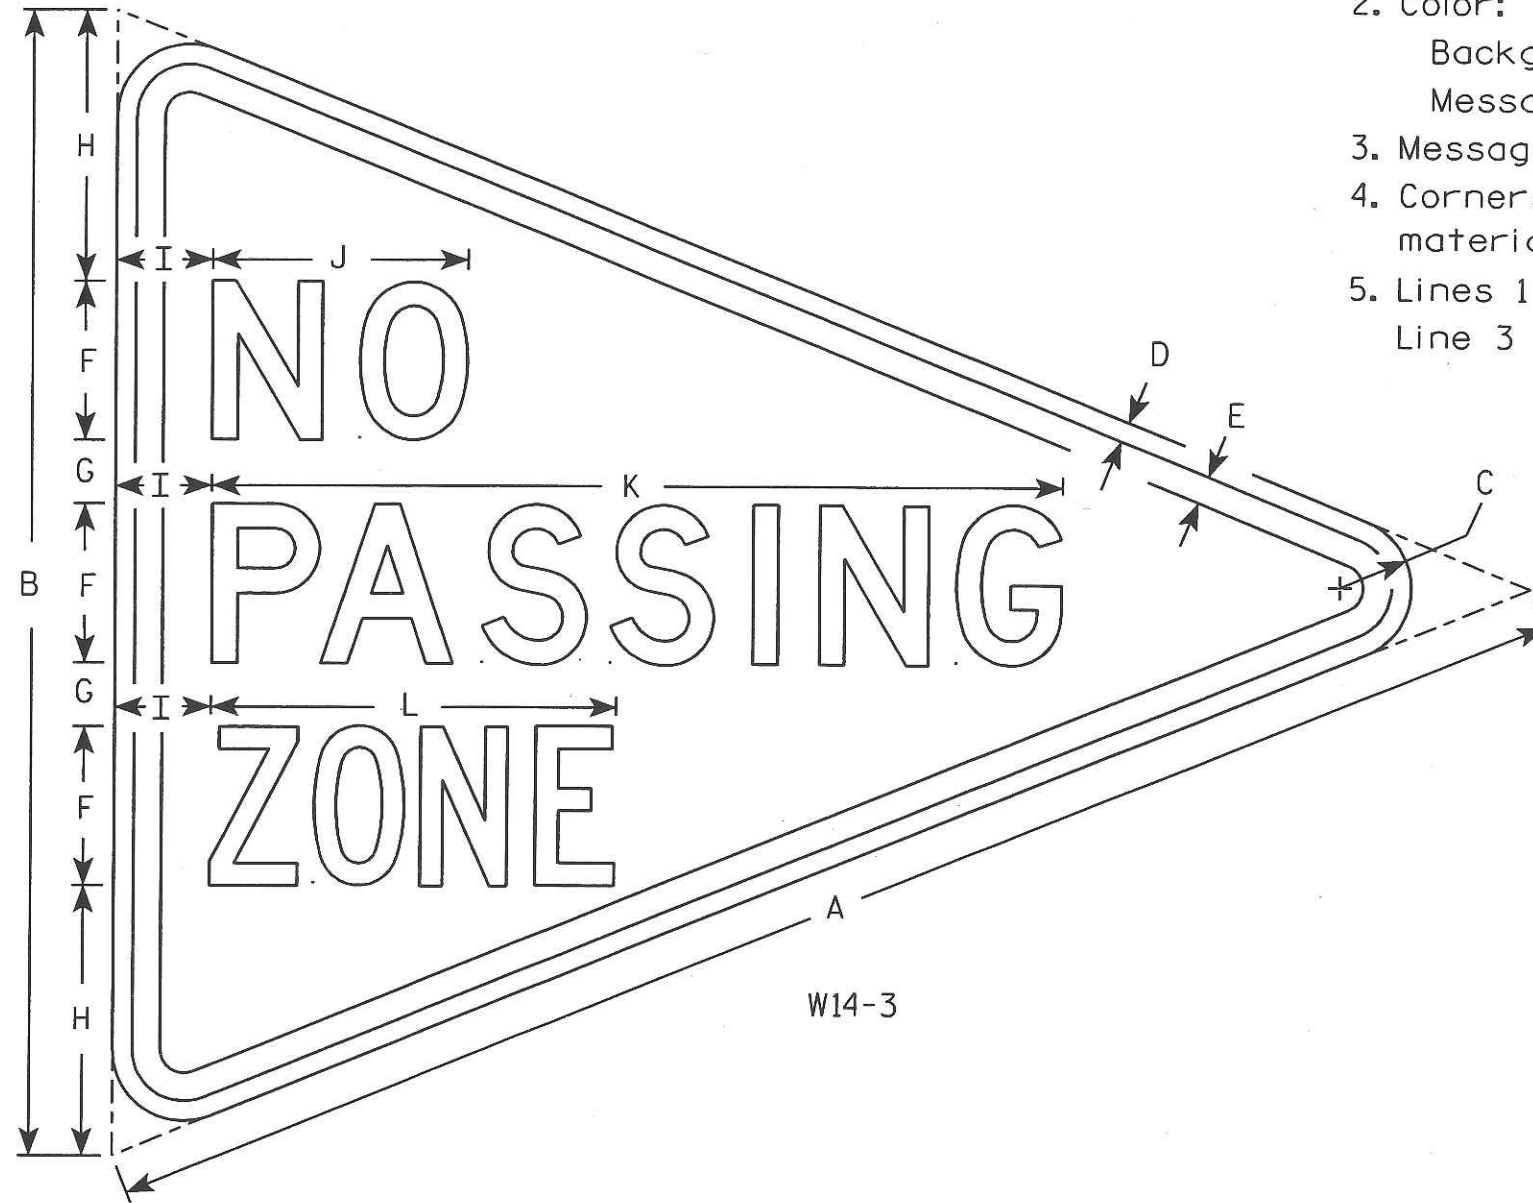

Metric equivalent  
for this sign is:

SIZE	
1	
2	1200 mm X 900 mm
3	1600 mm X 1200 mm
4	
5	


SIZE	A	B	C	D	E	F	G	H	I	J	K	L	M	N	O	P	Q	R	S	T	U	V	W	X	Y	Z	Area sq. ft.	Area m <sup>2</sup>
1																												
2	48	36	2 1/4	5/8	7/8	5	2	8 1/2	3	8	26 3/4	12 3/4															6.0	.54
3	64	48	3	3/4	1 1/4	6	3	12	4	10 3/4	33 5/8	16 1/2															10.7	.96
4																												
5																												

## STANDARD SIGN W14-3

WISCONSIN DEPT OF TRANSPORTATION  
APPROVED *Christa J. Spang*  
for State Traffic Engineer  
DATE 1/21/98 PLATE NO. W14-3.8

SHEET NO: 18 E



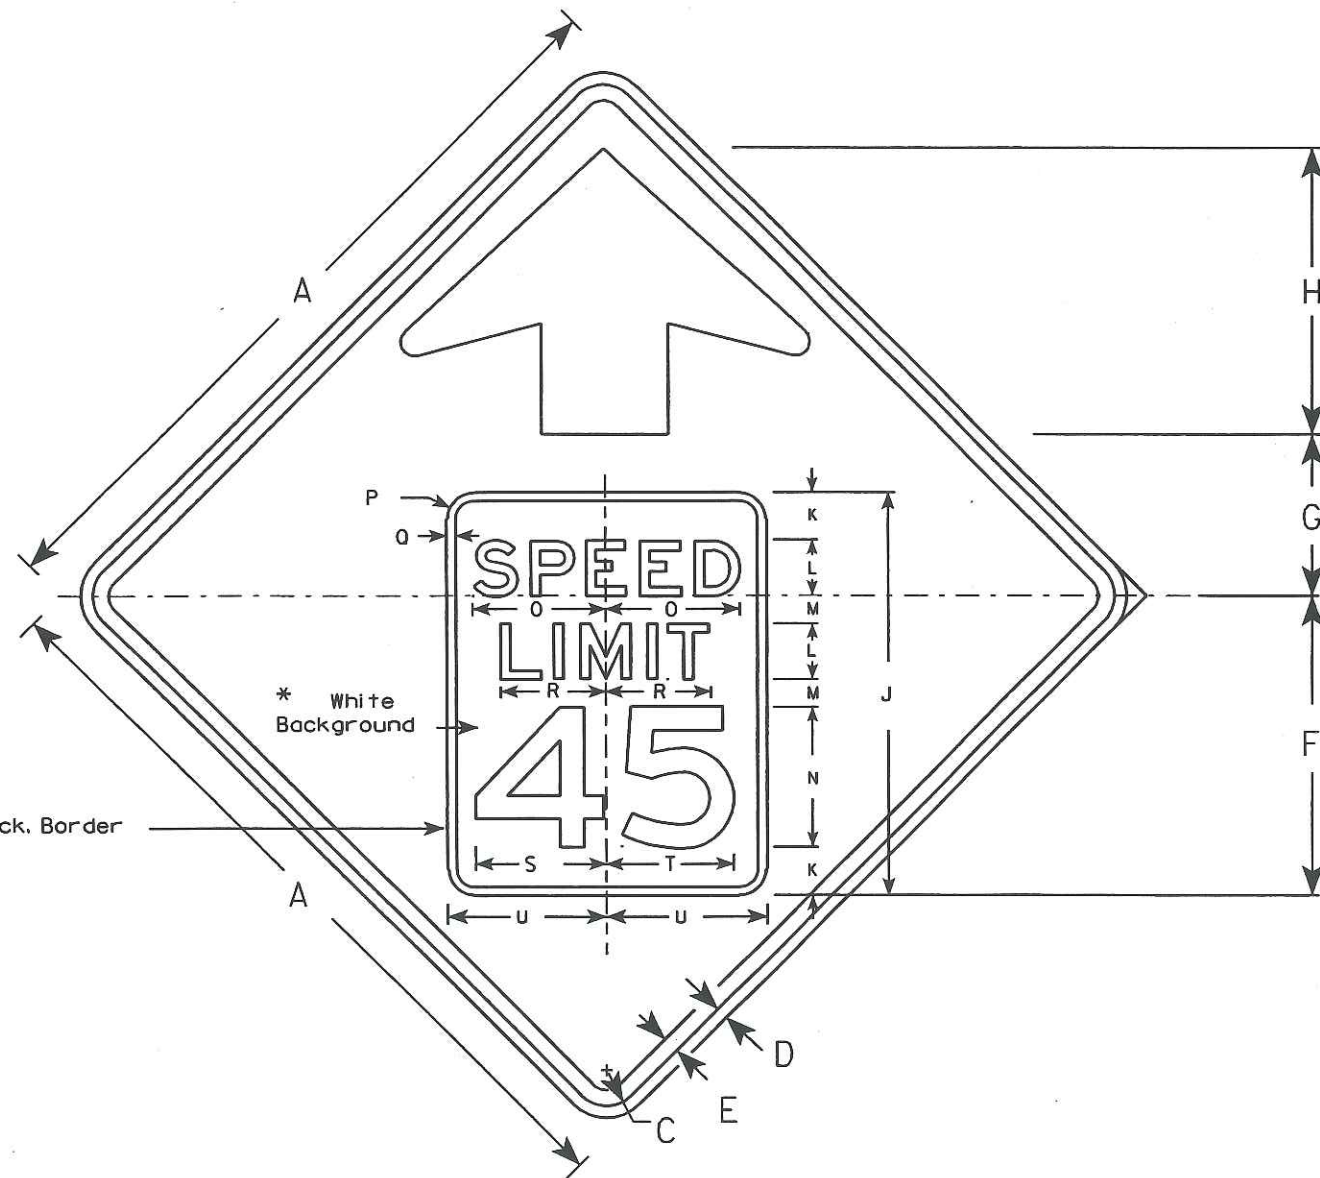

W3-5

Metric equivalent  
for this sign is:


SIZE	
1	
2	900 mm X 900 mm
3	1200 mm X 1200 mm
4	1200 mm X 1200 mm
5	1200 mm X 1200 mm

SIZE	A	B	C	D	E	F	G	H	I	J	K	L	M	N	O	P	Q	R	S	T	U	V	W	X	Y	Z	Area sq. ft.	Area sq. m.
1																												
2	36		1 5/8	5/8	3/4	14 1/8	7 1/2	13 1/2	5/8	19	2 1/4	2 5/8	1 3/8	6 1/2	6 1/4	1 1/2	3/8	4 7/8	6 1/4	6	7 1/2	6	19 1/4		9 3/4	1 5/8	9.0	0.81
3	36		1 5/8	5/8	3/4	14 1/8	7 1/2	13 1/2	5/8	19	2 1/4	2 5/8	1 3/8	6 1/2	6 1/4	1 1/2	3/8	4 7/8	6 1/4	6	7 1/2	6	19 1/4		9 3/4	1 5/8	9.0	0.81
4	48		2 1/4	3/4	1	18 3/4	10 1/8	17 7/8	7/8	25 1/4	3	3 1/2	1 3/4	8 3/4	8 3/8	1 5/8	1/2	6 5/8	8 1/4	8	10	8	25 5/8		13	2	16.0	1.44
5	48		2 1/4	3/4	1	18 3/4	10 1/8	17 7/8	7/8	25 1/4	3	3 1/2	1 3/4	8 3/4	8 3/8	1 5/8	1/2	6 5/8	8 1/4	8	10	8	25 5/8		13	2	16.0	1.44

## NOTES

1. All Signs Type II - Type H Reflective - reference WIS DOT Standard Specification for HIGHWAY and STRUCTURE CONSTRUCTION latest edition.
2. Color: \*  
Background - YELLOW\*  
Message - BLACK
3. Message Series - E
4. Substitute appropriate numerals and optically adjust spacing to achieve proper balance

\*Speed Limit Sign shall have a White Background

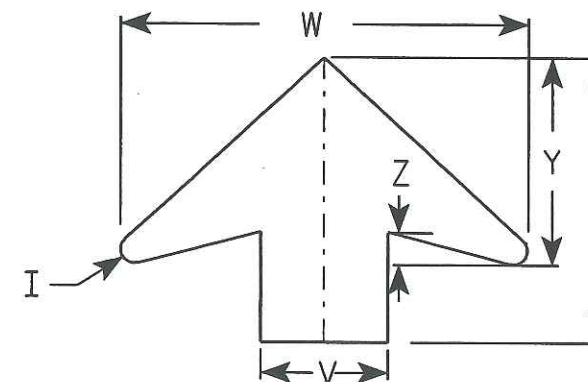

ARROW DETAIL

## STANDARD SIGN

W3-5

WISCONSIN DEPT OF TRANSPORTATION

APPROVED *Matthew R. Rauch*  
For State Traffic Engineer

DATE 2/18/04 PLATE NO. W3-5.1

PROJECT NO:

FILE NAME : C:\Users\Projects\tr\_std\plate\W35.DGN

PLOT DATE : 09-APR-2004 09:09

PLOT BY : DOT02K


SHEET NO: 49

E



# NOTES

1. Sign is Type II - Type H Reflective - reference WIS DOT Standard Specification for HIGHWAY and STRUCTURE CONSTRUCTION latest edition.
2. Color:  
Background - Yellow  
Message - Black
3. Corners may be square or rounded when base material is plywood but borders shall be rounded as shown. When base material is metal, the corners and borders shall be rounded.

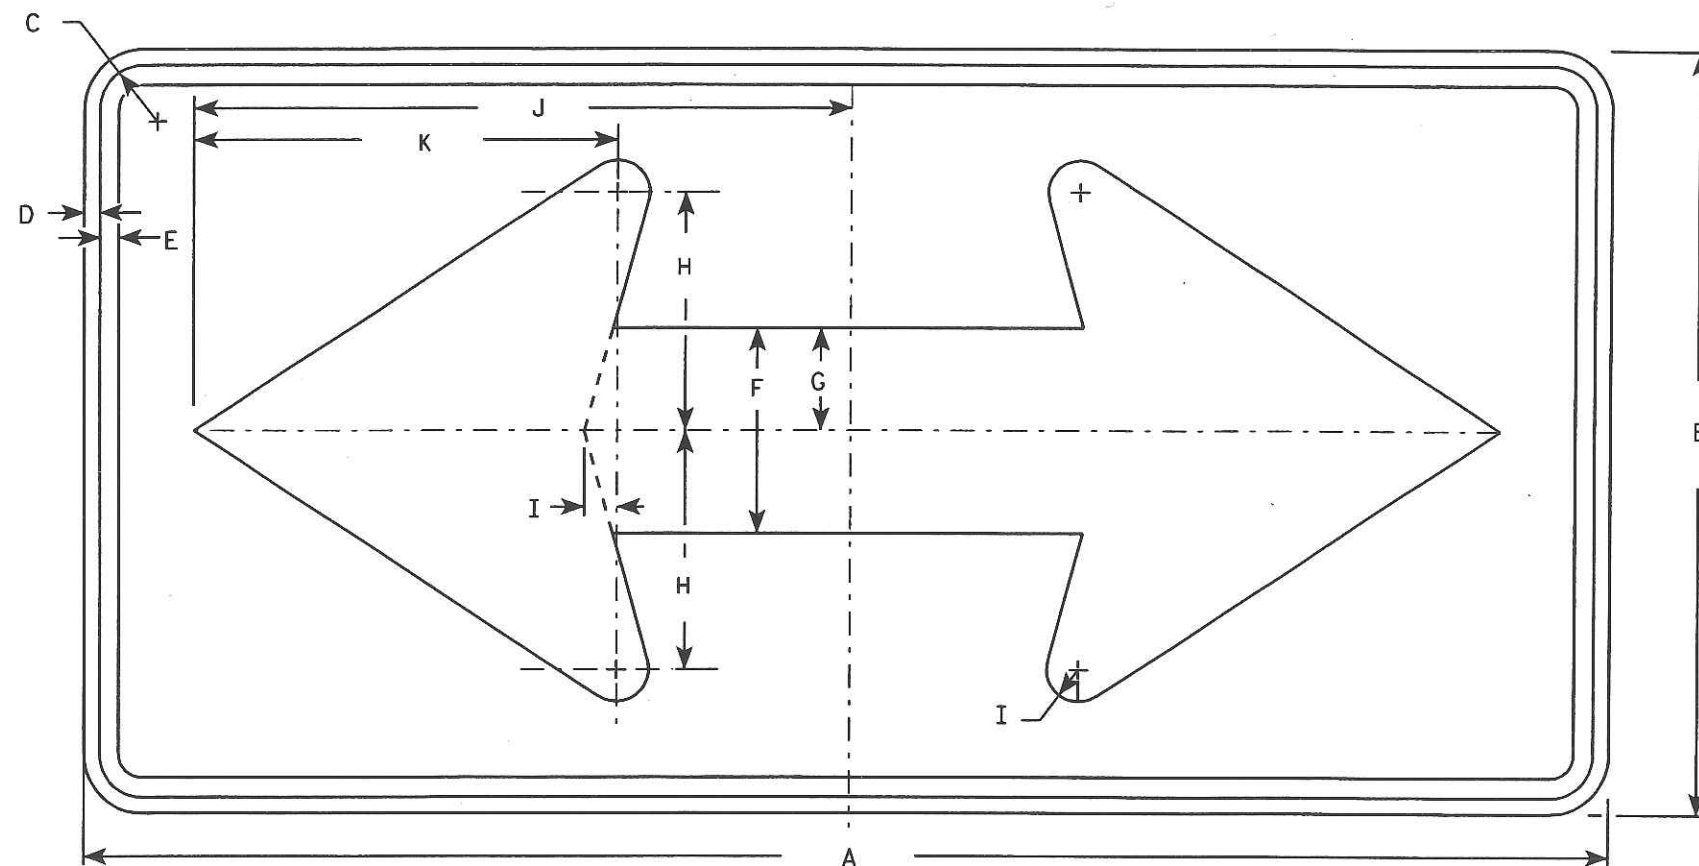

Metric equivalent  
for this sign is:

SIZE	
1	900 mm X 450 mm
2	1200 mm X 600 mm
3	1500 mm X 750 mm
4	1500 mm X 750 mm
5	2400 mm X 1200 mm

W1-7

SIZE	A	B	C	D	E	F	G	H	I	J	K	L	M	N	O	P	Q	R	S	T	U	V	W	X	Y	Z	Area sq. ft.	Area m <sup>2</sup>
1	36	18	1 1/8	3/8	1/2	5	2 1/2	5 3/4	3/4	15 5/8	10 1/8																4.5	0.41
2	48	24	1 3/8	1/2	5/8	6 1/2	3 1/4	7 1/2	1	20 1/2	13 1/4																8.0	0.72
3	60	30	1 3/8	1/2	5/8	8	4	9 1/4	1 1/4	25 3/8	16 1/4																12.5	1.13
4	60	30	1 3/8	1/2	5/8	8	4	9 1/4	1 1/4	25 3/8	16 1/4																12.5	1.13
5	96	48	2 1/4	3/4	1	13	6 1/2	15	2	41	26 1/2																32.0	2.88

## STANDARD SIGN W1-7

WISCONSIN DEPT OF TRANSPORTATION

APPROVED

*Christa J. Spang*  
for State Traffic Engineer

DATE 8/20/97

PLATE NO. W1-7.6

SHEET NO: 50 E