


Notice the comment also appears in the Markups List window at the bottom of the screen.

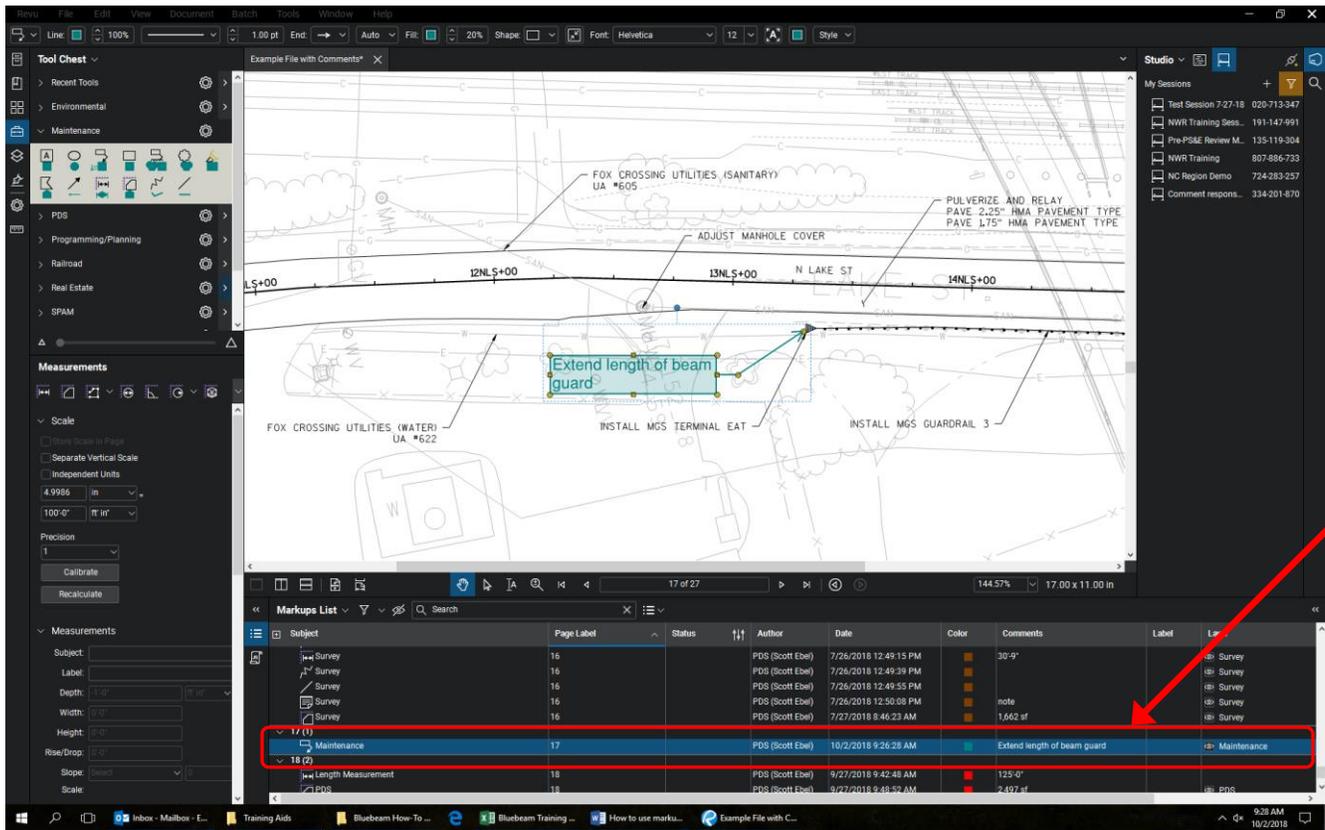

Here is the comment window zoomed in. Notice that comment text appears here as does the Section, Author, Page # and other information.

Subject	Page Label	Status	Author	Date	Color	Comments
Survey	16		PDS (Scott Ebel)	7/26/2018 12:49:15 PM		30'-9"
Survey	16		PDS (Scott Ebel)	7/26/2018 12:49:39 PM		
Survey	16		PDS (Scott Ebel)	7/26/2018 12:49:55 PM		
Survey	16		PDS (Scott Ebel)	7/26/2018 12:50:08 PM		note
Survey	16		PDS (Scott Ebel)	7/27/2018 8:46:23 AM		1,662 sf
Maintenance	17		PDS (Scott Ebel)	10/2/2018 9:26:28 AM		Extend length of beam guard
Length Measurement	18		PDS (Scott Ebel)	9/27/2018 9:42:48 AM		125'-0"
PDS	18		PDS (Scott Ebel)	9/27/2018 9:48:52 AM		2,497 sf

All comments made on a file can be found in this Markup List window. Separate training documents show how to organize comments and how to directly respond to comments.