


Draft Print

06/15/2018 10:02:52 AM

THOMAS W FLIESS
4217 HWY H
TAX KEY: 151032232002000

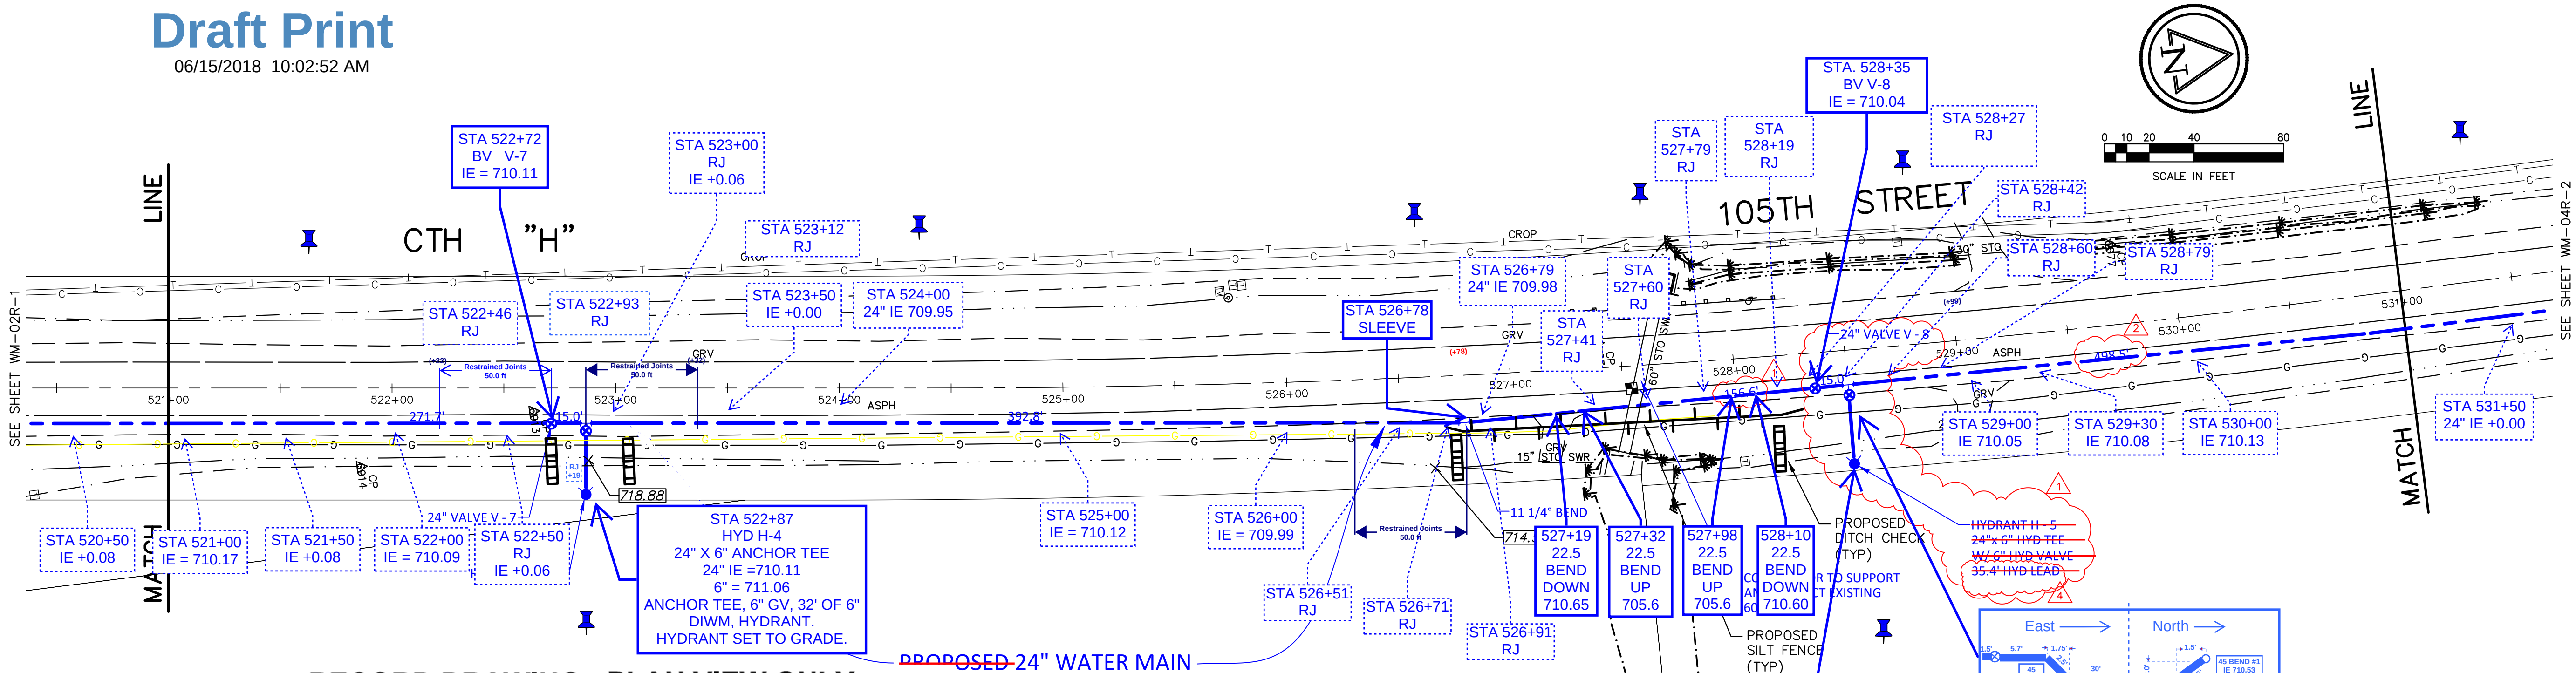


RECORD DRAWING - PLAN VIEW ONLY

GENERAL CONTRACTOR ADVANCE CONSTRUCTION
UNDERGROUND CONTRACTOR ADVANCE CONSTRUCTION
INSTALLATION DATE FEB/MARCH 2018 DRAWN BY SJZ DATE APRIL, 2018
CHECKED BY DATE

NOTES:
24\"/>

NOTE:
EXISTING UNDERGROUND UTILITIES SHOWN ON PLANS ARE A COMBINATION OF GIS MAPPING & FIELD SURVEY. CONTRACTOR TO VERIFY LOCATION OF ALL UTILITIES WHETHER SHOWN OR NOT PRIOR TO CONSTRUCTION TO HIS OWN SATISFACTION.

THOMAS W FLIESS
4217 HWY H
TAX KEY: 151032233014000

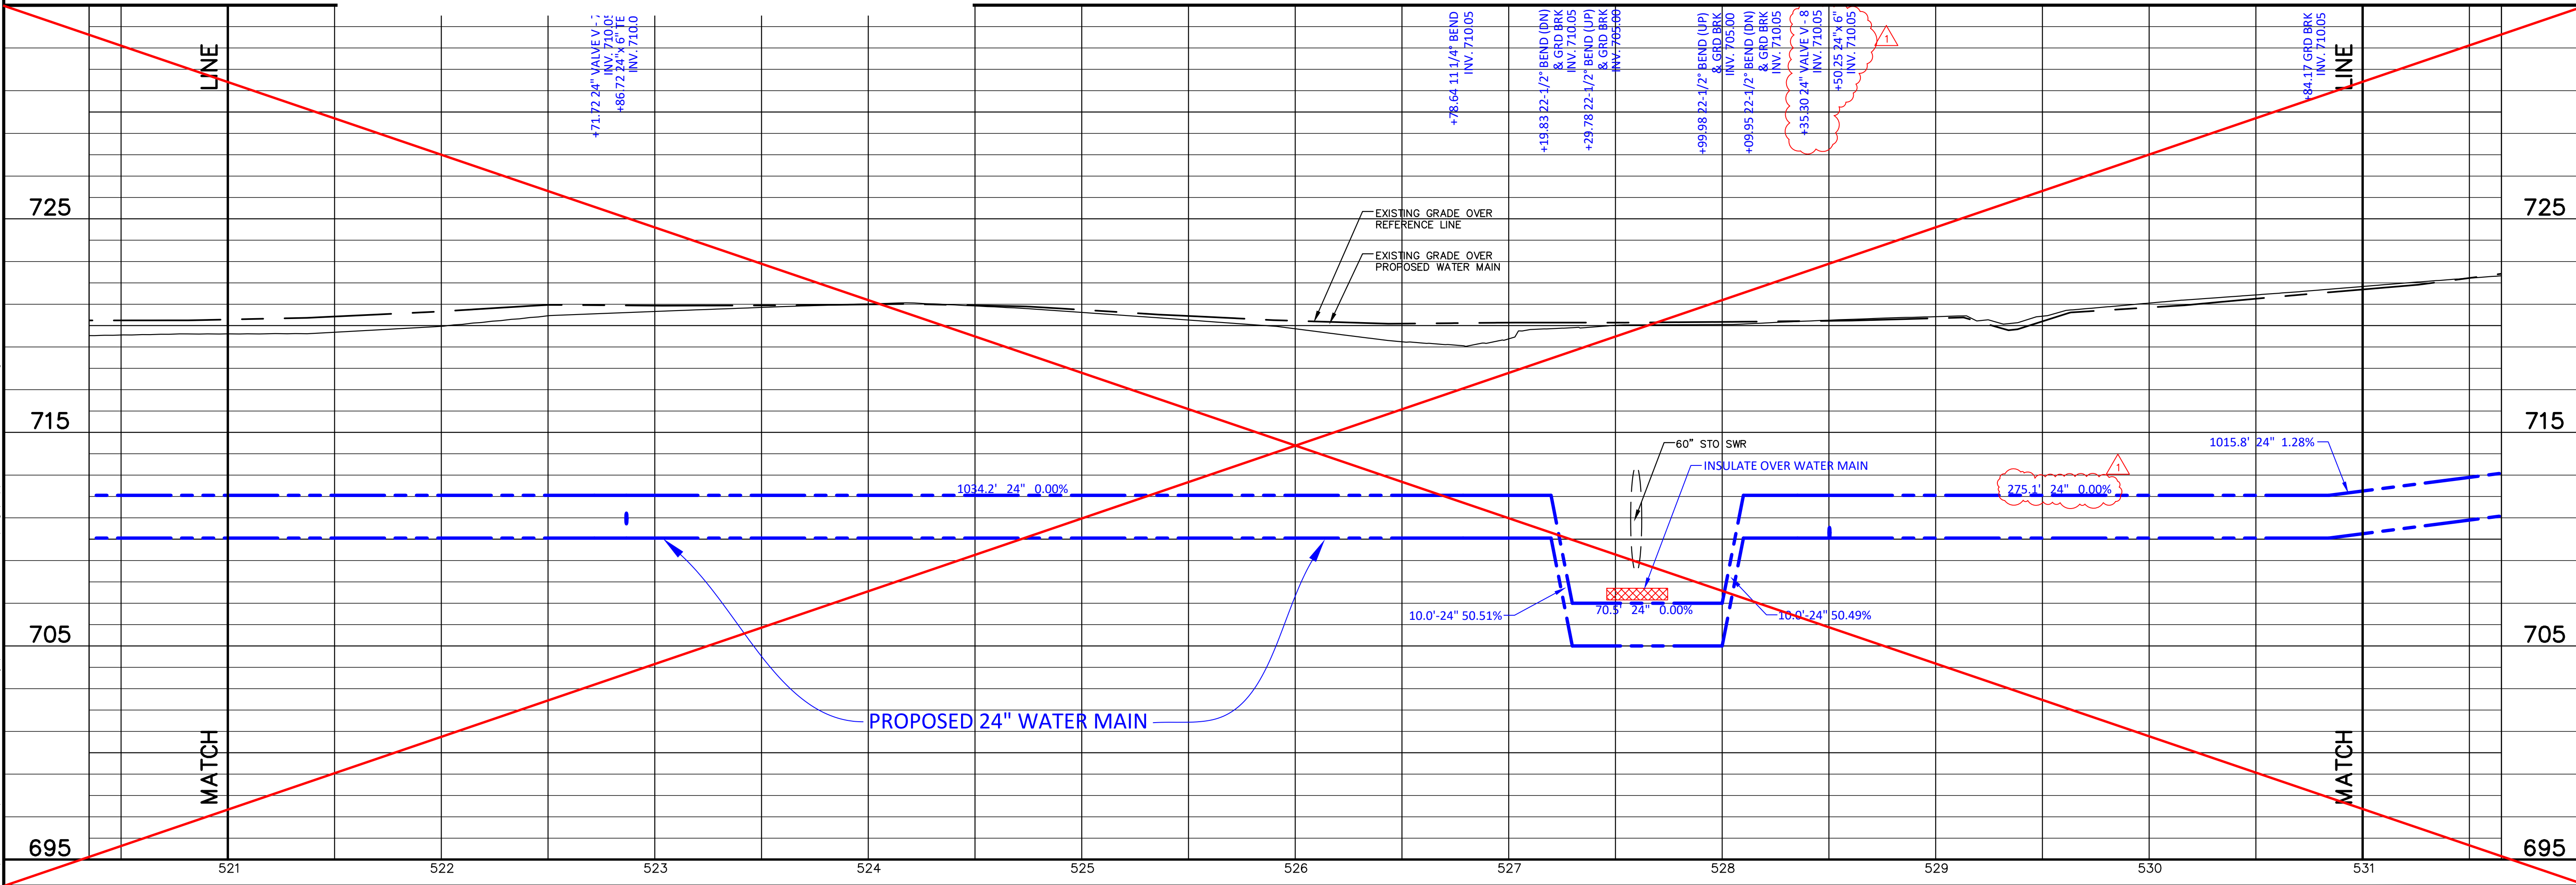

7	6	5	4	3	2	1
	</					

Ruekert • Mielke
Waukesha • Kenosha • Madison
Chicago • Global Water Center • Fox Valley
www.ruekertmielke.com

C.T.H. "H" TRANSMISSION WATER MAIN
PROPOSED WATER MAIN
IN: 105TH STREET / CTH "H"
FROM: 400' NORTH OF PRAIRIE VIEW DRIVE
TO: 1400' NORTH OF PRAIRIE VIEW DRIVE
RACINE COUNTY, WISCONSIN
RACINE WATER & WASTEWATER UTILITY

© COPYRIGHT 2017 RUEKERT & MIELKE INC.
DESIGNED BY: BEF
DRAFTED BY: AK1
CHECKED BY: KRW
DATE: DECEMBER 2017
FILE NO.
8022-10019.200
SHEET NO.
WM-03R-4


8/22/2018

Jan 18, 2018 4:00pm PLOTTED BY: dkruser SAVED BY: dkruser
IMAGES: RM SQUARE_Full Color-Print; C:\Users\mk2381\Documents\Projects\8022_Racine Water Utility\10019_Foxconn CTH H-4 Gas Loop WM CTH H-4 Gas Loop
G:\Users\mk2381\Documents\Projects\8022_Racine Water Utility\10019_Foxconn CTH H-4 Gas Loop WM CTH H-4 Gas Loop

Draft Print

06/15/2018 10:04:24 AM

THOMAS W FLIESS
4217 HWY H
TAX KEY: 151032232002000

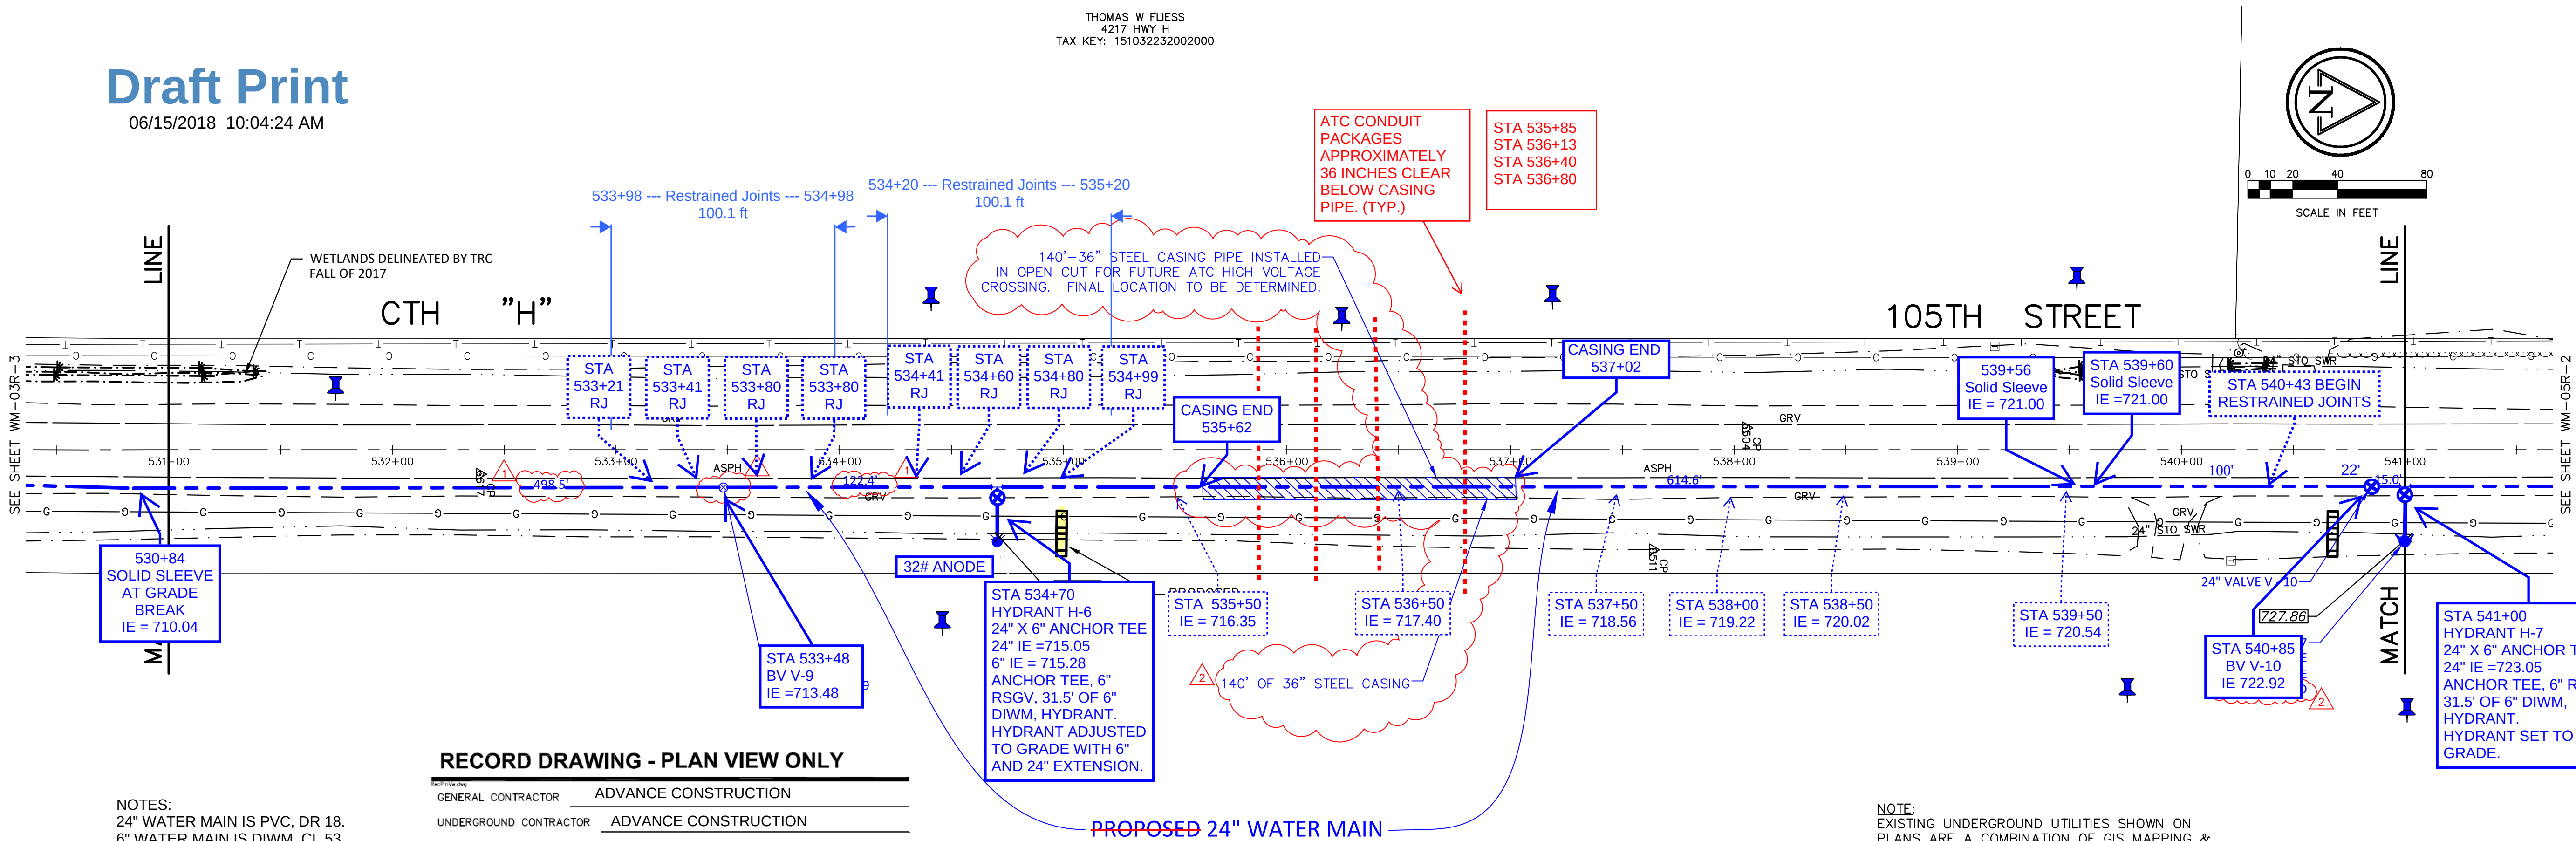


RECORD DRAWING - PLAN VIEW ONLY

GENERAL CONTRACTOR ADVANCE CONSTRUCTION
UNDERGROUND CONTRACTOR ADVANCE CONSTRUCTION
INSTALLATION DATE FEB/MARCH 2018 DRAWN BY SJZ DATE APRIL, 2018
CHECKED BY DATE

NOTES:
24" WATER MAIN IS PVC, DR 18.
6" WATER MAIN IS DIWM, CL 53.
ANODES PLACED AT ALL FITTINGS.
RESTRAINED JOINTS WHERE NOTED.
MEGALUGS USED AT ALL FITTINGS.

NOTE:
EXISTING UNDERGROUND UTILITIES SHOWN ON
PLANS ARE A COMBINATION OF GIS MAPPING &
FIELD SURVEY. CONTRACTOR TO VERIFY LOCATION
OF ALL UTILITIES WHETHER SHOWN OR NOT PRIOR
TO CONSTRUCTION TO HIS OWN SATISFACTION.

THOMAS W FLIESS
4217 HWY H
TAX KEY: 151032233014000


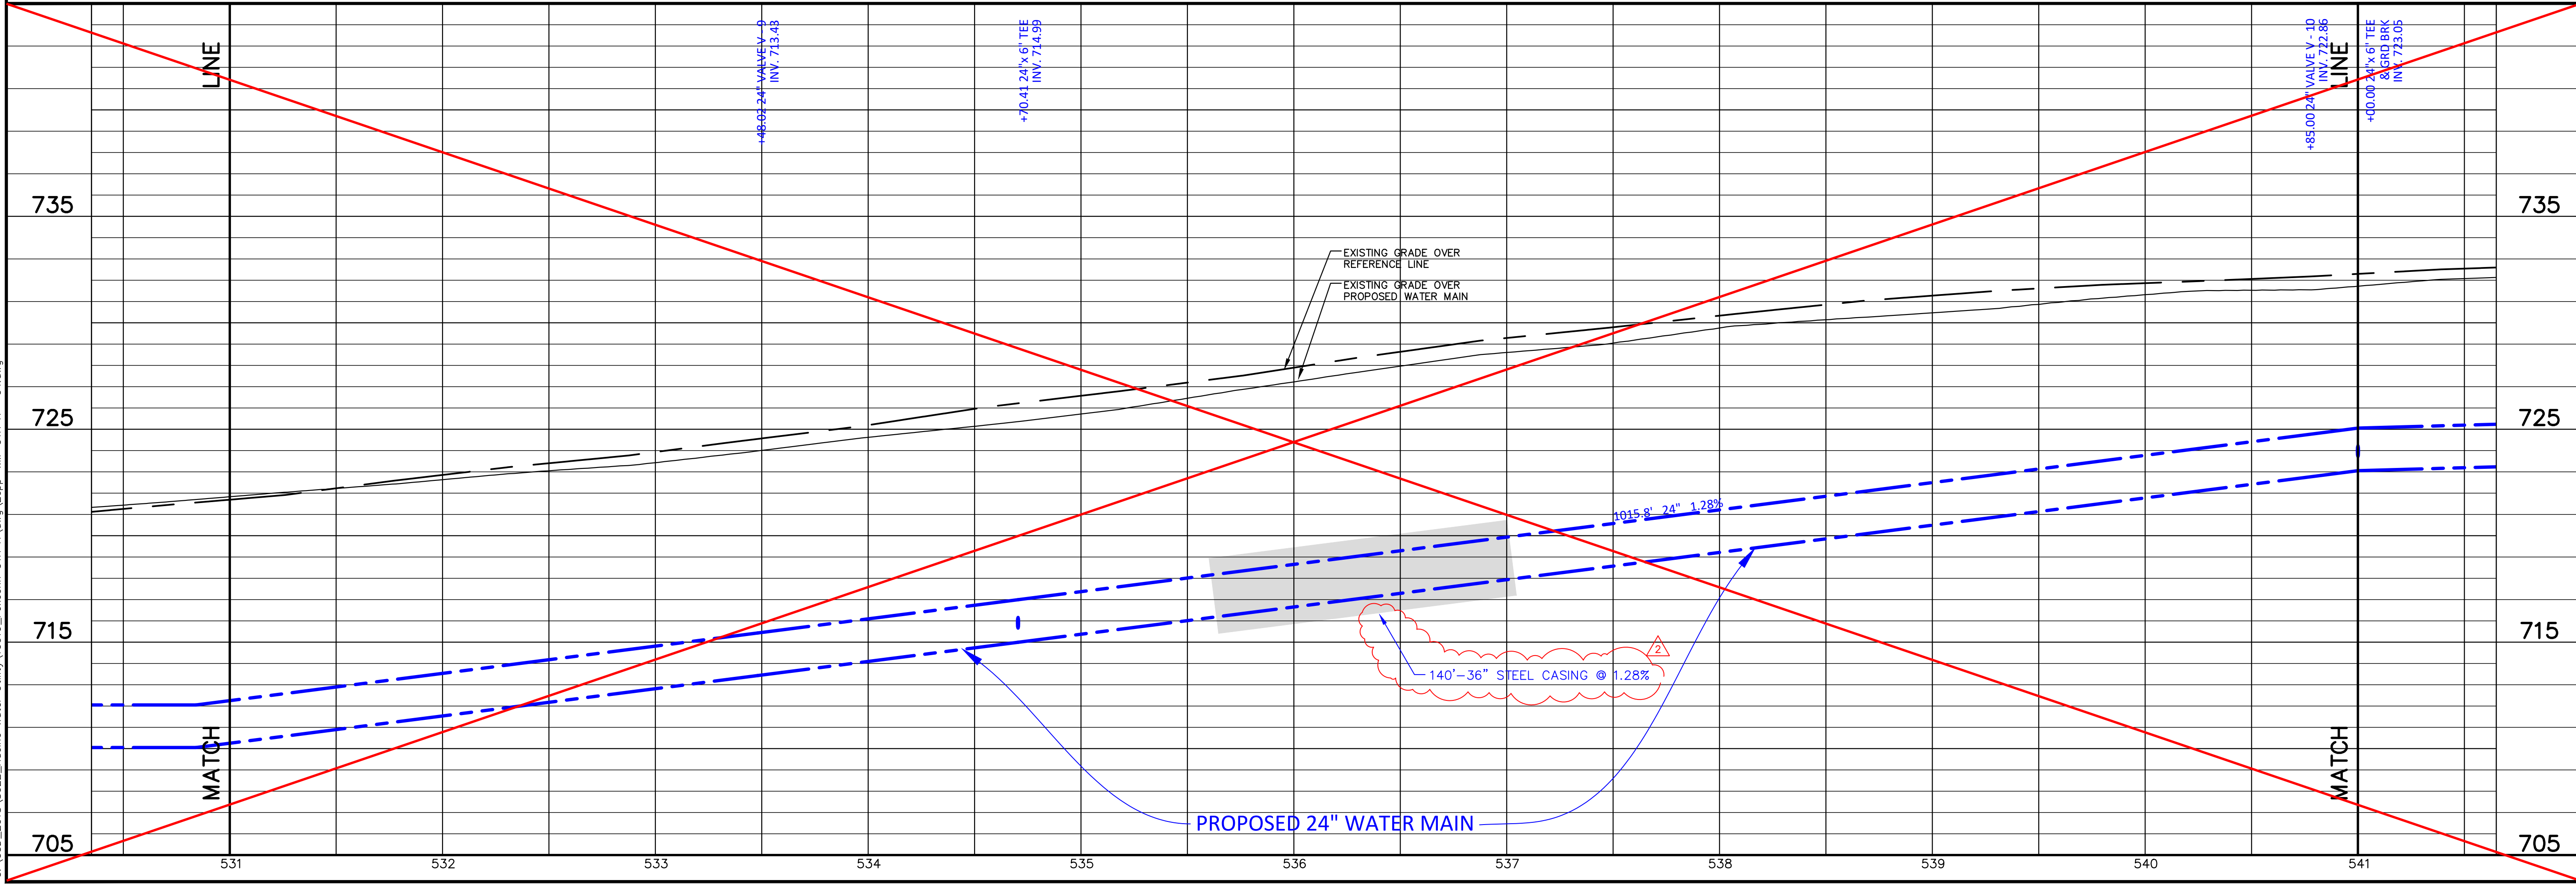


Ruekert • Mielke

Waukesha • Kenosha • Madison
Chicago • Global Water Center • Fox Valley
www.ruekermielke.com


C.T.H. "H" TRANSMISSION WATER MAIN
PROPOSED WATER MAIN
IN: 105TH STREET / CTH "H"
FROM: 1400' NORTH OF PRAIRIE VIEW DRIVE
TO: 2400' NORTH OF PRAIRIE VIEW DRIVE
RACINE COUNTY, WISCONSIN
RACINE WATER & WASTEWATER UTILITY

© COPYRIGHT 2017
RUEKERT & MIELKE INC.
DESIGNED BY: BEF
DRAFTED BY: AKI
CHECKED BY: KRW
DATE: DECEMBER 2017
FILE NO.
8022-10019.200
SHEET NO.
WM-04R-2

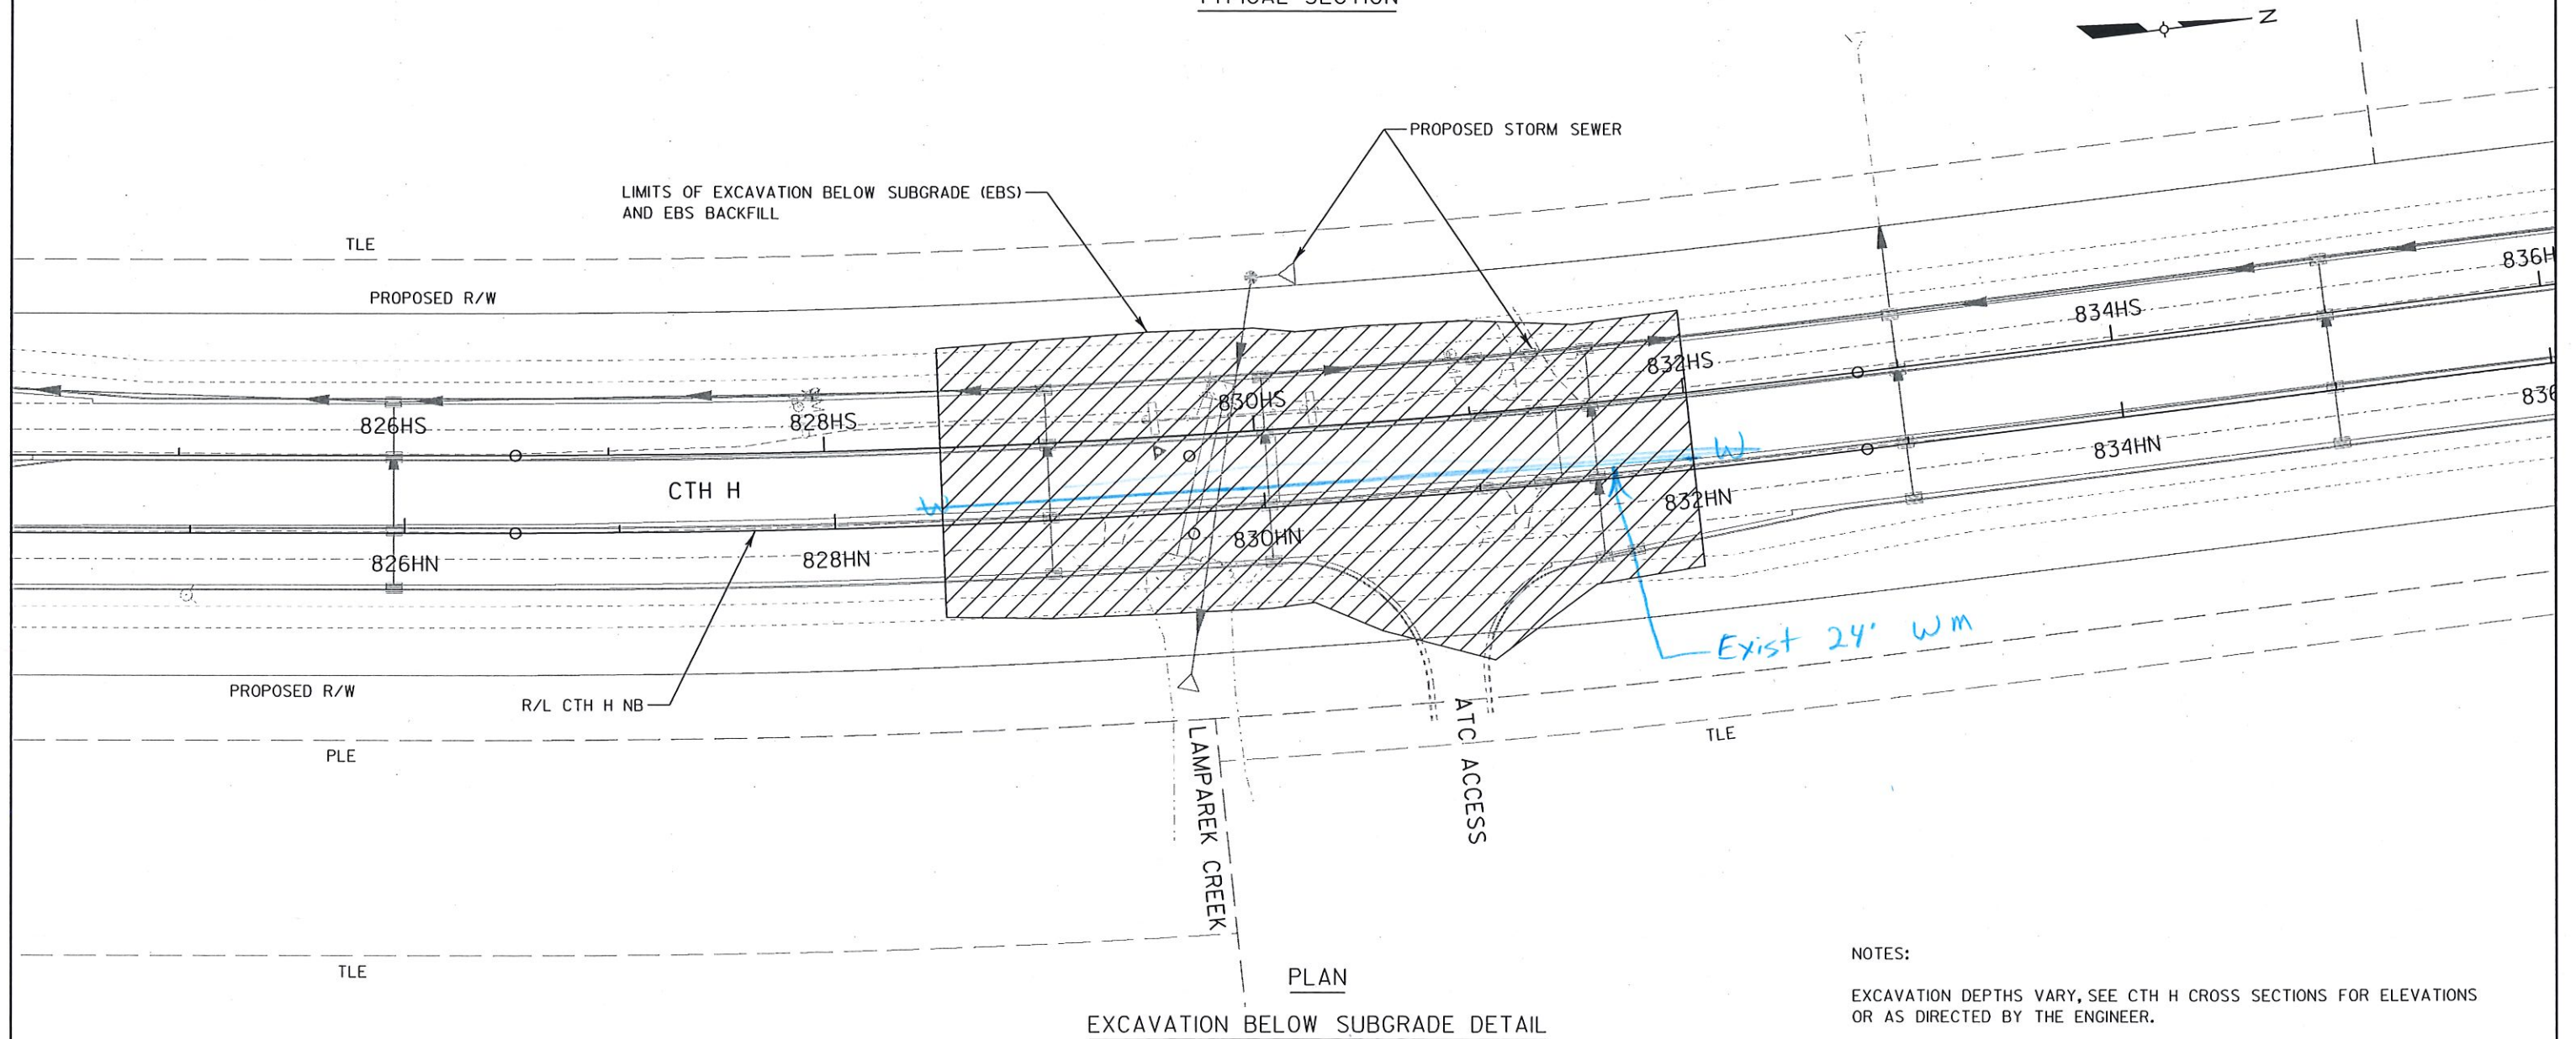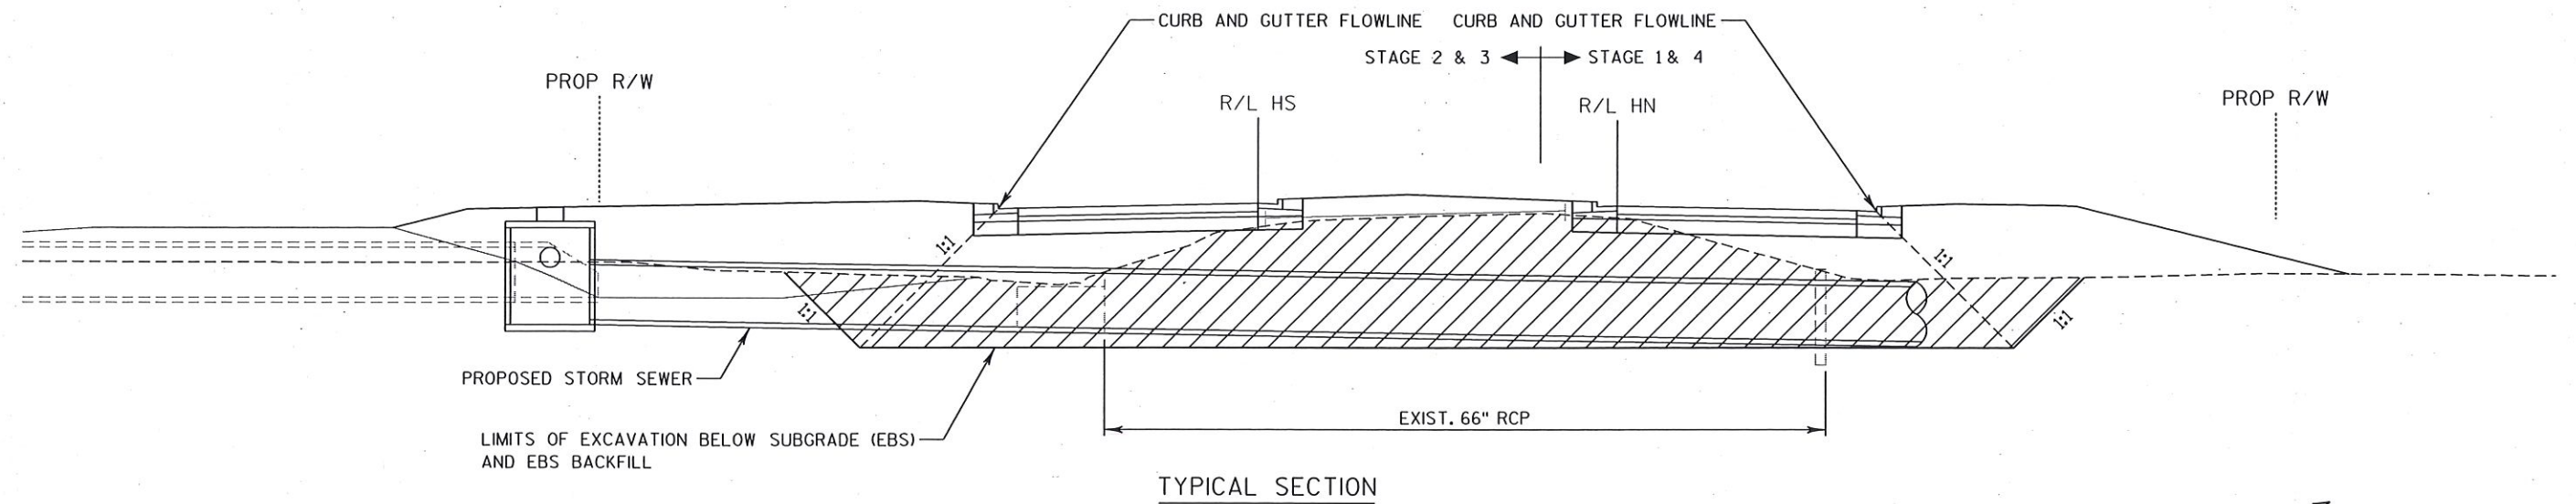

NOTES:

EXCAVATION DEPTHS VARY, SEE CTH H CROSS SECTIONS FOR ELEVATIONS
OR AS DIRECTED BY THE ENGINEER.

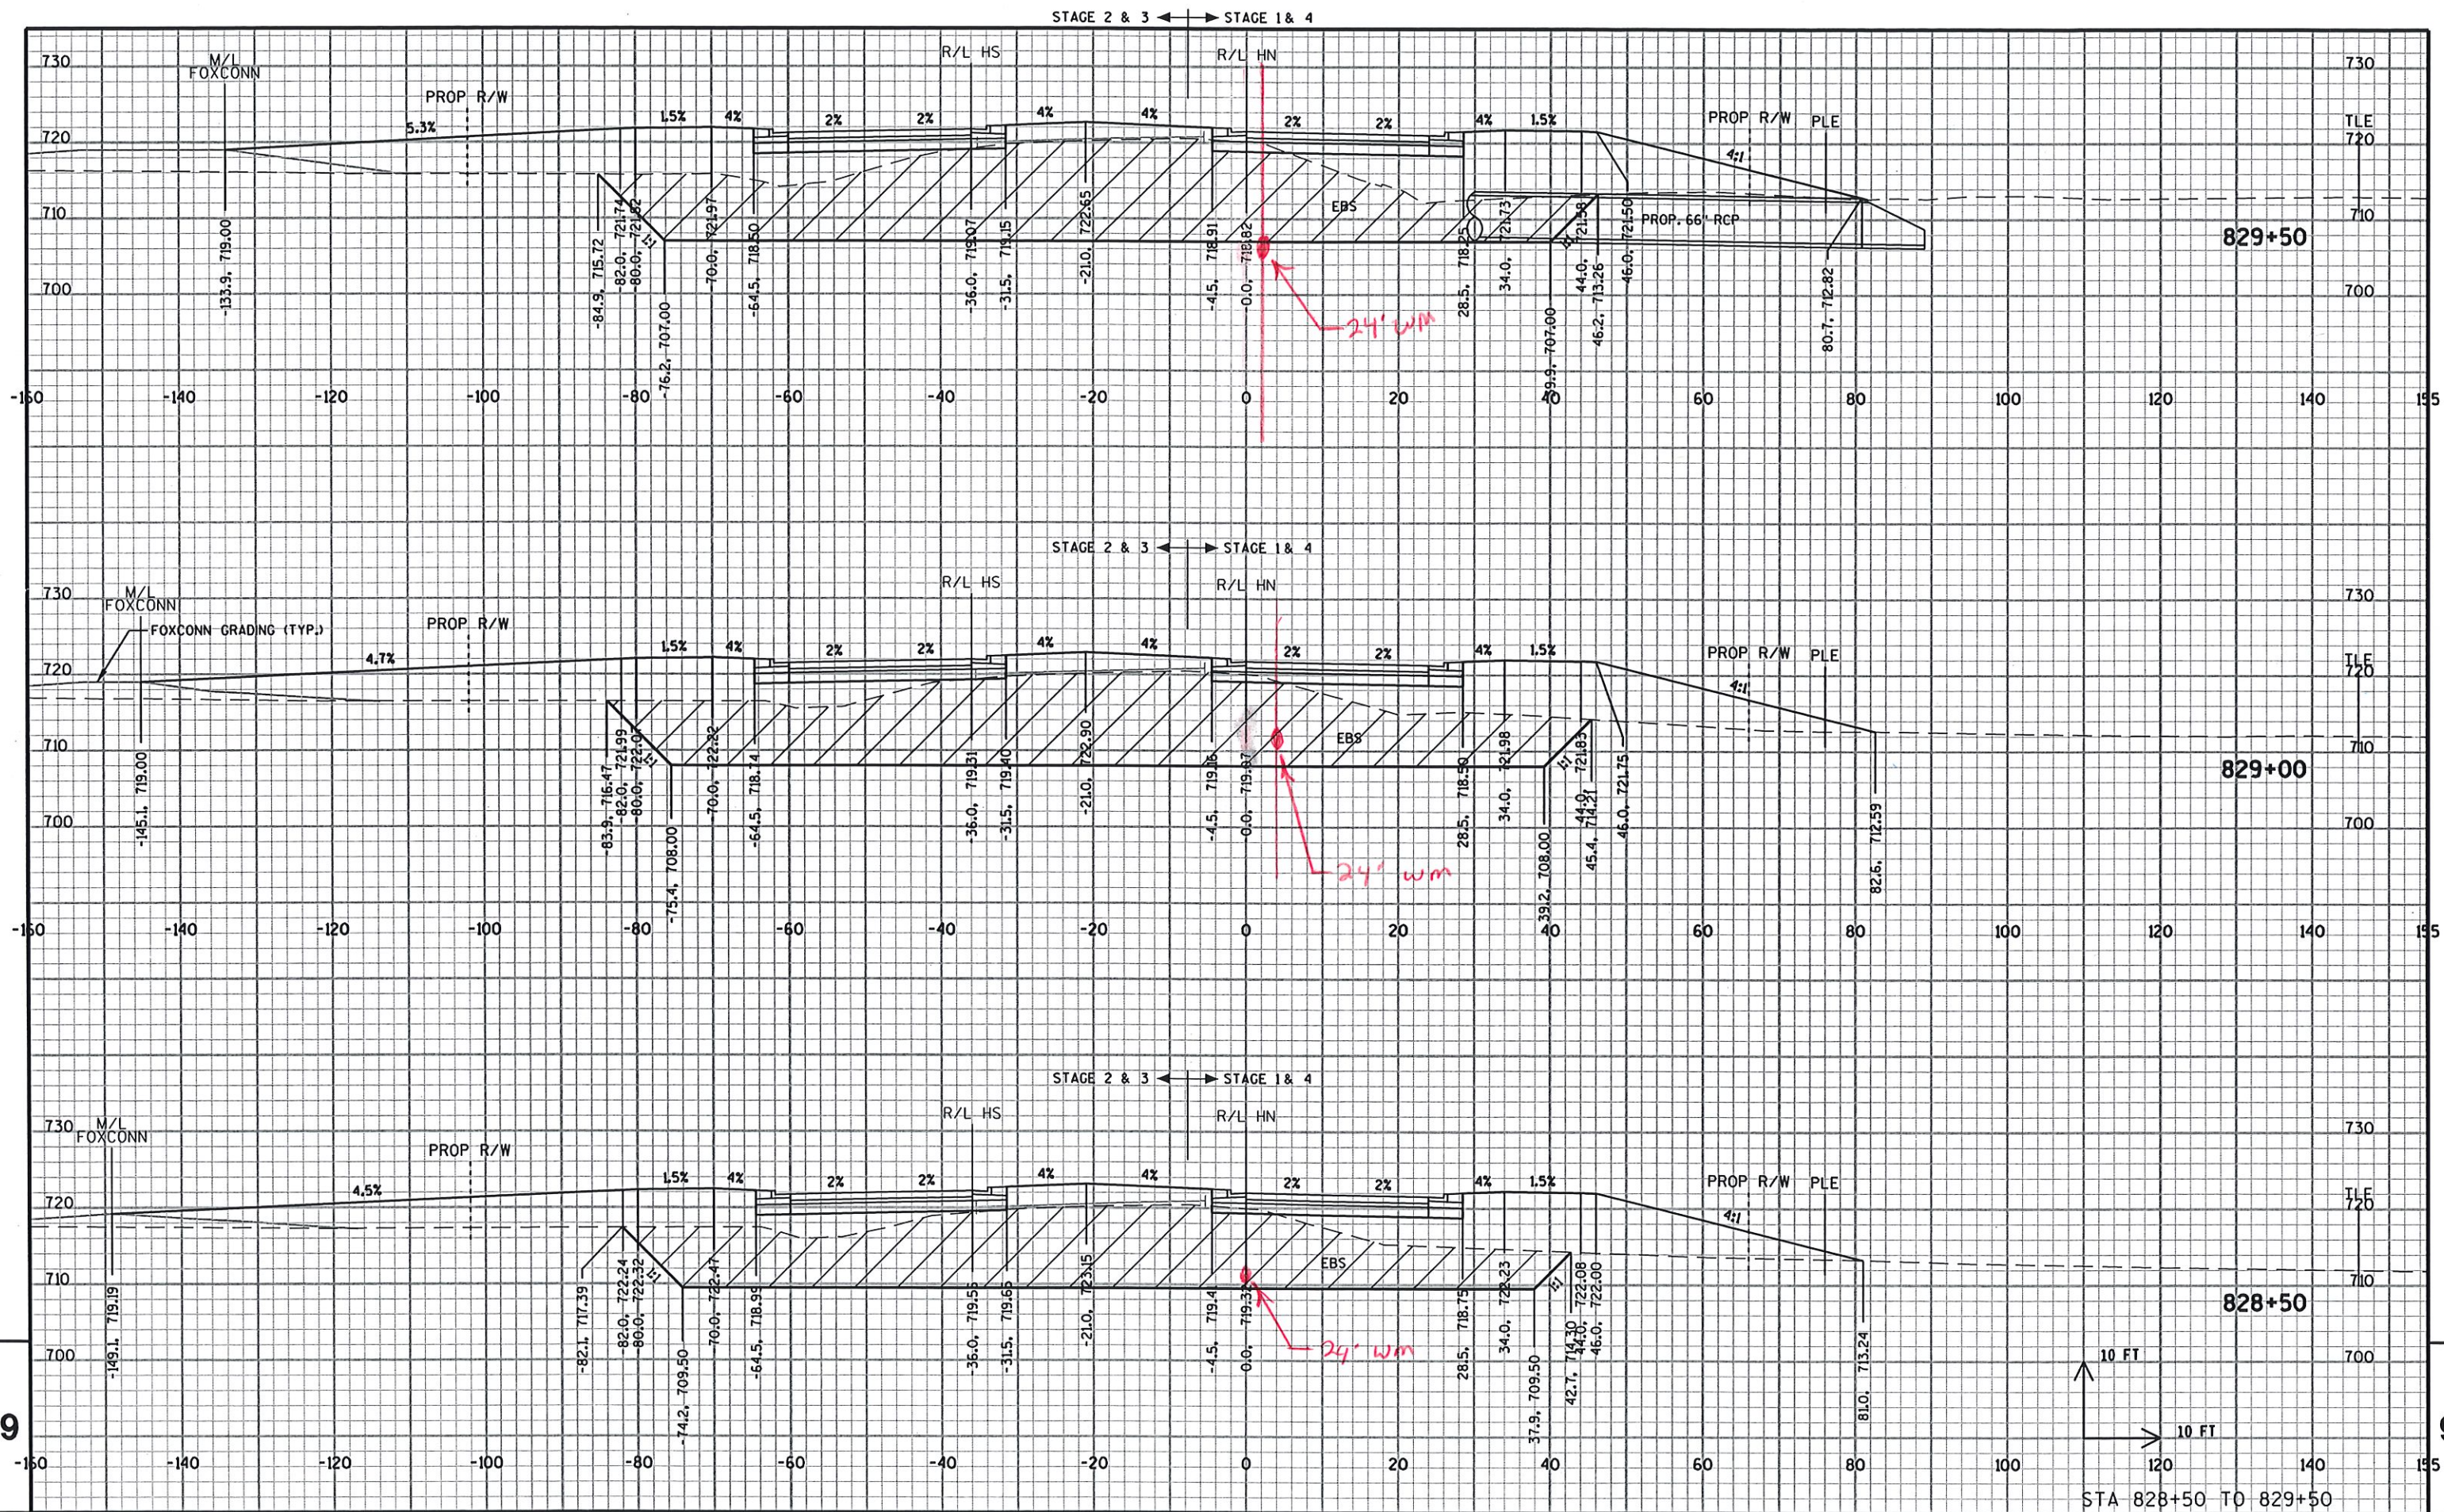

PROJECT NO: 3760-00-70

HWY: CTH H

COUNTY: RACINE

CROSS SECTIONS: CTH H


SHEET PRE 472 E

FILE NAME : pw:\pw-int.hntb.org\PWGreatLakes\Documents\Madison Projects\71190 I-94 Local Roads\4_Engineering\4.4_CTH-H\4.4.1_37600070\CD\4.4.1_37600000_xblm.dgn

PLOT NAME :

PLOT SCALE : 20:1

WISDOT/CADDs SHEET 21

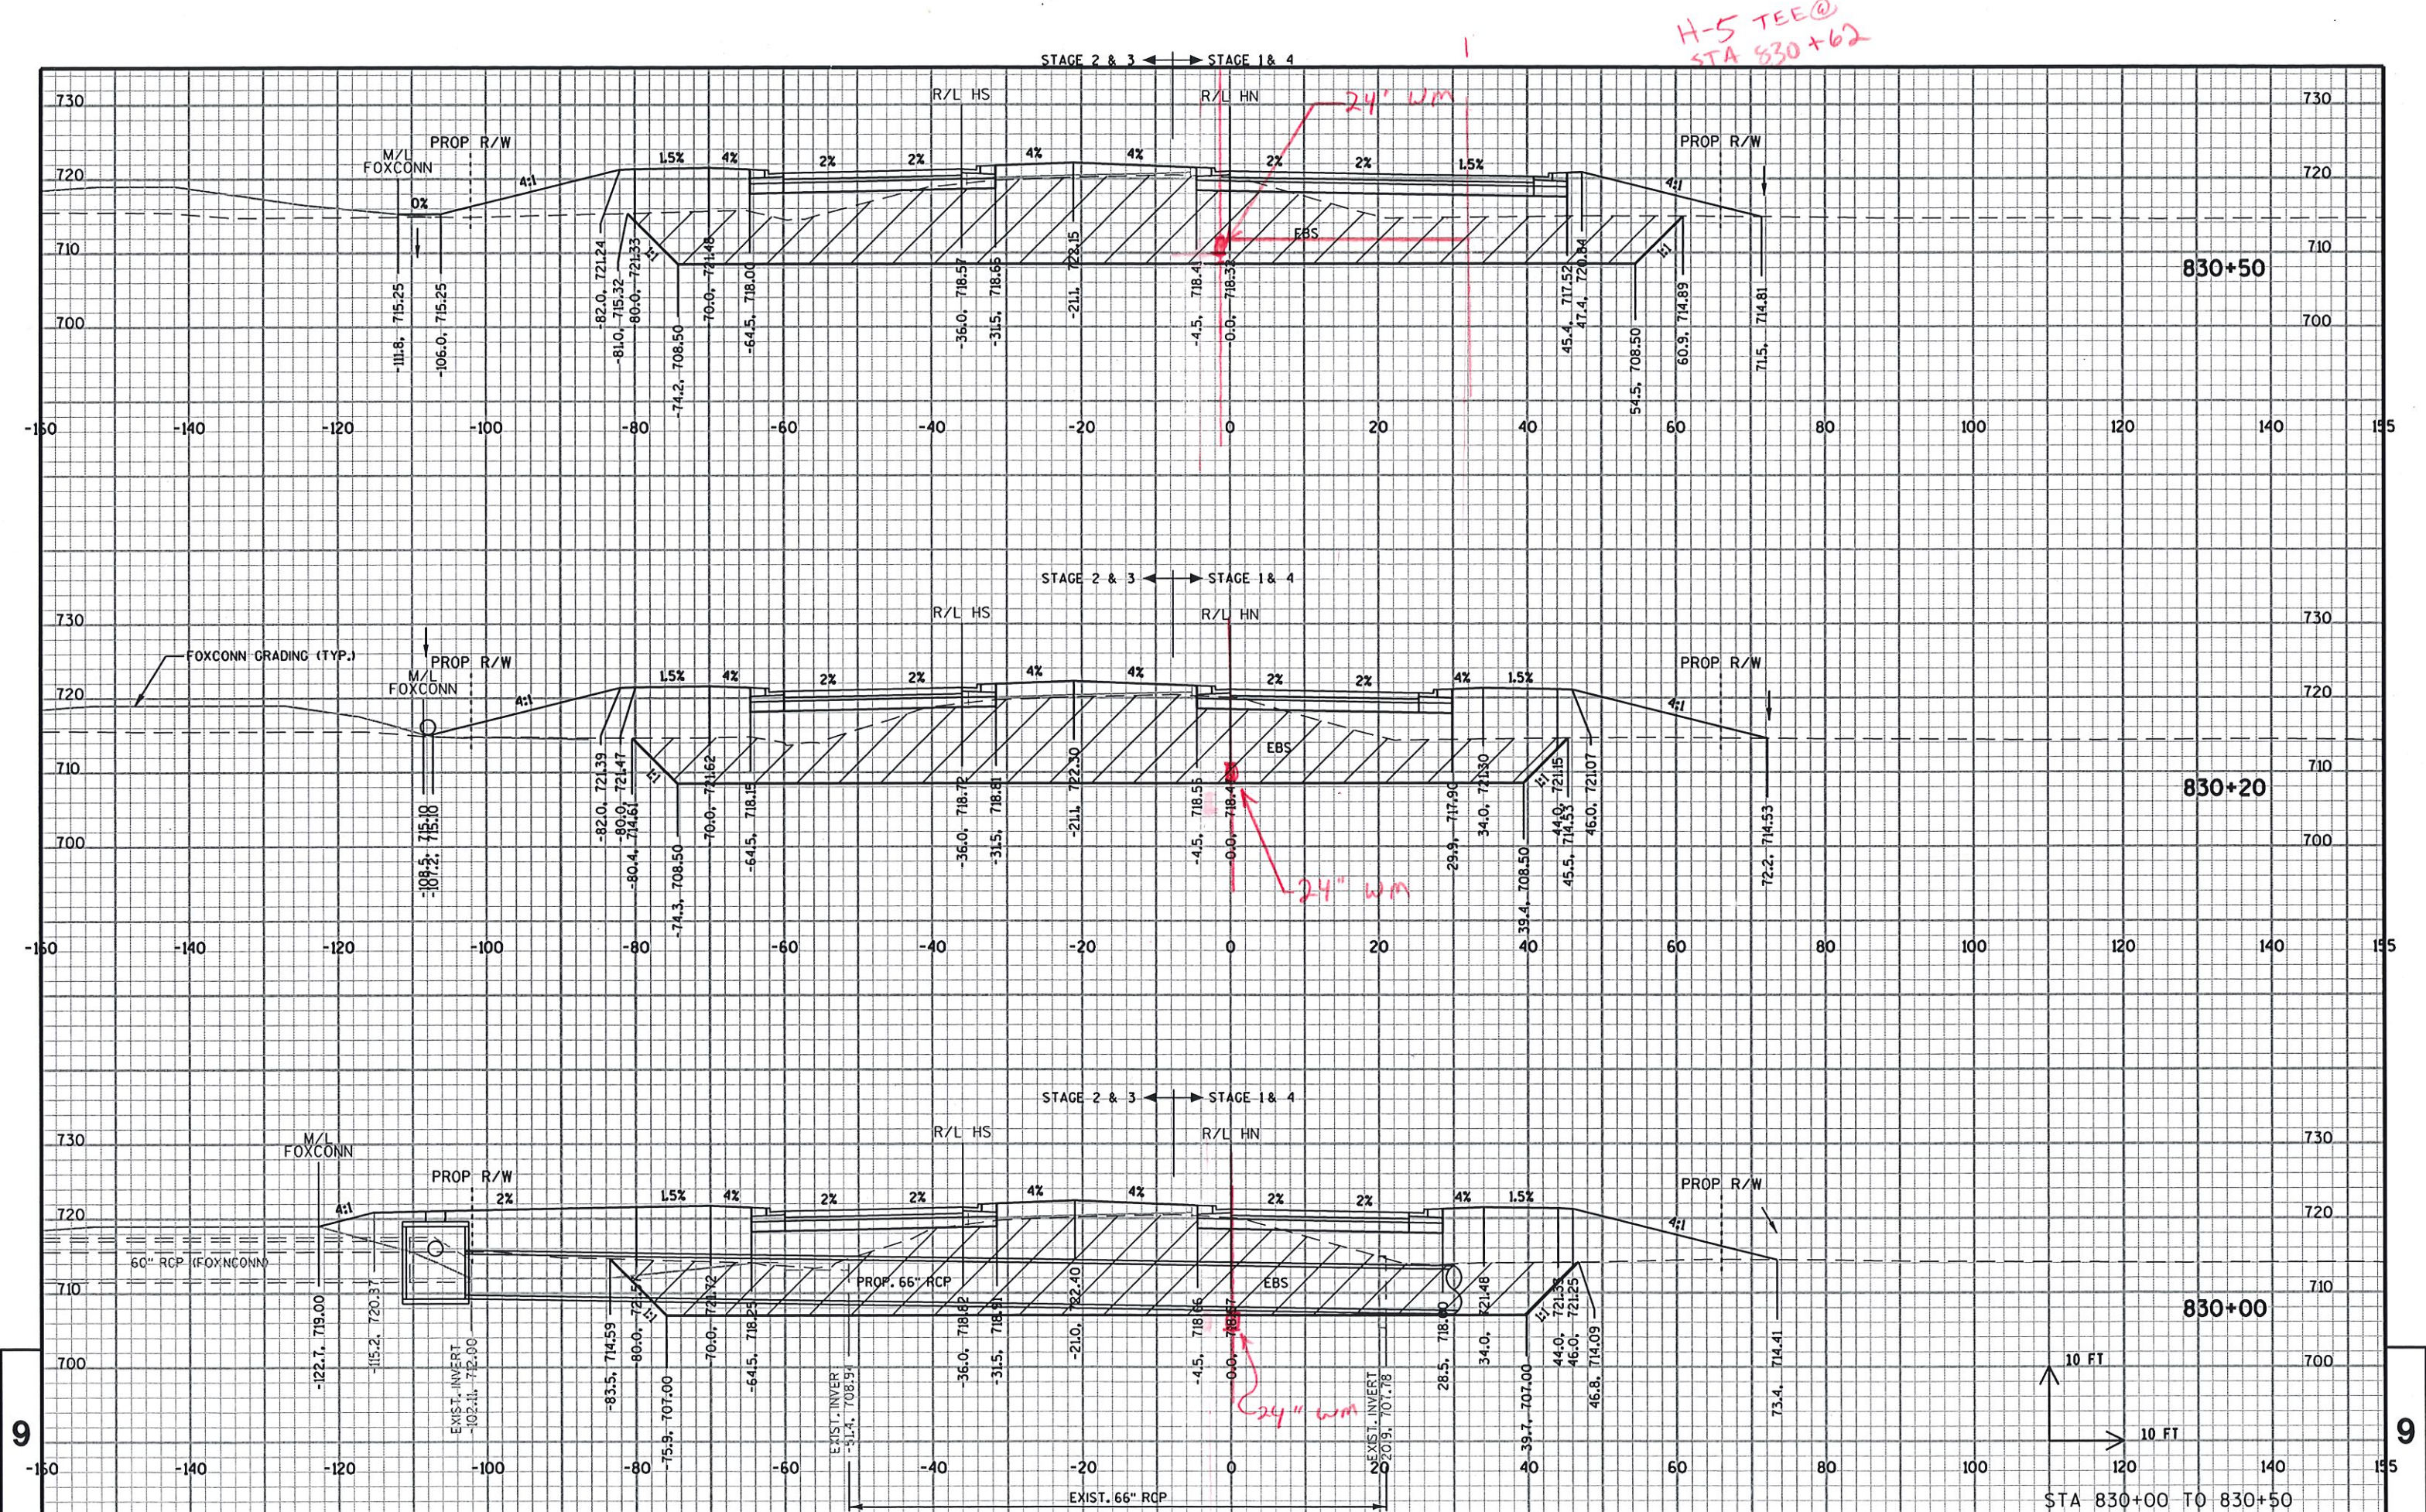

H-5 TEE@
STA 830+62

24" WM

24" WM

24" WM

