

WKE


PROJECT ID: 1033-02-70

WITH: COUNTY: RACINE

MAR 11
ORDER OF SHEETS

Section No. 1	Title
Section No. 2	Typical Sections and Details
Section No. 3	Estimate of Quantities
Section No. 3	Miscellaneous Quantities
Section No. 4	Right of Way Plat
Section No. 5	Plan and Profile
Section No. 6	Standard Detail Drawings
Section No. 7	Sign Plates
Section No. 8	Structure Plans
Section No. 9	Computer Earthwork Data
Section No. 9	Cross Sections

TOTAL SHEETS = 242

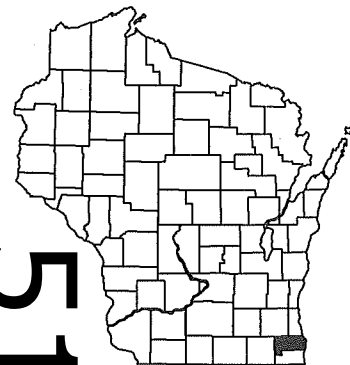

DESIGN DESIGNATION

	SE	NE
	FRONTAGE ROAD	FRONTAGE ROAD
A.A.D.T. 2010 = 7,130	2010 = 9,110	2010 = 4,770
A.A.D.T. 2030 = 9,300	2030 = 12,270	2030 = 6,040
D.H.V. = 410	= 840	= 450
D.D. = 58/42	= 65/35	= 51/49
T. = 2%	= 18%	= 12%
DESIGN SPEED = 55 MPH	= 40 MPH	= 40 MPH
ESALS = 817,600	= 1,138,800	= 1,138,800

CONVENTIONAL SYMBOLS

PLAN	
CORPORATE LIMITS	////
PROPERTY LINE	----
LOT LINE	----
LIMITED HIGHWAY EASEMENT	----
EXISTING RIGHT OF WAY	----
PROPOSED OR NEW R/W LINE	----
SLOPE INTERCEPT	----
REFERENCE LINE	----
EXISTING CULVERT	----
PROPOSED CULVERT (Box or Pipe)	----
COMBUSTIBLE FLUIDS	CAUTION
MARSH AREA	----
WOODED OR SHRUB AREA	----

PROFILE	
GRADE LINE	----
ORIGINAL GROUND	----
MARSH OR ROCK PROFILE (To be noted as such)	----
SPECIAL DITCH	----
GRADE ELEVATION	95.36
CULVERT (Profile View)	----
UTILITIES	
ELECTRIC	----
FIBER OPTIC	----
GAS	----
SANITARY SEWER	----
STORM SEWER	----
TELEPHONE	----
WATER	----
UTILITY PEDESTAL	----
POWER POLE	----
TELEPHONE POLE	----

STATE OF WISCONSIN
DEPARTMENT OF TRANSPORTATION

PLAN OF PROPOSED IMPROVEMENT

N-S FREEWAY - STH 20 INTERCHANGE

EAST FRONTAGE ROAD

IH 94

RACINE COUNTY

STATE PROJECT NUMBER
1033-02-70

Project Manager: Mark Klipstein (WisDOT)
Project Leader:
Jeff Reedy (Bloom Companies, LLC)
Project Personnel:
Greg Howell (Bloom Companies, LLC)
Nick Manning (Bloom Companies, LLC)
Mehran Sanati (Bloom Companies, LLC)
Badi Alsalami (Bloom Companies, LLC)
John Pawlak (Bloom Companies, LLC)

Date Work Started: 05/23/2011
Date Work Completed: 10/12/2012

Awarded Contract Amount: \$4,479,033.42
Current Contract Amount: \$4,742,511.78

Contractor: Mann Brothers, Inc. (Grading, Shouldering, Concrete Curb & Gutter, Concrete Pavement, Fencing, Restoration)
Sub-Contractors: Bradford Contractors, LLC (Storm Sewer, Culverts, Water and Sanitary)
Andrew Services Corp (Guardrail Removal, Erosion Control, Restoration)
Payne and Dolan (Milling, Asphalt Pavement, Asphalt Flumes and Asphalt Curb)
Q3 Contracting, Inc (Traffic Control)
Nielson Madsen & Barber, S.C. (Surveying)
Century Fence (Pavement Marking)
Interstate Tree (Clearing & Grubbing)

STATE PROJECT

1033-02-70


FEDERAL PROJECT

PROJECT

WISC 2011091

CONTRACT

1

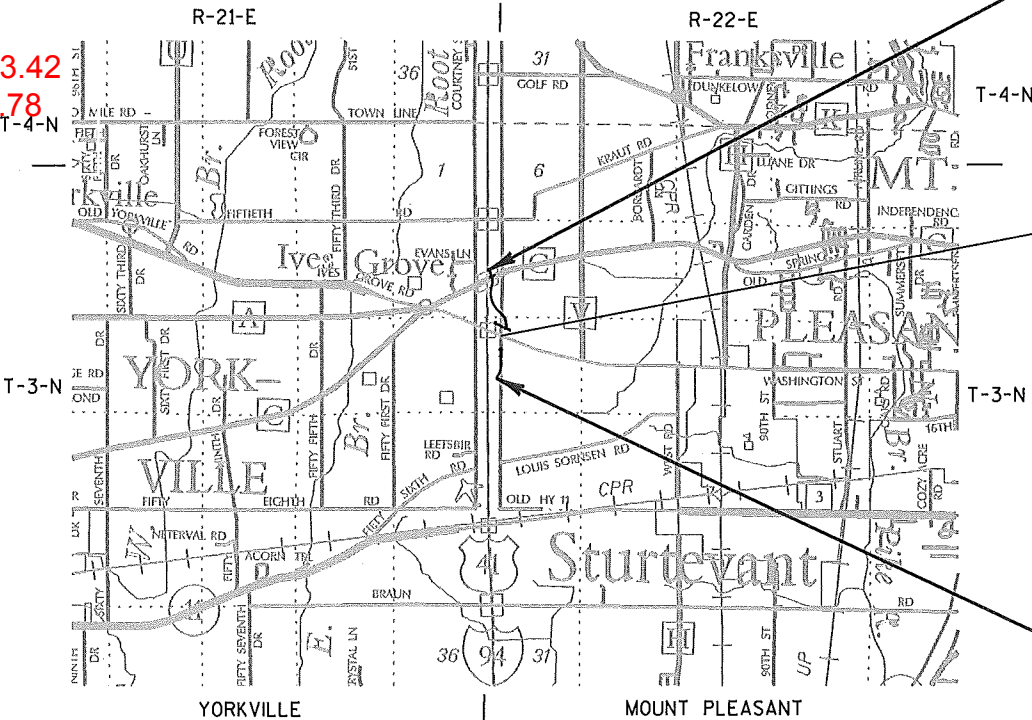

END PROJECT 1033-02-70
STA. 5901+23

STATION EQUATION
3858+95.98 BK =
5858+84.34 AH

BEGIN PROJECT 1033-02-70
STA. 3835+00
X=594,498.07
Y=182,834.64

LAYOUT
SCALE 0 1.0 MI.
TOTAL NET LENGTH OF CENTERLINE = 1.257 MI.

COORDINATES ON THIS PLAN ARE REFERENCED
TO THE WISCONSIN COUNTY COORDINATE SYSTEM
(WCCS), RACINE COUNTY, NAD 1983(97)

ELEVATIONS SHOWN ON THIS PLAN ARE REFERENCED
TO THE NORTH AMERICAN VERTICAL DATUM OF 1988
(91) (NAVD 88(91)).



ORIGINAL PLANS PREPARED BY
MILWAUKEE, WISCONSIN



8/2/2010 (Date) Andrea M. Masters (Signature)

STATE OF WISCONSIN
DEPARTMENT OF TRANSPORTATION

PREPARED BY
Surveyor WISDOT
Designer MTP
Project Manager JOSHUA LEVEQUE
District Examiner
District Supervisor WAFA ELOAO
C.O. Examiner Carl W. Benjamin

APPROVED FOR DISTRICT OFFICE
DATE: 8/2/10 (Signature)

E

UTILITY CONTACTS

TO OBTAIN LOCATION OF
PARTICIPANTS' UNDERGROUND
FACILITIES BEFORE YOU DIG IN
WISCONSIN

WIS. STATUTE 182.0175 (1974)
REQUIRES MIN. OF 3 WORK DAYS
NOTICE BEFORE YOU EXCAVATE.



Toll Free (800) 242-8511
Milwaukee Area 811
Hearing Impaired TDD (800) 542-2289
www.DiggersHotline.com

AT&T WISCONSIN

TODD BARTELS – AREA MANAGER
AT&T WISCONSIN
7721 W. FOND DU LAC AVE
PHONE: (414) 536-2971
tb1368@att.com

TDS METROCOM

MR.MICHAEL JOHNSON
TDS METROCOM
20875 CROSSROADS CIRCLE, SUITE 800
WAUKESHA, WI 53186
PHONE: (262) 754-3052
CELL: (262) 939-6355
michael.johnson@tdstelecom.com

VILLAGE OF MOUNT PLEASANT SANITARY

MR. ROBERT PUCELY
SEWER UTILITY
6126 DURAND AVE
RACINE, WI 53406
PHONE: (262) 554-8750 EXT.213
FAX: (262) 554-6785
rpucely@mtpleasantwi.gov

TIME WARNER CABLE

MR. ROBERT DETERT
TIME WARNER CABLE
1320 N. MARTIN LUTHER KING JR. DRIVE
MILWAUKEE, WI 53212
PHONE: (414) 277-4280
CELL: (414) 688 0348
FAX: (414) 277-0638
robert.detert@twcable.com

WE ENERGIES (ELECTRIC)

SEND ALL CORRESPONDENCE TO:
MR. DAN SANDE
333 W. EVERETT STREET - A299
MILWAUKEE, WI 53203
PHONE: (414) 221-4578
FAX: (414) 221-2336
dan.sande@we-energies.com

CONSTRUCTION FIELD CONTACT:

MR. LEO SCHUELLER
500 S. 116TH STREET
WEST ALLIS, WI 53214
PHONE: (414) 944-5511
CELL: (414) 588-5878
leo.schueller@we-energies.com

WE ENERGIES (GAS)

SEND ALL CORRESPONDENCE TO:
MR. DAN SANDE
333 W. EVERETT STREET - A299
MILWAUKEE, WI 53203
PHONE: (414) 221-4578
FAX: (414) 221-2336
dan.sande@we-energies.com

CONSTRUCTION FIELD CONTACT:

MR. LEO SCHUELLER
500 S. 116TH STREET
WEST ALLIS, WI 53214
PHONE: (414) 944-5511
CELL: (414) 588-5878
leo.schueller@we-energies.com

WISDOT STORM SEWER

MR. DAVE ZEMAN
WISDOT STORM SEWER
10190 W WATERTOWN RD
WAUWATOSA, WI 53226
PHONE: (414) 257-6567
dave.zeman@dot.wi.gov

OTHER AGENCIES

WISCONSIN DEPARTMENT OF
NATURAL RESOURCES

SHELLEY WARWICK, WATER RESOURCES
MANAGEMENT SPECIALIST
141 NW BARSTOW ST. ROOM 180
WAUKESHA, WI 53188
PHONE: (414) 550-4274
shelley.warwick@wisconsin.gov

WisDOT UTILITY COORDINATOR

RABI BISTA
WisDOT SE FREEWAYS UTILITY COORDINATOR
141 NW BARSTOW ST.
WAUKESHA, WI 53187-0798
PHONE: (414) 750-7224
Rabi.bista@dot.wi.gov

RACINE COUNTY DPW

MR. JEFFREY KATZ, COUNTY ENGINEER
RACINE COUNTY DPW
14200 WASHINGTON AVENUE
STURTEVANT, WI 53177
PHONE: (262) 886-8440
FAX: (262) 886-8480
jeff.katz@goracine.org

ORDER OF SECTION 2 DETAIL SHEETS

- GENERAL NOTES
- PROJECT OVERVIEW
- TYPICAL SECTIONS
- CONSTRUCTION DETAILS
 - PLAN DETAILS
 - EROSION CONTROL
 - EXISTING SIGNING
 - PERMANENT SIGNING
 - PAVEMENT MARKING
 - TRAFFIC CONTROL
- STAGE CONSTRUCTION
 - DETOURS
 - FENCING PLAN
 - ALIGNMENT LAYOUT

GENERAL NOTES

NO TREES OR SHRUBS SHALL BE REMOVED WITHOUT APPROVAL OF THE ENGINEER.

THE LOCATIONS OF EXISTING AND PROPOSED UTILITY INSTALLATION AS SHOWN ON THE PLANS ARE APPROXIMATE. THERE MAY BE OTHER UTILITY INSTALLATIONS WITHIN THE PROJECT AREA THAT ARE NOT SHOWN.

THE CONTRACTOR SHALL NOTIFY DIGGERS HOTLINE AND AFFECTED UTILITIES PRIOR TO THE START OF WORK. ANY LOCAL MUNICIPAL UTILITY WHICH IS NOT A MEMBER OF THE DIGGERS HOTLINE MUST BE CONTACTED SEPARATELY.

ALL HOLES OR OPENINGS BELOW SUBGRADE RESULTING FROM ABANDONMENT OR REMOVAL OF EXISTING STRUCTURES SHALL BE FILLED WITH GRANULAR BACKFILL AND PAID FOR AS INCIDENTAL TO THE ABANDON OR REMOVAL ITEM .

WHEN THE QUANTITY OF ASPHALTIC CONCRETE PAVEMENT OR BASE COURSE IS MEASURED FOR PAYMENT BY THE TON, THE DEPTH OR THICKNESS OF THE COURSE SHOWN ON THE PLAN IS APPROXIMATE AND THE ACTUAL THICKNESS WILL DEPEND ON THE DISTRIBUTION OF THE MATERIAL AS DIRECTED BY THE ENGINEER.

TACK COAT HAS BEEN ESTIMATED AT AN APPLICATION RATE OF 0.025 GALLON PER SQUARE YARD AND SHALL BE APPLIED BETWEEN ALL LAYERS OF ASPHALTIC PAVEMENT.

PRIOR TO ORDERING DRAINAGE PIPES AND STRUCTURES, THE CONTRACTOR SHALL VERIFY RELATED DRAINAGE INFORMATION IN THE PLANS AND PROVIDE DOCUMENTATION TO ENGINEER IN ACCORDANCE WITH SPECIFICATIONS.

INLET AND DISCHARGE ELEVATIONS FOR DRAINAGE STRUCTURES SHOWN ON THE PLAN MAY BE ADJUSTED BY THE ENGINEER TO FIT FIELD CONDITIONS.

THE QUANTITY OF SALVAGED TOPSOIL IS COMPUTED FROM MEASUREMENTS BETWEEN THE SUBGRADE SHOULDER POINTS AND THE SLOPE INTERCEPTS AS SHOWN ON THE CROSS SECTIONS PLUS 5 FEET FOR ROUNDING.

CURB HEIGHTS AT THE END OF CURB AND GUTTER SHALL BE TAPERED FROM 0 TO 4 INCHES OR 0 TO 6 INCHES IN 6 FEET.

CURB AND GUTTER GRADES ARE GIVEN TO THE FLANGE. CURB AND GUTTER RADII ARE MEASURED TO THE FLANGE.

EXISTING DRIVEWAYS AND FIELD ENTRANCES SHALL BE RESTORED IN KIND AS DIRECTED BY THE ENGINEER IN THE FIELD AND AT THE LOCATION DETERMINED BY THE ENGINEER.

TEMPORARY STORAGE OF ANY EXCAVATED MATERIAL WILL NOT BE PERMITTED IN WETLANDS.

BROKEN CONCRETE CONTAINING RE-BAR SHALL NOT BE USED AS RIPRAP OR HEAVY RIPRAP.

CROSS SECTIONS SHOWN INCLUDE THE THICKNESS OF TOPSOIL WHERE REQUIRED. TOPSOIL SHALL BE REPLACED WITH 4-INCH TYPICAL DEPTH.

A SAWED JOINT IS REQUIRED WHERE NEW ASPHALTIC CONCRETE SURFACE MEETS EXISTING ASPHALTIC CONCRETE SURFACE.

TRAFFIC CONTROL DEVICES SHALL BE ADJUSTED TO FIT FIELD CONDITIONS AS DIRECTED BY THE ENGINEER.

REMOVAL OF EROSION CONTROL DEVICES IS INCLUDED IN THE COST OF THEIR RESPECTIVE BID ITEMS.

THE EROSION CONTROL FEATURES AS SHOWN IN THE PLANS ARE AT SUGGESTED LOCATIONS. EXACT LOCATIONS WILL BE DETERMINED BY THE ENGINEER IN THE FIELD.

DISTURBED AREAS WITHIN THE RIGHT OF WAY, EXCEPT THE AREAS WITHIN THE FINISHED SHOULDER POINTS, SHALL BE TOPSOILED, FERTILIZED, MULCHED AND SEEDED AS DIRECTED BY THE ENGINEER.

INLET PROTECTION IS REQUIRED AT ALL INLETS AS PER DETAIL OR AS DIRECTED BY THE ENGINEER.

CONCRETE MEDIAN SLOPED NOSE SHALL BE CONSTRUCTED FOR ALL MEDIAN OPENINGS AT INTERSECTIONS WITH CURB & GUTTER.

HMA PAVEMENT AND CONCRETE DRIVEWAYS AND/OR PARKING LOTS SHALL BE SAWCUT AT THE MATCHLINE AS SHOWN ON THE PAVING DETAILS OR AS DIRECTED BY THE ENGINEER.

-A CONVERSION FACTOR OF 1.8 TONS/CY IS USED TO ESTIMATE QUANTITIES FOR SELECT CRUSHED MATERIAL.

-A CONVERSION FACTOR OF 2.10 TONS/CY IS USED TO ESTIMATE QUANTITIES FOR BASE AGGREGATE DENSE.

-A CONVERSION FACTOR OF 115 LB/SY/IN IS USED TO ESTIMATE QUANTITIES FOR HMA PAVEMENT.

EXISTING PIPE CULVERT SIZES AND CONCRETE BOX CULVERT SIZES SHOWN ARE APPROXIMATE AND CONTRACTOR WILL BASE BID ON THE ACTUAL FIELD CONDITIONS.


ALL TYPES OF HMA PAVEMENT SHALL BE CONSTRUCTED WITH THE FOLLOWING LAYERS AND GRADATIONS:


TOTAL LAYER PAVEMENT THICKNESS	LAYERS	NOMINAL MAXIMUM SIZE GRADATION	ASPHALTIC MATERIAL
7"	2" UPPER LAYER	12.5 MM	PG64-28
	2 1/2" UPPER-LOWER LAYER	19.0 MM	PG64-22
	2 1/2" LOWER-LOWER LAYER	19.0 MM	PG64-22

ALL EXISTING STREET NAME SIGNS WILL BE REMOVED AND REPLACED BY THE VILLAGE OF MOUNT PLEASANT.


STANDARD ABBREVIATIONS

AEW	APRON END WALL
AGG	AGGREGATE
BAD	BASE AGGREGATE DENSE
BM	BENCH MARK
C&G	CURB AND GUTTER
C/L OR Ȥ	CENTER OR CONSTRUCTION LINE
CONC	CONCRETE
CP	CULVERT PIPE
CPCM	CULVERT PIPE CORRUGATED METAL
CPCS	CULVERT PIPE CORRUGATED STEEL
CPRC	CULVERT PIPE REINFORCED CONCRETE
CPRCHE	CULVERT PIPE REINFORCED CONCRETE HORIZONTAL ELLIPTICAL
CSD	CONCRETE SURFACE DRAIN
CY	CUBIC-YARD
D	DEGREE OF CURVE
Δ	DELTA
DISCH	DISCHARGE
FE	FIELD ENTRANCE
HMA	HOT MIX ASPHALT
INV	INVERT
L	LENGTH OF CURVE
LHF	LEFT HAND FORWARD
LT	LEFT
MIN	MINIMUM
M/L	MATCHLINE
NB	NORTHBOUND
NC	NORMAL CROWN
PAVT	PAVEMENT
PC	POINT OF CURVE
PCC	POINT OF COMPOUND CURVE
PE	PRIVATE ENTRANCE
PI	POINT OF INTERSECTION
PLE	PERMANENT LIMITED EASMENT
PT	POINT OF TANGENT
R	RADIUS OF CURVE
R/L	REFERENCE LINE
R/W	RIGHT OF WAY
RC	REVERSE CROWN
RCAEW	APRON ENDWALL FOR CULVERT PIPE REINFORCE CONCRETE
REQD	REQUIRED
RHF	RIGHT HAND FORWARD
RO	RUN OFF LENGTH
RRSP	RAILROAD SPIKE
RT	RIGHT
SALV	SALVAGED
SB	SOUTHBOUND
SDD	STANDARD DETAIL DRAWING
SE	SUPER ELEVATION
SF	SQUARE FOOT
STA	STATION
SY	SQUARE YARD
T	TANGENT LENGTH
TLE	TEMPORARY LIMITED EASEMENT
VCL	VERTICAL CURVE LENGTH
VPC	POINT OF VERTICAL CURVE
VPI	POINT OF VERTICAL INTERSECTION
VPT	POINT OF VERTICAL TANGENT

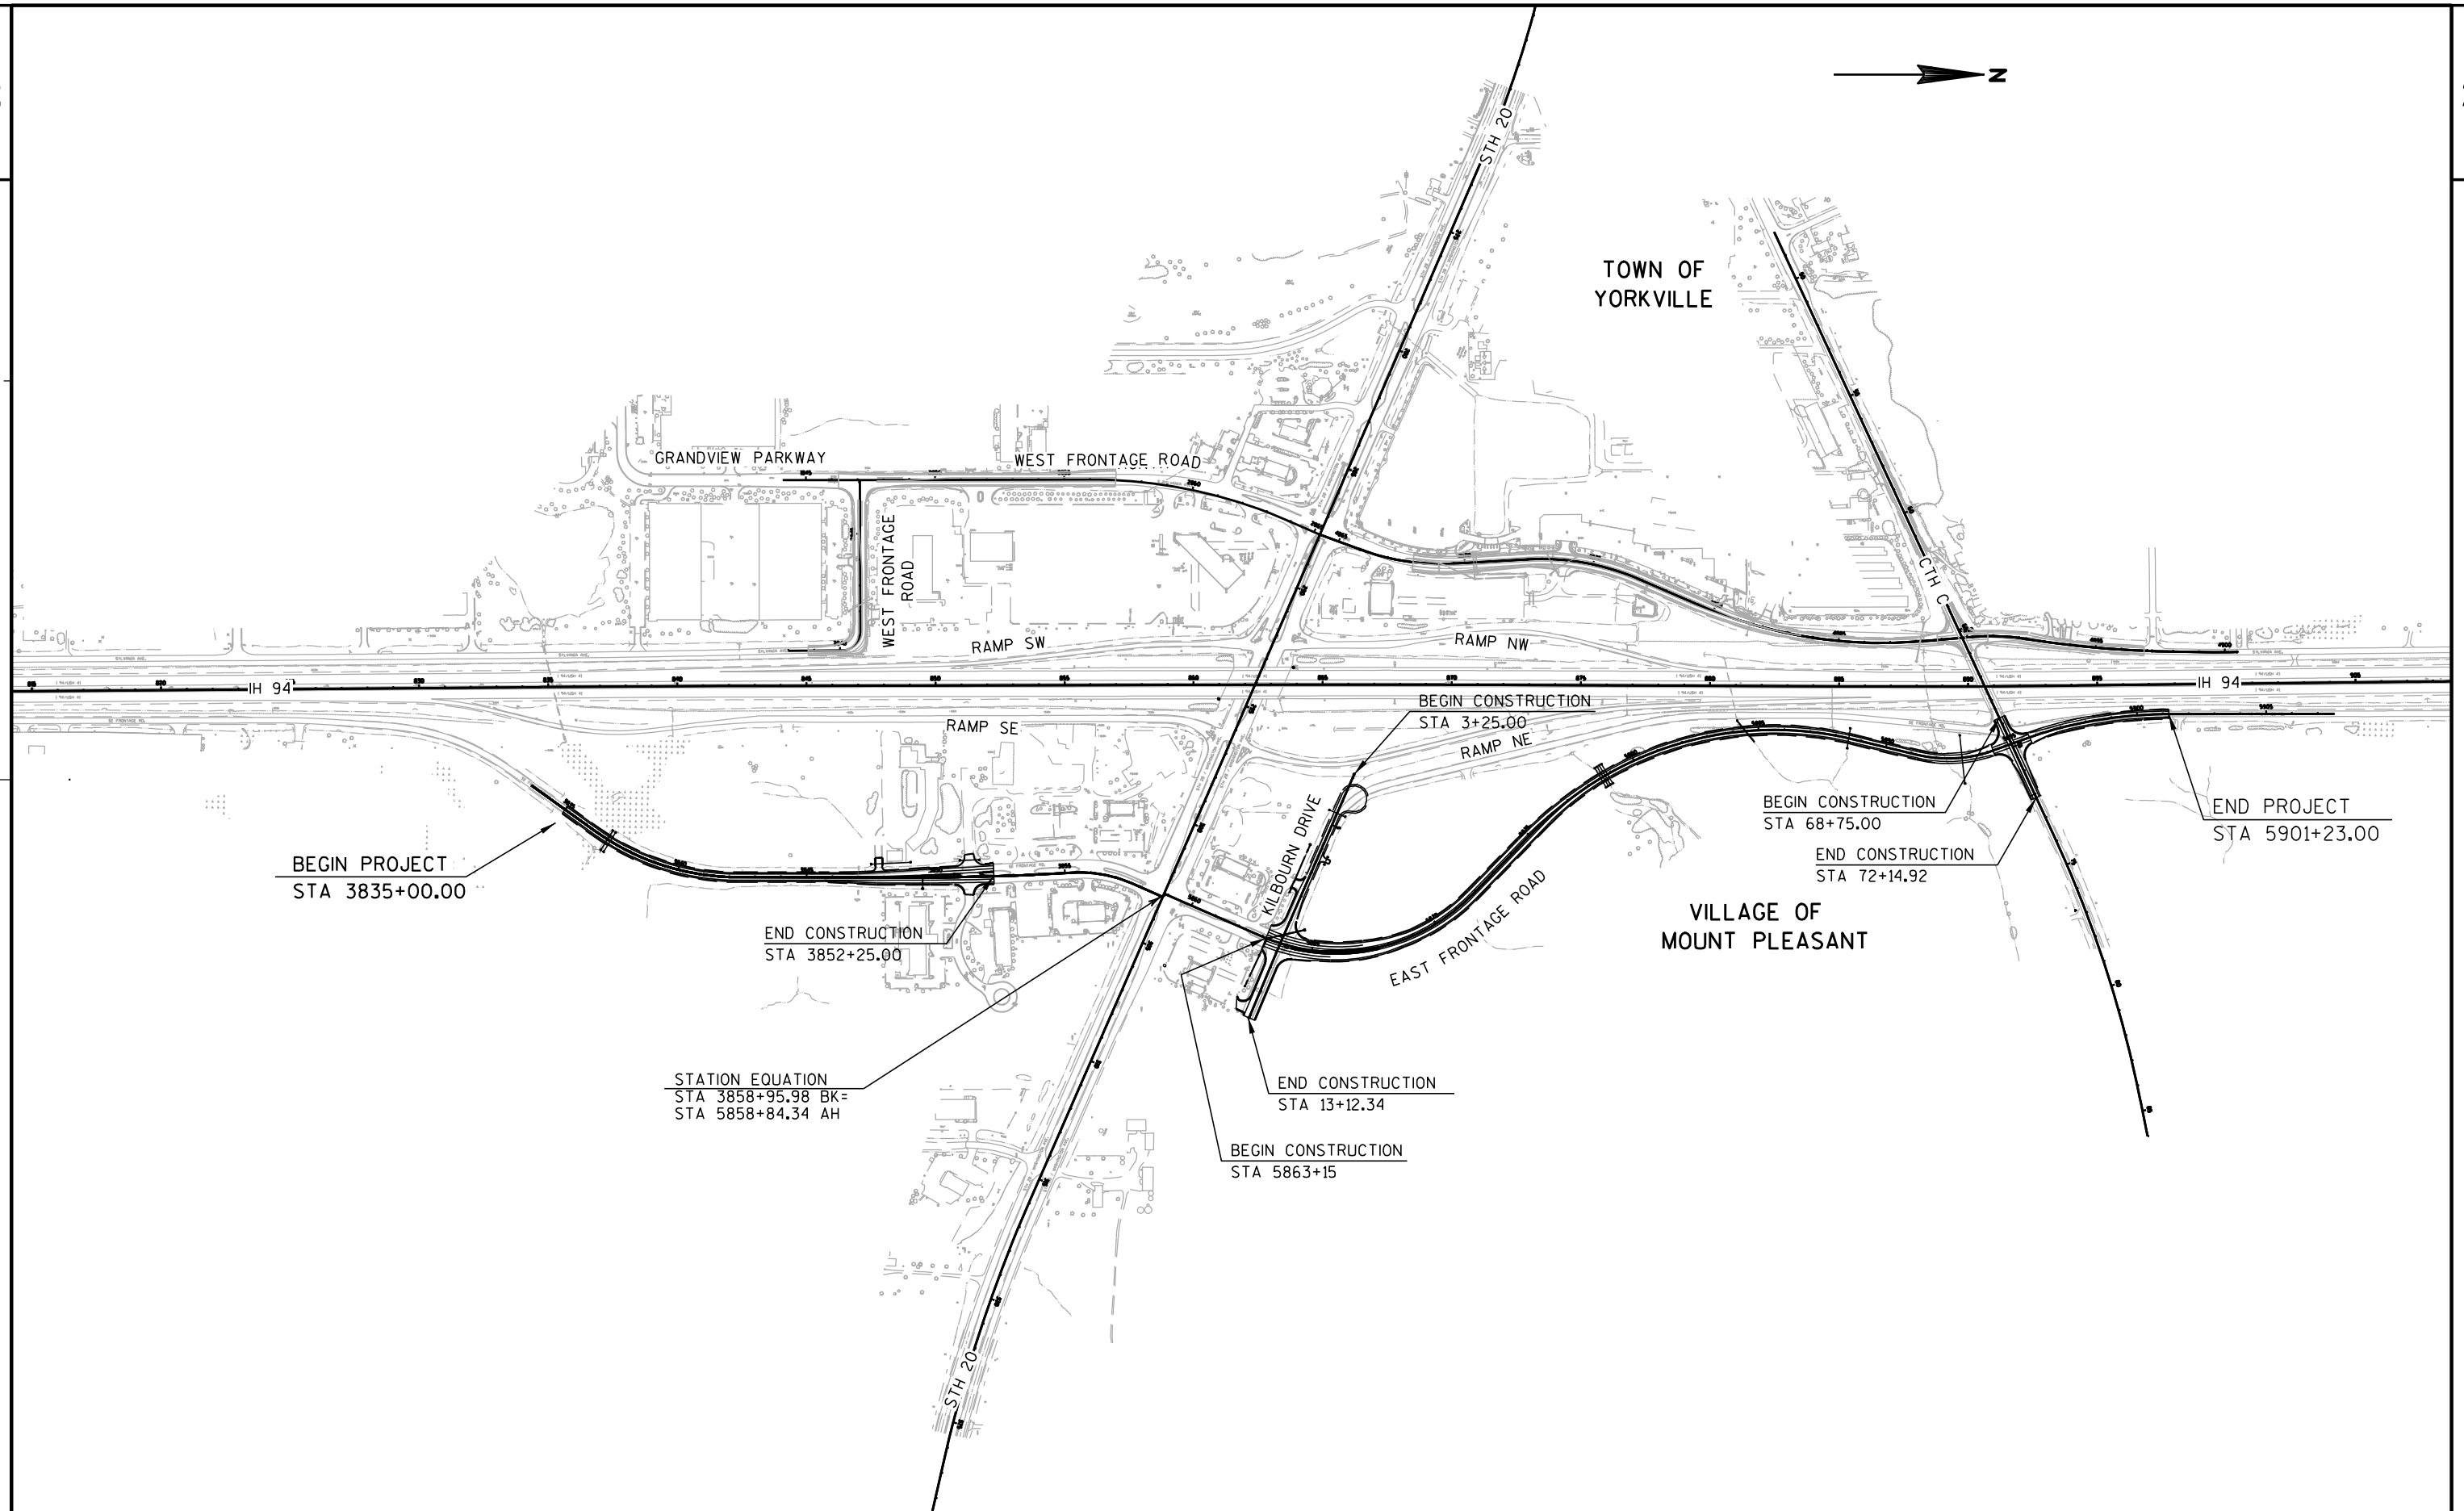


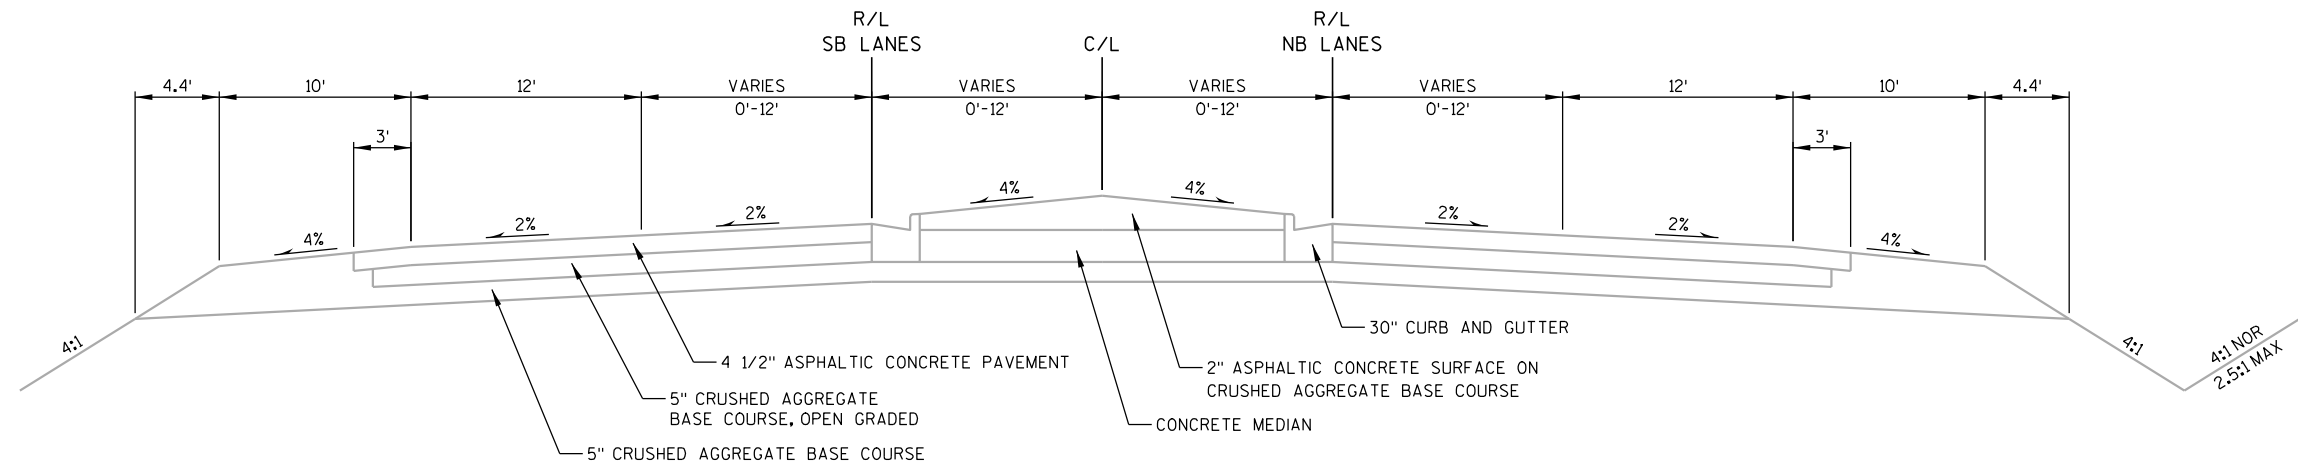

TYPICAL EXISTING SECTION
EAST FRONTAGE ROAD
SOUTH OF STH 20
STA 3849+75 TO STA 3852+25

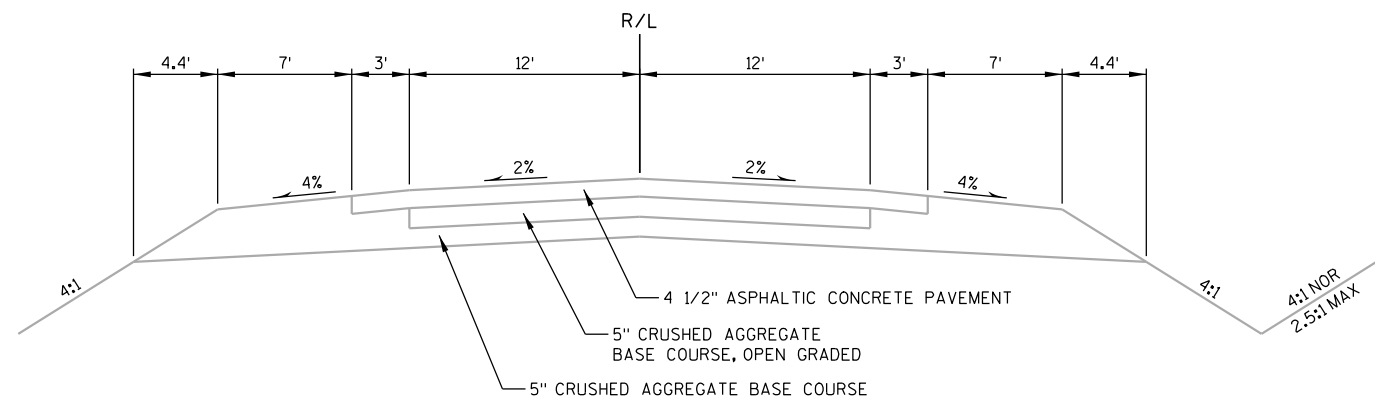

TYPICAL EXISTING SECTION
EAST FRONTAGE ROAD
NORTH OF STH 20
STA 3835+00 TO STA 3849+75
STA 5863+15 TO STA 5888+00

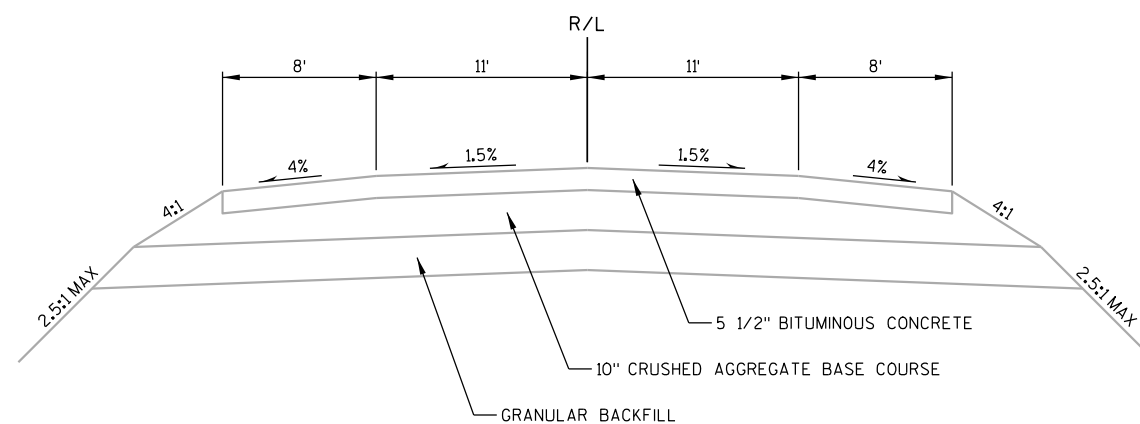


TYPICAL EXISTING SECTION

EAST FRONTAGE ROAD

AT CTH C


STA 5888+00 TO STA 5901+23

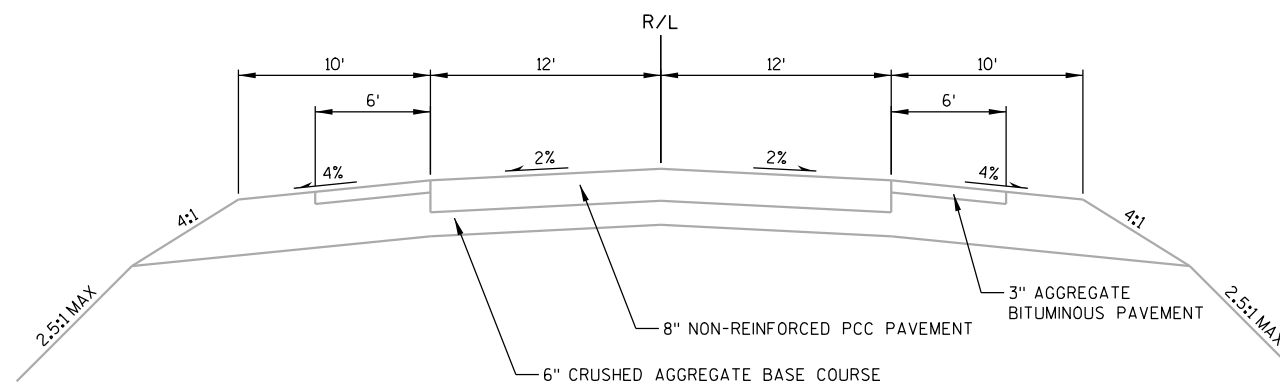

TYPICAL EXISTING SECTION

CTH C


STA 68+75 TO STA 72+15

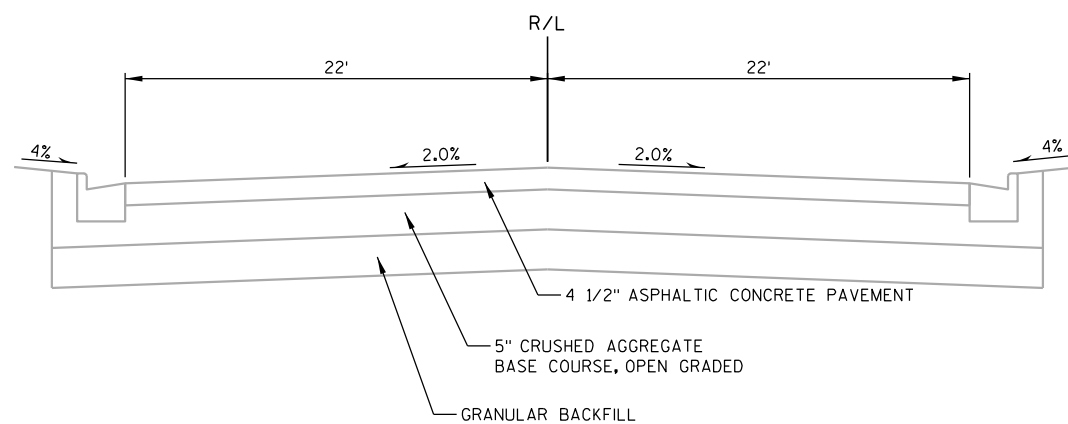


TYPICAL EXISTING SECTION

KILBOURN DRIVE


STA 10+39 TO STA 13+12

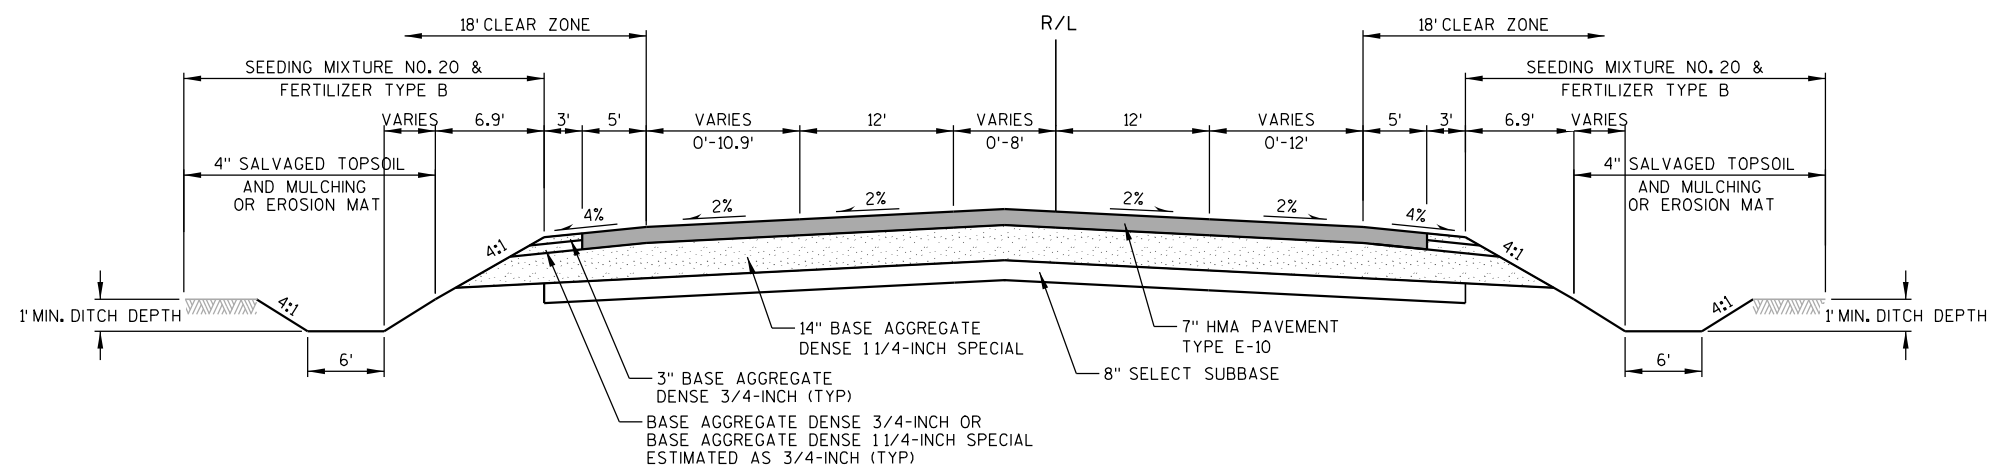

TYPICAL FINISHED SECTION
EAST FRONTAGE ROAD
 STA 3845+62 TO STA 3849+46

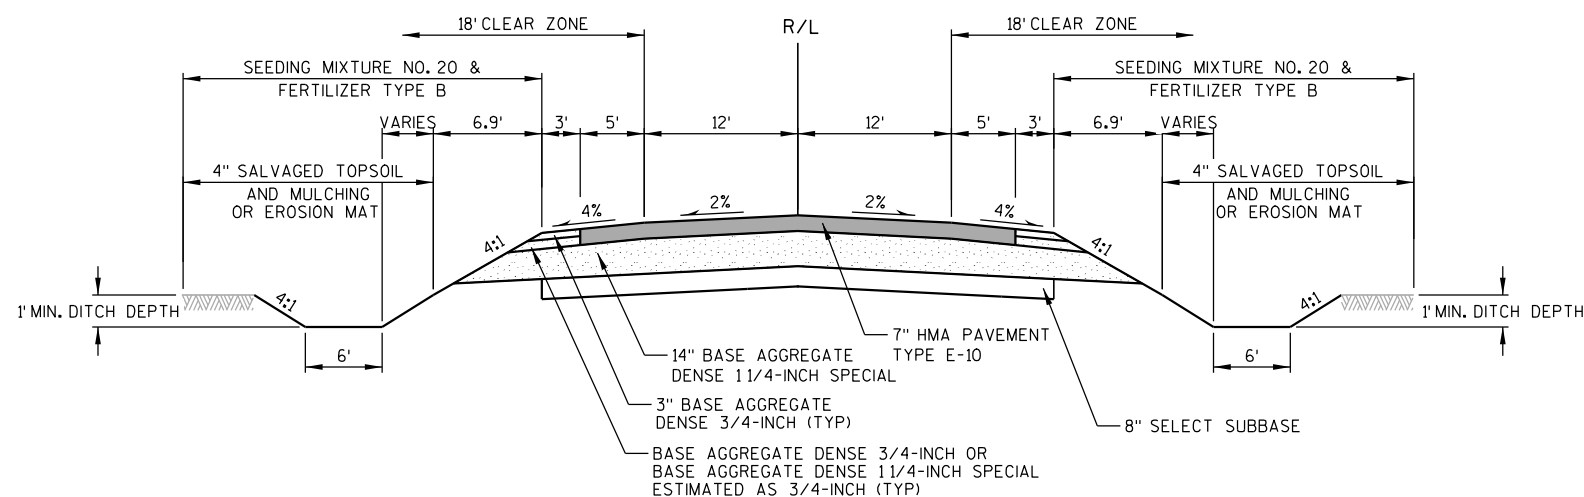


TYPICAL FINISHED SECTION
EAST FRONTAGE ROAD
 STA 3835+00 TO STA 3845+62

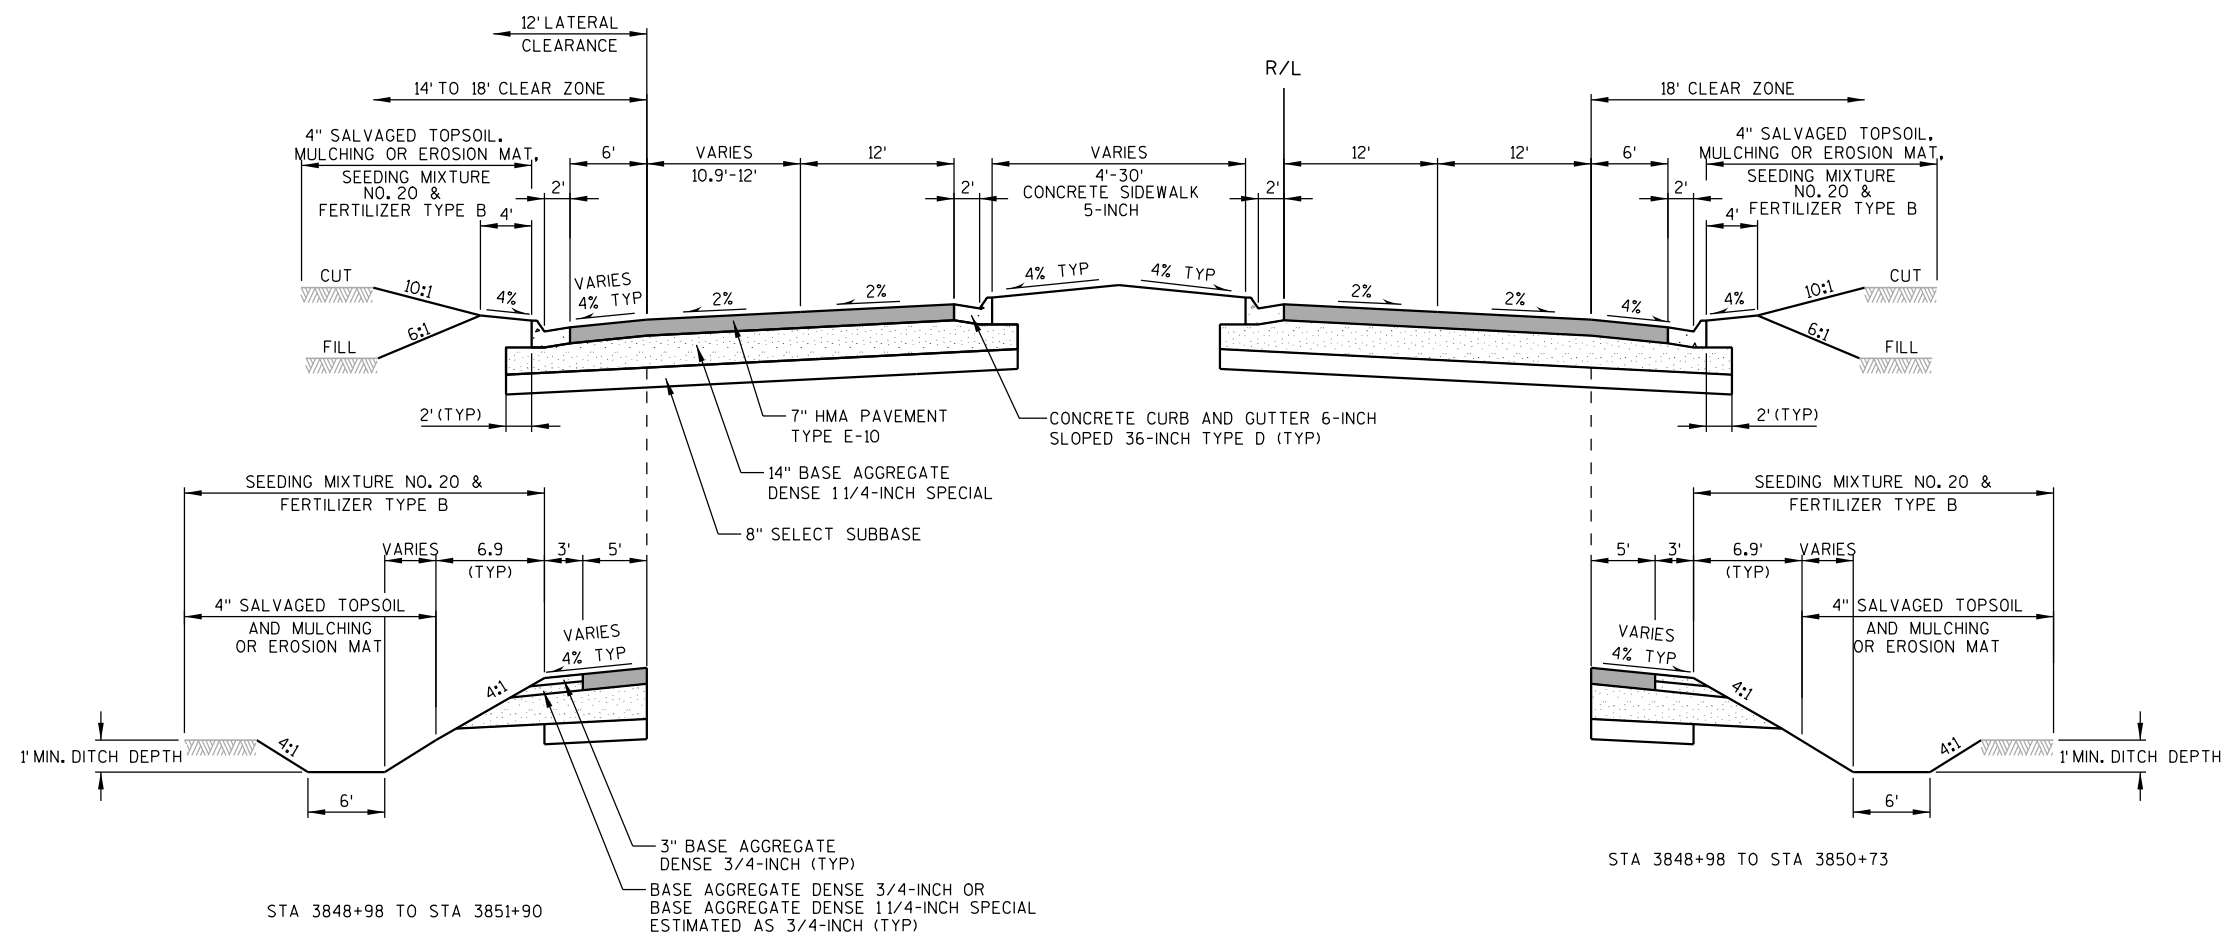

**TYPICAL FINISHED SECTION
EAST FRONTAGE ROAD**

STA 3849+46 TO STA 3852+25

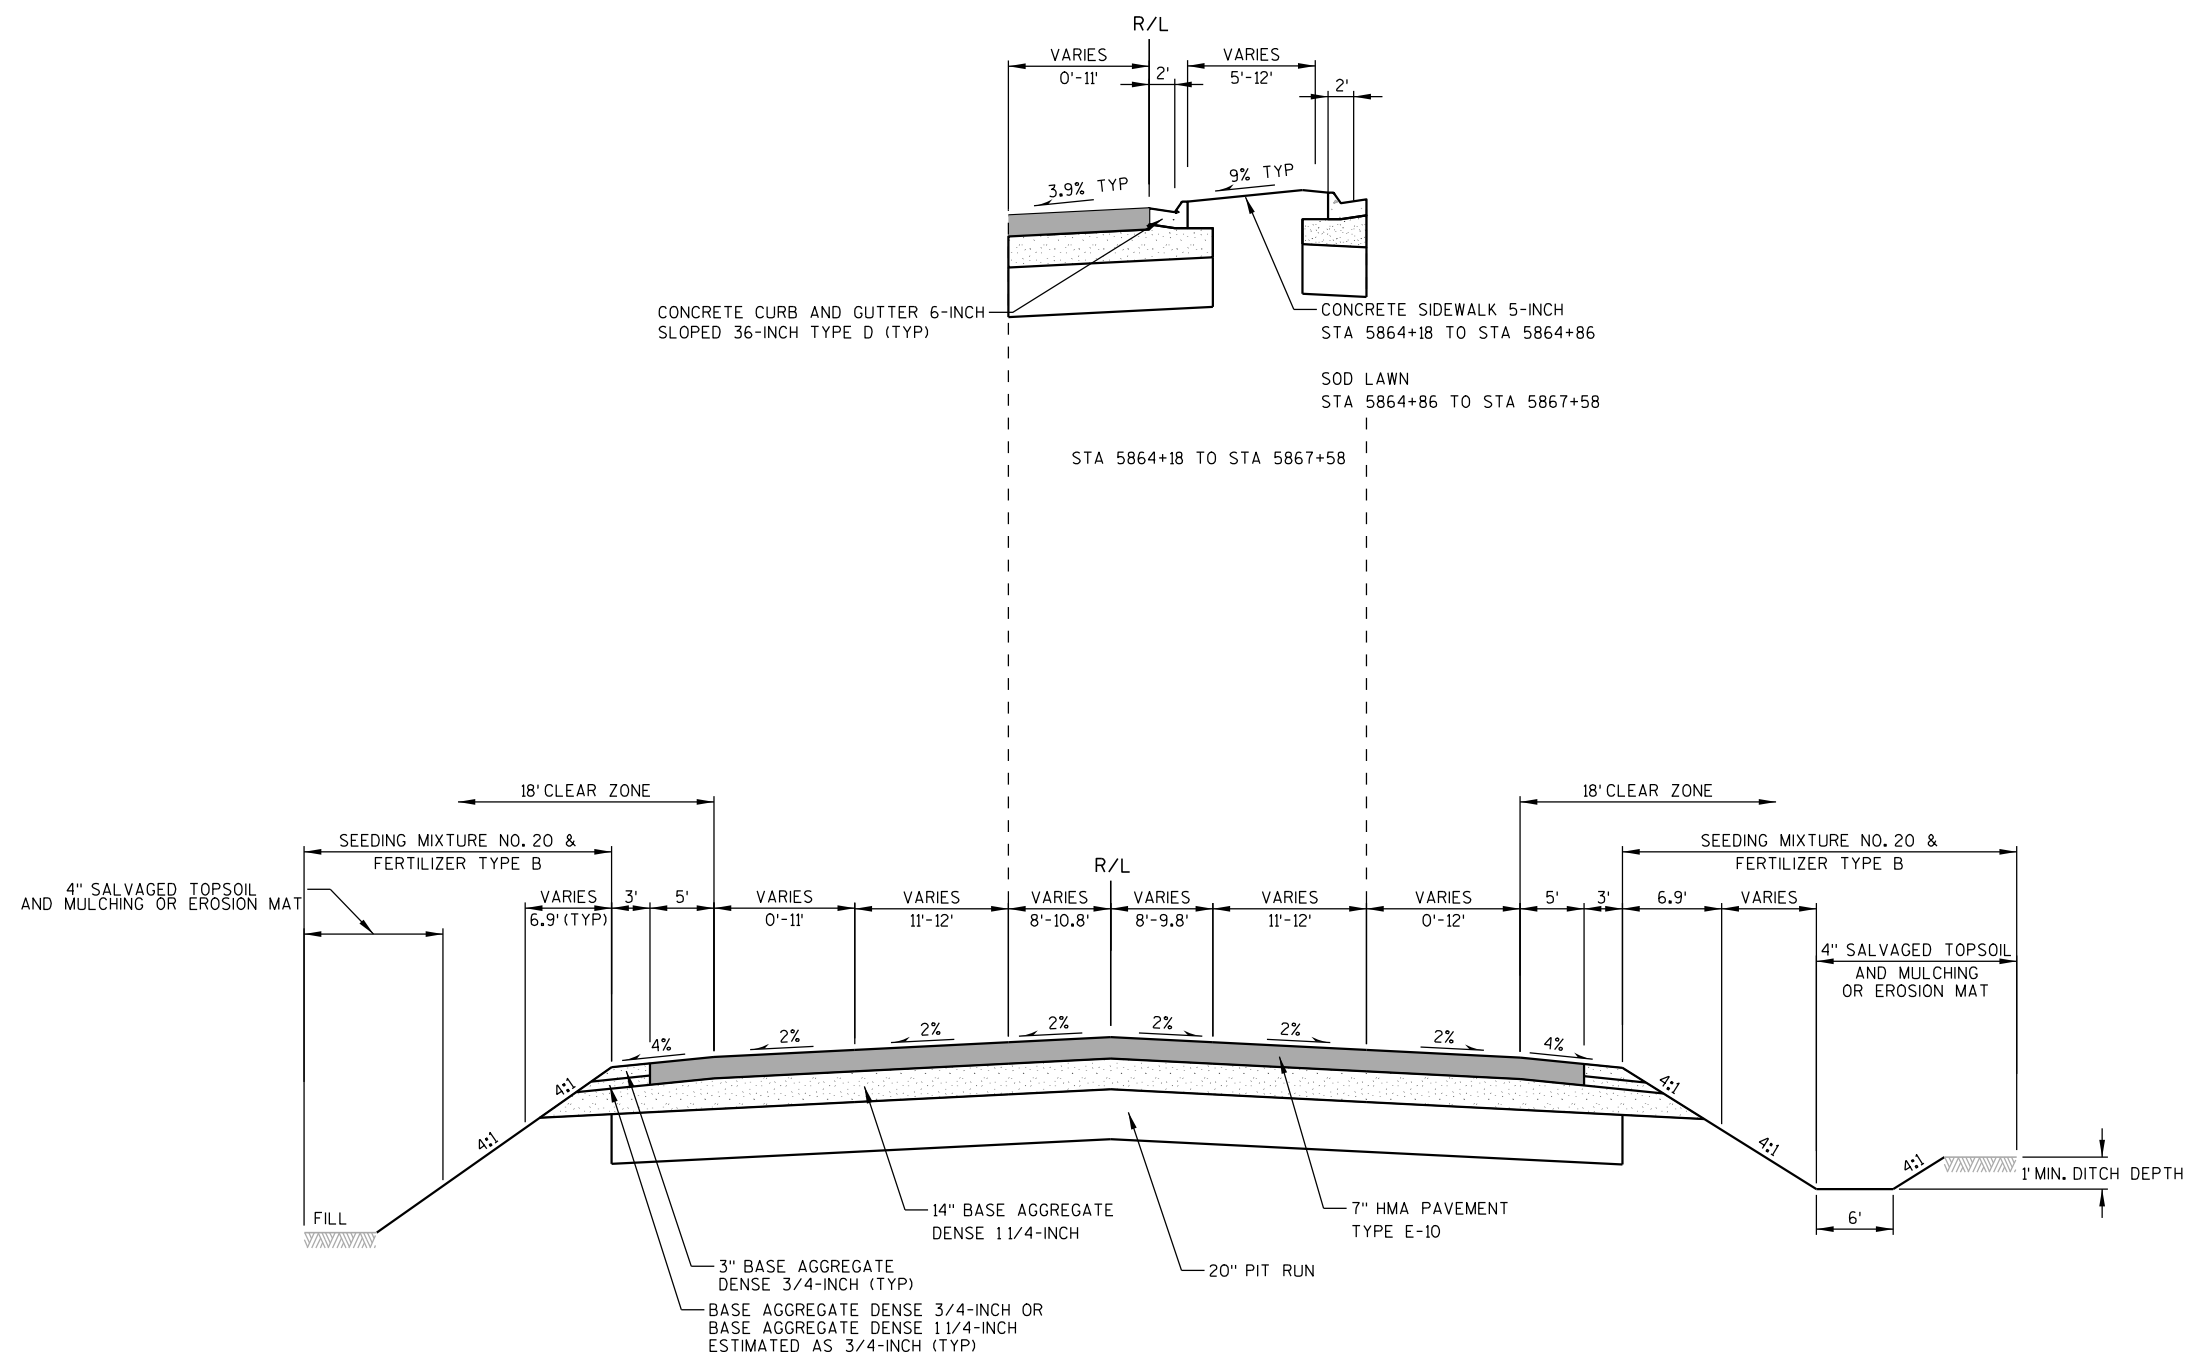


TYPICAL FINISHED SECTION


EAST FRONTAGE ROAD

STA 5863+15 TO STA 5874+59

2

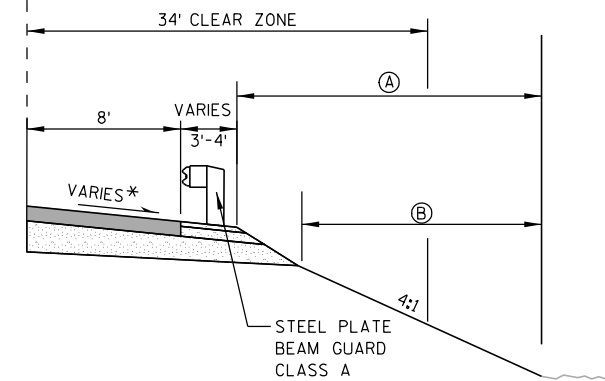

STA 5895+73 TO STA 5901+23

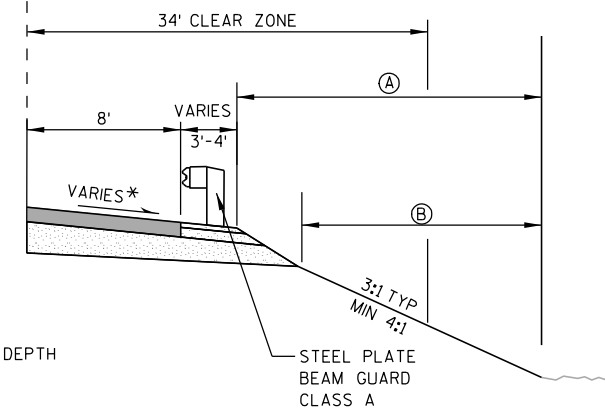


STA 5874+59 TO STA 5894+23

- LEGEND:**
- (A) SEEDING MIXTURE NO. 20
AND FERTILIZER TYPE B
- (B) 4" SALVAGED TOPSOIL
AND MULCHING OR EROSION MAT

2


2

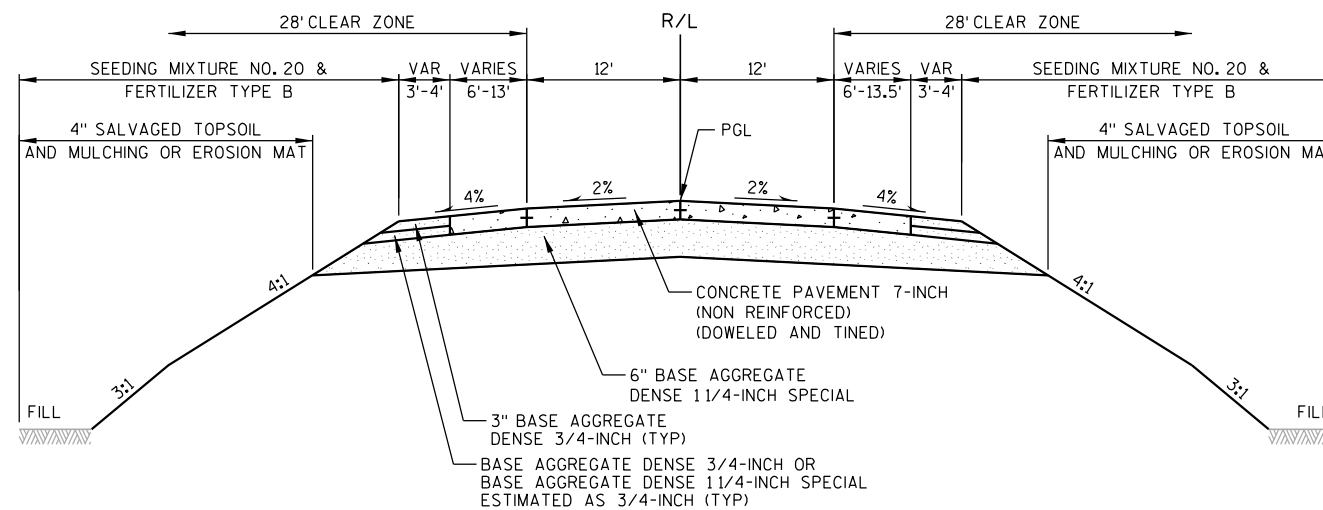

TYPICAL FINISHED SECTION

CTH C

STA 70+65 TO STA 72+15

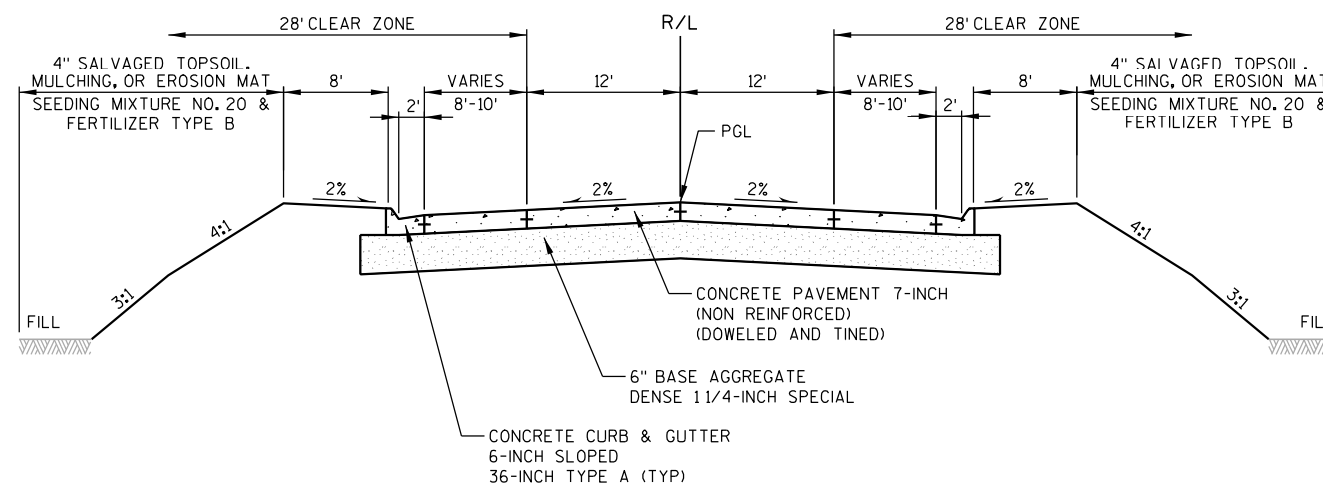


TYPICAL FINISHED SECTION

CTH C


STA 68+75 TO STA 70+65

2


2

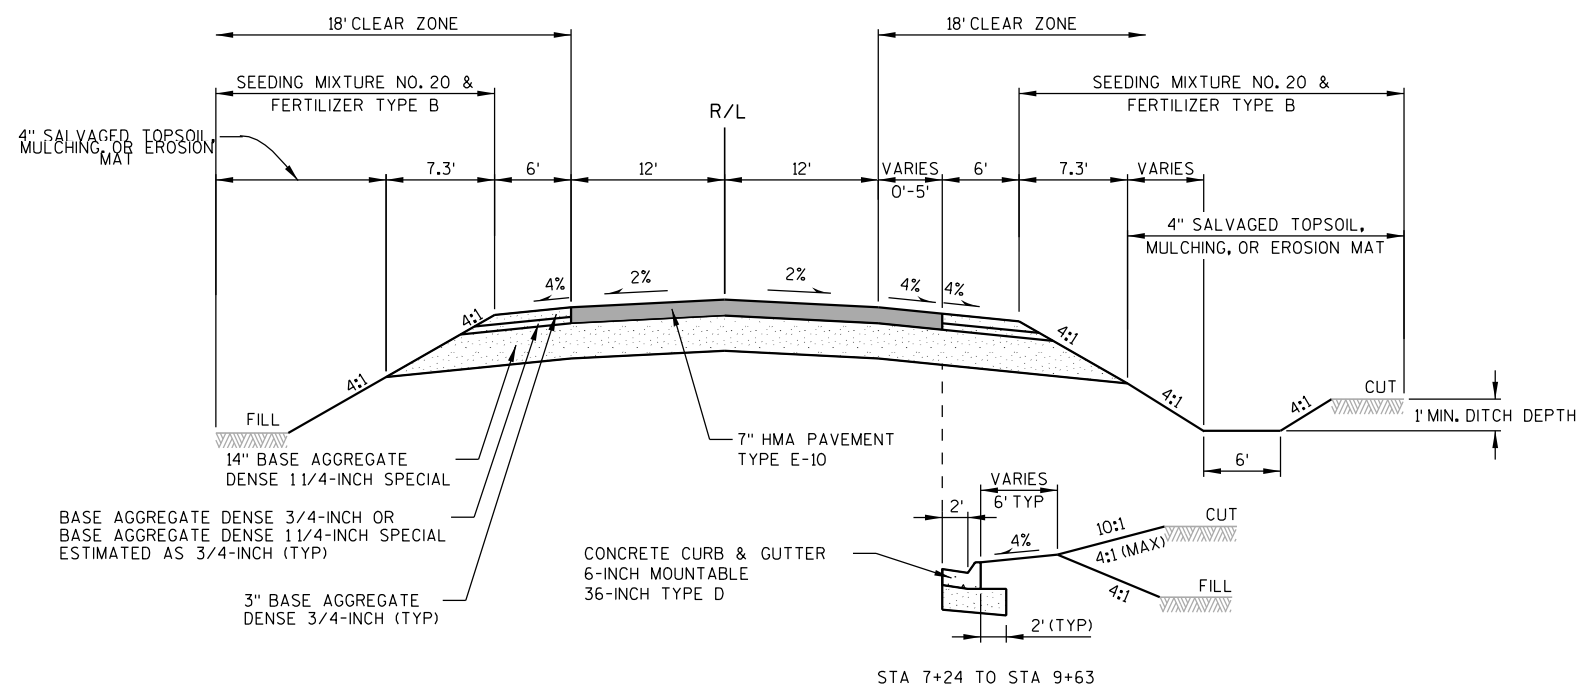

TYPICAL FINISHED SECTION
KILBOURN DRIVE
STA 4+62 TO STA 9+63

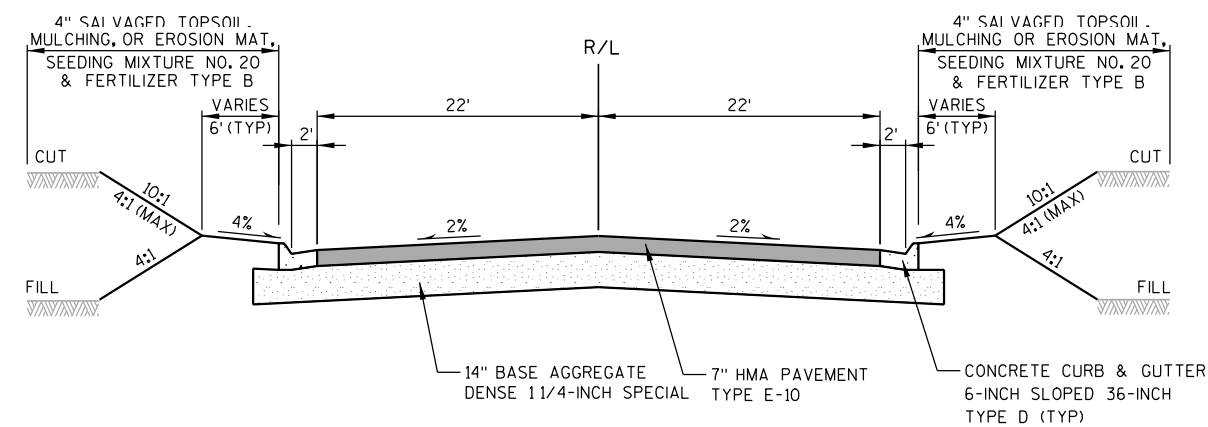


TYPICAL FINISHED SECTION
KILBOURN DRIVE
STA 10+39 TO STA 13+12
(SEE PAVING DETAILS FOR PARKING LOT DETAILS)

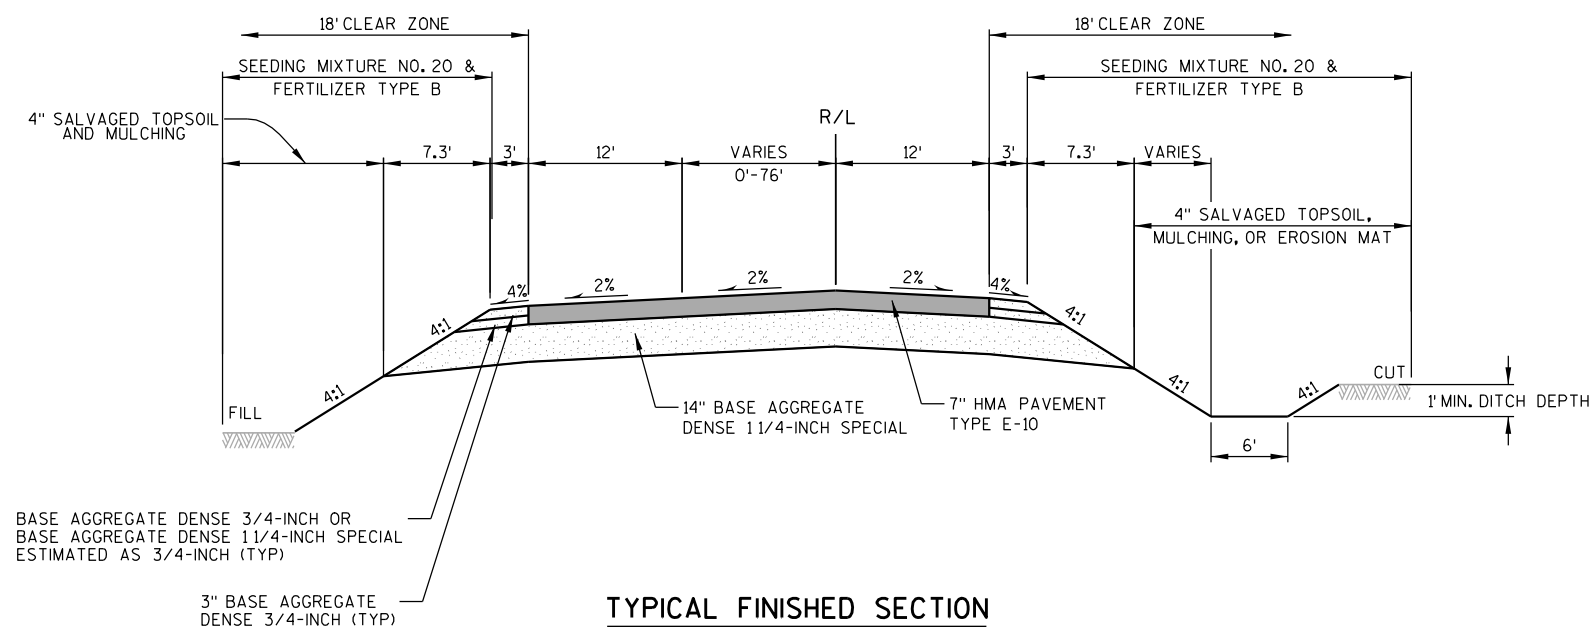

NOTE
CROWN CUL-DE-SAC AROUND
THE CENTER OF CIRCLE

TYPICAL FINISHED SECTION
KILBOURN DRIVE
STA 3+25 TO STA 4+62 (CUL-DE-SAC)

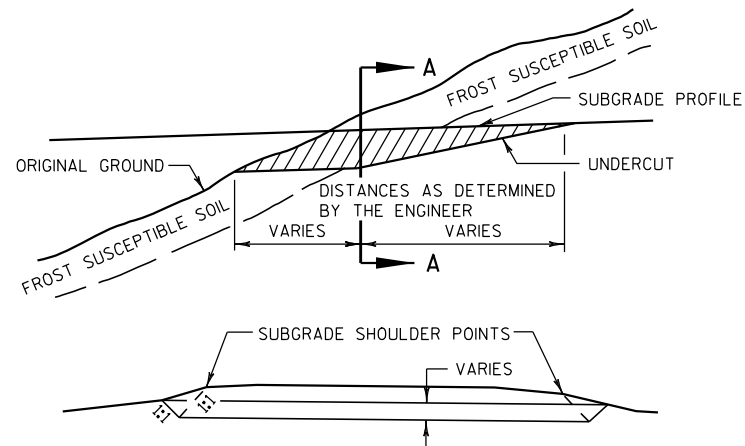


SECTION A-A
CROSS SECTION SHOWING UNDERCUT

NOTES

1. EXACT LOCATIONS AND EXTENT OF EBS SECTIONS SHALL BE DETERMINED BY THE ENGINEER IN THE FIELD.
2. EBS AREA TO BE BACKFILLED WITH MATERIAL ACCEPTABLE TO THE ENGINEER.
3. BACKFILL MUST BE HOMOGENEOUS WITH ADJOINING FILL MATERIAL.
4. THE FILL SECTION WITHIN 100' OF THE MOUTH OF THE CUT MUST BE KEPT 2' BELOW SUBGRADE UNTIL EBS IS COMPLETED.

EXCAVATION BELOW SUBGRADE AT CUTS


100813

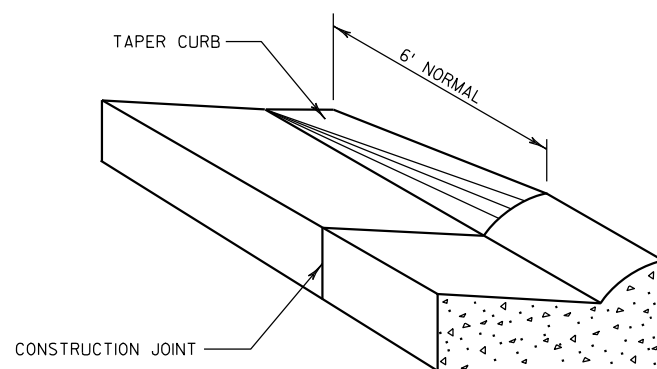

CURB & GUTTER TERMINI DETAIL

NOTE: USE 6 FT TRANSITION FOR CONCRETE AND ASPHALTIC CURB

100813

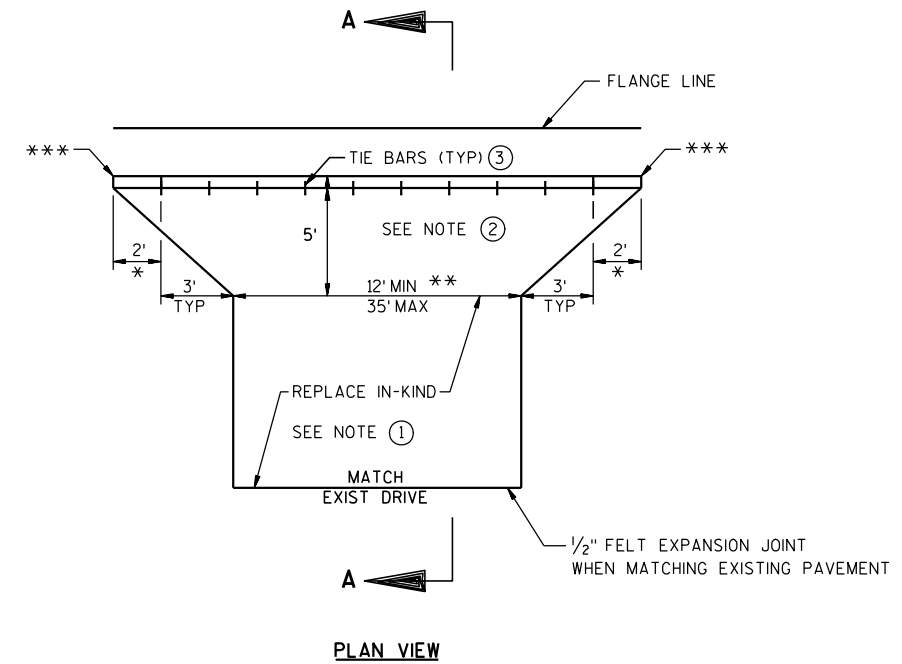

PLAN VIEW


NOTES:

- ① DRIVEWAY SURFACE BEYOND APRON TO BE REPLACED IN-KIND WITH MINIMUM SECTION OF:

ASPHALTIC SURFACE (3-INCH) DRIVEWAYS AND FIELD ENTRANCES OVER BASE AGGREGATE DENSE $\frac{3}{4}$ -INCH (4-INCH) OR
CONCRETE DRIVEWAY 6-INCH OVER BASE AGGREGATE DENSE $\frac{3}{4}$ -INCH (4-INCH) OR
BASE AGGREGATE DENSE $\frac{3}{4}$ -INCH (6-INCH)

- ② ALL URBAN DRIVEWAYS TO BACK OF APRON TO BE PAID FOR AS CONCRETE DRIVEWAY 6-INCH
- ③ TIE BARS ARE INCIDENTAL TO THE BID ITEM "CONCRETE DRIVEWAY 6-INCH"


* TAPER CURB HEAD
** SEE PAVING DETAILS FOR WIDTH REQD
*** STATION SHOWN ON PAVING DETAILS

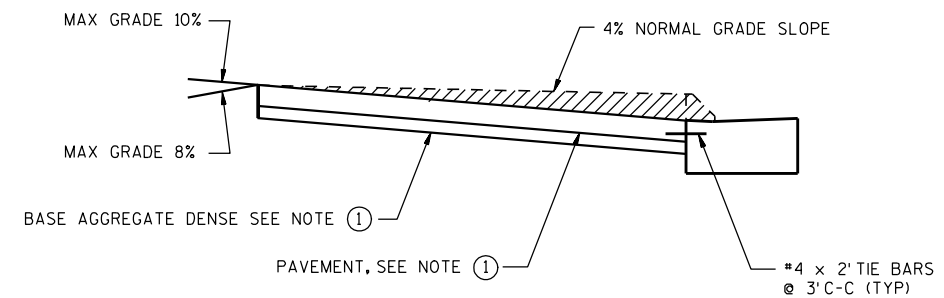

SECTION A-A

URBAN DRIVEWAY

081230

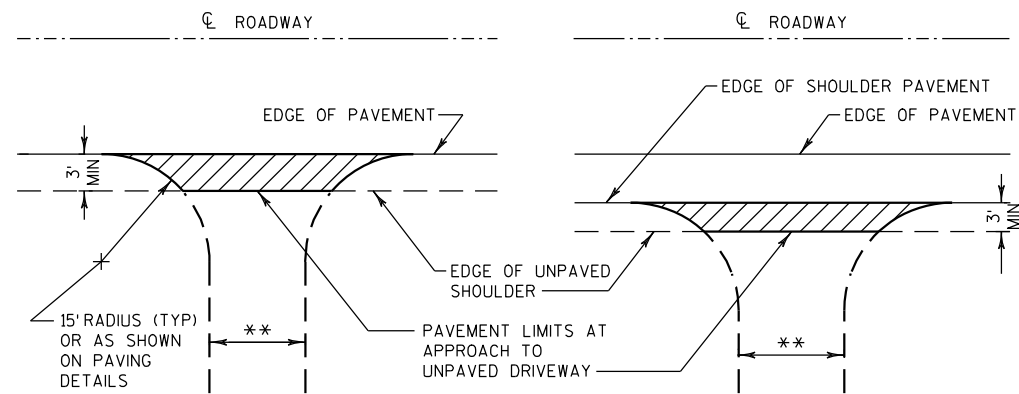


** SEE PAVING DETAILS FOR WIDTH REQUIRED.

PLAN VIEW

PLAN VIEW
(PAVED SHOULDER ON HIGHWAY)


RURAL DRIVEWAY INTERSECTION

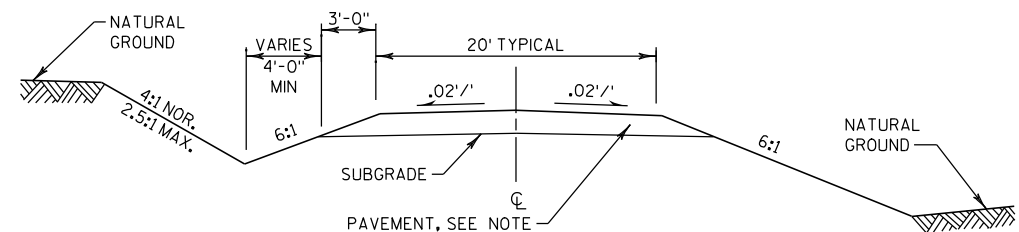

IN CUT

IN FILL

TYPICAL CROSS SECTION FOR PRIVATE DRIVE OR FIELD ENTRANCE

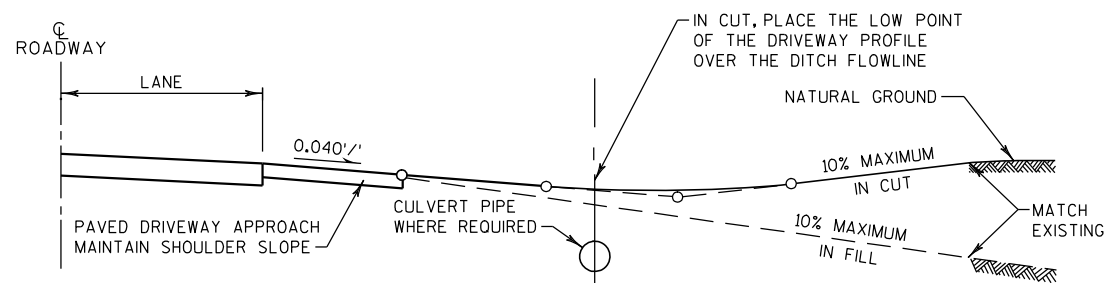


TYPICAL DRIVEWAY PROFILES

NOTES

- WHERE DRIVEWAY IS PAVED, APPROACH PAVEMENT SHOULD BE EXTENDED TO MATCH DRIVEWAY PAVEMENT. SAWCUT IS REQUIRED.
- DRIVEWAY SURFACE TO BE SAME AS EXISTING WITH MINIMUM SECTION OF:
 - ASPHALTIC SURFACE (3 OR 4-INCH) DRIVEWAYS AND FIELD ENTRANCES OVER BASE AGGREGATE DENSE 3/4 -INCH (4-INCH)
 - OR
 - CONCRETE DRIVEWAY 6-INCH OVER BASE AGGREGATE DENSE 3/4 -INCH (4-INCH)
 - OR
 - BASE AGGREGATE DENSE 3/4 -INCH (6-INCH)

RURAL DRIVEWAY

100902

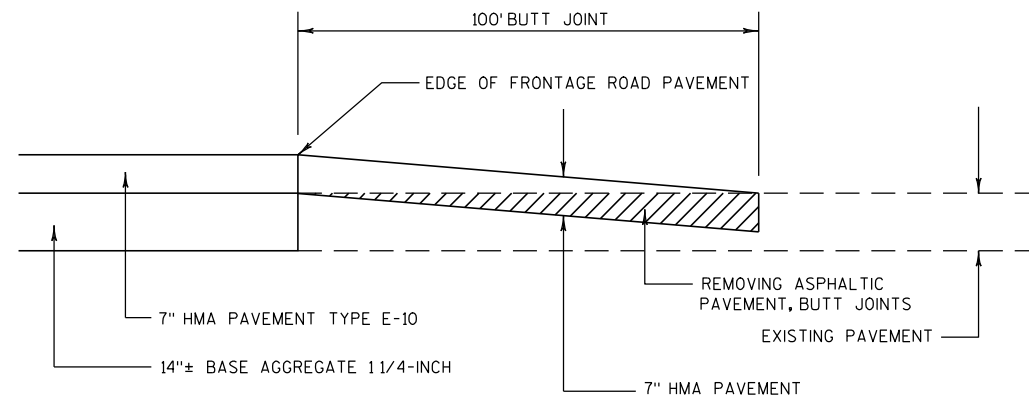


BUTT JOINT DETAIL

AT BEGIN CONSTRUCTION & END CONSTRUCTION

EAST FRONTAGE ROAD

STA 3835+00
STA 3852+25
STA 5863+15
STA 5901+23

100813

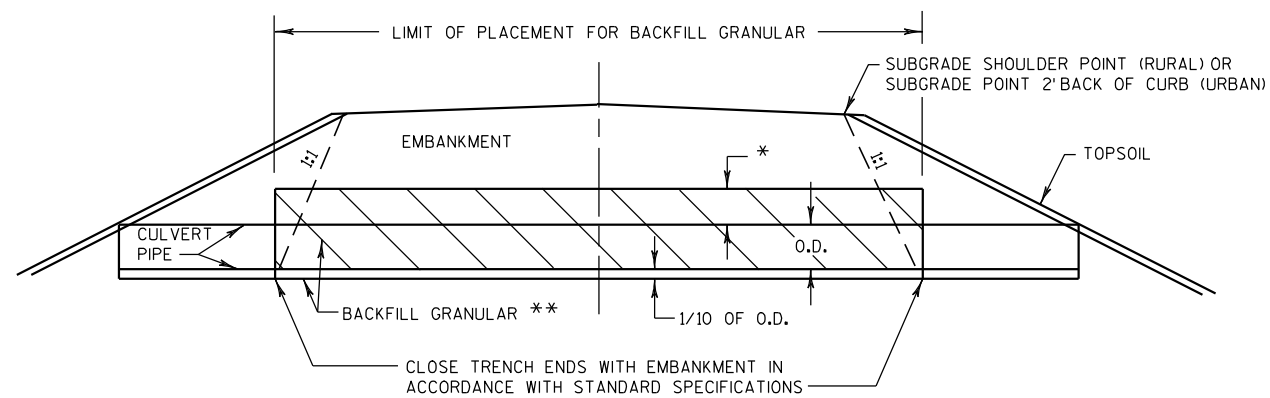


O.D. = OUTSIDE DIAMETER


- * CULVERT PIPE IN NEW EMBANKMENT = 1' MIN
- * CULVERT PIPE IN EXISTING EMBANKMENT = TO EXISTING GROUND ELEVATION
- ** INCIDENTAL TO CULVERT PIPE

CULVERT BACKFILL DETAIL

100813

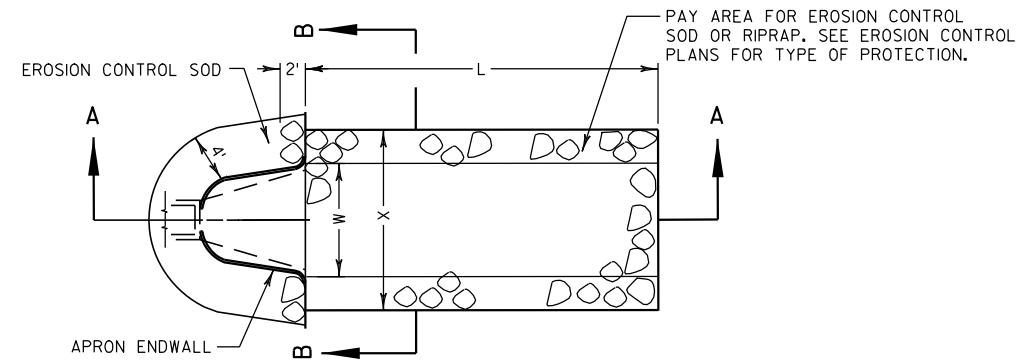

PLAN VIEW

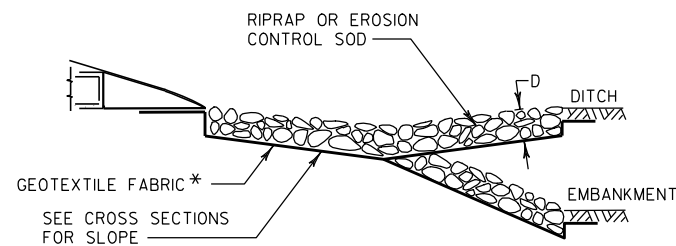

SECTION A-A


L = 3 x W (NOR) OR 10' MIN
OR AS INDICATED IN THE PLANS
OR AS DIRECTED BY THE ENGINEER

D = 12" FOR RIPRAP LIGHT
18" FOR RIPRAP MEDIUM
24" FOR RIPRAP HEAVY

X = W+2' FOR TYPICAL CULVERT
DISCHARGE INTO DITCH
W+5' FOR CULVERT DISCHARGE
DOWN EMBANKMENT SLOPE

Y = 0' FOR TYPICAL CULVERT
DISCHARGE INTO DITCH
12" FOR CULVERT DISCHARGE
DOWN EMBANKMENT SLOPE

* TYPE R (FOR RIPRAP LIGHT ONLY)
TYPE HR (FOR RIPRAP HEAVY AND MEDIUM ONLY)

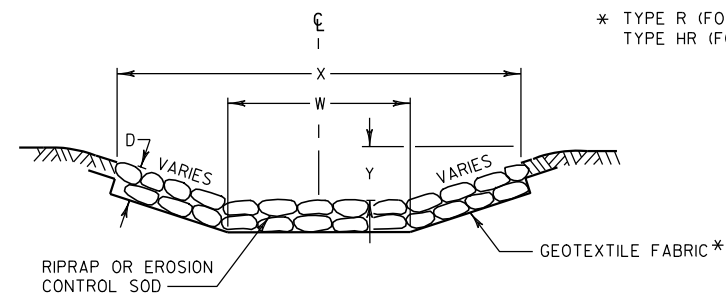


SECTION B-B

**SOD, RIPRAP AND GEOTEXTILE FABRIC DETAIL
AT APRON ENDWALLS**


SEE EROSION CONTROL PLAN FOR LOCATIONS

100914

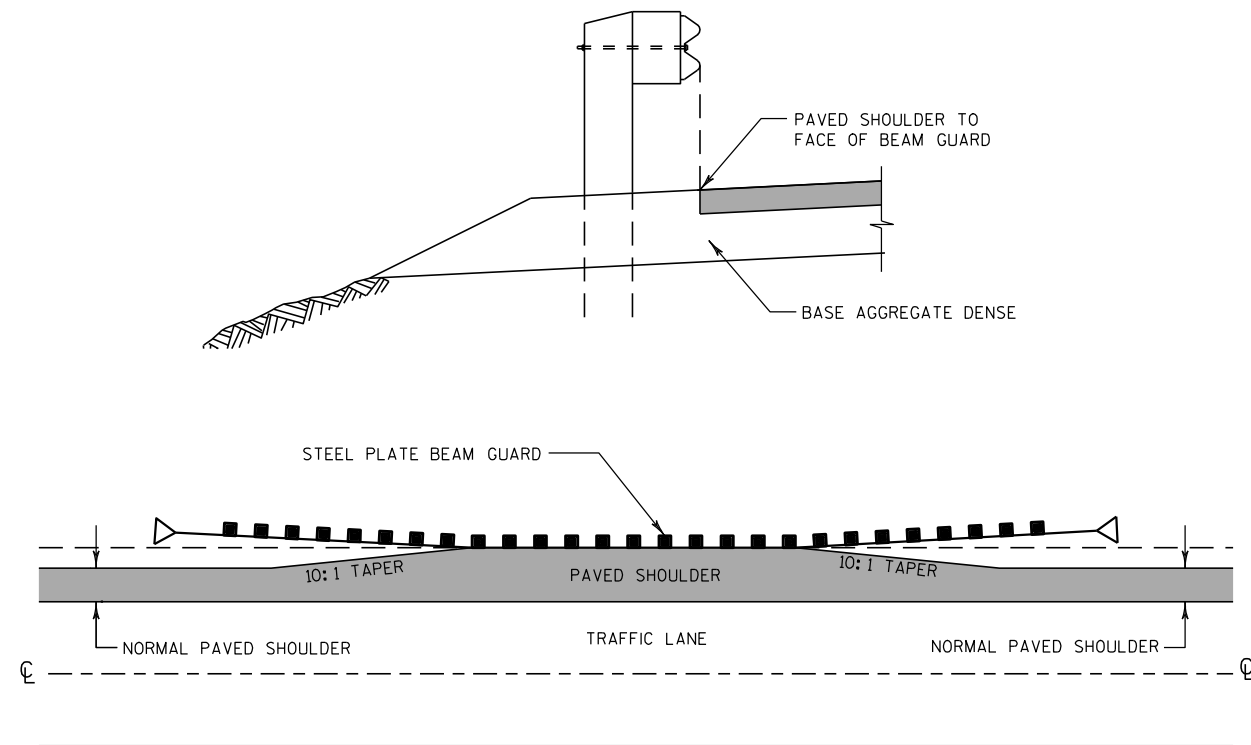

PAVED SHOULDER AT BEAM GUARD


100818

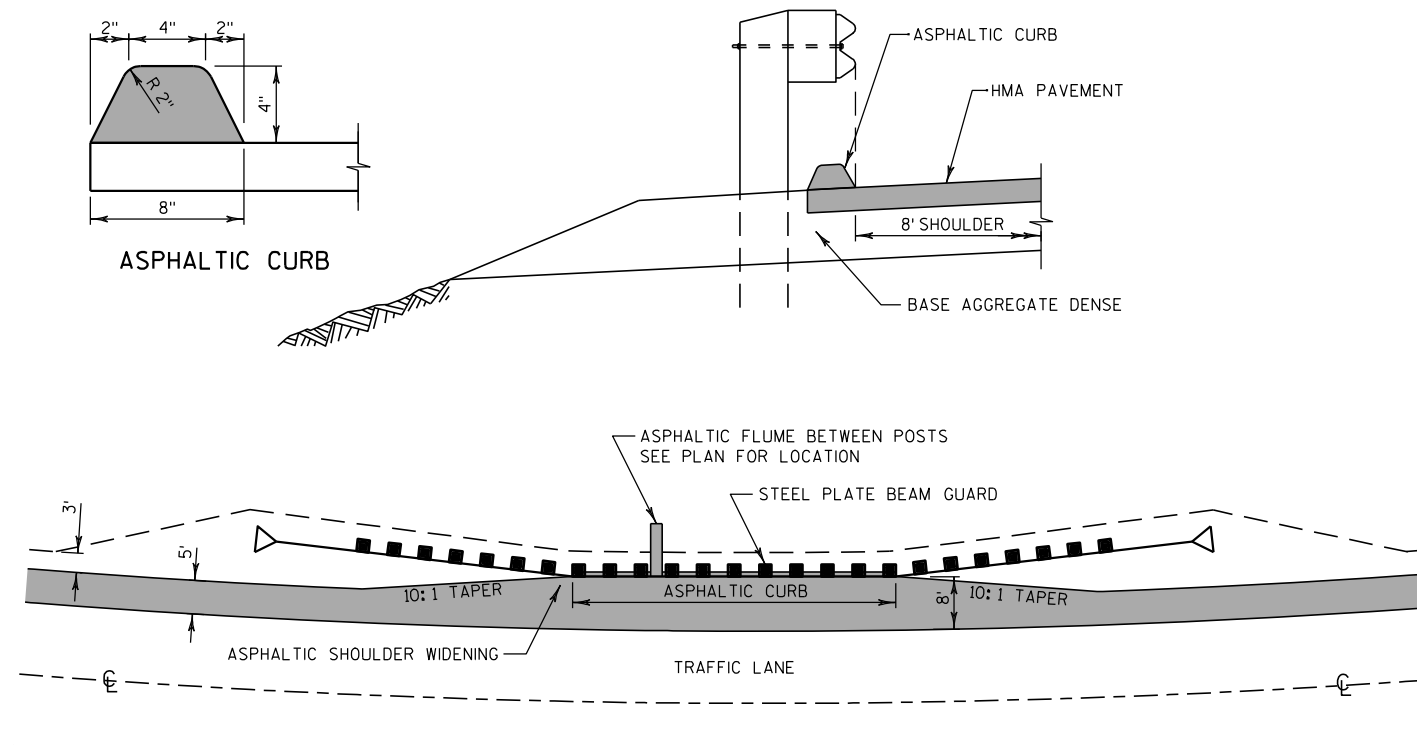

PAVED SHOULDER WIDENING AT BEAM GUARD

FOR LOW SIDE SHOULDER IN SUPERELEVATION SECTIONS

100818

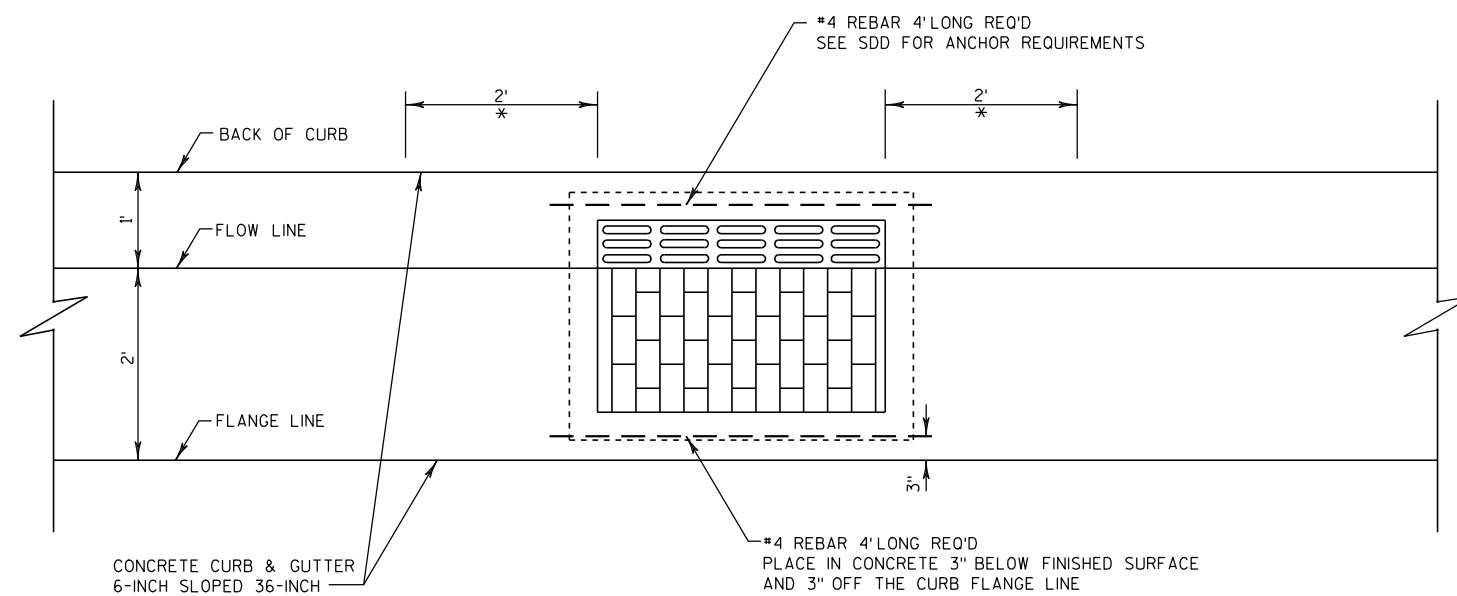

PLAN VIEW


* TRANSITION STANDARD CURB HEAD TO
MATCH THE TYPE HM INLET COVER.

INLET COVERS, TYPE HM

NOTES


1. SEE SDD "INLET COVERS TYPE F, HM, HM-S, S, V, HM-GJ, & HM-GJ-S" FOR ADDITIONAL INFORMATION.
2. THE TWO 2-FOOT LONG CURB TRANSITION SEGMENTS ARE PAID AS CONCRETE CURB & GUTTER 6-INCH SLOPED 36-INCH.
3. THE TWO 4-FOOT LENGTHS OF #4 REBAR ARE INCIDENTAL TO THE BID ITEM "INLET COVERS TYPE HM".

100813

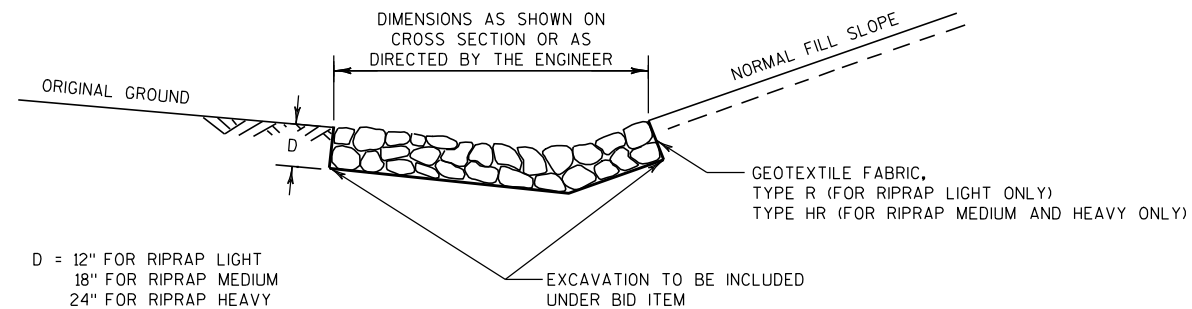

RIPRAP IN DITCHES

100901

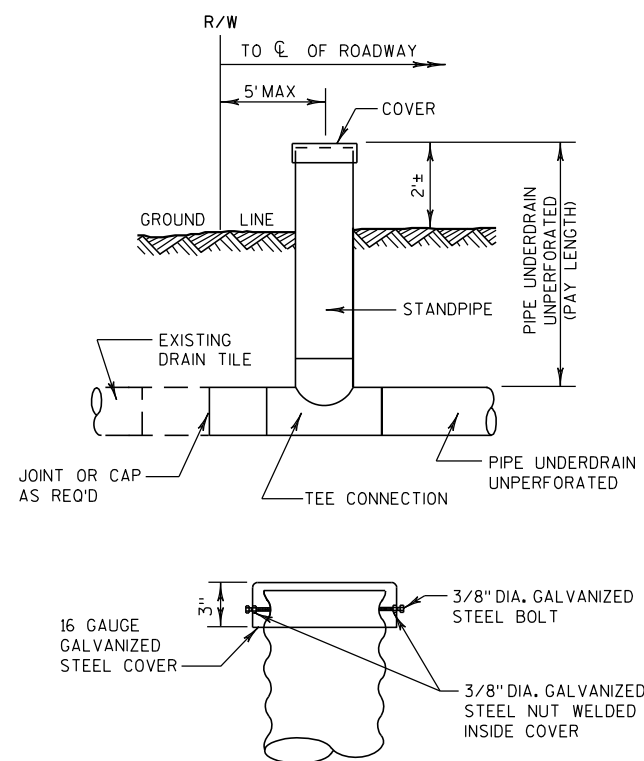


NOTE

THE COST OF FURNISHING AND INSTALLING THE CONNECTION TO THE UNDERDRAIN AND THE COVER SHALL BE CONSIDERED INCIDENTAL TO THE ITEM PIPE UNDERDRAIN, UNPERFORATED.

INSPECTION STANDPIPE AIR VENT

FOR DRAIN TILE


100813

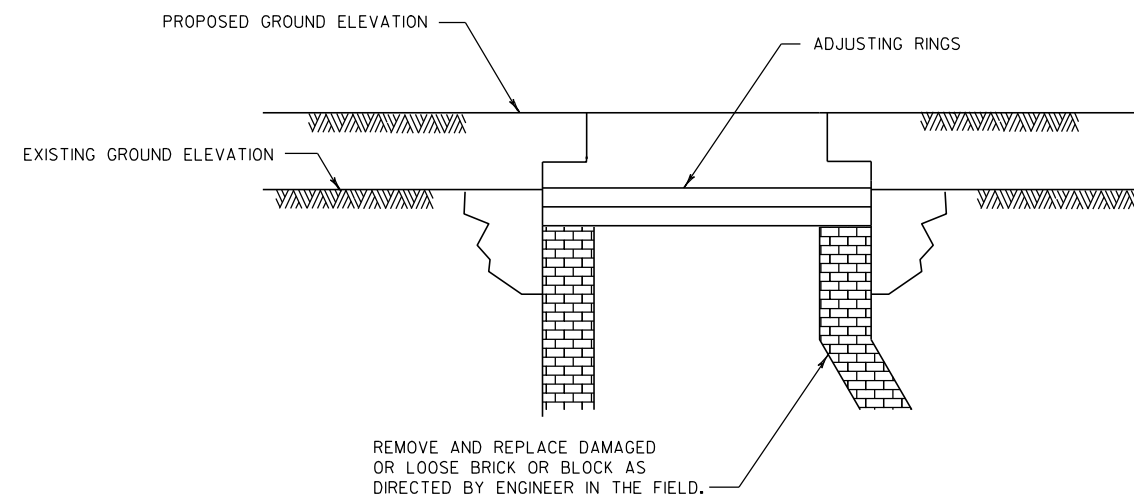

NON-PAVED AREA

NOTE


ADJUST CHIMNEY WITH PROPER SIZE CONCRETE ADJUSTING RINGS (SIZE OF OPENING OF CONCRETE ADJUSTING RING TO BE DETERMINED BY SIZE OF OPENING IN FRAME) AND REINSTALL EXISTING FRAME AND LID TO FINISHED GRADE. (BACKFILL AND OTHER WORK TO BE DONE IN ACCORDANCE WITH ITEM ADJUSTING INLET COVER.)

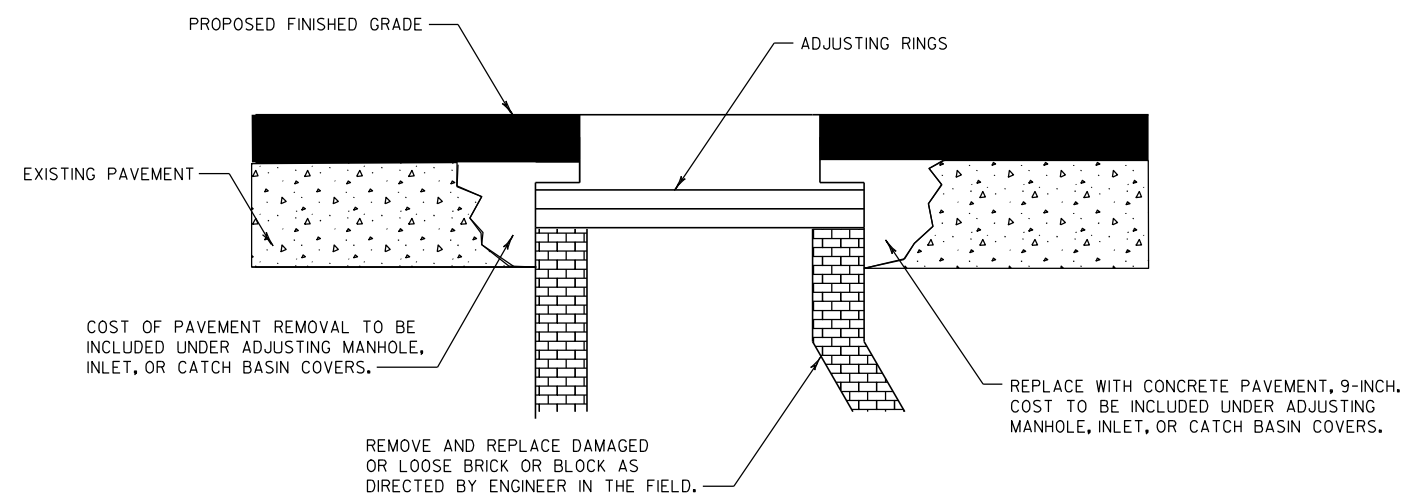

PAVED AREA

ADJUSTING MANHOLE OR INLET COVERS

100813

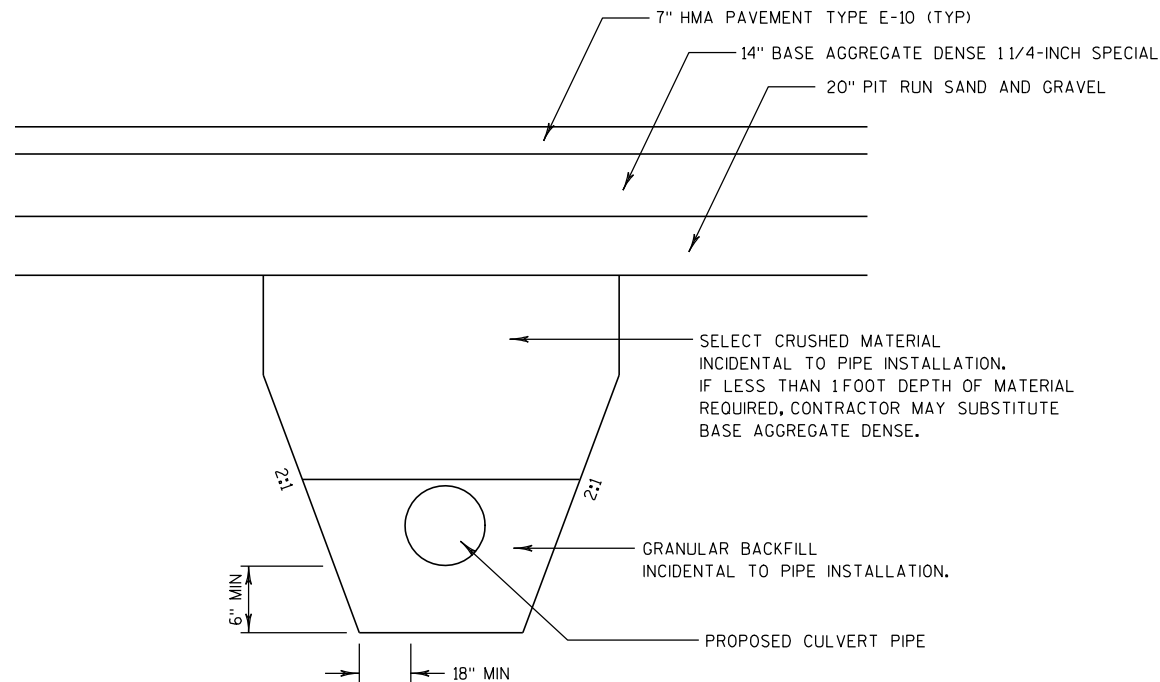

INSTALLATION OF PIPES


081231

RUNOFF COEFFICIENT TABLE

	HYDROLOGIC SOIL GROUP											
	A			B			C			D		
	SLOPE RANGE (PERCENT)			SLOPE RANGE (PERCENT)			SLOPE RANGE (PERCENT)			SLOPE RANGE (PERCENT)		
LAND USE:	0-2	2-6	6 & OVER	0-2	2-6	6 & OVER	0-2	2-6	6 & OVER	0-2	2-6	6 & OVER
ROW CROPS	.08	.16	.22	.12	.20	.27	.15	.24	.33	.19	.28	.38
	.22	.30	.38	.26	.34	.44	.30	.37	.50	.34	.41	.56
MEDIAN STRIP-TURF	.19	.20	.24	.19	.22	.26	.20	.23	.30	.20	.25	.30
	.24	.26	.30	.25	.28	.33	.26	.30	.37	.27	.32	.40
SIDE SLOPE-TURF			.25			.27			.28			.30
			.32			.34			.36			.38
PAVEMENT:												
ASPHALT	.70 - .95											
CONCRETE	.80 - .95											
BRICK	.70 - .80											
DRIVES, WALKS	.75 - .85											
ROOFS	.75 - .95											
GRAVEL ROADS, SHOULDERS	.40 - .60											

TOTAL PROJECT AREA = 148.8 ACRES (STH 20 TO CTH K R/W AREA)
TOTAL AREA EXPECTED TO BE DISTURBED BY CONSTRUCTION ACTIVITIES = 20.2 ACRES (I.D. 1033-02-70 DISTURBED AREA)

090805

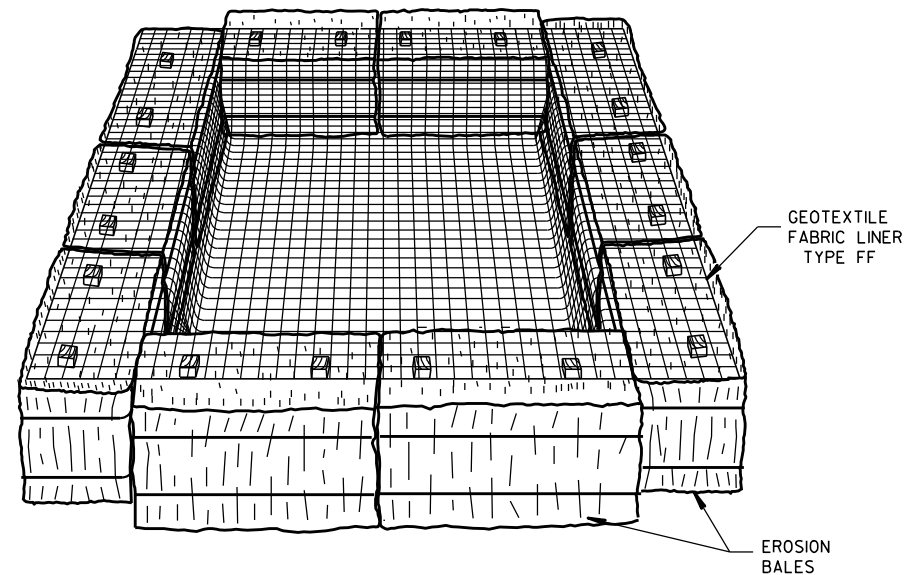

TEMPORARY SETTLING BASIN

(SIZE TO BE DETERMINED IN FIELD AS INDICATED BELOW:)

STORAGE VOLUME (C.F.) = 16 X GPM (PUMP RATE)


EXAMPLE:
CONTRACTOR INDICATES PUMP CAPABLE OF 50 GPM
HEIGHT OF BALES = 1.5 FT.

SOLUTION:
SV (C.F.) = 16 X 50
SV = 800 C.F.
800 C.F. / 1.5 FT. = 533 S.F.
USE A 20 FT. X 27 FT. BASIN

NOTES:

1. CONTRACTOR TO PUMP WATER FROM EXCAVATION TO BASIN PRIOR TO DISCHARGING TO THE WATERWAY.
2. BASIN TO BE KEPT LESS THAN 10% FULL OF SEDIMENT. GEOTEXTILE FABRIC AND SEDIMENTS TO BE DISPOSED BY THE CONTRACTOR OFF OF THE PROJECT SITE.
3. TEMPORARY SETTLING BASIN TO BE PAID FOR AS EROSION BALES AND GEOTEXTILE FABRIC TYPE FF.


081230

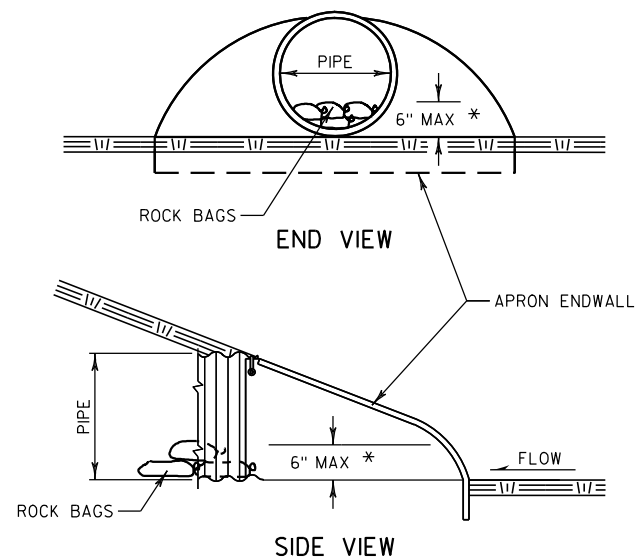

* OR AS DIRECTED BY THE ENGINEER

CULVERT PIPE CHECK


100813

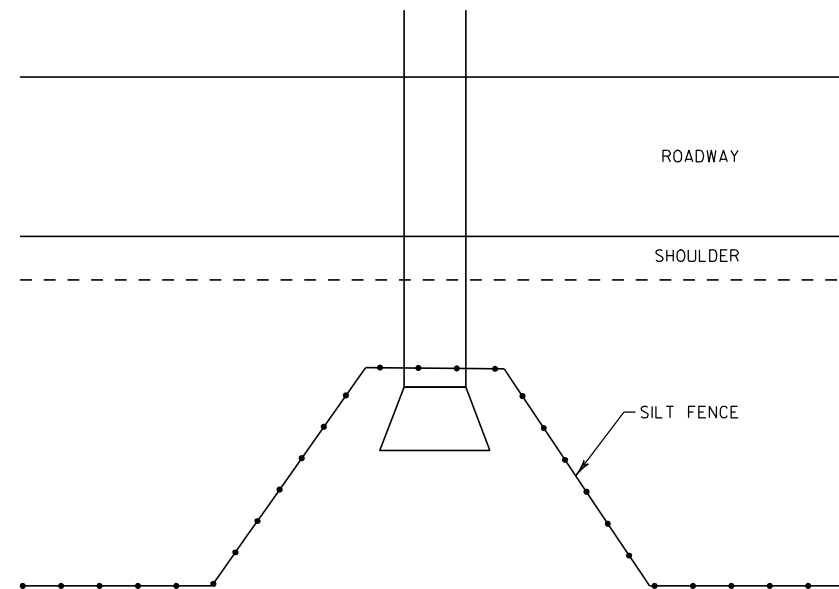

NOTE
SEE SILT FENCE SDD FOR ADDITIONAL INFORMATION.


TYPICAL SILT FENCE DETAIL AT PIPE INLET

100902

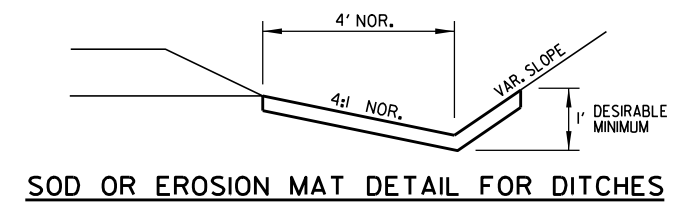

SOD OR EROSION MAT DETAIL FOR DITCHES


081231

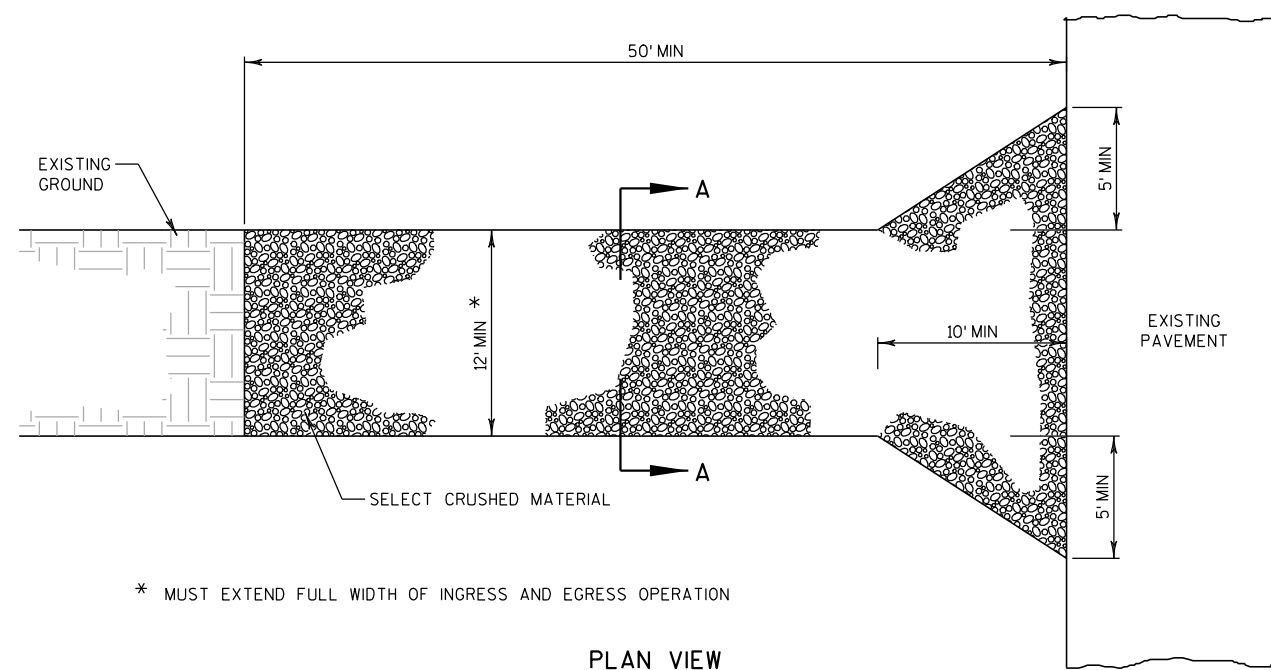

* MUST EXTEND FULL WIDTH OF INGRESS AND EGRESS OPERATION

TRACKING PADS

FOR CONSTRUCTION EGRESS POINTS


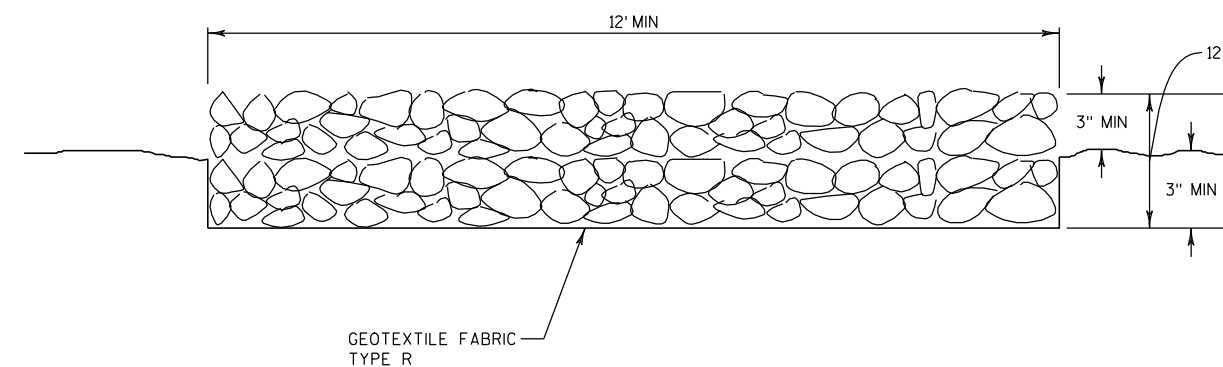


SECTION A-A


NOTE

TRACKING PADS TO BE INSPECTED DAILY. DEFICIENT AREAS TO BE REPAIRED OR REPLACED IMMEDIATELY.

100813

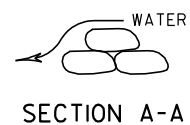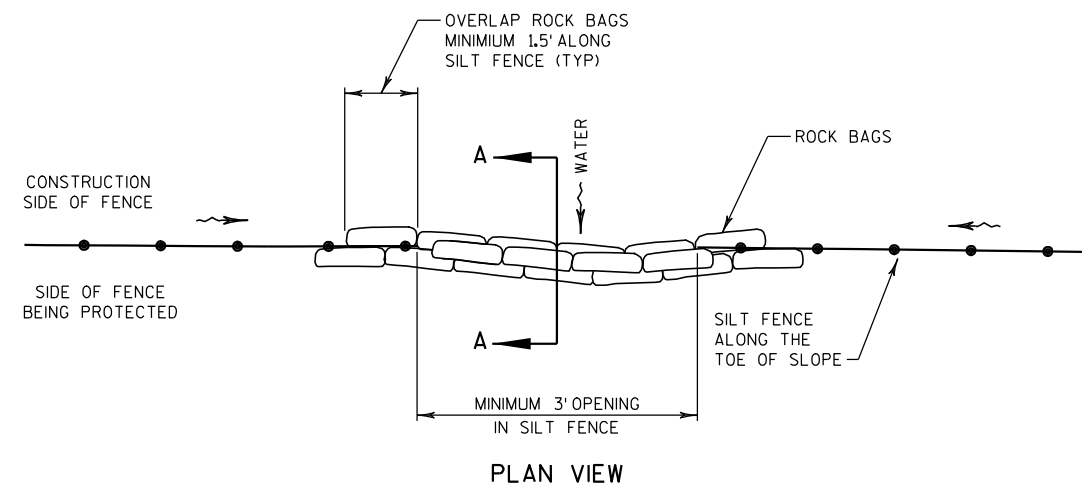

SILT FENCE DRAINAGE OUTLET, ROCK BAGS

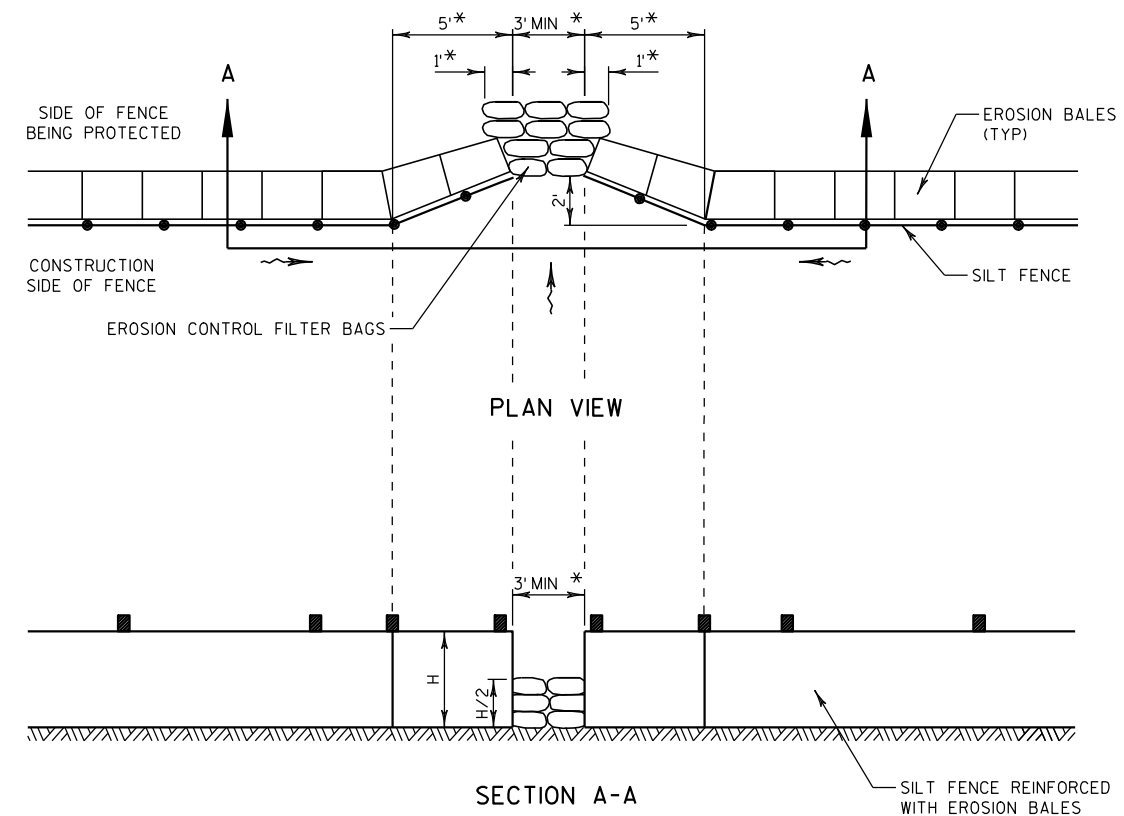


* DIMENSIONS MAY BE ADJUSTED TO FIT FIELD CONDITIONS
AS DIRECTED BY THE ENGINEER.


SILT FENCE DRAINAGE OUTLET, EROSION CONTROL FILTER BAGS
(FOR USE IN ENVIRONMENTALLY SENSITIVE AREAS)

NOTE TO DESIGNER: When using these detail drawings,
include the corresponding corridor specifications

100903

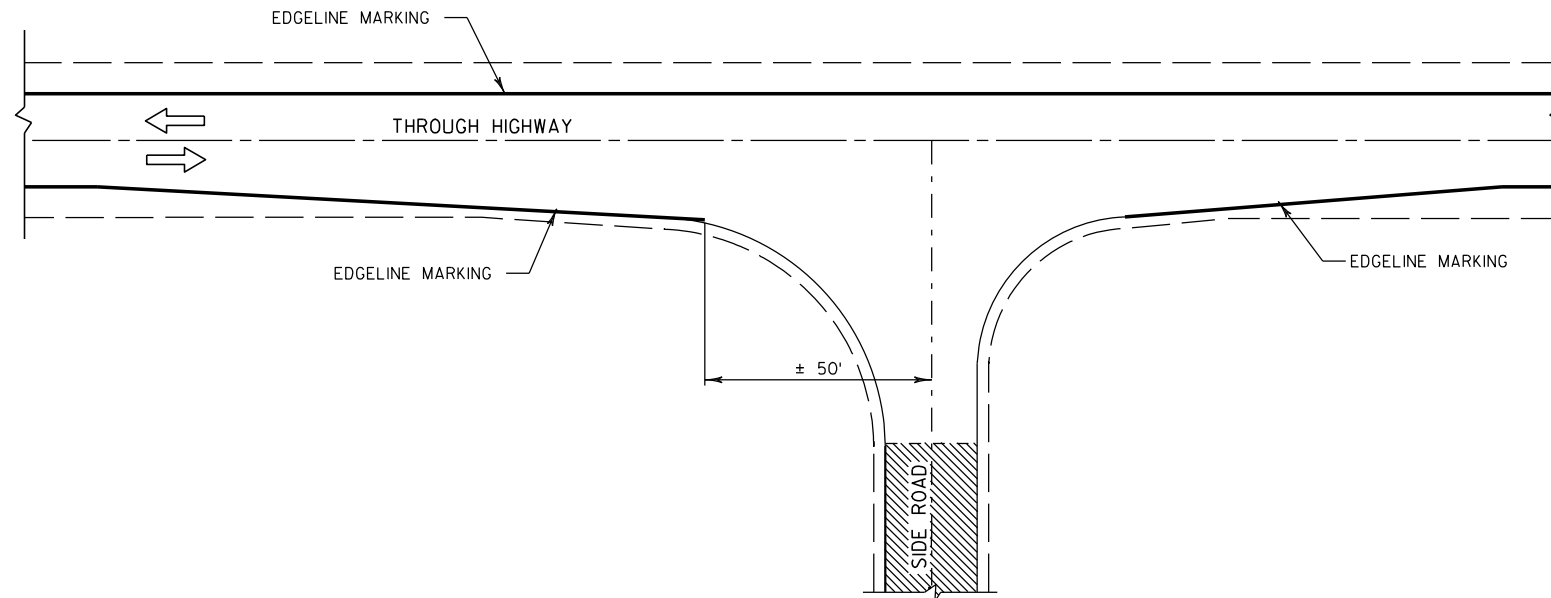




MINOR INTERSECTION WITHOUT CURBS
TYPICAL MARKING

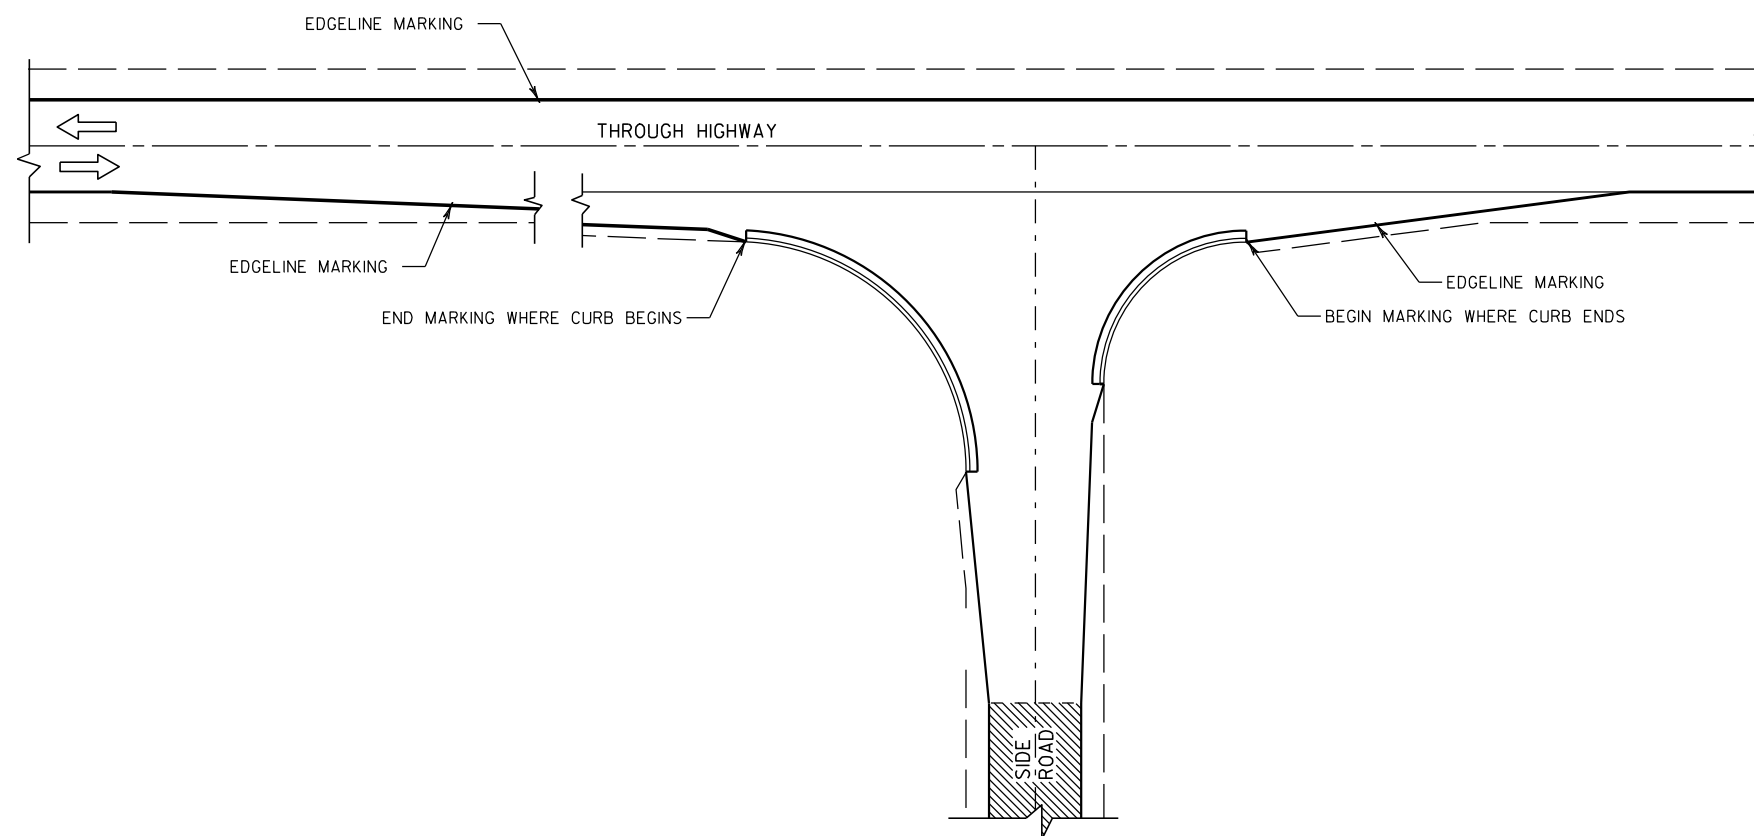

MINOR INTERSECTION WITH CURBS
TYPICAL MARKING

MINOR INTERSECTION EDGE LINE MARKING

100803

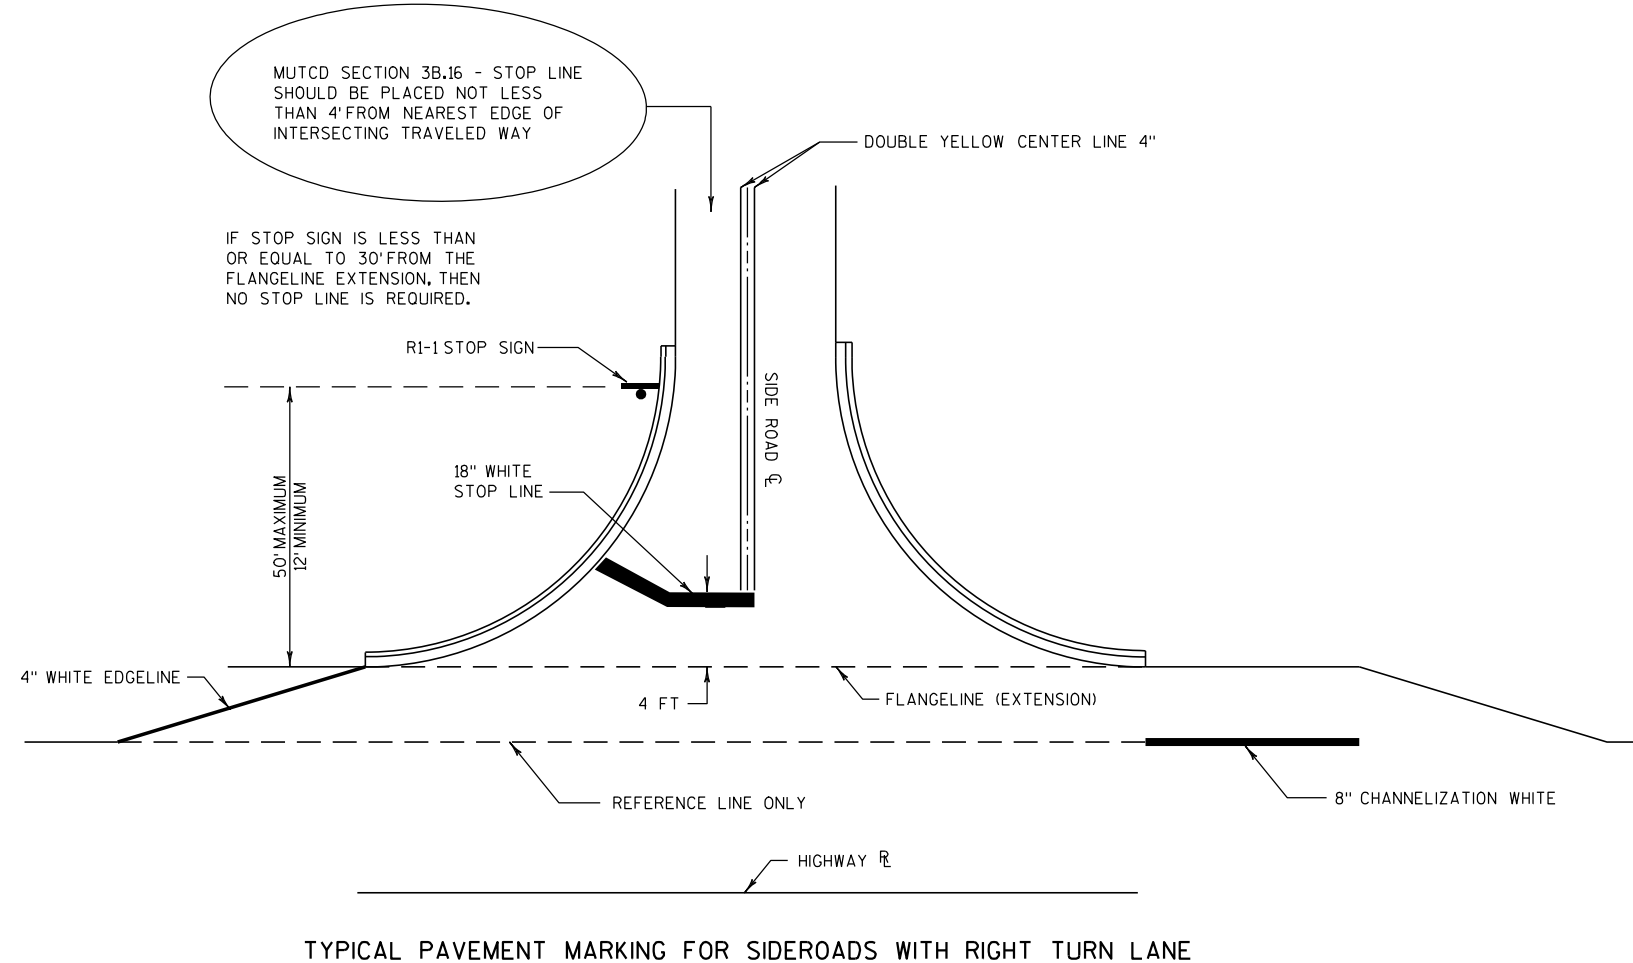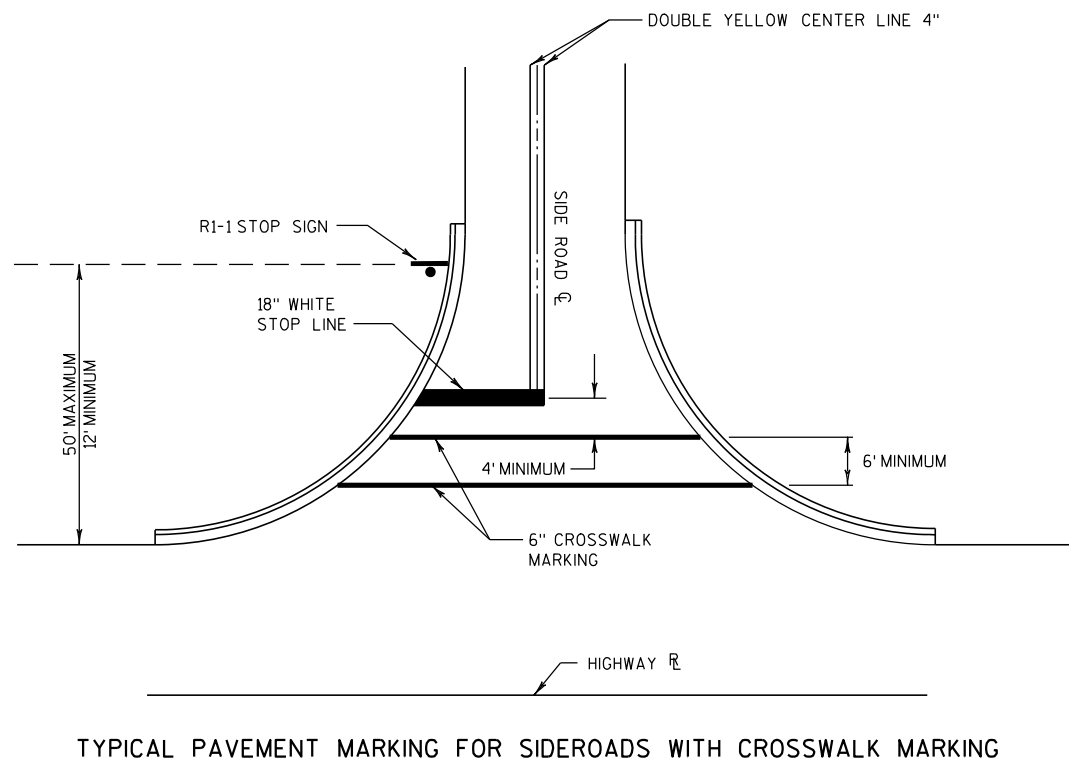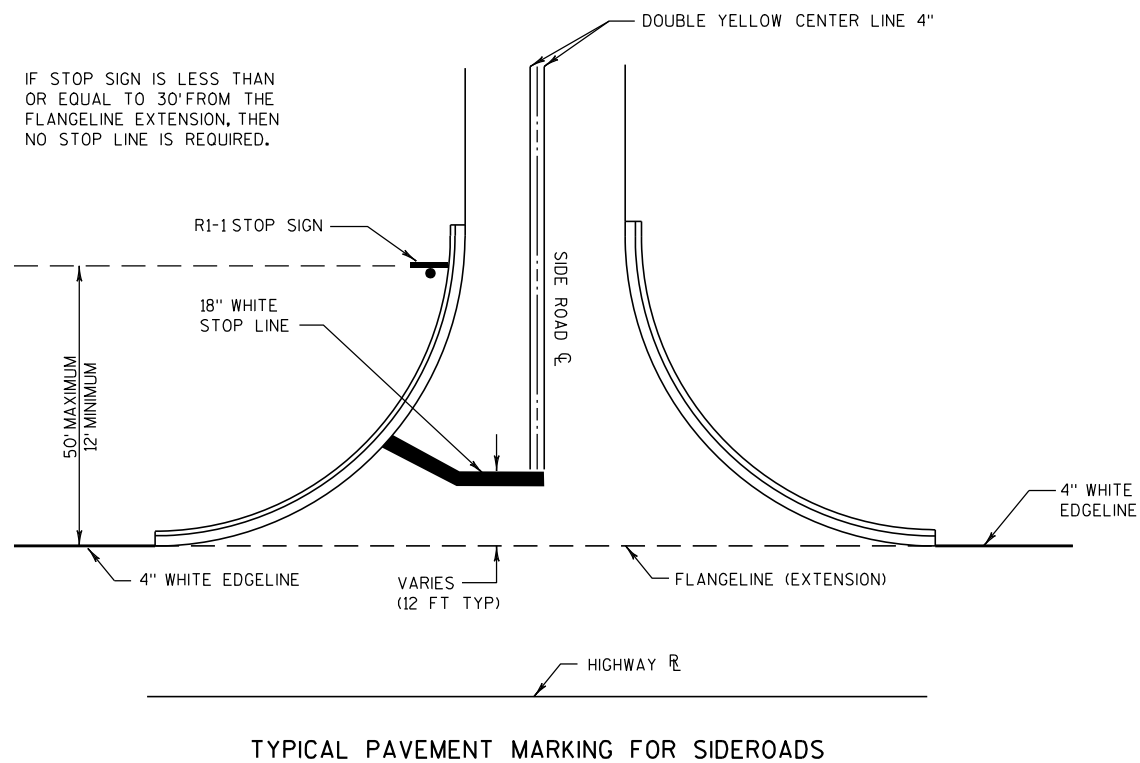


NOTES

1. 18-INCH STOP LINES MAY BE DELETED OR ADDED BY THE PROJECT ENGINEER BASED ON VISIBILITY AND SIGHT LINES.
2. STOP LINES REQUIRED WHERE:
 - A. CROSSWALK MARKINGS EXIST OR ARE BEING PROVIDED
 - B. LARGE RADII
 - C. OFFSET LEFT TURNS WHERE STOP BAR FOR LEFT TURN IS SET BACK FROM THRU MOVEMENT

PAVEMENT MARKING AT SIDEROADS

100818

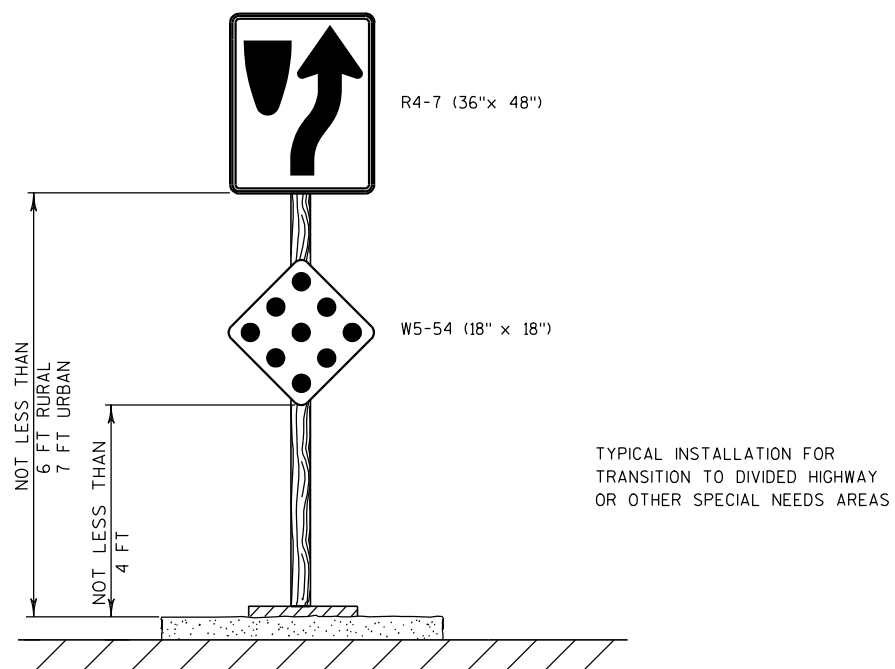


SIGNING DETAIL

SEE PERMANENT SIGNING PLANS FOR LOCATIONS

090610


SHALLOW CUT/FILL

** STA

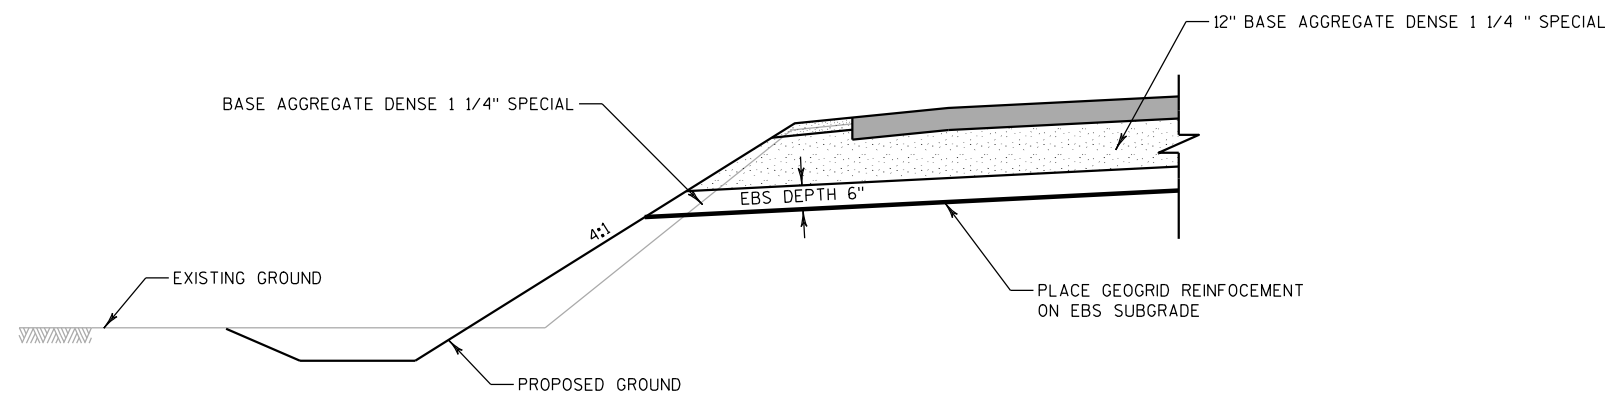

EXISTING DITCHES

** STA

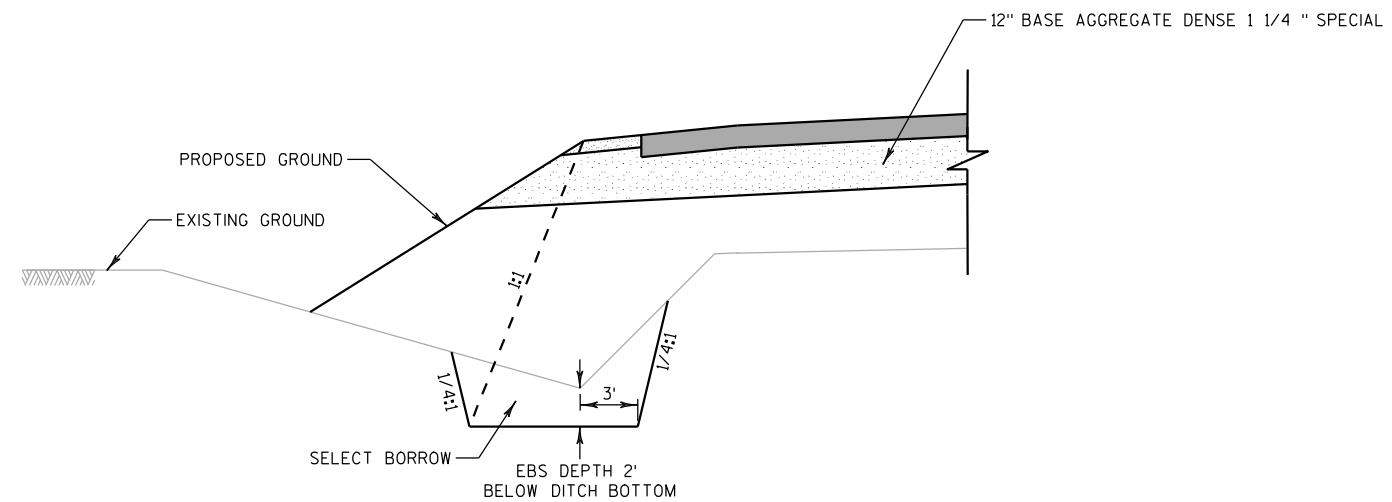


PAVEMENT SUBGRADE IMPROVEMENT DETAILS FOR FRONTAGE ROADS AND CROSSROADS

** ACTUAL LOCATION DEPENDENT ON FIELD CONDITIONS DURING GRADING OPERATIONS. GEOGRID REINFORCEMENT AND FILL MATERIAL SHALL NOT BE PLACED UNTIL AUTHORIZED BY THE ENGINEER OR SOILS ENGINEER.

100813


MINOR FILL EMBANKMENTS

** STA

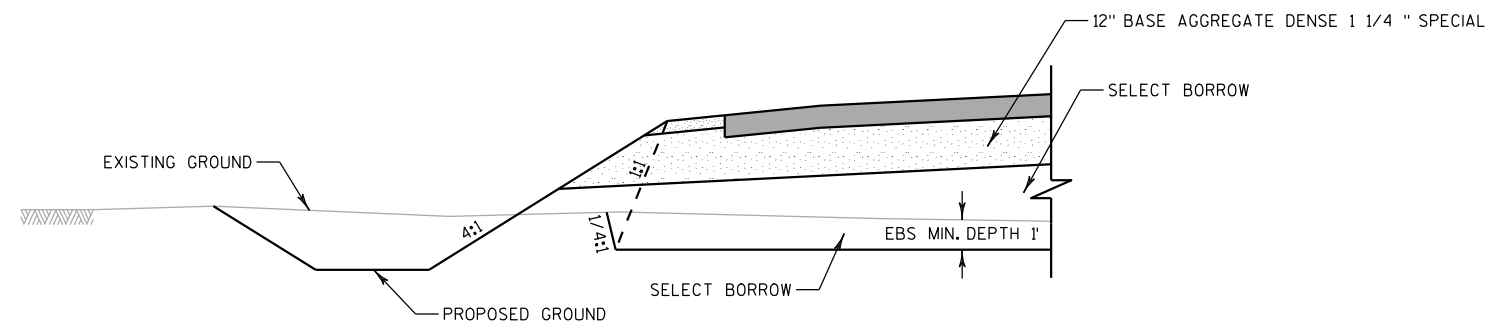


FILL EMBANKMENTS (RURAL)

** STA

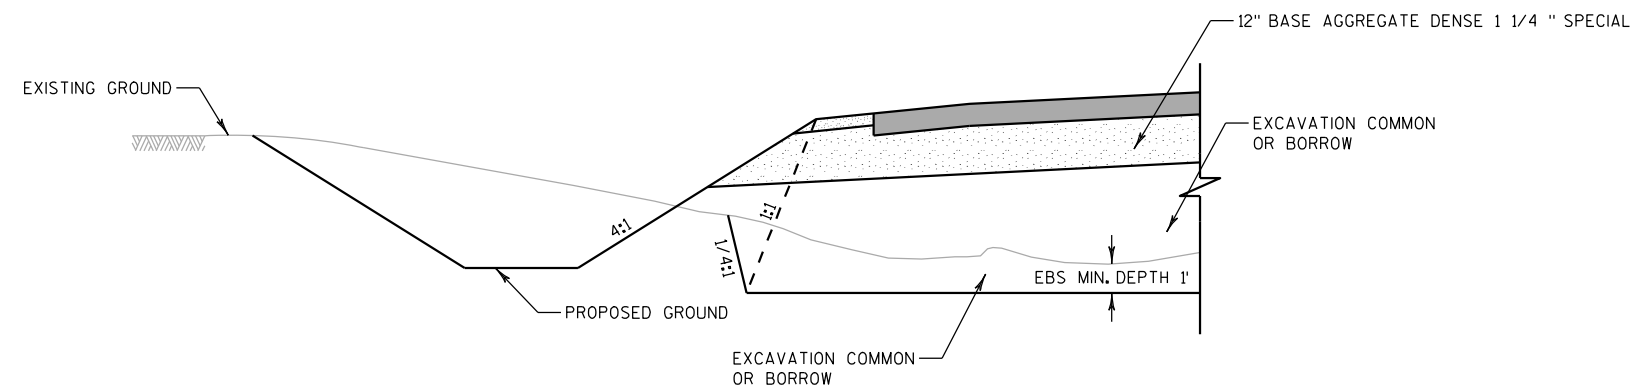

FILL EMBANKMENTS (URBAN)


** STA

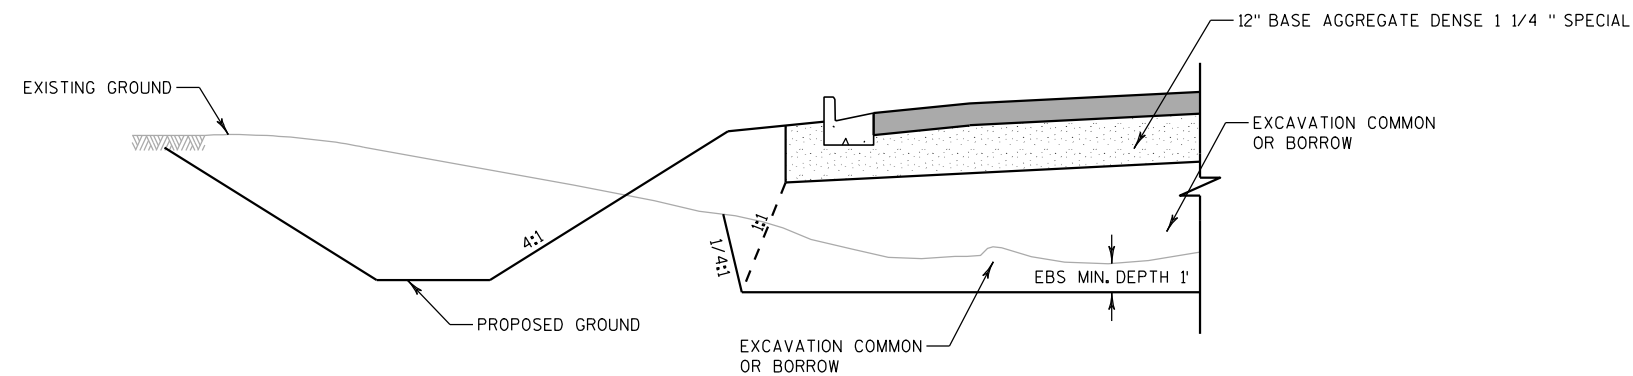

PAVEMENT SUBGRADE IMPROVEMENT DETAILS FOR FRONTAGE ROADS AND CROSSROADS


** ACTUAL LOCATION DEPENDENT ON FIELD CONDITIONS DURING GRADING OPERATIONS. GEOGRID REINFORCEMENT AND FILL MATERIAL SHALL NOT BE PLACED UNTIL AUTHORIZED BY THE ENGINEER OR SOILS ENGINEER.

100813

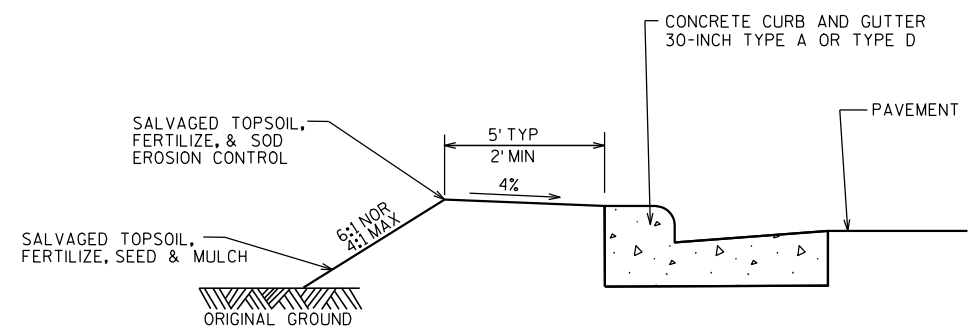

**TYPICAL PARTIAL SECTION
AT INTERSECTION RADII**


081230

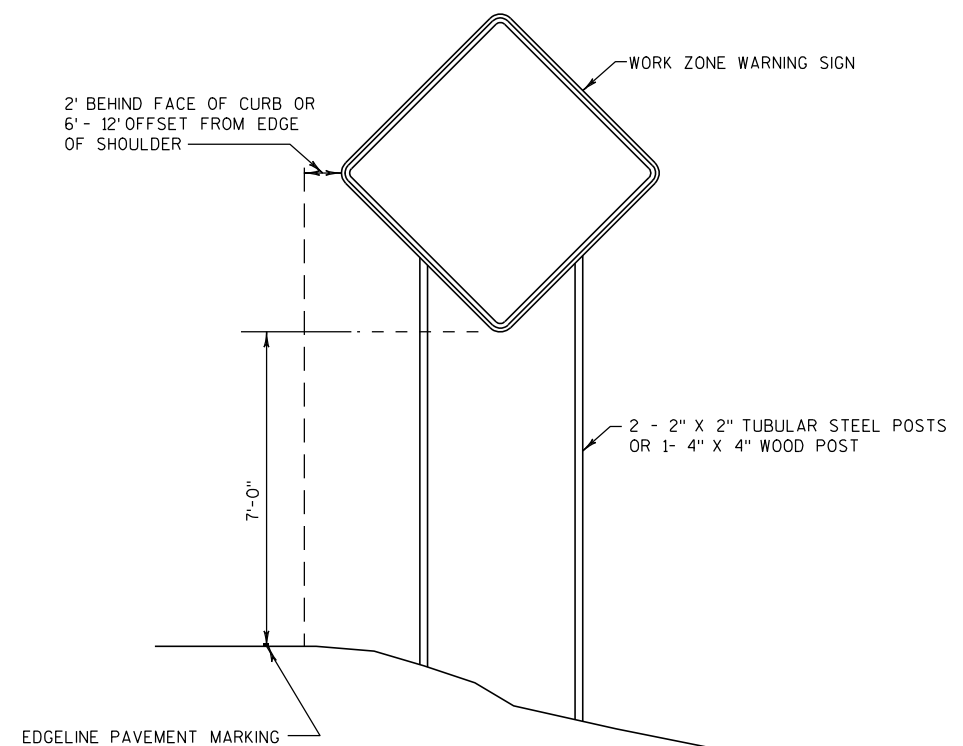


**TYPICAL TEMPORARY TRAFFIC CONTROL SIGN
MOUNTING ON FIXED SUPPORT**

LONG TERM
7 DAYS OR MORE

101105

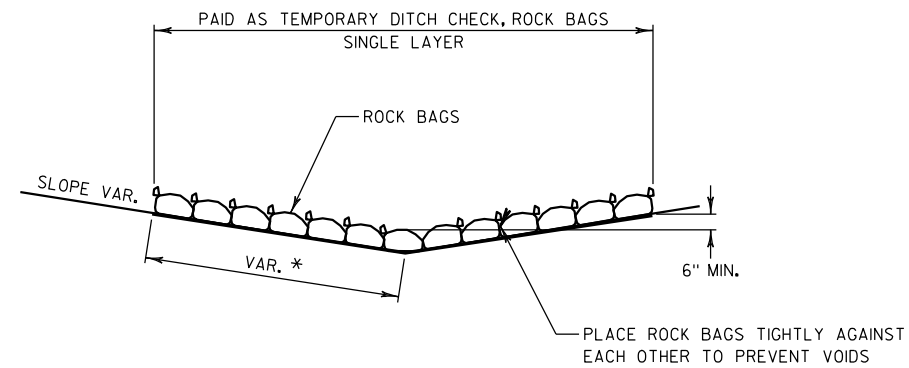

SIDE VIEW (SINGLE LAYER)

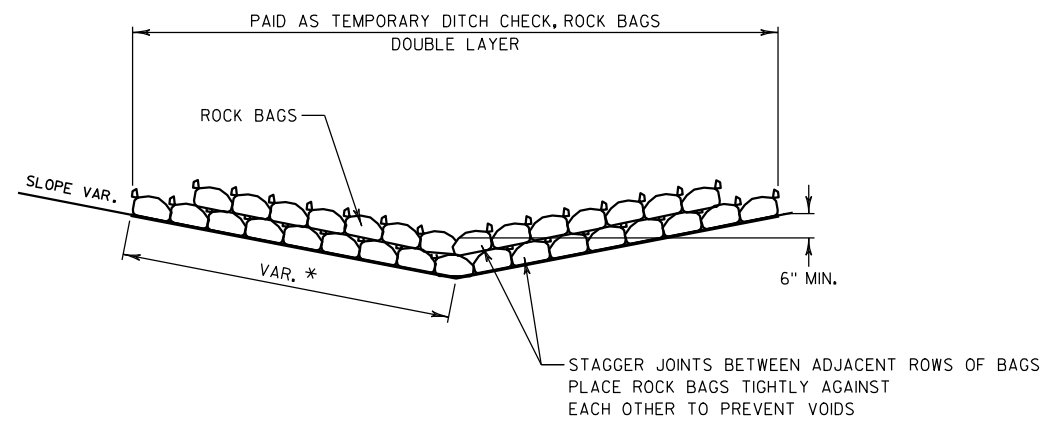

* LENGTH AND NUMBER OF BAGS MAY VARY
DEPENDING ON DESIRED DEPTH OF WATER POOL.

SIDE VIEW (DOUBLE LAYER)

TEMPORARY DITCH CHECK, ROCK BAGS,
SINGLE LAYER AND DOUBLE LAYER

TEMPORARY DITCH CHECKS

091218

2

2

BEGIN PROJECT
I.D. 1033-02-70
STA. 3835+00.00
= MATCH EXISTING

WETLAND BOUNDARY (TYP.)

EAST FRONTAGE ROAD

MATCHLINE 3841+50

LEGEND

- | | |
|--|--|
| (AP06) HMA PAVEMENT TYPE E-3, 7-INCH | (DR03) ASPHALTIC SURFACE DRIVEWAYS AND FIELD ENTRANCES, 3-INCH |
| (AG01) BASE AGGREGATE DENSE 3/4-INCH | (DR04) AGGREGATE DRIVEWAY, BASE AGGREGATE DENSE 3/4-INCH, 6-INCH |
| (PV01) CONCRETE PAVEMENT APPROACH SLAB | (BG01) STEEL THRIE BEAM STRUCTURE APPROACH |
| (PV02) SLOPE PAVING CONCRETE | (BG02) STEEL PLATE BEAM GUARD CLASS A |
| (PV05) ASPHALTIC FLUME | (BG04) STEEL PLATE BEAM GUARD ENERGY ABSORBING TERMINAL |
| (CG04) CONCRETE CURB AND GUTTER 6-INCH SLOPED 36-INCH TYPE D | (LS01) SOD LAWN |
| (CM01) CONCRETE MEDIAN SLOPED NOSE TYPE 1 | (SW01) SAWING EXISTING PAVEMENT |
| (CM05) CONCRETE SIDEWALK, 5-INCH | (SW02) SAWING CONCRETE PAVEMENT FULL DEPTH |
| (DR02) CONCRETE DRIVEWAY 9-INCH | |

See new sheet #30

PROJECT NO:1033-02-70

HWY: IH 94/STH 20

COUNTY: RACINE

PLAN DETAILS

SHEET

E

FILE NAME : S:\FinalDesign\20\10330270-EN\Roads\cds\021201.pd.dgn


PLOT DATE : 07-DEC-2010 16:57


PLOT BY : MSCDIS

PLOT NAME : 021201.pd

PLOT SCALE : 40:1

WISDOT/CADDs SHEET 42

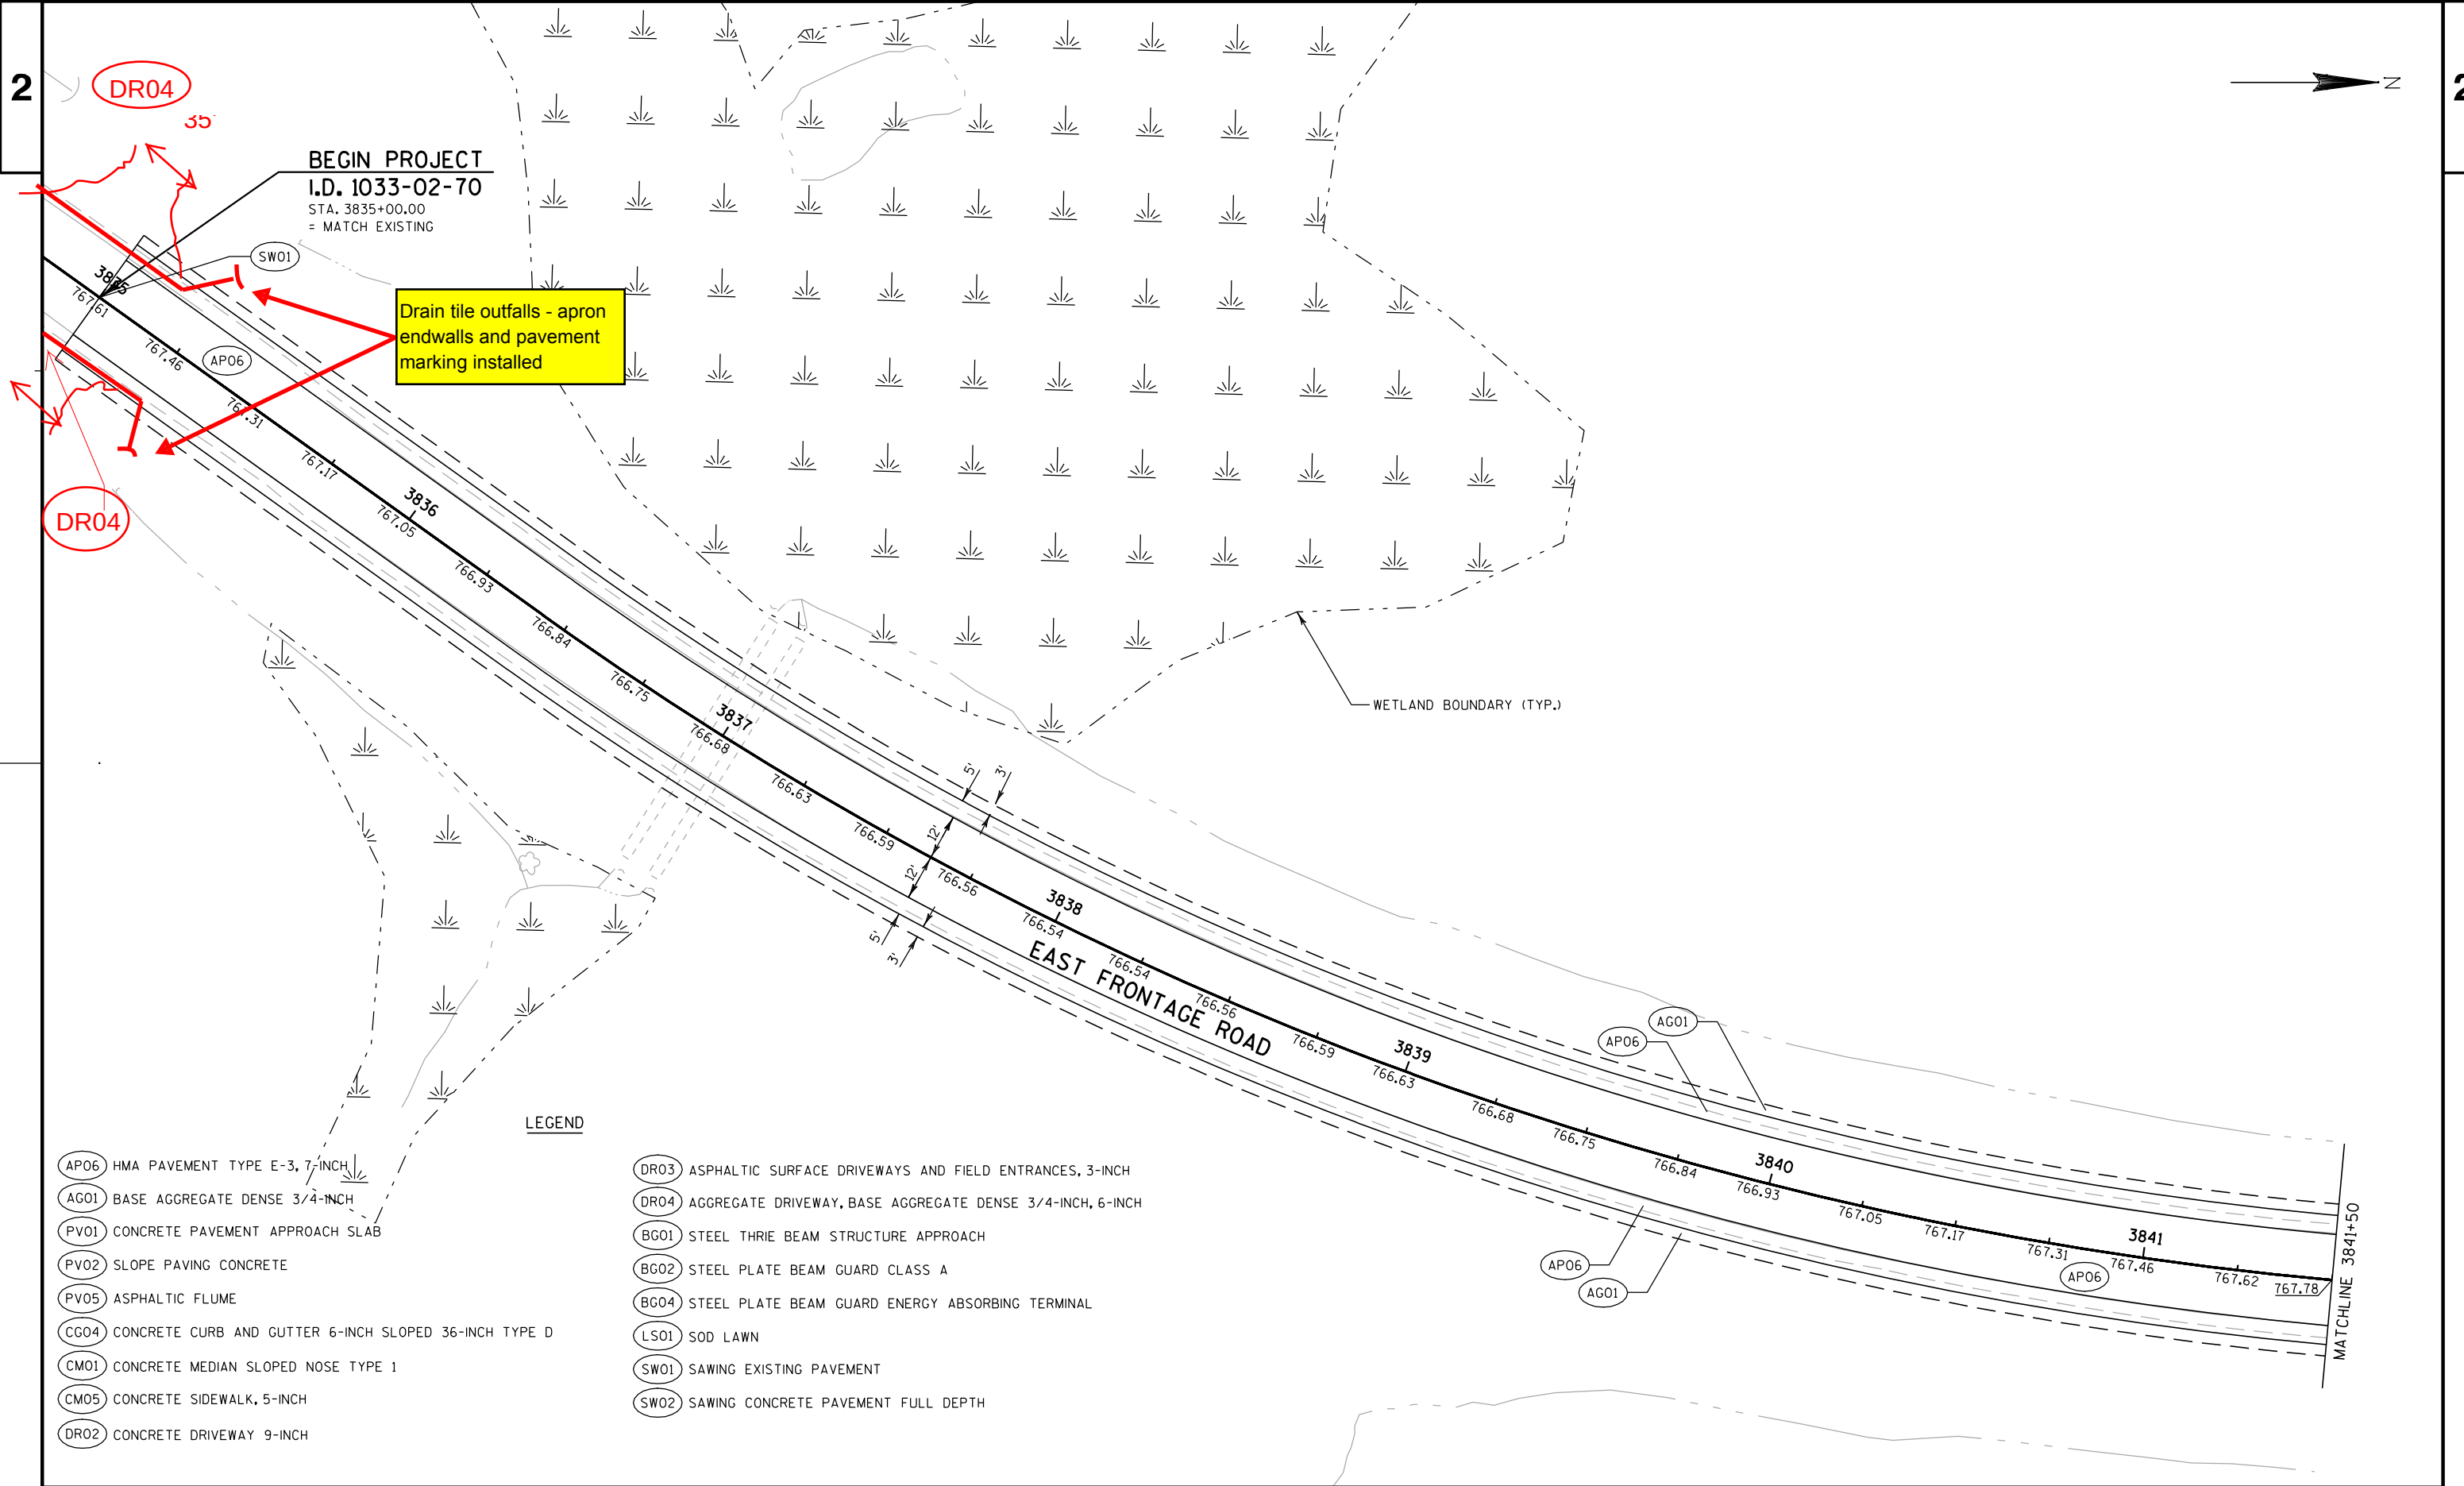


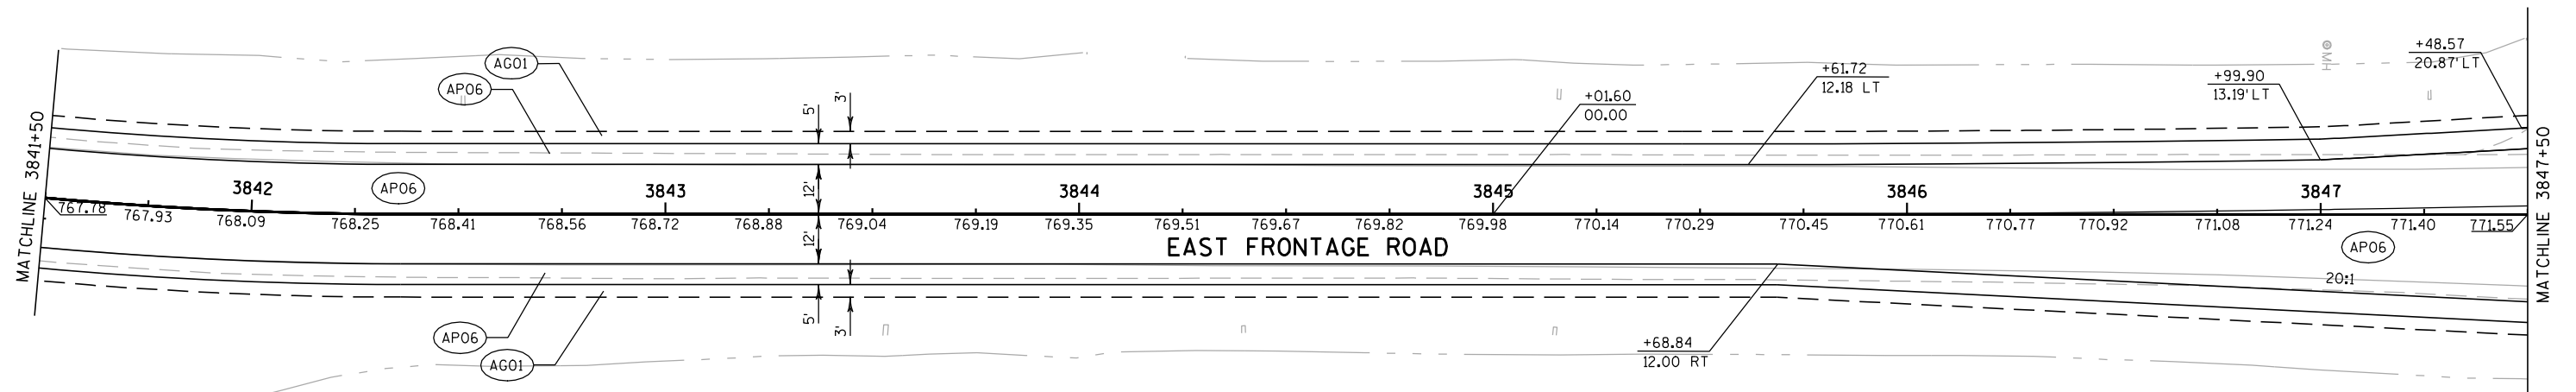


NOTE: SEE "ALIGNMENT PLAN-
TRANSITIONAL CURVES"
FOR LANE LAYOUT

LEGEND

- | | |
|--|--|
| AP06 HMA PAVEMENT TYPE E-3, 7-INCH | DR03 ASPHALTIC SURFACE DRIVEWAYS AND FIELD ENTRANCES, 3-INCH |
| AG01 BASE AGGREGATE DENSE 3/4-INCH | DR04 AGGREGATE DRIVEWAY, BASE AGGREGATE DENSE 3/4-INCH, 6-INCH |
| PV01 CONCRETE PAVEMENT APPROACH SLAB | BG01 STEEL THRIE BEAM STRUCTURE APPROACH |
| PV02 SLOPE PAVING CONCRETE | BG02 STEEL PLATE BEAM GUARD CLASS A |
| PV05 ASPHALTIC FLUME | BG04 STEEL PLATE BEAM GUARD ENERGY ABSORBING TERMINAL |
| CG04 CONCRETE CURB AND GUTTER 6-INCH SLOPED 36-INCH TYPE D | LS01 SOD LAWN |
| CM01 CONCRETE MEDIAN SLOPED NOSE TYPE 1 | SW01 SAWING EXISTING PAVEMENT |
| CM05 CONCRETE SIDEWALK, 5-INCH | SW02 SAWING CONCRETE PAVEMENT FULL DEPTH |
| DR02 CONCRETE DRIVEWAY 9-INCH | |

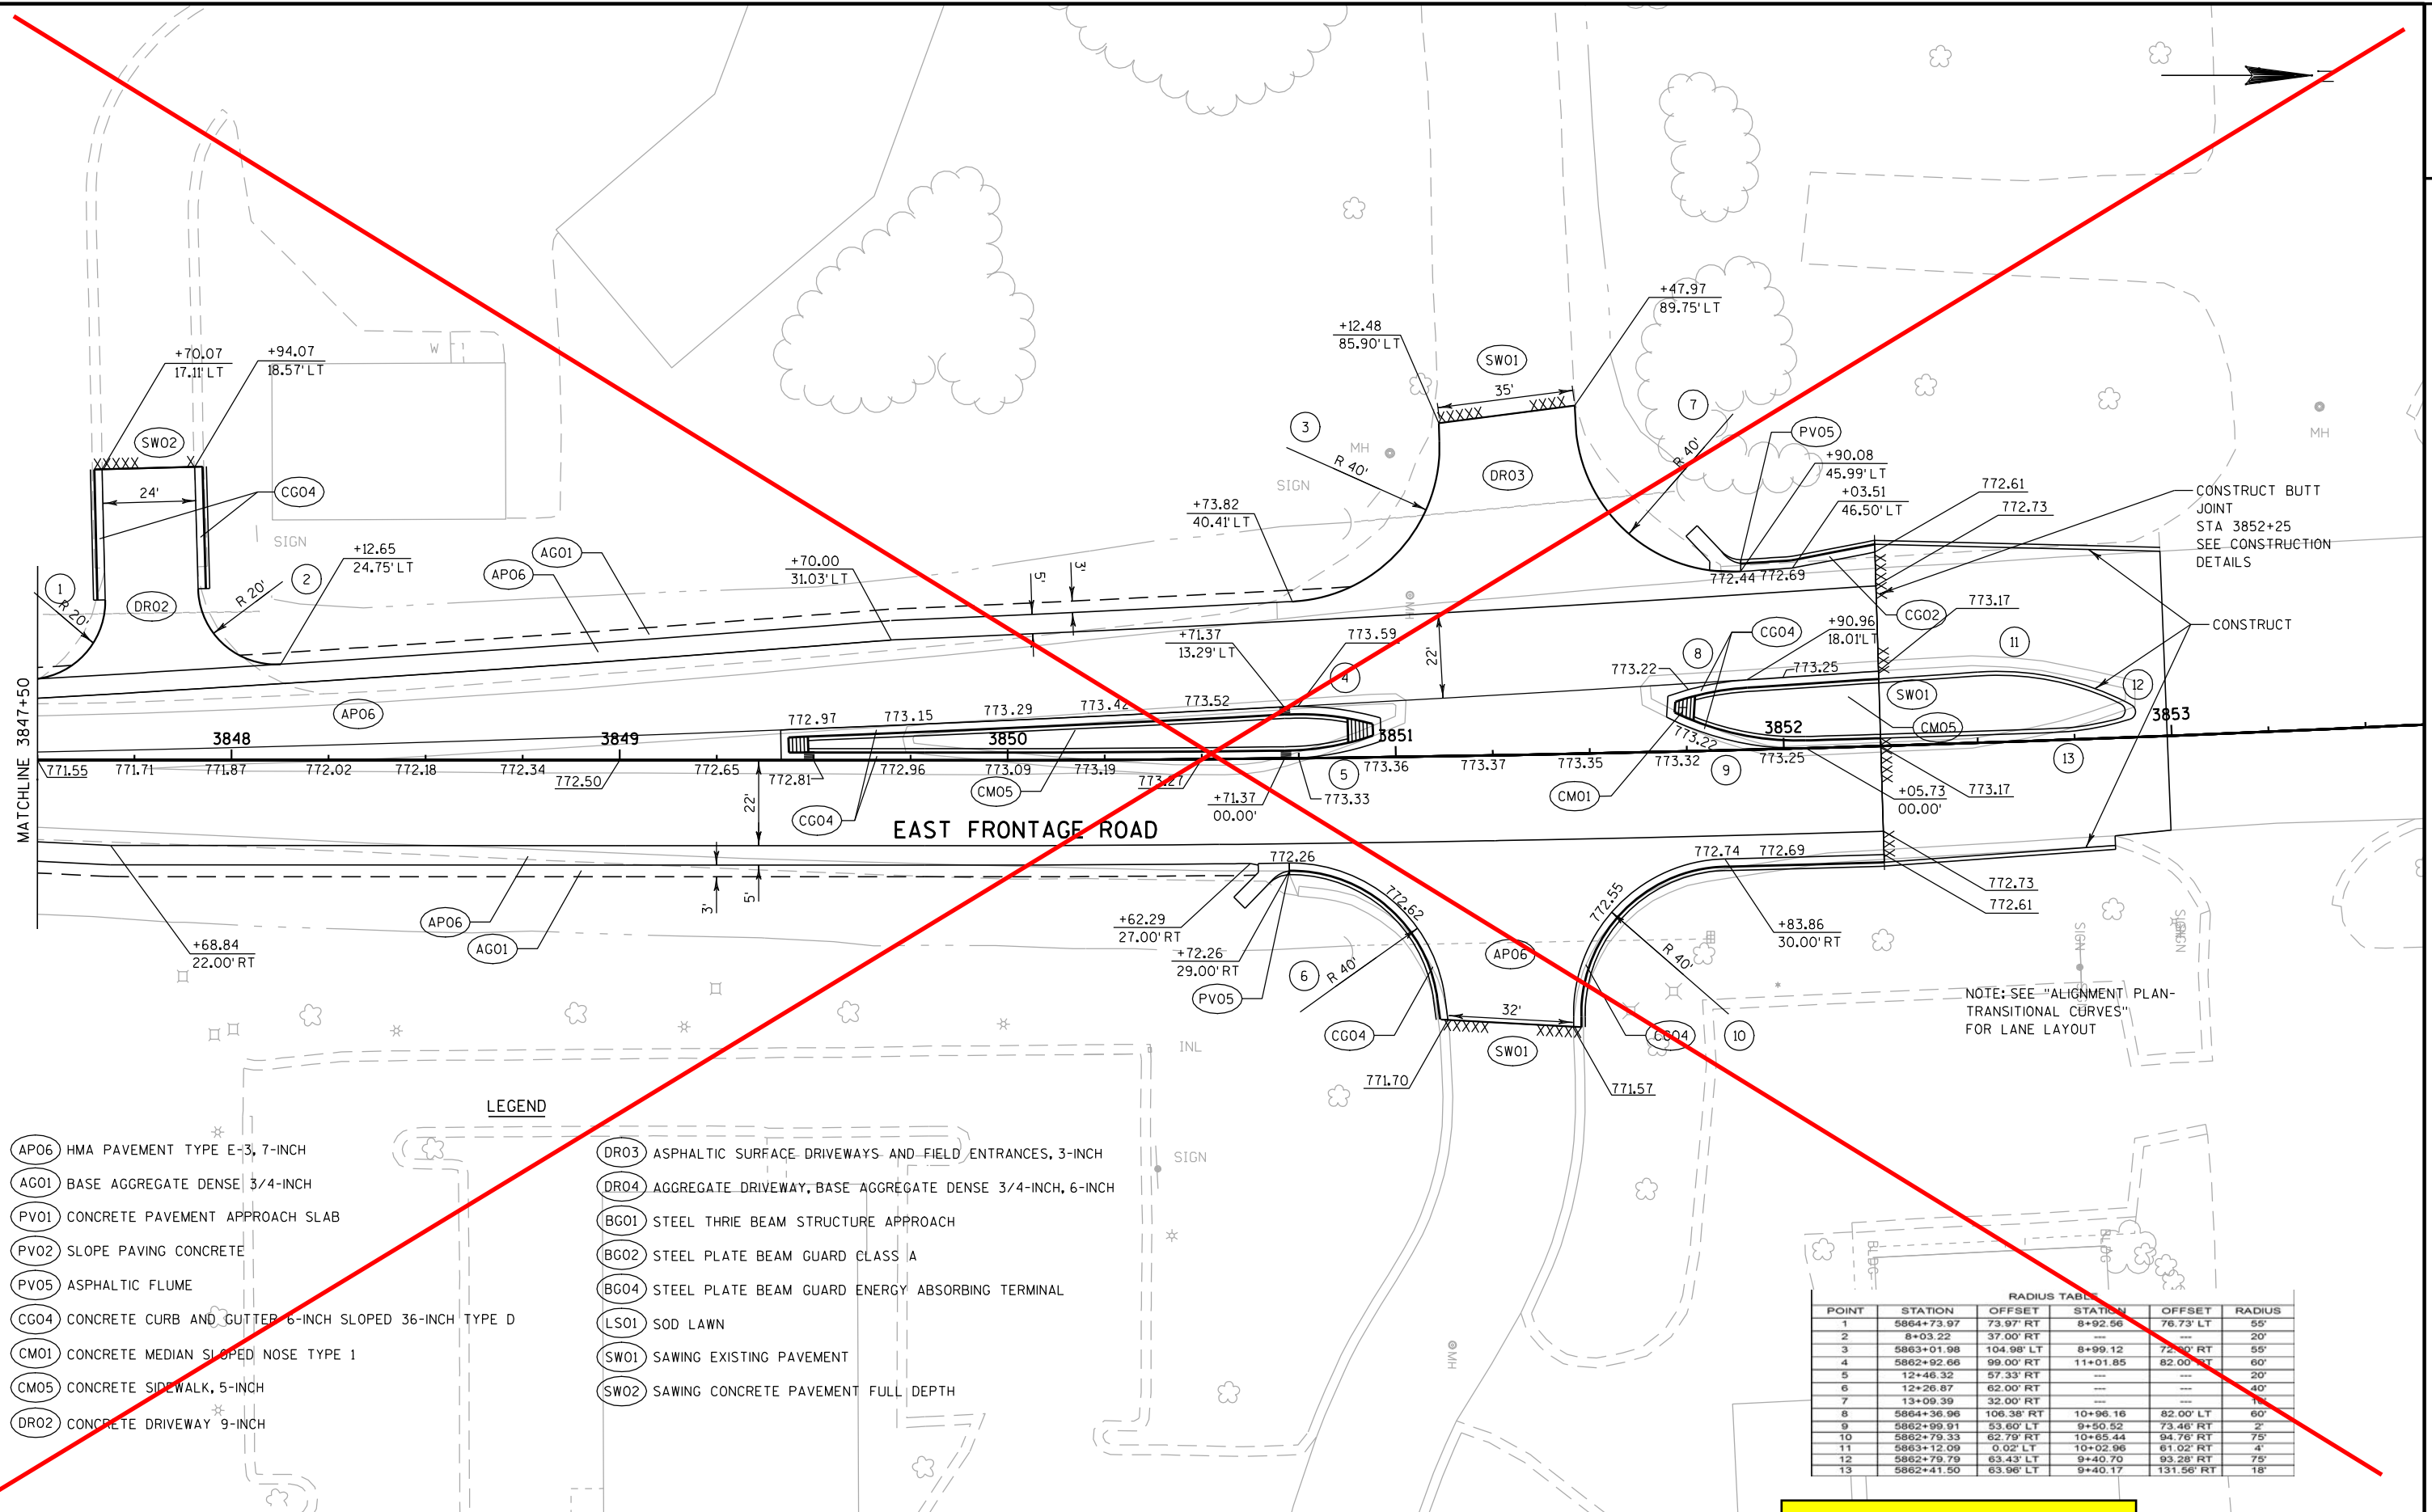


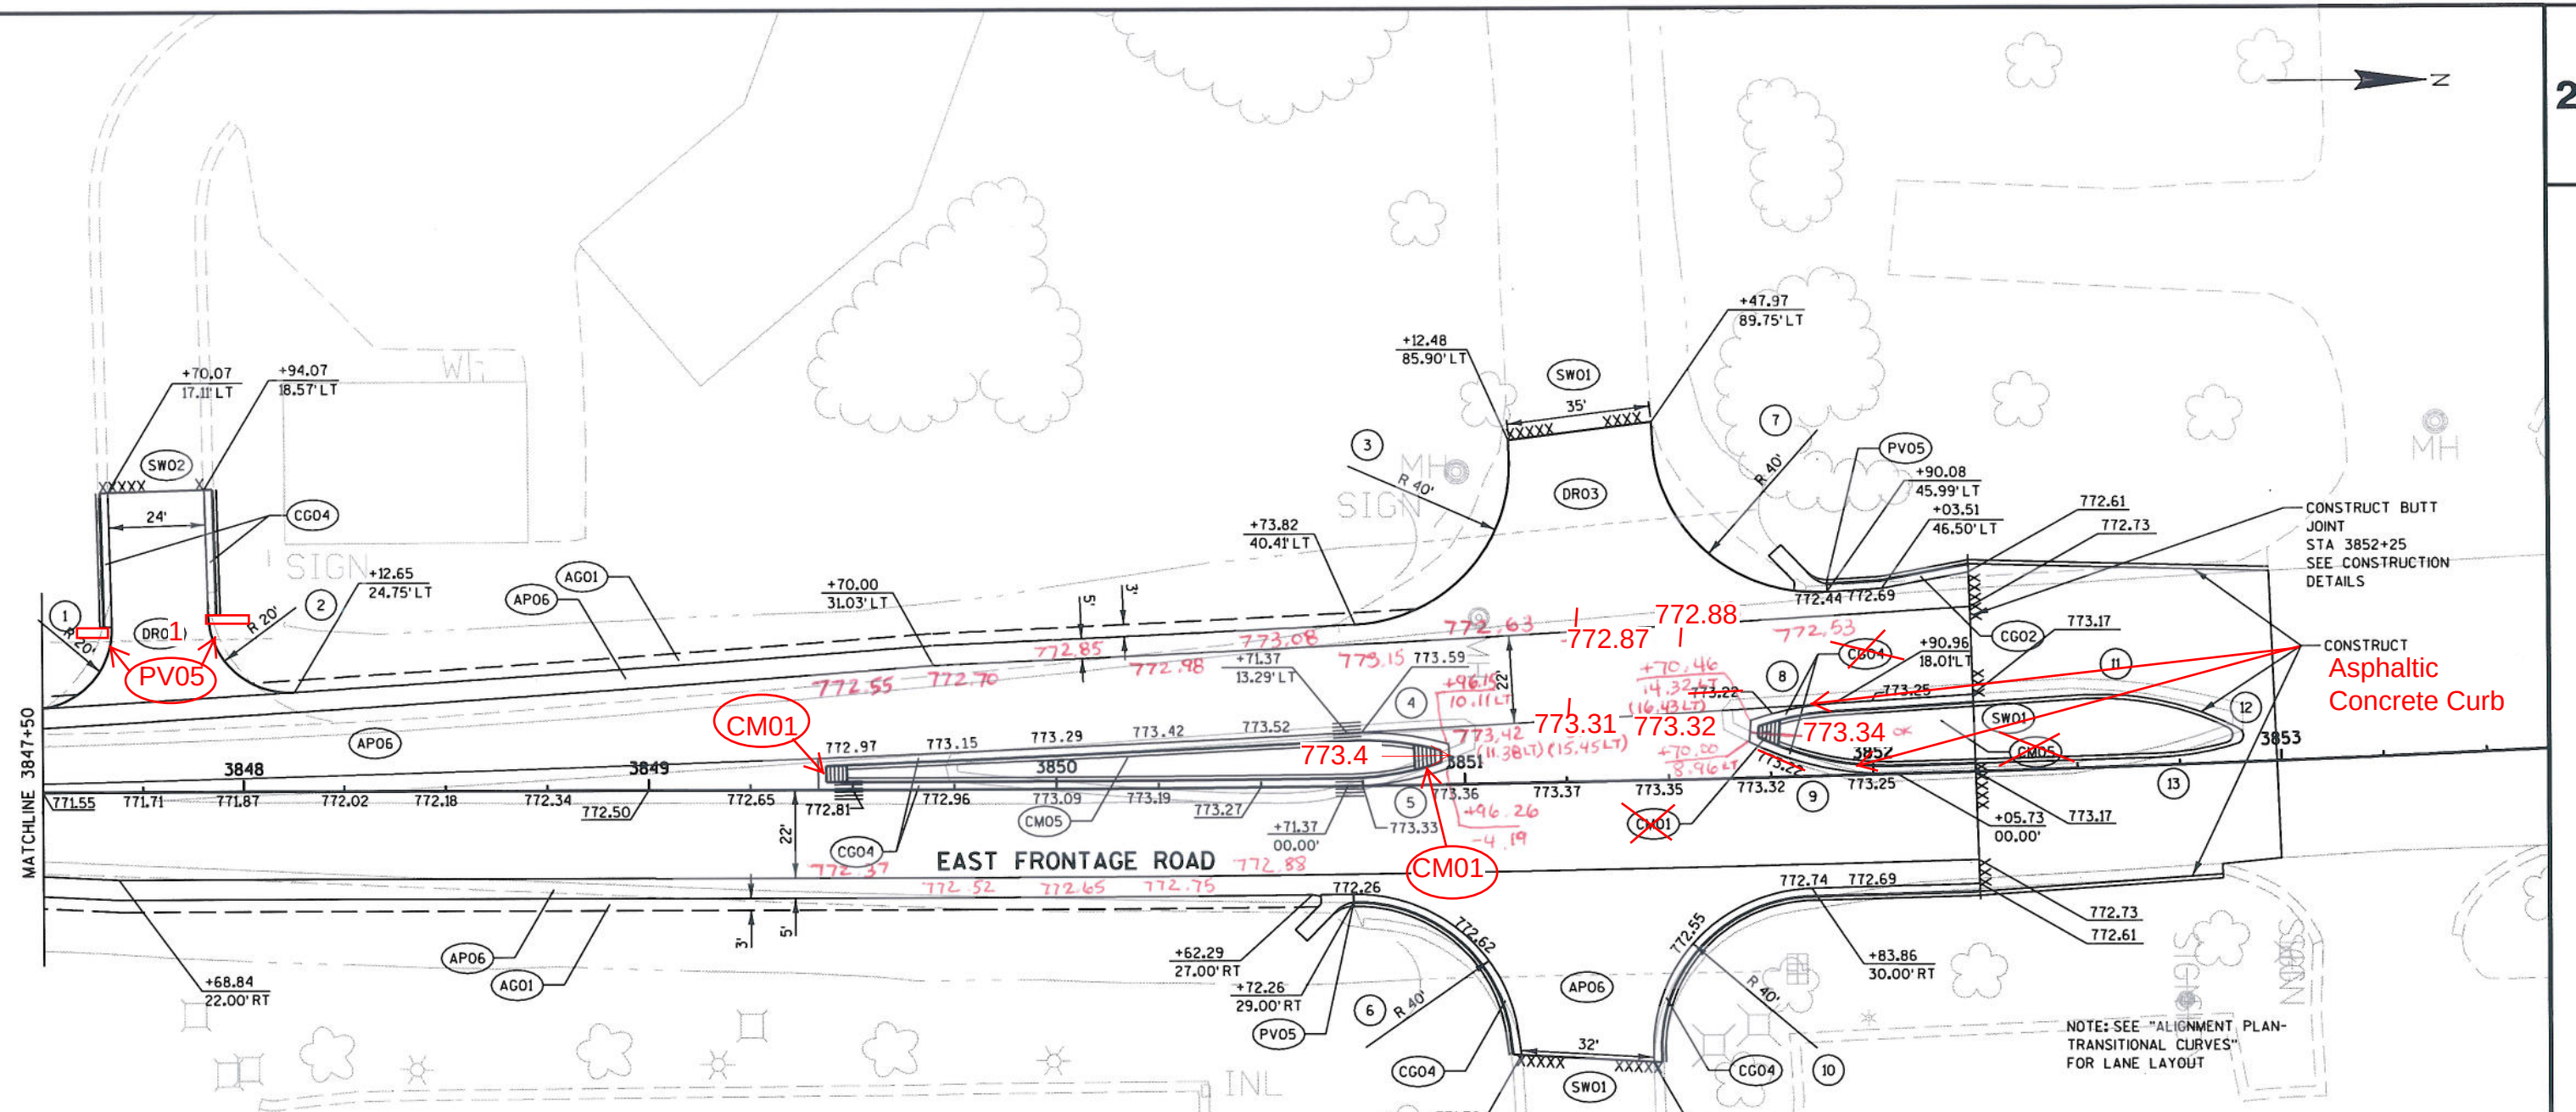



- LEGEND**
- AP06 HMA PAVEMENT TYPE E-3, 7-INCH
 - AG01 BASE AGGREGATE DENSE 3/4-INCH
 - PV01 CONCRETE PAVEMENT APPROACH SLAB
 - PV02 SLOPE PAVING CONCRETE
 - PV05 ASPHALTIC FLUME
 - CG04 CONCRETE CURB AND GUTTER 6-INCH SLOPED 36-INCH TYPE D
 - CM01 CONCRETE MEDIAN SLOPED NOSE TYPE 1
 - CM05 CONCRETE SIDEWALK, 5-INCH
 - DR02 CONCRETE DRIVEWAY 9-INCH
 - DR03 ASPHALTIC SURFACE DRIVEWAYS AND FIELD ENTRANCES, 3-INCH
 - DR04 AGGREGATE DRIVEWAY, BASE AGGREGATE DENSE 3/4-INCH, 6-INCH
 - BG01 STEEL THRIE BEAM STRUCTURE APPROACH
 - BG02 STEEL PLATE BEAM GUARD CLASS A
 - BG04 STEEL PLATE BEAM GUARD ENERGY ABSORBING TERMINAL
 - LS01 SOD LAWN
 - SW01 SAWING EXISTING PAVEMENT
 - SW02 SAWING CONCRETE PAVEMENT FULL DEPTH


DR01 Concrete Driveway 6-Inch

RADIUS TABLE					
POINT	STATION	OFFSET	STATION	OFFSET	RADIUS
1	3847+48.86	15.87' LT	---	---	20'
2	3848+12.97	19.76' LT	---	---	20'
3	3850+74.03	35.42' LT	---	---	40'
4	3850+74.42	61.65' RT	---	---	75'
5	3850+71.43	75.00' LT	---	---	75'
6	3850+72.26	22.00' RT	---	---	40'
7	3851+90.31	40.00' LT	---	---	40'
8	3851+93.79	56.94' RT	---	---	75'
9	3852+05.73	75.00' LT	---	---	75'
10	3851+84.09	68.00' RT	---	---	40'
11	3852+53.31	28.00' RT	---	---	72'
12	3852+86.26	6.80' LT	---	---	2'
13	3852+69.65	75.00' LT	---	---	72'

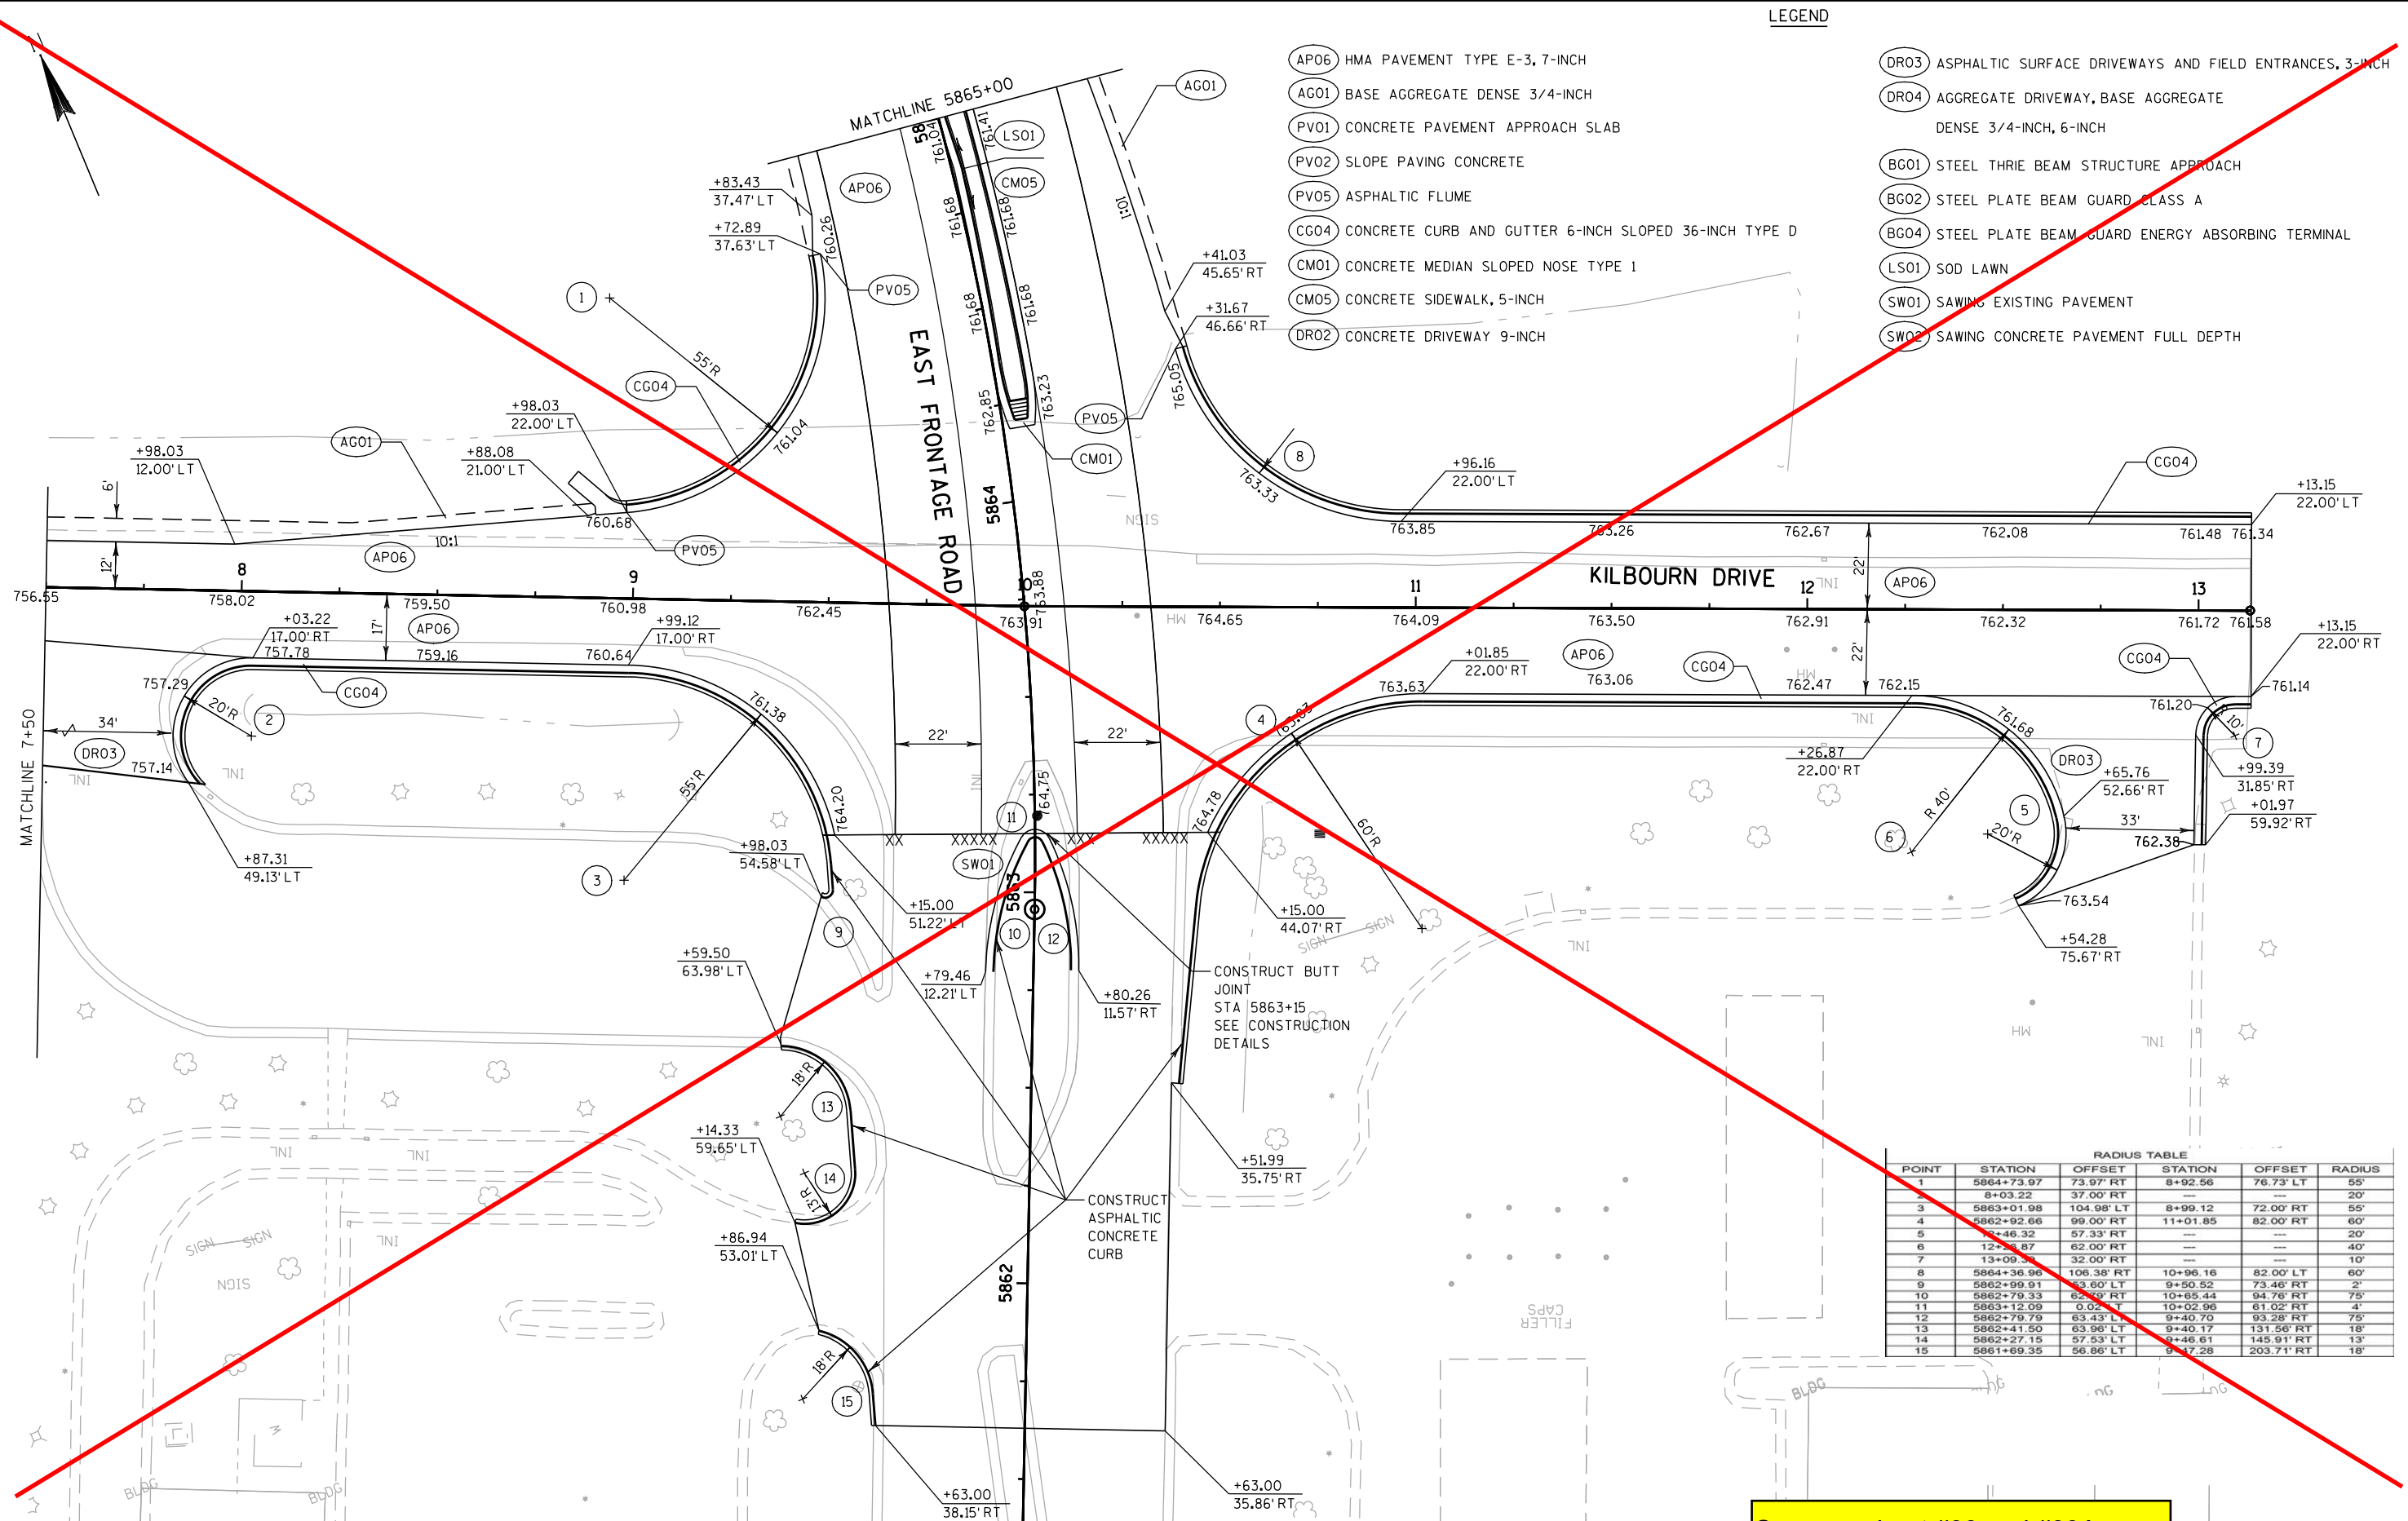


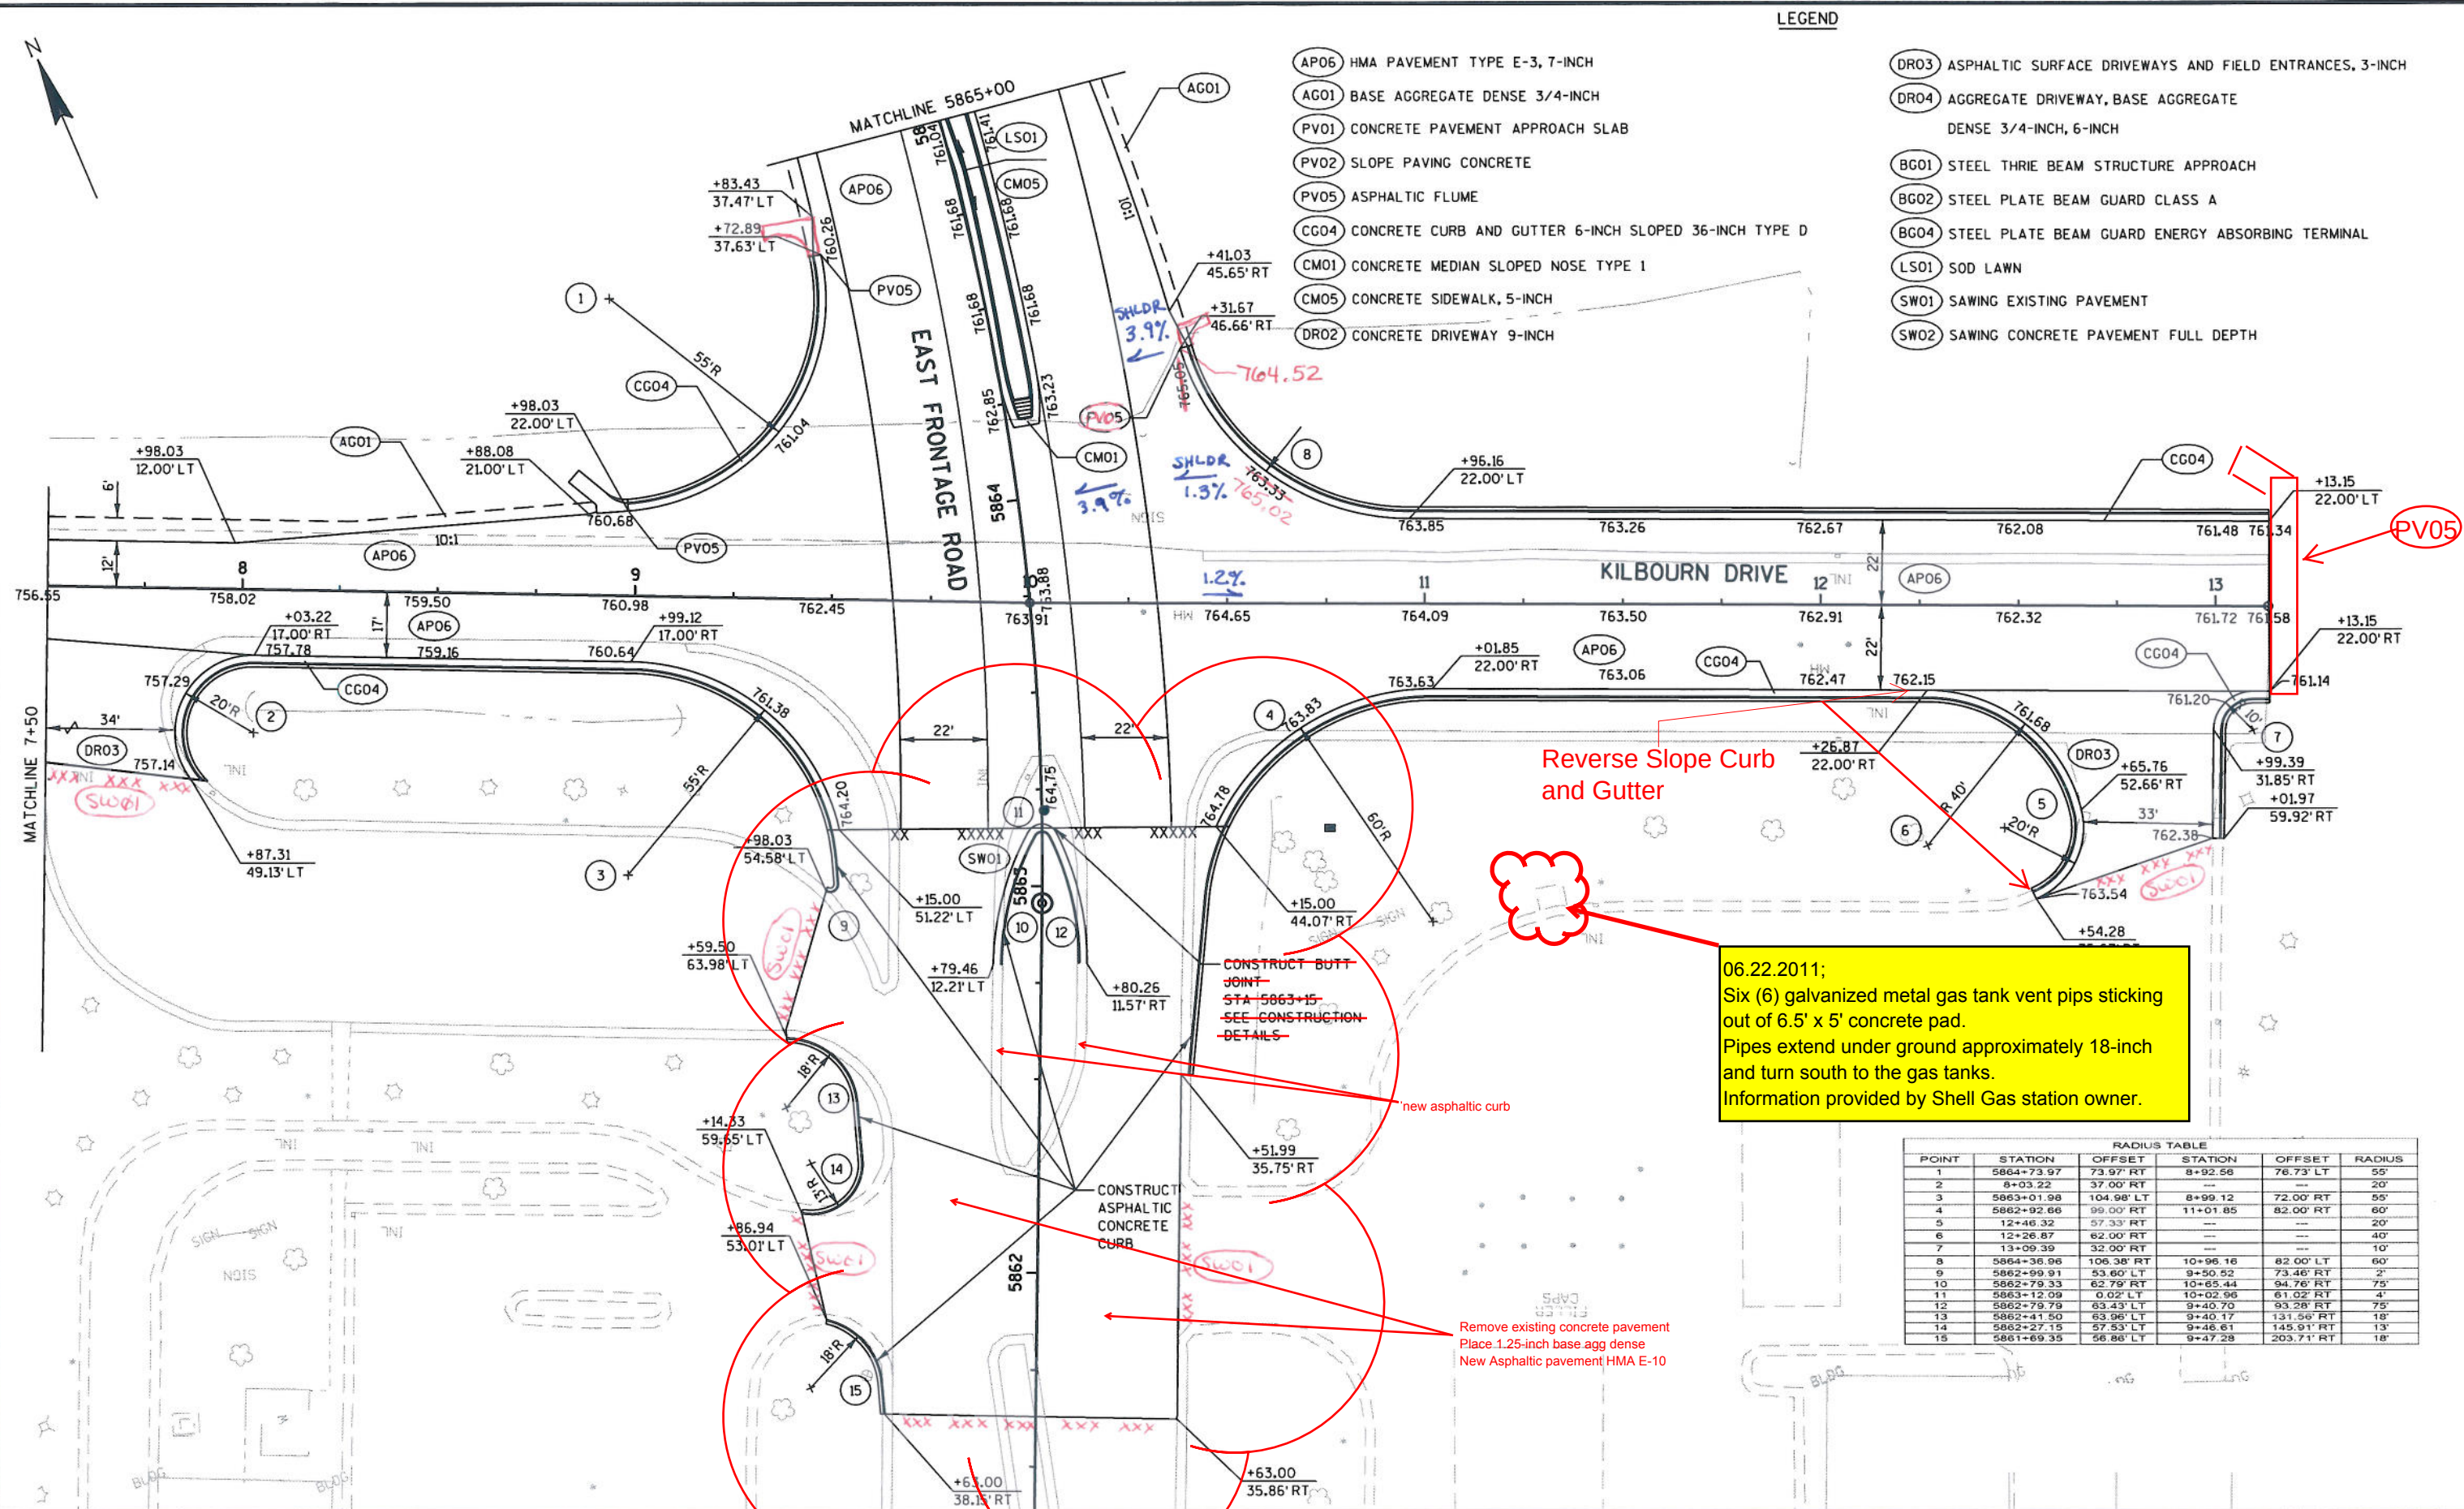

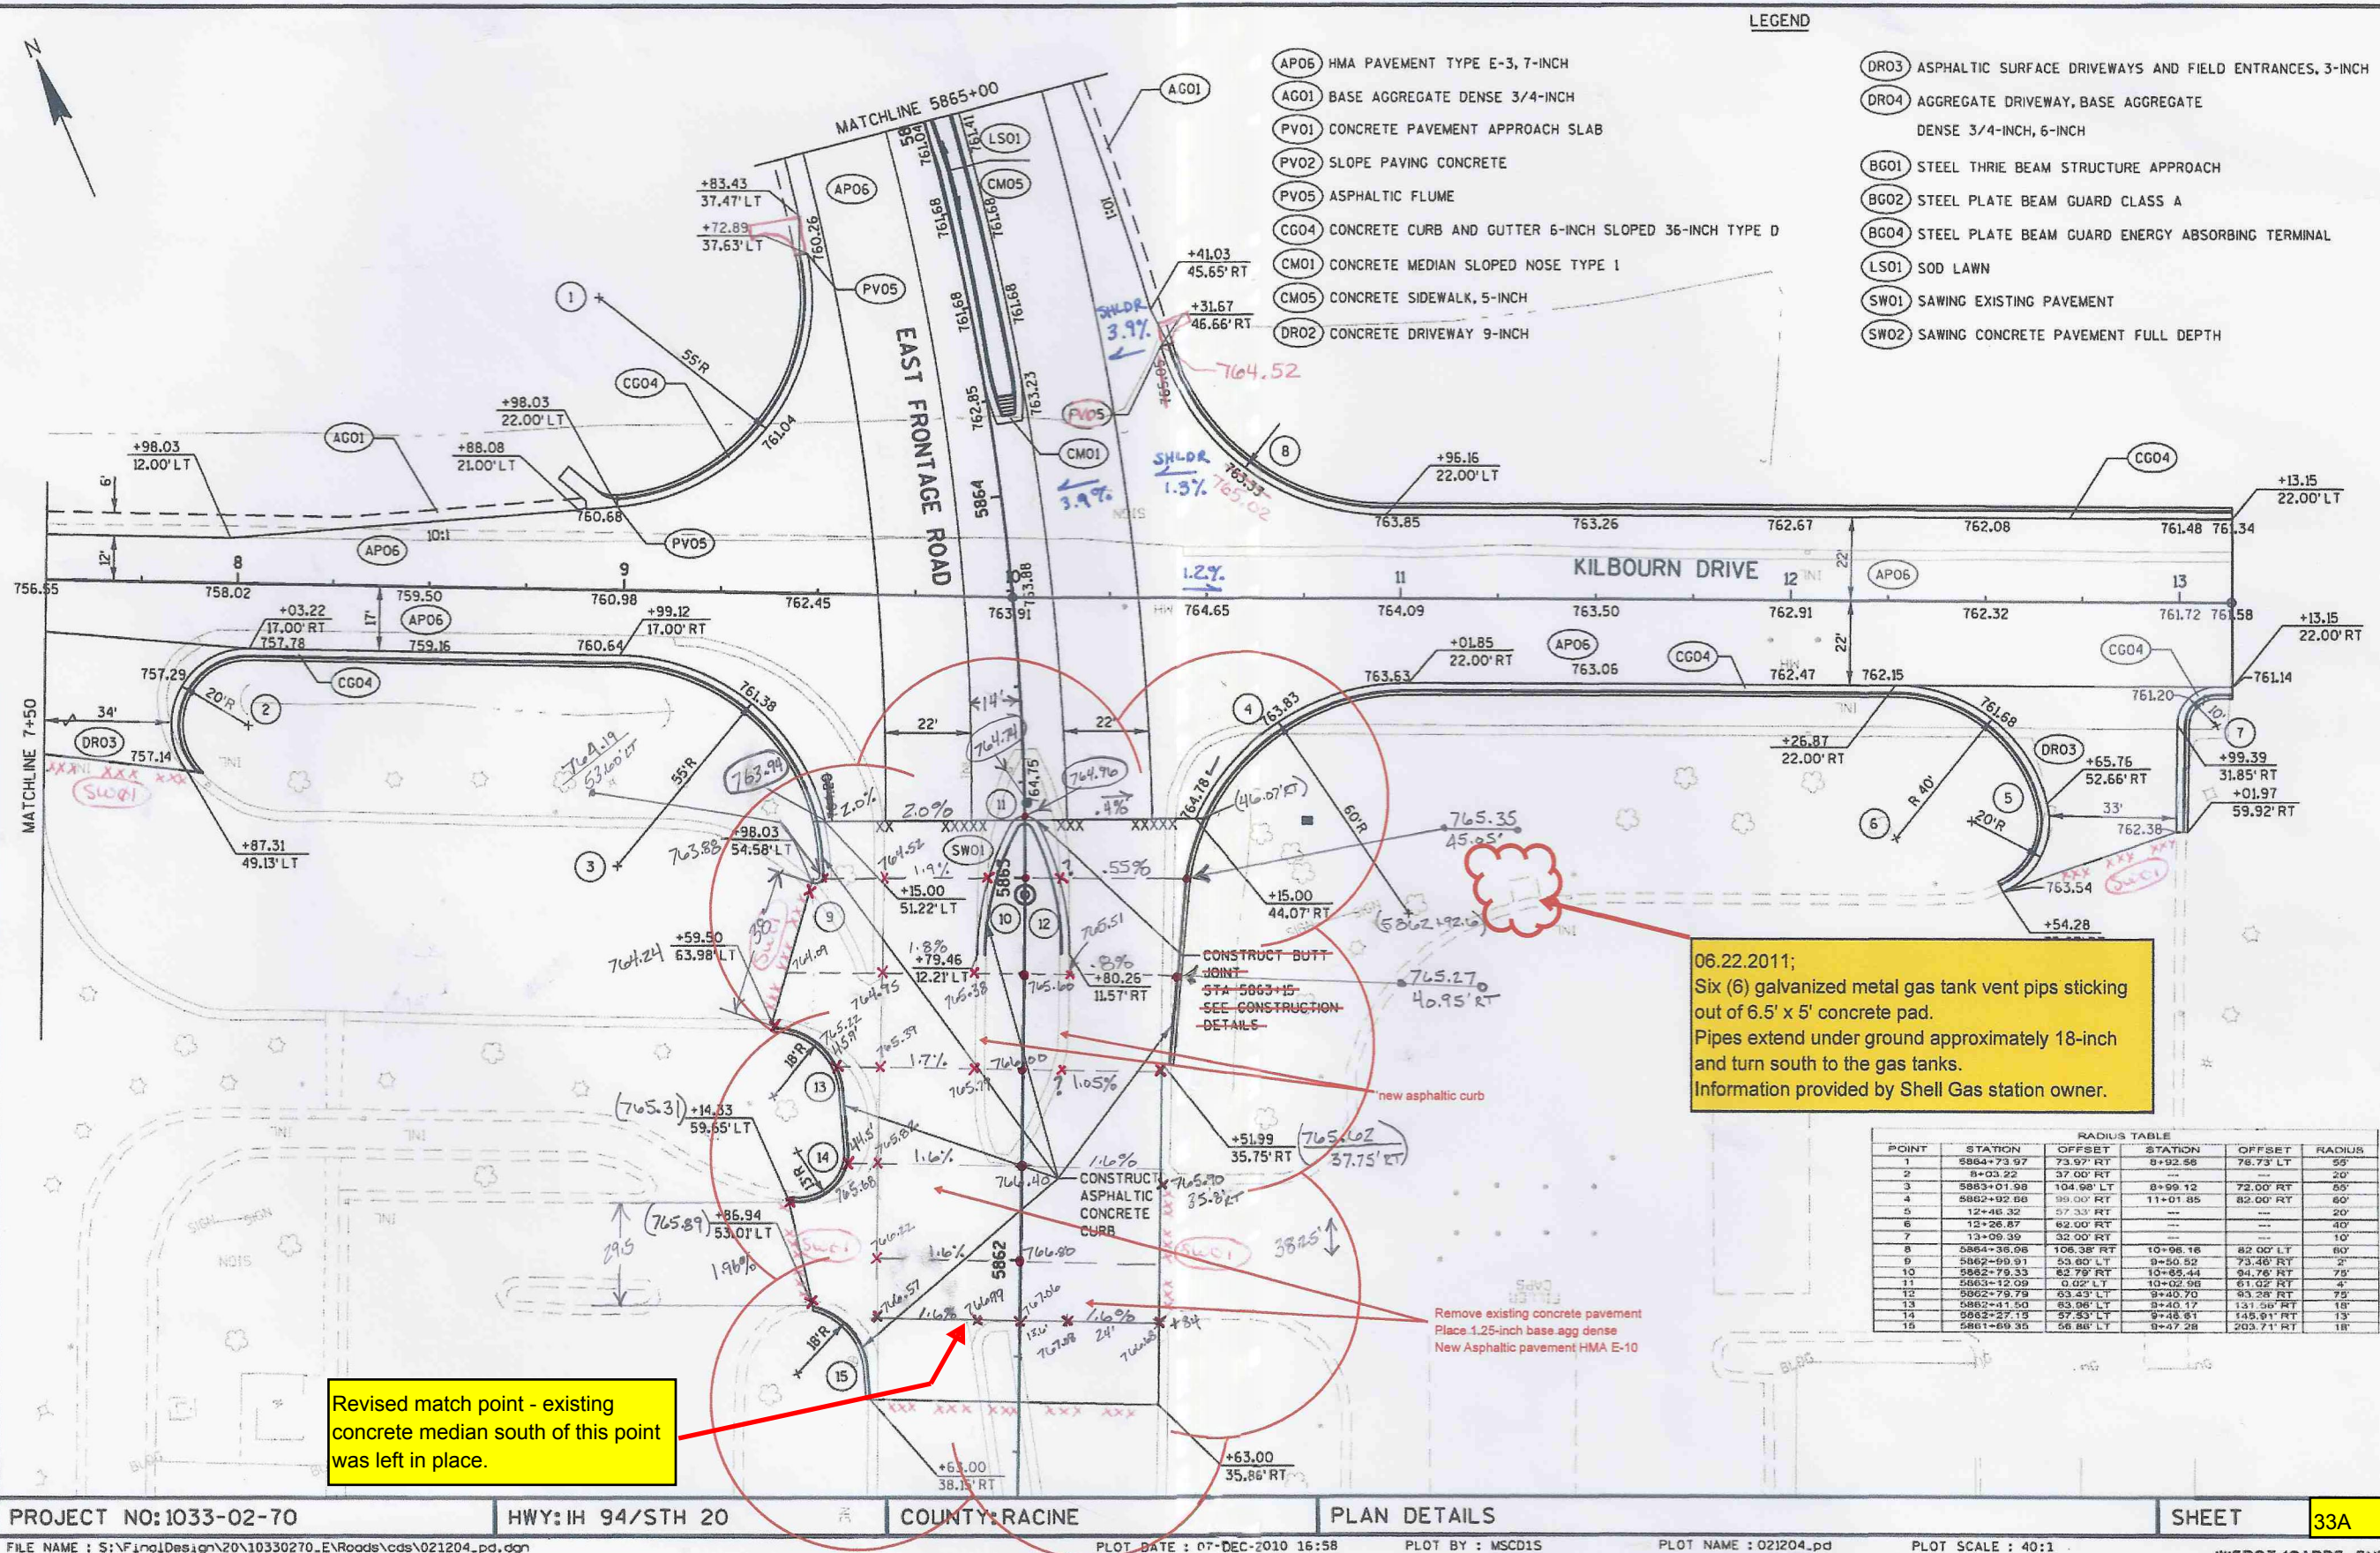

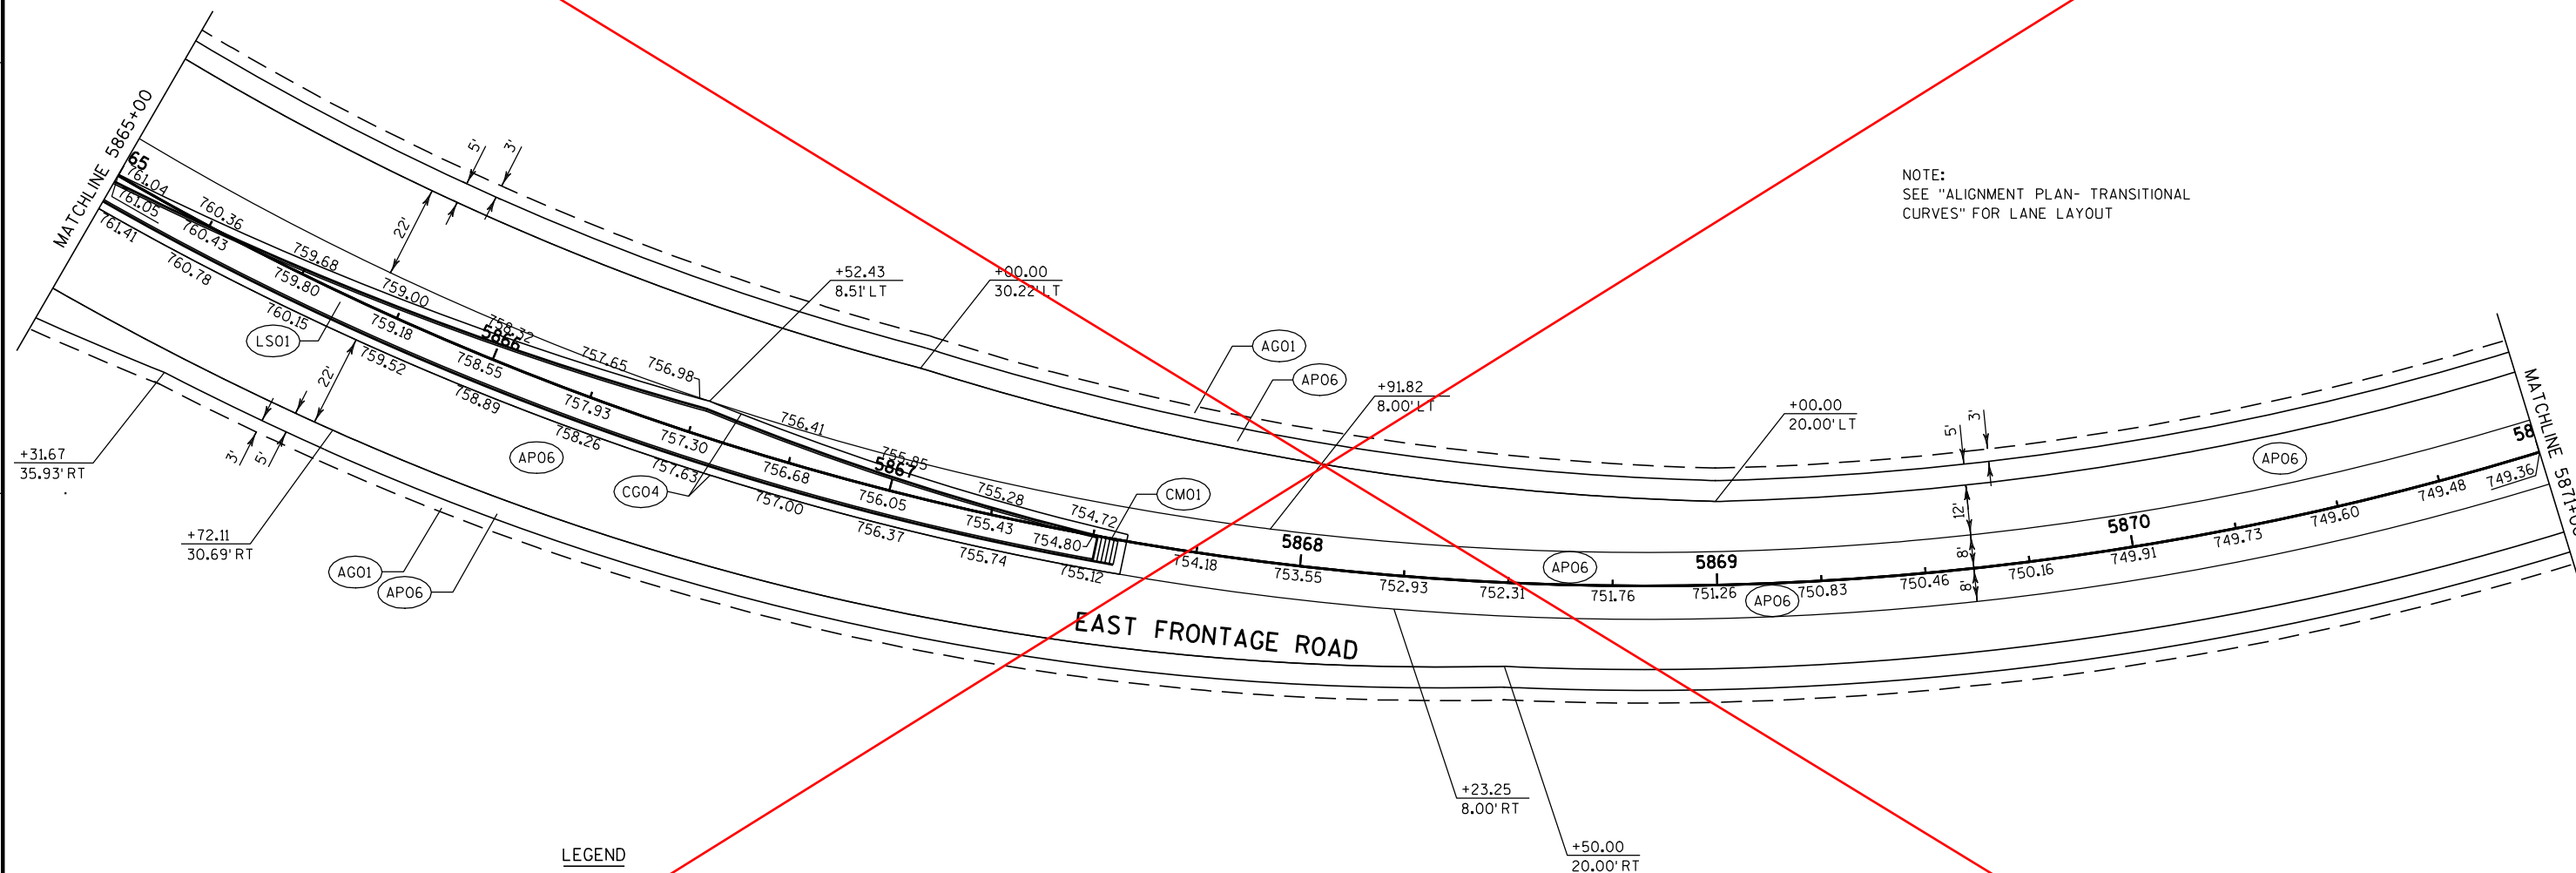**LEGEND**

- | | |
|--|--|
| (AP06) HMA PAVEMENT TYPE E-3, 7-INCH | (DR03) ASPHALTIC SURFACE DRIVEWAYS AND FIELD ENTRANCES, 3-INCH |
| (AG01) BASE AGGREGATE DENSE 3/4-INCH | (DR04) AGGREGATE DRIVEWAY, BASE AGGREGATE DENSE 3/4-INCH, 6-INCH |
| (PV01) CONCRETE PAVEMENT APPROACH SLAB | (BG01) STEEL THRIE BEAM STRUCTURE APPROACH |
| (PV02) SLOPE PAVING CONCRETE | (BG02) STEEL PLATE BEAM GUARD CLASS A |
| (PV05) ASPHALTIC FLUME | (BG04) STEEL PLATE BEAM GUARD ENERGY ABSORBING TERMINAL |
| (CG04) CONCRETE CURB AND GUTTER 6-INCH SLOPED 36-INCH TYPE D | (LS01) SOD LAWN |
| (CM01) CONCRETE MEDIAN SLOPED NOSE TYPE 1 | (SW01) SAWING EXISTING PAVEMENT |
| (CM05) CONCRETE SIDEWALK, 5-INCH | (SW02) SAWING CONCRETE PAVEMENT FULL DEPTH |
| (DR02) CONCRETE DRIVEWAY 9-INCH | |

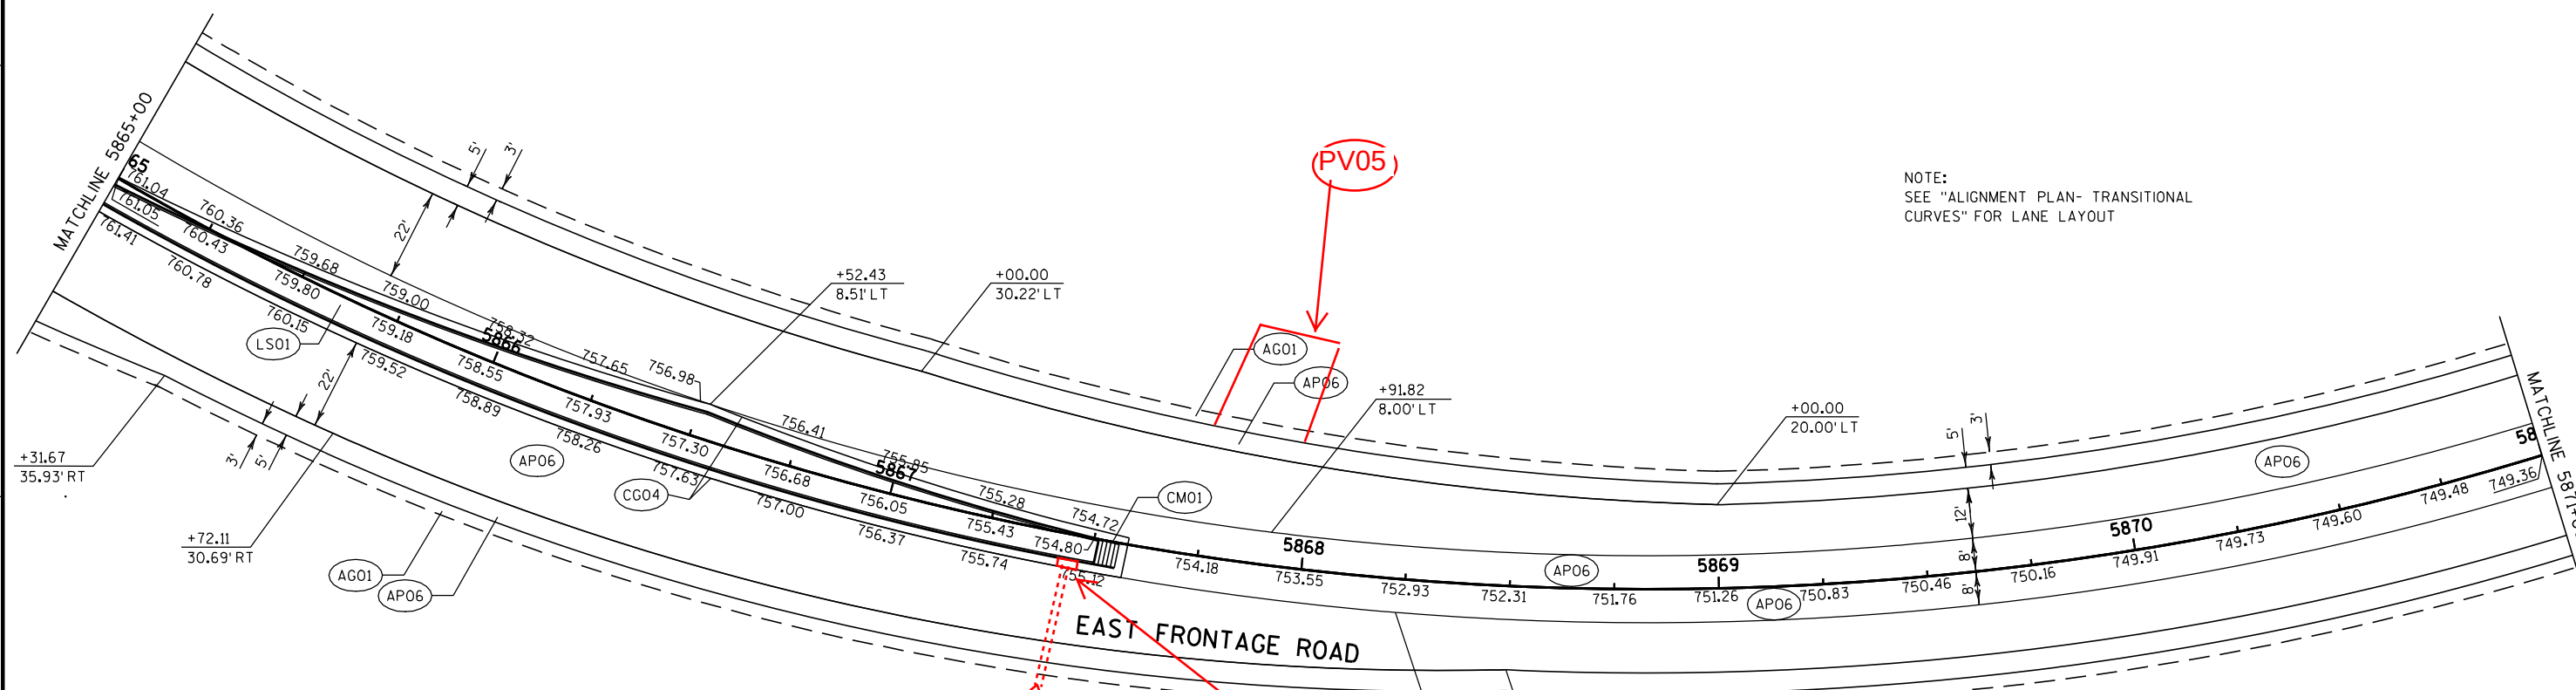


LEGEND

(AP06) HMA PAVEMENT TYPE E-3, 7-INCH	(DR03) ASPHALTIC SURFACE DRIVEWAYS AND FIELD ENTRANCES, 3-INCH
(AG01) BASE AGGREGATE DENSE 3/4-INCH	(DR04) AGGREGATE DRIVEWAY, BASE AGGREGATE DENSE 3/4-INCH, 6-INCH
(PV01) CONCRETE PAVEMENT APPROACH SLAB	(BG01) STEEL THRIE BEAM STRUCTURE APPROACH
(PV02) SLOPE PAVING CONCRETE	(BG02) STEEL PLATE BEAM GUARD CLASS A
(PV05) ASPHALTIC FLUME	(BG04) STEEL PLATE BEAM GUARD ENERGY ABSORBING TERMINAL
(CG04) CONCRETE CURB AND GUTTER 6-INCH SLOPED 36-INCH TYPE D	(LS01) SOD LAWN
(CM01) CONCRETE MEDIAN SLOPED NOSE TYPE 1	(SW01) SAWING EXISTING PAVEMENT
(CM05) CONCRETE SIDEWALK, 5-INCH	(SW02) SAWING CONCRETE PAVEMENT FULL DEPTH
(DR02) CONCRETE DRIVEWAY 9-INCH	


NEW TYPE 1 INLET
12" I.E = 752.08
NEW 12" PVC DIRECTIONAL BORE
WITH ENDWALL.
DISCHARGE = 751.75


NOTE:
SEE "ALIGNMENT PLAN- TRANSITIONAL
CURVES" FOR LANE LAYOUT

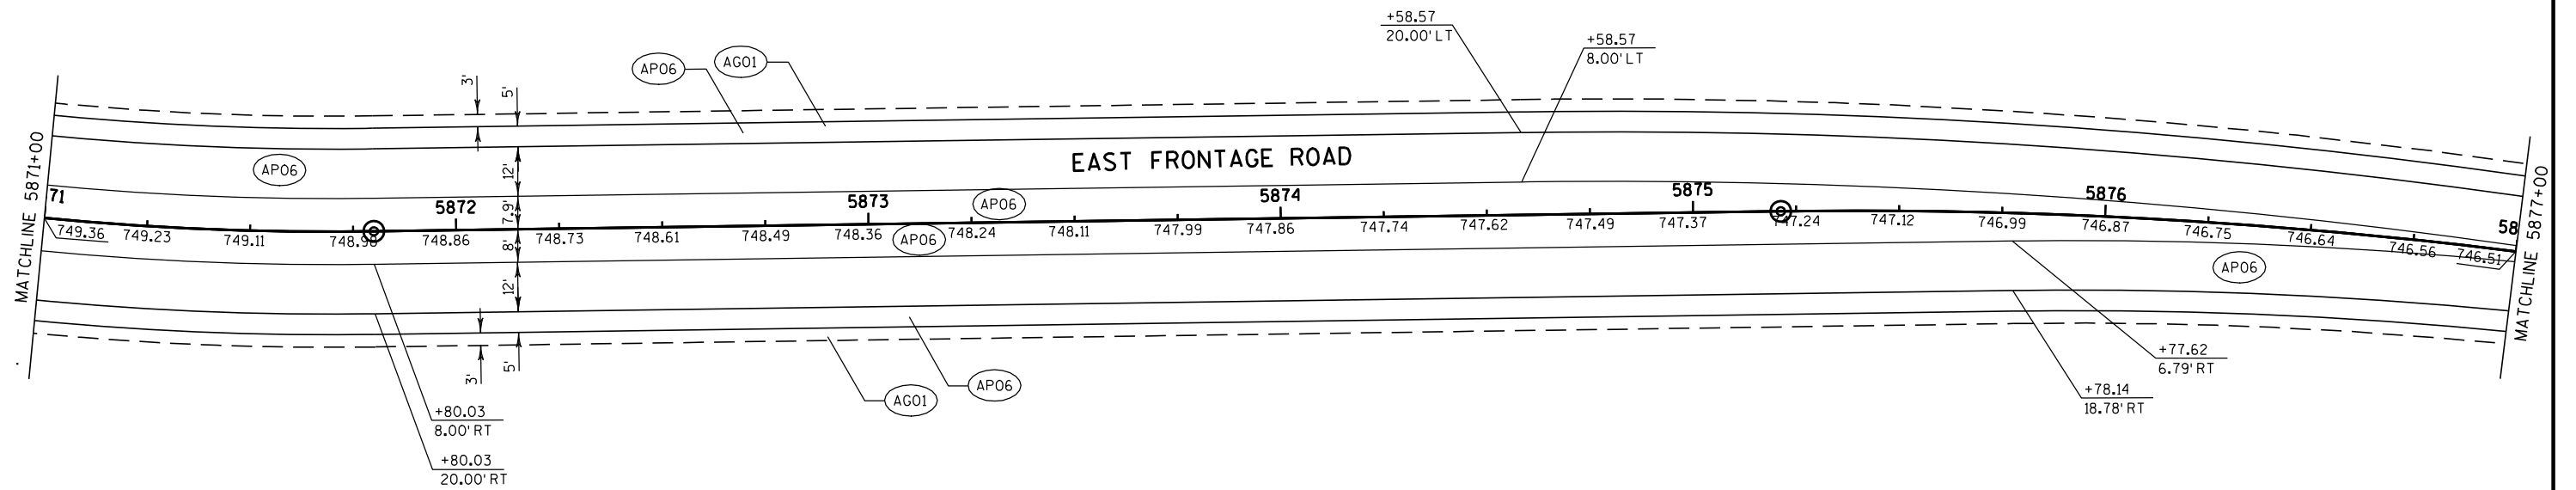


LEGEND

- | | |
|--|--|
| AP06 HMA PAVEMENT TYPE E-3, 7-INCH | DR03 ASPHALTIC SURFACE DRIVEWAYS AND FIELD ENTRANCES, 3-INCH |
| AG01 BASE AGGREGATE DENSE 3/4-INCH | DR04 AGGREGATE DRIVEWAY, BASE AGGREGATE DENSE 3/4-INCH, 6-INCH |
| PV01 CONCRETE PAVEMENT APPROACH SLAB | BG01 STEEL THRIE BEAM STRUCTURE APPROACH |
| PV02 SLOPE PAVING CONCRETE | BG02 STEEL PLATE BEAM GUARD CLASS A |
| PV05 ASPHALTIC FLUME | BG04 STEEL PLATE BEAM GUARD ENERGY ABSORBING TERMINAL |
| CG04 CONCRETE CURB AND GUTTER 6-INCH SLOPED 36-INCH TYPE D | LS01 SOD LAWN |
| CM01 CONCRETE MEDIAN SLOPED NOSE TYPE 1 | SW01 SAWING EXISTING PAVEMENT |
| CM05 CONCRETE SIDEWALK, 5-INCH | SW02 SAWING CONCRETE PAVEMENT FULL DEPTH |
| DR02 CONCRETE DRIVEWAY 9-INCH | |

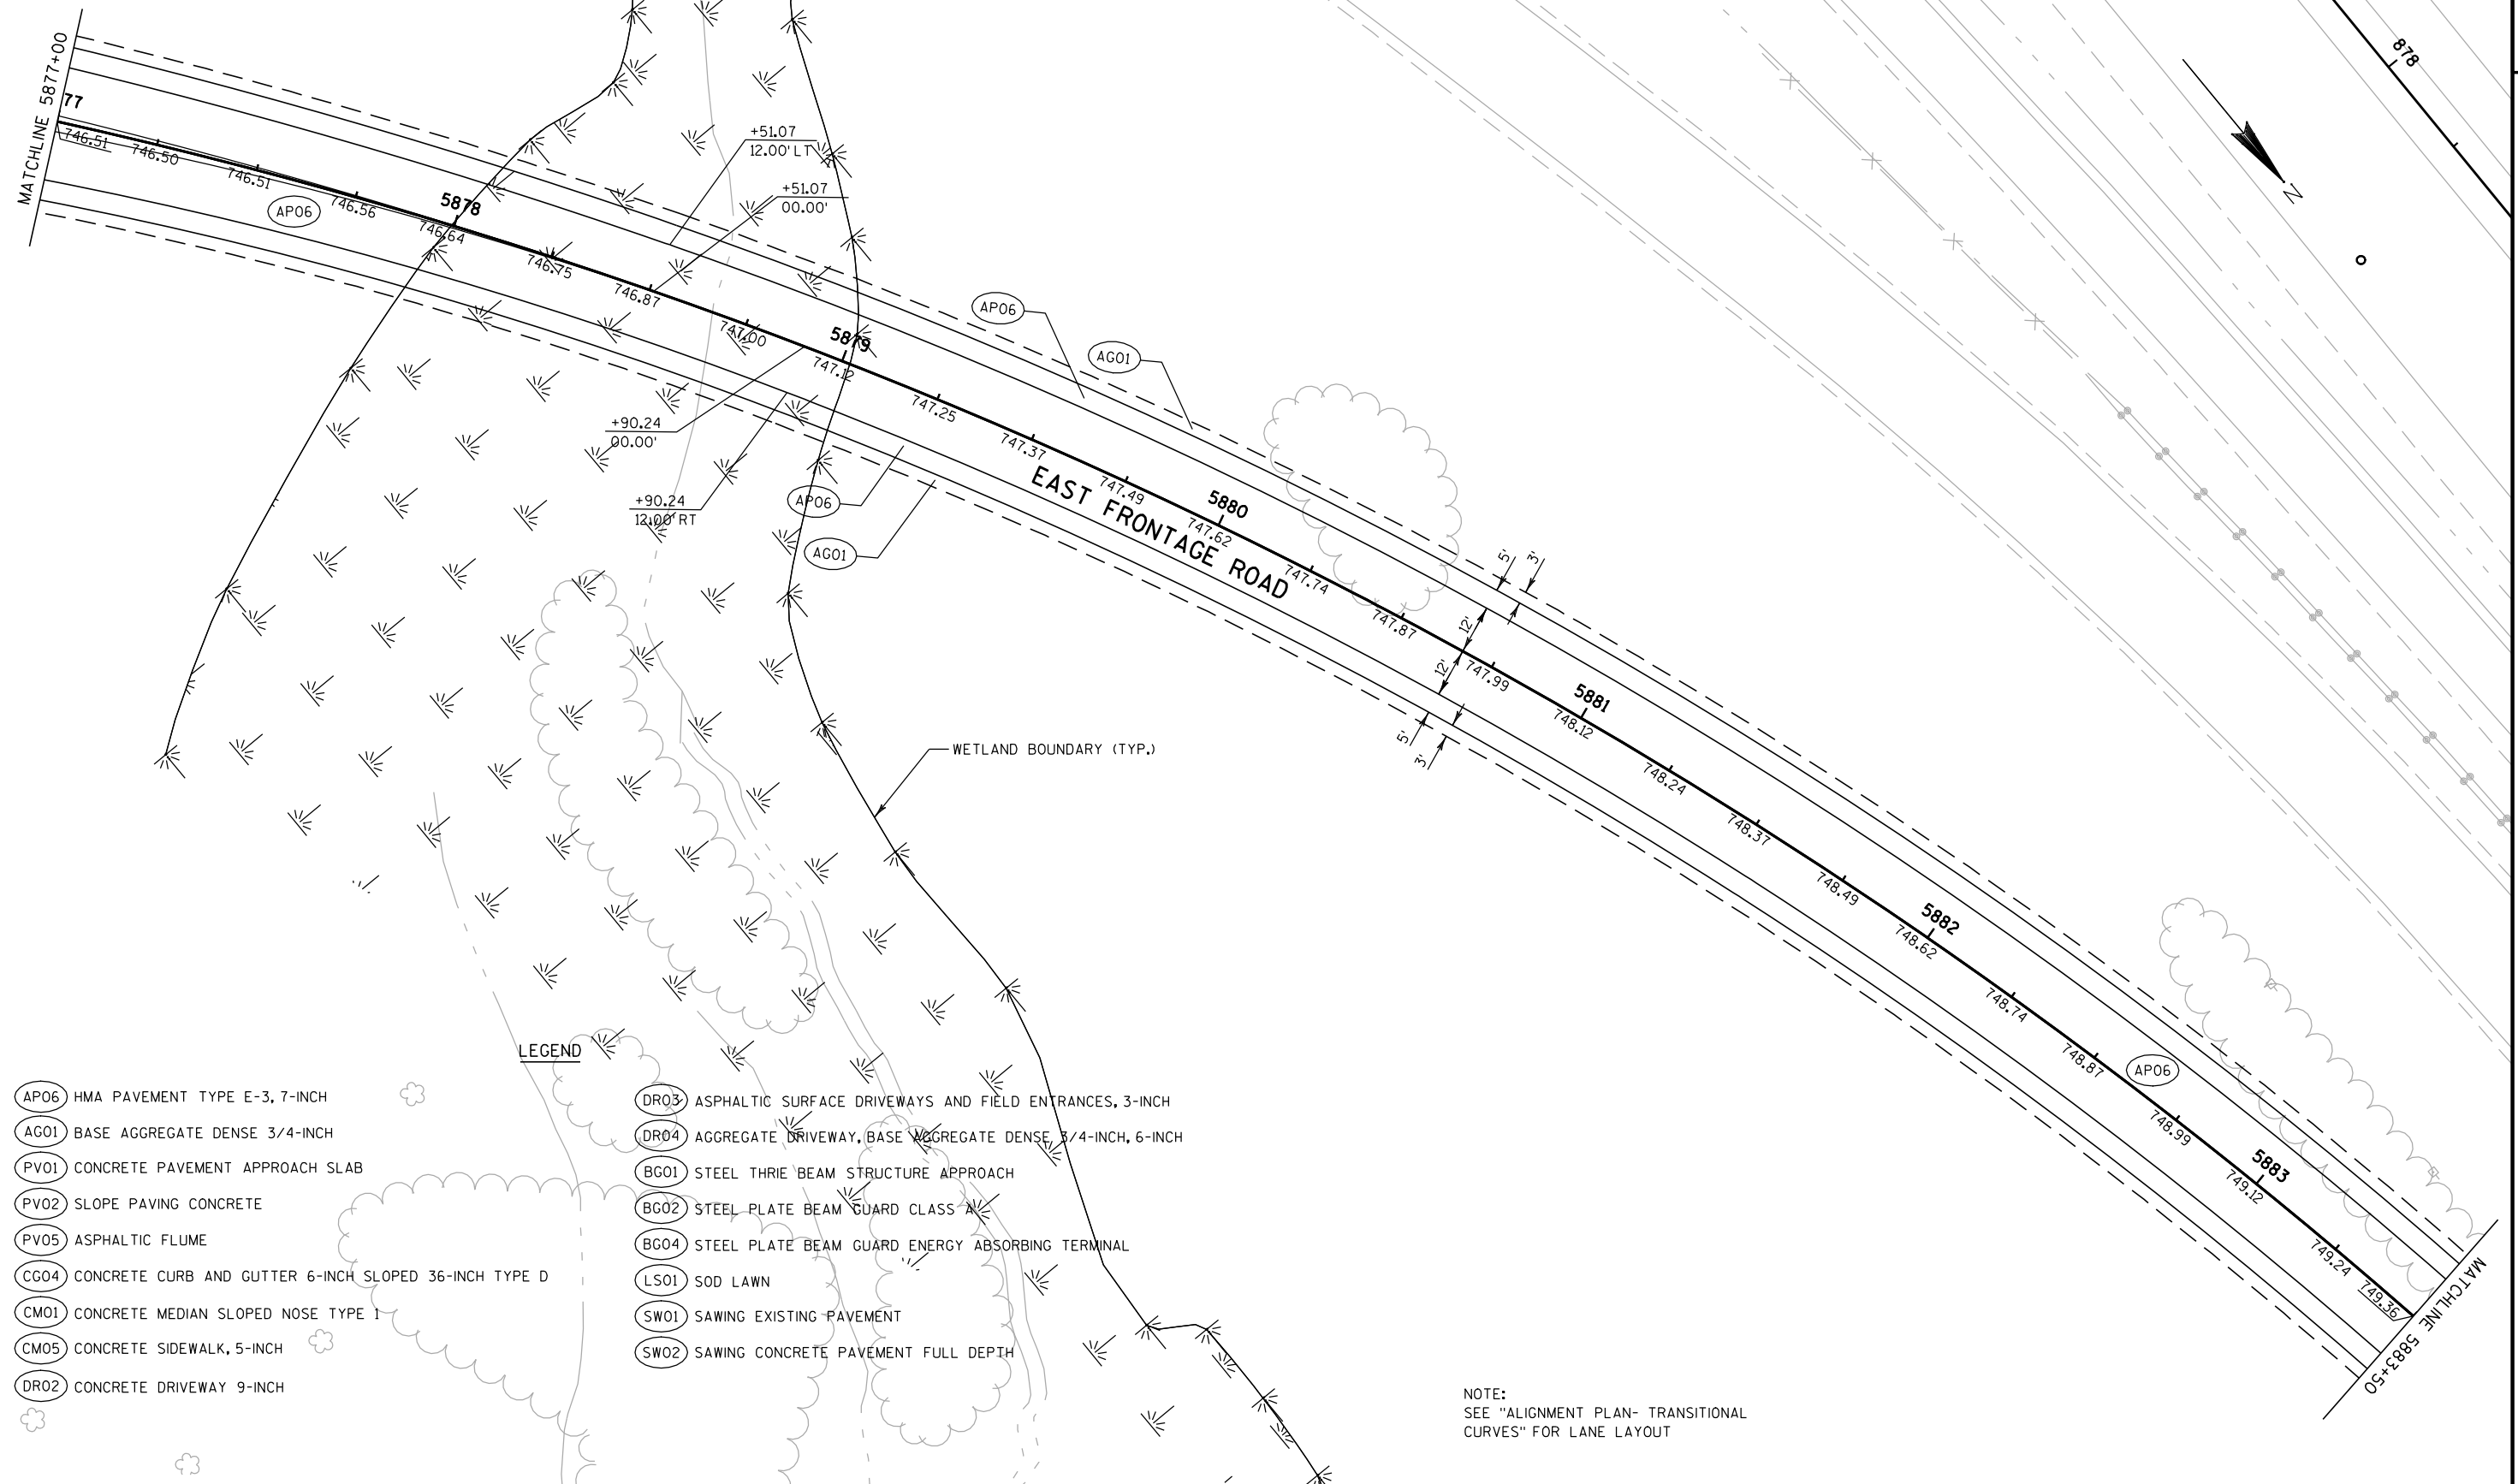


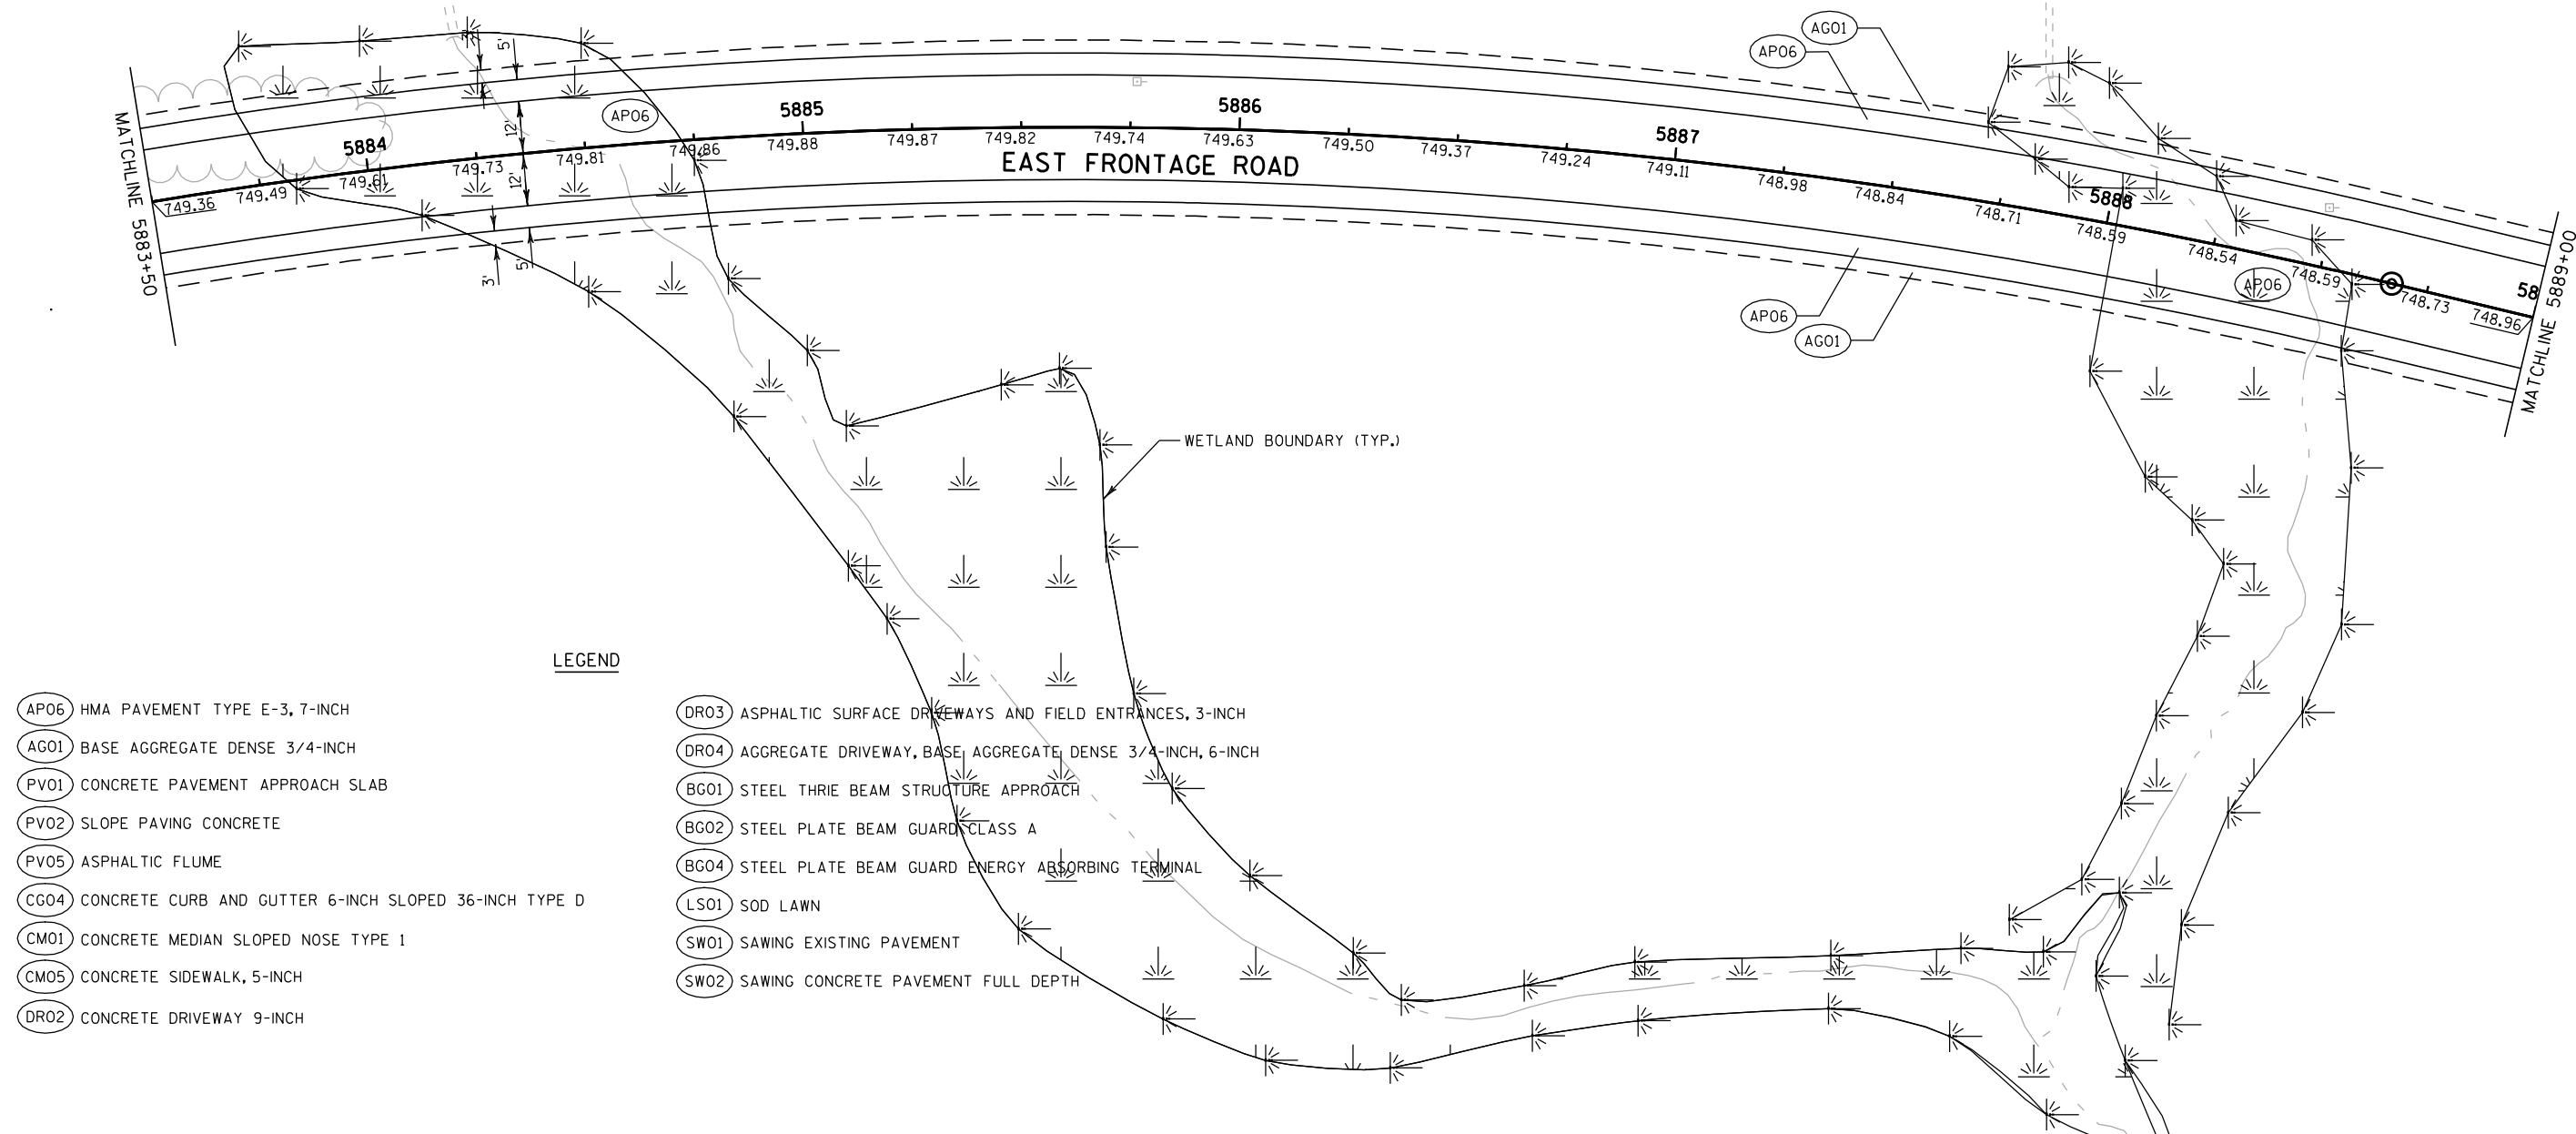

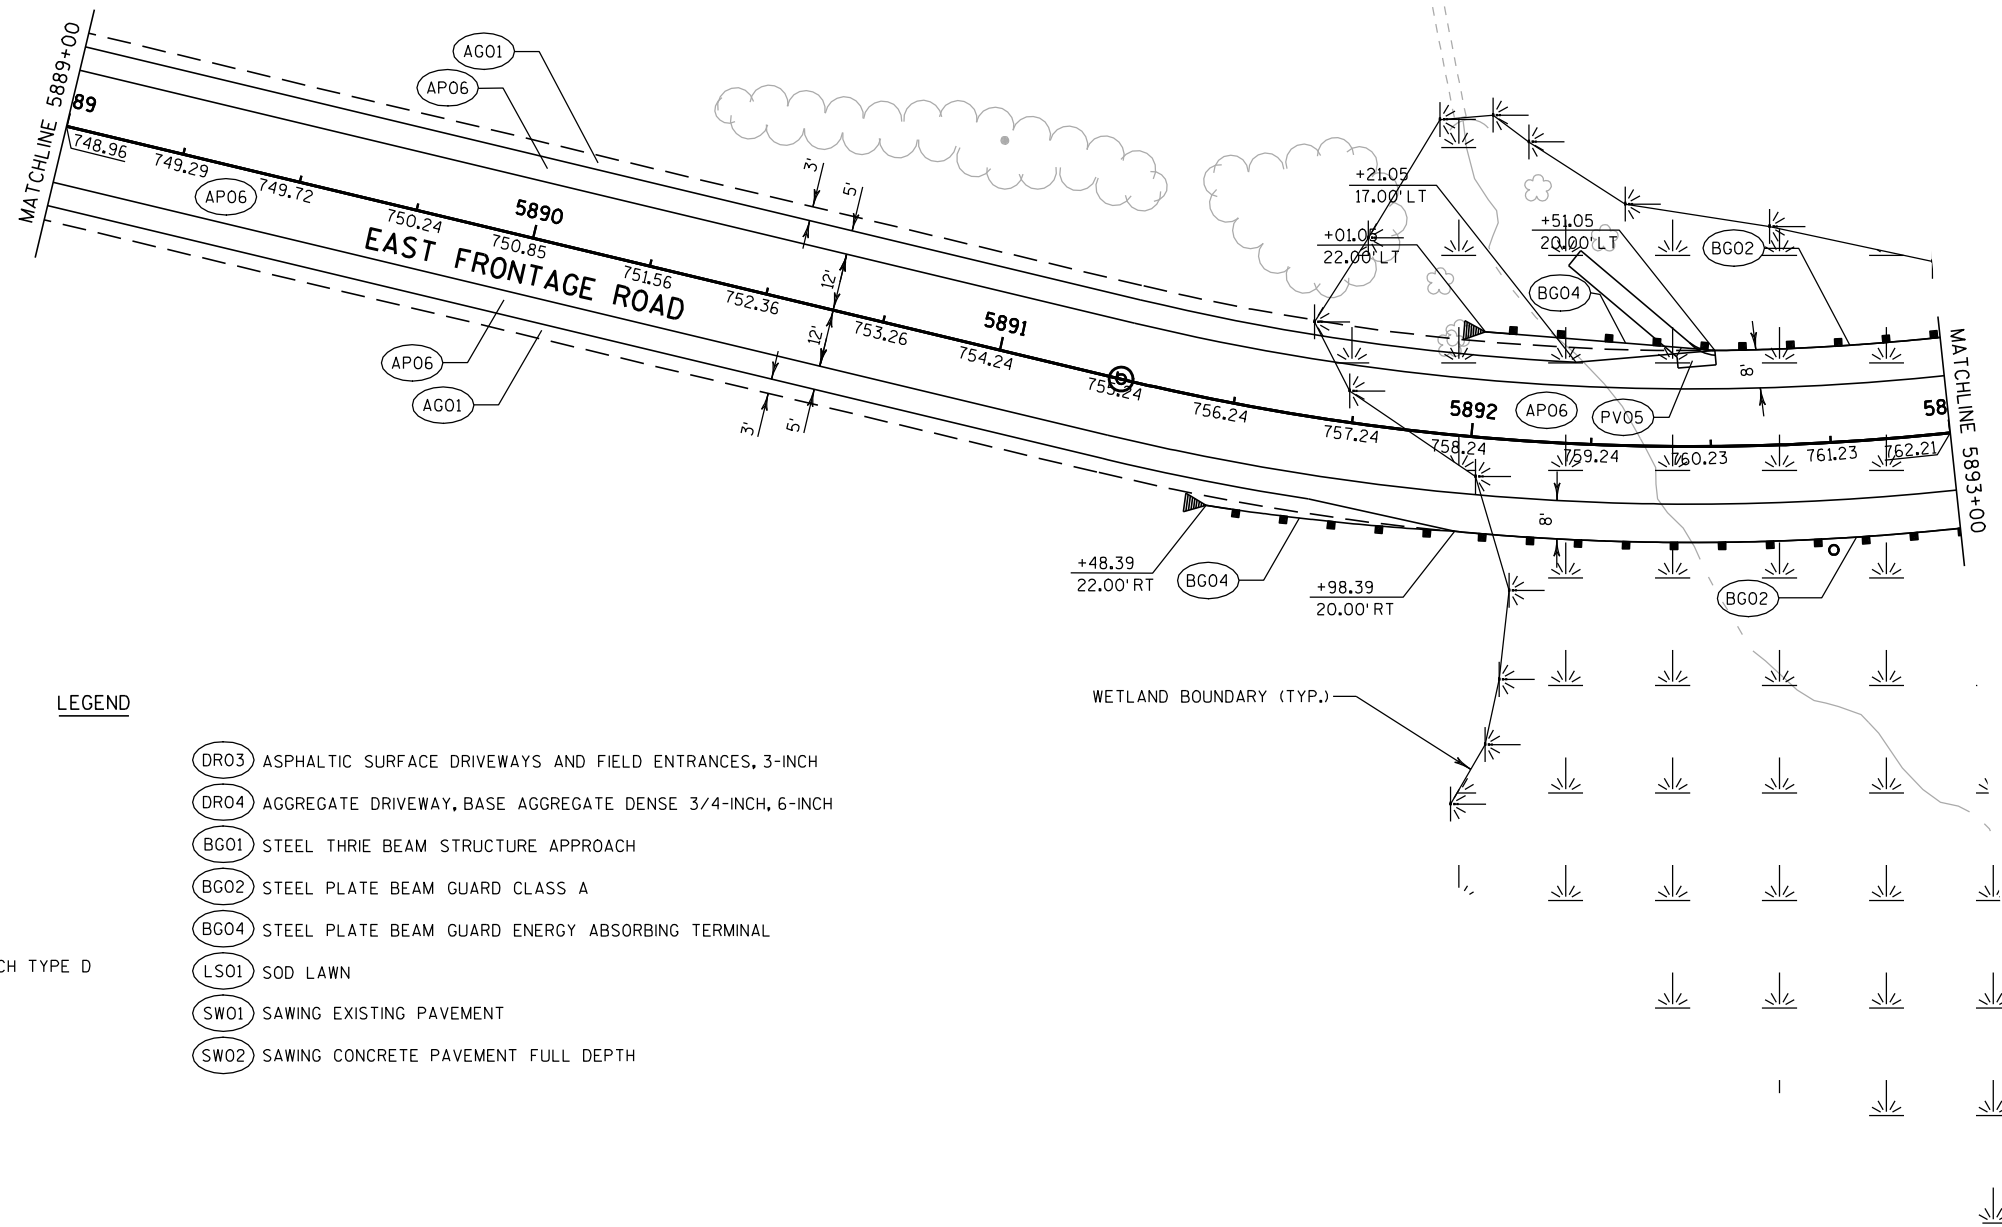


LEGEND

- | | |
|--|--|
| (AP06) HMA PAVEMENT TYPE E-3, 7-INCH | (DR03) ASPHALTIC SURFACE DRIVEWAYS AND FIELD ENTRANCES, 3-INCH |
| (AG01) BASE AGGREGATE DENSE 3/4-INCH | (DR04) AGGREGATE DRIVEWAY, BASE AGGREGATE DENSE 3/4-INCH, 6-INCH |
| (PV01) CONCRETE PAVEMENT APPROACH SLAB | (BG01) STEEL THRIE BEAM STRUCTURE APPROACH |
| (PV02) SLOPE PAVING CONCRETE | (BG02) STEEL PLATE BEAM GUARD CLASS A |
| (PV05) ASPHALTIC FLUME | (BG04) STEEL PLATE BEAM GUARD ENERGY ABSORBING TERMINAL |
| (CG04) CONCRETE CURB AND GUTTER 6-INCH SLOPED 36-INCH TYPE D | (LS01) SOD LAWN |
| (CM01) CONCRETE MEDIAN SLOPED NOSE TYPE 1 | (SW01) SAWING EXISTING PAVEMENT |
| (CM05) CONCRETE SIDEWALK, 5-INCH | (SW02) SAWING CONCRETE PAVEMENT FULL DEPTH |
| (DR02) CONCRETE DRIVEWAY 9-INCH | |

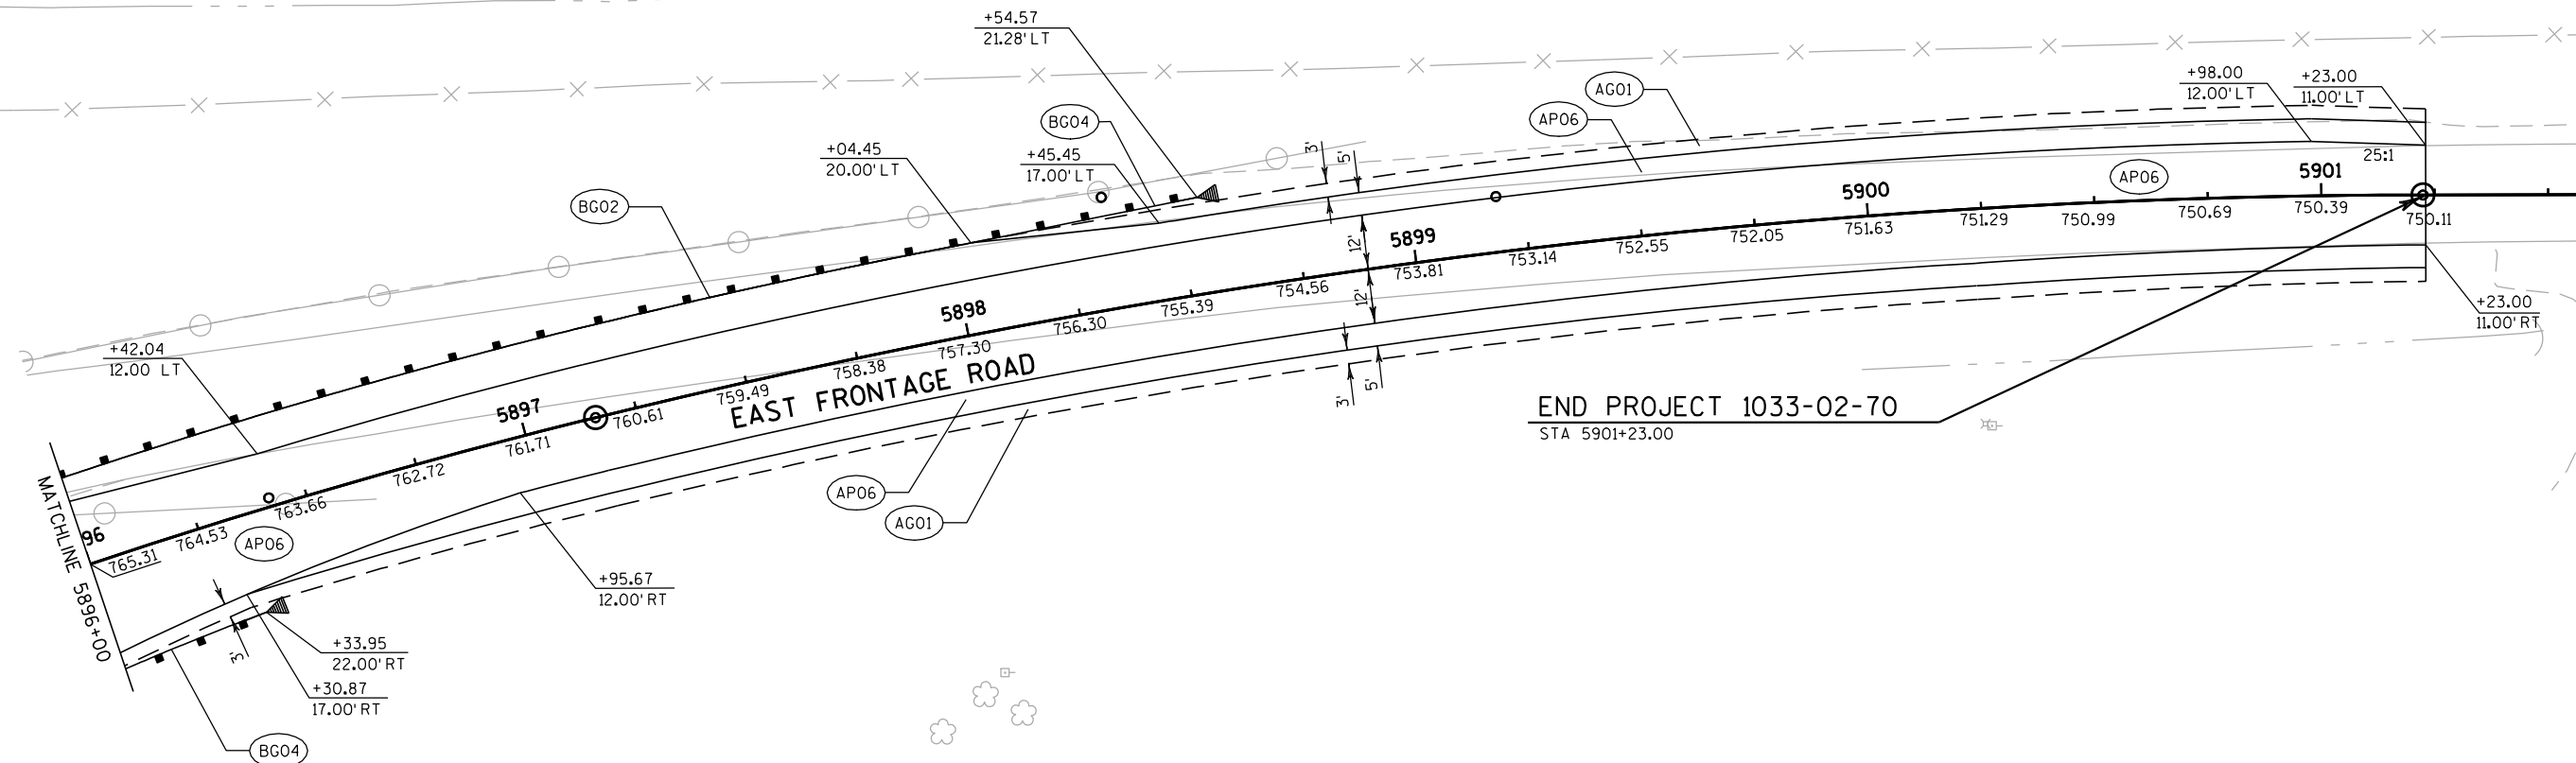


LEGEND

- | | |
|--|--|
| (AP06) HMA PAVEMENT TYPE E-3, 7-INCH | (DR03) ASPHALTIC SURFACE DRIVEWAYS AND FIELD ENTRANCES, 3-INCH |
| (AG01) BASE AGGREGATE DENSE 3/4-INCH | (DR04) AGGREGATE DRIVEWAY, BASE AGGREGATE DENSE 3/4-INCH, 6-INCH |
| (PV01) CONCRETE PAVEMENT APPROACH SLAB | (BG01) STEEL THRIE BEAM STRUCTURE APPROACH |
| (PV02) SLOPE PAVING CONCRETE | (BG02) STEEL PLATE BEAM GUARD CLASS A |
| (PV05) ASPHALTIC FLUME | (BG04) STEEL PLATE BEAM GUARD ENERGY ABSORBING TERMINAL |
| (CG04) CONCRETE CURB AND GUTTER 6-INCH SLOPED 36-INCH TYPE D | (LS01) SOD LAWN |
| (CM01) CONCRETE MEDIAN SLOPED NOSE TYPE 1 | (SW01) SAWING EXISTING PAVEMENT |
| (CM05) CONCRETE SIDEWALK, 5-INCH | (SW02) SAWING CONCRETE PAVEMENT FULL DEPTH |
| (DR02) CONCRETE DRIVEWAY 9-INCH | |

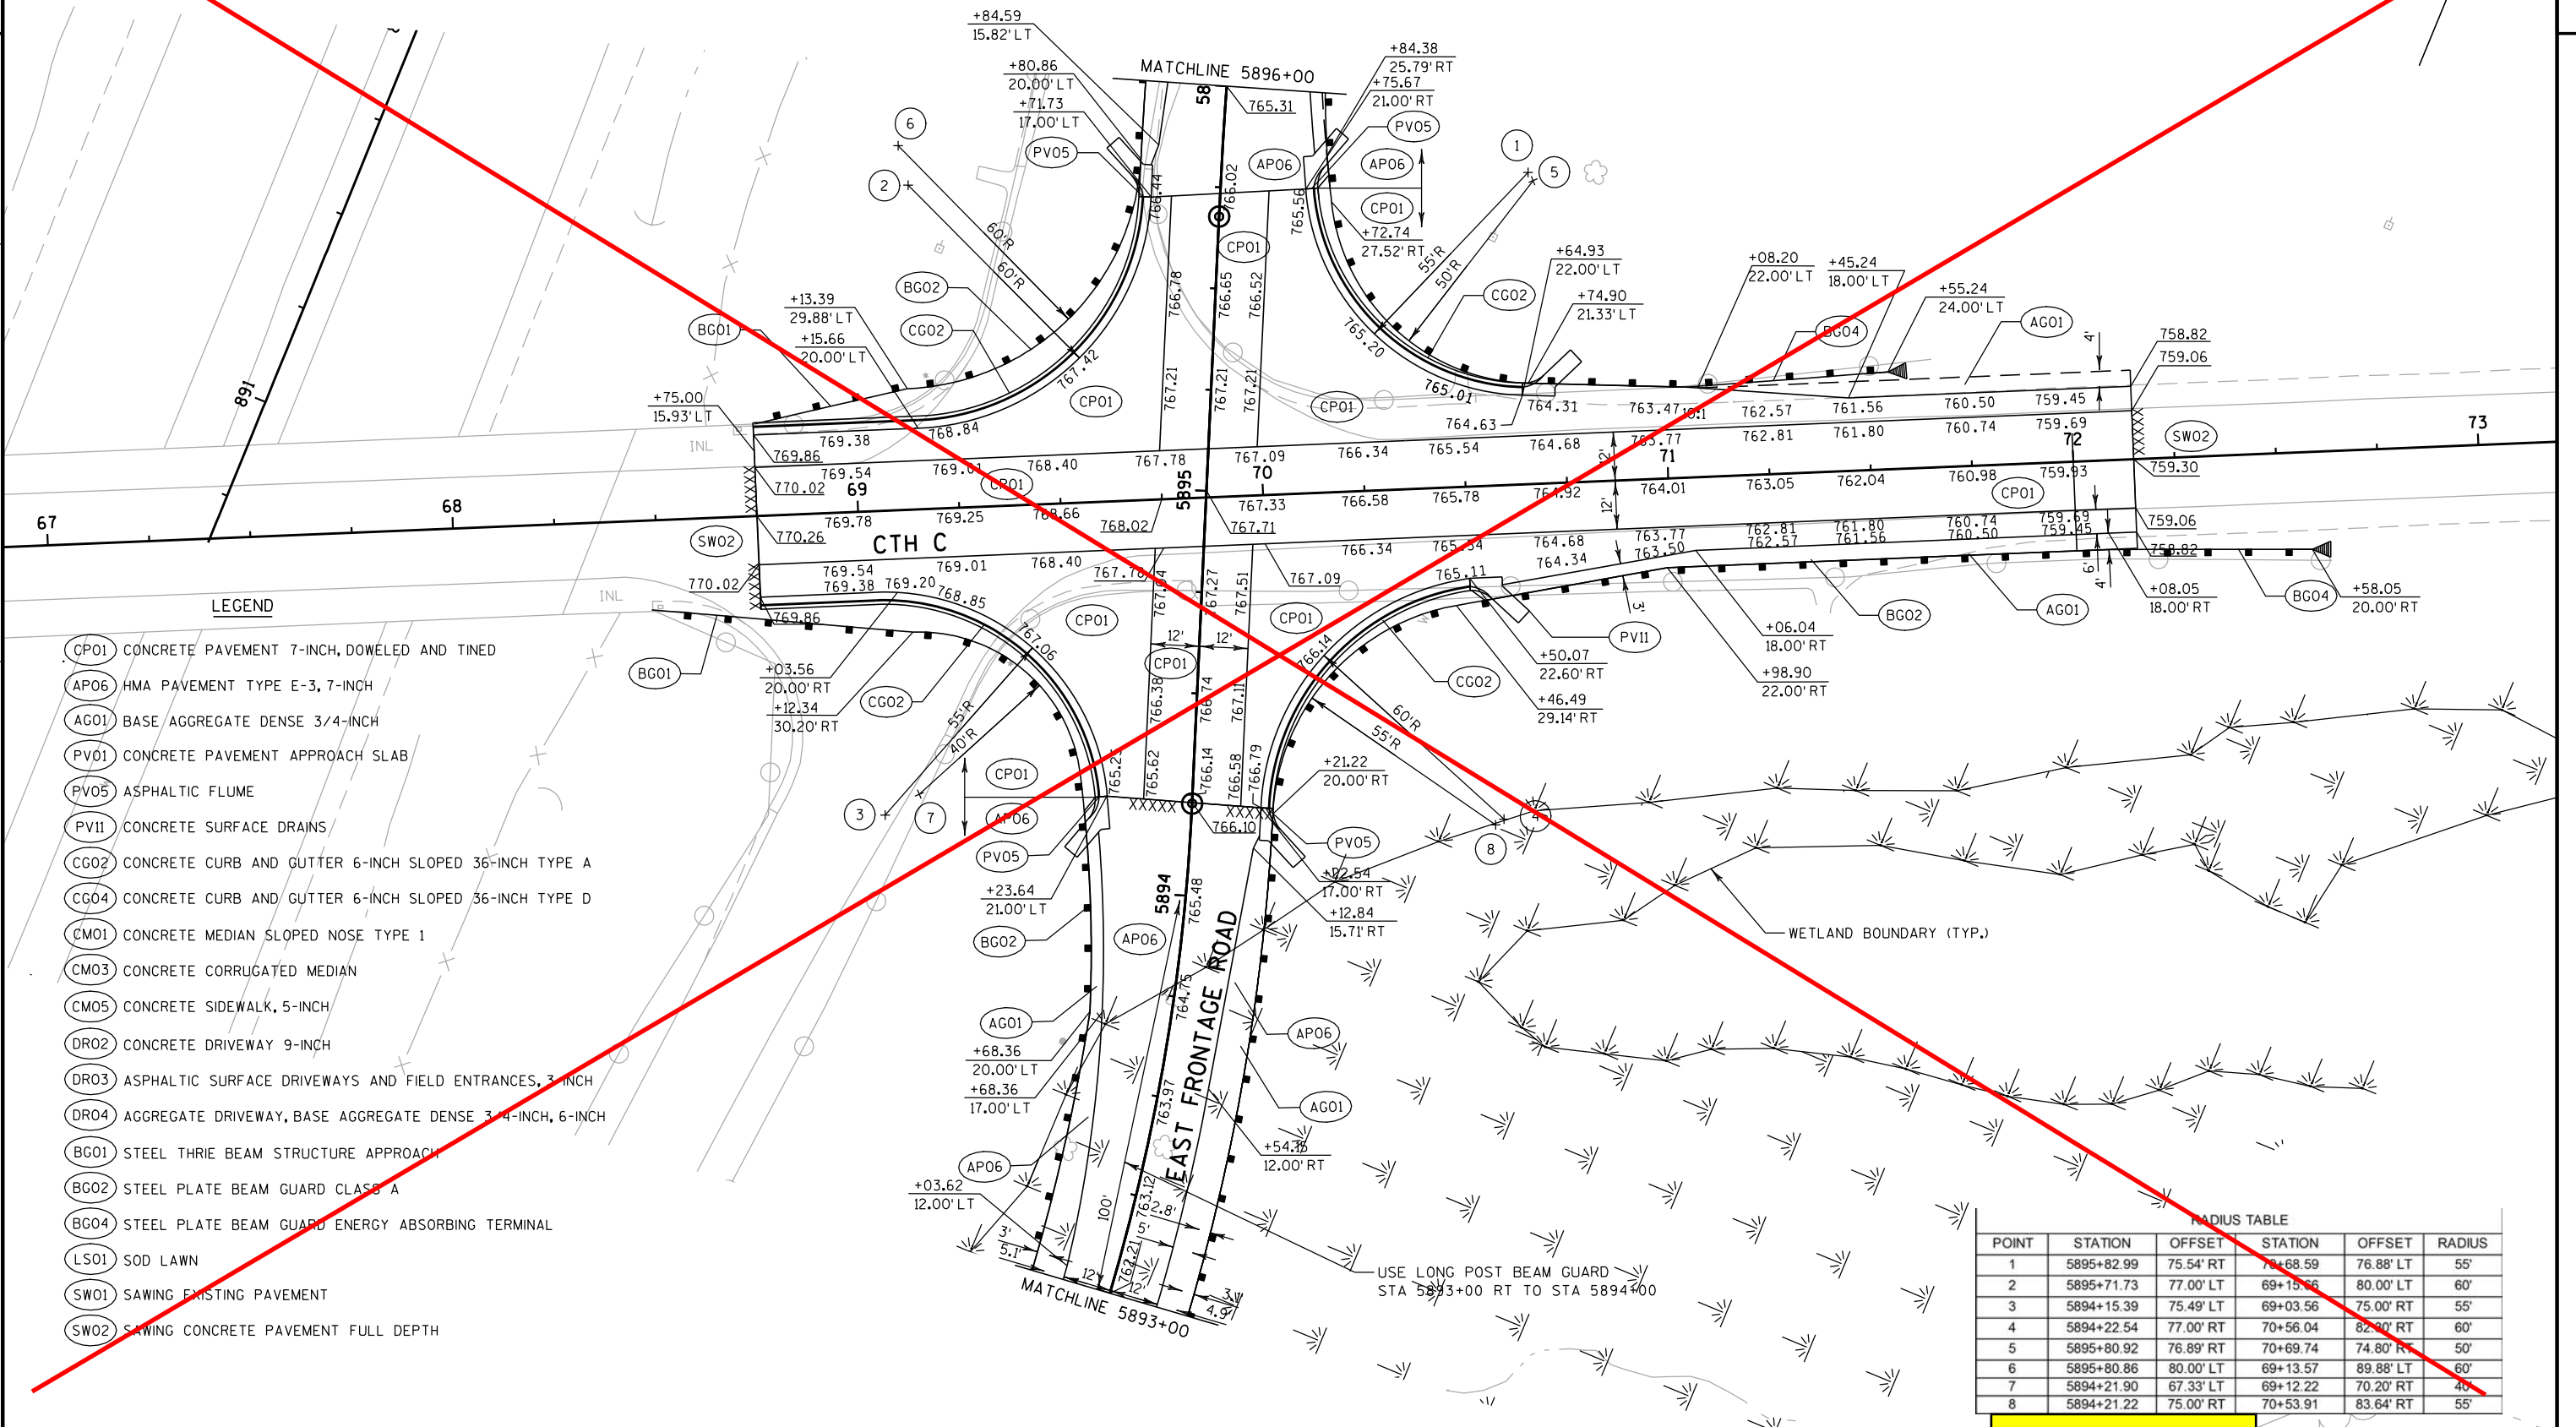

NOTE: HIGHLIGHTED AREA TO BE ADDED
TO 1033-02-72 (MAINLINE)

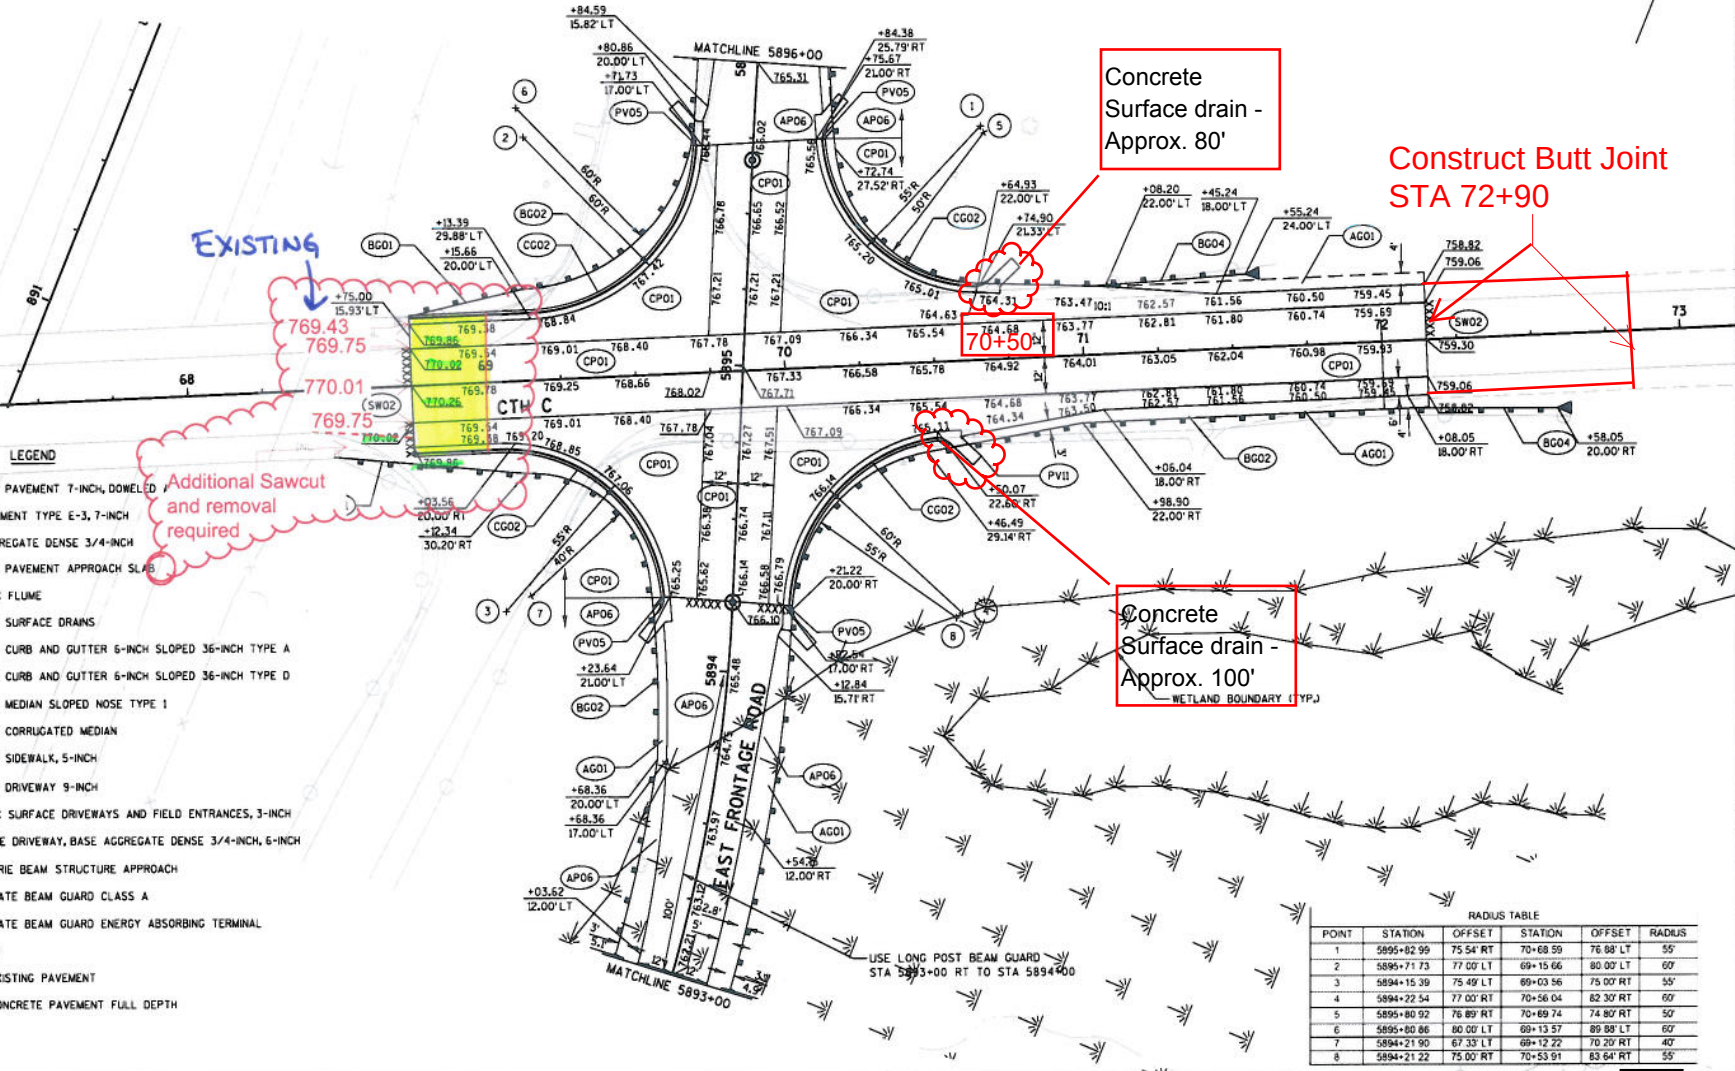

LEGEND

- (CP01) CONCRETE PAVEMENT 7-INCH, DOWELED
- (AP06) HMA PAVEMENT TYPE E-3, 7-INCH
- (AG01) BASE AGGREGATE DENSE 3/4-INCH
- (PV01) CONCRETE PAVEMENT APPROACH SLAB
- (PV05) ASPHALTIC FLUME
- (PV11) CONCRETE SURFACE DRAINS
- (CG02) CONCRETE CURB AND GUTTER 6-INCH SLOPED 36-INCH TYPE A
- (CG04) CONCRETE CURB AND GUTTER 6-INCH SLOPED 36-INCH TYPE D
- (CM01) CONCRETE MEDIAN SLOPED NOSE TYPE 1
- (CM03) CONCRETE CORRUGATED MEDIAN
- (CM05) CONCRETE SIDEWALK, 5-INCH
- (DR02) CONCRETE DRIVEWAY 9-INCH
- (DR03) ASPHALTIC SURFACE DRIVEWAYS AND FIELD ENTRANCES, 3-INCH
- (DR04) AGGREGATE DRIVEWAY, BASE AGGREGATE DENSE 3/4-INCH, 6-INCH
- (BG01) STEEL THRIE BEAM STRUCTURE APPROACH
- (BG02) STEEL PLATE BEAM GUARD CLASS A
- (BG04) STEEL PLATE BEAM GUARD ENERGY ABSORBING TERMINAL
- (LS01) SOD LAWN
- (SW01) SAWING EXISTING PAVEMENT
- (SW02) SAWING CONCRETE PAVEMENT FULL DEPTH


Concrete
Surface drain -
Approx. 80'

Construct Butt Joint
STA 72+90

Concrete
Surface drain -
Approx. 100'

RADIUS TABLE

POINT	STATION	OFFSET	STATION	OFFSET	RADIUS
1	5895+82.99	75.54' RT	70+68.59	76.88' LT	55'
2	5895+71.73	77.00' LT	69+15.66	80.00' LT	60'
3	5894+15.39	75.49' LT	69+03.56	75.00' RT	55'
4	5894+22.54	77.00' RT	70+56.04	82.30' RT	60'
5	5895+80.92	76.89' RT	70+69.74	74.80' RT	50'
6	5895+80.86	80.00' LT	69+15.57	80.88' LT	60'
7	5894+21.90	67.33' LT	69+12.22	70.20' RT	40'
8	5894+21.22	75.00' RT	70+53.91	83.64' RT	55'

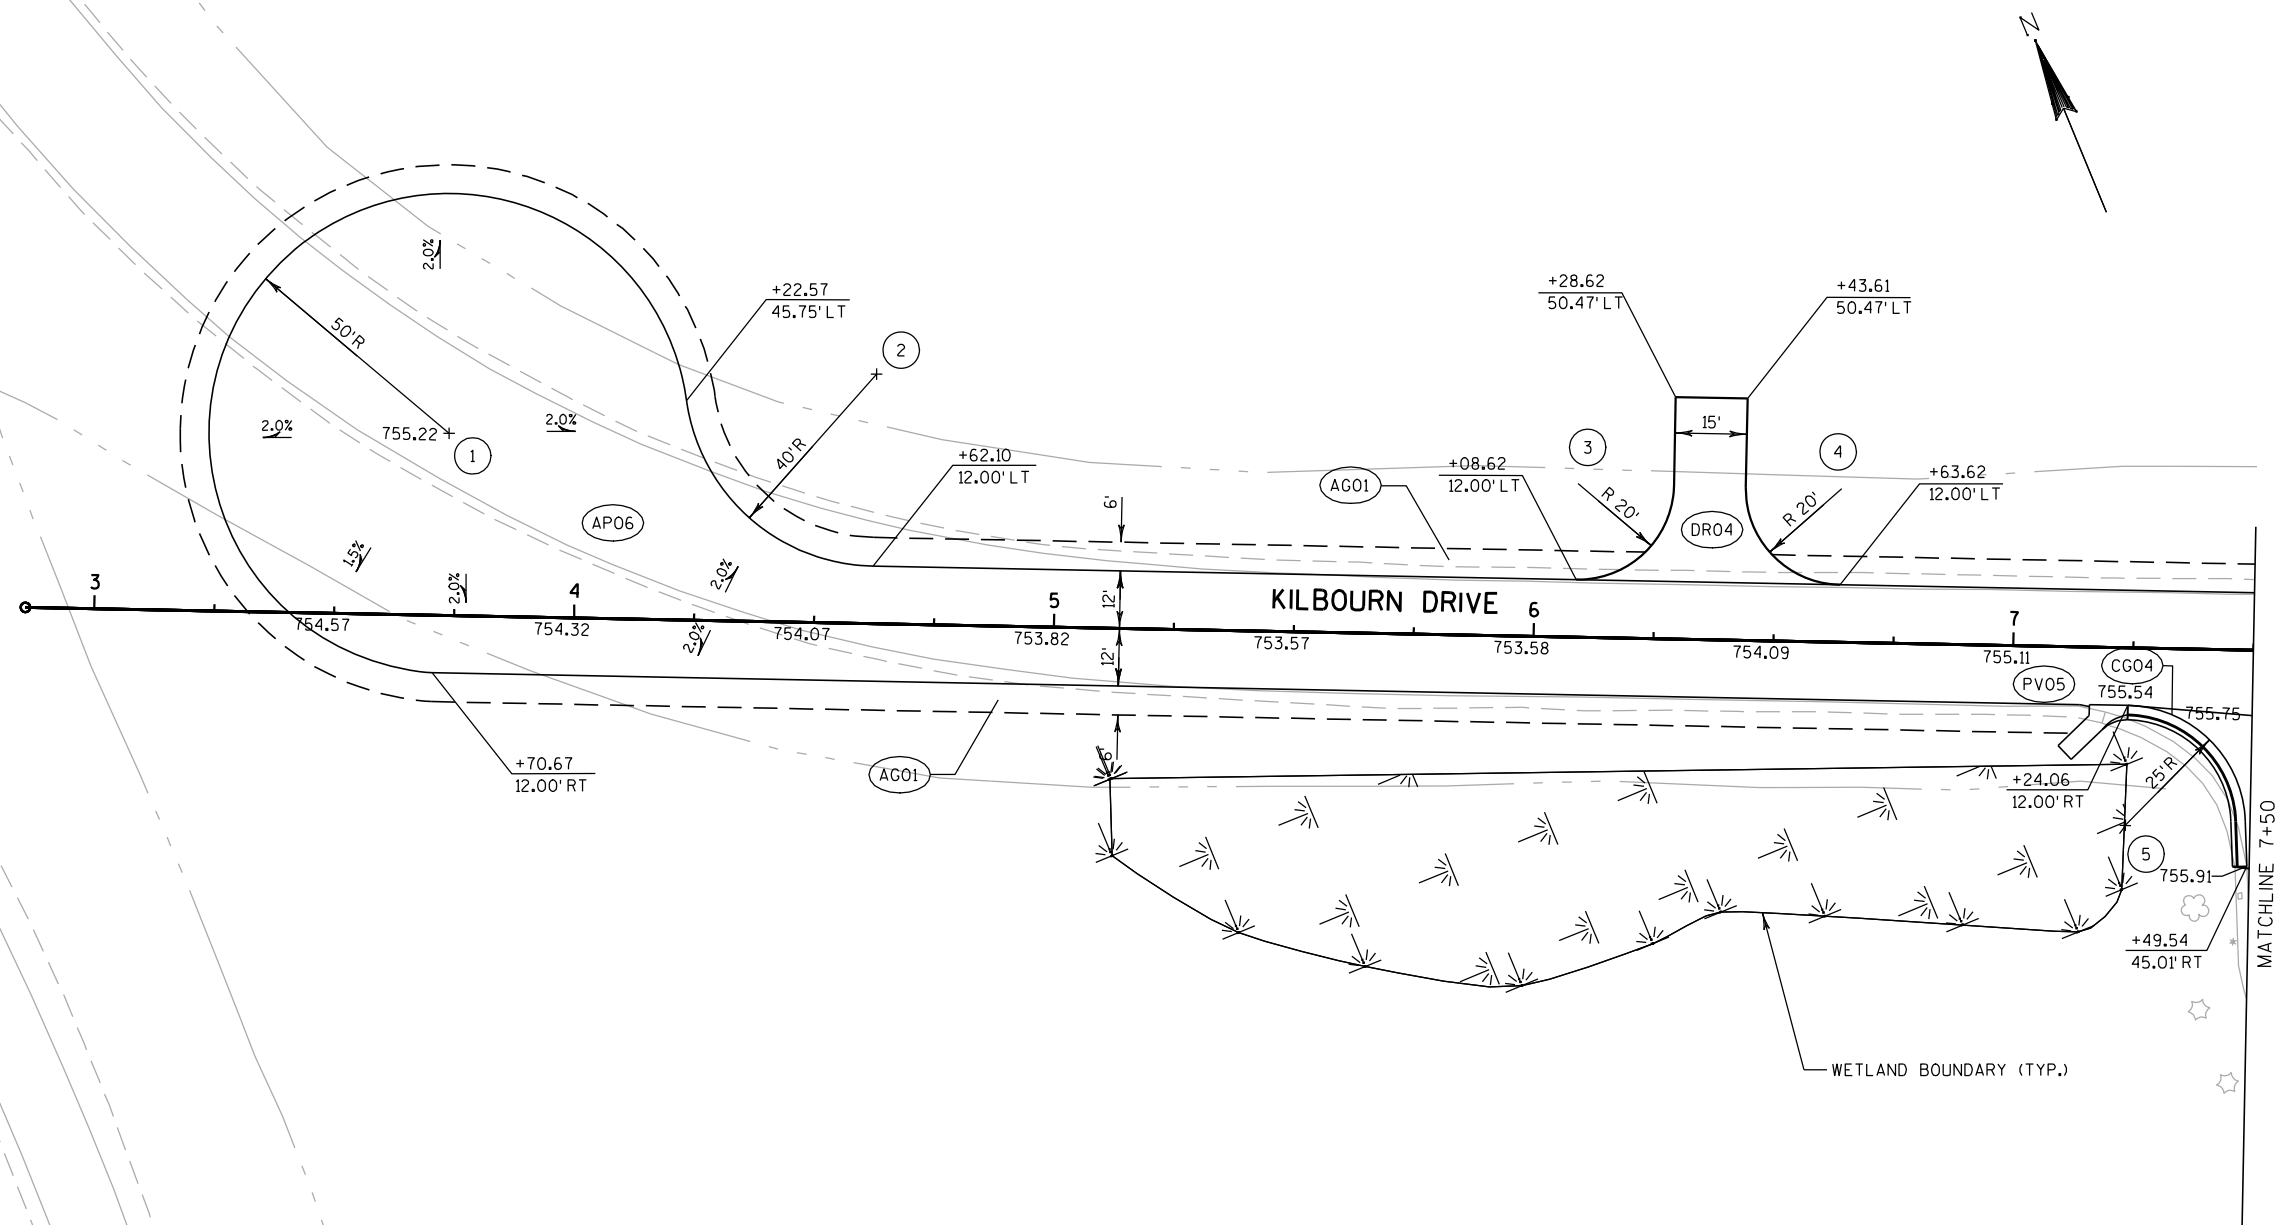


LEGEND

- | | | | |
|------|---|------|---|
| AP06 | HMA PAVEMENT TYPE E-3, 7-INCH | DR03 | ASPHALTIC SURFACE DRIVEWAYS AND FIELD ENTRANCES, 3-INCH |
| AG01 | BASE AGGREGATE DENSE 3/4-INCH | DR04 | AGGREGATE DRIVEWAY, BASE AGGREGATE DENSE 3/4-INCH, 6-INCH |
| PV01 | CONCRETE PAVEMENT APPROACH SLAB | BG01 | STEEL THRIE BEAM STRUCTURE APPROACH |
| PV02 | SLOPE PAVING CONCRETE | BG02 | STEEL PLATE BEAM GUARD CLASS A |
| PV05 | ASPHALTIC FLUME | BG04 | STEEL PLATE BEAM GUARD ENERGY ABSORBING TERMINAL |
| CG04 | CONCRETE CURB AND GUTTER 6-INCH SLOPED 36-INCH TYPE D | LS01 | SOD LAWN |
| CM01 | CONCRETE MEDIAN SLOPED NOSE TYPE 1 | SW01 | SAWING EXISTING PAVEMENT |
| CM05 | CONCRETE SIDEWALK, 5-INCH | SW02 | SAWING CONCRETE PAVEMENT FULL DEPTH |
| DR02 | CONCRETE DRIVEWAY 9-INCH | | |

RADIUS TABLE					
POINT	STATION	OFFSET	STATION	OFFSET	RADIUS
1	5895+82.99	75.54' RT	70+68.59	76.88' LT	55'
2	5895+71.73	77.00' LT	69+15.66	80.00' LT	60'
3	5894+15.39	75.49' LT	69+03.56	75.00' RT	55'
4	5894+22.54	77.00' RT	70+56.04	82.30' RT	60'
5	5895+80.92	76.89' RT	70+69.74	74.80' RT	50'

2

2

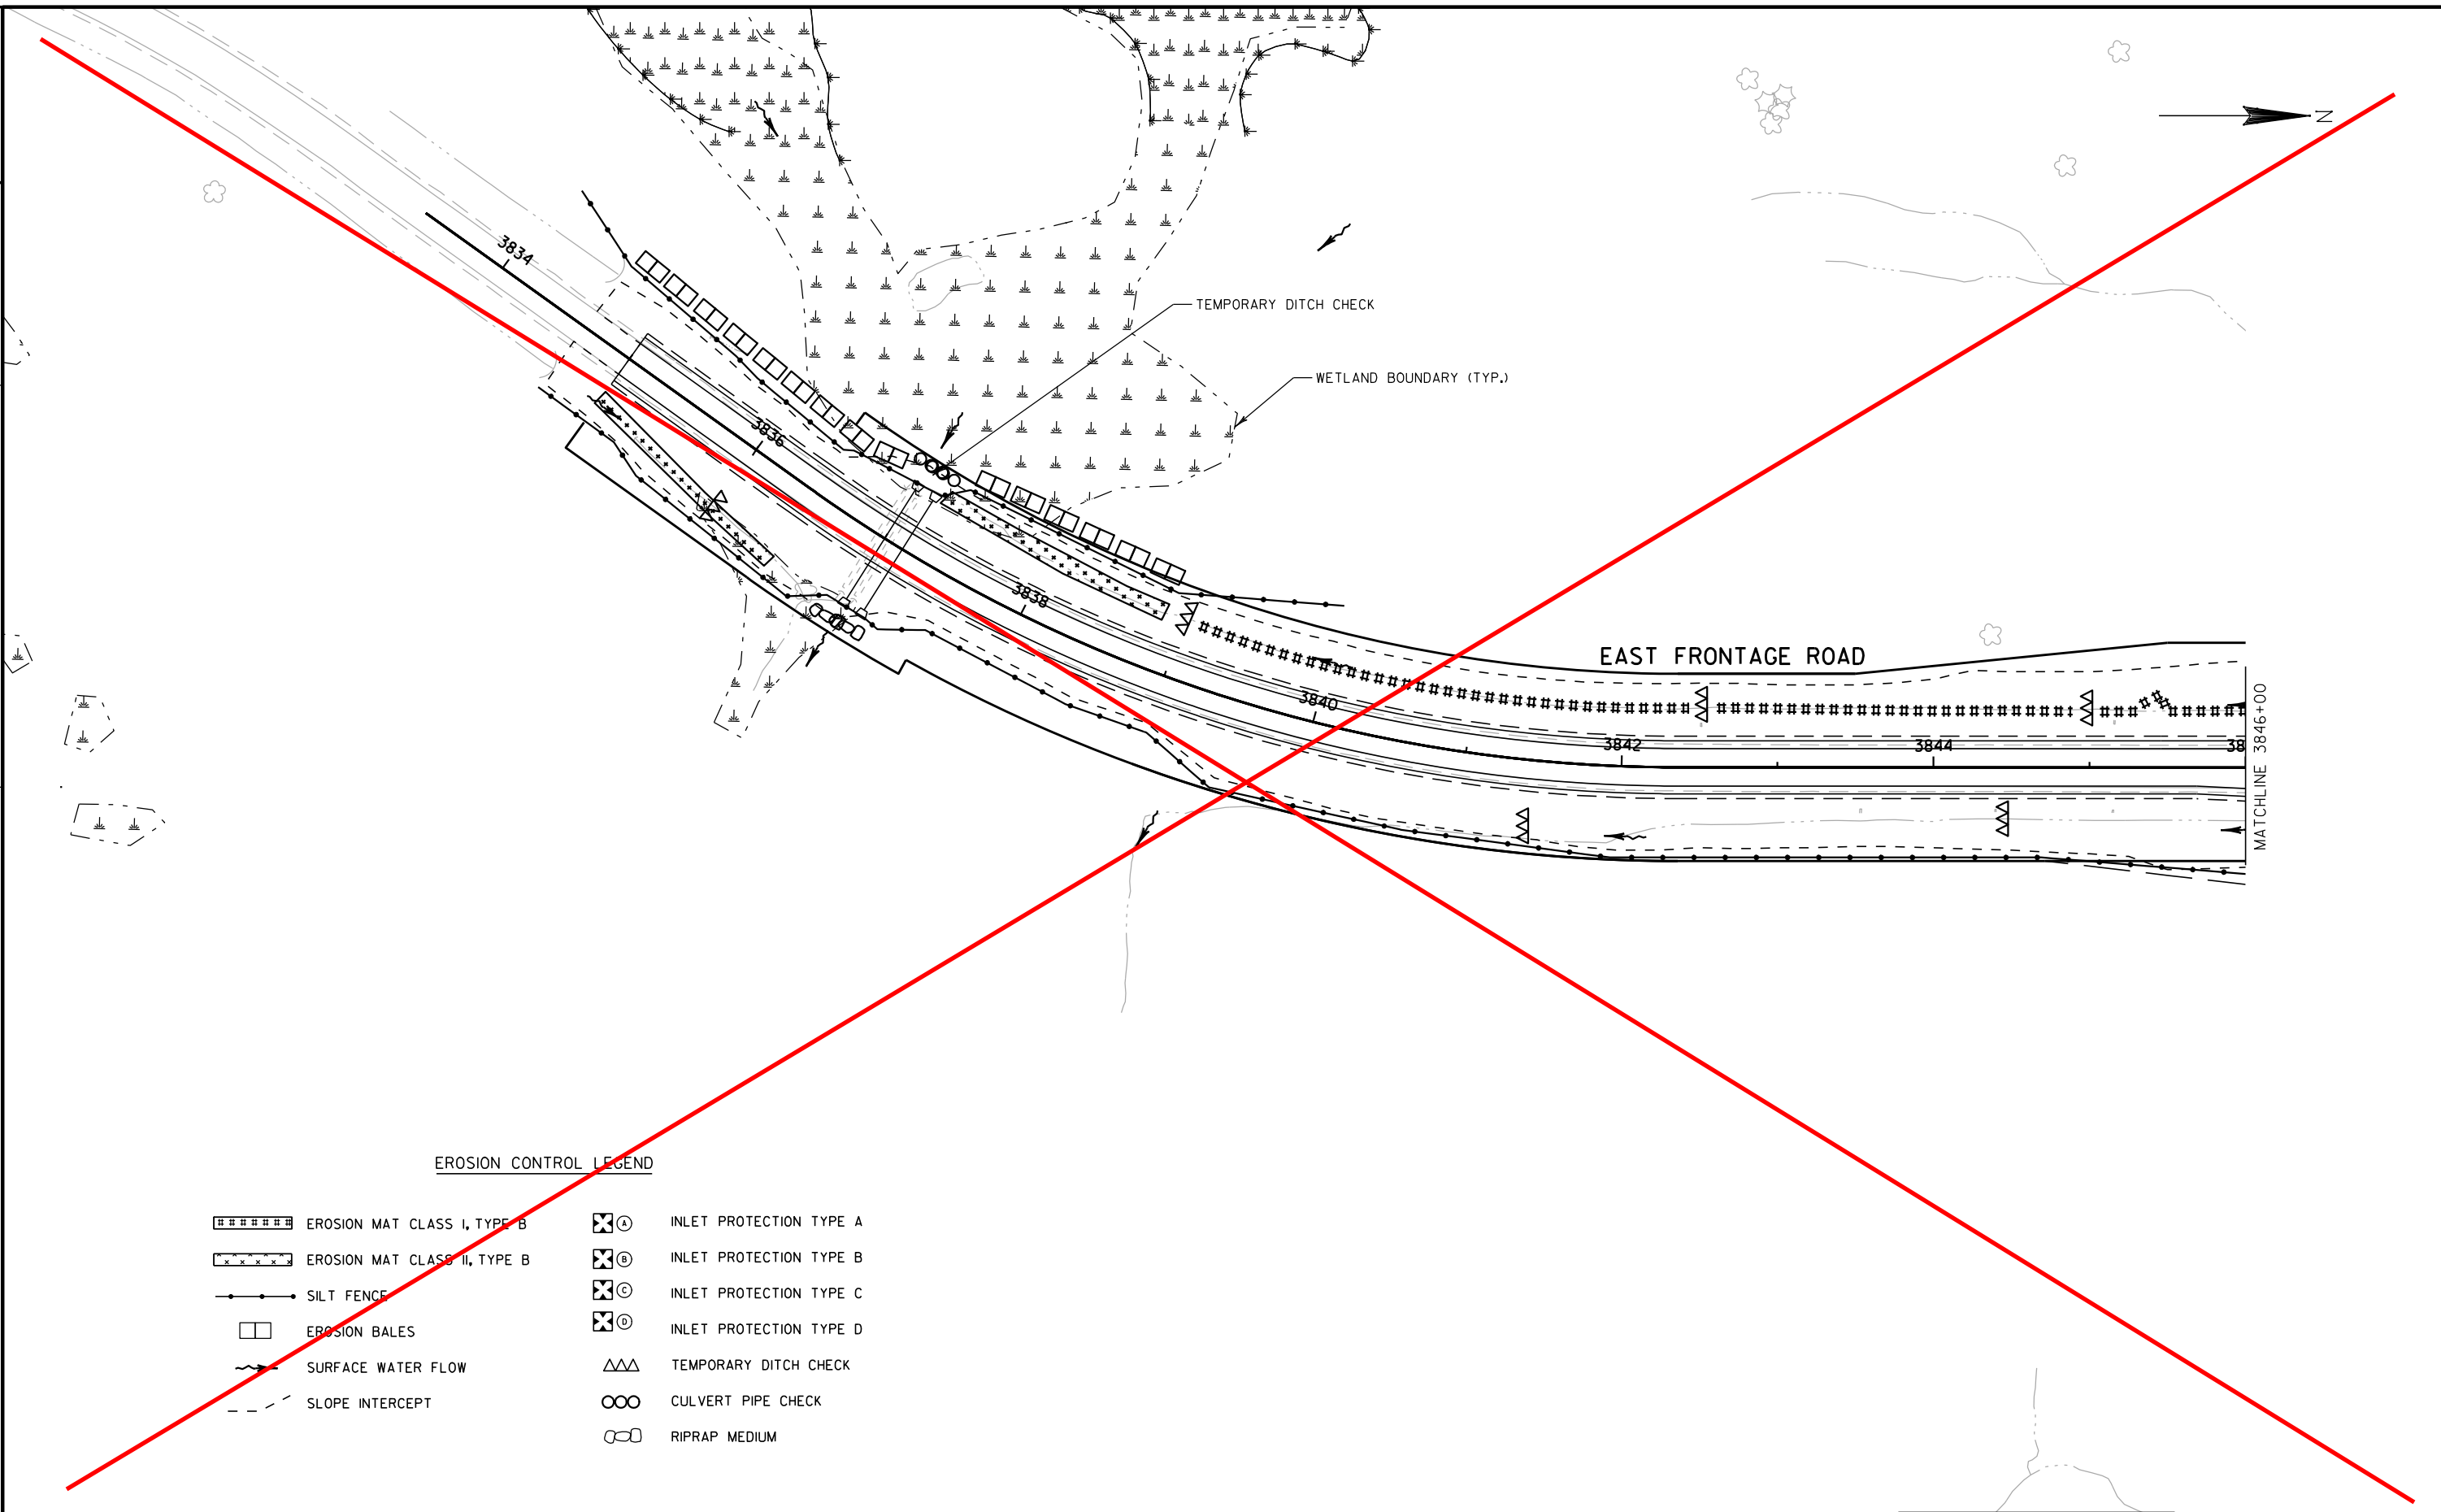

EROSION CONTROL LEGEND

- | | |
|-------------------------------------|--|
| ■■■■■■■ EROSION MAT CLASS I, TYPE B | ⊗ ^④ INLET PROTECTION TYPE A |
| ×××××× EROSION MAT CLASS II, TYPE B | ⊗ ^⑥ INLET PROTECTION TYPE B |
| —●—●—● SILT FENCE | ⊗ ^③ INLET PROTECTION TYPE C |
| □□ EROSION BALES | ⊗ ^① INLET PROTECTION TYPE D |
| ~ SURFACE WATER FLOW | △△△ TEMPORARY DITCH CHECK |
| - - - SLOPE INTERCEPT | ○○○ CULVERT PIPE CHECK |
| | ○ ○ RIPRAP MEDIUM |

PROJECT NO:1033-02-70

HWY: IH 94/STH 20

COUNTY: RACINE

EROSION CONTROL

See new sheet #42

SHEET

E



TEMPORARY DITCH CHECK

WETLAND BOUNDARY (TYP.)

EAST FRONTAGE ROAD

MATCHLINE 3846+00

Change to Erosion Mat Class II, Type C -
Changed areas are identified with a red
cloud.

EROSION CONTROL LEGEND

■■■■■■■■ EROSION MAT CLASS I, TYPE B

■■■■■■■■ EROSION MAT CLASS II, TYPE B

—●—●—● SILT FENCE

□□ EROSION BALES

~> SURFACE WATER FLOW

- - - SLOPE INTERCEPT

⊗Ⓐ INLET PROTECTION TYPE A

⊗Ⓑ INLET PROTECTION TYPE B

⊗Ⓒ INLET PROTECTION TYPE C

⊗Ⓓ INLET PROTECTION TYPE D


△△△ TEMPORARY DITCH CHECK

○○○ CULVERT PIPE CHECK

○○○ RIPRAP MEDIUM

2

2

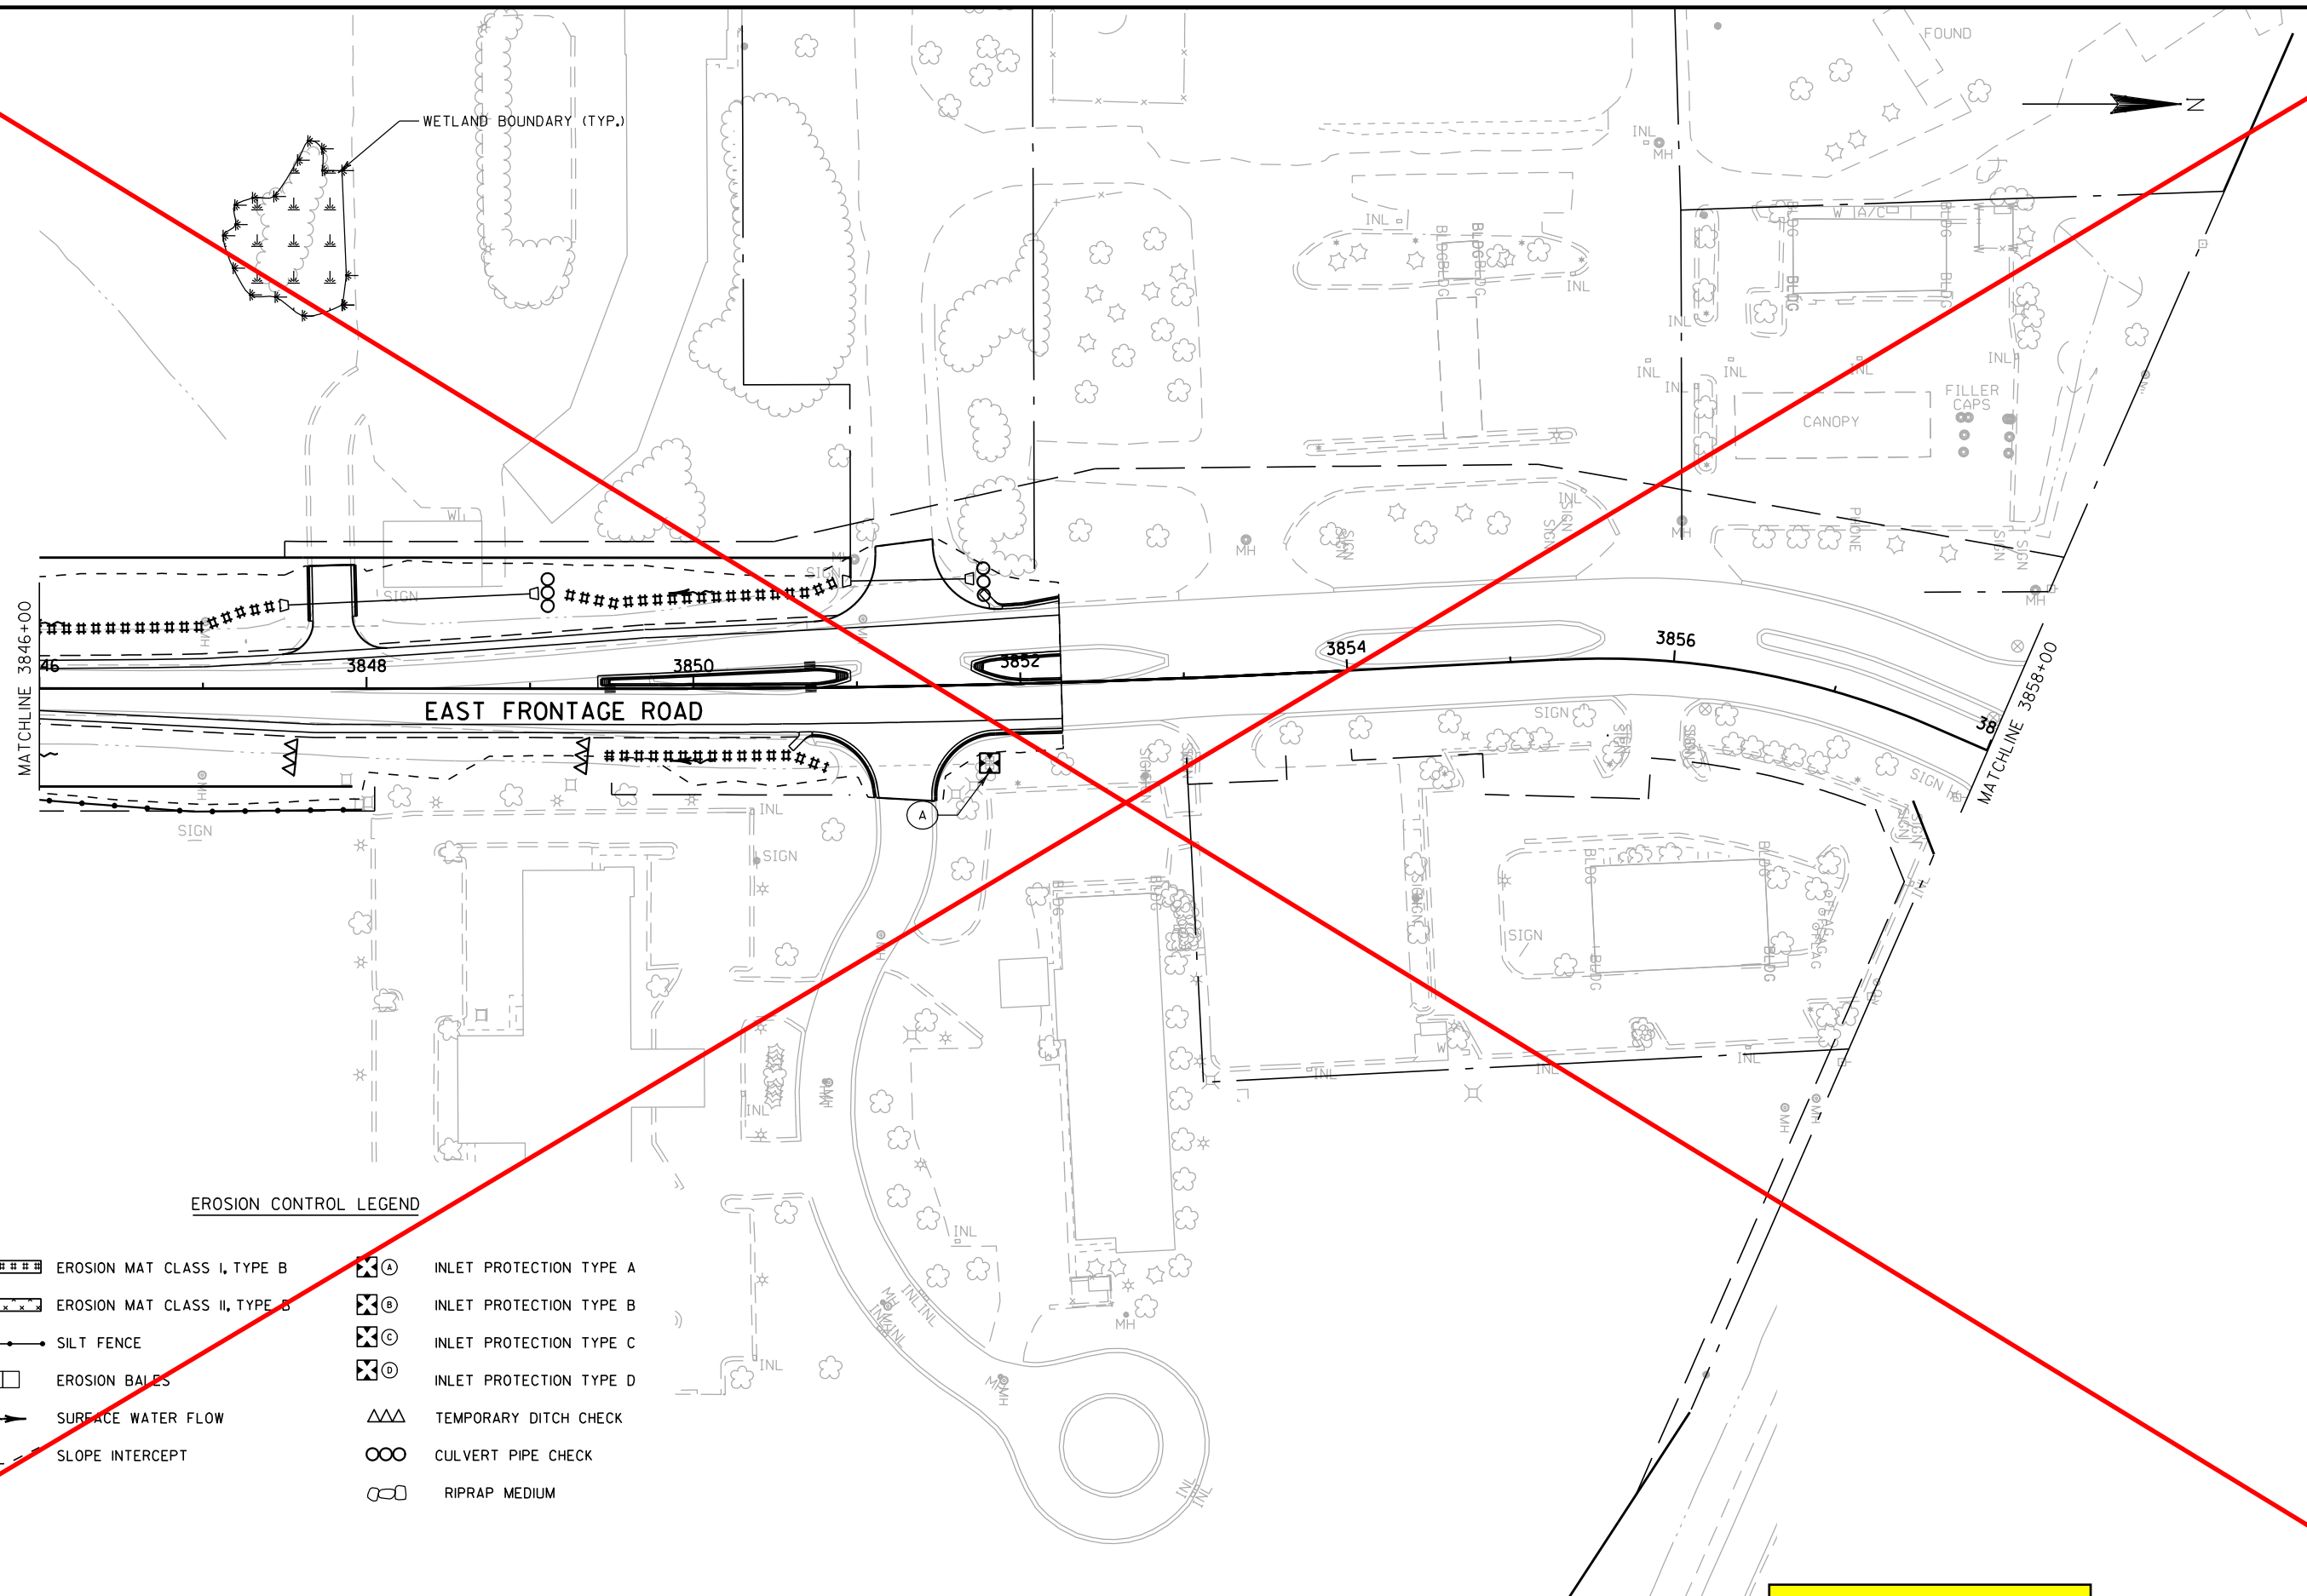

EROSION CONTROL LEGEND

- | | | | |
|--|------------------------------|--|-----------------------------|
| | EROSION MAT CLASS I, TYPE B | | (A) INLET PROTECTION TYPE A |
| | EROSION MAT CLASS II, TYPE B | | (B) INLET PROTECTION TYPE B |
| | SILT FENCE | | (C) INLET PROTECTION TYPE C |
| | EROSION BALES | | (D) INLET PROTECTION TYPE D |
| | SURFACE WATER FLOW | | TEMPORARY DITCH CHECK |
| | SLOPE INTERCEPT | | CULVERT PIPE CHECK |
| | | | RIPRAP MEDIUM |

PROJECT NO:1033-02-70

HWY: IH 94/STH 20

COUNTY: RACINE

EROSION CONTROL

See new sheet #43

SHEET

T E

FILE NAME : S:\FinalDesign\20\10330270_E\Roads\cds\022002_ec.dgn


PLOT DATE : 07-DEC-2010 16:37

PLOT BY : MSCKXK

PLOT NAME : 022002_ec

PLOT SCALE : 100:1

WISDOT/CADDS SHEET 42

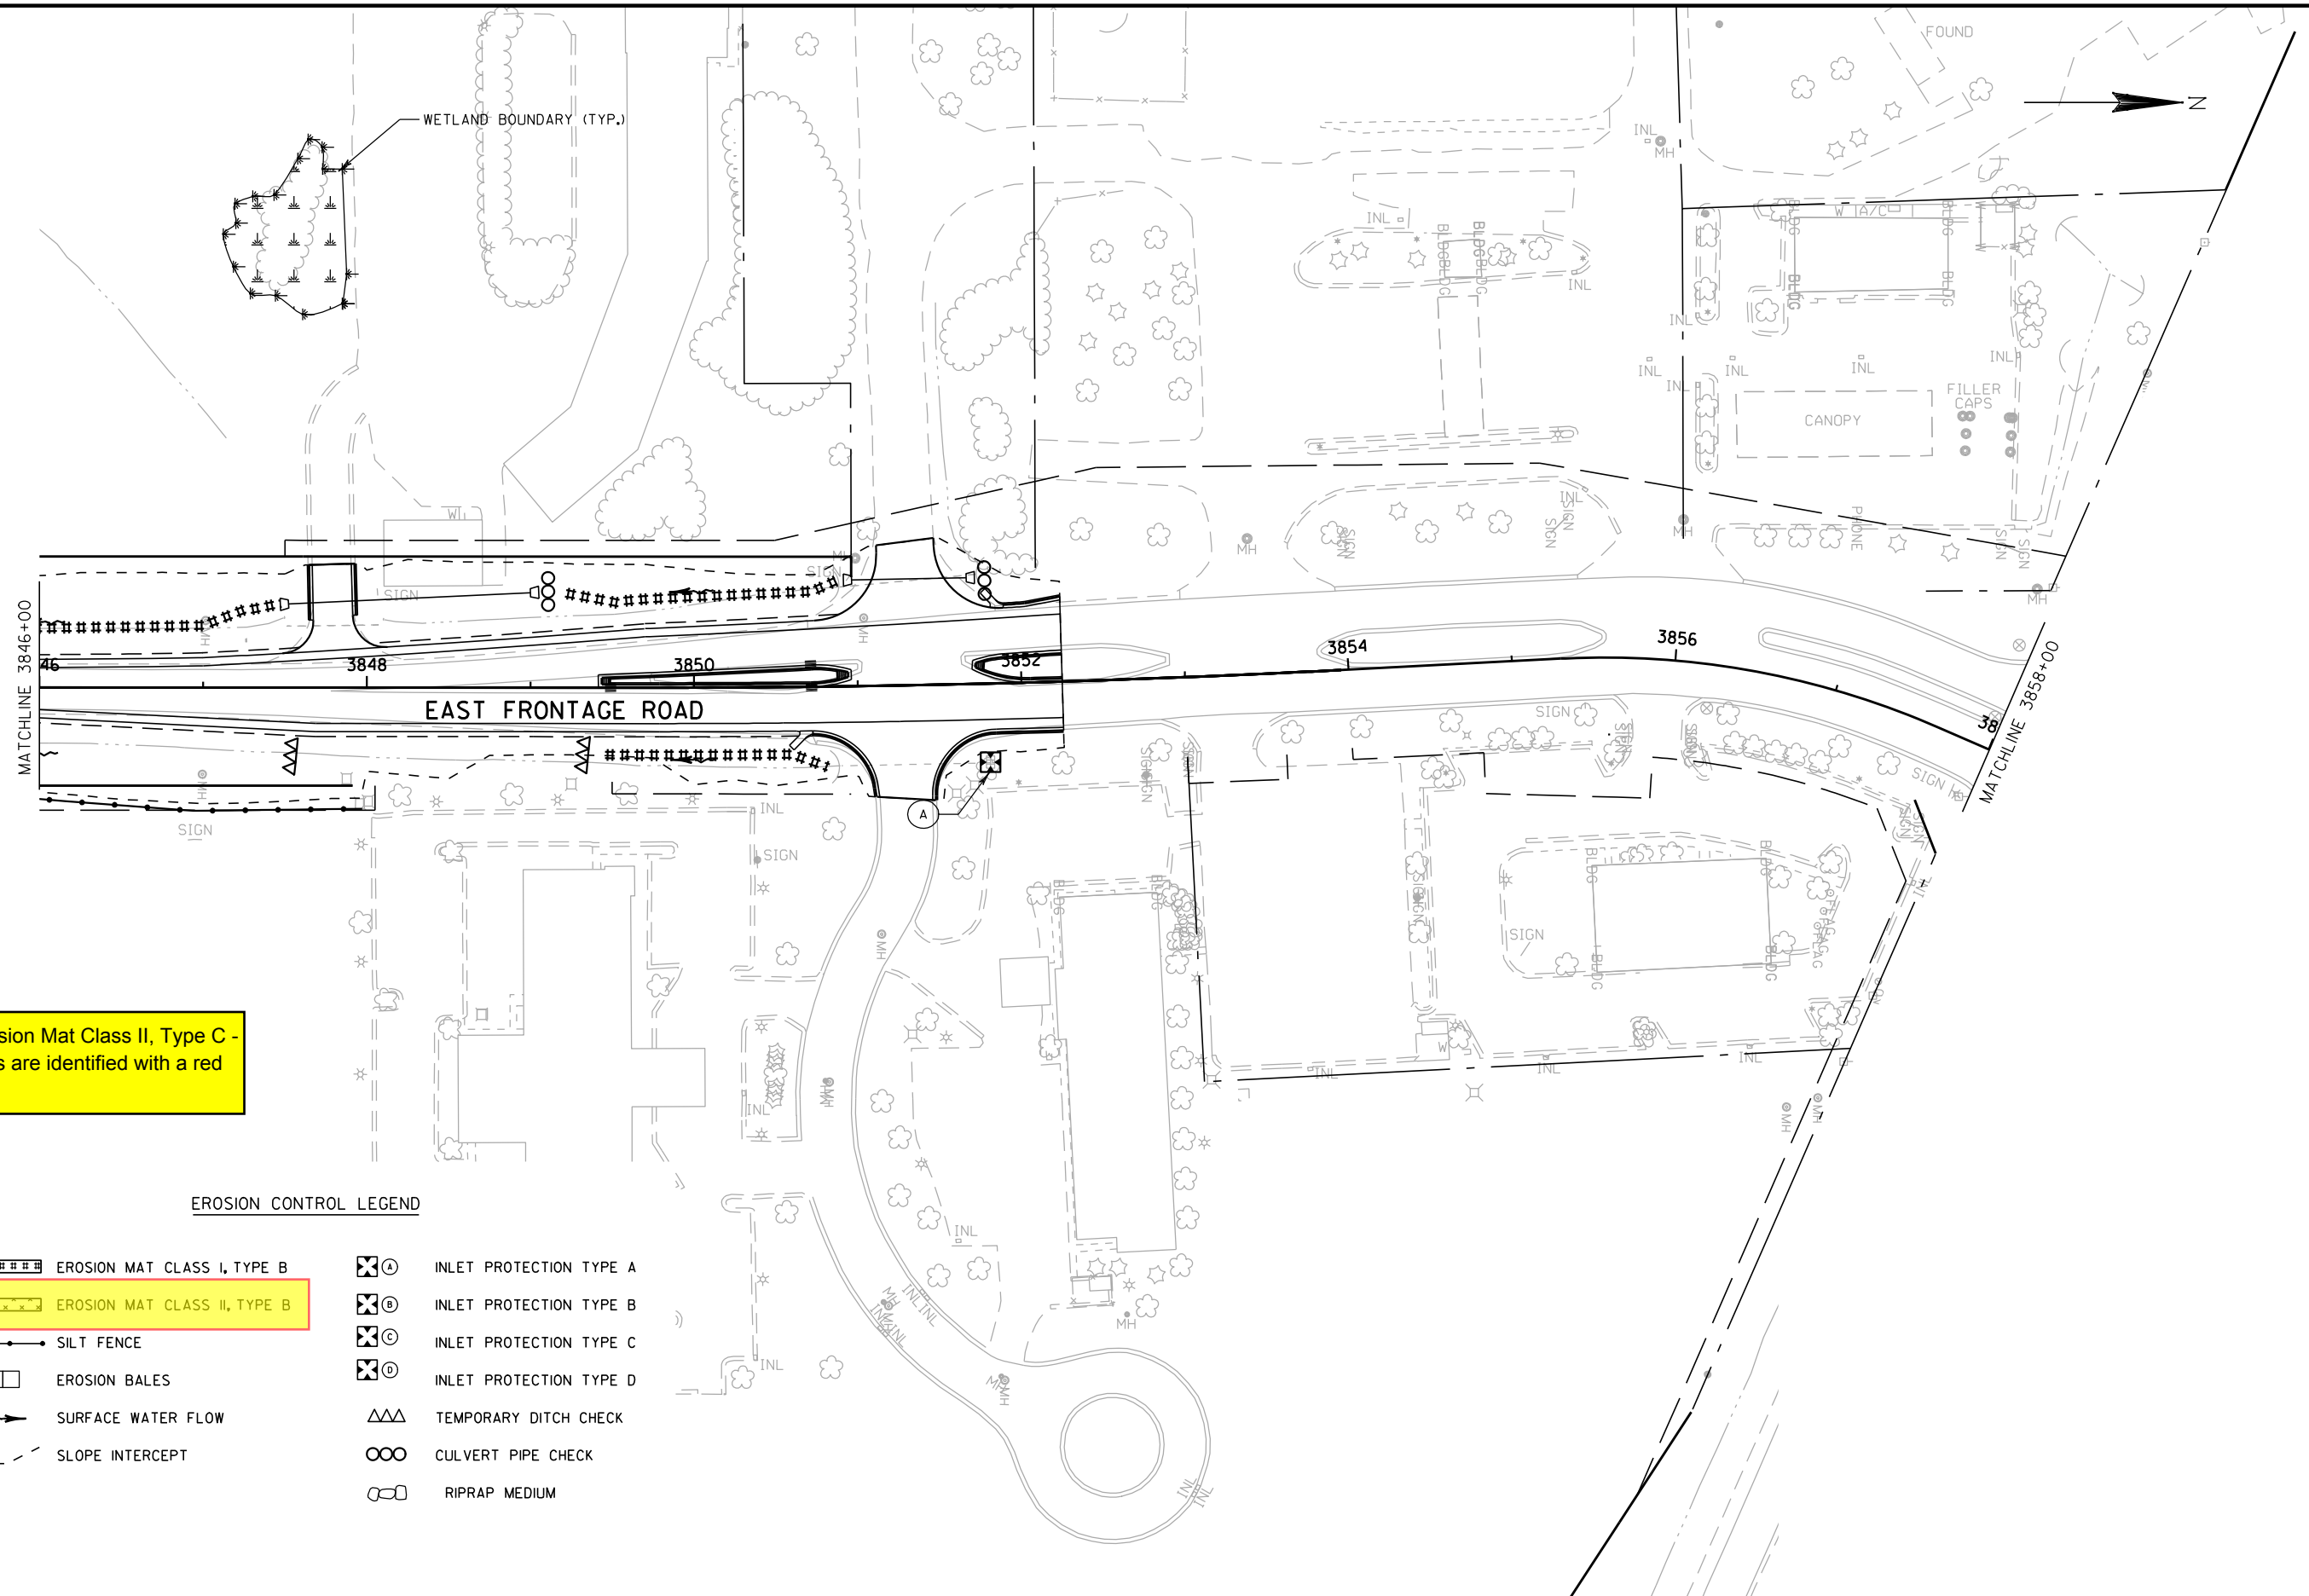

Change to Erosion Mat Class II, Type C -
Changed areas are identified with a red
cloud.

EROSION CONTROL LEGEND

EROSION MAT CLASS I, TYPE B

EROSION MAT CLASS II, TYPE B

SILT FENCE

EROSION BALES

SURFACE WATER FLOW

SLOPE INTERCEPT

INLET PROTECTION TYPE A

INLET PROTECTION TYPE B


INLET PROTECTION TYPE C

INLET PROTECTION TYPE D

TEMPORARY DITCH CHECK

CULVERT PIPE CHECK

RIPRAP MEDIUM

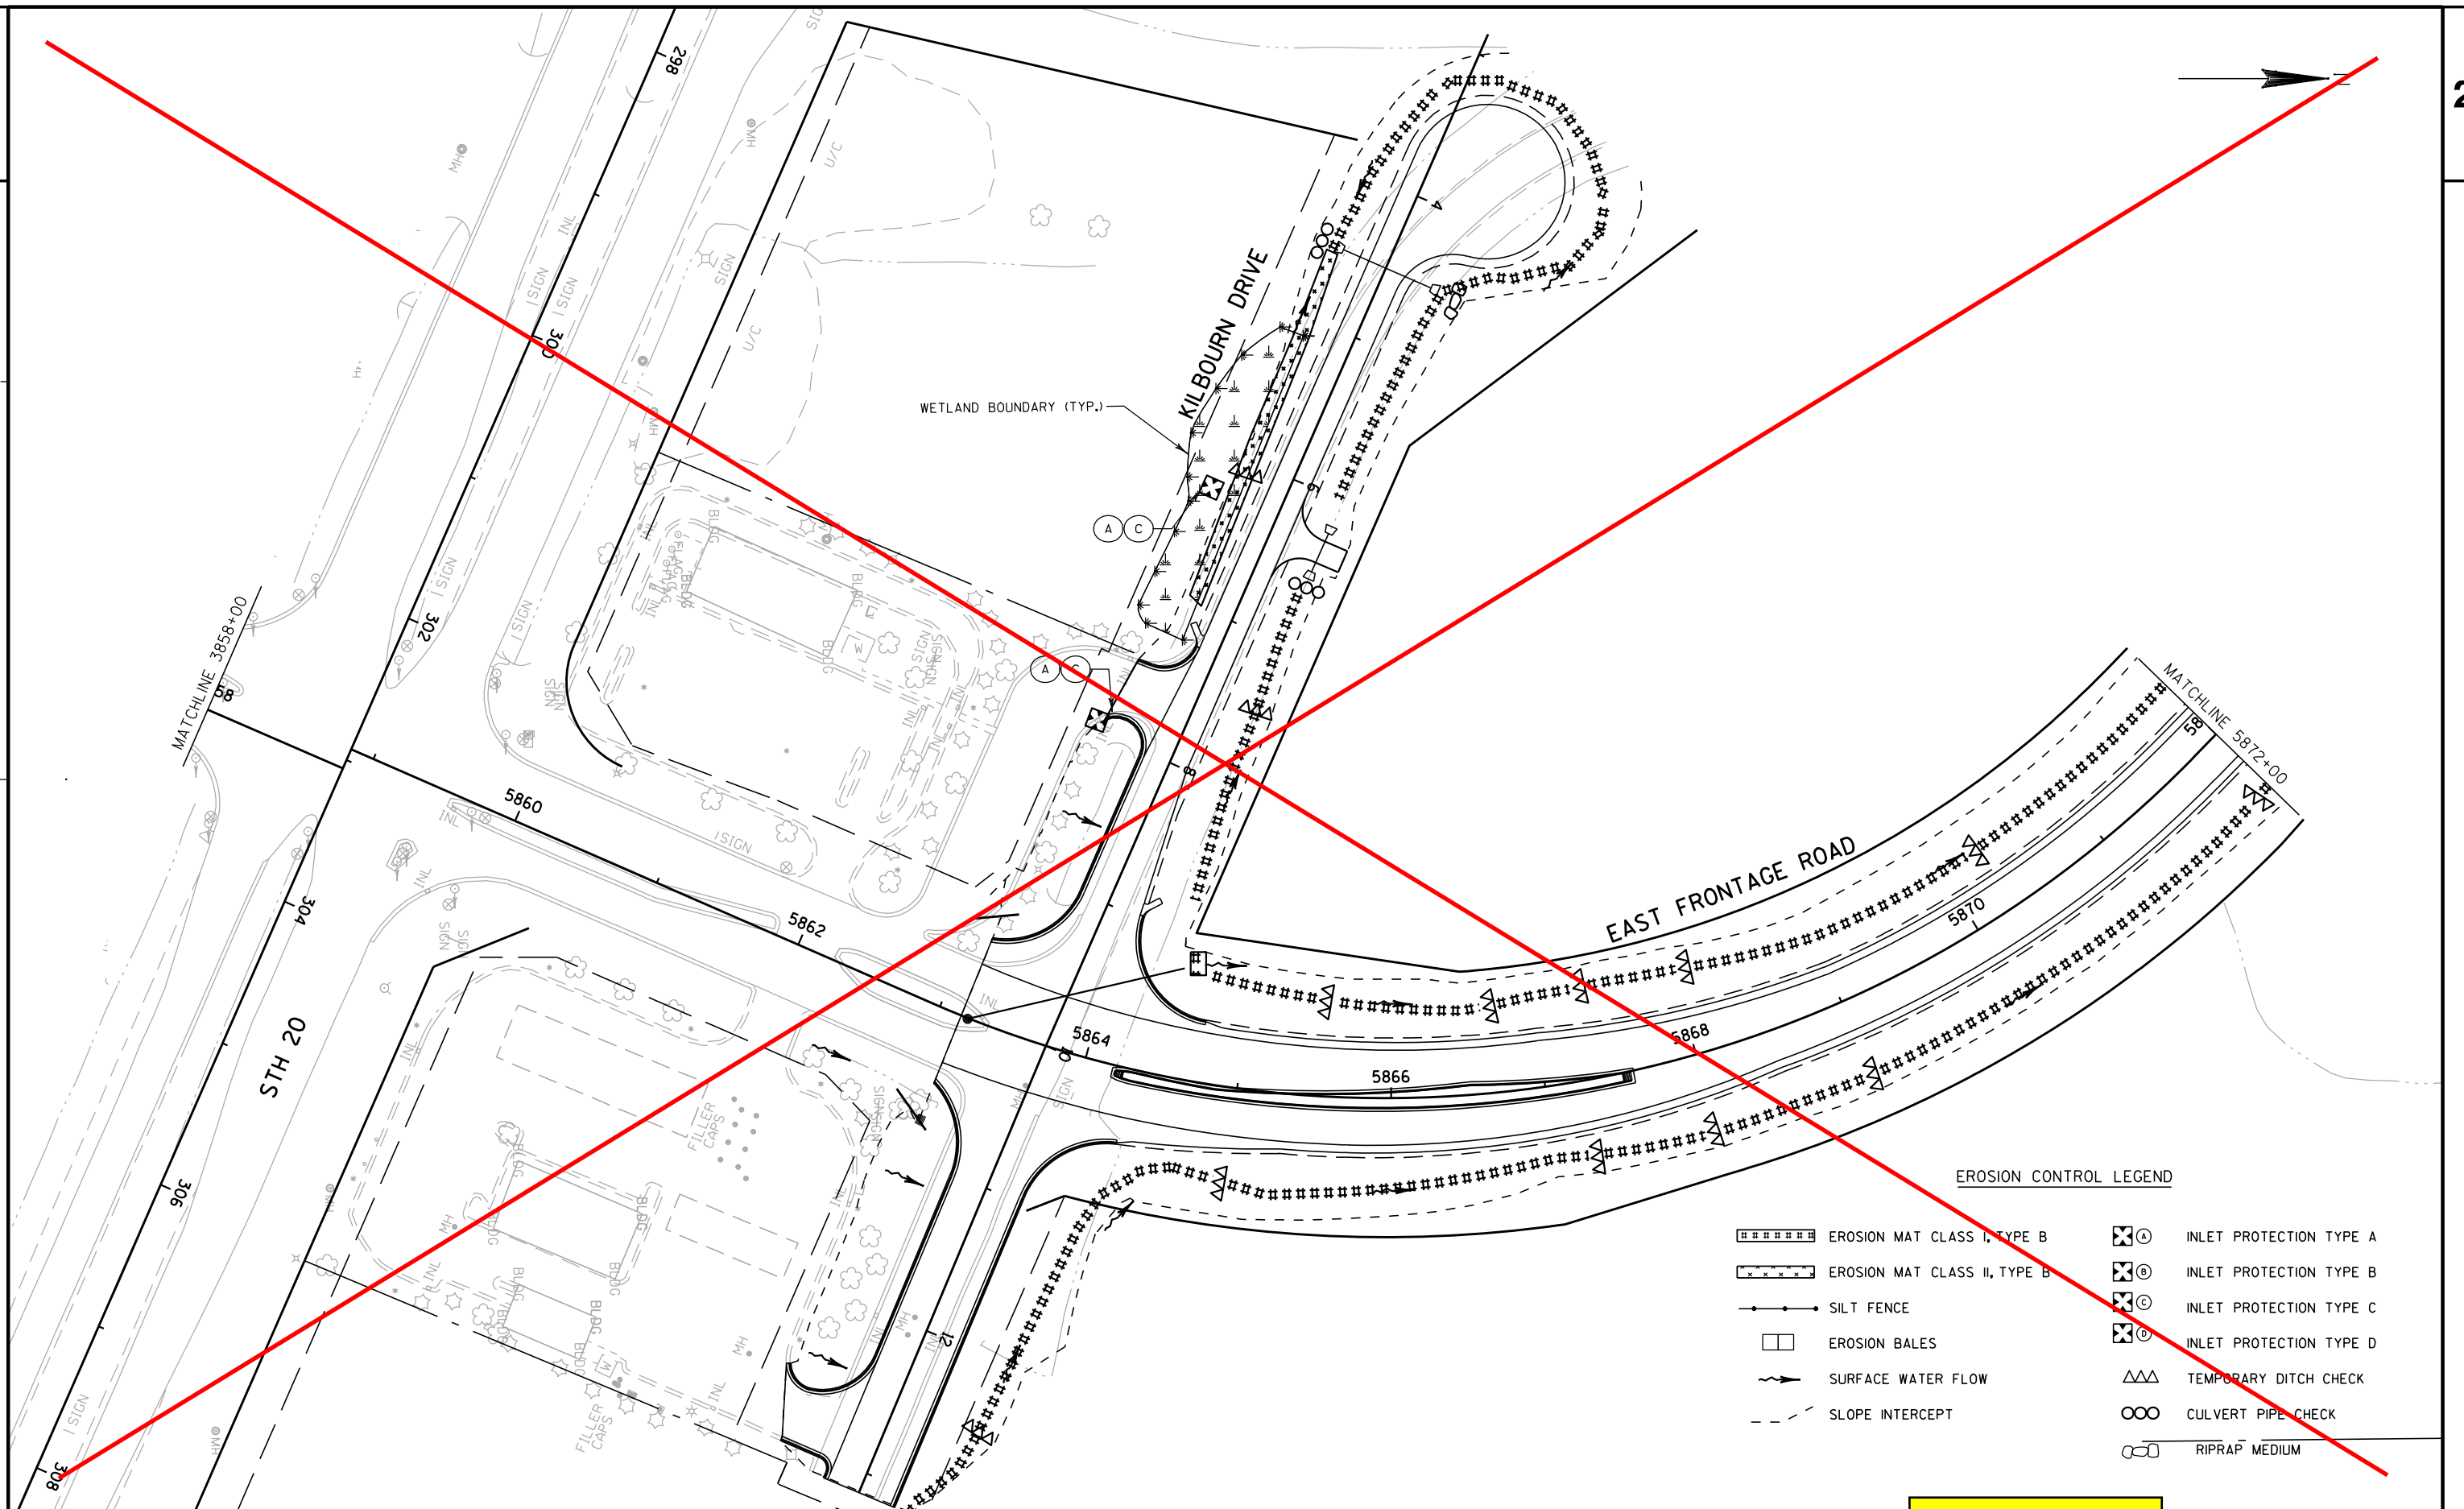

PROJECT NO:1033-02-70

HWY: IH 94/STH 20


COUNTY: RACINE

EROSION CONTROL

See new sheet #44

SHEET


E

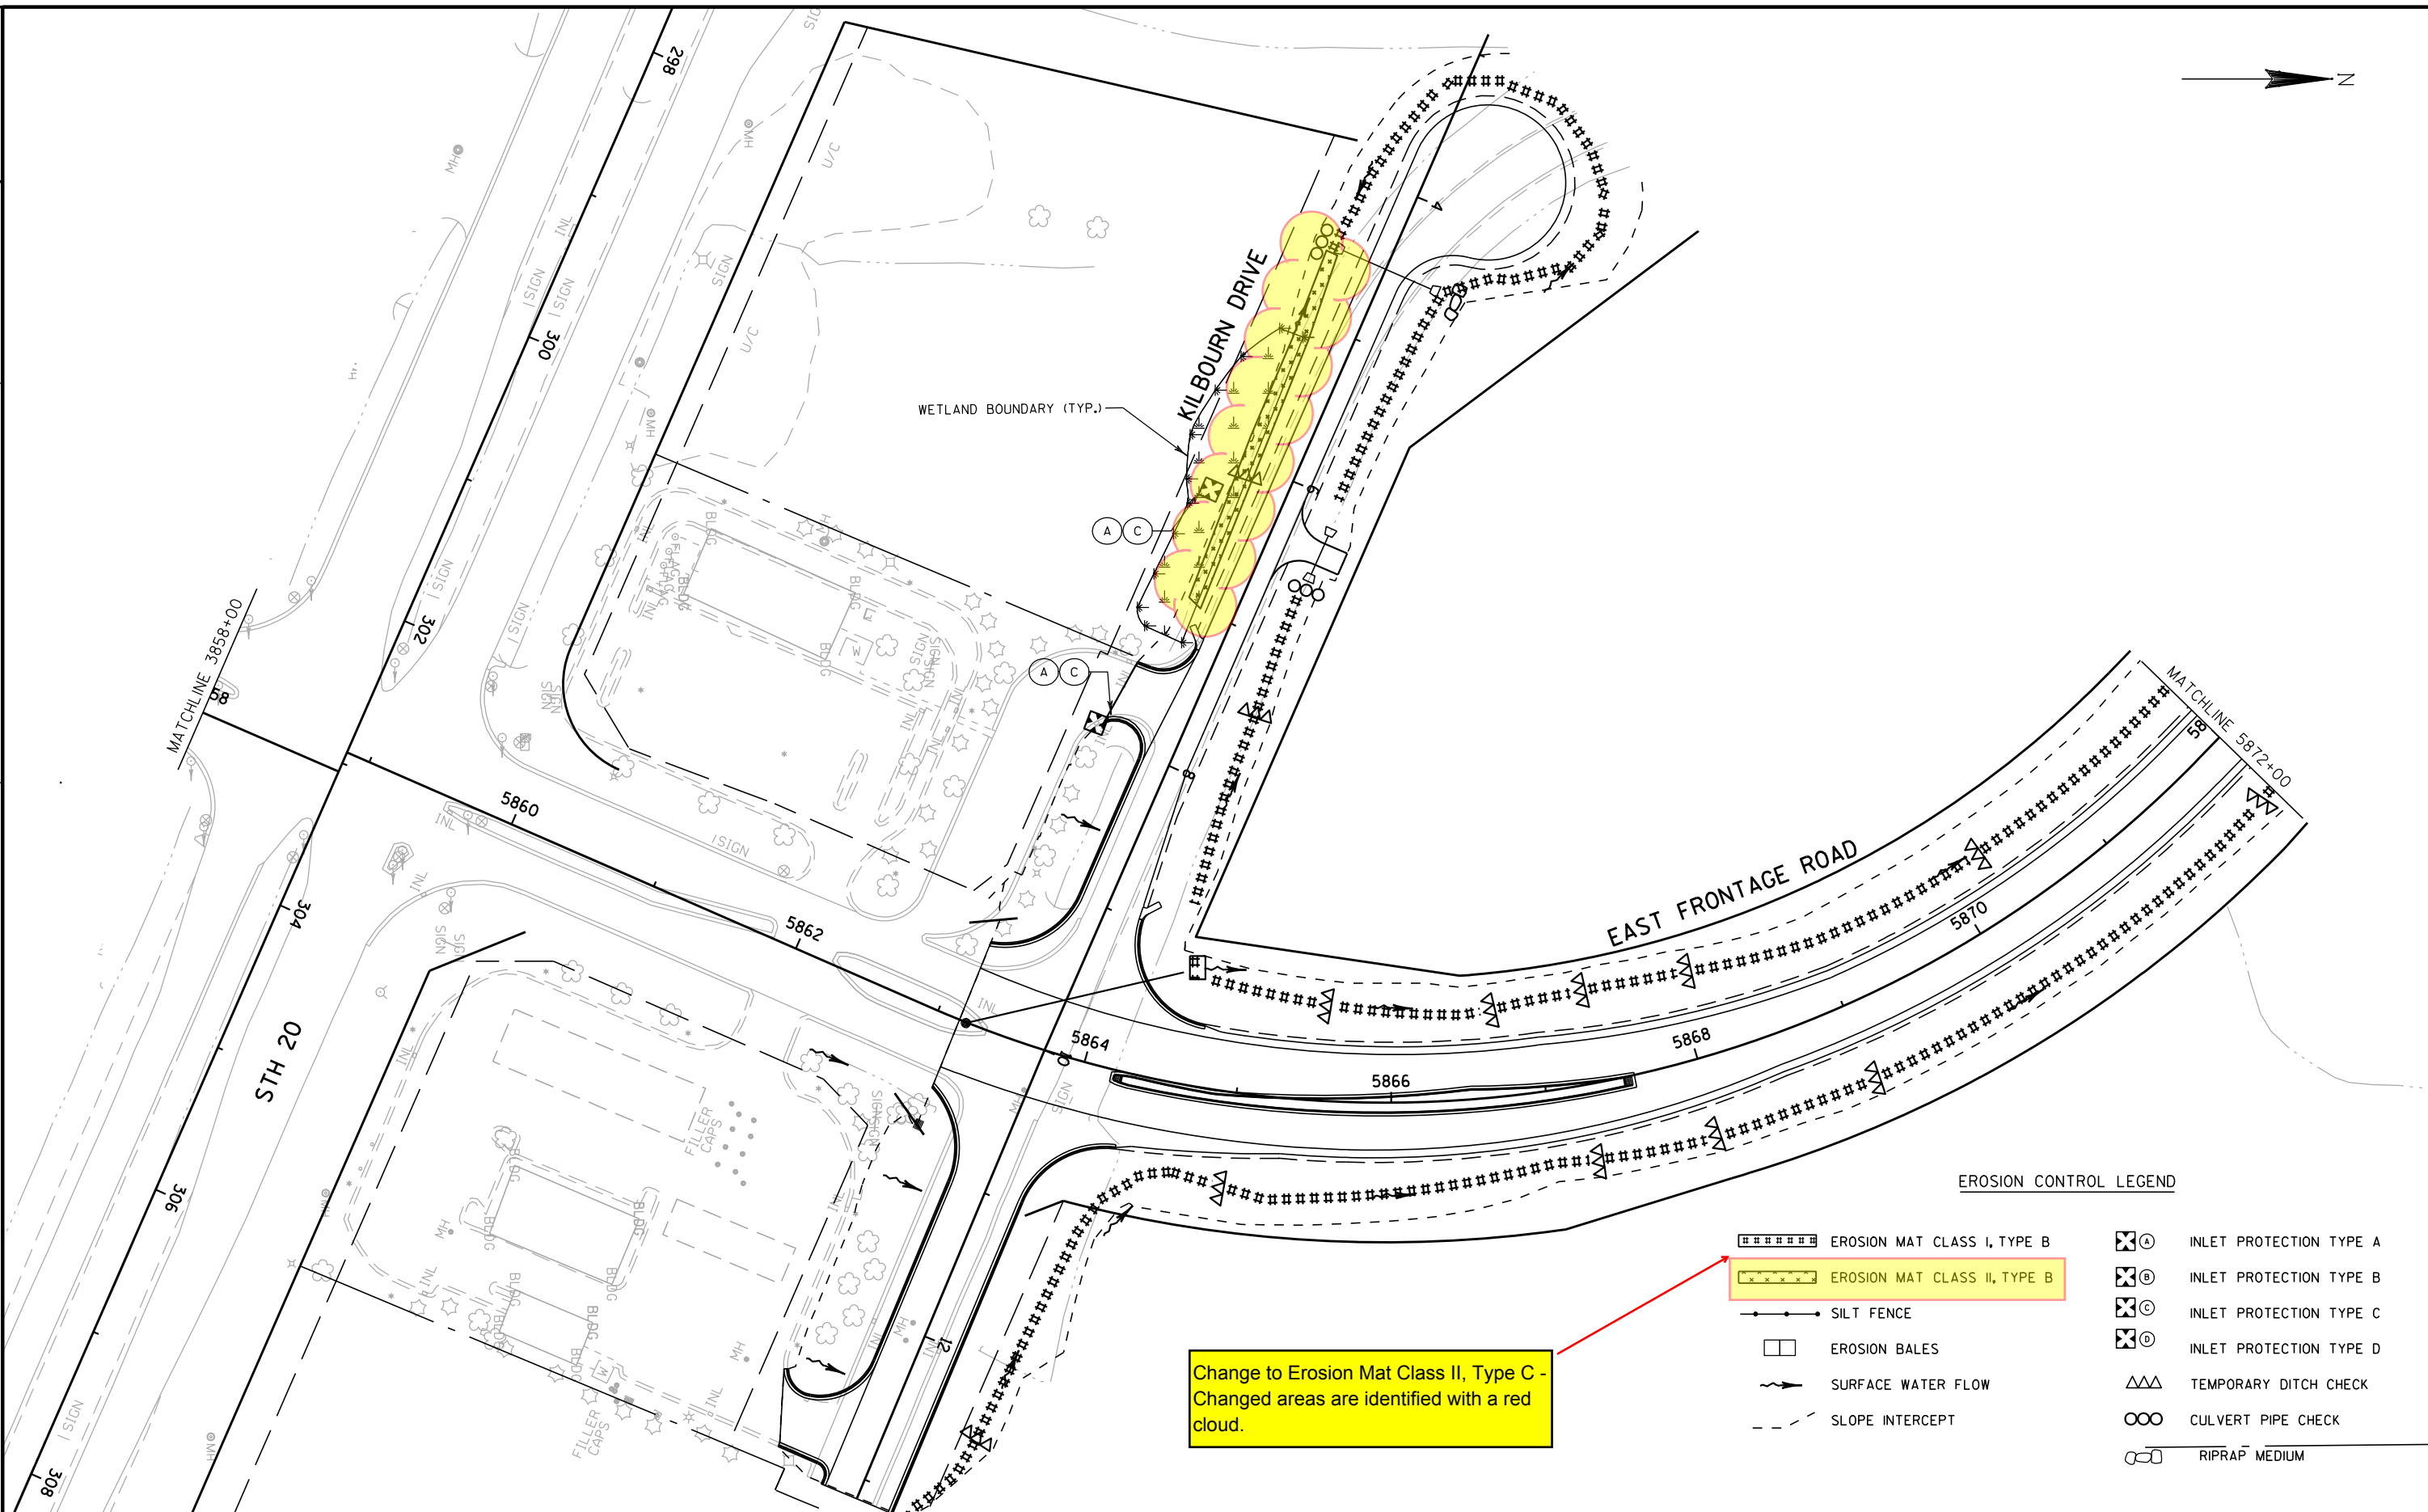

Change to Erosion Mat Class II, Type C -
Changed areas are identified with a red
cloud.

EROSION CONTROL LEGEND

- | | | | |
|---------|------------------------------|----|-------------------------|
| ##### | EROSION MAT CLASS I, TYPE B | ⊗A | INLET PROTECTION TYPE A |
| xxxxxx | EROSION MAT CLASS II, TYPE B | ⊗B | INLET PROTECTION TYPE B |
| —●—●—●— | SILT FENCE | ⊗C | INLET PROTECTION TYPE C |
| □ | EROSION BALES | ⊗D | INLET PROTECTION TYPE D |
| —▶— | SURFACE WATER FLOW | △△ | TEMPORARY DITCH CHECK |
| - - - | SLOPE INTERCEPT | ∞ | CULVERT PIPE CHECK |
| | | ⊗ | RIPRAP MEDIUM |

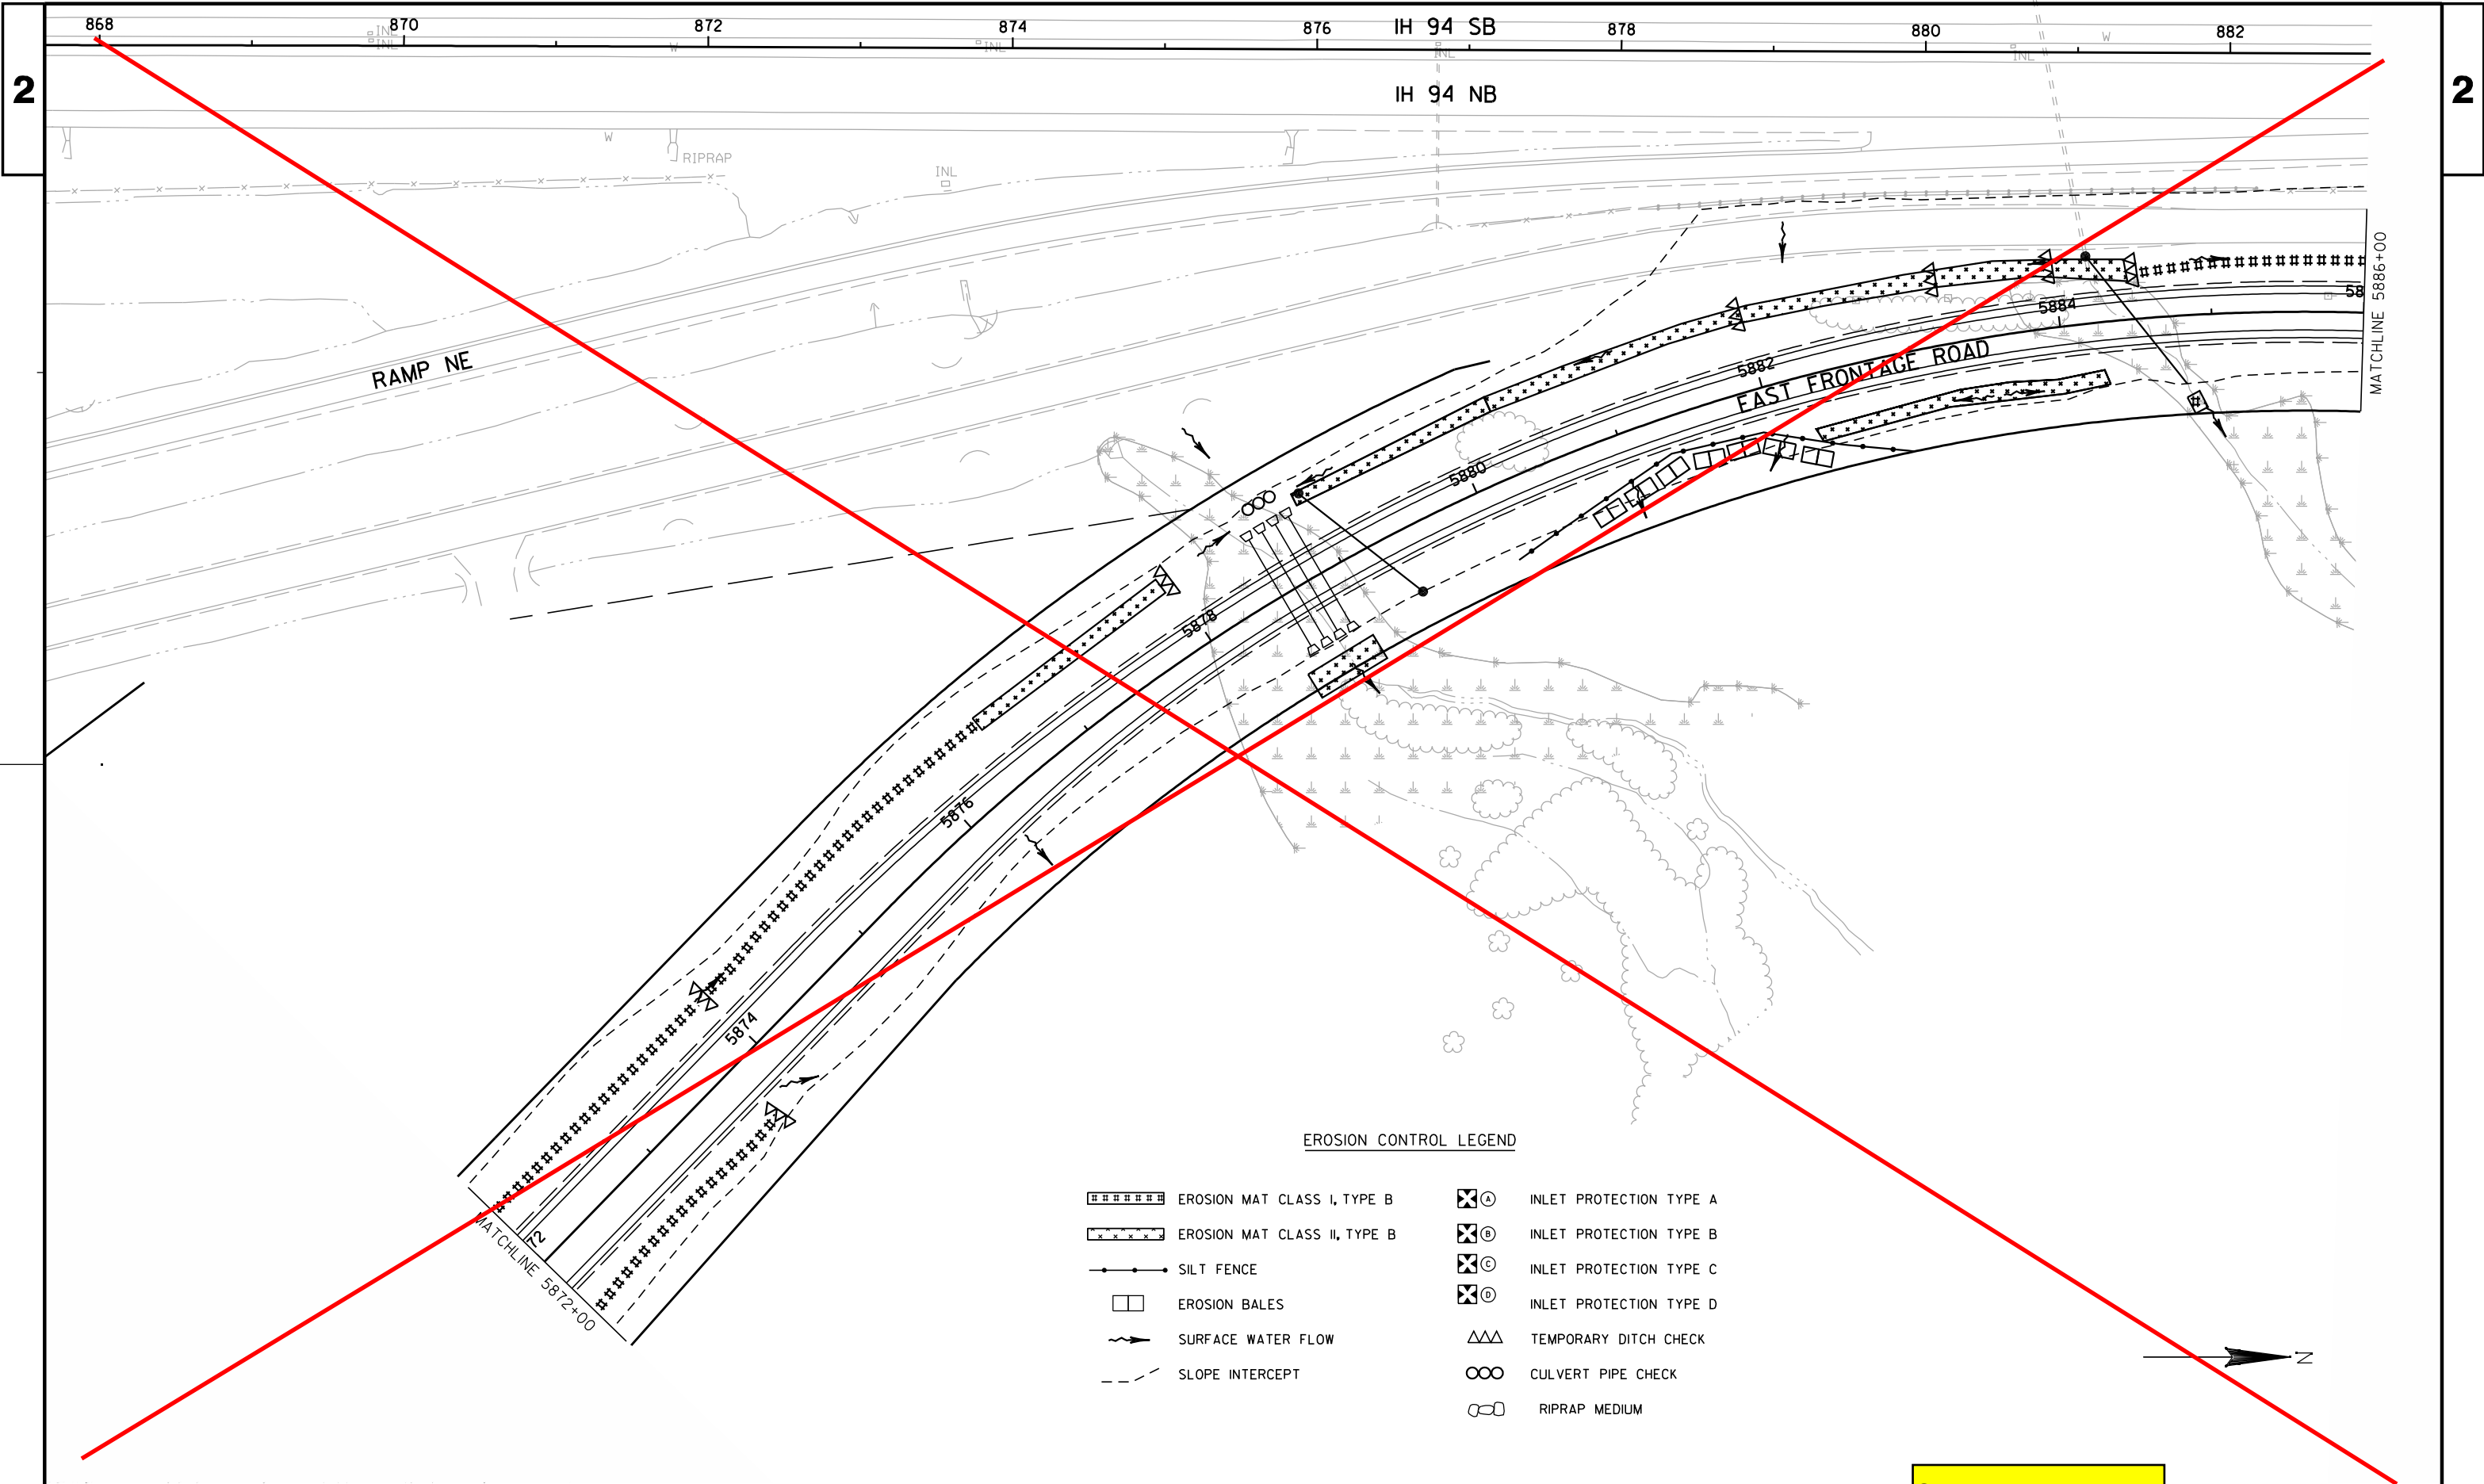

PROJECT NO:1033-02-70

HWY:IH 94/STH 20

COUNTY:RACINE


EROSION CONTROL


See new sheet #45


SHEET

45

E

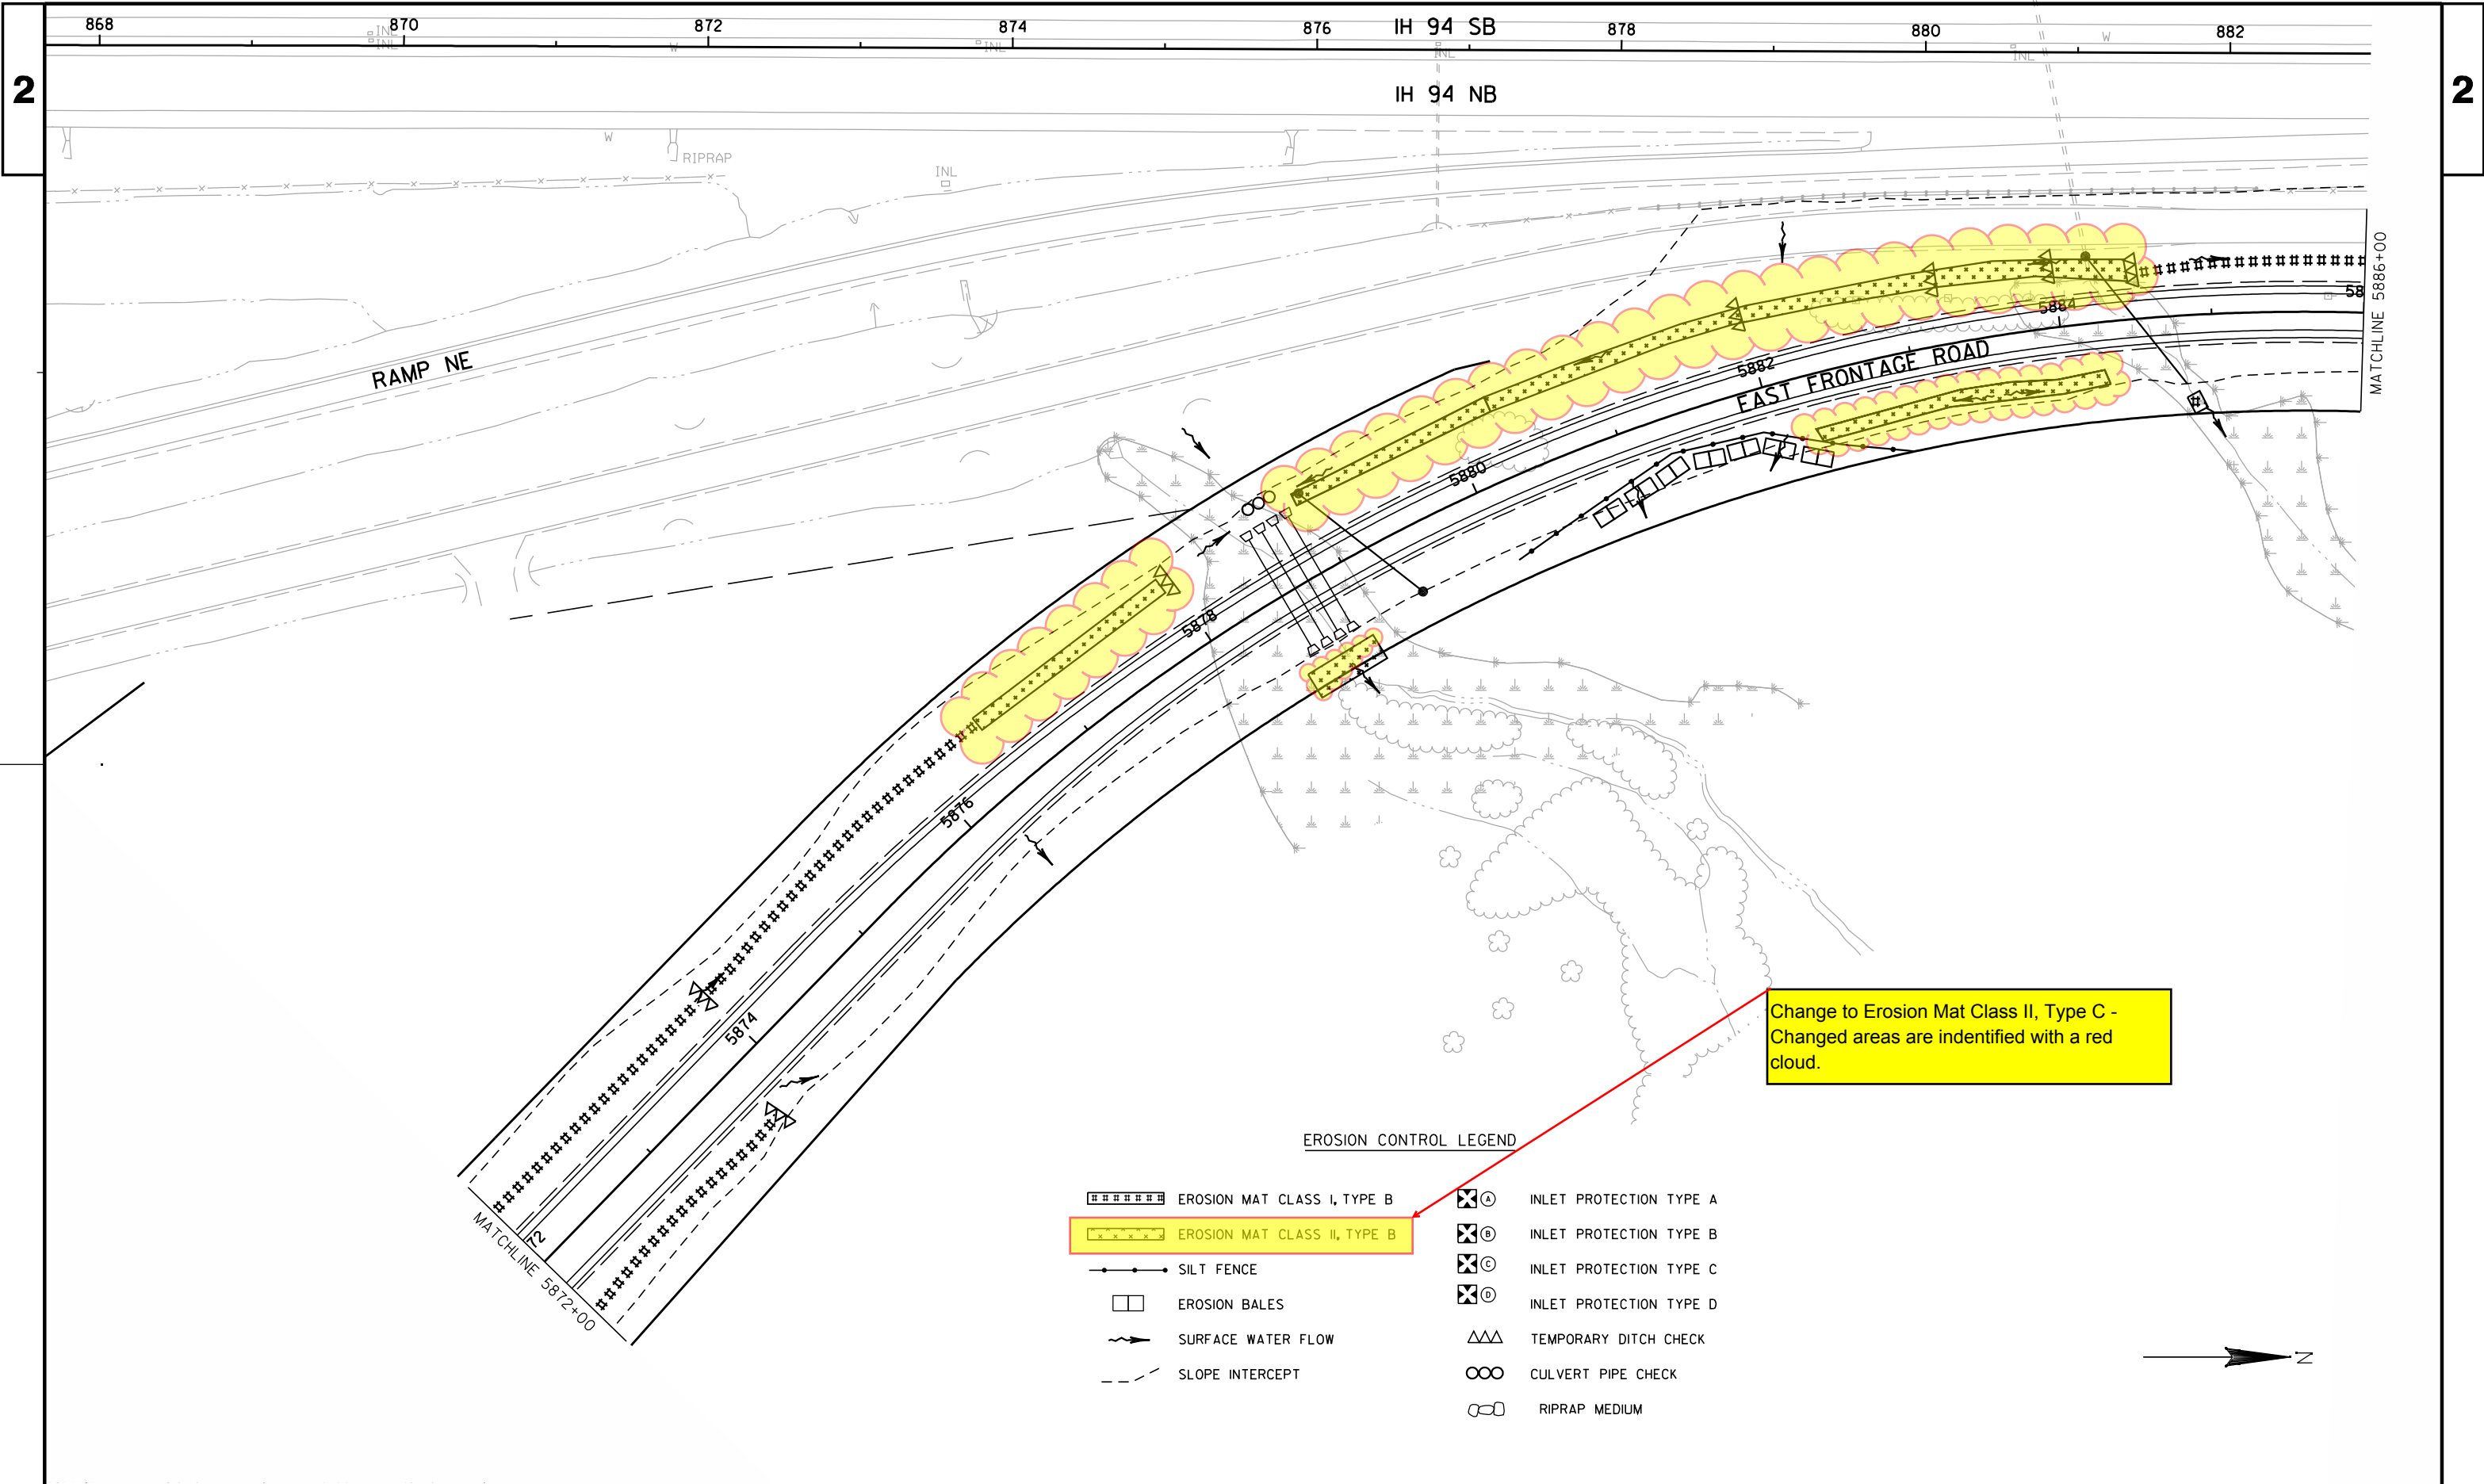


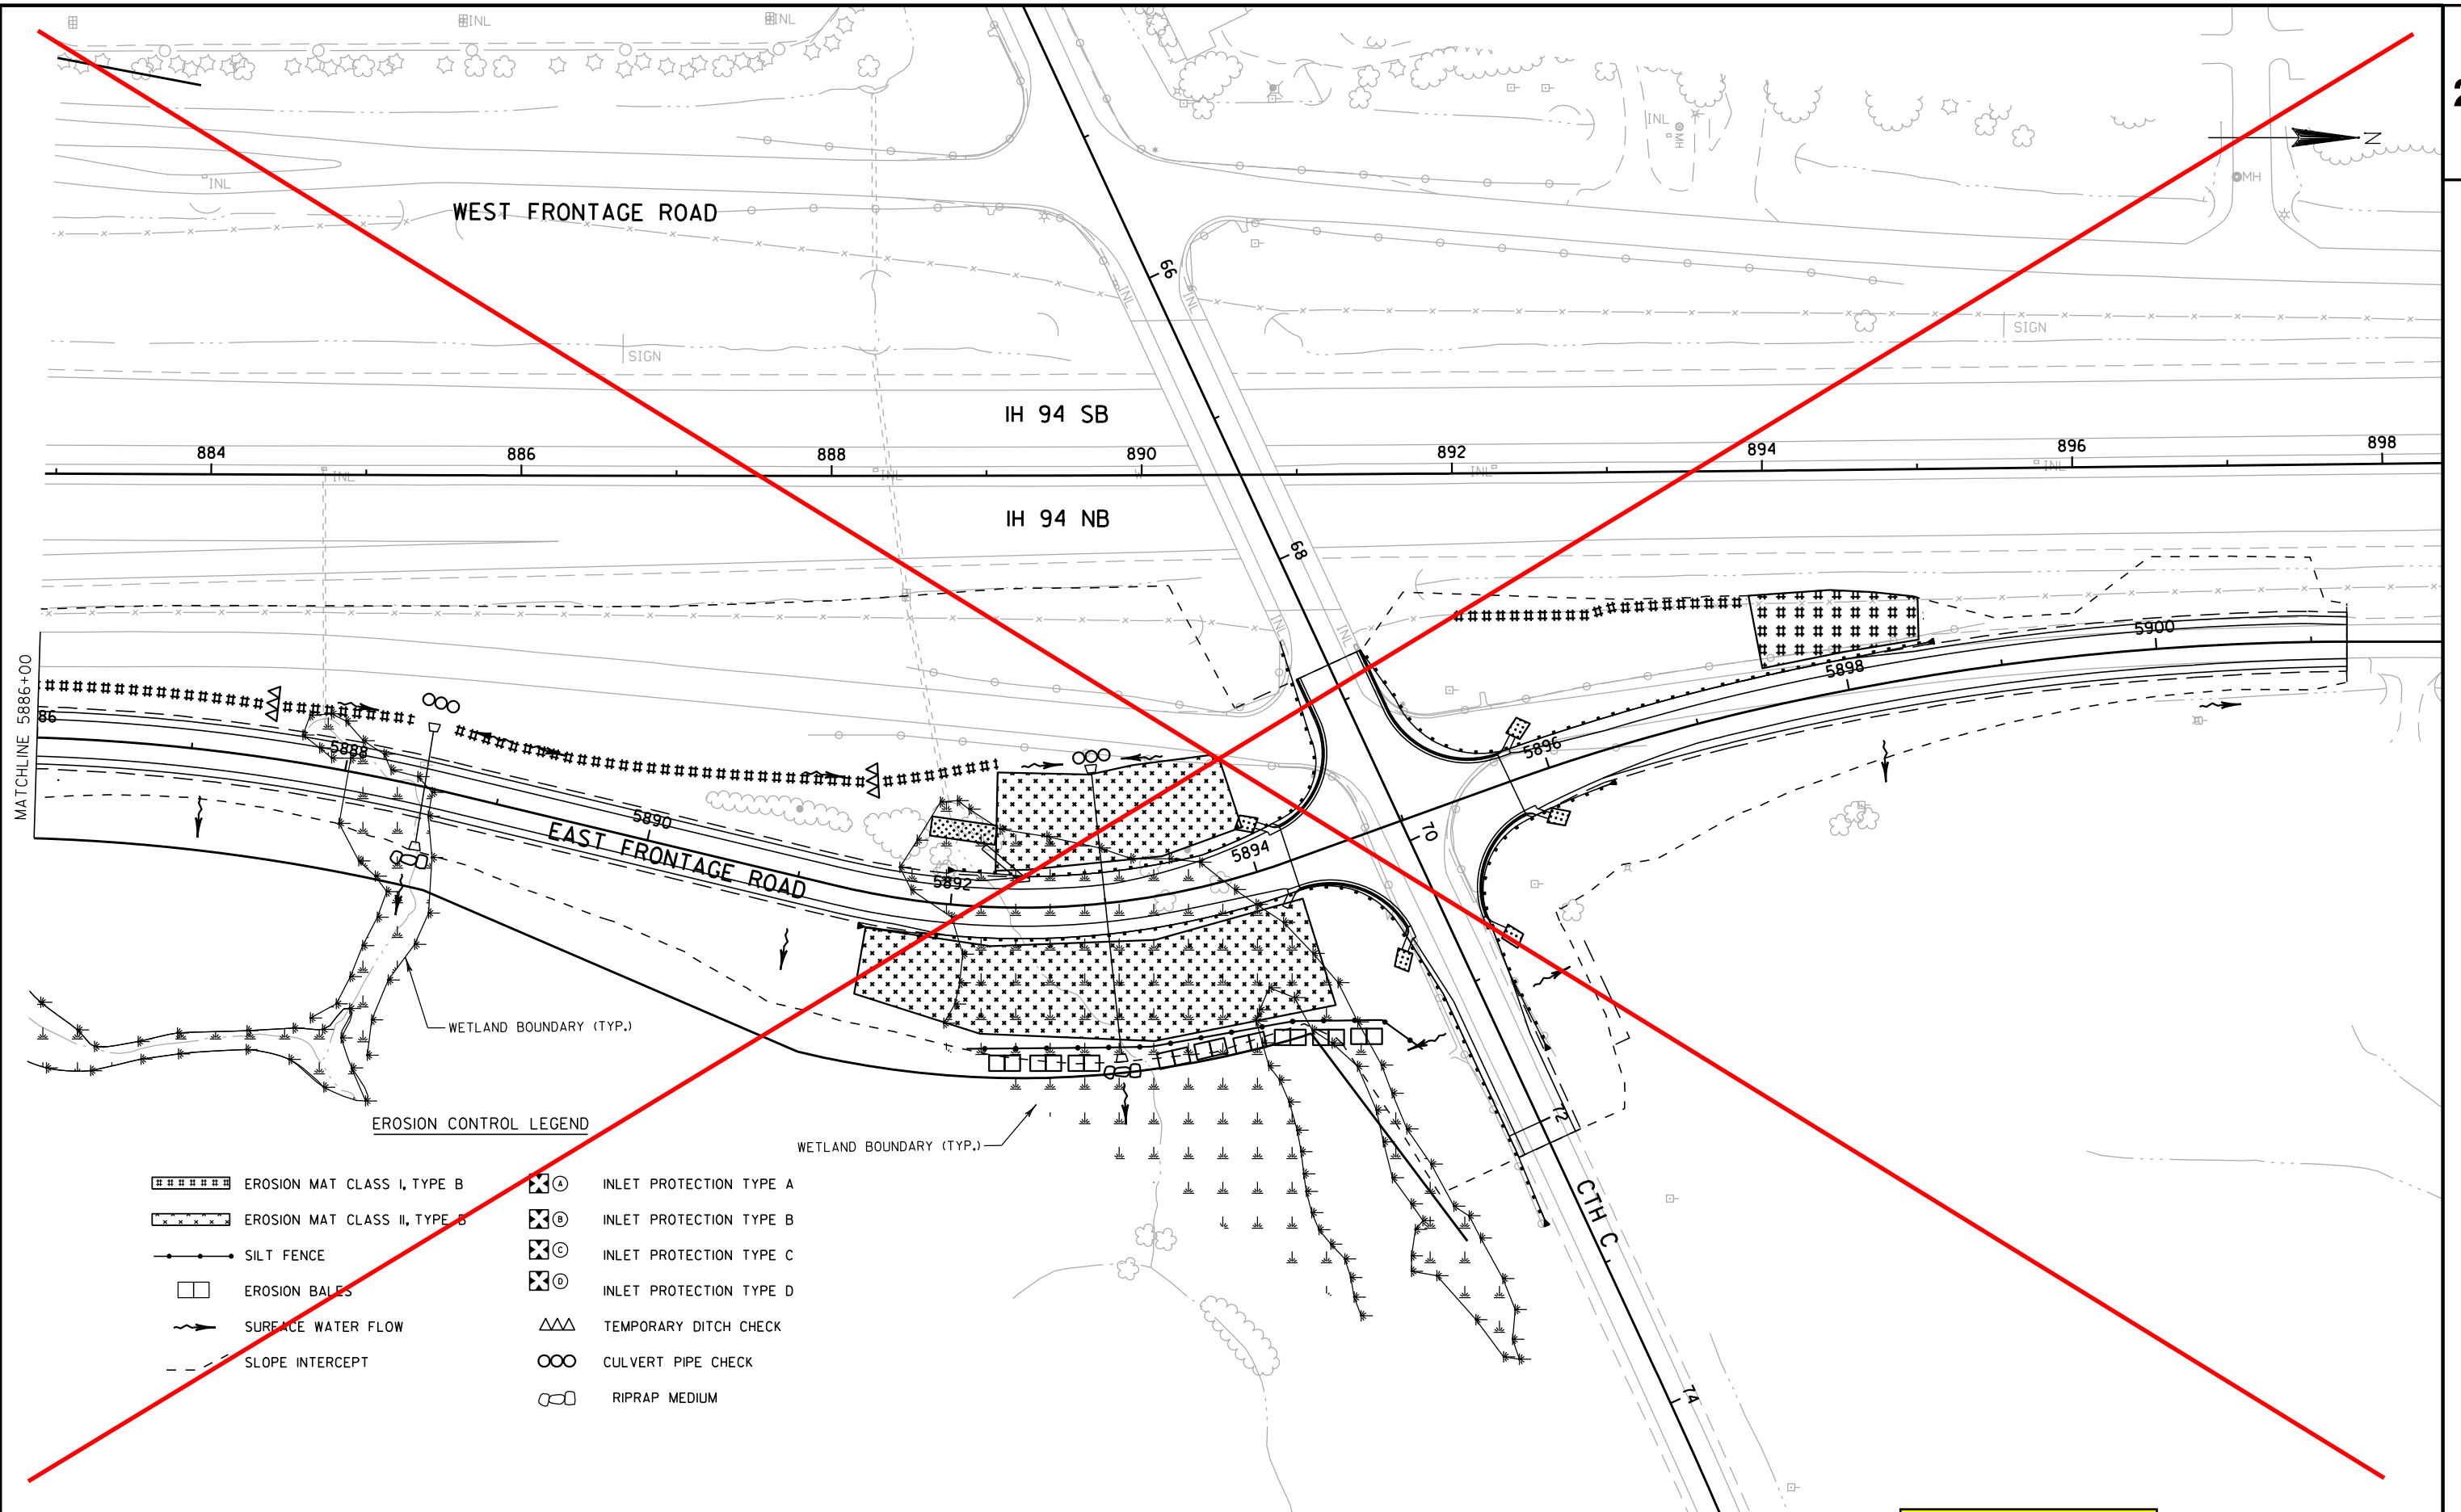

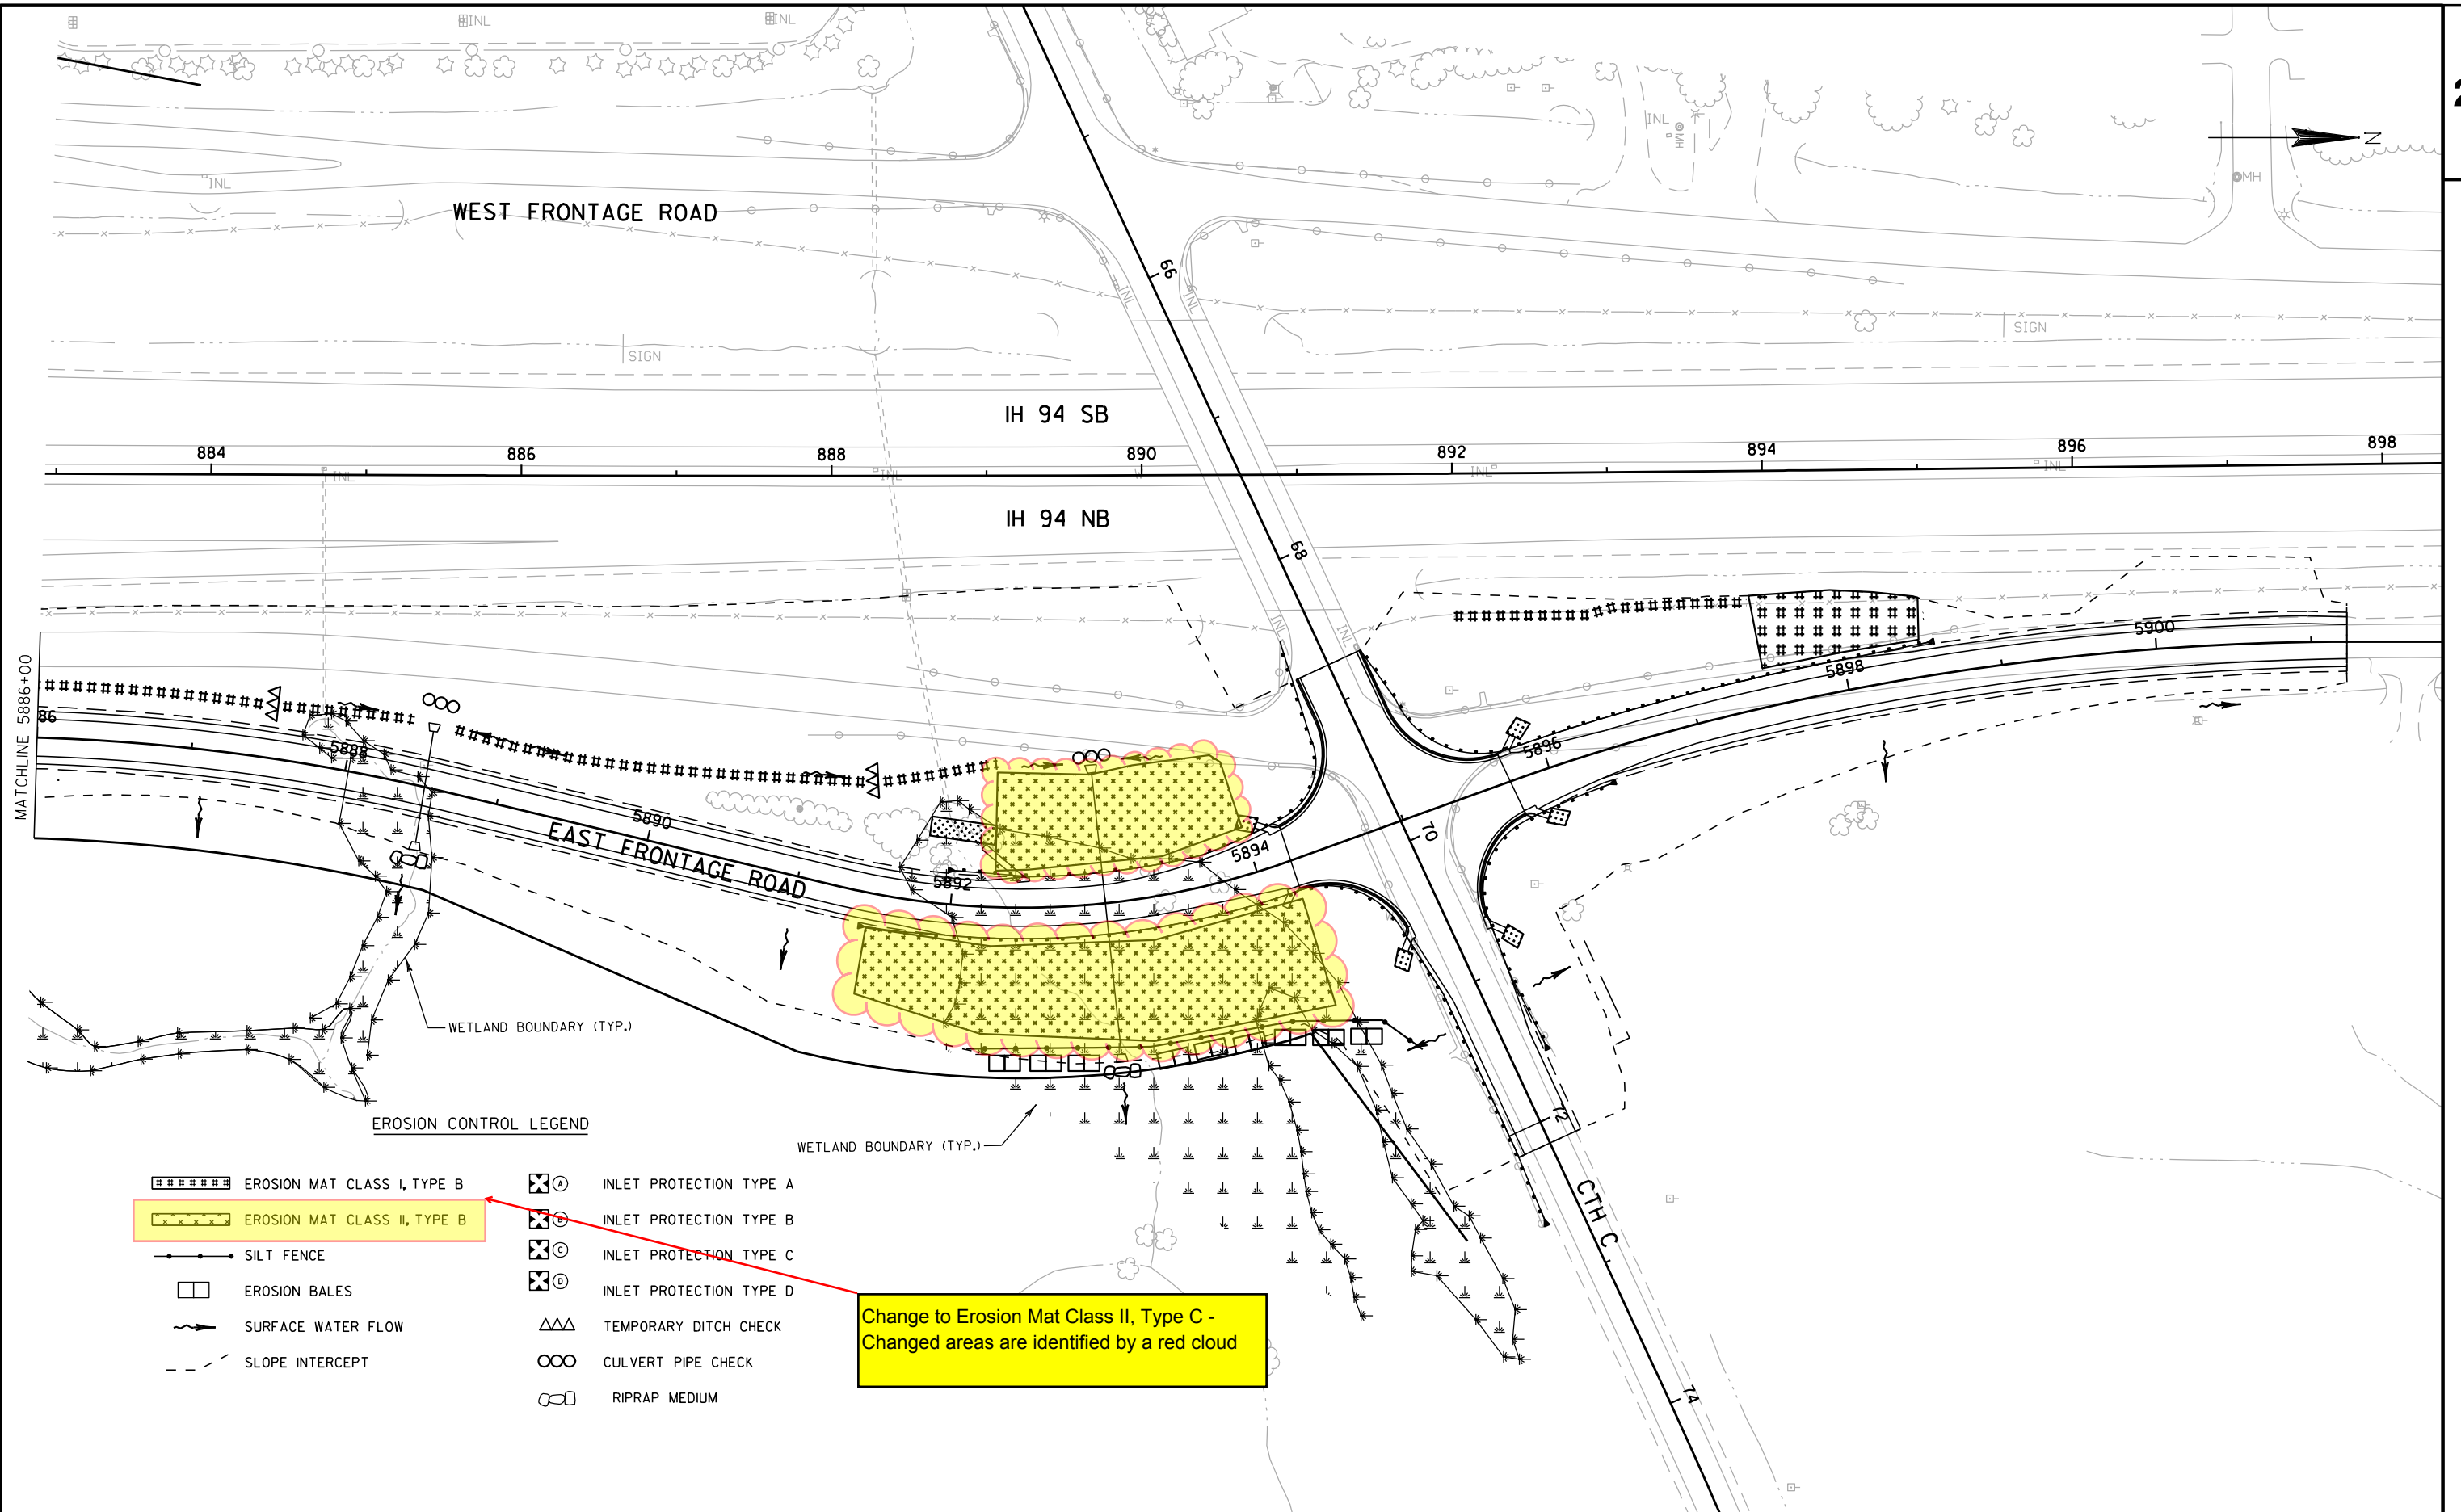

2

2

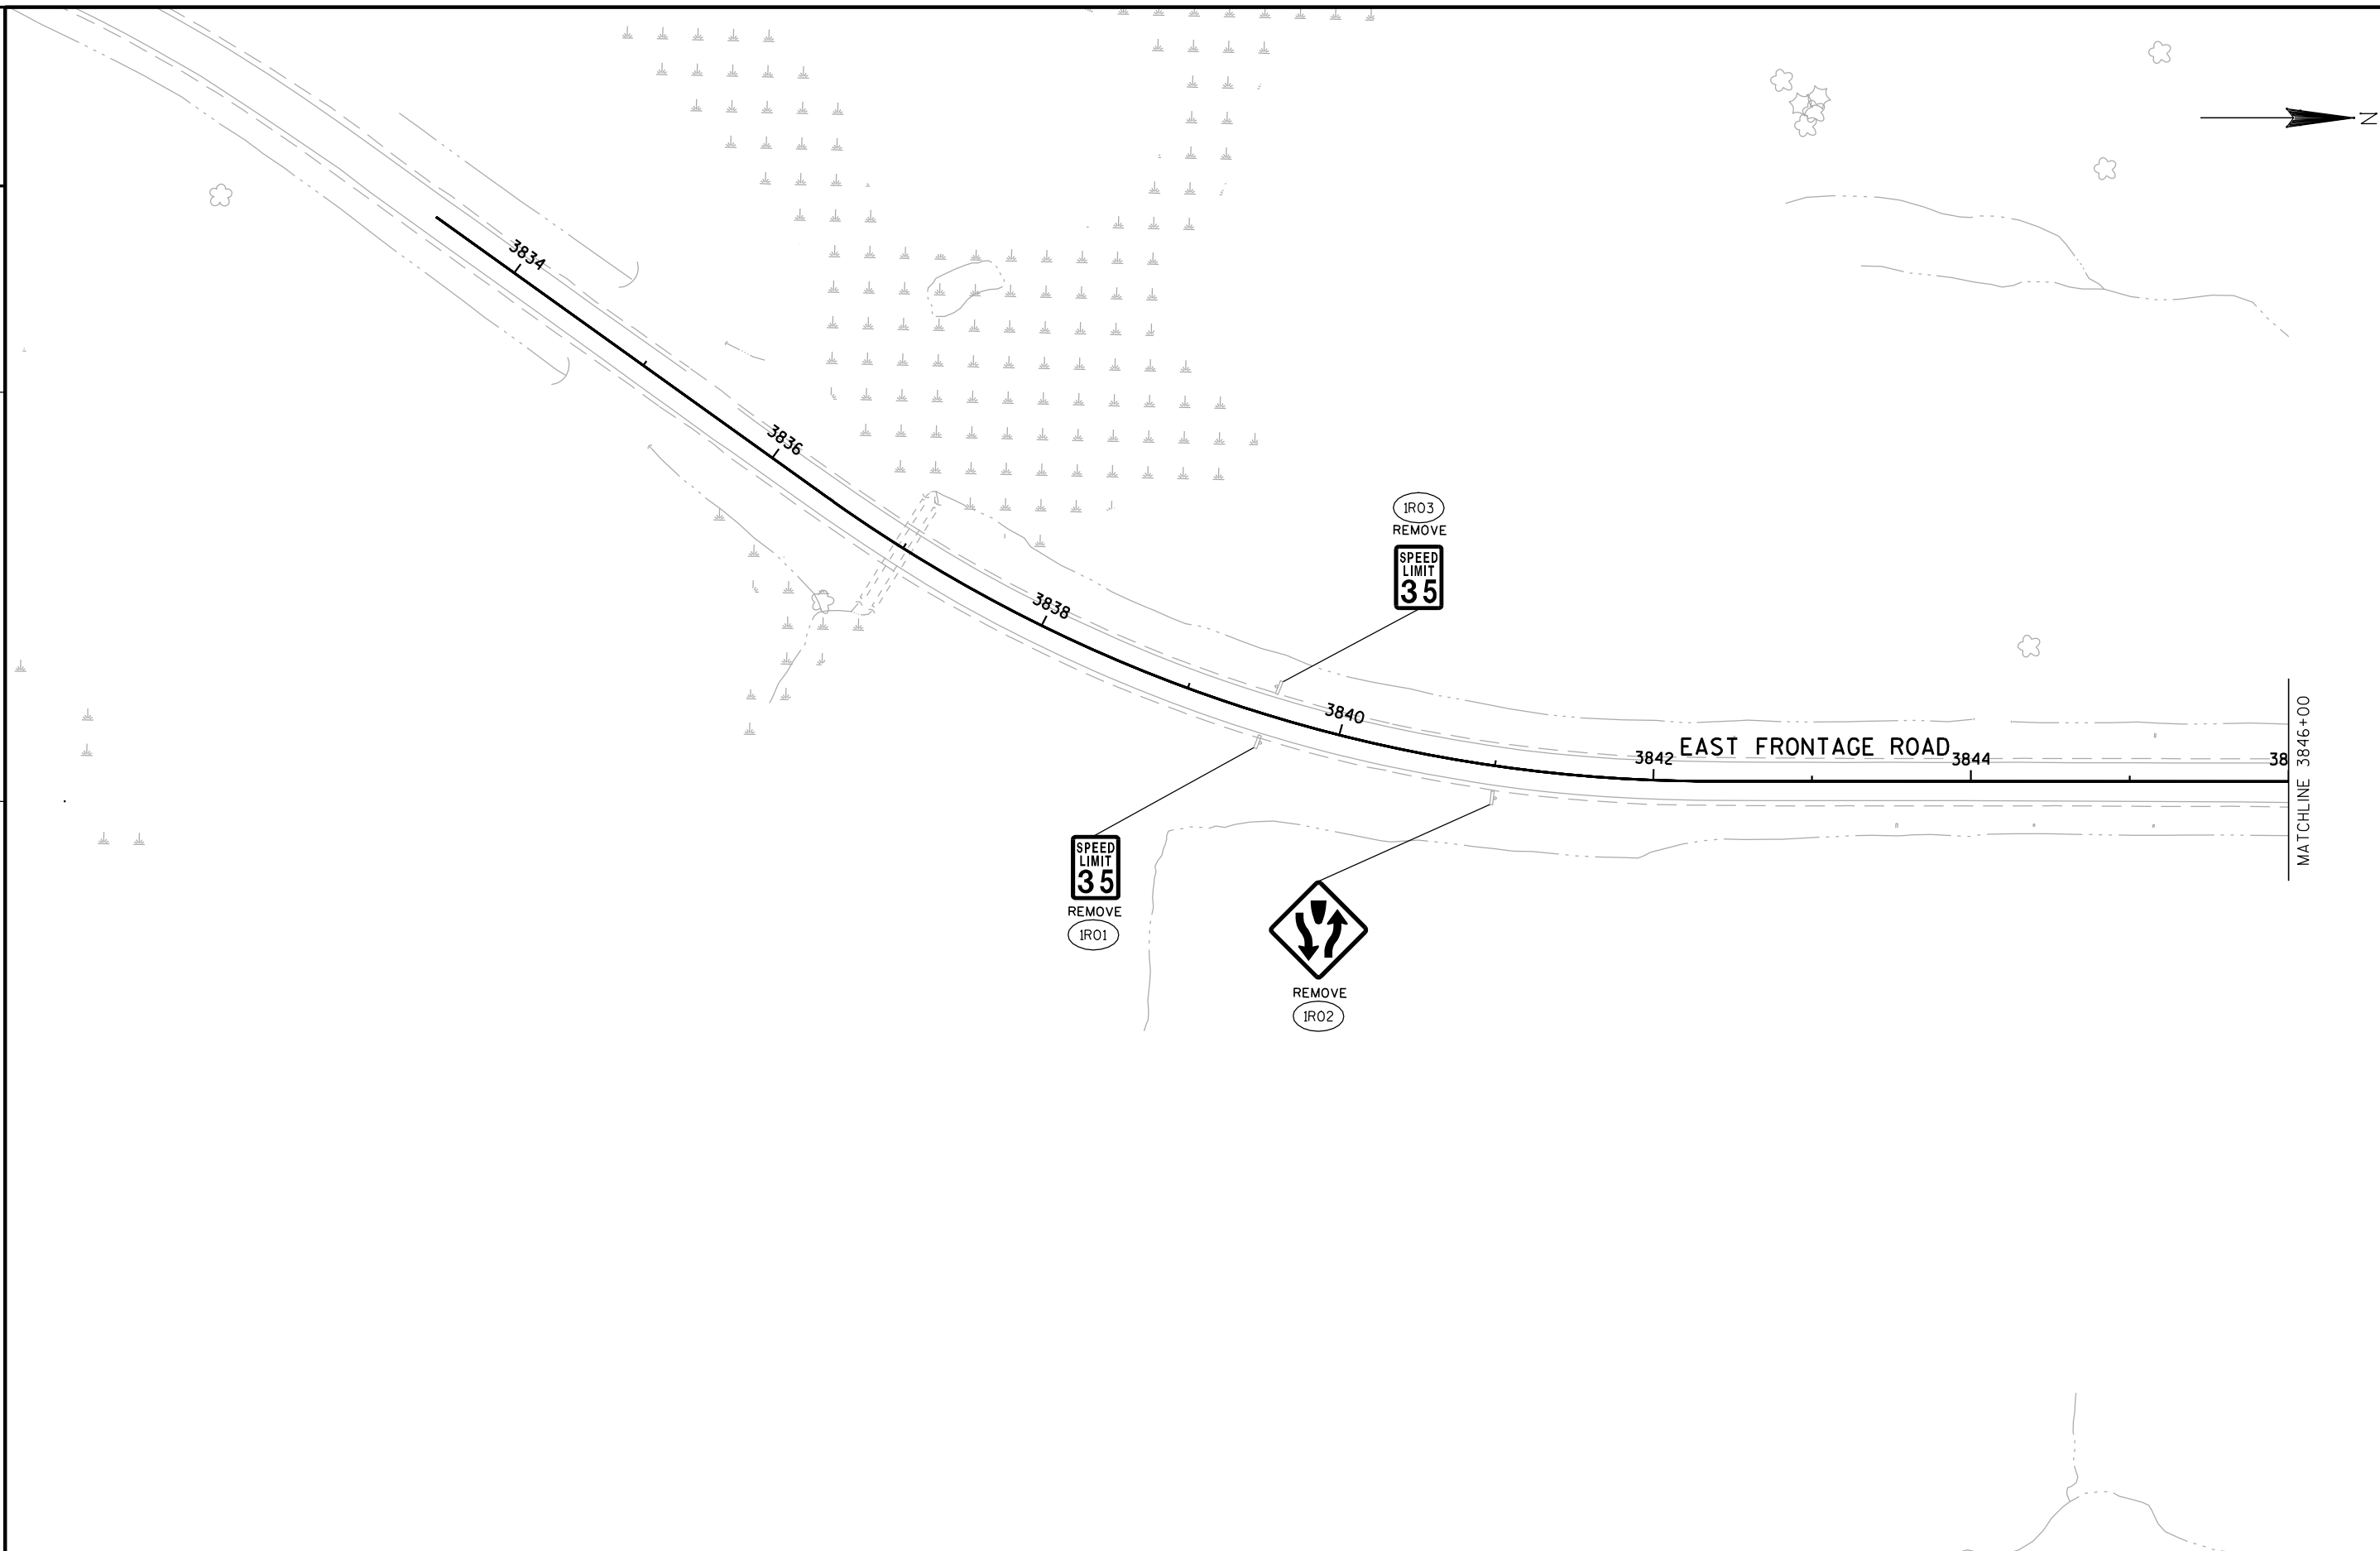

PROJECT NO:1033-02-70

HWY: IH 94/STH 20

COUNTY: RACINE

EXISTING SIGNING

SHEET 47

E

FILE NAME : s:\FinalDesign\20\10330270-E\Roads\cds\023201-es.dgn

PLOT DATE : 06-DEC-2010 20:22

PLOT BY : MSCD1S


PLOT NAME : 023201-es

PLOT SCALE : 100:1

WISDOT/CADDs SHEET 42

2

2

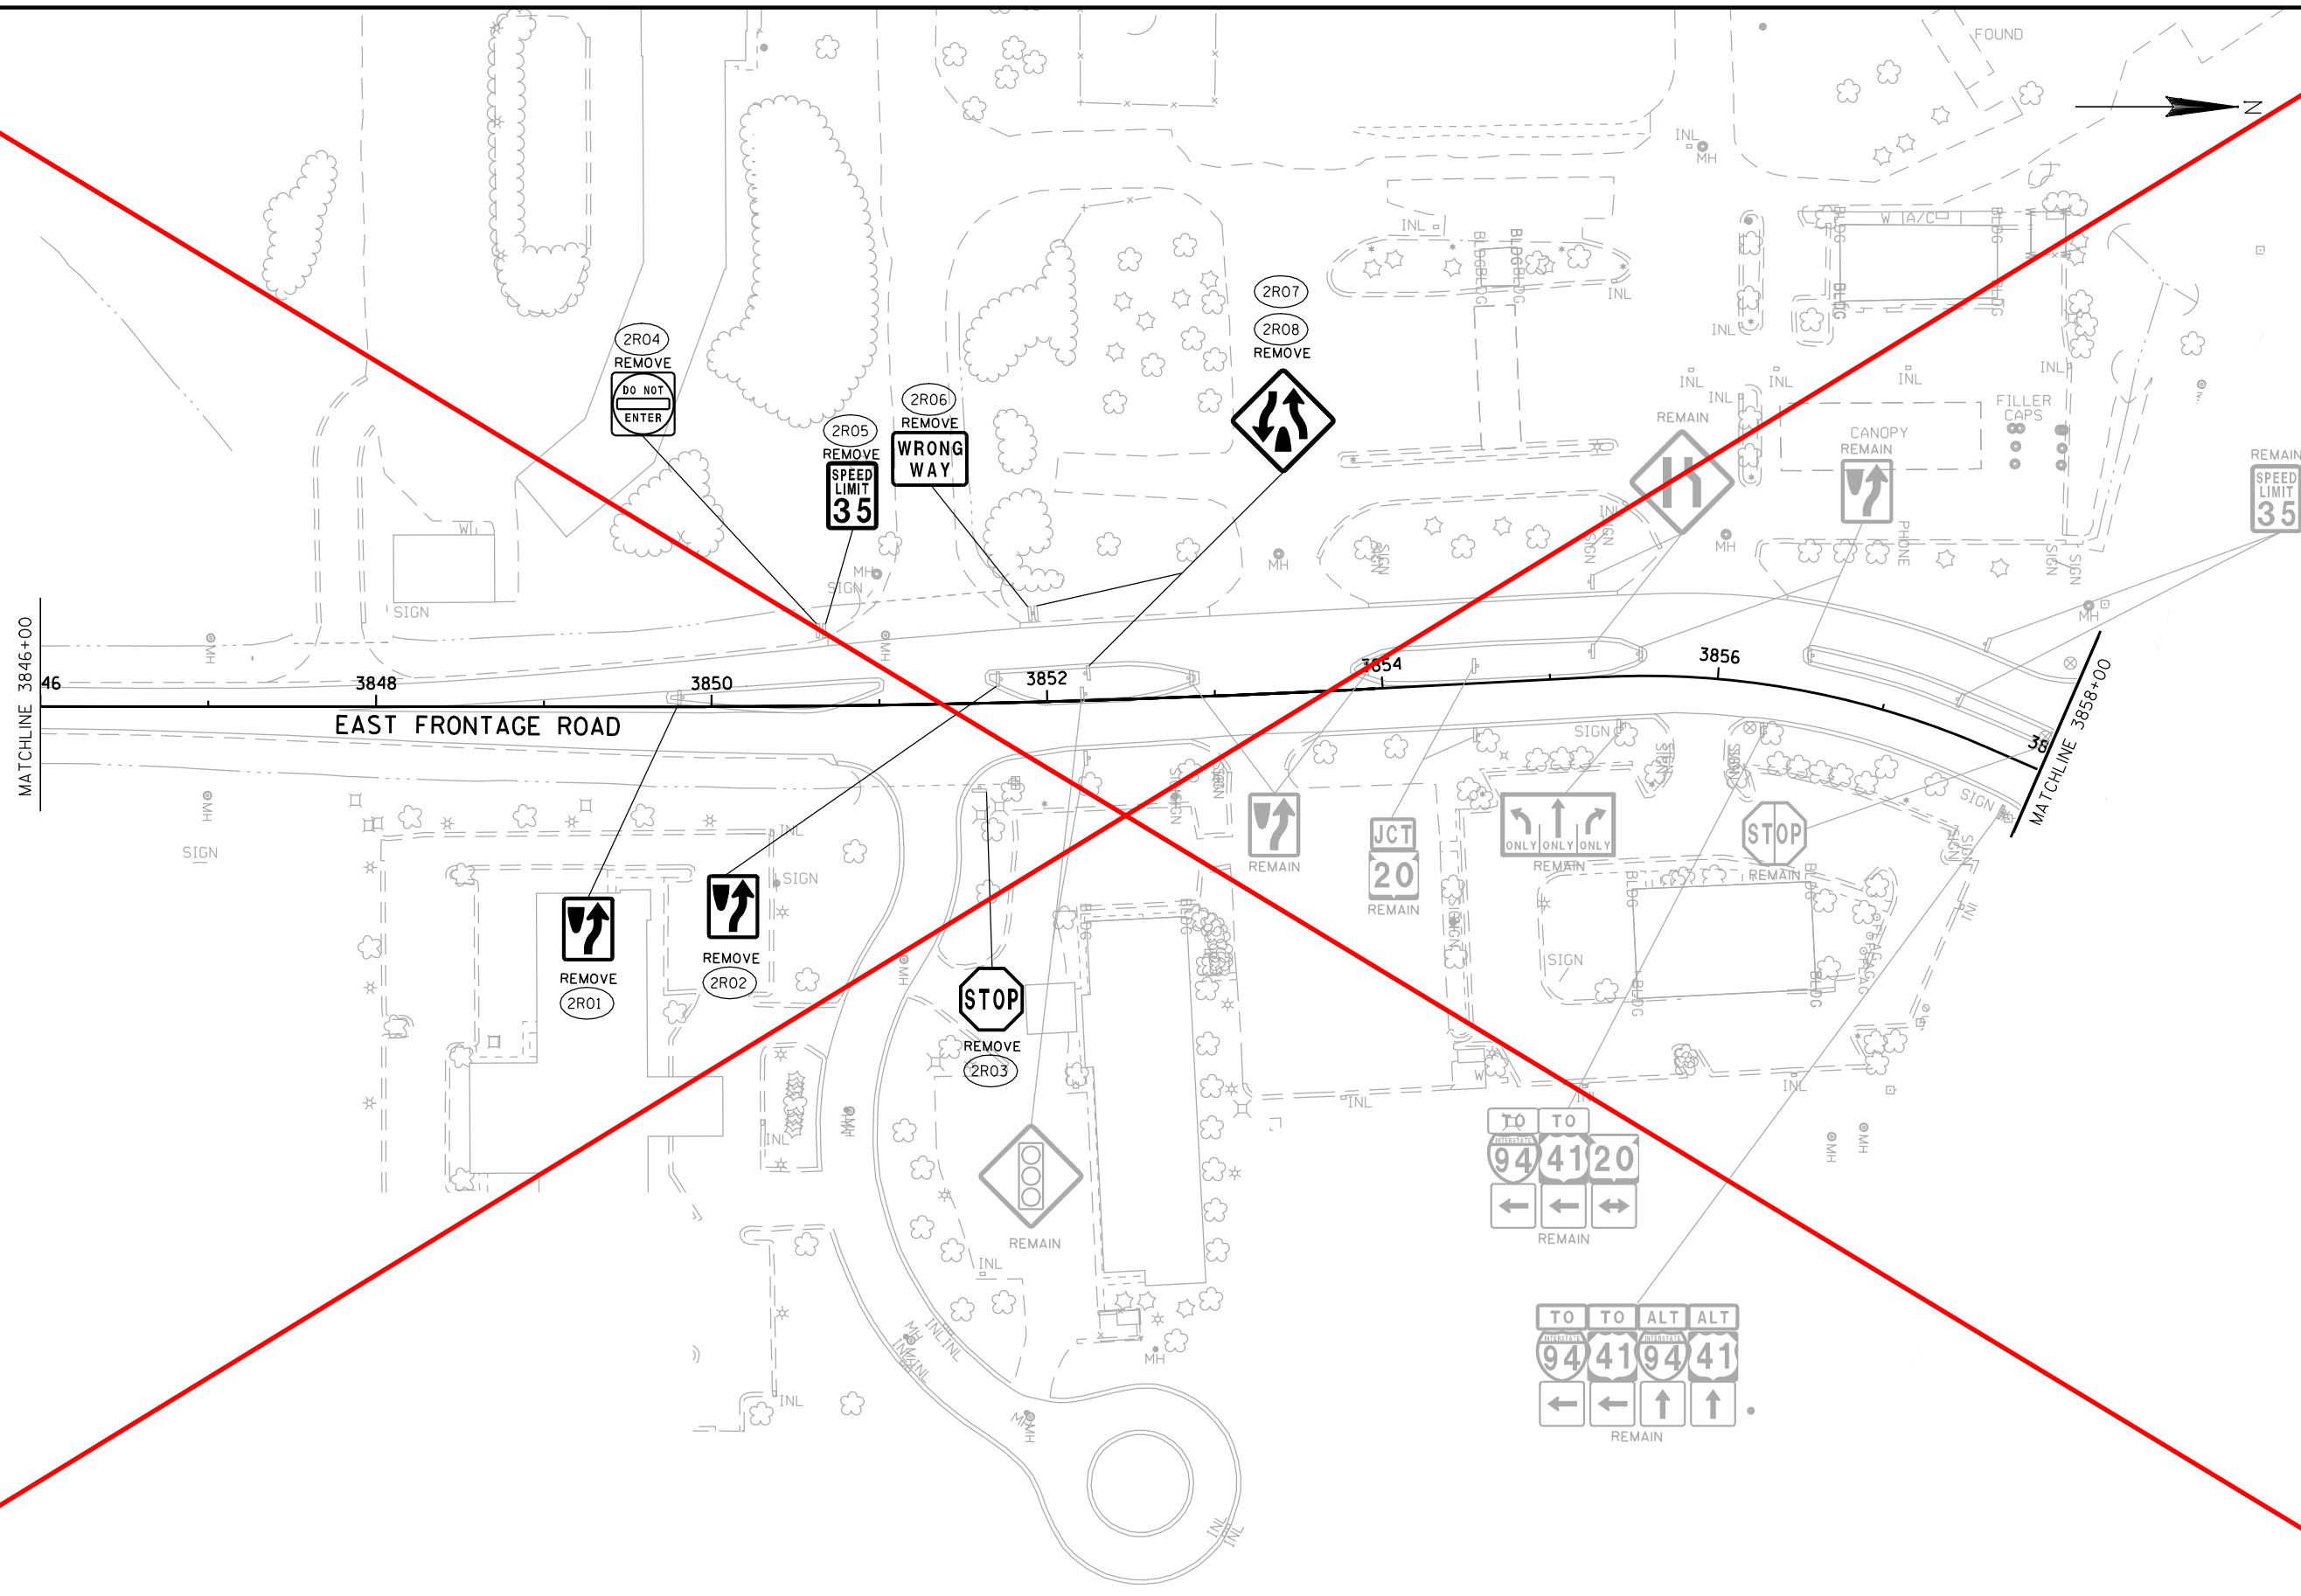

PROJECT NO:1033-02-70

HWY: IH 94/STH 20

COUNTY: RACINE

EXISTING	SIGNING
----------	---------

See new sheet #48

SHEET	48
-------	----

E

FILE NAME : s:\FinalDesign\20\10330270_E\Roads\cds\023202_es.dgn


PLOT DATE : 06-DEC-2010 20:22


PLOT BY : MSCD1S


PLOT NAME : 023202_es


PLOT SCALE : 100:1


WISDOT/CADDS SHEET 42

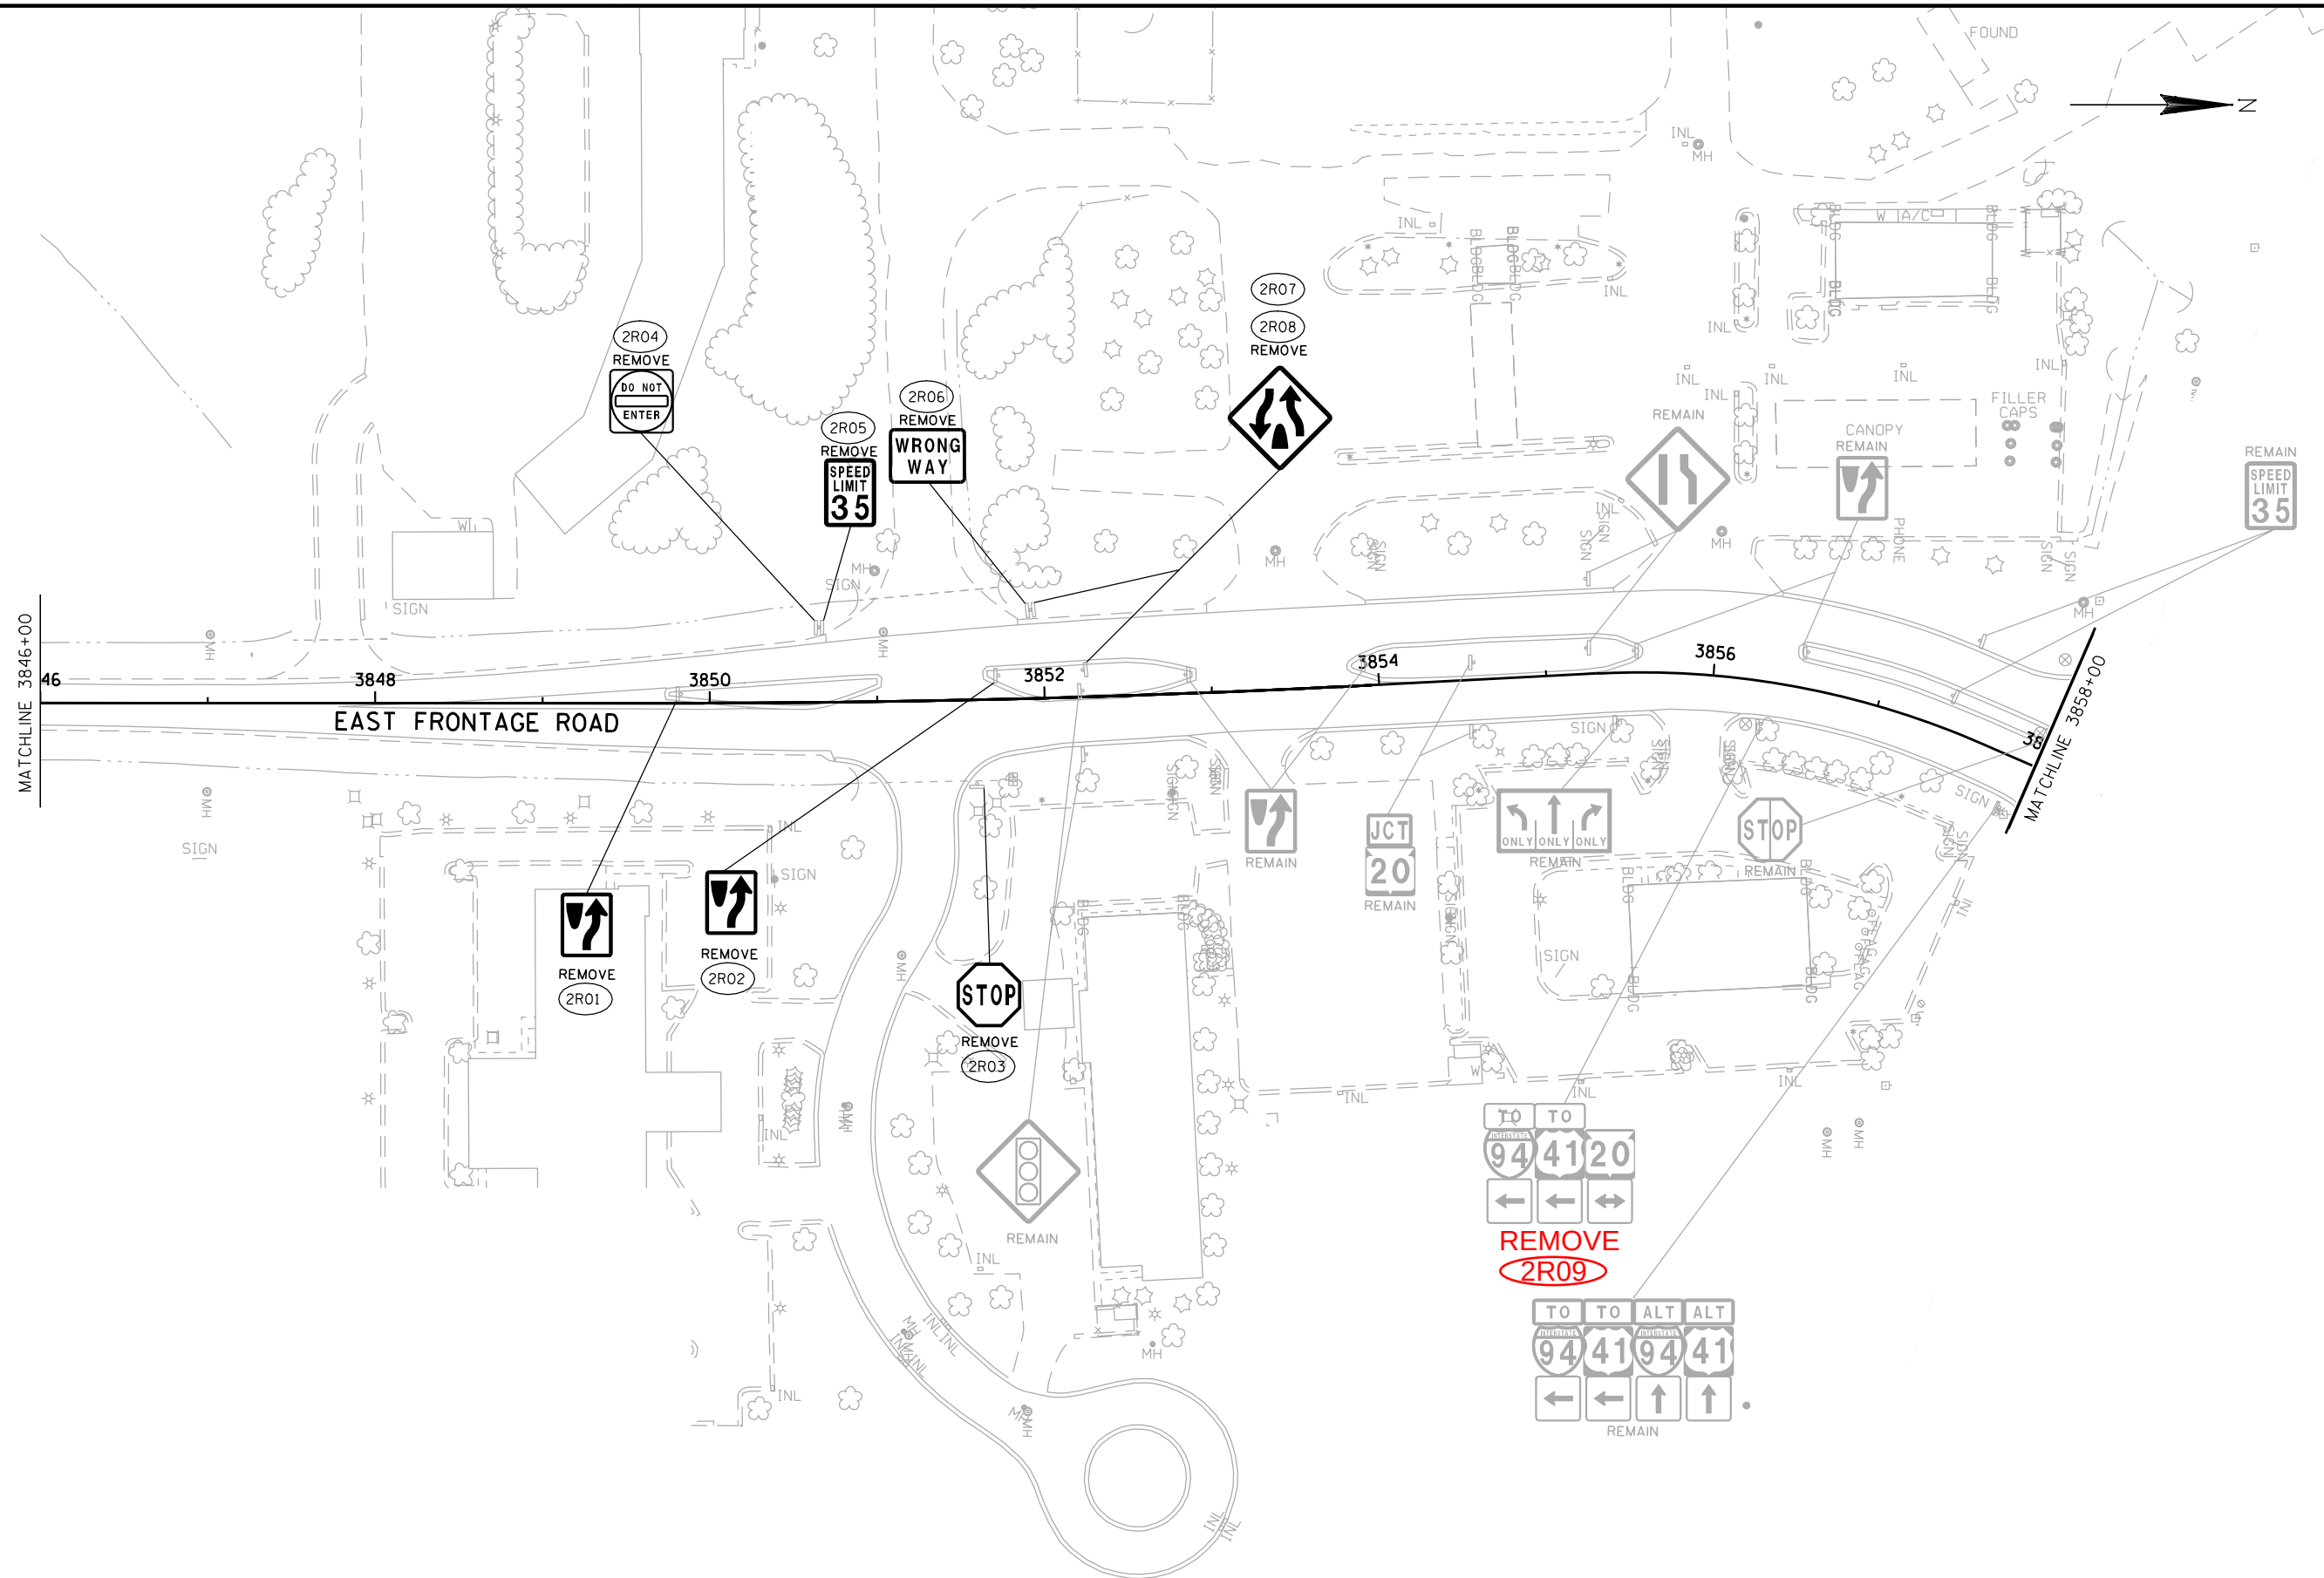


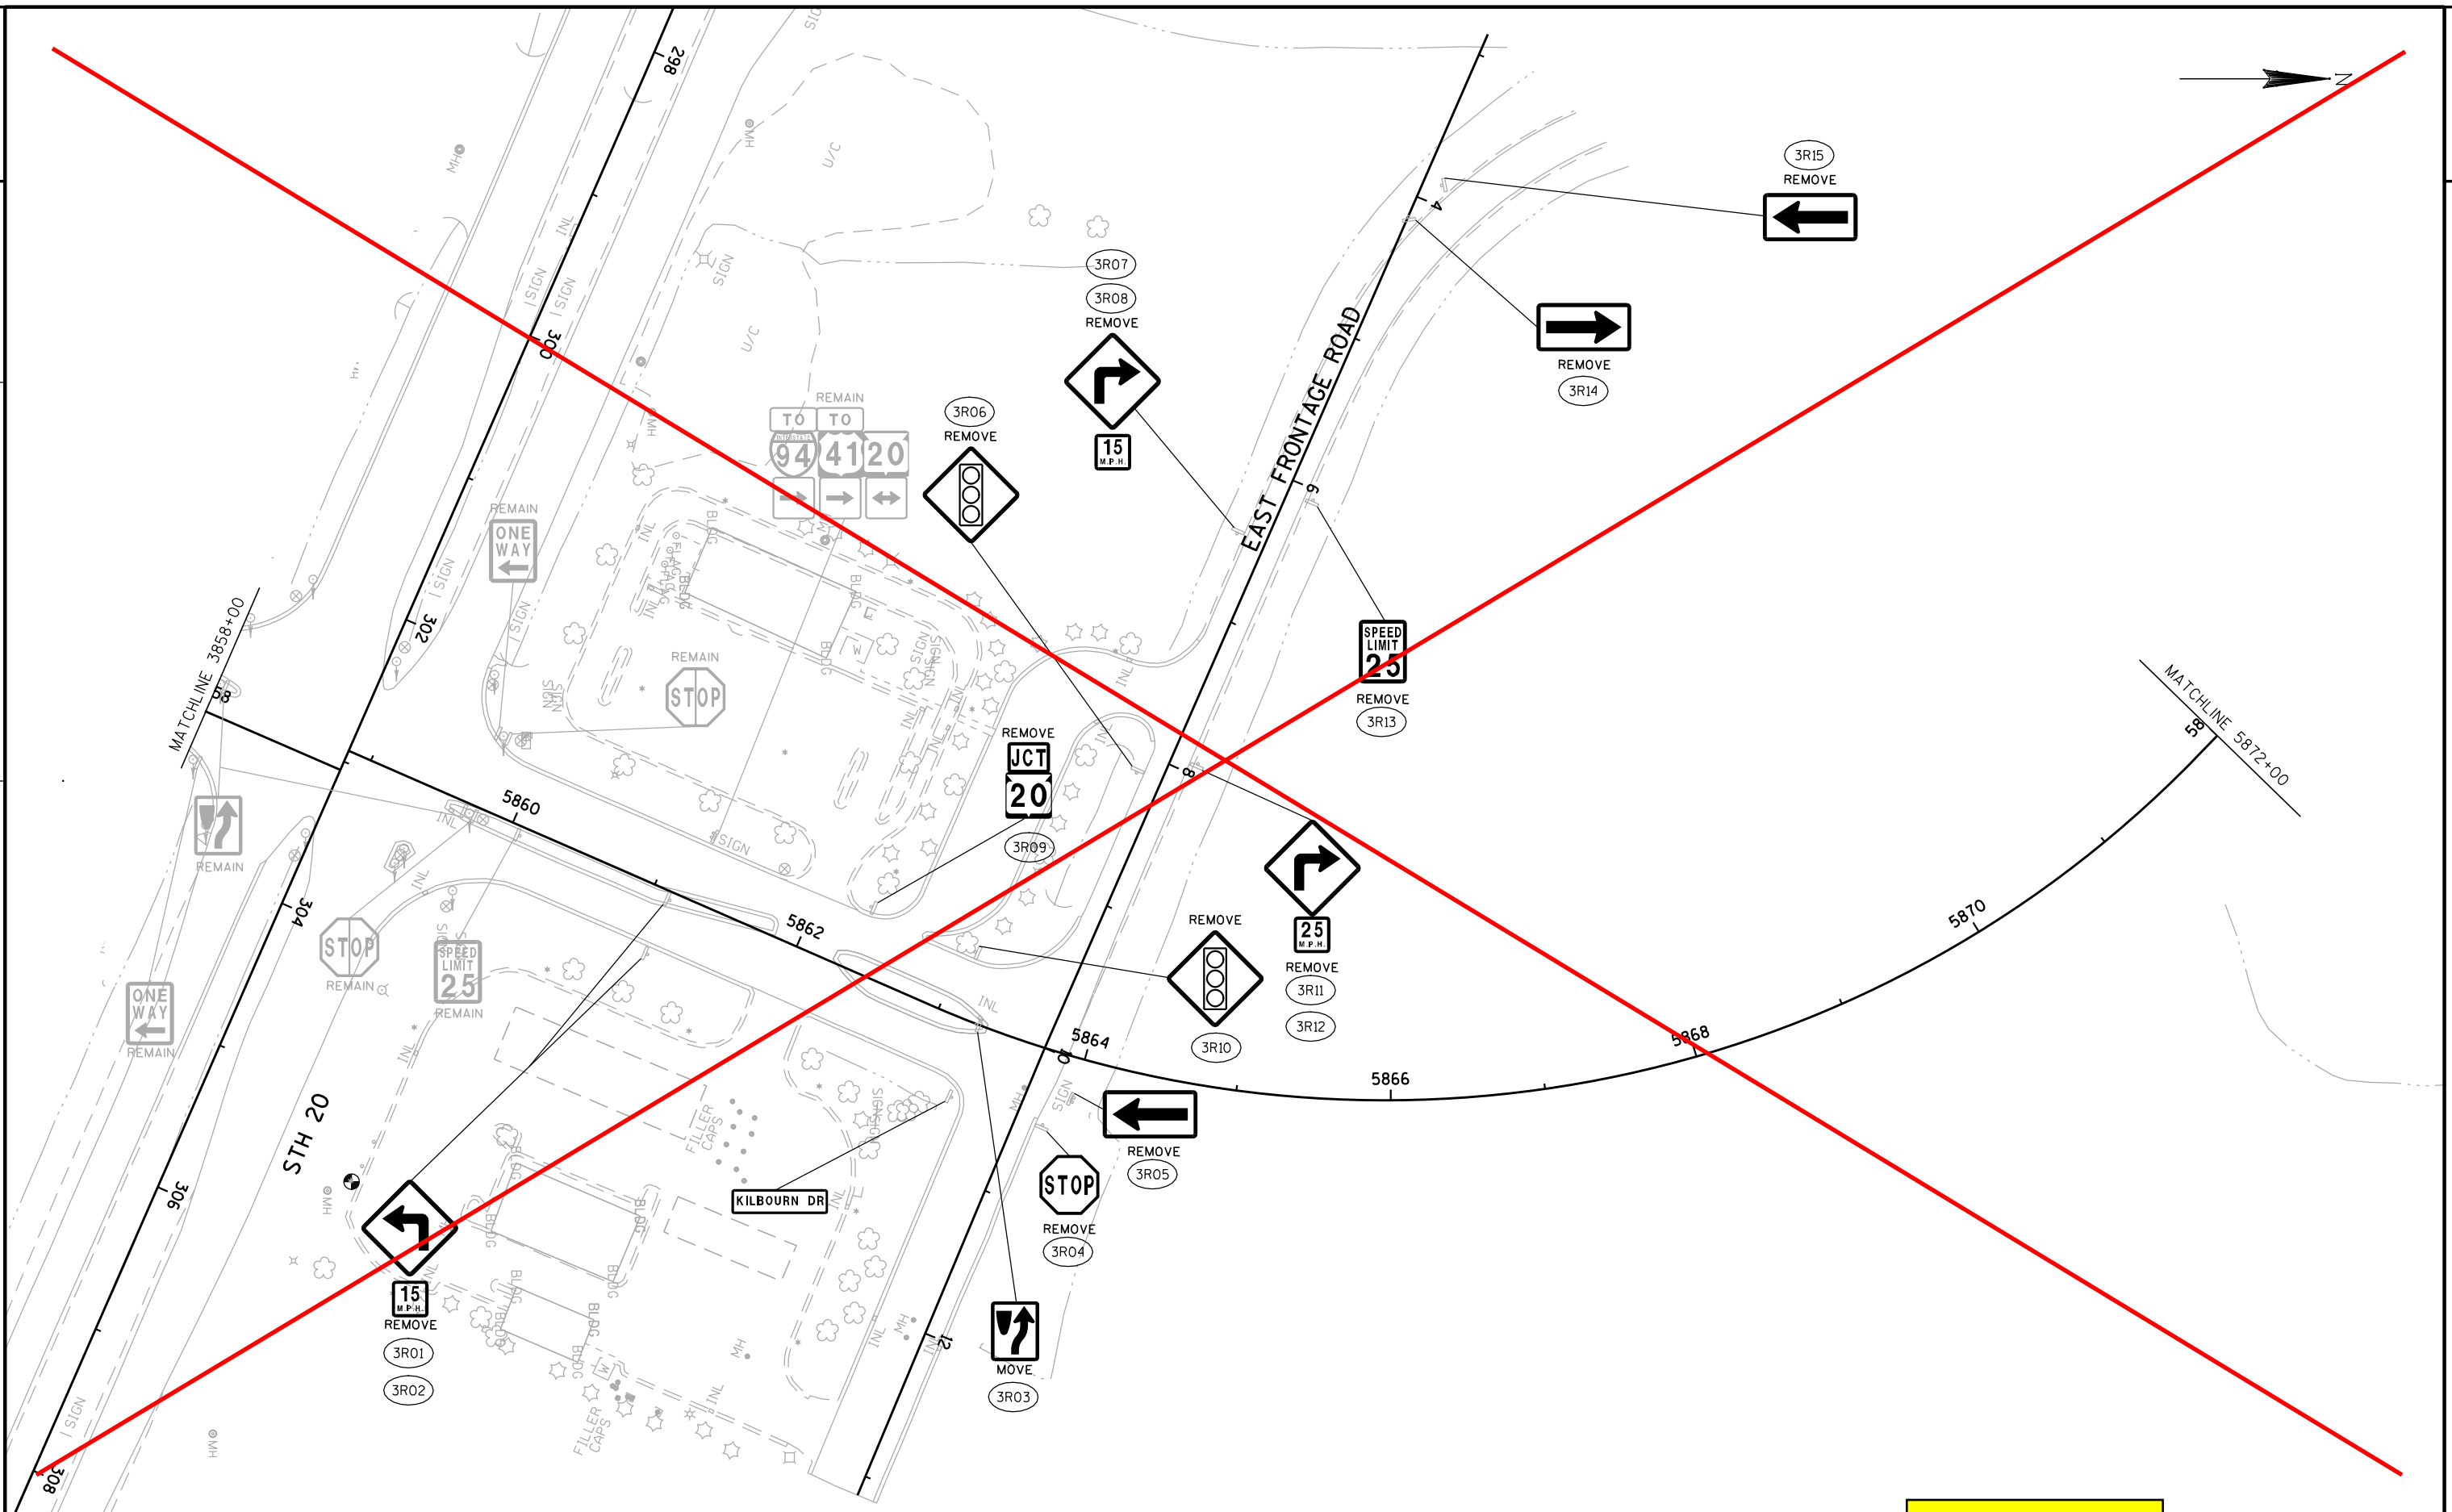

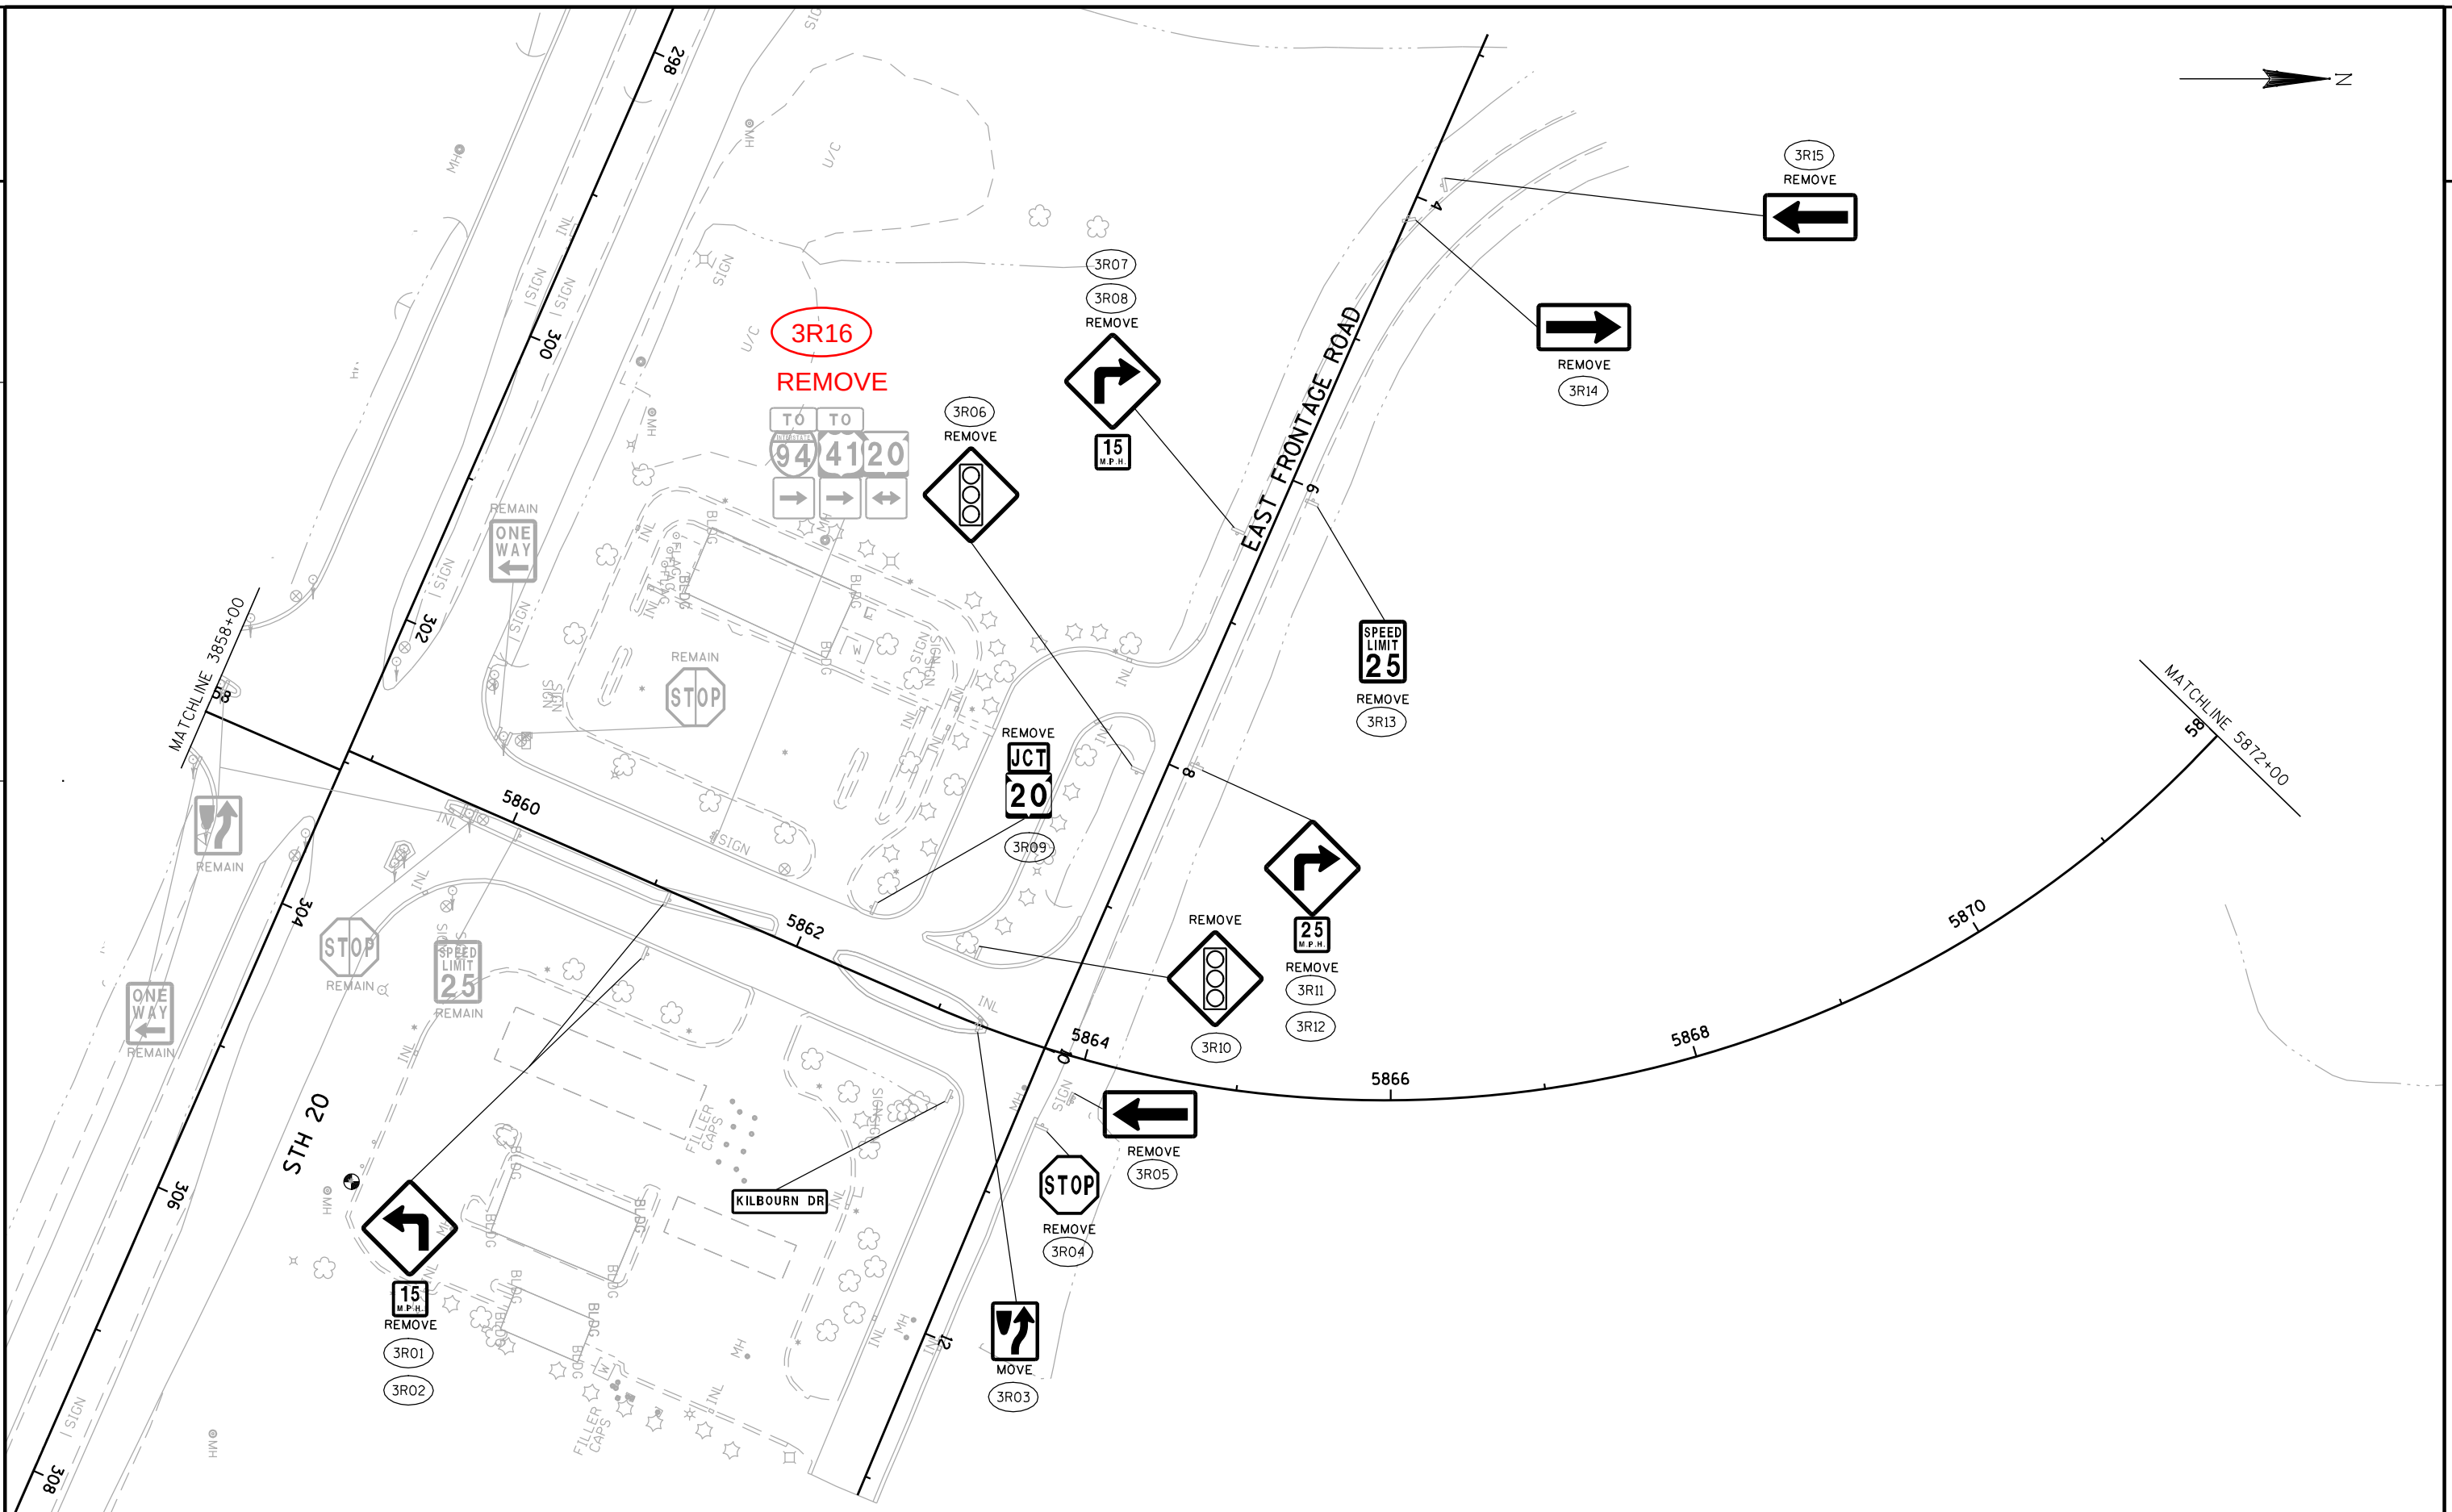


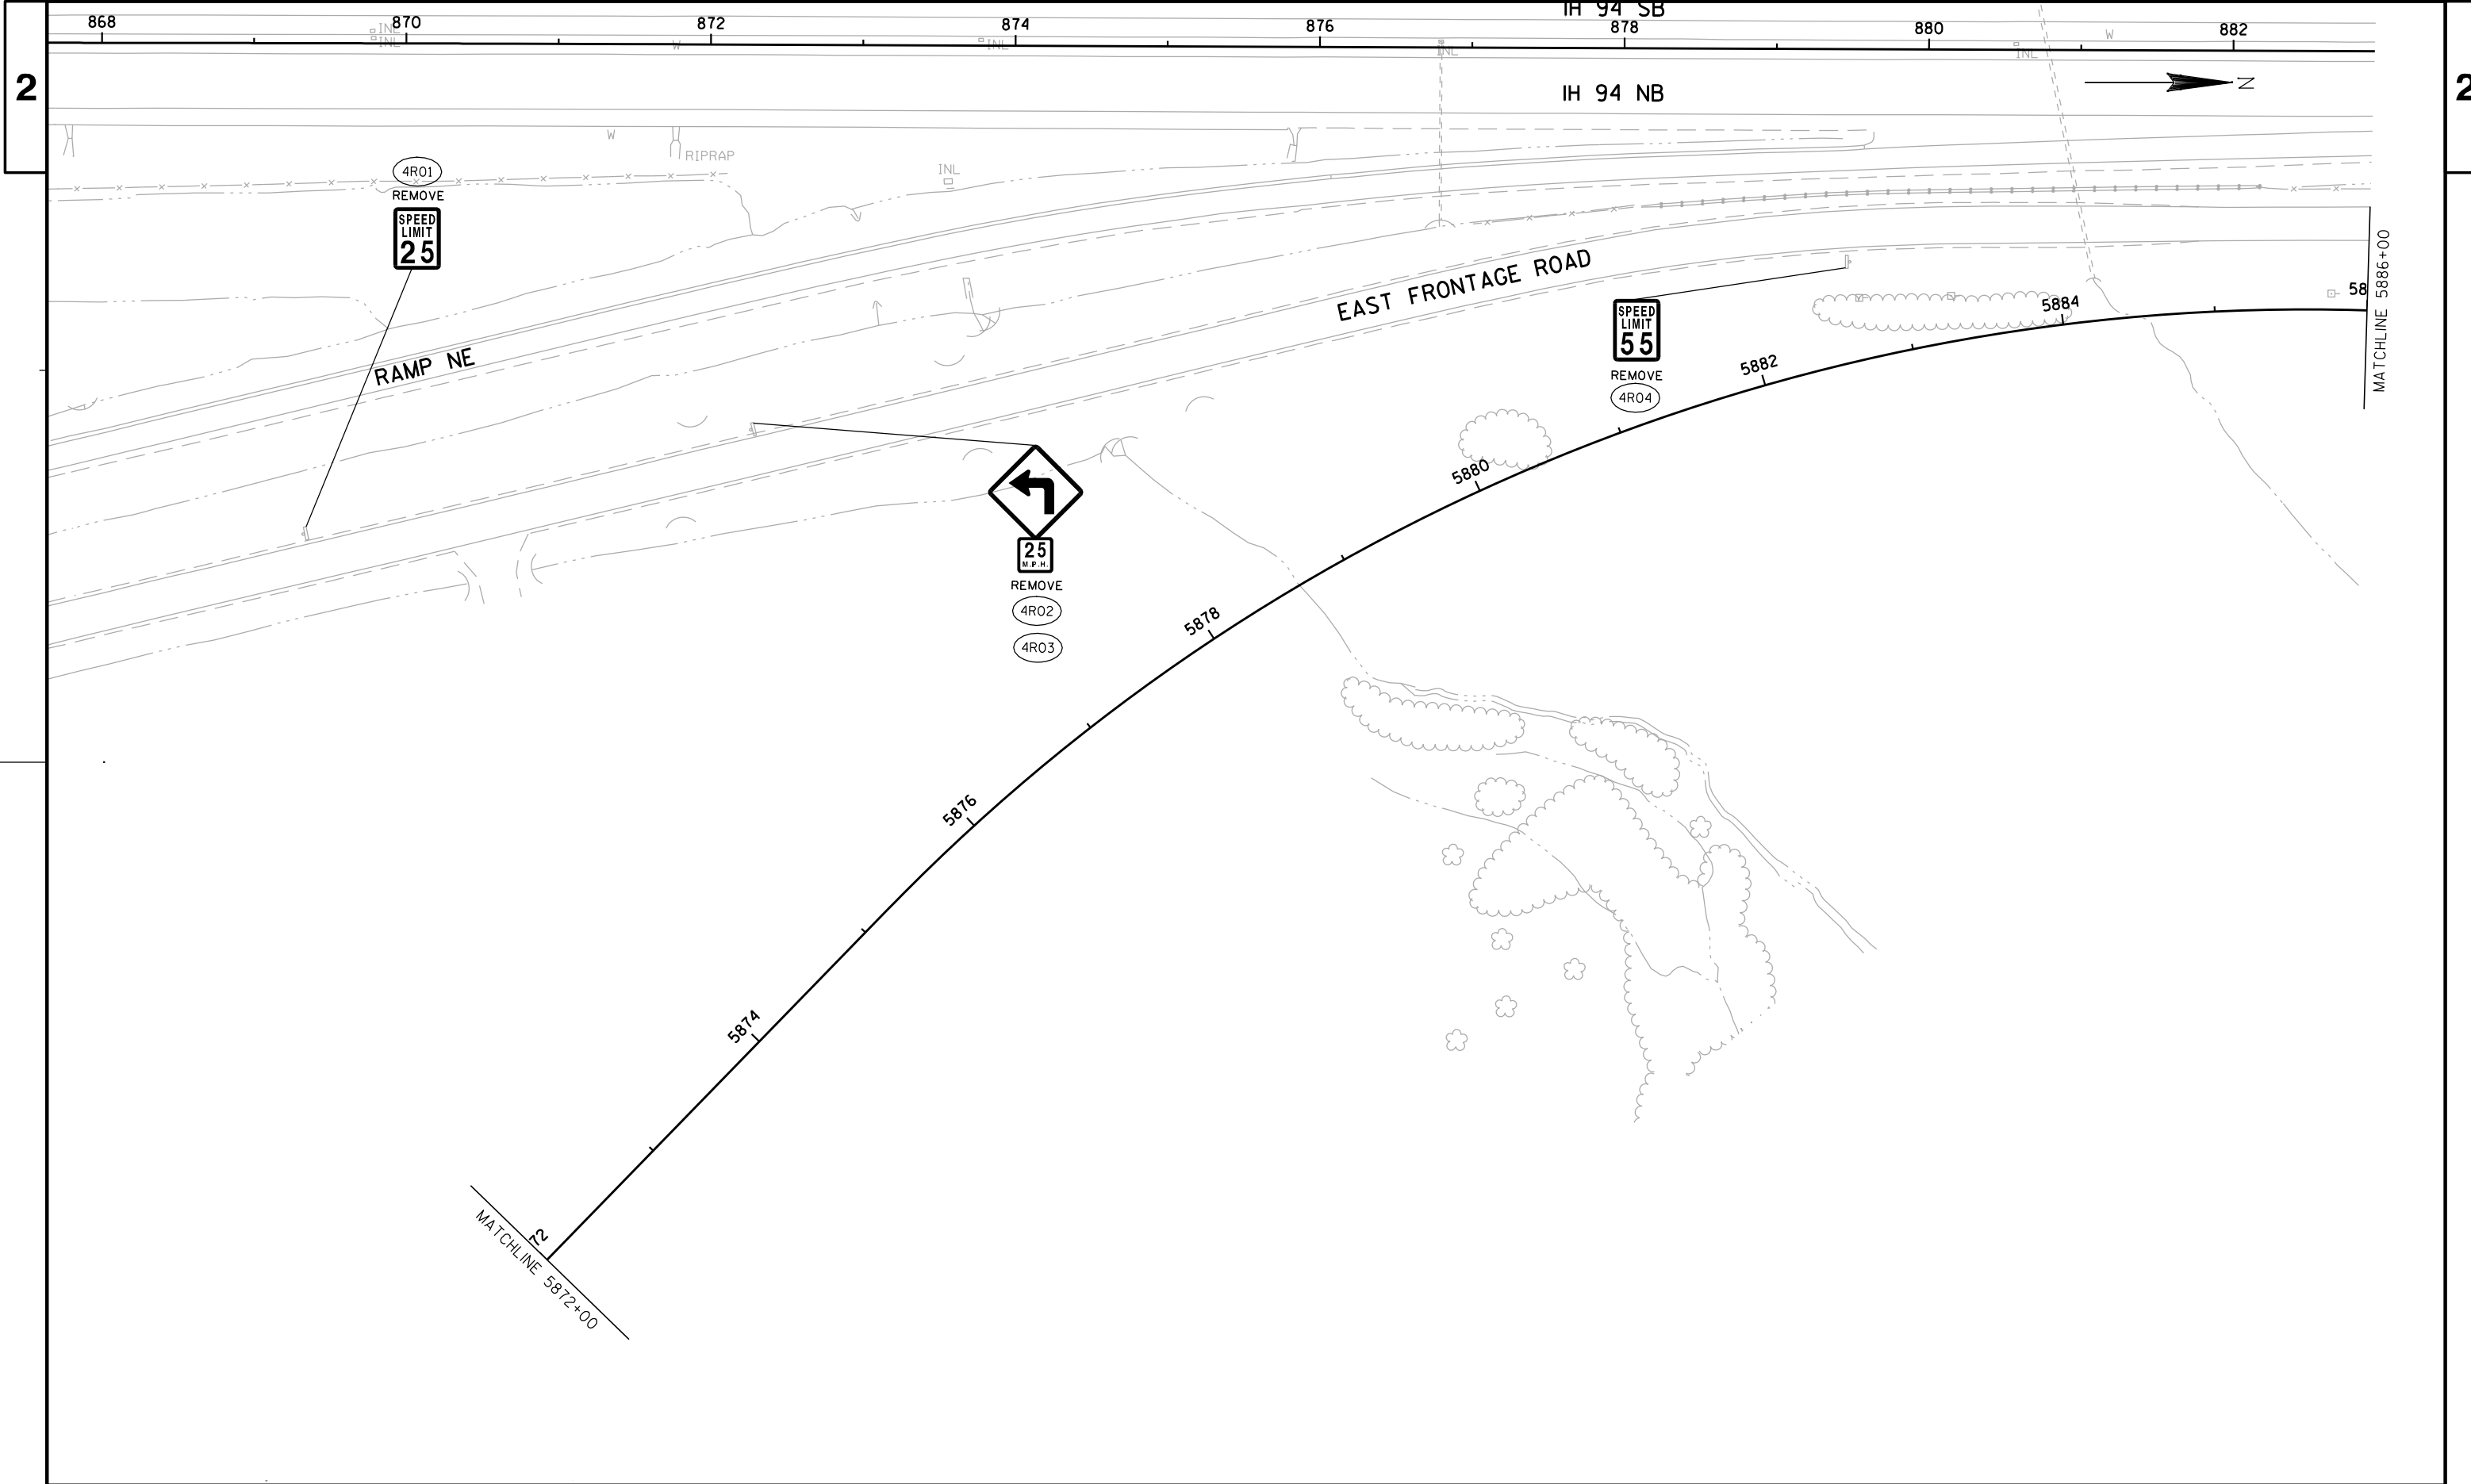

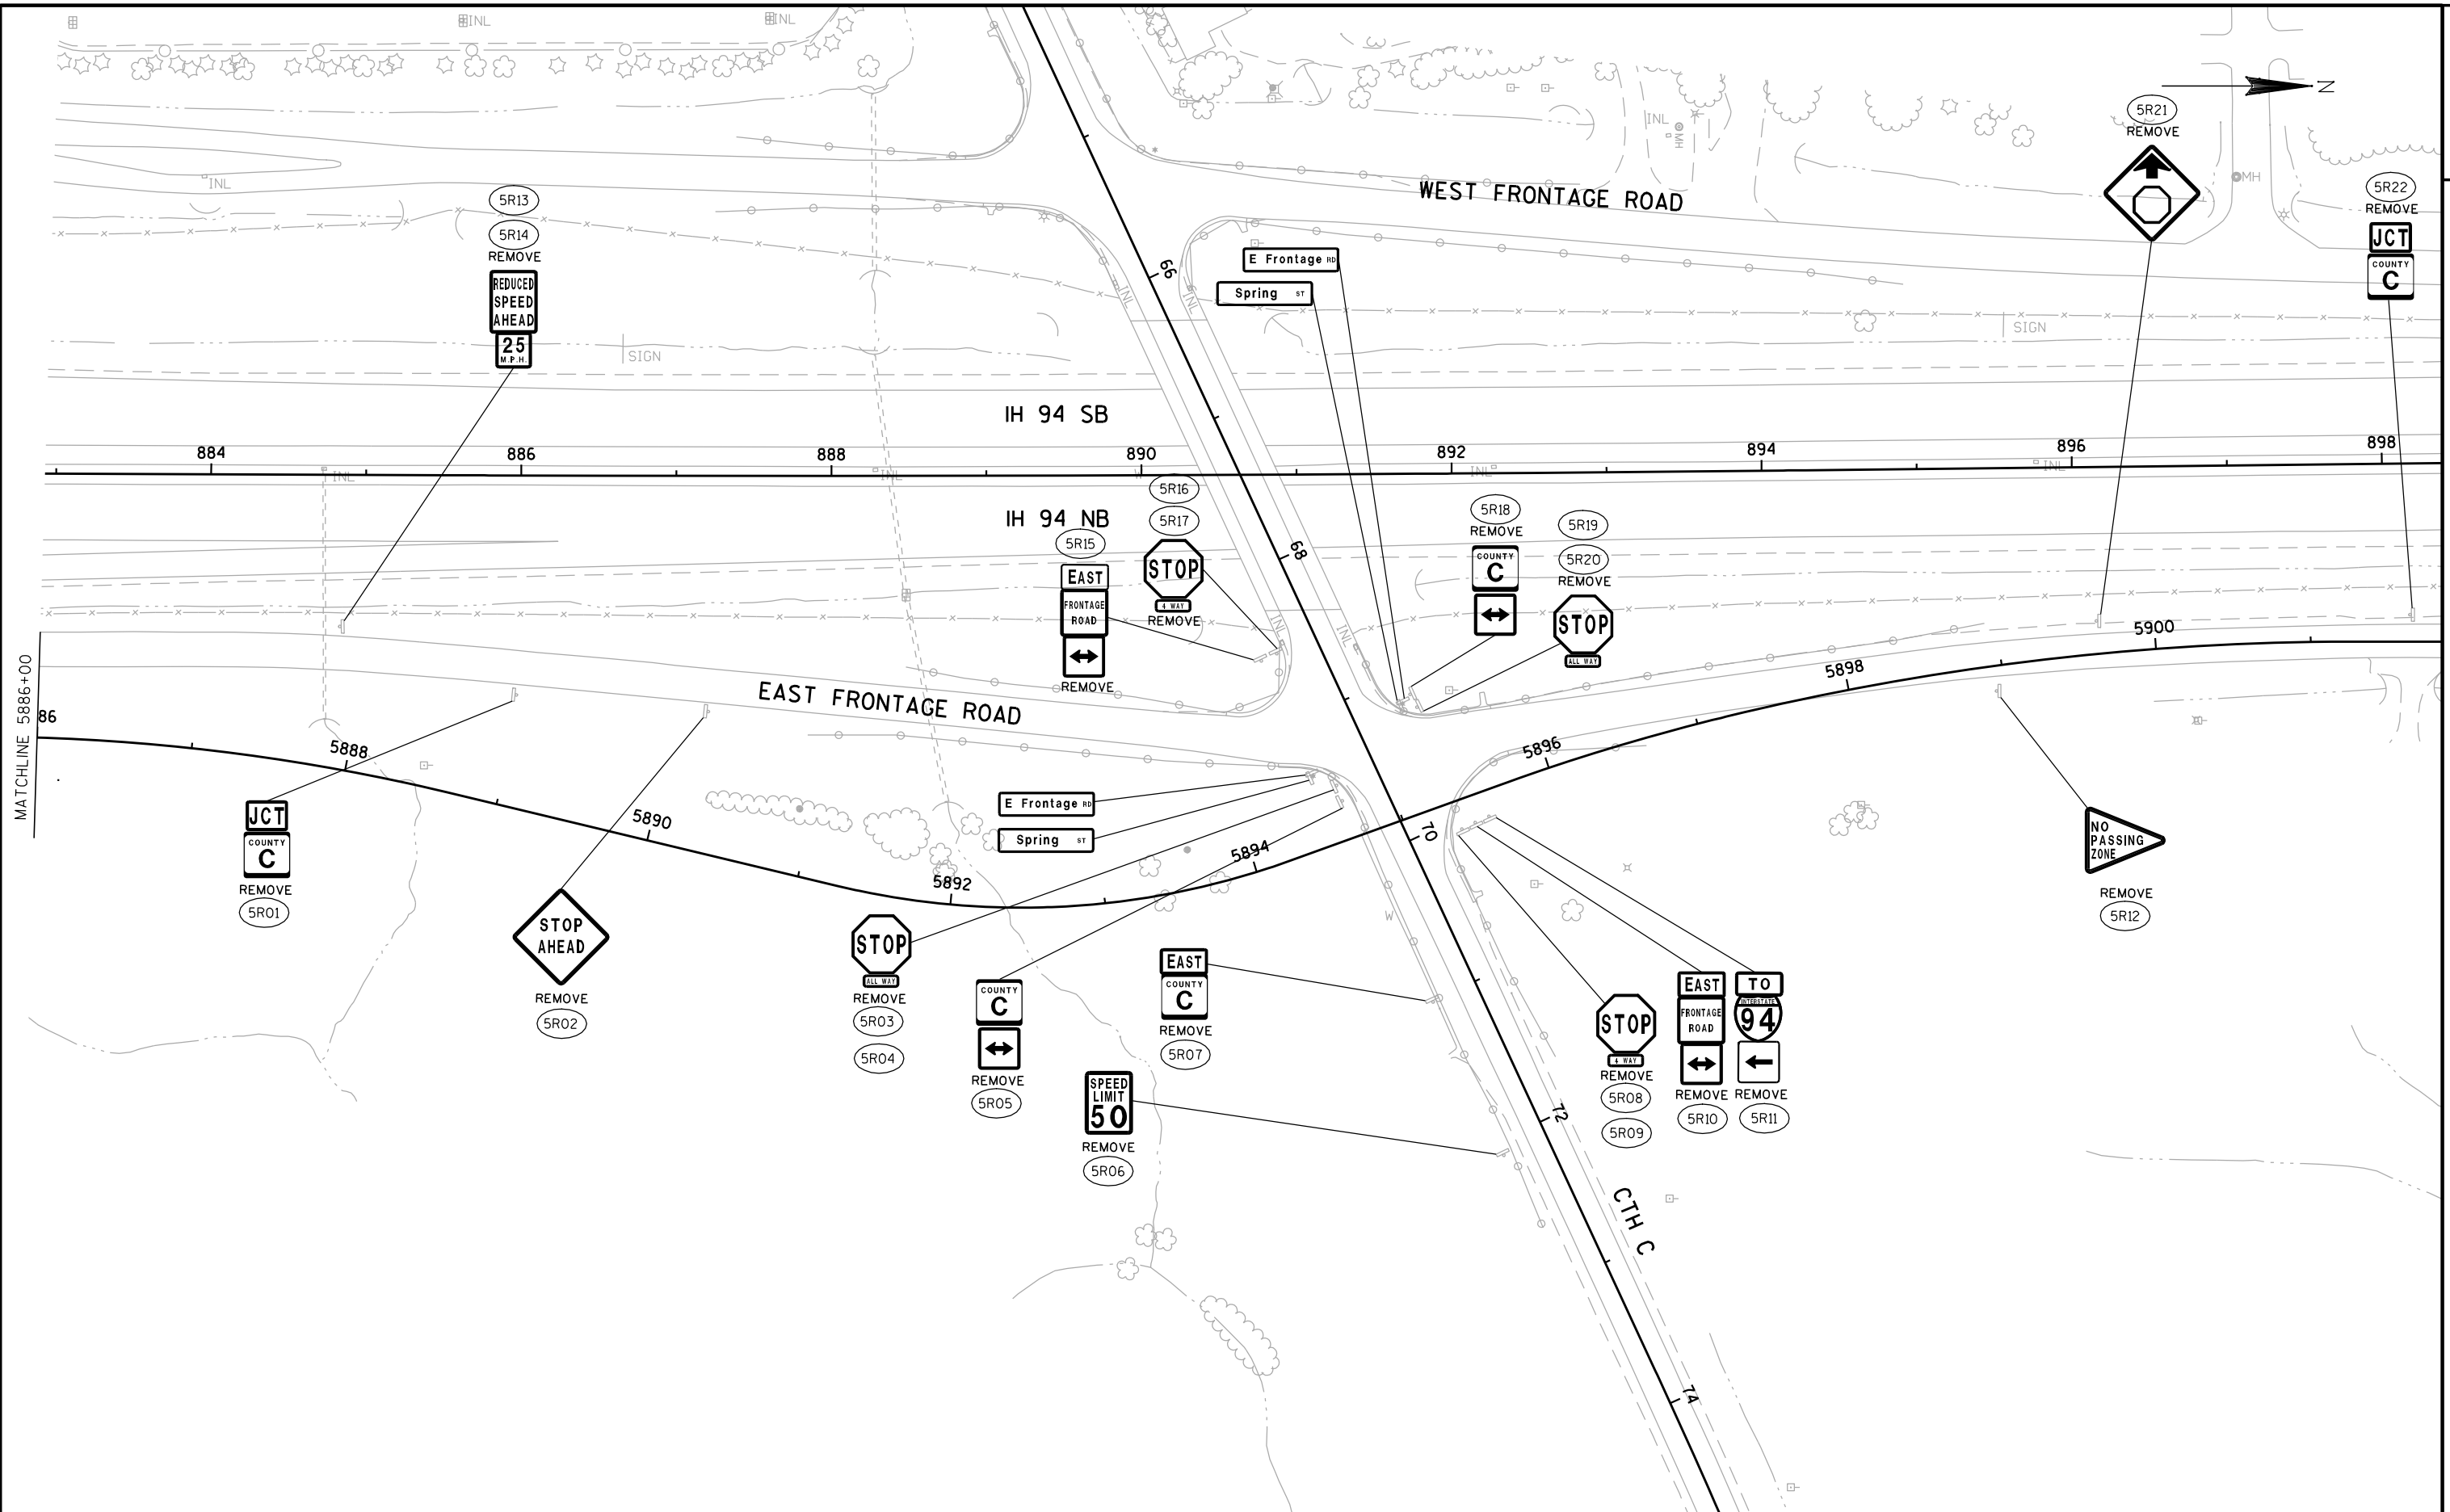

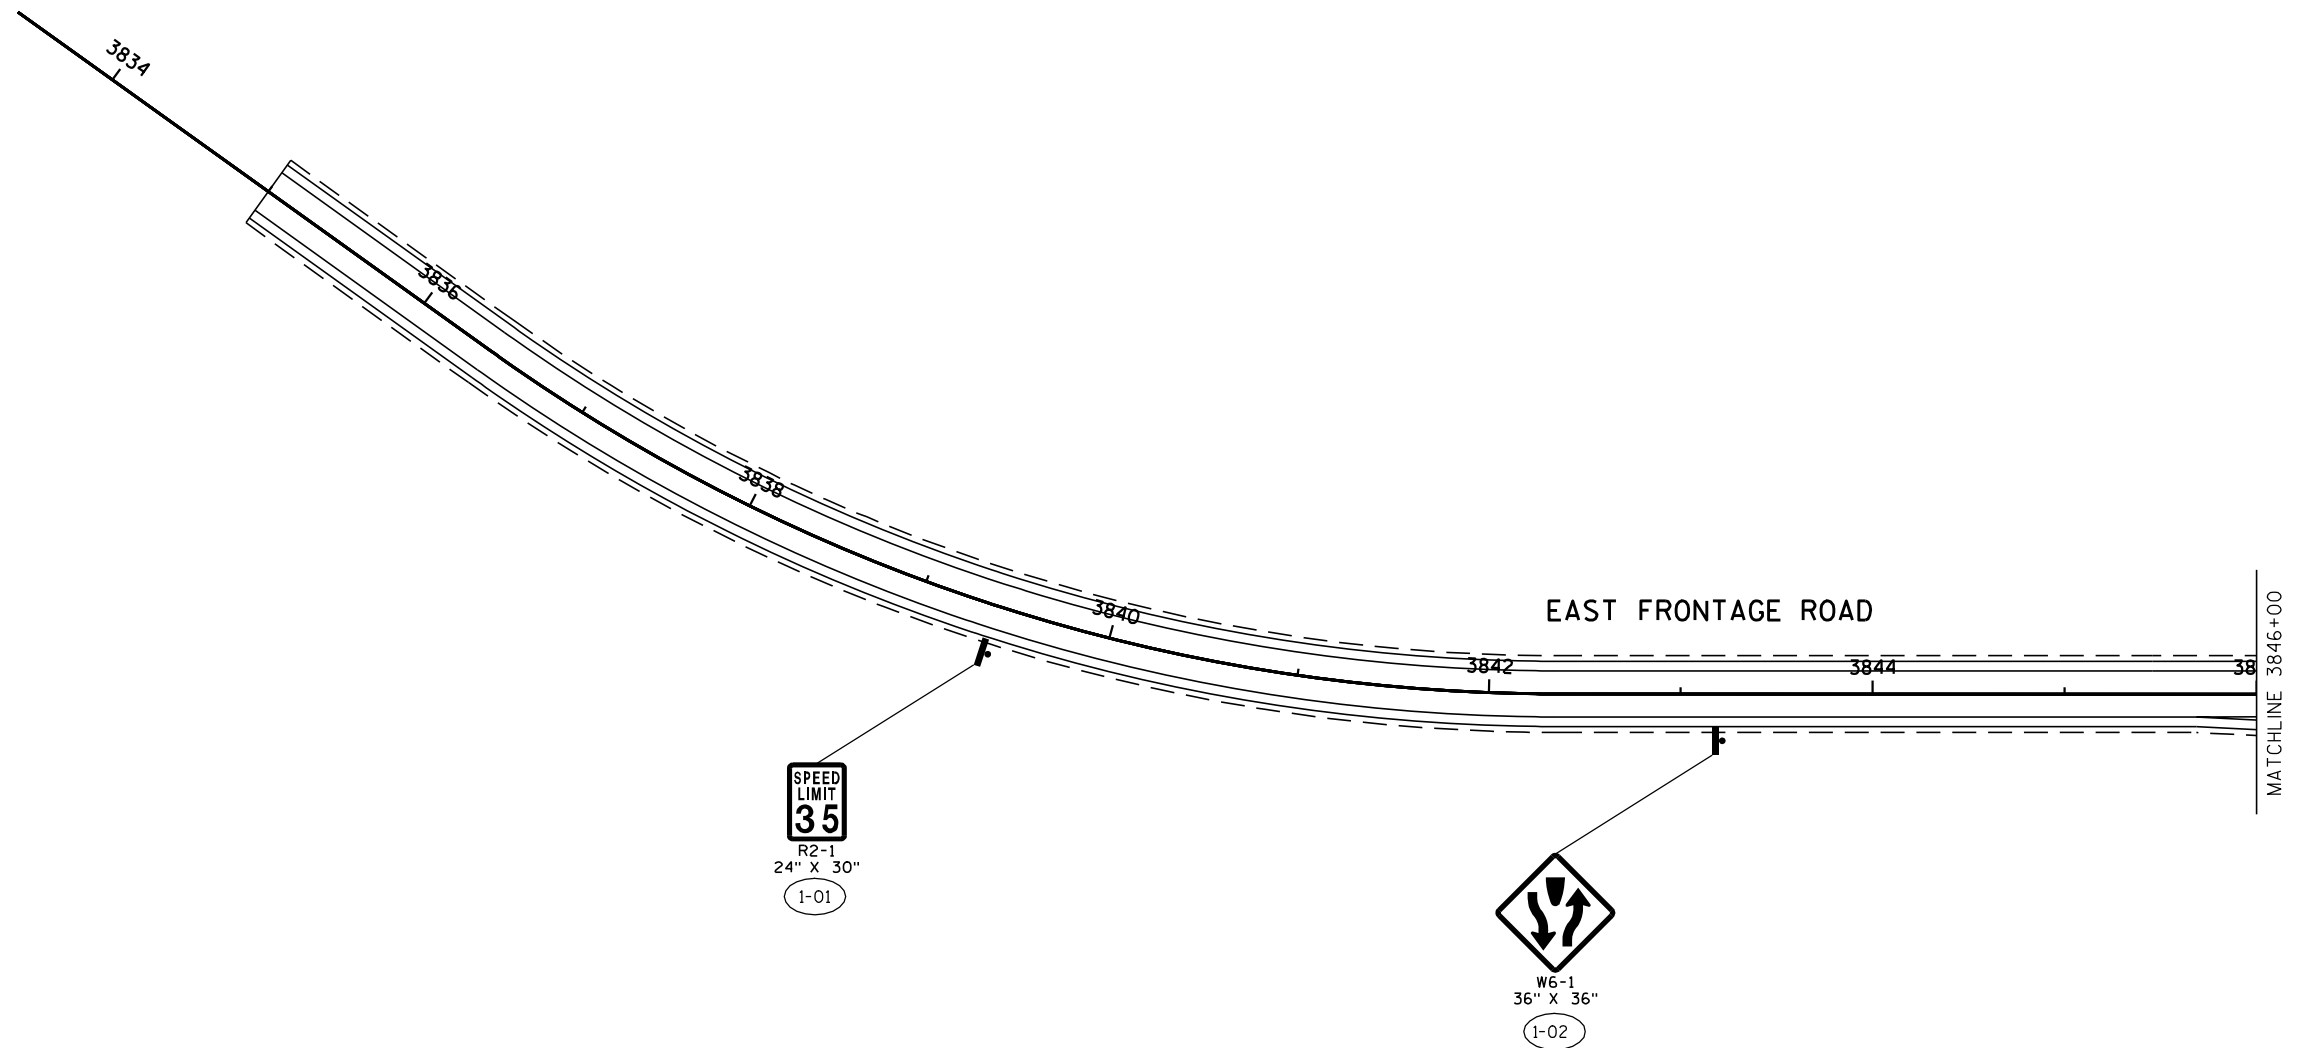
**LEGEND**

- EXISTING SIGN MOUNTED ON POST(S)
- EXISTING SIGN MOUNTED ON BRIDGE OR SIGN BRIDGE
- PROPOSED SIGN MOUNTED ON POST(S)
- PROPOSED SIGN MOUNTED ON BRIDGE OR SIGN BRIDGE
- DENOTES SIGN NUMBER

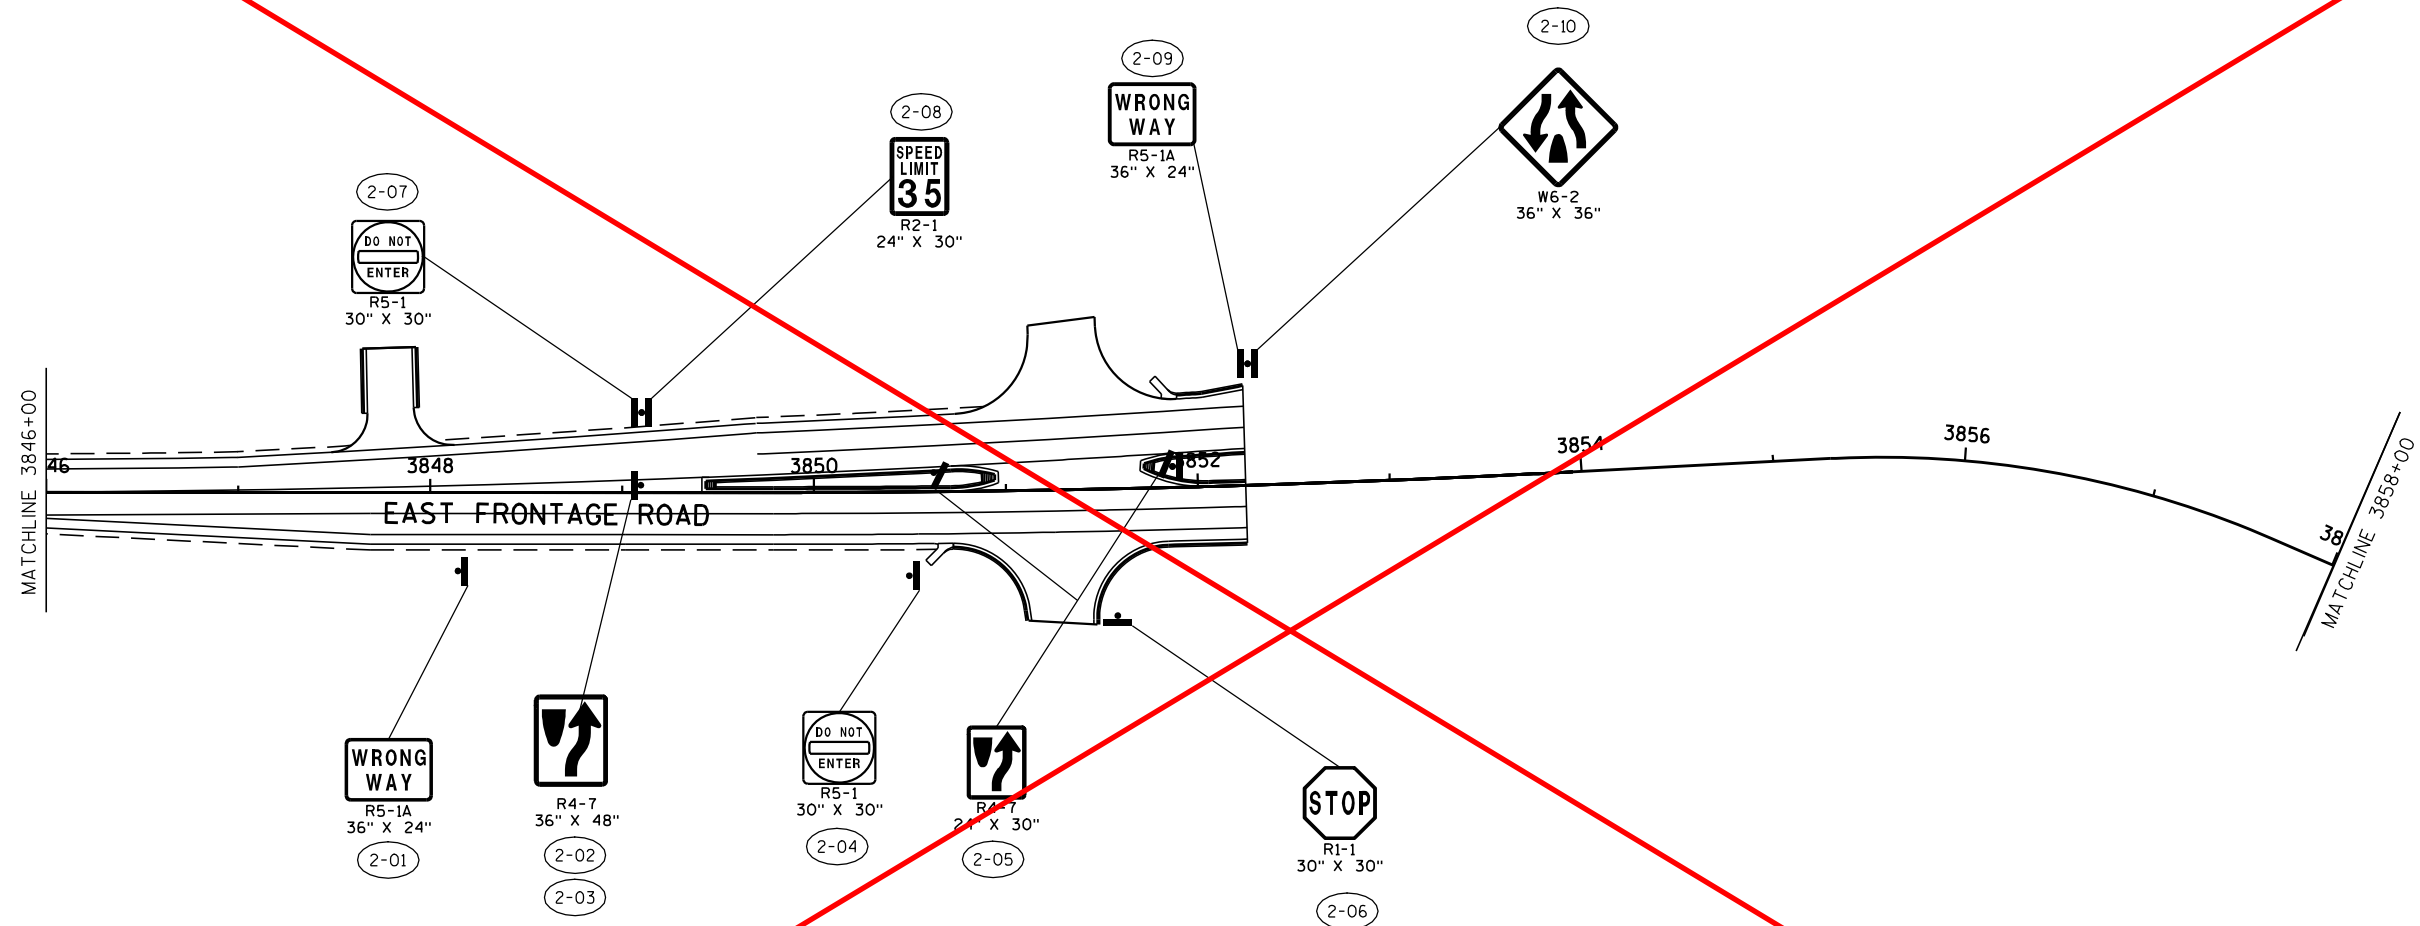


LEGEND

- EXISTING SIGN MOUNTED ON POST(S)
- EXISTING SIGN MOUNTED ON BRIDGE OR SIGN BRIDGE
- PROPOSED SIGN MOUNTED ON POST(S)
- PROPOSED SIGN MOUNTED ON BRIDGE OR SIGN BRIDGE
- DENOTES SIGN NUMBER

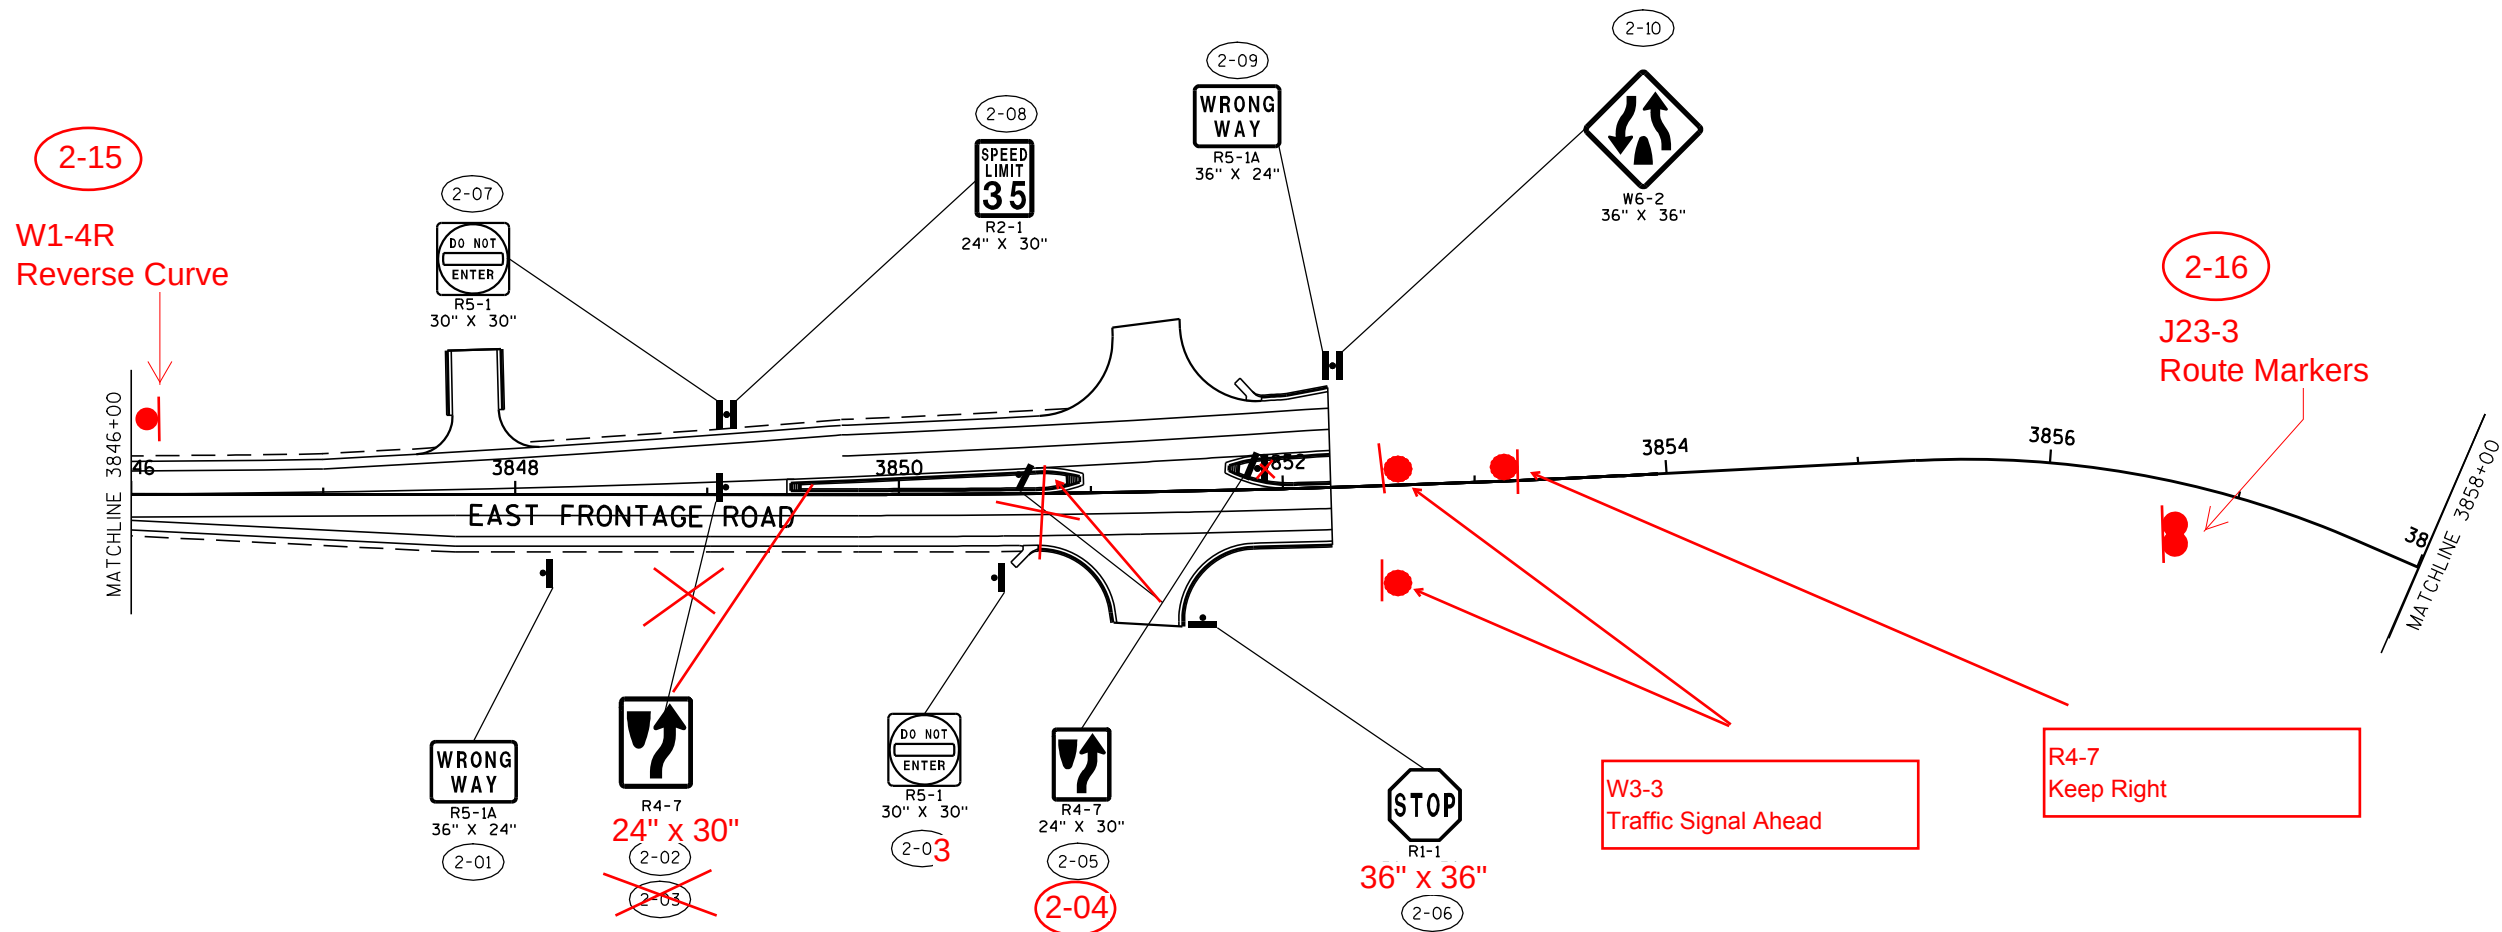



LEGEND


- EXISTING SIGN MOUNTED ON POST(S)
- EXISTING SIGN MOUNTED ON BRIDGE OR SIGN BRIDGE
- PROPOSED SIGN MOUNTED ON POST(S)
- PROPOSED SIGN MOUNTED ON BRIDGE OR SIGN BRIDGE
- DENOTES SIGN NUMBER

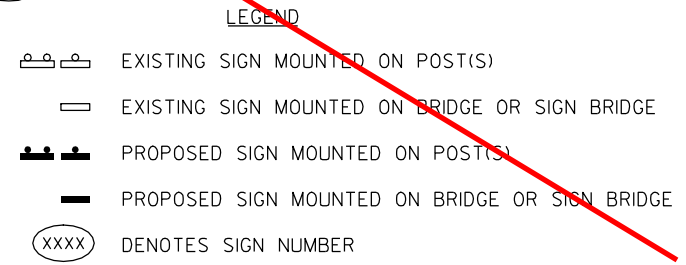

Existing median. Not drawn to scale, but drawn only for reference.

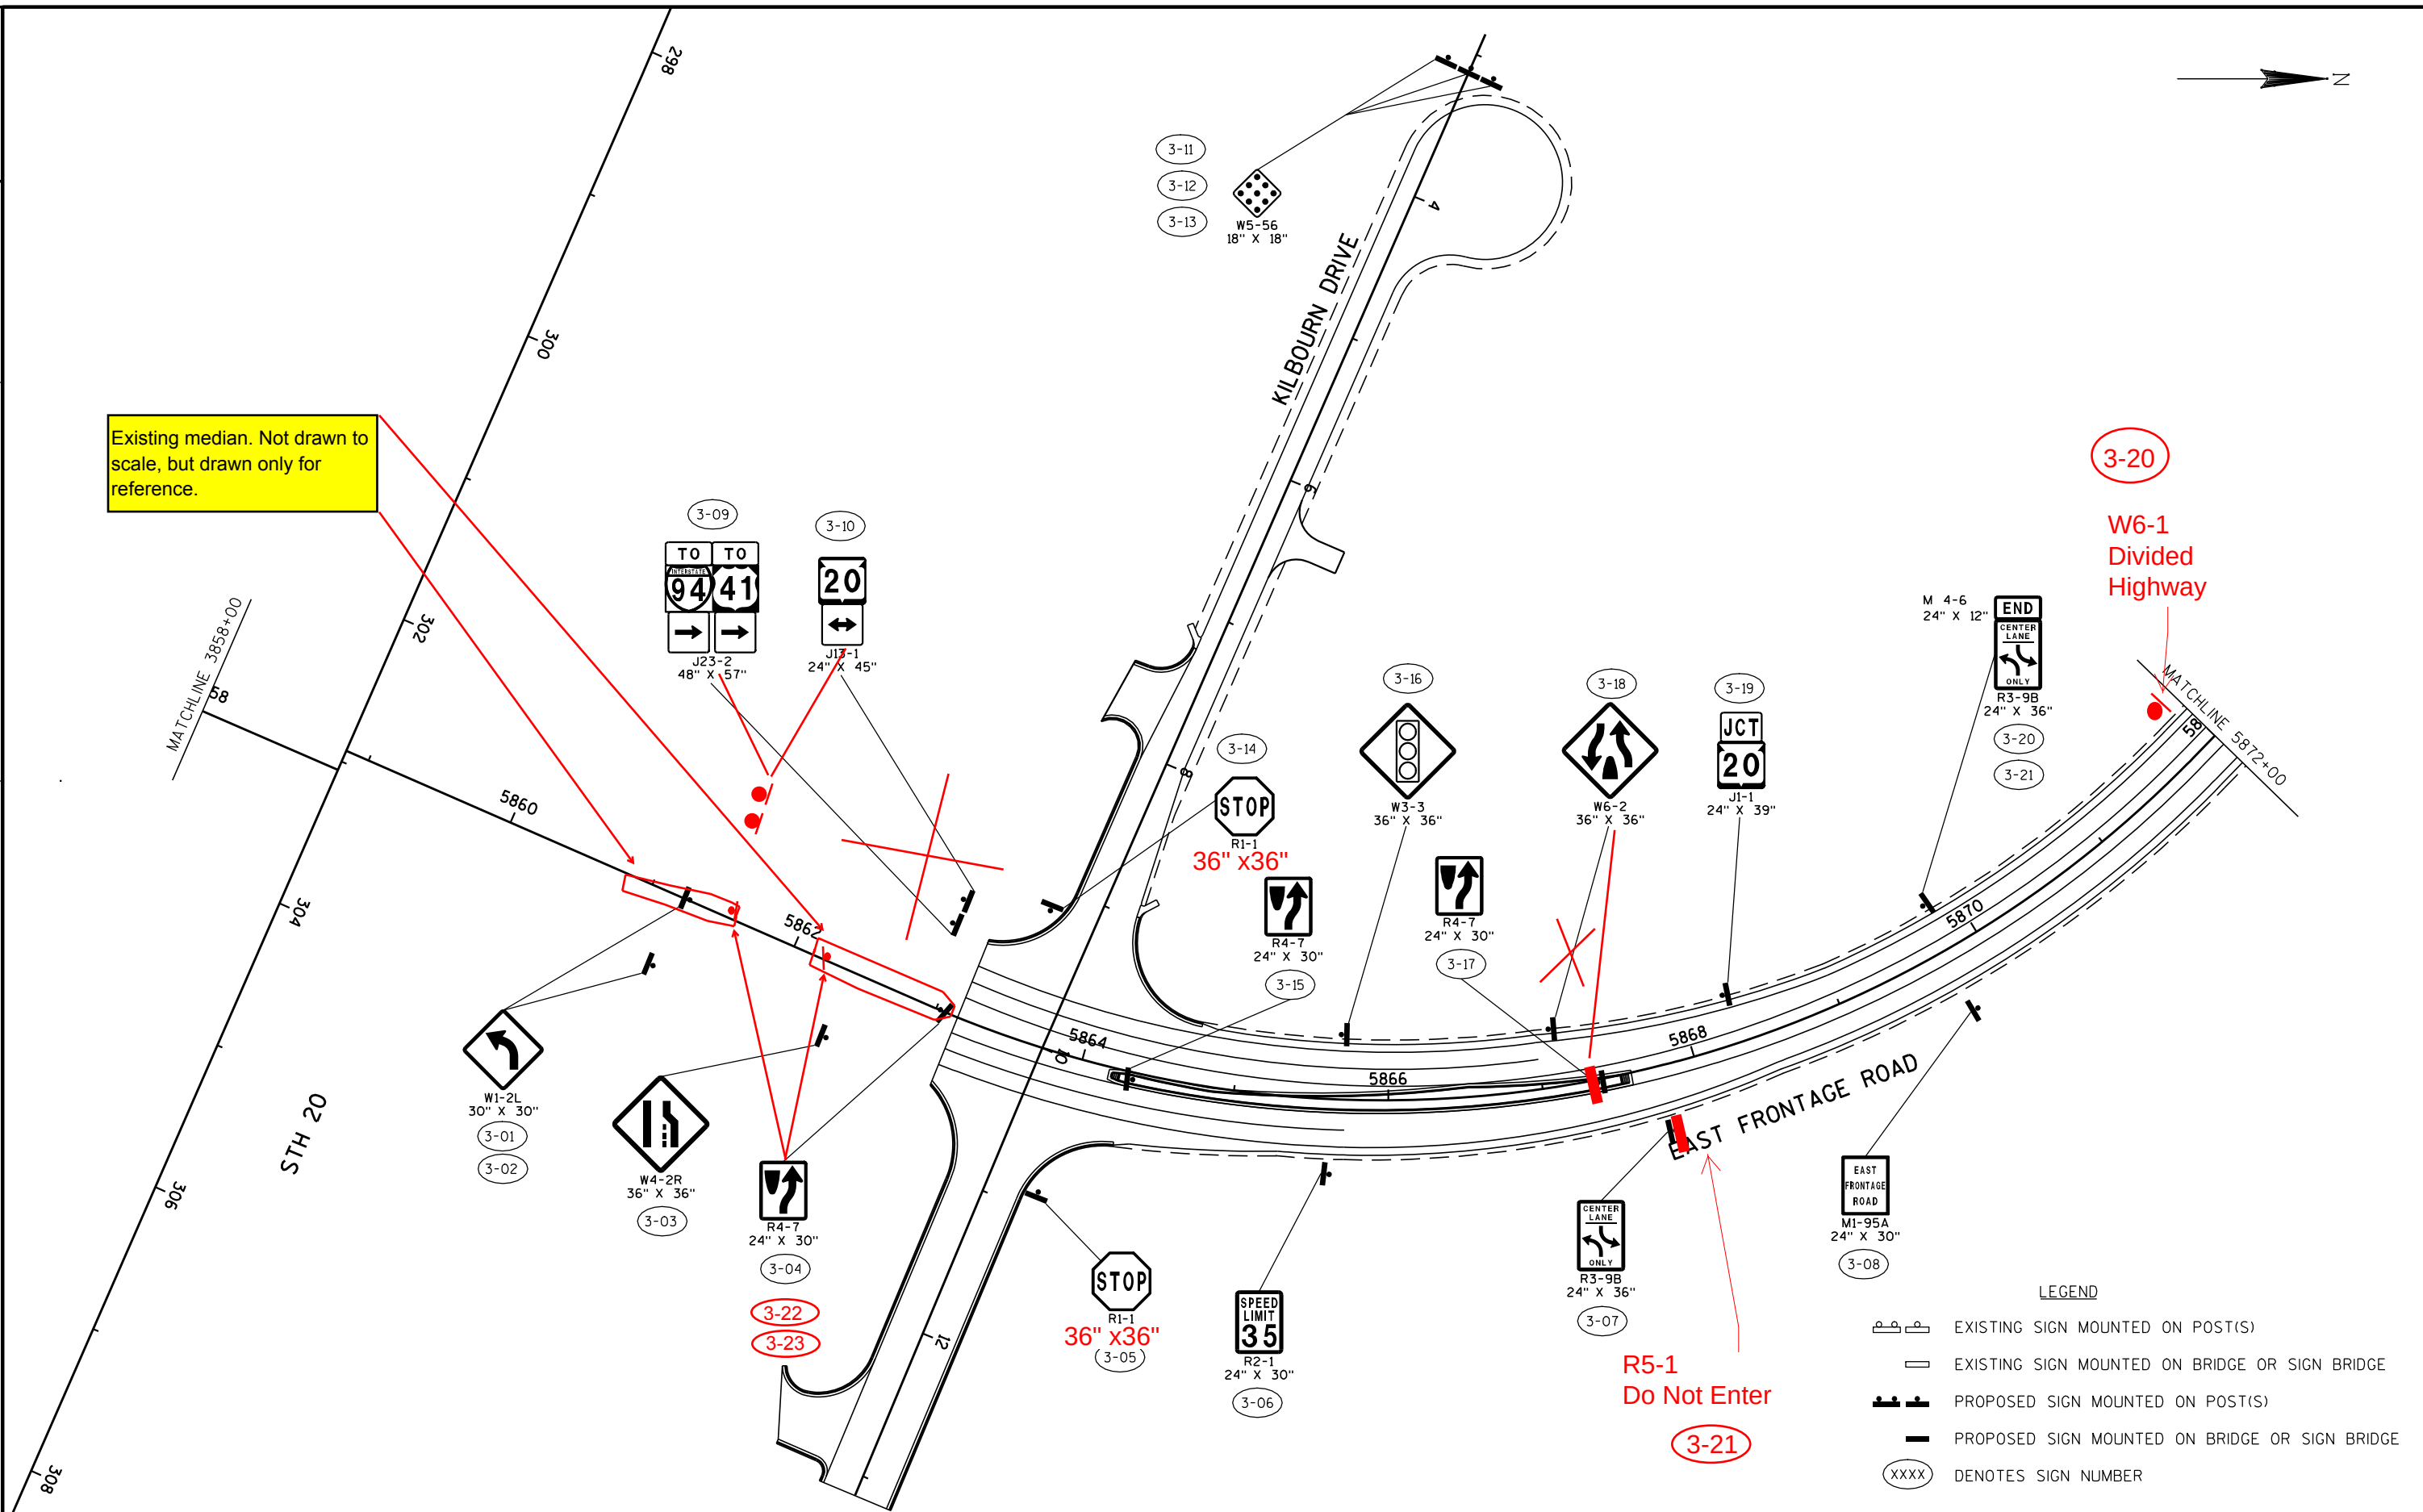

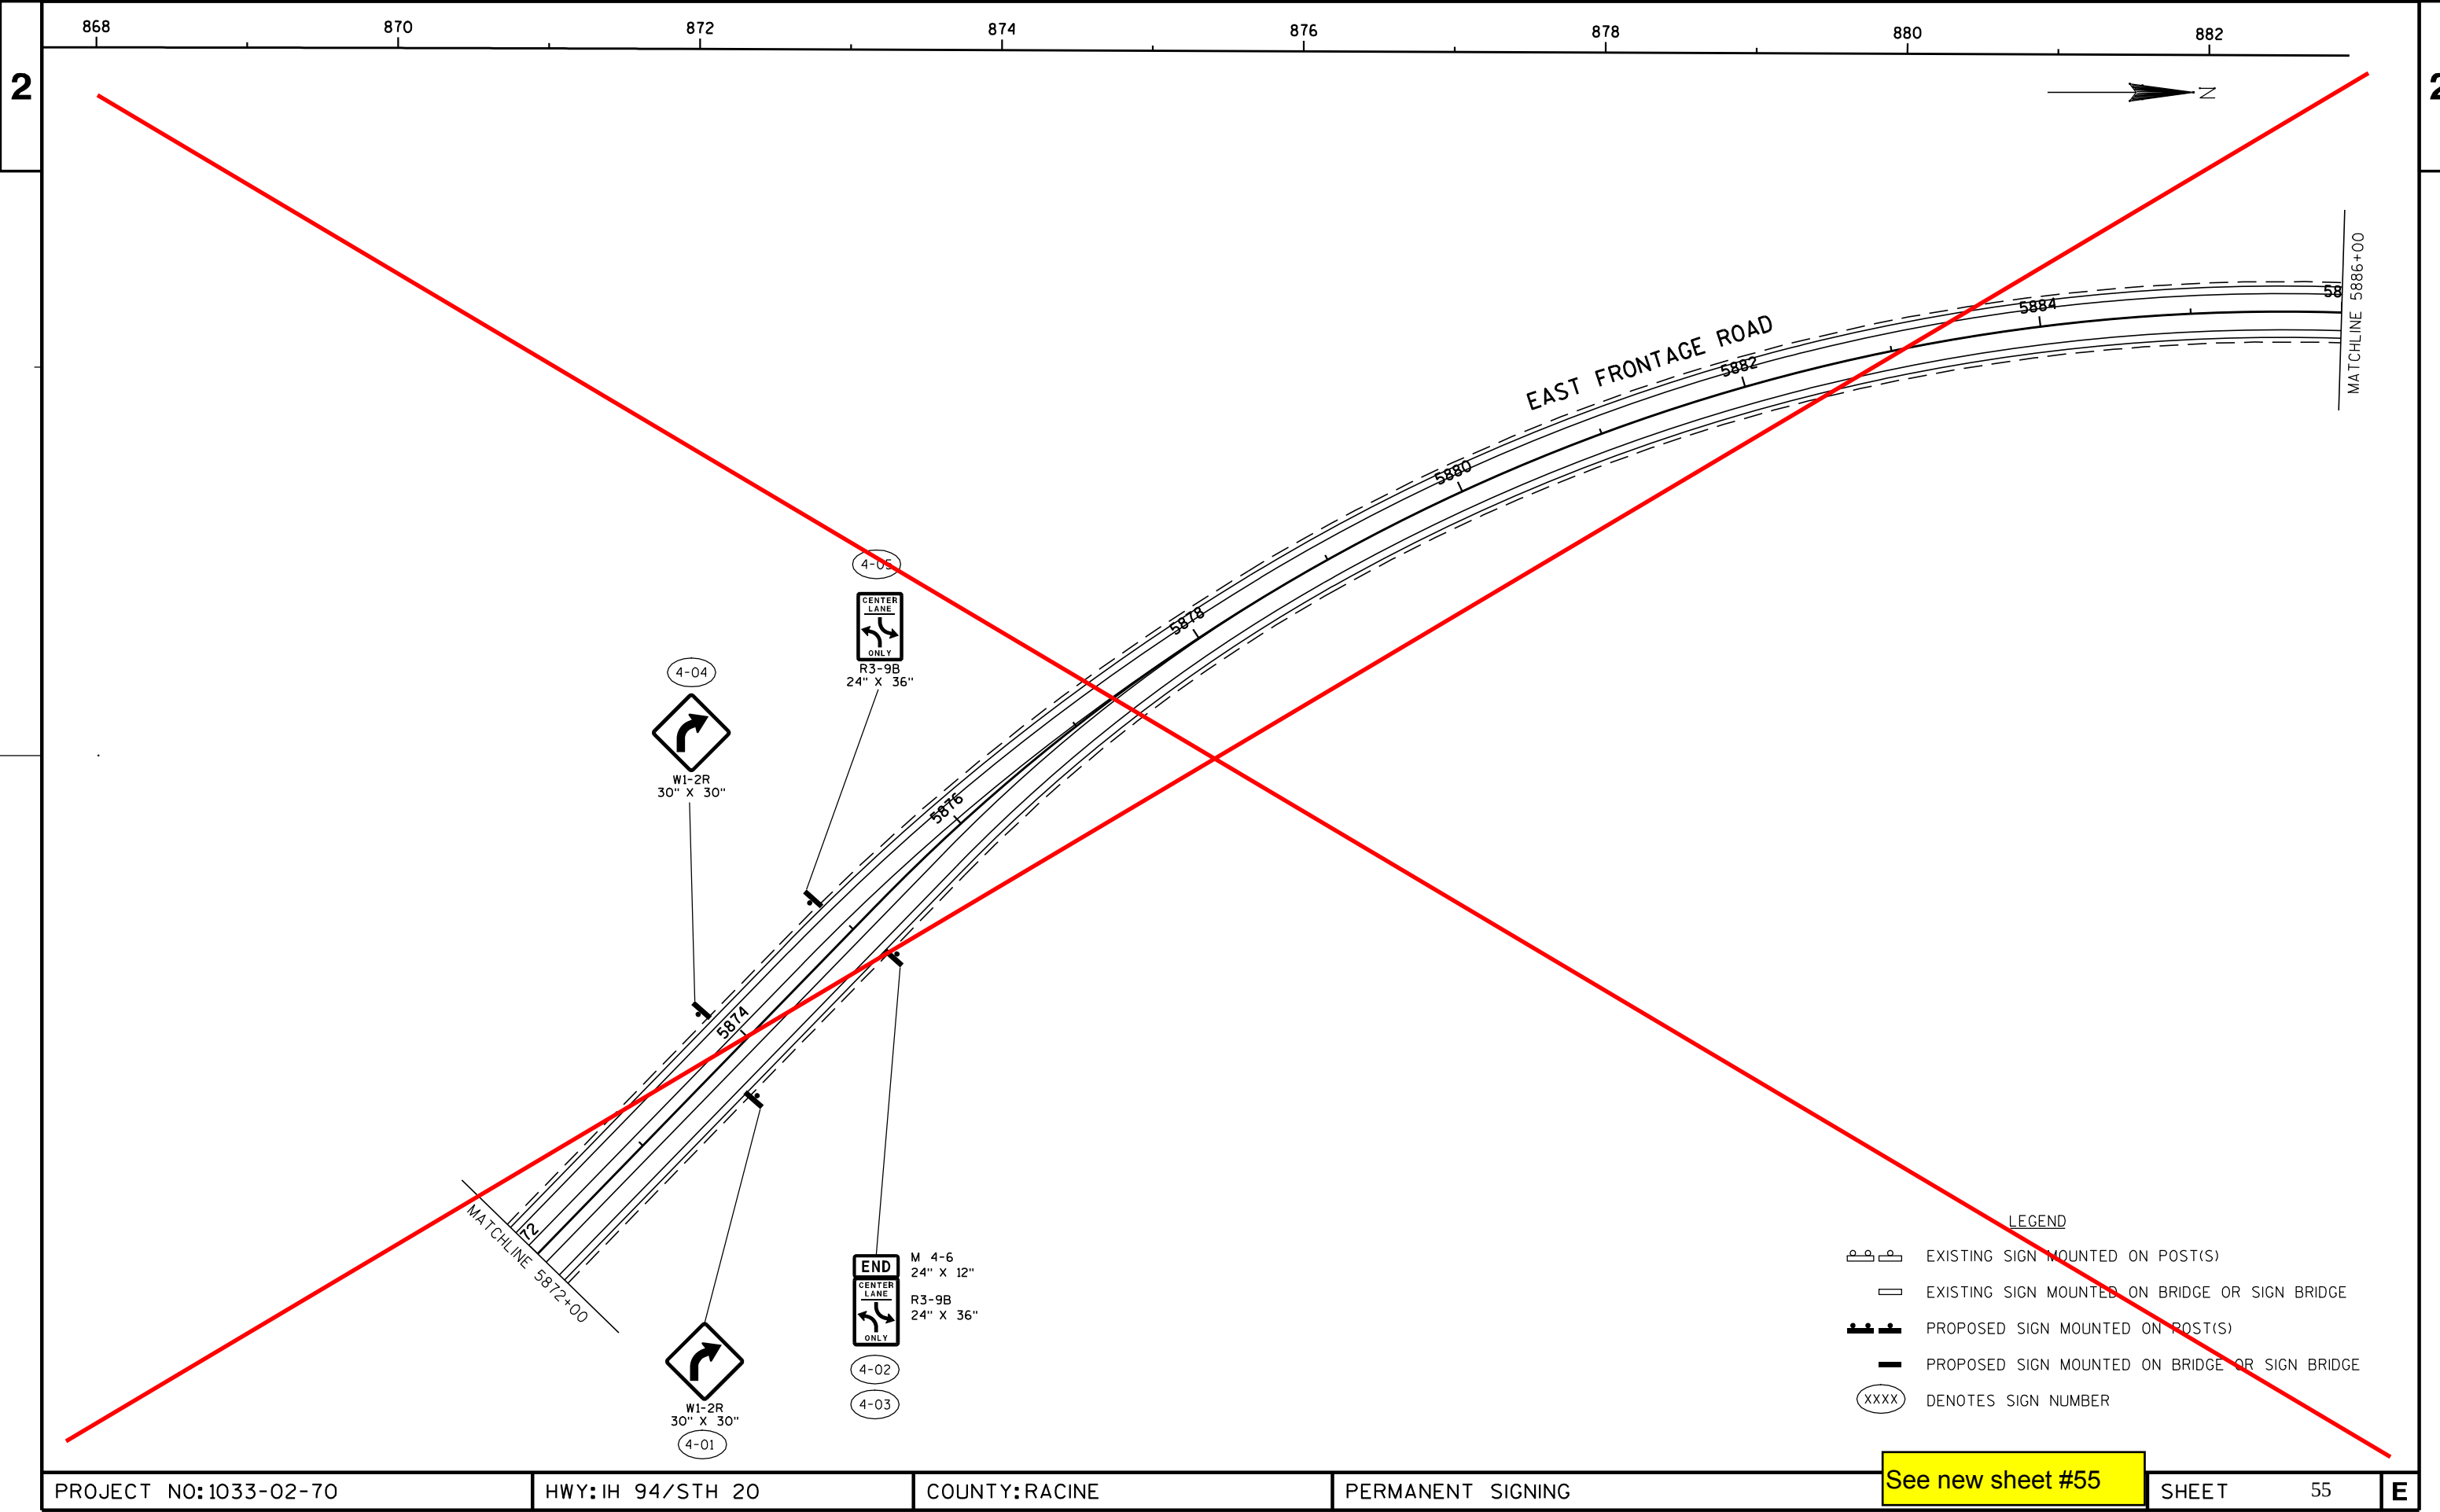

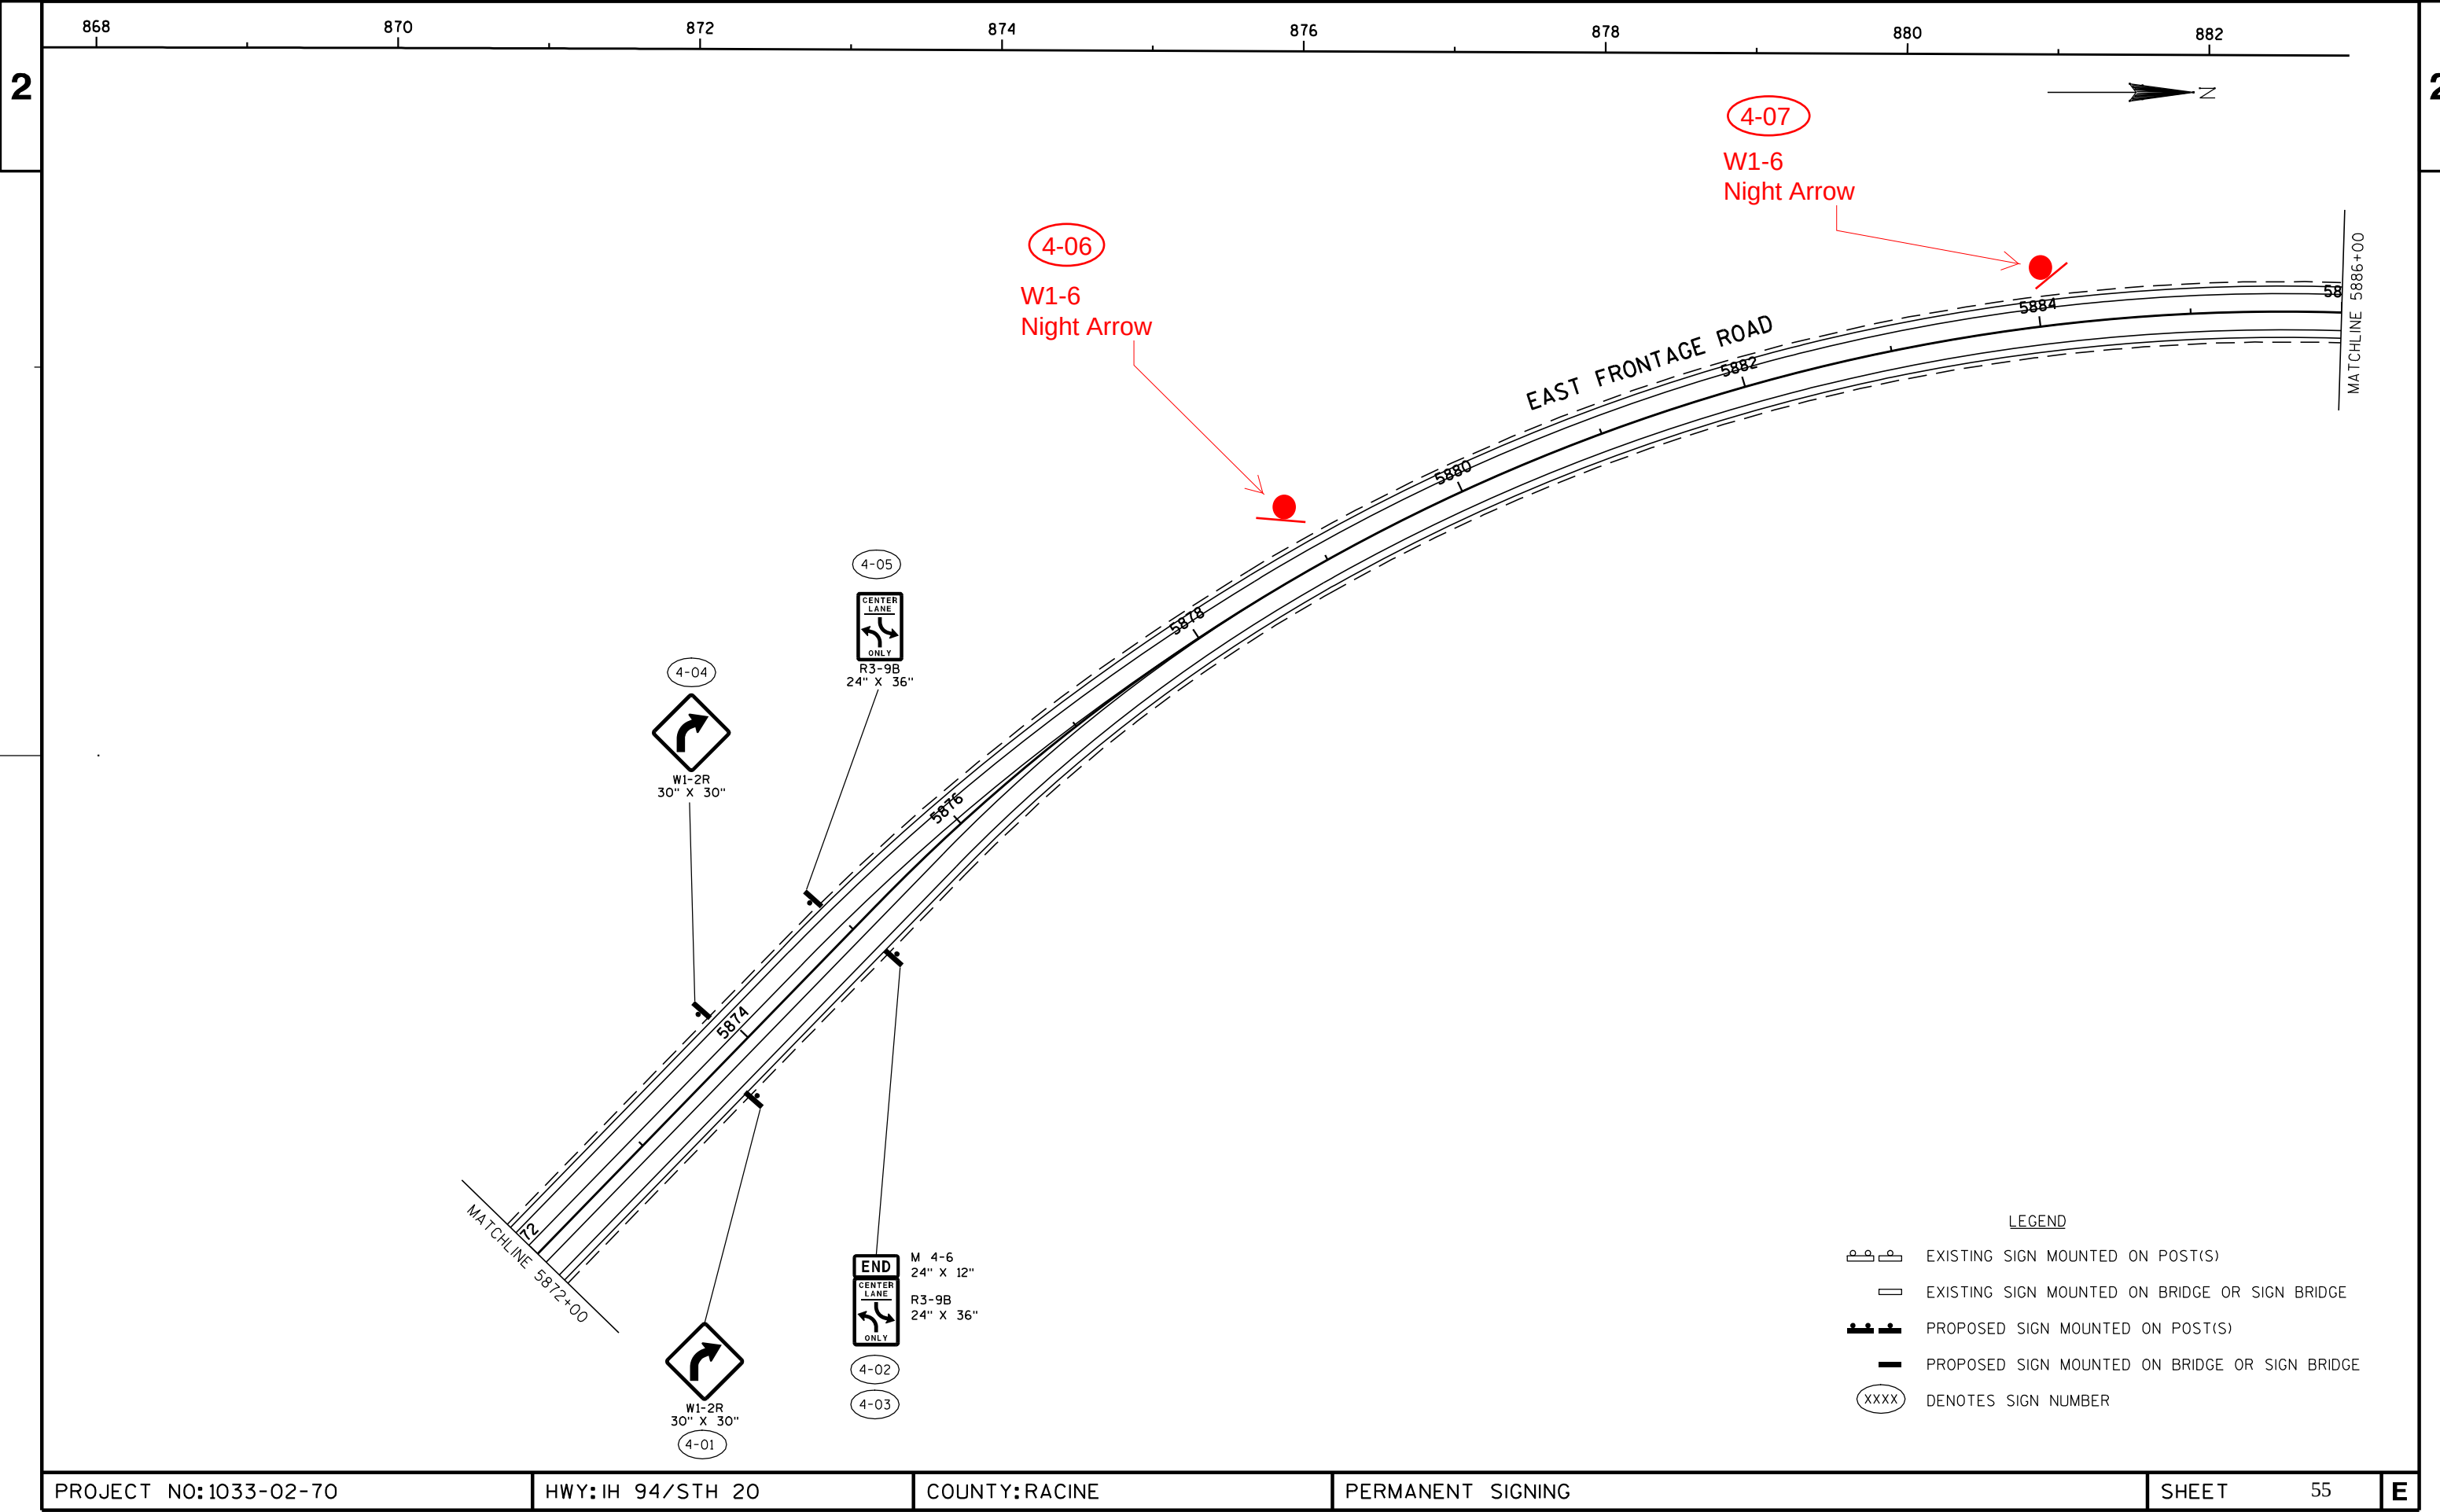

PROJECT NO:1033-02-70

HWY: IH 94/STH 20

COUNTY: RACINE

PERMANENT SIGNING

SHEET 55

E

MATCHLINE 5886+00

884

886

888

890

892

894

896

898

JCT
COUNTY
C
J1-1
24" X 39"
5-01

W3-1
36" X 36"
5-02

EAST FRONTAGE ROAD

5-10
M1-95A
24" X 30"
EAST FRONTAGE ROAD
M6-4
21" X 21"

5-11
30" X 30"
R1-1
5-12
STOP
ALL WAY
R1-4
18" X 6"

30" X 30"
R1-1
STOP
ALL WAY
R1-4
18" X 6"
5-03
5-04
COUNTY
C
J13-1
24" X 45"
5-05

5-13
COUNTY
C
J13-1
24" X 45"

5-14
30" X 30"
R1-1
STOP
ALL WAY
R1-4
18" X 6"

30" X 30"
R1-1
STOP
ALL WAY
R1-4
18" X 6"
5-06
5-07


24" X 30"
M1-95A
EAST FRONTAGE ROAD
M6-4
21" X 21"
5-08


5-16
W3-1
36" X 36"

5-17
JCT
COUNTY
C
J1-1
24" X 39"

LEGEND


- EXISTING SIGN MOUNTED ON POST(S)
 EXISTING SIGN MOUNTED ON BRIDGE OR SIGN BRIDGE
 PROPOSED SIGN MOUNTED ON POST(S)
 PROPOSED SIGN MOUNTED ON BRIDGE OR SIGN BRIDGE
 DENOTES SIGN NUMBER

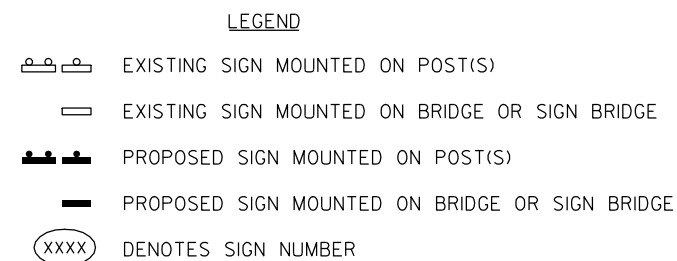

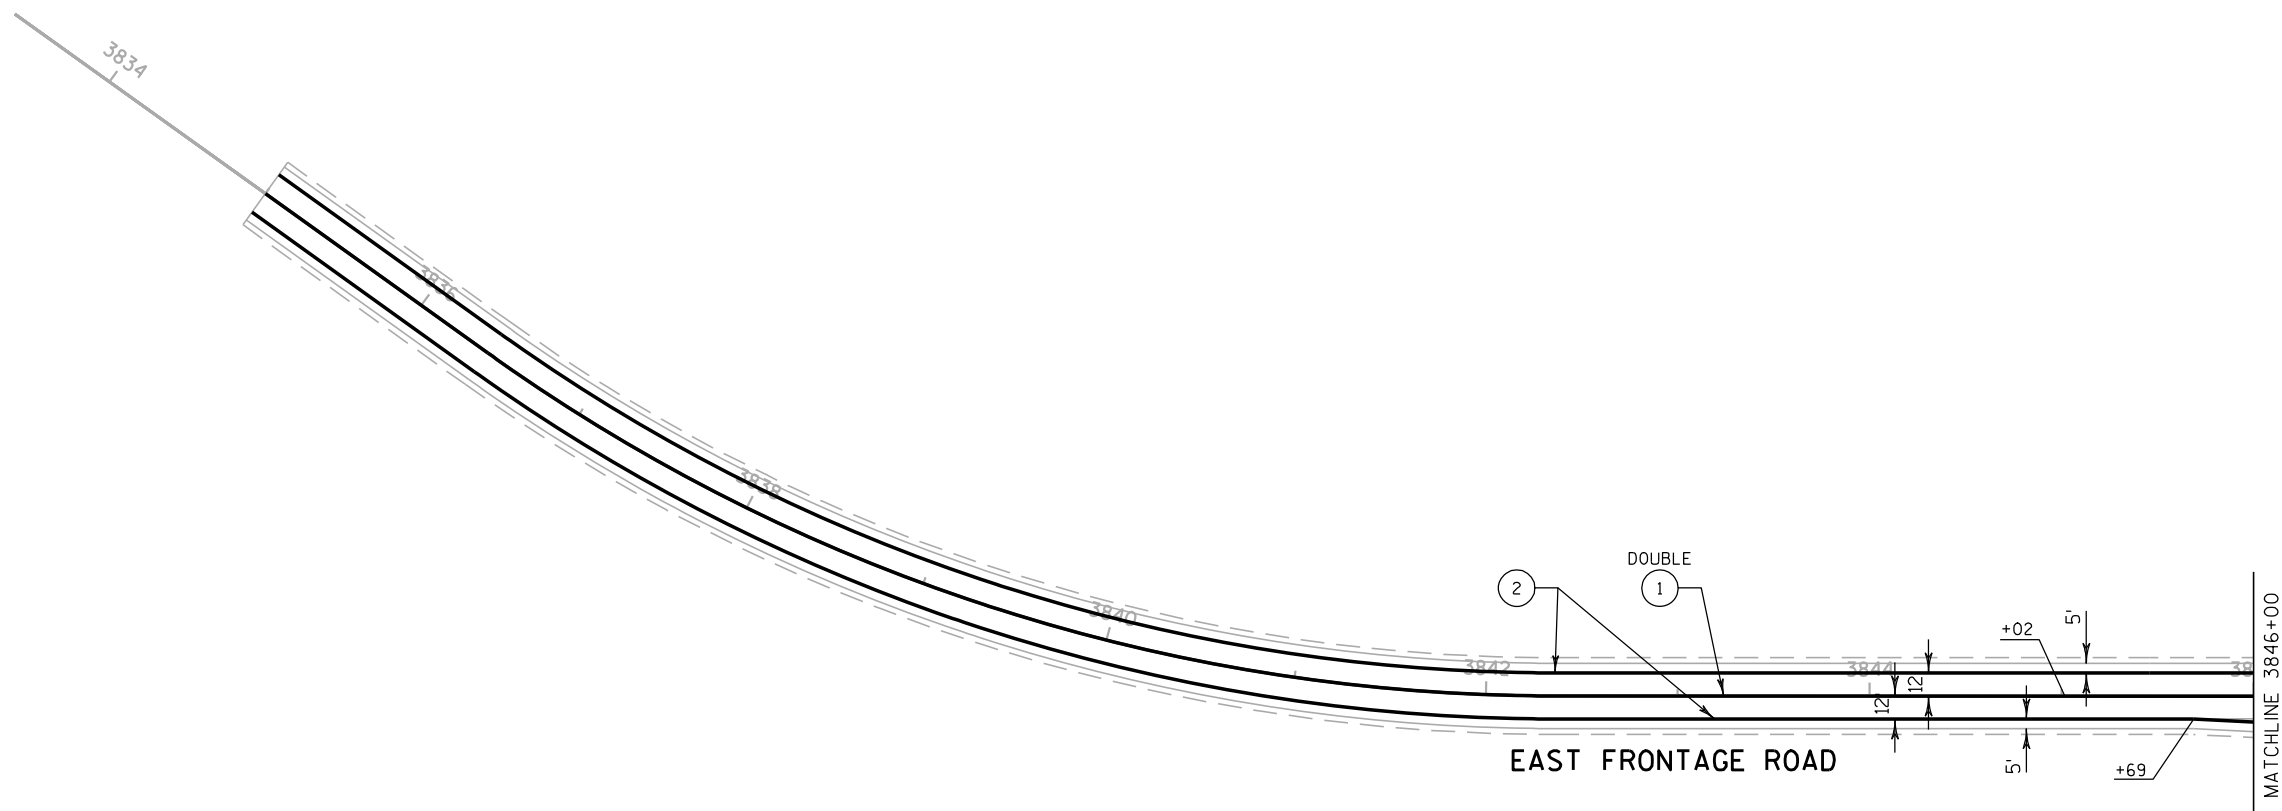


PAVEMENT MARKING LEGEND

- ① PAVEMENT MARKING EPOXY 4-INCH (YELLOW)
- ② PAVEMENT MARKING EPOXY 4-INCH (WHITE)
- ③ PAVEMENT MARKING EPOXY 4-INCH (DASHED WHITE)
(12.5 FT LINE, 37.5 FT SKIP)
- ⑦ PAVEMENT MARKING STOPLINE EPOXY 18-INCH (WHITE)
- ⑩ PAVEMENT MARKING DIAGONAL EPOXY 12-INCH (YELLOW)
- ⑩ PAVEMENT MARKING ARROWS EPOXY TYPE 2
- ⑩ PAVEMENT MARKING CURB EPOXY (YELLOW)
- ⑩ PAVEMENT MARKING ISLAND NOSE EPOXY
- ⑩ PAVEMENT MARKING EPOXY 4-INCH (DASHED YELLOW)
(12.5 FT LINE, 37.5 FT SKIP)

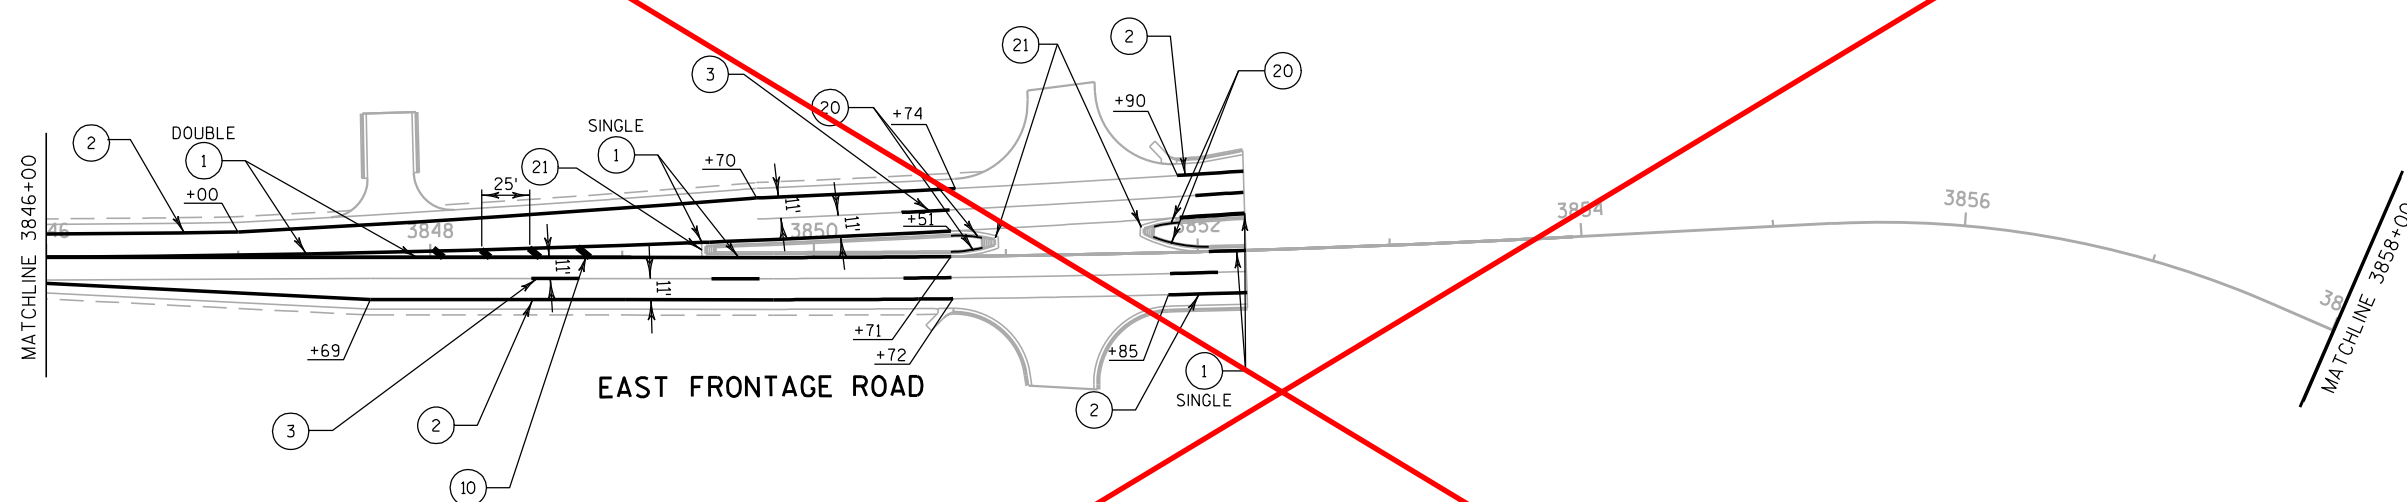


PAVEMENT MARKING LEGEND

- ① PAVEMENT MARKING EPOXY 4-INCH (YELLOW)
- ② PAVEMENT MARKING EPOXY 4-INCH (WHITE)
- ③ PAVEMENT MARKING EPOXY 4-INCH (DASHED WHITE)
(12.5 FT LINE, 37.5 FT SKIP)
- ⑦ PAVEMENT MARKING STOPLINE EPOXY 18-INCH (WHITE)
- ⑩ PAVEMENT MARKING DIAGONAL EPOXY 12-INCH (YELLOW)
- ⑯ PAVEMENT MARKING ARROWS EPOXY TYPE 2
- ⑳ PAVEMENT MARKING CURB EPOXY (YELLOW)
- ㉑ PAVEMENT MARKING ISLAND NOSE EPOXY
- ㉒ PAVEMENT MARKING EPOXY 4-INCH (DASHED YELLOW)
(12.5 FT LINE, 37.5 FT SKIP)

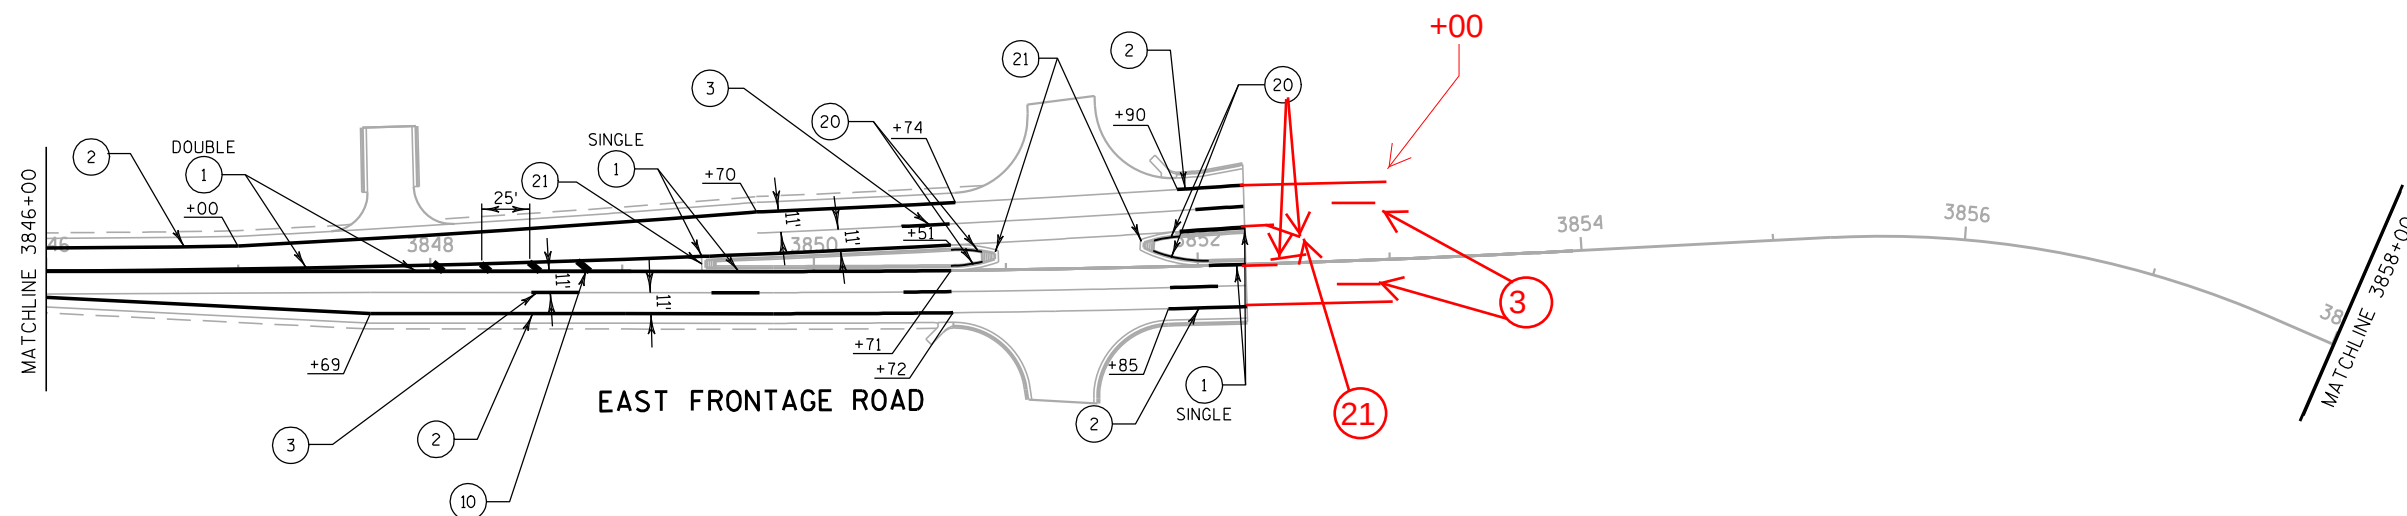

PAVEMENT MARKING LEGEND

- ① PAVEMENT MARKING EPOXY 4-INCH (YELLOW)
- ② PAVEMENT MARKING EPOXY 4-INCH (WHITE)
- ③ PAVEMENT MARKING EPOXY 4-INCH (DASHED WHITE)
(12.5 FT LINE, 37.5 FT SKIP)
- ⑦ PAVEMENT MARKING STOPLINE EPOXY 18-INCH (WHITE)
- ⑩ PAVEMENT MARKING DIAGONAL EPOXY 12-INCH (YELLOW)
- ⑯ PAVEMENT MARKING ARROWS EPOXY TYPE 2
- ⑳ PAVEMENT MARKING CURB EPOXY (YELLOW)
- ㉑ PAVEMENT MARKING ISLAND NOSE EPOXY
- ㉓ PAVEMENT MARKING EPOXY 4-INCH (DASHED YELLOW)
(12.5 FT LINE, 37.5 FT SKIP)

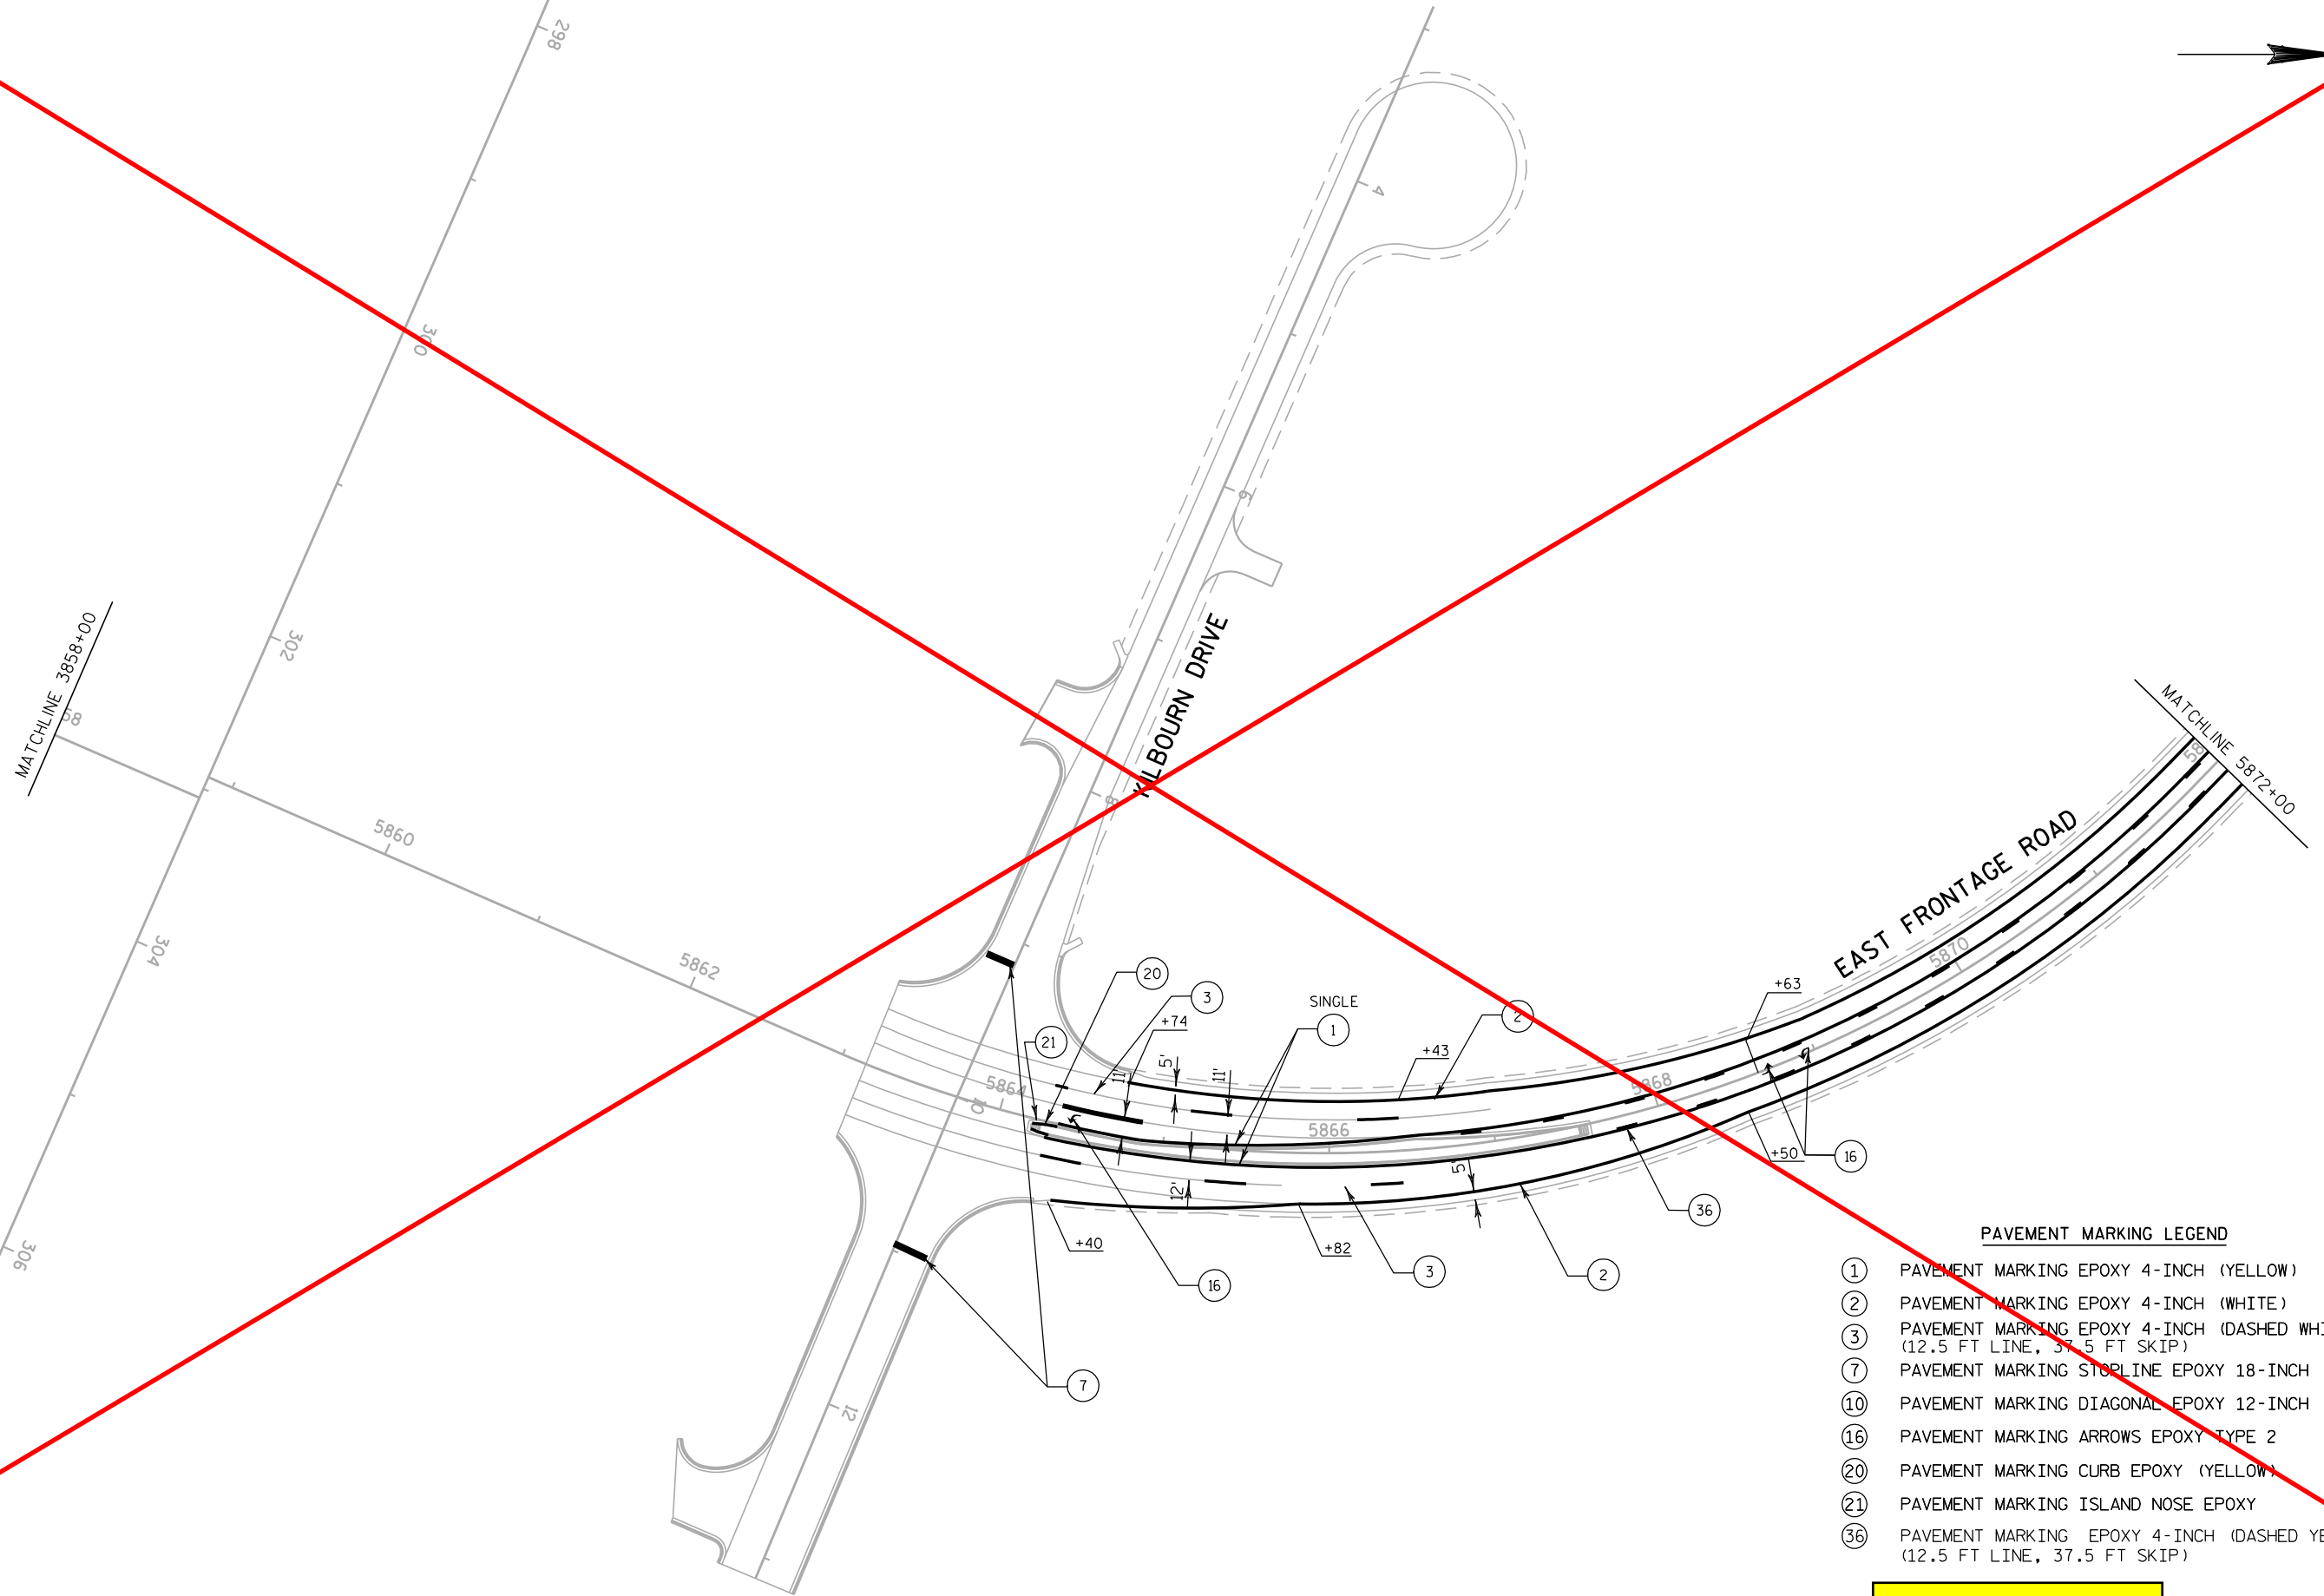

PAVEMENT MARKING LEGEND

- ① PAVEMENT MARKING EPOXY 4-INCH (YELLOW)
- ② PAVEMENT MARKING EPOXY 4-INCH (WHITE)
- ③ PAVEMENT MARKING EPOXY 4-INCH (DASHED WHITE)
(12.5 FT LINE, 37.5 FT SKIP)
- ⑦ PAVEMENT MARKING STOPLINE EPOXY 18-INCH (WHITE)
- ⑩ PAVEMENT MARKING DIAGONAL EPOXY 12-INCH (YELLOW)
- ⑯ PAVEMENT MARKING ARROWS EPOXY TYPE 2
- ⑳ PAVEMENT MARKING CURB EPOXY (YELLOW)
- ㉑ PAVEMENT MARKING ISLAND NOSE EPOXY
- ㉓ PAVEMENT MARKING EPOXY 4-INCH (DASHED YELLOW)
(12.5 FT LINE, 37.5 FT SKIP)

PROJECT NO:1033-02-70

HWY: IH 94/STH 20


COUNTY: RACINE


PAVEMENT MARKING

See new sheet #59

SHEET 59


E

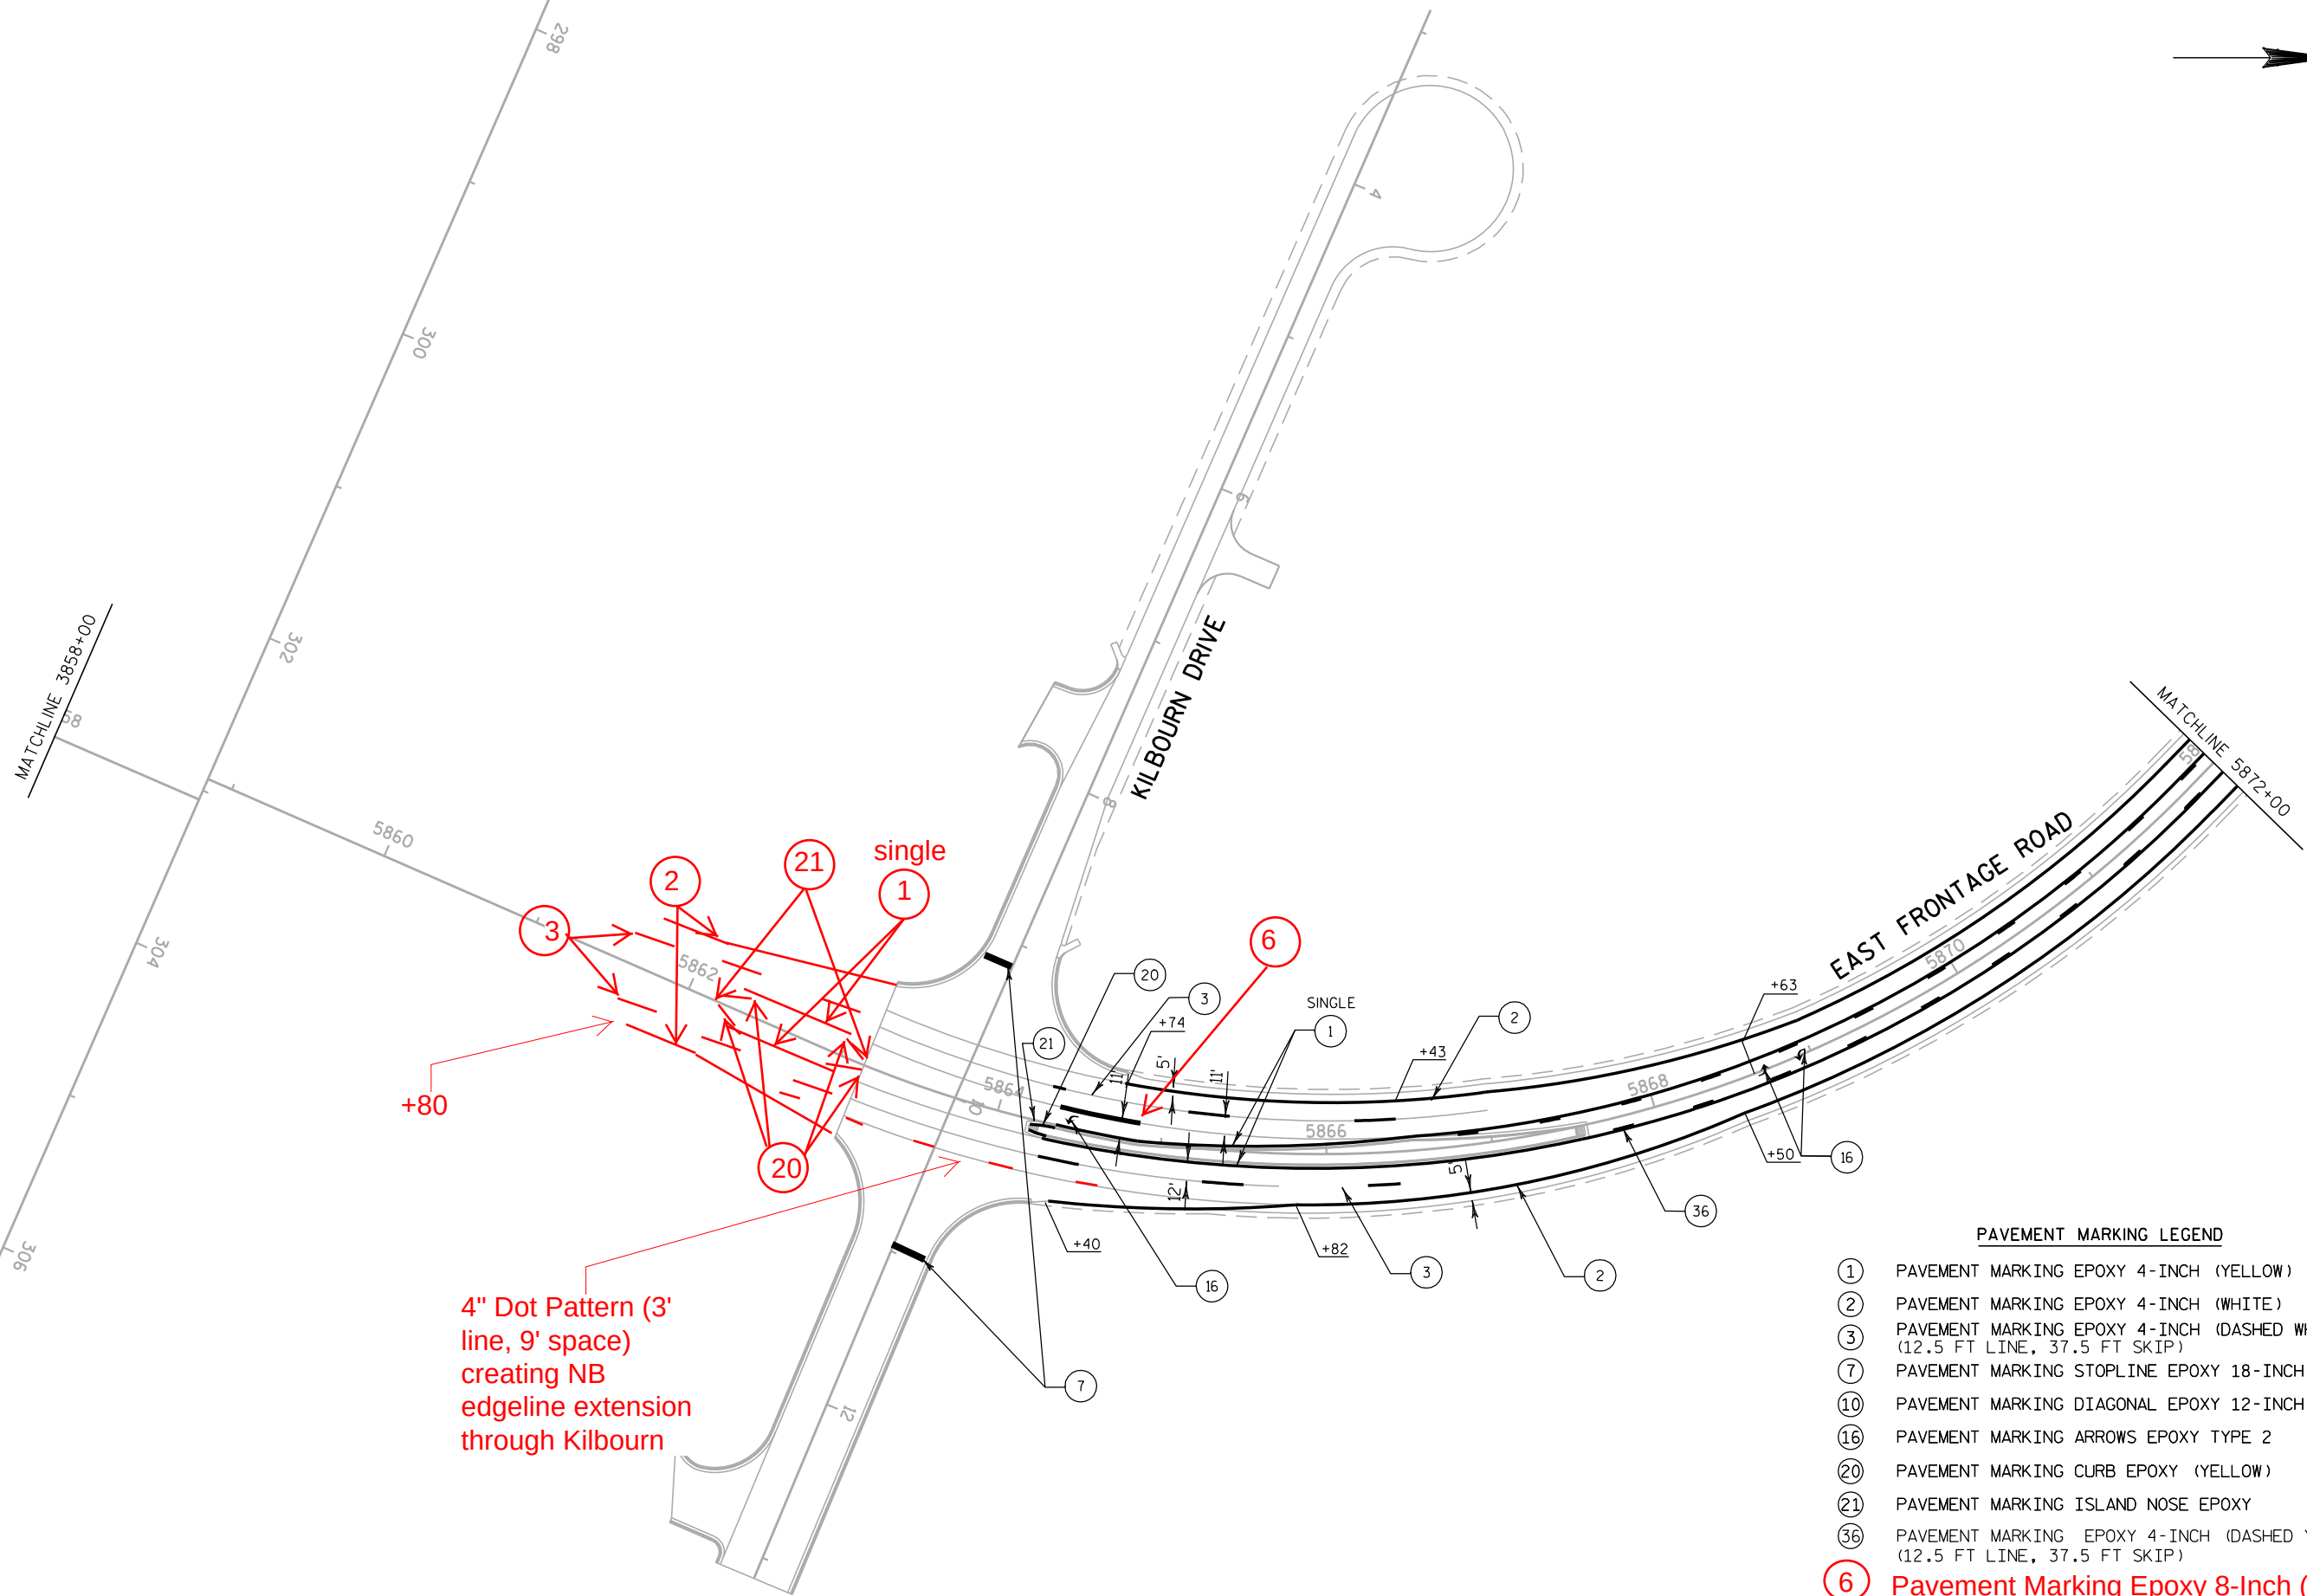


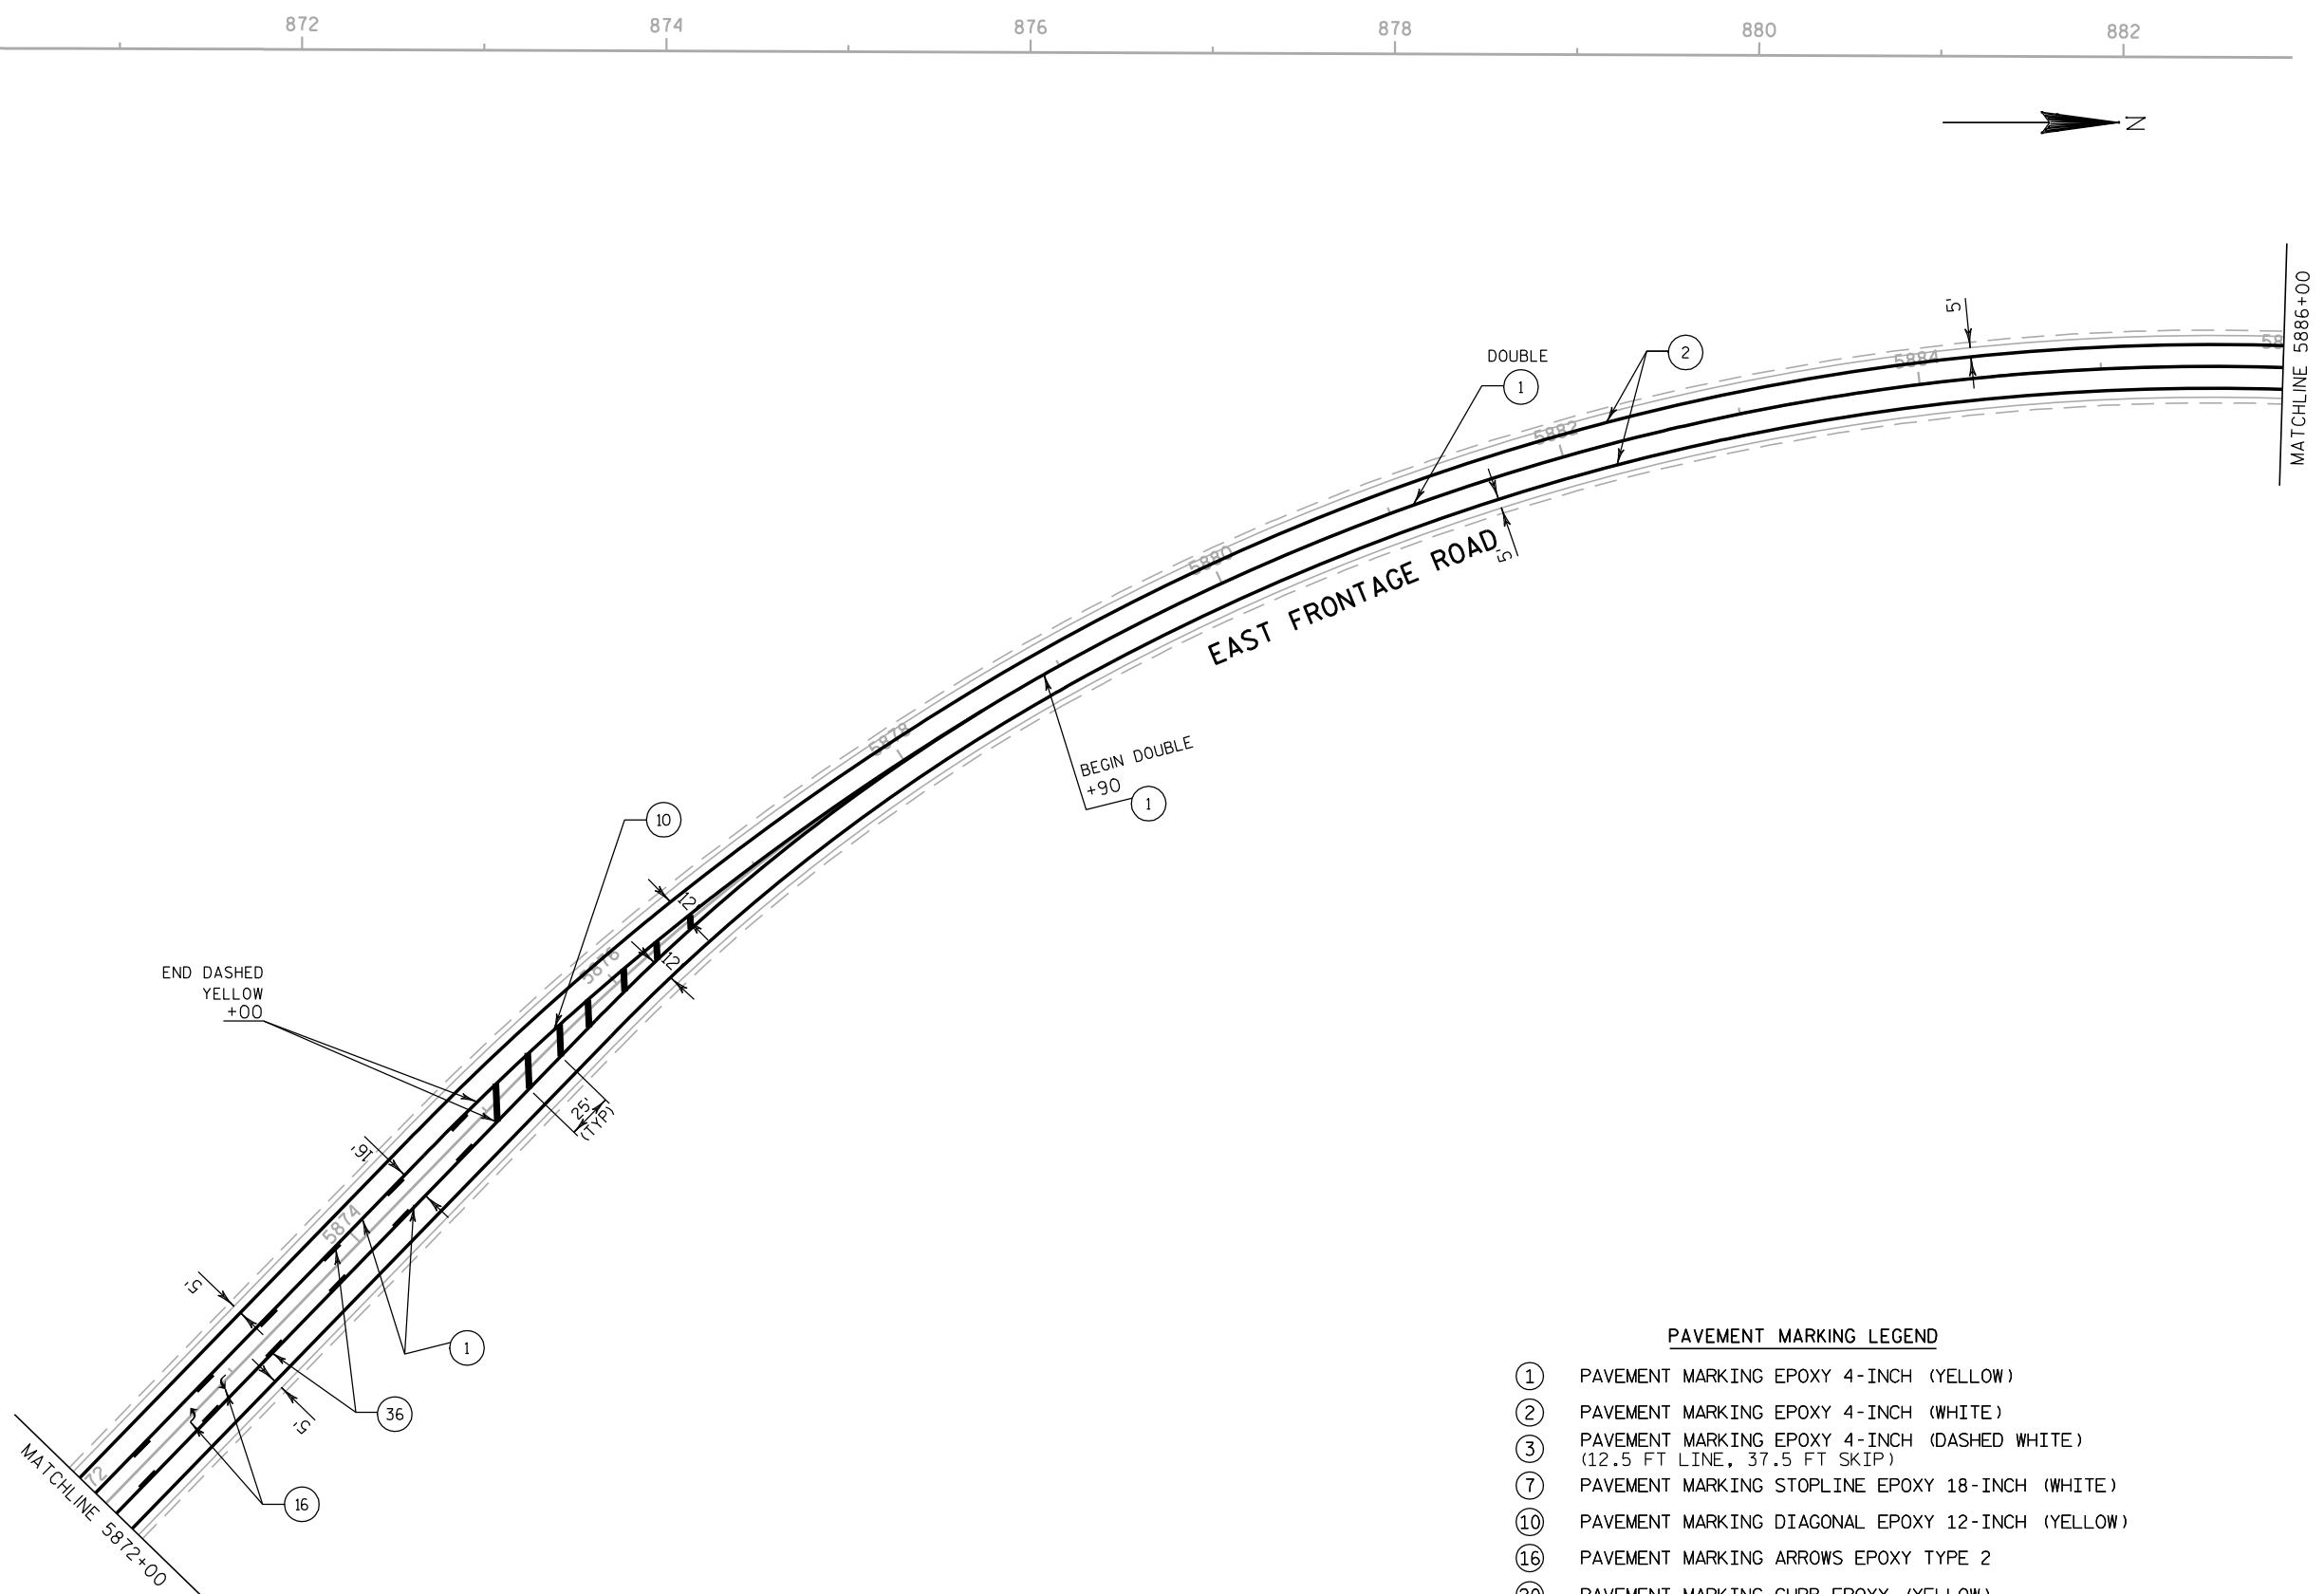


PAVEMENT MARKING LEGEND

①	PAVEMENT MARKING EPOXY 4-INCH (YELLOW)
②	PAVEMENT MARKING EPOXY 4-INCH (WHITE)
③	PAVEMENT MARKING EPOXY 4-INCH (DASHED WHITE) (12.5 FT LINE, 37.5 FT SKIP)
⑦	PAVEMENT MARKING STOPLINE EPOXY 18-INCH (WHITE)
⑩	PAVEMENT MARKING DIAGONAL EPOXY 12-INCH (YELLOW)
⑬	PAVEMENT MARKING ARROWS EPOXY TYPE 2
⑰	PAVEMENT MARKING CURB EPOXY (YELLOW)
⑳	PAVEMENT MARKING ISLAND NOSE EPOXY
㉔	PAVEMENT MARKING EPOXY 4-INCH (DASHED YELLOW) (12.5 FT LINE, 37.5 FT SKIP)

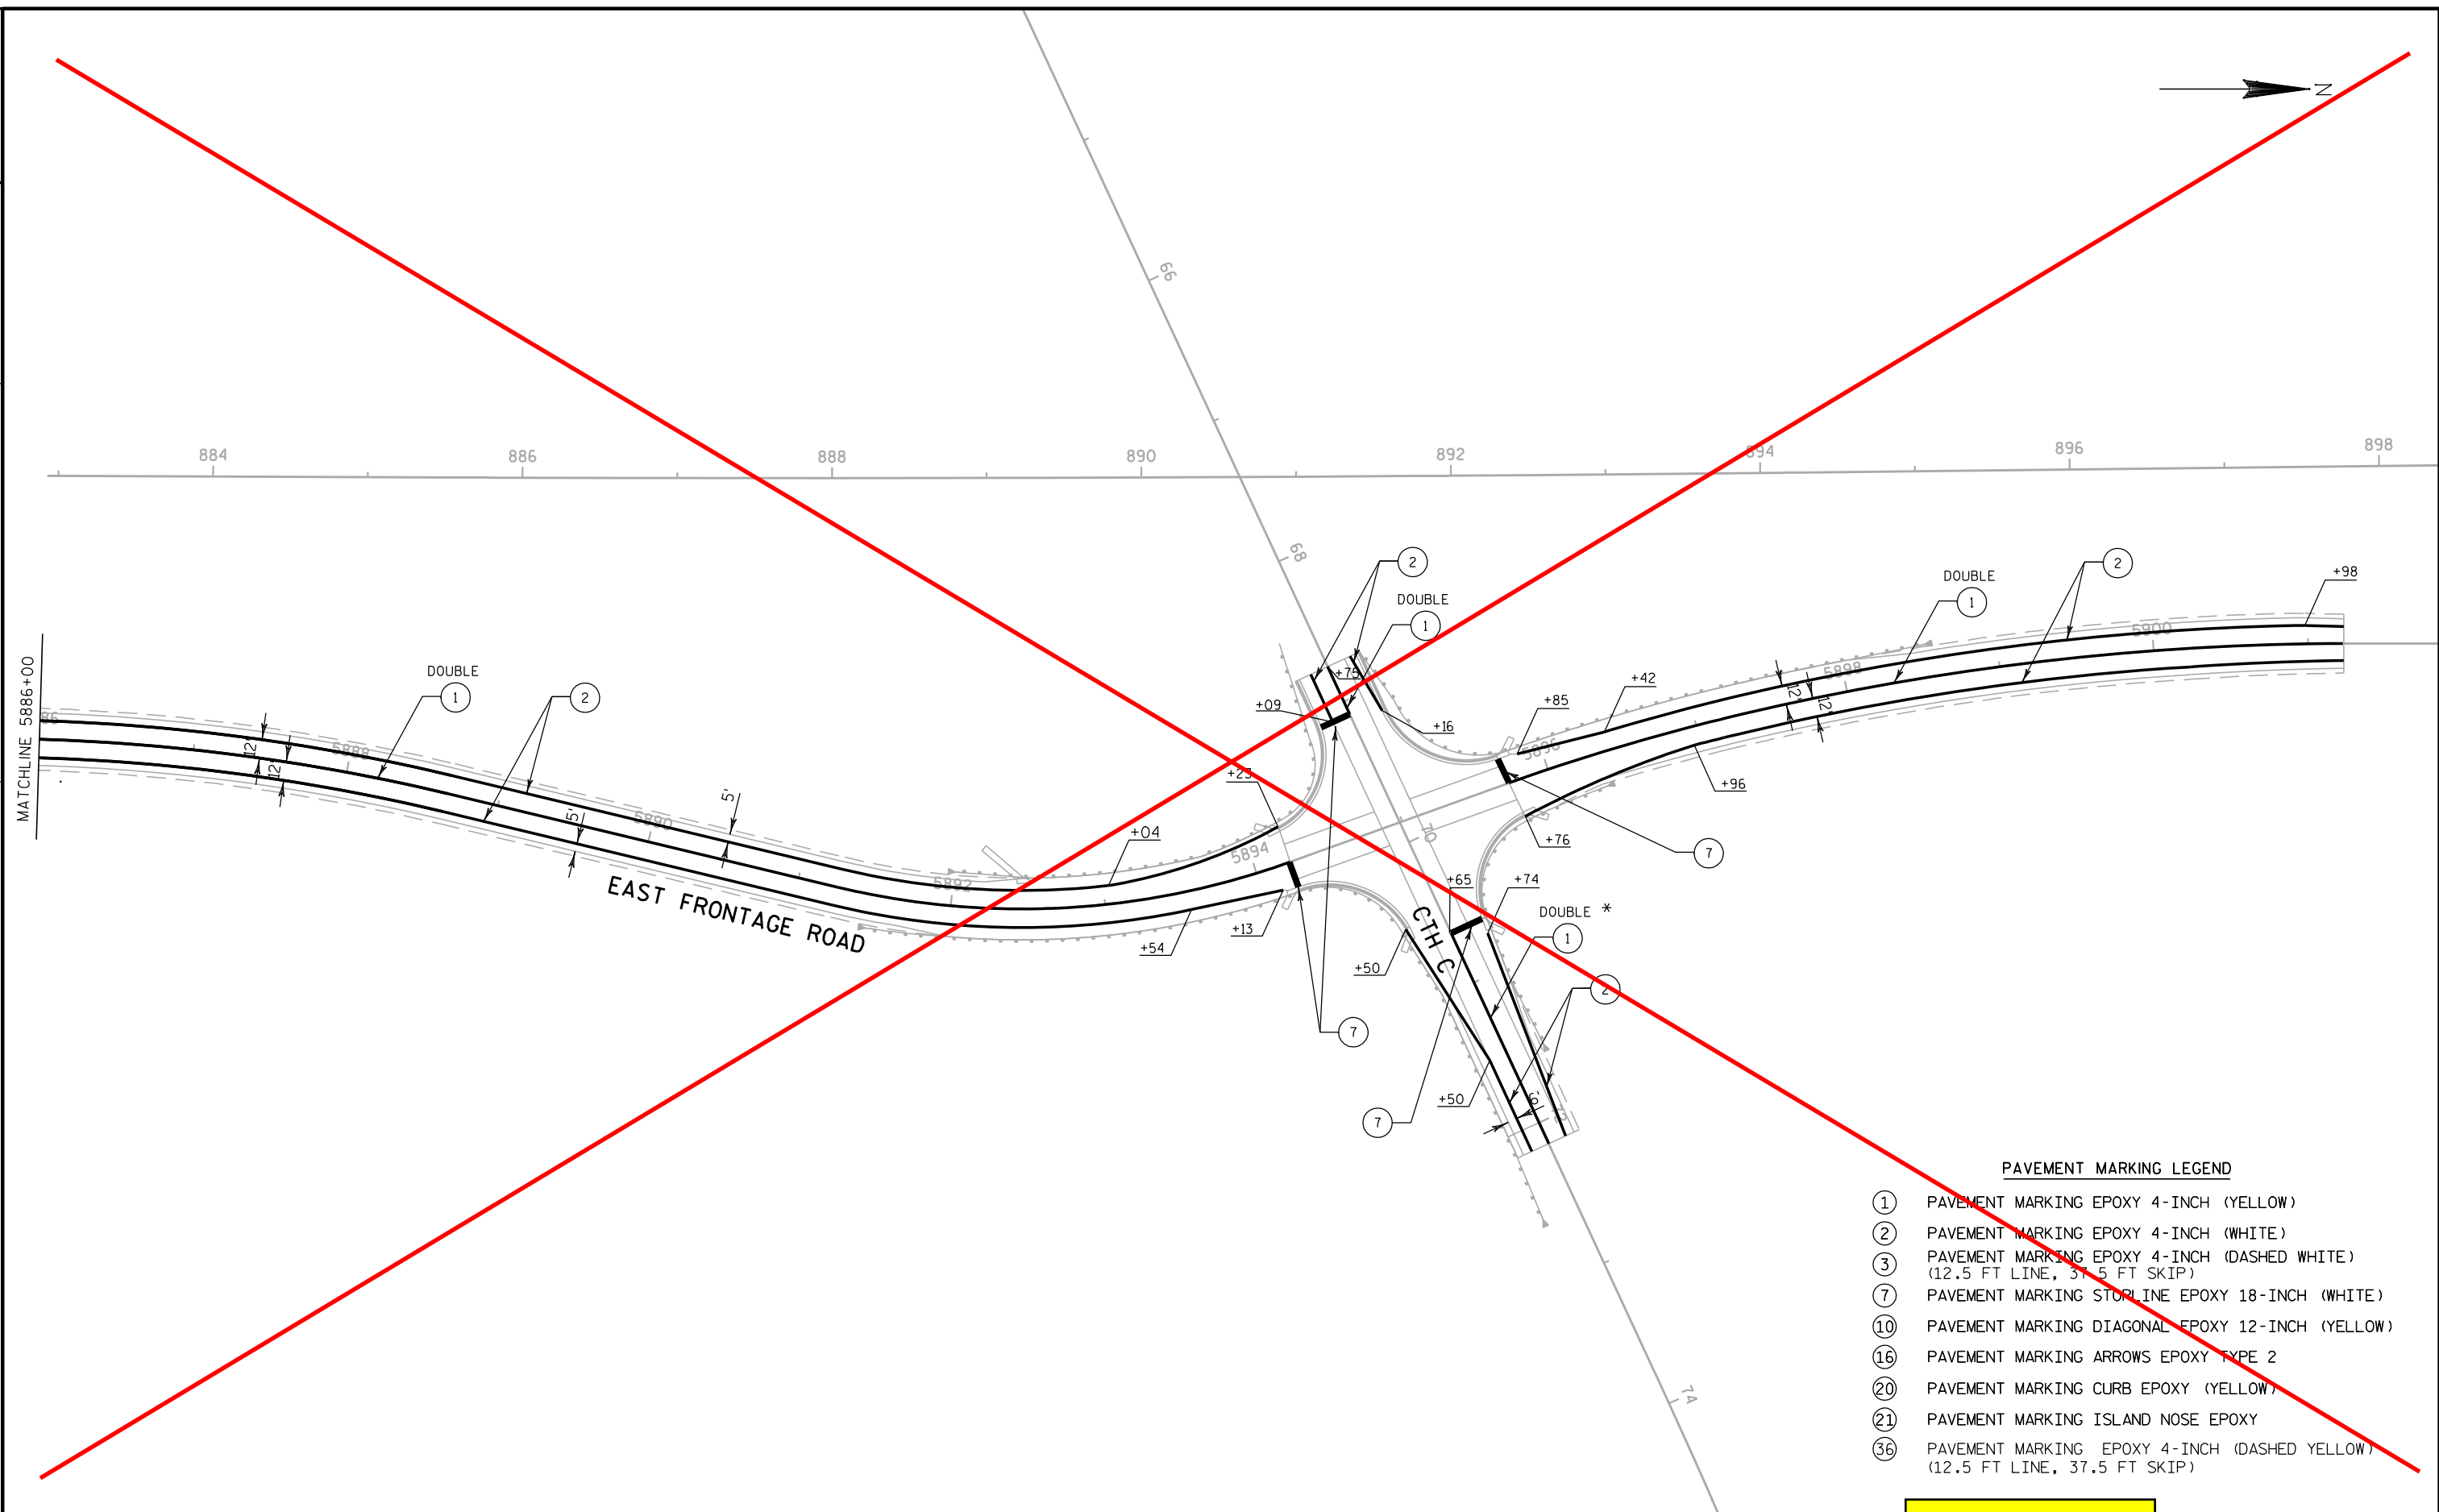

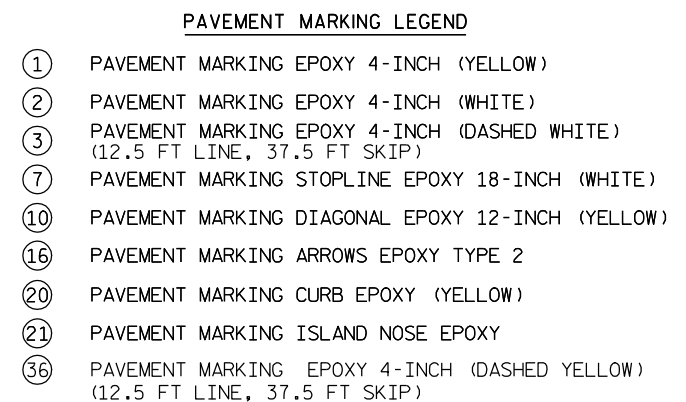

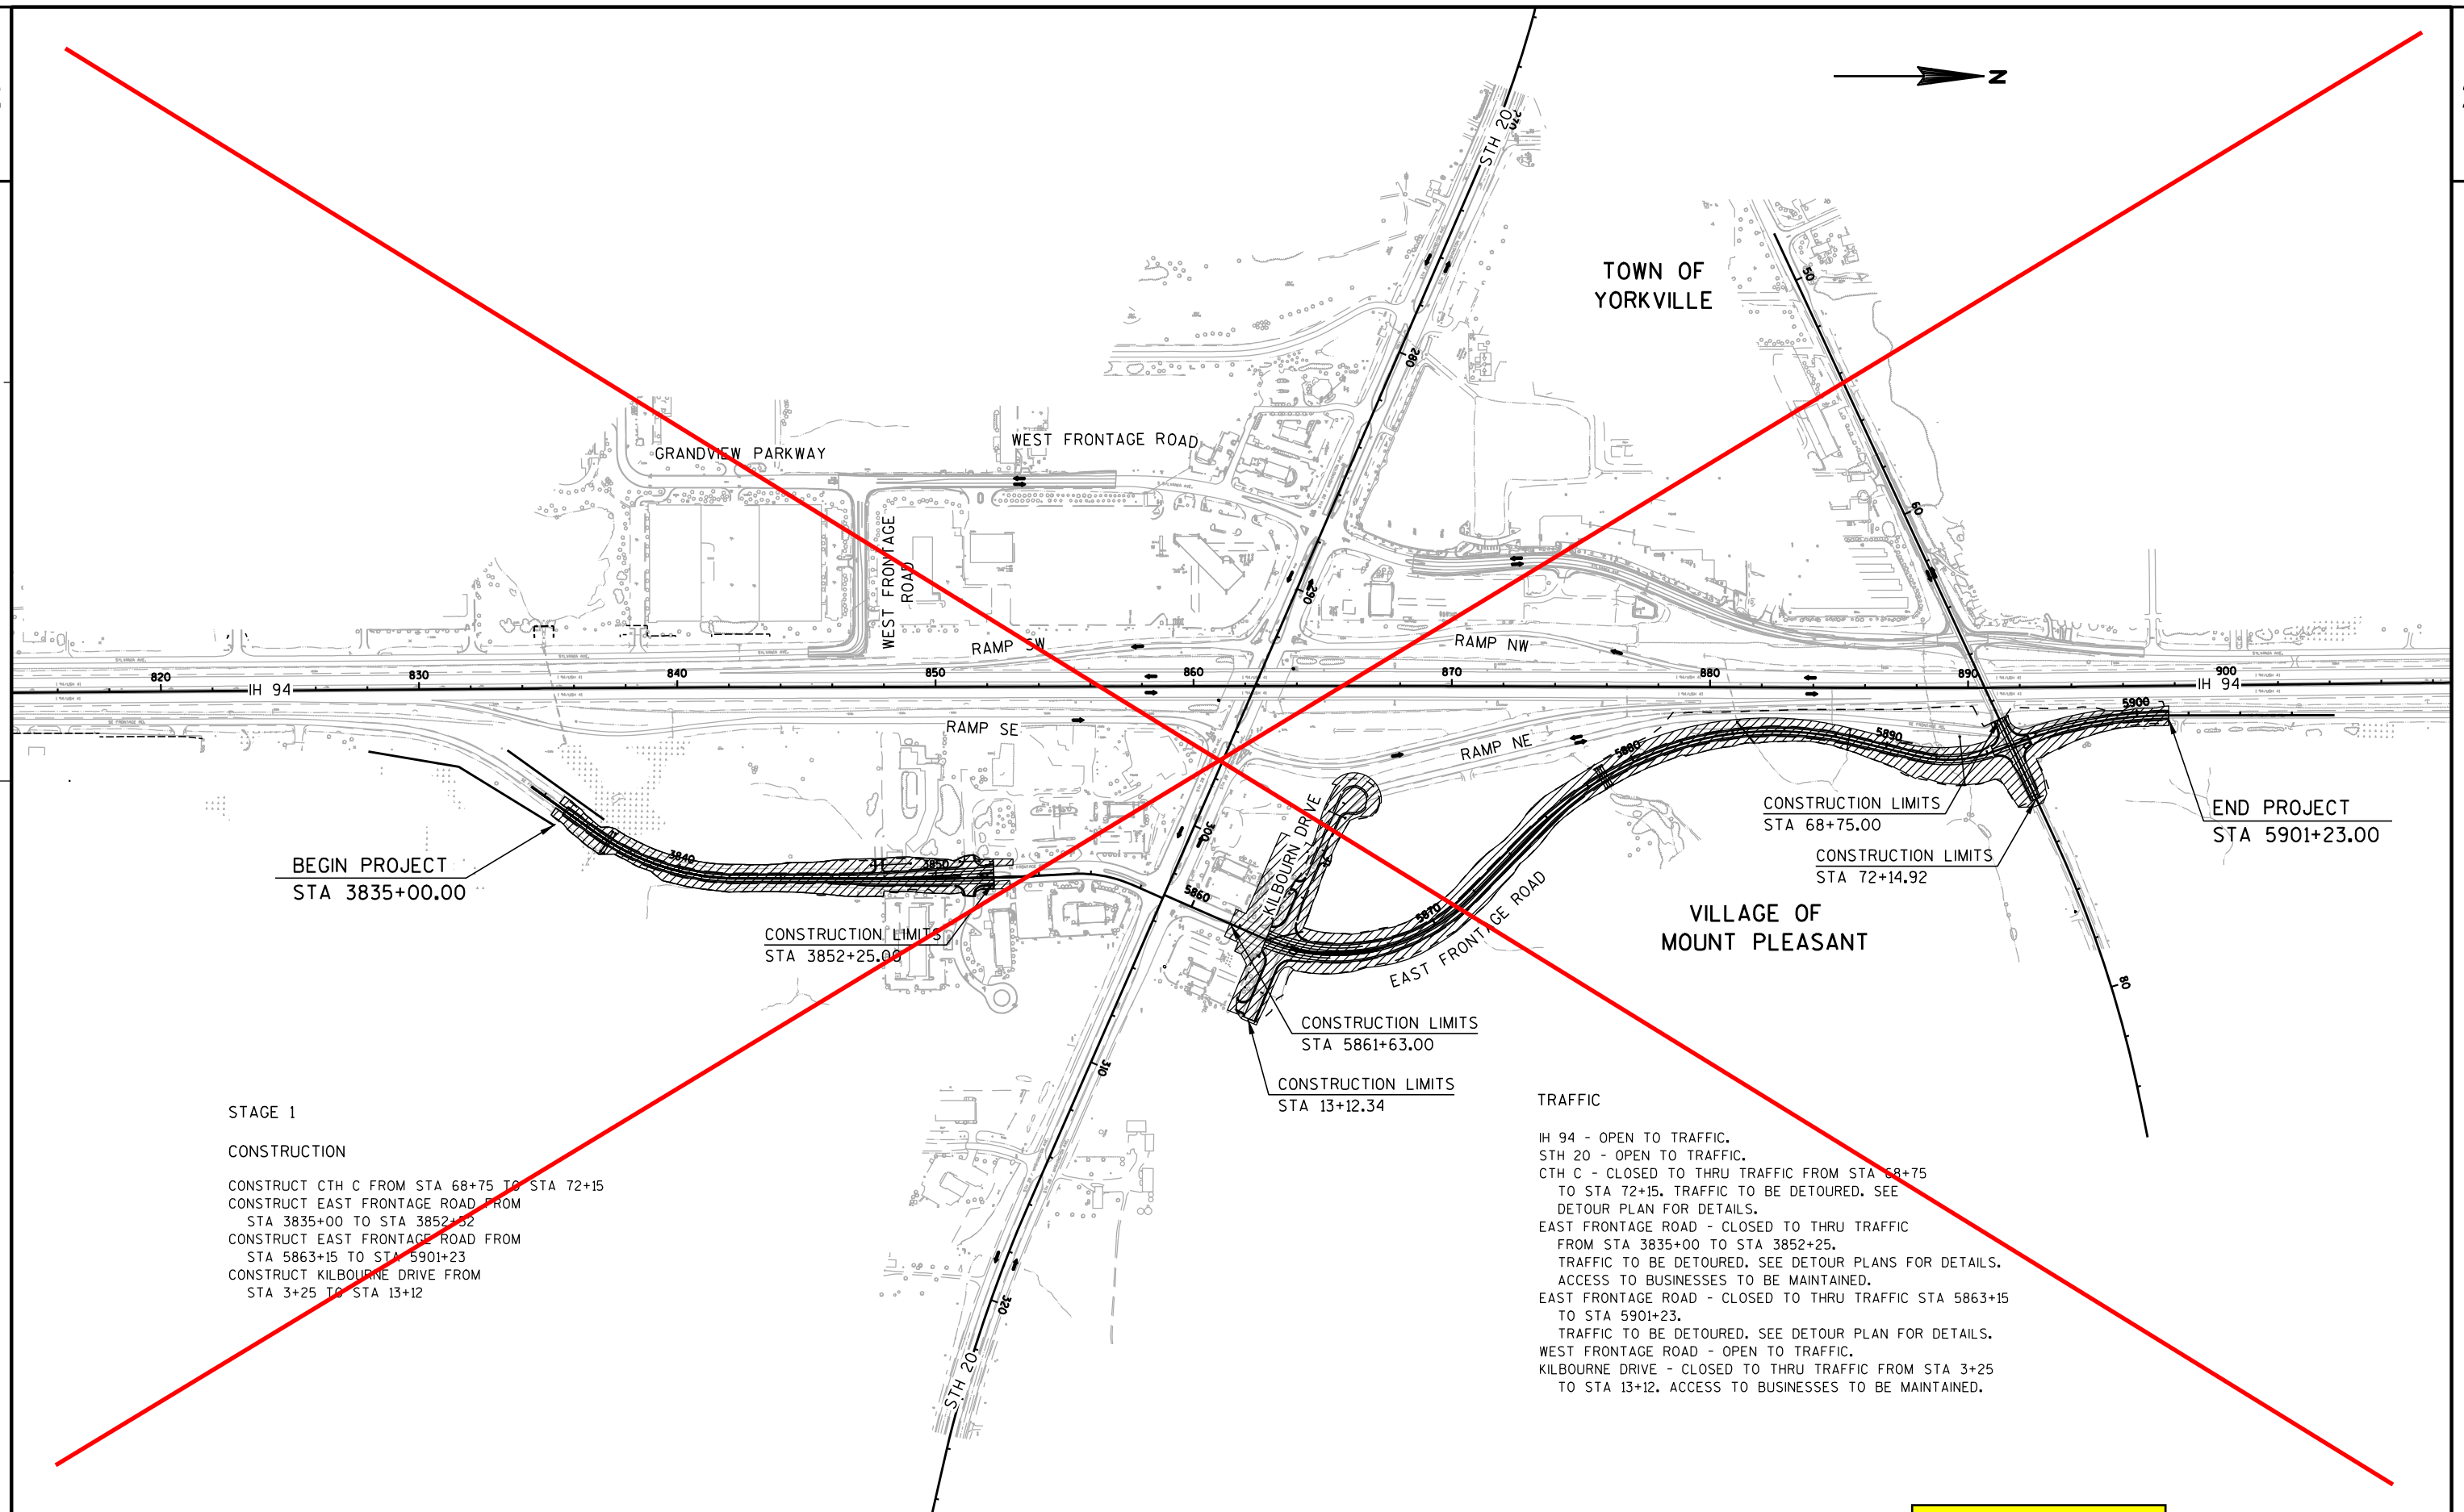




FMS

Fixed Message Sign -
Place FMS at
locations noted 14
days in advance of
closing roadway.

PCMS


Portable Changeable
Message Sign - Place
PCMS at locations
noted 14 days in
advance of closing
roadway.

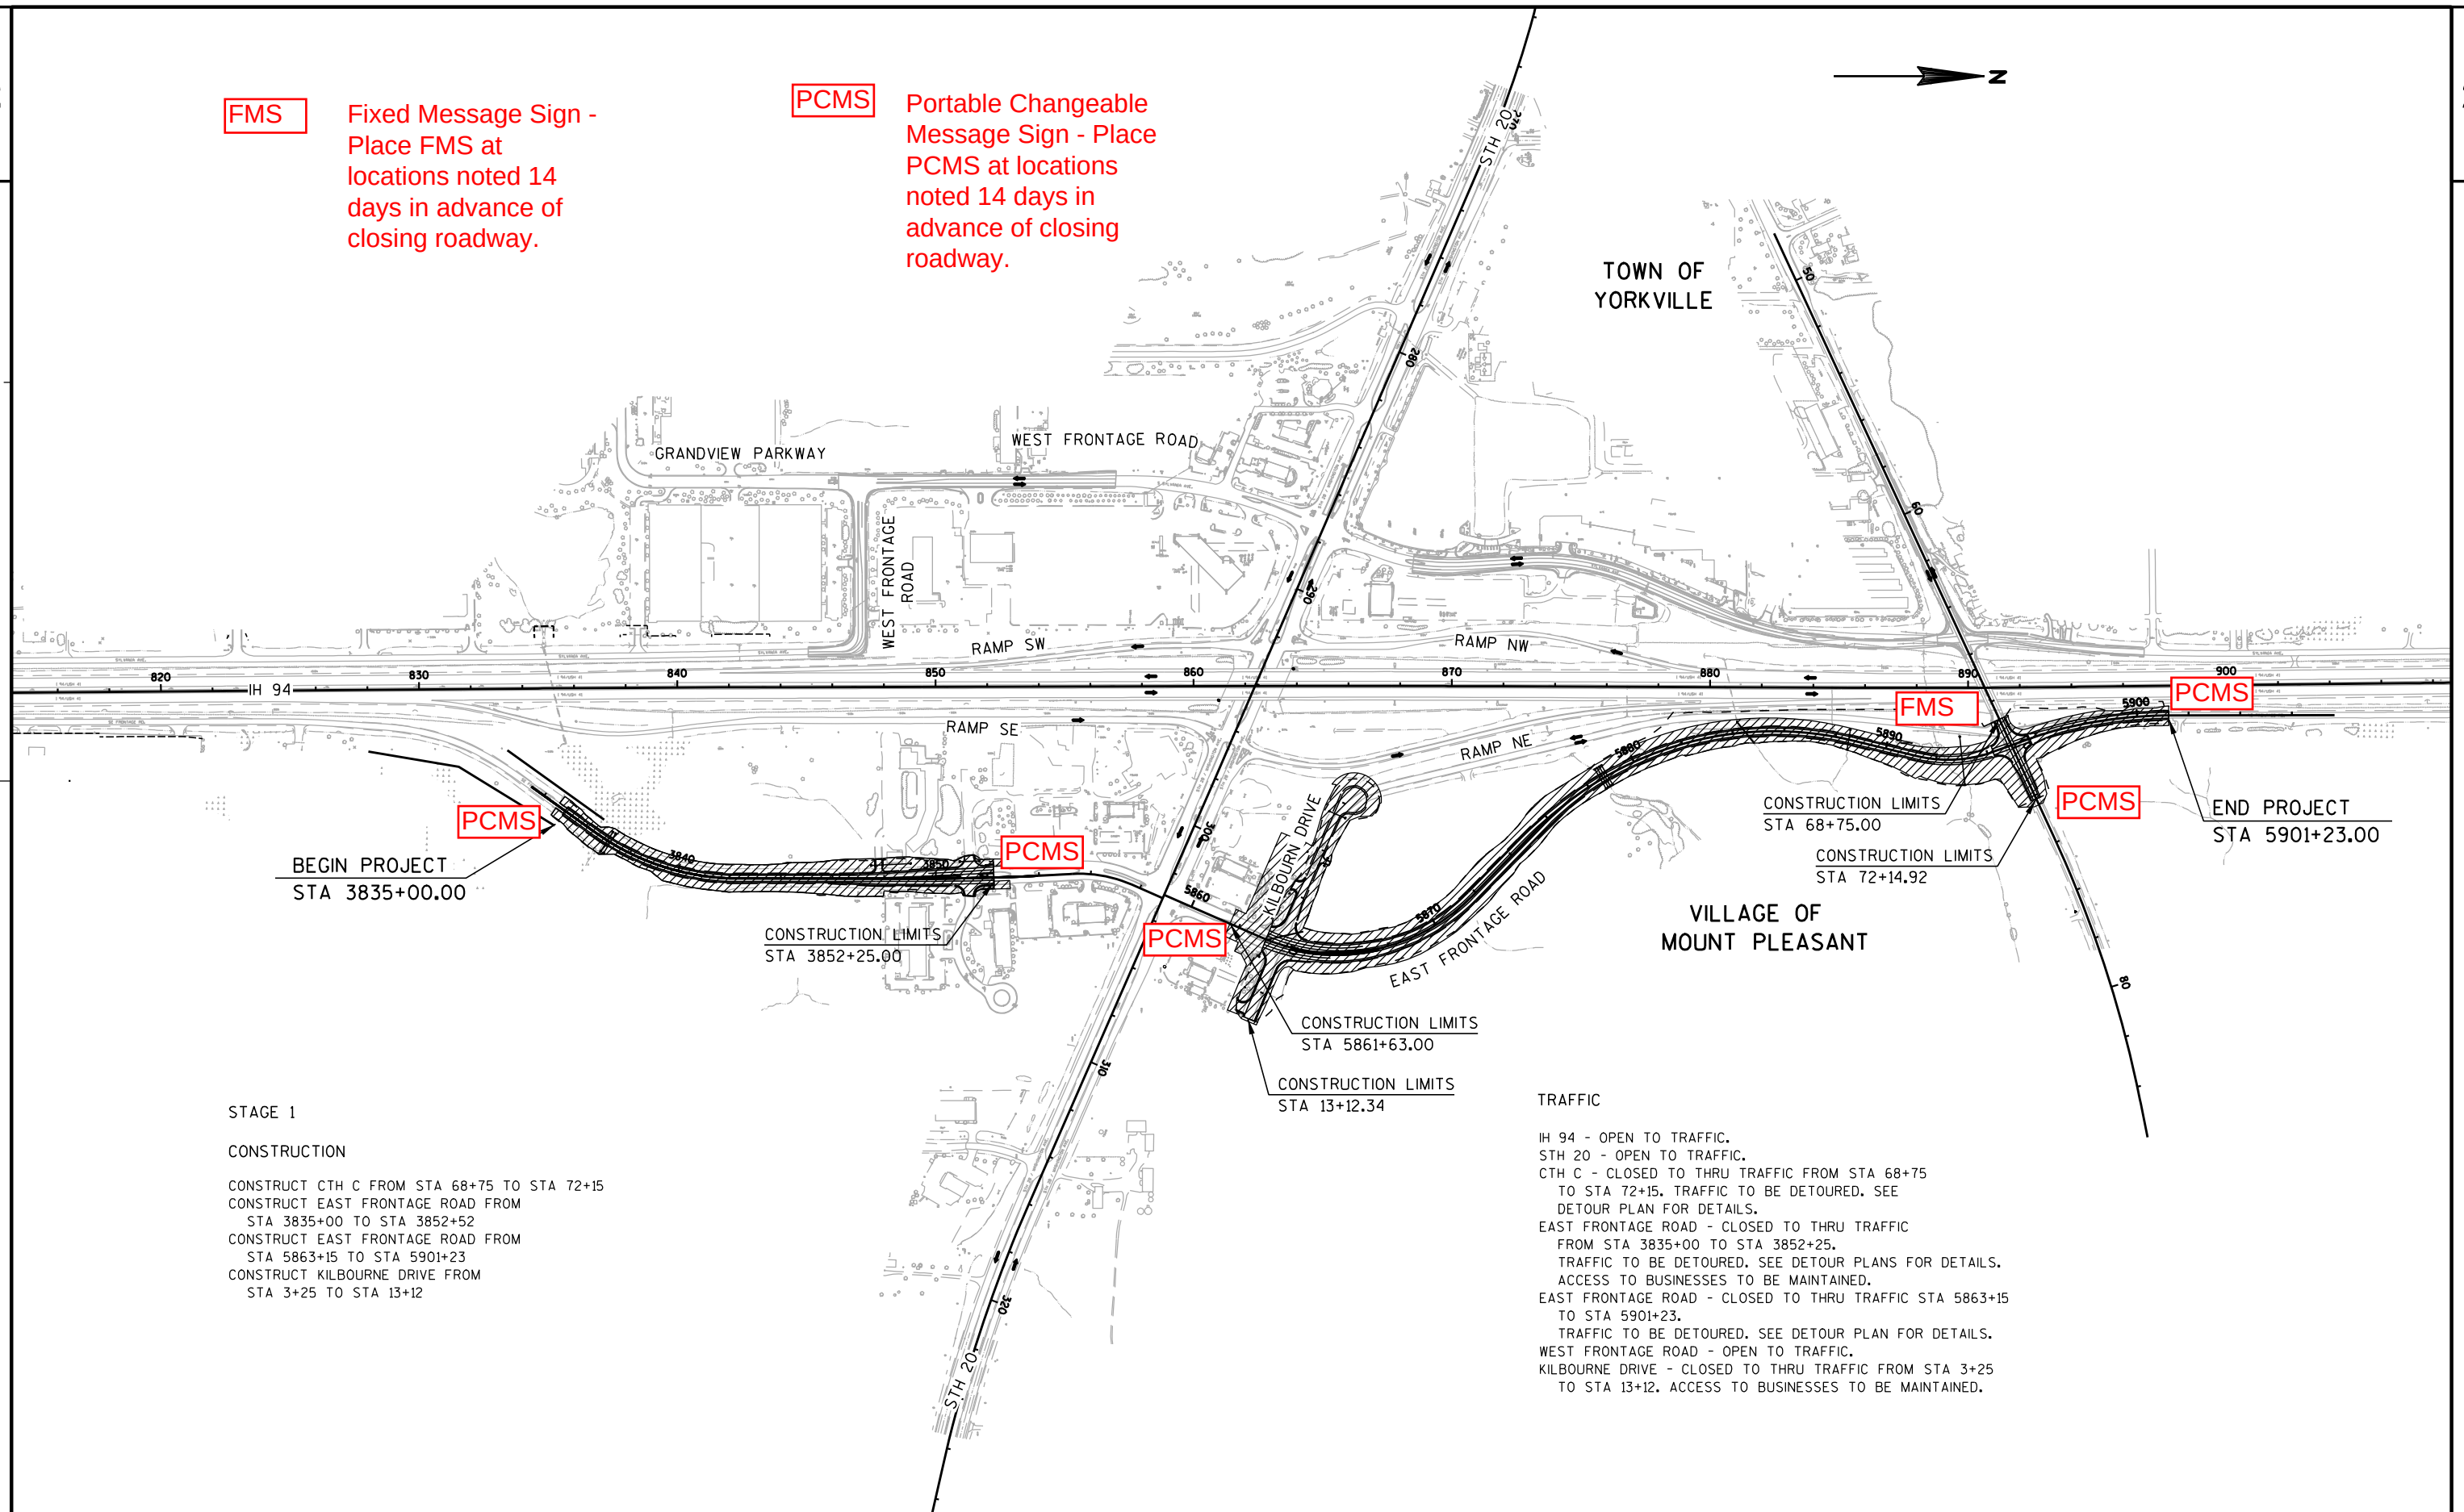


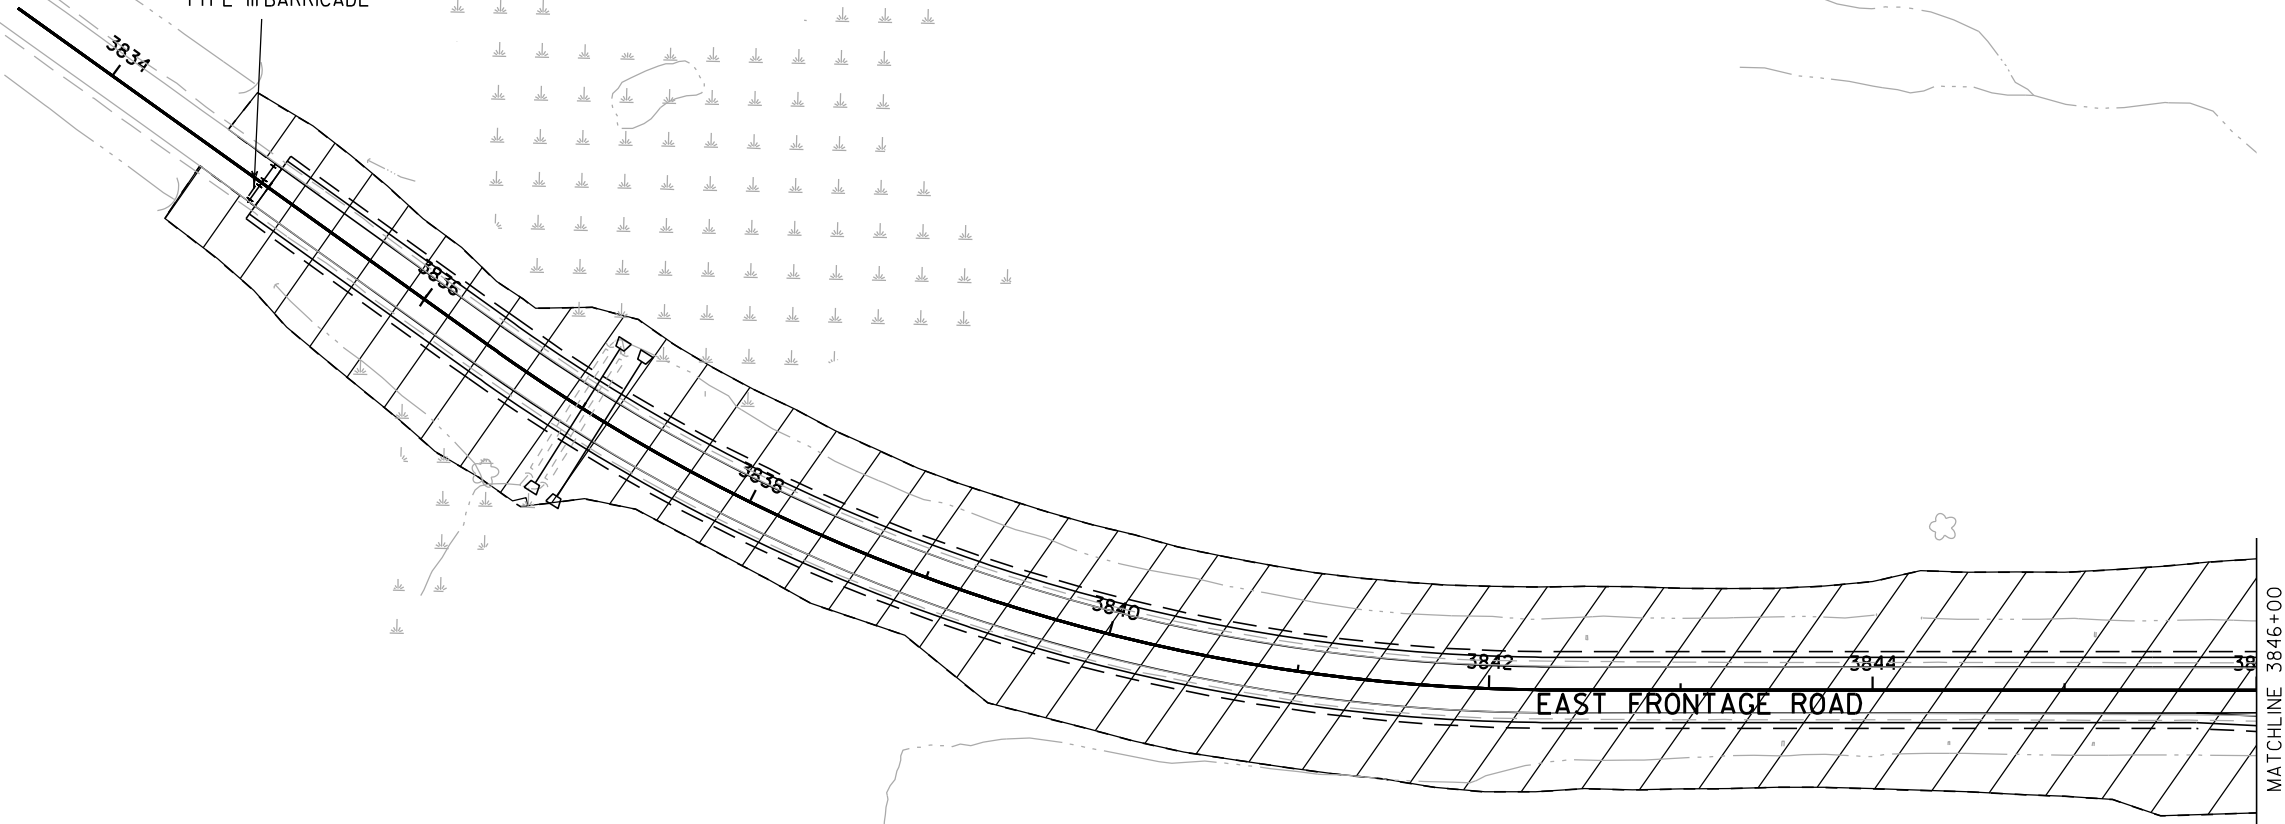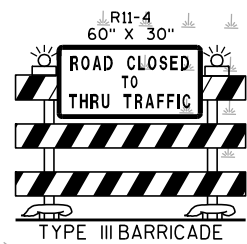


LEGEND

- | | | | |
|--|-----------------------------|--|---|
| | CONSTRUCTION THIS STAGE | | TRAFFIC CONTROL DRUM
WITH/WITHOUT TRAFFIC CONTROL
WARNING LIGHT TYPE C |
| | CONSTRUCTION BY OTHERS | | POST MOUNTED TRAFFIC CONTROL SIGN |
| | TRAFFIC FLOW | | TRAFFIC CONTROL BARRICADE TYPE III
WITH TWO TRAFFIC CONTROL WARNING
LIGHTS TYPE A WITH/WITHOUT SIGN |
| | TWO 18" SQUARE ORANGE FLAGS | | |

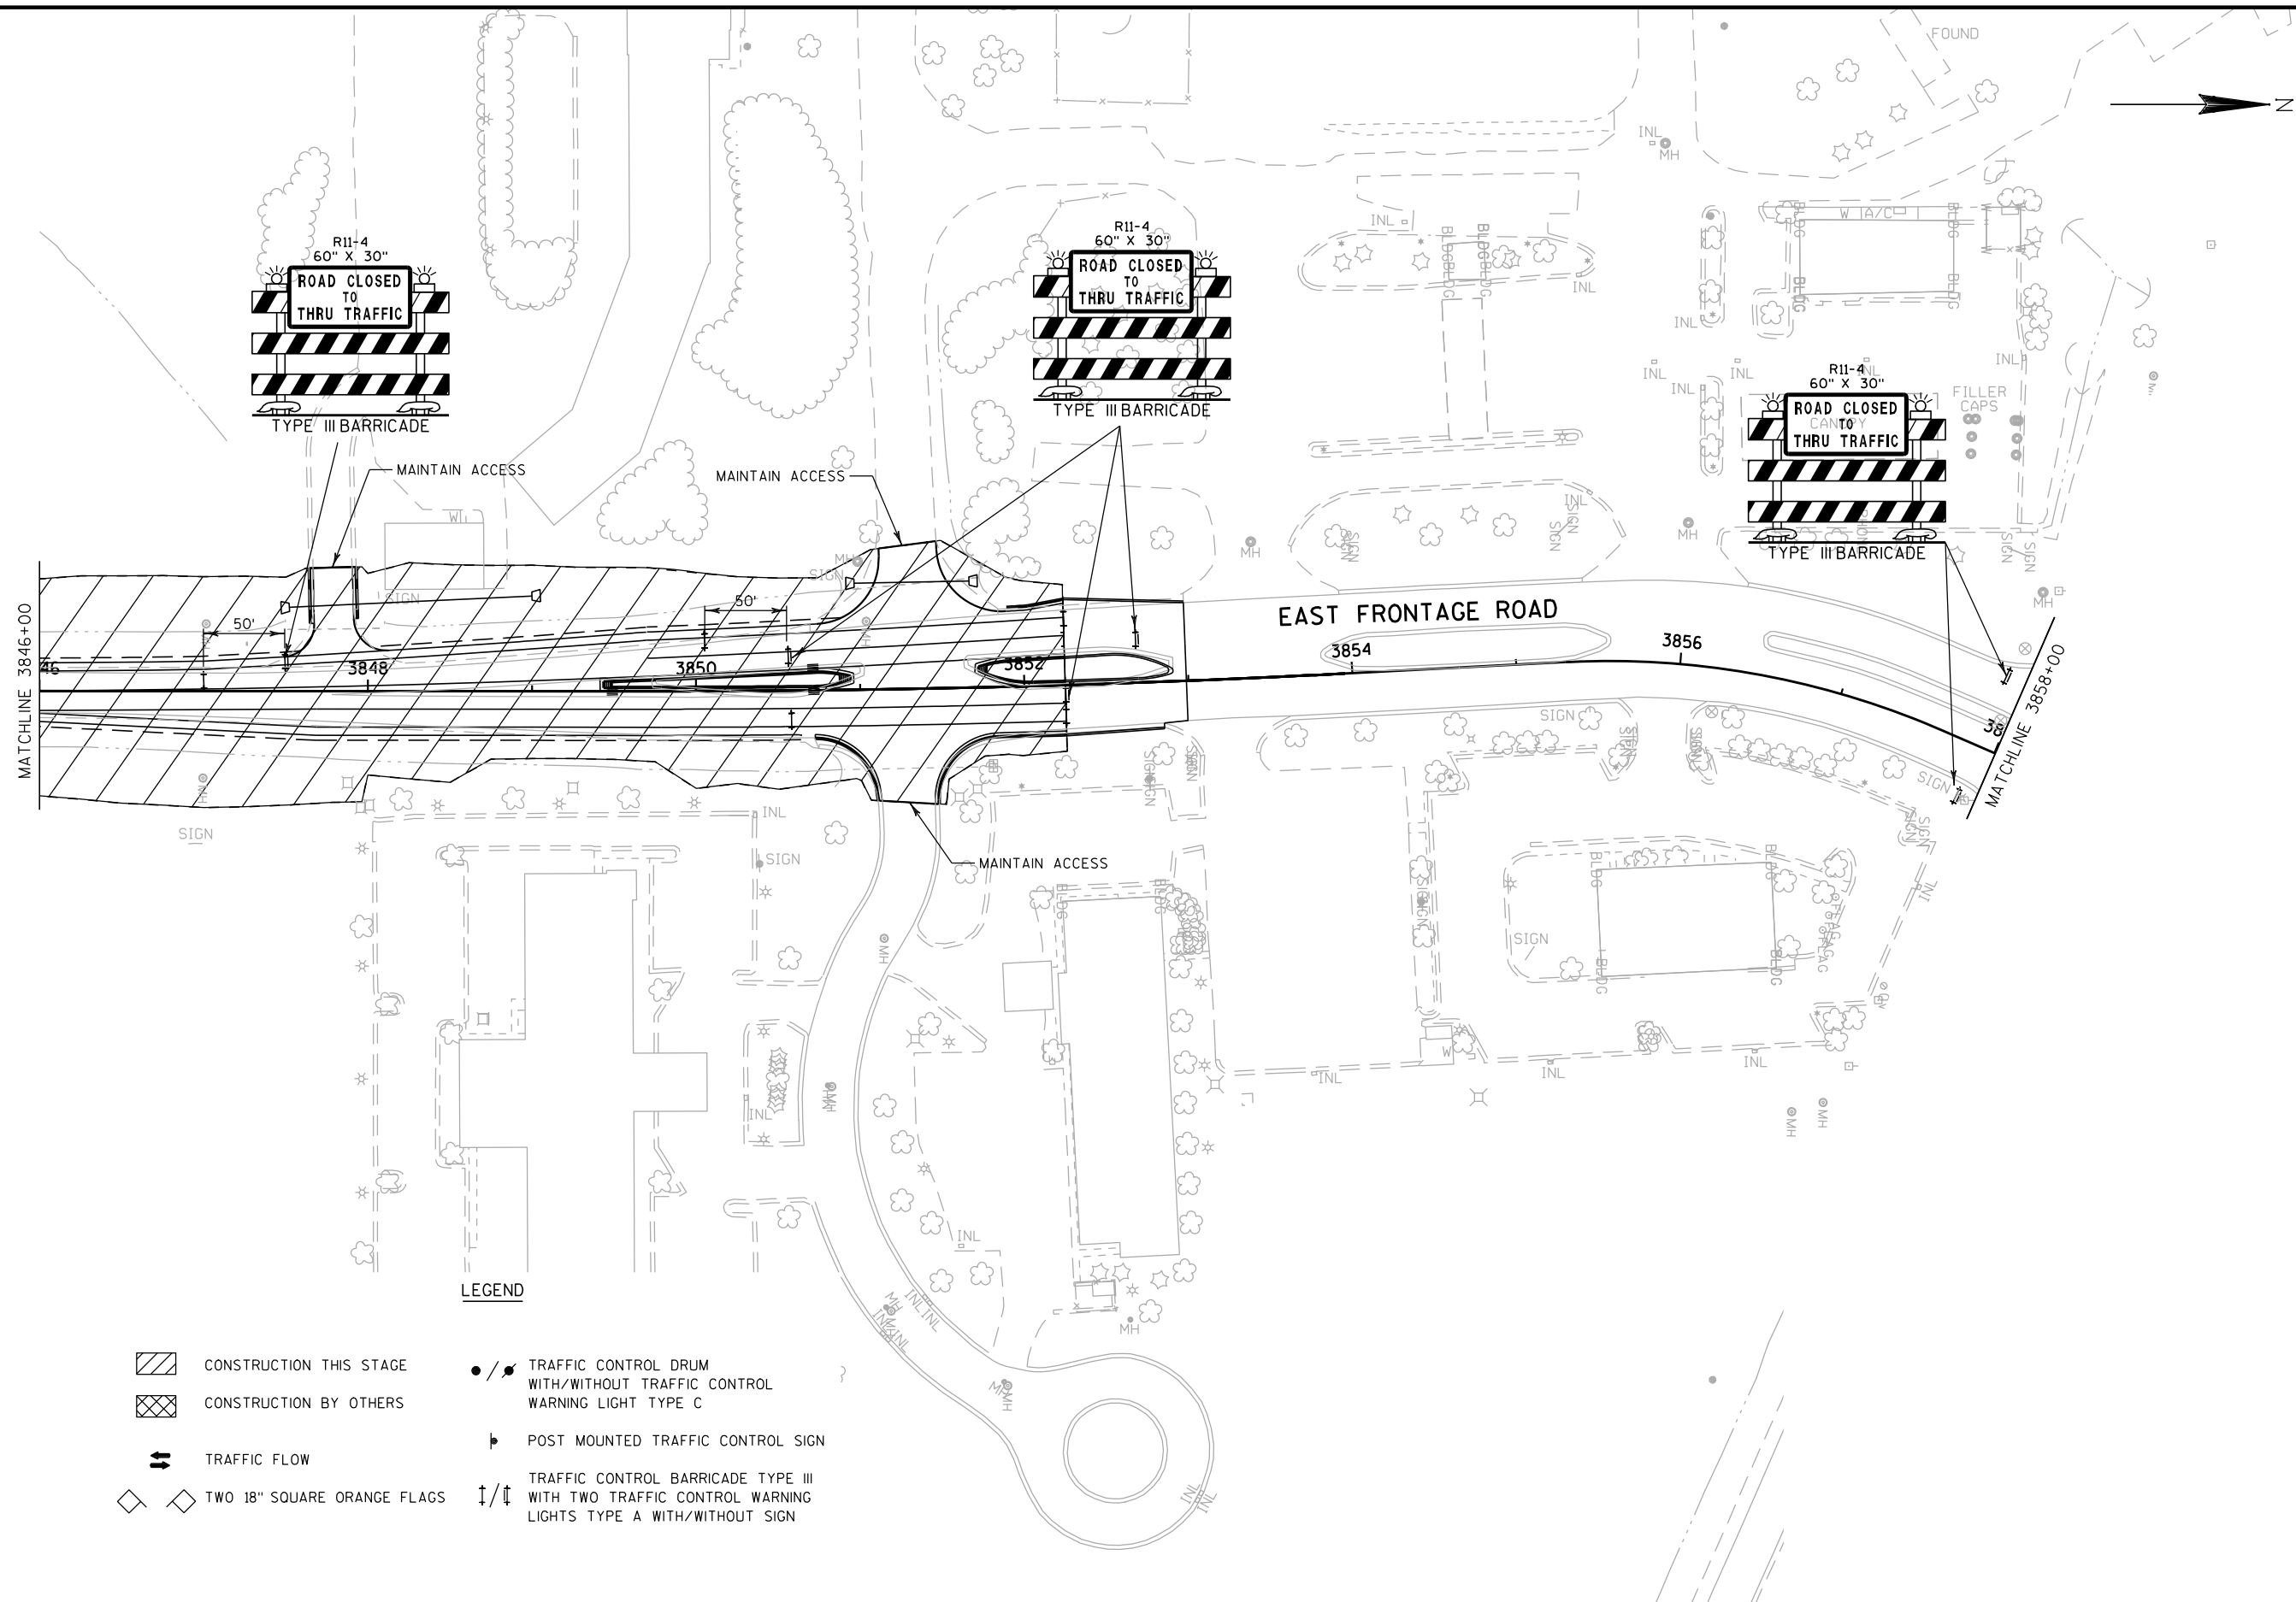


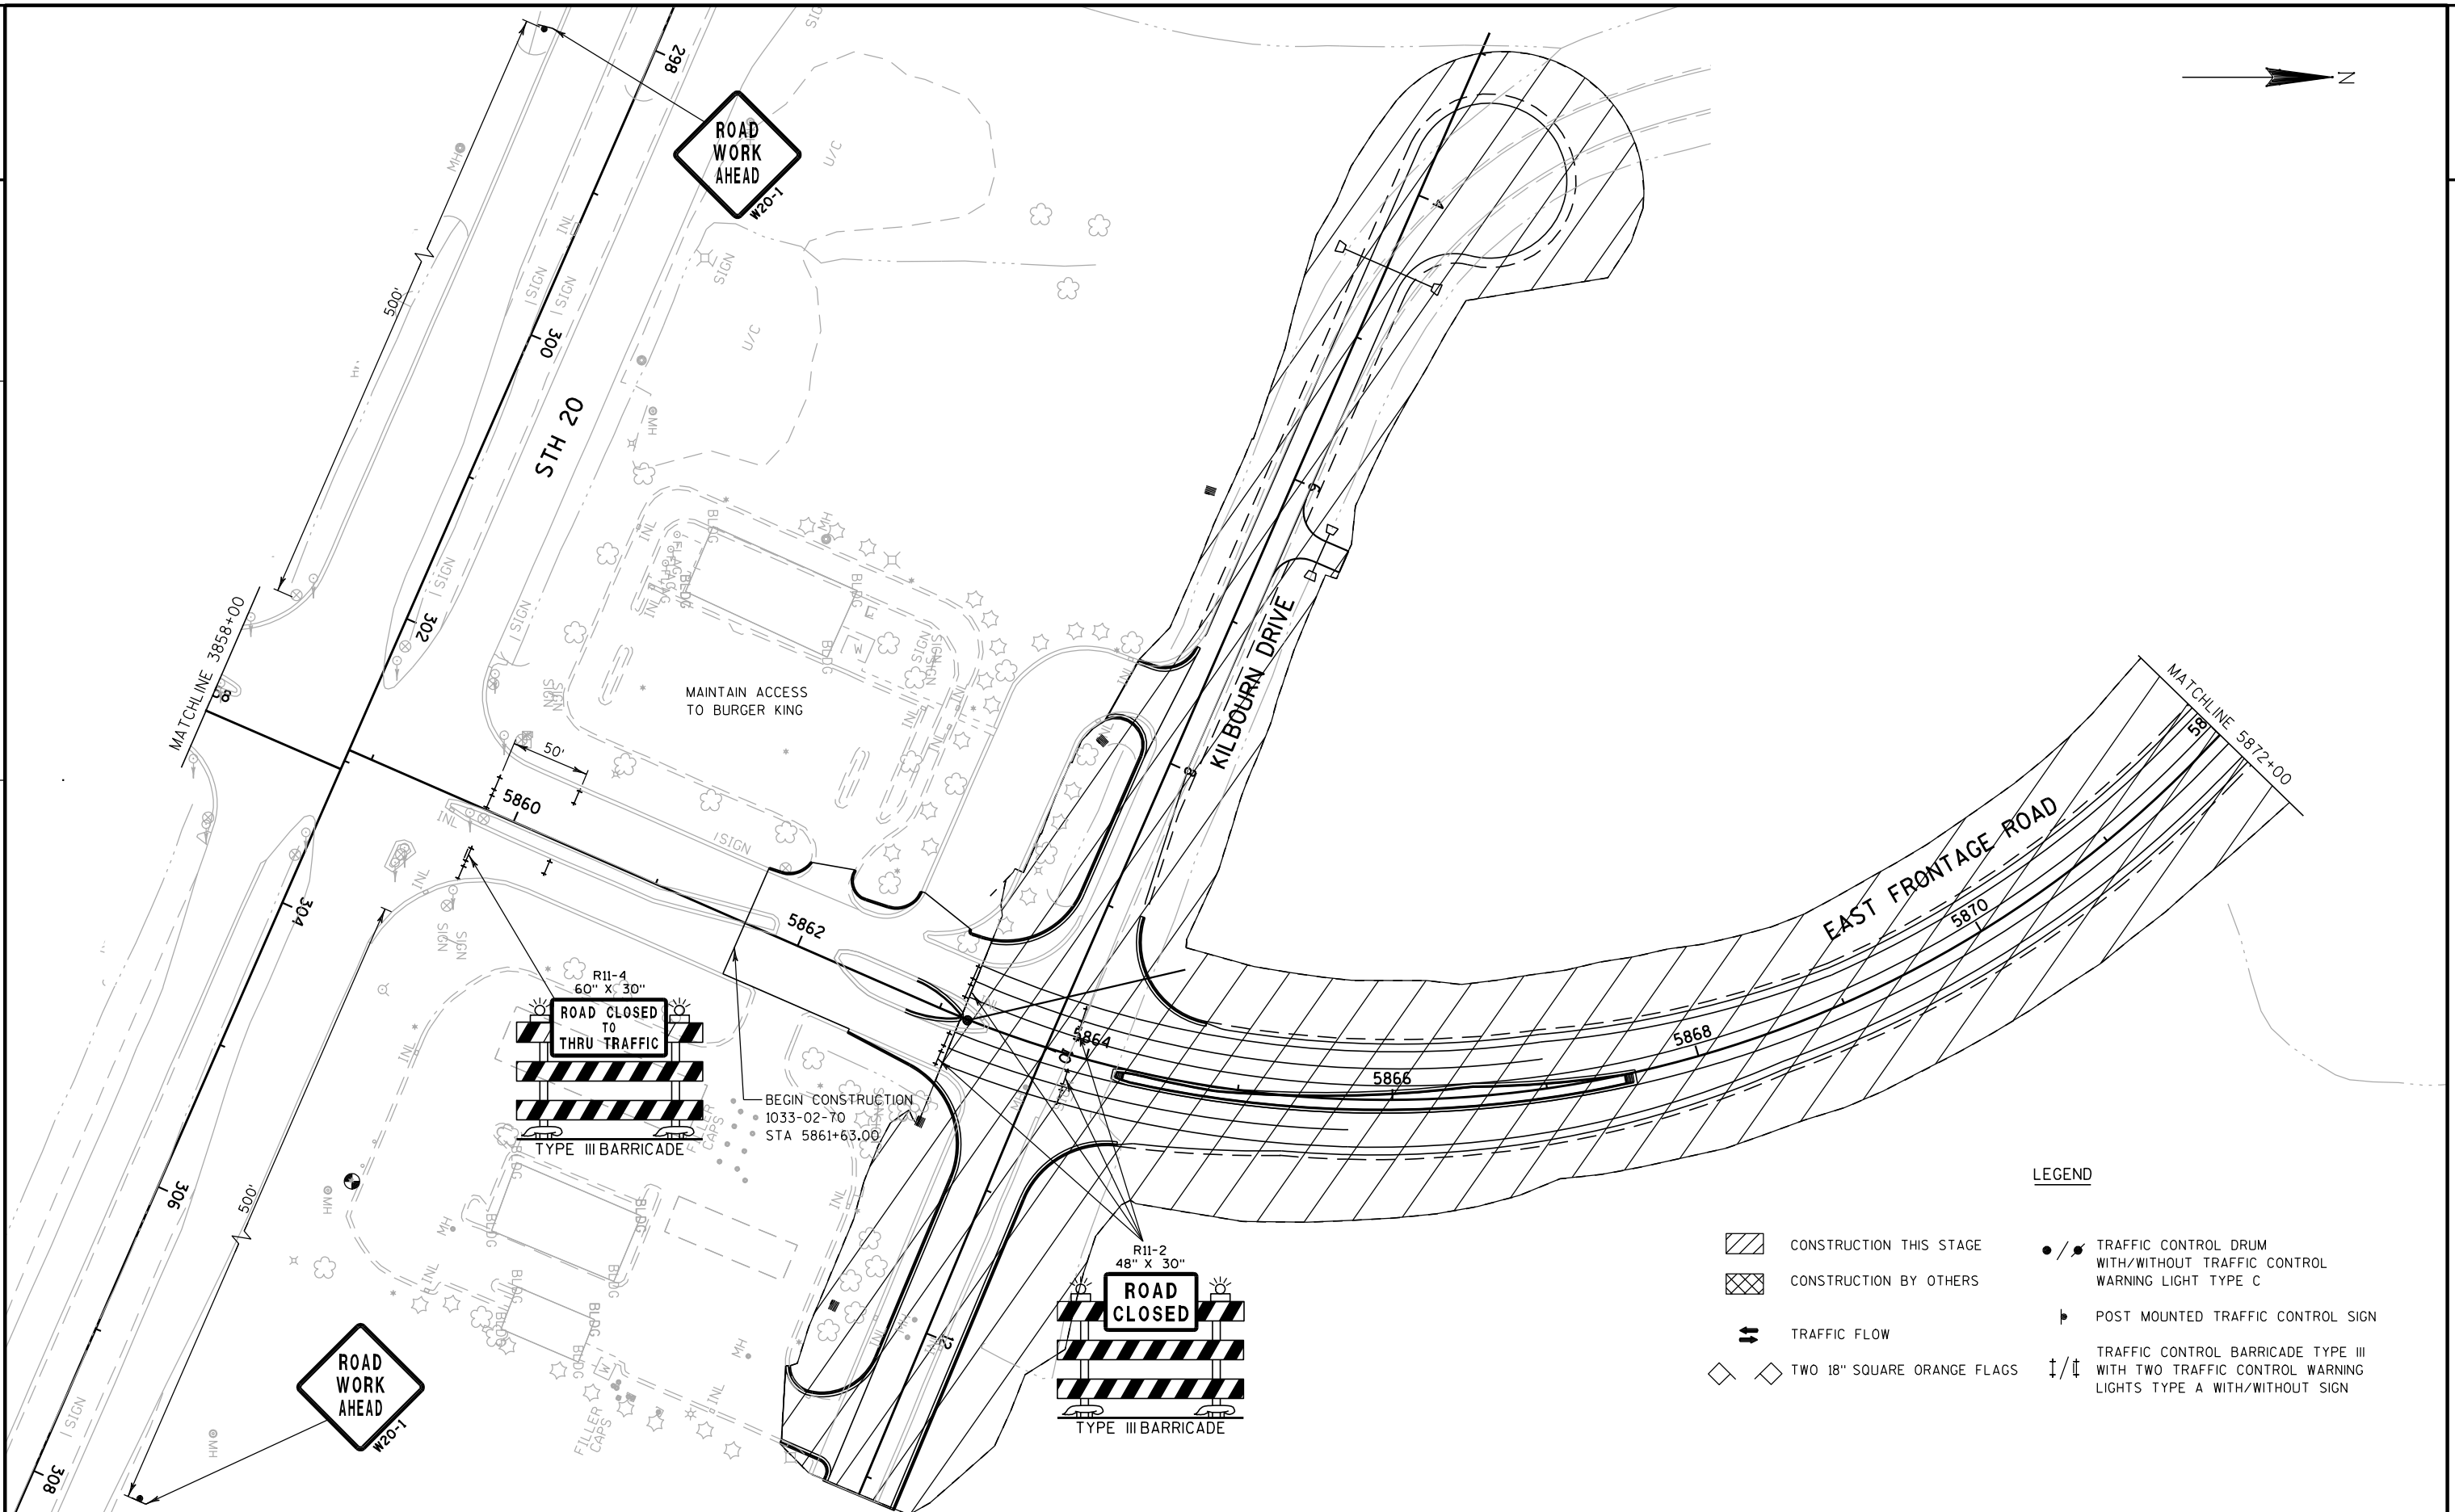

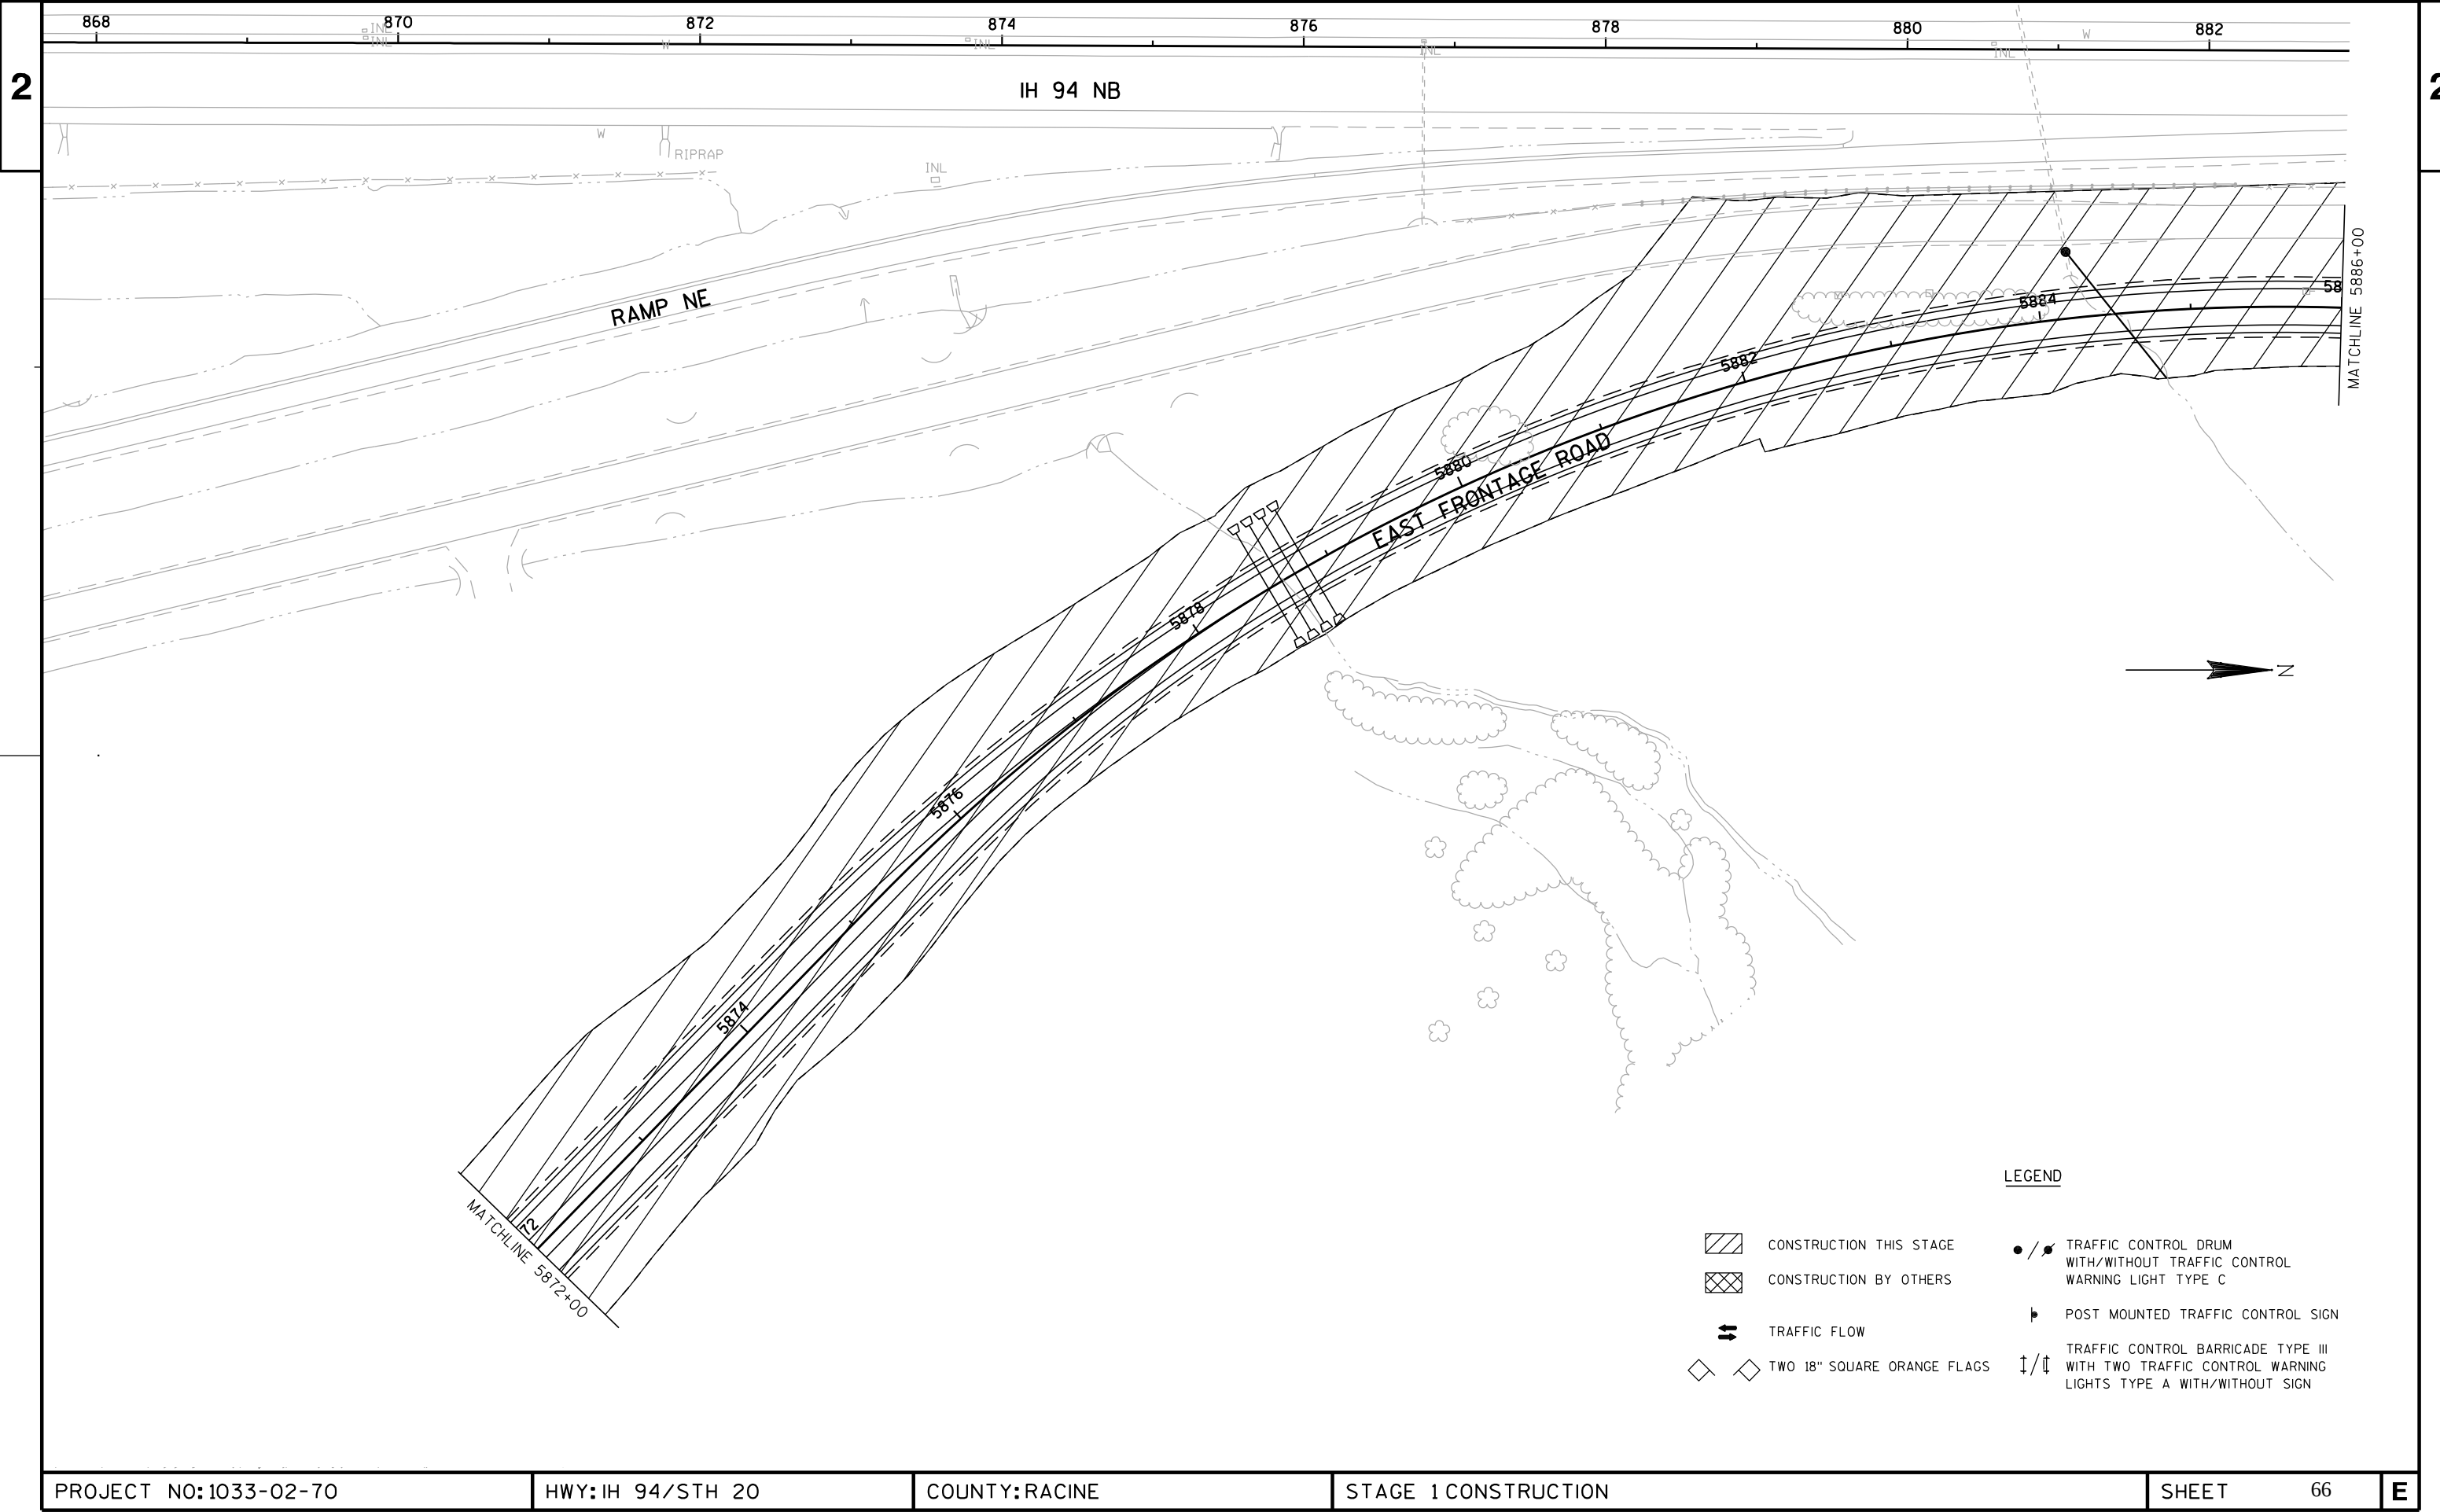

2

2

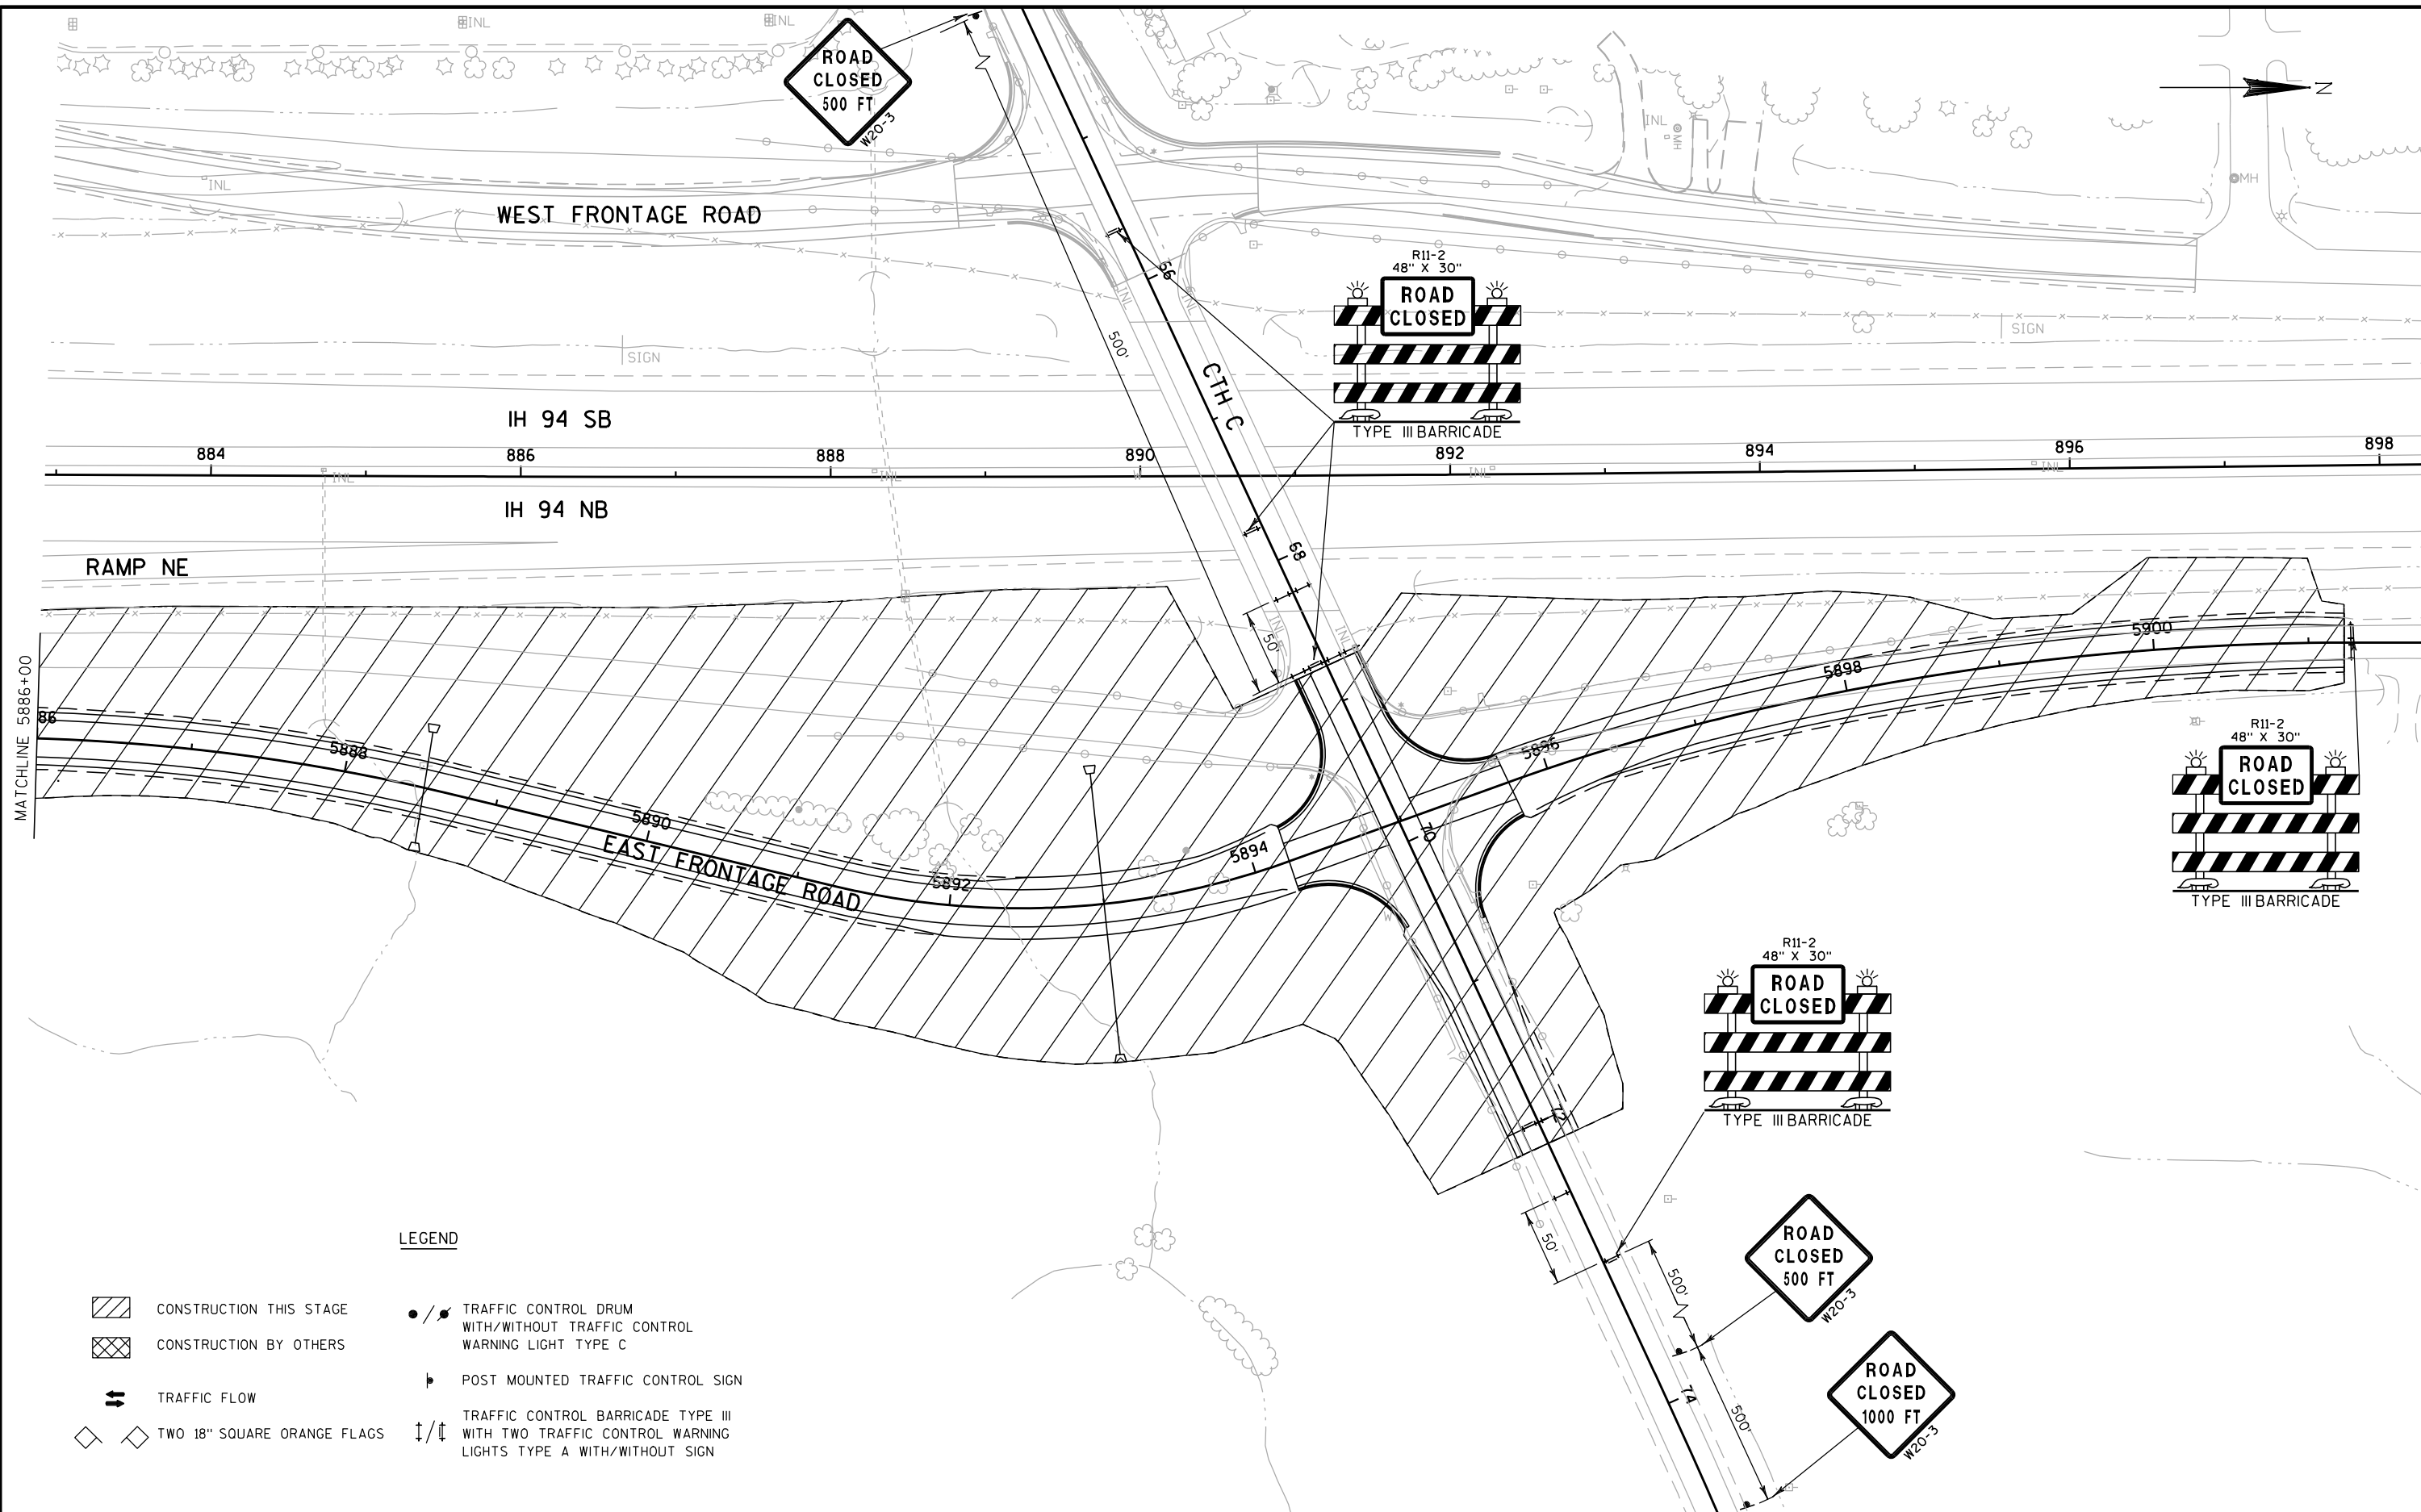

PROJECT NO:1033-02-70

HWY: IH 94/STH 20

COUNTY: RACINE

STAGE 1 CONSTRUCTION

SHEET	67
-------	----

E

FILE NAME : s:\FinalDesign\20\10330270_E\Roads\cds\026005_s1.dgn


PLOT DATE : 06-DEC-2010 20:27

PLOT BY : MSCD1S

PLOT NAME : 026005_s1

PLOT SCALE : 100:1

WISDOT/CADDS SHEET 42

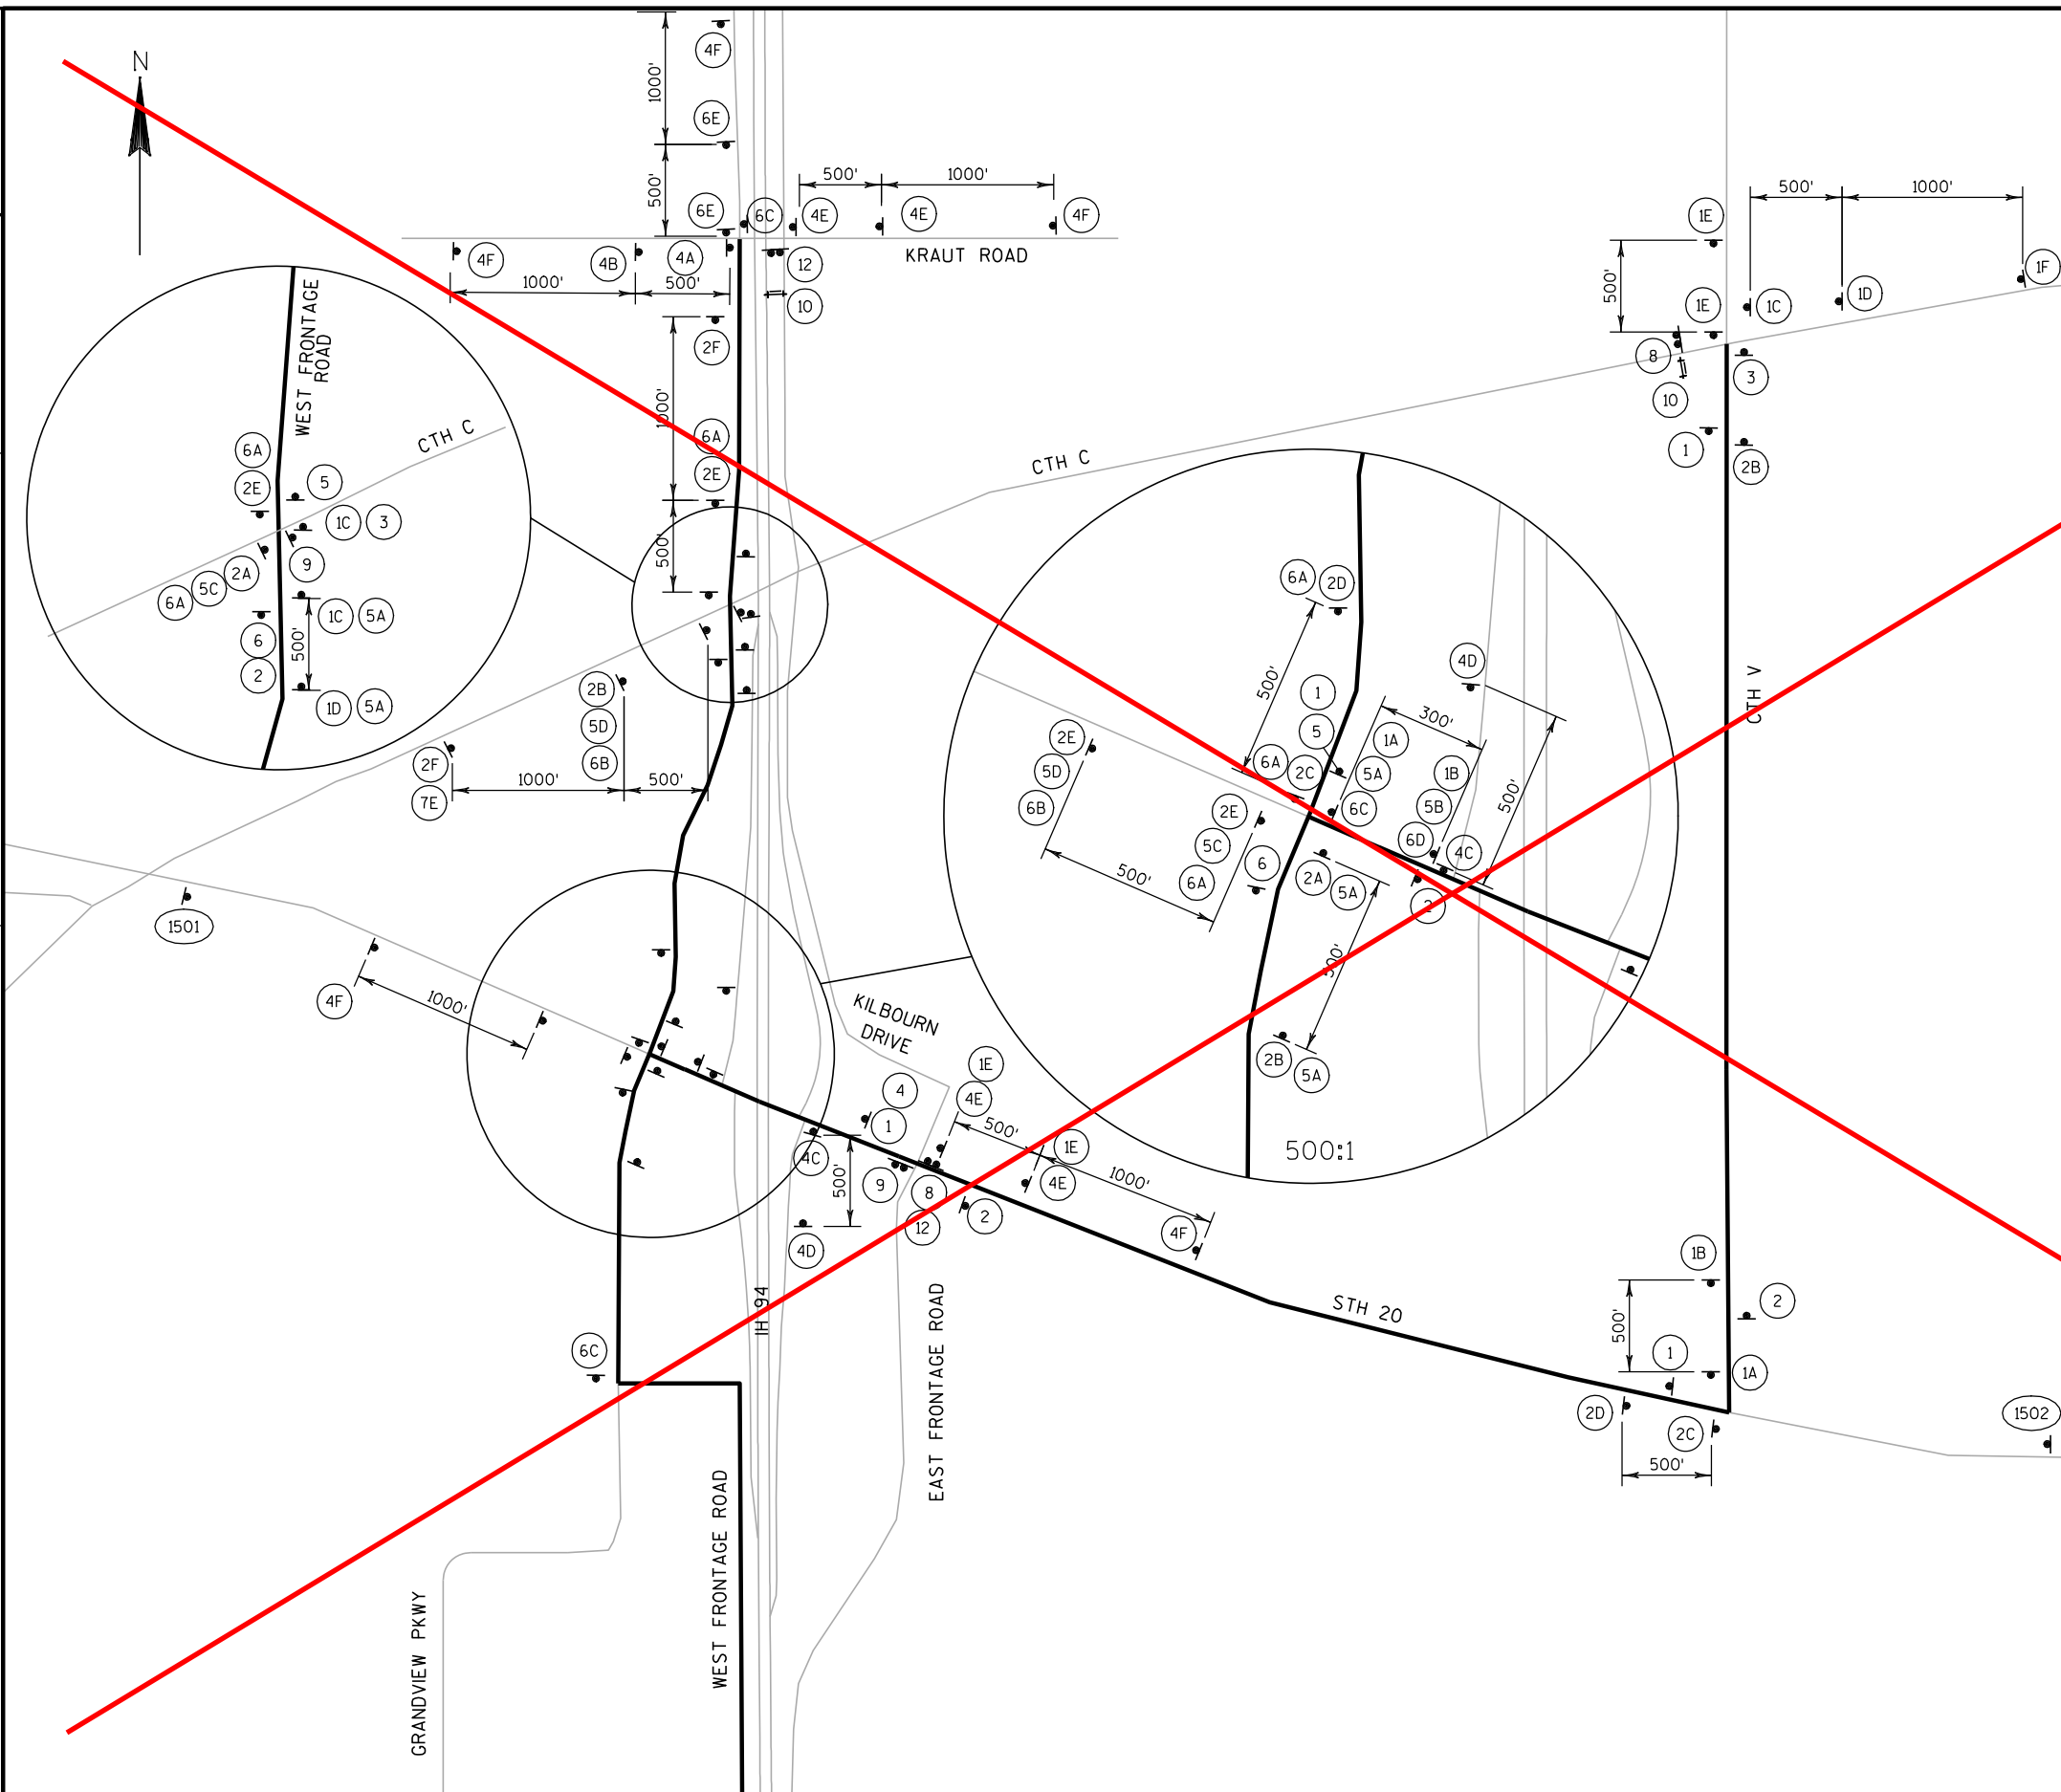

LEGEND

- PROPOSED SIGN MOUNTED ON POST(S)
- SIGN NUMBER
- DETOUR ROUTE
- TRAFFIC CONTROL BARRICADE TYPE III WITH ATTACHED SIGN
- FIXED MESSAGE SIGN NUMBER
(SEE TRAFFIC CONTROL DETAIL:
FIXED MESSAGE SIGN)

NOTES

EAST FRONTAGE ROAD AND CTH C ARE CLOSED FOR THE DURATION OF DETOUR


ALL SIGNS SHALL BE PLACED IN ACCORDANCE WITH THE MANUAL ON UNIFORM TRAFFIC CONTROL DEVICES.

EXACT NUMBER, LOCATION AND SPACING OF SIGNS AND DEVICES MAY BE ADJUSTED TO FIT FIELD CONDITIONS AS DIRECTED BY THE ENGINEER.

SIGN LAYOUTS SHALL BE IN ACCORDANCE WITH THE FEDERAL HIGHWAY ADMINISTRATION MANUAL OF STANDARD HIGHWAY SIGNS, UNLESS OTHERWISE PROVIDED IN THE PLAN.

ANY EXISTING TRAFFIC SIGNS THAT CONFLICT WITH THIS WORK SHALL BE COVERED AS DIRECTED BY THE ENGINEER.

DETOUR SIGNS SHALL BE COVERED OR REMOVED WHEN EAST FRONTAGE ROAD AND CTH C IS OPEN TO TRAFFIC AND SIGN DETOUR IS NOT IN USE.

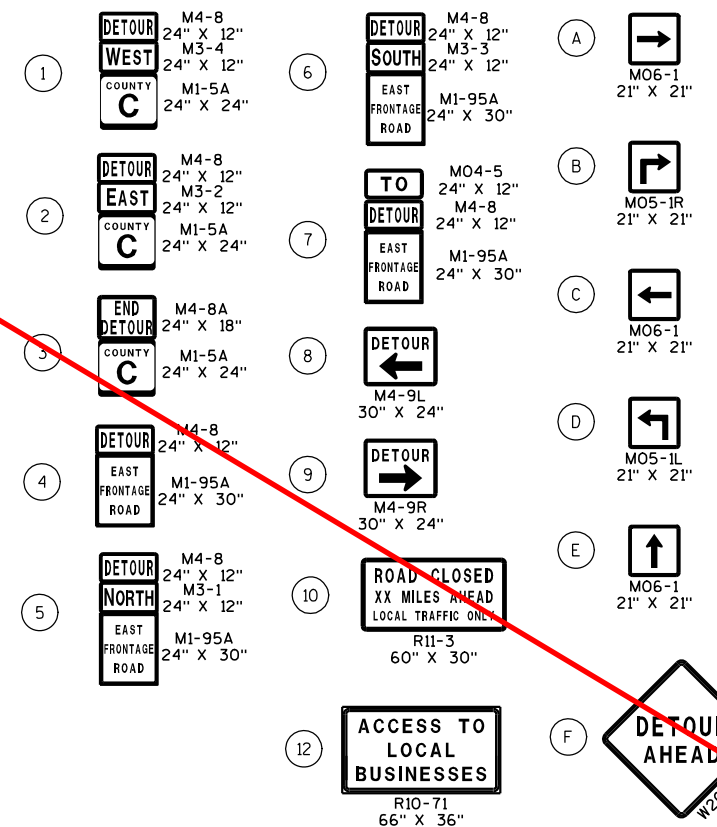

PROJECT NO:1033-02-70

HWY: IH 94/STH 20


COUNTY: RACINE

DETOUR PLAN

See new sheet #68

SHEET 68

E

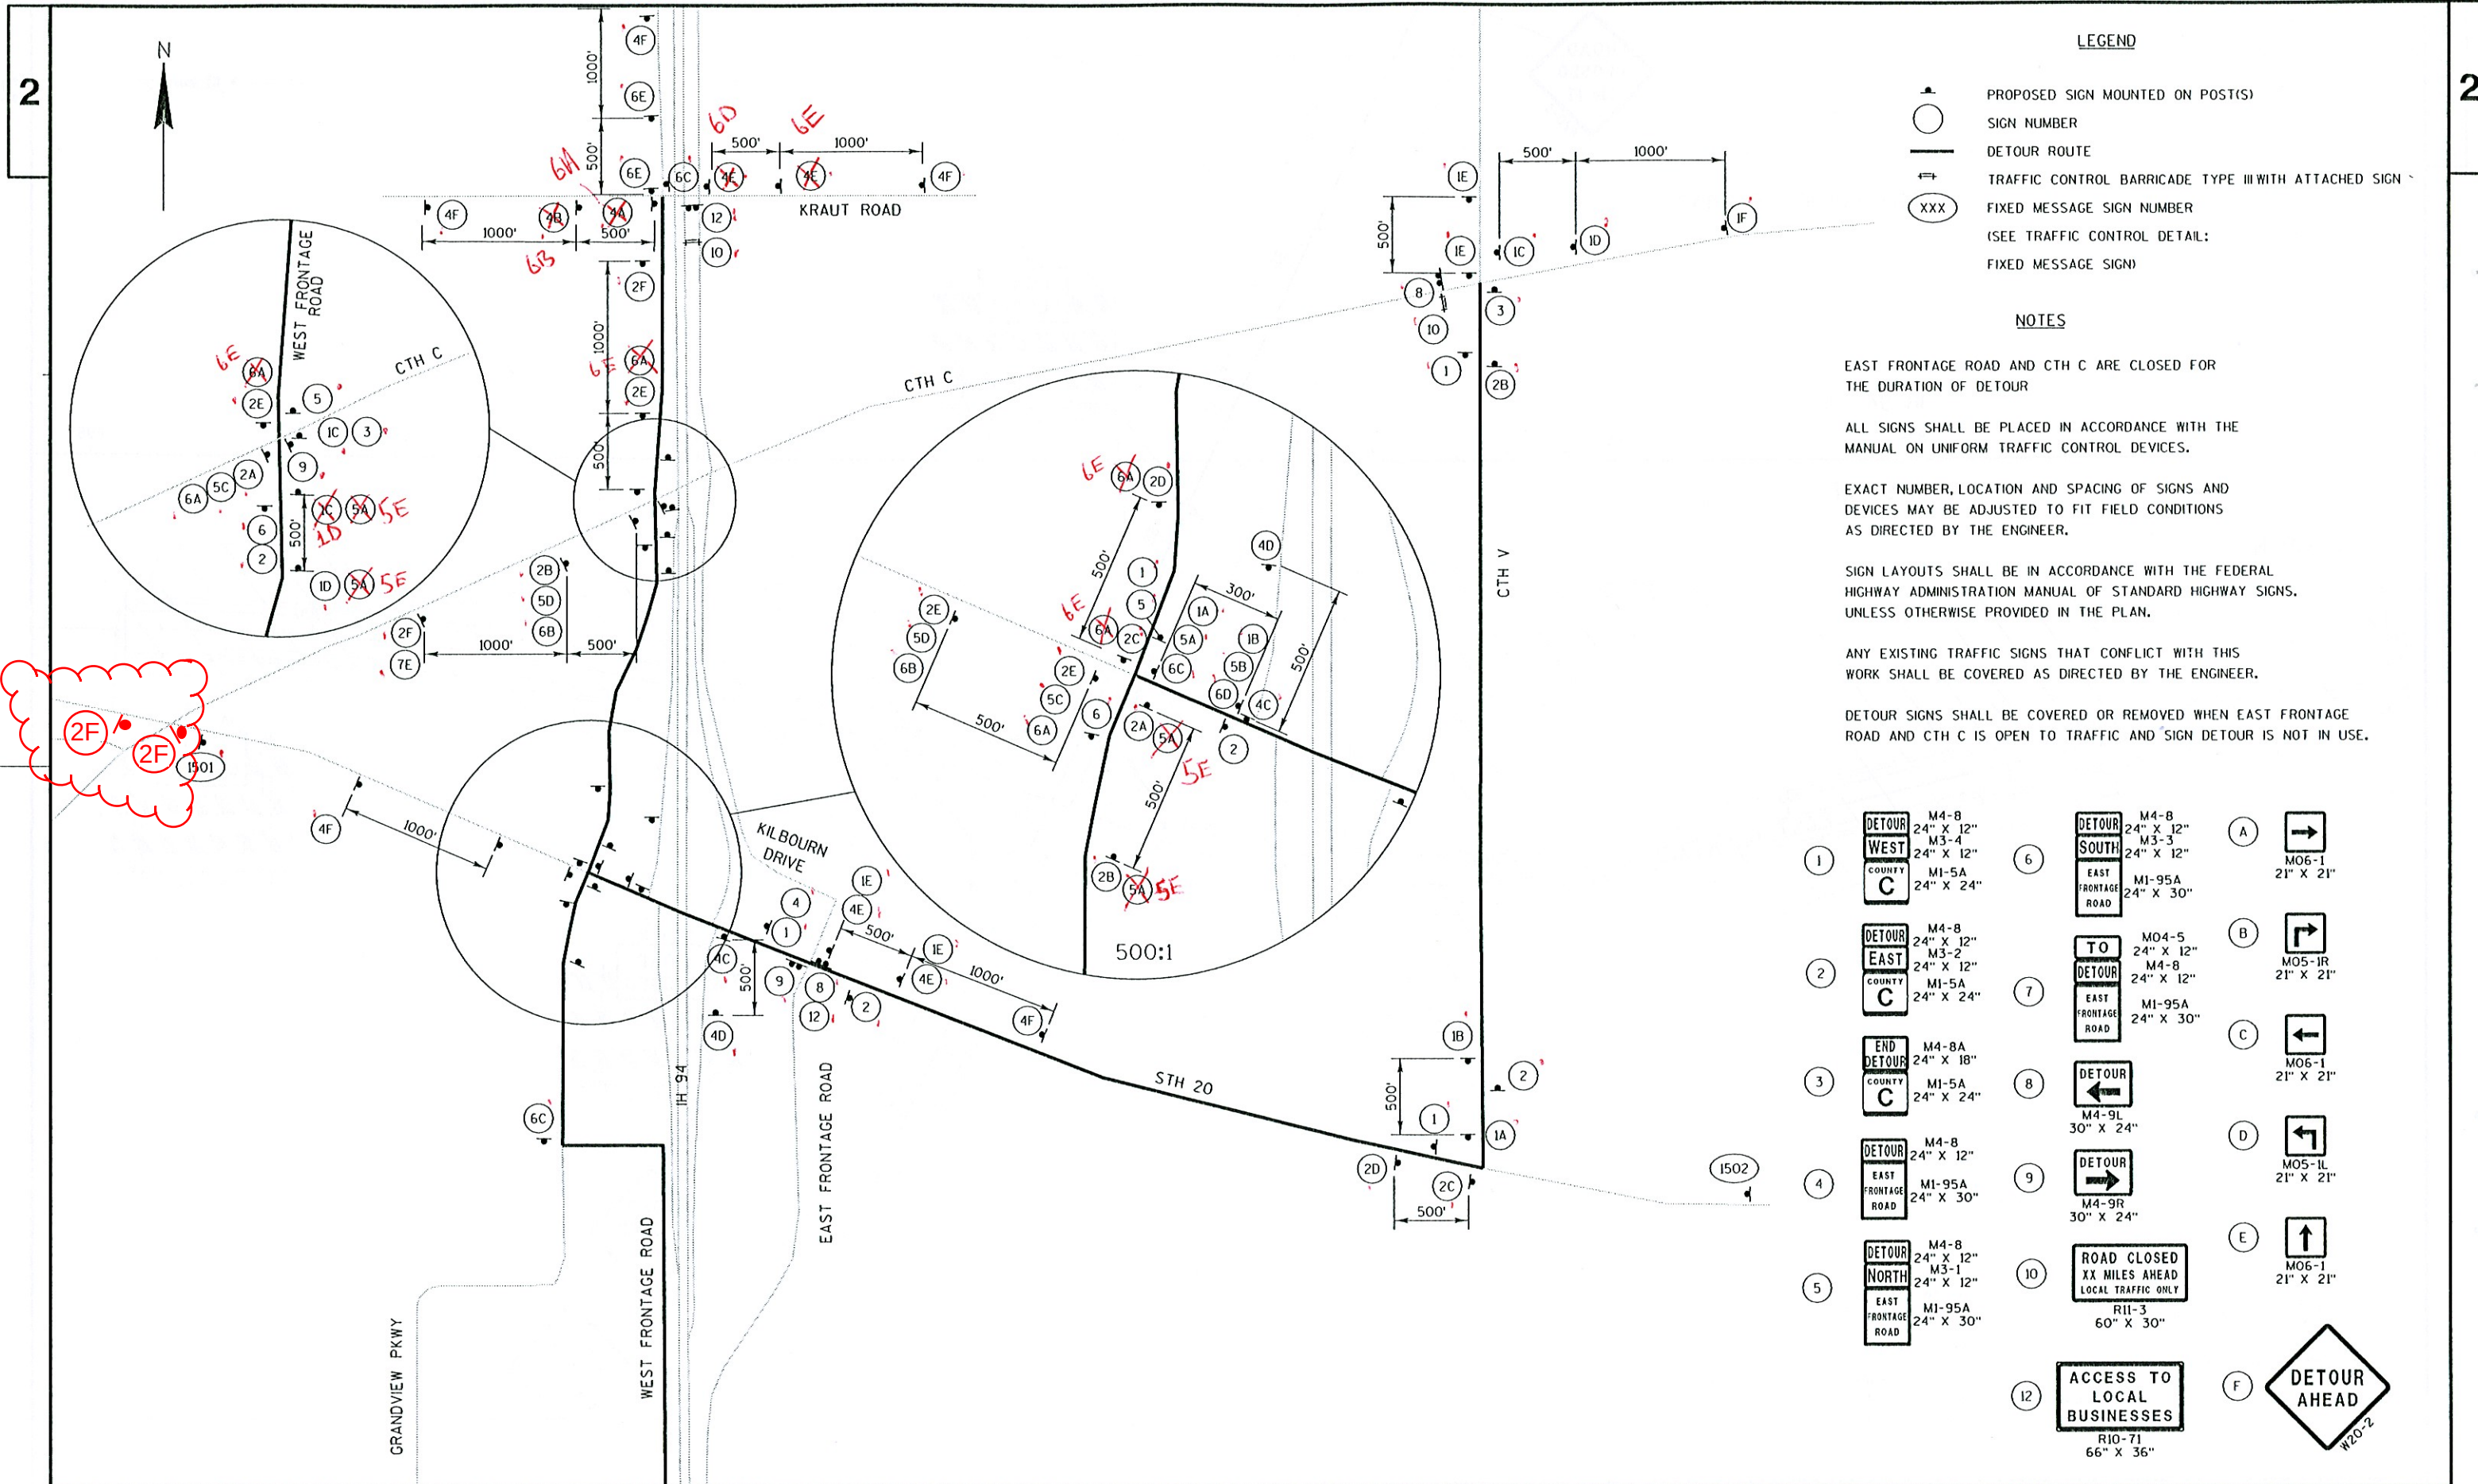

LEGEND

-  PROPOSED SIGN MOUNTED ON POST(S)
-  SIGN NUMBER
-  DETOUR ROUTE
-  TRAFFIC CONTROL BARRICADE TYPE III WITH ATTACHED SIGN

NOTES

EAST FRONTAGE ROAD AND CTH C ARE CLOSED FOR THE DURATION OF DETOUR



ALL SIGNS SHALL BE PLACED IN ACCORDANCE WITH THE MANUAL ON UNIFORM TRAFFIC CONTROL DEVICES.

EXACT NUMBER, LOCATION AND SPACING OF SIGNS AND DEVICES MAY BE ADJUSTED TO FIT FIELD CONDITIONS AS DIRECTED BY THE ENGINEER.

SIGN LAYOUTS SHALL BE IN ACCORDANCE WITH THE FEDERAL HIGHWAY ADMINISTRATION MANUAL OF STANDARD HIGHWAY SIGNS, UNLESS OTHERWISE PROVIDED IN THE PLAN.

ANY EXISTING TRAFFIC SIGNS THAT CONFLICT WITH THIS WORK SHALL BE COVERED AS DIRECTED BY THE ENGINEER.

DETOUR SIGNS SHALL BE COVERED OR REMOVED WHEN EAST FRONTAGE ROAD AND CTH C IS OPEN TO TRAFFIC AND SIGN DETOUR IS NOT IN USE.

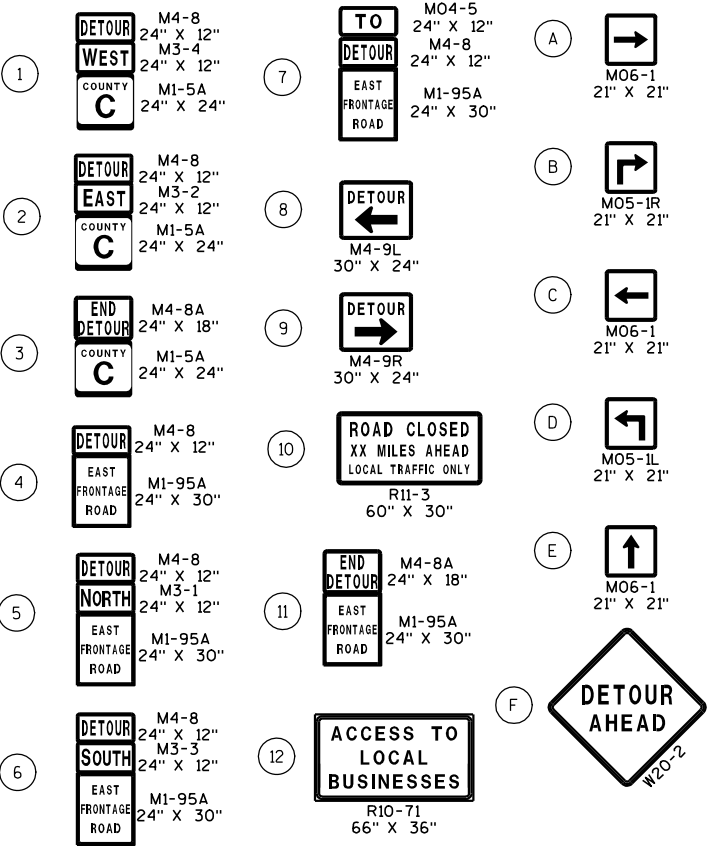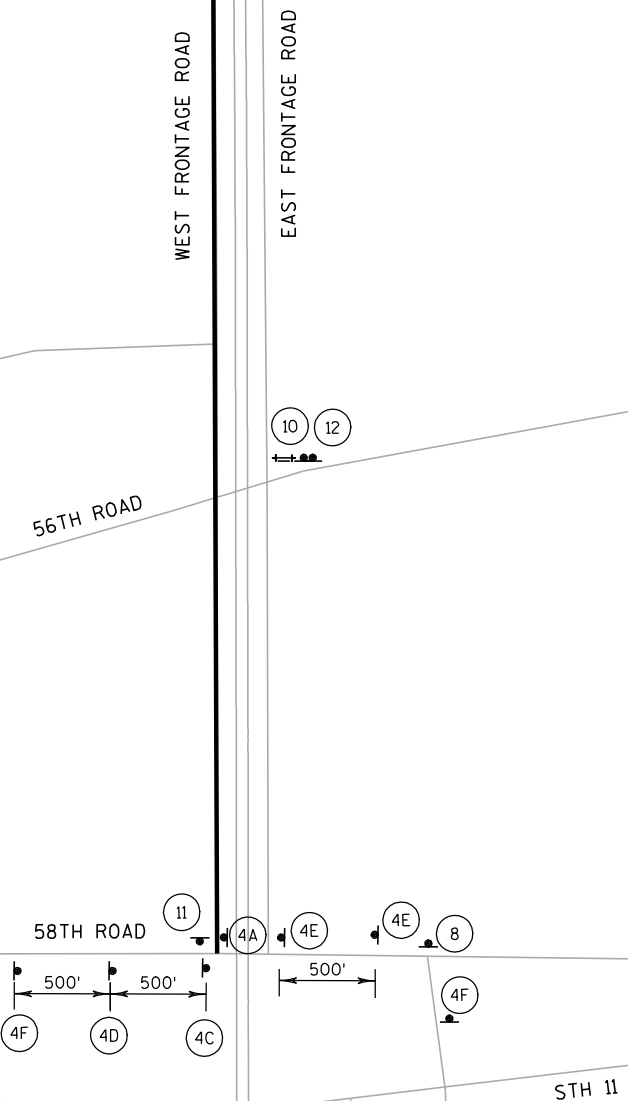

GENERAL NOTES

ALL SIGNS TO HAVE STANDARD REFLECTIVE SHEETING-REFERENCE: "WISDOT STANDARD SPECIFICATIONS FOR ROAD AND BRIDGE CONSTRUCTION"

ENGINEER WILL FIELD VERIFY THE LOCATION OF SIGNS AFTER INITIAL LAYOUT


SIGNS ON THIS SHEET TO BE PAID FOR AS "FIXED MESSAGE SIGNS"


SIGNS SHALL BE BLACK NON-REFLECTIVE MESSAGE ON ORANGE REFLECTIVE BACKGROUND


ALL SIGNS SHALL HAVE CAPITAL LETTERS: 6" CAPS SHALL BE SERIES "C"

(XXX) SIGN NUMBER NOTED ON TRAFFIC CONTROL PLAN

** CONTRACTOR TO VERIFY DIMENSIONS PRIOR TO FABRICATION

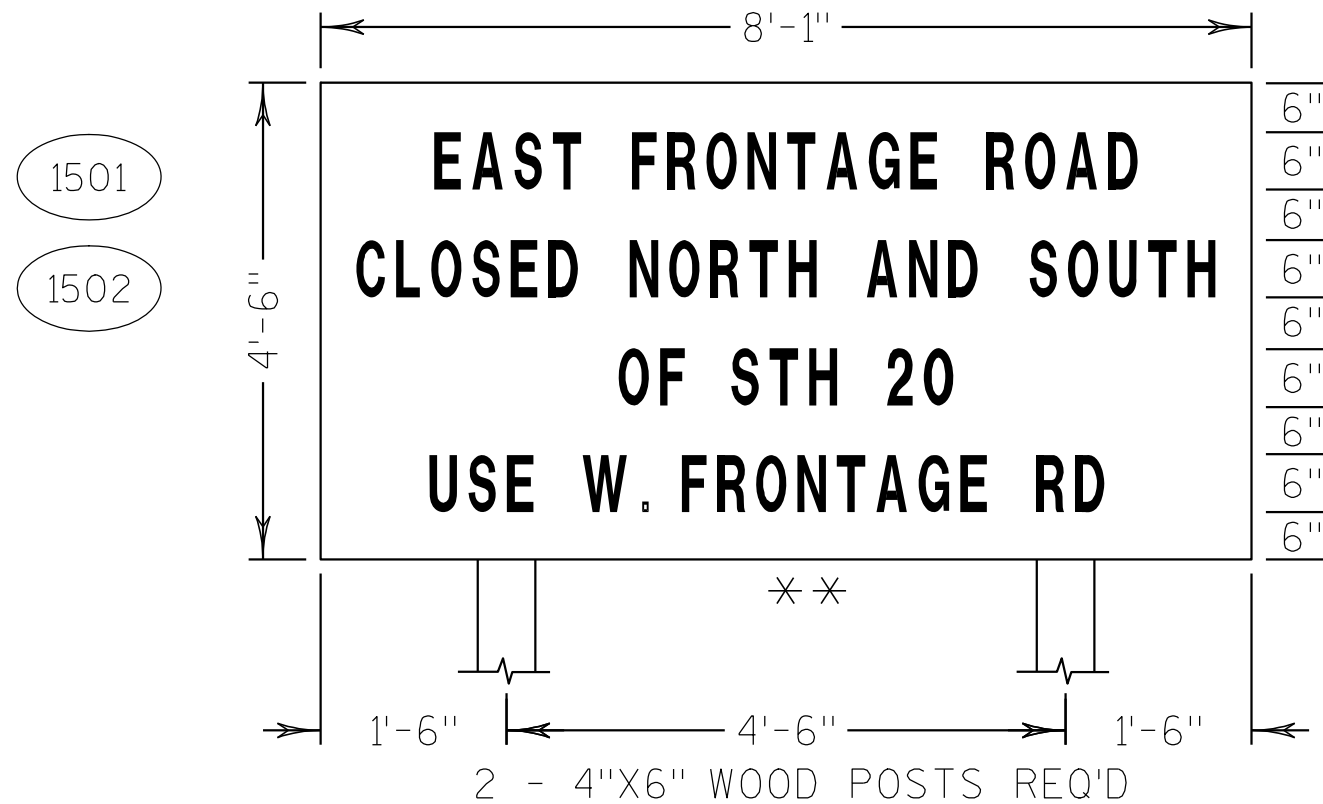

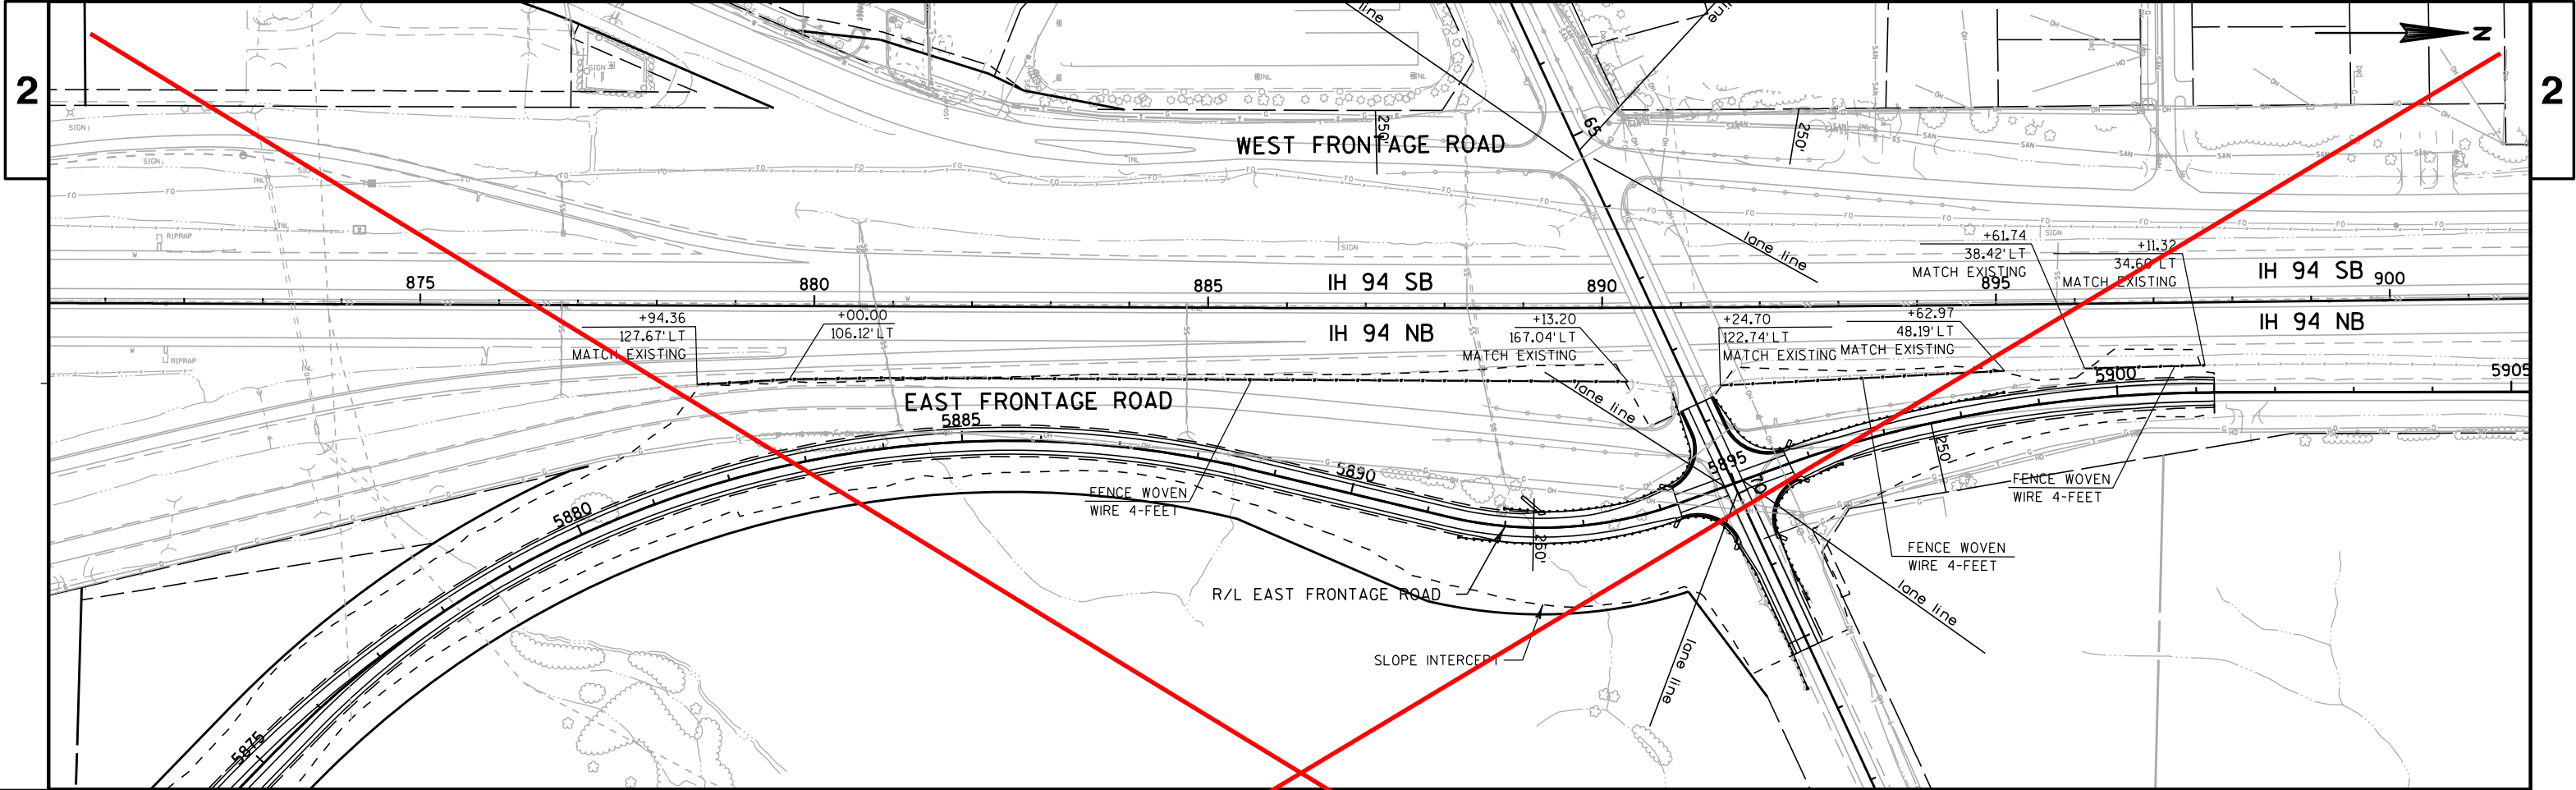

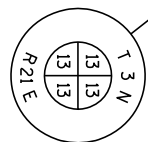

X=591455.76
Y=183658.74

CURVE NO.	PI	PI COORDINATES		CURVE DATA							
		X	Y	Δ	D	T	L	E	R	PC	PT
1	839+47.69	594019.87	183216.67	0°19'28"	0°02'00"	486.49	972.97	0.69	171881.34	834+61.20	844+34.17
ES1	3839+49.28	594759.75	183199.84	35°36'31"	6°00'00"	306.67	593.47	48.04	954.93	3836+42.61	3842+36.09
ES2	3851+87.15	594760.09	184457.58	2°59'07"	0°42'58"	208.45	416.81	2.72	8000.00	3849+78.70	3853+95.51
ES3	3856+49.68	594736.12	184919.59	26°28'10"	11°14'04"	119.95	235.61	13.91	510.00	3855+29.74	3857+65.35

N89°24'20"E
2644.54'
1/4 LINE


BEGIN PROJECT 1033-02-70

829+00.00
X = 594028.15
Y = 182169.01

835

PC

N0°27'11"W

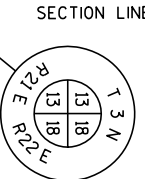

X=594106.88
Y=181033.47

3833+39.52 EAST FRONTAGE ROAD =
834+32.18 IH 94, 380.66' RT
X = 594404.59
Y = 182704.19


BEGIN PROJECT 1033-02-70

3835+00.00

X = 594498.06
Y = 182834.64


PC
ES1

3840
CURVE ES1
PI ES1

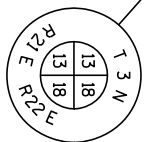

X=594100.15
Y=183686.18

S88°40'22"E
2504.78'
1/4 LINE

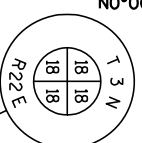

X=596604.26
Y=183628.16

3845

N0°00'55"E

850

N0°07'43"W

855

SECTION LINE

2660.98'


R/L IH 94

860

N0°12'02"W

TOWN OF YORKVILLE
VILLAGE OF MOUNT PLEASANT

865

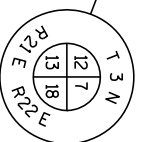

X=594090.84
Y=186347.14

3858+95.98 EAST FRONTAGE ROAD =
303+05.92 STH 20
X = 594836.03
Y = 185149.38

3855

N2°58'12"W


PC
ES3

CURVE ES3


PT
ES3

N23°29'58"E


5860

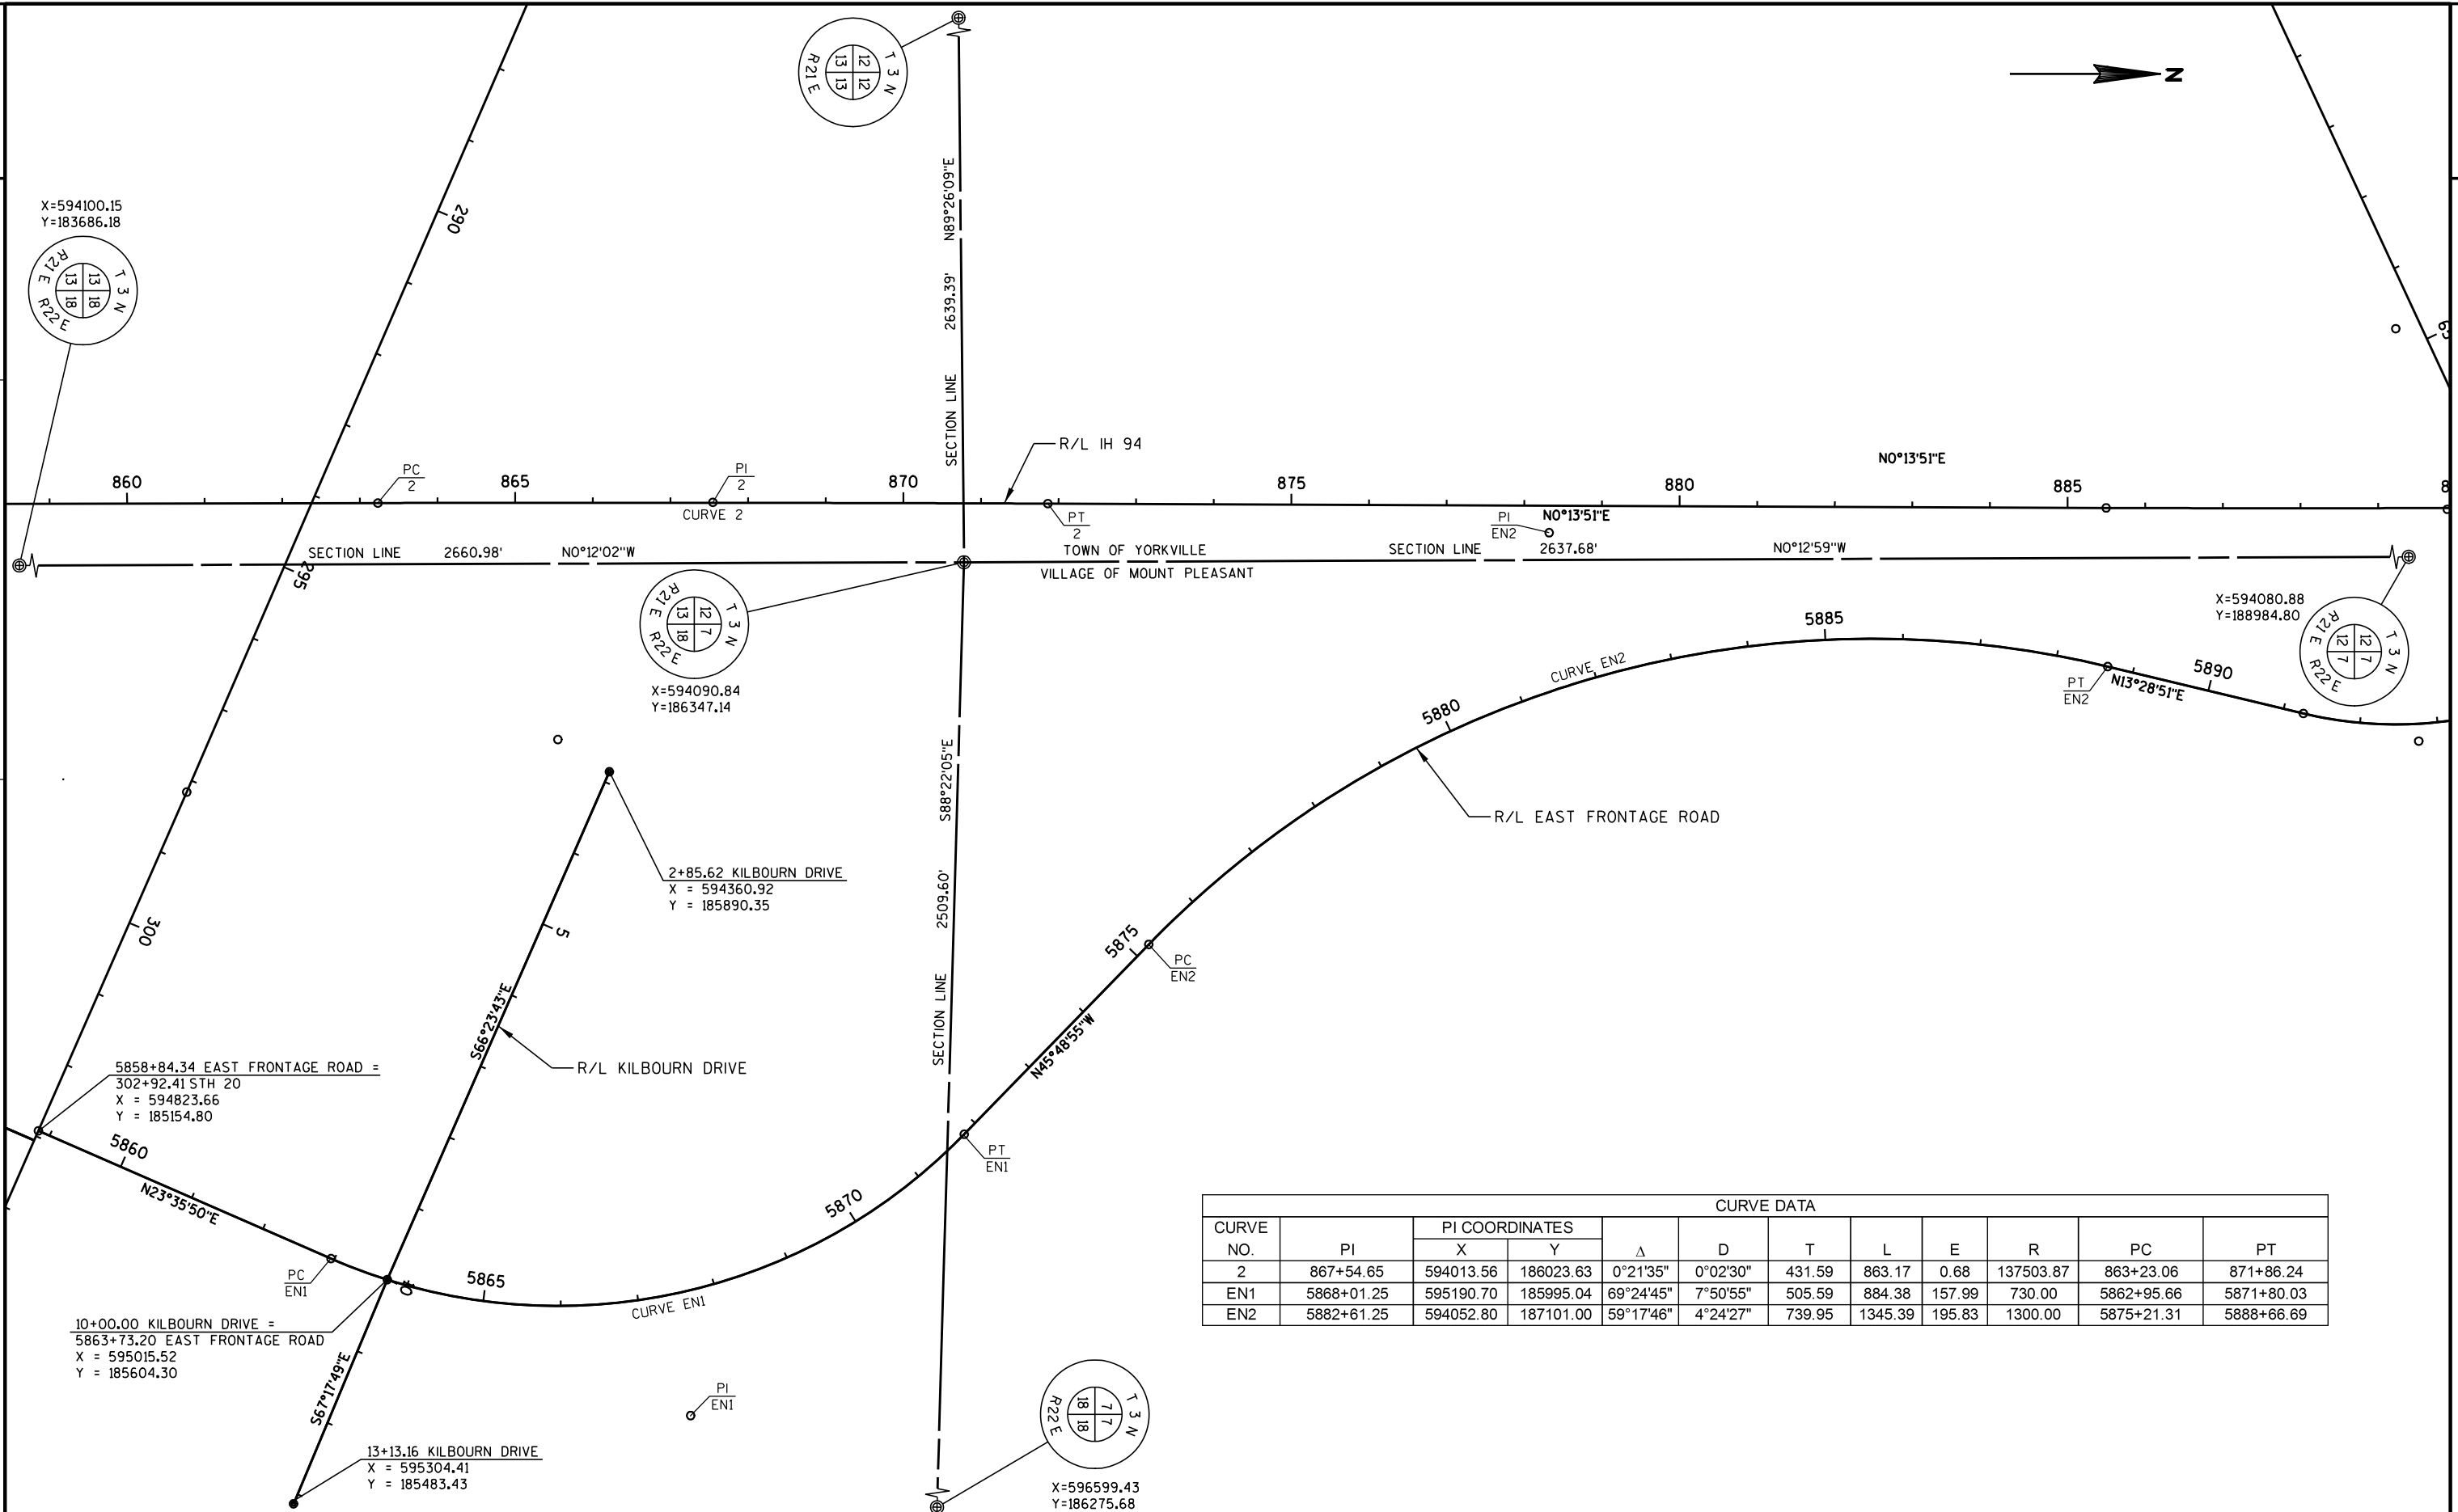

CURVE DATA											
CURVE NO.	PI	PI COORDINATES		Δ	D	T	L	E	R	PC	PT
		X	Y								
2	867+54.65	594013.56	186023.63	0°21'35"	0°02'30"	431.59	863.17	0.68	137503.87	863+23.06	871+86.24
EN1	5868+01.25	595190.70	185995.04	69°24'45"	7°50'55"	505.59	884.38	157.99	730.00	5862+95.66	5871+80.03
EN2	5882+61.25	594052.80	187101.00	59°17'46"	4°24'27"	739.95	1345.39	195.83	1300.00	5875+21.31	5888+66.69

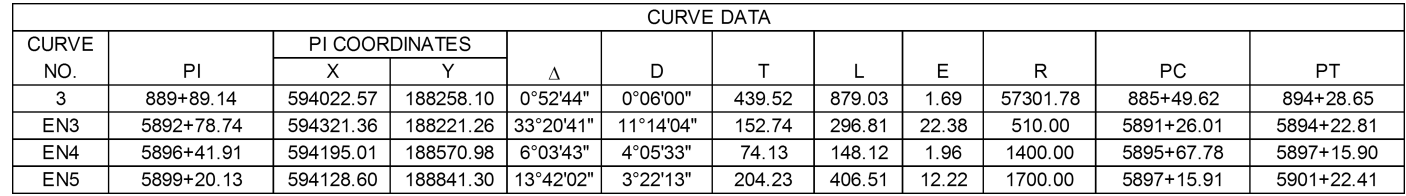


2

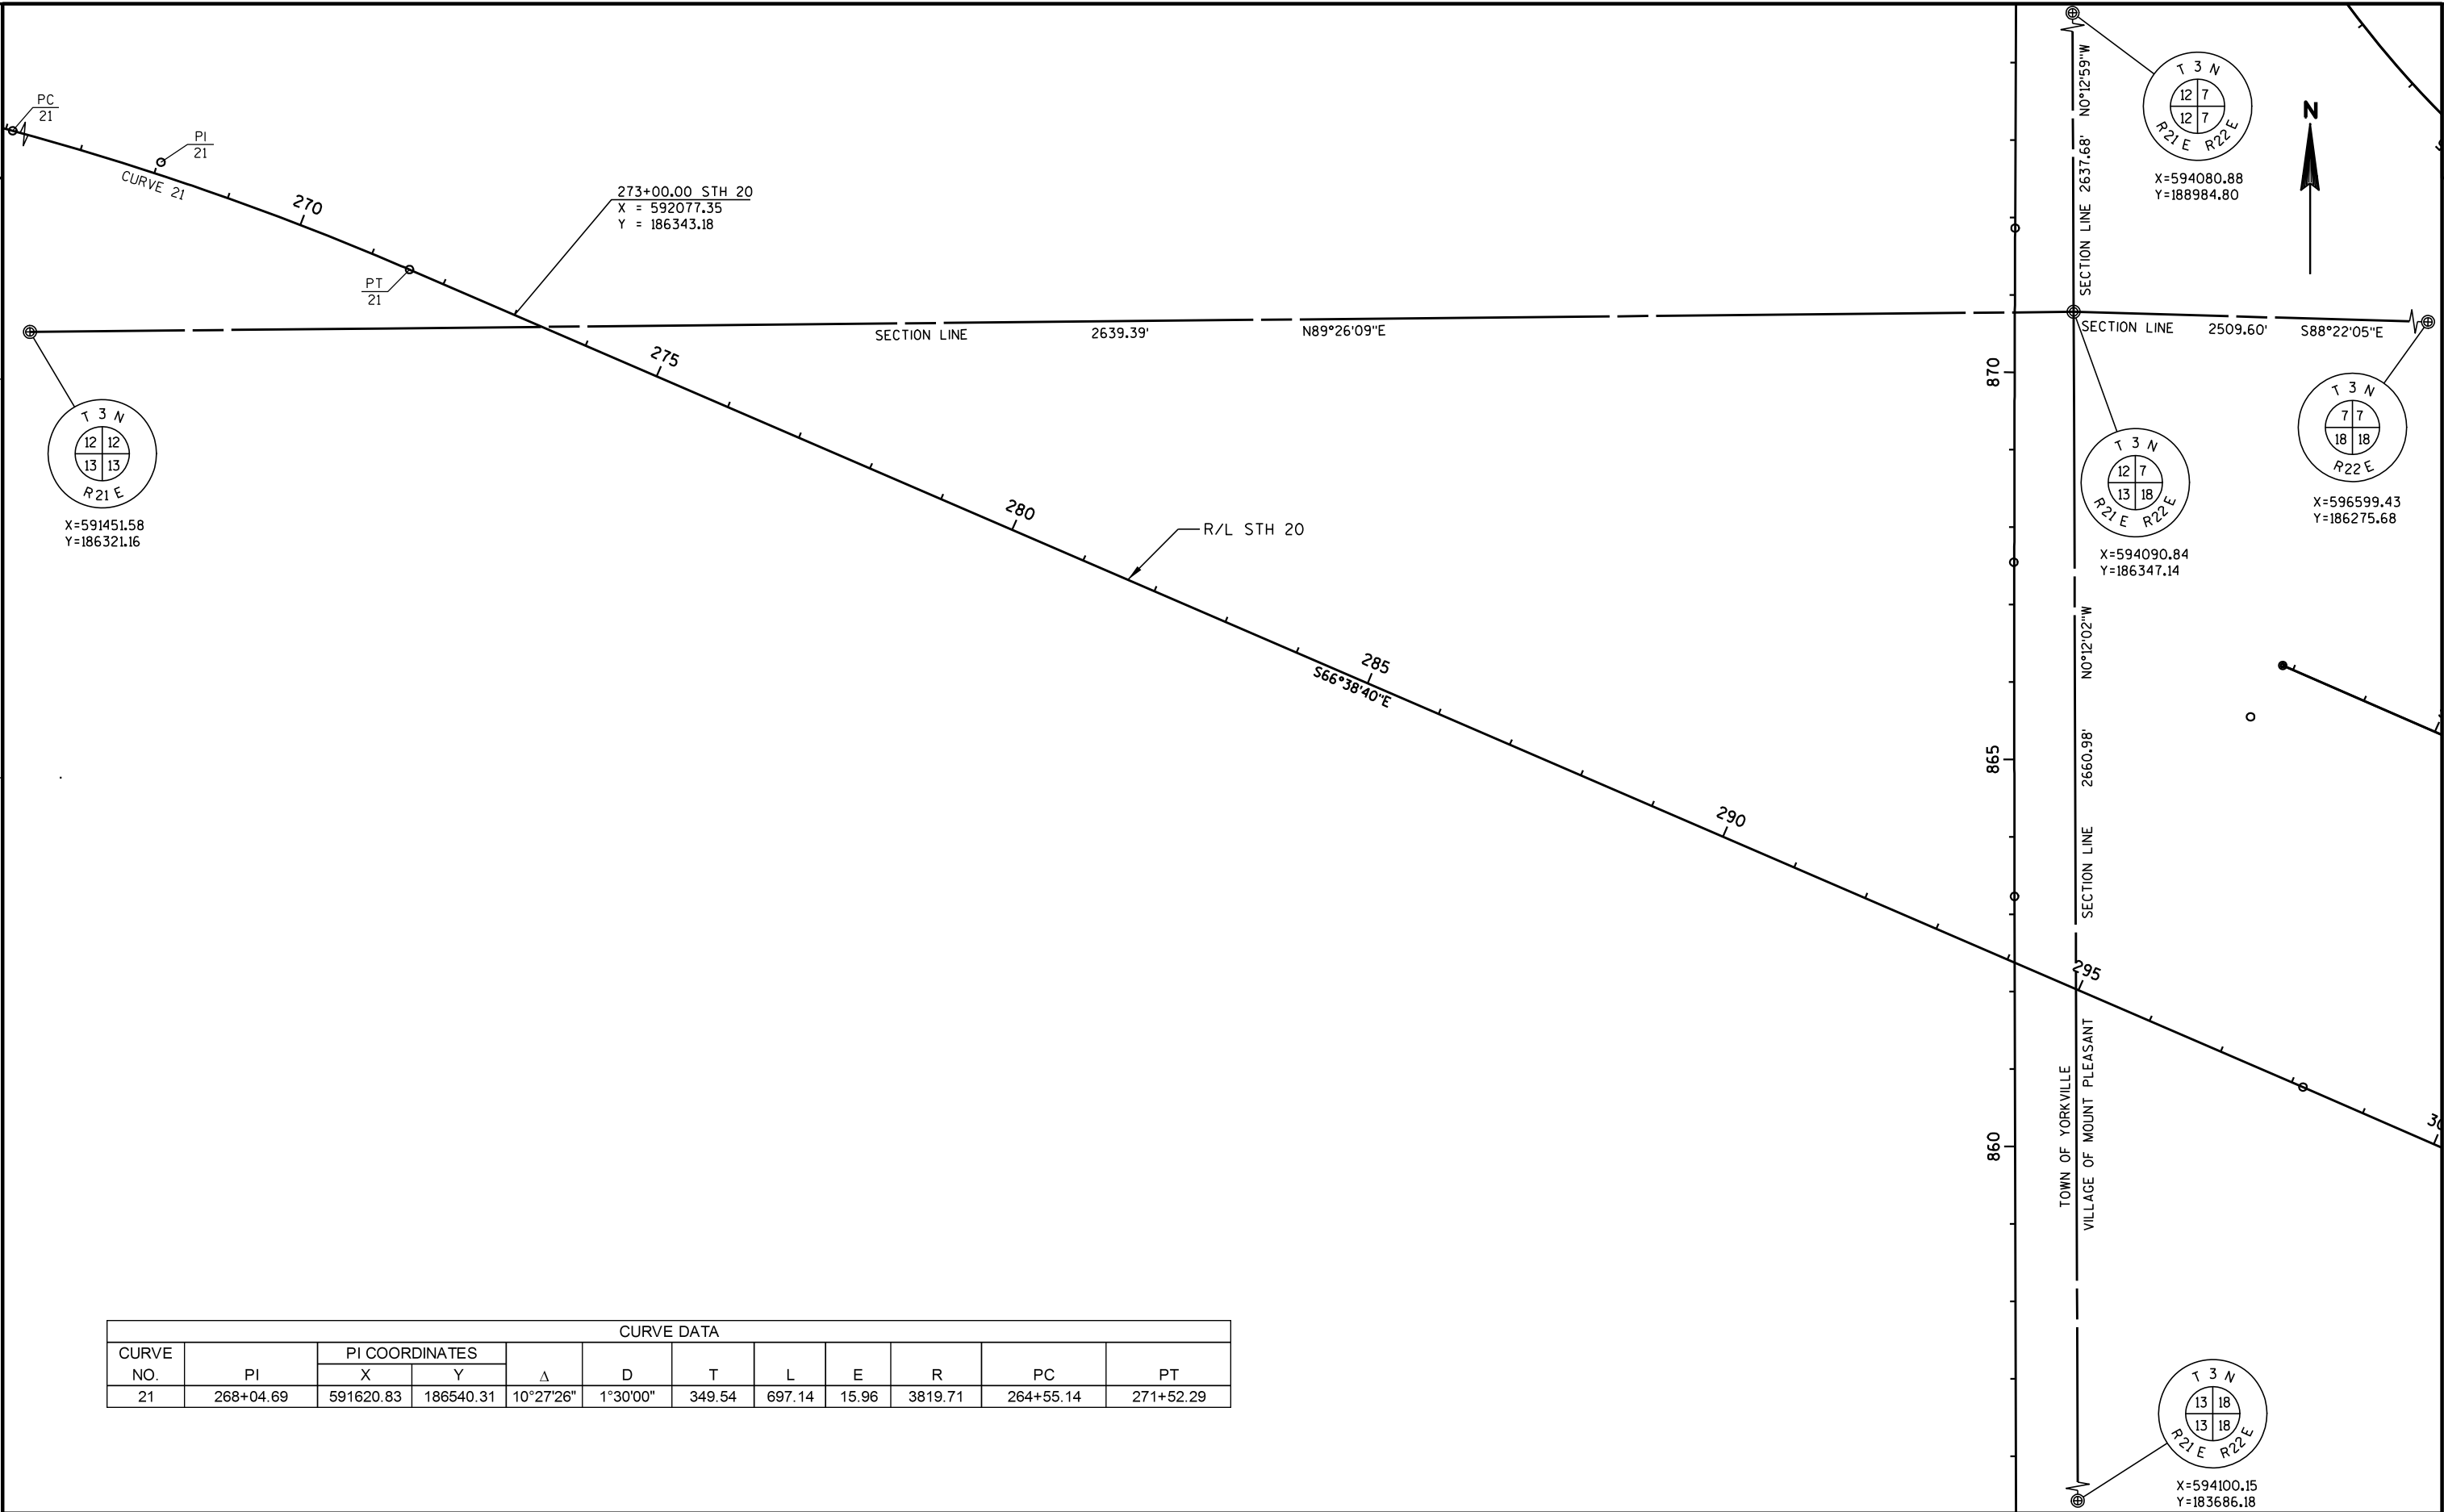


2



CURVE DATA											
CURVE NO.	PI	PI COORDINATES		Δ	D	T	L	E	R	PC	PT
		X	Y								
21	268+04.69	591620.83	186540.31	10°27'26"	1°30'00"	349.54	697.14	15.96	3819.71	264+55.14	271+52.29

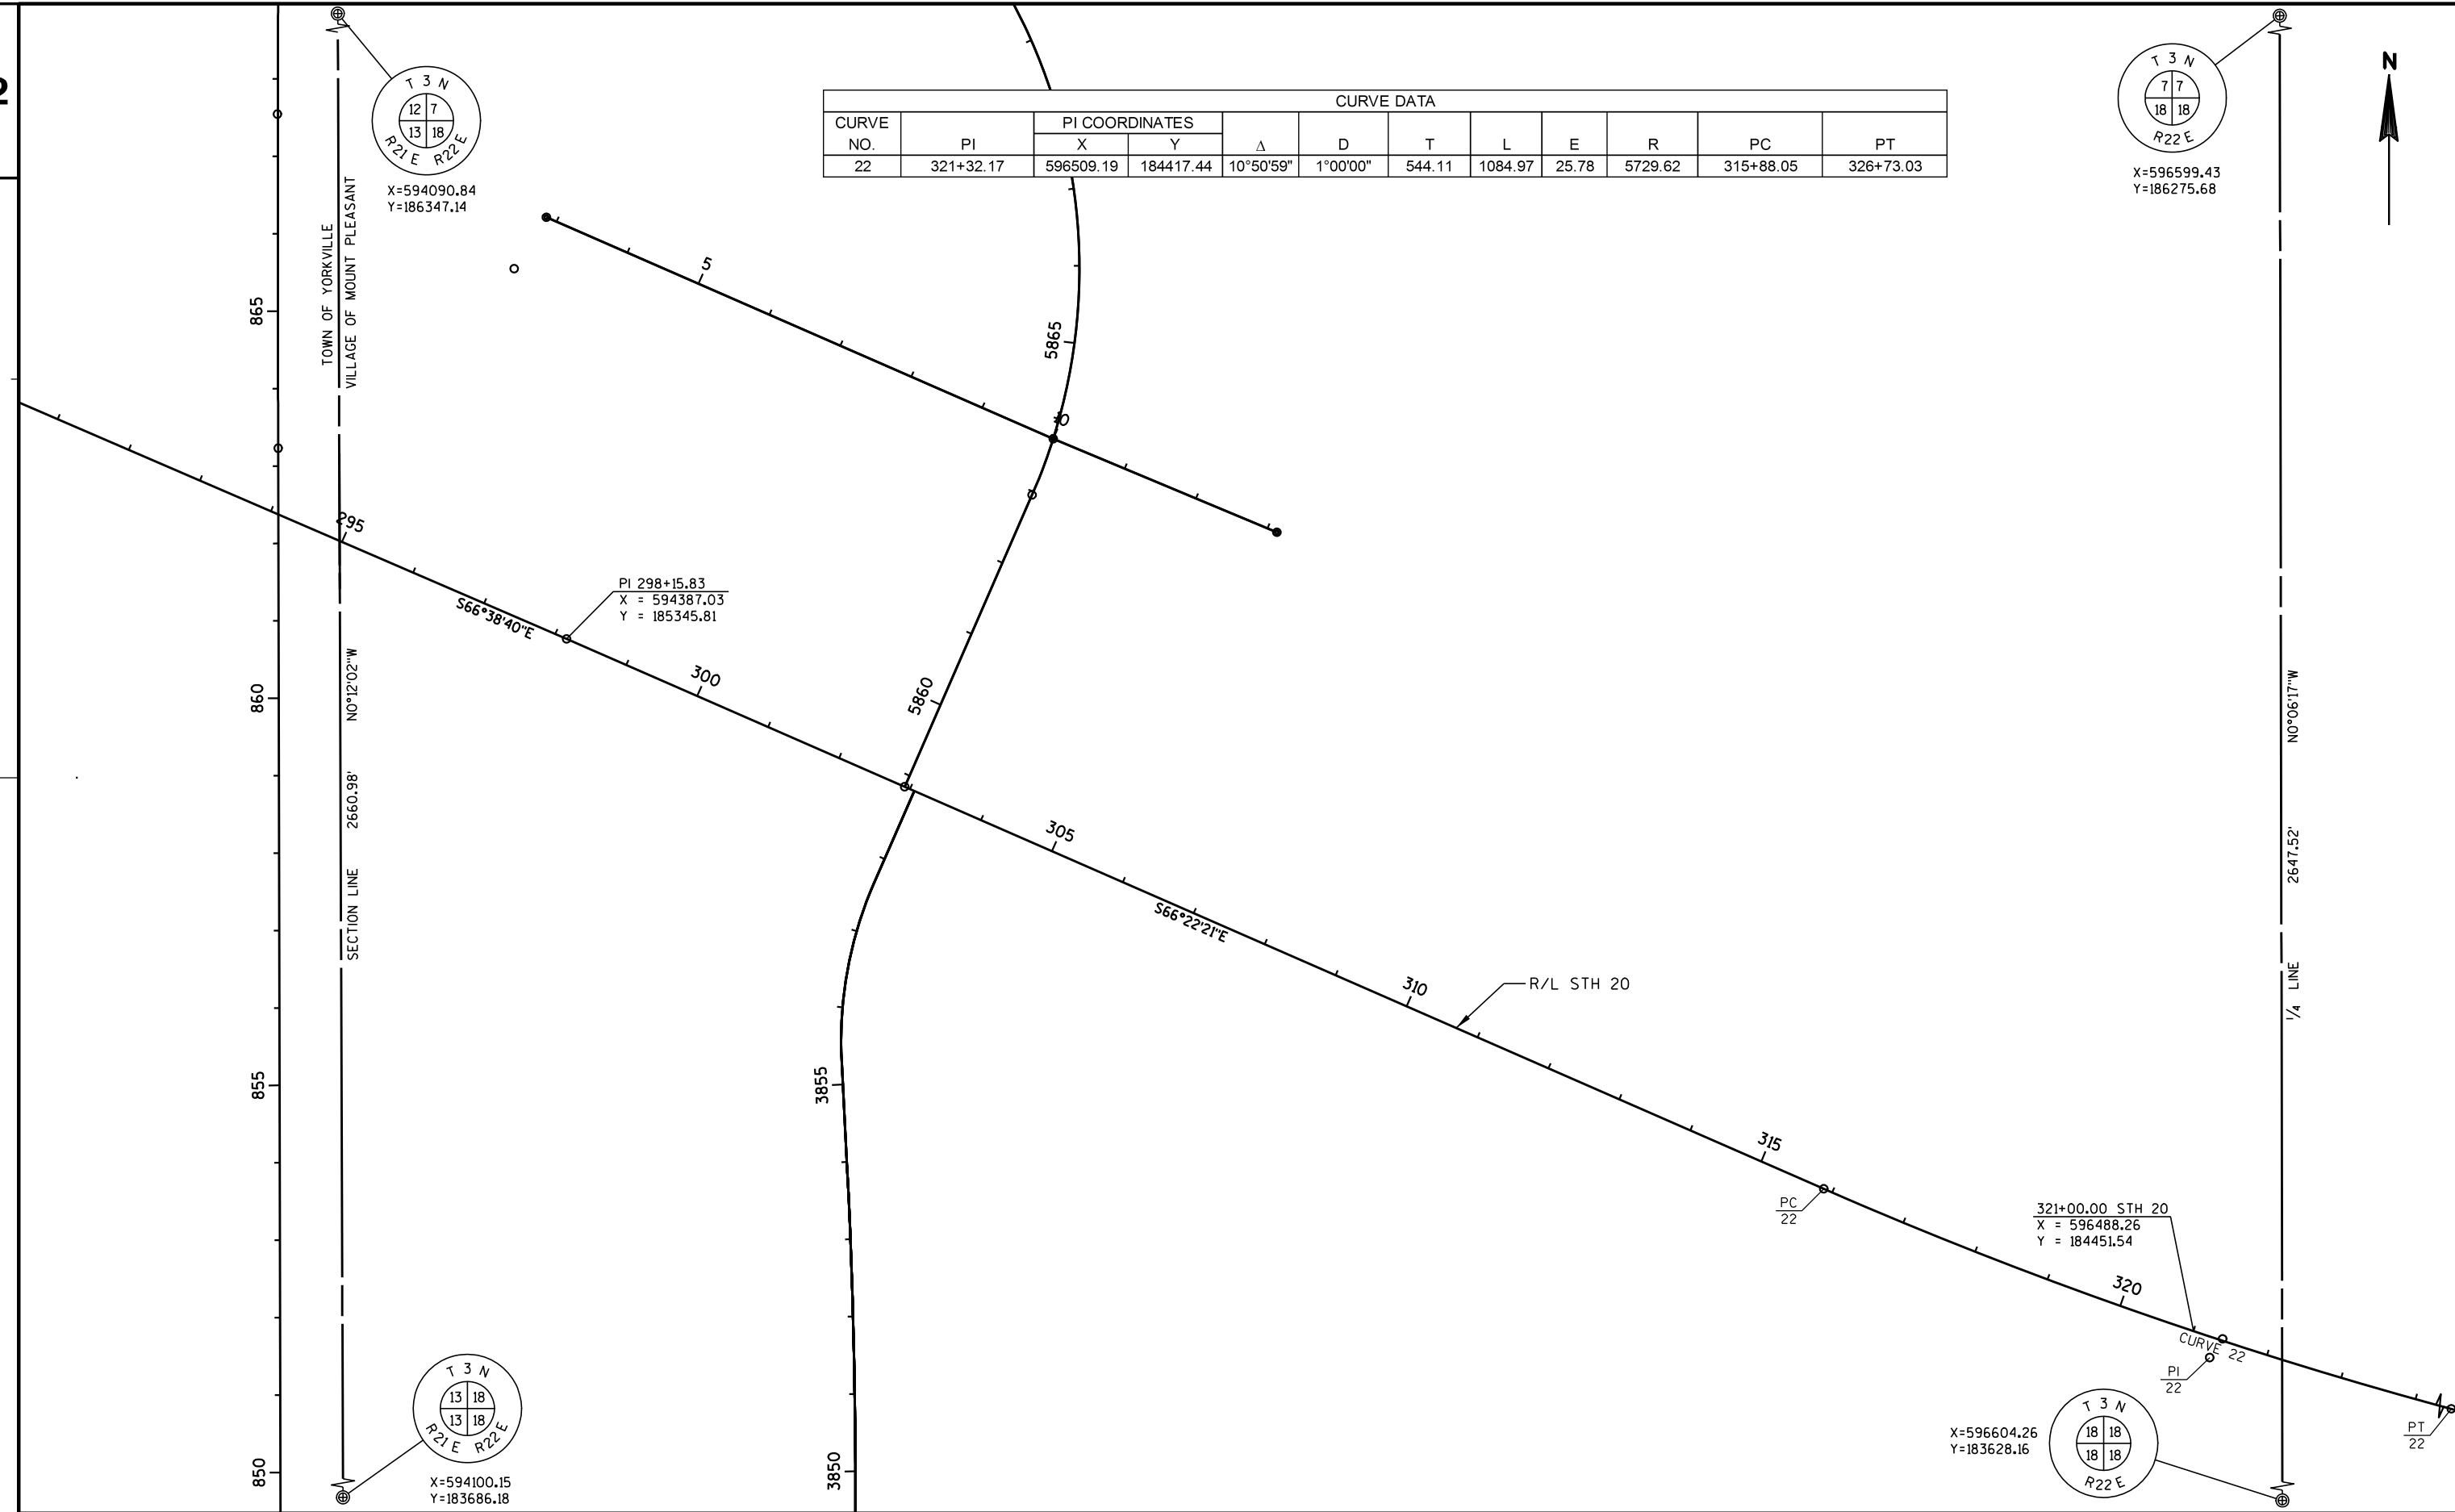

CURVE NO.	PI	PI COORDINATES		Δ	CURVE DATA						
		X	Y		D	T	L	E	R	PC	PT
22	321+32.17	596509.19	184417.44	10°50'59"	1°00'00"	544.11	1084.97	25.78	5729.62	315+88.05	326+73.03

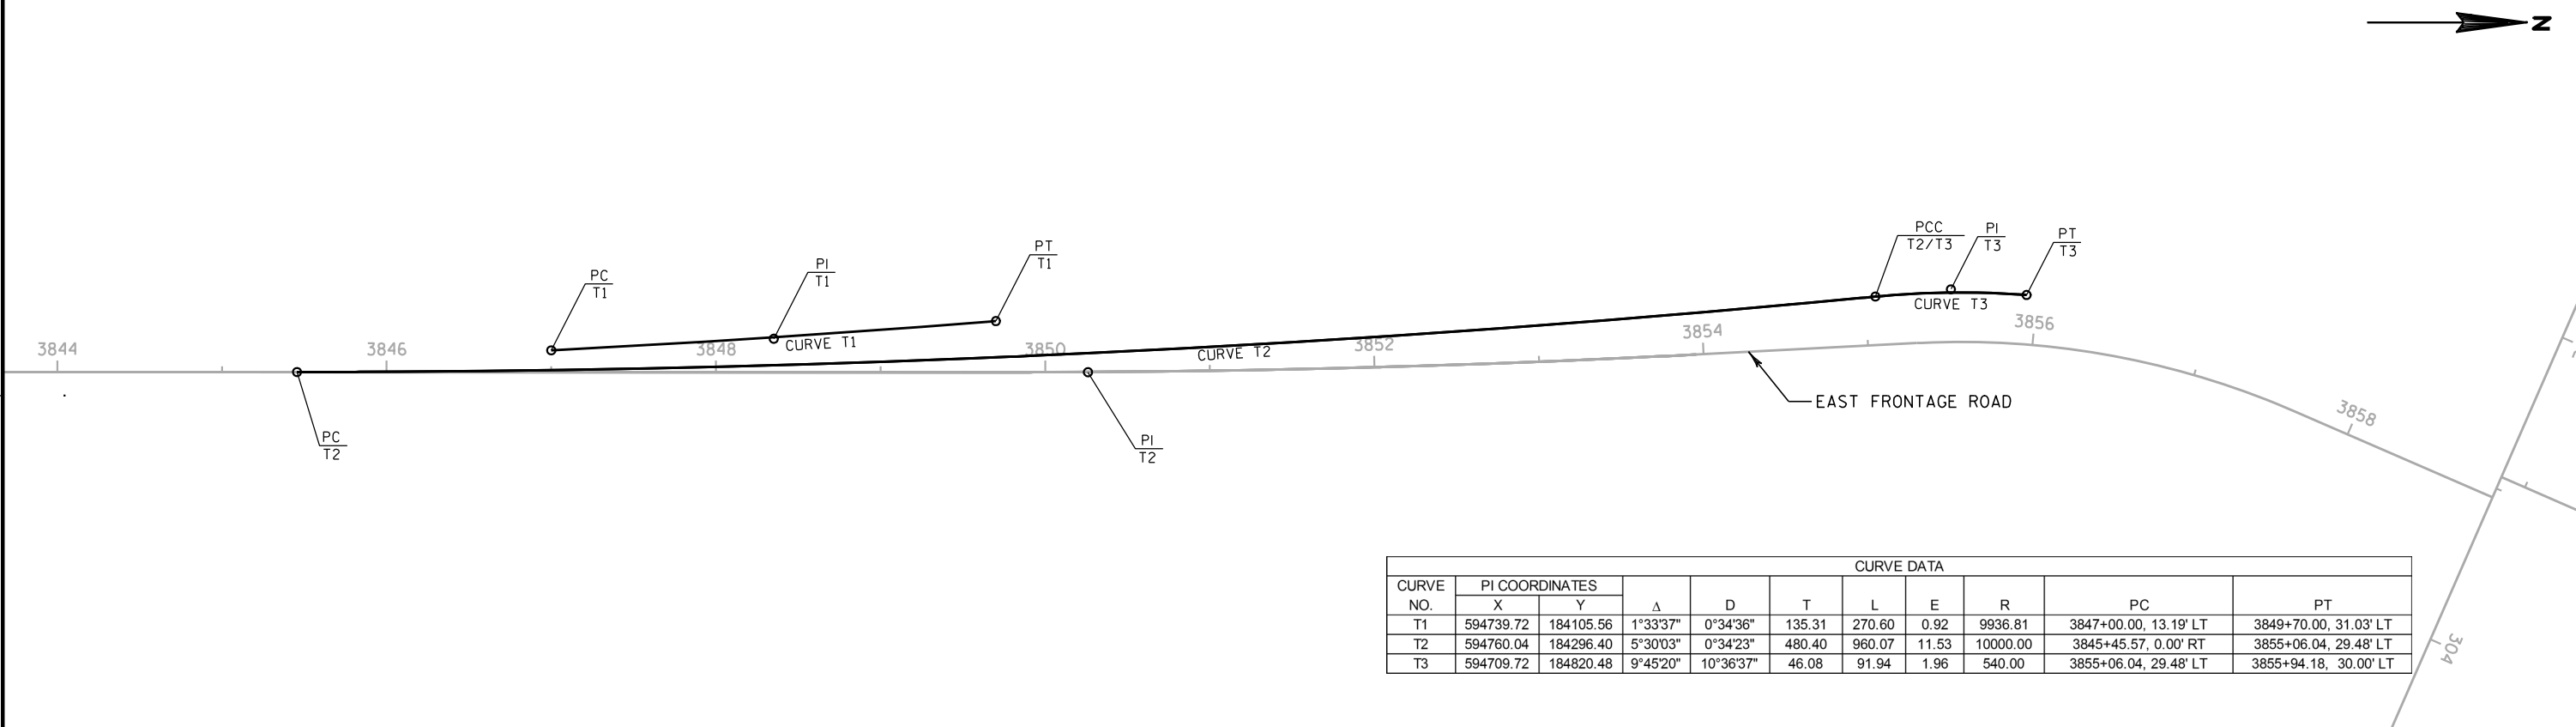

CURVE DATA										
CURVE NO.	PI COORDINATES		Δ	D	T	L	E	R	PC	PT
	X	Y								
T1	594739.72	184105.56	1°33'37"	0°34'36"	135.31	270.60	0.92	9936.81	3847+00.00, 13.19' LT	3849+70.00, 31.03' LT
T2	594760.04	184296.40	5°30'03"	0°34'23"	480.40	960.07	11.53	10000.00	3845+45.57, 0.00' RT	3855+06.04, 29.48' LT
T3	594709.72	184820.48	9°45'20"	10°36'37"	46.08	91.94	1.96	540.00	3855+06.04, 29.48' LT	3855+94.18, 30.00' LT

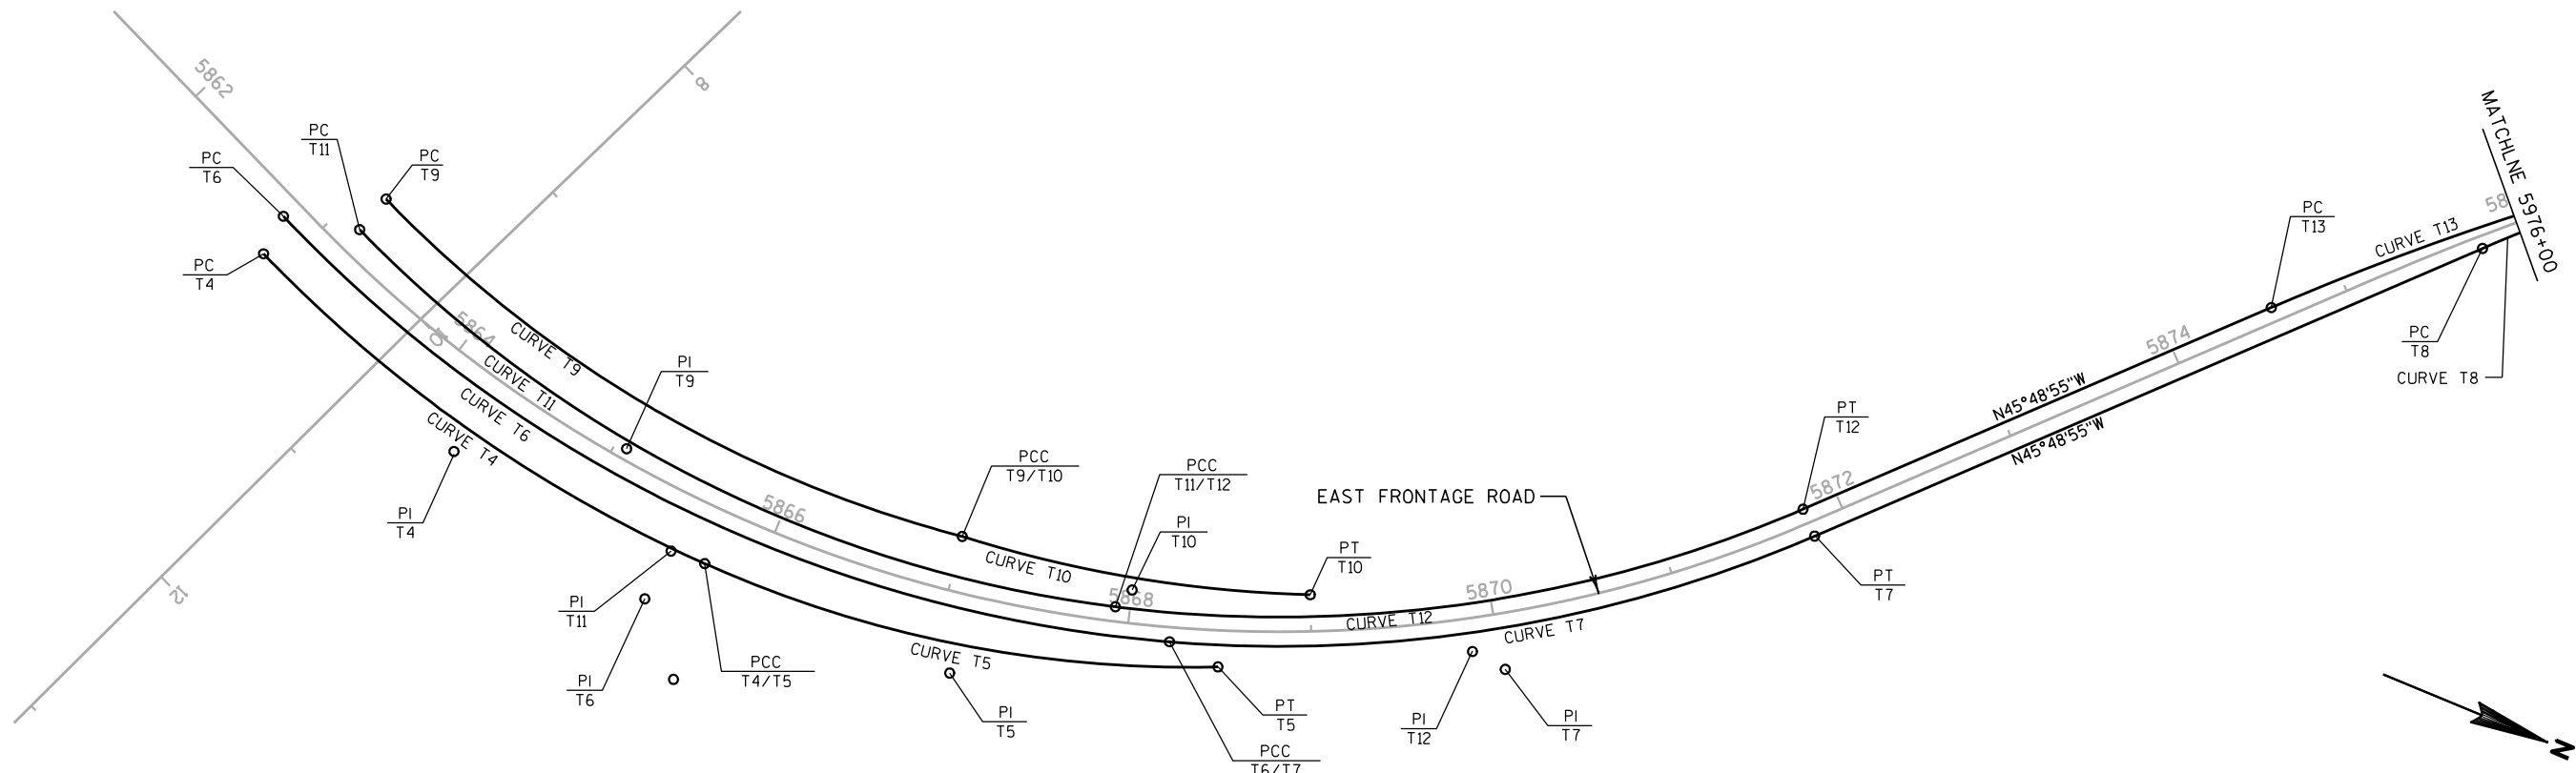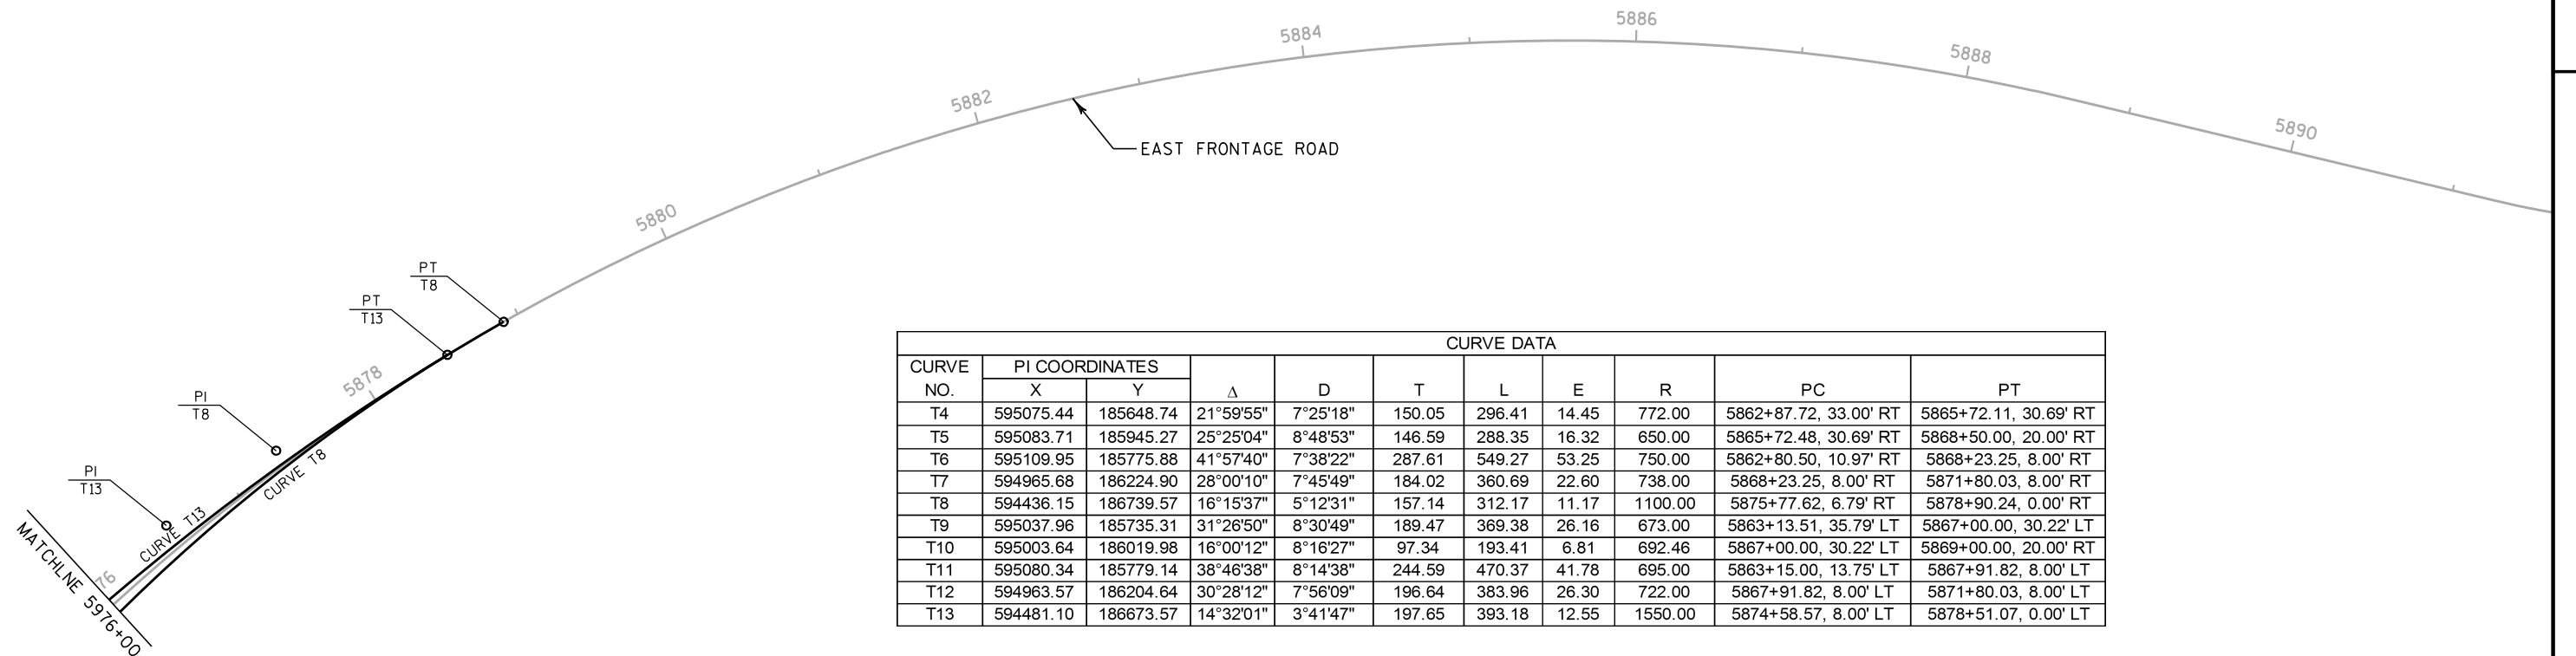


EAST FRONTAGE ROAD

SUPERELEVATION DATA	STATION	RATE	
		LEFT	RIGHT
END NORMAL CROWN	3834+25	2.0%	-2.0%
REMOVE CROWN	3835+00	FLAT	FLAT
SUPER EQUALS NORMAL CROWN	3835+75	-2.0%	2.0%
BEGIN FULL SUPER	3836+75	-5.0%	5.0%
END FULL SUPER	3842+00	-5.0%	5.0%
SUPER EQUALS NORMAL CROWN	3842+75	-2.0%	2.0%
REMOVE CROWN	3843+00	-2.0%	FLAT
BEGIN NORMAL CROWN	3843+50	-2.0%	-2.0%
END NORMAL CROWN	3854+25	-2.0%	-2.0%
REMOVE CROWN	3854+88	FLAT	-2.0%
SUPER EQUALS NORMAL CROWN	3855+00	2.0%	-2.0%
SUPER EQUALS NORMAL CROWN	3857+75	2.0%	-2.0%
REMOVE CROWN	3858+00	FLAT	-2.0%
WARP TO INTERSECTION	3858+50	-2.0%	-2.0%
END NORMAL CROWN	5862+75	-2.0%	-2.0%
REMOVE CROWN	5863+25	-2.0%	FLAT
SUPER EQUALS NORMAL CROWN	5863+50	-2.0%	2.0%
BEGIN FULL SUPER	5864+00	-3.9%	3.9%
END FULL SUPER	5871+50	-3.9%	3.9%
SUPER EQUALS NORMAL CROWN	5872+00	-2.0%	2.0%
REMOVE CROWN	5872+25	-2.0%	FLAT
BEGIN NORMAL CROWN	5872+75	-2.0%	-2.0%
END NORMAL CROWN	5874+25	-2.0%	-2.0%
REMOVE CROWN	5874+50	FLAT	-2.0%
SUPER EQUALS NORMAL CROWN	5875+00	2.0%	-2.0%
BEGIN FULL SUPER	5875+50	4.3%	-4.3%
END FULL SUPER	5888+25	4.3%	-4.3%
SUPER EQUALS NORMAL CROWN	5888+75	2.0%	-2.0%
REMOVE CROWN	5889+25	FLAT	-2.0%
BEGIN NORMAL CROWN	5889+75	-2.0%	-2.0%
END NORMAL CROWN	5890+00	-2.0%	-2.0%
REMOVE CROWN	5890+50	-2.0%	FLAT
SUPER EQUALS NORMAL CROWN	5890+75	-2.0%	2.0%
BEGIN FULL SUPER	5891+75	-6.0%	6.0%
END FULL SUPER	5893+75	-6.0%	6.0%
BEGIN REVERSE FULL SUPER	5896+25	4.1%	-4.1%
END REVERSE FULL SUPER	5897+16	4.1%	-4.1%
SUPER TRANSITION	5897+25	3.7%	-3.7%
SUPER TRANSITION	5900+50	3.7%	-3.7%
SUPER EQUALS NORMAL CROWN	5901+00	2.0%	-2.0%
REMOVE CROWN	5901+25	FLAT	-2.0%
BEGIN NORMAL CROWN	5901+75	-2.0%	-2.0%

The most current Right of Way information should be viewed in DTD View using the Real Estate Project ID. The Plat information contained in this AsBuilt Plan may not be the final records.

STATE OF WISCONSIN
DEPARTMENT OF TRANSPORTATION
TRANSPORTATION PROJECT PLAT TITLE SHEET
PROJECT NO. 1033-02-20
INTERSTATE 94
STH 20 INTERCHANGE
RACINE COUNTY

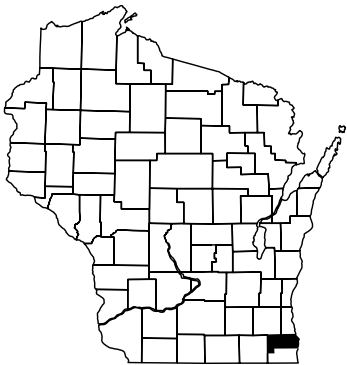

CONVENTIONAL ABBREVIATIONS			
ACCESS POINT	AP	RELEASE OF RIGHTS	ROR
ACCESS RIGHTS	AR	REMAINING	REM.
ACRES	AC.	RIGHT-OF-WAY	R/W
AND OTHERS	ET.AL.	SECTION	SEC.
CENTERLINE	C/L	STATION	STA.
CERTIFIED SURVEY MAP	CSM	TEMPORARY LIMITED EASEMENT	TLE
CORNER	COR.	VOLUME	V.
CONVEYANCE OF RIGHTS	CR	CURVE DATA	
DOCUMENT	DOC.		
EASEMENT	EASE.	LONG CHORD	LCH
LAND CONTRACT	LC	LONG CHORD BEARING	LCH
MONUMENT	MON.	RADIUS	R
PAGE	P.	DEGREE OF CURVE	D
PERMANENT LIMITED EASEMENT	PLE	CENTRAL ANGLE OR DELTA	DELTA
PROPERTY LINE	PL	LENGTH OF CURVE	L
RECORDED AS	(100')	TANGENT	TAN
REFERENCE LINE	R/L		

CONVENTIONAL SYMBOLS			
FOUND IRON PIPE/PIN	IF (1" UNLESS NOTED)	PROPOSED R/W LINE	---
R/W MONUMENT	• (SET)	EXISTING H.E. LINE	---
R/W STANDARD	Δ (SET)	PROPERTY LINE	---
SIGN	ISIGN	LOT & TIE LINES	---
SECTION CORNER MONUMENT	⊙	SLOPE INTERCEPTS	---
SECTION CORNER SYMBOL	⊙	CORPORATE LIMITS	---
		NO ACCESS (BY PREVIOUS ACQUISITION/CONTROL)	---
		NO ACCESS (BY ACQUISITION)	---
		NO ACCESS (BY STATUTORY AUTHORITY)	---
FEE (HATCH VARIES)		SECTION LINE	---
TEMPORARY LIMITED EASEMENT		QUARTER LINE	---
PERMANENT LIMITED EASEMENT		SIXTEENTH LINE	---
R/W BOUNDARY POINT	⊙	EXISTING CENTERLINE	---
PARCEL NUMBER	⊙	PROPOSED REFERENCE LINE	---
SIGN NUMBER (OFF PREMISE)	⊙	PARALLEL OFFSET	---
BUILDING			


CONVENTIONAL UTILITY SYMBOLS			
WATER	W	NON	
GAS	G	COMPENSABLE	
TELEPHONE	T	COMPENSABLE	
OVERHEAD	OH		
TRANSMISSION LINES			
ELECTRIC	E		
CABLE TELEVISION	TV		
FIBER OPTIC	FO		
SANITARY SEWER	SAN		
STORM SEWER	SS		
POWER POLE	⊙		
TELEPHONE POLE	⊙		
TELEPHONE PEDESTAL	⊙		
ELECTRIC TOWER	⊙		

THE NOTES, CONVENTIONAL SYMBOLS, AND VARIOUS ABBREVIATIONS ARE ASSOCIATED WITH EACH TRANSPORTATION PROJECT PLAT OF PROJECT 1033-02-20.

NOTES:
COORDINATES AND BEARINGS SHOWN ON THIS PLAT ARE REFERENCED TO THE WISCONSIN COUNTY COORDINATE SYSTEM, RACINE COUNTY ZONE, NAD83 (97) ADJUSTMENT AND ARE REFERENCED TO GPS HARN POINTS YORKVILLE EAST, RAYMOND SOUTH, AND PARIS EAST. THE COORDINATES SHOWN ARE GRID COORDINATES AND ARE TO BE USED AS GRID OR GROUND VALUES ON THIS PLAT. RIGHT-OF-WAY MONUMENTS ARE TYPE 2 AND WILL BE PLACED PRIOR TO THE COMPLETION OF THE PROJECT, BY SE REGION DOT SURVEY.
RIGHT-OF-WAY BOUNDARIES ARE DEFINED WITH COURSES OF THE PERIMETER OF THE HIGHWAY LANDS REFERENCED TO THE U.S. PUBLIC LAND SURVEY SYSTEM OR OTHER "SURVEYS OF PUBLIC RECORD".
PROPERTY LINES SHOWN ON THIS PLAT ARE DRAWN FROM DATA DERIVED FROM MAPS AND DOCUMENTS OF PUBLIC RECORD AND/OR EXISTING OCCUPATIONAL LINES. THIS PLAT MAY NOT BE A TRUE REPRESENTATION OF EXISTING PROPERTY LINES, EXCLUDING RIGHT-OF-WAY LINES, AND SHOULD NOT BE USED AS A SUBSTITUTE FOR AN ACCURATE FIELD SURVEY.

A **TEMPORARY LIMITED EASEMENT** (TLE) IS A RIGHT FOR CONSTRUCTION PURPOSES, AS DEFINED HEREIN, INCLUDING THE RIGHT TO OPERATE NECESSARY EQUIPMENT THEREON AND THE RIGHT OF INGRESS AND EGRESS, AS LONG AS REQUIRED FOR SUCH PUBLIC PURPOSE, INCLUDING THE RIGHT TO PRESERVE, PROTECT, REMOVE, OR PLANT THEREON ANY VEGETATION THAT THE HIGHWAY AUTHORITIES MAY DEEM NECESSARY OR DESIRABLE. ALL TLE EASEMENTS ARE TO TERMINATE UPON THE COMPLETION OF THIS PROJECT OR ON THE DAY THE HIGHWAY IS OPEN TO THE TRAVELING PUBLIC, WHICHEVER IS LATER.

A **PERMANENT LIMITED EASEMENT** (PLE) IS A RIGHT FOR CONSTRUCTION AND MAINTENANCE PURPOSES, AS DEFINED HEREIN, INCLUDING THE RIGHT TO OPERATE NECESSARY EQUIPMENT THEREON AND THE RIGHT OF INGRESS AND EGRESS, AS LONG AS REQUIRED FOR SUCH PUBLIC PURPOSE, INCLUDING THE RIGHT TO PRESERVE, PROTECT, REMOVE, OR PLANT THEREON ANY VEGETATION THAT THE HIGHWAY AUTHORITIES MAY DEEM NECESSARY OR DESIRABLE, BUT WITHOUT PREJUDICE TO THE OWNER'S RIGHT TO MAKE OR CONSTRUCT IMPROVEMENT ON SAID LANDS OR TO FLATTEN THE SLOPES, PROVIDING SAID ACTIVITIES WILL NOT IMPAIR OR OTHERWISE ADVERSELY AFFECT THE HIGHWAY FACILITIES.

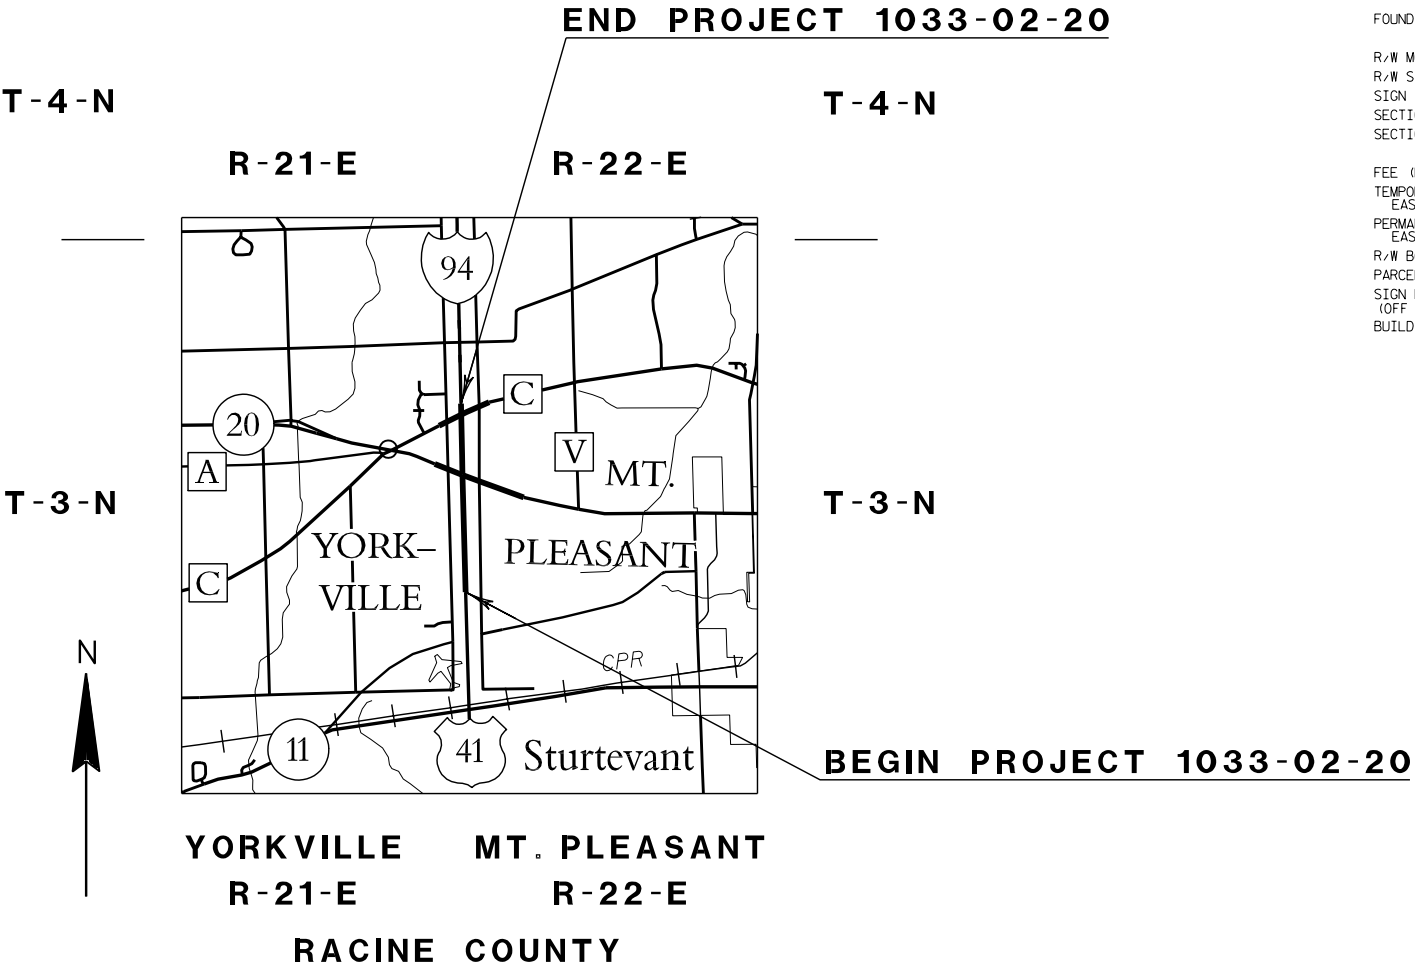

THIS IS A COPY, THE ORIGINAL DOCUMENT IS AT THE RACINE COUNTY REGISTER OF DEEDS


TPP NUMBER 1033-02-20-4.01
SHEET 2 OF 2

DOC # 2202146
Recorded
Feb. 18, 2009 AT 01:23PM
VOL. 1 P. 73

James A. Lantz
RACINE COUNTY
REGISTER OF DEEDS
Fee Amount: \$55.00

100

A Cast Iron Monument
w/ A Brass Cap
Y 181012.86
X 591458.89

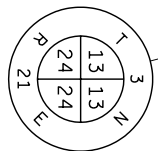

N89°33'14"E
2578.32'

SCHEDULE OF LANDS & INTERESTS REQUIRED		OWNERS NAMES ARE SHOWN FOR REFERENCE PURPOSES ONLY AND ARE SUBJECT TO CHANGE PRIOR TO THE TRANSFER OF LAND INTEREST TO THE DEPARTMENT.				
PARCEL NUMBER	OWNER	INTEREST REQUIRED	R/W REQUIRED ACRES			T.L.E. TEMP. ACRES
			NEW	EXISTING	TOTAL	
1	MLG/HWY 20	Fee AR	0.320	0.000	0.320	0.000
2	WOODSTOCK GROUP	Fee AR	0.122	0.000	0.122	0.000
100	WE-ENERGIES ELECTRIC	ROR	- -	- -	- -	- -
101	WE-ENERGIES GAS	ROR	- -	- -	- -	- -
103	AT&T WISCONSIN	ROR	- -	- -	- -	- -
108	TOWN OF YORKVILLE	ROR	- -	- -	- -	- -

HIGHWAY	BASIS OF EXISTING RIGHT-OF-WAY	WIDTH	YEAR
I-94	I 101-I(3)	VARIES	1956
EAST FRONTAGE ROAD	1032-06-29	VARIES	1989

TRANSPORTATION PROJECT PLAT NO: 1033-02-20 - 4.01


THAT PART OF THE NW1/4 OF THE SW1/4, SECTION 18, TOWN 3 NORTH, RANGE 22 EAST,
VILLAGE OF MT. PLEASANT, RACINE COUNTY, WISCONSIN.

RELOCATION ORDER IH-94/STH 20 RACINE COUNTY


TO PROPERLY ESTABLISH, LAY OUT, WIDEN, ENLARGE, EXTEND, CONSTRUCT, RECONSTRUCT, IMPROVE, OR MAINTAIN A PORTION OF THE HIGHWAY DESIGNATED ABOVE, THE STATE OF WISCONSIN DEPARTMENT OF TRANSPORTATION DEEMS IT NECESSARY TO RELOCATE OR CHANGE SAID HIGHWAY AND ACQUIRE CERTAIN LANDS AND INTERESTS OR RIGHTS IN LANDS FOR THE ABOVE PROJECT.

TO EFFECT THIS CHANGE, PURSUANT TO AUTHORITY GRANTED UNDER SECTION 84.02 (3) AND 84.09, WISCONSIN STATUTES, THE DEPARTMENT OF TRANSPORTATION HEREBY ORDERS THAT:
1. THAT PORTION OF SAID HIGHWAY AS SHOWN ON THIS PLAT IS Laid OUT AND ESTABLISHED TO THE LINES AND WIDTHS AS SO SHOWN FOR THE ABOVE PROJECT.
2. THE LANDS OR INTERESTS OR RIGHTS IN LANDS AS SHOWN ON THIS PLAT ARE REQUIRED BY THE DEPARTMENT FOR THE ABOVE PROJECT AND SHALL BE ACQUIRED IN THE NAME OF THE STATE OF WISCONSIN, PURSUANT TO THE PROVISIONS OF SECTION 84.09 (1) OR (2), WISCONSIN STATUTES.

I-94
PISTA 839+47.69
Y 183216.67
X 594019.87
PC STA 834+61.20
PT STA 844+34.17
DELTA 0°19'28"
D 0°02'00"
L 972.97
R 171881.34
LCH 972.97
LCB N 00°17'27" W

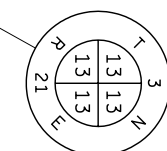


A Concrete Monument
w/ A Brass Cap
Y 183658.74
X 591455.76

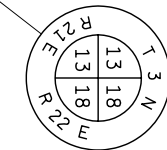

A Concrete Monument
w/ A Brass Cap
Y 183686.18
X 594100.16

SEE TPP
1033-02-20-4.02

SEE TPP
1033-02-20-4.02

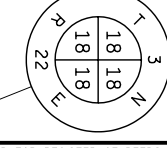

RESERVED FOR REGISTER OF DEEDS
PROJECT NUMBER 1033-02-20-4.01
SHEET 1 OF 2
AMENDMENT NO:

DOC # 2202146
Recorded
Feb. 16, 2009 AT 01:23PM
VOL. 1 P. 72

JAMES A. LAWIS
RACINE COUNTY
REGISTER OF DEEDS
Fee Based on: \$25.00

101

4

4

SOUTH PROJECT LIMITS
69.75'

STA 817+63.88

820

825

830


EXISTING I-94
N00°27'11"W

835

840

N00°08'43"W


81.34'

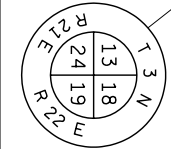

A Cast Iron Monument
w/ A Brass Cap
Y 181033.47
X 594106.88

T-3-N

R-21-E
R-22-E

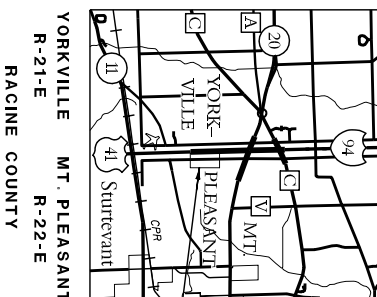


SHEET LOCATION

PARCEL 1
CSM 1301
V 4 P 100

VILLAGE OF
MOUNT PLEASANT

NW1/4-SW1/4

- 100 V. 2301 P. 39 DOC. 1437519 PCL. 1
- 101 NO RECORDED EASEMENT PCL. 1
- 103 V. 2301 P. 41 DOC. 1437519 PCL. 1

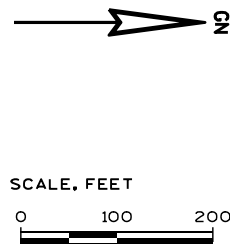

THIS IS A COPY, THE ORIGINAL DOCUMENT IS
AT THE RACINE COUNTY REGISTER OF DEEDS

EAST FRONTAGE ROAD
PISTA 3839+49.28
Y 183199.84
X 594759.75
PC STA 3836+42.61
PT STA 3842+36.09
DELTA -35°36'31"
D 06°00'00"
L 593.47
R 954.93
LCH 583.97
LCB N 17°49'10" E

I HEREBY CERTIFY THAT THIS PLAT MEETS ALL REQUIREMENTS OF SECTION 84.095, WISCONSIN STATUTES. THIS PLAT IS APPROVED FOR THE WISCONSIN DEPARTMENT OF TRANSPORTATION.
DATE: 2/10/09
Name Title
THIS PLAT WAS PREPARED BY OR UNDER THE DIRECTION OF:
DATE: 2/10/09
Name

NOTES:
COORDINATES AND BEARINGS SHOWN ON THIS PLAT ARE REFERENCED TO THE WISCONSIN COUNTY COORDINATE SYSTEM, RACINE COUNTY ZONE, NAD83 (97) ADJUSTMENT AND ARE REFERENCED TO GPS HARN POINTS YORKVILLE EAST, RAYMOND SOUTH, AND PARIS EAST. THE COORDINATES SHOWN ARE GRID COORDINATES AND ARE TO BE USED AS GRID OR GROUND VALUES ON THIS PLAT.
RIGHT-OF-WAY MONUMENTS ARE TYPE 2 (TYPICAL 3/4" REBAR) AND WILL BE PLACED PRIOR TO THE COMPLETION OF THE PROJECT, BY SE REGION DOT SURVEY.

FOR ADDITIONAL INFORMATION REFER TO THE TITLE SHEET, RECORDED AS SHEET 2 OF 2 OF DOCUMENT *2202146, OF TRANSPORTATION PROJECT PLATS IN THE RACINE COUNTY REGISTER OF DEEDS.

HIGHWAY	BASIS OF EXISTING RIGHT-OF-WAY	WIDTH	YEAR
I-94	I101-1(3)	VARIES	1956
I-94	DJ 2483	VARIES	1923
STH 20	F065-1(6)	VARIES	1963
EAST FRONTAGE ROAD	1032-06-29	VARIES	1989
EAST FRONTAGE ROAD	CSM 1378	60'	1988
HOSPITALITY COURT	CSM 1983	66'	1997
HOSPITALITY COURT	CSM 1783	66'	1995

CURVE 1
L 204.11
R 483.07
LCH 202.59
LCB N 09°08'04" E

CURVE 2
L 56.47
R 7579.44
LCH 56.47
LCB S 02°45'23" E

CURVE 3
L 367.35
R 7699.44
LCH 367.32
LCB N 01°36'53" W

CURVE 4
L 168.32
R 366.07
LCH 166.85
LCB N 10°18'49" E

TRANSPORTATION PROJECT PLAT NO: 1033-02-20 - 4.02

THAT PART OF LOT 1 OF CSM 1983, LOT 1 OF CSM 1378, LOTS 1 AND 2 OF CSM 1627, PARCELS 1 AND 2 OF CSM 1818, AND THAT PART OF THE NW1/4 OF THE NW1/4 AND THE SW1/4 OF THE NW1/4, SECTION 18, TOWN 3 NORTH, RANGE 22 EAST, VILLAGE OF MT. PLEASANT, RACINE COUNTY, WISCONSIN


RELOCATION ORDER IH-94/STH 20 RACINE COUNTY

TO PROPERLY ESTABLISH, LAY OUT, WIDEN, ENLARGE, EXTEND, CONSTRUCT, RECONSTRUCT, IMPROVE, OR MAINTAIN A PORTION OF THE HIGHWAY DESIGNATED ABOVE, THE STATE OF WISCONSIN DEPARTMENT OF TRANSPORTATION DEEMS IT NECESSARY TO RELOCATE OR CHANGE SAID HIGHWAY AND ACQUIRE CERTAIN LANDS AND INTERESTS OR RIGHTS IN LANDS FOR THE ABOVE PROJECT.
HEREBY ORDERS THAT:
1. THAT PORTION OF SAID HIGHWAY AS SHOWN ON THIS PLAT IS Laid OUT AND ESTABLISHED TO THE LINES AND WIDTHS AS SO SHOWN FOR THE ABOVE PROJECT.
2. THE LANDS OR INTERESTS OR RIGHTS IN LANDS AS SHOWN ON THIS PLAT ARE REQUIRED BY THE DEPARTMENT FOR THE ABOVE PROJECT AND SHALL BE ACQUIRED IN THE NAME OF THE STATE OF WISCONSIN, PURSUANT TO THE PROVISIONS OF SECTION 84.09 (1) OR (2), WISCONSIN STATUTES.


I-94
PISTA 839+47.69
Y 183216.67
X 594019.87
PC STA 834+61.20
PT STA 844+34.17
DELTA 0°19'28"
D 0°02'00"
L 972.97
R 171881.34
LCH 972.97
LCB N 00°17'27" W

EAST FRONTAGE ROAD
PISTA 3851+87.15
Y 184457.58
X 594760.09
PC STA 3849+78.70
PT STA 3853+95.51
DELTA 2°59'07"
D 00°42'58"
L 416.81
R 8000.00
LCH 416.76
LCB N 01°28'38" W

EAST FRONTAGE ROAD
PISTA 3856+49.68
Y 184919.59
X 594736.12
PC STA 3855+29.74
PT STA 3857+65.35
DELTA 26°28'10"
D 11°14'04"
L 235.61
R 510.00
LCH 233.52
LCB N 10°15'53" E

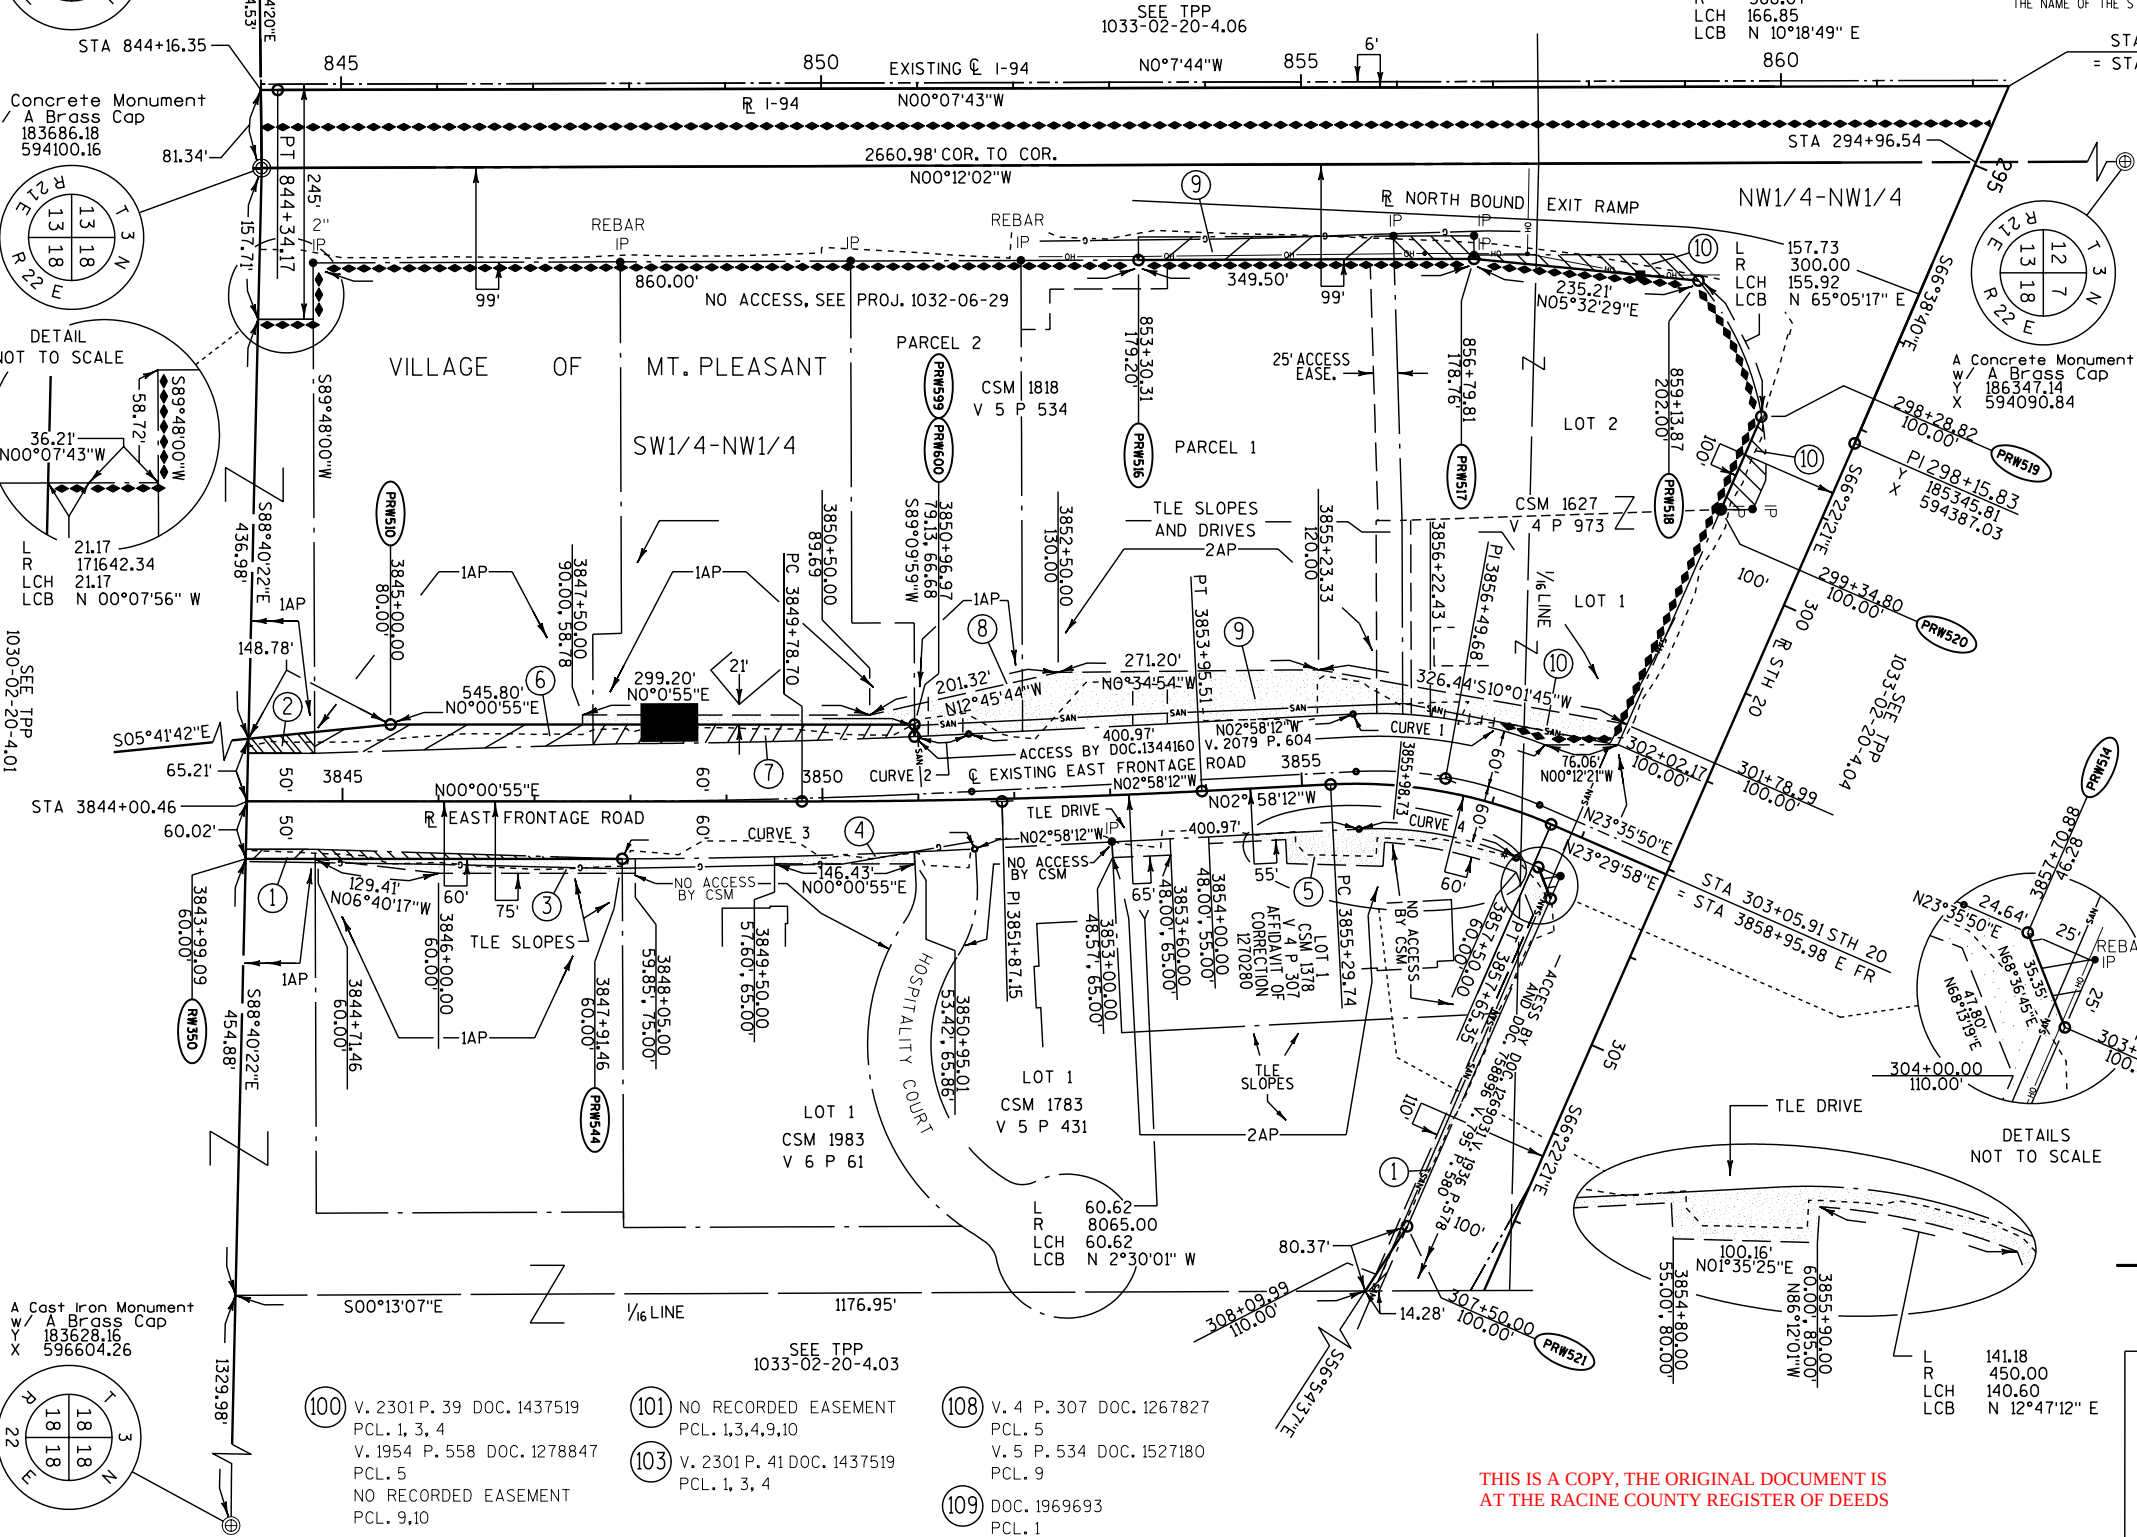

SCHEDULE OF LANDS & INTERESTS REQUIRED		OWNERS NAMES ARE SHOWN FOR REFERENCE PURPOSES ONLY AND ARE SUBJECT TO CHANGE PRIOR TO THE TRANSFER OF LAND INTEREST TO THE DEPARTMENT.				
PARCEL NUMBER	OWNER	INTEREST REQUIRED	R/W REQUIRED ACRES			T.L.E. TEMP. ACRES
			NEW	EXISTING	TOTAL	
1	MLG/HWY 20	Fee AR TLE	0.028	0.000	0.028	0.062
2	WOODSTOCK GROUP	Fee AR	0.030	0.000	0.030	0.000
3	HI LIFE PROPERTIES	Fee AR TLE	0.037	0.000	0.037	0.088
4	RACINE HOTEL LLC	TLE	0.000	0.000	0.000	0.037
5	MC DONALDS	Fee AR TLE	0.007	0.000	0.007	0.223
6	CHARNICK LLC	Fee AR TLE	0.162	0.000	0.162	0.003
7	SHAH	Fee AR TLE	0.135	0.000	0.135	0.083
8	B&G REALTY	AR TLE	0.000	0.000	0.000	0.111
9	KWIK TRIP INC.	Fee AR TLE	0.147	0.000	0.147	0.460
10	CONVENIENCE STORE INV.	Fee TLE	0.174	0.000	0.174	0.155
100	WE-ENERGIES ELECTRIC	ROR	- -	- -	- -	- -
101	WE-ENERGIES GAS	ROR	- -	- -	- -	- -
103	AT&T WISCONSIN	ROR	- -	- -	- -	- -
108	TOWN OF YORKVILLE	ROR	- -	- -	- -	- -
109	VILLAGE OF MT. PLEASANT	ROR	- -	- -	- -	- -

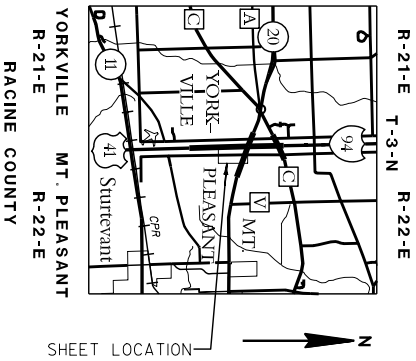

NOTES:
COORDINATES AND BEARINGS SHOWN ON THIS PLAT ARE REFERENCED TO THE WISCONSIN COUNTY COORDINATE SYSTEM, RACINE COUNTY ZONE, NAD83 (97) ADJUSTMENT AND ARE REFERENCED TO GPS HARN POINTS YORKVILLE EAST, RAYMOND SOUTH, AND PARIS EAST. THE COORDINATES SHOWN ARE GRID COORDINATES AND ARE TO BE USED AS GRID OR GROUND VALUES ON THIS PLAT.
RIGHT-OF-WAY MONUMENTS ARE TYPE 2 (TYPICAL 3/4" REBAR) AND WILL BE PLACED PRIOR TO THE COMPLETION OF THE PROJECT, BY SE REGION DOT SURVEY.

RESERVED FOR REGISTER OF DEEDS
PROJECT NUMBER 1033-02-20-4.02
AMENDMENT NO:

DOC # 2207205
Recorded
Mar. 27, 2009 AT 03:33PM
VOL. 1 P. 74

JAMES A. LAMUS
RACINE COUNTY
REGISTER OF DEEDS
Fee Amount: \$25.00

HEREBY CERTIFY THAT THIS PLAT MEETS ALL REQUIREMENTS OF SECTION 84.095, WISCONSIN STATUTES. THIS PLAT IS APPROVED FOR THE WISCONSIN DEPARTMENT OF TRANSPORTATION.

DATE: 3-18-09

THIS PLAT WAS PREPARED BY OR UNDER THE DIRECTION OF:


DATE: 3-18-09

SCALE, FEET
0 100 200

102

FOR ADDITIONAL INFORMATION REFER TO THE TITLE SHEET, RECORDED AS SHEET 2 OF 2 OF DOCUMENT #2202146, OF TRANSPORTATION PROJECT PLATS IN THE RACINE COUNTY REGISTER OF DEEDS.

A Cast Iron Monument
w/ A Brass Cap
Y 186275.68
X 596599.43

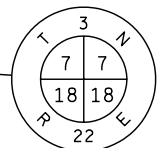

TRANSPORTATION PROJECT PLAT NO: 1033-02-20 - 4.03

THAT PART OF THE SE1/4 OF THE SE1/4 AND THE NE1/4 OF THE SE1/4, SECTION 18, TOWN 3 NORTH, RANGE 22 EAST, VILLAGE OF MT. PLEASANT, RACINE COUNTY, WISCONSIN.


RELOCATION ORDER IH-94/STH 20 RACINE COUNTY

TO PROPERLY ESTABLISH, LAY OUT, WIDEN, ENLARGE, EXTEND, CONSTRUCT, RECONSTRUCT, IMPROVE, OR MAINTAIN A PORTION OF THE HIGHWAY DESIGNATED ABOVE, THE STATE OF WISCONSIN DEPARTMENT OF TRANSPORTATION DEEMS IT NECESSARY TO RELOCATE OR CHANGE SAID HIGHWAY AND ACQUIRE CERTAIN LANDS AND INTERESTS OR RIGHTS IN LANDS FOR THE ABOVE PROJECT.

TO EFFECT THIS CHANGE, PURSUANT TO AUTHORITY GRANTED UNDER SECTION 84.02 (3) AND 84.09, WISCONSIN STATUTES, THE DEPARTMENT OF TRANSPORTATION HEREBY ORDERS THAT:
1. THAT PORTION OF SAID HIGHWAY AS SHOWN ON THIS PLAT IS LAID OUT AND ESTABLISHED TO THE LINES AND WIDTHS AS SO SHOWN FOR THE ABOVE PROJECT.
2. THE LANDS OR INTERESTS OR RIGHTS IN LANDS AS SHOWN ON THIS PLAT ARE REQUIRED BY THE DEPARTMENT FOR THE ABOVE PROJECT AND SHALL BE ACQUIRED IN THE NAME OF THE STATE OF WISCONSIN, PURSUANT TO THE PROVISIONS OF SECTION 84.09 (1) OR (2), WISCONSIN STATUTES.

SCHEDULE OF LANDS & INTERESTS REQUIRED		OWNERS NAMES ARE SHOWN FOR REFERENCE PURPOSES ONLY AND ARE SUBJECT TO CHANGE PRIOR TO THE TRANSFER OF LAND INTEREST TO THE DEPARTMENT.				
PARCEL NUMBER	OWNER	INTEREST REQUIRED	R/W REQUIRED ACRES			T.L.E. TEMP. ACRES
			NEW	EXISTING	TOTAL	
1	MLG/HWY 20	Fee	0.078	0.000	0.078	0.000
11	MT. PLEASANT GROUP LLC	Fee	0.105	0.000	0.105	0.000
12	HENRY J. KUIPER	Fee TLE	0.459	0.000	0.459	0.157
39	MT. PLEASANT GROUP LLC	Fee	0.111	0.000	0.111	0.000
100	WE-ENERGIES ELECTRIC	ROR	-	-	-	-
101	WE-ENERGIES GAS	ROR	-	-	-	-
103	AT&T WISCONSIN	ROR	-	-	-	-
109	VILLAGE OF MT. PLEASANT	ROR	-	-	-	-

HIGHWAY	BASIS OF EXISTING RIGHT-OF-WAY	WIDTH	YEAR
STH 20	F065-116)	VARIABLE	1963
TOWN ROAD	CSM 1171	66'	1986

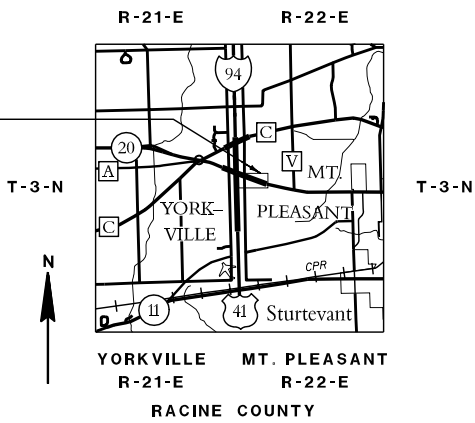

NOTES:
COORDINATES AND BEARINGS SHOWN ON THIS PLAT ARE REFERENCED TO THE WISCONSIN COUNTY COORDINATE SYSTEM, RACINE COUNTY ZONE, NAD83 (97) ADJUSTMENT AND ARE REFERENCED TO GPS HARN POINTS YORKVILLE EAST, RAYMOND SOUTH, AND PARIS EAST. THE COORDINATES SHOWN ARE GRID COORDINATES AND ARE TO BE USED AS GRID OR GROUND VALUES ON THIS PLAT.
RIGHT-OF-WAY MONUMENTS ARE TYPE 2 (TYPICAL 3/4" REBAR) AND WILL BE PLACED PRIOR TO THE COMPLETION OF THE PROJECT, BY SE REGION DOT SURVEY.

I HEREBY CERTIFY THAT THIS PLAT MEETS ALL REQUIREMENTS OF SECTION 84.09, WISCONSIN STATUTES. THIS PLAT IS APPROVED FOR THE WISCONSIN DEPARTMENT OF TRANSPORTATION.
DATE: 3-18-09
Name: Paul Krause
Title: Surveyor
THIS PLAT WAS PREPARED BY OR UNDER THE DIRECTION OF:
DATE: 3-18-09
Name: Paul Krause
Title: Surveyor

RESERVED FOR REGISTER OF DEEDS
PROJECT NUMBER 1033-02-20-4.03
AMENDMENT NO:
DOC # 2202146
Recorded
Mar. 27, 2009 AT 03:37PM
VOL. 1 P. 75
JAMES A. LAHAY
RACINE COUNTY
REGISTER OF DEEDS
Fee Amount: \$25.00
103

FOR ADDITIONAL INFORMATION REFER TO THE TITLE SHEET, RECORDED AS SHEET 2 OF 2 OF DOCUMENT #2202146, OF TRANSPORTATION PROJECT PLATS IN THE RACINE COUNTY REGISTER OF DEEDS.

I-94
PI STA 867+54.65
Y 186023.63
X 594013.56
PC STA 863+23.06
PT STA 871+86.23
DELTA 00°21'35"
D 00°02'30"
L 863.17
R 137503.87
LCH 863.17
LCB N 00°03'04" E

RELOCATED
EAST FRONTAGE ROAD
PI STA 5868+01.25
Y 185995.04
X 595190.70
PC STA 5862+95.66
PT STA 5871+80.03
DELTA 69°24'45"
D 7°50'55"
L 884.38
R 730.00
LCH 831.28
LCB N 11°06'33" W

A Concrete Monument
w/ A Brass Cap
Y 183686.18
X 594100.16


L 94.25
R 60.00
LCH 84.85
LCB N 68°35'50" E

DETAIL
NOT TO SCALE

DETAIL
NOT TO SCALE

DETAIL B
NOT TO SCALE

DETAIL C
NOT TO SCALE

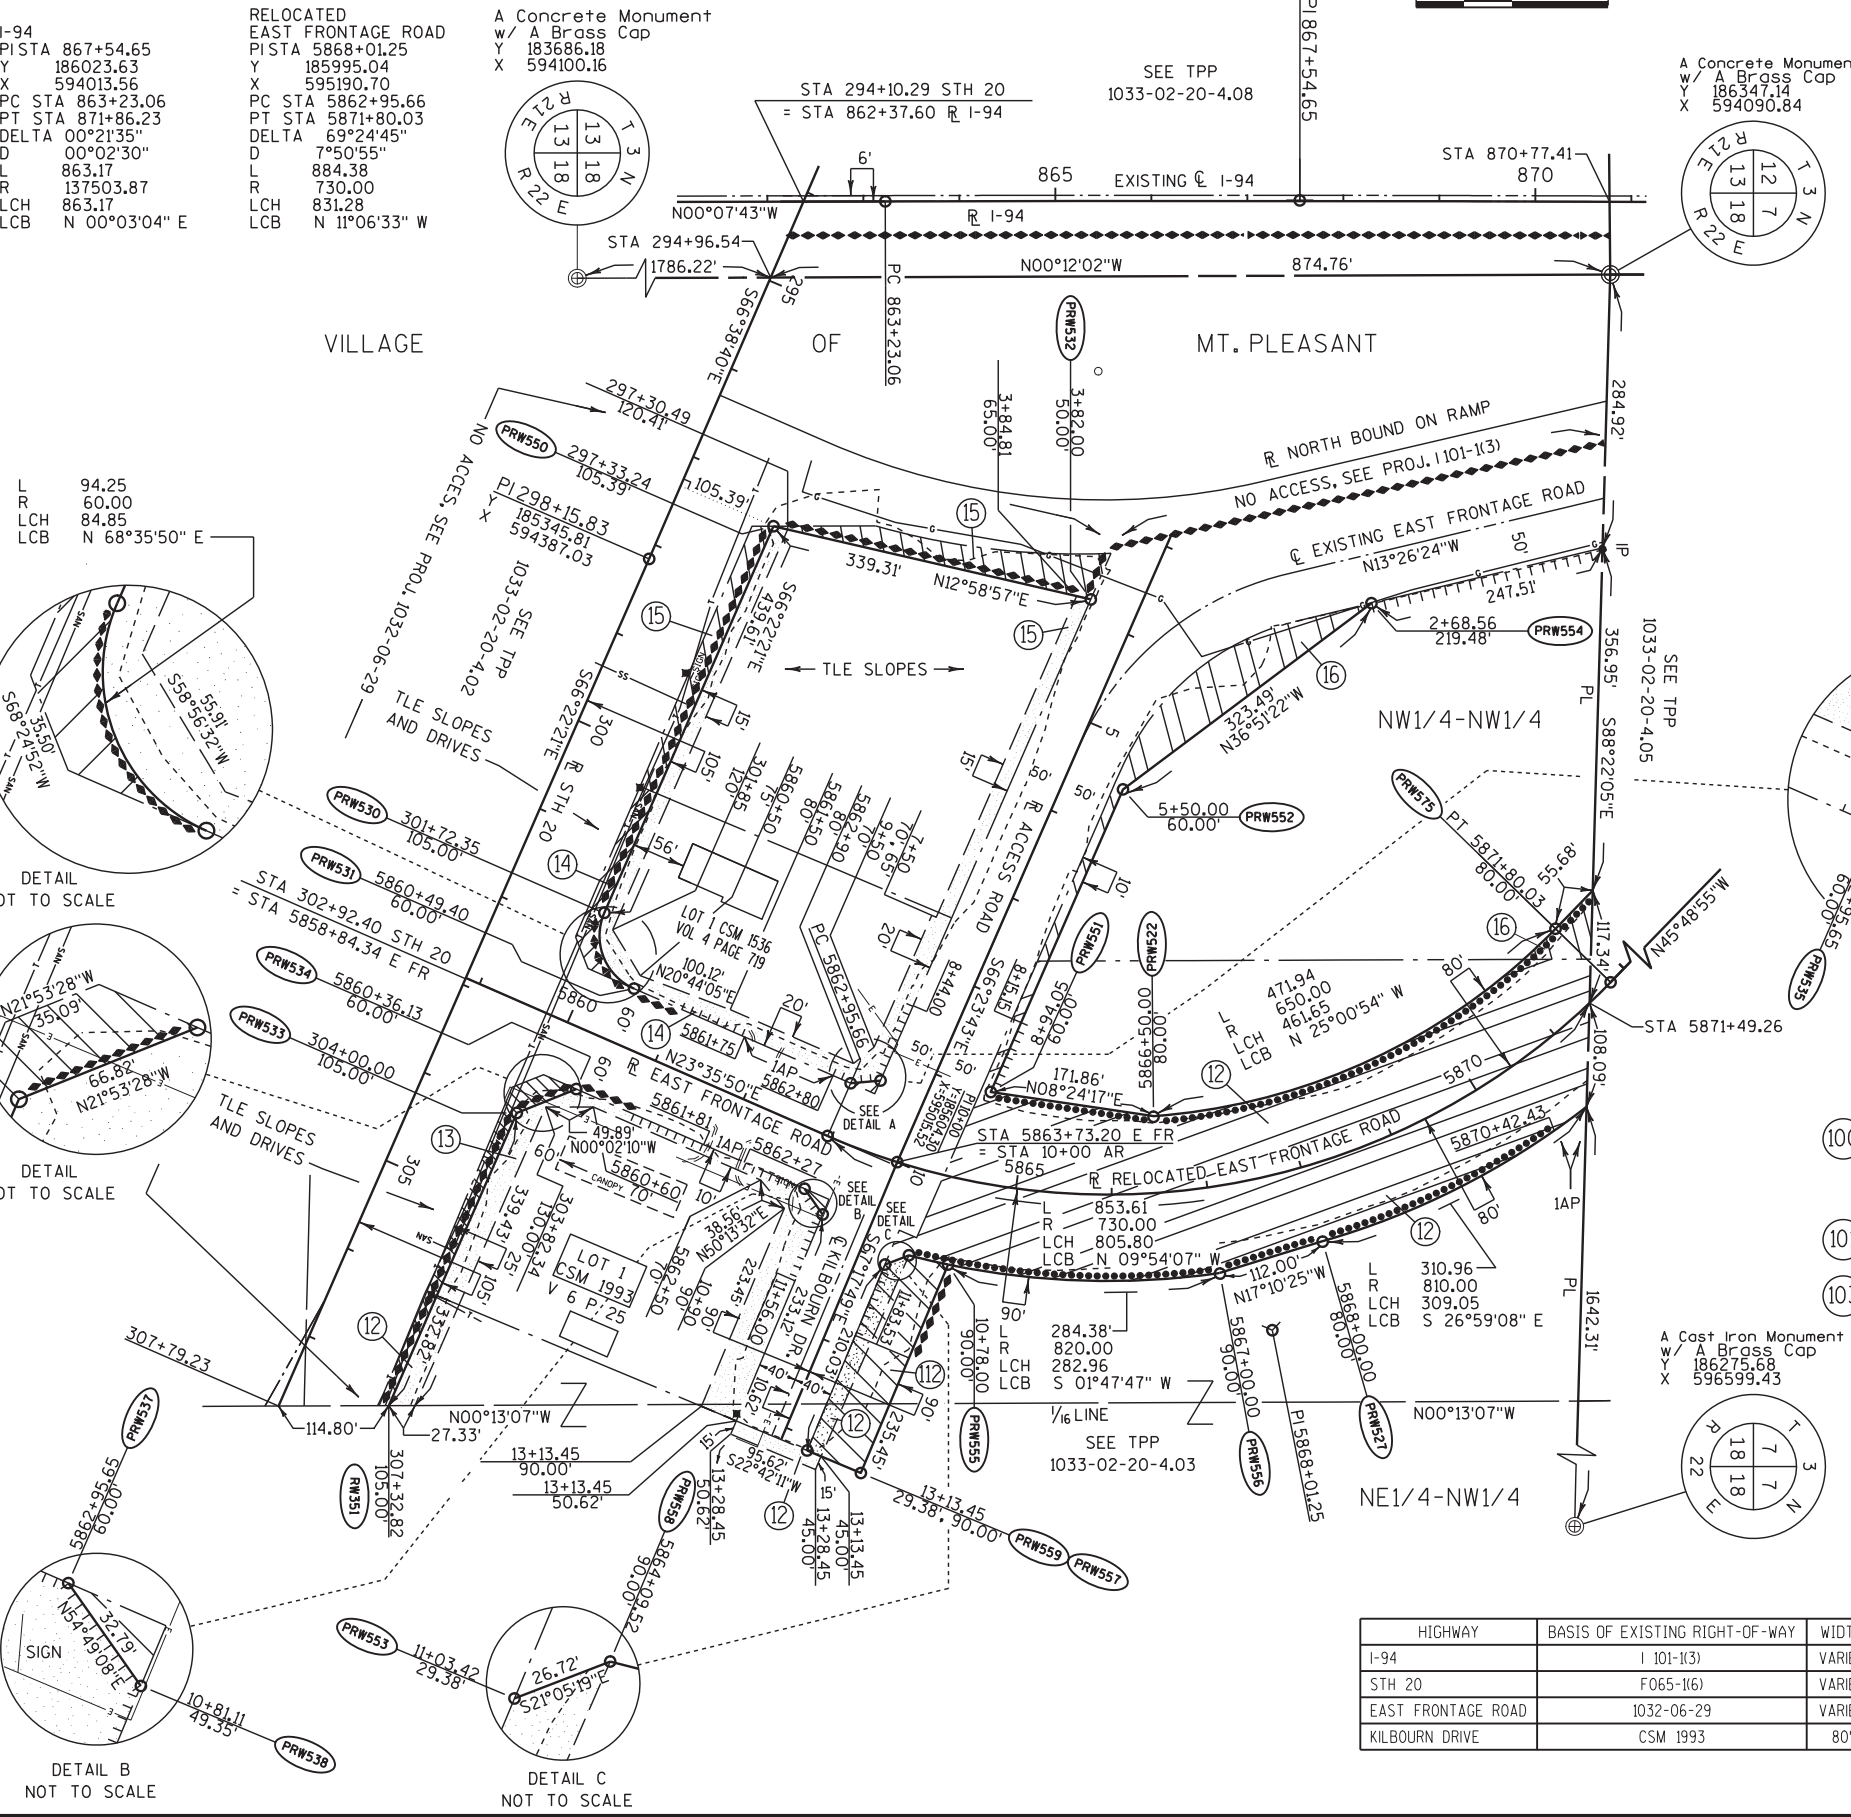

TRANSPORTATION PROJECT PLAT NO: 1033-02-20 - 4.04
AMENDMENT NO: 1

AMENDS PARCELS 13, 14, 100, 101 & ADDS PARCEL 112 OF TPP 1033-02-20-4.04, RECORDED AS DOCUMENT 2207207.

THAT PART OF LOT 1 OF CSM 1993, LOT 1 OF CSM 1536 AND THAT PART OF THE NE1/4 OF THE NW1/4 AND THE NW1/4 OF THE NW1/4, SECTION 18, TOWN 3 NORTH, RANGE 22 EAST, VILLAGE OF MT. PLEASANT, RACINE COUNTY, WISCONSIN.

RELOCATION ORDER IH-94/STH 20 RACINE COUNTY

TO PROPERLY ESTABLISH, LAY OUT, WIDEN, ENLARGE, EXTEND, CONSTRUCT, RECONSTRUCT, IMPROVE, OR MAINTAIN A PORTION OF THE HIGHWAY DESIGNATED ABOVE, THE STATE OF WISCONSIN DEPARTMENT OF TRANSPORTATION DEEMS IT NECESSARY TO RELOCATE OR CHANGE SAID HIGHWAY AND ACQUIRE CERTAIN LANDS AND INTERESTS OR RIGHTS IN LANDS FOR THE ABOVE PROJECT.

TO EFFECT THIS CHANGE, PURSUANT TO AUTHORITY GRANTED UNDER SECTION 84.02 (3) AND 84.09, WISCONSIN STATUTES, THE DEPARTMENT OF TRANSPORTATION HEREBY ORDERS THAT:
1. THAT PORTION OF SAID HIGHWAY AS SHOWN ON THIS PLAT IS LAID OUT AND ESTABLISHED TO THE LINES AND WIDTHS AS SO SHOWN FOR THE ABOVE PROJECT.
2. THE LANDS OR INTERESTS OR RIGHTS IN LANDS AS SHOWN ON THIS PLAT ARE REQUIRED BY THE DEPARTMENT FOR THE ABOVE PROJECT AND SHALL BE ACQUIRED IN THE NAME OF THE STATE OF WISCONSIN, PURSUANT TO THE PROVISIONS OF SECTION 84.09 (1) OR (2), WISCONSIN STATUTES.


NOTES:

COORDINATES AND BEARINGS SHOWN ON THIS PLAT ARE REFERENCED TO THE WISCONSIN COUNTY COORDINATE SYSTEM, RACINE COUNTY ZONE, NAD83 (97) ADJUSTMENT AND ARE REFERENCED TO GPS HARN POINTS YORKVILLE EAST, RAYMOND SOUTH, AND PARIS EAST. THE COORDINATES SHOWN ARE GRID COORDINATES AND ARE TO BE USED AS GRID OR GROUND VALUES ON THIS PLAT.

RIGHT-OF-WAY MONUMENTS ARE TYPE 2 (TYPICAL 3/4" REBAR) AND WILL BE PLACED PRIOR TO THE COMPLETION OF THE PROJECT, BY SE REGION DOT SURVEY.

- (108) V. 2090 P. 303 DOC. 1349538 PCL. 14, 15
- (109) DOC. 1969715 PCL. 13
DOC. 1969714 PCL. 14
DOC. 1969713 PCL. 15

- (100) V. 2708 P. 40 DOC. 1607079 PCL. 13
V. 2179 P. 414 DOC. 1387882 PCL. 14
- (101) NO RECORDED EASEMENT PCL. 15, 16
- (103) V. 2312 P. 133 DOC. 1441715 PCL. 12, 13
V. 2708 P. 40 DOC. 1607079 PCL. 13
V. 2312 P. 136 DOC. 1441716 PCL. 15
V. 2179 P. 414 DOC. 1387882 PCL. 14
V. 2428 P. 710 DOC. 1492467 PCL. 14
V. 2699 P. 507 DOC. 1603756 PCL. 12

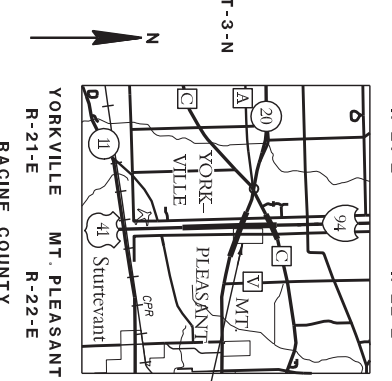

SCHEDULE OF LANDS & INTERESTS REQUIRED		OWNERS NAMES ARE SHOWN FOR REFERENCE PURPOSES ONLY AND ARE SUBJECT TO CHANGE PRIOR TO THE TRANSFER OF LAND INTEREST TO THE DEPARTMENT.				
PARCEL NUMBER	OWNER	INTEREST REQUIRED	R/W REQUIRED ACRES			T.L.E. TEMP. ACRES
			NEW	EXISTING	TOTAL	
12	KUIPER, HENRY J	Fee AR TLE	2.823	0.000	2.823	0.191
13	HWY 20 LLC	Fee AR TLE	0.102	0.000	0.102	0.421
14	SPIRIT MASTER FUNDING II LLC	Fee AR TLE	0.097	0.000	0.097	0.238
15	MEURER TRUST	Fee TLE	0.333	0.000	0.333	0.250
16	LV 20 LLC	Fee AR	0.373	0.000	0.373	0.000
112	KUIPER, HENRY J	Fee	0.317	0.000	0.317	0.000
100	WE-ENERGIES ELECTRIC	ROR	-	-	-	-
101	WE-ENERGIES GAS	ROR	-	-	-	-
103	AT&T WISCONSIN	ROR	-	-	-	-
108	TOWN OF YORKVILLE	ROR	-	-	-	-
109	VILLAGE OF MT. PLEASANT	ROR	-	-	-	-

HIGHWAY	BASIS OF EXISTING RIGHT-OF-WAY	WIDTH	YEAR
I-94	I 101-113	VARIES	1956
STH 20	F065-116	VARIES	1963
EAST FRONTAGE ROAD	1032-06-29	VARIES	1989
KILBOURN DRIVE	CSM 1993	80'	1997

I HEREBY CERTIFY THAT THIS PLAT MEETS ALL REQUIREMENTS OF SECTION 84.095, WISCONSIN STATUTES. THIS PLAT IS APPROVED FOR THE WISCONSIN DEPARTMENT OF TRANSPORTATION.

DATE: 6-29-2010

THIS PLAT WAS PREPARED BY OR UNDER THE DIRECTION OF:

DATE: 6-29-2010

PAUL KRAUSE

RESERVED FOR REGISTER OF DEEDS
PROJECT NUMBER 1033-02-20-4.04
AMENDMENT NO: 1

FOR ADDITIONAL INFORMATION REFER TO THE TITLE SHEET, RECORDED AS SHEET 2 OF 2 OF DOCUMENT *2202146, OF TRANSPORTATION PROJECT PLATS IN THE RACINE COUNTY REGISTER OF DEEDS.

NOTES:
COORDINATES AND BEARINGS SHOWN ON THIS PLAT ARE REFERENCED TO THE WISCONSIN COUNTY COORDINATE SYSTEM, RACINE COUNTY ZONE, NAD83 (97) ADJUSTMENT AND ARE REFERENCED TO GPS HARN POINTS YORKVILLE EAST, RAYMOND SOUTH, AND PARIS EAST. THE COORDINATES SHOWN ARE GRID COORDINATES AND ARE TO BE USED AS GRID OR GROUND VALUES ON THIS PLAT.
RIGHT-OF-WAY MONUMENTS ARE TYPE 2 (TYPICAL 3/4" REBAR) AND WILL BE PLACED PRIOR TO THE COMPLETION OF THE PROJECT, BY SE REGION DOT SURVEY.

SCHEDULE OF LANDS & INTERESTS REQUIRED		OWNERS NAMES ARE SHOWN FOR REFERENCE PURPOSES ONLY AND ARE SUBJECT TO CHANGE PRIOR TO THE TRANSFER OF LAND INTEREST TO THE DEPARTMENT.				
PARCEL NUMBER	OWNER	INTEREST REQUIRED	R/W REQUIRED ACRES			T.L.E. TEMP. ACRES
			NEW	EXISTING	TOTAL	
17	I-94 ASSOCIATES	Fee, AR, TLE	6.348	0.000	6.348	0.445

HIGHWAY	BASIS OF EXISTING RIGHT-OF-WAY	WIDTH	YEAR
I-94	I 101-103	VARIES	1956
STH 20	1032-06-29	VARIES	1989
CTH C	I 101-103	140'	1956


TRANSPORTATION PROJECT PLAT NO: 1033-02-20 - 4.05

THAT PART OF THE NW1/4 OF THE SW1/4 AND THE SW1/4 OF THE SW1/4 OF SECTION 7, TOWN 3 NORTH, RANGE 22 EAST, VILLAGE OF MT. PLEASANT, RACINE COUNTY, WISCONSIN.

RELOCATION ORDER IH-94/STH 20 RACINE COUNTY

TO PROPERLY ESTABLISH, LAY OUT, WIDEN, ENLARGE, EXTEND, CONSTRUCT, RECONSTRUCT, IMPROVE, OR MAINTAIN A PORTION OF THE HIGHWAY DESIGNATED ABOVE, THE STATE OF WISCONSIN DEPARTMENT OF TRANSPORTATION DEEMS IT NECESSARY TO RELOCATE OR CHANGE SAID HIGHWAY AND ACQUIRE CERTAIN LANDS AND INTERESTS OR RIGHTS IN LANDS FOR THE ABOVE PROJECT.

TO EFFECT THIS CHANGE, PURSUANT TO AUTHORITY GRANTED UNDER SECTION 84.02 (3) AND 84.09, WISCONSIN STATUTES, THE DEPARTMENT OF TRANSPORTATION HEREBY ORDERS THAT:
1. THAT PORTION OF SAID HIGHWAY AS SHOWN ON THIS PLAT IS LAID OUT AND ESTABLISHED TO THE LINES AND WIDTHS AS SO SHOWN FOR THE ABOVE PROJECT.
2. THE LANDS OR INTERESTS OR RIGHTS IN LANDS AS SHOWN ON THIS PLAT ARE REQUIRED BY THE DEPARTMENT FOR THE ABOVE PROJECT AND SHALL BE ACQUIRED IN THE NAME OF THE STATE OF WISCONSIN, PURSUANT TO THE PROVISIONS OF SECTION 84.09 (1) OR (2), WISCONSIN STATUTES.

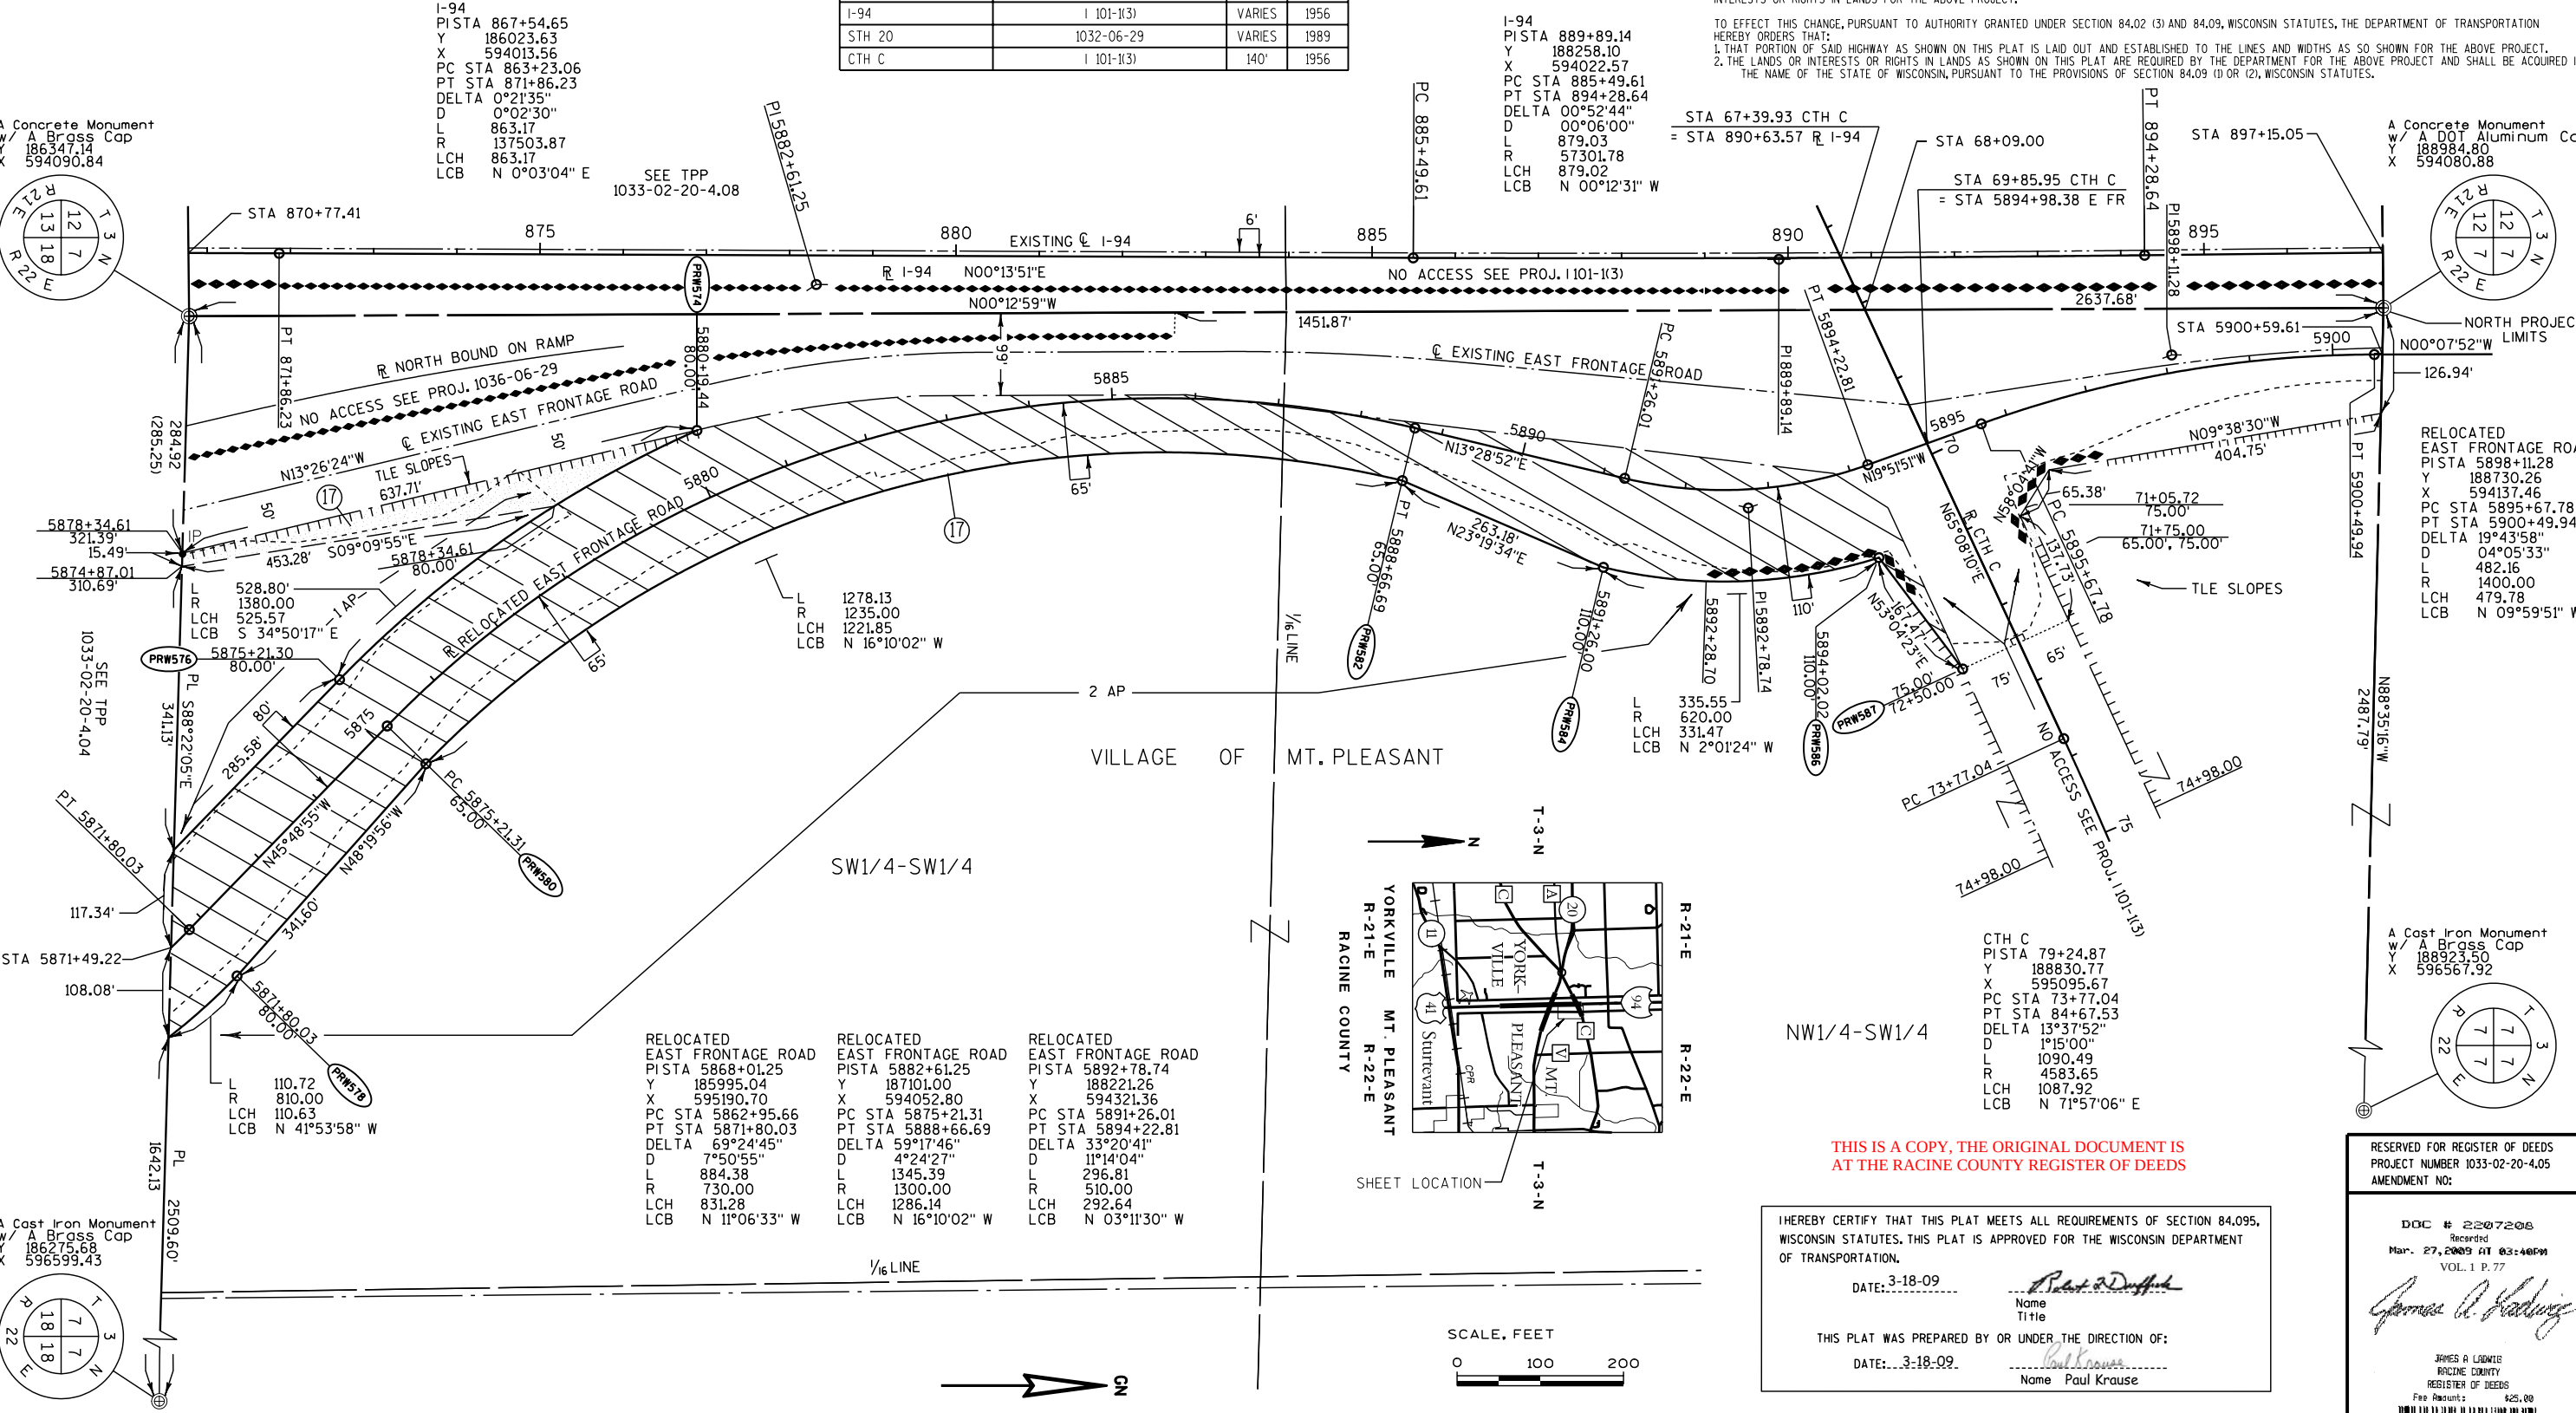

THIS IS A COPY, THE ORIGINAL DOCUMENT IS AT THE RACINE COUNTY REGISTER OF DEEDS

I HEREBY CERTIFY THAT THIS PLAT MEETS ALL REQUIREMENTS OF SECTION 84.09, WISCONSIN STATUTES. THIS PLAT IS APPROVED FOR THE WISCONSIN DEPARTMENT OF TRANSPORTATION.
DATE: 3-18-09
Name: Paul Krause
Title: Paul Krause
THIS PLAT WAS PREPARED BY OR UNDER THE DIRECTION OF:
DATE: 3-18-09
Name: Paul Krause

RESERVED FOR REGISTER OF DEEDS
PROJECT NUMBER 1033-02-20-4.05
AMENDMENT NO:

DOC # 2202146
Recorded
Mar. 27, 2009 11:03:40 AM
VOL. 1 P. 77
JAMES A. LAWIE
RACINE COUNTY
REGISTER OF DEEDS
Fee Product: \$25.00
105

SCHEDULE OF LANDS & INTERESTS REQUIRED		OWNERS NAMES ARE SHOWN FOR REFERENCE PURPOSES ONLY AND ARE SUBJECT TO CHANGE PRIOR TO THE TRANSFER OF LAND INTEREST TO THE DEPARTMENT.				
PARCEL NUMBER	OWNER	INTEREST REQUIRED	R/W REQUIRED ACRES			T.L.E. TEMP. ACRES
			NEW	EXISTING	TOTAL	
18	SIERRA PROPERTIES LLC	Fee AR	0.328	0.000	0.328	0.000
19	REICO INVESTMENTS INC.	Fee AR TLE	0.286	0.000	0.286	0.0310
20	WILLKOMM DEVELOPMENT LLP	Fee AR TLE	0.252	0.000	0.252	0.768
21	SNKNEJ CO.	Fee AR	0.564	0.000	0.564	0.000
22	MOSHI HOTELS	Fee AR	0.026	0.000	0.026	0.005
23	MASKAL LLC	Fee AR	0.023	0.000	0.023	0.008
24	XYLON OF WISCONSIN INC.	AR TLE	0.000	0.000	0.000	0.083
25	TRIPLE H	AR TLE	0.000	0.000	0.000	0.106
26	SPOKES LLC	TLE	0.000	0.000	0.000	0.015
27	RACINE COUNTY CONVENTION CENTER	TLE	0.000	0.000	0.000	0.036
36	SNKNEJ CO.	Fee AR	0.522	0.000	0.522	0.000
37	SNKNEJ CO.	TLE	0.000	0.000	0.000	0.060
100	WE-ENERGIES ELECTRIC	ROR	-	-	-	-
101	WE-ENERGIES GAS	ROR	-	-	-	-
103	AT&T WISCONSIN	ROR	-	-	-	-
107	TIME WARNER CABLE	ROR	-	-	-	-
108	TOWN OF YORKVILLE	ROR	-	-	-	-

- 100 V. 2683 P. 372 DOC. 1597577 PCL. 20
V. 2251 P. 323 DOC. 1417354 PCL. 20
V. 2435 P. 793 DOC. 1495719 PCL. 20
V. 2674 P. 417 DOC. 1594130 PCL. 24, 36
DOC. 1923809 PCL. 24
V. 2422 P. 248 DOC. 1489365 PCL. 21
V. 2362 P. 959 DOC. 1462193 PCL. 25
V. 2998 P. 592 DOC. 1715613 PCL. 25
V. 2998 P. 595 DOC. 1715614 PCL. 27
V. 2428 P. 702 DOC. 1492463 PCL. 27
V. 2251 P. 323 DOC. 1417354 PCL. 20
- 101 NO RECORDED EASEMENT PCL. 18
- 107 NO RECORDED EASEMENT PCL. 19, 20, 22, 23, 24, 25, 36
- 103 V. 3010 P. 829 DOC. 1720105 PCL. 20
V. 2435 P. 793 DOC. 1495719 PCL. 22, 23
V. 2312 P. 152 DOC. 1442099 PCL. 25, 26, 27, 37
V. 2674 P. 417 DOC. 1594130 PCL. 24, 36
V. 2422 P. 248 DOC. 1489365 PCL. 21
V. 2362 P. 959 DOC. 1462193 PCL. 25
V. 2998 P. 592 DOC. 1715613 PCL. 25
V. 2998 P. 595 DOC. 1715614 PCL. 27
V. 2428 P. 702 DOC. 1492463 PCL. 27
V. 2251 P. 323 DOC. 1417354 PCL. 20

TRANSPORTATION PROJECT PLAT NO: 1033-02-20 - 4.06


THAT PART OF PARCEL 4 OF CSM 2008, PARCELS 1 AND 2 OF CSM 1950, PARCELS 1 AND 2 OF CSM 2154, PARCELS 1 AND 2 OF CSM 2604, PARCELS 1 AND 2 OF CSM 2150, PARCELS 1 AND 2 OF CSM 2044, AND THAT PART OF THE NE1/4 OF THE NE1/4 AND THE SE1/4 OF THE NE1/4 OF SECTION 13, TOWN 3 NORTH, RANGE 21 EAST, TOWN OF YORKVILLE, RACINE COUNTY, WISCONSIN

RELOCATION ORDER IH-94/STH 20 RACINE COUNTY

TO PROPERLY ESTABLISH, LAY OUT, WIDEN, ENLARGE, EXTEND, CONSTRUCT, RECONSTRUCT, IMPROVE, OR MAINTAIN A PORTION OF THE HIGHWAY DESIGNATED ABOVE, THE STATE OF WISCONSIN DEPARTMENT OF TRANSPORTATION DEEMS IT NECESSARY TO RELOCATE OR CHANGE SAID HIGHWAY AND ACQUIRE CERTAIN LANDS AND INTERESTS OR RIGHTS IN LANDS FOR THE ABOVE PROJECT.

TO EFFECT THIS CHANGE, PURSUANT TO AUTHORITY GRANTED UNDER SECTION 84.02 (3) AND 84.09, WISCONSIN STATUTES, THE DEPARTMENT OF TRANSPORTATION HEREBY ORDERS THAT:

1. THAT PORTION OF SAID HIGHWAY AS SHOWN ON THIS PLAT IS LAY OUT AND ESTABLISHED TO THE LINES AND WIDTHS AS SO SHOWN FOR THE ABOVE PROJECT.
2. THE LANDS OR INTERESTS OR RIGHTS IN LANDS AS SHOWN ON THIS PLAT ARE REQUIRED BY THE DEPARTMENT FOR THE ABOVE PROJECT AND SHALL BE ACQUIRED IN THE NAME OF THE STATE OF WISCONSIN, PURSUANT TO THE PROVISIONS OF SECTION 84.09 (1) OR (2), WISCONSIN STATUTES.

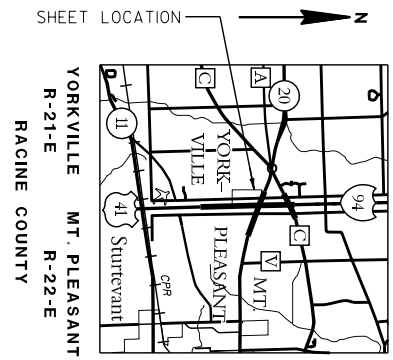

- 108 V. 2474 P. 431 DOC. 1512697 PCL. 19, 20
V. 2051 P. 183 DOC. 1329937 PCL. 20
V. 2474 P. 428 DOC. 1512696 PCL. 22, 23
V. 3033 P. 412 DOC. 1728759 PCL. 24
- V. 2474 P. 428 DOC. 1512698 PCL. 21, 24, 25, 36
DOC. 2069463 PCL. 21
V. 3014 P. 681 DOC. 1721604 PCL. 36
V. 3018 P. 001 DOC. 1722912 PCL. 27
V. 3014 P. 681 DOC. 1721605 PCL. 26, 37

THIS IS A COPY, THE ORIGINAL DOCUMENT IS AT THE RACINE COUNTY REGISTER OF DEEDS

NOTES:
COORDINATES AND BEARINGS SHOWN ON THIS PLAT ARE REFERENCED TO THE WISCONSIN COUNTY COORDINATE SYSTEM, RACINE COUNTY ZONE, NAD83 (97) ADJUSTMENT AND ARE REFERENCED TO GPS HARN POINTS YORKVILLE EAST, RAYMOND SOUTH, AND PARIS EAST. THE COORDINATES SHOWN ARE GRID COORDINATES AND ARE TO BE USED AS GRID OR GROUND VALUES ON THIS PLAT.
RIGHT-OF-WAY MONUMENTS ARE TYPE 2 (TYPICAL 3/4" REBAR) AND WILL BE PLACED PRIOR TO THE COMPLETION OF THE PROJECT, BY SE REGION DOT SURVEY.



I HEREBY CERTIFY THAT THIS PLAT MEETS ALL REQUIREMENTS OF SECTION 84.095, WISCONSIN STATUTES. THIS PLAT IS APPROVED FOR THE WISCONSIN DEPARTMENT OF TRANSPORTATION.

DATE: 3-18-09

THIS PLAT WAS PREPARED BY OR UNDER THE DIRECTION OF:

DATE: 3-18-09

Name: Paul Krause

RESERVED FOR REGISTER OF DEEDS
PROJECT NUMBER 1033-02-20-4.06
AMENDMENT NO:




DOC # 22072009
Recorded
Mar. 27, 2009 AT 8:34 AM
VOL. 1 P. 78

JAMES A. LUDWIG
RACINE COUNTY
REGISTER OF DEEDS
Fee: \$25.00

HIGHWAY	BASIS OF EXISTING RIGHT-OF-WAY	WIDTH	YEAR
I-94	I 101-1(3)	VARIES	1956
STH 20	2341-01-21	VARIES	1966
STH 20	1032-06-29	VARIES	1989

FOR ADDITIONAL INFORMATION REFER TO THE TITLE SHEET, RECORDED AS SHEET 2 OF 2 OF DOCUMENT #2202146, OF TRANSPORTATION PROJECT PLATS IN THE RACINE COUNTY REGISTER OF DEEDS.

- I-94
PI STA 839+47.69
Y 183216.67
X 594019.87
PC STA 834+61.20
PT STA 844+34.17
DELTA 0°19'28"
D 0°02'00"
L 972.97
R 171881.34
LCH 972.97
LCB N 00°17'27" W
- WEST FRONTAGE ROAD
PI STA 2840+78.93
Y 183978.02
X 593881.13
PC STA 2840+09.08
PT STA 2841+18.89
DELTA 89°52'47"
D 81°51'04"
L 109.81
R 70.00
LCH 98.89
LCB N 45°14'10" W
- WEST FRONTAGE ROAD
PI STA 2859+97.38
Y 185264.44
X 593219.32
PC STA 2856+03.11
PT STA 2863+80.62
DELTA 23°26'47"
D 3°00'56"
L 777.51
R 1900.00
LCH 772.10
LCB N 11°38'17" E

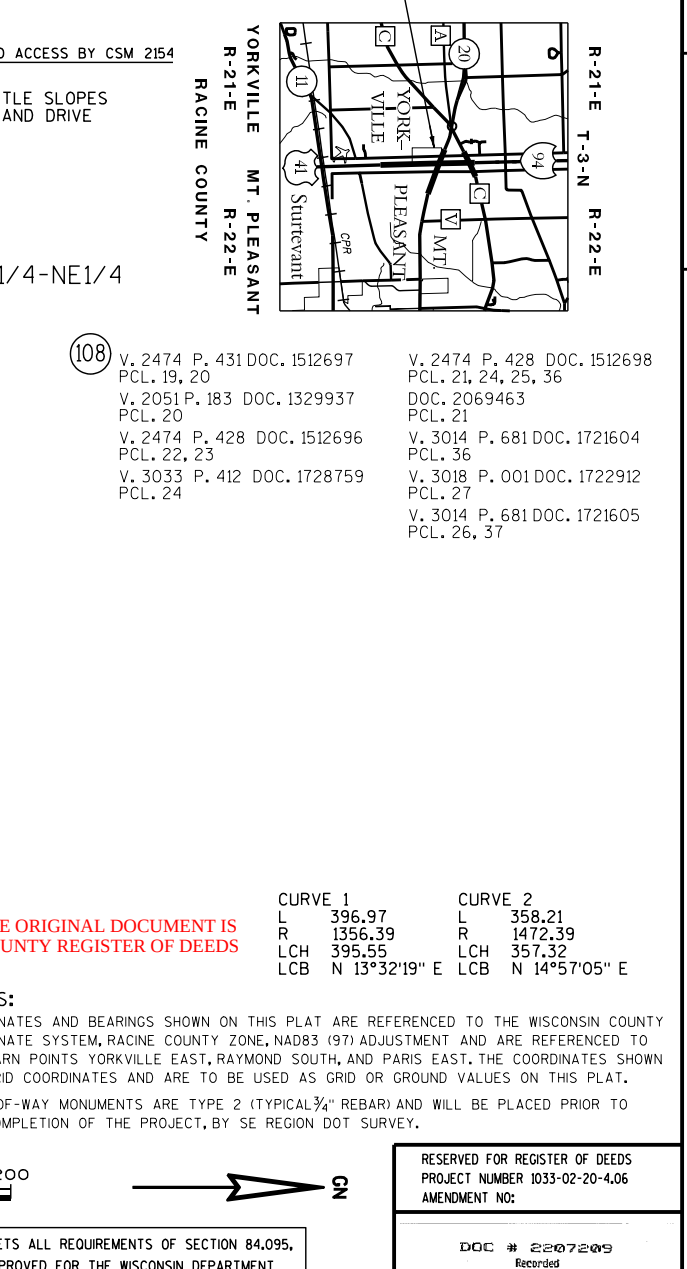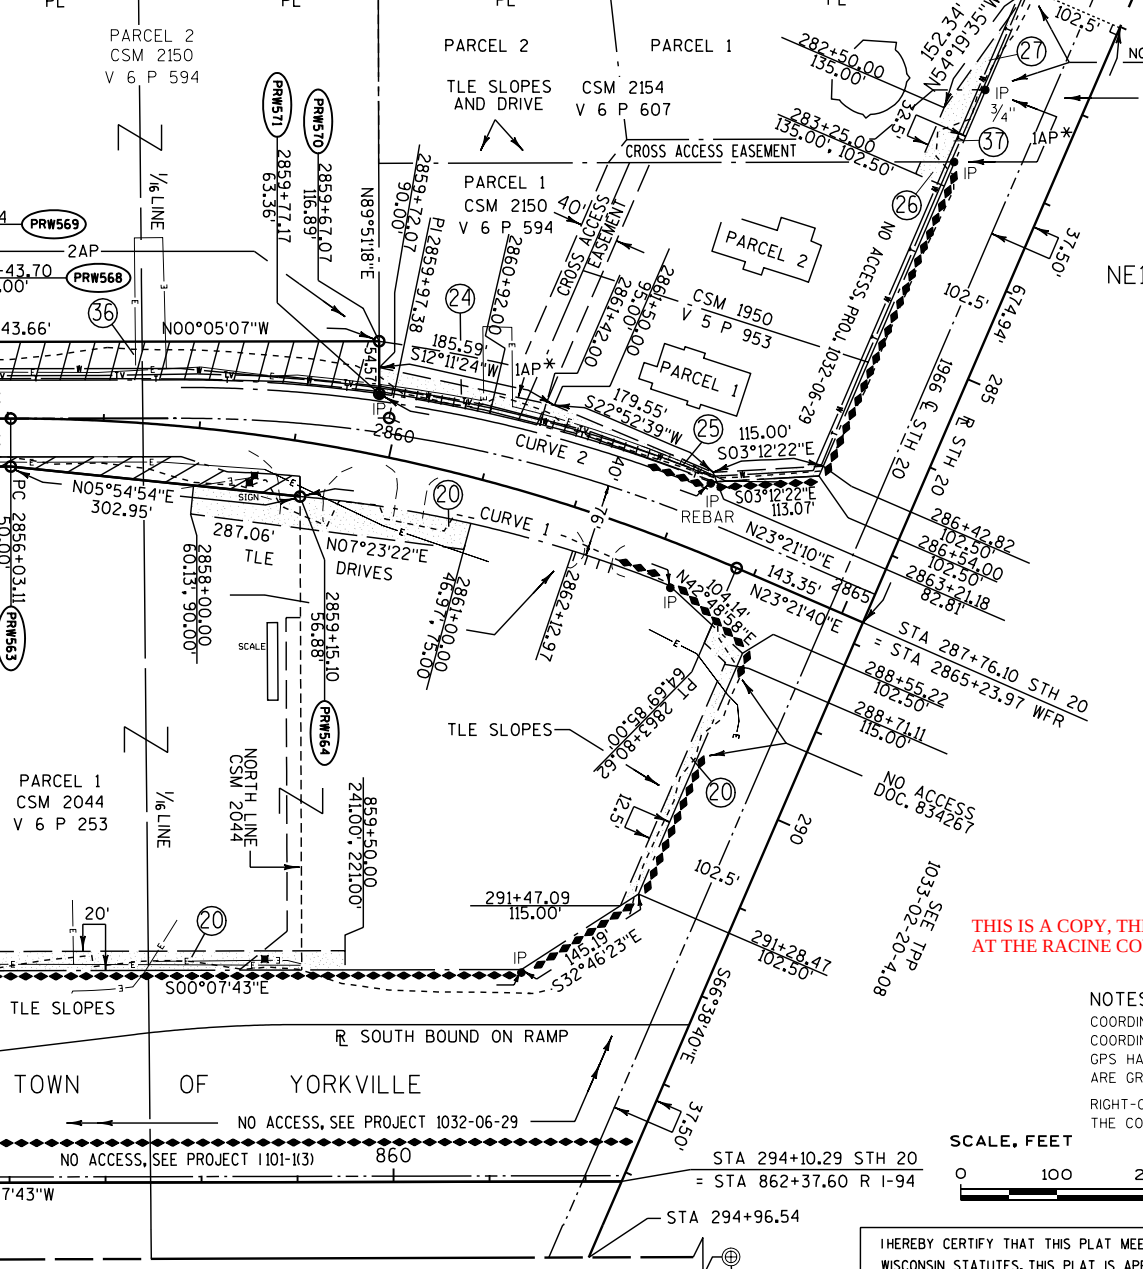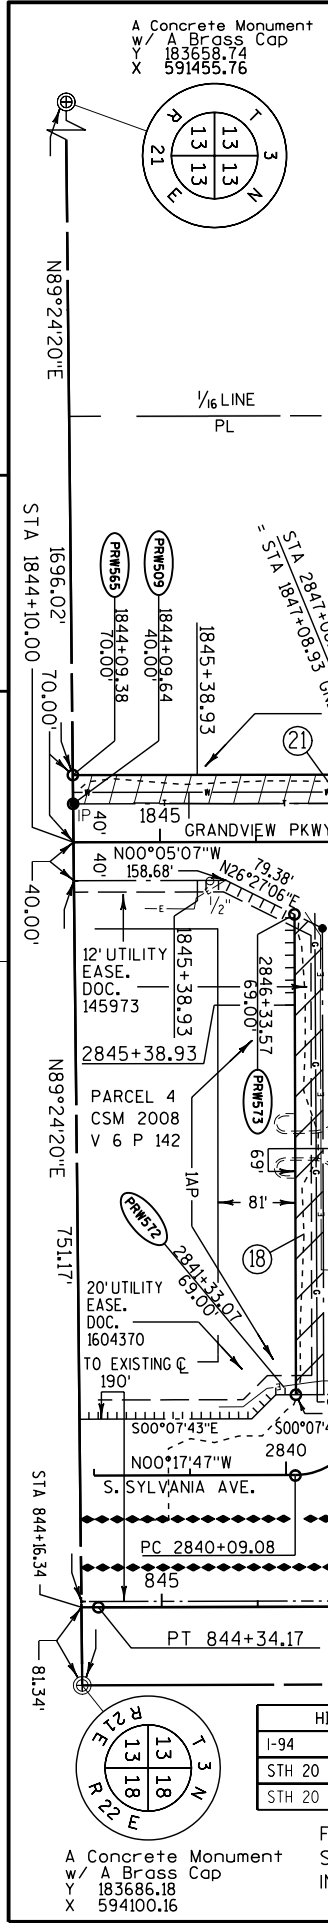

FOR ADDITIONAL INFORMATION REFER TO THE TITLE SHEET, RECORDED AS
SHEET 2 OF 2 OF DOCUMENT #2202146, OF TRANSPORTATION PROJECT PLATS
IN THE RACINE COUNTY REGISTER OF DEEDS.

TRANSPORTATION PROJECT PLAT NO: 1033-02-20 - 4.07

THAT PART OF THE NW1/4 OF THE NE1/4 OF SECTION 13, AND THAT PART OF THE SW1/4
OF THE SE1/4 OF SECTION 12, TOWN 3 NORTH, RANGE 21 EAST, TOWN OF YORKVILLE,
RACINE COUNTY, WISCONSIN.


RELOCATION ORDER IH-94/STH 20 RACINE COUNTY

TO PROPERLY ESTABLISH, LAY OUT, WIDEN, ENLARGE, EXTEND, CONSTRUCT, RECONSTRUCT, IMPROVE, OR MAINTAIN A PORTION OF THE HIGHWAY DESIGNATED ABOVE,
THE STATE OF WISCONSIN DEPARTMENT OF TRANSPORTATION DEEMS IT NECESSARY TO RELOCATE OR CHANGE SAID HIGHWAY AND ACQUIRE CERTAIN LANDS AND
INTERESTS OR RIGHTS IN LANDS FOR THE ABOVE PROJECT.



TO EFFECT THIS CHANGE, PURSUANT TO AUTHORITY GRANTED UNDER SECTION 84.02 (3) AND 84.09, WISCONSIN STATUTES, THE DEPARTMENT OF TRANSPORTATION
HEREBY ORDERS THAT:
1. THAT PORTION OF SAID HIGHWAY AS SHOWN ON THIS PLAT IS LAID OUT AND ESTABLISHED TO THE LINES AND WIDTHS AS SO SHOWN FOR THE ABOVE PROJECT.
2. THE LANDS OR INTERESTS OR RIGHTS IN LANDS AS SHOWN ON THIS PLAT ARE REQUIRED BY THE DEPARTMENT FOR THE ABOVE PROJECT AND SHALL BE ACQUIRED IN
THE NAME OF THE STATE OF WISCONSIN, PURSUANT TO THE PROVISIONS OF SECTION 84.09 (1) OR (2), WISCONSIN STATUTES.

4

4

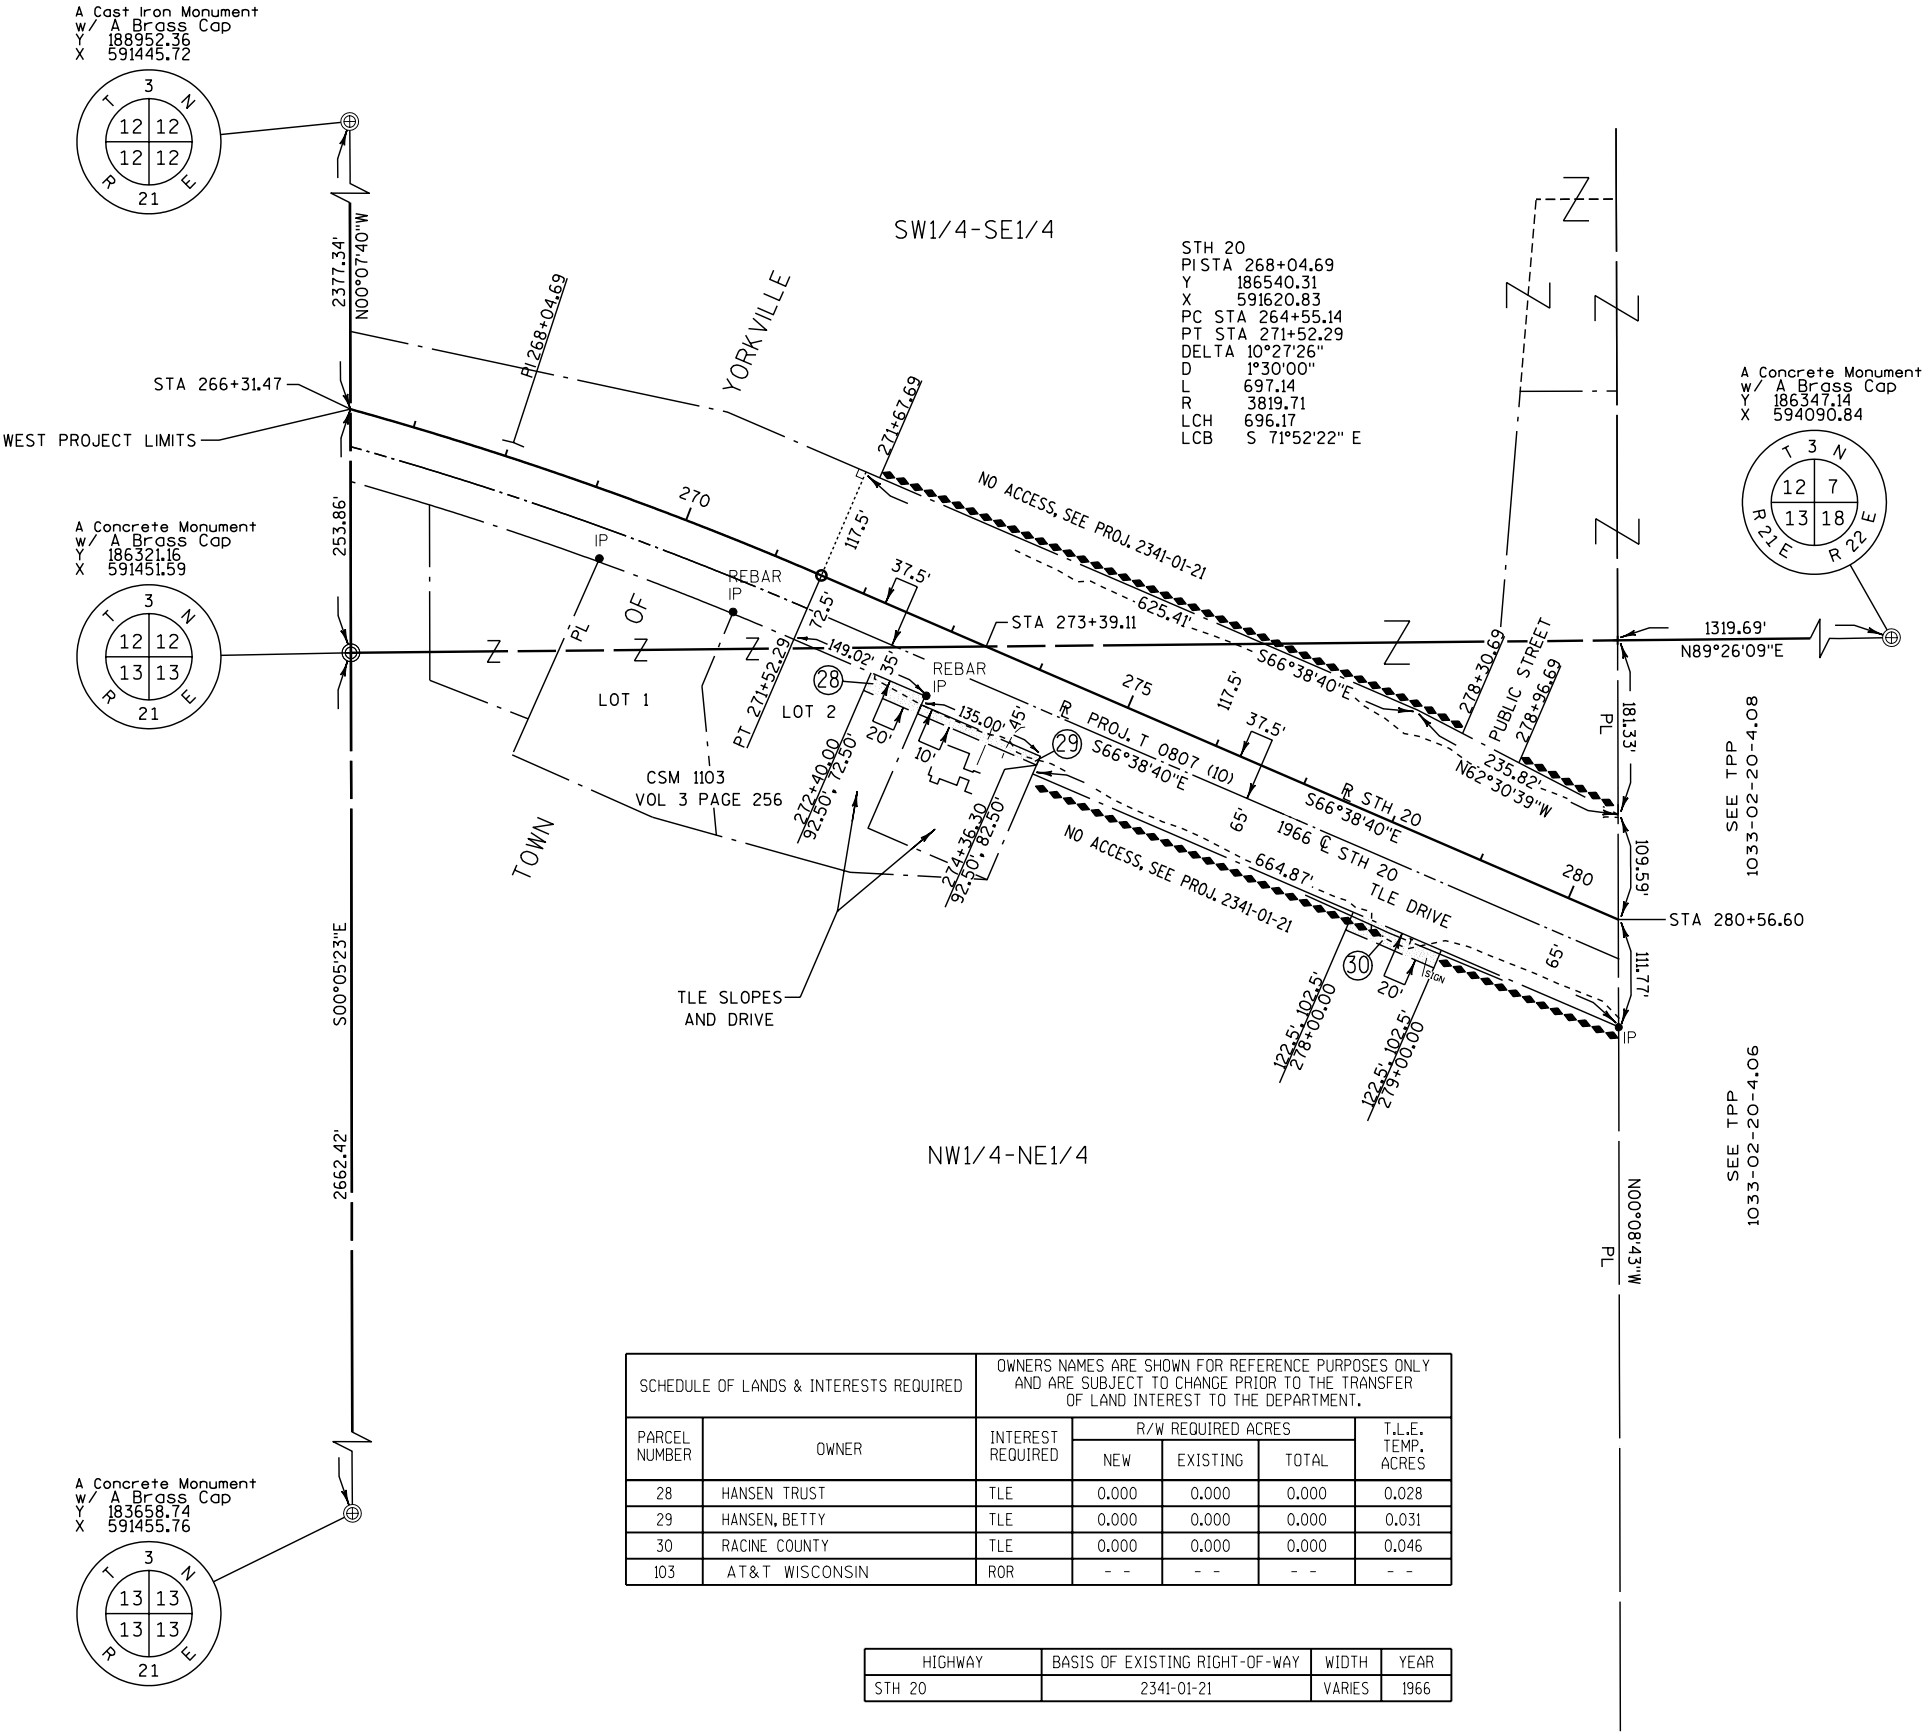

103 V. 2392 P. 056 DOC. 1475579
PCL. 30

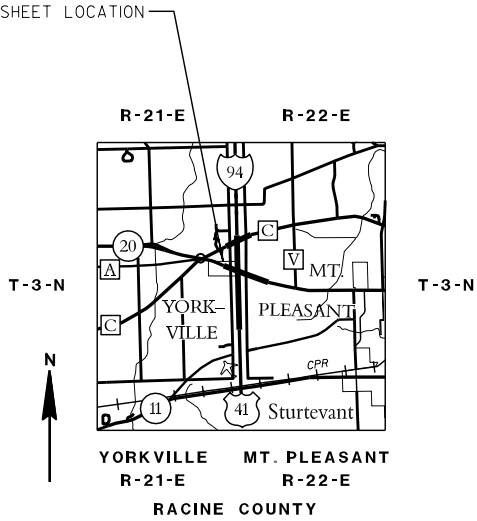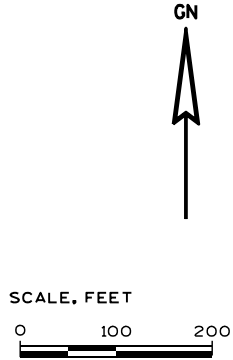

NOTES:
COORDINATES AND BEARINGS SHOWN ON THIS PLAT ARE REFERENCED TO THE WISCONSIN COUNTY
COORDINATE SYSTEM, RACINE COUNTY ZONE, NAD83 (97) ADJUSTMENT AND ARE REFERENCED TO
GPS HARN POINTS YORKVILLE EAST, RAYMOND SOUTH, AND PARIS EAST. THE COORDINATES SHOWN
ARE GRID COORDINATES AND ARE TO BE USED AS GRID OR GROUND VALUES ON THIS PLAT.
RIGHT-OF-WAY MONUMENTS ARE TYPE 2 (TYPICAL 3/4" REBAR) AND WILL BE PLACED PRIOR TO
THE COMPLETION OF THE PROJECT, BY SE REGION DOT SURVEY.

THIS IS A COPY, THE ORIGINAL DOCUMENT IS
AT THE RACINE COUNTY REGISTER OF DEEDS

I HEREBY CERTIFY THAT THIS PLAT MEETS ALL REQUIREMENTS OF SECTION 84.095,
WISCONSIN STATUTES. THIS PLAT IS APPROVED FOR THE WISCONSIN DEPARTMENT
OF TRANSPORTATION.
DATE: 3-18-09
Name: Robert A. Duff
Title: [Signature]
THIS PLAT WAS PREPARED BY OR UNDER THE DIRECTION OF:
DATE: 3-18-09
Name: Paul Krause

RESERVED FOR REGISTER OF DEEDS
PROJECT NUMBER 1033-02-20-4.07
AMENDMENT NO:
DOC # 2207210
Recorded
Mar. 27, 2009 AT 03:43 PM
James A. Harding
VOL. 1 P. 79
JAMES A. HARDING
RACINE COUNTY
REGISTER OF DEEDS
Fee Amount: \$25.00

FOR ADDITIONAL INFORMATION REFER TO THE TITLE SHEET, RECORDED AS SHEET 2 OF 2 OF DOCUMENT #2202146, OF TRANSPORTATION PROJECT PLATS IN THE RACINE COUNTY REGISTER OF DEEDS.

WEST FRONTAGE ROAD
PISTA 4883+89.59
Y 187639.40
X 593884.10
PC STA 4879+37.26
PT STA 4888+23.56
DELTA 28°12'42"
D 03°10'59"
L 886.30
R 1800.00
LCH 877.37
LCB N 09°14'25" E

CURVE 1
L 302.24
R 676.20
LCH 299.73
LCB N 10°36'17" E

CURVE 2
L 461.09
R 994.93
LCH 456.97
LCB N 10°04'13" E

CURVE 4
L 732.26
R 137754.87
LCH 732.26
LCB N 00°04'43" E

CURVE 3
L 149.46
R 914.93
LCH 149.27
LCB S 01°28'22" W

NE1/4-NE1/4

WEST FRONTAGE ROAD
PISTA 4867+75.39
Y 186088.90
X 593555.31
PC STA 4865+87.63
PT STA 4869+57.83
DELTA 23°34'09"
D 06°00'00"
L 442.54
R 954.93
LCH 438.59
LCB N 10°04'12" E

I-94
PISTA 867+54.65
Y 186023.63
X 594013.56
PC STA 863+23.06
PT STA 871+86.23
DELTA 00°21'35"
D 00°02'30"
L 863.17
R 137503.87
LCH 863.17
LCB N 00°03'04" E

WEST FRONTAGE ROAD
PISTA 4867+75.39
Y 186088.90
X 593555.31
PC STA 4865+87.63
PT STA 4869+57.83
DELTA 23°34'09"
D 06°00'00"
L 442.54
R 954.93
LCH 438.59
LCB N 10°04'12" E

NOTES:



COORDINATES AND BEARINGS SHOWN ON THIS PLAT ARE REFERENCED TO THE WISCONSIN COUNTY COORDINATE SYSTEM, RACINE COUNTY ZONE, NAD83 (97) ADJUSTMENT AND ARE REFERENCED TO GPS HARN POINTS YORKVILLE EAST, RAYMOND SOUTH, AND PARIS EAST. THE COORDINATES SHOWN ARE GRID COORDINATES AND ARE TO BE USED AS GRID OR GROUND VALUES ON THIS PLAT.

RIGHT-OF-WAY MONUMENTS ARE TYPE 2 (TYPICAL 3/4" REBAR) AND WILL BE PLACED PRIOR TO THE COMPLETION OF THE PROJECT, BY SE REGION DOT SURVEY.

HIGHWAY	BASIS OF EXISTING RIGHT-OF-WAY	WIDTH	YEAR
I-94	1101-1131	VARIES	1956
STH 20	2341-01-21	VARIES	1966
STH 20	1032-06-29	VARIES	1989

A Concrete Monument
w/ A Brass Cap
Y 183686.18
X 594100.16

A Concrete Monument
w/ A Brass Cap
Y 186347.14
X 594090.84

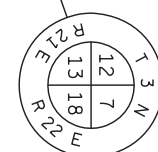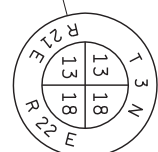

TRANSPORTATION PROJECT PLAT NO: 1033-02-20 - 4.08 AMENDMENT NO: 1

AMENDS PARCELS 31, 100, & 103 OF TPP 1033-02-20-4.08, RECORDED AS DOCUMENT 2207211.

THAT PART OF THE SE1/4 OF THE SE1/4 OF SECTION 12, AND THAT PART OF THE NE1/4 OF THE NE1/4 OF SECTION 13, TOWN 3 NORTH, RANGE 21 EAST, TOWN OF YORKVILLE, RACINE COUNTY, WISCONSIN.

RELOCATION ORDER IH-94/STH 20 RACINE COUNTY

TO PROPERLY ESTABLISH, LAY OUT, WIDEN, ENLARGE, EXTEND, CONSTRUCT, RECONSTRUCT, IMPROVE, OR MAINTAIN A PORTION OF THE HIGHWAY DESIGNATED ABOVE, THE STATE OF WISCONSIN DEPARTMENT OF TRANSPORTATION DEEMS IT NECESSARY TO RELOCATE OR CHANGE SAID HIGHWAY AND ACQUIRE CERTAIN LANDS AND INTERESTS OR RIGHTS IN LANDS FOR THE ABOVE PROJECT.

TO EFFECT THIS CHANGE, PURSUANT TO AUTHORITY GRANTED UNDER SECTION 84.02 (3) AND 84.09, WISCONSIN STATUTES, THE DEPARTMENT OF TRANSPORTATION HEREBY ORDERS THAT:
1. THAT PORTION OF SAID HIGHWAY AS SHOWN ON THIS PLAT IS LAID OUT AND ESTABLISHED TO THE LINES AND WIDTHS AS SO SHOWN FOR THE ABOVE PROJECT.
2. THE LANDS OR INTERESTS OR RIGHTS IN LANDS AS SHOWN ON THIS PLAT ARE REQUIRED BY THE DEPARTMENT FOR THE ABOVE PROJECT AND SHALL BE ACQUIRED IN THE NAME OF THE STATE OF WISCONSIN, PURSUANT TO THE PROVISIONS OF SECTION 84.09 (1) OR (2), WISCONSIN STATUTES.

SCHEDULE OF LANDS & INTERESTS REQUIRED		OWNERS NAMES ARE SHOWN FOR REFERENCE PURPOSES ONLY AND ARE SUBJECT TO CHANGE PRIOR TO THE TRANSFER OF LAND INTEREST TO THE DEPARTMENT.				
PARCEL NUMBER	OWNER	INTEREST REQUIRED	R/W REQUIRED ACRES			T.L.E. TEMP. ACRES
			NEW	EXISTING	TOTAL	
31	RALPH O. & MARY JANE TURNOCK	Fee AR TLE	0.200	0.000	0.200	1.213
32	RV CAPITOL	Fee AR TLE	0.099	0.000	0.099	0.897
33	YORKVILLE - IVES GROVE	AR TLE	0.000	0.000	0.000	0.121
34	POMP TIRE	Fee TLE	0.063	0.000	0.063	0.019
35	BRUCE HELLER	Fee TLE	0.067	0.000	0.067	0.005
38	SBA STRUCTURES INC.	Fee AR TLE	0.144	0.000	0.144	0.200
100	WE-ENERGIES ELECTRIC	ROR	-	-	-	-
101	WE-ENERGIES GAS	ROR	-	-	-	-
103	AT&T WISCONSIN	ROR	-	-	-	-
108	TOWN OF YORKVILLE	ROR	-	-	-	-

100 DOC. 2048716
PCL. 32
V. 2304 P. 782 DOC. 1438969
PCL. 31
NO RECORDED EASEMENT
PCL. 32

101 NO RECORDED EASEMENT
PCL. 35

108 V. 3089 P. 270 DOC. 1748734
PCL. 32
V. 3307 P. 711 DOC. 1802361
PCL. 33
V. 3094 P. 873 DOC. 1750721
PCL. 35

103 V. 3418 P. 924 DOC. 1828629
PCL. 32CH
V. 2304 P. 782 DOC. 1438969
PCL. 31
V. 3418 P. 922 DOC. 1828628
PCL. 34
V. 3418 P. 920 DOC. 1828627
PCL. 35
DOC. 2048716
PCL. 32

1AP*
EXISTING SHARED
ACCESS DRIVEWAY
TO REMAIN

A Concrete Monument
w/ A DOT Aluminum Cap
Y 188984.80
X 594080.88

I HEREBY CERTIFY THAT THIS PLAT MEETS ALL REQUIREMENTS OF SECTION 84.09, WISCONSIN STATUTES. THIS PLAT IS APPROVED FOR THE WISCONSIN DEPARTMENT OF TRANSPORTATION.

DATE: 6-28-2010

Craig Andersen
Name: Craig Andersen
Title: RE Supervisor


THIS PLAT WAS PREPARED BY OR UNDER THE DIRECTION OF:

DATE: 6-28-2010

Paul Krause
Name: PAUL KRAUSE

SCALE, FEET




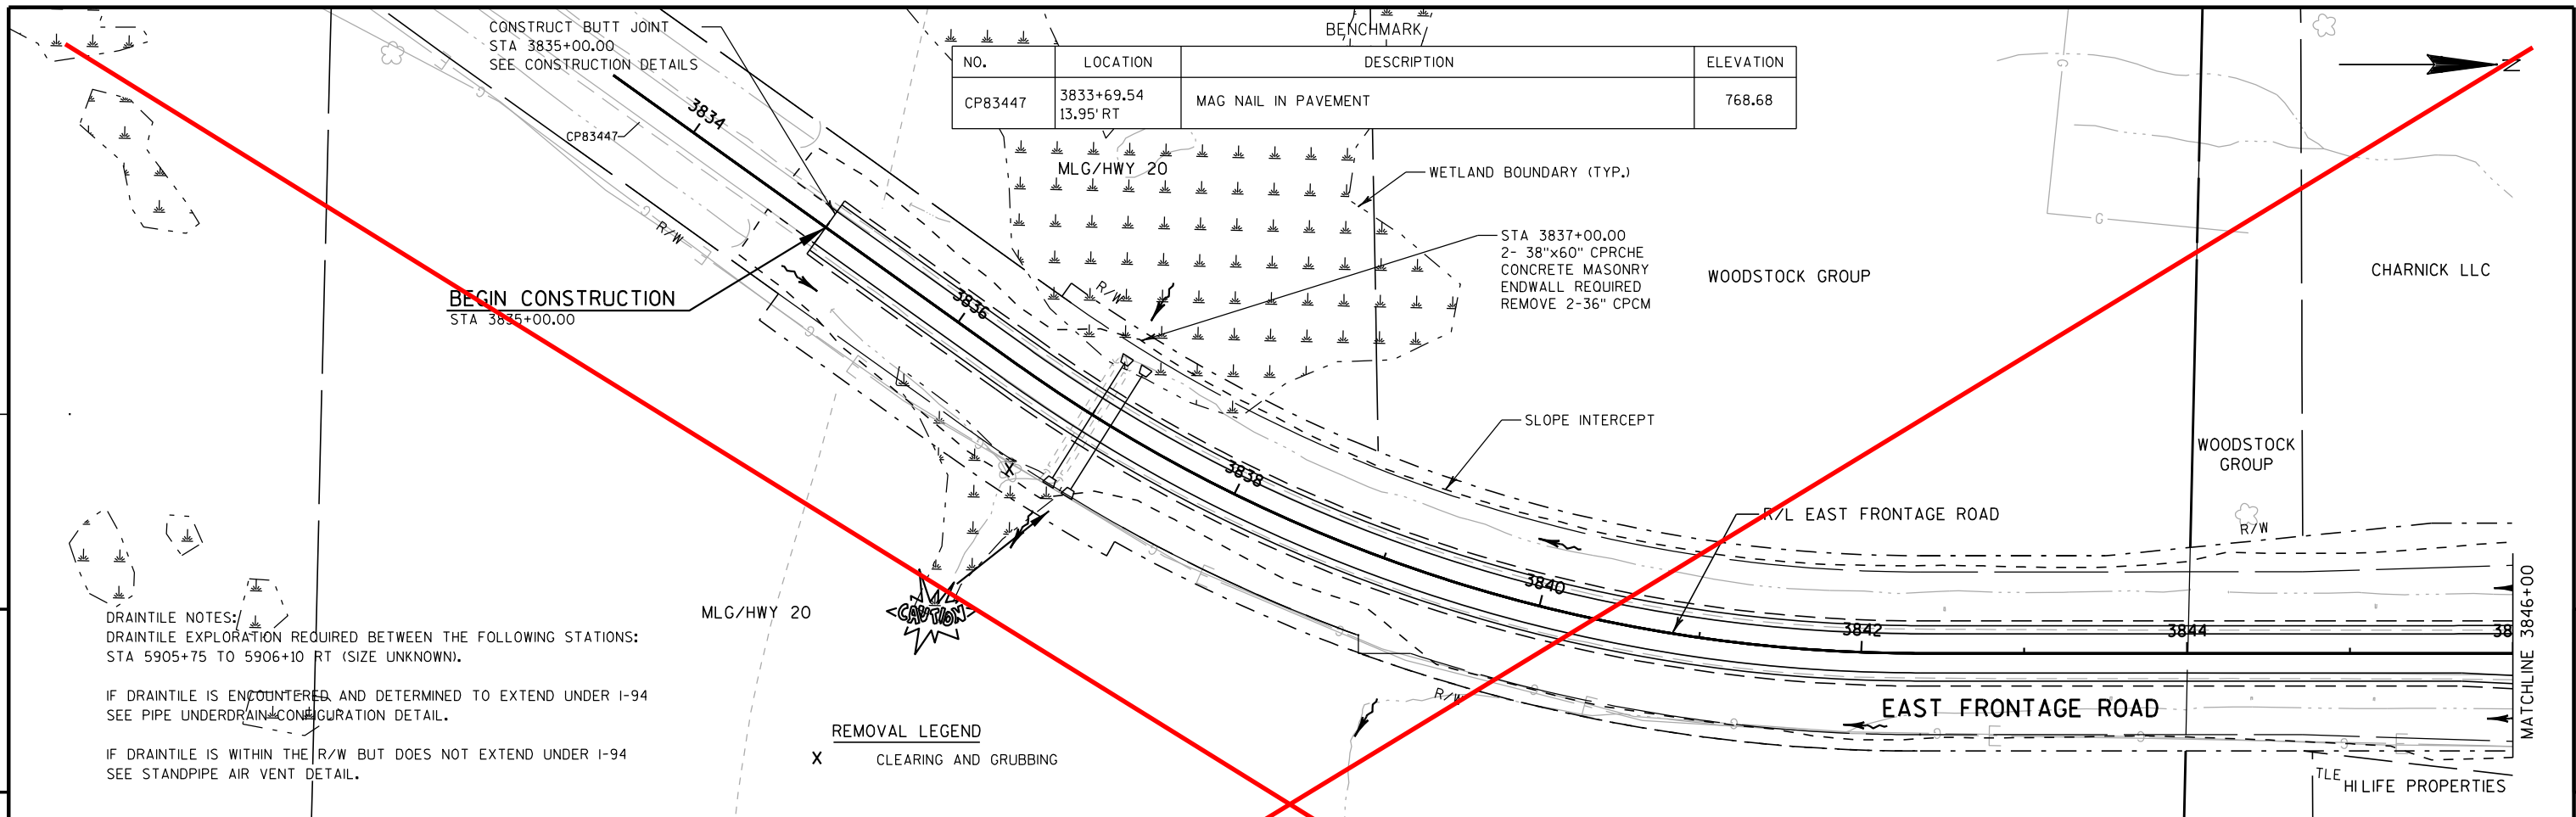

DRAINTILE NOTES:
DRAINTILE EXPLORATION REQUIRED BETWEEN THE FOLLOWING STATIONS:
STA 5905+75 TO 5906+10 RT (SIZE UNKNOWN).


IF DRAINTILE IS ENCOUNTERED AND DETERMINED TO EXTEND UNDER I-94
SEE PIPE UNDERDRAIN CONFIGURATION DETAIL.

IF DRAINTILE IS WITHIN THE R/W BUT DOES NOT EXTEND UNDER I-94
SEE STANDPIPE AIR VENT DETAIL.

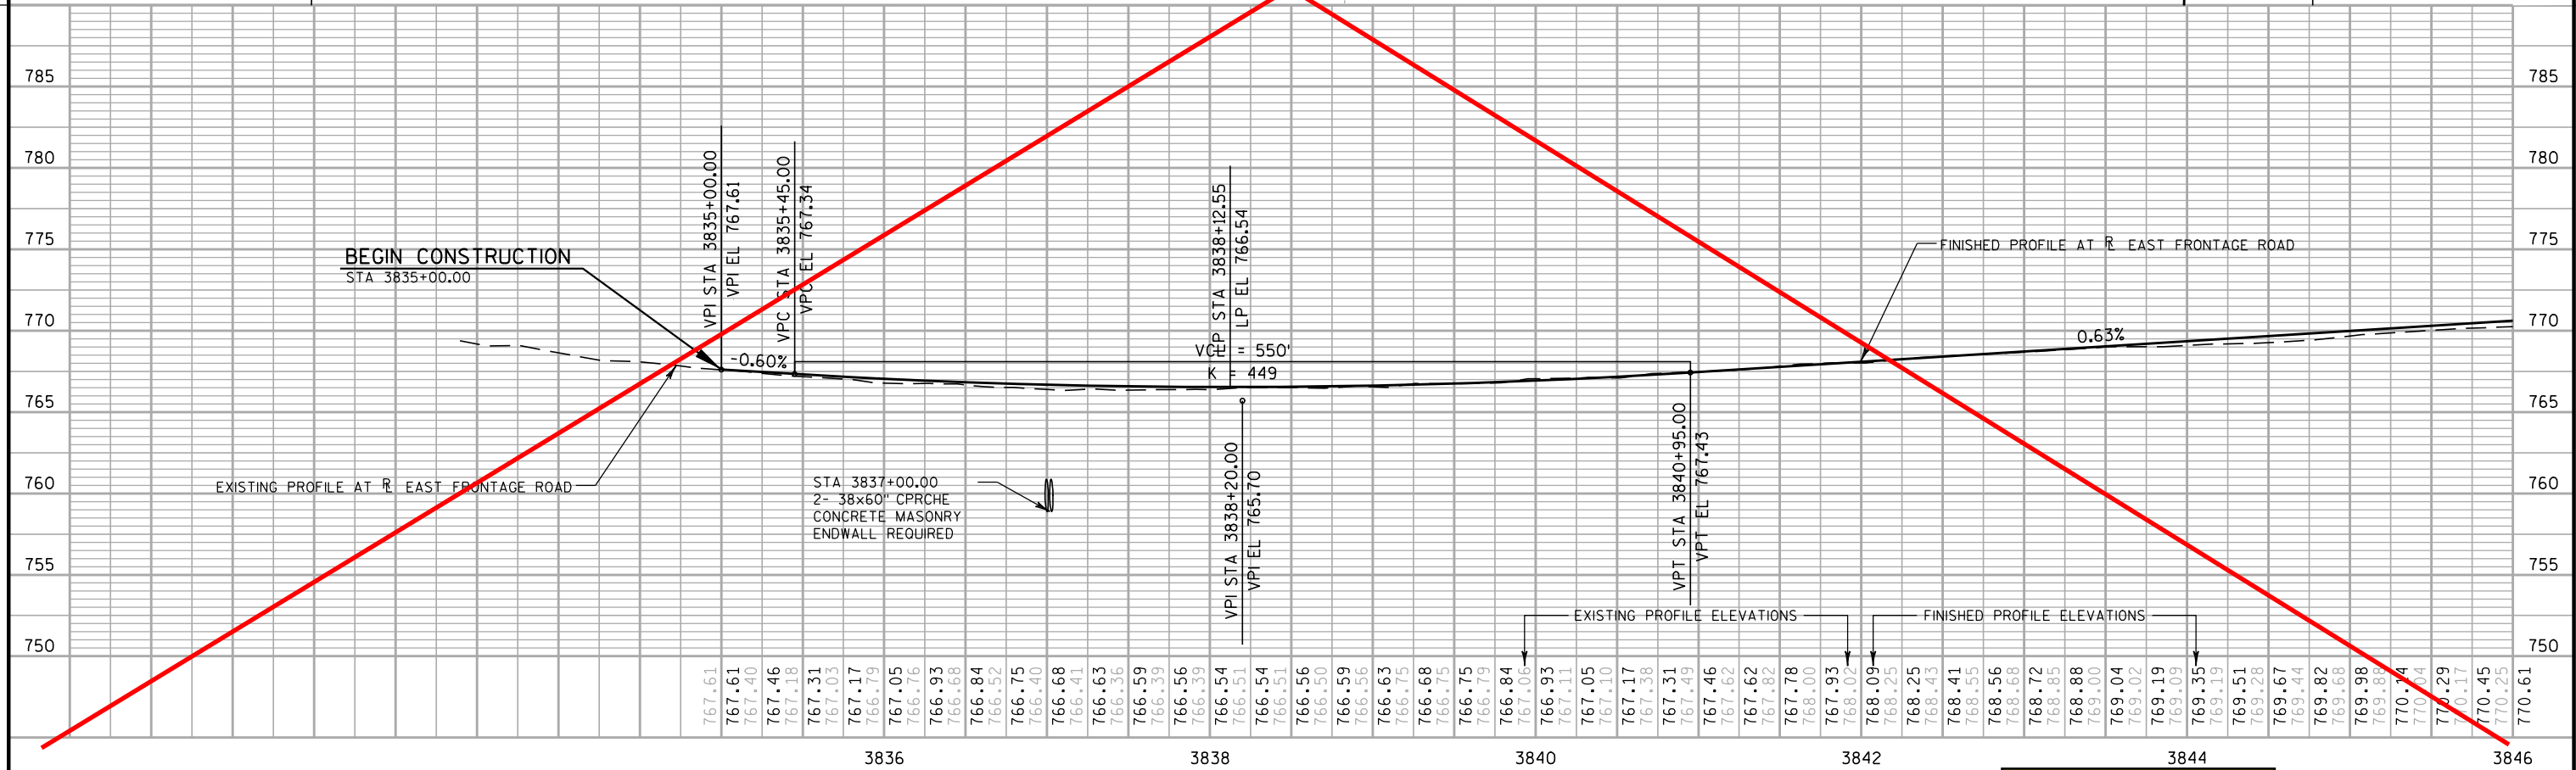

5


5


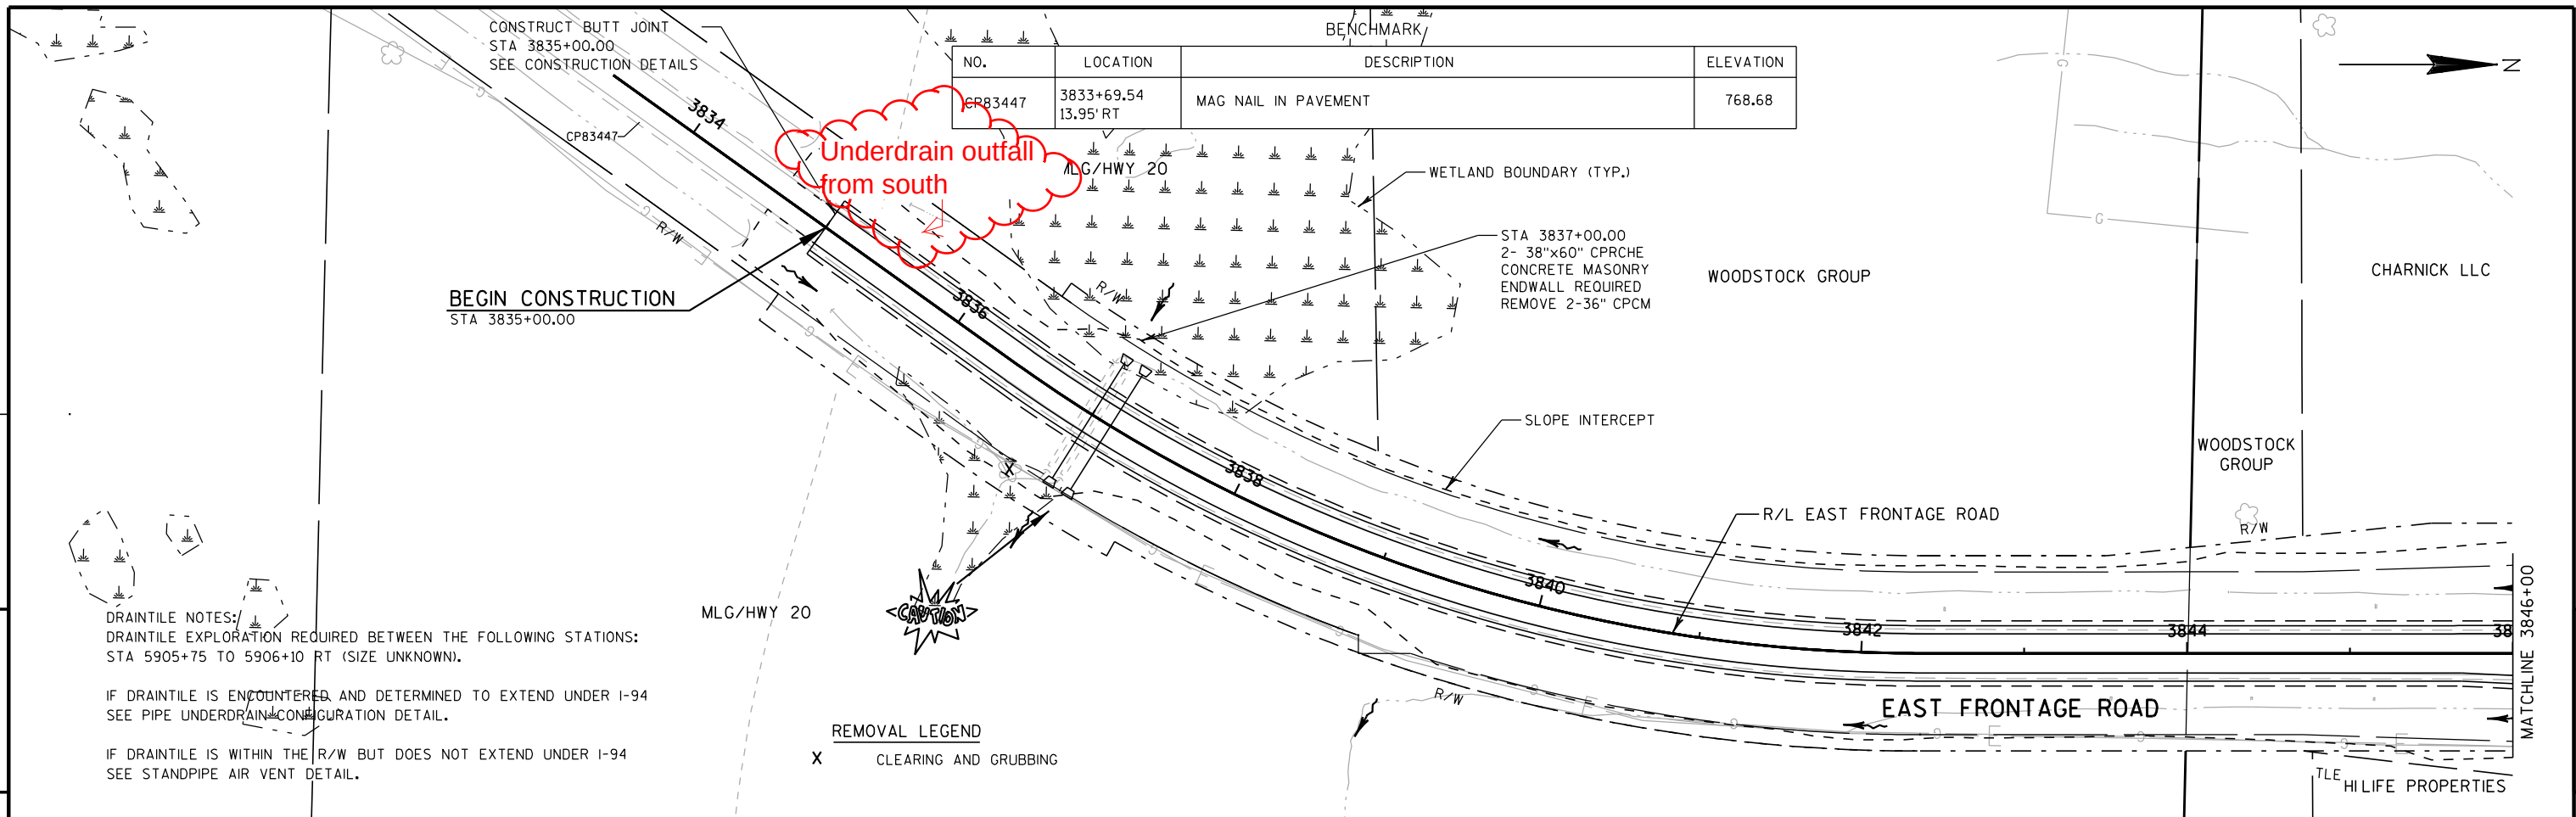



DRAINTILE NOTES:
DRAINTILE EXPLORATION REQUIRED BETWEEN THE FOLLOWING STATIONS:
STA 5905+75 TO 5906+10 RT (SIZE UNKNOWN).

IF DRAINTILE IS ENCOUNTERED AND DETERMINED TO EXTEND UNDER I-94
SEE PIPE UNDERDRAIN CONFIGURATION DETAIL.


IF DRAINTILE IS WITHIN THE R/W BUT DOES NOT EXTEND UNDER I-94
SEE STANDPIPE AIR VENT DETAIL.


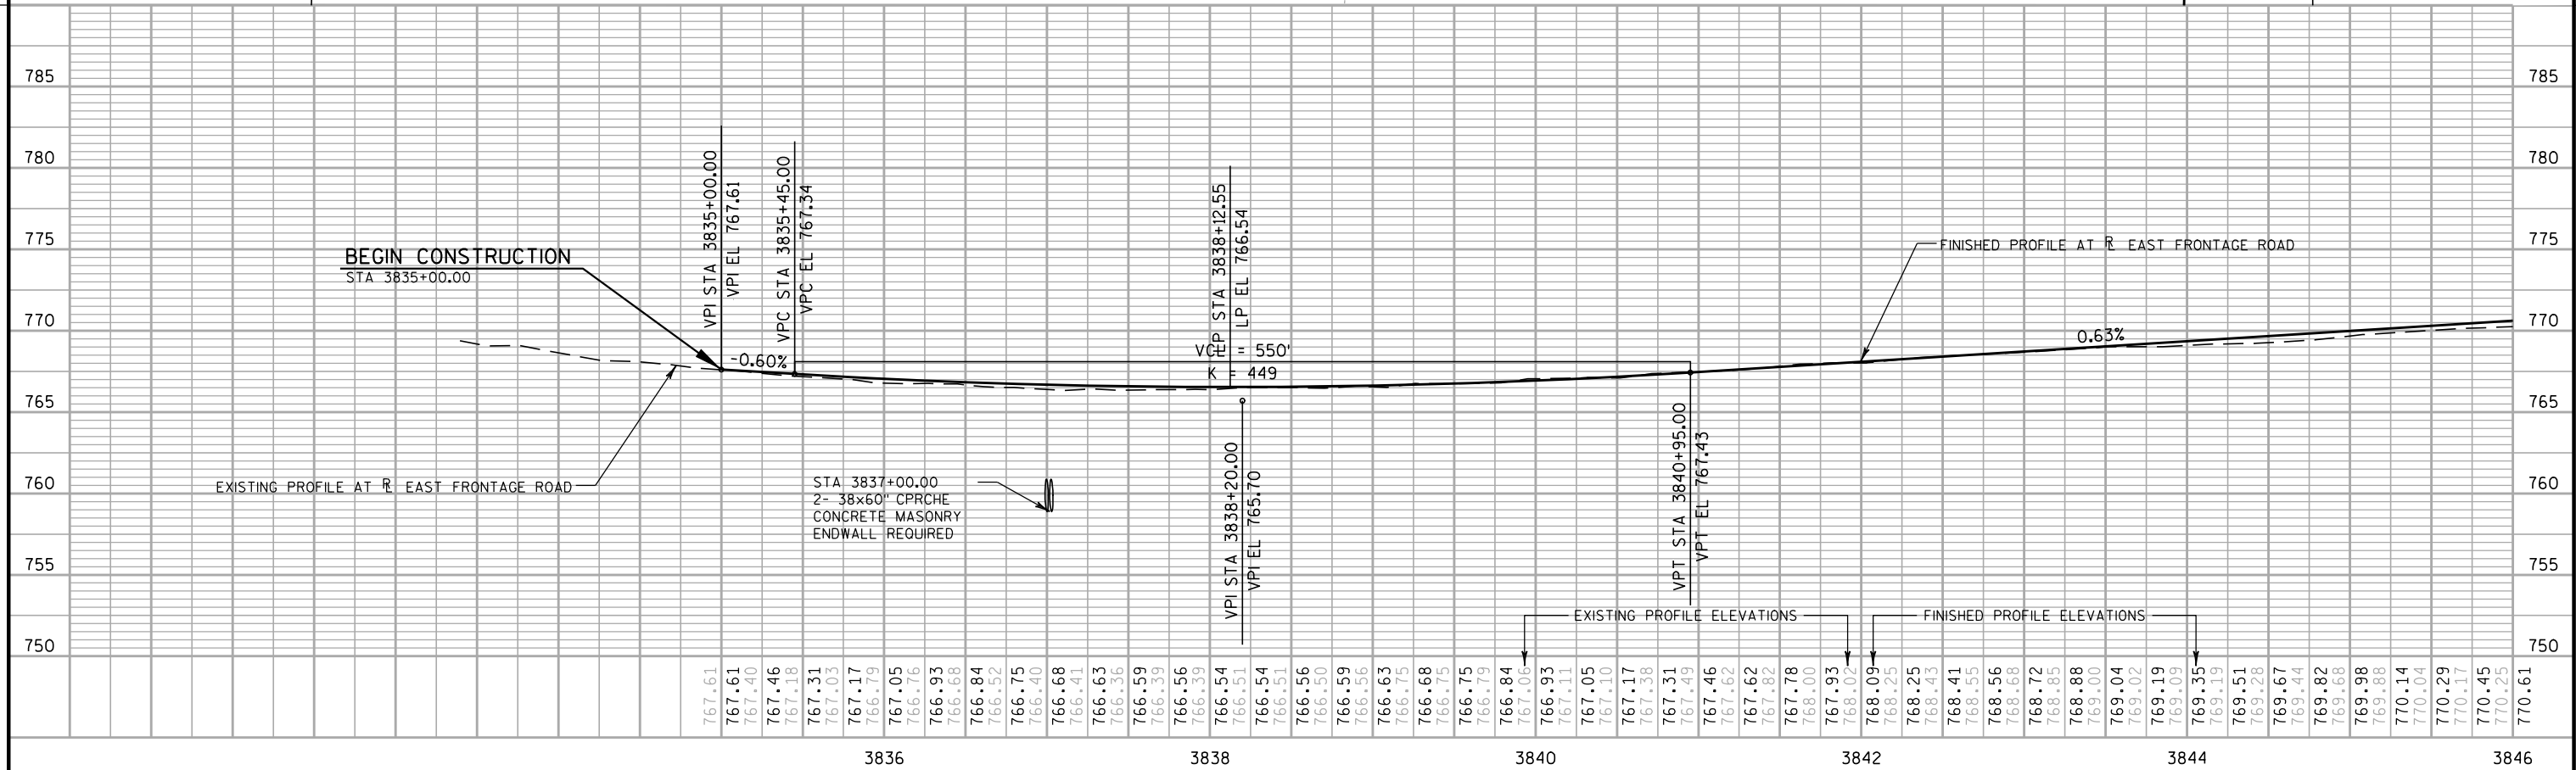


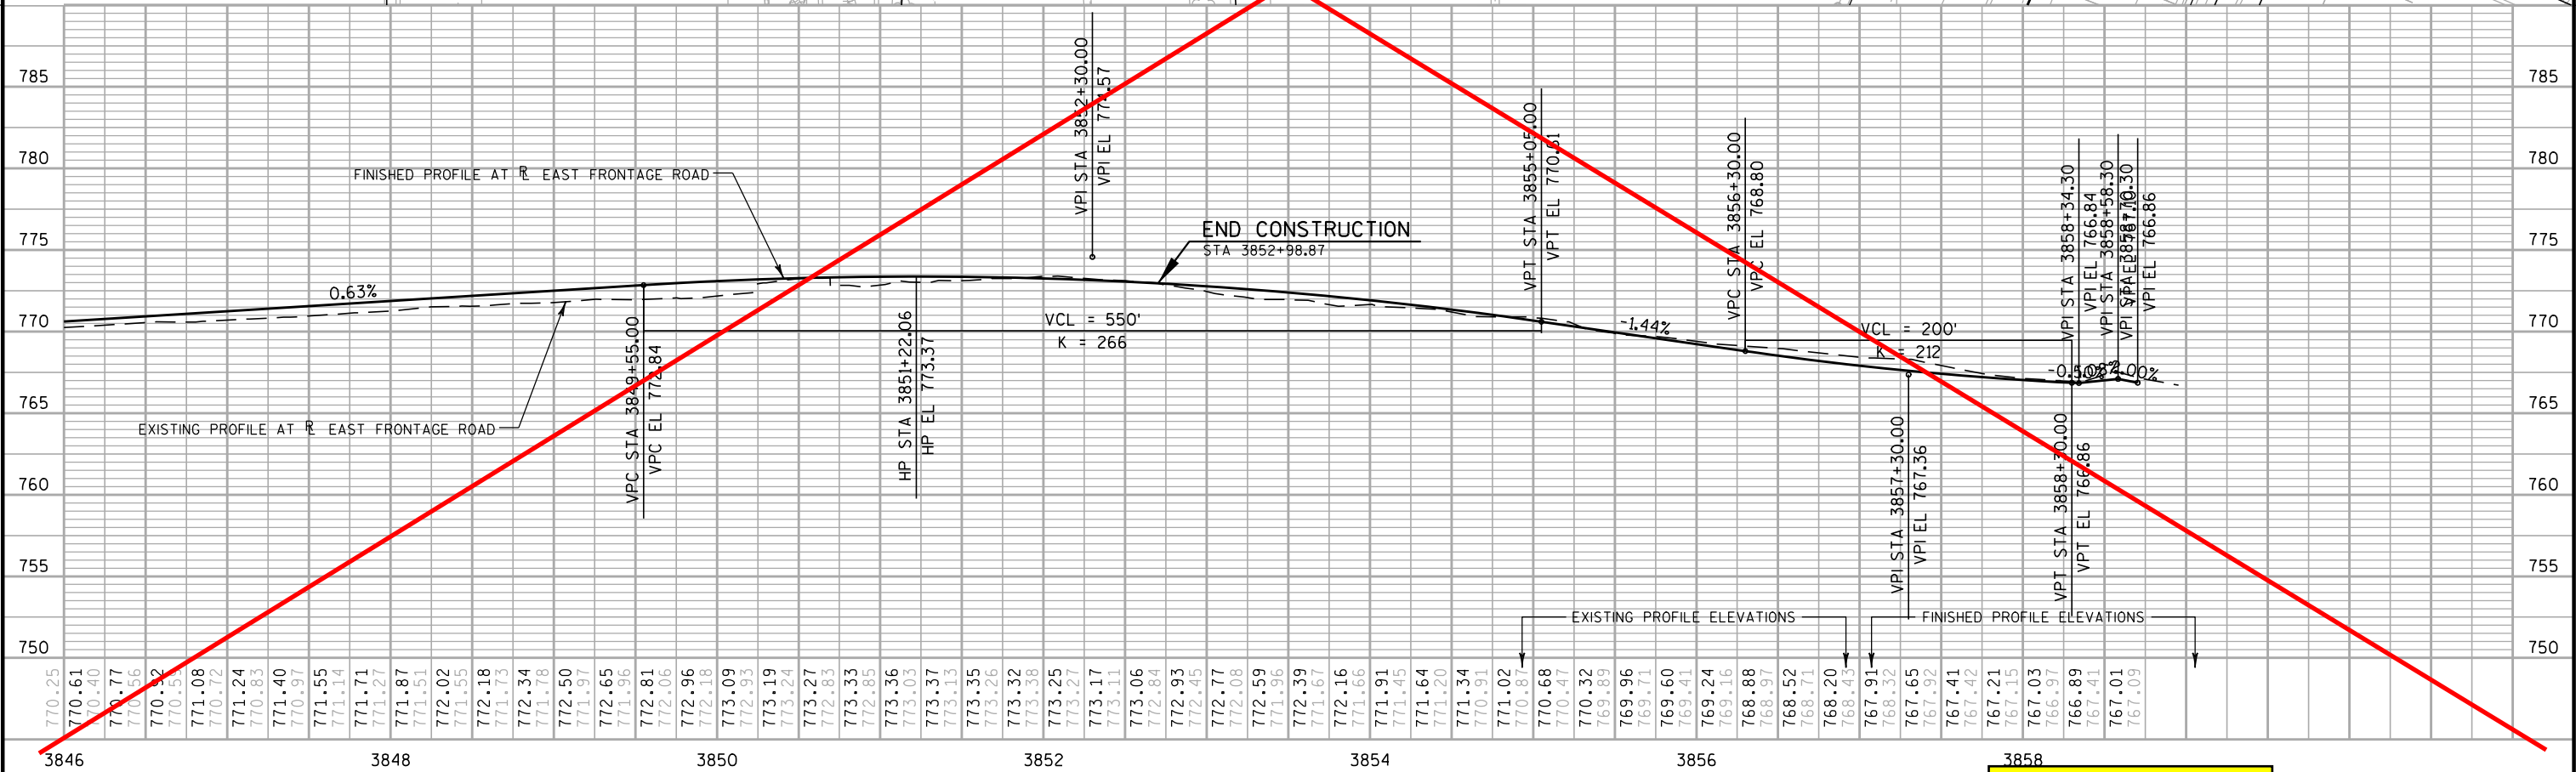
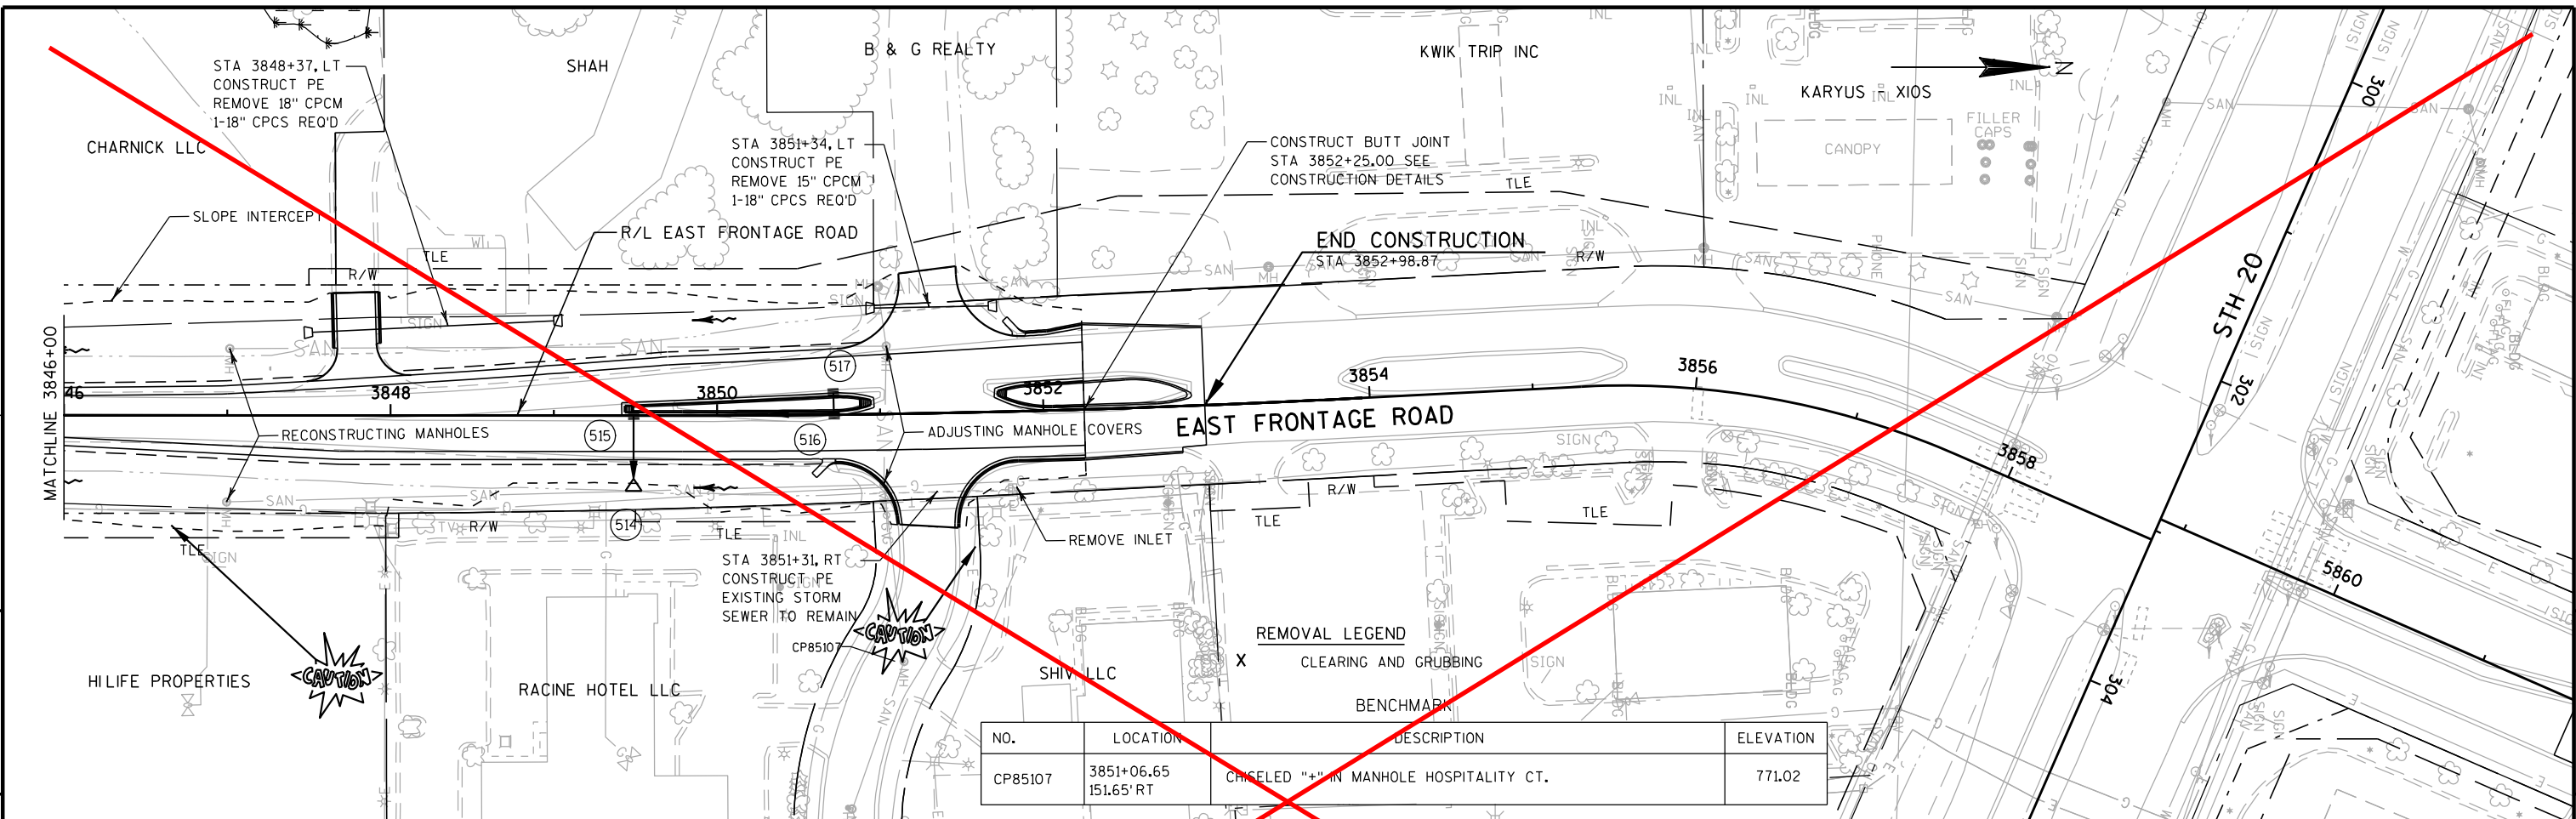



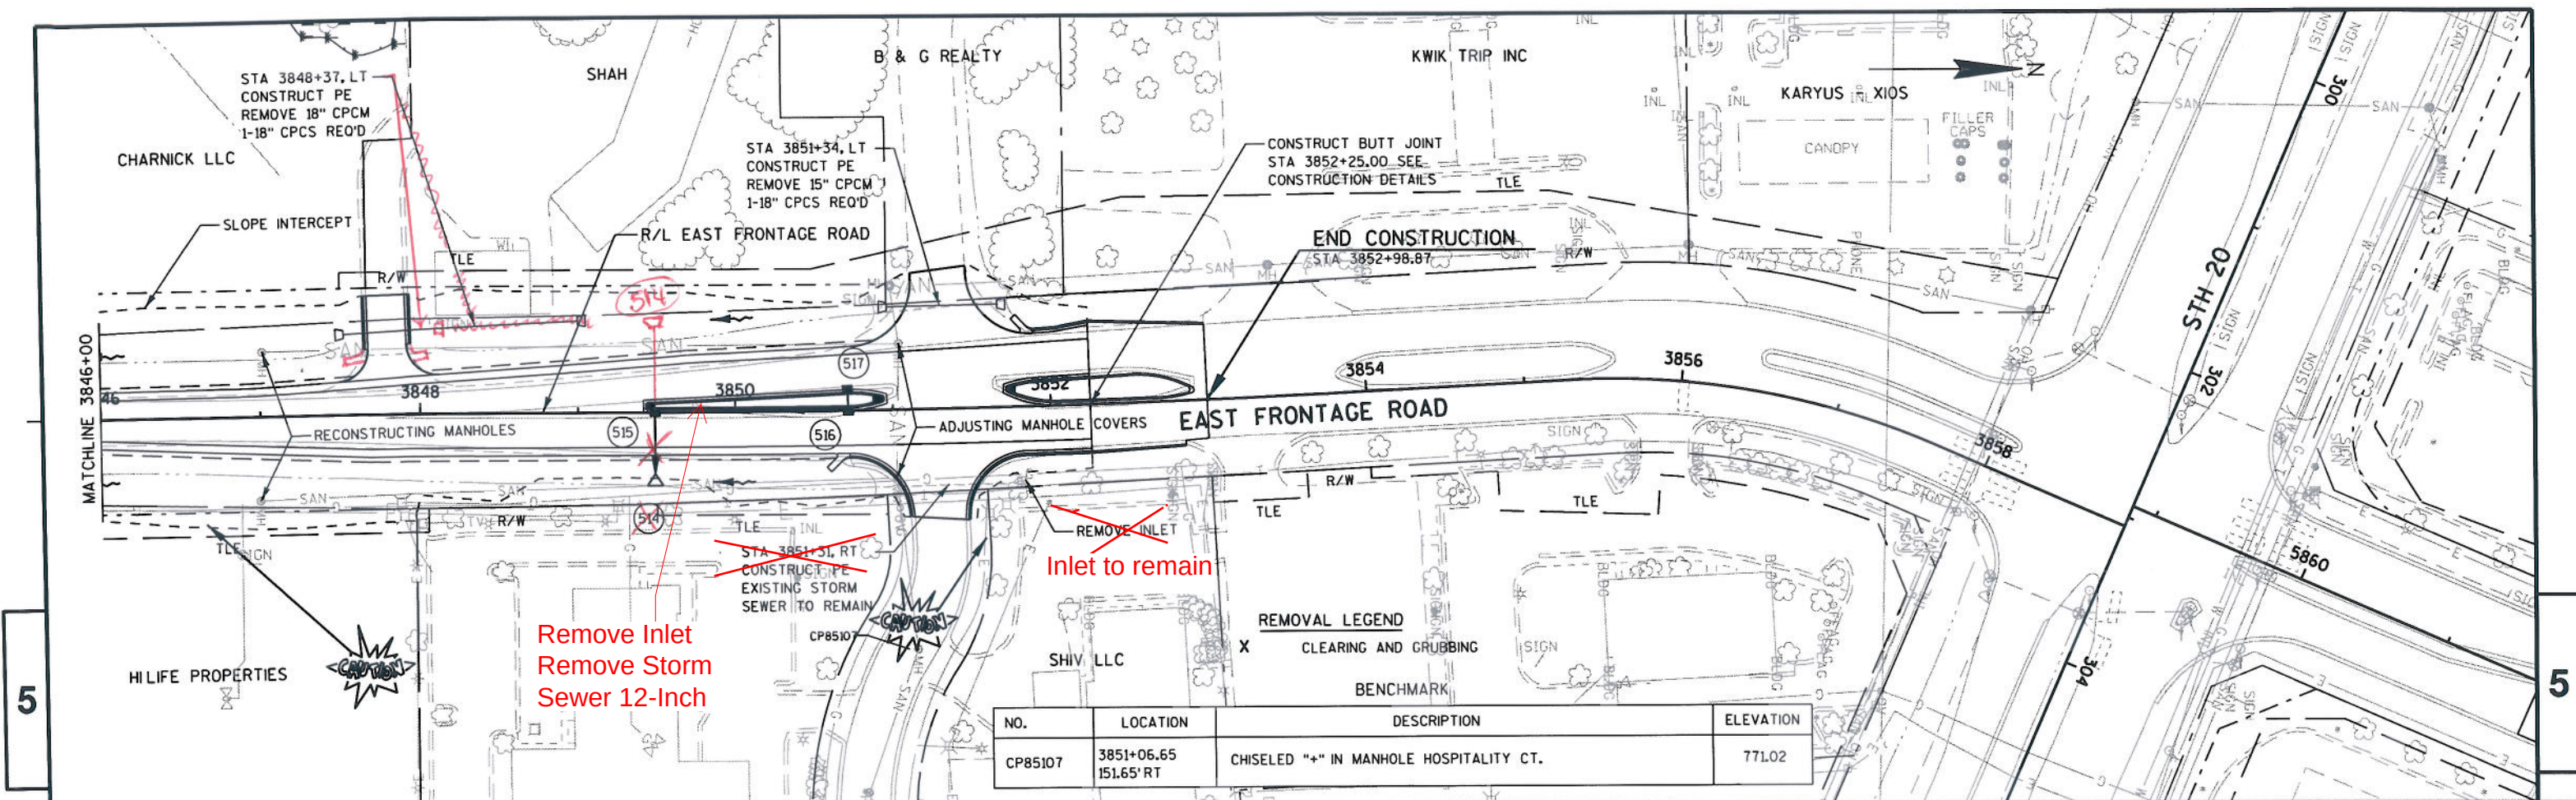




NO.	LOCATION	DESCRIPTION	ELEVATION
CP85107	3851+06.65 151.65' RT	CHISELED "+" IN MANHOLE HOSPITALITY CT.	771.02


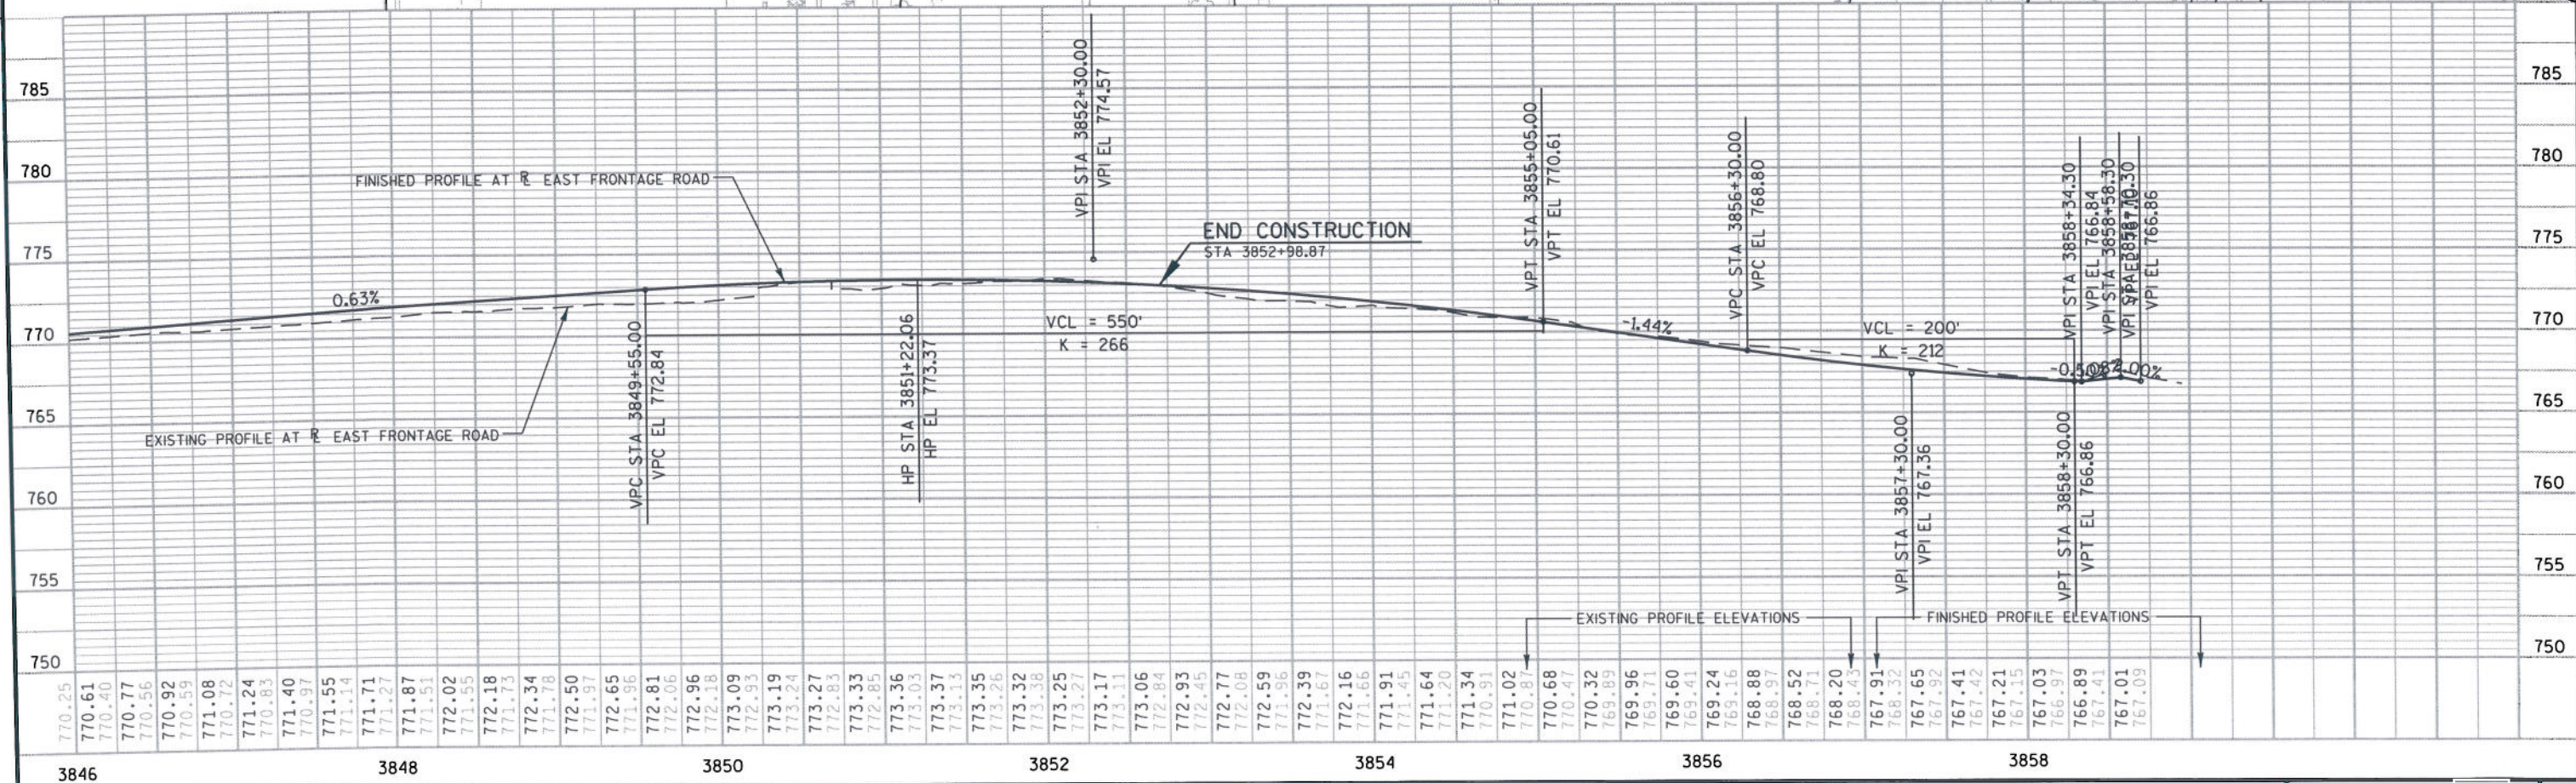


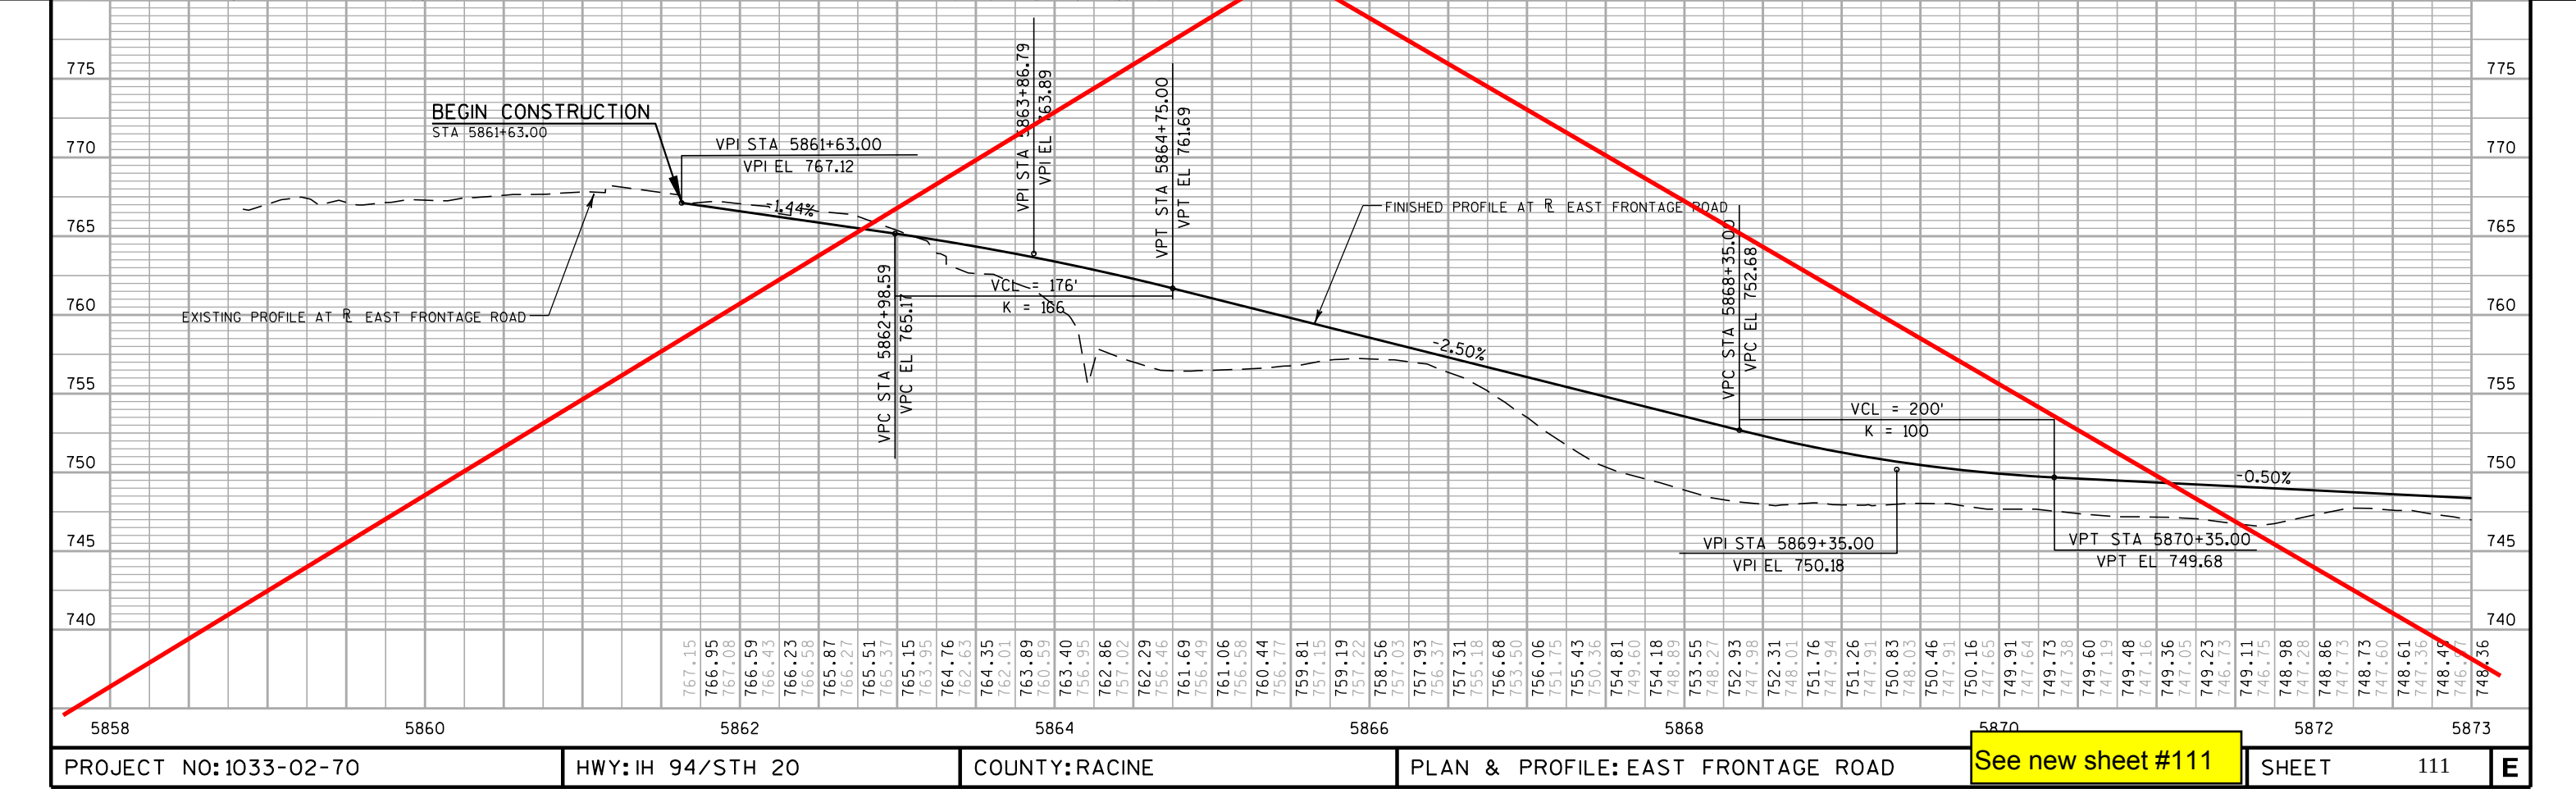
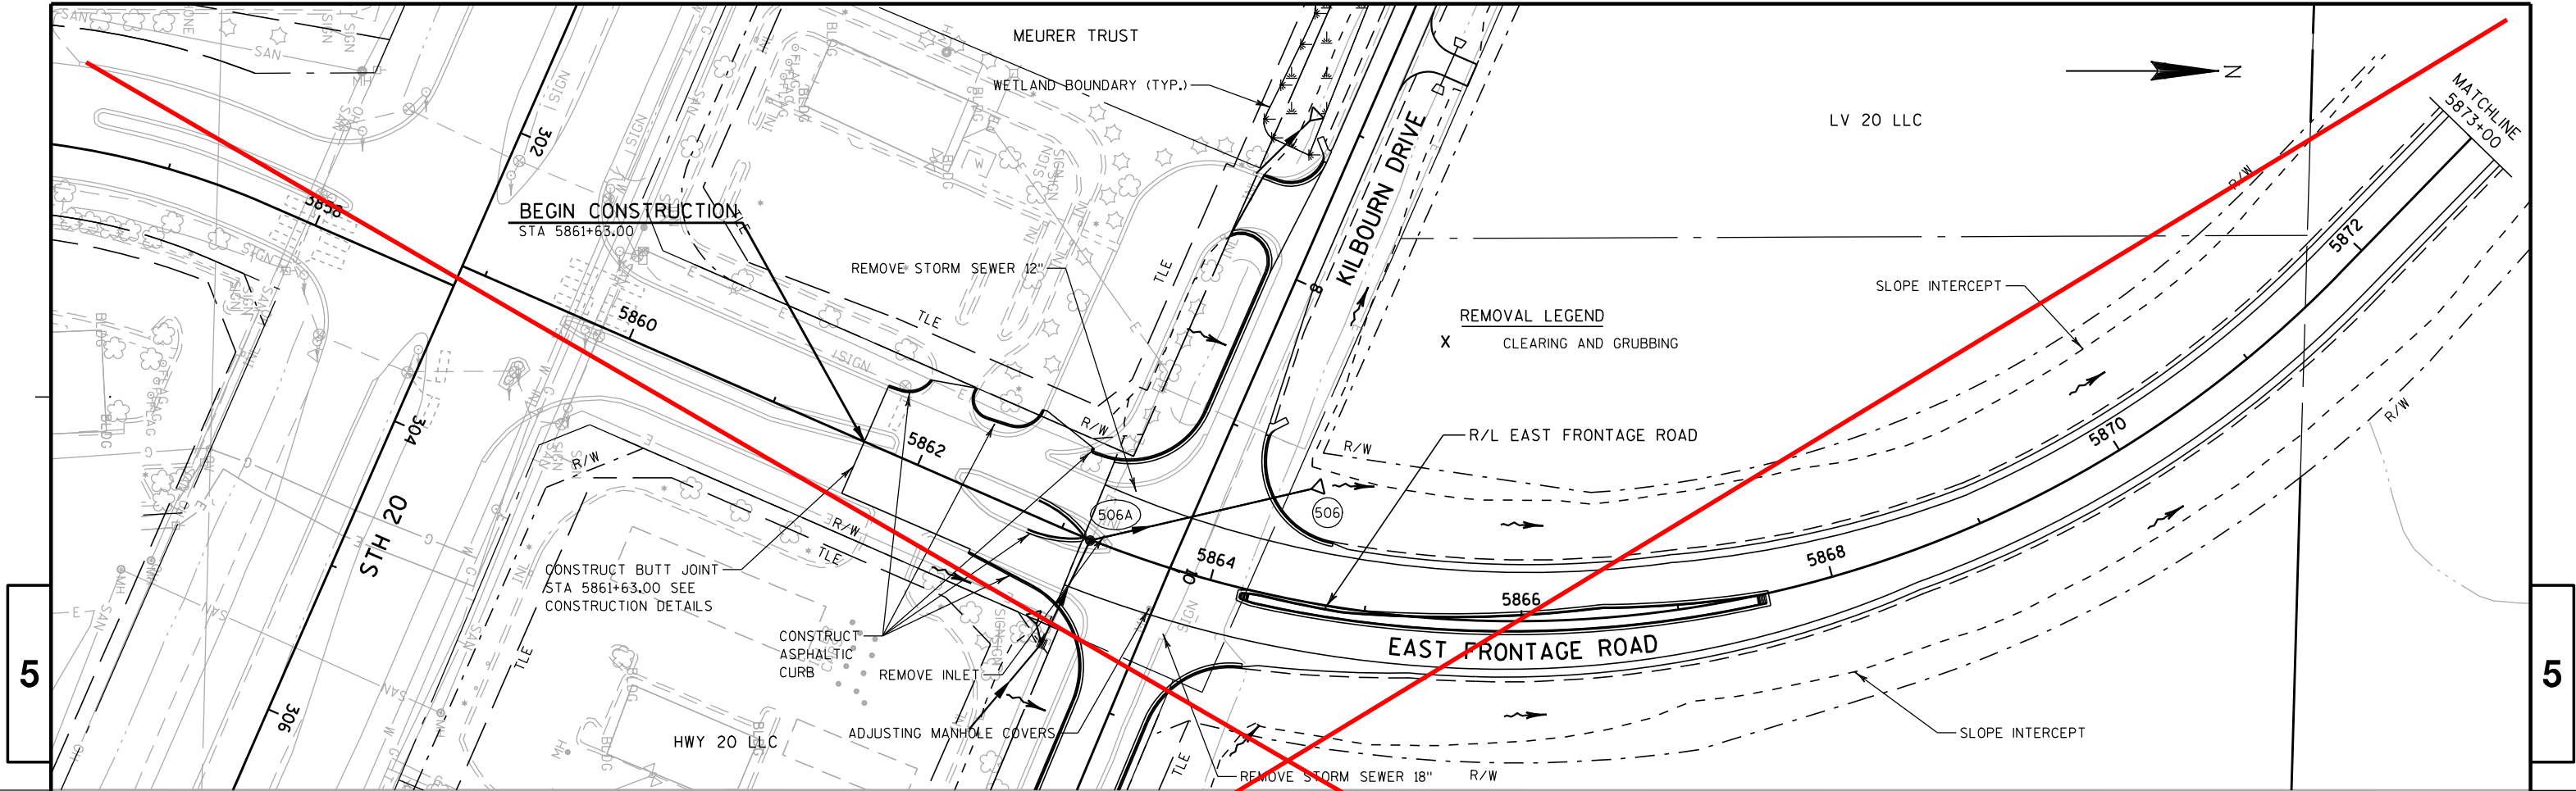


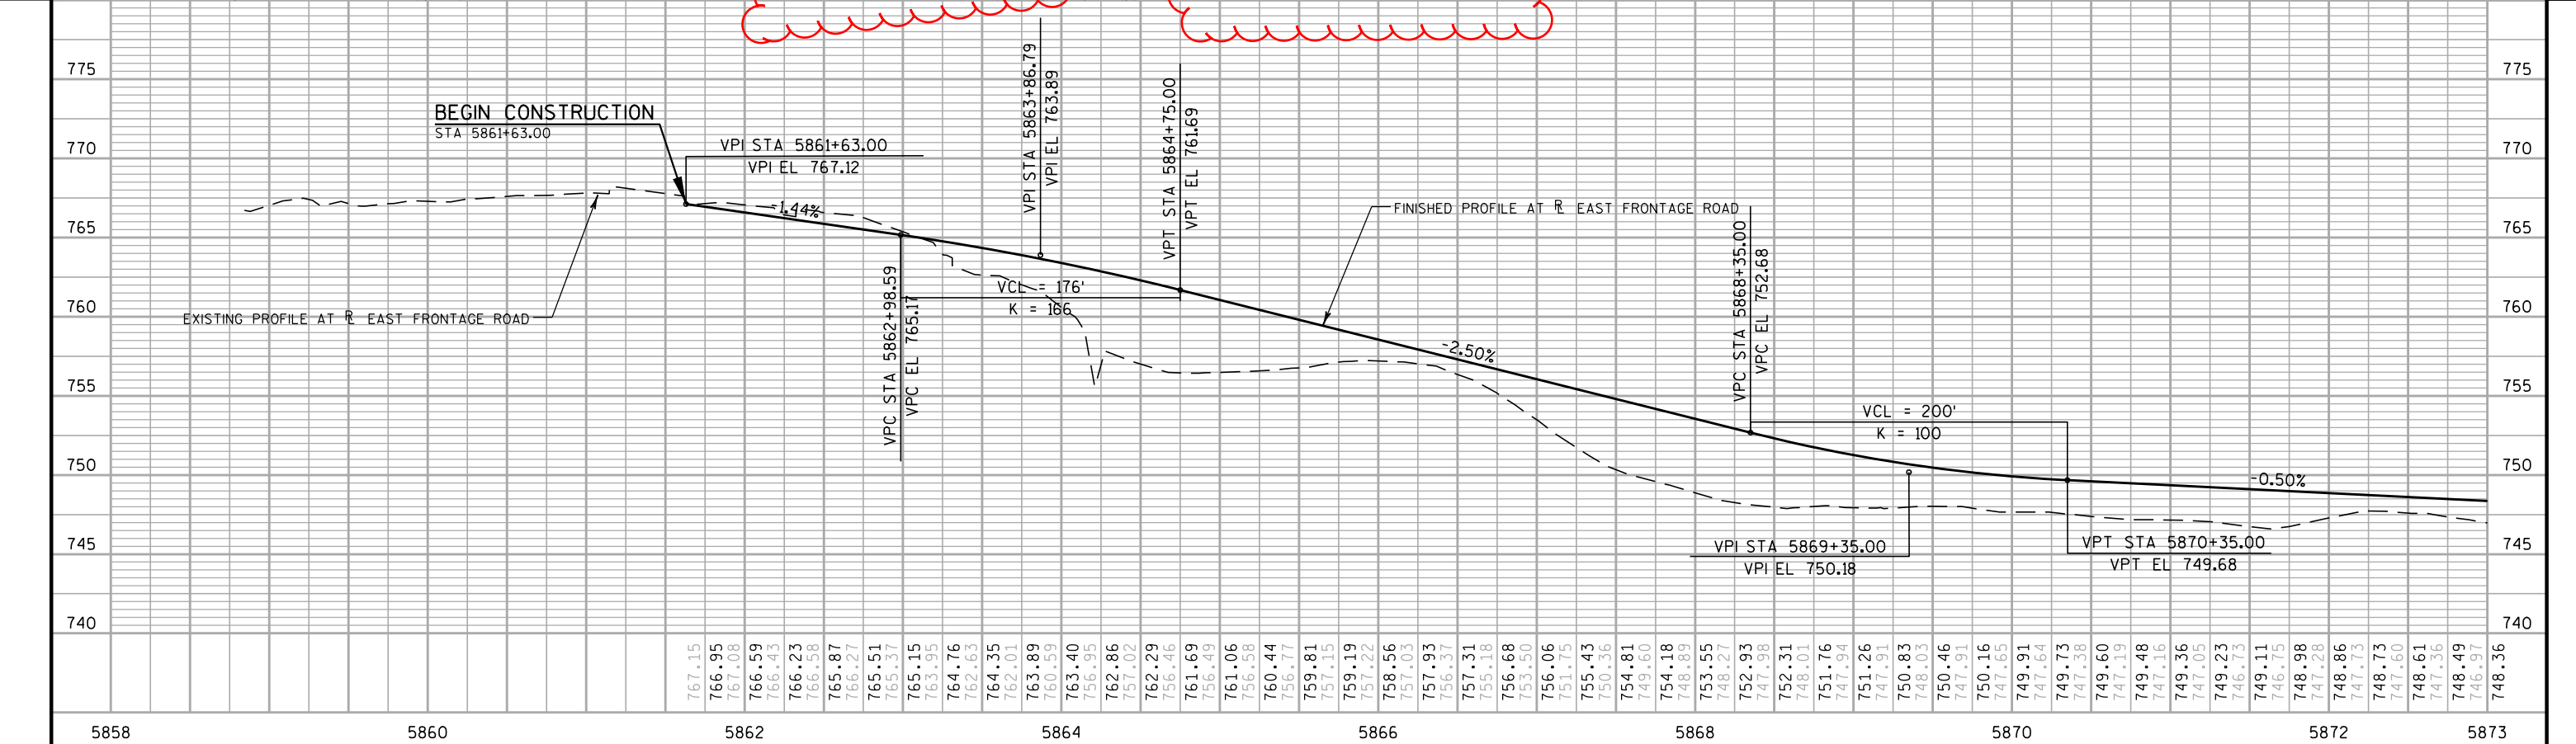
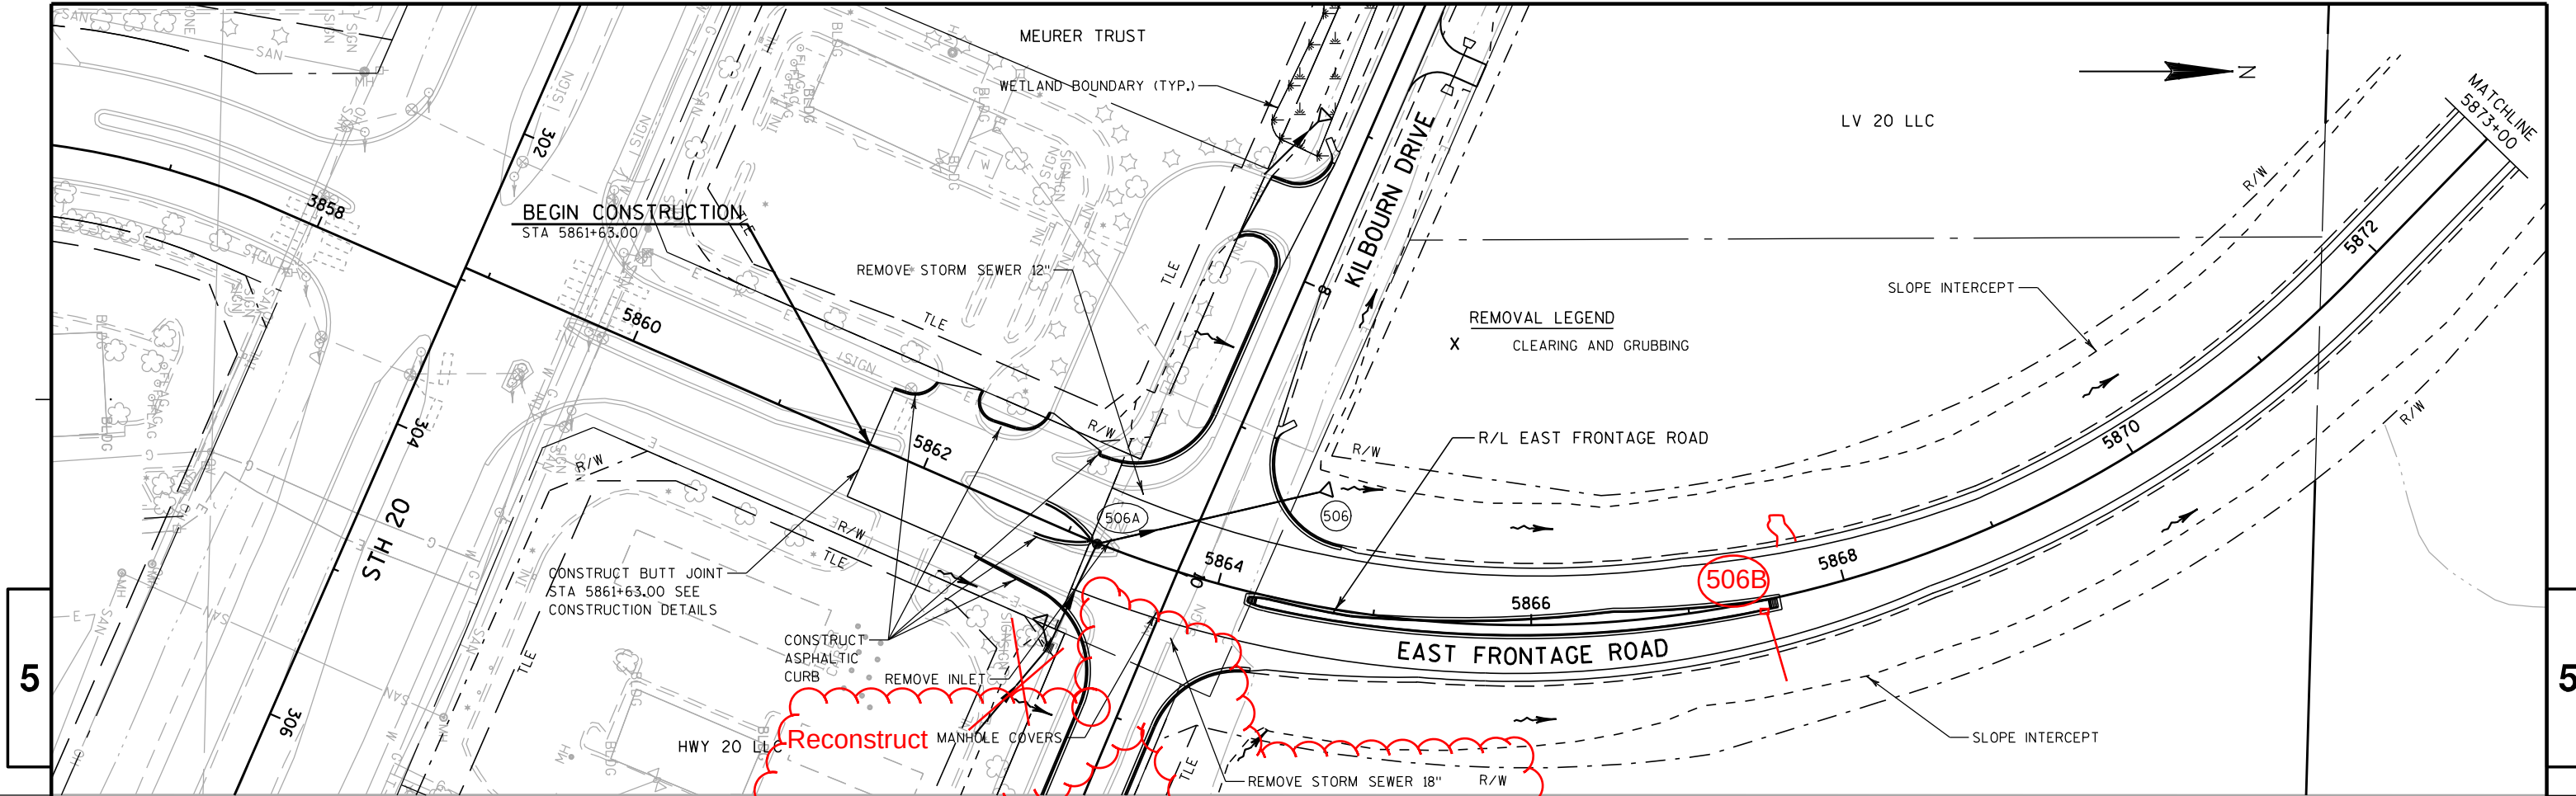


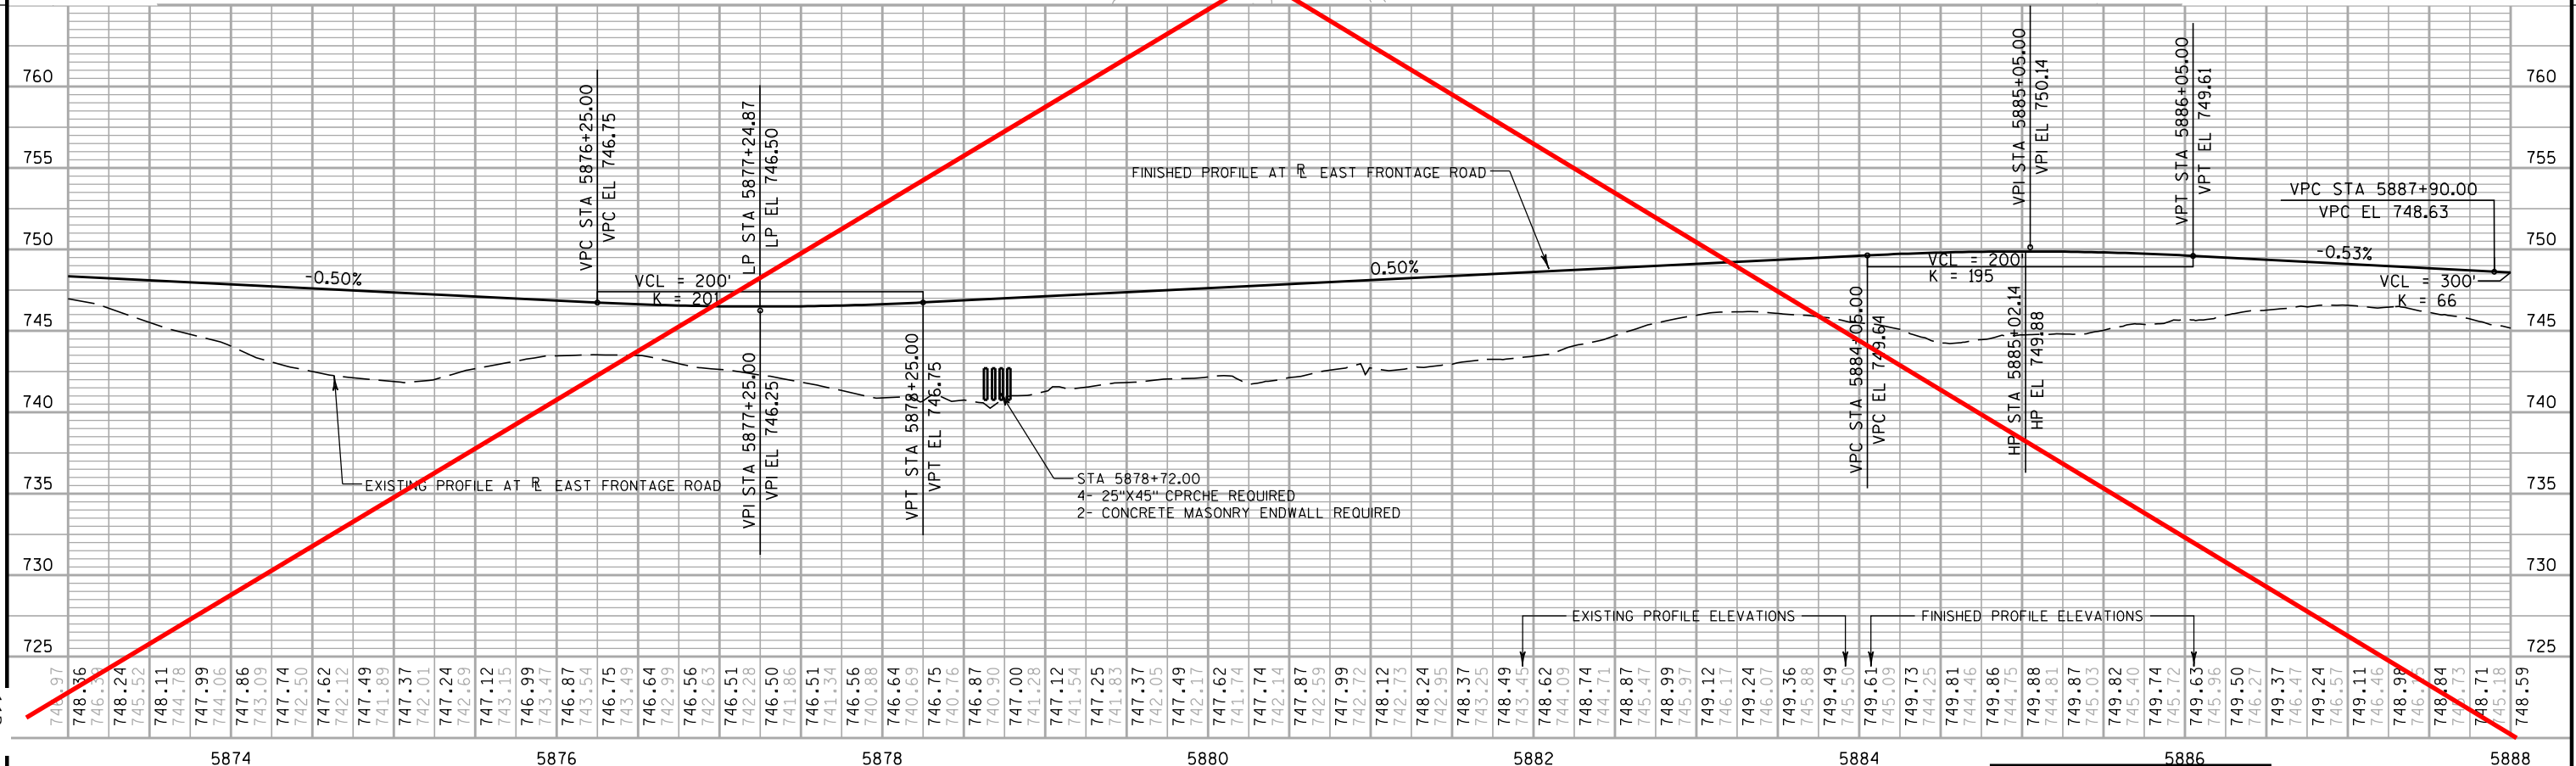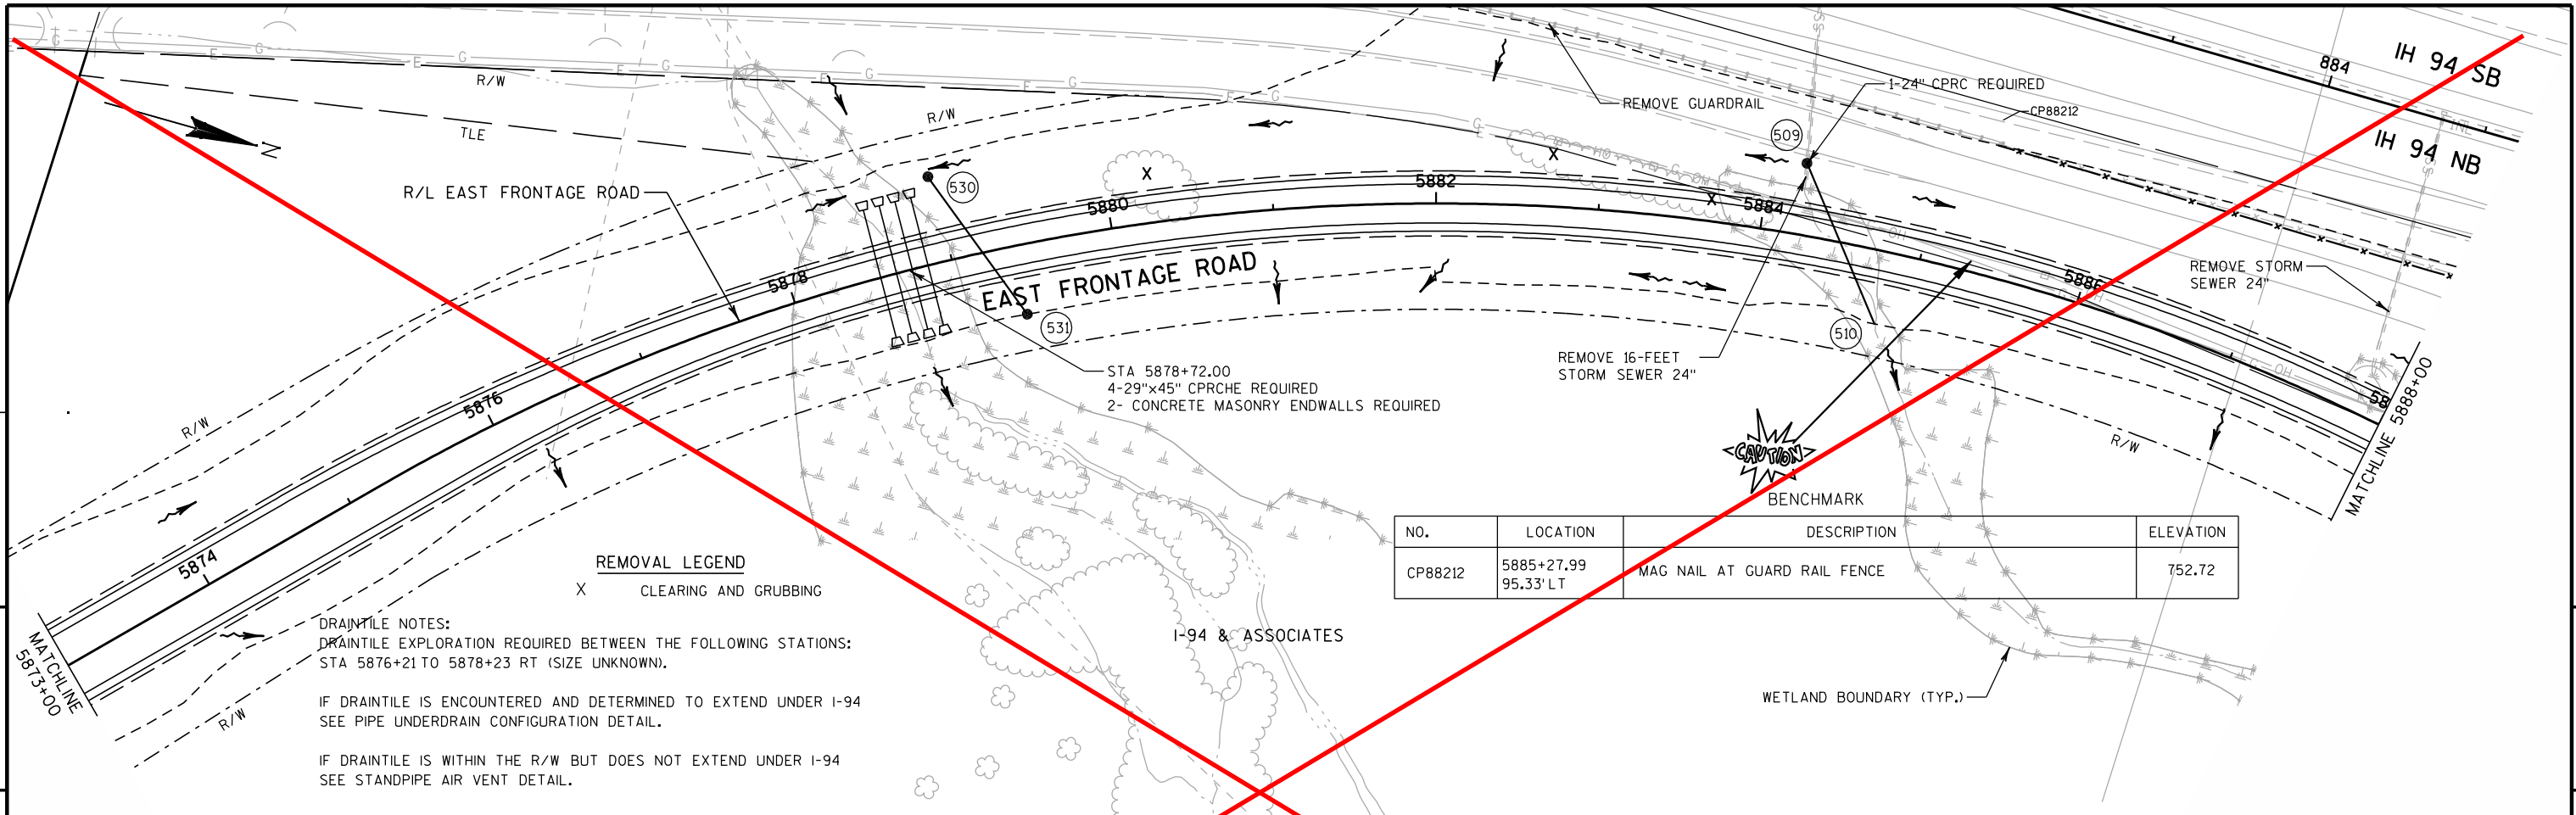

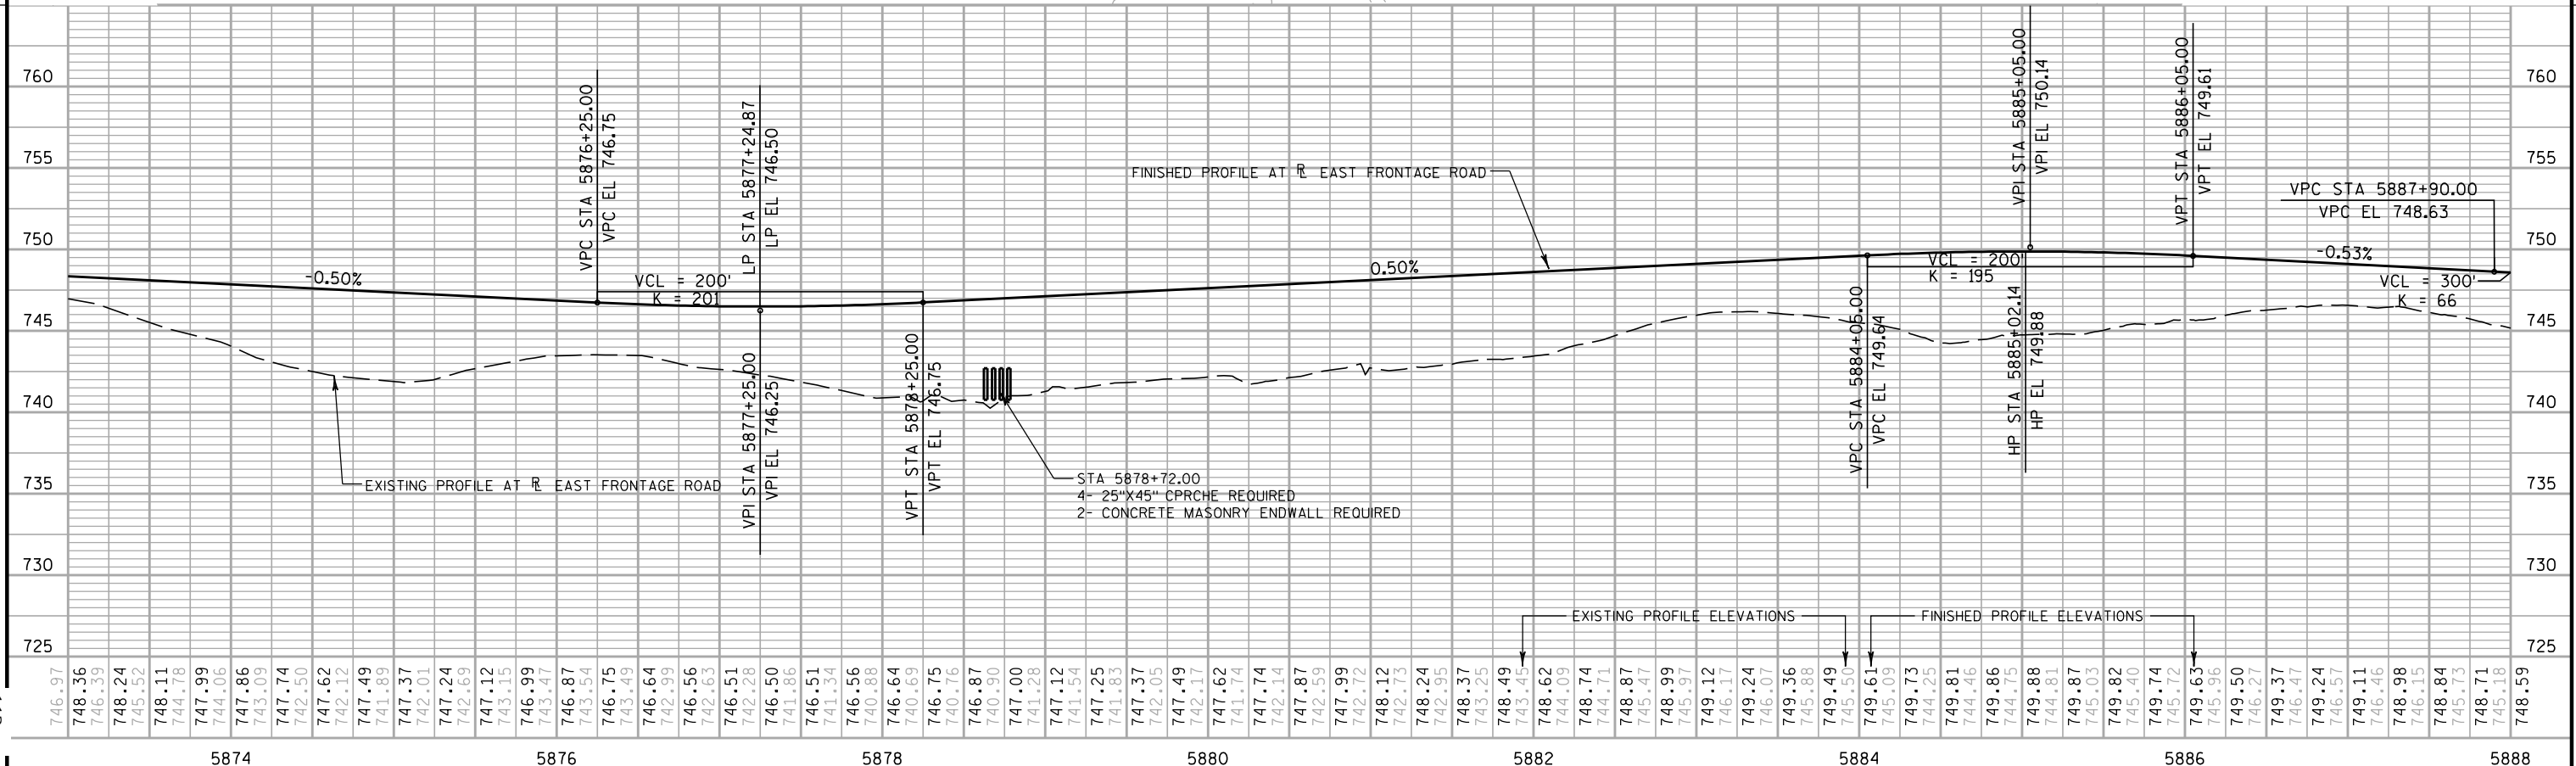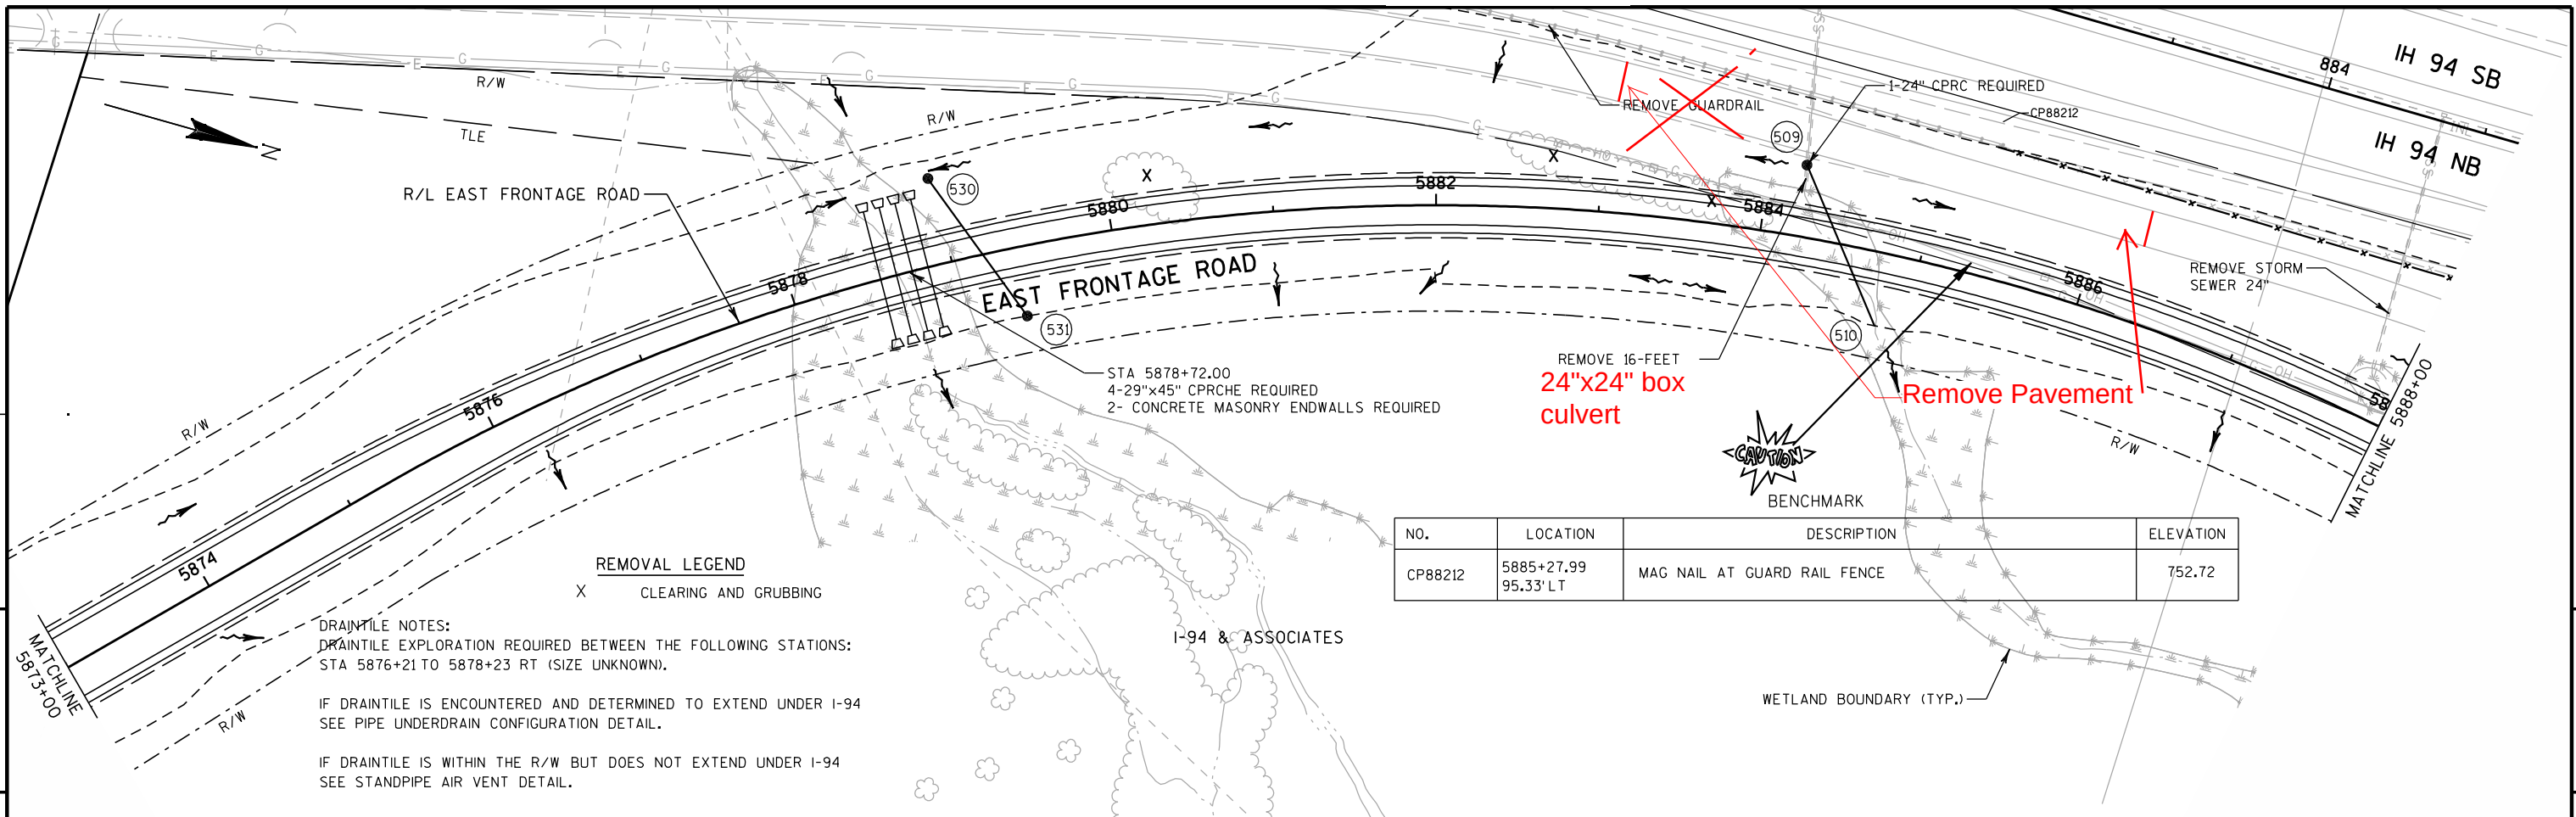

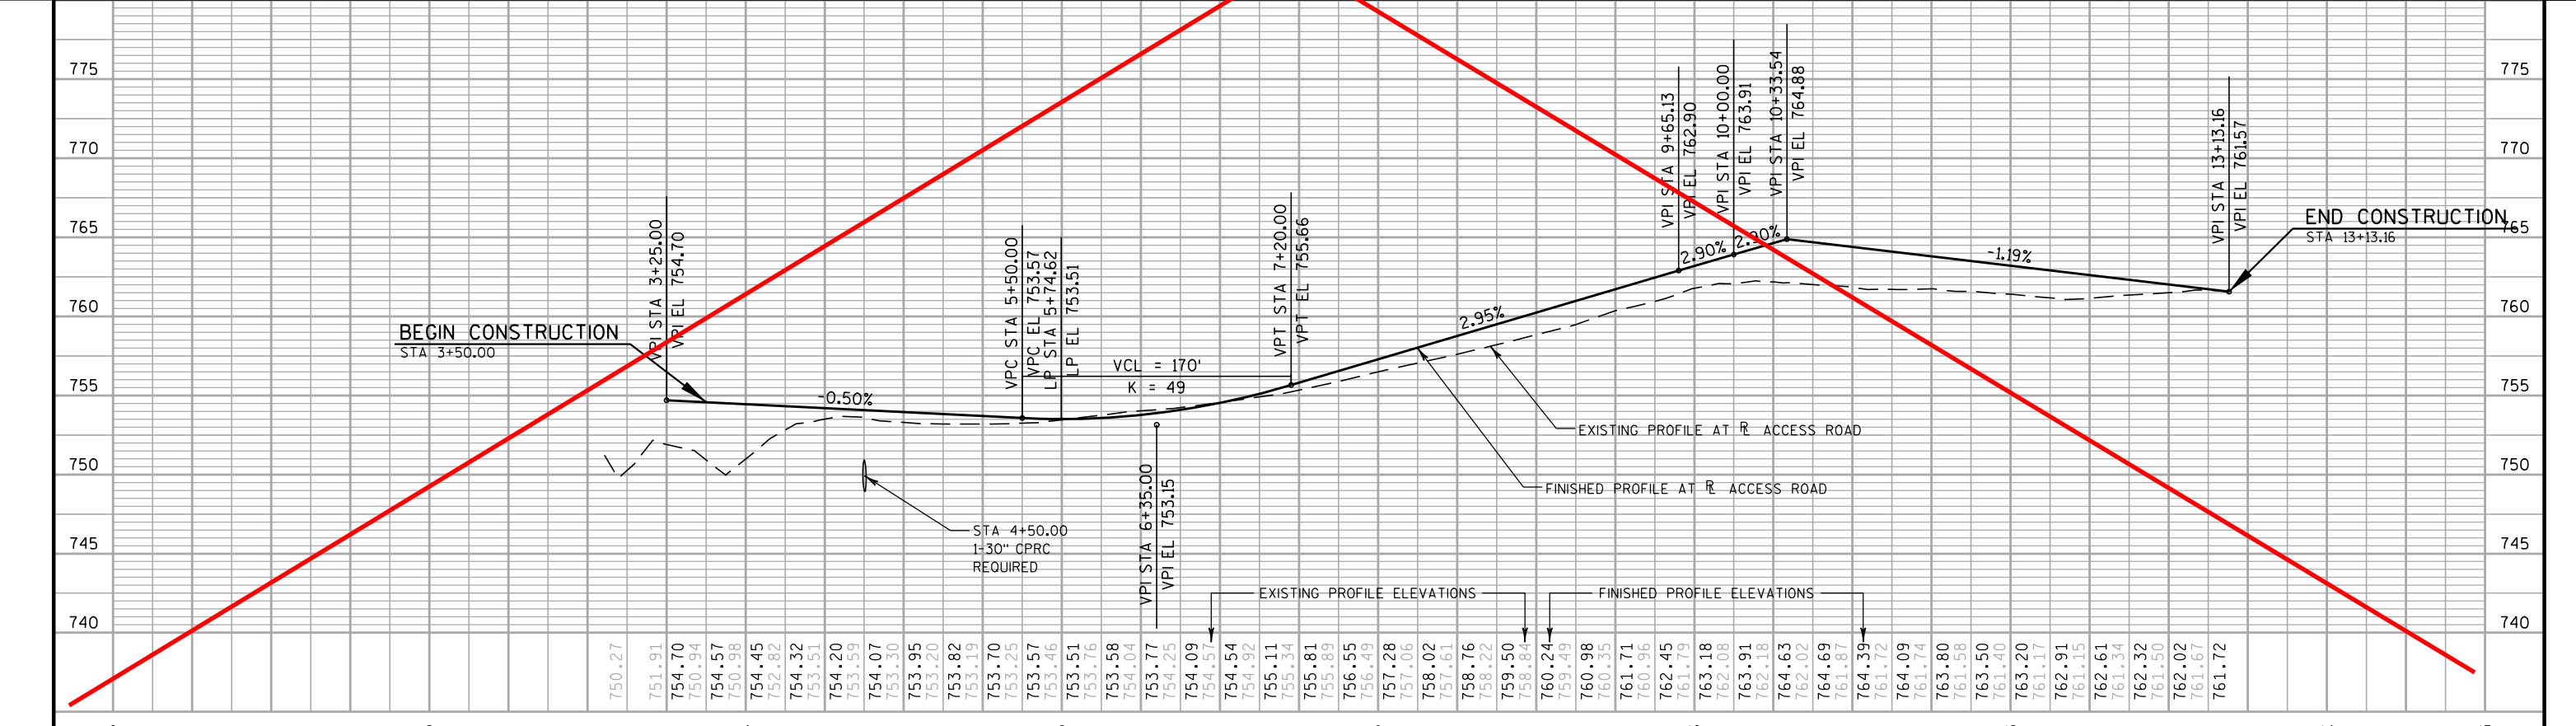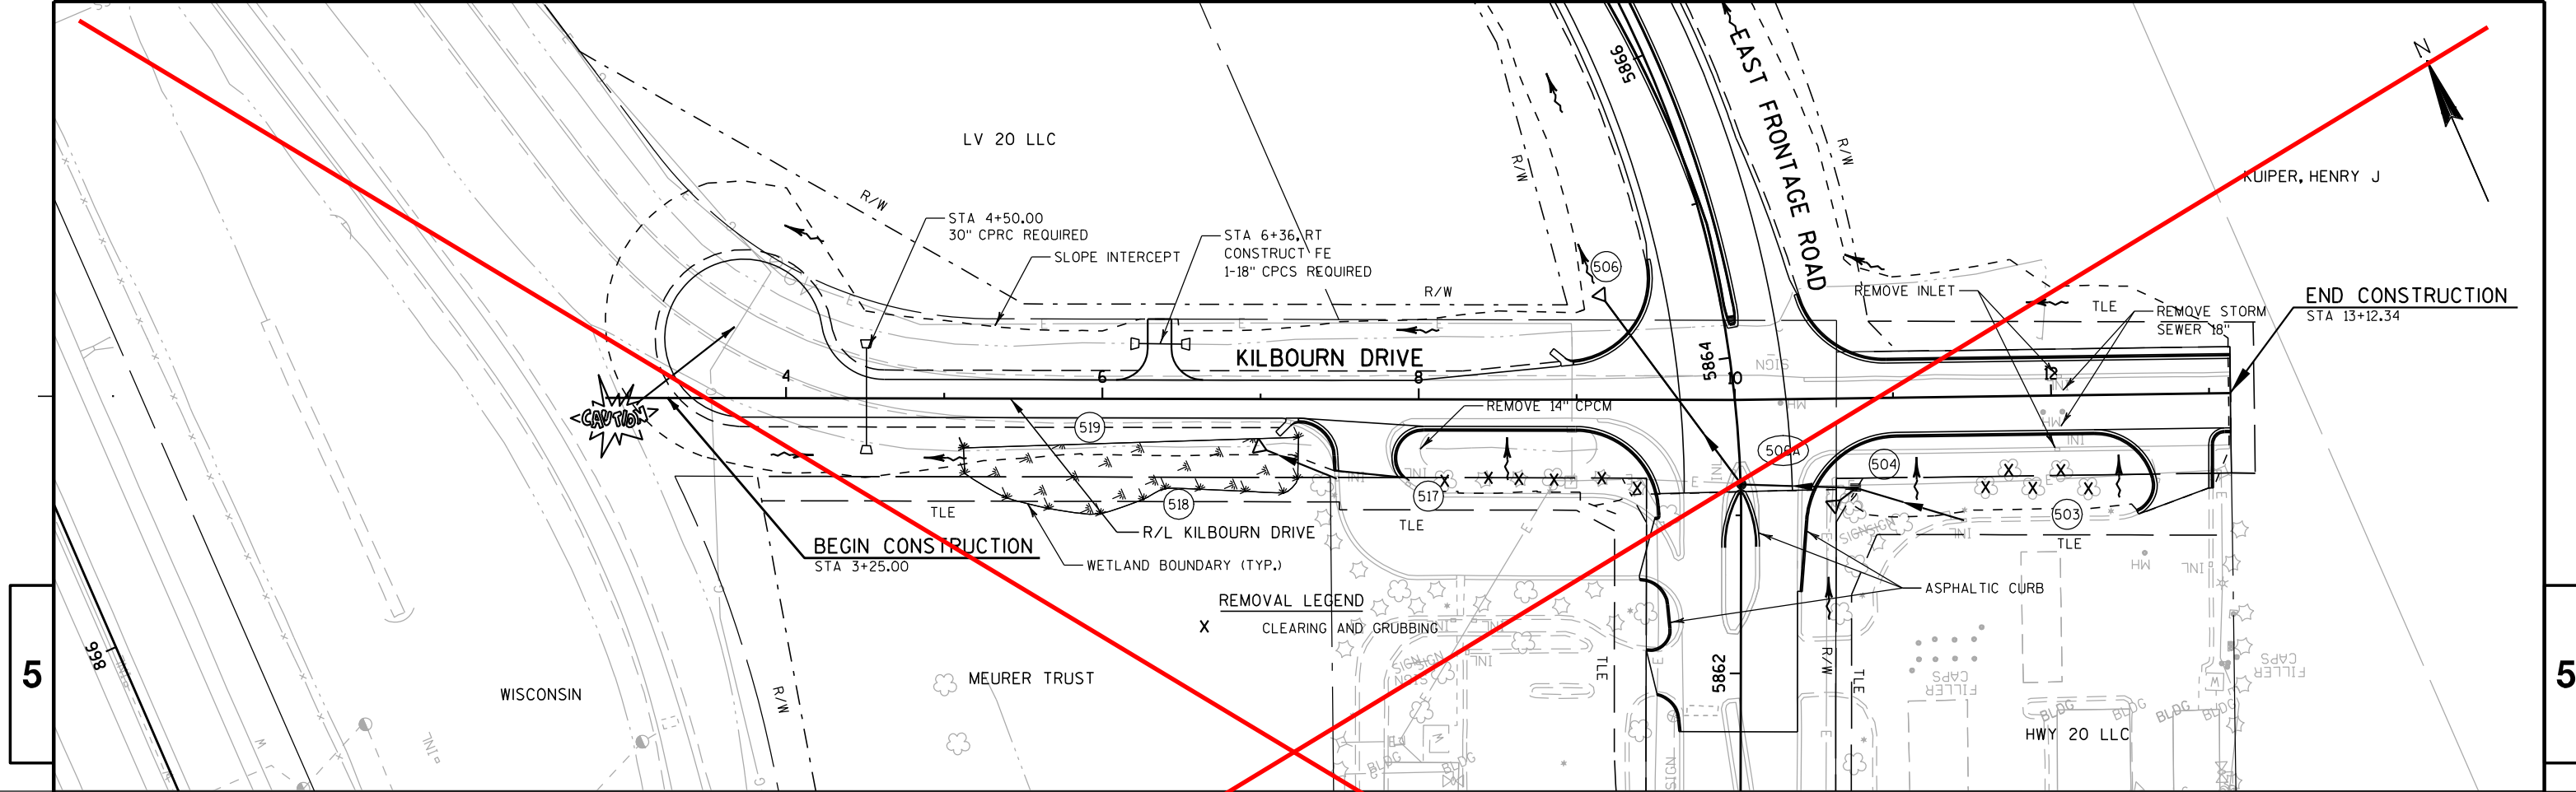

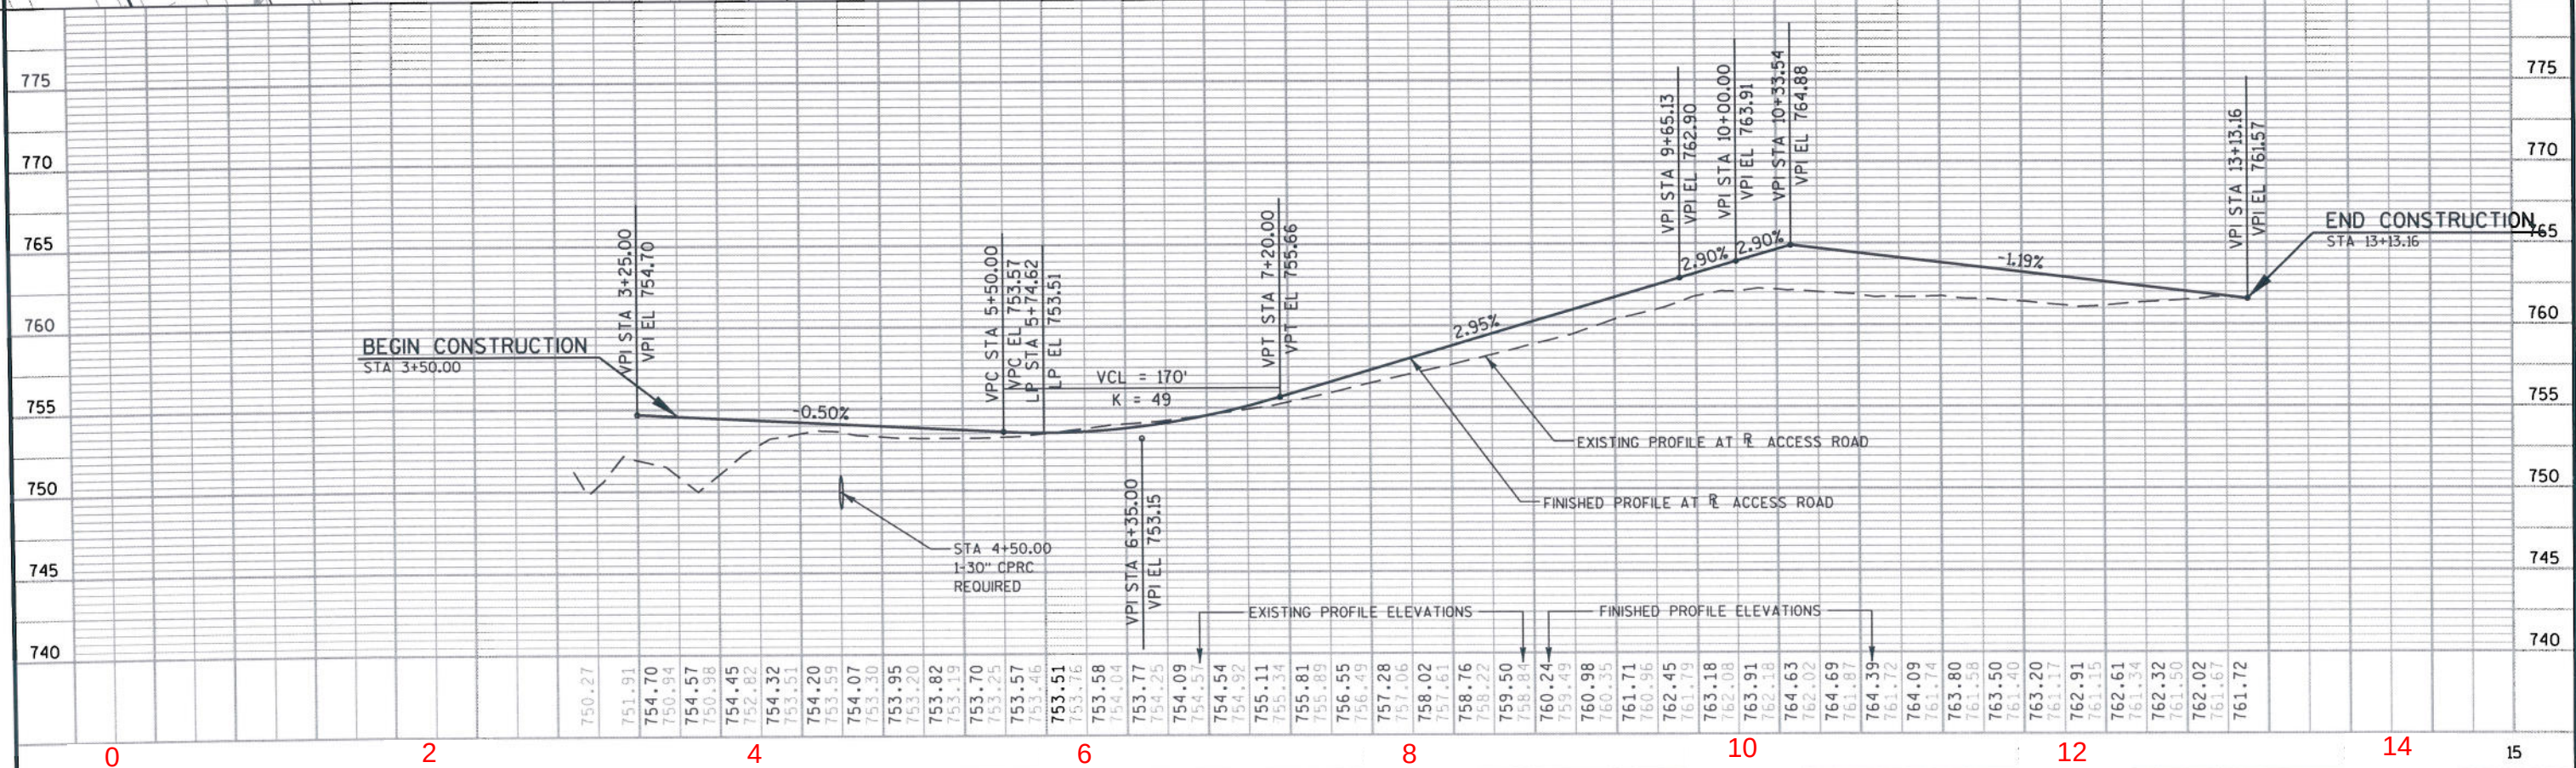
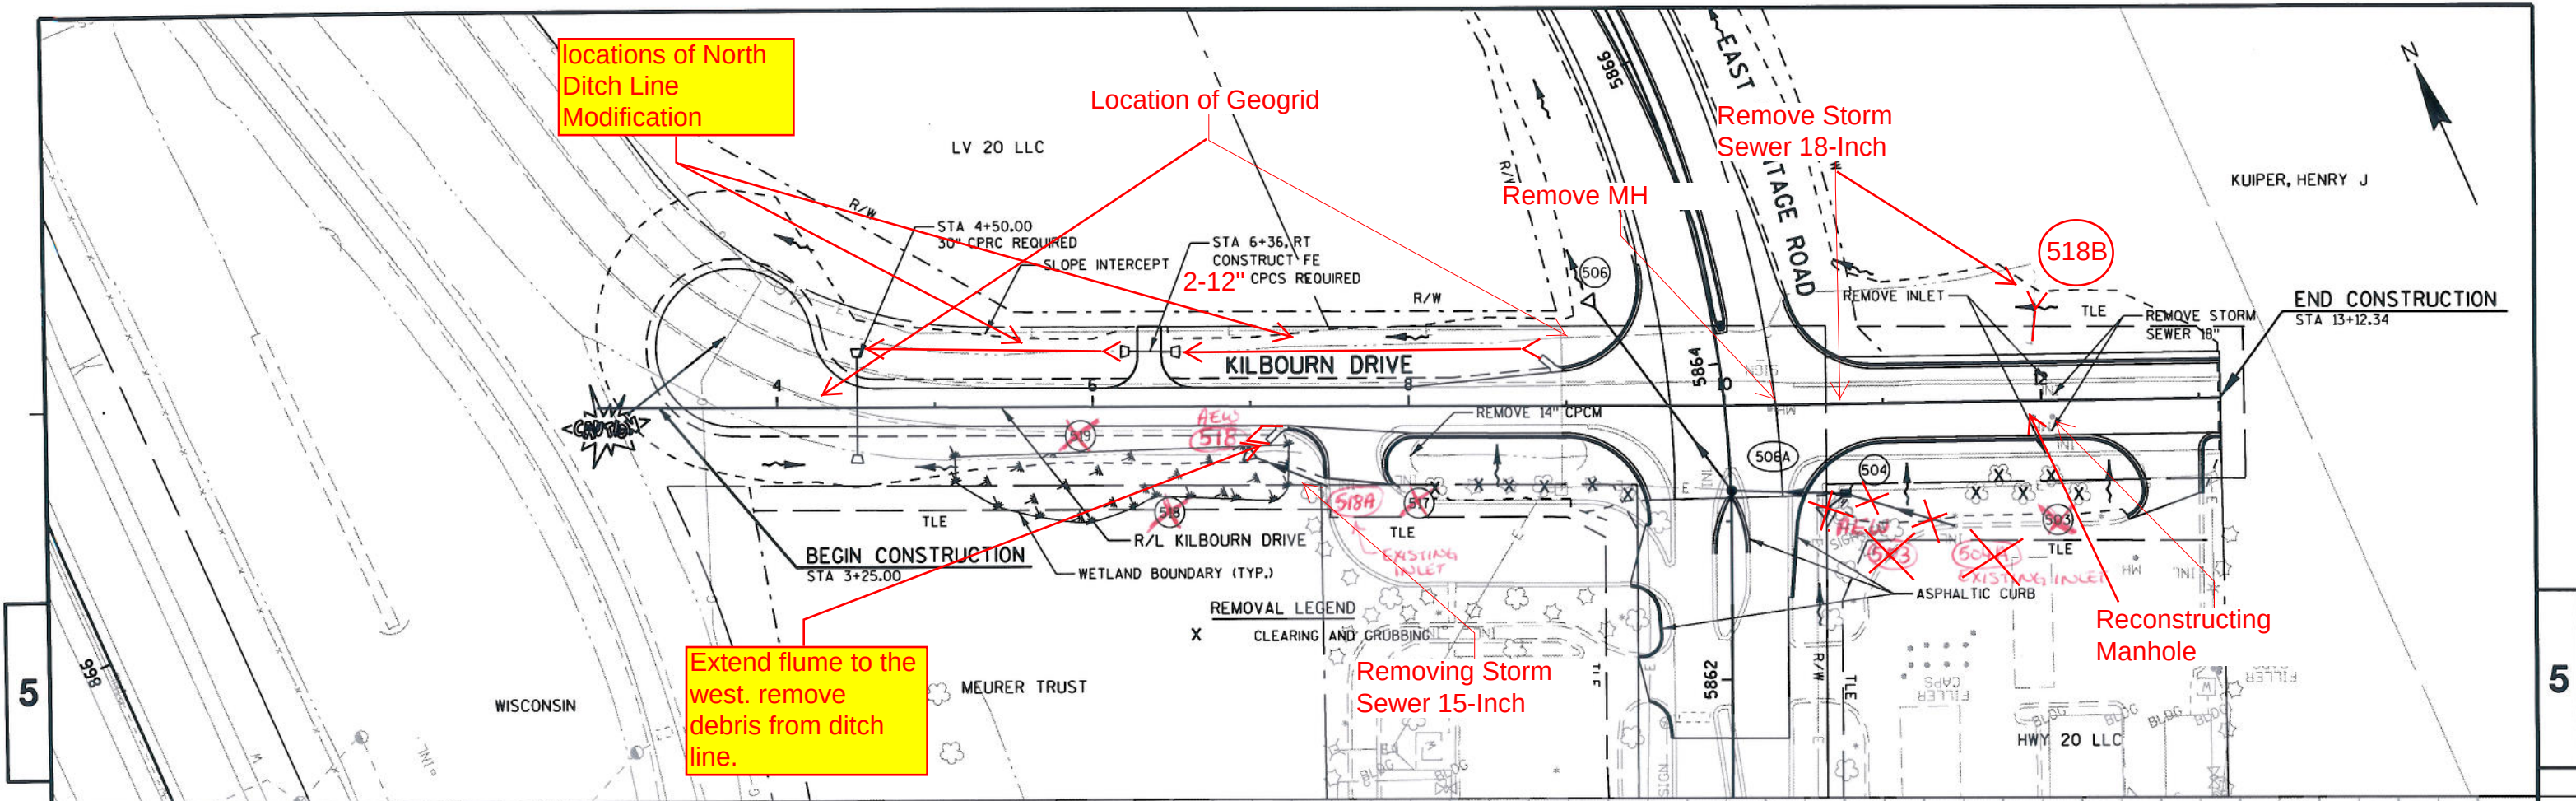


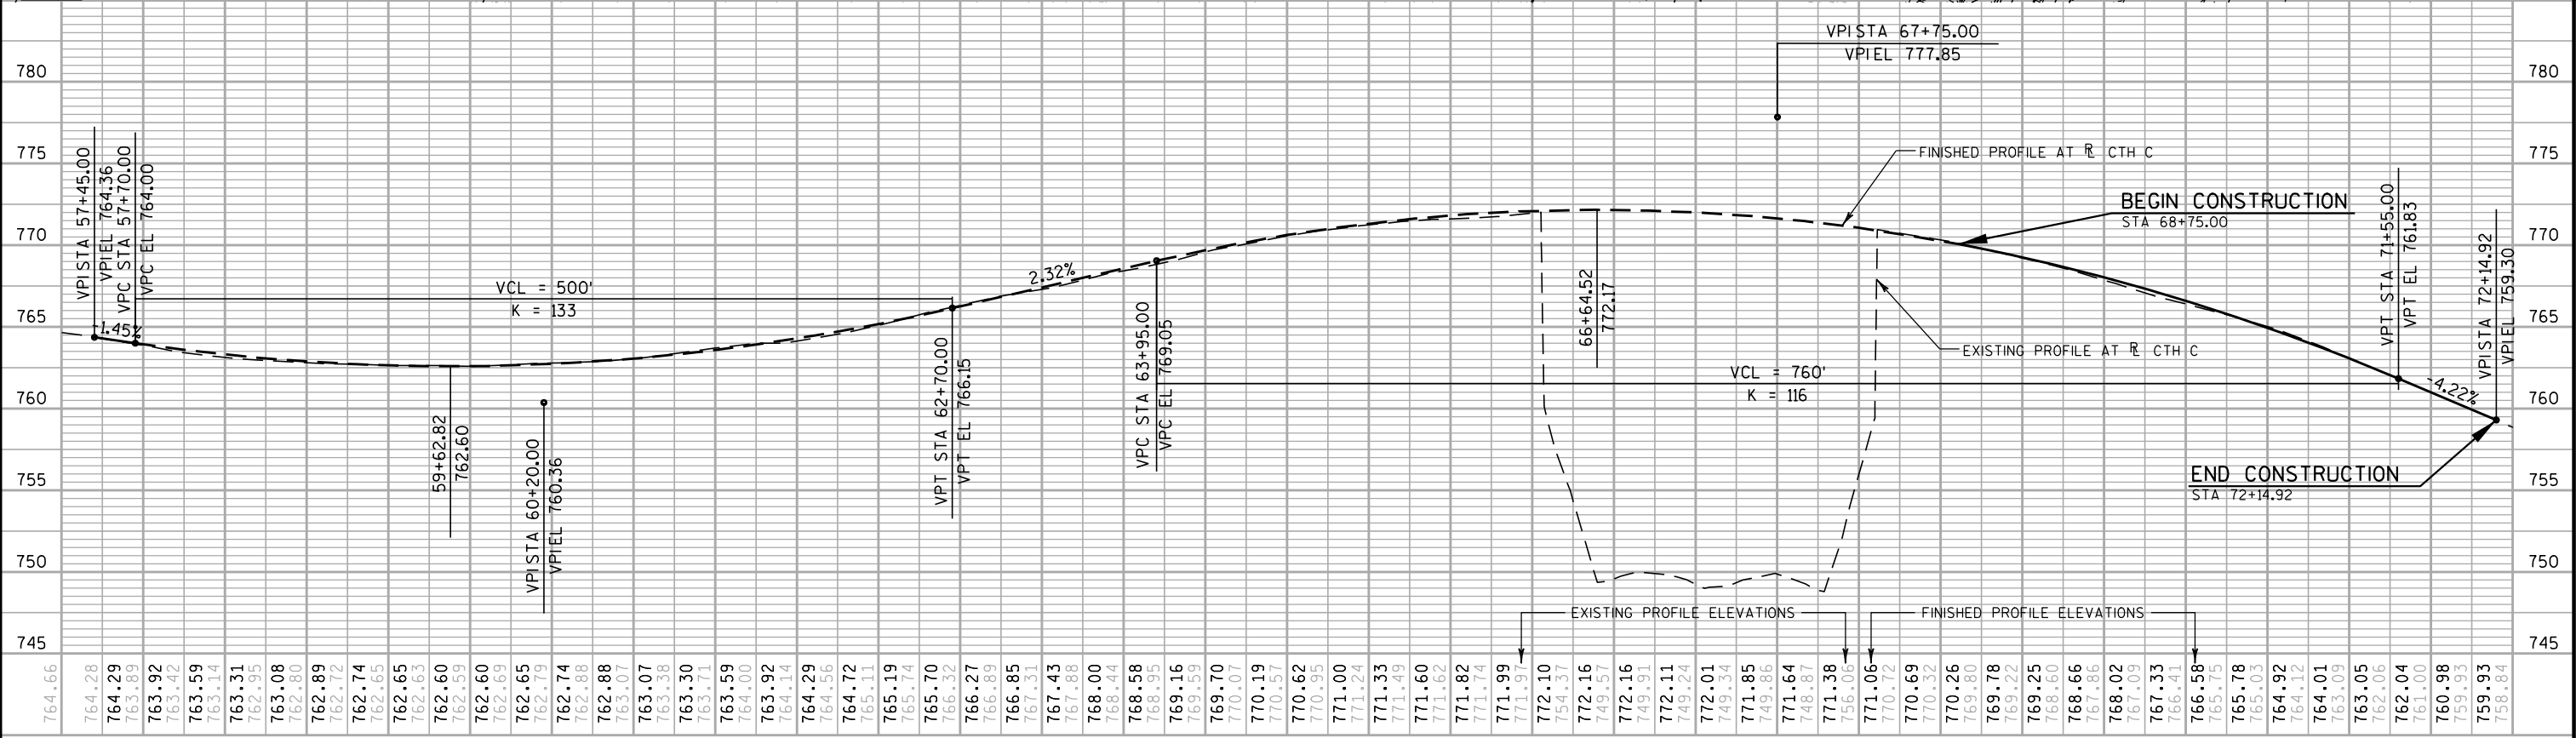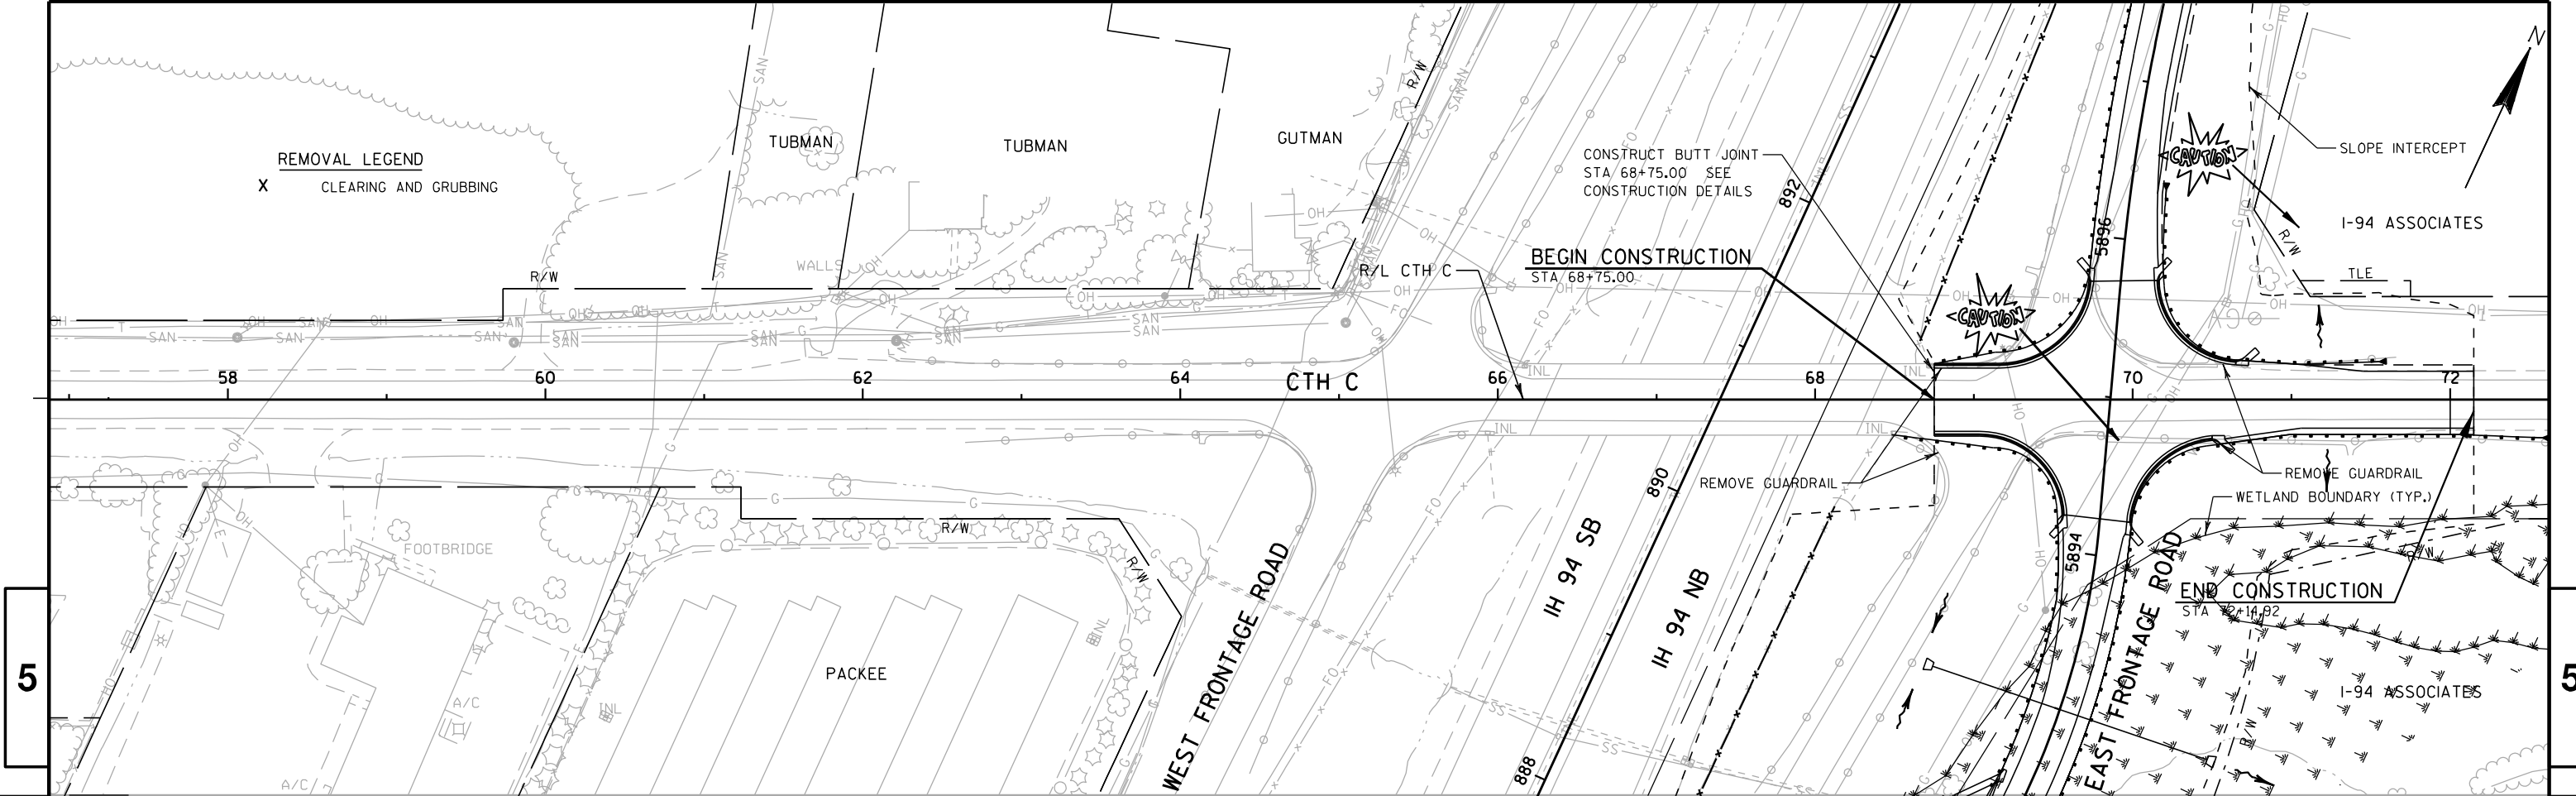


PROJECT NO:1033-02-70	HWY: IH 94/STH 20	COUNTY: RACINE	PLAN & PROFILE: CTH C	SHEET 115	E
-----------------------	-------------------	----------------	-----------------------	-----------	---

Standard Detail Drawing List

08A5-16B	INLET COVERS TYPE B, B-A, C, MS, MS-A, & WM
08A5-17C	INLET COVERS TYPE F, HM, HM-S, S, T, V, HM-GJ, & HM-GJ-S
08A5-17D	INLET COVER, TYPE Z MANHOLE COVERS, TYPE K, J, J-S, J-H, J-H-S, L & M
08B6-4	MANHOLES TYPE 1
08C1-5	INLETS TYPE 1, 2, 3 & 4
08C5-2	INLETS TYPE 8, 9, 10, AND 11
08D1-17	CONCRETE CURB, CONCRETE CURB AND GUTTER AND TIES
08D4-5	CONCRETE SURFACE DRAINS & ASPHALTIC FLUMES
08E8-3	TYPICAL INSTALLATIONS OF EROSION BALES / TEMPORARY DITCH CHECKS
08E9-6	SILT FENCE
08E10-2	INLET PROTECTION TYPE A, B, C AND D
08F1-11	APRON ENDWALLS FOR CULVERT PIPE
08F2-1	APRON ENDWALLS FOR PIPE ARCH AND ELLIPTICAL PIPE
08F4-6	JOINT TIES FOR CONCRETE PIPE
08F8-1	SLOPED STEEL ENDWALLS FOR CULVERT PIPE AND PIPE ARCH CROSS DRAINS
09A1-12A	AT-GRADE SIDE ROAD INTERSECTION, TYPES "B1", "B2", "C" AND D AND TEE INTERSECTION BYPASS LANE
09A1-12B	AT-GRADE SIDE ROAD INTERSECTION, TYPE "A1" & "A2"
11B2-2	CONCRETE MEDIAN NOSE
13C1-14	CONCRETE PAVEMENT LONGITUDINAL JOINTS AND TIES
13C11-10A	RURAL DOWELED CONCRETE PAVEMENT
13C11-10B	RURAL DOWELED CONCRETE PAVEMENT
13C13-7	URBAN DOWELED CONCRETE PAVEMENT
14B15-6A	STEEL PLATE BEAM GUARD, CLASS "A" INSTALLATION & ELEMENTS
14B15-6B	STEEL PLATE BEAM GUARD, CLASS "A" INSTALLATION & ELEMENTS
14B18-6A	STEEL PLATE BEAM GUARD, CLASS "A" (AT BRIDGES, OBSTACLES AND SIDEROADS/DRIVEWAYS)
14B20-9A	STEEL THRIE BEAM STRUCTURE APPROACH
14B24-7A	STEEL PLATE BEAM GUARD ENERGY ABSORBING TERMINAL
14B24-7B	STEEL PLATE BEAM GUARD ENERGY ABSORBING TERMINAL
14B24-7C	STEEL PLATE BEAM GUARD ENERGY ABSORBING TERMINAL
15A3-1	MARKER POSTS, FLEXIBLE, FOR CULVERT END
15B1-8A	FENCE WOVEN WIRE
15B1-8B	FENCE WOVEN WIRE
15C3-1	BARRICADES AND SIGNS FOR SIDEROAD CLOSURES
15C7-11D	PAVEMENT MARKING ARROWS
15C8-13A	PAVEMENT MARKING (MAINLINE)
15C8-13F	PAVEMENT MARKING (ISLANDS, STOP LINE & CROSS WALK)
15C18-3	MEDIAN ISLAND MARKING
15C21-3	SIGNING AND MARKING FOR TWO LANE TO FOUR LANE DIVIDED TRANSITIONS
15D11-3	TRAFFIC CONTROL, SINGLE LANE CROSSOVER
15D20-1	TRAFFIC CONTROL, SINGLE LANE CLOSURE, NON-FREEWAY/EXPRESSWAY
15D21-1	TRAFFIC CONTROL, INTERSECTION WITHIN SINGLE LANE CLOSURE
16A1-6	LANDMARK REFERENCE MONUMENTS AND COVERS

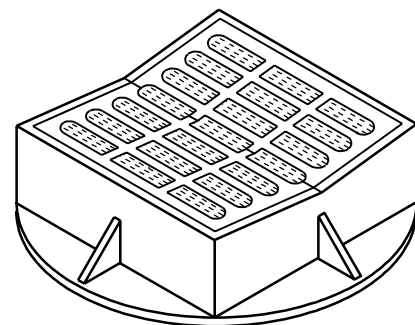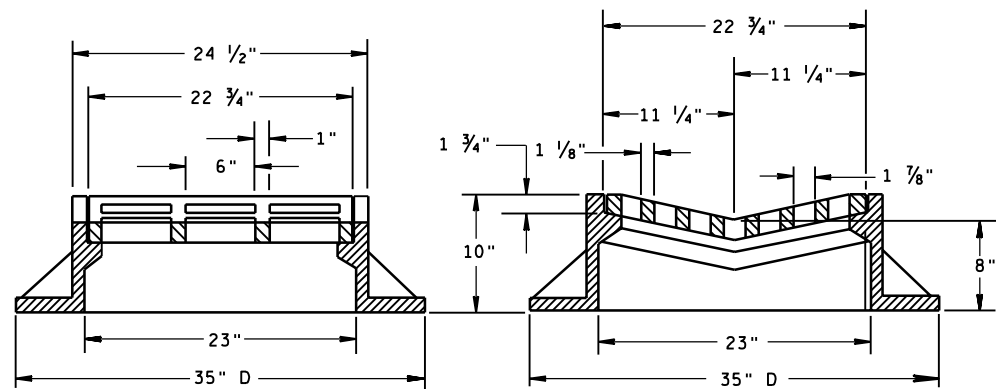


TYPE "B"
(APPROXIMATE WEIGHT 395 LBS.)
FRAME..... 285 LBS.
GRATE..... 110 LBS.

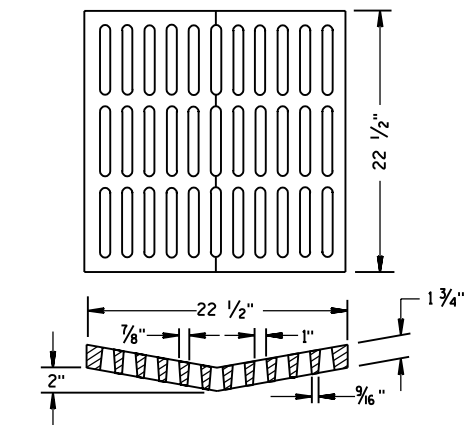

**ALTERNATIVE GRATE FOR
TYPE "B" COVER**

(APPROXIMATE GRATE WEIGHT 125 LBS.)
GRATE..... 125 LBS.
USE WHERE PEDESTRIAN OR BICYCLE TRAFFIC IS POSSIBLE.
NOTED AS TYPE B-A ON THE DRAINAGE TABLE

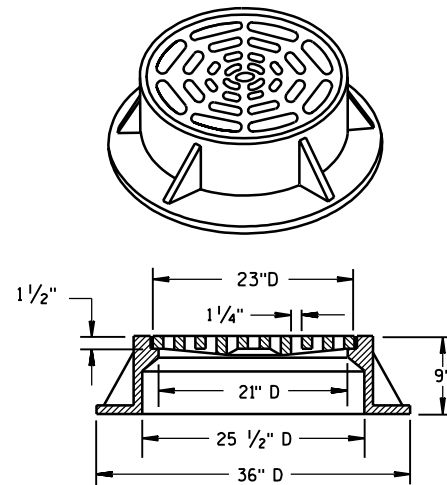

TYPE "C"
(APPROXIMATE WEIGHT 340 LBS.)
FRAME..... 235 LBS.
GRATE..... 105 LBS.


GENERAL NOTES

DETAILS OF CONSTRUCTION, MATERIALS AND WORKMANSHIP NOT SHOWN ON THIS DRAWING SHALL CONFORM TO THE PERTINENT REQUIREMENTS OF THE STANDARD SPECIFICATIONS AND THE APPLICABLE SPECIAL PROVISIONS.

DETAIL DRAWINGS FOR PROPOSED ALTERNATE DESIGNS FOR CATCH BASIN, MANHOLE AND INLET COVERS SHALL BE SUBMITTED TO THE ENGINEER FOR APPROVAL PROVIDING THAT SUCH ALTERNATE DESIGNS MAKE PROVISION FOR EQUIVALENT CAPACITY AND STRENGTH.


ROUND FRAMES AND COVERS SHALL HAVE CONTINUOUSLY MACHINED BEARING SURFACES TO PREVENT ROCKING AND RATTLING.

THE ACTUAL WEIGHT OF COVERS MAY VARY WITHIN 5 PERCENT, PLUS OR MINUS, OF THE APPROXIMATE WEIGHT.

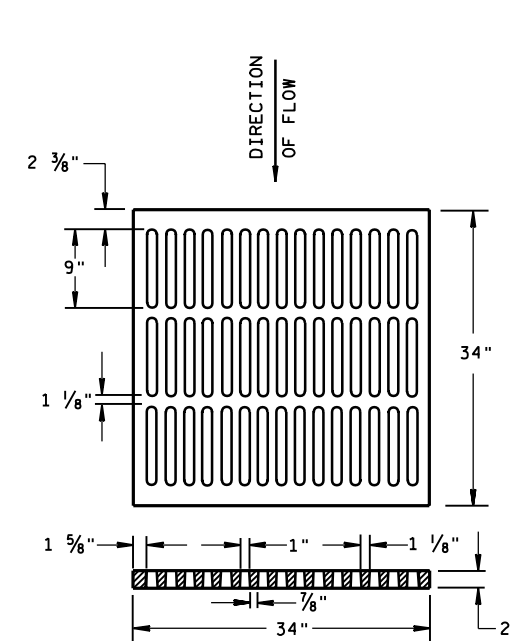


ALTERNATIVE TYPE "MS"
(APPROXIMATE GRATE WEIGHT 365 LBS.)
GRATE..... 365 LBS.

USE WHERE PEDESTRIAN OR BICYCLE TRAFFIC IS PERMITTED
NOTED AS TYPE MS-A ON THE DRAINAGE TABLE

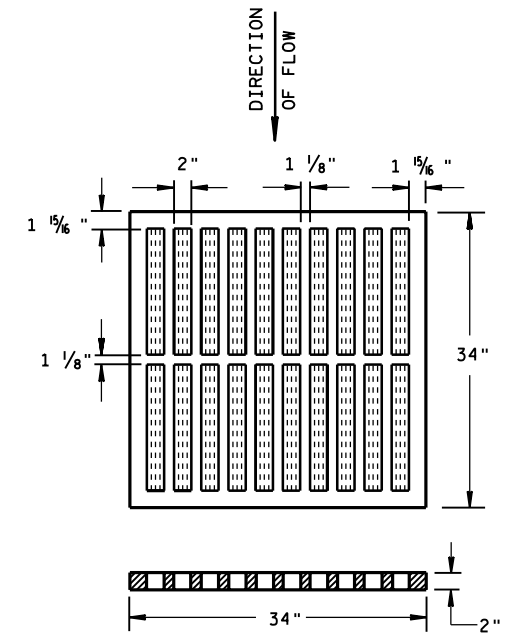


TYPE "MS"
(APPROXIMATE GRATE WEIGHT 270 LBS.)
GRATE..... 270 LBS.
USE ON FREEWAYS AND EXPRESSWAYS
NOTED AS TYPE MS ON DRAINAGE TABLE

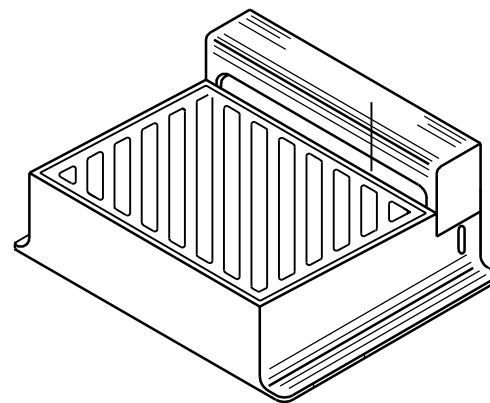

DIAGONAL SLOTS, SHALL BE ORIENTED
TO THE DIRECTION OF FLOW AS ILLUSTRATED.
GRATES ARE MANUFACTURED TO BE REVERSIBLE.



DIRECTION
OF FLOW

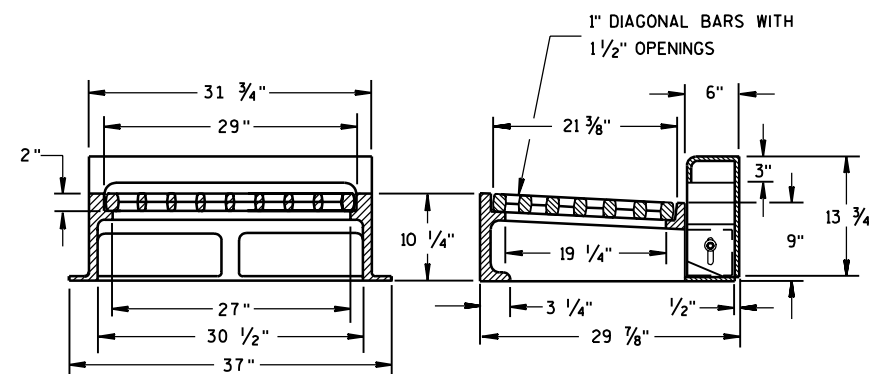

NOTE: CURB BOX HEIGHT ADJUSTABLE 6" TO 9"

TYPE "WM"
(APPROXIMATE WEIGHT 670 LBS.)
FRAME..... 360 LBS.
GRATE..... 160 LBS.
CURB BOX..... 150 LBS.

INLET COVERS TYPE B, B-A, C, MS, MS-A, & WM	
STATE OF WISCONSIN DEPARTMENT OF TRANSPORTATION	
APPROVED 10/4/99 DATE FHWA	 CHIEF ROADWAY DEVELOPMENT ENGINEER

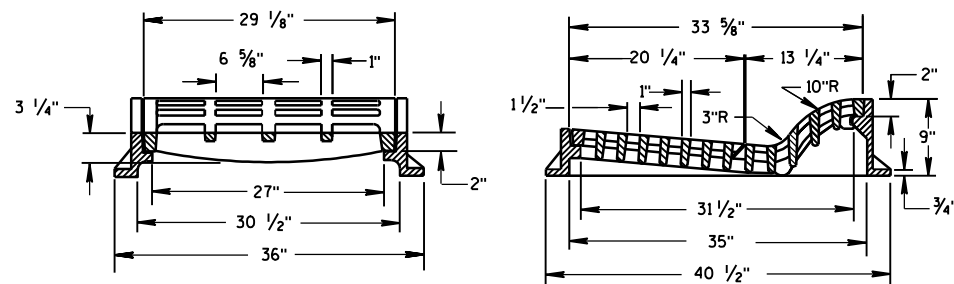
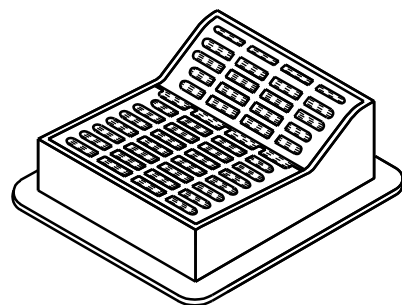


TYPE "F"

(APPROXIMATE WEIGHT 645 LBS.)

FRAME.....300 LBS.
GRATE.....165 LBS.
GRATE.....180 LBS.



USE WITH TYPES A & D CONCRETE CURB & GUTTER, 36 INCH.

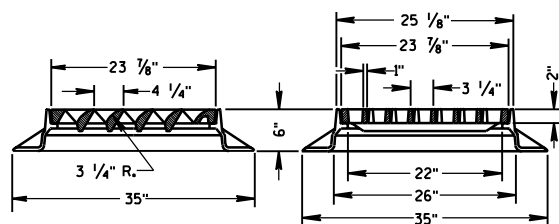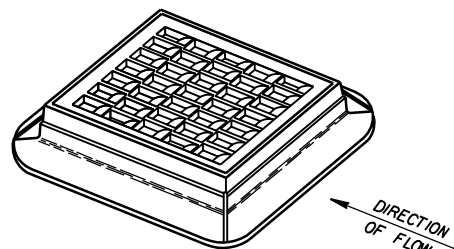

TYPE "S"

(APPROXIMATE WEIGHT 334 LBS.)


FRAME.....165 LBS.
GRATE.....169 LBS.

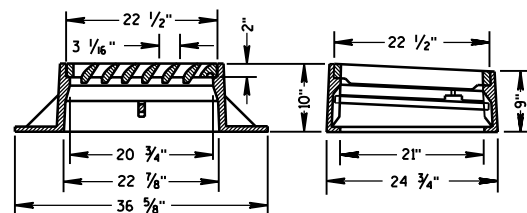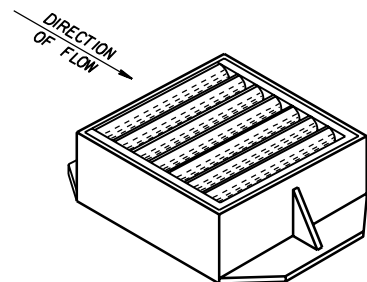

TYPE "V"

(APPROXIMATE WEIGHT 405 LBS.)

FRAME.....270 LBS.
GRATE.....130 LBS.
SAFETY BAR.....5 LBS.

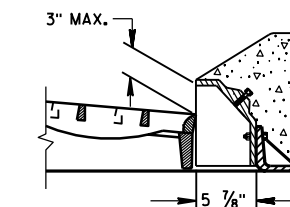

ALTERNATIVE CURB BOX FOR TYPE "HM" COVER

(APPROXIMATE WEIGHT 79 LBS.)

CURB BOX.....79 LBS.


USE WITH TYPES G & J CONCRETE CURB & GUTTER, 30 INCH
NOTED AS TYPE HM-GJ ON DRAINAGE TABLE

GENERAL NOTES

DETAILS OF CONSTRUCTION, MATERIALS AND WORKMANSHIP NOT SHOWN ON THIS DRAWING SHALL CONFORM TO THE PERTINENT REQUIREMENTS OF THE STANDARD SPECIFICATIONS AND THE APPLICABLE SPECIAL PROVISIONS.

DETAIL DRAWINGS FOR PROPOSED ALTERNATE DESIGNS FOR INLET COVERS SHALL BE SUBMITTED TO THE ENGINEER FOR APPROVAL PROVIDING THAT SUCH ALTERNATE DESIGNS MAKE PROVISION FOR EQUIVALENT CAPACITY AND STRENGTH.

THE ACTUAL WEIGHT OF COVERS MAY VARY WITHIN 5 PERCENT, PLUS OR MINUS, OF THE APPROXIMATE WEIGHT.

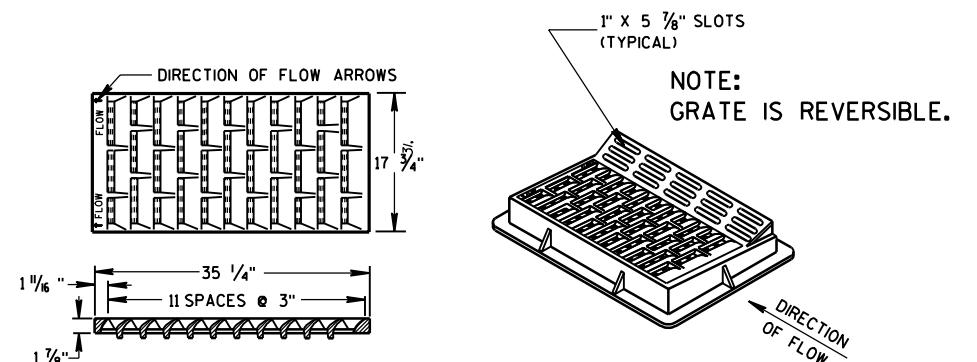


TYPE "HM"

(APPROXIMATE WEIGHT 375 LBS.)

FRAME.....175 LBS.
GRATE.....138 LBS.
CURB BOX.....62 LBS.

USE WITH TYPES A & D CONCRETE CURB & GUTTER, 36 INCH.

NOTE:
SPECIAL GRATE FOR THE
TYPE "H" COVER MAY ALSO BE
USED FOR THE TYPE "HM" COVER
NOTED AS TYPE HM-S ON DRAINAGE TABLE

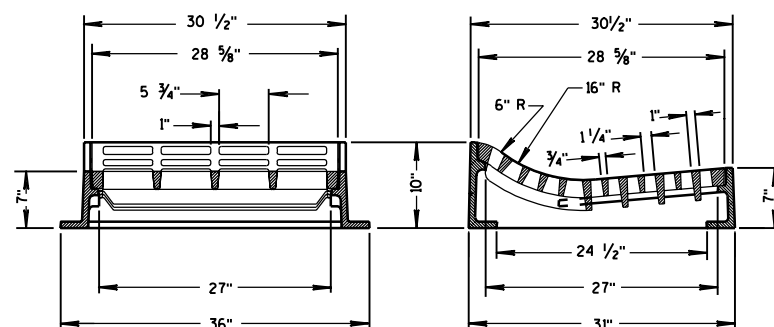


TYPE "T"

(APPROXIMATE WEIGHT 530 LBS.)

FRAME.....270 LBS.
GRATE.....260 LBS.



USE WITH TYPES R & T CONCRETE CURB & GUTTER, 30 INCH.

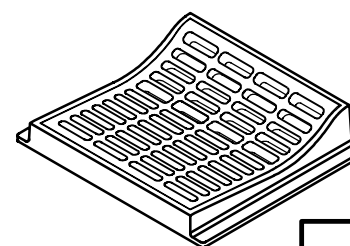



INLET COVERS
TYPE F, HM, HM-S, S, T, V,
HM-GJ, & HM-GJ-S

STATE OF WISCONSIN
DEPARTMENT OF TRANSPORTATION



APPROVED
12/17/07 /S/ Jerry H. Zogg
DATE ROADWAY STANDARDS DEVELOPMENT
ENGINEER
FHWA

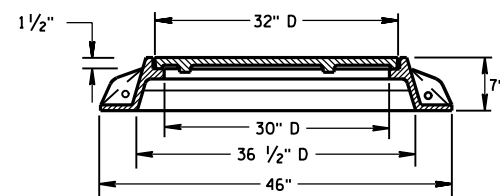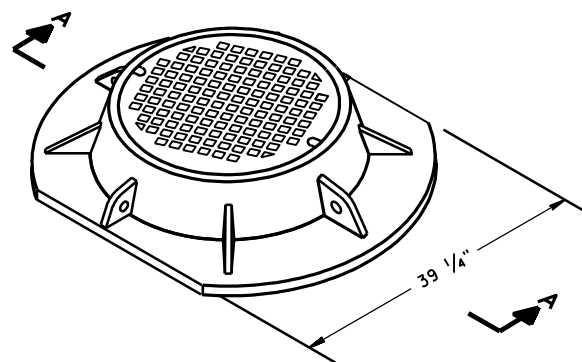

SECTION A-A
TYPE "K"
(APPROXIMATE WEIGHT 415 LBS.)
FRAME.....210 LBS.
LID.....205 LBS.

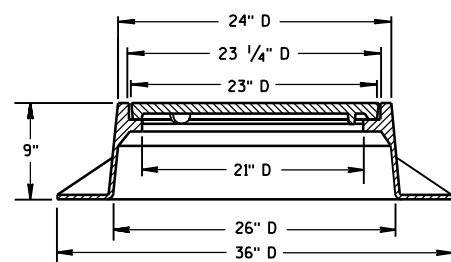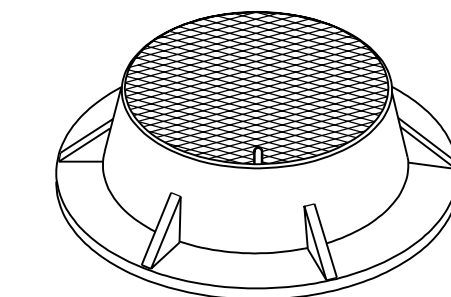

TYPE "J"
(APPROXIMATE WEIGHT 250 LBS.)
FRAME.....135 LBS.
LID.....115 LBS.

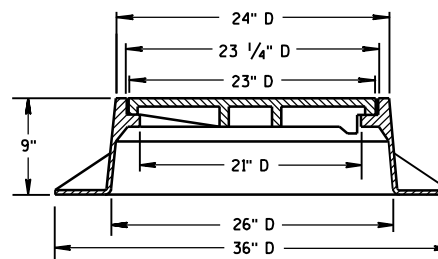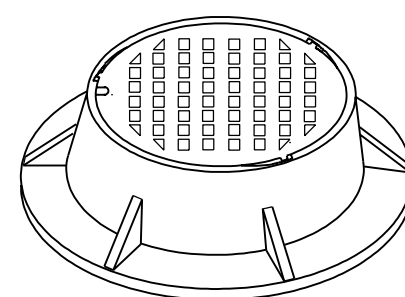

TYPE "J" SPECIAL
TYPE "B" NON-ROCKING SELF-SEAL LID
(APPROXIMATE WEIGHT 245 LBS.)
FRAME.....145 LBS.
LID.....100 LBS.
(NOTED AS TYPE J-S ON THE DRAINAGE TABLE)

GENERAL NOTES



DETAILS OF CONSTRUCTION, MATERIALS AND WORKMANSHIP NOT SHOWN ON THIS DRAWING SHALL CONFORM TO THE PERTINENT REQUIREMENTS OF THE STANDARD SPECIFICATIONS AND THE APPLICABLE SPECIAL PROVISIONS.

DETAIL DRAWINGS FOR PROPOSED ALTERNATE DESIGNS FOR MANHOLE COVERS SHALL BE SUBMITTED TO THE ENGINEER FOR APPROVAL PROVIDING THAT SUCH ALTERNATE DESIGNS MAKE PROVISION FOR EQUIVALENT CAPACITY AND STRENGTH.



ROUND FRAMES AND COVERS SHALL HAVE CONTINUOUSLY MACHINED BEARING SURFACES TO PREVENT ROCKING AND RATTLING.

THE ACTUAL WEIGHT OF COVERS MAY VARY WITHIN 5 PERCENT, PLUS OR MINUS, OF THE APPROXIMATE WEIGHT.



- ① MANUFACTURER MAY PROVIDE ADDITIONAL SEALS OR GASKETS.

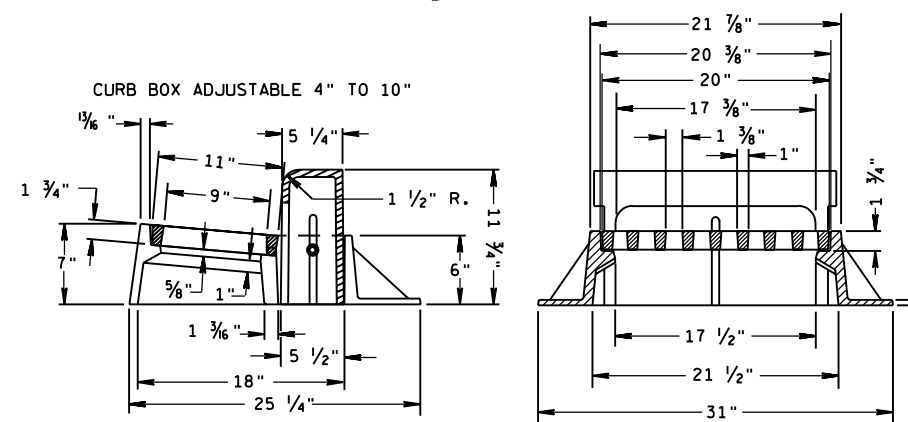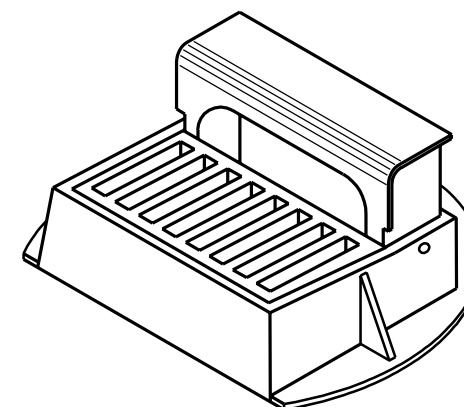



INLET COVER TYPE "Z"
(APPROXIMATE WEIGHT 340 LBS.)
FRAME.....198 LBS.
GRATE..... 50 LBS.
CURB BOX..... 92 LBS.

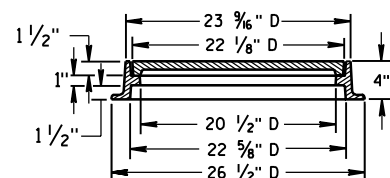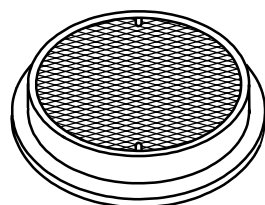


TYPE "L"
(APPROXIMATE WEIGHT 145 LBS.)
FRAME..... 75 #
LID..... 70 #

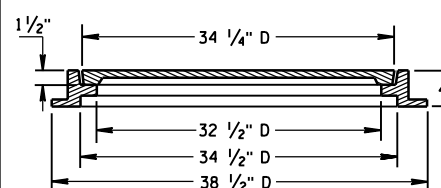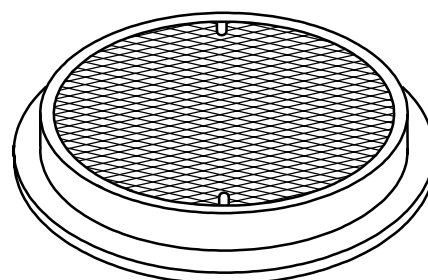


TYPE "M"
(APPROXIMATE WEIGHT 385 LBS.)
FRAME..... 125 #
LID..... 260 #

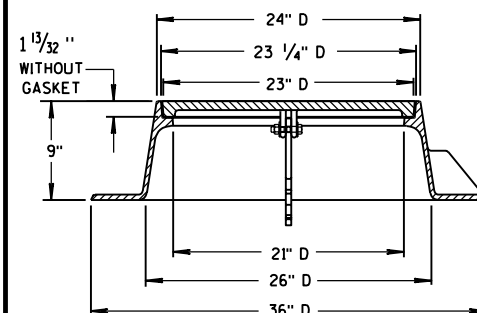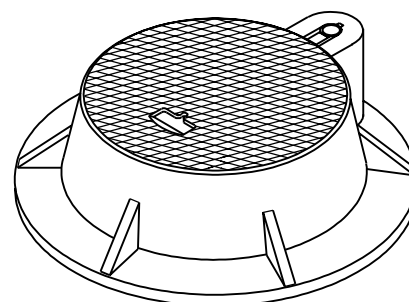

TYPE "J" HINGED
LID WITHOUT "T SEAL" GASKET
(APPROXIMATE WEIGHT 310 LBS.)
FRAME.....190 LBS.
LID.....120 LBS.
(NOTED AS TYPE J-H ON THE DRAINAGE TABLE)

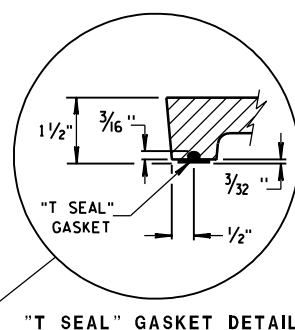

"T SEAL" GASKET DETAIL

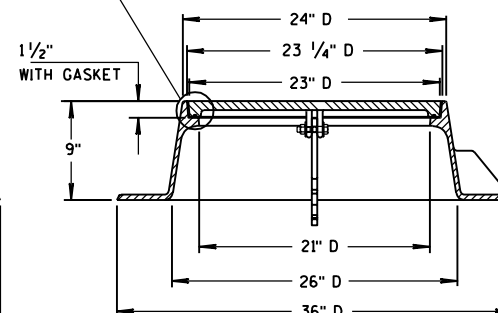

TYPE "J" HINGED-SPECIAL ①
LID WITH "T SEAL" GASKET
(APPROXIMATE WEIGHT 310 LBS.)
FRAME.....190 LBS.
LID.....120 LBS.
(NOTED AS TYPE J-S-H ON THE DRAINAGE TABLE)

INLET COVER, TYPE Z
MANHOLE COVERS, TYPE
K, J, J-S, J-H, J-H-S, L & M


STATE OF WISCONSIN
DEPARTMENT OF TRANSPORTATION

APPROVED
4-29-05
DATE
FHWA


[Signature]
CHIEF ROADWAY DEVELOPMENT ENGINEER

6

S.D.D. 8 B 6-4

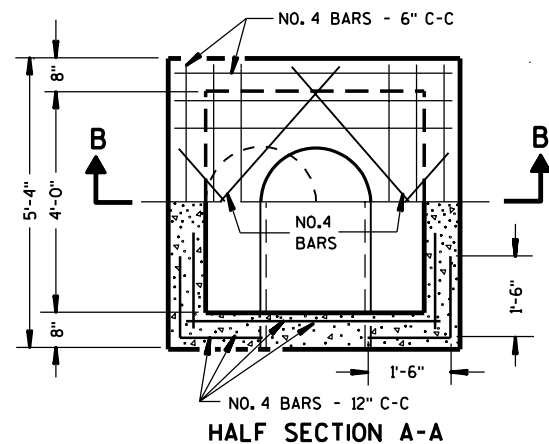


HALF SECTION A-A

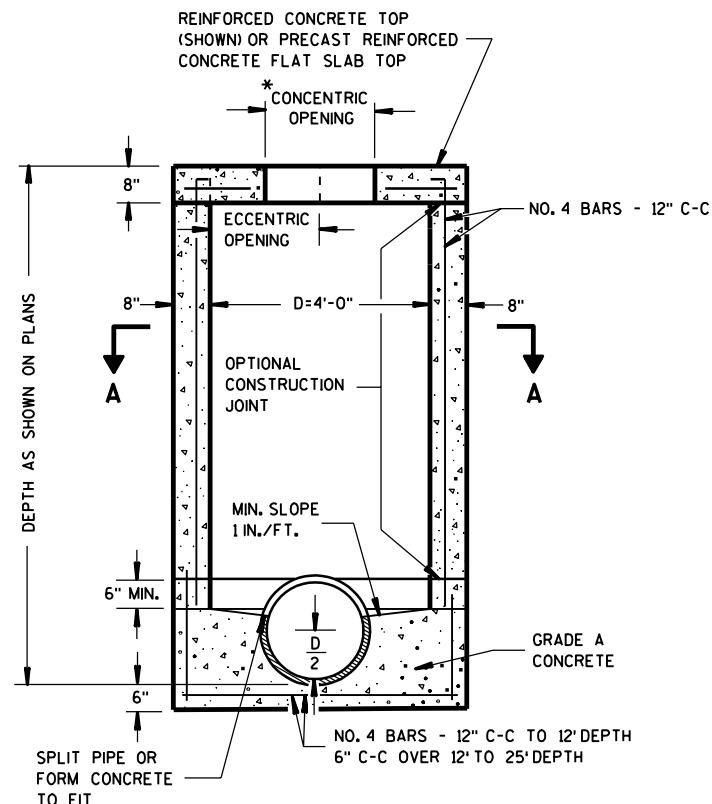


SECTION B-B
REINFORCED CONCRETE

MANHOLES TYPE 1

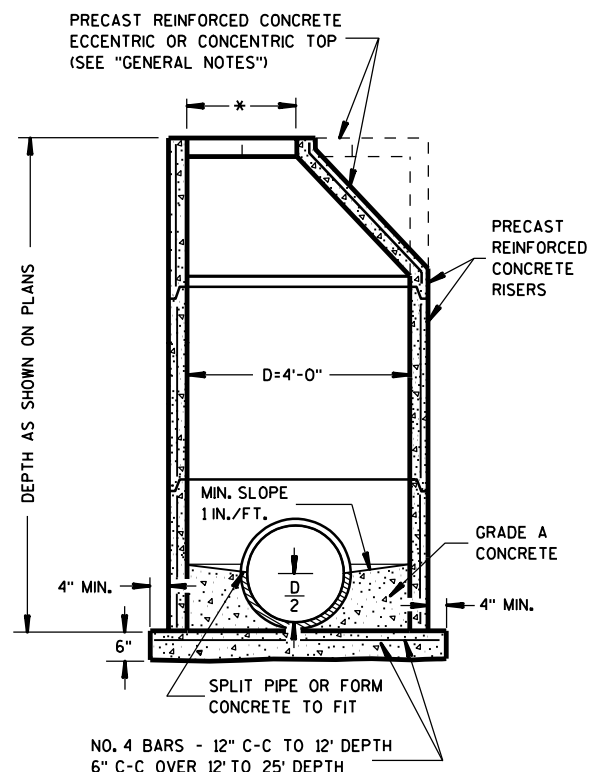

PRECAST REINFORCED CONCRETE

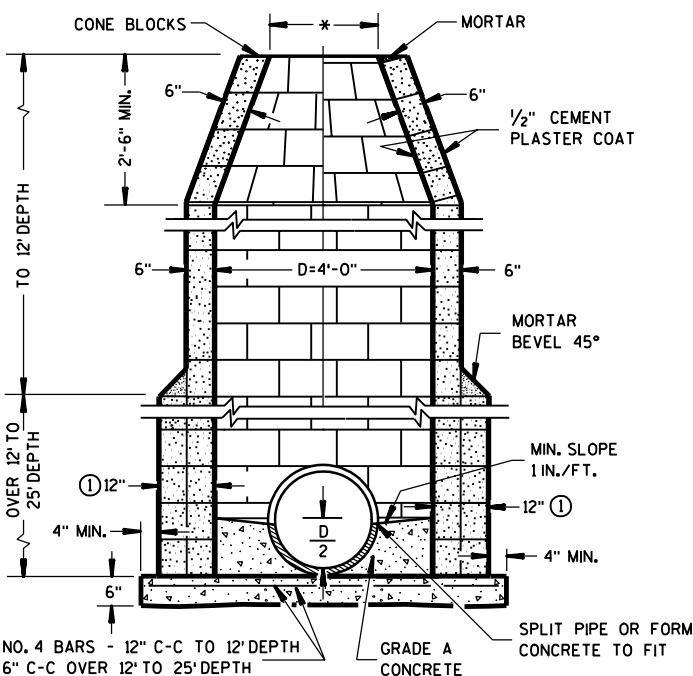

CONCRETE BLOCK

GENERAL NOTES

DETAILS OF CONSTRUCTION, MATERIALS AND WORKMANSHIP NOT SHOWN ON THIS DRAWING SHALL CONFORM TO THE PERTINENT REQUIREMENTS OF THE STANDARD SPECIFICATIONS AND THE APPLICABLE SPECIAL PROVISIONS.

DETAILED DRAWINGS FOR PROPOSED ALTERNATE DESIGNS FOR UNDERGROUND DRAINAGE STRUCTURES SHALL BE SUBMITTED TO THE ENGINEER FOR APPROVAL PROVIDING THAT SUCH ALTERNATE DESIGNS MAKE PROVISION FOR EQUIVALENT CAPACITY AND STRENGTH.

ALL DRAINAGE STRUCTURES ARE DESIGNATED ON THE PLANS AS "MANHOLES 1-C", "CATCH BASINS 1-B", "INLETS 3-H", ETC. THE FIRST DIGIT DESIGNATES THE MASONRY PORTION OF THE STRUCTURE, AND THE FOLLOWING LETTER DESIGNATES THE TYPE OF COVER TO BE USED TO COMPRISE THE COMPLETE UNIT.

PRECAST REINFORCED BASES SHALL BE PLACED ON A BED OF MATERIAL AT LEAST 6 INCHES IN DEPTH, WHICH MEETS THE REQUIREMENTS OF GRANULAR BACKFILL. THIS BEDDING SHALL BE COMPACTED AND PROVIDE UNIFORM SUPPORT FOR THE ENTIRE AREA OF THE BASE.

PRECAST REINFORCED CONE TOPS (ECCENTRIC OR CONCENTRIC) MAY BE USED ON CONCRETE BLOCK STRUCTURES. THE CONE TOPS SHALL BE INSTALLED ON A BED OF MORTAR.

ECCENTRIC CONE TOPS MAY BE USED ON ALL STRUCTURES, AND CONCENTRIC CONE TOPS SHALL BE USED ONLY ON STRUCTURES 5 FEET OR LESS IN DEPTH, UNLESS OTHERWISE DIRECTED BY THE ENGINEER.

STEPS CONFORMING TO AASHTO M 199 SHALL BE INSTALLED IN ALL STRUCTURES OVER 5 FEET IN DEPTH.

SOLID ALUMINUM STEPS SHALL HAVE A MINIMUM CROSS SECTIONAL DIMENSION OF 0.75 INCH. ALUMINUM SURFACES TO BE EMBEDDED IN CONCRETE SHALL BE GIVEN ONE COAT OF SUITABLE QUALITY PAINT, SUCH AS ZINC CHROMATE PRIMER CONFORMING TO FEDERAL SPECIFICATION TT-P-645 OR EQUIVALENT.

ALL BAR STEEL REINFORCEMENT SHALL BE EMBEDDED 2 INCHES CLEAR UNLESS OTHERWISE SHOWN OR NOTED.

PRECAST REINFORCED CONCRETE RISERS MAY BE PLACED WITH TONGUE UP OR DOWN.

ALL PRECAST INLET UNITS AND MANHOLES SHALL CONFORM TO THE PERTINENT REQUIREMENTS OF AASHTO DESIGNATION M 199.

* USE 2'-0" DIAMETER OPENING WITH TYPE "C", "L" AND "J" COVERS, OR 3'-0" DIAMETER WITH TYPE "K" AND "M" COVERS.

① 2 COURSES 6" BLOCK.

6

S.D.D. 8 B 6-4

MANHOLES TYPE 1	
STATE OF WISCONSIN DEPARTMENT OF TRANSPORTATION	
APPROVED 9/9/05 DATE	/S/ Jerry H. Zogg ROADWAY STANDARDS DEVELOPMENT ENGINEER
FHWA	

6


6



INLETS TYPE 1



- ① USE 2'-6" OPENING FOR TYPE 2 INLETS, 3'-0" OPENING FOR TYPE 3 INLETS, AND 2'-11" FOR TYPE 4 INLETS.
- ② USE 2'-0" OPENING FOR TYPE 1, 2 & 3 INLETS, 2'-6½" OPENING FOR TYPE 4 INLETS.

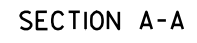

SECTION B-B


INLETS TYPE 2, 3 & 4

SECTION C-C


SECTION D-D

Roy L. Hines
CHIEF ROADWAY DEVELOPMENT ENGINEER

6

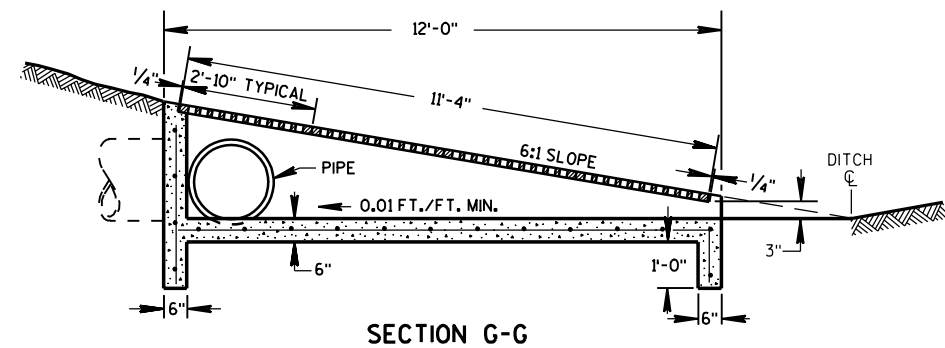


SECTION G-G

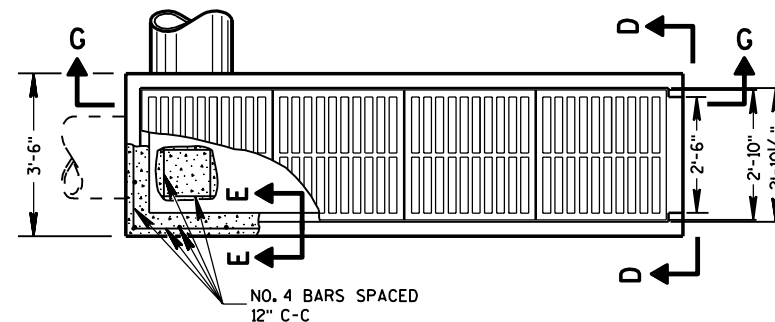


PLAN VIEW

REINFORCED CONCRETE INLET TYPE 11

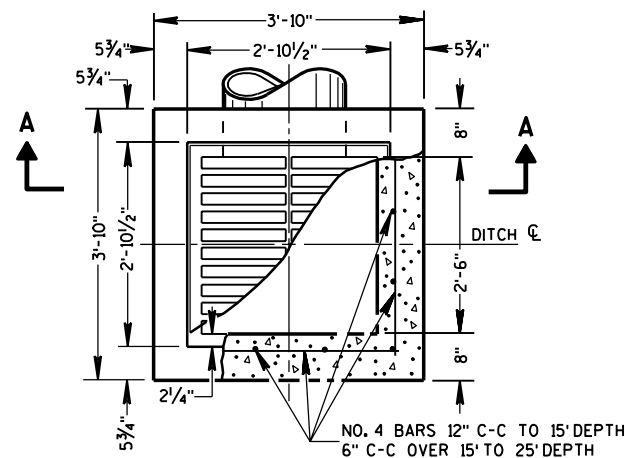


PLAN VIEW

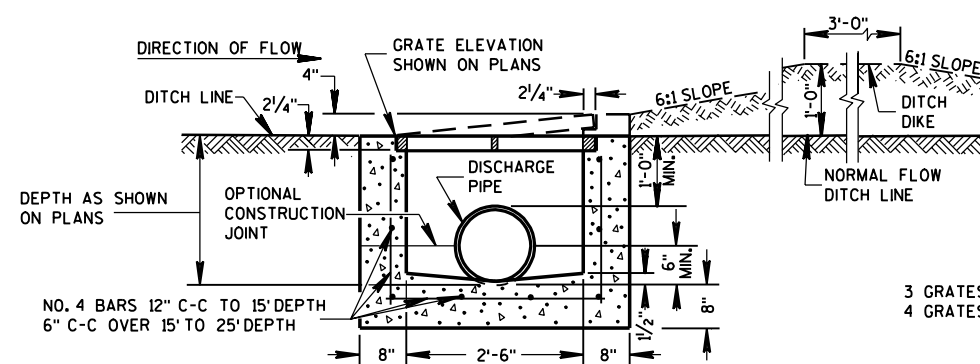


SECTION A-A


REINFORCED CONCRETE INLET TYPE 8

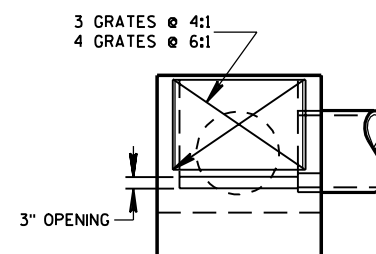

SECTION D-D

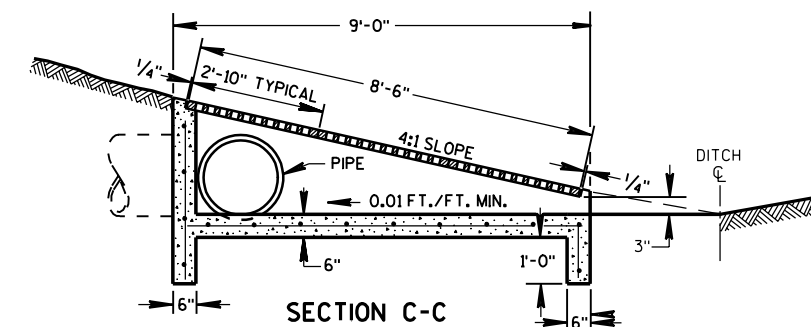


SECTION C-C

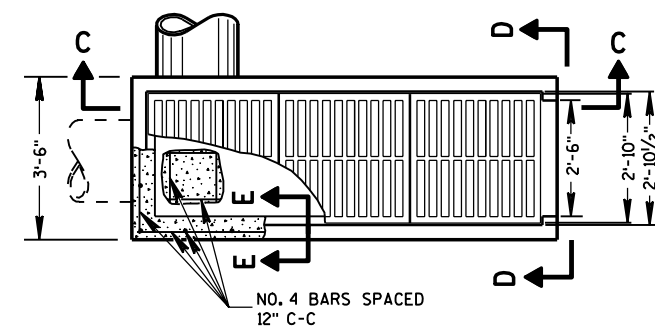


PLAN VIEW

REINFORCED CONCRETE INLET TYPE 10

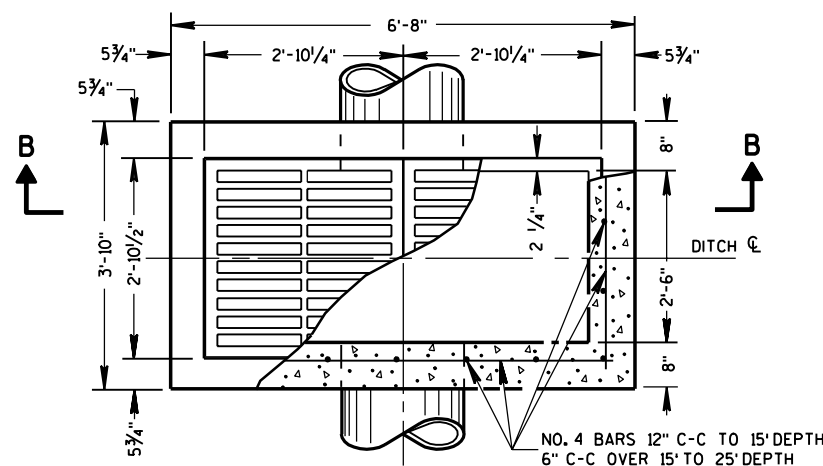


PLAN VIEW

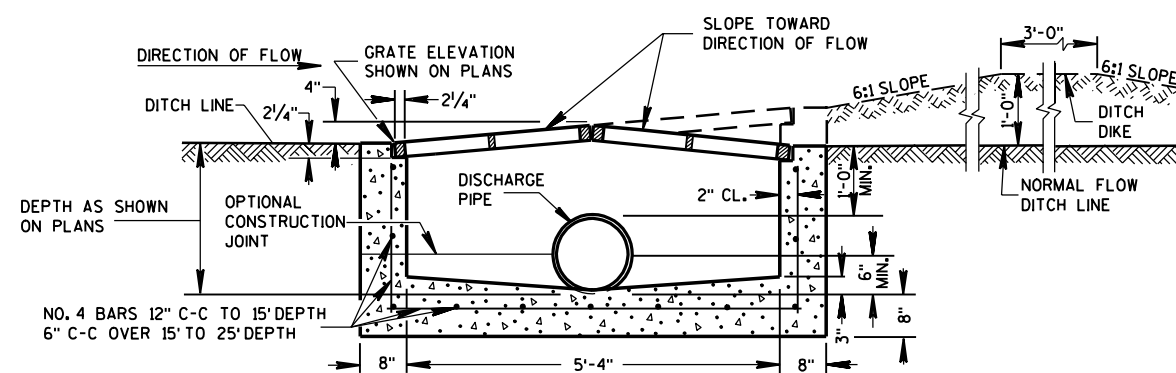

SECTION B-B

REINFORCED CONCRETE INLET TYPE 9

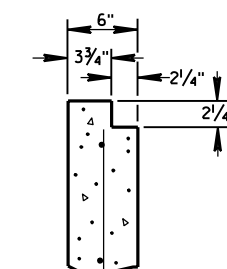

SECTION E-E

GENERAL NOTES

DETAILS OF CONSTRUCTION, MATERIALS AND WORKMANSHIP NOT SHOWN ON THIS DRAWING SHALL CONFORM TO THE PERTINENT REQUIREMENTS OF THE STANDARD SPECIFICATIONS AND THE APPLICABLE SPECIAL PROVISIONS.

DETAILED DRAWINGS FOR PROPOSED ALTERNATE DESIGNS FOR INLETS WHICH MAY INCLUDE PRECAST REINFORCED CONCRETE INLETS, SHALL BE SUBMITTED TO THE ENGINEER FOR APPROVAL PROVIDING THAT SUCH ALTERNATE DESIGNS MAKE PROVISION FOR EQUIVALENT CAPACITY AND STRENGTH.

PRECAST REINFORCED CONCRETE INLET UNITS, IF USED, SHALL CONFORM TO THE REQUIREMENTS OF THE CATCH BASINS, MANHOLES AND INLETS SECTION OF THE STANDARD SPECIFICATIONS. UNLESS OTHERWISE AUTHORIZED IN WRITING BY THE ENGINEER, THE CONTRACTOR SHALL NOT ORDER AND DELIVER PRECAST INLET UNITS REQUIRED FOR THE PROJECT UNTIL A CORRECTED LIST OF SIZES IS FURNISHED BY THE ENGINEER.

ALL INLETS ARE DESIGNATED ON THE PLANS AS "INLETS, 8-MS", ETC. THIS DESIGNATION IS INTERPRETED TO MEAN THAT THE NUMBER, OR FIRST DIGIT DESIGNATES THE MASONRY PORTION OF THE STRUCTURE AND THE FOLLOWING LETTER DESIGNATES THE TYPE OF COVER OR IRON CASTING TO BE USED THEREWITH TO COMPRISE THE COMPLETE UNIT.

ALL BAR STEEL REINFORCEMENT SHALL BE EMBEDDED 2 INCHES CLEAR UNLESS OTHERWISE SHOWN OR NOTED.

6

INLETS TYPE 8, 9, 10 AND 11

STATE OF WISCONSIN
DEPARTMENT OF TRANSPORTATION


APPROVED

8/10/94


DATE

FHWA


Ray E. Rasmussen
CHIEF ROADWAY DEVELOPMENT ENGINEER

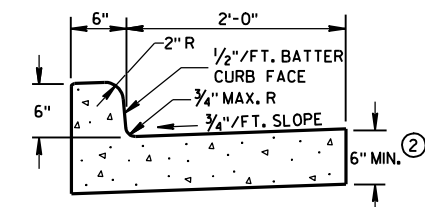

TYPES A & D ①

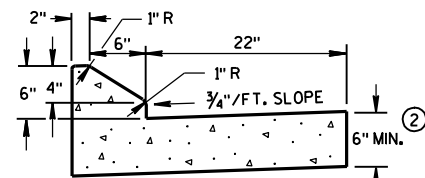


6" SLOPED CURB TYPES G & J ①

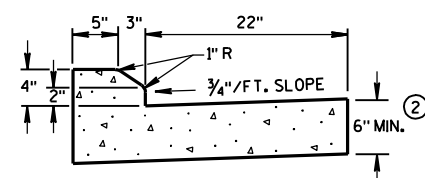


4" SLOPED CURB TYPES G & J ①


CONCRETE CURB & GUTTER 30"

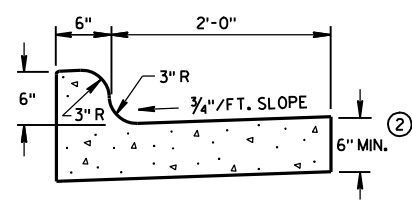


TYPES K & L ①

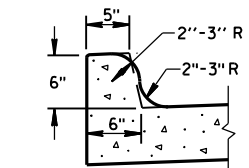


OPTIONAL CURB SHAPE FOR TYPES K & L ①

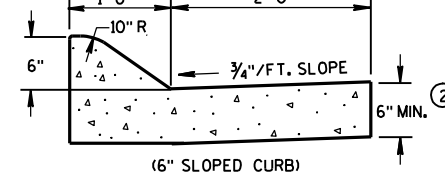


(6" SLOPED CURB)

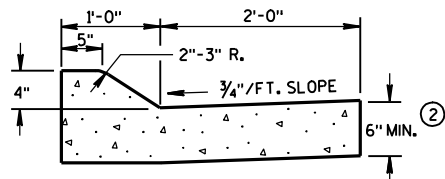

TYPES A & D ①

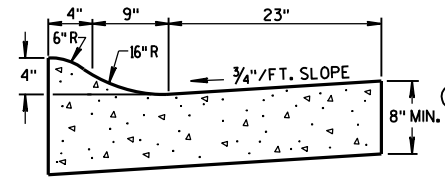


4" SLOPED CURB TYPES R & T ① ④

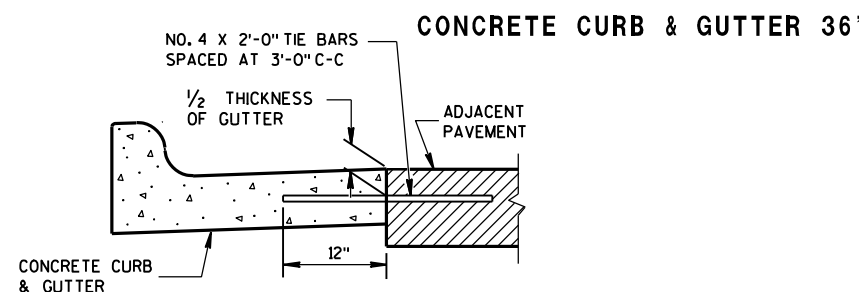


CONCRETE CURB & GUTTER 36"


TYPICAL TIE BAR LOCATION ①

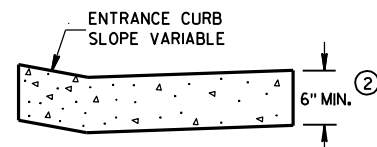


DRIVEWAY ENTRANCE CURB (WHEN DIRECTED BY THE ENGINEER)

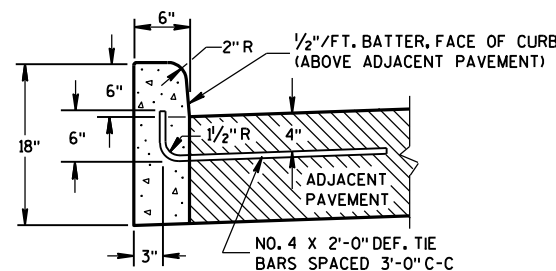


TYPES A & D ①

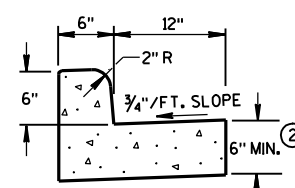


TYPES A & D CONCRETE CURB & GUTTER 18"

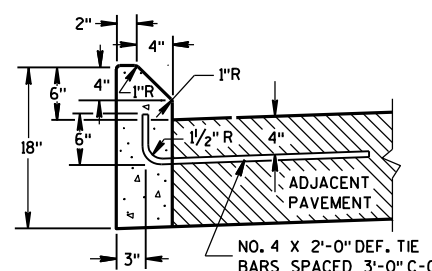


TYPES G & J ①

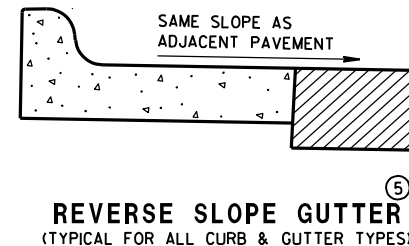

REVERSE SLOPE GUTTER (TYPICAL FOR ALL CURB & GUTTER TYPES) ⑤

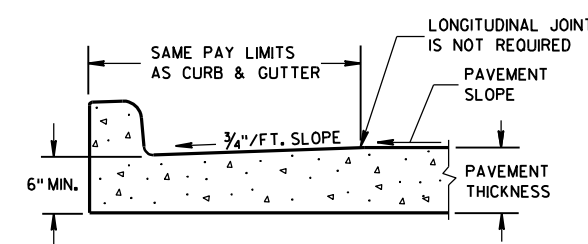

PARTIAL SECTION OF PAVEMENT WITH INTEGRAL CURB & GUTTER

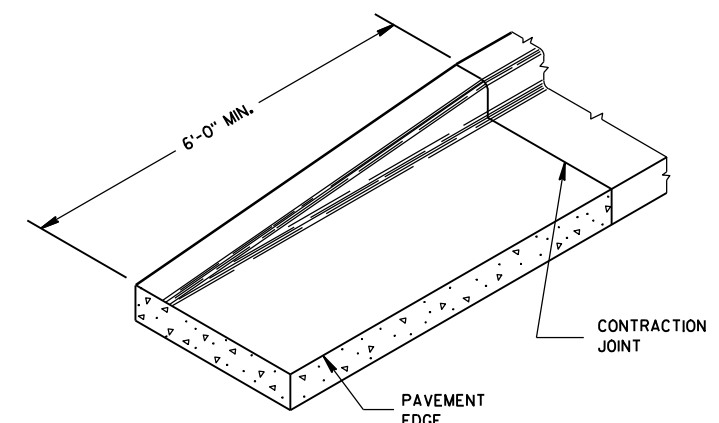

END SECTION CURB & GUTTER

GENERAL NOTES


DETAILS OF CONSTRUCTION, MATERIALS AND WORKMANSHIP NOT SHOWN ON THIS DRAWING SHALL CONFORM TO THE PERTINENT REQUIREMENTS OF THE CONTRACT. PAVEMENT TIES AND TIE BARS SHALL BE EPOXY COATED IN CONFORMANCE WITH SUBSECTION 505.2.6.2 OF THE STANDARD SPECIFICATIONS.

INTEGRAL CURB & GUTTER SHALL CONFORM TO THE DETAILS SHOWN FOR CONCRETE CURB & GUTTER INCLUDING THE TRANSVERSE GUTTER SLOPE. A LONGITUDINAL CONSTRUCTION JOINT IS NOT REQUIRED WITH INTEGRAL CURB AND GUTTER.


WHERE THE TRANSVERSE JOINTS IN THE PAVEMENT ARE REQUIRED TO BE SEALED, THE JOINTS IN THE INTEGRAL CURB AND GUTTER SHALL BE SEALED TO THE FACE OF CURB WITH THE SAME TYPE OF SEALANT. THE COST OF FURNISHING AND INSTALLING THIS SEALANT SHALL BE INCIDENTAL TO THE ITEM CONCRETE CURB AND GUTTER.

UNLESS OTHERWISE SHOWN ON THE TYPICAL CROSS SECTIONS, THE BASE AGGREGATE AND COMMON EXCAVATION LIMITS ARE 2'-0" BEHIND THE BACK OF CURBS.

- TIE BARS ARE REQUIRED FOR CURB AND GUTTER TYPES A, G, K AND R.
- THE BOTTOM OF CURB AND GUTTER MAY BE CONSTRUCTED EITHER LEVEL OR PARALLEL TO THE SLOPE OF THE SUBGRADE OR BASE AGGREGATE PROVIDED A 6" MINIMUM GUTTER THICKNESS IS MAINTAINED.
- THE BOTTOM OF CURB AND GUTTER MAY BE CONSTRUCTED EITHER LEVEL OR PARALLEL TO THE SLOPE OF THE SUBGRADE OR BASE AGGREGATE PROVIDED A 8" MINIMUM GUTTER THICKNESS IS MAINTAINED.
- THE FACE OF CURB IS 6" FROM THE BACK OF CURB.
- WHEN REVERSE SLOPE GUTTER IS REQUIRED, THE LOCATION(S) WILL BE SHOWN ELSEWHERE IN THE PLAN.

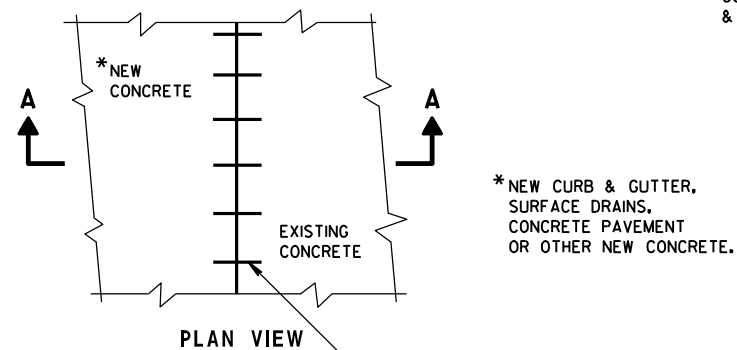

PLAN VIEW

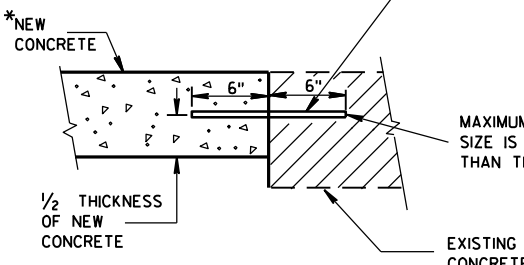

SECTION A-A TIE BARS DRILLED INTO EXISTING PAVEMENT

*NEW CURB & GUTTER, SURFACE DRAINS, CONCRETE PAVEMENT OR OTHER NEW CONCRETE.

NO. 6 TIE BARS SPACED 2'-6" C-C, INSTALLED PERPENDICULAR TO THE LONGITUDINAL JOINT.

MAXIMUM DRILL HOLE SIZE IS 1/8" GREATER THAN TIE BAR DIAMETER

EXISTING CONCRETE

CONCRETE CURB, CONCRETE CURB & GUTTER AND TIES


STATE OF WISCONSIN DEPARTMENT OF TRANSPORTATION

APPROVED 9/4/08 DATE /S/ Jerry H. Zogg ROADWAY STANDARDS DEVELOPMENT ENGINEER

6


S.D.D. 8 D 4-5

ASPHALTIC FLUME

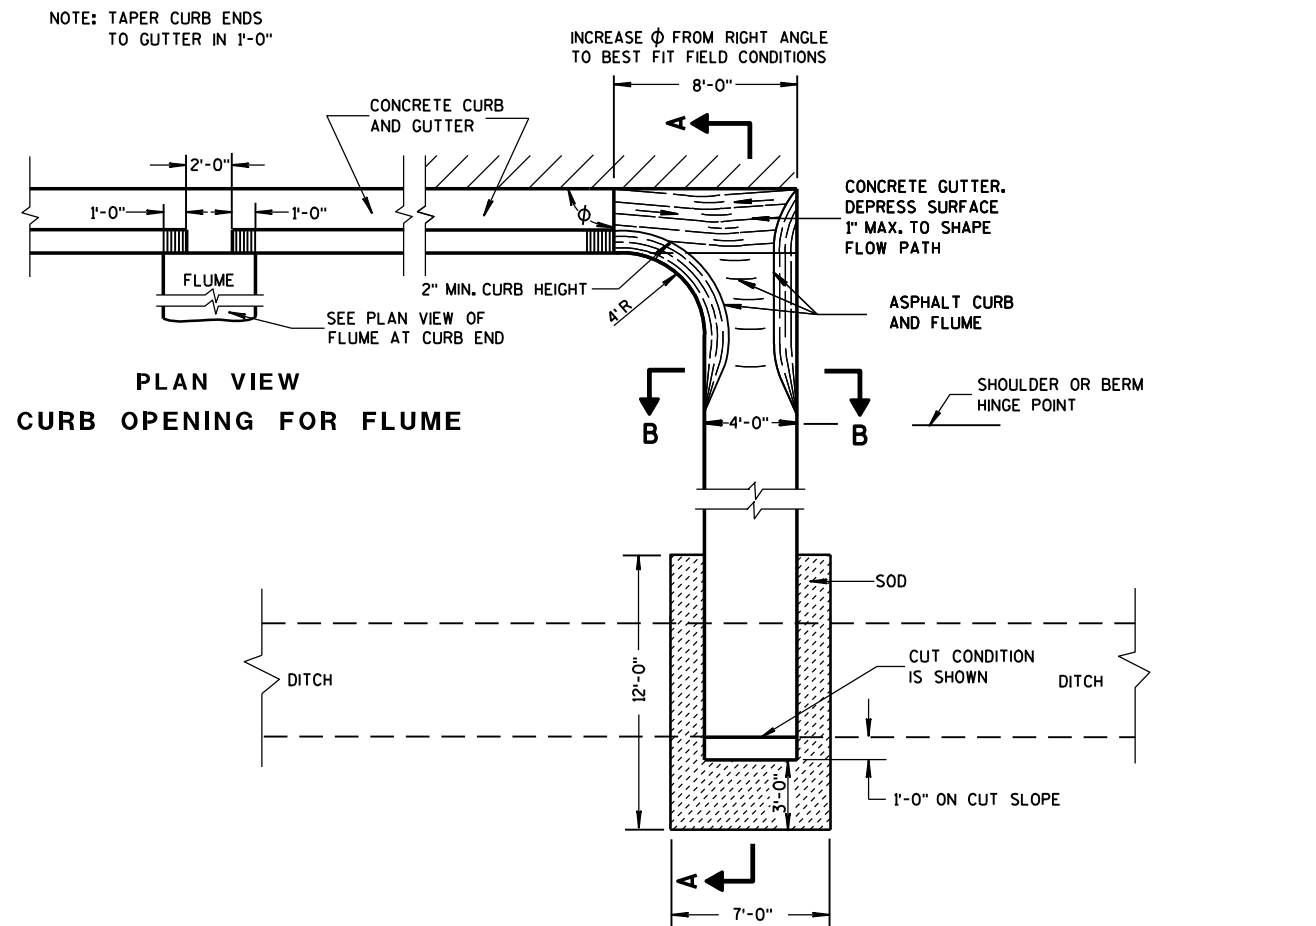


PLAN VIEW
CURB OPENING FOR FLUME

PLAN VIEW
FLUME AT CURB END

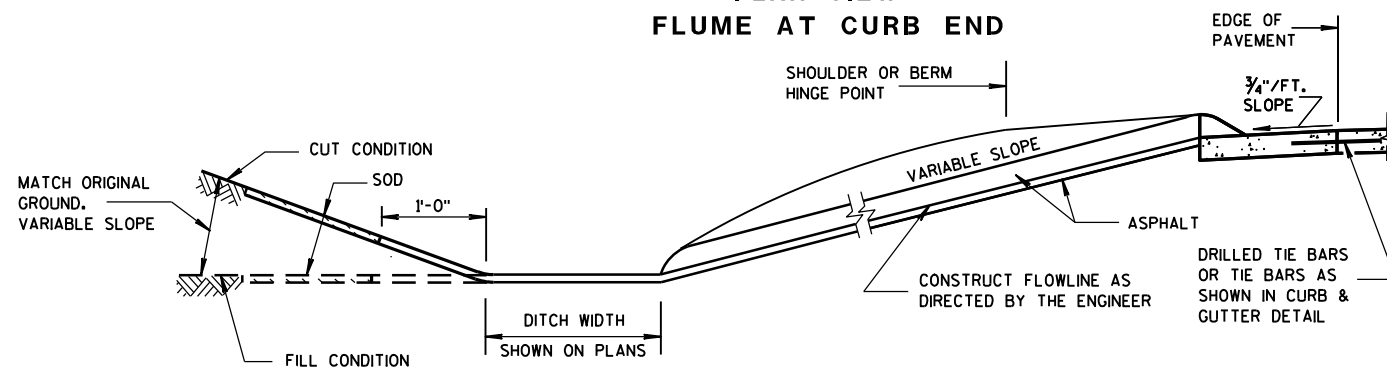

SECTION A-A

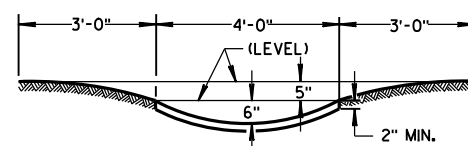

SECTION B-B


GENERAL NOTES

DETAILS OF CONSTRUCTION, MATERIALS AND WORKMANSHIP NOT SHOWN ON THIS DRAWING SHALL CONFORM TO PERTINENT REQUIREMENTS OF THE STANDARD SPECIFICATIONS AND APPLICABLE SPECIAL PROVISIONS.


WELDED STEEL WIRE FABRIC SHALL BE IN ACCORDANCE WITH AASHTO SPECIFICATION M55.

- JOINTS SHALL BE 1/8 TO 1/4 INCH WIDE BY 1 1/2 INCHES DEEP AND SPACED AT UNIFORM INTERVALS OF APPROXIMATELY 4 FEET.
- GEOTEXTILE FABRIC TYPE "R" SHALL UNDERLAY THE FULL LENGTH AND WIDTH OF THE CONCRETE SURFACE DRAIN AND RIPRAP.
- CONCRETE SURFACE DRAIN WITHOUT CURB AND GUTTER MAY BE USED ON BACKSLOPES WHEN SPECIFIED


③ CONCRETE SURFACE DRAIN

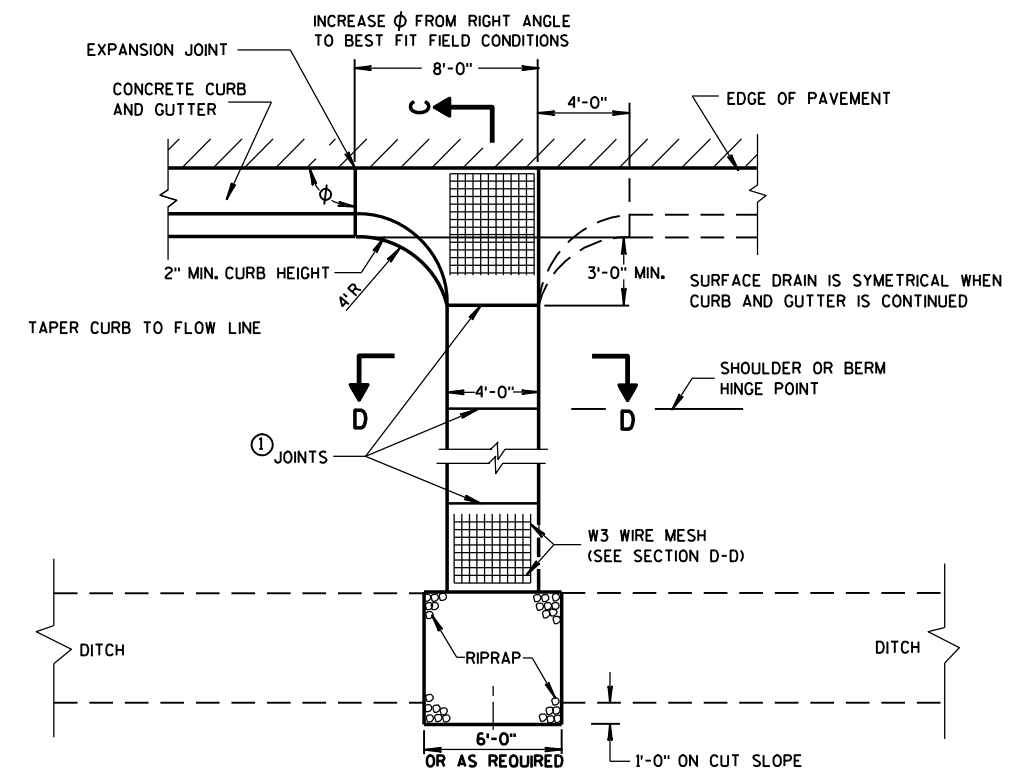

PLAN VIEW

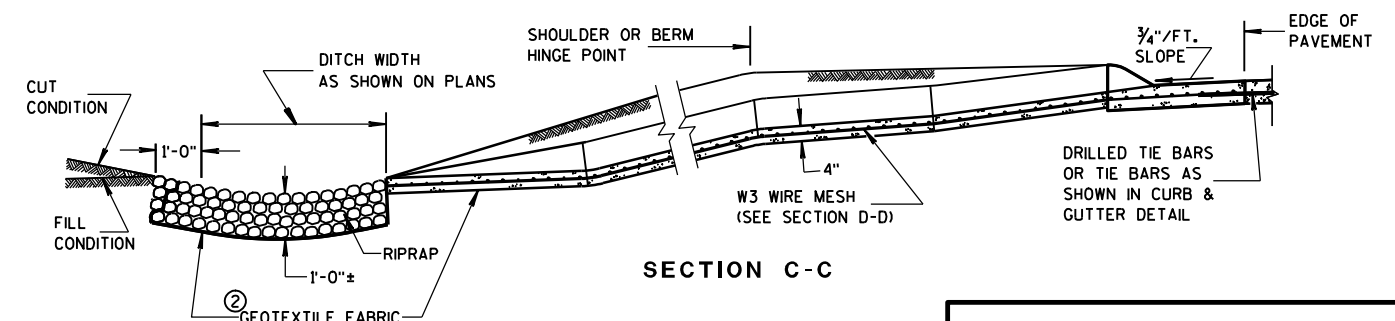

SECTION C-C

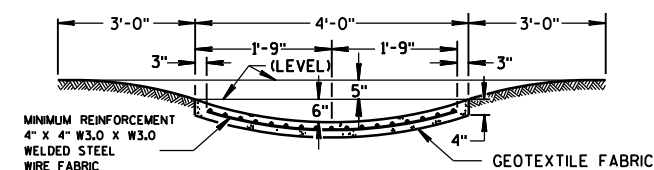

SECTION D-D

CONCRETE SURFACE DRAINS & ASPHALTIC FLUMES


STATE OF WISCONSIN
DEPARTMENT OF TRANSPORTATION

APPROVED
9-4-08 /S/ Jerry H. Zogg
DATE ROADWAY STANDARDS DEVELOPMENT
ENGINEER
FHWA

6

S.D.D. 8 D 4-5


WOOD STAKES (2 PER BALE)
NOMINAL 2" X 2" X 30" MIN.
LENGTH OR EQUIVALENT

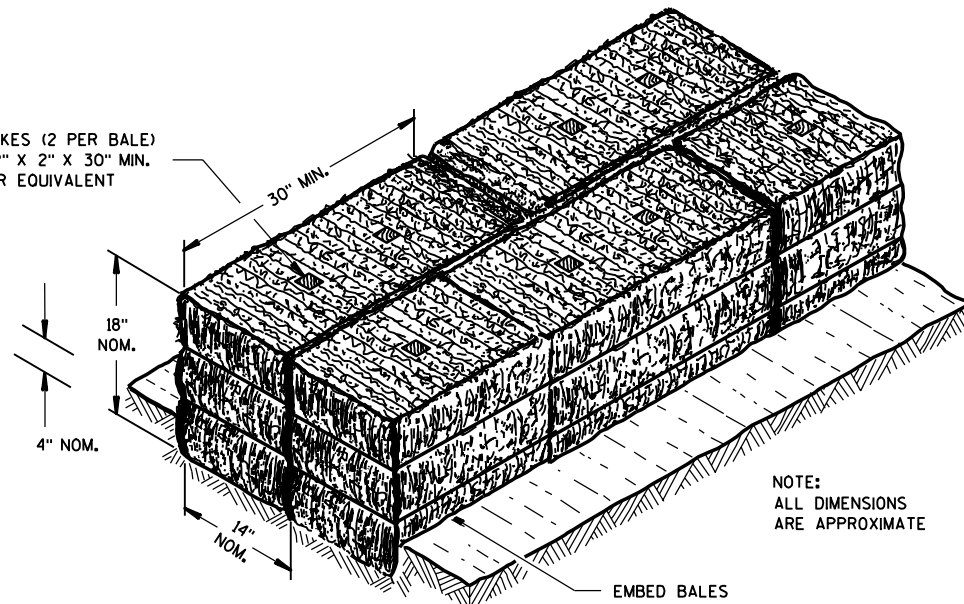

NOTE:
ALL DIMENSIONS
ARE APPROXIMATE

EMBED BALES

SECTION A-A

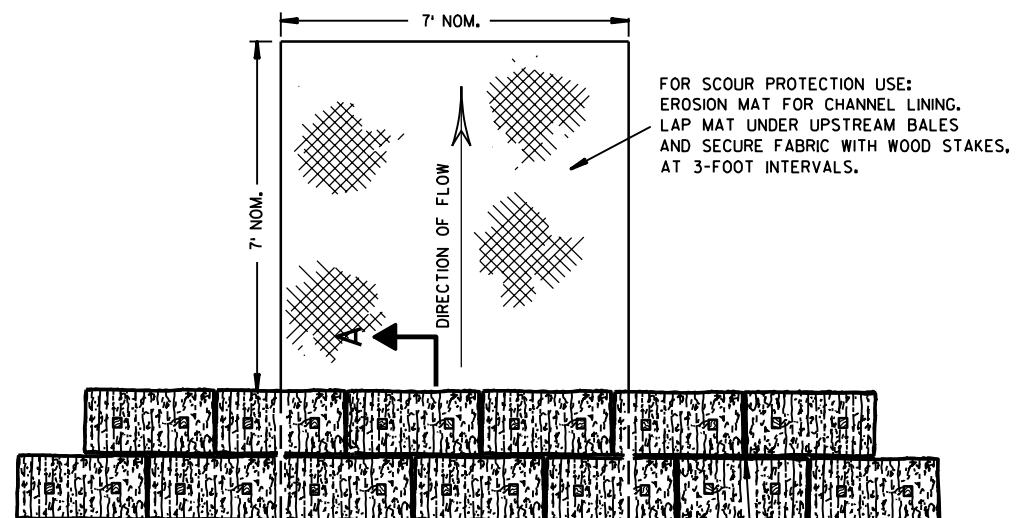


FOR SCOUR PROTECTION USE:
EROSION MAT FOR CHANNEL LINING.
LAP MAT UNDER UPSTREAM BALES
AND SECURE FABRIC WITH WOOD STAKES,
AT 3-FOOT INTERVALS.



PLAN VIEW

BOTTOM ELEVATION OF END BALE SHALL
BE EQUAL TO OR GREATER THAN TOP OF
LOWEST MIDDLE BALE.

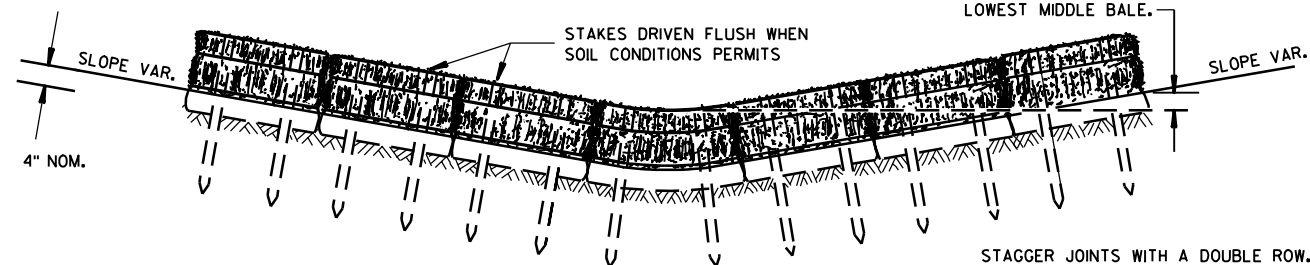


FRONT ELEVATION

TEMPORARY DITCH CHECK USING EROSION BALES ①

GENERAL NOTES


DETAILS OF CONSTRUCTION, MATERIALS AND WORKMANSHIP NOT SHOWN ON THIS DRAWING SHALL CONFORM TO THE PERTINENT REQUIREMENTS OF THE STANDARD SPECIFICATIONS AND THE APPLICABLE SPECIAL PROVISIONS.

- ① TEMPORARY DITCH CHECKS EITHER EROSION BALES OR MANUFACTURED SHALL BE PAID FOR UNDER THE BID ITEM OF TEMPORARY DITCH CHECK. THE DEPARTMENT WILL NOT PAY FOR TEMPORARY DITCH CHECKS CONSTRUCTED OF A SINGLE ROW OF EROSION BALES.

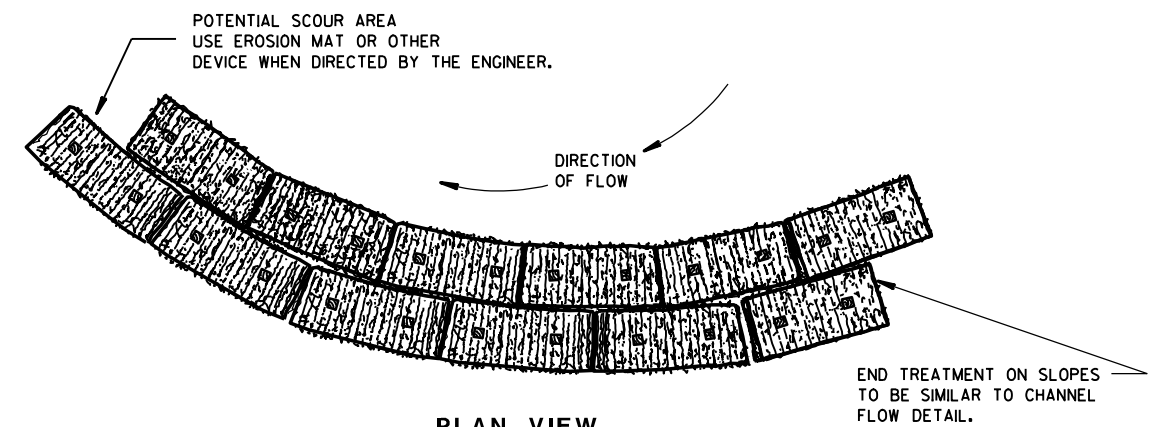


PLAN VIEW

WHEN ALTERING THE DIRECTION OF FLOW

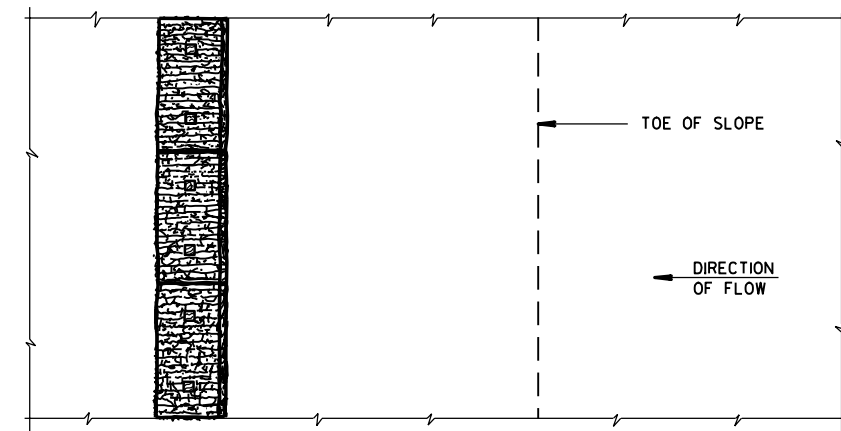

PLAN VIEW

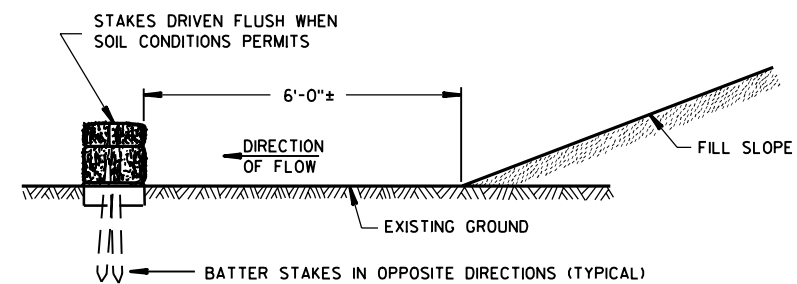

FRONT ELEVATION

WHEN EXISTING GROUND SLOPES AWAY FROM FILL SLOPE

EROSION BALES FOR SHEET FLOW


TYPICAL INSTALLATIONS OF
EROSION BALES / TEMPORARY
DITCH CHECKS

STATE OF WISCONSIN
DEPARTMENT OF TRANSPORTATION


APPROVED
6/04/02
DATE

CHIEF ROADWAY DEVELOPMENT ENGINEER


FHWA

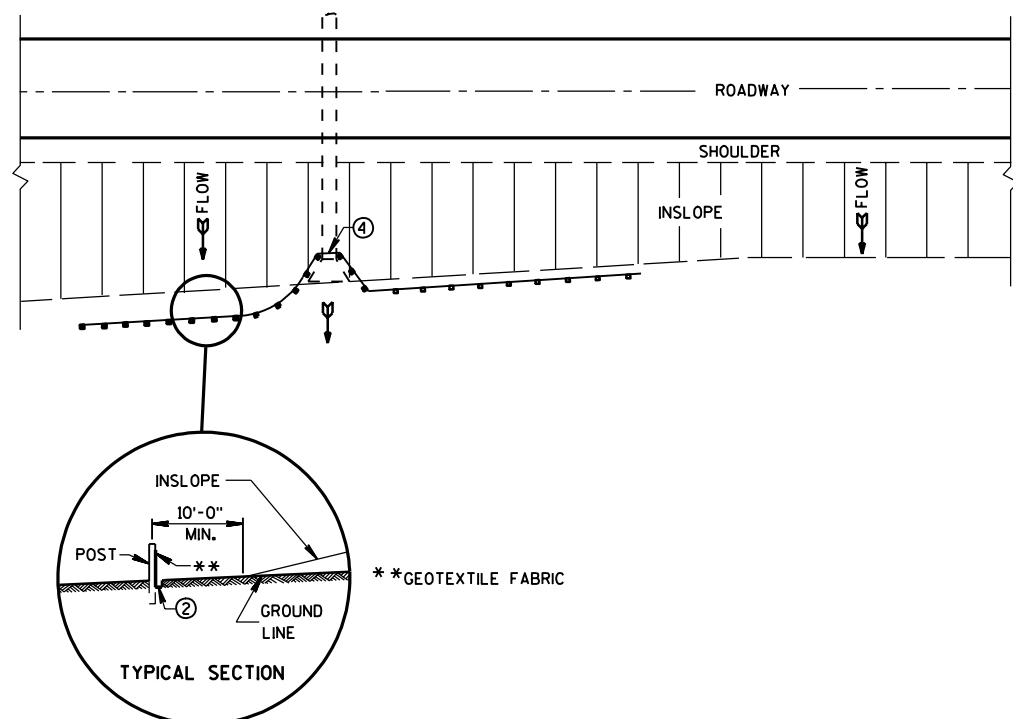


PLAN VIEW
TYPICAL APPLICATION OF SILT FENCE

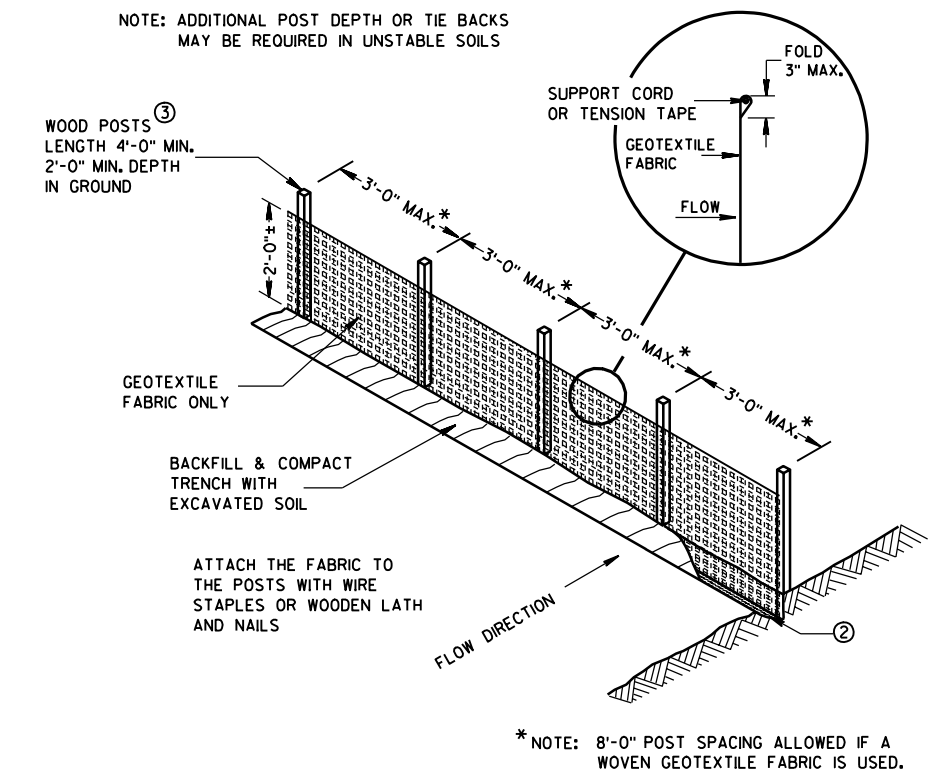

SILT FENCE

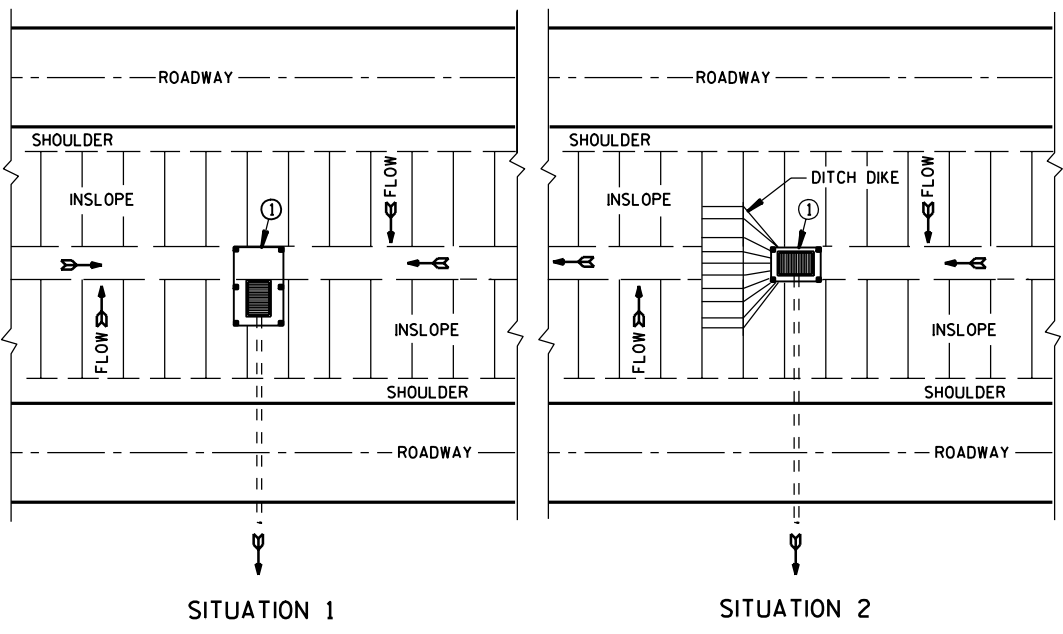

PLAN VIEW
SILT FENCE AT MEDIAN SURFACE DRAINS

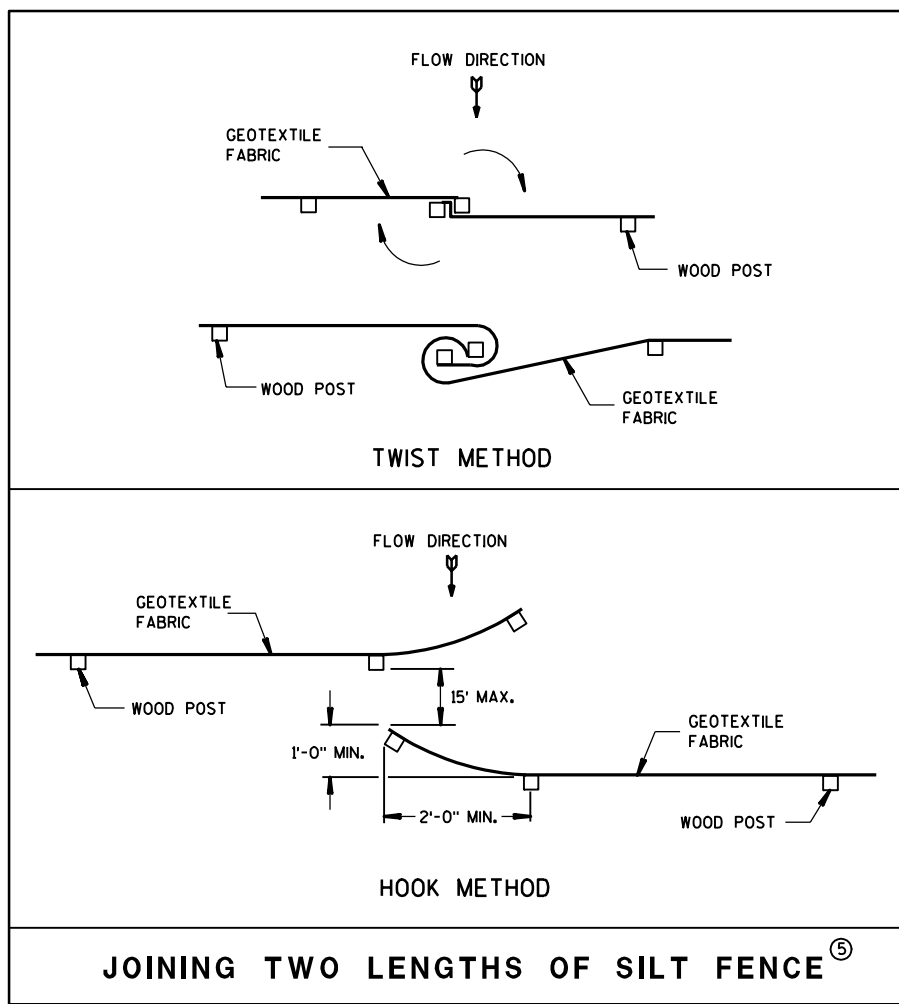


JOINING TWO LENGTHS OF SILT FENCE^⑤


GENERAL NOTES

DETAILS OF CONSTRUCTION NOT SHOWN ON THIS DRAWING SHALL CONFORM TO THE PERTINENT REQUIREMENTS OF THE STANDARD SPECIFICATIONS AND APPLICABLE SPECIAL PROVISIONS.

- ① HORIZONTAL BRACE REQUIRED WITH 2" X 4" WOODEN FRAME OR EQUIVALENT AT TOP OF POSTS.
- ② FOR MANUAL INSTALLATIONS THE TRENCH SHALL BE A MINIMUM OF 4" WIDE & 6" DEEP TO BURY AND ANCHOR THE GEOTEXTILE FABRIC, FOLD MATERIAL TO FIT TRENCH AND BACKFILL & COMPACT TRENCH WITH EXCAVATED SOIL.
- ③ WOOD POSTS SHALL BE A MINIMUM SIZE OF 1/8" X 1/8" OF OAK OR HICKORY.
- ④ SILT FENCE TO EXTEND ACROSS THE TOP OF THE PIPE.
- ⑤ CONSTRUCT SILT FENCE FROM A CONTINUOUS ROLL IF POSSIBLE BY CUTTING LENGTHS TO AVOID JOINTS. IF A JOINT IS NECESSARY USE ONE OF THE FOLLOWING TWO METHODS; A) OVERLAP THE END POSTS AND TWIST, OR ROTATE, AT LEAST 180 DEGREES, B) HOOK THE END OF EACH SILT FENCE LENGTH.


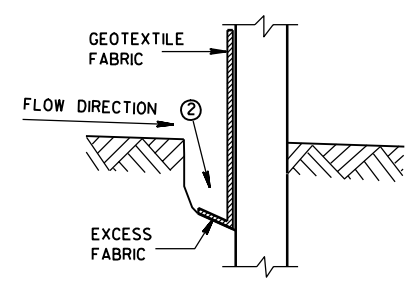


TRENCH DETAIL

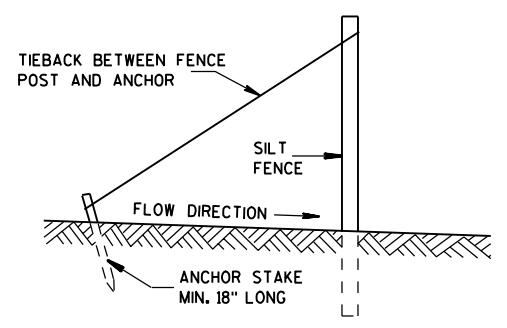

SILT FENCE TIE BACK
(WHEN REQUIRED BY THE ENGINEER)

SILT FENCE	
STATE OF WISCONSIN DEPARTMENT OF TRANSPORTATION	
APPROVED 4-29-05 DATE FHWA	CHIEF ROADWAY DEVELOPMENT ENGINEER

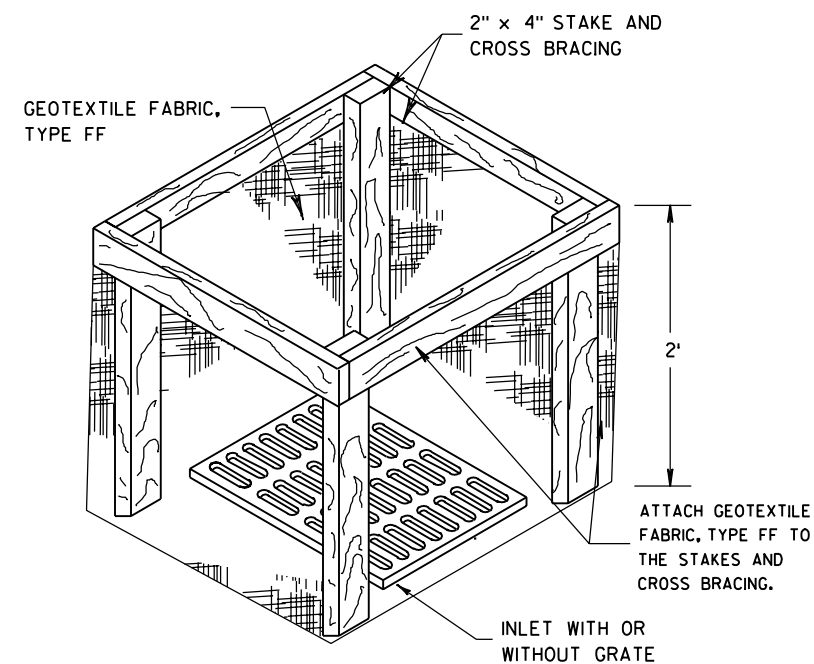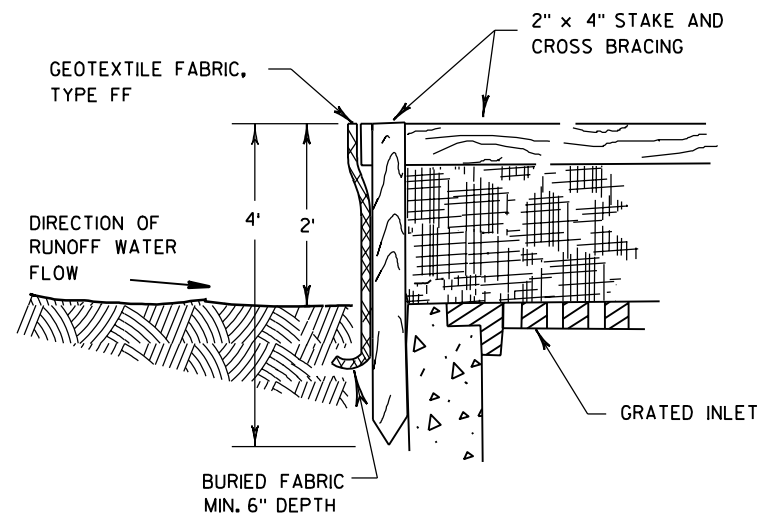

INLET PROTECTION, TYPE A


GENERAL NOTES

INLET PROTECTION DEVICES SHALL BE MAINTAINED OR REPLACED AT THE DIRECTION OF THE ENGINEER.


MANUFACTURED ALTERNATIVES APPROVED AND LISTED ON THE DEPARTMENT'S EROSION CONTROL PRODUCT ACCEPTABILITY LIST MAY BE SUBSTITUTED.

WHEN REMOVING OR MAINTAINING INLET PROTECTION, CARE SHALL BE TAKEN SO THAT THE SEDIMENT TRAPPED ON THE GEOTEXTILE FABRIC DOES NOT FALL INTO THE INLET. ANY MATERIAL FALLING INTO THE INLET SHALL BE REMOVED IMMEDIATELY.

- ① FINISHED SIZE, INCLUDING FLAP POCKETS WHERE REQUIRED, SHALL EXTEND A MINIMUM OF 10" AROUND THE PERIMETER TO FACILITATE MAINTENANCE OR REMOVAL.
- ② FOR INLET PROTECTION, TYPE C (WITH CURB BOX), AN ADDITIONAL 18" OF FABRIC IS WRAPPED AROUND THE WOOD AND SECURED WITH STAPLES. THE WOOD SHALL NOT BLOCK THE ENTIRE HEIGHT OF THE CURB BOX OPENING.
- ③ FLAP POCKETS SHALL BE LARGE ENOUGH TO ACCEPT WOOD 2X4.

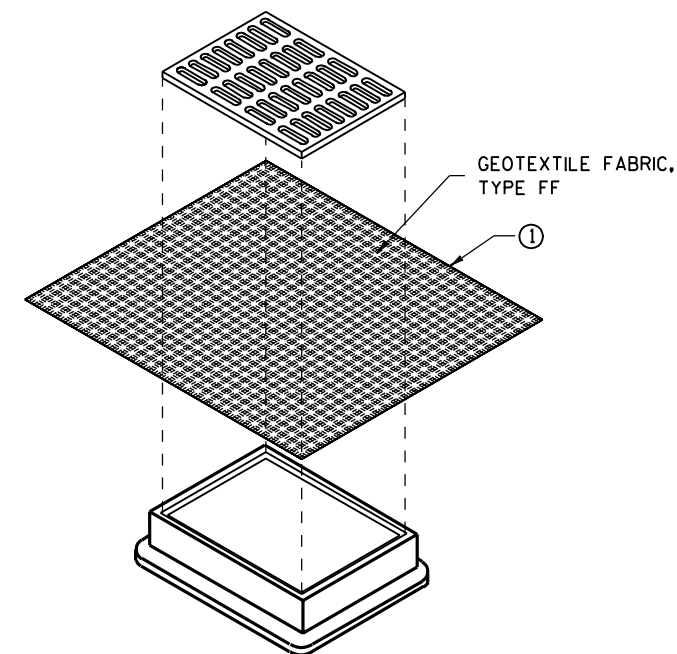

**INLET PROTECTION, TYPE B
(WITHOUT CURB BOX)**
(CAN BE INSTALLED IN ANY INLET WITHOUT A CURB BOX)

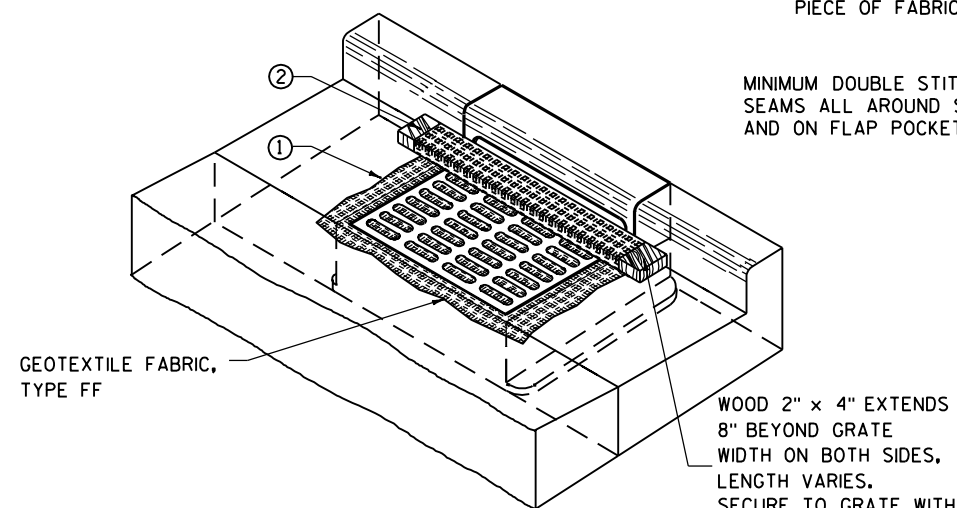

INLET PROTECTION, TYPE C (WITH CURB BOX)

INSTALLATION NOTES

TYPE B & C

TRIM EXCESS FABRIC IN THE FLOW LINE TO WITHIN 3" OF THE GRATE.


THE CONTRACTOR SHALL DEMONSTRATE A METHOD OF MAINTENANCE, USING A SEWN FLAP, HAND HOLDS OR OTHER METHOD TO PREVENT ACCUMULATED SEDIMENT FROM ENTERING THE INLET.

TYPE D

DO NOT INSTALL INLET PROTECTION TYPE D IN INLETS SHALLOWER THAN 30", MEASURED FROM THE BOTTOM OF THE INLET TO THE TOP OF THE GRATE.

TRIM EXCESS FABRIC IN THE FLOW LINE TO WITHIN 3" OF THE GRATE.

THE INSTALLED BAG SHALL HAVE A MINIMUM SIDE CLEARANCE, BETWEEN THE INLET WALLS AND THE BAG, MEASURED AT THE BOTTOM OF THE OVERFLOW HOLES, OF 3". WHERE NECESSARY THE CONTRACTOR SHALL CINCH THE BAG, USING PLASTIC ZIP TIES, TO ACHIEVE THE 3" CLEARANCE. THE TIES SHALL BE PLACED AT A MAXIMUM OF 4" FROM THE BOTTOM OF THE BAG.

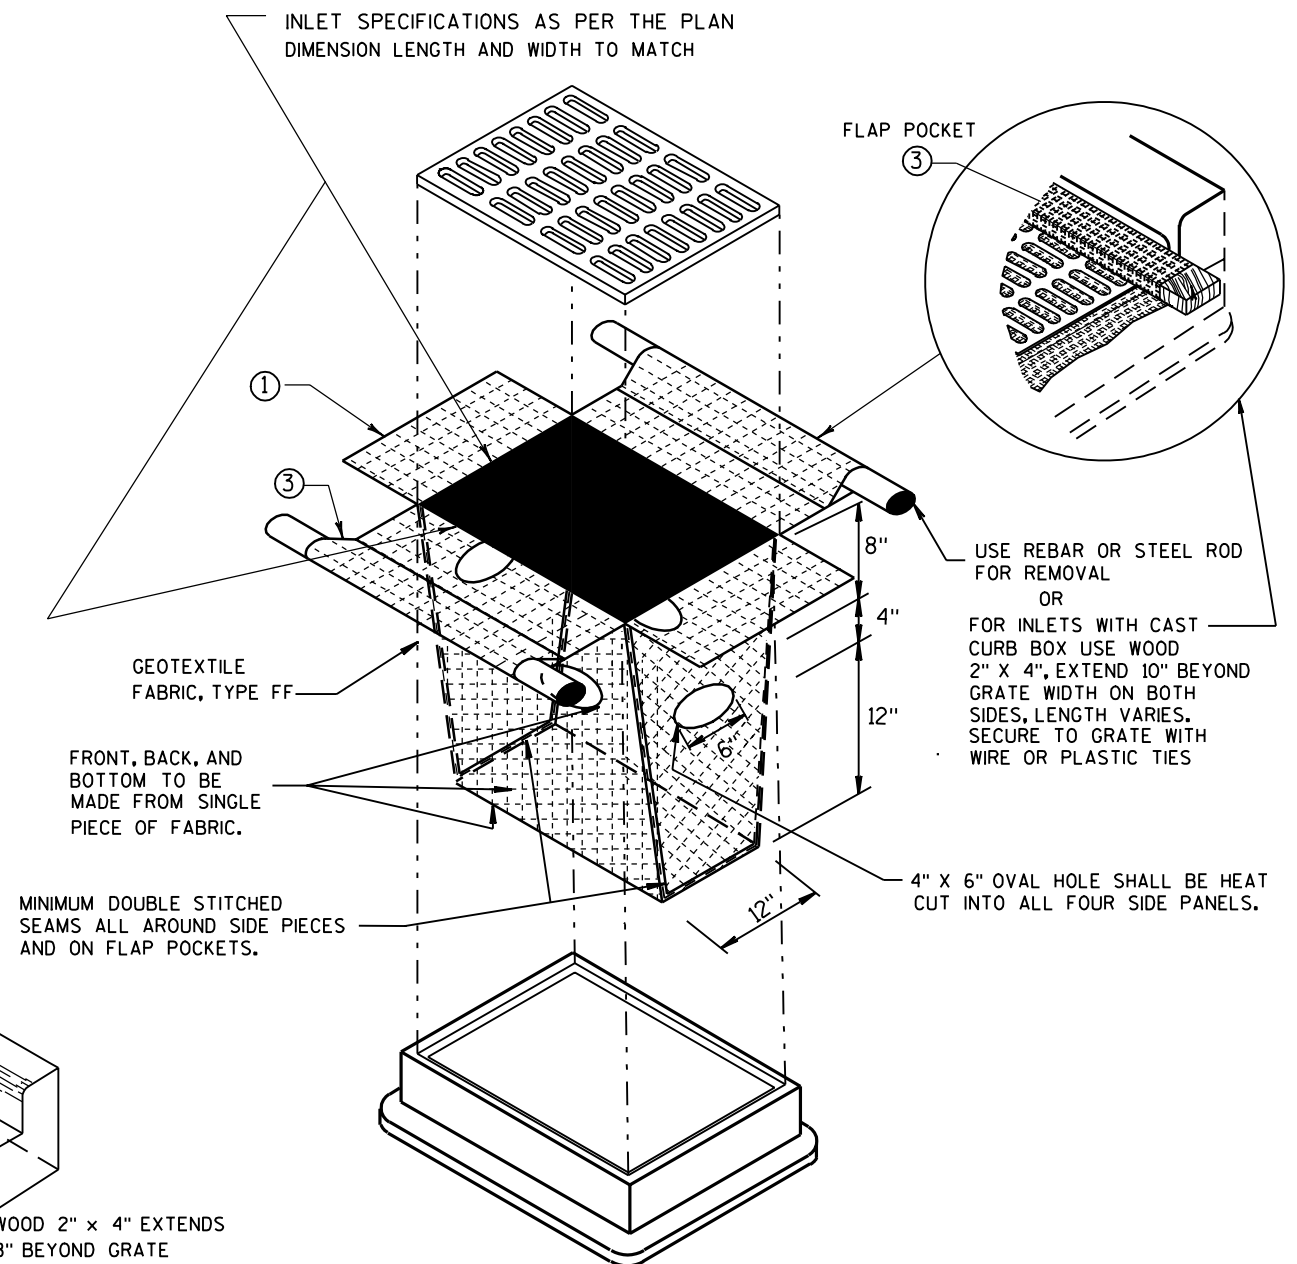

INLET PROTECTION, TYPE D

(CAN BE INSTALLED IN ANY INLET TYPE WITH OR WITHOUT A CURB BOX AS PER NOTE ②)

**INLET PROTECTION
TYPE A, B, C, AND D**




STATE OF WISCONSIN
DEPARTMENT OF TRANSPORTATION

APPROVED
10/16/02
DATE
FHWA

CHIEF ROADWAY DEVELOPMENT ENGINEER

METAL APRON ENDWALLS											
PIPE DIA. (IN.)	MIN. THICK. (Inches)		DIMENSIONS (Inches)							APPROX. SLOPE	BODY
	STEEL	ALUM.	A (±1")	B (MAX.)	H (±1")	L (±1 1/2")	L1 ①	L2 ①	W (±2")		
12	.064	.060	6	6	6	21	12	17 1/2	24	2 1/2 to 1	1 Pc.
15	.064	.060	7	8	6	26	14	21 3/4	30	2 1/2 to 1	1 Pc.
18	.064	.060	8	10	6	31	15	28 1/4	36	2 1/2 to 1	1 Pc.
21	.064	.060	9	12	6	36	18	29 3/8	42	2 1/2 to 1	1 Pc.
24	.064	.075	10	13	6	41	18	37 1/4	48	2 1/2 to 1	1 Pc.
30	.079	.075	12	16	8	51	18	52 1/4	60	2 1/2 to 1	1 Pc.
36	.079	.105	14	19	9	60	24	59 3/4	72	2 1/2 to 1	2 Pc.
42	.109	.105	16	22	11	69	24	75 5/8	84	2 1/2 to 1	2 Pc.
48	.109	.105	18	27	12	78	24	81	90	2 1/4 to 1	3 Pc.
54	.109	.105	18	30	12	84	30	85 1/2	102	2 1/4 to 1	3 Pc.
60	.109x	.105x	18	33	12	87	—	—	114	2 to 1	3 Pc.
66	.109x	.105x	18	36	12	87	—	—	120	2 to 1	3 Pc.
72	.109x	.105x	18	39	12	87	—	—	126	2 to 1	3 Pc.
78	.109x	.105x	18	42	12	87	—	—	132	1 1/2 to 1	3 Pc.
84	.109x	.105x	18	45	12	87	—	—	138	1 1/2 to 1	3 Pc.
90	.109x	.105x	18	37	12	87	—	—	144	1 1/2 to 1	3 Pc.
96	.109x	.105x	18	35	12	87	—	—	150	1 1/2 to 1	3 Pc.




* EXCEPT CENTER PANEL
SEE GENERAL NOTES

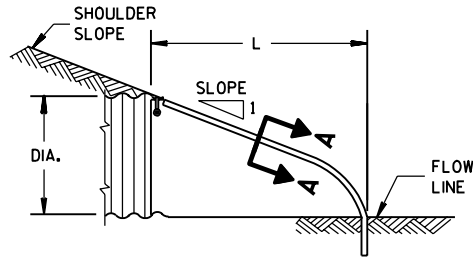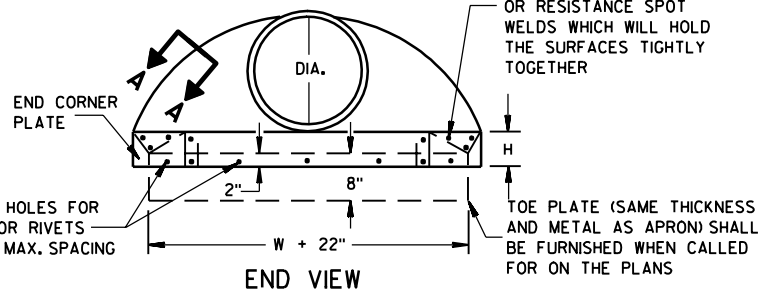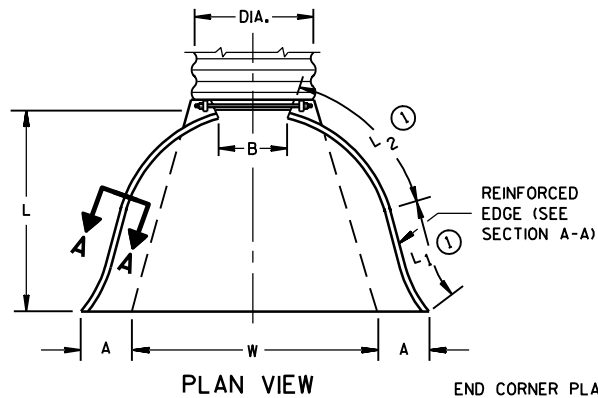

SIDE ELEVATION
METAL ENDWALLS


REINFORCED CONCRETE APRON ENDWALLS											
PIPE DIA. (IN.)	DIMENSIONS (Inches)							APPROX. SLOPE			
	T	A	B	C	D	E	G				
12	2	4	24	48 1/8	72 1/8	24	2	3 to 1			
15	2 1/4	6	27	46	73	30	2 1/4	3 to 1			
18	2 1/2	9	27	46	73	36	2 1/2	3 to 1			
21	2 3/4	9	36	37 1/2	73 1/2	42	2 3/4	3 to 1			
24	3	9 1/2	43 1/2	30	73 1/2	48	3	3 to 1			
27	3 1/4	10 1/2	49 1/2	24	73 1/2	54	3 1/4	3 to 1			
30	3 1/2	12	54	19 1/4	73 1/2	60	3 1/2	3 to 1			
36	4	15	63	34 3/4	97 1/4	72	4	3 to 1			
42	4 1/2	21	63	35	98	78	4 1/2	3 to 1			
48	5	24	72	26	98	84	5	3 to 1			
54	5 1/2	27	65	33 1/4	98 1/4	90	5 1/2	2 5/8 to 1			
60	6	30-35	60	39	99	96	5	2 to 1			
66	6 1/2	24-30	72-78	21-27	99	102	5 1/2	2 to 1			
72	7	24-36	78	21	99	108	6	2 to 1			
78	7 1/2	24-36	78	21	99	114	6 1/2	2 to 1			
84	8	36	90 1/2	21	111 1/2	120	6 1/2	1 1/2 to 1			
90	8 1/2	41	87 1/2	24	111 1/2	132	6 1/2	1 1/2 to 1			

* MINIMUM
** MAXIMUM


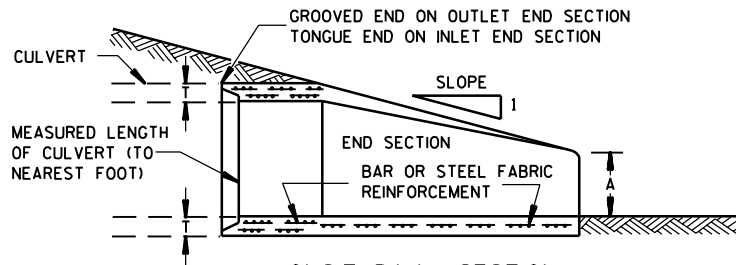
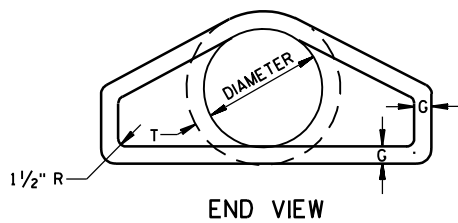
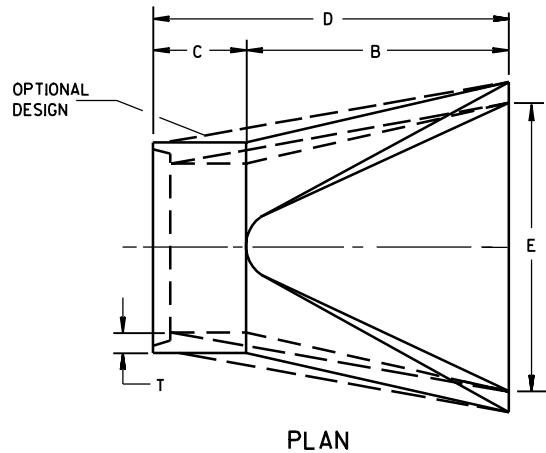


LONGITUDINAL SECTION
CONCRETE ENDWALLS

1" WIDE, 12 GA. (0.109" THICK) GALVANIZED STRAP WITH STANDARD 6" X 1/2" BAND BOLT AND NUT

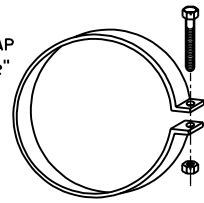

ALTERNATE FOR TYPE 1 CONNECTION
END SECTION CONNECTOR STRAP

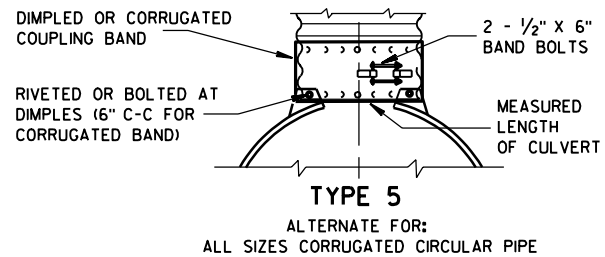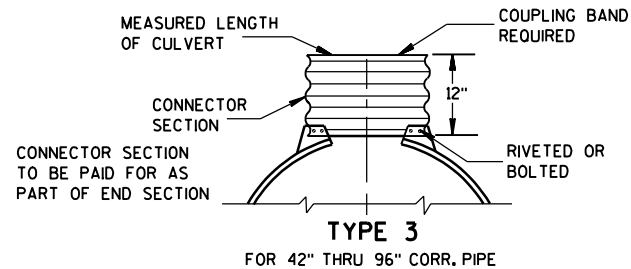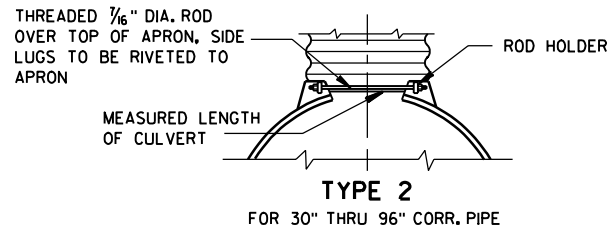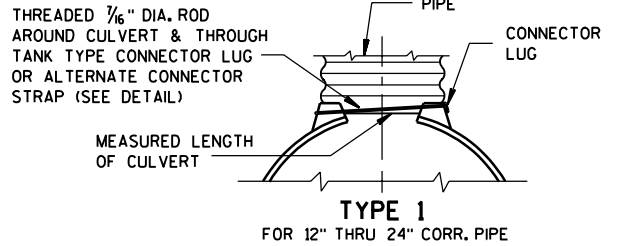


NOTE: DIMPLED BAND FITS OVER OUTSIDE OF ENDWALL, AND CORRUGATED BAND FITS INSIDE ENDWALL. DIMPLED BAND MAY BE USED WITH HELICALLY CORRUGATED PIPE.

FOR CIRCUMFERENTIALLY CORRUGATED PIPE USE ENDWALL CONNECTION DETAILS 1, 2, 3 OR 5 AS APPLICABLE.

FOR HELICALLY CORRUGATED PIPE USE ENDWALL CONNECTION DETAILS 1, 2 OR 5.

FOR HELICALLY CORRUGATED PIPES WITH TWO CIRCUMFERENTIAL CORRUGATIONS AT EACH END USE ENDWALL CONNECTION DETAILS 1, 2 OR 3.

CONNECTION DETAILS

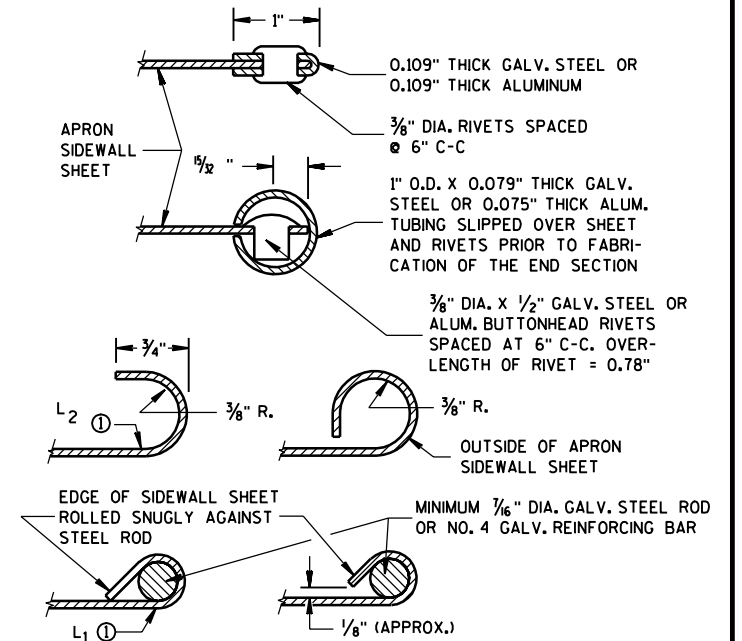

SECTION A-A

GENERAL NOTES

DETAILS OF CONSTRUCTION, MATERIALS AND WORKMANSHIP NOT SHOWN ON THIS DRAWING SHALL CONFORM TO THE PERTINENT REQUIREMENTS OF THE STANDARD SPECIFICATIONS AND THE APPLICABLE SPECIAL PROVISIONS.

CONCRETE CULVERT ENDWALLS MAY NOT BE USED WITH GALVANIZED STEEL OR ALUMINUM CULVERT PIPE OR VISE VERSA. GALVANIZED STEEL OR ALUMINUM ENDWALLS SHALL NORMALLY BE INSTALLED ON CULVERT PIPE OF THE SAME METAL.

ALL THREE PIECE STEEL APRON ENDWALLS FOR 60" DIAMETER PIPE AND LARGER SHALL HAVE 0.109" SIDES AND 0.138" CENTER PANELS. ALL THREE PIECE ALUMINUM APRON ENDWALLS FOR 60" DIAMETER PIPE AND LARGER SHALL HAVE 0.105" SIDES AND 0.134" CENTER PANELS. THE WIDTH OF CENTER PANELS SHALL BE GREATER THAN 20 PERCENT OF THE PIPE PERIMETER.

LAP SEAMS SHALL BE TIGHTLY JOINED BY GALVANIZED RIVETS OR BOLTS FOR STEEL UNITS AND ALUMINUM RIVETS AND BOLTS FOR ALUMINUM UNITS. FOR THE 60" THROUGH 96" DIAMETER APRON ENDWALL SIZES, THE REINFORCED EDGES AND CENTER PANEL SEAMS SHALL BE FURTHER REINFORCED WITH GALVANIZED STEEL OR ALUMINUM STIFFENER ANGLES. THE ANGLES SHALL BE ATTACHED BY GALVANIZED NUTS AND BOLTS FOR STEEL UNITS AND ALUMINUM NUTS AND BOLTS FOR ALUMINUM UNITS.




WHERE TWO OR MORE PIPES WITH APRON ENDWALLS ARE LAID ADJACENT TO EACH OTHER, THEY SHALL BE SEPARATED BY A DISTANCE SUFFICIENT TO PROVIDE A MINIMUM CLEARANCE OF 6 INCHES BETWEEN APRON ENDWALLS.

① FOR PIPE SIZES UP TO 60" DIAMETER, A 180° ROLLED EDGE MAY BE USED INSTEAD OF STEEL ROD REINFORCEMENT. SEE SECTION A-A.

APRON ENDWALLS FOR CULVERT PIPE

STATE OF WISCONSIN
DEPARTMENT OF TRANSPORTATION

APPROVED
11/30/94
DATE
CHIEF ROADWAY DEVELOPMENT ENGINEER
FHWA

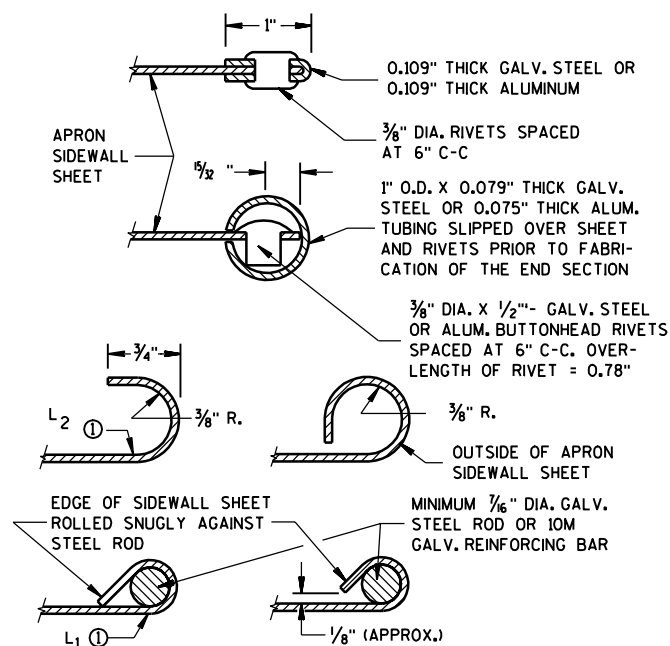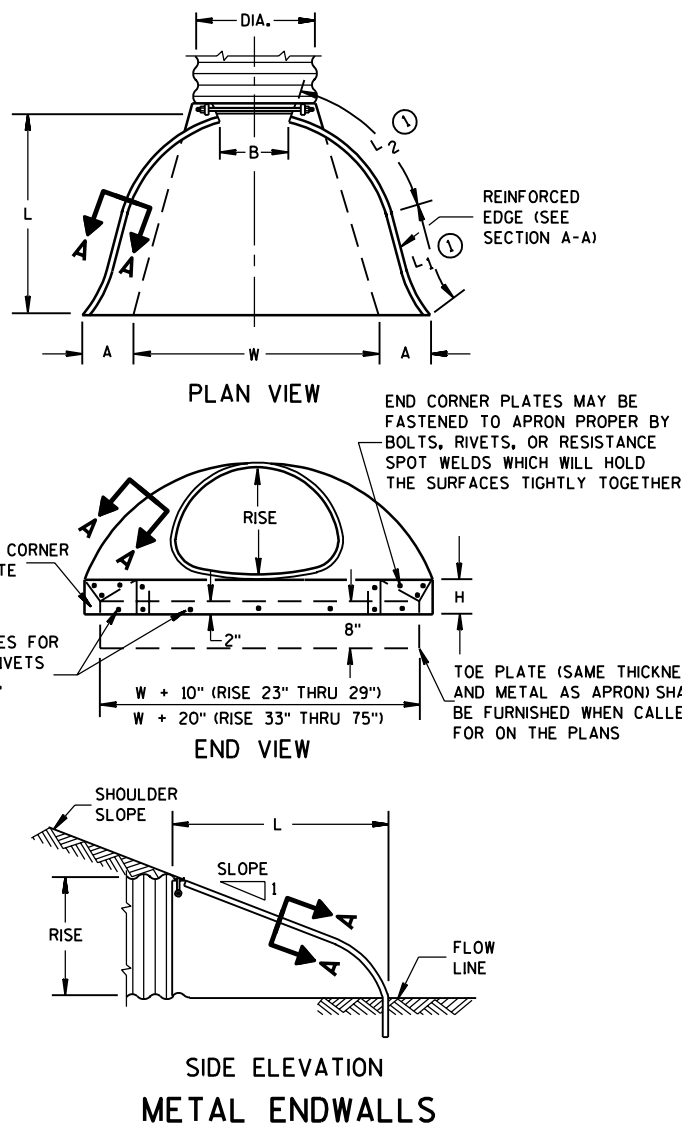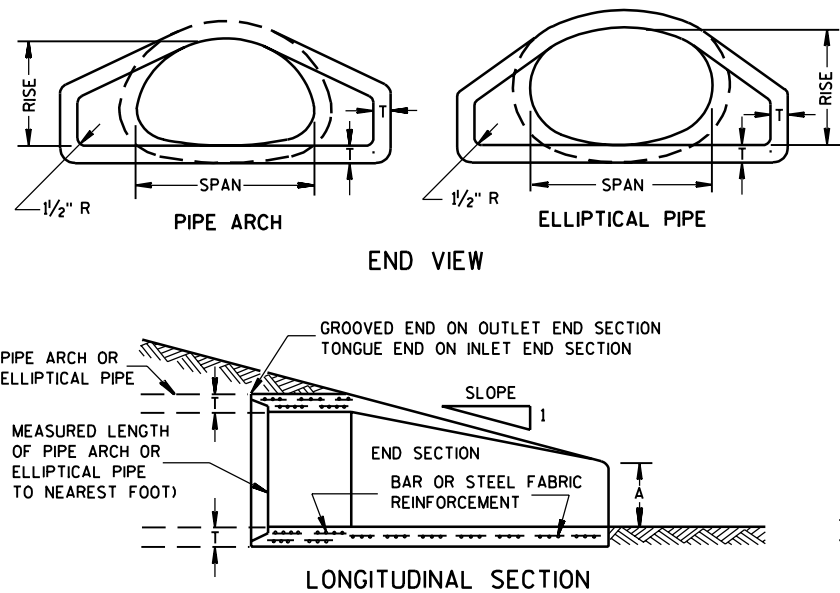


SECTION A-A

2- 2 ² / ₃ " x 1 ¹ / ₂ " CORRUGATIONS													
EQUIV. DIA. (Inches)	(Inches)		MIN. THICK. (Inches)		DIMENSIONS (Inches)							APPROX. SLOPE	BODY
	SPAN	RISE	STEEL	ALUM.	A	B	H	L	L ₁	L ₂	W		
					(±1")	(MAX.)	(±1")	(±1 ¹ / ₂ ")	⓪	⓪	(±2")		
15	17	13	.064	.060	7	9	6	19	14	16	30	2 ¹ / ₂ to 1	1 Pc.
18	21	15	.064	.060	7	10	6	23	14	19 ³ / ₈	36	2 ¹ / ₂ to 1	1 Pc.
21	24	18	.064	.060	8	12	6	28	18	21 ¹ / ₄	42	2 ¹ / ₂ to 1	1 Pc.
24	28	20	.064	.060	9	14	6	32	18	27 ¹ / ₂	48	2 ¹ / ₂ to 1	1 Pc.
30	35	24	.079	.075	10	16	6	39	18	37 ⁵ / ₈	60	2 ¹ / ₂ to 1	1 Pc.
36	42	29	.079	.075	12	18	8	46	24	45 ³ / ₈	75	2 ¹ / ₂ to 1	1 Pc.
42	49	33	.109	.105	13	21	9	53	24	54 ³ / ₄	85	2 ¹ / ₂ to 1	2 Pc.
48	57	38	.109	.105	18	26	12	63	24	68	90	2 ¹ / ₂ to 1	3 Pc.
54	64	43	.109	.105	18	30	12	70	24	72 ³ / ₄	102	2 ¹ / ₄ to 1	3 Pc.
60	71	47	.109*	.105*	18	33	12	77	30	82 ¹ / ₄	114	2 ¹ / ₄ to 1	3 Pc.
66	77	52	.109*	.105*	18	36	12	77	—	—	126	2 to 1	3 Pc.
72	83	57	.109*	.105*	18	39	12	77	—	—	138	2 to 1	3 Pc.

3" X 1" CORRUGATIONS													
EQUIV. DIA. (Inches)	(Inches)		MIN. THICK. (Inches)		DIMENSIONS (Inches)							APPROX. SLOPE	BODY
	SPAN	RISE	STEEL	ALUM.	A	B	H	L	L ₁	L ₂	W		
					(±1")	(MAX.)	(±1")	(±1 ¹ / ₂ ")	⓪	⓪	(±2")		
48	53	41	.109	.105	18	26	12	63	24	72 ³ / ₄	90	2 ¹ / ₂ to 1	2 Pc.
54	60	46	.109	.105	18	30	12	70	30	82 ¹ / ₄	102	2 to 1	2 Pc.
60	66	51	.109*	.105*	18	33	12	77	—	—	114	1 ¹ / ₂ to 1	3 Pc.
66	73	55	.109*	.105*	18	36	12	77	—	—	126	1 ¹ / ₂ to 1	3 Pc.
72	81	59	.109*	.105*	18	39	12	77	—	—	138	2 to 1	3 Pc.
78	87	63	.109*	.105*	22	38	12	77	—	—	148	1 ¹ / ₂ to 1	3 Pc.
84	95	67	.109*	.105*	22	34	12	77	—	—	162	1 ¹ / ₂ to 1	3 Pc.
90	103	71	.109*	.105*	22	38	12	77	—	—	174	1 ¹ / ₂ to 1	3 Pc.
96	112	75	.109*	.105*	24	40	12	77	—	—	174	1 ¹ / ₂ to 1	3 Pc.

NOTE: ALL SPLICES TO BE LAP RIVETED OR BOLTED. * EXCEPT CENTER PANEL SEE GENERAL NOTES

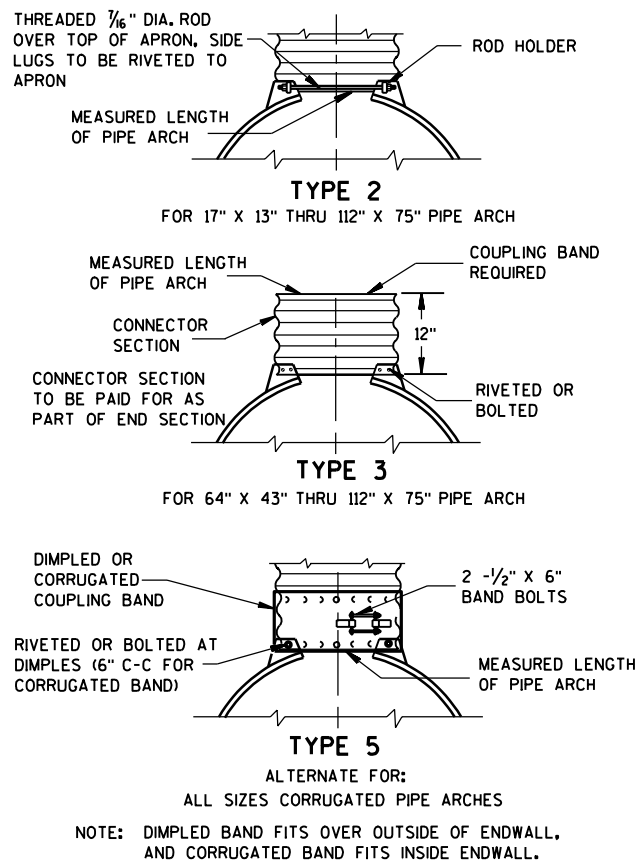

CONNECTION DETAILS

REINFORCED CONCRETE PIPE ARCH									
EQUIV. DIA. (Inches)	DIMENSIONS (Inches)							APPROX. SLOPE	
	** SPAN	** RISE	T	A	B	C	D		E
24	29	18	3	8½	39	33	72	48	3 to 1
30	36	22	3½	9½	50	46	96	60	3 to 1
36	44	27	4	11⅞	60	36	96	72	3 to 1
42	51	31	4½	15⅞	60	36	96	78	3 to 1
48	58	36	5	21	60	36	96	84	3 to 1
54	65	40	5½	25½	60	36	96	90	3 to 1
60	73	45	6	31	60	36	96	96	3 to 1
72	88	54	7	31	60	39	99	120	2 to 1
84	102	62	8	28½	83	19	102	144	2 to 1

REINFORCED CONCRETE ELLIPTICAL PIPE									
EQUIV. DIA. (Inches)	DIMENSIONS (Inches)							APPROX. SLOPE	
	** SPAN	** RISE	T	A	B	C	D		E
24	30	19	3¼	8½	39	33	72	48	3 to 1
30	38	24	3¾	9½	54	18	72	60	3 to 1
36	45	29	4½	11⅞	60	24	84	72	2½ to 1
42	53	34	5	15¾	60	36	96	78	2½ to 1
48	60	38	5½	21	60	36	96	84	2½ to 1
54	68	43	6	25½	60	36	96	90	2½ to 1
60	76	48	6½	30	60	36	96	96	2½ to 1

**NOMINAL SIZE

GENERAL NOTES

DETAILS OF CONSTRUCTION, MATERIALS AND WORKMANSHIP NOT SHOWN ON THIS DRAWING SHALL CONFORM TO THE PERTINENT REQUIREMENTS OF THE STANDARD SPECIFICATIONS AND THE APPLICABLE SPECIAL PROVISIONS.

CONCRETE APRON ENDWALLS MAY NOT BE USED WITH GALVANIZED STEEL OR ALUMINUM CULVERT PIPE OR VISE VERSA. GALVANIZED STEEL OR ALUMINUM APRON ENDWALLS SHALL NORMALLY BE INSTALLED ON CULVERT PIPE OF THE SAME METAL.

ALL THREE PIECE STEEL APRON ENDWALLS FOR 66" X 51" PIPE ARCH AND LARGER SHALL HAVE 0.109" SIDES AND 0.138" CENTER PANELS. ALL THREE PIECE ALUMINUM APRON ENDWALLS FOR 66" X 51" PIPE ARCH AND LARGER SHALL HAVE 0.105" SIDES AND 0.134" CENTER PANELS. THE WIDTH OF CENTER PANELS SHALL BE GREATER THAN 20 PERCENT OF THE PIPE ARCH PERIMETER.

LAP SEAMS SHALL BE TIGHTLY JOINED BY GALVANIZED RIVETS OR BOLTS FOR STEEL UNITS AND ALUMINUM RIVETS AND BOLTS FOR ALUMINUM UNITS. FOR THE 77" X 52" THROUGH 112" X 75" APRON ENDWALL SIZES, THE REINFORCED EDGES AND CENTER PANEL SEAMS SHALL BE FURTHER REINFORCED WITH GALVANIZED STEEL OR ALUMINUM STIFFENER ANGLES. THE ANGLES SHALL BE ATTACHED BY GALVANIZED NUTS AND BOLTS FOR STEEL UNITS AND ALUMINUM NUTS AND BOLTS FOR ALUMINUM UNITS.

WHERE TWO OR MORE PIPES WITH APRON ENDWALLS ARE LAID ADJACENT TO EACH OTHER, THEY SHALL BE SEPARATED BY A DISTANCE SUFFICIENT TO PROVIDE A MINIMUM CLEARANCE OF 6 INCHES BETWEEN APRON ENDWALLS.

① FOR PIPE ARCH SIZES UP TO 73" X 55" A 180° ROLLED EDGE MAY BE USED INSTEAD OF STEEL ROD REINFORCEMENT. SEE SECTION A-A.

APRON ENDWALLS FOR PIPE ARCH AND ELLIPTICAL PIPE


STATE OF WISCONSIN
DEPARTMENT OF TRANSPORTATION

APPROVED


11/30/94
DATE

FHWA

CHIEF ROADWAY DEVELOPMENT ENGINEER

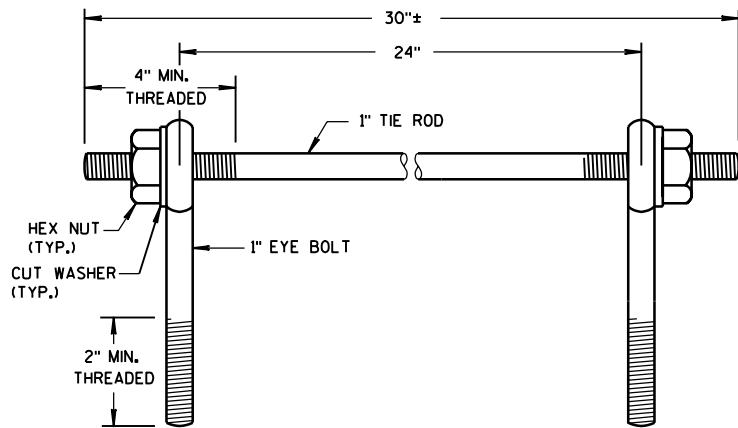

EYE BOLTS AND TIE ROD

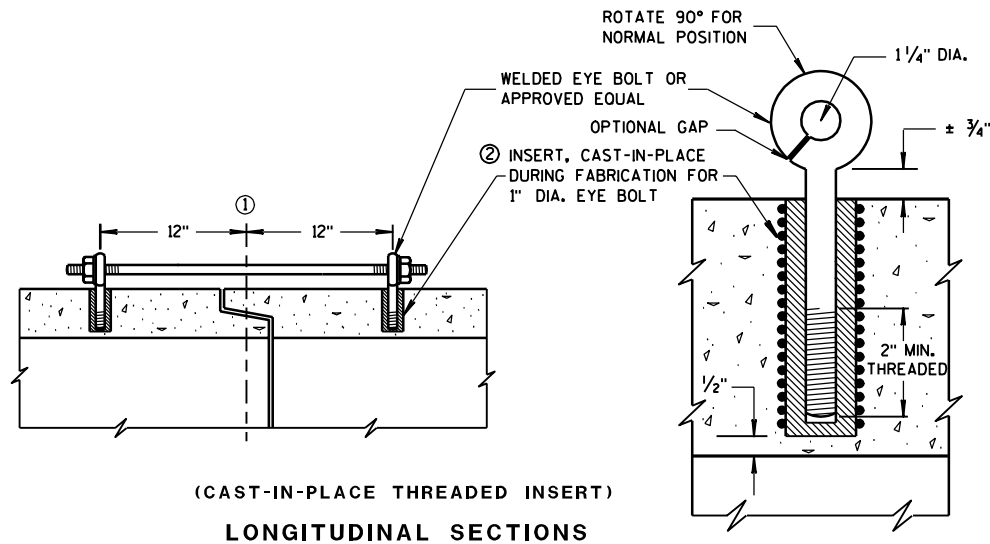

GENERAL NOTES


DETAILS OF CONSTRUCTION, MATERIALS, AND WORKMANSHIP NOT SHOWN ON THIS DRAWING SHALL CONFORM TO THE PERTINENT REQUIREMENTS OF THE STANDARD SPECIFICATIONS AND APPLICABLE SPECIAL PROVISIONS.

CONCRETE CULVERT PIPE SHALL BE TIED TOGETHER IN THE MANNER ILLUSTRATED BY THIS DETAIL AT LOCATIONS DESIGNATED ON THE PLAN. THE CONTRACTOR MAY USE EITHER ALTERNATE 1, 2 OR 3 FOR DRAINAGE STRUCTURES. ONLY ALTERNATE 1 AND 3 MAY BE USED FOR CATTLE PASSES. UNLESS OTHERWISE STATED IN THE CONTRACT THE MATERIALS, FABRICATION AND WORK NECESSARY TO TIE CULVERT PIPE AS INDICED ON THE PLANS AND BY THIS DETAIL WILL BE CONSIDERED INCIDENTAL TO CULVERT PIPE, REINFORCED CONCRETE CULVERT PIPE, OR REINFORCED CONCRETE PIPE CATTLE PASS.


DETAILED DRAWINGS FOR PROPOSED ALTERNATE DESIGNS FOR JOINT TIES SHALL BE SUBMITTED TO THE ENGINEER FOR APPROVAL.

1. C. OF TONGUE AND GROOVE OR BELL AND SPIGOT JOINTS.
2. THE INSIDE OF THE THREADED INSERTS SHALL BE CLEAN TO ALLOW THE INSERTION OF THREADED EYE BOLTS.
3. HOLES SHALL BE CAST-IN-PLACE OR DRILLED 12 INCHES FROM C. OF TONGUE AND GROOVE.
4. BOLT PROJECTION INSIDE OF PIPE SHALL NOT EXCEED 2 INCHES.
5. OPENING TO BE ROD DIAMETER PLUS 1 INCH.
6. LENGTH ADEQUATE TO EXTEND TO WITHIN 1/2 INCH OF THE INNER SURFACE OF THE PIPE.

EYE BOLT AND TIE ROD ASSEMBLY (ALTERNATE NO. 1)

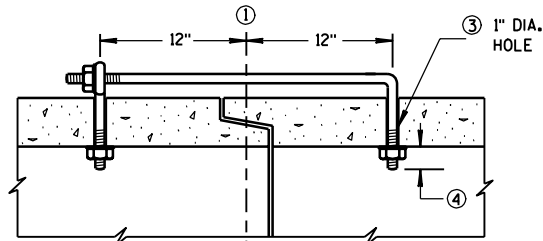

(TONGUE & GROOVE PIPE)

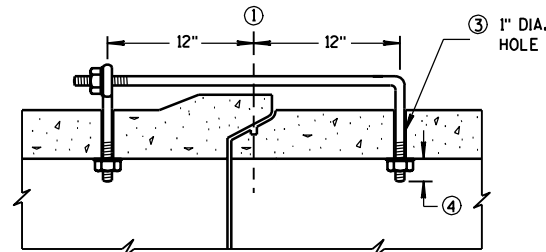

(MODIFIED BELL PIPE)
LONGITUDINAL SECTION


EYE BOLT DIMENSION TABLE

PIPE SIZE	L = LENGTH	
	TONGUE & GROOVE PIPE	MODIFIED BELL PIPE
18" TO 24"	4 1/2"	6 1/4"
30"	5"	7"
36"	5 1/2"	7"
42"	6"	
48"	6 1/2"	
60"	7 1/2"	
66"	8"	


ADJUSTABLE TIE ROD TABLE

PIPE DIAMETER	TIE ROD DIAMETER	D	L ₁	N
12-60	5/8	5/8	5	1/2
66-84	3/4	3/4	5	1/2
90-108	1	1	7	1 1/8

DIMENSIONS SHOWN ARE IN INCHES

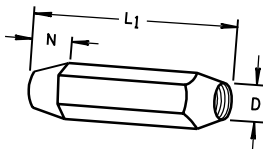


TAPERED

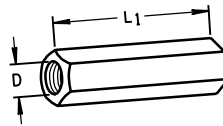

PLAIN


RIGHT AND LEFT THREADS

SLEEVE NUTS

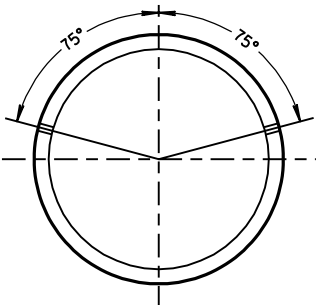


PLACEMENT OF (2) CAST-IN-PLACE
INSERTS OR HOLES DURING FABRICATION
FOR PIPE SECTIONS REQUIRING TIE RODS

TRANSVERSE SECTION

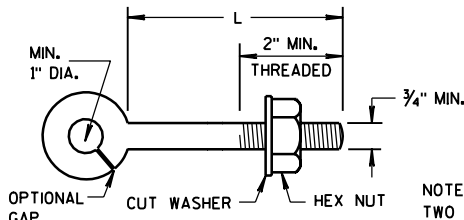

EYE BOLT


NOTE:
TWO EYE BOLTS MAY BE USED WITH
A 30" LONG THREADED ROD IN LIEU
OF THE 90° BENT TIE ROD.

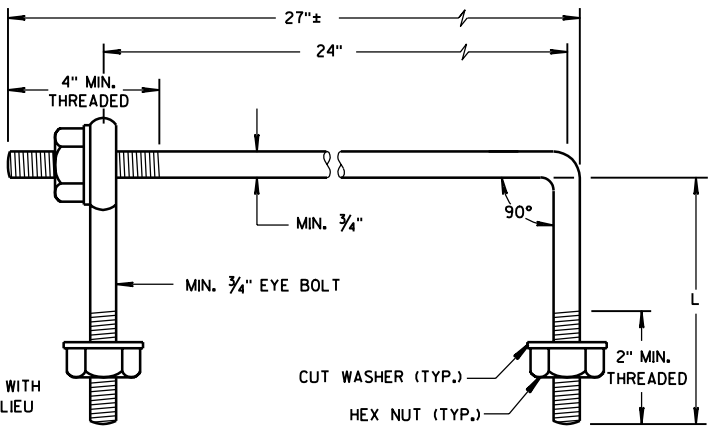

EYE BOLT AND TIE ROD

(JOINT TIES FOR 18" TO 66" DIA. CONCRETE PIPE)

EYE BOLT AND TIE ROD ASSEMBLY (ALTERNATE NO. 2)

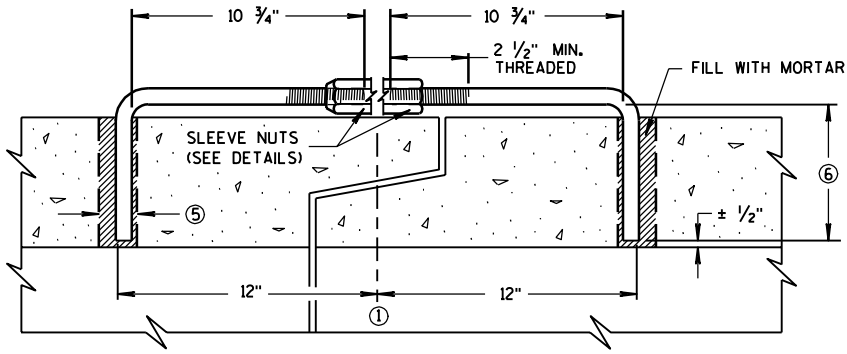

LONGITUDINAL SECTION


(JOINT TIES FOR 12" TO 108" DIA. CONCRETE PIPE)

ADJUSTABLE TIE ROD (ALTERNATE NO. 3)

JOINT TIES FOR
CONCRETE PIPE

STATE OF WISCONSIN
DEPARTMENT OF TRANSPORTATION

APPROVED
12/17/07 /S/ Jerry H. Zogg
DATE ROADWAY STANDARDS DEVELOPMENT
ENGINEER
FHWA

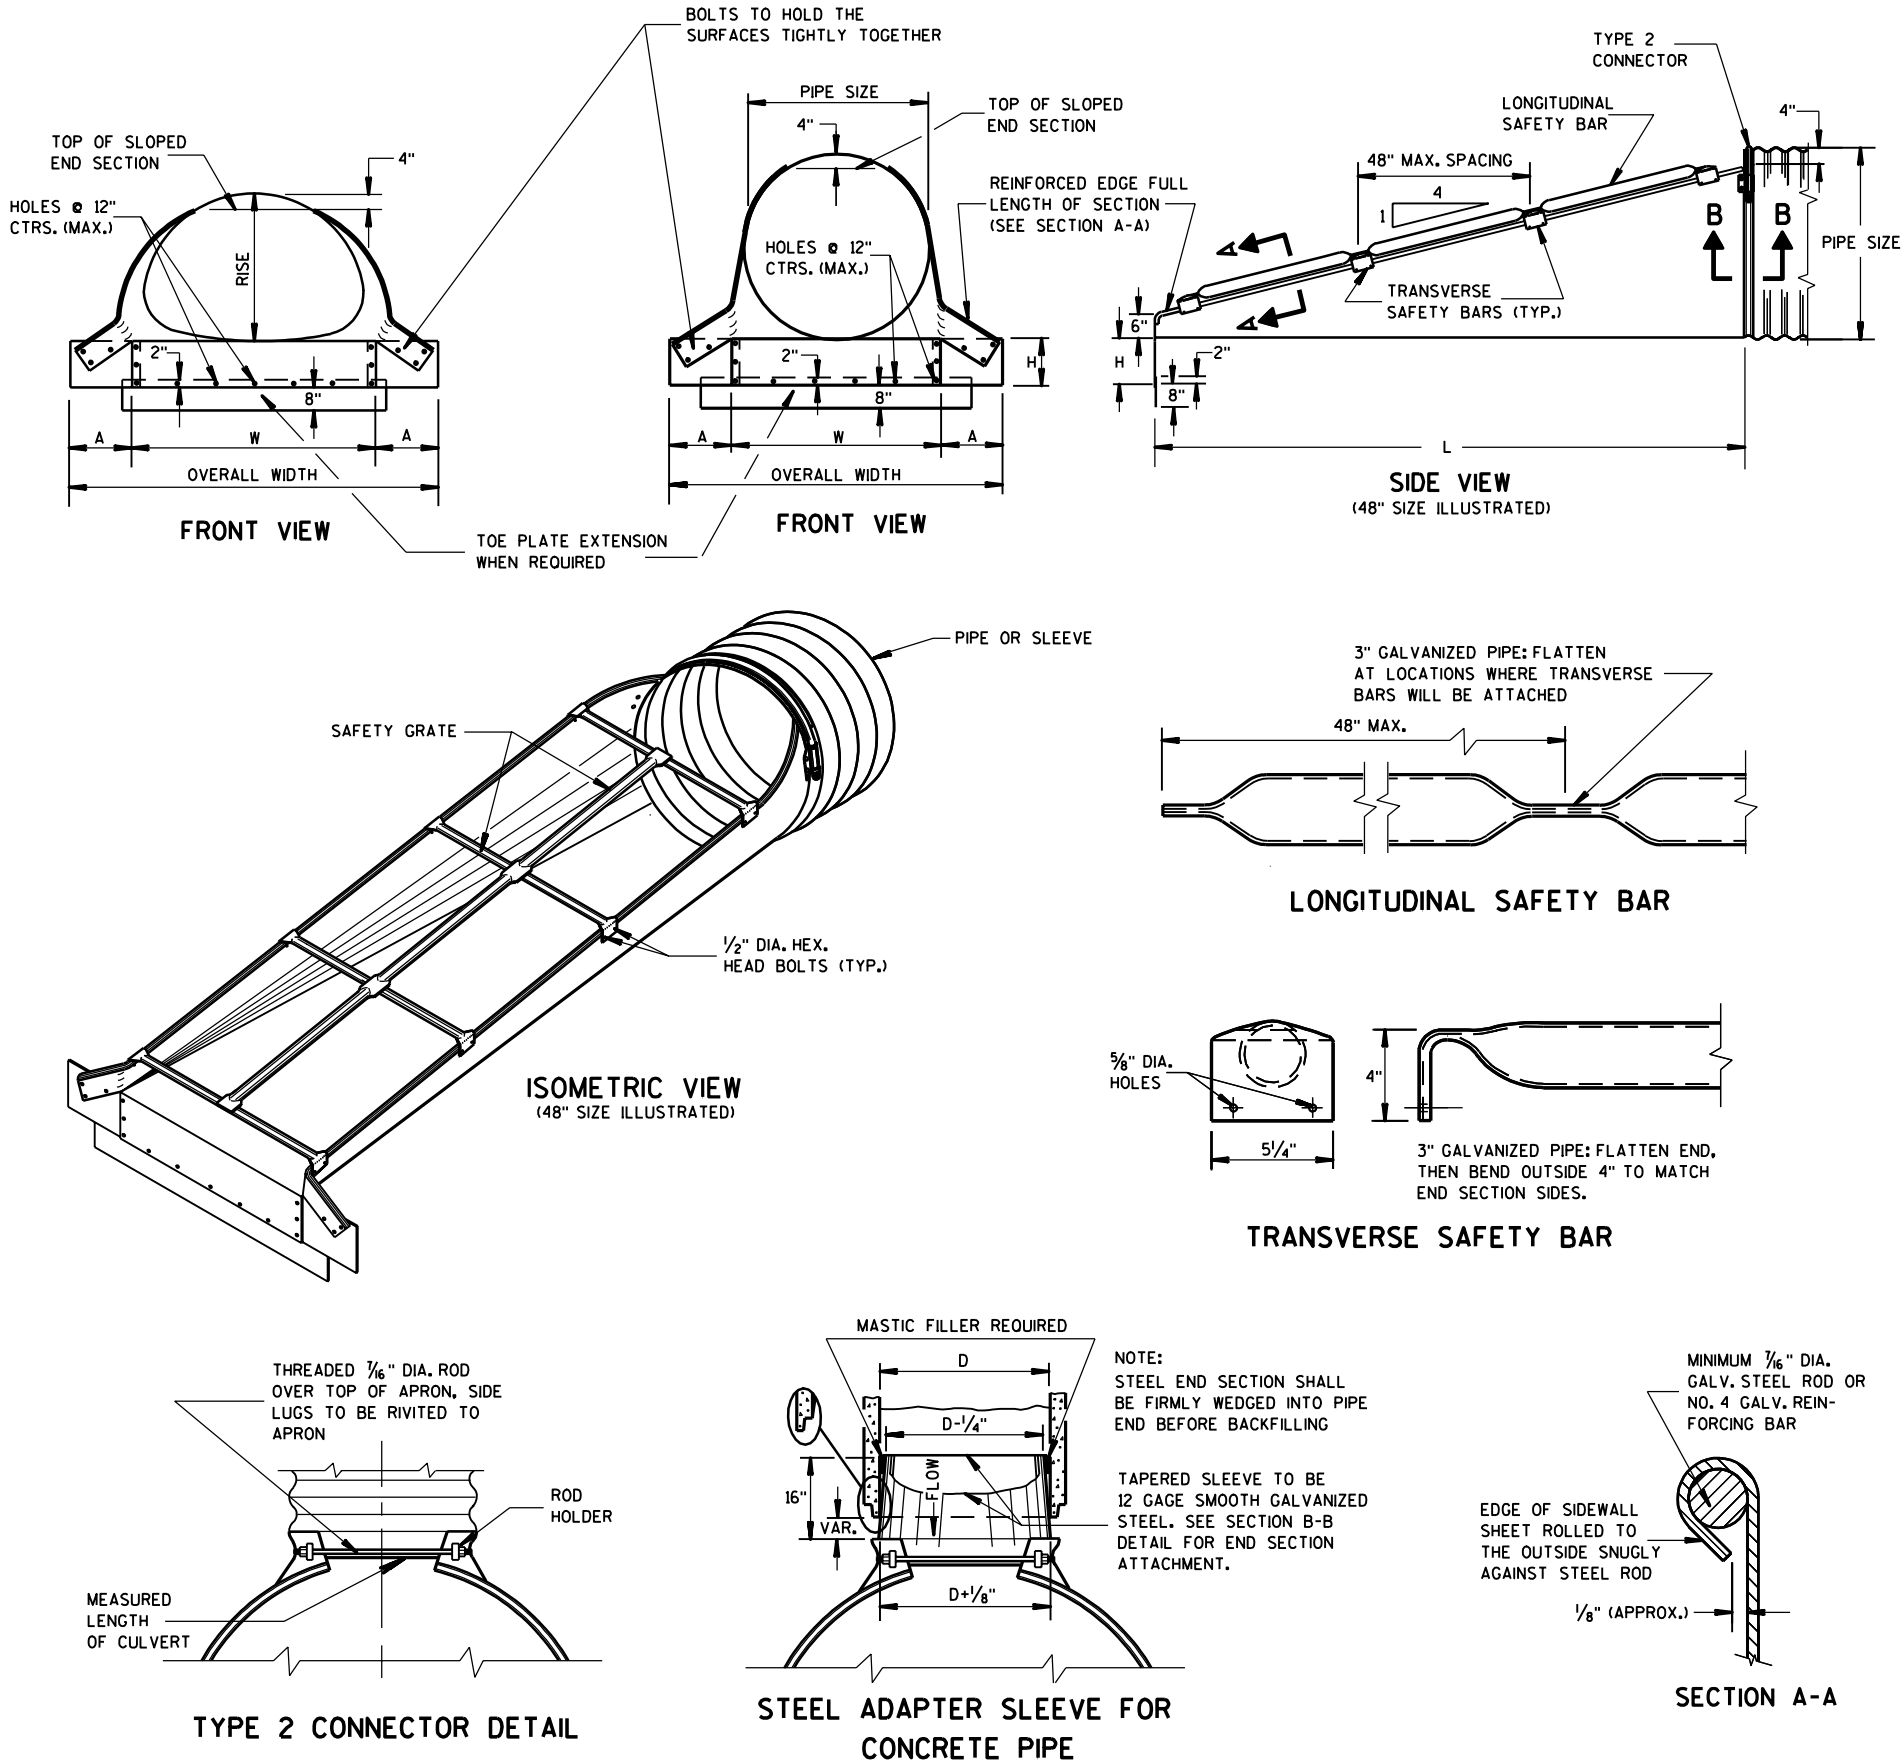

GENERAL NOTES

DETAILS OF CONSTRUCTION, MATERIALS AND WORKMANSHIP NOT SHOWN ON THIS DRAWING SHALL CONFORM TO THE PERTINENT REQUIREMENTS OF THE STANDARD SPECIFICATIONS AND APPLICABLE SPECIAL PROVISIONS.

SAFETY GRATES SHALL BE FABRICATED FROM 3-INCH DIAMETER GALVANIZED PIPE MEETING THE REQUIREMENTS OF ASTM A-53, GRADE B, SCHEDULE 40 OR APPROVED EQUAL. THE LONGITUDINAL BAR SHALL BE WELDED TO THE TRANSVERSE BARS WHERE THE BARS CROSS. THE NUMBER OF TRANSVERSE BARS REQUIRED WILL VARY DEPENDING ON THE LENGTH OF THE END SECTION.

SLOPED STEEL ENDWALLS LOCATED AT THE ENDS OF CONCRETE CULVERT PIPE SHALL BE FURNISHED WITH STEEL ADAPTER SLEEVES.

SLOPED STEEL ENDWALLS FOR CULVERT PIPE CROSS DRAINS									
PIPE DIA. (IN.)	MIN. THICK.		DIMENSIONS (Inches)					L DIMENSIONS	
	IN.	GAGE	A	H	W	OVERALL WIDTH	SLOPE	LENGTH INCHES	
36	.109	12	12	9	42	66	4:1	104	
42	.109	12	16	12	48	80	4:1	128	
48	.109	12	16	12	54	86	4:1	152	
54	.109	12	16	12	60	92	4:1	176	
60	.109	12	16	12	66	98	4:1	200	

SLOPED STEEL ENDWALLS FOR PIPE ARCH CROSS DRAINS									
EQUIV. DIA. (IN.)	INCHES		MIN. THICK.		DIMENSIONS (Inches)				
	SPAN	RISE	IN.	GAGE	A	H	W	OVERALL WIDTH	L DIMENSIONS
36	42	29	.079	12	12	9	48	72	4:1 76
42	49	33	.109	12	16	12	55	87	4:1 92
48	57	38	.109	12	16	12	63	95	4:1 112
54	64	43	.109	12	16	12	70	102	4:1 132
60	71	47	.109	12	16	12	77	109	4:1 148

DESIGN NOTE:(WILL NOT APPEAR ON CONTRACT PLANS)

THE INTENDED APPLICATION OF SLOPED STEEL ENDWALLS IS A SAFETY TREATMENT FOR CROSS DRAIN CULVERT PIPES/ARCHES LOCATED WITHIN THE CLEAR ZONE AND RECOVERY AREA OF RURAL HIGHWAYS. THIS SAFETY TREATMENT MAY BE A COST-EFFECTIVE ALTERNATIVE TO EXTENDING CULVERT PIPE OR SHIELDING THE CULVERT ENDS WITH TRAFFIC BARRIER. SLOPED STEEL ENDWALLS SHOULD NOT BE USED IF SIGNIFICANT HYDRAULIC CAPACITY OR CLOGGING PROBLEMS COULD RESULT.


USE 90,XXX BID ITEMS: SLOPED STEEL ENDWALL FOR CULVERT PIPE, CROSS DRAIN, (SIZE); OR SLOPED STEEL ENDWALL FOR PIPE ARCH, CROSS DRAIN, (SIZE).

SLOPED STEEL ENDWALLS FOR CULVERT PIPE AND PIPE ARCH CROSS DRAINS

STATE OF WISCONSIN
DEPARTMENT OF TRANSPORTATION

APPROVED
7/6/90
DATE
FHWA

STATE DESIGN ENGINEER FOR HWYS.

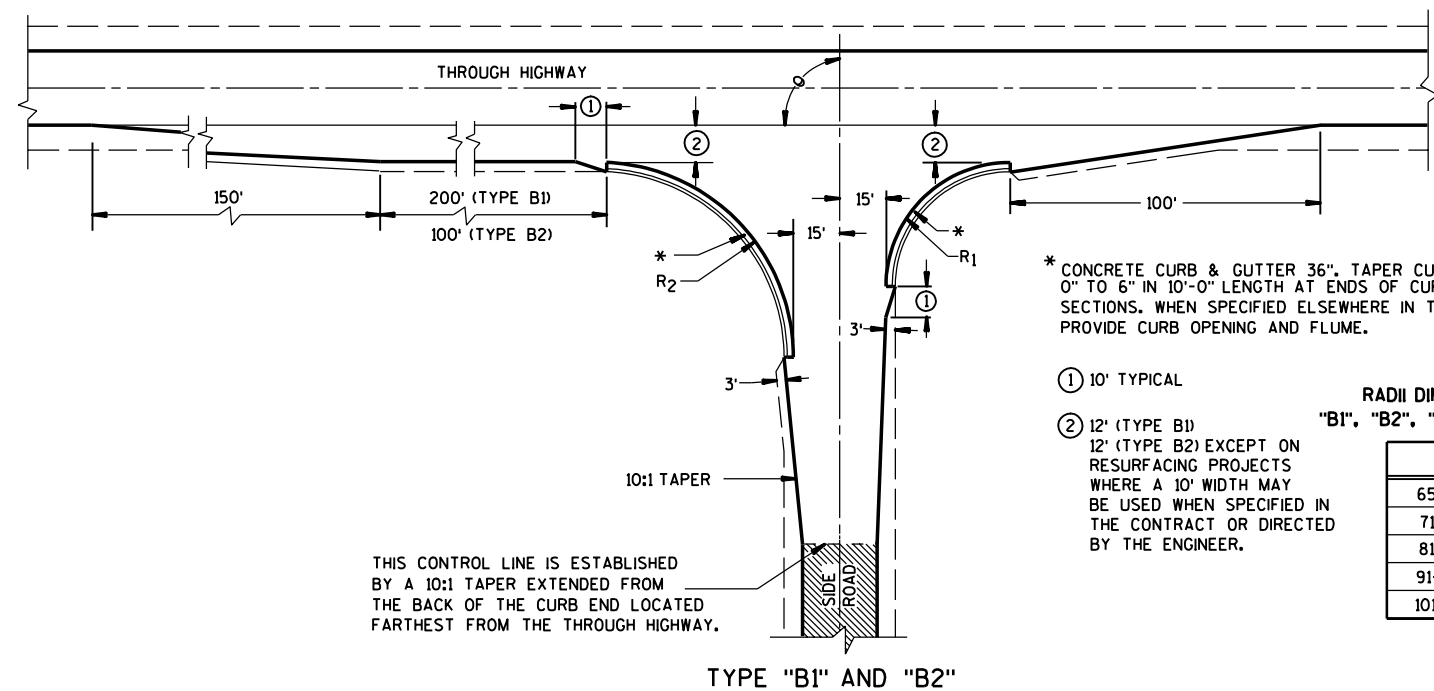

GENERAL NOTES

DESIGNS MAY BE USED INTERCHANGEABLY IN COMBINATION OR SEPARATELY FOR ANY ONE COMPLETE INTERSECTION DEPENDING UPON INTERSECTION ANGLE AND SURFACING OF EACH APPROACH ROADWAY.


SIDE ROAD SURFACING NOTE

WHEN THE SIDE ROAD IS NOT PRESENTLY PAVED, PAVEMENT SHALL BE PLACED TO THE LIMITS SHOWN UNLESS OTHERWISE PROVIDED IN THE CONTRACT. WHERE THE CONSTRUCTION LIMITS ARE BEYOND THE PAVING LIMITS, CRUSHED AGGREGATE SURFACING SHALL BE PLACED BETWEEN THE PAVING LIMITS AND CONSTRUCTION LIMITS.




WHEN THE SIDE ROAD IS PRESENTLY PAVED, NEW PAVEMENT SHALL BE PLACED TO THE LIMITS OF DESIGN AS SHOWN AND BEYOND, IF NECESSARY, TO MEET EXISTING PAVEMENT.

WHEN THE SIDE ROAD IS THE CONSTRUCTION PROJECT, THE INTERSECTION SURFACING SHALL BE THE SAME AS FOR THE PROJECT.

EXISTING SURFACE

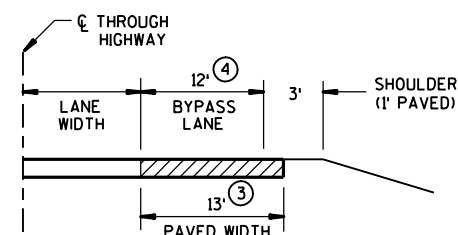



SECTION A-A
(SHOWING BYPASS LANE AND SHOULDER)

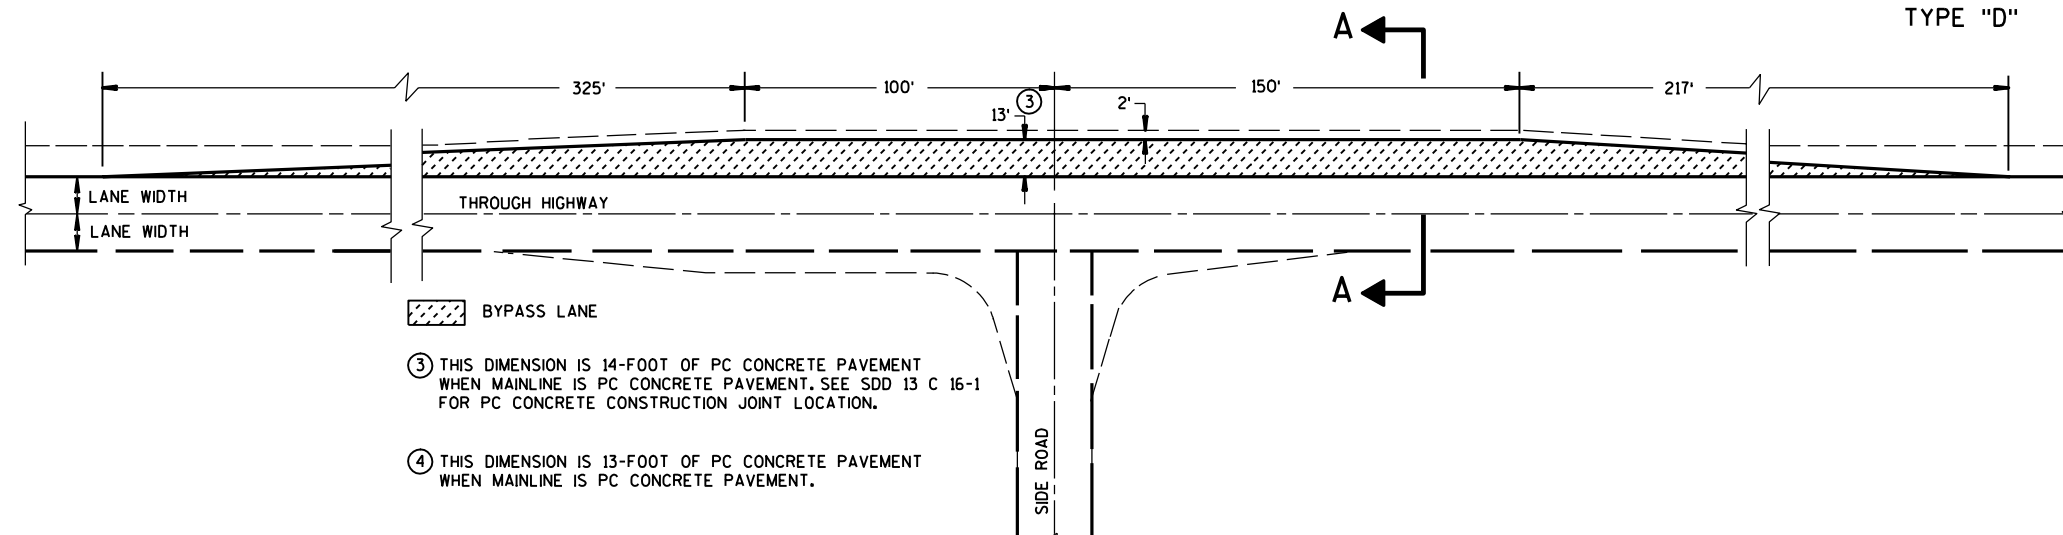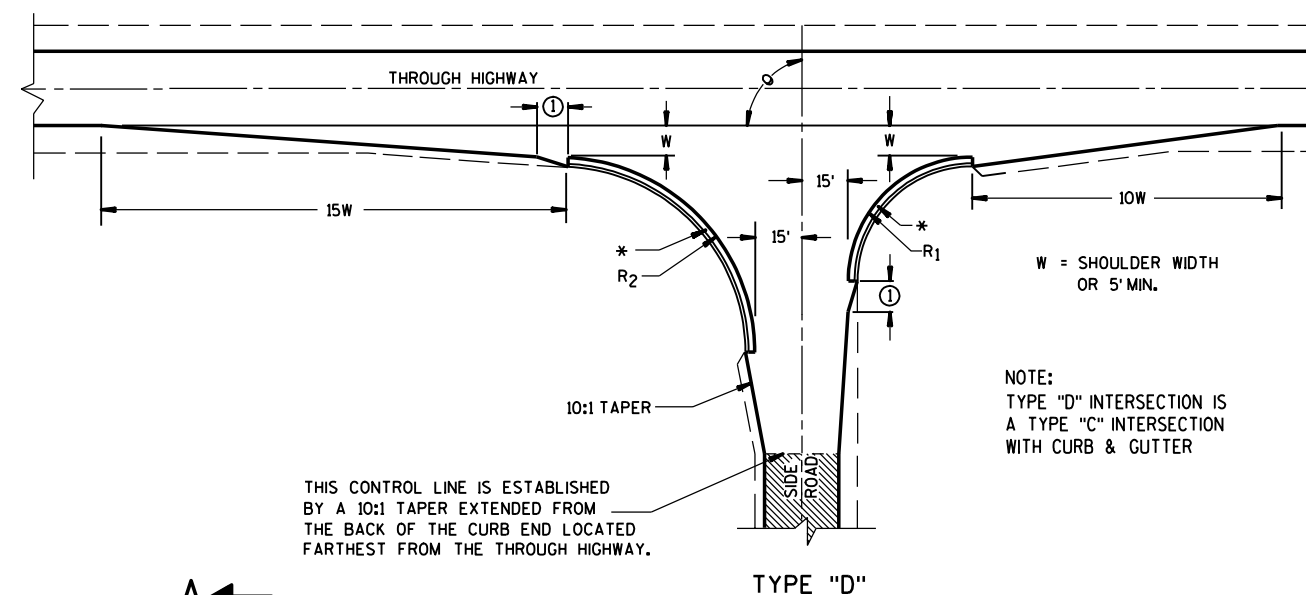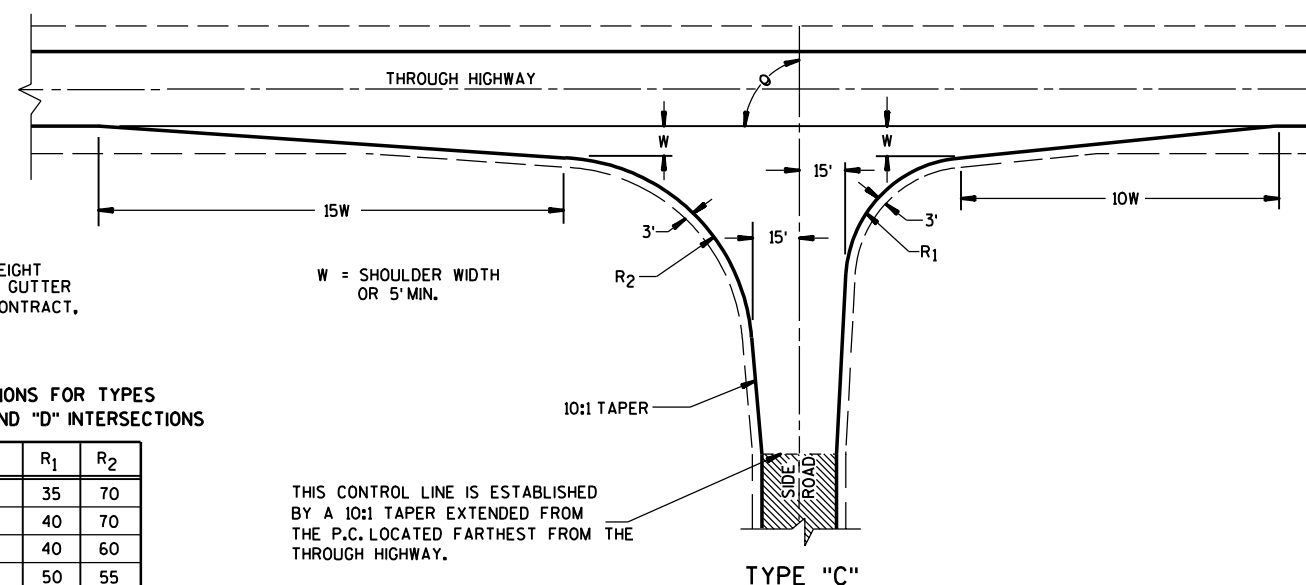

TEE INTERSECTION BYPASS LANE DETAIL


AT-GRADE SIDE ROAD
INTERSECTION, TYPES "B1", "B2", "C"
AND "D" AND TEE INTERSECTION
BYPASS LANE

STATE OF WISCONSIN
DEPARTMENT OF TRANSPORTATION

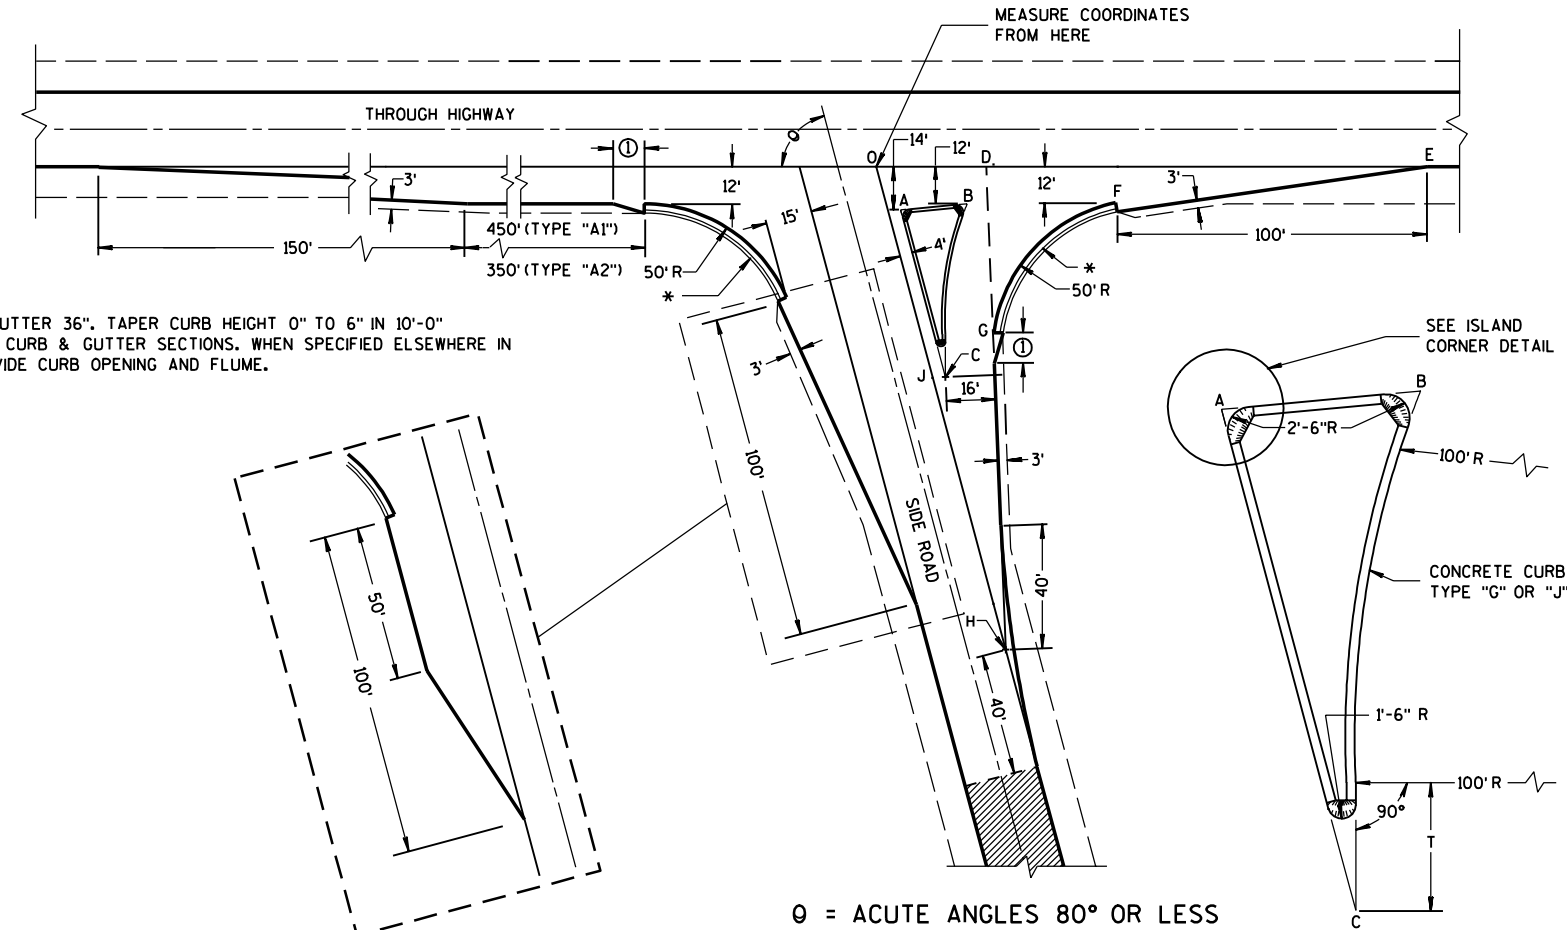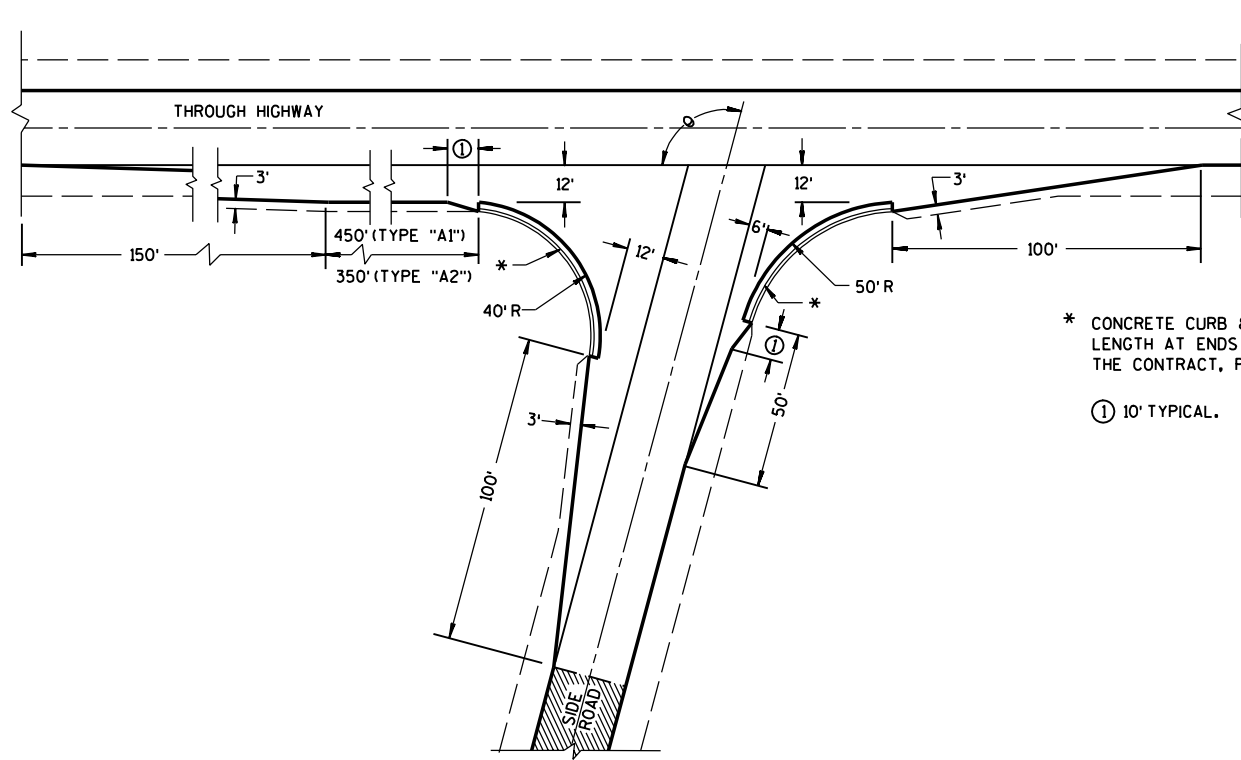

* CONCRETE CURB & GUTTER 36". TAPER CURB HEIGHT 0" TO 6" IN 10'-0" LENGTH AT ENDS OF CURB & GUTTER SECTIONS. WHEN SPECIFIED ELSEWHERE IN THE CONTRACT, PROVIDE CURB OPENING AND FLUME.

① 10' TYPICAL.

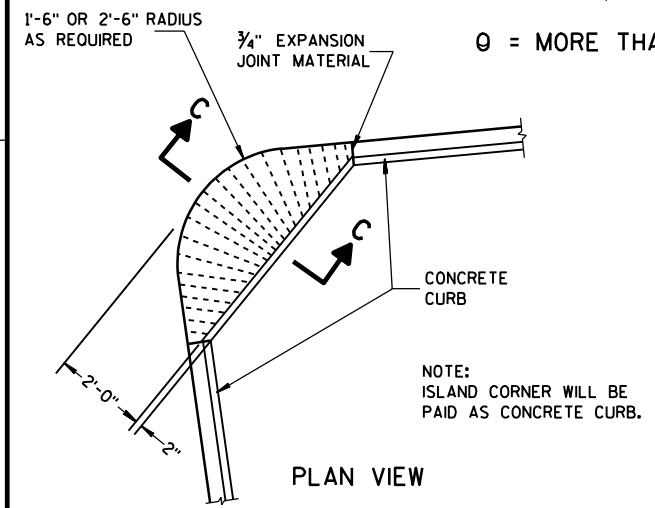

$\theta = \text{MORE THAN } 80^\circ$


EXISTING SURFACE

SIDE ROAD WIDENING AND TAPER REQUIRED WHERE THE THROUGH HIGHWAY CARRIES TWO-WAY TRAFFIC
 $\theta = \text{ACUTE ANGLES } 70^\circ \text{ OR LESS}$

TABLE OF DIMENSIONS FOR
 VARIABLE SIDE ROAD INTERSECTION ANGLES
 (INTERPOLATE VALUES FOR ANGLES NOT SHOWN)

ANGLE θ DEGREES	COORDINATES IN FEET (MEASURED FROM POINT "O")								LENGTH IN FEET				
	A	B	C	D	E	F	G	H	AB	AC	T	OJ	OH
60	12.7	44.9	46.4	41.9	205.0	104.6	64.0	85.0	32.3	67.4	4.9	85.9	169.9
	-14.0	-12.0	-72.4	0.0	0.0	-12.0	-75.5	-147.1					
65	10.9	39.0	37.8	39.4	196.1	95.7	54.1	70.5	28.2	63.6	8.5	80.9	166.9
	-14.0	-12.0	-71.6	0.0	0.0	-12.0	-71.5	-151.3					
70	9.4	33.9	29.8	37.4	188.3	87.8	45.6	56.1	24.6	59.7	11.5	76.1	164.1
	-14.0	-12.0	-70.1	0.0	0.0	-12.0	-67.5	-154.2					
75	7.9	29.3	22.3	35.7	181.2	80.7	38.2	41.8	21.5	55.8	13.8	71.4	161.4
	-14.0	-12.0	-67.9	0.0	0.0	-12.0	-63.4	-155.9					
80	6.5	25.4	15.6	34.4	174.8	74.4	31.8	27.6	18.9	52.0	15.6	66.9	158.9
	-14.0	-12.0	-65.2	0.0	0.0	-12.0	-59.3	-156.5					

TYPE "A1" & "A2" SIDE ROAD INTERSECTION DETAILS

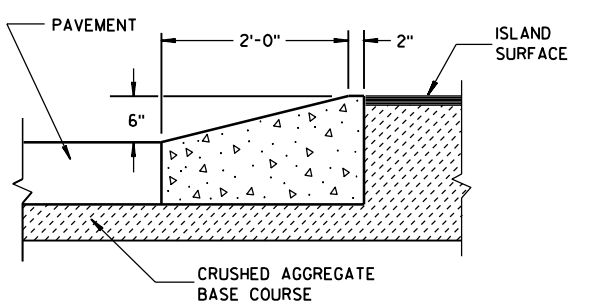

SECTION C-C





ISLAND CORNER DETAIL
 (TO BE CONSTRUCTED AT ALL ISLAND CORNERS)

AT-GRADE SIDE ROAD
 INTERSECTION, TYPE "A1" & "A2"




STATE OF WISCONSIN
 DEPARTMENT OF TRANSPORTATION

APPROVED
 12/17/02
 DATE
 FHWA



CHIEF ROADWAY DEVELOPMENT ENGINEER

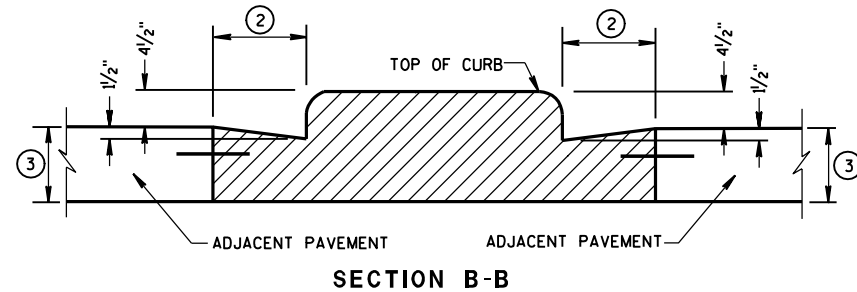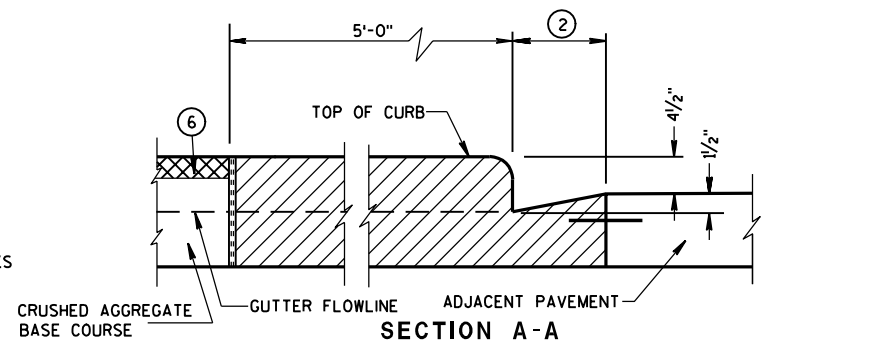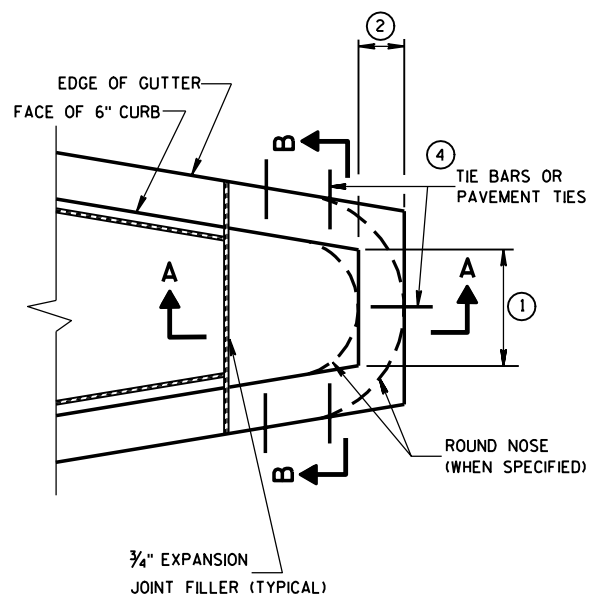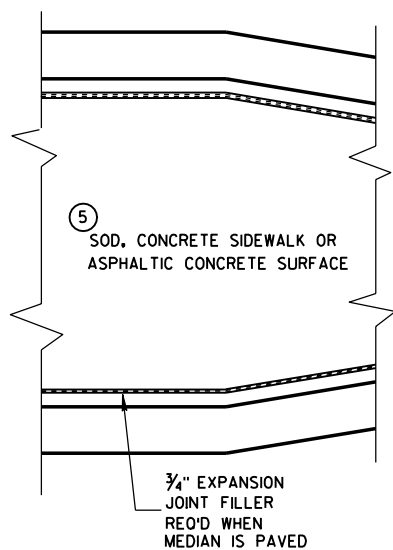


CONCRETE MEDIAN BLUNT NOSE DETAIL

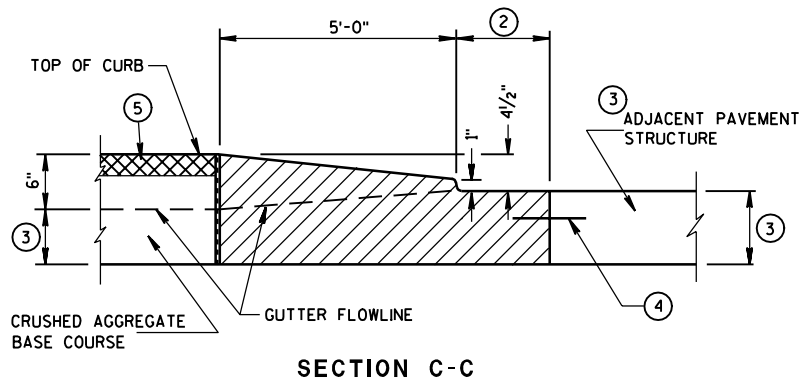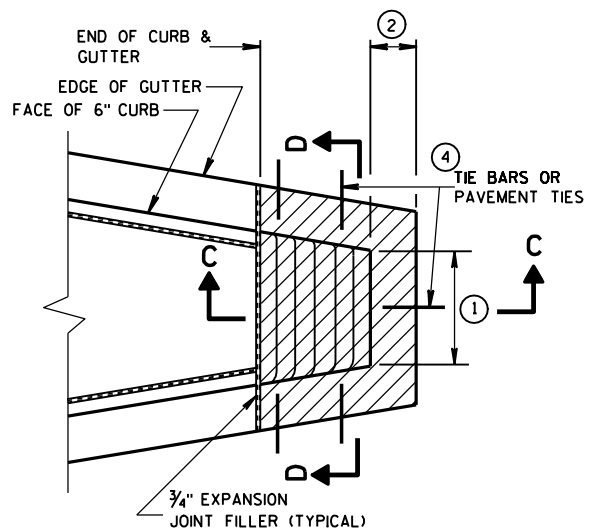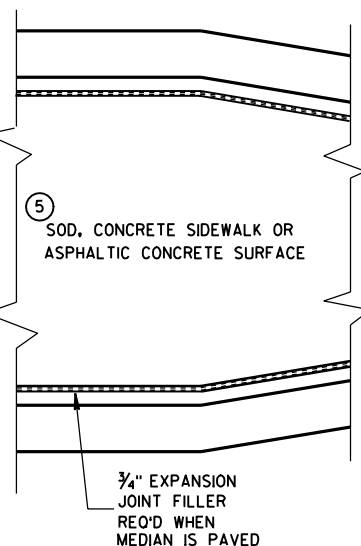

CONCRETE MEDIAN SLOPED NOSE TYPE 1

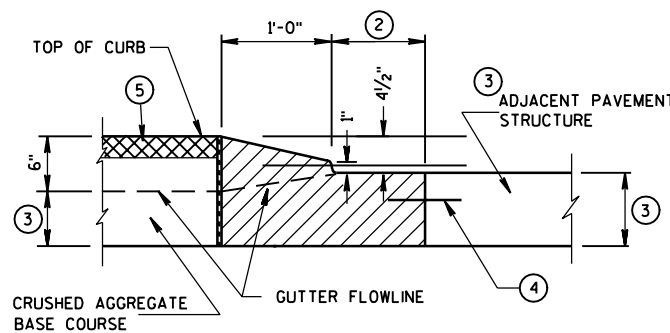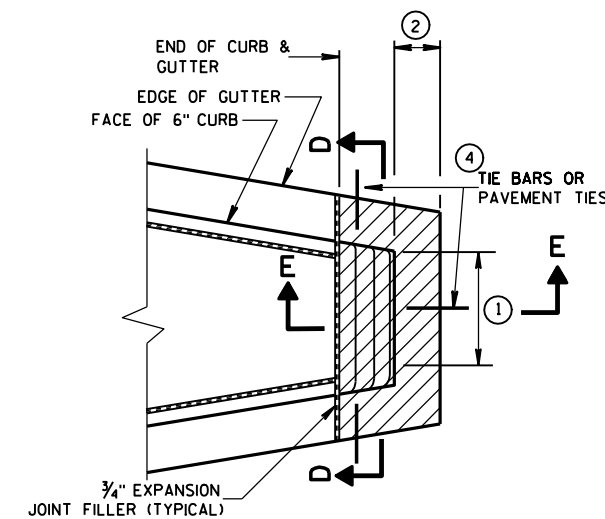

CONCRETE MEDIAN SLOPED NOSE TYPE 2

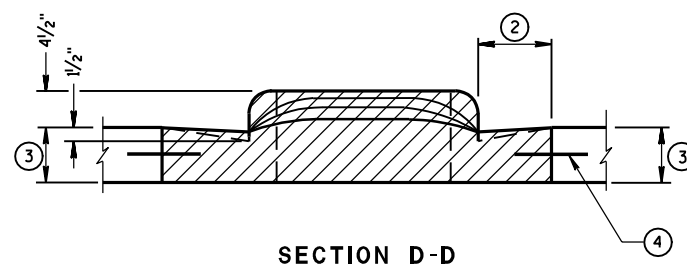

SECTION D-D

GENERAL NOTES

DETAILS OF CONSTRUCTION, MATERIALS AND WORKMANSHIP NOT SHOWN ON THIS DRAWING SHALL CONFORM TO THE PERTINENT REQUIREMENTS OF THE STANDARD SPECIFICATIONS AND THE APPLICABLE SPECIAL PROVISIONS.

- ① SEE PLAN FOR MEDIAN NOSE WIDTH AND RADIUS (FOR ROUND NOSE ALTERNATE).
- ② WIDTH OF GUTTER TO MATCH EXISTING ADJACENT GUTTER OR AS SPECIFIED ELSEWHERE IN THE PLAN.
- ③ DEPTH EQUAL TO ADJACENT PAVEMENT. ADJACENT PAVEMENT STRUCTURE DETAILS ARE SHOWN ON THE PLAN. TYPICAL OPTIONS ARE:
 - (1) NEW OR EXISTING CONCRETE PAVEMENT.
 - (2) ASPHALTIC CONCRETE PAVEMENT OVER NEW OR EXISTING CONCRETE BASE COURSE.
 - (3) ASPHALTIC CONCRETE PAVEMENT OVER CRUSHED AGGREGATE BASE COURSE.

- ④ TIE BARS OR PAVEMENT TIES REQUIRED IN NEW CONCRETE PAVEMENT OR CONCRETE BASE COURSE. TIE BARS SHALL BE NO. 4 X 2'-0" SPACED AT 2'-0" C-C.
- PAVEMENT TIES REQUIRED IN EXISTING CONCRETE BASE COURSE. PAVEMENT TIES SHALL BE NO. 6 X 1'-0" SPACED AT 3'-0" C-C INSTALLED ON A HORIZONTAL SKEW OF 6:1. THE DIRECTION OF SKEW SHALL ALTERNATE AFTER EVERY ONE OR TWO BARS.


- ⑤ SURFACE TYPE AND DETAILS ARE SHOWN ELSEWHERE IN THE PLAN.

CONCRETE MEDIAN NOSE


STATE OF WISCONSIN
DEPARTMENT OF TRANSPORTATION

APPROVED
6/8/06
DATE
FHWA

/S/ Jerry H. Zogg
ROADWAY STANDARDS DEVELOPMENT
ENGINEER

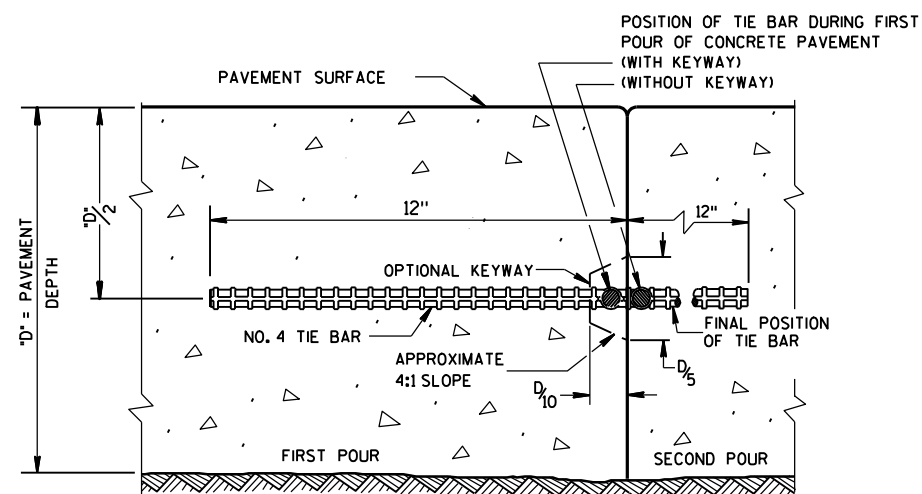

CONSTRUCTION JOINT

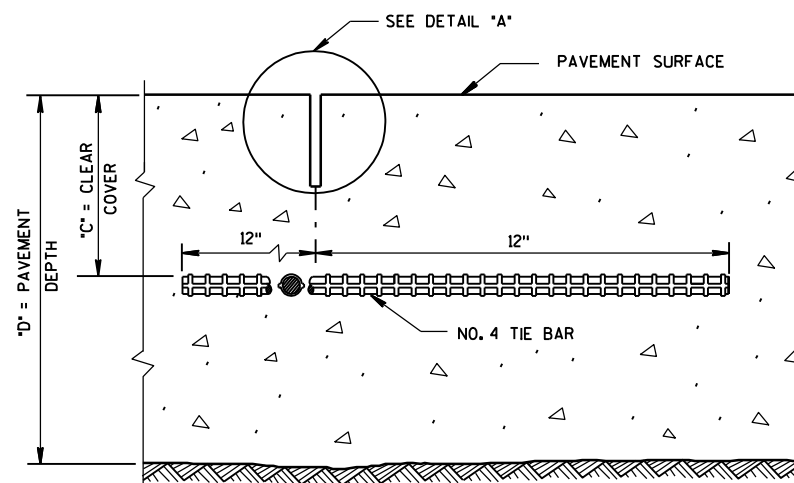


SAWED JOINT

GENERAL NOTES


DO NOT SEAL OR FILL LONGITUDINAL JOINTS.

- ① ANCHOR TIE BARS INTO DRILLED HOLES WITH AN EPOXY.

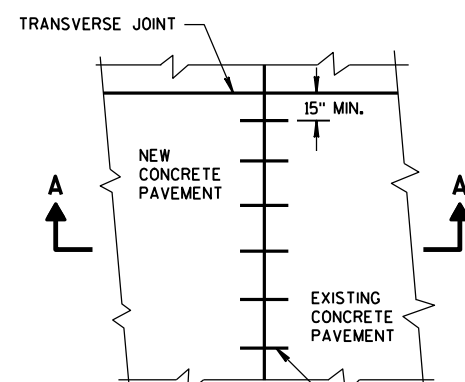


PLAN VIEW

NO. 6 TIE BARS SPACED 2'-6" C-C, INSTALLED PERPENDICULAR TO THE LONGITUDINAL JOINT. ①

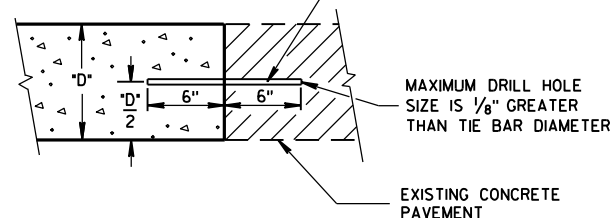


SECTION A-A
LONGITUDINAL CONSTRUCTION JOINT
TIE BARS ANCHORED
INTO EXISTING PAVEMENT

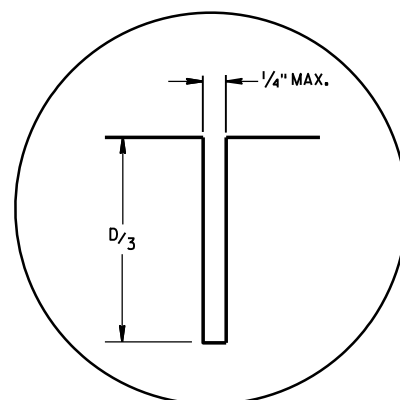

DETAIL "A"

PAVEMENT DEPTH "D"	CLEAR COVER "C"	MAXIMUM TIE BAR SPACING "S"	
		PAVEMENT WIDTH 24' OR 26'	≥ 30'
6, 6 1/2"	3" ± 1/2"	48"	42"
7, 7 1/2"	3 1/4" ± 1"	45"	36"
8, 8 1/2"	3 3/4" ± 1"	39"	30"
9, 9 1/2"	4 1/4" ± 1"	33"	27"
10, 10 1/2"	4 3/4" ± 1"	30"	24"
11, 11 1/2"	5 1/4" ± 1"	27"	21"
12"	5 3/4" ± 1"	24"	21"

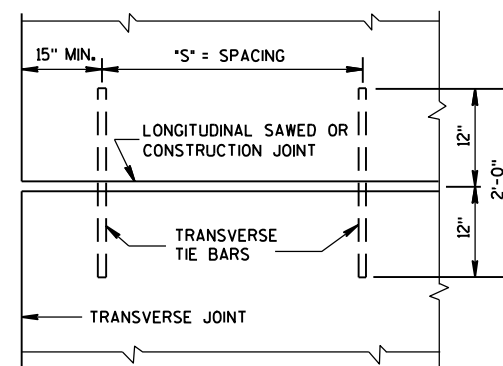

PLAN VIEW
SHOWING LOCATION OF TIE BARS

CONCRETE PAVEMENT LONGITUDINAL JOINTS AND TIES




STATE OF WISCONSIN
DEPARTMENT OF TRANSPORTATION

APPROVED

12/11/2009
DATE

FHWA

/S/ Deb Bischoff
PAVEMENT POLICY & DESIGN ENGINEER

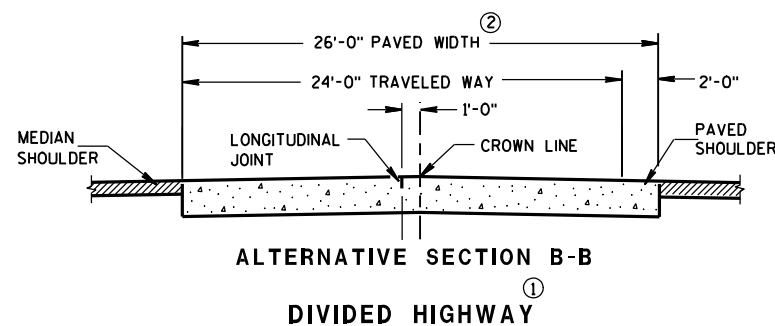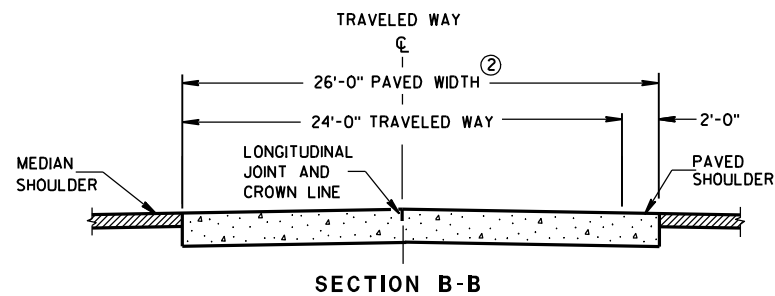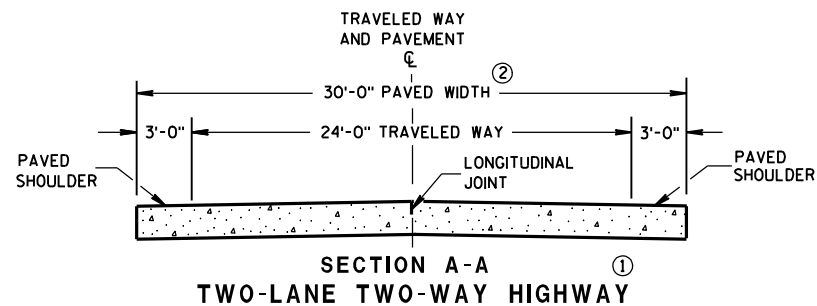

GENERAL NOTES

CONTRACTION JOINTS

CONSTRUCT CONTRACTION JOINTS NORMAL TO THE CENTERLINE. SHOW THE LOCATION OF CONTRACTION JOINTS THROUGH INTERSECTIONS ON THE PLANS OR AS DIRECTED BY THE ENGINEER.

DO NOT SEAL OR FILL CONTRACTION JOINTS.

INSTALL DOWEL BARS PARALLEL TO THE PAVEMENT CENTERLINE AND PAVEMENT SURFACE.

FOR PAVEMENT SLABS OF VARYING WIDTHS, CENTER THE DOWEL ASSEMBLY ACROSS THE LANES. LOCATE THE INNER AND OUTER MOST DOWEL BARS SO THAT THE CENTER OF THE BARS ARE A MINIMUM OF 6 INCHES AND A MAXIMUM OF 12 INCHES FROM THE LONGITUDINAL JOINT AND THE EDGE OF PAVEMENT.

CONSTRUCTION JOINTS


LOCATE CONSTRUCTION JOINTS A MINIMUM OF 4 FEET FROM THE NEAREST CONTRACTION JOINT AND ALIGN PARALLEL TO CONTRACTION JOINTS.

THE CONTRACTOR MAY INSERT TIE BARS THROUGH THE HEADER BOARD AFTER THE CONCRETE HAS BEEN PLACED.


- ① REFER TO TYPICAL CROSS SECTIONS FOR ADDITIONAL DETAILS.
- ② MEASURE THE ENTIRE PAVED WIDTH INCLUDING THE PORTION(S) LABELED PAVED SHOULDER AS CONCRETE PAVEMENT.

PAVEMENT DEPTH, DOWEL BAR SIZE AND JOINT SPACING TABLE

PAVEMENT DEPTH (D)	DOWEL BAR DIAMETER	CONTRACTION JOINT SPACING
5 1/2", 6", 6 1/2"	NONE	12'
7", 7 1/2"	1"	14'
8", 8 1/2"	1 1/4"	15'
9", 9 1/2"	1 1/4"	15'
10" & ABOVE	1 1/2"	15'

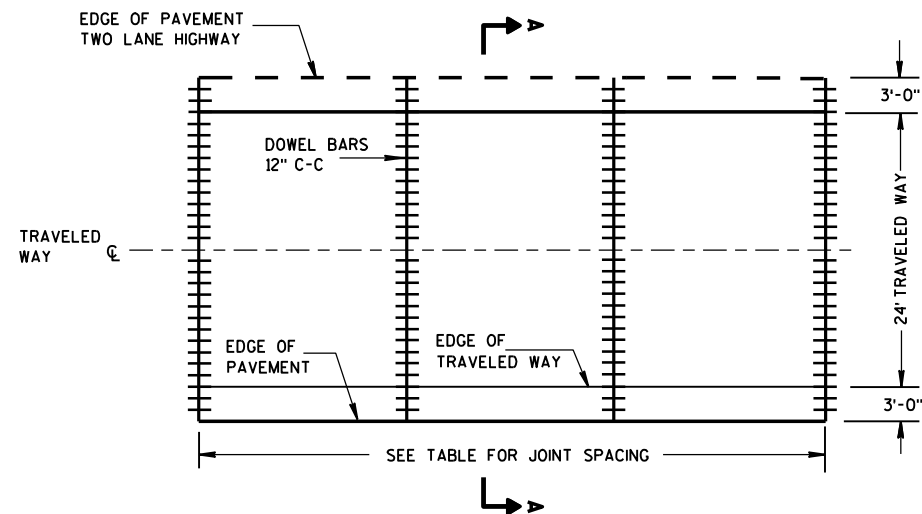


CONTRACTION JOINT LAYOUT FOR TWO-LANE TWO-WAY HIGHWAY

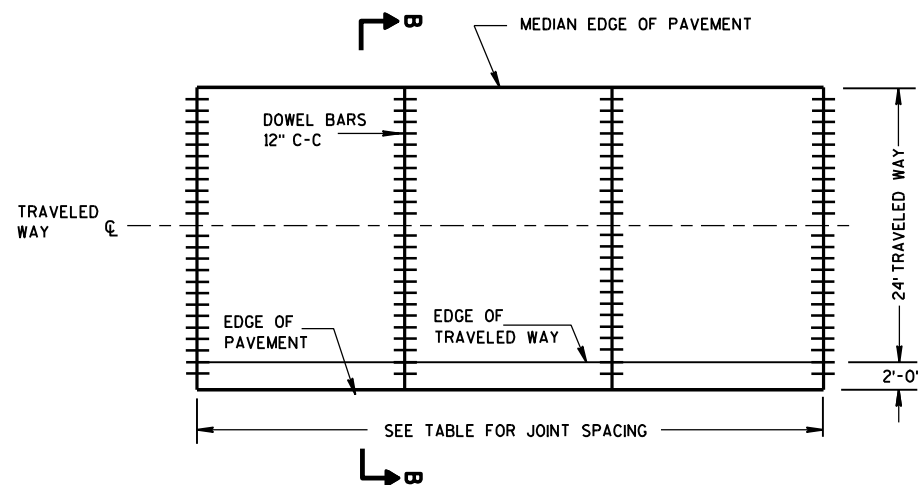


CONTRACTION JOINT LAYOUT FOR DIVIDED HIGHWAY

RURAL DOWELED
CONCRETE PAVEMENT


STATE OF WISCONSIN
DEPARTMENT OF TRANSPORTATION

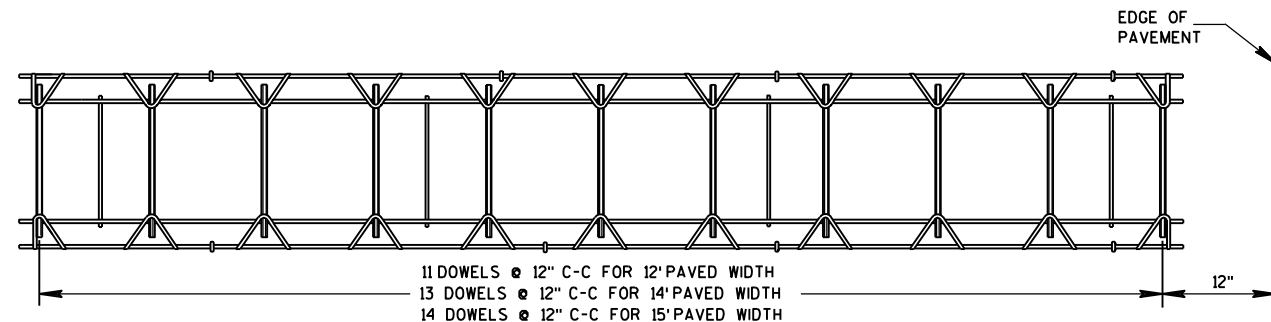


PLAN VIEW

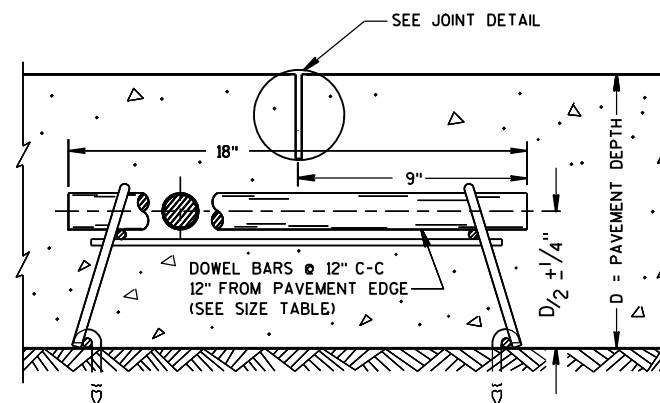SIDE VIEW
(NORMAL TO CENTERLINE)CONTRACTION JOINT DOWEL ASSEMBLY^①

DOWELED CONTRACTION JOINT

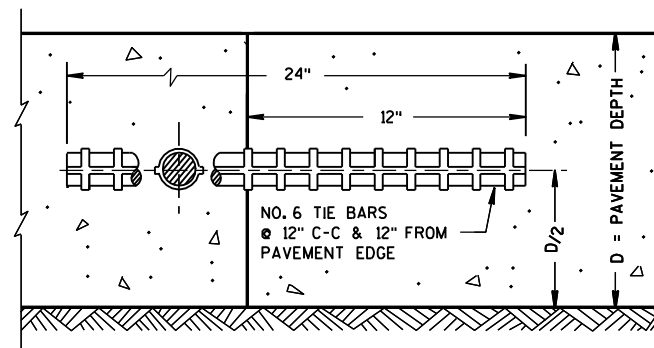

CONSTRUCTION JOINT

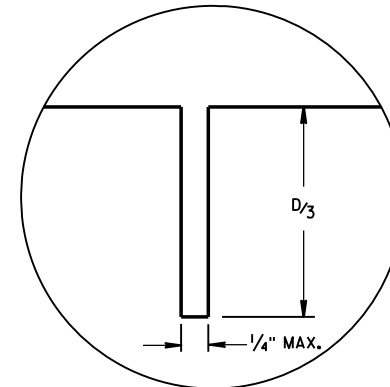


JOINT DETAIL

GENERAL NOTES

- ① THE ENGINEER MAY APPROVE THE USE OF ALTERNATIVE DESIGNS OF THE DOWEL ASSEMBLY. THE CONTRACTOR MAY USE MECHANICAL DOWEL BAR INSERTERS INSTEAD OF DOWEL ASSEMBLIES.
- ② ANCHOR DOWEL BARS INTO DRILLED HOLES WITH AN EPOXY.
- ③ APPLY A THIN UNIFORM COATING OF SURFACE TREATMENT TO THE FREE END OF DOWEL BARS TO PREVENT BONDING.
- ④ SPACE DOWEL BARS INSTALLED BY DRILLING 1'-3" ON CENTER. CENTER THE GROUPING OF DOWEL BARS INSIDE THE SLAB BASED ON ALL THE FOLLOWING SITUATIONS:

BETWEEN THE EDGES OF PAVEMENTS WITHOUT LONGITUDINAL JOINTS OR BETWEEN THE EDGE OF PAVEMENT AND NEAREST LONGITUDINAL JOINT OR BETWEEN TWO ADJACENT LONGITUDINAL JOINTS.
- ⑤ SECURE BASKETS WITH ANCHORS TO HOLD DOWEL BARS IN THE CORRECT POSITION AND ALIGNMENT. TYPE, LOCATION, NUMBER AND LENGTH OF ANCHORS ARE DEPENDENT UPON FIELD CONDITIONS.

18" DOWEL BARS ANCHORED
INTO EXISTING PAVEMENT^②

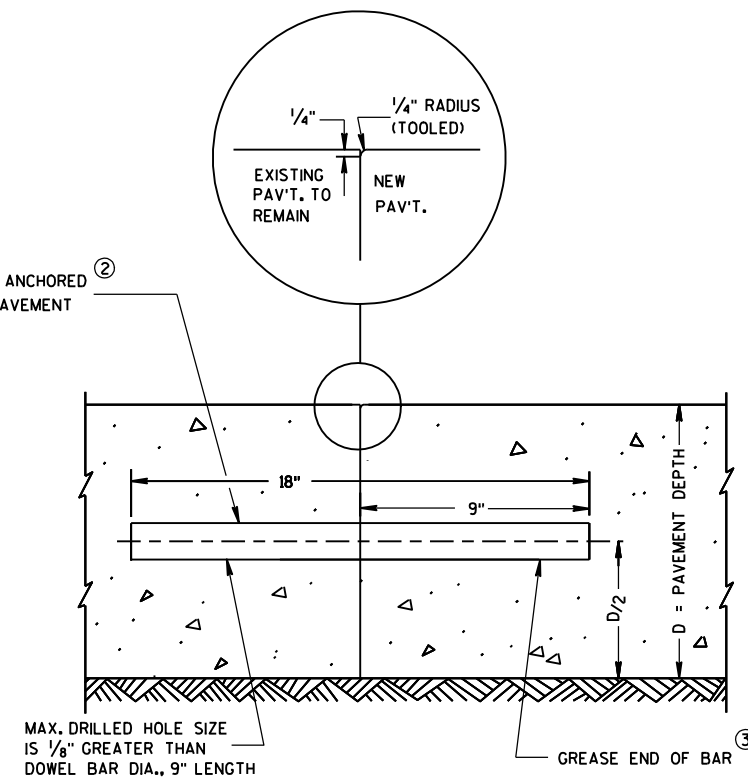TRANSVERSE CONTRACTION JOINTS ABUTTING
EXISTING PAVEMENT

④ DOWEL BAR DETAIL

RURAL DOWELED
CONCRETE PAVEMENT

STATE OF WISCONSIN
DEPARTMENT OF TRANSPORTATION


APPROVED

12/11/09
DATE

FHWA

/S/ Deb Bischoff

PAVEMENT POLICY & DESIGN ENGINEER

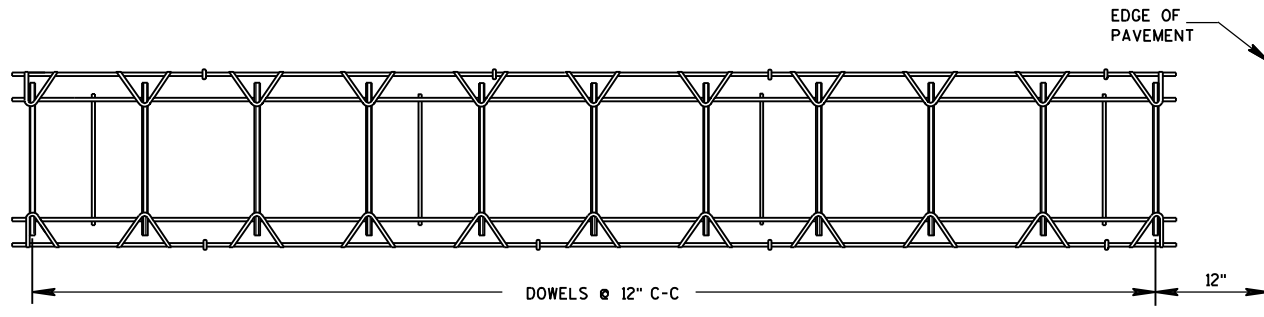


PLAN VIEW




SIDE VIEW
CONTRACTION JOINT DOWEL ASSEMBLY

PAVEMENT DEPTH, DOWEL BAR SIZE
AND JOINT SPACING TABLE


PAVEMENT DEPTH (D)	DOWEL BAR DIAMETER	CONTRACTION JOINT SPACING
5 1/2", 6", 6 1/2"	NONE	12'
7", 7 1/2"	1"	14'
8", 8 1/2"	1 1/4"	15'
9", 9 1/2"	1 1/4"	15'
10" & ABOVE	1 1/2"	15'

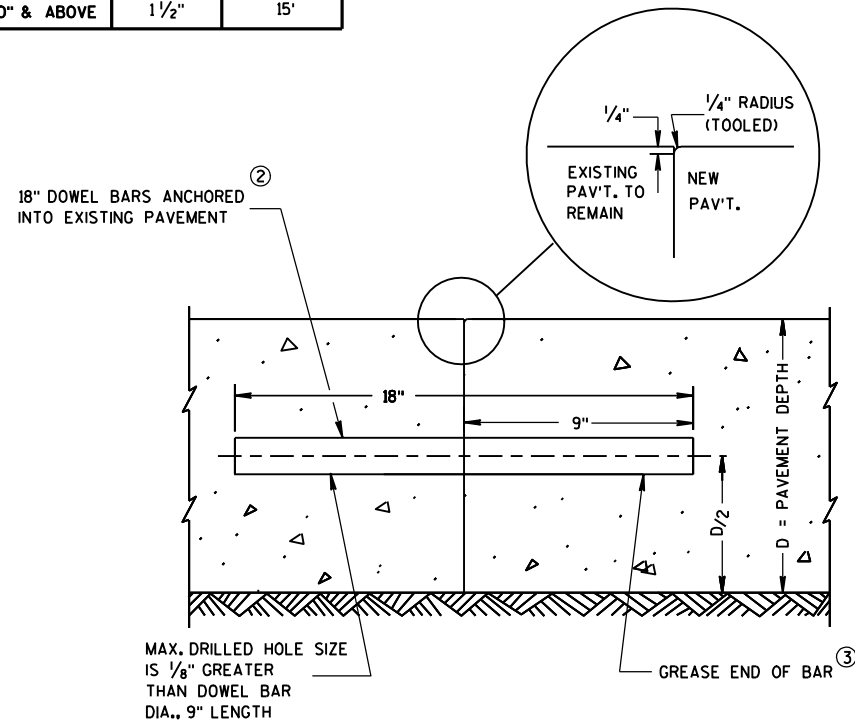


TRANSVERSE CONTRACTION JOINTS ABUTTING
EXISTING PAVEMENT
DOWEL BAR DETAIL

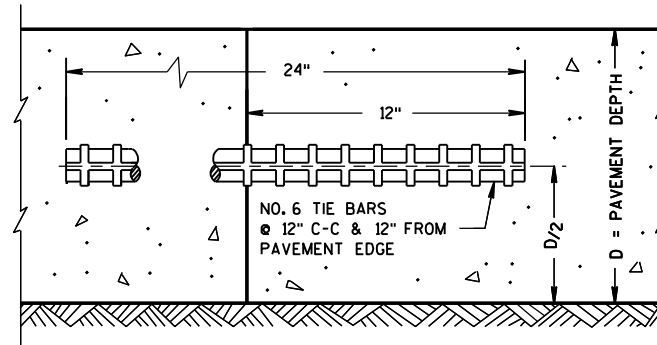


TRANSVERSE CONSTRUCTION JOINT

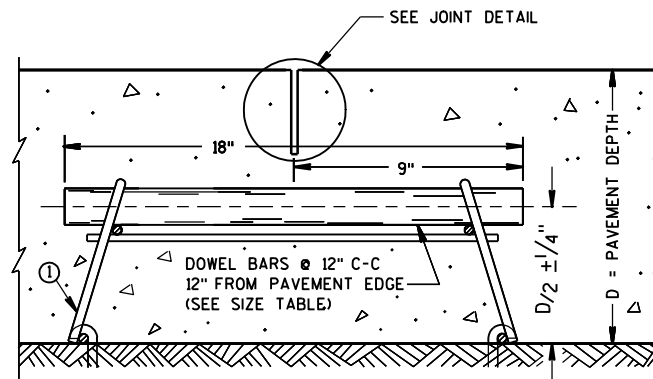

DOWELED CONTRACTION JOINT

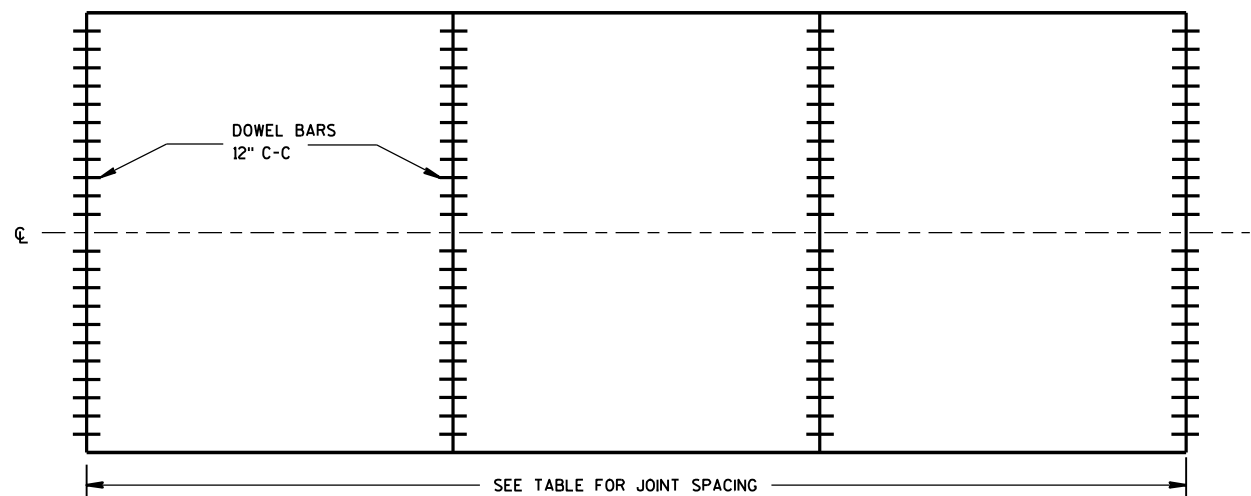

CONTRACTION JOINT LOCATIONS

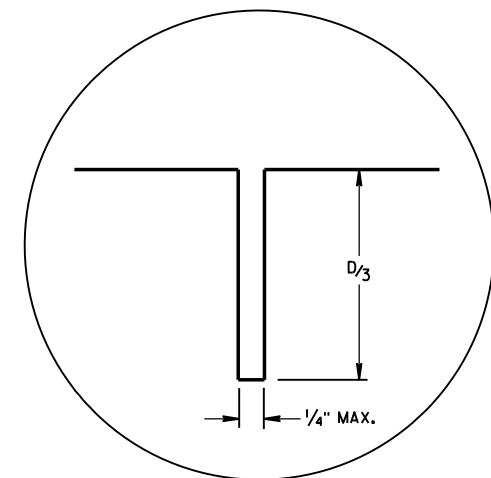

JOINT DETAIL

GENERAL NOTES

CONTRACTION JOINTS

CONSTRUCT CONTRACTION JOINTS NORMAL TO THE CENTERLINE. SHOW THE LOCATION OF CONTRACTION JOINTS THROUGH INTERSECTIONS ON THE PLANS OR AS DIRECTED BY THE ENGINEER.

DO NOT SEAL OR FILL CONTRACTION JOINTS.

INSTALL DOWEL BARS PARALLEL TO THE PAVEMENT CENTERLINE AND PAVEMENT SURFACE.

FOR PAVEMENT SLABS OF VARYING WIDTHS, CENTER THE DOWEL ASSEMBLY ACROSS THE LANES. LOCATE THE INNER AND OUTER MOST DOWEL BARS SO THAT THE CENTER OF THE BARS ARE A MINIMUM OF 6 INCHES AND A MAXIMUM OF 12 INCHES FROM THE LONGITUDINAL JOINT AND THE EDGE OF PAVEMENT.

CONSTRUCTION JOINTS

LOCATE CONSTRUCTION JOINTS A MINIMUM OF 4 FEET FROM THE NEAREST CONTRACTION JOINT AND ALIGN PARALLEL TO CONTRACTION JOINTS.

THE CONTRACTOR MAY INSERT TIE BARS THROUGH THE HEADER BOARD AFTER THE CONCRETE HAS BEEN PLACED.

- THE ENGINEER MAY APPROVE THE USE OF ALTERNATIVE DESIGNS OF THE DOWEL ASSEMBLY. THE CONTRACTOR MAY USE MECHANICAL DOWEL BAR INSERTERS INSTEAD OF DOWEL ASSEMBLIES.
- ANCHOR DOWEL BARS INTO DRILLED HOLES WITH AN EPOXY.
- APPLY A THIN UNIFORM COATING OF SURFACE TREATMENT TO THE FREE END OF DOWEL BARS TO PREVENT BONDING.
- SPACE DOWEL BARS INSTALLED BY DRILLING 1'-3" ON CENTER. CENTER THE GROUPING OF DOWEL BARS INSIDE THE SLAB BASED ON ALL THE FOLLOWING SITUATIONS:

BETWEEN THE EDGES OF PAVEMENTS WITHOUT LONGITUDINAL JOINTS OR
BETWEEN THE EDGE OF PAVEMENT AND NEAREST LONGITUDINAL JOINT OR
BETWEEN TWO ADJACENT LONGITUDINAL JOINTS.
- SECURE BASKETS WITH ANCHORS TO HOLD DOWEL BARS IN THE CORRECT POSITION AND ALIGNMENT. TYPE, LOCATION, NUMBER AND LENGTH OF ANCHORS ARE DEPENDENT UPON FIELD CONDITIONS.

URBAN DOWELED
CONCRETE PAVEMENT

STATE OF WISCONSIN
DEPARTMENT OF TRANSPORTATION

APPROVED

12/11/2009

DATE



FHWA

/S/ Deb Bischoff

PAVEMENT POLICY & DESIGN ENGINEER



DETAILS OF CONSTRUCTION, MATERIALS AND WORKMANSHIP NOT SHOWN ON THIS DRAWING SHALL CONFORM TO THE PERTINENT REQUIREMENTS OF THE STANDARD SPECIFICATIONS, AND THE APPLICABLE SPECIAL PROVISIONS.

- INSTALL BEAM GUARD SECTIONS AND ALL NECESSARY HARDWARE ACCORDING TO THE APPLICABLE PLAN AND CURRENT STANDARD AND SUPPLEMENTAL SPECIFICATIONS. ALL DIMENSIONS ARE SUBJECT TO MANUFACTURER'S TOLERANCES EXCEPT WHERE ALLOWABLE TOLERANCES ARE SHOWN.

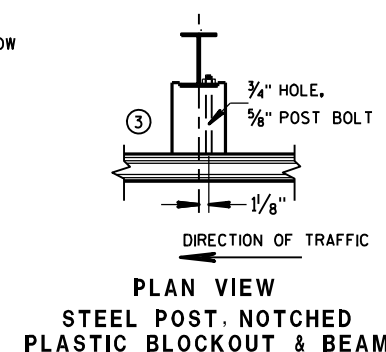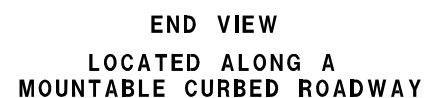




STEEL PLATE BEAM GUARD,
CLASS "A"
INSTALLATION & ELEMENTS

STATE OF WISCONSIN
DEPARTMENT OF TRANSPORTATION

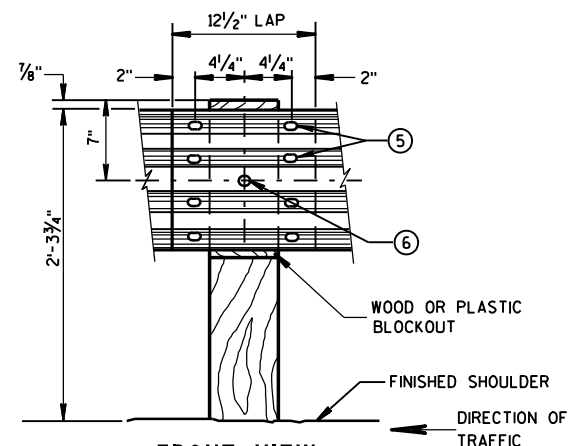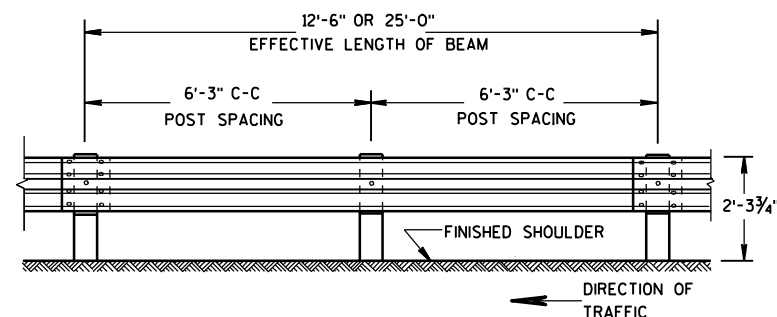



- ## GENERAL NOTES

- ① PROVIDE TYPE "H" SILVER REFLECTIVE SHEETING ON ALL REFLECTORS EXCEPT THOSE LOCATED ALONG THE LEFT EDGE OF ONE-WAY ROADWAYS, WHICH SHALL BE PROVIDED WITH TYPE "H" YELLOW REFLECTIVE SHEETING.
- ② DO NOT INSTALL REFLECTORS ON THE FIRST 50 FEET OF THE APPROACH END OF THE ENERGY ABSORBING TERMINAL.
- ③ REVERSE EVERY OTHER REFLECTOR FOR 2-WAY VISIBILITY. THE CONTRACTOR MAY FURNISH TWO-SIDED REFLECTORS IN LIEU OF ONE-SIDED REFLECTORS.
- ④ PROVIDE AN ANGLE OF BEND OF $90^\circ \pm 1^\circ$ FOR TWO-SIDED REFLECTORS.
- ⑤ 8 - $\frac{5}{8}$ " $\diamond$ X 2 " BUTTON HEAD BOLTS WITH OVAL SHOULDERS & RECESS NUTS.
- ⑥ $\frac{5}{8}$ " $\diamond$ X 1'-6" BUTTON HEAD BOLT AND AND RECESS NUT WITH ROUND WASHER UNDER NUT.

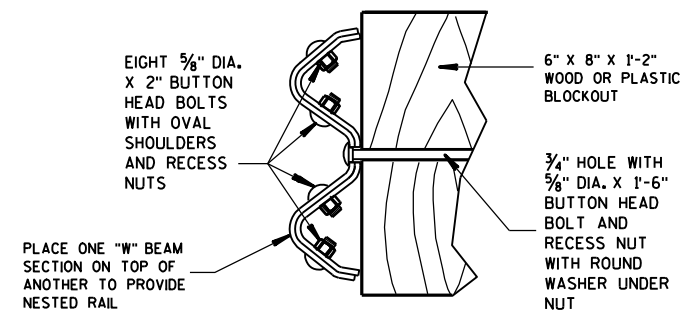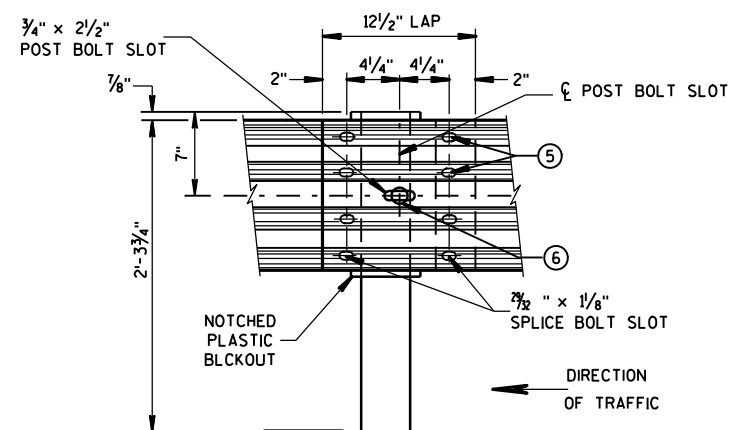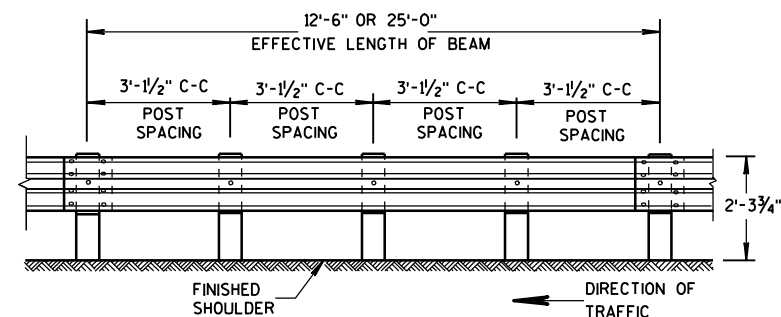


NESTED W BEAM (NW)
USE ALL OTHER STANDARD BEAM GUARD DETAILS FOR
CONSTRUCTING NESTED W BEAM (NW)

	BEAM GUARD LENGTH	REFLECTOR SPACING	NO. SURFACES REFLECTORIZED	MIN. NO. REFLECTORS
ONE WAY TRAFFIC	< 200' > 200'	50' C-C 100' C-C	1 1	3
TWO WAY TRAFFIC	< 200' > 200'	25' C-C 50' C-C	1 ③	6
TWO WAY TRAFFIC	< 200' > 200'	50' C-C 100' C-C	2 ④	3

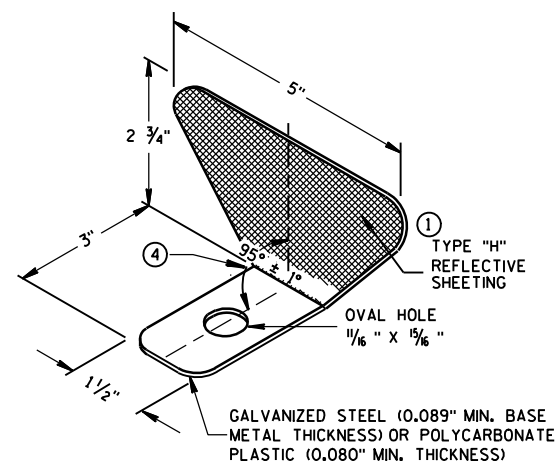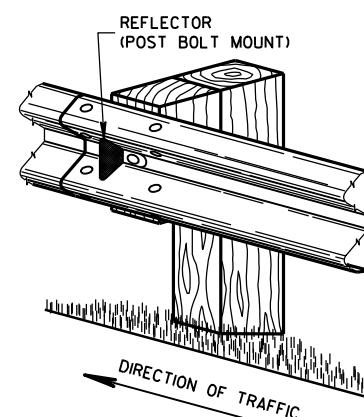


STEEL PLATE BEAM GUARD, CLASS "A", INSTALLATION & ELEMENTS


STATE OF WISCONSIN
DEPARTMENT OF TRANSPORTATION

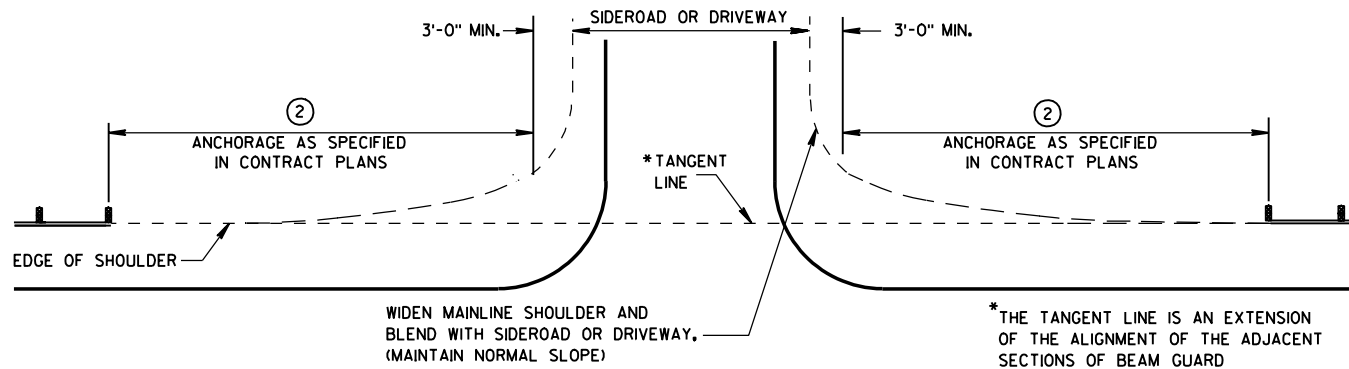


BEAM GUARD AT SIDEROADS OR DRIVEWAYS

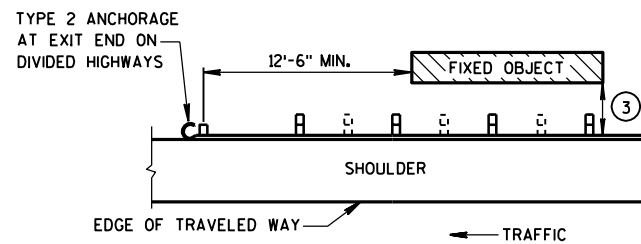

BEAM GUARD AT OBSTACLES EXIT END - ONE WAY TRAFFIC

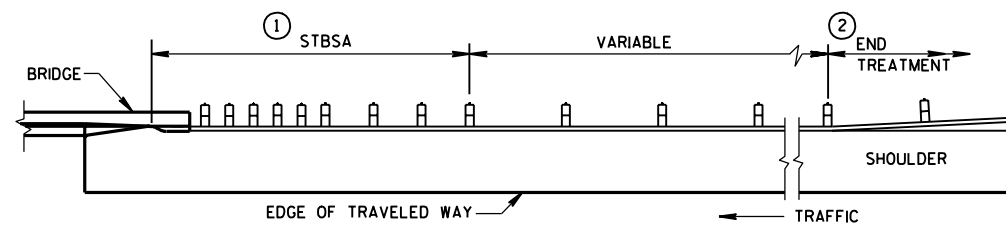

BEAM GUARD AT FULL WIDTH BRIDGES

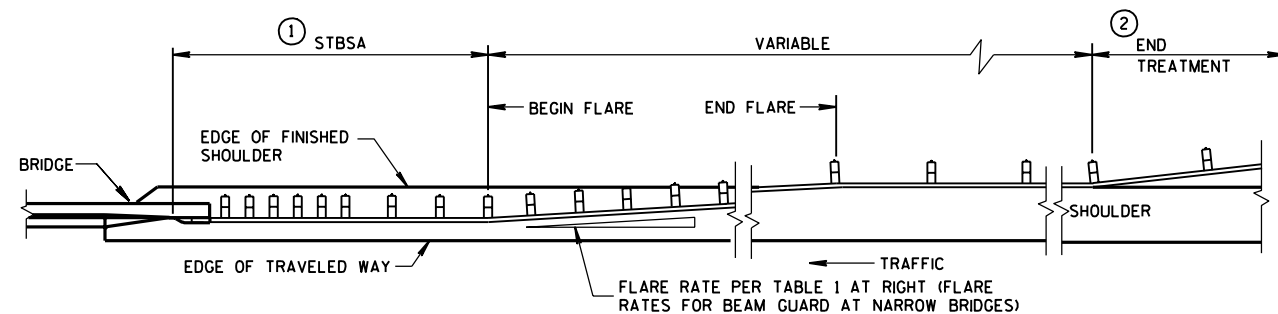

BEAM GUARD AT NARROW BRIDGES (FLARED TO SHOULDER EDGE, THEN PARALLEL TO ROADWAY)

GENERAL NOTES


DETAILS OF CONSTRUCTION, MATERIALS AND WORKMANSHIP SHALL CONFORM TO THE PERTINENT STANDARD SPECIFICATIONS AND THE APPLICABLE SPECIAL PROVISIONS.

W6 X 9 OR W6 X 8.5 STEEL POSTS WITH NOTCHED PLASTIC BLOCKOUTS ARE ACCEPTABLE ALTERNATIVES FOR 6" X 8" WOOD POSTS WITH WOOD OR PLASTIC BLOCKOUTS. USE APPROVED NOTCHED PLASTIC BLOCKOUTS WITH STEEL POSTS.

THE LOCATIONS AND LENGTHS OF BEAM GUARD ARE SHOWN ELSEWHERE IN THE PLAN.

- ① STEEL THRIE BEAM STRUCTURAL APPROACH (STBSA) - SEE CURRENT SDD 14B20.
- ② USE AN APPROVED END TREATMENT FOR THE TRAFFIC APPROACH SIDE OF BRIDGE/OBSTACLES. USE TYPE 2 ANCHORAGE ONLY AT THE DOWNSTREAM ENDS OF BEAM GUARD LOCATED ALONG ROADWAYS WITH ONE WAY TRAFFIC.

MINIMUM LATERAL DISTANCE FROM FACE OF BEAM GUARD TO FIXED OBJECT	POST SPACING
3'-6"	3' - 1½"
4'-6"	6' - 3"

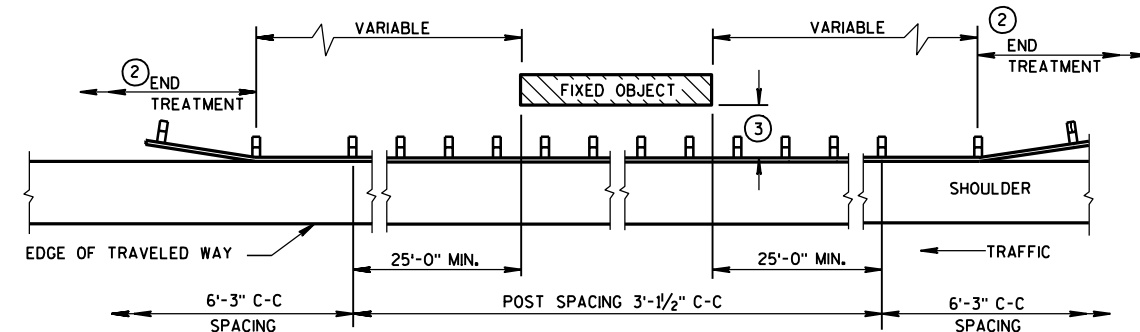



BEAM GUARD AT OBSTACLES - TWO WAY TRAFFIC

(RAIL TO OBSTACLE CLEARANCE 3'-6" TO 4'-6")




TABLE 1
FLARE RATES FOR BEAM
GUARD AT NARROW BRIDGES

POSTED SPEED (MPH)	FLARE RATE
25	13:1
30	15:1
35	16:1
40	18:1
45	21:1
50	24:1
55	26:1
65	30:1

STEEL PLATE BEAM GUARD, CLASS "A" (AT BRIDGES, OBSTACLES AND SIDEROADS/DRIVEWAYS)	
STATE OF WISCONSIN DEPARTMENT OF TRANSPORTATION	
APPROVED 8-21-07 DATE	/S/ Jerry H. Zogg ROADWAY STANDARDS DEVELOPMENT ENGINEER
FHWA	

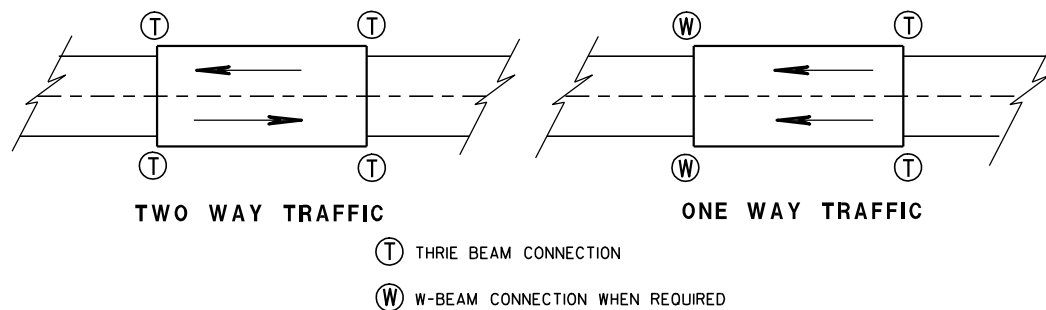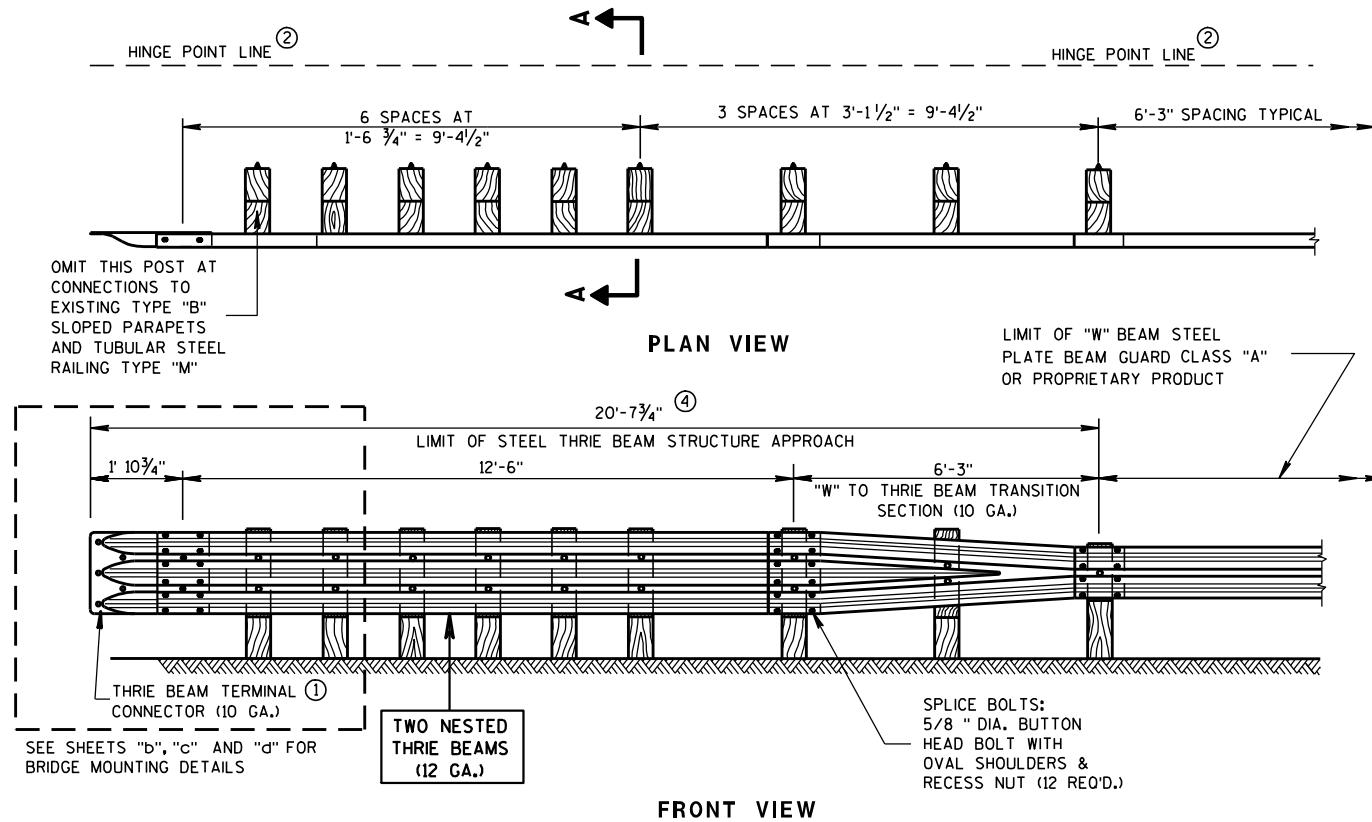

TYPICAL LOCATIONS OF THRIE BEAM AND W-BEAM CONNECTIONS TO BRIDGE

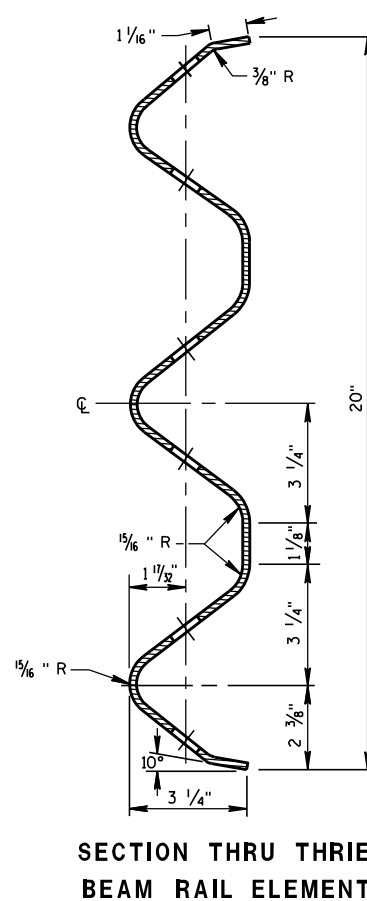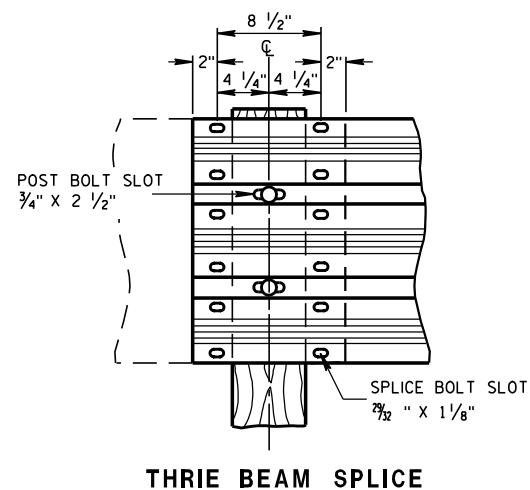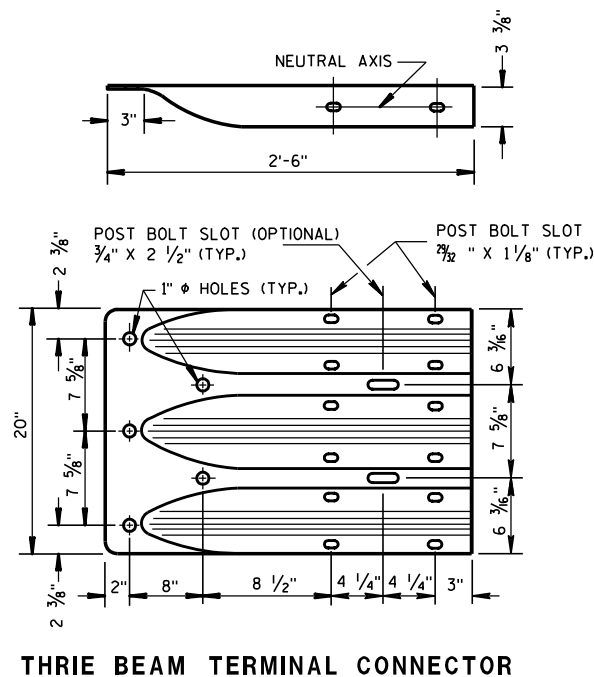

GENERAL NOTES

DETAILS OF CONSTRUCTION, MATERIALS AND WORKMANSHIP NOT SHOWN ON THIS DRAWING SHALL CONFORM TO THE PERTINENT REQUIREMENTS OF THE STANDARD SPECIFICATIONS AND THE APPLICABLE SPECIAL PROVISIONS.


FURNISH AND CONSTRUCT THRIE BEAM STRUCTURAL APPROACH ACCORDING TO THE REQUIREMENTS OF SECTION 614 OF THE STANDARD SPECIFICATIONS. THRIE BEAM SECTIONS SHALL CONFORM TO THE REQUIREMENTS OF AASHTO DESIGNATION M180, CLASS "A", TYPE 2.

BOLT THE THRIE BEAM TO ALL POSTS AND BLOCKOUTS. DRILL OR PUNCH BOLT HOLES IN THE BEAM IF THE POST SPACING IS LESS THAN 6'-3".

DO NOT USE STEEL POSTS AND NOTCHED PLASTIC BLOCKOUTS IN THE STEEL THRIE BEAM STRUCTURAL APPROACH AND THE TRANSITION SECTION OF STEEL PLATE BEAM GUARD, CLASS "A" INSTALLATIONS.

IF ROCK IS ENCOUNTERED DURING EXCAVATION, THE ENGINEER MAY APPROVE USING A 12 INCH DIAMETER POST HOLE EXTENDING 20 INCHES DEEP INTO THE ROCK. PLACE GRANULAR MATERIAL IN THE BOTTOM OF THE HOLE APPROXIMATELY 2 1/2 INCHES DEEP. CUT THE POSTS TO LENGTH AND PLACE IN THE HOLE. BACKFILL WITH MATERIAL EXCAVATED FROM THE HOLE AND COMPACT ADEQUATELY, (SEE SDD 14 B 15-40).

- ① BRIDGE RAILING TYPE "W" DOES NOT REQUIRE A TERMINAL CONNECTOR.
- ② MINIMUM EMBEDMENT SHALL BE 4'-0". WHERE EXISTING CONDITIONS DO NOT PERMIT THE APPROPRIATE EARTHWORK SHOWN ON THE PLAN TYPICAL SECTIONS OR DETAILS, THE ENGINEER MAY ALLOW THE REDUCTION OR ELIMINATION OF THE 2 FOOT DISTANCE TO THE HINGE POINT. OTHERWISE BUILD AS THE PLAN SHOWS OR AS THE ENGINEER DIRECTS. IF THE 2 FOOT DISTANCE TO THE HINGE POINT IS REDUCED OR ELIMINATED, INCREASE THE POST EMBEDMENT DEPTH TO 4'-6" OR MORE.
- ③ BOLTS SHALL CONFORM TO THE REQUIREMENTS OF ASTM F-1554, GRADE 55. NUTS SHALL CONFORM TO THE REQUIREMENTS OF ASTM A-563 DH.
- ④ ALL WOOD POSTS MUST BE 6" X 8" AND AT LEAST 7'-0" LONG.

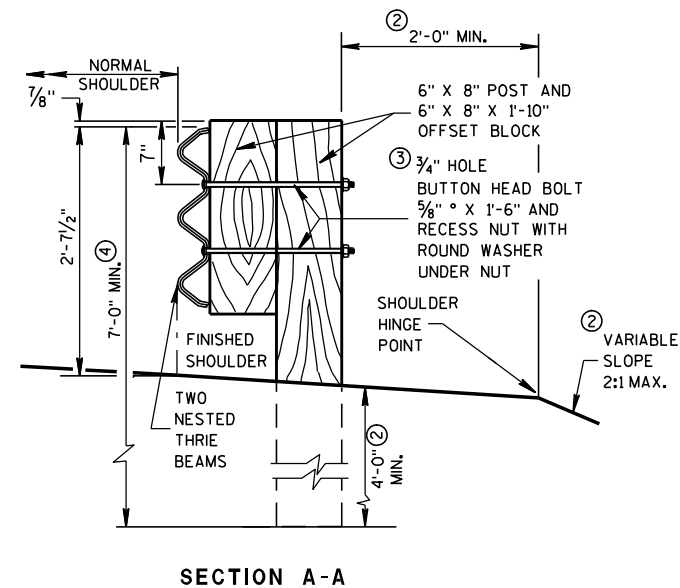

STEEL THRIE BEAM STRUCTURE APPROACH

STATE OF WISCONSIN
DEPARTMENT OF TRANSPORTATION

APPROVED
6-3-2010 /S/ Jerry H. Zogg
DATE ROADWAY STANDARDS DEVELOPMENT ENGINEER
FHWA

6


S.D.D. 14 B 24-70

BILL OF MATERIALS


NOTE NO.	QTY.	DESCRIPTION
①	4	WOOD BREAKAWAY TERMINAL POST: 5 1/2" X 7 1/2" X 3'-9"
②	**	STEEL TUBE: OPTION 1 - QUANTITY OF 4 TS 8" X 6" X 0.188", 4'-6" LONG OR OPTION 2 - QUANTITY OF 2 TS 8" X 6" X 0.188", 6'-0" AND 2 TS 8" X 6" X 0.188", 4'-6" LONG
③	2	SOIL PLATE: 2'-0" X 1'-6" X 1/4" **
④	4	WOOD BREAKAWAY CRT POST: 6" X 8" X 6'-0"
⑤	6	WOOD OFFSET BLOCKS: 6' X 8" X 1'-2"
⑥	1	PIPE SLEEVE: 2" X 5 1/2" STANDARD PIPE
⑦	1	BEARING PLATE
⑧	1	BCT CABLE ASSEMBLY
⑨	1	CABLE ANCHOR BOX
⑩	1	STRUT & YOKE
⑪	1	STEEL PLATE BEAM, END PANEL 12 GA. 13'-6 1/2" LONG FOR SKT-350, ET-2000 AND ET-2000 PLUS
⑫	3	STEEL PLATE BEAM: 12 GA. 13'-6 1/2"
⑬	1	ET-2000/ET-2000 PLUS GUARDRAIL EXTRUDER OR SKT-350 IMPACT HEAD: AS FURNISHED BY MANUFACTURER
⑭	1	REFLECTIVE SHEETING TYPE H: 18" X 18"
⑮	1	E.A.T. MARKER POST

GENERAL NOTES


- FOLLOW MANUFACTURE'S BOLTING RECOMMENDATIONS, IF NONE ARE AVAILABLE, INSTALL 5/8" ϕ X 1'-6" BUTTON HEAD BOLTS AT ALL POSTS EXCEPT FOR POST 1.
- (A) THE SLOPE IN THE AREA BOUNDED BY THE EXTENDED VEHICLE RUNOUT PATH (EVRP), THE HINGE POINT LINE (HPL), AND THE CLEAR ZONE LIMITS (CZL) SHALL BE 4:1 OR FLATTER.
- (B) AFTER FINAL ASSEMBLY, RECHECK CABLE TO BE SURE IT IS TAUT AND HAS NOT RELAXED.
- (C) THE 13 SLOT FIRST RAIL PANEL MAY BE USED IN LIEU OF THE 3 SLOT RAIL PANEL ON SKT-350 ONLY.
- (D) THE TOP OF THE STEEL TUBE ON POSTS 1 THROUGH 4 SHALL NOT BE MORE THAN 3" ABOVE THE FINISH GROUND ELEVATION.
- (E) THE CENTER OF THE UPPER 3/2" DIAMETER HOLE ON POST 5 THROUGH 8 SHALL BE 3/4" ABOVE THE FINISHED GROUND LINE.
- (F) SHEETING IS ATTACHED TO 0.040 ALUMINUM SHEET AND ATTACHED TO E.A.T. HEAD USING 4 STAINLESS STEEL SELF-TAPPING SCREWS, ONE SCREW PER CORNER OF E.A.T. STEEL POSTS SHALL NOT BE ALLOWED FOR USE WITH ENERGY ABSORBING TERMINALS.
- DO NOT INSTALL REFLECTORS ON THE FIRST 50 FEET OF THE APPROACH END OF THE ENERGY ABSORBING TERMINAL.
- * DO NOT ATTACH BLOCKOUTS TO POSTS 1 AND 2.
- ** SDD SHOWS 4 - 54 INCH STEEL TUBES WITH SOIL PLATES INSTALLED ON POST 1 AND POST 2. POST 3 AND 4 DO NOT NEED SOIL PLATES. AN ALTERNATIVE INSTALLATION WOULD CONSIST OF 2 - 72 INCH STEEL TUBES ON POST 1 AND POST 2 AND 54 INCH SOIL TUBES ON POSTS 3 AND 4. THE ALTERNATIVE INSTALLATION DOES NOT REQUIRE SOIL PLATES.

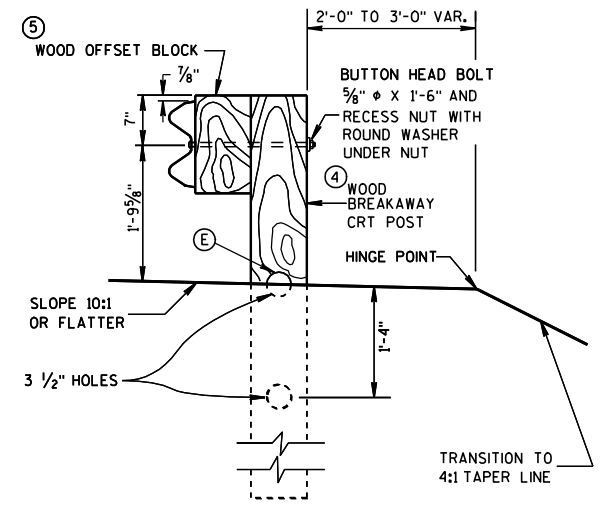

SECTION C-C
TYPICAL AT POST NOS. 6, 8

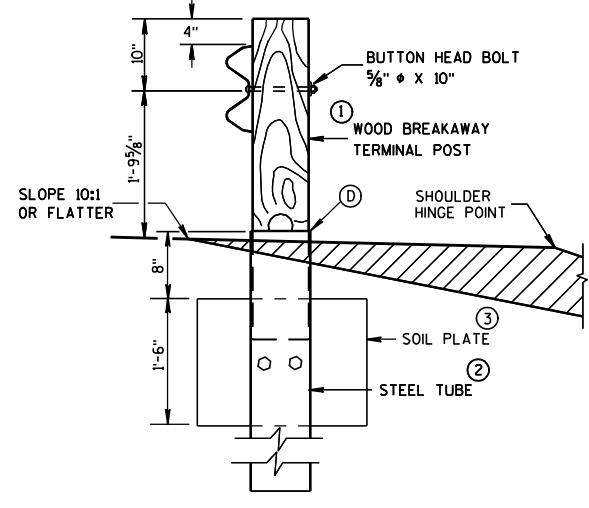


SECTION B-B
TYPICAL AT POST NO. 2*

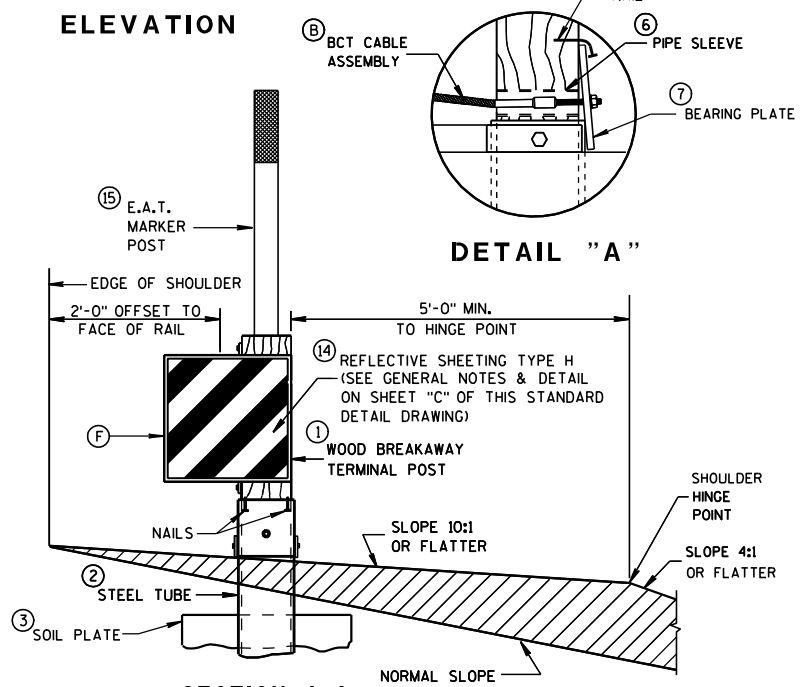

SECTION A-A
TYPICAL AT POST NO. 1*

ELEVATION

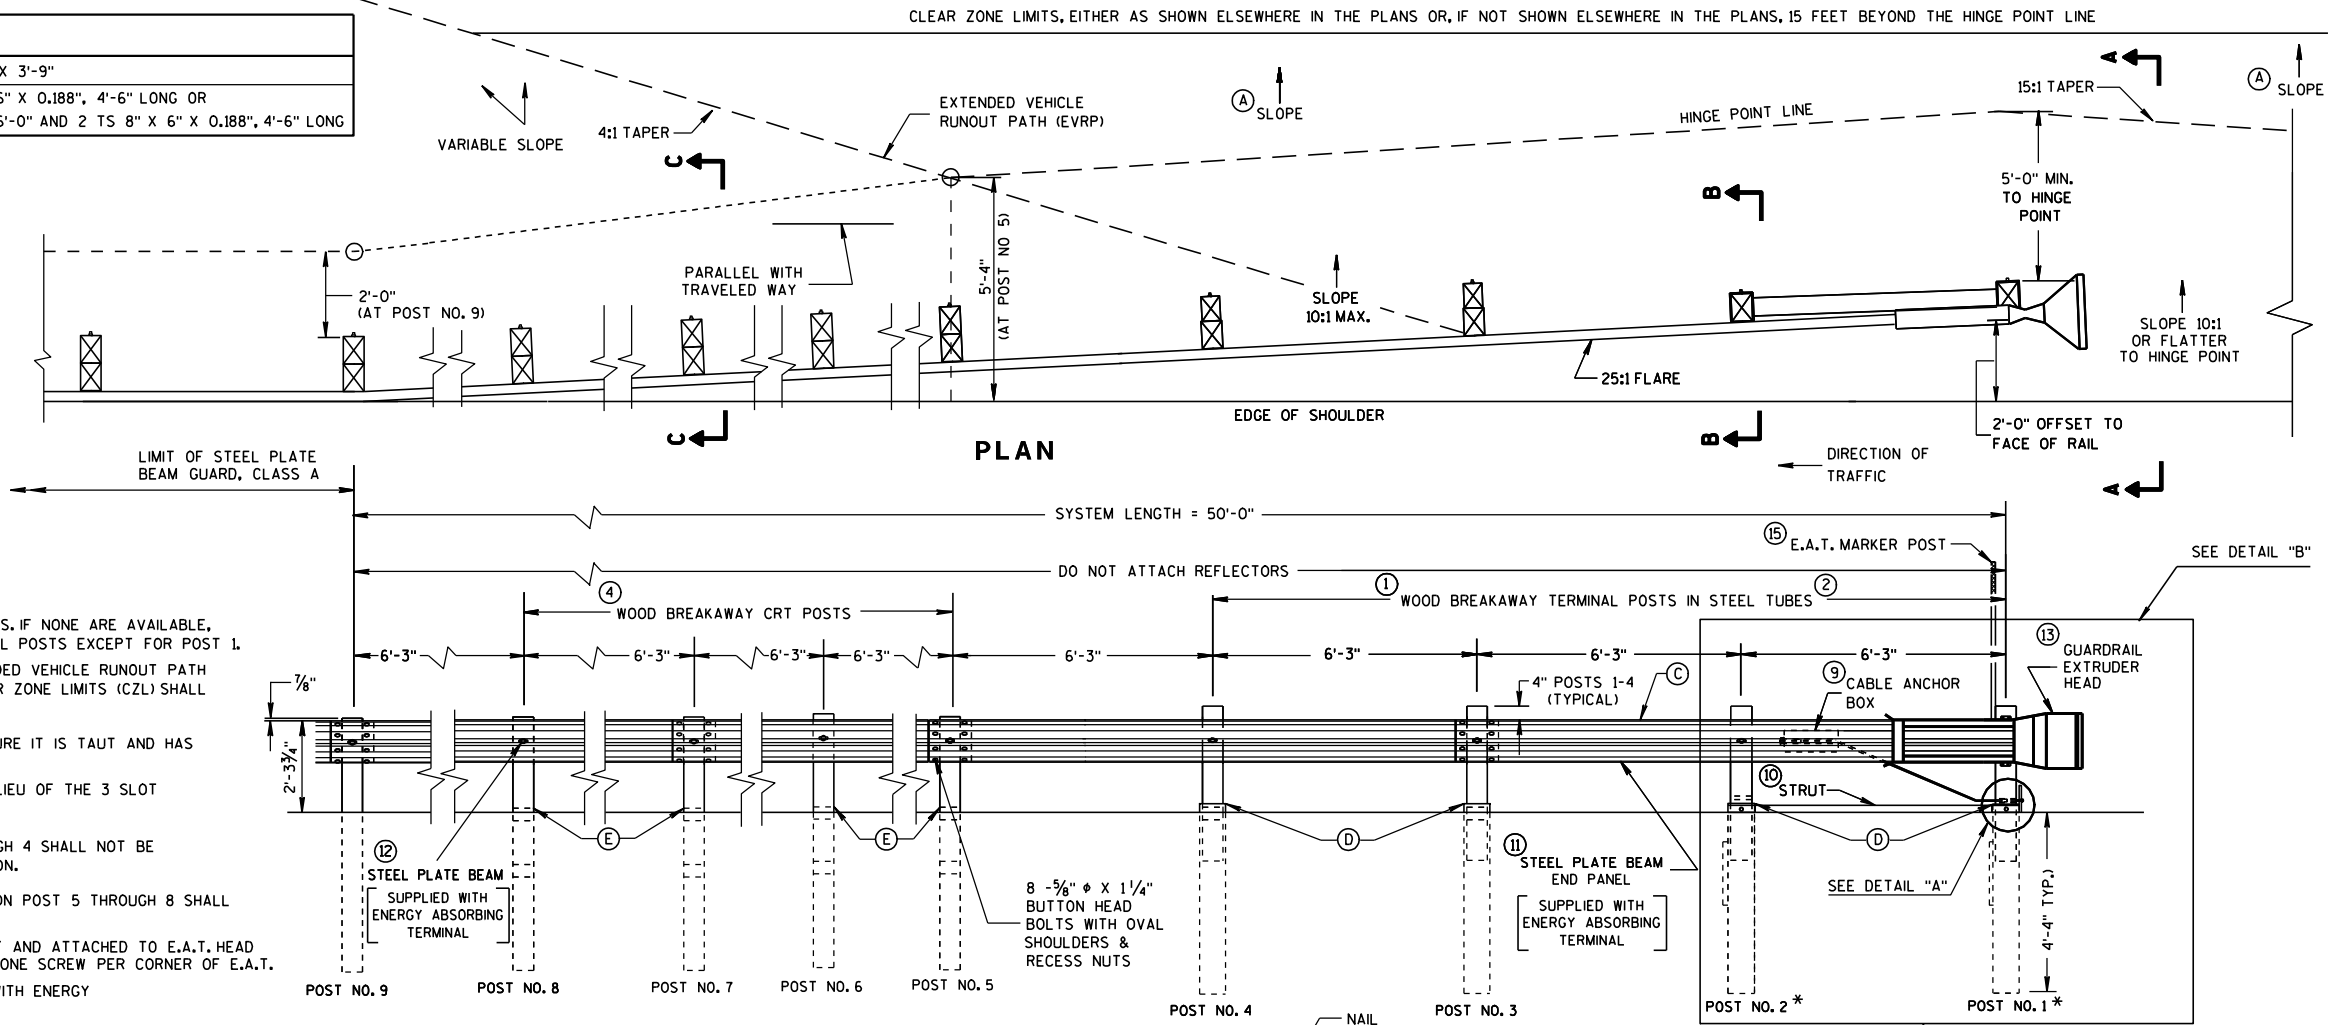

PLAN

DETAIL "A"


DETAIL "B"

STEEL PLATE BEAM GUARD
ENERGY ABSORBING TERMINAL


STATE OF WISCONSIN
DEPARTMENT OF TRANSPORTATION

6


S.D.D. 14 B 24-70

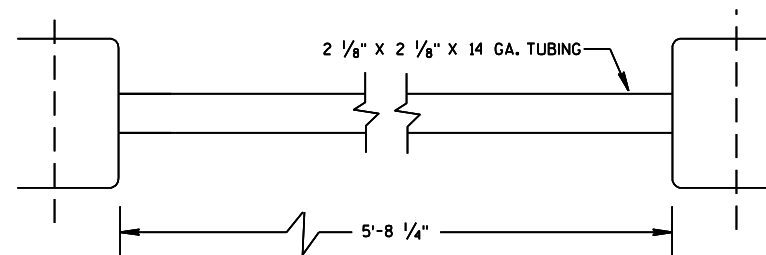

⑩ STRUT DETAIL (SKT-350)

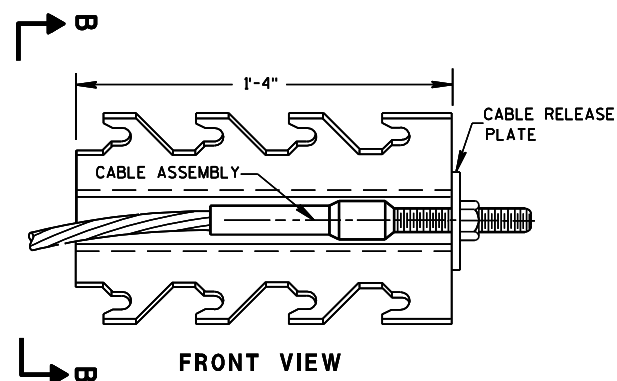


FRONT VIEW

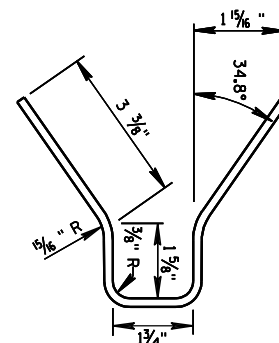

SECTION B-B

⑨ CABLE ANCHOR BOX (SKT-350)


(SKT-350)

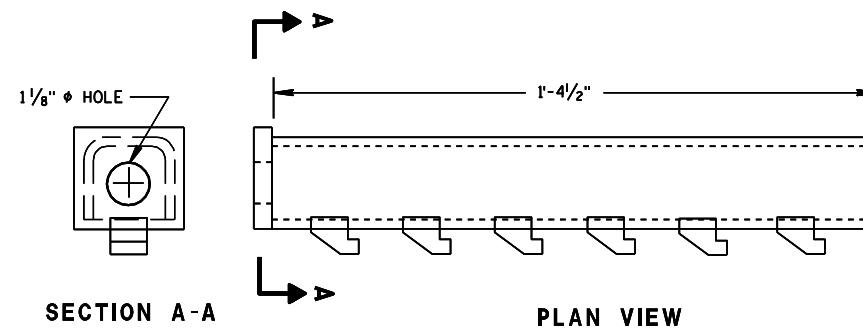

SECTION A-A


PLAN VIEW

⑨ CABLE ANCHOR BOX (ET-2000/ET-2000 PLUS)

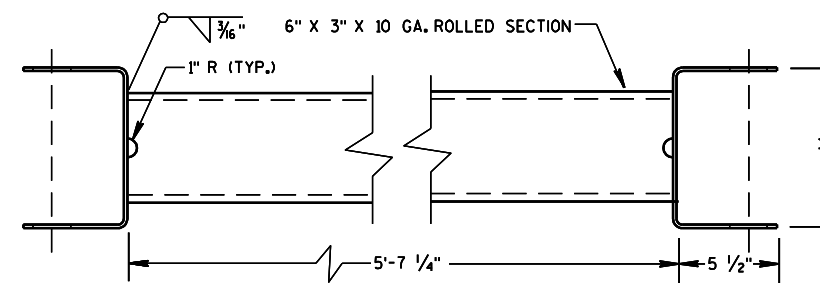


⑩ STRUT DETAIL (ET-2000/ET-2000 PLUS)

(ET-2000/ET-2000 PLUS)

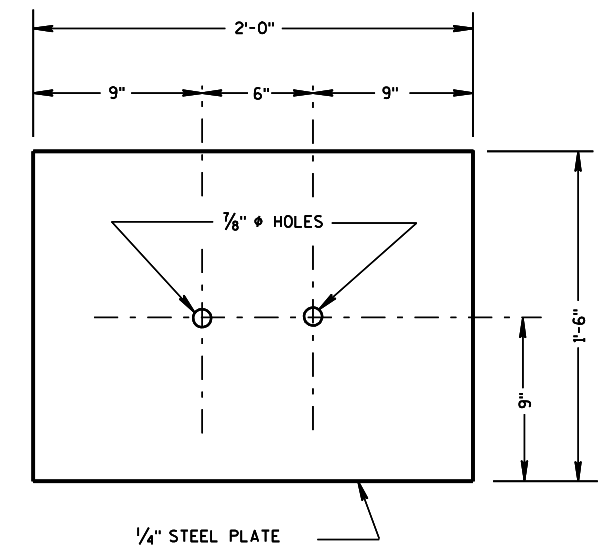

③ SOIL PLATE

(SKT-350, ET-2000/ET-2000 PLUS)

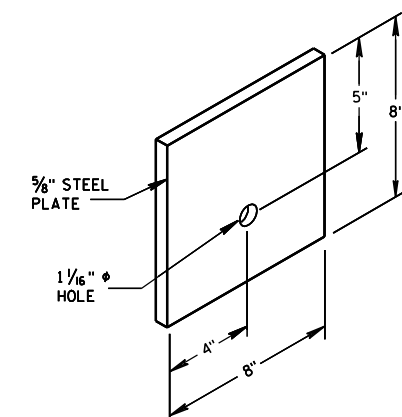


⑦ STEEL BEARING PLATE


(SKT-350, ET-2000/ET-2000 PLUS)

STEEL PLATE BEAM GUARD
ENERGY ABSORBING TERMINAL


STATE OF WISCONSIN
DEPARTMENT OF TRANSPORTATION

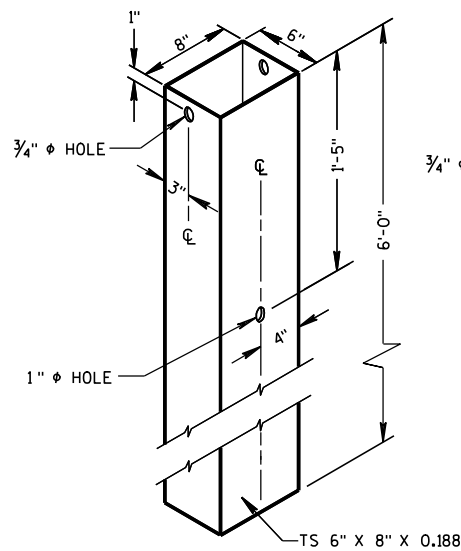

② 72" STEEL TUBE
(POSTS NO. 1-4)

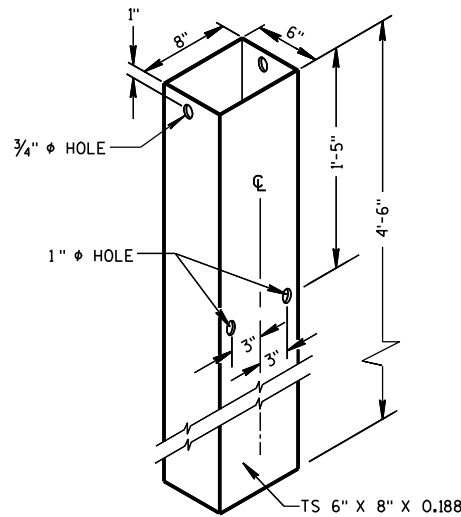


② 54" STEEL TUBE
(POSTS NO. 1-4)

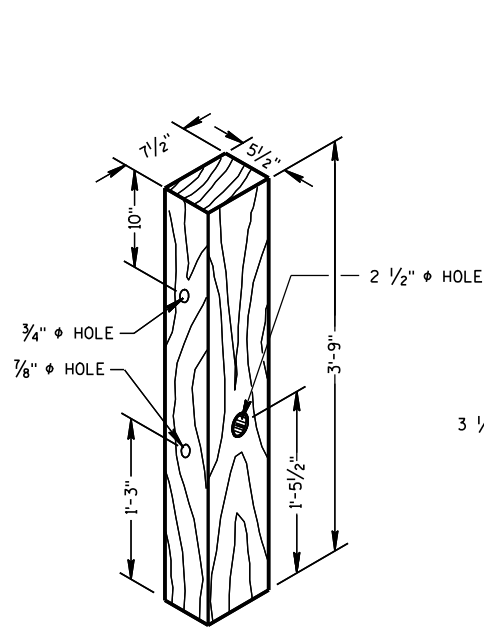


① TERMINAL POST
(POSTS NO. 1-4)


WOOD BREAKAWAY POSTS

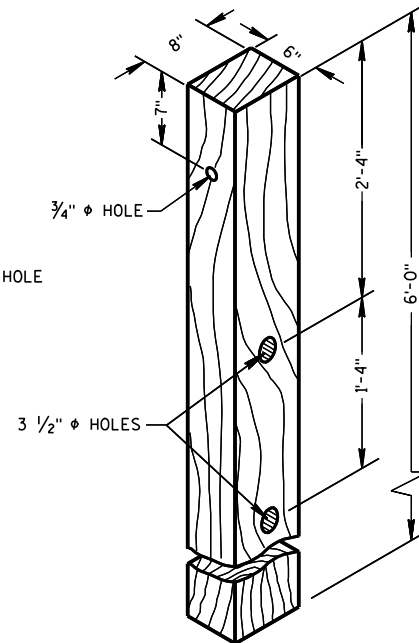

④ CRT POST
(POSTS NO'S 5-8)

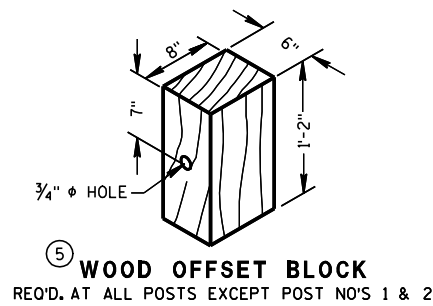


⑤ WOOD OFFSET BLOCK
REQ'D. AT ALL POSTS EXCEPT POST NO'S 1 & 2

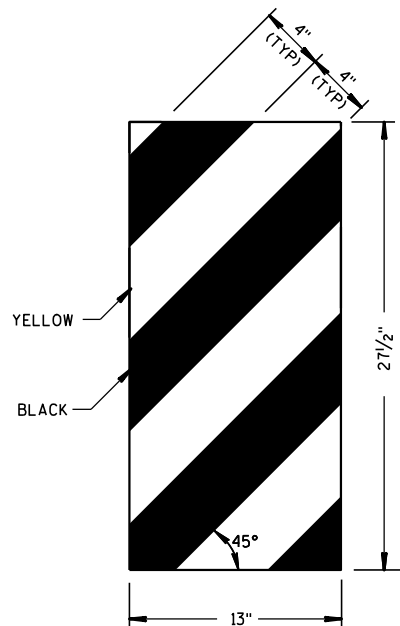


ET-2000 PLUS ONLY

⑭ REFLECTIVE SHEETING DETAILS

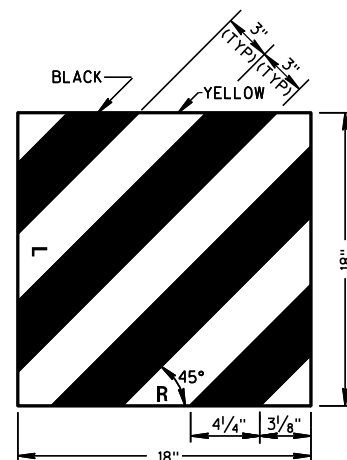


ET-2000 AND SKT-350

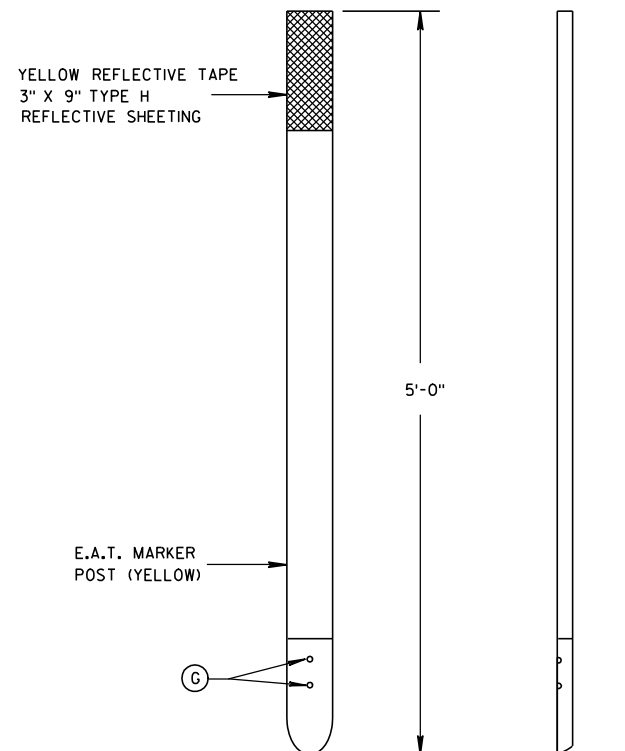


FRONT VIEW

SIDE VIEW

⑮ E.A.T. MARKER POST

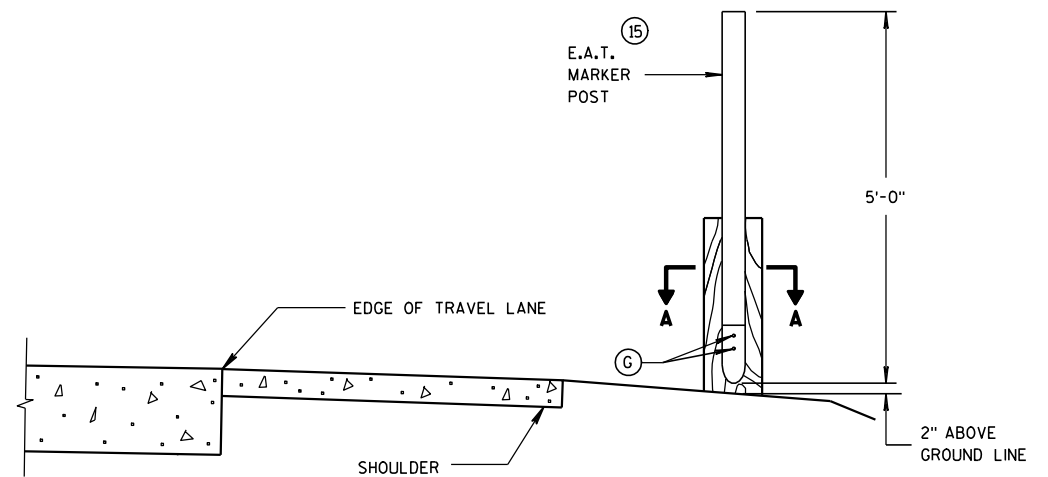

TYPICAL INSTALLATION OF E.A.T.
MARKER POST BACKSIDE OF POST NO. 1
(E.A.T. AND RAIL REMOVED FOR CLARITY)

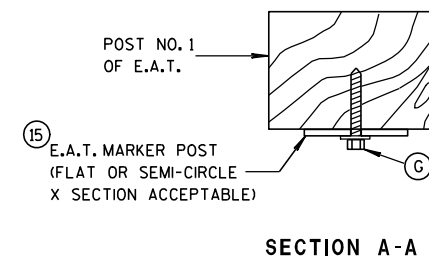

SECTION A-A

GENERAL NOTES


STEEL PLATE BEAM GUARD, ENERGY ABSORBING TERMINAL SHALL BE PAID FOR AT THE CONTRACT UNIT PRICE EACH, WHICH SHALL INCLUDE HARDWARE, STEEL PLATE BEAM GUARD, POSTS, REFLECTIVE SHEETING AND INSTALLATION AS SHOWN.

WHEN ROCK IS ENCOUNTERED DURING EXCAVATION, A 12 INCH DIA. POST HOLE EXTENDING 20 INCHES DEEP INTO THE ROCK MAY BE USED IF APPROVED BY THE ENGINEER. GRANULAR MATERIAL SHALL BE PLACED IN THE BOTTOM OF THE HOLE APPROXIMATELY 2 1/2" INCHES DEEP TO PROVIDE DRAINAGE. THE SOIL TUBES SHALL BE FIELD CUT TO LENGTH, PLACED IN THE HOLE AND BACKFILLED WITH ADEQUATELY COMPACTED MATERIAL EXCAVATED FROM THE HOLE.



SEE APPROVED PRODUCTS LIST FOR ACCEPTABLE E. A. T. MARKER POST.

⑮ 1/2" DIA. X 3" LAG BOLT WITH WASHER.

STEEL PLATE BEAM GUARD ENERGY ABSORBING TERMINAL	
STATE OF WISCONSIN DEPARTMENT OF TRANSPORTATION	
APPROVED 4-12-10 DATE FHWA	/S/ Jerry H. Zogg ROADWAY STANDARDS DEVELOPMENT ENGINEER

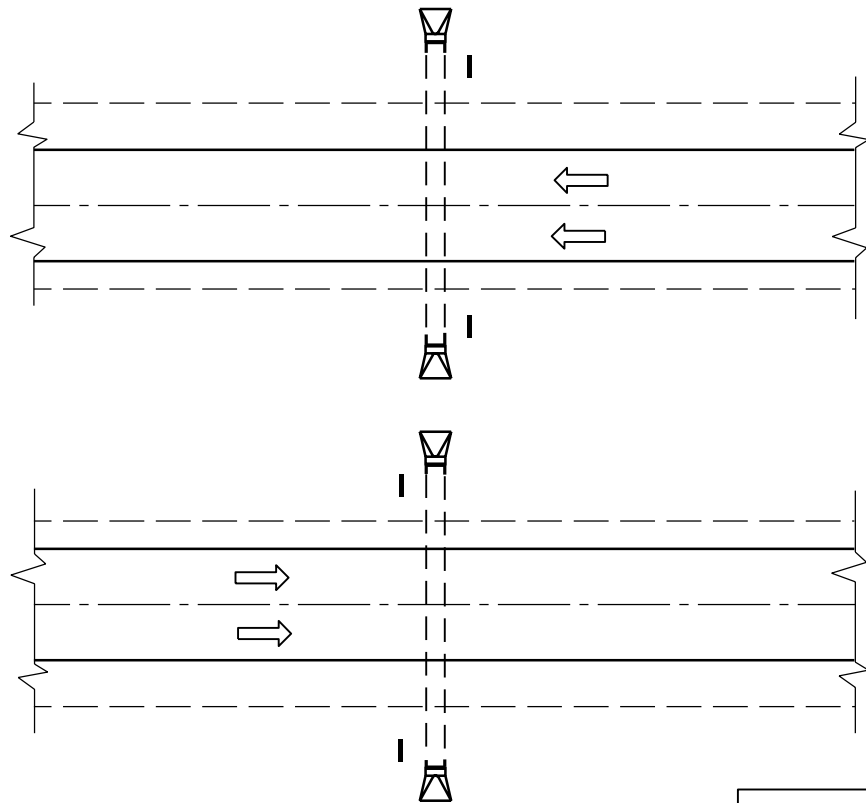

PLAN VIEW
DIVIDED HIGHWAY

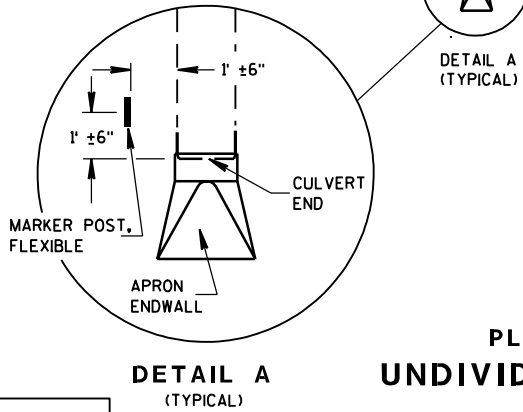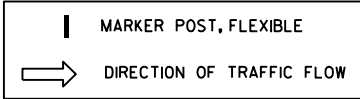


DETAIL A
(TYPICAL)

PLAN VIEW
UNDIVIDED HIGHWAY


FLEXIBLE MARKER POST LOCATION

GENERAL NOTES


DETAILS OF CONSTRUCTION, MATERIALS AND WORKMANSHIP NOT SHOWN ON THIS DRAWING SHALL CONFORM TO THE PERTINENT REQUIREMENTS OF THE STANDARD SPECIFICATIONS AND THE APPLICABLE SPECIAL PROVISIONS.

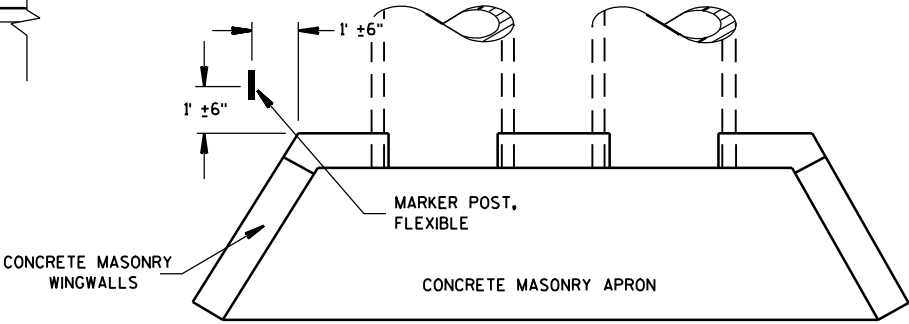

PLAN VIEW
CONCRETE MASONRY ENDWALLS FOR
CULVERT PIPE AND PIPE ARCH

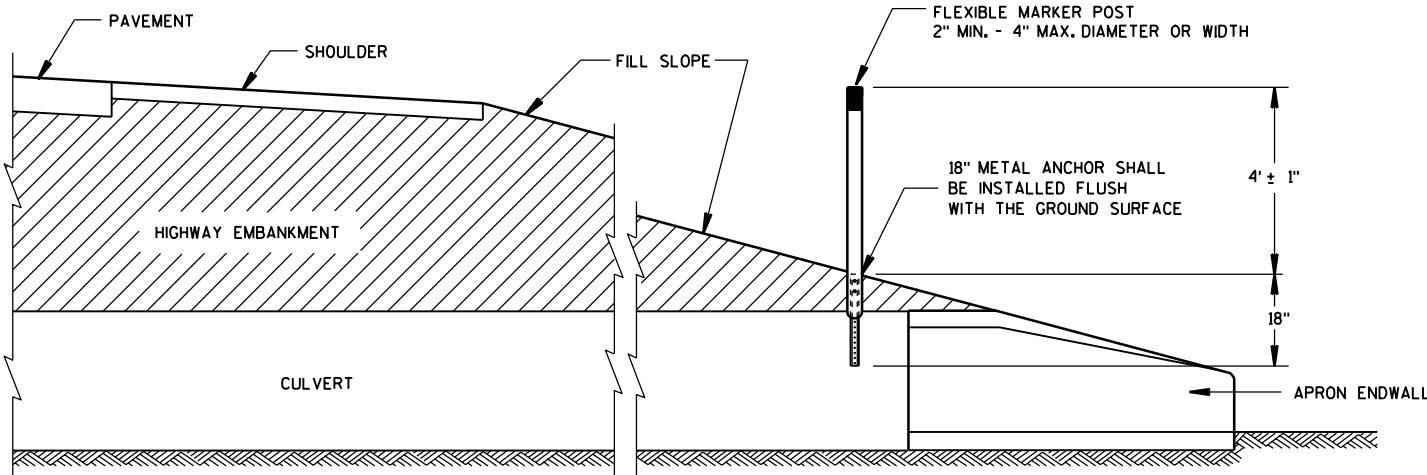


CROSS SECTION
FLEXIBLE MARKER POST

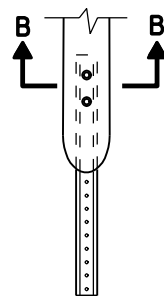


FRONT VIEW
CURVED MARKER



SIDE VIEW

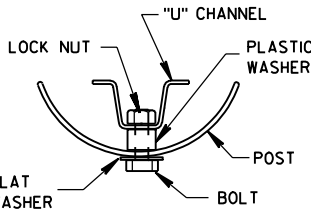


SECTION B-B

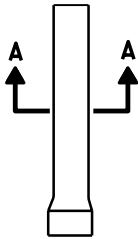

FRONT VIEW
ROUND MARKER




SIDE VIEW

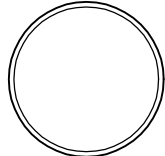

SECTION A-A

FLEXIBLE MARKER POST ANCHORS

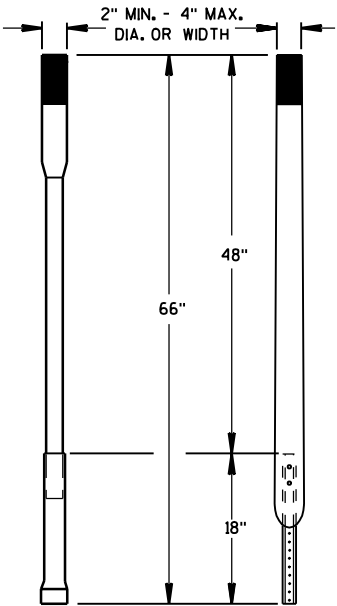


ALTERNATE 1 ALTERNATE 2
FLEXIBLE MARKER POST

MARKER POST, FLEXIBLE, FOR CULVERT END	
STATE OF WISCONSIN DEPARTMENT OF TRANSPORTATION	
APPROVED 10/1/98 DATE FHWA	 CHIEF ROADWAY DEVELOPMENT ENGINEER

NOTE: PULL OR STRETCHER POST ASSEMBLIES SHALL BE PLACED MIDWAY BETWEEN END POSTS AND CORNER POSTS WHERE A RUN OF FENCE EXCEEDS 660' BUT IS LESS THAN 1,320'. FOR RUNS OF FENCE IN EXCESS OF 1,320' MAXIMUM SPACING OF PULL OR STRETCHER POST ASSEMBLIES SHALL BE 660'± C-C.

ILLUSTRATION SHOWS POSITION OF STANDARD STEEL BRACE, DOUBLE STRAND GALVANIZED WIRE, AND THE POST TO BE EMBEDDED IN CONCRETE WHEN WIRE FENCE IS INSTALLED FROM LEFT TO RIGHT. THE BRACES SHALL BE POSITIONED ON THE OPPOSITE DIAGONALS AND THE OPPOSITE POST SHALL BE EMBEDDED IN CONCRETE WHEN WIRE FENCE IS INSTALLED FROM RIGHT TO LEFT.

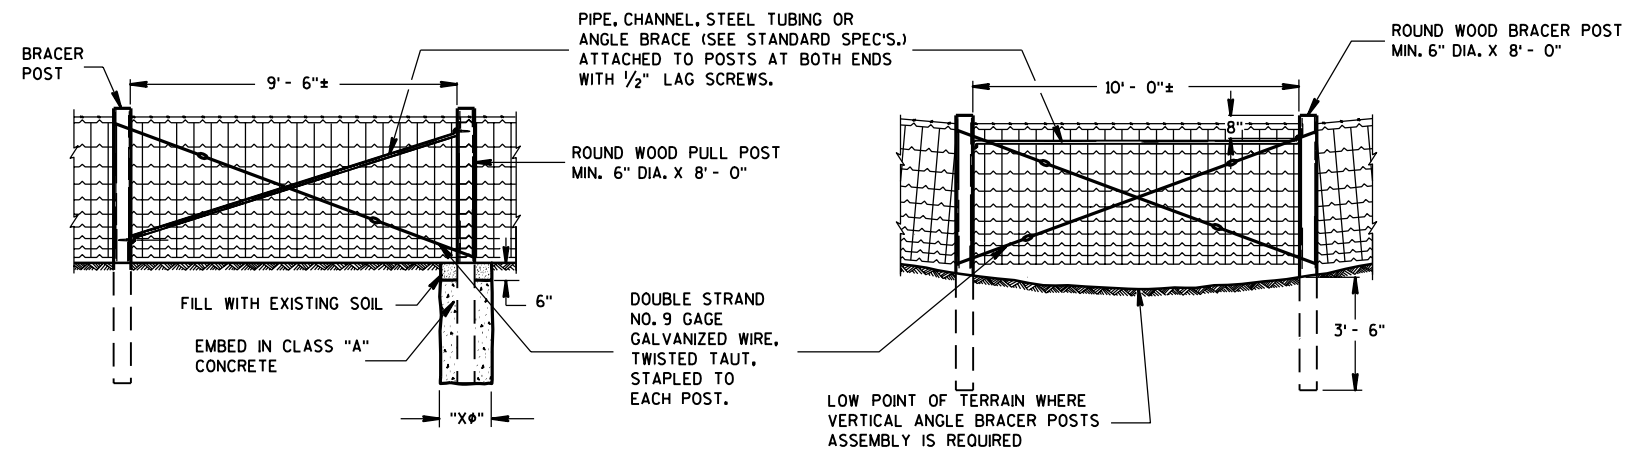

PULL OR STRETCHER POSTS ASSEMBLY

VERTICAL ANGLE BRACER POSTS ASSEMBLY


GENERAL NOTES

"X ϕ " = DIAMETER OF THE POST PLUS 12".

FENCE STAPLES SHOULD NEVER BE DRIVEN VERTICALLY INTO WOOD POSTS (WITH BOTH LEGS PARALLEL WITH THE WOOD GRAIN), DOING SO CAN SEPARATE THE GRAIN AND SIGNIFICANTLY REDUCE THE HOLDING POWER. ROTATING THE STAPLES SLIGHTLY OFF VERTICAL STRADDLES THE GRAIN AND PROVIDES MORE RESISTANCE TO PULL-OUT.


DO NOT STAPLE WIRE TIGHT TO THE LINE POSTS. ALLOW MOVEMENT OF WIRE FOR EXPANSION AND CONTRACTION. STAPLE ARRANGEMENT SHALL BE THE SAME FOR ALL OTHER POSTS EXCEPT THAT THEY SHALL BE DRIVEN TIGHT TO POSTS. ALL STAPLES SHALL BE 2" X 9 GAGE AND SHALL BE MANUFACTURED FROM GALVANIZED WIRE OR HOT DIP GALVANIZED AFTER FORMING. STAPLES SHALL HAVE SLASH-CUT POINTS.

FENCE SHALL BE LOCATED 3'-0" INSIDE
THE RIGHT OF WAY LINE UNLESS
OTHERWISE INDICATED ON THE PLANS.

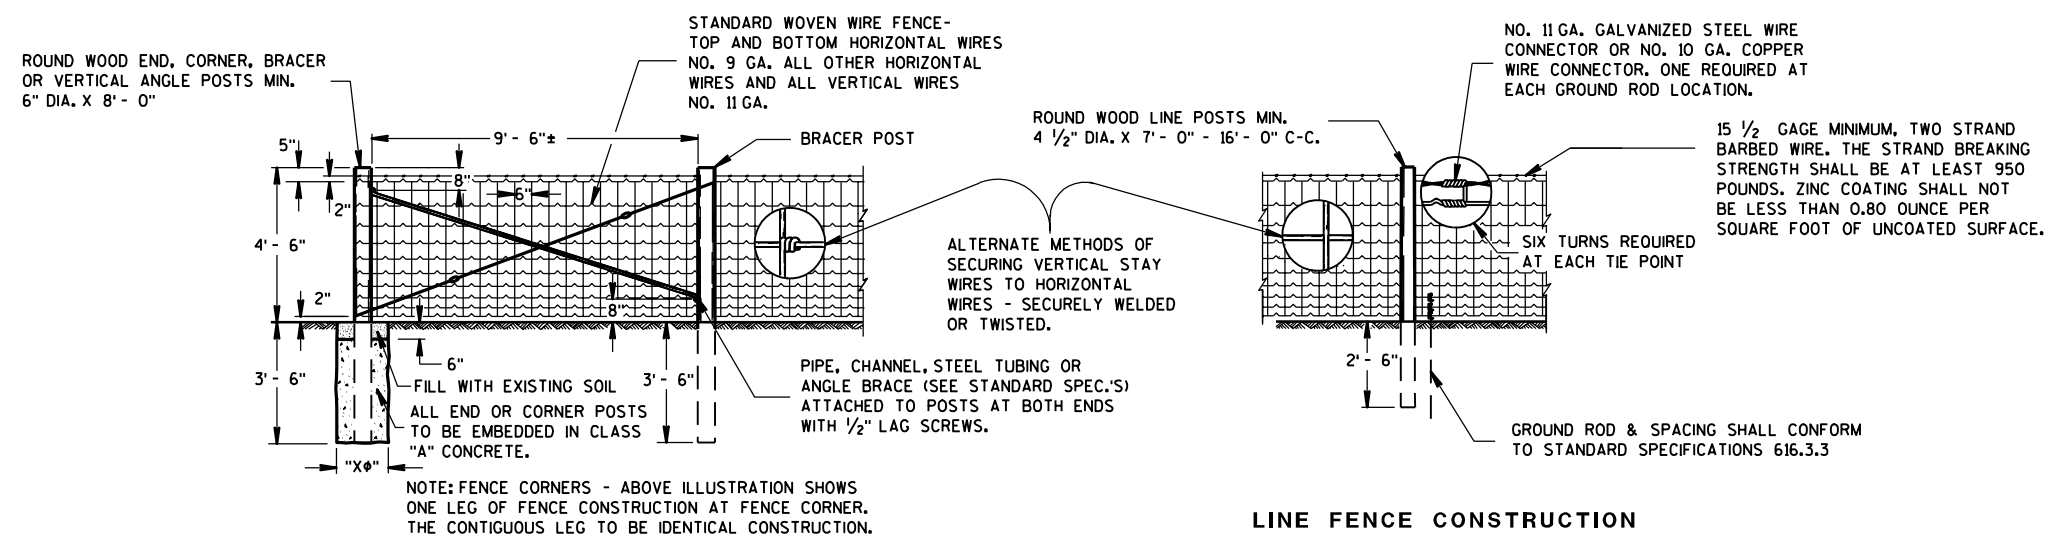


END OR CORNER POSTS ASSEMBLY

GENERAL ROADSIDE VIEW OF WOVEN WIRE FENCE

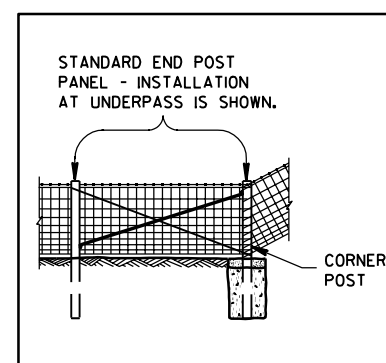

ALTERNATE FENCE DESIGN AT STRUCTURE








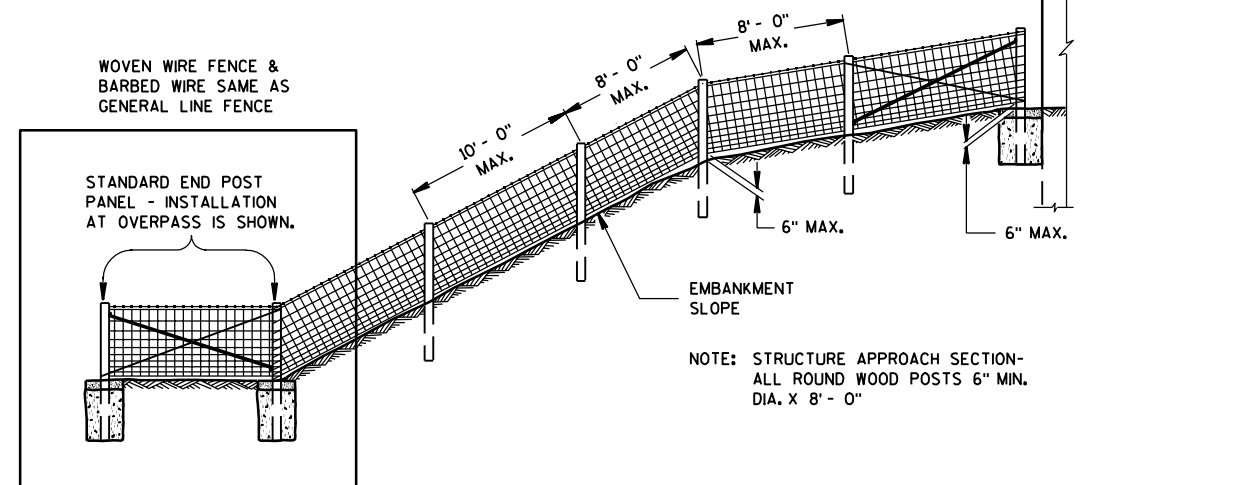


FENCE DESIGN AT STRUCTURE APPROACH

FENCE WOVEN WIRE

STATE OF WISCONSIN
DEPARTMENT OF TRANSPORTATION


6

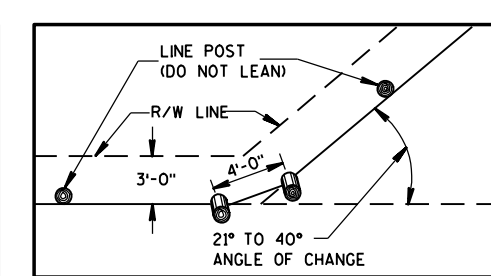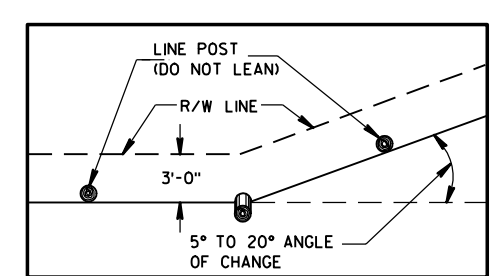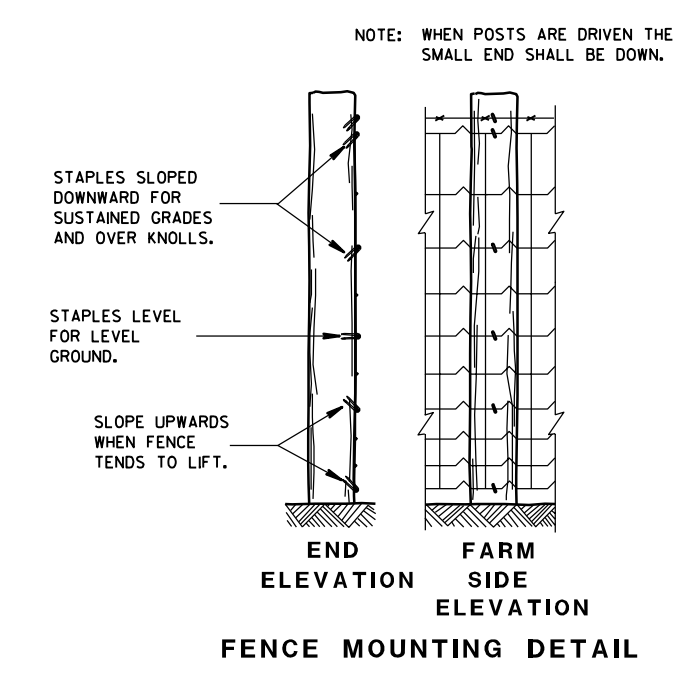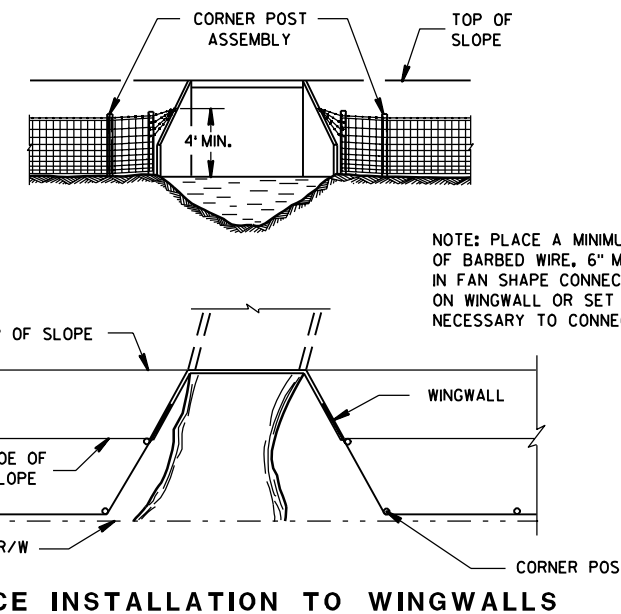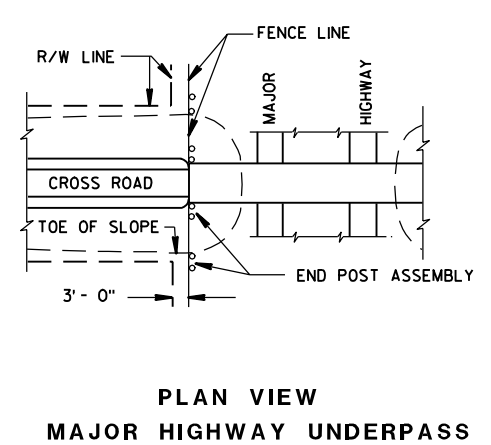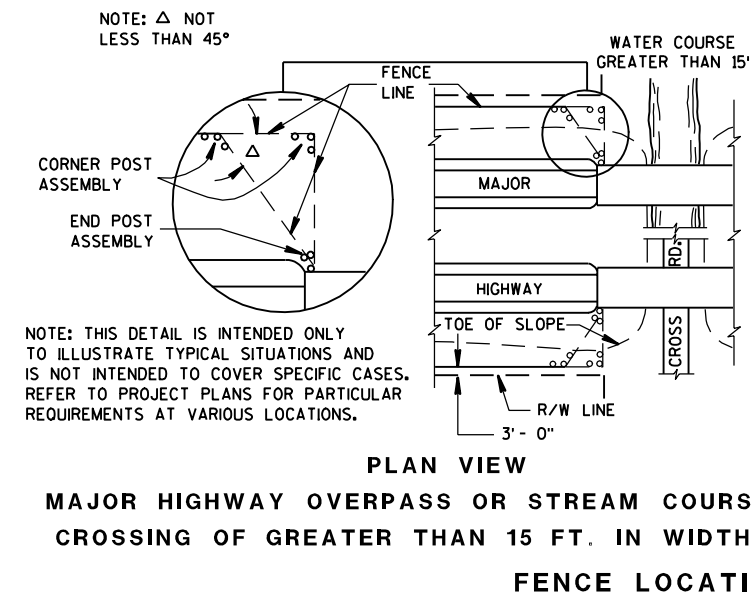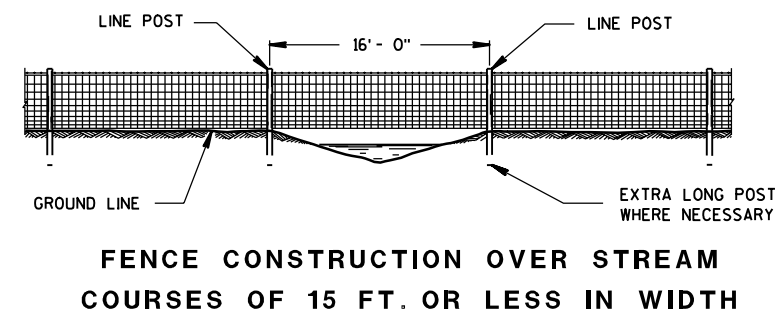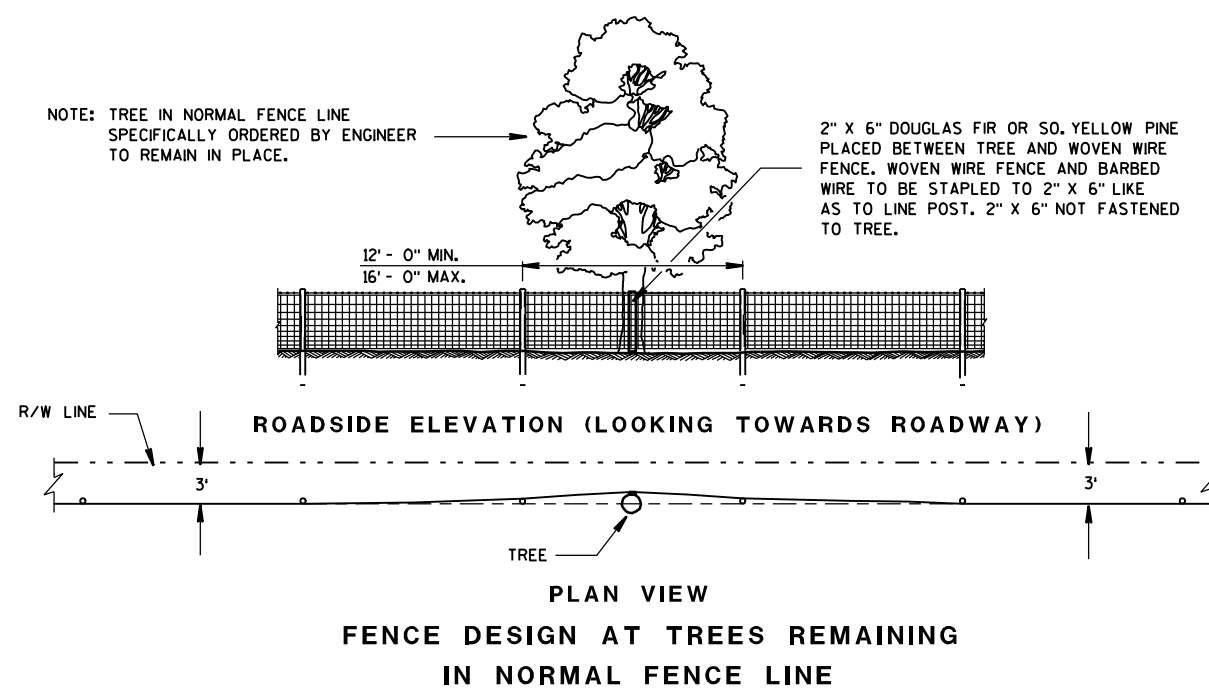

RIGHT OF WAY LINE CHANGE 40° AND LESS

NOTE: SINGLE AND DOUBLE POSTS SHALL BE A MIN. 6" DIA. X 8'-0" WITH A LEAN OF 4" TOWARD THE OUTSIDE OF THE CURVE.

WHEN THE RIGHT OF WAY LINE CHANGE IS MORE THAN 40° USE THE CORNER OR STRETCHER POSTS ASSEMBLY.

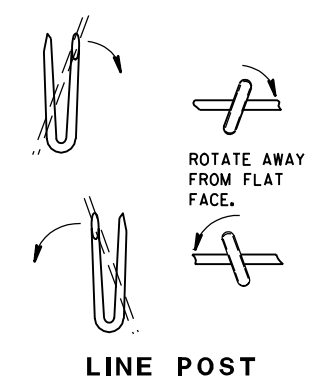


FENCE WOVEN WIRE	
STATE OF WISCONSIN DEPARTMENT OF TRANSPORTATION	
APPROVED 4/4/08 DATE	/S/ Jerry H. Zogg ROADWAY STANDARDS DEVELOPMENT ENGINEER
FHWA	


6

S.D.D. 15 B 1-8b


S.D.D. 15 B 1-8b

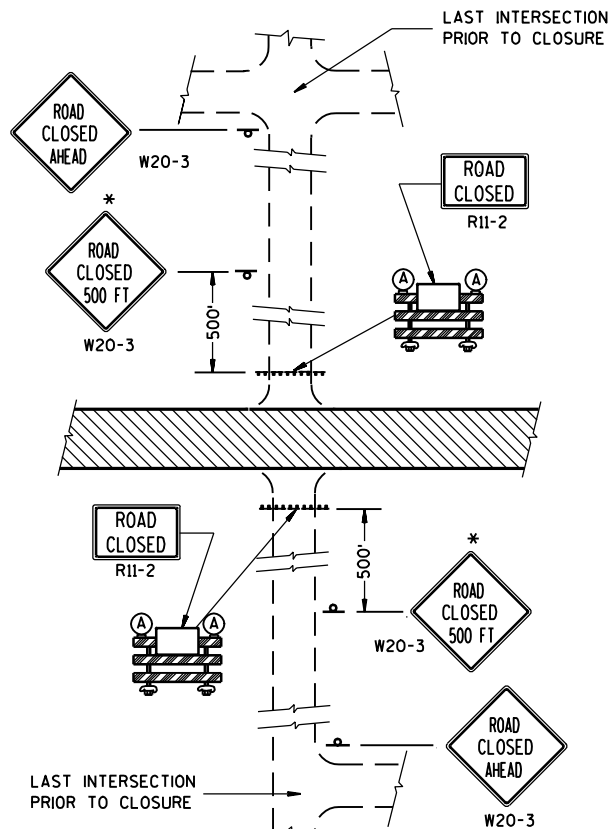


DETAIL 1
(NO ACCESS TO PROJECT)

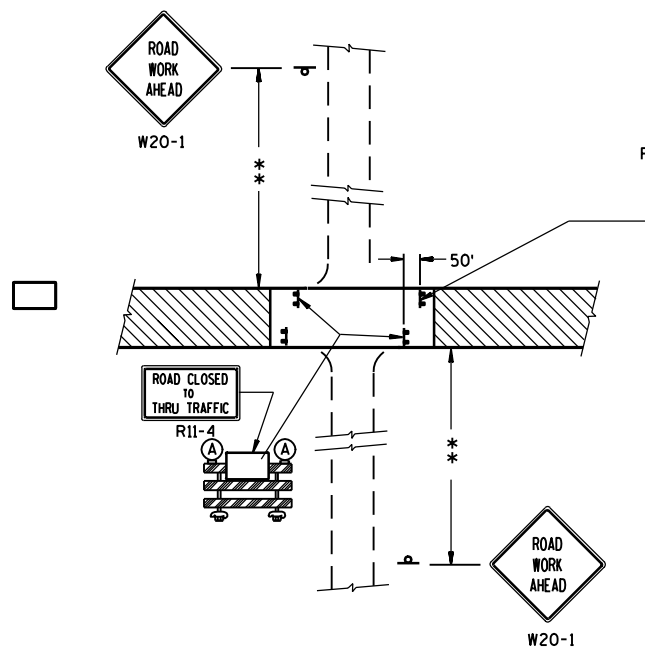

DETAIL 3
(PUBLIC CROSS-TRAFFIC MAINTAINED. CONTRACTOR, LOCAL BUSINESS AND RESIDENT ACCESS).

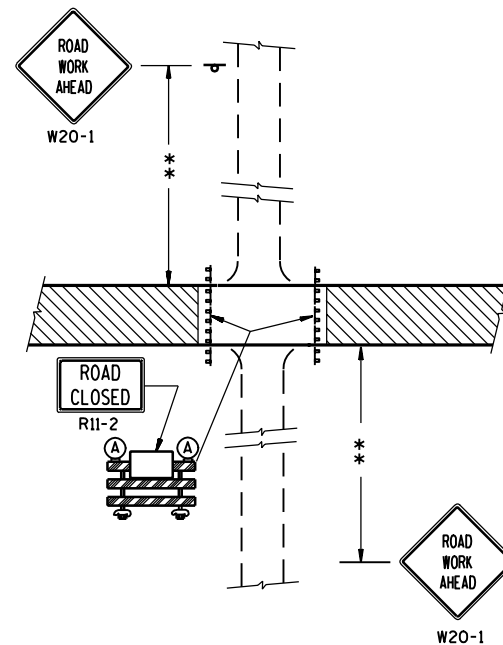

DETAIL 2
(PUBLIC CROSS-TRAFFIC MAINTAINED.
NO ACCESS TO PROJECT).

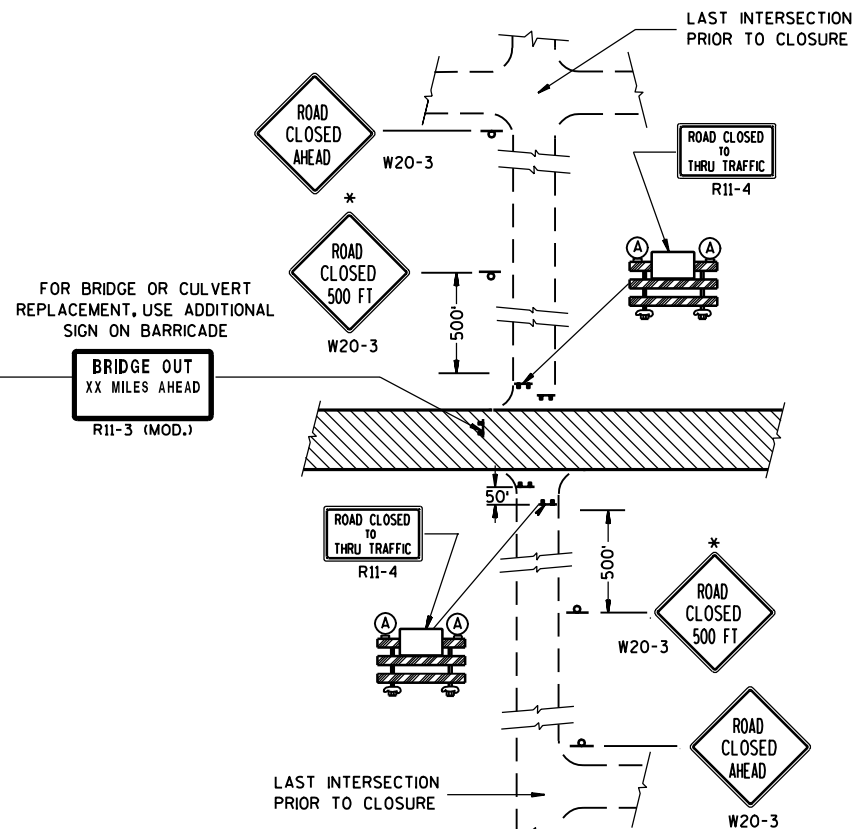

DETAIL 4
(CONTRACTOR, LOCAL BUSINESS AND
RESIDENT ACCESS TO PROJECT)

GENERAL NOTES

THE EXACT NUMBER, LOCATION, AND SPACING OF ALL SIGNS AND BARRICADES SHALL BE ADJUSTED TO FIT FIELD CONDITIONS AS APPROVED BY THE ENGINEER.

ANY SIGNS TEMPORARY OR EXISTING, WHICH CONFLICT WITH TRAFFIC CONTROL "IN USE" SHALL BE REMOVED OR COVERED AS NEEDED AND AS APPROVED BY THE ENGINEER.

THE SPACING BETWEEN TRAFFIC CONTROL SIGNS SHOULD BE ADJUSTED TO NOT CONFLICT WITH AND SHOULD PROVIDE A DESIRABLE MINIMUM OF 200 FEET CLEARANCE TO EXISTING SIGNS THAT WILL REMAIN IN PLACE.

IF A "STOP" SIGN MUST BE REMOVED FOR A WORK OPERATION, A TEMPORARY "STOP" SIGN SHALL BE PLACED PRIOR TO THE SIGN REMOVAL, OR A FLAGGER SHALL BE PROVIDED UNTIL THE SIGN IS RE-ESTABLISHED.

BARRICADES THAT MUST BE MOVED FOR A WORK OPERATION SHALL BE IMMEDIATELY RE-ESTABLISHED UPON COMPLETION OF THE OPERATION OR, FOR CONTINUING OPERATIONS, AT THE END OF EACH WORKING DAY.

SIGNS THAT WILL BE IN PLACE LESS THAN 7 CONTINUOUS DAYS AND NIGHTS MAY BE MOUNTED ON PORTABLE SUPPORTS.

ALL TYPE III BARRICADES SHALL HAVE RAILS REFLECTORIZED ON BOTH FACES. STRIPES SHALL BE PROPERLY SLOPED DOWN TOWARD THE TRAFFIC SIDE OR AS SHOWN IN THE ROAD CLOSURE BARRICADE DETAIL D FOR FULL ROAD CLOSURES.

TYPE "A" LOW-INTENSITY FLASHING WARNING LIGHTS SHALL BE VISIBLE ON BOTH SIDES OF THE BARRICADE.

THE R11-2, R11-3 AND R11-4 SIGNS PLACED ON BARRICADES SHALL COVER NO MORE THAN THE TOP RAIL. THE SIGNS SHALL NOT COVER ANY PORTION OF THE MIDDLE OR BOTTOM RAILS.

THE REFLECTIVE SHEETING USED ON R11-2, R11-3 AND R11-4 SIGNS SHALL COMPLY WITH SUBSECTION 637.2.2.2 OF THE STANDARD SPECIFICATIONS.

ALL SIGNS SHALL BE 48" X 48" UNLESS OTHERWISE NOTED BELOW:

R11-2 SHALL BE 48" X 30".

R11-4 AND R11-3 SHALL BE 60" X 30".

*OMIT THE "ROAD CLOSED 500 FT." SIGN IF THE LAST INTERSECTION IS 500 FT. OR LESS FROM THE WORK ZONE.

**500' MAX. OR AT LAST INTERSECTION WHICHEVER IS CLOSER.

LEGEND

POST MOUNTED WARNING SIGN

TYPE III BARRICADES

TYPE "A" LOW INTENSITY FLASHING WARNING LIGHT (FOR NIGHT USE)

WORK AREA

BARRICADES AND SIGNS FOR SIDEROAD CLOSURES

STATE OF WISCONSIN
DEPARTMENT OF TRANSPORTATION


APPROVED

9-16-03


DATE

FHWA


Thomas N. Nottbohm for
CHIEF SIGNS AND MARKING ENGINEER

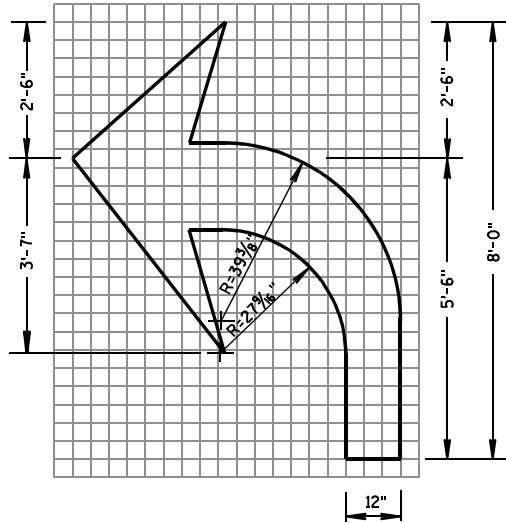


TYPE 2

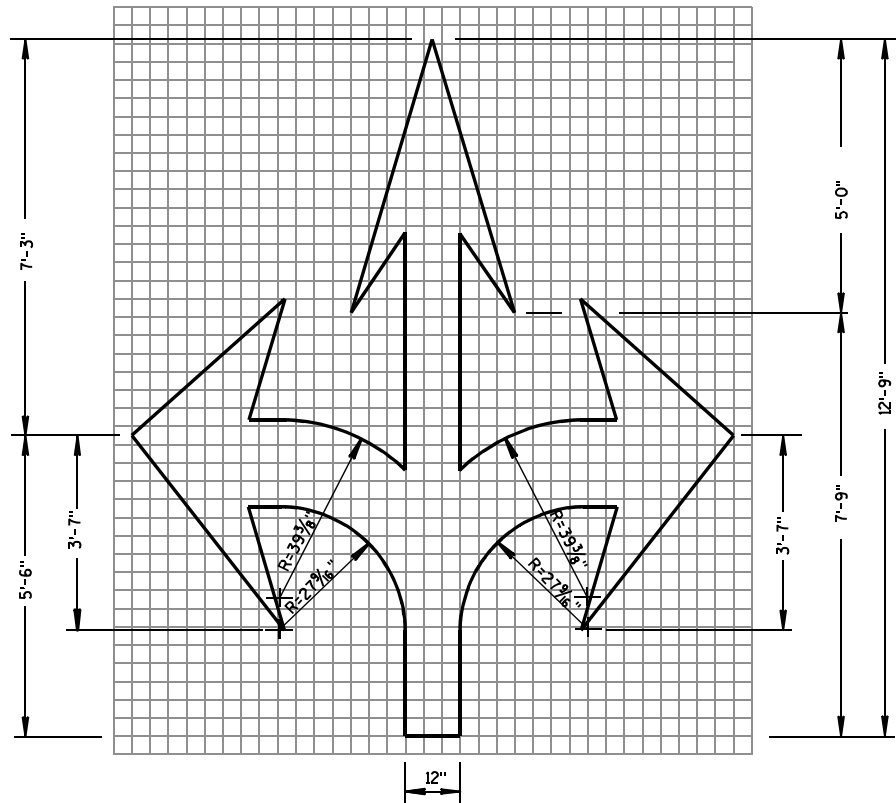


TYPE 6

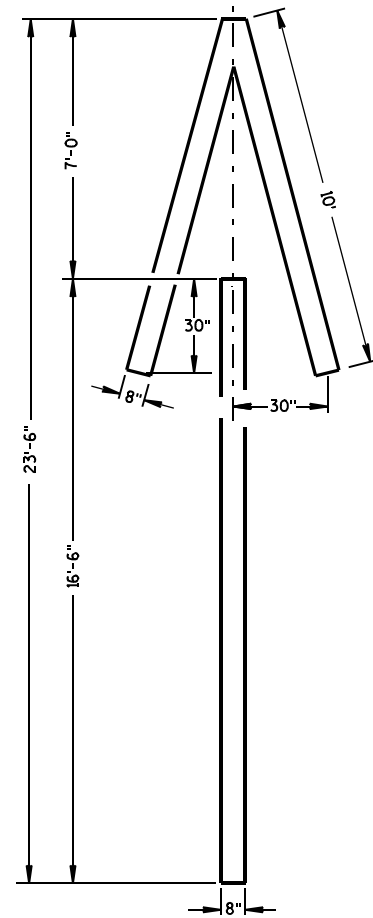


TYPE 4

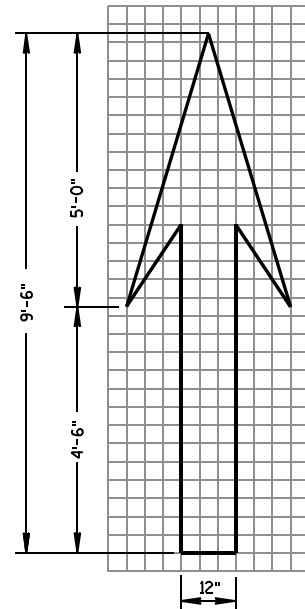

TYPE 1

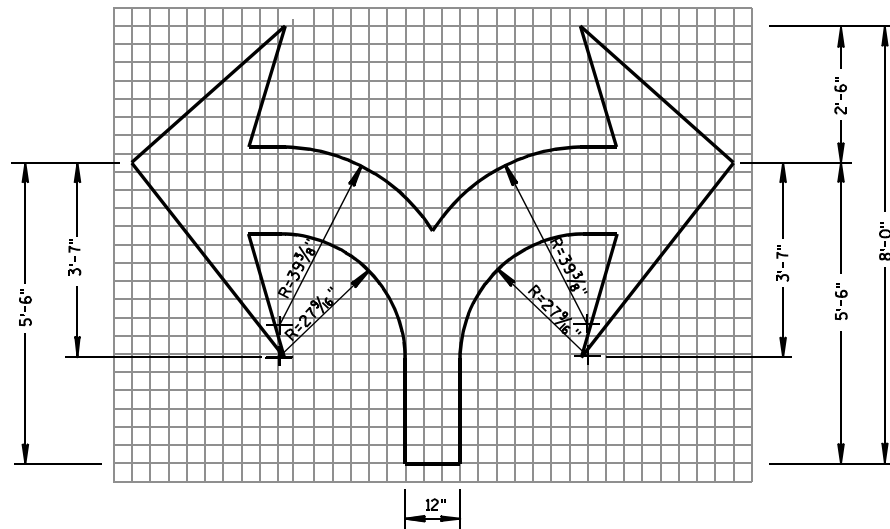

TYPE 7

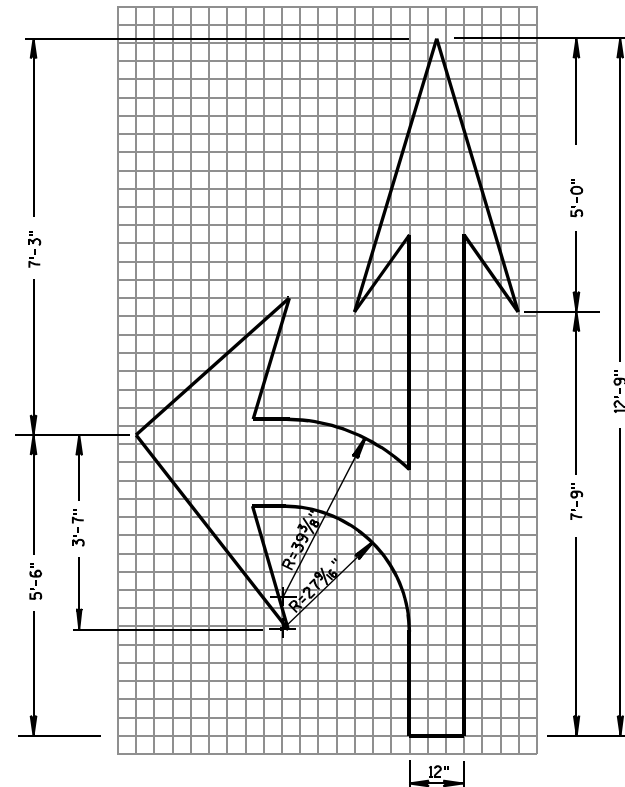


TYPE 3

GENERAL NOTES

DETAILS OF INSTALLATION, MATERIALS AND WORKMANSHIP NOT SHOWN ON THIS DRAWING SHALL CONFORM TO THE PERTINENT REQUIREMENTS OF THE STANDARD SPECIFICATIONS AND APPLICABLE SPECIAL PROVISIONS.

ALL LETTERS, ARROWS AND SYMBOLS SHALL BE IN CONFORMANCE WITH REQUIREMENTS INCLUDED IN "STANDARD ALPHABETS FOR HIGHWAY SIGNS AND PAVEMENT MARKING" BOOK BY THE FEDERAL HIGHWAY ADMINISTRATION. ALL LETTERS, ARROWS AND SYMBOLS SHALL BE WHITE AND REFLECTORIZED. SMALL DIFFERENCES IN DIMENSIONS WITHIN THE TOLERANCES OF THAT BOOK ARE ACCEPTABLE.

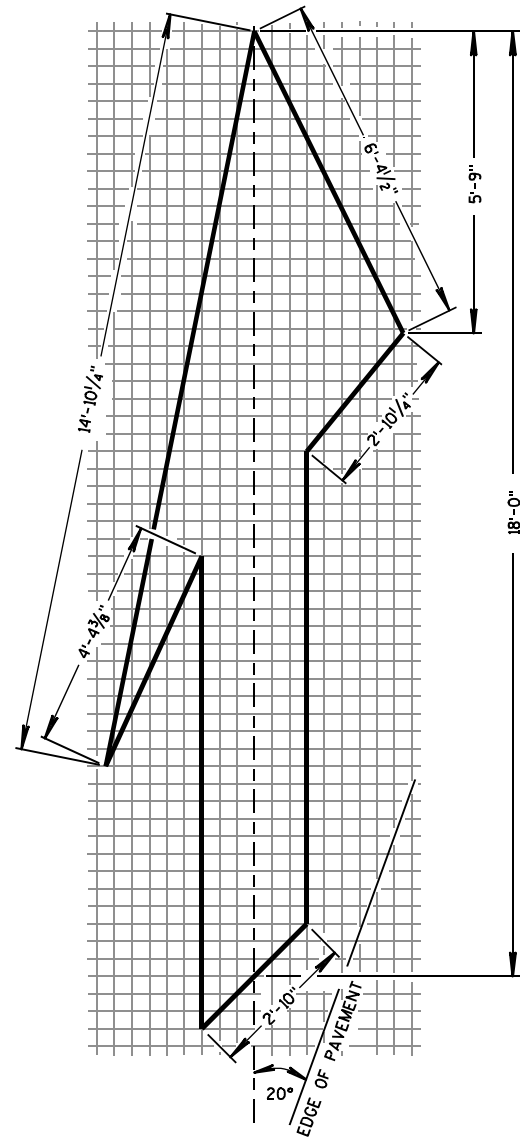

TYPE 5 LANE DROP ARROW

PAVEMENT MARKING ARROWS


STATE OF WISCONSIN
DEPARTMENT OF TRANSPORTATION

APPROVED


5/13/10
DATE

FHWA

/S/ Thomas N. Notbohm
STATE TRAFFIC ENGINEER OF DESIGN

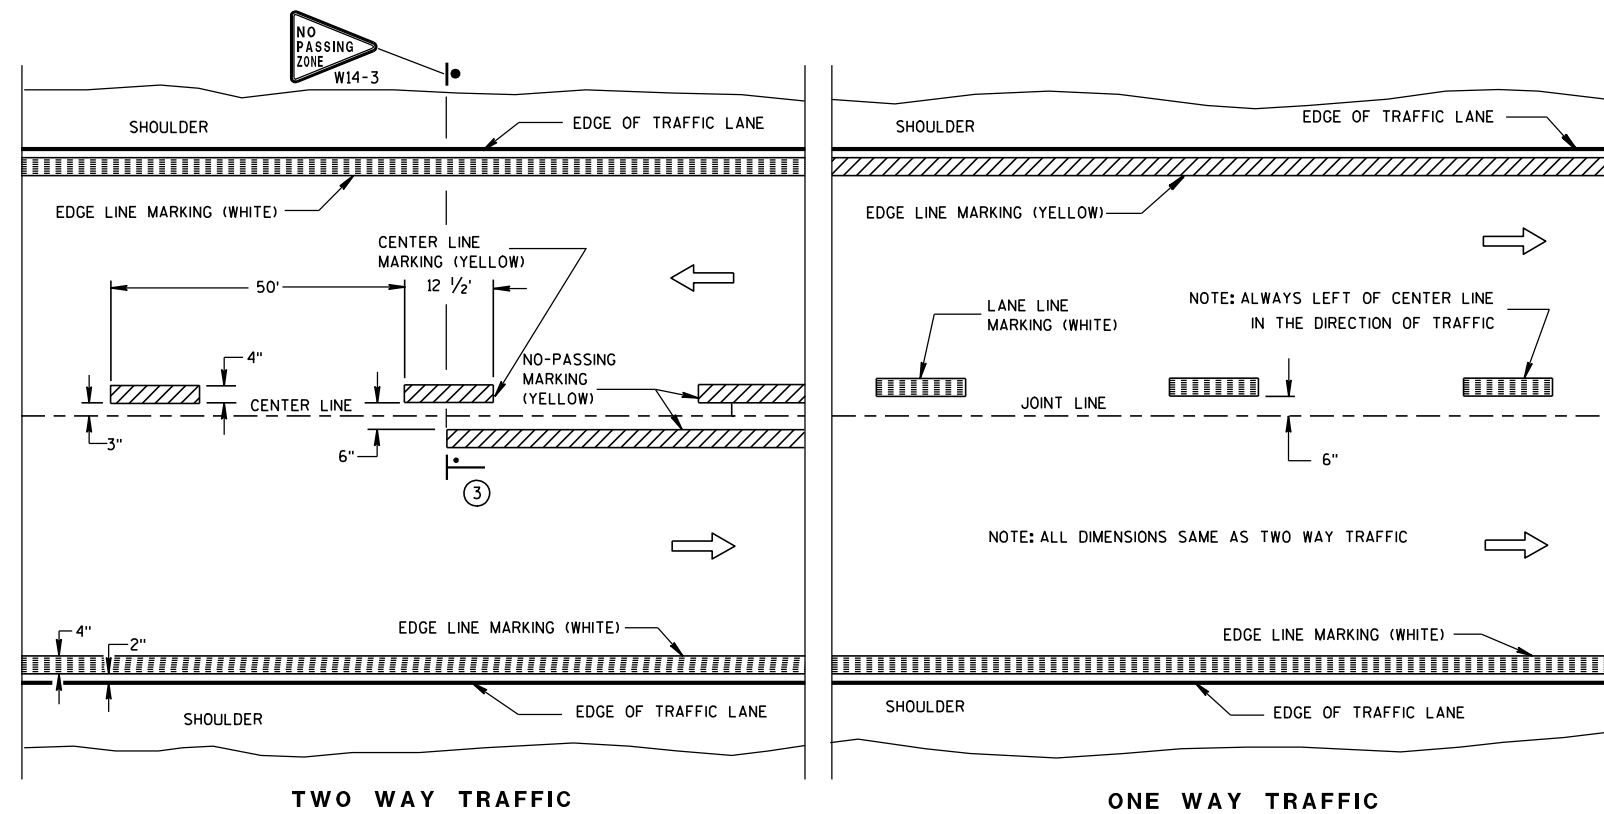

PERMANENT PAVEMENT MARKING

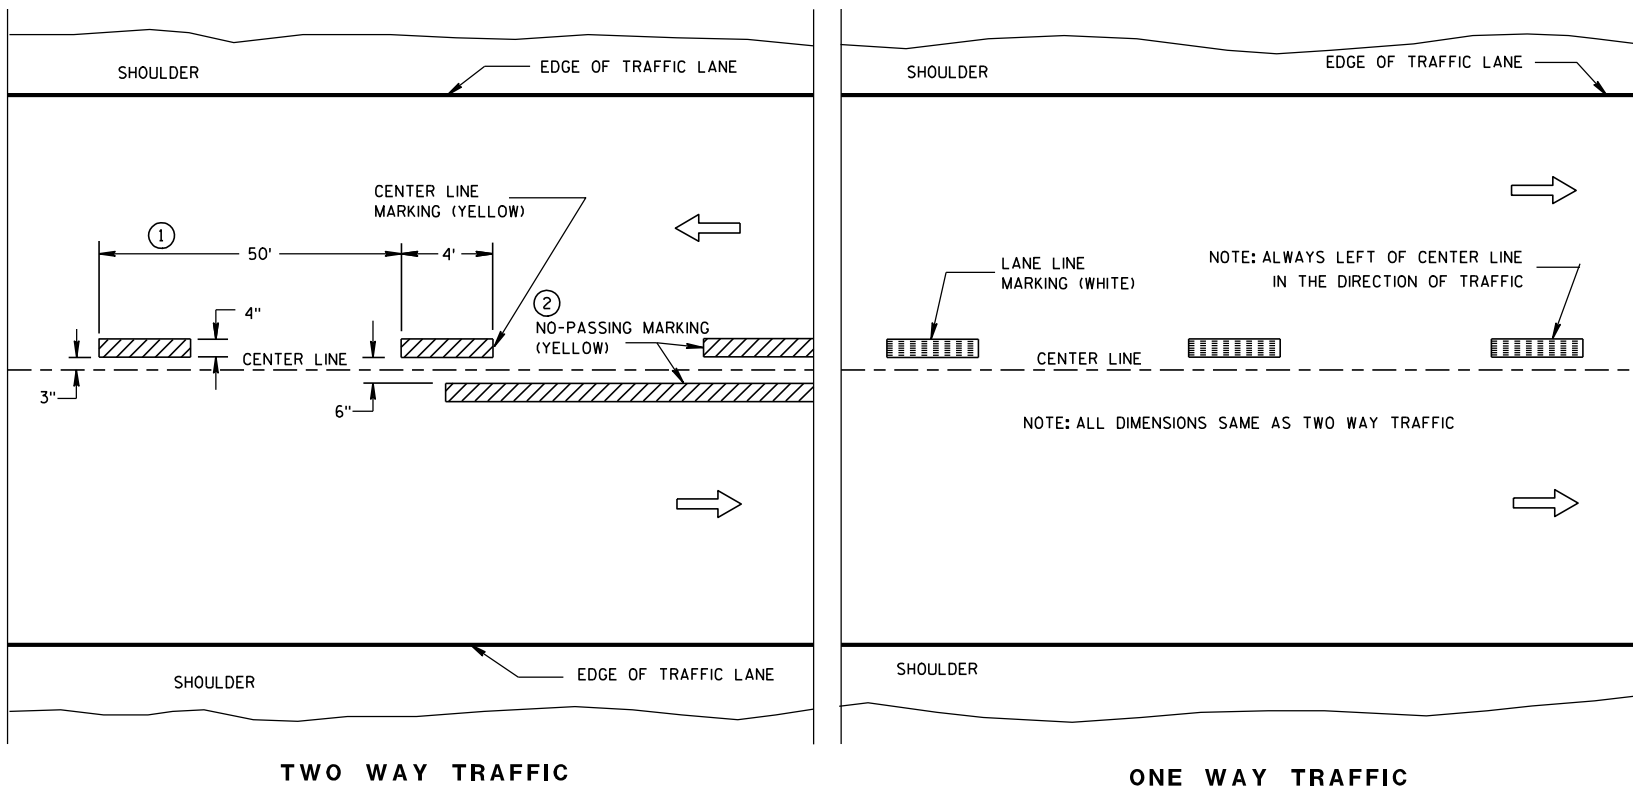

TEMPORARY (INTERMEDIATE) PAVEMENT MARKING (SHOWS CYCLE FOR TEMPORARY CENTER LINE OR TEMPORARY LANE LINE MARKING)


GENERAL NOTES

DETAILS OF CONSTRUCTION NOT SHOWN ON THIS DRAWING SHALL CONFORM TO STANDARD SPECIFICATIONS AND SPECIAL PROVISIONS.

- ① HALF CYCLE LENGTHS (25'±) WITH 2' MINIMUM STRIPE LENGTHS SHALL BE PROVIDED ON ROADWAYS (INCLUDING TEMPORARY TRAVELED WAYS) WITH REVERSE CURVATURE, CURVATURE OF OVER 5 DEGREES OR WHEN DIRECTED BY THE ENGINEER TO MARK UNUSUAL ALIGNMENT OF THE TRAVELED WAY.
- ② NO PASSING ZONE TEMPORARY PAVEMENT MARKING IS REQUIRED TO BE PLACED, WHERE APPROPRIATE, ALONG WITH CENTERLINE TEMPORARY PAVEMENT MARKING WHEN A SAME DAY PERMANENT PAVEMENT MARKING ITEM IS INCLUDED IN THE CONTRACT.
- ③ NO PASSING ZONE MARKINGS ARE PLACED ACCORDING TO "T" MARKINGS. IF EXISTING NO PASSING ZONE W14-3 SIGNS ARE BEYOND 50 FEET IN EITHER DIRECTION, THE SIGNS SHALL BE MOVED TO THE "T" MARKINGS.

NOTE

ARROW SYMBOL (→) SHOWS DIRECTION OF TRAVEL

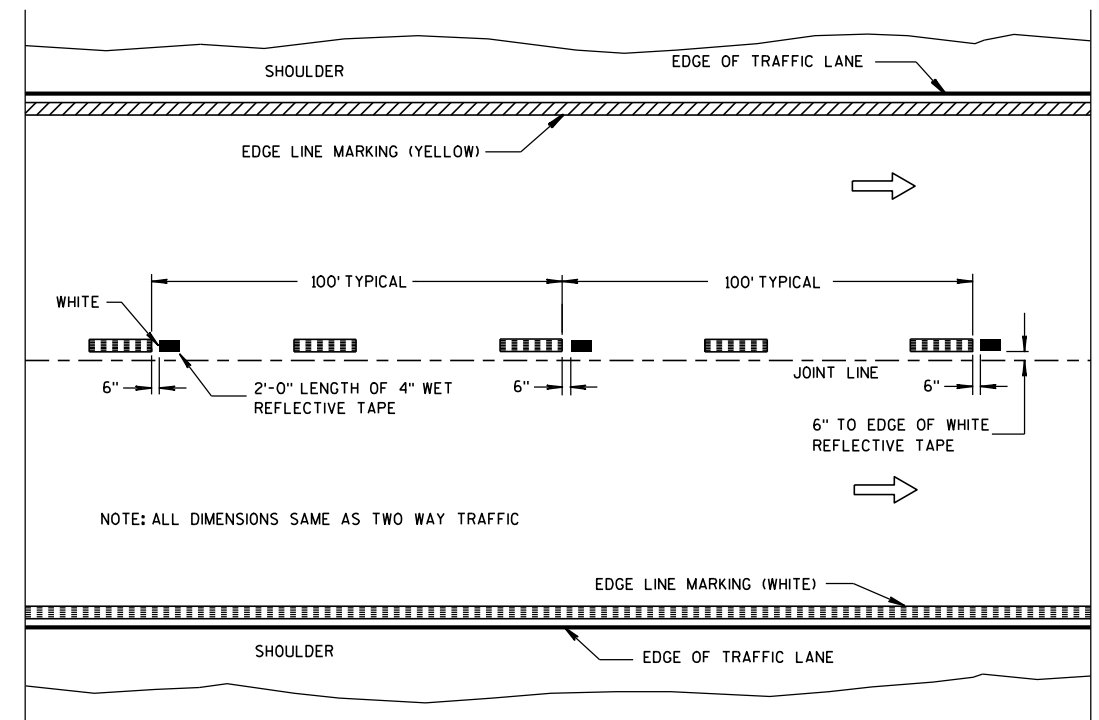

LEGEND

— "T" MARKING

● POST MOUNTED SIGN

PAVEMENT MARKING
(MAINLINE)

STATE OF WISCONSIN
DEPARTMENT OF TRANSPORTATION


APPROVED

5-13-10
DATE


FHWA

/S/ Thomas N. Notbohm


STATE TRAFFIC ENGINEER OF DESIGN

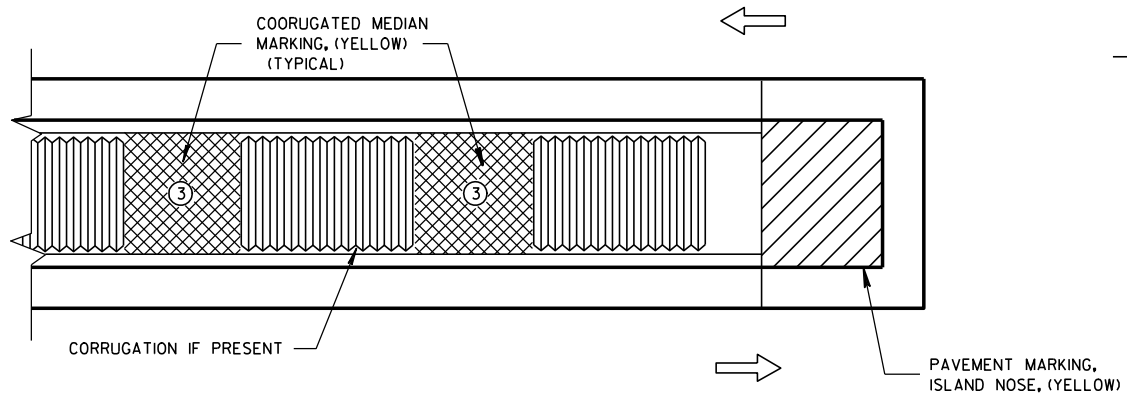

MEDIAN ISLAND WITH SQUARE BLUNT NOSE

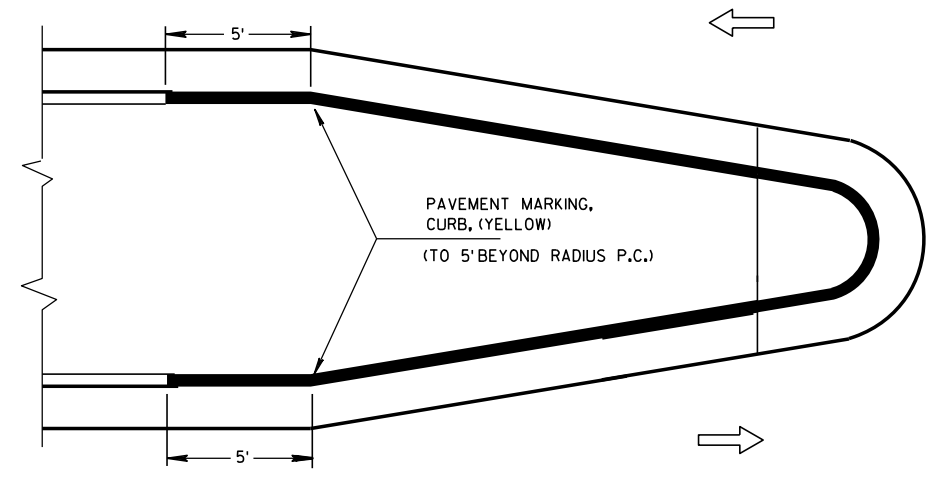


MEDIAN ISLAND WITH ROUND BLUNT NOSE

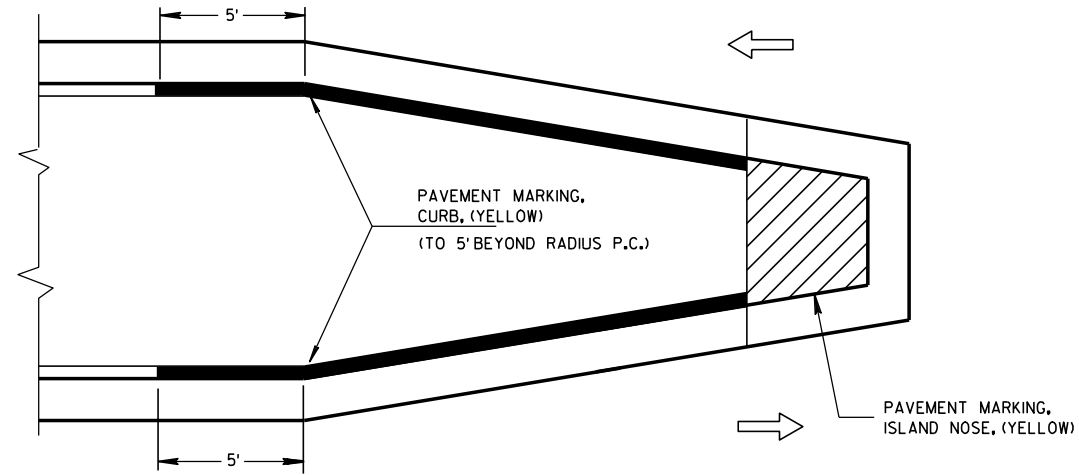

MEDIAN ISLAND WITH SLOPED NOSE


TYPICAL PLACEMENT OF PAVEMENT MARKING ON MEDIAN ISLANDS

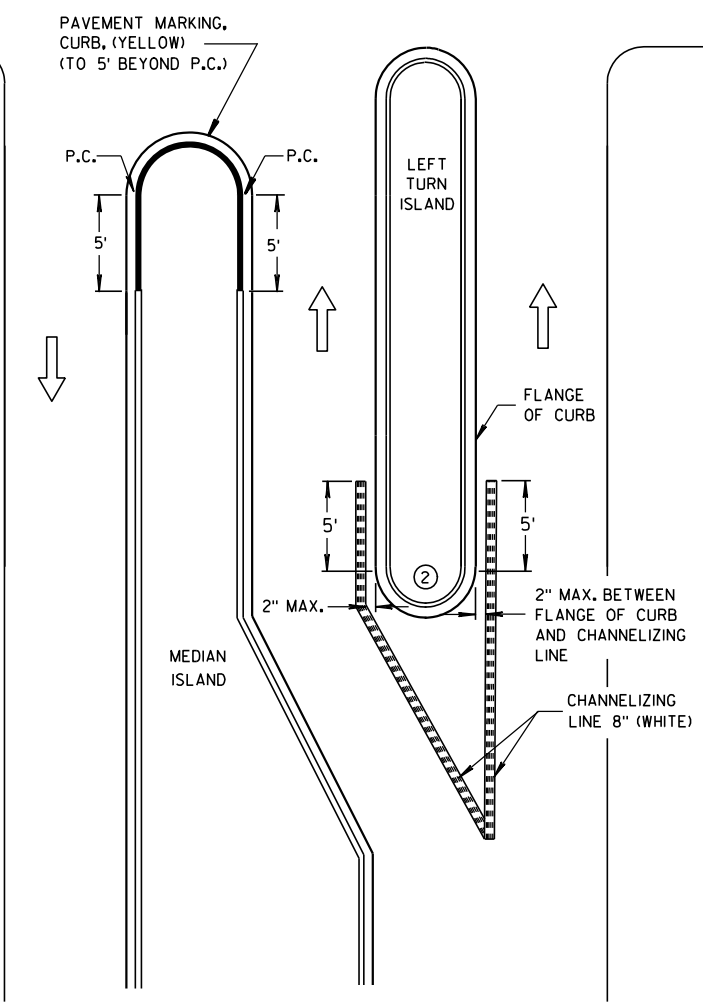

LEFT TURN & MEDIAN ISLAND

GENERAL NOTES


- ① STOP LINE IS REQUIRED ONLY WHEN SPECIFIED IN THE CONTRACT.
- ② DO NOT MARK CURB NOSES THAT SEPARATE LANES OF TRAFFIC TRAVELING IN THE SAME DIRECTION.
- ③ WHEN CONCRETE CORRUGATED MEDIAN IS CONSTRUCTED TO SEPARATE TRAFFIC OPERATING IN THE OPPOSING DIRECTION YELLOW PAVEMENT MARKING SHALL BE APPLIED TO THE FLAT PORTION OF THE CONCRETE CORRUGATED MEDIAN. THE ITEM OF PAVEMENT MARKING, CONCRETE CORRUGATED MEDIAN, WILL BE MEASURED IN PLACE AND AND ACCEPTED IN ACCORDANCE WITH THE CONTRACT AND PAID FOR AT THE CONTRACT UNIT PRICE PER SQUARE FOOT.

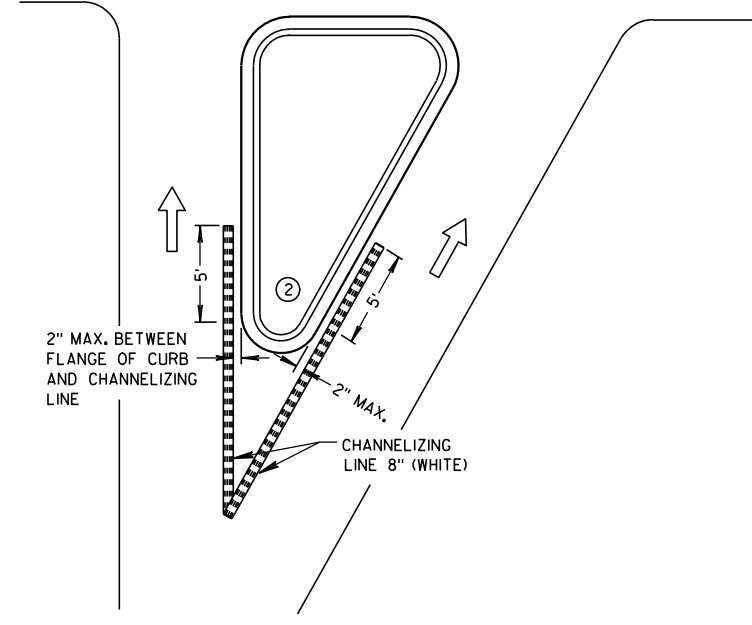

RIGHT TURN ISLAND


LEGEND

- ISLAND NOSE MARKING
- CURB MAKING
- CORRUGATED MEDIAN MARKING
- DIRECTION OF TRAVEL

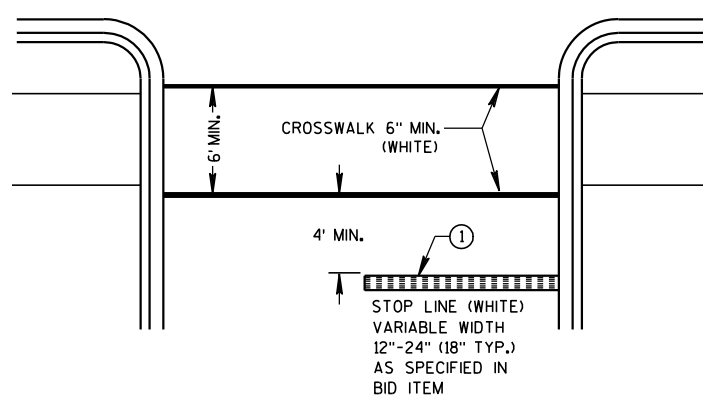

STOP LINE AND CROSSWALK


PAVEMENT MARKING (ISLANDS, STOP LINE & CROSS WALK)
STATE OF WISCONSIN
DEPARTMENT OF TRANSPORTATION

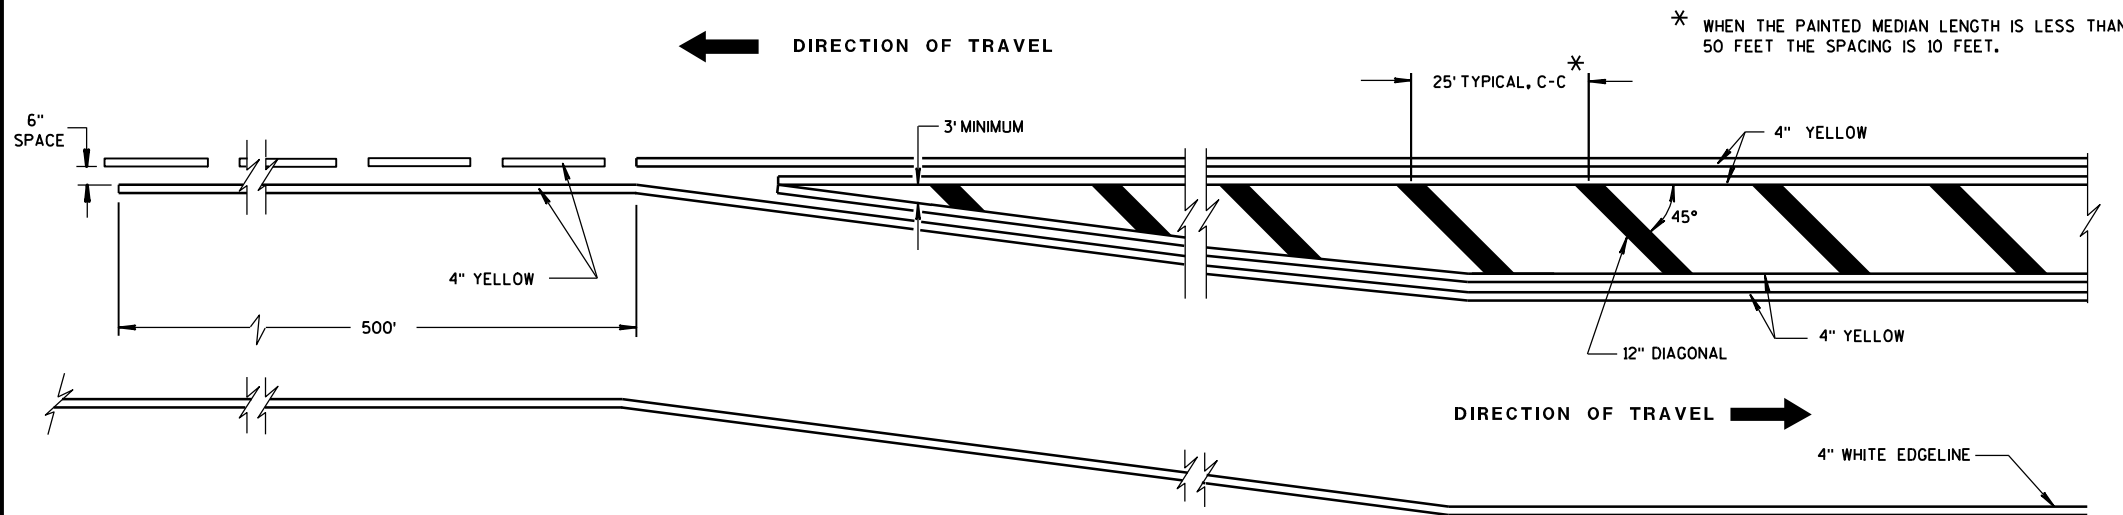


MEDIAN ISLAND DETAIL

GENERAL NOTE

DIAGONALS ARE OPTIONAL WHEN PAINTED ISLAND IS LESS THAN 6 FEET AT WIDEST POINT.

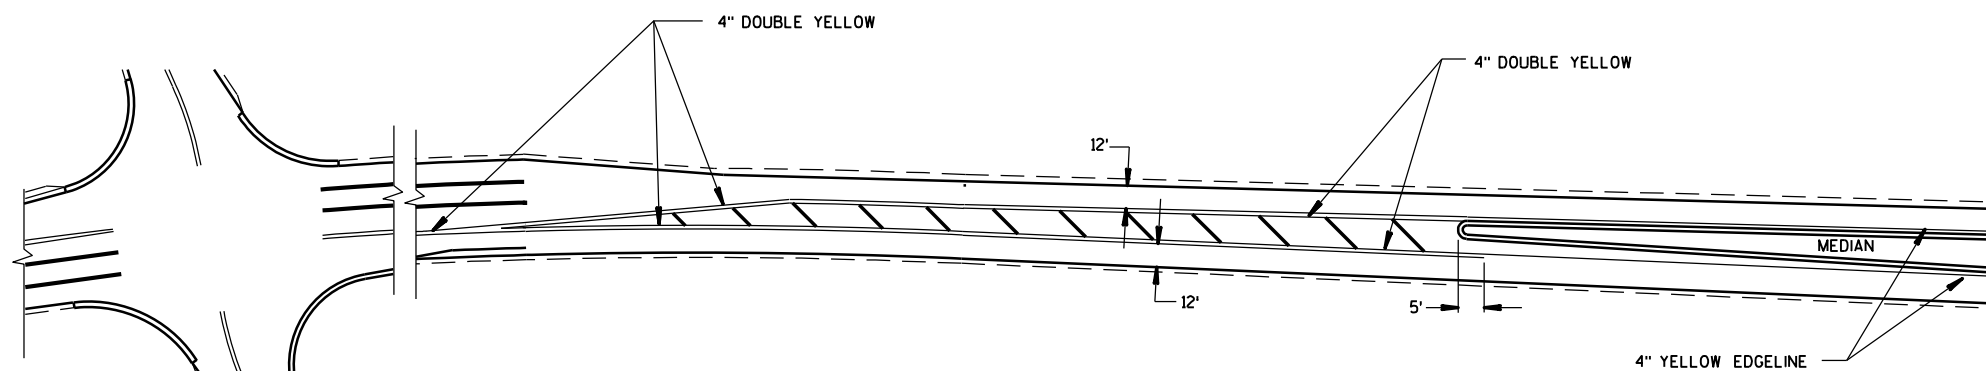

APPROACH MARKINGS FOR OTHER MEDIAN TYPES

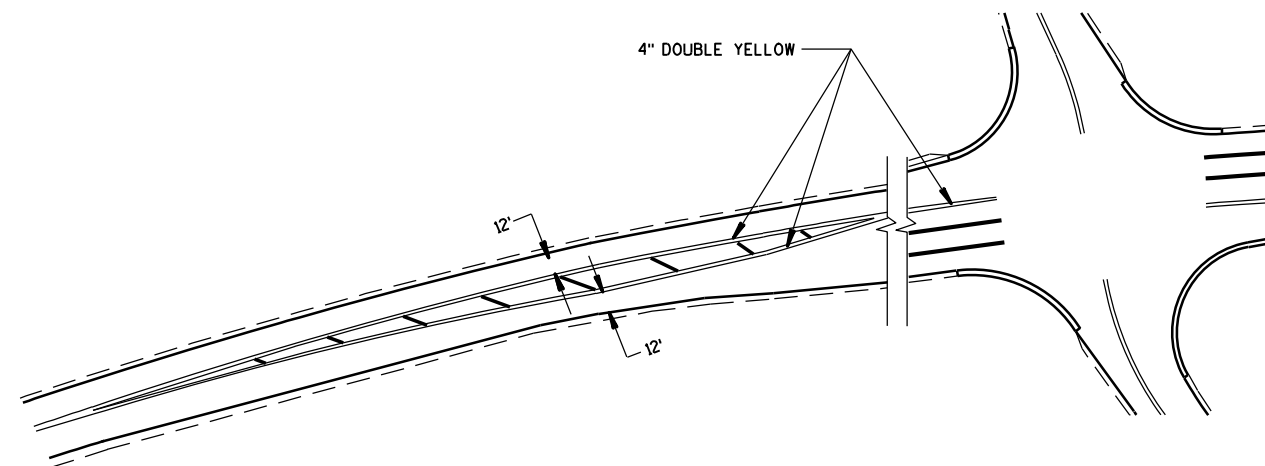

NON APPROACH MARKINGS

MEDIAN ISLAND MARKING	
STATE OF WISCONSIN DEPARTMENT OF TRANSPORTATION	
APPROVED 2-5-09 DATE	/S/ Thomas N. Notbohm STATE TRAFFIC ENGINEER OF DESIGN
FHWA	

GENERAL NOTES


SIGNING AND MARKING IS SHOWN AS TYPICAL PLACEMENT. FIELD CONDITIONS MAY DICTATE CHANGES IN SIGNING AND MARKING PLACEMENT.

A DISTANCE DEPENDENT ON SPEED (SEE TABLE)

1 WRONG WAY PREVENTION SIGNS ARE DISCUSSED IN T G M 2-15-12

SYMBOLS

- * OPTIONAL SIGNS
- ** SIGNS MAY BE OMITTED IF SPACE DOES NOT PERMIT
- † POST MOUNTED SIGN
- DIRECTION OF TRAFFIC FLOW

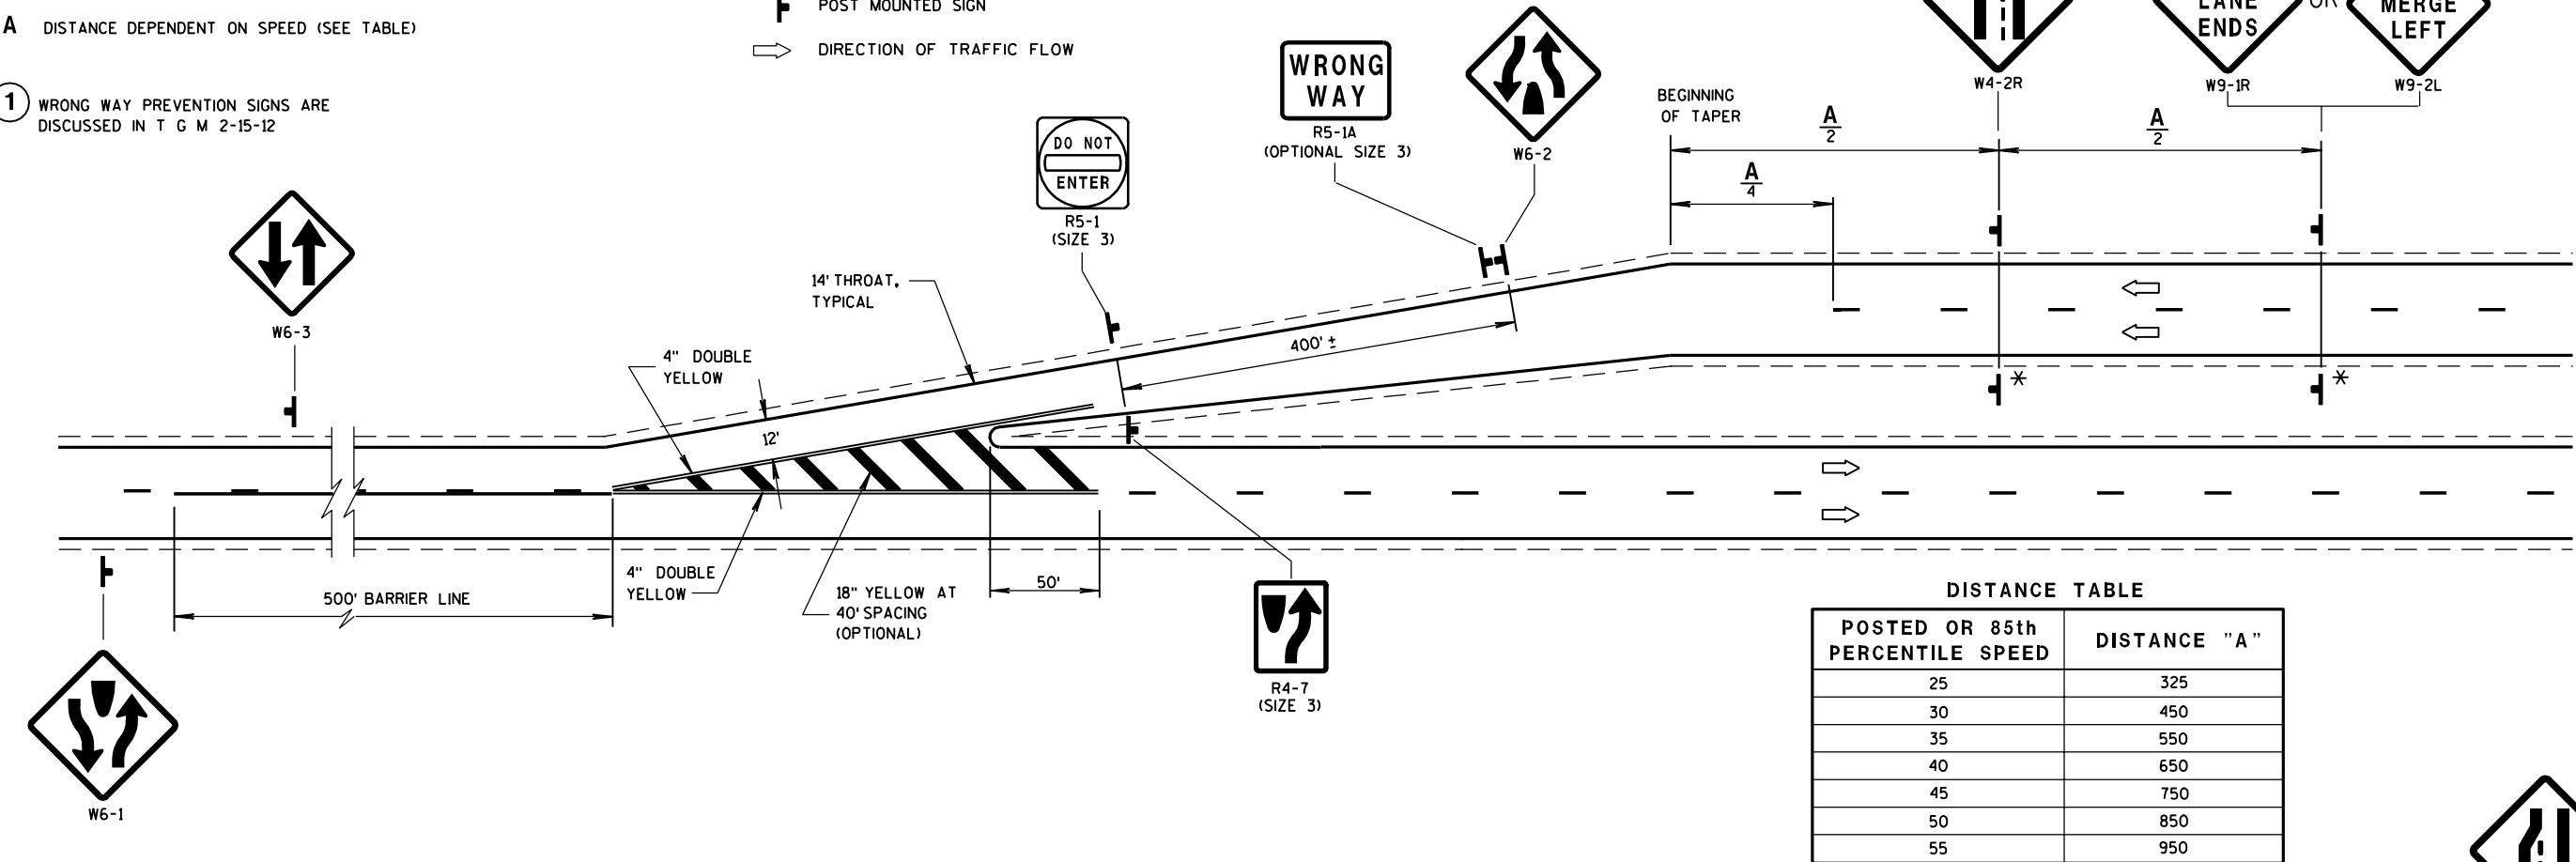



DISTANCE TABLE	
POSTED OR 85th PERCENTILE SPEED	DISTANCE "A"
25	325
30	450
35	550
40	650
45	750
50	850
55	950

(1) THE LEFT LANE IS PUSHED TO THE RIGHT:

USE W4-2L IF :

OR



(2) THERE IS A VERY PROMINENT CONSTRUCTION JOINT ENDING THE LEFT LANE.

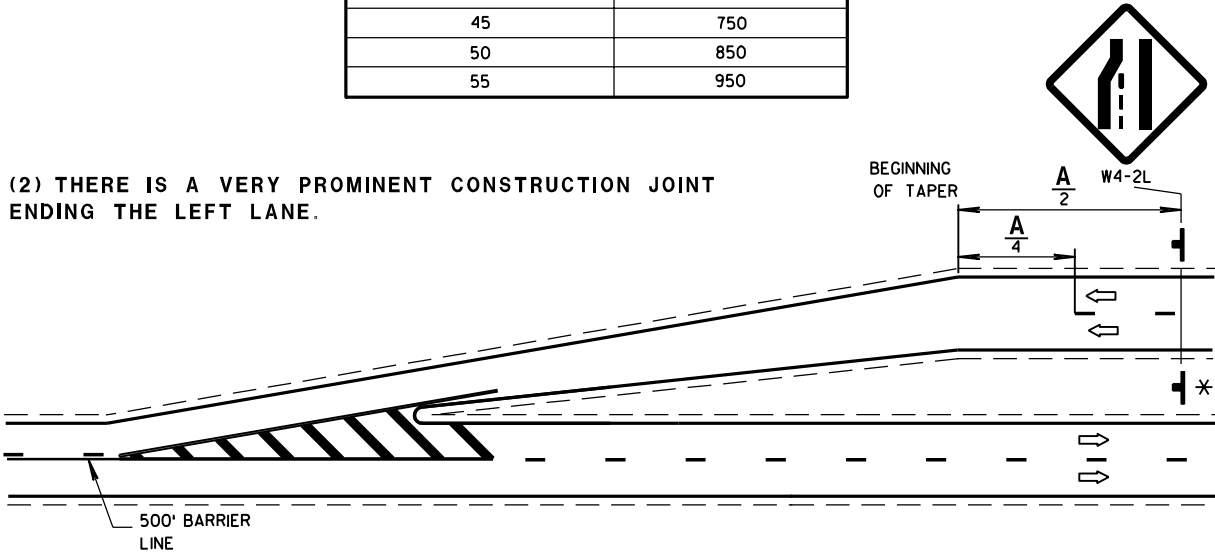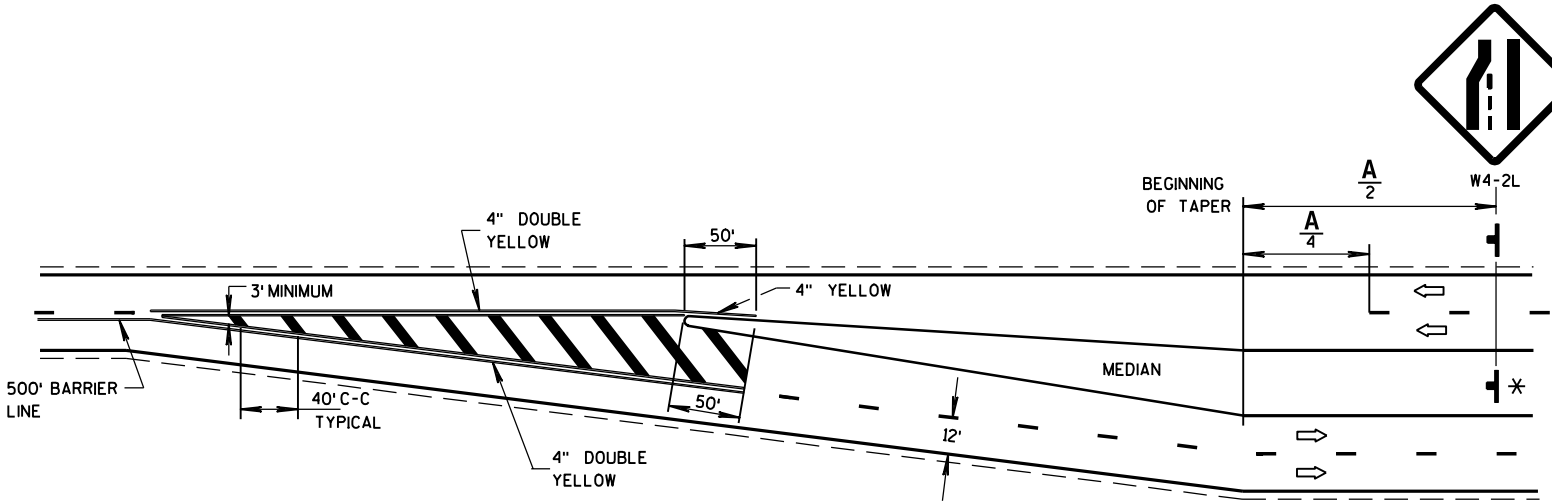

SIGNING AND MARKING FOR
TWO LANE TO FOUR LANE
DIVIDED TRANSITIONS

STATE OF WISCONSIN
DEPARTMENT OF TRANSPORTATION

APPROVED
4/7/08 /S/ Thomas N. Na+bohm
DATE STATE TRAFFIC ENGINEER OF DESIGN
FHWA

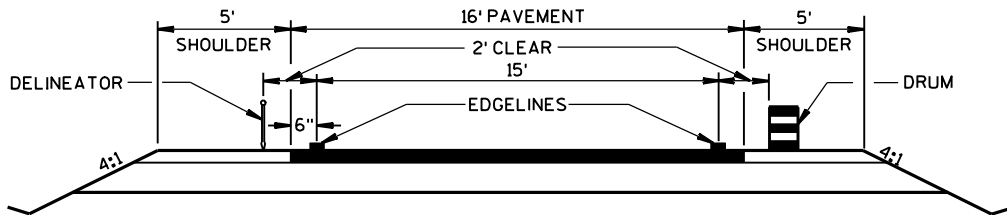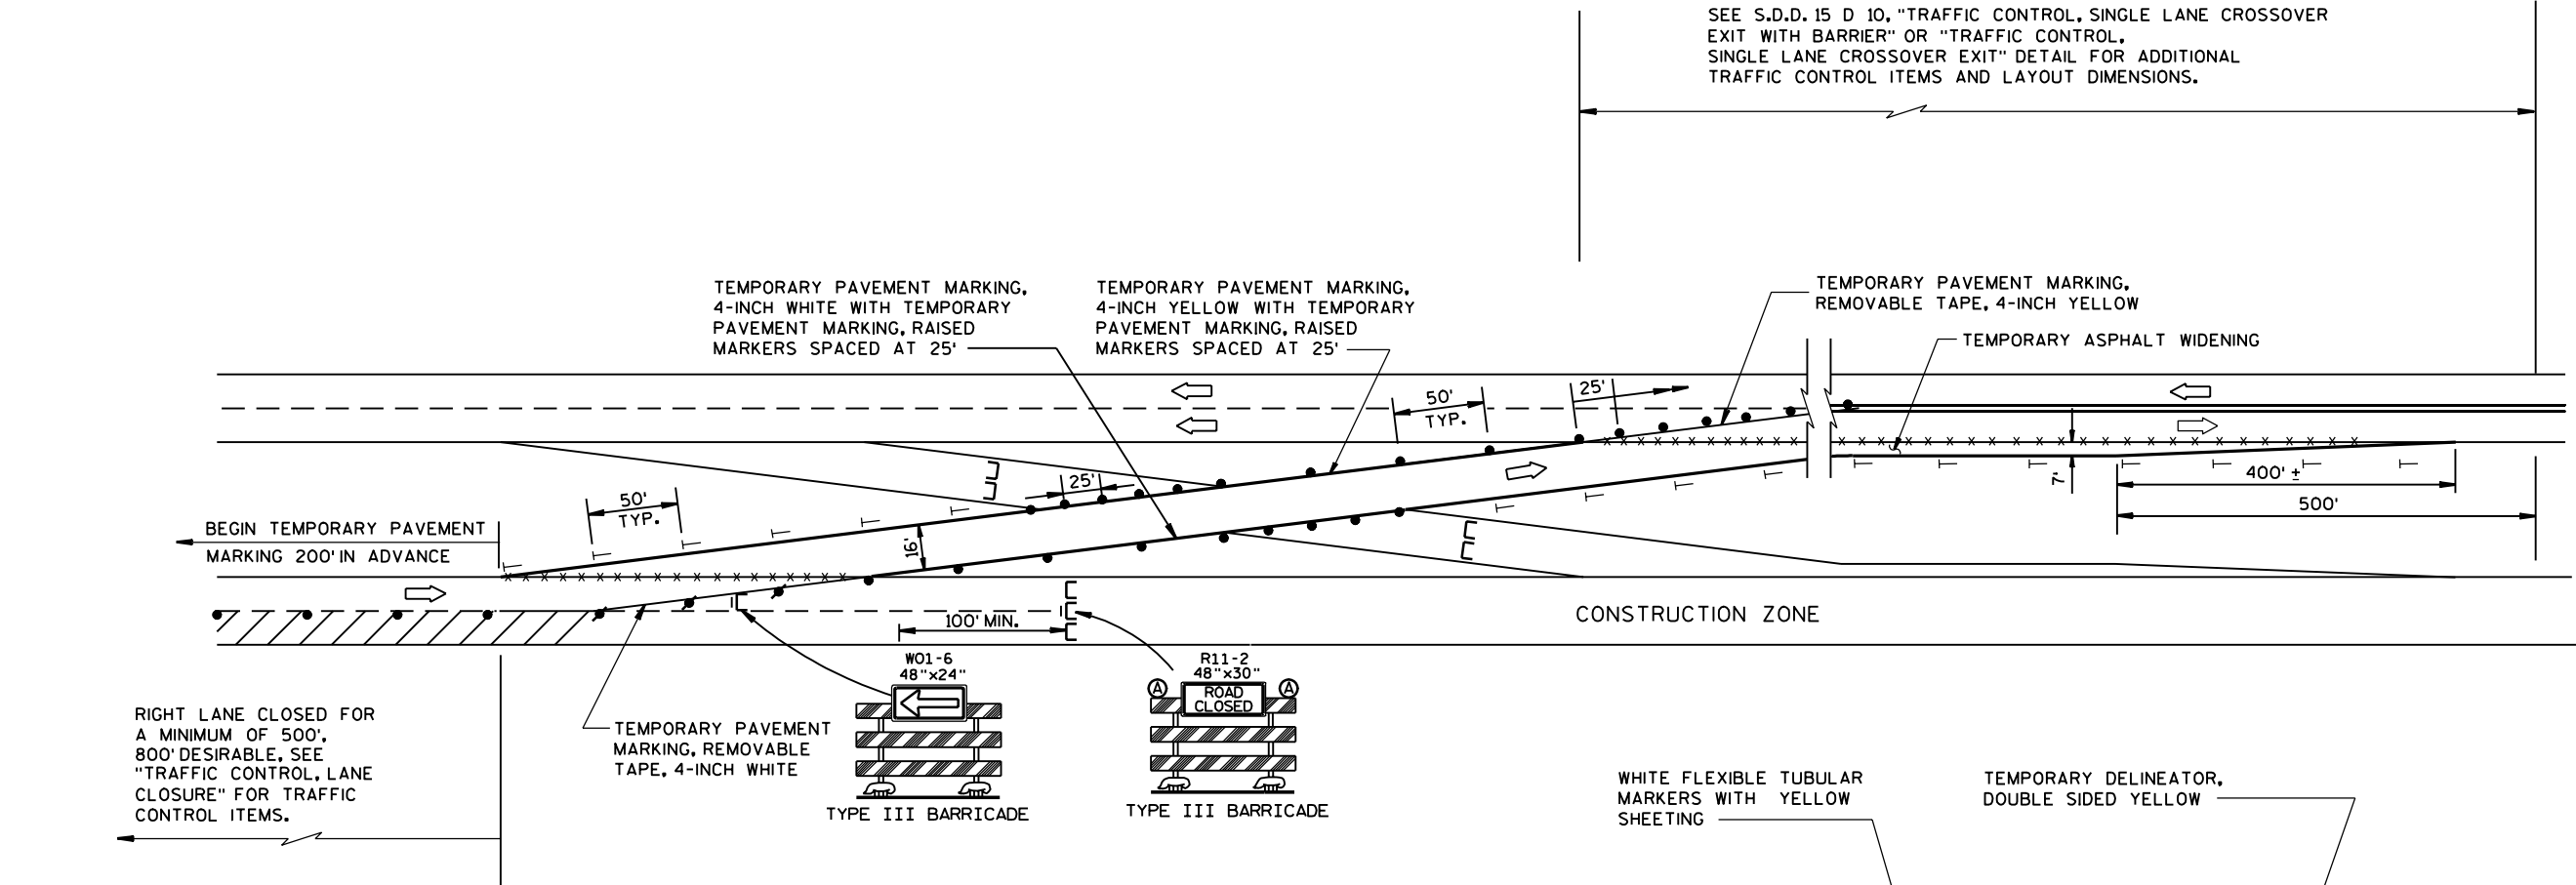

TYPICAL CROSSOVER ROADWAY DIMENSIONS

LEGEND

- | | |
|---|---|
|  | 8' TYPE III BARRICADE WITHOUT/ WITH ATTACHED SIGN |
|  | DRUM WITH WARNING LIGHTS, TYPE C |
|  | DRUM |
|  | TEMPORARY DELINEATOR
(STEEL POST W/SINGLE DELINEATOR)
COLOR OF DELINEATOR SHALL MATCH
THE COLOR OF THE RESPECTIVE EDGELINE PAINT |
|  | WARNING LIGHT, TYPE A |
|  | REMOVING PAVEMENT MARKINGS |
|  | TEMPORARY DELINEATOR (DOUBLE SIDED) |
|  | FLEXIBLE TUBULAR MARKER AND BASE |
|  | DIRECTION OF TRAFFIC |

GENERAL NOTES :

THE EXACT NUMBER, LOCATION, AND SPACING OF ALL SIGNS AND DEVICES SHALL BE ADJUSTED TO FIT FIELD CONDITIONS AS APPROVED BY THE ENGINEER.

THE SPACING BETWEEN PROPOSED SIGNS SHOULD BE ADJUSTED TO NOT CONFLICT WITH AND TO PROVIDE A MINIMUM OF 200 FEET (500 FEET DESIRABLE) DISTANCE TO EXISTING SIGNS.


TEMPORARY PAVEMENT MARKING REMOVABLE TAPE SHALL BE USED WHEN CROSSING PERMANENT ROADWAY SURFACES THAT WILL REMAIN AFTER USE OF CROSSOVER AND TEMPORARY PAVEMENT MARKING WHERE USED.

ALL SIGNS ARE 48"x48" UNLESS OTHERWISE NOTED.

"WO" IS THE SAME AS "W" EXCEPT THE BACKGROUND IS ORANGE.

ANY SIGNS TEMPORARY OR EXISTING, WHICH CONFLICT WITH THE TRAFFIC CONTROL "IN USE" SHALL BE REMOVED OR COVERED AS NEEDED AND AS APPROVED BY THE ENGINEER. NO WARNING LIGHTS SHALL BE WORKING ON "COVERED" OR "DOWNED" SIGNS.

REVERSE DEVICES WHEN OTHER LEG OF CROSSOVER IS IN USE.

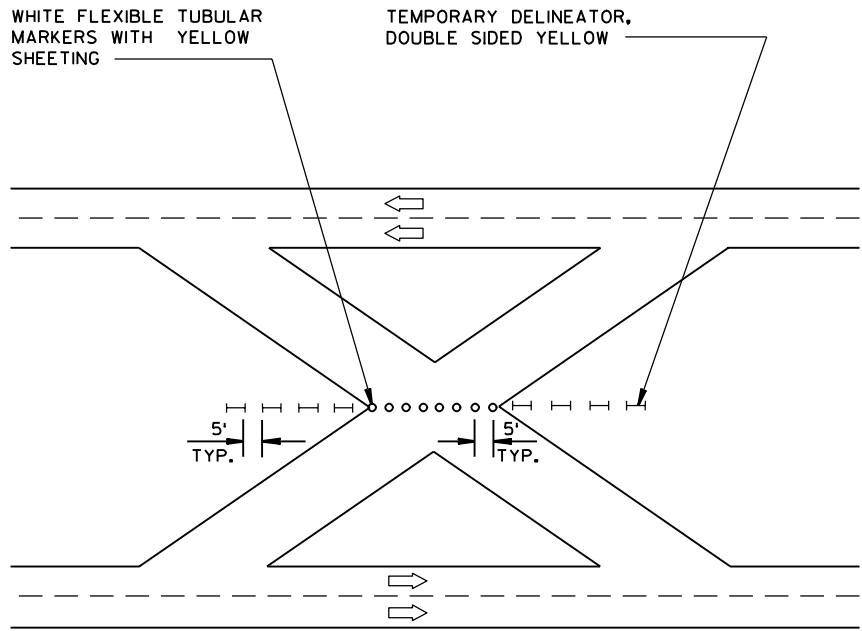

PROTECTION OF CROSSOVER NOT IN USE
WHEN CONSTRUCTION IS NOT TAKING PLACE


TRAFFIC CONTROL, SINGLE LANE CROSSOVER

STATE OF WISCONSIN
DEPARTMENT OF TRANSPORTATION

APPROVED
10-22-96
DATE

Chute J. Spay
for DIRECTOR, OFFICE OF TRAFFIC

FHWA

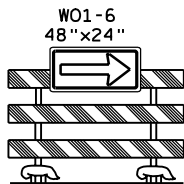





S	L	BUFFER SPACE
25	125'	55'
30	180'	85'
35	245'	120'
40	320'	170'
45	540'	220'
50	600'	280'
55	660'	335'

W = WIDTH OF LANE CLOSURE

	DRUM WITH/WITHOUT WARNING LIGHT, TYPE C (STEADY-BURN)
	POST MOUNTED SIGN
	ARROW BOARD
	TYPE III BARRICADE (8' EQUIVALENT) AND WARNING LIGHT
	TYPE A (FLASHING) WITH/WITHOUT SIGN
	DIRECTION OF TRAFFIC FLOW
	REMOVING PAVEMENT MARKING (SEE GENERAL NOTES)

WARNING LIGHTS ARE NOT REQUIRED IF THE LANE CLOSURE IS A DAYTIME ONLY OPERATION.

Chester J. Spang
CHIEF SIGNS AND MARKING ENGINEER

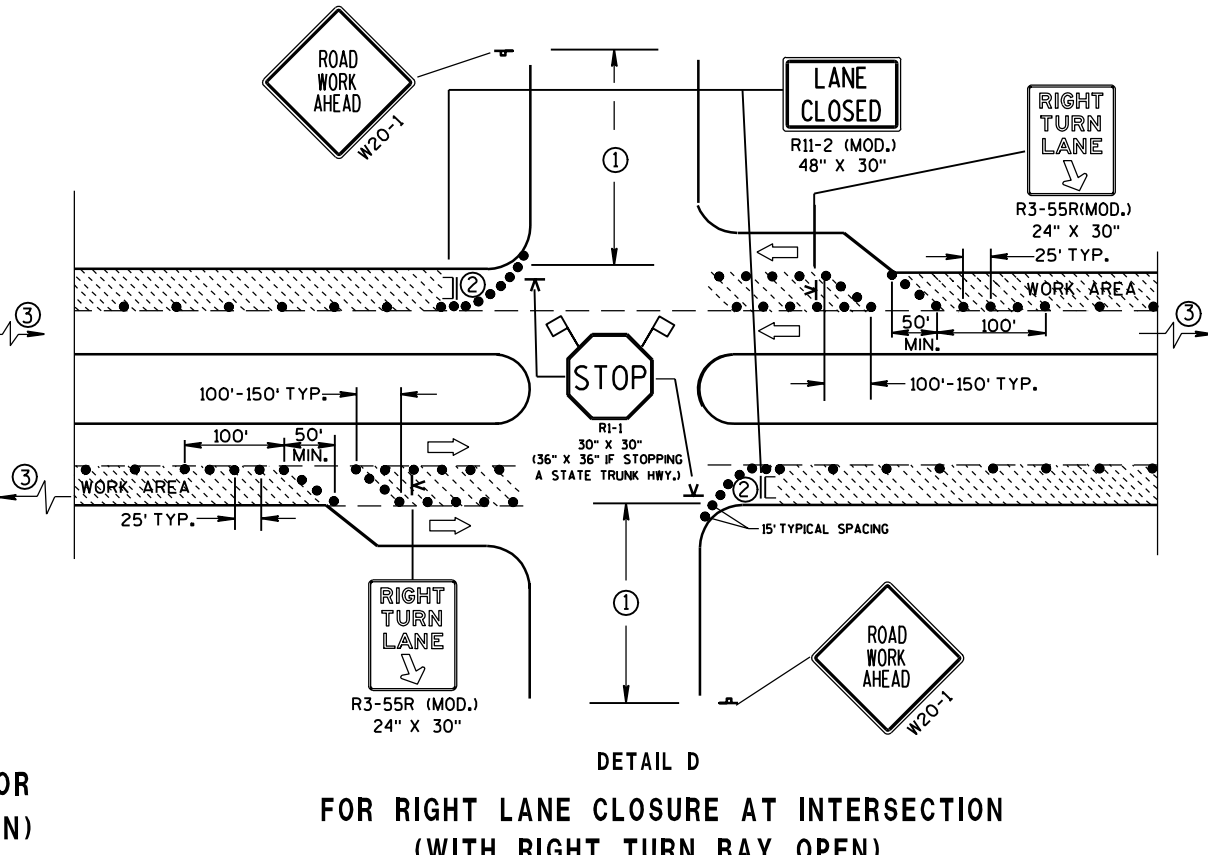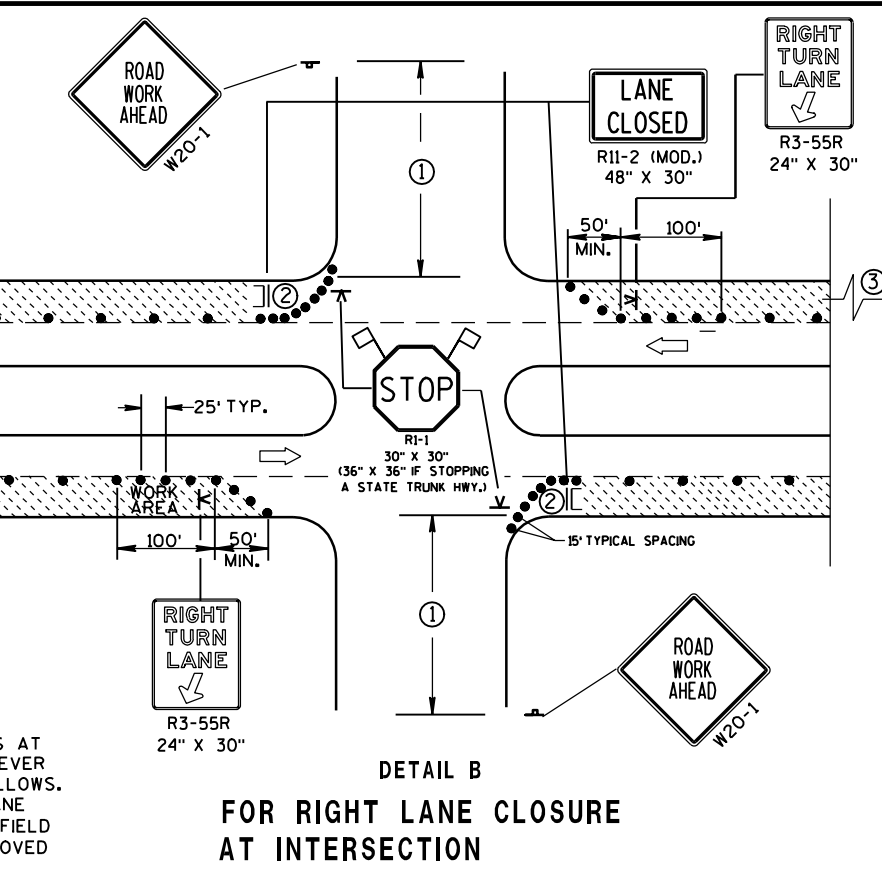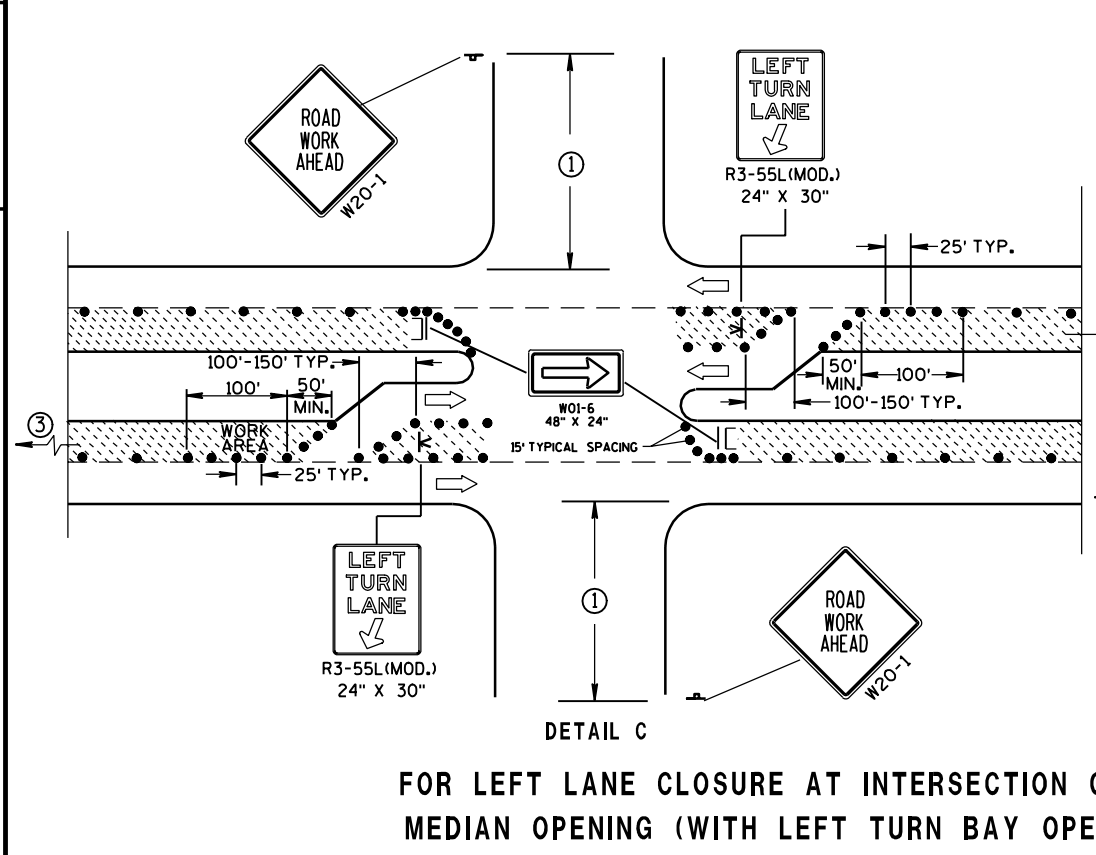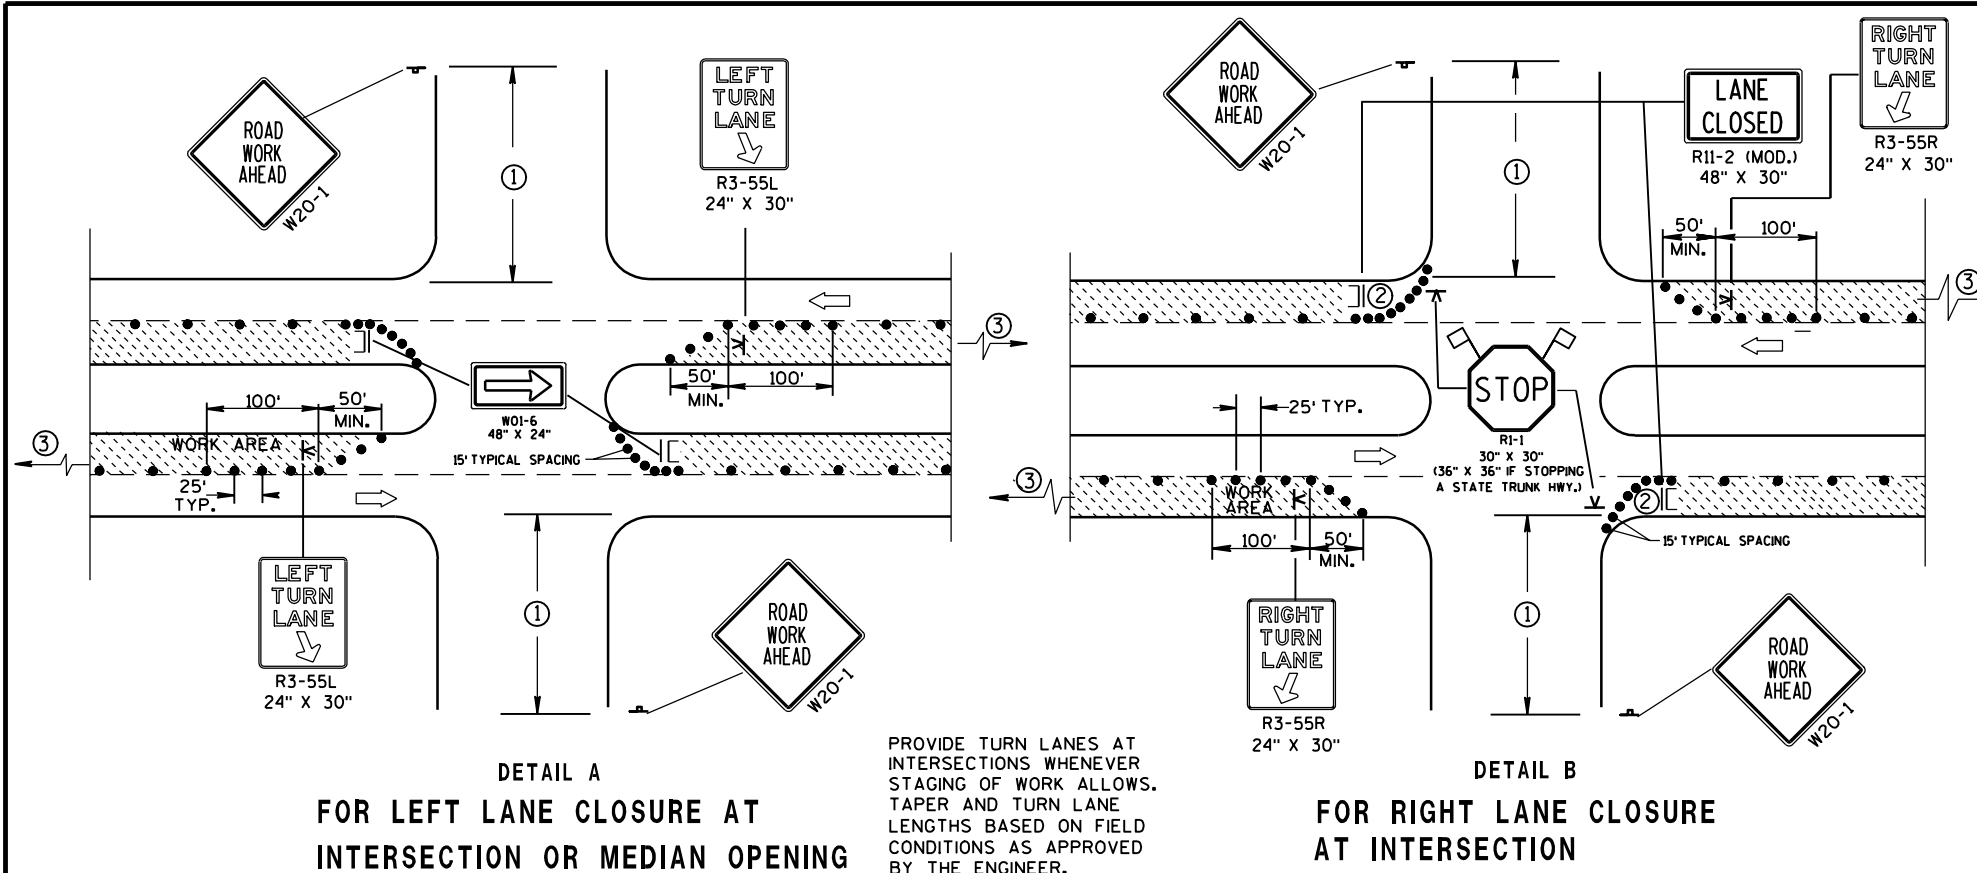

GENERAL NOTES

THE EXACT NUMBER, LOCATION, AND SPACING OF ALL SIGNS AND DEVICES SHALL BE ADJUSTED TO FIT FIELD CONDITIONS AS APPROVED BY THE ENGINEER.

THE SPACING BETWEEN SIGNS SHOULD BE ADJUSTED TO NOT CONFLICT WITH AND SHOULD PROVIDE A DESIRABLE MINIMUM OF 200 FEET CLEARANCE TO EXISTING SIGNS THAT WILL REMAIN IN PLACE.

ALL SIGNS ARE 48"x48" UNLESS OTHERWISE NOTED. IF NECESSARY DUE TO SPACE CONSTRAINTS IN URBAN AREAS, 36" X 36" SIGNS MAY BE USED IF APPROVED BY DISTRICT TRAFFIC UNIT.

"WO" SIGNS ARE THE SAME AS "W" SIGNS EXCEPT THE BACKGROUND IS ORANGE.

SIGN LAYOUTS SHALL BE IN ACCORDANCE WITH THE FHWA'S MANUAL OF STANDARD HIGHWAY SIGNS OR THE WISCONSIN STANDARD SIGN PLATES.

SIGNS THAT WILL BE IN PLACE LESS THAN 7 CONTINUOUS DAYS AND NIGHTS, OR THAT WILL BE PLACED IN A CLOSED LANE, MAY BE MOUNTED ON PORTABLE SUPPORTS.

ANY SIGNS TEMPORARY OR EXISTING, WHICH CONFLICT WITH TRAFFIC CONTROL "IN USE" SHALL BE REMOVED OR COVERED AS NEEDED AND AS APPROVED BY THE ENGINEER.

CHANNELIZING DEVICES PLACED ADJACENT TO WORK AREA SHALL BE PULLED BACK FROM THE TRAVEL LANE WHEN WORK IS NOT IN PROGRESS.

BARRICADES IN A CLOSED LANE THAT MUST BE MOVED FOR A WORK OPERATION SHALL BE IMMEDIATELY RE-ESTABLISHED UPON COMPLETION OF THE OPERATION OR, FOR CONTINUING OPERATIONS, AT THE END OF EACH WORKING DAY.


① 500' TYPICAL OR AT LAST INTERSECTION, WHICHEVER IS CLOSER.
350' IF 35-40 MPH.
200' IF 25-30 MPH.

② ALSO USE BARRICADE AND 15' TYPICAL DRUM SPACING AT COMMERCIAL DRIVEWAYS.

③ SEE SEPARATE LANE CLOSURE DETAIL FOR ADDITIONAL TRAFFIC CONTROL.



- LEGEND**
- DRUM
 - ⌞ POST MOUNTED SIGN
 - ⌞ SIGN ON PORTABLE SUPPORT (5' MIN. MOUNTING HEIGHT)
 - ⌞ TYPE III BARRICADE (8' EQUIVALENT) AND WARNING LIGHT, TYPE A (FLASHING) WITH SIGN
 - ➡ DIRECTION OF TRAFFIC FLOW
 - ⚠ FLAGS, 16" X 16" MIN., ORANGE

TRAFFIC CONTROL, INTERSECTION WITHIN SINGLE LANE CLOSURE	
STATE OF WISCONSIN DEPARTMENT OF TRANSPORTATION	
APPROVED 5/23/00 DATE	/S/ Chester J. Spang CHIEF SIGNS AND MARKING ENGINEER
FHWA	

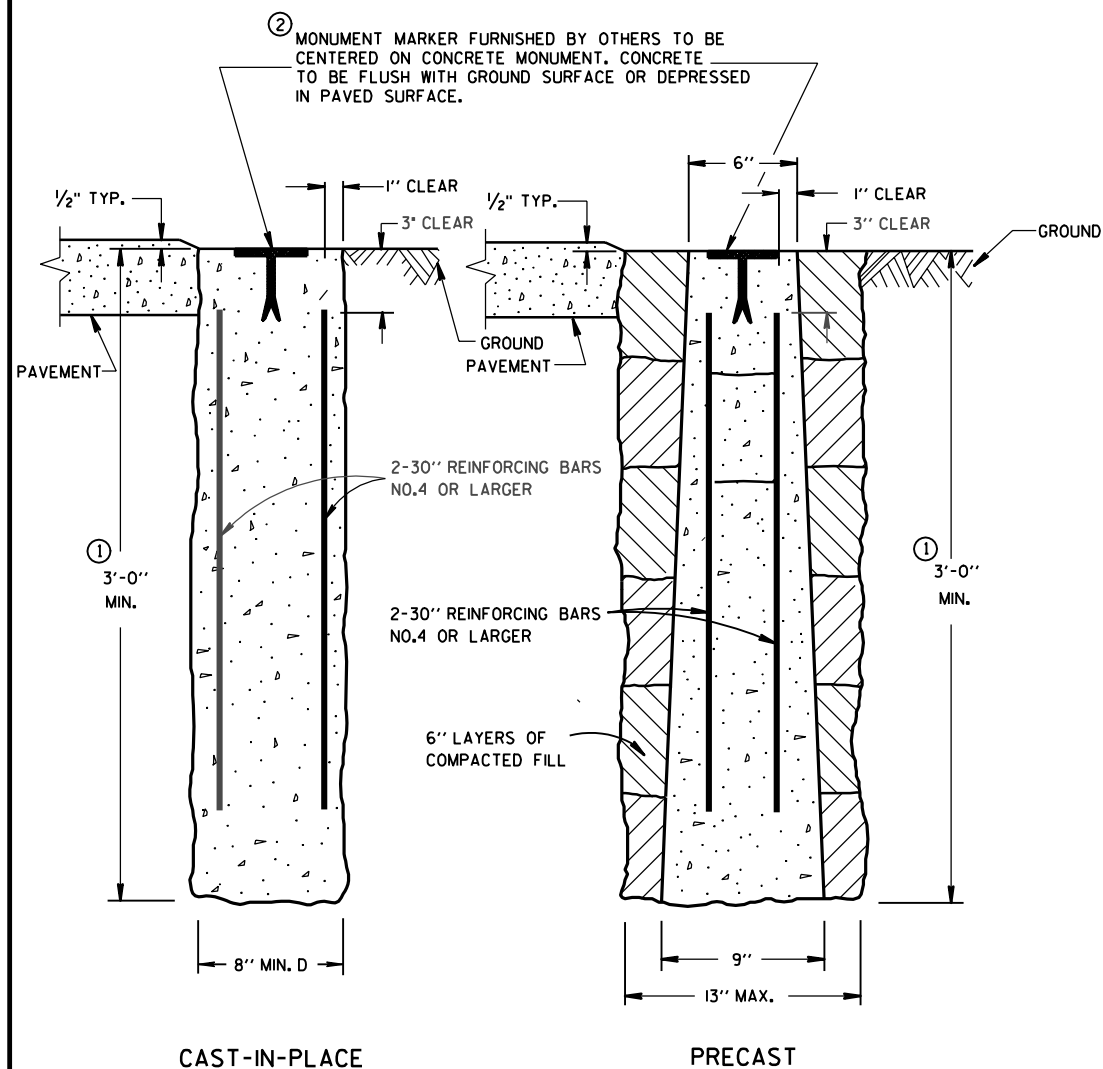

CAST-IN-PLACE

PRECAST

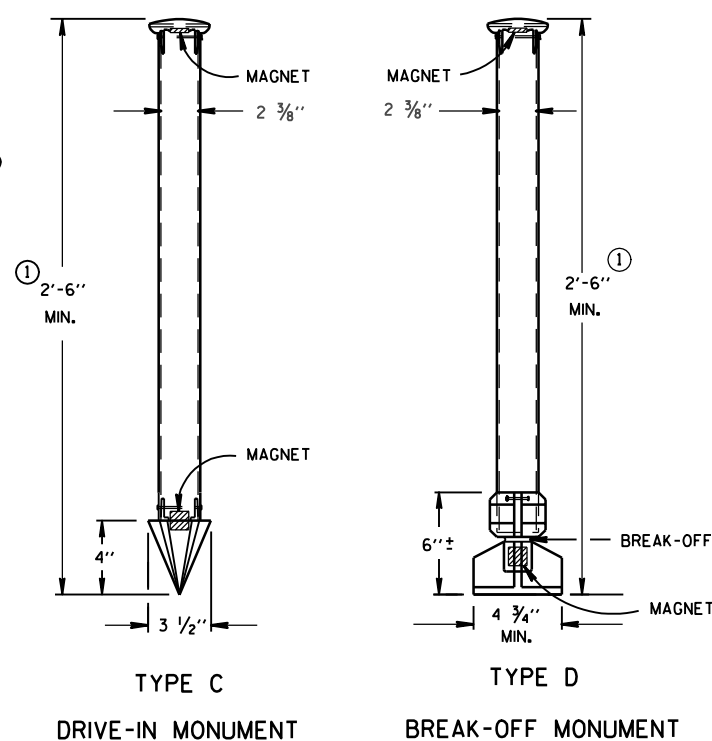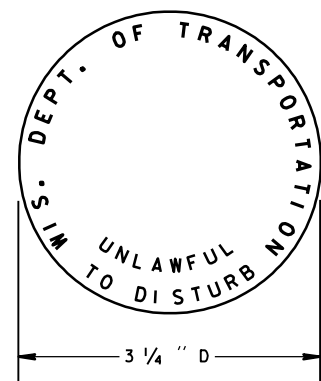CONCRETE MONUMENTS
TYPE ATYPE C
DRIVE-IN MONUMENTTYPE D
BREAK-OFF MONUMENTALUMINUM MONUMENTS
(INCLUDES MARKER)

GENERAL NOTES

DETAILS OF CONSTRUCTION, MATERIALS AND WORKMANSHIP NOT SHOWN ON THIS DRAWING SHALL CONFORM TO THE PERTINENT REQUIREMENTS OF THE STANDARD SPECIFICATIONS AND THE APPLICABLE SPECIAL PROVISIONS.

DETAILED DRAWINGS OF PROPOSED ALTERNATE DESIGNS FOR METAL MONUMENTS OR MONUMENT COVERS SHALL BE SUBMITTED TO THE ENGINEER FOR APPROVAL.

INSTALLED METAL MONUMENTS MUST BE EASILY DETECTED WITH A DIP NEEDLE. INSERT PERMANENT MAGNETS SHALL BE ATTACHED NEAR THE TOP AND BOTTOM OF THOSE MONUMENTS CONSTRUCTED OF A METAL ALLOY WHICH IS NOT ATTRACTIVE TO A DIP NEEDLE.

THE CAST IRON MONUMENT COVER SHALL BE A "NON-ROCKING" TYPE. ADJUSTMENT OF THE COVER TO GRADE MAY BE ACCOMPLISHED BY THE USE OF MORTAR AND BRICK, OR BY EITHER PRECAST OR CAST-IN-PLACE REINFORCED CONCRETE GRADE RINGS.

MONUMENTS SHALL BE LOCATED AND PLACED AT THE DIRECTION OF THE ENGINEER.



ALUMINUM MONUMENTS AND MONUMENT COVERS SHALL BE MADE FROM AN ALUMINUM AND MAGNESIUM ALLOY AS DETERMINED BY THE MANUFACTURER.

THE MONUMENT COVERS DETAILED ON THIS DRAWING ARE NOT EQUAL ALTERNATES. MONUMENT COVERS SHALL BE CAST IRON UNLESS ALUMINUM IS SPECIFIED ELSEWHERE IN THE CONTRACT.

MONUMENT SHALL BE CAST-IN-PLACE CONCRETE UNLESS PRECAST CONCRETE OR ALUMINUM MONUMENTS ARE SPECIFIED IN THE CONTRACT OR PERMITTED BY THE ENGINEER.

① MINIMUM LENGTH SHALL BE 4'-0" FOR MONUMENTS INSTALLED IN PAVED AREAS.

② AN OFFICIAL COUNTY MONUMENT MARKER SUPPLIED BY A COUNTY MAY BE REQUIRED FOR SOME SECTION CORNERS AND WITNESS MONUMENTS INSTEAD OF THIS WIS DOT MARKER.

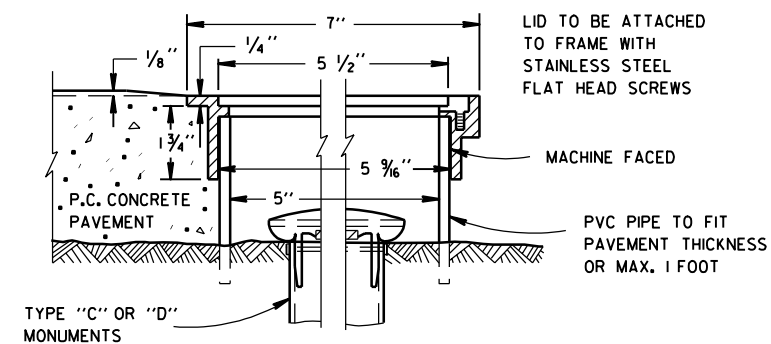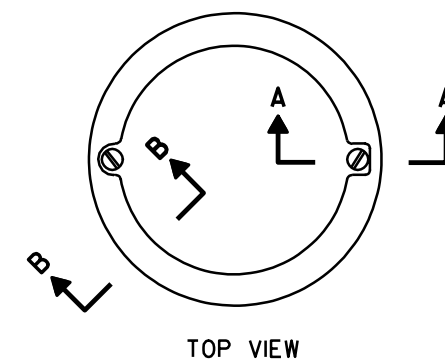SECTION B-B SECTION A-A
ALUMINUM MONUMENT COVER

(APPROXIMATE WEIGHT 2 LBS.)
(FOR CONCRETE PAVEMENT ONLY)


LANDMARK REFERENCE
MONUMENTS AND COVERS

STATE OF WISCONSIN
DEPARTMENT OF TRANSPORTATION


APPROVED
9/22/99
DATE
FHWA

CHIEF ROADWAY DEVELOPMENT ENGINEER


TYPICAL ASSEMBLIES

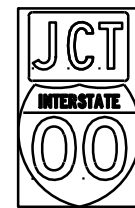

J1-1

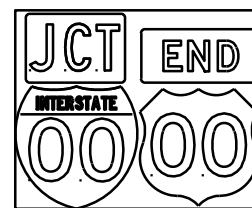


J1-2

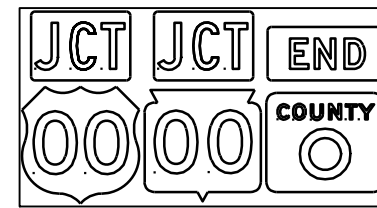


J1-3




J2-1

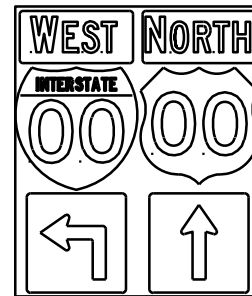


J2-2

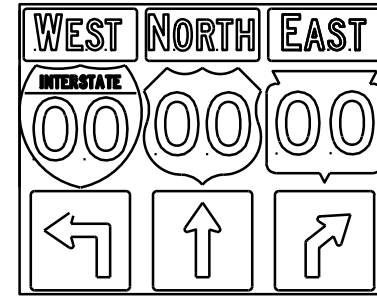


J2-3

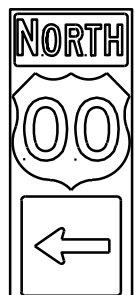

J3-1

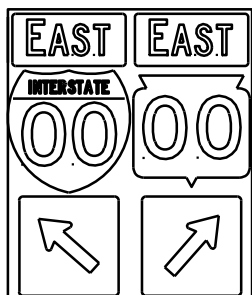


J3-2

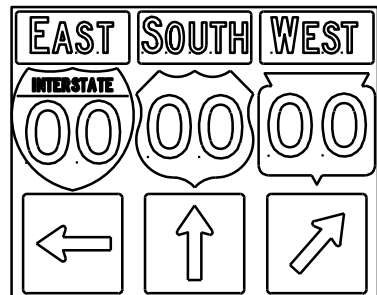


J3-3



J4-1

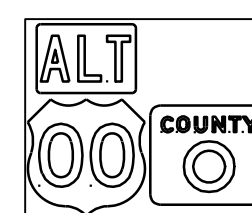

J4-2

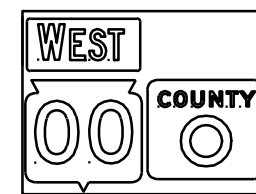

J4-2



J13-1



J12-1



J32-1



J33-1



J23-1



J22-1






JV

NOTES

- Signs are Type II - Type H Reflective - reference WIS DOT Standard Specification for HIGHWAY and STRUCTURE CONSTRUCTION latest edition.
- Color:
Background - Black Non-reflective
Message - see Note 5
- Message Series - See Note 5
- Corners shall be square since base material is plywood.
- The colors and message spacing on each marker shall be according to the applicable route marker panel specifications.
- Certain marker heads require the component pieces to be the same color. As an example, all the components used with an M1-1 Interstate marker shall be blue.
- Single panel j-assemblies shall only be used with route marker shields that are same size. If the route marker shields are different size use multiple piece component.
- Route assemblies that have 24 inch route shields and have dimensions greater than 48 inches (both vertical and horizontal) shall have one horizontal splice between the arrows and route shields. Vertical splices shall not be used on route assemblies with a horizontal dimension of 144 inches or less. The contractor shall not use more than one vertical joint per sign and the joint shall be between route shields.
- Route assemblies that have 36 inch shields and have dimensions greater than 48 inches (both vertical and horizontal) shall have two horizontal splices. One horizontal splice shall be between the cardinal direction and route shields and the other horizontal splice shall be between the arrows and route shields. Vertical splices shall not be used on route assemblies with a horizontal dimension of 144 or less. The contractor shall not use more than one vertical joint per sign and the joint shall be between route shields.

[blue background with interstate]

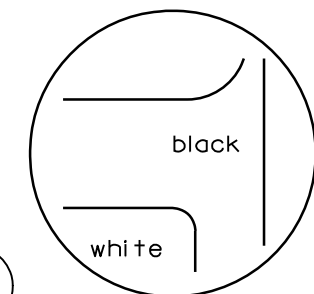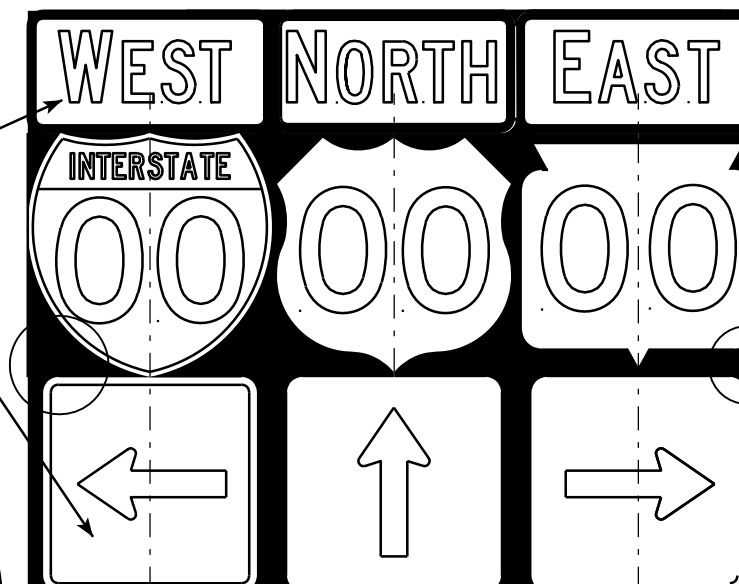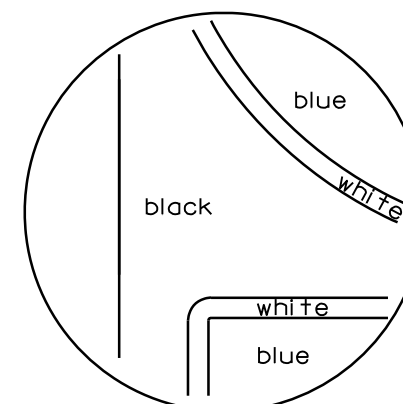

[black background]



ROUTE MARKERS & COMPONENTS IN TYPICAL ASSEMBLIES	
WISCONSIN DEPT OF TRANSPORTATION	
APPROVED	<i>Matthew R. Rauch</i> For State Traffic Engineer
DATE 10/21/09	PLATE NO. A2-1S.6

PROJECT NO:



SHEET NO: 159

E

URBAN AREA

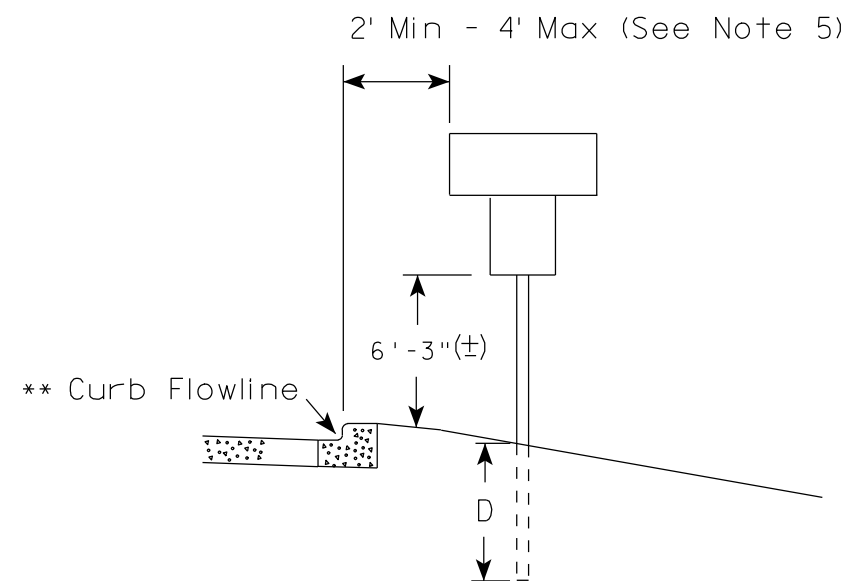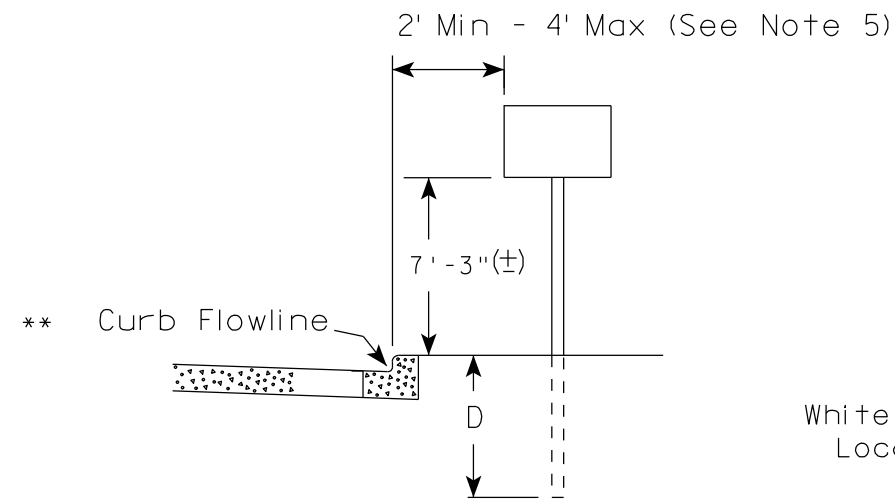

RURAL AREA (See Note 2)

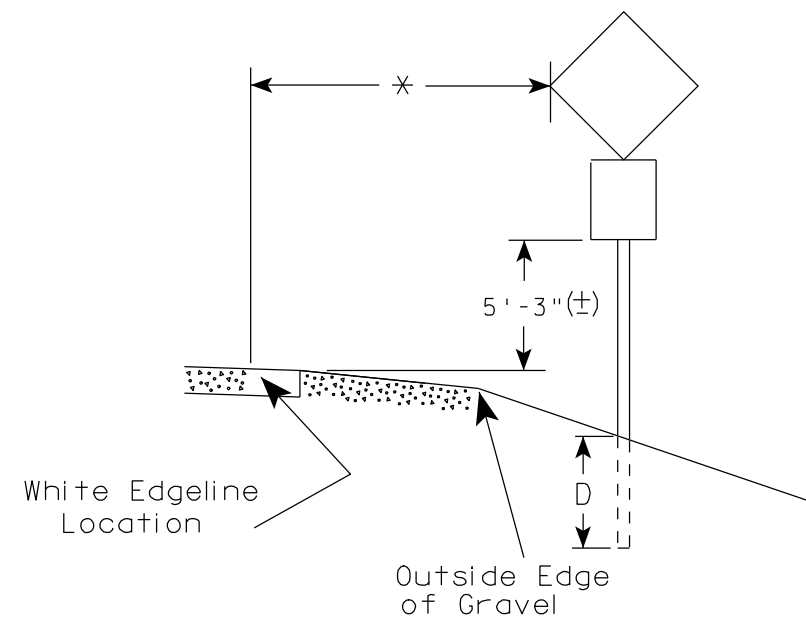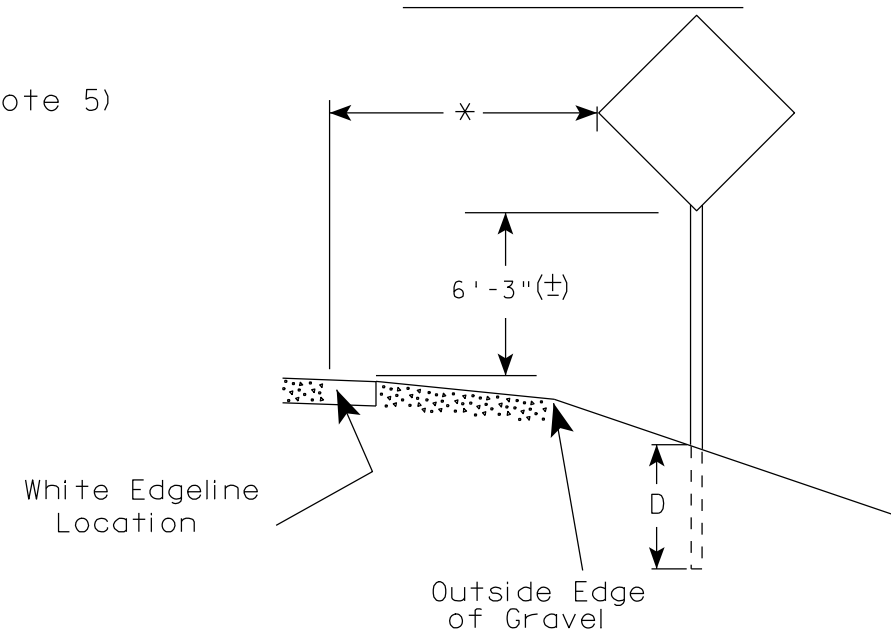

GENERAL NOTES

1. Signs wider than 4 feet or larger than 20 sq. ft. shall be mounted on multiple posts. Refer to plate A4-4.
2. If signs are mounted on barrier wall, see A4-10 sign plate.
3. For expressways and freeways, mounting height is 7'-3" (±) or 6'-3" (±) depending upon existence of a sub-sign.
4. Minimum mounting height for J assemblies (A4-5) is 7'-3" (±) or 6'-3" (±) per urban or rural detail respectively.
5. Minimum mounting height for signs mounted on traffic signal poles is 5'-3" (±).
6. Offset distance shall be consistent with existing signs or consistent throughout length of project.
7. The (±) tolerance for mounting height is 3 inches.
8. Folding stop signs (R1-1F) shall be mounted at a height of 5'-3" (±) or as directed by the Engineer.
9. The Double Arrow sign (W12-1) shall be mounted at a height of 2'-3" (±). The Chevron sign (W1-8), Roundabout Chevron panel (W1-8A), Clearance Markers (W5-52), Mile Markers (D10 series) & End of Road Markers (W5-56 & W5-56A) shall be mounted at a height of 4'-3" (±).

POST EMBEDMENT DEPTH

Area of Sign Installation (Sq. Ft.)	D (Min)
20 or Less	4'
Greater than 20	5'

✱✱ The existence of curb and gutter does not in itself mandate the vertical clearance illustrated. That height is typically measured where there is sidewalk adjacent to the roadway or parking is permitted. In the absence of sidewalk vertical clearance is measured from the top of the curb. Offset of signs is measured from the flow line.

* 6 feet from edge of a paved shoulder or 12 feet from the edge of pavement (edge line location) or 2 feet from outside edge of gravel, whichever is greater unless directed by project engineer.

TYPICAL INSTALLATION
OF PERMANENT TYPE II
SIGNS ON SINGLE POSTS

WISCONSIN DEPT OF TRANSPORTATION

APPROVED *Matthew R. Rauch*
for State Traffic Engineer

DATE 9/30/09 PLATE NO. A4-3.15

PROJECT NO:

HWY:

COUNTY:

SHEET NO: 160

E

GENERAL NOTES


- For multiple post installations, individual post spacing shall be greater than 3'-6".
- See tables below for required number of posts.
- For expressways and freeways, mounting height is 7'-3" (±) or 6'-3" (±) depending upon existence of sub-sign.
- The (±) tolerance for mounting height is 3 inches.
- Minimum mounting height for J assemblies (A4-5) is 7'-3" (±) or 6'-3" (±) per urban or rural detail respectively.
- Offset distance shall be consistent with existing signs or consistent throughout length of project.
- Folding stop signs (R1-1F) shall be mounted at a height of 5'-3" (±) or as directed by the engineer.
- The Double Arrow sign (W12-1) shall be mounted at a height of 2'-3" (±). The Chevron sign (W1-8), Roundabout Chevron panel (W1-8A), Clearance Markers (W5-52), Mile Markers (D10 series) & End of Road Markers (W5-56 & W5-56A) shall be mounted at a height of 4"-3" (±).

* 6 feet from edge of a paved shoulder or 12 feet from the edge of pavement (edge line location) or 2 feet from outside edge of gravel, whichever is greater unless directed by project engineer.



** The existence of curb and gutter does not in itself mandate the vertical clearance illustrated. That height is typically measured where there is sidewalk adjacent to the roadway or parking is permitted. In the absence of sidewalk vertical clearance is measured from the top of the curb. Offset of signs is measured from the flow line.

*** See A4-3 sign plate for signs 4' or less in width or 20 S.F. or less in area.


URBAN AREA

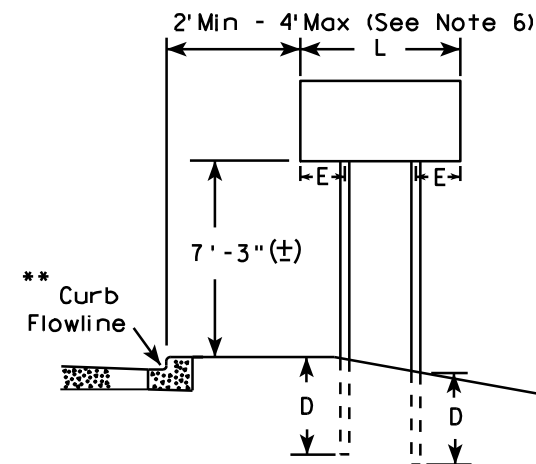


RURAL AREA (See Note 3)

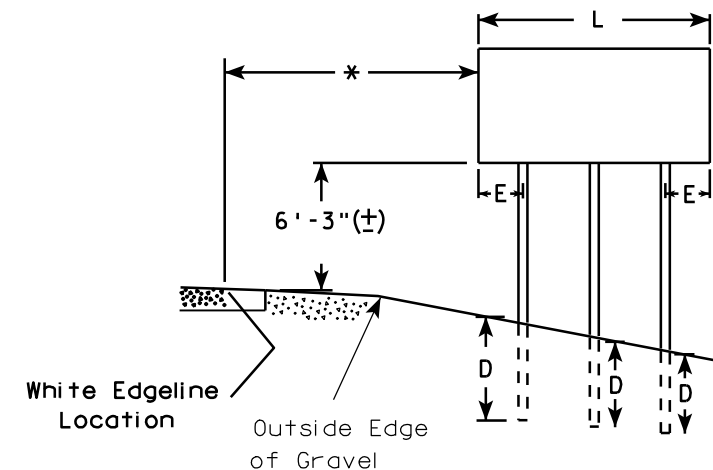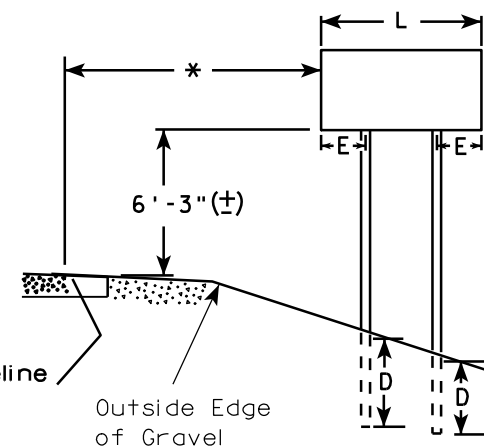

2' Min - 4' Max (See Note 6)

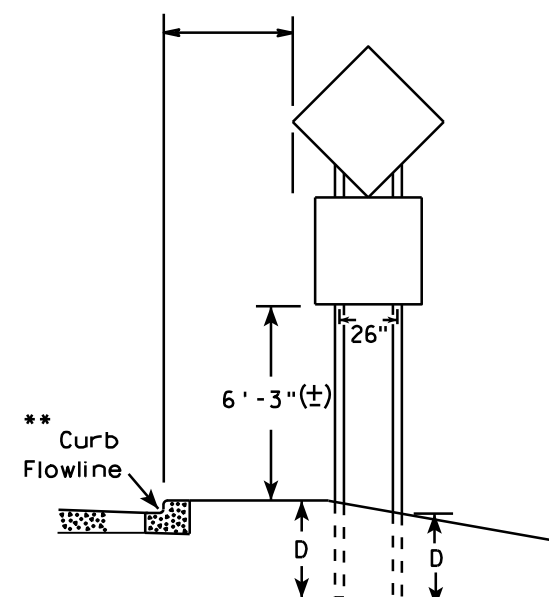

48" DIAMOND WARNING SIGN

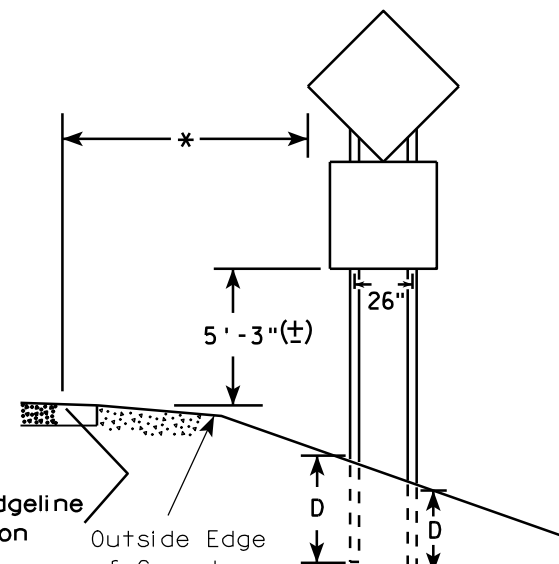

48" DIAMOND WARNING SIGN

SIGN SHAPE OTHER THAN DIAMOND (TWO POSTS REQUIRED)	
L	E
Greater than 48" Less than 60"	12"
60" to 120"	L/5

SIGN SHAPE OTHER THAN DIAMOND (THREE POSTS REQUIRED)	
L	E
Greater than 120" less than 168"	12"

SIGN SHAPE OTHER THAN DIAMOND (FOUR POSTS REQUIRED)	
L	E
168" and greater	12"

POST EMBEDMENT DEPTH

Area of Sign Installation (Sq. Ft.)	D (Min)
20 or Less	4'
Greater than 20	5'

TYPICAL INSTALLATION
OF TYPE II SIGNS
ON MULTIPLE POSTS

WISCONSIN DEPT OF TRANSPORTATION

APPROVED *Matthew R. Rauch*
For State Traffic Engineer

DATE 9/30/09 PLATE NO. A4-4.10


PROJECT NO:

HWY:

COUNTY:

SHEET NO: 161

E

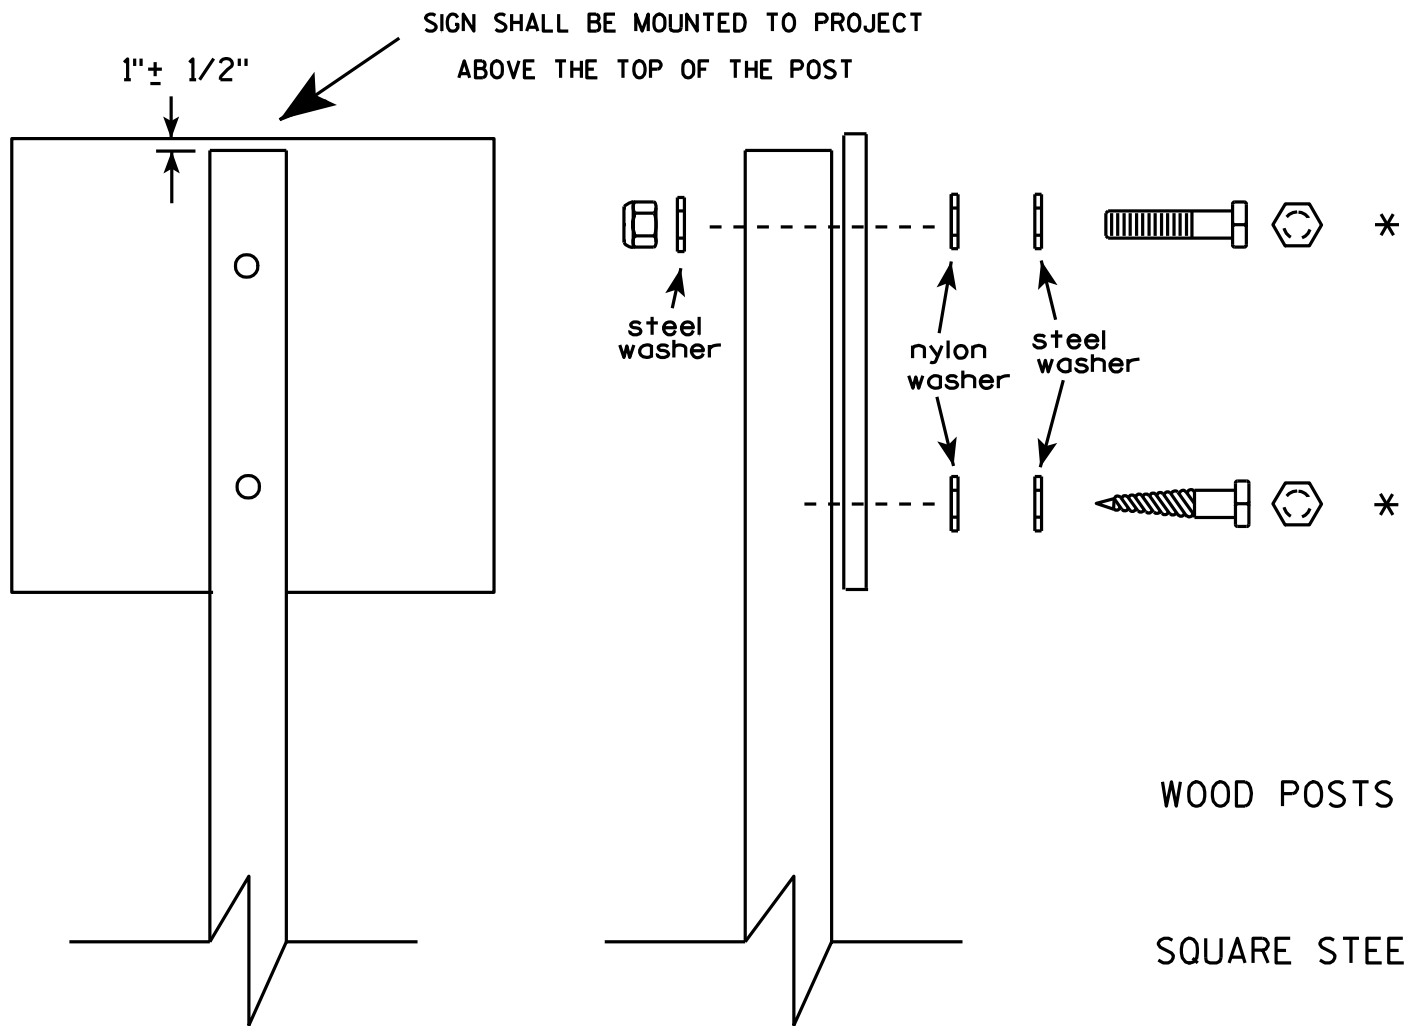


Nuts, bolts and lags used for mounting signs shall have hexagonal heads and shall be either :

- a. Hot dip galvanized in accordance with ASTM Designation: A 153, Class D, or SC 3
- b. Electro-galvanized in accordance with ASTM Designation : B 633, TYPE III, SC 3.

Threads on bolts and nuts shall be manufactured with sufficient allowance for the cadmium plate or galvanized coating to permit the nuts to run freely on the bolts.

- WOOD POSTS (4" x 4" or 4" x 6")
LAG SCREWS - 3/8" X 3"
MACHINE BOLTS - 5/16" X 6-1/2" or 7" Length w/ nuts
- SQUARE STEEL POSTS (2" x 2")
MACHINE BOLTS - 3/8" X 3-1/4" Length w/ nuts
RIVETS - 9/32" (6605-9-6) BULB-TITE, TRI-FOLD, ALUMINUM BODY/MANDREL
O.D. FLANGE .720-.765 INCH, GRIP RANGE .042-.375 INCH
- WASHERS (ALL POSTS) -
1-1/4" O.D. X 3/8" I.D. X 1/16" STEEL
1-1/4" O.D. X 3/8" I.D. X .080 NYLON for all Type H signs.

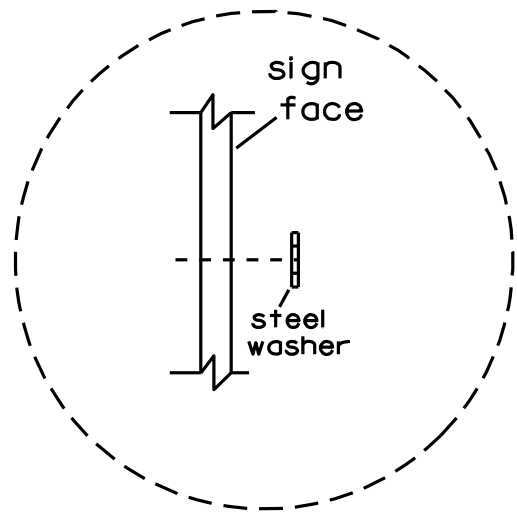


Washer Placement when Sign Has Other Than Type H or Type F Face

* Two different fastening systems are shown for illustration purposes. On any individual sign, either one or the other system shall be used. Actual number of fasteners per sign varies with the sign area, but normally there are two. For a single post installation, all signs greater than 9 sq. ft. require the use of 3 fasteners.

ATTACHMENT OF SIGNS TO POSTS	
WISCONSIN DEPT OF TRANSPORTATION	
APPROVED	<i>Matthew R. Rauch</i> For State Traffic Engineer
DATE 3/23/10	PLATE NO. A4-8.7

7

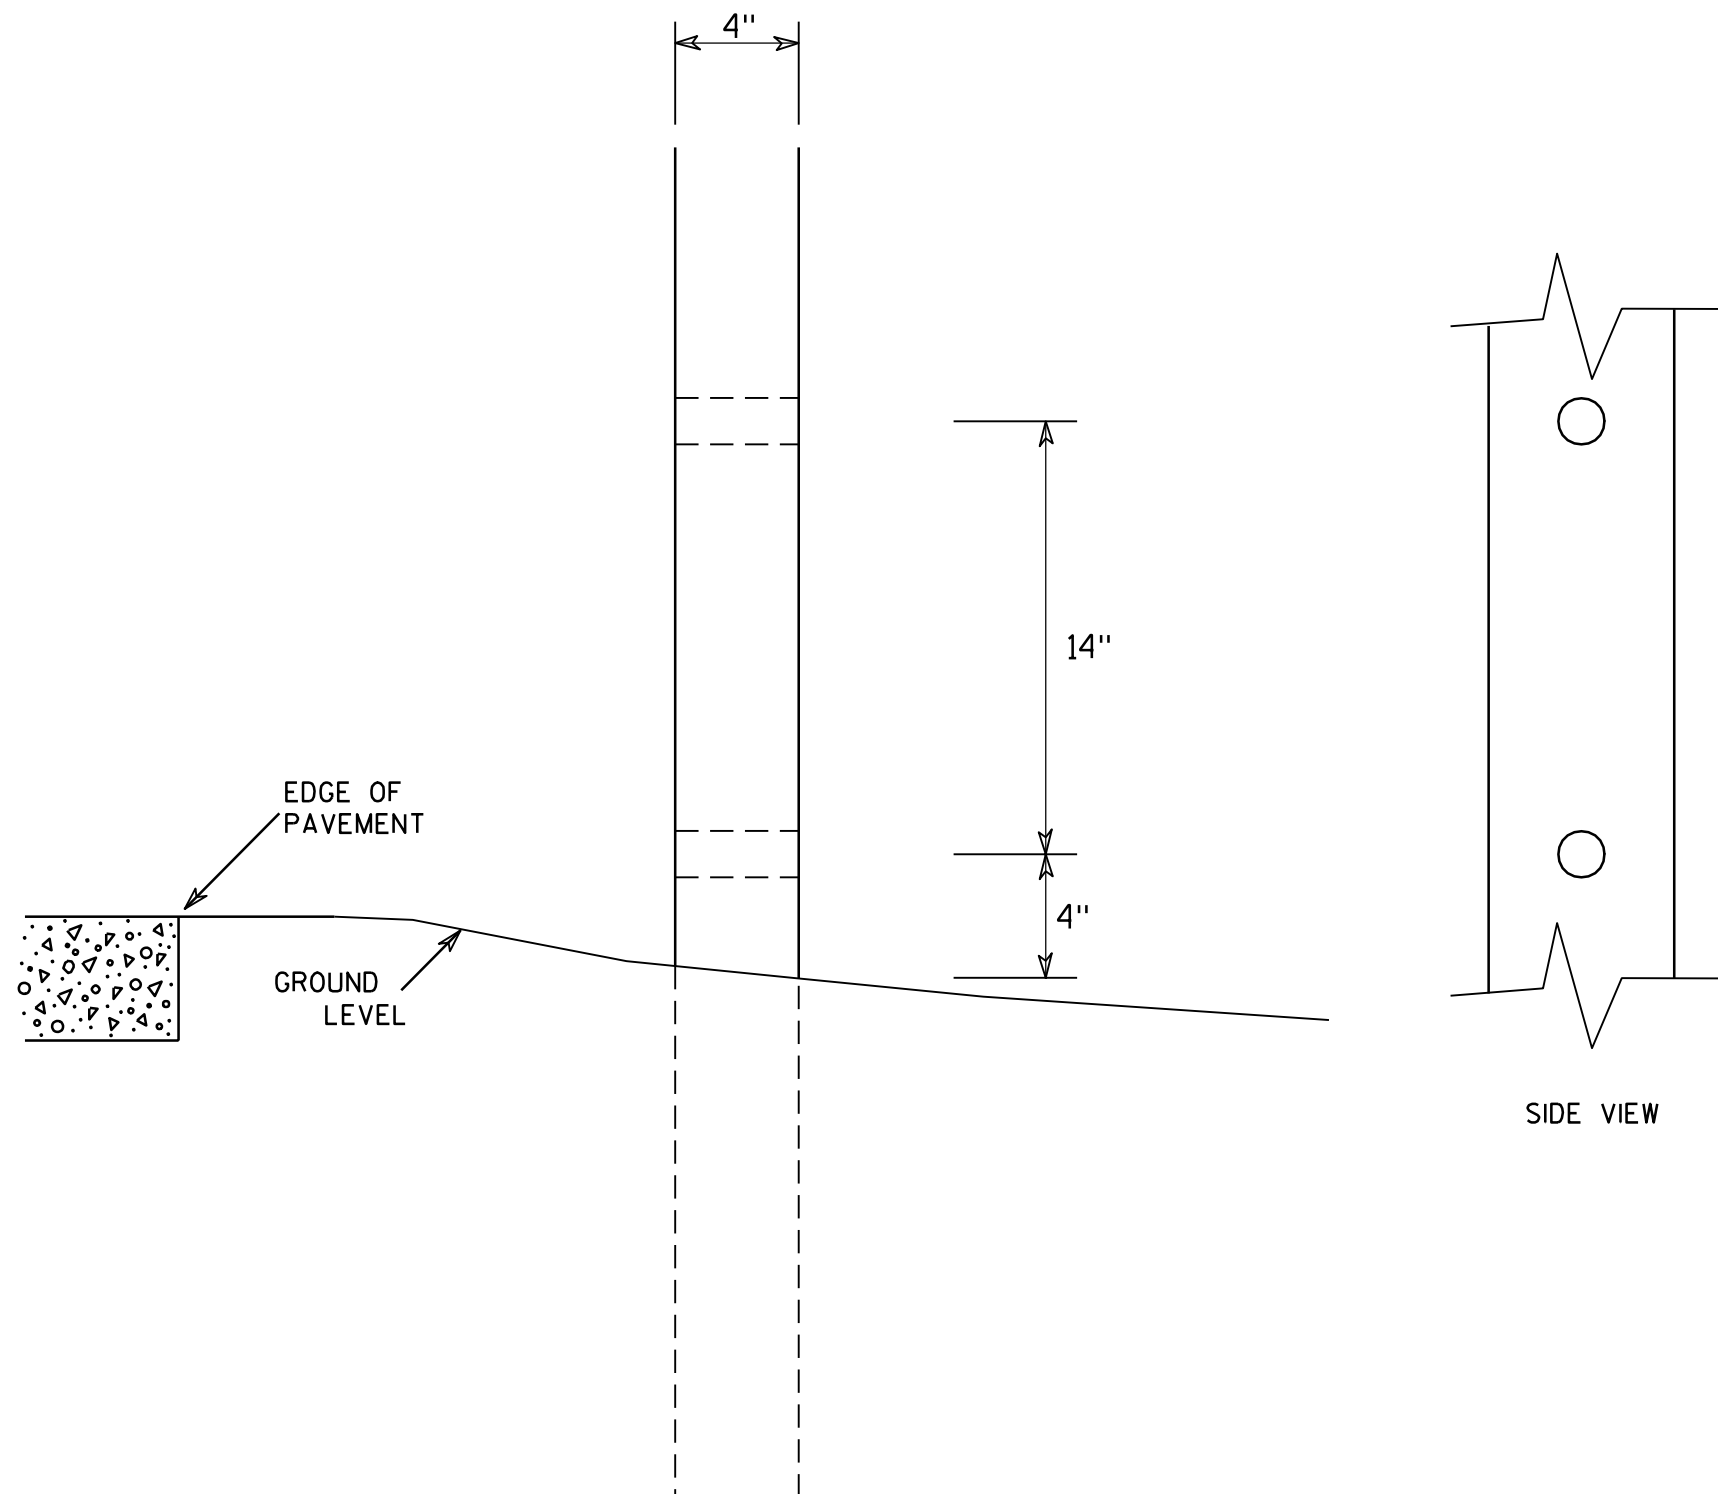GENERAL NOTES

1. All 4 x 6 Wood Posts shall be modified by having two 1½" diameter holes drilled perpendicular to the roadway centerline.

7

**4 X 6 WOOD POST
MODIFICATIONS**

WISCONSIN DEPT OF TRANSPORTATION

APPROVED

Chester J. Spang
for State Traffic Engineer

DATE 3/27/97

PLATE NO. A4-11.2

PROJECT NO:


HWY:

COUNTY:

SHEET NO: 163

E

BRACE BANDING


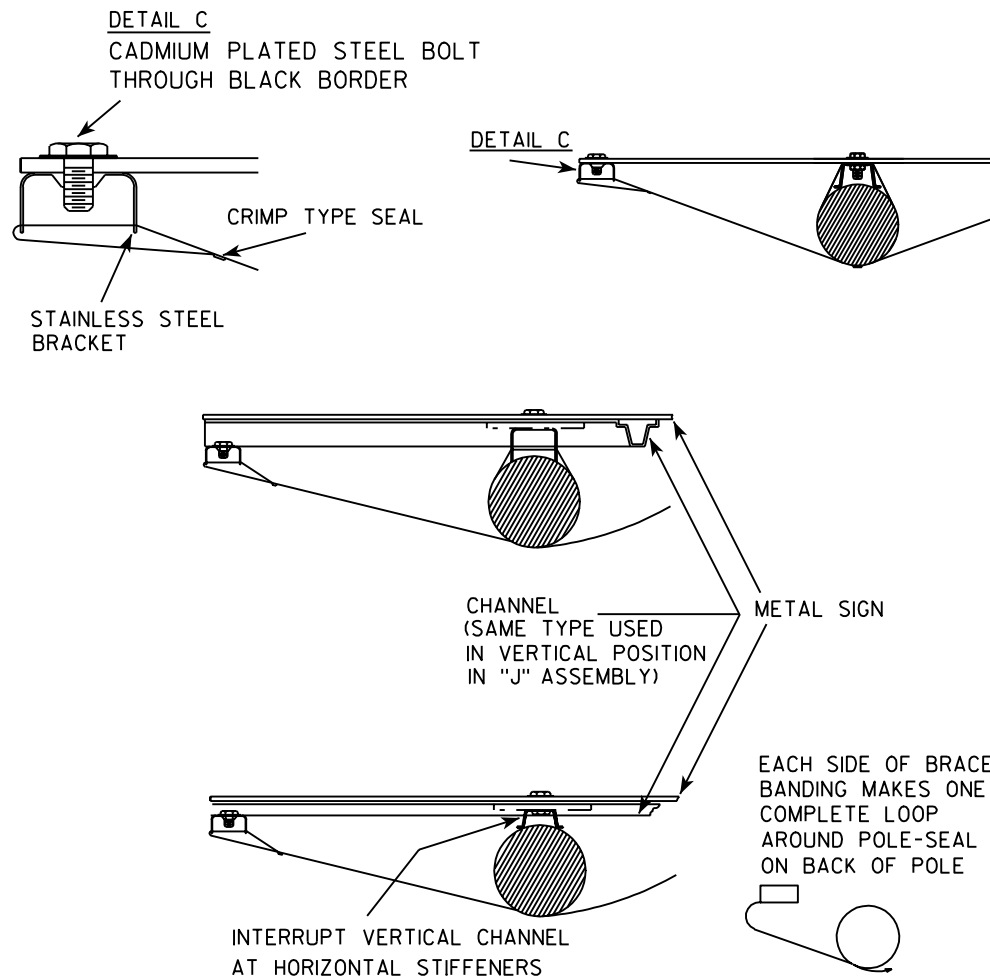


BRACE BANDING


BRACE BANDING SHALL BE TIGHTENED FIRMLY
BUT NOT SO TIGHT AS TO APPRECIABLY
CURVE FACE OF SIGN.

BRACKET BANDING

SINGLE SIGN

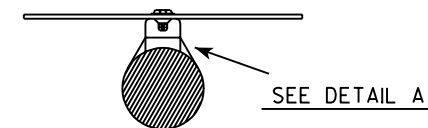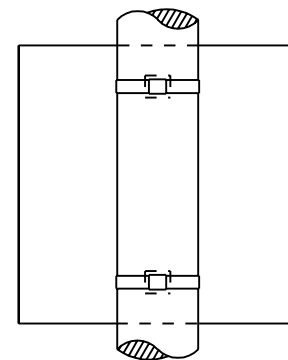


"J" ASSEMBLY

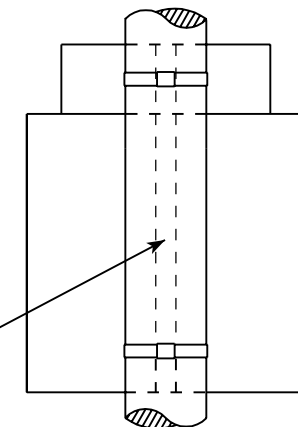

CHANNEL
SEE TYPICAL PANEL
INSTALLATION SHEET


SEE DETAIL B

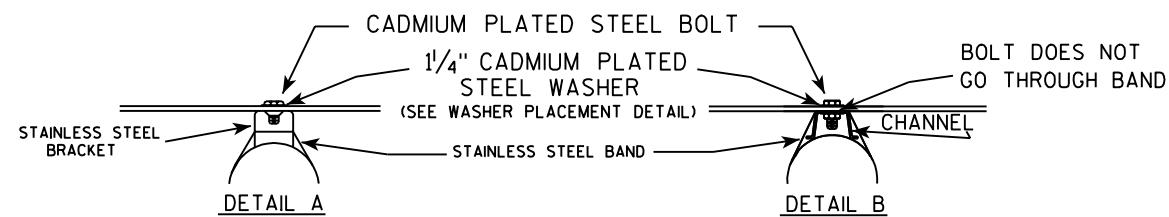

GENERAL NOTES

1. Signs 4' or greater in width shall have one brace band installed at the center of the sign.
2. Signs 3' or greater in height shall have three bracket bands installed. Signs less than 3' in height shall have two bracket bands installed.
3. Banding and assembly bracket shall be stainless steel. All bands shall be 3/4" in width and 0.025" thickness.

WASHER PLACEMENT

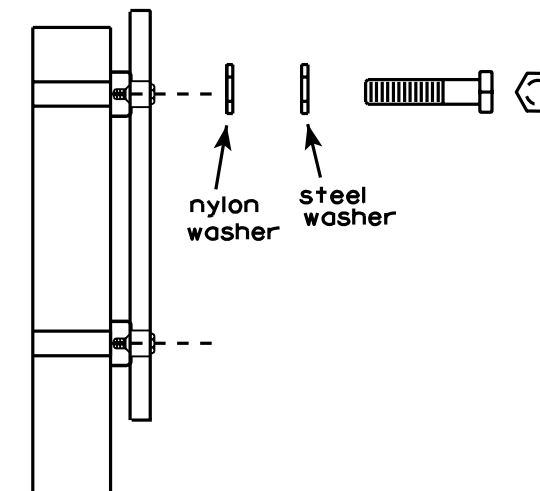

WASHERS (ALL POSTS) -

1-1/4" O.D. X 3/8" I.D. X 1/16" STEEL
1-1/4" O.D. X 3/8" I.D. X .080 NYLON
FOR ALL TYPE H SIGNS

STANDARD SIGN SIGN BANDING DETAILS

WISCONSIN DEPT OF TRANSPORTATION

APPROVED *Matthew R. Rauch*
For State Traffic Engineer

DATE 11/08/05 PLATE NO. A5-9.2



PROJECT NO:

HWY:

COUNTY:

SHEET NO: 164

E

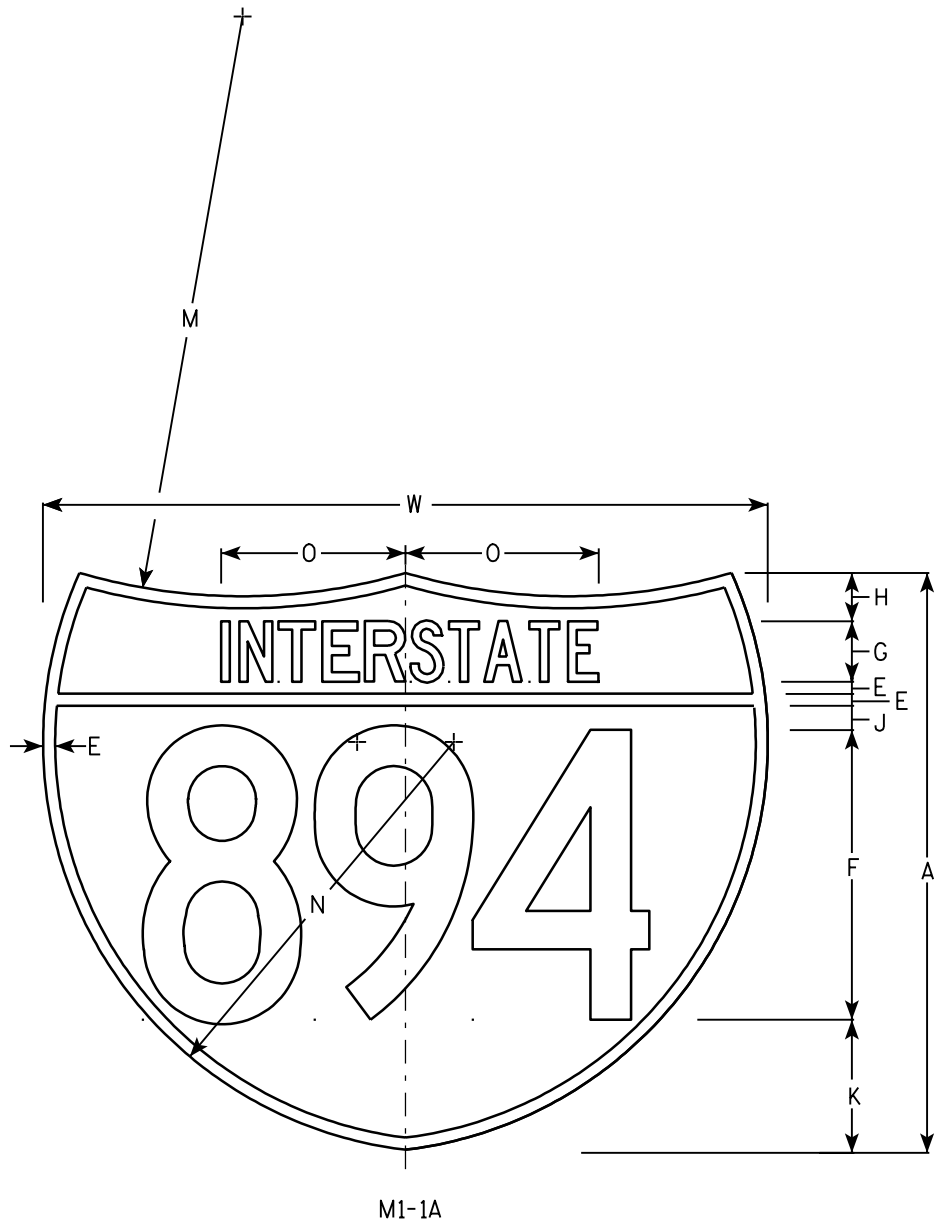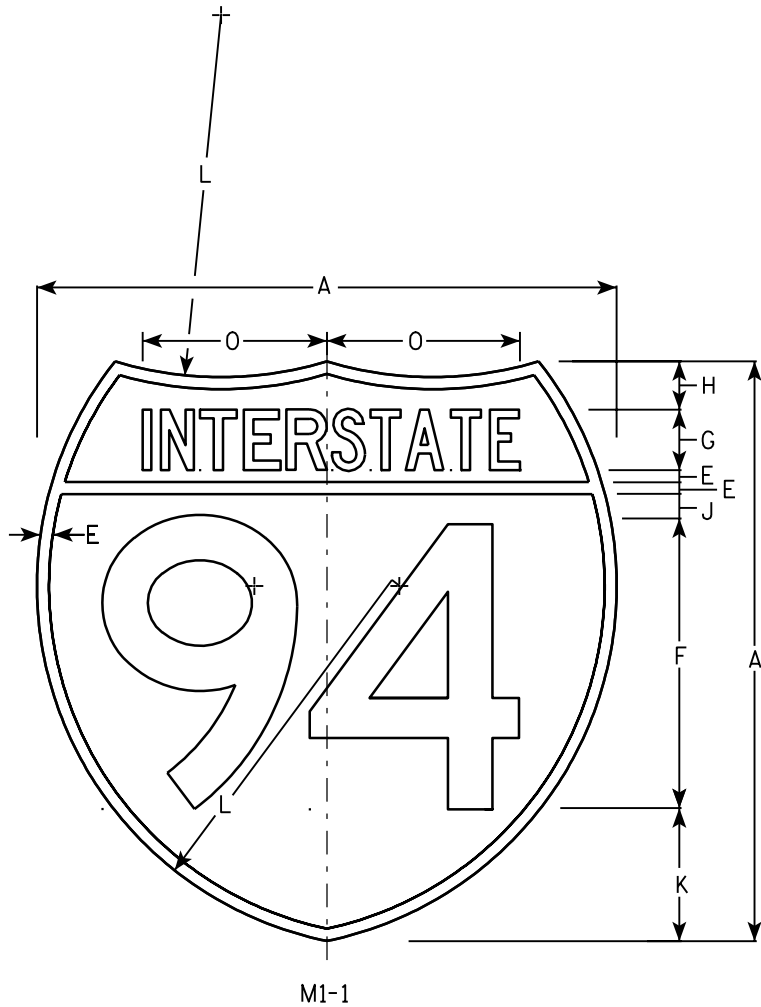

NOTES

- 1. Sign is Type II - See Note 6 - reference WIS DOT Standard Specification for HIGHWAY and STRUCTURE CONSTRUCTION latest edition.
- 2. Color:
Background - Top Red - Bottom Blue (See Note 6)
Message - White - See Note 6
- 3. Message Series - See note 5
- 4. Substitute appropriate numerals & adjust spacing as per plate A10-1.
- 5. M1-1 - Numerals - D
Interstate - C
M1-1A - All copy - C
- 6. Permanent Signs
Message - Type H Reflective
Detour or other temporary signs
Background - Reflective
Message - Reflective

Metric equivalent for these signs are:

SIZE	M1 - 1	SIZE	M1 - 1A
1			
2	600 mm X 600 mm	2	600 mm X 750 mm
3	900 mm X 900 mm	3	900 mm X 1125 mm
4	900 mm X 900 mm	4	900 mm X 1125 mm
5	900 mm X 900 mm	5	900 mm X 1125 mm



SIZE	A	B	C	D	E	F	G	H	I	J	K	L	M	N	O	P	Q	R	S	T	U	V	W	X	Y	Area sq. ft.	Area sq. ft.	Area m ²	Area m ²
1																													
2	24				1/2	12	2 1/2	2		1	5 1/2	15	24	17	7 7/8								30			3.13	3.91	.36	.46
3	36				3/4	18	3 3/4	3		1 1/2	8 1/4	22 1/2	36	25 1/2	11 3/4								45			7.03	8.79	.81	1.05
4	36				3/4	18	3 3/4	3		1 1/2	8 1/4	22 1/2	36	25 1/2	11 3/4								45			7.03	8.79	.81	1.05
5	36				3/4	18	3 3/4	3		1 1/2	8 1/4	22 1/2	36	25 1/2	11 3/4								45			7.03	8.79	.81	1.05

INTERSTATE ROUTE MARKER
M1-1 FOR ASSEMBLIES

WISCONSIN DEPT OF TRANSPORTATION
APPROVED *Matthew R. Rauch*
for State Traffic Engineer
DATE 08/23/05 PLATE NO. M1-1.8

NOTES

1. Sign is Type II - See Note 6 - reference
WIS DOT Standard Specification for HIGHWAY
and STRUCTURE CONSTRUCTION latest edition.
2. Color:
Background - White & Black - See Note 6
Message - Black
3. Message Series - See note 5
4. Corners may be square or rounded when base
material is plywood but borders shall be rounded
as shown. When base material is metal, the
corners and borders shall be rounded.
5. Substitute appropriate numerals and adjust
spacing as per Plate A10-1.
6. Permanent Signs
Background - Type H Reflective
Detour or other temporary signs
Background - Reflective

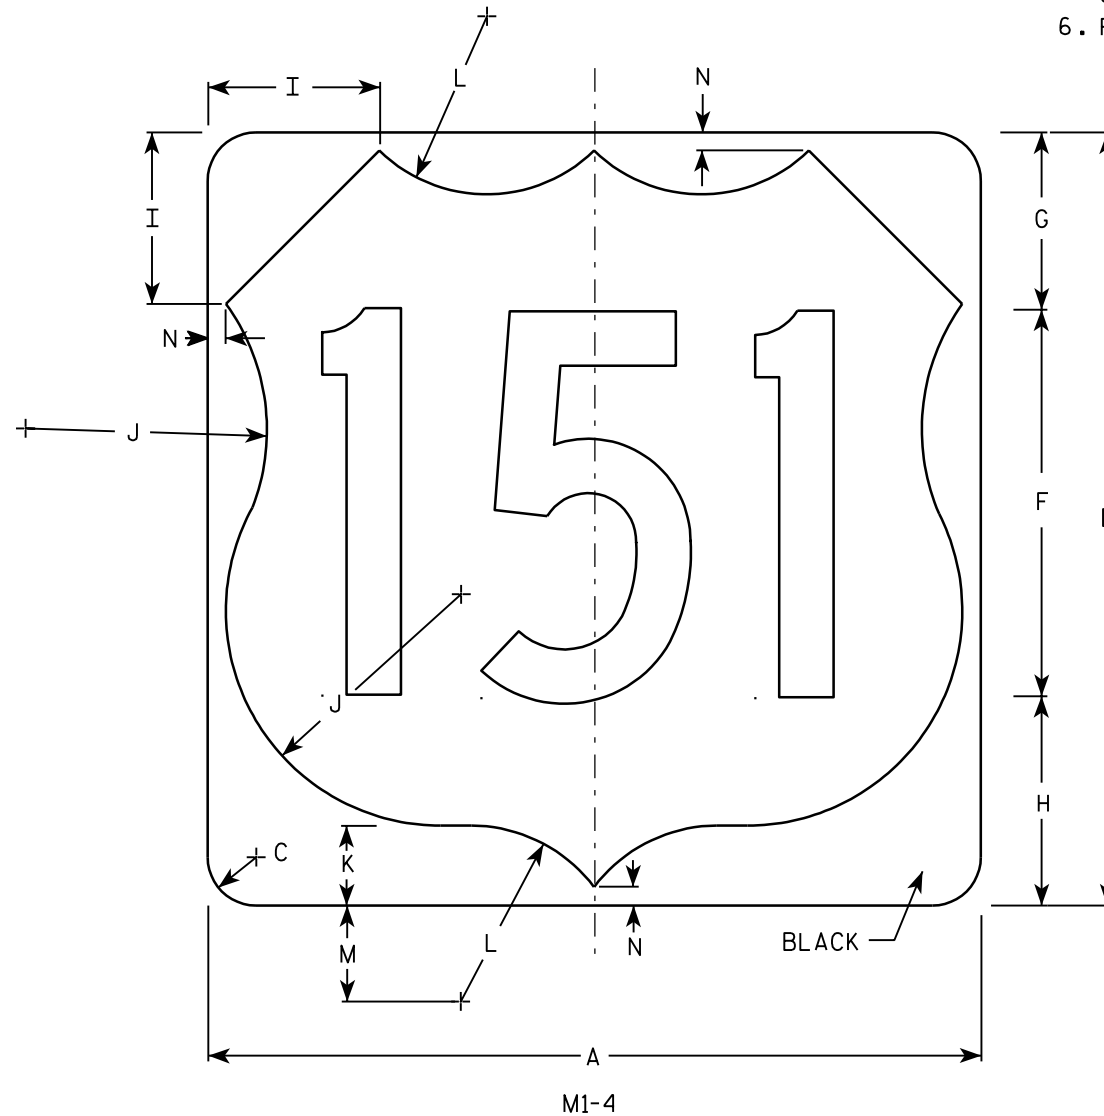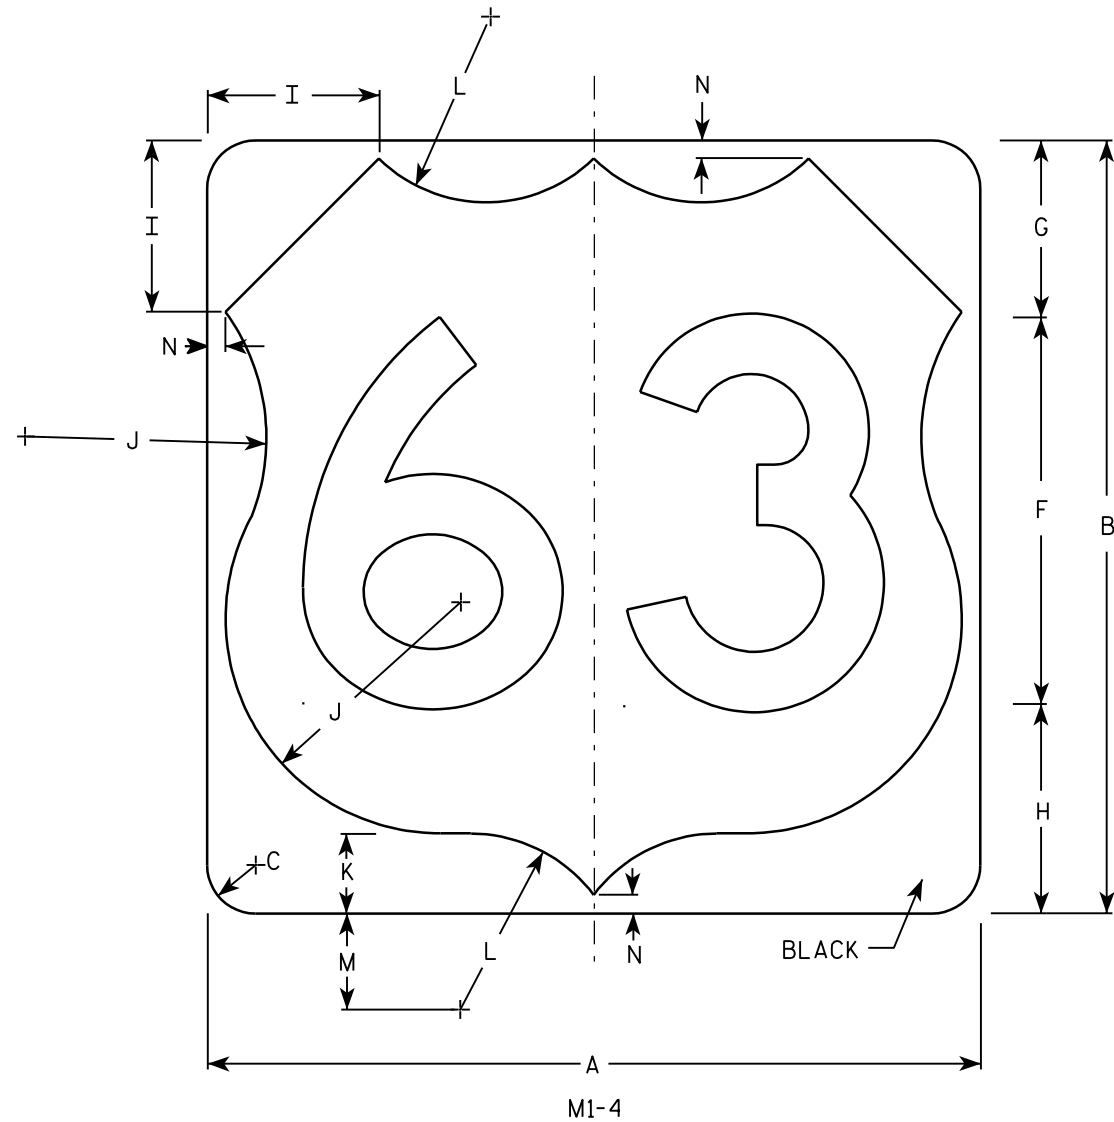

Metric equivalent
for this sign is:

SIZE	
1	
2	600 mm X 600 mm
3	900 mm X 900 mm
4	900 mm X 900 mm
5	900 mm X 900 mm

SIZE	A	B	C	D	E	F	G	H	I	J	K	L	M	N	O	P	Q	R	S	T	U	V	W	X	Y	Z	Areq sq. ft.	Area m ²
1																												
2	24	24	1 1/2			12	5 1/2	6 1/2	5	7 1/2	2 1/2	5 1/2	3	1/2													4.0	.36
3	36	36	2 1/4			18	8 1/4	9 1/4	7 1/4	11 1/4	3 3/4	8 1/4	4 1/2	3/4													9.0	.81
4	36	36	2 1/4			18	8 1/4	9 1/4	7 1/4	11 1/4	3 3/4	8 1/4	4 1/2	3/4													9.0	.81
5	36	36	2 1/4			18	8 1/4	9 1/4	7 1/4	11 1/4	3 3/4	8 1/4	4 1/2	3/4													9.0	.81

PROJECT NO:	HWY:	COUNTY:	SHEET NO: 166	E
-------------	------	---------	---------------	---

7

Metric equivalent
for this sign is:

SIZE	
1	
2	600 mm X 600 mm
3	900 mm X 900 mm
4	900 mm X 900 mm
5	900 mm X 900 mm

SIZE	A	B	C	D	E	F	G	H	I	J	K	L	M	N	O	P	Q	R	S	T	U	V	W	X	Y	Z	Area sq. ft.	Area m ²
1																												
2	24		1 1/2			10	3	5 1/8	4 1/8	9 1/4	9 5/8	2	11 1/2	10 1/8	9 3/8												4.0	.36
3	36		2 1/4			16	4	7 5/8	5 5/8	12 1/4	12 7/8	3	17 1/8	15 1/4	14												9.0	.81
4	36		2 1/4			16	4	7 5/8	5 5/8	12 1/4	12 7/8	3	17 1/8	15 1/4	14												9.0	.81
5	36		2 1/4			16	4	7 5/8	5 5/8	12 1/4	12 7/8	3	17 1/8	15 1/4	14												9.0	.81

PROJECT NO:

HWY:

COUNTY:

FILE NAME : C:\Users\Projects\tr_stdp\late\M15A.DGN

PLOT DATE : 13-OCT-2005 14:53

PLOT BY : DITJPH



PLOT NAME :

PLOT SCALE : 5.960833:1.000000

WISDOT/CADDs SHEET 42

NOTES

- Sign is Type II - see Note 7 - reference WIS DOT Standard Specification for HIGHWAY and STRUCTURE CONSTRUCTION latest edition.
- Color:
Background - White & Black - See Note 7
Message - Black
- Message Series - see Note 5
- Corners may be square or rounded when base material is plywood but borders shall be rounded as shown. When base material is metal, the corners and borders shall be rounded.
- Message Series E for 1 letter.
Message Series D for 2 letters unless message is too big then Series C.
Message Series C for 3 letters unless message is too big then Series B.
- Substitute appropriate letters & optically adjust spacing to achieve proper balance.
- Permanent Signs
Background - Type H Reflective
Detour or temporary Signs
Background - Reflective

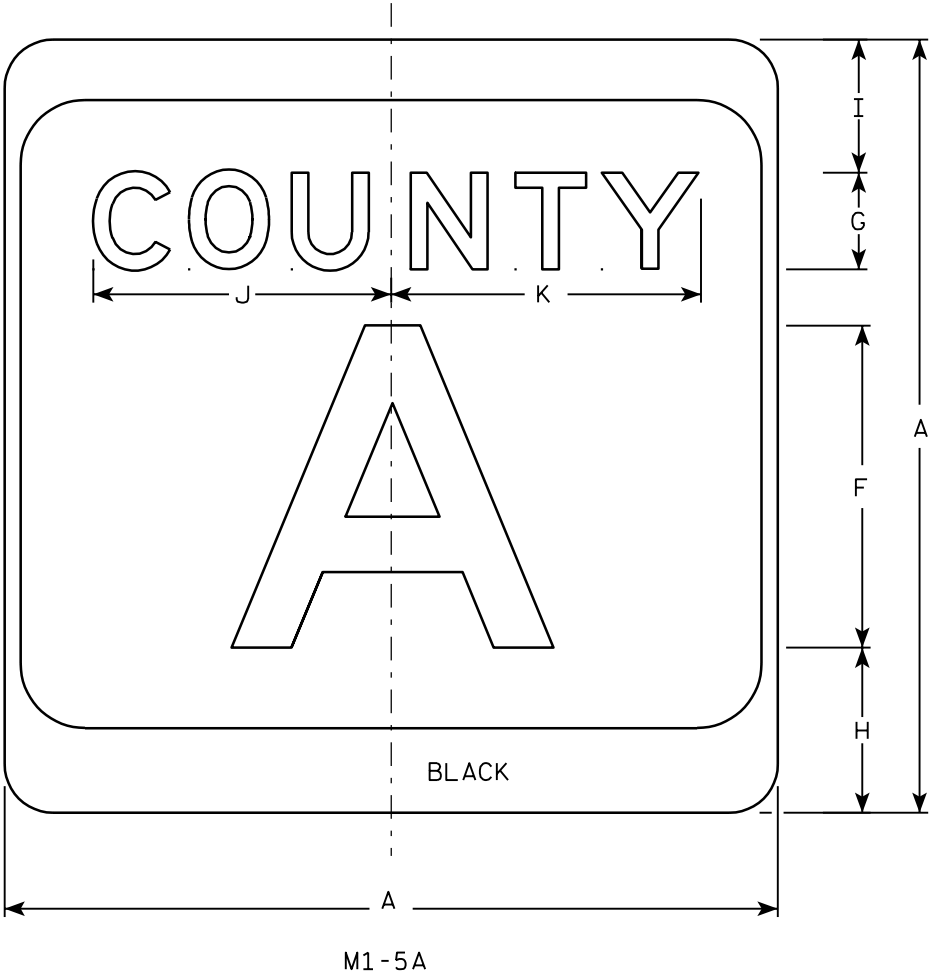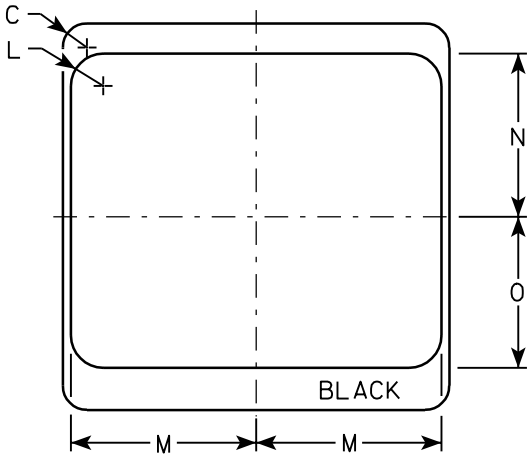

CTH MARKER

M1-5A FOR ASSEMBLIES

WISCONSIN DEPT OF TRANSPORTATION

APPROVED


for State Traffic Engineer

DATE 3/20/02


PLATE NO. M1-5A.7

SHEET NO: 167

E

7

7

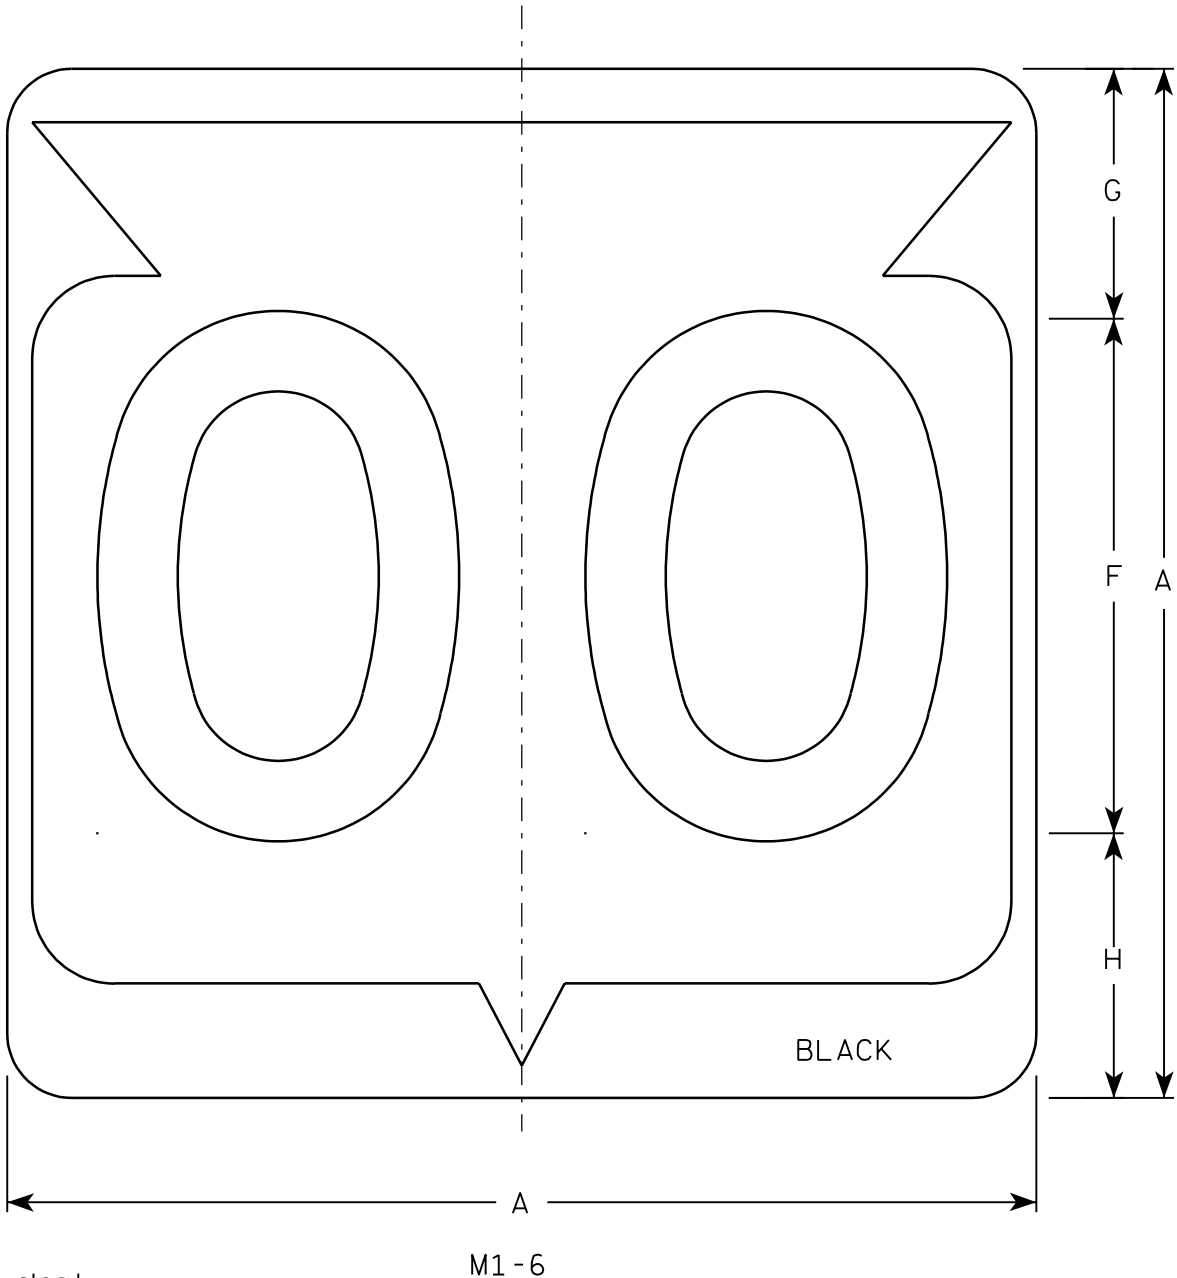

Metric equivalent
for this sign is:

SIZE	
1	
2	600 mm X 600 mm
3	900 mm X 900 mm
4	900 mm X 900 mm
5	900 mm X 900 mm

SIZE	A	B	C	D	E	F	G	H	I	J	K	L	M	N	O	P	Q	R	S	T	U	V	W	X	Y	Z	Area sq. ft.	Area m ²
1																												
2	24		1 1/2			12	5 1/2	6 1/2	10 1/4	2 1/2	8 7/8	11 1/2	1	1 7/8	11 1/4	21 7/8											4.0	.36
3	36		2 1/4			18	8 3/4	9 1/4	15 3/8	5 3/8	12 5/8	17 1/8	1 1/2	2 7/8	16 7/8	33											9.0	.81
4	36		2 1/4			18	8 3/4	9 1/4	15 3/8	5 3/8	12 5/8	17 1/8	1 1/2	2 7/8	16 7/8	33											9.0	.81
5	36		2 1/4			18	8 3/4	9 1/4	15 3/8	5 3/8	12 5/8	17 1/8	1 1/2	2 7/8	16 7/8	33											9.0	.81

PROJECT NO:

HWY:

COUNTY:

SHEET NO: 168

E

FILE NAME : C:\Users\Projects\tr_stdp\late\M16.DGN

PLOT DATE : 13-OCT-2005 14:55

PLOT BY : DITJPH


PLOT NAME :

PLOT SCALE : 6.715871:1.000000

WISDOT/CADDs SHEET 42

NOTES

1. Sign is Type II - See Note 6 - reference
WIS DOT Standard Specification for HIGHWAY
and STRUCTURE CONSTRUCTION latest edition.
2. Color:
Background - White & Black - See Note 6
Message - Black
3. Message Series - See note 5
4. Corners may be square or rounded when base
material is plywood but borders shall be rounded
as shown. When base material is metal, the
corners and borders shall be rounded.
5. Substitute appropriate Series numerals and
adjust spacing as per plate A10-1.
6. Permanent Signs
Background - Type H Reflective
Detour or temporary Signs
Background - Reflective

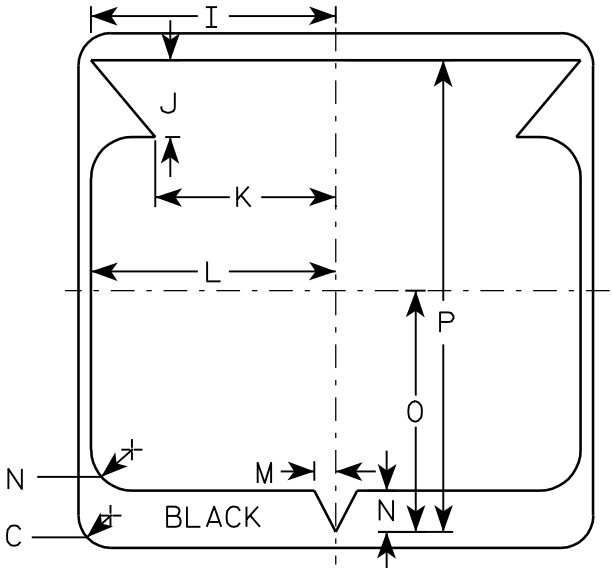

STATE ROUTE MARKER
M1-6 FOR ASSEMBLIES

WISCONSIN DEPT OF TRANSPORTATION

APPROVED

Chester J. Spang
for State Traffic Engineer

DATE 3/20/02

PLATE NO. M1-6.9

7

Metric equivalent
for this sign is:

SIZE	
1	600 mm X 600 mm
2	600 mm X 600 mm
3	
4	900 mm X 900 mm
5	

SIZE	A	B	C	D	E	F	G	H	I	J	K	L	M	N	O	P	Q	R	S	T	U	V	W	X	Y	Z	Area sq. ft.	Area m ²
1	24		1 1/8	3/8	1/2	4	6	10	10 1/8	5 1/2	6 1/8																4.0	0.36
2	24		1 1/8	3/8	1/2	4	6	10	10 1/8	5 1/2	6 1/8																4.0	0.36
3																												
4	36		1 3/8	1/2	5/8	6	9	15	15 1/4	8 1/4	9 1/8																9.0	0.81
5																												


PROJECT NO:

HWY:

COUNTY:

SHEET NO: 169

E

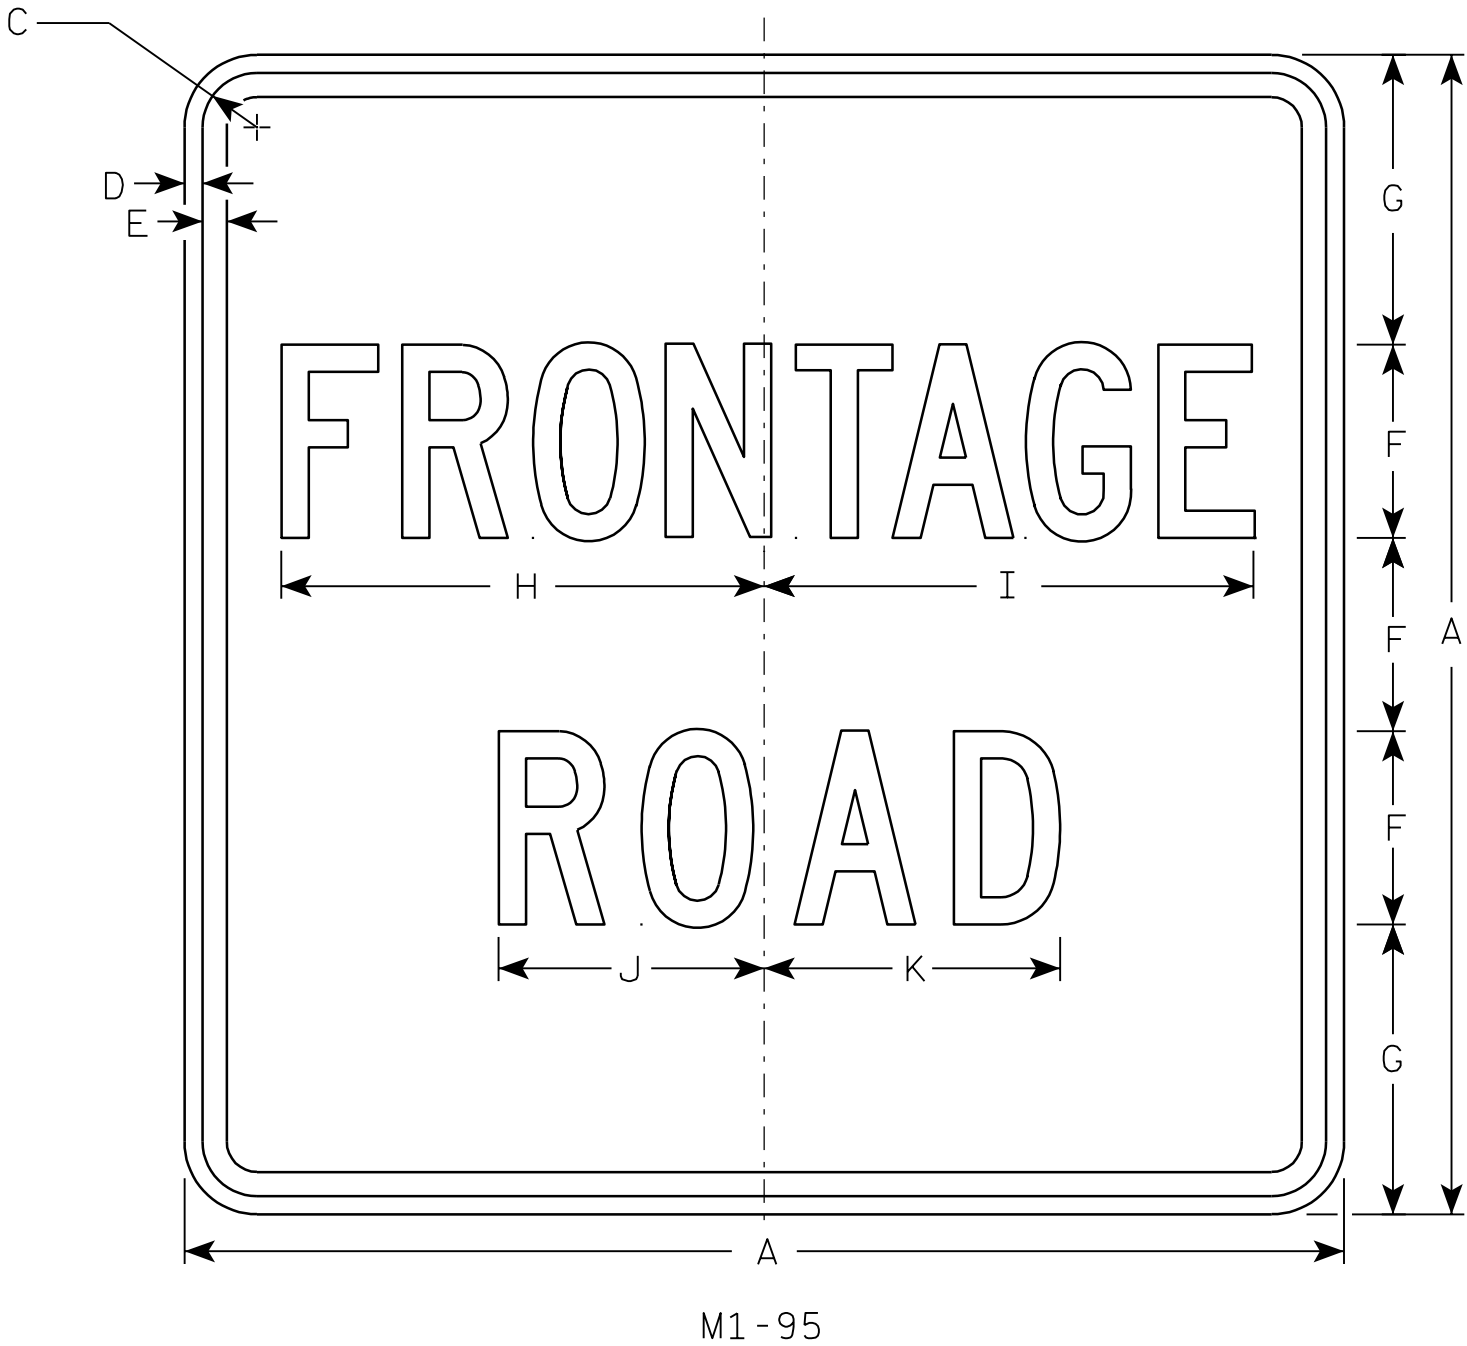

NOTES

1. Sign is Type II - Type H Reflective - reference WIS DOT Standard Specification for HIGHWAY and STRUCTURE CONSTRUCTION latest edition.
2. Color:
Background - White
Message - Black
3. Message Series - C
4. Corners may be square or rounded when base material is plywood but borders shall be rounded as shown. When base material is metal, the corners and borders shall be rounded.

STANDARD SIGN
M1-95


WISCONSIN DEPT OF TRANSPORTATION

APPROVED 
for State Traffic Engineer


DATE 1/30/02 PLATE NO. M1-95.6

NOTES

1. Sign is Type II - See Note 5 - reference
WIS DOT Standard Specification for HIGHWAY
and STRUCTURE CONSTRUCTION latest edition.
2. Color:
Background - See note 5
Message - See note 5
3. Message Series - C
4. Corners may be square or rounded when base
material is plywood but borders shall be rounded
as shown. When base material is metal, the
corners and borders shall be rounded.
5. M2-1 Background - White - Type H Reflective
(Detour or temporary Signs - Reflective)
Message - Black
MB2-1 Background - Blue
Message - White - Type H Reflective
(Detour or temporary Signs - Reflective)
MG2-1 Background - Green
Message - White - Type H Reflective
MK2-1 Background - Green
Message - White - Type H Reflective
MM2-1 Background - White - Type H Reflective
Message - Green
MN2-1 Background - Brown
Message - White - Type H Reflective
MR2-1 Background - Brown
Message - Yellow - Type H Reflective

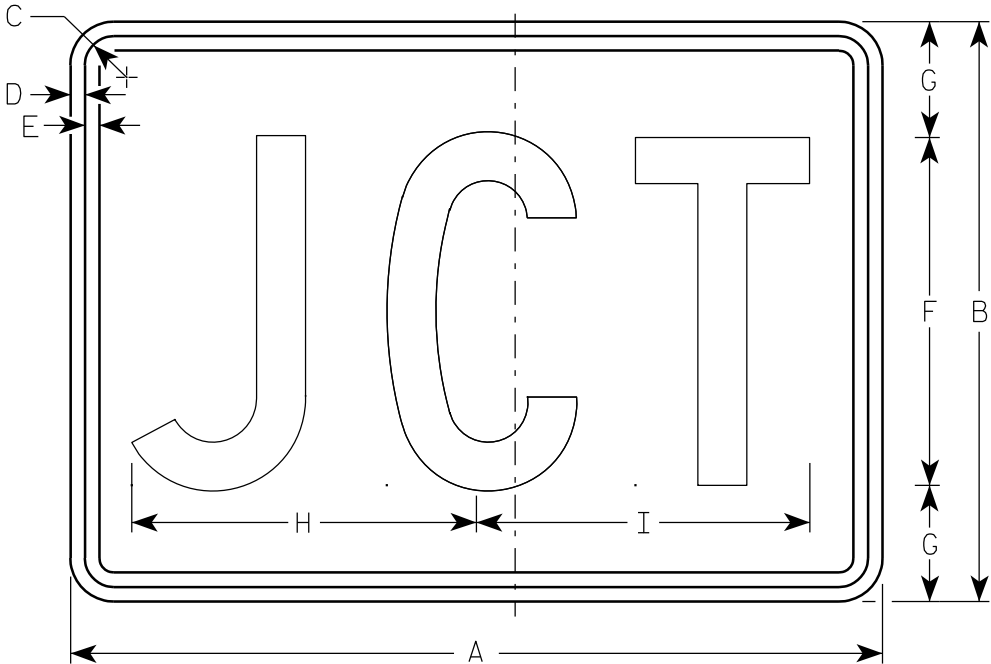

M2-1
MK2-1
MM2-1
MR2-1

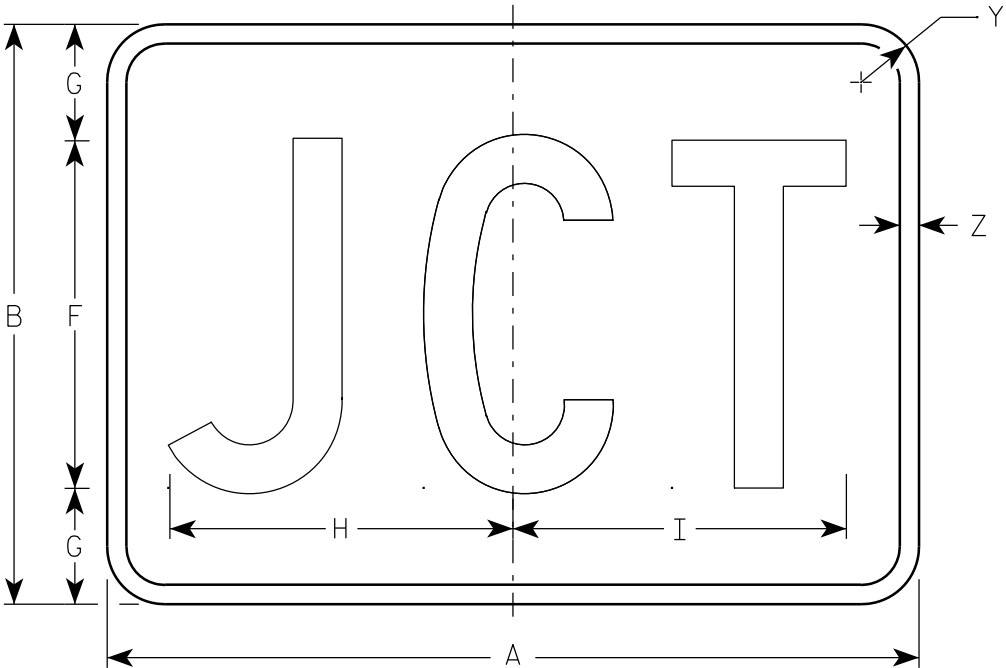

MB2-1
MG2-1
MN2-1

Metric equivalent
for this sign is:

SIZE	
1	
2	525 mm X 375 mm
3	750 mm X 525 mm
4	750 mm X 525 mm
5	750 mm X 525 mm


SIZE	A	B	C	D	E	F	G	H	I	J	K	L	M	N	O	P	Q	R	S	T	U	V	W	X	Y	Z	Area sq. ft.	Area m ²
1																												
2	21	15	1 1/8	3/8	3/8	9	3	8 7/8	8 5/8																1 1/2	1/2	2.20	0.20
3	30	21	1 1/8	3/8	3/8	13	4	12 7/8	12 3/8																1 1/2	1/2	4.40	0.20
4	30	21	1 1/8	3/8	3/8	13	4	12 7/8	12 3/8																1 1/2	1/2	4.40	0.20
5	30	21	1 1/8	3/8	3/8	13	4	12 7/8	12 3/8																1 1/2	1/2	4.40	0.20

STANDARD SIGN
M2-1


WISCONSIN DEPT OF TRANSPORTATION

APPROVED
Matthew R. Rauch
for State Traffic Engineer

DATE 3/16/10 PLATE NO. M2-1.10

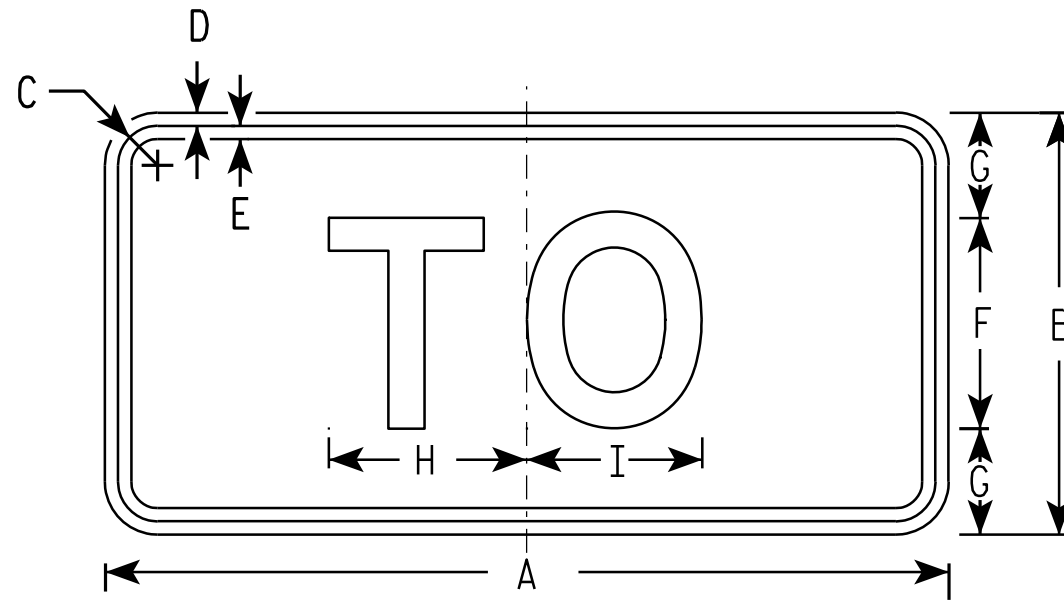

M4-5
MK4-5
MM4-5

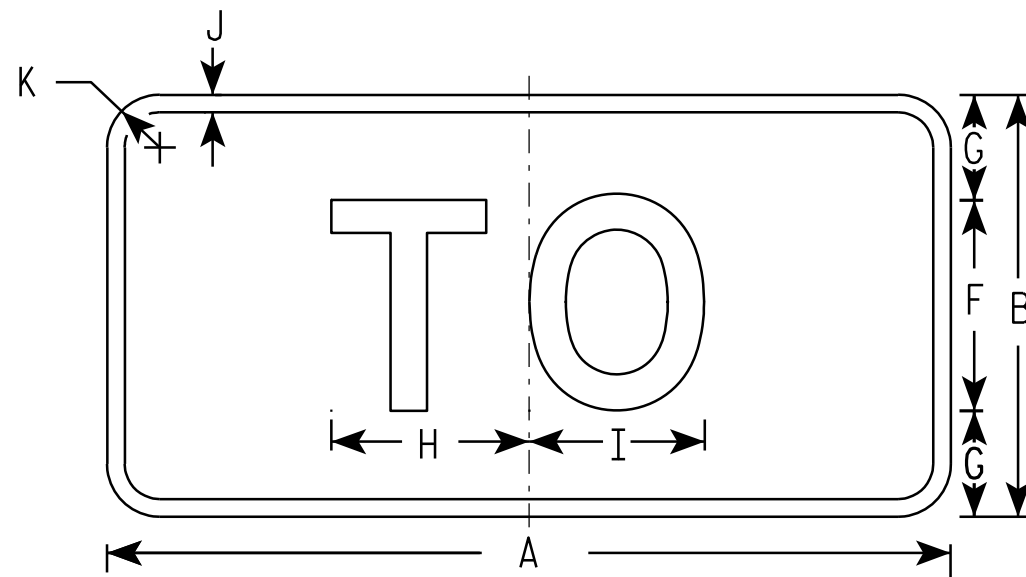

MB4-5
MG4-5
MN4-5

NOTES


1. Sign is Type II - See Note 5 - reference
WIS DOT Standard Specification for HIGHWAY
and STRUCTURE CONSTRUCTION latest edition.
2. Color:
Background - See note 5
Message - See note 5
3. Message Series - D
4. Corners may be square or rounded when base
material is plywood but borders shall be rounded
as shown. When base material is metal, the
corners and borders shall be rounded.
5. M4-5 Background - White - Type H Reflective
(Detour or temporary Signs - Reflective)
Message - Black
MB4-5 Background - Blue
Message - White - Type H Reflective
(Detour or temporary Signs - Reflective)
MG4-5 Background - Green
Message - White - Type H Reflective
MK4-5 Background - Green
Message - White - Type H Reflective
MM4-5 Background - White - Type H Reflective
Message - Green
MN4-5 Background - Brown
Message - White - Type H Reflective

Metric equivalent
for this sign is:


SIZE	
1	
2	600 mm X 300 mm
3	750 mm X 375 mm
4	750 mm X 375 mm
5	750 mm X 375 mm

SIZE	A	B	C	D	E	F	G	H	I	J	K	L	M	N	O	P	Q	R	S	T	U	V	W	X	Y	Z	Area sq. ft.	Area sq
1																												
2	24	12	1 1/8	3/8	3/8	6	3	5 5/8	5	1/2	1 1/2																2.00	0.18
3	30	15	1 3/8	3/8	1/2	8	3 1/2	7 1/2	6 5/8	1/2	1 1/2																3.13	0.28
4	30	15	1 3/8	3/8	1/2	8	3 1/2	7 1/2	6 5/8	1/2	1 1/2																3.13	0.28
5	30	15	1 3/8	3/8	1/2	8	3 1/2	7 1/2	6 5/8	1/2	1 1/2																3.13	0.28

PROJECT NO: HWY: COUNTY: SHEET NO: 171 E

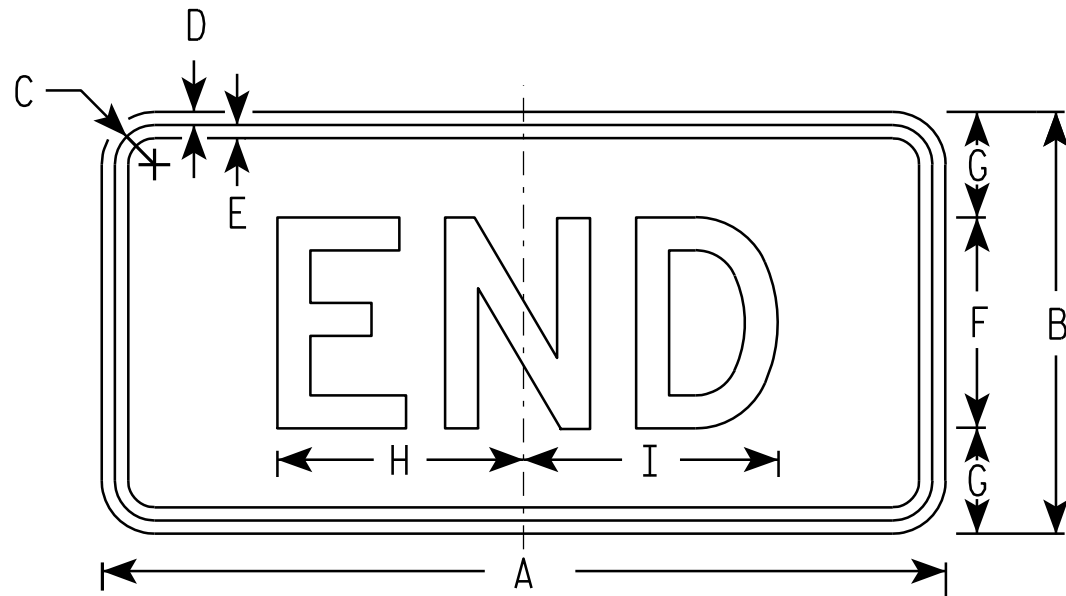

M4-6
MK4-6
MM4-6
MR4-6

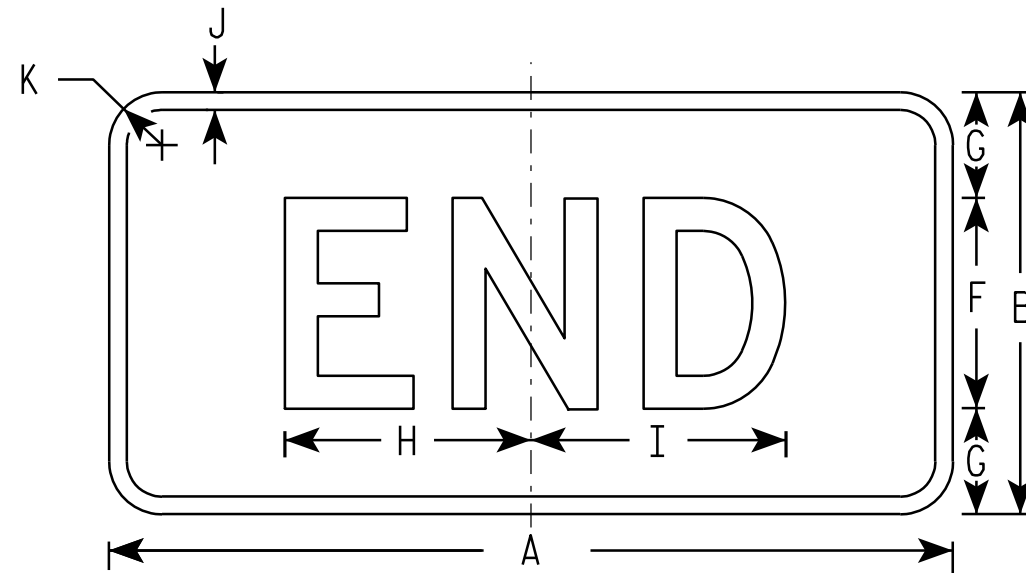

MB4-6
MG4-6
MN4-6

NOTES

1. Sign is Type II - See Note 5 - reference
WIS DOT Standard Specification for HIGHWAY
and STRUCTURE CONSTRUCTION latest edition.
2. Color:
Background - See note 5
Message - See note 5
3. Message Series - D
4. Corners may be square or rounded when base
material is plywood but borders shall be rounded
as shown. When base material is metal, the
corners and borders shall be rounded.
5. M4-6 Background - White - Type H Reflective
(Detour or temporary Signs - Reflective)
Message - Black
MB4-6 Background - Blue
Message - White - Type H Reflective
(Detour or temporary Signs - Reflective)
MG4-6 Background - Green
Message - White - Type H Reflective
MK4-6 Background - Green
Message - White - Type H Reflective
MM4-6 Background - White - Type H Reflective
Message - Green
MN4-6 Background - Brown
Message - White - Type H Reflective
MR4-6 Background - Brown
Message - Yellow - Type H Reflective


7

Metric equivalent
for this sign is:


SIZE	
1	
2	600 mm X 300 mm
3	750 mm X 375 mm
4	750 mm X 375 mm
5	750 mm X 375 mm

SIZE	A	B	C	D	E	F	G	H	I	J	K	L	M	N	O	P	Q	R	S	T	U	V	W	X	Y	Z	Area sq. ft.	Area m ²
1																												
2	24	12	1 1/8	3/8	3/8	6	3	7	7 1/4	1/2	1 1/2																2.00	0.18
3	30	15	1 1/8	3/8	1/2	8	3 1/2	9 1/4	9 3/4	1/2	1 1/2																3.13	0.28
4	30	15	1 1/8	3/8	1/2	8	3 1/2	9 1/4	9 3/4	1/2	1 1/2																3.13	0.28
5	30	15	1 1/8	3/8	1/2	8	3 1/2	9 1/4	9 3/4	1/2	1 1/2																3.13	0.28


PROJECT NO: HWY: COUNTY: SHEET NO: 172 E

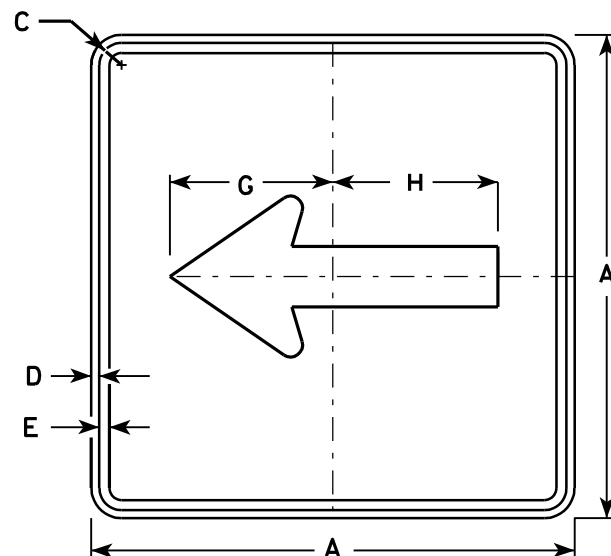


M6-1
MK6-1
MM6-1
MO6-1
MR6-1

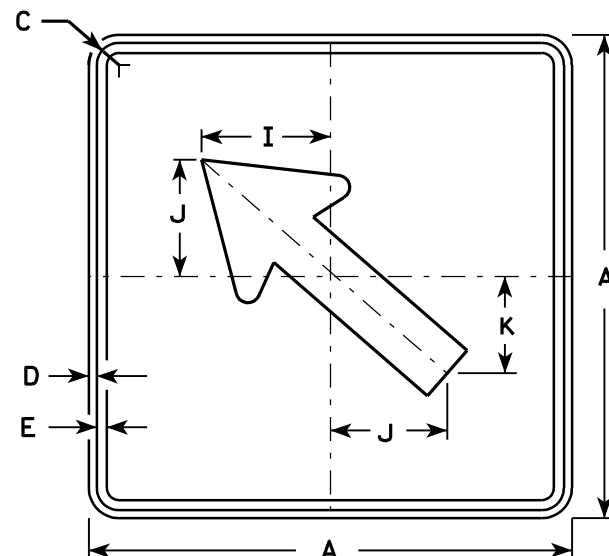

M6-2
MK6-2
MM6-2
MO6-2
MR6-2

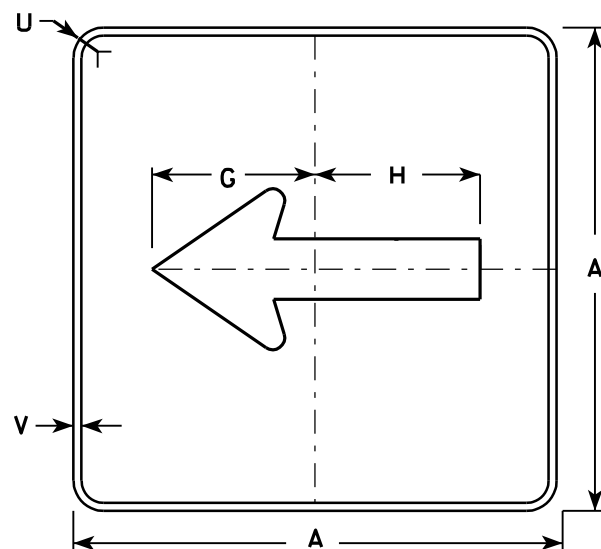


MB6-1
MG6-1
MN6-1

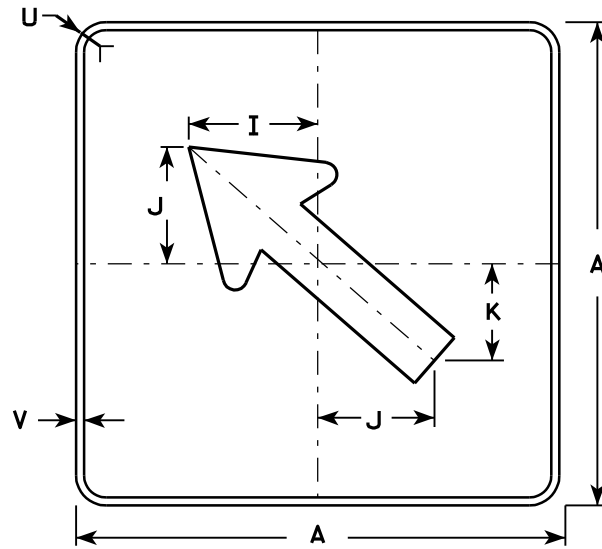

MB6-2
MG6-2
MN6-2

NOTES

- Signs are Type II - See Note 4 - reference WIS DOT Standard Specification for HIGHWAY and STRUCTURE CONSTRUCTION latest edition.
- Color:
Background - See note 4
Message - See note 4
- Corners may be square or rounded when base material is plywood but borders shall be rounded as shown. When base material is metal, the corners and borders shall be rounded.
- M6-1 and M6-2 Background - White - Type H Reflective
(Detour or temporary Signs - Reflective)
Message - Black
MB6-1 and MB6-2 Background - Blue
Message - White - Type H Reflective
(Detour or temporary Signs - Reflective)
MG6-1 and MG6-2 Background - Green
Message - White - Type H Reflective
MK6-1 and MK6-2 Background - Green
Message - White - Type H Reflective
MM6-1 and MM6-2 Background - White - Type H Reflective
Message - Green
MN6-1 and MN6-2 Background - Brown
Message - White - Type H Reflective
MO6-1 and MO6-2 Background - Orange - Reflective
Message - Black
MR6-1 and MR6-2 Background - Brown
Message - Yellow - Type H Reflective

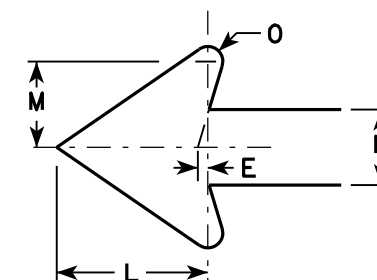

Metric equivalent
for this sign is:


SIZE	
1	
2	525 mm X 525 mm
3	750 mm X 750 mm
4	750 mm X 750 mm
5	750 mm X 750 mm

SIZE	A	B	C	D	E	F	G	H	I	J	K	L	M	N	O	P	Q	R	S	T	U	V	W	X	Y	Z	Area sq. ft.	Area m2
1																												
2	21		1 1/8	3/8	3/8		7 1/2	7 1/8	5 5/8	5	4 1/4	5 1/4	3	2 5/8	1/2						1 1/2	1/2					3.06	0.28
3	30		1 3/8	1/2	5/8		10 3/4	10 1/4	8	7 1/4	6	7 1/2	4 1/4	3 3/4	3/4						1 7/8	1/2					6.25	0.56
4	30		1 3/8	1/2	5/8		10 3/4	10 1/4	8	7 1/4	6	7 1/2	4 1/4	3 3/4	3/4						1 7/8	1/2					6.25	0.56
5	30		1 3/8	1/2	5/8		10 3/4	10 1/4	8	7 1/4	6	7 1/2	4 1/4	3 3/4	3/4						1 7/8	1/2					6.25	0.56


PROJECT NO: HWY: COUNTY: SHEET NO: 173 E

STANDARD SIGN M6-1 & M6-2 SERIES


WISCONSIN DEPT OF TRANSPORTATION
APPROVED *Matthew R. Rauch*
for State Traffic Engineer
DATE 3/16/10 PLATE NO. M6-1.12

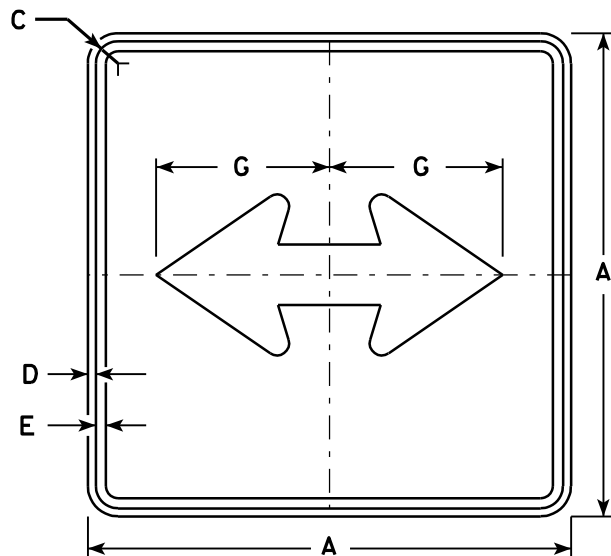


M6 - 4
MK6 - 4
MM6 - 4
MO6 - 4
MR6 - 4

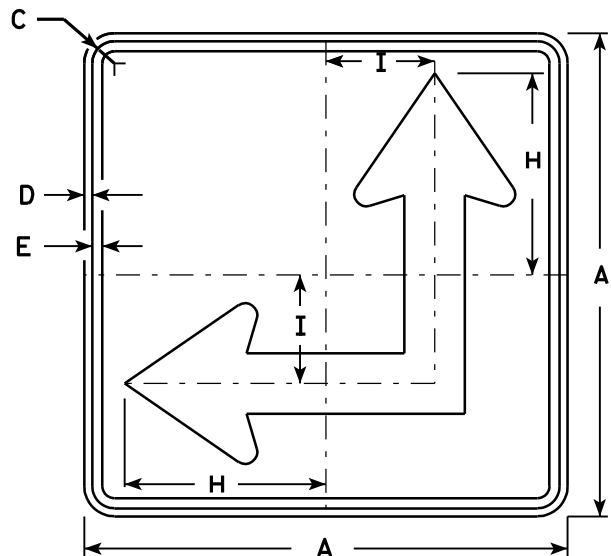

M6 - 6
MK6 - 6
MM6 - 6
MO6 - 6
MR6 - 6

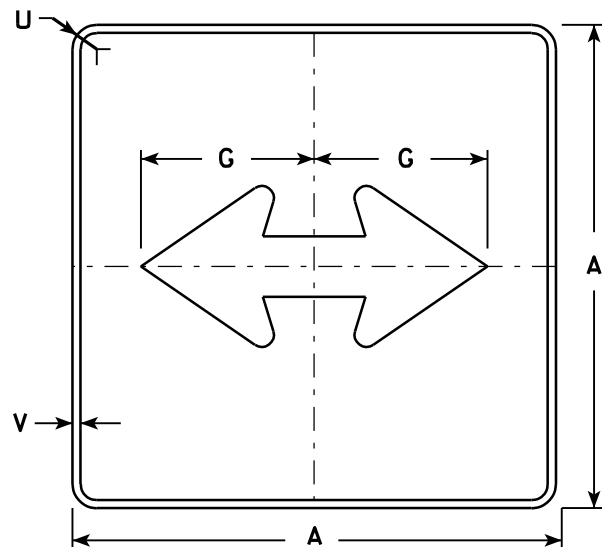


MB6 - 4
MG6 - 4
MN6 - 4

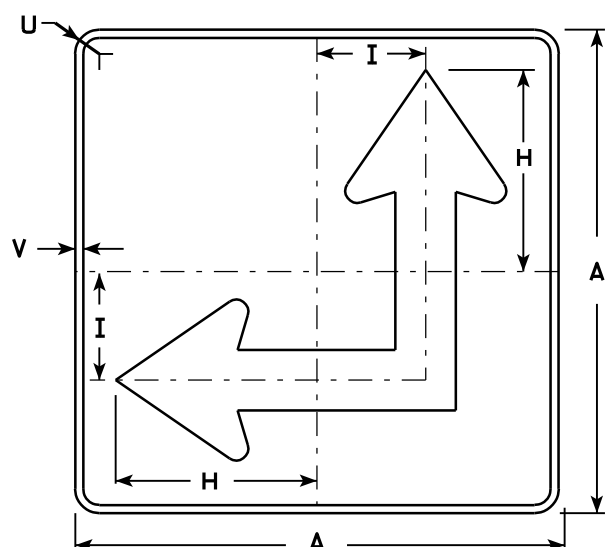

MB6 - 6
MG6 - 6
MN6 - 6

NOTES

- Signs are Type II - See Note 4 - reference WIS DOT Standard Specification for HIGHWAY and STRUCTURE CONSTRUCTION latest edition.
- Color:
Background - See Note 4
Message - See Note 4
- Corners may be square or rounded when base material is plywood but borders shall be rounded as shown. When base material is metal, the corners and borders shall be rounded.
- M6-4 and M6-6 Background - White - Type H Reflective
(Detour or temporary Signs - Reflective)
Message - Black
MB6-4 and MB6-6 Background - Blue
Message - White - Type H Reflective
(Detour or temporary Signs - Reflective)
MG6-4 and MG6-6 Background - Green
Message - White - Type H Reflective
MK6-4 and MK6-6 Background - Green
Message - White - Type H Reflective
MM6-4 and MM6-6 Background - White - Type H Reflective
Message - Green
MN6-4 and MN6-6 Background - Brown
Message - White - Type H Reflective
MO6-4 and MO6-6 Background - Orange - Reflective
Message - Black
MR6-4 and MR6-6 Background - Brown
Message - Yellow - Type H Reflective
- M6-6R same as M6-6L except arrow points ahead and right.

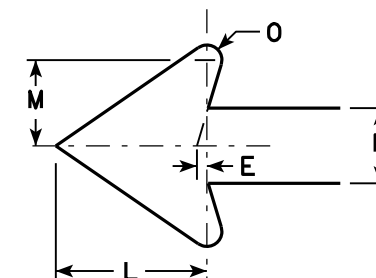

Metric equivalent
for this sign is:

SIZE	
1	
2	525 mm X 525 mm
3	750 mm X 750 mm
4	750 mm X 750 mm
5	750 mm X 750 mm

SIZE	A	B	C	D	E	F	G	H	I	J	K	L	M	N	O	P	Q	R	S	T	U	V	W	X	Y	Z	Area sq. ft.	Area m ²
1																												
2	21		1 1/8	3/8	3/8		7 1/2	8 3/4	4 1/4			5 1/4	3	2 5/8	1/2						1 1/2	1/2					3.06	0.28
3	30		1 3/8	1/2	5/8		10 3/4	12 1/2	6 3/4			7 1/2	4 1/4	3 3/4	3/4						1 7/8	1/2					6.25	0.56
4	30		1 3/8	1/2	5/8		10 3/4	12 1/2	6 3/4			7 1/2	4 1/4	3 3/4	3/4						1 7/8	1/2					6.25	0.56
5	30		1 3/8	1/2	5/8		10 3/4	12 1/2	6 3/4			7 1/2	4 1/4	3 3/4	3/4						1 7/8	1/2					6.25	0.56

PROJECT NO:	HWY:	COUNTY:		SHEET NO: 174	E
-------------	------	---------	--	---------------	---


STANDARD SIGN
M6 - 4 & M6 - 6
SERIES

WISCONSIN DEPT OF TRANSPORTATION

APPROVED *Matthew R. Rauch*
for State Traffic Engineer

DATE 3/16/10 PLATE NO. M6-4.7

7

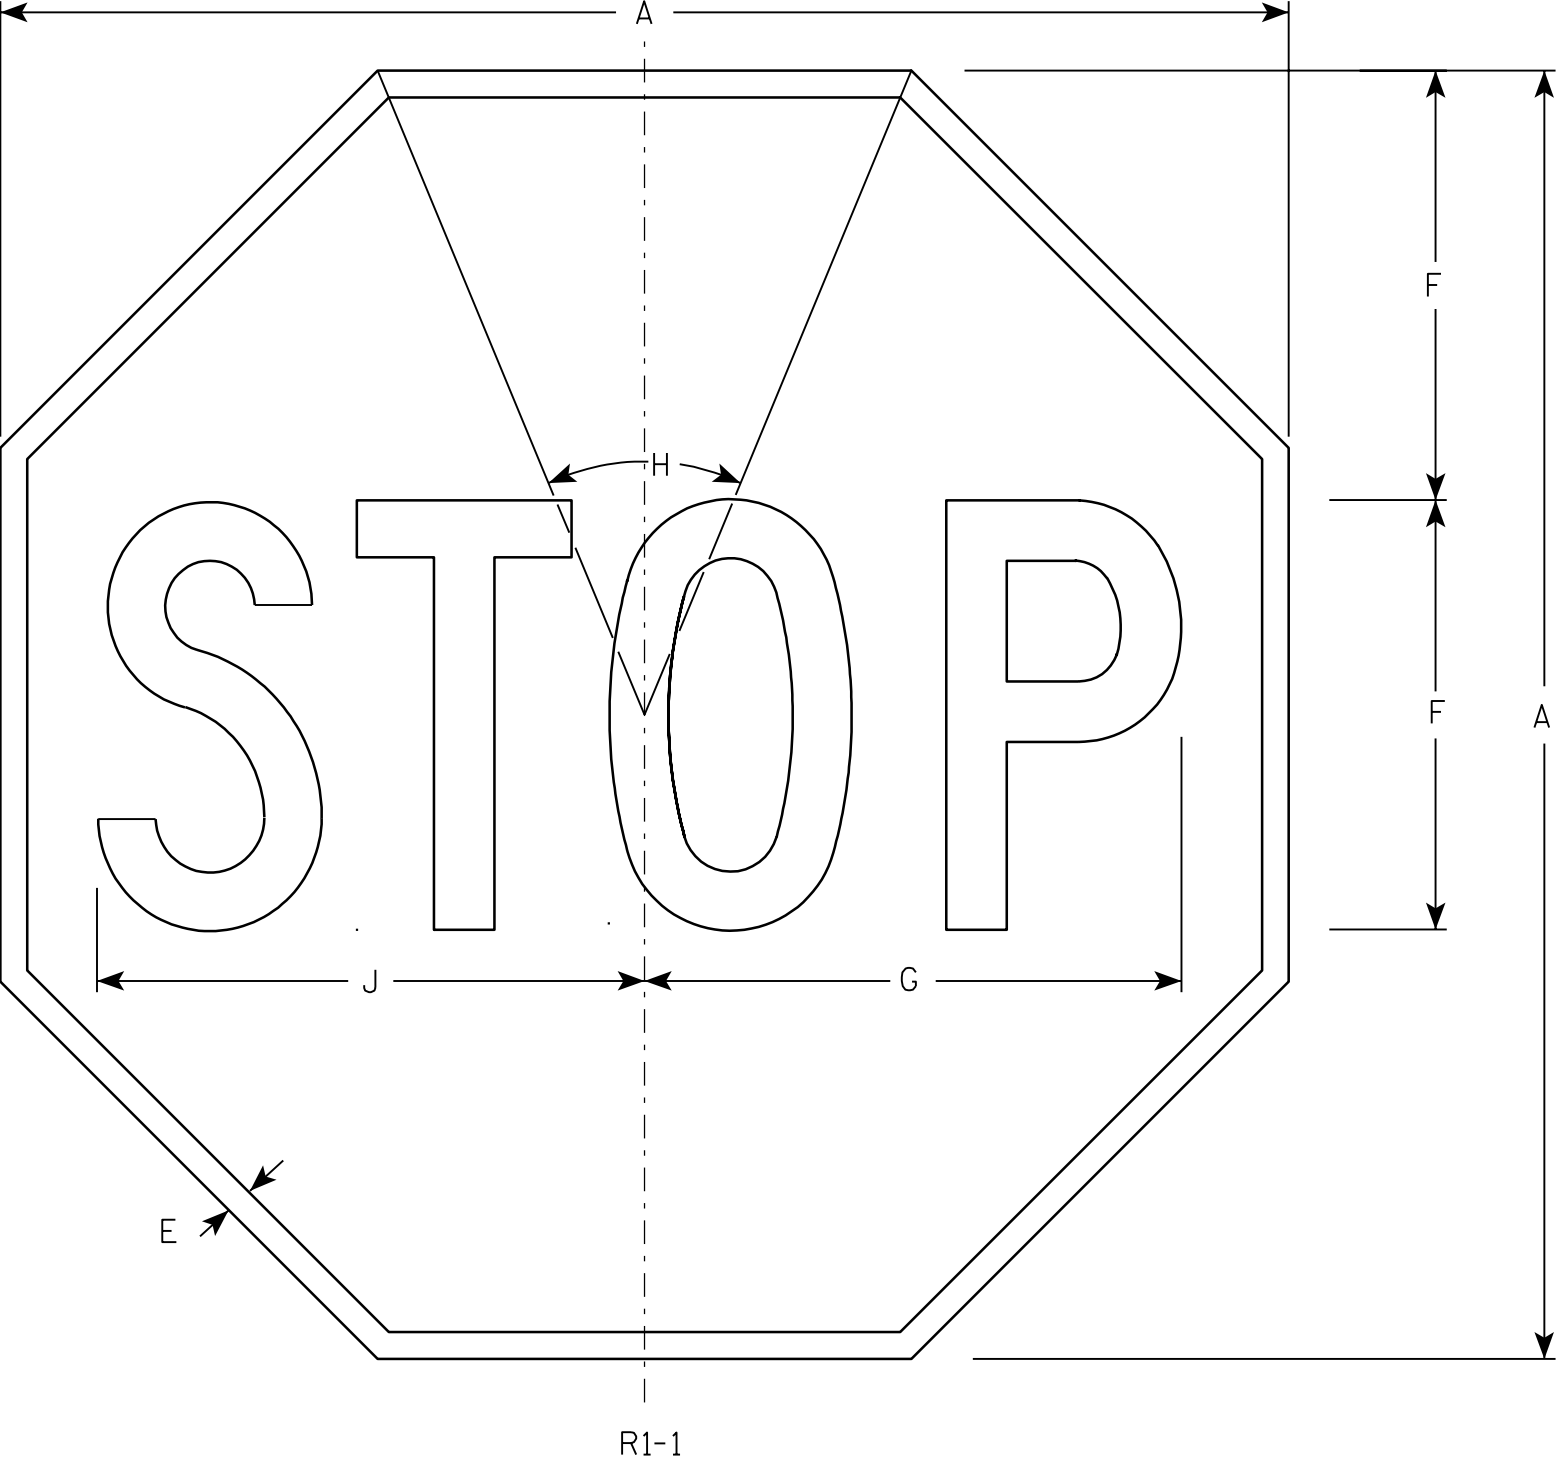

- NOTES
- 1. Sign is Type II - Type H Reflective - reference WIS DOT Standard Specification for HIGHWAY and STRUCTURE CONSTRUCTION latest edition.
 - 2. Color:
 - Background - Red
 - Message - White
 - 3. Message Series - C

Metric equivalent
for this sign is:

SIZE	
1	600 mm X 600 mm
2	750 mm X 750 mm
3	900 mm X 900 mm
4	1200 mm X 1200 mm
5	1200 mm X 1200 mm
6	450 mm X 450 mm
7	300 mm X 300 mm

SIZE	A	B	C	D	E	F	G	H	I	J	K	L	M	N	O	P	Q	R	S	T	U	V	W	X	Y	Z	Area sq. ft.	Area m ²
1	24				$\frac{3}{8}$	8	10	45°		10 $\frac{1}{4}$																	3.31	0.31
2	30				$\frac{5}{8}$	10	12 $\frac{1}{2}$	45°		12 $\frac{3}{4}$																	5.18	0.48
3	36				$\frac{3}{4}$	12	15	45°		15 $\frac{3}{8}$																	7.46	0.69
4	48				1	16	20	45°		20 $\frac{1}{2}$																	13.25	1.23
5	48				1	16	20	45°		20 $\frac{1}{2}$																	13.25	1.23
6	18				$\frac{3}{8}$	6	7 $\frac{3}{4}$	45°		7 $\frac{3}{4}$																	1.86	0.17
7	12				$\frac{1}{4}$	4	5	45°		5 $\frac{1}{8}$																	0.78	0.07

STANDARD SIGN
R1-1

WISCONSIN DEPT OF TRANSPORTATION

APPROVED

Chester J. Spang
for State Traffic Engineer

DATE 10/15/98

PLATE NO. R1-1.11

PROJECT NO:

HWY:

COUNTY:


SHEET NO: 175

E

7


NOTES

1. Sign is Type II - Type H Reflective - reference WIS DOT Standard Specification for HIGHWAY and STRUCTURE CONSTRUCTION latest edition.
2. Color:
Background - Red
Message - White
3. Message Series - C
4. Corners may be square or rounded when base material is plywood but borders shall be rounded as shown. When base material is metal, the corners and borders shall be rounded.

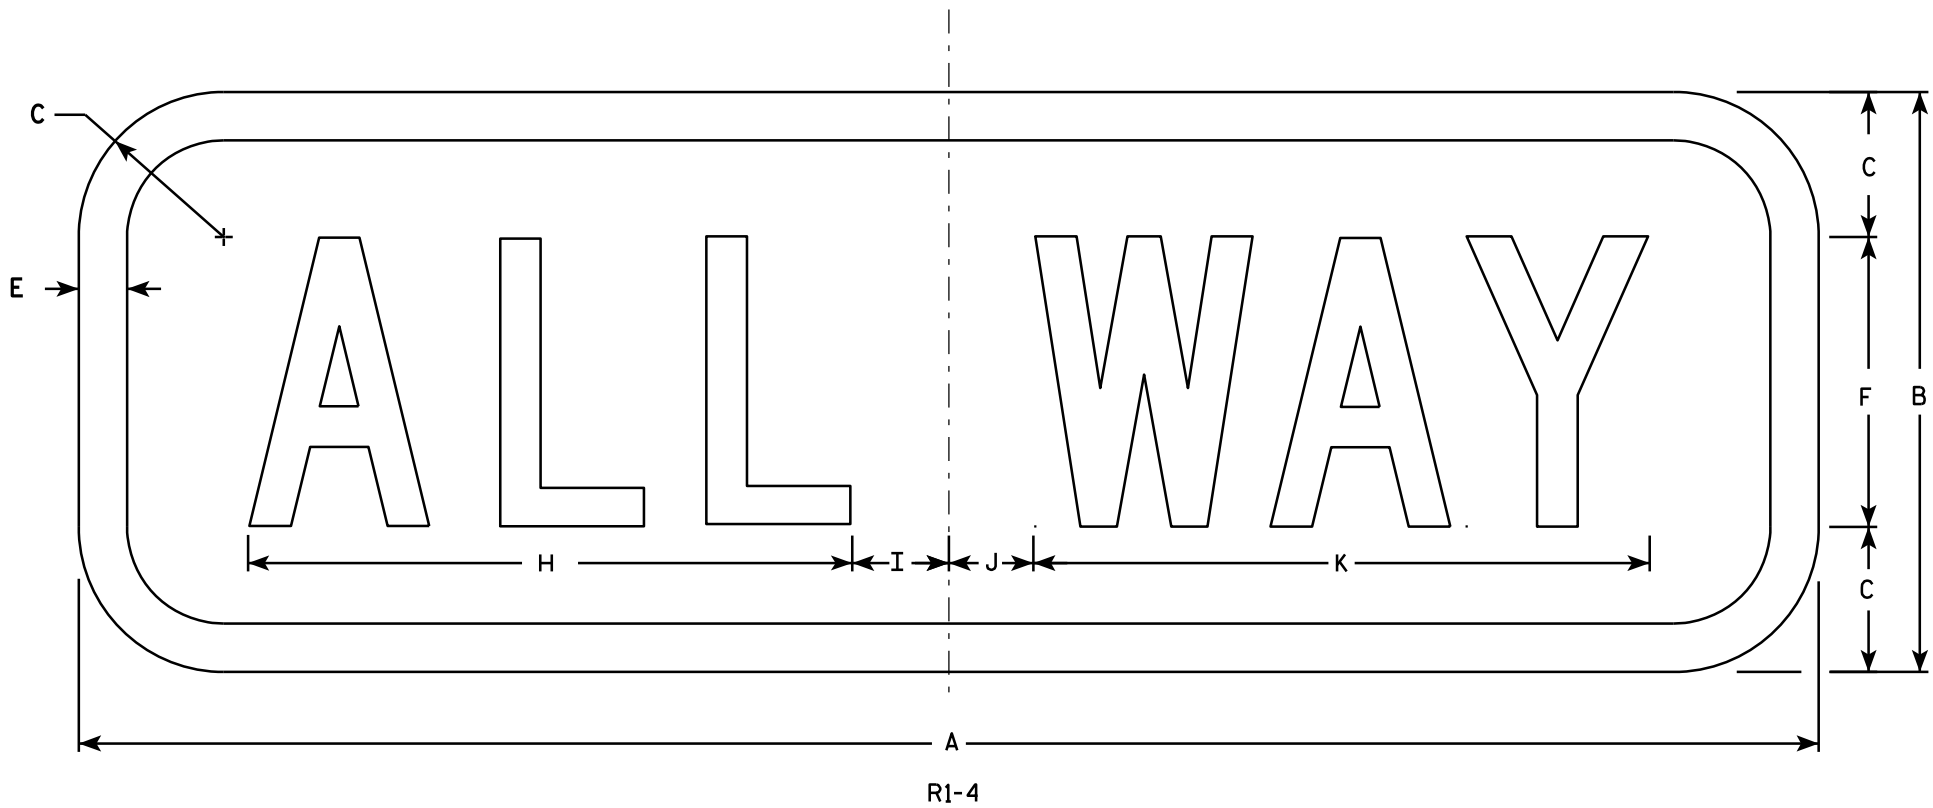

SIZE	A	B	C	D	E	F	G	H	I	J	K	L	M	N	O	P	Q	R	S	T	U	V	W	X	Y	Z	Area sq. ft.
1	18	6	1 1/2		1/2	3		6 1/4	1 1/4	7/8	6 3/8																0.75
2S	24	9	1 1/2		1/2	5		9 1/4	1 1/4	3/4	9 3/4																1.5
2M	24	9	1 1/2		1/2	5		9 1/4	1 1/4	3/4	9 3/4																1.5
3	24	9	1 1/2		1/2	5		9 1/4	1 1/4	3/4	9 3/4																1.5
4																											
5																											

STANDARD SIGN R1 - 4	
WISCONSIN DEPT OF TRANSPORTATION	
APPROVED	<i>Matthew R. Rauch</i> for State Traffic Engineer
DATE 8/3/10	PLATE NO. R1-4.5

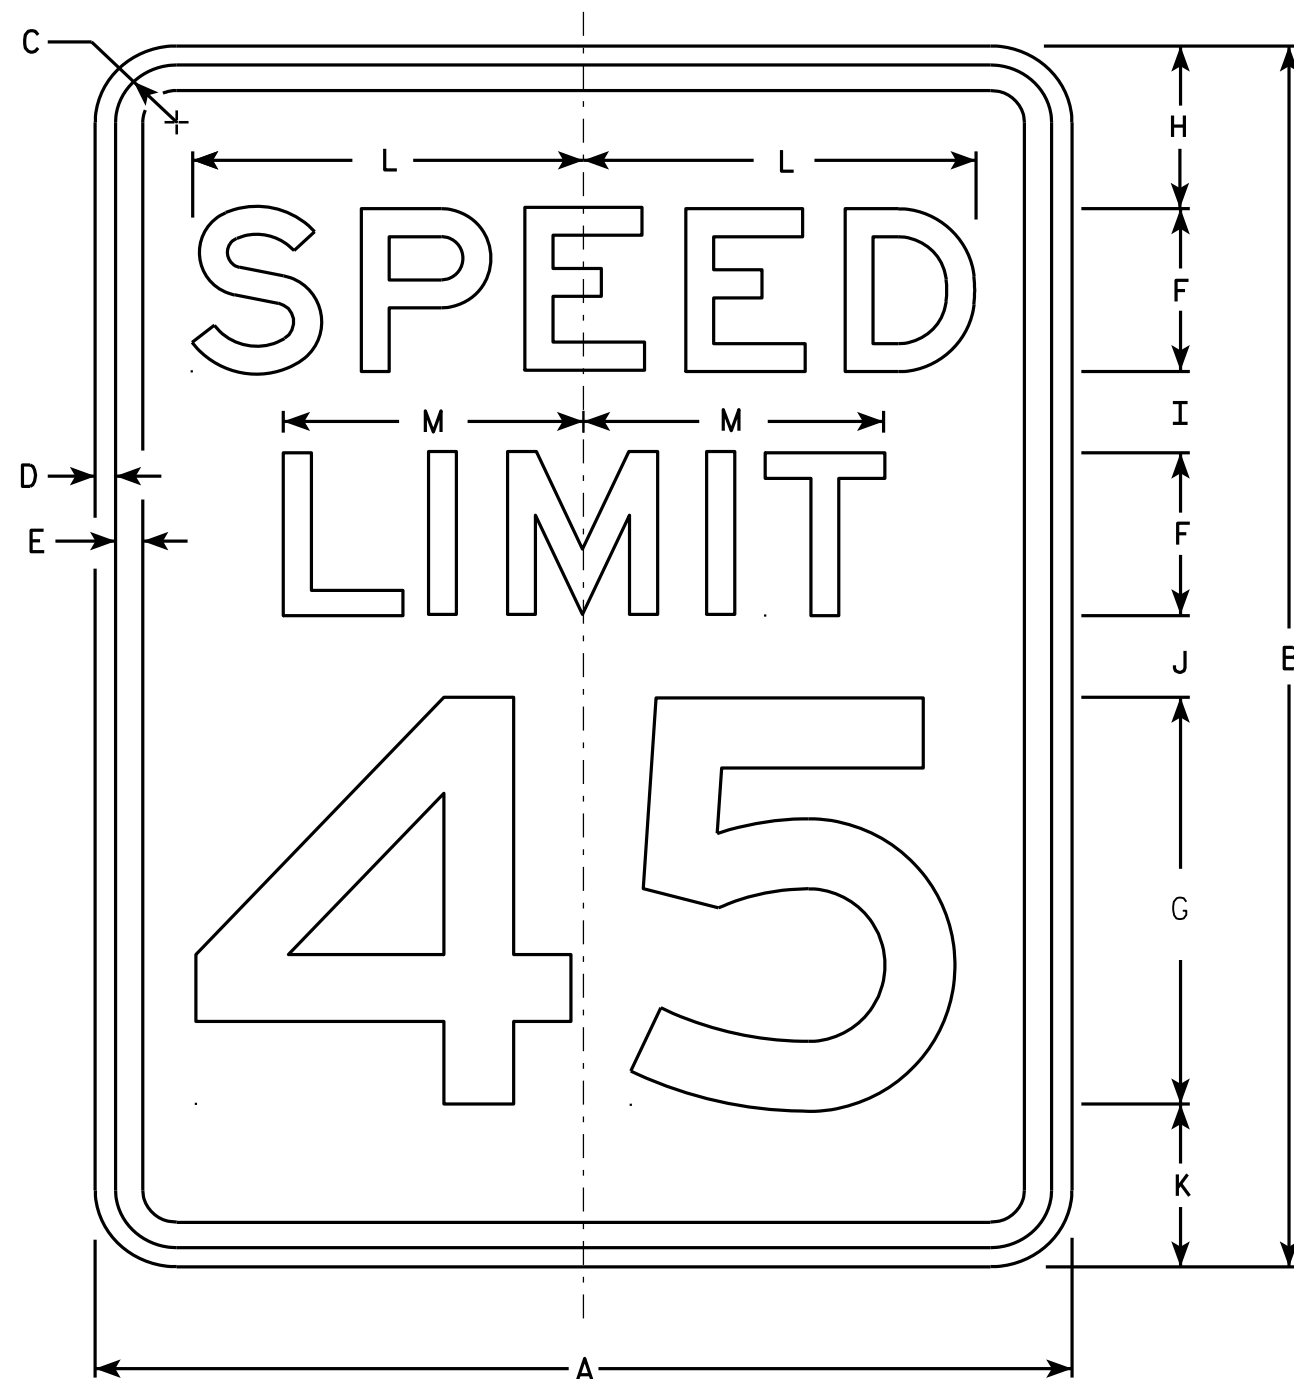

NOTES

1. Sign is Type II - Type H Reflective - reference WIS DOT Standard Specification for HIGHWAY and STRUCTURE CONSTRUCTION latest edition.
2. Color:
Background - White
Message - Black
3. Message Series - E
4. Corners may be square or rounded when base material is plywood but borders shall be rounded as shown. When base material is metal, the corners and borders shall be rounded.
5. Substitute appropriate numerals and optically adjust spacing to achieve proper balance.

R2-1

SIZE	A	B	C	D	E	F	G	H	I	J	K	L	M	N	O	P	Q	R	S	T	U	V	W	X	Y	Z	Area sq. ft.
1	18	24	1 1/8	3/8	1/2	3	8	3	2	2	3	7 1/4	5 1/2														3.0
2S	24	30	1 1/8	3/8	1/2	4	10	3	2 1/4	3 3/8	3 3/8	9 5/8	7 3/8														5.0
2M	30	36	1 3/8	1/2	5/8	5	12	5	2 1/2	2 1/2	4	12	9 1/4														7.5
3	36	48	1 3/8	1/2	5/8	6	14	6	5	5	6	14 3/8	11														12.0
4	36	48	1 3/8	1/2	5/8	6	14	6	5	5	6	14 3/8	11														12.0
5	48	60	2 1/4	3/4	1	8	20	6	4 1/2	6 3/4	6 3/4	19 1/4	14 5/8														20.0

STANDARD SIGN
R2-1

WISCONSIN DEPT OF TRANSPORTATION

APPROVED *Matthew R. Rauch*
For State Traffic Engineer

DATE 5/26/10 PLATE NO. R2-1.13

PROJECT NO:

HWY:

COUNTY:

SHEET NO: 177

E

7

Metric equivalent
for this sign is:

SIZE	
1	
2	600 mm X 900 mm
3	900 mm X 1200 mm
4	
5	

SIZE	A	B	C	D	E	F	G	H	I	J	K	L	M	N	O	P	Q	R	S	T	U	V	W	X	Y	Z	Area sq. ft.	Area m ²
1																												
2	24	36	$\frac{3}{8}$	$\frac{1}{2}$	2 $\frac{1}{2}$	3	1 $\frac{1}{2}$	16		1 $\frac{1}{2}$	8 $\frac{1}{2}$	5 $\frac{3}{4}$	8	2 $\frac{1}{2}$		6	2	5 $\frac{1}{8}$	1 $\frac{1}{2}$		2 $\frac{3}{8}$	4 $\frac{3}{8}$	$\frac{3}{8}$				6.0	0.54
3	36	48	$\frac{5}{8}$	$\frac{7}{8}$	3 $\frac{1}{2}$	5	1 $\frac{1}{2}$	20		2 $\frac{1}{4}$	14 $\frac{1}{8}$	9 $\frac{1}{2}$	12	3		4	3	9 $\frac{7}{8}$	2		3 $\frac{1}{2}$	6 $\frac{1}{8}$	$\frac{1}{2}$				12.0	1.08
4																												
5																												


PROJECT NO:

HWY:

COUNTY:

SHEET NO: 178

E

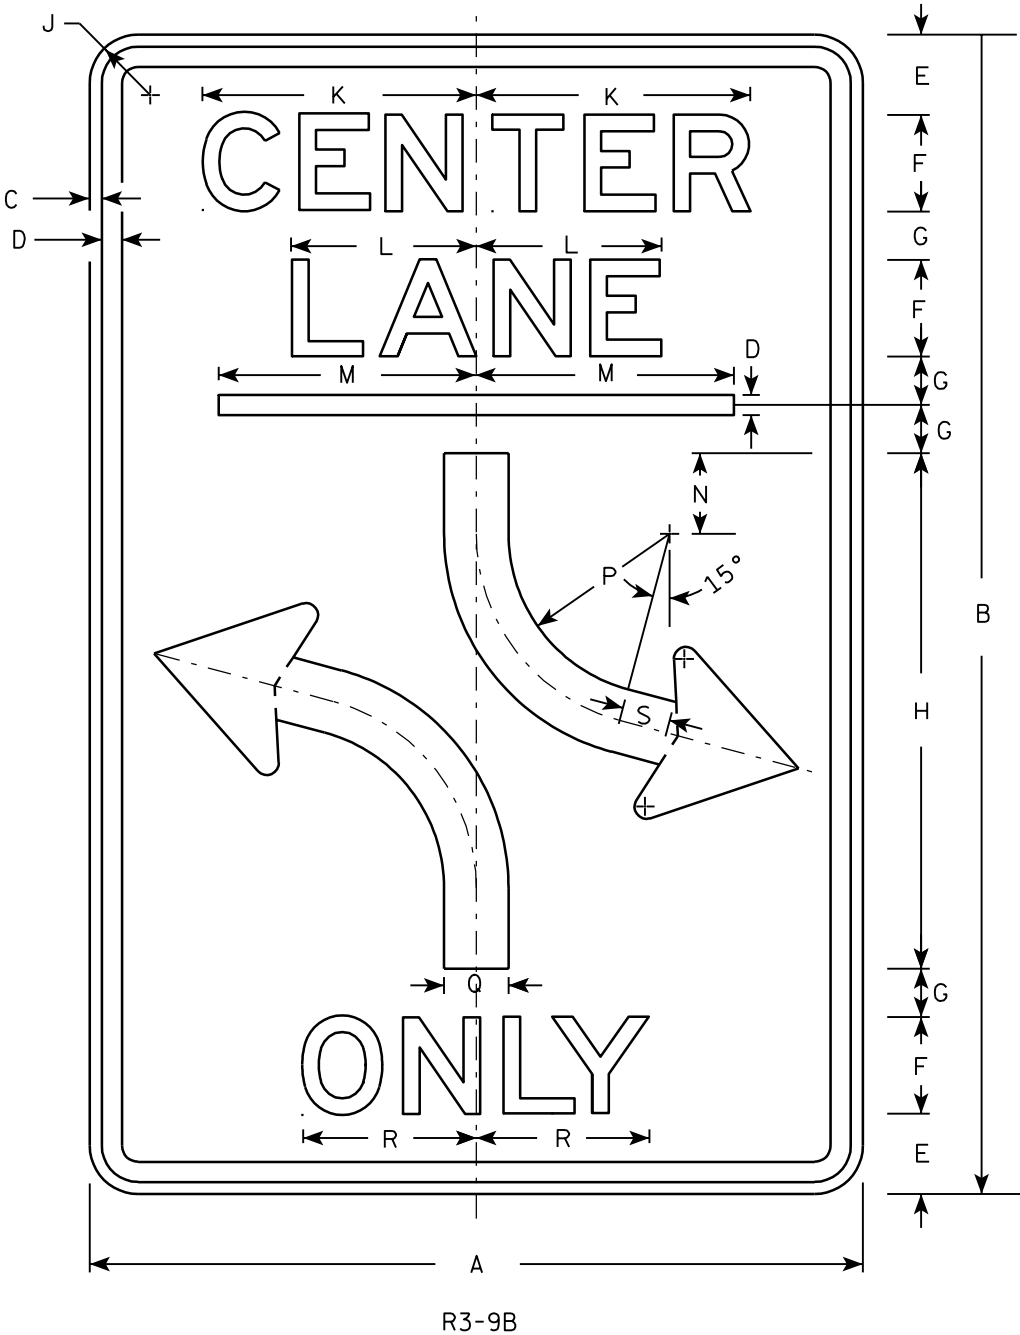

ARROW DETAIL

NOTES



1. Sign is Type II - Type H Reflective - reference WIS DOT Standard Specification for HIGHWAY and STRUCTURE CONSTRUCTION latest edition.
2. Color:
Background - White
Message - Black
3. Message Series - E
4. Corners may be square or rounded when base material is plywood but borders shall be rounded as shown. When base material is metal, the corners and borders shall be rounded.

STANDARD SIGN
R3-9B

WISCONSIN DEPT OF TRANSPORTATION

APPROVED
Charles J. Spang
for State Traffic Engineer

DATE 2/05/02
PLATE NO. R3-9B.4

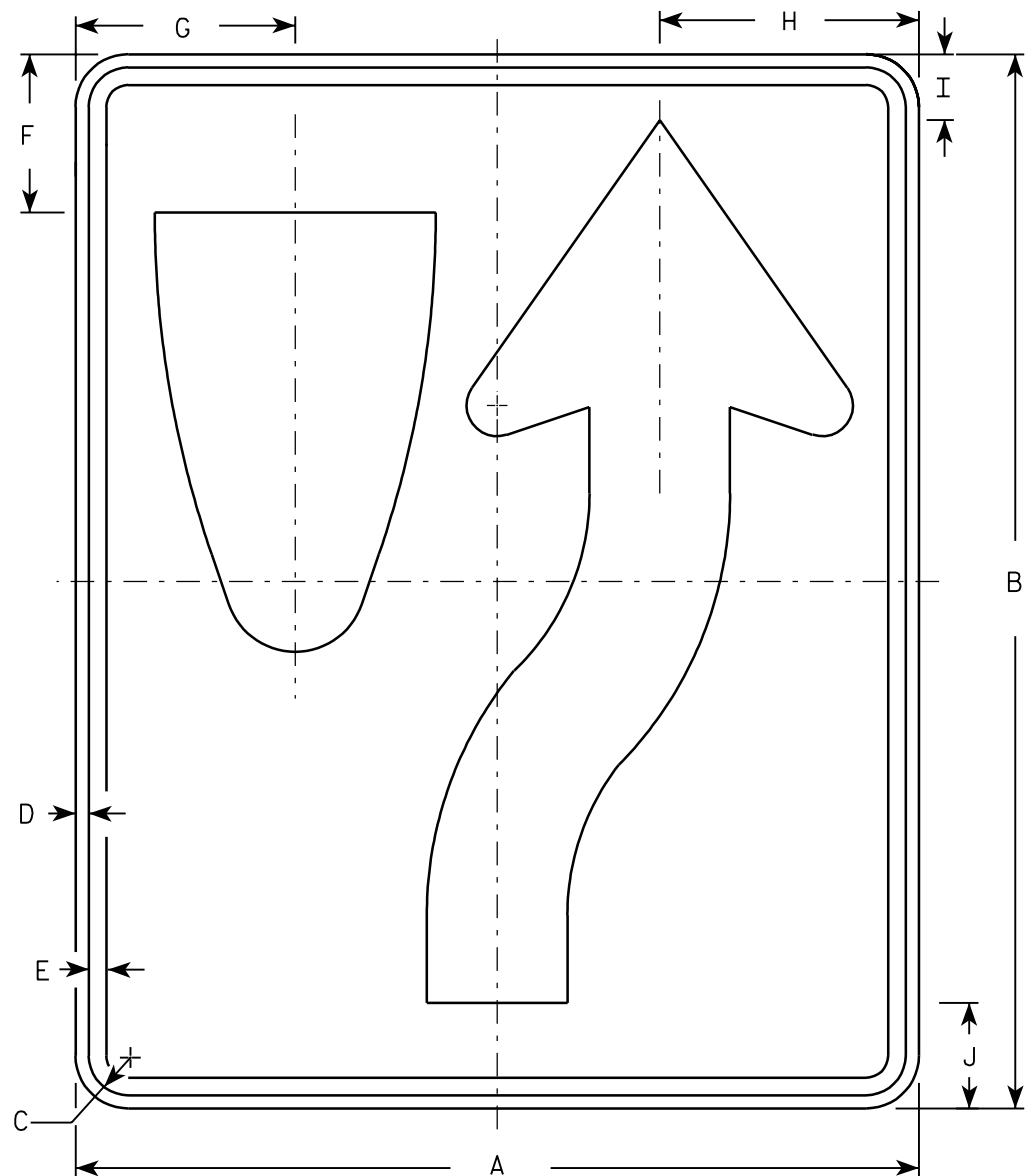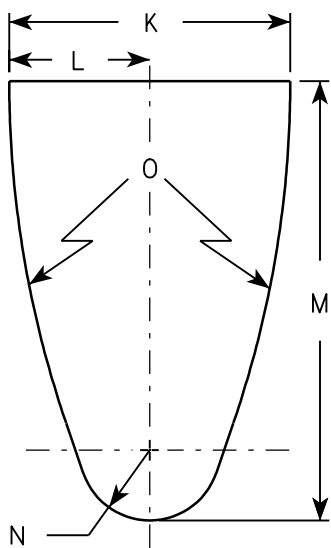

R4-7


Metric equivalent
for this sign is:

SIZE	
1	450 mm X 600 mm
2	600 mm X 750 mm
3	900 mm X 1200 mm
4	900 mm X 1200 mm
5	900 mm X 1200 mm

SIZE	A	B	C	D	E	F	G	H	I	J	K	L	M	N	O	P	Q	R	S	T	U	V	W	X	Y	Z	Area sq. ft.	Area m ²
1	18	24	1 1/8	3/8	1/2	3 3/8	4 3/4	5 1/2	1 3/8	2 1/4	6	3	9 3/8	1 1/2	22 1/2	3 1/2	6 1/8	5/8	1 7/8	3 1/4	6 3/4	1/2	20 3/8				3.0	.27
2	24	30	1 1/8	3/8	1/2	4 1/2	6 1/4	7 3/8	1 7/8	3	8	4	12 1/2	2	30	4 5/8	8 1/8	7/8	2 1/2	4 3/8	9	5/8	25 1/8				5.0	.45
3	36	48	1 3/4	1/2	5/8	6 3/4	9 3/8	11 1/8	2 7/8	4 1/2	12	6	18 3/4	3	45	6 7/8	12 1/4	1 1/4	3 3/4	6 5/8	13 1/2	1	40 3/4				12.0	1.08
4	36	48	1 3/4	1/2	5/8	6 3/4	9 3/8	11 1/8	2 7/8	4 1/2	12	6	18 3/4	3	45	6 7/8	12 1/4	1 1/4	3 3/4	6 5/8	13 1/2	1	40 3/4				12.0	1.08
5	48	60	2 1/4	3/4	1	9	12 1/2	14 3/4	3 3/4	6	16	8	25	4	60	9 1/4	16 1/4	1 5/8	5	8 3/4	18	1 1/4	50 1/4				20.0	1.08

NOTES

1. Sign is Type II - Type H Reflective - reference WIS DOT Standard Specification for HIGHWAY and STRUCTURE CONSTRUCTION latest edition. material is plywood but borders shall be rounded
2. Color:
Background - White
Message - Black
3. Corners may be square or rounded when base as shown. When base material is metal, the corners and borders shall be rounded.
4. R4-8 is the same as R4-7 except Legend is reversed.

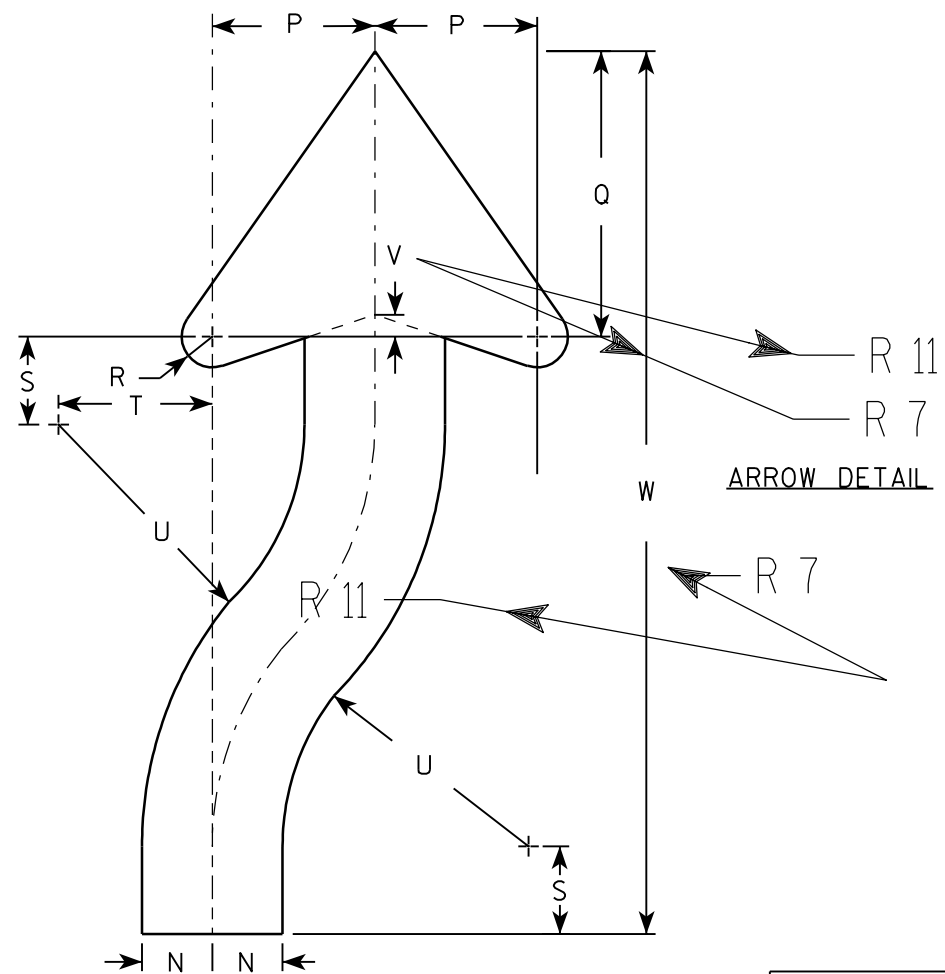

STANDARD SIGN
R4-7 & R4-8

WISCONSIN DEPT OF TRANSPORTATION

APPROVED

Christen J. Spang
for State Traffic Engineer


DATE 2/6/02 PLATE NO. R4-7.7

NOTES

1. Sign is Type II - Type H Reflective - reference WIS DOT Standard Specification for HIGHWAY and STRUCTURE CONSTRUCTION latest edition.
2. Color:

Background - See detail

Message - White - Type H Reflective
3. Message Series - D
4. Corners may be square or rounded when base material is plywood but when base material is metal, the corners shall be rounded.

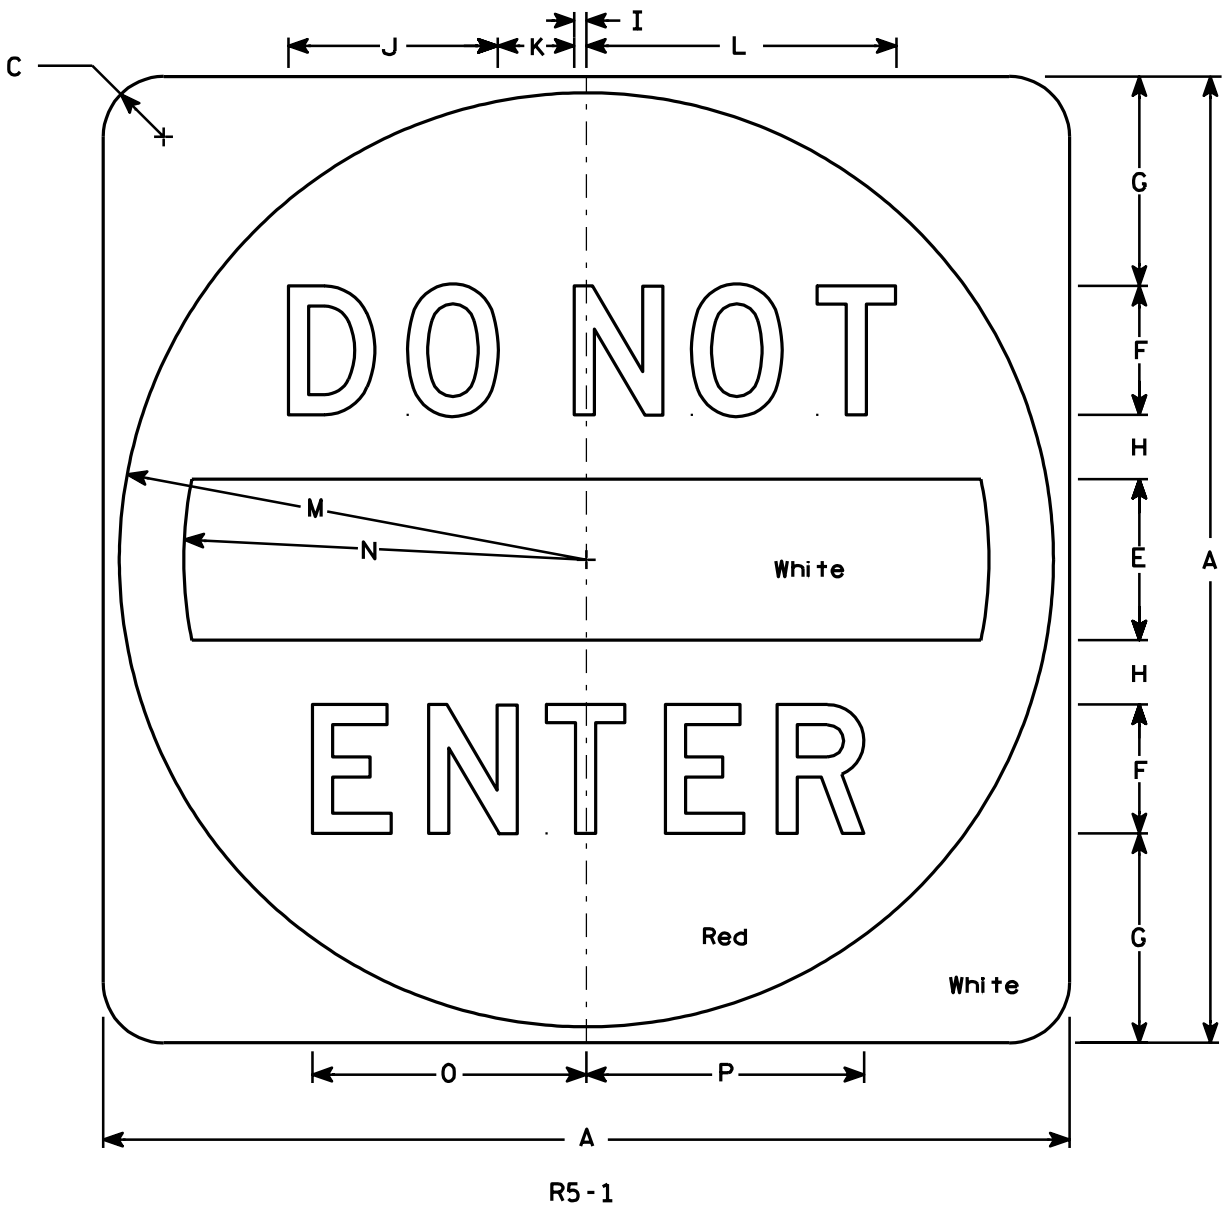

Metric equivalent
for this sign is:

SIZE	
1	
2	750 mm X 750 mm
3	900 mm X 900 mm
4	900 mm X 900 mm
5	1200 mm X 1200 mm

SIZE	A	B	C	D	E	F	G	H	I	J	K	L	M	N	O	P	Q	R	S	T	U	V	W	X	Y	Z	Area sq. ft.	Area m ²
1																												
2	30		1 7⁄8		5	4	6 1⁄2	2	3⁄8	6 1⁄2	2 3⁄8	9 5⁄8	14 1⁄2	12 1⁄2	8 1⁄2	8 5⁄8											6.26	0.56
3	36		2 1⁄4		6	5	7 1⁄2	2 1⁄2	1⁄2	8 1⁄8	3	12 1⁄8	17 1⁄2	15	10 5⁄8	10 3⁄4											9.0	0.81
4	36		2 1⁄4		6	5	7 1⁄2	2 1⁄2	1⁄2	8 1⁄8	3	12 1⁄8	17 1⁄2	15	10 5⁄8	10 3⁄4											9.0	0.81
5	48		3		8	6	11	3	5⁄8	9 3⁄4	3 5⁄8	14 1⁄2	23 1⁄2	20	12 3⁄4	12 7⁄8											16.0	1.44

STANDARD SIGN
R5 - 1

WISCONSIN DEPT OF TRANSPORTATION

APPROVED *Matthew R. Rauch*
For State Traffic Engineer

DATE 7/05/05 PLATE NO. R5-1.14


PROJECT NO:

HWY:

COUNTY:

SHEET NO: 180

E

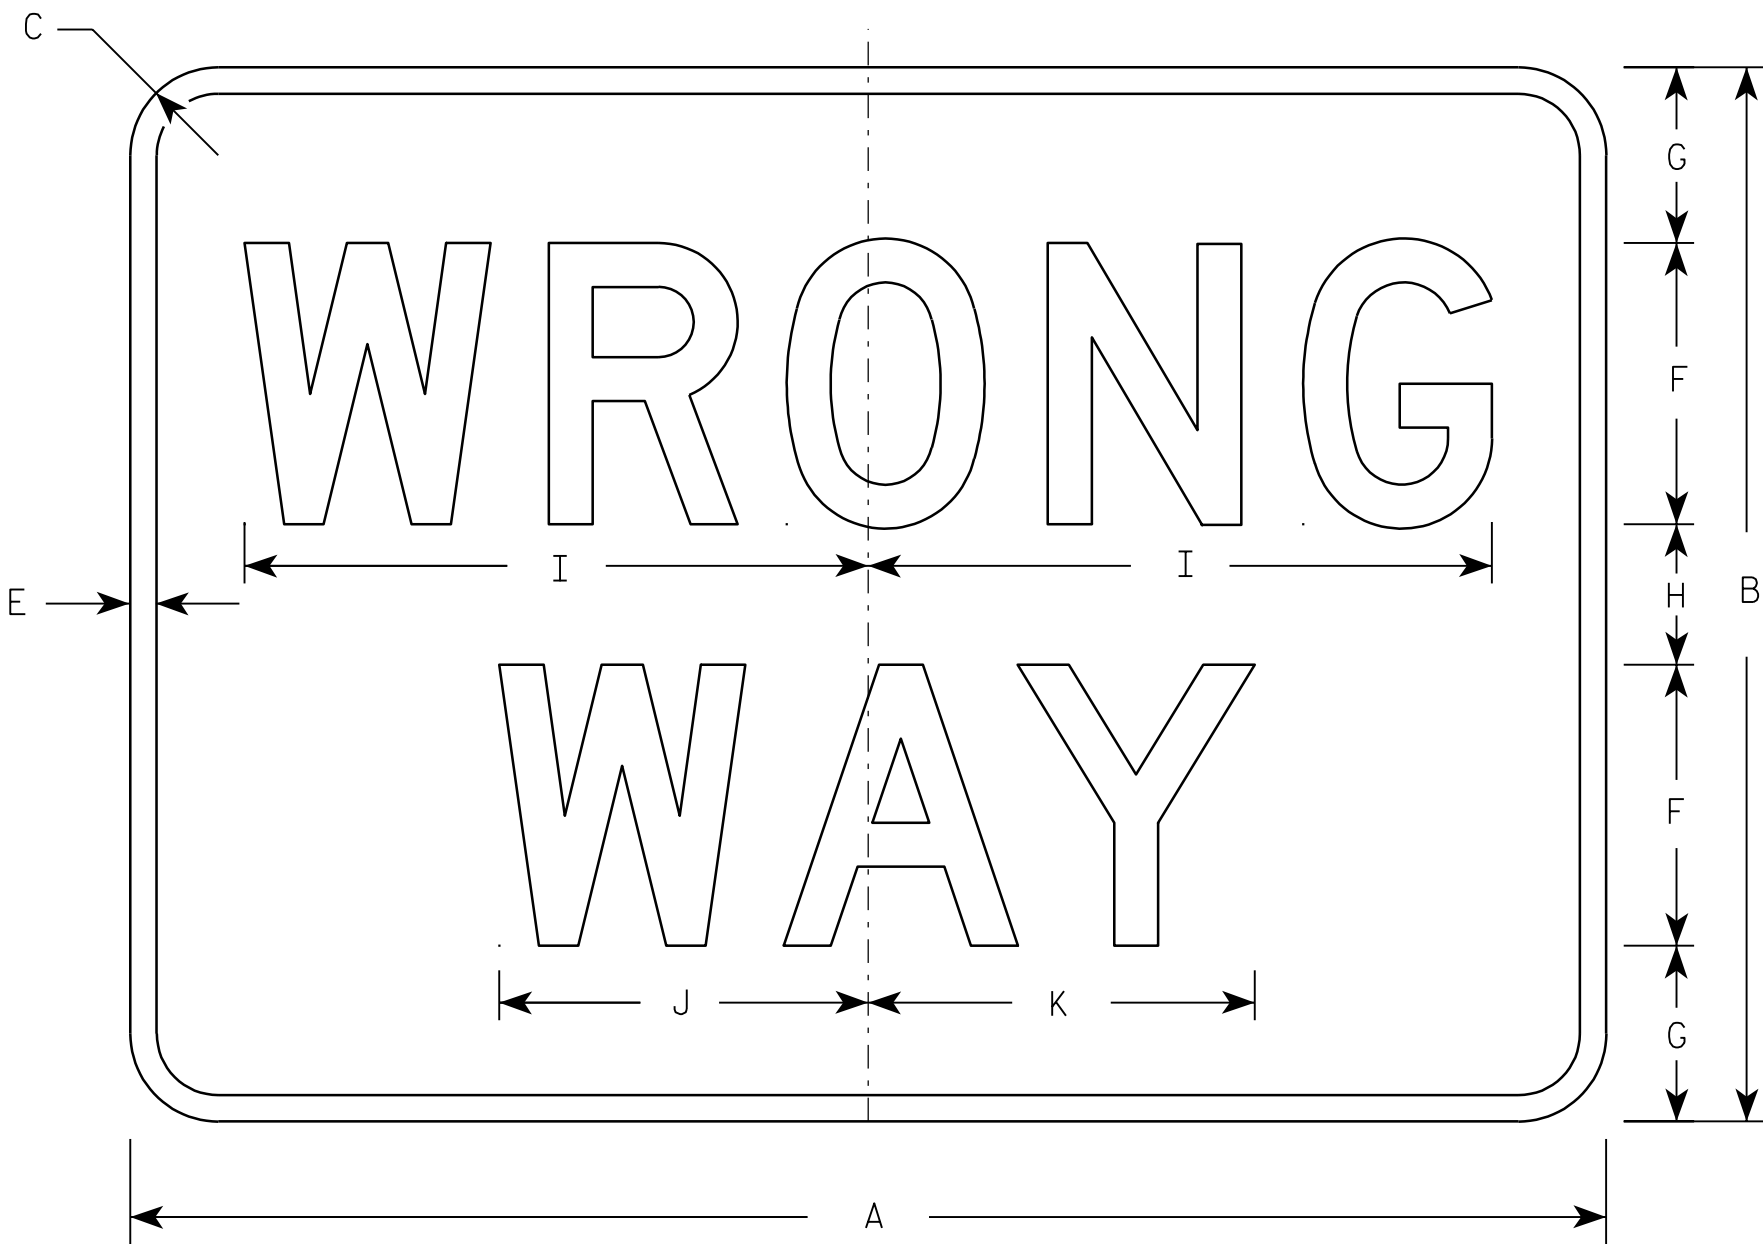

NOTES

1. Sign is Type II - Type H Reflective - reference WIS DOT Standard Specification for HIGHWAY and STRUCTURE CONSTRUCTION latest edition.
2. Color:
Background - Red
Message - White
3. Message Series - D
4. Corners may be square or rounded when base material is plywood but borders shall be rounded as shown. When base material is metal, the corners and borders shall be rounded.

7

Metric equivalent
for this sign is:

SIZE	
1	750 mm X 450 mm
2	900 mm X 600 mm
3	1050 mm X 750 mm
4	1050 mm X 750 mm
5	1050 mm X 750 mm

SIZE	A	B	C	D	E	F	G	H	I	J	K	L	M	N	O	P	Q	R	S	T	U	V	W	X	Y	Z	Area sq. ft.	Area m ²
1	30	18	1 1/2		1/2	5	3	2	11	6 1/2	6 7/8																3.75	0.34
2	36	24	2		5/8	6	4 1/2	3	13 1/4	7 7/8	8 1/4																6.00	0.54
3	42	30	2 1/2		3/4	8	5	4	17 3/4	10 1/2	11																8.75	0.79
4	42	30	2 1/2		3/4	8	5	4	17 3/4	10 1/2	11																8.75	0.79
5	42	30	2 1/2		3/4	8	5	4	17 3/4	10 1/2	11																8.75	0.79

R5-1A

STANDARD SIGN
R5-1A

WISCONSIN DEPT OF TRANSPORTATION

APPROVED
Matthew R. Rauch
for State Traffic Engineer

DATE 10/24/02 PLATE NO. R5-1A.1

PROJECT NO:

HWY:



COUNTY:

SHEET NO: 181

E

NOTES

1. Sign is Type II - Type H Reflective - reference
WIS DOT Standard Specification for HIGHWAY
and STRUCTURE CONSTRUCTION latest edition.
2. Color:
Background - Yellow
Message - Black
3. Corners may be square or rounded when base
material is plywood but borders shall be rounded
as shown. When base material is metal, the
corners and borders shall be rounded.
4. W1-2L is the same as W1-2R except the arrow is
reversed along the vertical centerline.

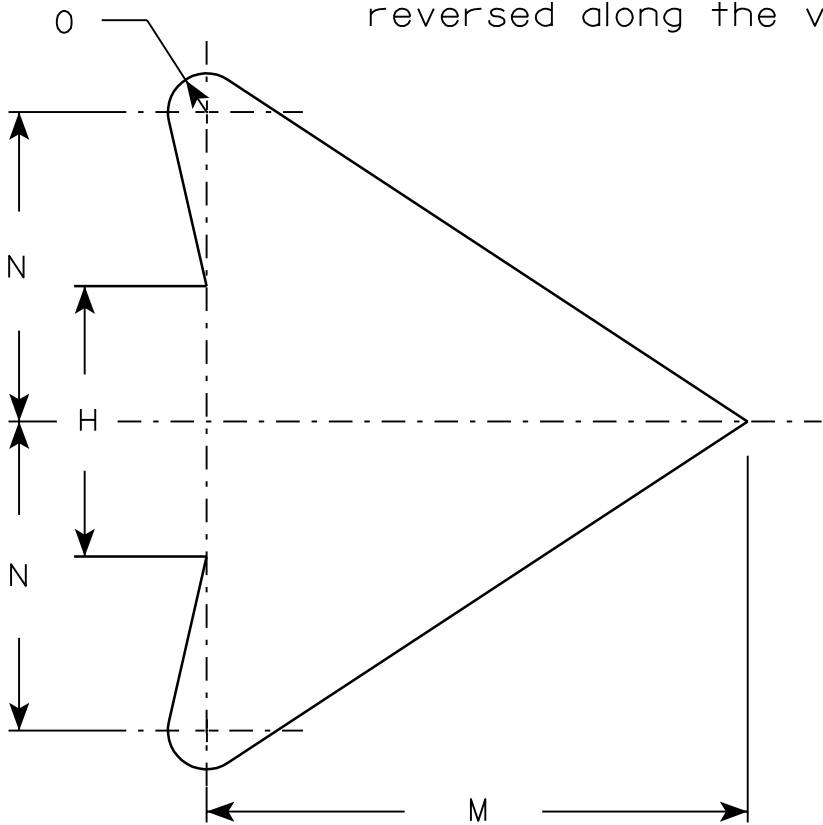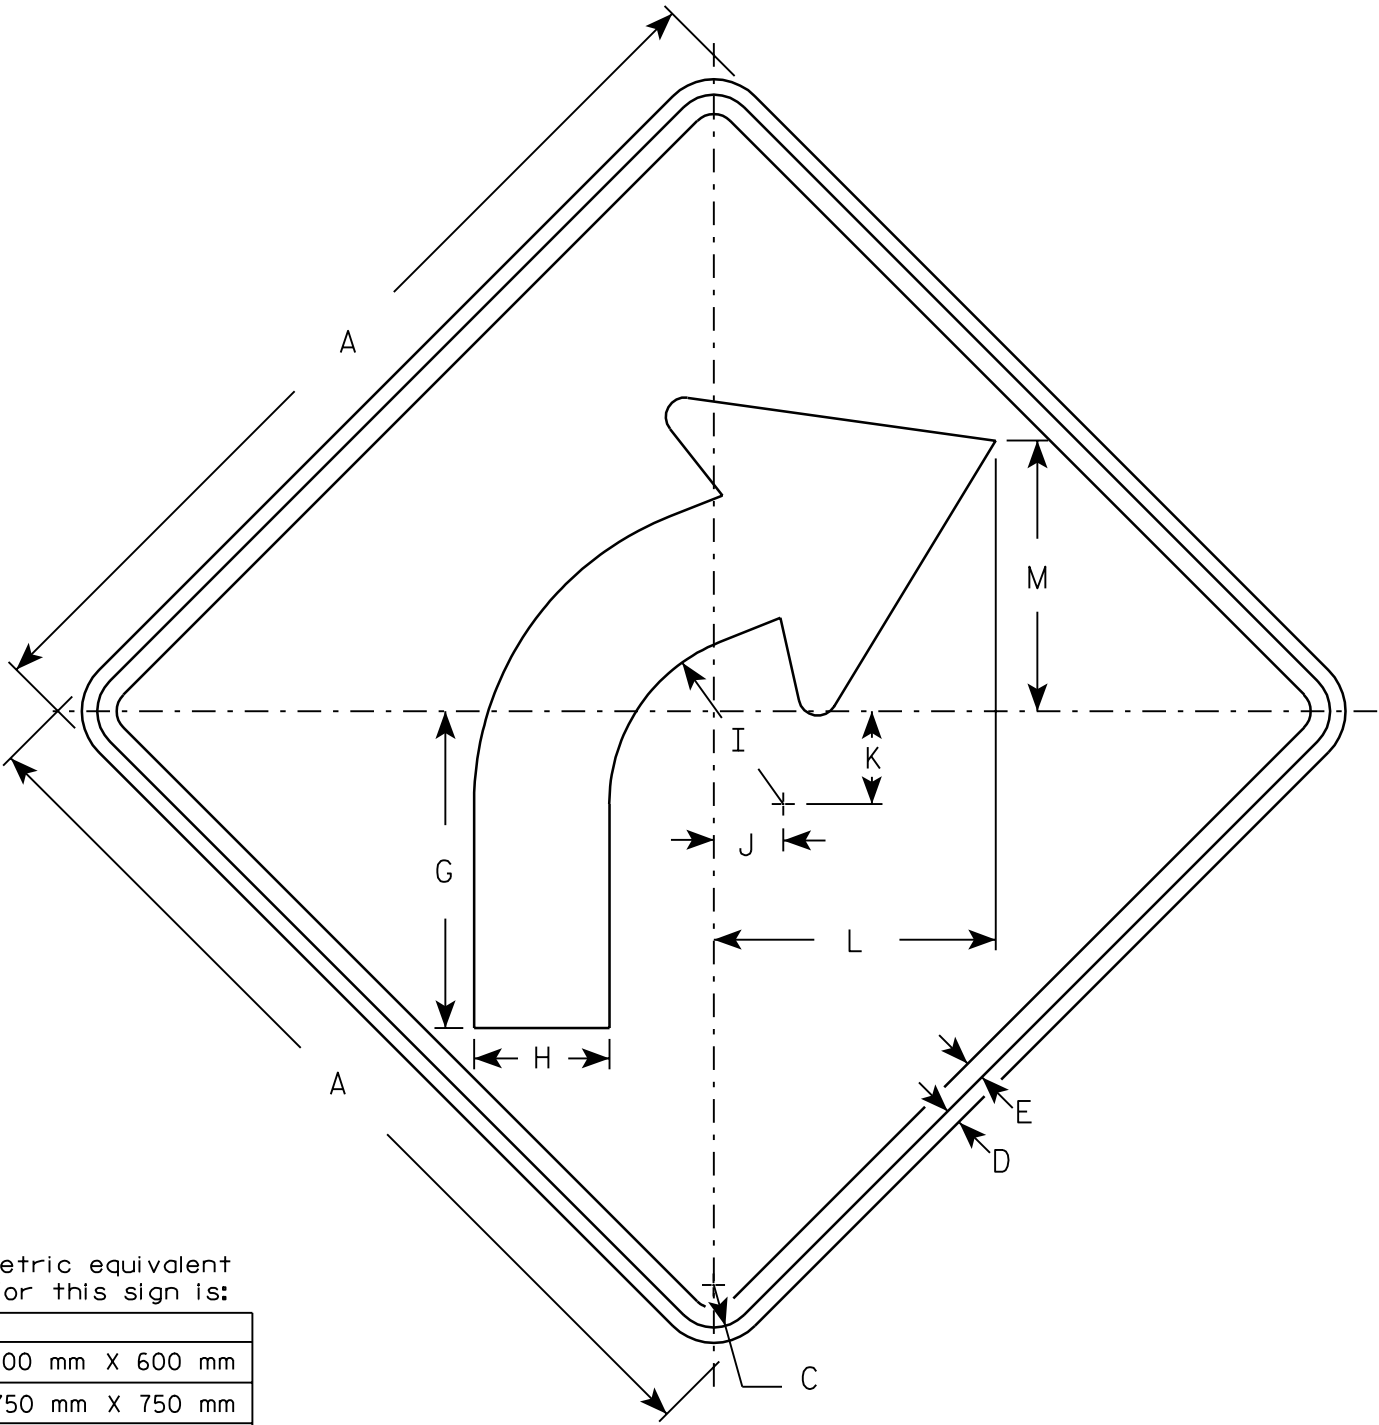

Metric equivalent
for this sign is:

SIZE	
1	600 mm X 600 mm
2	750 mm X 750 mm
3	900 mm X 900 mm
4	900 mm X 900 mm
5	1200 mm X 1200 mm

SIZE	A	B	C	D	E	F	G	H	I	J	K	L	M	N	O	P	Q	R	S	T	U	V	W	X	Y	Z	Area sq. ft.	Area m ²
1	24		1 1/8	3/8	1/2		8 1/4	3 1/2	4 1/2	1 3/4	2 3/8	7 1/4	7	4	1/2												4.0	0.36
2	30		1 3/8	1/2	5/8		10 1/4	4 3/8	5 5/8	2 1/4	3	9 1/8	8 3/4	5	5/8												6.25	0.56
3	36		1 5/8	5/8	3/4		12 3/8	5 1/4	6 3/4	2 5/8	3 1/2	10 7/8	10 1/2	6	3/4												9.0	0.81
4	36		1 5/8	5/8	3/4		12 3/8	5 1/4	6 3/4	2 5/8	3 1/2	10 7/8	10 1/2	6	3/4												9.0	0.81
5	48		2 1/4	3/4	1		16 1/2	7	9	3 1/2	4 5/8	14 1/2	14	8	1												16.0	1.44

STANDARD SIGN
W1-2

WISCONSIN DEPT OF TRANSPORTATION

APPROVED

Christa J. Spang
for State Traffic Engineer

DATE 01/14/02

PLATE NO. W1-2.8


PROJECT NO:

HWY:

COUNTY:


SHEET NO: 182

E

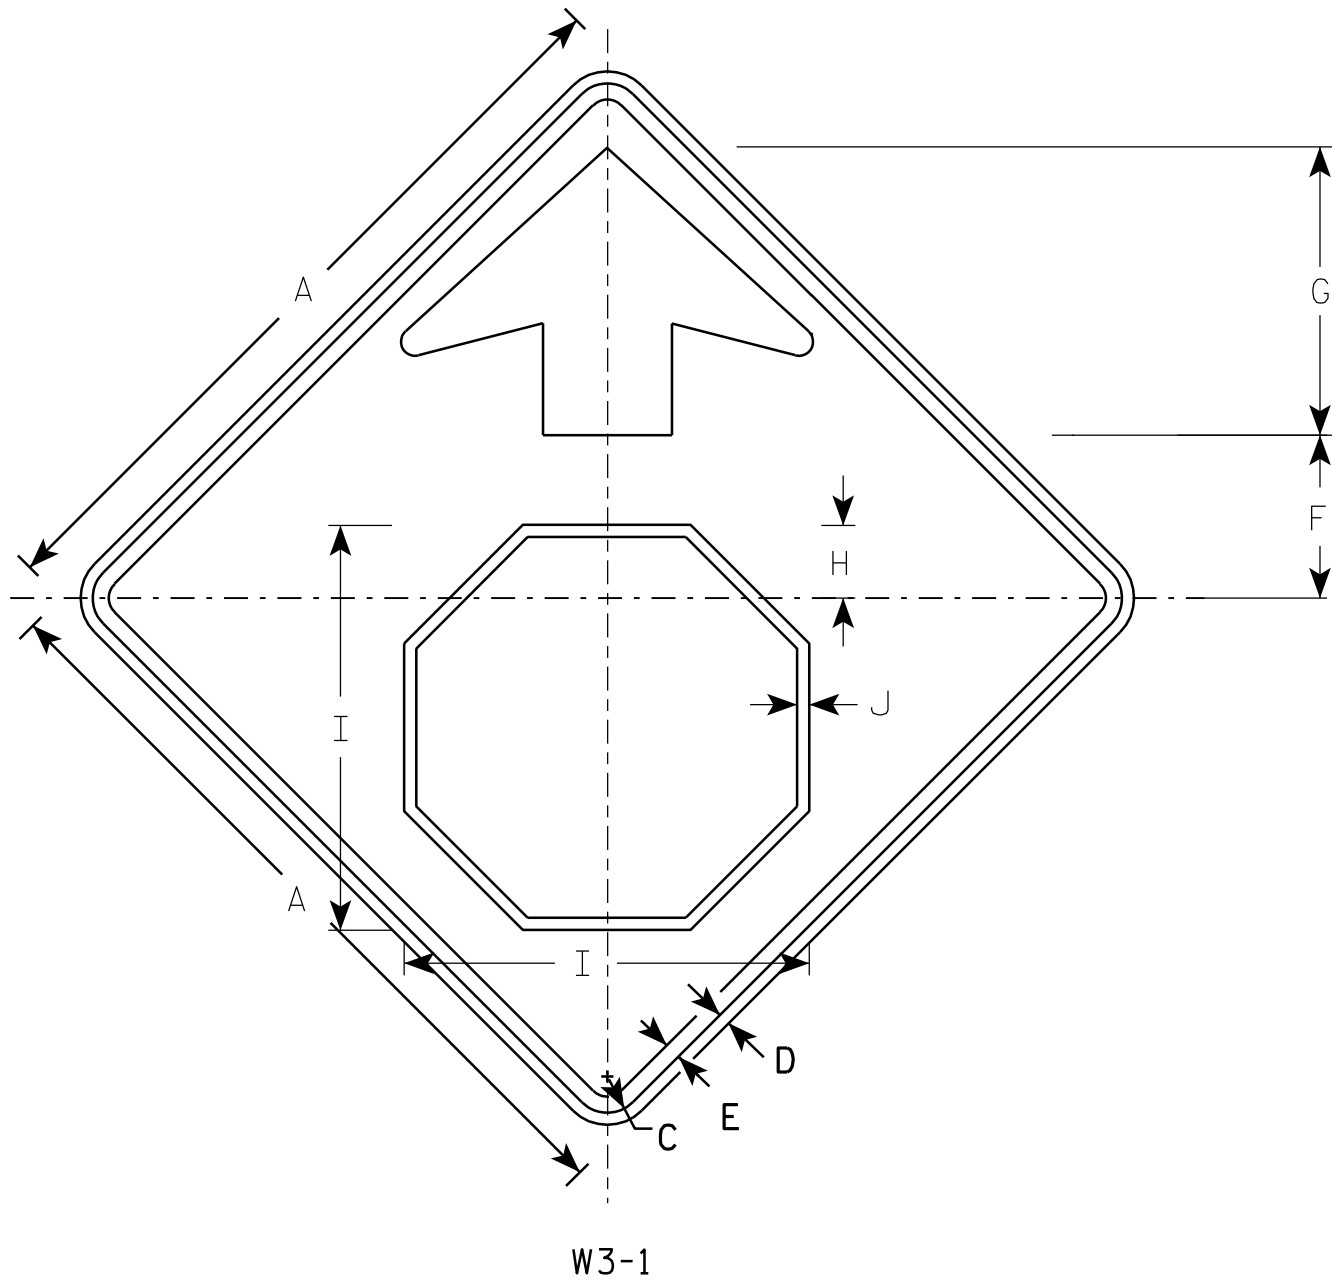

NOTES

1. All Signs Type II - Type F Reflective - reference WIS DOT Standard Specification for HIGHWAY and STRUCTURE CONSTRUCTION latest edition.
2. Color:
Background - YELLOW
Arrow & Border - BLACK
Stop Symbol - WHITE BORDER ON RED BACKGROUND

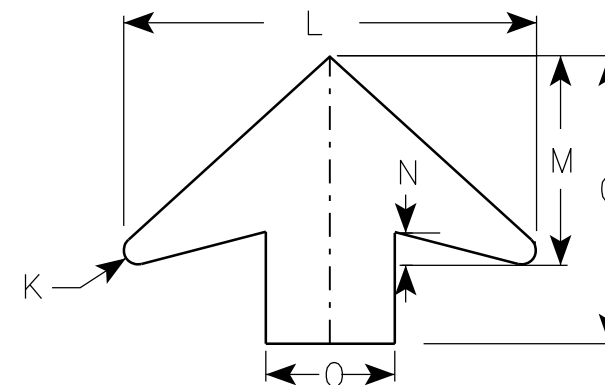

ARROW DETAIL

SIZE	A	B	C	D	E	F	G	H	I	J	K	L	M	N	O	P	Q	R	S	T	U	V	W	X	Y	Z	Area sq. ft.
1	30		1 ³ / ₈	1/2	5/8	6 1/4	11 1/4	2 7/8	15 3/4	1/2	1/2	16	8	1 1/4	5												6.25
2S	36		1 5/8	5/8	3/4	7 1/2	13 1/2	3 1/2	19	5/8	5/8	19 1/4	9 3/4	1 5/8	6												9.0
2M	36		1 5/8	5/8	3/4	7 1/2	13 1/2	3 1/2	19	5/8	5/8	19 1/4	9 3/4	1 5/8	6												9.0
3	36		1 5/8	5/8	3/4	7 1/2	13 1/2	3 1/2	19	5/8	5/8	19 1/4	9 3/4	1 5/8	6												9.0
4	48		2 1/4	3/4	1	10	17 7/8	4 1/2	25 1/8	3/4	7/8	25 5/8	13	2	8												16.0
5	48		2 1/4	3/4	1	10	17 7/8	4 1/2	25 1/8	3/4	7/8	25 5/8	13	2	8												16.0


PROJECT NO:

STANDARD SIGN
W3-1

WISCONSIN DEPT OF TRANSPORTATION

APPROVED *Matthew R. Rauch*
for State Traffic Engineer
DATE 6/7/10 PLATE NO. W3-1.12

SHEET NO: 183

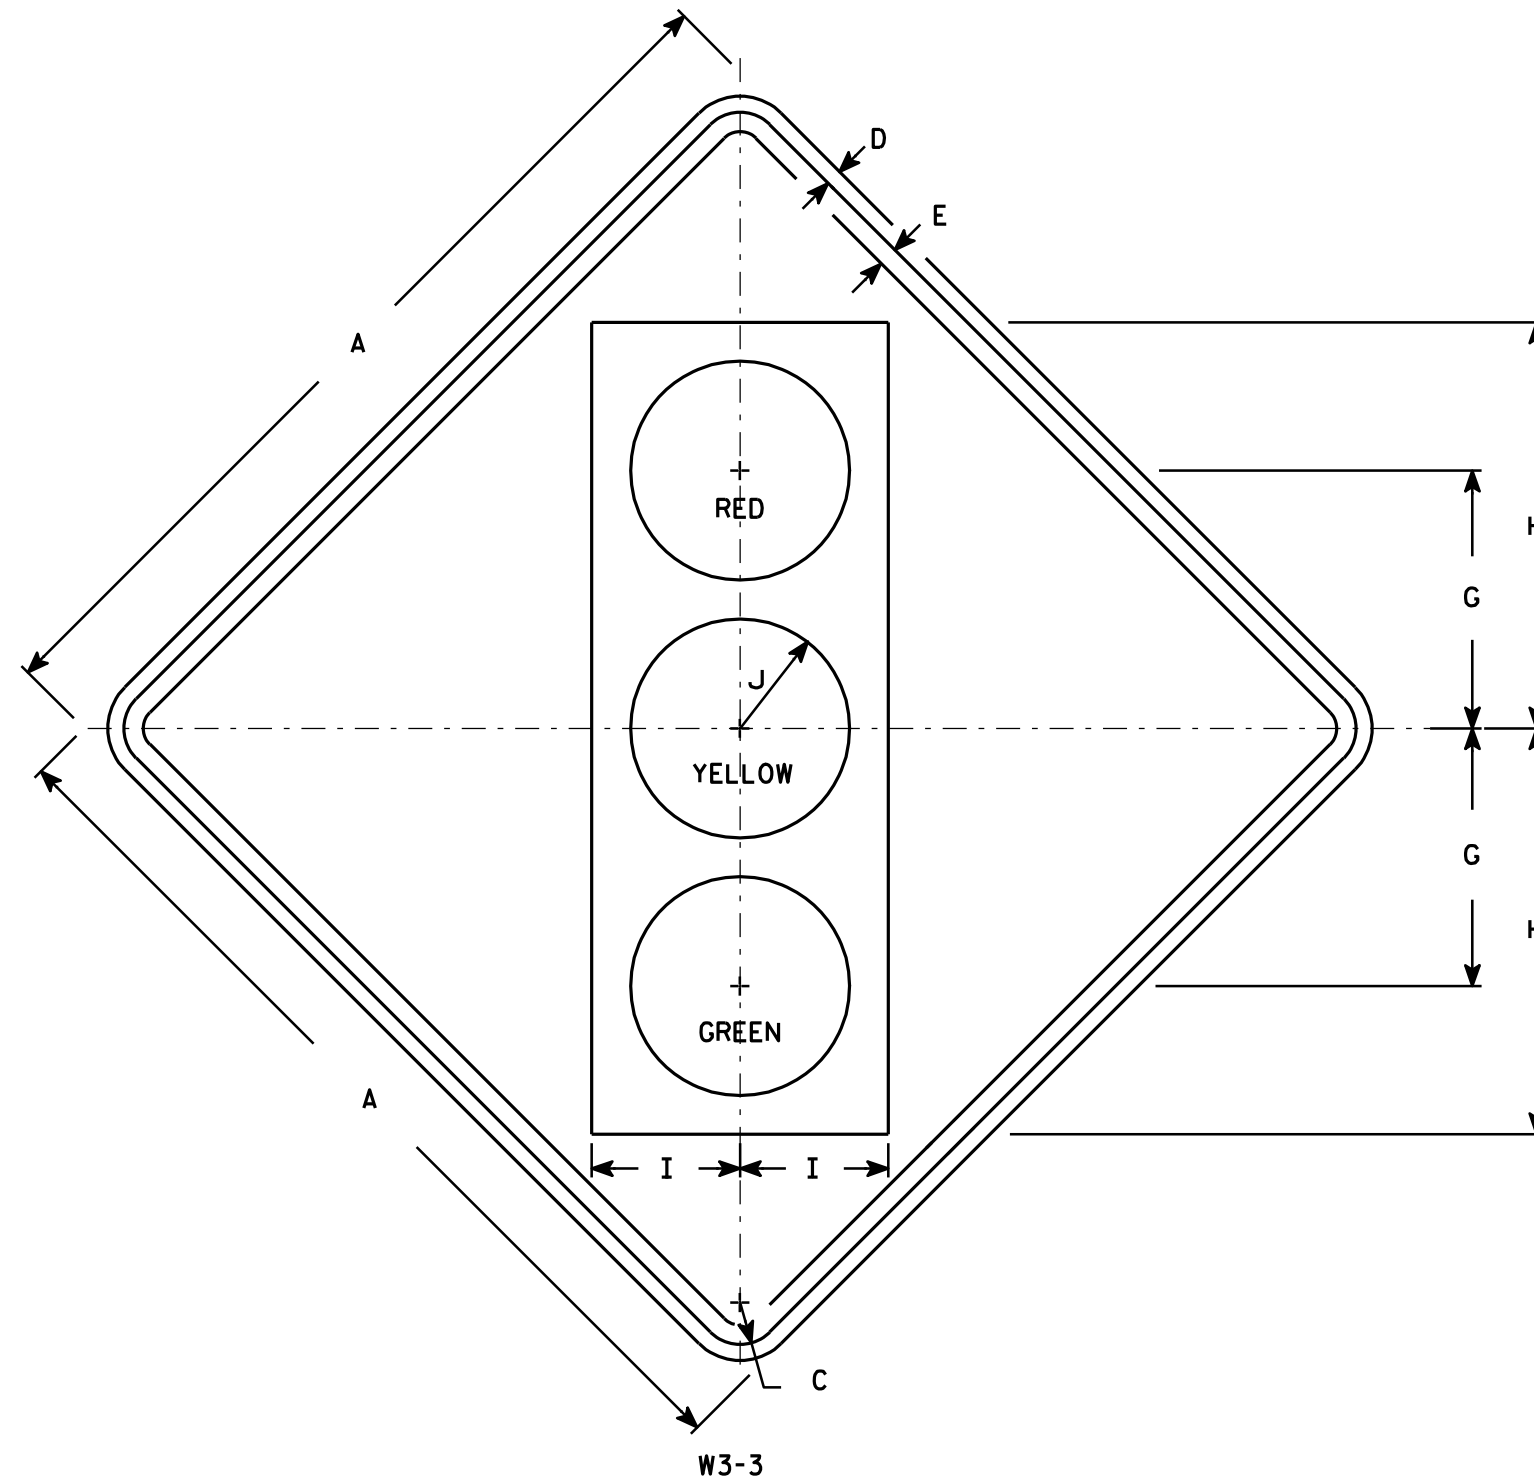

NOTES

1. Sign is Type II - Type F Reflective - reference WIS DOT Standard Specification for HIGHWAY and STRUCTURE CONSTRUCTION latest edition.
2. Color:
Background - Yellow
Message - See Note 4
3. Corners may be square or rounded when base material is plywood but borders shall be rounded as shown. When base material is metal, the corners and borders shall be rounded.
4. Symbol and border are non-reflective black.
Top circle - Type H Reflectorized Red
Center circle - Same as background
Bottom circle - Type H Reflectorized Green


SIZE	A	B	C	D	E	F	G	H	I	J	K	L	M	N	O	P	Q	R	S	T	U	V	W	X	Y	Z	Area sq. ft.
1	30		1 3/8	1/2	5/8		8 3/4	13 3/4	5	3 3/4																	6.25
2S	36		1 5/8	5/8	3/4		10	15 3/4	5 3/4	4 1/4																	9.0
2M	36		1 5/8	5/8	3/4		10	15 3/4	5 3/4	4 1/4																	9.0
3	36		1 5/8	5/8	3/4		10	15 3/4	5 3/4	4 1/4																	9.0
4	48		2 1/4	3/4	1		12 1/2	20	7 1/2	5																	16.0
5	48		2 1/4	3/4	1		12 1/2	20	7 1/2	5																	16.0

STANDARD SIGN W3-3

WISCONSIN DEPT OF TRANSPORTATION
APPROVED *Matthew R. Rauch*
for State Traffic Engineer
DATE 6/7/10 PLATE NO. W3-3.11

PROJECT NO: HWY: COUNTY: SHEET NO: 184 E

7

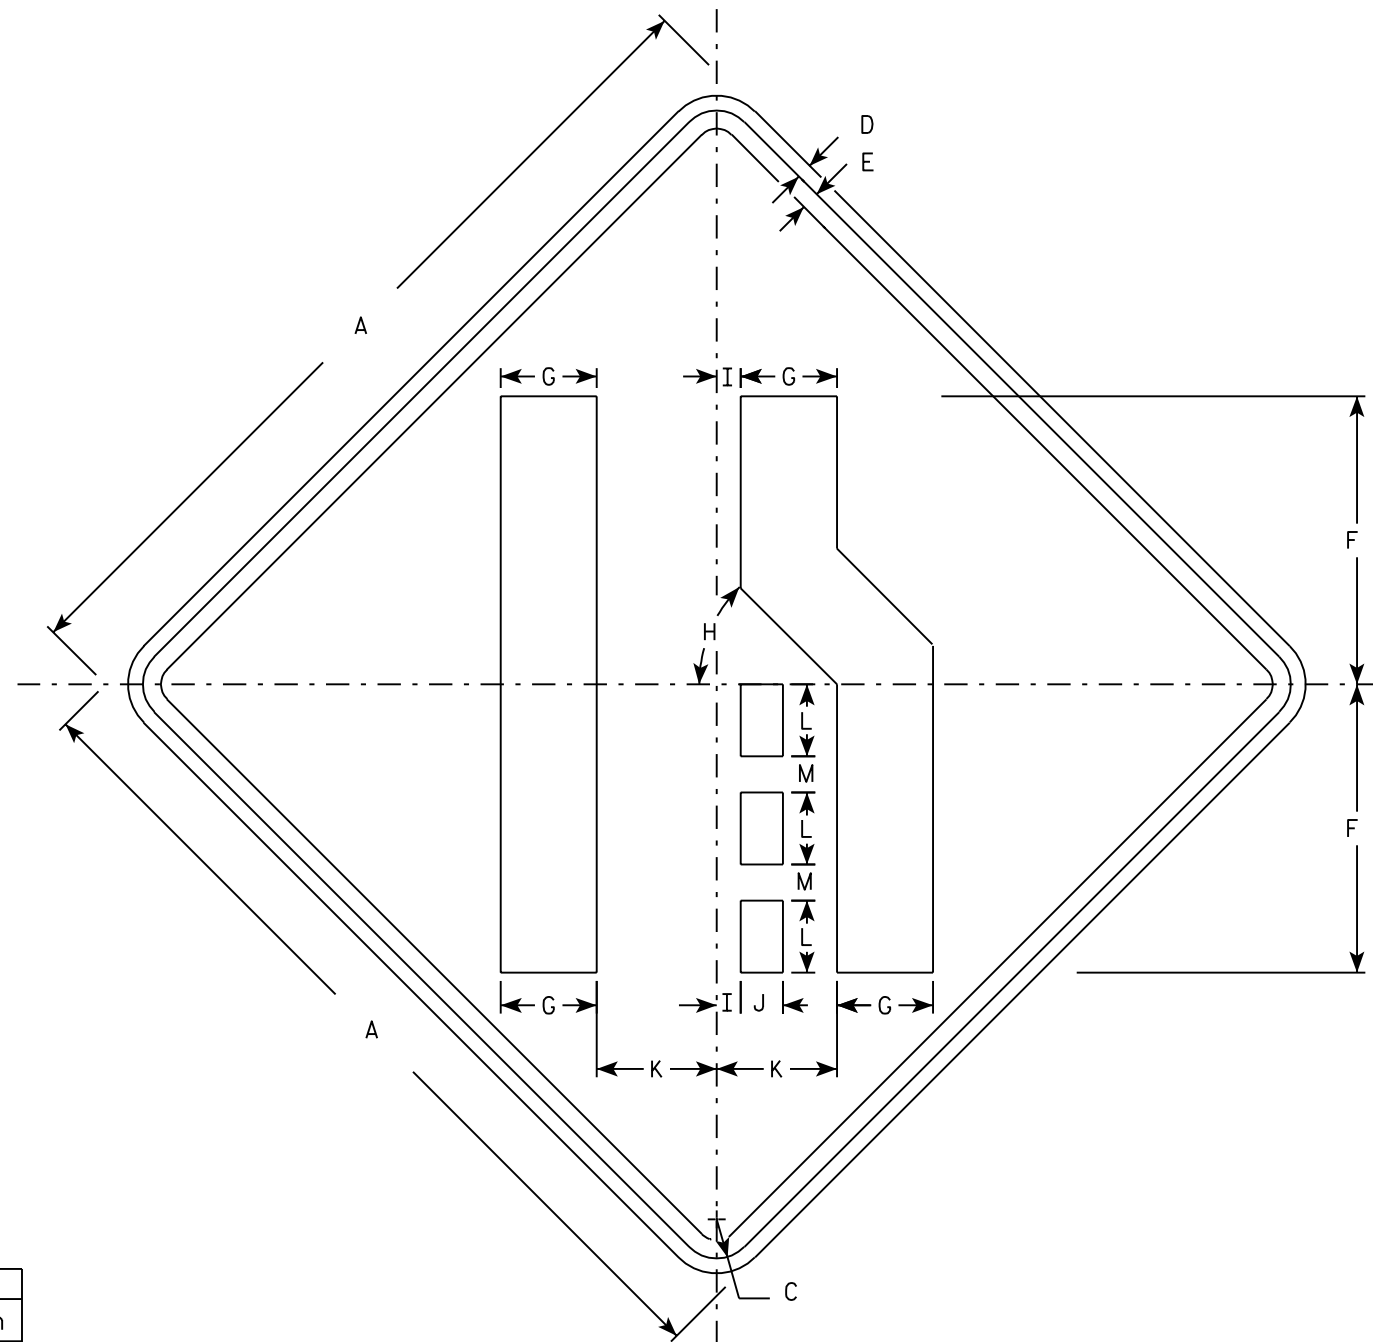

Metric equivalent
for this sign is:

SIZE	
1	750 mm X 750 mm
2	900 mm X 900 mm
3	1200 mm X 1200 mm
4	1200 mm X 1200 mm
5	1200 mm X 1200 mm

SIZE	A	B	C	D	E	F	G	H	I	J	K	L	M	N	O	P	Q	R	S	T	U	V	W	X	Y	Z	Area sq. ft.	Area m ²
1	30		1 3⁄8	1⁄2	5⁄8	10	3 3⁄8	45°	7⁄8	1 1⁄2	4 1⁄4	2 1⁄2	1 1⁄4														6.25	0.56
2	36		1 5⁄8	5⁄8	3⁄4	12	4	45°	1	1 3⁄4	5	3	1 1⁄2														9.0	0.81
3	48		2 1⁄4	3⁄4	1	16	5 3⁄8	45°	1 1⁄4	2 3⁄8	6 3⁄4	4	2														16.0	1.44
4	48		2 1⁄4	3⁄4	1	16	5 3⁄8	45°	1 1⁄4	2 3⁄8	6 3⁄4	4	2														16.0	1.44
5	48		2 1⁄4	3⁄4	1	16	5 3⁄8	45°	1 1⁄4	2 3⁄8	6 3⁄4	4	2														16.0	1.44

NOTES

1. Sign is Type II - Type H Reflective - reference
WIS DOT Standard Specification for HIGHWAY
and STRUCTURE CONSTRUCTION latest edition.
2. Color:
Background - Yellow
Message - Black
3. Corners may be square or rounded when base
material is plywood but borders shall be rounded
as shown. When base material is metal, the
corners and borders shall be rounded.
4. W4-2L is the same as W4-2R except the message is
reversed along the vertical centerline.

7

STANDARD SIGN
W4 - 2


WISCONSIN DEPT OF TRANSPORTATION

APPROVED *Matthew R. Rauch*
for State Traffic Engineer


DATE 2/08/05 PLATE NO. W4-2.11

NOTES

- 1. Sign is Type II - See Note 5 - reference WIS DOT Standard Specification for HIGHWAY and STRUCTURE CONSTRUCTION latest edition.
- 2. Color:
 - Background - Red (See Note 5)
 - Message - See Note 3
- 3. W5-56 Message Units are 3" center mount Red delineators as per 633.2.3.
- 4. Base material for W5-56 shall be metal and corners shall be rounded. Base material for W5-56A may be plywood or metal and corners may be square or rounded when material is plywood but rounded when metal.
- 5. W5-56 Background is Reflective
W5-56A Background is Type H Reflective

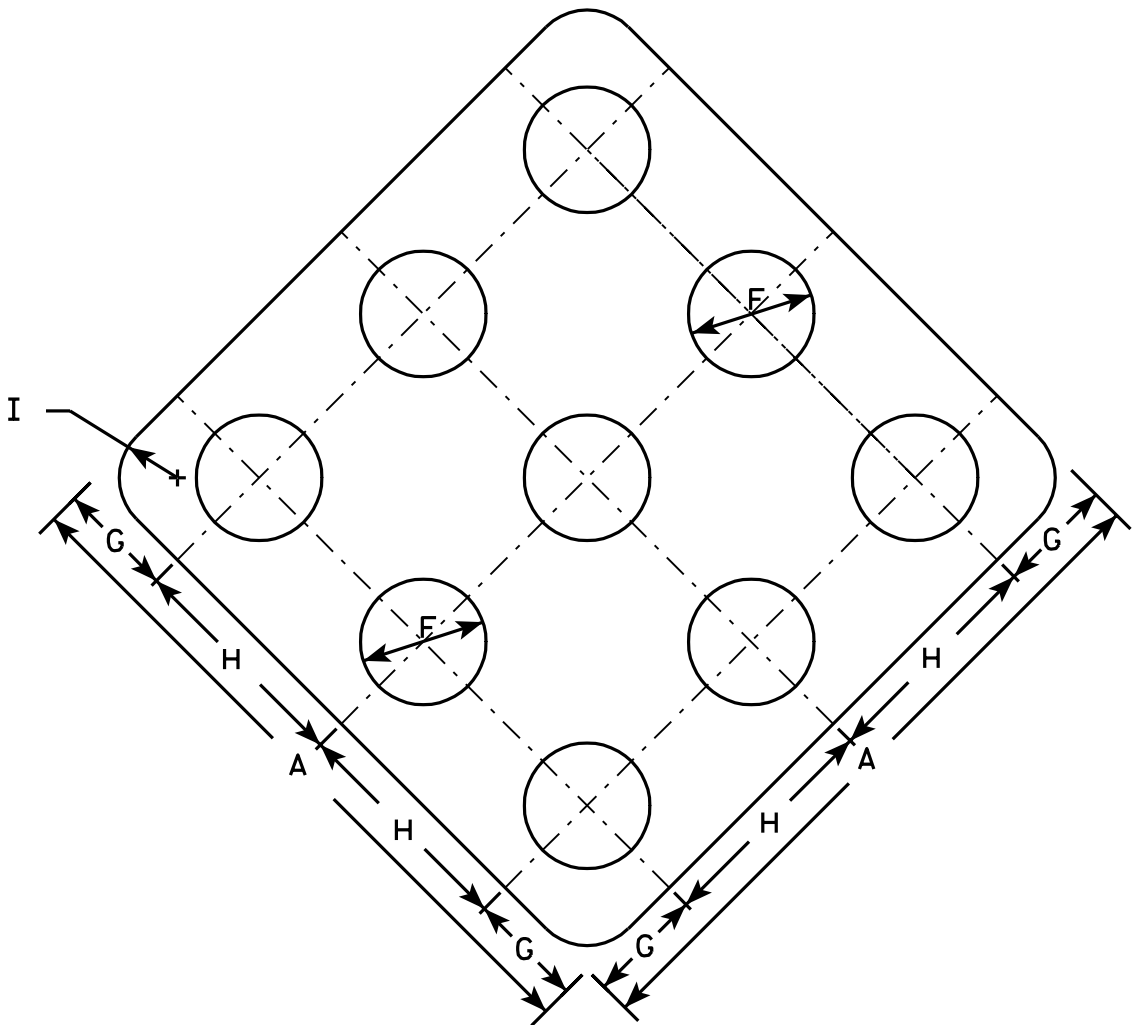

W5-56

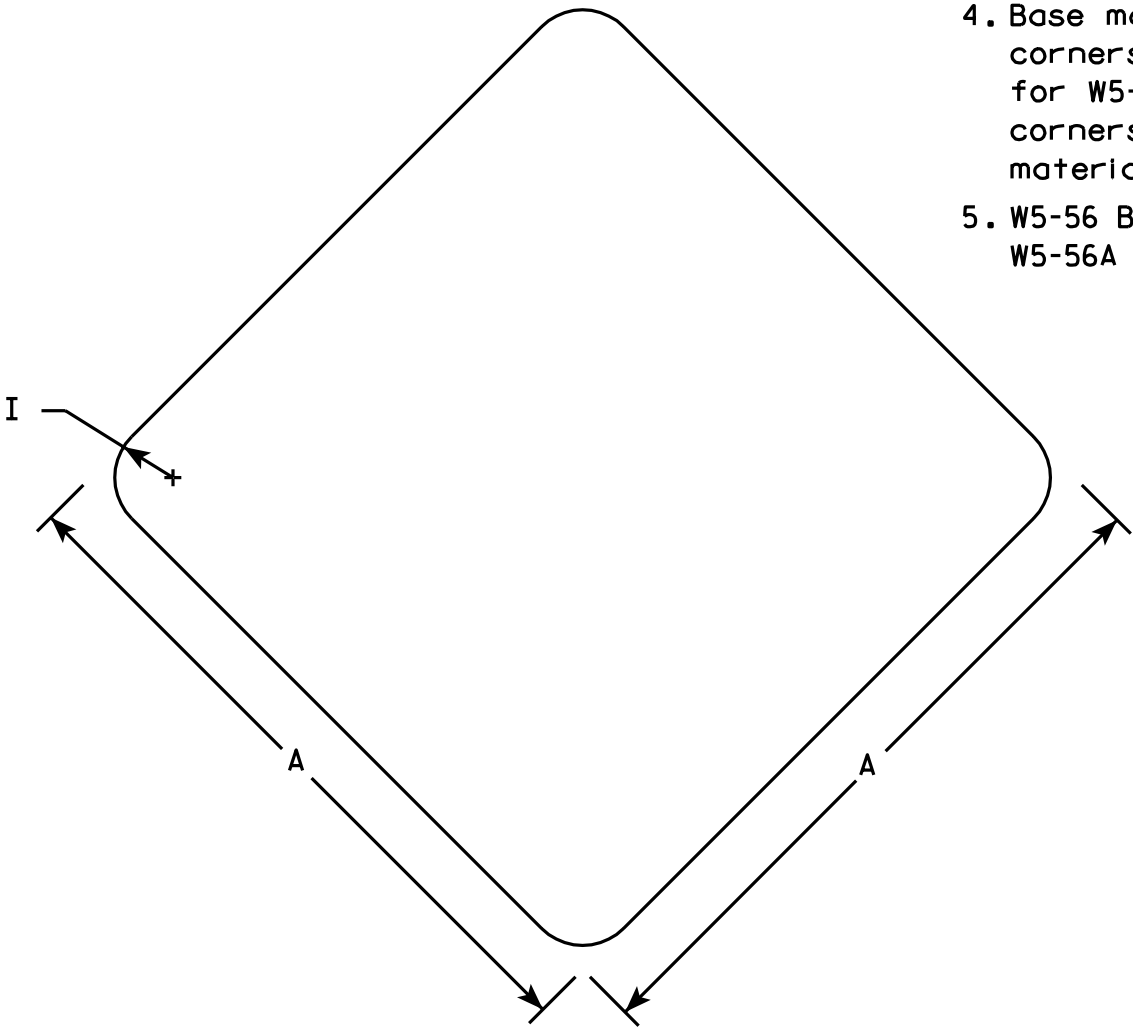

W5-56A

Metric equivalent
for this sign is:

SIZE	
1	300 mm X 300 mm
2	450 mm X 450 mm
3	
4	
5	


SIZE	A	B	C	D	E	F	G	H	I	J	K	L	M	N	O	P	Q	R	S	T	U	V	W	X	Y	Z	Area sq. ft.	Area m ²
1	12					3 1/4	2	4	1																		1.0	0.09
2	18					3 1/4	3	6	1 1/2																		2.25	0.20
3																												
4																												
5																												

STANDARD SIGN
W5-56 & W5-56A

WISCONSIN DEPT OF TRANSPORTATION

APPROVED *Matthew R. Rauch*
for State Traffic Engineer

DATE 7/05/05 PLATE NO. W5-56.5

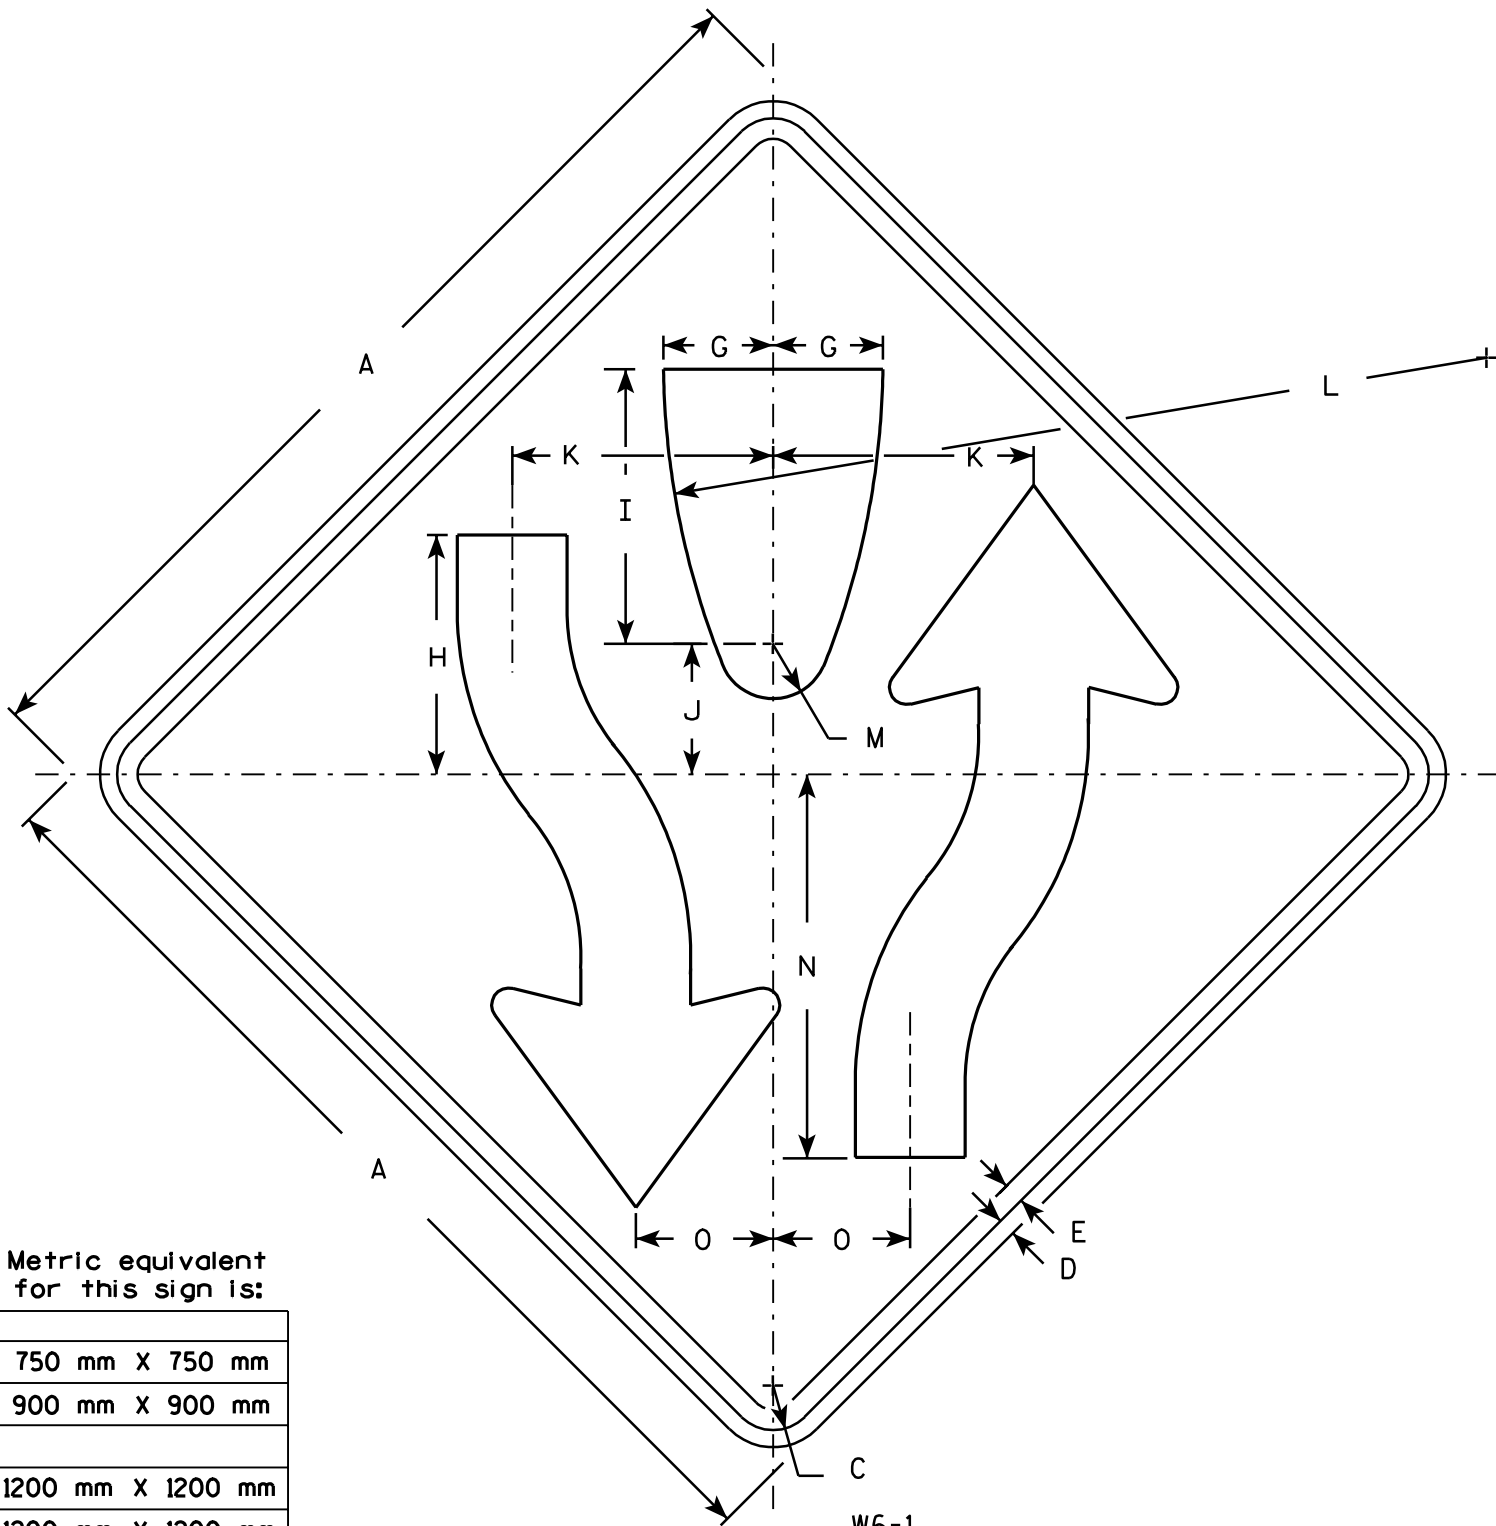


Metric equivalent
for this sign is:

SIZE	
1	750 mm X 750 mm
2	900 mm X 900 mm
3	
4	1200 mm X 1200 mm
5	1200 mm X 1200 mm

SIZE	A	B	C	D	E	F	G	H	I	J	K	L	M	N	O	P	Q	R	S	T	U	V	W	X	Y	Z	Area sq. ft.	Area m ²
1	30		1 3/8	1/2	5/8		3 1/4	8	8 1/4	4 1/8	7 7/8	25	1 3/4	11 5/8	4 1/8	3 7/8	6 3/4	5/8	6 5/8	9 7/8	21 5/8	2					6.25	0.56
2	36		1 5/8	5/8	3/4		4	8 3/4	10	4 3/4	9 1/2	30	2	14	5	4 5/8	7 3/8	7/8	8	12	24 1/2	2 1/2					9.0	0.81
3																												
4	48		2 1/4	3/4	1		5 3/8	11 5/8	13 3/8	6 3/8	12 5/8	40	2 5/8	18 5/8	6 5/8	6 1/4	9 7/8	1 1/4	10 5/8	16	32 5/8	3 3/8					16.0	1.44
5	48		2 1/4	3/4	1		5 3/8	11 5/8	13 3/8	6 3/8	12 5/8	40	2 5/8	18 5/8	6 5/8	6 1/4	9 7/8	1 1/4	10 5/8	16	32 5/8	3 3/8					16.0	1.44

NOTES

1. Sign is Type II - Type H Reflective - reference WIS DOT Standard Specification for HIGHWAY and STRUCTURE CONSTRUCTION latest edition.
2. Color:
Background - Yellow
Message - Black
3. Corners may be square or rounded when base material is plywood but borders shall be rounded as shown. When base material is metal, the corners and borders shall be rounded.
4. W6-2 same as W6-1 but is rotated 180° when mounted.

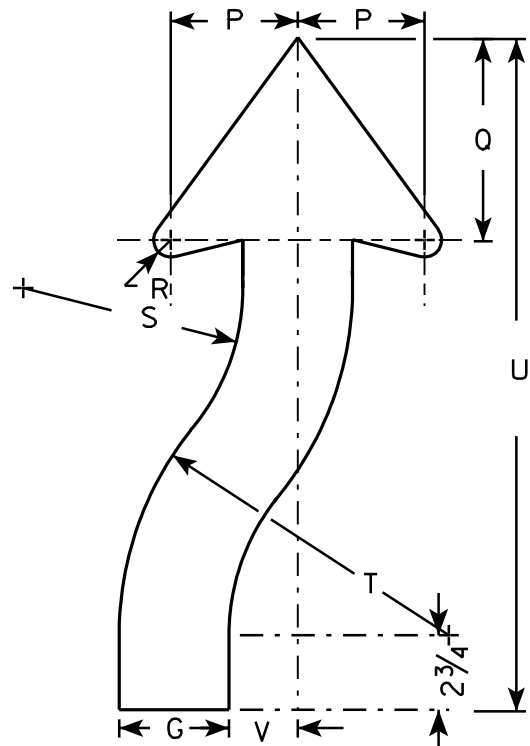

ARROW DETAIL

STANDARD SIGN W6-1 & W6-2

WISCONSIN DEPT OF TRANSPORTATION

APPROVED

Matthew R. Rauch
for State Traffic Engineer

DATE 3/01/05

PLATE NO. W6-1.12

PROJECT NO:

HWY:

COUNTY:

SHEET NO: 187

E

EAST FRONTAGE ROAD SOUTH														
STATION	Distance	AREA (SF)				Incremental Vol (CY) (Unadjusted)				Cumulative Vol (CY)				Mass Ordinate
		Cut	Salvaged/Unusable Pavement Material	Fill	EBS	Cut	Salvaged/Unusable Pavement Material	Fill	EBS	Cut 1.00	Expanded Fill 1.20	Expanded EBS Backfill 1.30	Reduced EBS In Fill 0.80	
3835+00 AH		163.21	0.00	0	0.00	0	0.00	0	0.00	0.00	0.00	0.00	0.00	0.00
3835+50	50.00	103.79	11.25	0	0.00	247.22	10.42	0.00	0.00	247.22	0.00	0.00	0.00	236.81
3836+00	50.00	82.97	11.25	1.07	0.00	172.93	20.83	0.99	0.00	420.15	1.19	0.00	0.00	387.71
3836+50	50.00	70.13	11.25	17.05	0.00	141.76	20.83	16.78	0.00	561.91	21.32	0.00	0.00	488.50
3837+00	50.00	72.48	11.25	35.95	0.00	132.05	20.83	49.07	0.00	693.95	80.21	0.00	0.00	540.83
3837+50	50.00	77.55	11.25	0	0.00	138.92	20.83	33.29	0.00	832.87	120.16	0.00	0.00	618.96
3838+00	50.00	89.12	11.25	0	0.00	154.32	20.83	0.00	0.00	987.19	120.16	0.00	0.00	752.46
3838+50	50.00	100.54	11.25	0	0.00	175.61	20.83	0.00	0.00	1162.81	120.16	0.00	0.00	907.23
3839+00	50.00	112.65	11.25	0	0.00	197.40	20.83	0.00	0.00	1360.20	120.16	0.00	0.00	1083.80
3839+50	50.00	116.73	11.25	11.24	0.00	212.39	20.83	10.41	0.00	1572.59	132.64	0.00	0.00	1262.86
3840+00	50.00	114.86	11.25	9.64	0.00	214.44	20.83	19.33	0.00	1787.03	155.84	0.00	0.00	1433.27
3840+50	50.00	126.42	11.25	0	0.00	223.41	20.83	8.93	0.00	2010.44	166.56	0.00	0.00	1625.13
3841+00	50.00	135.26	11.25	0	0.00	242.30	20.83	0.00	0.00	2252.73	166.56	0.00	0.00	1846.59
3841+50	50.00	145.71	11.25	0	0.00	260.16	20.83	0.00	0.00	2512.89	166.56	0.00	0.00	2085.92
3842+00	50.00	152.76	11.25	0	0.00	276.36	20.83	0.00	0.00	2789.25	166.56	0.00	0.00	2341.44
3842+50	50.00	154.78	11.25	0	0.00	284.76	20.83	0.00	0.00	3074.01	166.56	0.00	0.00	2605.37
3843+00	50.00	161.96	11.25	0	0.00	293.28	20.83	0.00	0.00	3367.29	166.56	0.00	0.00	2877.81
3843+50	50.00	164.86	11.25	0	0.00	302.61	20.83	0.00	0.00	3669.90	166.56	0.00	0.00	3159.59
3844+00	50.00	159.04	11.25	0	0.00	299.91	20.83	0.00	0.00	3969.81	166.56	0.00	0.00	3438.67
3844+50	50.00	169.32	11.25	0	0.00	304.04	20.83	0.00	0.00	4273.84	166.56	0.00	0.00	3721.87
3845+00	50.00	177.68	11.25	0	0.00	321.30	20.83	0.00	0.00	4595.14	166.56	0.00	0.00	4022.33
3845+50	50.00	272.01	11.81	1.22	0.00	416.38	21.35	1.13	0.00	5011.52	167.91	0.00	0.00	4416.00
3846+00	50.00	249.27	12.38	0	0.00	482.67	22.40	1.13	0.00	5494.19	169.27	0.00	0.00	4874.92
3846+50	50.00	264.17	12.38	0.07	0.00	475.41	22.92	0.06	0.00	5969.59	169.34	0.00	0.00	5327.33
3847+00	50.00	231.18	12.38	0.23	0.00	458.66	22.92	0.28	0.00	6428.25	169.68	0.00	0.00	5762.74
3847+50	50.00	215.63	13.31	1.65	0.00	413.71	23.78	1.74	0.00	6841.96	171.77	0.00	0.00	6150.58
3848+00	50.00	170.16	14.25	6.08	0.00	357.21	25.52	7.16	0.00	7199.18	180.36	0.00	0.00	6473.68
3848+50	50.00	178.31	16.31	11.5	0.00	322.66	28.30	16.28	0.00	7521.83	199.89	0.00	0.00	6748.51
3849+00	50.00	167.69	18.38	4.48	0.00	320.37	32.12	14.80	0.00	7842.20	217.64	0.00	0.00	7019.00
3849+50	50.00	81.08	20.63	32.76	0.00	230.34	36.11	34.48	0.00	8072.55	259.02	0.00	0.00	7171.86
3850+00	50.00	52.28	22.88	26.68	0.00	123.48	40.28	55.04	0.00	8196.03	325.07	0.00	0.00	7189.02
3850+50	50.00	42.19	25.50	19.26	0.00	87.47	44.79	42.54	0.00	8283.50	376.11	0.00	0.00	7180.65
3851+00	50.00	146.81	28.13	9.16	0.00	175.00	49.65	26.31	0.00	8458.50	407.69	0.00	0.00	7274.42
3851+50	50.00	292.11	24.19	0	0.00	406.41	48.44	8.48	0.00	8864.91	417.87	0.00	0.00	7622.21
3852+00	50.00	167.04	20.25	12.74	0.00	425.14	41.15	11.80	0.00	9290.05	432.02	0.00	0.00	7992.05
3852+25 BK	25.00	167.3	21.75	7.76	0.00	154.79	19.44	9.49	0.00	9444.83	443.41	0.00	0.00	8116.01
Column totals						9444.83	885.42	369.51	0.00					


EAST FRONTAGE ROAD NORTH														
STATION	Distance	AREA (SF)				Incremental Vol (CY) (Unadjusted)				Cumulative Vol (CY)				Mass Ordinate
		Cut	Salvaged/Unusable Pavement Material	Fill	EBS	Cut	Salvaged/Unusable Pavement Material	Fill	EBS	Cut 1.00	Expanded Fill 1.20	Expanded EBS Backfill 1.30	Reduced EBS In Fill 0.80	
5863+15	AH	295.49	0.00	62.02	0.00	0	0.00	0	0.00	0.00	0.00	0.00	0.00	0.00
5863+50	35.00	267.41	0.00	96.61	0.00	364.84	0.00	102.82	0.00	364.84	123.38	0.00	0.00	241.46
5864+00	50.00	182.00	27.00	106.12	0.00	416.12	25.00	187.71	0.00	780.96	348.63	0.00	0.00	407.33
5864+50	50.00	36.30	0.00	368.19	0.00	202.13	25.00	439.18	0.00	983.09	875.65	0.00	0.00	57.45
5865+00	50.00	60.40	0.00	165.28	0.00	89.54	0.00	493.95	0.00	1072.63	1468.39	0.00	0.00	-445.76
5865+50	50.00	121.64	0.00	23.17	0.00	168.56	0.00	174.49	0.00	1241.19	1677.78	0.00	0.00	-486.59
5866+00	50.00	285.78	0.00	0	0.00	377.24	0.00	21.45	0.00	1618.43	1703.52	0.00	0.00	-135.10
5866+50	50.00	306.40	0.00	0	0.00	548.31	0.00	0.00	0.00	2166.74	1703.52	0.00	0.00	413.22
5867+00	50.00	110.91	0.00	10.59	0.00	386.40	0.00	9.81	0.00	2553.14	1715.29	0.00	0.00	787.85
5867+50	50.00	35.18	0.00	111.18	0.00	135.27	0.00	112.75	0.00	2688.41	1850.59	0.00	0.00	787.82
5868+00	50.00	37.92	0.00	144.32	0.00	67.69	0.00	236.57	0.00	2756.09	2134.48	0.00	0.00	571.61
5868+50	50.00	42.77	0.00	105.15	0.00	74.71	0.00	230.99	0.00	2830.81	2411.67	0.00	0.00	369.14
5869+00	50.00	81.56	0.00	58.54	0.00	115.12	0.00	151.56	0.00	2945.93	2593.55	0.00	0.00	302.38
5869+50	50.00	148.29	0.00	35.86	0.00	212.82	0.00	87.41	0.00	3158.75	2698.43	0.00	0.00	410.32
5870+00	50.00	164.33	0.00	26.9	0.00	289.46	0.00	58.11	0.00	3448.21	2768.17	0.00	0.00	630.05
5870+50	50.00	164.35	0.00	24.9	0.00	304.33	0.00	47.96	0.00	3752.55	2825.72	0.00	0.00	876.82
5871+00	50.00	158.35	0.00	27.94	0.00	298.80	0.00	48.93	0.00	4051.34	2884.43	0.00	0.00	1116.91
5871+50	50.00	163.46	0.00	32.58	0.00	297.97	0.00	56.04	0.00	4349.31	2951.68	0.00	0.00	1347.64
5872+00	50.00	247.53	0.00	4.76	0.00	380.55	0.00	34.57	0.00	4729.86	2993.17	0.00	0.00	1686.69
5872+50	50.00	326.31	0.00	0	0.00	531.33	0.00	4.41	0.00	5261.19	2998.46	0.00	0.00	2212.74
5873+00	50.00	306.99	0.00	0	0.00	586.39	0.00	0.00	0.00	5847.58	2998.46	0.00	0.00	2799.13
5873+50	50.00	182.02	0.00	8.33	0.00	452.79	0.00	7.71	0.00	6300.37	3007.71	0.00	0.00	3242.66
5874+00	50.00	48.63	0.00	50.81	0.00	213.56	0.00	54.76	0.00	6513.94	3073.42	0.00	0.00	3390.51
5874+50	50.00	15.32	0.00	169.16	0.00	59.21	0.00	203.68	0.00	6573.15	3317.83	0.00	0.00	3205.31
5875+00	50.00	9.27	0.00	221.32	0.00	22.77	0.00	361.56	0.00	6595.92	3751.70	0.00	0.00	2794.22
5875+50	50.00	31.26	0.00	125.81	0.00	37.53	0.00	321.42	0.00	6633.44	4137.40	0.00	0.00	2446.04
5876+00	50.00	84.77	0.00	39.42	0.00	107.44	0.00	152.99	0.00	6740.88	4320.99	0.00	0.00	2369.89
5876+50	50.00	90.22	0.00	34.34	0.00	162.03	0.00	68.30	0.00	6902.91	4402.95	0.00	0.00	2449.96
5877+00	50.00	50.73	0.00	66.36	0.00	130.51	0.00	93.24	0.00	7033.42	4514.83	0.00	0.00	2468.58
5877+50	50.00	24.28	0.00	130.5	0.00	69.45	0.00	182.28	0.00	7102.87	4733.57	0.00	0.00	2319.30
5878+00	50.00	13.42	0.00	213.79	0.00	34.91	0.00	318.79	0.00	7137.78	5116.11	0.00	0.00	1971.67
5878+50	50.00	4.78	0.00	261.58	0.00	16.85	0.00	440.16	0.00	7154.63	5644.30	0.00	0.00	1460.33
5878+72	22.00	20.28	0.00	269.25	0.00	10.21	0.00	216.26	0.00	7164.84	5903.82	0.00	0.00	1211.02
5879+00	28.00	23.11	0.00	227.76	0.00	22.50	0.00	257.71	0.00	7187.34	6213.07	0.00	0.00	924.27
5879+50	50.00	31.58	0.00	196.57	0.00	50.64	0.00	392.90	0.00	7237.98	6684.55	0.00	0.00	503.43
5880+00	50.00	33.13	0.00	203.54	0.00	59.92	0.00	370.47	0.00	7297.89	7129.11	0.00	0.00	118.78
5880+50	50.00	34.98	0.00	209.21	0.00	63.06	0.00	382.18	0.00	7360.96	7587.72	0.00	0.00	-276.77
5881+00	50.00	342.39	0.00	200.31	0.00	349.42	0.00	379.19	0.00	7710.37	8042.75	0.00	0.00	-382.37
5881+50	50.00	317.18	0.00	183.5	0.00	610.71	0.00	355.38	0.00	8321.09	8469.20	0.00	0.00	-198.11
5882+00	50.00	294.90	11.25	268.75	0.00	566.74	10.42	418.75	0.00	8887.83	8971.70	0.00	0.00	-144.29
5882+50	50.00	199.11	11.25	222.27	0.00	457.42	20.83	454.65	0.00	9345.25	9517.28	0.00	0.00	-253.28
5883+00	50.00	186.55	11.25	154.94	0.00	357.09	20.83	349.27	0.00	9702.34	9936.40	0.00	0.00	-336.15
5883+50	50.00	183.16	11.25	42.19	0.00	342.32	20.83	182.53	0.00	10044.66	10155.44	0.00	0.00	-233.69
5884+00	50.00	167.96	11.25	294.5	0.00	325.11	20.83	311.75	0.00	10369.77	10529.54	0.00	0.00	-303.51
5884+50	50.00	115.97	11.25	255.84	0.00	262.90	20.83	509.57	0.00	10632.67	11141.02	0.00	0.00	-672.94
5885+00	50.00	110.97	11.25	126.59	0.00	210.13	20.83	354.10	0.00	10842.80	11565.95	0.00	0.00	-908.56
5885+50	50.00	126.02	11.25	111.6	0.00	219.44	20.83	220.55	0.00	11062.24	11830.60	0.00	0.00	-974.62
5886+00	50.00	142.86	11.25	70.93	0.00	248.96	20.83	169.01	0.00	11311.20	12033.41	0.00	0.00	-949.30
5886+50	50.00	167.75	11.25	25.53	0.00	287.60	20.83	89.31	0.00	11598.80	12140.59	0.00	0.00	-789.71
5887+00	50.00	201.09	11.25	20.8	0.00	341.52	20.83	42.90	0.00	11940.32	12192.07	0.00	0.00	-520.50
5887+50	50.00	220.35	11.25	23.07	0.00	390.22	20.83	40.62	0.00	12330.54	12240.81	0.00	0.00	-199.85
5888+00	50.00	272.44	11.25	38.3	0.00	456.29	20.83	56.82	0.00	12786.83	12309.00	0.00	0.00	167.41
5888+50	50.00	342.52	14.25	115.4	0.00	569.41	23.61	142.31	0.00	13356.24	12479.78	0.00	0.00	542.43
5889+00	50.00	358.54	14.25	171.12	0.00	649.13	26.39	265.30	0.00	14005.37	12798.14	0.00	0.00	846.81
5889+50	50.00	444.91	14.25	283.17	0.00	743.94	26.39	420.64	0.00	14749.30	13302.90	0.00	0.00	1059.59
5890+00	50.00	589.08	14.25	379.39	0.00	957.40	26.39	613.48	0.00	15706.70	14039.08	0.00	0.00	1254.42
5890+50	50.00	761.65	14.25	517.47	0.00	1250.68	26.39	830.43	0.00	16957.37	15035.59	0.00	0.00	1482.20
5891+00	50.00	963.42	14.25	877.02	0.00	1597.29	26.39	1291.19	0.00	18554.66	16585.02	0.00	0.00	1503.67
5891+50	50.00	1162.77	14.25	1415.3	0.00	1968.69	26.39	2122.52	0.00	20523.36	19132.05	0.00	0.00	898.95
5892+00	50.00	1327.89	14.25	1843.7	0.00	2306.17	26.39	3017.56	0.00	22829.52	22753.11	0.00	0.00	-442.34
5892+50	50.00	1618.72	14.25	2193.2	0.00	2728.34	26.39	3737.86	0.00	25557.87	27238.55	0.00	0.00	-2225.82
5893+00	50.00	1877.37	14.25	2392.1	0.00	3237.12	26.39	4245.70	0.00	28794.99	32333.39	0.00	0.00	-4109.93
5893+50	50.00	1941.23	14.25	2392.8	0.00	3535.74	26.39	4430.46	0.00	32330.73	37649.95	0.00	0.00	-5917.14
5894+00	50.00	1464.79	14.25	2037	0.00	3153.72	26.39	4101.64	0.00	35484.45	42571.91	0.00	0.00	-7711.77
5894+50	50.00	68.32	14.25	517.47	0.00	1419.55	26.39	2365.25	0.00	36904.00	45410.21	0.00	0.00	-9156.91
5894+78	BK 28.00	68.32	14.25	517.47	0.00	70.85	14.78	536.64	0.00	36974.85	46054.18	0.00	0.00	-9744.80
Column totals						36974.85	665.47	38378.48	0.00					


EAST FRONTAGE ROAD NORTH																	
STATION		Real Station	Distance	AREA (SF)				Incremental Vol (CY) (Unadjusted)				Cumulative Vol (CY)				Mass Ordinate	
				Cut	Salvaged/Unusable Pavement Material	Fill	EBS	Cut	Salvaged/Unusable Pavement Material	Fill	EBS	Cut 1.00	Expanded Fill 1.20	Expanded EBS Backfill 1.30	Reduced EBS In Fill 0.80		
5895+18	AH	589518.00		275.35	14.25	0	0.00	0	0.00	0	0.00	0.00	0.00	0.00	0.00		
5895+50		589550.00	32.00	112.24	14.25	205.5	0.00	229.68	16.89	121.78	0.00	229.68	146.13	0.00	0.00	66.66	
5896+00		589600.00	50.00	349.04	14.25	384.04	0.00	427.11	26.39	545.87	0.00	656.79	801.18	0.00	0.00	-187.66	
5896+50		589650.00	50.00	244.7	14.25	268.9	0.00	549.76	26.39	604.57	0.00	1206.55	1526.67	0.00	0.00	-389.78	
5897+00		589700.00	50.00	186.14	14.25	176.24	0.00	398.93	26.39	412.17	0.00	1605.48	2021.27	0.00	0.00	-511.84	
5897+50		589750.00	50.00	191.01	14.25	104.85	0.00	349.21	26.39	260.27	0.00	1954.69	2333.59	0.00	0.00	-501.34	
5898+00		589800.00	50.00	216.88	14.25	54.41	0.00	377.68	26.39	147.46	0.00	2332.37	2510.54	0.00	0.00	-327.01	
5898+50		589850.00	50.00	162.34	14.25	31.21	0.00	351.13	26.39	79.28	0.00	2683.50	2605.68	0.00	0.00	-97.40	
5899+00		589900.00	50.00	140.22	14.25	14.02	0.00	280.15	26.39	41.88	0.00	2963.65	2655.93	0.00	0.00	106.10	
5899+50		589950.00	50.00	134.76	14.25	8.55	0.00	254.61	26.39	20.90	0.00	3218.26	2681.01	0.00	0.00	309.25	
5900+00		590000.00	50.00	126.99	14.25	5.12	0.00	242.36	26.39	12.66	0.00	3460.62	2696.20	0.00	0.00	510.03	
5900+50		590050.00	50.00	122.62	14.25	5.09	0.00	231.12	26.39	9.45	0.00	3691.74	2707.54	0.00	0.00	703.42	
5901+00		590100.00	50.00	124.53	14.25	5.84	0.00	228.84	26.39	10.12	0.00	3920.58	2719.69	0.00	0.00	893.73	
5901+23		BK	590123.00	23.00	127.96	14.25	6.65	0.00	107.54	12.14	5.32	0.00	4028.12	2726.07	0.00	0.00	982.74
Column totals								4028.12	319.31	2271.73	0.00						


CTH C																
STATION	Real Station	Distance	AREA (SF)				Incremental Vol (CY) (Unadjusted)				Cumulative Vol (CY)				Mass Ordinate	
			Cut	Salvaged/Unusable Pavement Material	Fill	EBS	Cut	Salvaged/Unusable Pavement Material	Fill	EBS	Cut 1.00	Expanded Fill 1.20	Expanded EBS Backfill 1.30	Reduced EBS In Fill 0.80		
68+75 AH	6875.00	25.00	996.69	0.00	13.41	0.00	0	0.00	0.00	0.00	0.00	0.00	0.00	0.00	0.00	
69+00	6900.00		573.31	19.00	71.42	0.00	726.85	8.80	39.27	0.00	726.85	47.13	0.00	0.00	670.93	
69+50	6950.00		50.00	50.04	19.00	0	0.00	577.18	35.19	66.13	0.00	1304.03	126.48	0.00	0.00	1133.56
70+00	7000.00		50.00	39.42	19.00	0	0.00	82.83	35.19	0.00	0.00	1386.86	126.48	0.00	0.00	1181.21
70+50	7050.00		50.00	48.83	19.00	34.54	0.00	81.71	35.19	31.98	0.00	1468.57	164.86	0.00	0.00	1189.36
71+00	7100.00		50.00	56.06	19.00	288.72	0.00	97.12	35.19	299.31	0.00	1565.69	524.04	0.00	0.00	892.12
71+50	7150.00		50.00	58.79	19.00	188.23	0.00	106.34	35.19	441.62	0.00	1672.04	1053.98	0.00	0.00	433.33
72+00	7200.00		50.00	57.47	19.00	101.79	0.00	107.65	35.19	268.54	0.00	1779.69	1376.23	0.00	0.00	183.55
72+15 BK	7214.92	14.92	59.06	19.00	102.52	0.00	32.20	10.50	56.45	0.00	1811.88	1443.97	0.00	0.00	137.51	
Column totals							1811.88	230.41	1203.31	0.00						

KILBOURN AVENUE															
STATION	Real Station	Distance	AREA (SF)				Incremental Vol (CY) (Unadjusted)				Cumulative Vol (CY)				Mass Ordinate
			Cut	Salvaged/Unusable Pavement Material	Fill	EBS	Cut	Salvaged/Unusable Pavement Material	Fill	EBS	Cut 1.00	Expanded Fill 1.20	Expanded EBS Backfill 1.30	Reduced EBS In Fill 0.80	
3+50.01 AH	325.00		133.53	0.00	109.69	0.00	0.00	0.00	0.00	0.00	0.00	0.00	0.00	0.00	0.00
4+00.00	350.00	25.00	159.99	11.25	105.73	0.00	135.89	5.21	99.73	0.00	135.89	119.68	0.00	0.00	11.00
4+50.00	375.00	25.00	91.1	11.25	2.14	0.00	116.25	10.42	49.94	0.00	252.13	179.61	0.00	0.00	56.90
5+00.00	400.00	25.00	88.98	11.25	1.76	0.00	83.37	10.42	1.81	0.00	335.50	181.77	0.00	0.00	127.69
5+50.00	425.00	25.00	96.99	11.25	1.76	0.00	86.10	10.42	1.63	0.00	421.60	183.73	0.00	0.00	201.42
6+00.00	450.00	25.00	117.52	11.25	0	0.00	99.31	10.42	0.81	0.00	520.91	184.71	0.00	0.00	289.33
6+50.00	475.00	25.00	114.82	11.25	0	0.00	107.56	10.42	0.00	0.00	628.48	184.71	0.00	0.00	386.48
7+00.00	500.00	25.00	87.88	11.25	0	0.00	93.84	10.42	0.00	0.00	722.32	184.71	0.00	0.00	469.91
7+50.00	525.00	25.00	52.24	11.25	4.18	0.00	64.87	10.42	1.94	0.00	787.19	187.03	0.00	0.00	522.04
8+00.00	550.00	25.00	16.98	11.25	100.85	0.00	32.05	10.42	48.63	0.00	819.24	245.38	0.00	0.00	485.32
8+50.00	575.00	25.00	13.1	11.25	149.15	0.00	13.93	10.42	115.74	0.00	833.16	384.27	0.00	0.00	349.94
9+00.00 BK	600.00	25.00	4.56	11.25	237.46	0.00	8.18	10.42	178.99	0.00	841.34	599.05	0.00	0.00	132.91
Column totals							841.34	109.38	499.21	0.00					

KILBOURN AVENUE															
STATION	Real Station	Distance	AREA (SF)				Incremental Vol (CY) (Unadjusted)				Cumulative Vol (CY)				Mass Ordinate
			Cut	Salvaged/Unusable Pavement Material	Fill	EBS	Cut	Salvaged/Unusable Pavement Material	Fill	EBS	Cut 1.00	Expanded Fill 1.20	Expanded EBS Backfill 1.30	Reduced EBS In Fill 0.80	
11+00.00 AH	1100.00		37.11	16.50	214.23	0.00	0.00	0.00	0.00	0.00	0.00	0.00	0.00	0.00	0.00
11+50.00	1125.00	25.00	68.47	16.50	142.3	0.00	48.88	15.28	165.06	0.00	48.88	198.07	0.00	0.00	-164.47
12+00.00	1150.00	25.00	27.54	16.50	158.48	0.00	44.45	15.28	139.25	0.00	93.33	365.17	0.00	0.00	-302.40
12+50.00	1175.00	25.00	95.48	16.50	51.29	0.00	56.95	15.28	97.12	0.00	150.28	481.71	0.00	0.00	-377.26
13+00.00	1200.00	25.00	112.39	16.50	11.9	0.00	96.24	15.28	29.25	0.00	246.52	516.82	0.00	0.00	-331.41
13+12.34 BK	1225.00	25.00	102.14	16.50	9.41	0.00	99.32	15.28	9.87	0.00	345.84	528.66	0.00	0.00	-259.21
Column totals							345.84	76.39	440.55	0.00					

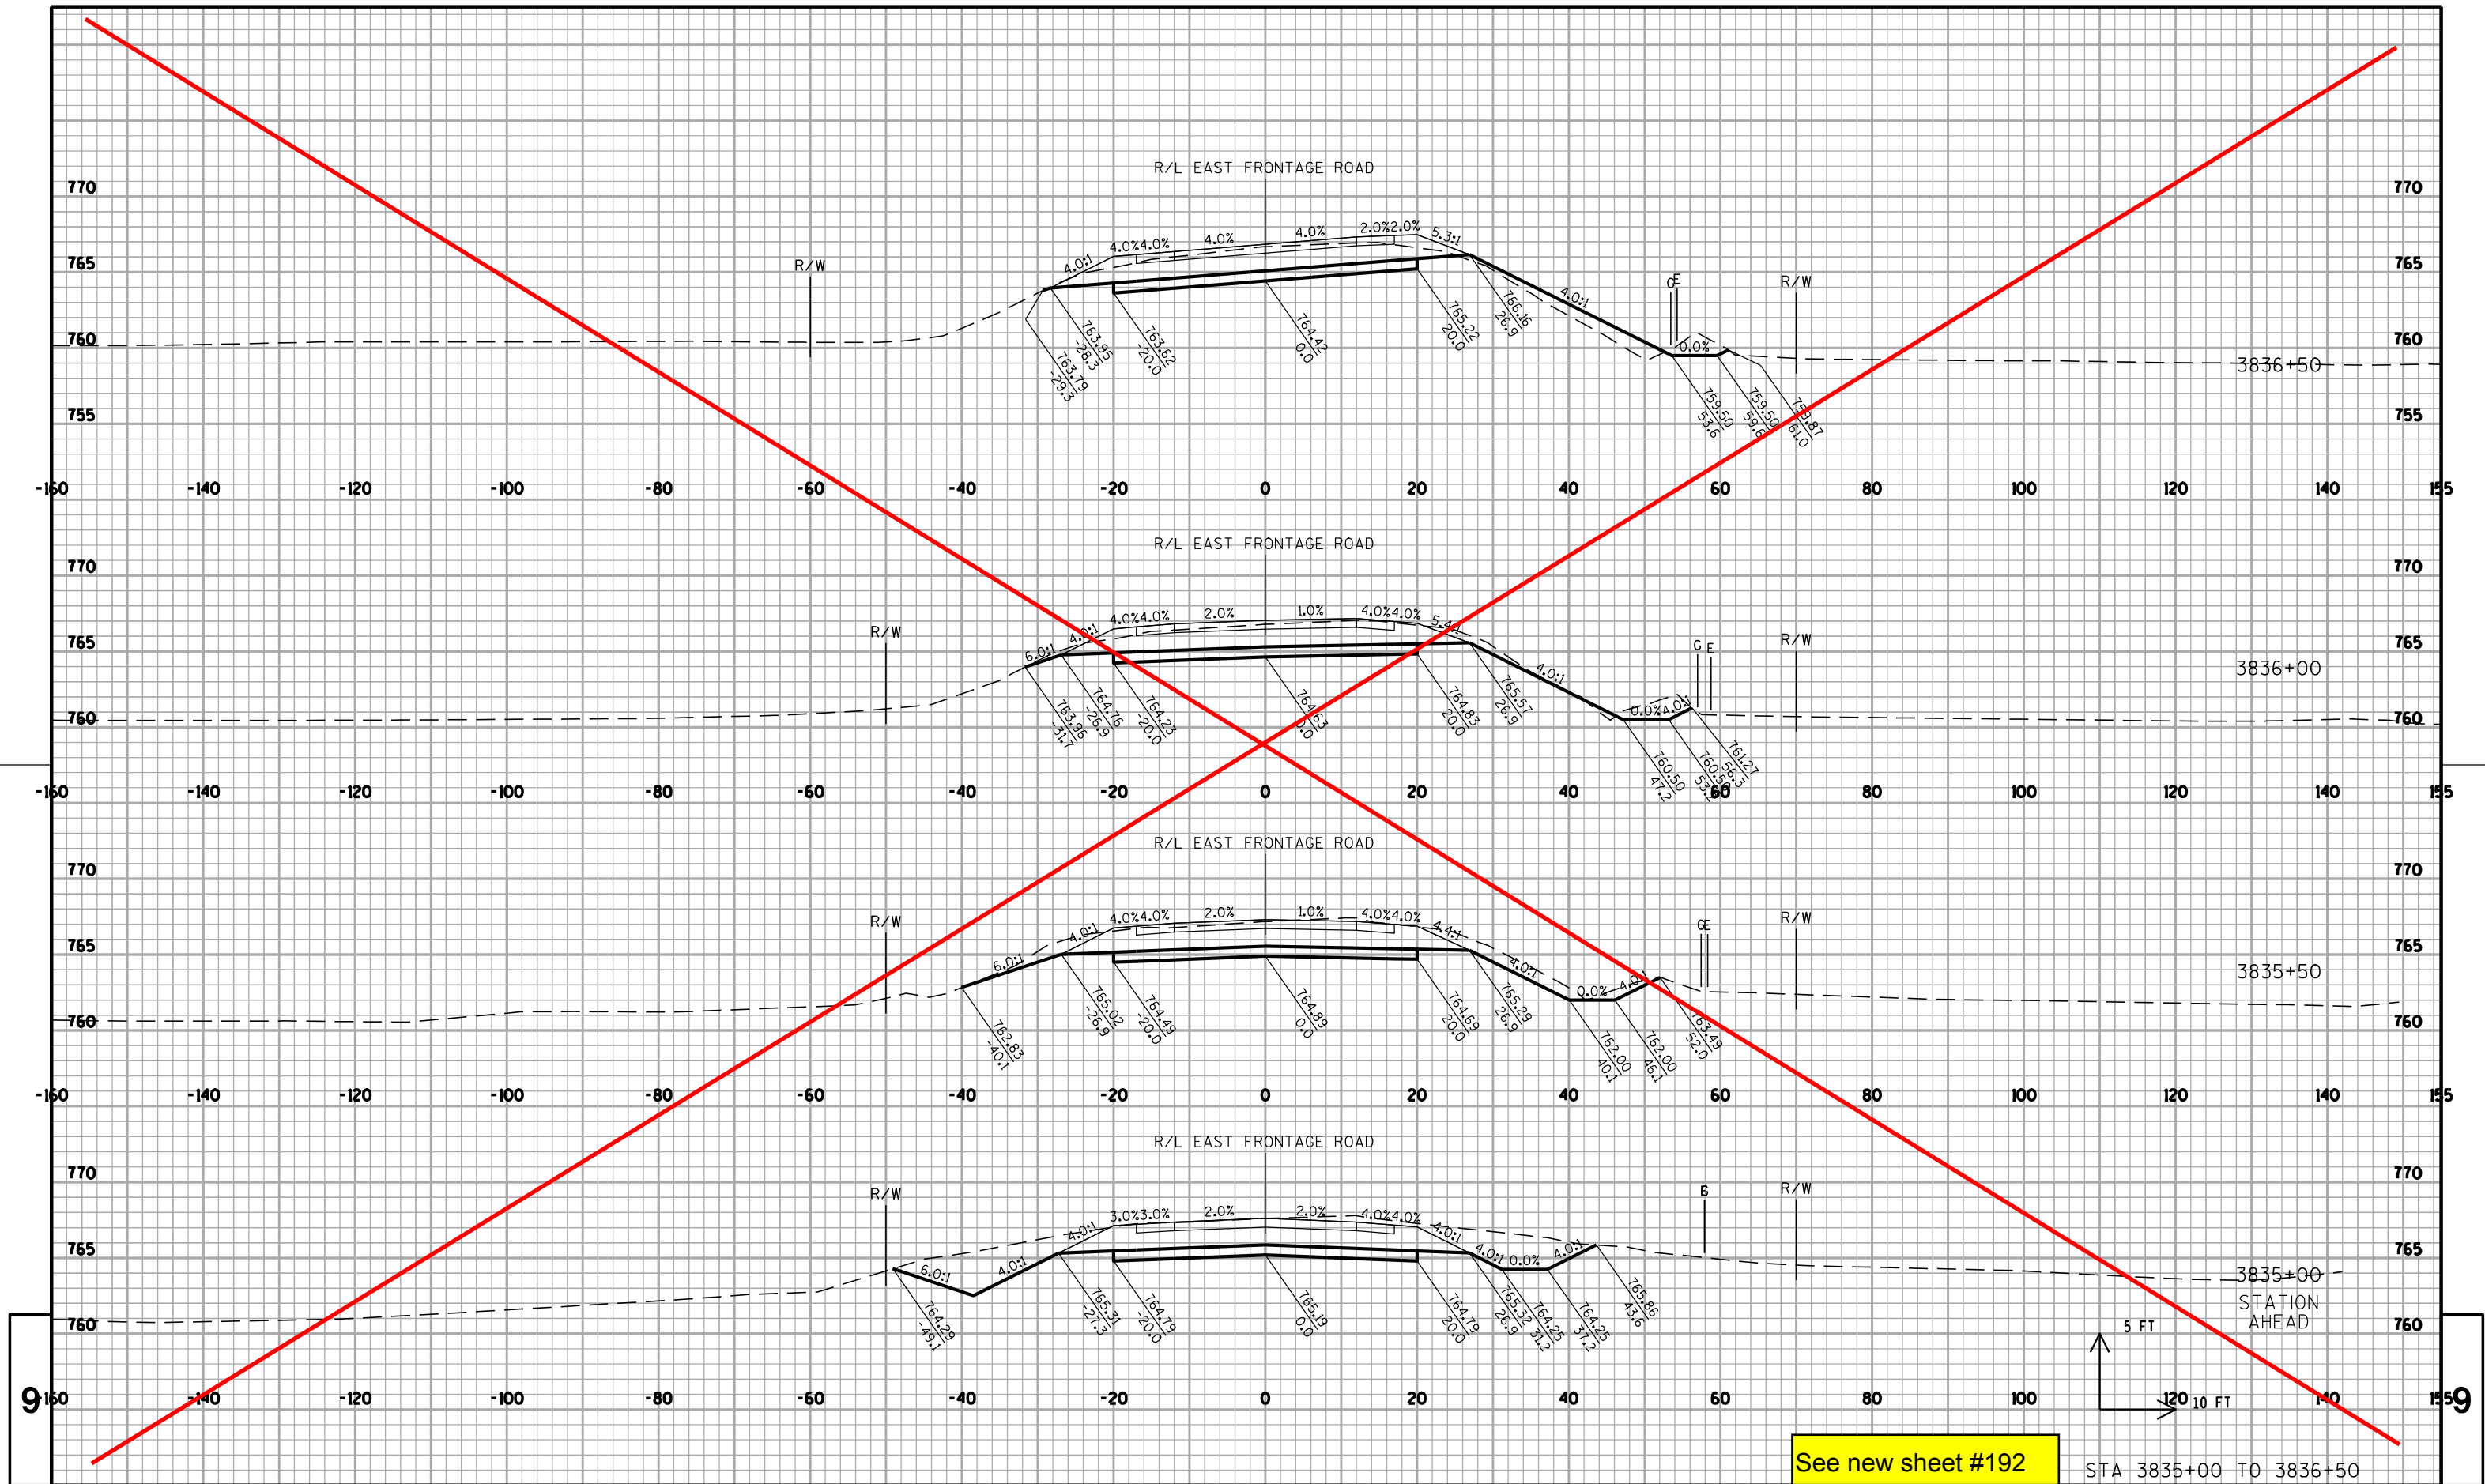

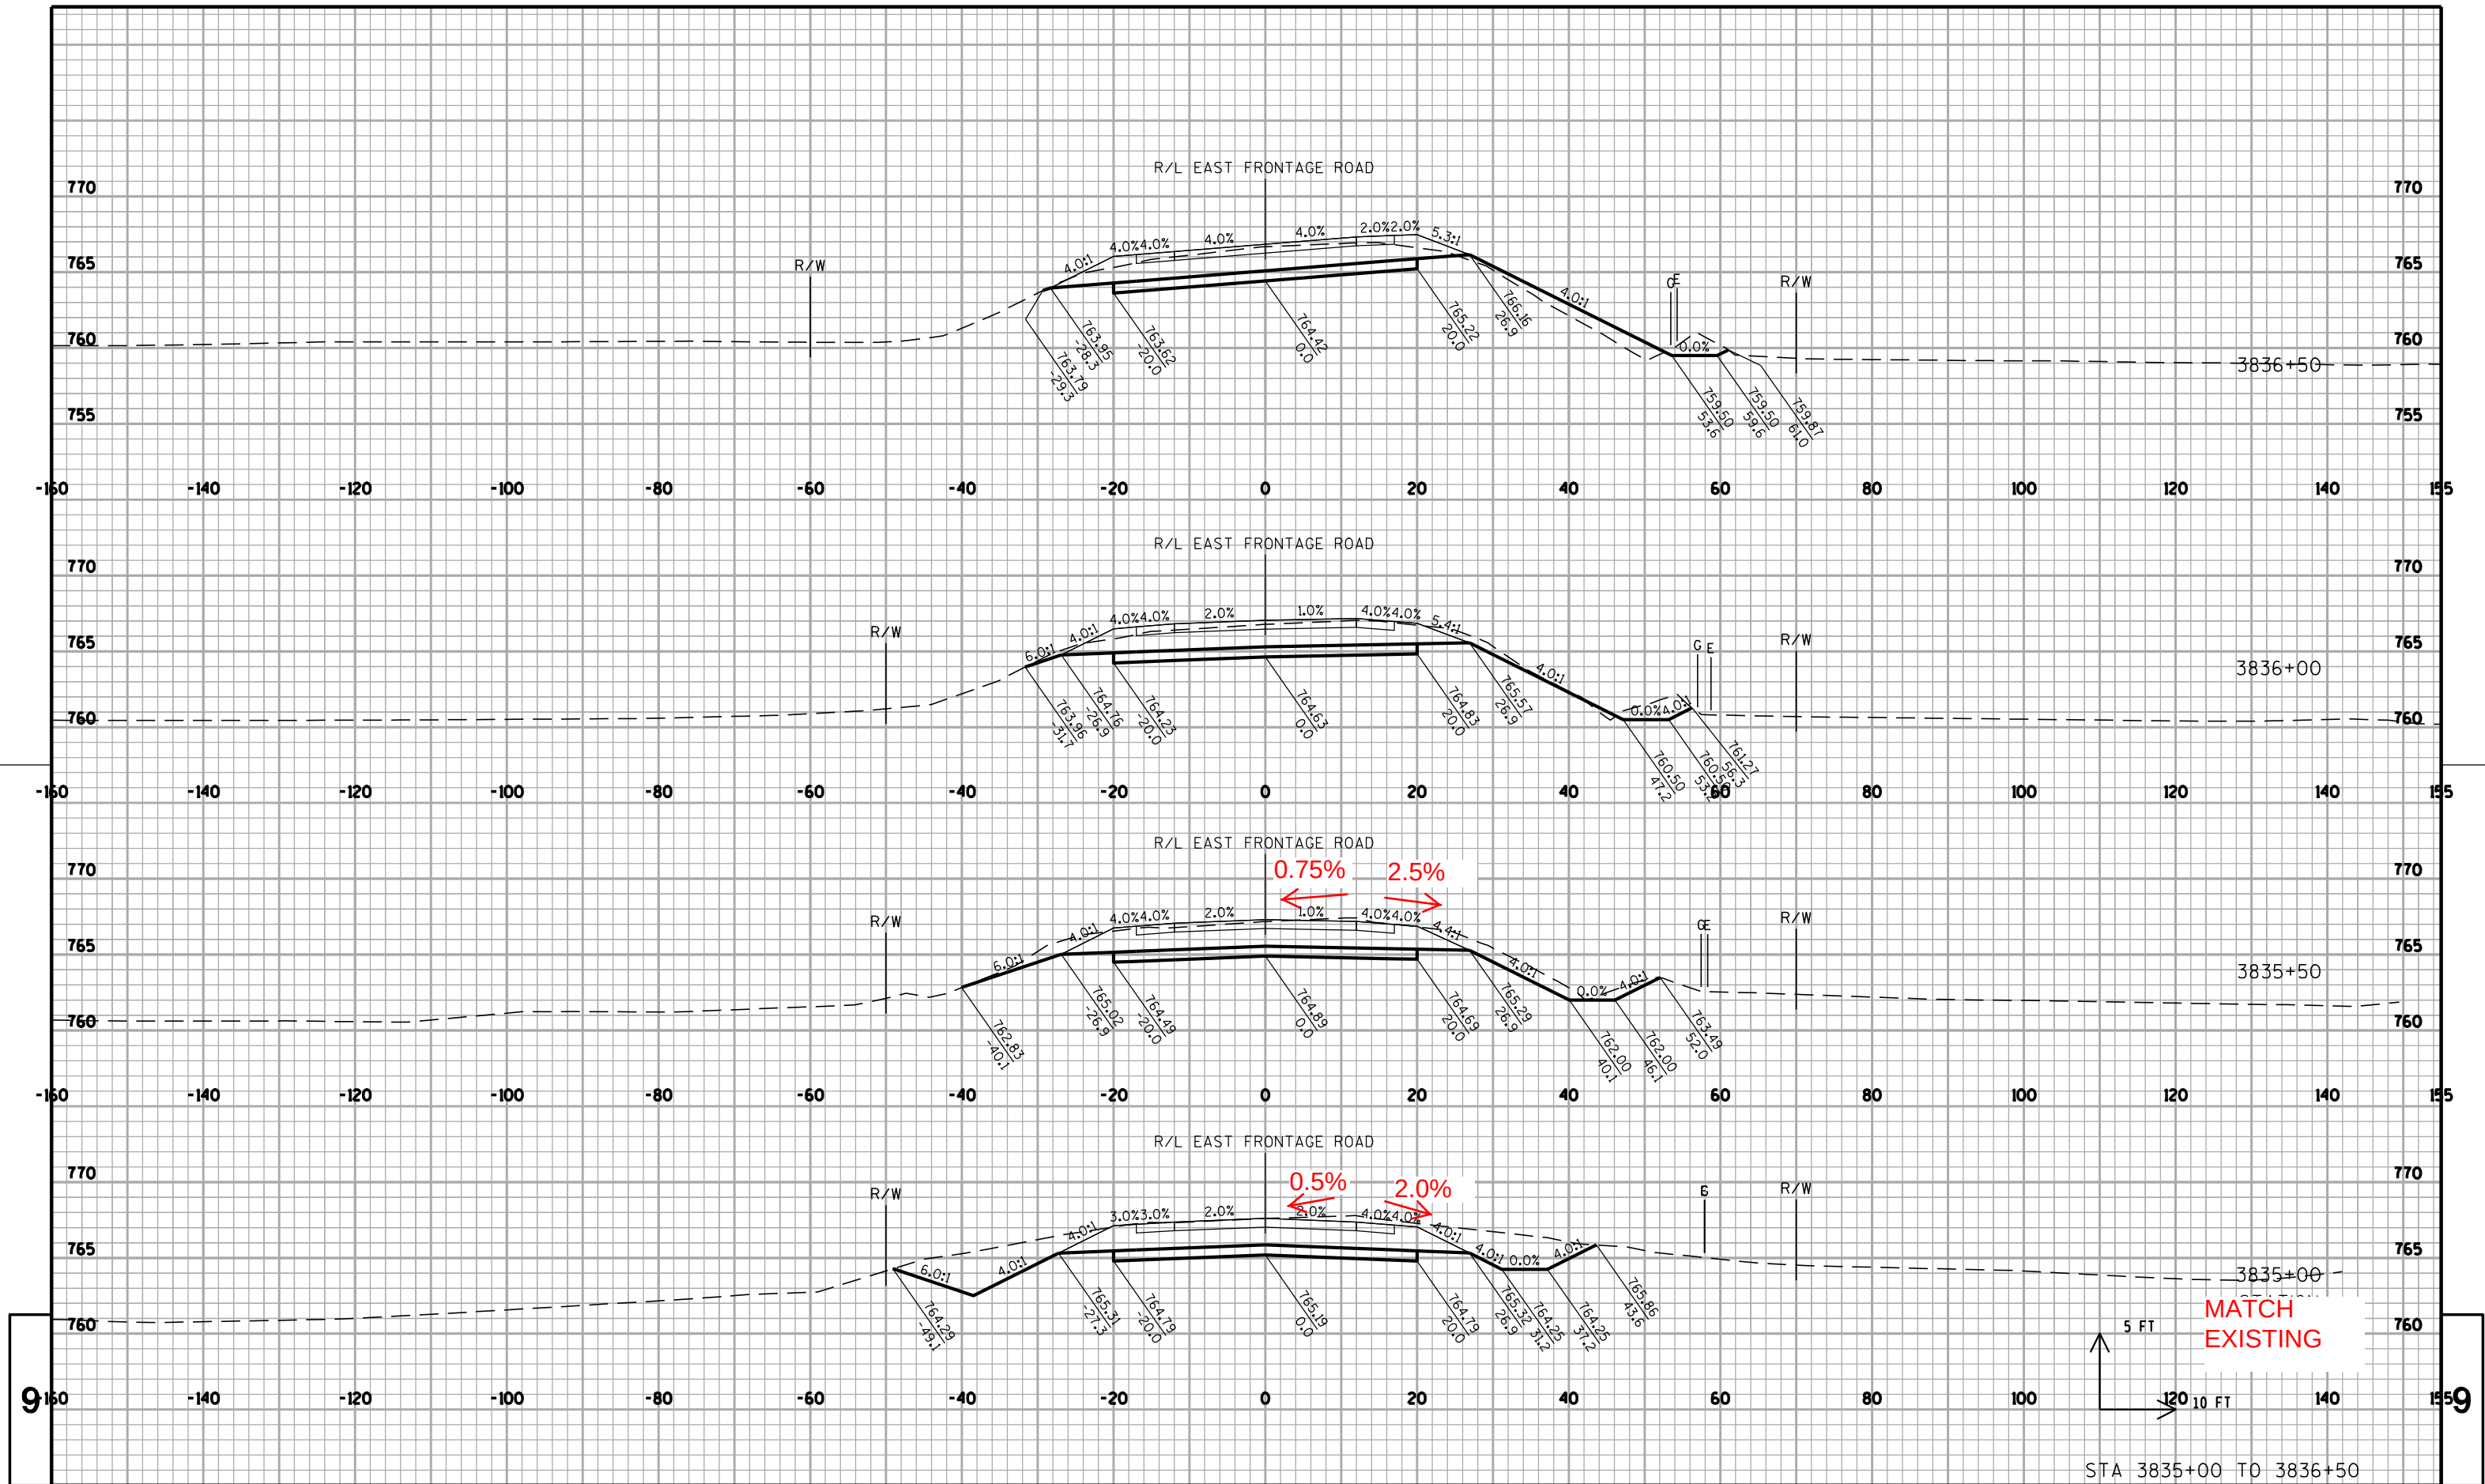

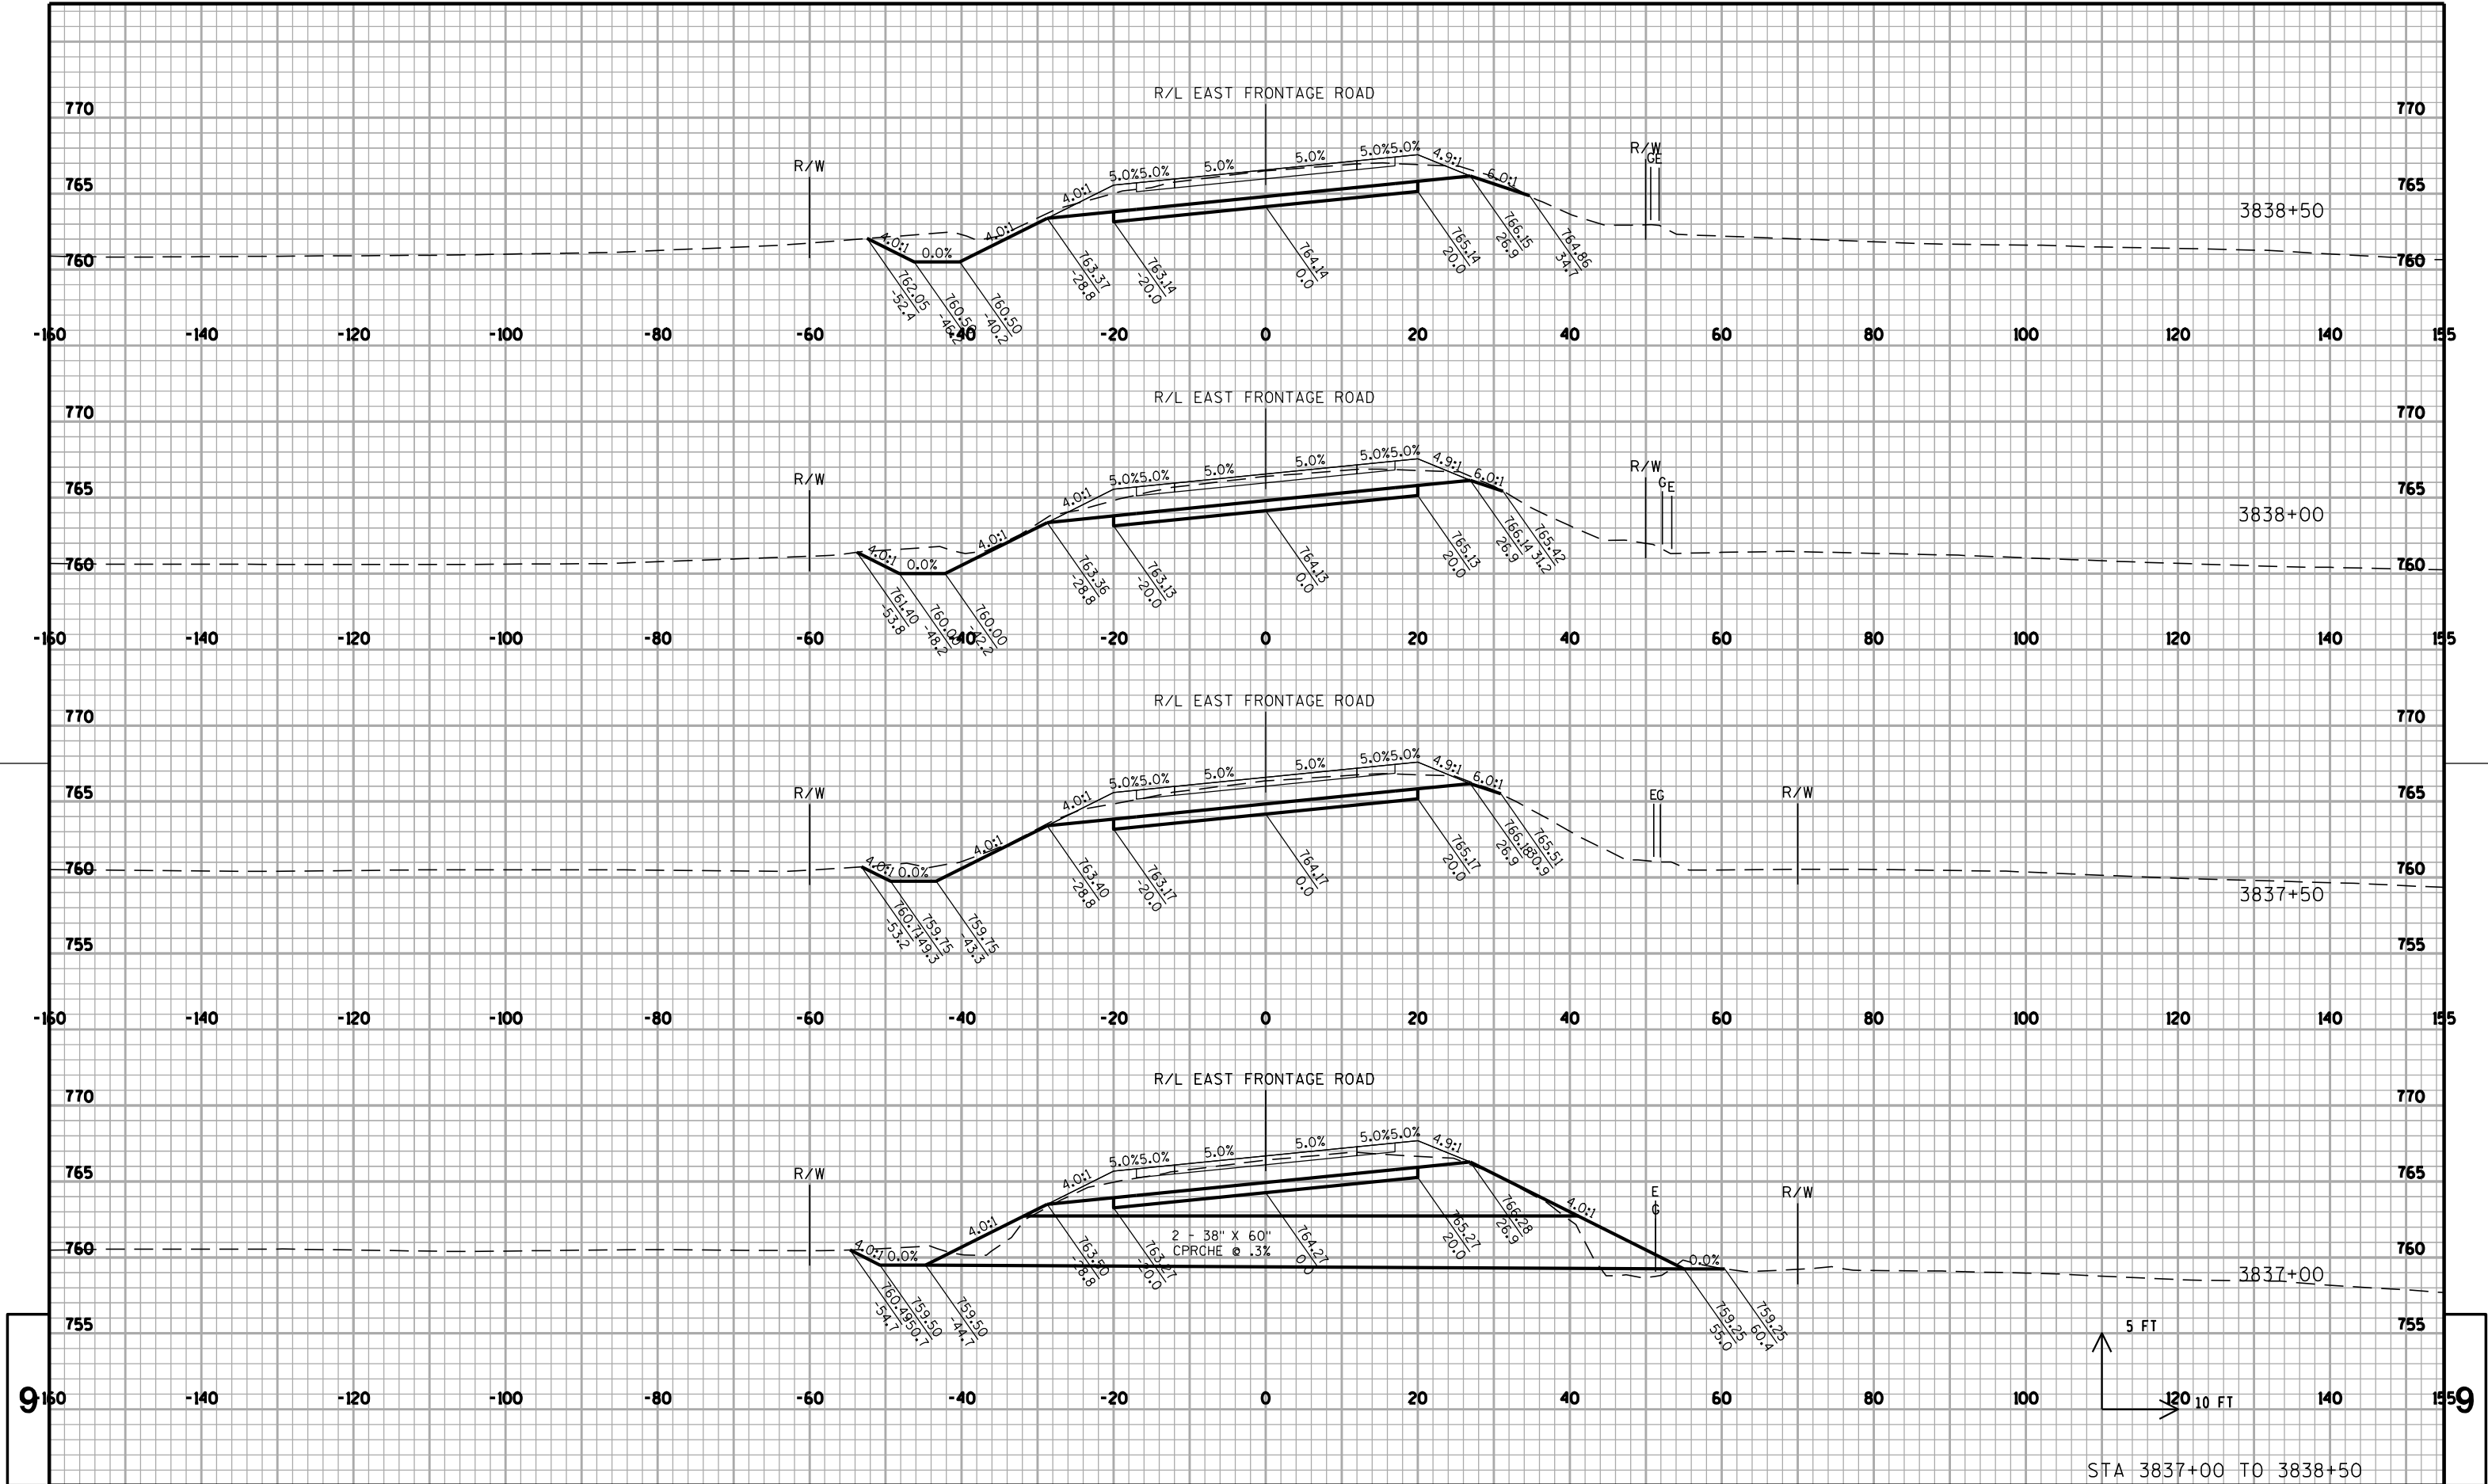

PROJECT NO:1033-02-70

HWY: IH 94/STH 20

COUNTY: RACINE

CROSS SECTIONS: EAST FRONTAGE ROAD - SOUTH

SHEET 193

E

FILE NAME : S:\FinalDesign\20\10330270-ENRoads\cds\090201-xs_frse.dgn


PLOT DATE : 07-DEC-2010 10:25


PLOT BY : MSCDIS


PLOT NAME : 090201-xs_frse1


PLOT SCALE : 20:1


WISDOT/CADDs SHEET 21

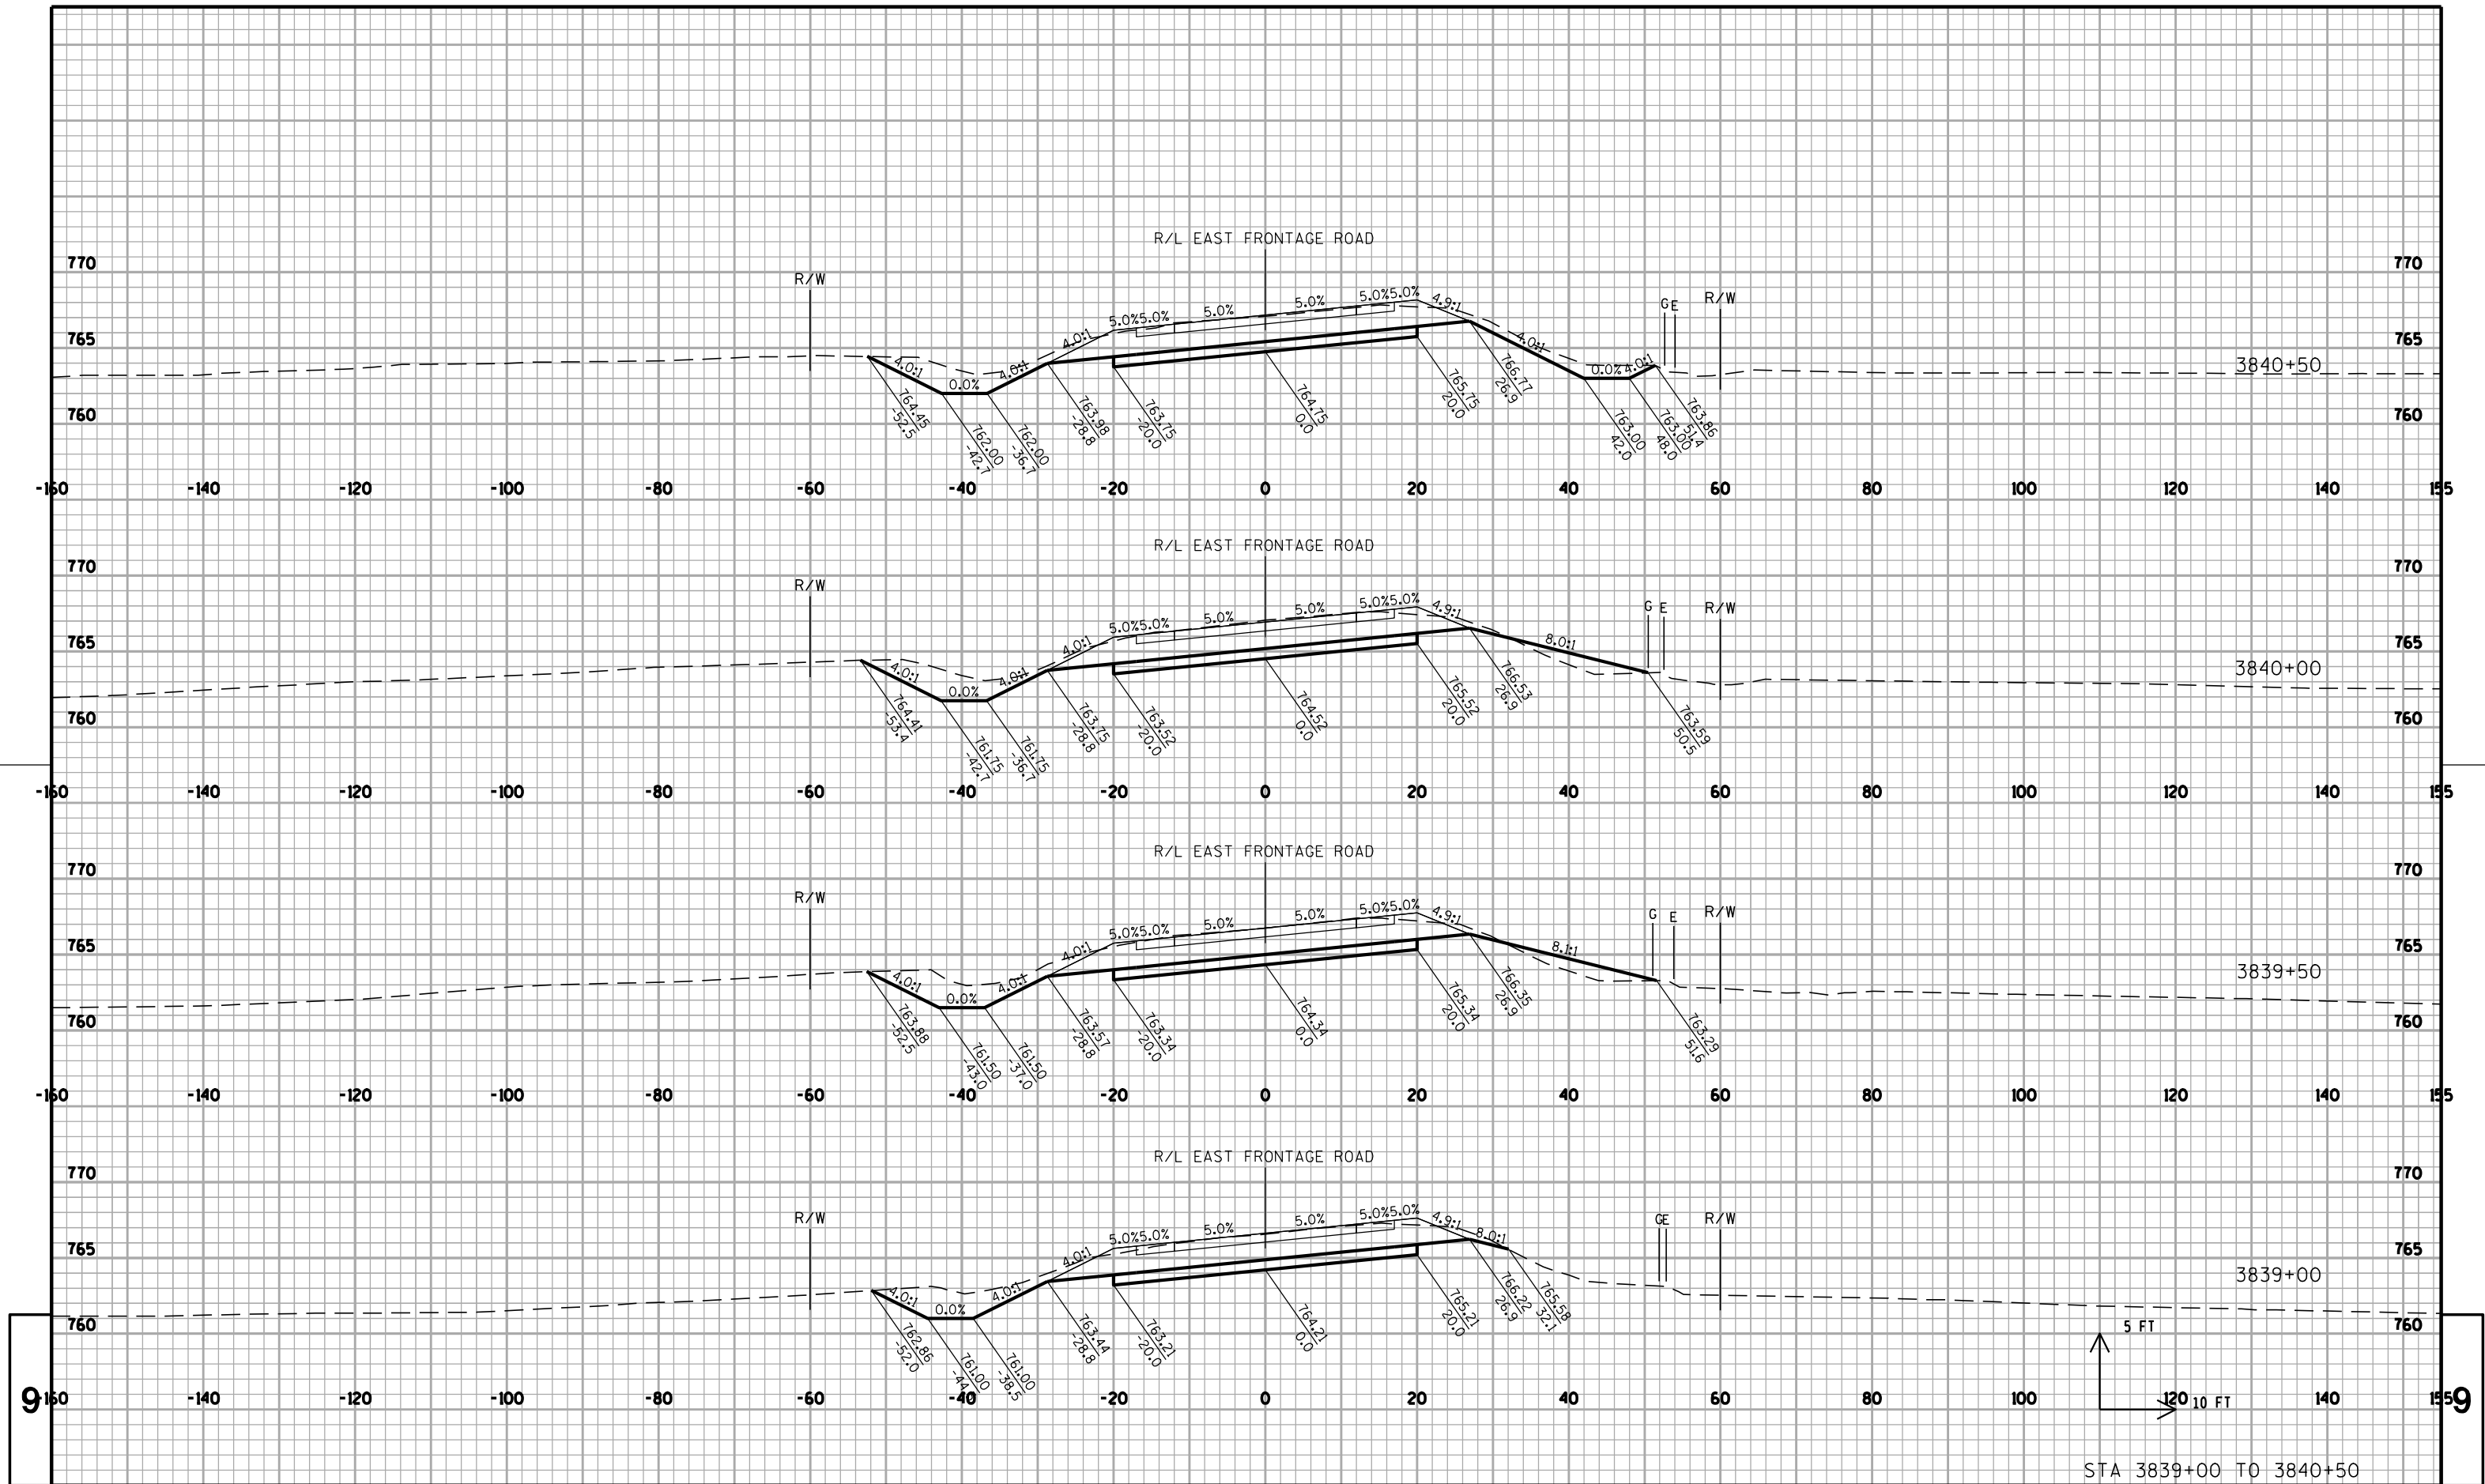

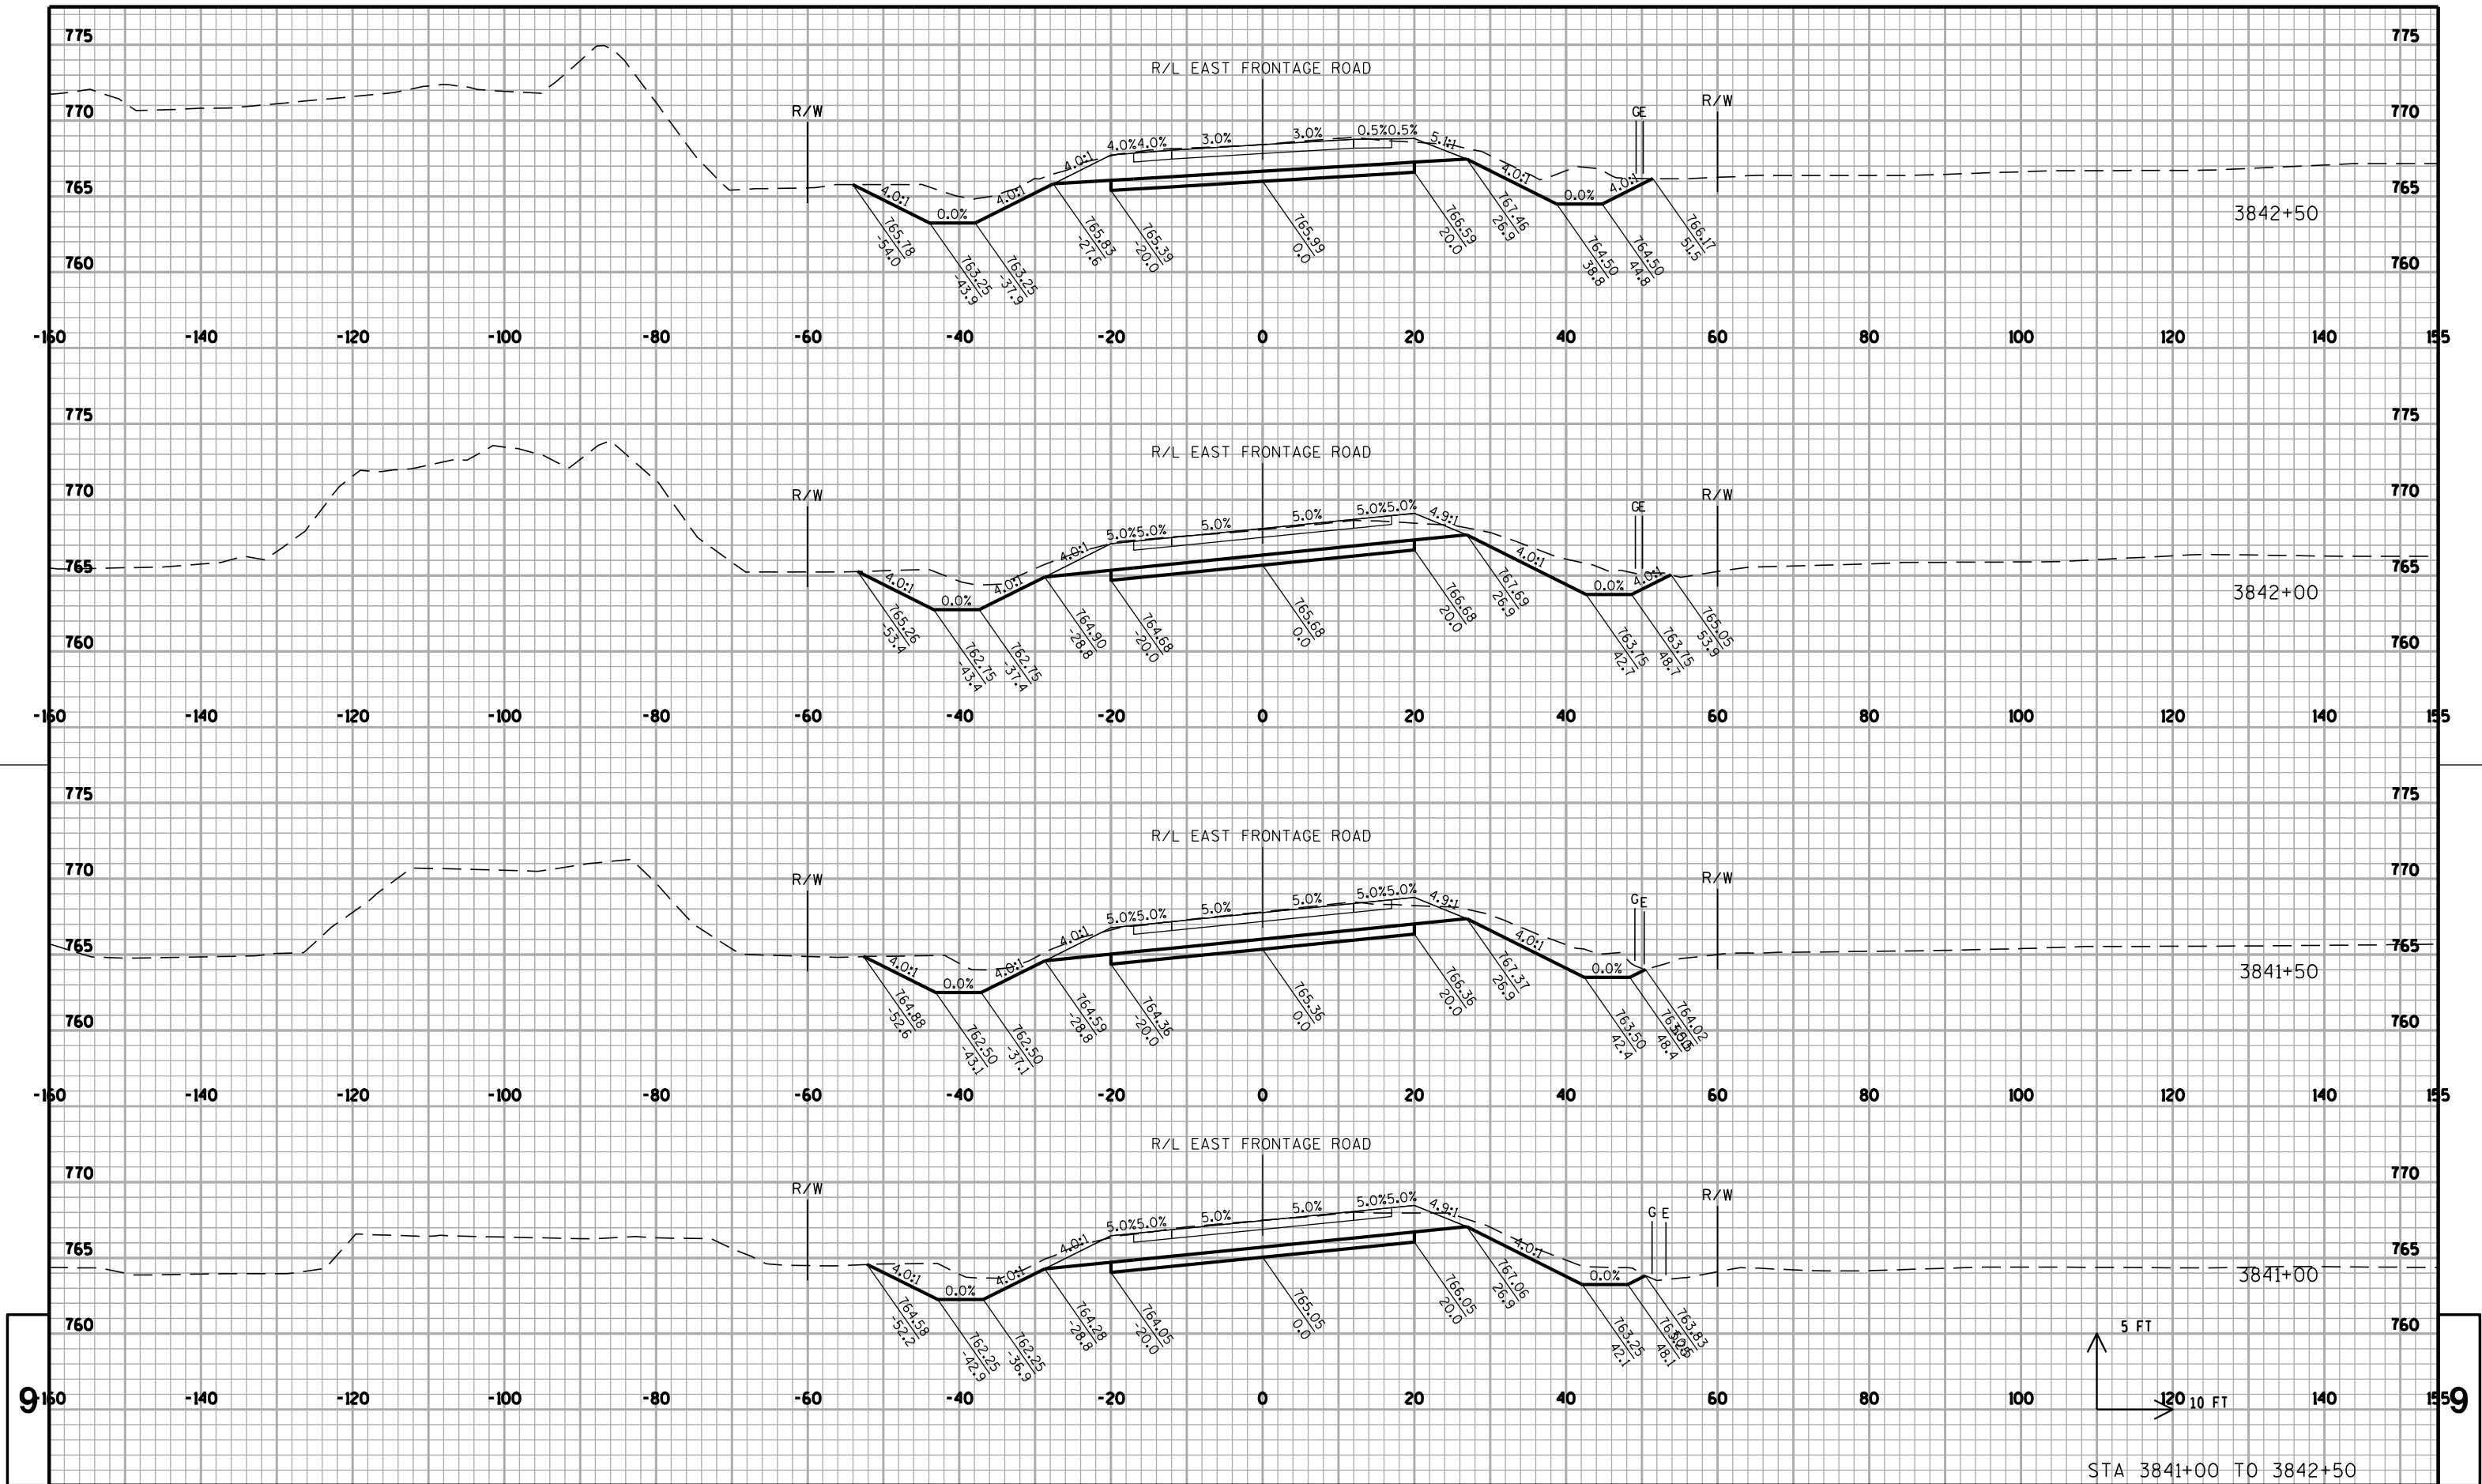

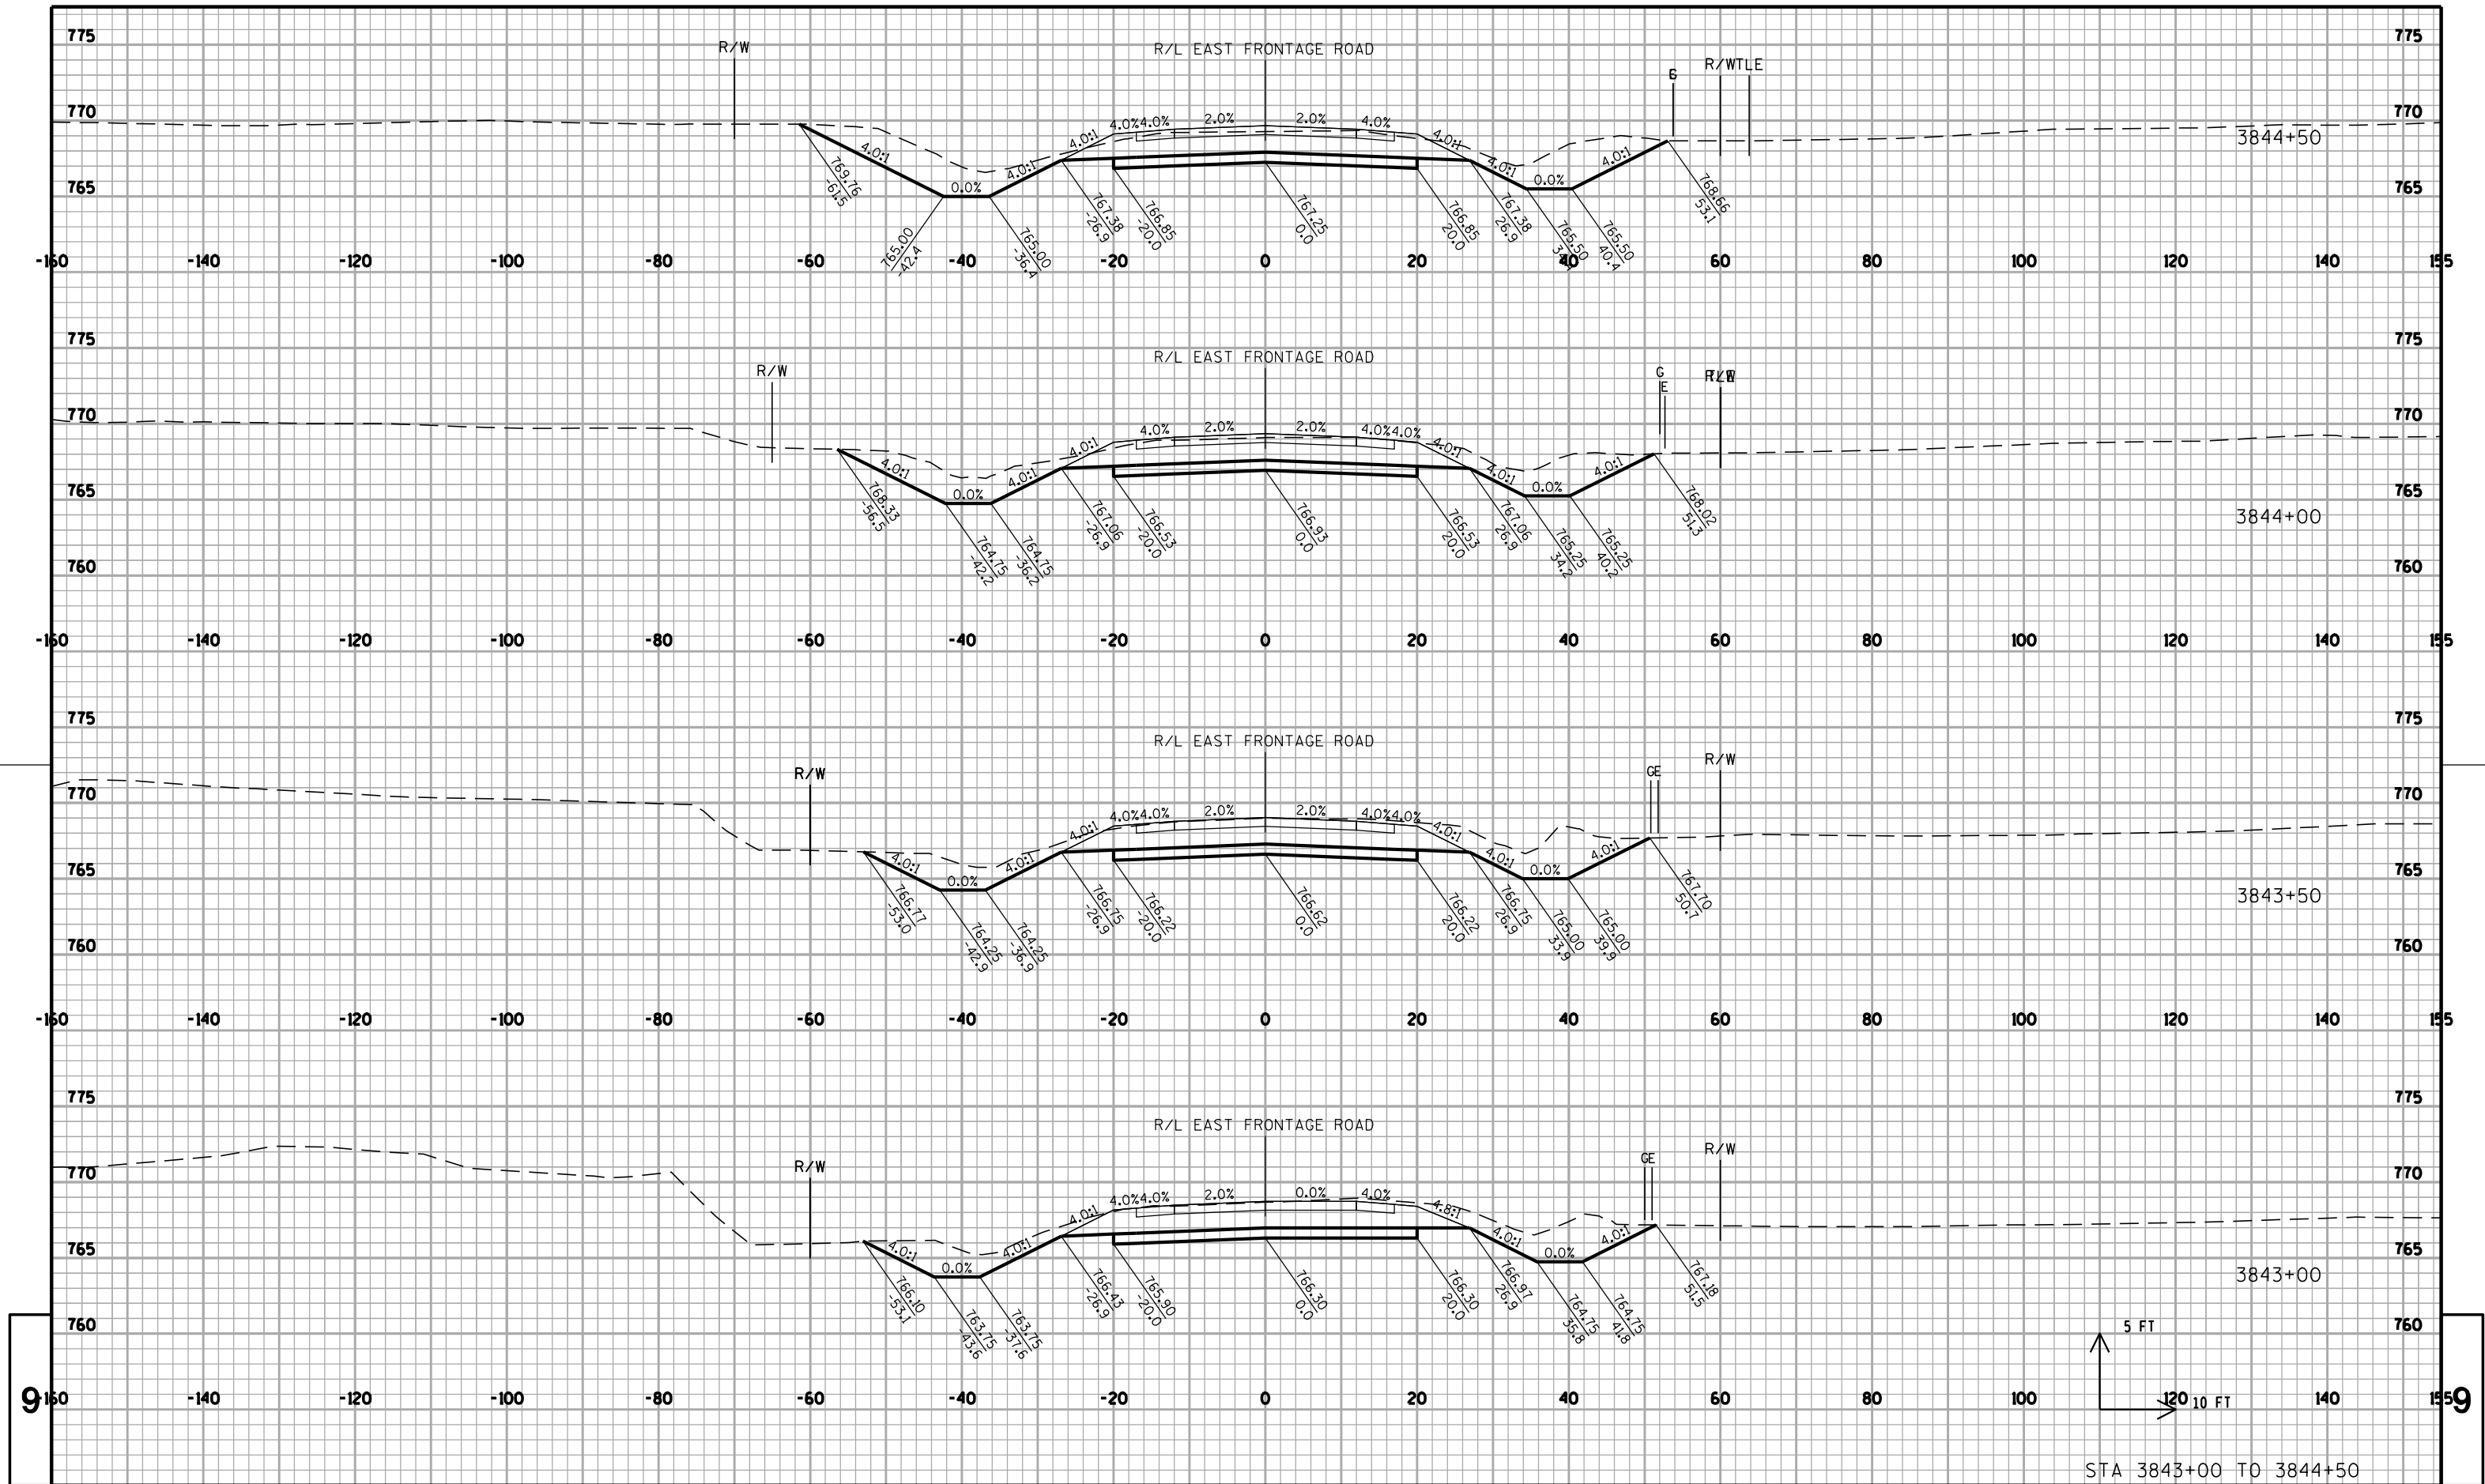

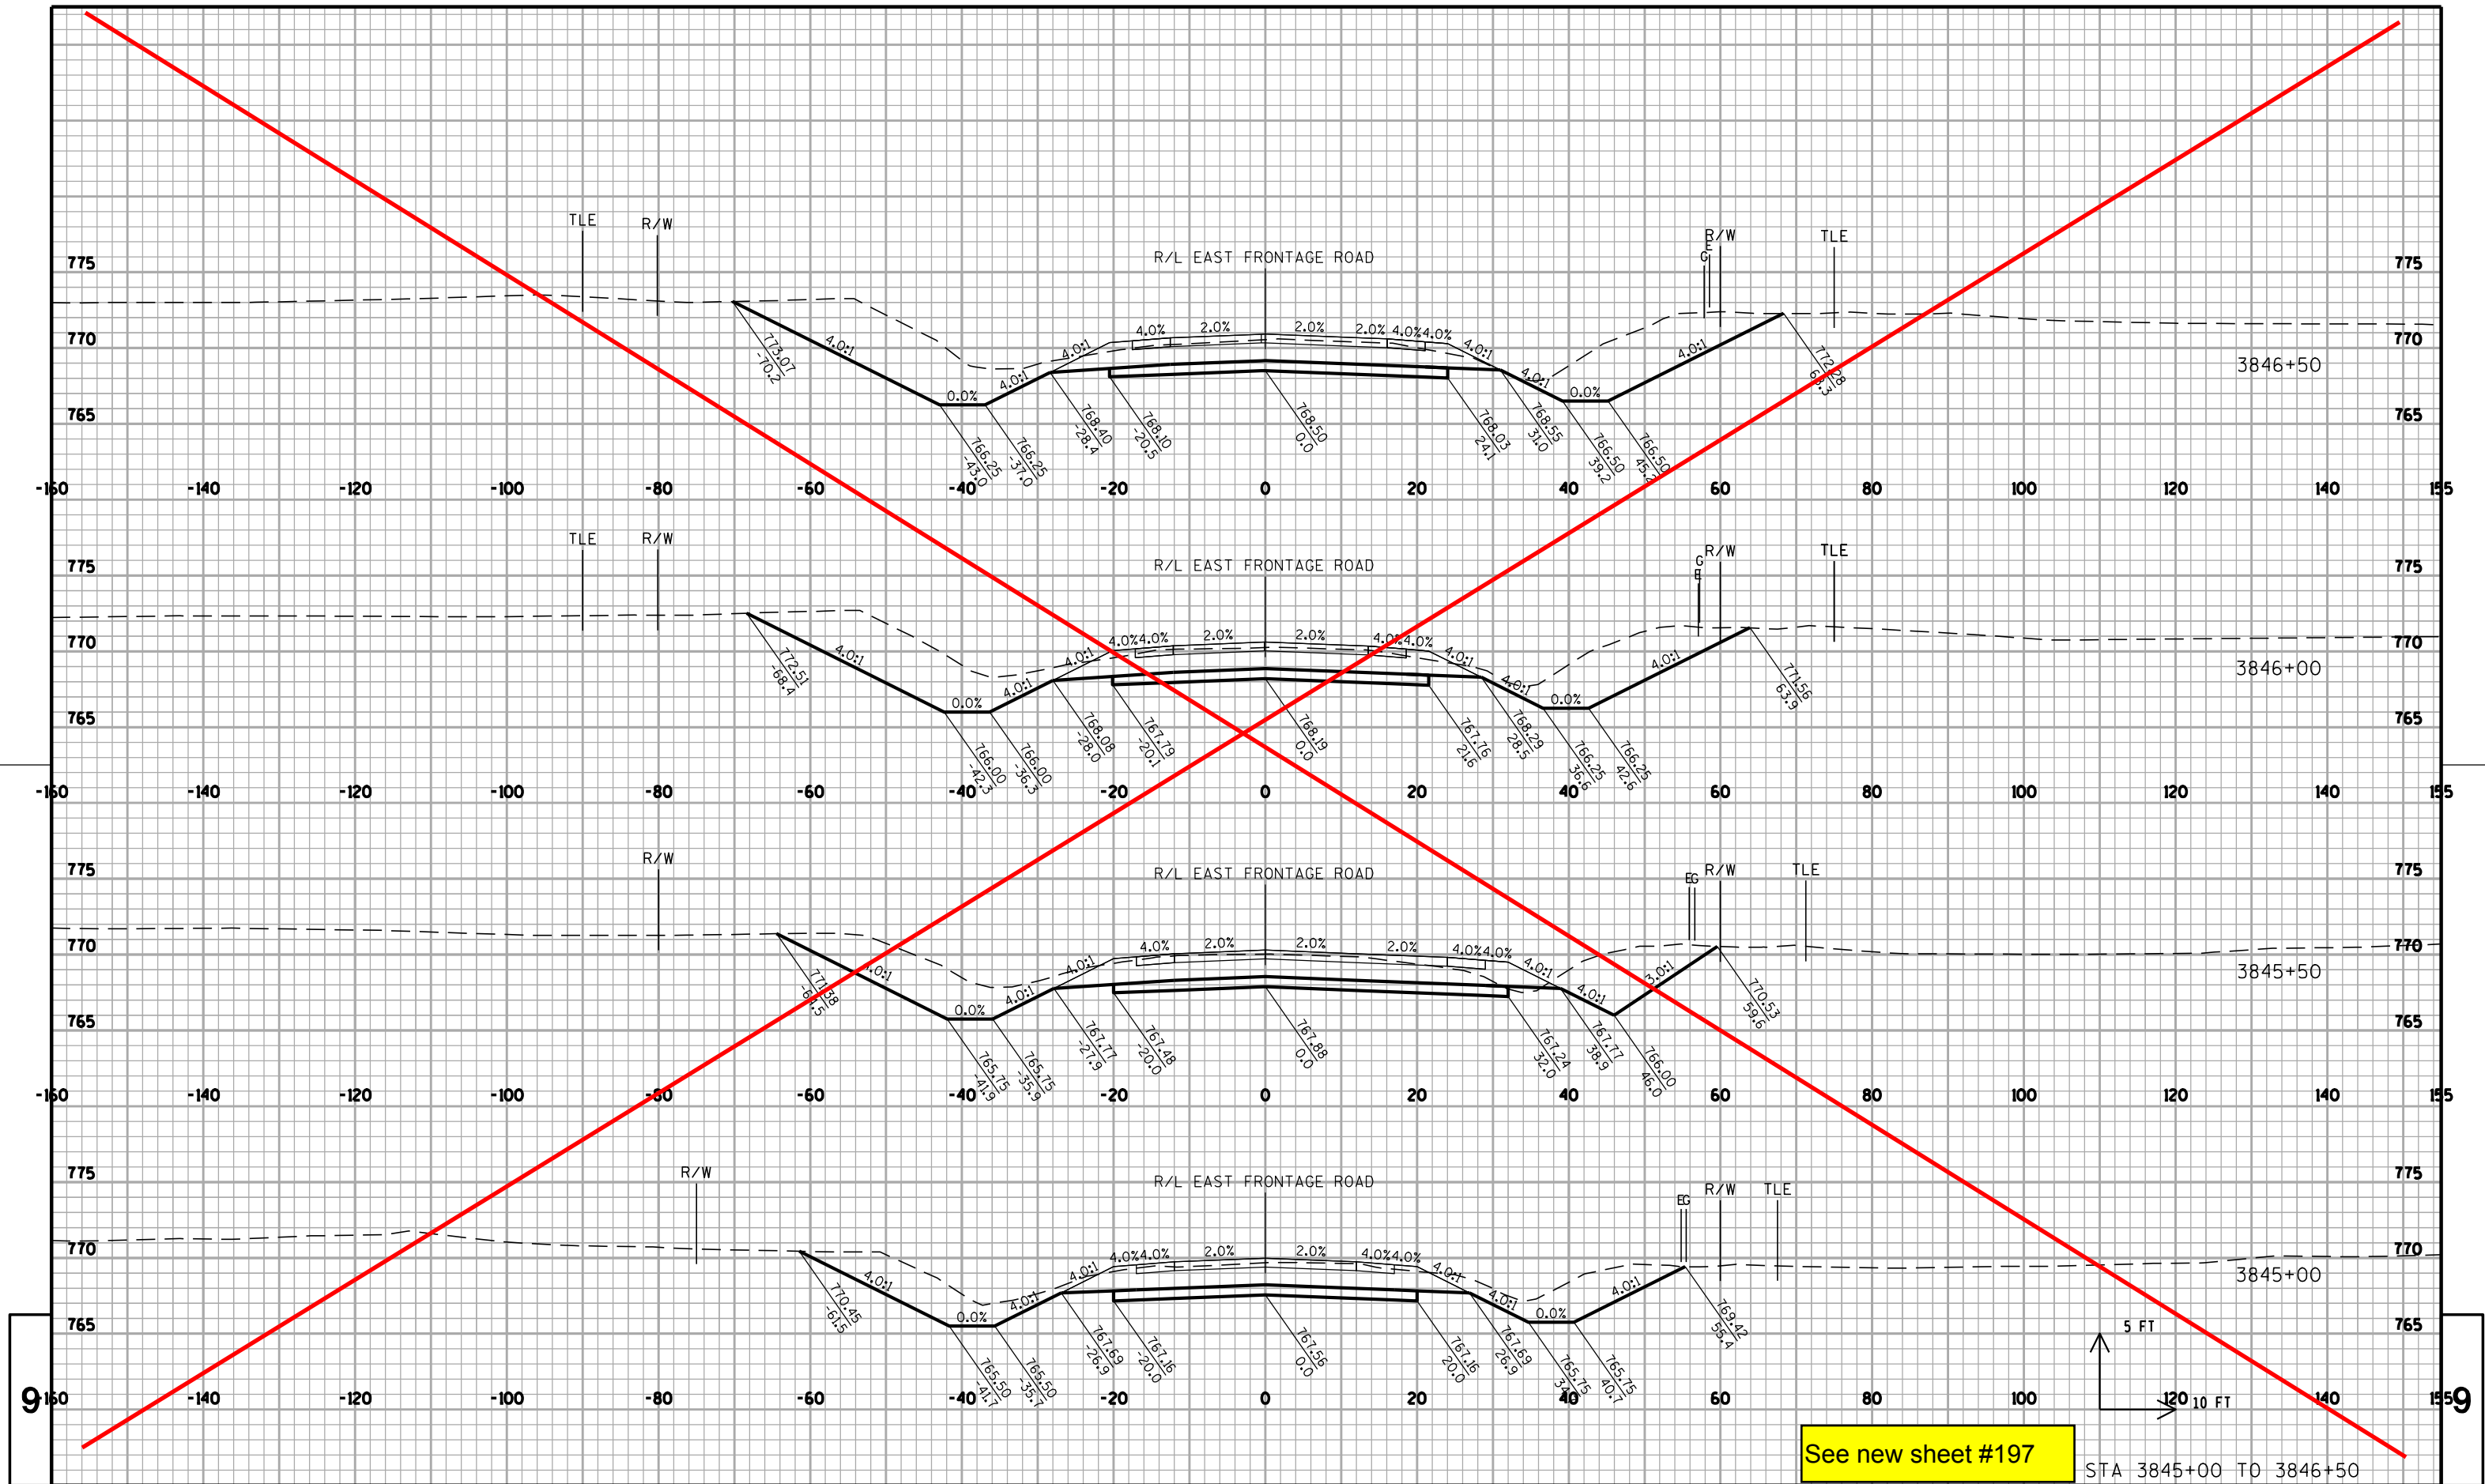

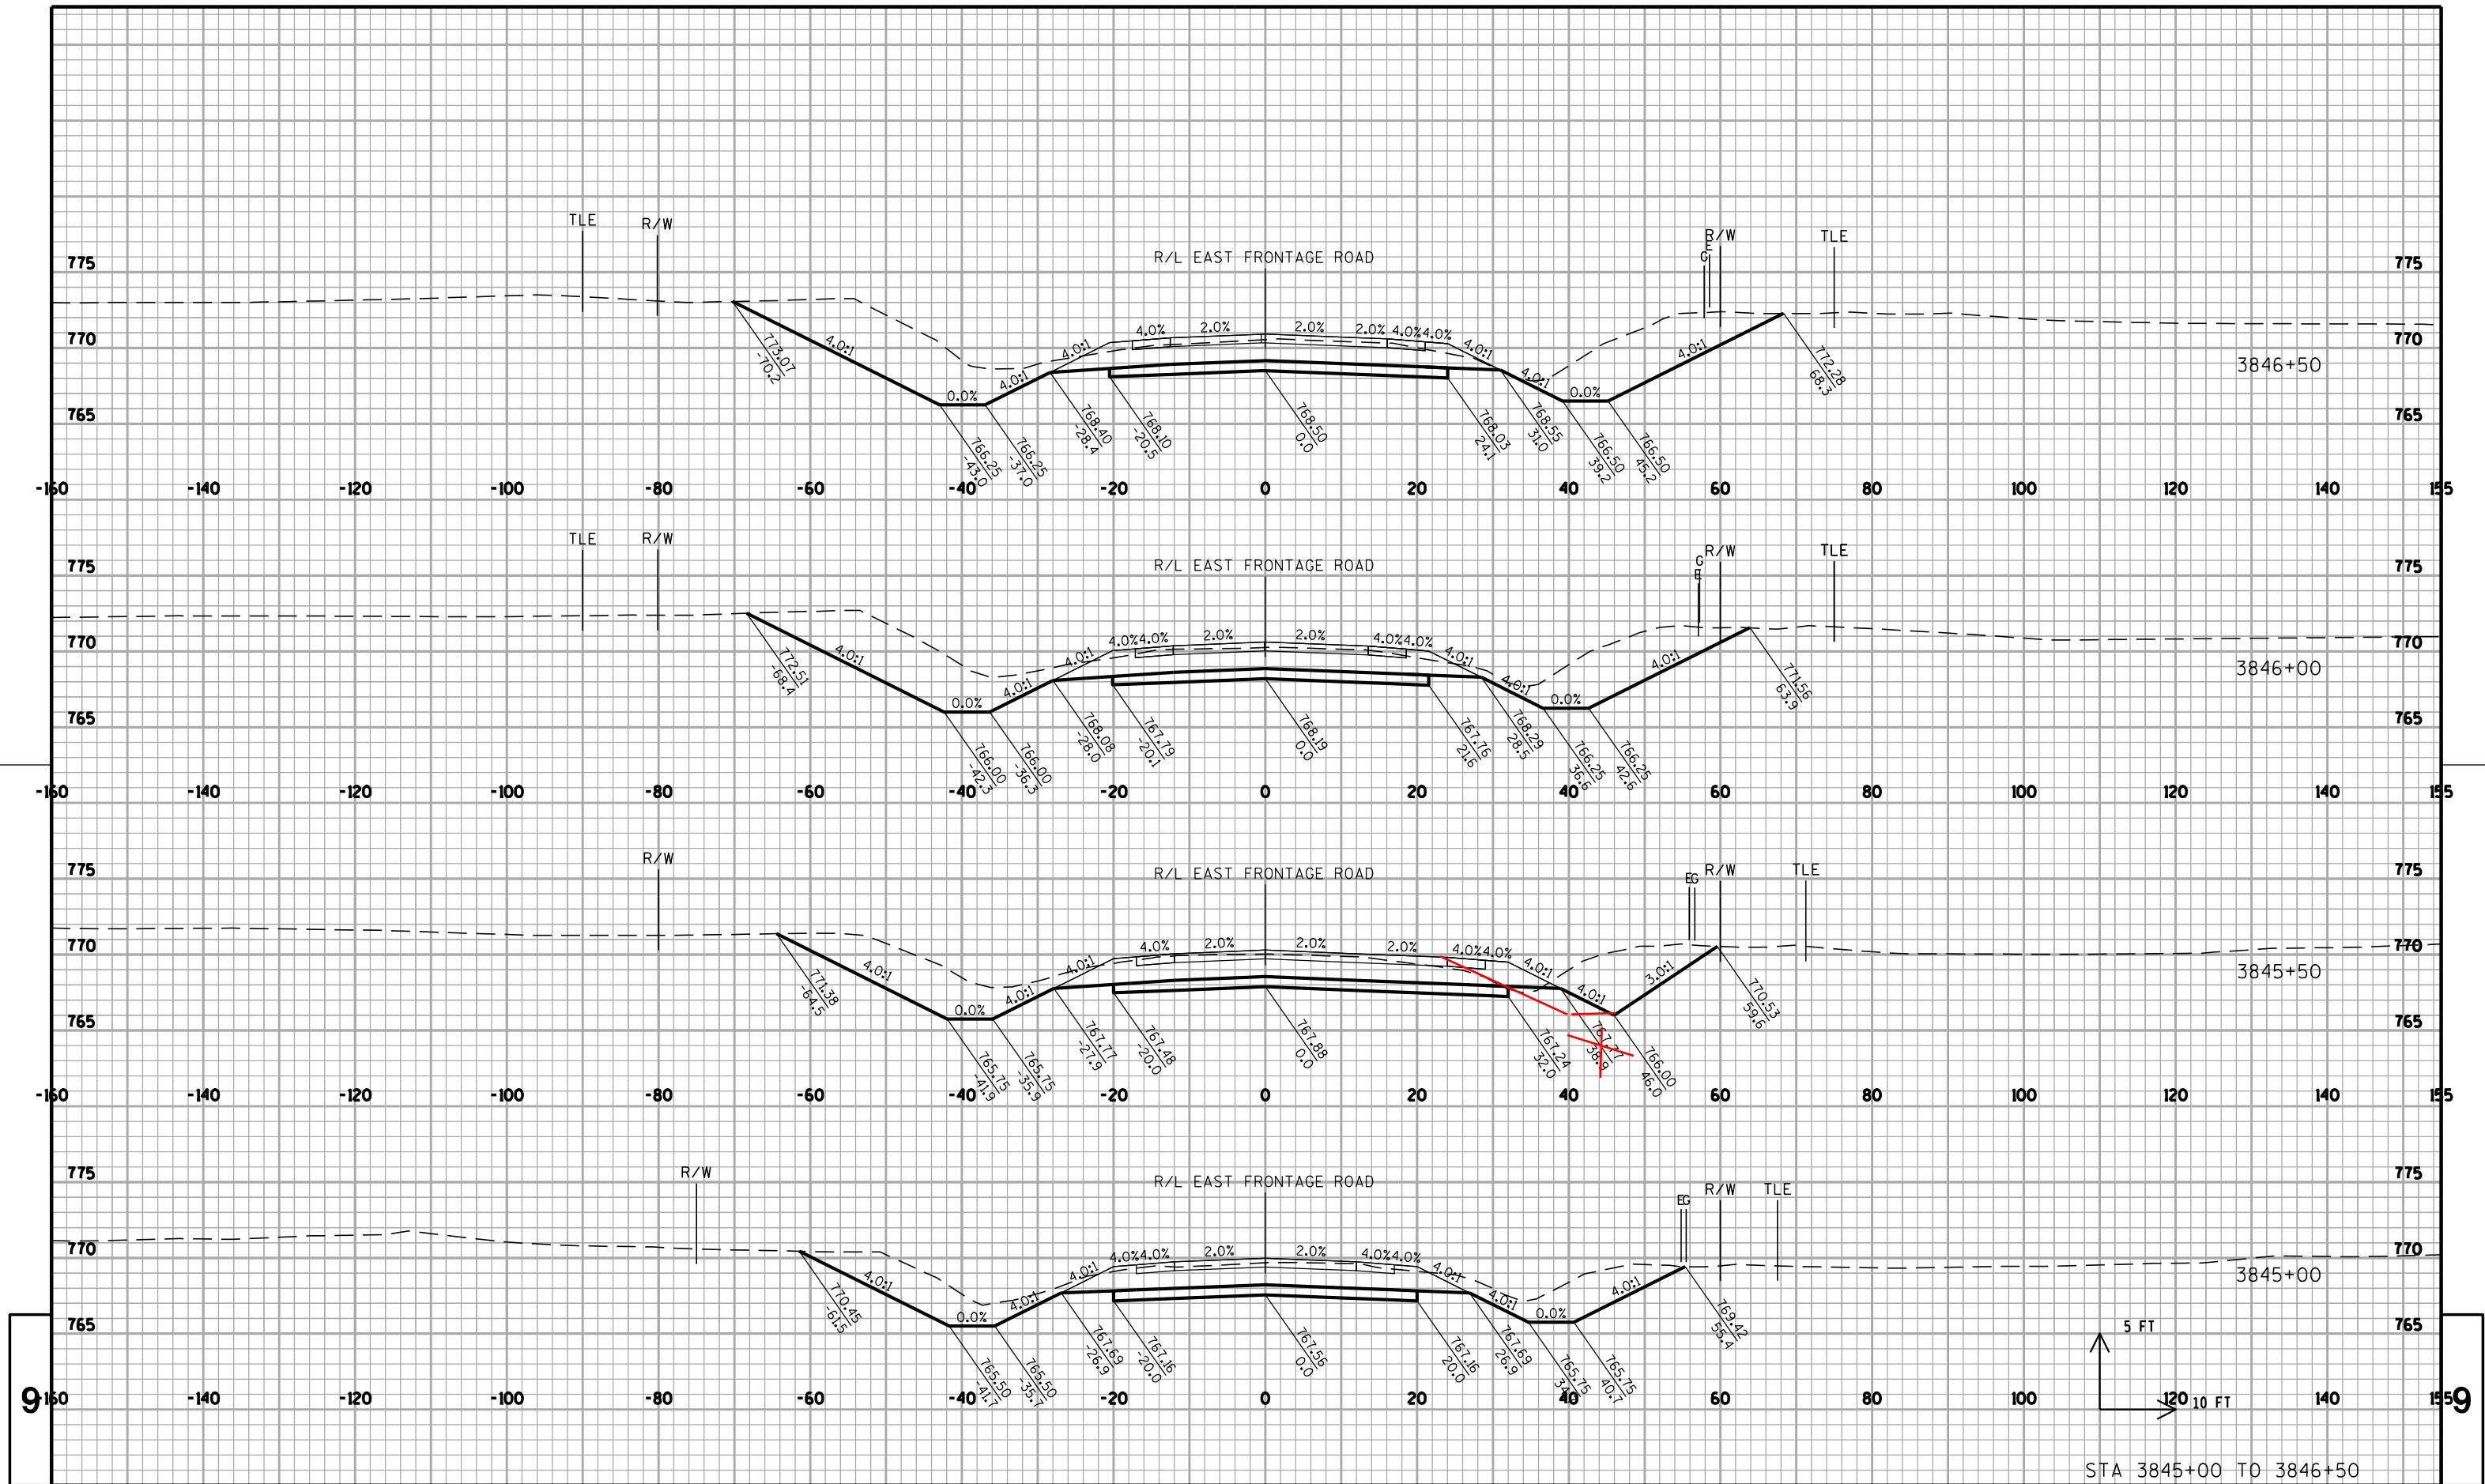

PROJECT NO:1033-02-70

HWY: IH 94/STH 20

COUNTY: RACINE

CROSS SECTIONS: EAST FRONTAGE ROAD - SOUTH

SHEET 197

E

FILE NAME : S:\FinalDesign\20\10330270-ENRoads\cds\090201-xs_frse.dgn


PLOT DATE : 07-DEC-2010 10:26

PLOT BY : MSCDIS

PLOT NAME : 090201-xs_frse5

PLOT SCALE : 20:1

WISDOT/CADDs SHEET 21

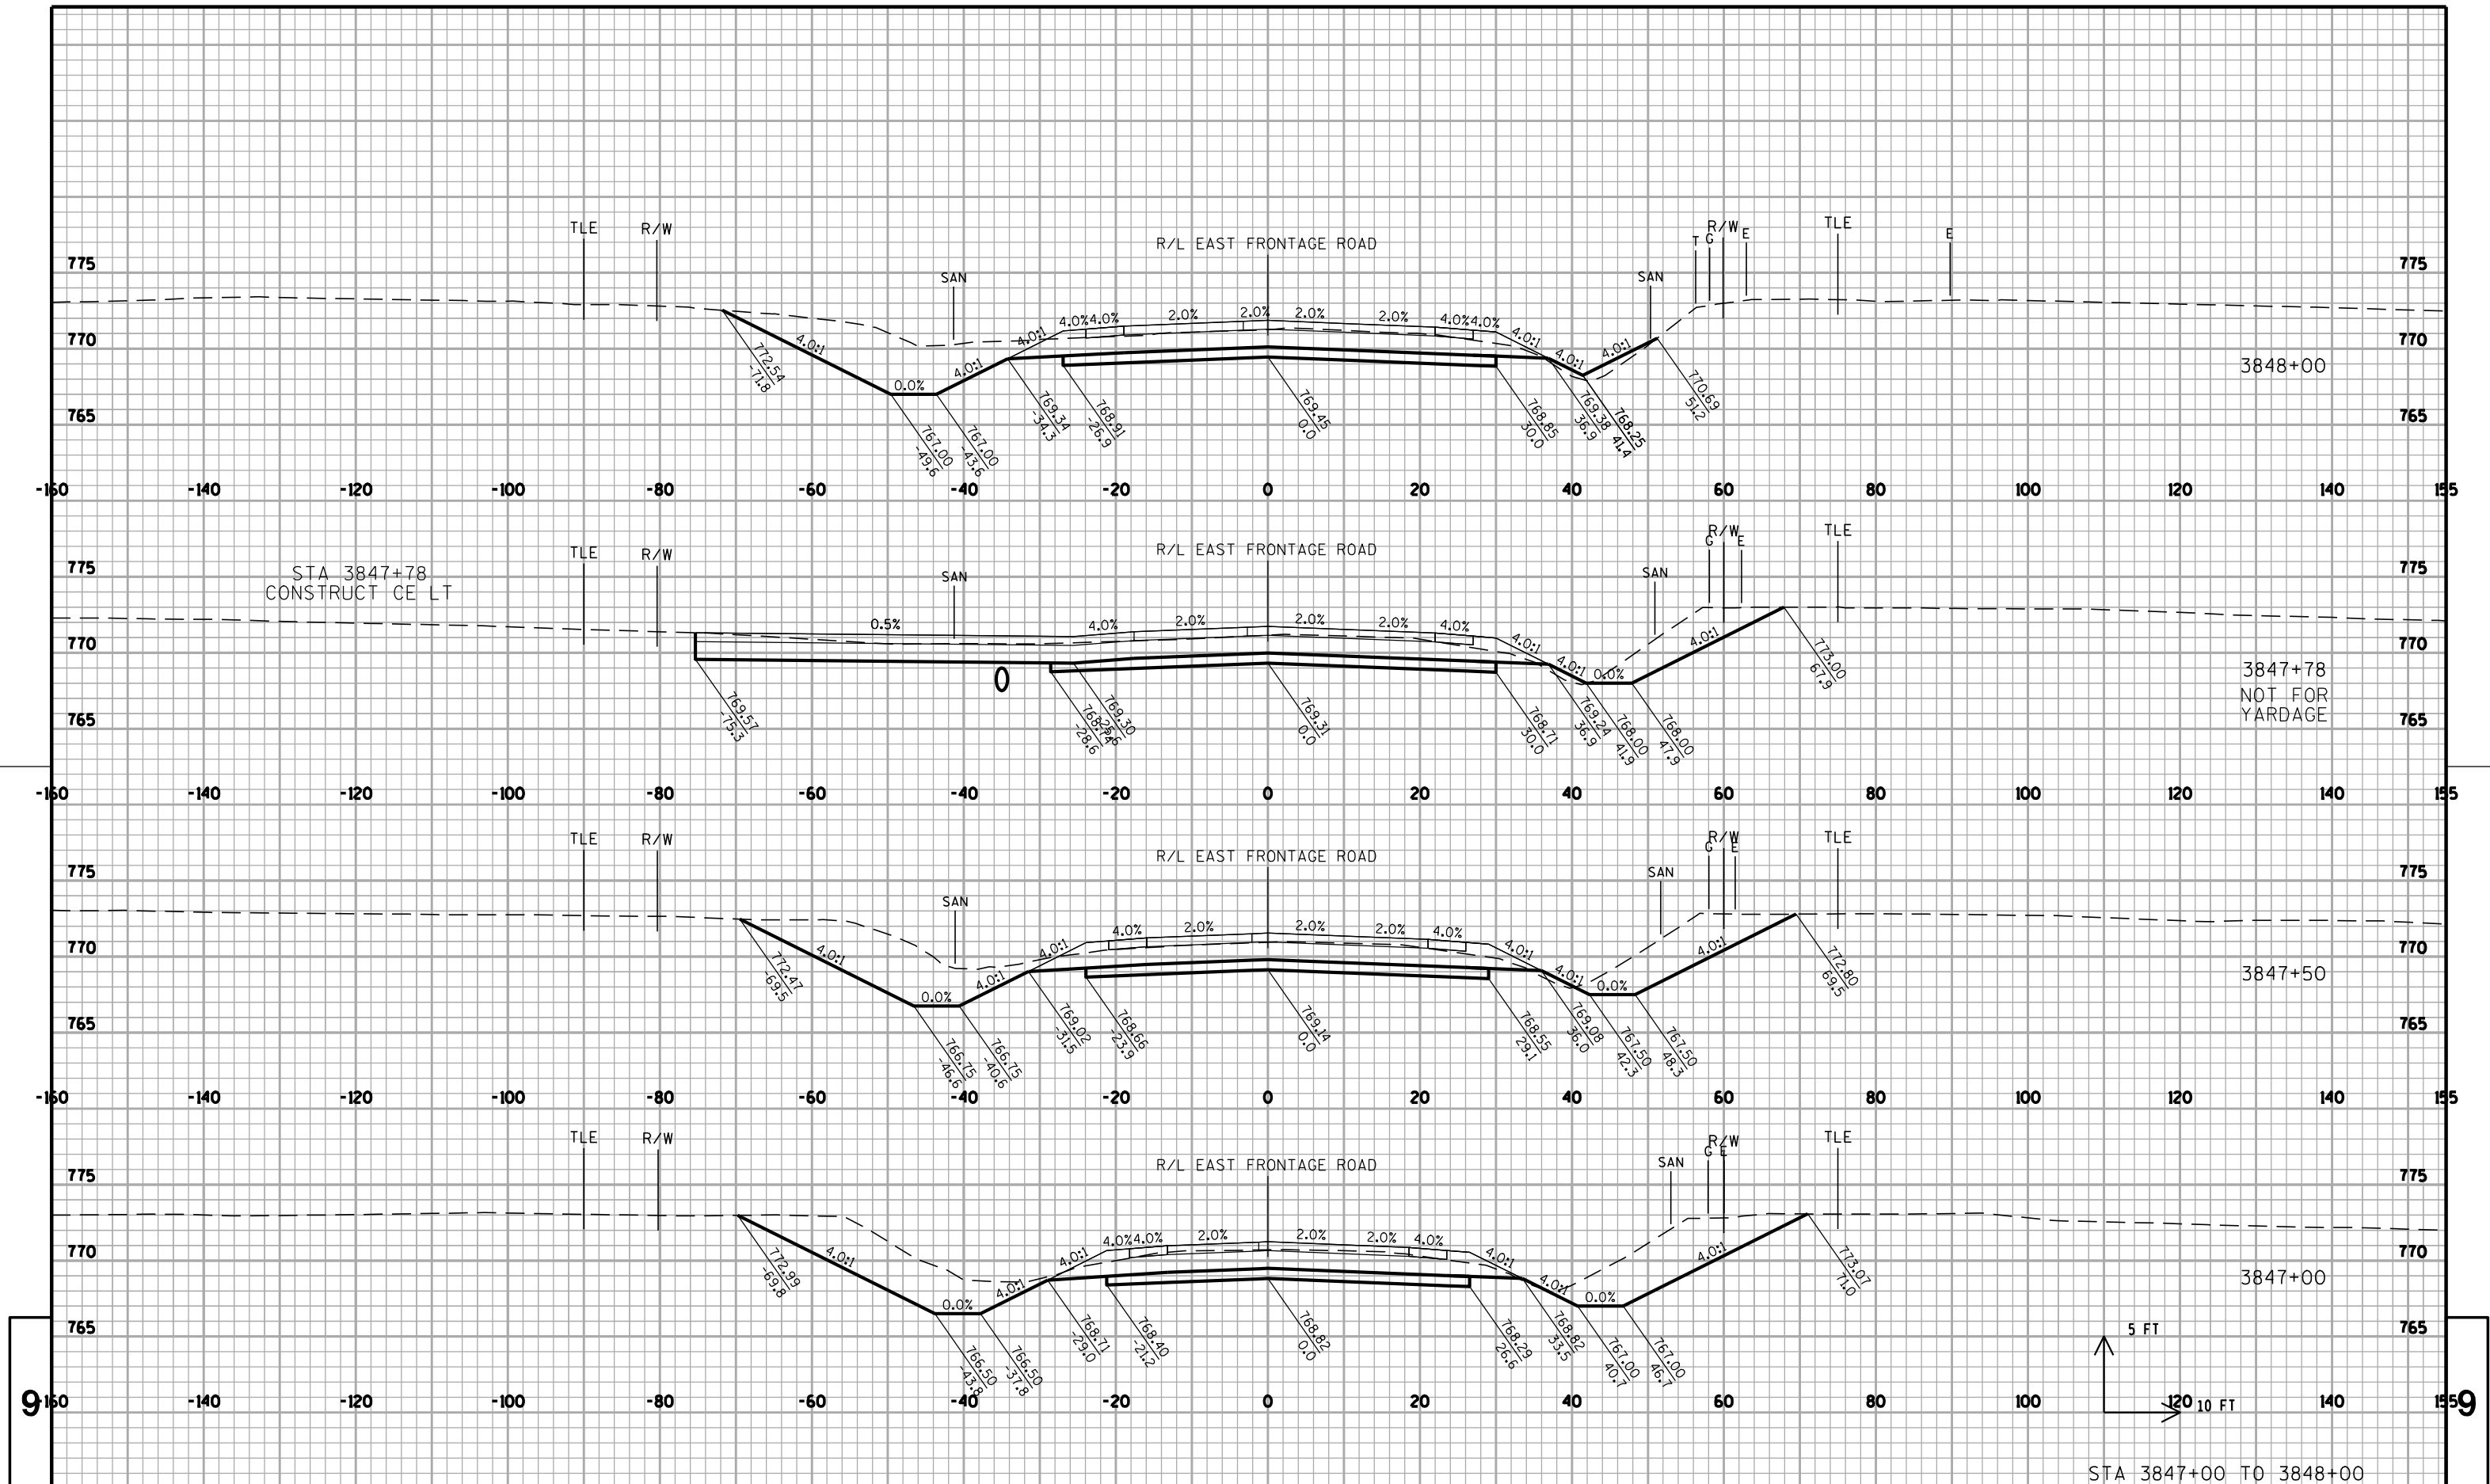

PROJECT NO:1033-02-70

HWY: IH 94/STH 20

COUNTY: RACINE

CROSS SECTIONS: EAST FRONTAGE ROAD - SOUTH

SHEET 198

E

FILE NAME : S:\FinalDesign\20\10330270-ENRoads\cds\090201-xs_frse.dgn

PLOT DATE : 07-DEC-2010 10:26

PLOT BY : MSCDIS

PLOT NAME : 090201-xs_frse6


PLOT SCALE : 20:1


WISDOT/CADDs SHEET 21





See new sheet #199


STA 3848+50 TO 3850+00

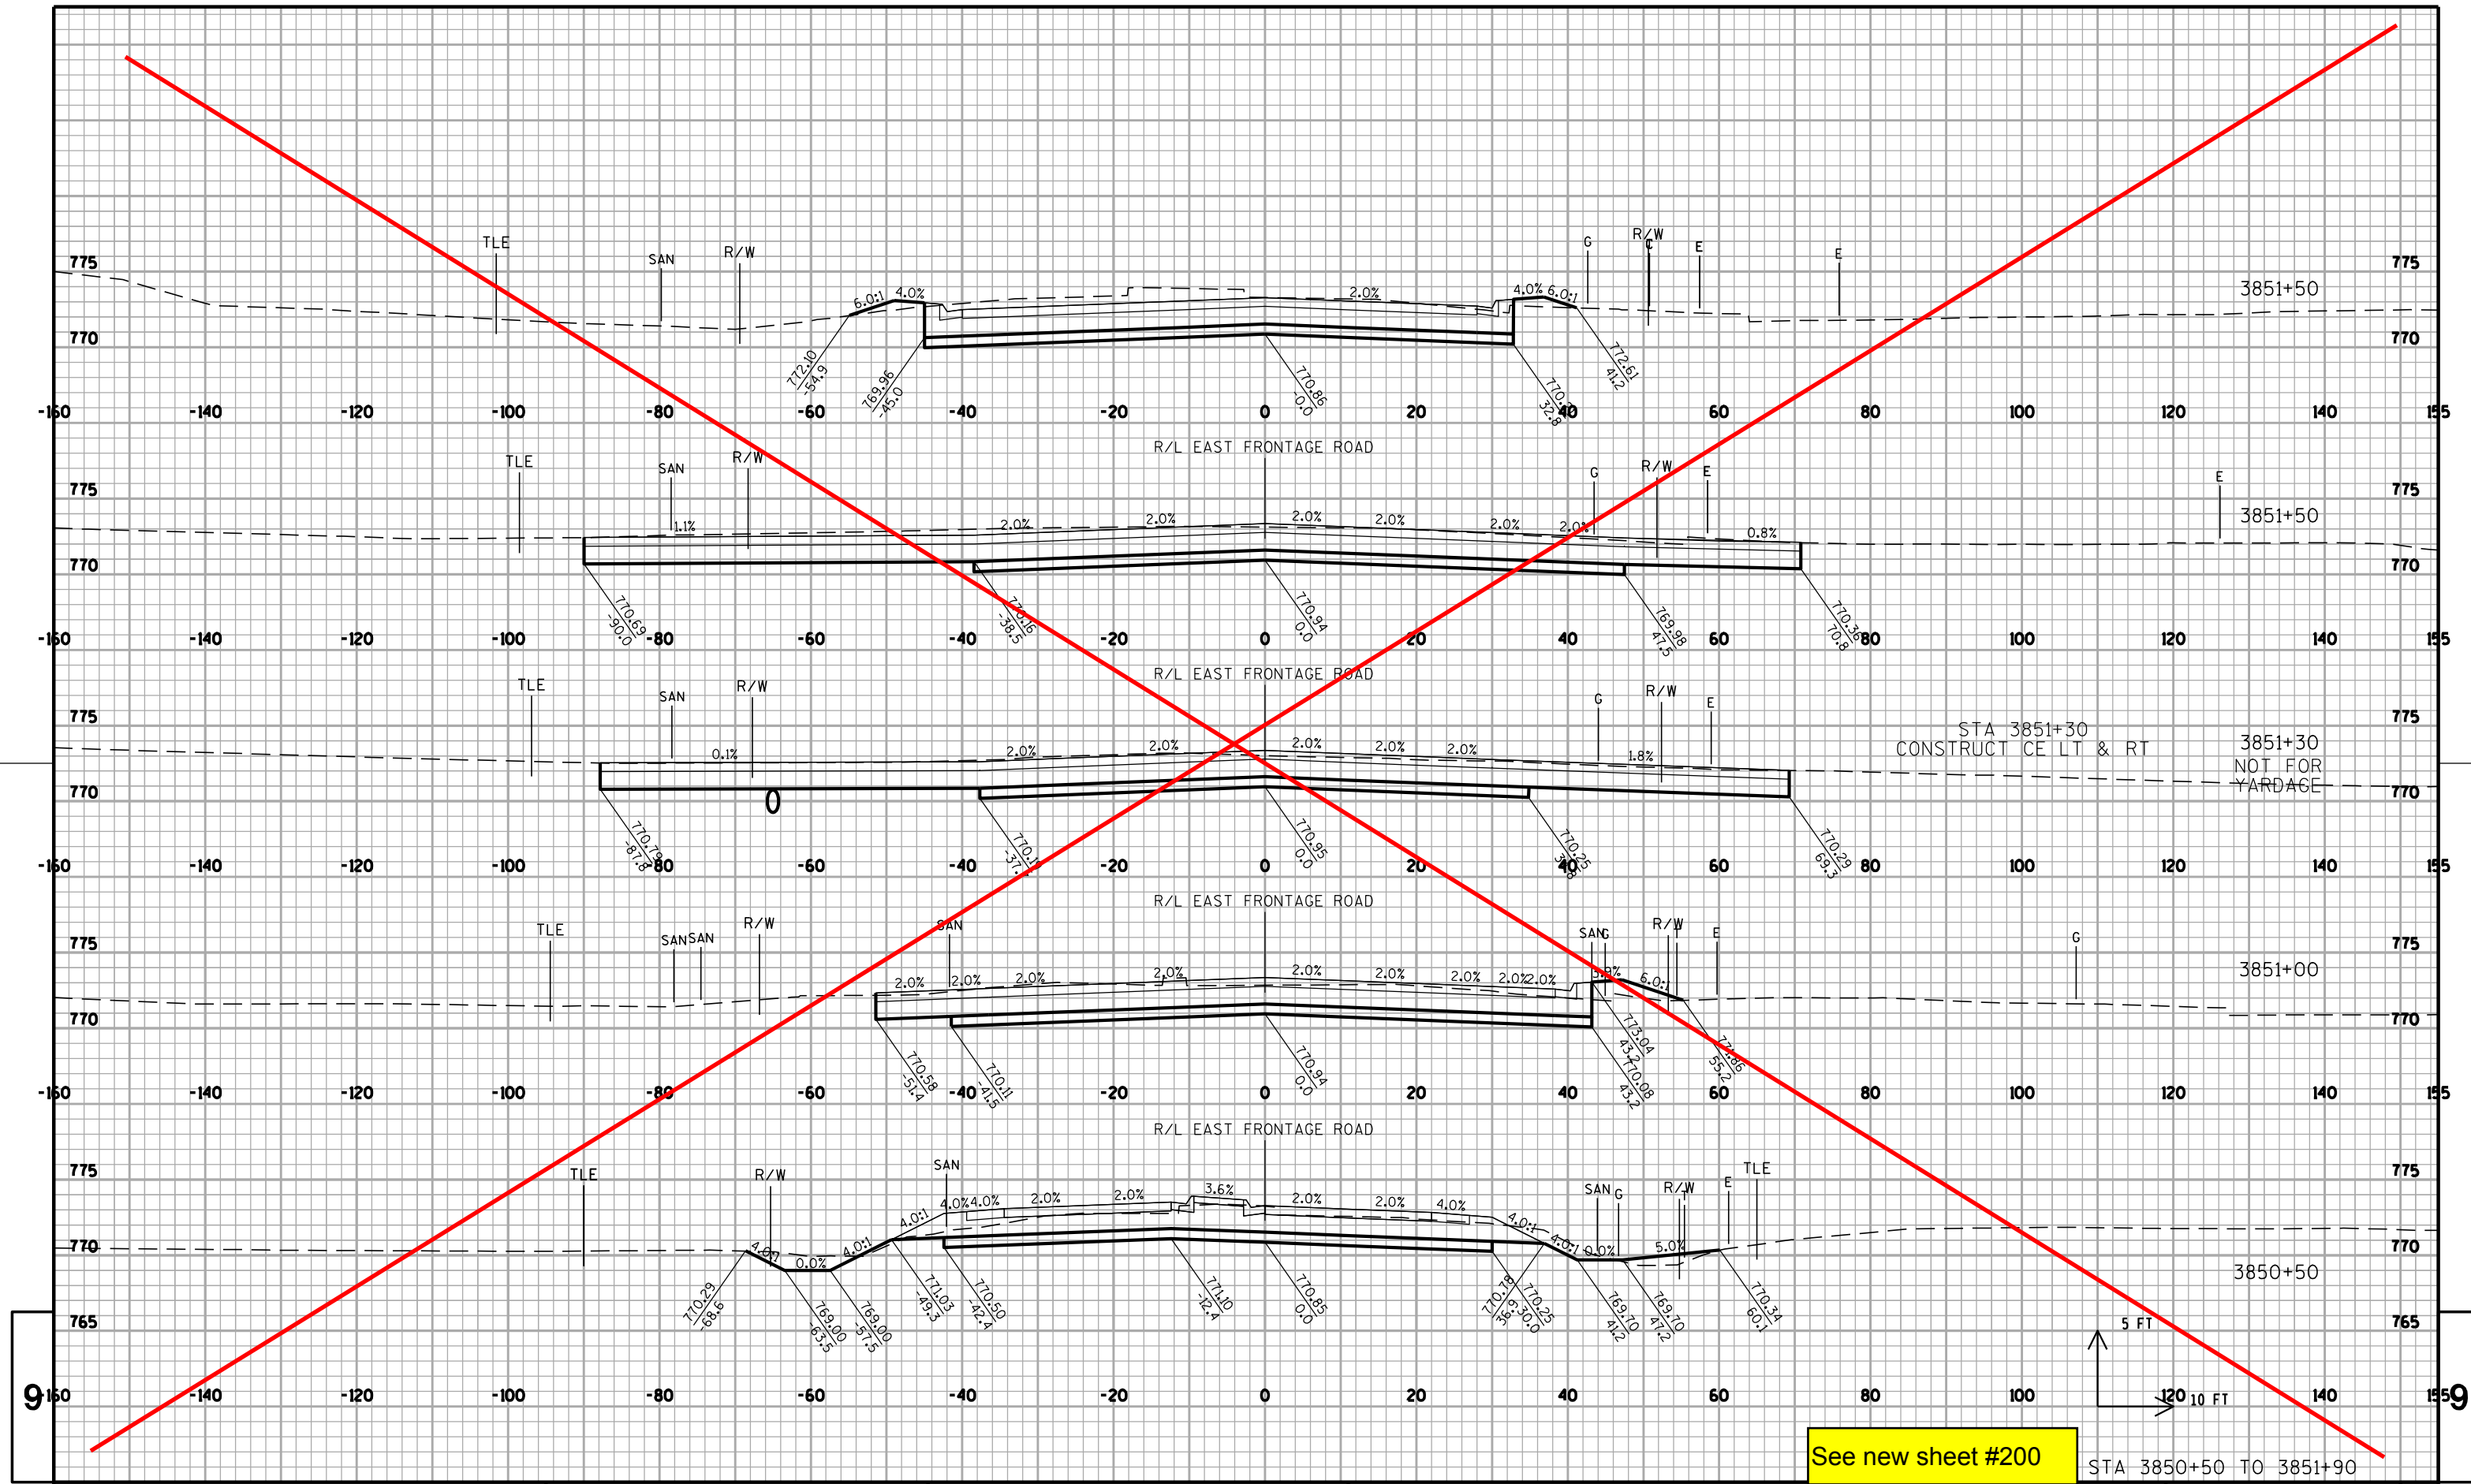

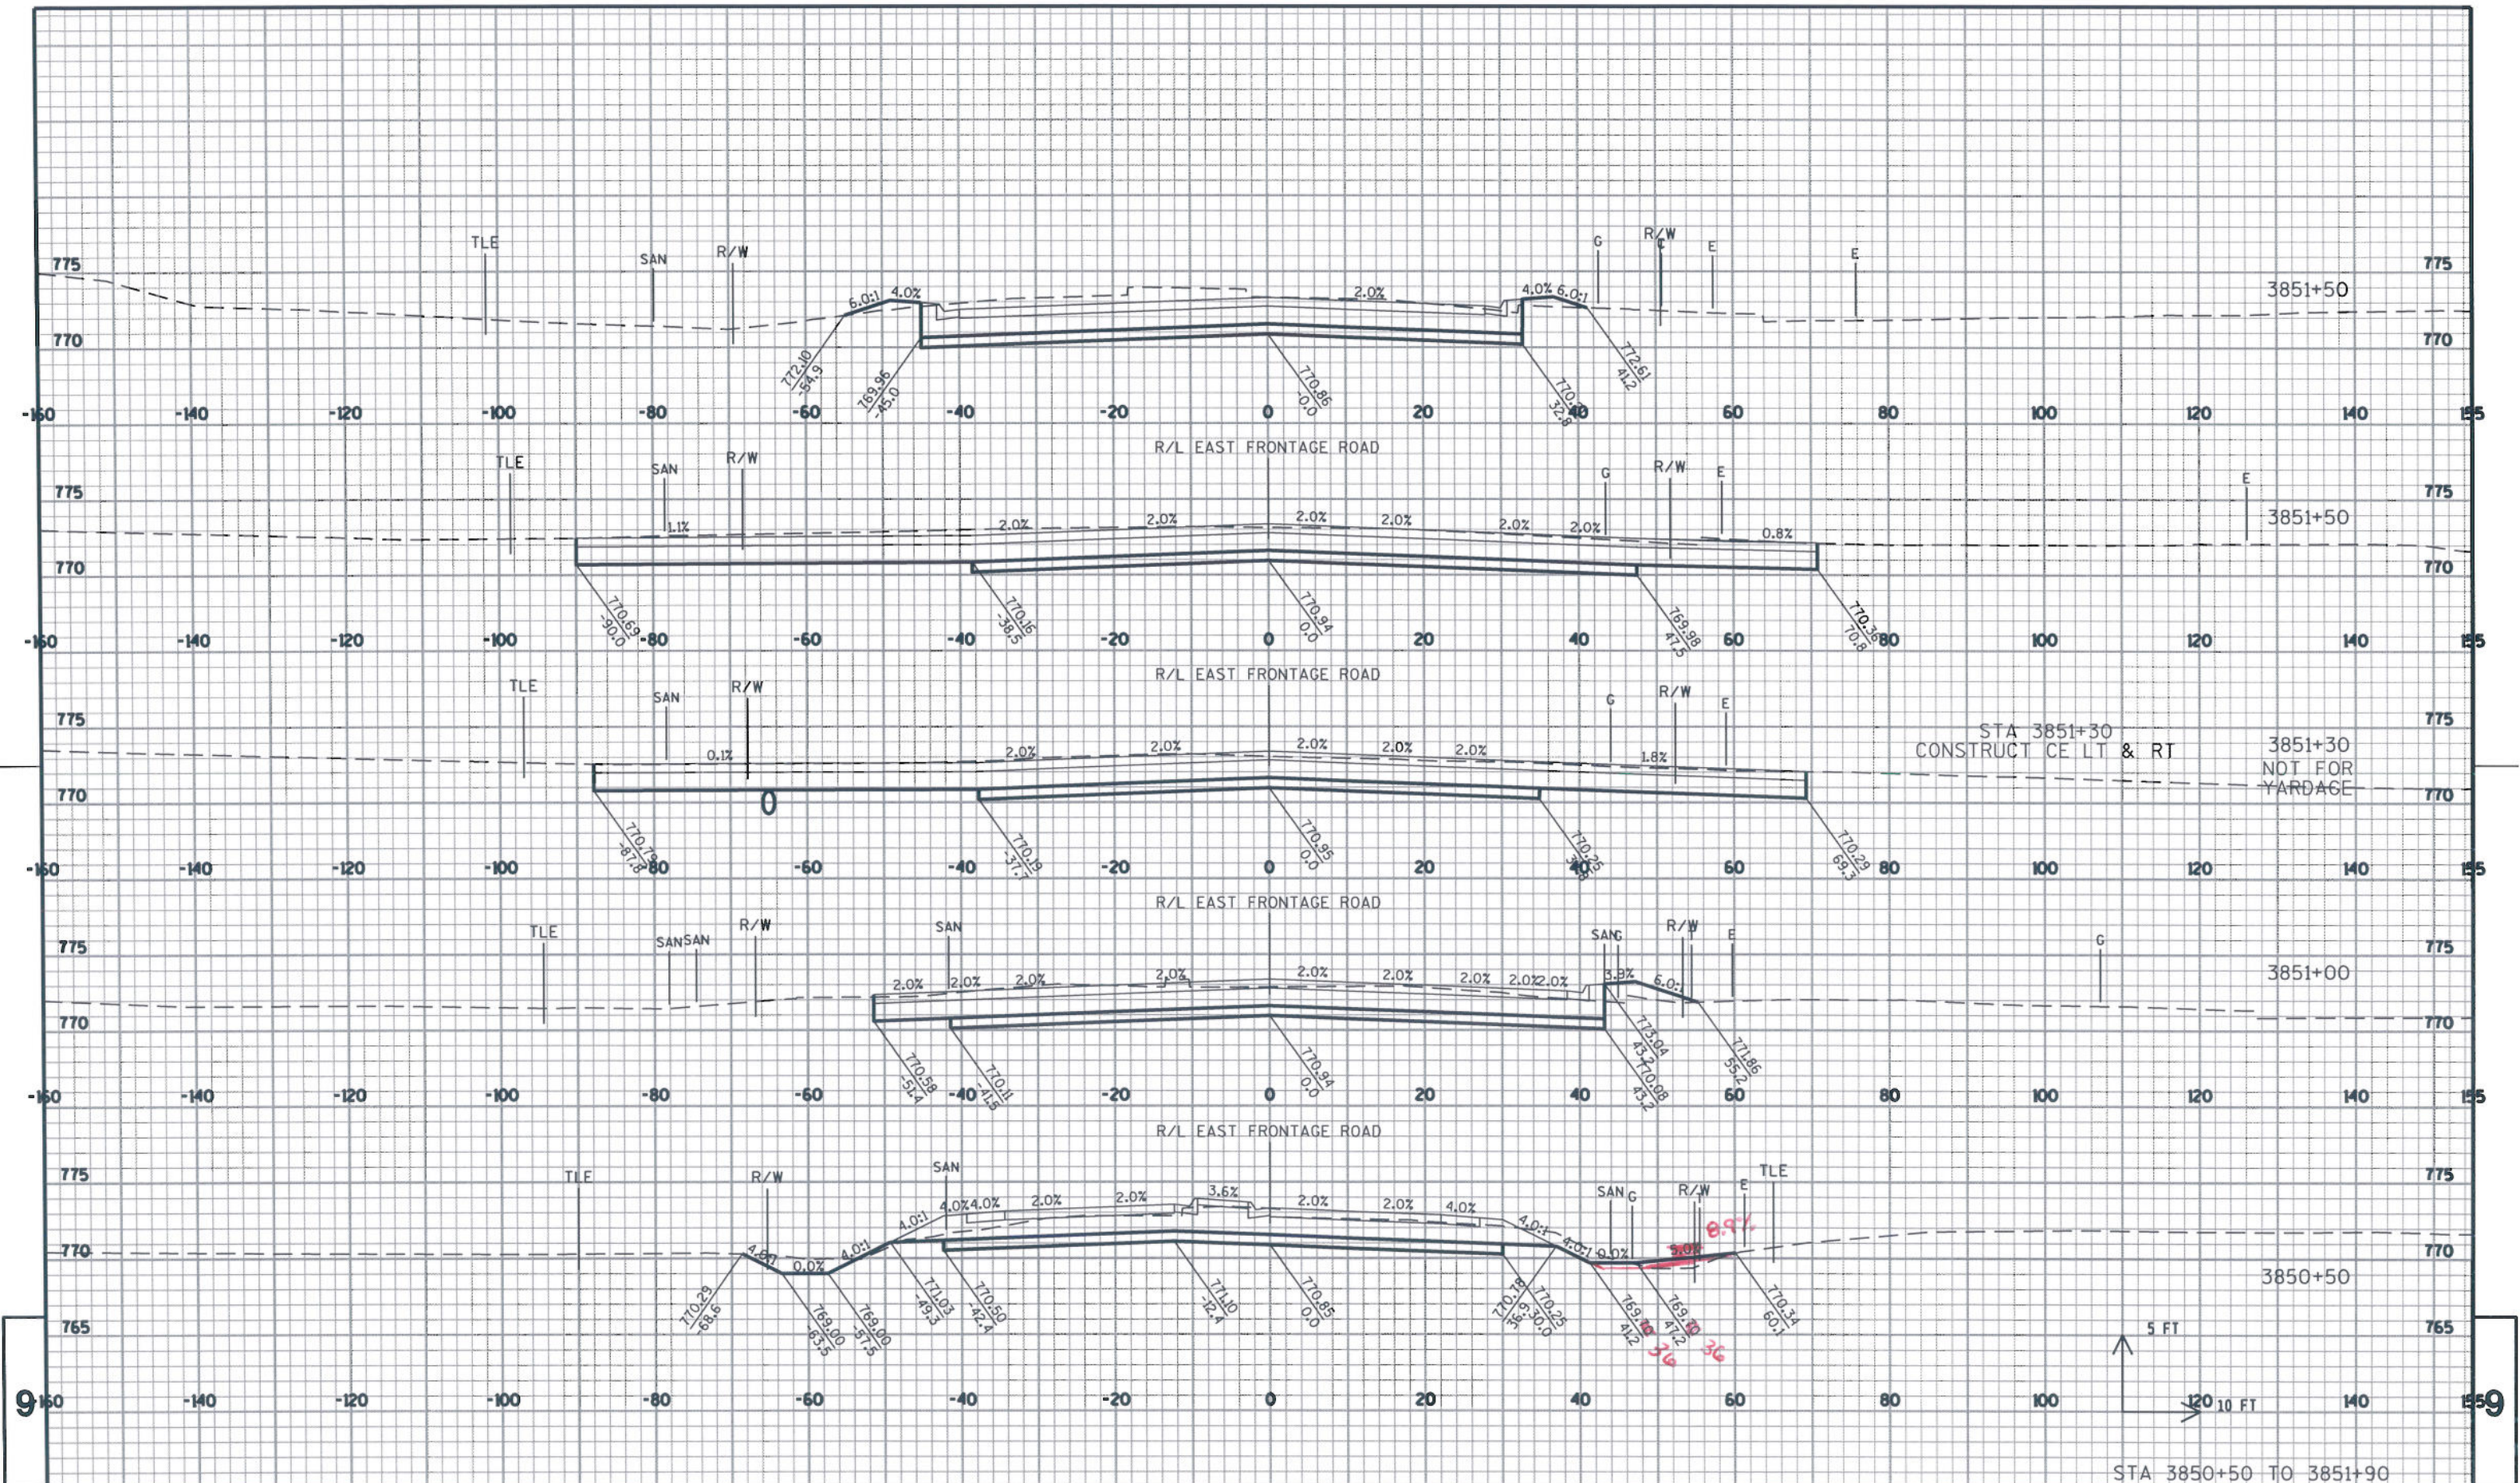

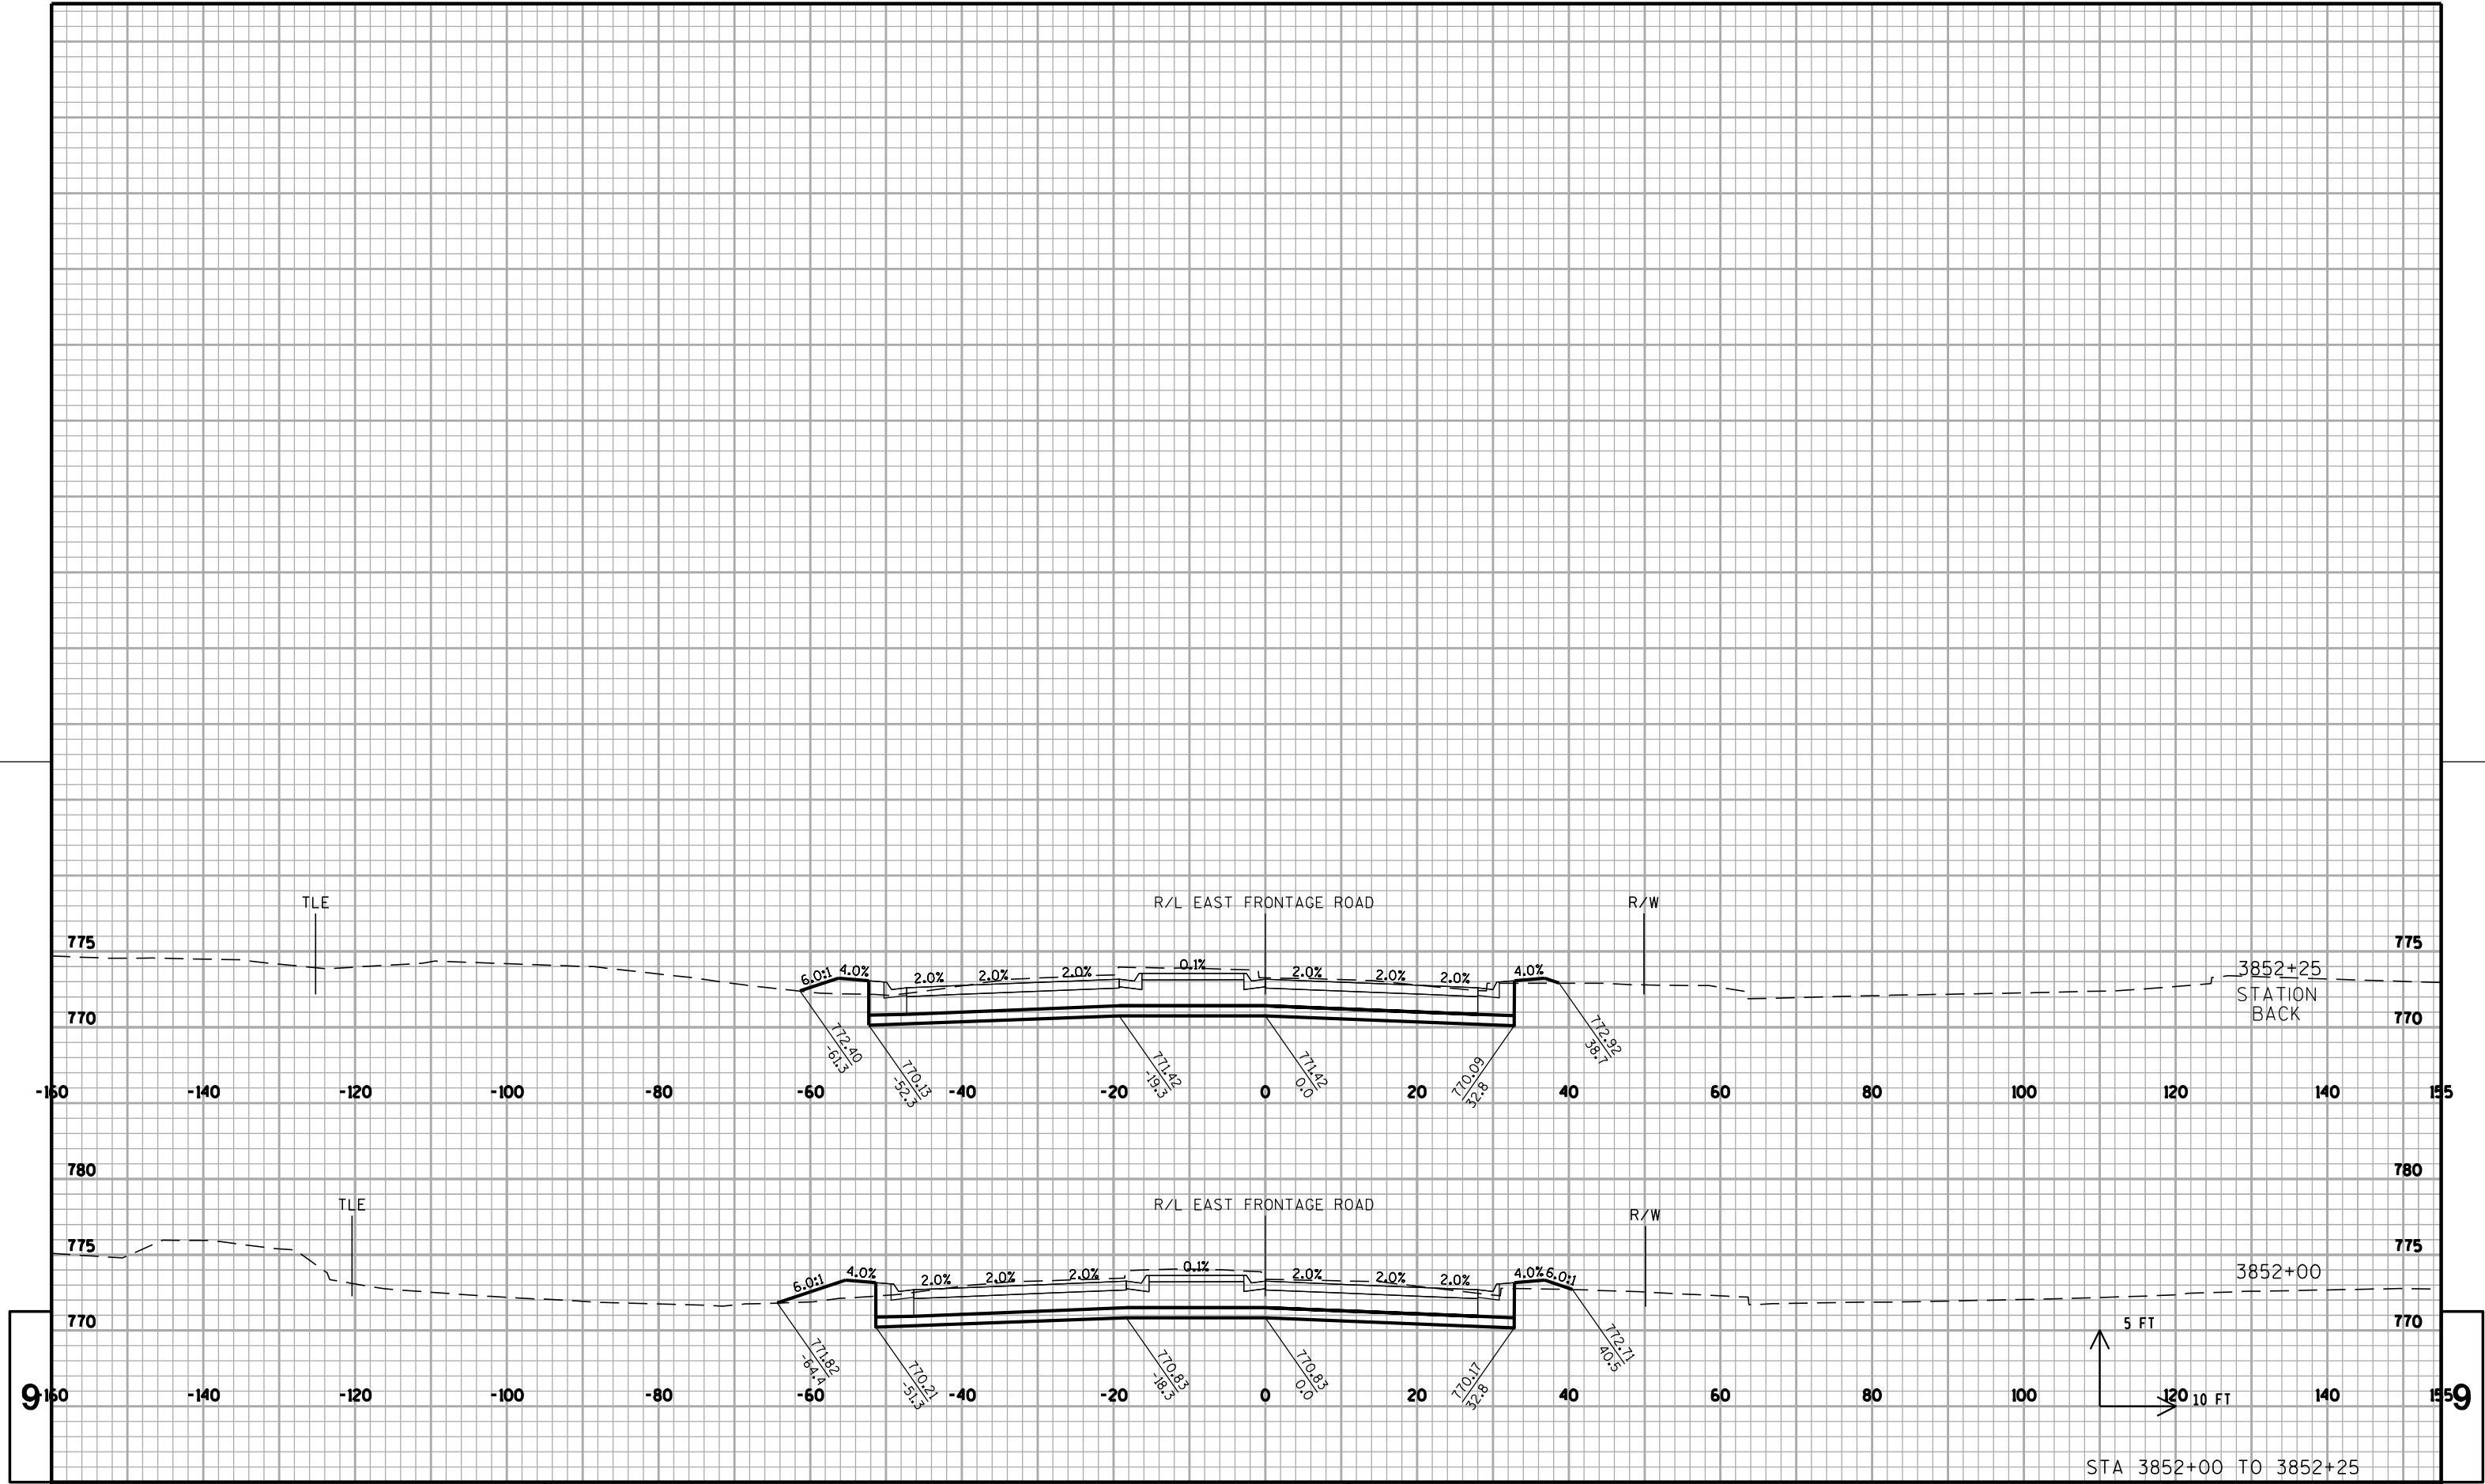

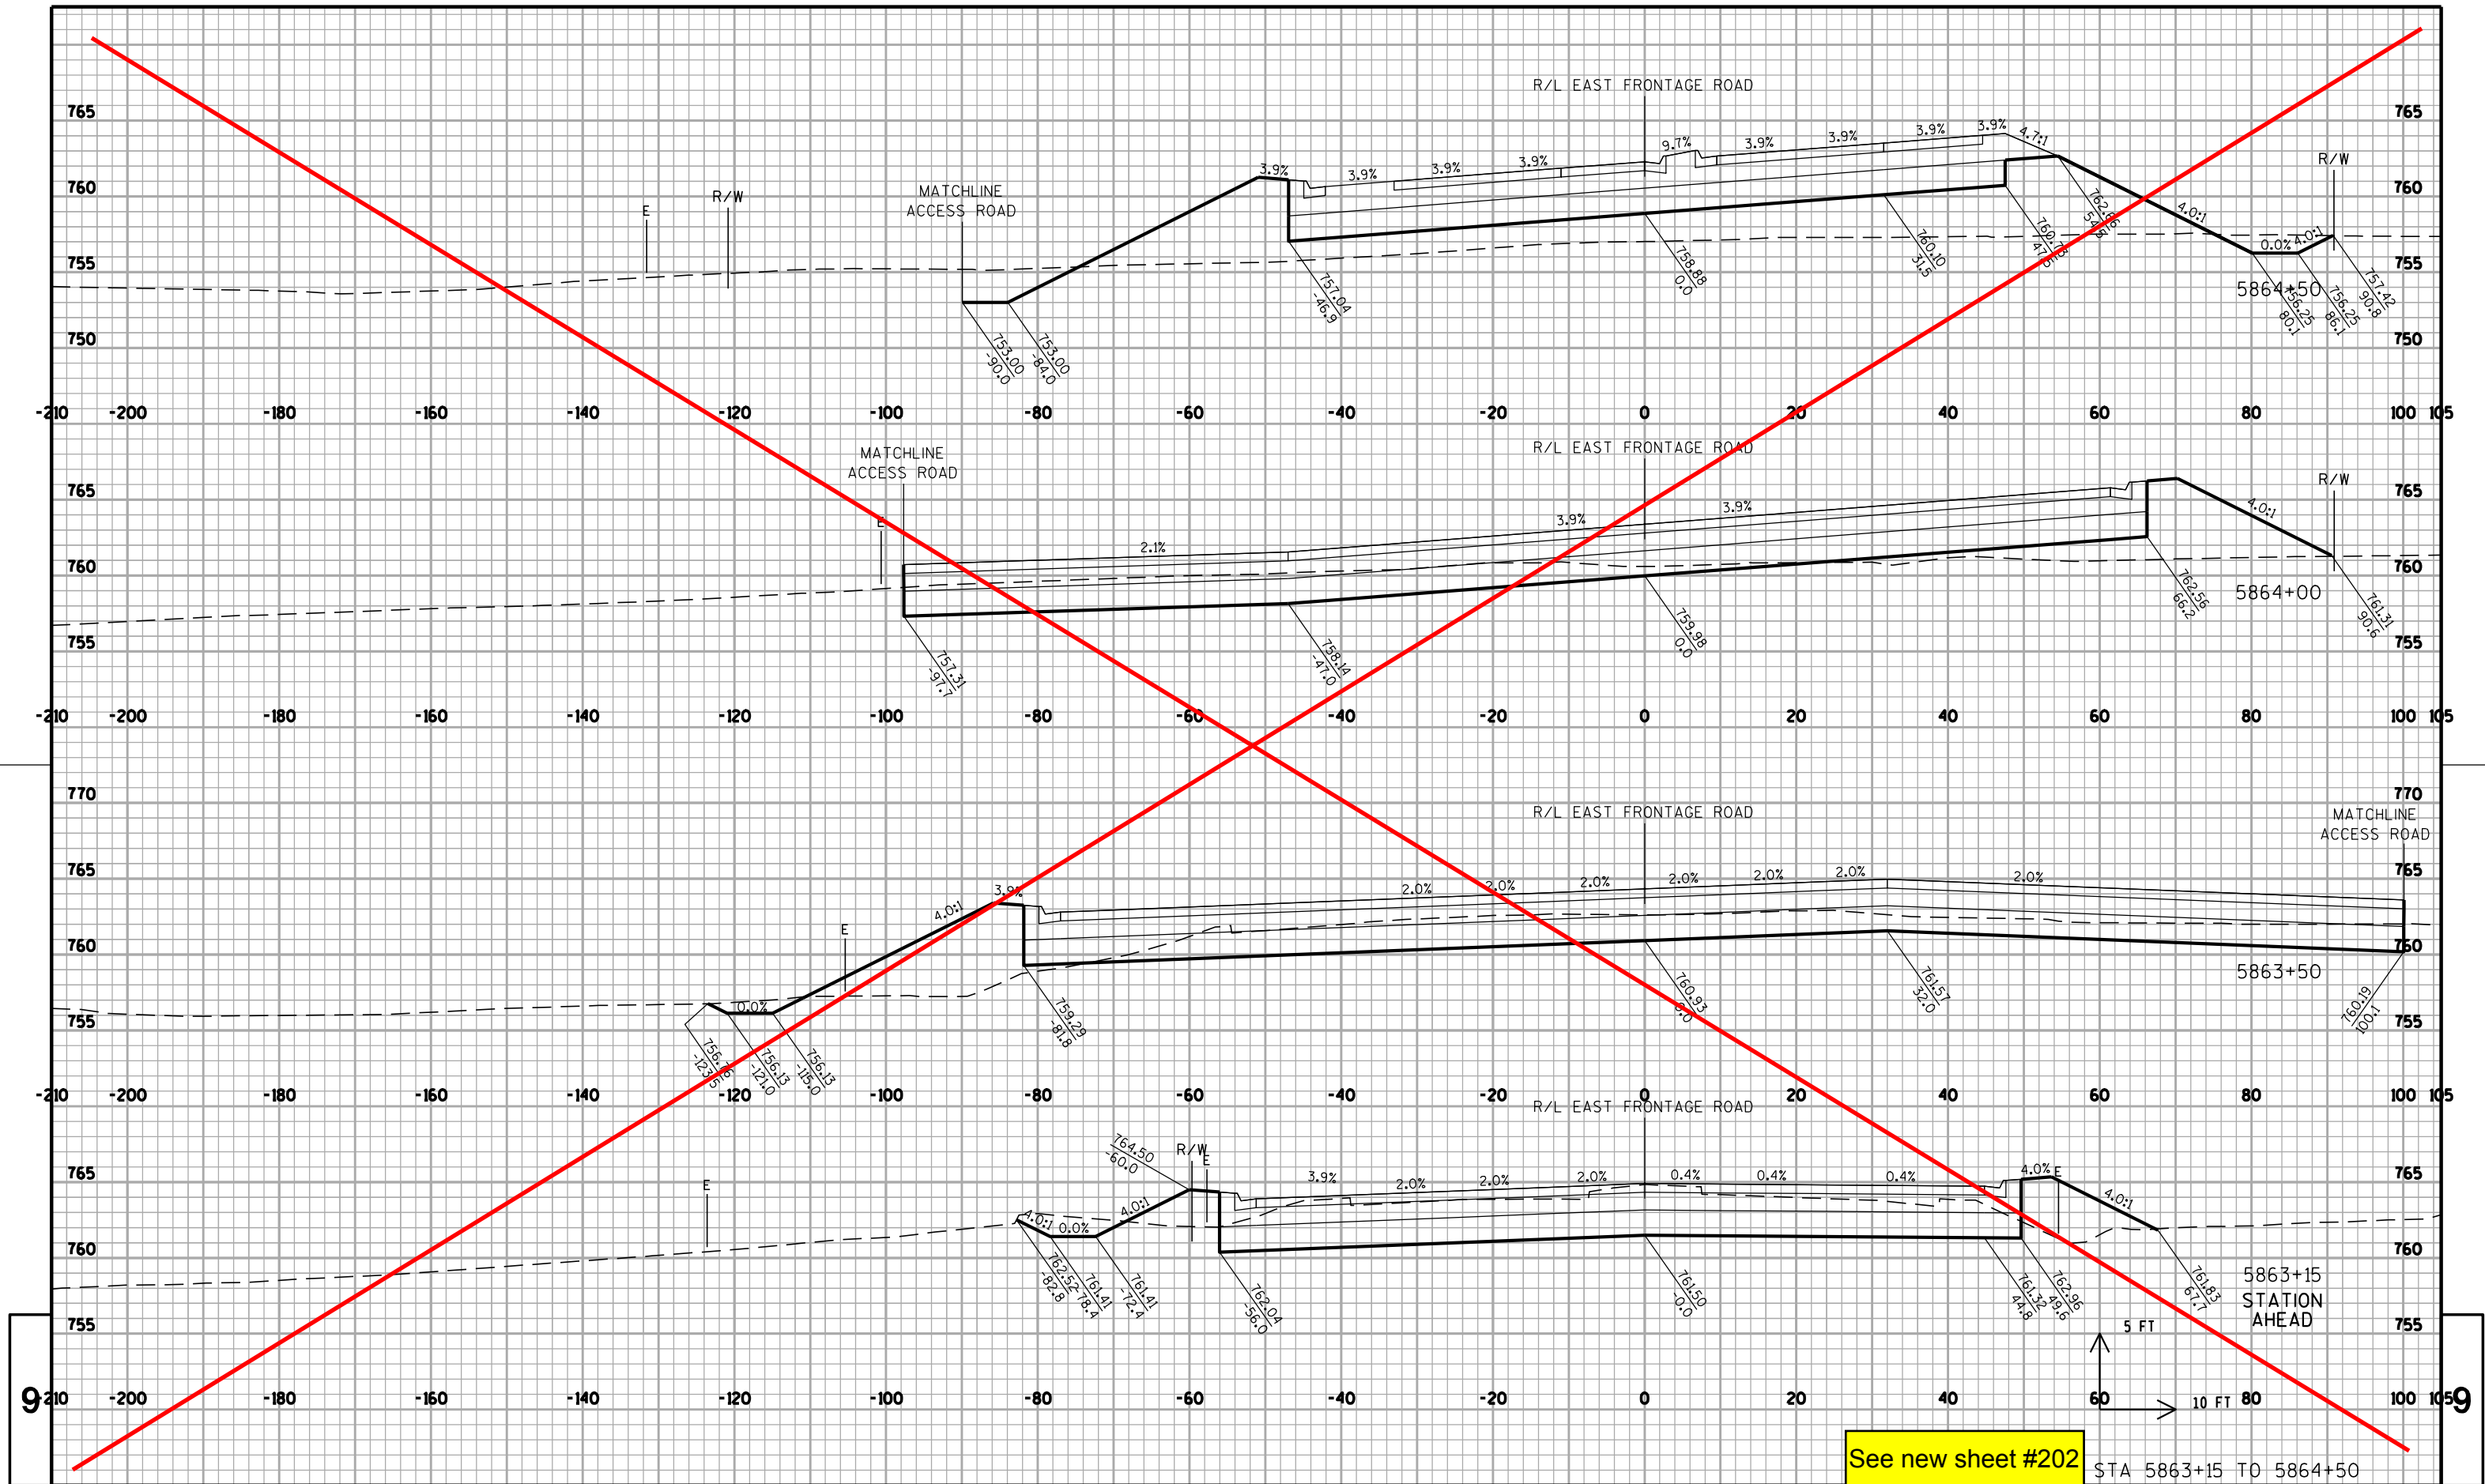

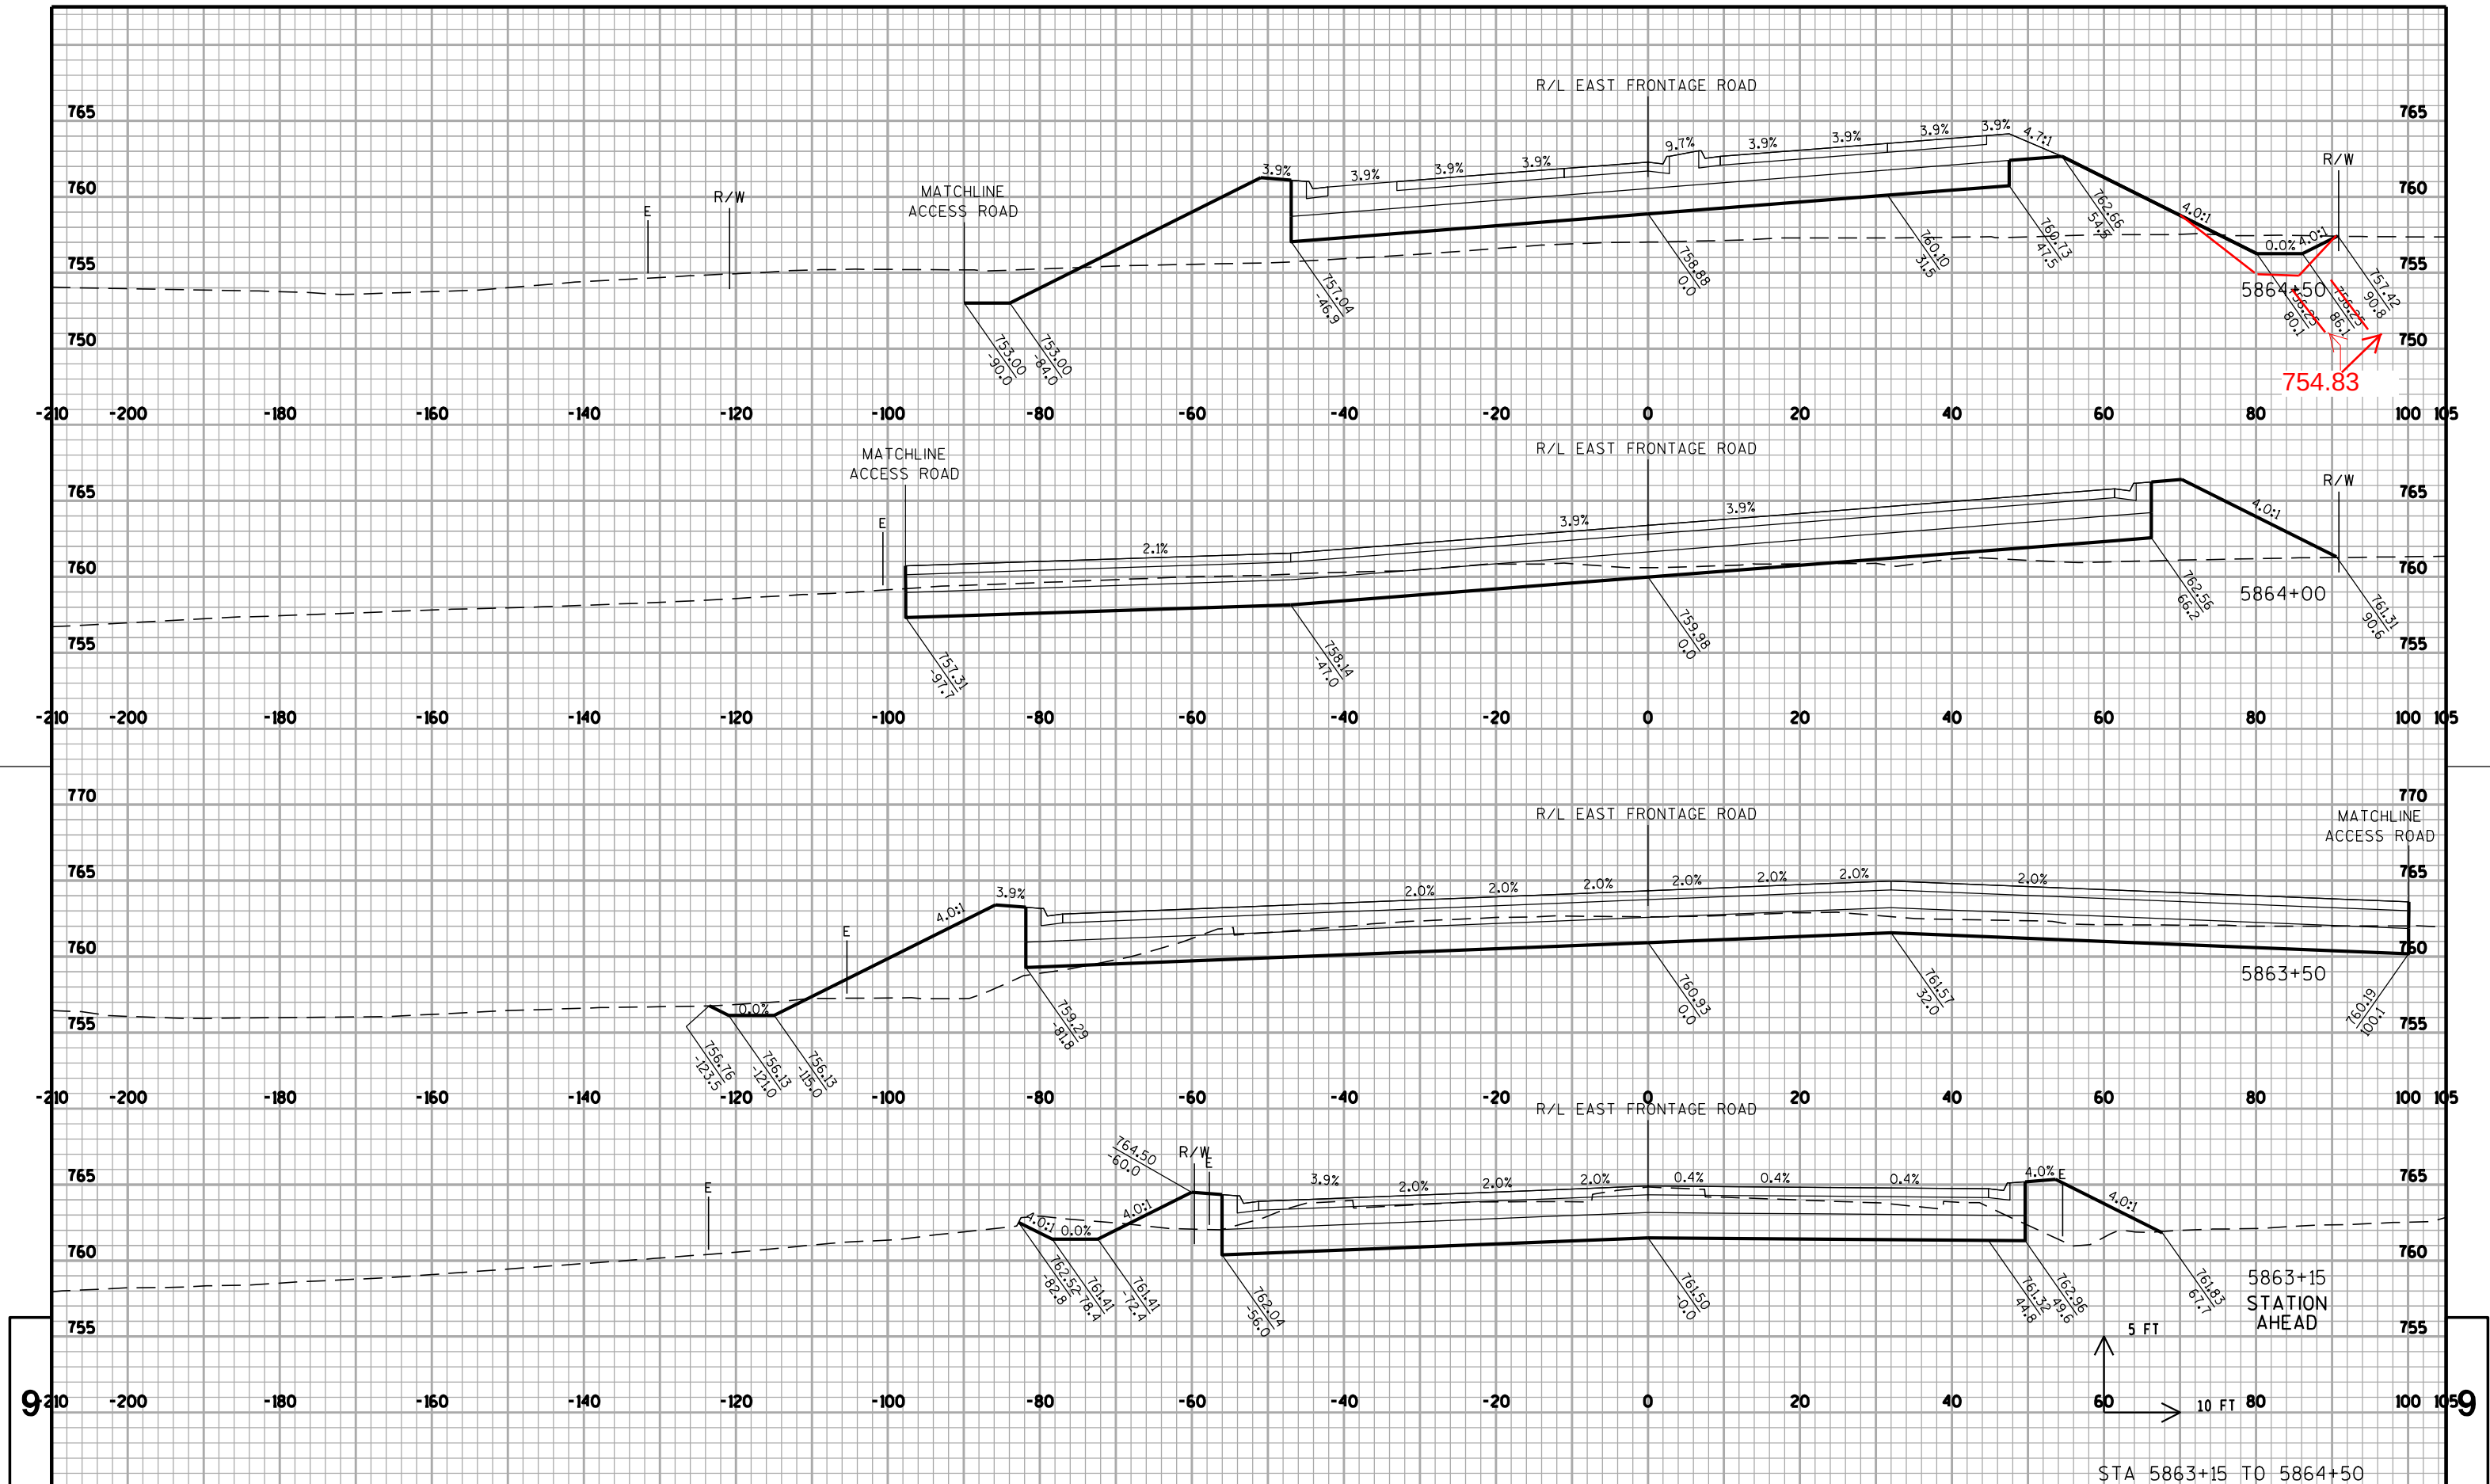

PROJECT NO:1033-02-70

HWY: IH 94/STH 20

COUNTY: RACINE

CROSS SECTIONS: EAST FRONTAGE ROAD - NORTH

SHEET 202

E

FILE NAME : s:\FinalDesign\20\10330270-EN\Roads\cds\090202_xs_frne.dgn

PLOT DATE : 06-DEC-2010 20:32


PLOT BY : MSCDIS


PLOT NAME : 090202_xs_frne


PLOT SCALE : 20:1


WISDOT/CADDs SHEET 21




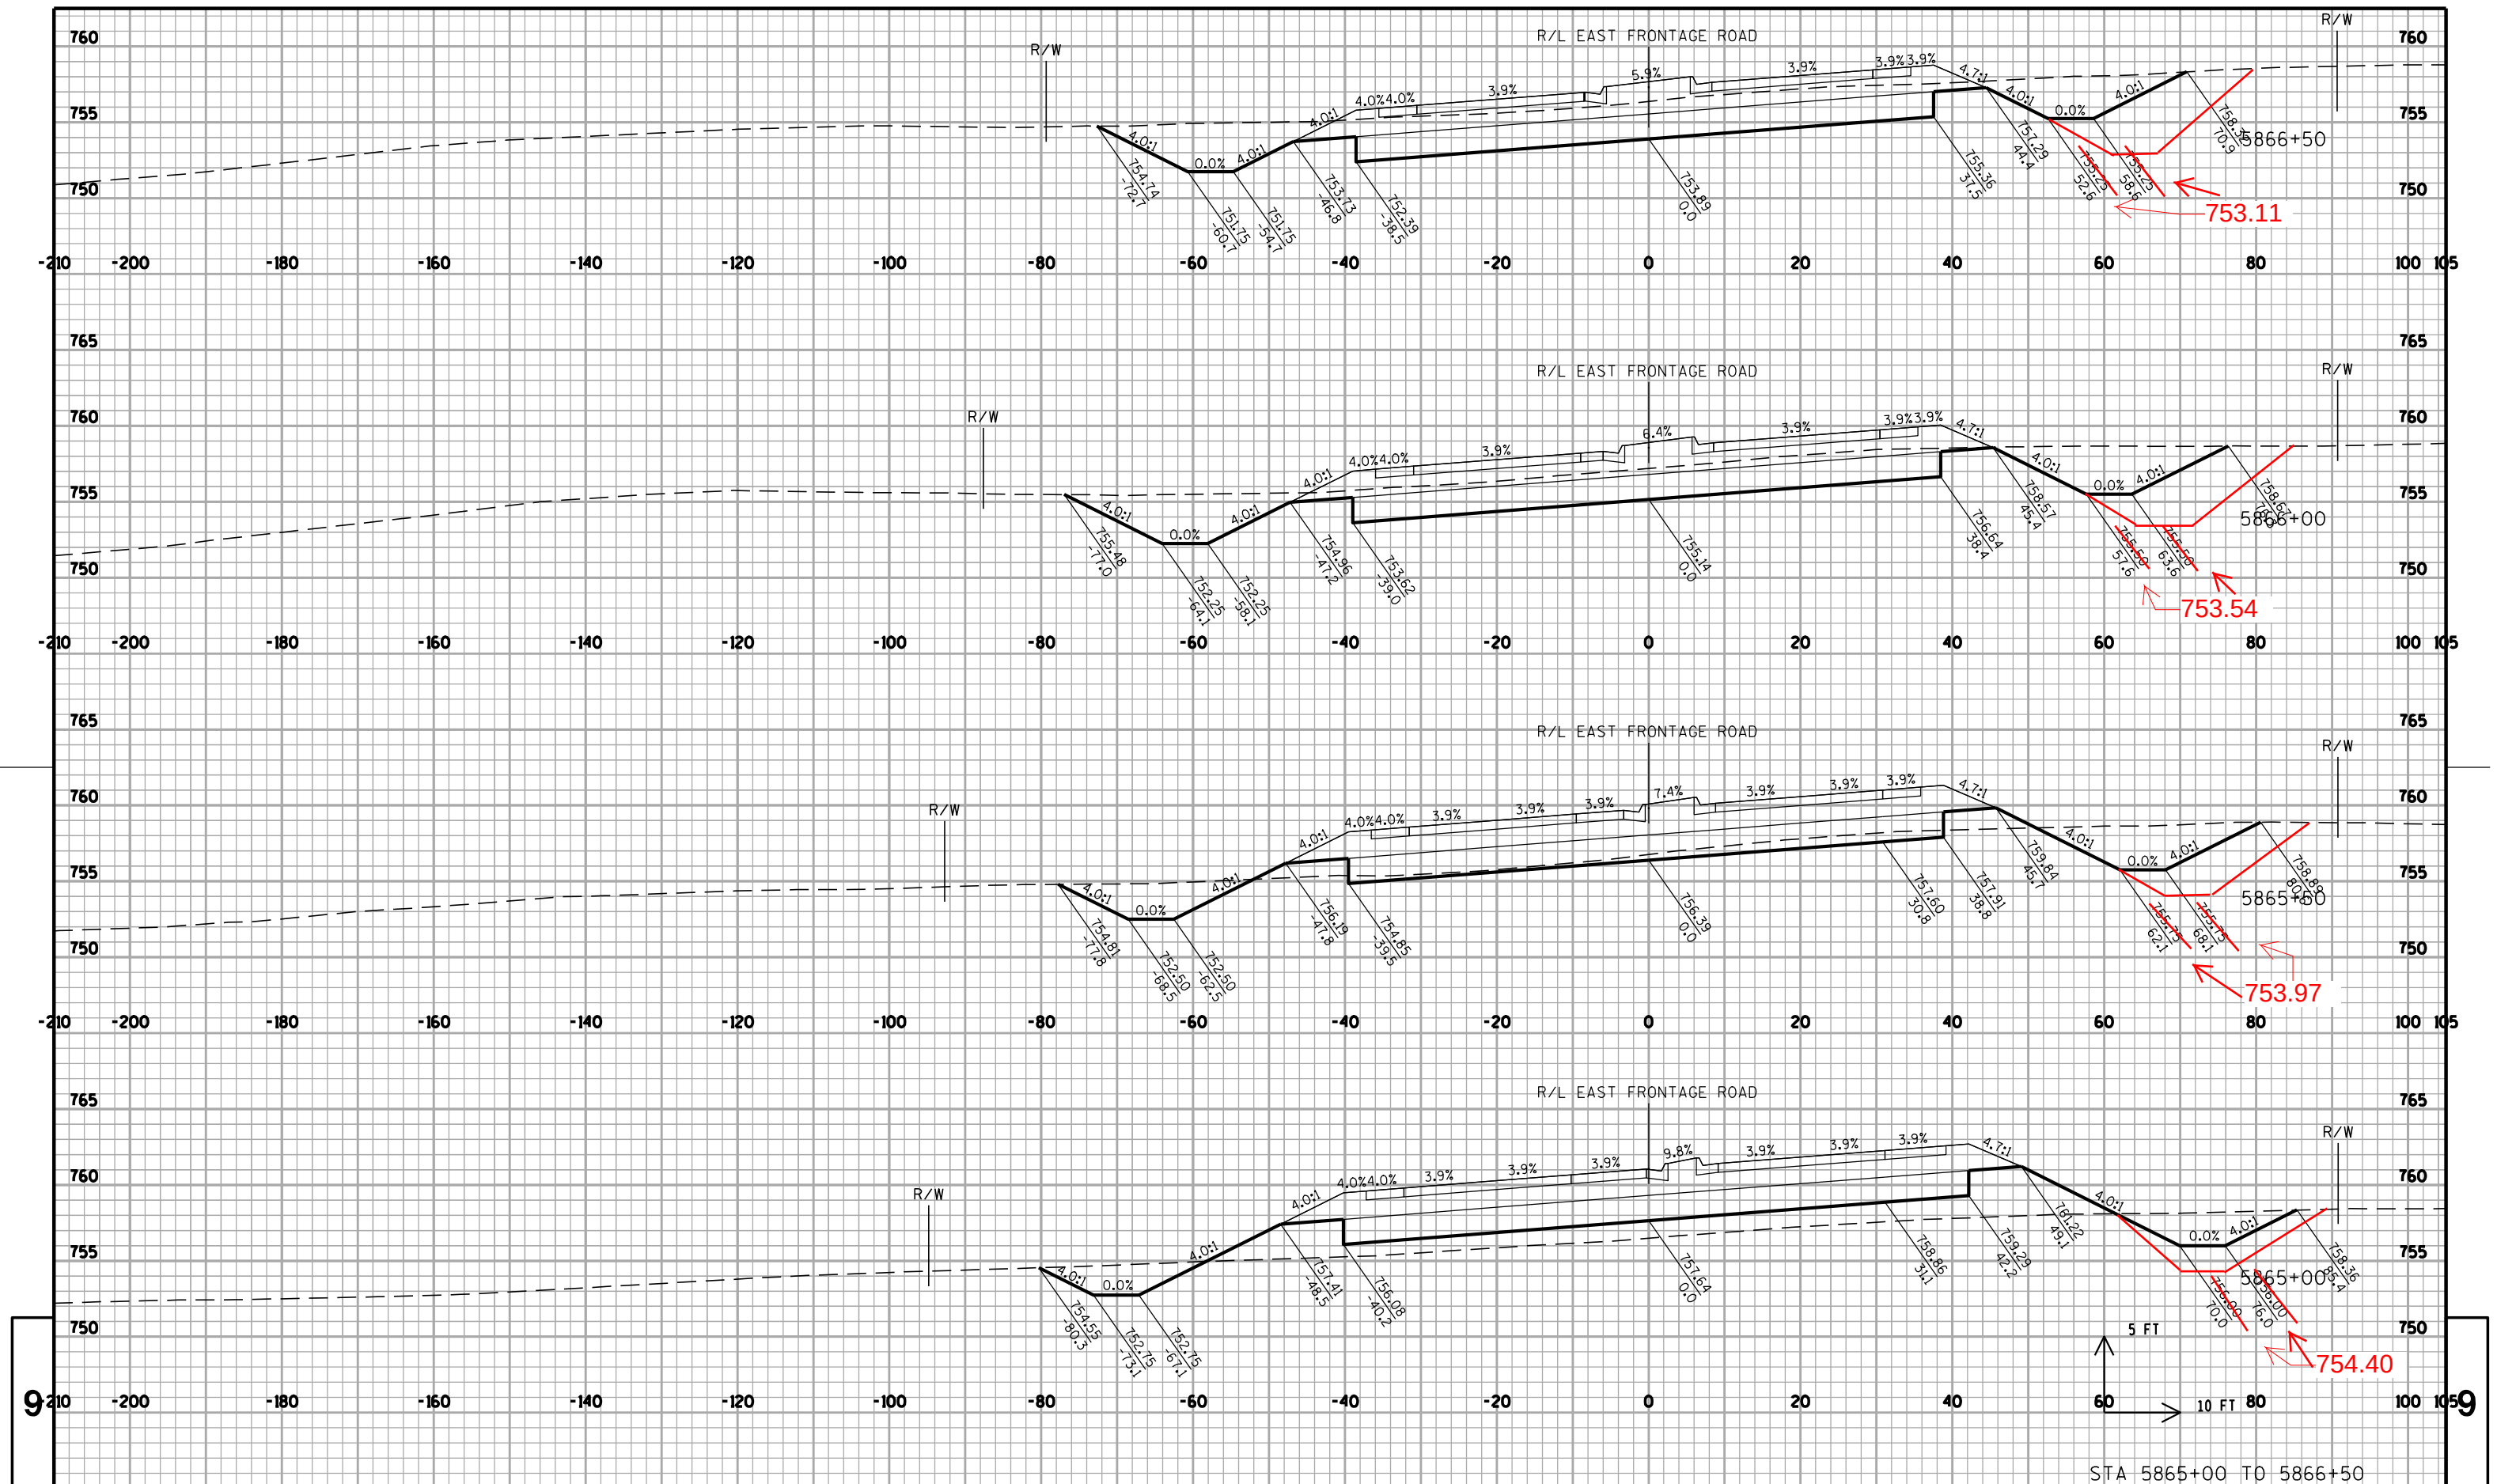


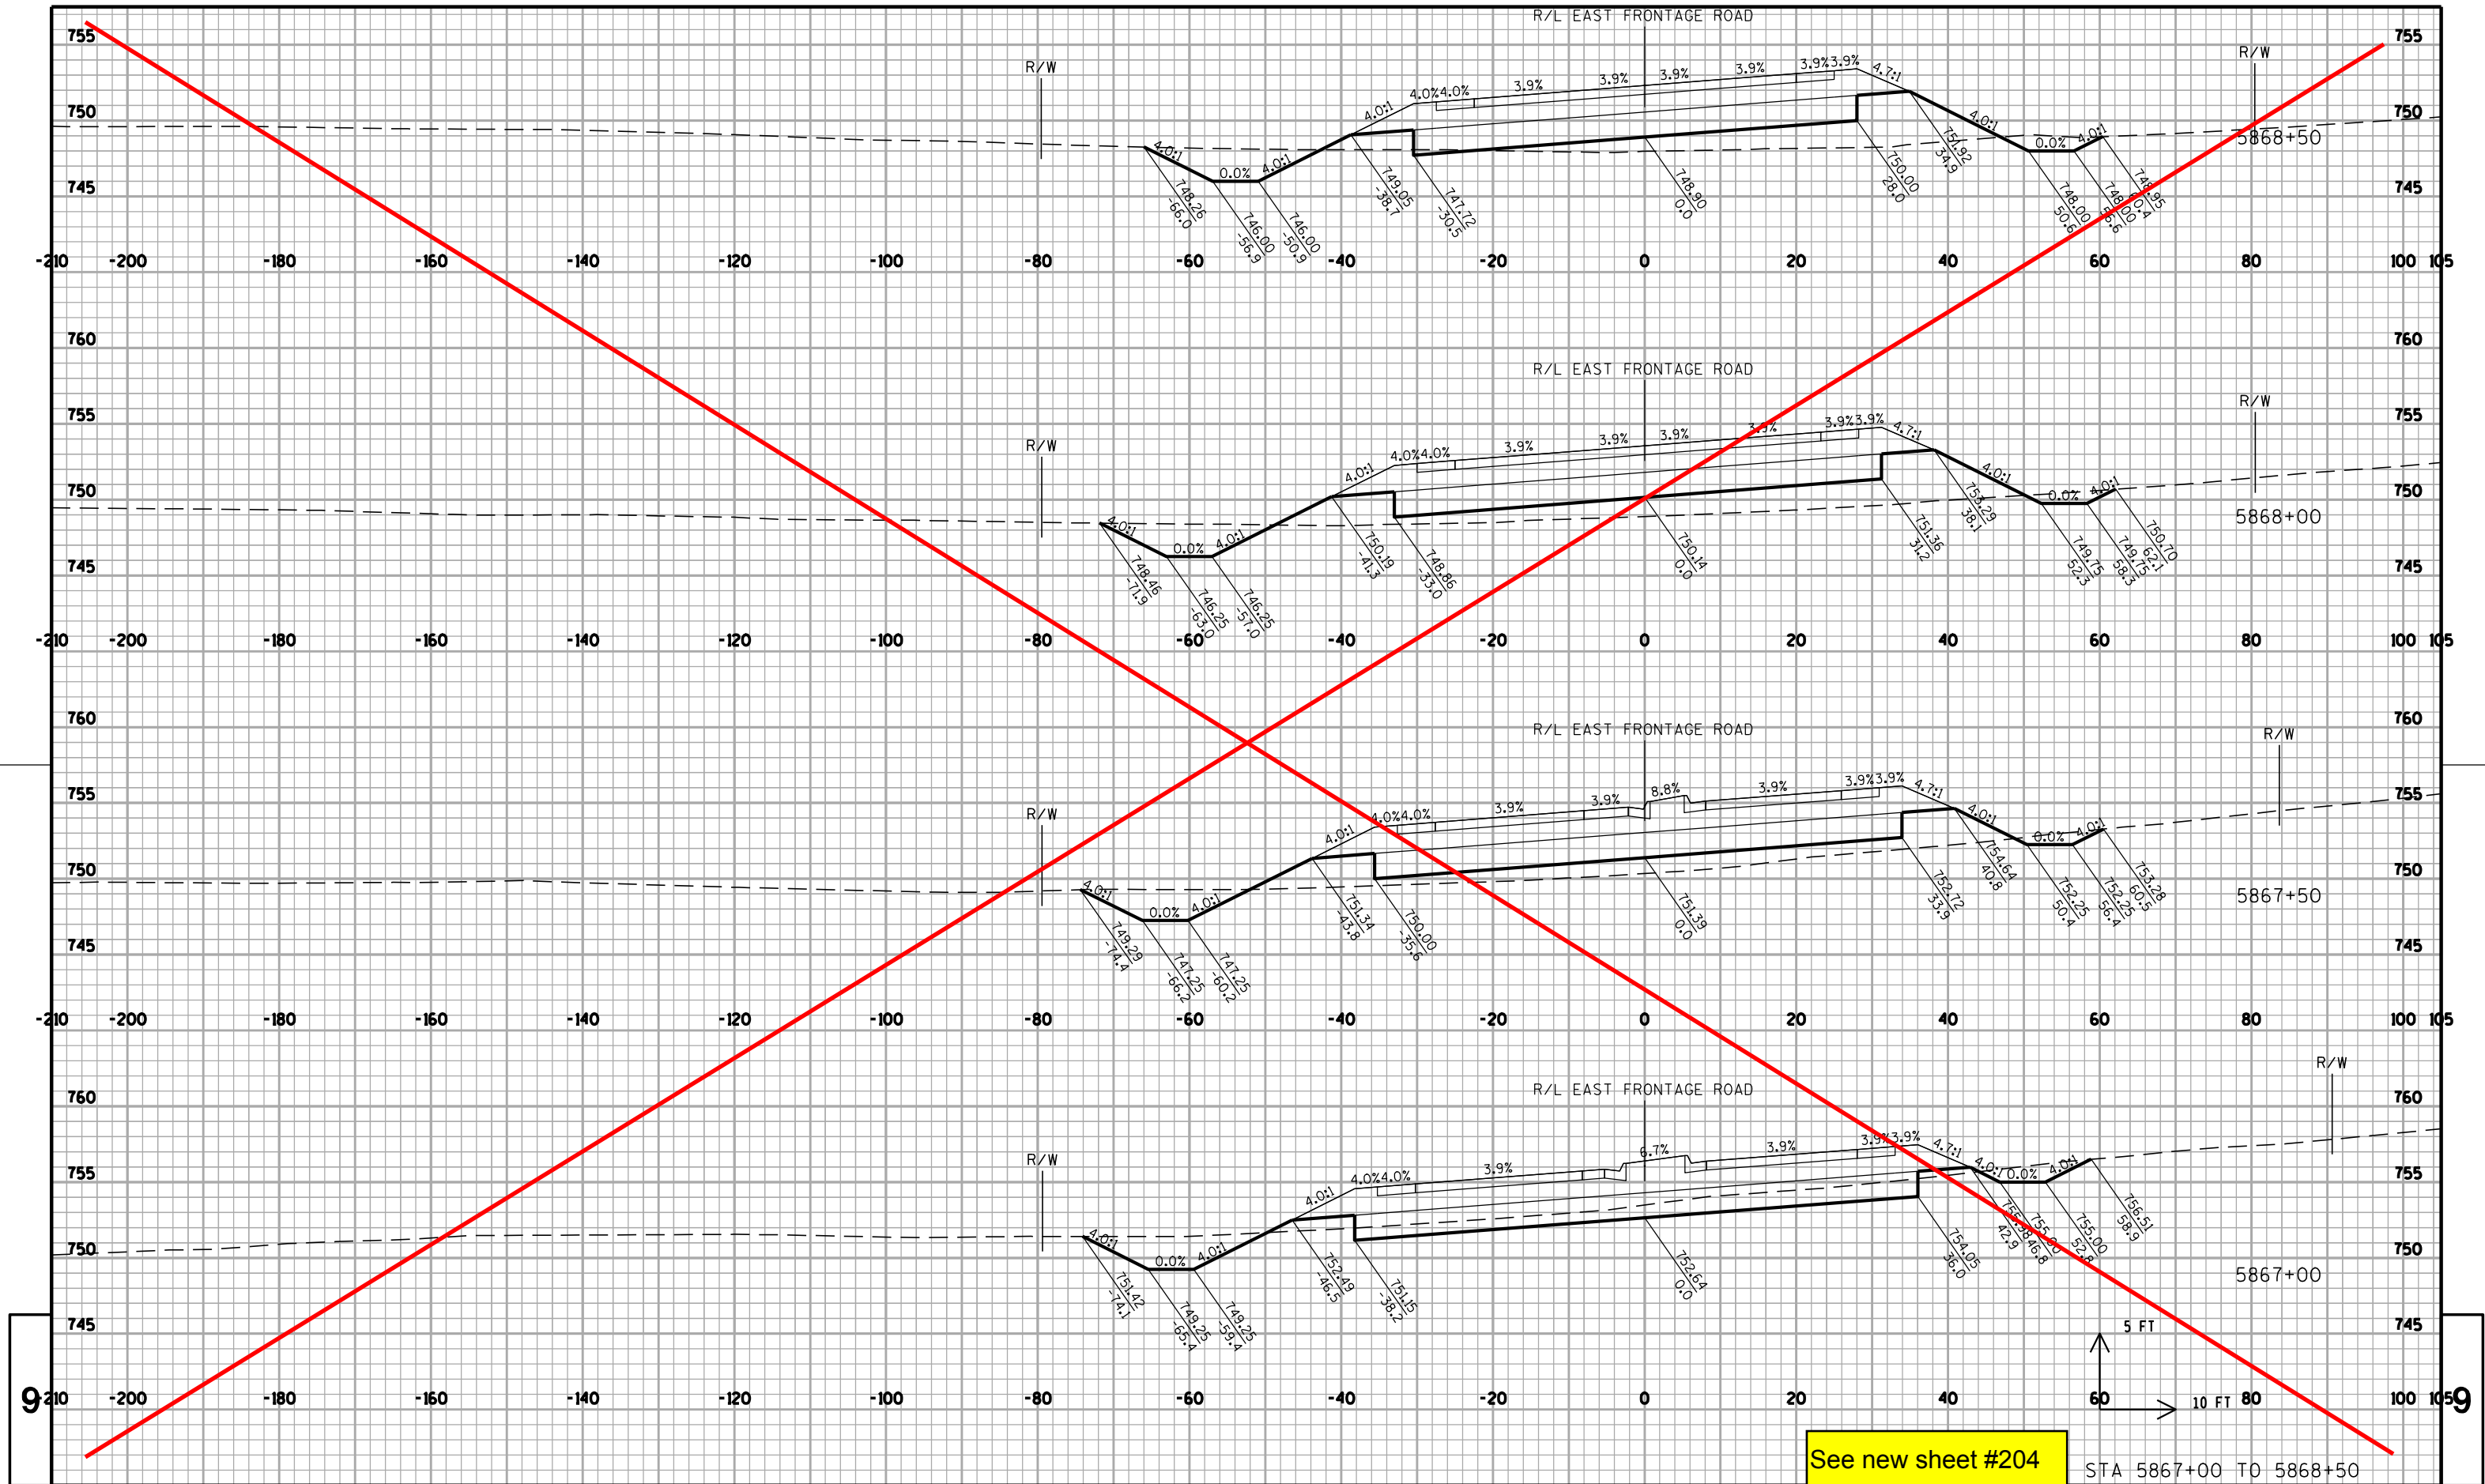


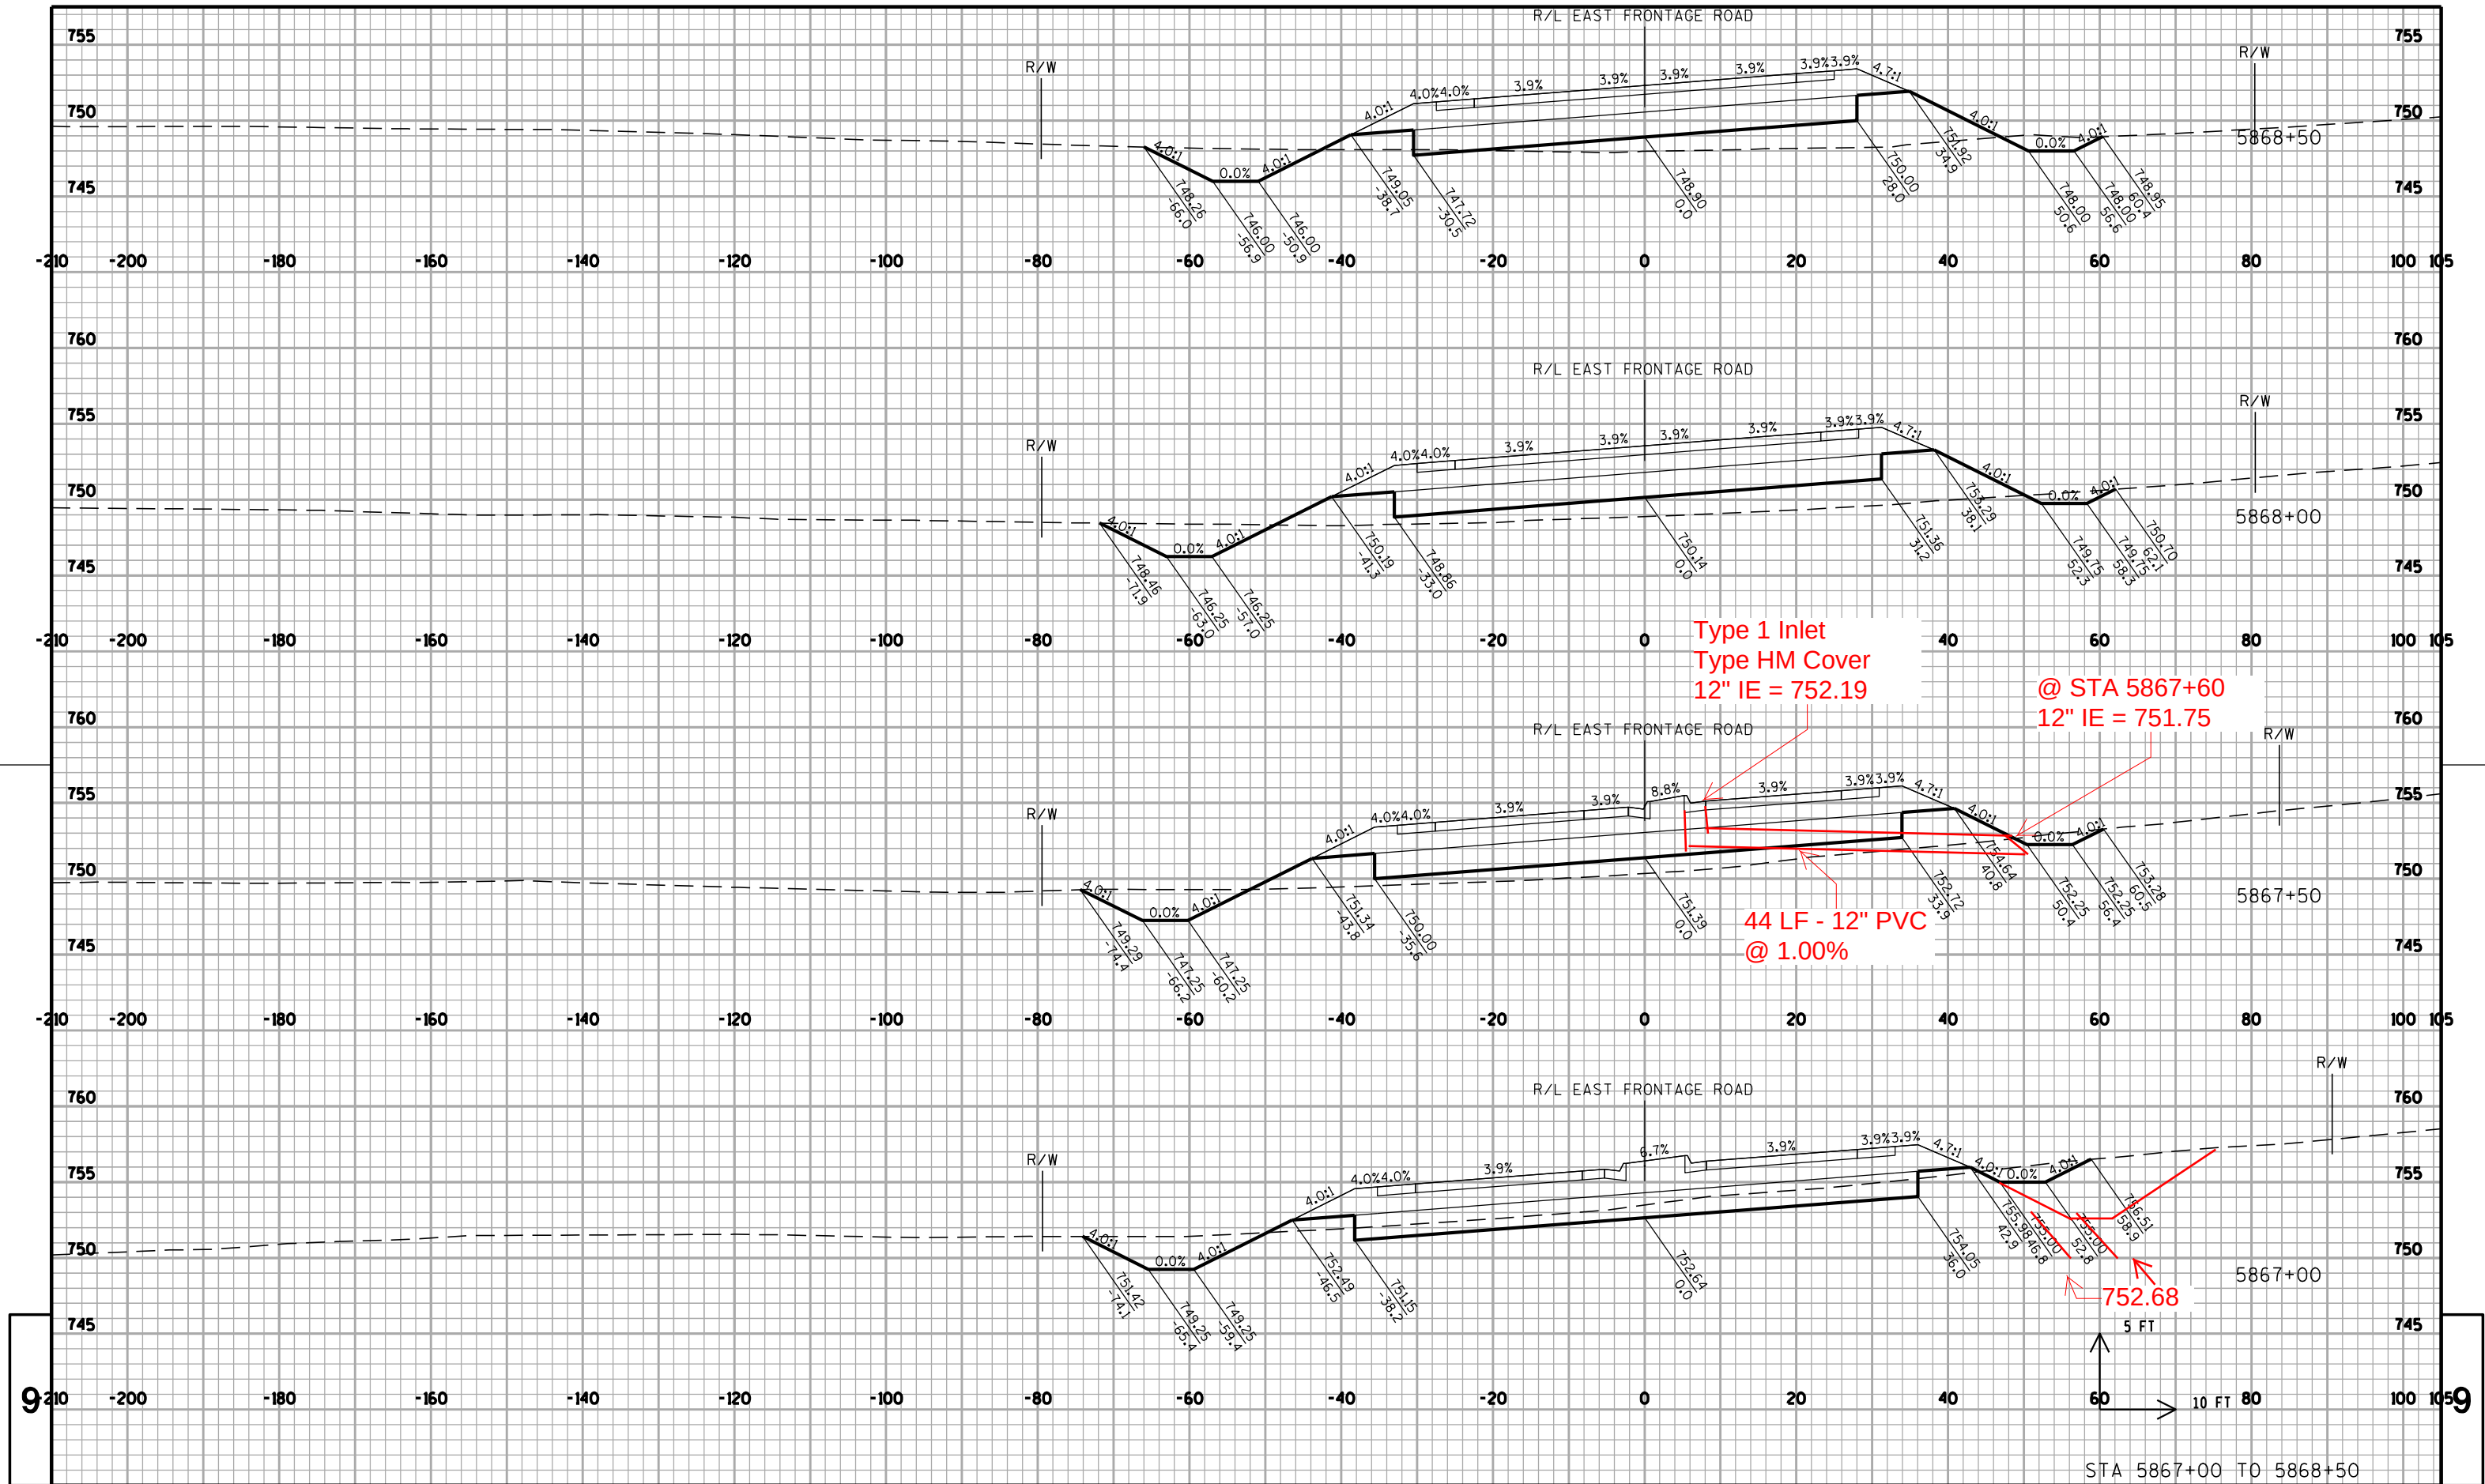


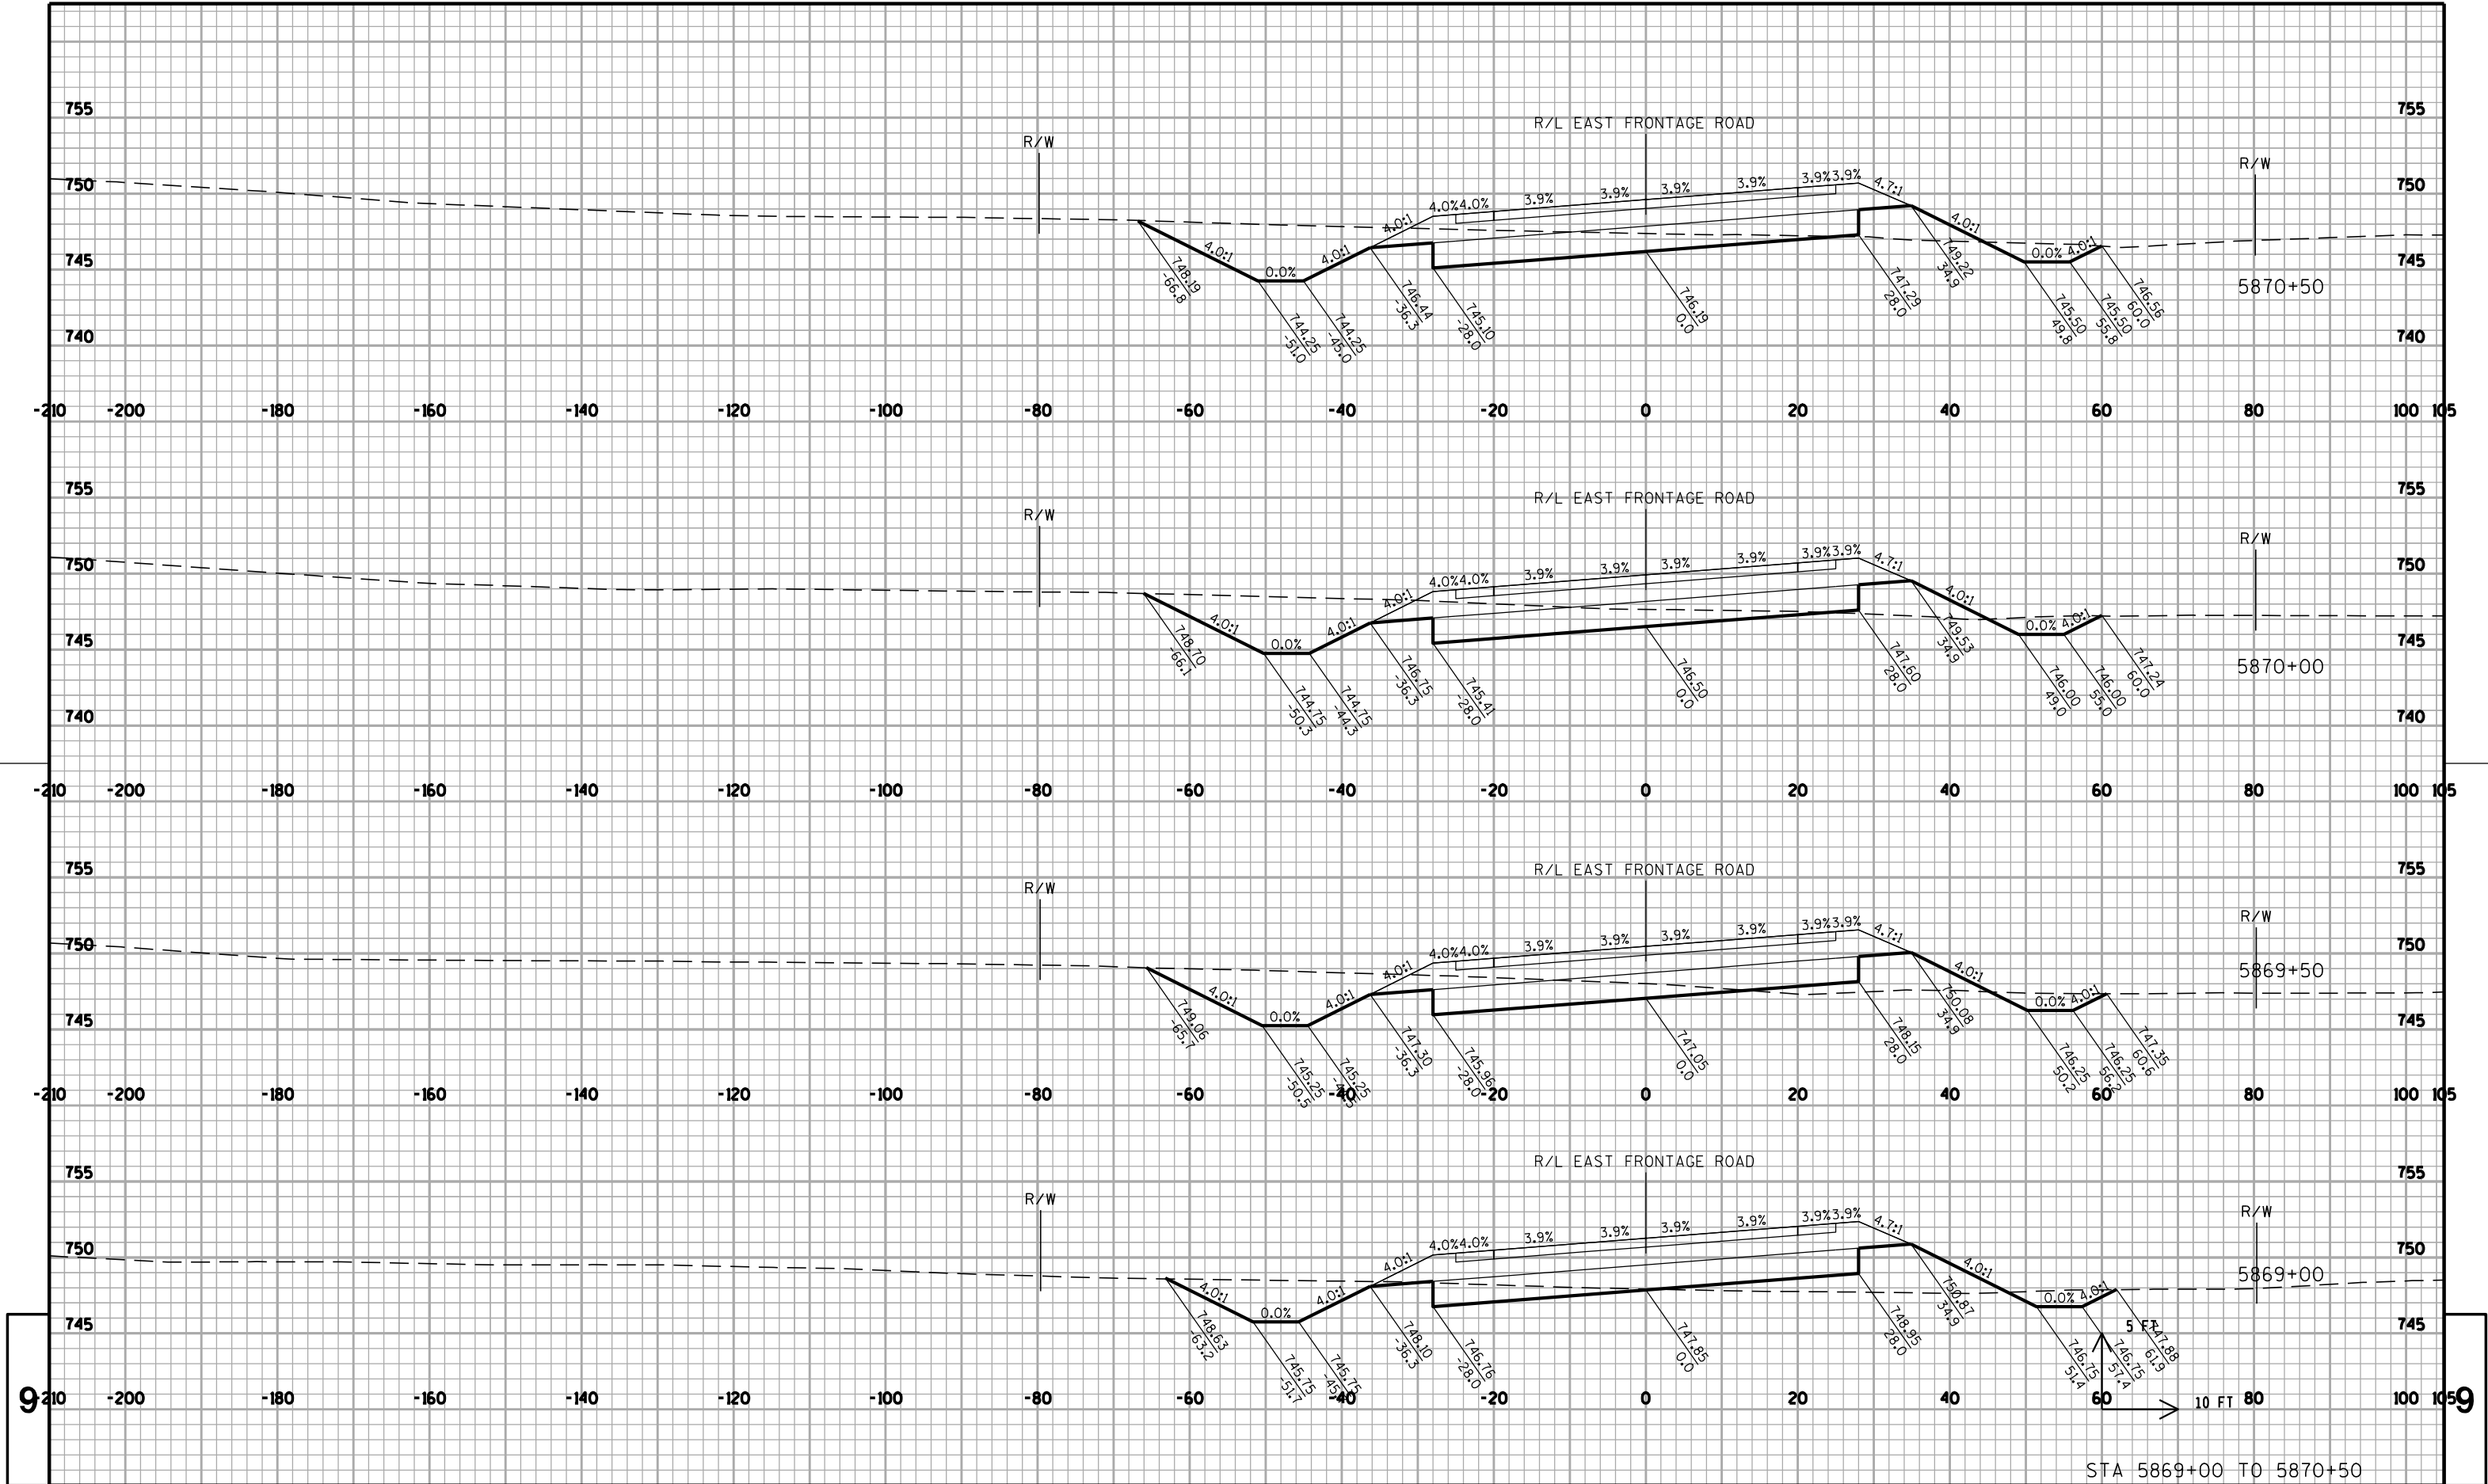


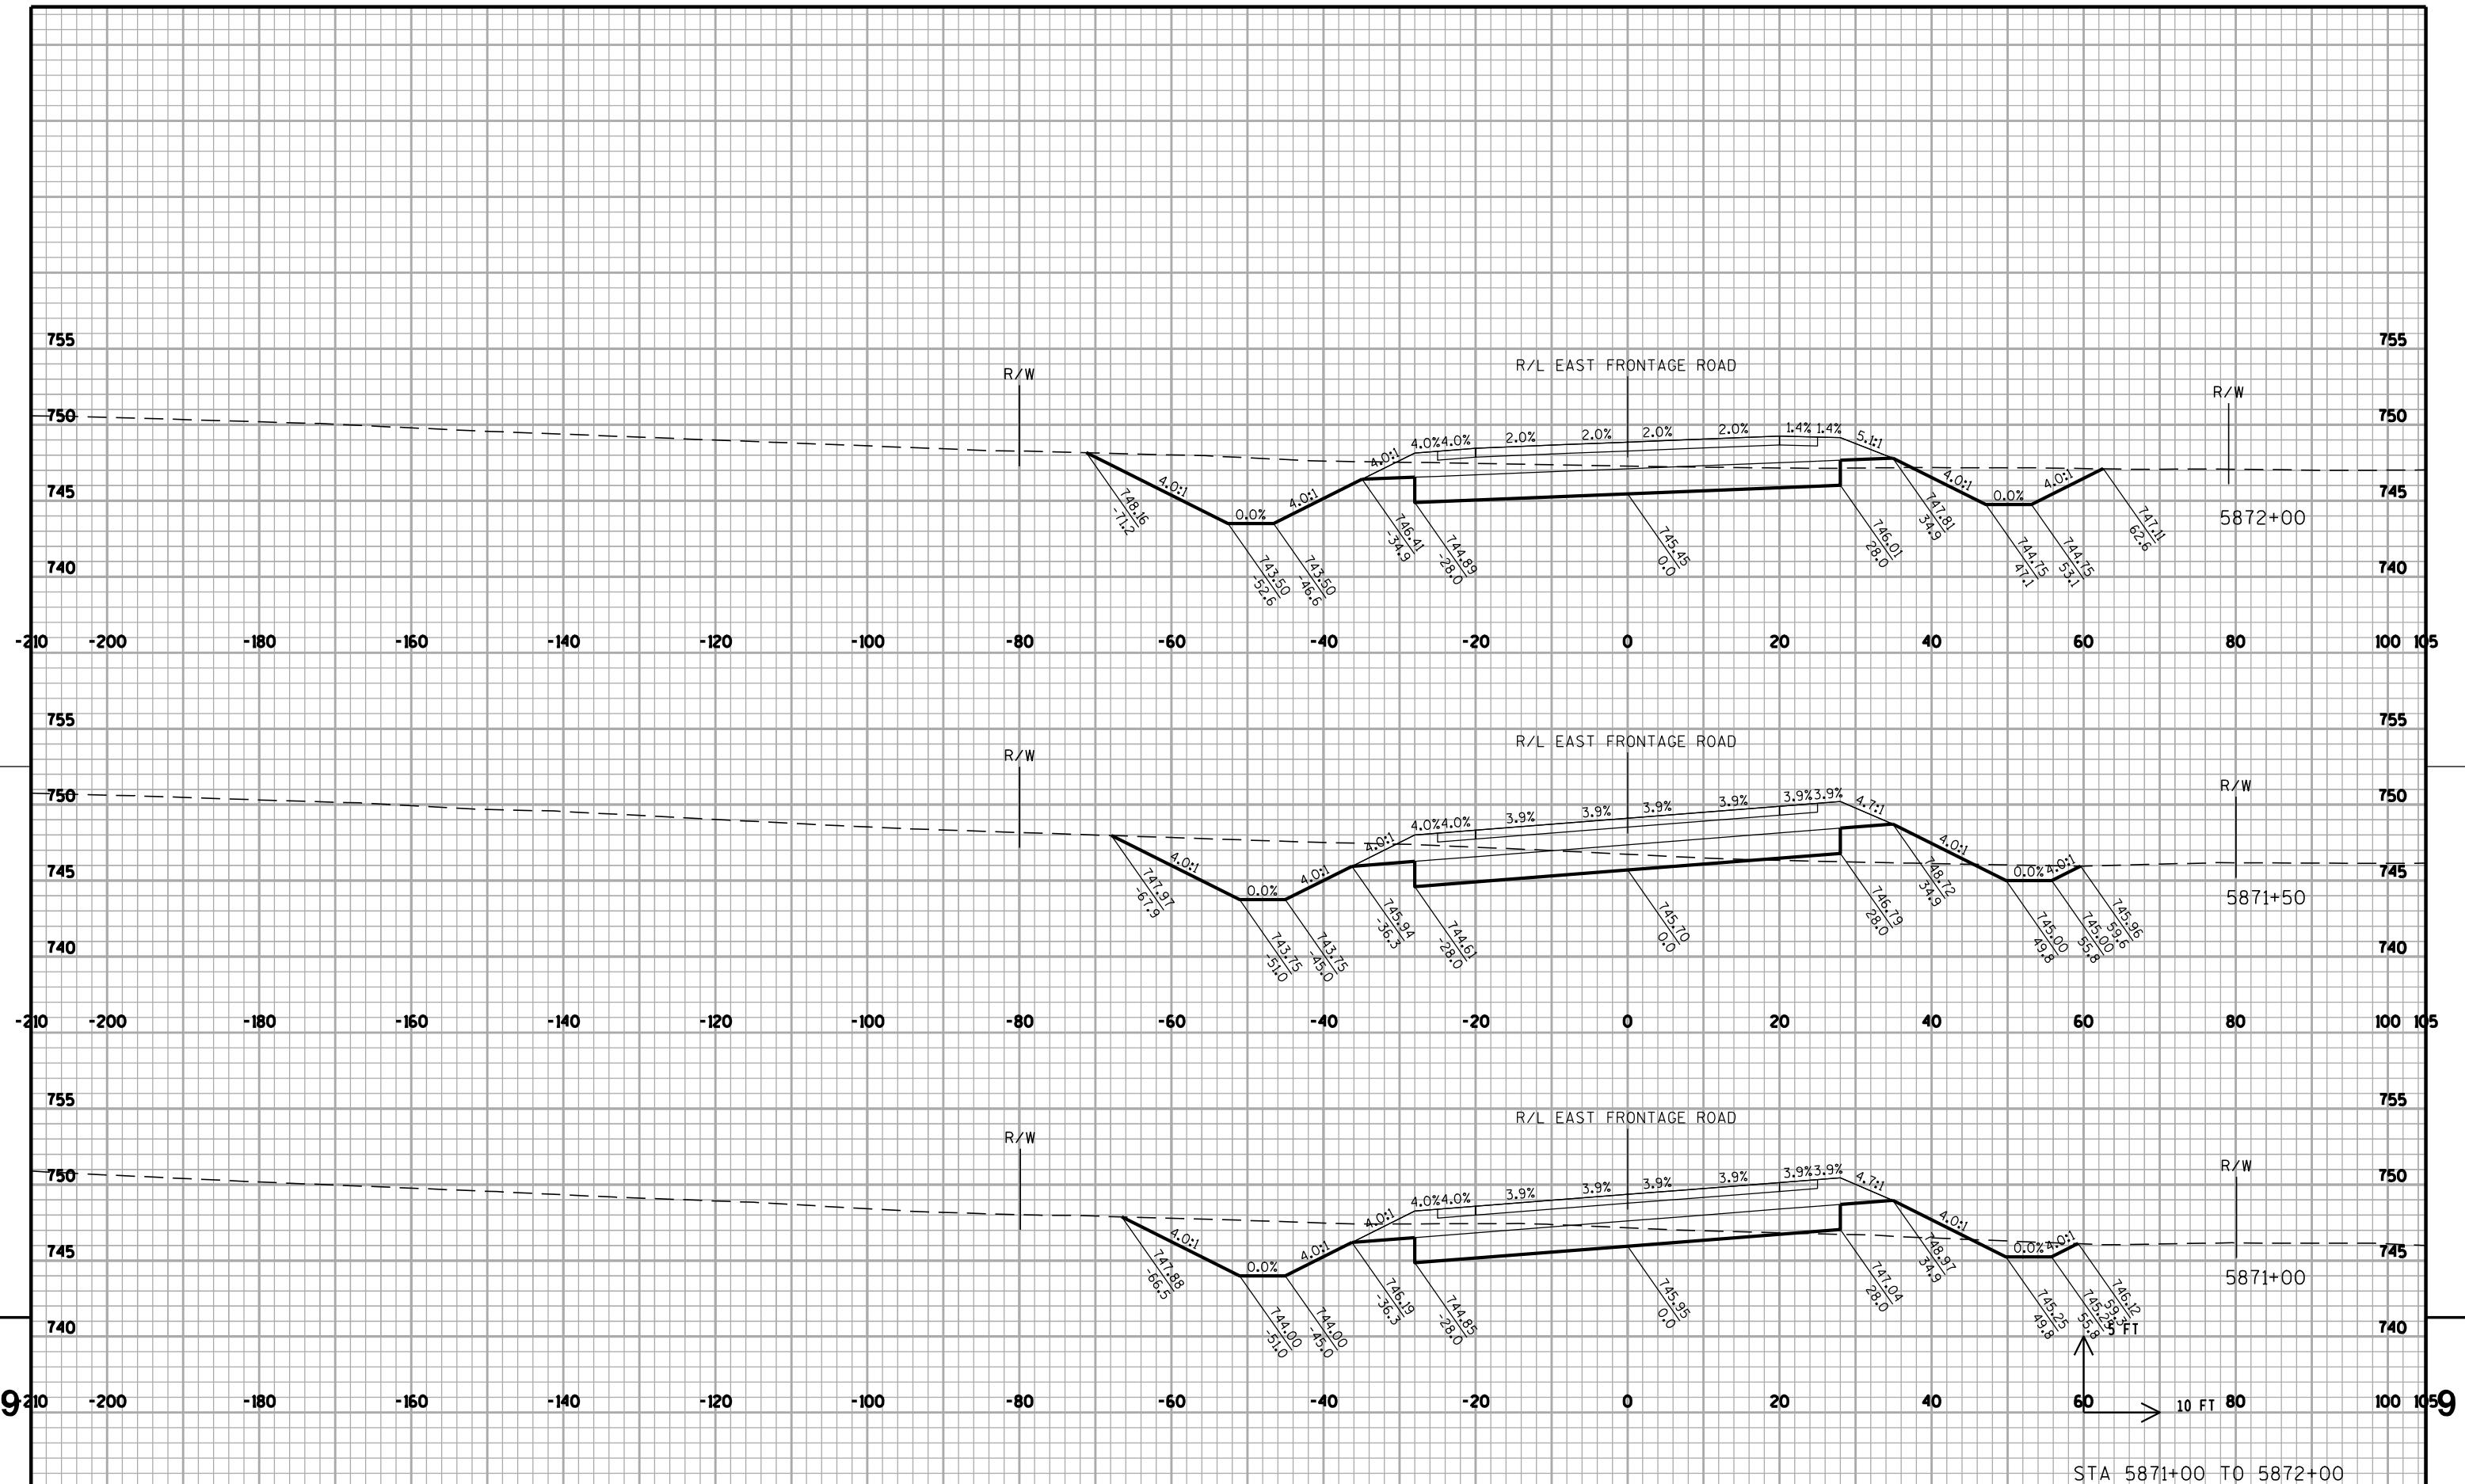


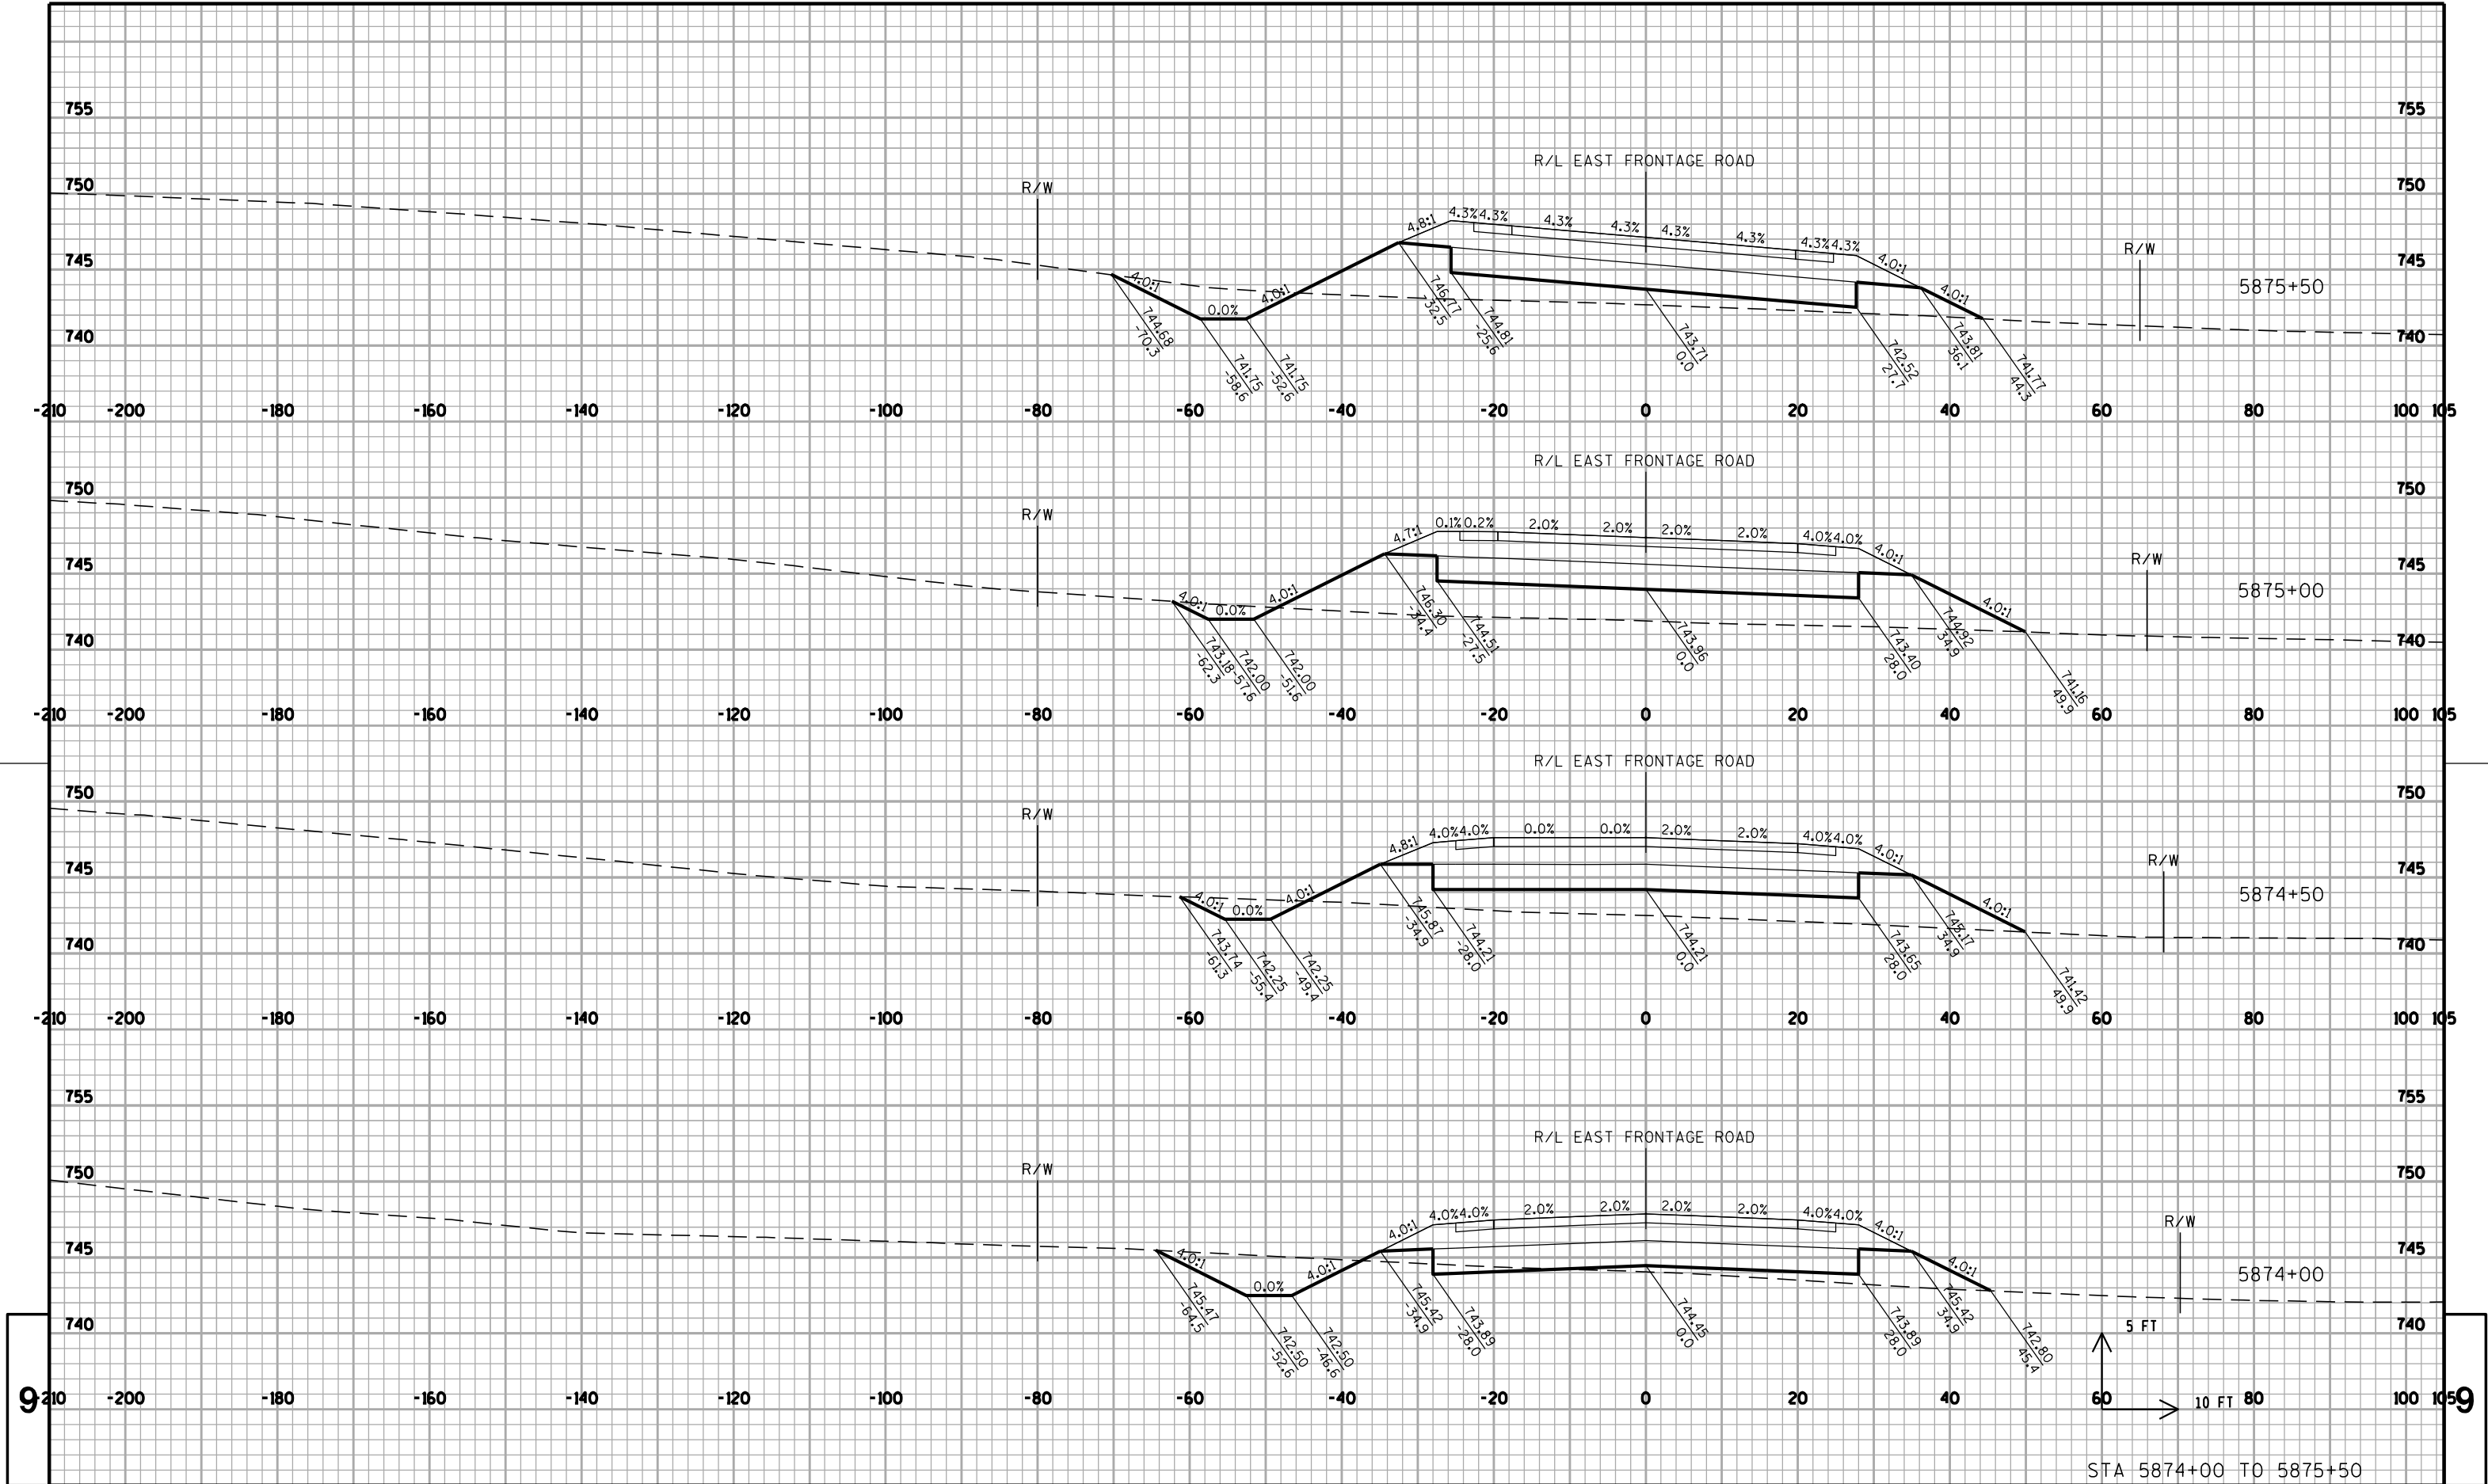


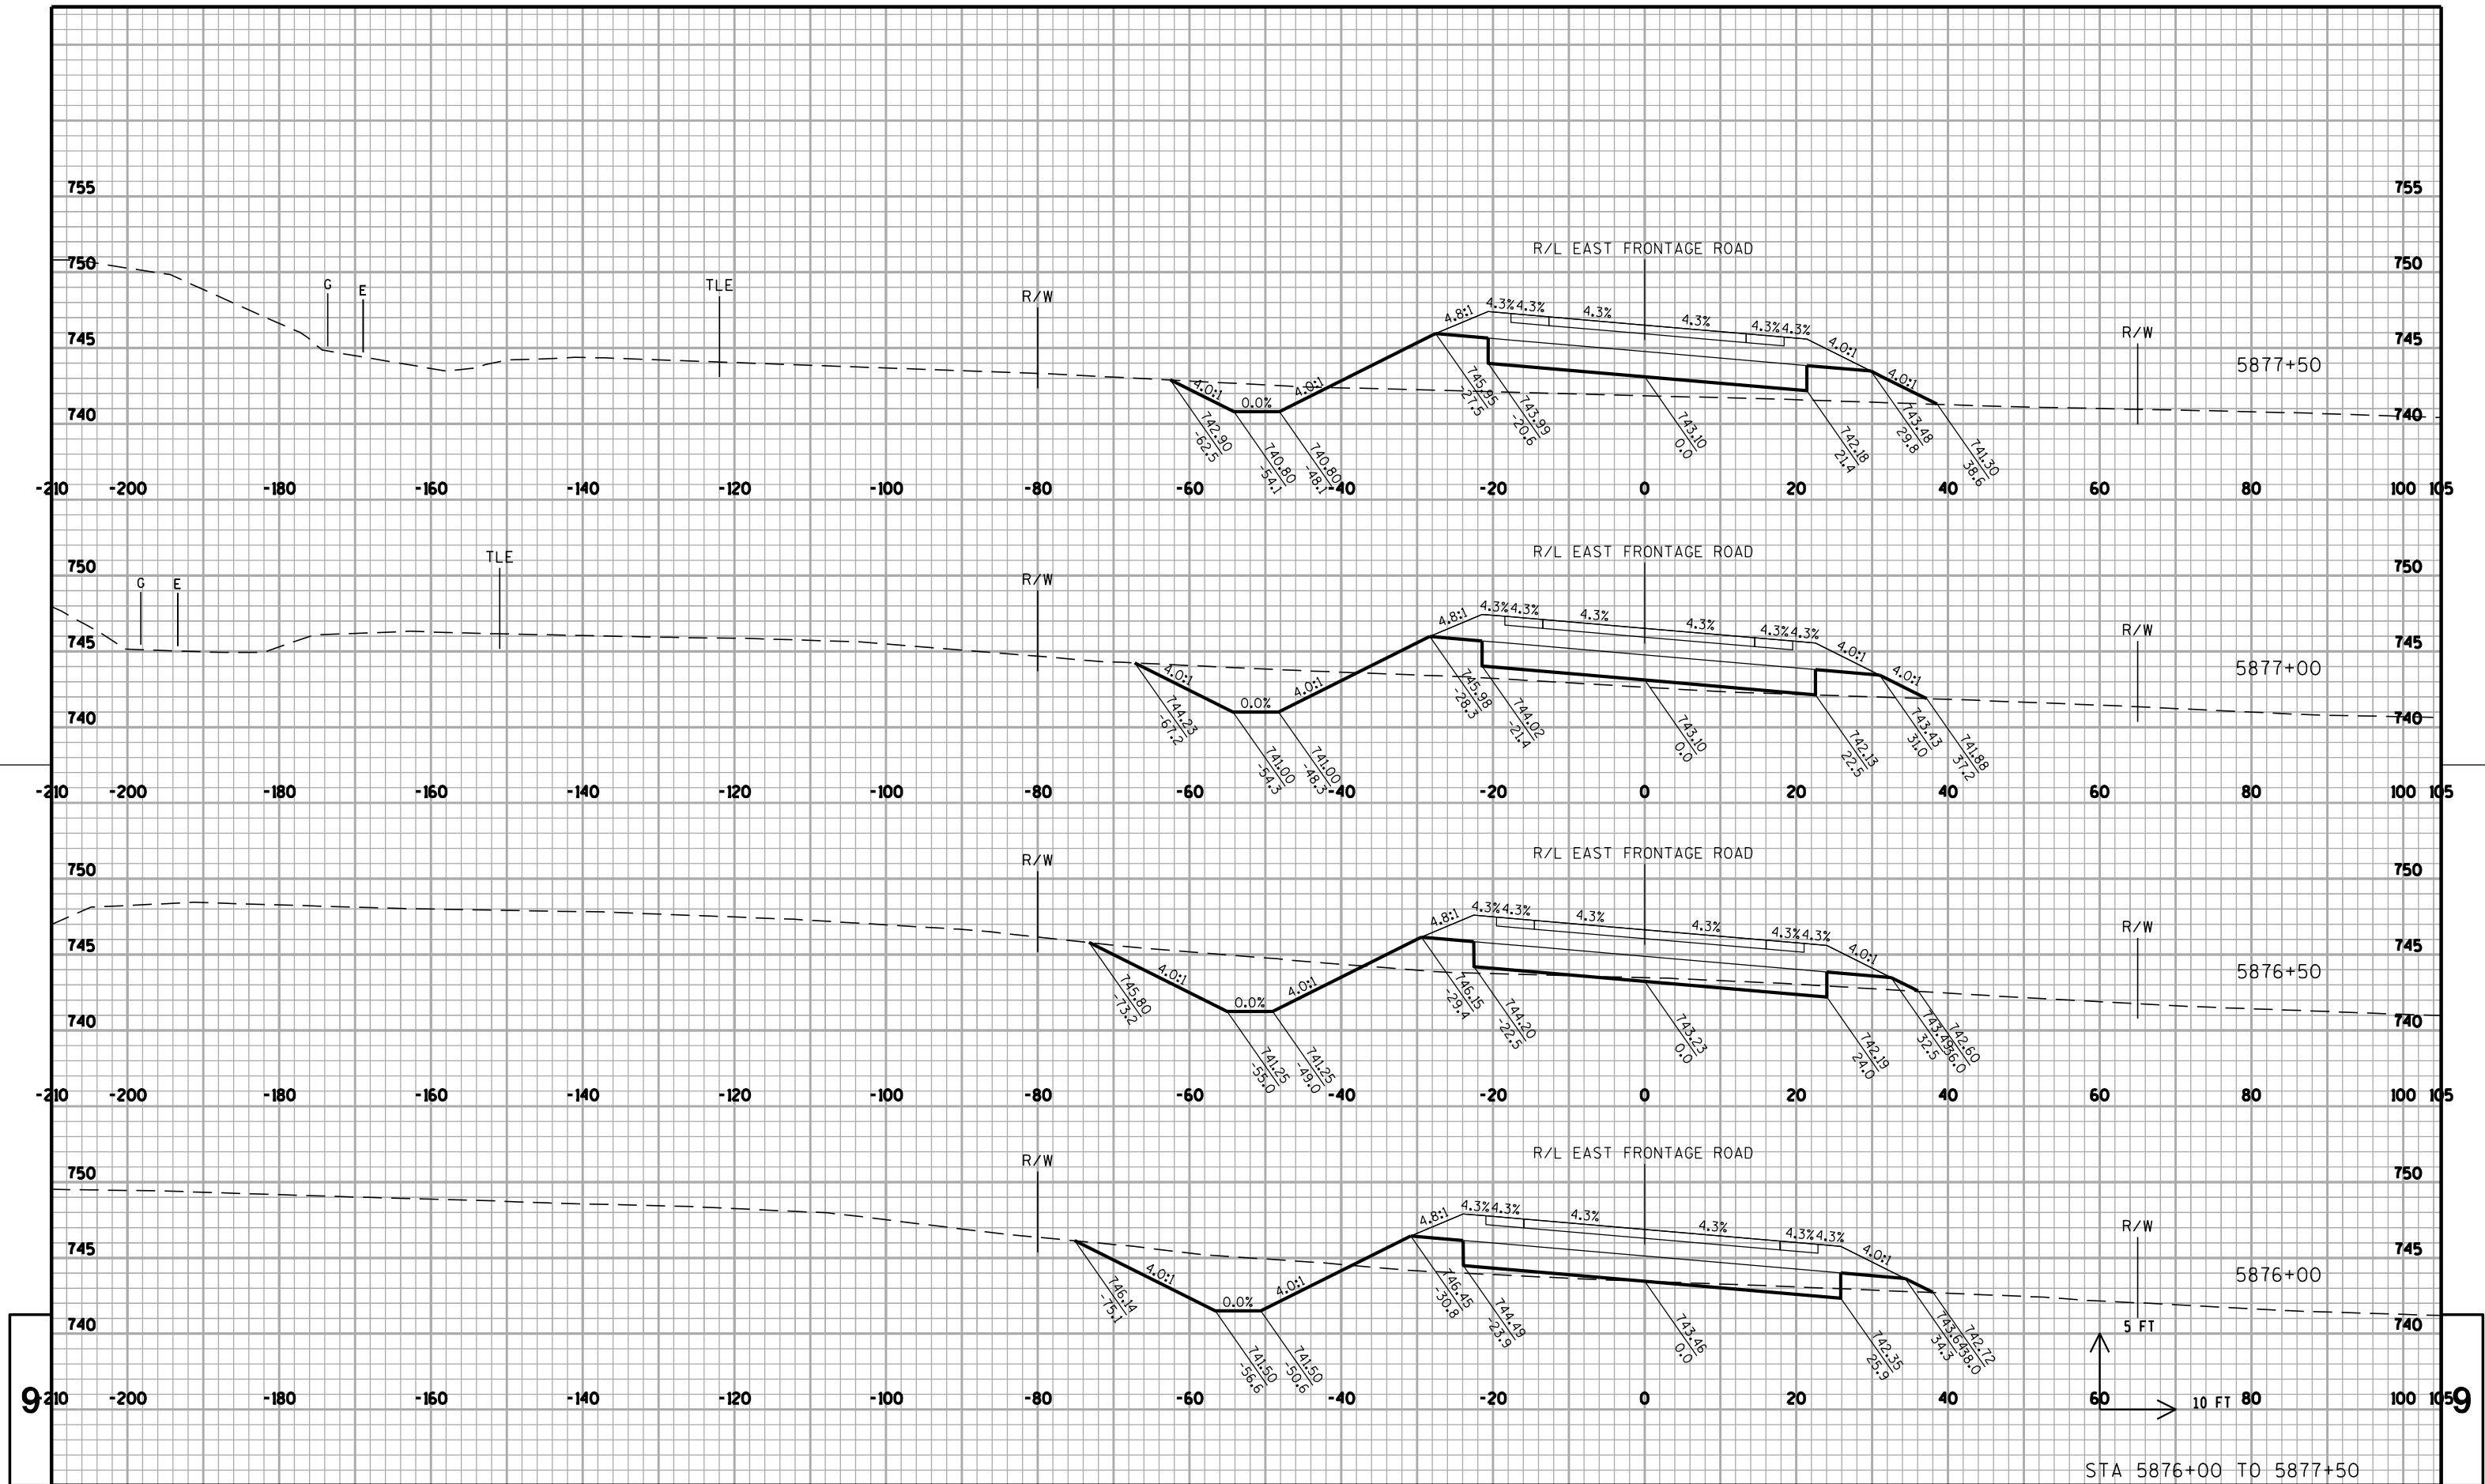


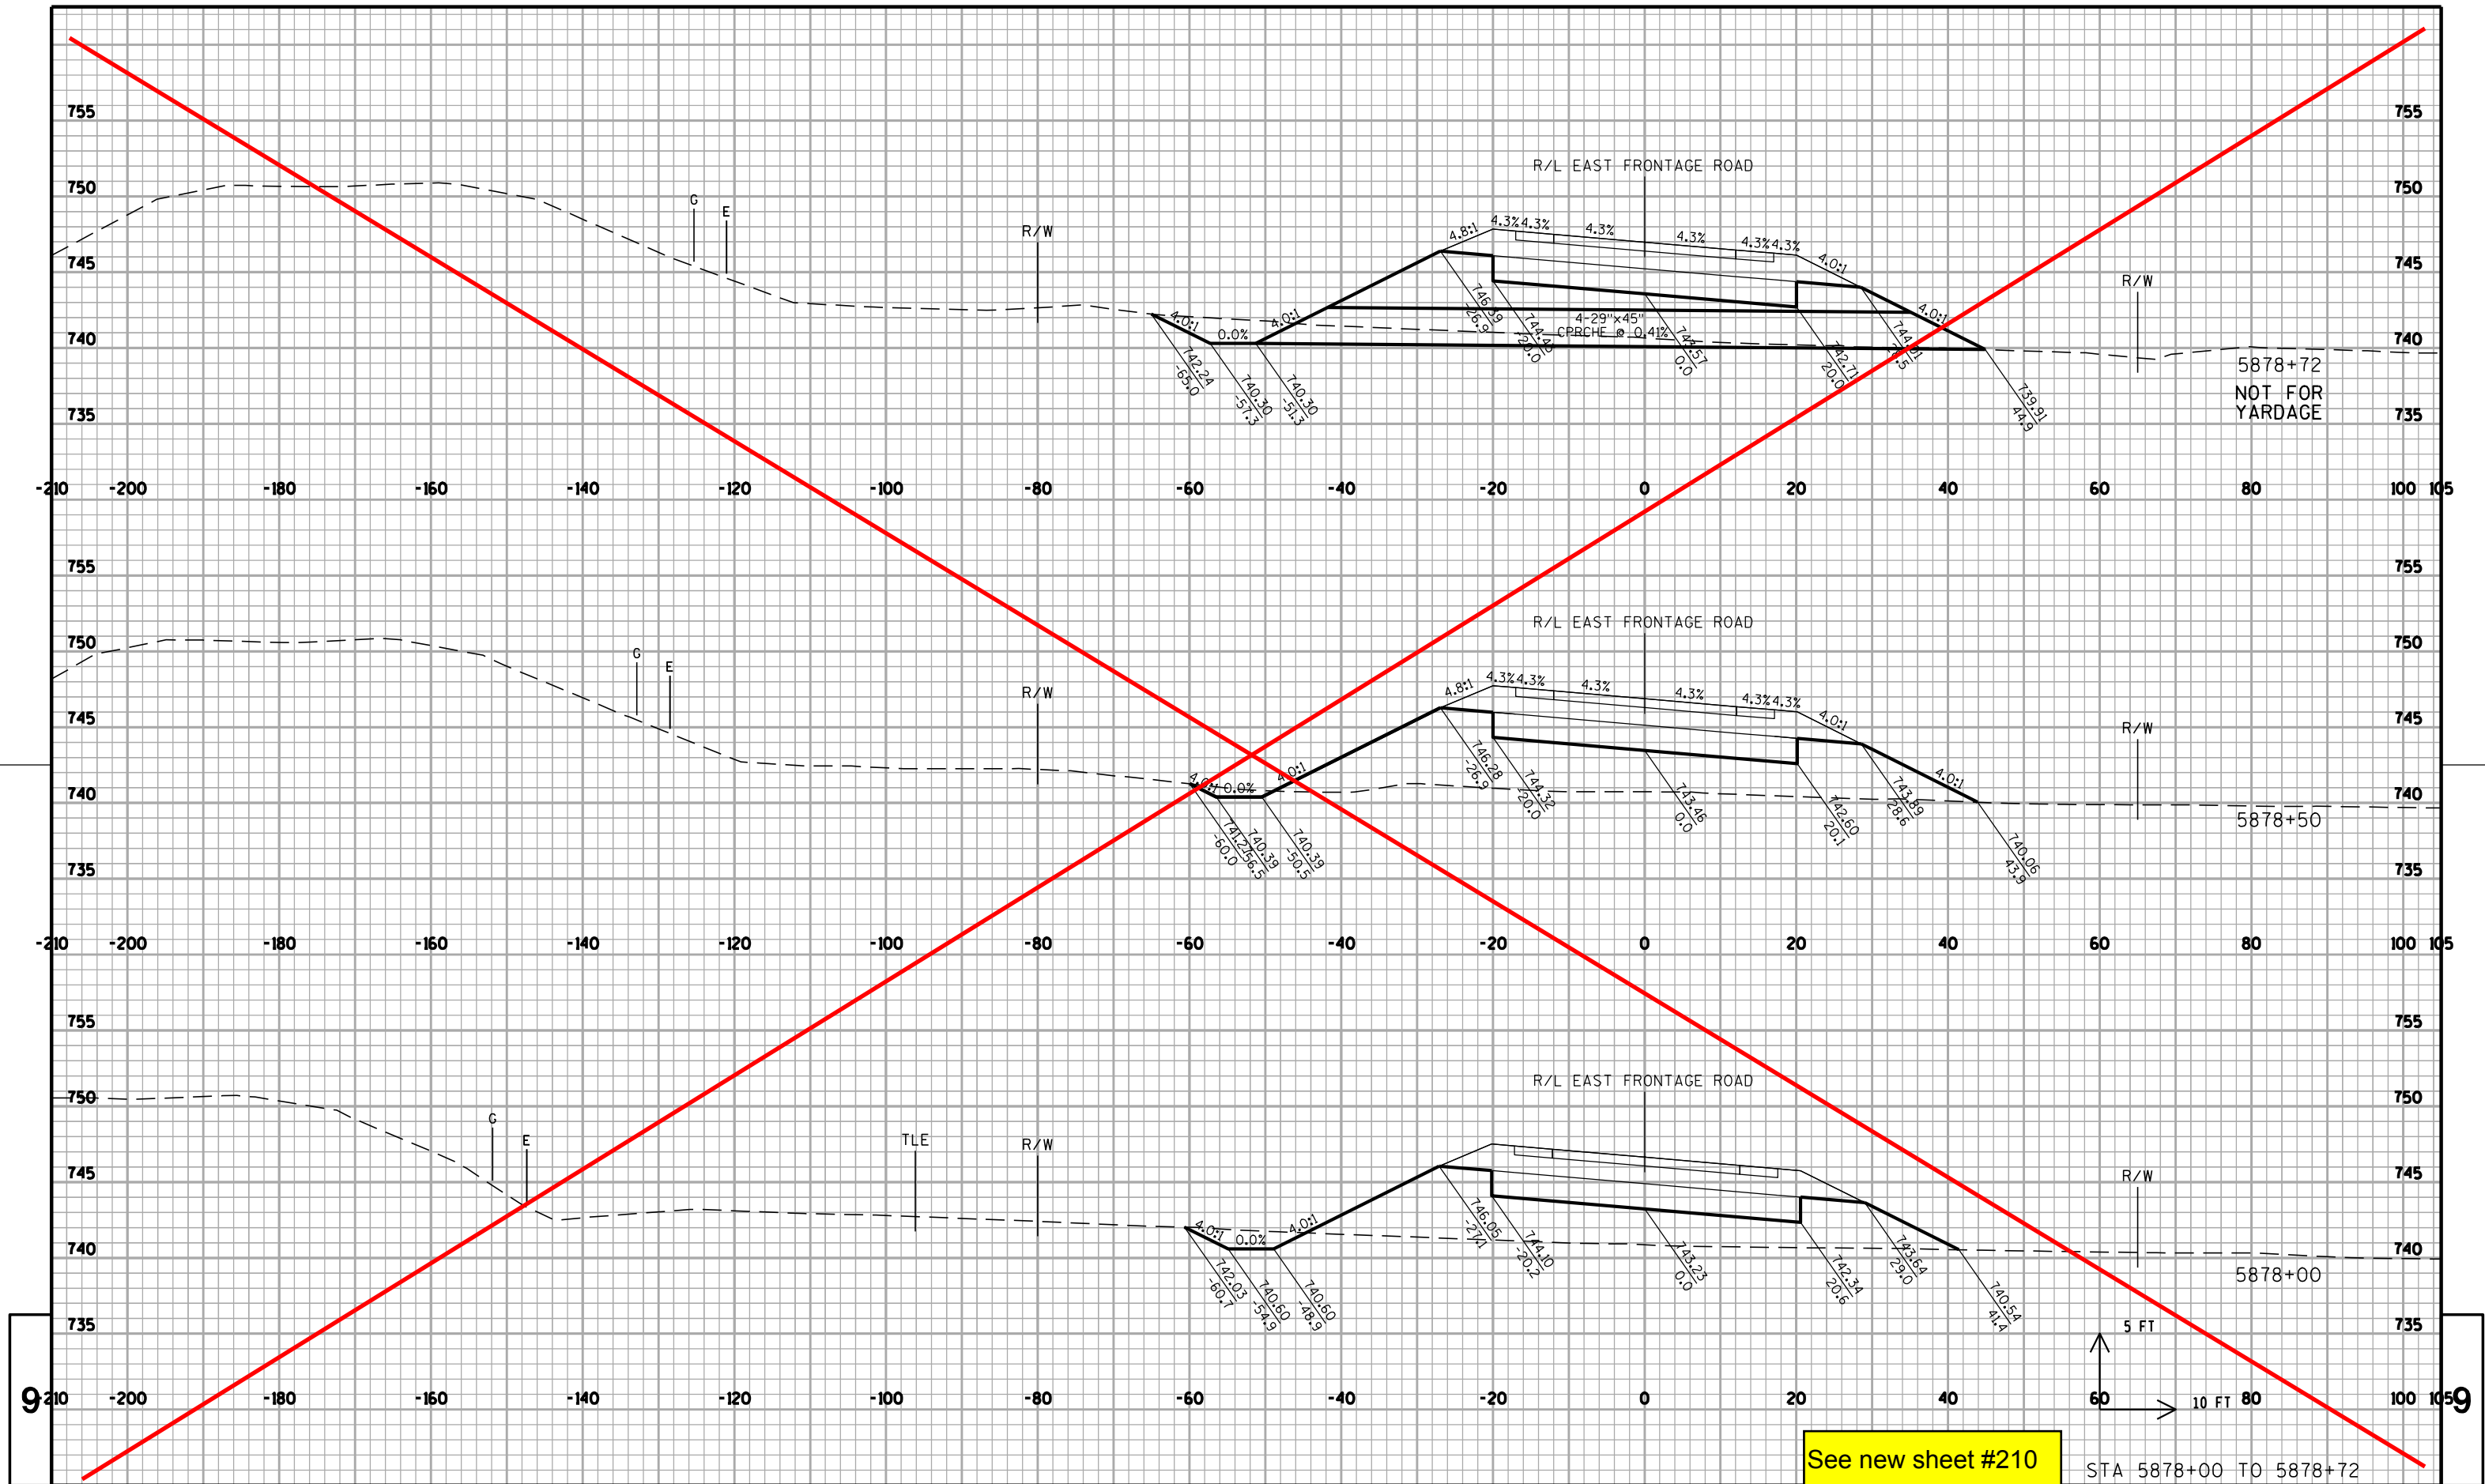


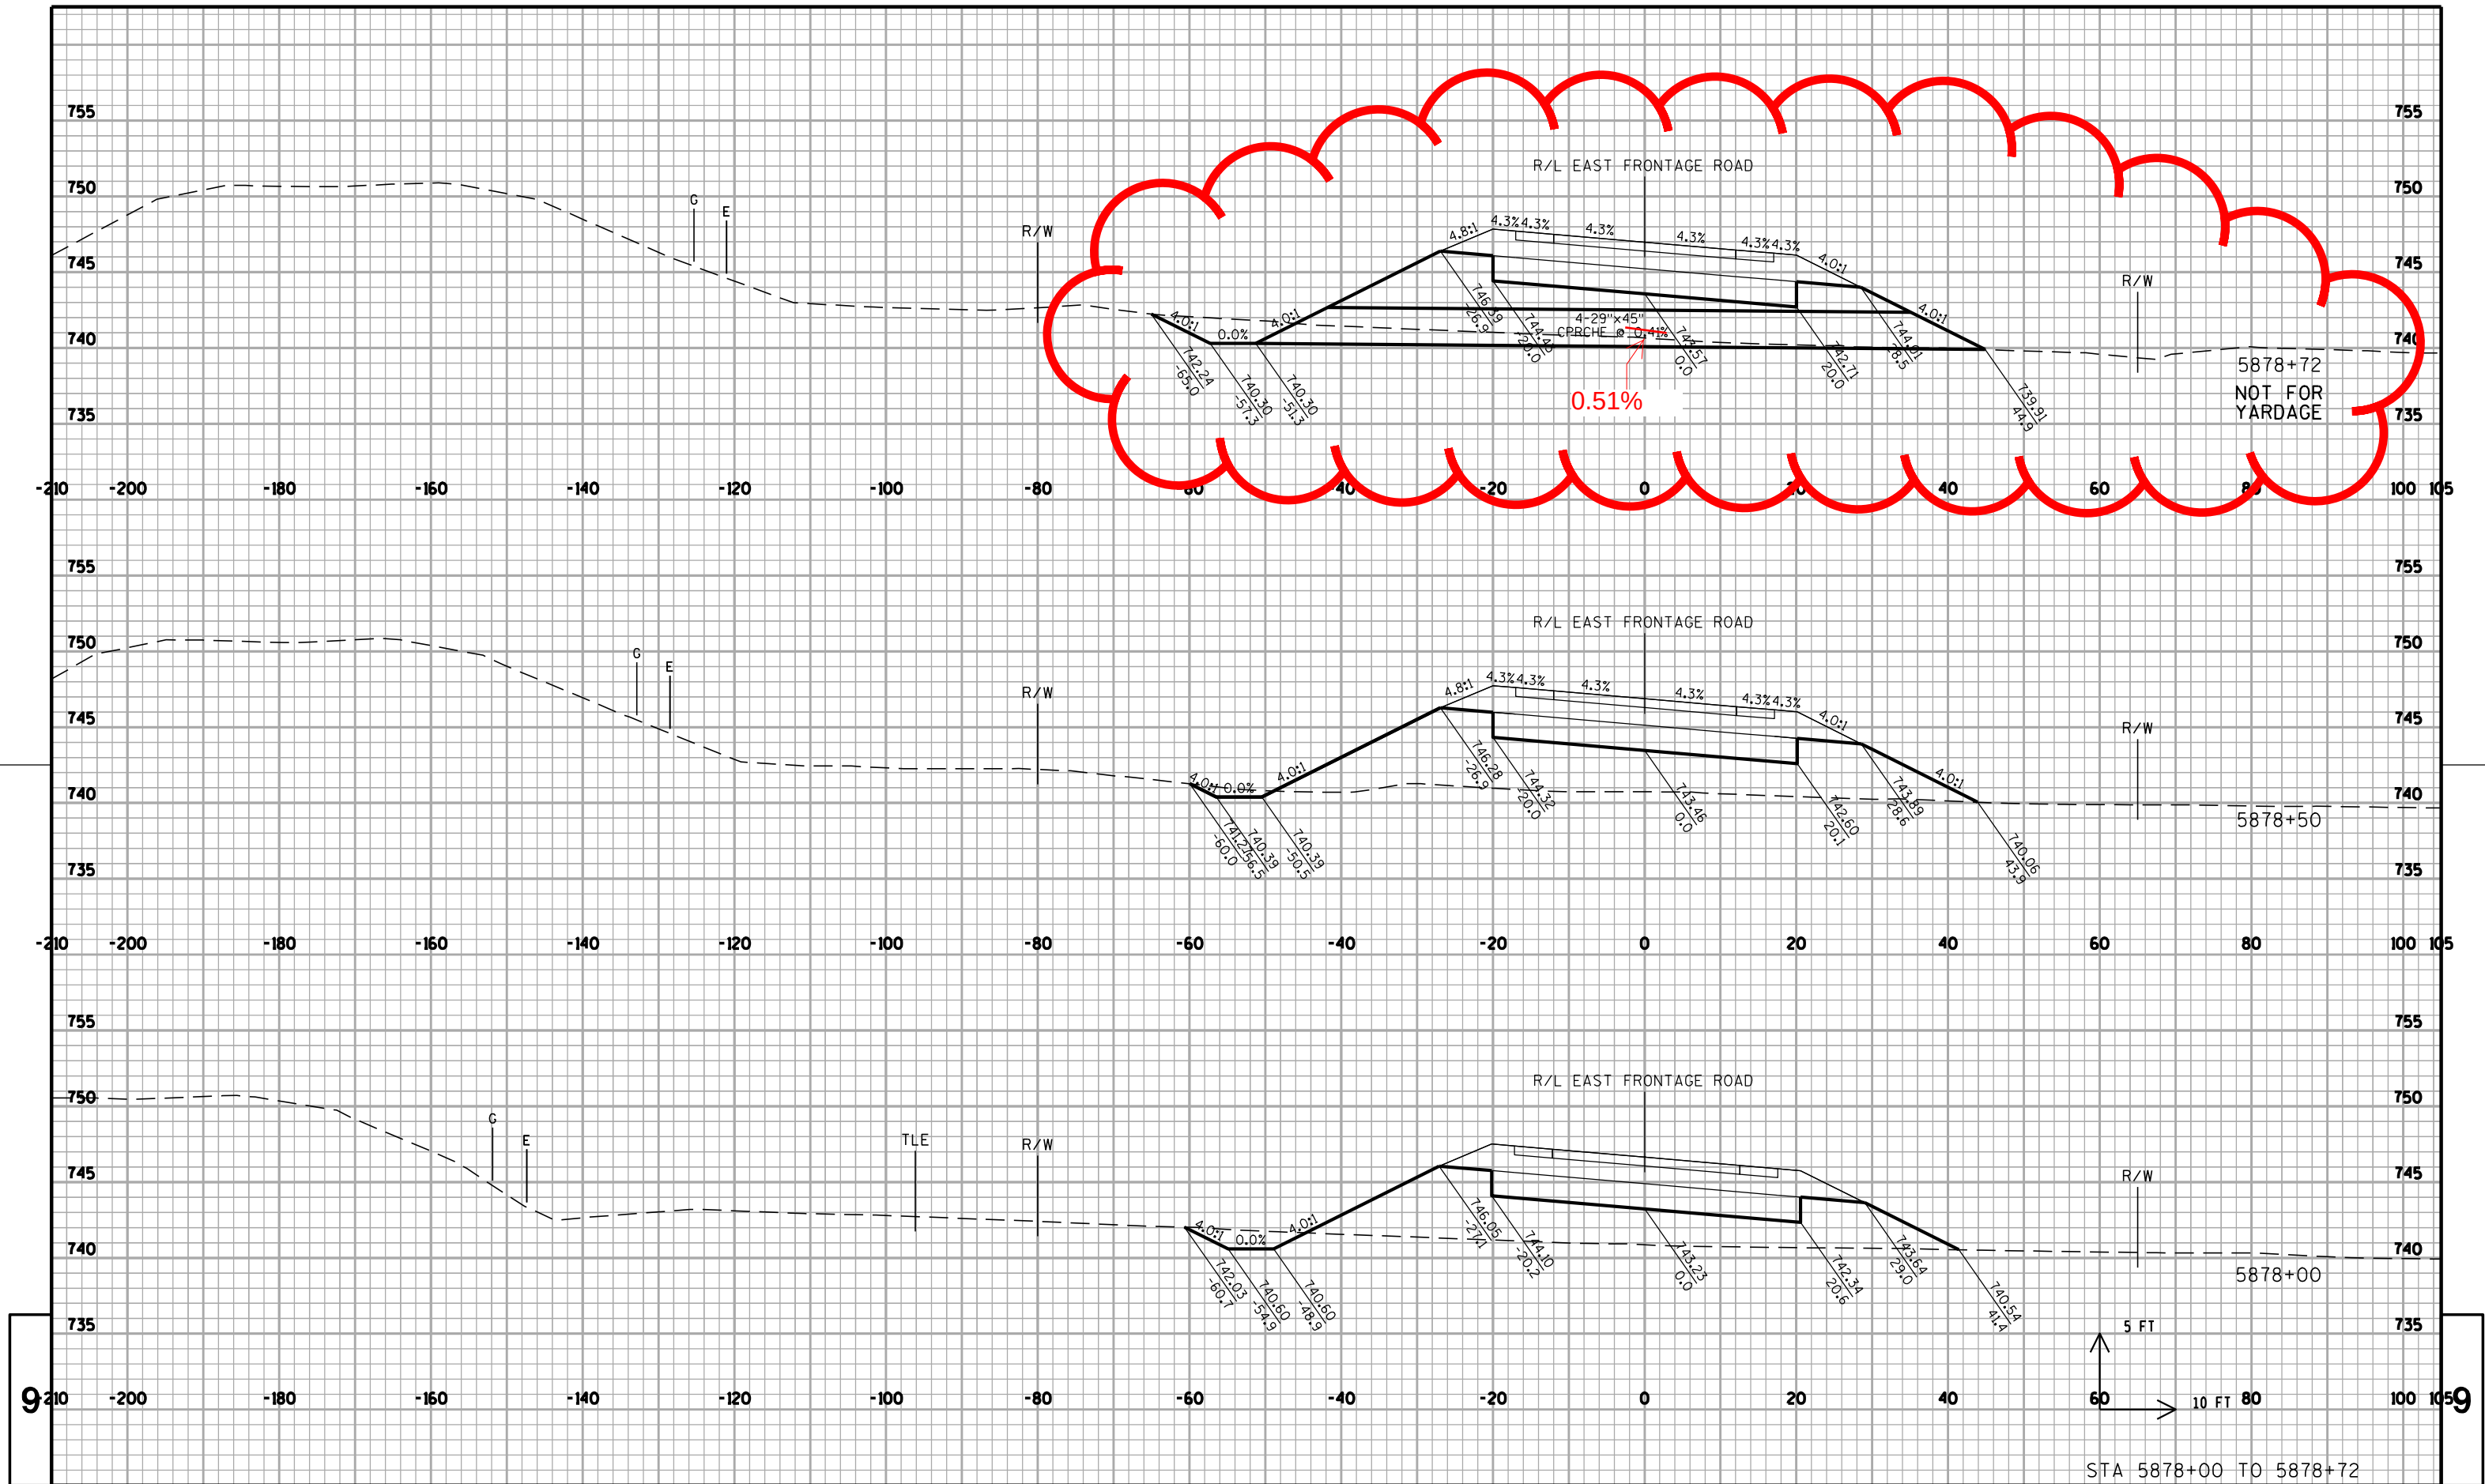

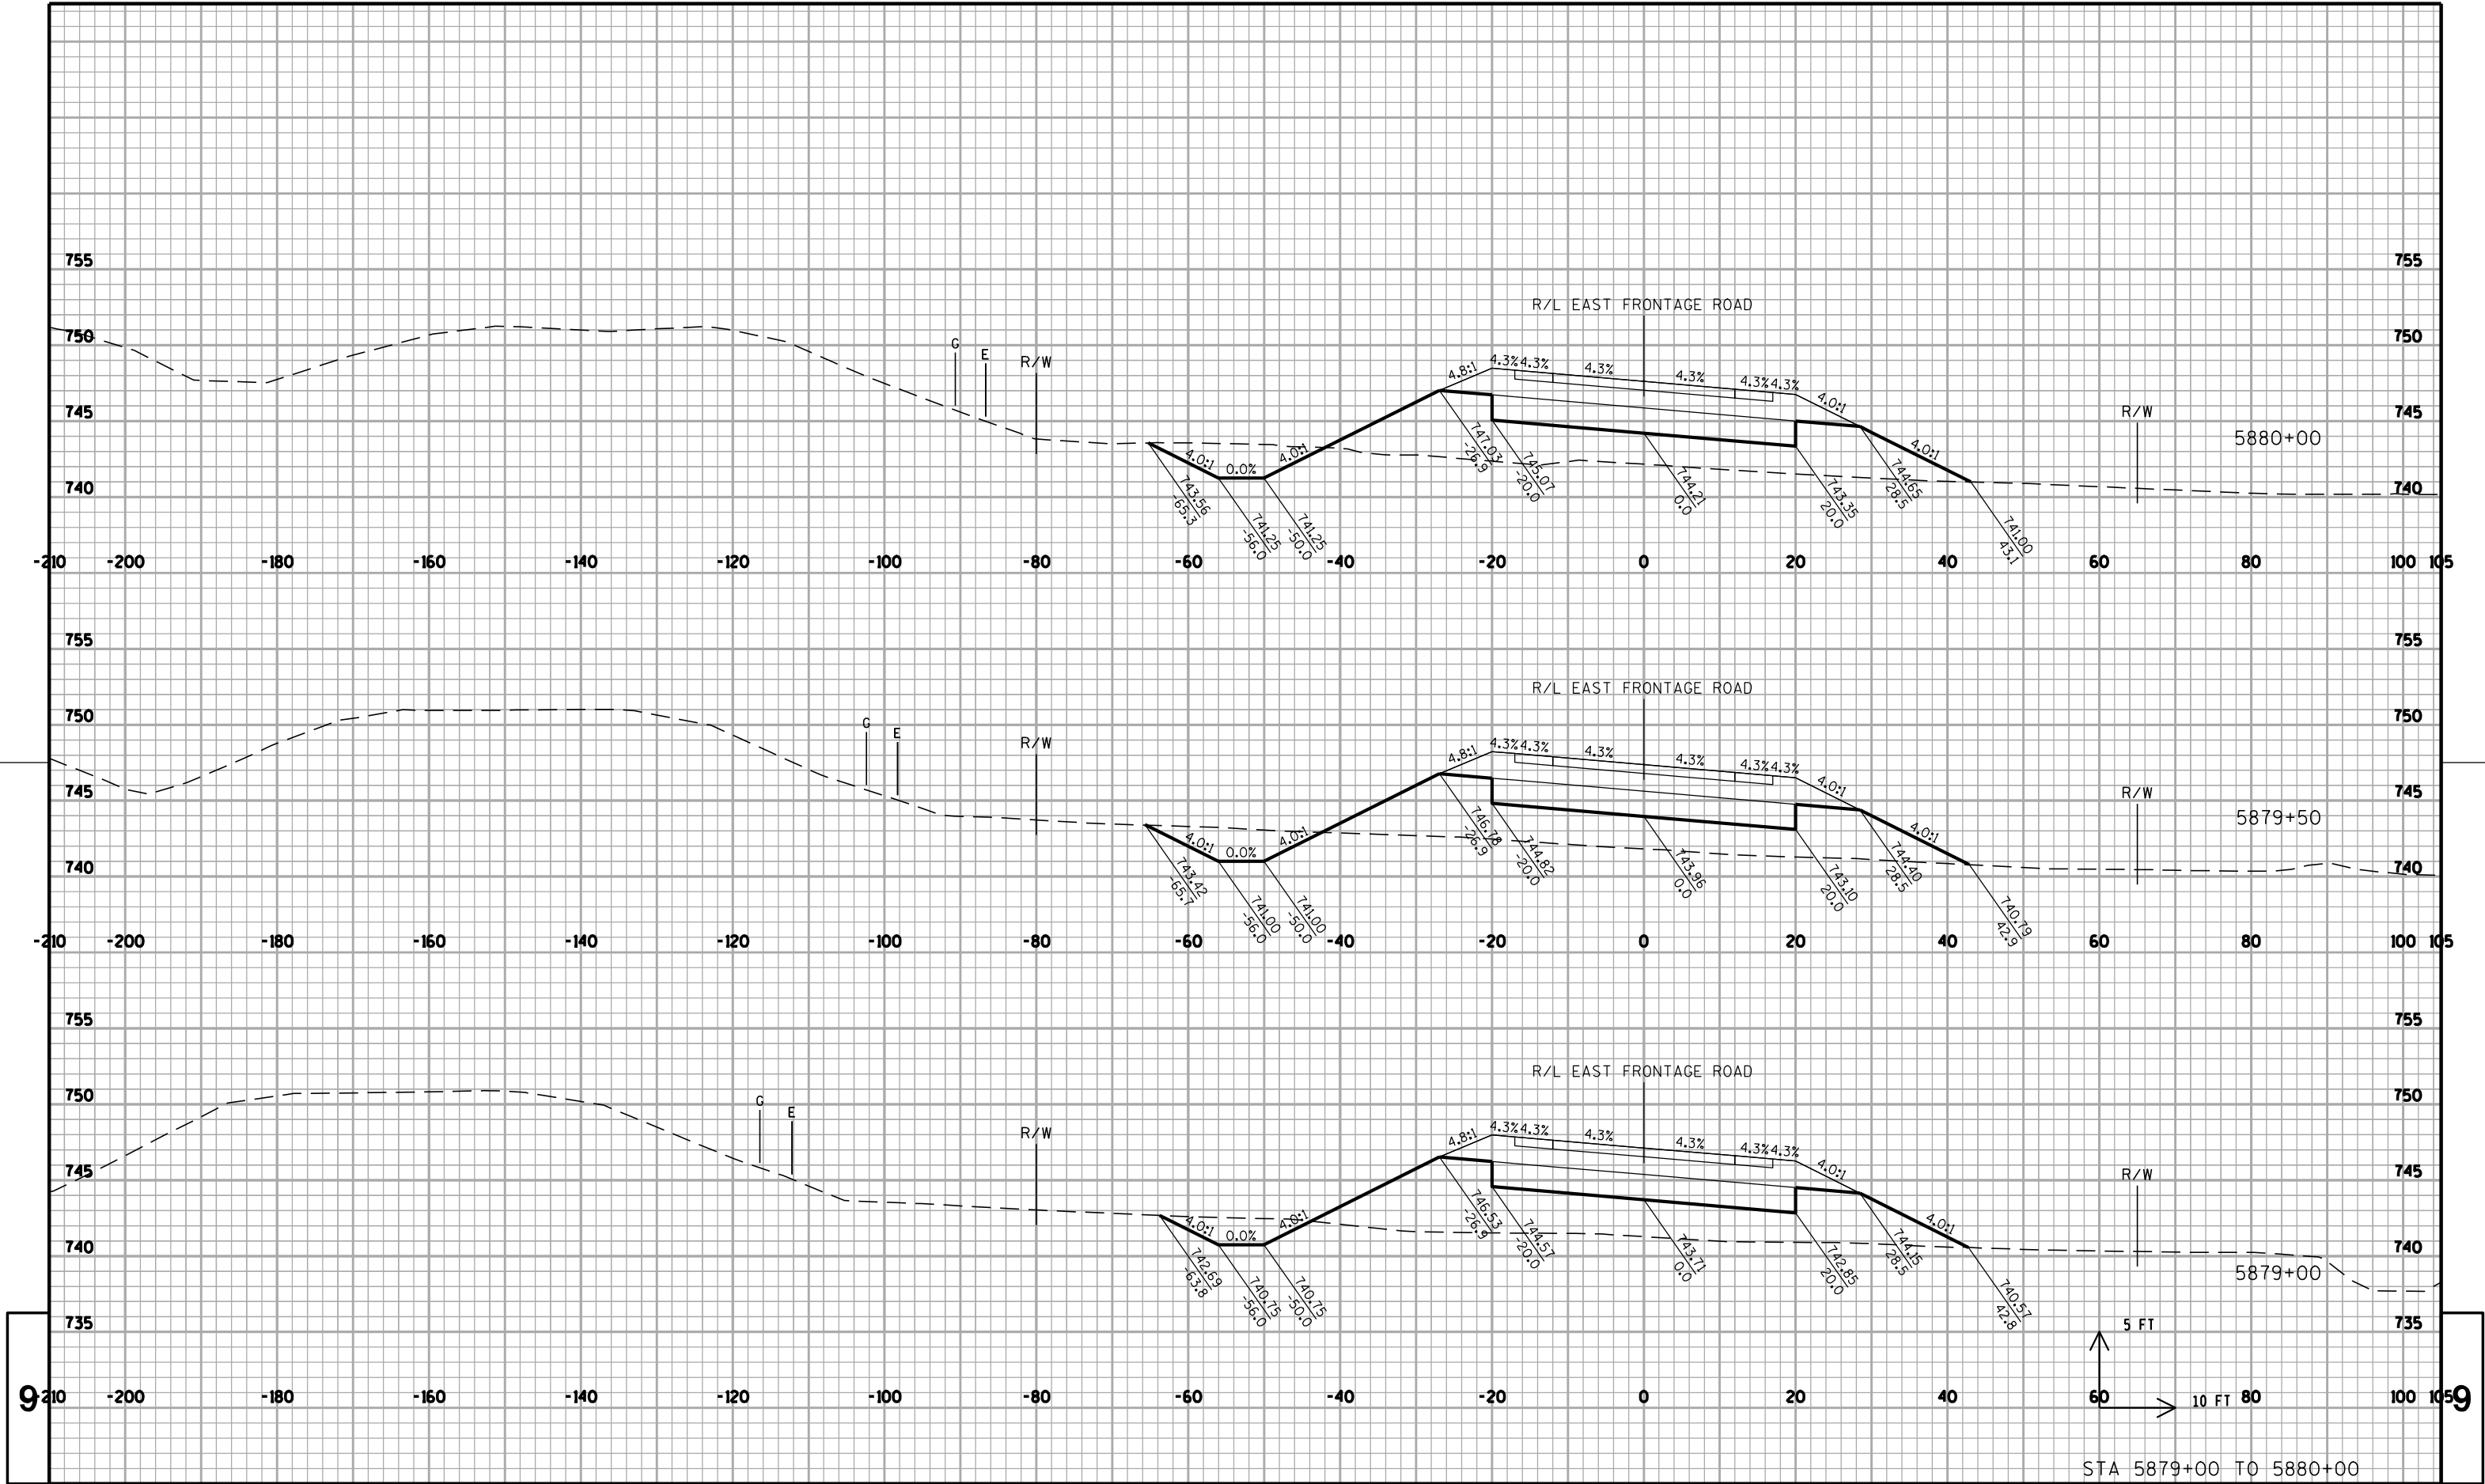

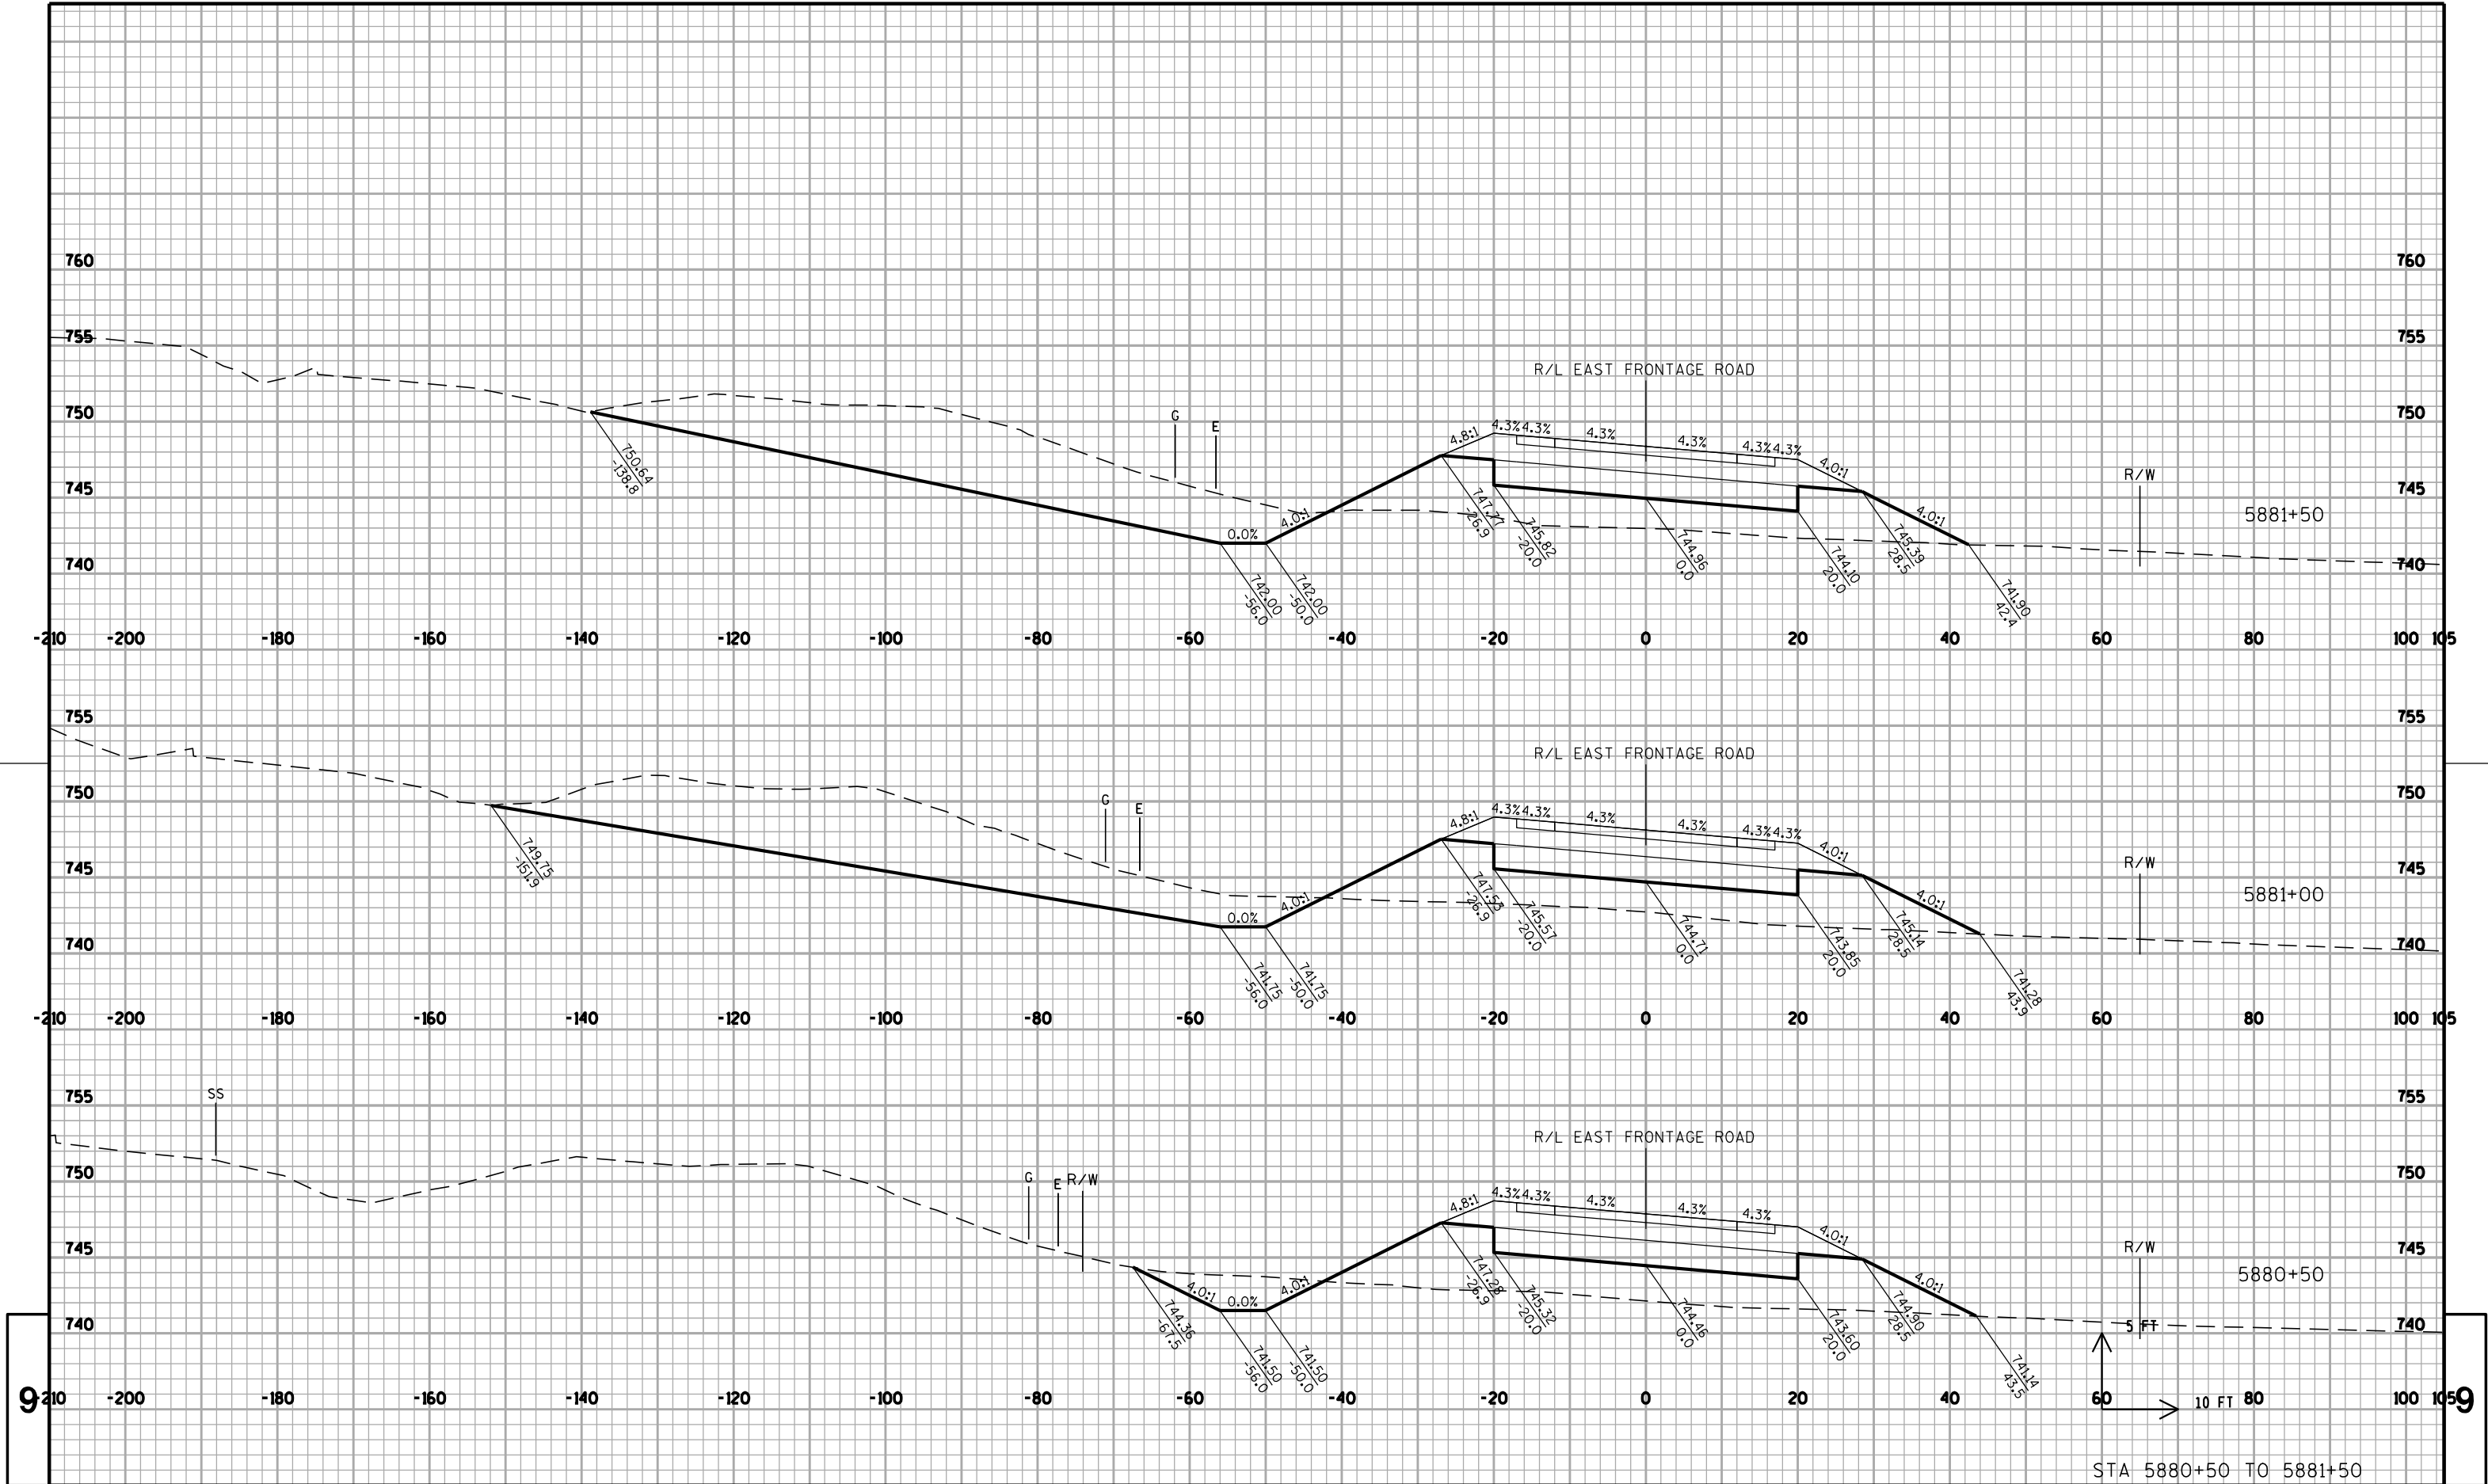

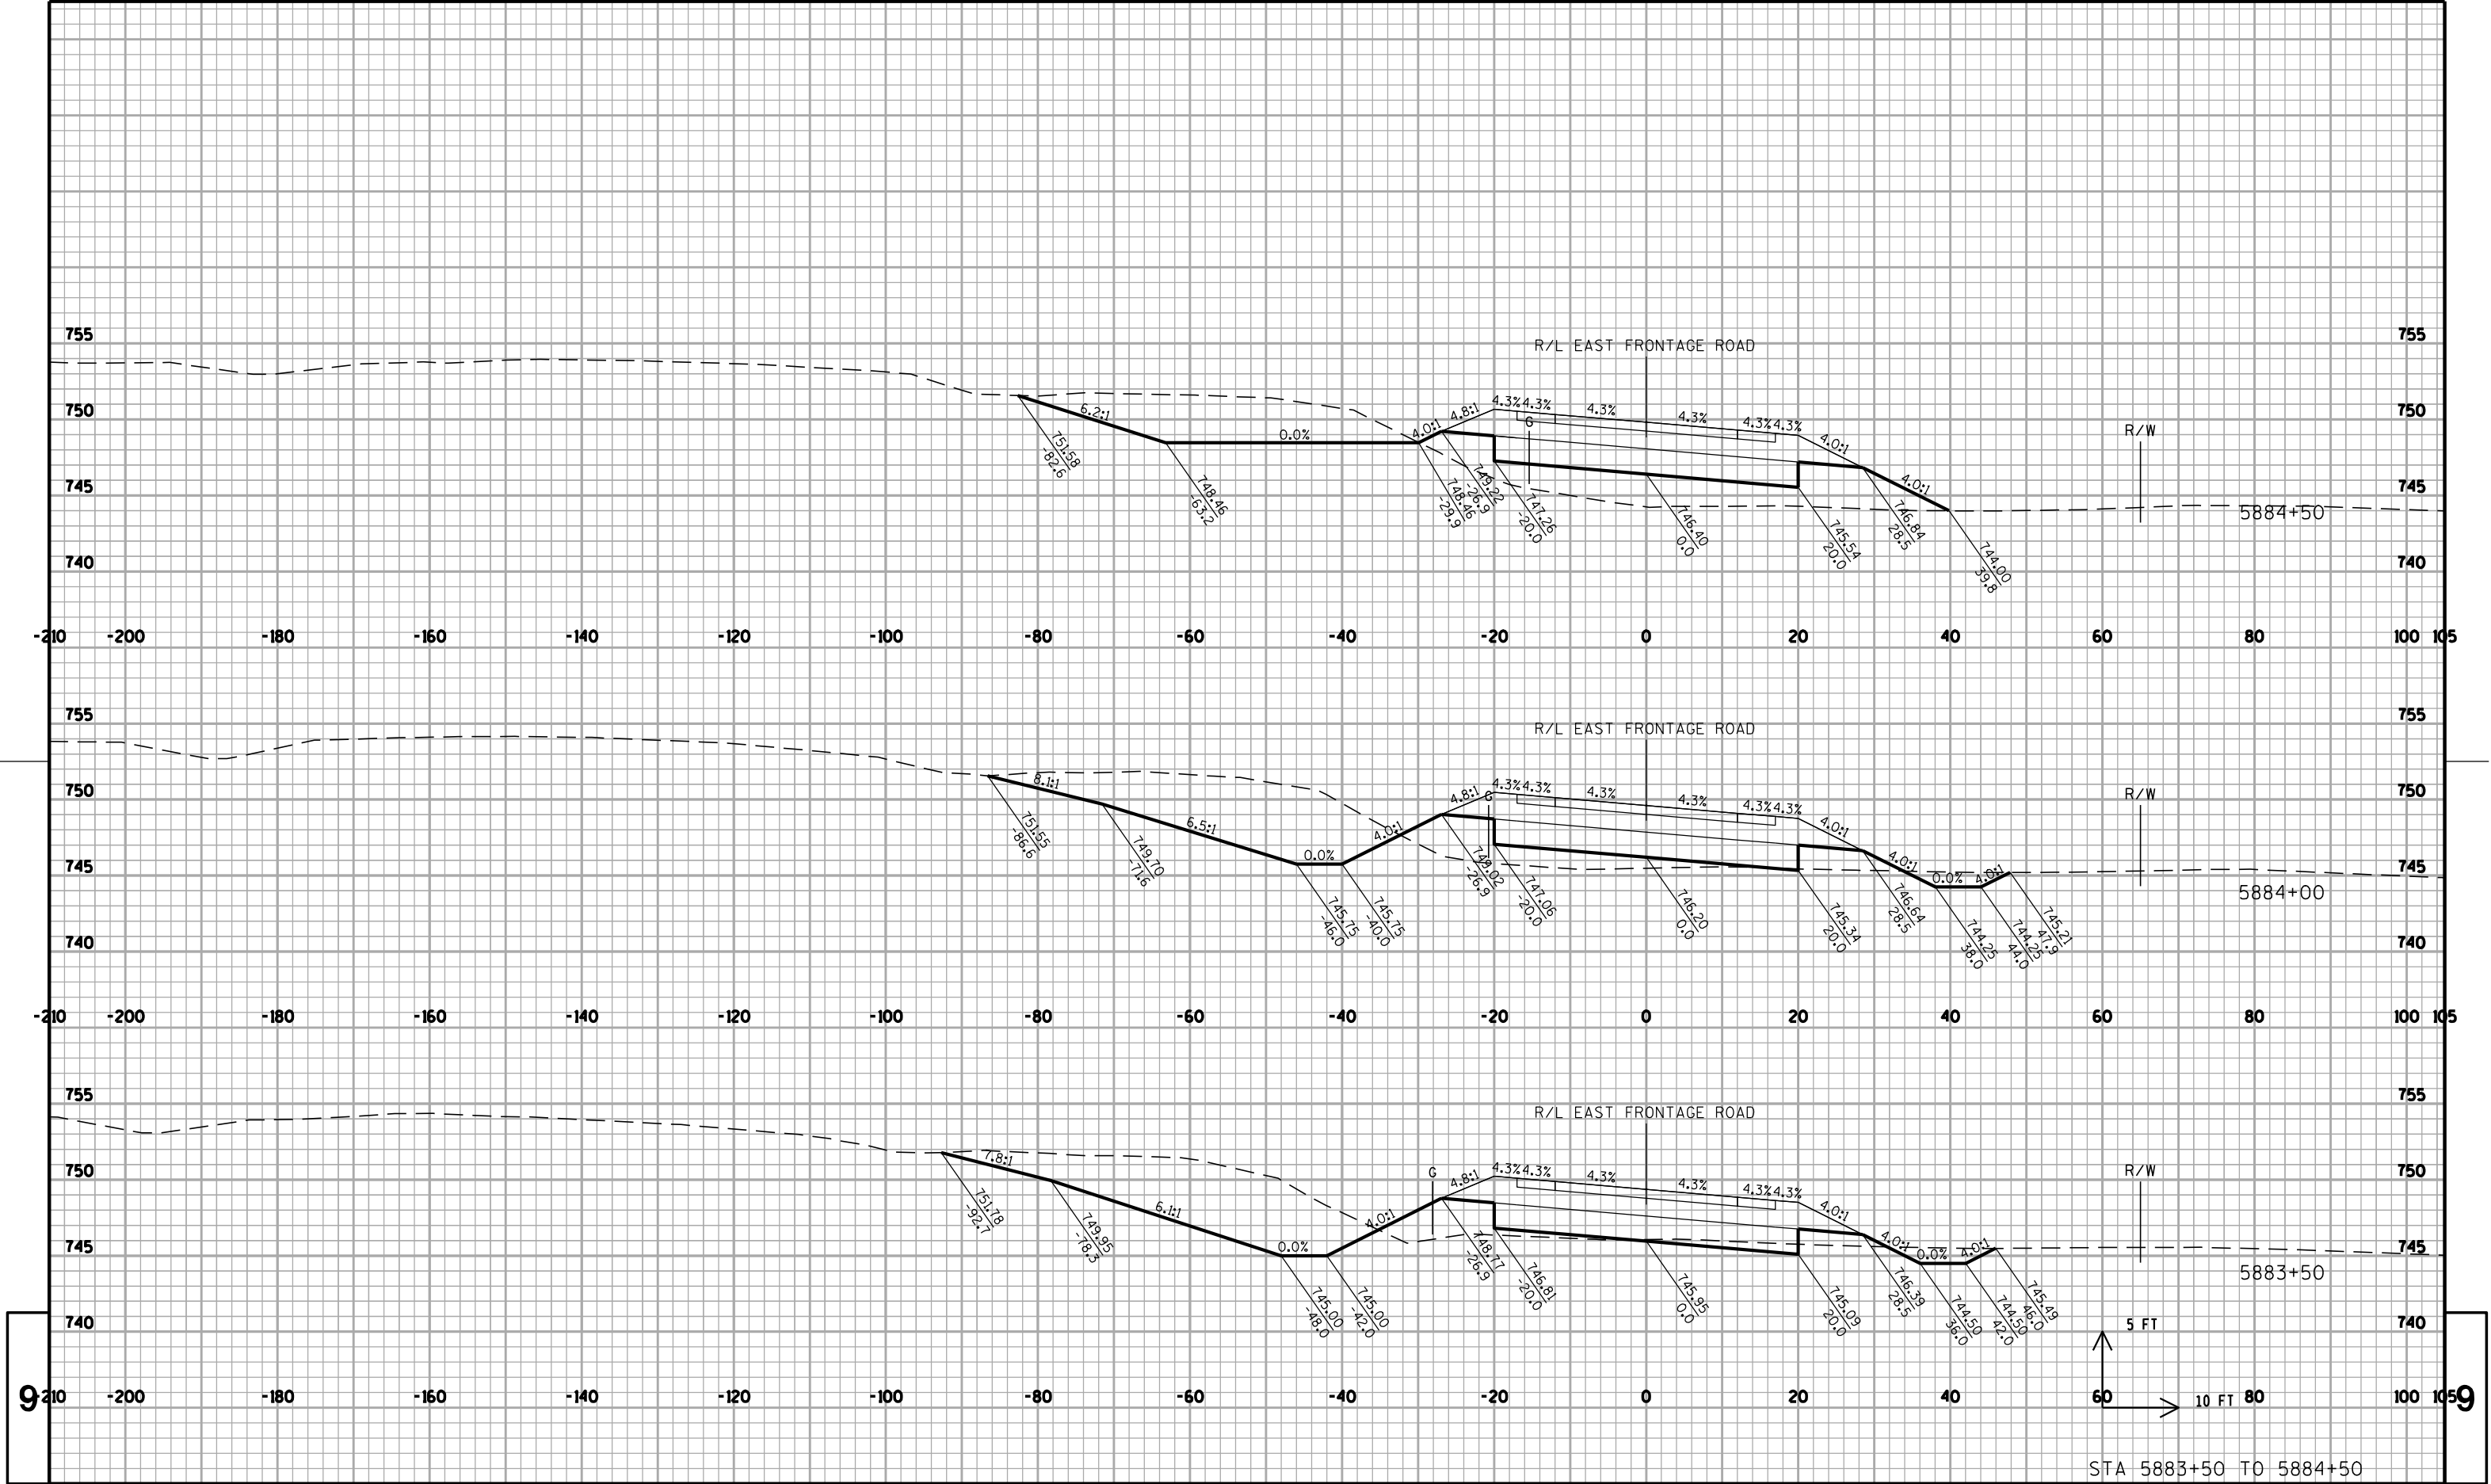

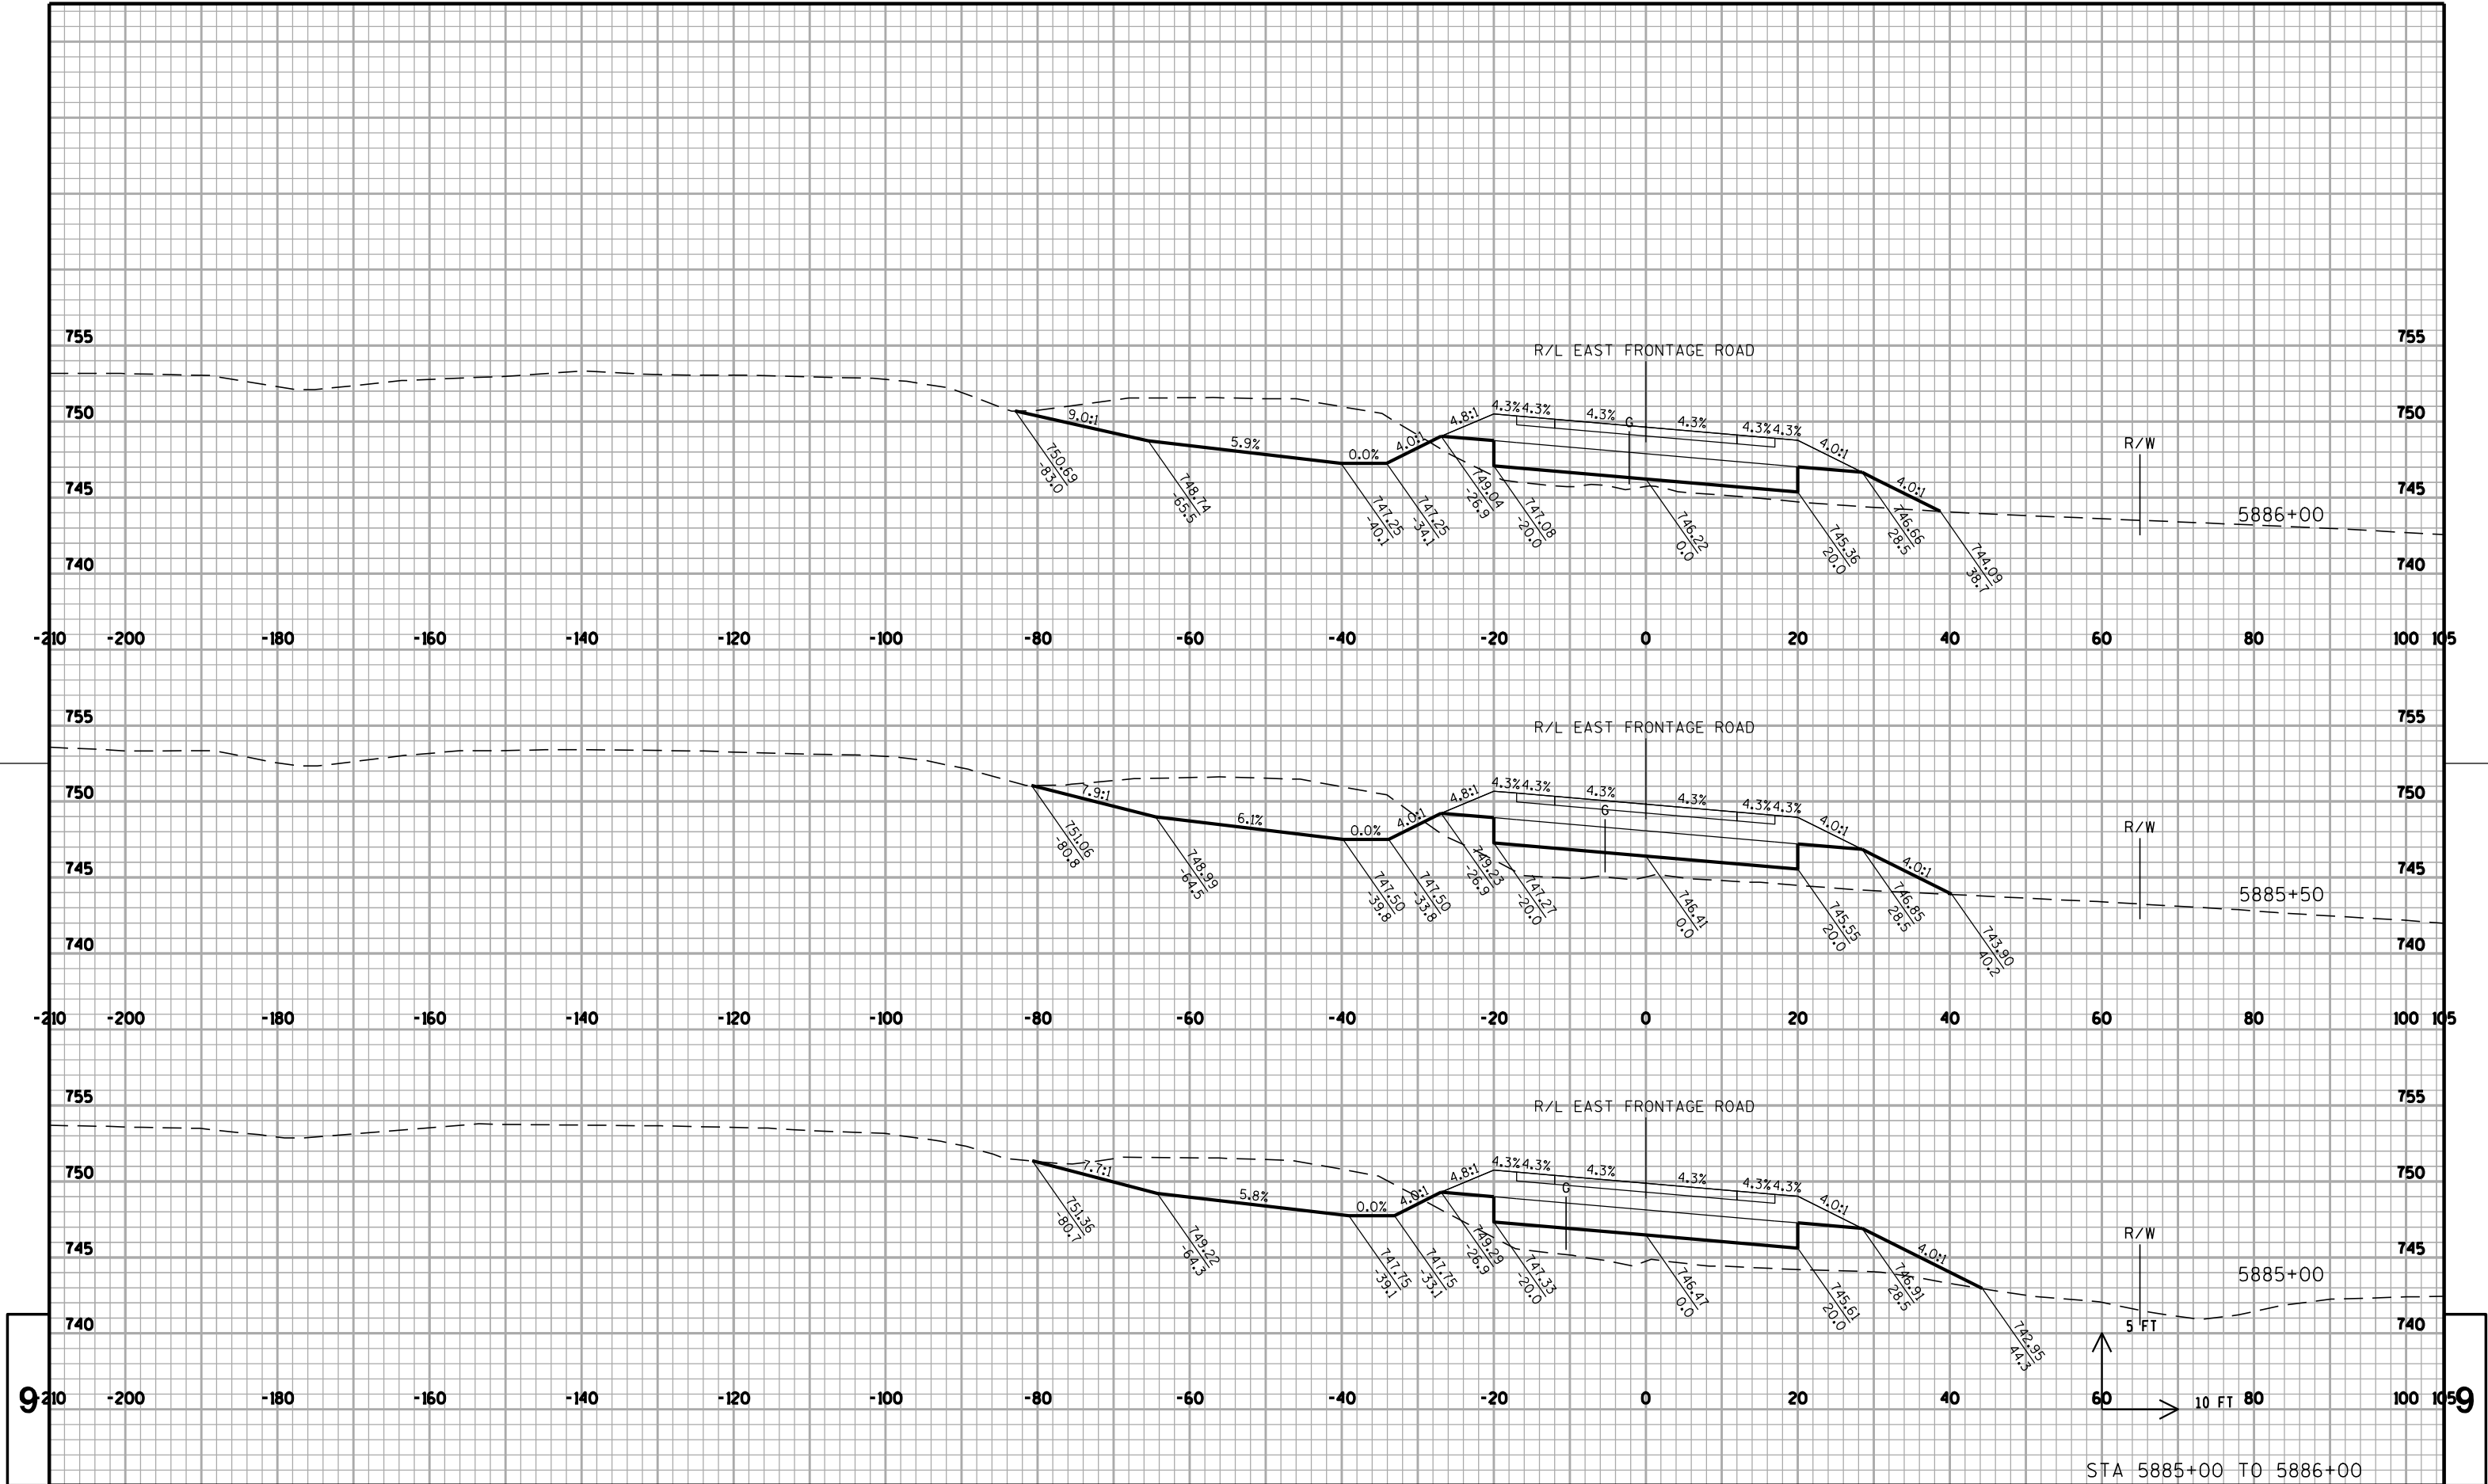

PROJECT NO:1033-02-70

HWY: IH 94/STH 20

COUNTY: RACINE

CROSS SECTIONS: EAST FRONTAGE ROAD - NORTH

SHEET 215

E


FILE NAME : s:\FinalDesign\20\10330270_E\Roads\cds\090202_xs_frne.dgn


PLOT DATE : 06-DEC-2010 20:32


PLOT BY : MSCDIS


PLOT NAME : 090202_xs_frnel3 PLOT SCALE : 20:1


WISDOT/CADDs SHEET 21

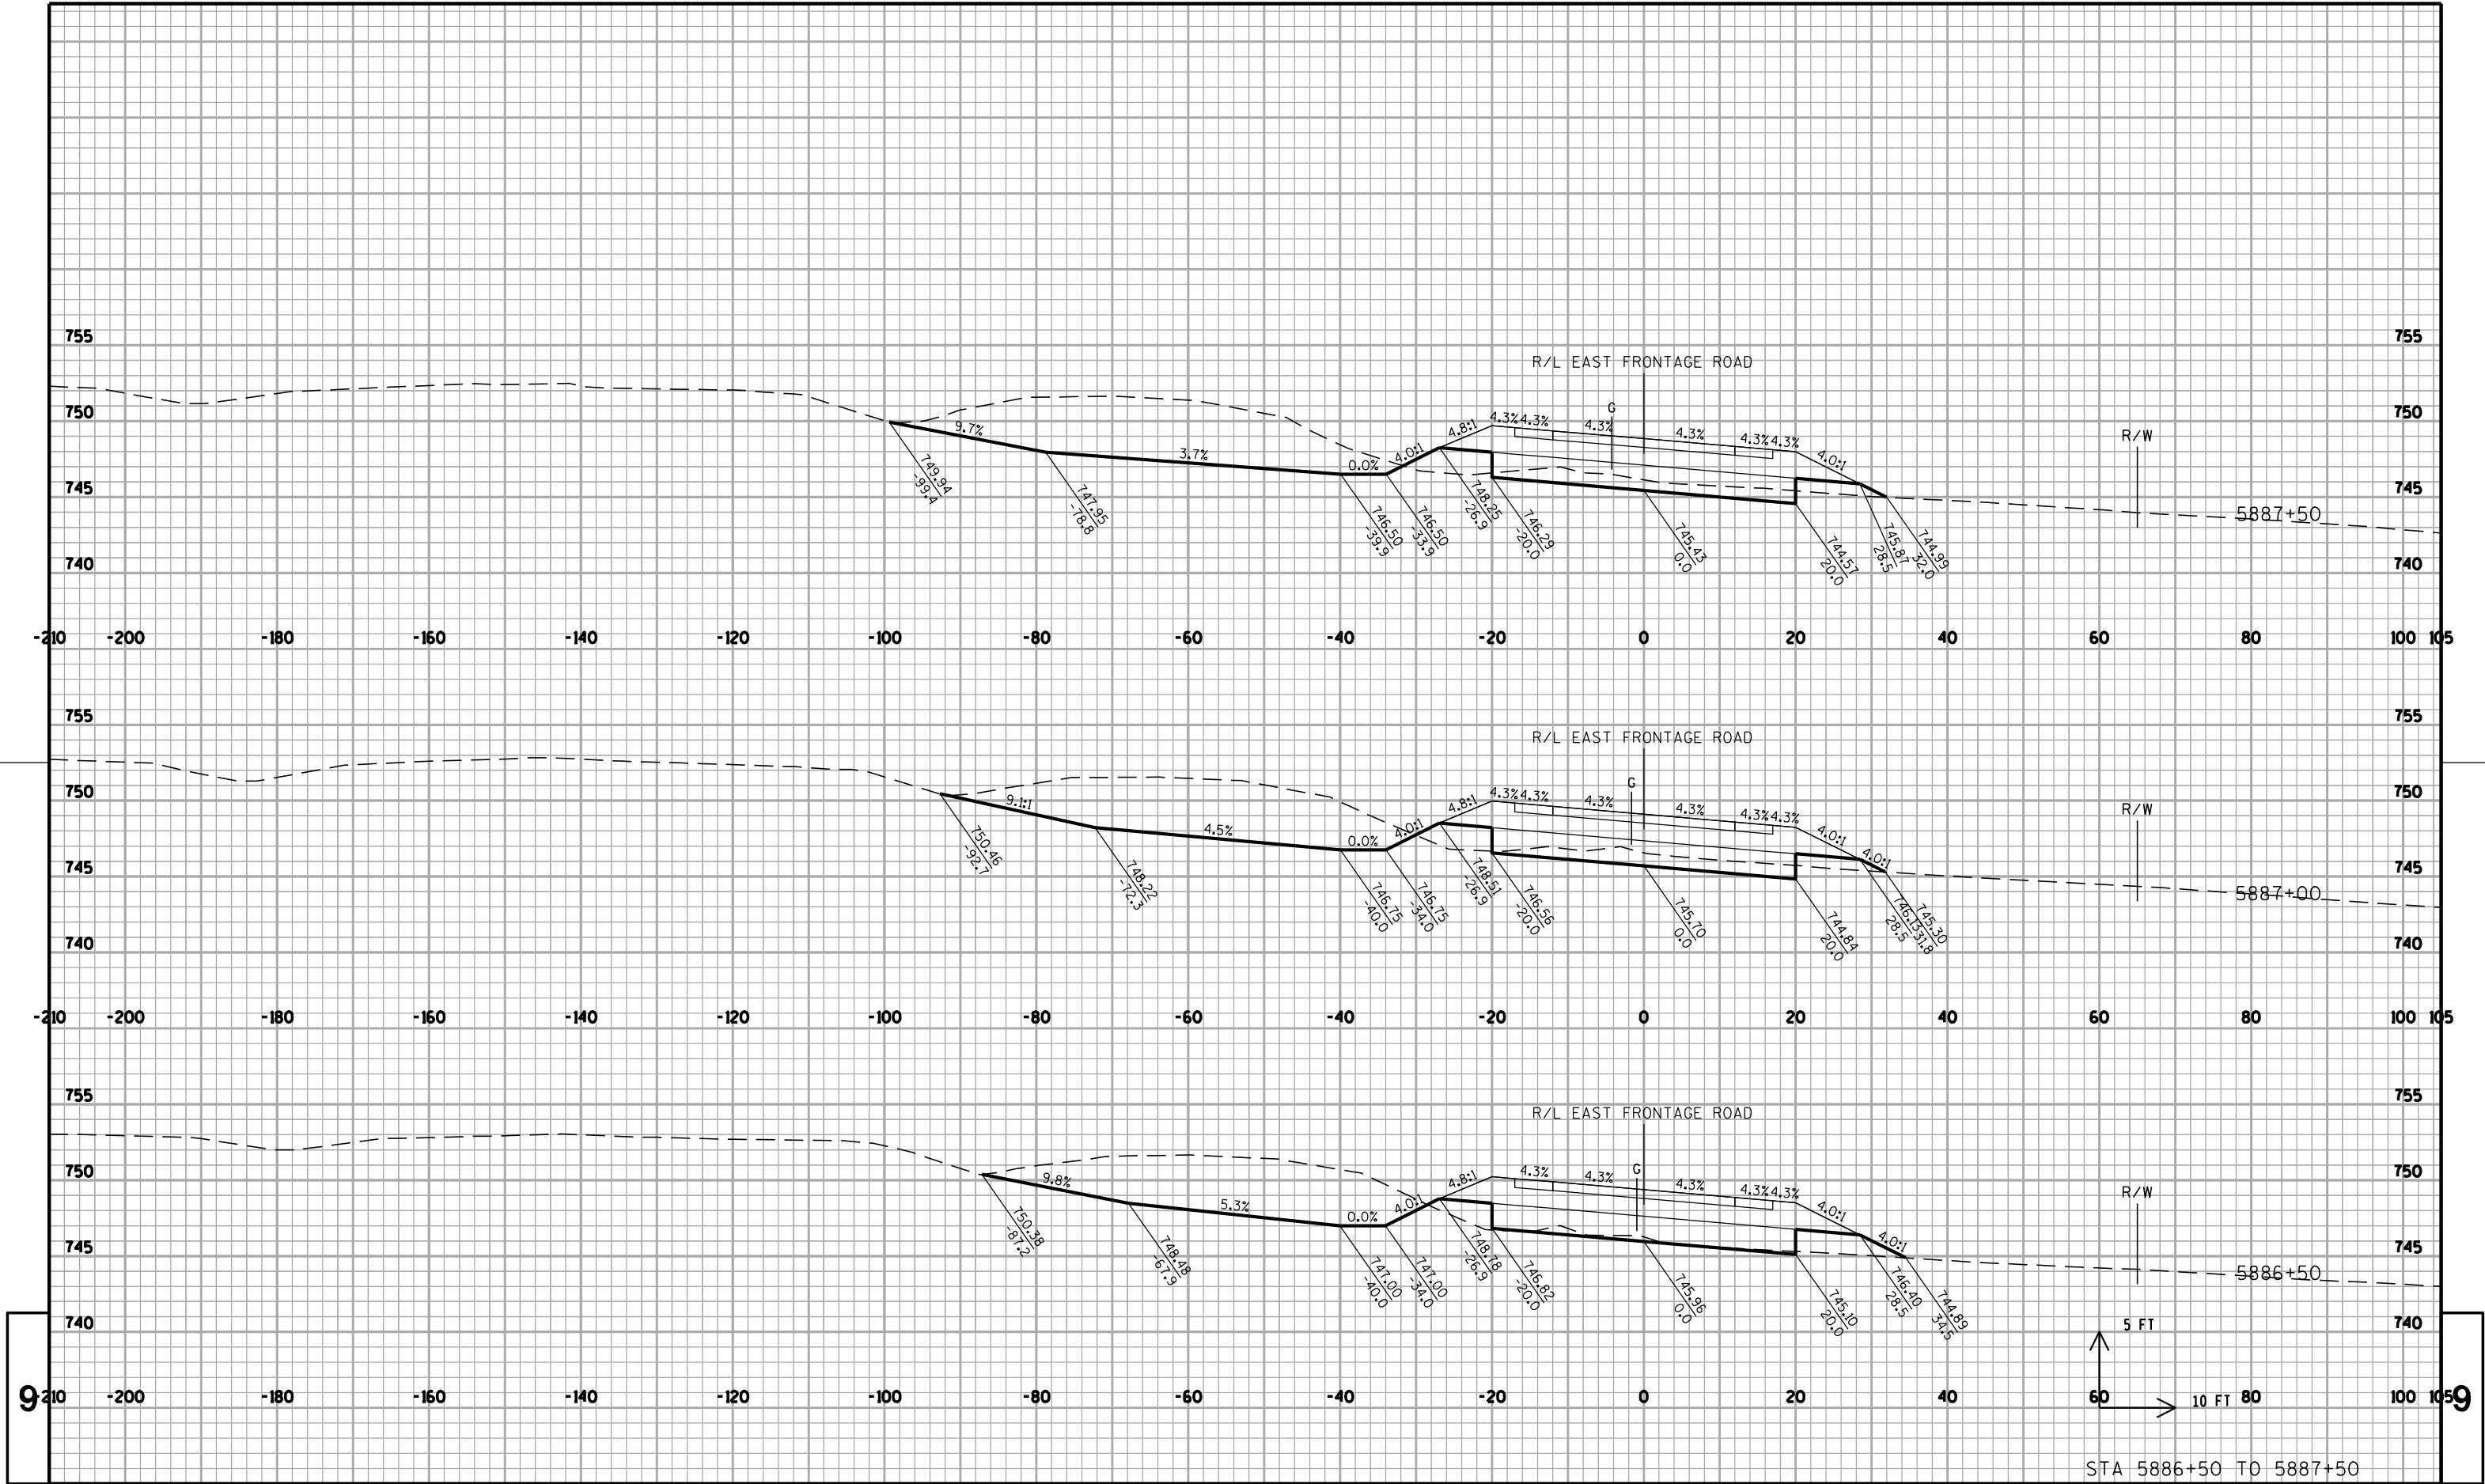


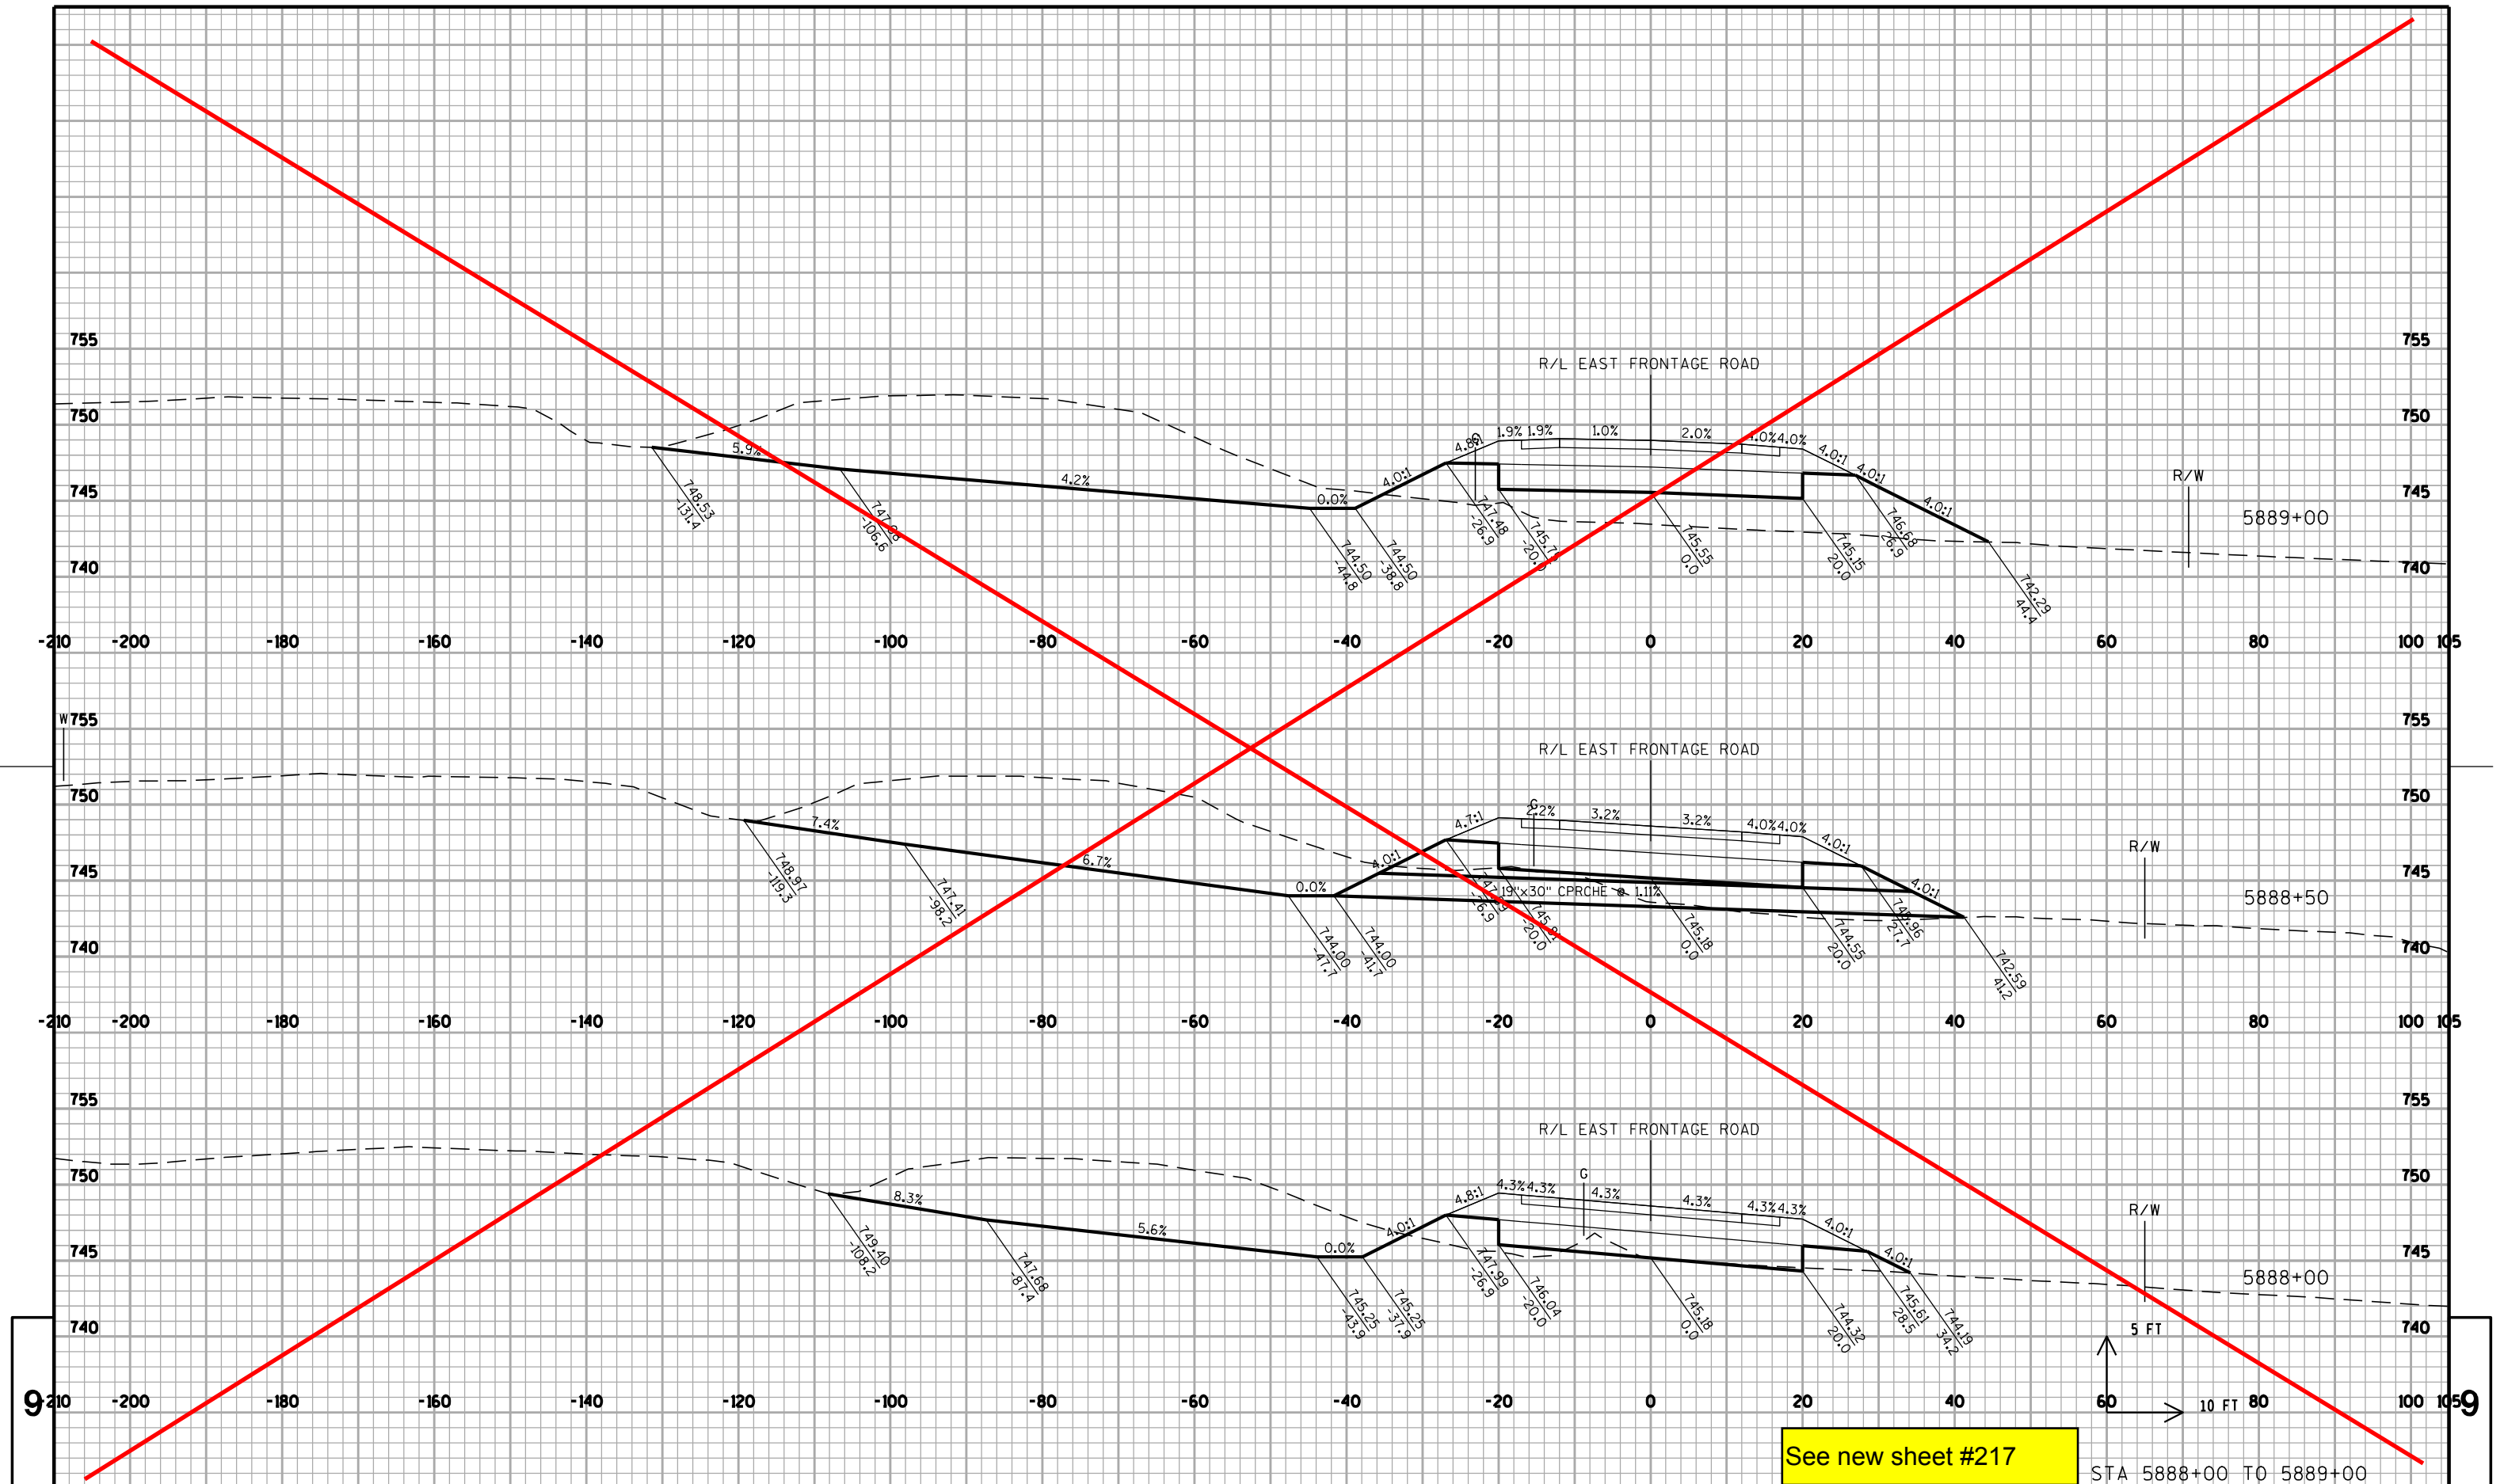


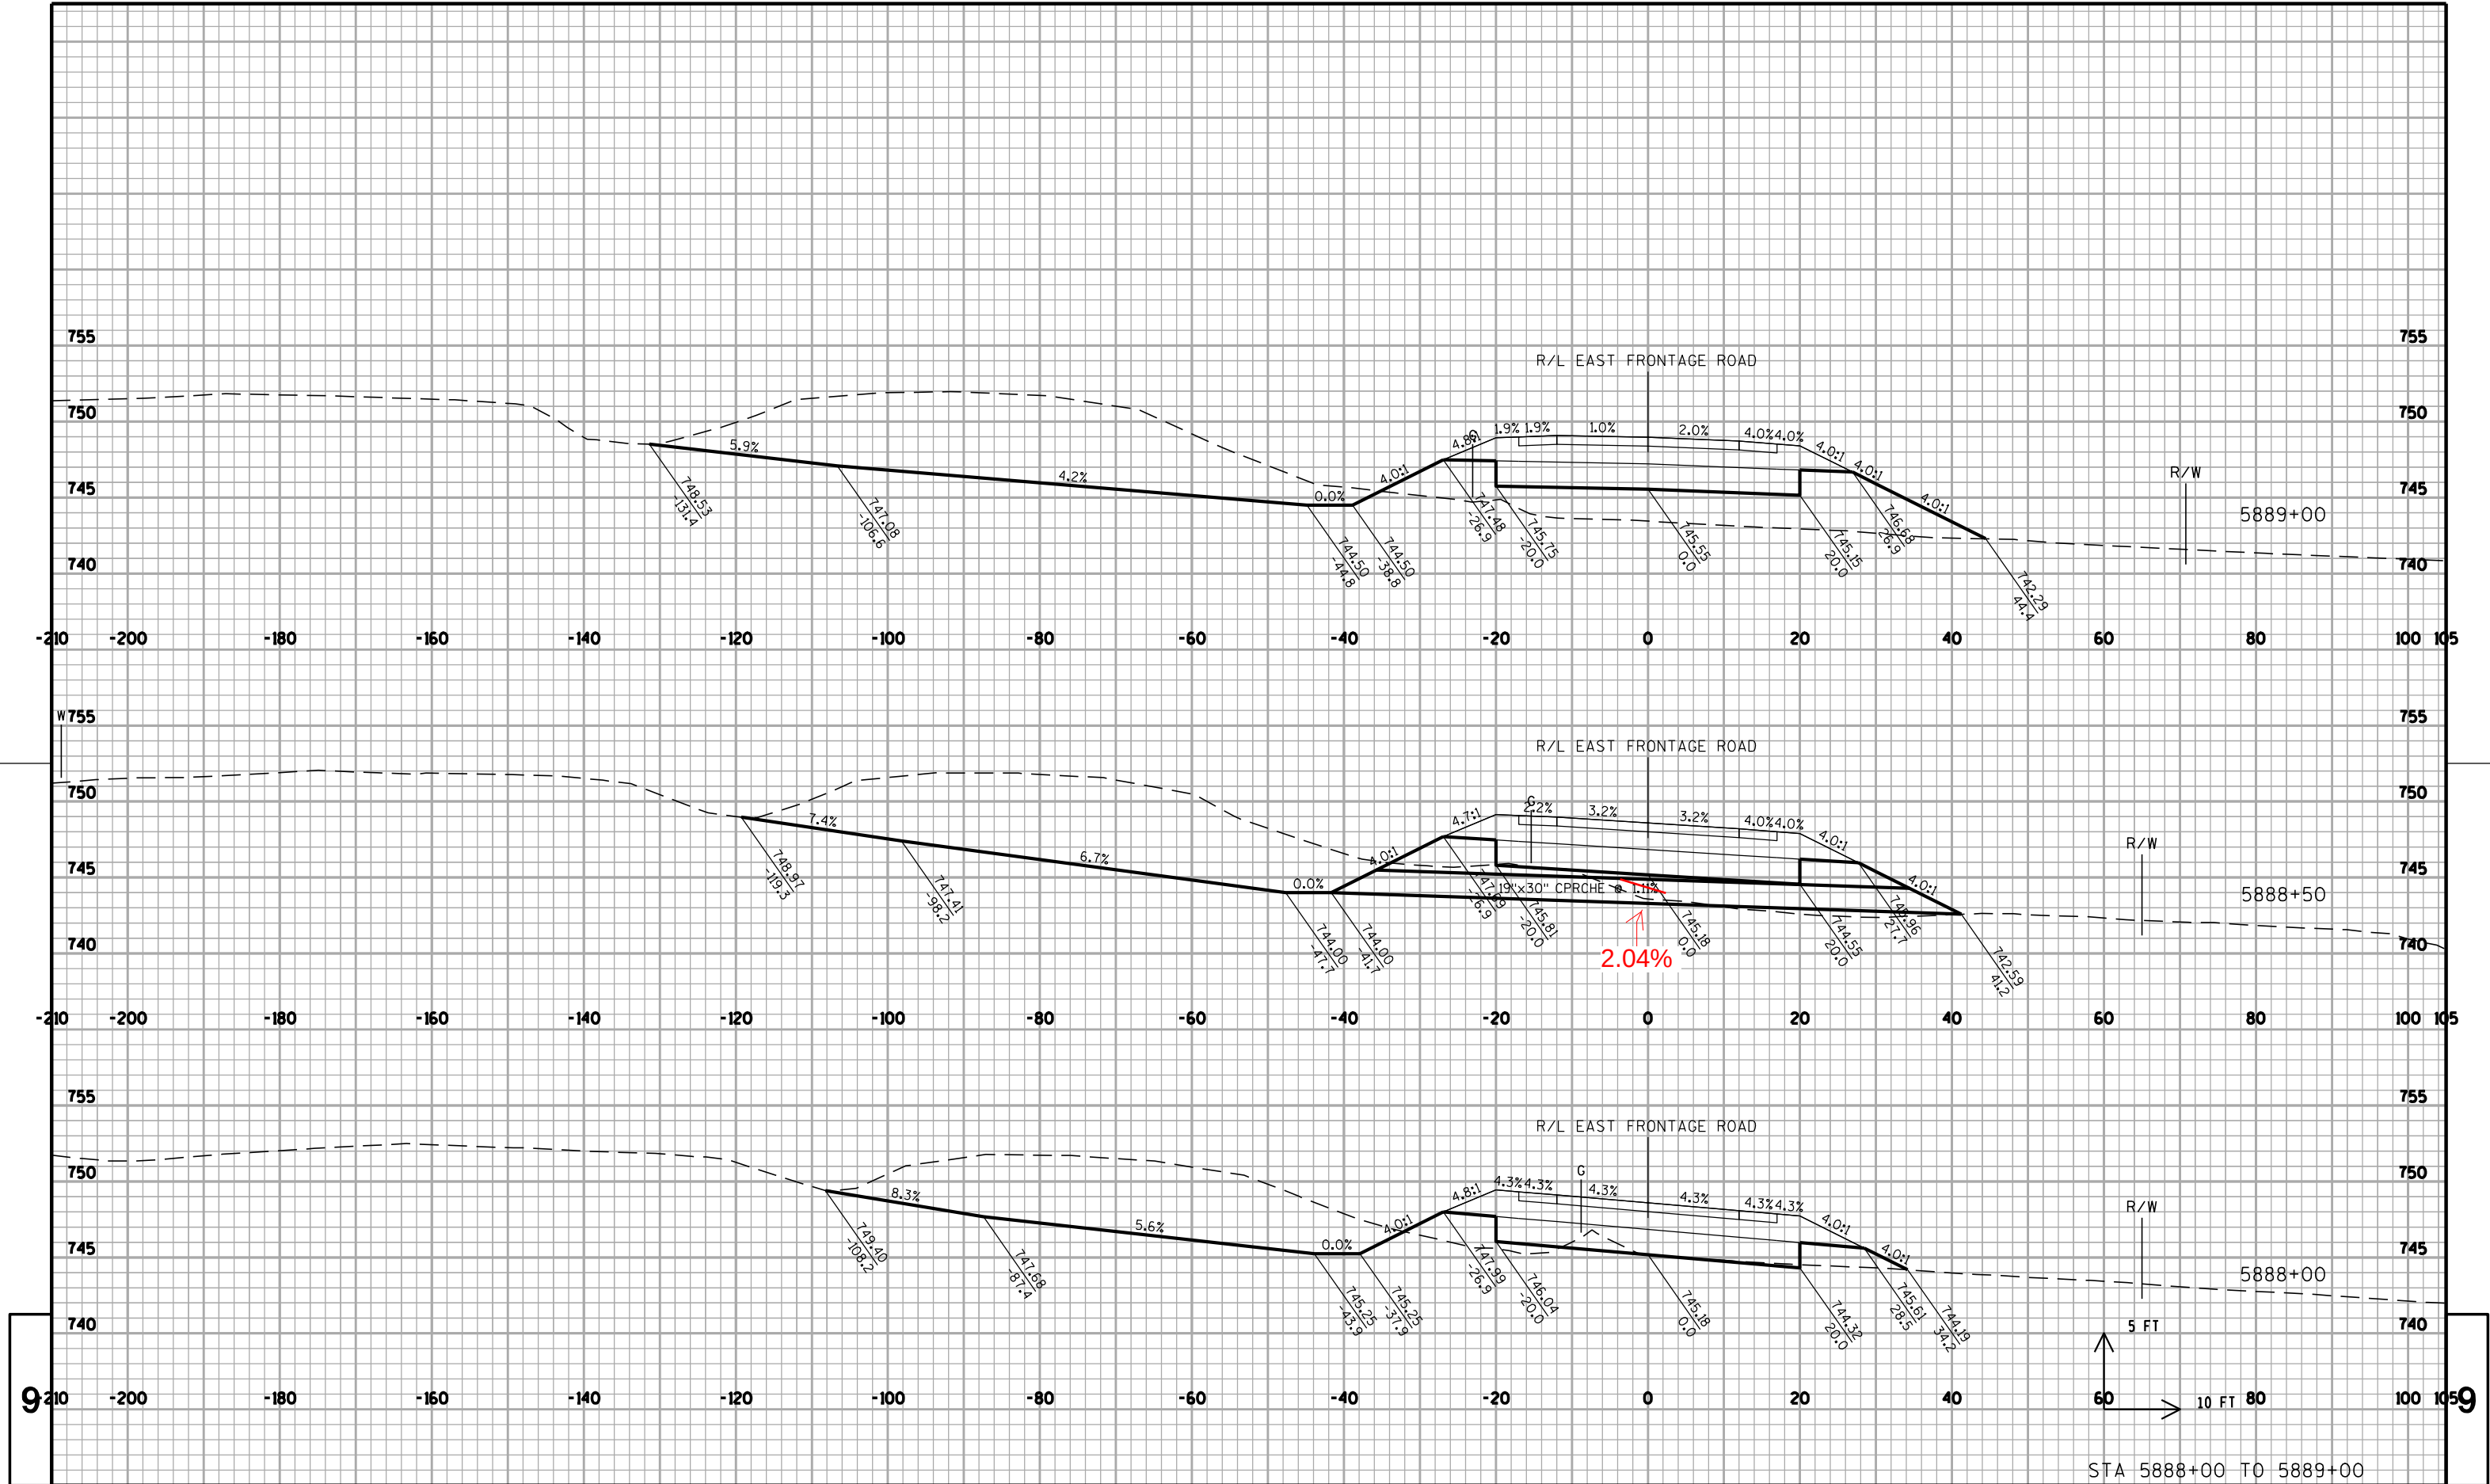


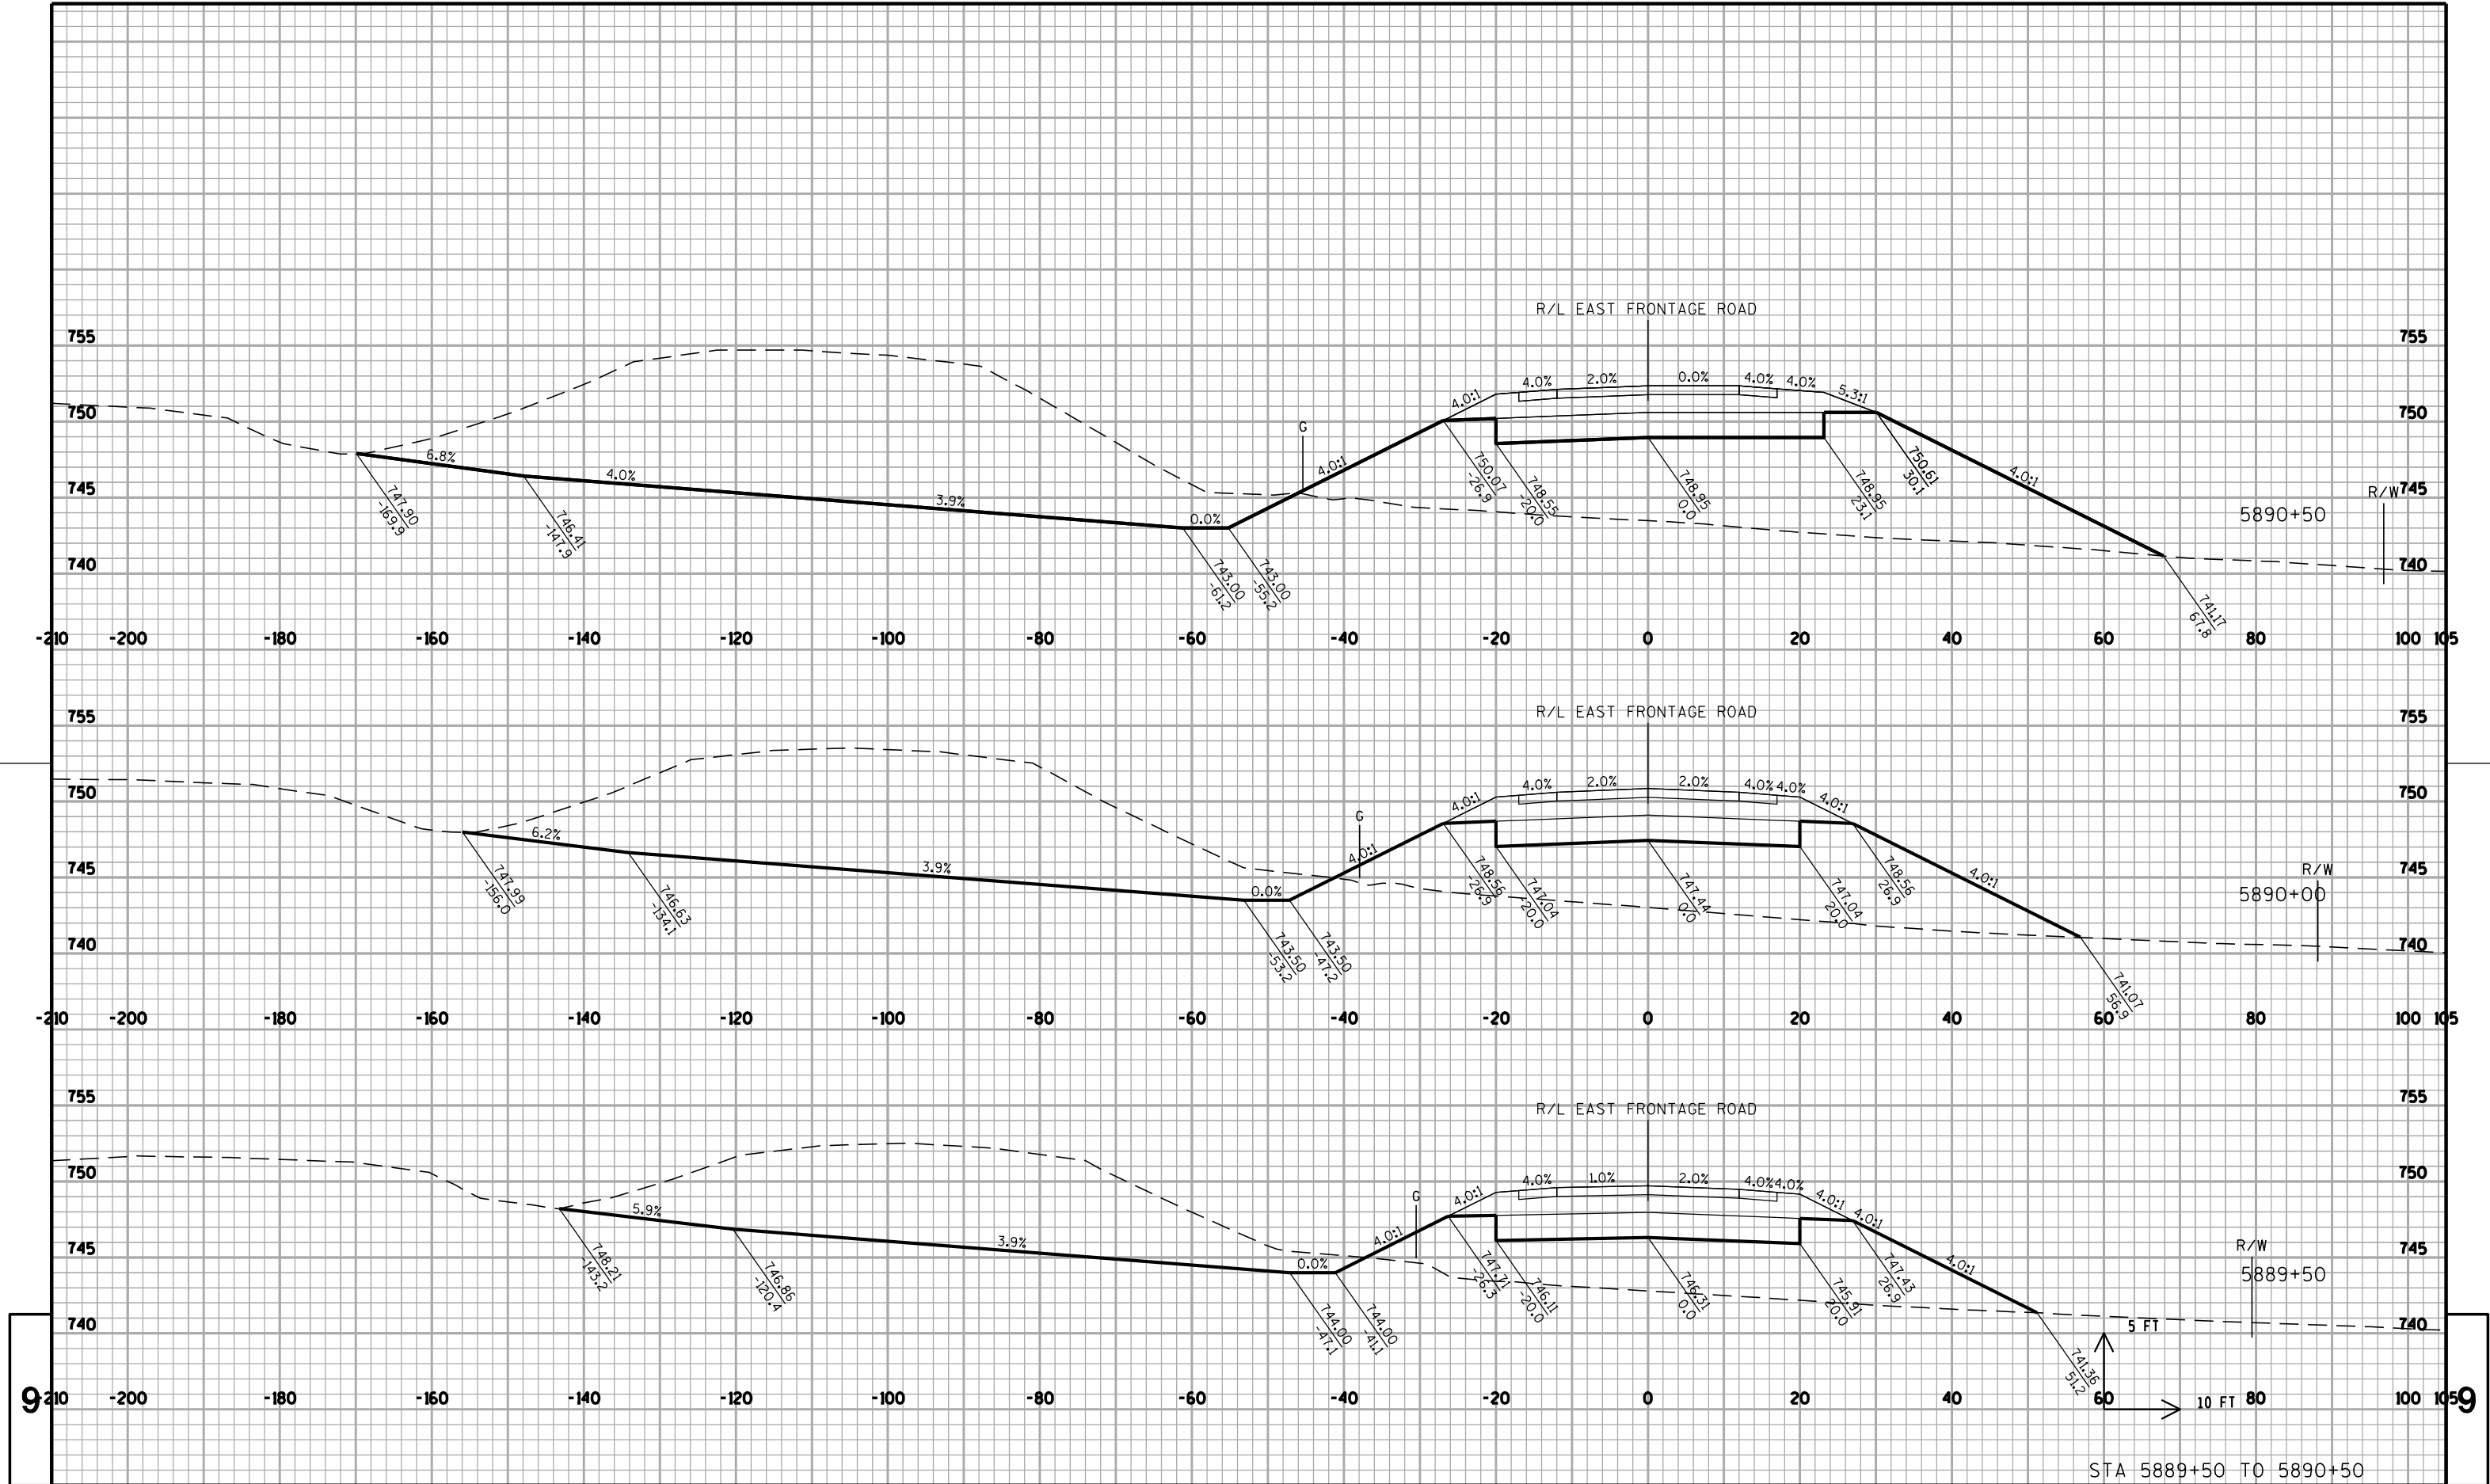


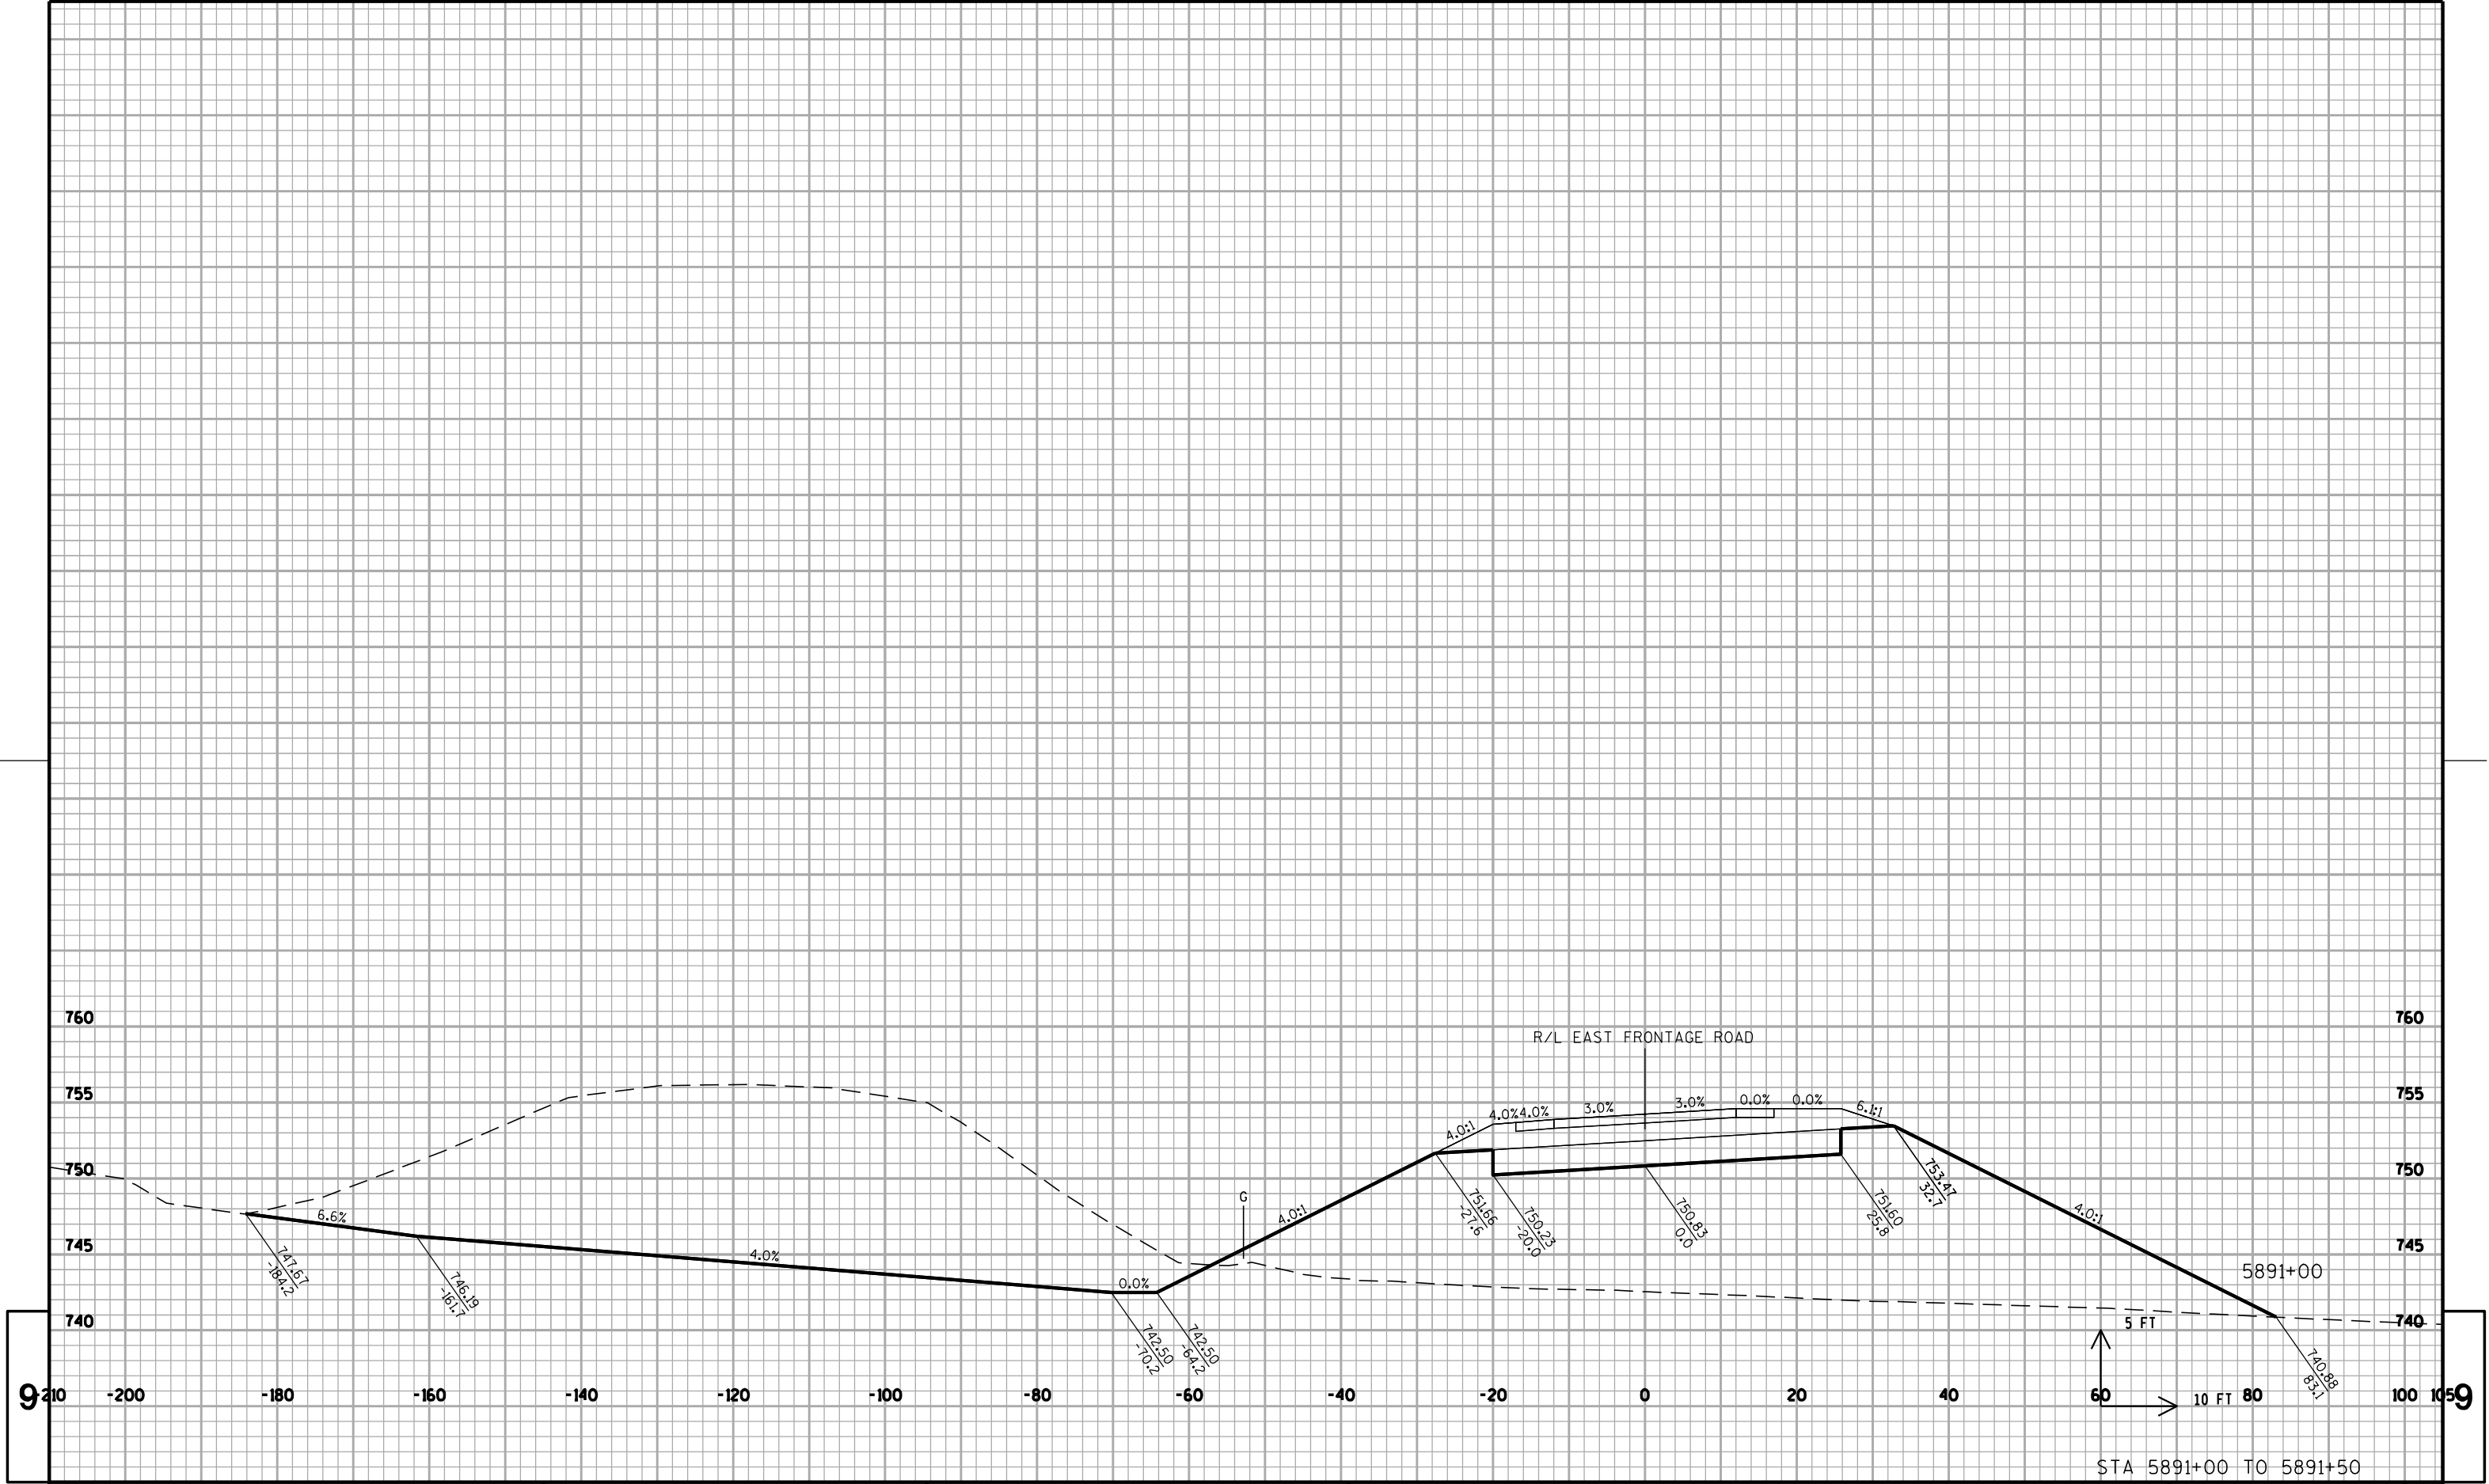


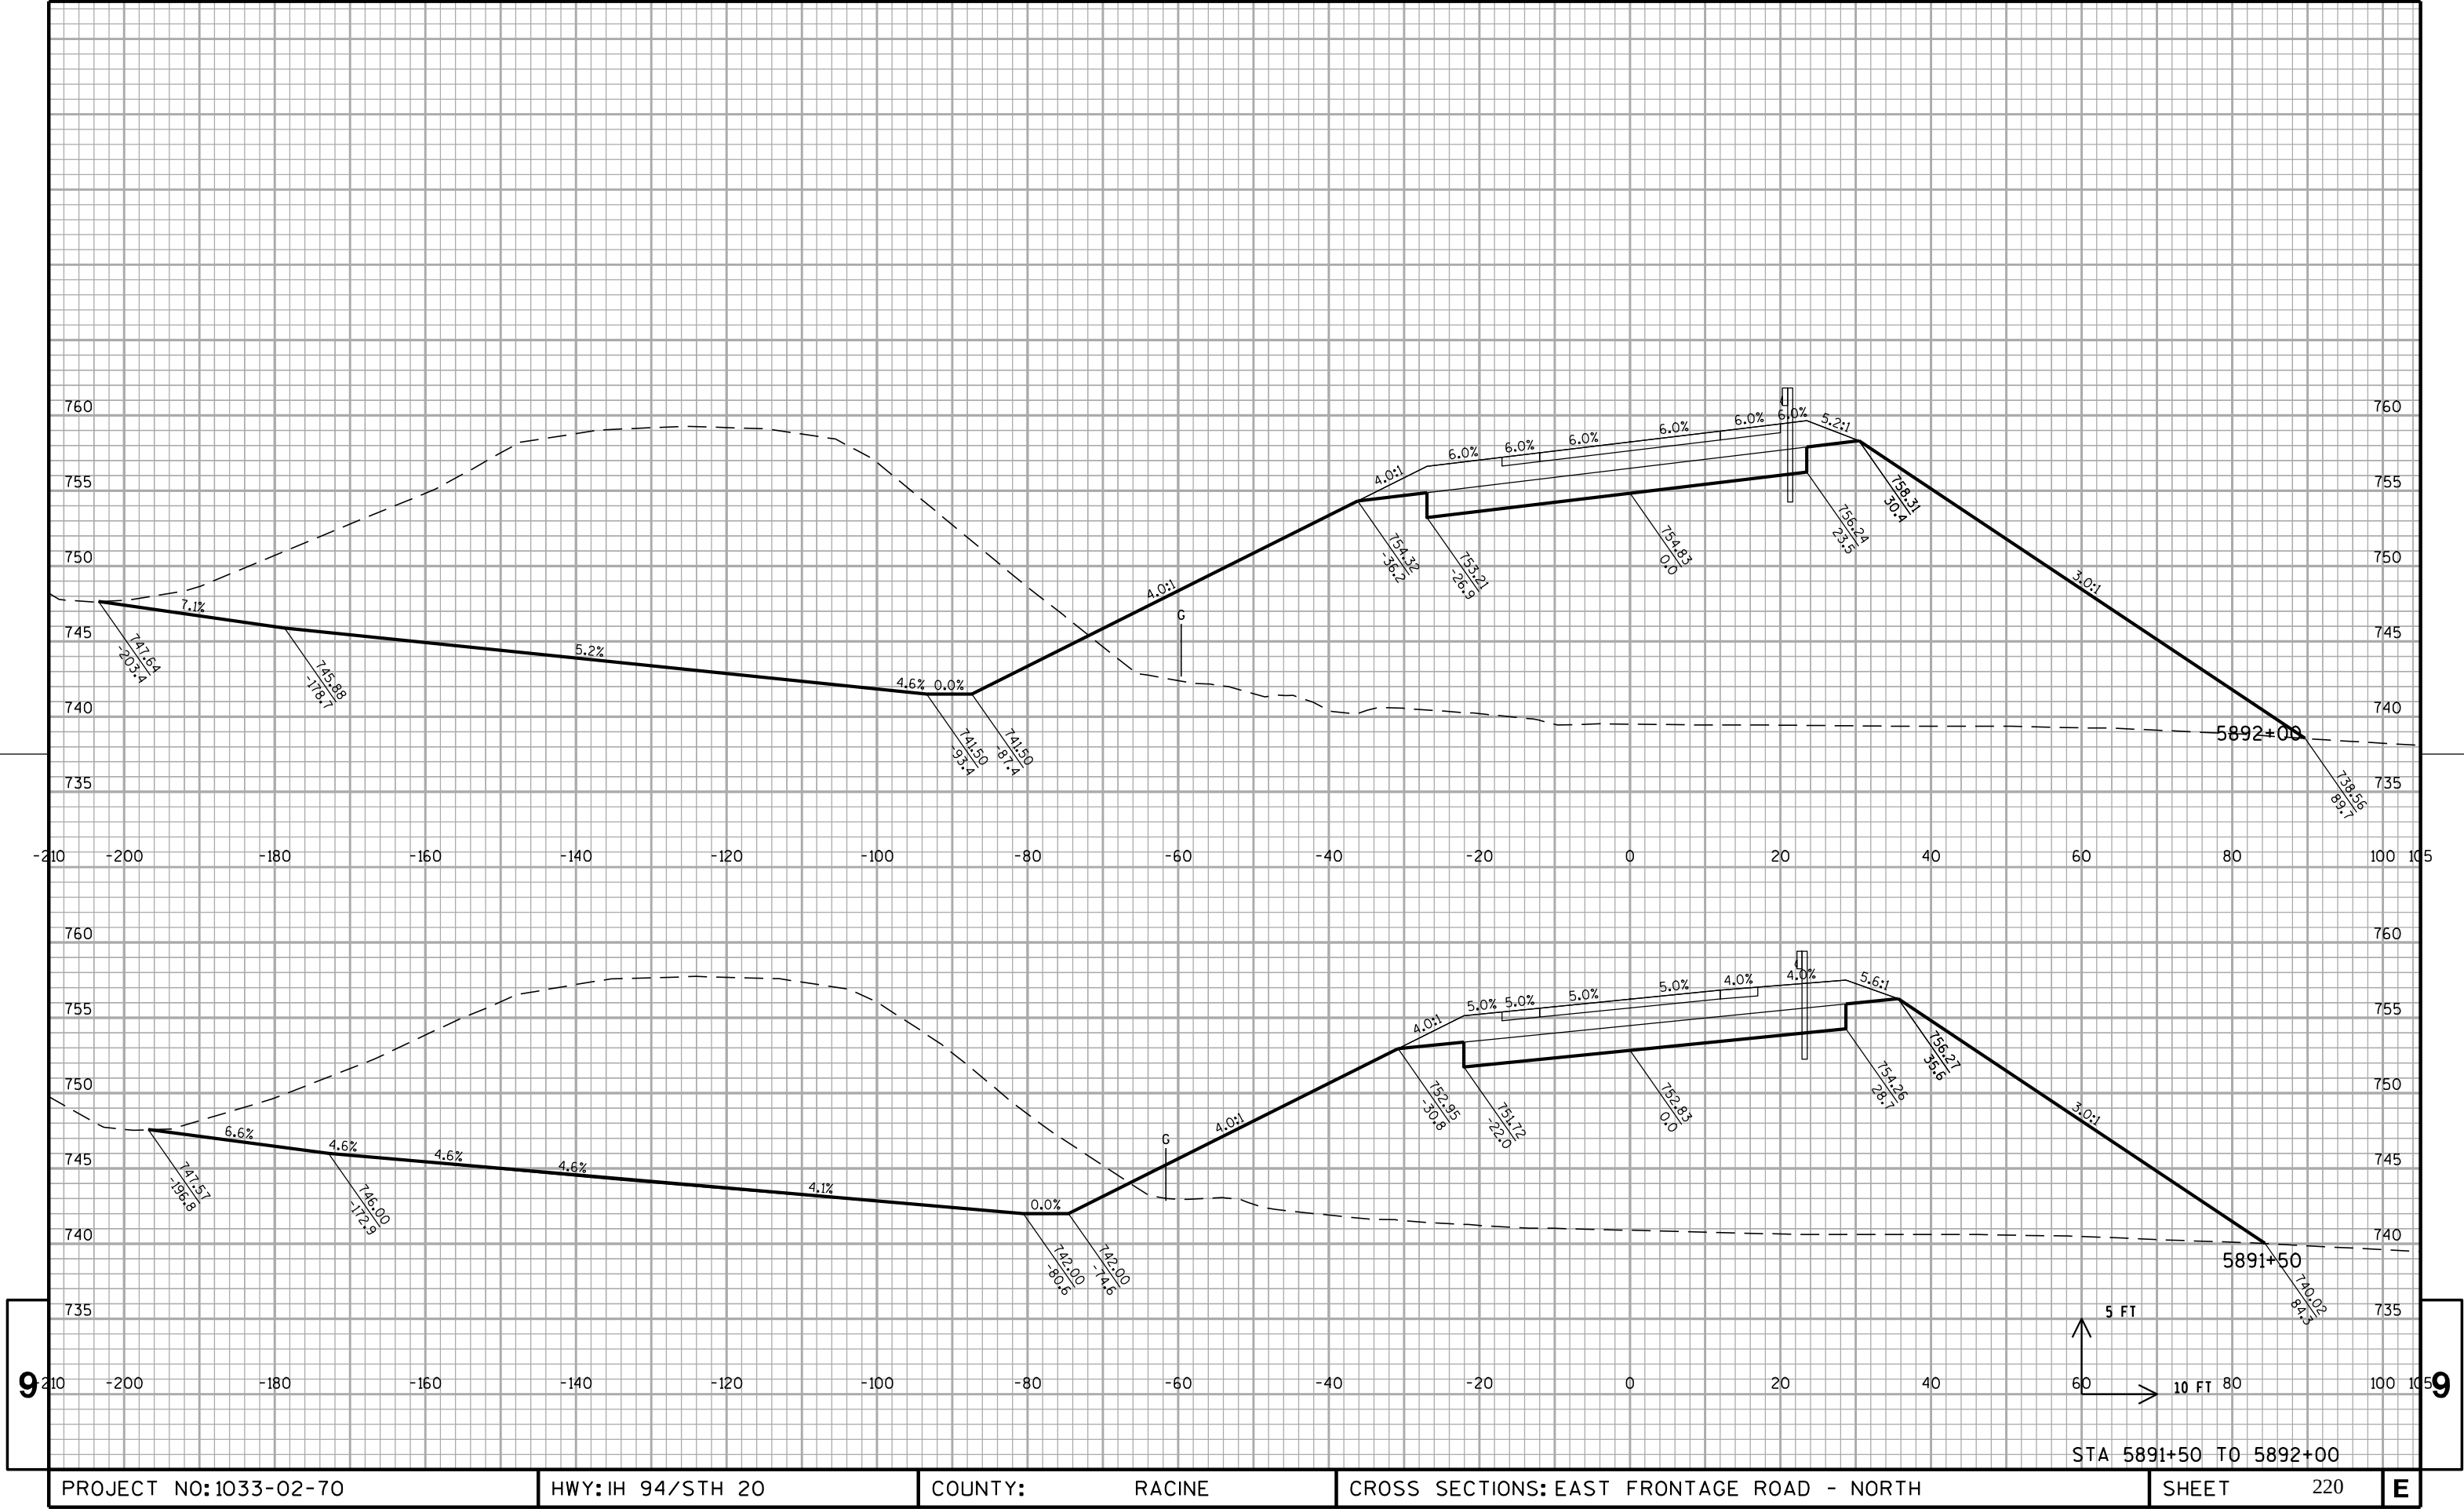


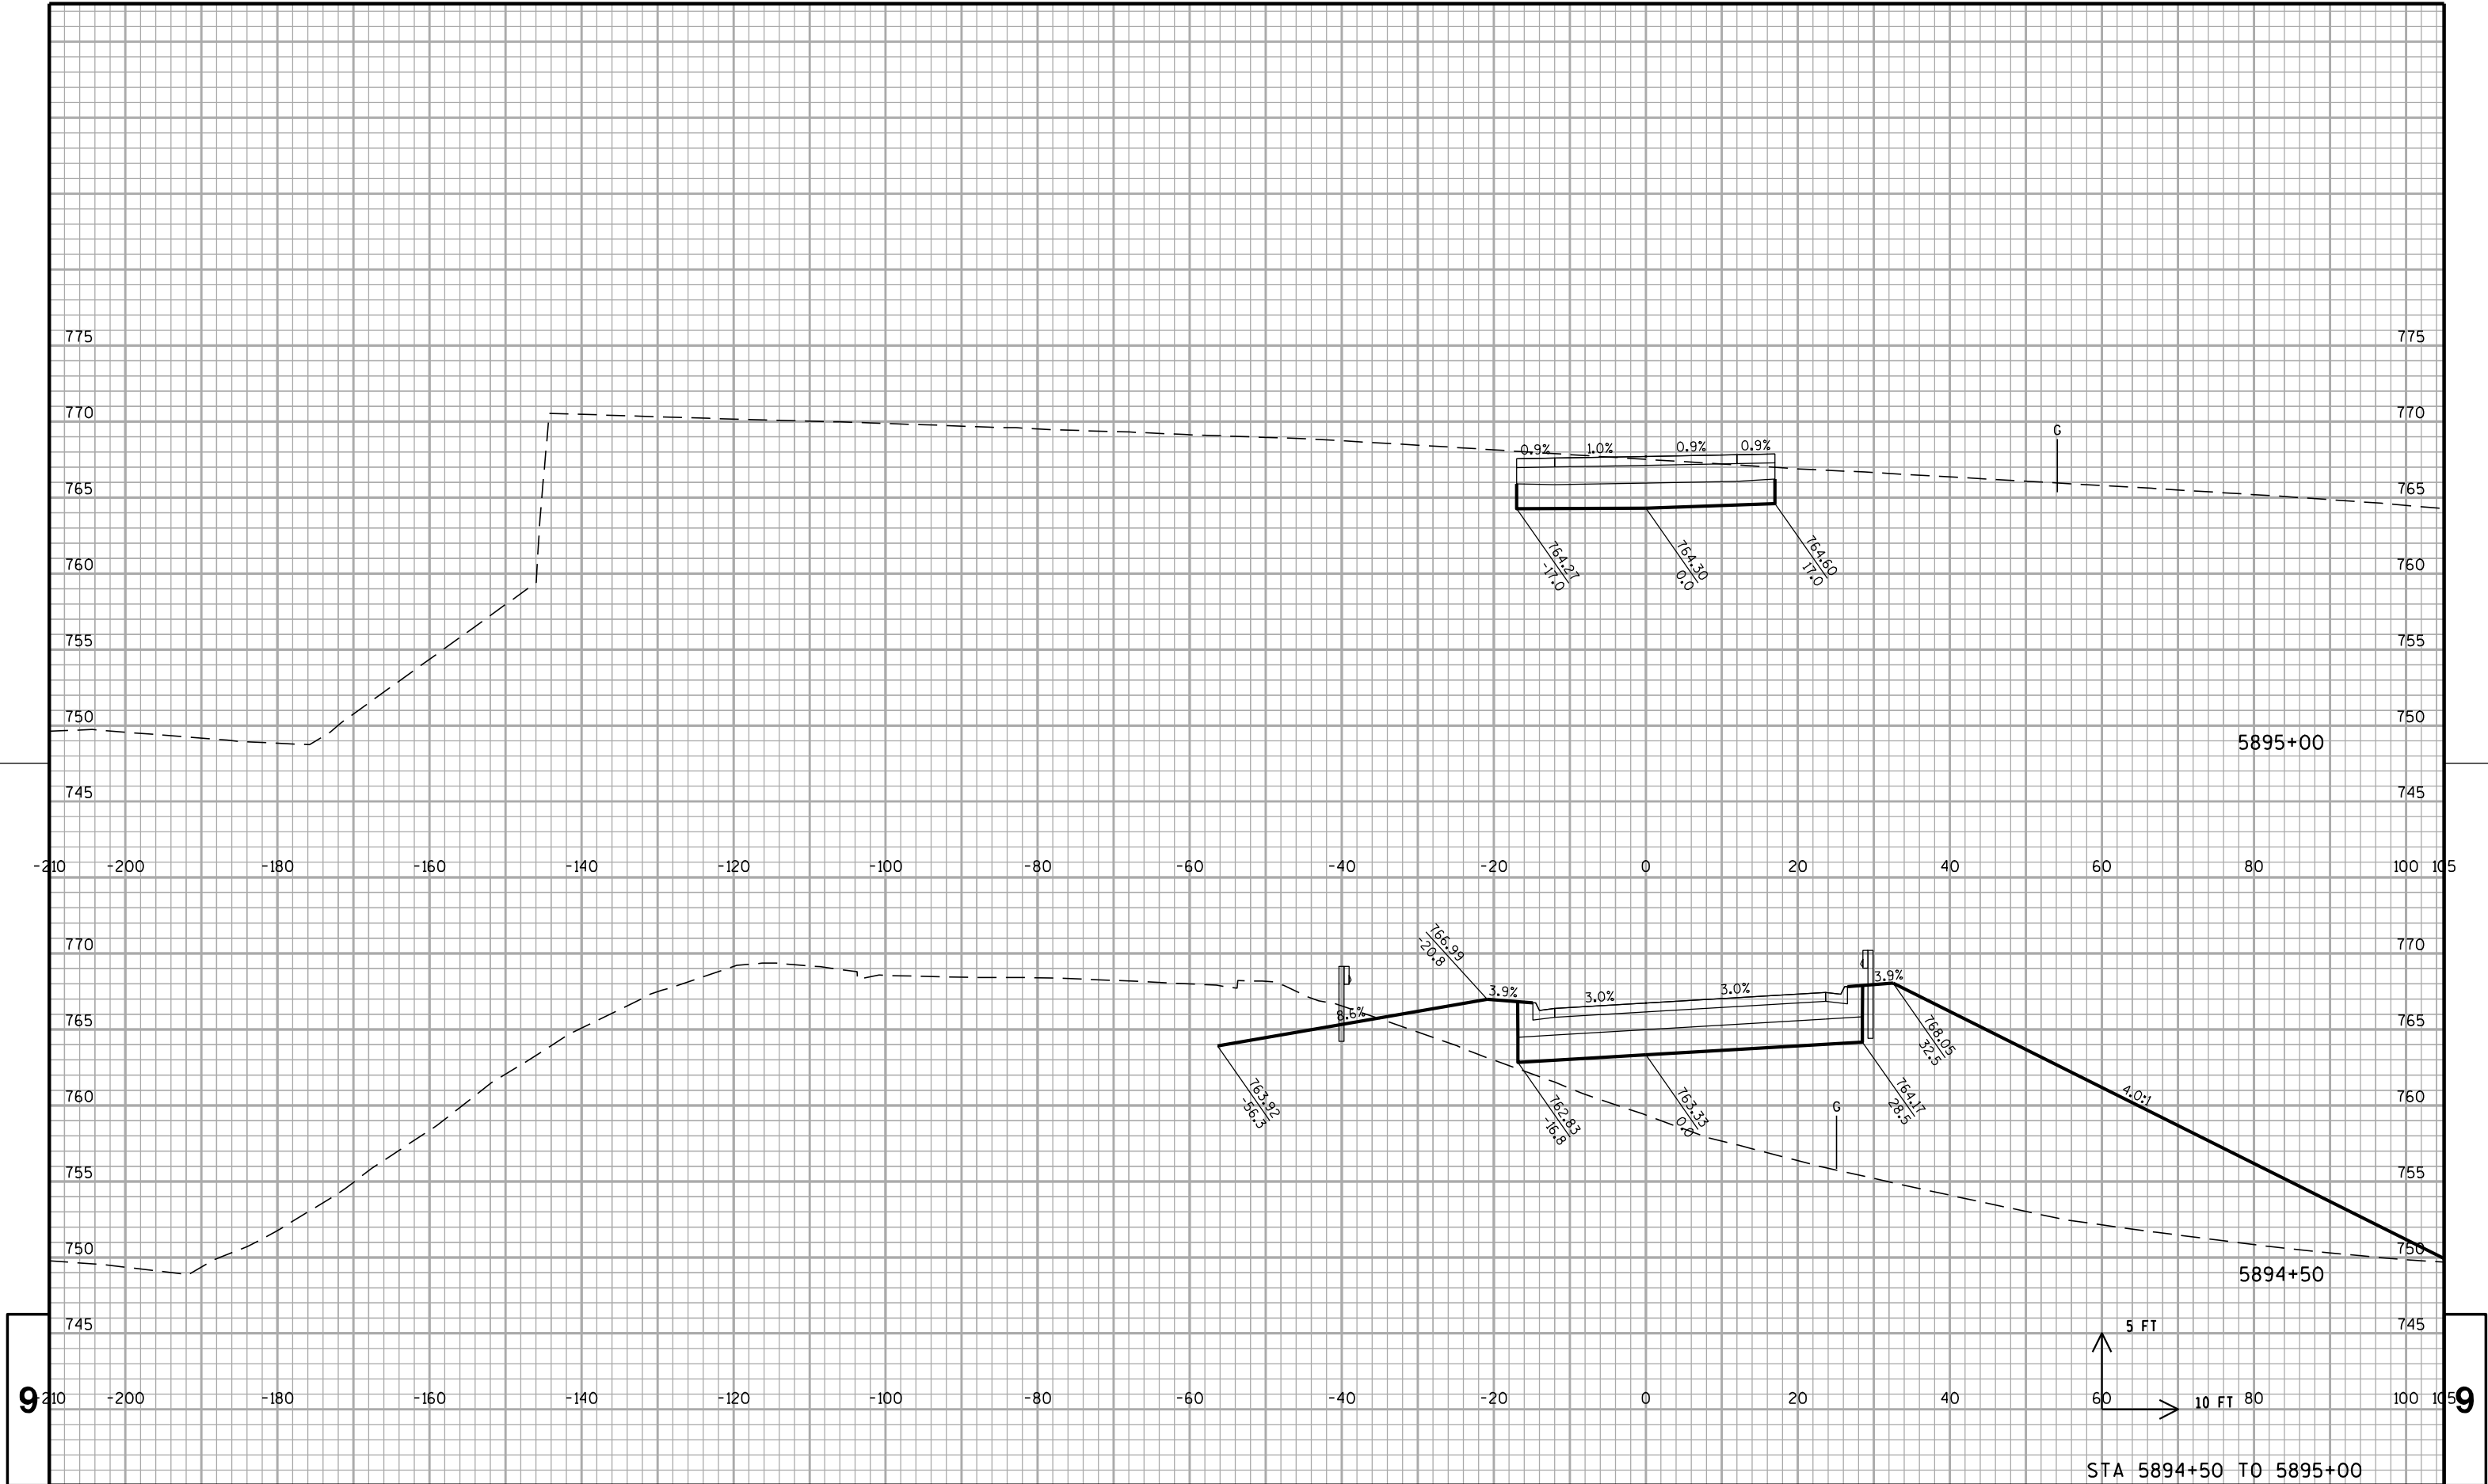

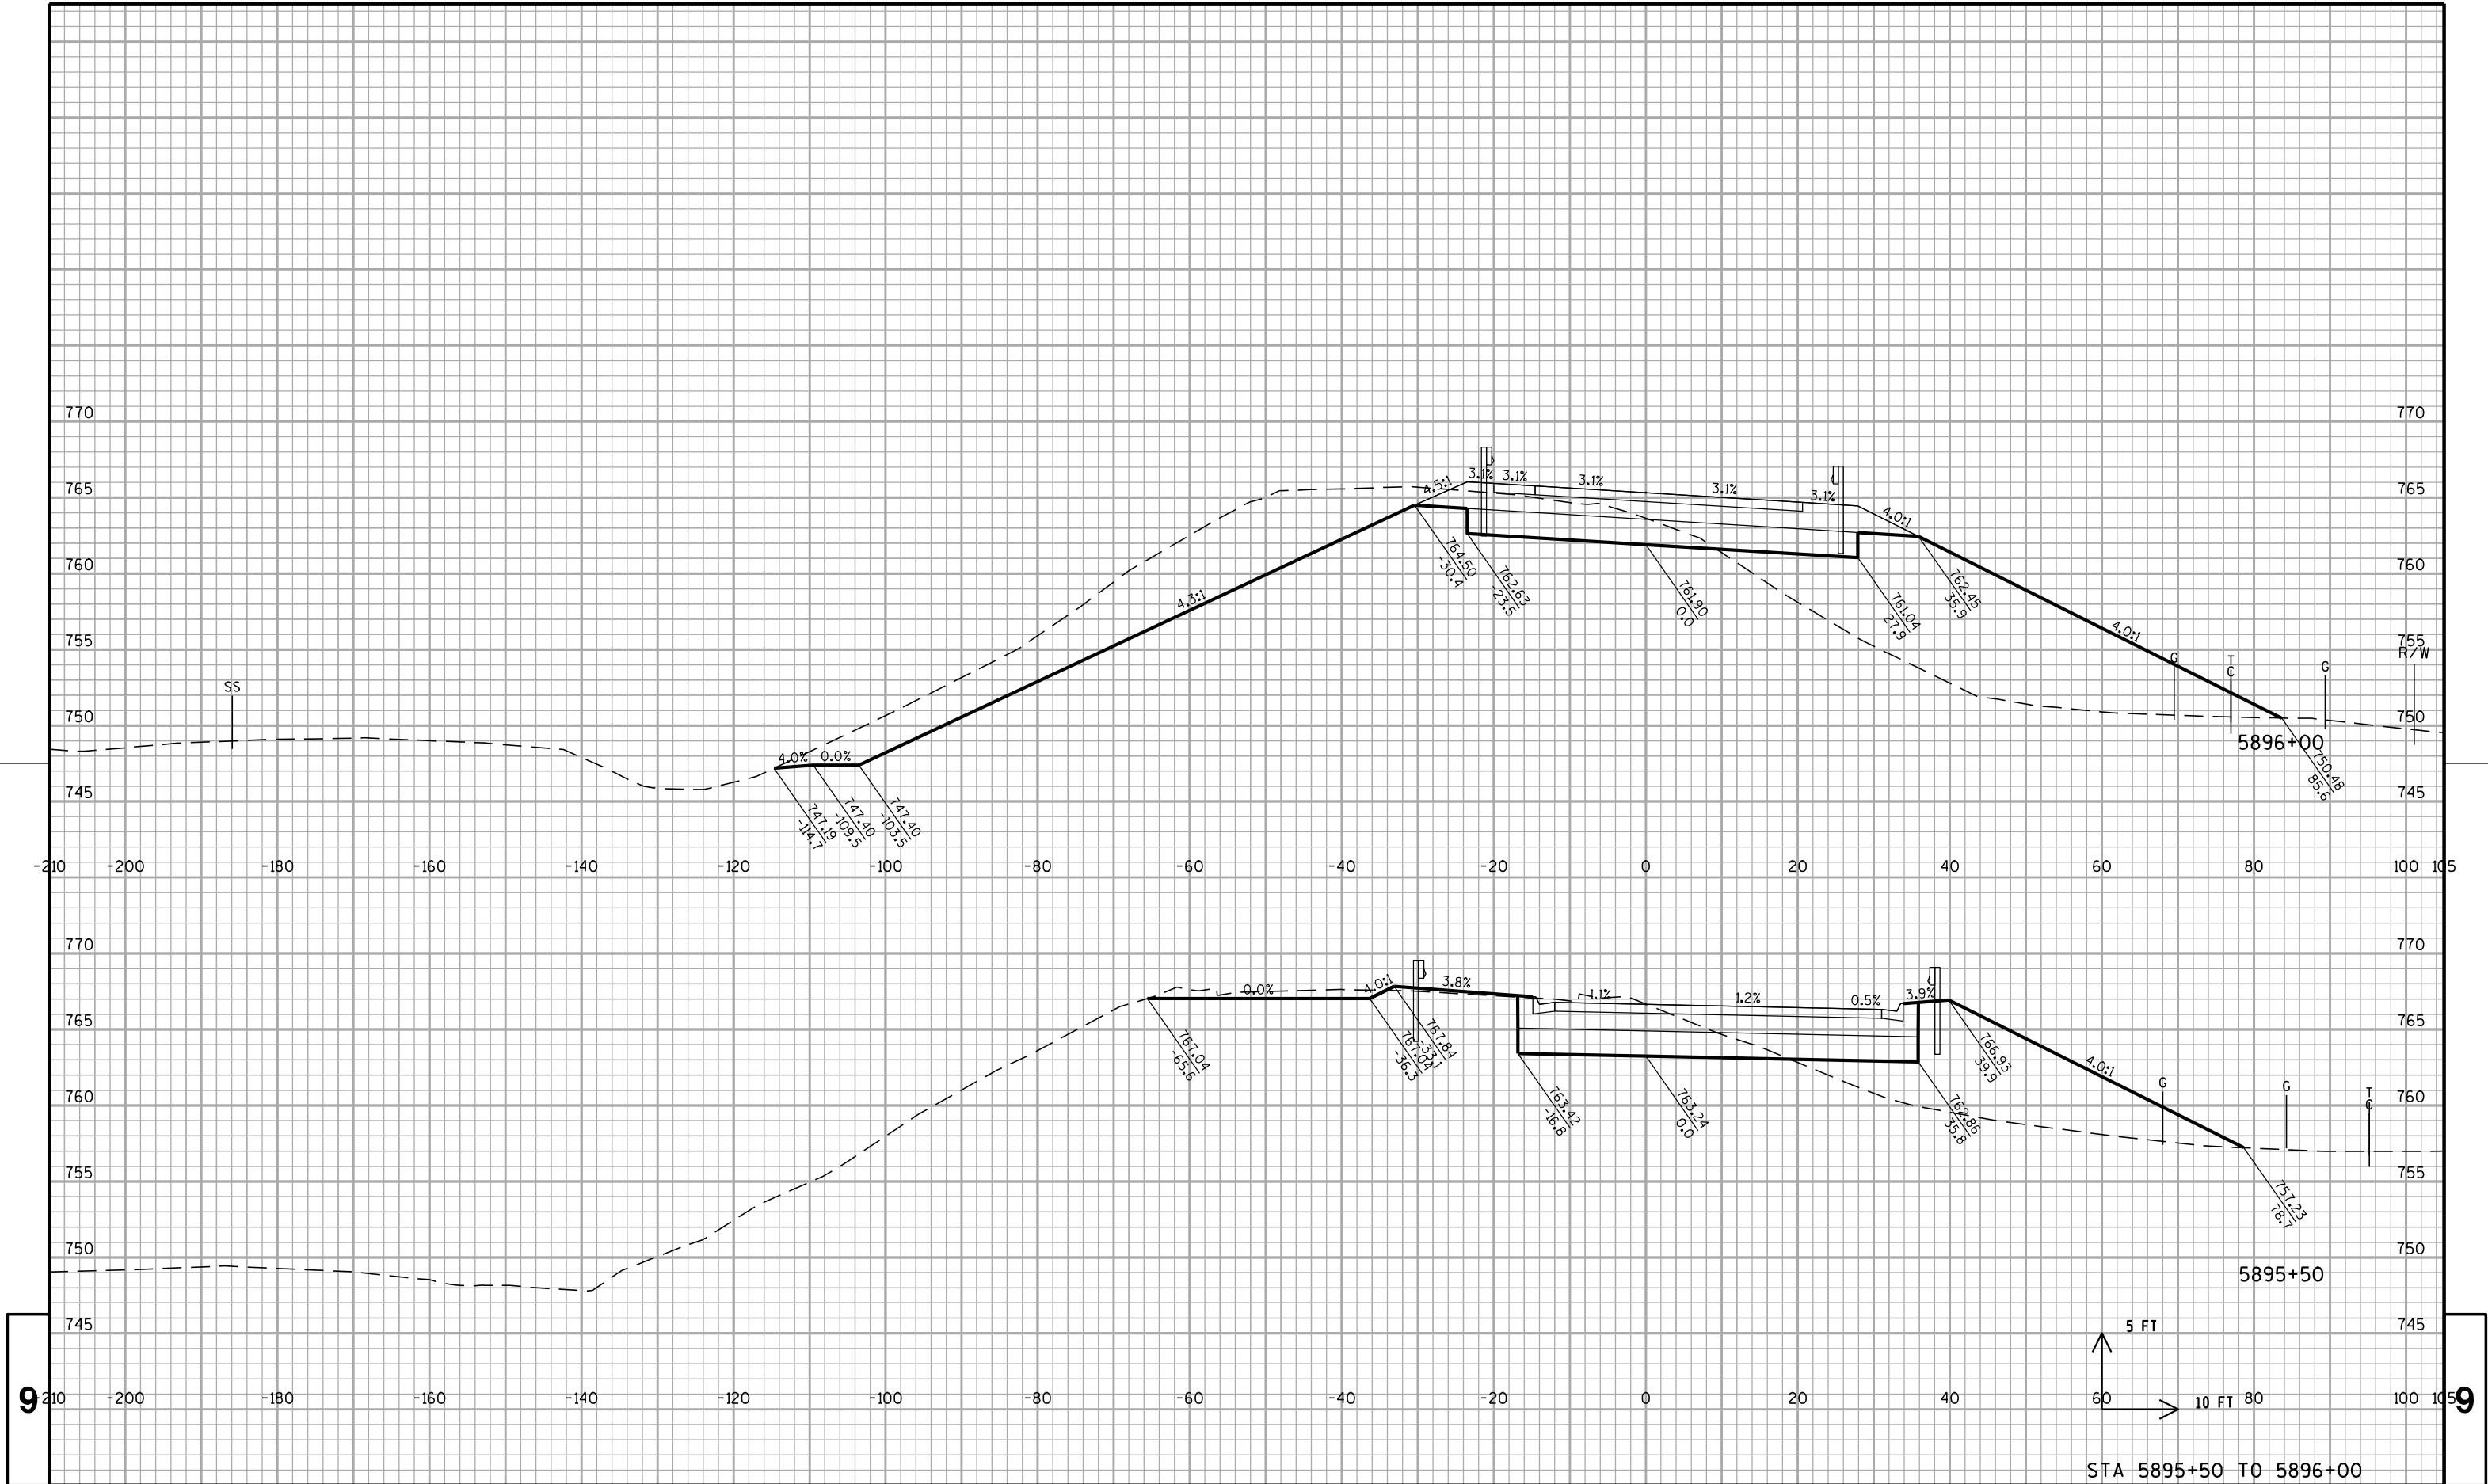

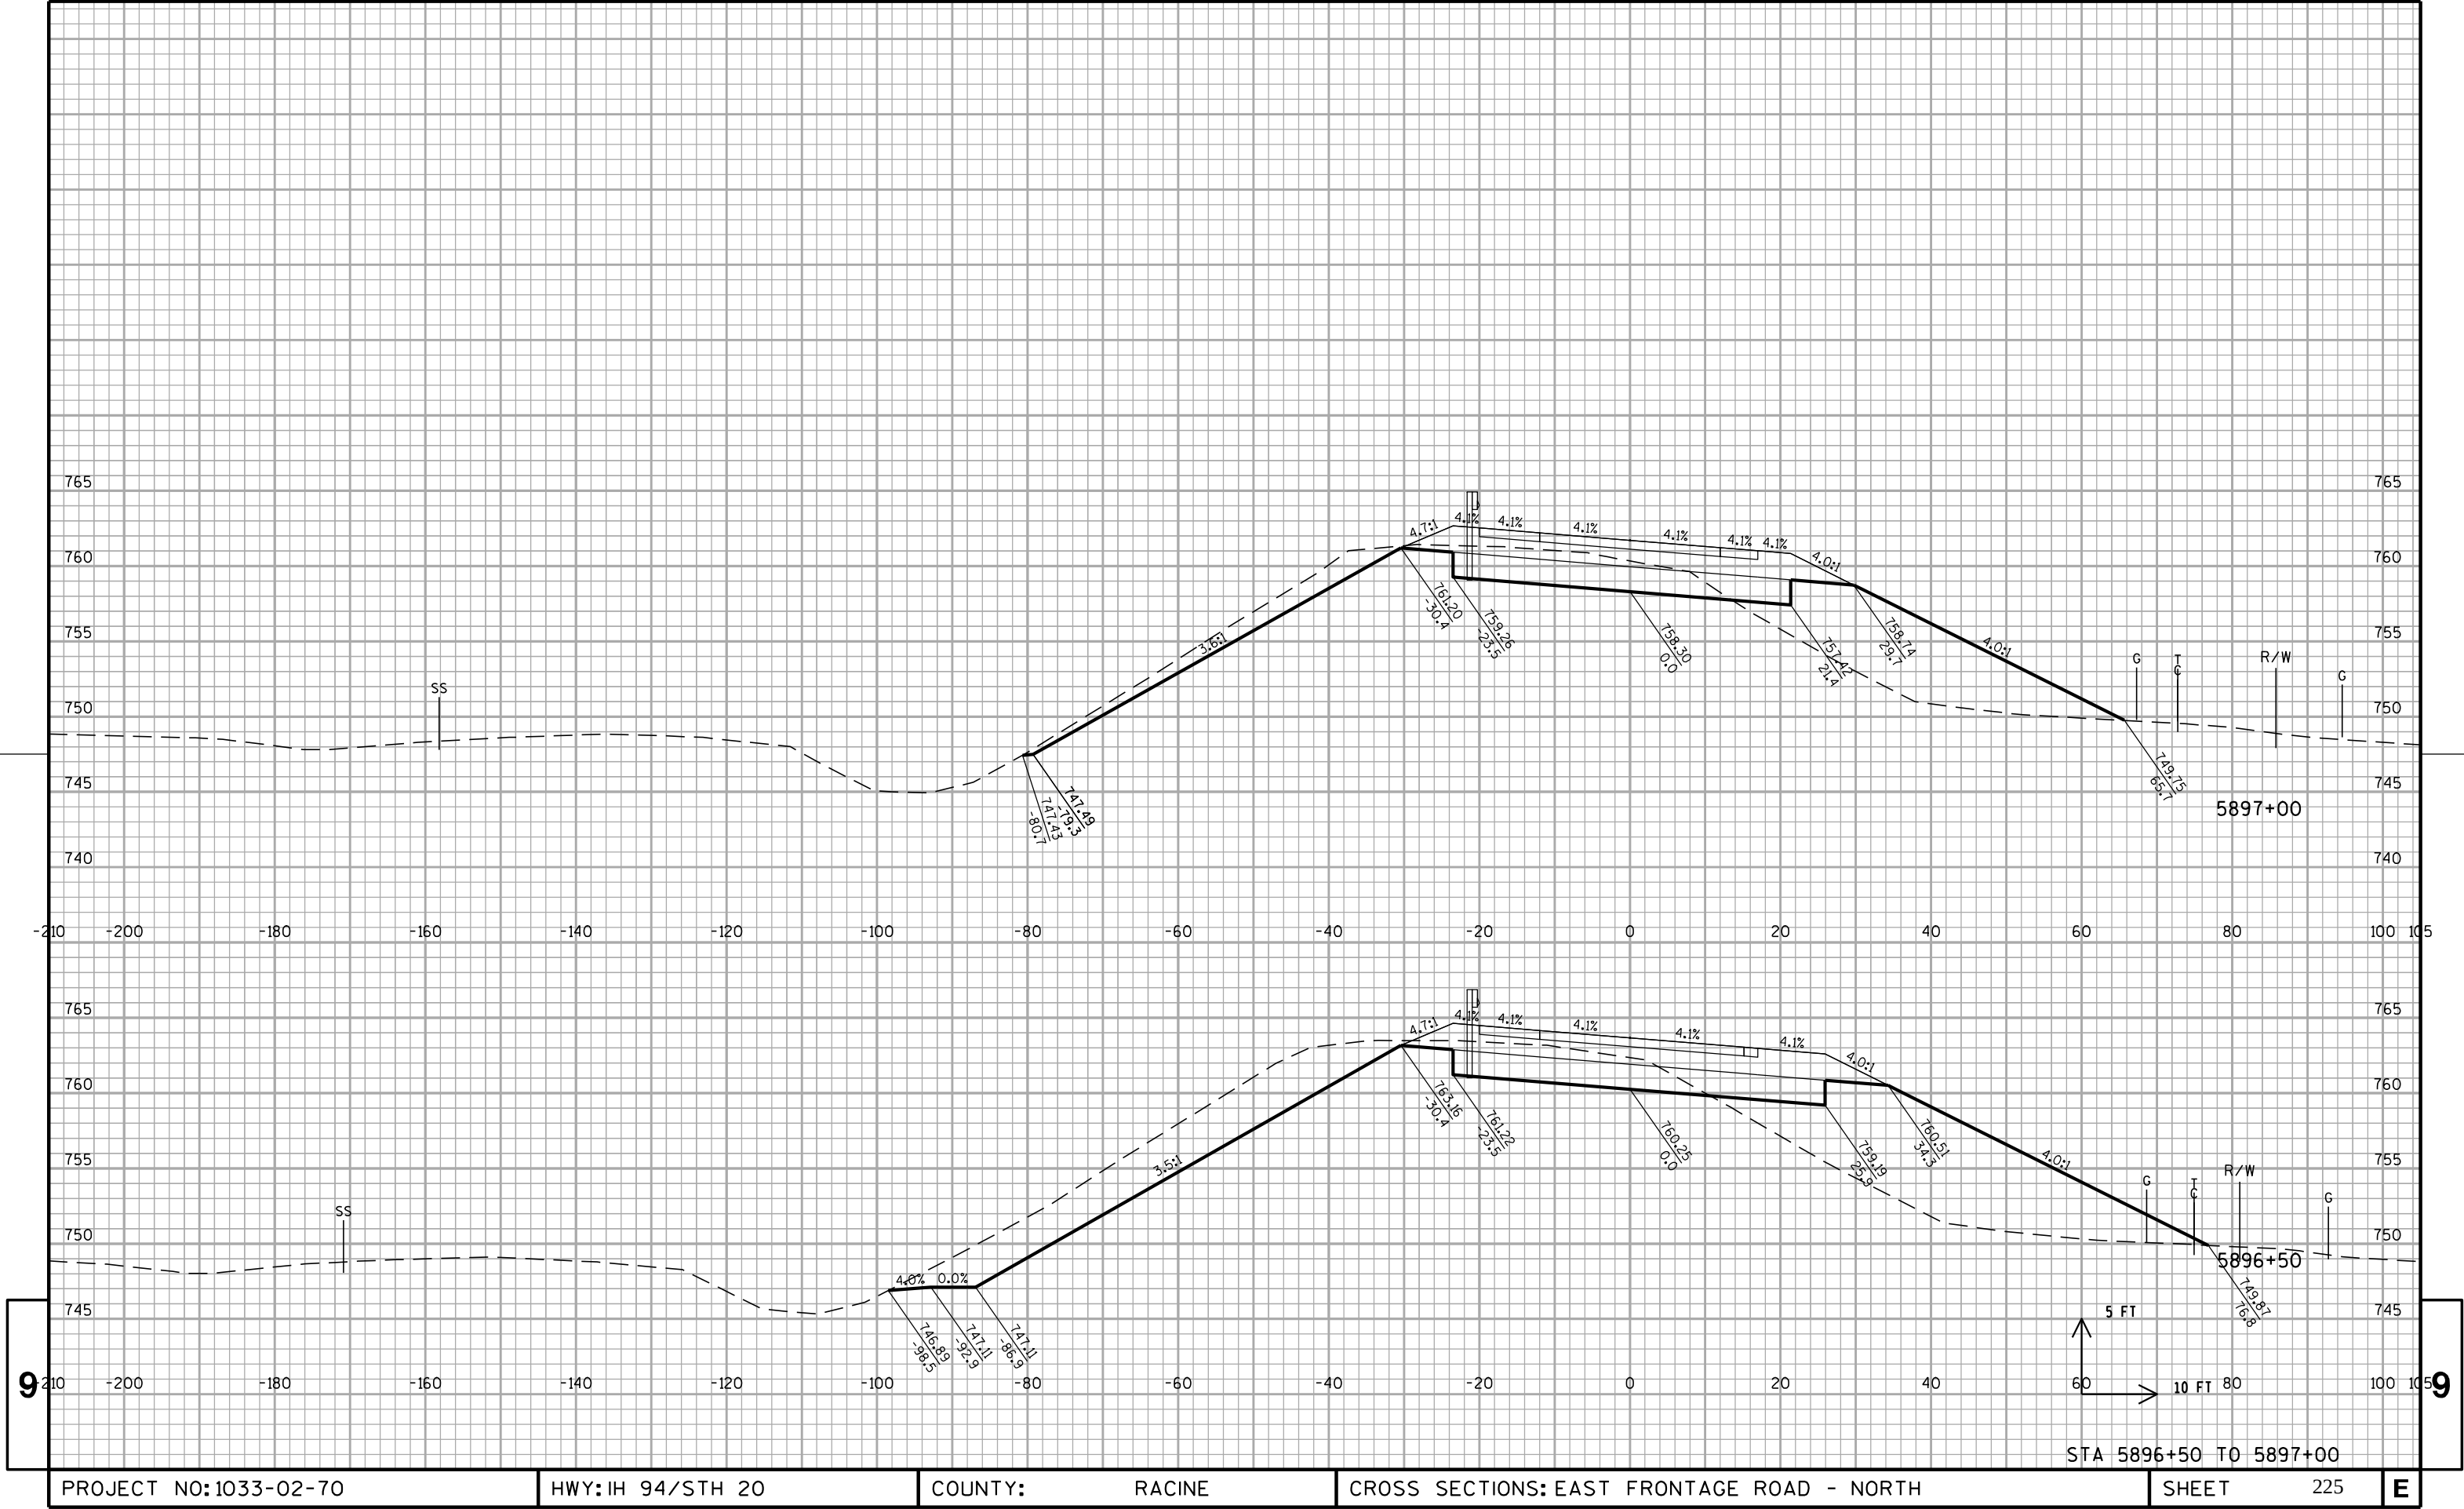

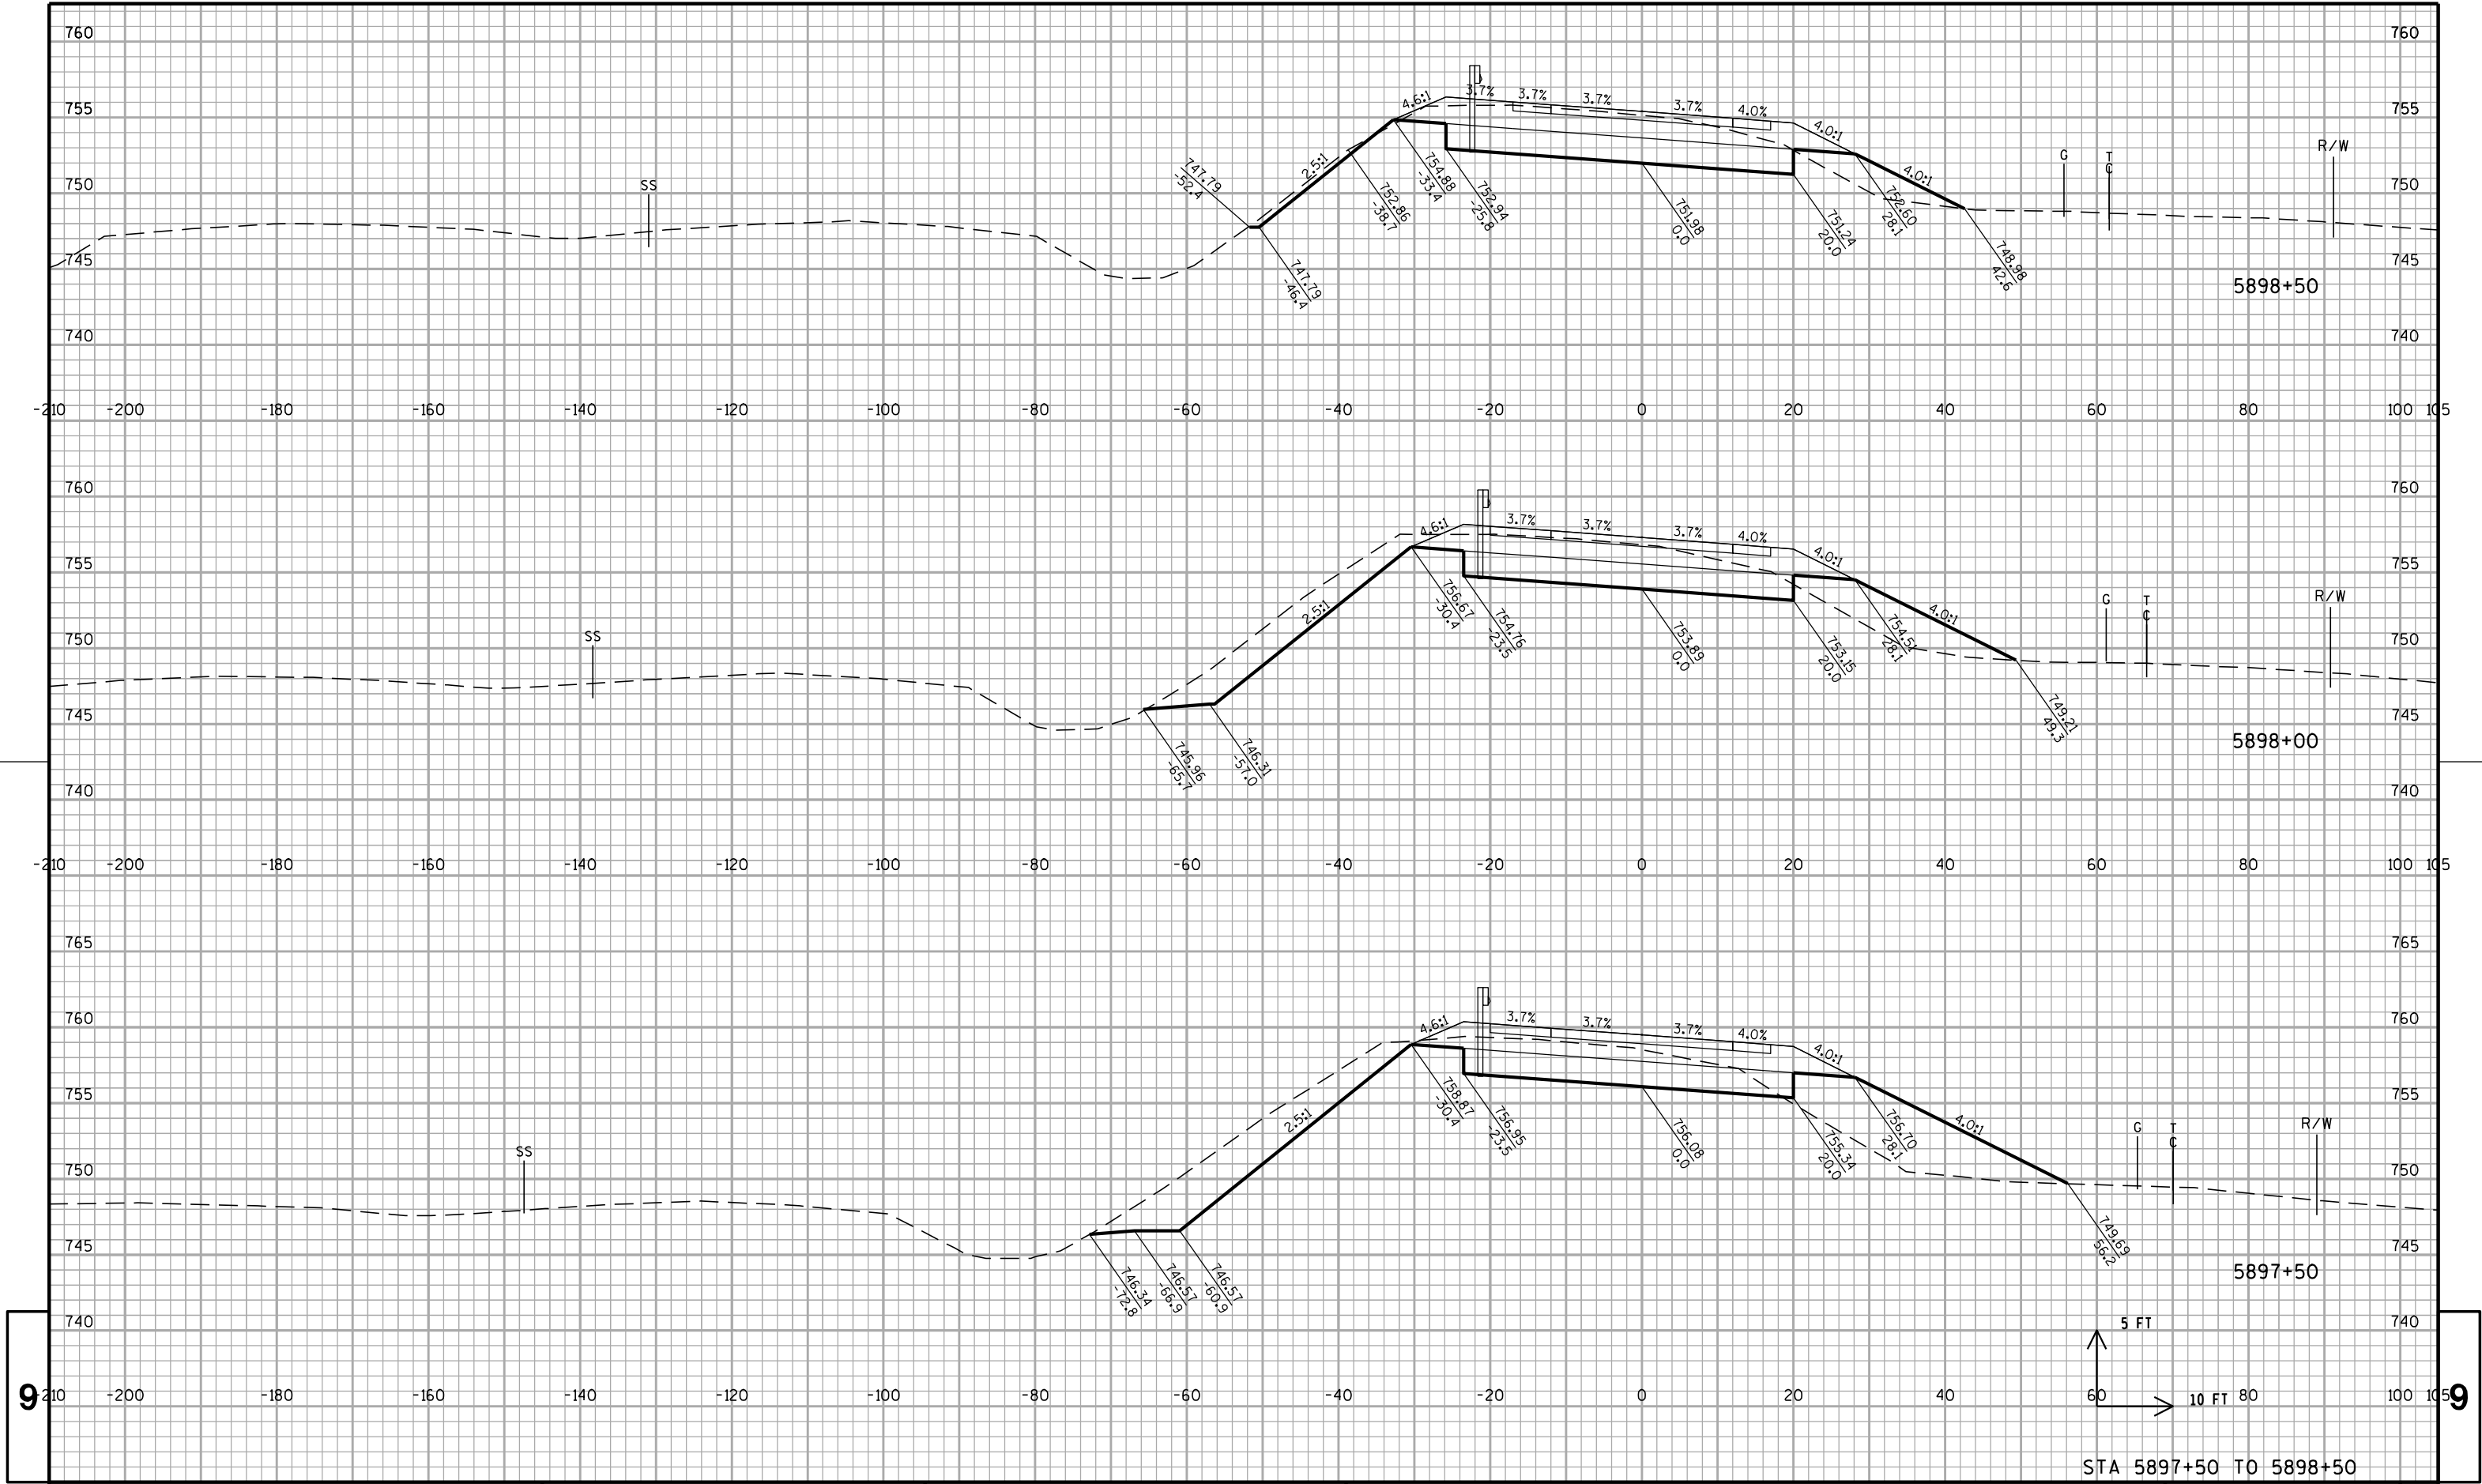

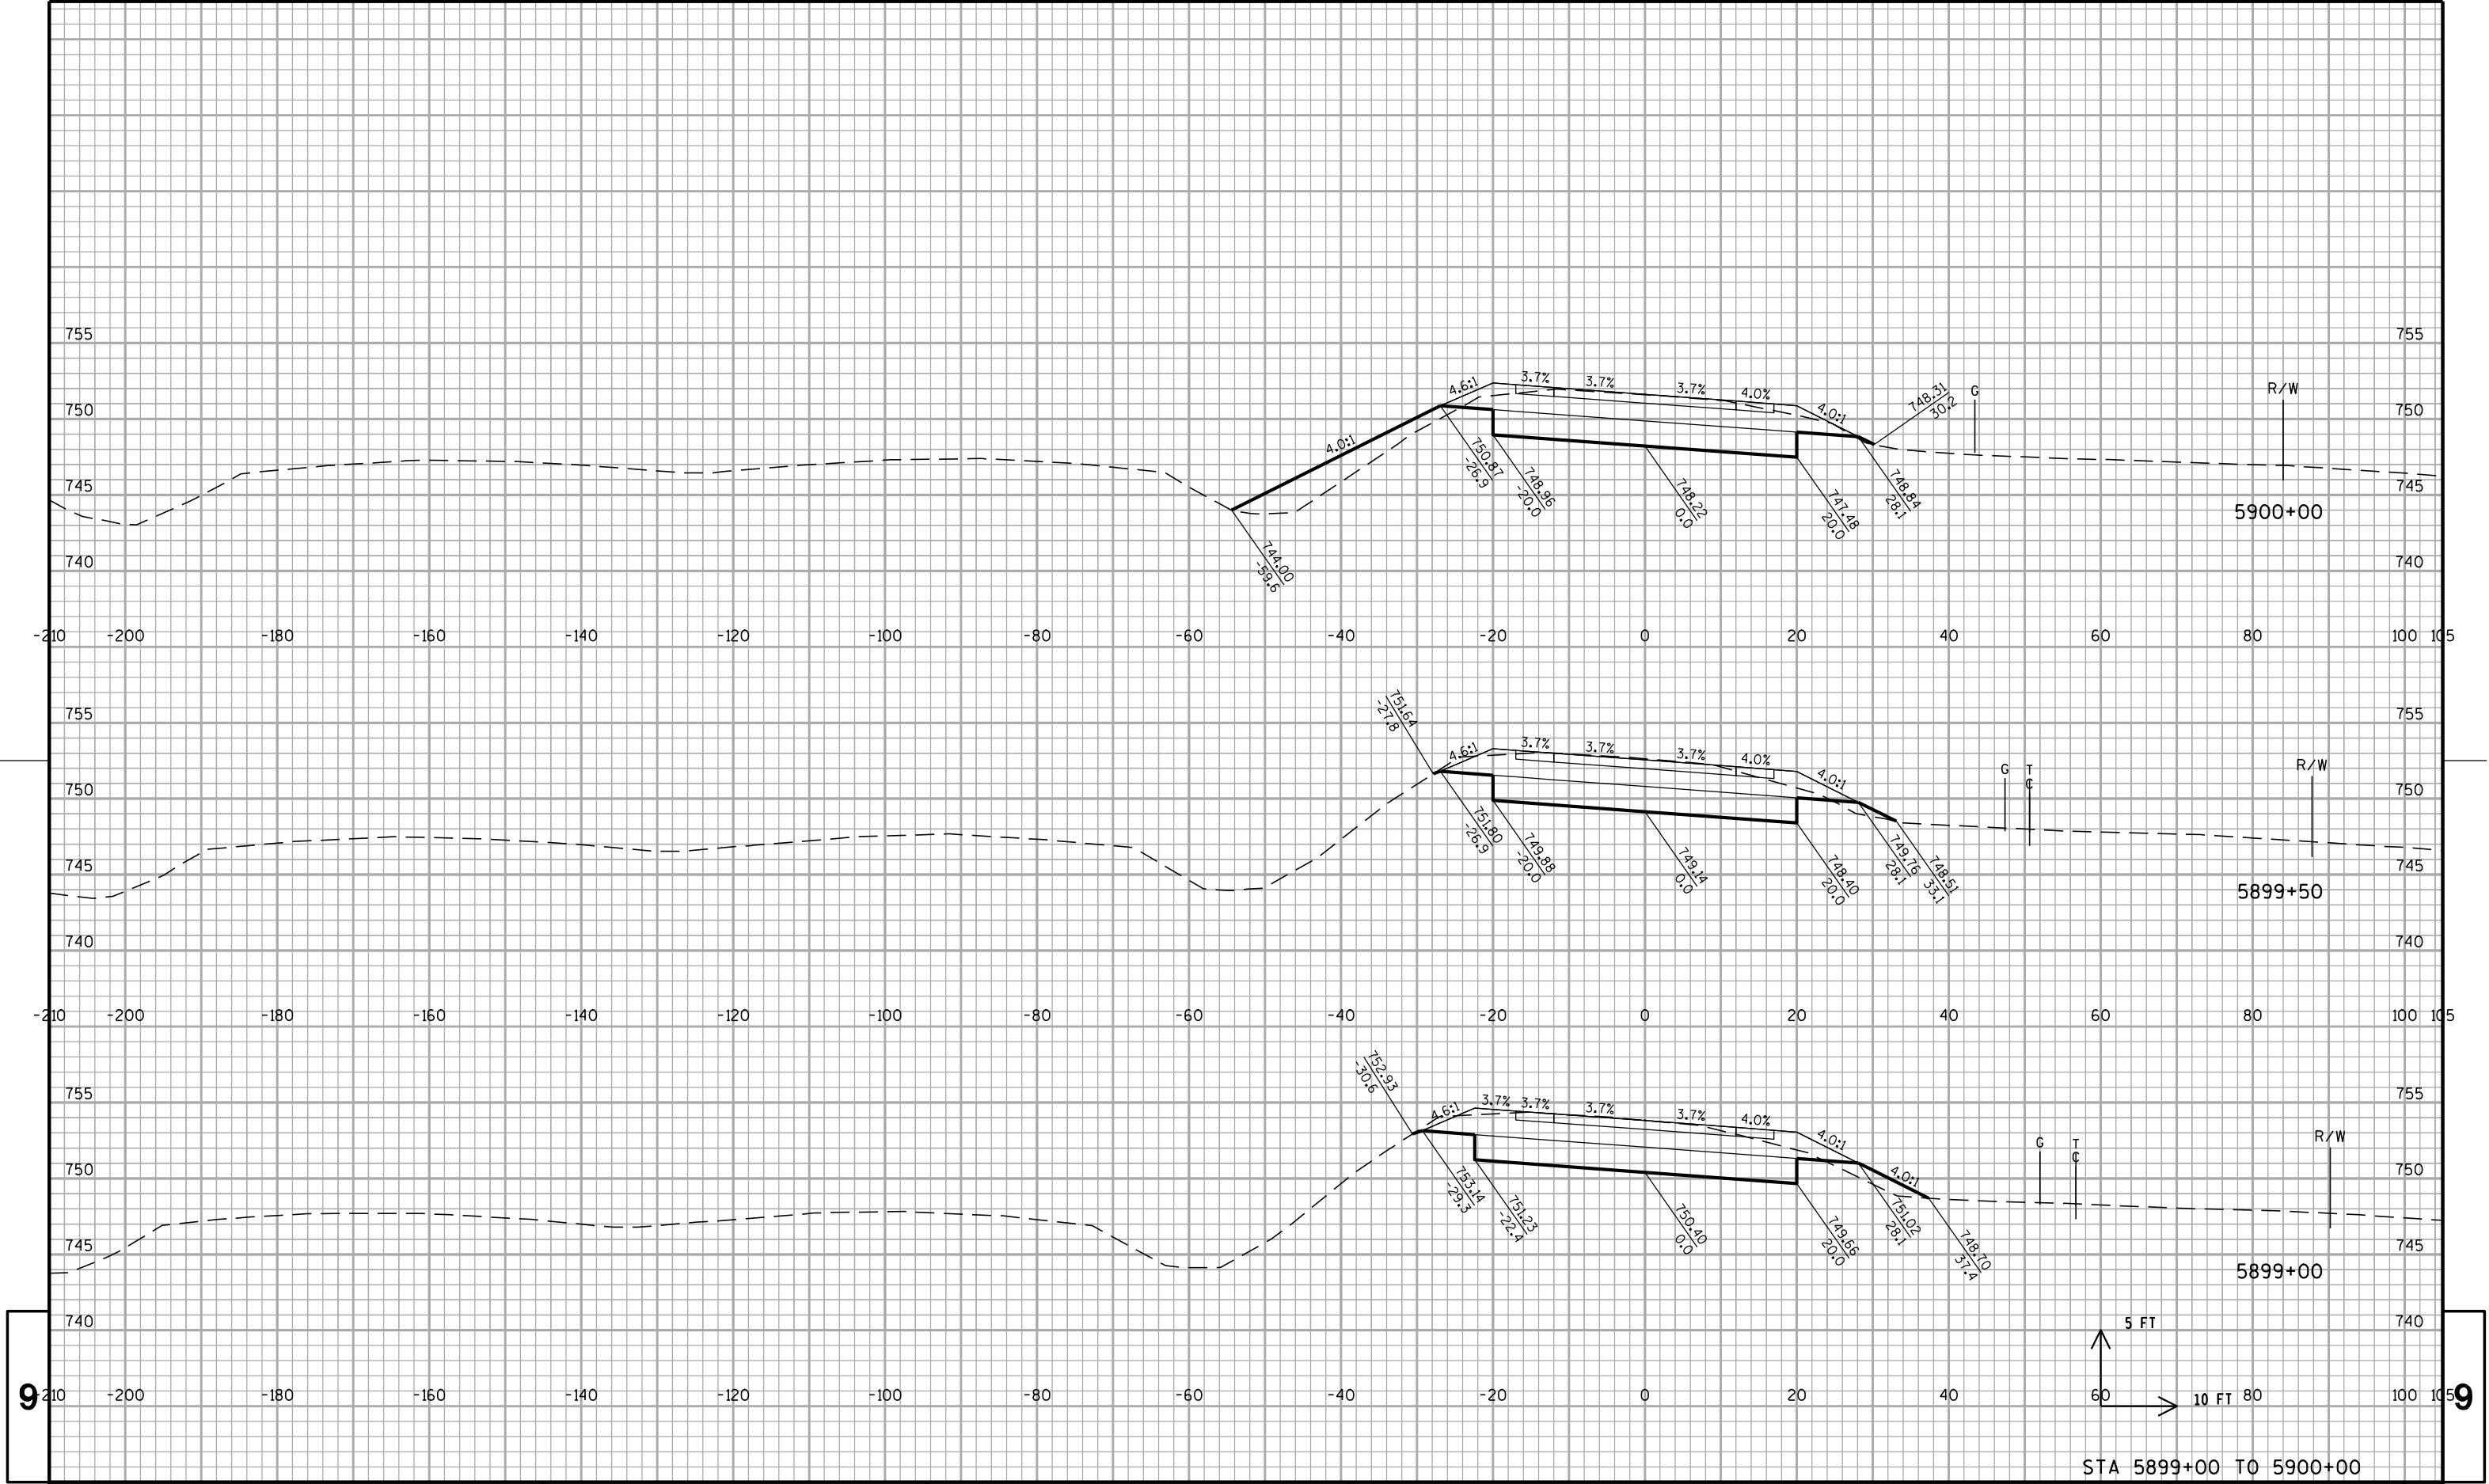

PROJECT NO:1033-02-70

HWY: IH 94/STH 20

COUNTY: RACINE

CROSS SECTIONS: EAST FRONTAGE ROAD - NORTH

SHEET 227

E


FILE NAME : s:\FinalDesign\20\10330270_E\Roads\cds\090202_xs_frne.dgn


PLOT DATE : 06-DEC-2010 20:33


PLOT BY : MSCDIS

PLOT NAME : 090202_xs_frne25 PLOT SCALE : 20:1

WISDOT/CADDs SHEET 21

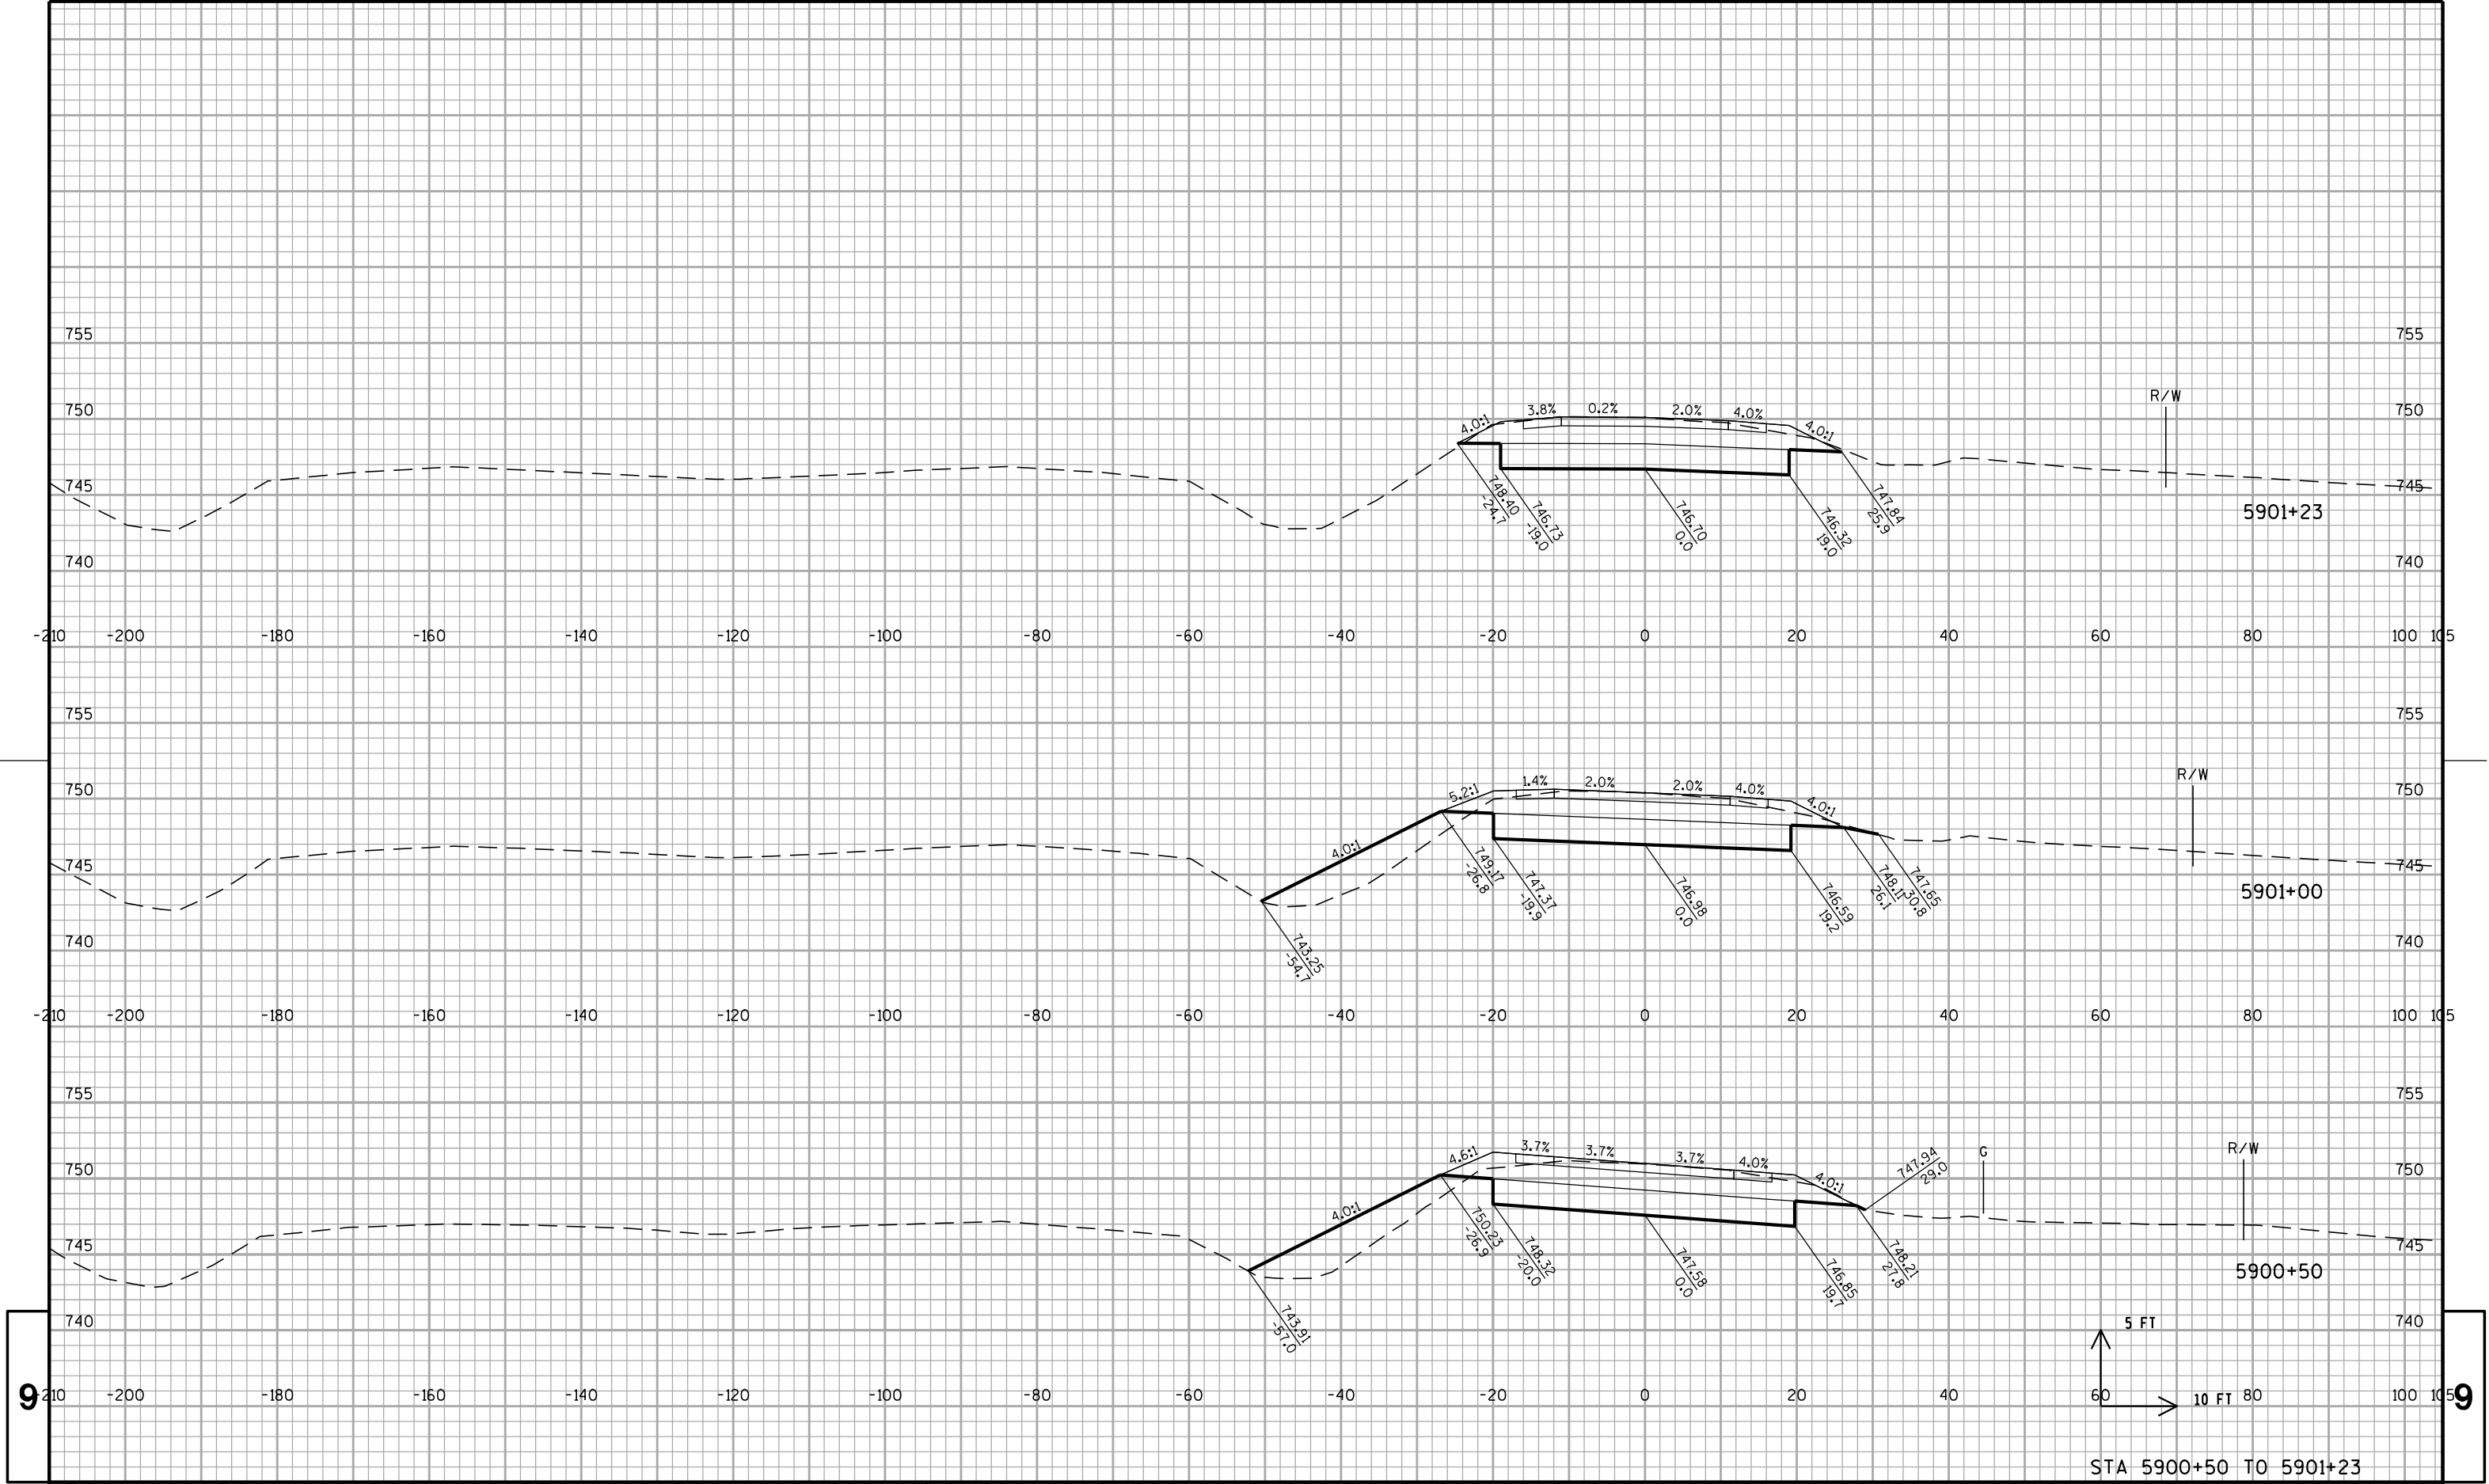

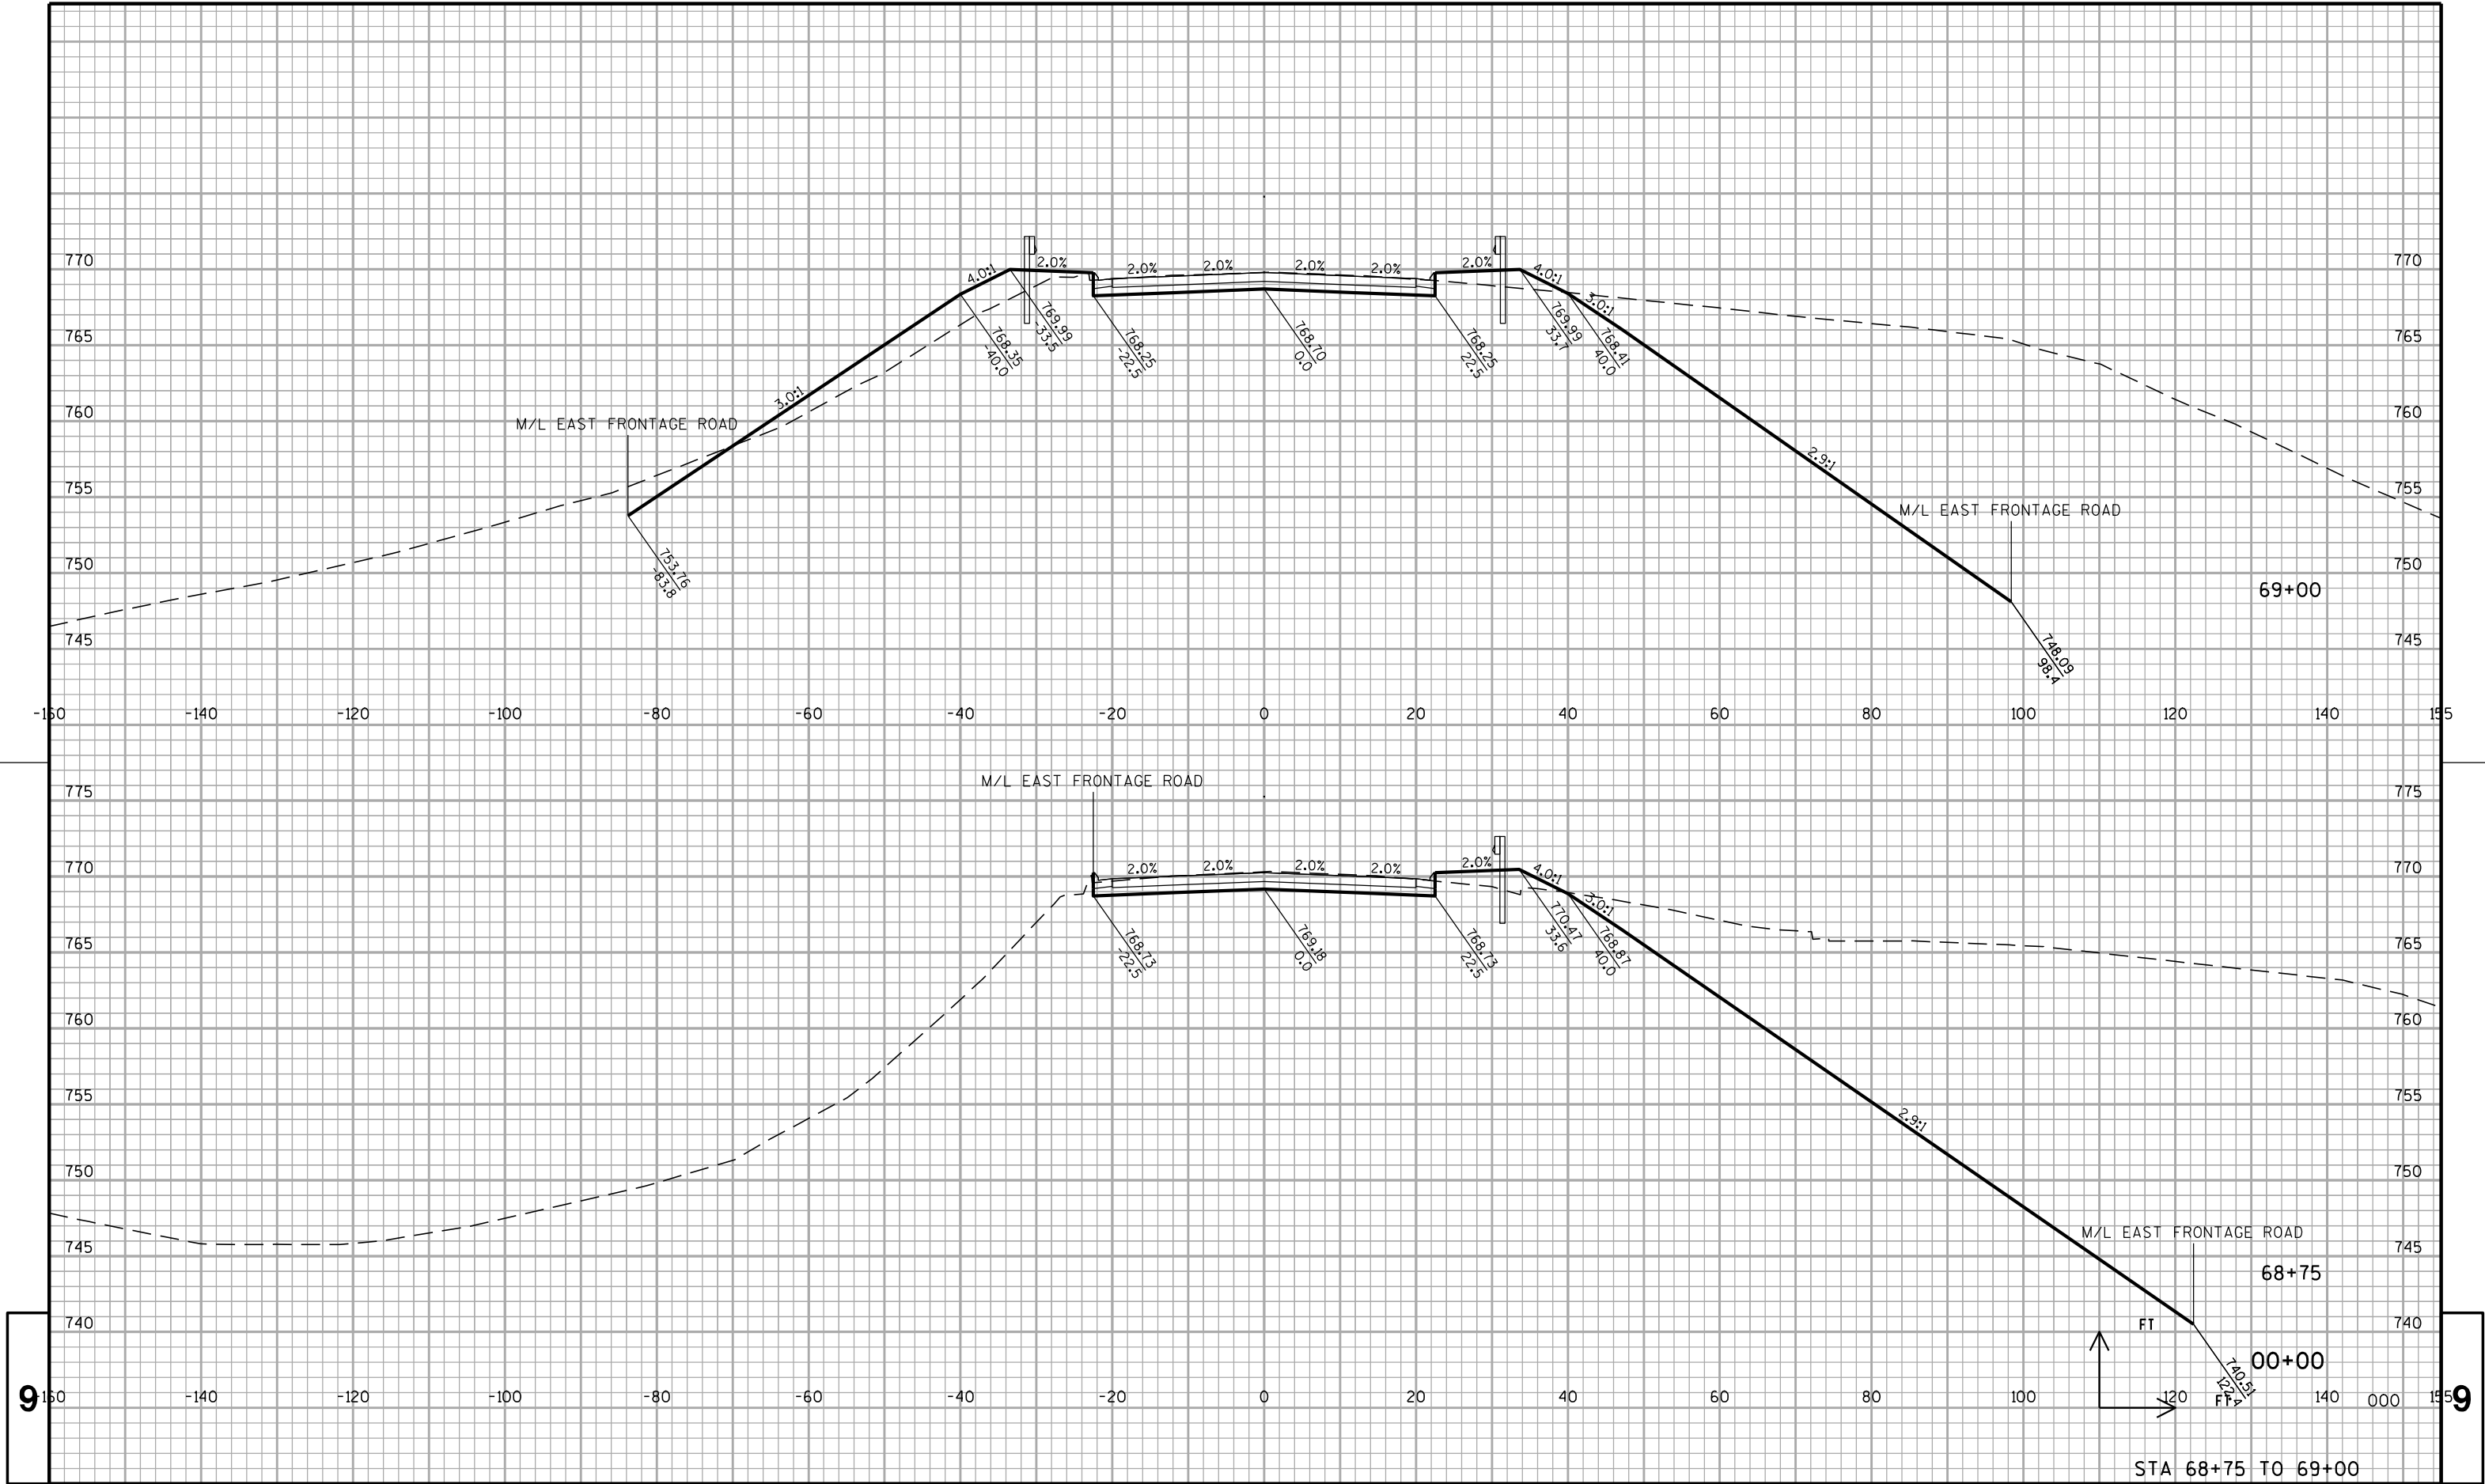

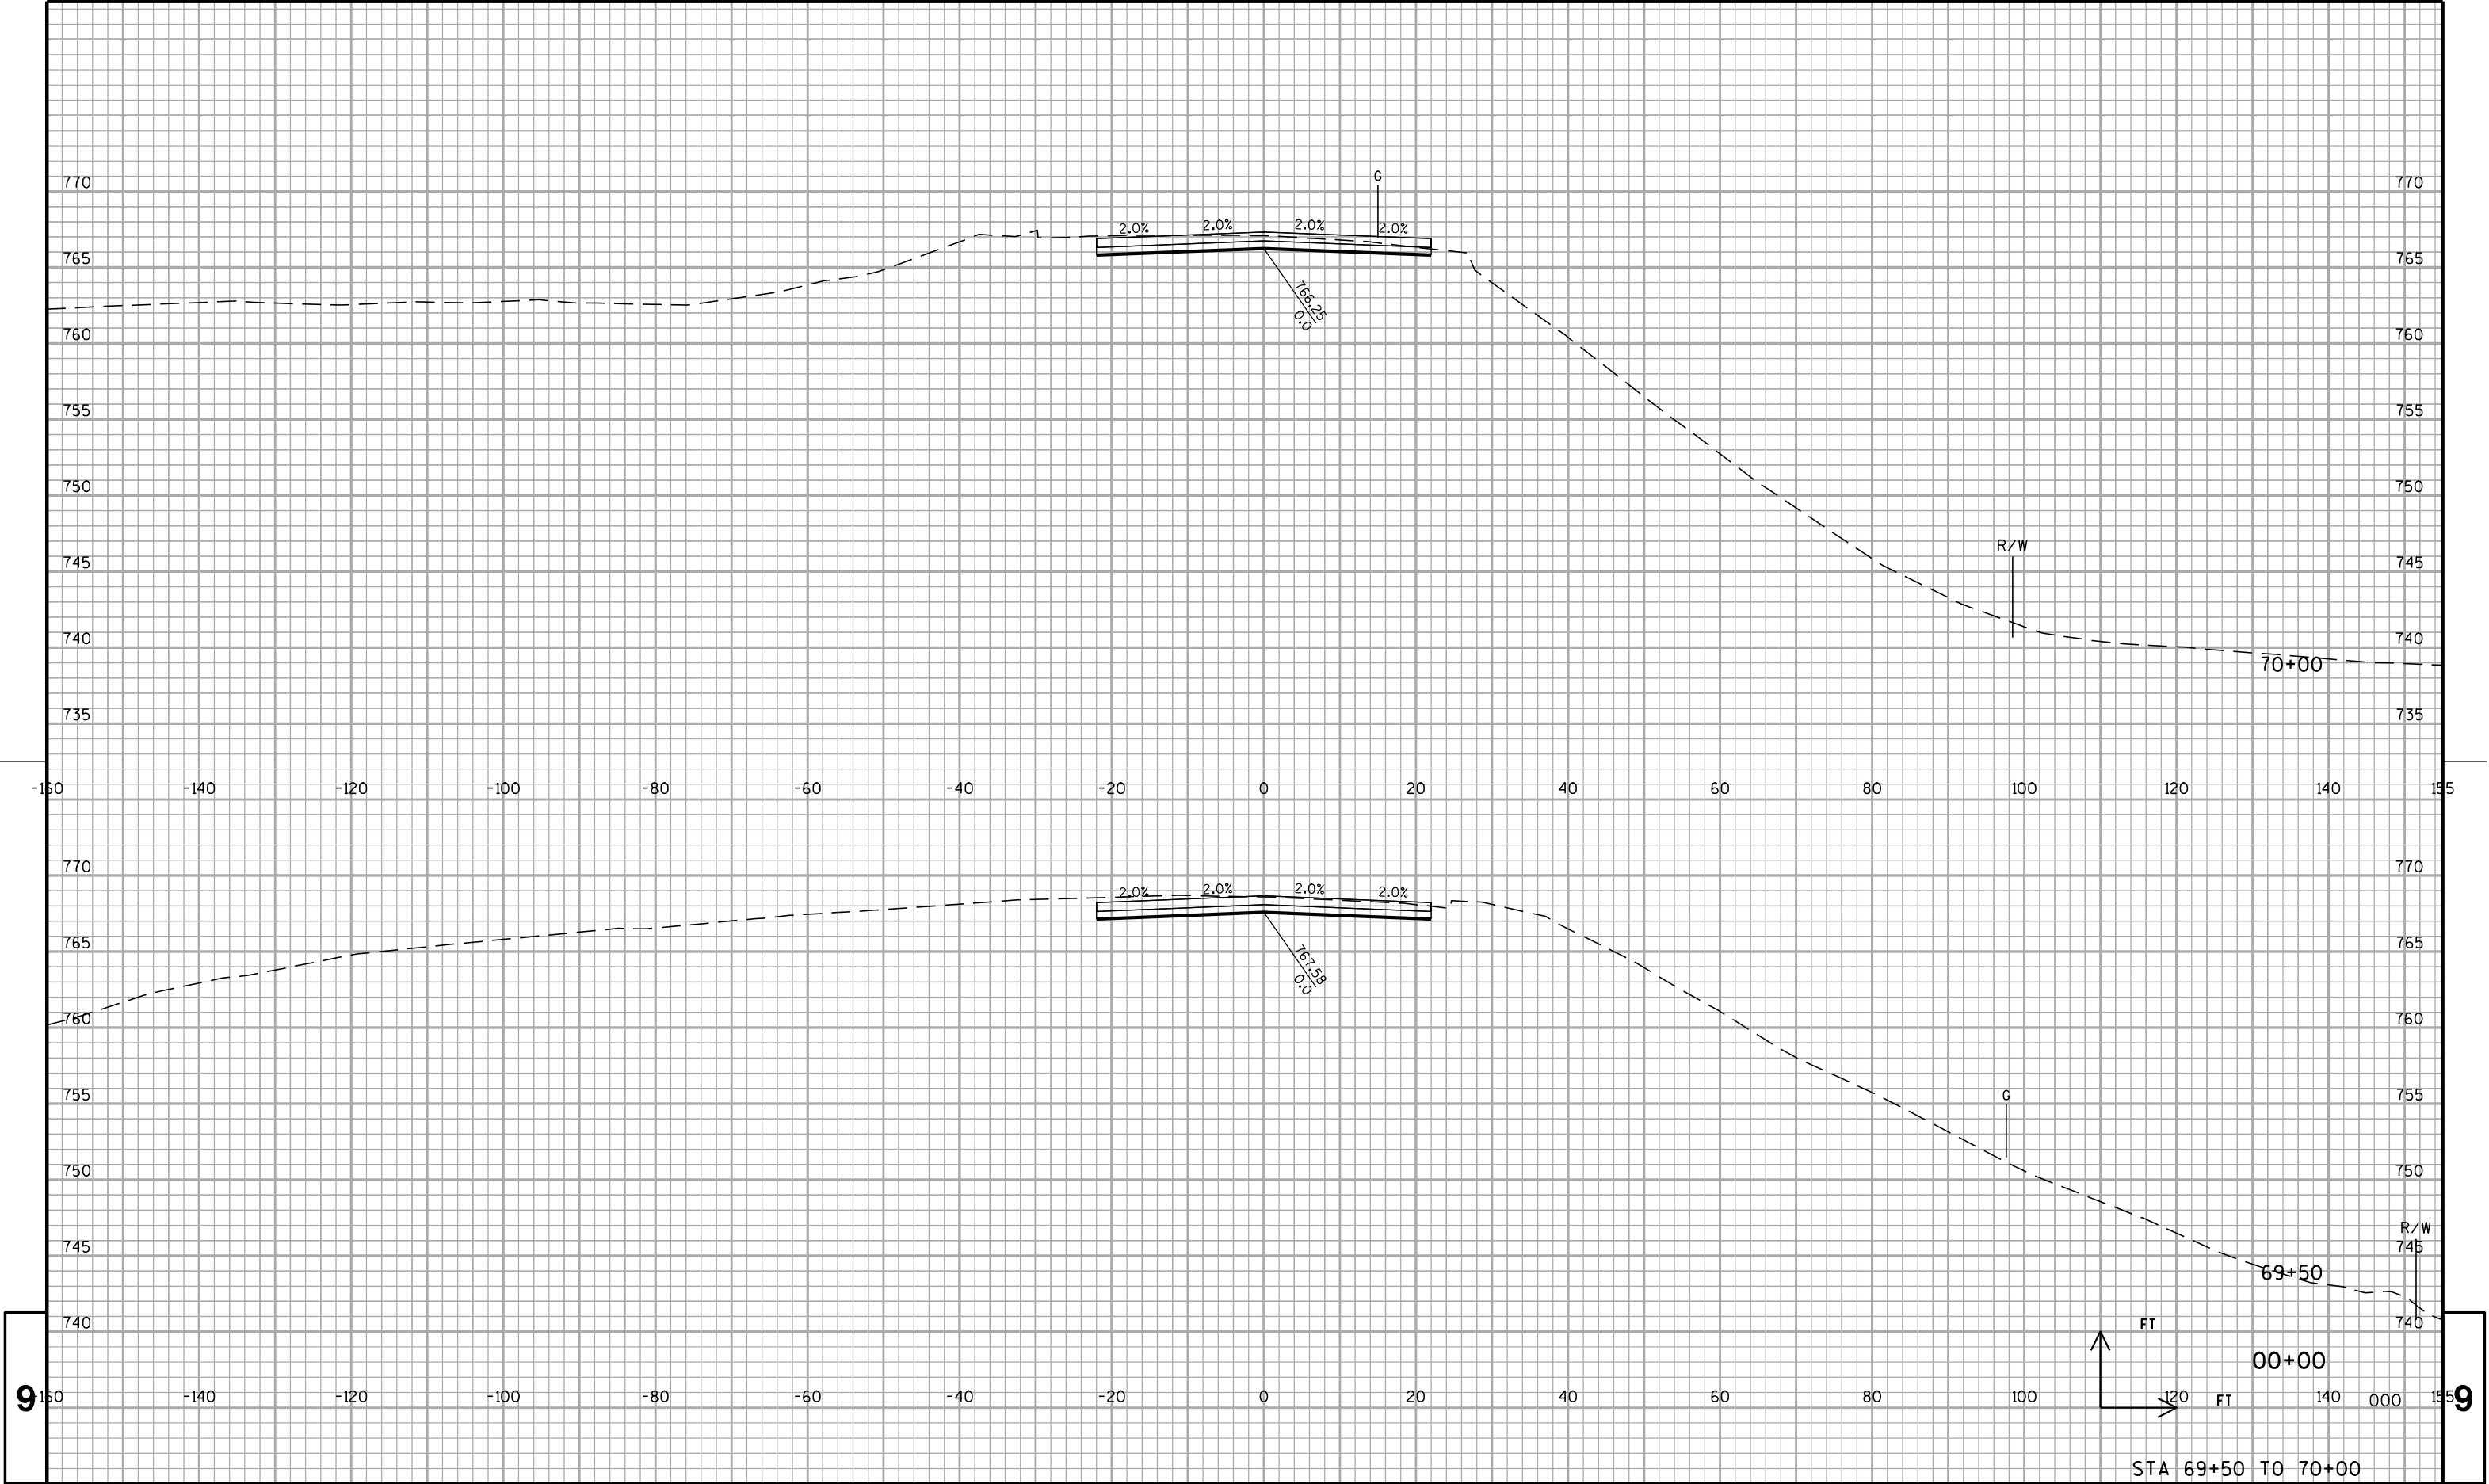

PROJECT NO:1033-02-70

HWY: IH 94/STH 20

COUNTY: RACINE

CROSS SECTIONS: CTH C

SHEET 230

E

FILE NAME : s:\FinalDesign\20\10330270-EN\Roads\cds\090203_xs_c\thc.dgn


PLOT DATE : 06-DEC-2010 20:33


PLOT BY : MSCD1S


PLOT NAME : 090203_xs_c\thc1


PLOT SCALE : 20:1


WISDOT/CADDs SHEET 21

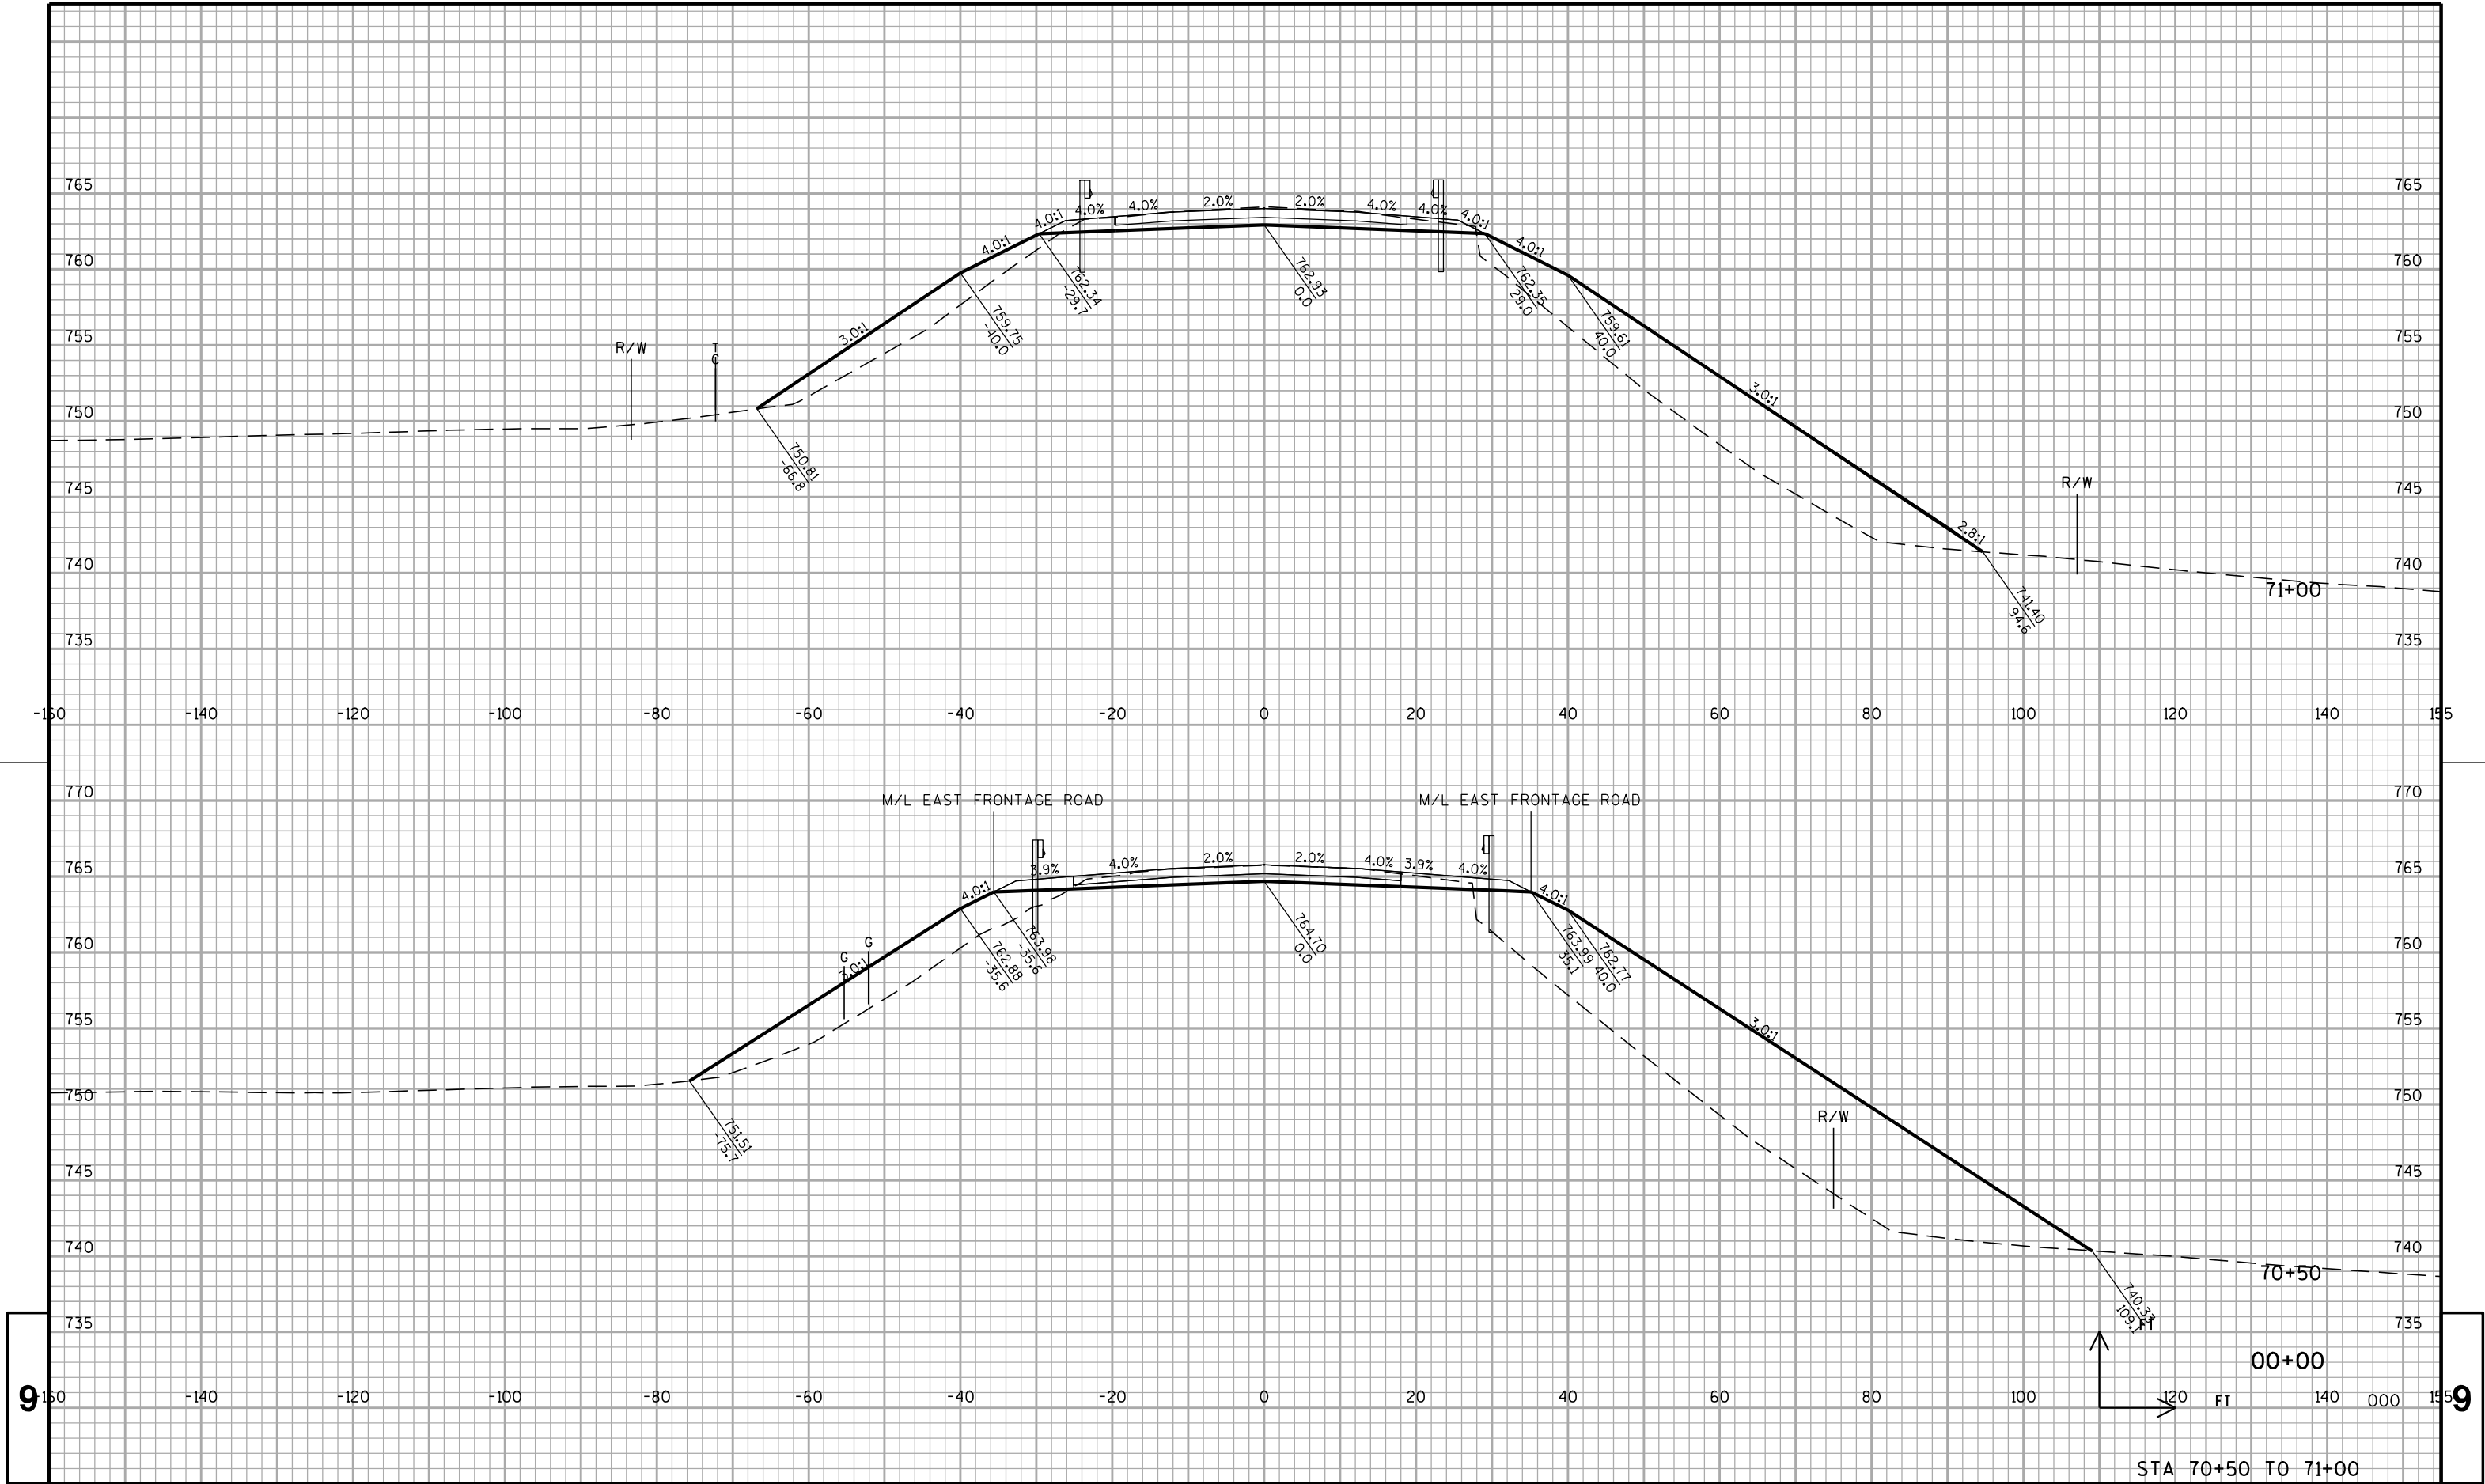

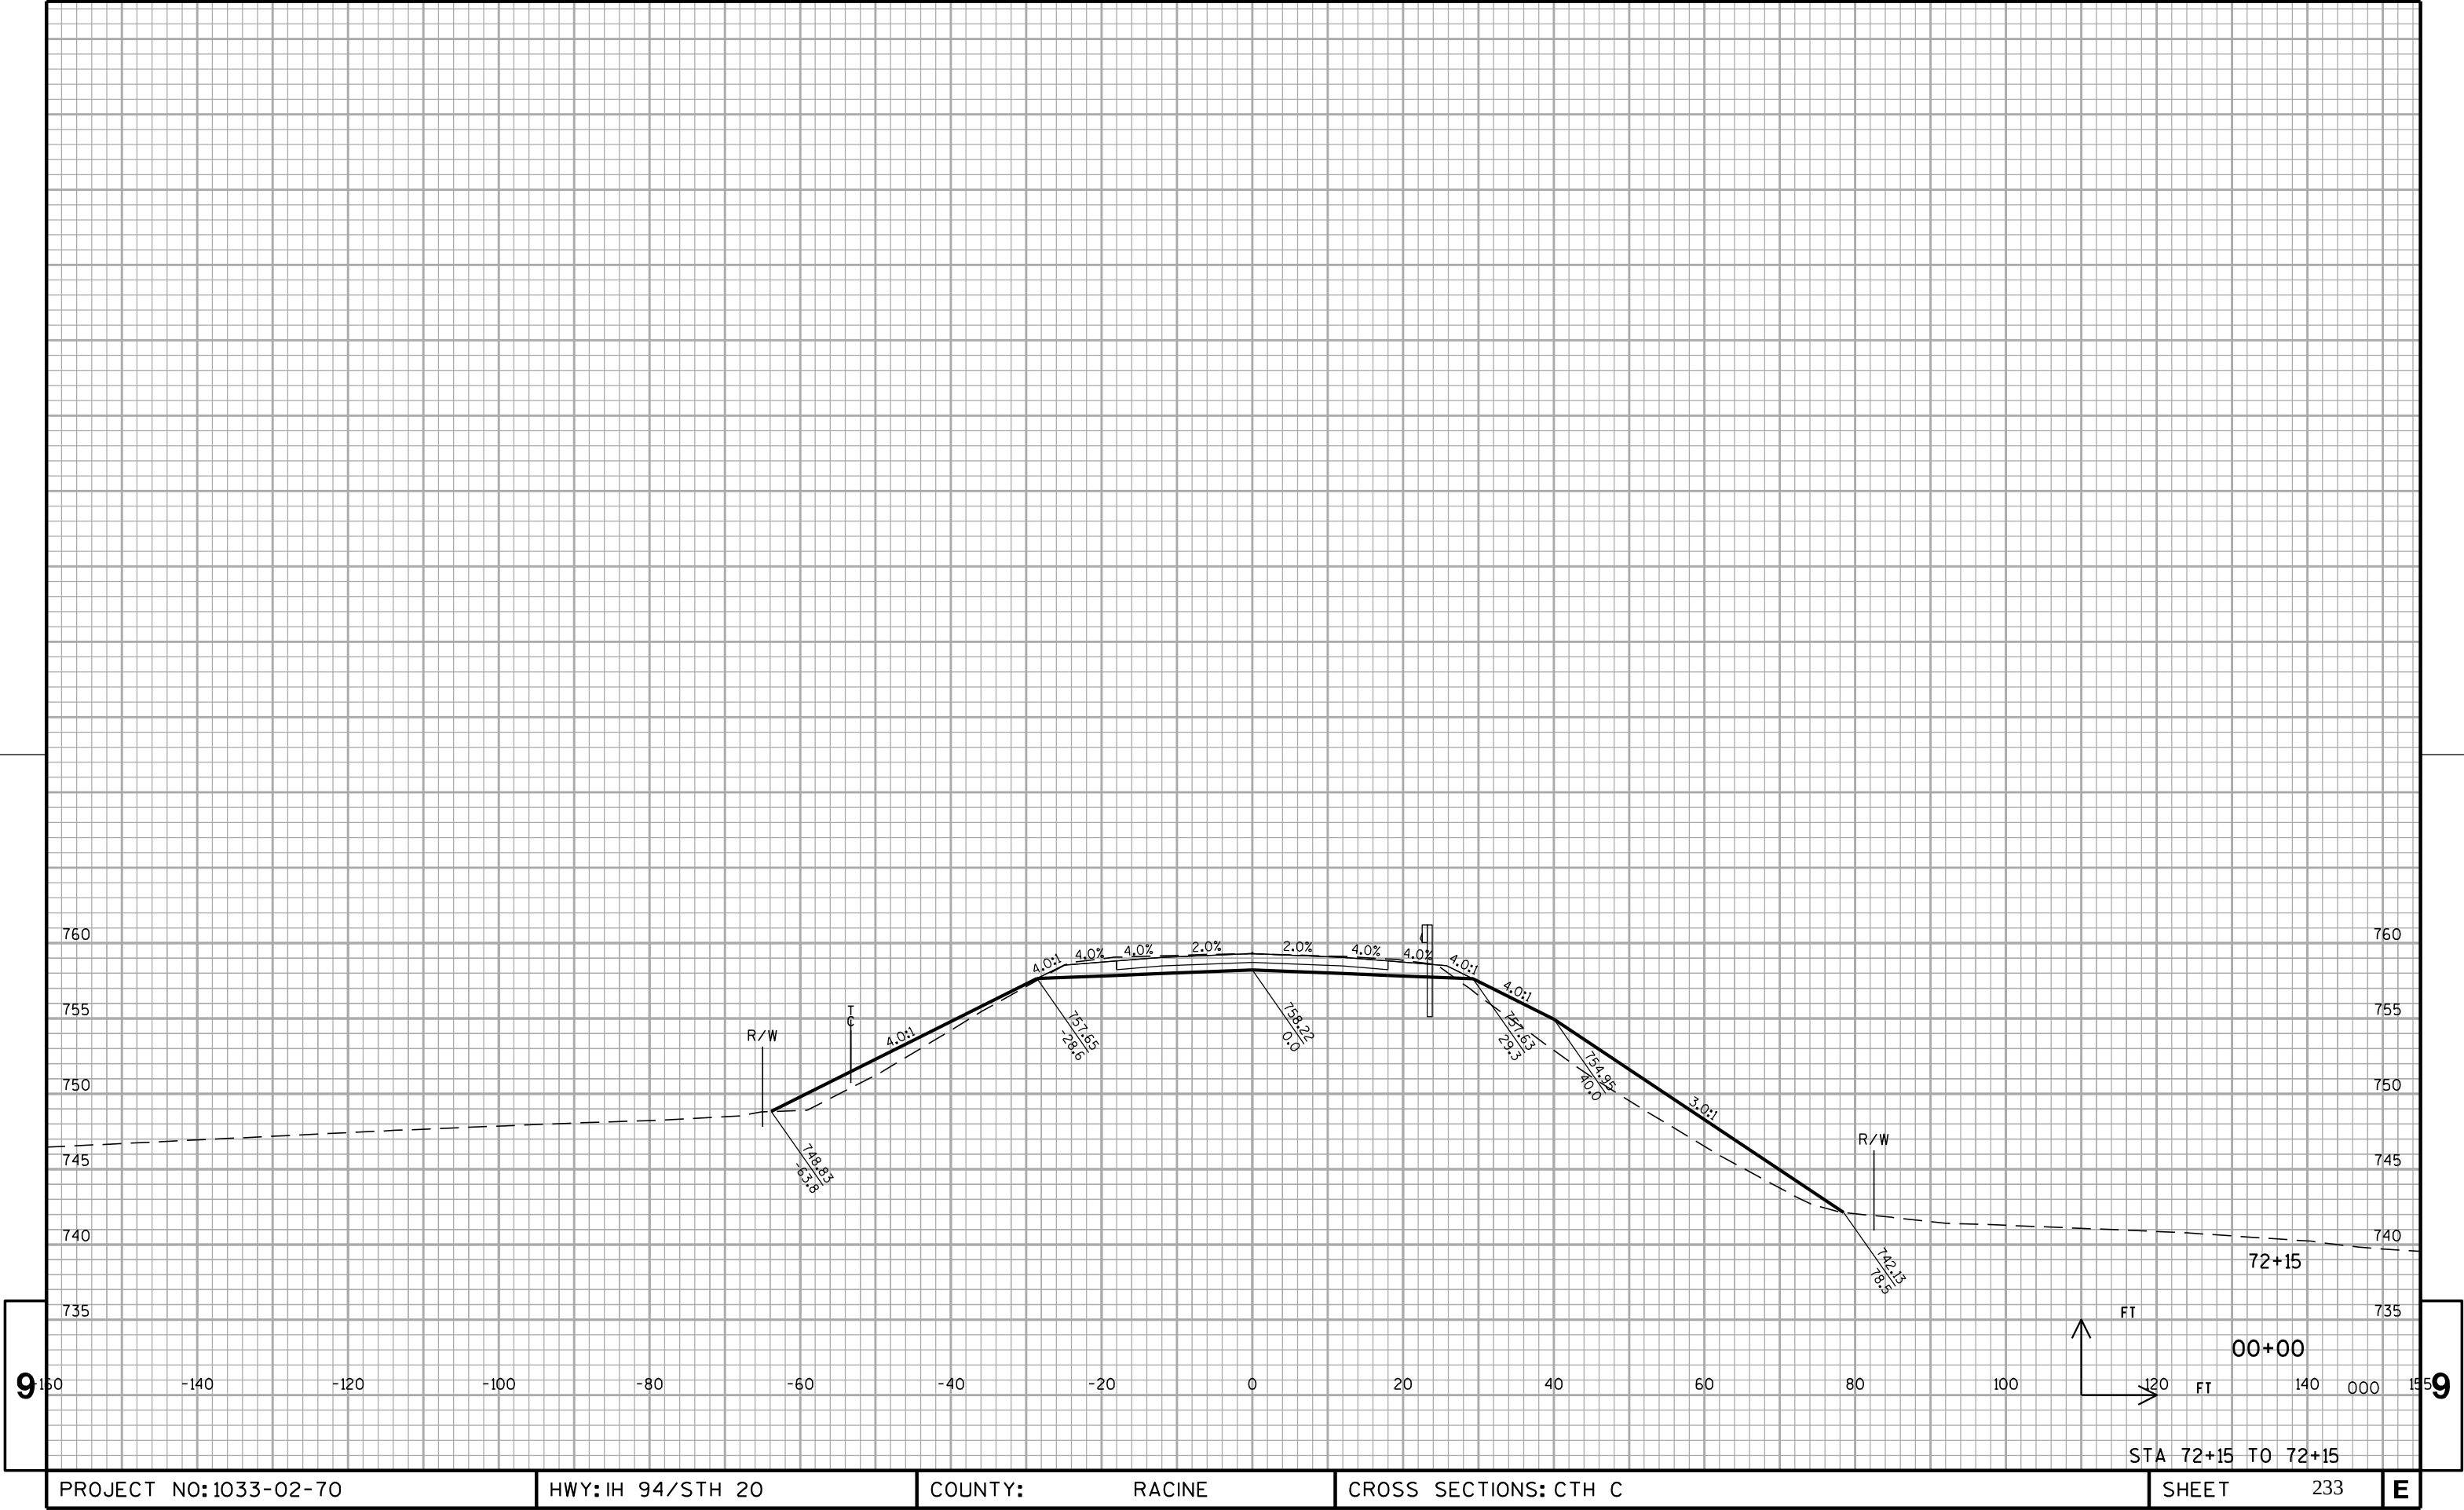

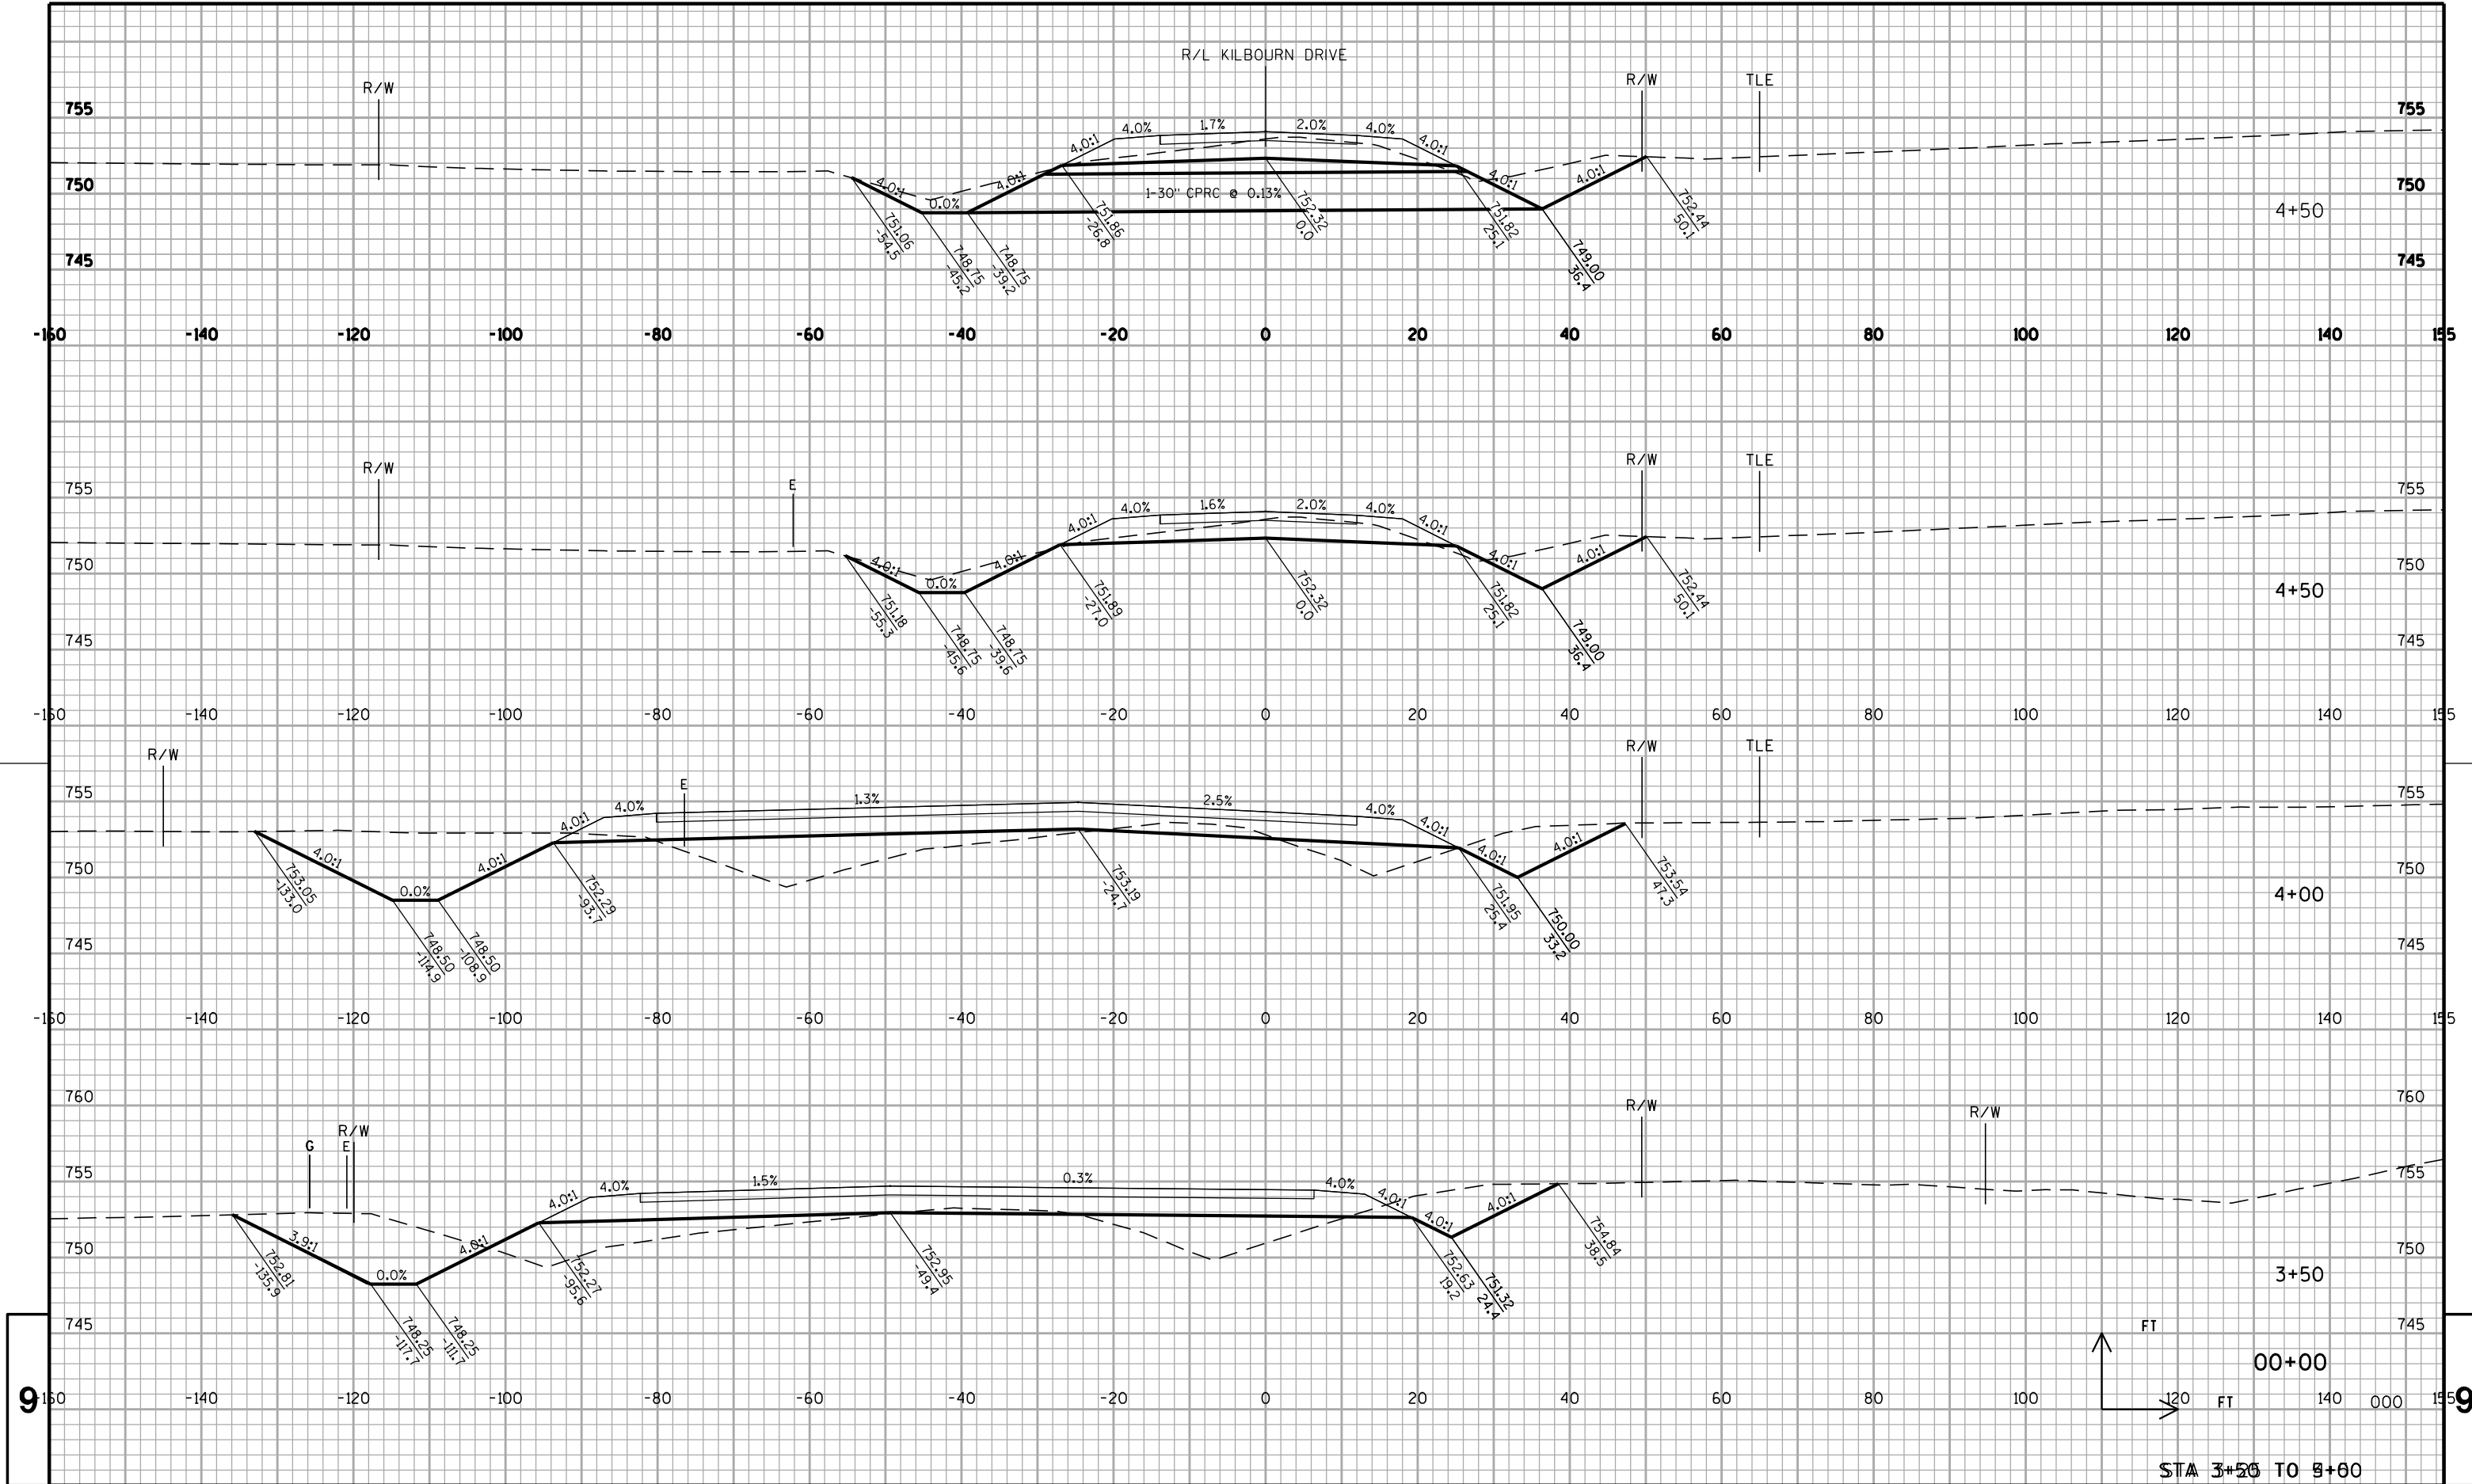

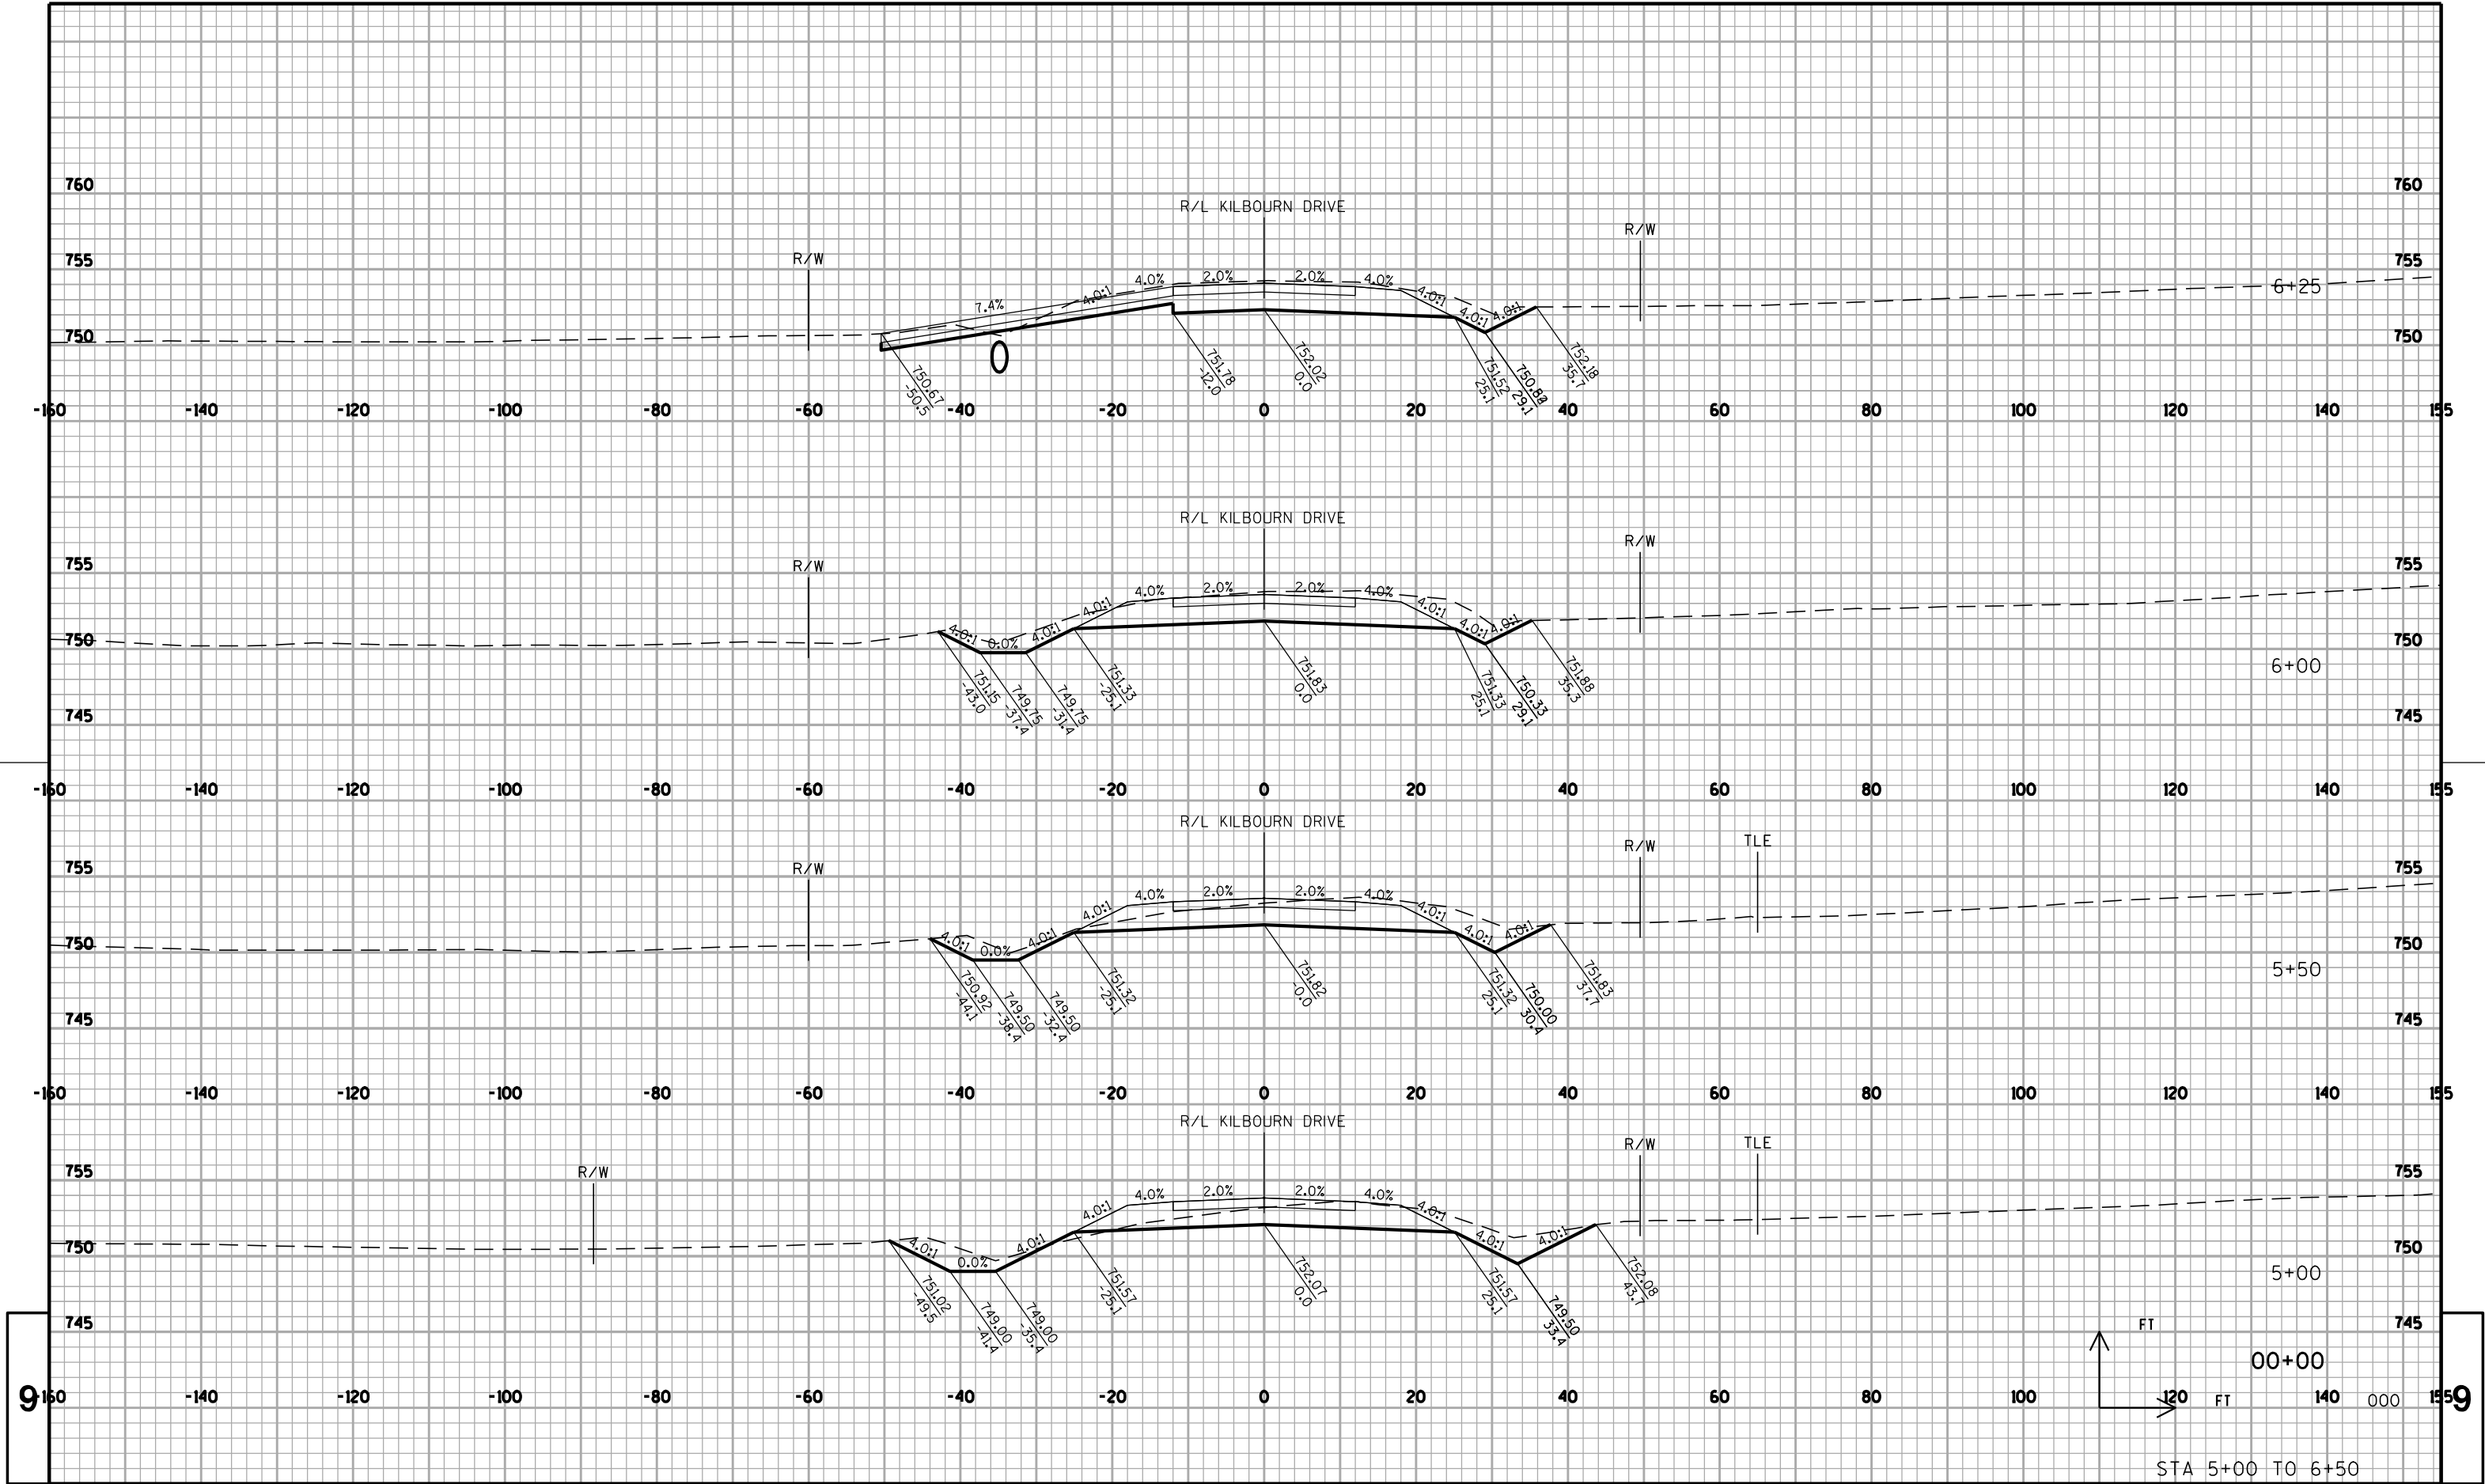

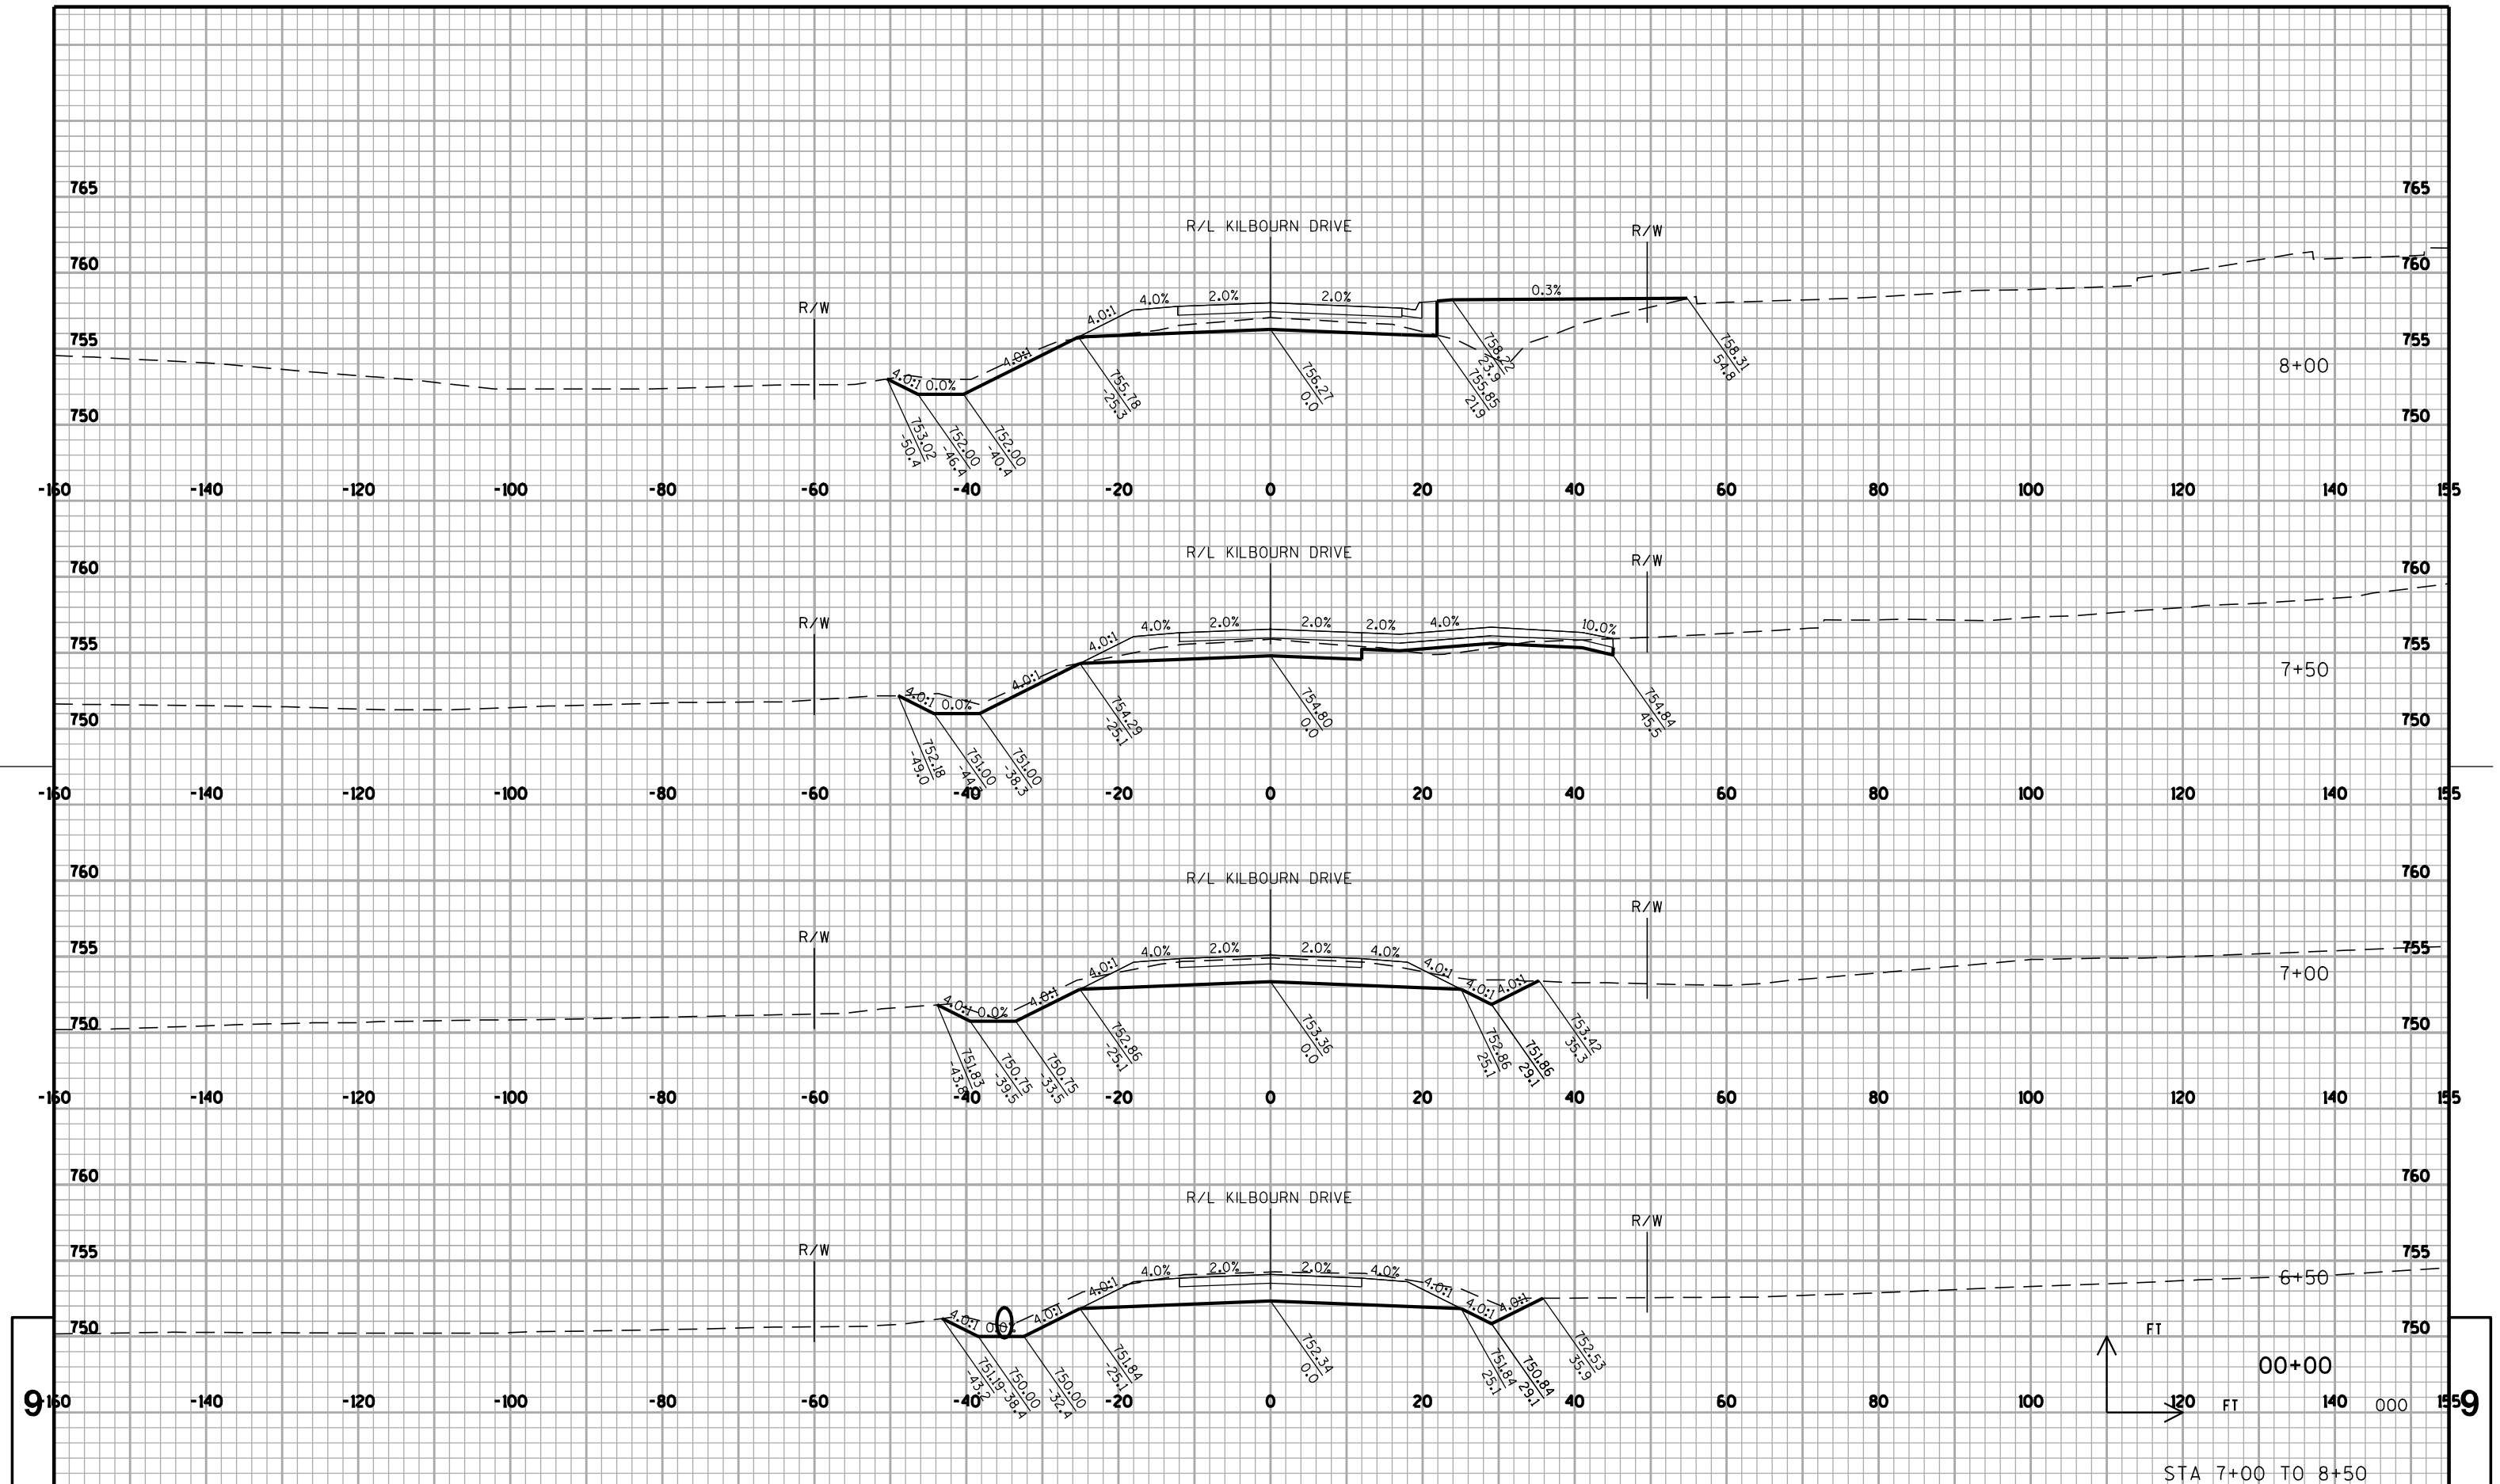

PROJECT NO:1033-02-70

HWY: IH 94/STH 20

COUNTY: RACINE

CROSS SECTIONS: KILBOURN DRIVE

SHEET 236

--	--


FILE NAME : s:\FinalDesign\20\10330270_E\Roads\cds\090204_xs_kilbourn.dgn


PLOT DATE : 06-DEC-2010 20:34


PLOT BY : MSCD1S


PLOT NAME : 090204_xs_kilbourn2 PLOT SCALE : 20:1

WISDOT/CADDS SHEET 21

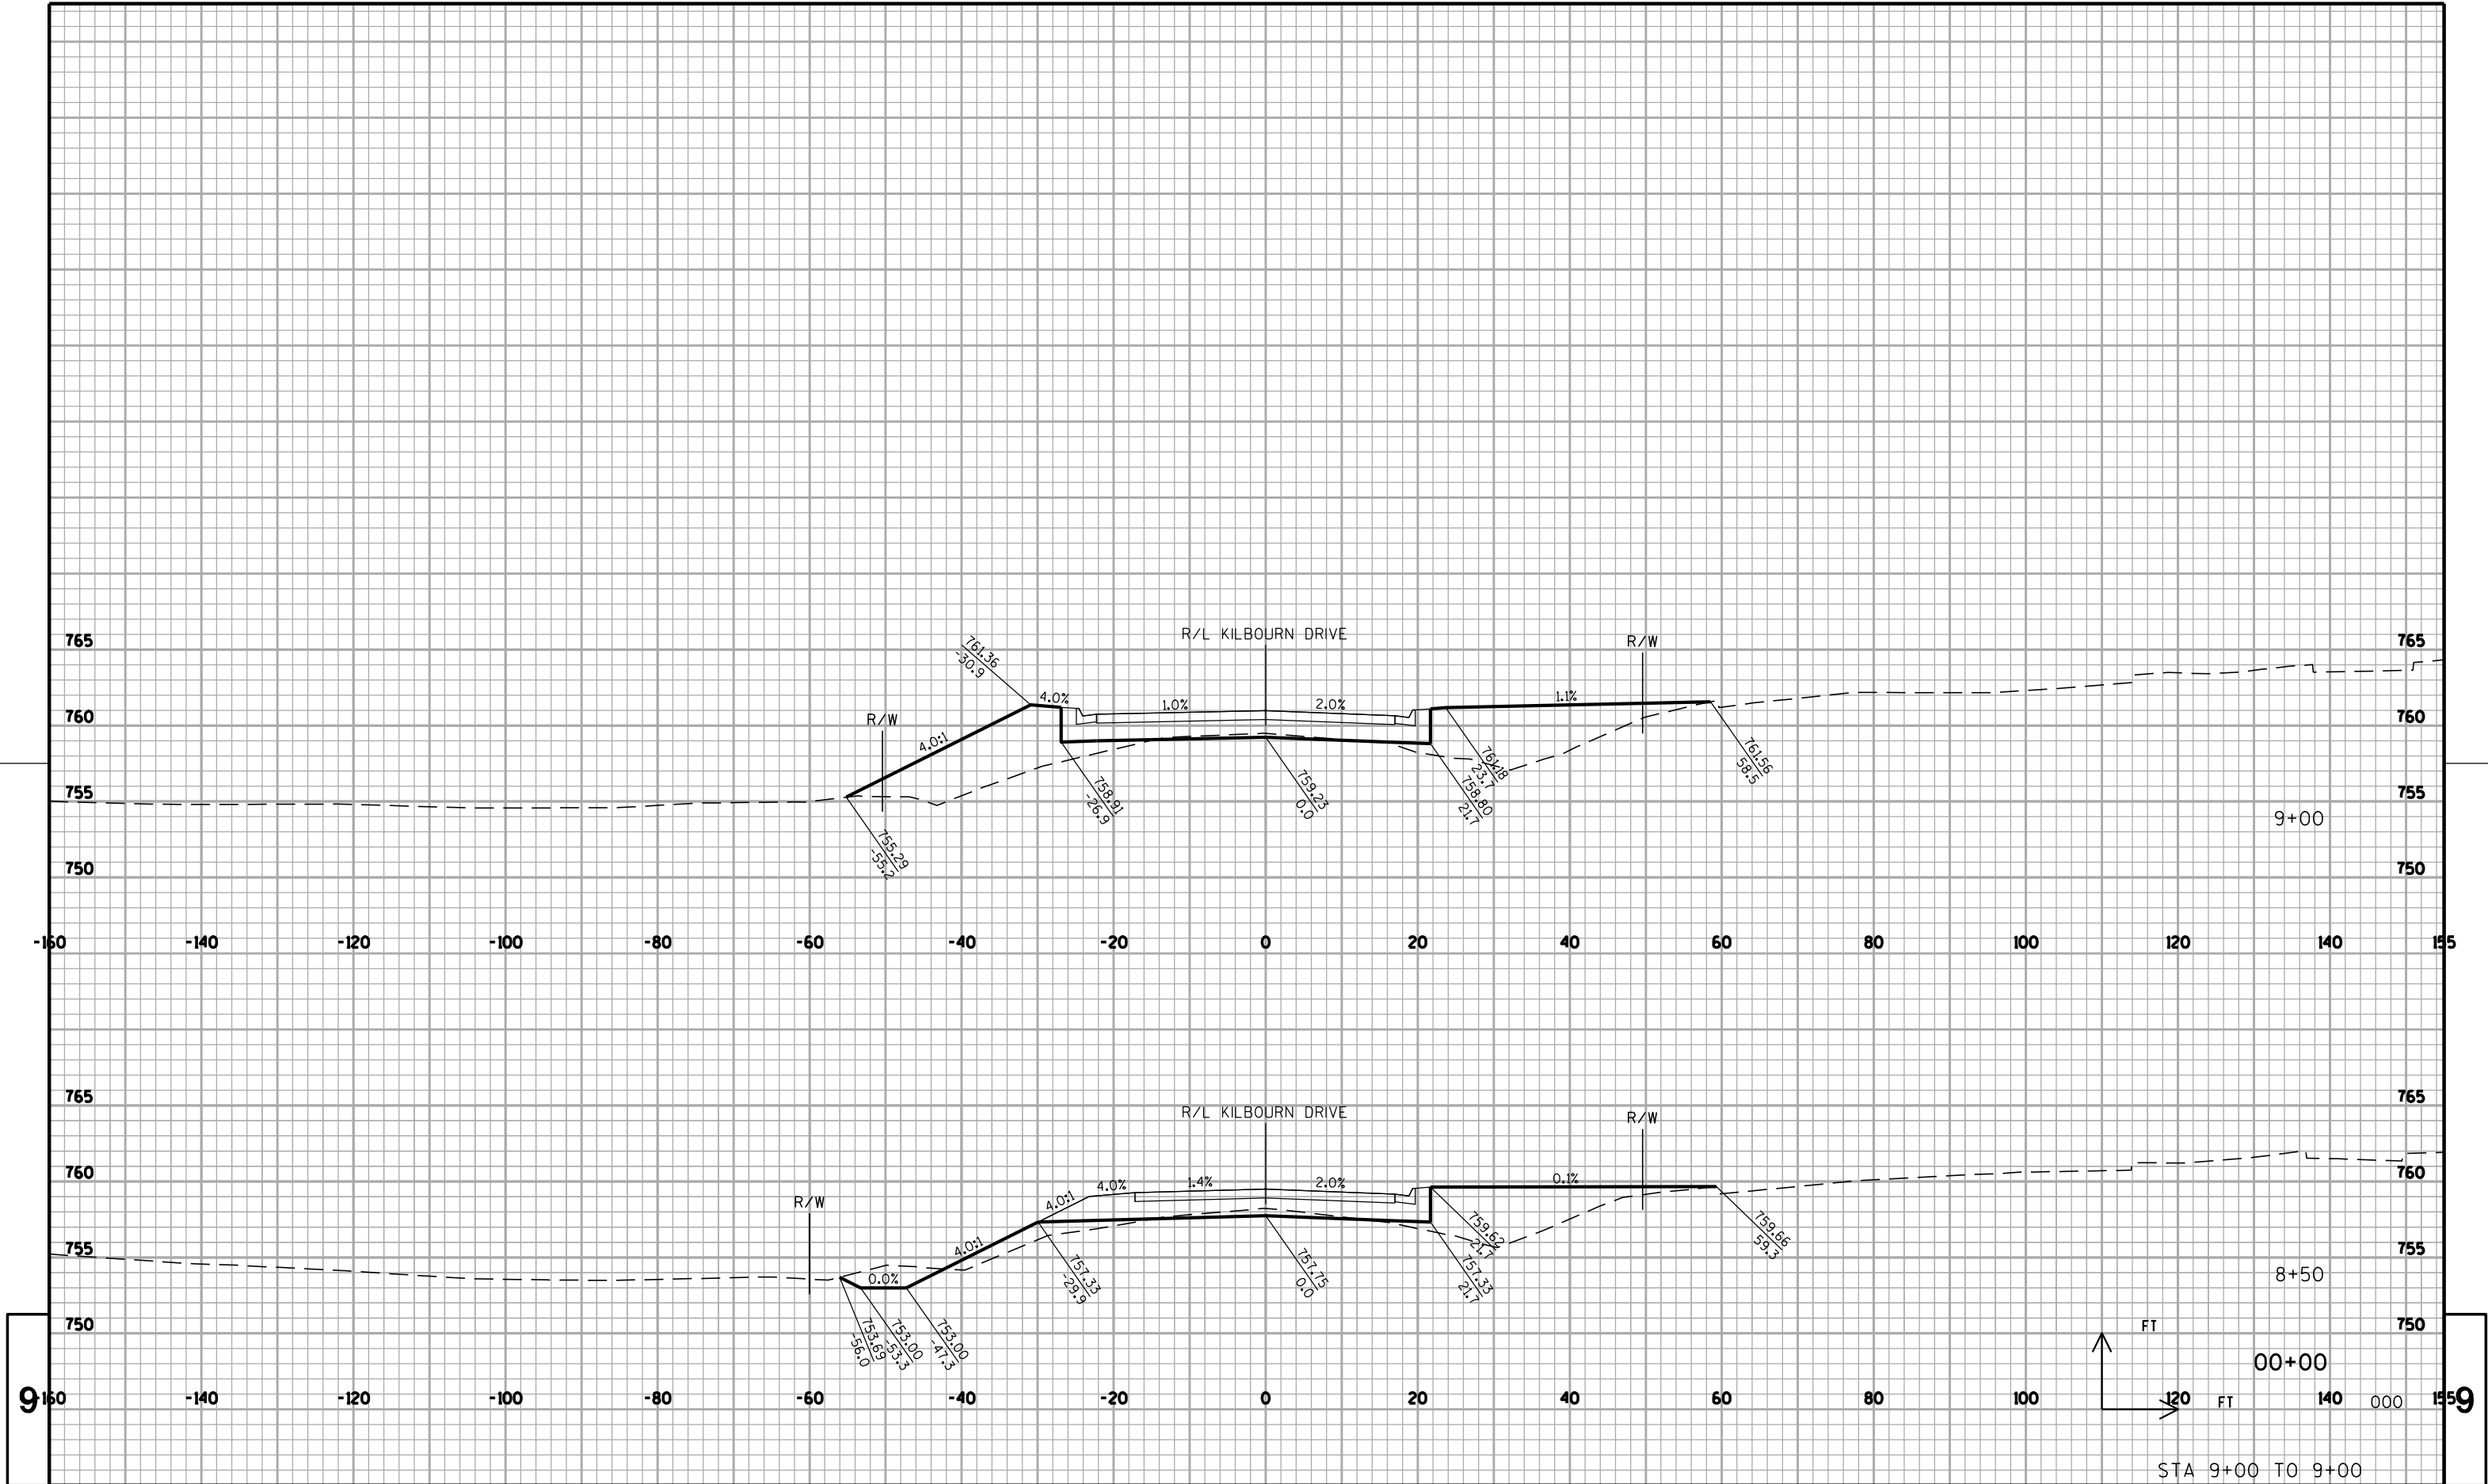


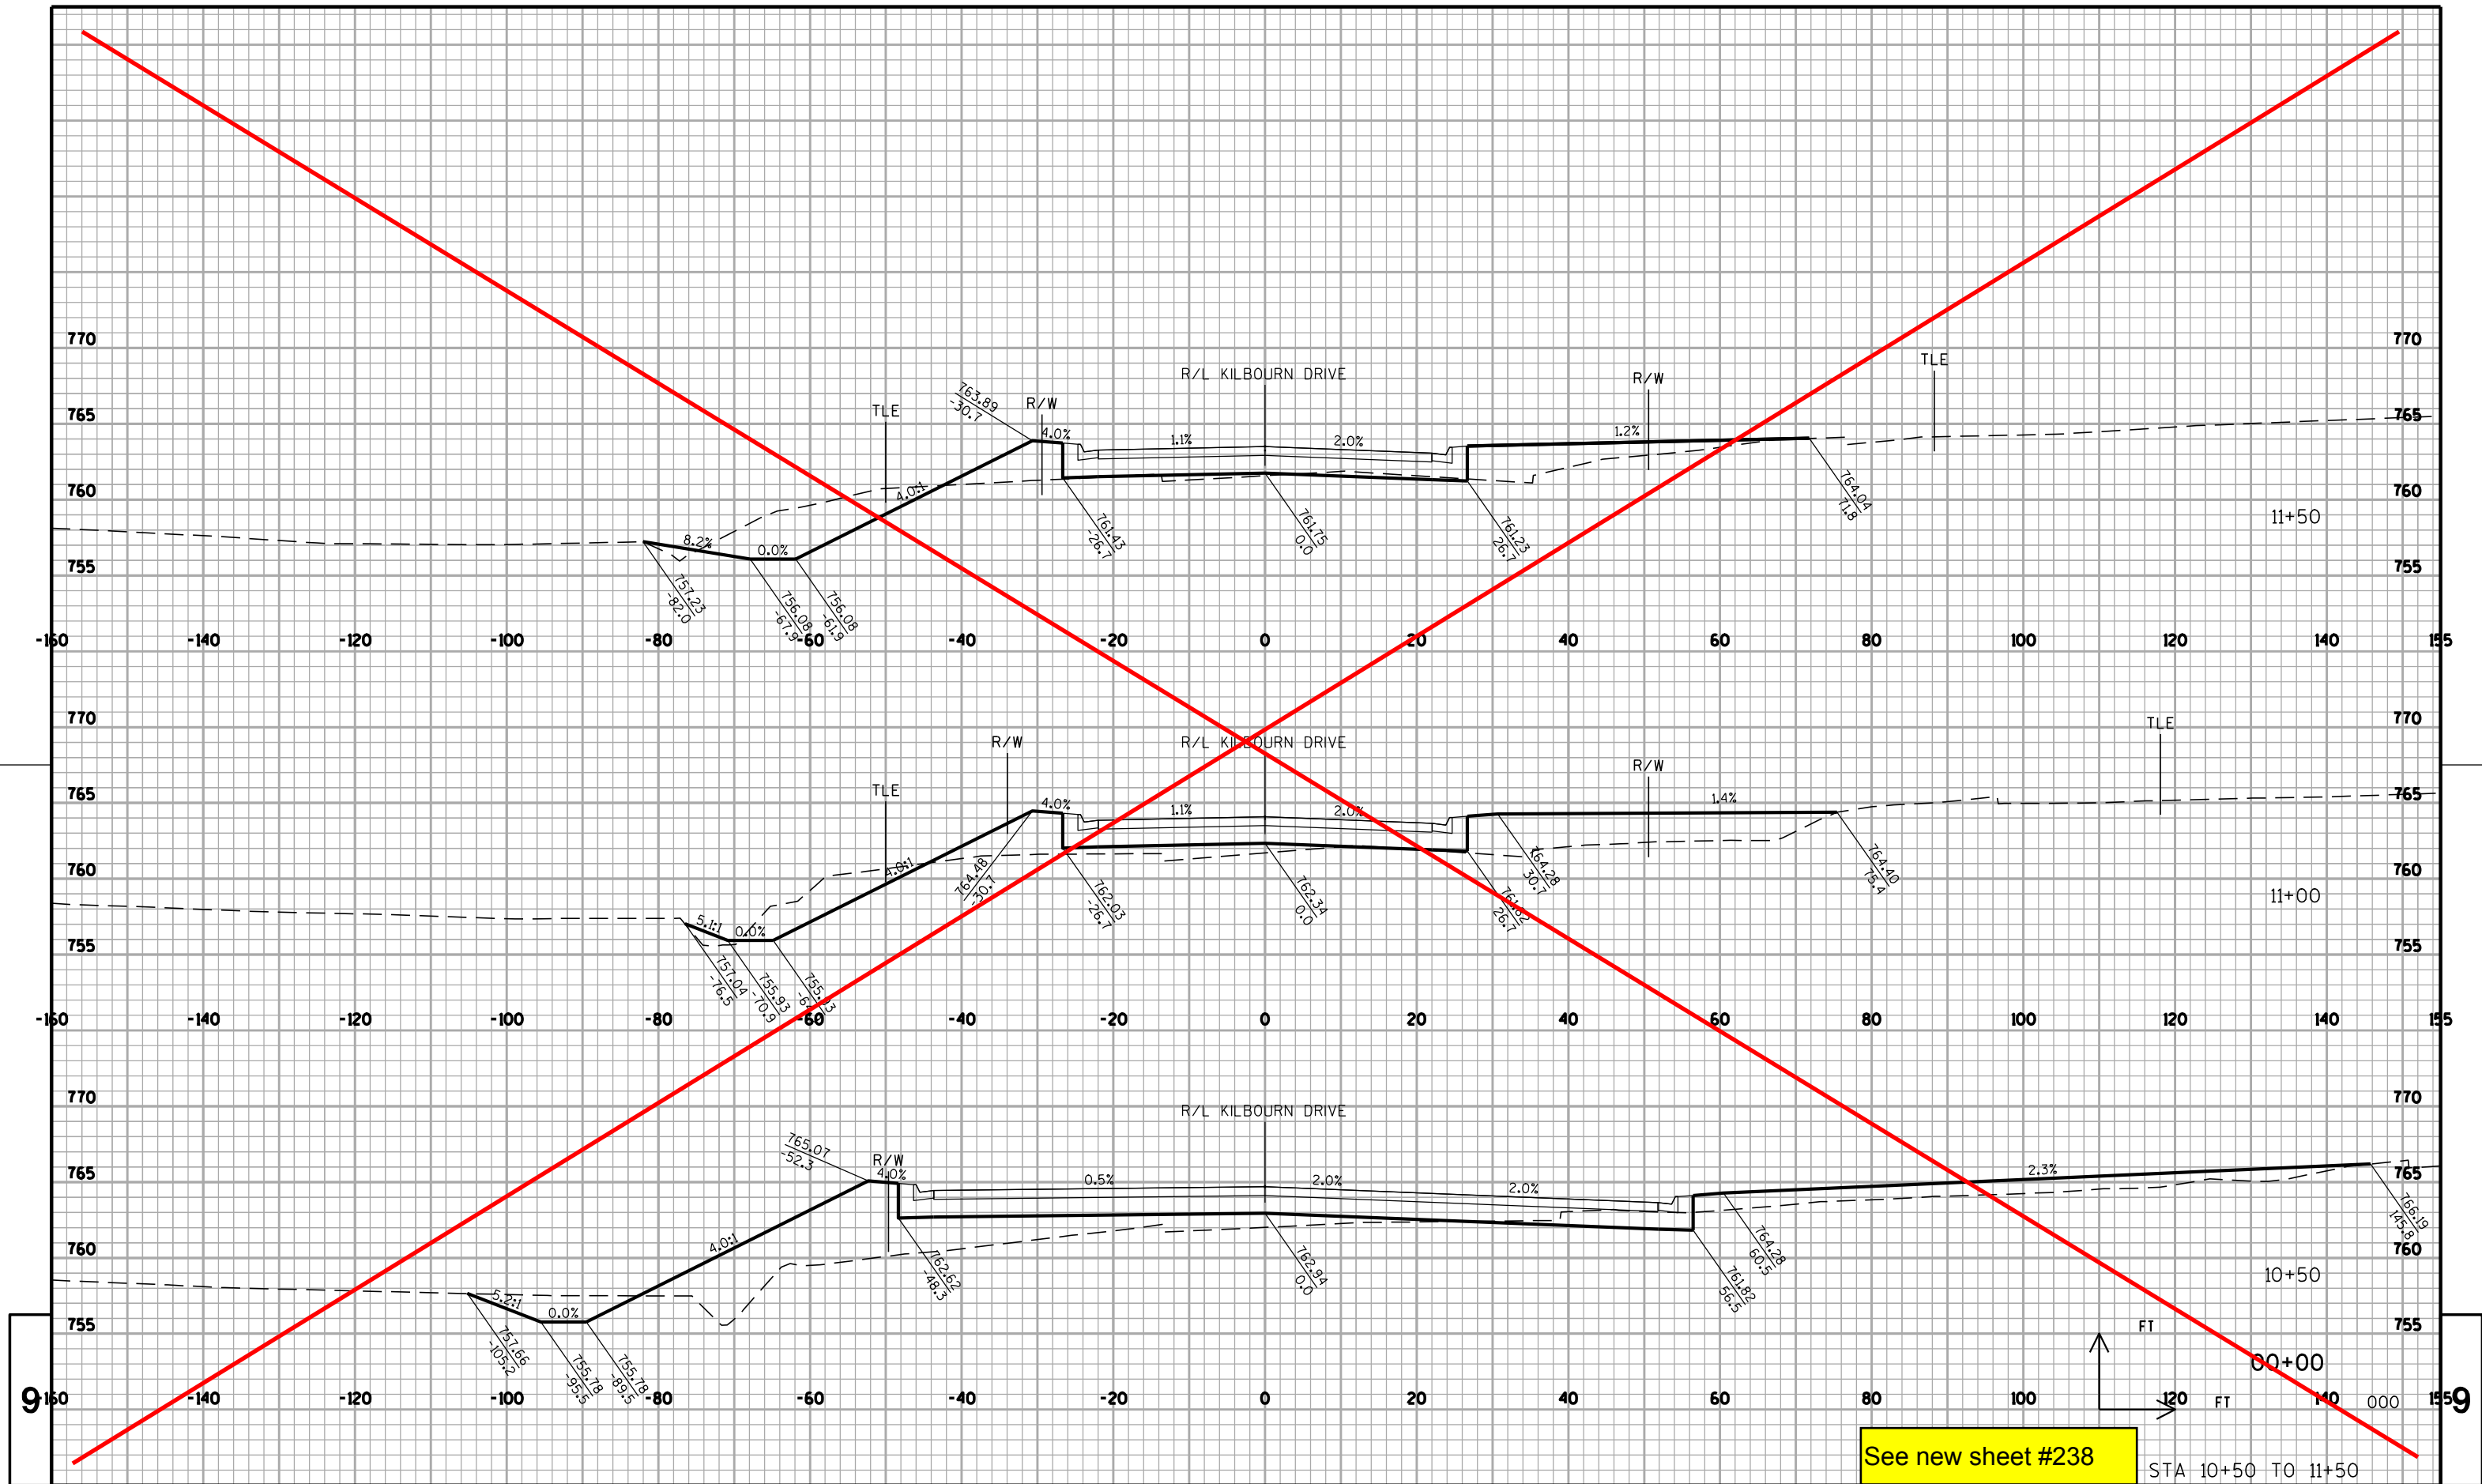

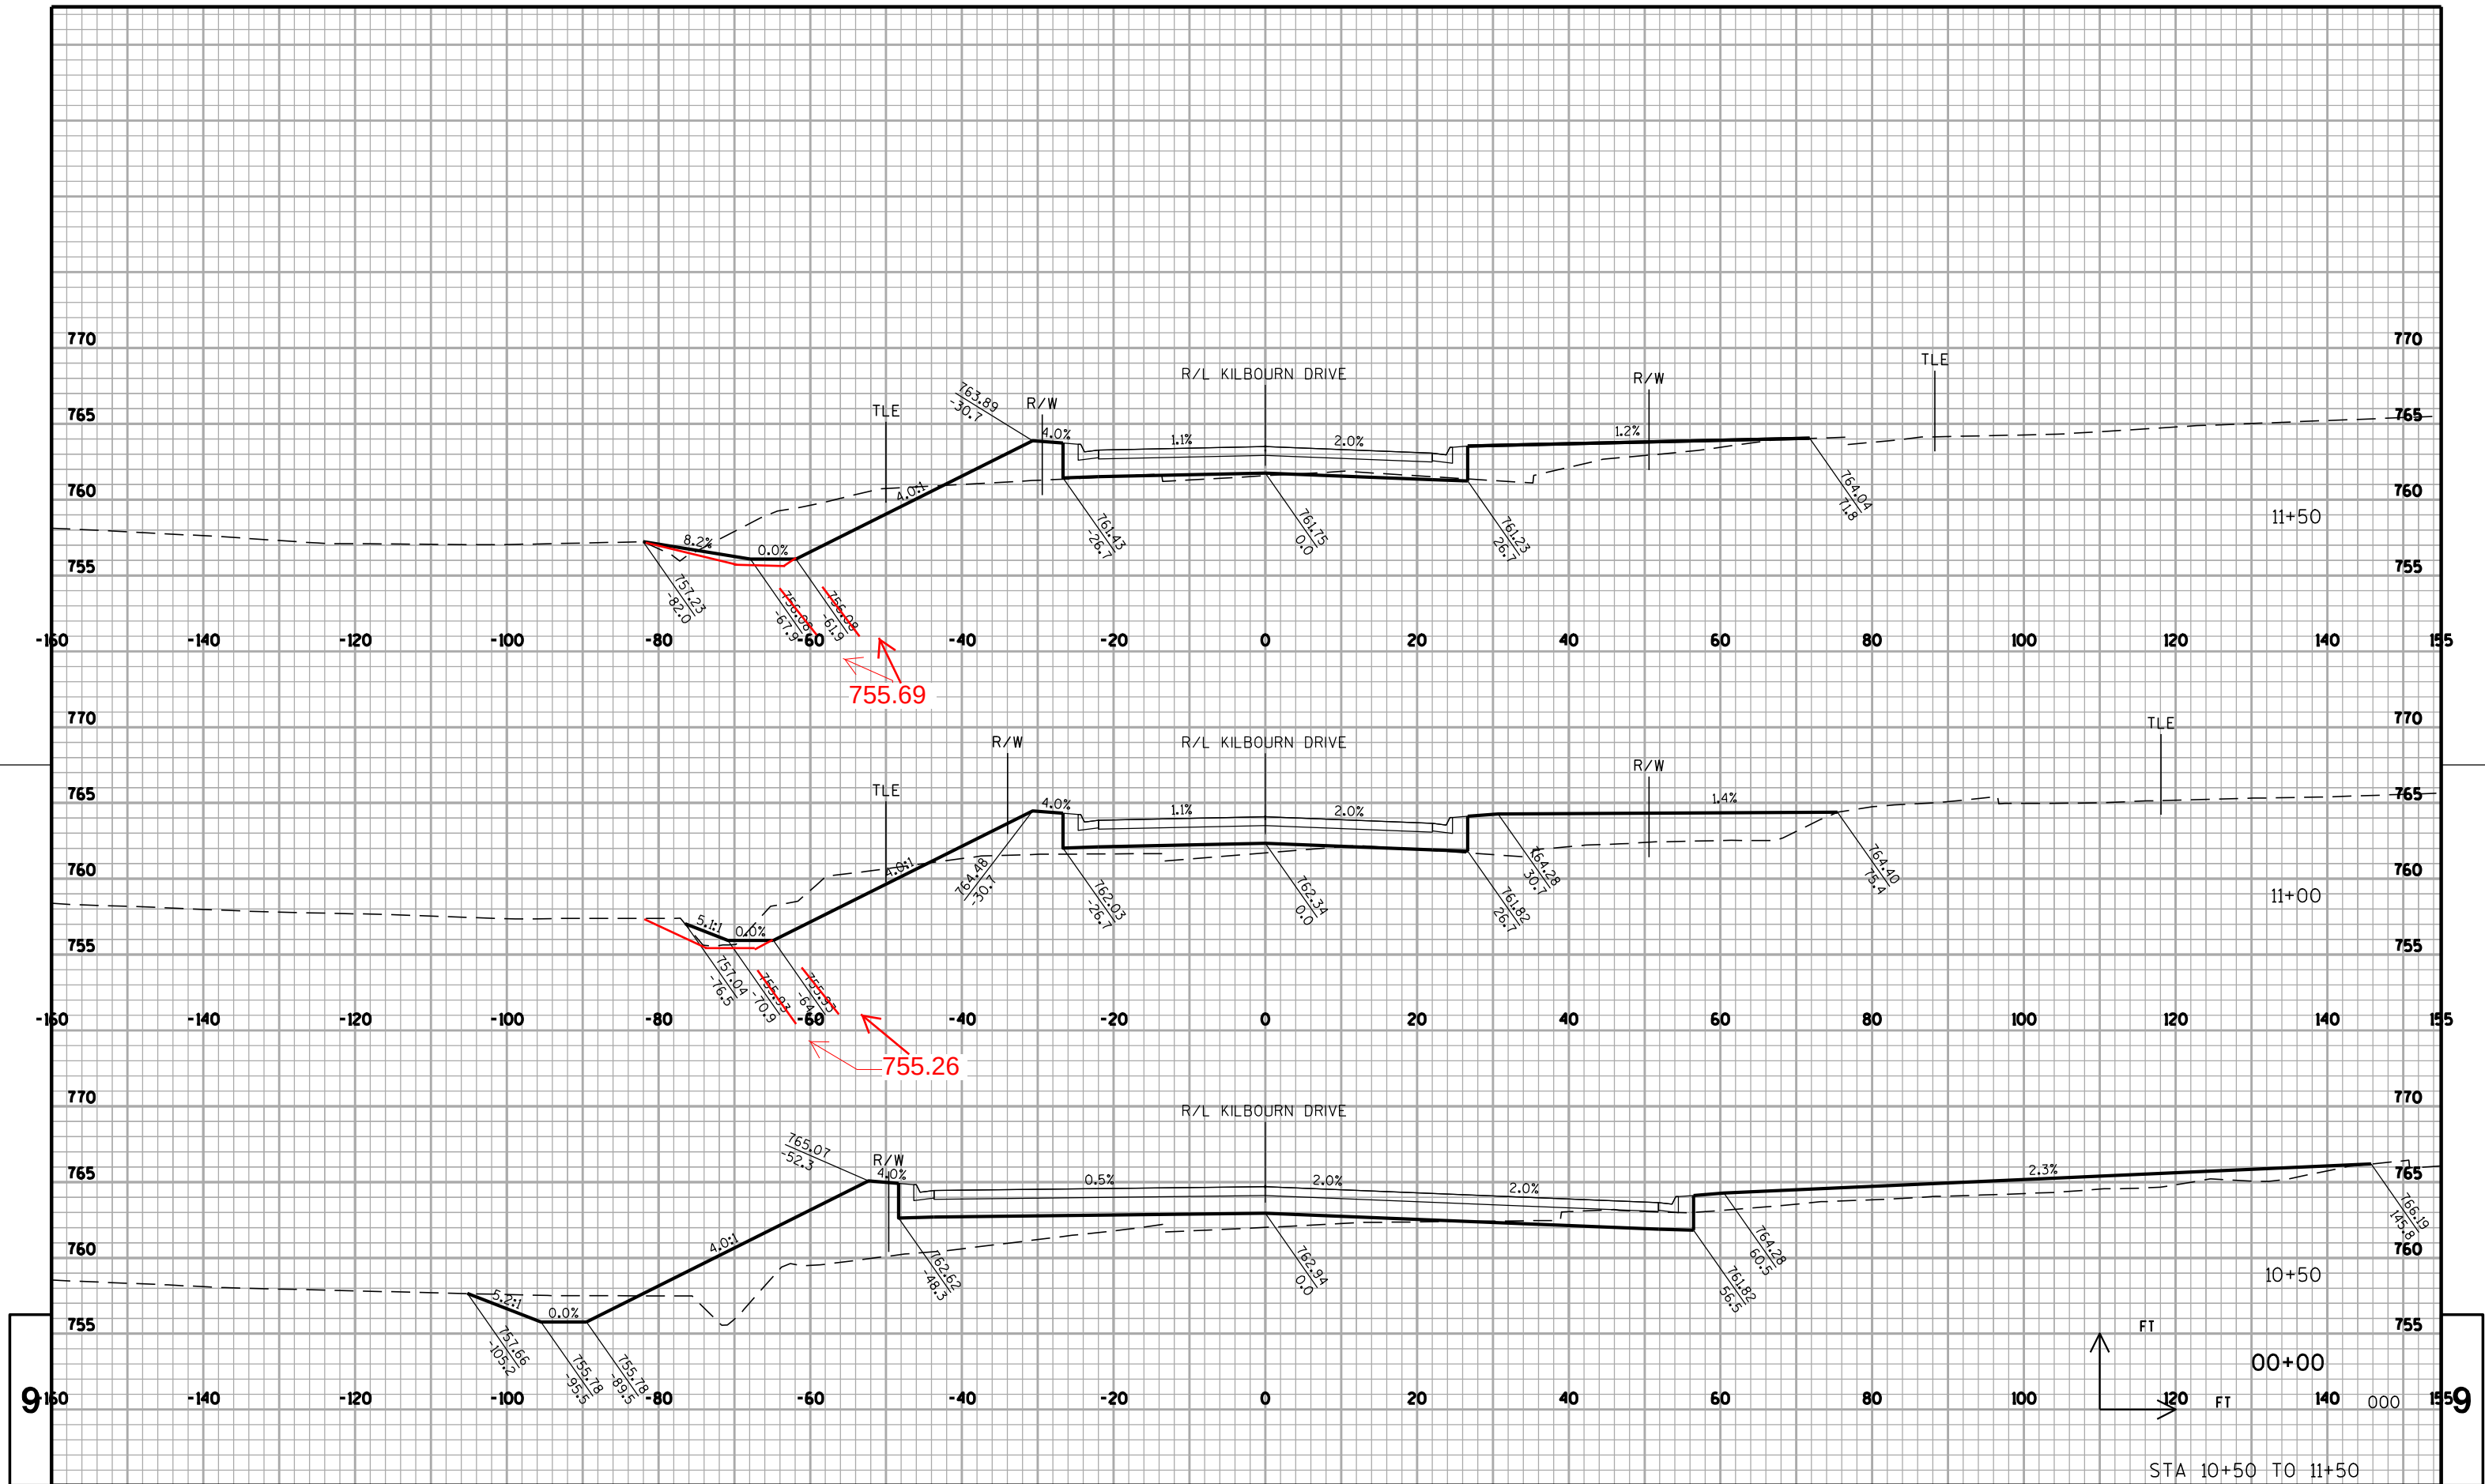

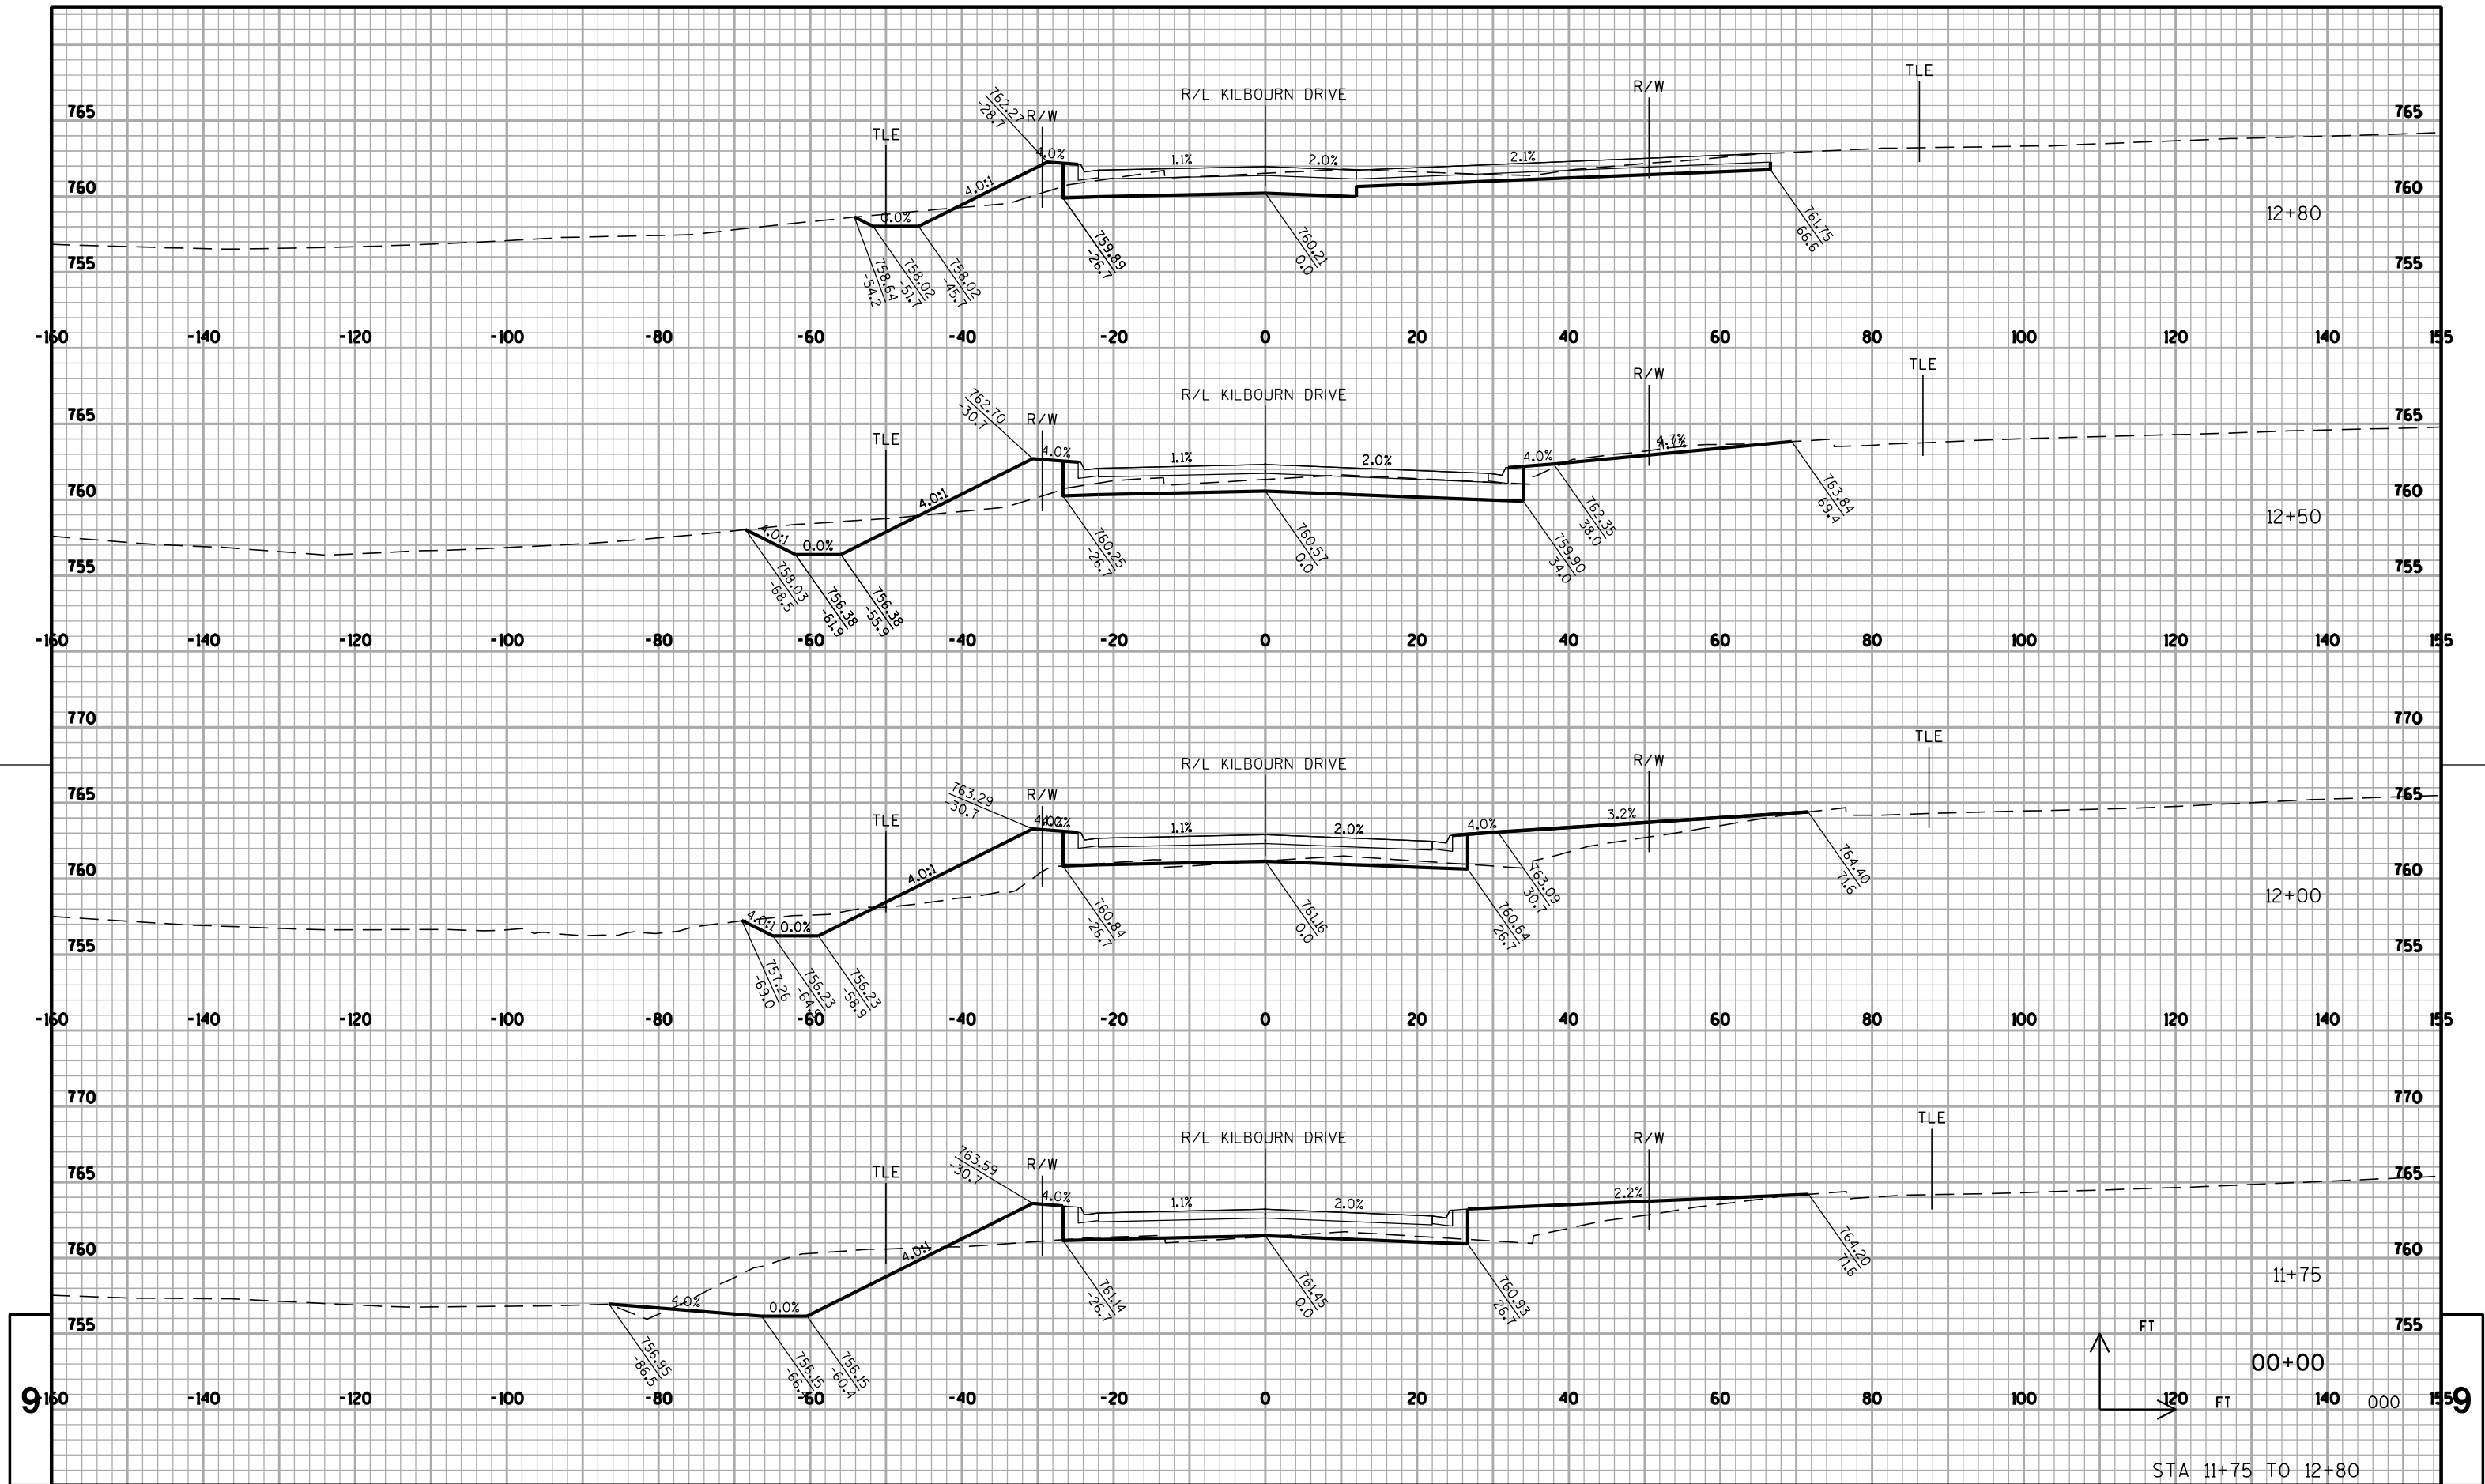

Notes

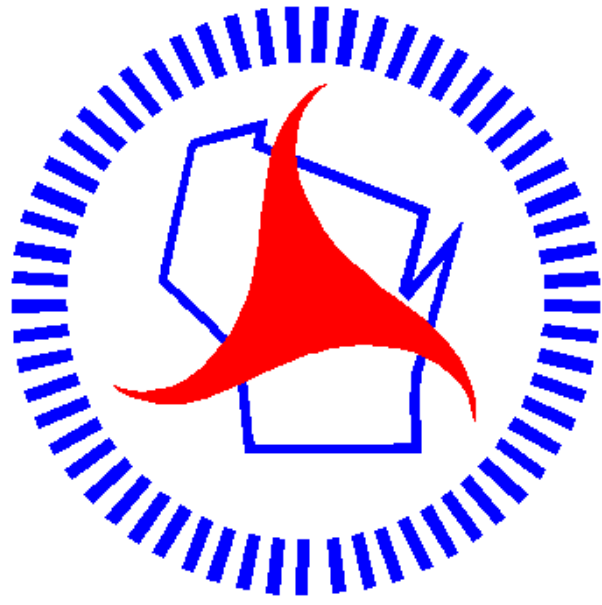

Wisconsin Department of Transportation

Dedicated people creating transportation solutions
through innovation and exceptional service.

<http://www.dot.wisconsin.gov>