



# REHABILITATION STRUCTURE SURVEY REPORT

Wisconsin Department of Transportation  
DT1696 4/2017

RECEIVED  
07/02/2019  
BUREAU OF STRUCTURES

- ☒ **Grade Separation**    ☐ **Stream Crossing**    ☐ **Culvert**  
☐ **Railroad**    ☐ **Retaining Wall**    ☐ **Noise Barrier**  
☐ **Sign Structure**    ☐ **Other:** \_\_\_\_\_

For guidance see: <http://wisconsindot.gov/Pages/doing-bus/eng-consultants/cnslt-rsrcs/strct/survey.aspx>

Design Project ID 1021-03-10	Construction Project ID	Highway (Project Name) STH 93			
Final Plan Due Date February 1, 2020	Preliminary Plan Due Date May 1, 2019	<input checked="" type="checkbox"/> Town <input type="checkbox"/> Village <input type="checkbox"/> City Washington			
PS&E Date May 1, 2020	Letting Date July 9, 2024	County Eau Claire			
Structure Number B-18-0034		Section 3	Town 26N	Range 9W	
Station 669+79	Latitude: 44.765804 Longitude: -91.459132	<input type="checkbox"/> YES <input type="checkbox"/> NO    Structure Located on National Highway System			
For Survey and CADD Files Horizontal Coordinate System: Eau Claire County Vertical Datum: NAVD88		<b>Traffic Forecast Data</b>			
		Design Year	Average Daily Traffic (ADT)	Roadway Design Speed	Functional Class
Feature On STH 93 SB		Feature On 2042	25400	45 MPH	Principal Arterial
Feature Under IH 94		Feature Under 2042	38800	70 MPH	Principal Arterial
Region Contact: Stacie Lambelle (Area Code) Telephone Number(s): 715-577-2967 Email: stacie.lambele@dot.wi.gov		Consultant Contact: Tara Krista (Area Code) Telephone Number(s): 715-720-6291 Email: tkrista@sehinc.com			

## Work To Be Performed

## Field Information Required Item Number (see Pages 2-4)

- ☐ A. Structural Repair ..... 1-3, 22
- ☒ B. Overlay ..... 1-3, 10-22, 26-28, 32, 34
- ☐ Concrete Overlay                      ☐ Asphalt Overlay
- ☒ Polymer Modified Asphalt Overlay    ☒ Thin Bonded Polymer Overlay
- ☐ Other: \_\_\_\_\_
- ☐ C. New Bearings ..... 3, 8, 9, 22
- ☐ D. New Railings ..... 15-17, 20-23
- ☐ E. Curb and Sidewalk Repair ..... 2, 3, 16, 22, 23
- ☒ F. Abutment Repair ..... 2, 3, 12, 16
- ☒ G. Pier Repair ..... 2, 3, 12, 16
- ☐ H. New Deck ..... 1-6, 9, 10, 13-28, 32-34
- ☐ I. Widening ..... 1-28, 30, 32-35
- ☒ J. Joint Repair ..... 2, 3, 8, 16, 19, 22
- ☒ K. Surface Repair ..... 2, 3, 22
- ☐ L. Raising Bridge ..... 3, 6, 9, 16, 20-24
- ☐ M. Slope Stabilization ..... 1-3, 30
- ☐ N. Scour Repair ..... 1, 2 or 3, 16, 19, 21, 27, 29, 31-35
- ☐ O. Painting ..... 16, 22, 24
- ☒ P. Other: Fence replacement, encase girder ends (bearing conversion) and NE wingwall replacement

### Field Information Required

If no structure number exists provide the following: Small County Map on which the location of proposed structure is shown in red and any highway relocation in green. In addition, provide Location Map of scale not less than 1" = 2000' showing the structure location and number.

- ☒ 1. Most recent inspection report, brief history of bridge construction date, and description of repairs with dates.
- ☒ 2. Outline deficient areas on existing structure plan or drawing.
- ☒ 3. Photographs of details requiring repairs or modifications, such as: bearings, x-frames, joints, etc. Photograph all deficient areas. Clearly label all photographs.
- ☐ 4. Provide proposed typical section for roadway and structure showing dimensions and cross slopes.
- ☐ 5. Survey beam seat or girder elevations at both sides of bridge at all substructure units.
- ☐ 6. Provide cross-section elevations at 10 foot intervals extending across the structure and a minimum of 100 feet beyond each end. Sections should be normal to centerline and show elevations at centerline roadway and gutter line. Take elevations along joints and at floor drains.
- ☐ 7. Show and identify starting stationing on bridge.
- ☒ 8. Record measurement, temperature of the structure, and date taken for each of the following:
  - (a) Joint opening measured normal to joint at centerline of roadway and both curb lines.
  - (b) Clearance between girder ends at piers.
  - (c) Distance from front face of abutment backwall to closest point of girder end measured parallel to girder.
  - (d) Temperature of structure determined by averaging top and under deck (if accessible) readings.
- ☐ 9. Fixed and expansion bearings - condition and orientation.
- ☒ 10. Number and width of proposed pours including construction staging sequence.
- ☒ 11. Location of existing construction joints in the deck.
- ☒ 12. Estimated Quantities:
 

Preparation, Decks, Type 1	Sq. Yd. <u>126</u>	
Preparation, Decks, Type 2	Sq. Yd. <u>102</u>	
Full Depth Deck Repair	Sq. Yd. <u>13</u>	Galvanic Anodes? _____
Concrete Surface Repair Superstructure	Sq. Ft. <u>9</u>	Galvanic Anodes? _____
Concrete Surface Repair Substructure	Sq. Ft. <u>13</u>	Galvanic Anodes? _____
Curb Repair	LF. <u>0</u>	Galvanic Anodes? _____

☒ 13. Sufficiency number: 68.1 (obtain from HSI Bridge Inventory System)

☒ 14. Appraisal and Condition Rating

	Deck Condition	Superstructure Condition	Substructure Condition	Load Capacity Appraisal	Structural EVAL Appraisal
Current	5	5	5		5

☒ 15. Load Ratings

	Inventory	Operational
Current Calculated Date: 08-23-2017	HS18	HS34
After Completed by Bridge Designer		

- ☒ 16. Utilities on/near Structure. (WisDOT policy is to avoid placing utilities on the structure.)

☐ Yes ☒ No

Type	Owner and Contact Information	Size	Opening at Abutment	Weight	Pressure

- ☒ 17. Is existing bridge railing deficient?

☐ Yes ☒ No If Yes – Replacement Rail Type:

- ☒ 18. Drains to be:

☐ Raised ☐ Closed ☐ Downspouted ☐ New

- ☒ 19. Traffic maintained on bridge during work?

☒ Yes ☐ No If Yes – Include sketches

- ☒ 20. Will guard rail be attached?

☒ Yes ☐ No If Yes – Which corners? All four quadrants

- ☒ 21. Will work to be performed eliminate all deficiencies?

☒ Yes ☐ No If No – Explain:

- ☒ 22. Hazardous waste (asbestos) to be removed?

☐ Yes ☒ No If Yes – Explain:

- ☐ 23. Wing location(s) for surface drain anchors:

- ☐ 24. Painting?

☐ Yes ☐ No If Yes – Explain on Page 4

(all, part, railing, color system, containment, bid items)

- ☐ 25. Desired roadway width: (new deck / widening) \_\_\_\_\_ Ft.

Desired sidewalk clear width: Left: \_\_\_\_\_ Ft. Right: \_\_\_\_\_ Ft.

- ☒ 26. Maximum increase in grade line elevation 0.25 In.

- ☒ 27. Benchmark description to be shown

- ☒ 28. Desired final cross slopes on bridge 0.02 Ft./Ft.

- ☐ 29. Underwater Inspection Report including:

- Streambed Cross Section With Pier, Footing and Seal Elevations
- Pier Elevation Drawings
- Pier Layout
- Hydrographic Survey

- ☐ 30. Slope stabilization, provide:

Type: \_\_\_\_\_ Quantity: \_\_\_\_\_ CY.

Slope: \_\_\_\_\_ Ft./Ft. Fill: \_\_\_\_\_ CY.

- ☐ 31. Preliminary layout of grout bags or proposed scour repair.

C.I.P. Articulated Mats (for Scour) \_\_\_\_\_ CY.

Grout Bags (for Scour) \_\_\_\_\_ CY.

Heavy Riprap \_\_\_\_\_ CY.

Extra Heavy Riprap \_\_\_\_\_ CY.

- ☒ 32. Report submitted with Preliminary Plan requires **no** CADD file submittal (*See ESubmittal instructions*).
- ☐ 33. Report submitted for development of Preliminary Plan to structure design engineer requires CADD file (if available) submittal and Report submittal to Soils Engineer if project involves foundation modifications.
- ☒ 34. Coordinate with structure design engineer **before** going into the field if existing structure has no available plans, if staged construction is planned, or if there are adjoining/adjacent structures that will remain in place.
- ☐ 35. If project involves substructure widening coordinate with structure and/or hydraulic design engineer to determine if information on the separation and/or stream crossing SSR will be required.

### Additional Information

Elaborate on other concerns such as: DNR, Local, Utility Conflicts, Aesthetics, Railing Type and Staged Construction.  
*Please be as detailed and specific as possible.*

- 1. See attachments
- 2. See attachments. Attachments include as-built plans with redlines of all deficient areas found during site visit are shown.
- 3. See photos.
- 16. No utilities on structure. Utility conflicts not anticipated.
- 18. Existing structure does not have drains.
- 22. No asbestos present.
- 27. See roadway plans for benchmark information.

Proposed work based on SEH observations:

- Apply polymer overlay to structure
- Remove and replace north and south abutment backwall
- Remove and replace NE parapet and wingwall
- Fiber wrap all columns from top to bottom on all 3 piers
- Repair ends of various concrete girders
- Eliminate the joints at each abutment and encase the ends of the girders with concrete diaphragms (bearing conversion)
- Replace all beam guard attached to the structure \*\*
- Replace ~50' of roadway approach including concrete approach slabs, concrete pavement, 36" Curb & Gutter, and HMA shoulder will be replaced and shown on roadway plans \*\*

Traffic control: Work is to be completed half at a time with single lane closures

WDNR concurrence received September 11, 2018. See attachment.

On Screening list for Archeology & History dated June 21, 2018.

SEH visited the site on March 25, 2019 and only reviewed items that could be physically touched without the use of a snooperscope.

- See zip file uploaded to WisDOT FTP site for additional pictures.
- See marked up asbuilt plans for all repairs.

\*\*Per email from Nick Pitsch, WisDOT on 6/28/2019: WisDOT is only replacing the first panel after the approaches. For beamguard WisDOT is only replacing the bullnoses. For the other beamguard they will just remove and reinstall the third beam. They would like to avoid asphalt due to small quantity so anywhere asphalt removal is needed will be replaced with 8" concrete pavement.



September 11, 2018

Nicholas Pitsch  
WI-DOT NW Region  
718 W Clairemont Avenue  
Eau Claire, WI 54701

**Subject: DNR Initial Project Review**  
Project I.D. 1021-03-10/80  
STH 93 Bridges B-18-0034, B-18-0119  
Eau Claire County  
T26N, R9W, Section 3

Dear Mr. Pitsch:

The Wisconsin Department of Natural Resources (DNR) has received the information you provided for the above-referenced project. According to your proposal, the purpose of this project is bridge rehabilitation on bridges B-18-0034 & B-18-0119. Proposed improvements for structure B-18-0034 include replacing the northeast wingwall, replacing the joints at both abutments with concrete diaphragms, fiber wrapping all three piers, and applying a polymer overlay. Proposed improvements for structure B-18-0119 include replacing the northwest wingwall and fiber wrapping all three piers. Replace pavement, curb and gutter, beam guard and pavement marking on approaches to both structures as necessary.

Preliminary information has been reviewed by DNR staff for the project under the DNR/DOT (Wisconsin Department of Transportation) Cooperative Agreement. Initial comments on the project as proposed are included below, and we assume that additional information will be provided that addresses all resource concerns identified. To ensure compliance with resource protections, we are recommending that Special Provisions be developed for specific resource protections described below. DNR expects that the full range of DOT roadway standards will be applied throughout the design and construction process.

#### **A. Project-Specific Resource Concerns**

##### **Wetlands:**

There are no wetland concerns with this project, based on the information provided.

##### **Endangered Resources:**

Based upon a review of the Natural Heritage Inventory (NHI) dated September 11, 2018, there are no known Endangered Resources or suitable habitat that could be impacted by this project. With this review the following has also been determined:

- There are no known Northern Long-eared Bat (NLEB) maternity roost trees within 150 feet of the project, or known hibernacula within 0.25 miles of the proposed project area.

- This project is located outside of any High Potential Zones (HPZ) for the Rusty Patched Bumblebee (RPBB), and therefore should have no impact on this federally endangered species.

This project is covered by the [Broad Incidental Take Permit/Authorization for No/Low Impact Activities](#). No further actions for endangered resources are required/recommended.

- ❖ *NHI Disclaimer: This review letter may contain NHI data, including specific locations of endangered resources, which are considered sensitive and are not subject to Wisconsin's Open Records Law. As a result, information contained in this review letter may be shared only with individuals or agencies that require this information in order to carry out specific roles in the permitting, planning and implementation of the proposed project. Specific locations of endangered resources may not be released or reproduced in any publicly disseminated documents.*

### **Invasive Species and Viral Hemorrhagic Septicemia (VHS):**

All project equipment shall be decontaminated for removal of invasive species prior to and after each use on the project site by utilizing other best management practices to avoid the spread of invasive species as outlined in NR 40, Wis. Adm. Code. For more information, refer to <http://dnr.wi.gov/topic/Invasives/bmp.html>.

### **Storm Water Management & Erosion Control:**

- For projects disturbing an acre or more of land, erosion control and storm water measures must adhere to the Wisconsin Pollutant Discharge Elimination System Transportation Construction General Permit (TCGP) for Storm Water Discharges. Coverage under TCGP is required prior to construction. DOT should apply for permit coverage just before the project goes to final PS&E. Permit coverage will be issued by the DNR after design is complete and documentation shows that the project will meet construction and post-construction performance standards. For more information regarding the TCGP you can go to the following link, and click on the "Transportation" tab: <https://dnr.wi.gov/topic/Sectors/Transportation.html>.
- All projects require an Erosion Control Plan (ECP) that describes best management practices that will be implemented before, during and after construction to minimize pollution from storm water discharges. Additionally, the plan should address how post-construction storm water performance standards will be met for the specific site. The project design and Erosion Control Implementation Plan (ECIP) must comply with the TCGP in order to receive "permit-coverage" from the DNR.
- Once the project contract has been awarded, the contractor will be required to outline their construction methods in the ECIP. An adequate ECIP for the project must be developed by the contractor and submitted to this office for review at least 14 days prior to the preconstruction conference. For projects regulated under the TCGP, submit the ECIP as an amendment to the ECP.

### **Selected Site & Commercial Non-Metallic Mines:**

- The DOT Select Site process must be adhered to for clean fill or any other material that leaves the work site. The DNR liaison will review all proposed select sites and a site visit may be required. Filling of wetlands, waterways or floodplain is not allowed under the select site process, unless the site owner obtains required permits. No new impermeable surfaces can be left at a select site (including gravel roads or pads), unless the site owner obtains required

permits. Contaminated materials leaving the site need to adhere to the Hazardous Material Management Plan.

**Asbestos:**

A Notification of Demolition and/or Renovation and Application for Permit Exemption, DNR form 4500-113 (chapters NR 406, 410, and 447 Wis. Adm. Code) may be required. Please refer to DOT FDM 21-35-45 and the DNR's notification requirements web page: <http://dnr.wi.gov/topic/Demo/Asbestos.html> for further guidance on asbestos inspections and notifications. Contact Mark Davis, Air Management Specialist 262-574-2118, with questions on the form. The notification must be submitted 10 working days in advance of demolition projects.

**Other Issues:**


The above comments represent the DNR's initial concerns for the proposed project and do not constitute final concurrence. Final concurrence will be granted after further review of refined project plans, and additional consultation if necessary. If any of the concerns or information provided in this letter requires further clarification, please contact this office at (715) 934-9014, or email at Leah.Nicol@wisconsin.gov.

Sincerely,

A handwritten signature in black ink that reads "Leah Nicol". The signature is written in a cursive, flowing style.

Leah Nicol  
Environmental Analysis & Review Specialist

cc: Nick Schaff, WisDOT Regional Environmental Coordinator

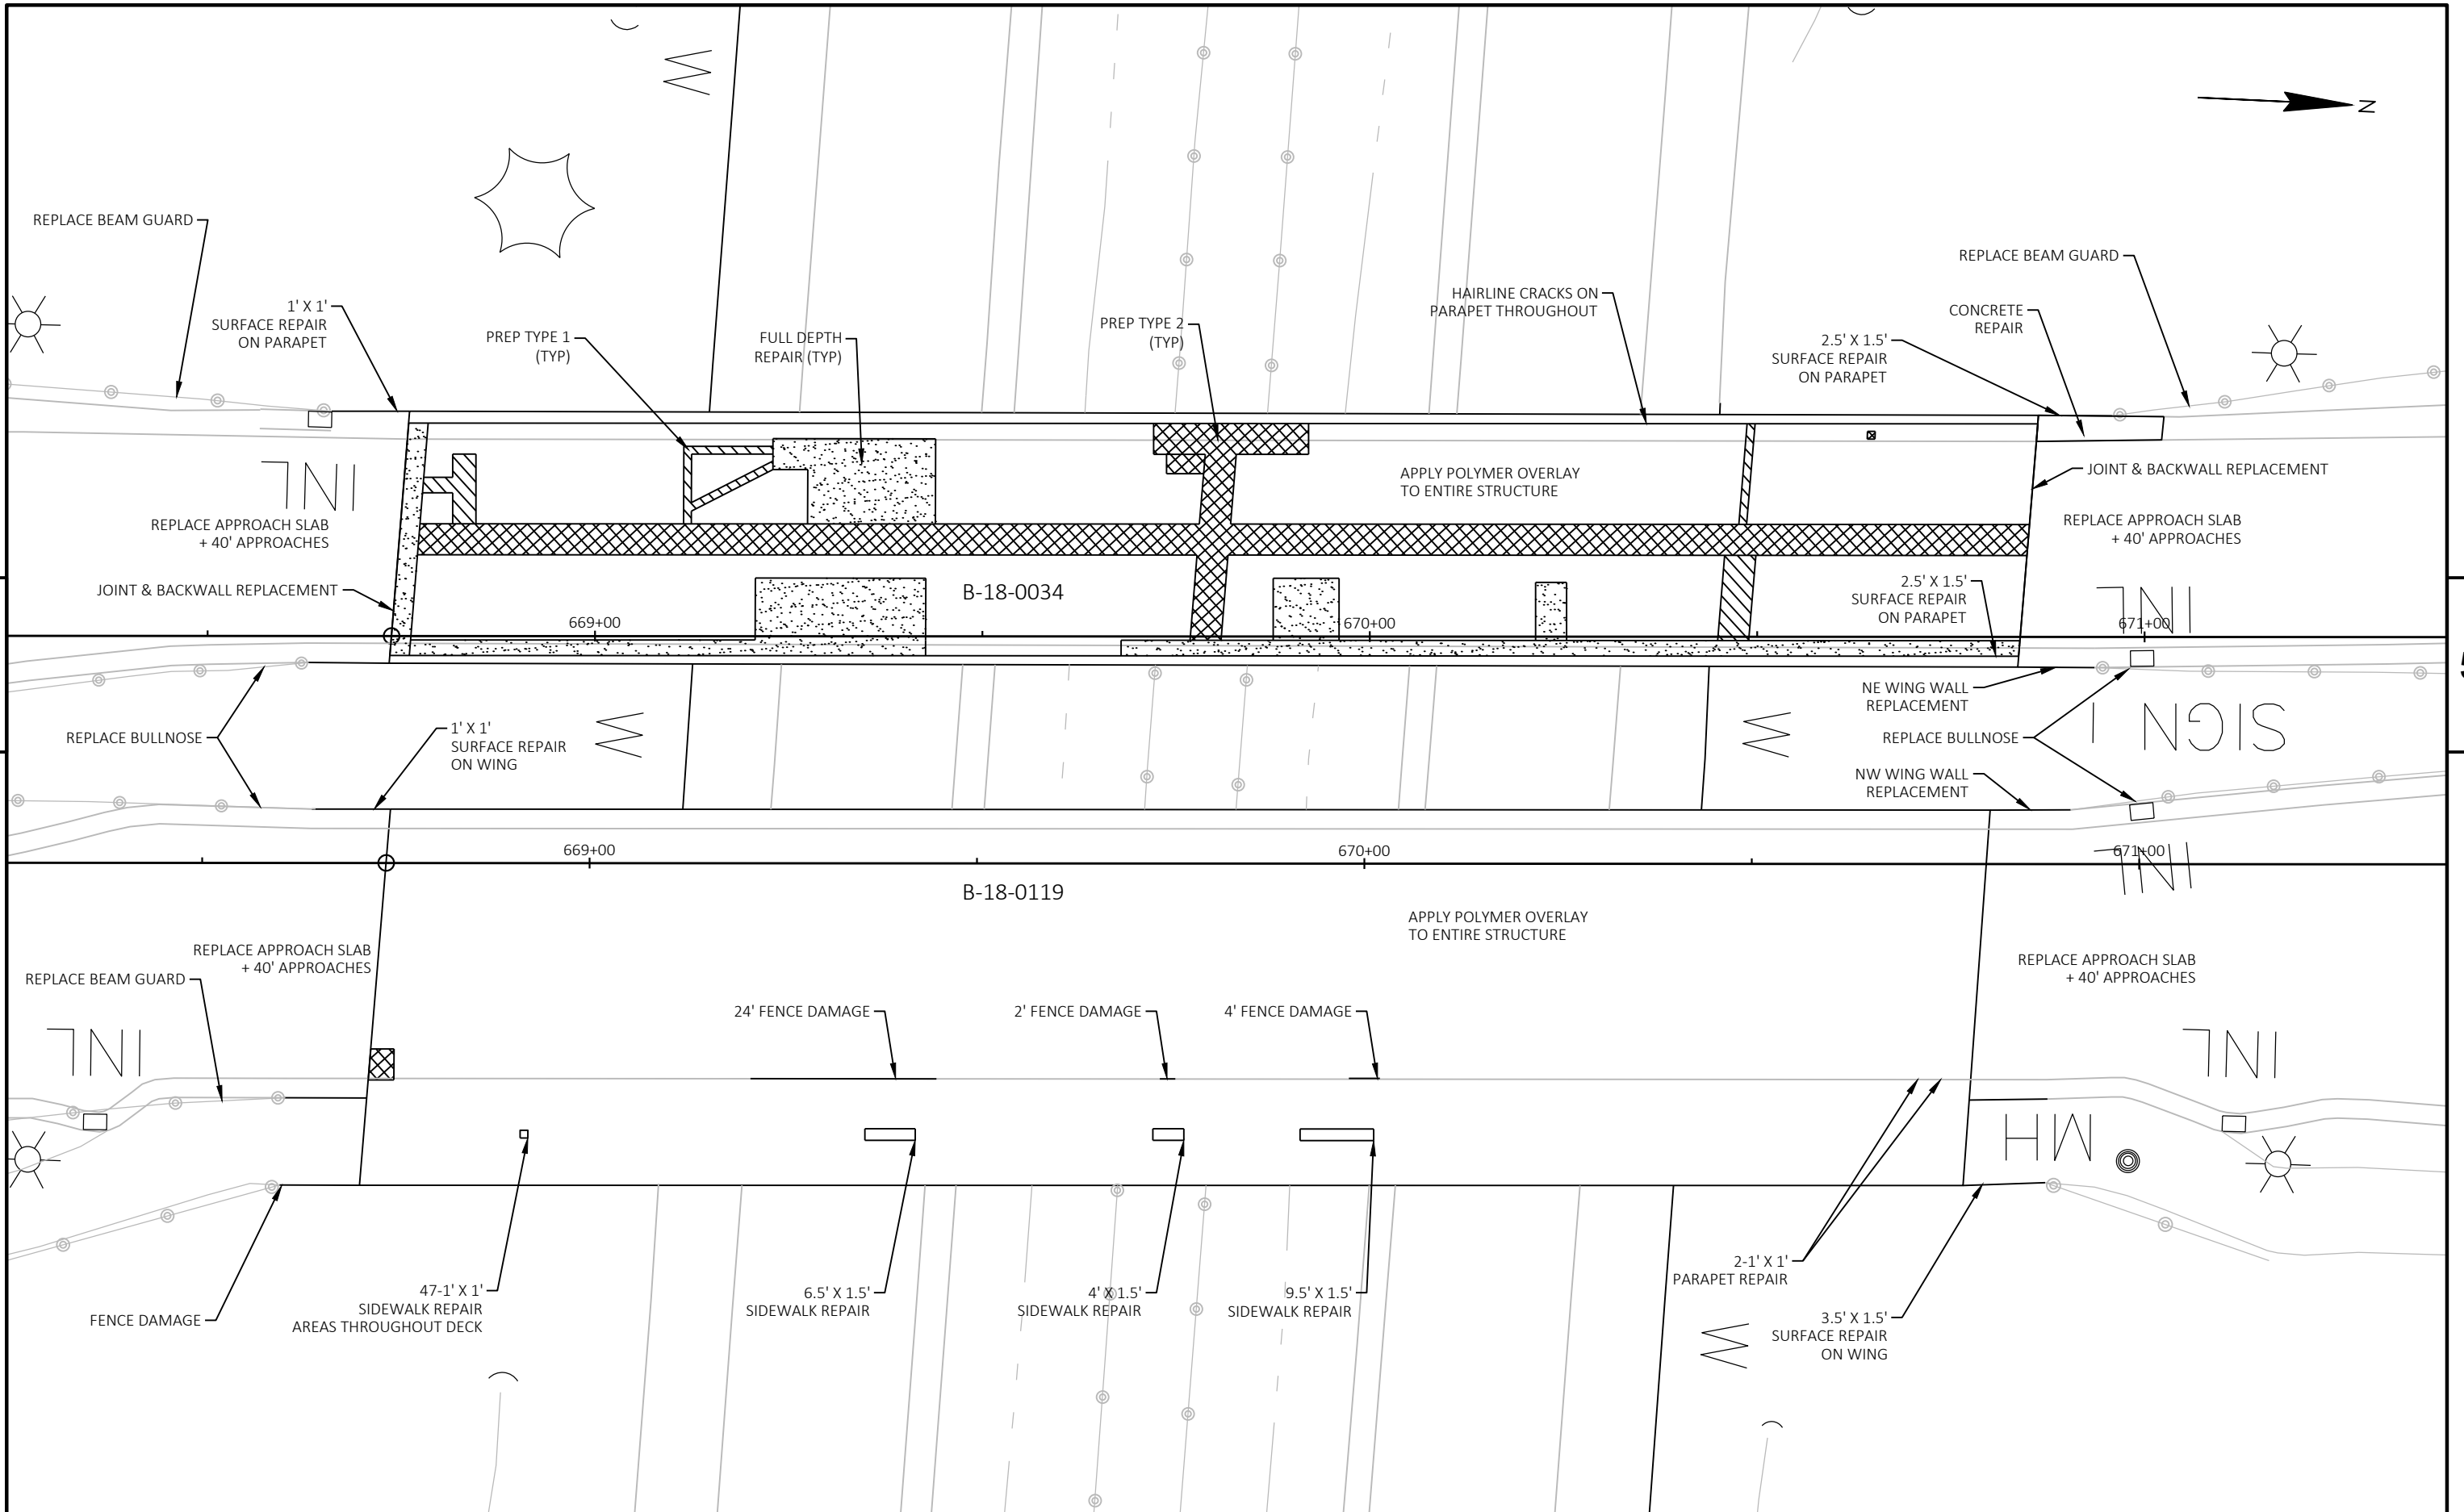


PROJECT NO: 1021-03-80	HWY: STH 93	COUNTY: EAU CLAIRE	PLAN	SHEET	E
------------------------	-------------	--------------------	------	-------	---





1022-00-71

830

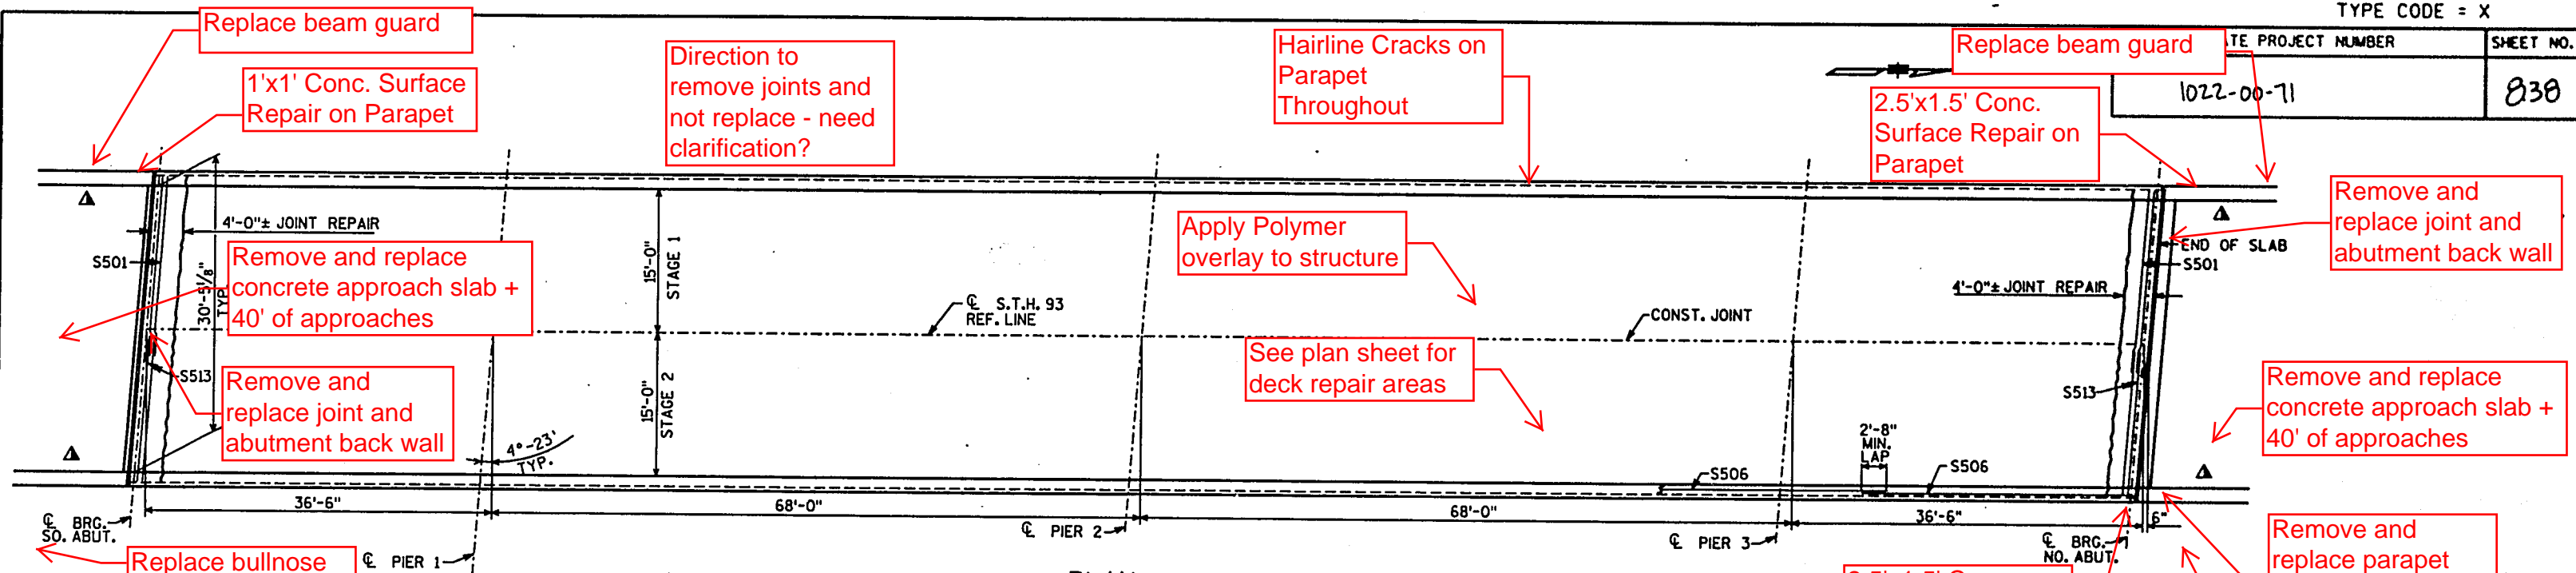

## PLAN

4 SPAN 36" PRESTRESSED GIRDERS

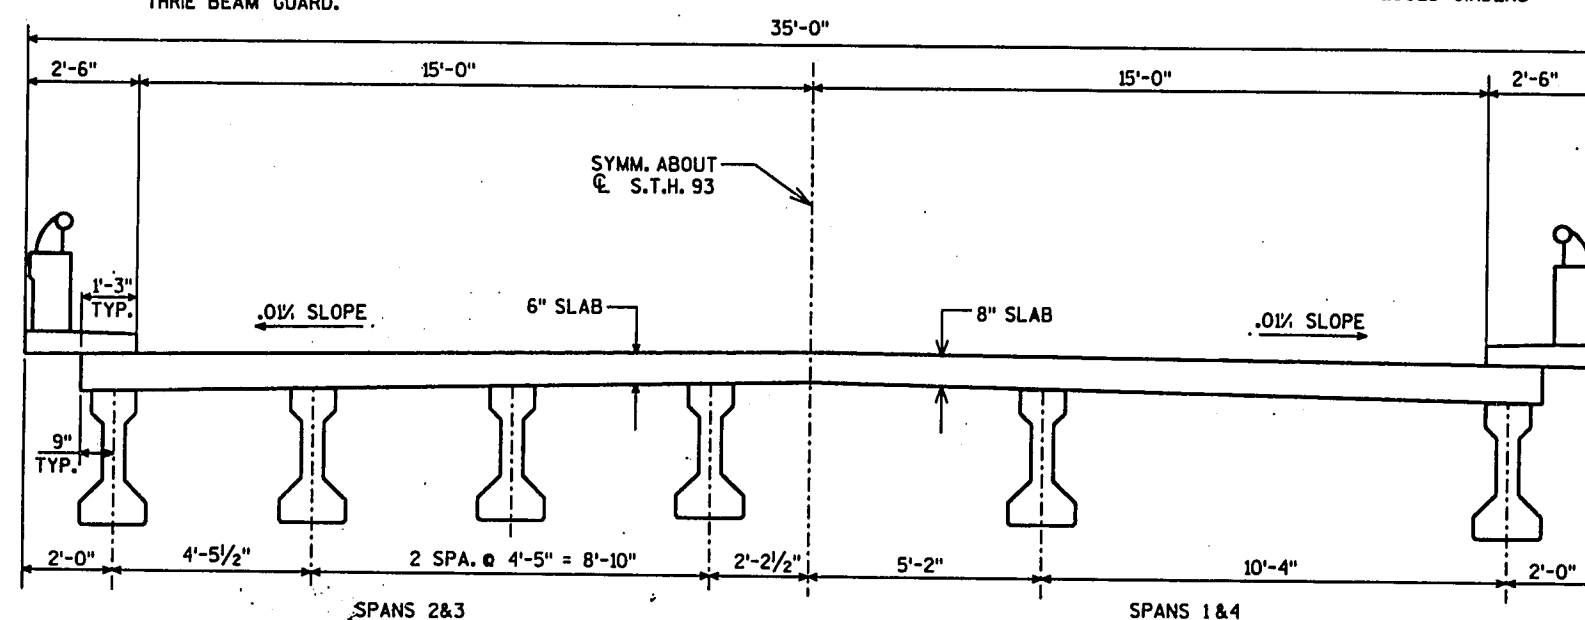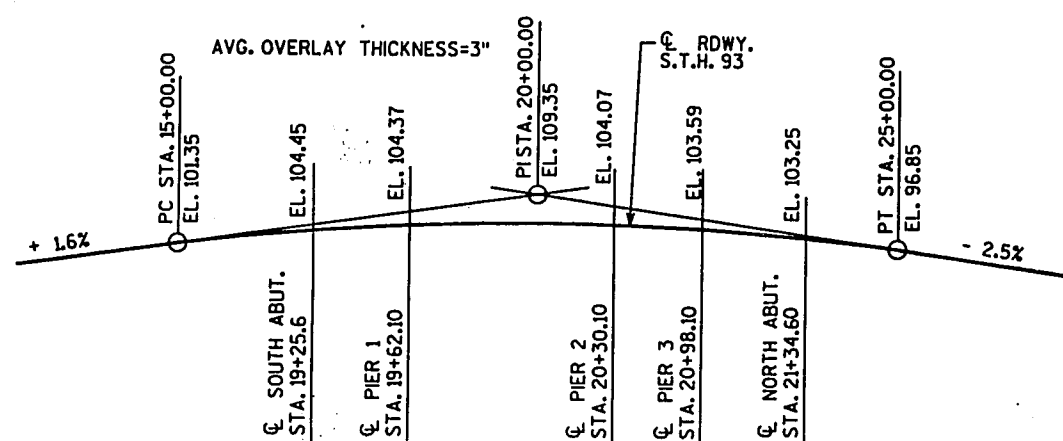EXISTING CROSS SECTION THRU ROADWAY  
(LOOKING NORTH)

## PROFILE GRADE LINE

NOTE: PROPOSED BENCH MARK: KEEL MARK ON S.W. ABUT. EL. 100.00  
FIELD MODIFICATIONS TO PROFILE GRADE LINE WHICH INCREASE OVERLAY THICKNESS BY MORE THAN 1/2" MUST BE REPORTED TO BRIDGE OFFICE. THIS INFORMATION IS REQUIRED TO RECALCULATE VEHICLE CAPACITY RATINGS.

## LIST OF DRAWINGS

1. OVERLAY
2. SUPERSTRUCTURE
3. EXPANSION DEVICE
4. PRESTRESSED GIRDER BEARINGS
5. SLOPED FACE PARAPET 'B'

## GENERAL NOTES

DRAWINGS SHALL NOT BE SCALED.  
CONTRACTOR SHALL VERIFY DIMENSIONS IN FIELD.  
PROTECTIVE SURFACE TREATMENT SHALL BE 150 S.F. PER GALLON OR PER MANUFACTURERS RECOMMENDATIONS.  
BAR STEEL REINFORCEMENT SHALL BE IMBEDDED 2" CLEAR UNLESS SHOWN OR NOTED OTHERWISE.  
ALUMINUM RAILINGS AND POSTS SHALL BE CAREFULLY REMOVED AND STOCKPILED AT A LOCATION ON THE RIGHT OF WAY, OUTSIDE THE CONST. LIMITS, FOR DISPOSAL BY THE STATE OF WIS. DEPT. OF TRANS.

## TOTAL ESTIMATED QUANTITIES

BID ITEMS	UNIT	TOTAL
REMOVING OLD BRIDGE, STA. 30+30.10	L.S.	1
EXCAVATION FOR STRUCTURES, BRIDGES B-18-34	L.S.	1
CONCRETE MASONRY, OVERLAY, DECKS	C.Y.	115
CLEANING, DECKS	S.Y.	707
PREPARATION, DECKS	S.Y.	60
PROTECTIVE SURFACE TREATMENT	GAL.	53
FULL DEPTH DECK REPAIR	S.Y.	5
CONCRETE SURFACE REPAIR **	S.F.	8
EXPANSION DEVICE, STRUCTURE B-18-34	L.S.	1
CONCRETE MASONRY ANCHORS, TYPE L, NO. 5 BARS	EACH	648
COATED HIGH-STRENGTH BAR STEEL REINFORCEMENT, BRIDGES	LB.	8,020
CONCRETE MASONRY, BRIDGES	C.Y.	42
LAMINATED ELASTOMERIC BEARING PADS	EACH	8
REMOVING BEARINGS	EACH	8
ANCHOR ASSEMBLIES FOR STEEL PLATE BEAM GUARD	EACH	4
JOINT REPAIR	S.Y.	32

## DESIGN DATA

## LIVE LOAD:

INVENTORY RATING: HS-18  
OPERATIONAL RATING: HS-33  
MAXIMUM STANDARD PERMIT VEHICLE LOAD = 237 Kips.


## ALLOWABLE DESIGN STRESSES:

CONCRETE MASONRY SLAB  $f_c = 4,000$  P.S.I.




\*\* AREA TO BE DETERMINED BY THE ENGINEER IN THE FIELD.

BRIDGE OFFICE CONTACT - R.L. REESE (608)266-8488  
K.A. BAHLER (608)266-8490

NO.	DATE	REVISION	BY
STATE OF WISCONSIN DEPARTMENT OF TRANSPORTATION DIVISION OF HIGHWAYS			
STRUCTURE B-18-34			
S.T.H. 93 (SB) OVER I-94			
COUNTY	EAU CLAIRE	TOWNSHIP	WASHINGTON
DESIGN SPEC.	AASHTO 1989	LOAD	CONST. SPEC. 1989
DESIGNED BY	JSH C&D	VT	DRWN BY C.M.J.F.
APPROVED	DATE		
OVERLAY			
SHEET 1			
DATE:			

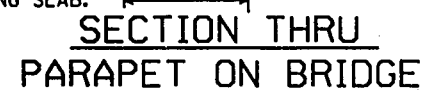

BACKWALL OF ABUT.  
EL. 104.14 (S.W.)  
EL. 104.15 (S.E.)  
EL. 102.93 (N.W.)  
EL. 102.95 (N.E.)

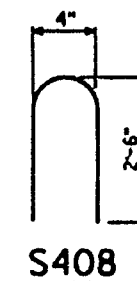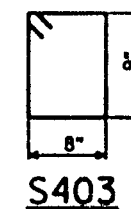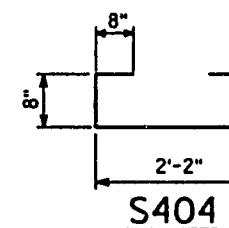

NOTE: THE FIRST OR FIRST TWO DIGITS OF THE  
BAR MARK SIGNIFIES THE BAR SIZE.

[illegible]

NO.	DATE	REVISION	BY
STATE OF WISCONSIN DEPARTMENT OF TRANSPORTATION DIVISION OF HIGHWAYS			
STRUCTURE B-18-34			
CONST. SPEC.	1989	DRAWN BY C.M.F.	PLANS CARD. HIGH
SUPERSTRUCTURE		SHEET 2	

1022-00-71

840

## LEGEND

1. NEOPRENE STRIP SEAL & STEEL EXTRUSIONS D.S. BROWN SSA2-400AZ, LEWIS ENGINEERING W-400L, STRUCTURAL ACCESSORIES SA2-40SS, WATSON-BOWMAN-ACME COMPANIES A3-400SE. EXTRUSIONS TO BE A.S.T.M. A36.
2. STUDS  $\frac{5}{8}$ " x  $6\frac{3}{8}$ " LONG AT 6" ALTERNATE CENTERS WELD TO EXTRUSIONS & BEND AS SHOWN AFTER WELDING.
3.  $\frac{3}{4}$ " THREADED ROD WITH 2 NUTS AND WASHERS. FOR PRESTRESSED GIRDERS FIELD SET ON CL OF GIRDER A MINIMUM OF 4" FROM END OF GIRDER. FOR STEEL GIRDERS WELD THREADED ROD TOP FLANGE OR ATTACH BY BOLTING THRU FLANGE, ON ABUTMENT SIDE GROUT THREADED ROD INTO FIELD DRILLED HOLES IN ABUTMENT BACKWALL AS SHOWN.
4.  $\frac{3}{4}$ " THREADED ROD WITH NUT. TACK WELD NUT TO NO. 5.
5. FABRICATE SUPPORT FROM 3" x  $\frac{1}{2}$ " BAR AS SHOWN OR EQUIVALENT. ONE PER GIRDER PER SIDE. WELD TO NO. 1. PROVIDE  $\frac{1}{2}$ " HOLE FOR NO. 3 & 1" HOLE FOR NO. 4.
6. 3" x  $\frac{1}{2}$ " ANCHOR PLATE WITH  $\frac{5}{8}$ " ROD. WELD ROD TO ANCHOR PLATE. WELD ANCHOR PLATE TO #1 AT 1'-6" CTRS. BETWEEN GIRDERS.

## NOTES

ONE FIELD SPLICE PERMITTED IN STEEL EXTRUSIONS. IF USED, DETAILS SHALL BE SUBMITTED FOR APPROVAL. NO SPLICING PERMITTED IN NEOPRENE STRIP SEAL. AFTER FABRICATION, BUT BEFORE SHIPMENT, STRAIGHTEN STEEL EXTRUSIONS SUCH THAT THEY SHALL BE FREE FROM WARP, TWIST & SWEEP.

AFTER FABRICATION, SAND BLAST CLEAN STEEL EXTRUSION SURFACES TO SSPC SP. 10. SAND BLAST CLEAN ANCHORAGE COMPONENTS TO SSPC SP. 6. PRIME ALL SURFACES INCLUDING ANCHORAGE COMPONENTS WITH 3 MILS. OF ORGANIC ZINC RICH PRIMER.

FABRICATOR SHALL PROVIDE MEANS OF KEEPING COATED EXTRUSIONS CLEAN DURING SHIPMENT AND PRIOR TO APPLYING LUBRICANT ADHESIVE FOR NEOPRENE GLAND INSTALLATION.

MATERIAL FOR #2A SHALL CONFORM TO ASTM A36 STEEL. MATERIAL SHALL BE FLAME CUT OR SHEARED. REMOVE ALL SLAG OR SHEARED EDGES BY GRINDING TO A SMOOTH UNIFORM SQUARE SURFACE. PRIOR TO BENDING CHECK PLATES FOR FLATNESS TO WITHIN A TOLERANCE OF  $\frac{1}{16}$ " IN ANY DIRECTION. BEND LINE MUST BE PERPENDICULAR TO PLATE GRAIN. SANDBLAST PLATES AFTER FABRICATION IN ACCORDANCE WITH SSPC SP. #6 IF GALVANIZING OR SSPC SP. #10 IF PAINTING. THE PLATES SHALL BE HOT DIPPED GALVANIZED OR SHOP PRIMED WITH 3 MILS. MINIMUM OF ORGANIC ZINC RICH PRIMER.


STRIP SEAL EXPANSION JOINT ASSEMBLY, INCLUDING ANCHOR STUDS & HARDWARE WILL BE PAID FOR AT THE LUMP SUM PRICE BID FOR "EXPANSION DEVICE"

## TEMPERATURE TABLE

90	$1\frac{1}{8}$ "
80	2"
70	$2\frac{1}{8}$ "
60	$2\frac{1}{4}$ "
50	$2\frac{1}{2}$ "
45	$2\frac{3}{4}$ "
40	$2\frac{1}{2}$ "
30	$2\frac{3}{8}$ "
20	$2\frac{1}{2}$ "
10	$2\frac{1}{2}$ "


DIM. MEASURED NORMAL  
TO JOINT OPENING

SHADED UNDERSIDE  
DECK TEMPERATURE  
(°F)

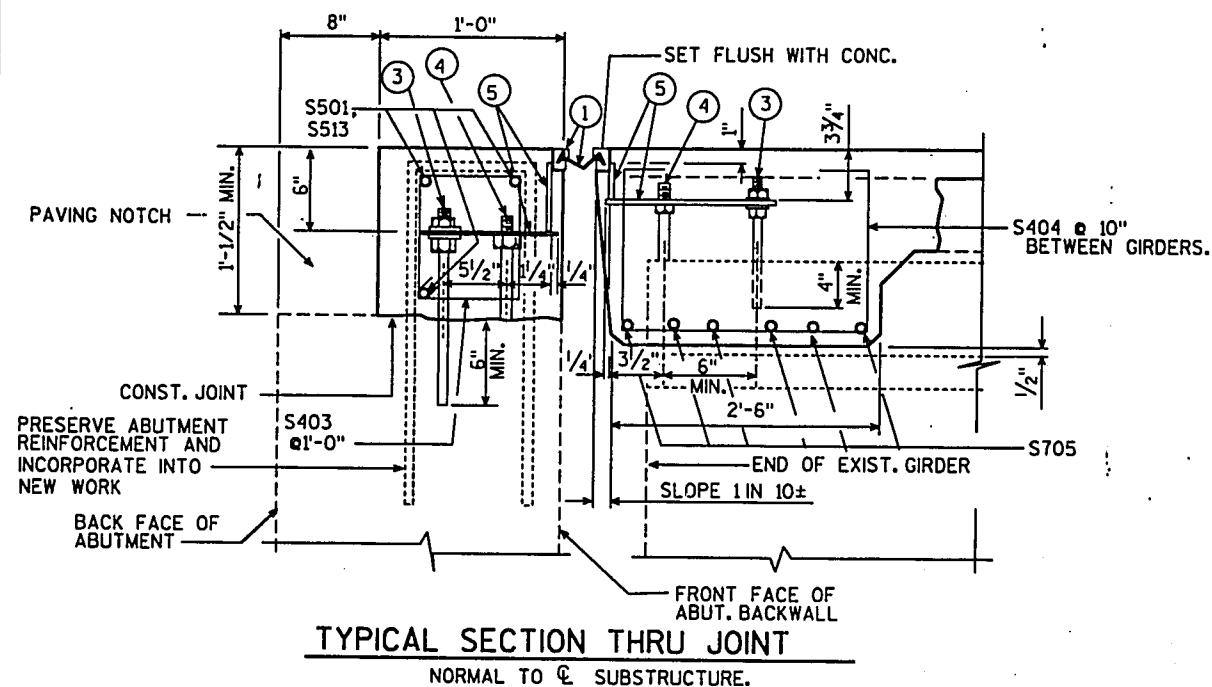


TYPICAL SECTION THRU JOINT

NORMAL TO C SUBSTRUCTURE.

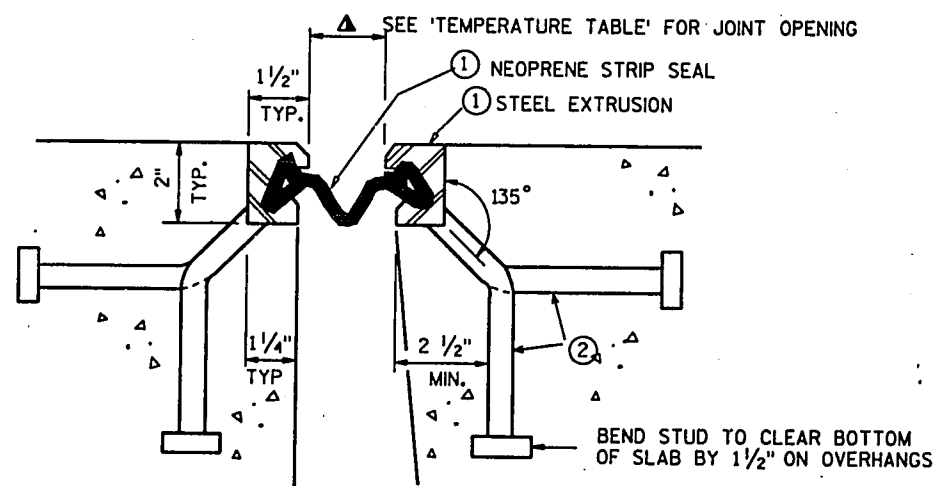


SECTION THRU JOINT

EXTERIOR GIRDER TO EDGE OF SLAB &amp; AT PARAPETS, MEDIANS &amp; SIDEWALKS

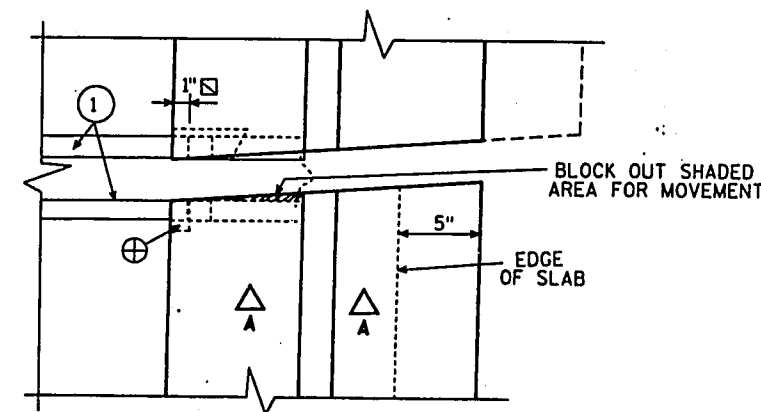


PLAN AT PARAPET 'B'

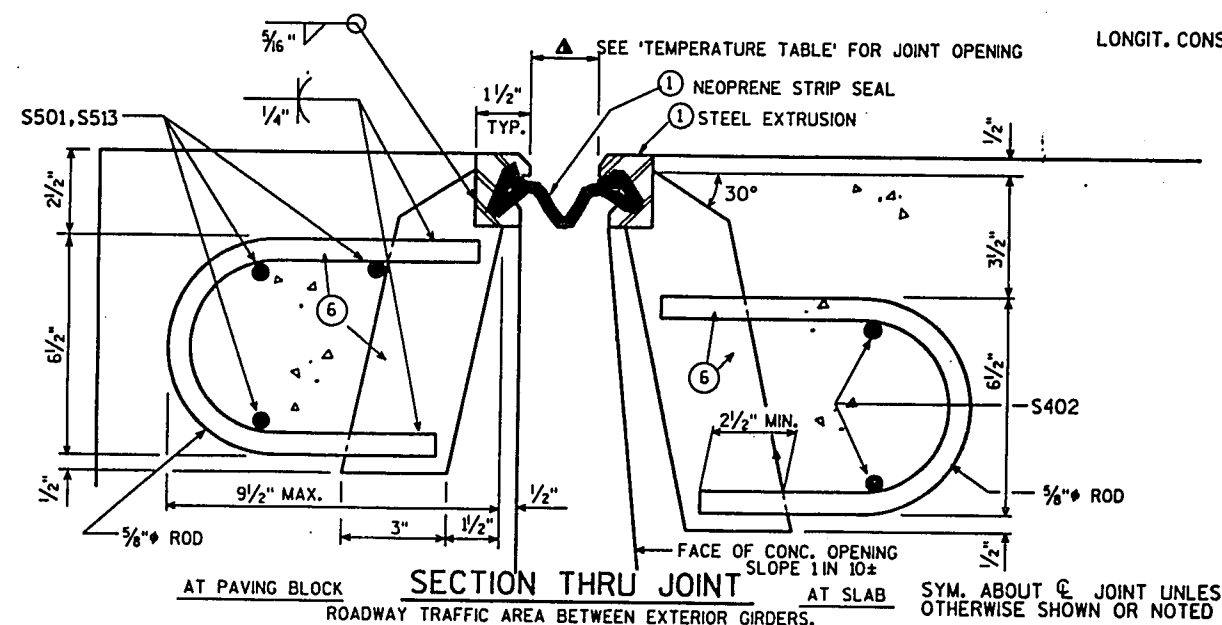


SECTION THRU JOINT

ROADWAY TRAFFIC AREA BETWEEN EXTERIOR GIRDERS.

SYM. ABOUT C JOINT UNLESS OTHERWISE SHOWN OR NOTED

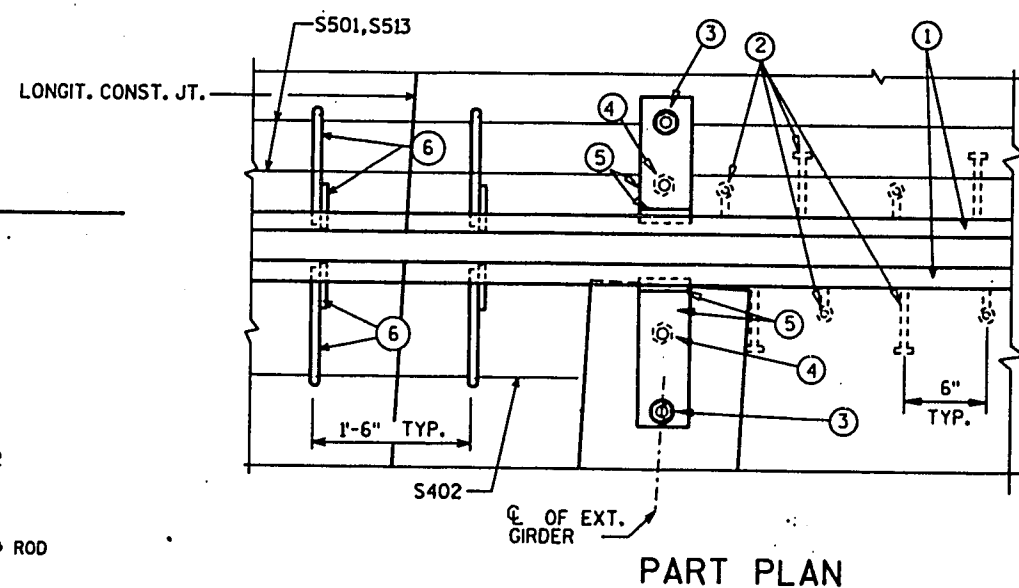

PART PLAN

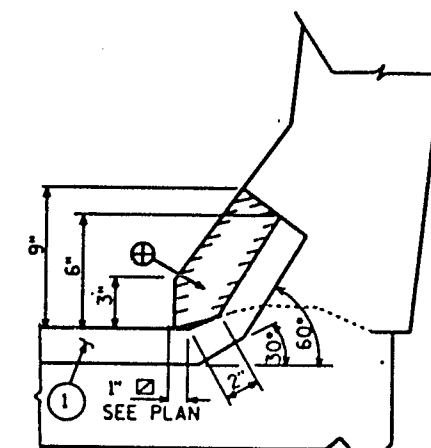


SECTION A-A

⊕ BLOCK OUT CONCRETE 2" EACH SIDE  
FOR JOINT OPENING


NO.	DATE	REVISION	BY
STATE OF WISCONSIN DEPARTMENT OF TRANSPORTATION DIVISION OF HIGHWAYS			
STRUCTURE B-18-34			
CONST. SPEC.	1989	DRAWN BY C.M.F.	PLANS C.R.D. M.O.M.
EXPANSION DEVICE			SHEET 3

SCALE 1


BR\_81834\_EXPJT.DFN

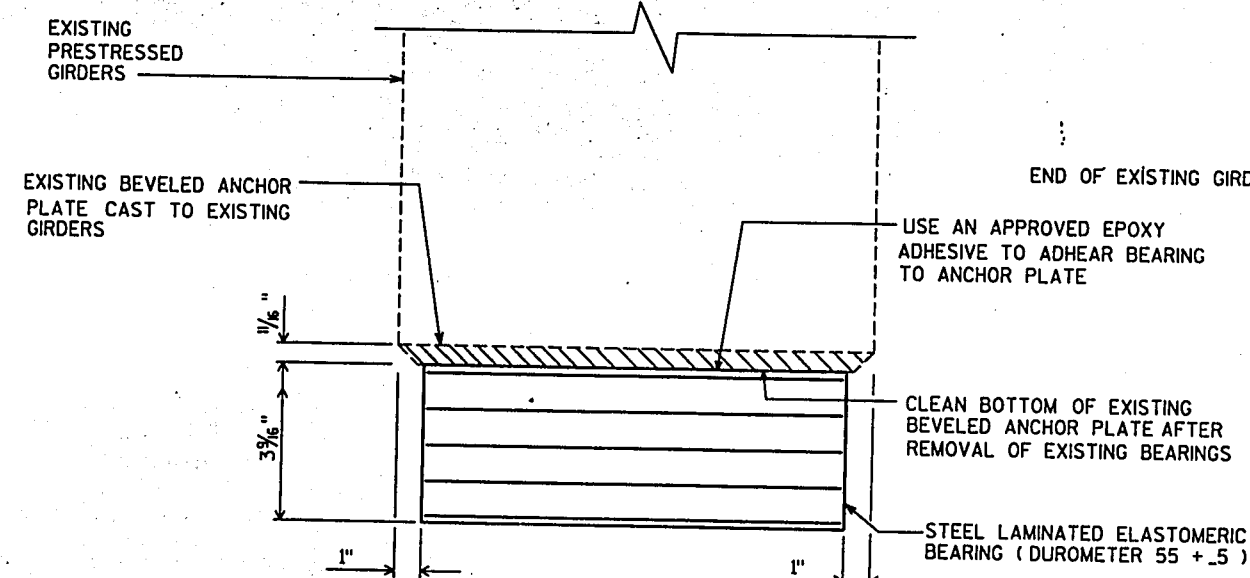

END VIEW

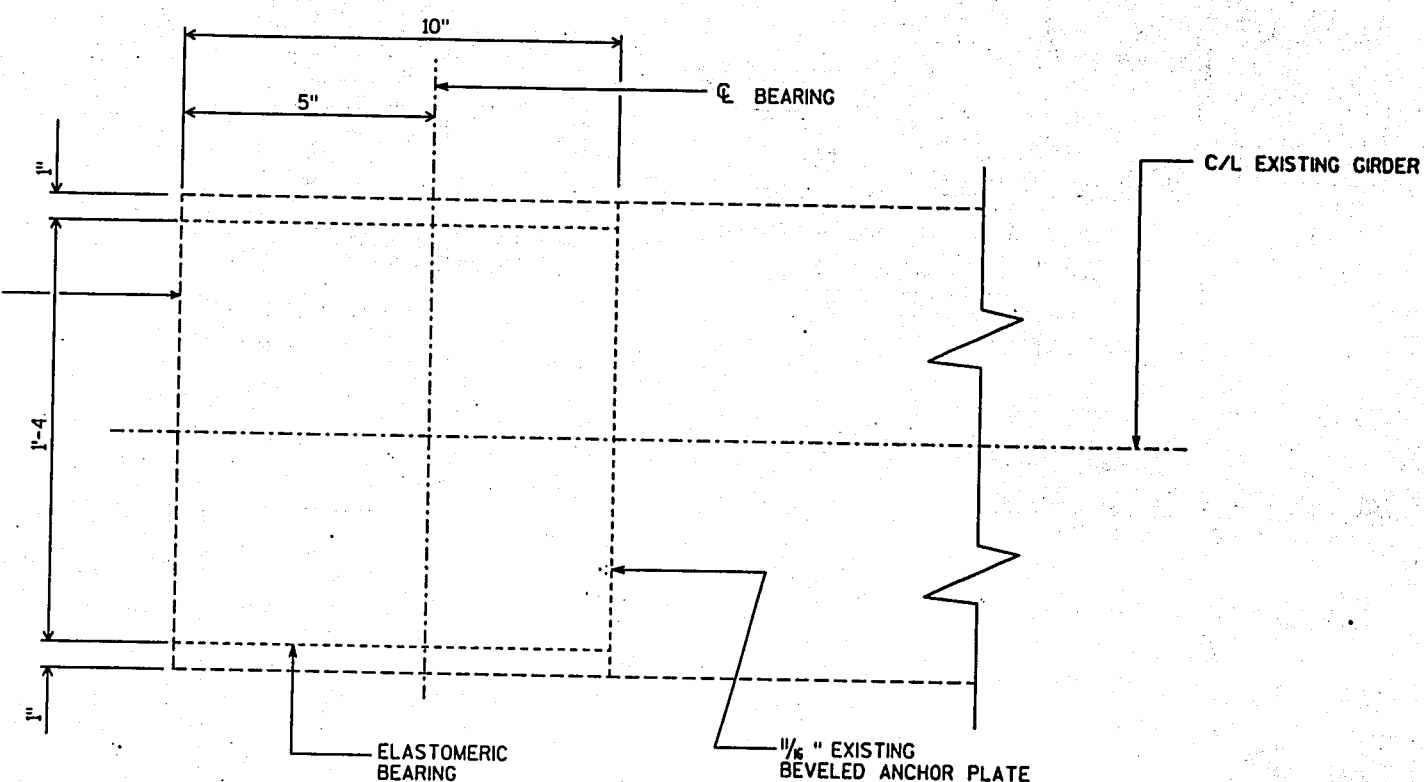

PLAN VIEW

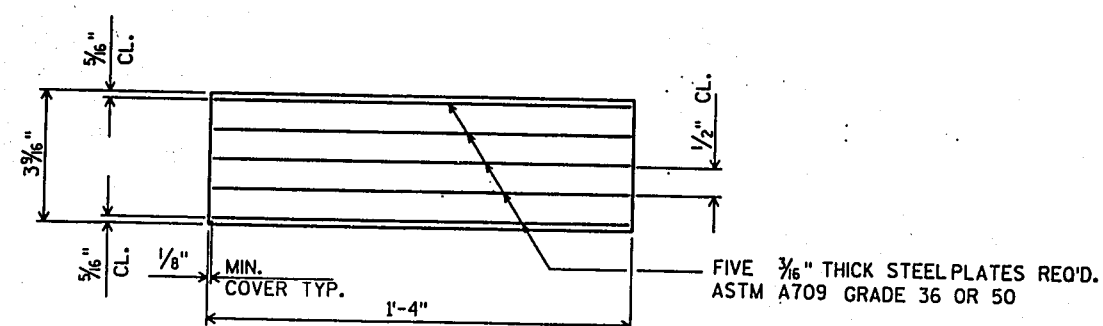

SECTION THRU ELASTOMERIC BEARING

(8 REQ'D.)

## NOTE:


BEARINGS SHALL NOT BE PLACED AT A TEMPERATURE GREATER THAN 70° F.

ALL MATERIAL USED FOR BEARINGS SHALL BE PAID AT THE UNIT PRICE BID FOR "LAMINATED ELASTOMERIC BEARING PAD."

PLACE NEW BEARINGS PRIOR TO PLACING OVERLAY.

NO.	DATE	REVISION	BY
STATE OF WISCONSIN DEPARTMENT OF TRANSPORTATION DIVISION OF HIGHWAYS			
STRUCTURE B-18-34			
CONST. SPEC.	1989	DRAWN BY C.M.F.	PLANS C.D. HODAN
PRESTRESSED GIRDER BEARINGS			SHEET 4


BILL OF BARS NOTE: THE FIRST OR FIRST TWO DIGITS OF THE  
BAR MARK SIGNIFIES THE BAR SIZE.

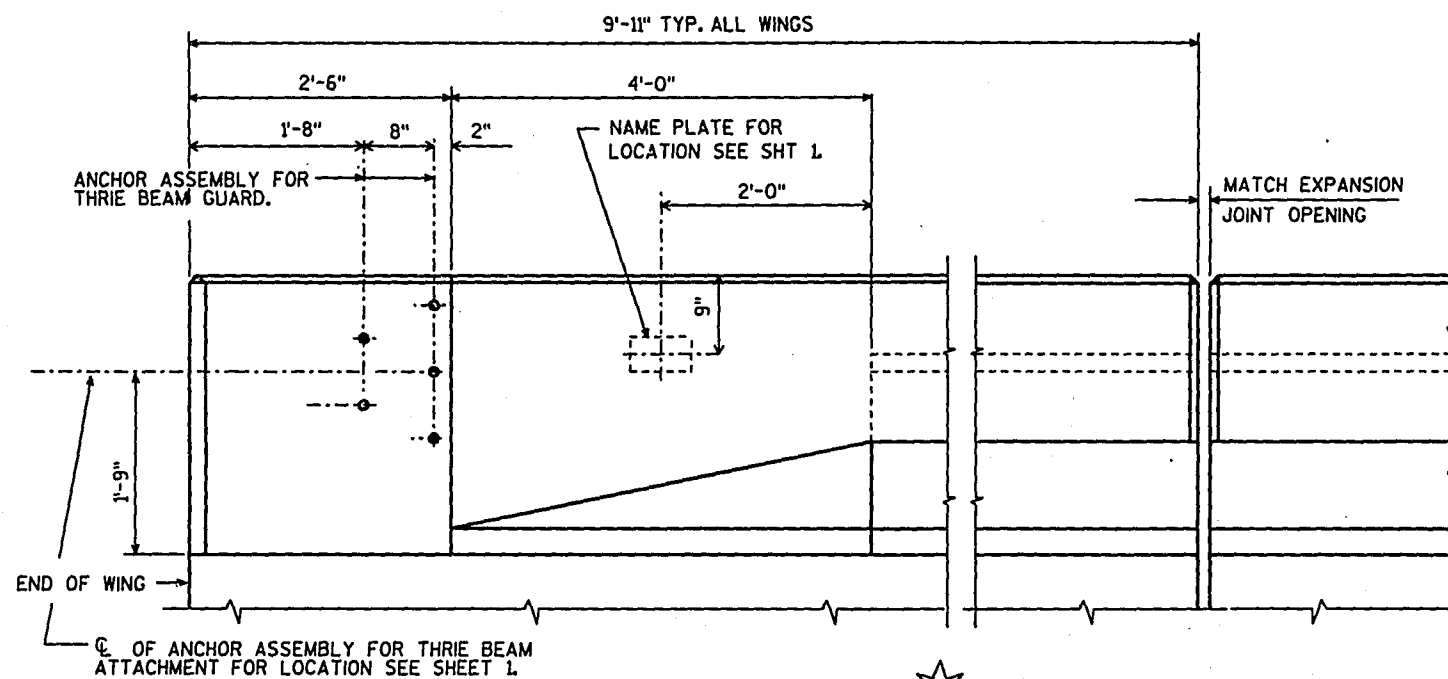[illegible]


### INSIDE ELEVATION

★ CONCRETE MASONRY ANCHORS (EPOXY), NO. 5 BARS  
TYPE L & SPACING SHOWN.  
MIN. PULLOUT TO BE 16.0 KIPS.  
DRILL HOLES 6½" DEEP.

■ PRESERVE EXIST. BARS  
& INCORPORATE INTO  
NEW WORK - CUT & BEND  
AS REQ'D. TO PROVIDE  
2' CLEAR.

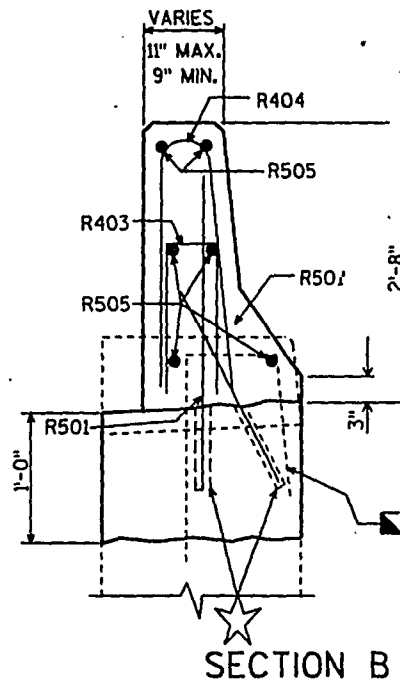


SECTION B

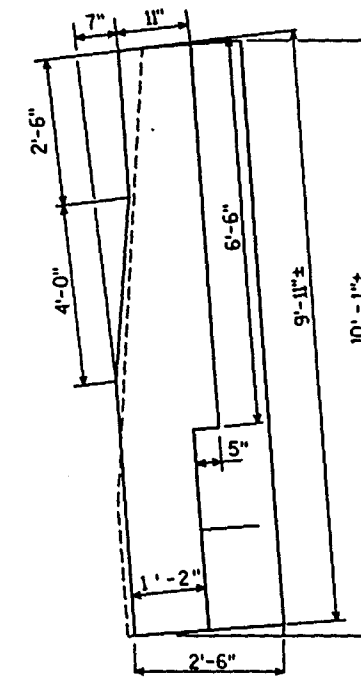

## PLAN


(B - PARAPET ON WING )

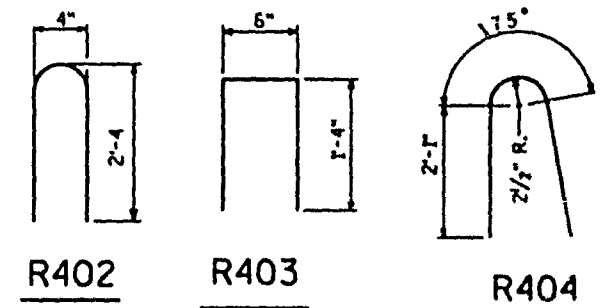

R402


R403

R404

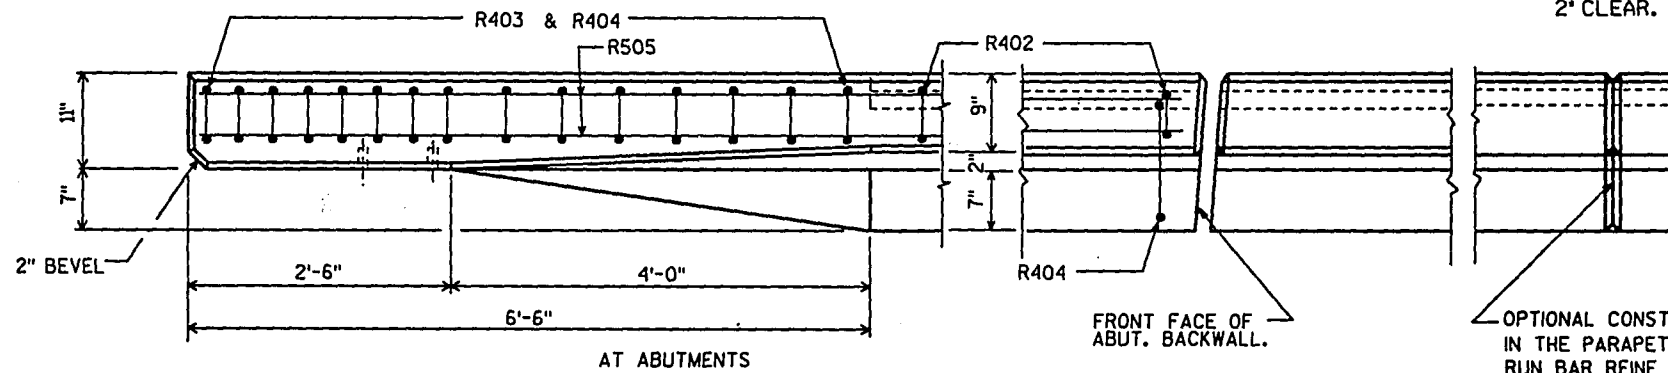


### PLAN

OPTIONAL CONSTRUCTION JOINTS  
IN THE PARAPETS MAY BE USED.  
RUN BAR REINF THRU THE JOINT.  
LAP LONGIT. BARS A MIN. OF 1'-9".  
MIN. JOINT SPACING OF 80'-0".  
DEFINE CONST. JOINT  
WITH A 1" 'V' GROOVE.

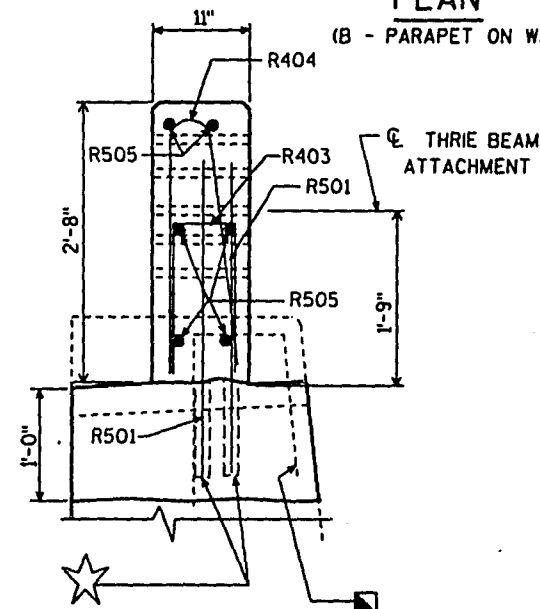


## SECTION A

—PRESERVE EXIST. VERT. RAIL POST  
& CURB BARS. INCORPORATE INTO NEW  
WORK. BEND AS NECESSARY TO PROVIDE  
2' CLEAR COVER.

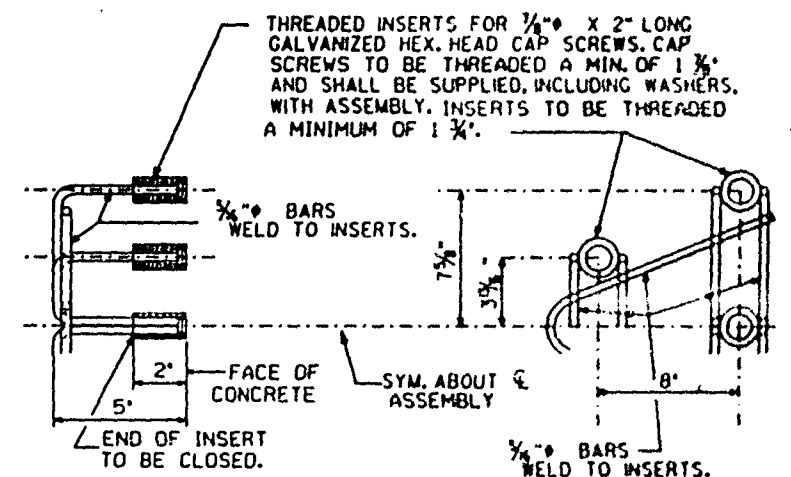


### DETAIL OF ANCHOR ASSEMBLY

NOTE: HEX. HEAD CAP SCREWS & WASHERS TO BE  
GALVANIZED IN ACCORDANCE WITH AASHTO M232 CLASS C.  
SEE SHEET 1 FOR LOCATION.

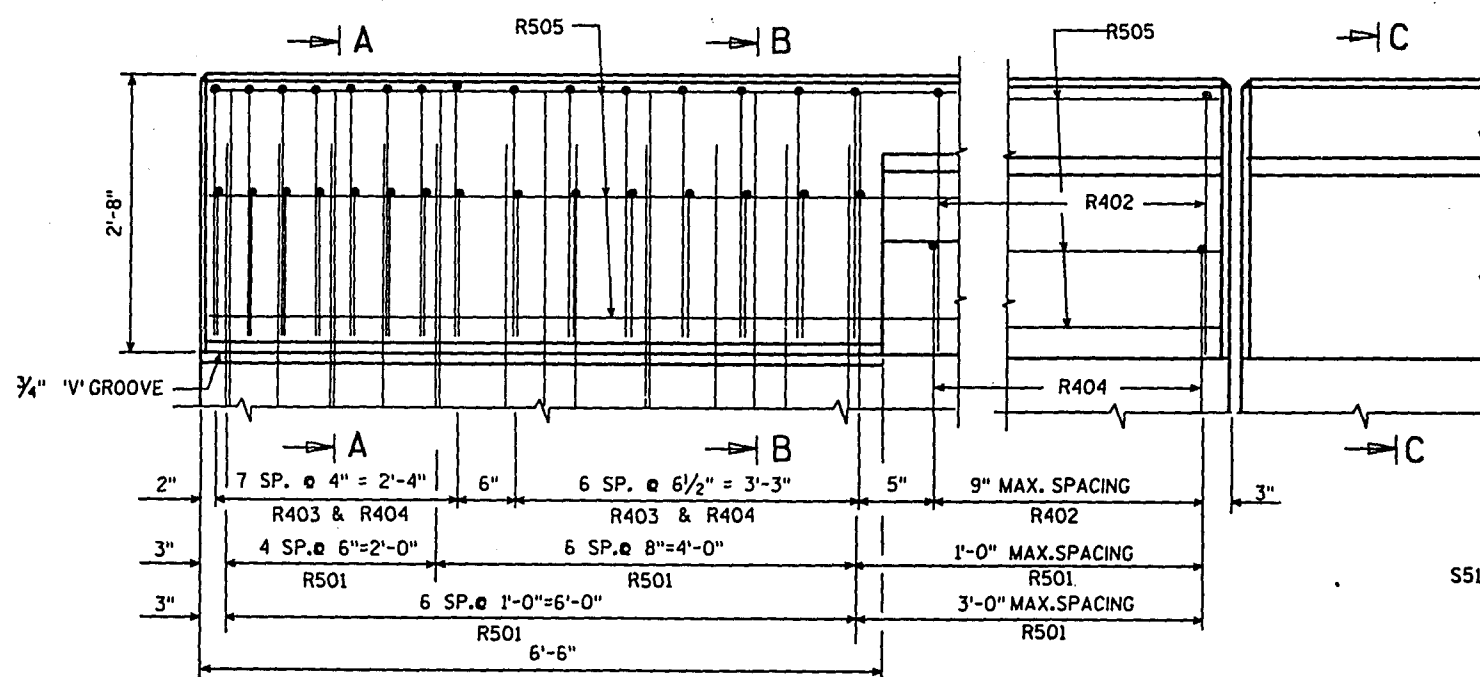

OUTSIDE ELEVATION

SHOWING REINF.

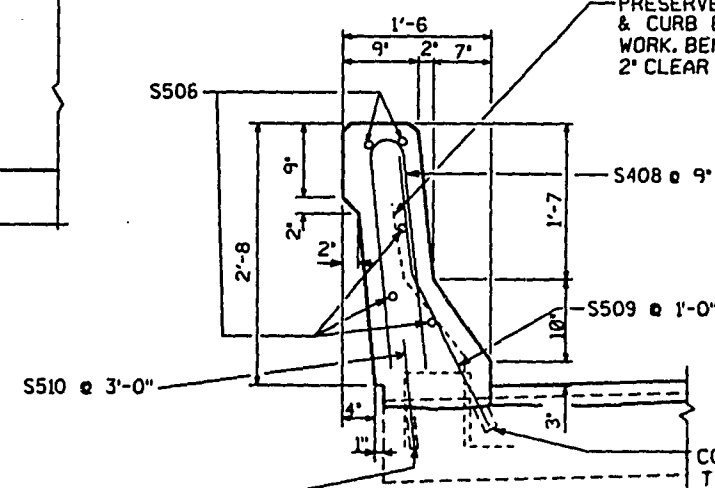

SECTION C


CONCRETE MASONRY ANCHORS (EPOXY).  
TYPE L, NO. 5 BARS,  
PULLOUT LOAD=16.0 KIPS.  
DRILL HOLES 6 1/2" DEEP.

CONCRETE MASONRY ANCHORS (EPOXY),  
- TYPE L, NO. 5 BARS,  
PULLOUT LOAD=16.0 KIPS.  
DRILL HOLES 6 1/2" DEEP.

NO.	DATE	REVISION	BY
STATE OF WISCONSIN DEPARTMENT OF TRANSPORTATION DIVISION OF HIGHWAYS			
STRUCTURE B-18-34			
CONST. SPEC.	1989	DRAWN BY C.M.F.	PLANS CND. NOM
SLOPED FACE PARAPET "B"		SHEET 5	

COUNTY & ROUTE & C. 11.1 4 1.54-2(04) 42 142  
 STATE & FEDERAL OFFICE PROJECT SHEET TOTAL  
 72.3 94.2 11.1 4 1.54-2(04) 42 142


## LOCALITY MAP

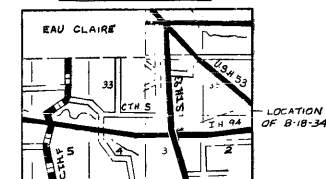


## GENERAL NOTES

DRAWINGS SHALL NOT BE SCALED  
 BEVEL EXPOSED EDGES OF CONCRETE 1" UNLESS  
 OTHERWISE SHOWN OR NOTED  
 WEDGED ALL BAR STEEL 2" UNLESS OTHERWISE SHOWN.  
 ALL CONCRETE MASONRY SHALL BE GRADE "A-A"  
 #400 (P. 5)  
 RC EXPANSION JOINT FILLER SHALL CONFORM TO  
 AASHTO DESIGNATION M183 TYPE 2L  
 THE SLOPE IN FRONT OF THE ABUTMENTS SHALL  
 BE COVERED WITH "SLOPE PAVING" AS SHOWN IN  
 PLAN ON THIS SHEET AND IN SECTION AA" ON  
 SHEET B  
 ELASTOMERIC BEARING PADS NEED NOT BE  
 INDIVIDUALLY MOLDED PROVIDED THE CUT EDGES  
 ARE SMOOTH AND TRUE  
 401 WEDGED ELASTIC TYPE JOINT SEALER SHALL  
 CONFORM TO ASTM DESIGNATION D1180  
 UPPER LIMITS OF "EXCAVATION FOR STRUCTURES"  
 SHALL BE BOTTOM OF SLOPE BEING ON BERM  
 AT ABUTMENTS AND FINISHED GRADED SECTION AT PIERS.  
 ALL EXCAVATED VOLUME NOT OCCUPIED BY THE  
 ABUTMENTS SHALL BE BRICKLAYERED WITH GRANULAR  
 BACKFILL TO THE LIMITS SPECIFIED FOR EXCAVATION  
 FOR STRUCTURES. SHEET WILL BE MADE ONLY  
 FOR MATERIAL ACTUALLY PLACED WITHIN LIMITS  
 SPECIFIED FOR "EXCAVATION FOR STRUCTURES".


## ELEVATION

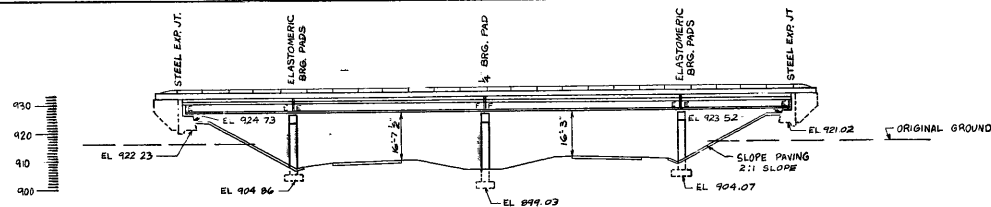

## GRADE LINE E.B. LANE I.H. 94

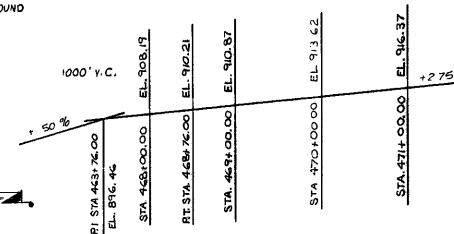


## GRADE LINE W.B. LANE I.H. 94

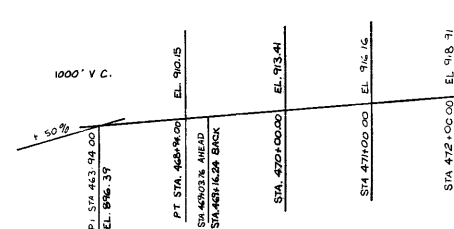


## PLAN

4 SPAN PRE TENSION GIRDER  
 WITH R.C. PEDESTAL PIERS  
 AND R.C. SILL ABUTMENTS  
 (36'-0" 68'-0" 68'-0" 36'-0")

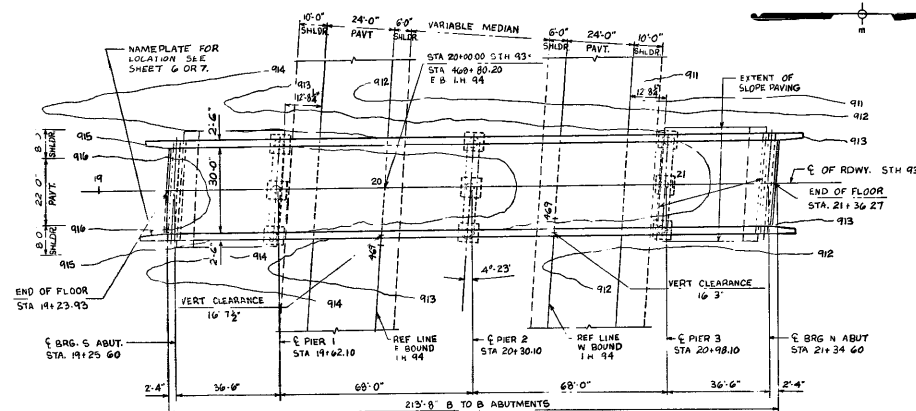

## GRADE LINE S.T.H. 93

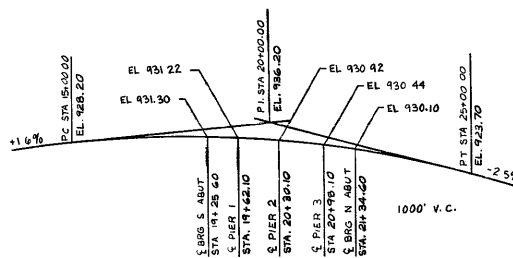

## TOTAL ESTIMATED QUANTITIES

BID ITEMS	A-1	SUPER S ABUT	PIER 1	PIER 2	PIER 3	N ABUT	TOTAL
EXCAVATION FOR STRUCTURES	C.Y.	—	85	65	50	65	250
GRANULAR BACKFILL	C.Y.	—	15	—	—	15	30
CONCRETE MASONRY	C.Y.	221.3	52.4	40.7	41.9	40.7	444.4
BAR STEEL REINFORCEMENT	LB	58,430	1,040	5,210	6,050	5,210	78,800
STRUCTURAL LOW-ALLOY STEEL	LB	6,440	—	—	—	—	6,440
TUBULAR RAILING TYPE-G	LF	458	—	—	—	—	458
SLOPE PAVING - CONCRETE	S.Y.	—	190	—	—	105	295
LIBRICATION BRODITE PLATES	LB	102.4	—	—	—	—	102.4
BEARING PADS	S.F.	2.7	—	—	—	—	2.7
ELASTOMERIC BEARING PADS	S.F.	1.8	—	—	—	—	1.8
PRESTRESSED GIRDER TYPE 36"	LF	1,380	—	—	—	—	1,380
NON-BID ITEMS							
ALUMINUM OR ZINC PLATE	S.F.	34	—	—	—	—	34
FILLER	SIZE	1/2	—	—	—	—	1/2

## LIST OF DRAWINGS

1 GENERAL PLAN	K27535
2 SUPERSTRUCTURE	K27536
3 LONG SECTION & BEARINGS	K27537
4 PRE TENSION GIRDER DETAILS	K27538
5 EXPANSION JOINT	K27539
6 TUBULAR ALUMINUM RAILING - TYPE G	K27540
7 TUBULAR STEEL RAILING - TYPE G	K27541
8 ABUTMENTS	K27542
9 PIER 1	K27543
10 PIER 2	K27544
11 PIER 3	K27545
12 SUBSURFACE EXPLORATION	K27546

REVISION

STATE HIGHWAY COMMISSION OF WISCONSIN

GENERAL PLAN

NO EAU CLAIRE WASHINGTON STA 30+10

SECTION 3 TOWN 26 N RANGE 9 W

DESIGN SPEC: AASHTO 61 (LOADING H20 S16) 1963

DATE 11-7-63 DESIGN VGM DRAWING DB

RECOMMENDED H.B. Smith

APPROVED E.B. Smith

STRUCTURE B-18-34 SHEET 1 OF 12

K27935




PROJECT: I-94-2(14) 43 142  
SHEET: 67

**BILL OF BARS** 58,000<sup>#</sup>


DIMENSIONS IN BENDING DETAILS ARE OUT TO OUT.

POUR MARK	NO	SIZE	LENGTH	SPACING	LOCATION	DET
SUPERSTRUCTURE	S1	520	5	32-3	FLOOR - TOP BOTTOM TRANS. SPAN 213	
	S2	280	6	32-3	" " " " " " 114	
	S3	84	5	34-6	" " " " " " BOTTOM SPAN 114	
	S4	112	4	32-6	" " " " " " BOTTOM SPAN 213	
	S5	54	5	30-6	" " " " " " TOP SPAN 114	
	S6	112	5	28-6	" " " " " " TOP SPAN 213	
	S7	84	8	15-0	HAUNCH - SYM ABT. & PIERS	
	S8	64	5	11-0	" " " " " " AT DIER 2	A
	S9	21	5	7-4	" " " " " " AT DIER 2	B
	S10	24	4	9-0	SHOWN " " SPANS 114	
	S11	56	6	3-0	" " DIAPHRAGMS	
	S12	420	6	2-6	1-0 CURB - TRANS.	D
	S13	20	6	36-6	SHOWN " " SPAN 114 - LONG.	
	S14	40	6	34-3	" " " " SPAN 213 - LONG.	
	S15	420	5	4-0	1-0 " " TRANS.	C
	S16	420	5	5-0	" " CURB & RAIL PARAPET	E
RAIL PARAPET	R1	16	5	21-3	SHOWN RAIL PARAPET	
	R2	16	5	15-9	" " " " " "	
	R3	32	5	22-3	" " " " " "	
	R4	16	5	22-0	" " " " " "	


# #6 PLAIN BAR - THREAD ONE END 3"

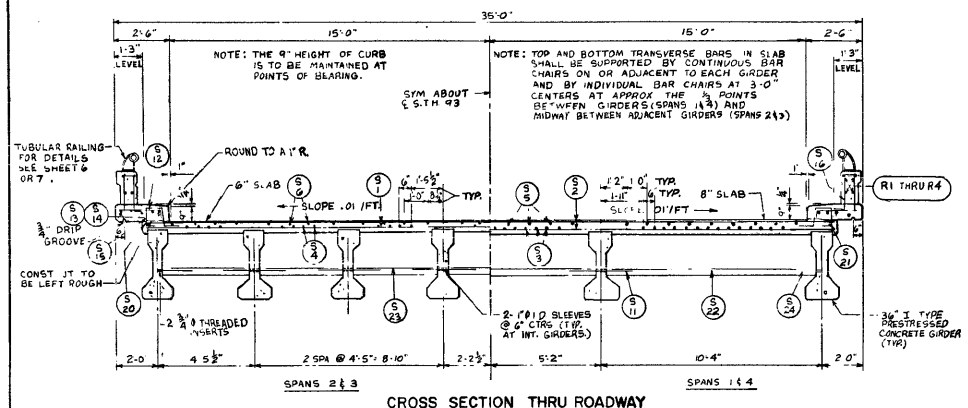


**CROSS SECTION THRU ROADWAY**

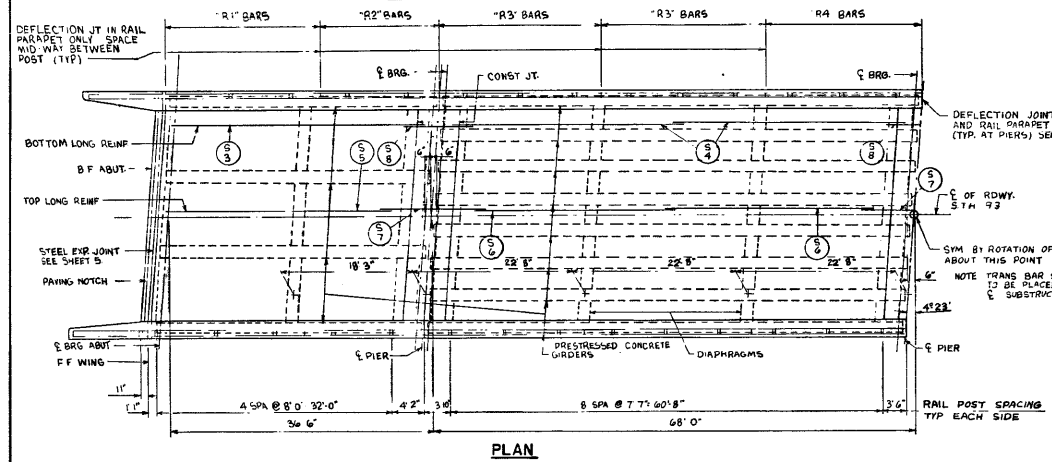


**PLAN**

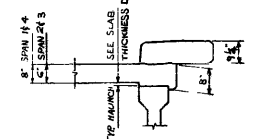


**SLAB DETAIL AT CURBS**

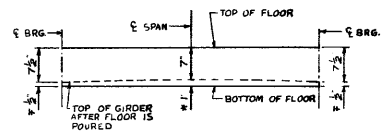


**SLAB THICKNESS DIAGRAM**

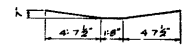


**DETAIL A**

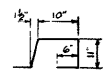

**DETAIL C**

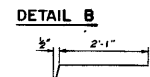

**DETAIL D**

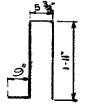



**DETAIL E**

\* TO COMPENSATE FOR VARIATION IN PRESTRESS  
CAMBER AND OTHER MINOR CONSTRUCTION  
DISCREPANCIES THE IMBEDMENT SHOWN  
AT E MAY BE INCREASED TO A MAXIMUM  
OF 15" SLAB THICKNESS SHALL BE HELD  
CONSTANT  
† CONSTANT UNLESS IMBEDMENT AT E WOULD  
OTHERWISE EXCEED 15"



DESIGNED BY	STATE HIGHWAY COMMISSION OF WISCONSIN
<b>SUPERSTRUCTURE</b>	
DESIGN SPEC. AASHTO 61	LOADING H20S16
DATE 11-1-53	DESIGN YGH
STRUCTURE B-18-34	SHEET 2 OF 12

N27936

GEN CONST. JOINTS OVER PIERS TO BE PLACED  
SLAB IN TWO ADJACENT SPANS IS IN PLACE,  
IT BE OMITTED AND CONCRETE FOR ANY TWO  
PLACED IN ONE CONTINUOUS POUR IF PLACEMENT  
BE MADE IN NOT LONGER THAN A 5 HOUR PERIOD.

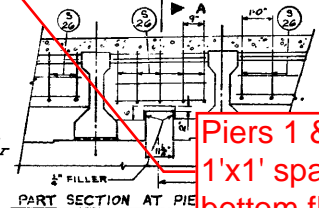
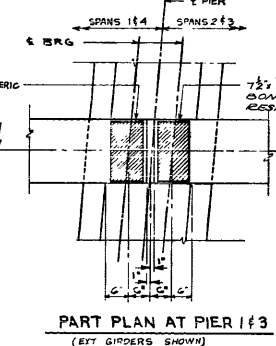


ALL STRUCTURAL  
ROLLED STEEL PLATE  
FROM WARP AND ALL  
ALL PLATE CUTS 4  
ALL SURFACES MAY  
ALL MATERIAL EN  
SHALL BE MADE OF A242 STEEL, WITH A CORROSIVE RESISTANCE  
OF 4 OR MORE TIMES THAT OF A36 STEEL.  
ALL BEARING MATERIAL EXCEPT BRONZE PLATES, BEARING  
PADS AND ANCHOR PLATES SHALL BE PAID FOR AT THE  
UNIT PRICE BID FOR "STRUCTURAL LOW-ALLOY STEEL".

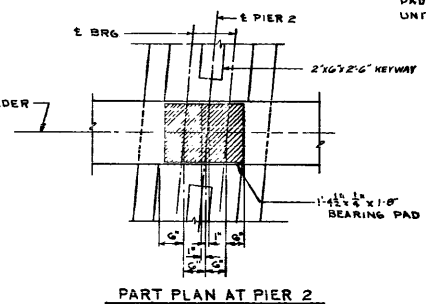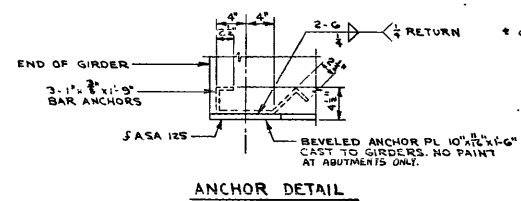


REVISION	STATE HIGHWAY COMMISSION OF WISCONSIN		
	LONG. SECTION & BEARINGS		
	DESIGN SPEC	AASHTO	LOADING H. 20-S16
	DATE: 7/63	DESIGN: VGH	CHECK: DB
			CONTRACT NO. 1963
STRUCTURE	B - 18 - 34		SHEET 3 OF 12



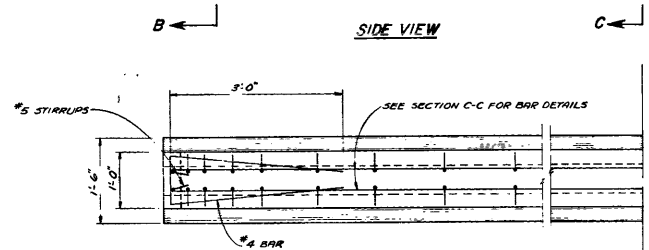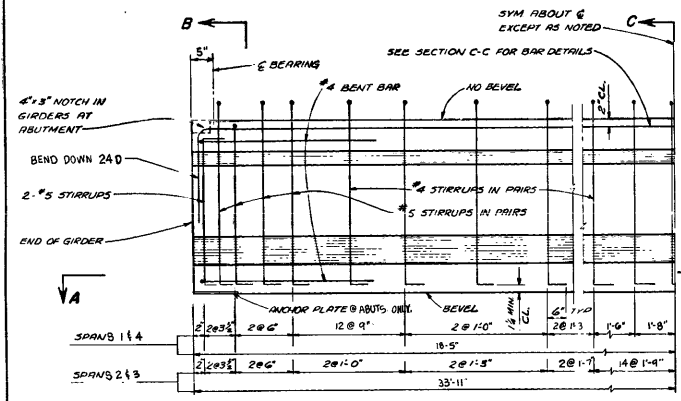


TOP VIEW

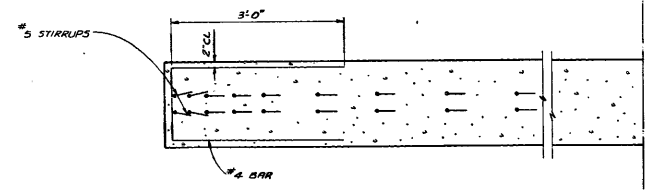

SECTION A-A


MINIMUM CYLINDER STRENGTH OF CONCRETE AT TIME OF TRANSFER OF PRE-STRESS FORCE (FCI)

GIRDER TYPE	SPAN 1 & 4	SPAN 2 & 3
DRAPED PATTERN	4000	4100
SPREAD PATTERN	4000	—

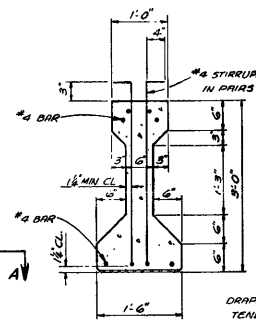


SECTION B-B

TYPICAL ALL SPANS  
(PRE-STRESSED TENDONS NOT SHOWN)

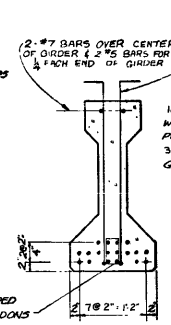


SECTION C-C

SPAN 1 & 4 DRAPED

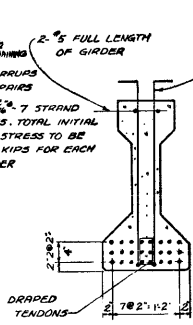

SECTION C-C


SPAN 2 & 3 DRAPED

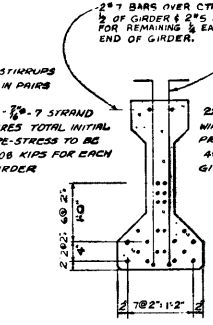


SECTION C-C

SPAN 1 & 4 SPREAD

NOTE: 270,000 P.S.I. ULTIMATE TENSILE STRENGTH STRAND STEEL SHALL BE USED. IF THE CONTRACTOR WISHES TO USE OTHER GRADE OF STRAND STEEL HE SHALL SUBMIT DETAILED PLANS FOR APPROVAL.

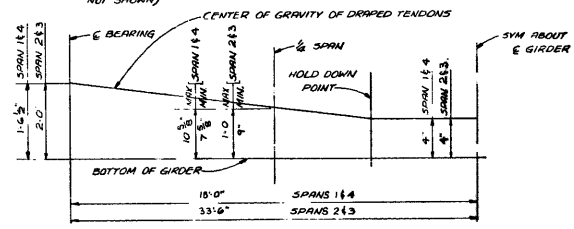

DRAPED TENDON PROFILE

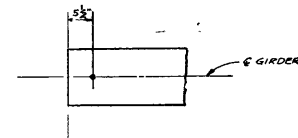

EXPANSION PLATE ANCHOR BOLT LAYOUT

DEFLECTION DATA

CAMBER	SPAN 1 & 4	SPAN 2 & 3
*A - PRE-STRESS CAMBER	1/2"	1/8"
*B - DEAD LOAD DEFLECTION	1/2"	5/8"
*C - RESIDUAL CAMBER	1/2"	1"

\* PRE-STRESS CAMBER AND DEAD LOAD DEFLECTION DATA SHOWN ARE THEORETICAL AND MAY VARY WITH CONCRETE STRENGTH, VARIABLE PRE-STRESSING CONDITIONS AND PRE-STRESS LOSSES.

NOTES:  
ALL GIRDERS SHALL BE CAST FULL LENGTH AS SHOWN WIRES SHALL BE PLUSH WITH END OF GIRDER AND DRAPED. SEE NOTE "A" ON SHEETS X279360 / X279361.  
TOPS OF GIRDERS SHALL BE ROUGH FLOATED AND BROOMED TRANSVERSELY FOR BONDING TO SLAB.  
THE GIRDER MANUFACTURER SHALL PROVIDE A SUITABLE LIFTING DEVICE FOR HANDLING AND ERECTING THE GIRDERS. DETAILS OF THE LIFTING DEVICE TO BE USED SHALL BE SUBMITTED FOR APPROVAL.


REVISION	STATE HIGHWAY COMMISSION OF WISCONSIN
	PRE-TENSIONED GIRDER DETAILS
DESIGN BY: ARS HD 661	DATE: 11-7-63
CHECKED BY: VGM	DATE: 11-7-63
STRUCTURE: B-18-34	SHEET: 4 OF 12

X27936


# LEGEND

- 1 ST 6" W 39.5" ROWY WIDTH PROVIDE 1/2" VENT HOLES 10" AT 2'0" CTRS.
- 2 1/2" x 4" 1/2" ROWY WIDTH PROVIDE 1/2" VENT HOLES 10" AT 2'0" CTRS.
- 3 1/2" x 4" 1/2" ROWY WIDTH WELD TO L#2 WITH 2 LINES OF 1/2" FILLET WELD.
- 4 1/2" x 4" 1/2" ROWY WIDTH WELD TO L#2 WITH 2 LINES OF 1/2" FILLET WELD.
NOTES:  
ALL ITEMS, MARKED #, SHALL BE MADE OF A242 STEEL WITH A CORROSIVE RESISTANCE OF 4 OR MORE TIMES THAT OF A36 STEEL.  
EXPANSION JOINT SHALL BE BUILT TO CONFORM TO ROWY CROWN AND GRADE.  
ALL MATERIAL IN EXPANSION JOINT TO BE PAID FOR AS STRUCTURAL LOW ALLOY STEEL.  
AFTER CONCRETE HAS SET REMOVE BOLTS NO 9 & NO 19 AND FILL HOLES WITH HOT POURED ELASTIC TYPE JOINT SEALER.  
NO PAINT SHALL BE APPLIED TO EXPANSION JOINT EXCEPT AS NOTED.

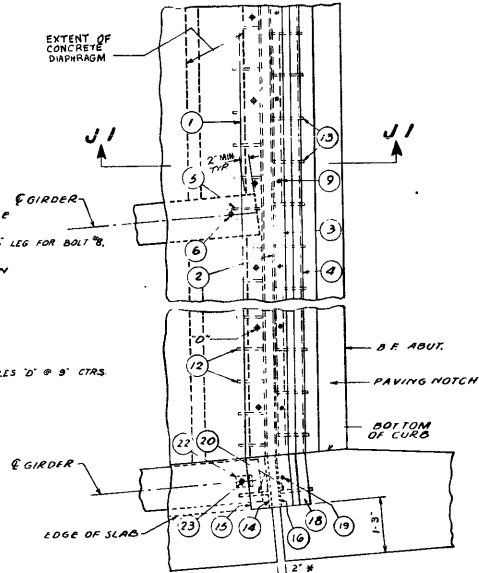


PART PLAN (2 REQ'D)

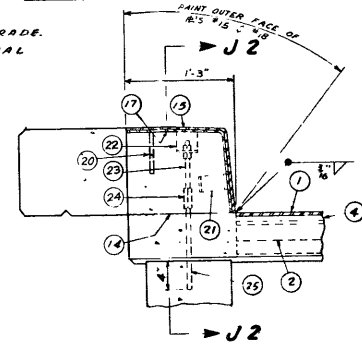

SECTION THRU JOINT AT CURB

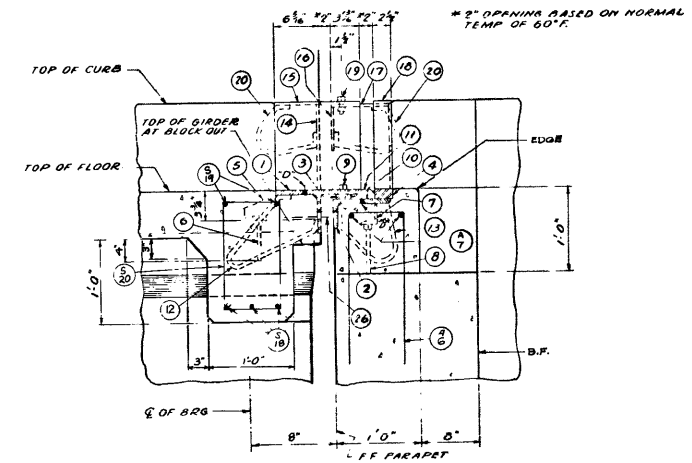


SECTION J1

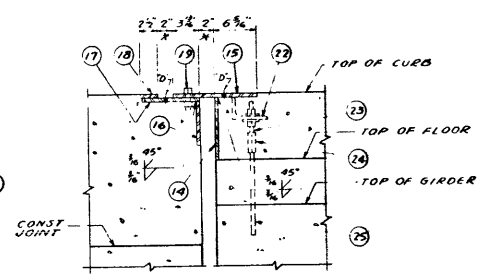


SECTION J2

STATE HIGHWAY COMMISSION OF WISCONSIN	
EXPANSION JOINT	
AA1 NO 61	H20-S10 1963
110	DB 34
STRUCTURE B-18-34	SHEET 5 OF 12



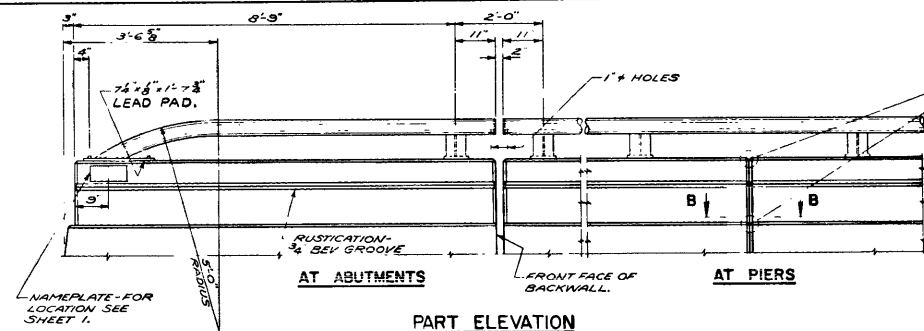


PART ELEVATION

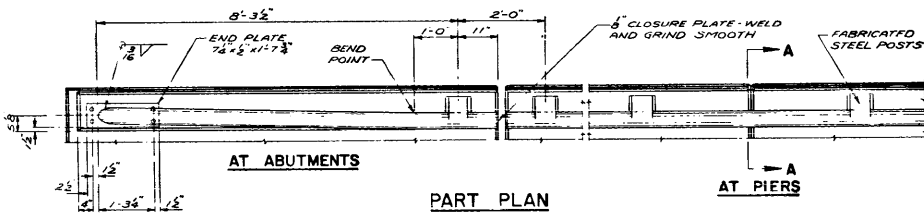

PART PLAN

FILL WITH NON-STAINING GRAY TWO COMPONENT POLYSULFIDE LIQUID POLYMER (GUN GRADE) WITH SURFACE PRIMER, MEETING APPROVAL OF THE ENGINEER.

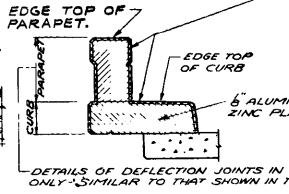


SECTION A

SECTION THRU CURB

SECTION B


SLEEVE SHALL BE WELDED TO DOWNGRADE SIDE OF JOINT

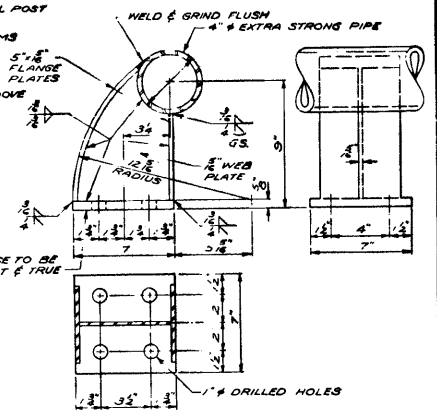


POST DETAILS

NOTES


- 1 STEEL RAIL POSTS SHALL BE SET NORMAL TO GRADE
- 2 RAILING SHALL BE FABRICATED IN 2 & 3 PANEL LENGTHS
- 3 STEEL SHIMS SHALL BE USED UNDER POSTS AND UNDER END PLATES WHERE REQUIRED FOR ALIGNMENT
- 4 WHEN PARAPETS AND CURBS ARE POURED CONTINUOUSLY FROM END TO END THEY SHALL BE SEPARATED AT THE DEFLECTION JOINTS BY A PIECE OF 6 ZINC OR ALUMINUM PLATE CUT AS SHOWN IN SECTION A B SHOWN AREA
- 5 THE FOLLOWING MATERIALS SHALL BE USED:  
 1. RAILING SHALL BE 4" EXTRA STRONG PIPE CONFORMING TO ASTM DESIGNATION A53, GRADE B  
 2. SLEEVES SHALL BE 3" x 4" x 1/2" THICK SEAMLESS MECHANICAL TUBING MADE OF STEEL WITH A MINIMUM ULTIMATE TENSILE STRENGTH OF 60,000 PSI AND A MINIMUM ELONGATION OF 10%  
 3. POSTS SHALL BE FABRICATED FROM MATERIAL CONFORMING TO ASTM DESIGNATION A36  
 4. ANCHOR BOLTS TO BE MADE FROM MATERIAL CONFORMING TO ASTM A307.  
 5. GALVANIZE ENTIRE RAILING AFTER FABRICATION INCLUDING NUTS, WASHERS, SHIMS AND TOP 3/2 OF ANCHOR BOLTS

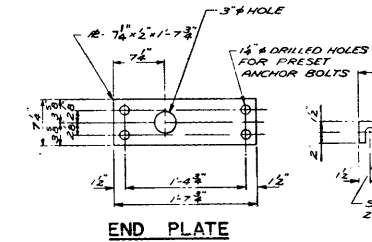

END PLATE

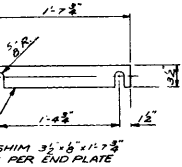



END PLATE SHIM DETAILS

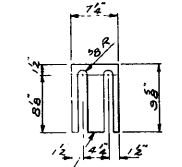


POST SHIM DETAILS

SHOP RAIL SPLICE DETAIL

FIELD ERECTION JOINT DETAIL

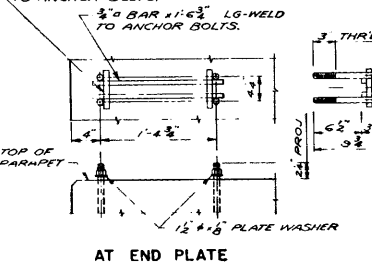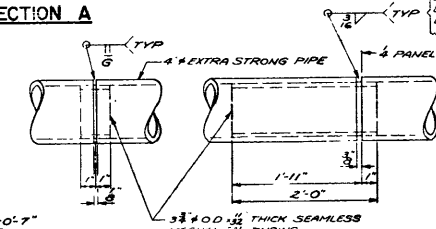

AT END PLATE

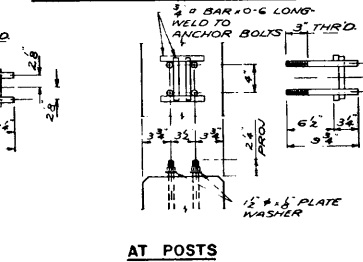

AT POSTS

ANCHOR BOLT SETTING DETAILS

THE SHANK AND ROOT OF THREAD DIAMETER FOR ANCHOR BOLTS SHALL BE A MINIMUM OF 0.62 INCHES.

STATE HIGHWAY COMMISSION OF WISCONSIN	TUBULAR STEEL RAILING
DESIGN BY A.A.S. & S. / 1/2" x 6" x 1'-7 3/8"	TYPE 6
DATE 11/1/63	BY S.T.O. / 1/2" x 6" x 1'-7 3/8"
STRUCTURE B-18-34	SHEET 7 OF 12

Remove and replace abutment backwall.

2.5'x1.5' Conc. Surface repair

North Abutment

3'x1.5' Conc. Surface Repair


Significant spalling, cracking and efflorescence on NW abutment backwall and beam seat.

Beam seat may need to be removed to a certain elevation.


1.5' of girder end significantly deteriorated with exposed rebar and separated strands.

Remove and replace N. abutment backwall


Direction to clean all girder ends and place concrete diaphragm. This bridge has an expansion joint and expansion bearings under the girders - WisDOT has directed for a bearing conversion to occur.

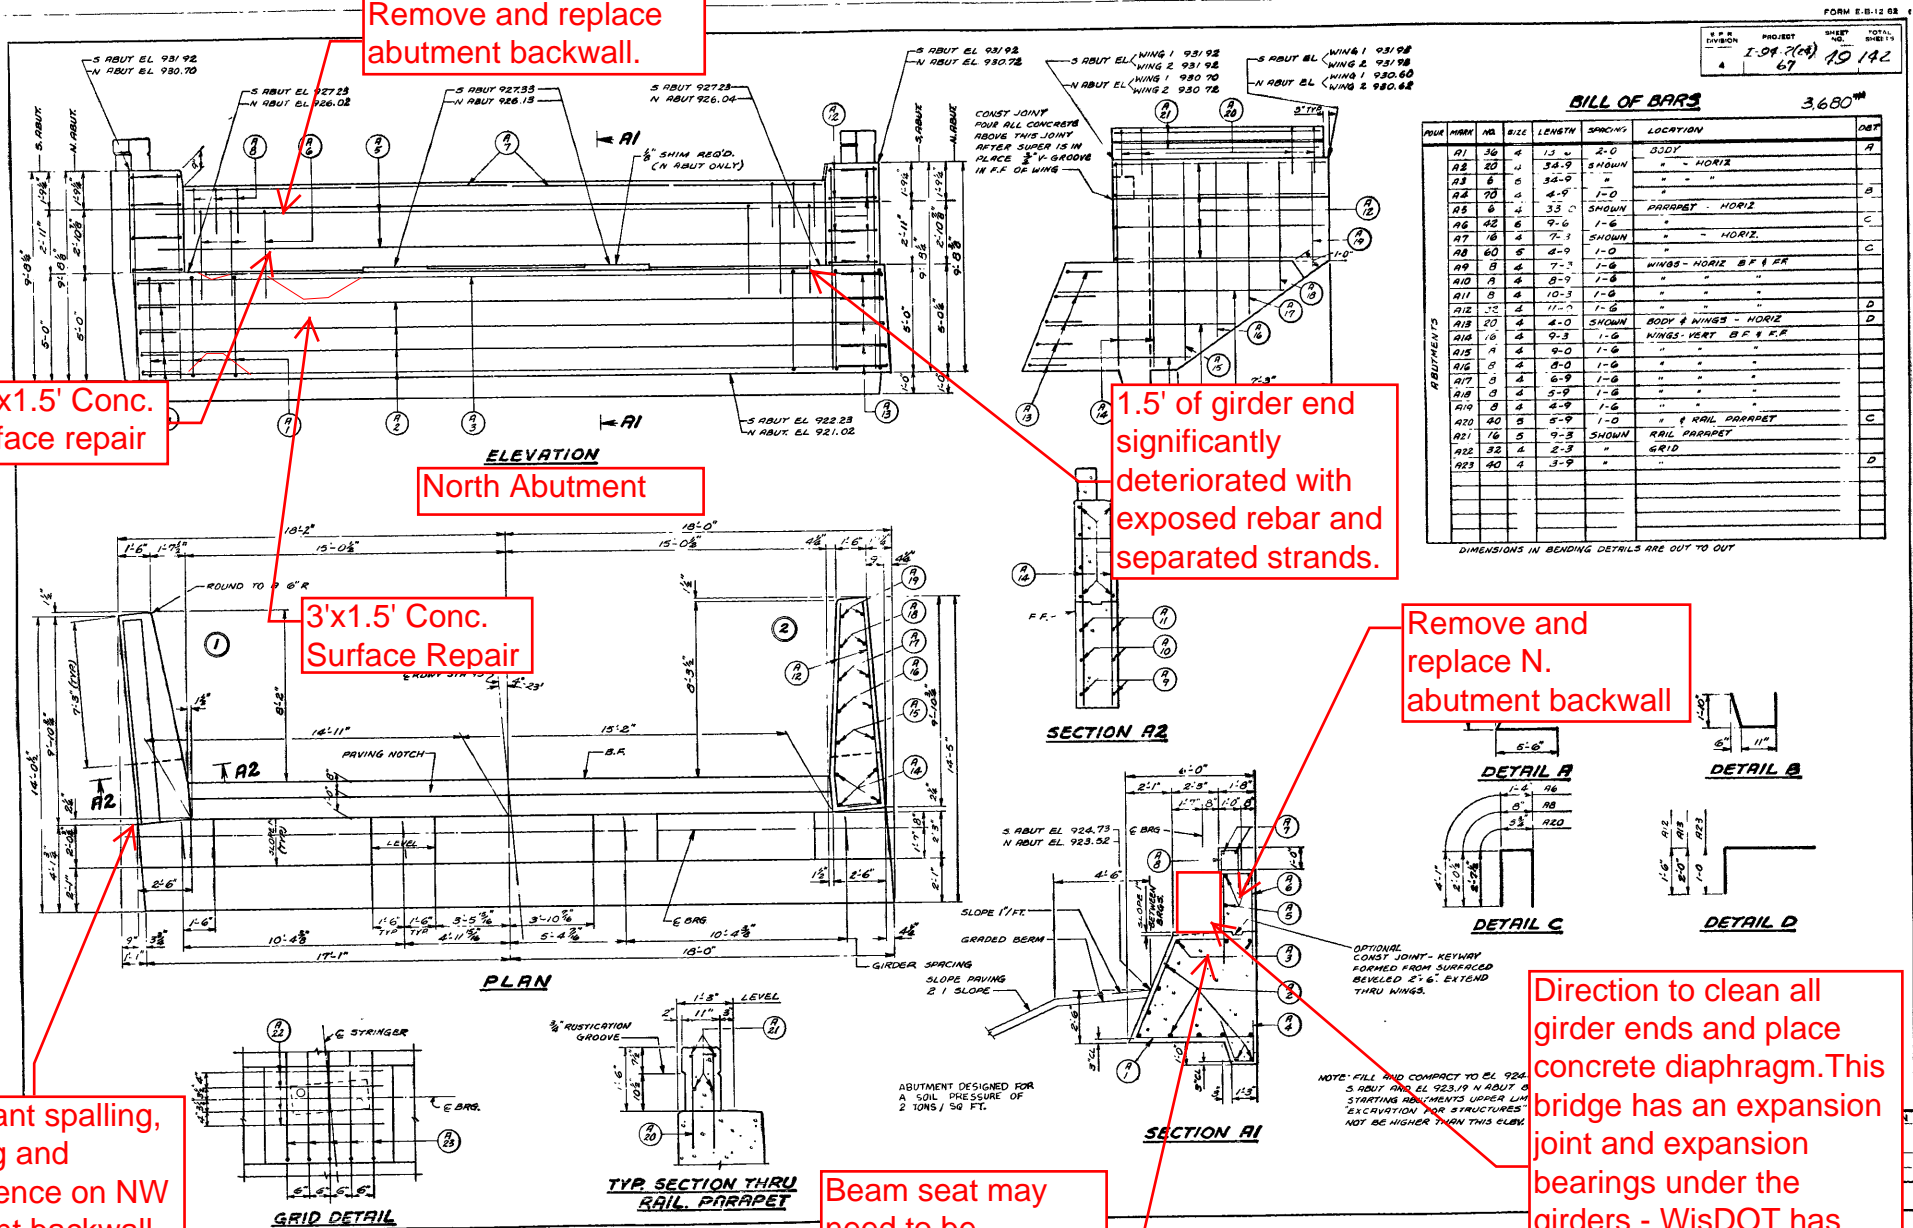

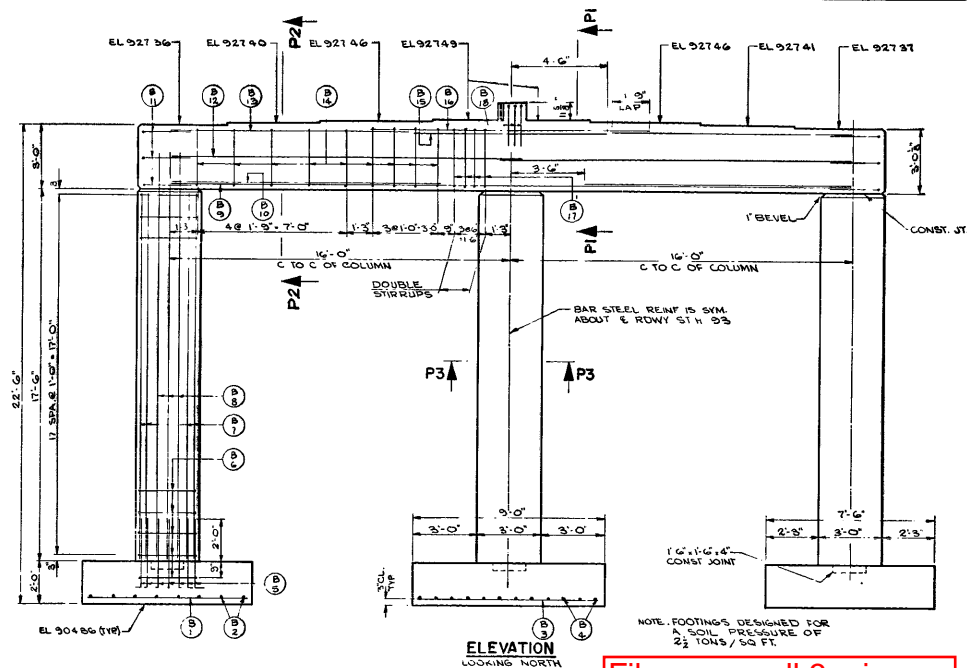


ELEVATION  
LOOKING NORTH


Fiber wrap all 3 piers

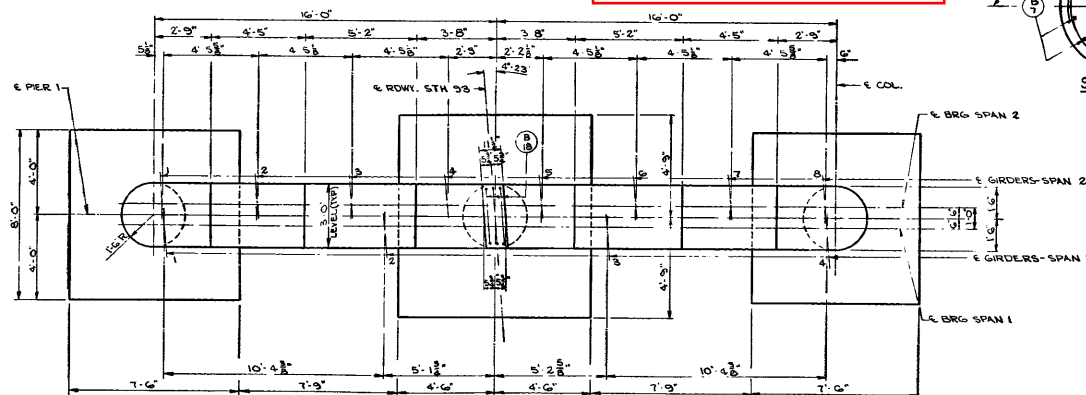


PLAN

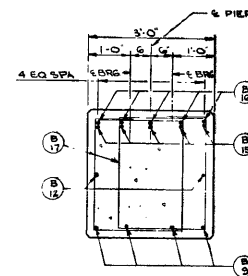

SECTION P1

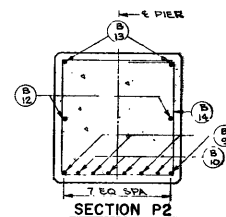

SECTION P2

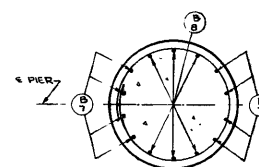

SECTION P3

5,210\*

BILL OF BARS  
DIMENSIONS IN BRACKETING DETAILS ARE OUT TO OUT

MARK	NO.	SIZE	LENGTH	SPACING	LOCATION	UNIT
B1	16	5	7'-0"	SHOWN	FOOTINGS - EXTERIOR	
B2	16	5	7'-0"	SHOWN	FOOTINGS - EXTERIOR	
B3	11	7	8'-6"	"	INTERIOR	
B4	12	7	9'-0"	"	"	
B5	42	8	4'-0"	"	- DOWELS	
B6	3	4	9'-6"	"	- HOOPS	
B7	24	4	9'-6"	1'-0"	COLUMNS - HOOPS	
B8	18	8	17'-3"	SHOWN	"	
B9	5	5	16'-0"	"	CAP - HORIZ.	
B10	5	5	12'-0"	"	ENDS	
B11	4	4	16'-0"	"	HORIZ.	
B12	4	4	16'-0"	"	"	
B13	4	5	11'-3"	"	STIRRUPS	
B14	18	4	11'-3"	"	HORIZ. #	
B15	5	10	9'-0"	"	"	
B16	5	10	13'-0"	"	"	
B17	16	5	10'-6"	"	DOUBLE STIRRUPS	
B18	3	5	6'-6"	"	CAP @ SHEAR KEY	

\* BUNDLED BARS - SEE DETAIL



DETAIL A




DETAIL B




DETAIL C




BUNDLE DETAIL

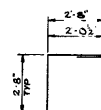


DETAIL D

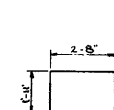

DETAIL E

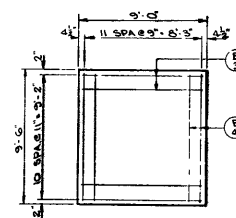

INTERIOR

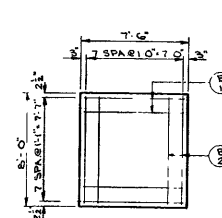

EXTERIOR

FOOTING PLAN

## CONCRETE MASONRY

FOOTINGS	15.2 CY
COLUMNS	13.7 CY
CAP	11.8 CY
TOTAL	407 CY


REVISION	STATE HIGHWAY COMMISSION OF WISCONSIN
PROJECT	PIER 1
DESIGN BY	A.A.S.H.O. 101 (LOADING H20 S16) 1965
DATE	11-7-63
BY	V.G.M. FORAN J.C.K. LEO
STRUCTURE	B-18-34
SHEET	9 OF 12

N27943









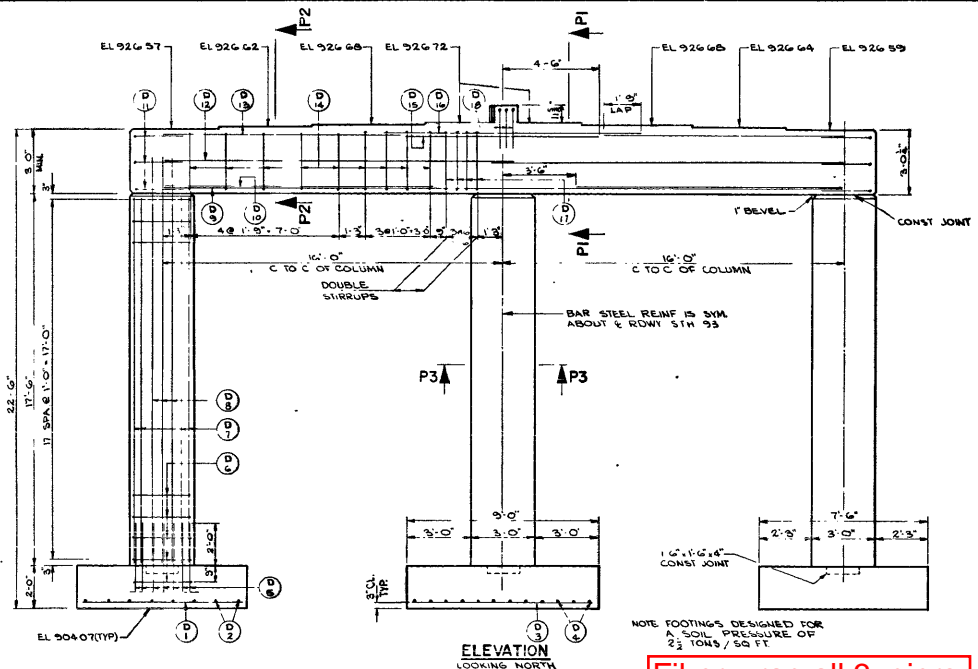

Fiber wrap all 3 piers

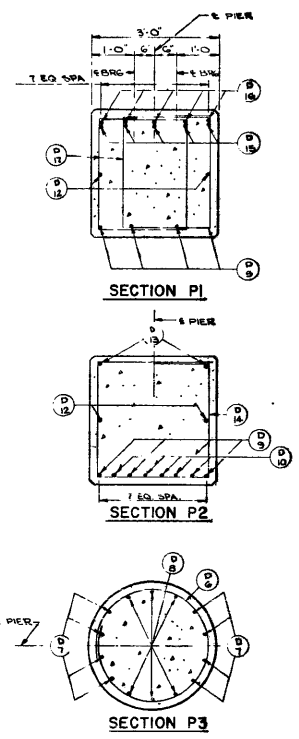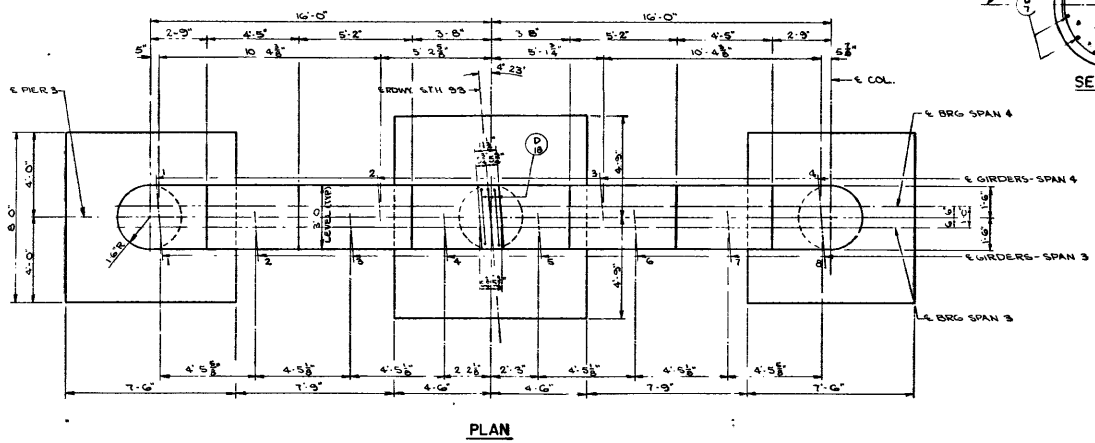


**BILL OF BARS** 5.210'

DIMENSIONS IN BRACKET DETAILS ARE OUT TO OUT


FOOTING	NO	SIZE	LENGTH	SPACING	LOCATION	QTY
D1	16	5	7'-0"	SHOWN	FOOTINGS - EXTERIOR	
D2	16	5	7'-6"	"	"	
D3	11	7	8'-6"	"	"	
D4	12	7	9'-0"	"	"	
D5	42	8	4'-0"	"	"	
D6	3	4	9'-6"	"	"	
D7	24	8	17'-0"	SHOWN	COLUMNS - HOOPS	
D8	15	8	19'-6"	"	"	
D9	8	9	16'-0"	"	"	
D10	8	9	12'-6"	"	"	
D11	6	4	6'-3"	"	"	
D12	4	4	16'-6"	"	"	
D13	4	5	11'-3"	"	"	
D14	15	4	11'-0"	"	"	
D15	10	9	9'-0"	"	"	
D16	5	10	13'-0"	"	"	
D17	16	5	10'-6"	"	"	
D18	3	5	6'-6"	"	"	

\* BUNDLED BAR SEE DETAIL.

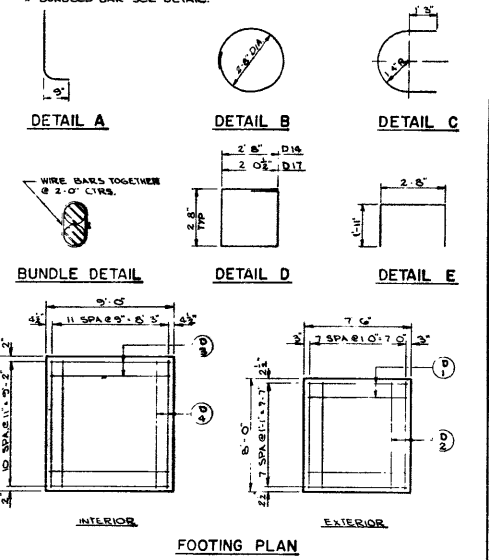

**CONCRETE MASONRY**  
FOOTINGS 15.2 CY  
COLUMNS 15.7 CY  
CAP 11.8 CY  
TOTAL 42.7 CY


STATE HIGHWAY COMMISSION OF WISCONSIN  
PROJECT: I-94 (201) 52 142  
SHEET: 67  
STRUCTURE: B 18-34  
SHEET: 11 of 12  
X 27945

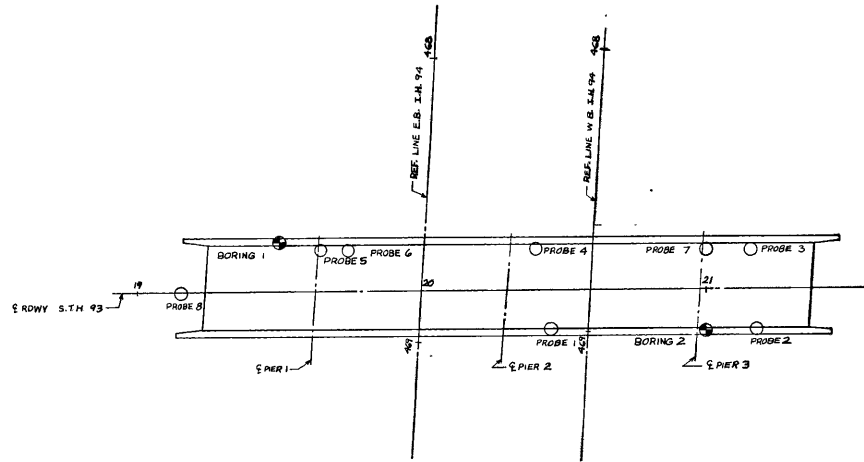

# SUBSURFACE EXPLORATION FOR FOUNDATION DESIGN

FOR THE DESIGN OF THE STRUCTURE FOUNDATION, TO OBTAIN RELATIVE DATA CONCERNING THE CHARACTER OF MATERIAL IN AND UPON WHICH THE FOUNDATION MIGHT BE BUILT, BORINGS AND/OR SOUNDINGS WERE MADE AT POINTS APPROXIMATELY AS INDICATED ON THIS DRAWING WITH THE LOG OF SUCH EXPLORATION DATA AS INTERPRETED FOR SUCH DESIGN PURPOSE AS SHOWN. THE EXPLORATIONS WERE MADE BY ORDINARY AND CONVENTIONAL METHODS AND CARE OFFERED ADEQUATE FOR SUCH PURPOSE. HOWEVER, SINCE IT IS A MATTER OF COMMON KNOWLEDGE THAT THE EXACT CHARACTER OF ANY MATERIAL AND ITS REACTION IS DIFFICULT TO DETERMINE FROM SUCH SUBSURFACE EXPLORATION AND THAT THE KIND AND CHARACTER OF MATERIAL AT THE SITE WHERE THE FOUNDATIONS ARE BUILT MAY VARY SUBSTANTIALLY FROM THAT INDICATED BY THE LOG THEY ARE MADE AVAILABLE TO THE BIDDERS SIMPLY FOR WHAT THEY ARE WORTH, WITHOUT ANY WARRANTY, EXPRESSED OR IMPLIED THAT THE MATERIAL TO BE ENCOUNTERED IN BUILDING THE FOUNDATION WILL CONFORM THEREWITH. IF THE LOG IS USED BY THE CONTRACTOR OR IN MAKING HIS BID, IT IS HEREBY EXPRESSLY STIPULATED THAT THE COMMISSION ACCEPTS NO RESPONSIBILITY FOR SAID USE.

UNLESS OTHERWISE SPECIFIED THE BLOWS PER FOOT AT THE LOCATIONS INDICATED ARE BASED ON DRIVING A 2" OD X 1.4" ID SPLIT SPOON SAMPLER WITH A 140 LB. HAMMER HAVING A FREE FALL OF 30 INCHES. THE BLOW COUNT IS TAKEN IN UNDISTURBED SOIL IMMEDIATELY BELOW A CASED OR OPEN HOLE ELIMINATING SIDE FRICTION ON THE DRIVE PIPE.

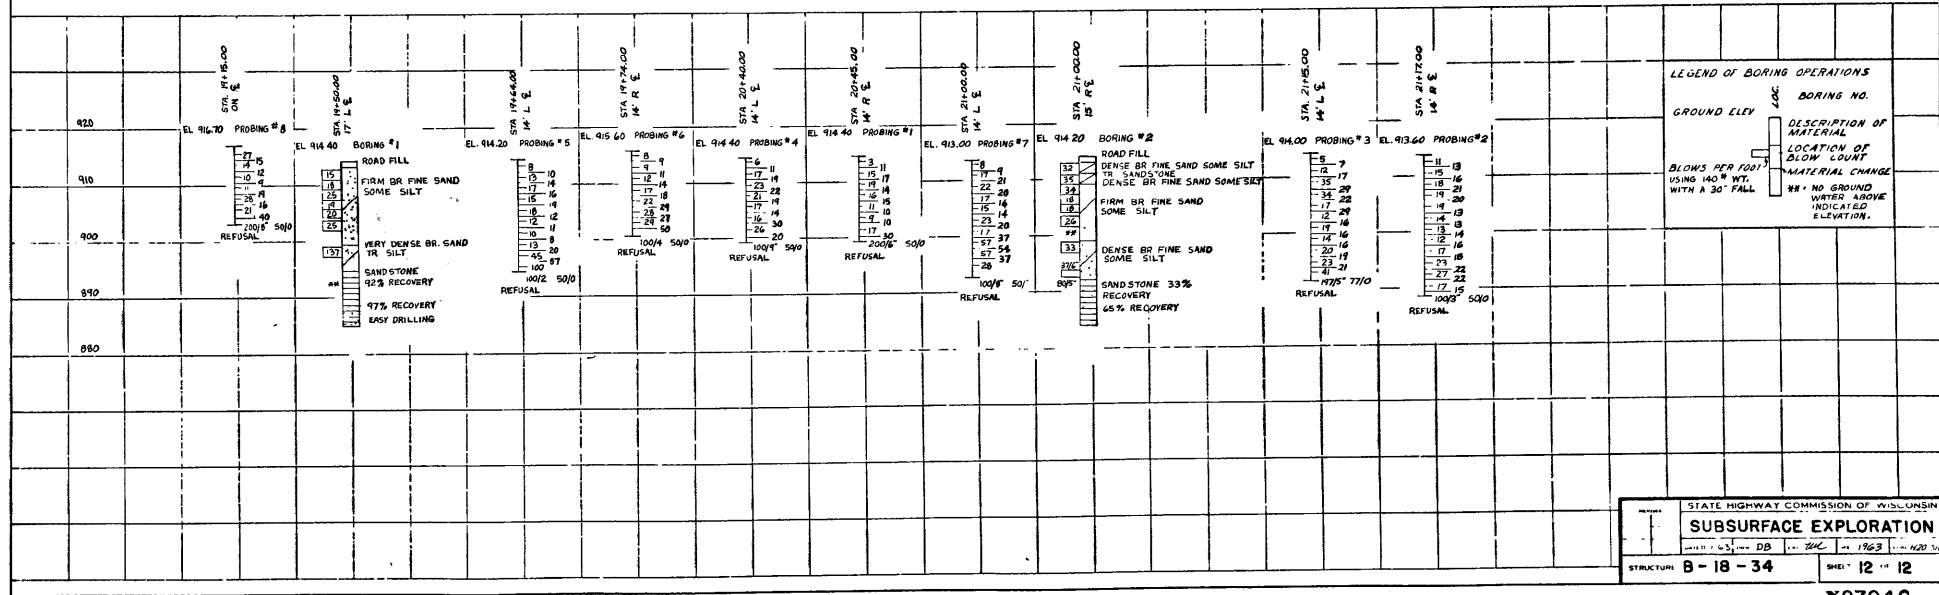

STATE HIGHWAY COMMISSION OF WISCONSIN  
**SUBSURFACE EXPLORATION**  
 STRUCTURE: 8-18-34 SHEET: 12 OF 12  
 X27946