



STATE OF WISCONSIN  
DEPARTMENT OF TRANSPORTATION

# Inspection Report for B-03-015

USH 53 NB over CARLSON SCHOOL DRIVE  
Jun 08,2017



Type	Prior	Frequency (mos)	Performed
Routine	06-25-15	24	X
Interim	02-25-13	0	
SIA Review	06-13-13	48	X

Latitude 45°13'16.59"N  
Longitude 91°34'51.25"W

Owner STATE HIGHWAY DEPT  
Maintainer STATE HIGHWAY DEPT

## Time Log

Hours	Minutes	Team members
1	15	wjk

## Team members

Inspector	Name	Number	Signature	Date
	Kovaleski, William J	8007	<i>William J Kovaleski</i> E-signed by Bill(dotwjk)	09-06-17

**BRIDGE INSPECTION REPORT**  
**Wisconsin Department of Transportation**  
**DT2007 2003 s.84.17 Wis. Stats.**

page 2

**Identification & Location**

Feature On: USH 53 NB	Section Town Range: S26 T32N R10W	Structure Number:  <b>B-03-015</b>
Feature Under: CARLSON SCHOOL DRIVE	County: BARRON	
Location 1.5M N JCT CTH M TO E	Municipality: DOVRE	Structure Name:

**Geometry**

measurements in feet, except where noted

Approach Roadway Width: 40	Bridge Roadway Width: 40.0	Total Length: 147.2
Approach Pavement Width: 24	Deck Width: 43.8	Deck Area (sq ft): 6447

**Traffic**

	Lanes	ADT	ADT year	Traffic Pattern
On	2	5550	2014	ONE WAY TRAFFIC
Under	2	3220	1988	TWO WAY TRAFFIC

**Capacity**

**Load Rating**

Inventory rating: HS18	Overburden depth (in): 2.0	Last rating date: 06-18-13	Controlling: SLAB Positive Moment
Operating rating: HS31	Deck surface material: LOW SLUMP CONCRETE	Re-rate for capacity (Y/N):	Control location: 0.6 SPAN 1
Posting:	Re-rate notes:		

**Hydraulic**

**Classification**

Scour Critical Code(113): (N) NO WATERWAY	Q100 (ft3/sec): 0	
High water elevation (ft): 0.0	Velocity (ft/sec): 0.0	Sufficiency #: 93.8

**Span(s)**

Span #	Material	Configuration	Depth (in)	Length (ft)	Main
1	CONT CONCRETE	HAUNCHED SLAB		39.5	
2	CONT CONCRETE	HAUNCHED SLAB		67.0	Y
3	CONT CONCRETE	HAUNCHED SLAB		38.0	

**Expansion joint(s)**

**Temperature:**

File:	New:
-------	------

**Clearance**

Item	File Measurement (ft)	File Date	New Measurement (ft)
Highway Min Vertical Under Cardinal	14.35	07-Jun-2007	
Highway Min Vertical Under Non-Cardinal			
Horizontal Under Cardinal	55.5		
Horizontal Under Non-Cardinal			
Highway Min Vertical On Cardinal			
Horizontal On Cardinal			

**Special Components**

Component	Year	Work Performed	Note
DECK - IOWA MIX	1989	OVERLAY - CONCRETE	

**Construction History**

Year	Work Performed	FOS id
1989	OVERLAY - CONCRETE	0003-84-01
1972	NEW STRUCTURE	1196-06-71

**BRIDGE INSPECTION REPORT**  
**Wisconsin Department of Transportation**  
**DT2007 2003 s.84.17 Wis. Stats.**

page 3

Structure No.: **B-03-015**

**Maintenance Items History**

Item	Recommended by	Status	Status change	Year completed
<b>Misc - Wash Bridge</b>	Kurtz, William G (8008)	REJECTED	09/01/17	
Power wash structure to remove swallow nests.				
<b>Deck - Patching</b>	Bjorklund, Allan M (8003)	COMPLETE	01/17/13	
Approx. 40 sf mainly at joints.				
<b>Deck - Patching</b>	Harrington, Daniel J (8004)	COMPLETE	01/17/13	
approx 16 sq ft of deck patching				
<b>Deck - Patching</b>	Harrington, Daniel J (8004)	COMPLETE	01/17/13	
approx 20 sf. various spalls.				

**Maintenance Items**

Item	Priority	Recommended by	Status	Status change
<b>Deck - Surface Repair Spalls</b>	HIGH	Kurtz, William G (8008)	IDENTIFIED	07/02/15
Repair SPL in Wearing Surface (103SF).				
<b>Deck - Patching</b>	HIGH	Kurtz, William G (8008)	IDENTIFIED	07/02/15
Repair SPL in Reinforced Concrete Deck (102SF). Repair CRK in Reinforced Concrete Deck (5SF).				
<b>Deck - Repair Railing</b>	MEDIUM	Kurtz, William G (8008)	IDENTIFIED	07/02/15
Repair SPL in RAILS (22LF).				
<b>Substructure - Other Work</b>	MEDIUM	Kurtz, William G (8008)	IDENTIFIED	07/02/15
Seal Columns.				

**Elements**

Chk	Element	Defect	Description	UOM	Total	Quantity in Condition State			
						1	2	3	4
X	38		<b>Reinforced Concrete Slab</b>	SF	6,447	6,235	207	5	0
			Delamination - Spall - Patched Area	SF		0	136	5	0
		1080	<b>Faces: few small impact edge spalls w no exposed rebar. CS3 Edge delam w/ rust staining and efflorescence north/adjacent to Pier 2 on west face. Underside: areas of concrete deterioration w/ It efflorescence (begin delam) - Span 1 = 8ftx8ft, Span 2 = 2x4ftx8ft areas.</b> East edge west bound no rebar showing west edge eastbound about 4" rebar showing 6/25/2015 SP1 C/L SPL CS3 64SF. 6/25/2015 SP2 SPL CS3 32SF   W IMPACT SPL CS3 2SF   E IMPACT SPL CS3 4SF.						
		1130	Cracking (RC)	SF		0	71	0	0
			<b>Faces: multiple fine to hrline vert cracks at pier locations and parapet joints some w It to med efflorescence. Underside: Hrline longitudinal approx. half span of SP1 extends into half of SP2 btwn Cols 1 &amp; 2. Span 3 full span fine longitudinal crack w/ It to med efflorescence.</b>						
	8514		Concrete Overlay	SF	6,447	62	6,282	103	0
			More extensive cracking in overlay. Worse 07 large areas of delam found with chaining approx 16 sq ft of spalls in deck at compression joints 20 SF 2011.						
		3210	Debonding/Spall/Patched Area/Pothole	SF		0	482	103	0
			<b>Delam/debonding from previous inspect. Spot locations of spalling at joint locations w asphalt filling.</b>						
		3220	Crack (Wearing Surface)	SF		0	5,800	0	0
			<b>Fine to hrline map cracking throuthour - approx. 91%.</b>						

**BRIDGE INSPECTION REPORT**  
**Wisconsin Department of Transportation**  
**DT2007 2003 s.84.17 Wis. Stats.**

page 4

Structure No.: **B-03-015**

X	205		<b>Reinforced Concrete Column</b>	EA	8	5	1	2	0
			C2 and 3 on P1 and C3 on P2 have a horizontal crack approx 3 inches below haunch. Monitor.						
		1130	Cracking (RC)	EA		0	1	2	0
			<b>Pier 1 - Col 2 &amp; 3 have CS3 horiz cracks at tops half of circum primarily at S and E faces (Col 2 worse). Pier 2 - Col 3 CS3 horiz on top / Col 2 fine horiz top approx. grter around.</b>						
X	215		<b>Reinforced Concrete Abutment</b>	LF	187	173	11	3	0
			1 vertical crack c/I S abut.						
		1080	Delamination - Spall - Patched Area	LF		0	2	2	0
			<b>SOUTH: spalls at ADW edges.</b>						
		1130	Cracking (RC)	LF		0	9	1	0
			<b>SOUTH: CS3 vert at CL / fine to hrlne vert cracks at Brg 2 &amp; 4 and Bay 2. NORTH: fine to hrlne vert crack at mid east half.</b>						
X	300		<b>Strip Seal Expansion Joint</b>	LF	95	95	0	0	0
			<b>Some filled not all visible - no obvious indications of problems.</b>						
X	311		<b>Moveable Bearing</b>	EA	6	0	6	0	0
			<b>South abutment</b>						
		1000	Corrosion	EA		0	6	0	0
			<b>Med rust on btm plates w/ some edge rusting.</b>						
X	331		<b>Reinforced Concrete Bridge Rail</b>	LF	294	42	230	22	0
		1080	Delamination - Spall - Patched Area	LF		0	0	22	0
			<b>CS3 horiz cracks and delam spot locations w/ rust staining - NE worse. 8ft top edge spall in NE.</b>						
		1130	Cracking (RC)	LF		0	230	0	0
			<b>Multiple areas of hrlne vert cracks and hrlne horiz cracks.</b>						
X	8400		<b>Integral Wingwall</b>	EA	4	4	0	0	0

**Assessments**

Chk	Element	Defect	Description	UOM	Total	Quantity in Condition State			
						1	2	3	4
X	9001		<b>Drainage - Approach</b>	EA	4	4	0	0	0
			NE drain has hole in back of catch basin. clean and clear Repaired 2010 with paving project. Clear 2013.						
X	9030		<b>Signs - Object Markers</b>	EA	2	2	0	0	0
X	9043		<b>Slope Protection- Crushed Aggregate with Bit.</b>	EA	2	2	0	0	0
			<b>Rocks tightly adhered. Vegetation and bleaching at edges.</b>						
X	9322		<b>Approach Roadway - Concrete (non-structural)</b>	EA	2	0	2	0	0
			both cracked and broken <b>and filled w/ asphalt</b>						
X	9335		<b>Decorative Rail</b>	EA	2	0	2	0	0
			<b>Type J tubular rail on parapets. Missing section from NE.</b>						

**NBI Ratings**

	File	New
Deck	4	6
Superstructure	6	6
Substructure	7	7
Culvert	N	N
Channel	N	N
Waterway	N	N



**BRIDGE INSPECTION REPORT**  
**Wisconsin Department of Transportation**  
**DT2007 2003 s.84.17 Wis. Stats.**

page 5

Structure No.: **B-03-015**

**Structure Specific Notes**

**OLD:** Overall, condition of structure is good, the deteriorated element for this structure is the superstructure/deck. This is a three span haunched slab with 7.4% delam - 1995. Approx 10 gals of epoxy was **used to fill the extensive map cracking on this wearing surface. Record shows this as original deck built 1972. Should program for overlay. 359 crack @ CL span 3, approx 20LF.**  
**(99) Bearings should be wire brushed and painted. Deck extensively cracked with random/spider cracks. Otherwise in good condition.**  
**(01) Structure is in good overall condition. The surface of the deck and parapets being the only areas of concern. Deck has extensive map cracking and is beginning to spall.**

**Inspection Specific Notes**

**Inspector Site-Specific Safety Considerations**

**Structure Inspection Procedures**

**Walk-thru**

**Special Requirements**

Chk	Hours	Cost	Comments
-----	-------	------	----------

Routine  
Document Comment/Description

Col 2, Pier 1 - south face



Routine  
Document Comment/Description

West face over Pier 2



**Routine**  
**Document Comment/Description**

NE rail



# STRUCTURE INVENTORY AND APPRAISAL FIELD REVIEW FORM

**B-03-015**  
**USH 53 NB over CARLSON SCHOOL DRIVE**

## LOCATION

(3) Municipality:  
 (16) Latitude(° ' "):  
 (17) Longitude(° ' "):

DOVRE
45°13'16.59"N
91°34'51.25"W

## TRAFFIC SERVICE

(28A) Lanes On:  
 (28B) Lanes Under:  
 (102) Traffic Pattern On:  
 (102) Traffic Pattern Under:  
 (19) Detour Length(mi):

2
2
-NO TRAFFIC <input checked="" type="checkbox"/> -ONE WAY TRAFFIC -TWO WAY TRAFFIC
-NO TRAFFIC -ONE WAY TRAFFIC <input checked="" type="checkbox"/> -TWO WAY TRAFFIC
1

## GEOMETRY

(49) Structure Length(ft):  
 (50) Sidewalk Width(ft):  
 (50) Curb Width(ft):  
 (52) Culvert Barrel Length(ft):  
 (34) Skew:  
  
 (51) Bridge Roadway Width(ft):  
 (52) Deck Width(ft):  
 Right Wingwall Length(ft):  
 Left Wingwall Length(ft):  
 (32) Approach Roadway Width(ft):  
  
 (47) Minimum Horizontal(ft):  
 (55) Minimum Right Lateral(ft):  
 (56) Minimum Left Lateral(ft):

147.2	
Left: 0.0	Right: 0.0
3.8	
Angle(°): 30	Direction: -RIGHT FORWARD <input checked="" type="checkbox"/> -LEFT FORWARD
Cardinal	Non-Cardinal
40.0	40.0
43.8	43.8
40	0
Cardinal Under Clearance	Non-Cardinal Under Clearance
55.5	
12.2	
13.2	

## RAILING APPRAISAL

(36A) Bridge Rail Adequacy:  
 (36B) Transition Adequacy:  
 (36C) Approach Guardrail Adequacy:  
 (36D) Guardrail Termination Adequacy:  
 Outer Rail:

-SUB-STANDARD X-STANDARD -NOT APPLICABLE		
X-SUB-STANDARD -STANDARD -NOT APPLICABLE		
-SUB-STANDARD X-STANDARD -NOT APPLICABLE		
-SUB-STANDARD X-STANDARD -NOT APPLICABLE		
Left	Right	Type
		TYPE F (TWO SQUARE TUBES) - STEEL(8)
		TYPE F (3 SQUARE TUBES) - STEEL(65)
		TYPE F (4 SQUARE TUBES) - STEEL(72)
		TYPE M-STEEL 3 SQUARE TUBES(93)
		SLOPED FACE PARAPET LF(91)
		SLOPED FACE PARAPET HF(92)
		VERTICAL FACE PARAPET TYPE A(74)
		TYPE W-THRIE BEAM(79)
		TYPE H ON VERTICAL PARAPET(80)
		TIMBER(38)
X	X	OTHER(99) (Please specify)  Left: TYPE J (ALUMINUM) ON SLOPED PPT(45)  Right: TYPE J (ALUMINUM) ON SLOPED PPT(45)
		CONT GUARD RAIL
		NO APP GRDRL
		NO ATTACHMENT
5		22 MM(7/8") BOLT (Please enter quantity)
		25 MM(1") BOLT (Please enter quantity)
		OTHER (Please specify)
X		(01) ENERGY ABSORBING TERMINAL/EAT
		(02) TURN DOWN
		(99) OTHER (Please specify)

Transition Type:

Approach Attachment Rail Note:  
 Guardrail Termination Type:

Guardrail Termination Note:

## ROADWAY ALIGNMENT APPRAISAL

(72) Approach Alignment Appraisal:

	3 Intolerable- Substantial speed reduction
	6 Fair- Minor speed reduction
X	8 Good- No speed reduction





"As Builts"

# INDEX OF SHEETS

Sheet No. 1	Title
Sheet No. 2	2.2 Typical Sections and Details
Sheet No. 3	Estimate of Quantities
Sheet No. 4	Miscellaneous Quantities
Sheet No. 5	Right of Way Plat
Sheet No. 6	Plan and Profile
Sheet No. 7	4.2 Standard Detail Drawings
Sheet No. 8	Sign Plates
Sheet No. 9	8.2 Structure Plans
Sheet No. 10	Computer Earthwork Data
Sheet No. 11	Cross Sections


TOTAL SHEETS = 15

## STATE OF WISCONSIN DEPARTMENT OF TRANSPORTATION

### PLAN OF PROPOSED IMPROVEMENT BRIDGE FLOOR REPAIR

STRUCTURE B-3-15  
U.S.H. 53 S.B. OVER CARLSON SCHOOL DRIVE BRIDGE  
U.S.H. 53  
BARRON COUNTY

STATE PROJECT	FEDERAL PROJECT	
	PROJECT	CONTRACT
0003-84-01		

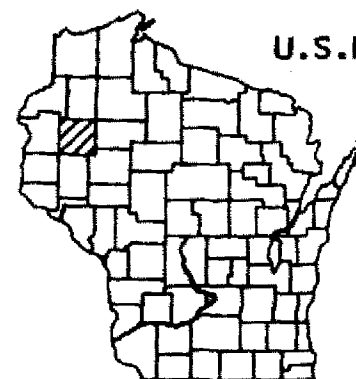

STRUCTURE B-3-14  
U.S.H. 53 N.B. OVER CARLSON SCHOOL DRIVE BRIDGE  
U.S.H. 53  
BARRON COUNTY

STATE PROJECT NUMBER  
0003-84-01

STRUCTURE B-3-19  
U.S.H. 53 N.B. OVER C.T.H. A BRIDGE  
U.S.H. 53  
BARRON COUNTY





#### DESIGN DESIGNATION

A.D.T.	"
A.D.T.	"
D.H.V.	"
D.	"
T.	"
V.	"

#### CONVENTIONAL SIGNS

COUNTY LINE	---
CORPORATE LIMITS	////
PROPERTY LINE	----
LOT LINE	----
LIMITED HIGHWAY EASEMENT	----
EXISTING RIGHT OF WAY	----
NEW RIGHT OF WAY	----
REFERENCE LINE	----
SLOPE INTERCEPT	----
ORIGINAL GROUND	----
MARSH OR ROCK PROFILE	----
CULVERT IN PLACE	----
CULVERT REQUIRED	----
CULVERT REQUIRED (Profile)	----

COMBUSTIBLE FLUIDS (UNDER PRESSURE)
UNDERGROUND UTILITIES
GAS
ELECTRIC
TELEPHONE
SERVICE PEDESTAL
CABLE MARKER
POWER POLE
TELEPHONE POLE
RAILROADS
MARSH
WOODED AREA

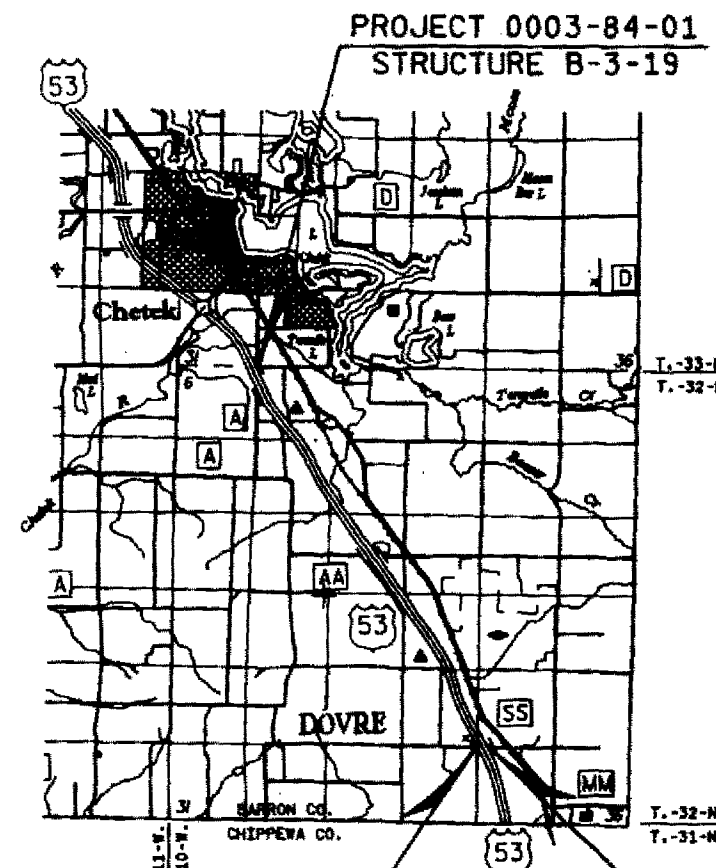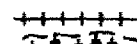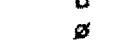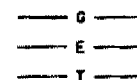

PROJECT 0003-84-01  
STRUCTURE B-3-15

LAYOUT  
SCALE 0 1/4 1/2 3/4 1 1 1/2 2 3 4 100

TOTAL NET LENGTH OF CENTERLINE =

#### STATE OF WISCONSIN DEPARTMENT OF TRANSPORTATION

Surveyor B.G. District Engineer B.G.  
Designer B.G. C.E. Plan Designer B.G.  
District Supervisor B.G. C.E. Coordinator B.G.

APPROVED:

DATE 2/2/99 E.H. G. [Signature]

APPROVED: DISTRICT TRANSPORTATION DIRECTOR

DATE 2-18-99 W. [Signature]

STATE MAINTENANCE ENGINEER FOR HWYS

APPROVED:

DATE

DIRECTOR OF ENGINEERING OPERATIONS







DETAIL AT N. ABUT.

No.	Date	Revision	By
STATE OF WISCONSIN DEPARTMENT OF TRANSPORTATION DIVISION OF HIGHWAYS			
<b>STRUCTURE B-3-15</b>			
<b>U.S.H. 53 S.B. OVER CARLSON SCHOOL DRIVE</b>			
County	<b>BARRON</b>	Town/Rdwy/Village	<b>DOVER</b>
Design Spec.	<b>A.A.S.H.T.O. '66</b>	Load	Const. Spec. <b>1981</b>
Designed By	<b>D.C.G.</b>	Design Checked	<b>B.D.</b>
Drawn By	<b>R.J.S.</b>	Plan Checked	<b>LOV</b>
Approved	<i>[Signature]</i> Chief Bridge Engineer		2-2-83 Date
<b>CONCRETE OVERLAY</b>			SHEET 1 OF 2  <b>X82318</b>

## LAYOUT



\*ATTACH BEAM TYPE GUARD RAIL TO WING PARAPET.

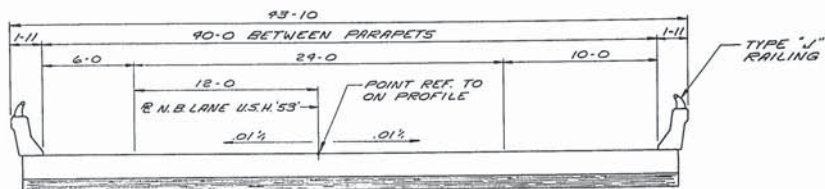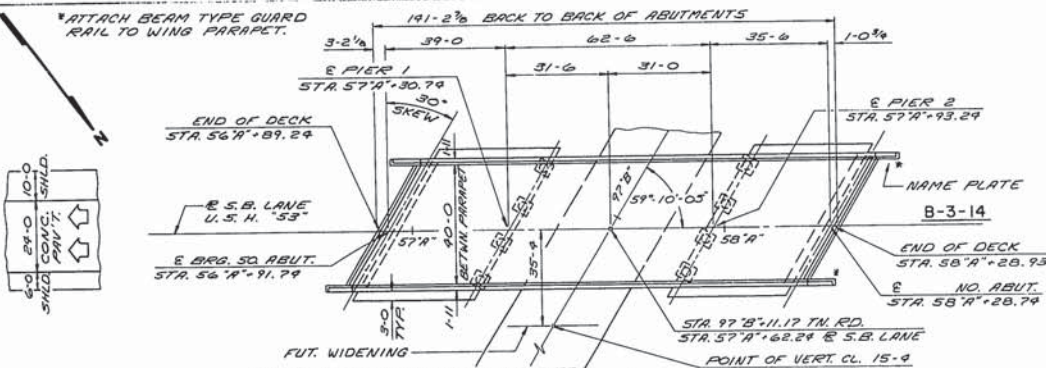

CROSS SECTION THRU ROADWAY  
3 SPAN HAUNCHED SLAB (LOOKING NORTH)


GENERAL NOTES

DRAWINGS SHALL NOT BE SCALED. BAR STEEL REINFORCEMENT SHALL BE EMBEDDED 2" CLEAR UNLESS OTHERWISE SHOWN OR NOTED. THE FIRST DIGIT OF A THREE DIGIT BAR NO. AND THE FIRST TWO DIGITS OF A FOUR DIGIT BAR NO. SIGNIFIES THE BAR SIZE. THE SLOPE OF THE FILL IN FRONT OF THE ABUTMENTS SHALL BE COVERED WITH SLOPE PAVING, CRUSHED AGGREGATE TO THE EXTENT SHOWN ON THIS SHEET AND IN THE ABUTMENT DETAILS. THE FINISHED GRADED SECTION WAS USED AS THE UPPER LIMITS OF EXCAVATION FOR COMPUTATION OF EXCAVATION AT THE PIERS. FOR UPPER LIMITS OF EXCAVATION AT THE ABUTMENTS SEE SHEETS NO. 38 & 9. PILING AT ABUTMENTS SHALL BE PREBORED THRU FILL TO THE ORIGINAL GROUND LINE.


A concrete overlay was placed on the deck from Sta 55+44 to Sta 56+11.

DESIGN DATA

LIVE LOAD: H520  
ALLOWABLE DESIGN STRESSES:  
CONCRETE MASONRY, GRADE "A" —  $f'_c$  1,900 P.S.I.  
BAR STEEL REINFORCEMENT —  $f_y$  80,000 P.S.I.  
FOUNDATION DATA:  
ABUTMENTS AND PIERS TO BE SUPPORTED ON CAST-IN-PLACE CONCRETE PILING 10" Ø. DRIVE TO A MIN. BRG. VALUE OF 20 T/PILE. 55'-0" EST. LENGTH AT SOUTH ABUT., 20 T/PILE, 55'-0" EST. LENGTH AT NORTH ABUT., AND 55 T/PILE, 55'-0" EST. LENGTH AT THE PIERS.  
TRAFFIC VOLUME:  
U.S.H. "53" — 5300 (1980)  
D.H.V. — 80 M.P.H.  
TOWN ROAD — 100 (2000)  
A.D.T. —

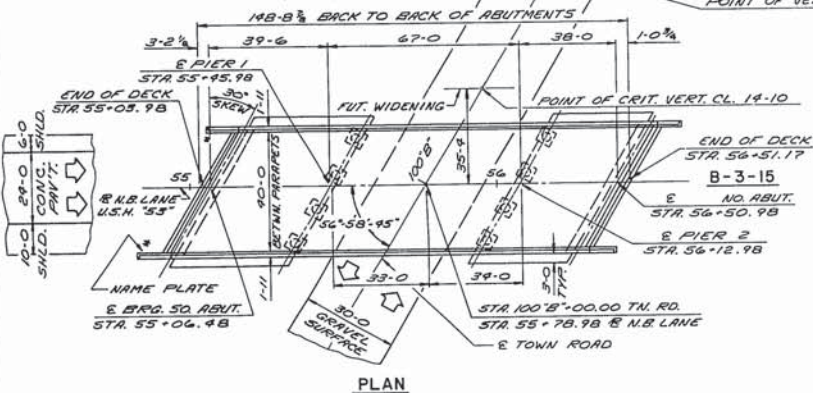


PLAN

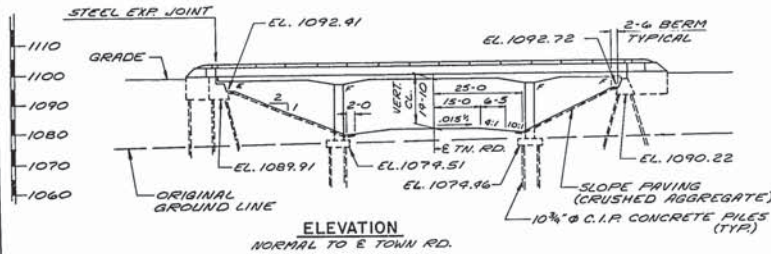


ELEVATION

NORMAL TO E TOWN RD.

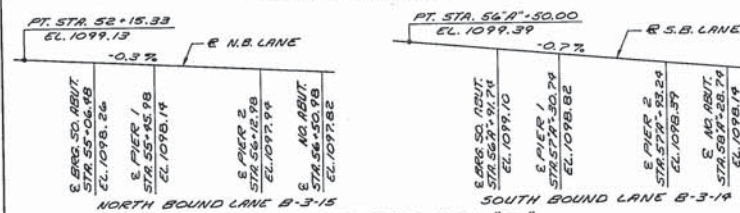

PROFILE GRADE U.S.H. "53"

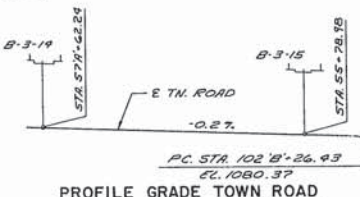

PROFILE GRADE TOWN ROAD

TOTAL ESTIMATED QUANTITIES

BID ITEMS	UNIT	S.ABUT.	PIER 1	PIER 2	N.ABUT.	SUPER.	TOTAL
EXCAVATION FOR STRUCTURE	C.Y.	92	150	130	90	—	362
CONCRETE MASONRY	C.Y.	64	63	48	43	495	715
BAR STEEL REINFORCEMENT	L.B.	3080	10,015	8805	2180	113,750	137,910
STRUCTURAL CARBON STEEL	L.B.	—	—	—	—	3970	3970
STRUCTURAL LOW ALLOY STEEL	L.B.	—	—	—	—	1100	1100
LUBRICATED BRONZE PLATES	S.F.	—	—	—	—	77	77
BEARING PADS	S.F.	526	1041	882	538	7	2000
CAST-IN-PLACE CONC. PILING DEL. & OR. 10" Ø	L.F.	—	—	—	—	—	497
PREBORING, CAST-IN-PLACE CONC. PILING 10" Ø	L.F.	255	—	—	292	—	317
TUBULAR RAILING, TYPE "J"	L.F.	—	—	—	—	317	317
SLOPE PAVING, CRUSHED AGGREGATE	S.Y.	257	—	—	257	—	514
NON-BID ITEMS							
1/4" ALUMINUM OR ZINC PLATE	S.F.	—	—	—	—	40	40
FILLER	SIZES	—	1/4"	1/4"	—	1/4"	1/4"
POLYVINYL CHLORIDE WATERSTOP	L.F.	—	—	—	—	46	46




LIST OF DRAWINGS

1. GENERAL PLAN	X46270
2. SUBSURFACE EXPLORATION	X46271
3. SOUTH ABUTMENT	X46272
4. NORTH ABUTMENT	X46273
5. PIERS	X46274
6. SUPERSTRUCTURE	X46275
7. SUPERSTRUCTURE	X46276
8. EXPANSION JOINT & BEARING DETAILS	X46277
9. SLOPED FACE PARAPET "A"	X46278
10. TUBULAR RAILING TYPE "J"	X46279



No.	Date	Revision	By
STATE OF WISCONSIN DEPARTMENT OF TRANSPORTATION DIVISION OF HIGHWAYS			
STRUCTURE B-3-15			
U.S.H. "53" OVER TOWN ROAD			
County	BARRON	Design	A.A.S.H.O. 89
Drawn	R.T.B.	Checked	F.P.R.
Approved	W.A. Kline	Chief Bridge Engineer	11-17-71
GENERAL PLAN			SHEET 1 OF 10 X46270



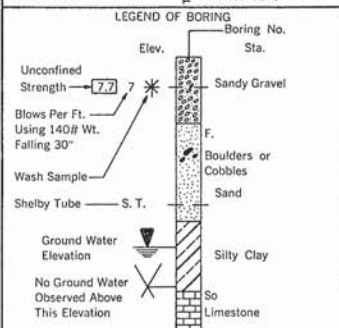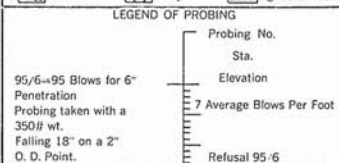
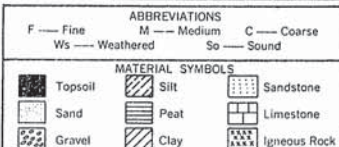


Unless otherwise specified, the blows per foot at the locations indicated are based on driving a 2" O. D. x 1.4" I. D. split spoon sampler with a 140# hammer having a free fall of 30". The blow count is taken in undisturbed soil immediately below a cased or open hole eliminating side friction on the drive pipe.


### SUBSURFACE EXPLORATION FOR FOUNDATION DESIGN AND BIDDERS INFORMATION

To obtain relative data concerning the character of material in and upon which the foundation might be built borings and/or soundings were made at points approximately as indicated on this drawing. The data presented herein represents the findings of the subsurface explorations made. However, because the depths investigated are limited and the area of the borings and/or soundings is very small in relation to the entire area, the Division of Highways does not warrant conditions below the depths investigated or that the classification of material encountered in these investigations is necessarily typical of the entire site.

No.	Date	Revised	By
		STATE OF WISCONSIN DEPARTMENT OF TRANSPORTATION DIVISION OF HIGHWAYS	
STRUCTURE B-3-15			
1969	D.J.R.	J.H.G.	
SUBSURFACE EXPLORATION		SHEET 2 OF 10 X46271	

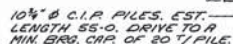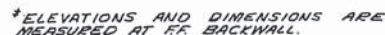

 ALL HORIZONTAL BARS IN ABUTMENT BODY ARE  
#903 BARS UNLESS SHOWN OR NOTED OTHERWISE.  
FILL TO EL. 1091.91 BEFORE DRIVING PILING. UPPER  
LIMIT FOR "EXCAVATION FOR STRUCTURES" SHALL  
NOT EXCEED THIS ELEVATION.




BAR NO.	NO. REQ'D	LENGTH	BEHT	LOCATION
				2,720#
A901	24	10-9	X	BODY - VERTICAL
A902	24	10-8	X	" " "
A903	22	25-2	"	" - HORIZONTAL
A904	6	25-7	"	" - TOP
A505	97	9-1	X	BACKWALL - STIRRUP
A906	12	29-9	"	" - HORIZONTAL
A907	47	5-2	X	PRVING BLOCK - STIRRUP
A508	12	7-7	"	" " - HORIZONTAL
A509	36	4-5	X	SEATS - GRID DETAIL
A510	24	2-8	"	" " "
A511	17	7-5	X	WING I - STIRRUP
A912	19	7-6	X	" 122 - HORIZONTAL F.F.
A913	9	6-10	"	" 1 " - " F.F.
A914	5	11-6	"	" 1 - " B.F.
A915	16	9-2	"	" 122 - VERTICAL F.F.
A916	16	9-5	"	" 122 - " B.F.
A917	6	5-11	X	" 122 - HORIZONTAL F.F.
A918	6	10-8	X	" 122 - " B.F.
A919	18	7-5	X	" 2 - STIRRUP
A920	9	6-10	"	" 2 - HORIZONTAL F.F.
A921	5	11-10	"	" 2 - " B.F.

‡ A408- NO LAP FOR RAIL PARAPET BARS,  
1-10" SEE SHEET 9.



BAR#	DIM. 'A'	DIM. 'B'
A901	4-5	3-6
A505	1-9	3-5
A507	9	2-3
A911	4-7	1-6
A919	4-7	1-6

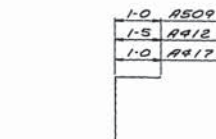

A418

8-OPTIONAL KEYED CONST. JOINT FORMED  
BY A SURFACED BEVELED 2x6.

FOR PILE SPLICE DETAIL SEE SHT. 4

No.	Date	Revision	By
STATE OF WISCONSIN DEPARTMENT OF TRANSPORTATION DIVISION OF HIGHWAYS			
STRUCTURE B-3-15			
Const. Spec.	1969	Drawn By D. A.	Plans Checked J. H. G.
SOUTH ABUTMENT		SHEET 3 OF 10	
		X 46272	





\* ELEVATIONS AND DIMENSIONS ARE TAKEN AT R.F. ABUTMENT.



INDICATES BATTERED  
PILING - BATTER PILING 3"  
PER FOOT IN DIRECTION SHOWN.



ALL HORIZONTAL BARS IN ABUTMENT BODY  
ARE B402 BARS UNLESS SHOWN OR NOTED OTHERWISE.  
FILL TO EL. 1092.22 BEFORE DRIVING PILING.  
UPPER LIMIT FOR "EXCAVATION FOR STRUCTURES"  
SHALL NOT EXCEED THIS ELEVATION.

BAR NO.	NO. REQ'D	LENGTH	BENT	1820 #	
				LOCATION	
B401	50	9-0	X	BODY - VERTICAL	
B402	16	25-6		" - HORIZONTAL	
B503	8	19-0	X	" - "	
B604	9	25-11		" - " TOP	
B505	33	2'-6"		" - DOWEL	
B406	16	7'-6"	X	WINGS 3'-6" - HORIZONTAL F.F.	
B407	6	5-11	X	" 3'-6" " F.F.	
B408	9	6'-4"		" 3 - " F.F.	
B809	2	12'-2"	X	" 3 - " BF & F.F.	
B410	6	10-8	X	" 3'-6" " BF.	
B811	5	13'-0"	X	" 3 - " BF.	
B412	16	3'-9"		" 3 - VERTICAL F.F. & BF.	
B413	32	6'-5"	X	" 3'-6" " F.F. & BF.	
B414	3	4'-7"		" 3'-6" " F.F.	
B415	9	4'-8"		" 3 - HORIZONTAL F.F.	
B816	2	13'-8"	X	" 6 - " BF & F.F.	
B817	5	13'-0"	X	" 4 - " BF.	
B418	16	3'-5"		" 4 - VERTICAL F.F. & BF.	

FOR RAIL PARAPET BARS, SEE SHEET 9.



No.	Date	Revision	By
STATE OF WISCONSIN DEPARTMENT OF TRANSPORTATION DIVISION OF HIGHWAYS			
STRUCTURE B-3-15			
Case:	1969	Drawn By: D.J.R.	Plans Checked: J.H.G.
NORTH ABUTMENT			SHEET 4 OF 10  X46273

PROJECT NO.	1196-6-71	SHEET NO.	42	TOTAL SHEETS	296
FEDERAL PROJECT DESIGNATION	EMP F08-4(36)				

# BILL OF BARS.

BAR NO.	NO. REQ'D	LENGTH	BENT	LOCATION
		18,900'		
P901	32	10'-6"		EXTERIOR FOOTINGS - PIER 1
P902	20	9'-6"		" " " " 1
P903	32	11'-0"		INTERIOR " " " 1
P504	29	7'-6"		" " " " 1
P505	18	7'-0"		EXTERIOR " " " 2
P906	38	8'-0"		EXT. & INT. " " " 2
P1007	22	9'-0"		INTERIOR " " " 2
P1108	96	7'-6"	X	FOOTING & COLUMN - DOWELS
P409	152	9'-5"	X	COLUMN - TIES
P1110	29	17'-1"		PIER 1, COLUMN 1 & 4 - VERTICAL
P1111	98	17'-2"		PIER 1, COL. 2 & 3, PIER 2, COL. 1 & 4 - VERT.
P1112	12	17'-9"		PIER 2, COLUMN 2 - VERTICAL
P1113	12	17'-3"		" 2, " 3 "
P814	32	2'-0"		COLUMN & SLAB - DOWELS



P409





P1108

## ELEVATION AND COLUMN LENGTH


		ELEV. "A"	LENGTH "L"
PIER 1	COLUMN 1	1094.76	17'-3"
	" 2	1094.92	17'-4 1/2"
	" 3	1094.90	17'-4 1/2"
	" 4	1094.79	17'-3 3/4"
PIER 2	" 1	1094.56	17'-4 1/4"
	" 2	1094.71	17'-6"
	" 3	1094.70	17'-5 3/4"
	" 4	1094.59	17'-4 1/2"

NOTES:  
 TOP OF COLUMN ELEVATIONS (EL. "A") AND COLUMN LENGTH "L" ARE MEASURED AT E PIER AND E COLUMN.  
 SLOPE TOP OF COLUMN TO MATCH SLOPE OF SUPERSTRUCTURE.  
 CONSTRUCTION JOINT KEY FORMED BY A SURFACED BEVELED 1-6" 1-6" 0-2".  
 P814 BARS MAY BE PLACED AFTER COLUMN CONCRETE IS POURED BUT BEFORE INITIAL SET HAS TAKEN PLACE.  
 FOR PILE SPLICE DETAIL SEE SHEET 4.


No.	Date	Revision	By
STATE OF WISCONSIN DEPARTMENT OF TRANSPORTATION DIVISION OF HIGHWAYS			
STRUCTURE B-3-15			
Contract	1969	Drawn By	D. J. A.
		Check	J. H. G.
PIERS			SHEET 5 OF 10
			X46274

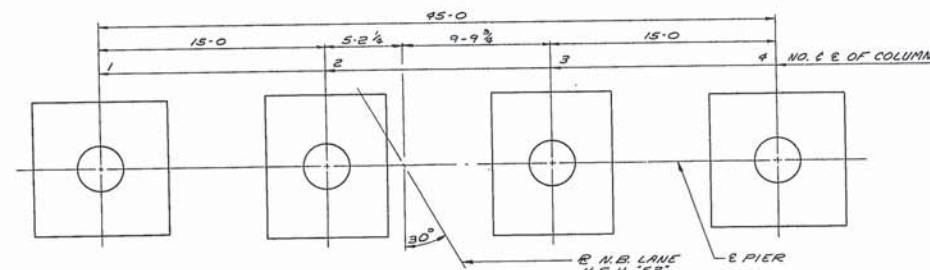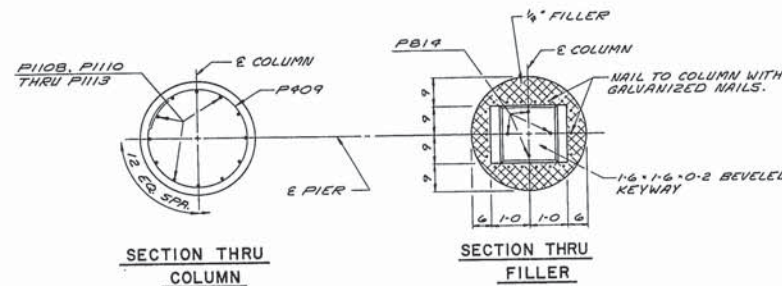


PIER PLAN

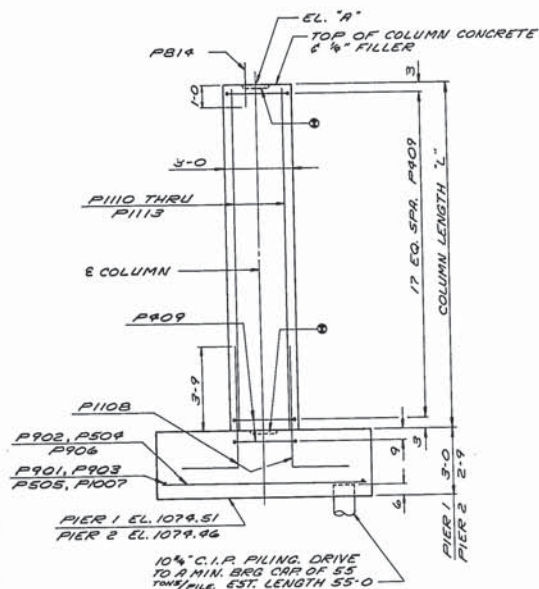

TYPICAL COLUMN ELEVATION

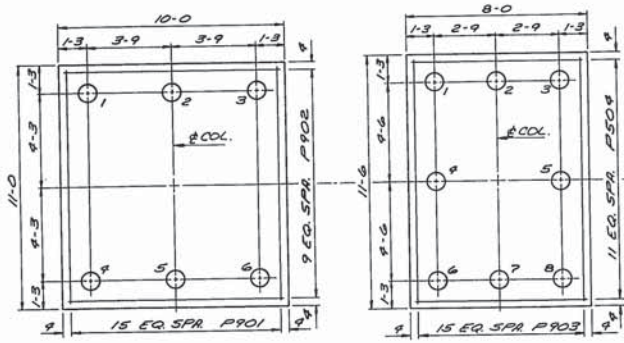


TYPICAL FOOTING PLAN - PIER 1

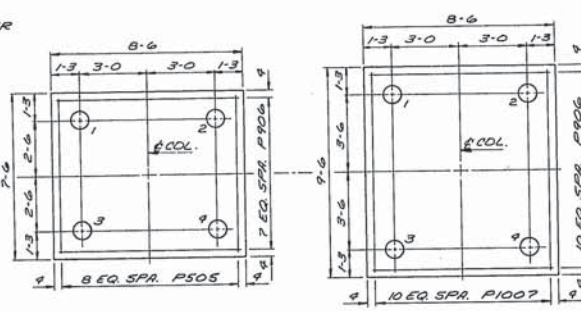


TYPICAL FOOTING PLAN - PIER 2



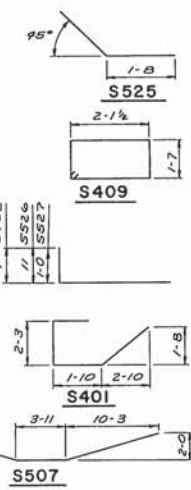

FOR RAIL PARAPET BARS, SEE SHEET 9.

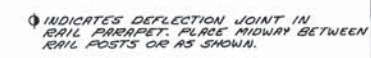

No.	Date	Revision	By
STATE OF WISCONSIN DEPARTMENT OF TRANSPORTATION DIVISION OF HIGHWAYS			
<b>STRUCTURE B-3-15</b>			
Canal Spec. <i>1969</i>	Drawn By <i>D. J. R.</i>	Plans Check <i>J. H. G.</i>	
<b>SUPERSTRUCTURE</b>		SHEET 6 OF 10  <b>X46275</b>	

LONGITUDINAL SECTION

The diagram illustrates the longitudinal section of a bridge with three spans. Key features include:

- Span 1:** 39.6' span, 21 spans @ 1.6' = 31.6' SS16.
- Span 2:** 67.0' span, 39 spans @ 1.6' = 58.6' SS16.
- Span 3:** 38.0' span, 22 spans @ 1.6' = 33.0' SS16.
- Piers:** E PIER 1 and E PIER 2.
- Structural Details:** Various structural elements are labeled with numbers such as 5915, 51117, 51006, 51005, 51118, 51110, 51111, 51121, 51122, 5924, 5913, and 5919.
- Dimensions:** Numerous dimensions are provided, including span lengths, pier widths, and distances between structural elements.
- Notes:** A note indicates "OPT. TRANS. CONST. JT. FORMED WITH A SURFACED, BEVELED 2" x 8."

[illegible]

CAMBER DIAGRAM  
DEAD LOAD DEFLECTION IS 0.9" CAMBER  
SHOWN. CAMBER DOES NOT INCLUDE ALLOWANCE  
FOR FORM SETTLEMENT.

NOTES


ALTERNATE TOP TRANSVERSE BARS IN SLAB SHALL BE SUPPORTED BY INDIVIDUAL BAR CHAIRS AT APPROX. 9'-0" SPACING. BOTTOM LONGITUDINAL BARS SHALL BE SUPPORTED AT CENTERS. BOTTOM LONGITUDINAL APPROX. 9'-0" CENTERS. BY CONTINUOUS BARS. LESS DIMENSIONS ARE MIN. ANY DEVIANCES ALL DIMENSIONS SHALL BE TO MAINTAIN CLEARANCES ARE NECESSARY TO CORRECT CONSTRUCTION DISCREPANCIES ARE TO BE PLUS (+).

PARAMENTS ARE TO BE POURED AFTER FALSEWORK HAS BEEN REMOVED.

• CONCRETE IN THIS AREA SHALL BE PLACED AFTER SUPER-STRUCTURE IS POURED. EXP. JOINT HAS BEEN SET. REMOVE FORMS FROM TOP OF SLAB BEFORE MAKING THIS POUR. DO NOT REMOVE FALSEWORK WHICH IS SUPPORTING THE JOCK JOINT MAY BE OMITTED WITH THE APPROVAL OF THE ENGINEER.

No	Date	Revision	By
STATE OF WISCONSIN DEPARTMENT OF TRANSPORTATION DIVISION OF HIGHWAYS			
STRUCTURE B-3-15			
Const. Sect.	1969	Drawn By	D. J. R.
		Plans Checked	M. H. G.
SUPERSTRUCTURE		SHEET 7 OF 10	
		X 46276	



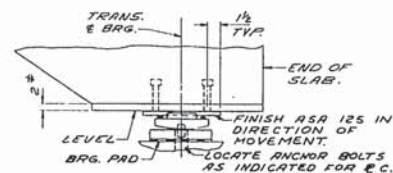

## BEARING ASSEMBLY

ALL STRUCTURAL STEEL BEARING PLATES SHALL BE FLAT ROLLED STEEL PLATES WITH ALL SURFACES SMOOTH AND FREE FROM WARP AND ALL EDGES SMOOTH, STRAIGHT AND VERTICAL. ALL PLATE CUTS SHALL BE MACHINE OR MACHINE FLAME CUTS. MACHINE FINISH THE BOTTOM SURFACE ONLY OF PLATES SHOWN TO BE FINISHED.

ALL MATERIAL EXCLUDING BRONZE PLATES, BEARING PADS,  
" SHALL BE PAID FOR AT THE UNIT PRICE BID FOR  
"STRUCTURAL LOW ALLOY STEEL."

ALL ANCHOR BOLTS TO BE 1 1/4"  $\phi$  x 1-3 LONG, SET FLUSH AND CAULK WITH LEAD TO THE TOP OF PLATE 'C'. EXCESS LENGTH MAY BE FURNISHED, THREADED FOR SETTING AND THEN CUT OFF FLUSH.

CHAMFER TOP OF PINTLES  $\frac{1}{8}$ ". DRILL HOLES FOR PINTLES IN  
PLATE 'C' FOR DRIVING FIT.

PROVIDE  $\frac{1}{8}$ " THICK BEARING PAD SAME SIZE AS PLATE 'C'  
FOR EACH BEARING.  
ALL BEARINGS ARE SYMMETRICAL


[illegible]

FIELD CUT 3" LEG  
OF ANGLE AS  
REQUIRED

Diagram illustrating a counter-sunk bolt assembly. The dimensions shown are:

- $R 5 \times \frac{7}{8} \times 1-0$
- $R 4 \frac{1}{2} \times \frac{3}{8} \times 1-0$
- $2 \text{ B's } 2 \frac{1}{2} \times \frac{3}{4} \times 1-0$
- $\frac{1}{4} \text{ B F.H. BOLTS COUNTERSUNK}$

OPTIONAL FIELD SPLICE DETAIL  
ONE SPLICE SHALL BE PERMITTED IN JOINT

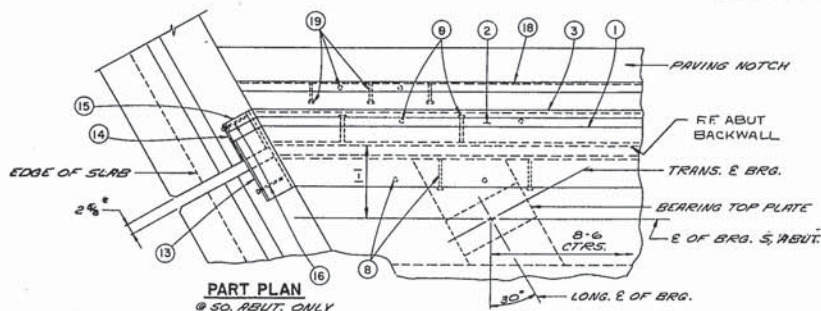


EXPANSION JOINT SHALL BE NOTED TO CONFORM TO ROADWAY CROWN AND GRADE.

AFTER CONCRETE HAS SET THE JOINT OPENING SHALL BE THOROUGHLY CLEANED AND BOLTS REMOVED AND THE HOLES FILLED WITH NOT POURED ELASTIC JOINT SEALER.

APPLY 1/8" COAT OF BITUMASTIC TO METAL SURFACES FORMING JOINT AND FILL OPENING WITH NOT POURED ELASTIC JOINT SEALER.

ALL MATERIAL SHALL BE PAID FOR AT THE UNIT PRICE  
BID FOR "STRUCTURAL CARBON STEEL"

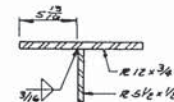


DETAIL A  
WELOMENT OPTION FOR 1









No.	Date	Revision	By
STATE OF WISCONSIN DEPARTMENT OF TRANSPORTATION DIVISION OF HIGHWAYS			
STRUCTURE B-3-15			
Contract No. 1969 Drawn By D.T.A. Check J.H.G.	SHEET 8 OF 10 X46277		
EXPANSION JOINT & BEARING DETAILS			



PROJECT ID 1196-6-71	SHEET NUMBER 46	TOTAL SHEETS 296
FEDERAL PROJECT DESIGNATION EMP F0B-4 (36)		

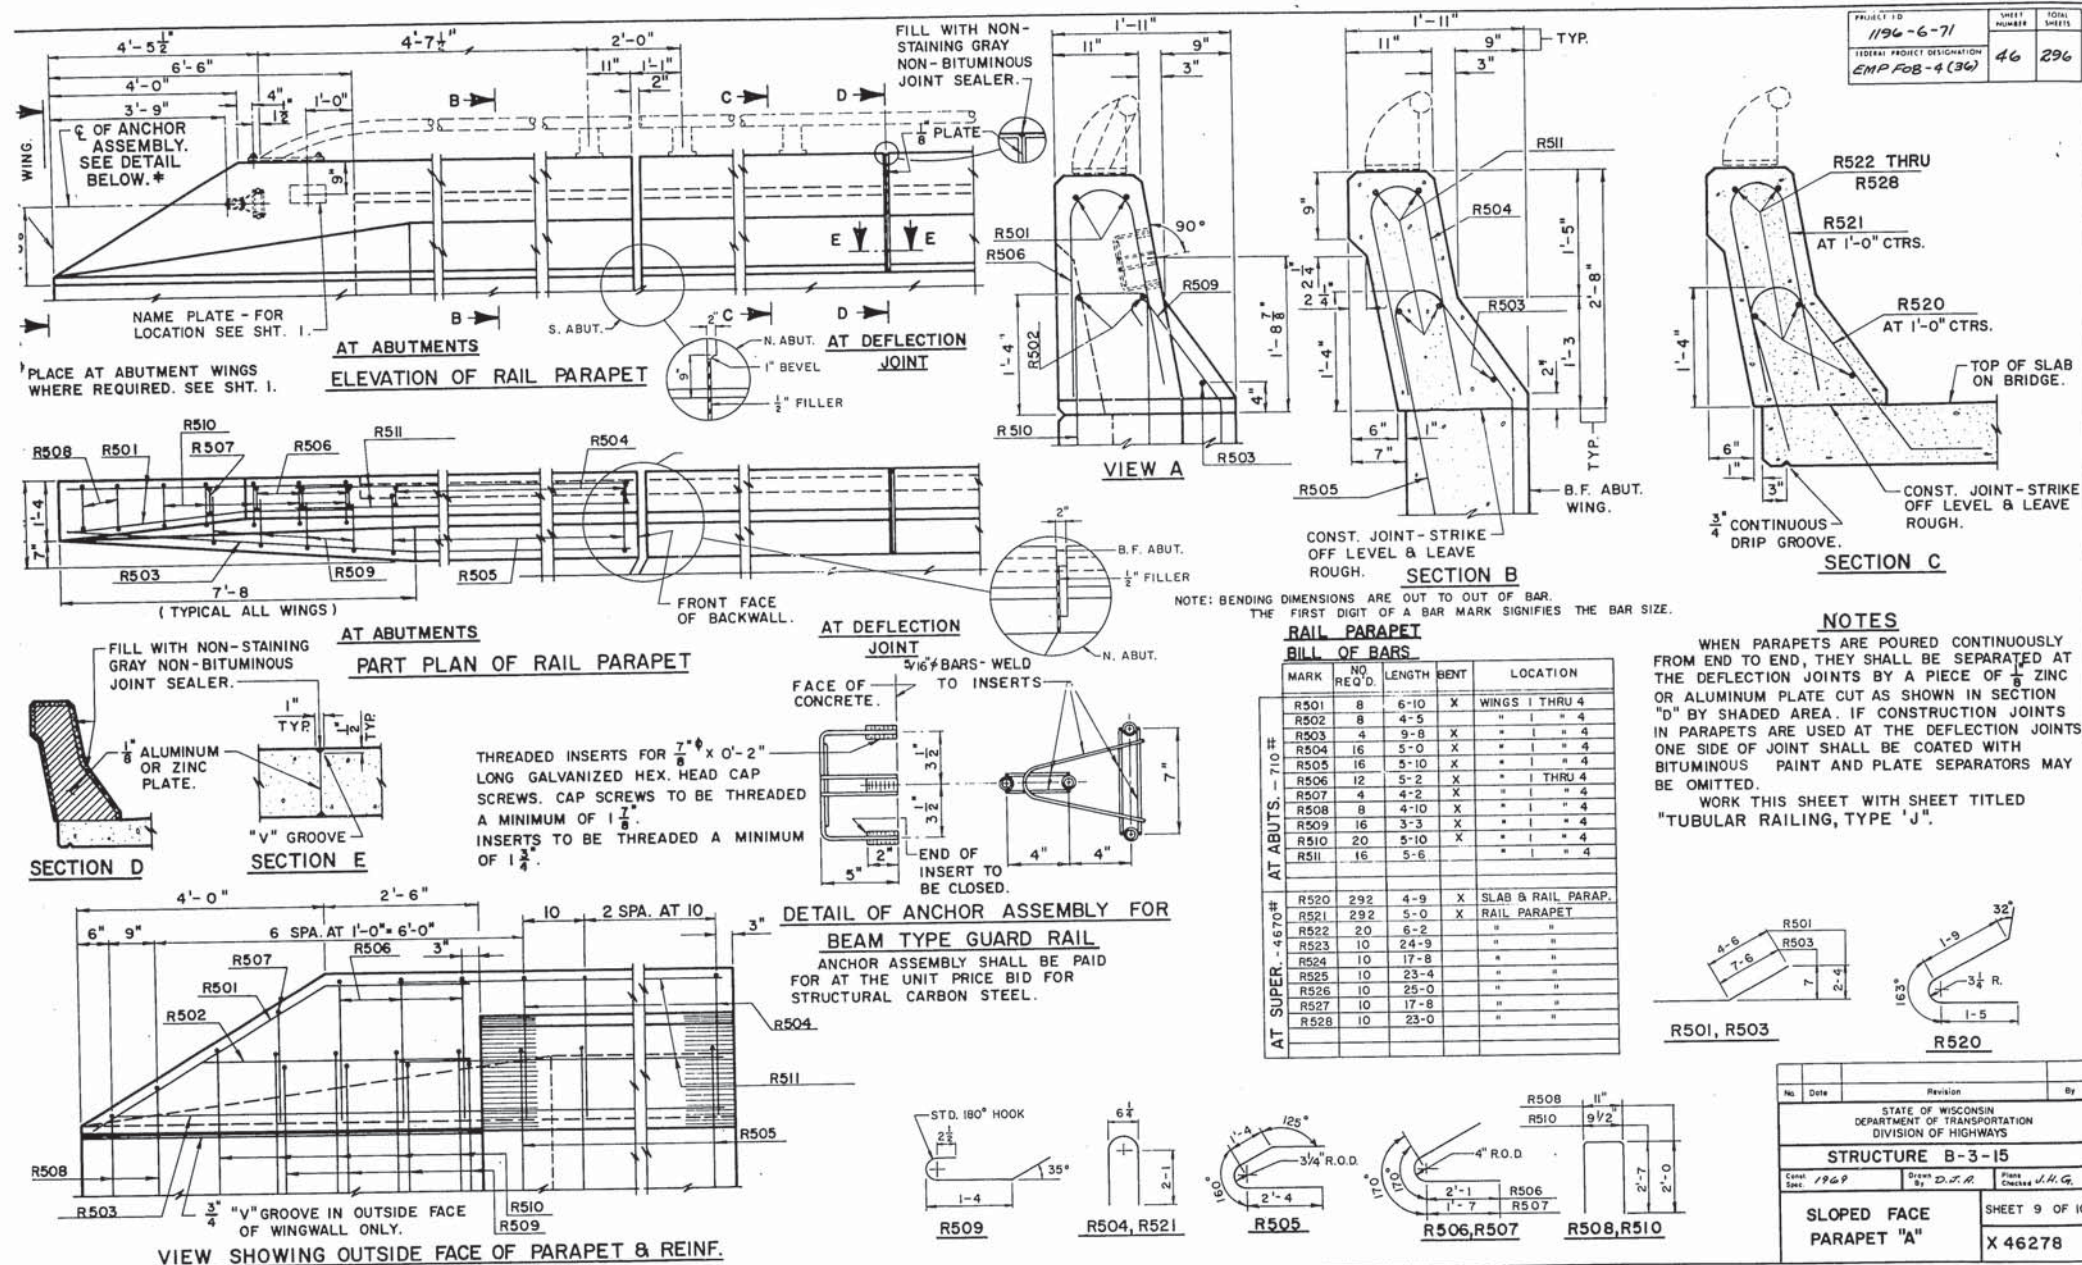




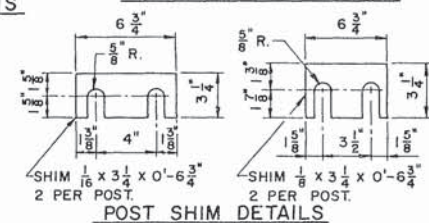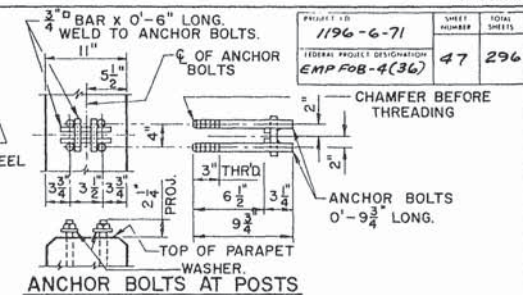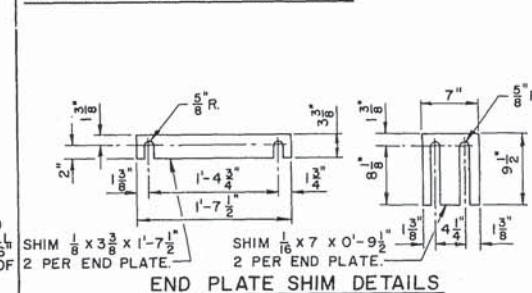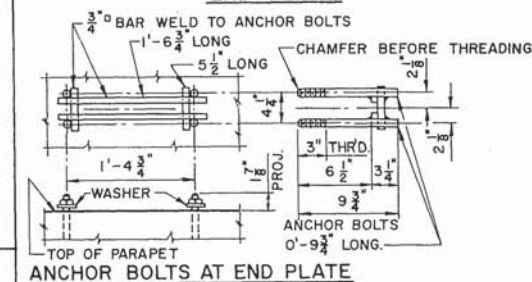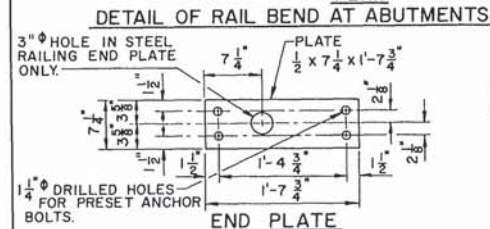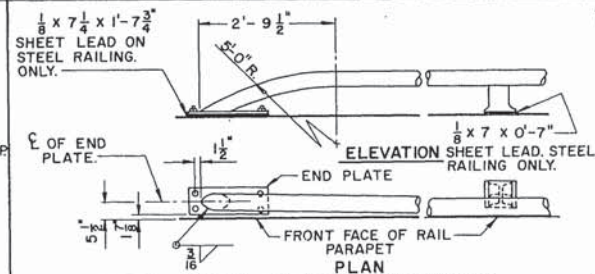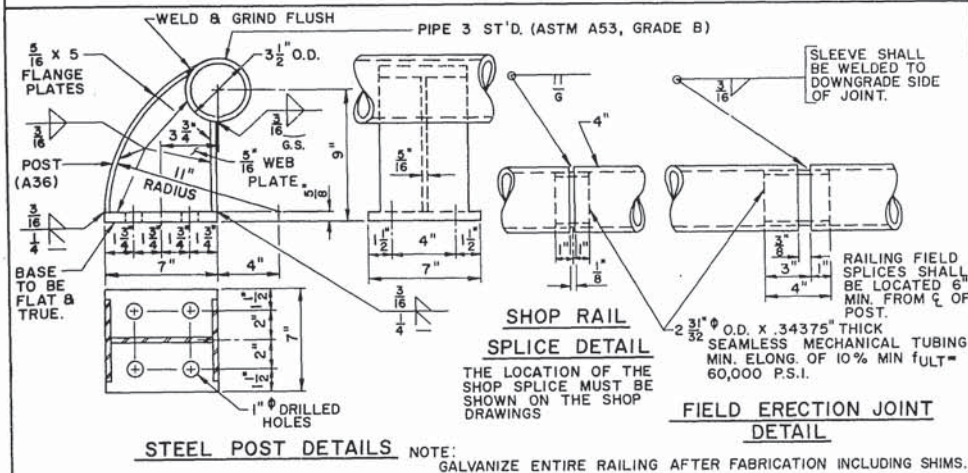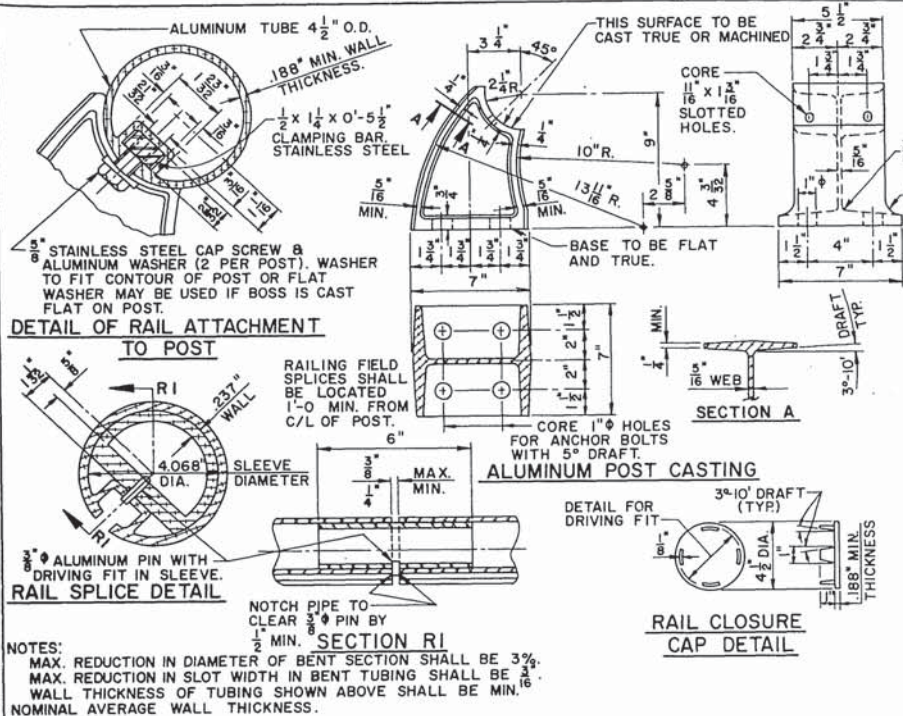

### GENERAL NOTES

- BID ITEM SHALL BE TUBULAR RAILING, TYPE 'J'.
- ALL POST SPACINGS ARE TAKEN HORIZONTALLY ALONG C/L OF ANCHOR BOLTS.
- RAILING SHALL BE FABRICATED IN TWO OR THREE PANEL LENGTHS.
- SHIMS CONFORMING TO SAME MATERIAL AS POSTS SHALL BE USED UNDER POSTS AND END PLATES WHERE REQ'D FOR ALIGNMENT.
- RAIL POSTS SHALL BE SET NORMAL TO GRADE.
- THE SHANK AND ROOT OF THREAD DIAMETER FOR ANCHOR BOLTS SHALL BE A MIN. OF 0.62 INCHES.
- ANCHOR BOLTS, NUTS & WASHERS FOR ALUMINUM RAILING SHALL BE STAINLESS STEEL.
- ANCHOR BOLTS, NUTS & WASHERS FOR STEEL RAILING SHALL BE EITHER STAINLESS STEEL OR ASTM A307. IF A307 IS USED ELECTRO-GALVANIZE NUTS, WASHERS & TOP  $\frac{3}{2}"$  OF ANCHOR BOLTS.
- SHIMS SHALL CONFORM TO SAME MATERIAL AS POSTS.

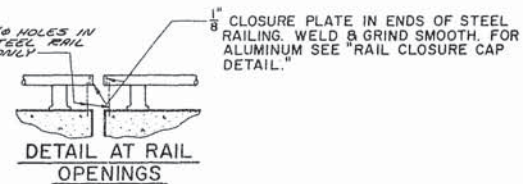


No.	Date	Revision	By
1			
STATE OF WISCONSIN DEPARTMENT OF TRANSPORTATION DIVISION OF HIGHWAYS			
STRUCTURE B-3-15			
Scale: 1/8" = 1'-0"	Drawn By: D.J.R.	Files Checked: J.H.G.	
TUBULAR RAILING TYPE 'J'			SHEET 10 OF 10 X 46279

AS BUILT

Sheet Number	Total Sheets
1	296

## Index of Sheets

Sheet No. 1	Title
Sheet No. 2-2.10	Typical Cross Sections
Sheet No. 3-3.2	Estimate of Quantities
Sheet No. 3A-31	Miscellaneous Quantities
Sheet No. 4-4.6	Right of Way Plat
Sheet No. 5-26	Plan and Profile Sta. 0 + 18.72 to Sta.
Sheet No. 27-27.15	Standard Details
Sheet No. 28-107	Drainage Structures
Sheet No. 108-296	Cross Sections

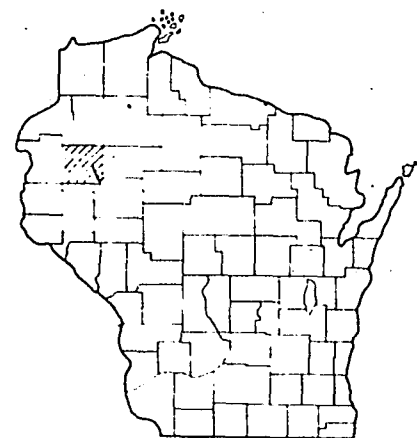

## Design Designation

CONTROL OF ACCESS = FULL	
A.D.T. 1980	= 5300
A.D.T. 2000	= 8400
D.H.V.	= 1260
D.	= 50-50
TRUCKS	= 11.3% ADT
V.	= 80 M.P.H.

## Conventional Signs


State Line	---
County Line	---
Township or Range Line	---
Section Line	---
New Right of Way Line	---
Present Right of Way Line	---
Wire Fence	{ Woven Barbed }
Lot Line	---
Corporate or City Limits	---
Property Line	---
Traveled Way or P.E.	---
Railroads	---
Base or Survey Line	---

Culverts in Place	---
Culverts Required	---
Drop Inlet	---
Power Pole	---
Telephone or Telegraph Pole	---
Right of Way Markers	---
Reference Stake for Hubs Only	---
Marsh	---
Hedge	---
Trees	---
Ground Elevation	Datum Line 73.9
Grade Elevation	Datum Line 76.15

# STATE OF WISCONSIN DEPARTMENT OF TRANSPORTATION DIVISION OF HIGHWAYS PLAN AND PROFILE OF PROPOSED NEW AUBURN - U.S.H. 8 ROAD So. Co. LINE-C.T.H. "A" U.S.H. 53 BARRON COUNTY

FEDERAL IDENTIFICATION NUMBER	FEDERAL PROJECT DESIGNATION
1196-6-72	EMP F08-4(36)

Scales  
Plan 1 in. = 100 ft.  
Profile Hor. 1 in. = 100 ft. Vert. 1 in. = 10 ft.  
Cross Sections Hor. 1 in. = 10 ft. Vert. 1 in. = 10 ft.

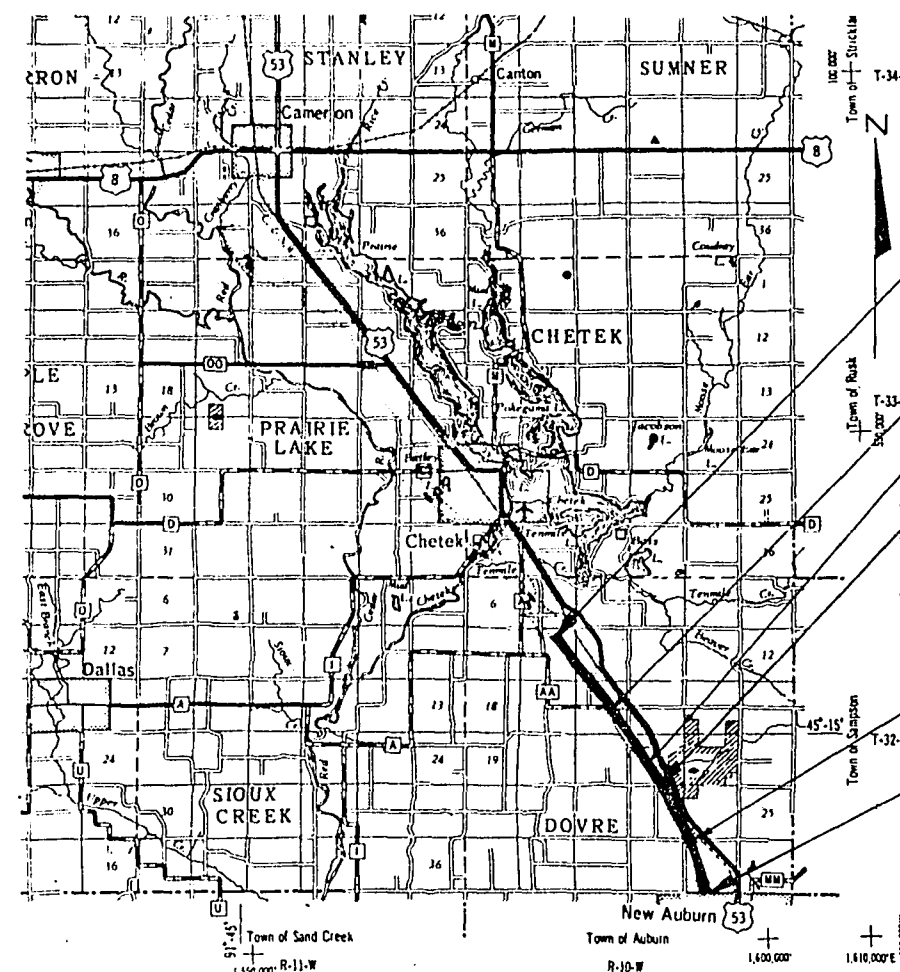

### END PROJECT 1196-6-76 / EMP F08-4(36)

STA. 290+00 N.B. R.  
\* N = 40,942.678  
\* E = 2,066,583.314  
APPROX. 1200' S. 8° 14' 30" W. OF N.E. COR., SEC. 8, T-32-N, R-10-W

B-3-16 AND B-3-17

PROJECT 1196-6-72

B-3-32 AND B-3-33  
PROJECT 1196-6-72

### END PROJECT 1196-6-71 (CONTRACT 1) BEGIN PROJECT 1196-6-76 (CONTRACT 3)

STA. 120+50 N.B. R.  
\* N = 26,859.460  
\* E = 2,075,115.519  
APPROX. 400' S. 8° 31' 75" W. OF THE S.W. 1/4 SEC. 27  
T 33 N, R 10 W

B-3-14 AND B-3-15

PROJECT 1196-6-72

### BEGIN PROJECT 1196-6-71 / EMP F08-4(36)

STA. 0+18.72 N.B. R.  
\* N = 20,432.168  
\* E = 2,079,997.887  
428.12' W. OF THE S. 1/4 COR., SEC. 35,  
T 32 N, R 10 W


CONTROL OF ACCESS  
WITHIN THE LIMITS OF THE PROJECT WHERE  
CONTROL OF ACCESS IS SHOWN THUS, TTTT  
NO ACCESS IS PERMITTED TO U.S.H. 53  
TRAFFIC LANES EXCEPT BY RAMPS AT  
INTERCHANGES.

\* CENTRAL ZONE COORDINATES


Layout	
Scale	MILES
0	1 2
Net Length of Centerline	= 2.278 Mi. Contract 1
" " " "	= 3.211 " " 3
TOTAL	" " " " = 5.489 " " "

STATE OF WISCONSIN DEPARTMENT OF TRANSPORTATION DIVISION OF HIGHWAYS	
Surveyor DIST. # 8	Note Book
District Computer N.B.	M.O. Checker L.L.J.
District Checker B.J.F.	Correct
Correct:	
Date 11/26/71	T.R. Kinsley District Engineer
Recommended for Approval:	
Date 12/6/71	J.C. Henned Chief Design Engineer
Approved:	
Date 12/7/71	W.J. Burmeister State Highway Engineer
U.S. DEPARTMENT OF TRANSPORTATION FEDERAL HIGHWAY ADMINISTRATION BUREAU OF PUBLIC ROADS	
Approved:	
Date	Project Engineer

EMP F08-4(36)

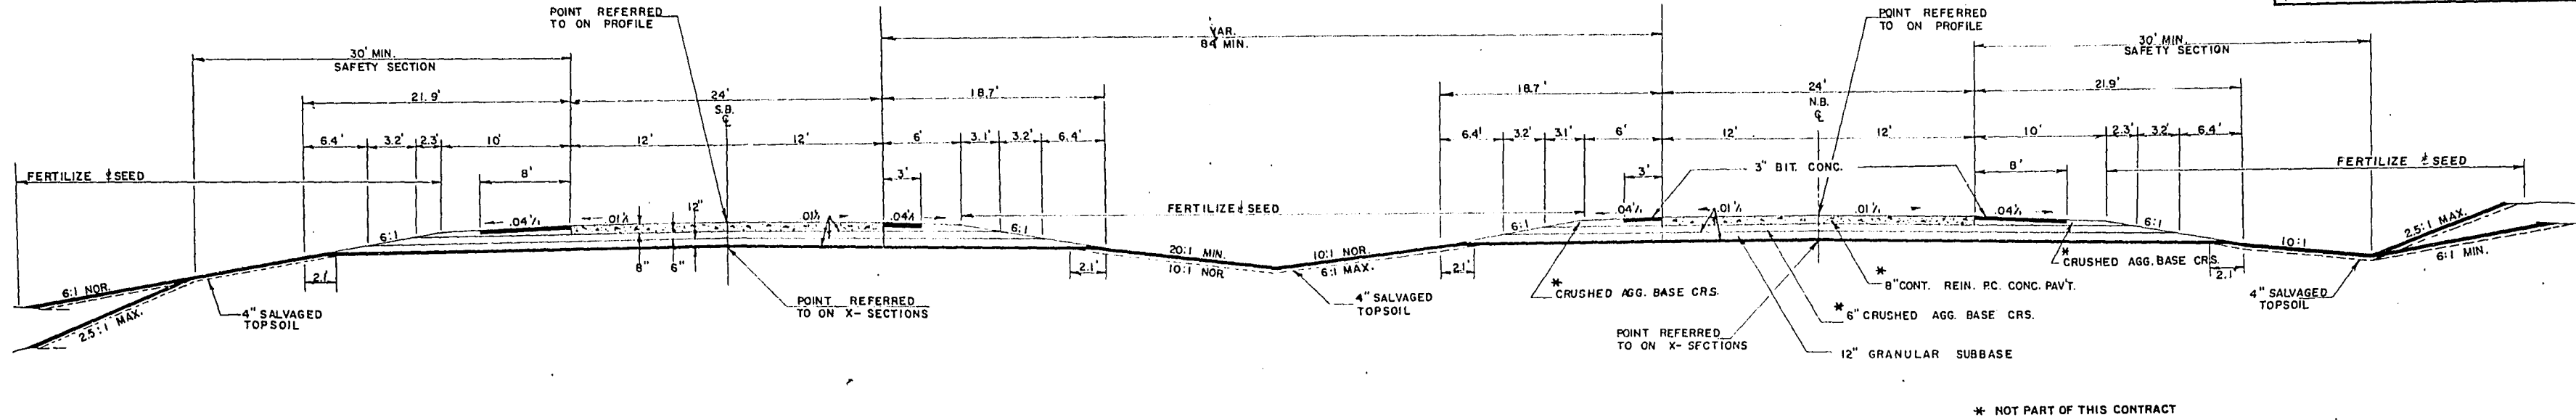

U.S.H. 53  
TYPICAL FINISHED TANGENT SECTION

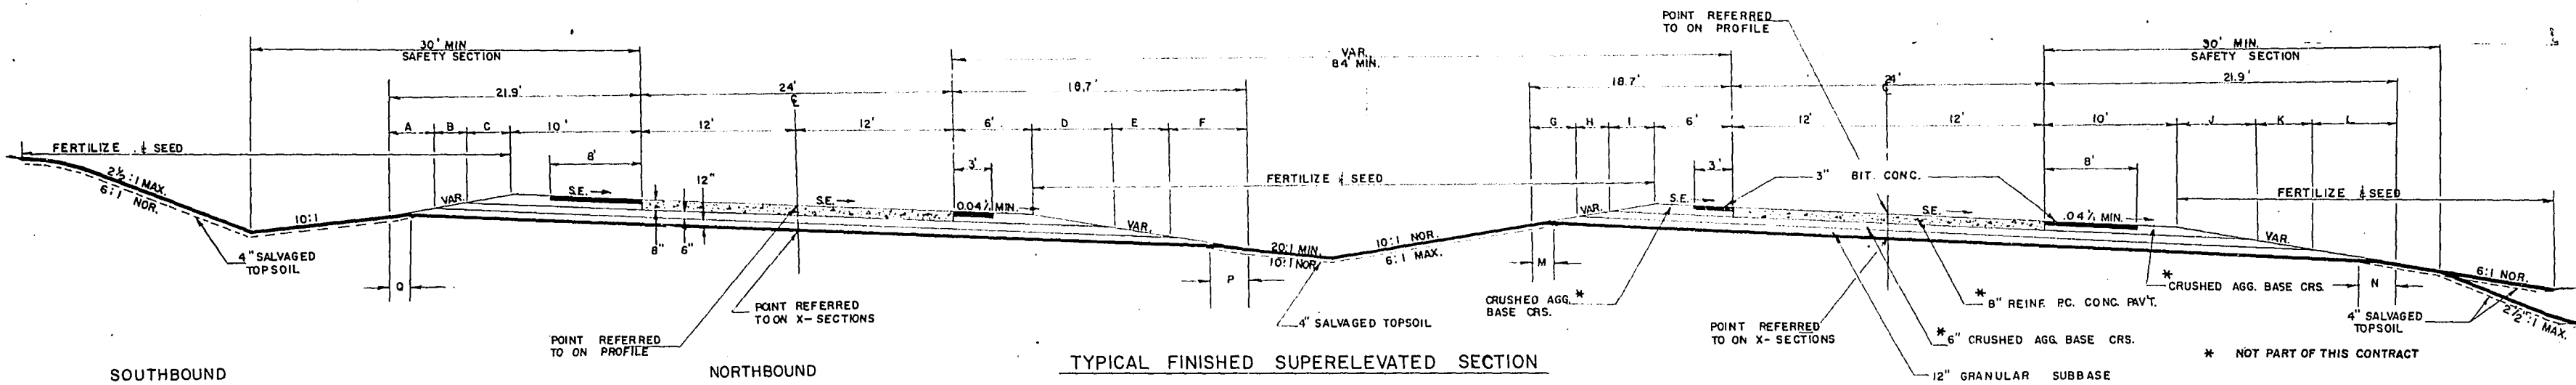

TYPICAL FINISHED SUPERELEVATED SECTION

SOUTHBOUND											NORTHBOUND										
CURVE	S.E.	TRANS.	A	B	C	D	E	F	G	P	CURVE	S.E.	TRANS.	G	H	I	J	K	L	M	N
0+15' RT.	.01	240	6.4	3.2	2.3	3.1	3.2	6.4	2.1	2.1	0+15' RT.	.01	240	6.4	3.2	3.1	2.3	3.2	6.4	2.1	2.1
0+15' LT.	.01	240	6.4	3.2	2.3	3.1	3.2	6.4	2.1	2.1	0+20' RT.	.01	240	6.4	3.2	3.1	2.3	3.2	6.4	2.1	2.1
0+30' LT.	.024	240	5.9	3.0	3.0	3.9	2.9	5.9	2.3	1.8	0+30' RT.	.024	240	5.9	2.9	3.9	3.0	3.0	5.9	1.8	1.3
0+40' RT.	.032	240	5.5	2.7	3.7	3.7	3.0	6.0	1.7	2.5	0+40' LT.	.032	240	5.9	2.9	3.9	3.4	2.8	5.7	1.7	2.5
0+45' RT.	.036	240	5.5	2.7	3.7	3.8	3.0	5.9	1.7	2.5	0+45' RT.	.036	240	5.9	2.9	3.9	3.5	2.8	5.6	1.7	2.5
1+00' RT.	.047	240	5.5	2.7	3.7	3.9	2.9	5.9	1.6	2.8	0+45' LT.	.036	240	5.9	3.0	3.8	3.7	2.7	5.5	2.5	1.7
1+00' LT.	.047	240	5.5	2.7	3.7	3.9	2.9	5.9	1.6	2.8	1+00' RT.	.047	240	5.9	2.9	3.9	3.7	2.7	5.5	1.6	2.8
1+15' RT.	.056	280	5.5	2.7	3.7	3.9	2.9	5.9	1.5	3.0	1+00' LT.	.047	240	5.9	2.9	3.9	3.7	2.7	5.5	2.8	1.6
1+15' LT.	.056	280	5.5	2.7	3.7	3.9	2.9	5.9	1.5	3.0	1+15' RT.	.056	280	5.9	2.9	3.9	3.7	2.7	5.5	1.5	3.0
1+30' LT.	.065	320	5.5	2.7	3.7	3.9	2.9	5.9	1.5	3.0	1+30' LT.	.065	320	5.9	2.9	3.9	3.7	2.7	5.5	1.5	3.0

GENERAL NOTES (CONT.)

UNLESS OTHERWISE SHOWN ON THE PLANS, ALL INTERSECTIONS SHALL BE TYPE "C" AS SHOWN ON THE STANDARD DETAIL DRAWING.

UTILITIES:

BARRON COUNTY ELEC. CO-OP., BARRON  
CITIZEN'S TELEPHONE CO-OP., INC., NEW AUBURN  
NORTHERN NATURAL GAS CO.

GENERAL NOTES

WHEN THE QUANTITY OF THE ITEMS OF SUBBASE, BASE OR SURFACE COURSE IS MEASURED FOR PAYMENT BY THE TON OR CUBIC YARD THE DEPTH OR THICKNESS OF THE COURSE SHOWN ON THE PLANS IS APPROXIMATE AND THE ACTUAL THICKNESS WILL DEPEND ON THE DISTRIBUTION OF THE MATERIAL AS DIRECTED BY THE ENGINEER.

STRAW MULCH ALL SLOPES STEEPER THAN 4:1 EXCEPT ROCK CUTS.

SALVAGED TOPSOIL TO BE PLACED AS SHOWN ON TYPICAL SECTIONS AT AN APPROXIMATE DEPTH OF 4" AT THE TIME OF PLACING.

ITEMS SHOWN ON PLANS BUT NOT ON ESTIMATE OF QUANTITIES SHEETS ARE NOT A PART OF THIS CONTRACT.

EXCAVATION BELOW SUBGRADE (EBS) IS NOT USED TO BALANCE YARDAGE AND IS NOT SHOWN ON THE CROSS SECTIONS BUT IS MEASURED AND PAID FOR AS UNCLASSIFIED EXCAVATION. THE LOCATION FOR EBS WILL BE DETERMINED BY THE ENGINEER.




CURVE DATA IS BASED ON THE ARC DEFINITION.

NO TREES ARE TO BE REMOVED WITHOUT THE APPROVAL OF THE ENGINEER.

DISTURBED AREAS WITHIN THE RIGHT OF WAY, EXCEPT THE AREA WITHIN THE FINISHED SHOULDER POINTS, ARE TO BE FERTILIZED AND SEEDED AS DIRECTED BY THE ENGINEER.

STANDARD ABBREVIATIONS									
ABND.	ABANDON	C	CUT	MAX.	MAXIMUM				
A.D.T.	AVERAGE DAILY TRAFFIC	D	DEGREE OF CURVE	MIN.	MINIMUM				
AH.	AHEAD	D.H.W.	DAILY HOURLY VOLUME	MI.	MILE				
BEG. CONST.	BEGIN CONSTRUCTION	ELEV.	ELEVATION	N.	NORTH	R.R.	RAILROAD		
BEG. TAPER	BEGIN TAPER	ENC.	ENCASED	N.B.	NORTH BOUND	REL.	RELOCATED		
BEG. PROJ.	BEGIN PROJECT	END CONST.	END CONSTRUCTION	N.E.	NORTH EAST	R.L.	REFERENCE LINE		
BK.	BACK	EX.	EXISTING	N.W.	NORTH WEST	R.C.C.P.	REINFORCED CONCRETE CULVERT PIPE		
BIT. CONC.	BITUMINOUS CONCRETE	E	EXTERNAL DISTANCE	NOR.	NORMAL	REQ'D.	REQUIRED	U.S.H.	UNITED STATES HIGHWAY
BOX CULV.	BOX CULVERT	F.E.	FIELD ENTRANCE	ORIG.	ORIGINAL	R.H.F.	RIGHT HAND FORWARD	V.	VELOCITY
Δ	CENTERLINE	F.L.	FLOW LINE	ORIG. GRD.	ORIGINAL GROUND	RT.	RIGHT	VAR.	VARIABLE
CH.	CHANNEL	FT.	FEET	PAV'T.	PAVEMENT	SHR.	SHRINKAGE	V.C.	VERTICAL CURVE
CH. CH.	CHANNEL CHANGE	FUTURE CONST.	FUTURE CONSTRUCTION	P.C.	POINT OF CURVATURE	R/W	RIGHT OF WAY	X-SEC'S.	CROSS-SECTIONS
C. & N.W. RY.	CHICAGO & NORTH WESTERN RAILROAD	Δ OR I	INTERSECTION ANGLE	P.I.	POINT OF INTERSECTION	S.B.	SOUTH BOUND		
CONC.	CONCRETE	LT.	LEFT	P.L.	PROPERTY LINE	S.S.D.	STOPPING SIGHT DISTANCE		
C.T.H.	COUNTY TRUNK HIGHWAY	L.	LENGTH OF CURVE	P.T.	POINT OF TANGENCY	S.E.	SUPERELEVATION		
CULV. OR C.	CULVERT PIPE	L.H.F.	LEFT HAND FORWARD	P.O.S.T.	POINT OF SEMI-TANGENT	T.	TANGENT LENGTH OF CURVE		
C.M.C.P.	CORRUGATED METAL CULVERT PIPE	LIN. FT.	LINEAR FEET	P.P.	POWER POLE	T.P.	TELEPHONE POLE		
CO.	COUNTY	L.H.E.	LIMITED HIGHWAY EASEMENT	PROJ.	PROJECT	TN. RD.	TOWN ROAD		
		M.H.	MANHOLE	R.	RADIUS OR RANGE	TRANS.	TRANSITION		



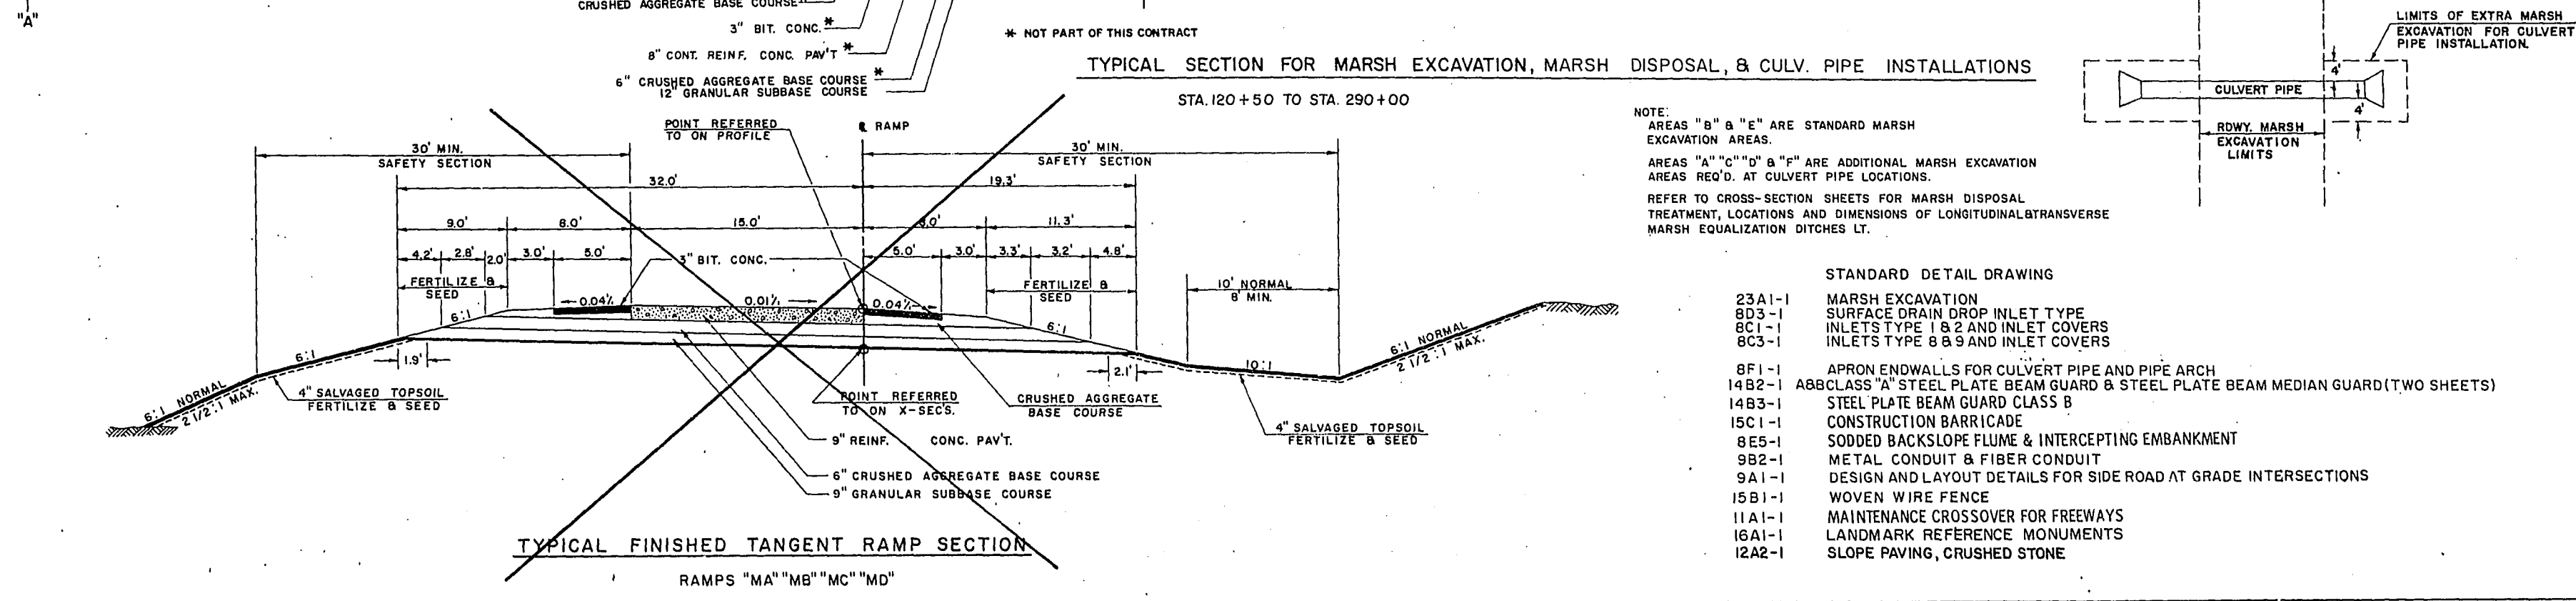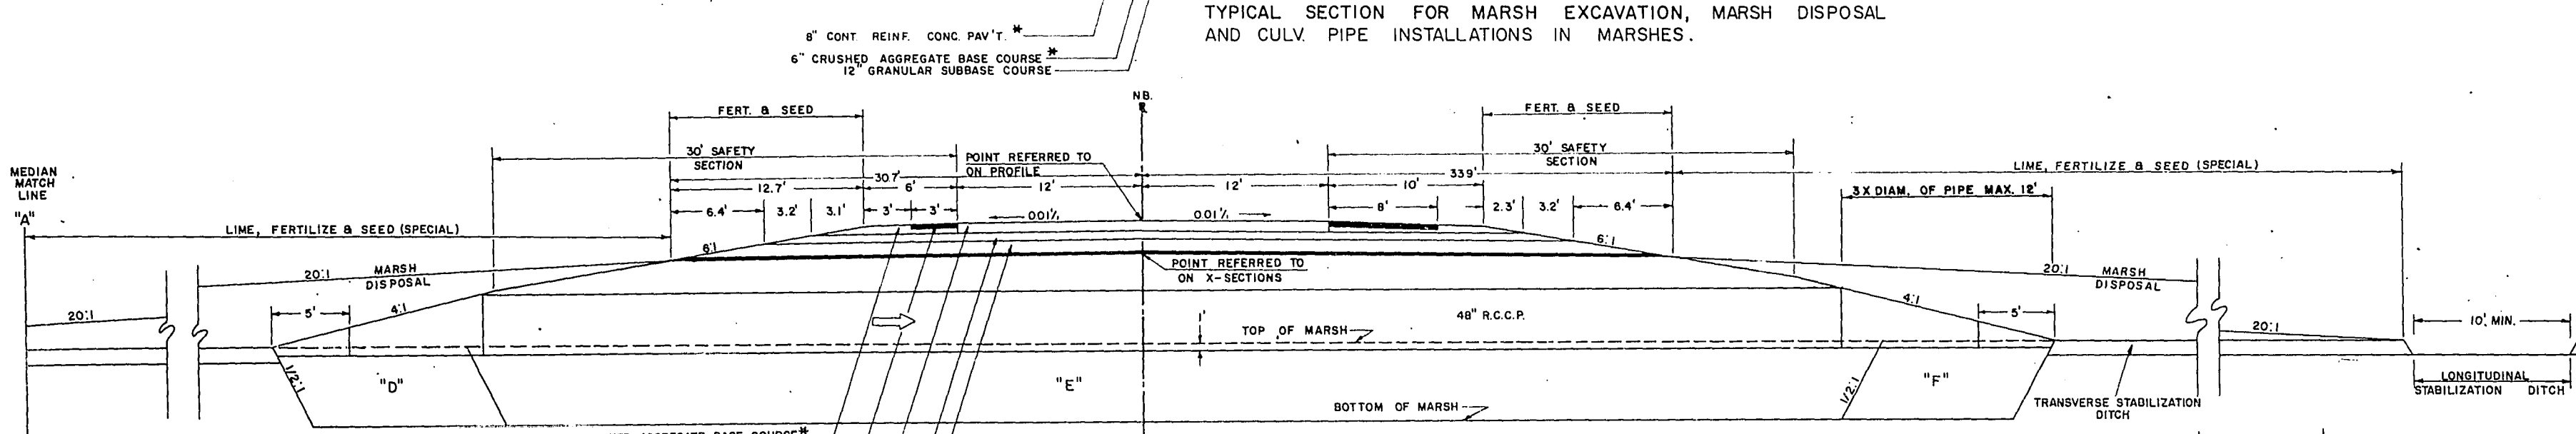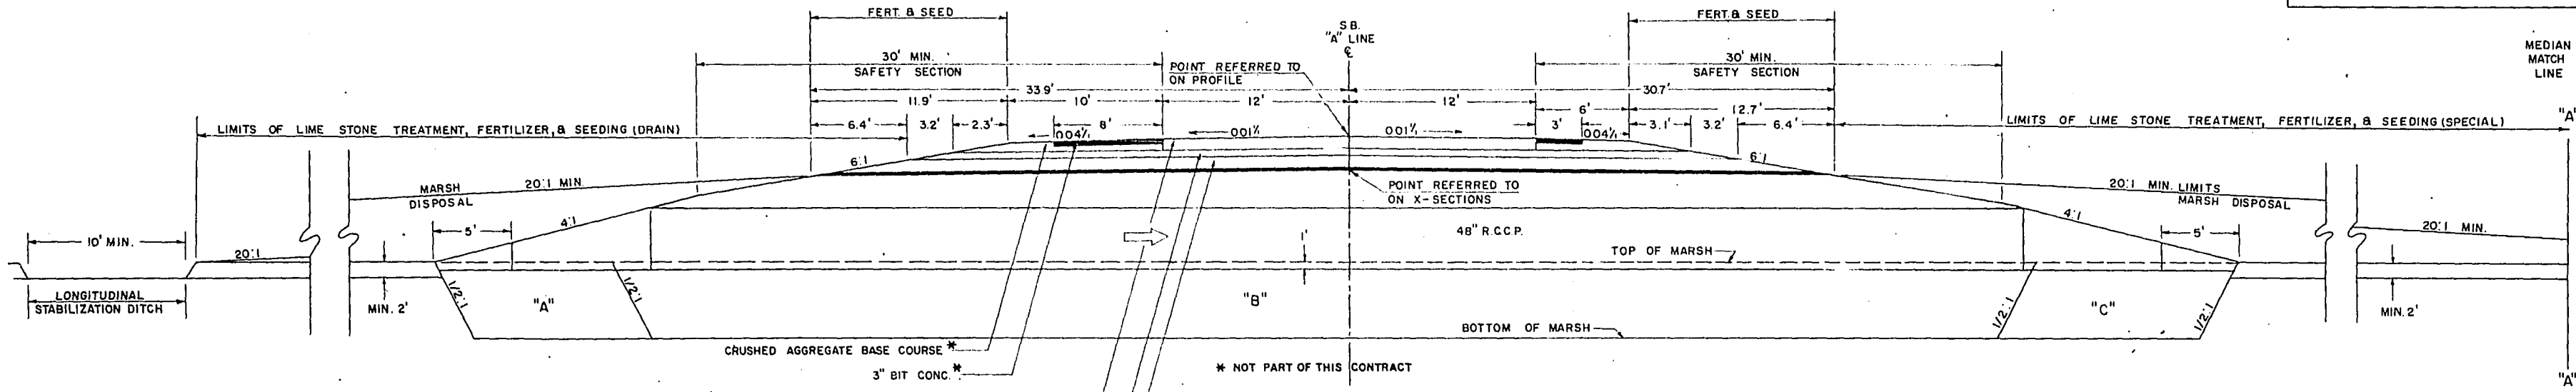

NOTE:  
 AREAS "B" & "E" ARE STANDARD MARSH EXCAVATION AREAS.  
 AREAS "A" "C" "D" & "F" ARE ADDITIONAL MARSH EXCAVATION AREAS REQ'D. AT CULVERT PIPE LOCATIONS.  
 REFER TO CROSS-SECTION SHEETS FOR MARSH DISPOSAL TREATMENT, LOCATIONS AND DIMENSIONS OF LONGITUDINAL&TRANSVERSE MARSH EQUALIZATION DITCHES LT.

- STANDARD DETAIL DRAWING
- 23A1-1 MARSH EXCAVATION
  - 8D3-1 SURFACE DRAIN DROP INLET TYPE
  - 8C1-1 INLETS TYPE 1 & 2 AND INLET COVERS
  - 8C3-1 INLETS TYPE 8 & 9 AND INLET COVERS
  - 8F1-1 APRON ENDWALLS FOR CULVERT PIPE AND PIPE ARCH
  - 14B2-1 ABB CLASS "A" STEEL PLATE BEAM GUARD & STEEL PLATE BEAM MEDIAN GUARD (TWO SHEETS)
  - 14B3-1 STEEL PLATE BEAM GUARD CLASS B
  - 15C1-1 CONSTRUCTION BARRICADE
  - 8E5-1 SODDED BACKSLOPE FLUME & INTERCEPTING EMBANKMENT
  - 9B2-1 METAL CONDUIT & FIBER CONDUIT
  - 9A1-1 DESIGN AND LAYOUT DETAILS FOR SIDE ROAD AT GRADE INTERSECTIONS
  - 15B1-1 WOVEN WIRE FENCE
  - 11A1-1 MAINTENANCE CROSSOVER FOR FREEWAYS
  - 16A1-1 LANDMARK REFERENCE MONUMENTS
  - 12A2-1 SLOPE PAVING, CRUSHED STONE

## ESTIMATE OF QUANTITIES

THIS PROJECT IS TO BE EXECUTED UNDER THE STANDARD SPECIFICATIONS FOR ROAD AND BRIDGE CONSTRUCTION OF THE WISCONSIN DIVISION OF HIGHWAYS ——— EDITION OF 1969 APPROVED MARCH 3, 1969; FEDERAL AID REQUIRED CONTRACT PROVISIONS APPROVED NOVEMBER 15, 1968; AND SPECIAL PROVISION AS ATTACHED TO PROPOSALS.

CONTRACT NO. 2  
STRUCTURES NO. B-3-14  
B-3-15, B-3-16, B-3-17

B.P.R. REGION	PROJECT	SHEET NO.	TOTAL SHEETS
4	1196 - 6 - 72 EMPFO8 - 4(36)	3.1	296
ESTIMATE OF QUANTITIES			

[illegible]

SEC. NO.	BRIDGES (STRUCTURES OVER 20FT. SPAN)																	
	STRUCTURE NO.	EXCAVATION FOR STRUCTURES BRIDGES	CONCRETE MASONRY, BRIDGES	PRESTRESSED GIRDER, I TYPE 45-INCH	BAR STEEL REINFORCEMENT BRIDGES	STRUCTURAL CARBON STEEL	STRUCTURAL LOW ALLOY STEEL	LUBRICATED BRONZE PLATES	BEARING PADS	BEARING PADS, ELASTOMERIC	SLOPE PAVING, CRUSHED AGGREGATE	FIELD OFFICE, TYPE A	STEEL PILING DELIVERED AND DRIVEN HP 10"X 42LB.	TUBULAR RAILING, TYPE J	CAST-IN-PLACE CONCRETE PILING, DELIVERED & DRIVEN 10 3/4-INCH	PREBORING, CAST-IN-PLACE CONCRETE PILING.	ON THE JOB TRAINING	
		20601	50201	50305	50501	50601	50605	50614	50621	50625	60405	64201	90001	90002	90003	51020	90004	
	CU.YD.	CU.YD.	LIN. FT.	POUND	POUND	POUND	POUND	SQ. FT.	SQ. FT.	SQ. YD.	LUMP SUM	LIN. FT.	LIN. FT.	LIN. FT.	LIN. FT.	HRS.		
	B-3-14	312	664		127,320	3,970	1,100	77	7		476			302	4,070	497		
	B-3-15	362	715		137,910	3,970	1,100	77	7		514			317	4,070	497		
	B-3-16	395	557	590	121,870	3,780	2,070	190	17	19	511		800	332				
	B-3-17	395	556	590	121,900	3,720	2,070	190	17	19	508		800	332				
	TOTALS	1464	2,492	1,180	509,000	15,440	6,340	534	48	38	2,009	1	1,600	1,283	8,140	994	1,000	

[illegible]

# STANDARD ABBREVIATIONS

ABANDON	ABND.	MAILING ADDRESS	#0000
ABSTRACT	ABS.	MANHOLE	M.H.
ACCESS POINT	A. P.	MANUFACTURING	MFG.
ACRES	AC.	MAXIMUM	MAX.
ADDITION	ADD.	MEASURED	(M)
AGRICULTURAL	AGRI.	MILE	MI.
AHEAD	AH.	MILK ROOM	M.R.
AND OTHERS	ET. AL	MINIMUM	MIN.
AND WIFE	ET. UX.	MONUMENT	MON.
APARTMENT	APT.	MOTEL	MO.
ASSUMED	(A)	MUNICIPAL	MCPL.
AUXILIARY REFERENCE LINE	A. R.	NORTHEAST	NE
AVENUE	AVE.	NORTHWEST	NW
BACK	BK.	NUMBER	NO.
BARN	B.	OUTLOT	O. L.
BASE LINE	B.	PARALLEL	PLL
BEARING LONG CHORD	B. L. C.	PAVEMENT	PAV'T.
BITUMINOUS	BIT.	PERMANENT	PERM.
BLOCK	BLK.	POINT OF CURVATURE	P. C.
BOULEVARD	BLVD.	POINT OF INTERSECTION	P. I.
BRICK	BRK.	POINT OF TANGENCY	P. T.
BUILDINGS	BLDGS.	POINT OF COMPOUND CURVE	P. C. C.
CATCH BASIN	C. B.	POINT OF REVERSE CURVE	P. R. C.
CEMETERY	CEM.	POINT ON CURVE	P. O. C.
CENTERLINE	CL	PRIVATE DRIVE	P. D.
CENTRAL ANGLE	Δ	PROJECT	PROJ.
CHANNEL	CH.	PROPERTY LINE	P. L.
CHANNEL CHANGE	CH. CH.	QUIT CLAIM DEED	Q. C. D.
CHICKEN HOUSE	C. H.	RADIUS	R
COMMERCIAL	COMM.	RAILROAD	RR.
COMPANY	COM.	RAILWAY	RY.
COMPUTED	(C)	REFERENCE LINE	R
CONCRETE	CONC.	RELOCATED	REL
CONSTRUCTION	CONST.	REQUIRED	REQ'D.
CORN CRIB	C. C.	RESIDENTIAL	RES.
CORNER	COR.	RESTAURANT	REST.
CORPORATION	CORP.	RIGHT	RT.
CORRUGATED	CORR.	RIGHT OF WAY	R/W
COUNTY	CO.	ROAD	RD.
COUNTY TRUNK HIGHWAY	C. T. H.	ROADWAY	RDWY.
CREEK	CR.	SANITARY	SAN.
CULVERT	CULV.	SCALED	(S)
DEED	(D)	SCHOOL	SCH.
DEGREE OF CURVE	D	SECTION	SEC.
DISPOSAL	DISP.	SERVICE STATION	S. S.
DISTRICT	DIST.	SEPTIC TANK	SEP.
DRIVE	DR.	SIDEWALK	SWK.
DRIVEWAY	DWY.	SHED	S.
ESTATE	EST.	SOUTHEAST	SE
EXISTING	EX.	SOUTHWEST	SW
EXTERNAL DISTANCE	E	SPECIAL CROSSING	S. C.
FACTORY	FACT.	SPECIAL DRIVE	S. D.
FEDERAL AID PROJECT	F. A. P.	SQUARE	SQ.
FIELD ENTRANCE	F. E.	STANDARD	STD.
FIRE HYDRANT	F. H.	STATE TRUNK HIGHWAY	S. T. H.
FOOT (FEET)	FT.	STATION	STA.
FOUNDATION	FDN.	STORY	STY
FRAME	FR.	STREET	ST.
GARAGE	G.	SUBDIVISION	SUBD.
GOVERNMENT	GOV'T.	SURVEY	(S)
GREEN HOUSE	G. H.	TANGENT	TAN.
HIGHWAY	HWY.	TANGENT LENGTH OF CURVE	T.
HOTEL	HO.	TAPER	TAP.
HOUSE	H.	TAVERN	TAV.
HOUSE TRAILER	H. T.	TEMPORARY	TEMP.
INCHES	IN.	TRANSIT LINE	T
INCORPORATED	INC.	TRANSMISSION TOWER	T. T.
INCLUSIVE	INCL.	UNITED STATES COAST & GEODETIC SURVEY	U. S. C. & G. S.
INTERSECTION ANGLE	I	UNITED STATES GEOLOGICAL SURVEY	U. S. G. S.
INTERSTATE HIGHWAY	I. H.	UNITED STATE HIGHWAY	U. S. Highway
IRON PIN	I. P.	VENDEE	VDE.
ISLAND	IS.	VENDOR	VDR.
LEFT	LT.	VITRIFIED	VIT.
LENGTH OF CURVE	L	WAREHOUSE	WH.
LESSEE	LSE.	WATER TOWER	W. T.
LESSOR	LSR.	WELL	W.
LIMITED HIGHWAY EASEMENT	L. H. E.	WINDMILL	WM.
MACHINERY SHED	M. S.	WOOD	WD.
MAGNETIC	MAG.		

## SCHEDULE OF LANDS AND INTERESTS REQUIRED

PARCEL NUMBER	SHEET NUMBER	OWNER	INTEREST REQUIRED	ACRES	OPERATIONS PROJECT I. D.
1(3)	4.3	ROBERT BUCHANAN	FEE & ACCESS RIGHTS	19.80	1196-6-21
2(3)	4.3	LEROY H. JOHNSON, ET AL	FEE & ACCESS RIGHTS	14.95	1196-6-21
3(3)	4.3	DUFFEK SAND & GRAVEL, INC.	FEE & ACCESS RIGHTS	31.98	1196-6-21
4(3)	4.3	JAMES K. PLUMMER	FEE	0.57	1196-6-21
5(3)	4.4	LELAND P. HURLEY	FEE & ACCESS RIGHTS	9.75	1196-6-21
6(3)	4.4	LOYAL L. PEDERSON	FEE & ACCESS RIGHTS	28.33	1196-6-21
7	4.4	BARRON COUNTY	FEE, L.H.E. & ACCESS RIGHTS	5.35	1196-6-21
8	4.4	DONALD E. SCHROEDER	FEE & ACCESS RIGHTS	11.24	1196-6-21
9	4.4 & 4.5	DUFFEK SAND & GRAVEL, INC., ET AL	FEE & ACCESS RIGHTS	77.01	1196-6-21
10	4.5	ORVILLE MOE	FEE & ACCESS RIGHTS	30.28	1196-6-21
11	4.5 & 4.6	ARTHUR J. HANSEN	FEE & ACCESS RIGHTS	46.53	1196-6-21
12	4.5	CARL PINNERUD, ET AL	FEE	0.44	1196-6-21
13	4.6	CARLSON FRYERS, INC.	FEE & ACCESS RIGHTS	19.88	1196-6-21
14	4.6	CHRISTIAN C. CARLSON	FEE	0.08	1196-6-21
15	4.6	KENNETH J. JACOBSON	FEE & ACCESS RIGHTS	13.35	1196-6-21
16	4.6 & 4.7	HERMAN GOODMANSON	FEE & ACCESS RIGHTS	46.63	1196-6-21
17	4.7	WILLIAM NOVAK	FEE & ACCESS RIGHTS	1.65	1196-6-21
18	4.7	RAYMOND KARSHBAUM	FEE & ACCESS RIGHTS	1.63	1196-6-21
20	4.7	MELVIN L. DEVOSS	FEE & ACCESS RIGHTS	16.14	1196-6-21
* 21	4.6 & 4.7	HERMAN GOODMANSON	FEE	37.38	1196-6-21
* 22	4.7	WILLIAM NOVAK	FEE	10.42	1196-6-21
23	4.7	DUFFEK SAND & GRAVEL, INC., ET AL	FEE & ACCESS RIGHTS	19.76	1196-6-21
24(3)	4.3	NORTHERN NATURAL GAS COM.	RELEASE OF RIGHTS	—	1196-6-40

\* TO BE ACQUIRED FOR SCENIC PURPOSES

## CONVENTIONAL SIGNS

STATE LINE		HIGHWAY HIGHWAY SEPARATION		CEMETERY	
COUNTY LINE		HIGHWAY OVERPASS		FOUNDATION	
TOWNSHIP AND RANGE LINES		RAIL LINE OVERPASS		GAS PUMP ISLAND	
SECTION LINE		ALL OTHER BRIDGES		BUILDING	
QUARTER LINE		STREAM OR RIVER		IRON PIN	
SIXTEENTH LINE		LAKE		POWER POLE	
NEW CENTERLINE		CATTLE PASS		TELEPHONE POLE	
NEW R/W LINE		RELOCATED STREAM OR RIVER		RAIL LINE	
OLD R/W LINE		TRAVELED WAY (Shown only in area of Frontage Roads, Interchanges or Dual Lanes)		TRANSMISSION TOWER AND LINE	
PROPERTY LINE				UNDERGROUND CABLE MARKER	
CORPORATE LIMITS				WELL	
SLOPE INTERCEPTS				STONE MONUMENT	
LOT, TIE AND OTHER MINOR DASHED LINES				SEPTIC TANK	
UNDERGROUND FACILITY (POWER, TELEPHONE, TELEGRAPH, GAS, ETC.)				WINDMILL	
NO ACCESS					
LIMITED HIGHWAY EASEMENT					

3.1-8.4-23.33

REVISION DATE	PROJECT I.D.	SHEET NUMBER	TOTAL SHEETS
OCT. 21, 1970	1196-6-21	4.1	
JAN. 21, 1971	FEDERAL PROJECT DESIGNATION		
APR. 26, 1971			
JULY 20, 1971			
NEW AUBURN - U.S.H. 8 ROAD SOUTH COUNTY LINE - C.H.A. SECTION BARRON CO.			
AUG. 14, 1970			

1196-6-71, 72, 76 EMP-208-4(36) 4-296

OFFICIAL PLAT ON FILE WITH  
THE REGISTER OF DEEDS OFFICE

SCHEDULE OF LANDS AND INTERESTS REQUIRED


3.1-8.4-23.33

PARCEL NUMBER	SHEET NUMBER	OWNER	INTEREST REQUIRED	ACRES
1(3)	4.3	ROBERT BUCHANAN	FEE & ACCESS RIGHTS	19.80
2(3)	4.3	LEROY H. JOHNSON, ET AL	FEE & ACCESS RIGHTS	14.95
3(3)	4.3	DUFFEK SAND & GF. WEL, INC	FEE & ACCESS RIGHTS	31.98
4(3)	4.3	JAMES K. PLUMMER	FEE	0.57
24(3)	4.3	NORTHERN NATURAL GAS COM.	RELEASE OF RIGHTS	—

REVISION DATE	PROJECT ID	SHEET NUMBER	TOTAL SHEETS
APR. 26, 1971	1196-6-21	4.3	
JULY 20, 1971 NC.	FEDERAL PROJECT DESIGNATION		
NEW AUBURN - U.S.H. 8 ROAD SOUTH COUNTY LINE - C.T.H. 'A' SEC. U.S.H. 53 BARRON CO			
SCALE 0 ±100 ±200 ±400 ft. DATE JAN. 21, 1971			
CONST. PROJECT 1196-6-11, 12 EMP FOR 4-3(6) 4.2-296			

LEGEND  
DENOTES  
NO ACCESS


NOTE:  
BEARINGS SHOWN ON THIS PLAT  
ARE THE TRUE BEARINGS OF EACH  
TANGENT TO THE NEAREST MINUTE

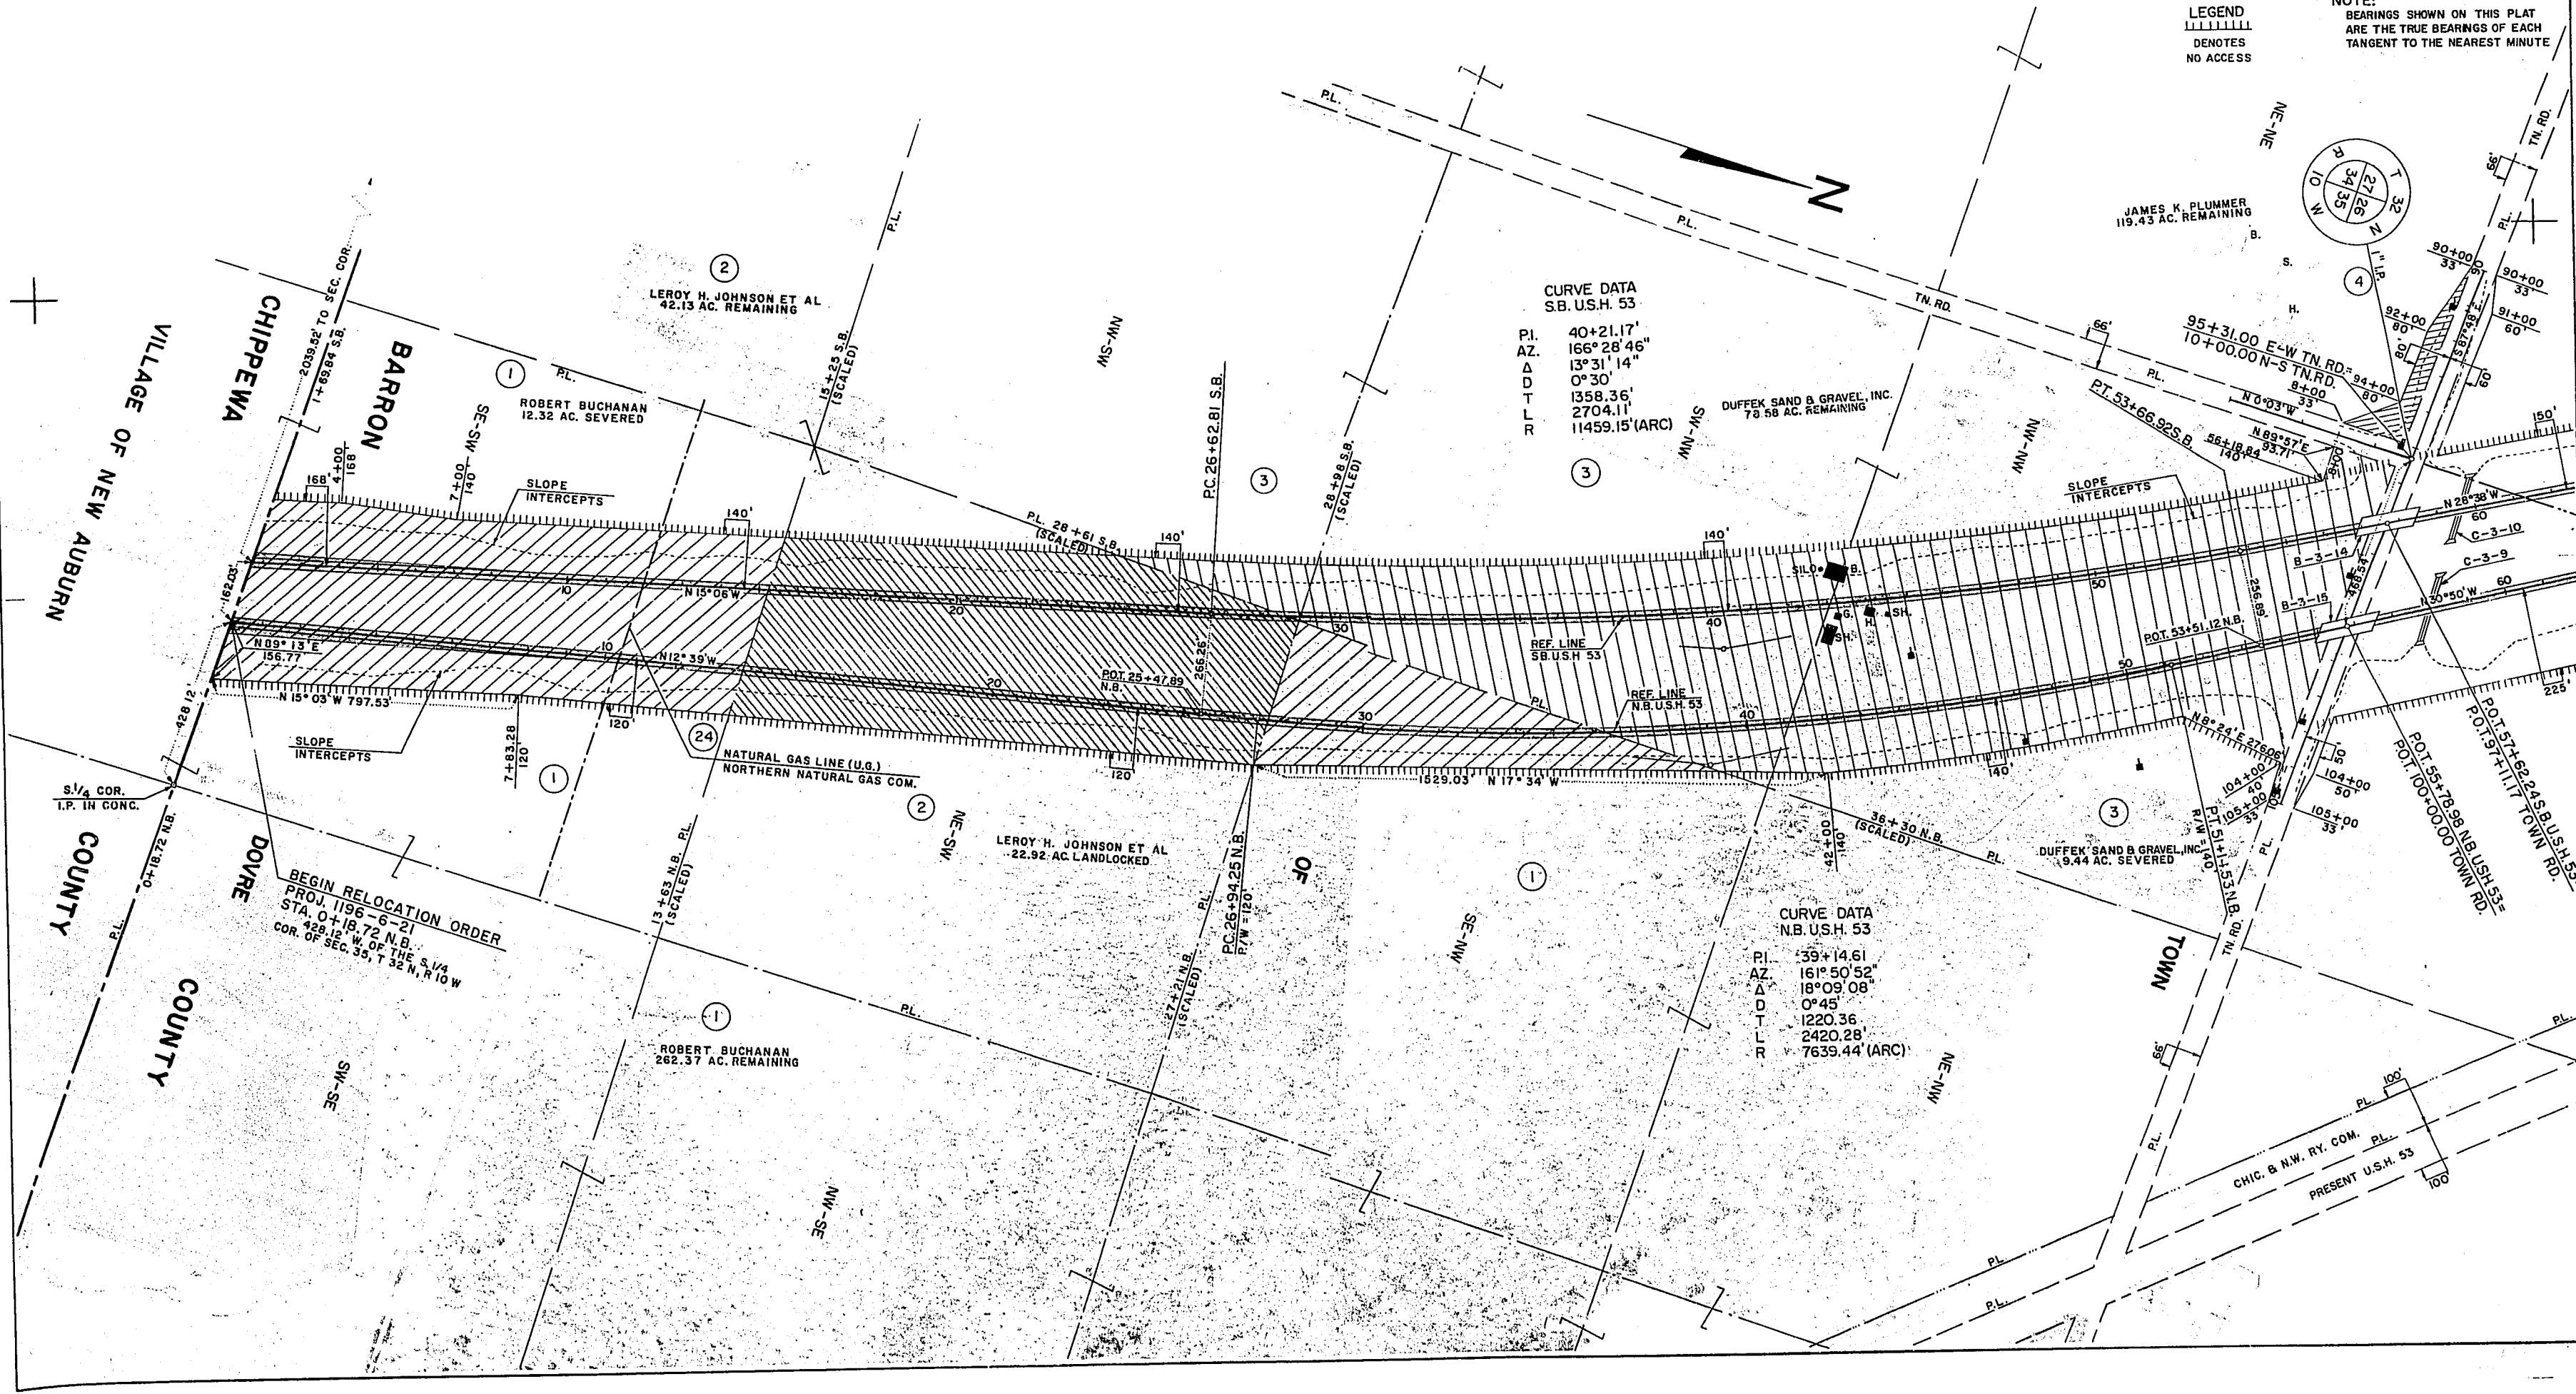



**LEGEND** *M* **NOTE:**  
 BEARINGS SHOWN ON THIS PLAT  
 ARE THE TRUE BEARINGS OF EACH  
 TANGENT TO THE NEAREST MINUTE.

PARCEL NUMBER	SHEET NUMBER	OWNER	INTEREST REQUIRED	ACRES
5 (3)	4.4	LELAND P. HURLEY	FEE & ACCESS RIGHTS	9.75
6 (3)	4.4	LOYAL L. PEDERSON	FEE & ACCESS RIGHTS	28.33
7	4.4	BARRON COUNTY	FEE, L.H.E. & ACCESS RIGHTS	5.35
8	4.4	DONALD E. SCHROEDER	FEE & ACCESS RIGHTS	11.24
9	4.4 & 4.5	DUFFEK SAND & GRAVEL INC., ET AL	SEE NEXT PLAT 4.5	SEE NEXT PLAT 4.5

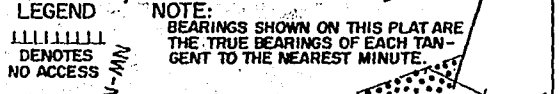

SCHEDULE OF LANDS AND INTERESTS REQUIRED				
PARCEL NUMBER	SHEET NUMBER	OWNER	INTEREST REQUIRED	ACRES
11	4.5 & 4.6	ARTHUR J. HANSEN	FEE & ACCESS RIGHTS	46.33
13	4.6	CARLSON FRYERS, INC.	FEE & ACCESS RIGHTS	19.89
14	4.6	CHRISTIAN C. CARLSON	FEE	0.08
15	4.6	KENNETH J. JACOBSON	FEE & ACCESS RIGHTS	13.35
16	4.6 & 4.7	HERMAN GOODMANSON	SEE NEXT PLAT 4.7	SEE NEXT PLAT 4.7
21	4.6 & 4.7	HERMAN GOODMANSON	SEE NEXT PLAT 4.7	SEE NEXT PLAT 4.7


**CURVE DATA**  
**"A" LINE**  
 P.I. 40+21.17  
 N. 19,354.748  
 E. 2,078,097.398  
 Δ 13° 31' 14"  
 D 0° 30'  
 T 1358.36'  
 L 2704.11'  
 R 11459.15'  
 E. 80.23'

PROJECT ID	1196-6-71,72	SHEET NUMBER	8	TOTAL SHEETS	296
FEDERAL PROJECT DESIGNATION	EMPFO8-4(36)				

**CURVE DATA**  
 P.I. 39+14.61  
 N. 19,429.176  
 E. 2,078,411.137  
 Δ 18° 09' 08"  
 D 0° 45'  
 T 1220.36'  
 L 2420.28'  
 R 7639.44'  
 E. 96.86'

BENCH MARKS			
NO.	STA.	DESCRIPTION	ELEV.
6 WEST	52 ± 30	7" ELM 65' RT. OF SB. LANE	1083.32
TBM		SW COR. INTERSECTION BOLT IN POWER POLE	1079.79


NET LENGTH OF CENTERLINE STA. 30+00 TO STA. 60+00 = 3,000 LIN. FT.

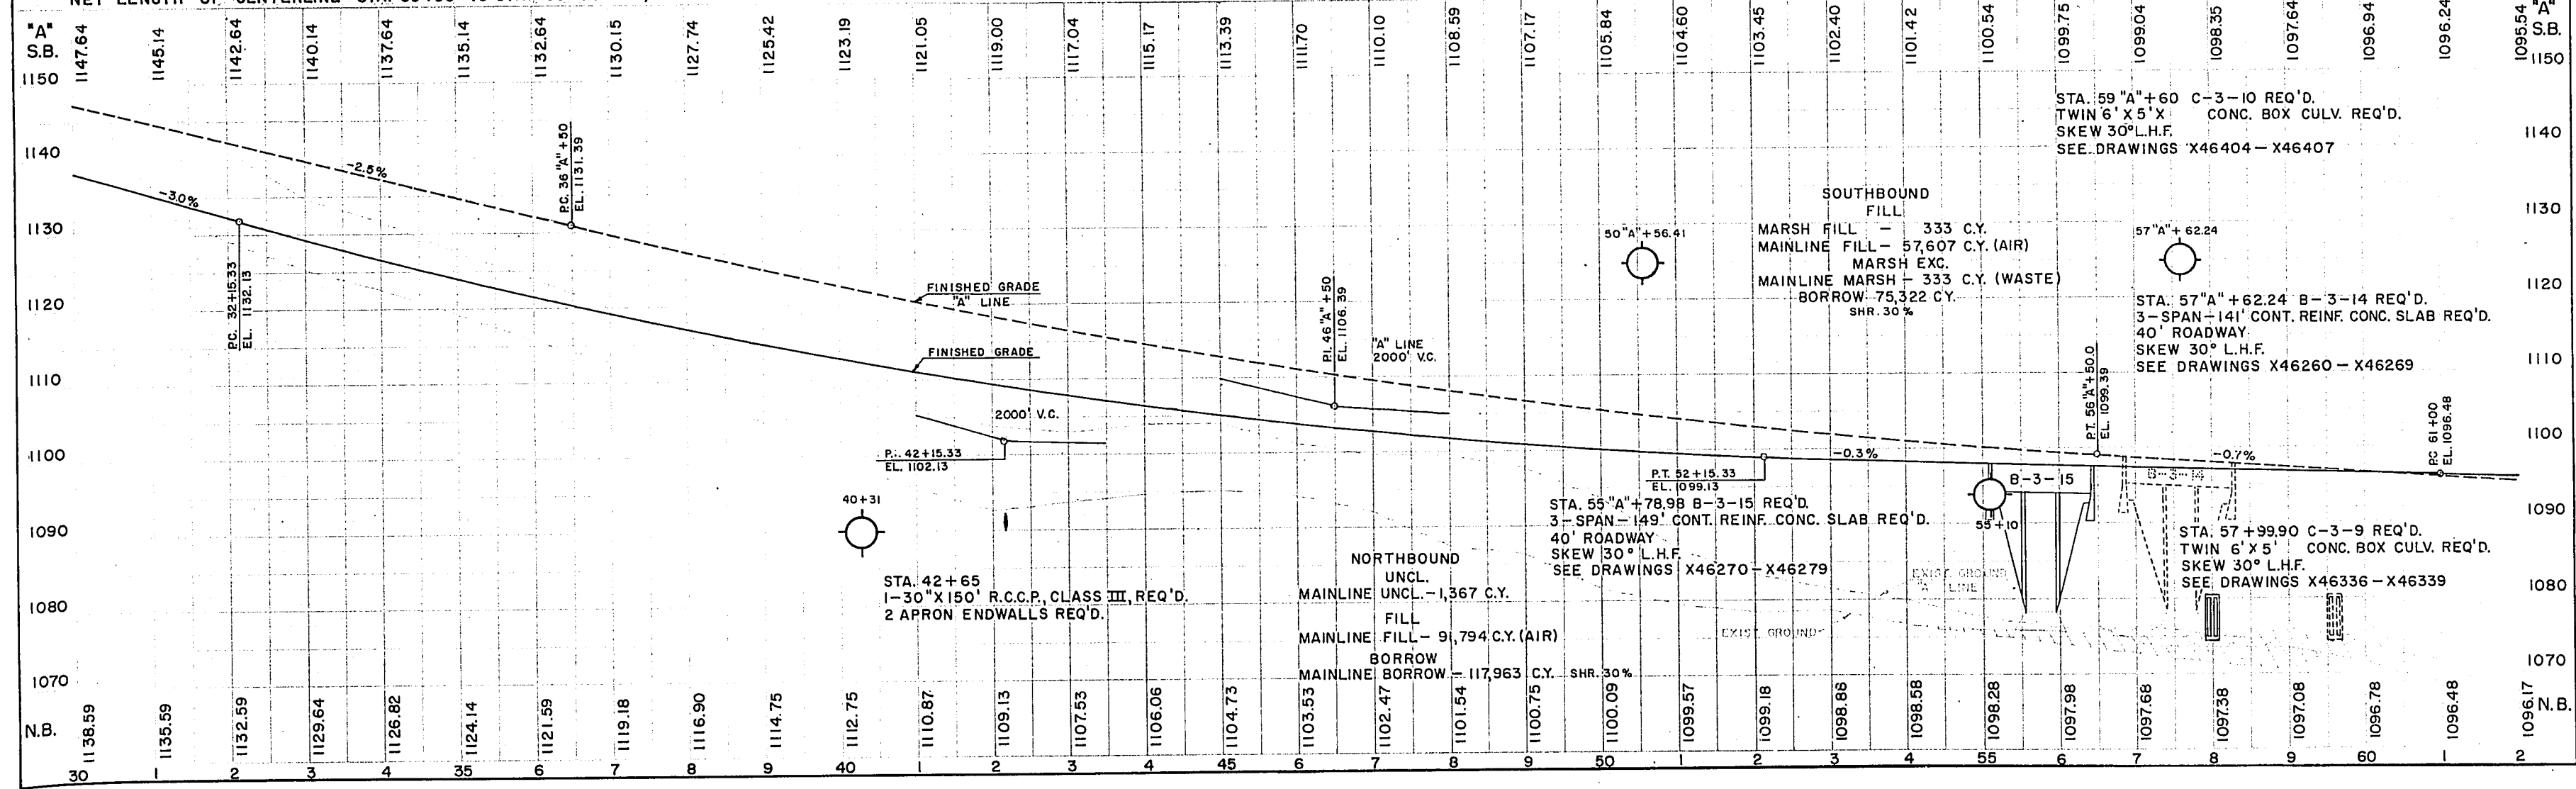




CURVE DATA  
FRONTAGE ROAD  
PI. 205+00.00  
AZ. 174° 38' 02"  
Δ 5° 21' 58"  
D 2° 00'  
T 134.25'  
L 268.31'  
R 2864.79 (ARC.)

PROJECT NO.	1196-6-72,76	SHEET NUMBER	19	TOTAL SHEETS	296
FEDERAL PROJECT DESIGNATION	EMPFO8-4(36)				

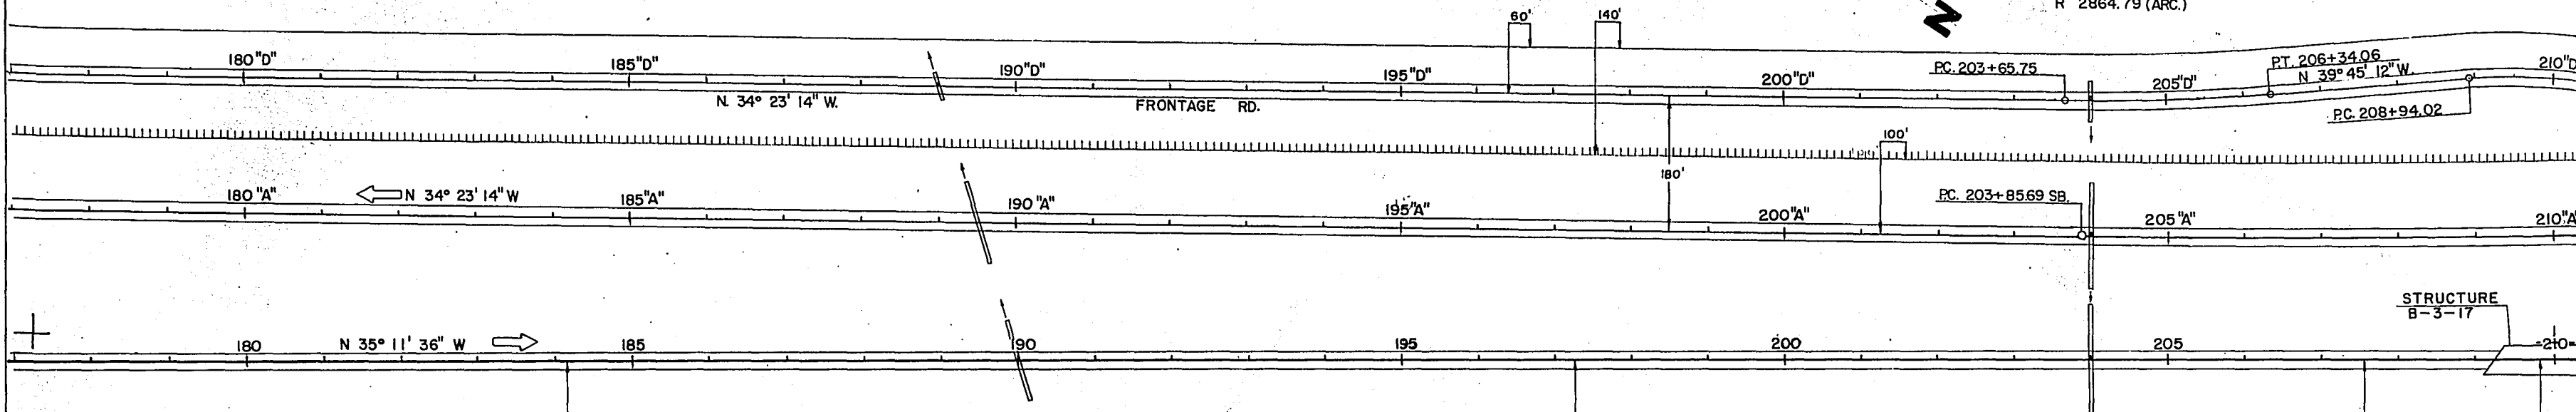

BENCH MARKS			
NO.	STA.	DESCRIPTION	ELEV.
19	185±00	10' ELM 140' LT. OF S.B. LANE	1078.69
20	192±00	8" CHEERY 135' RT. OF N.B. LANE	1093.19
21	201±00	CONC. MONUMENT BRASS CAP 225' LT. OF S.B. LANE	1106.27
22	210±00	24' ELM 400' RT. OF N.B. LANE	1098.48

CURVE DATA  
"A" LINE  
PI. 213+97.71  
N. 34,472.858  
E. 2,069,648.779  
AZ. 174° 57' 35"  
Δ 5° 03' 25"  
D 0° 15'  
T 1012.02'  
L 2022.73'  
R 22,918.31'

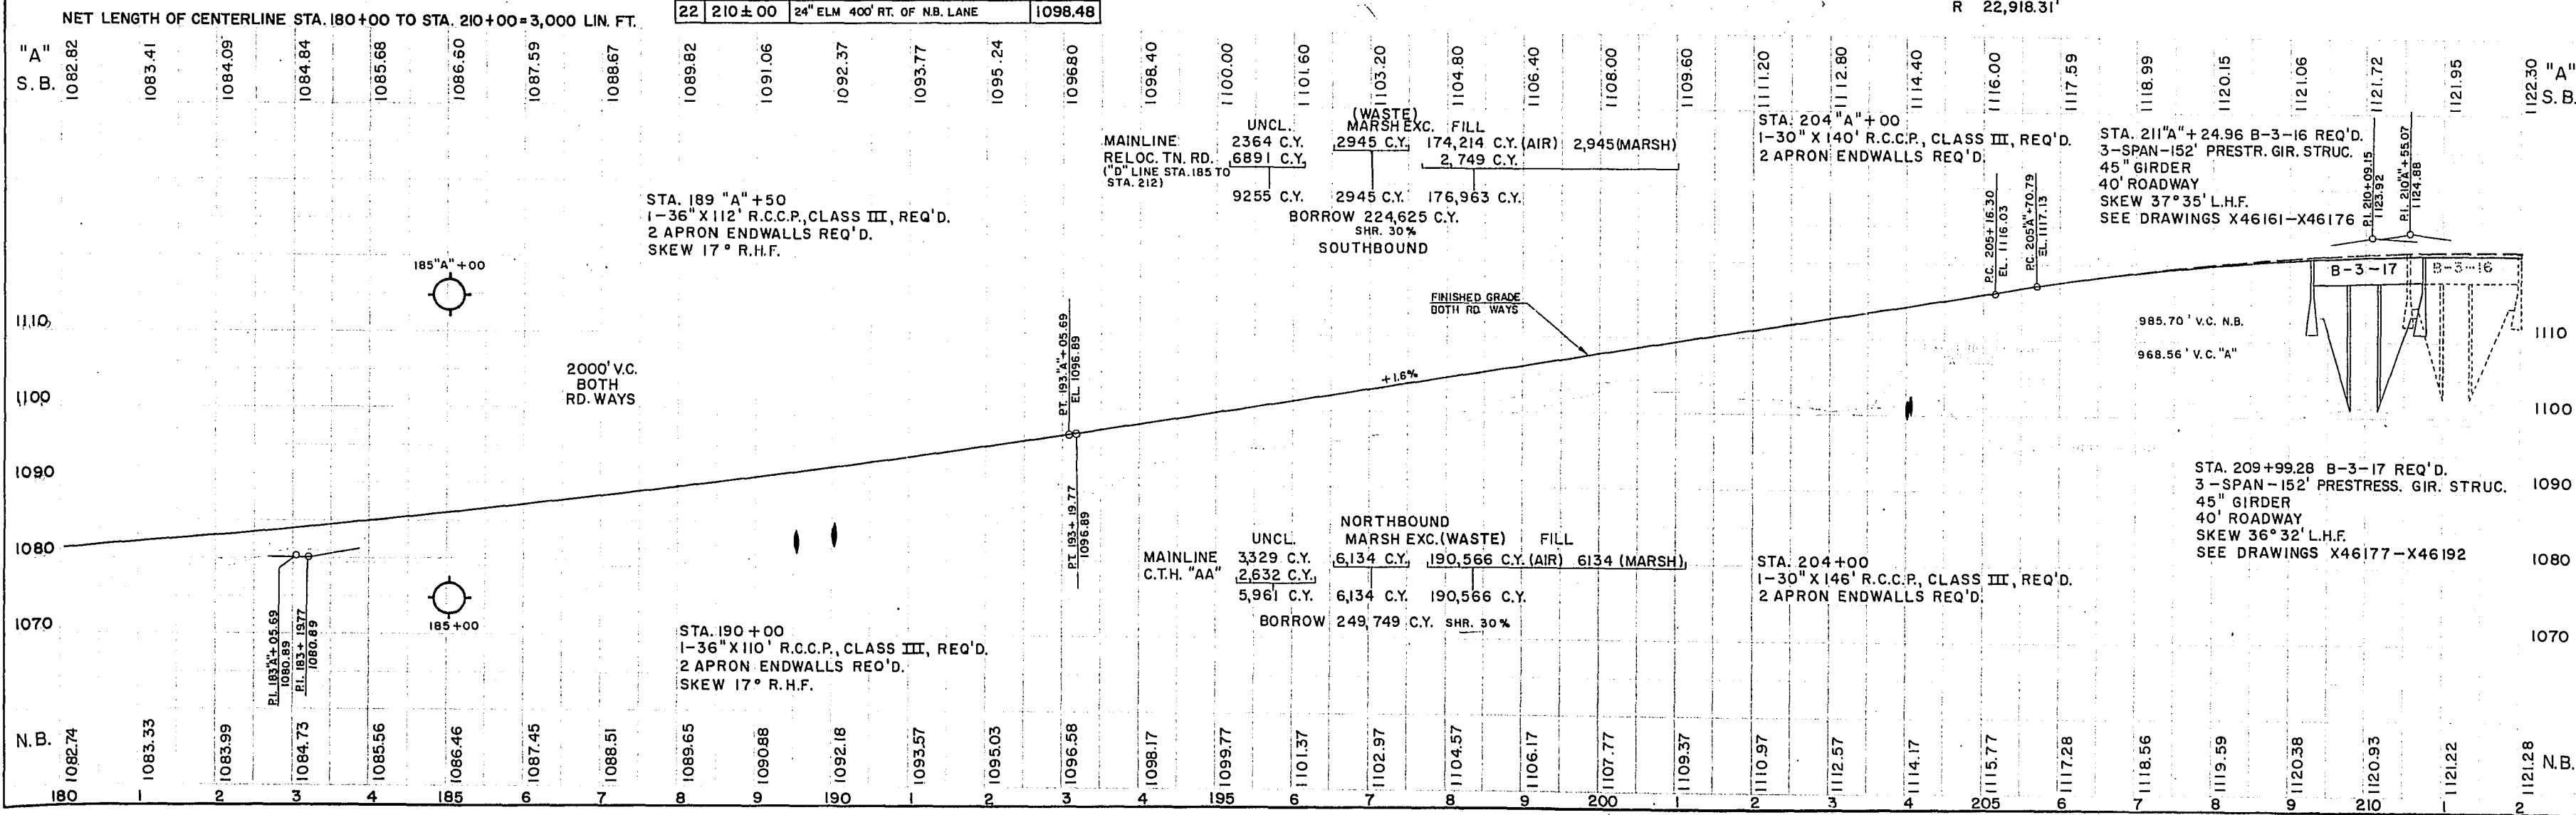

STA. 189 "A" + 50  
1-36" X 112' R.C.C.P. CLASS III, REQ'D.  
2 APRON ENDWALLS REQ'D.  
SKEW 17° R.H.F.

MAINLINE RELOC. TN. RD. ("D" LINE STA. 185 TO STA. 212)  
UNCL. 2364 C.Y.  
MARSH EXC. 2945 C.Y.  
FILL 174,214 C.Y. (AIR) 2,945 (MARSH)  
2,749 C.Y.  
9255 C.Y. 2945 C.Y. 176,963 C.Y.  
BORROW 224,625 C.Y. SHR. 30%  
SOUTHBOUND

STA. 204 "A" + 00  
1-30" X 140' R.C.C.P. CLASS III, REQ'D.  
2 APRON ENDWALLS REQ'D.

STA. 211 "A" + 24.96 B-3-16 REQ'D.  
3-SPAN-152' PRESTR. GIR. STRUC.  
45" GIRDER  
40' ROADWAY  
SKEW 37° 35' L.H.F.  
SEE DRAWINGS X46161-X46176

STA. 209+99.28 B-3-17 REQ'D.  
3-SPAN-152' PRESTR. GIR. STRUC.  
45" GIRDER  
40' ROADWAY  
SKEW 36° 32' L.H.F.  
SEE DRAWINGS X46177-X46192

STA. 190 + 00  
1-36" X 110' R.C.C.P. CLASS III, REQ'D.  
2 APRON ENDWALLS REQ'D.  
SKEW 17° R.H.F.

MAINLINE C.T.H. "AA"  
UNCL. 3329 C.Y.  
MARSH EXC. (WASTE) 6,134 C.Y.  
FILL 190,566 C.Y. (AIR) 6134 (MARSH)  
5,961 C.Y. 6,134 C.Y. 190,566 C.Y.  
BORROW 249,749 C.Y. SHR. 30%  
NORTHBOUND

STA. 204+00  
1-30" X 146' R.C.C.P. CLASS III, REQ'D.  
2 APRON ENDWALLS REQ'D.


CURVE DATA  
FRONTAGE ROAD  
P.I. 210+02.84  
AZ. 196°12'45"  
Δ 16°12'45"  
D 7°30'  
T 108.81'  
L 216.17'  
R 763.94 (ARC)

CURVE DATA  
"A" LINE  
P.I. 213+97.71  
N. 34.472.858  
E. 2,069,648.779  
AZ. 174°57'35"  
Δ 5°03'25"  
D 0°15'  
T 1012.02'  
L 2022.73'  
R 22,918.31

CURVE DATA  
"A" LINE  
P.I. 252+65.10  
N. 37,470.554  
E. 2,067,193.959  
AZ. 191°33'50"  
Δ 11°33'50"  
D 0°15'  
T 2320.68'  
L 4625.60'  
R 22918.31


PROJECT ID	SHEET NUMBER	TOTAL SHEETS
1196-6-72,76	20	296
FEDERAL PROJECT DESIGNATION EMPFO8-4(36)		


TO BE ACQUIRED FOR  
SCENIC PURPOSES  
(SEE R/W PLAT 4.7)

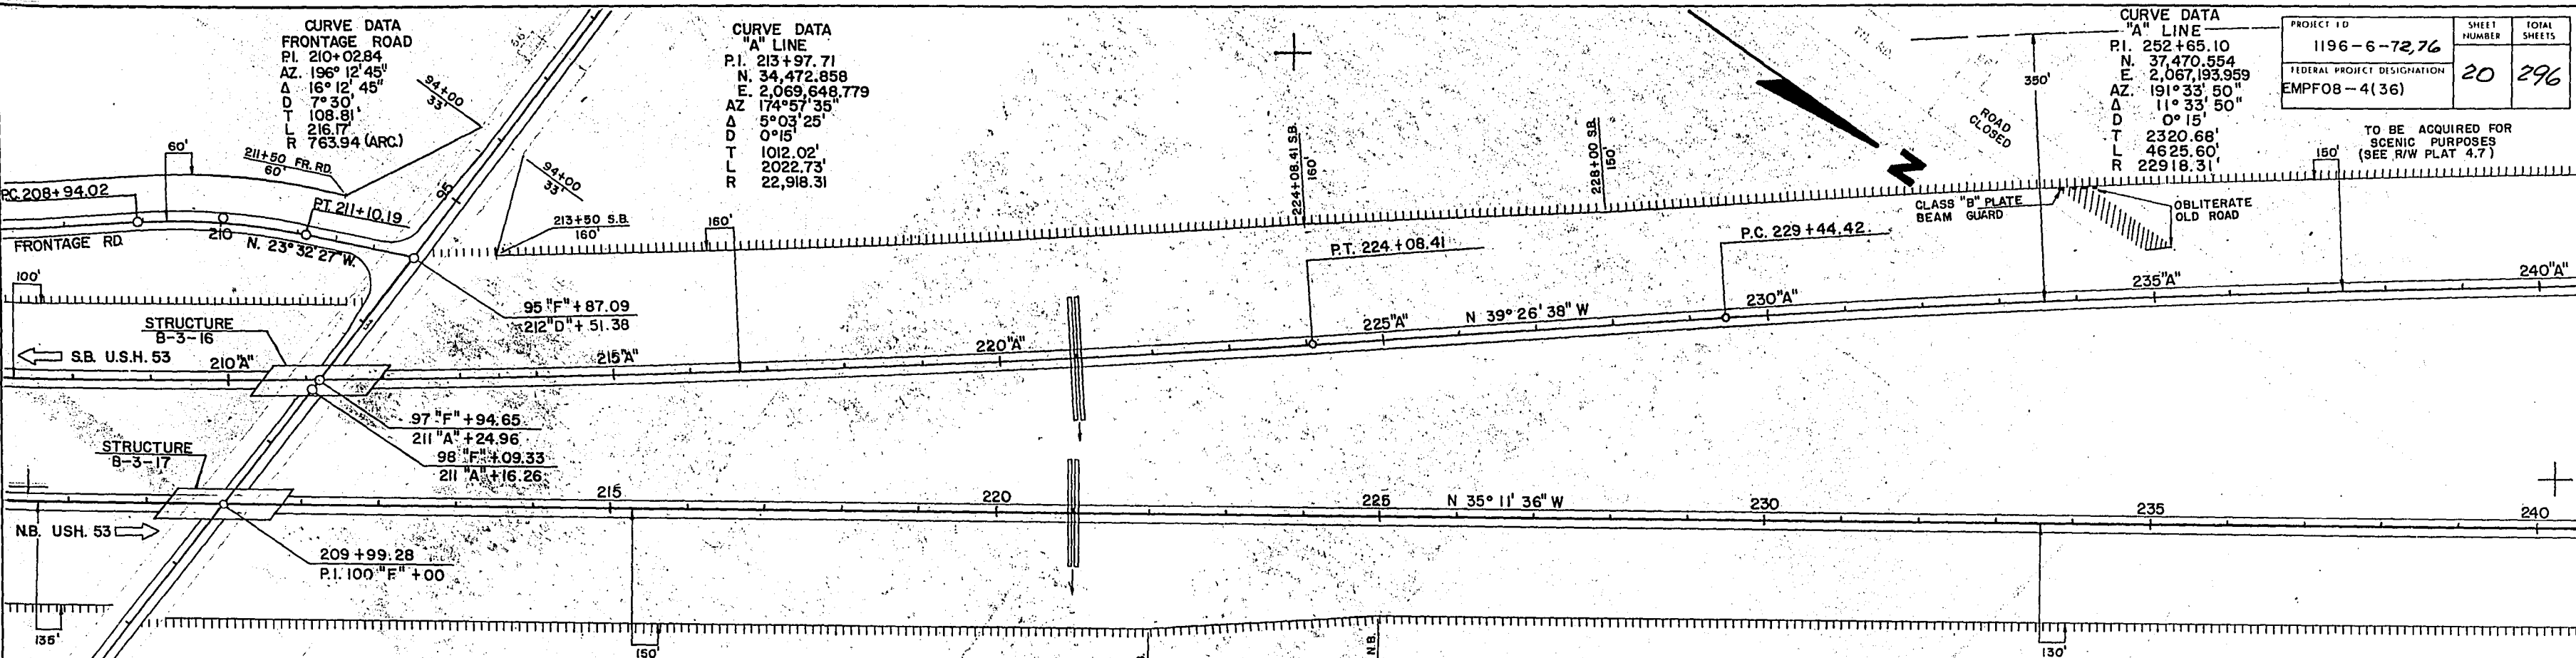


BENCH MARKS			
NO.	STA.	DESCRIPTION	ELEV.
22	210±00	24" ELM 400' RT. OF N.B. LANE	1098.48
23	220±00	30" MAPLE 135' LT. OF S.B. LANE	1104.14
24	230±00	6" W. BIRCH 110' LT. OF S.B. LANE	1105.02
25	240±00	14" MAPLE BETWEEN LANES (R.R. SPIKE)	1119.52

NET LENGTH OF CENTERLINE STA. 210+00 TO STA. 240+00 = 3,000 LIN. FT.

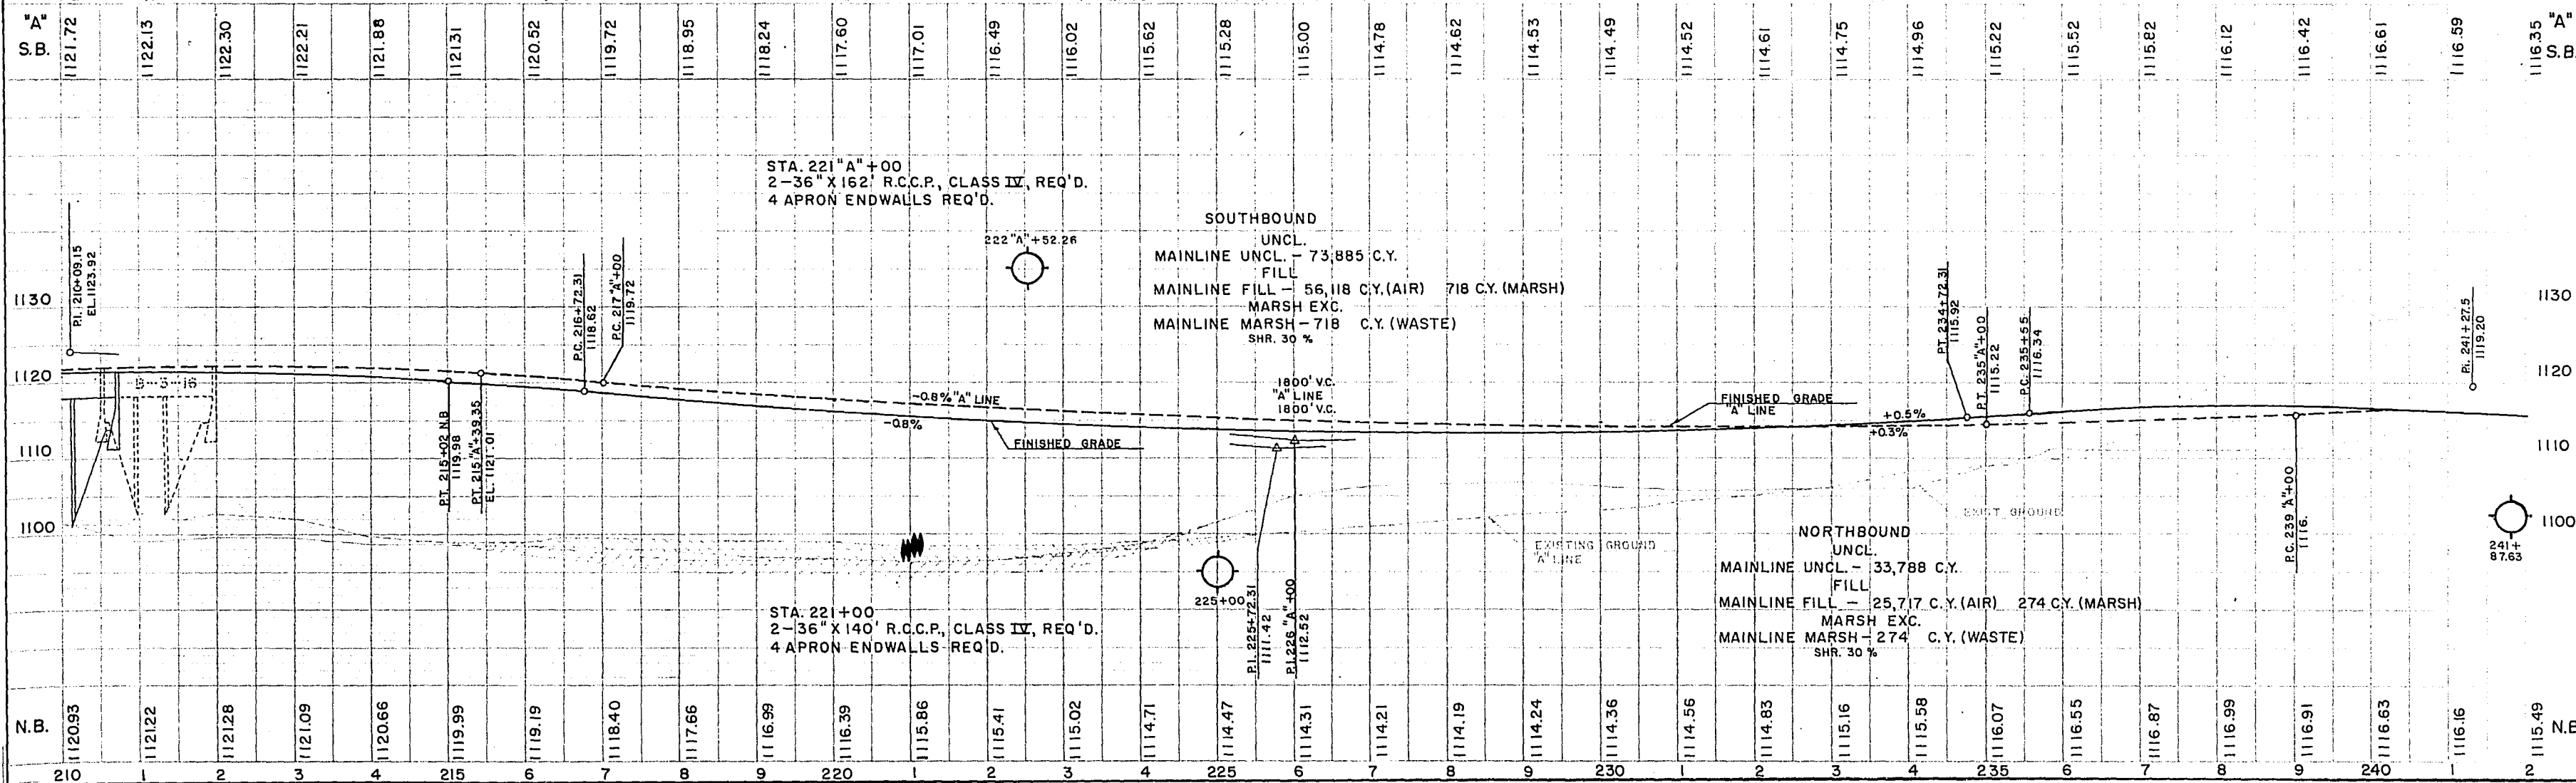


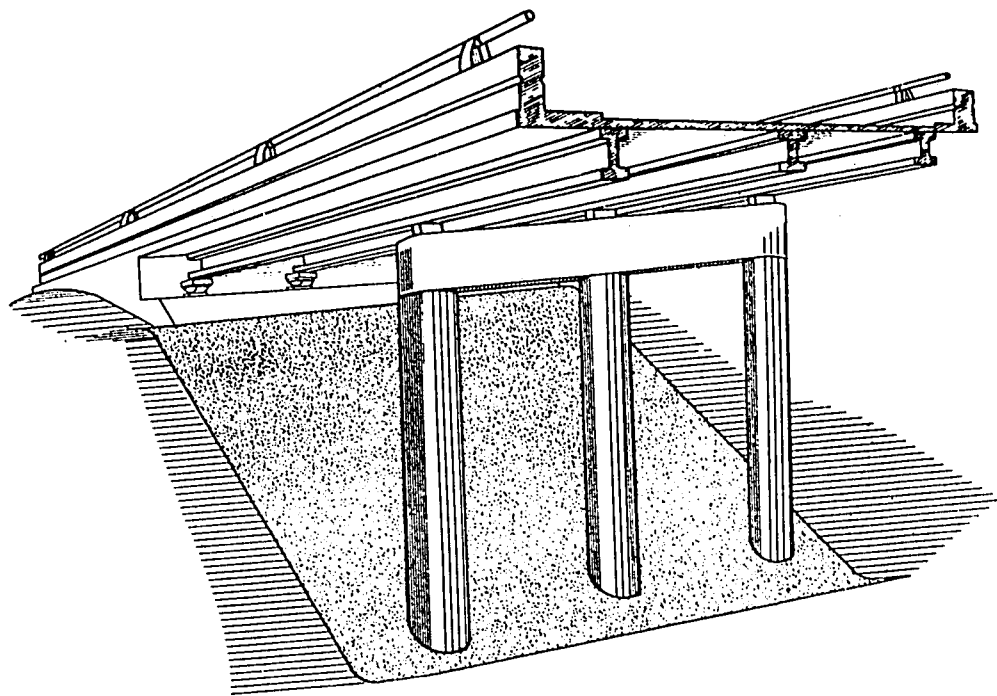


**TYPICAL LOCATION DIAGRAM FOR  
SLOPE PAVING UNDER STRUCTURES**

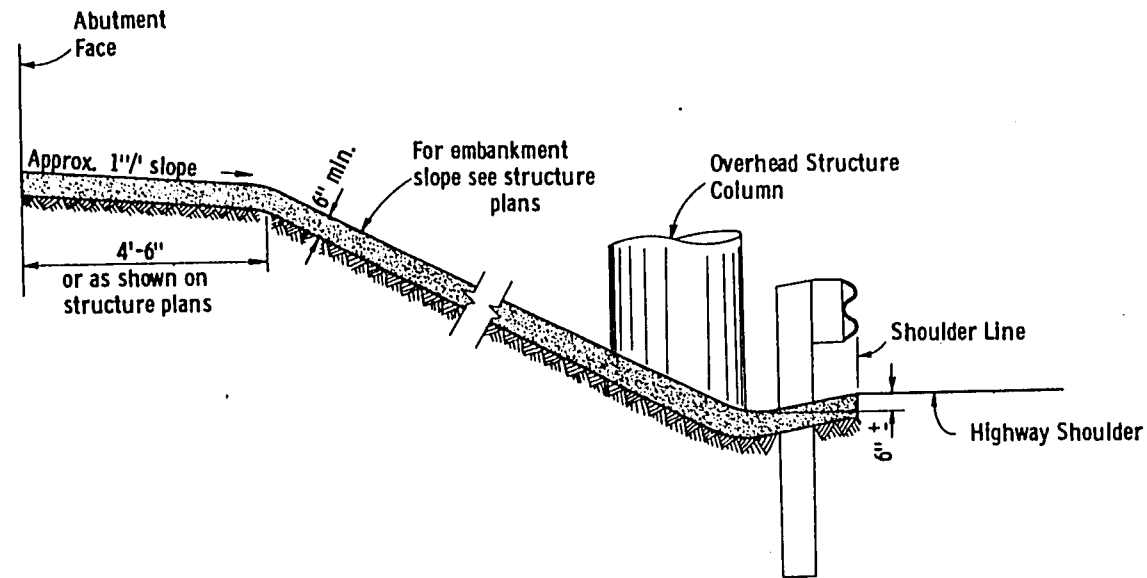


**TYPICAL RURAL SECTION  
HIGHWAY GRADE SEPARATION  
SILL TYPE ABUTMENT**

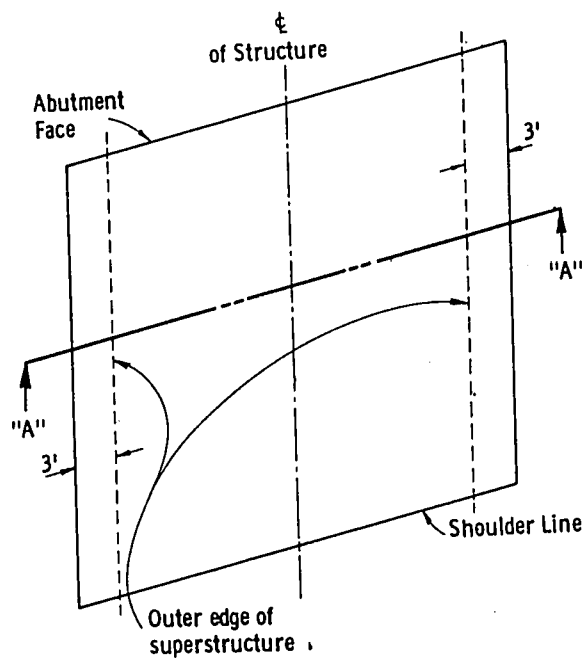

**PLAN VIEW**

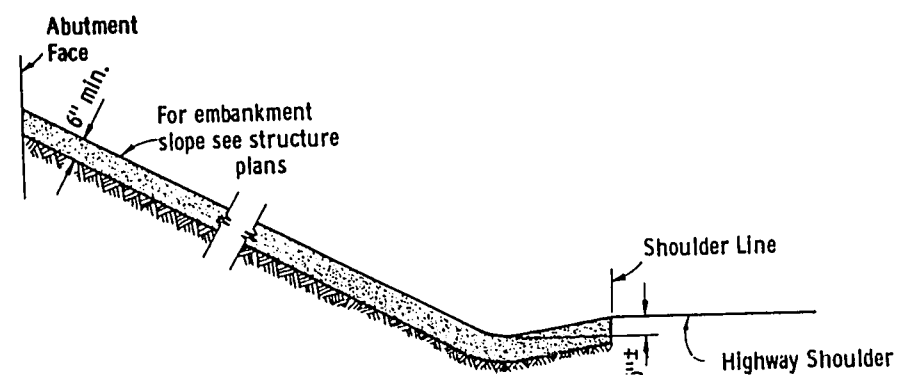

**TYPICAL RURAL SECTION  
HIGHWAY GRADE SEPARATION  
SEMI-RETAINING TYPE ABUTMENT**

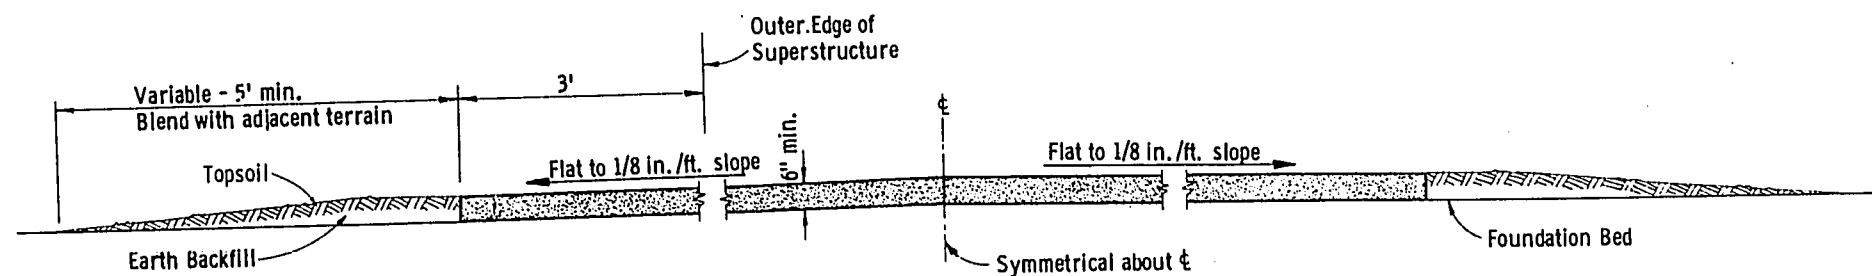

**SECTION "A"-"A"**

**GENERAL NOTES**

Details of construction not shown hereon shall conform to the pertinent requirements of the Standard Specifications and the applicable Special Provisions.

**CRUSHED STONE**

The material shall conform to the gradation requirements for coarse aggregate for concrete masonry, size No. 2 of either series No. 1 or series No. 2.

**BITUMINOUS MATERIAL**

The upper portion of the paving shall be stabilized by means of an application of bituminous material conforming to the requirements of the applicable Standard Specification or Special Provisions. The bituminous material shall be applied at a rate sufficient to assure penetration into and binding together of the particles in the upper two inches of the crushed stone. The surface of the adjacent structure shall be protected so as to prevent their being splattered or discolored with bituminous material.

**METHOD OF MEASUREMENT & PAYMENT**

This work shall be measured and paid for by the square yard, which yardage shall be the summation of the total area measured on the plane of the surface thereof, and as provided for in the Standard Specifications and applicable Special Provisions.

**SLOPE PAVING  
CRUSHED STONE**

State of Wisconsin  
Department of Transportation  
Division of Highways

RECOMMENDED FOR APPROVAL



DATE 1/25/68

APPROVED: 2/8/68


DATE

E. J. Bykik  
CHIEF DESIGN ENGINEER

A. J. Lurmeister  
STATE HIGHWAY ENGINEER

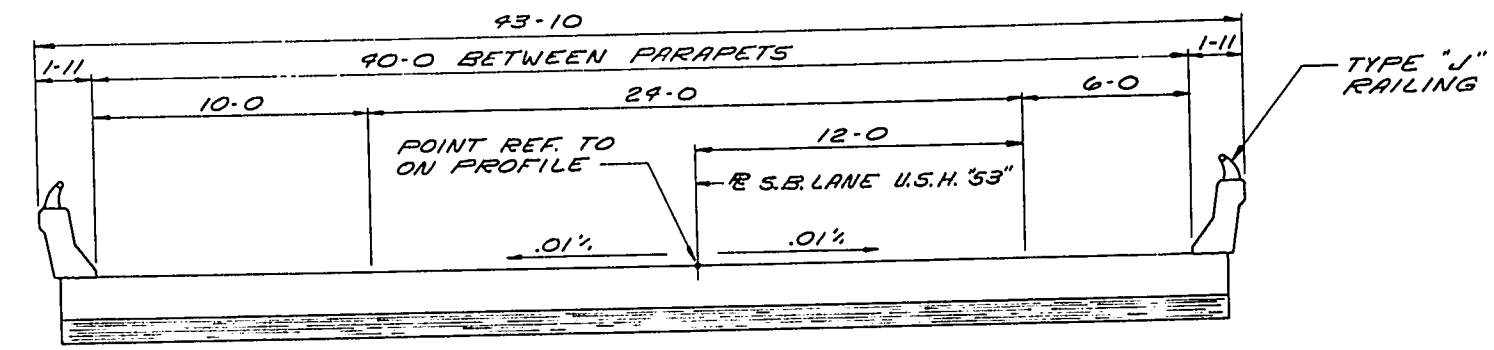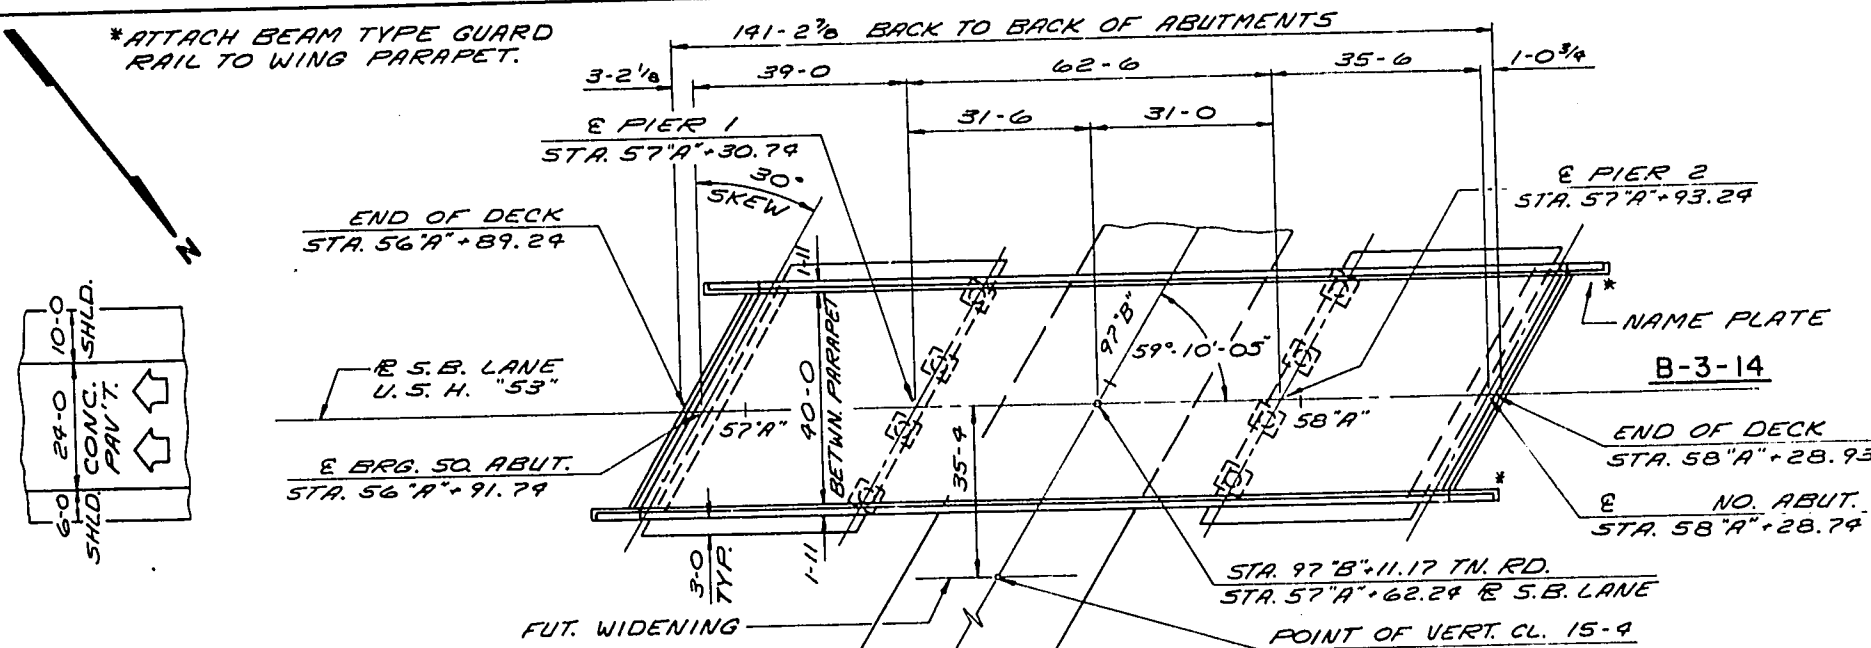

CROSS SECTION THRU ROADWAY  
3 SPAN HAUNCHED SLAB (LOOKING NORTH)

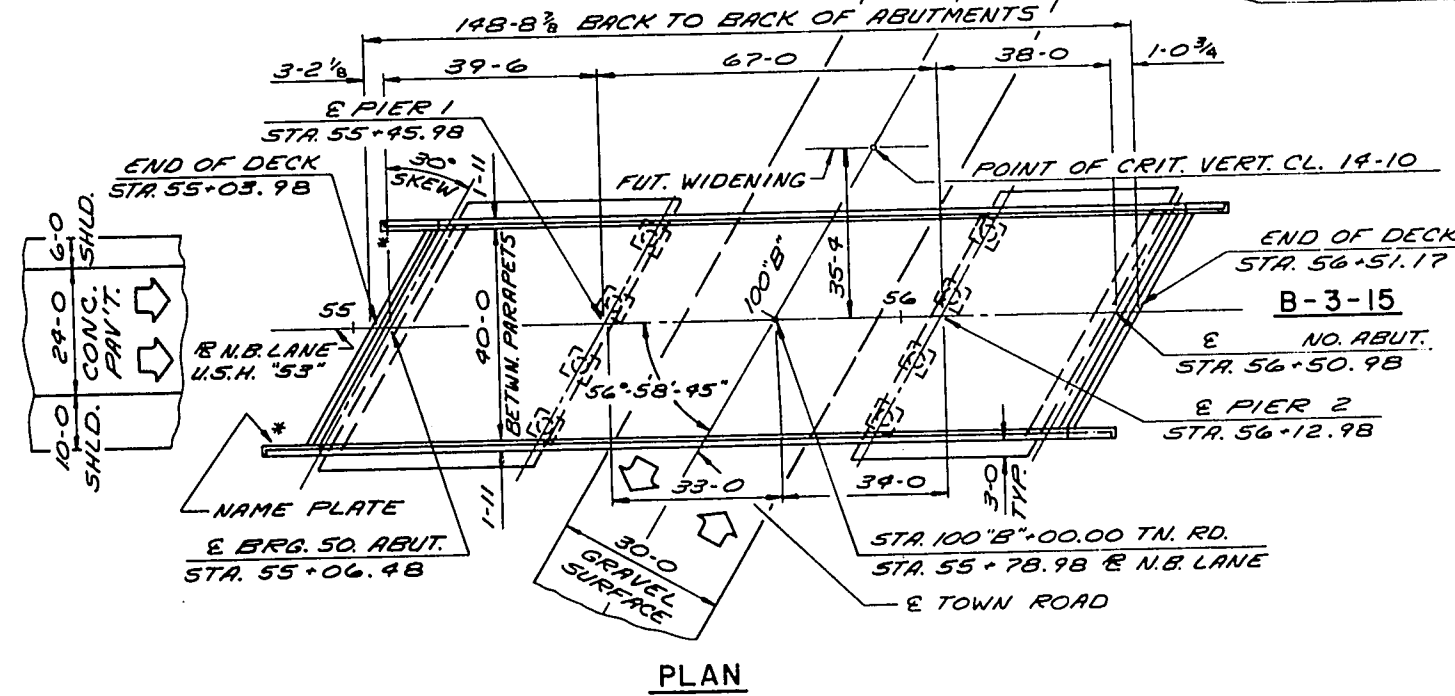

DESIGN DATA

LIVE LOAD: HS 20

ALLOWABLE DESIGN STRESSES:

CONCRETE MASONRY, GRADE "AA"  $f_c = 1,900$  P.S.I.

BAR STEEL REINFORCEMENT  $f_s = 20,000$  P.S.I.

FOUNDATION DATA:

ABUTMENTS AND PIERS TO BE SUPPORTED ON CAST-IN-PLACE CONCRETE PILING 10 3/4"  $\phi$ . DRIVE TO A MIN. BRG. VALUE OF 20 T/PILE, 55-0 EST. LENGTH AT SOUTH ABUT., 20 T/PILE, 55-0 EST. LENGTH AT NORTH ABUT., AND 55 T/PILE, 55-0 EST. LENGTH AT THE PIERS.

TRAFFIC VOLUME:

U.S.H. "53"

D.H.V. 5300 (1980)

R.D.S. 80 M.P.H.

TOWN ROAD

A.D.T. 100 (2000)

GENERAL NOTES

DRAWINGS SHALL NOT BE SCALED. BAR STEEL REINFORCEMENT SHALL BE EMBEDDED 2" CLEAR UNLESS OTHERWISE SHOWN OR NOTED.


THE FIRST DIGIT OF A THREE DIGIT BAR NO. AND THE FIRST TWO DIGITS OF A FOUR DIGIT BAR NO. SIGNIFIES THE BAR SIZE.

THE SLOPE OF THE FILL IN FRONT OF THE ABUTMENTS SHALL BE COVERED WITH SLOPE PAVING, CRUSHED AGGREGATE TO THE EXTENT SHOWN ON THIS SHEET AND IN THE ABUTMENT DETAILS.

THE FINISHED GRADED SECTION WAS USED AS THE UPPER LIMITS OF EXCAVATION FOR COMPUTATION OF EXCAVATION AT THE PIERS.


FOR UPPER LIMITS OF EXCAVATION AT THE ABUTMENTS SEE SHEETS NO. 3 & 4.

PILING AT ABUTMENTS SHALL BE PREBORED THRU FILL TO THE ORIGINAL GROUND LINE.

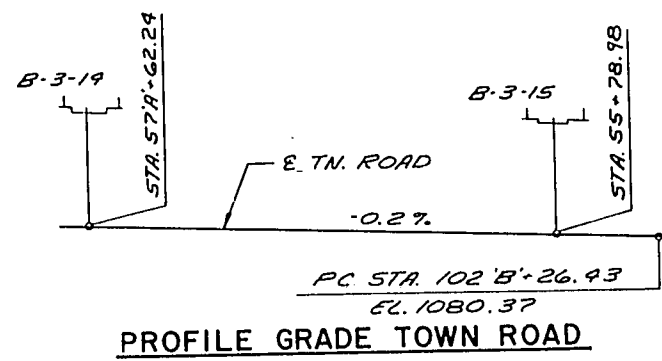


LIST OF DRAWINGS

1. GENERAL PLAN	X46260
2. SUBSURFACE EXPLORATION	X46261
3. SOUTH ABUTMENT	X46262
4. NORTH ABUTMENT	X46263
5. PIERS	X46264
6. SUPERSTRUCTURE	X46265
7. SUPERSTRUCTURE	X46266
8. EXPANSION JOINT & BEARING DETAILS	X46267
9. SLOPED FACE PARAPET "A"	X46268
10. TUBULAR RAILING TYPE "J"	X46269

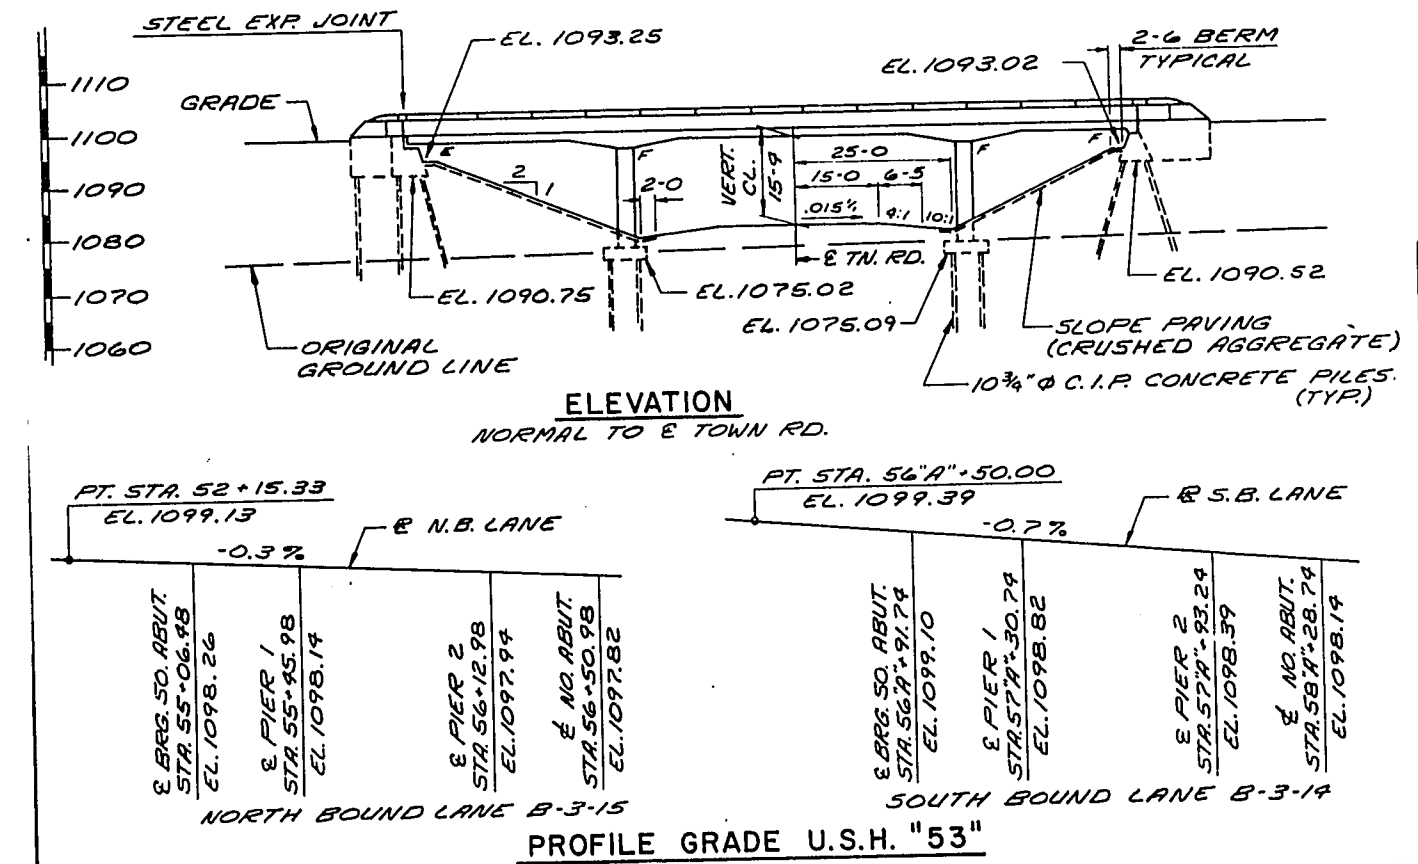

TOTAL ESTIMATED QUANTITIES

BID ITEMS	UNIT	S. ABUT.	PIER 1	PIER 2	N. ABUT.	SUPER.	TOTAL
EXCAVATION FOR STRUCTURE	C.Y.	90	132	100	90	—	312
CONCRETE MASONRY	C.Y.	66	63	47	43	445	664
BAR STEEL REINFORCEMENT	L.B.	3060	10105	8885	2180	103090	127320
STRUCTURAL CARBON STEEL	L.B.	—	—	—	—	3970	3970
STRUCTURAL LOW ALLOY STEEL	L.B.	—	—	—	—	1100	1100
LUBRICATED BRONZE PLATES	L.B.	—	—	—	—	77	77
BEARING PADS	S.F.	604	1411	765	573	7	7
CAST-IN-PLACE CONC. PILING DEL. & DR. 10 3/4" $\phi$	L.F.	888	1540	888	446	—	4670
PREBORING, CAST-IN-PLACE CONC. PILING 10 3/4" $\phi$	L.F.	252	—	—	295	—	497
TUBULAR RAILING, TYPE "J"	L.F.	—	—	—	—	302	302
SLOPE PAVING, CRUSHED AGGREGATE	S.Y.	247	—	—	229	—	476
NON-BID ITEMS							
1/8" ALUMINUM OR ZINC PLATE	S.F.	—	—	—	—	40	40
FILLER	SIZE	—	1/4"	1/4"	—	1/2"	1/4" 1/2"
POLYVINYL CHLORIDE WATERSTOP	L.F.	—	—	—	—	46	46

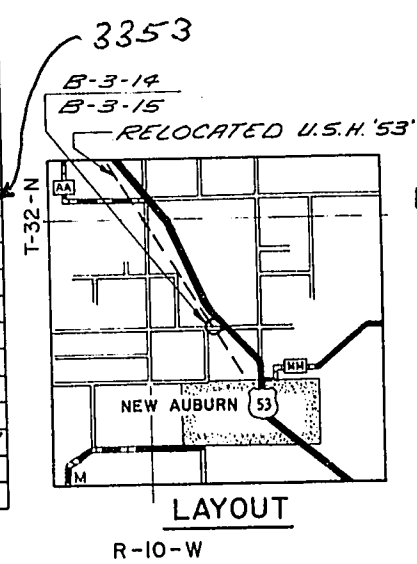

STATE OF WISCONSIN  
DEPARTMENT OF TRANSPORTATION  
DIVISION OF HIGHWAYS

STRUCTURE B-3-14

U.S.H. "53" OVER TOWN ROAD

County BARRON City Village

Design Spec. A.A.S.H.O. 69 Load HS 20 Const. Spec. 1969

Designed By R.T.B. Design Checked F.P.R. Drawn By D.J.A. Plan Checked J.H.G.

Approved W.A. Kline Chief Bridge Engineer Date 11-17-71

GENERAL PLAN SHEET 1 OF 10 X46260

PROJECT ID <b>1196-6-71</b>	SHEET NUMBER <b>29</b>	TOTAL SHEETS <b>296</b>
FEDERAL PROJECT DESIGNATION <b>EMP FOB-4(36)</b>		

ABBREVIATIONS  
 F — Fine M — Medium C — Coarse  
 Ws — Weathered So — Sound

MATERIAL SYMBOLS

Topsoil	Silt	Sandstone
Sand	Peat	Limestone
Gravel	Clay	Igneous Rock

LEGEND OF PROBING

95/6=95 Blows for 6"  
 Penetration  
 Probing taken with a  
 350# wt.  
 Falling 18" on a 2"  
 O. D. Point.

Probing No.  
 Sta.  
 Elevation  
 7 Average Blows Per Foot  
 Refusal 95/6

LEGEND OF BORING

Unconfined Strength — 7.7  
 Blows Per Ft. Using 140# Wt. Falling 30"  
 Wash Sample  
 Shelby Tube — S.T.

Elev.  
 Boring No.  
 Sta.

Sandy Gravel  
 F.  
 Boulders or Cobbles  
 Sand  
 Silty Clay  
 So  
 Limestone

Ground Water Elevation  
 No Ground Water Observed Above This Elevation

Unless otherwise specified, the blows per foot at the locations indicated are based on driving a 2" O. D. x 1.4" I. D. split spoon sampler with a 140# hammer having a free fall of 30". The blow count is taken in undisturbed soil immediately below a cased or open hole eliminating side friction on the drive pipe.

SUBSURFACE EXPLORATION FOR FOUNDATION DESIGN AND BIDDERS INFORMATION

To obtain relative data concerning the character of material in and upon which the foundation might be built, borings and/or soundings were made at points approximately as indicated on this drawing. The data presented herein represents the findings of the subsurface explorations made. However, because the depths investigated are limited and the area of the borings and/or soundings is very small in relation to the entire area, the Division of Highways does not warrant conditions below the depths investigated or that the classification of material encountered in these investigations is necessarily typical of the entire site.


No.	Date	By
-----	------	----

STATE OF WISCONSIN  
 DEPARTMENT OF TRANSPORTATION  
 DIVISION OF HIGHWAYS


STRUCTURE **B-3-14**

1969 D.J.A. J.H.G.


SUBSURFACE EXPLORATION SHEET 2 OF 10  
 X46261

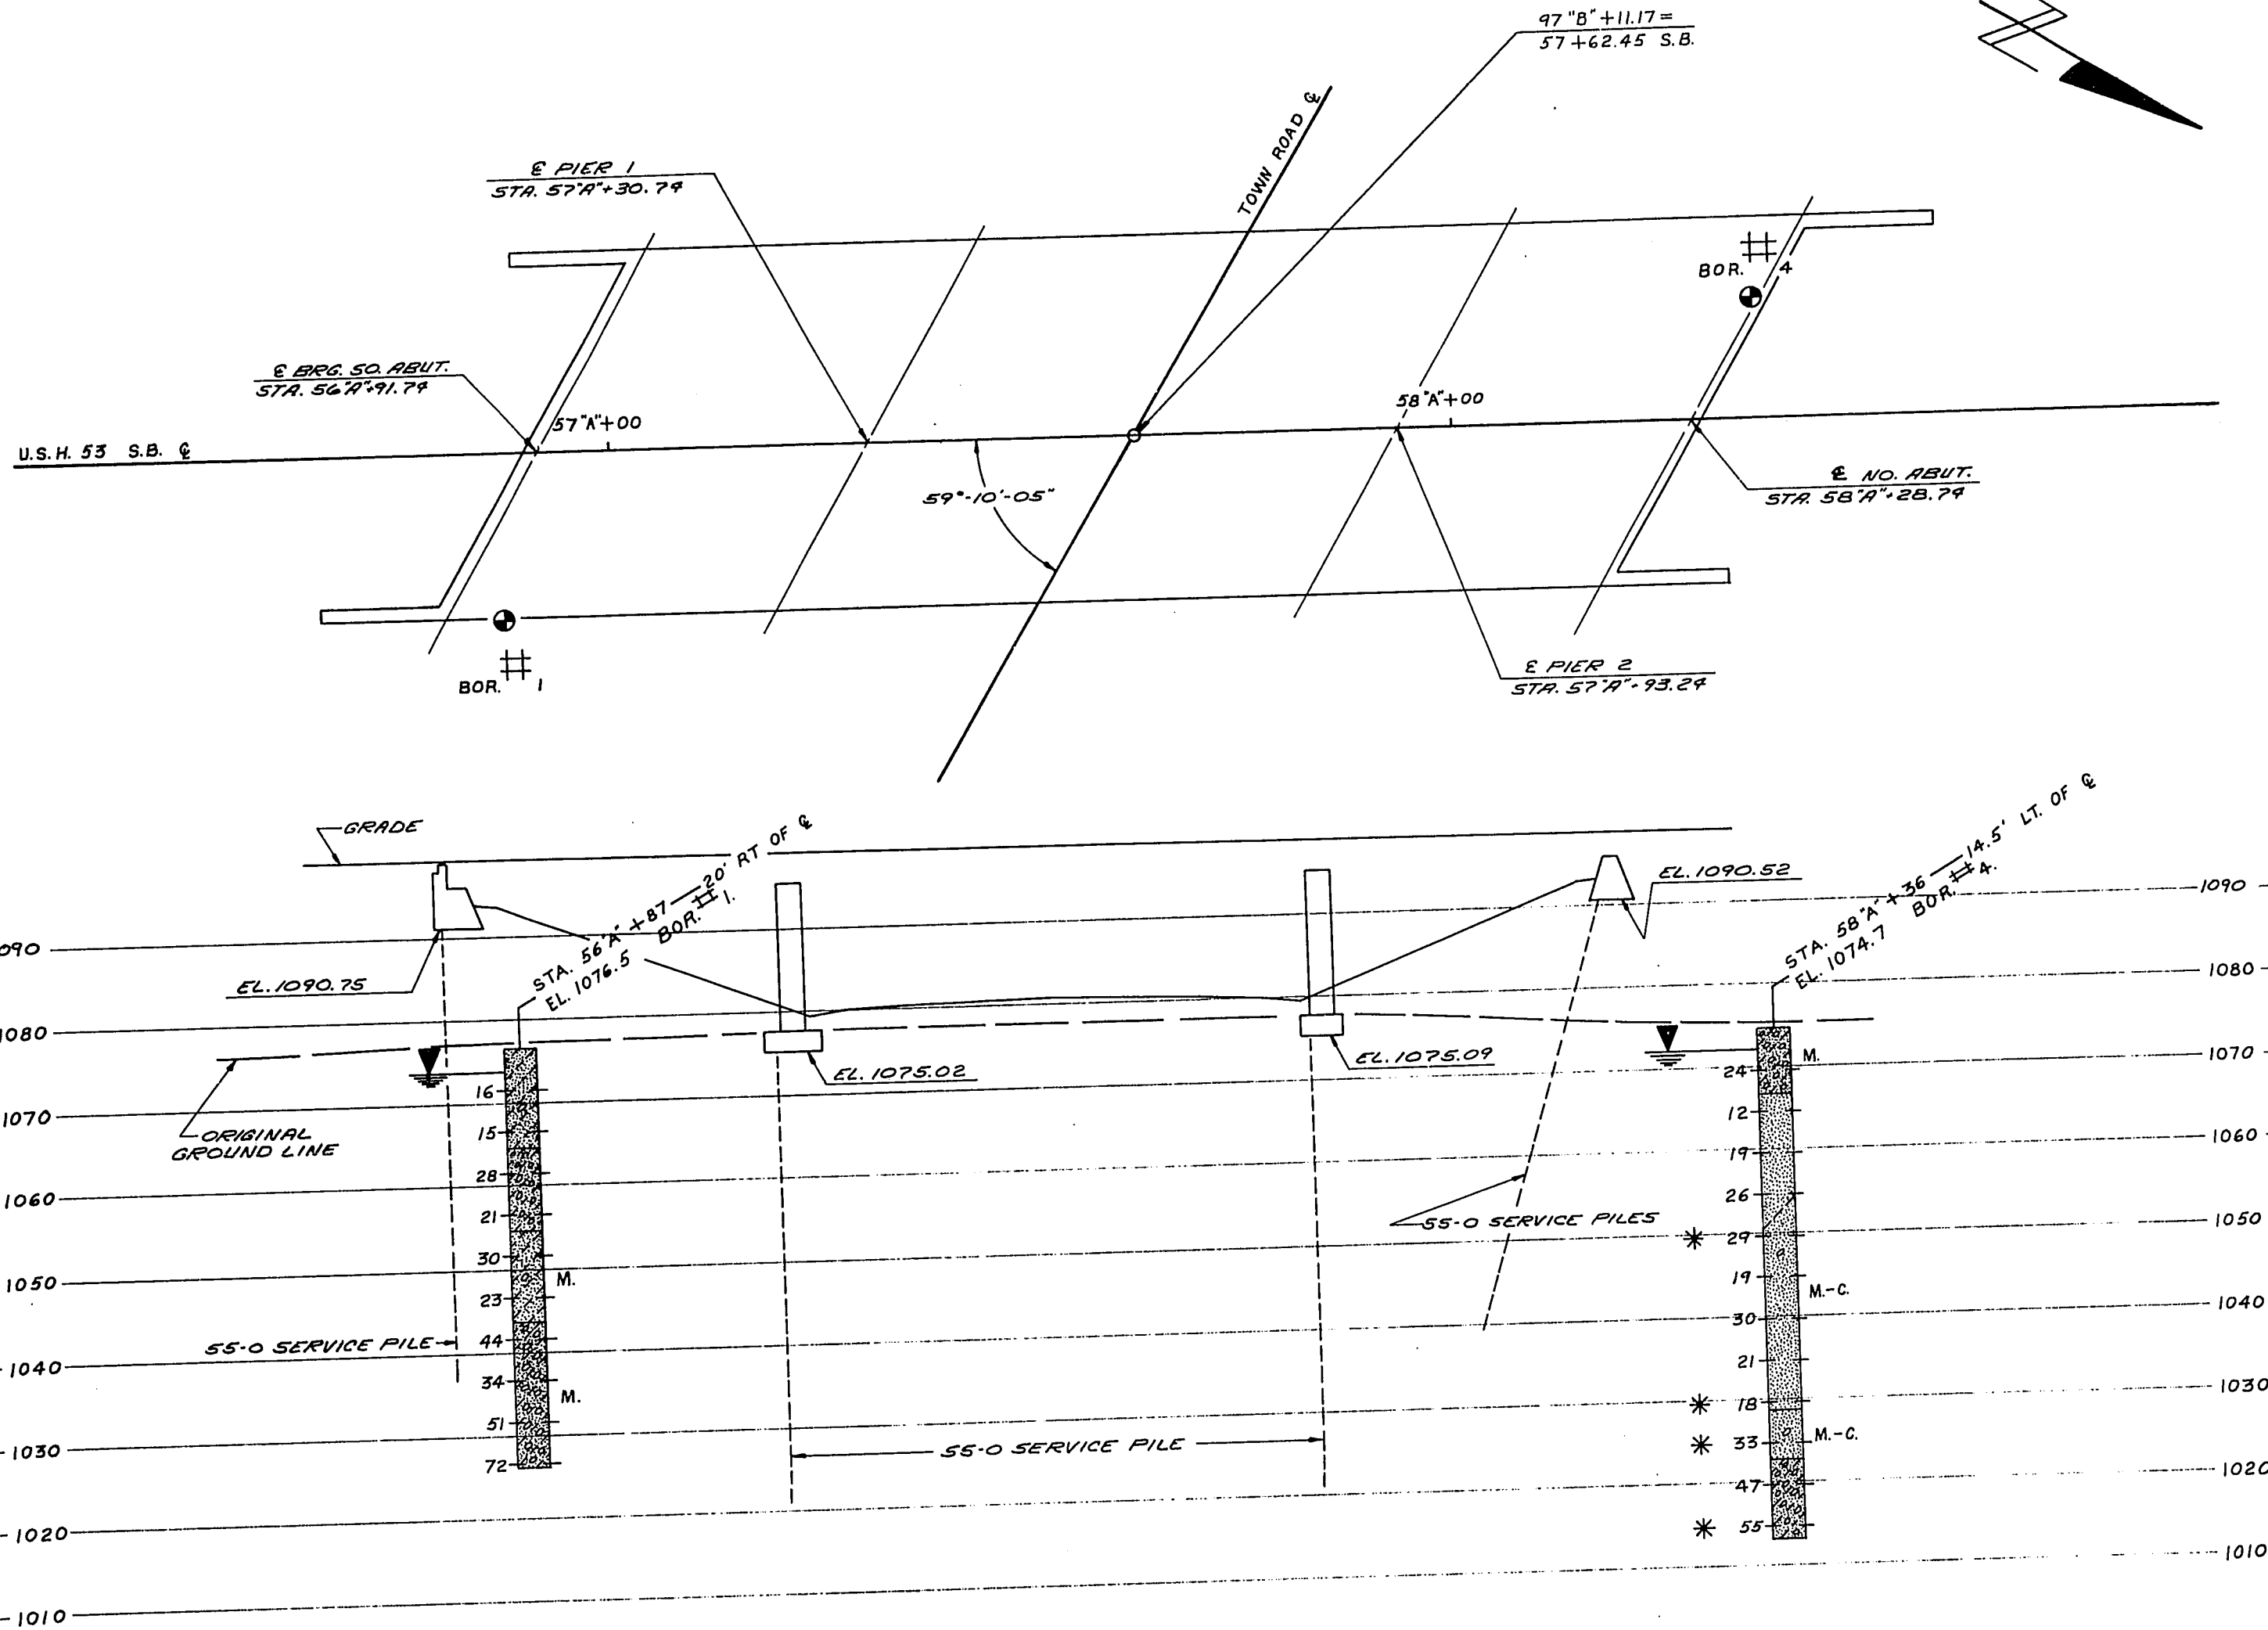




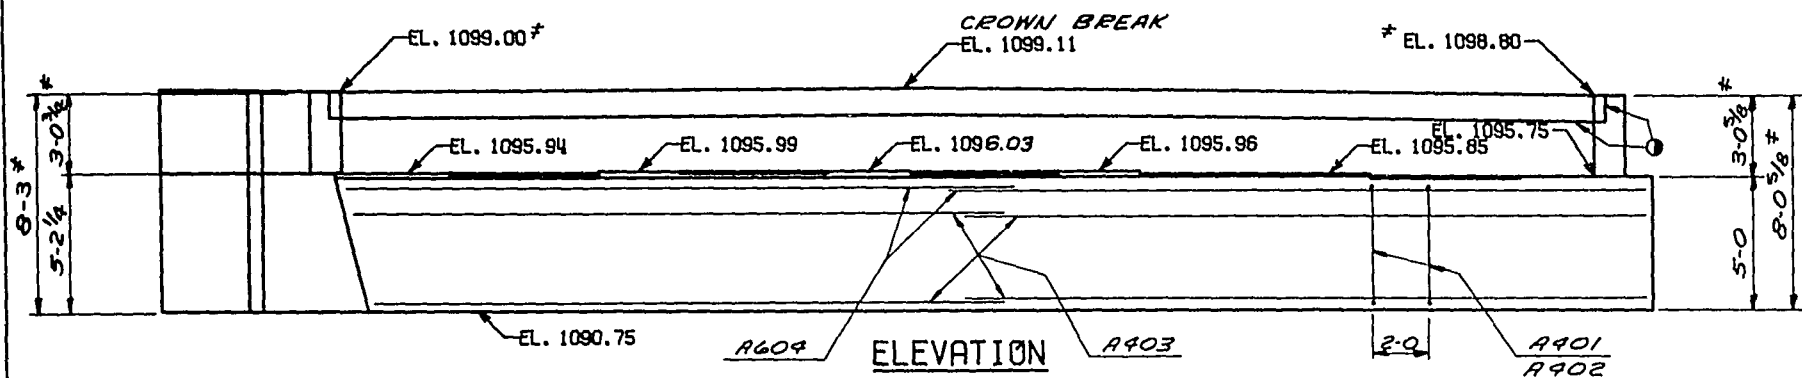


\* ELEVATIONS AND DIMENSIONS  
ARE MEASURED AT FF BACKWALL.

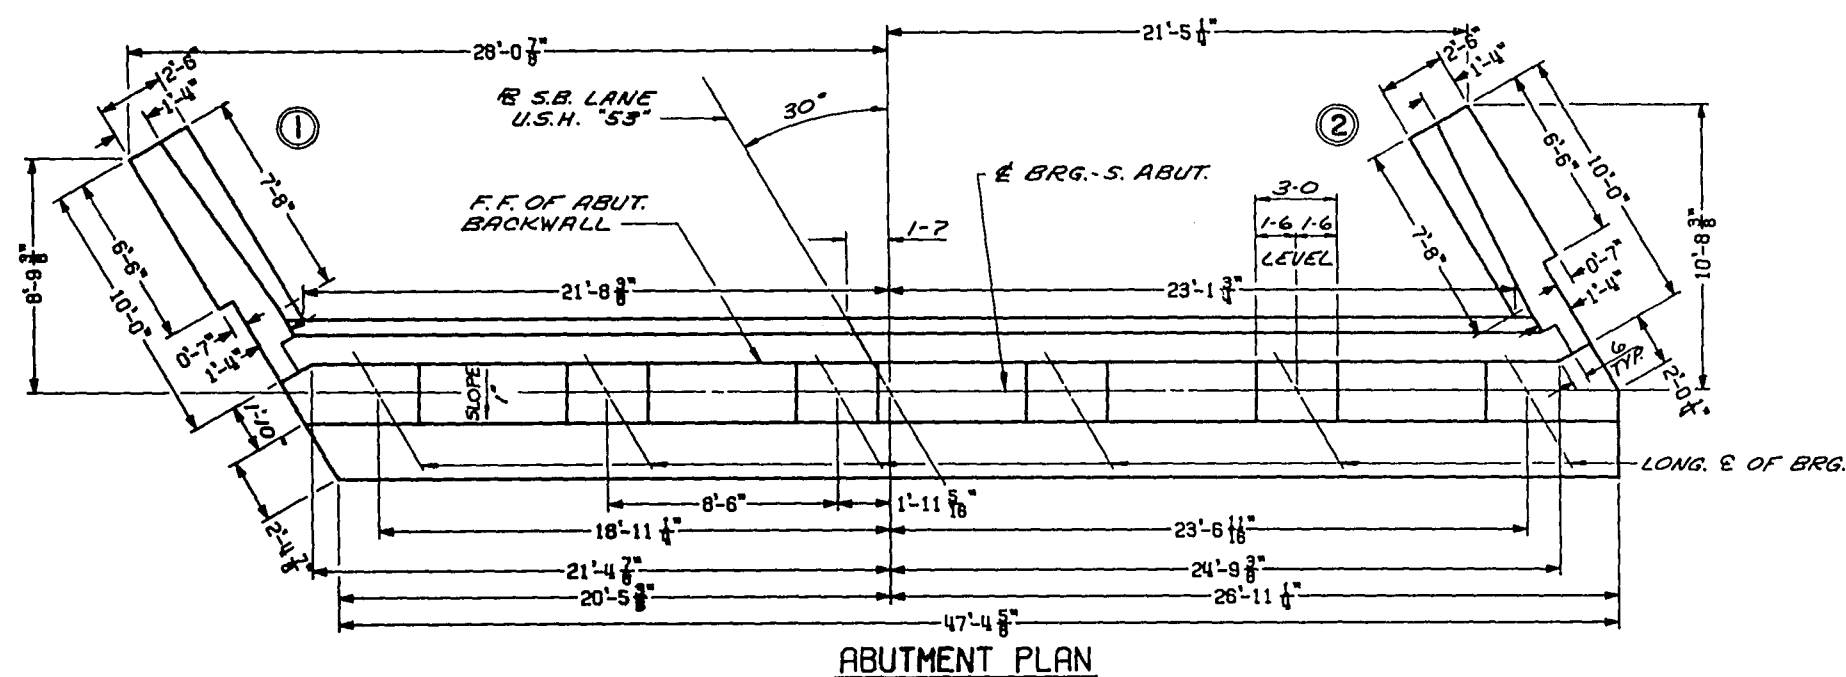

① CONSTRUCTION JOINT-POUR CONCRETE ABOVE THIS JOINT AFTER SUPERSTRUCTURE CONCRETE IS IN PLACE. STRIKE OFF LEVEL AND LEAVE ROUGH.

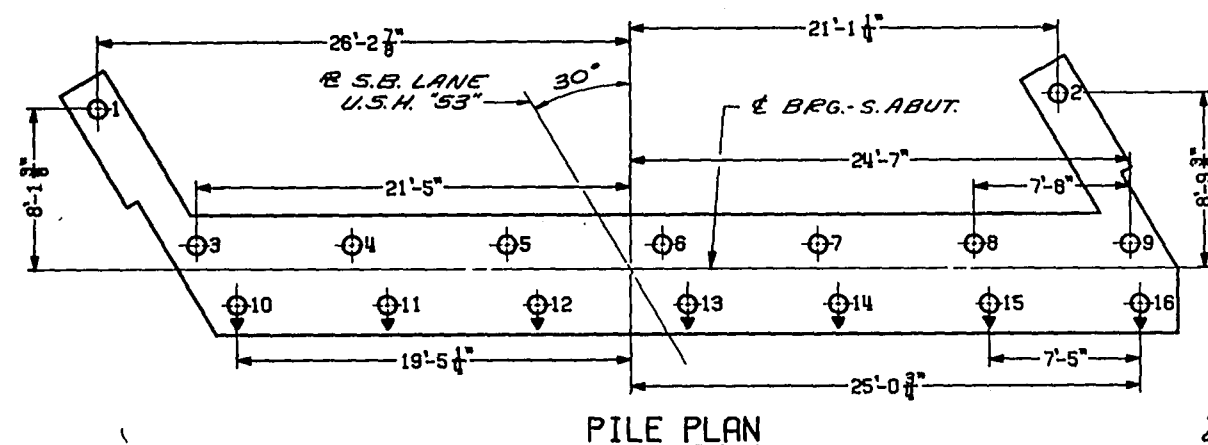


⊕ INDICATES BATTERED  
PILING - BATTER PILING 3"  
PER FOOT IN DIRECTION SHOWN.

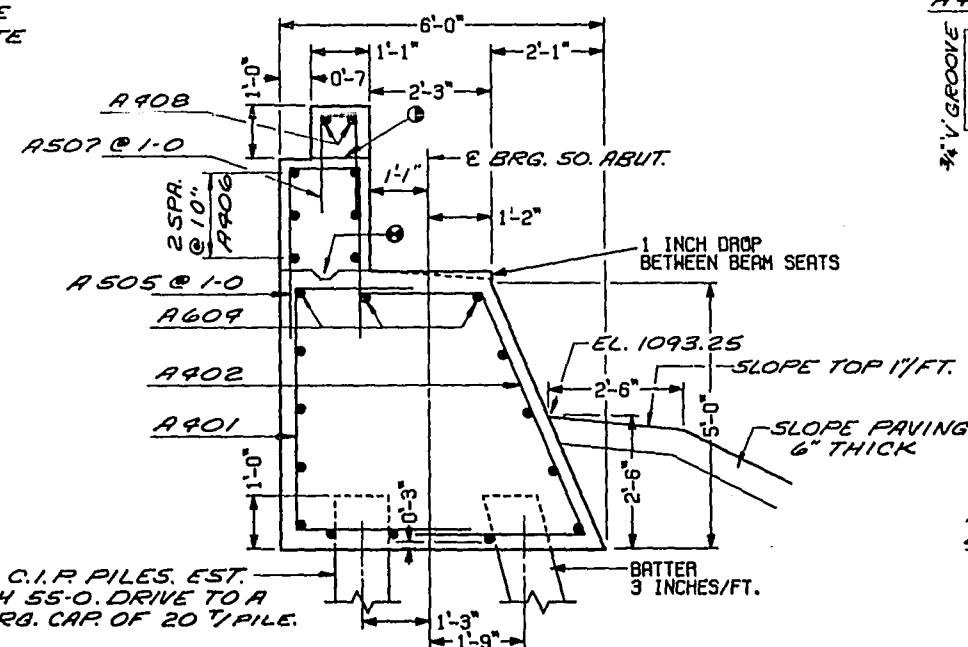


**BODY SECTION**


ALL HORIZONTAL BARS IN ABUTMENT BODY ARE  
A403 BARS UNLESS SHOWN OR NOTED OTHERWISE.  
FILL TO EL. 1092.75 BEFORE DRIVING PILING.  
UPPER LIMIT FOR "EXCAVATION FOR STRUCTURES"  
SHALL NOT EXCEED THIS ELEVATION.

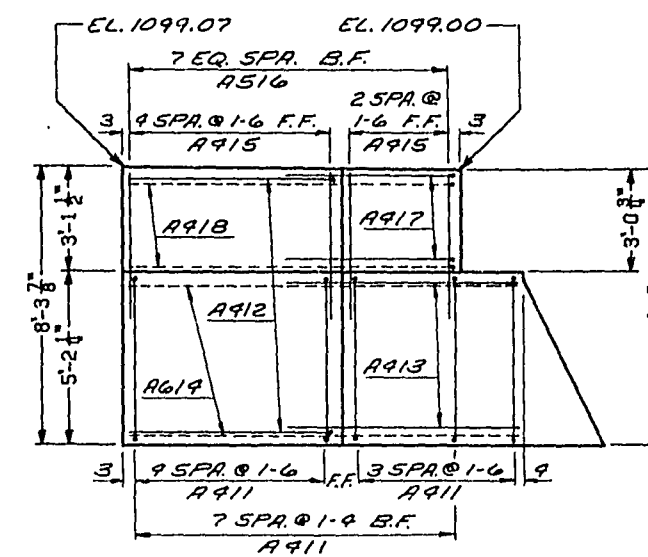


WING I ELEVATION

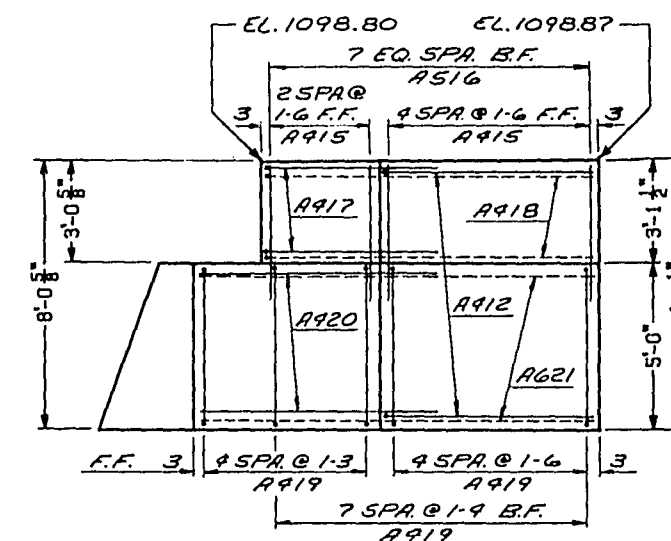

WING 2 ELEVATION

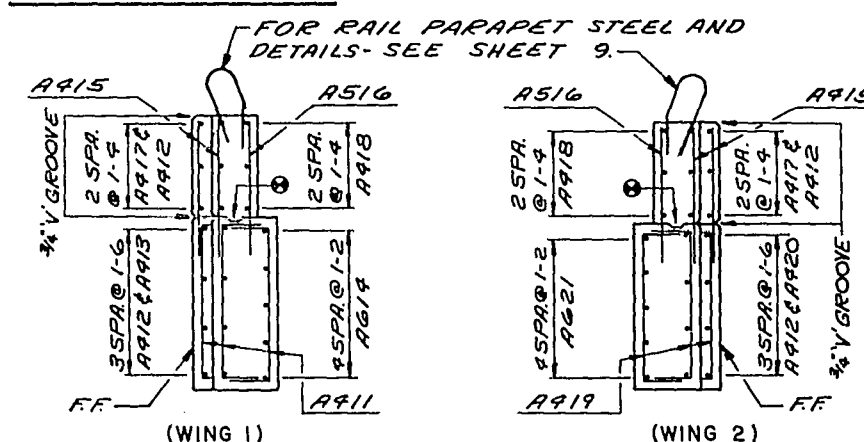


SECTION THRU WINGS

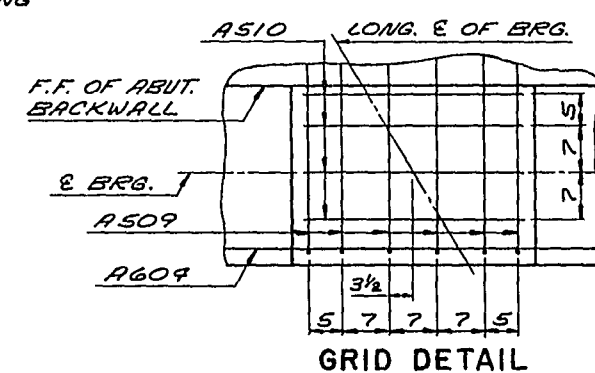

### GRID DETAIL

[illegible]

\* A408-NO LAP FOR RAIL PARAPET BARS,  
1-10½ SEE SHEET 9.

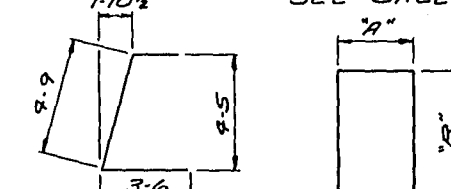

A402

BAR #	DIM. 'A'	DIM. 'B'
A401	4-5	3-6
A505	1-4	3-4
A507	9	2-3
A411	4-9	1-6
A419	4-7	1-6

1-0	A509
1-5	A412
1-0	A417


A418

④ OPTIONAL KEYED CONST. JOINT FORMED BY A SURFACED BEVELED 2x6.

FOR PILE SPLICE DETAIL SEE SHEET 4

No.	Date	Revision	By
STATE OF WISCONSIN DEPARTMENT OF TRANSPORTATION DIVISION OF HIGHWAYS			
STRUCTURE B-3-14			
Const. Spec.	1969	Drawn By	Plans Checked
SOUTH ABUTMENT		SHEET 3 OF 10	
		X 46262	




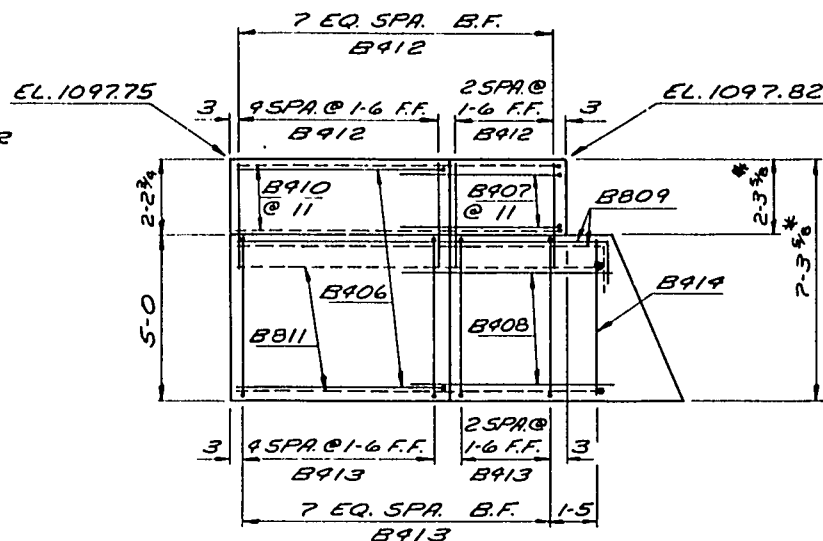


## BILL OF BARS

BAR NO.	NO. REQ'D.	LENGTH	ZENT	1820 #
				LOCATION
B401	50	9-0	X	BODY - VERTICAL
B402	16	25-6		" - HORIZONTAL
B503	8	14-0	X	" - "
B604	4	25-11		" - " TOP
B505	33	2-6		" - DOWEL
B406	16	7-6	X	WINGS 3&4 - HORIZONTAL F.F.
B407	6	5-11	X	" 3&4 - " F.F.
B408	4	6-4		" 3 - " F.F.
B809	2	12-2	X	" 3 - " B.F. & F.F.
B410	6	10-8	X	" 3&4 - " B.F.
B811	5	13-0	X	" 3 - " B.F.
B412	16	3-3		" 3 - VERTICAL F.F. & B.F.
B413	32	6-5	X	" 3&4 - " F.F. & B.F.
B414	3	4-7		" 3&4 - " F.F.
B415	4	7-8		" 4 - HORIZONTAL F.F.
B816	2	13-8	X	" 4 - " B.F. & F.F.
B817	5	13-0	X	" 4 - " B.F.
B418	16	3-6		" 4 - VERTICAL F.F. & B.F.


FOR RAIL PARAPET BARS, SEE SHEET 9.

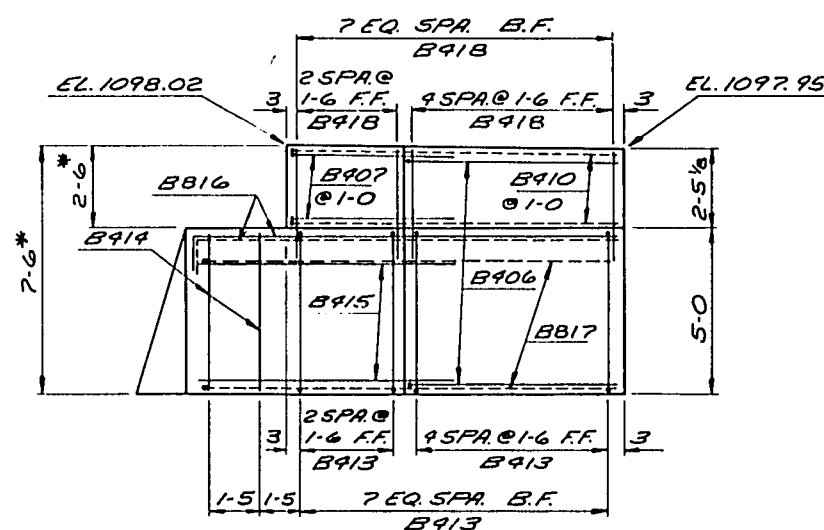

ELEVATIONS WING 4

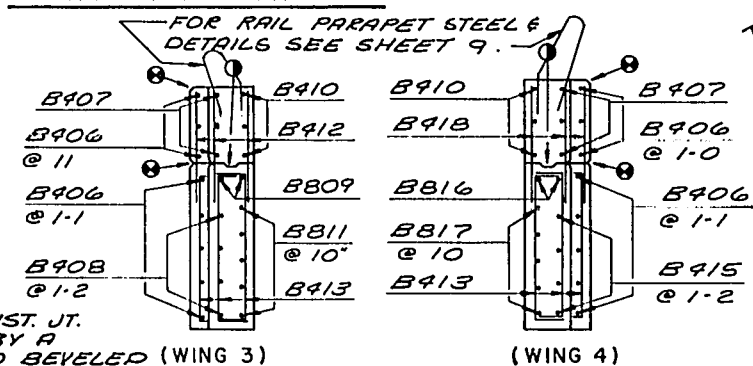


## SECTION THRU WINGS

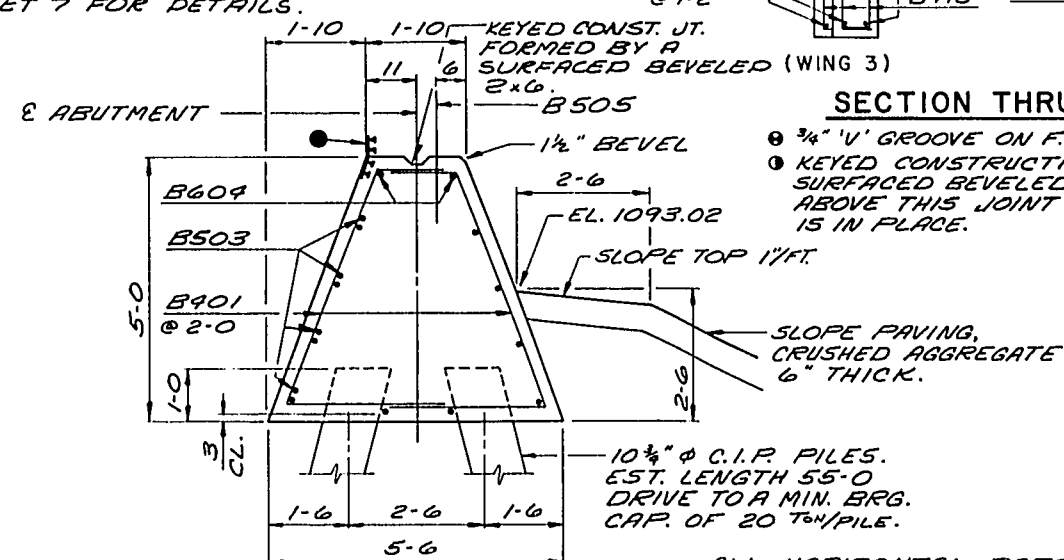

SECTION THRU  
ABUTMENT

ALL HORIZONTAL BARS IN ABUTMENT BODY  
ARE B402 BARS UNLESS SHOWN OR NOTED OTHERWISE.  
FILL TO EL. 1092.52 BEFORE DRIVING PILING.  
UPPER LIMIT FOR "EXCAVATION FOR STRUCTURES"  
SHALL NOT EXCEED THIS ELEVATION.

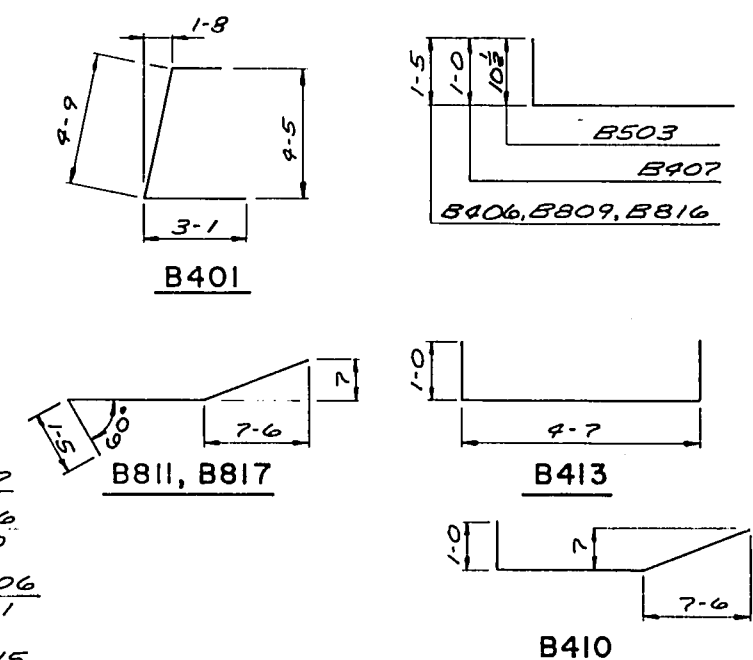


### PILE SPLICE DETAIL



No	Date	Revision	By
STATE OF WISCONSIN DEPARTMENT OF TRANSPORTATION DIVISION OF HIGHWAYS			
STRUCTURE B-3-14			
Const Spec	1969	Drawn By	Plans Checked
		D. J. A.	J. H. G.
NORTH ABUTMENT		SHEET 4 OF 10 X46263	

INDICATES BATTERED  
PILING - BATTER PILING 3"  
PER FOOT IN DIRECTION SHOWN.


BILL OF BARS.

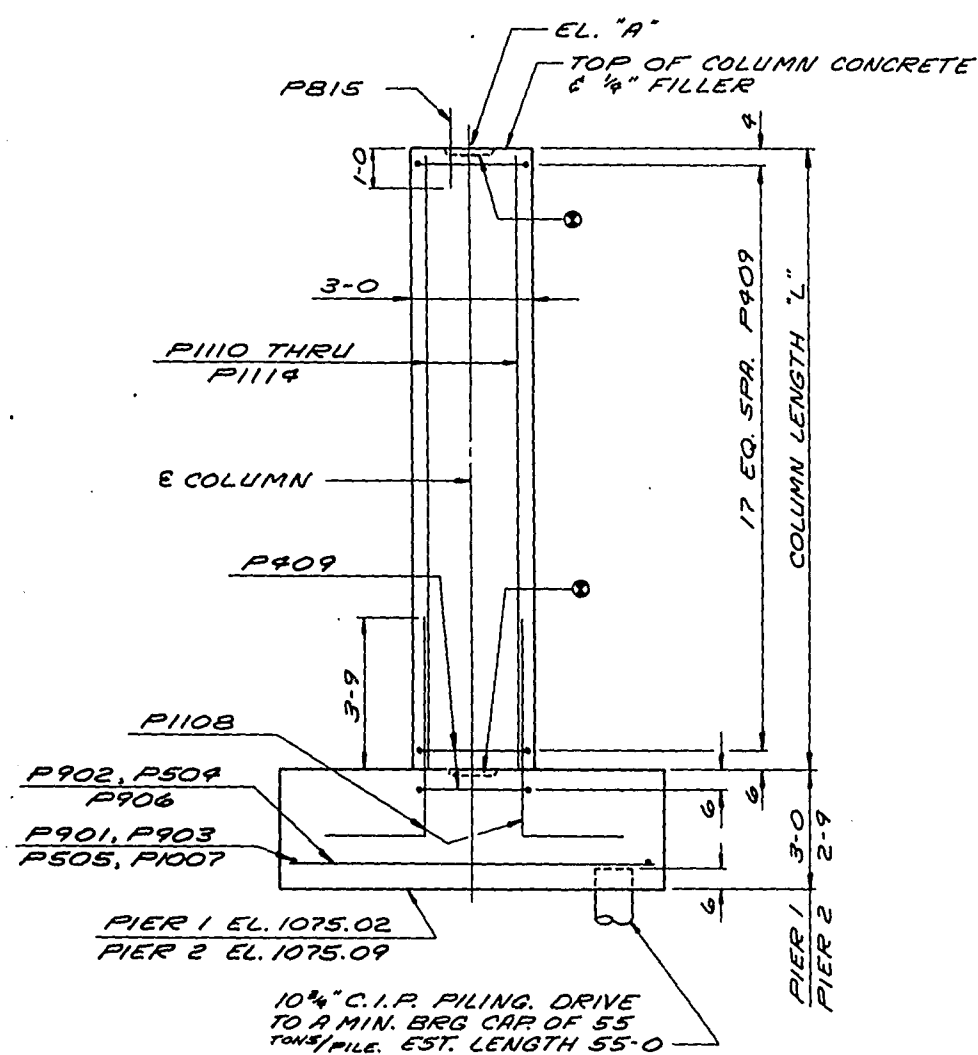[illegible]

### TYPICAL COLUMN ELEVATION

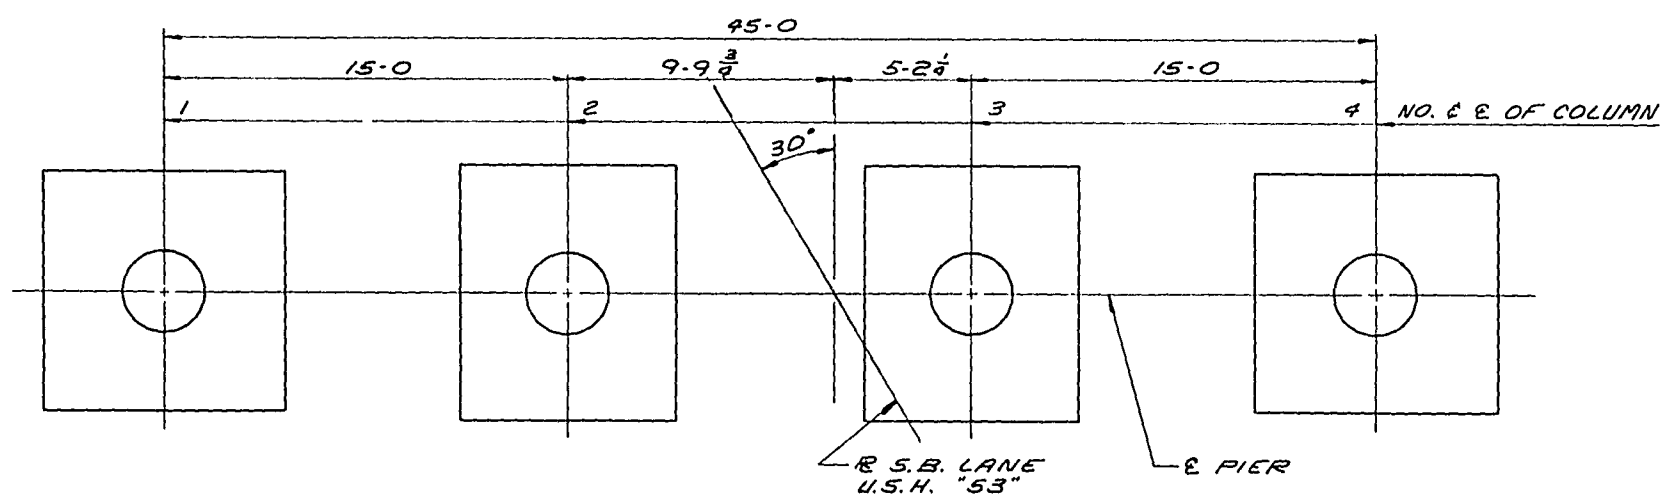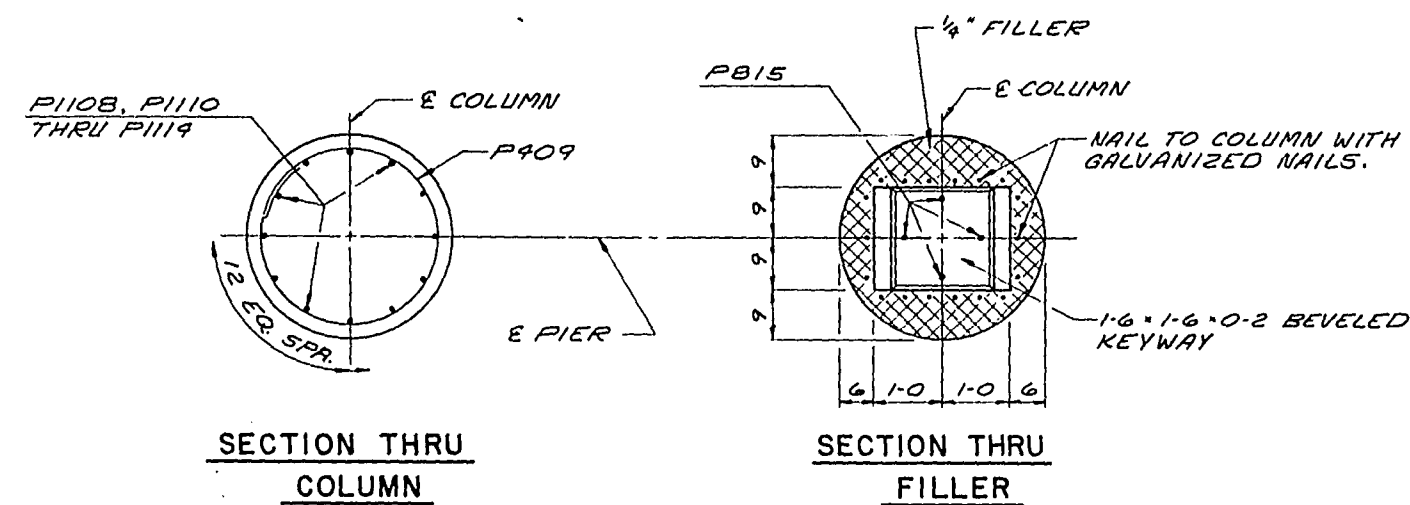


PIER PLAN

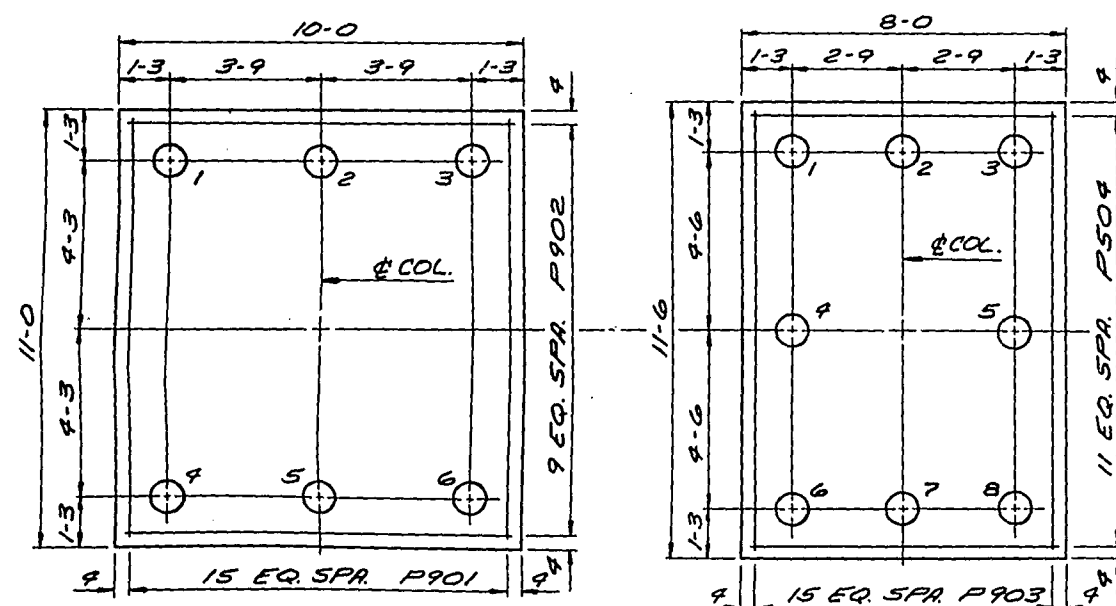

### EXTERIOR FOOTING

## INTERIOR FOOTING


TYPICAL FOOTING PLAN - PIER 1

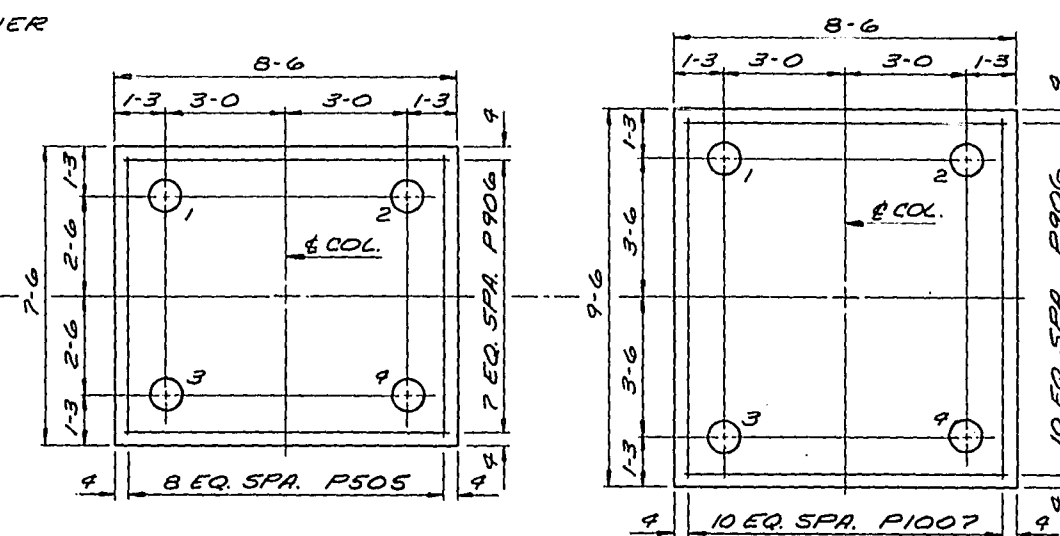

## EXTERIOR FOOTING

### INTERIOR FOOTING

TYPICAL FOOTING PLAN - PIER 2

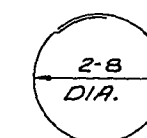

P409




P1108

ELEVATION AND  
COLUMN LENGTH

		ELEV. "A"	LENGTH "L"
PIER 1	COLUMN 1	1095.52	17'-6"
	" 2	1095.71	17'-8 $\frac{1}{4}$ "
	" 3	1095.80	17'-9 $\frac{3}{8}$ "
	" 4	1095.72	17'-8 $\frac{3}{8}$ "
PIER 2	" 1	1095.09	17'-3"
	" 2	1095.27	17'-5 $\frac{1}{8}$ "
	" 3	1095.36	17'-6 $\frac{1}{4}$ "
	" 4	1095.28	17'-5 $\frac{1}{4}$ "


NOTES:  
TOP OF COLUMN ELEVATIONS (EL. "A") AND COLUMN LENGTH "L"  
ARE MEASURED AT E PIER AND E COLUMN.  
SLOPE TOP OF COLUMN TO MATCH SLOPE OF SUPERSTRUCTURE.  
① CONSTRUCTION JOINT KEY FORMED BY A SURFACED  
BEVELED 1'-6" x 1'-6" x 0'-2".  
PBIS BARS MAY BE PLACED AFTER COLUMN CONCRETE IS POURED  
BUT BEFORE INITIAL SET HAS TAKEN PLACE.  
FOR PILE SPLICE DETAIL SEE SHEET 4.

No.	Date	Revision	By
STATE OF WISCONSIN DEPARTMENT OF TRANSPORTATION DIVISION OF HIGHWAYS			
STRUCTURE B-3-14			
Const. Spec.	1969	Drawn By	D. J. R. Plans Checked
PIERS		SHEET 5 OF 10 X46264	

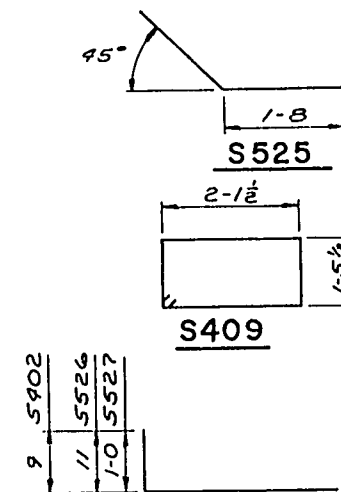

BAR NO.	NO. REQ'D	LENGTH	BENT	38,850*
				LOCATION
5401	64	8-7	X	SLAB @ SO. ABUT. HAUNCH
5402	29	6-8	X	" @ " " "
5703	3	98-10		" @ " " " -TRANS.
5504	67	48-10		" SPAN 1 & 3 - TRANS.
51005	44	32-0		" " 1 - LONG.
51006	27	23-9		" " 1 - "
5507	86	23-2	X	" @ PIER HAUNCH
5908	20	98-10		" @ " " - TRANS.
5409	180	7-8	X	" STIRRUP - SPAN 2
51110	55	49-3		" SPAN 2 - LONG.
51111	36	33-9		" " 2 - "
5612	45	98-10		" " 2 - TRANS.
51013	43	28-6		" " 3 - LONG.
51014	28	19-9		" " 3 - LONG.
5415	29	12-3		" " 1 - "
5516	94	98-10		" " 1, 2, & 3 - TRANS.
51117	42	42-6		" OVER PIER 1 - LONG.
51118	43	38-0		" " " 1 - "
5419	24	24-6		" SPAN 2 - LONG.
5820	18	27-6		" EDGE SPAN 2 - LONG.
51121	40	38-6		" OVER PIER 2 - LONG
51122	39	45-6		" " " 2 - "
5923	28	48-10		" @ PIER HAUNCH - TRANS.
5424	29	5-0		" SPAN 3 - LONG.
5525	43	4-1	X	" @ NO. ABUT. HAUNCH
5526	43	3-0	X	" @ " " "
5527	43	2-10	X	" @ " " "






The diagram shows two cross-sections of beams. The top section, labeled **S401**, is a T-beam with a total width of 10 inches (divided into 1.10 and 2.10 inches) and a total height of 2.2 inches. The bottom section, labeled **S507**, is a wide-flange beam with a total width of 12 inches (divided into 3.11 and 9.6 inches).

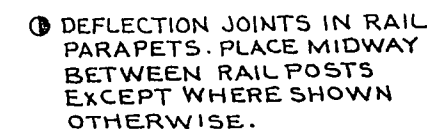


RAIL POST AND DEFL. JOINT  
SPACING SAME FOR BOTH SIDES.

No.	Date	Revision	By
STATE OF WISCONSIN DEPARTMENT OF TRANSPORTATION DIVISION OF HIGHWAYS			
STRUCTURE B-3-14			
Const. Spec.	1969	Drawn By	D. J. A. Plans Checked
SUPERSTRUCTURE		SHEET 6 OF 1 X46265	



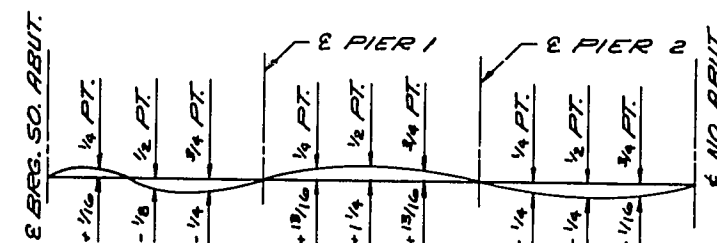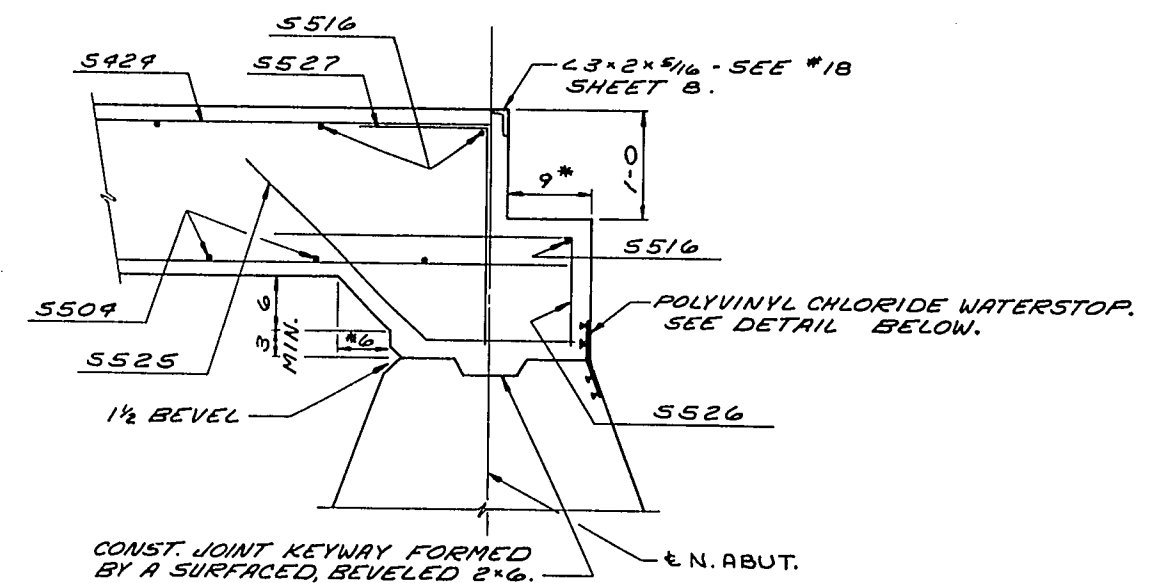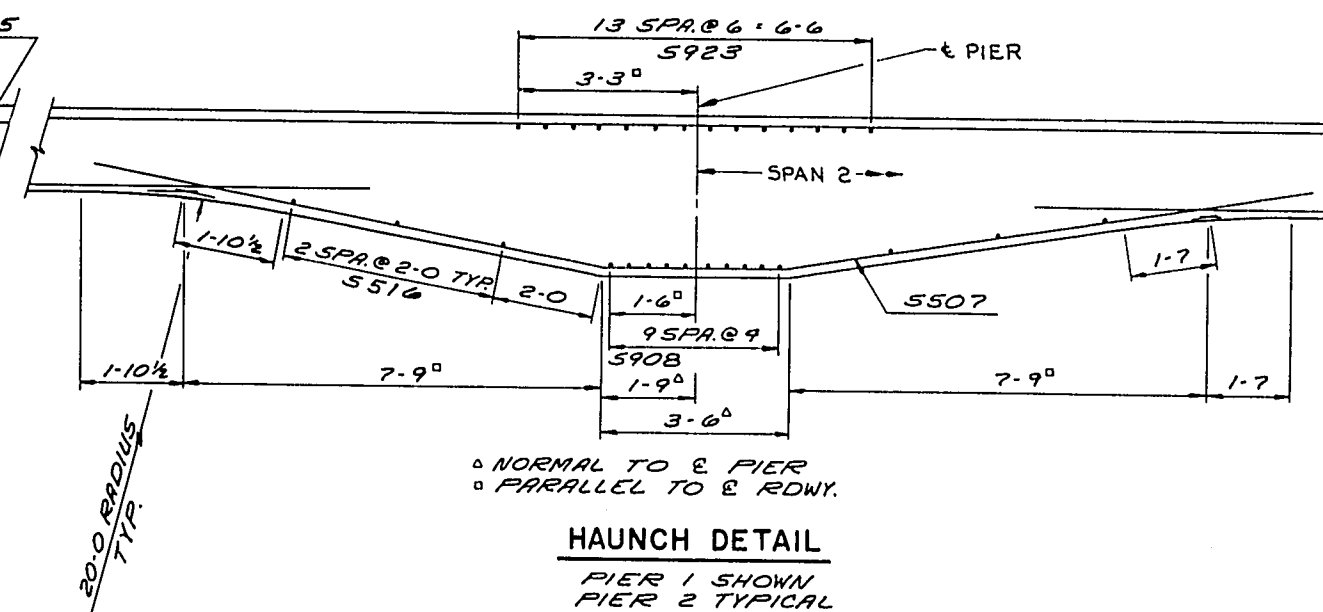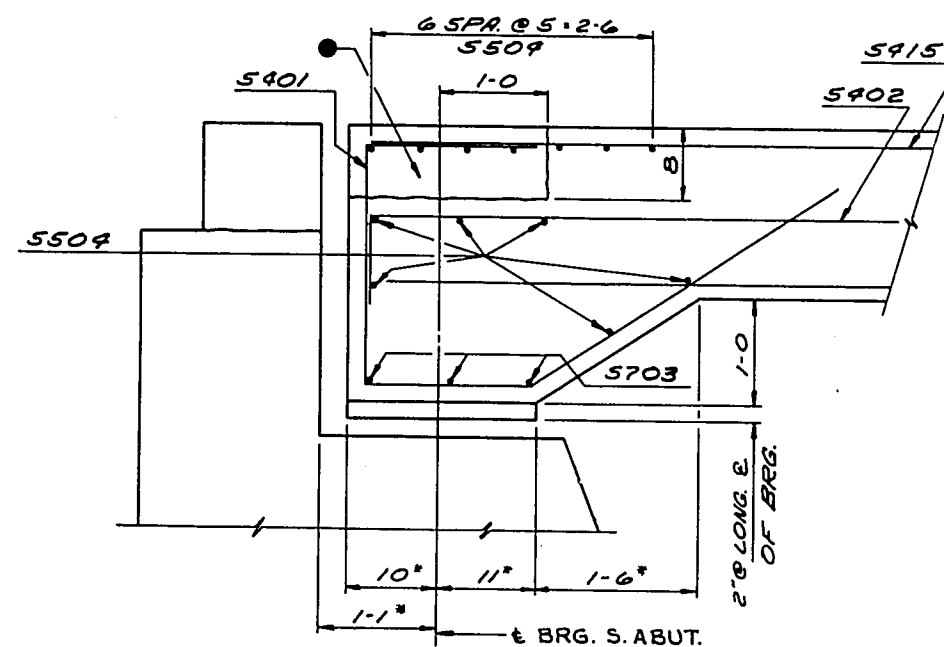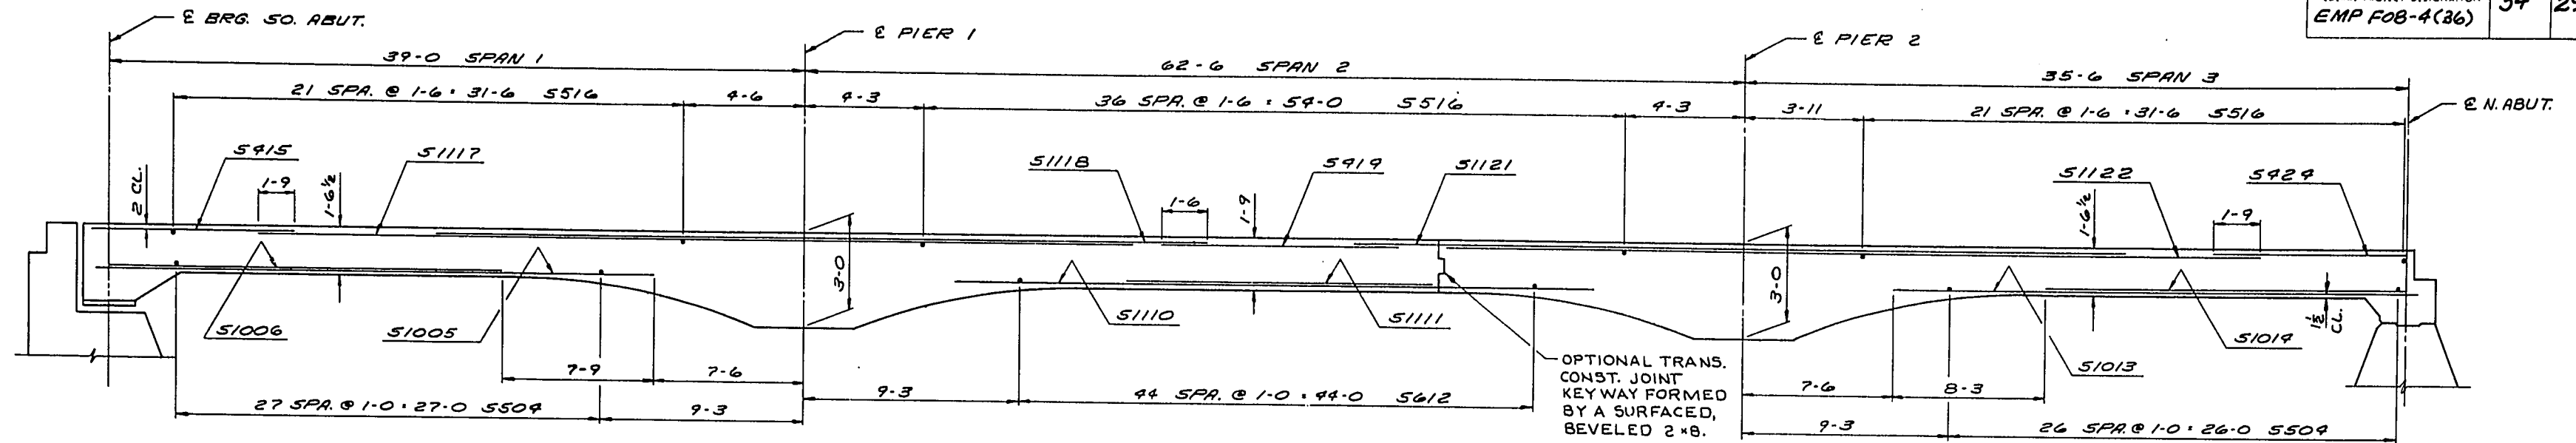

## NOTES

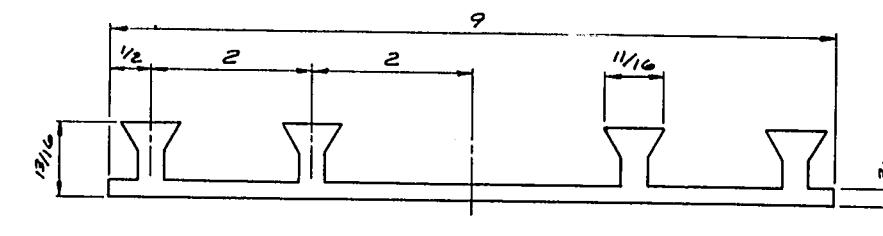

No.	Date	Revision	By
STATE OF WISCONSIN DEPARTMENT OF TRANSPORTATION DIVISION OF HIGHWAYS			
<b>STRUCTURE B-3-14</b>			
Const. Spec.	1969	Drawn By	<i>D. J. A.</i>
		Plans Checked	<i>J. H. G.</i>
<b>SUPERSTRUCTURE</b>		SHEET 7 OF 10	
		<b>X 46266</b>	

1196-6-71	SHEET	TOTAL
EMP F08-4(36)	35	296

## BEARING NOTES

ALL MATERIAL EXCLUDING ANCHOR BOLTS, PINTLES, NUTS, STUDS, WASHERS SHALL BE MADE OF A588 STEEL. PINTLES SHALL BE MADE OF A449 STEEL.

ALL STRUCTURAL STEEL BEARING PLATES SHALL BE FLAT ROLLED STEEL PLATES WITH ALL SURFACES SMOOTH AND FREE FROM WARP AND ALL EDGES SMOOTH, STRAIGHT AND VERTICAL.

ALL PLATE CUTS SHALL BE MACHINE OR MACHINE FLAME CUTS. MACHINE FINISH THE BOTTOM SURFACE ONLY OF PLATES SHOWN TO BE FINISHED.

ALL MATERIAL EXCLUDING BRONZE PLATES & BEARING PADS SHALL BE PAID FOR AT THE UNIT PRICE BID FOR "STRUCTURAL LOW ALLOY STEEL."

ALL ANCHOR BOLTS TO BE 1 1/4" x 1-3" LONG, SET FLUSH AND CAULK WITH LEAD TO THE TOP OF PLATE 'C'. EXCESS LENGTH MAY BE FURNISHED, THREADED FOR SETTING AND THEN CUT OFF FLUSH.

CHAMFER TOP OF PINTLES 1/8". DRILL HOLES FOR PINTLES IN PLATE 'C' FOR DRIVING FIT.

PROVIDE 1/8" THICK BEARING PAD SAME SIZE AS PLATE 'C' FOR EACH BEARING.

ALL BEARINGS ARE SYMMETRICAL.

## LEGEND

- WT 6 x 39.5 x ROADWAY WIDTH. WELDMENT MAY BE USED. SEE DETAIL A.
- 2 L 7 x 9 x 7/16 x RDWY. WIDTH LONG DIMENSION OF 7/16 x 1 1/2" SLOTTED HOLE TO BE PARALLEL TO DIRECTION OF MOVEMENT.
- BAR 1 1/2 x 3/4 x RDWY. WIDTH. WELD TO L#2 WITH 2 LINES OF 1/4" FILLET WELD, 20°.
- 3/4" FLAT HEAD CAP SCREW x 2 3/4" LONG WITH SQ. NUT AT 4-0 CENTERS. GREASE FOR EASY REMOVAL. 1 3/16 x 1 1/2" SLOTTED HOLE IN L#2.
- 5 L 2 1/2 x 2 x 1/4 x RDWY. WIDTH. 3/16" CONTINUOUS FIELD WELD TO WT #1. 2 1/2" LEG VERT.
- 6 3/4" x 6 LG. ROD & NUT. THREAD 3". TACK WELD NUT TO L#10.
- 7 VENT HOLES, 1 3/16" AT 2-0 CTRS. IN WT#1 AND L#2 AND 3-0 CTRS. IN 1B.
- 8 5/8" STUDS x 6 3/8" LONG. WELD TO WT#1 AT 6" ALTERNATE CENTERS.
- 9 5/8" STUDS x 6 3/8" LONG. WELD TO L#2 AT 9" ALTERNATE CENTERS.
- 10 L 3 x 2 1/2 x 3/8 x 3" LONG AT 3-0 CENTERS. WELD TO L#2 AND WT #1 PROVIDE 1 1/16" HOLES IN 2 1/2" LEG FOR RODS #6 AND #11.
- 11 3/4" ROD x 9" LONG & NUT. THREAD 3". TACK WELD NUT TO L#10.
- 12 1/2 x 1/2 x 1/4 LONG KEEPER BAR ONE PER #4 BOLT PLACE BAR WITH LONG DIMENSION PARALLEL TO & OF RDWY. 1/8" CLEAR FROM #4 SQUARE NUT AND WELD BAR AT SIDE FACING AWAY FROM NUT WITH 3/16" FILLET WELD 1 1/4" LONG TO L#2.
- 13 R 1 1/2 x 3/8 - FIELD WELD TO WT #1.
- 14 R 8/16 x 3/8 - WELD TO L#15 WITH ONE LINE OF 1/4" MAX. FILLET WELD, N.S. & F.S.
- 15 R 1 3/4 x 3/8 - FIELD WELD TO BAR #3.
- 16 5/8" STUDS x 6 3/8" LONG. WELD TO R#5 #13 AND #14.
- 17 BLOCK AND BOLT FOR SHIPMENT WITH PIPE SLEEVE AND 1/2" BOLT. PROVIDE 3/16" HOLES AT 3-0 CENTERS IN WT #1 AND L#2 FOR BOLT.
- 18 L 3 x 2 x 1/4 x RDWY. WIDTH. ONE WELDED FIELD SPLICE WILL BE PERMITTED. SEE DETAIL #19. ONE L REQ'D @ EACH ABUT.
- 19 3/8" STUDS x 4" LONG. WELD TO L18 AT 6" ALTERNATE CENTERS.
- 20 R 7/4 x 1/4 x RDWY. WIDTH. 3/16" CONTINUOUS FIELD WELD TO L#2.


## EXPANSION JOINT NOTES

EXPANSION JOINT SHALL BE BUILT TO CONFORM TO ROADWAY CROWN AND GRADE.

AFTER CONCRETE HAS SET THE JOINT OPENING SHALL BE THOROUGHLY CLEANED AND BOLTS #4 REMOVED AND THE HOLE FILLED WITH HOT POURED ELASTIC JOINT SEALER.



APPLY 1 1/2" COAT OF BITUMASTIC TO METAL SURFACES FORMING JOINT AND FILL OPENING WITH HOT POURED ELASTIC JOINT SEALER.

ALL MATERIAL SHALL BE PAID FOR AT THE UNIT PRICE BID FOR "STRUCTURAL CARBON STEEL."

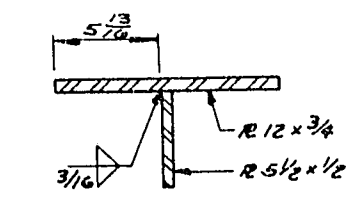


DETAIL A  
WELDMENT OPTION FOR 1

No.	Date	Revision	By
STATE OF WISCONSIN DEPARTMENT OF TRANSPORTATION DIVISION OF HIGHWAYS			
STRUCTURE B-3-14			
Comp. Spec. 1969	Drawn By D.J.A.	Plans Checked J.H.G.	
EXPANSION JOINT & BEARING DETAILS			SHEET 8 OF X46267

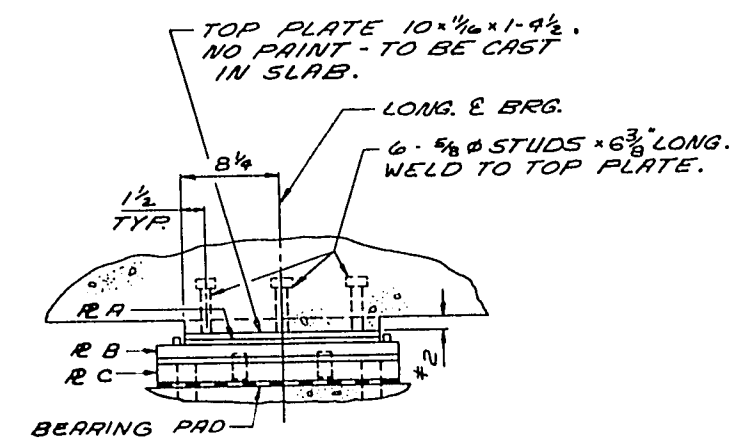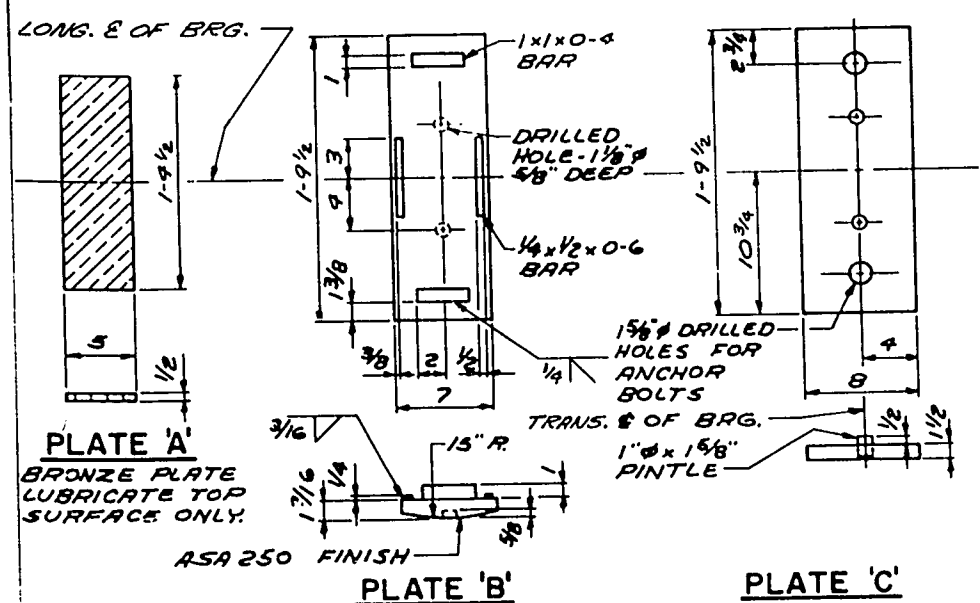


BEARING ELEVATION  
BEARING DETAILS

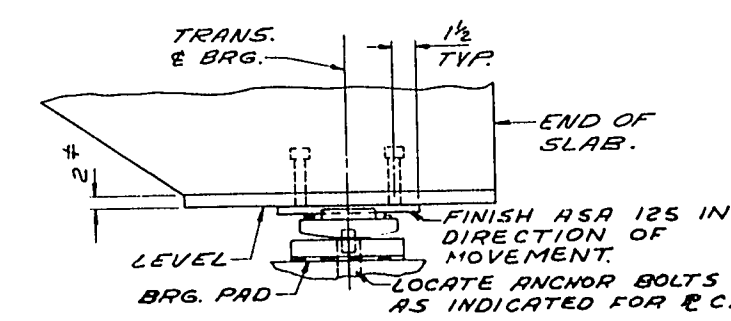


BEARING ASSEMBLY


\* @ LONG. & OF BRG.

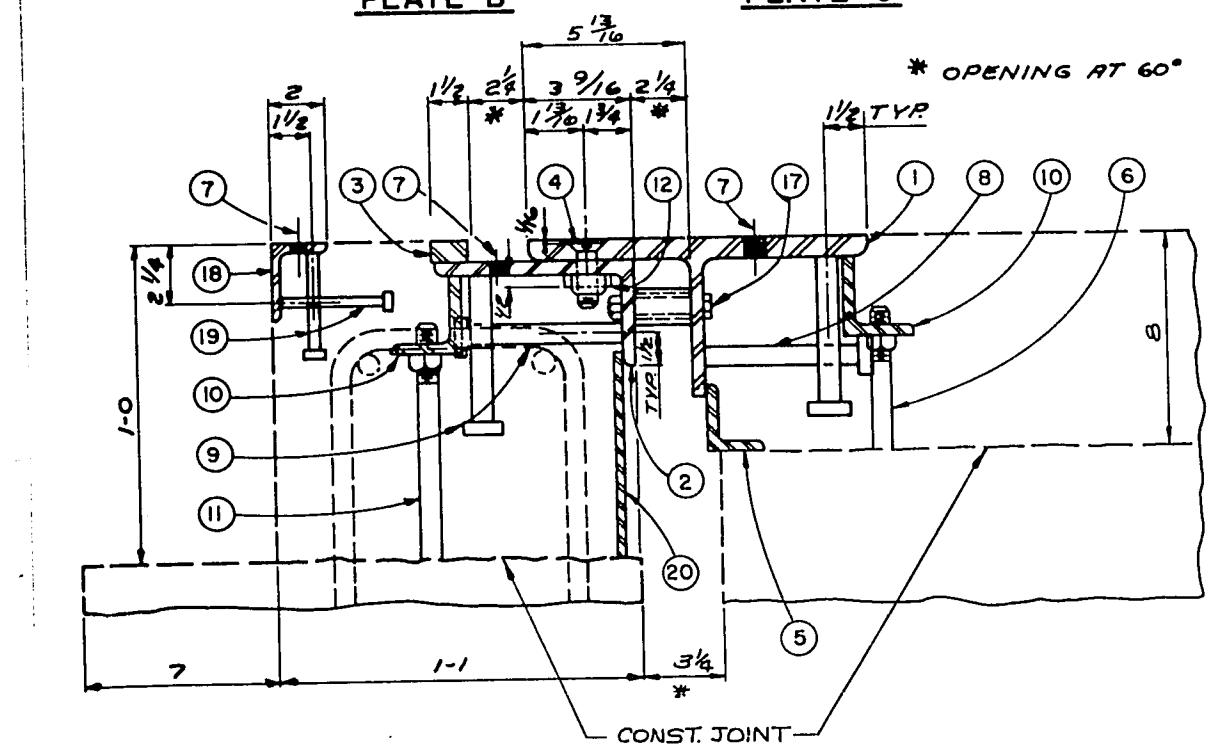

TRANSVERSE SECTION THRU JOINT


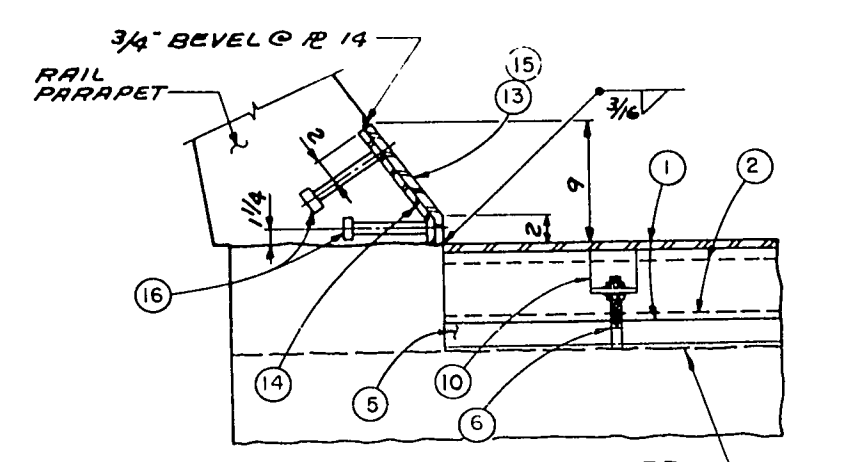


SECTION THRU JOINT AT CURB

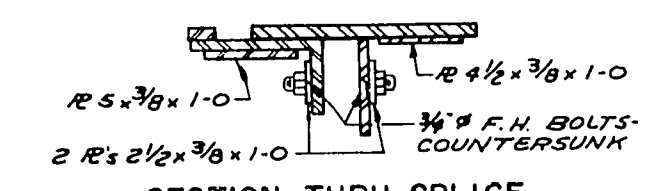

SECTION THRU SPLICE

OPTIONAL FIELD SPLICE DETAIL  
ONE SPLICE SHALL BE PERMITTED IN JOINT.

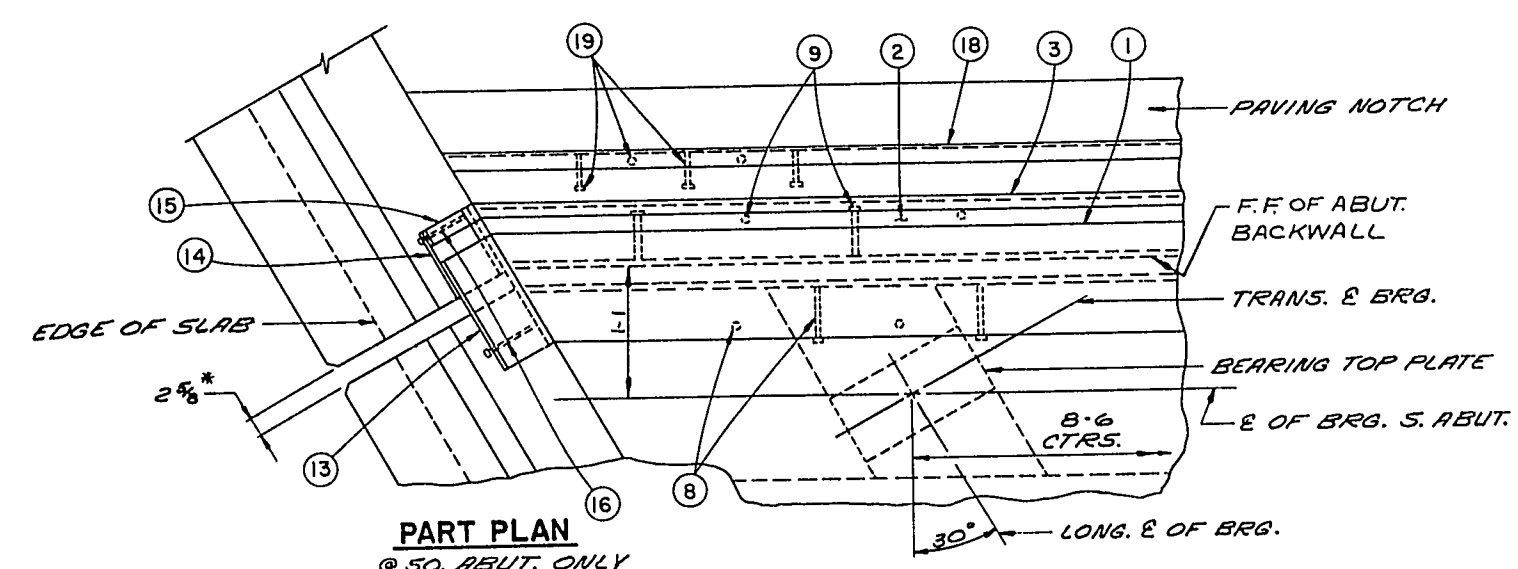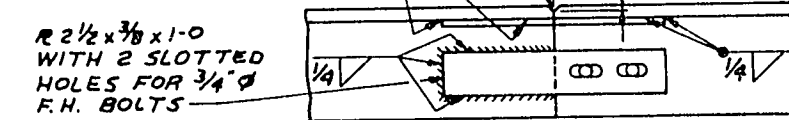

PART PLAN  
@ 50' ABUT. ONLY



06

R511



R509

R505


R504

S. ABUT.

FRONT FACE OF BACKWALL. AT DEFLECTION

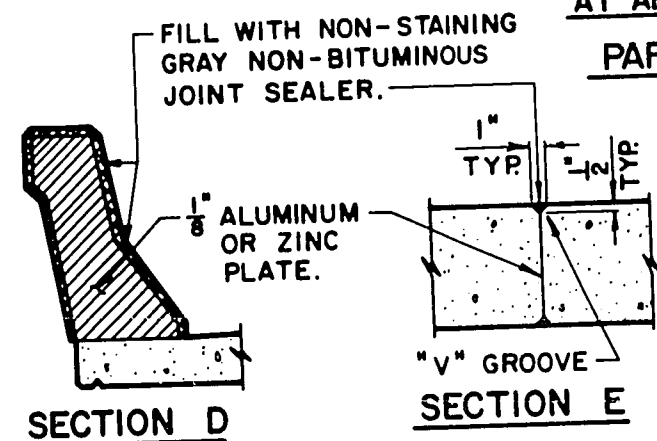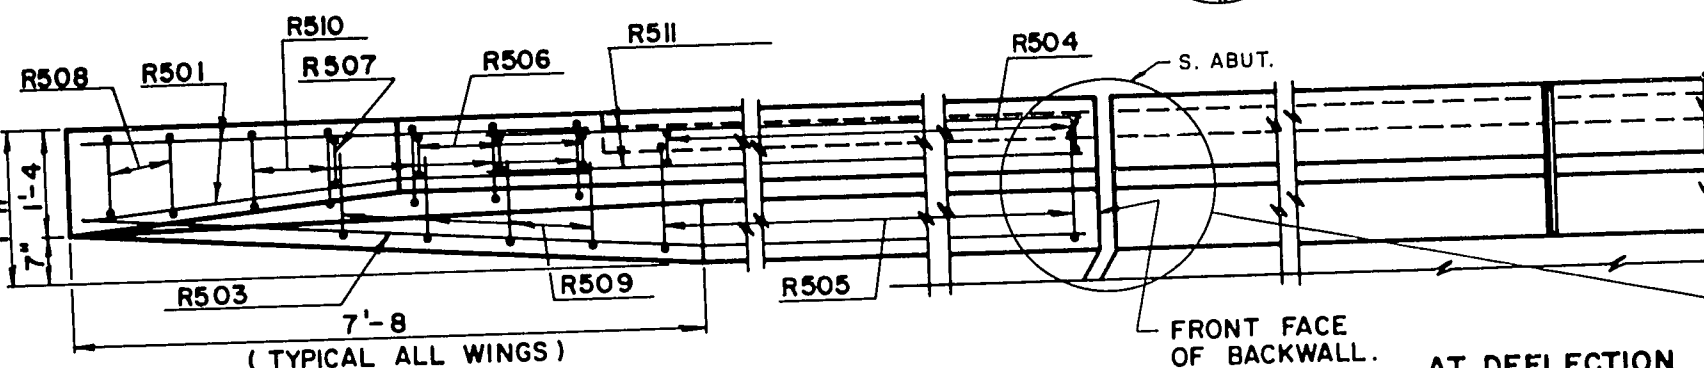


## SECTION D

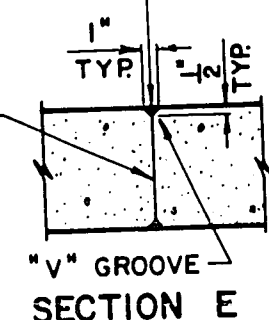


"V" GROOVE  
SECTION E


THREADED INSERTS FOR  $\frac{7}{8} \phi \times 0'-2"$  —  
LONG GALVANIZED HEX. HEAD CAP  
SCREWS. CAP SCREWS TO BE THREADED  
A MINIMUM OF  $1\frac{7}{8}$ .  
INSERTS TO BE THREADED A MINIMUM  
OF  $1\frac{3}{4}$ .

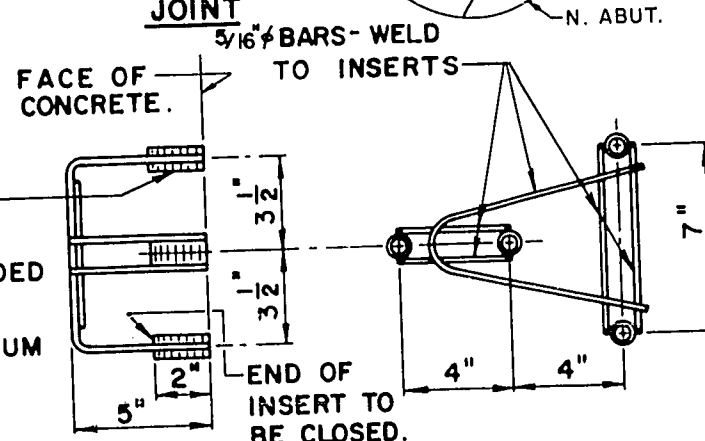

DETAIL OF ANCHOR ASSEMBLY FOR  
BEAM TYPE GUARD RAIL  
ANCHOR ASSEMBLY SHALL BE PAID  
FOR AT THE UNIT PRICE BID FOR  
STRUCTURAL CARBON STEEL.

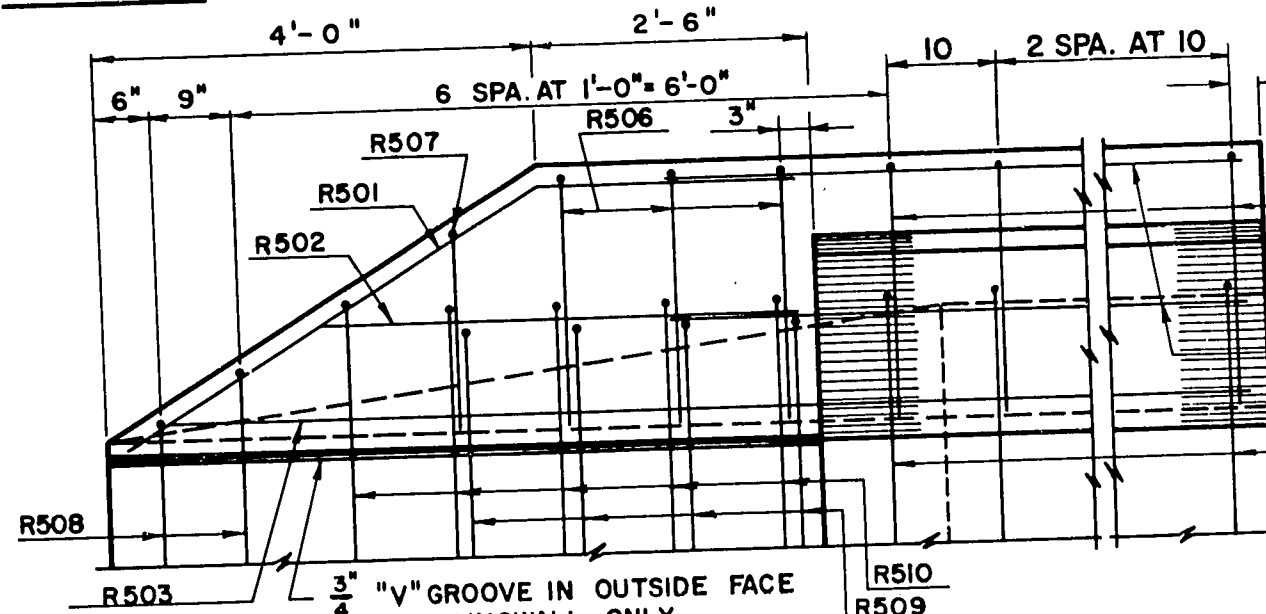

VIEW SHOWING OUTSIDE FACE OF PARAPET & REINF

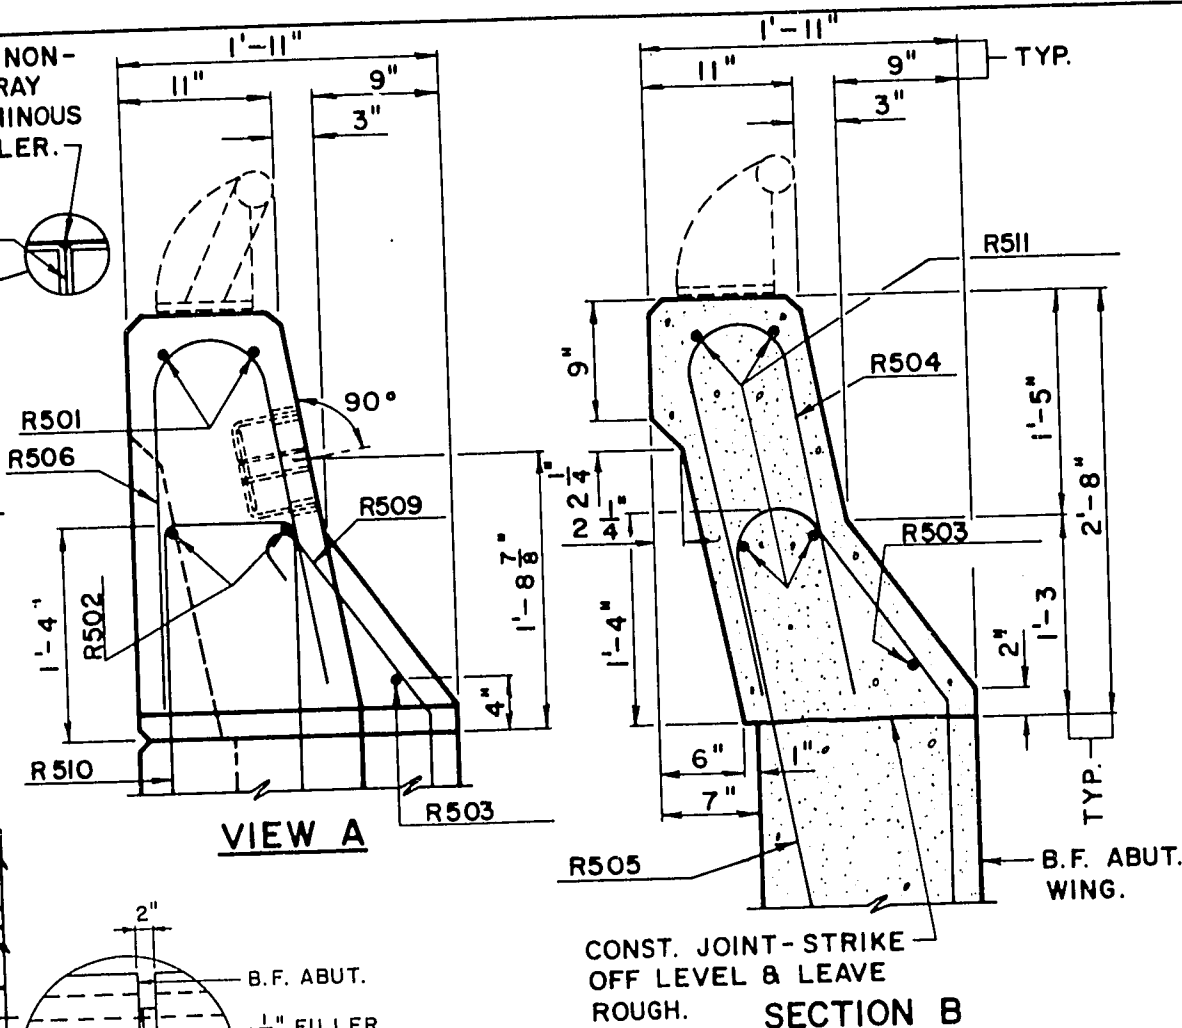

VIEW A

SECTION E

NOTE: BENDING DIMENSIONS ARE OUT TO OUT OF BAR.  
THE FIRST DIGIT OF A BAR MARK SIGNIFIES THE BAR SIZE.

RAIL PARAPET  
BILL OF BARS


BILL OF MATERIALS					
MARK	NO. REQ'D.	LENGTH	BENT	LOCATION	
R501	8	6-10	X	WINGS   THRU 4	
R502	8	4-5		"   "	4
R503	4	9-8	X	"   "	4
R504	16	5-0	X	"   "	4
R505	16	5-10	X	"   "	4
R506	12	5-2	X	"   THRU 4	
R507	4	4-2	X	"   "	4
R508	8	4-10	X	"   "	4
R509	16	3-3	X	"   "	4
R510	20	5-10	X	"   "	4
R511	16	5-6		"   "	4
R520	278	4-9	X	SLAB & RAIL PARAPET	
R521	278	5-0	X	RAIL PARAPET	
R522	20	6-3		"	"
R523	10	24-0		"	"
R524	10	17-8		"	"
R525	10	25-8		"	"
R526	10	19-1		"	"
R527	10	15-8		"	"
R528	10	21-2		"	"

SIZE.

NOTES


WHEN PARAPETS ARE POURED CONTINUOUSLY FROM END TO END, THEY SHALL BE SEPARATED AT THE DEFLECTION JOINTS BY A PIECE OF  $\frac{1}{8}$ " ZINC OR ALUMINUM PLATE CUT AS SHOWN IN SECTION "D" BY SHADED AREA. IF CONSTRUCTION JOINTS IN PARAPETS ARE USED AT THE DEFLECTION JOINTS, ONE SIDE OF JOINT SHALL BE COATED WITH BITUMINOUS PAINT AND PLATE SEPARATORS MAY BE OMITTED.

WORK THIS SHEET WITH SHEET TITLED "TUBULAR RAILING TYPE 'J'".

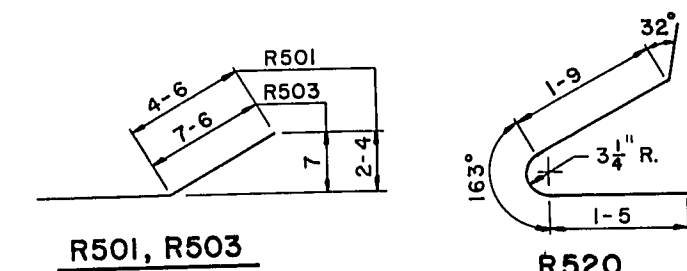


R501, R503


R520

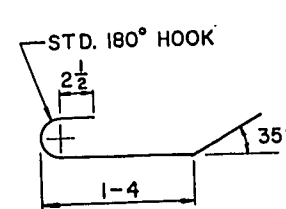


**R509**

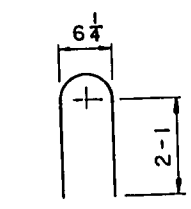


R504, R521

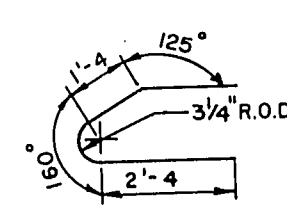

R505

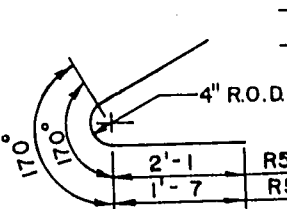







R506, R507

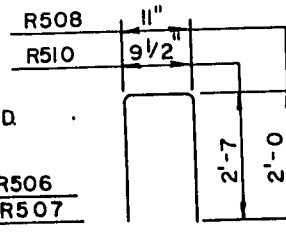



R508, R510

No.	Date	Revision		By
STATE OF WISCONSIN DEPARTMENT OF TRANSPORTATION DIVISION OF HIGHWAYS				
STRUCTURE B-3-14				
Const. Spec.	1969	Drawn By	D. J. R.	Plans Checked
SLOPED FACE PARAPET "A"		SHEET 9 OF 10 X 46268		




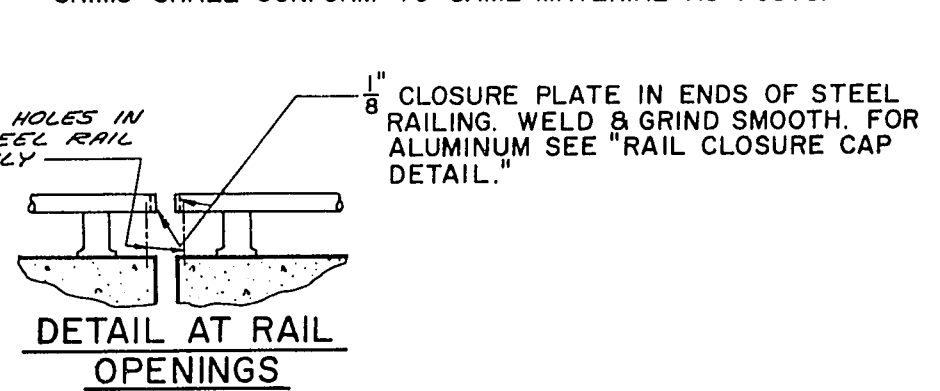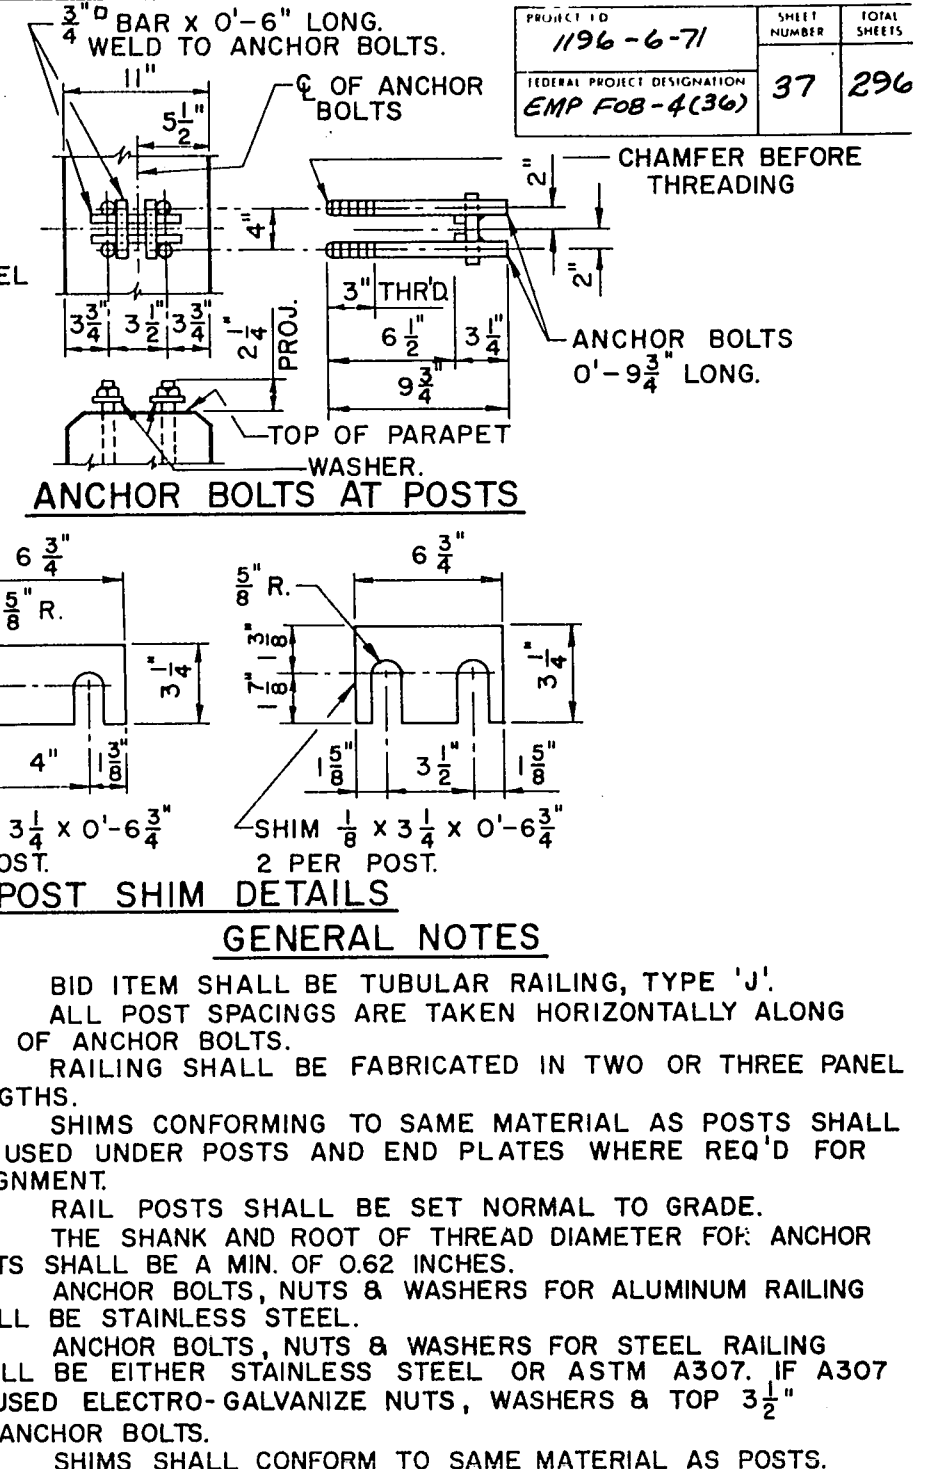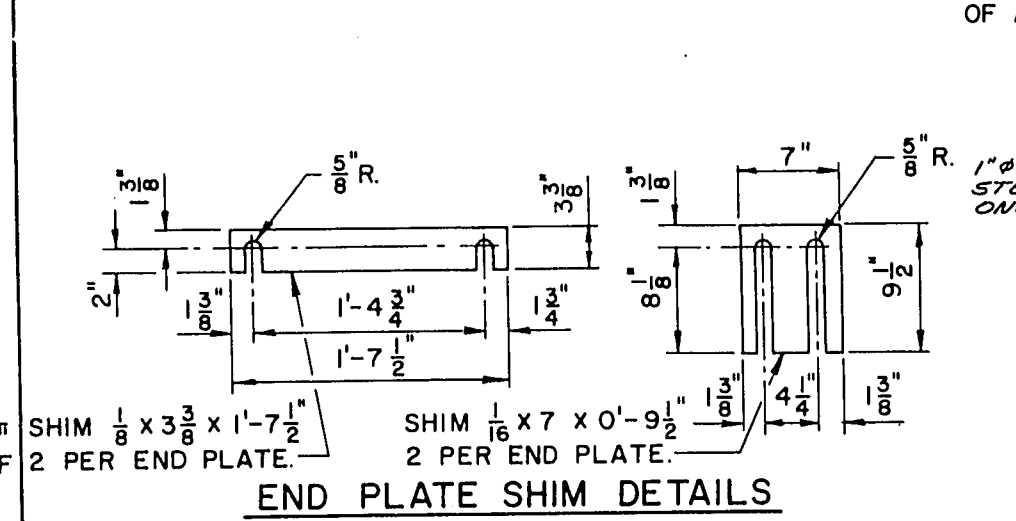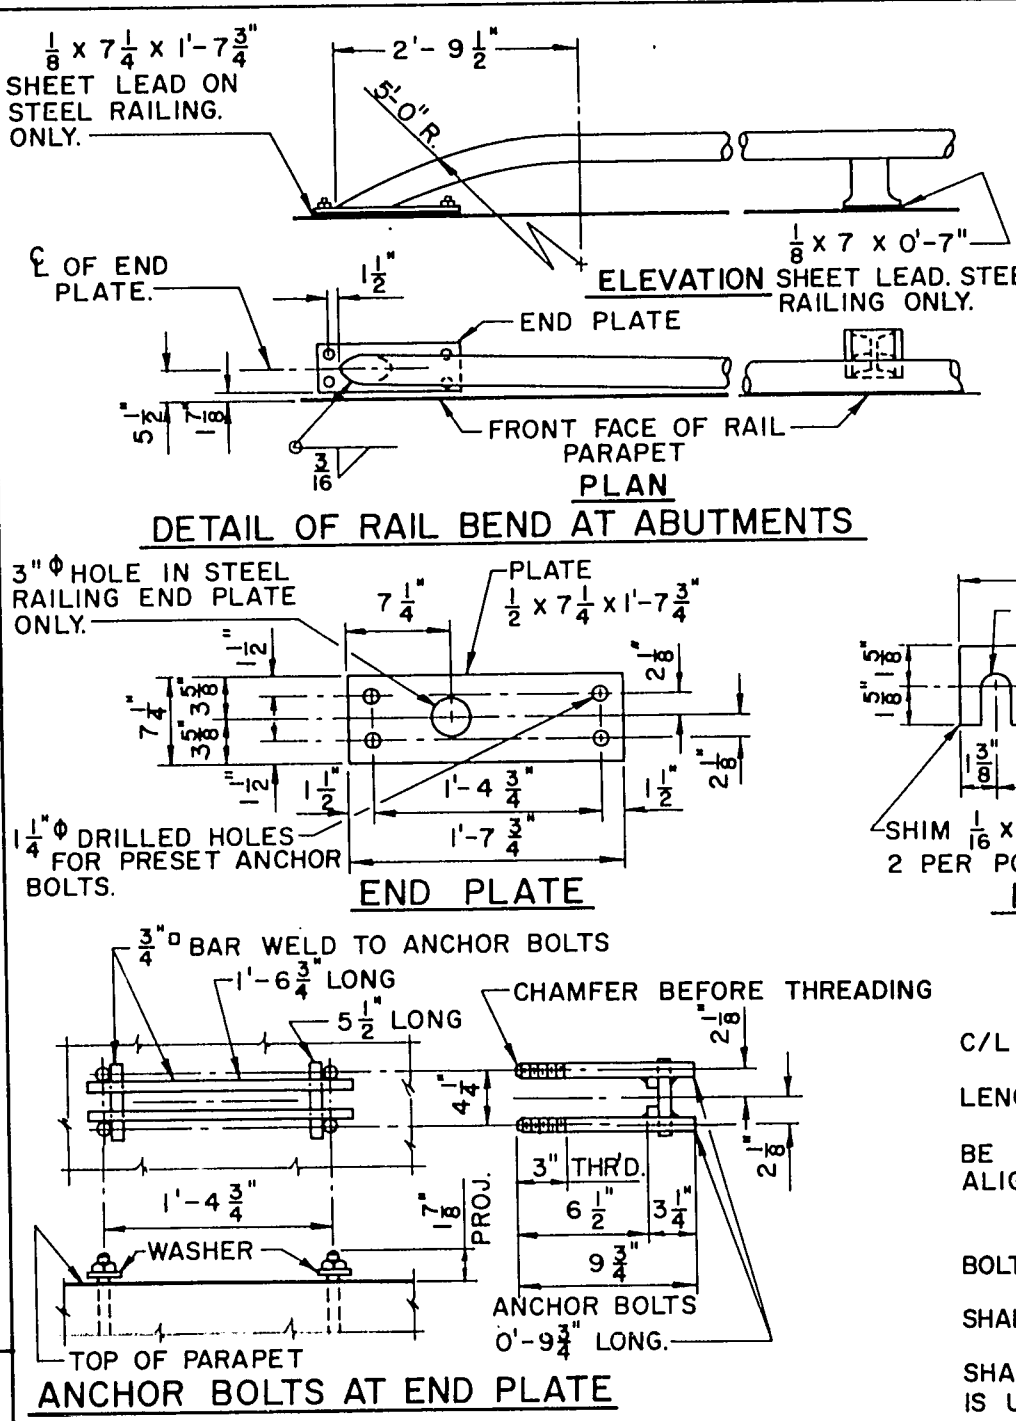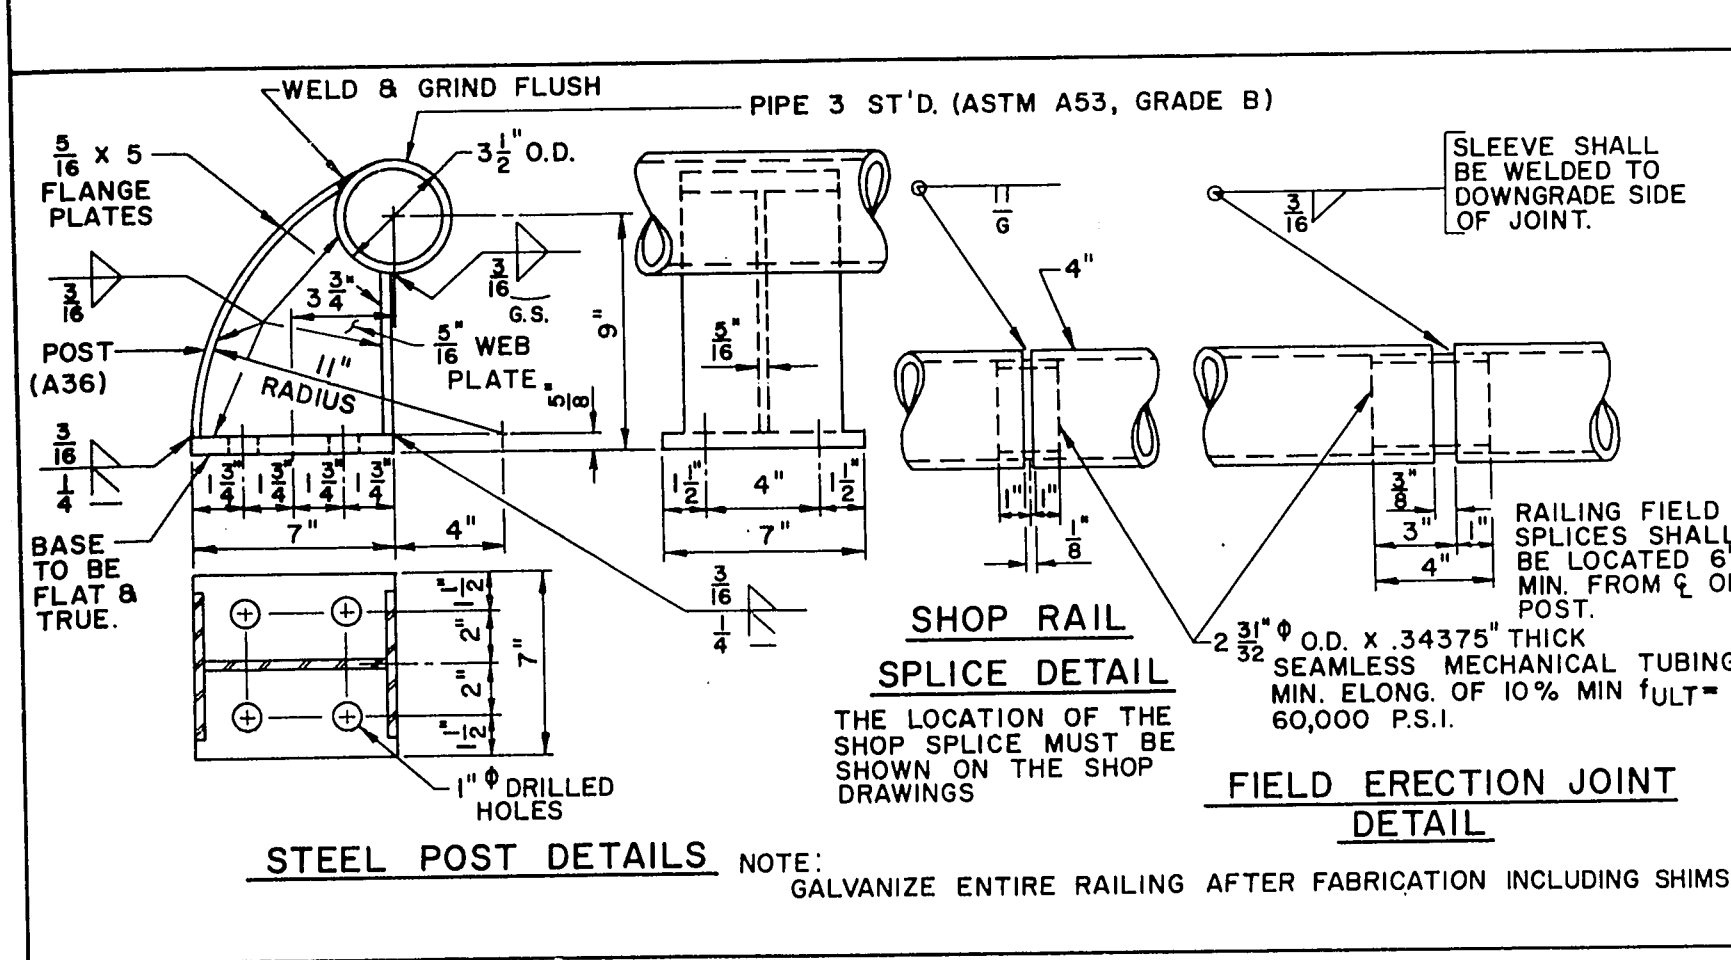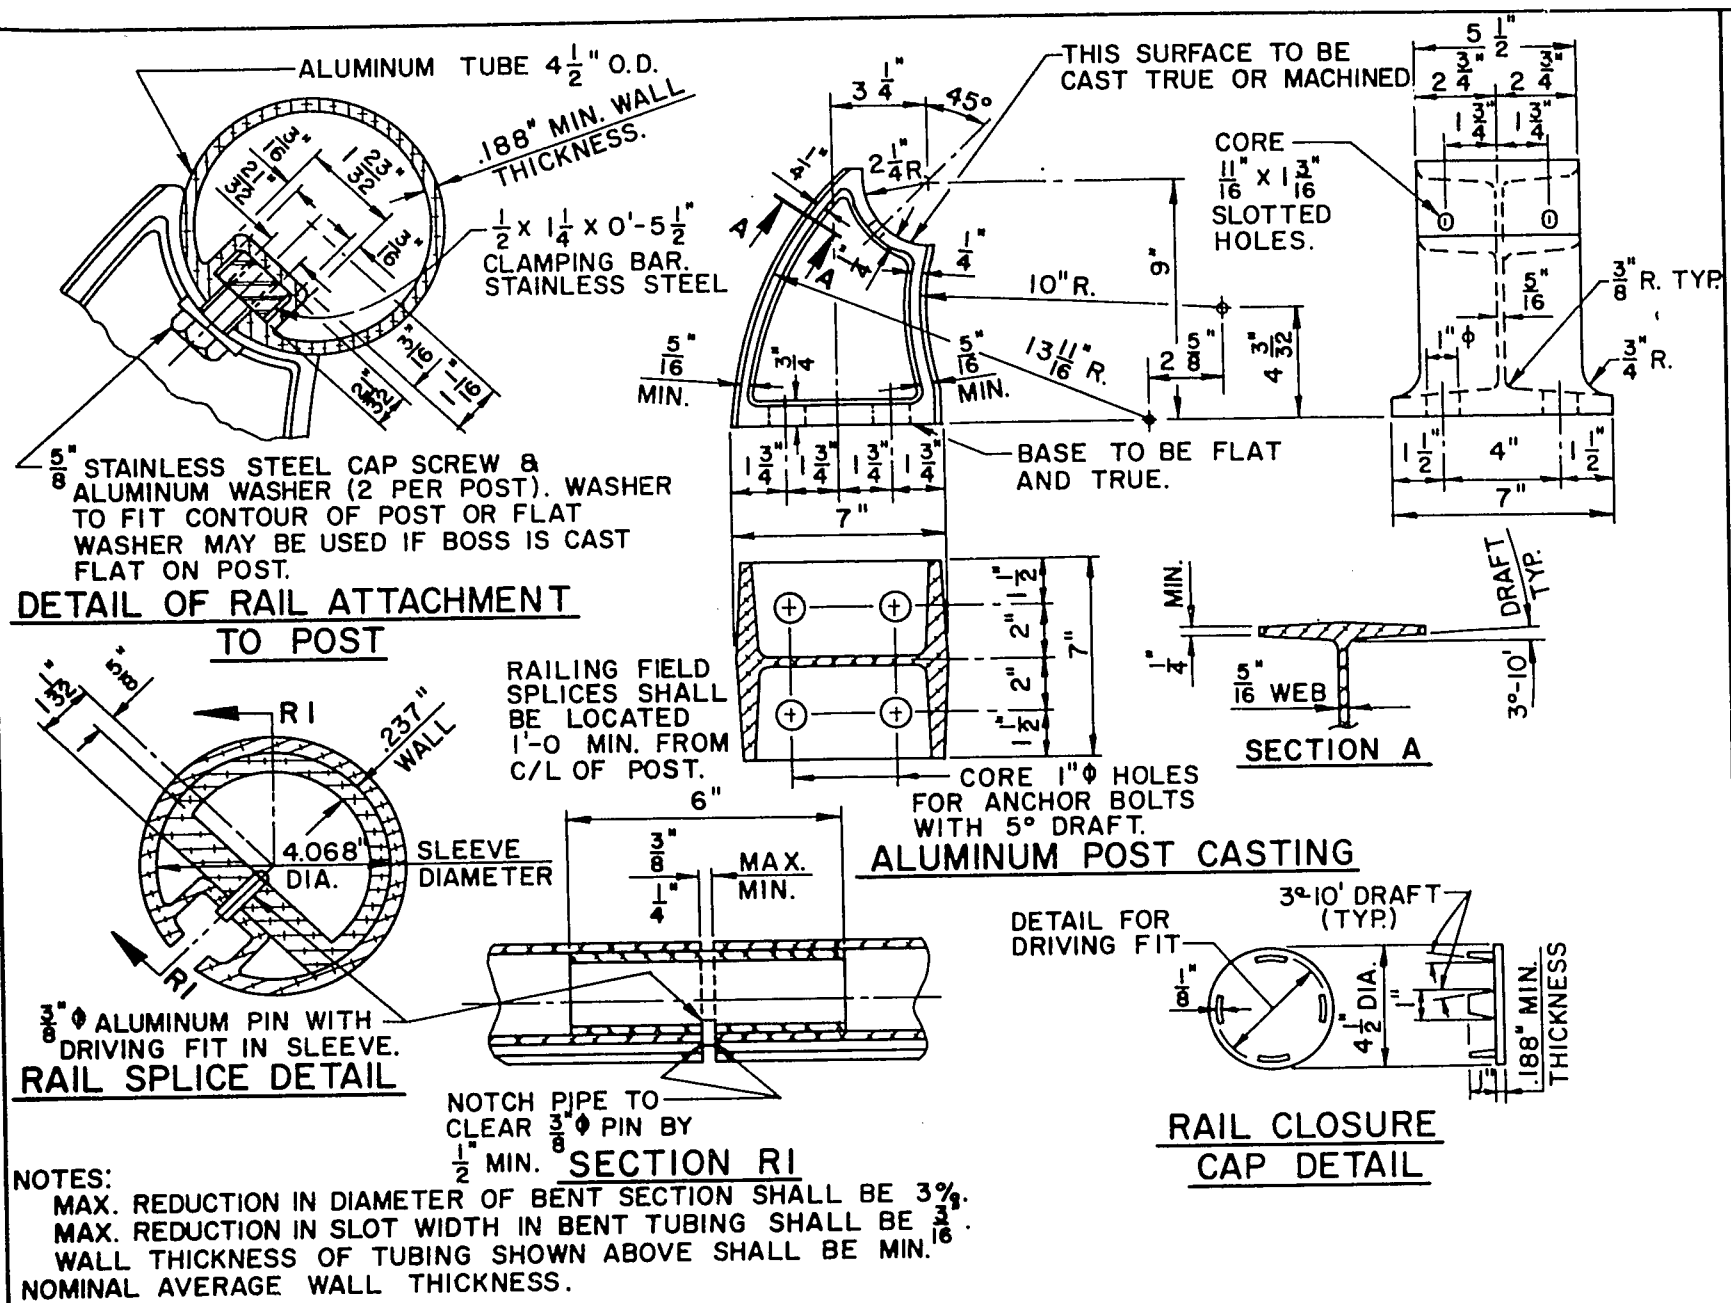

No.	Date	Revision	By
STATE OF WISCONSIN DEPARTMENT OF TRANSPORTATION DIVISION OF HIGHWAYS			
STRUCTURE B-3-14			
Const. Spec. 1969	Drawn By D. J. A.	Plans Checked J. H. G.	
TUBULAR RAILING TYPE 'J'			SHEET 10 OF 11 X 46269

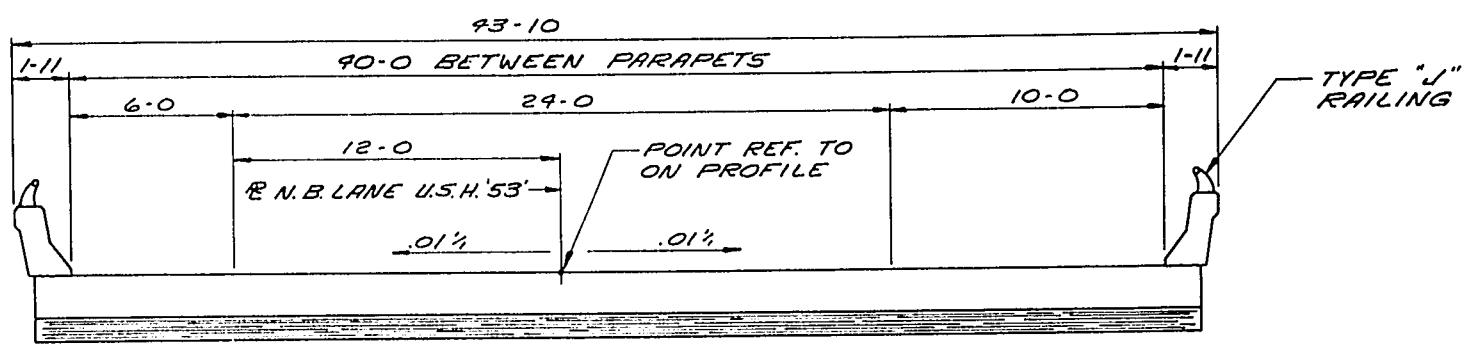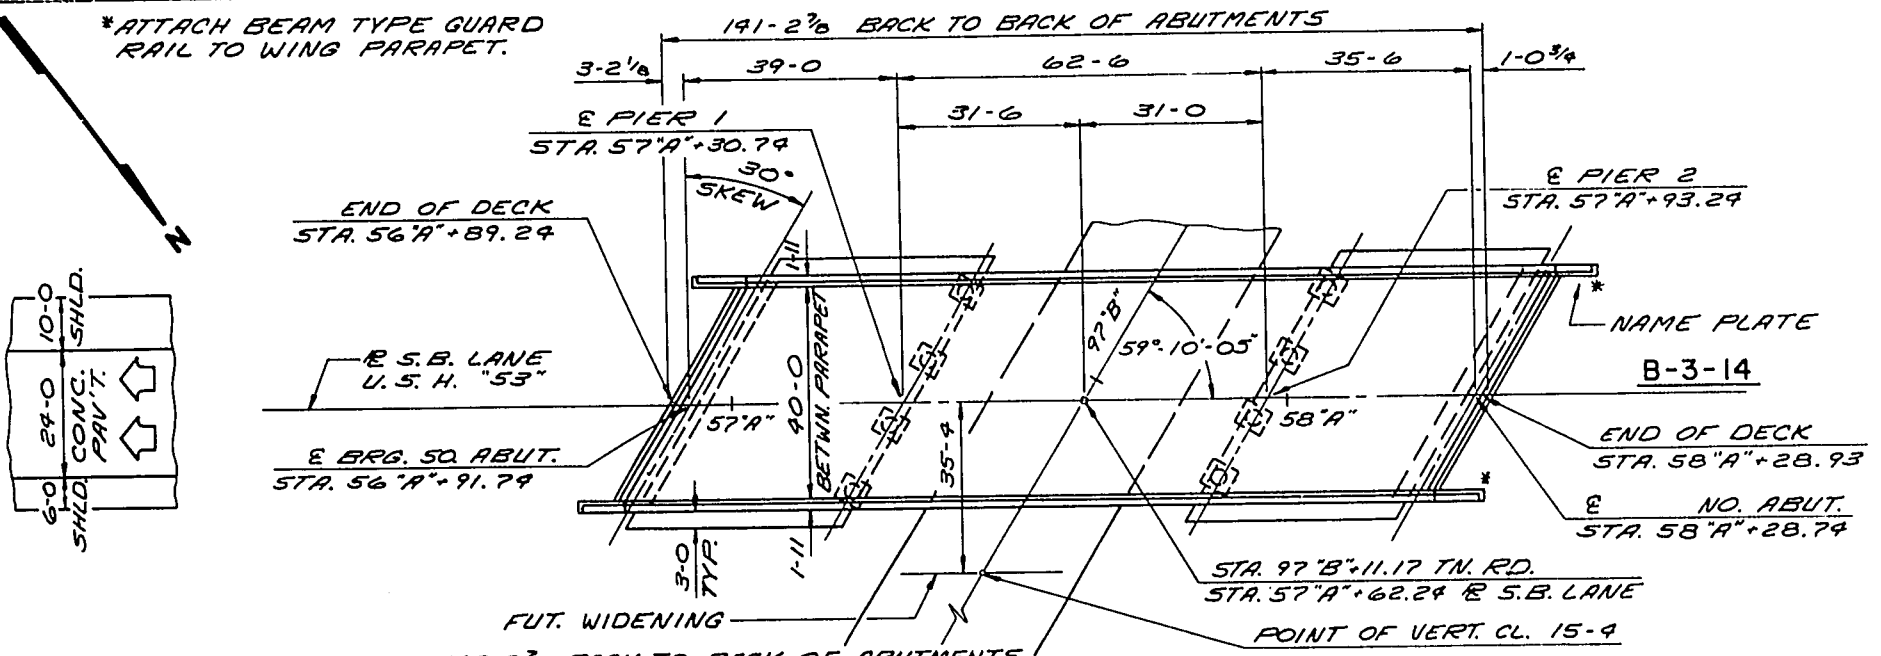

CROSS SECTION THRU ROADWAY  
3 SPAN HAUNCHED SLAB (LOOKING NORTH)

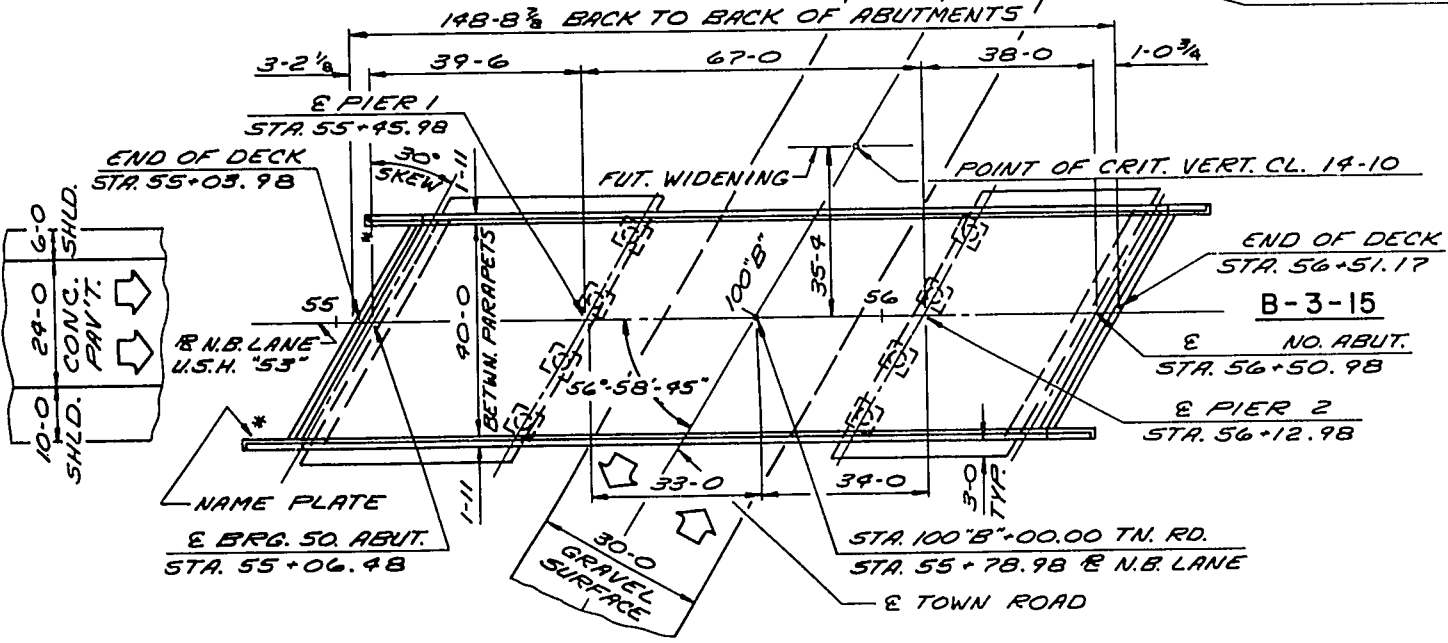

DESIGN DATA

LIVE LOAD: HS 20

ALLOWABLE DESIGN STRESSES:

CONCRETE MASONRY, GRADE "AA" —  $f_c$  : 1,900 P.S.I.

BAR STEEL REINFORCEMENT —  $f_s$  : 20,000 P.S.I.

FOUNDATION DATA:

ABUTMENTS AND PIERS TO BE SUPPORTED ON CAST-IN-PLACE CONCRETE PILING 10 3/4"  $\phi$ . DRIVE TO A MIN. BRG. VALUE OF 20 T/PILE, 55-0 EST. LENGTH AT SOUTH ABUT., 20 T/PILE, 55-0 EST. LENGTH AT NORTH ABUT., AND 55 T/PILE, 55-0 EST. LENGTH AT THE PIERS.

TRAFFIC VOLUME:

U.S.H. "53" — 5300 (1980)

D.H.V. — 80 M.P.H.

R.D.S. — 80 M.P.H.

TOWN ROAD

A.D.T. — 100 (2000)

GENERAL NOTES

DRAWINGS SHALL NOT BE SCALED. BAR STEEL REINFORCEMENT SHALL BE EMBEDDED 2" CLEAR UNLESS OTHERWISE SHOWN OR NOTED.

THE FIRST DIGIT OF A THREE DIGIT BAR NO. AND THE FIRST TWO DIGITS OF A FOUR DIGIT BAR NO. SIGNIFIES THE BAR SIZE.



THE SLOPE OF THE FILL IN FRONT OF THE ABUTMENTS SHALL BE COVERED WITH SLOPE PAVING, CRUSHED AGGREGATE TO THE EXTENT SHOWN ON THIS SHEET AND IN THE ABUTMENT DETAILS.

THE FINISHED GRADED SECTION WAS USED AS THE UPPER LIMITS OF EXCAVATION FOR COMPUTATION OF EXCAVATION AT THE PIERS.

FOR UPPER LIMITS OF EXCAVATION AT THE ABUTMENTS SEE SHEETS NO. 3 & 4.


PILING AT ABUTMENTS SHALL BE PREBORED THRU FILL TO THE ORIGINAL GROUND LINE.

A concrete overlay was placed on the deck from  $\pm$  Sta 55+44 to  $\pm$  Sta 56+11.

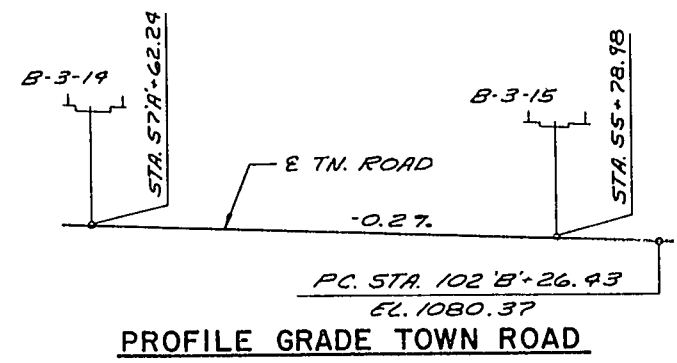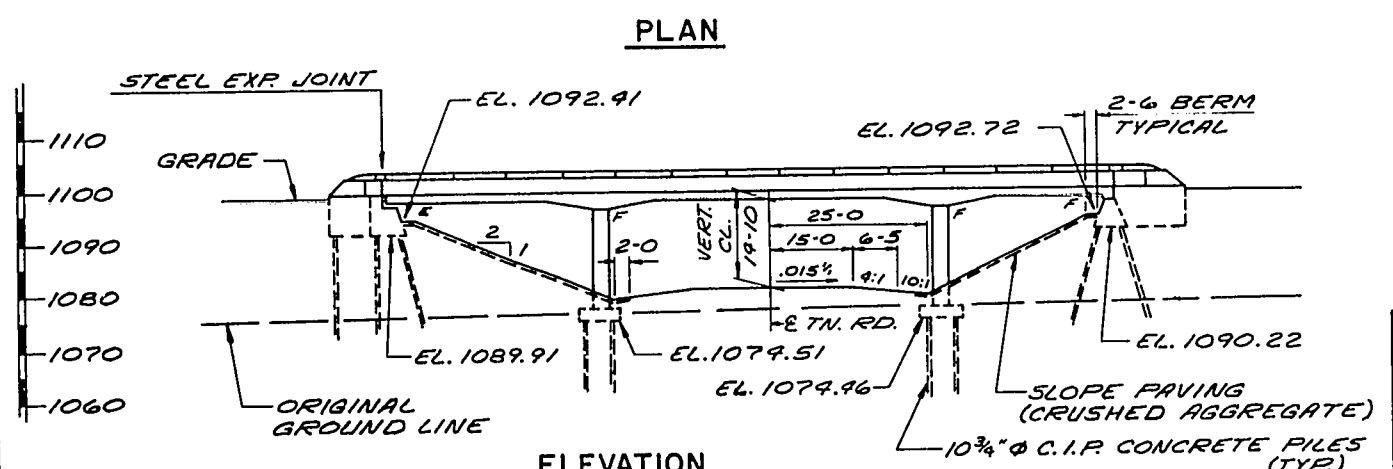


LIST OF DRAWINGS

1. GENERAL PLAN	X46270
2. SUBSURFACE EXPLORATION	X46271
3. SOUTH ABUTMENT	X46272
4. NORTH ABUTMENT	X46273
5. PIERS	X46274
6. SUPERSTRUCTURE	X46275
7. SUPERSTRUCTURE	X46276
8. EXPANSION JOINT & BEARING DETAILS	X46277
9. SLOPED FACE PARAPET "A"	X46278
10. TUBULAR RAILING TYPE "J"	X46279



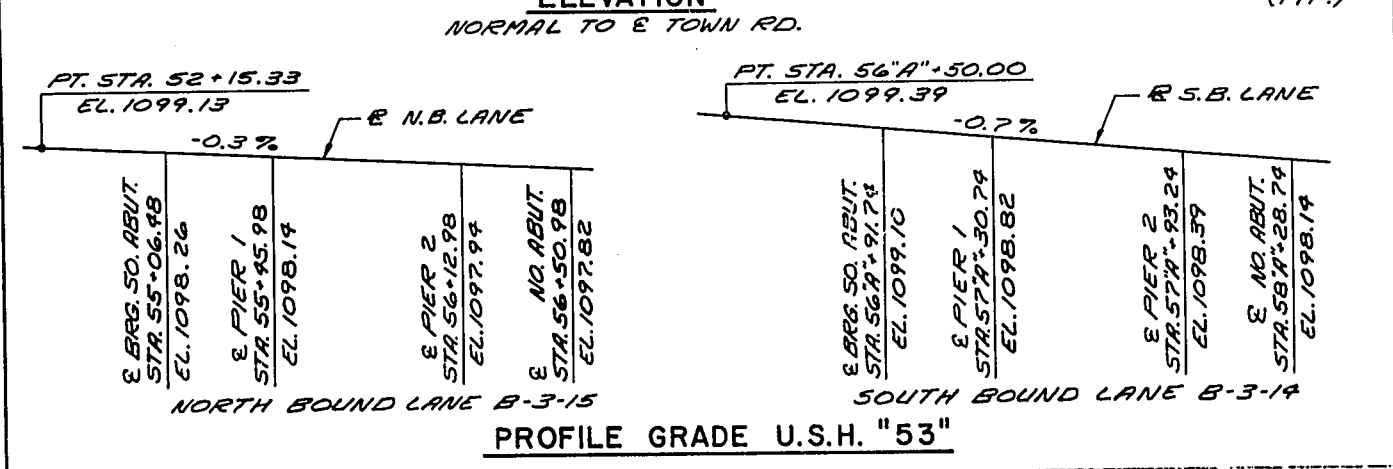


TOTAL ESTIMATED QUANTITIES

BID ITEMS	UNIT	S. ABUT.	PIER 1	PIER 2	N. ABUT.	SUPER.	TOTAL
EXCAVATION FOR STRUCTURE	C.Y.	92	150	130	40	—	362
CONCRETE MASONRY	C.Y.	66	63	48	43	495	715
BAR STEEL REINFORCEMENT	LB.	3080	10,015	8885	2180	113,750	137,910
STRUCTURAL CARBON STEEL	LB.	—	—	—	—	3970	3970
STRUCTURAL LOW ALLOY STEEL	LB.	—	—	—	—	1100	1100
LUBRICATED BRONZE PLATES	LB.	—	—	—	—	77	77
BEARING PADS	S.F.	52.6	1041	882	538	7	7
CAST-IN-PLACE CONC. PILING DEL. & DR. 10 3/4" $\phi$	L.F.	986	1440	960	190	—	4096
PREBORING, CAST-IN-PLACE CONC. PILING 10 3/4" $\phi$	L.F.	255	—	—	242	—	497
TUBULAR RAILING, TYPE "J"	L.F.	—	—	—	—	317	317
SLOPE PAVING, CRUSHED AGGREGATE	S.Y.	257	—	—	257	—	514
NON-BID ITEMS							
1/8" ALUMINUM OR ZINC PLATE	S.F.	—	—	—	—	40	40
FILLER	SIZE	—	—	—	—	1/4"	1/4", 1/2"
POLYVINYL CHLORIDE WATERSTOP	L.F.	—	—	—	—	46	46

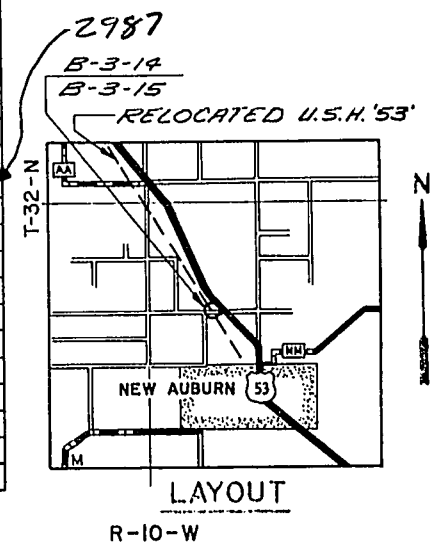

No.	Date	Revision	By
STATE OF WISCONSIN DEPARTMENT OF TRANSPORTATION DIVISION OF HIGHWAYS			
STRUCTURE B-3-15 U.S.H. "53" OVER TOWN ROAD			
County	BARRON	City	HS 20
Design Spec	A.A.S.H.O. 69	Design	HS 20
By	R.T.B.	Checked	F.P.R.
Approved	W.A. Kline	Date	11-17-71
Chief Bridge Engineer		J.H.G.	
GENERAL PLAN		SHEET 1 OF 10	
		X46270	

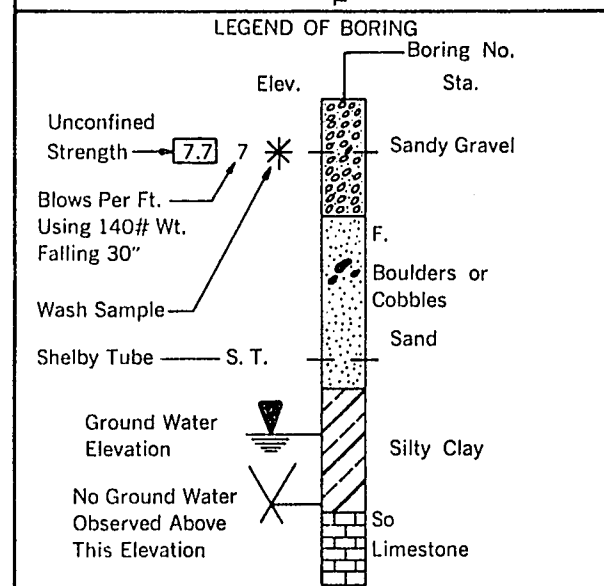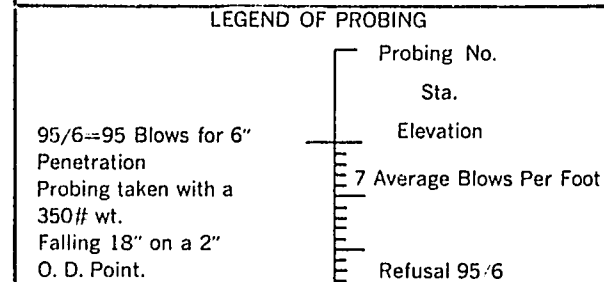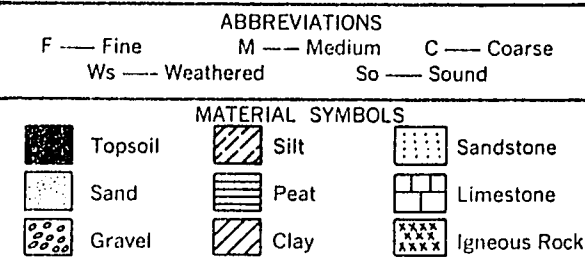


Unless otherwise specified, the blows per foot at the locations indicated are based on driving a 2" O. D. x 1.4" I. D. split spoon sampler with a 140# hammer having a free fall of 30". The blow count is taken in undisturbed soil immediately below a cased or open hole eliminating side friction on the drive pipe.

To obtain relative data concerning the character of material in and upon which the foundation might be built, borings and/or soundings were made at points approximately as indicated on this drawing. The data presented herein represents the findings of the subsurface explorations made. However, because the depths investigated are limited and the area of the borings and/or soundings is very small in relation to the entire area, the Division of Highways does not warrant conditions below the depths investigated or that the classification of material encountered in these investigations is necessarily typical of the entire site.

No.	Date	Reason	By
STATE OF WISCONSIN DEPARTMENT OF TRANSPORTATION DIVISION OF HIGHWAYS			
STRUCTURE B-3-15			
1969	D.J.A.	J.H.G.	
SUBSURFACE EXPLORATION		SHEET 2 OF 10	
		X 46271	



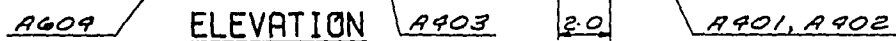


\*ELEVATIONS AND DIMENSIONS ARE MEASURED AT F.F. BACKWALL.



① CONSTRUCTION JOINT. POUR CONCRETE ABOVE THIS JOINT AFTER SUPERSTRUCTURE CONCRETE IS IN PLACE. STRIKE OFF AND LEAVE ROUGH.





INDICATES BATTERED  
PILING - BATTER PILING 3"  
PER FOOT IN DIRECTION SHOWN


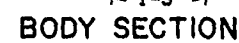


10 3/4" Ø C.I.P. FILES. EST. —  
LENGTH 55'-0. DRIVE TO A  
MIN. BRG. CAP. OF 20 T/PILE.

ALL HORIZONTAL BARS IN ABUTMENT BODY ARE  
A403 BARS UNLESS SHOWN OR NOTED OTHERWISE.  
FILL TO EL. 1091.91 BEFORE DRIVING PILING. UPPER  
LIMIT FOR "EXCAVATION FOR STRUCTURES" SHALL  
NOT EXCEED THIS ELEVATION.

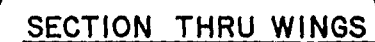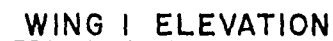
[illegible]

\* A408- NO LAP FOR RAIL PARAPET BARS,  
1-10% SEE SHEET 9.

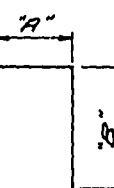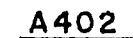

BAR#	DIM. 'A'	DIM. 'B'
A901	4-5	3-6
A505	1-9	3-5
A507	9	2-3
A911	4-7	1-6
A919	4-7	1-6

1-0	A509
1-5	A412
1-0	A417

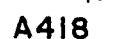




⊕ OPTIONAL KEYED CONST. JOINT FORMED BY A SURFACED BEVELED 2"x6.

FOR PILE SPLICE DETAIL SEE SHT. 4.

No.	Date	Revision	By
STATE OF WISCONSIN DEPARTMENT OF TRANSPORTATION DIVISION OF HIGHWAYS			
STRUCTURE B-3-15			
Const. Spec.	1969	Drawn By D. J. R.	Plans Checked J. H. G.
SOUTH ABUTMENT		SHEET 3 OF 10  X 46272	





NOTE: SEAL ALL EXPOSED HORIZONTAL & VERTICAL SURFACES OF 1/2" FILLER WITH NON-STAINING GRAY NON-BITUMINOUS JOINT SEALER. PLACE SEALER 1" DEEP AND HOLD 1/8" BELOW SURFACE OF CONCRETE

PROJECT ID	1196-6-71	SHEET NUMBER	41	TOTAL SHEETS	296
FEDERAL PROJECT DESIGNATION	EMP F08-4(36)				

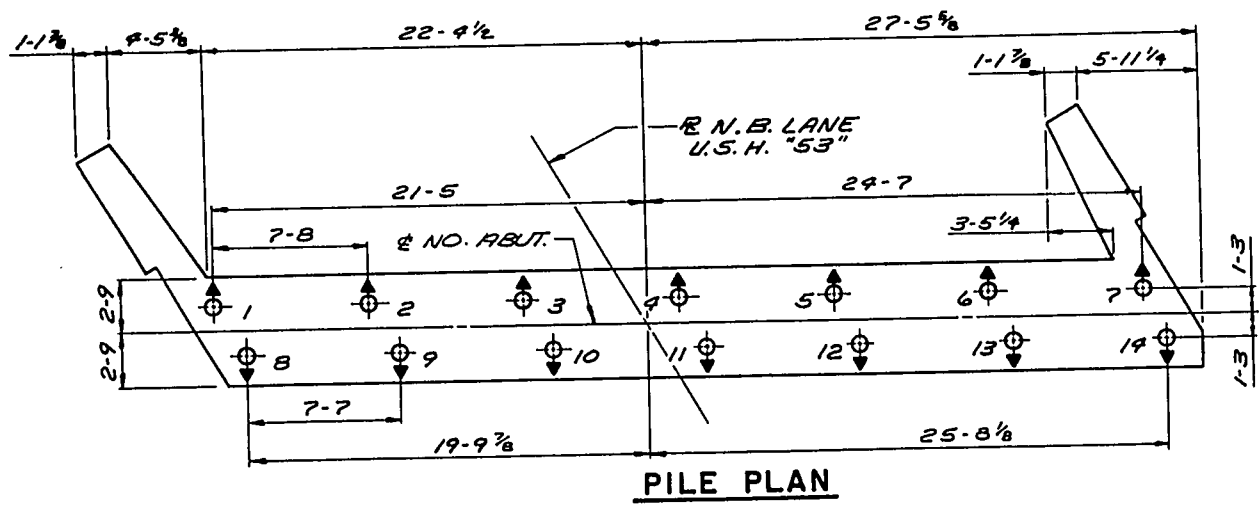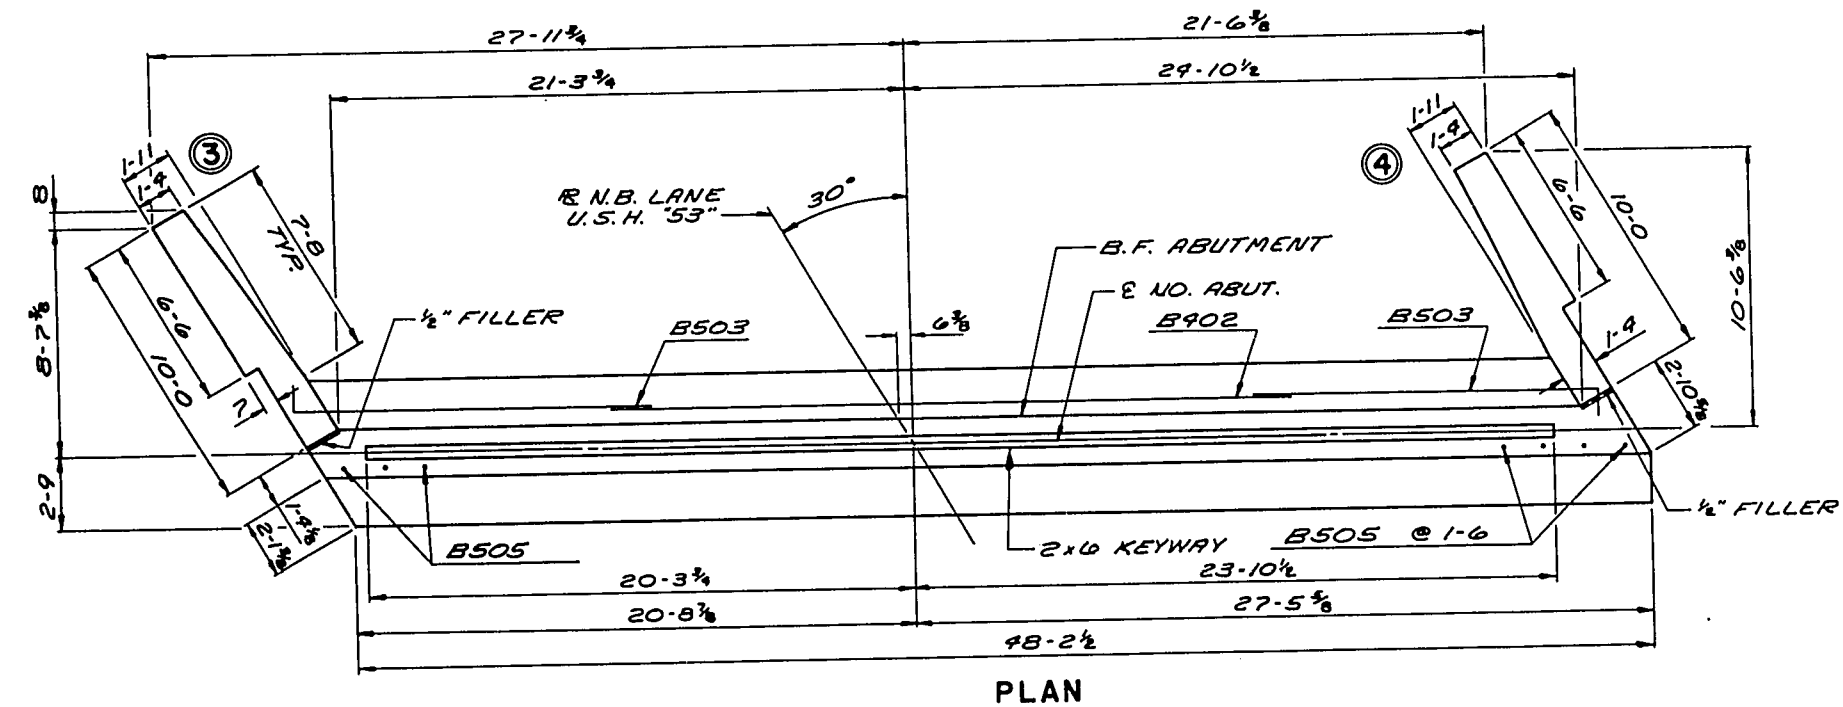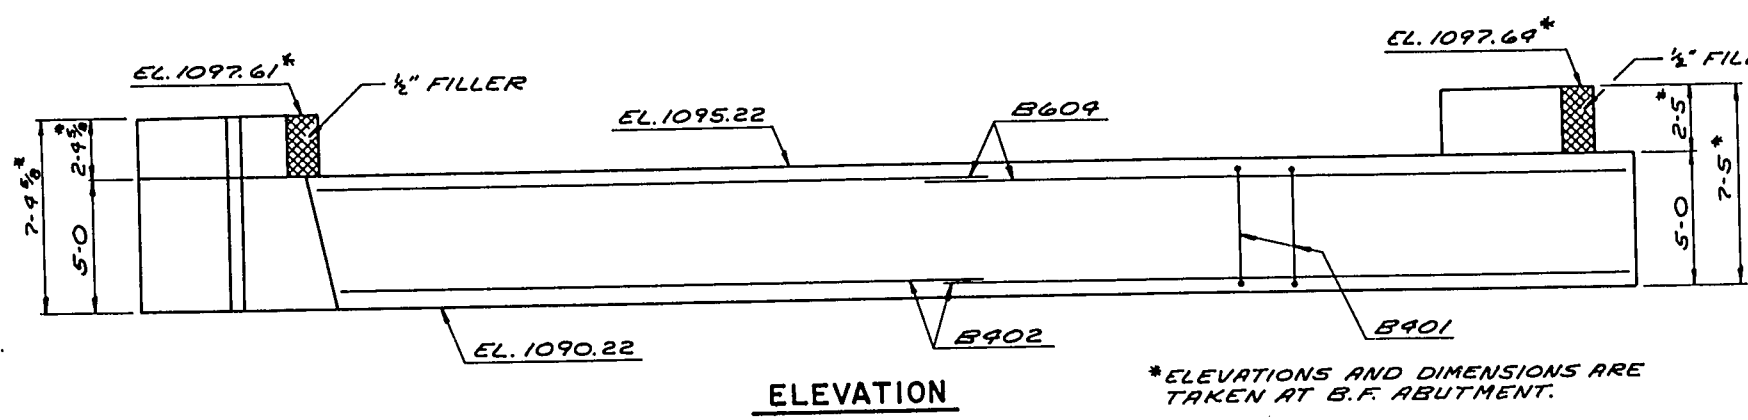

INDICATES BATTERED PILING - BATTER PILING 3" PER FOOT IN DIRECTION SHOWN.


B505 BARS MAY BE PLACED AFTER CONCRETE IS POURED. IMBED 1-3 IN CONCRETE, BEFORE INITIAL SET HAS TAKEN PLACE. POLYVINYL CHLORIDE WATERSTOP PLACE BETWEEN WINGS. SEE SHEET 7 FOR DETAILS.

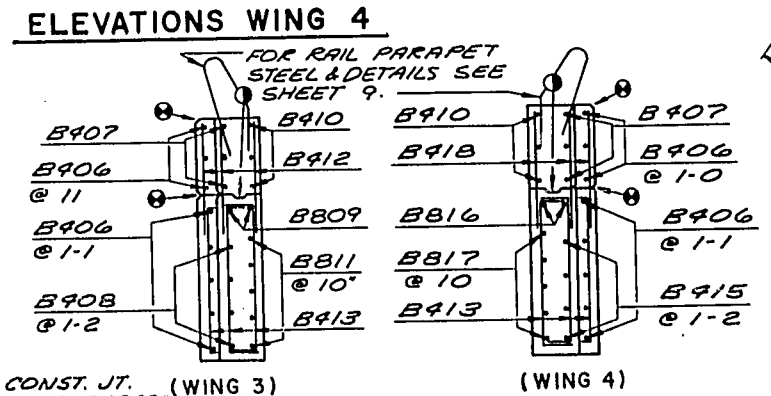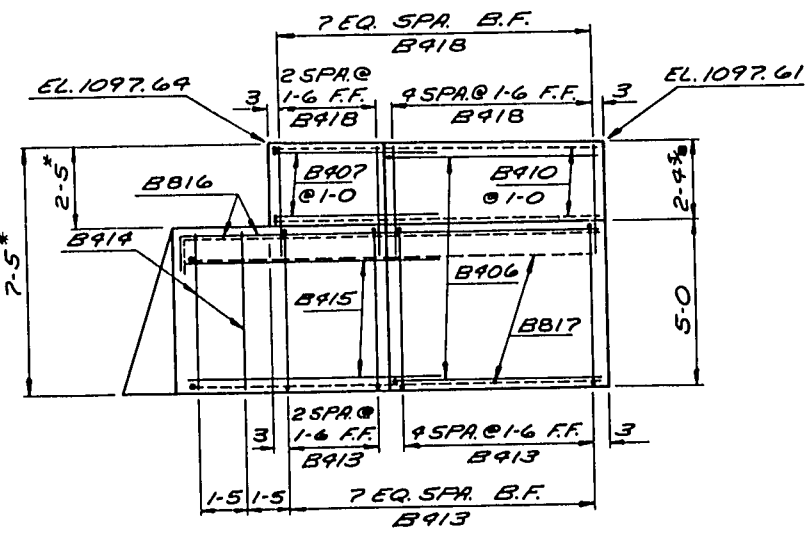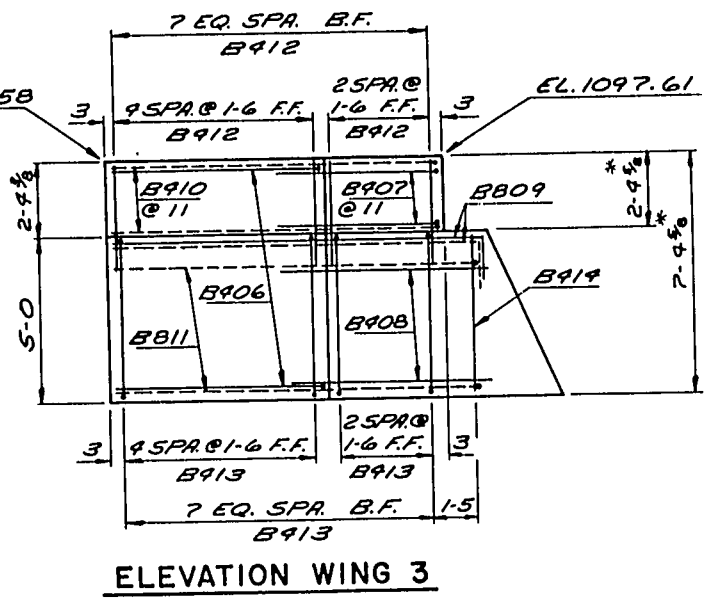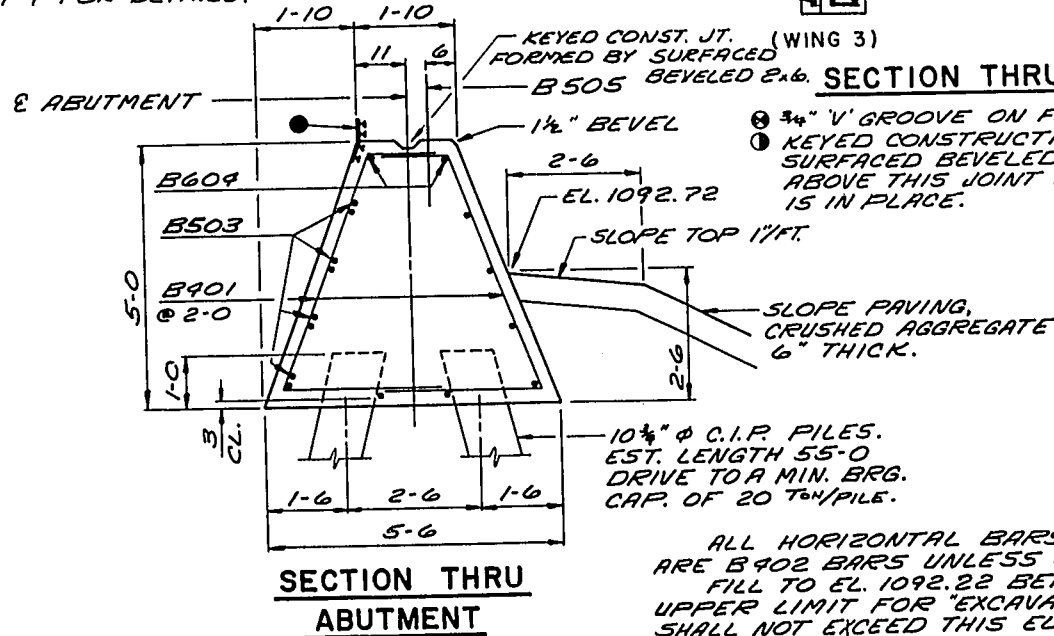

BILL OF BARS

BAR NO.	NO. REQ'D	LENGTH	BENT	1820 #	LOCATION
B901	50	9-0	X		BODY - VERTICAL
B902	16	25-6			" - HORIZONTAL
B503	8	14-0	X		" - " TOP
B604	4	25-11			" - " " - DOWEL
B505	33	2-6			" - " " - F.F.
B906	16	7-0	X		WINGS 3 & 4 - HORIZONTAL F.F.
B907	6	5-11	X		" 3 & 4 - " F.F.
B908	4	6-4			" 3 - " F.F.
B809	2	12-2	X		" 3 - " BF & F.F.
B910	6	10-8	X		" 3 & 4 - " B.F.
B811	5	13-0	X		" 3 - " B.F.
B912	16	3-4			" 3 - VERTICAL F.F. & B.F.
B913	32	6-5	X		" 3 & 4 - " F.F. & B.F.
B914	3	4-7			" 3 & 4 - " F.F.
B915	4	7-8			" 4 - HORIZONTAL F.F.
B816	2	13-8	X		" 4 - " BF & F.F.
B817	5	13-0	X		" 4 - " B.F.
B918	16	3-5			" 4 - VERTICAL F.F. & B.F.

FOR RAIL PARAPET BARS, SEE SHEET 9.

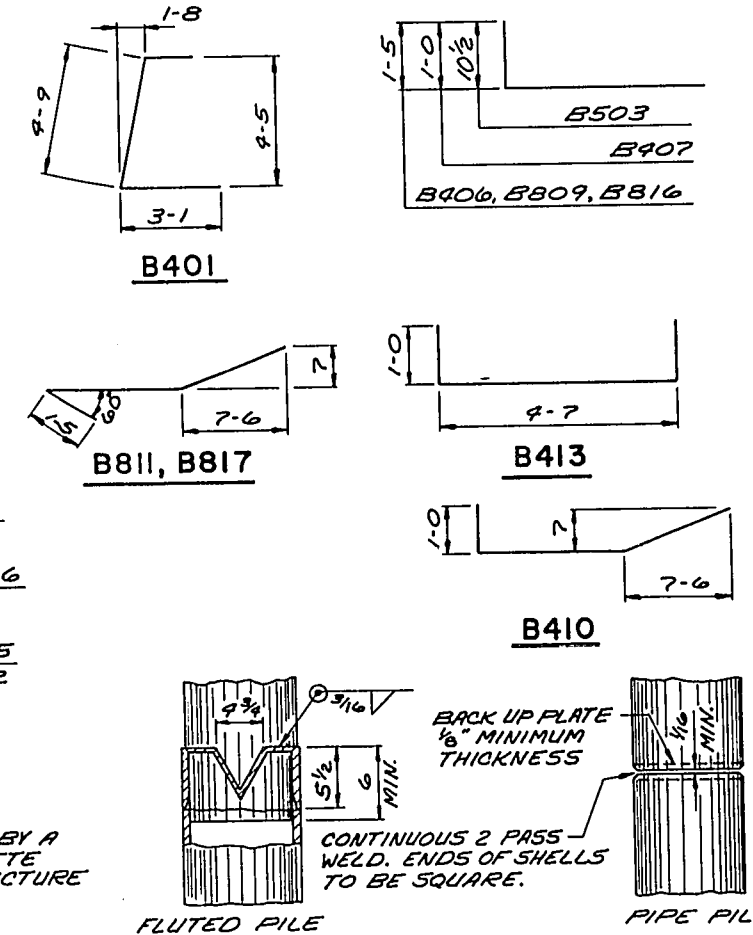


No.	Date	Revision	By
STATE OF WISCONSIN DEPARTMENT OF TRANSPORTATION DIVISION OF HIGHWAYS			
STRUCTURE B-3-15			
Const. Spec.	1969	Drawn By	D.J.R.
		Plans Checked	J.H.G.
NORTH ABUTMENT			SHEET 4 OF 10
			X 46273



ALL HORIZONTAL BARS IN ABUTMENT BODY ARE B902 BARS UNLESS SHOWN OR NOTED OTHERWISE. FILL TO EL. 1092.22 BEFORE DRIVING PILING. UPPER LIMIT FOR "EXCAVATION FOR STRUCTURES" SHALL NOT EXCEED THIS ELEVATION.

# BILL OF BARS



BAR NO.	NO. REQ'D	LENGTH	BENT	18,900 <sup>#</sup>	LOCATION
P901	32	10-6			EXTERIOR FOOTINGS - PIER 1
P902	20	9-6			" " " " 1
P903	32	11-0			INTERIOR " " " " 1
P904	28	7-0			" " " " 1
P905	18	7-0			EXTERIOR " " " " 2
P906	38	8-0			EXT. & INT. " " " " 2
P1007	22	9-0			INTERIOR " " " " 2
P1108	96	7-6	X		FOOTING & COLUMN - DOWELS
P909	152	9-5	X		COLUMN - TIES
P1110	24	17-1			PIER 1, COLUMN 1 & 4 - VERTICAL
P1111	48	17-2			PIER 1, COL. 2 & 3, PIER 2, COL. 1 & 4 - VERT.
P1112	12	17-9			PIER 2, COLUMN 2 - VERTICAL
P1113	12	17-3			" 2, " 3 - "
P814	32	2-0			COLUMN & SLAB - DOWELS

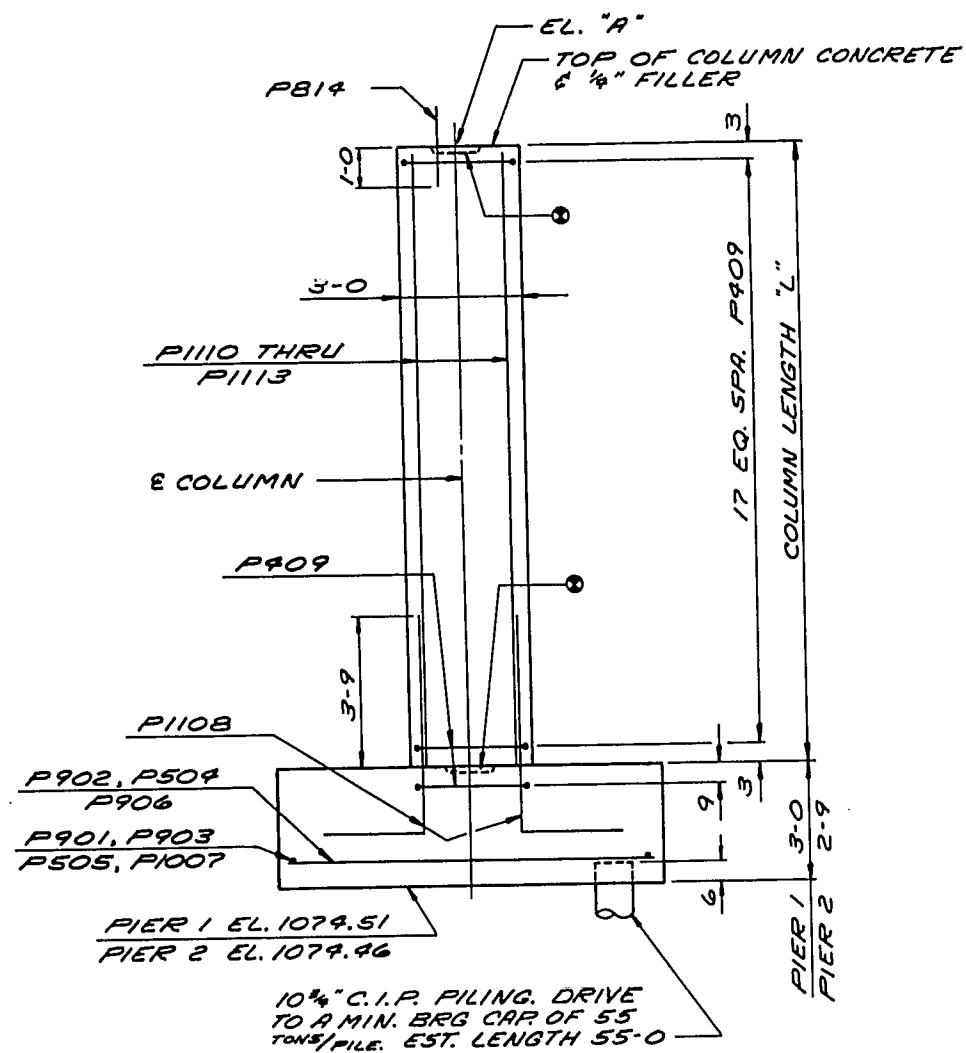

TYPICAL COLUMN ELEVATION

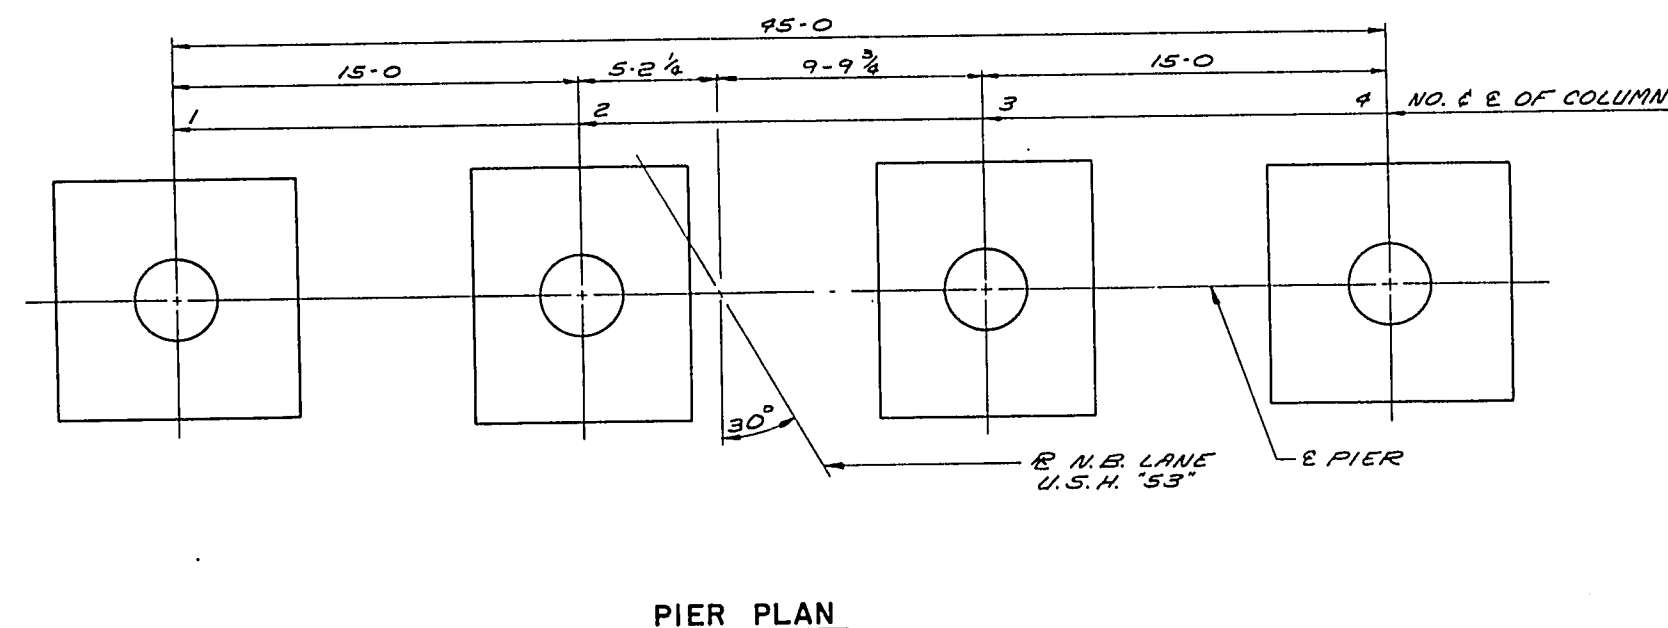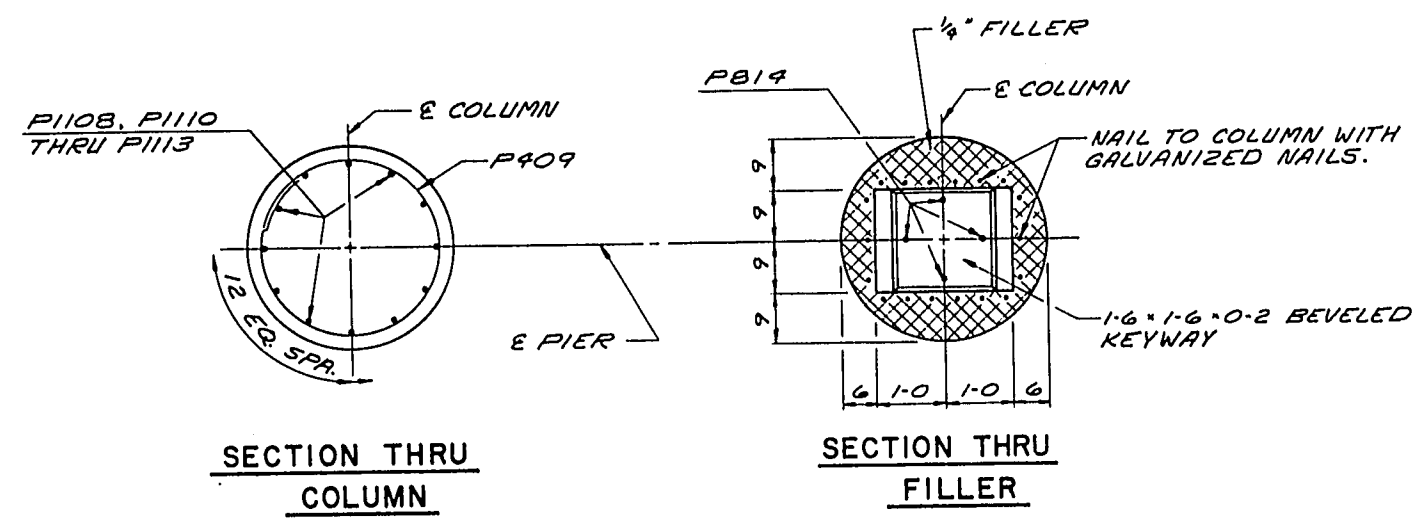


PIER PLAN

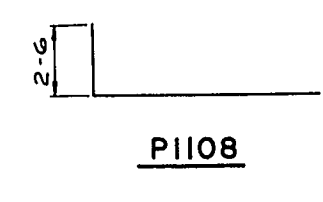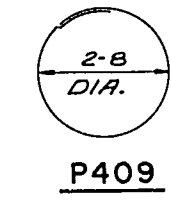

# ELEVATION AND COLUMN LENGTH

		ELEV. "A"	LENGTH "L"
PIER 1	COLUMN 1	1094.76	17-3
	" 2	1094.92	17-4 3/8
	" 3	1094.90	17-4 3/8
	" 4	1094.79	17-3 3/8
PIER 2	" 1	1094.56	17-4 1/4
	" 2	1094.71	17-6
	" 3	1094.70	17-5 3/8
	" 4	1094.59	17-4 1/2

NOTES:  
TOP OF COLUMN ELEVATIONS (EL. "A") AND COLUMN LENGTH "L" ARE MEASURED AT E PIER AND E COLUMN.  
SLOPE TOP OF COLUMN TO MATCH SLOPE OF SUPERSTRUCTURE.  
CONSTRUCTION JOINT KEY FORMED BY A SURFACED BEVELED 1-6 x 1-6 x 0-2.  
P814 BARS MAY BE PLACED AFTER COLUMN CONCRETE IS POURED BUT BEFORE INITIAL SET HAS TAKEN PLACE.  
FOR PILE SPLICE DETAIL SEE SHEET 4.

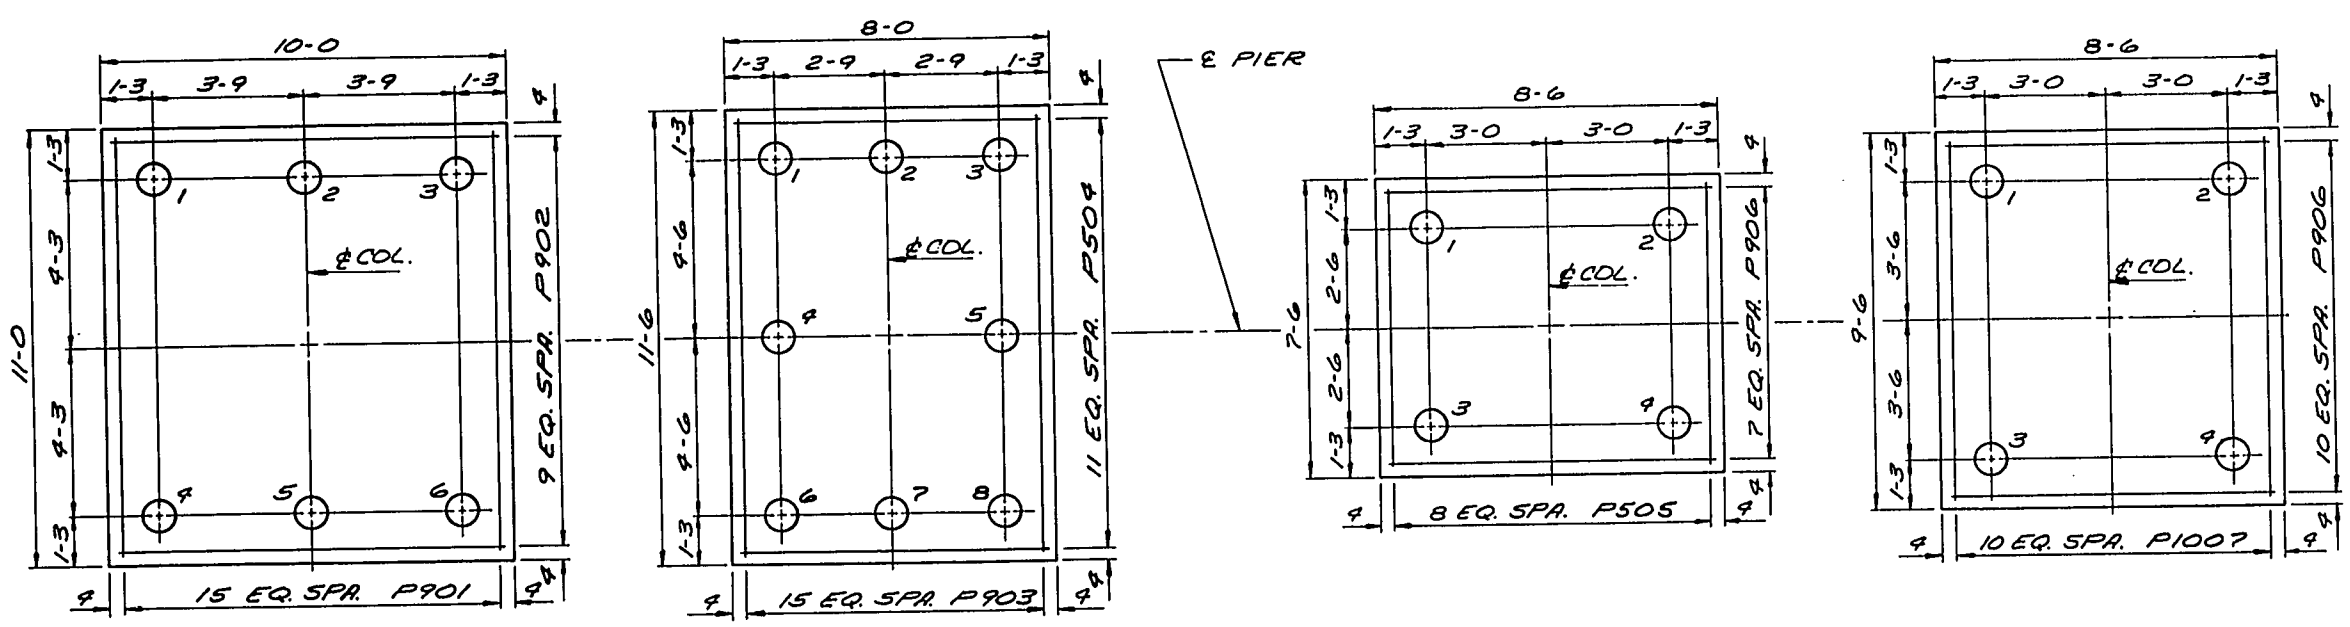


TYPICAL FOOTING PLAN - PIER 1

TYPICAL FOOTING PLAN - PIER 2


No.	Date	Revision	By
STATE OF WISCONSIN DEPARTMENT OF TRANSPORTATION DIVISION OF HIGHWAYS			
STRUCTURE B-3-15			
Const. Spec. 1969	Drawn By D.J.A.	Plans Checked J.H.G.	
PIERS			SHEET 5 OF 10
			X46274









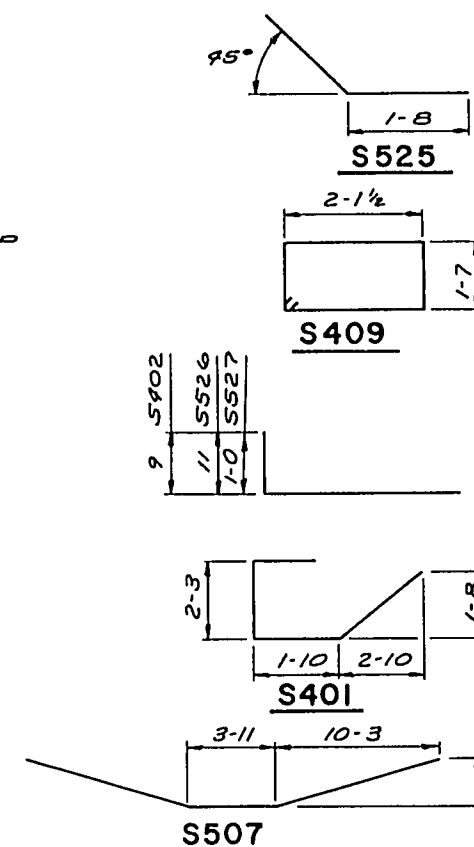

BAR NO.	NO. REQ'D	LENGTH	BENT	109,280 #	
				LOCATION	
5401	64	8-8	X	SLAB @ SO. ABUT. HAUNCH	
5402	29	6-8	X	"	" " " "
5703	3	48-10		"	" " " " -TRANS.
5504	69	48-10		"	SPAN 1 & 3 - TRANS.
51005	40	32-0		"	" " 1 - LONG.
51006	27	23-6		"	" " 1 - "
5507	86	29-8	X	"	@ PIER HAUNCH
5908	20	48-10		"	" " " " - TRANS.
5409	189	7-11	X	"	STIRRUP - SPAN 2
51110	66	52-0		"	SPAN 2 - LONG.
51111	41	36-3		"	" " 2 - "
5712	48	48-10		"	" " 2 - TRANS.
5913	52	30-3		"	" " 3 - LONG.
5914	37	21-3		"	" " 3 - "
5415	29	9-6		"	" " 1 - "
5516	98	48-10		"	" " 1, 2, & 3 - TRANS.
51117	42	46-3		"	OVER PIER 1 - LONG.
51118	43	39-6		"	" " " 1 - "
5419	24	28-6		"	SPAN 2 - LONG.
5820	18	31-6		"	EDGE SPAN 2 - LONG.
51121	43	39-6		"	OVER PIER 2 - LONG
51122	42	47-3		"	" " " 2 - "
5923	28	48-10		"	@ PIER HAUNCH - TRANS.
5524	29	6-6		"	SPAN 3 - LONG.
5525	43	4-1	X	"	@ NO. ABUT. HAUNCH
5526	43	3-0	X	"	@ " " "
5527	43	2-11	X	"	@ " " "

FOR RAIL PARAPET BARS, SEE SHEET 9.

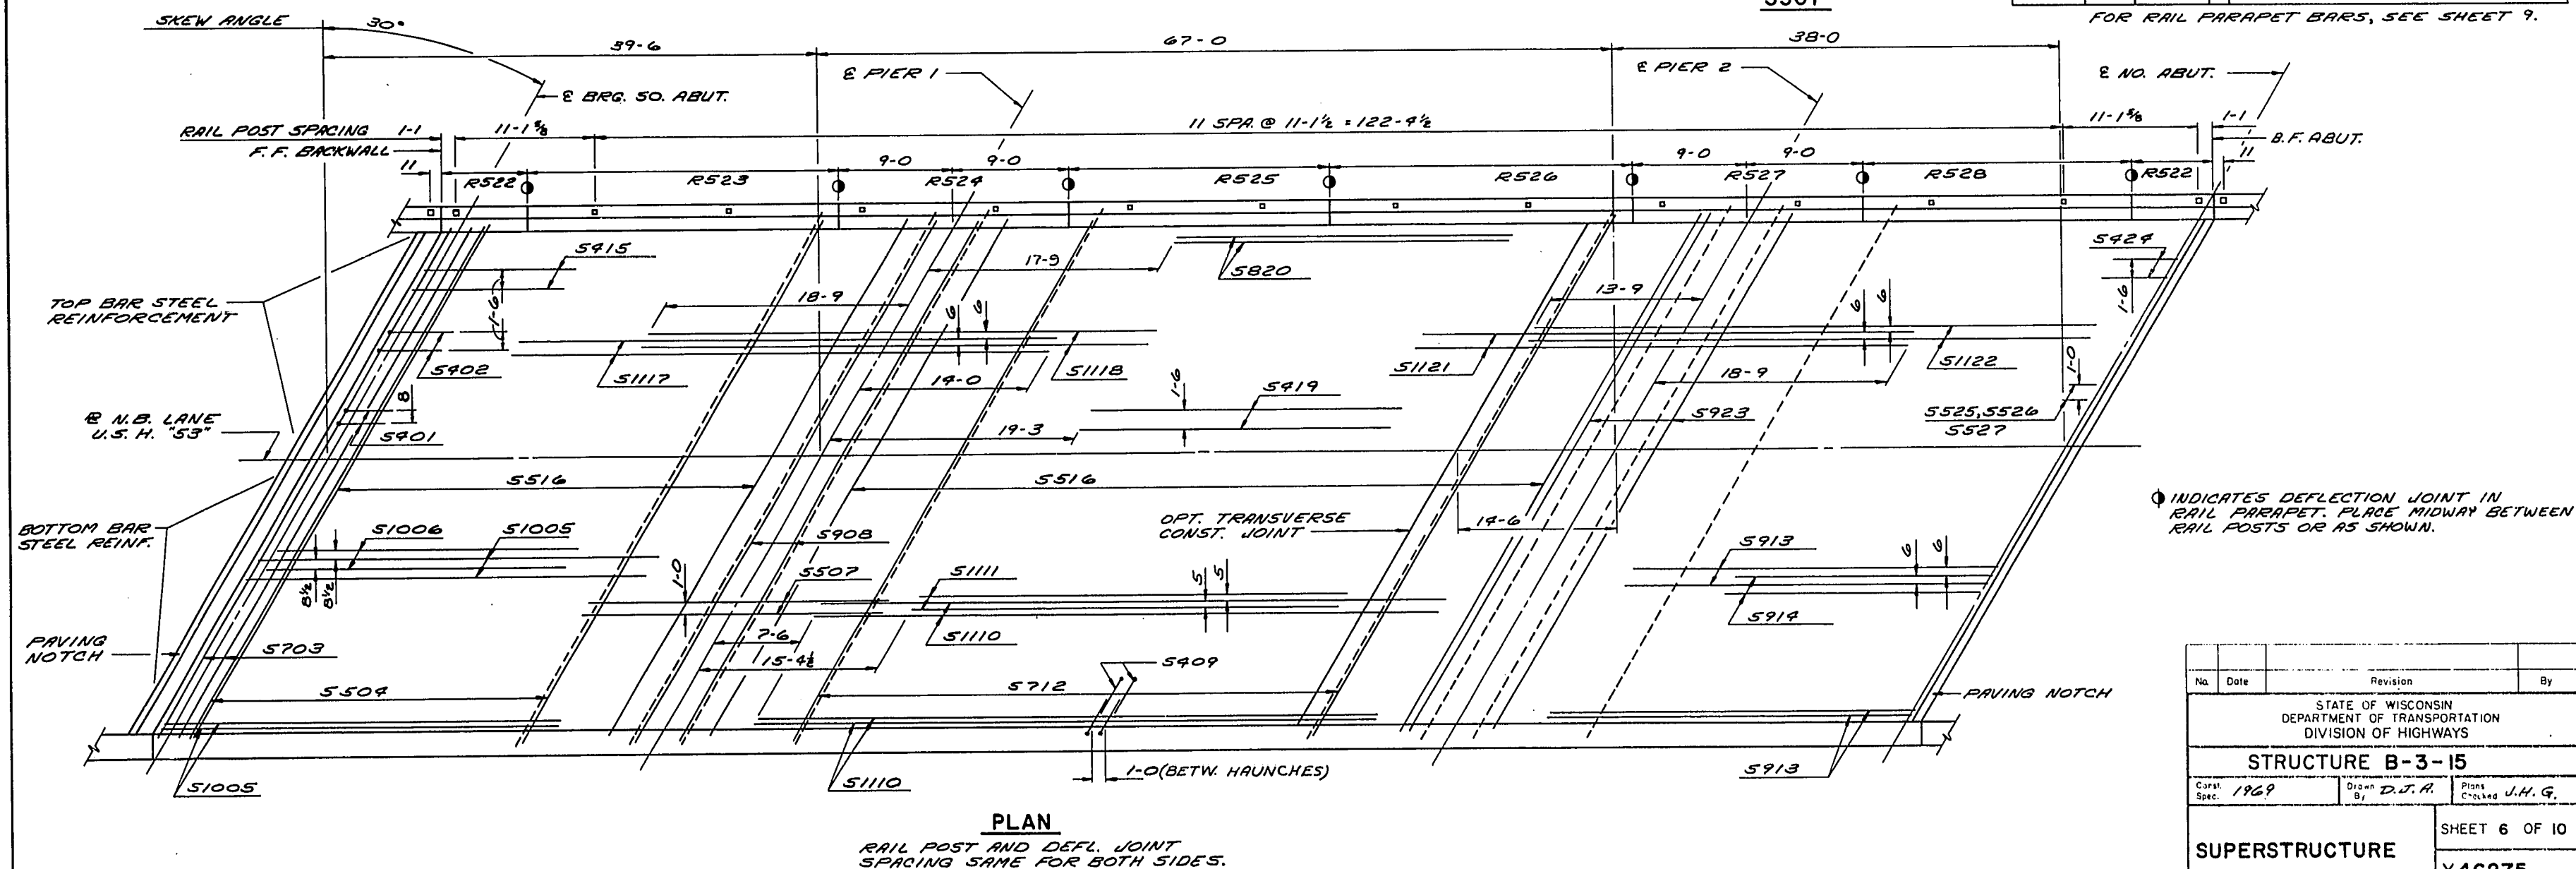

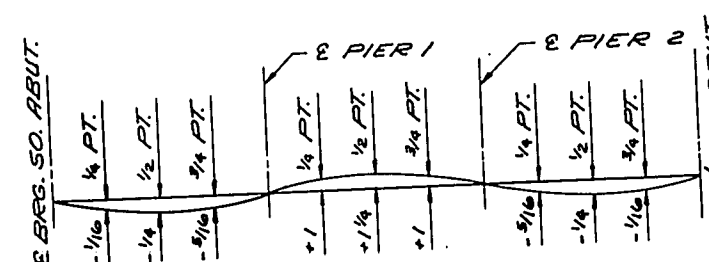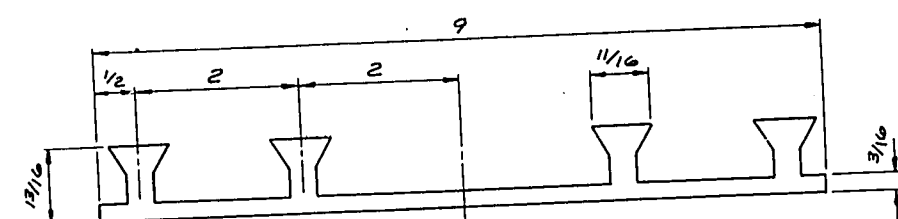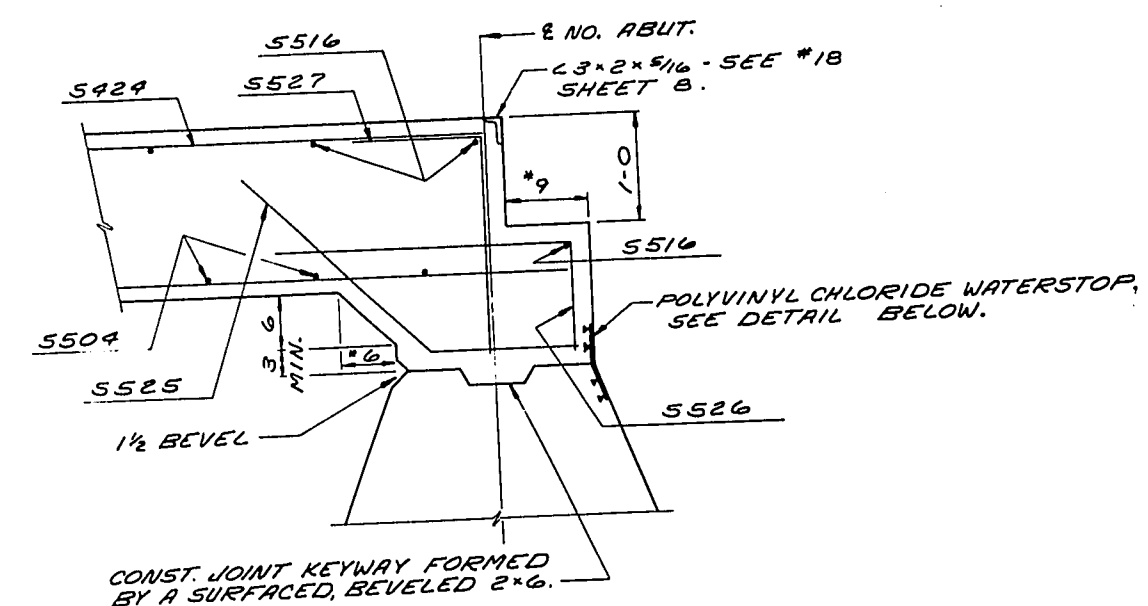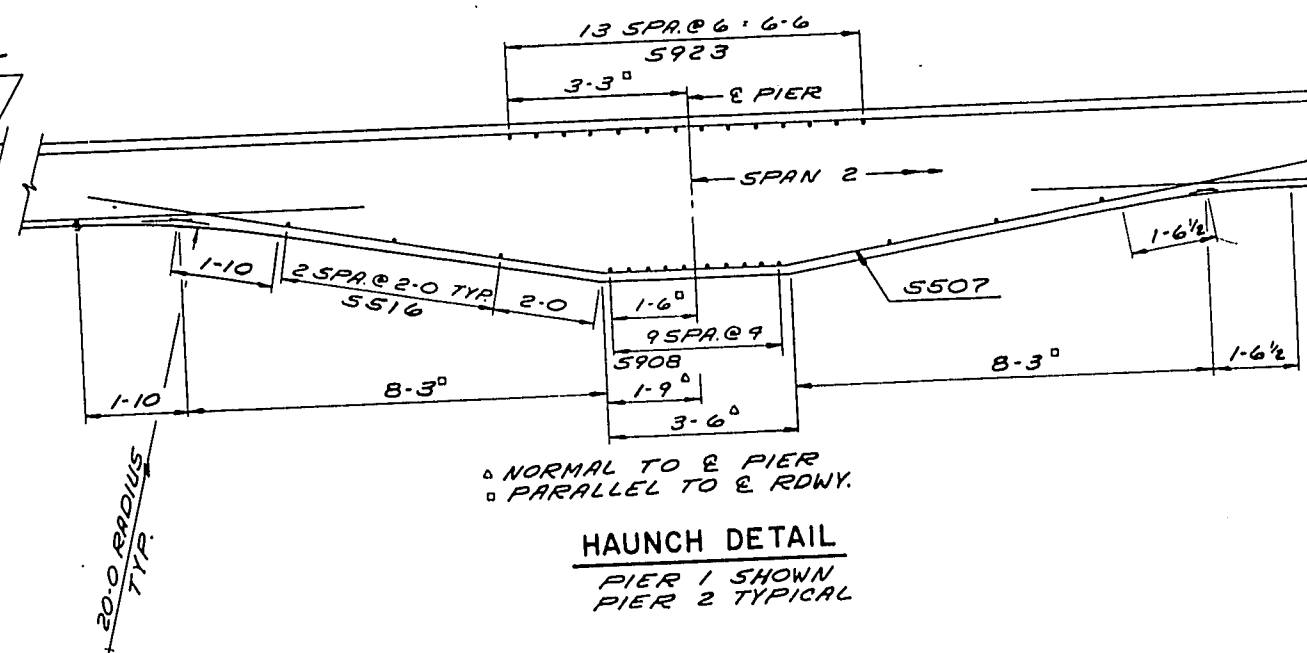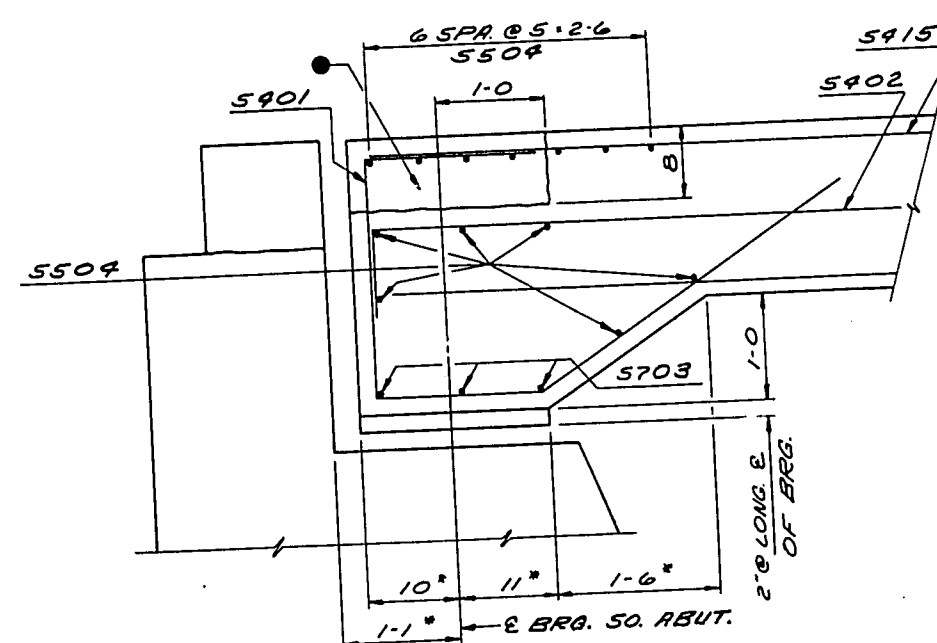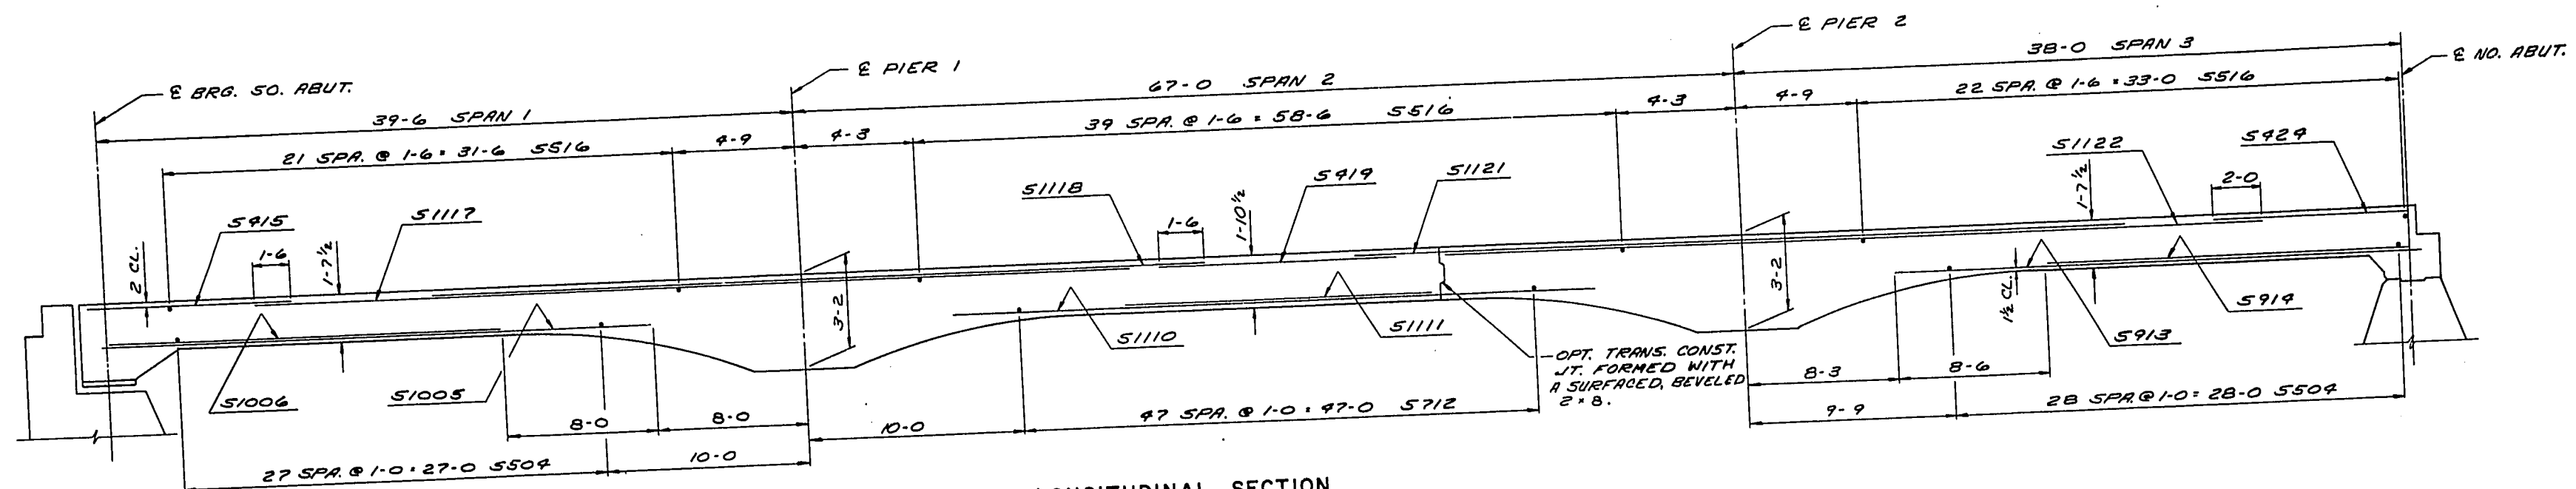

CAMBER DIAGRAM.  
DEAD LOAD DEFLECTION IS  $0.9 \times$  CAMBER  
SHOWN. CAMBER DOES NOT INCLUDE ALLOWANCE  
FOR FORM SETTLEMENT.

## NOTES

NOTES

ALTERNATE TOP TRANSVERSE BARS IN SLAB SHALL BE SUPPORTED BY INDIVIDUAL BAR CHAIRS AT APPROX. 3'-0" CENTERS. BOTTOM LONGITUDINAL BARS SHALL BE SUPPORTED BY CONTINUOUS BAR CHAIRS AT APPROX. 9'-0" CENTERS. ALL SLAB THICKNESS DIMENSIONS ARE MIN. ANY TOLERANCES NECESSARY TO CORRECT CONSTRUCTION DISCREPANCIES ARE TO BE PLUS (+). CONCRETE TO BE POURED AFTER FALSEWORK HAS

PARAPETS ARE TO BE POURED AFTER FALSEWORK HAS BEEN RELEASED.






● CONCRETE IN THIS AREA SHALL BE PLACED AFTER SUPER  
STRUCTURE IS POURED & EXP JOINT HAS BEEN SET. REMOVE  
FORMS FROM END OF SLAB BEFORE MAKING THIS POUR. JOINT MAY  
REMOVE FALSEWORK WHICH IS SUPPORTING THE DECK. JOINT MAY  
BE OMITTED WITH THE APPROVAL OF THE ENGINEER.

No.	Date	Revision	By
STATE OF WISCONSIN DEPARTMENT OF TRANSPORTATION DIVISION OF HIGHWAYS			
STRUCTURE B-3-15			
Const. Spec.	1969	Drawn By	<i>D. J. R.</i>
		Plans Checked	<i>J. H. G.</i>
SUPERSTRUCTURE		SHEET 7 OF 10	
		X46276	








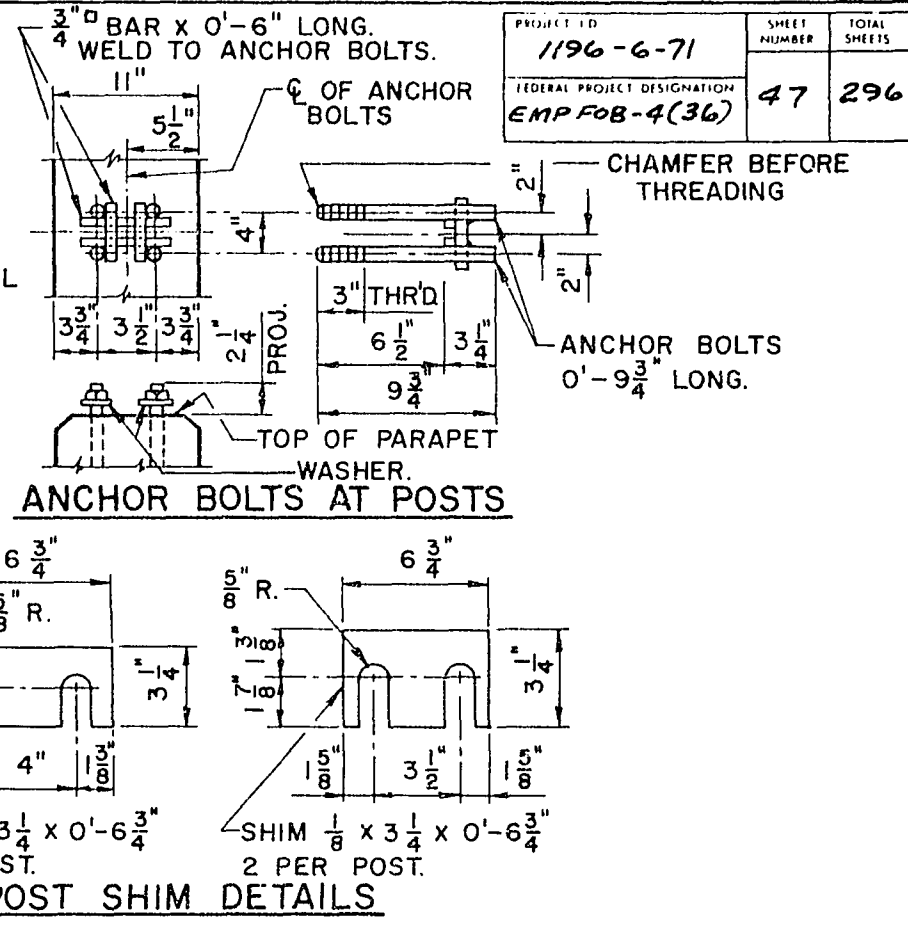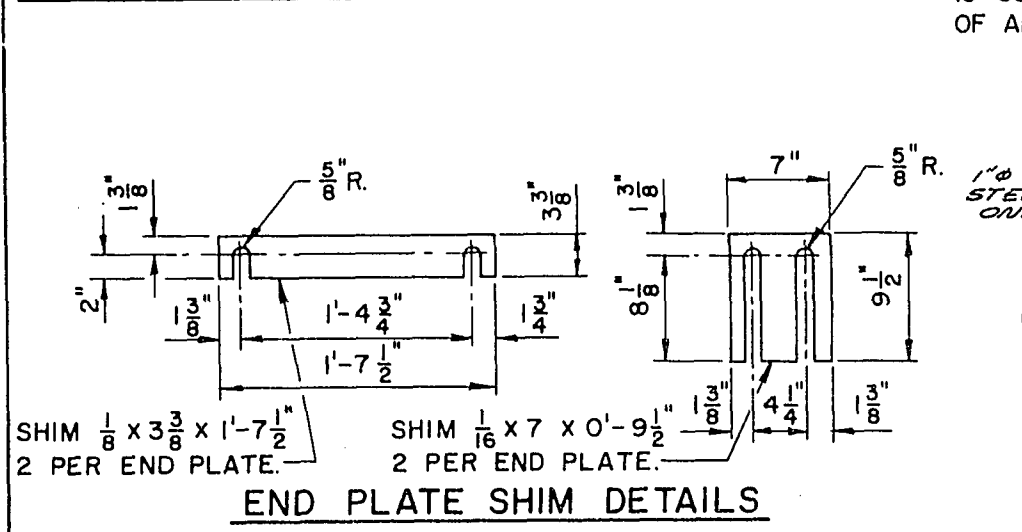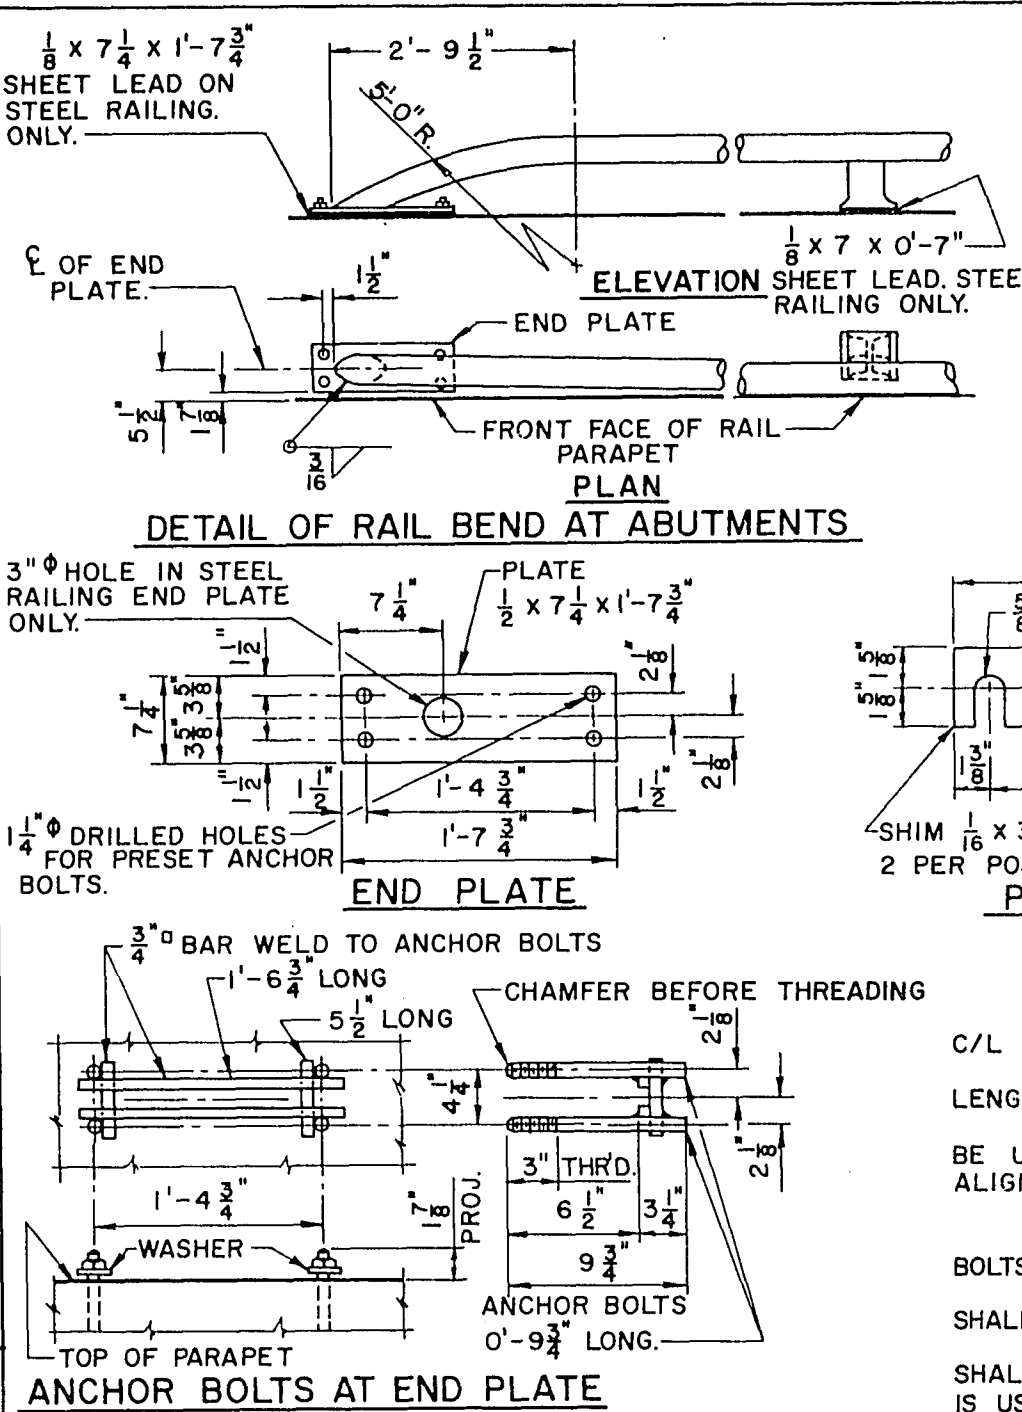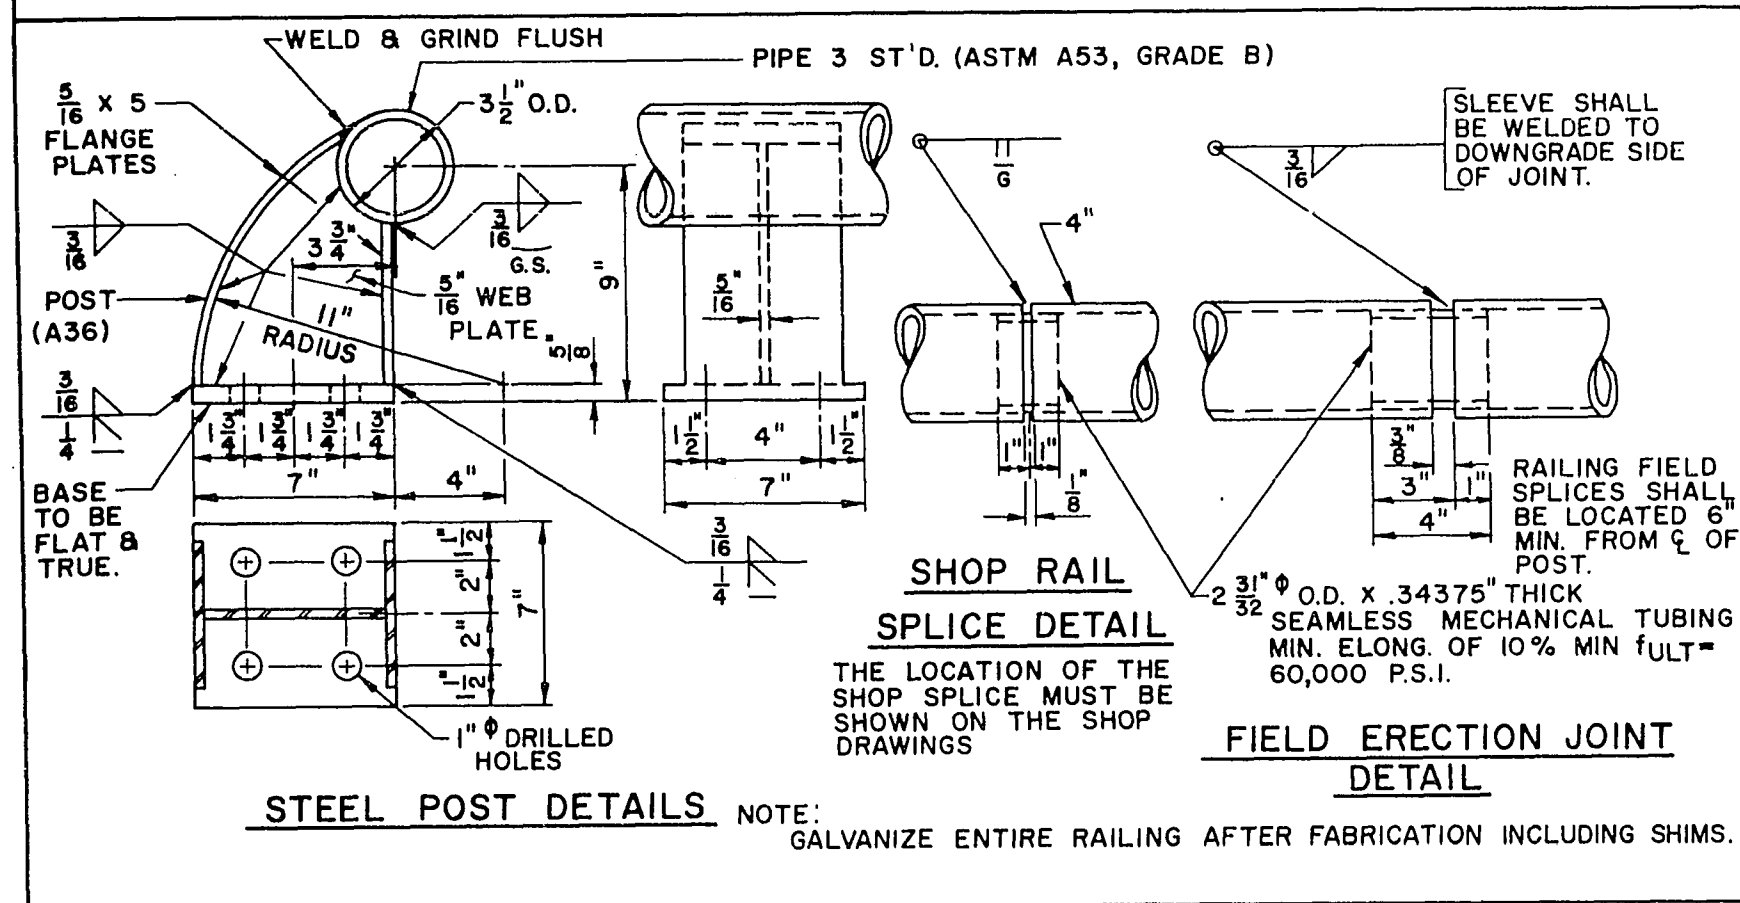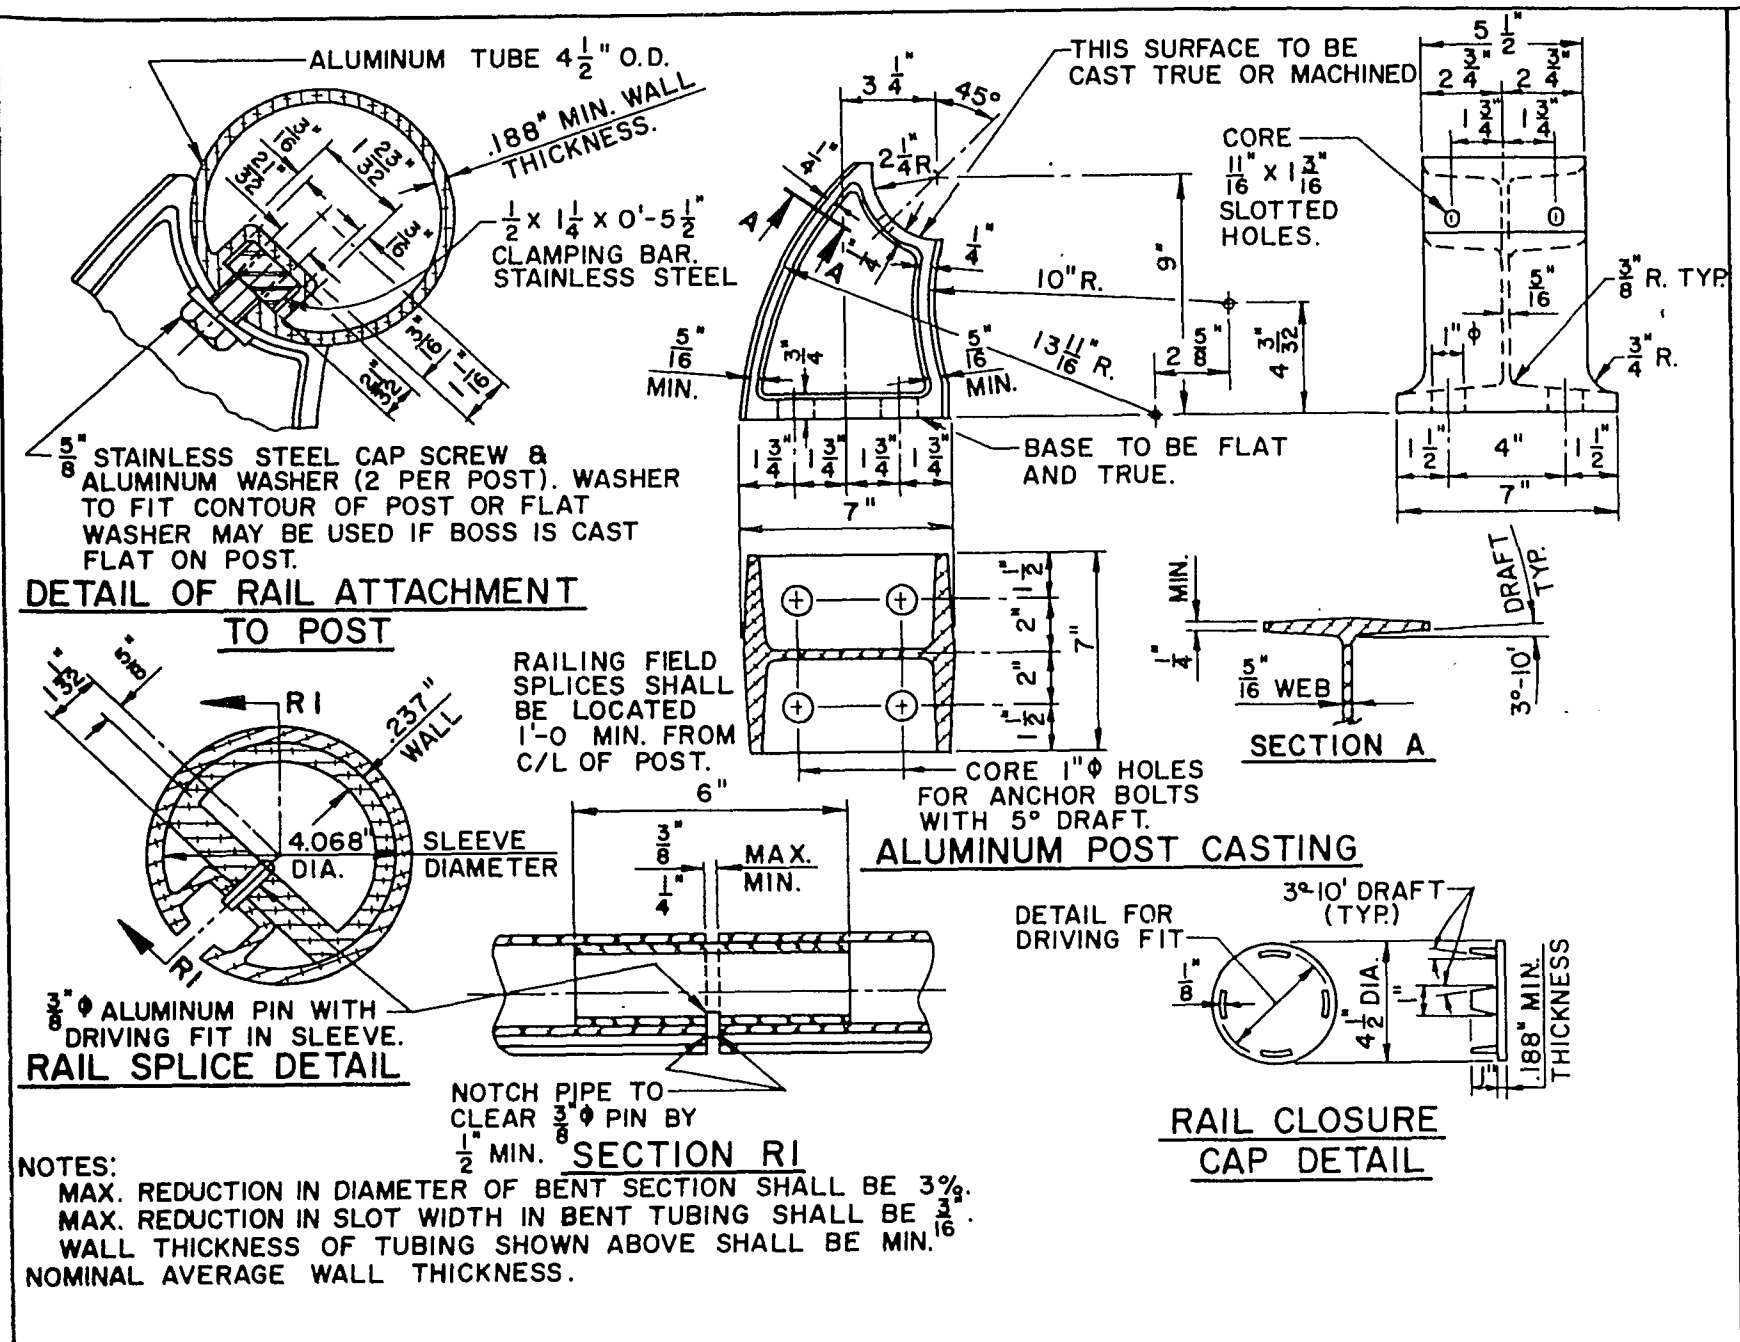


**GENERAL NOTES**

BID ITEM SHALL BE TUBULAR RAILING, TYPE 'J'. ALL POST SPACINGS ARE TAKEN HORIZONTALLY ALONG C/L OF ANCHOR BOLTS. RAILING SHALL BE FABRICATED IN TWO OR THREE PANEL LENGTHS. SHIMS CONFORMING TO SAME MATERIAL AS POSTS SHALL BE USED UNDER POSTS AND END PLATES WHERE REQ'D FOR ALIGNMENT. RAIL POSTS SHALL BE SET NORMAL TO GRADE. THE SHANK AND ROOT OF THREAD DIAMETER FOR ANCHOR BOLTS SHALL BE A MIN. OF 0.62 INCHES. ANCHOR BOLTS, NUTS & WASHERS FOR ALUMINUM RAILING SHALL BE STAINLESS STEEL. ANCHOR BOLTS, NUTS & WASHERS FOR STEEL RAILING SHALL BE EITHER STAINLESS STEEL OR ASTM A307. IF A307 IS USED ELECTRO-GALVANIZE NUTS, WASHERS & TOP 3 1/2" OF ANCHOR BOLTS. SHIMS SHALL CONFORM TO SAME MATERIAL AS POSTS.

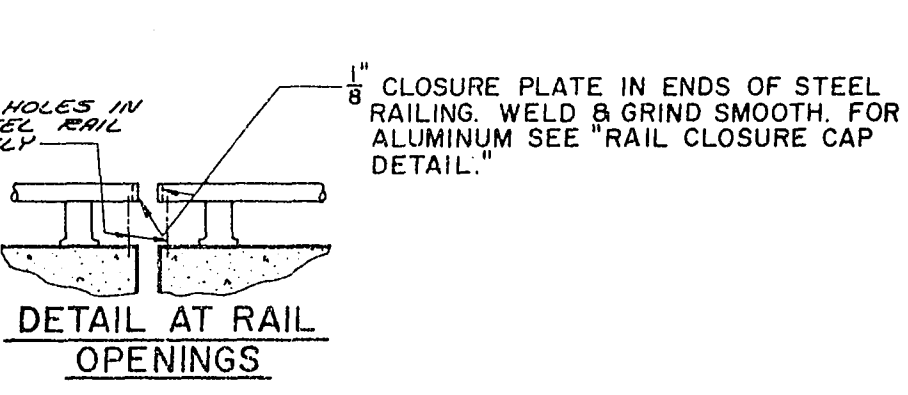

No.	Date	Revision	By
STATE OF WISCONSIN DEPARTMENT OF TRANSPORTATION DIVISION OF HIGHWAYS			
STRUCTURE B-3-15			
Const. Spec. 1969	Drawn By D.J.A.	Plans Checked J.H.G.	
TUBULAR RAILING TYPE 'J'			SHEET 10 OF 10 X 46279

**CURVE DATA B-3-16**  
 U.S.H. 53 SB. LANE  
 P.C. STA. 203+85.70  
 P.T. STA. 224+08.43  
 P.I. STA. 213+96.39  
 Δ = 5° 03' 24.59"  
 D = 9° 15'  
 T = 1012.023'  
 L = 2022.732'  
 E = 22° 15' 31.2"  
 SE = 0.017

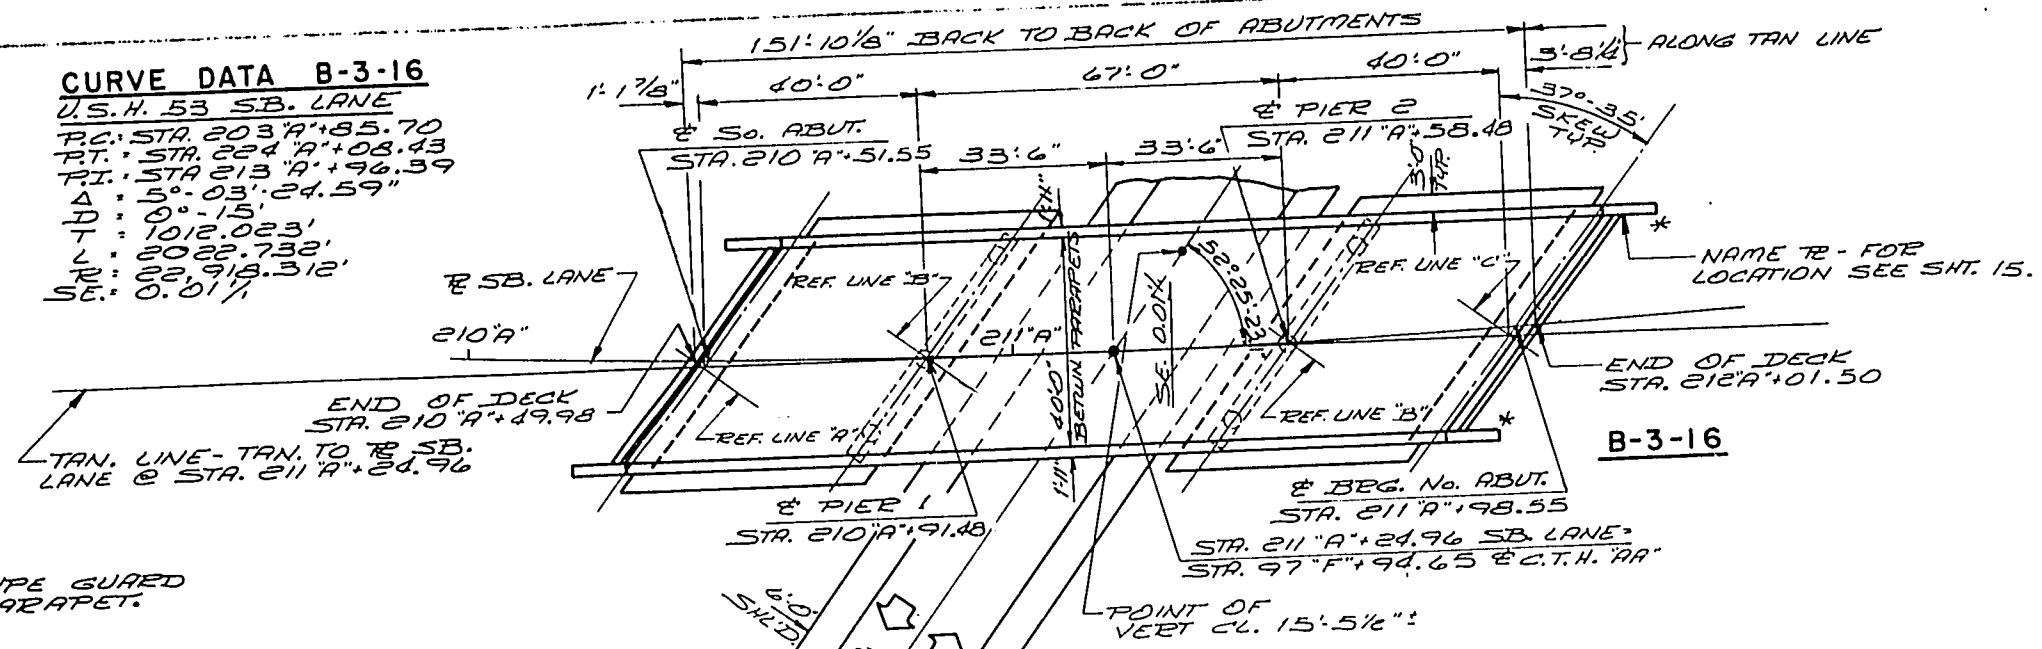

**DESIGN DATA**

LIVELOAD: HS-20  
 ALLOWABLE DESIGN STRESSES:  
 CONCRETE MASONRY - GRADE "AA" - SLAB  $f_c = 1,200$  P.S.I.  
 ALL OTHER  $f_c = 1,400$  P.S.I.  
 BAR STEEL REINFORCEMENT  $f_s = 20,000$  P.S.I.  
 STRUCTURAL CARBON STEEL  $f_s = 20,000$  P.S.I.  
 PRESTRESSED GIRDERS  $f_c = 6,000$  P.S.I.  
 CONCRETE MASONRY STRANDS - 1/2" DIA. WITH ULTIMATE TENSILE STRENGTH OF 270,000 P.S.I.  
 FOUNDATION DATA:  
 SUPPORT ABUTMENTS ON HP 10.42 STEEL "H" PILES. EST. 25'-0" LONG, & DENVER TO A MIN. BEG. VALUE OF 55T/PILE.  
 SUPPORT PIERS ON SPREAD FOOTINGS WITH A MINIMUM ALLOWABLE BEG. PRESSURE OF 2 1/2 T/SQ. FT.


**GENERAL NOTES**

DRAWINGS SHALL NOT BE SCALED.  
 BAR STEEL REINFORCEMENT SHALL BE EMBEDDED 2" CLEAR UNLESS OTHERWISE SHOWN OR NOTED.  
 ELASTOMERIC BEARING PADS NEED NOT BE INDIVIDUALLY MOLDED PROVIDED THE CUT EDGES ARE SMOOTH & TRUE.  
 THE SLOPE OF THE FILL IN FRONT OF THE ABUTMENTS SHALL BE COVERED WITH SLOPE PAVING, CRUSHED AGGREGATE TO THE EXTENT SHOWN ON THIS SHT. & IN THE ABUTMENT DETAILS.  
 THE FINISHED GRADED SECTION WAS USED AS THE UPPER LIMITS OF EXCAVATION FOR COMPUTATION OF EXCAVATION QUANTITIES AT THE PIERS.  
 THE UPPER LIMITS OF "EXCAVATION FOR STRUCTURES" FOR THE ABUTMENTS SHALL BE THE BOTTOM OF THE SLOPE PROTECTION & THE QUANTITIES WERE COMPUTED FROM THIS LINE.  
 FILLER SHALL CONFORM TO THE REQUIREMENTS OF A.A.S.H.O. DESIGNATION M153 OR M213.

**LIST OF DRAWINGS**

- |                                |        |
|--------------------------------|--------|
| 1. GENERAL PLAN                | X46161 |
| 2. GENERAL PLAN                | X46162 |
| 3. SUBSURFACE EXPLORATION      | X46163 |
| 4. SOUTH ABUTMENT              | X46164 |
| 5. SOUTH ABUTMENT DETAILS      | X46165 |
| 6. NORTH ABUTMENT              | X46166 |
| 7. NORTH ABUTMENT DETAILS      | X46167 |
| 8. PIERS                       | X46168 |
| 9. SUPERSTRUCTURE              | X46169 |
| 10. SUPERSTRUCTURE             | X46170 |
| 11. SUPERSTRUCTURE             | X46171 |
| 12. PRESTRESSED GIRDER DETAILS | X46172 |
| 13. BEARING DETAILS            | X46173 |
| 14. EXPANSION JOINT            | X46174 |
| 15. SLOPED FACE PARAPET "A"    | X46175 |
| 16. TUBULAR RAILING TYPE "I"   | X46176 |


\* ATTACH BEAM TYPE GUARD RAIL TO WING PARAPET.

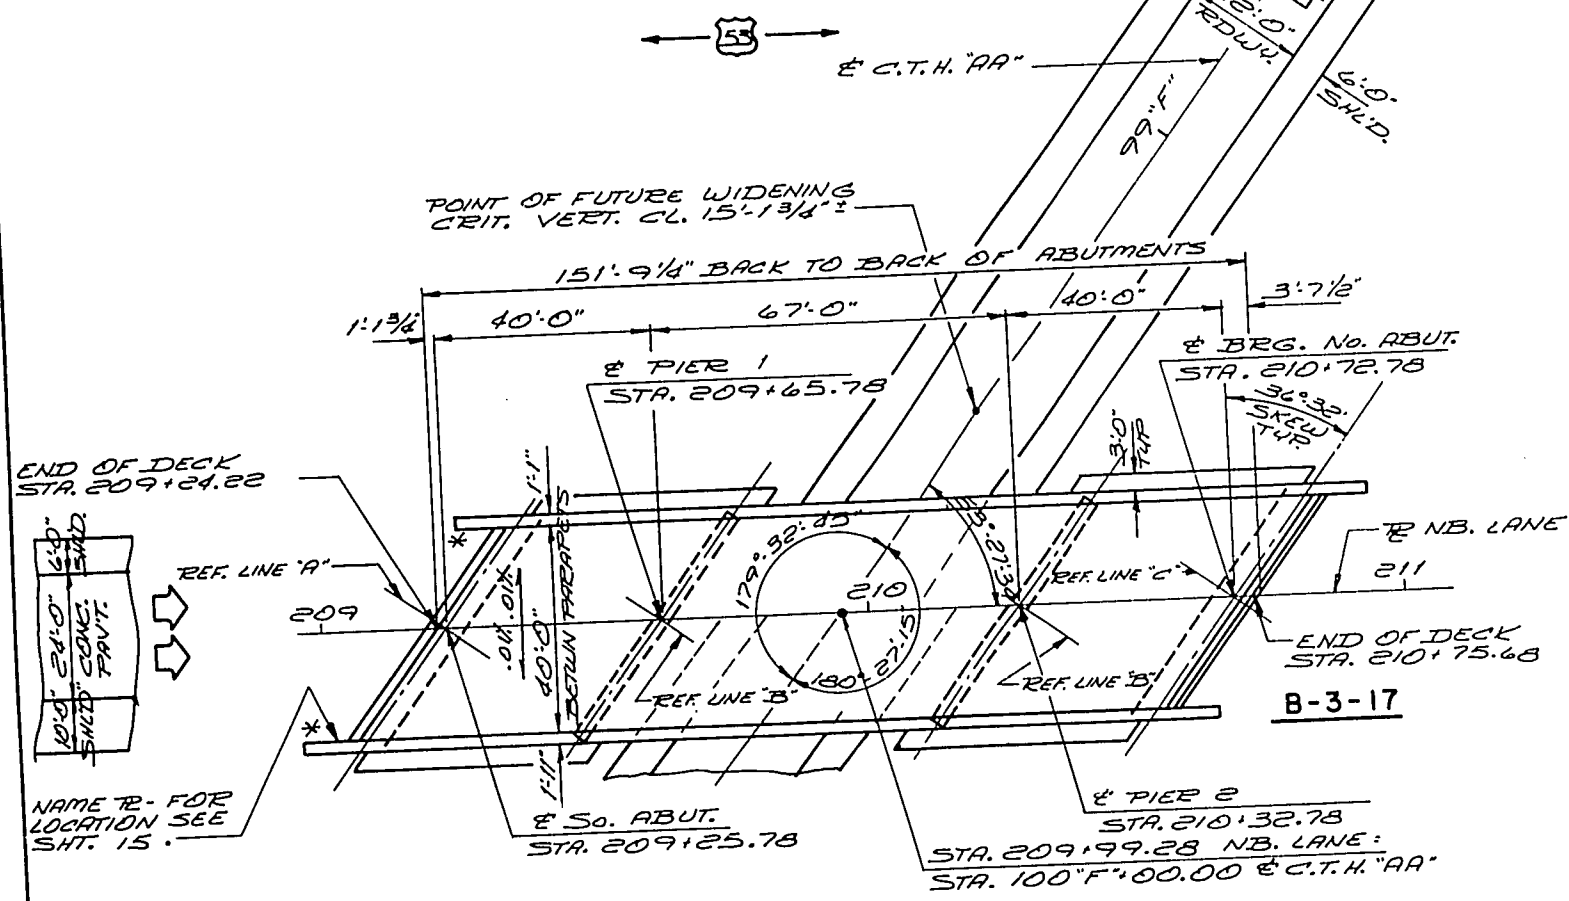


**PLAN**  
 (3 SPAN PRESTRESSED GIRDER)

**TRAFFIC VOLUME**

U.S.H. 53  
 A.D.T. = 5300 (1980)  
 C.T.H. "AA"  
 A.D.T. = 250 (1980)

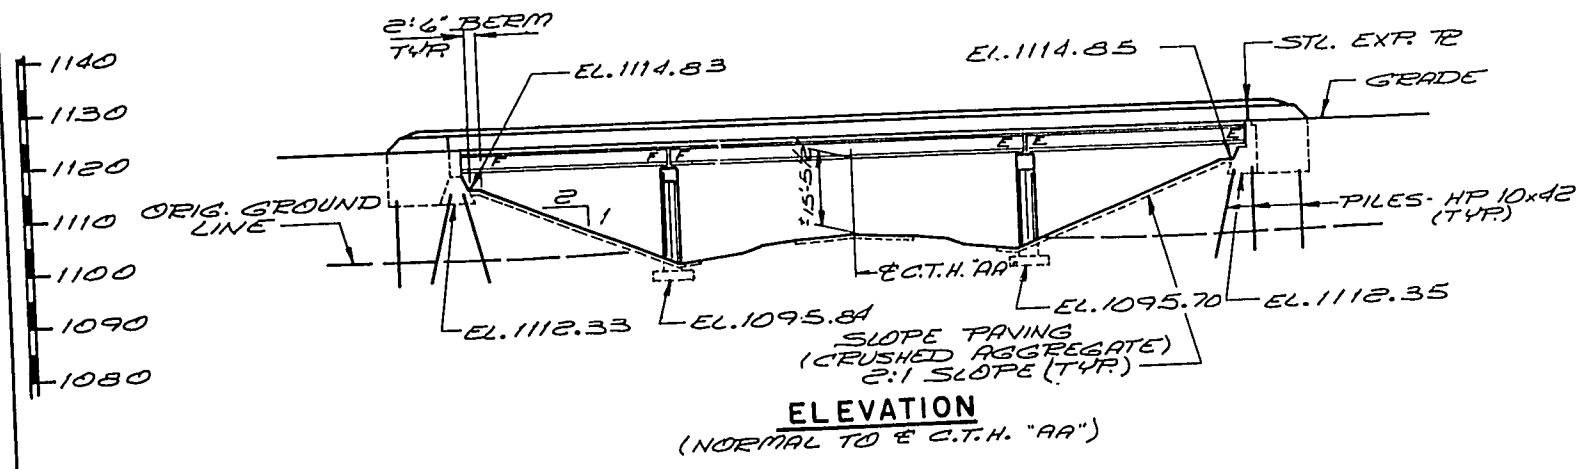

**ELEVATION**  
 (NORMAL TO C.T.H. "AA")

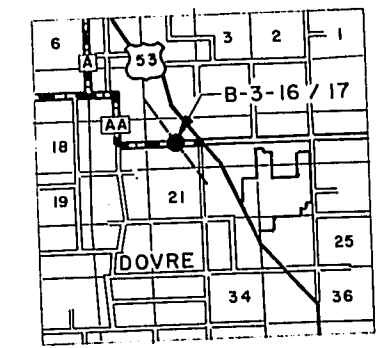

**LAYOUT**


No.	Date	Revision	By
STATE OF WISCONSIN DEPARTMENT OF TRANSPORTATION DIVISION OF HIGHWAYS			
<b>STRUCTURE B-3-16</b>			
U.S.H. 53 OVER C.T.H. "AA"			
County	BARRON	City	DOVRE
Design Spec.	A.A.S.H.O. 1969	Load	HS-20
Designed	G.H.A.	Checked	R.L.P.
By		Drawn	BUDD
Planned		Checked	G.H.A.
Approved <i>W.A. Klein</i> Chief Bridge Engineer			Date 11-17-71
GENERAL PLAN			SHEET 1 OF 16
			X46161




## TOTAL ESTIMATED QUANTITIES

BID ITEMS	UNIT	SUPER.	SO. ABUT.	PIER 1	PIER 2	NO. ABUT.	TOTAL
EXCAVATION FOR STRUCTURES	C.Y.	—	45	150	150	50	395
CONCRETE MASONRY	C.Y.	266.4	60.0	69.3	69.3	92.0	557.0
PRESTRESSED GIRDERS, I TYPE 45"	L.F.	590	—	13,590	13,590	—	590
BAR STEEL REINFORCEMENT	LBS.	61,090	2,700	32,179	32,179	3,730	131,178
STRUCTURAL CARBON STEEL	LBS.	3,780	—	—	—	—	3,780
STRUCTURAL LOW ALLOY STEEL	LBS.	2,070	—	—	—	—	2,070
LUBRICATED BRONZE PLATES	LBS.	190	—	—	—	—	190
BEARING PADS	S.F.	17	—	—	—	—	17
BEARING PADS, ELASTOMERIC	S.F.	19	—	—	—	—	19
STEEL PILING, DELIVERED & DRIVEN HP 10x42	L.F.	—	403	—	—	391	794
TUBULAR RAILING, TYPE "T"	L.F.	332	—	—	—	—	332
SLOPE PAVING, CRUSHED AGGREGATE	S.Y.	—	255	—	—	256	511
NON-BID ITEMS							
ALUMINUM OR ZINC PLATE	S.F.	35	—	—	—	—	35
POLYVINYL CHLORIDE WATERSTOP	L.F.	—	55	—	—	59	114
FILLER	SIZE	—	—	—	—	—	1/4" 1/2" 3/4" 1"


94,700

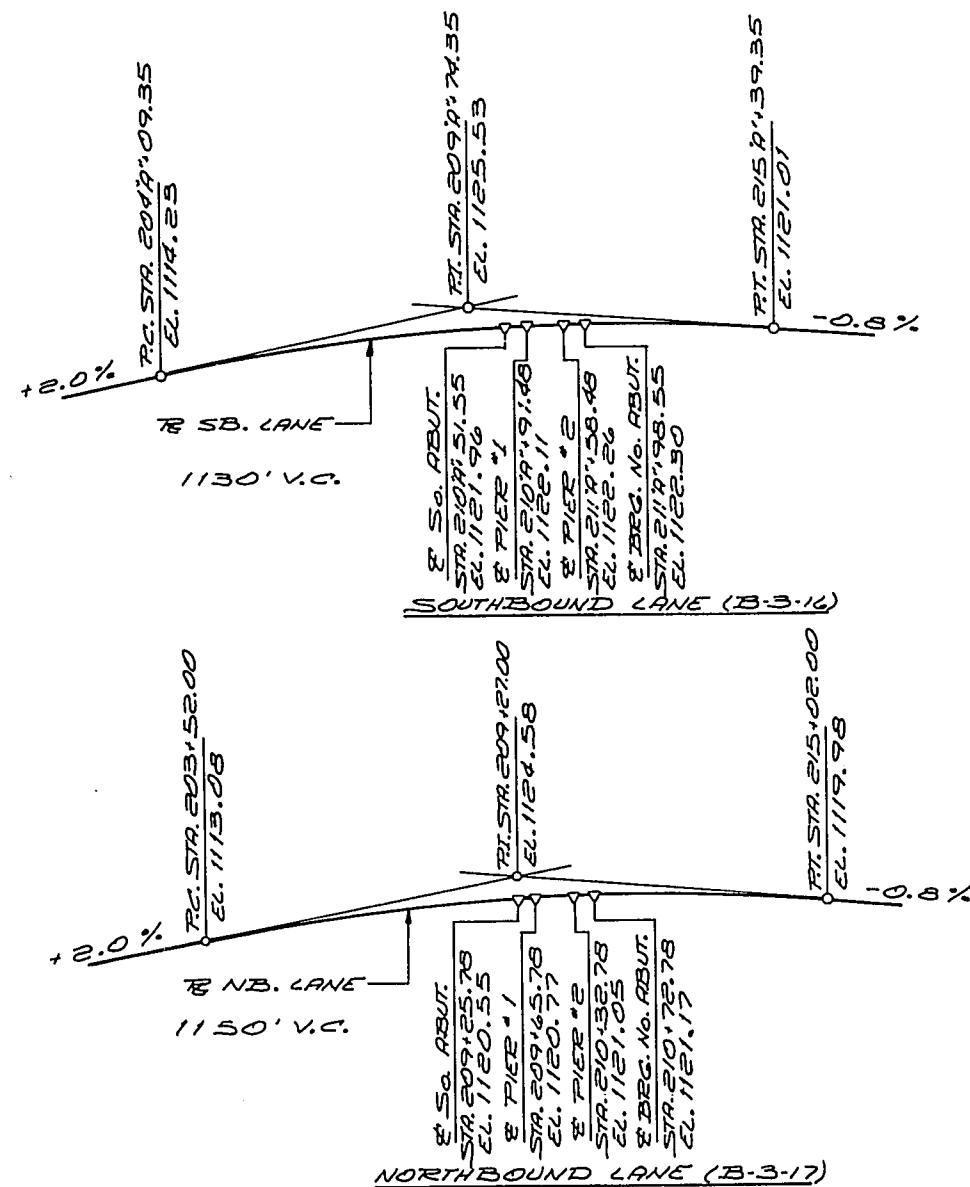BAR STEEL QUANTITY WAS  
DOUBLED ON THE PLAN

PROFILE GRADES U.S.H. 53

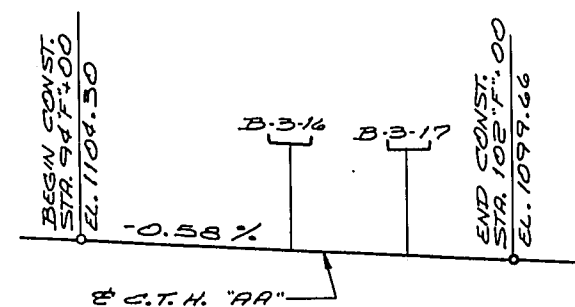



PROFILE GRADE C.T.H. "AA"

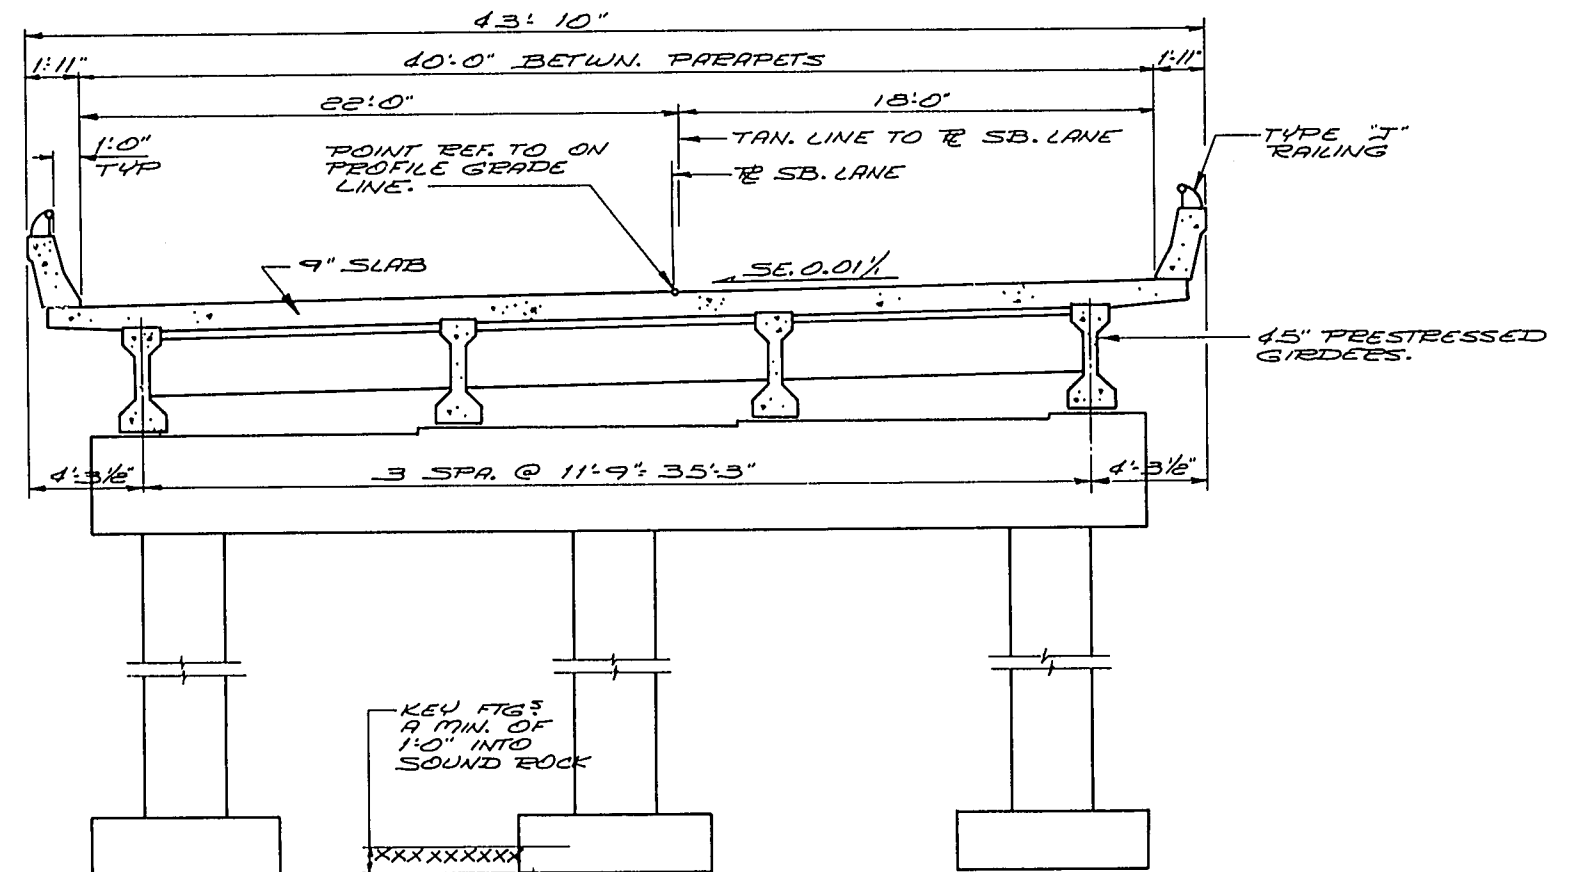

CROSS SECTION THRU ROADWAY LOOKING NORTHWEST

PROJECT ID	1196-6-76	SHEET NUMBER	49	TOTAL SHEETS	296
FEDERAL PROJECT DESIGNATION	EMP F08-4(36)				

No.	Date	Revision	By
STATE OF WISCONSIN DEPARTMENT OF TRANSPORTATION DIVISION OF HIGHWAYS			
STRUCTURE B-3-16			
Const. Spec. 1969	Drawn By BUDD	Plans Checked G.H.A.	
GENERAL PLAN			SHEET 2 OF 16
			X 46162

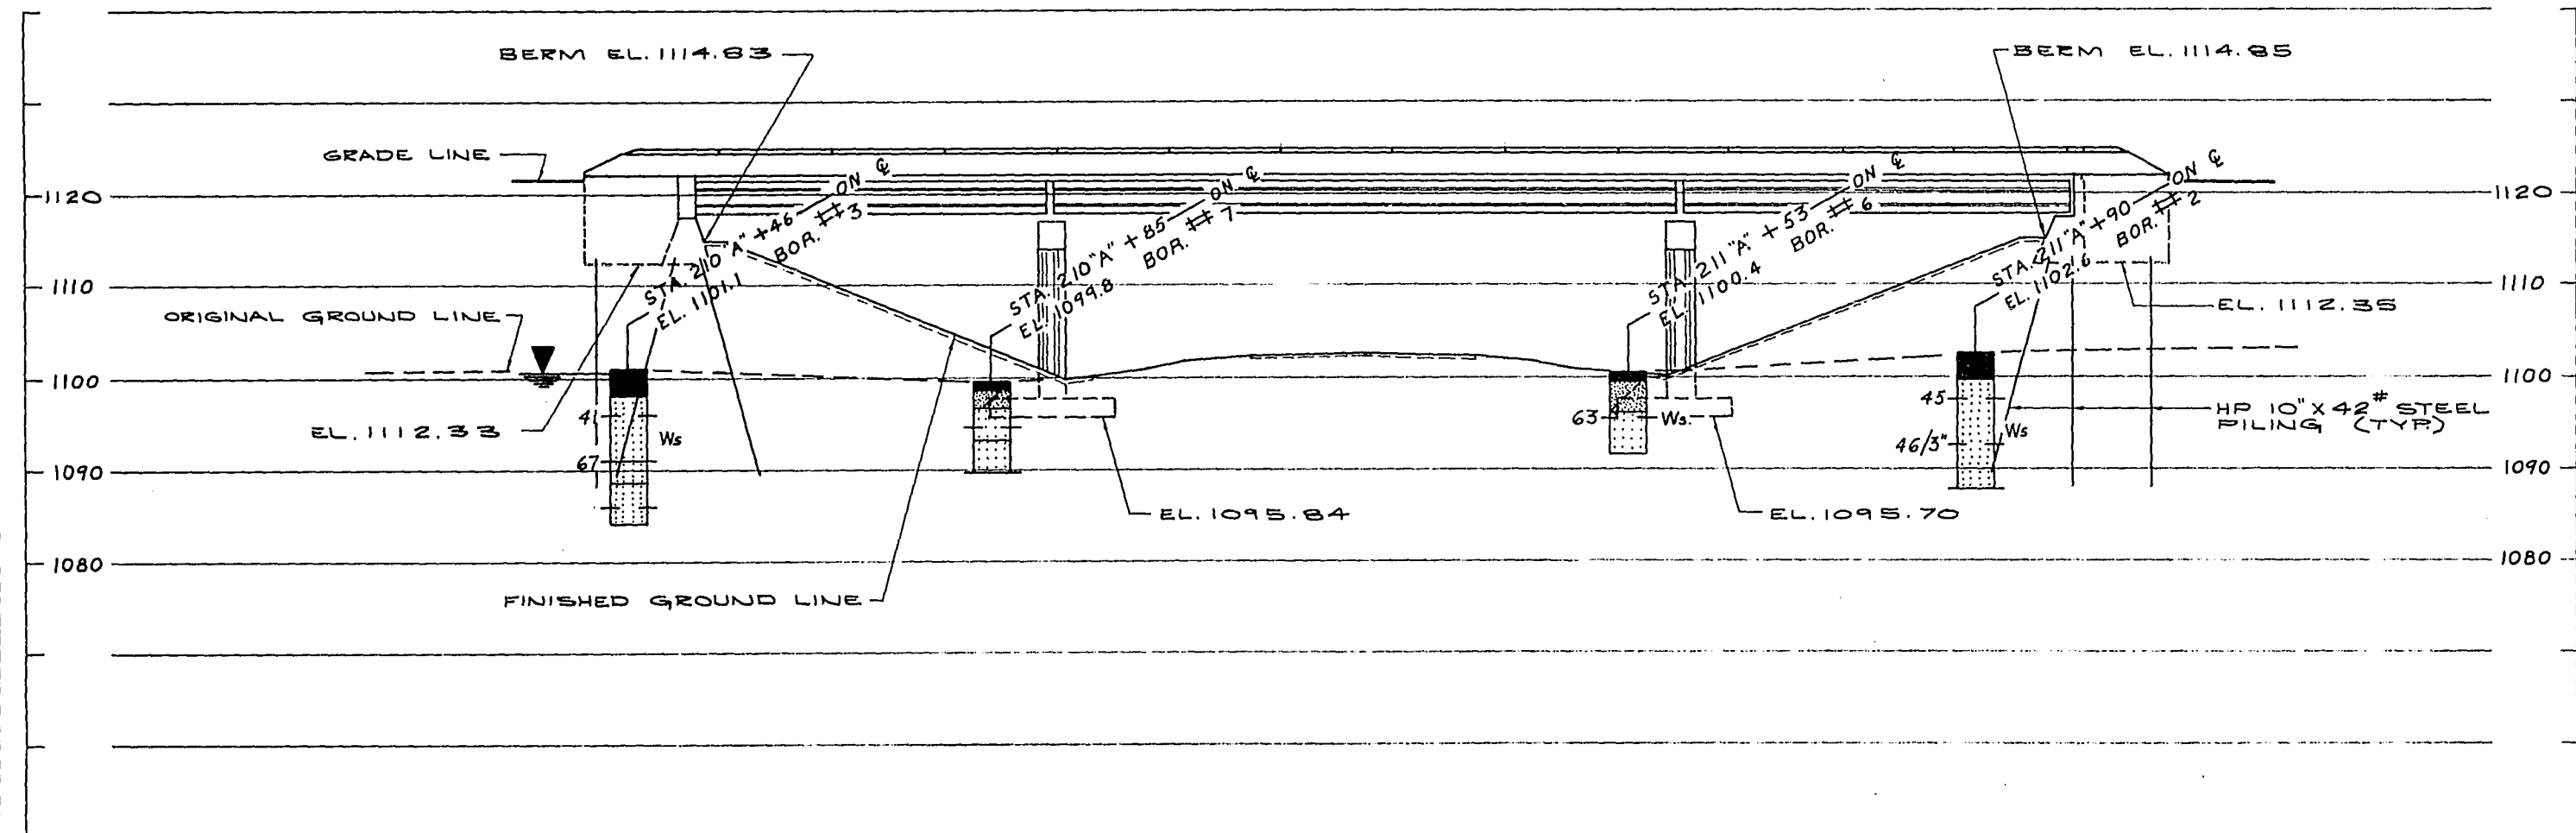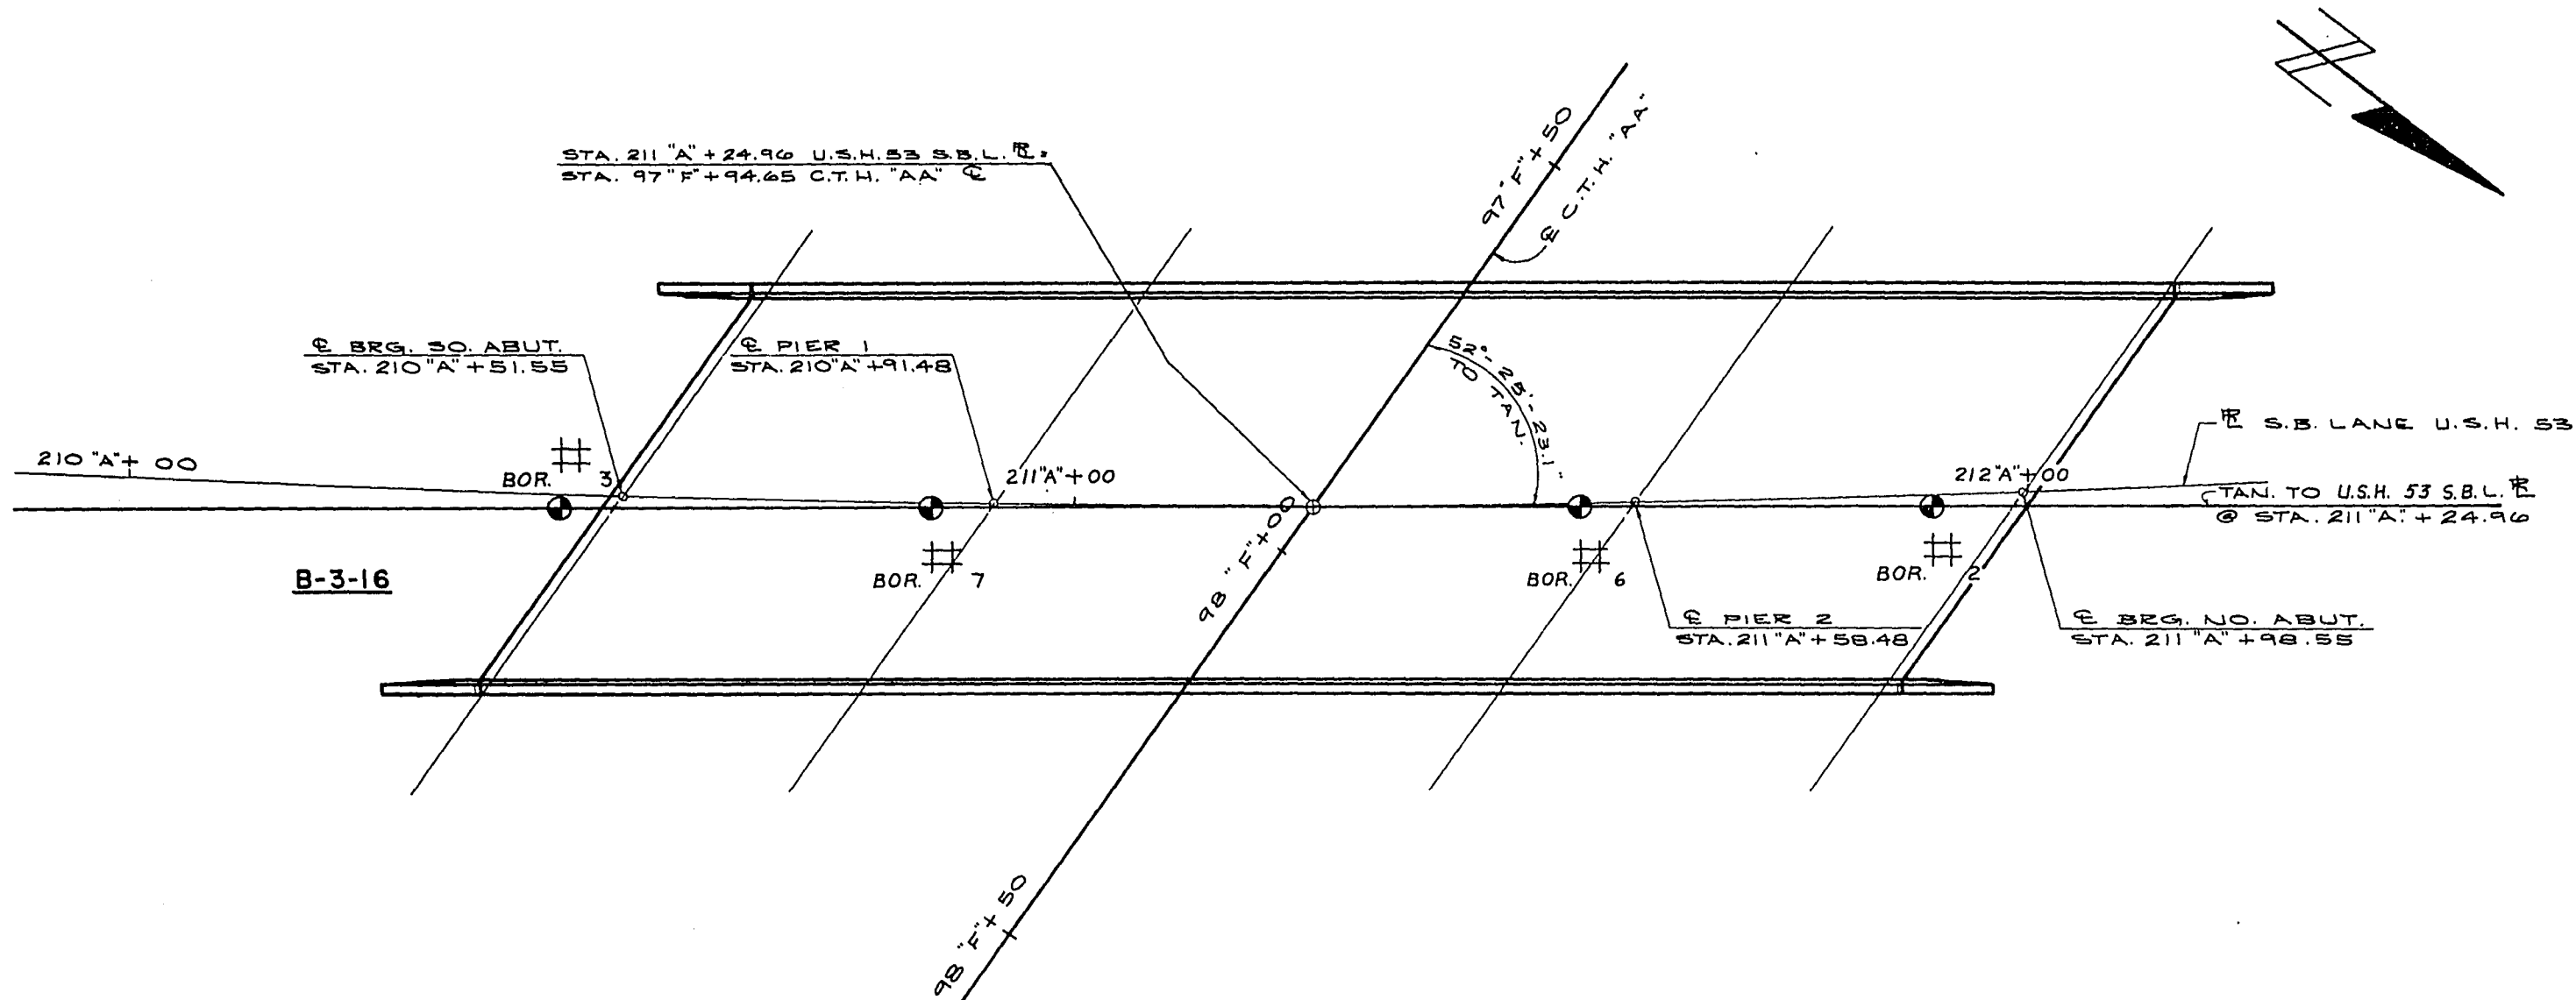

ABBREVIATIONS  
F --- Fine M --- Medium C --- Coarse  
Ws --- Weathered So --- Sound

MATERIAL SYMBOLS  
Topsoil Silt Sandstone  
Sand Peat Limestone  
Gravel Clay Igneous Rock

LEGEND OF PROBING  
Probing No.  
Sta.  
Elevation  
95/6=95 Blows for 6"  
Penetration  
Probing taken with a  
350# wt.  
Falling 18" on a 2"  
O. D. Point.  
7 Average Blows Per Foot  
Refusal 95.6

LEGEND OF BORING  
Boring No.  
Sta.  
Elev.  
Unconfined  
Strength 7.7  
Blows Per Ft.  
Using 140# Wt.  
Falling 30"  
Wash Sample  
Shelby Tube S. T.  
Ground Water  
Elevation  
No Ground Water  
Observed Above  
This Elevation  
Sandy Gravel  
Boulders or  
Cobbles  
Sand  
Silty Clay  
So  
Limestone


Unless otherwise specified, the blows per foot at the locations indicated are based on driving a 2" O. D. x 1.4" I. D. split spoon sampler with a 140# hammer having a free fall of 30". The blow count is taken in undisturbed soil immediately below a cased or open hole eliminating side friction on the drive pipe.

SUBSURFACE EXPLORATION FOR FOUNDATION  
DESIGN AND BIDDERS INFORMATION

To obtain relative data concerning the character of material in and upon which the foundation might be built, borings and/or soundings were made at points approximately as indicated on this drawing. The data presented herein represents the findings of the subsurface explorations made. However, because the depths investigated are limited and the area of the borings and/or soundings is very small in relation to the entire area, the Division of Highways does not warrant conditions below the depths investigated or that the classification of material encountered in these investigations is necessarily typical of the entire site.

No.	Date	Revision	By
STATE OF WISCONSIN DEPARTMENT OF TRANSPORTATION DIVISION OF HIGHWAYS			
STRUCTURE B-3-16			
Const. Spec. 1969	Drawn By D.C.M.TLA	Plans Checked GHA	
SUBSURFACE EXPLORATION			SHEET 3 OF 16 X 46163

W.T. EL.1122.02

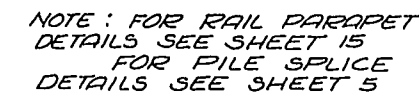

KEYED CONST. JOINT  
FORMED BY SURFACED,  
BEVELED 2"X6".


SEAL JOINT WITH CONTRACTION  
TYPE POLYVINYL CHLORIDE WATERSTOP-  
TO EXTEND FROM BOTTOM TO TOP OF  
ABUT. FLUSH WITH FACE OF CONCRETE.  
FOR DETAIL SEE SHEET 5

NOTE : HORIZ. WATERSTOP TO BE RUN  
FULL LENGTH. VERTICAL WATERSTOP  
TO BE CUT.

● SEAL JOINT WITH CONTRACTION  
TYPE POLYVINYL CHLORIDE  
WATERSTOP - TO EXTEND FULL  
LENGTH BETWEEN WINGS.  
FOR DETAIL SEE SHEET 5

NOTE: SPACE AAOI BARS TO  
MISS PILING.

SEAL ALL EXPOSED HORIZONTAL AND VERTICAL SURFACES OF  $\frac{1}{2}$ " FILLER WITH NON-STAINING GRAY NON-BITUMINOUS JOINT SEALER (1" DEEP AND HOLD  $\frac{1}{8}$ " BELOW SURFACE OF CONCRETE).

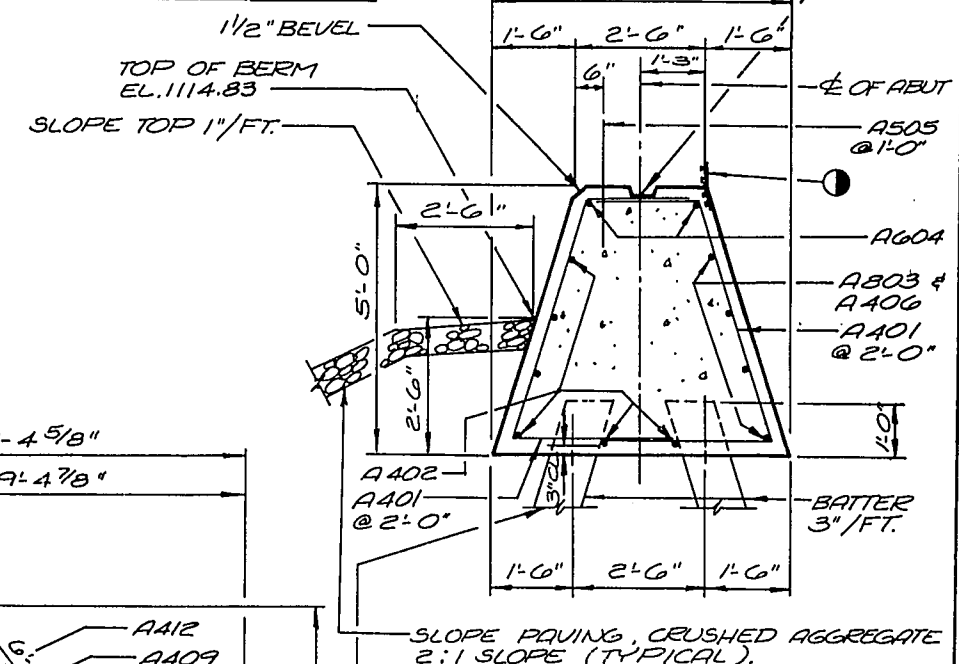

SECTION THRU BODY

— H.P. 10 X 42 STEEL PILES EST. 25'-0"  
LONG AND DRIVEN TO A MIN.  
BEARING CAPACITY OF 55 TONS  
PER PILE.








No.	Date	Revision	By
STATE OF WISCONSIN DEPARTMENT OF TRANSPORTATION DIVISION OF HIGHWAYS			
STRUCTURE <b>B - 3 - 16</b>			
Const. Spec.	1969	Drawn By	A. G.
		Plans Checked	G. H. A.
SOUTH ABUTMENT		SHEET 4 OF 16	
		X 46164	



NOTE : DIMENSIONS IN BENDING DETAILS ARE  
OUT TO OUT.

THE FIRST DIGIT OF A THREE DIGIT BAR  
MARK AND THE FIRST TWO DIGITS OF A FOUR  
DIGIT BAR MARK SIGNIFIES THE BAR SIZE.

BILL OF BARS

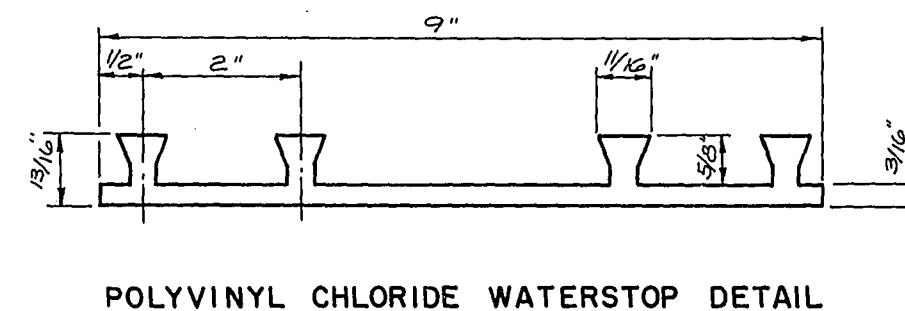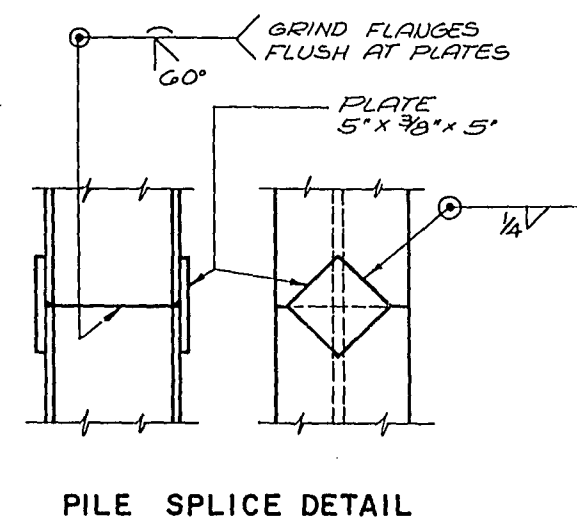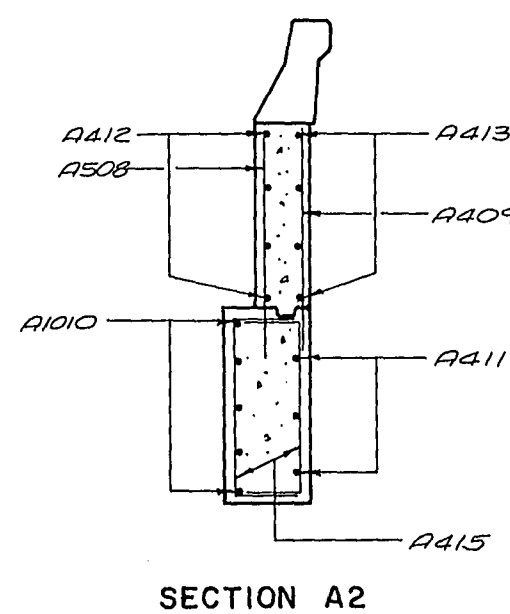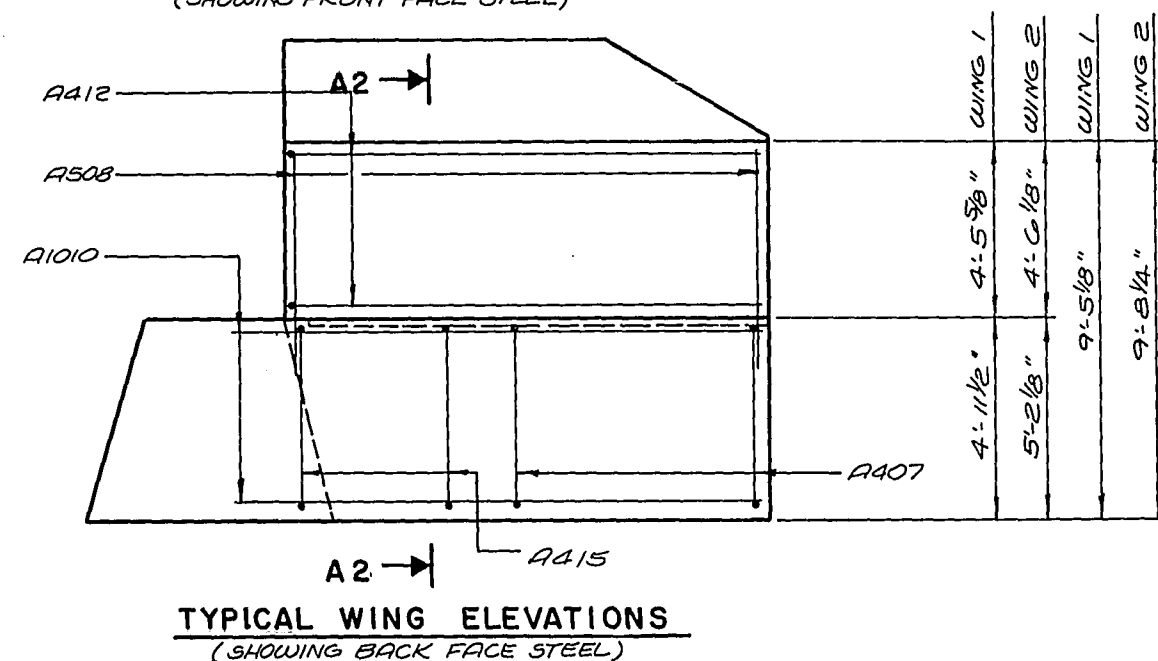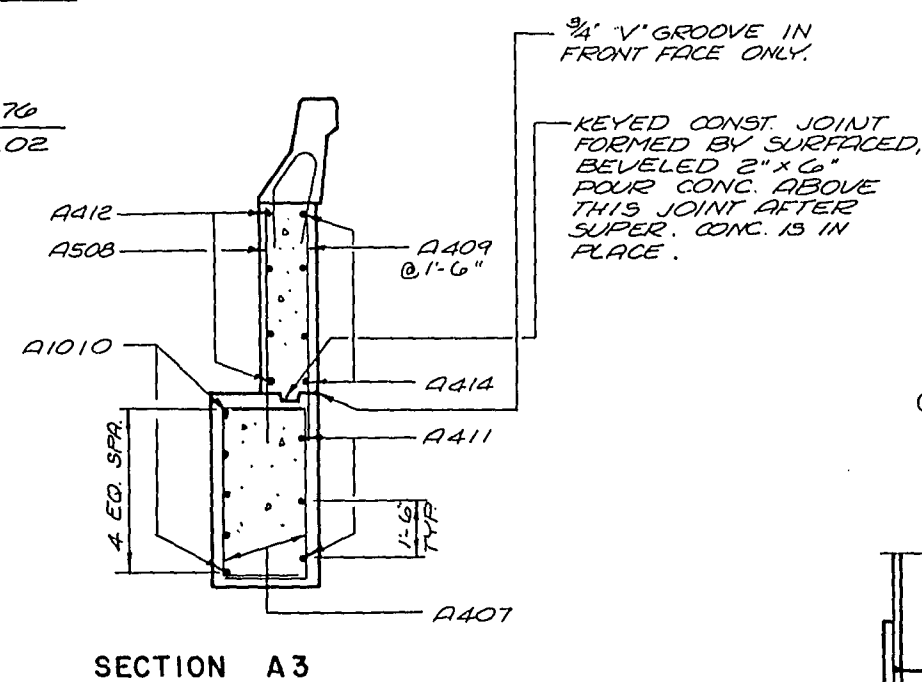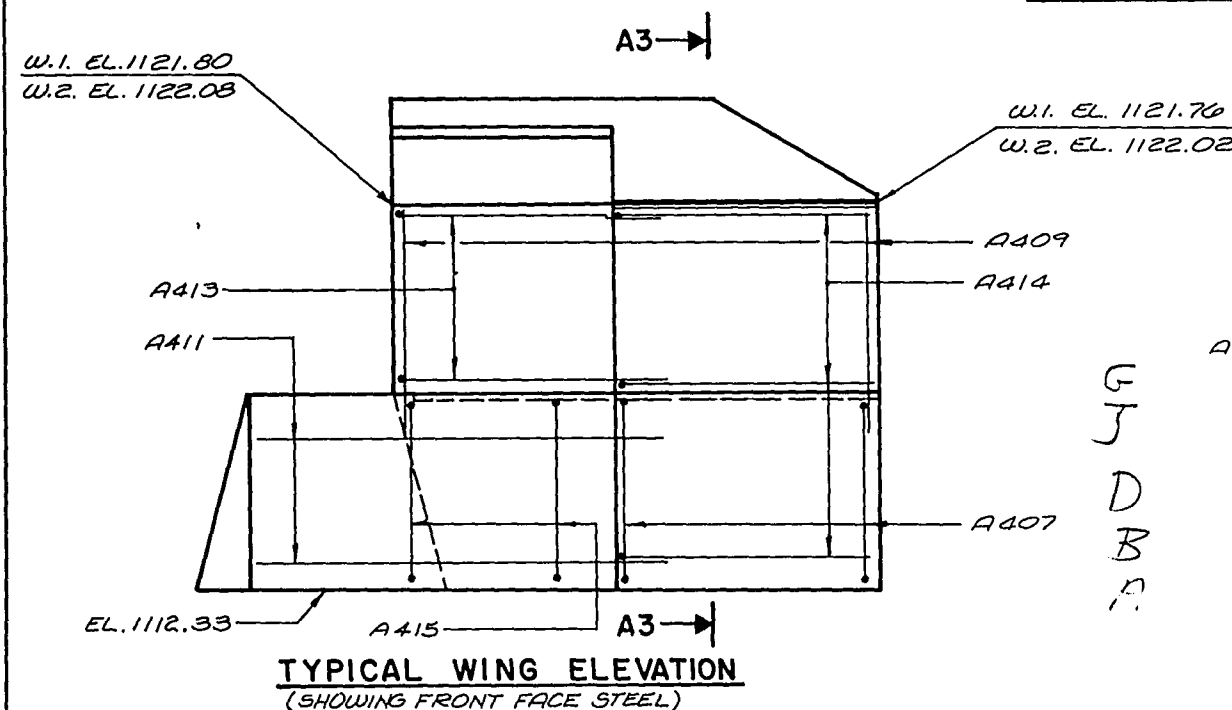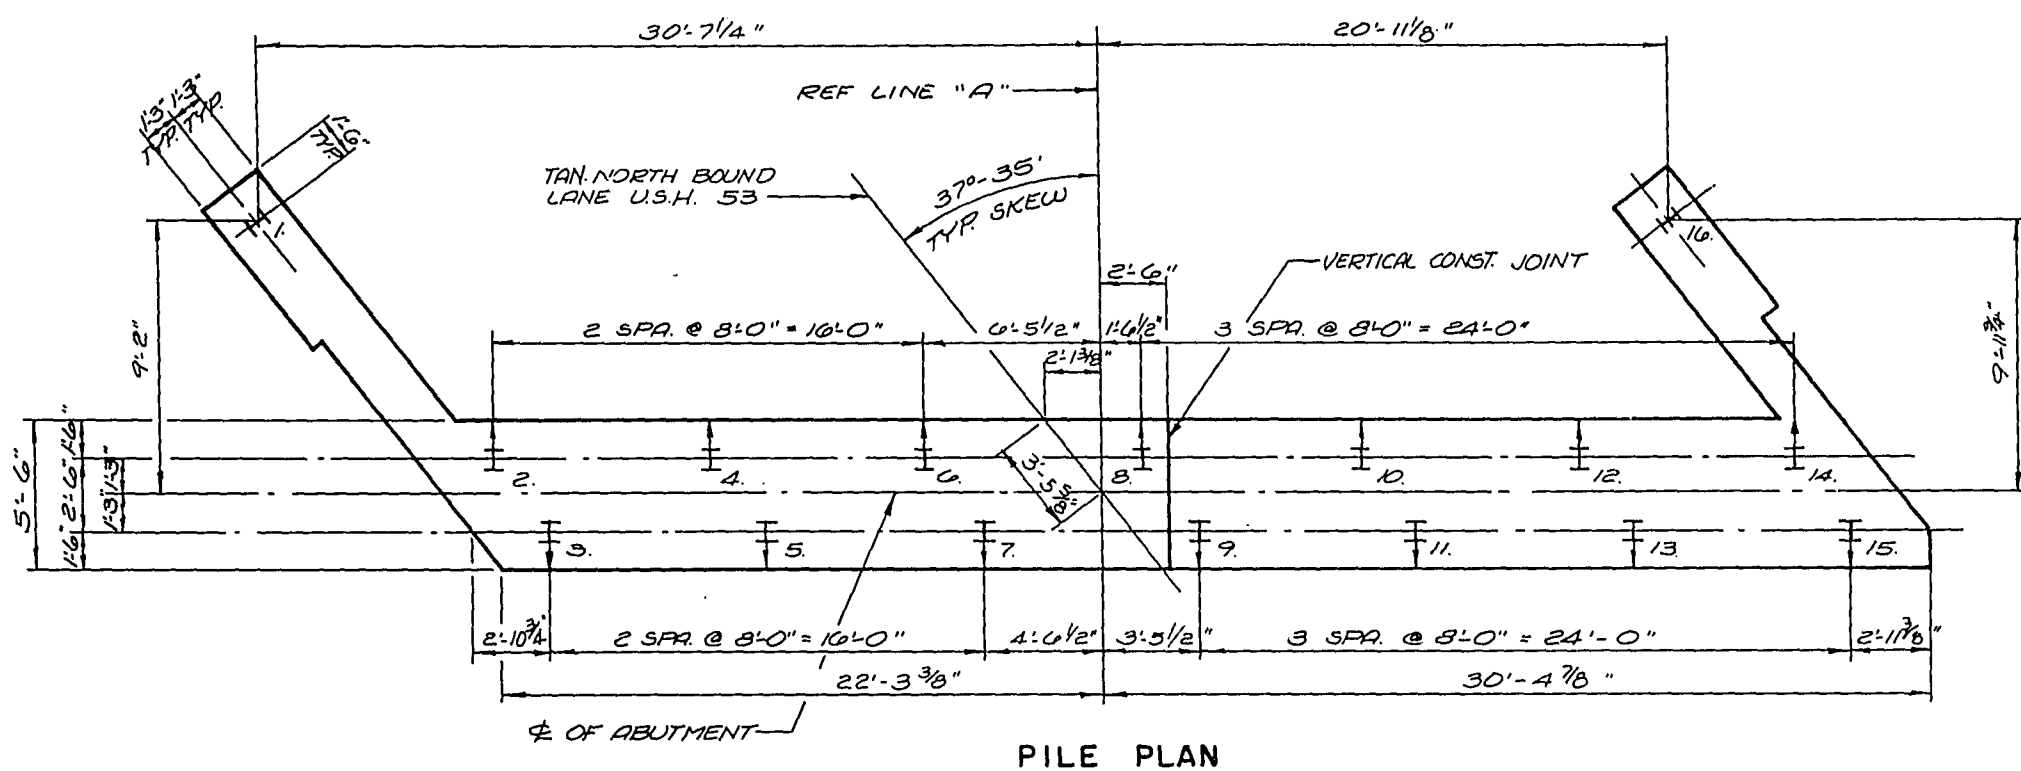[illegible]

No.	Date	Revision	By
STATE OF WISCONSIN DEPARTMENT OF TRANSPORTATION DIVISION OF HIGHWAYS			
STRUCTURE      B-3-16			
Const. Spec.	1969	Drawn By	A. G.
		Plans Checked	G. H. A.
SOUTH ABUTMENT DETAILS		SHEET 5 OF 16  X 46165	

— CONST. JOINT- STRIKE OFF AND LEAVE  
ROUGH. POUR CONCRETE ABOVE THIS  
JOINT AFTER SUPERSTRUCTURE  
IS IN PLACE.

L 3" x 2" x 5/16" FOR  
DETAIL SEE SHEET 14-

ELEVATION  
( LOOKING NORTH )

1 SEAL JOINT WITH CONTRACTION TYPE  
POLYVINYL CHLORIDE WATERSTOP TO  
EXTEND FULL LENGTH BETWEEN WINGS.  
FOR DETAIL SEE SHEET 5

NOTE : SPACE CA06 & CA05  
BARS TO MISS PILING.

SEAL ALL EXPOSED HORIZONTAL  
AND VERTICAL SURFACES OF 1/2"  
FILLER WITH NON-STAINING  
GRAY NON-BITUMINOUS JOINT  
SEALER (1" DEEP AND HOLD 1/8"  
BELOW SURFACE OF CONCRETE.)

§ OF BEARING \_\_\_\_\_  
 KEYED CONST. JOINT FORMED  
 BY SURFACED, BEVELED  
 2" X 6" \_\_\_\_\_  
 TOP OF BERM EL. 1114.85 \_\_\_\_\_  
 SLOPE 1"/FT.  
 SLOPE PAVING  
 CRUSHED AGGREGATE \_\_\_\_\_

— H.P. 10X42 STEEL PILES EST. 25'-0"  
LONG AND DRIVEN TO A MIN. BEARING  
CAPACITY OF 55 TONS PER PILE.








[illegible]

No.	Date	Revision		By
STATE OF WISCONSIN DEPARTMENT OF TRANSPORTATION DIVISION OF HIGHWAYS				
STRUCTURE      B - 3-16				
Const. Spec.	1969	Drawn By	A. G.	Plant Checked G. H. A.
NORTH ABUTMENT			SHEET 6 OF 16	
			X 46166	

NOTE : DIMENSIONS IN BENDING DETAILS ARE OUT TO OUT.  
THE FIRST DIGIT OF A THREE DIGIT BAR MARK AND THE FIRST TWO DIGITS OF A FOUR DIGIT BAR MARK SIGNIFIES THE BAR SIZE.

### BILL OF BARS

MARK	NO REQ	LENGTH	BENT	LOCATION
C401	14	27'-0"		BODY HORIZ.
C602	4	10'-0"		" " B.F.
C403	4	19'-0"		" " "
C604	6	27'-0"		" " "
C405	27	13'-0"	X	" STIRRUPS
C406	27	9'-0"	X	" " "
C407	12	28'-0"		BACKWALL HORIZ.
C508	51	10'-10"	X	" " VERT.
C509	51	4'-8"	X	PAVING NOTCH
C410	12	8'-3"		" " HORIZ.
C411	20	7'-11"	X	WING STIRRUPS
C412	16	6'-11"		" " "
C1013	10	14'-3"		WING HORIZ. B.F.
C414	8	12'-5"	X	" " "
C515	18	5'-10"		" VERT "
C416	6	8'-0"		" HORIZ. F.F.
C417	14	6'-9"	X	" " "
C418	8	7'-5"	X	" " "
C419	18	5'-7"		" VERT. "

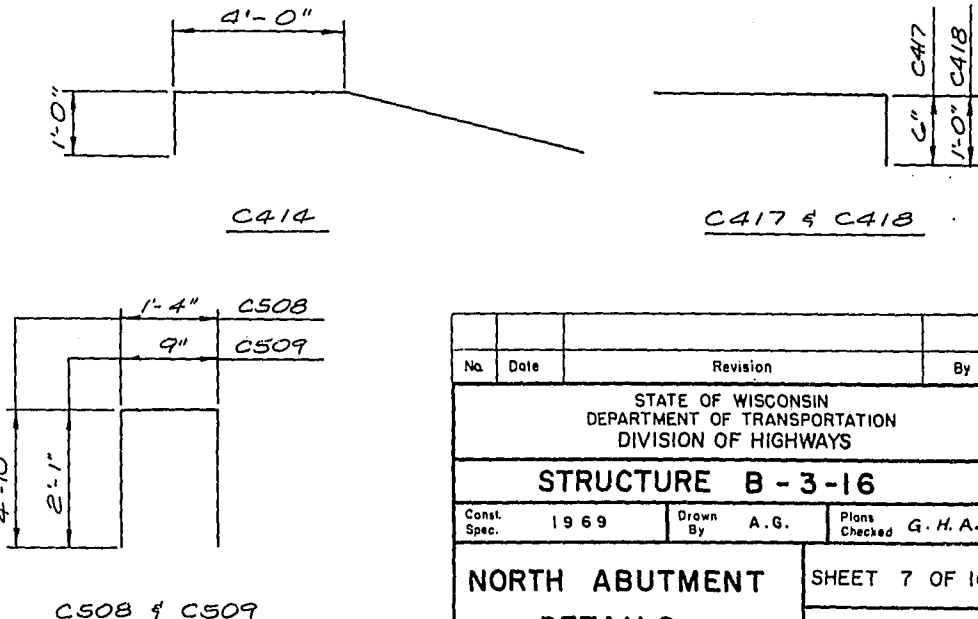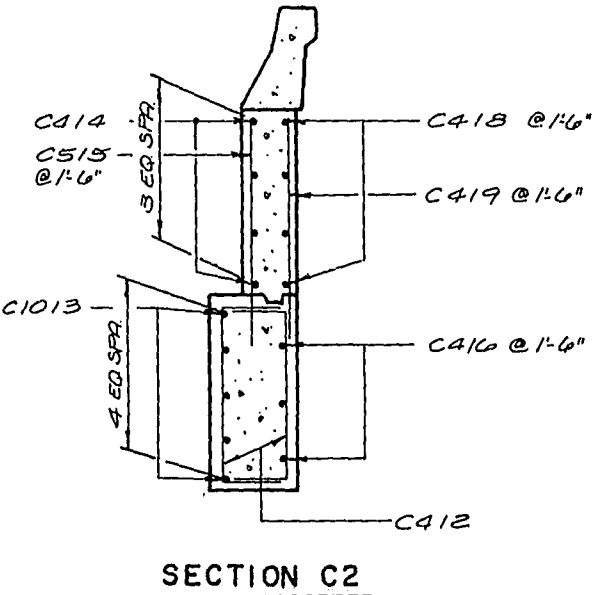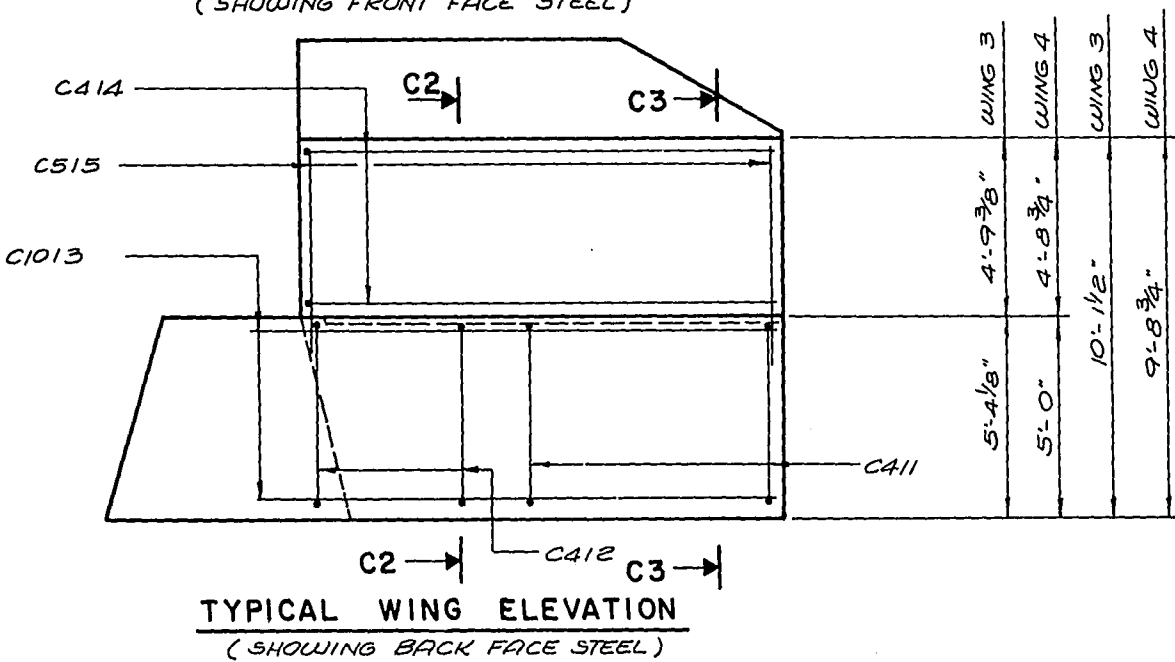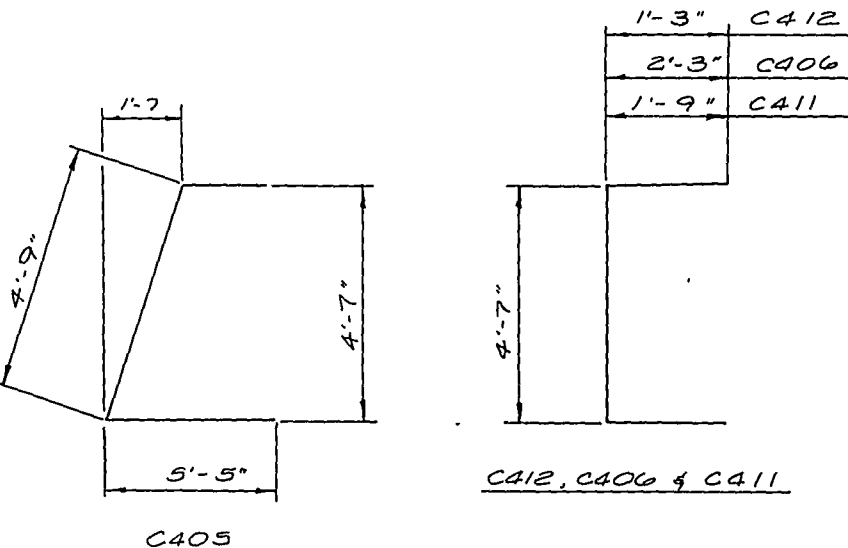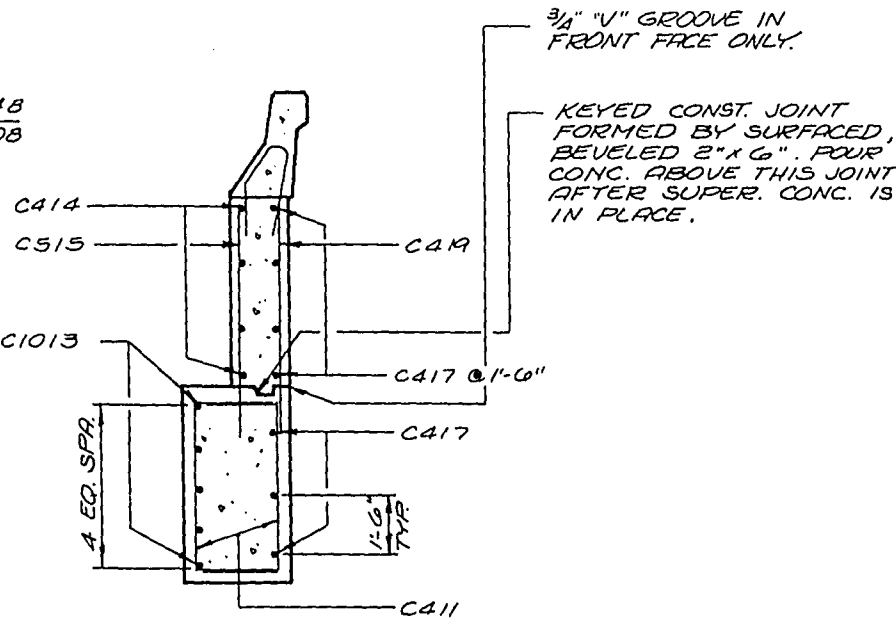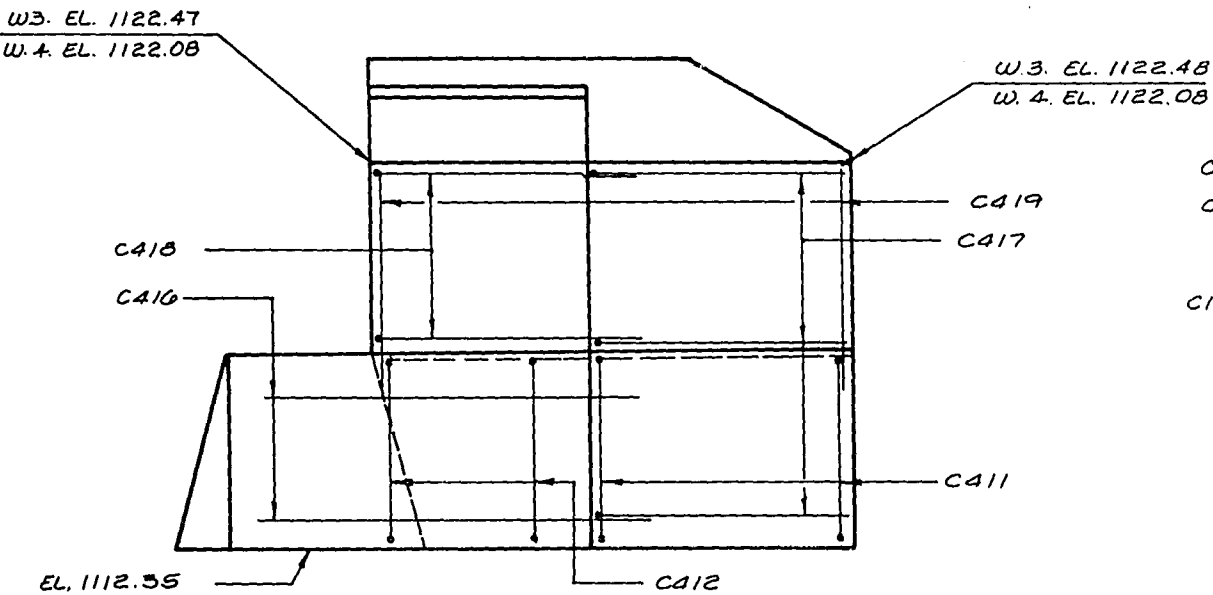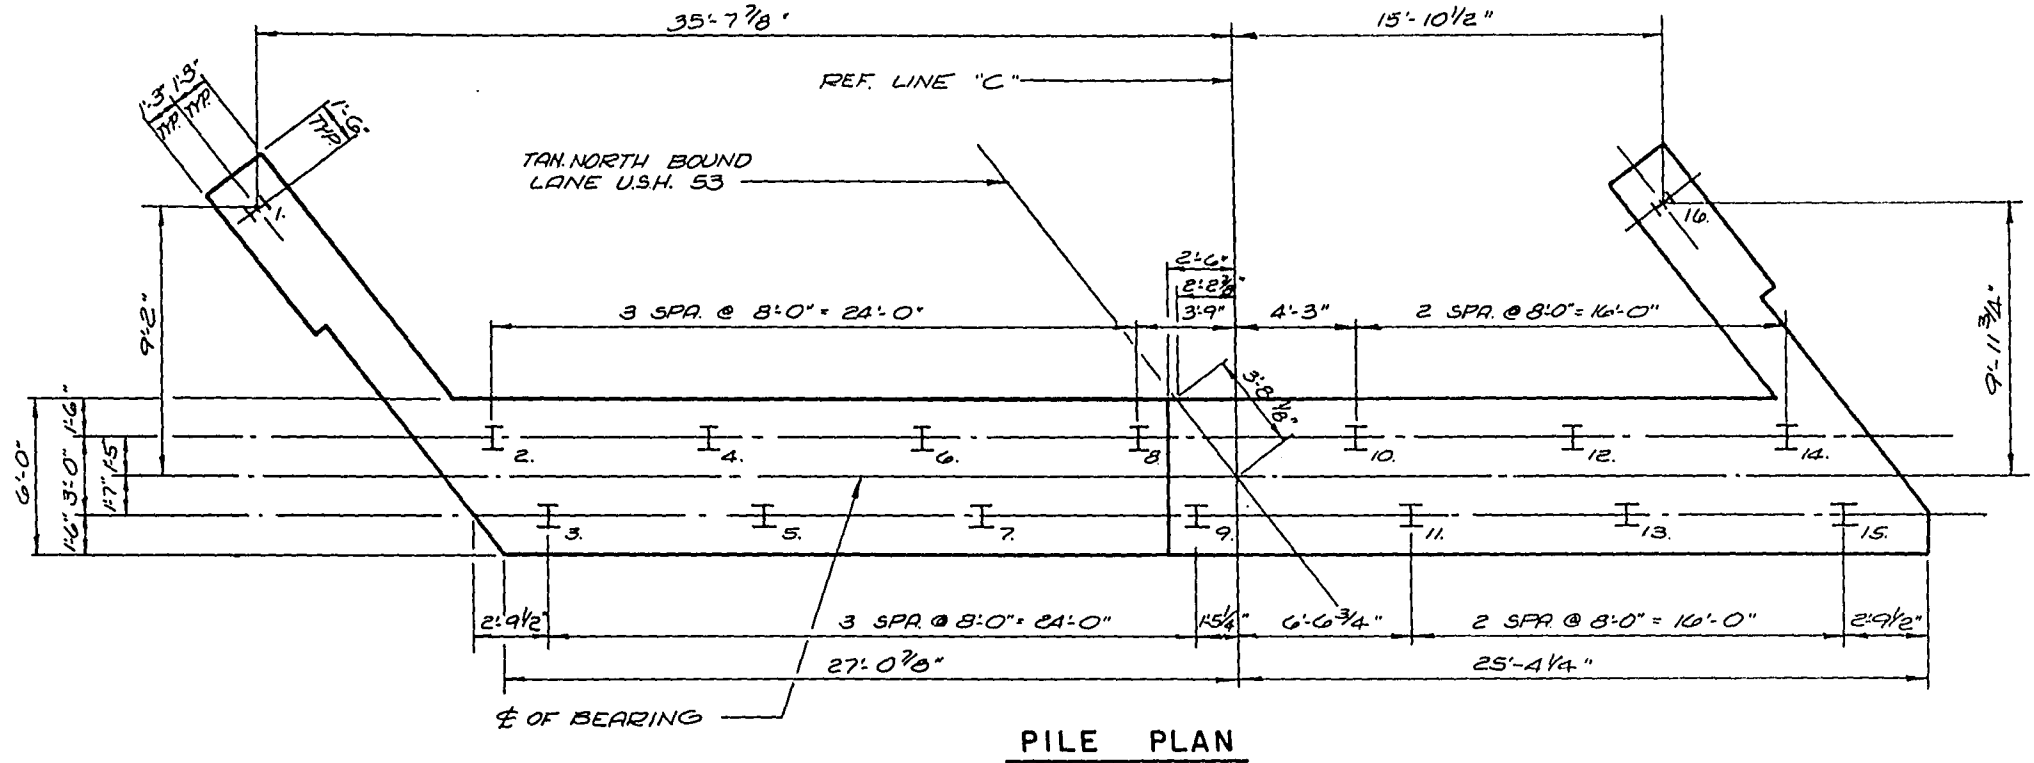

No.	Date	Revision	By
STATE OF WISCONSIN DEPARTMENT OF TRANSPORTATION DIVISION OF HIGHWAYS			
STRUCTURE B-3-16			
Const. Spec.	1969	Drawn By	A. G.
		Plans Checked	G. H. A.
NORTH ABUTMENT DETAILS			SHEET 7 OF 16 X 46167

\* ELEVATIONS ARE GIVEN AT P OF PIERS.

\* EL. 1117.42  
\* EL. 1117.28

\* EL. 1117.51  
\* EL. 1117.39

\* EL. 1117.60  
\* EL. 1117.49

\* EL. 1117.68 PIER 1  
\* EL. 1117.60 PIER 2

NOTE: BARS LISTED ARE COMBINED TOTAL FOR PIER 1 & PIER 2.

PROJECT ID 1196-6-76	SHEET NUMBER 55	TOTAL SHEETS 296
FEDERAL PROJECT DESIGNATION EMP FOB-4(36)		


### BILL OF BARS

MARK	NO. REQ'D	LENGTH	BENT	BUND.	LOCATION
P701	162	11-6			FOOTING
P802	144	13-0			"
P1103	72	6-5	X		" & COLUMN-DOWEL
P1104	72	19-1			COLUMN
P405	108	9-5	X		" - HOOPS
P506	27	2-6			CAP-TOP-VEET.
P407	16	4-9			" - BOTTOM-ENDS
P1008	8	38-0			" - "
P1009	16	18-6			" - "
P510	8	25-6			" - CENTER
P1111	4	12-0		X	" - TOP
P1112	12	56-2	X	X	" - "
P513	32	10-7	X		" - STIRRUP-DOUBLE
P514	64	12-5	X		" - " - SINGLE






ALL BENDING DIMENSIONS ARE OUT TO OUT OF BAR.  
THE FIRST DIGIT OF A THREE DIGIT BAR MARK & THE FIRST TWO DIGITS OF A FOUR DIGIT BAR MARK SIGNIFIES THE BAR SIZE.

WIRE BARS TOGETHER @ 2'-0" CTRS.

### BUNDLING DETAIL

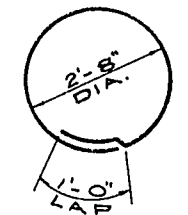

P 405

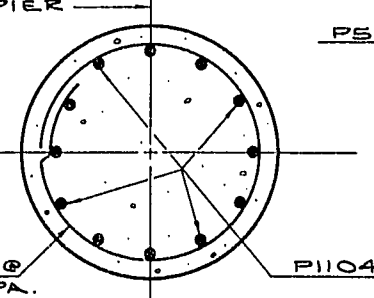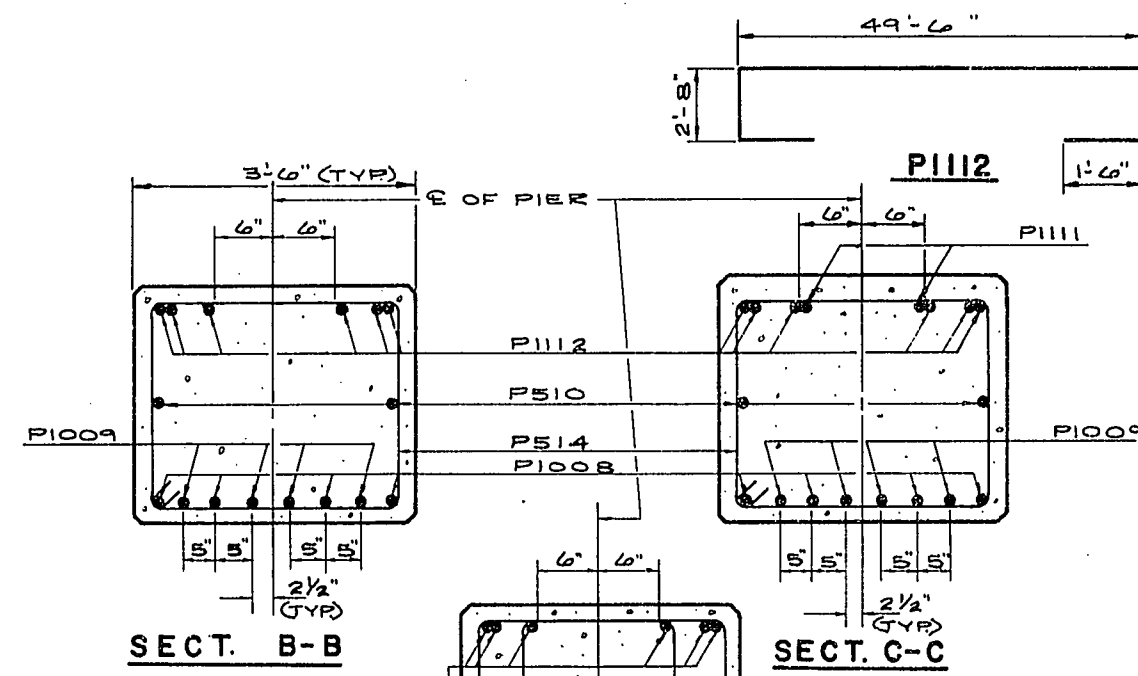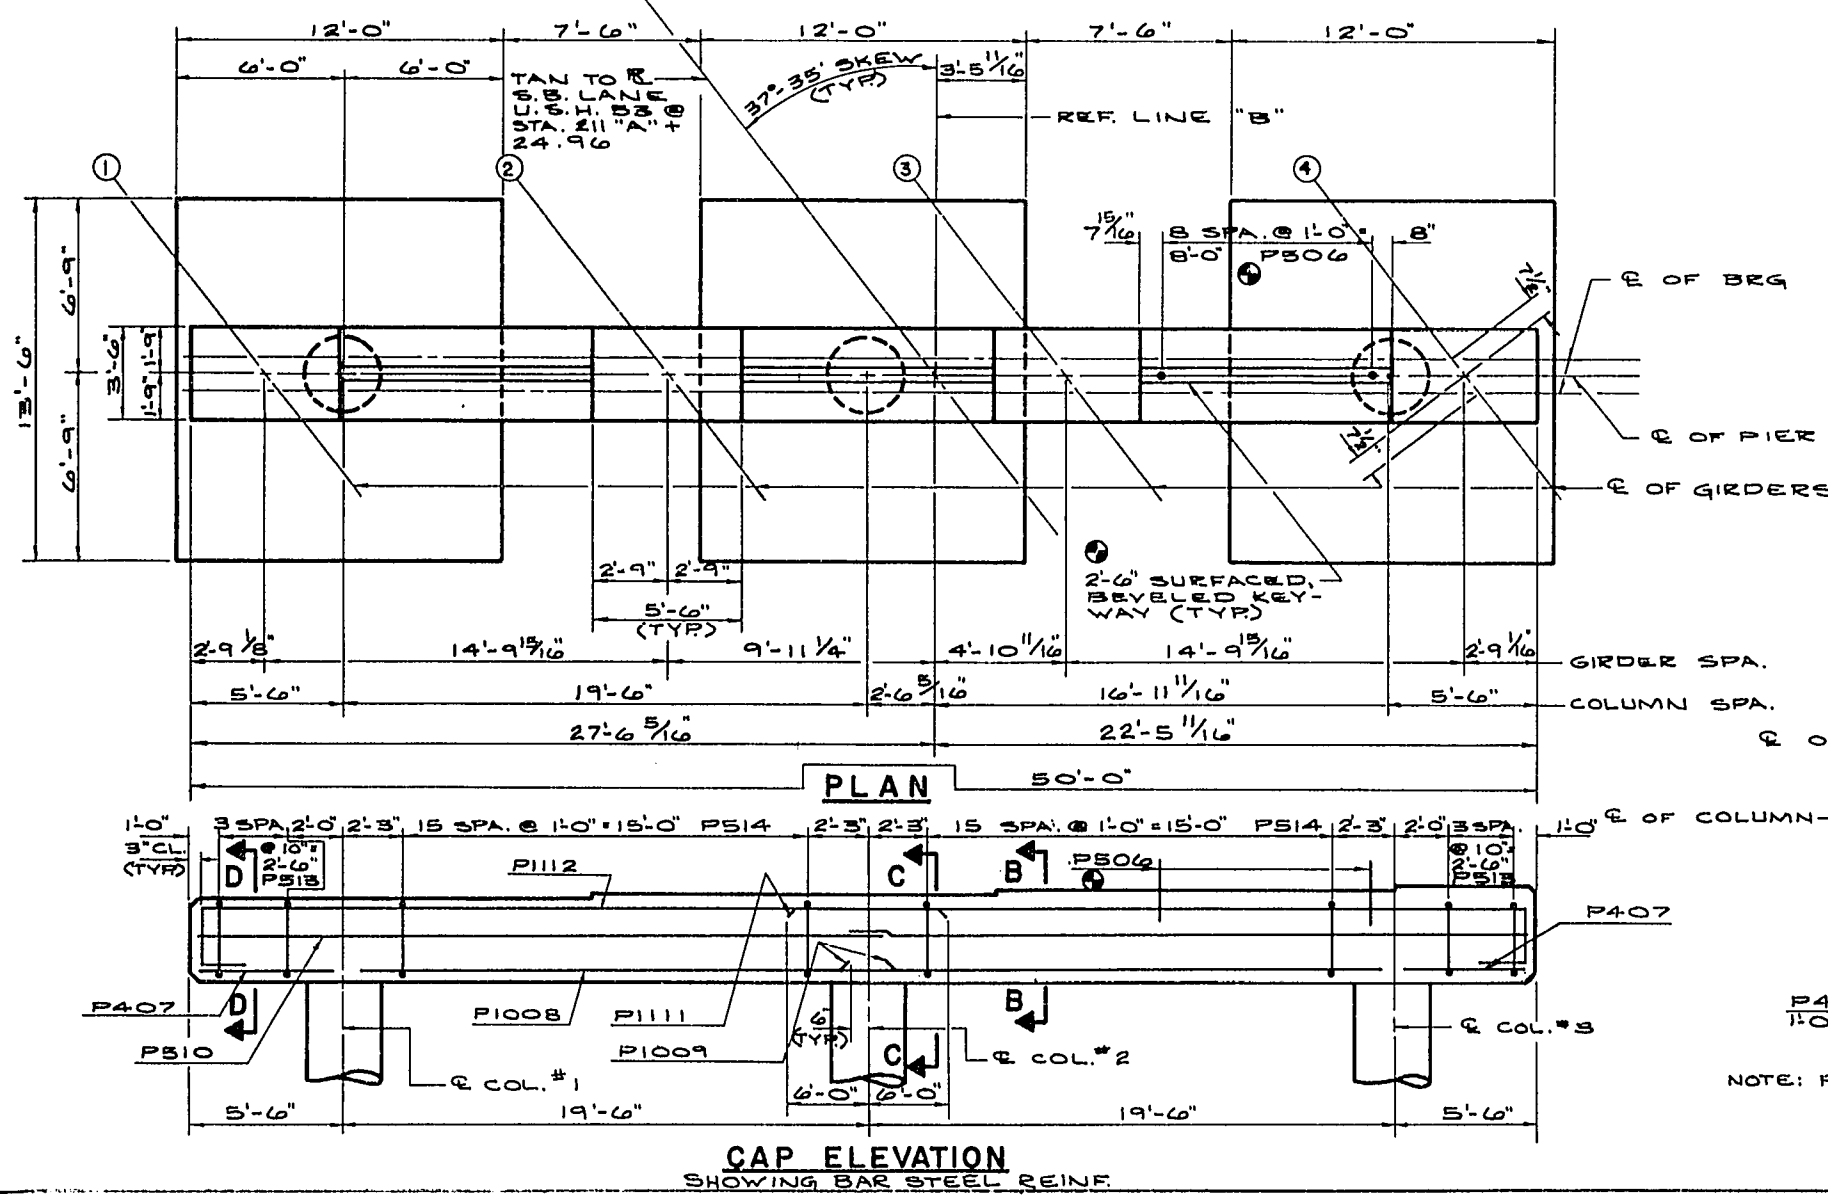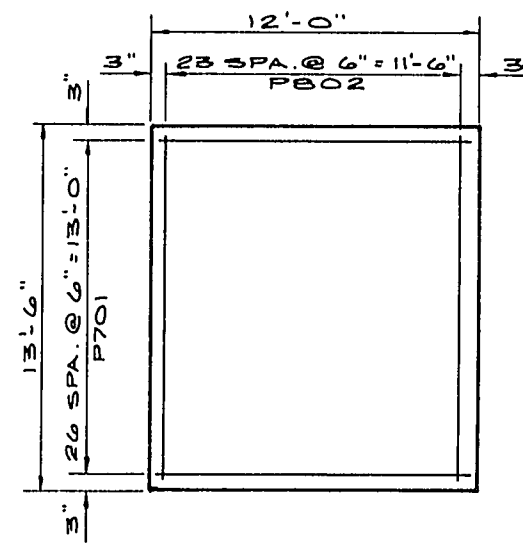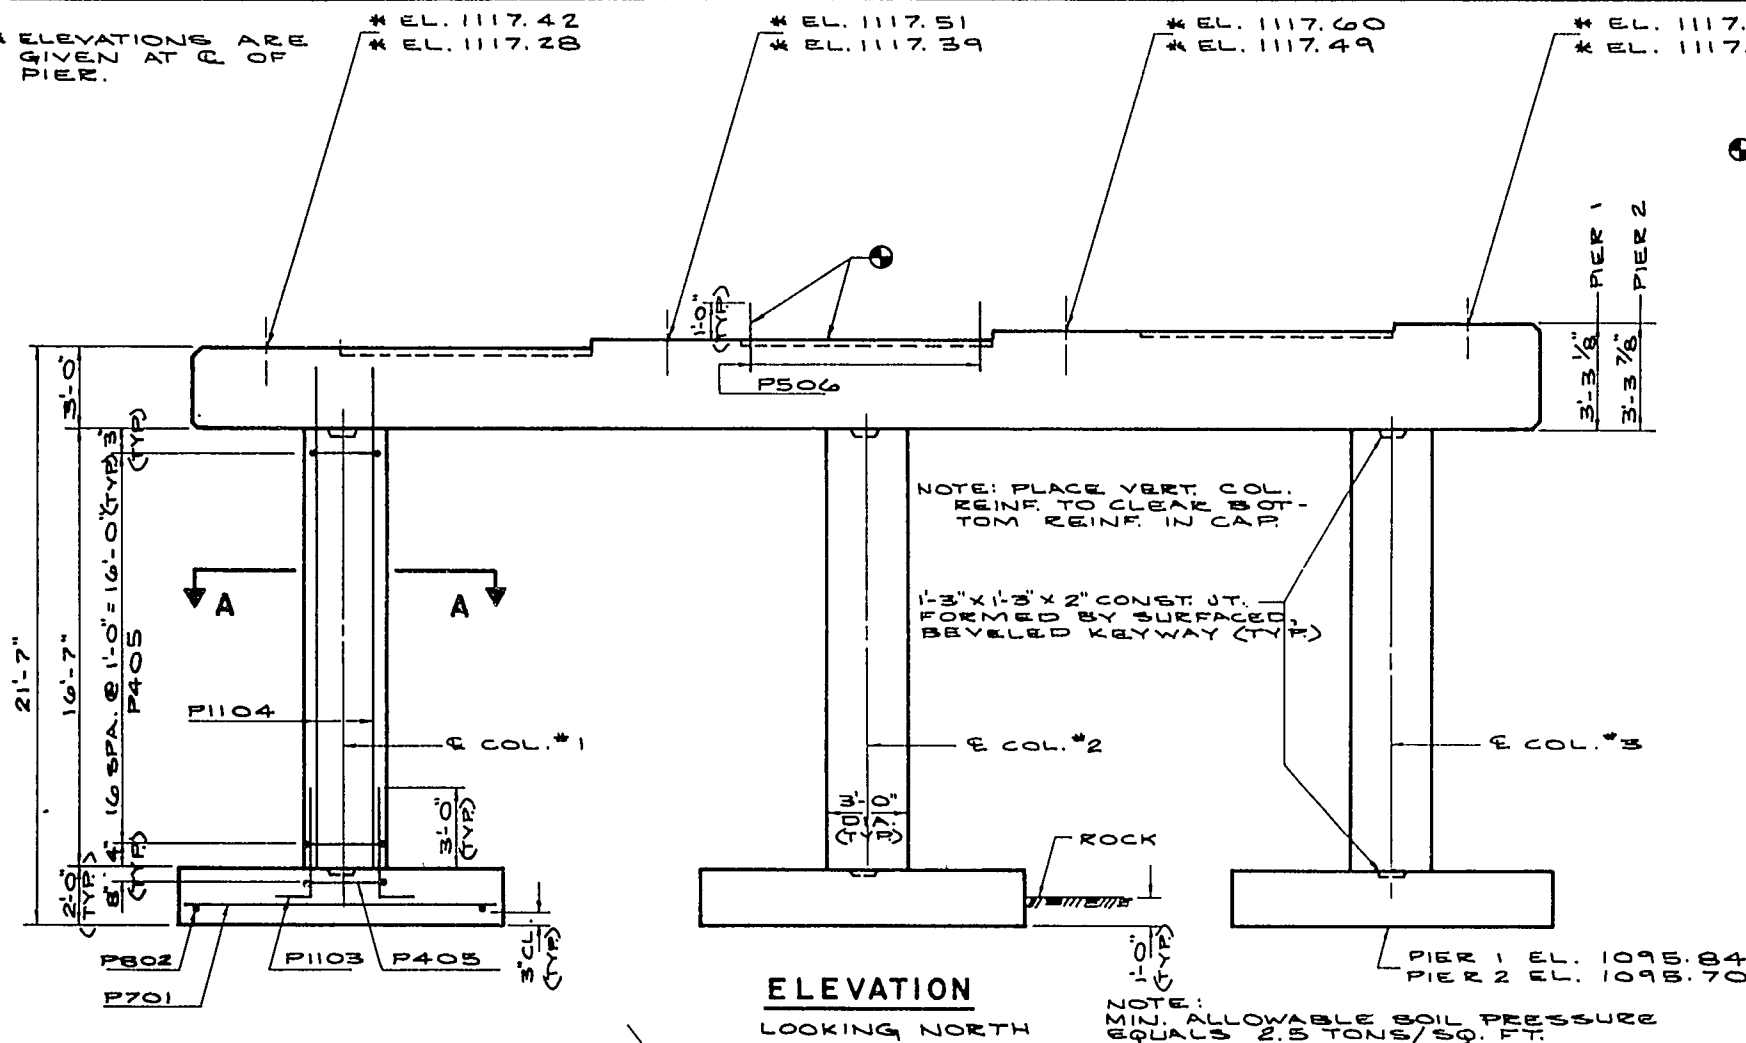

### ESTIMATED CONCRETE MASONRY

	PIER 1	PIER 2
FOOTINGS	36.0 C.Y.	36.0 C.Y.
COLUMNS	13.1 C.Y.	13.1 C.Y.
PIER CAP	20.2 C.Y.	20.2 C.Y.
TOTAL	69.3 C.Y.	69.3 C.Y.

No.	Date	Revision	By
STATE OF WISCONSIN DEPARTMENT OF TRANSPORTATION DIVISION OF HIGHWAYS			
<b>STRUCTURE B-3-16</b>			
Const. 1969	Drawn By TLA	Plans Checked GHA	
<b>PIERS</b>			SHEET 8 OF 16
			X46168




PROJECT ID <i>1196-6-76</i>	SHEET NUMBER	TOTAL SHEETS
FEDERAL PROJECT DESIGNATION <i>EMP F08-4(36)</i>	<i>56</i>	<i>296</i>

## PLAN


BOTTOM TRANSVERSE BARS IN SLAB SHALL BE SUPPORTED BY CONTINUOUS BAR CHAIRS ON OR ADJACENT TO EACH GIRDER & BY INDIVIDUAL BAR CHAIRS AT 3'-0" CTS. APPROX. THE 1/2 FT. BETWEEN GIRDERS.

TOP LONGITUDINAL BAR STEEL SHALL BE SUPPORTED BY CONTINUOUS BAR CHAIRS AT APPROX. 4'-0" C/C. THE 2" HEIGHT OF RAIL HEAD IS TO BE MAINTAINED AT ALL POINTS OF BEARING.

THE CONC. IN ANY SPAN SHALL BE PLACED WITHIN 4 HRS OF THE TIME THAT CONC. WAS PLACED OVER AN ADJACENT PIER.

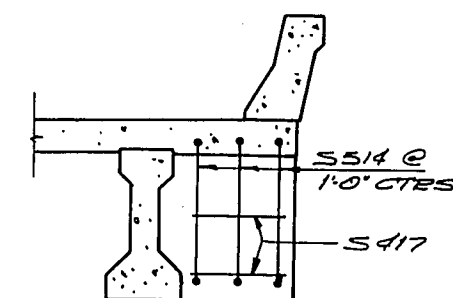


CONC. DIAPH. AT SO. ABUT.

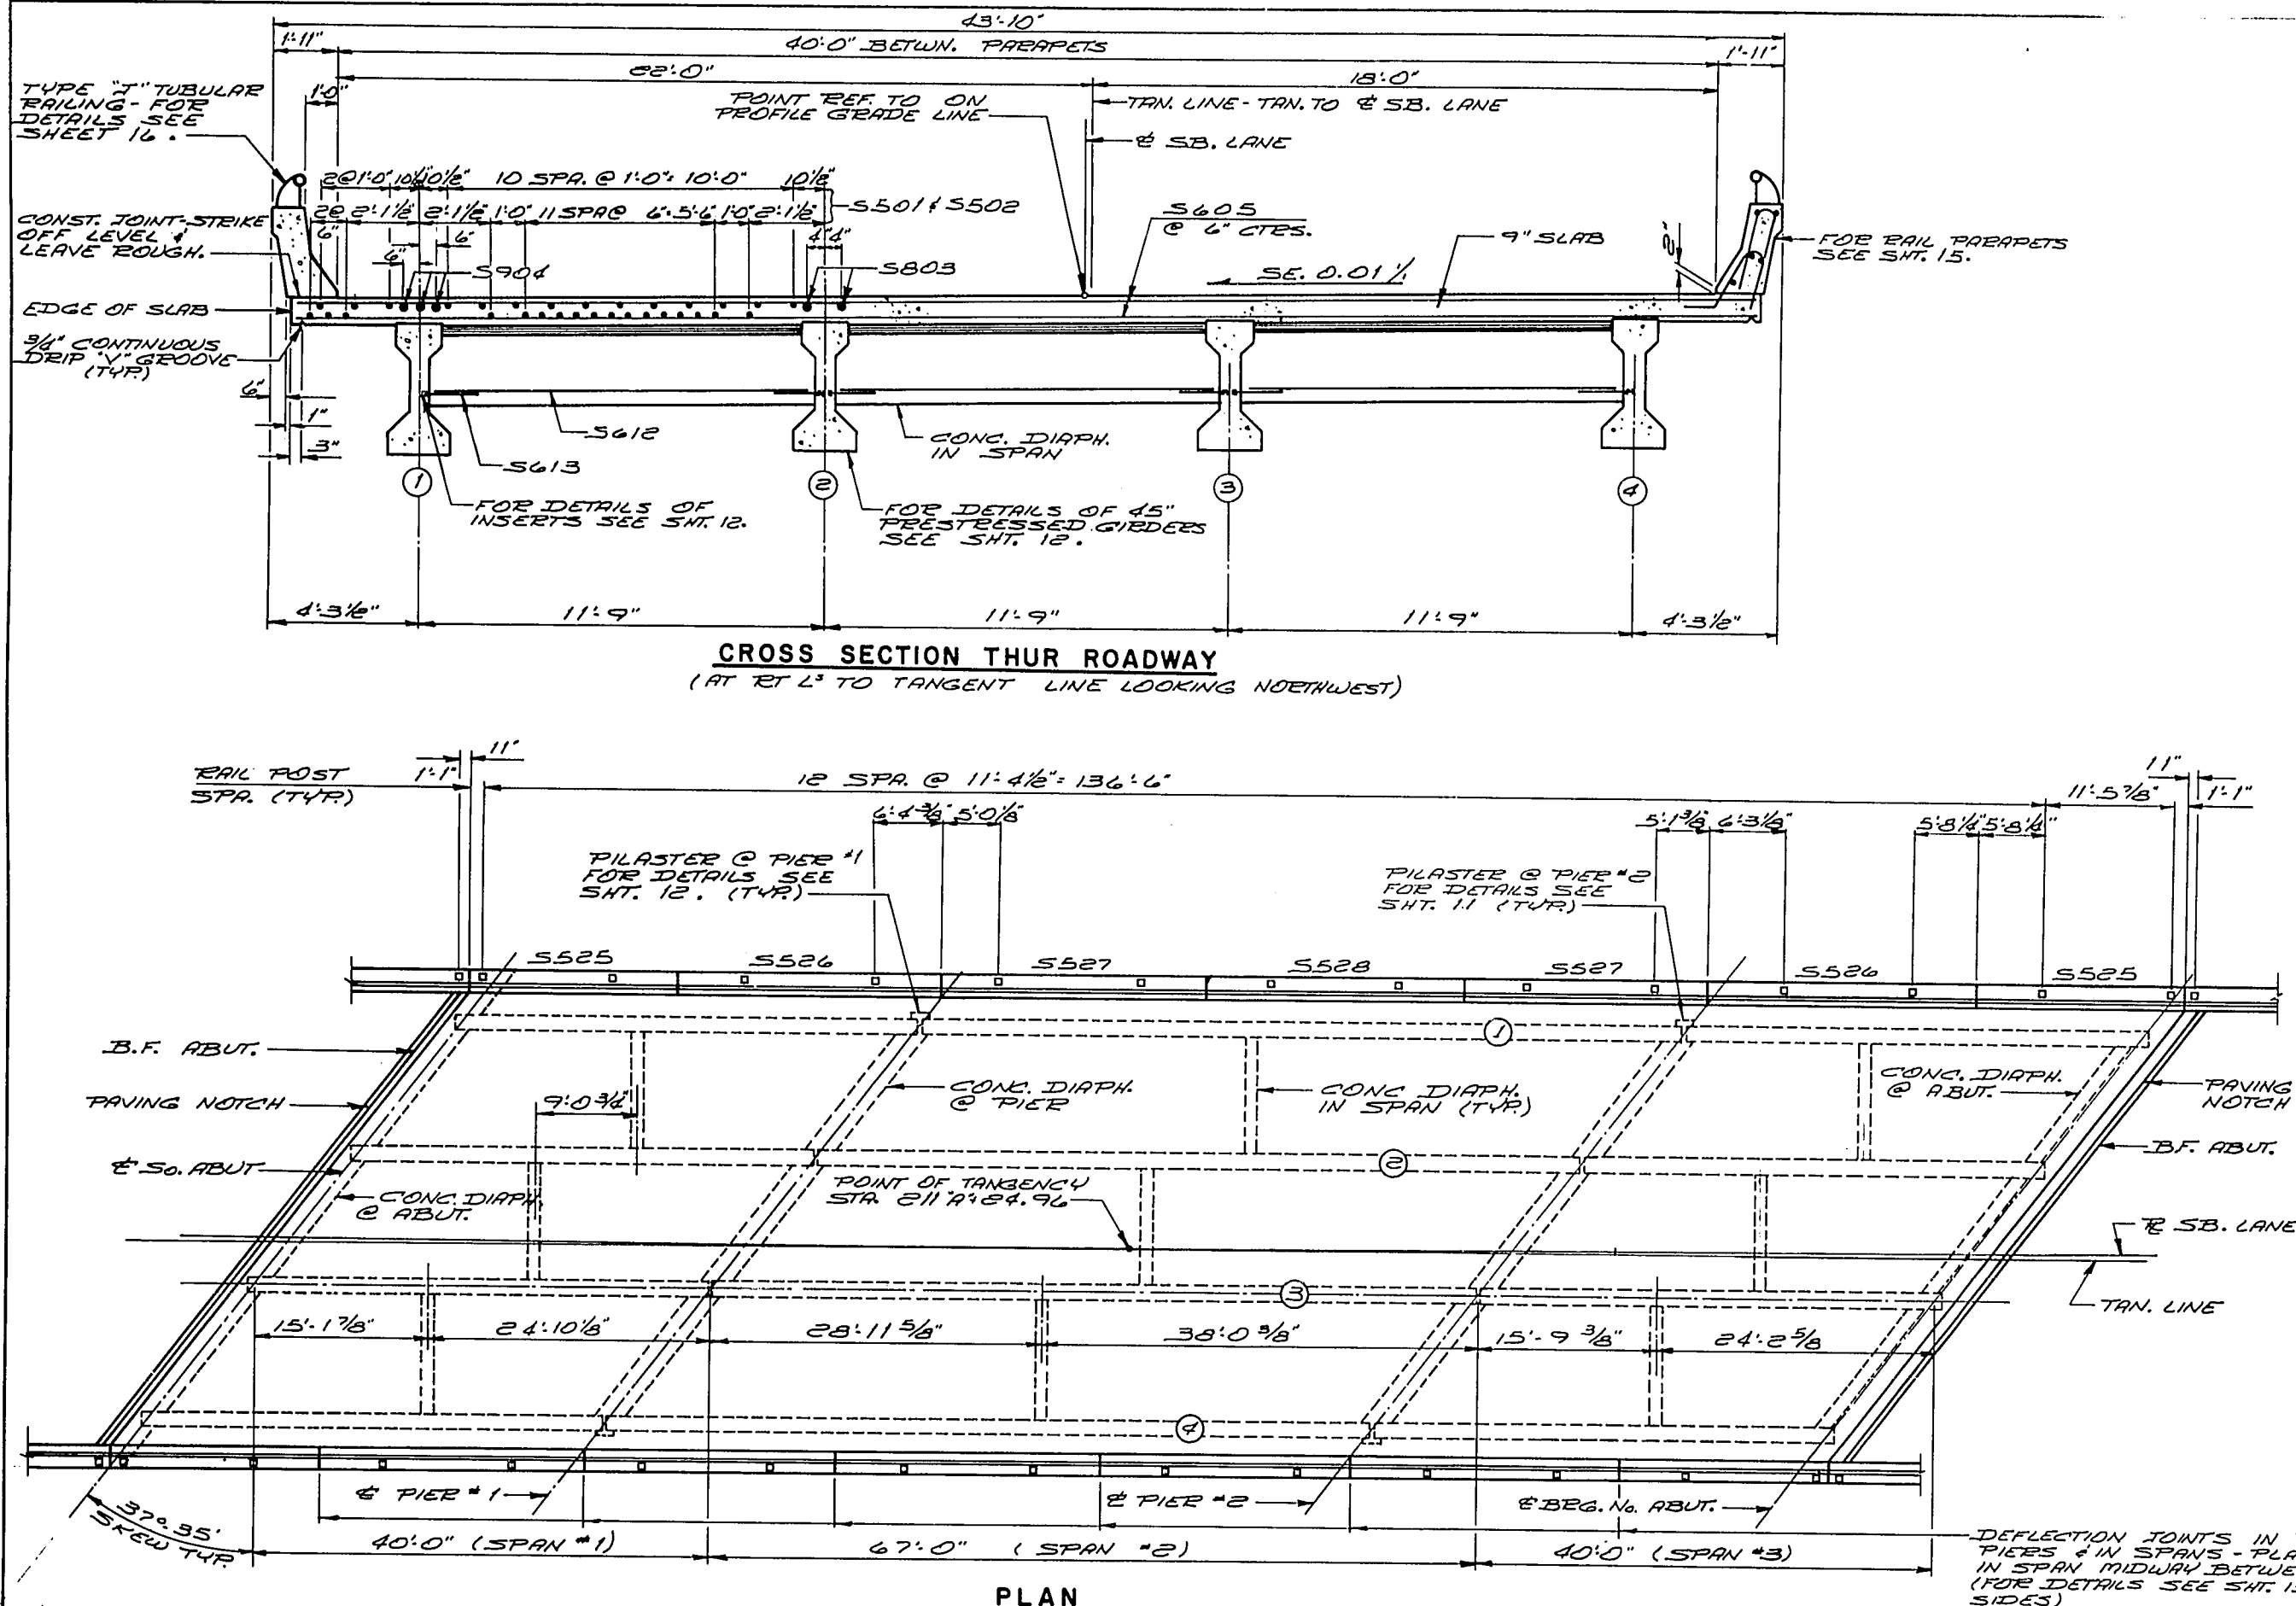

- DEFLECTION JOINTS IN PARAPET @ PIERS & IN SPANS - PLACE JOINTS IN SPAN MIDWAY BETWEEN RAIL POSTS. (FOR DETAILS SEE SHT. 15.) (TYP. BOTH SIDES)

No.	Date	Revision	By
STATE OF WISCONSIN DEPARTMENT OF TRANSPORTATION DIVISION OF HIGHWAYS			
STRUCTURE <b>B-3-16</b>			
Const. Spec.	1969	Drawn By	BUDD
		Plans Checked	G.H.A.
SUPERSTRUCTURE		SHEET 9 OF 16  <b>X 46169</b>	

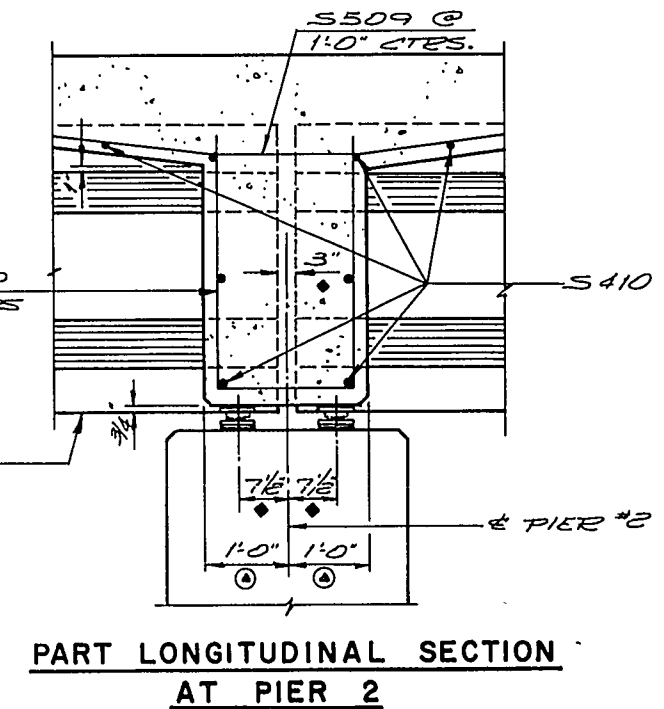


No.	Date	Revision	By
STATE OF WISCONSIN DEPARTMENT OF TRANSPORTATION DIVISION OF HIGHWAYS			
<b>STRUCTURE B-3-16</b>			
Const. Spec.	1969	Drawn By	BUDD Plans Checked G. H. A.
<b>SUPERSTRUCTURE</b>		SHEET 10 OF 16	
		<b>X 4 6 1 7 0</b>	

### BILL OF BARS

DIMENSIONS ARE OUT TO OUT OF BAR. THE FIRST DIGIT OF A 3 DIGIT BAR MARK SIGNIFIES THE BAR SIZE.


MARK	No. REQ'D.	LENGTH	BENT	CUT, DIR.	LOCATION	
S501	174	24.9			SLAB TOP & BOT.	LONGIT.
S502	261	35.0			" " "	"
S503	8	20.0			" " C PIER GIRD. 2 & 3	"
S504	12	20.0			" " " " 1 & 4	"
S605	469	42.4			" " & BOT.	TRANS.
S606	31	43.9	X		" BOT. SET 1	"
S607	30	42.10	X		" " " 2	"
S608	60	42.3	X		" TOP " 3	"
S509	66	10.10	X		" HAUNCH @ PIER	LONGIT.
S410	60	12.3			" " " "	TRANS.
S511	66	9.9	X		" " " "	"
S612	18	10.10			DIAPH. @ MID SPAN	"
S613	36	2.0			" " " " THREAD, ONE END 3"	"
S514	36	14.0	X		" " SO. ABUT.	"
S415	14	27.3			" " " "	"
S416	6	12.2			" " " "	"
S417	4	3.1			" " " "	"
S418	33	4.2	X		" " NO. "	"
S419	6	14.9			" " " "	"
S620	9	13.3			" " " "	"
S421	51	3.11	X		PAVING NOTCH	"
S322	12	3.2	X		PILASTER @ PIER	"
S423	8	4.4	X		" " "	VERT.
S424	8	3.4	X		" " "	"
S525	20	17.6			RAIL PARAPET	HORIZ.
S526	20	23.0			" " "	"
S527	20	21.9			" " "	"
S528	10	22.5			" " "	"
S529	298	5.0	X		" " "	VERT.
S530	298	4.9	X		" " "	"

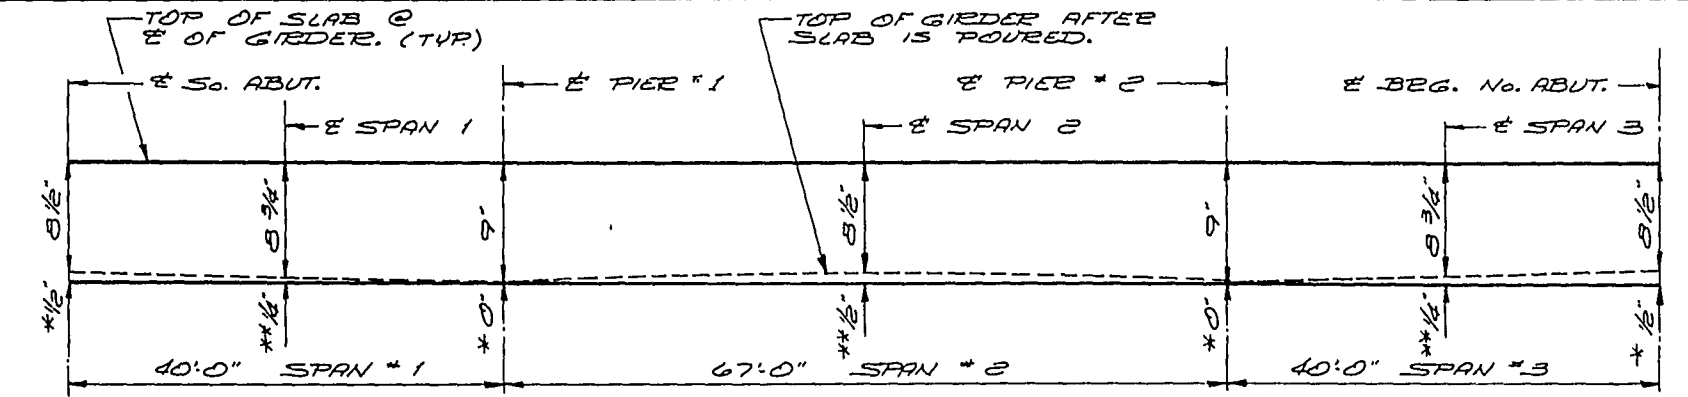

\* IF VARIATIONS IN PRESTRESS CAMBER & OTHER CONST. DISCREPANCIES ARE OF SUCH A MAGNITUDE THAT THE MAXIMUM ALLOWABLE IMBEDMENT AS NOTED ABOVE SHALL BE EXCEEDED THESE DIMENSIONS SHALL BE REVISED. THE 1/2" IMBEDMENT & THE PLAN SLAB THICKNESS SHALL BE HELD WHILE THE GRADE LINE WILL BE REVISED.

\*\* TO COMPENSATE FOR VARIATIONS IN PRESTRESS CAMBER & OTHER MINOR CONST. DISCREPANCIES THE EMBEDMENT AT THE E OF THE SPAN MAY BE VARIED WITH A MAXIMUM OF 1/2" ALLOWABLE IMBEDMENT & THE SLAB HELD TO PLAN THICKNESS.


SLAB FORMING DIAGRAM

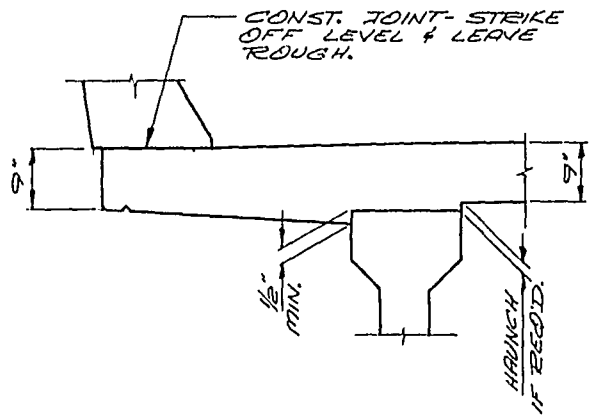



SLAB DETAIL AT EXTERIOR GIRDER

"H" IS NUMBER OF BARS REQ'D BEFORE CUTTING





MARK	SET No.	C	D	E	F	G	H	SETS REQ'D.
S606	SET 1	21.11	21.6	43.9	2.0	41.9	31	1 SET 1
S607	" 2	21.1	21.9	42.10	2.3	40.7	30	" 2
S608	" 3	20.10	21.5	42.3	1.11	40.4	30	" 3

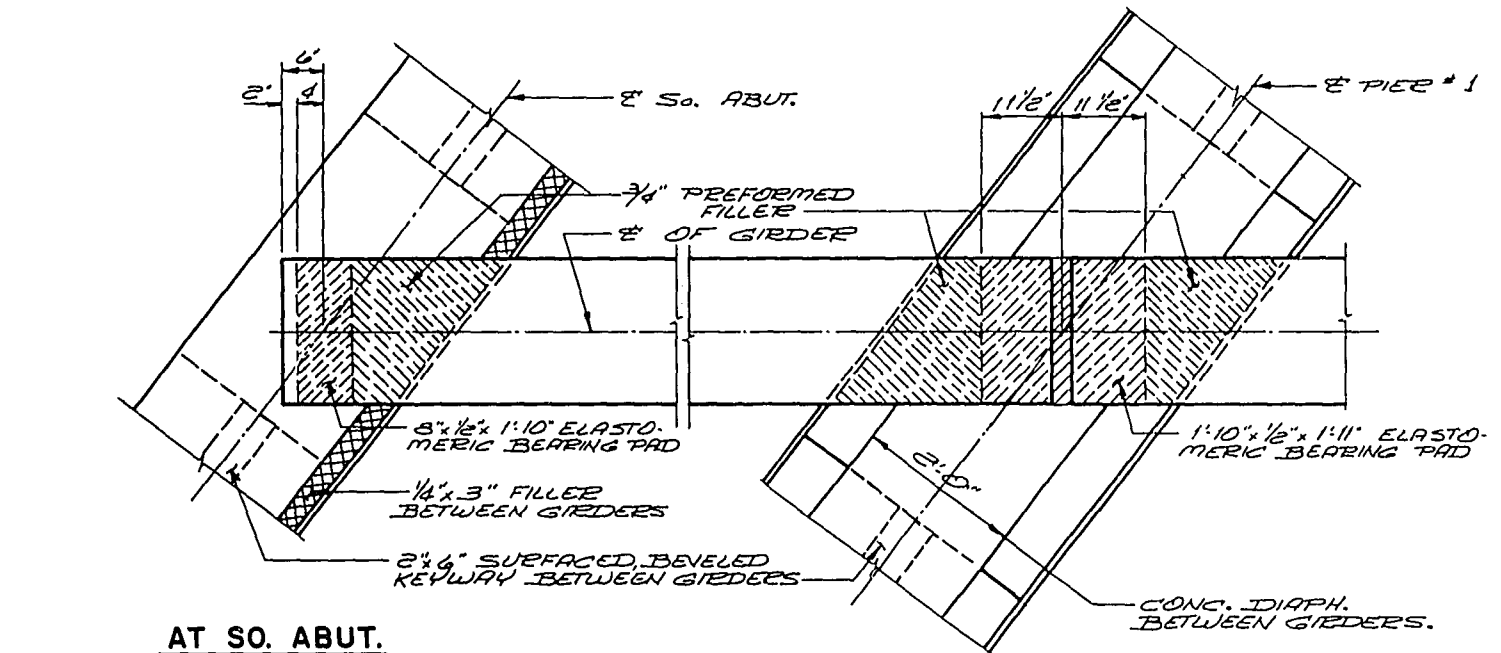







ELASTOMERIC BEARING PAD DETAILS

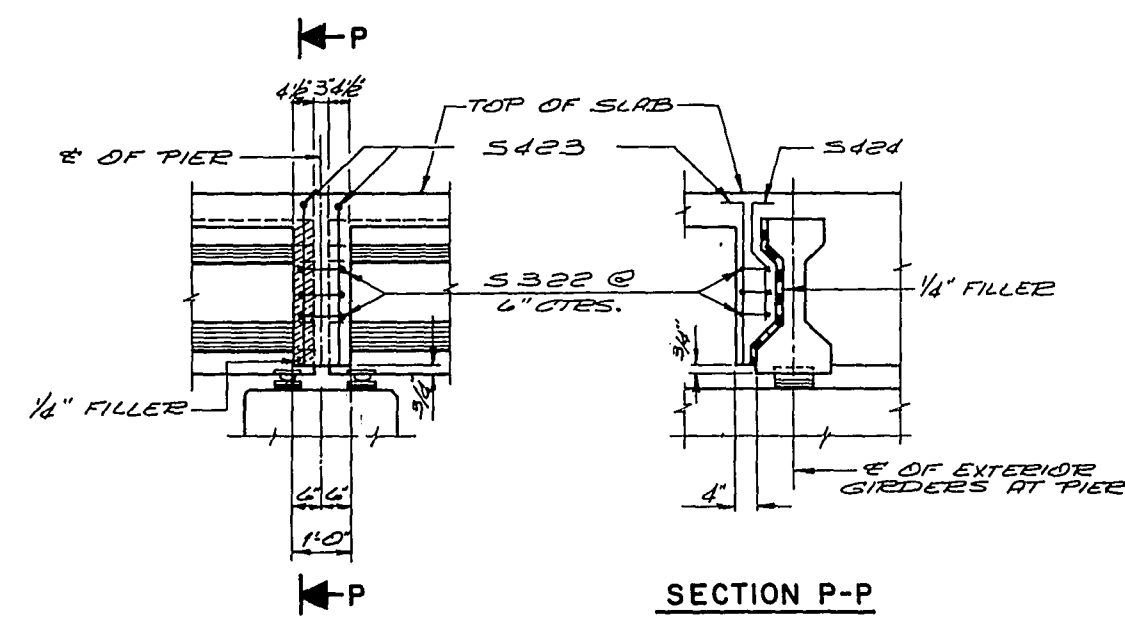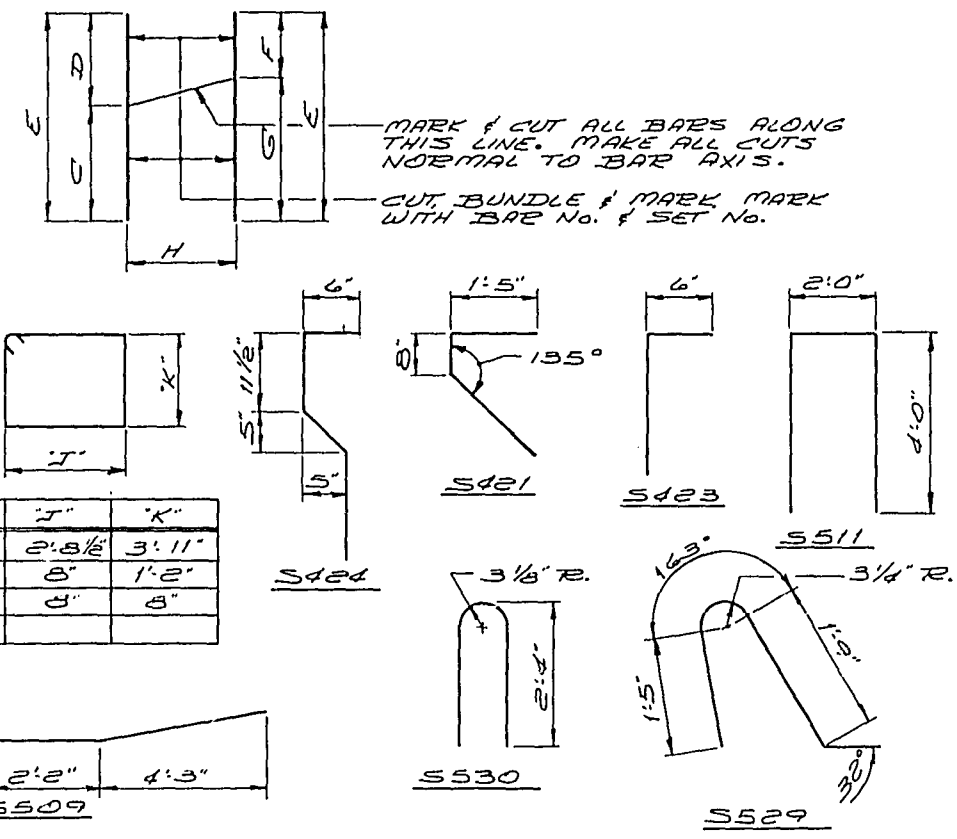

PILASTER DETAILS AT PIER

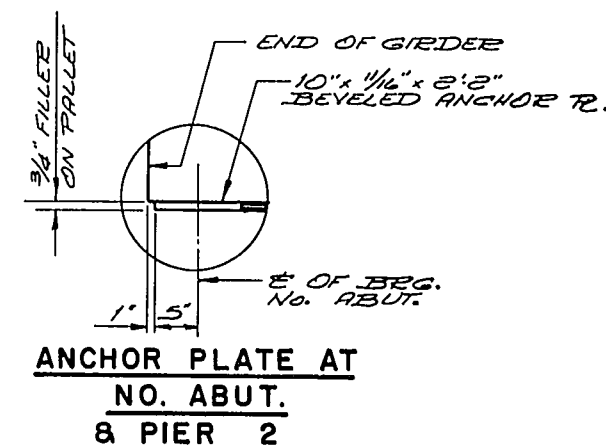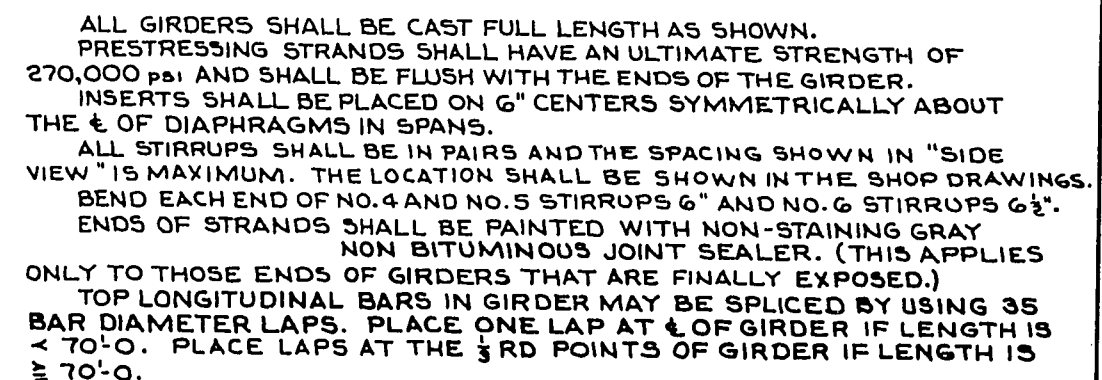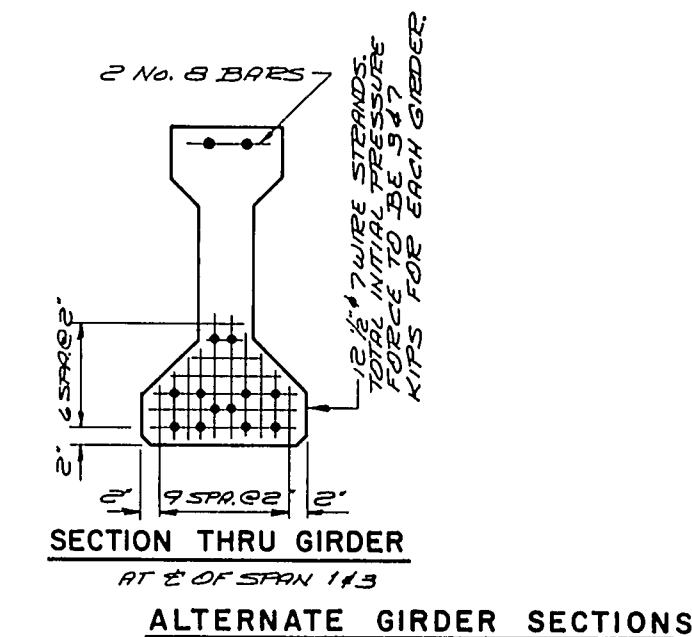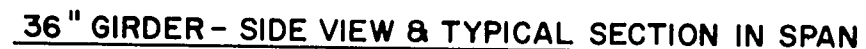

		A"	B"		C"
			MAX.	MIN.	
SPANS	1 & 3	29"	16"	13"	3"
	2	32"	14 3/4"	11 3/4"	5"
	ALT. 2	35"	14 3/4"	11 3/4"	4"

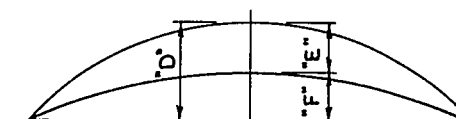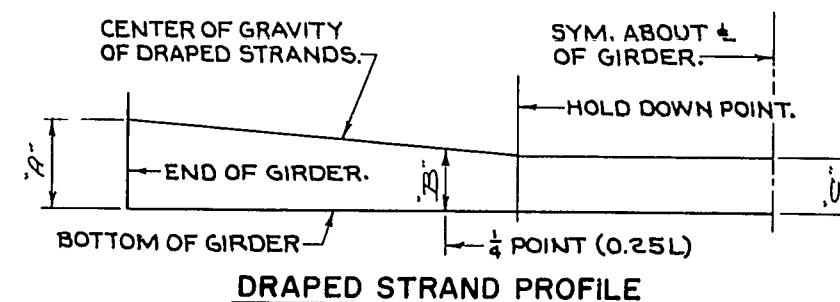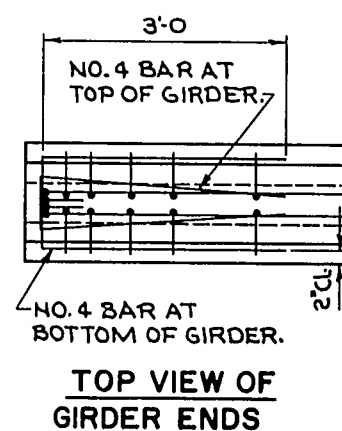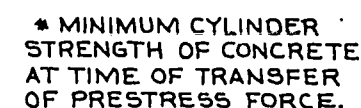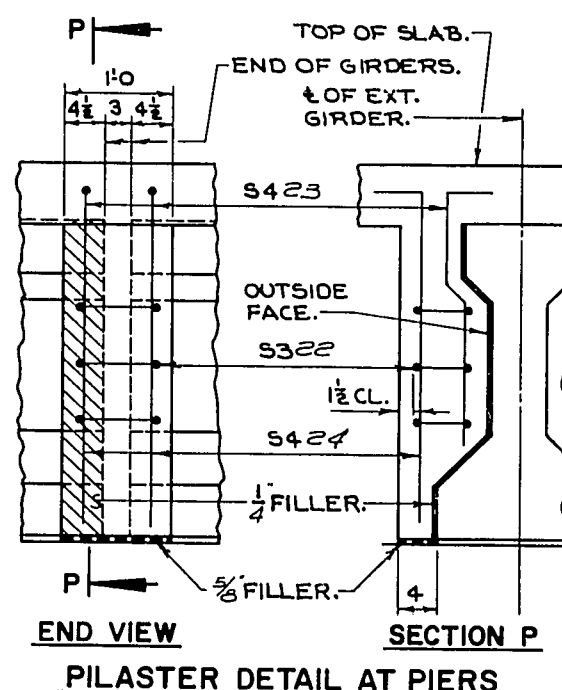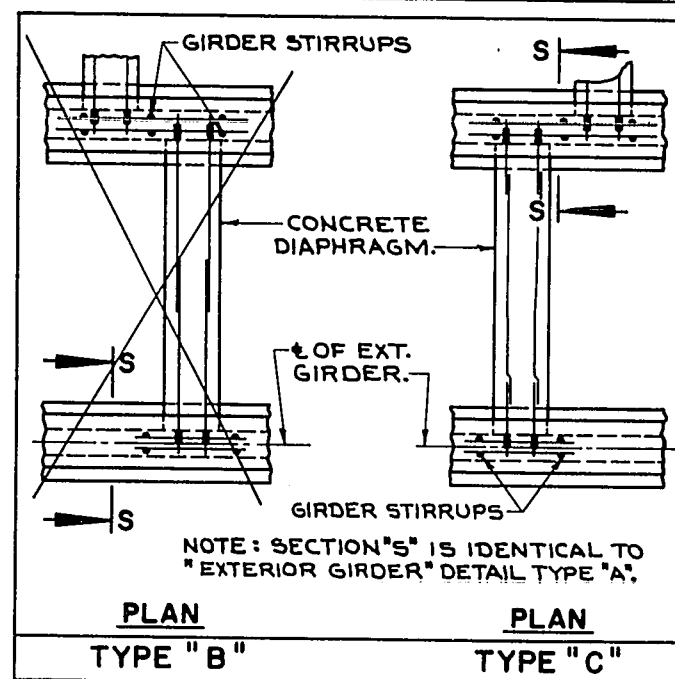


## DATA SHOWN IS THEORETICAL  
AND MAY VARY WITH CONCRETE  
STRENGTH, VARIABLE PRESTRESS  
CONDITIONS AND PRESTRESS LOSSES.


GIRDER DATA				
GIRDER SIZE REQUIRED			45" ALTERNATE	
SPANS		14.3	2	14.3
GIRDER LENGTH "L" REQUIRED		40'-4 1/2"	66'-9"	40'-4 1/2"
f'ci (psi)*	DRAPED PATTERN	4,800	5,000	4,800
	SPREAD PATTERN	4,800	5,000	4,800
DEFLECTION DATA **	PRESTRESS CAMBER "D"	1/4"	1 5/8"	1/4"
	DEAD LOAD DEFLECTION "E"	1/8"	1"	1/8"
	RESIDUAL CAMBER "F"	1/8"	5/8"	1/8"
USE DIAPHRAGM INSERT DETAIL TYPE "C"				

No.	Date	Revision	By
STATE OF WISCONSIN DEPARTMENT OF TRANSPORTATION DIVISION OF HIGHWAYS			
<b>STRUCTURE B-3-16</b>			
Const. Spec.	1969	Drawn By	BUDD
		Plone Checked	G.H.A.
<b>PRESTRESSED GIRDER DETAILS</b>		SHEET 12 OF 16  <b>X 46172</b>	



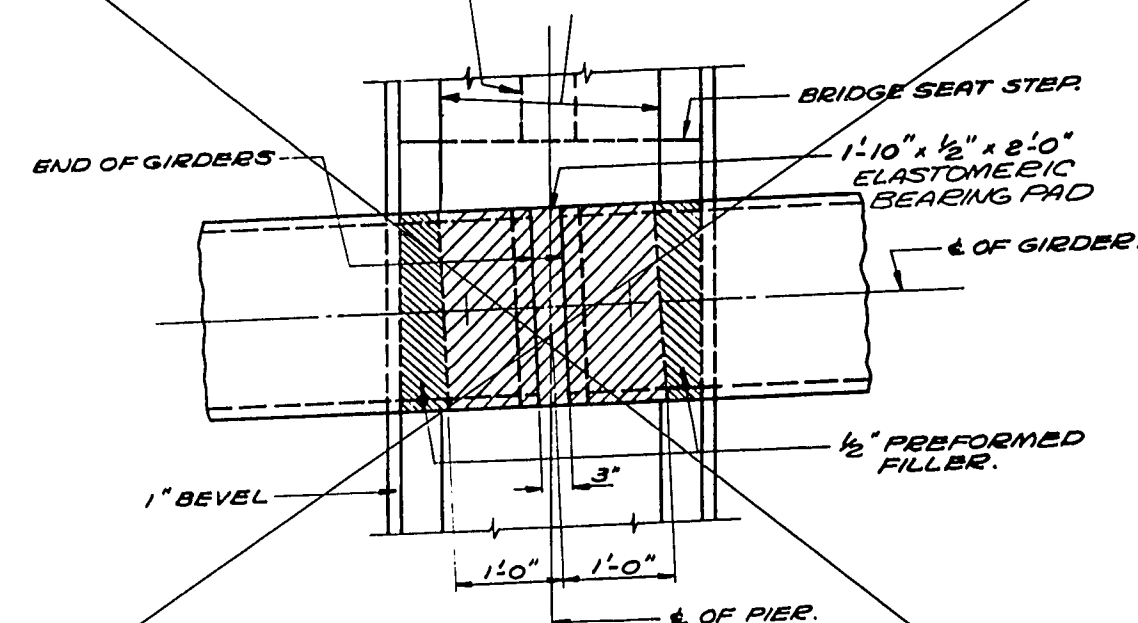

BEARING PAD DETAIL  
AT PIER

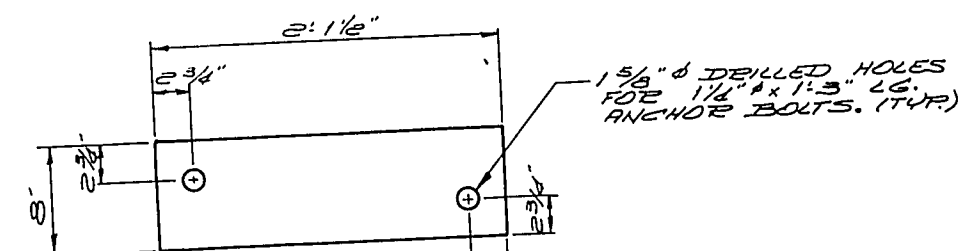

PLAN VIEW OF MASONRY PLATE  
(SHOWING ANCHOR BOLT HOLES)

## NOTES

NOTES


ALL PLATE CUTS SHALL BE MACHINE OR MACHINE FLAME CUTS.

ALL SURFACES MARKED & SHALL BE MACHINE FINISHED, BY AN AUTOMATIC PROCESS.

ALL MATERIAL EXCEPT ANCHOR BOLTS SHALL BE MADE OF A242 STEEL WITH A CORROSIVE RESISTANCE OF 4 OR MORE TIMES THAT OF A36 STEEL.

ALL BEARING MATERIAL EXCEPT BRONZE PLATES, BEARING PADS, AND ANCHOR PLATES SHALL BE PAID FOR AT THE UNIT PRICE BID FOR "STRUCTURAL LOW ALLOY STEEL."


ALL STRUCTURAL STEEL PLATES SHALL BE FLAT ROLLED STEEL PLATES WITH ALL SURFACES SMOOTH AND FREE FROM WARP AND ALL EDGES SMOOTH, STRAIGHT AND VERTICAL.

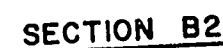

EXPANSION BEARING  
REQ'D. AT NORTH ABUT.  
" " PIER #2

FIXED BEARING  
6 REQ'D. AT NORTH ABUT.

No.	Date	Revision	By
STATE OF WISCONSIN DEPARTMENT OF TRANSPORTATION DIVISION OF HIGHWAYS			
<b>STRUCTURE      B-3-16</b>			
Const. Spec.	1969	Drawn By BUDD	Plans Checked G. H. A.
<b>BEARING DETAILS</b>			SHEET 13 OF 16  <b>X 46173</b>

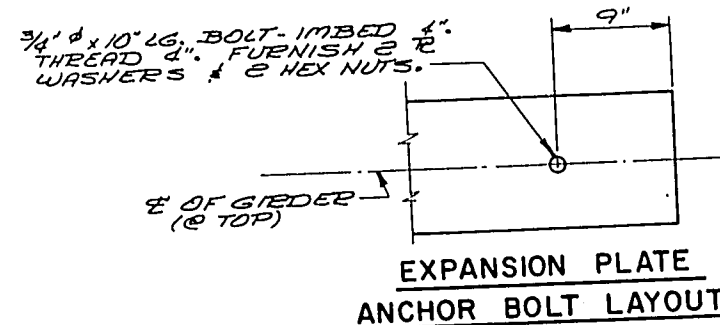

1. WT 6 x 3.95 x EDWY. WIDTH. WELDMENT MAY BE USED. SEE DETAIL.  
2. L 7" x 4" x 1/16" x ROWY WIDTH. LONG DIM. OF 13/16" x 1 1/2" SLOTTED HOLE TO BE PARALLEL TO DIRECTION OF MS. EXENT


4. BAR  $1\frac{1}{2}$ " x  $\frac{3}{4}$ " x PDWY. WIDTH WELD TO L #2 WITH 2 LINES OF  $\frac{1}{4}$ " FILLET WELD, 2 @ 6.
6. L  $3\frac{1}{2}$ " x  $3\frac{1}{2}$ " x  $\frac{3}{8}$ " PROVIDE  $1\frac{3}{8}$ "  $\phi$  HOLE IN  $3\frac{1}{2}$ " LEG FOR  $\frac{3}{4}$ "  $\phi$  x 0'-10" BOLT. FILLET WELD TO FLANGE & WEB OF WT #1 NEAR SIDE & FAR SIDE.
8.  $\frac{3}{4}$ "  $\phi$  FLAT HEAD CAP SCREW x 0'-2" LONG WITH SQ. NUT AT 4'-0" CTRS. GREASE FOR EASY REMOVAL.  $\frac{1}{4}$ " x  $\frac{1}{2}$ " x  $\frac{1}{4}$ " KEOPER BAR WELD TO L #2 TO KEEP SQ. NUT FROM TURNING.  $\frac{5}{16}$ " x  $1\frac{1}{2}$ " SLOTTED HOLE IN L #2.  $\frac{3}{16}$ "  $\phi$  HOLE C/SK 7" DEEP IN WT #1. MAKE SLOT IN L #2 PARALLEL TO DIRECTION OF MOVEMENT.
9.  $\frac{3}{16}$ "  $\phi$  VENT HOLES AT 2'-0" CENTERS ON WT #1 AND L #2.
10.  $\frac{3}{8}$ "  $\phi$  STUDS x 0'-6 $\frac{3}{8}$ " LONG AT 6" ALTERNATE CTRS. BETWEEN GIRDERS. WELD TO WT #1.
11.  $\frac{3}{8}$ "  $\phi$  STUDS x 0'-6 $\frac{3}{8}$ " LONG AT 9" ALTS CTRS. WELD TO L #2.
12. L  $3\frac{1}{2}$ " x  $2\frac{1}{2}$ " x  $\frac{3}{8}$ " x 0'-3" LONG AT 3'-0" CTRS. WELD TO L #2. PROVIDE  $\frac{15}{16}$ "  $\phi$  HOLE IN  $2\frac{1}{2}$ " LEG FOR ROD #13.
13.  $\frac{3}{4}$ "  $\phi$  ROD x 0'-9" LONG AND NUT. TACK WELD NUT TO L #12. THREAD 3".
14. PLATE  $\frac{3}{8}$ " x 6" x  $8\frac{1}{4}$ ".
15. PLATE  $\frac{3}{8}$ " x 6" x  $15\frac{5}{16}$ " FIELD WELD TO WT #1.
16. BRK 15 $\frac{1}{2}$ " x  $1\frac{3}{4}$ " x 6". WELD TO BAR #14 WITH TWO LINES OF  $\frac{3}{16}$ " FILLET WELD. FIELD WELD TO BAR #4.
17.  $\frac{3}{8}$ "  $\phi$  STUDS x 0'-6 $\frac{3}{8}$ " LONG. WELD TO WT #14 AND R #15.
18. BLOCK AND BOLT FOR SHIPMENT WITH PIPE SLEEVE AND  $\frac{1}{2}$ "  $\phi$  BOLT. PROVIDE  $\frac{9}{16}$ "  $\phi$  HOLES @ 3'-0" CTRS. IN WT #1 AND L #2 FOR  $\frac{1}{2}$ "  $\phi$  BOLT.

NOTES

EXPANSION JOINT SHALL BE BUILT TO CONFORM TO ROADWAY CROWN AND GRADE.  
ALL MATERIAL IN EXPANSION JOINT SHALL BE PAID FOR AS STRUCTURAL CARBON STEEL.  
AFTER CONCRETE HAS SET:

1. THE JOINT OPENING SHALL BE THOROUGHLY CLEANED.
2. REMOVE BOLTS NO. 8.
3. APPLY  $\frac{1}{16}$ " OF BITUMASTIC TO VERTICAL METAL SURFACES FORMING THE JOINT.
4. FILL OPENING AND HOLES FOR BOLT NO. 3 WITH HOT POURED ELASTIC TYPE JOINT SEALER CONFORMING TO A.S.T.M. D1190.

ONE FIELD SPLICE SHALL BE PERMITTED.

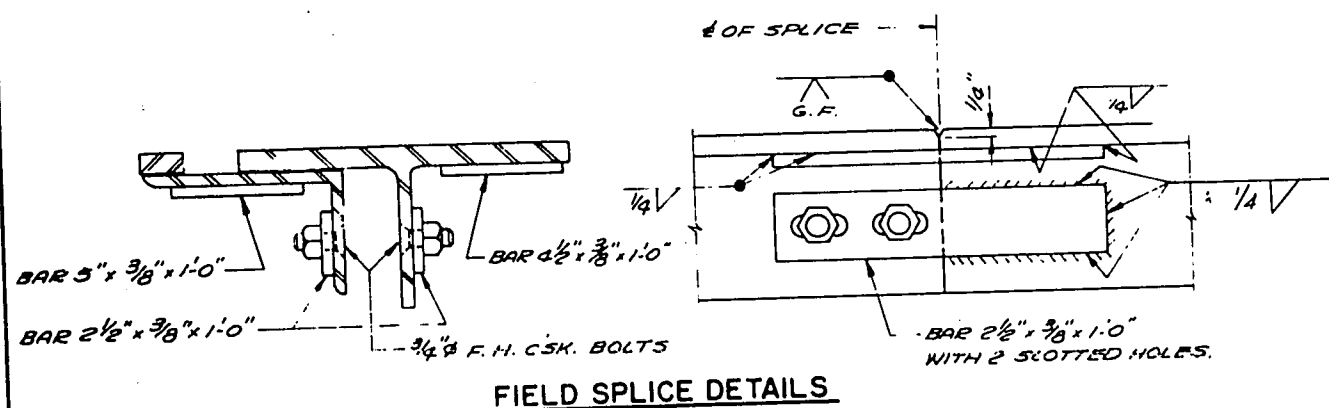


The image contains two technical drawings of a parapet wall. The left drawing is a cross-section titled "SECTION THRU PARAPET". It shows a concrete wall with a sloped top surface. Dimensions include a total width of 2 1/2 feet, a vertical height of 1 foot, and a sloped section of 3/8 inch. A "TOP OF SLAB" is indicated. The right drawing is an elevation titled "ELEVATION AT PARAPET". It shows a wall with a grid of horizontal and vertical lines. Dimensions include a total width of 8 feet, with segments of 2 1/2, 4 7/8, 2 1/2, and 1 7/8 feet. A vertical dimension of 1 7/8 feet is also shown. A note indicates "1/4\" MAX WIDTH OF WELD". Both drawings include numbered callouts (1 through 17) pointing to specific features. A section line A-A is shown on the right drawing. Below the drawings, there is a note: "3/8\" \phi STUDS" and "2\" \phi 51\" ANGLE".

L 3" x 2" x 5/16"  
 RDWY WIDTH  
 2"  
 1 1/2"  
 1/4" Ø HOLES  
 @ 3.0" CTRS.  
 3"  
 2 1/2"  
 3/8" Ø STUDS x 0.4' LG.  
 WELD TO ANGLE @ 6"  
 ALTERNATE CTRS.  
 FIELD CUT 3" LEG OF ANGLE AS REQ'D.  
 FOR BENDING ANGLE TO CONFORM TO RDWY.  
 CROWN. ONE CUT SHALL BE AT CENTER OF  
 CROWN.  
 6"  
 TYP  
 6"  
 1/2"  
 TYP  
 3/4"  
 1/2"

DETAIL "B"








NOTE: ONE FIELD SPICE SHALL BE PERMITTED IN ANGLES.  
ANGLE AND STUDS SHALL BE PAID FOR AS STRUCTURAL CARBON STEEL.

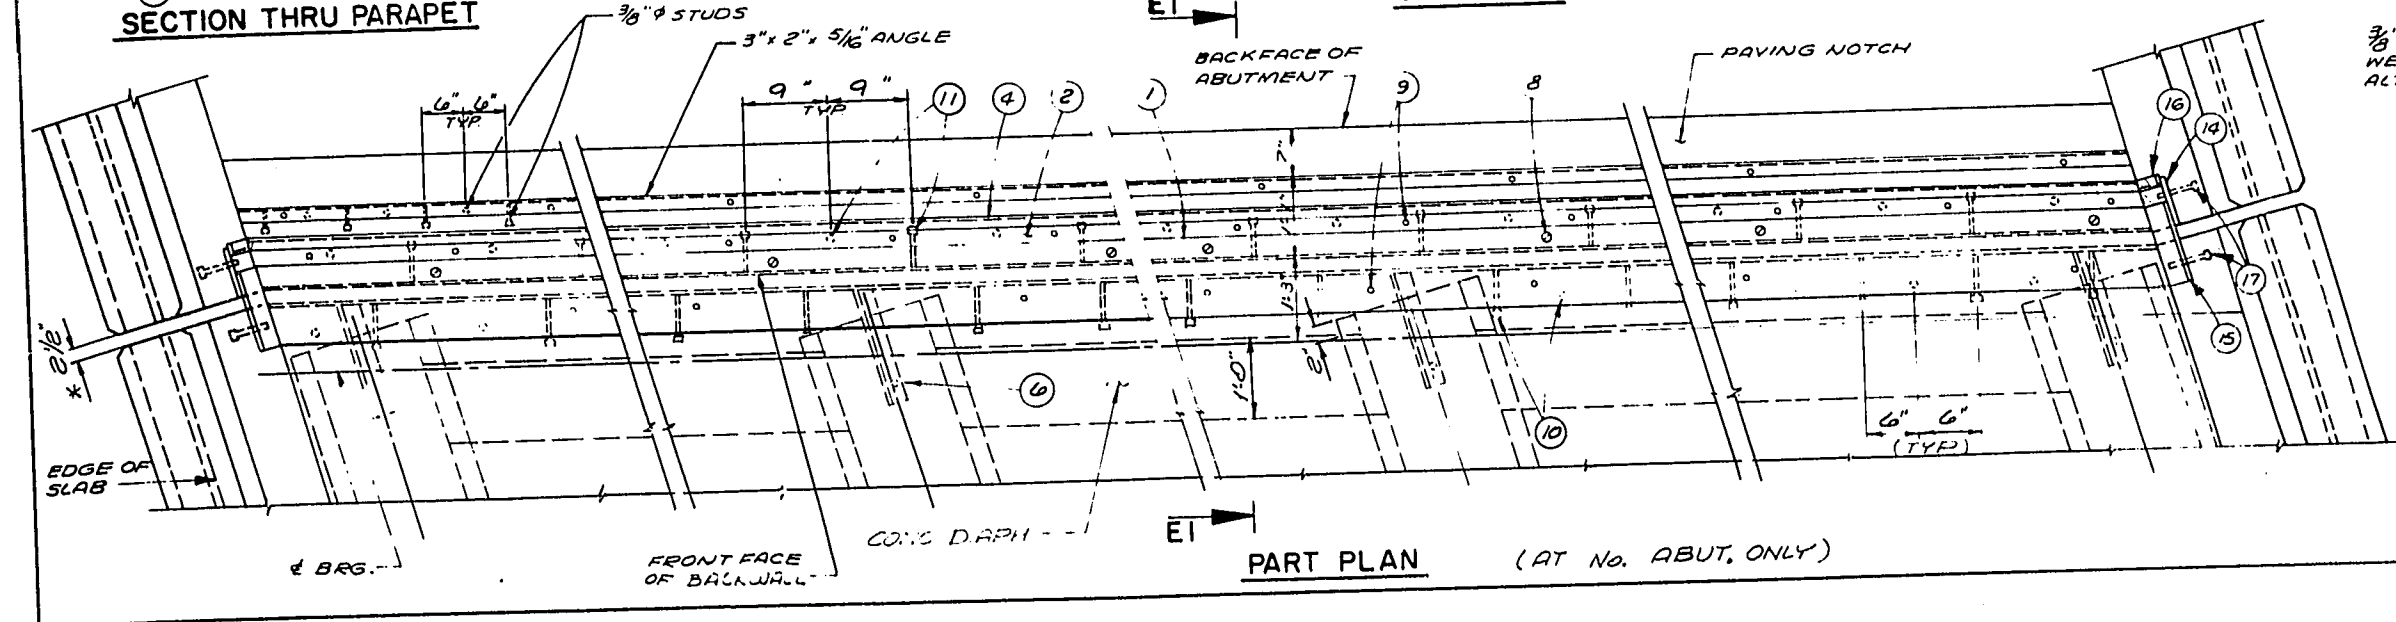

WELDMENT OPTION FOR WT NO. 1

No.	Date	Revision		By
STATE OF WISCONSIN DEPARTMENT OF TRANSPORTATION DIVISION OF HIGHWAYS				
STRUCTURE B-3-16				
Const Spec	1969	Drawn By	BUDD	Plans Checked G. H. A.
EXPANSION JOINT			SHEET 14 OF 1	
			X 46174	



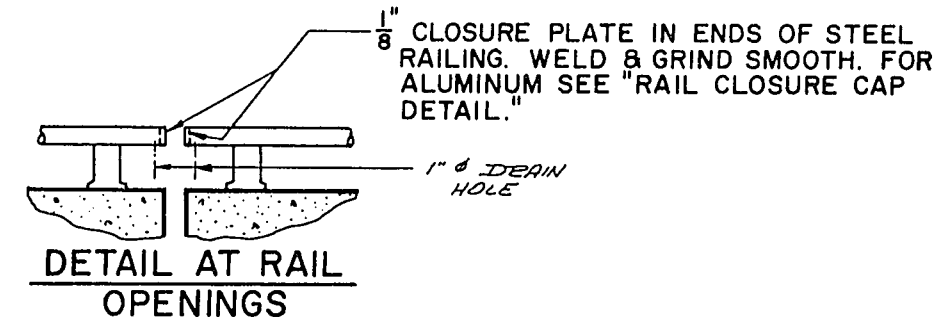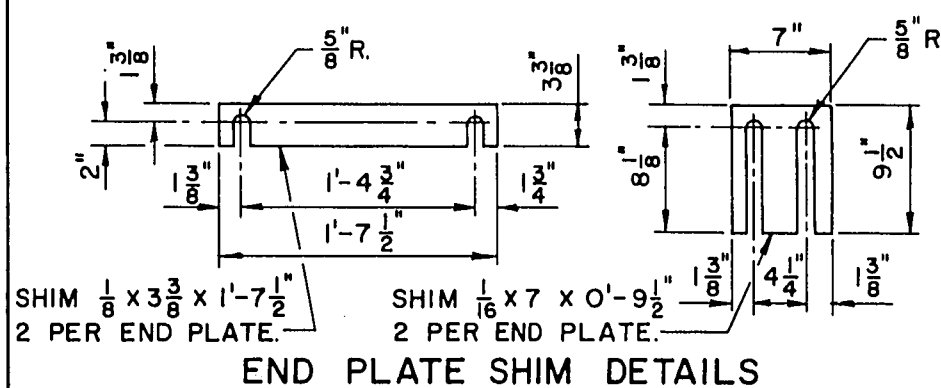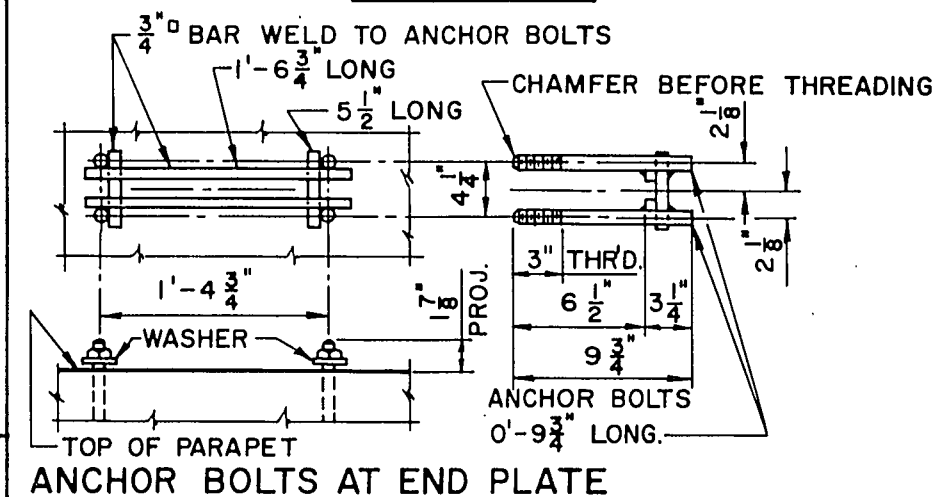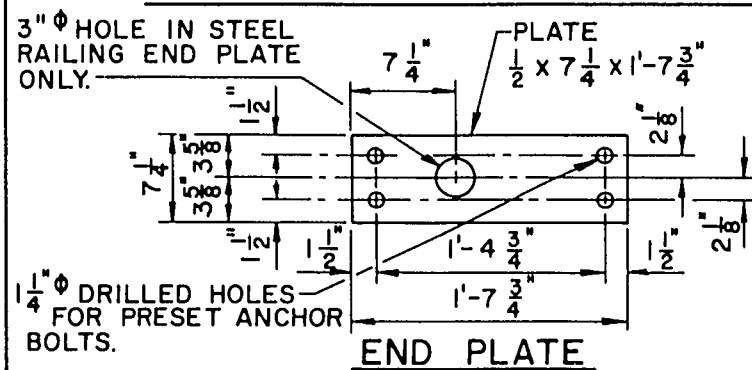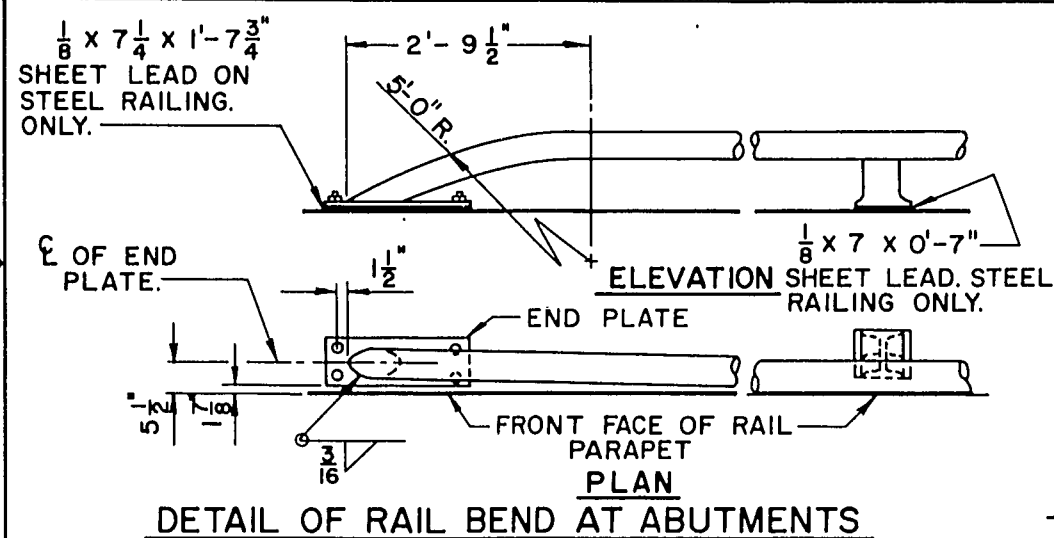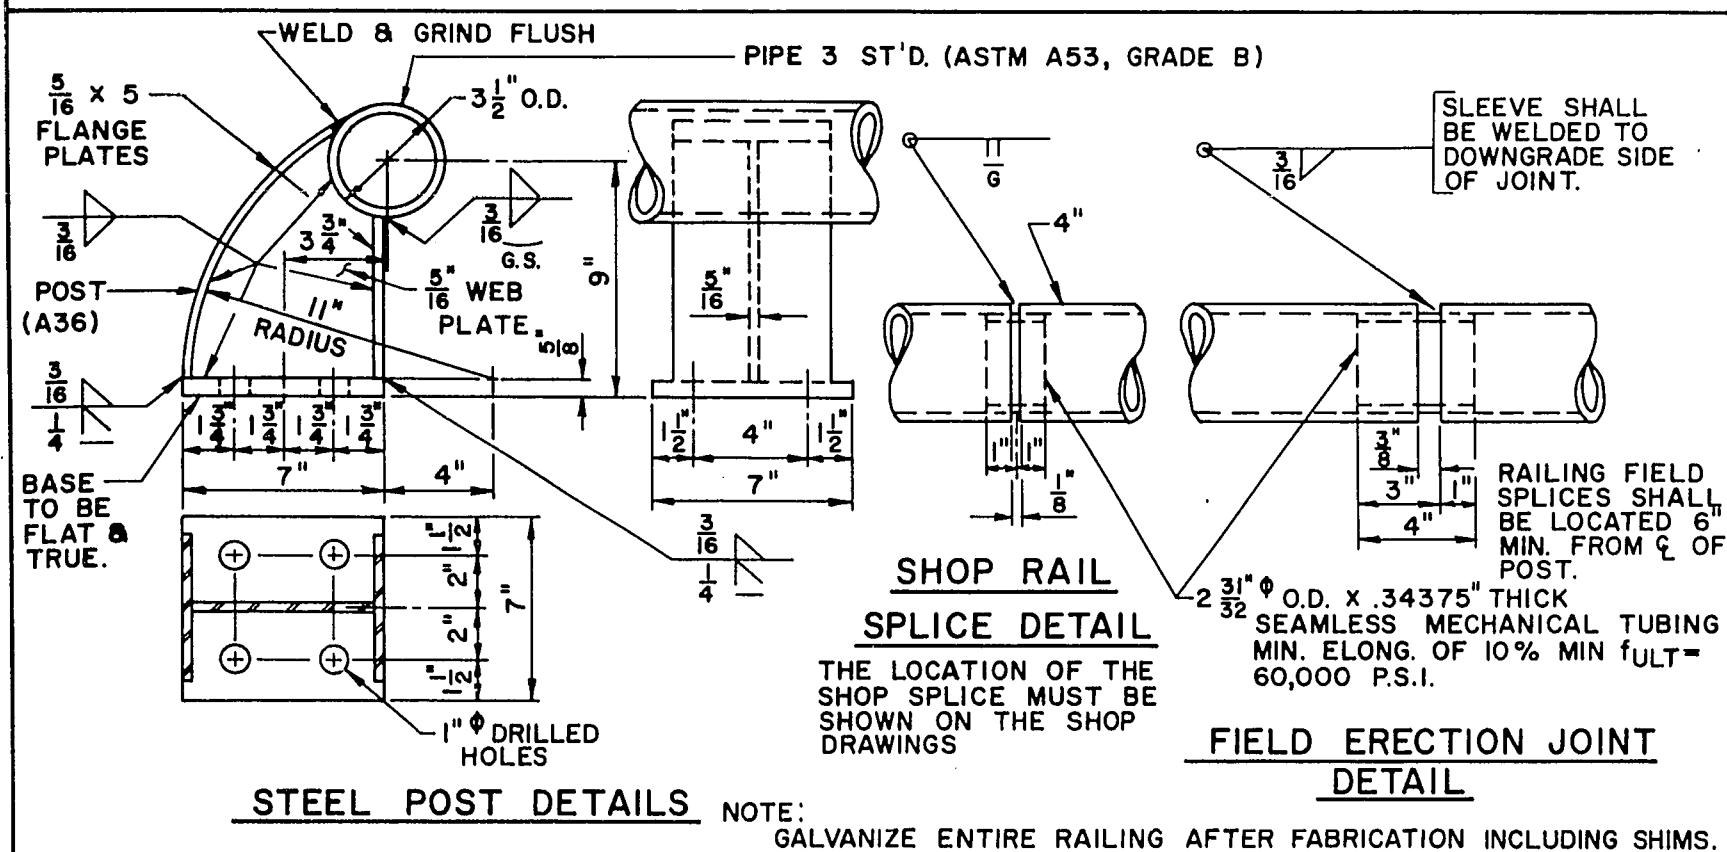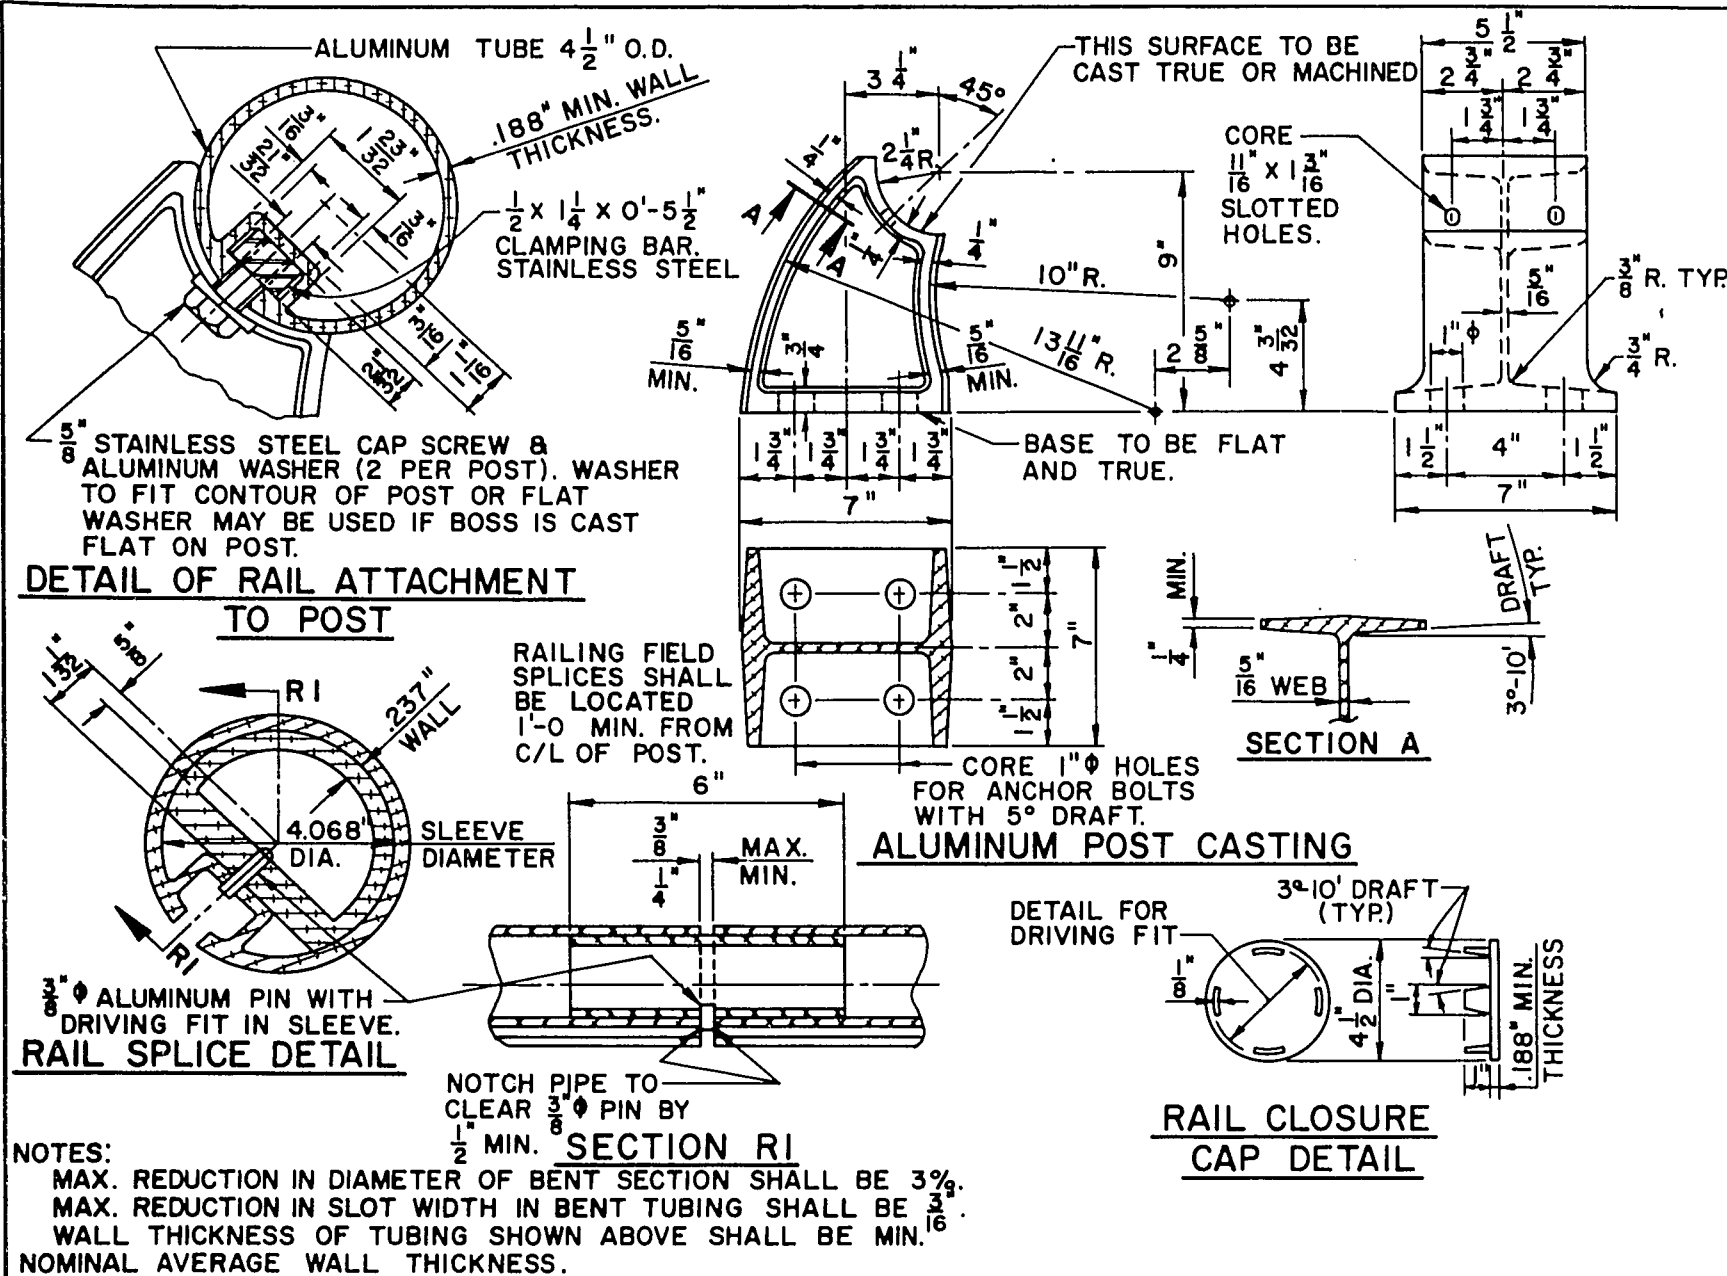


## GENERAL NOTES



- BID ITEM SHALL BE TUBULAR RAILING, TYPE 'J'.  
 ALL POST SPACINGS ARE TAKEN HORIZONTALLY ALONG C/L OF ANCHOR BOLTS.  
 RAILING SHALL BE FABRICATED IN TWO OR THREE PANEL LENGTHS.  
 SHIMS CONFORMING TO SAME MATERIAL AS POSTS SHALL BE USED UNDER POSTS AND END PLATES WHERE REQ'D FOR ALIGNMENT.  
 RAIL POSTS SHALL BE SET NORMAL TO GRADE.  
 THE SHANK AND ROOT OF THREAD DIAMETER FOR ANCHOR BOLTS SHALL BE A MIN. OF 0.62 INCHES.  
 ANCHOR BOLTS, NUTS & WASHERS FOR ALUMINUM RAILING SHALL BE STAINLESS STEEL.  
 ANCHOR BOLTS, NUTS & WASHERS FOR STEEL RAILING SHALL BE EITHER STAINLESS STEEL OR ASTM A307. IF A307 IS USED ELECTRO-GALVANIZE NUTS, WASHERS & TOP  $3\frac{1}{2}"$  OF ANCHOR BOLTS.  
 SHIMS SHALL CONFORM TO SAME MATERIAL AS POSTS.

No.	Date	Revision	By
STATE OF WISCONSIN DEPARTMENT OF TRANSPORTATION DIVISION OF HIGHWAYS			
STRUCTURE B-3-16			
Const. Spec. 1969	Drawn By BUDD	Plans Checked G. H. A.	
TUBULAR RAILING TYPE 'J'			SHEET 16 OF 16 X 46176



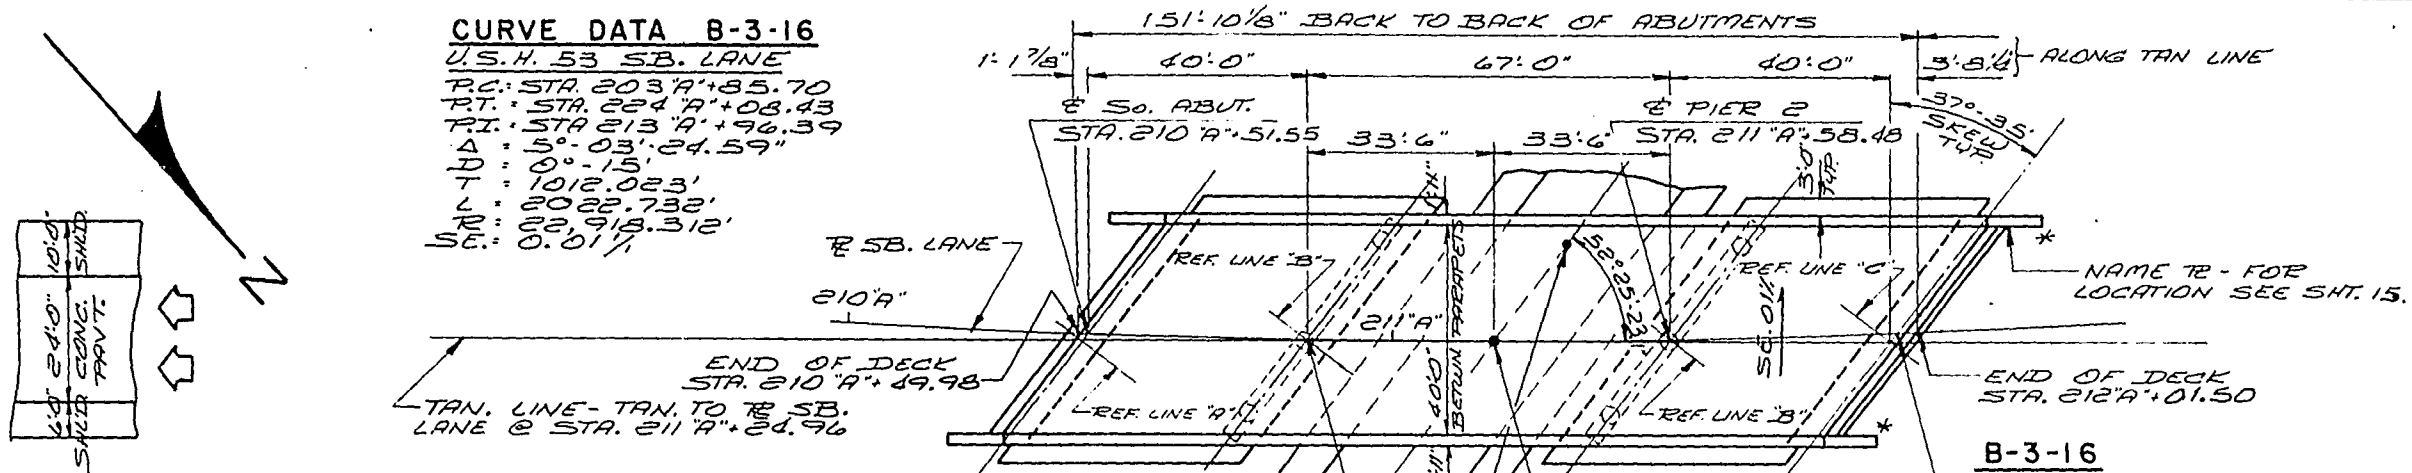

\* ATTACH BEAM TYPE GUARD RAIL TO WING PARAPET.

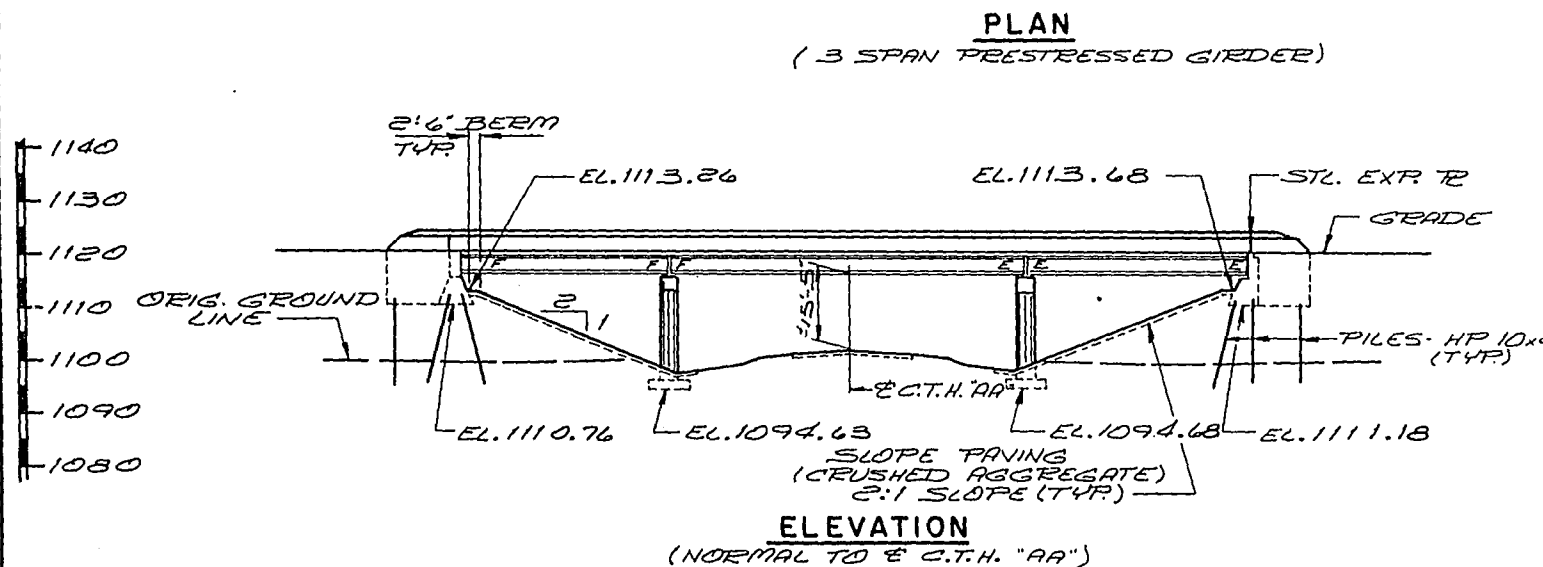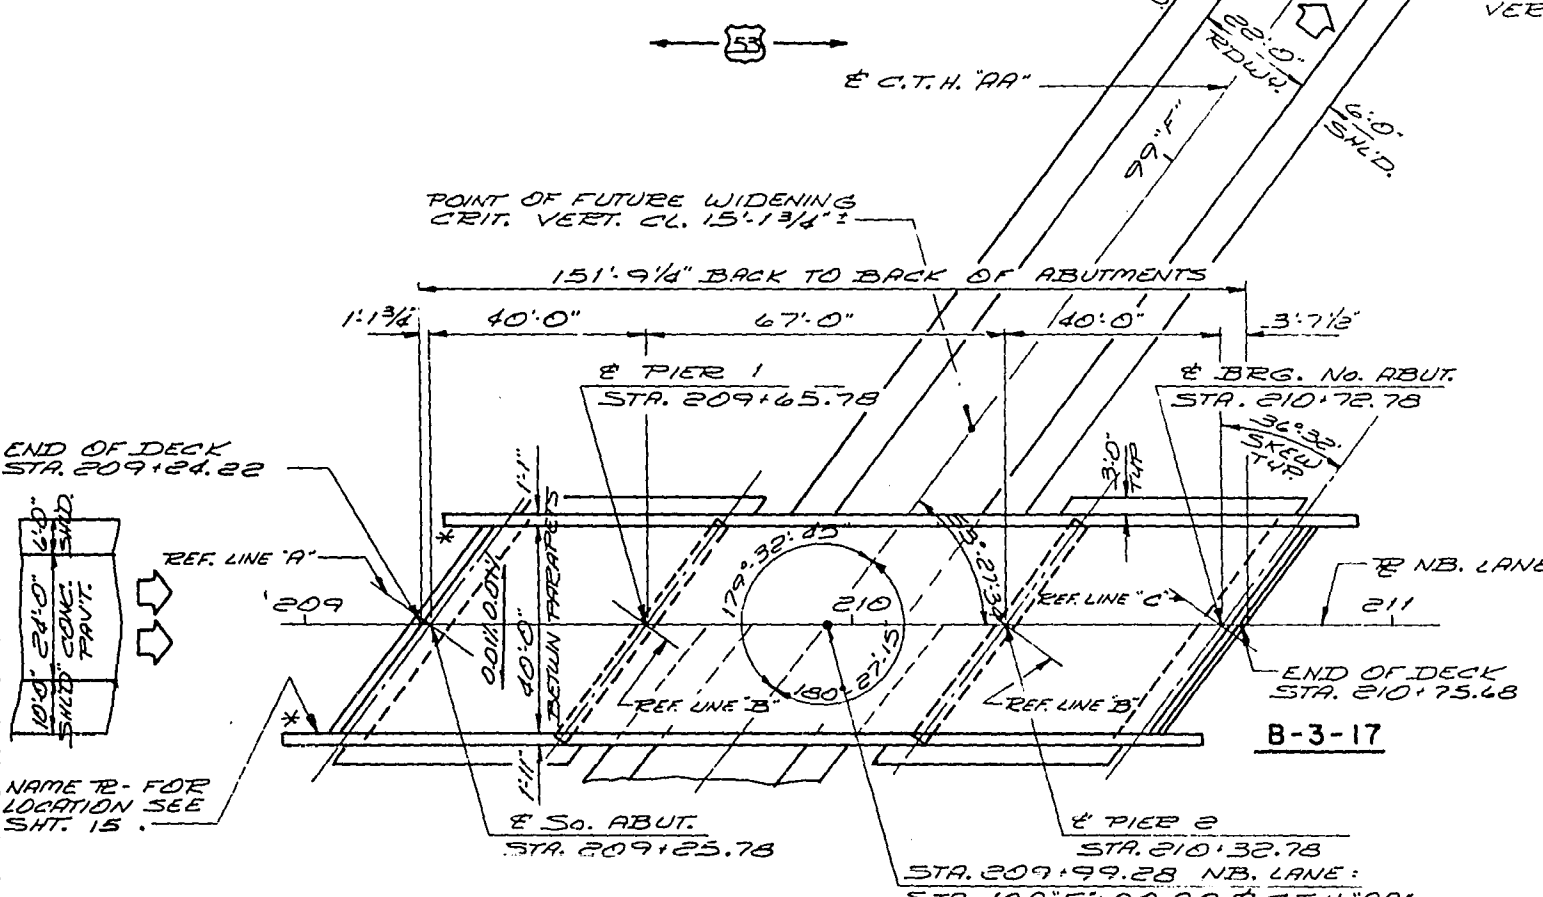

### LIST OF DRAWINGS

1. GENERAL PLAN	X46177
2. GENERAL PLAN	X46178
3. SUBSURFACE EXPLORATION	X46179
4. SOUTH ABUTMENT	X46180
5. SOUTH ABUTMENT DETAILS	X46181
6. NORTH ABUTMENT	X46182
7. NORTH ABUTMENT DETAILS	X46183
8. PIERS	X46184
9. SUPERSTRUCTURE	X46185
10. SUPERSTRUCTURE	X46186
11. SUPERSTRUCTURE	X46187
12. PRESTRESSED GIRDER DETAILS	X46188
13. BEARING DETAILS	X46189
14. EXPANSION JOINT	X46190
15. SLOPE FACE PARAPET "A"	X46191
16. TUBULAR RAILING TYPE "T"	X46192

### DESIGN DATA

LIVELOAD: HS-20  
 ALLOWABLE DESIGN STRESSES:  
 CONCRETE MASONRY - GRADE "AA" - SLAB -  $f_c = 1,200$  P.S.I.  
 ALL OTHER -  $f_c = 1,400$  P.S.I.  
 BAR STEEL REINFORCEMENT -  $f_s = 20,000$  P.S.I.  
 STRUCTURAL CARBON STEEL -  $f_s = 20,000$  P.S.I.  
 PRESTRESSED GIRDERS -  $f_s = 20,000$  P.S.I.  
 CONCRETE MASONRY STRANDS -  $f_s = 6,000$  P.S.I.  
 STRANDS - 1/2" DIA. WITH ULTIMATE TENSILE STRENGTH OF 270,000 P.S.I.


FOUNDATION DATA:  
 SUPPORT ABUTMENTS ON HP 10x42 STEEL "H" PILES. EST. 25' 0" LONG, & DRIVEN TO A MIN. BEG. VALUE OF 55T/PILE.  
 SUPPORT PIERS ON SPREAD FOOTINGS WITH A MINIMUM ALLOWABLE BEG. PRESSURE OF 2 1/2 T/SQ. FT.

### GENERAL NOTES

DRAWINGS SHALL NOT BE SCALED.  
 BAR STEEL REINFORCEMENT SHALL BE EMBEDDED 2" CLEAR UNLESS OTHERWISE SHOWN OR NOTED.  
 ELASTOMERIC BEARING PADS NEED NOT BE INDIVIDUALLY MOLDED PROVIDED THE CUT EDGES ARE SMOOTH & TRUE.  
 THE SLOPE OF THE FILL IN FRONT OF THE ABUTMENTS SHALL BE COVERED WITH SLOPE PAVING, CRUSHED AGGREGATE TO THE EXTENT SHOWN ON THIS SHT. & IN THE ABUTMENT DETAILS.  
 THE FINISHED GRADED SECTION WAS USED AS THE UPPER LIMITS OF EXCAVATION FOR COMPUTATION OF EXCAVATION QUANTITIES AT THE PIERS.  
 THE UPPER LIMITS OF "EXCAVATION FOR STRUCTURES" FOR THE ABUTMENTS SHALL BE THE BOTTOM OF THE SLOPE PROTECTION & THE QUANTITIES WERE COMPUTED FROM THIS LINE.  
 FILLER SHALL CONFORM TO THE REQUIREMENTS OF A.A.S.H.O. DESIGNATION M153 OR M213.

### TRAFFIC VOLUME

U.S.H. 53  
 A.D.T. 5300 (1980)  
 C.T.H. "AA"  
 A.D.T. 250 (1980)



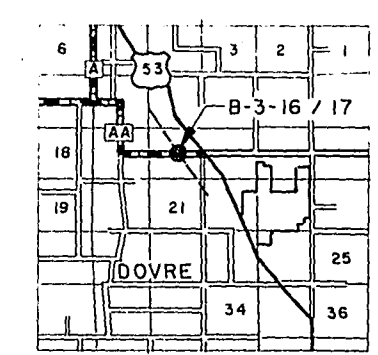


No.	Date	Revision	By
STATE OF WISCONSIN DEPARTMENT OF TRANSPORTATION DIVISION OF HIGHWAYS			
<b>STRUCTURE B-3-17</b>			
U.S.H. 53 OVER C.T.H. "AA"			
County	BARRON	City	Village TN. DOVRE
Design Spec.	A.A.S.H.O. 1969	Load	HS-20
Designed By	G.H.A.	Design Checked	R.L.P.
Drawn By	BUDD	Const. Spec.	1969
Plans Checked	G.H.A.	Planned	
Approved <u>W.A. Kline</u> Chief Bridge Engineer			Date 11-17-71
GENERAL PLAN			SHEET 1 OF 16
			X46177

## TOTAL ESTIMATED QUANTITIES

BID ITEMS	UNIT	SUPER	SO. ABUT.	PIER 1	PIER 2	NO. ABUT.	TOTAL
EXCAVATION FOR STRUCTURES	C.Y.	—	45	150	150	50	395
CONCRETE MASONRY	C.Y.	265.8	60.0	69.1	69.1	92.0	556.0
PRESTRESSED GIRDERS, I TYPE 45"	L.F.	590	—	13,590	13,590	—	590
BAR STEEL REINFORCEMENT	LBS.	61,120	2,700	27,100	27,100	3,730	121,490
STRUCTURAL CARBON STEEL	LBS.	3,780	—	—	—	—	3,780
STRUCTURAL LOW ALLOY STEEL	LBS.	2,070	—	—	—	—	2,070
LUBRICATED BRONZE PLATES	LBS.	190	—	—	—	—	190
BEARING PADS	S.F.	17	—	—	—	—	17
BEARING PADS, ELASTOMERIC	S.F.	19	—	—	—	—	19
STEEL PILING, DELIVERED & DRIVEN HP 10 x 42	L.F.	—	410	—	—	395	805
TUBULAR RAILING, TYPE "T"	L.F.	332	—	—	—	—	332
SLOPE PAVING, CRUSHED AGGREGATE	S.Y.	—	253	—	—	255	508
NON-BID ITEMS							
ALUMINUM OR ZINC PLATE	S.F.	35	—	—	—	—	35
POLYVINYL CHLORIDE WATERSTOP FILLER	L.F.	—	55	—	—	59	114
	SIZE	—	—	—	—	—	1/8" x 3/4" x 3/4"

94730

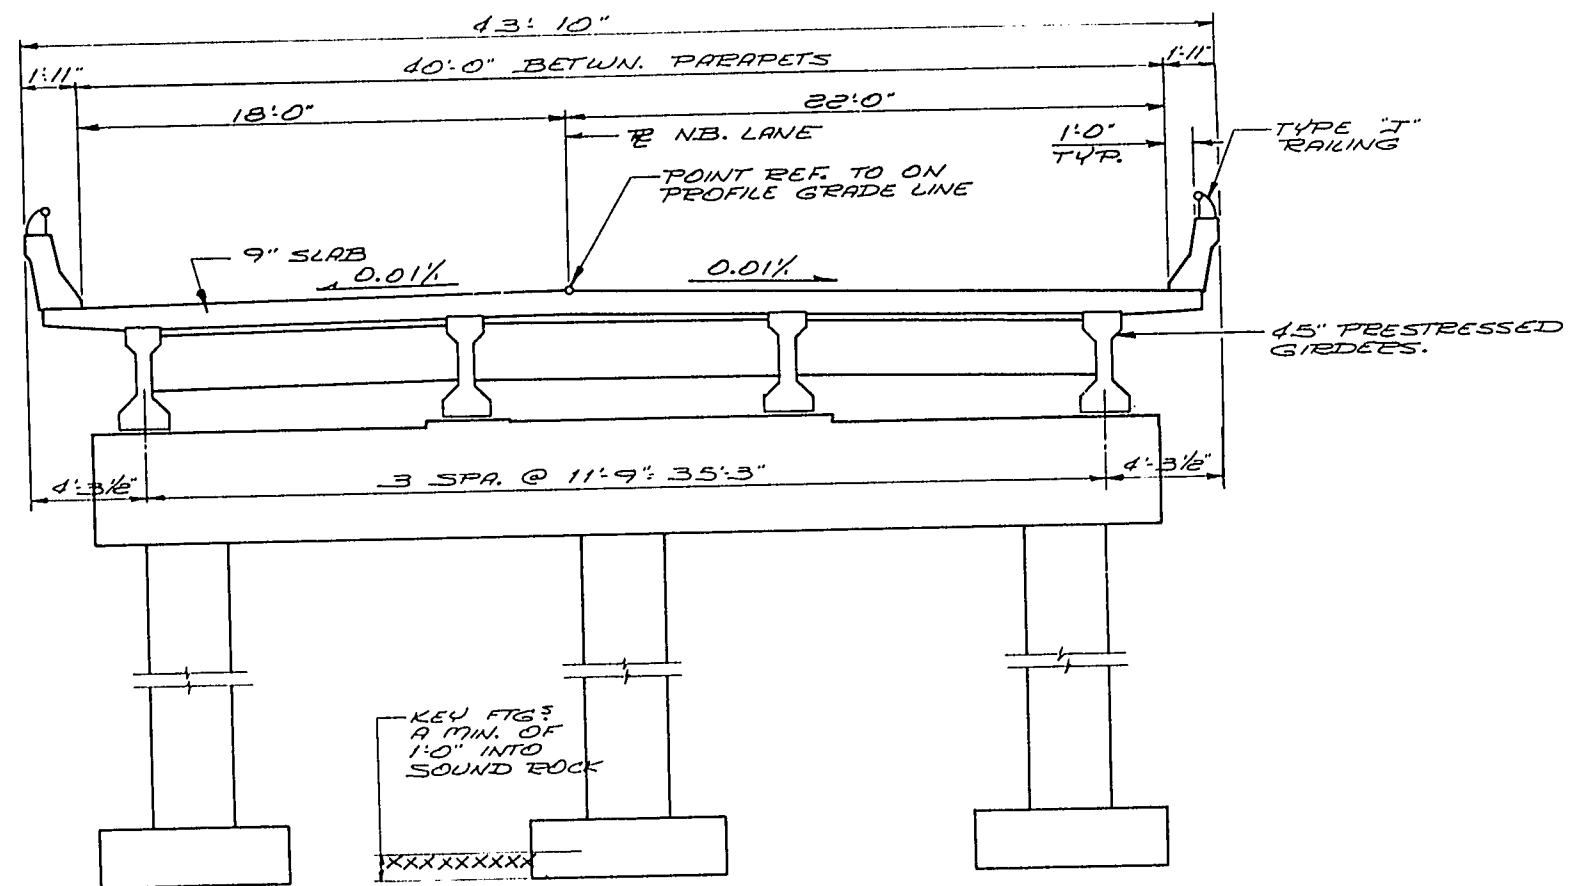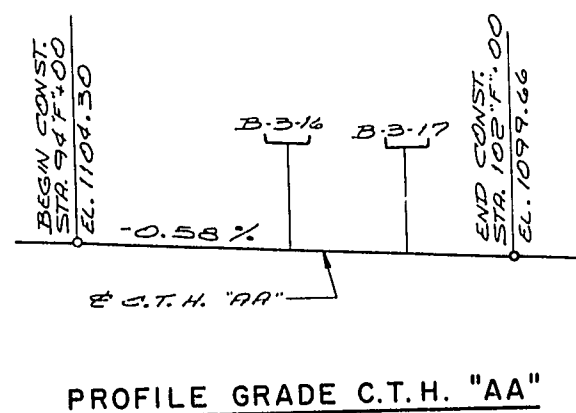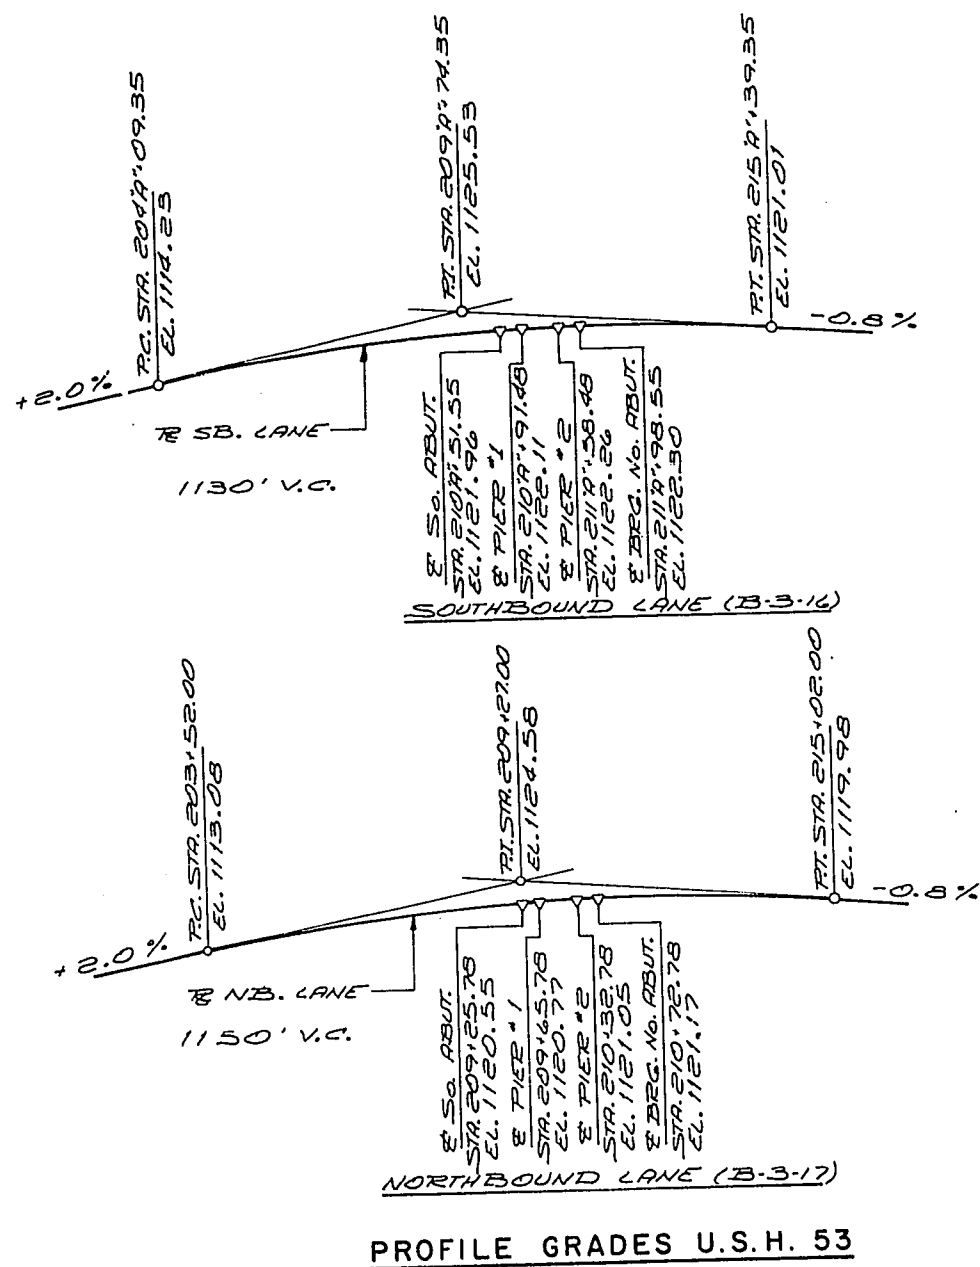

PROJECT ID	1196-6-76	SHEET NUMBER	65	TOTAL SHEETS	296
FEDERAL PROJECT DESIGNATION	EMP F08-4(36)				

No.	Date	Revision	By
STATE OF WISCONSIN DEPARTMENT OF TRANSPORTATION DIVISION OF HIGHWAYS			
STRUCTURE B-3-17			
Const. Spec.	1969	Drawn By	BUDD
		Plants Checked	G.H.A.
GENERAL PLAN			SHEET 2 OF 16
			X46178

ABBREVIATIONS		
F — Fine	M — Medium	C — Coarse
Ws — Weathered	So — Sound	

MATERIAL SYMBOLS		
Topsoil	Silt	Sandstone
Sand	Peat	Limestone
Gravel	Clay	Igneous Rock

**LEGEND OF PROBING**

95/6=95 Blows for 6" Penetration  
Probing taken with a 350# wt. Falling 18" on a 2" O. D. Point.

Probing No.  
Sta.  
Elevation  
7 Average Blows Per Foot  
Refusal 95/6

**LEGEND OF BORING**

Elev.  
Boring No.  
Sta.

Unconfined Strength 7.7  
Blows Per Ft. Using 140# Wt. Falling 30"  
Wash Sample  
Shelby Tube — S. T.

Ground Water Elevation  
No Ground Water Observed Above This Elevation



Sandy Gravel  
F.  
Boulders or Cobbles  
Sand  
Silty Clay  
So  
Limestone

Unless otherwise specified, the blows per foot at the locations indicated are based on driving a 2" O. D. x 1.4" I. D. split spoon sampler with a 140# hammer having a free fall of 30". The blow count is taken in undisturbed soil immediately below a cased or open hole eliminating side friction on the drive pipe.

**SUBSURFACE EXPLORATION FOR FOUNDATION DESIGN AND BIDDERS INFORMATION**

To obtain relative data concerning the character of material in and upon which the foundation might be built, borings and/or soundings were made at points approximately as indicated on this drawing. The data presented herein represents the findings of the subsurface explorations made. However, because the depths investigated are limited and the area of the borings and/or soundings is very small in relation to the entire area, the Division of Highways does not warrant conditions below the depths investigated or that the classification of material encountered in these investigations is necessarily typical of the entire site.


No.	Date	Revision	By
STATE OF WISCONSIN DEPARTMENT OF TRANSPORTATION DIVISION OF HIGHWAYS			
STRUCTURE <b>B-3-17</b>			
Const. Sec.	1969	Drawn By <b>D.C.M.T.A.</b>	Plans Checked <b>G.H.A.</b>
SUBSURFACE EXPLORATION			SHEET 3 OF 16 <b>X46179</b>

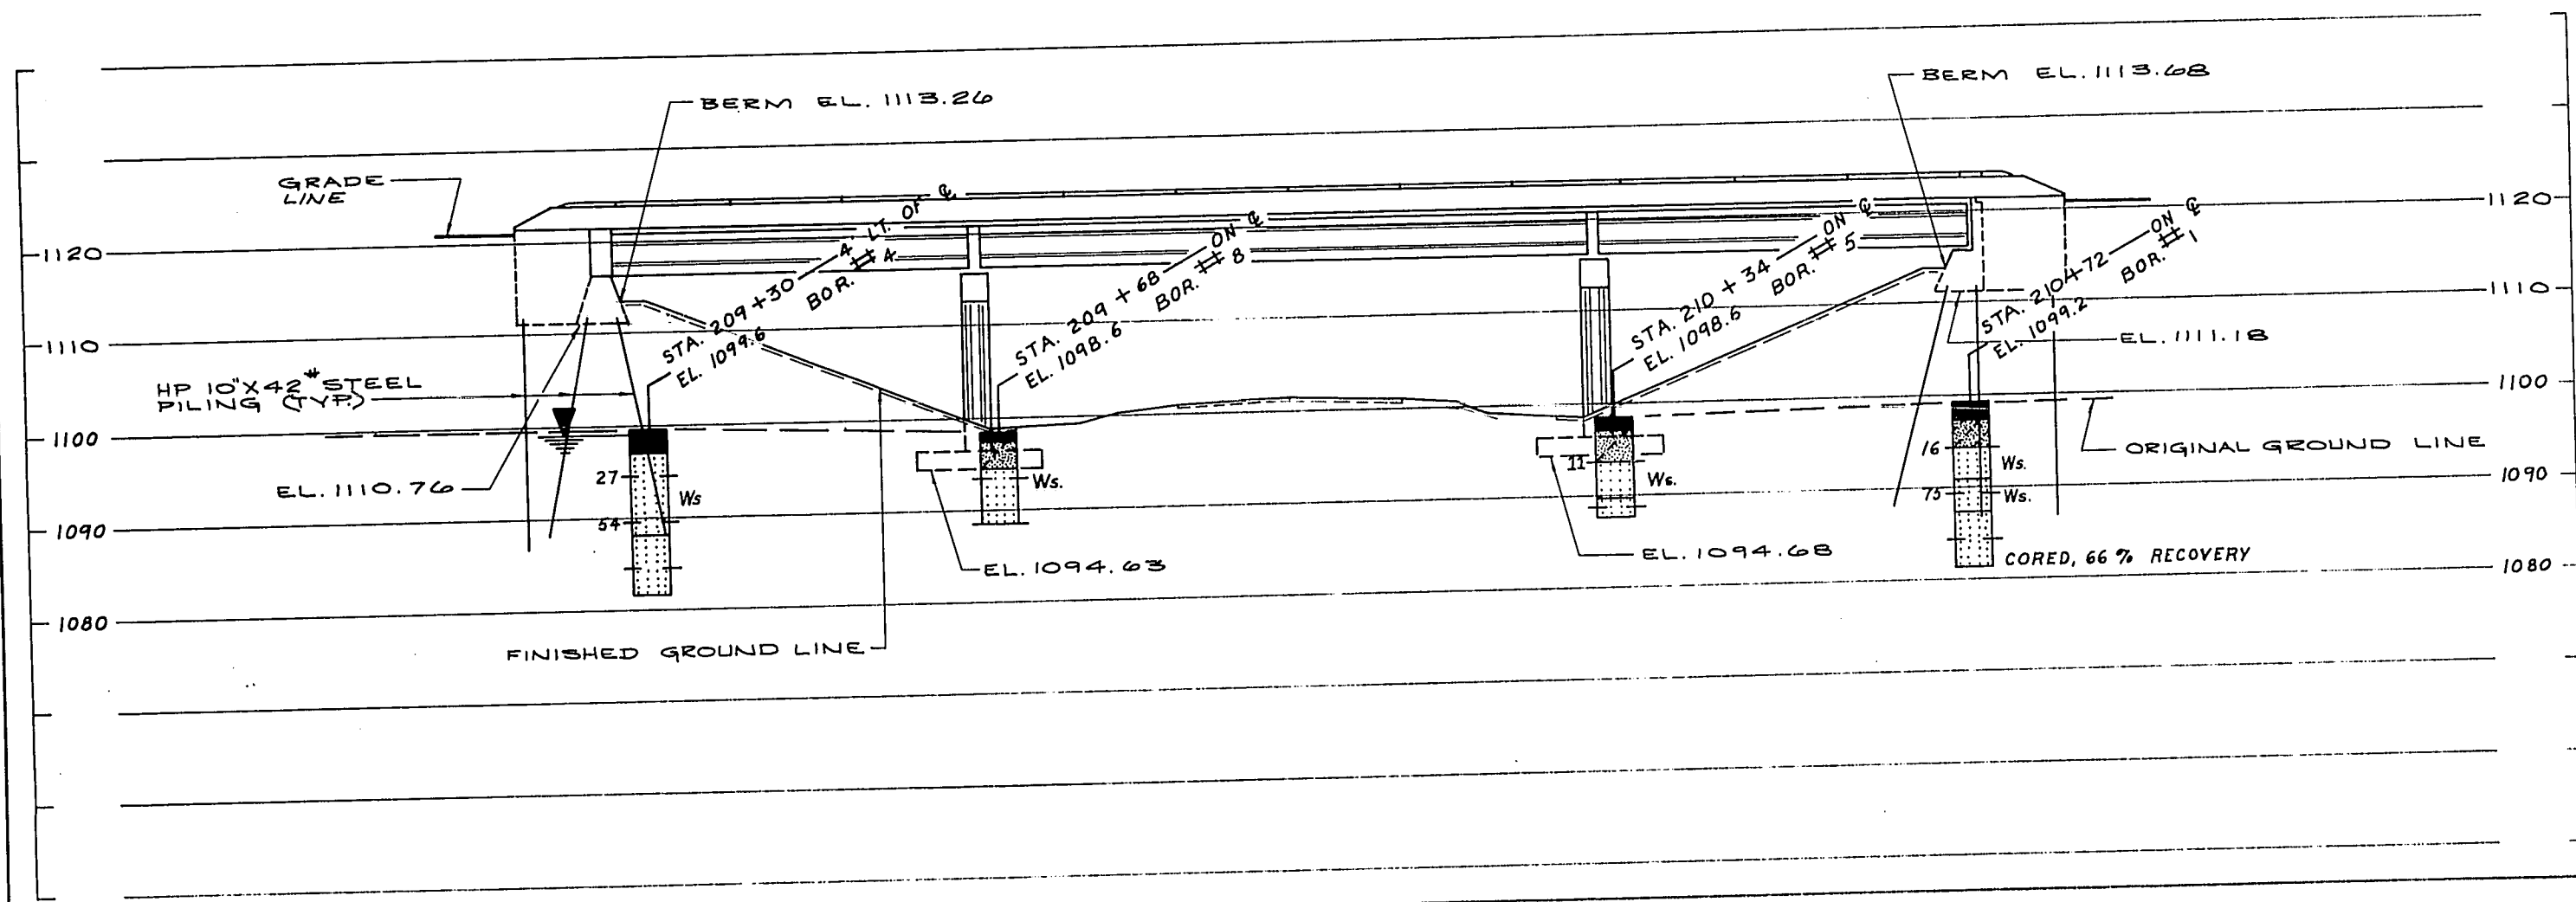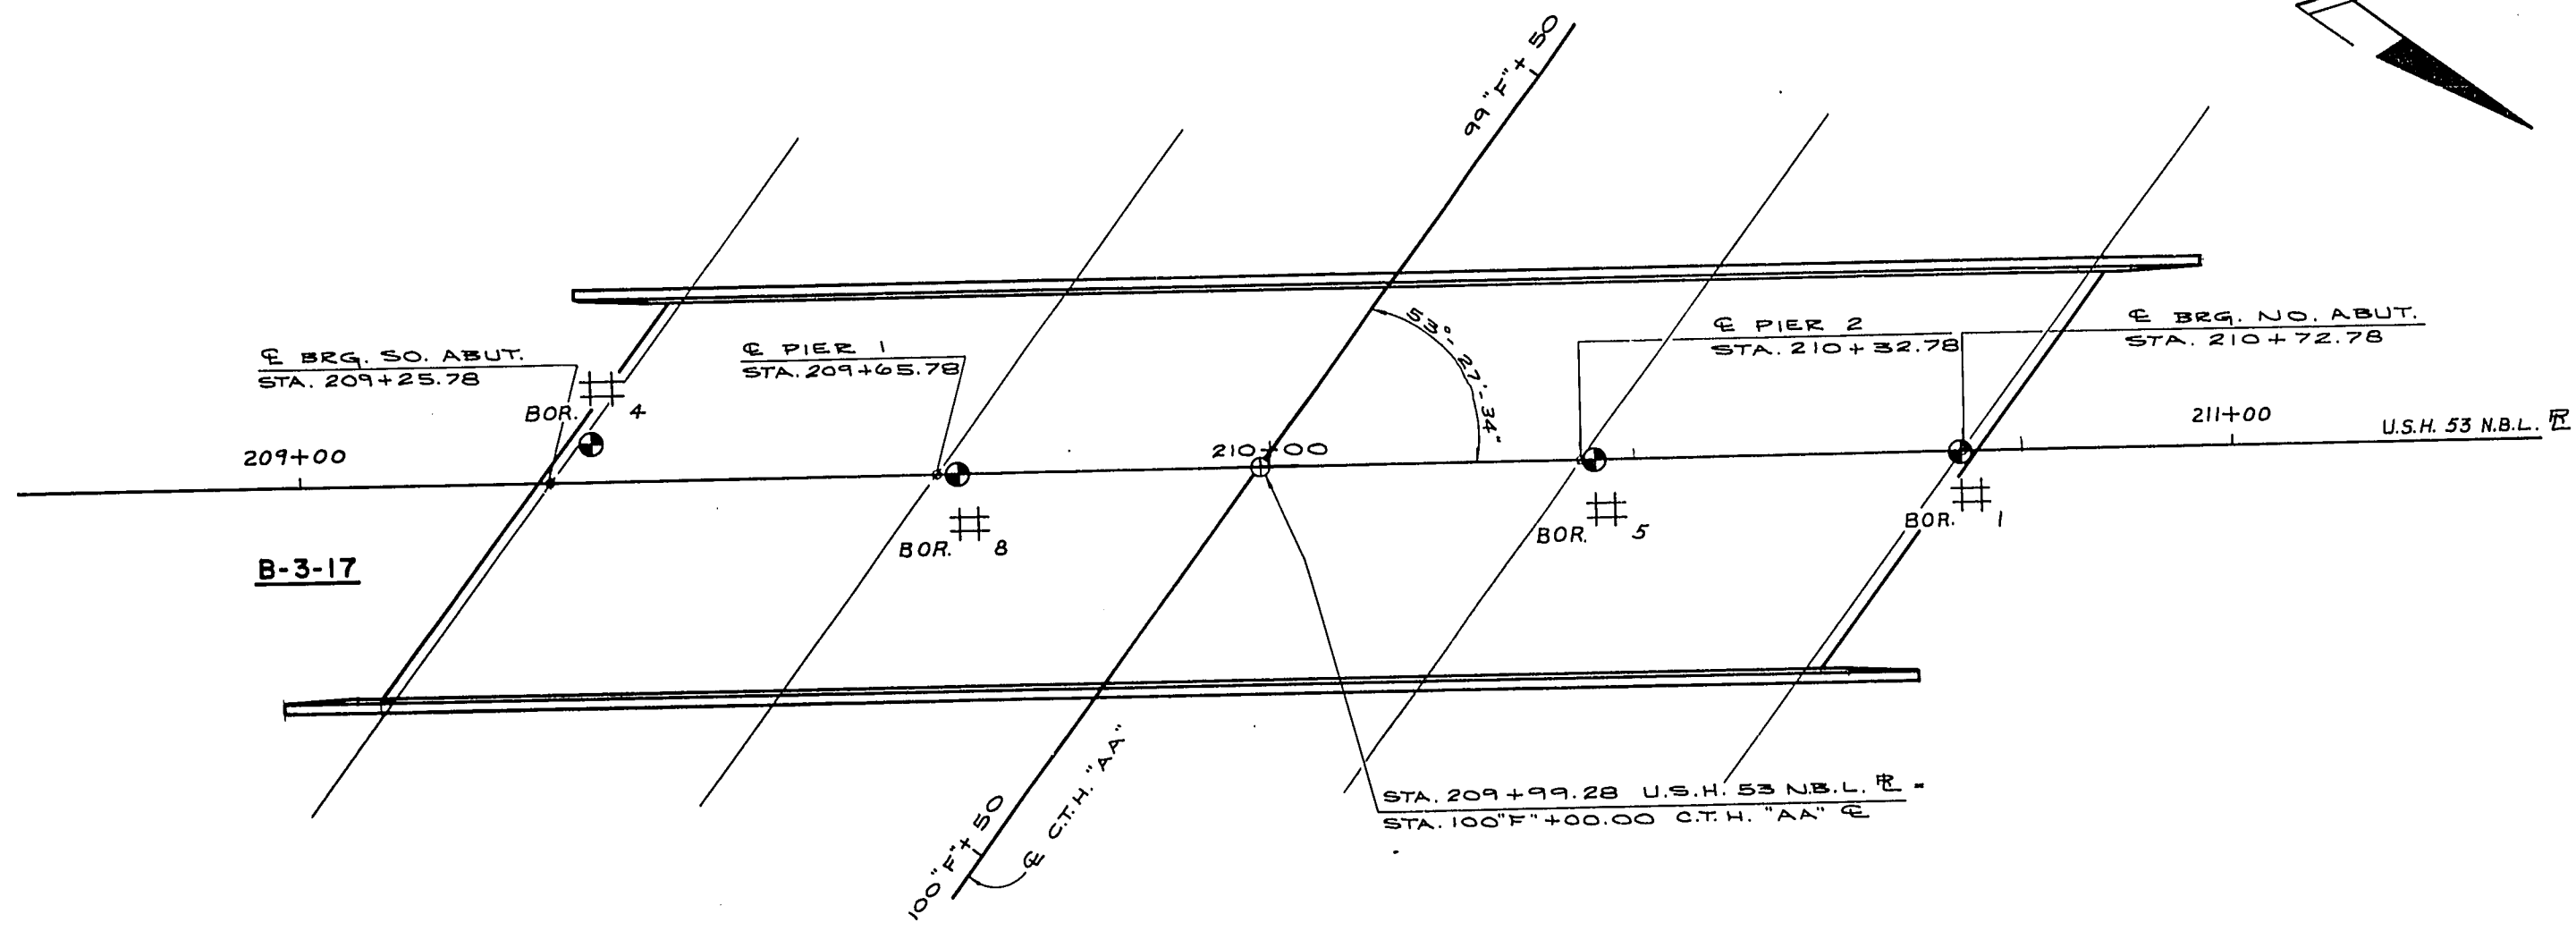

\* THESE ELEV. GIVEN AT  $\phi$  OF ABUT.  
 \*\* THESE DIMENSIONS GIVEN AT BACK FACE OF ABUT. \* EL. 1115.76  
 W.T. EL. 1120.14 — F.F. EL. 1120.22 —

PROJECT ID <b>1196-6-76</b>	SHEET NUMBER	TOTAL SHEETS
FEDERAL PROJECT DESIGNATION <b>EMP F08-4(36)</b>	<b>67</b>	<b>296</b>

NOTE: FOR RAIL PARAPET DETAILS  
SEE SHEET 15  
FOR FILE SPLICE DETAILS  
SEE SHEET 5

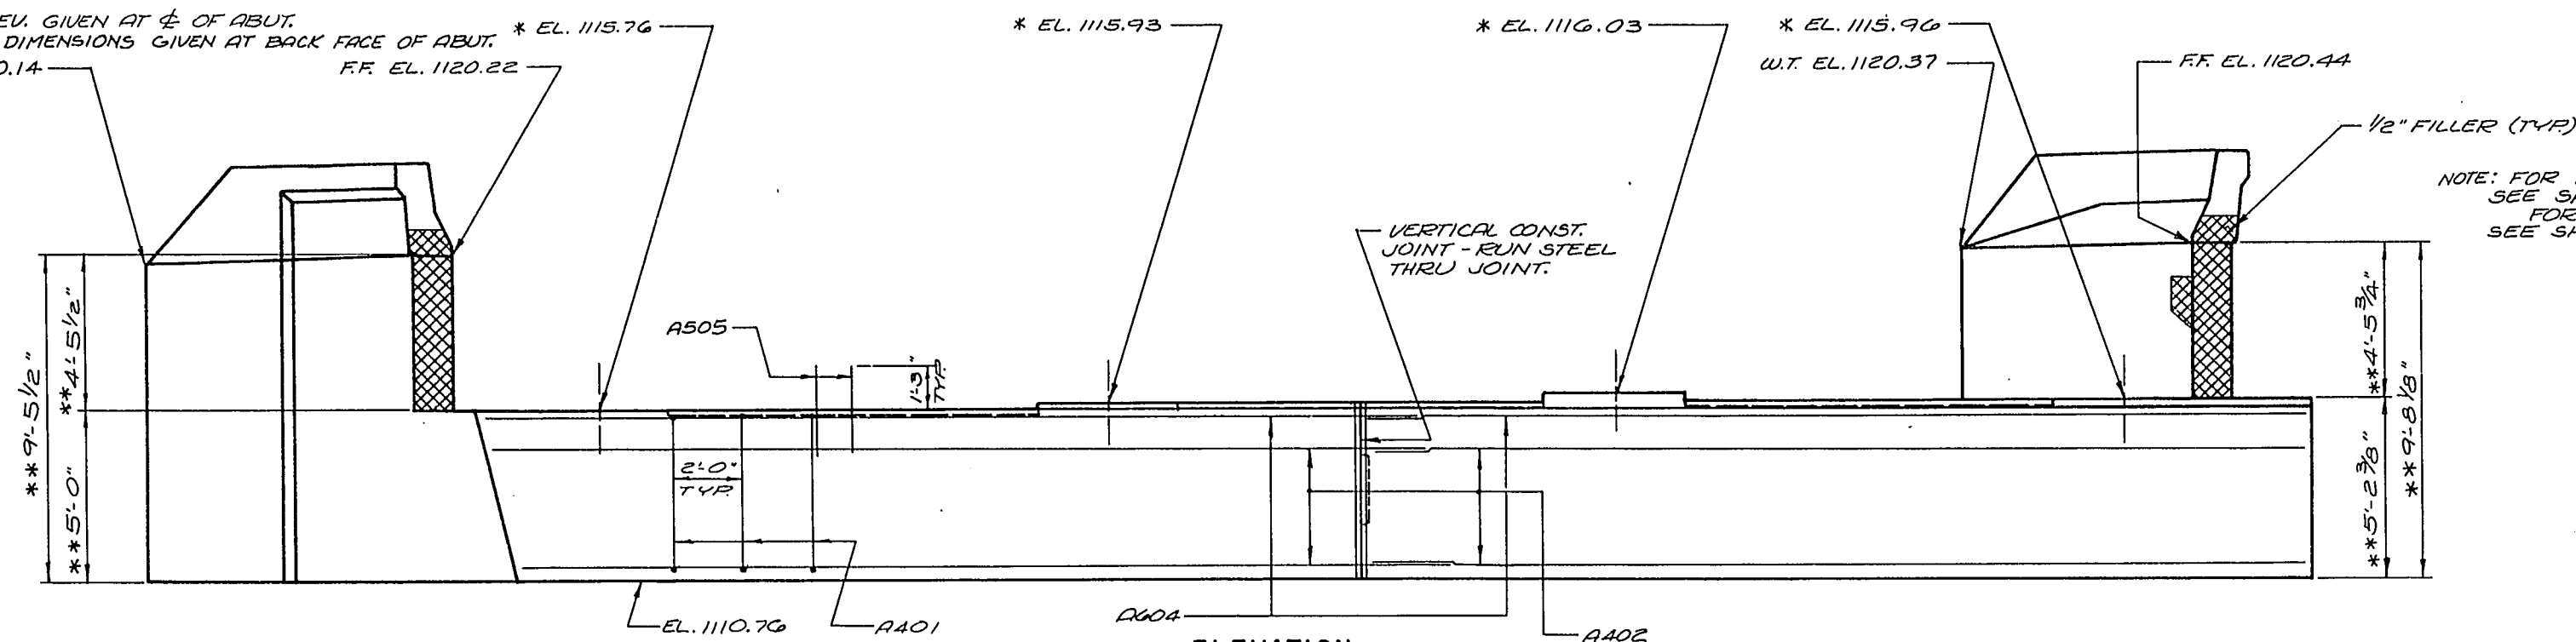

ELEVATION  
(LOOKING SOUTH)


SEAL JOINT WITH CONTRACTION TYPE  
POLYVINYL CHLORIDE WATERSTOP - TO  
EXTEND FROM BOTTOM TO TOP OF ABUT.  
FLUSH WITH FACE OF CONCRETE. FOR  
DETAIL SEE SHEET 5

NOTE: HORIZ. WATERSTOP TO BE RUN FULL LENGTH. VERTICAL WATERSTOP TO BE CUT.

● SEAL JOINT WITH CONTRACTION  
TYPE POLYVINYL CHLORIDE  
WATERSTOP - TO EXTEND FULL  
LENGTH BETWEEN WINGS . FOR  
DETAIL SEE SHEET 5


NOTE: SPACE A401 BARS  
TO MISS PILING.

SEAL ALL EXPOSED HORIZONTAL AND VERTICAL SURFACES OF 1/2" FILLER WITH NON-STAINING GRAY NON-BITUMINOUS JOINT SEALER (1" DEEP AND HOLD 1/8" BELOW SURFACE OF CONCRETE.)

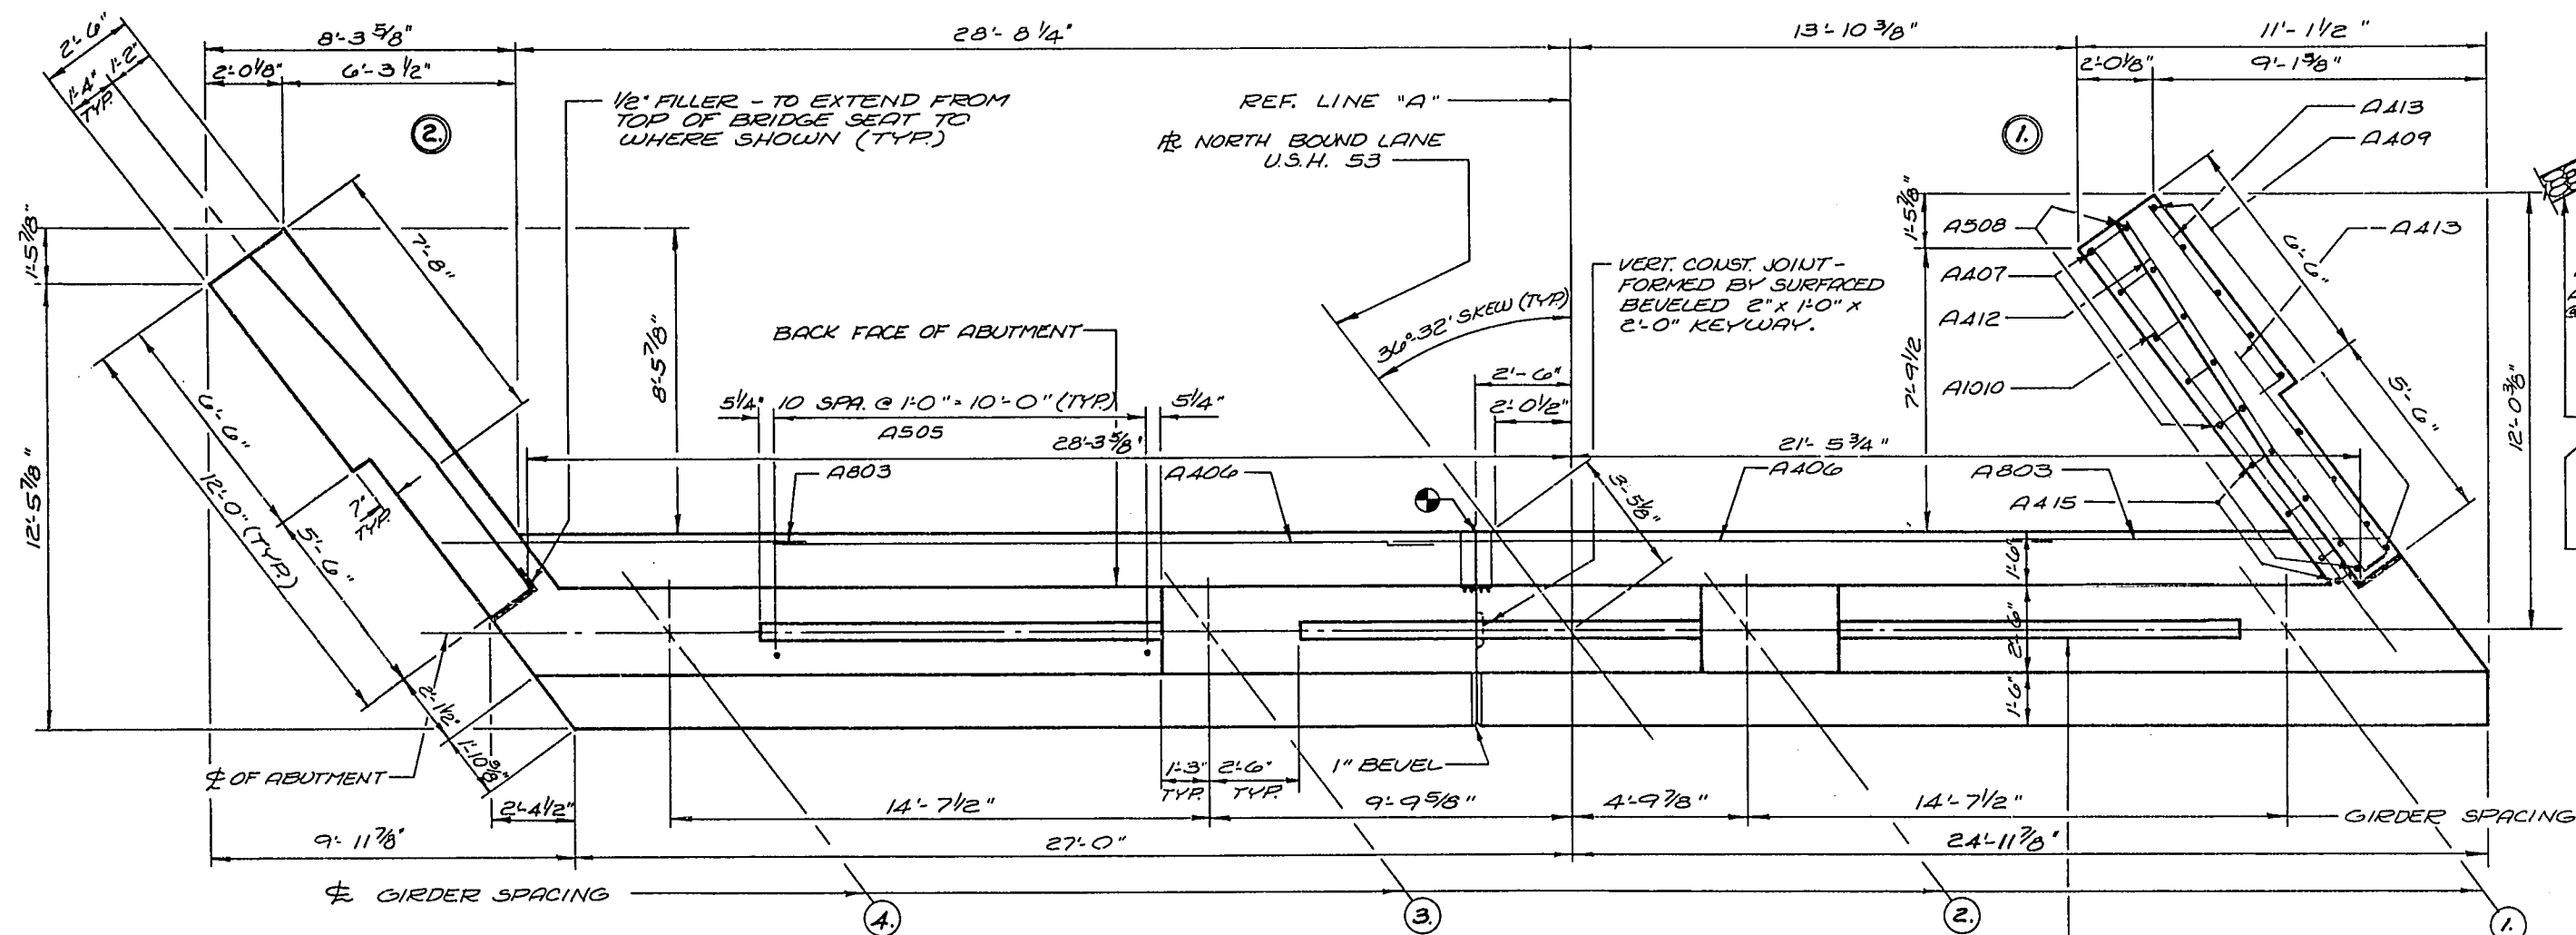

### ABUTMENT PLAN

KEYED CONST. JOINT FORMED  
BY SURFACED, BEVELED 2"x6"

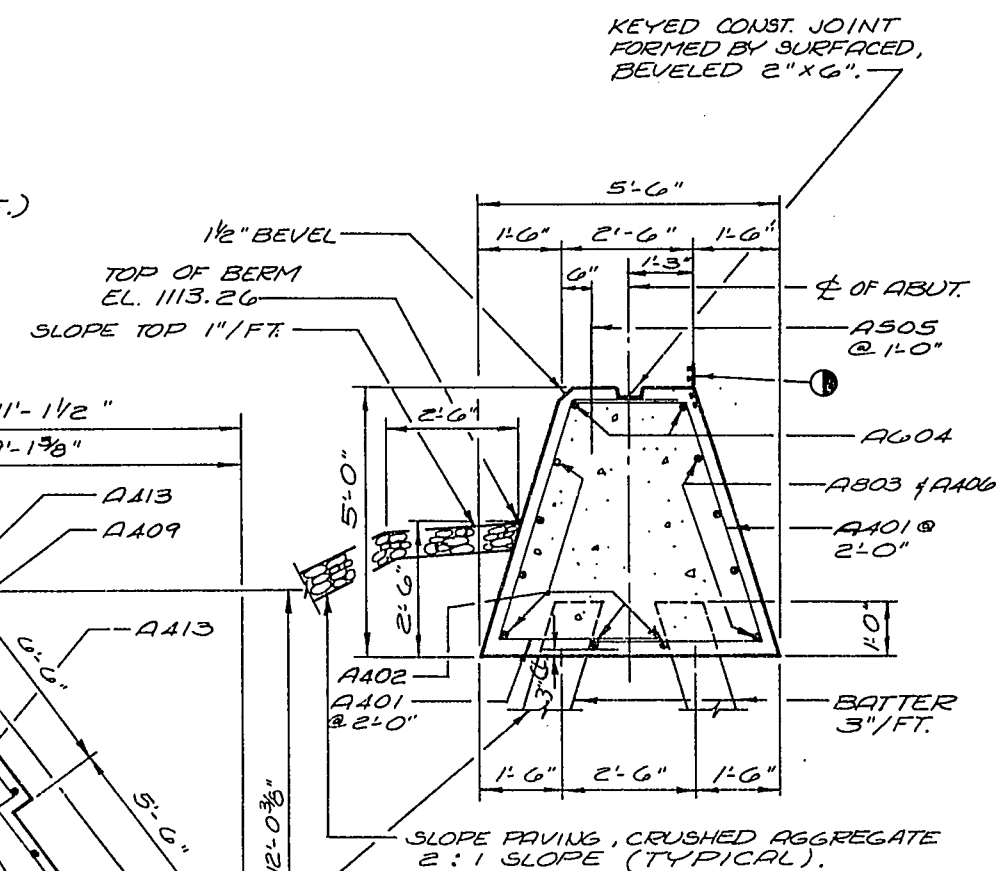

SECTION THRU BODY

H.P. 10x42 STEEL PILES EST. 25'-0" LONG  
AND DRIVEN TO A MIN. BRG. CAPACITY  
OF 55 TONS PER PILE.









No.	Date	Revision	By
STATE OF WISCONSIN DEPARTMENT OF TRANSPORTATION DIVISION OF HIGHWAYS			
STRUCTURE      B-3-17			
Const. Spec.	19 69	Drawn By      A.G.	Plans Checked      G.H.A.
SOUTH ABUTMENT			SHEET 4 OF 16  X 46180



NOTE : DIMENSIONS IN BENDING DETAILS ARE OUT TO OUT.

THE FIRST DIGIT OF A THREE DIGIT BAR MARK AND THE FIRST TWO DIGITS OF A FOUR DIGIT BAR MARK SIGNIFIES THE BAR SIZE.

BILL OF BARS

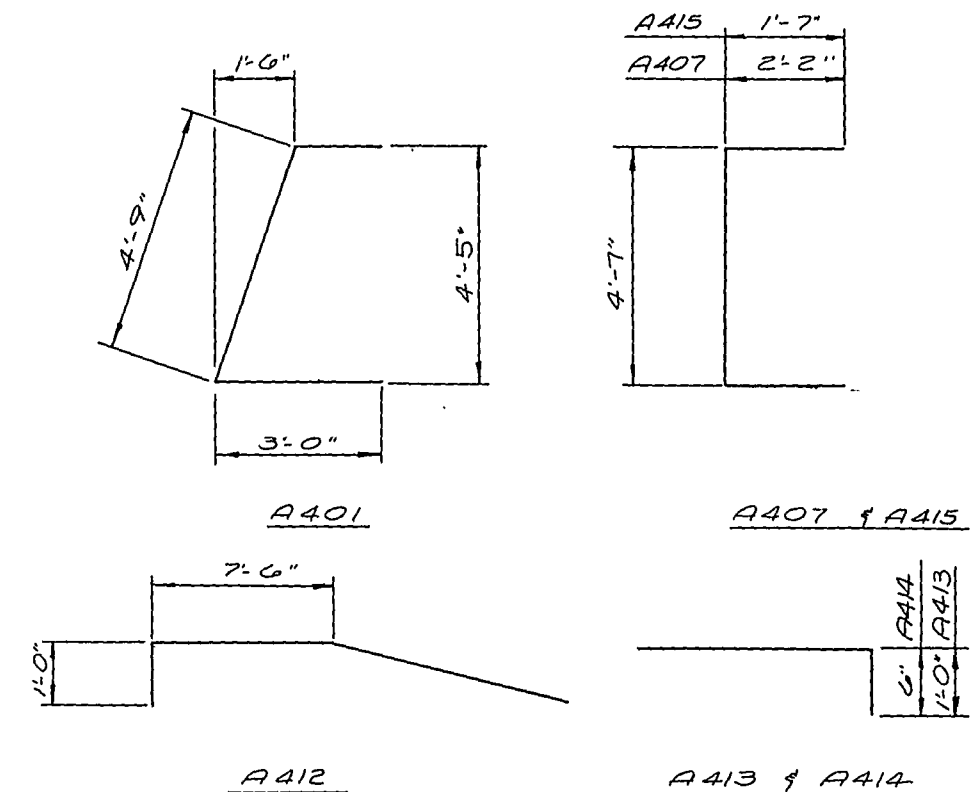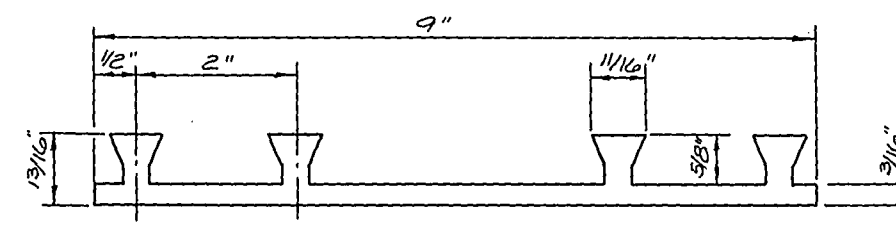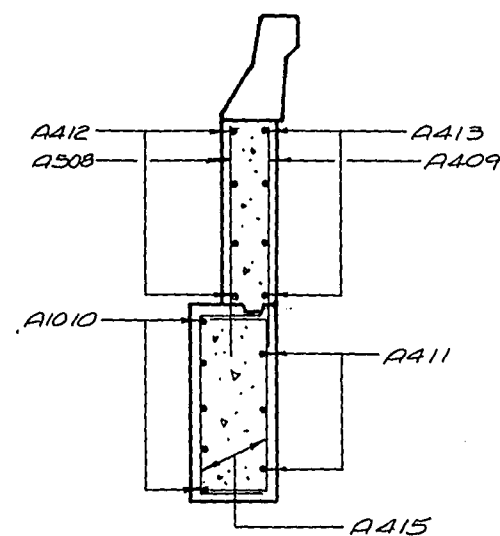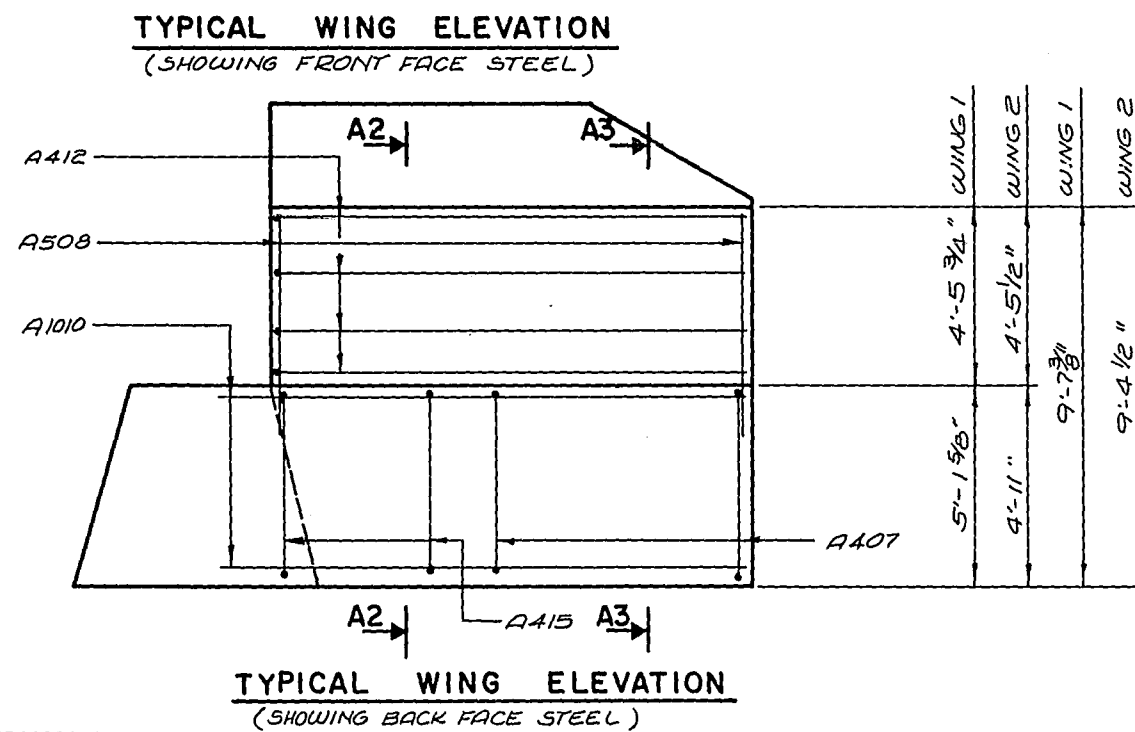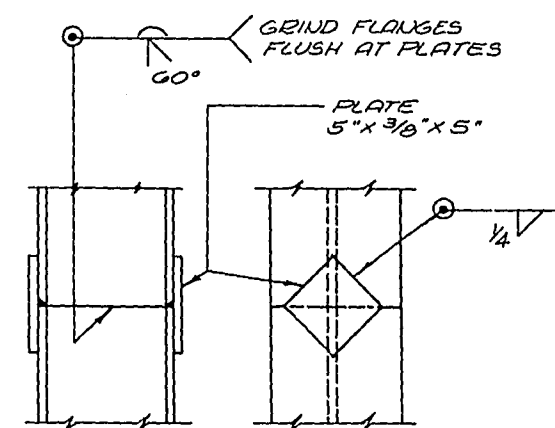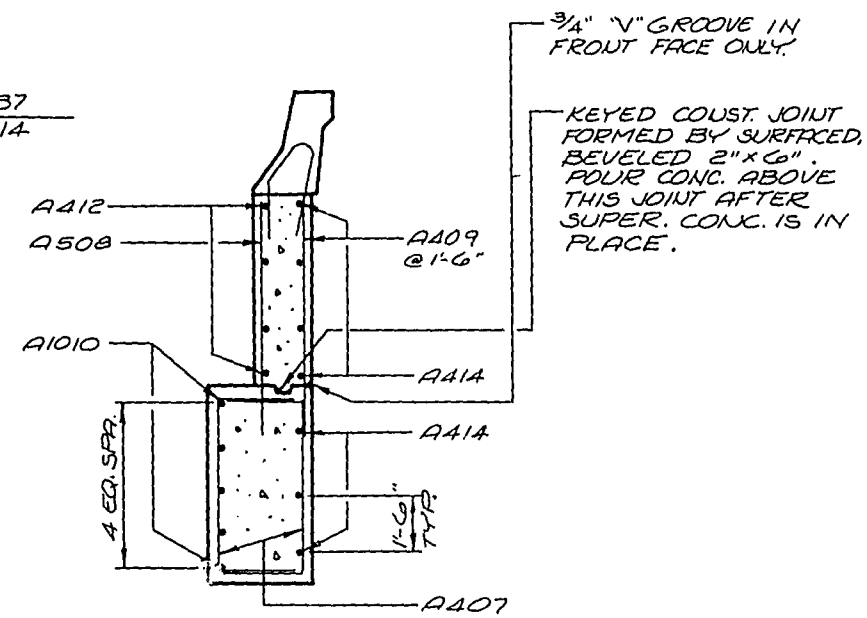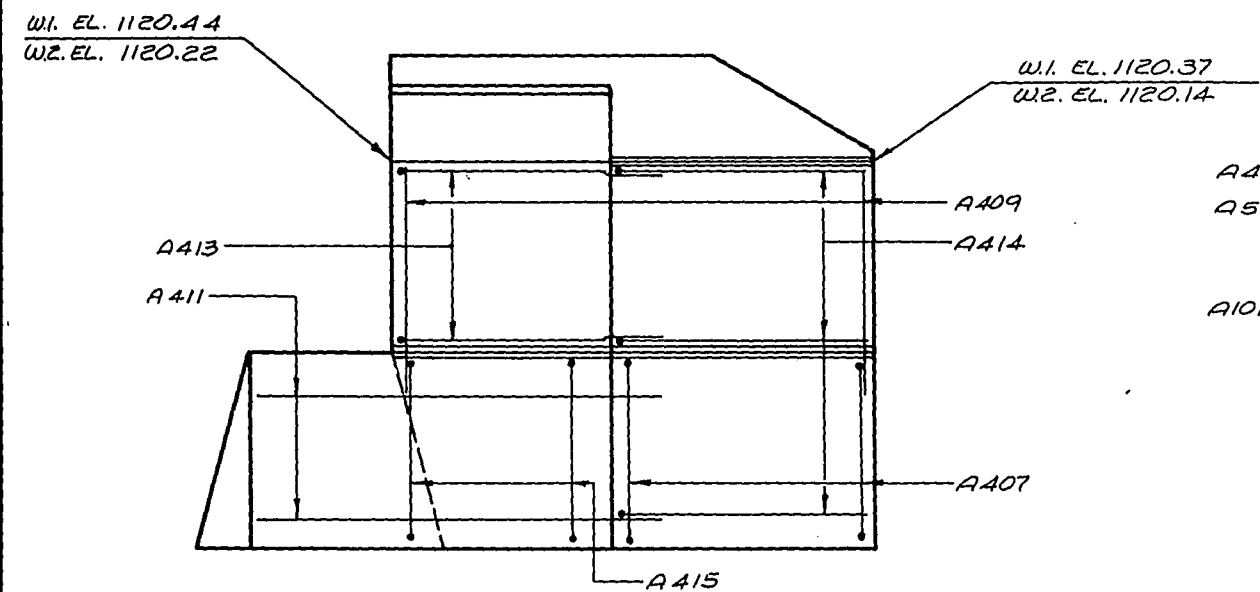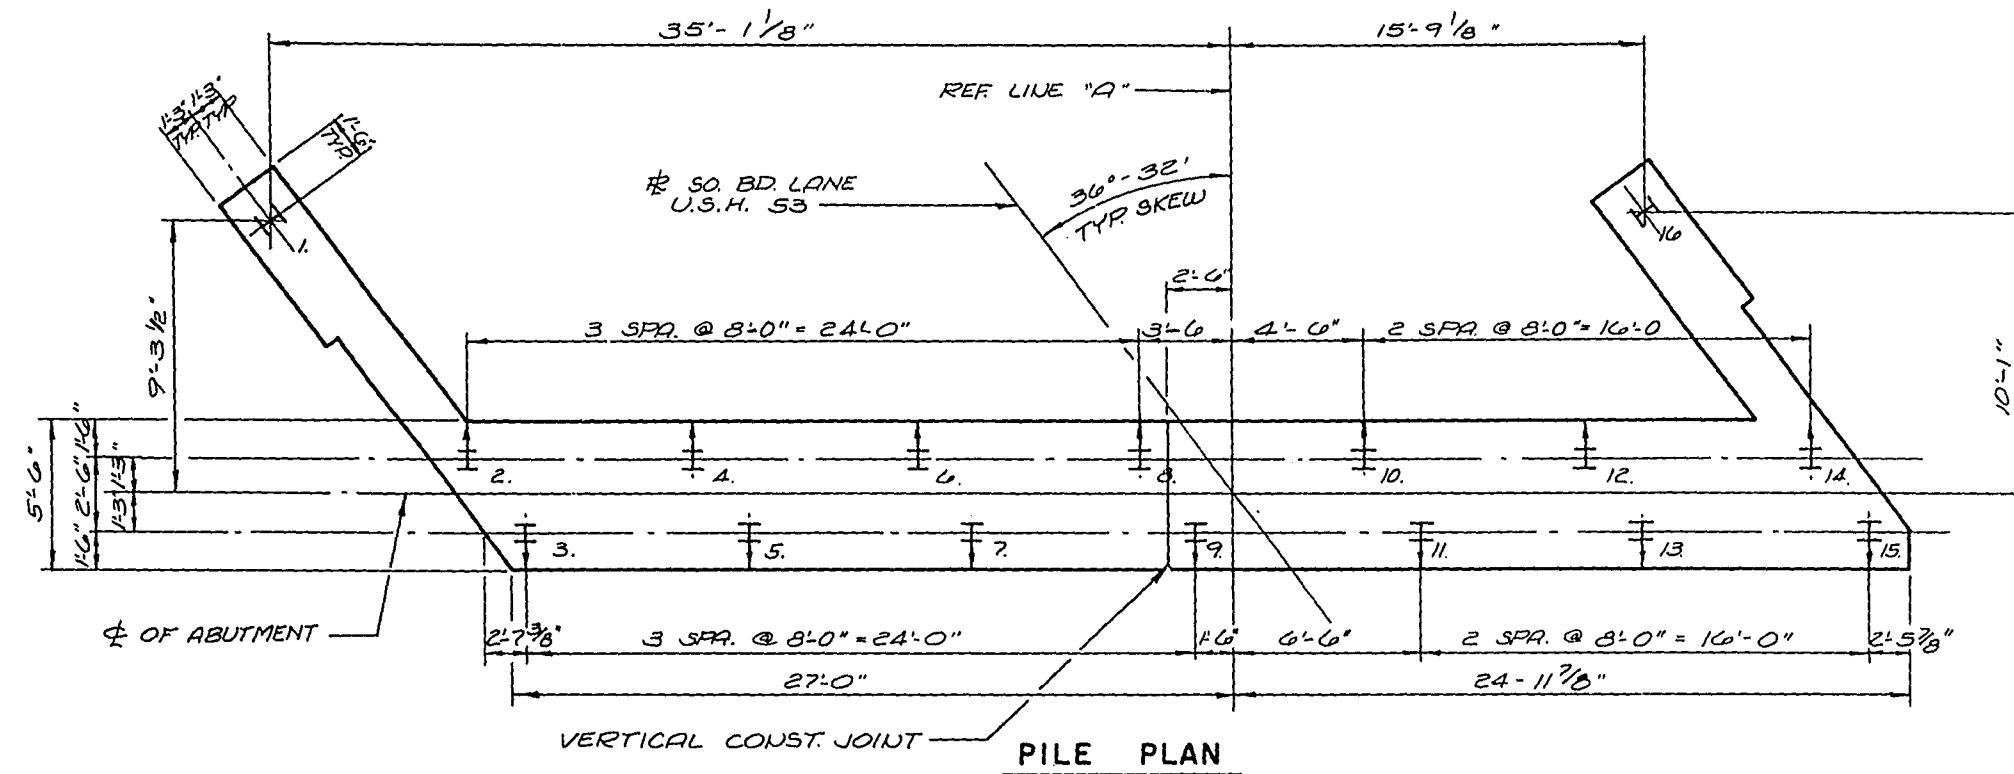
[illegible]

No.	Date	Revision	By
STATE OF WISCONSIN DEPARTMENT OF TRANSPORTATION DIVISION OF HIGHWAYS			
STRUCTURE      B - 3 - 17			
Const. Spec.	1969	Drawn By	A. G.      Plans Checked      G. H. A.
SOUTH ABUTMENT  DETAILS		SHEET 5 OF 16  X 46181	

\* THESE ELEV. GIVEN AT  $\frac{1}{2}$  OF ABUT.  
\* \* THESE DIMENSIONS TAKEN AT FRONT FACE OF PARAPET  
W.T. EL. 1121.05 \* F.F. EL. 1121.02

PROJECT I.D. 1196-6-76	SHEET NUMBER	TOTAL SHEETS
FEDERAL PROJECT DESIGNATION EMP FOB-4(36)	69	296

NOTE: FOR RAIL PARAPET DETAILS  
SEE SHEET 15  
FOR PILE SPLICE DETAIL  
SEE SHEET 5

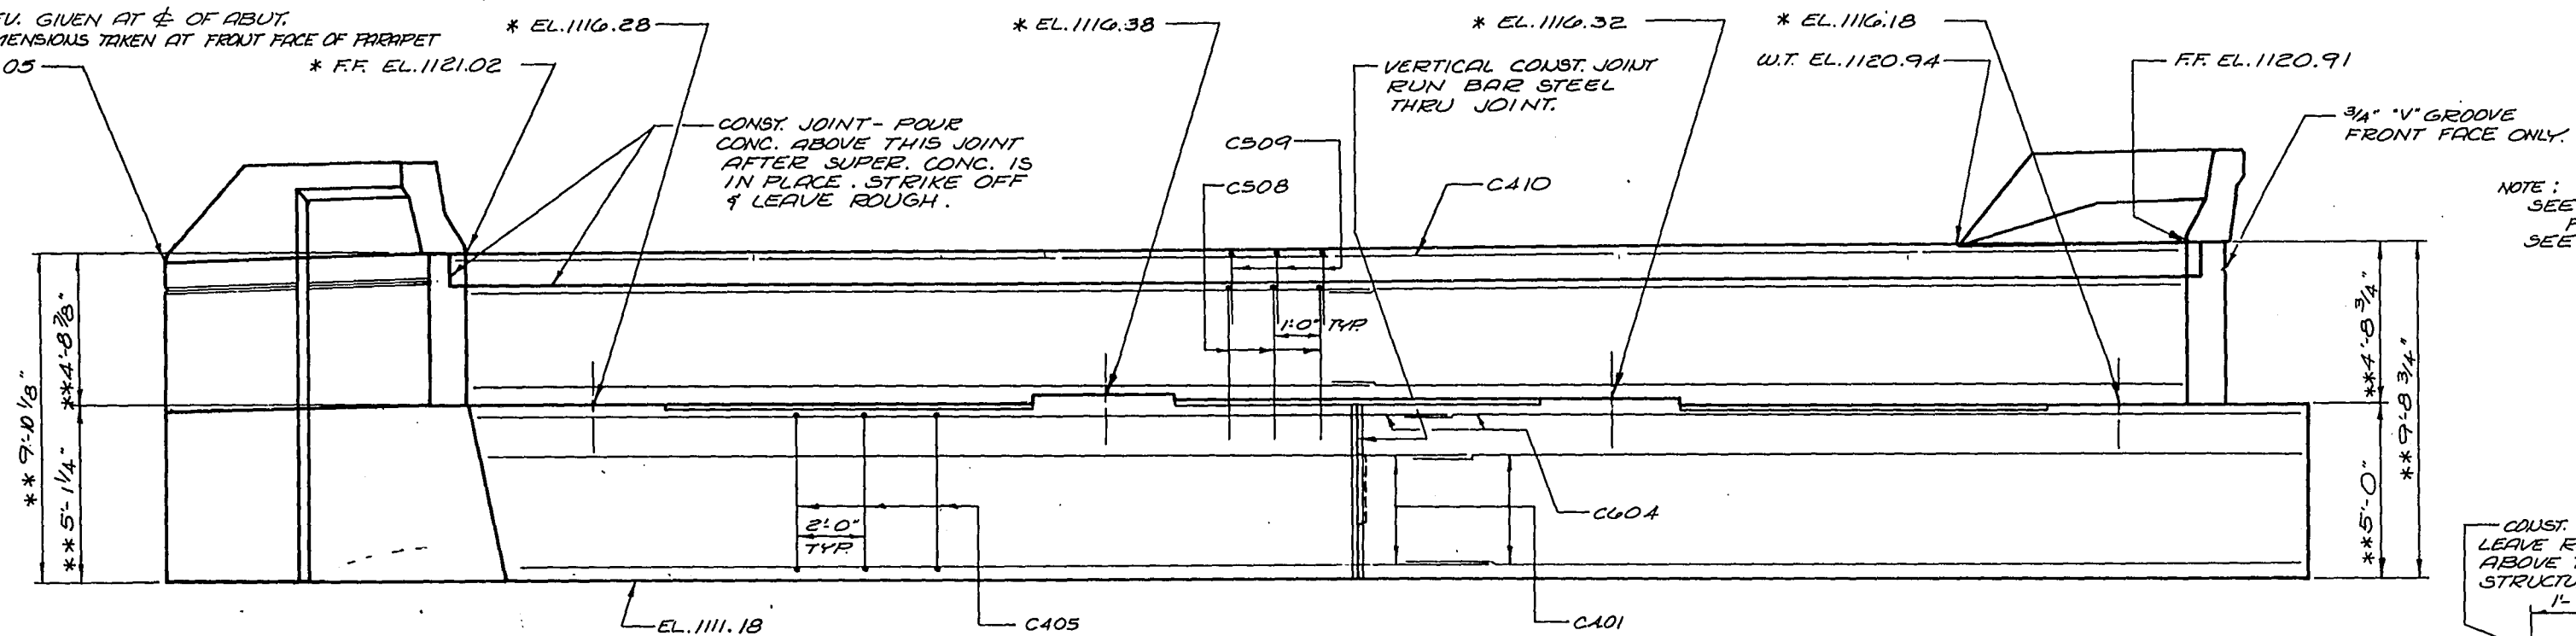

SEAL JOINT WITH CONTRACTION TYPE  
POLYVINYL CHLORIDE WATERSTOP - TO  
EXTEND FROM BOTTOM TO TOP OF ABUT.  
FLUSH WITH FACE OF CONCRETE. FOR  
DETAIL SEE SHEET 5

NOTE: HORIZ. WATERSTOP TO BE RUN FULL LENGTH. VERTICAL WATERSTOP TO BE CUT.


● SEAL JOINT WITH CONTRACTION  
TYPE POLYVINYL CHLORIDE WATER-  
STOP. TO EXTEND FULL LENGTH  
BETWEEN WINGS. FOR DETAIL  
SEE SHEET 5

NOTE: SPACE C405 & C406  
BARS TO MISS PILING.


SEAL ALL EXPOSED HORIZONTAL AND VERTICAL SURFACES OF 1/2" FILLER WITH NON-STAINING GRAY NON-BITUMINOUS JOINT SEALER (1" DEEP AND HOLD 1/8" BELOW SURFACE OF CONCRETE.)

KEYED CONST. JOINT FORMED  
BY SURFACED, BEVELED  
3" x 6"

TOP OF BERM EL. 1113.68  
SLOPE 1"/FT. \_\_\_\_\_  
SLOPE PAVING  
CRUSHED AGGREGATE

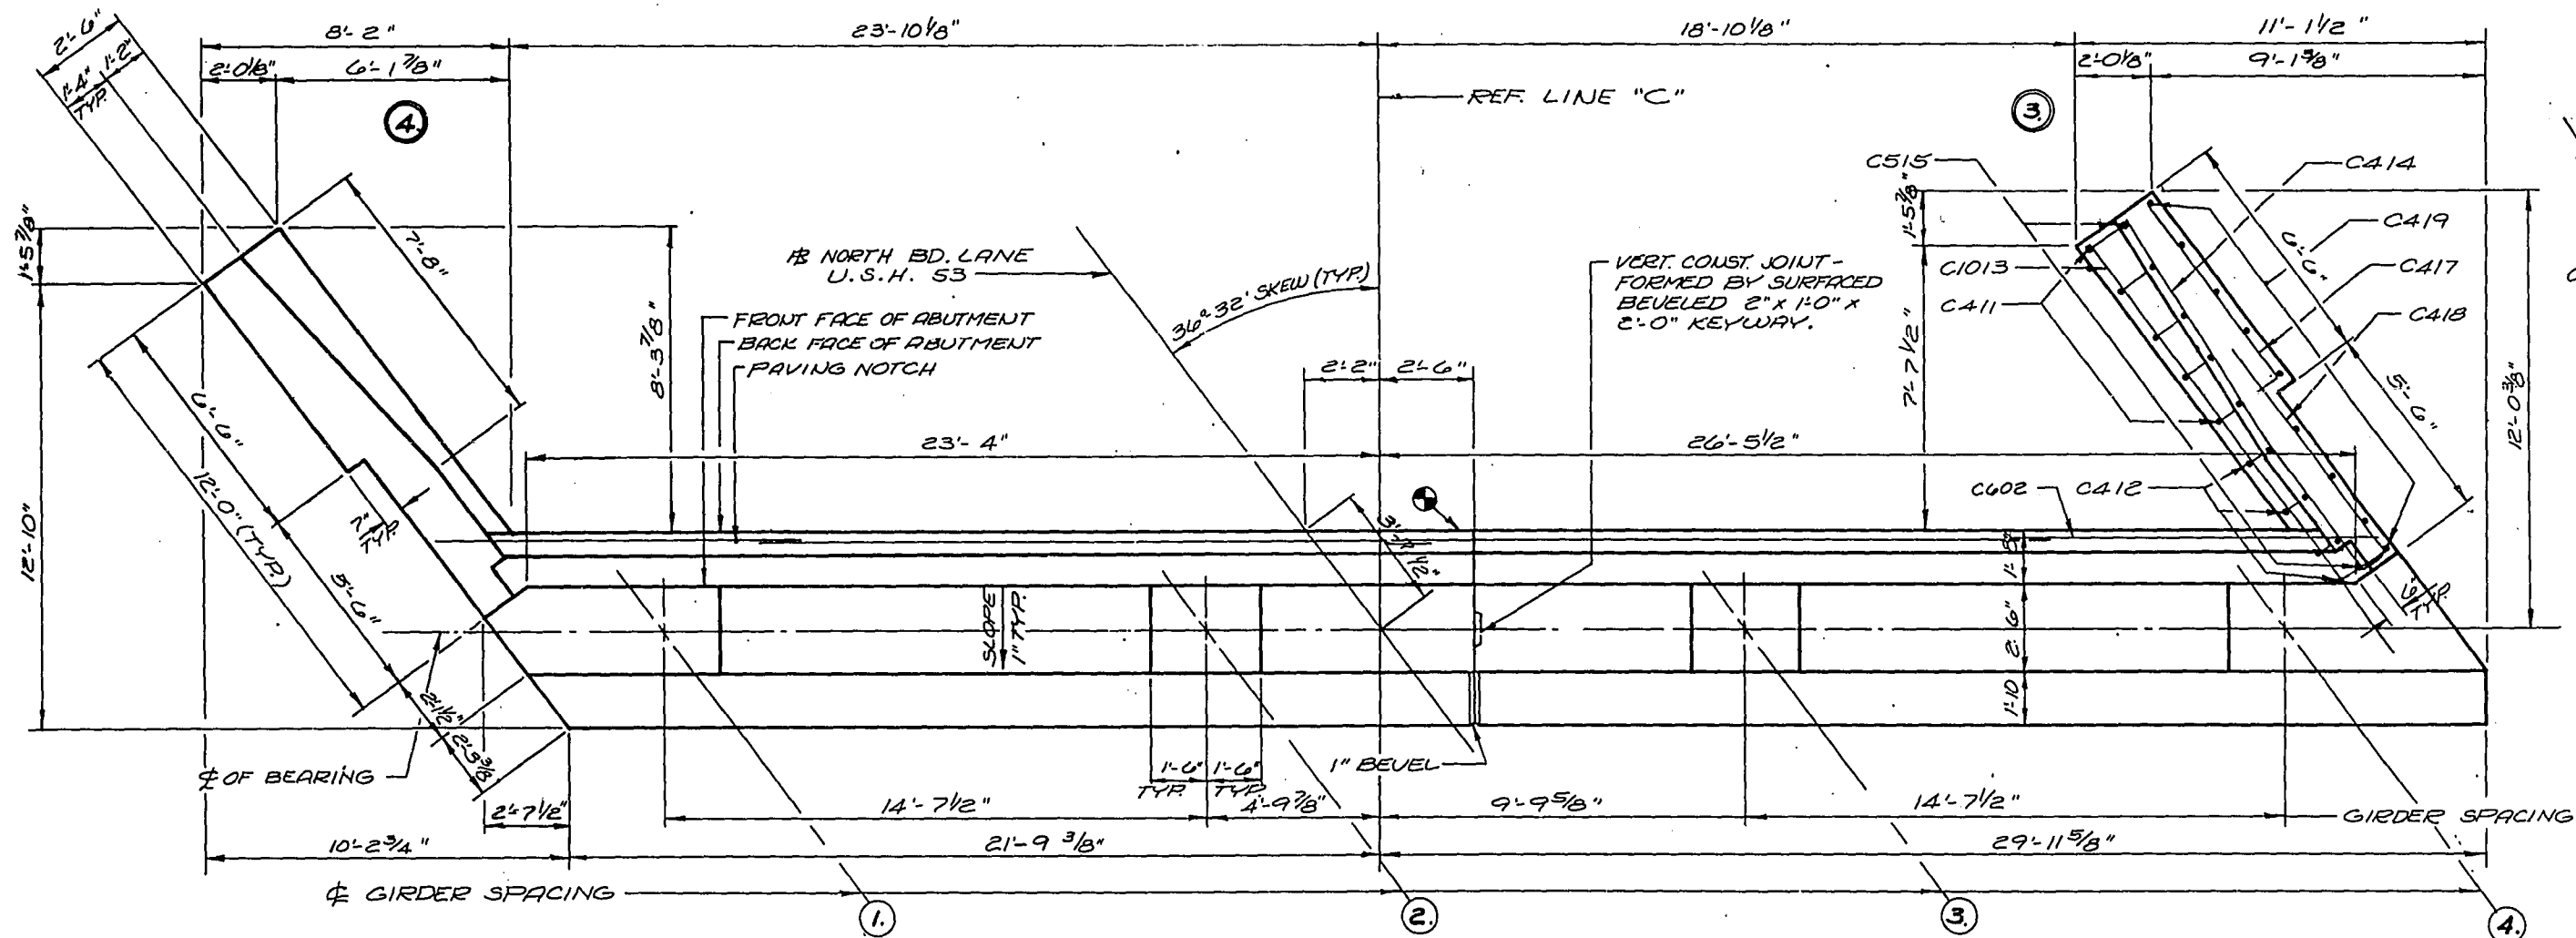

ABUTMENT PLAN

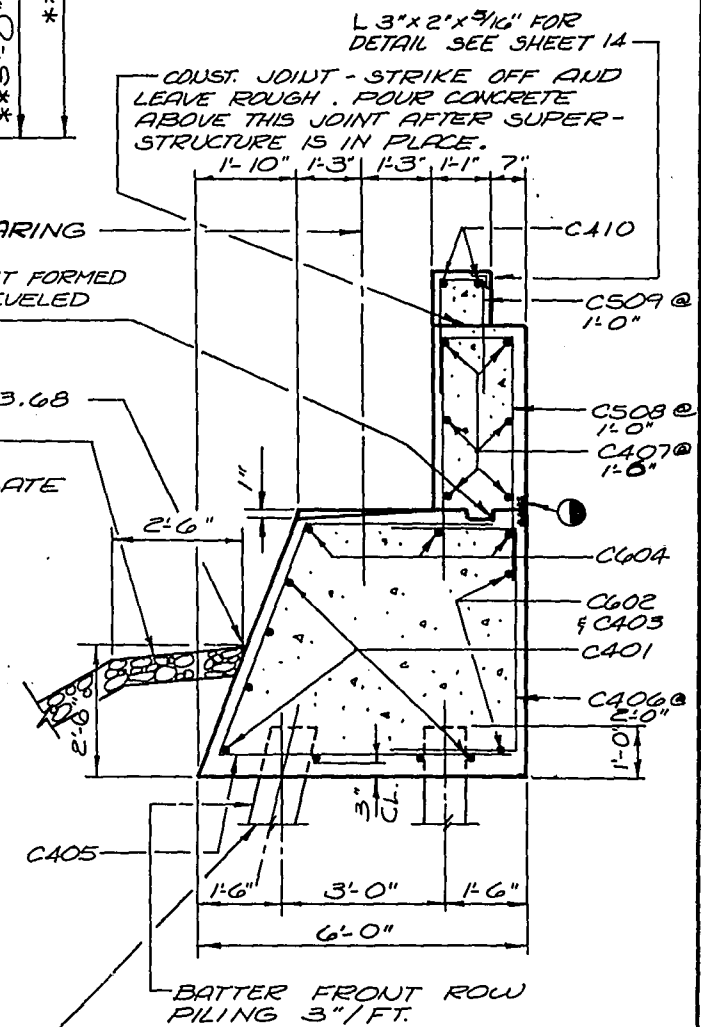

SECTION THRU BODY








— H.P. 10X42 STEEL PILES EST. 25'-0"  
LONG AND DRIVEN TO A MIN. BEARING  
CAPACITY OF 55 TONS PER PILE.

No.	Date	Revision	By
STATE OF WISCONSIN DEPARTMENT OF TRANSPORTATION DIVISION OF HIGHWAYS			
STRUCTURE B - 3 - 17			
Const. Spec.	1969	Drawn By	A. G.
		Plans Checked	G. H. A.
NORTH ABUTMENT		SHEET 6 OF 16	
		X 46182	

NOTE: DIMENSIONS IN BENDING DETAILS ARE OUT TO OUT THE FIRST DIGIT OF A THREE DIGIT BAR MARK AND THE FIRST TWO DIGITS OF A FOUR DIGIT BAR MARK SIGNIFIES THE BAR SIZE.

### BILL OF BARS

MARK	NO. REQ'D	LENGTH	BENT	LOCATION
C401	14	27-6		BODY HORIZ.
C402	4	10-0		" "
C403	4	19-0		" "
C404	6	27-0		" "
C405	27	13-0	X	" STIRRUPS
C406	27	9-0	X	" "
C407	12	28-0		BACKWALL HORIZ.
C508	51	10-10	X	" STIRRUPS
C509	51	4-8	X	PAVING BLOCK
C410	12	8-3		" "
C411	20	7-11	X	WING STIRRUPS
C412	10	6-11	X	" "
C1013	10	14-3		" HORIZ. B.F.
C414	8	12-5	X	" "
C515	18	5-10		" VERT. "
C416	6	8-6		" HORIZ. F.F.
C417	14	6-9	X	" "
C418	8	7-5	X	" "
C419	18	5-7		" VERT. "

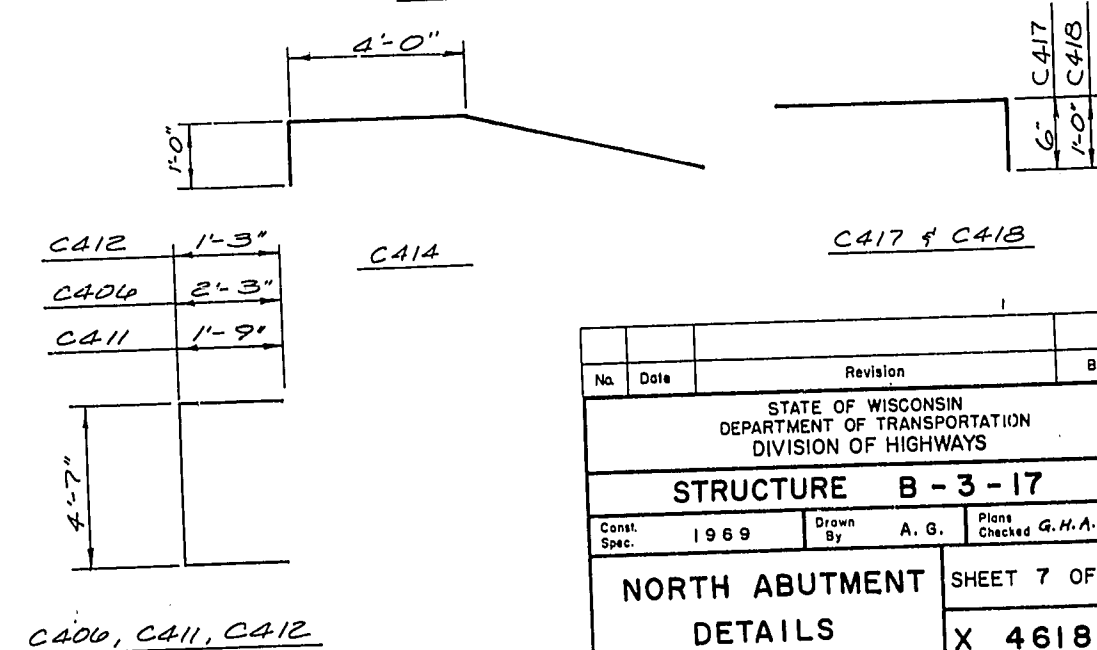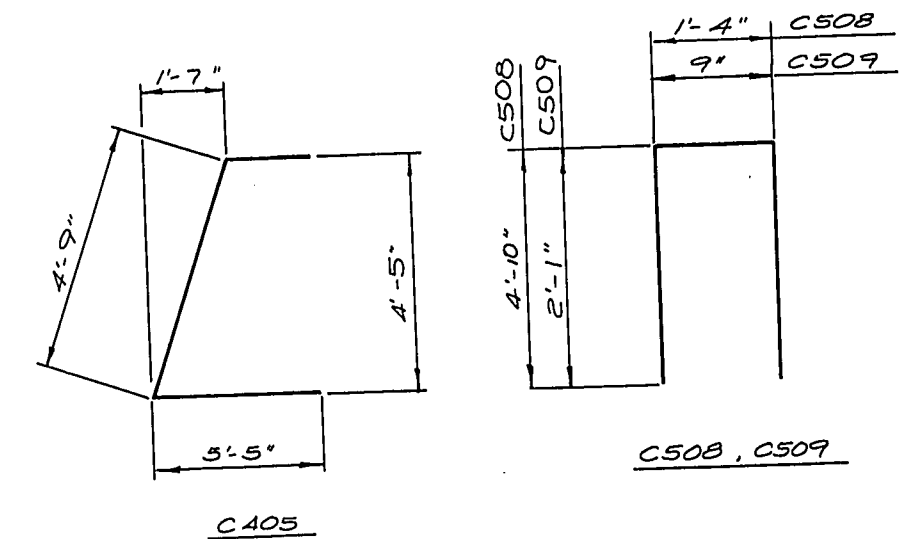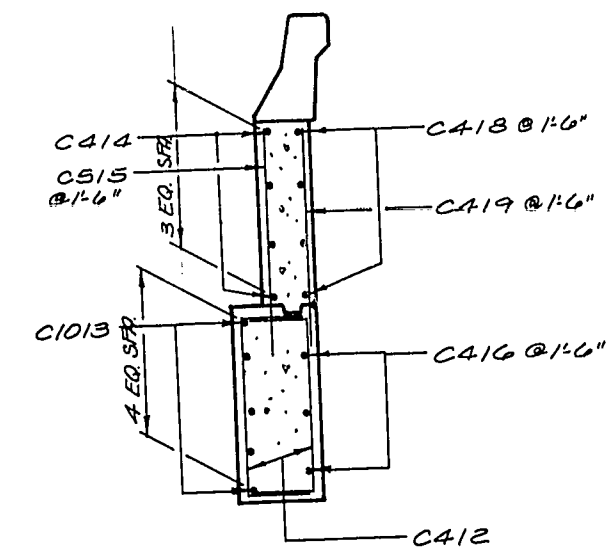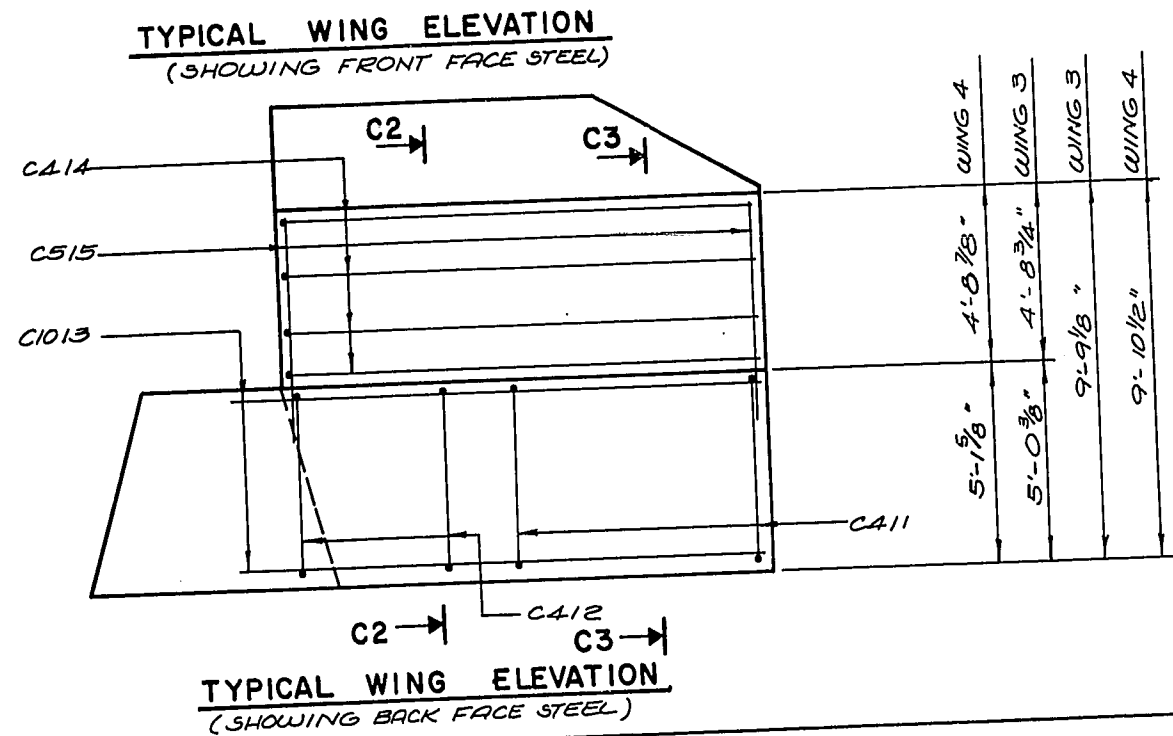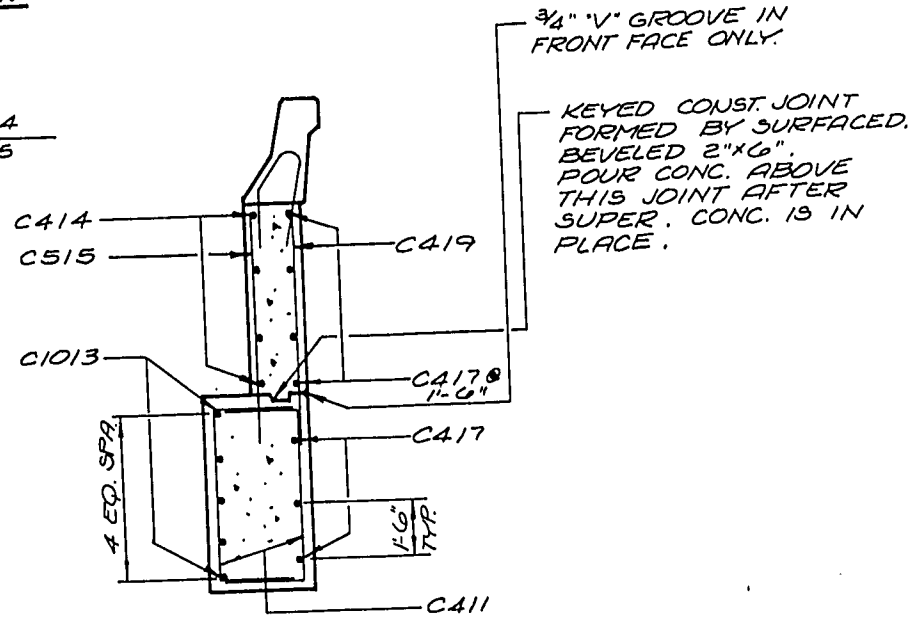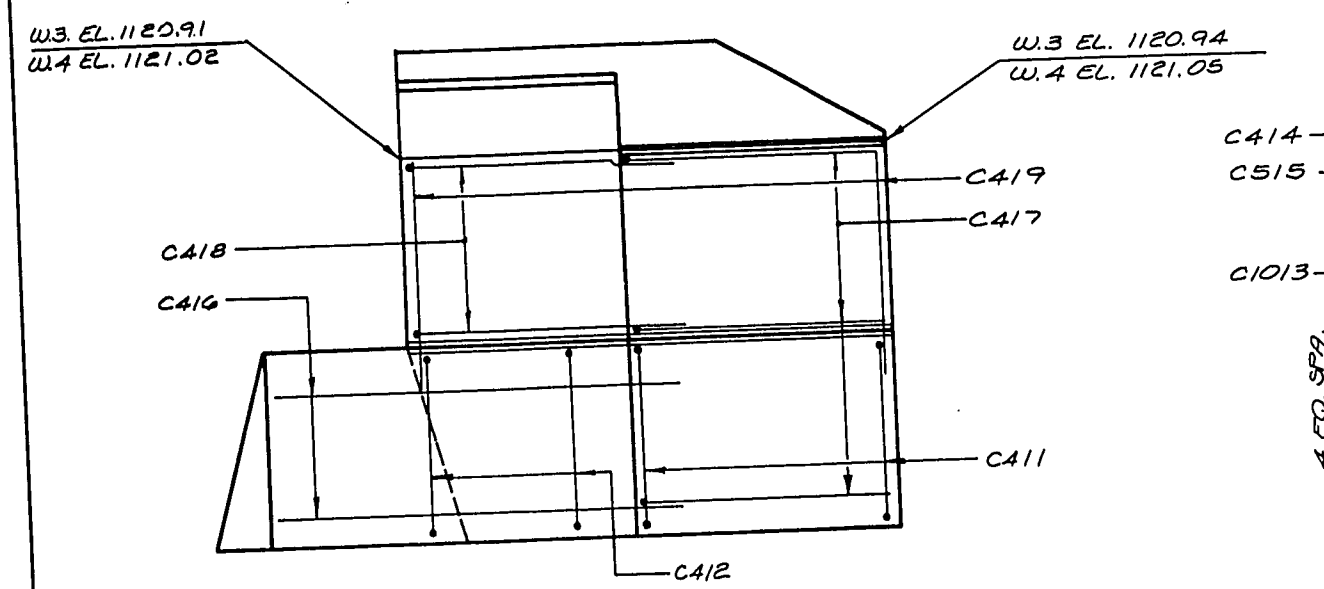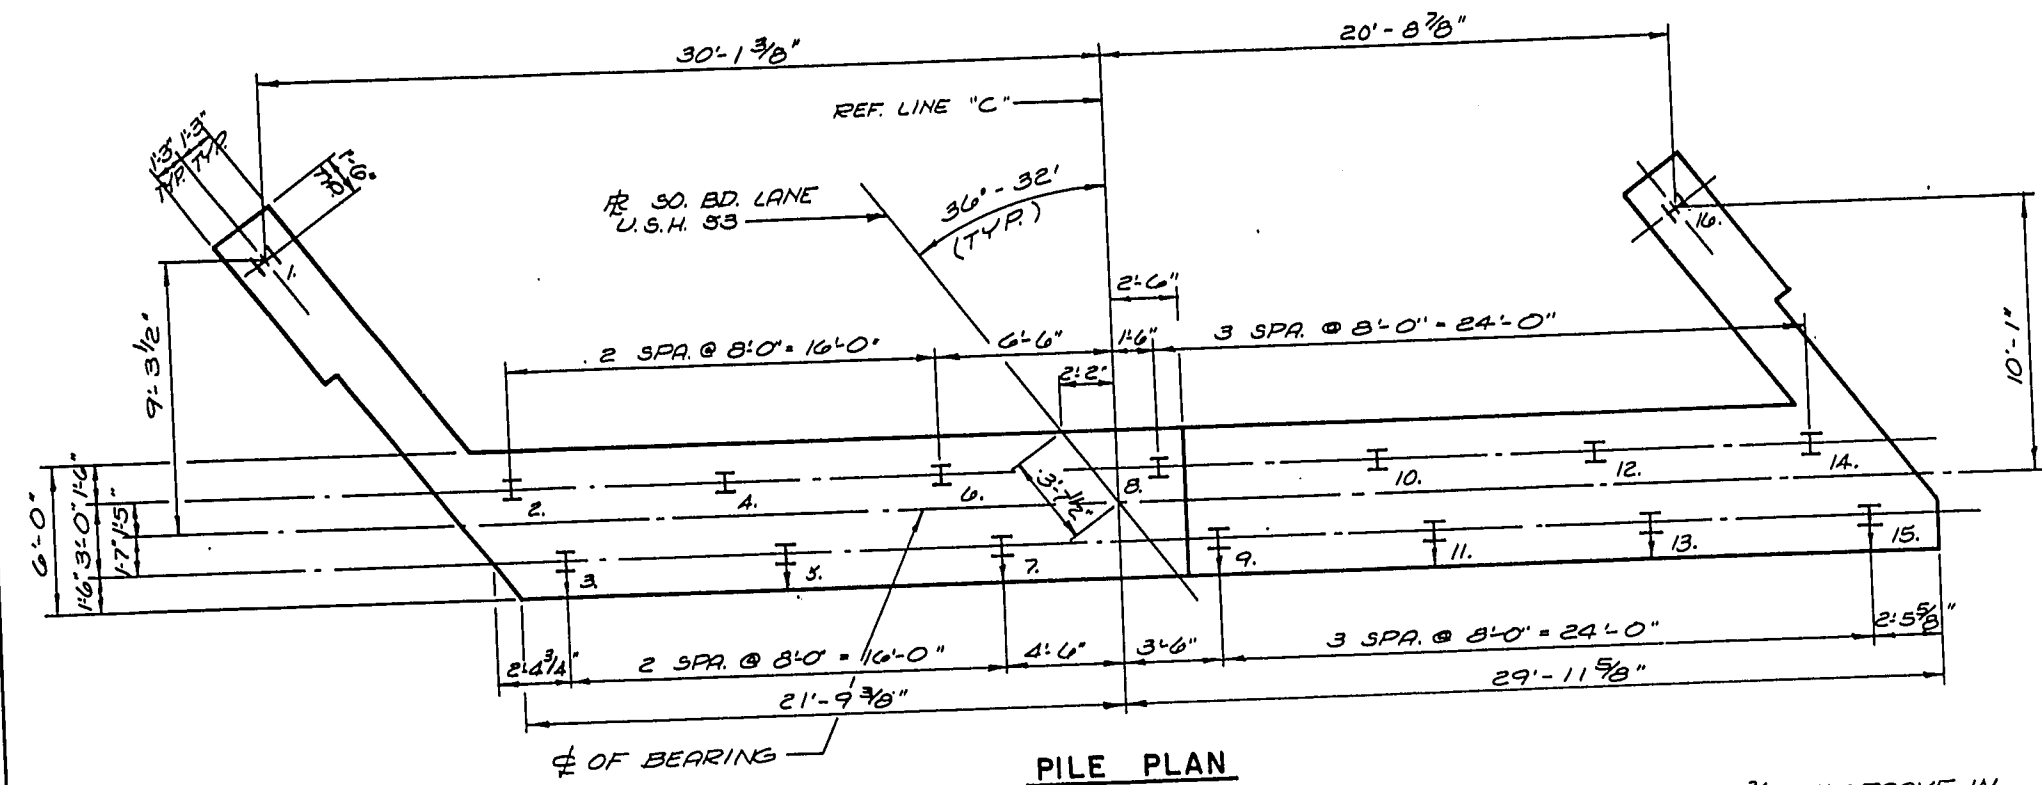

No.	Date	Revision	By
STATE OF WISCONSIN DEPARTMENT OF TRANSPORTATION DIVISION OF HIGHWAYS			
STRUCTURE B-3-17			
Const. Spec.	1969	Drawn By A. G.	Plans Checked G. H. A.
NORTH ABUTMENT DETAILS			SHEET 7 OF 16
			X 46183

\* ELEVATIONS ARE GIVEN AT P. OF PIER.

\* EL. 1116.13  
\* EL. 1116.14

\* EL. 1116.20  
\* EL. 1116.23

\* EL. 1116.12  
\* EL. 1116.16

\* EL. 1115.96 PIER 1  
\* EL. 1116.01 PIER 2


NOTE: BARS LISTED ARE COMBINED TOTAL FOR PIER 1 & PIER 2.

PROJECT NO.	1196-6-76	SHEET NUMBER	71	TOTAL SHEETS	296
FEDERAL PROJECT DESIGNATION	EMP F08-4(36)				

### BILL OF BARS

MARK	NO. REQ'D	LENGTH	BENT	BUND.	LOCATION
P701	162	11-6			FOOTING
P802	144	13-0			"
P1103	72	6-5	X		" & COLUMN-DOWEL
P1104	72	19-1			COLUMN
P405	108	9-5	X		" - HOOPS
P506	27	2-6			CAP-TOP-VEET.
P407	16	4-9			" - BOTTOM-ENDS
P1008	8	38-0			" - "
P1009	16	18-6			" - "
P510	8	25-6			" - CENTER
P1111	4	12-0	X	X	" - TOP
P1112	12	56-2	X		" - "
P513	32	10-7	X		" - STIRRUP-DOUBLE
P514	64	12-5	X		" - " - SINGLE

ALL BENDING DIMENSIONS ARE OUT TO OUT OF BAR.  
THE FIRST DIGIT OF A THREE DIGIT BAR MARK & THE FIRST TWO DIGITS OF A FOUR DIGIT BAR MARK SIGNIFIES THE BAR SIZE.

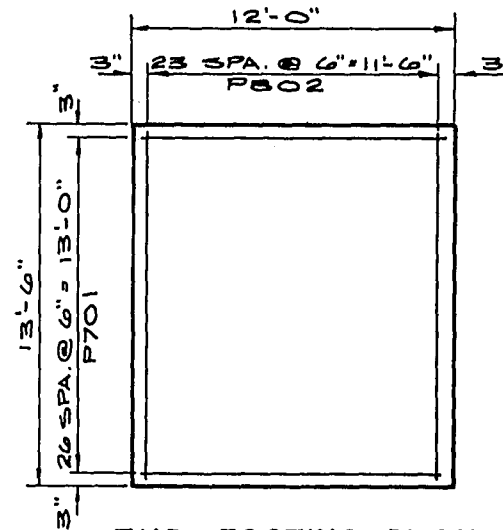

TYP. FOOTING PLAN

NOTE: PLACE VERT. COL. REIN. TO CLEAR SQ. TON. REIN. IN CAP.

1'-3" x 1'-3" CONST. UT. BEVELED KEYWAY (TYP.)

ELEVATION  
LOOKING NORTH


NOTE: MIN. ALLOWABLE SOIL PRESSURE EQUALS 2.5 TONS/SQ. FT.

WIRE BARS TOGETHER @ 2'-0" CTRS.

BUNDLING DETAIL



P 405

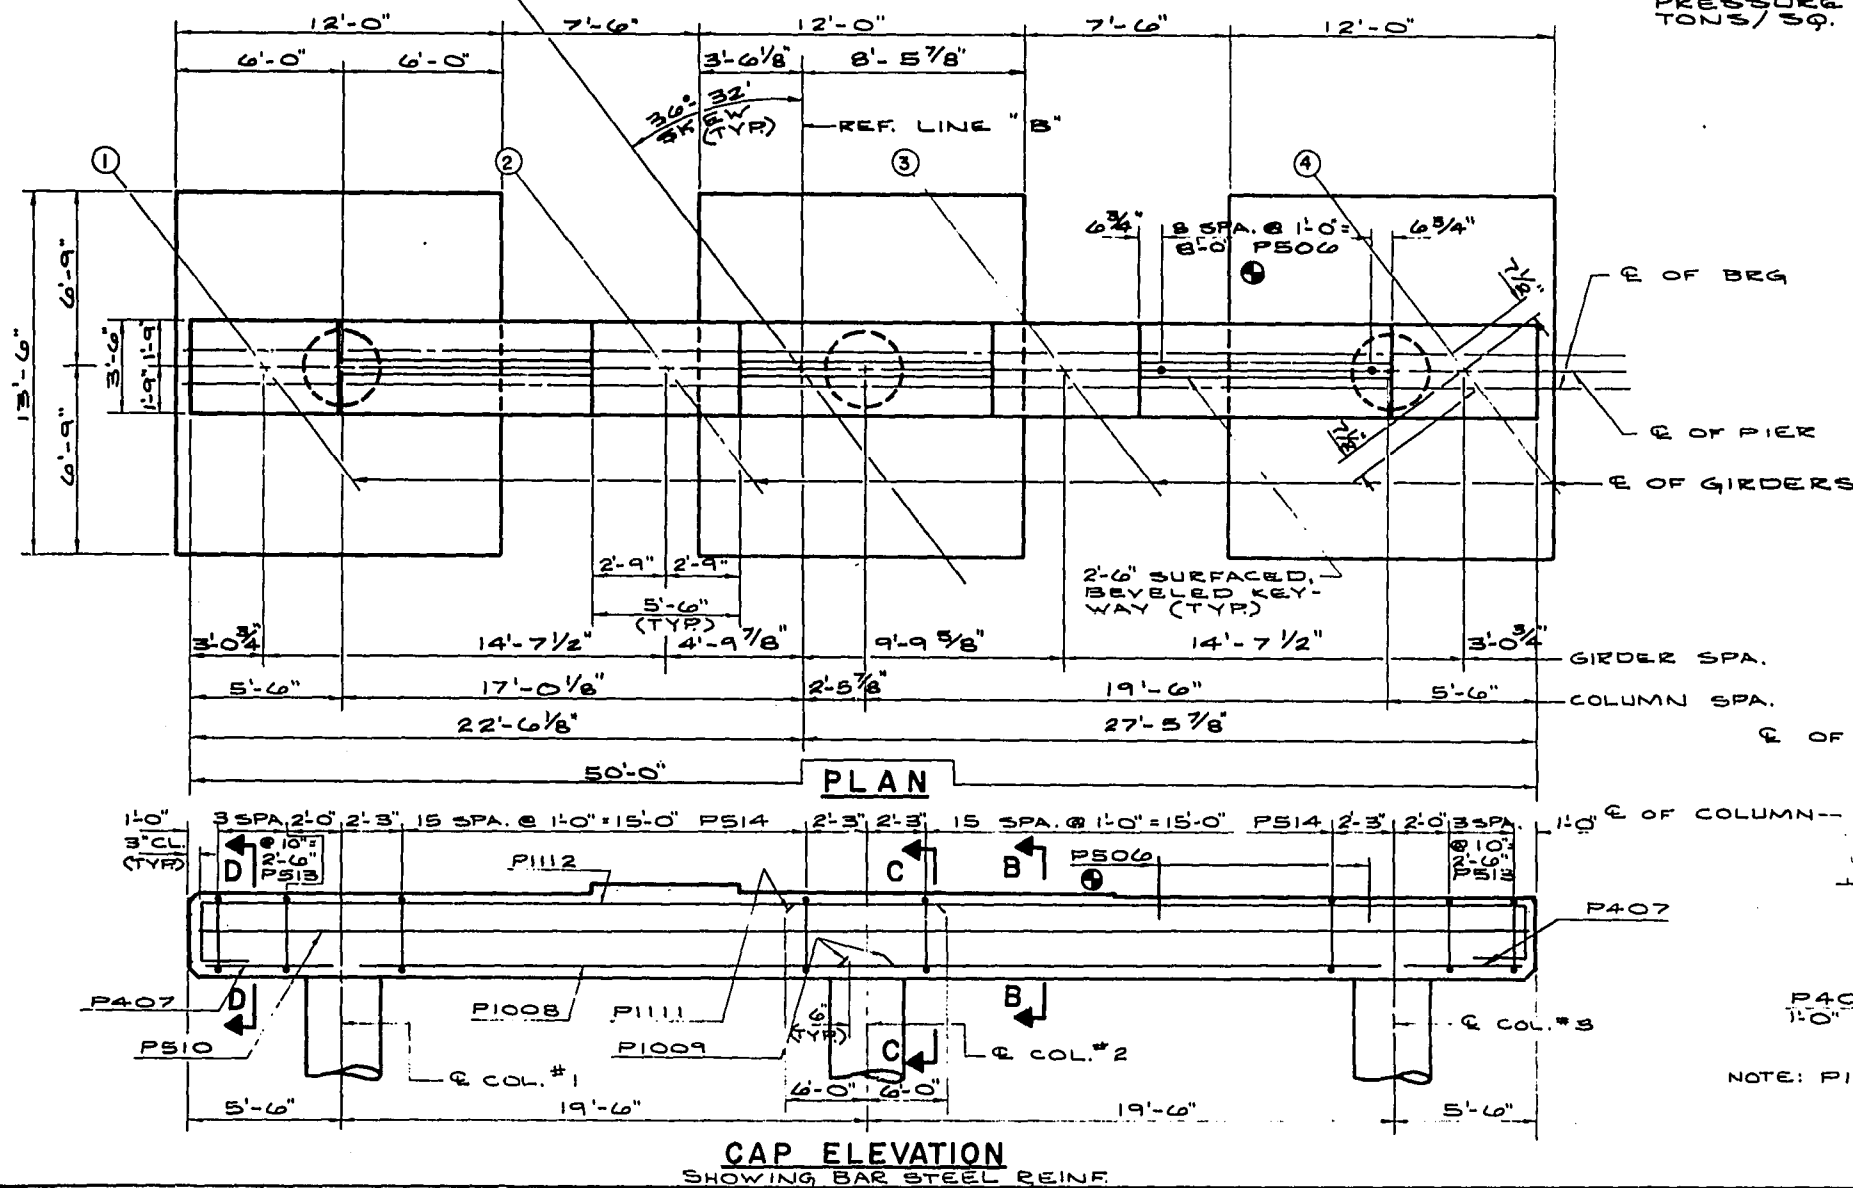

PLAN

CAP ELEVATION  
SHOWING BAR STEEL REIN.

SECT. B-B

SECT. C-C

SECT. D-D

### ESTIMATED CONCRETE MASONRY

	PIER 1	PIER 2
FOOTINGS	36.0 C.Y.	36.0 C.Y.
COLUMNS	12.9 C.Y.	12.9 C.Y.
PIER CAP	20.2 C.Y.	20.2 C.Y.
TOTAL	69.1 C.Y.	69.1 C.Y.

No.	Date	Revision	By
STATE OF WISCONSIN DEPARTMENT OF TRANSPORTATION DIVISION OF HIGHWAYS			
STRUCTURE B-3-17			
Const. Spec. 1969	Drawn By TLA	Plans Checked GHA	
PIERS			SHEET 8 OF 16
			X46184




PROJECT ID	1196-6-76	SHEET NUMBER	72	TOTAL SHEETS	296
FEDERAL PROJECT DESIGNATION	EMP FOB-4(36)				

# PLAN

BOTTOM TRANSVERSE BARS IN SLAB SHALL BE SUPPORTED BY CONTINUOUS BAR CHAIRS ON OR ADJACENT TO EACH GIRDER & BY INDIVIDUAL BAR CHAIRS AT 3'-0" CTRS. APPROX. THE 15 FT. BETWEEN GIRDERS.


TOP LONGITUDINAL BAR STEEL SHALL BE SUPPORTED BY CONTINUOUS BAR CHAIRS AT APPROX. 4'-0" CTRS. THE 2" HEIGHT OF RAIL PREARPET IS TO BE MAINTAINED AT ALL POINTS OF BEARING.

THE CONC. IN ANY SPAN SHALL BE PLACED WITHIN 4 HRS. OF THE TIME THAT CONC. WAS PLACED OVER AN ADJACENT PIER.

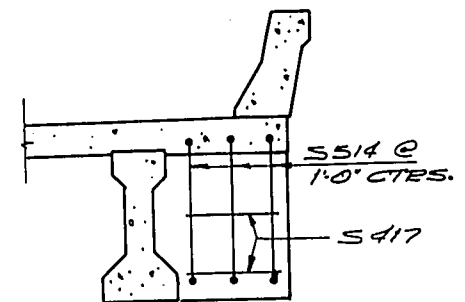

CONC. DIAPH. AT SO. ABUT.


CROSS SECTION THUR ROADWAY  
(AT RT L<sup>3</sup> TO REFERENCE LINE LOOKING NORTHWEST)

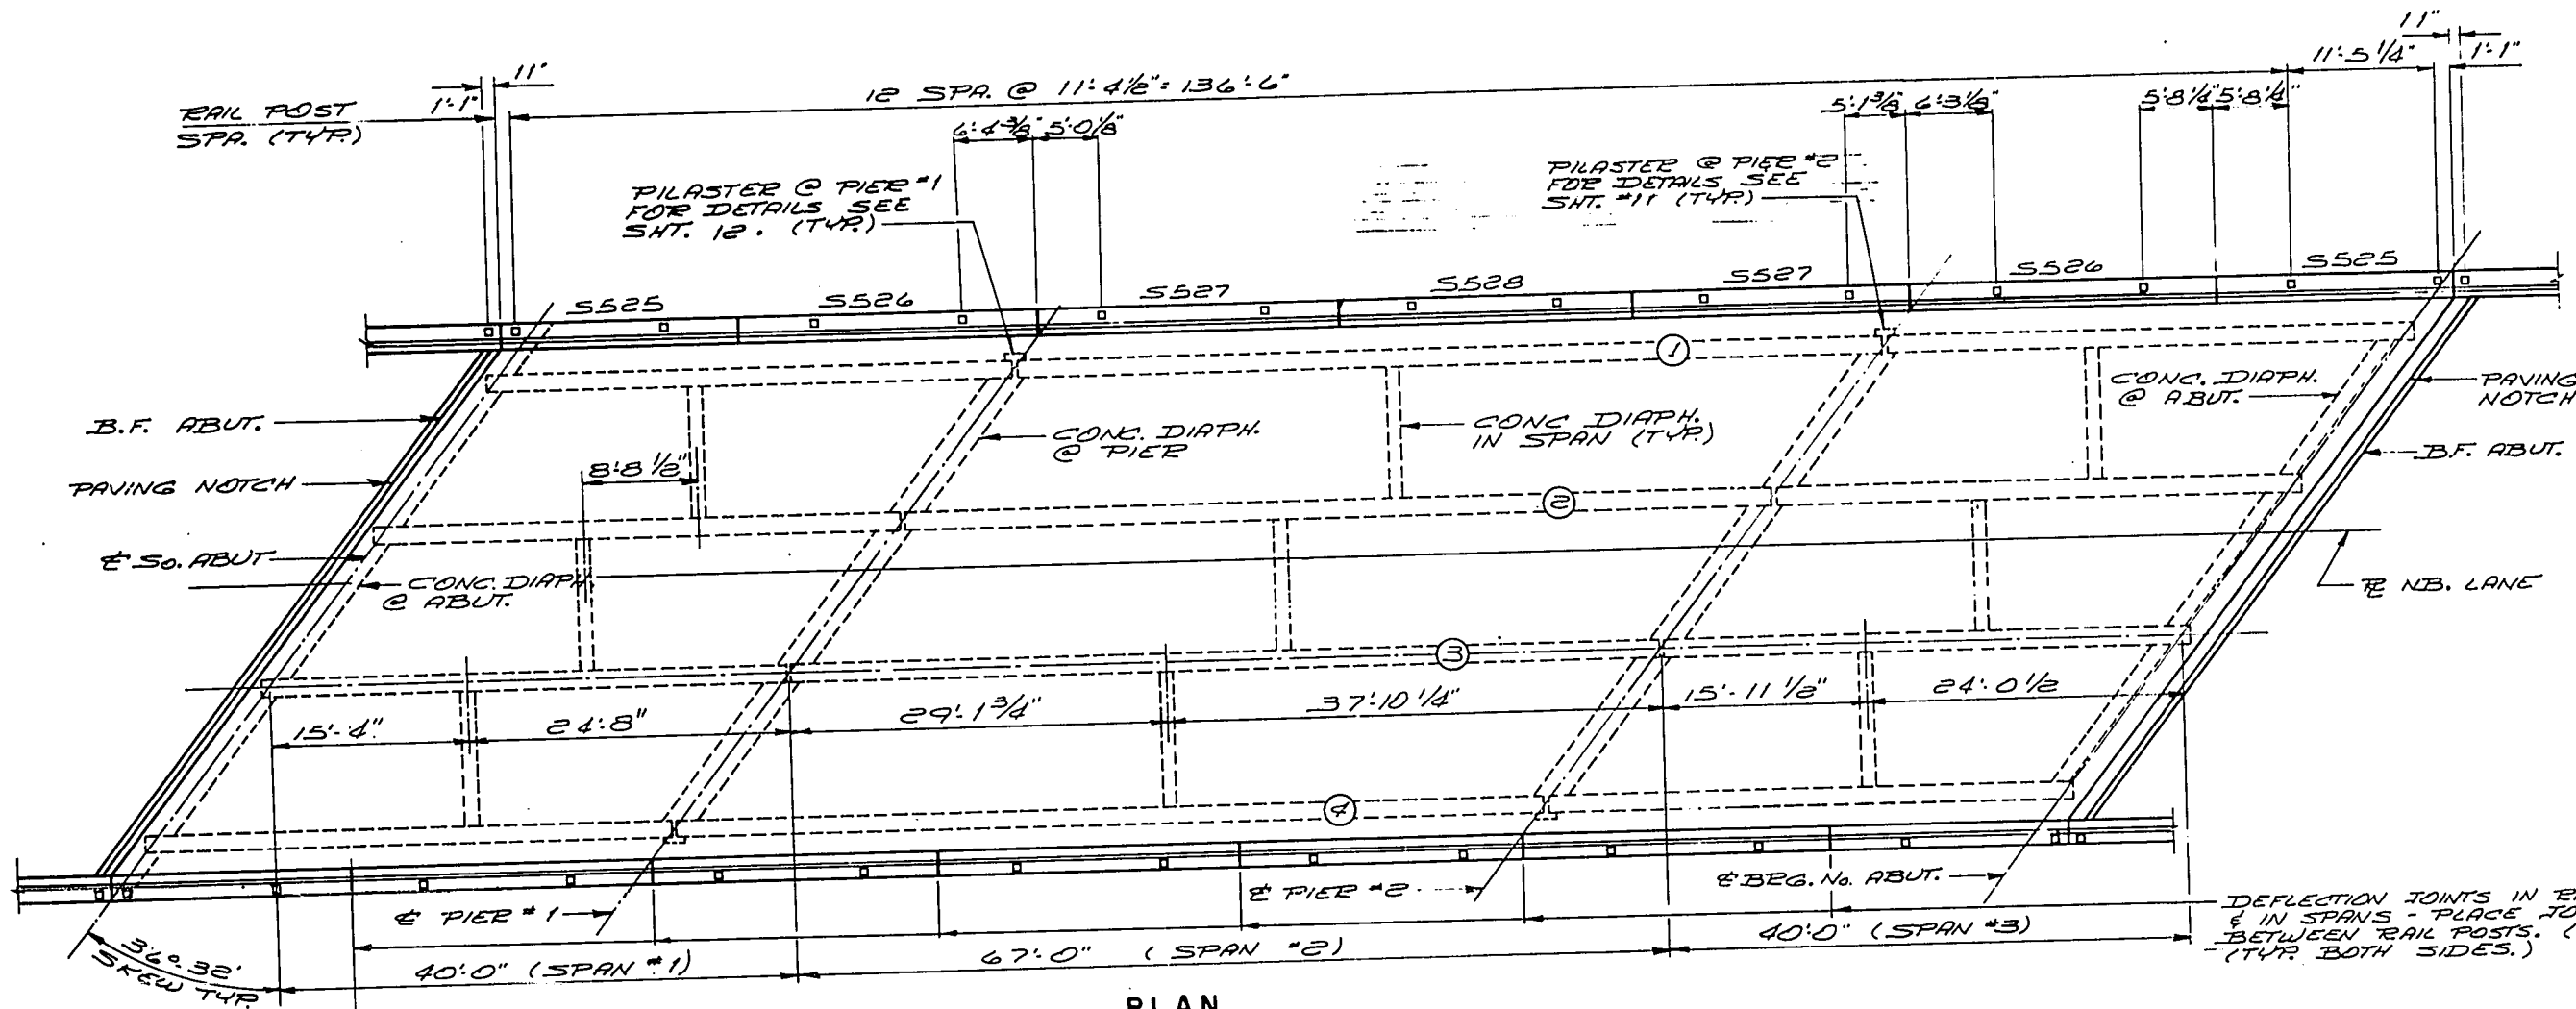


# PLAN

No.	Date	Revision	By
STATE OF WISCONSIN DEPARTMENT OF TRANSPORTATION DIVISION OF HIGHWAYS			
STRUCTURE B-3-17			
Const. Spec. 1969	Drawn By BUDD	Plans Checked G.H.A.	
SUPERSTRUCTURE			SHEET 9 OF 16
			X 46184


PROJECT ID <b>1196-6-76</b>	SHEET NUMBER <b>73</b>	TOTAL SHEETS <b>296</b>
FEDERAL PROJECT DESIGNATION <b>EMP F08-4(36)</b>		

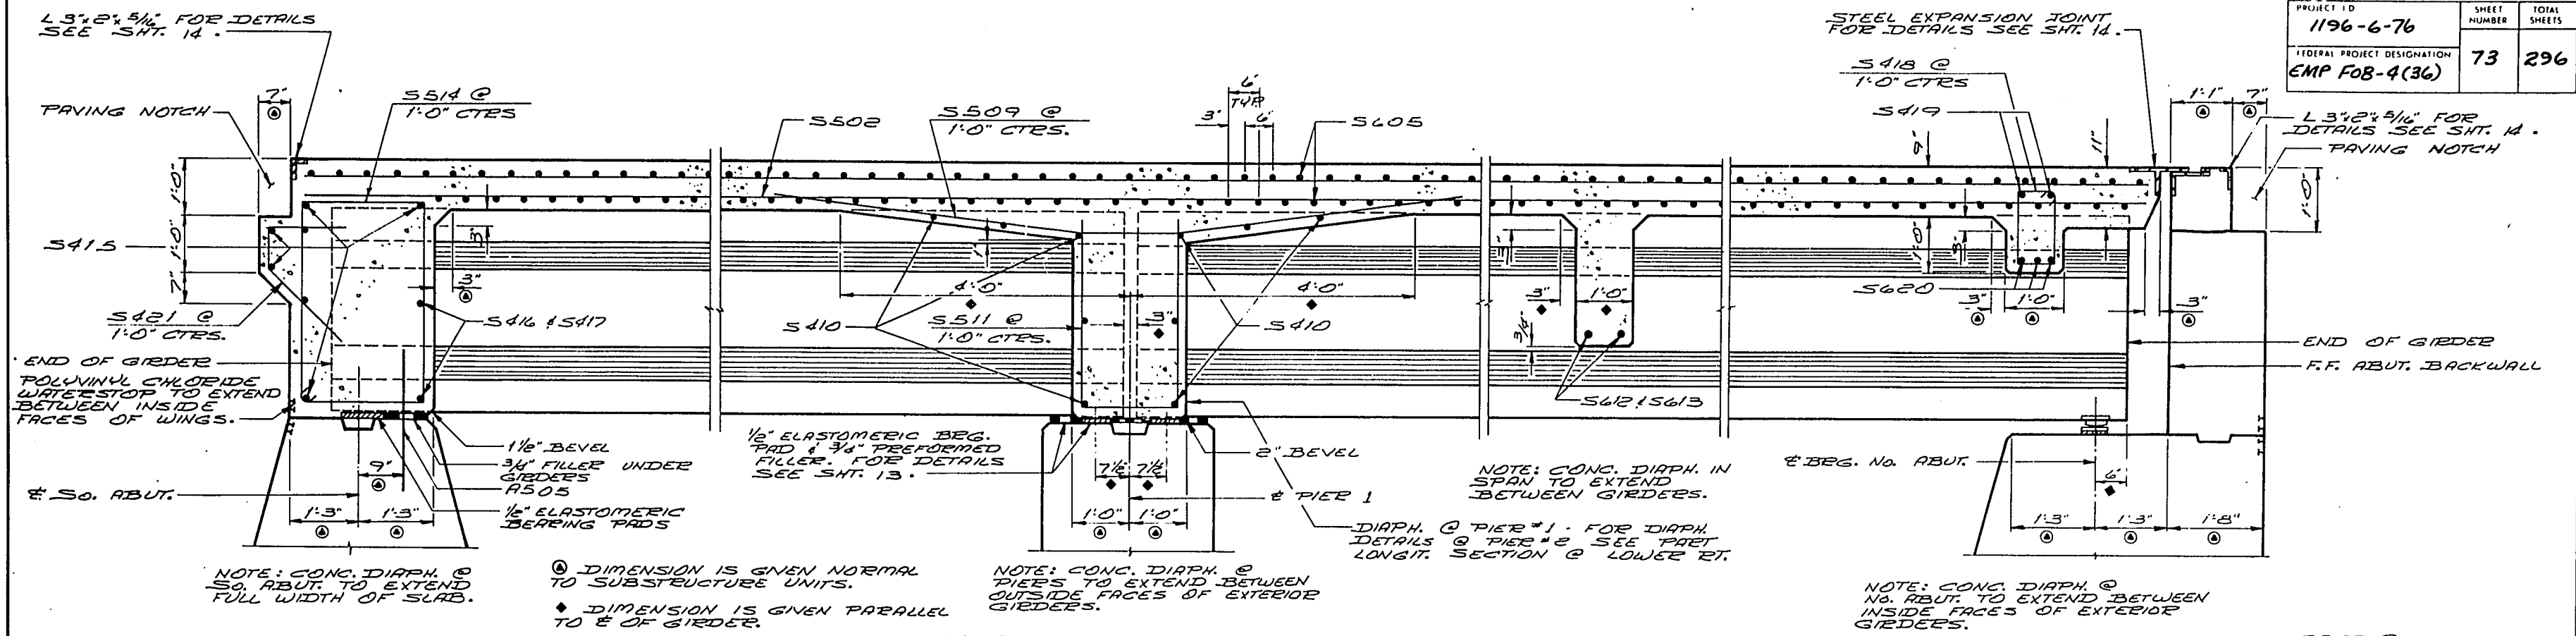

**PART LONGITUDINAL SECTION**

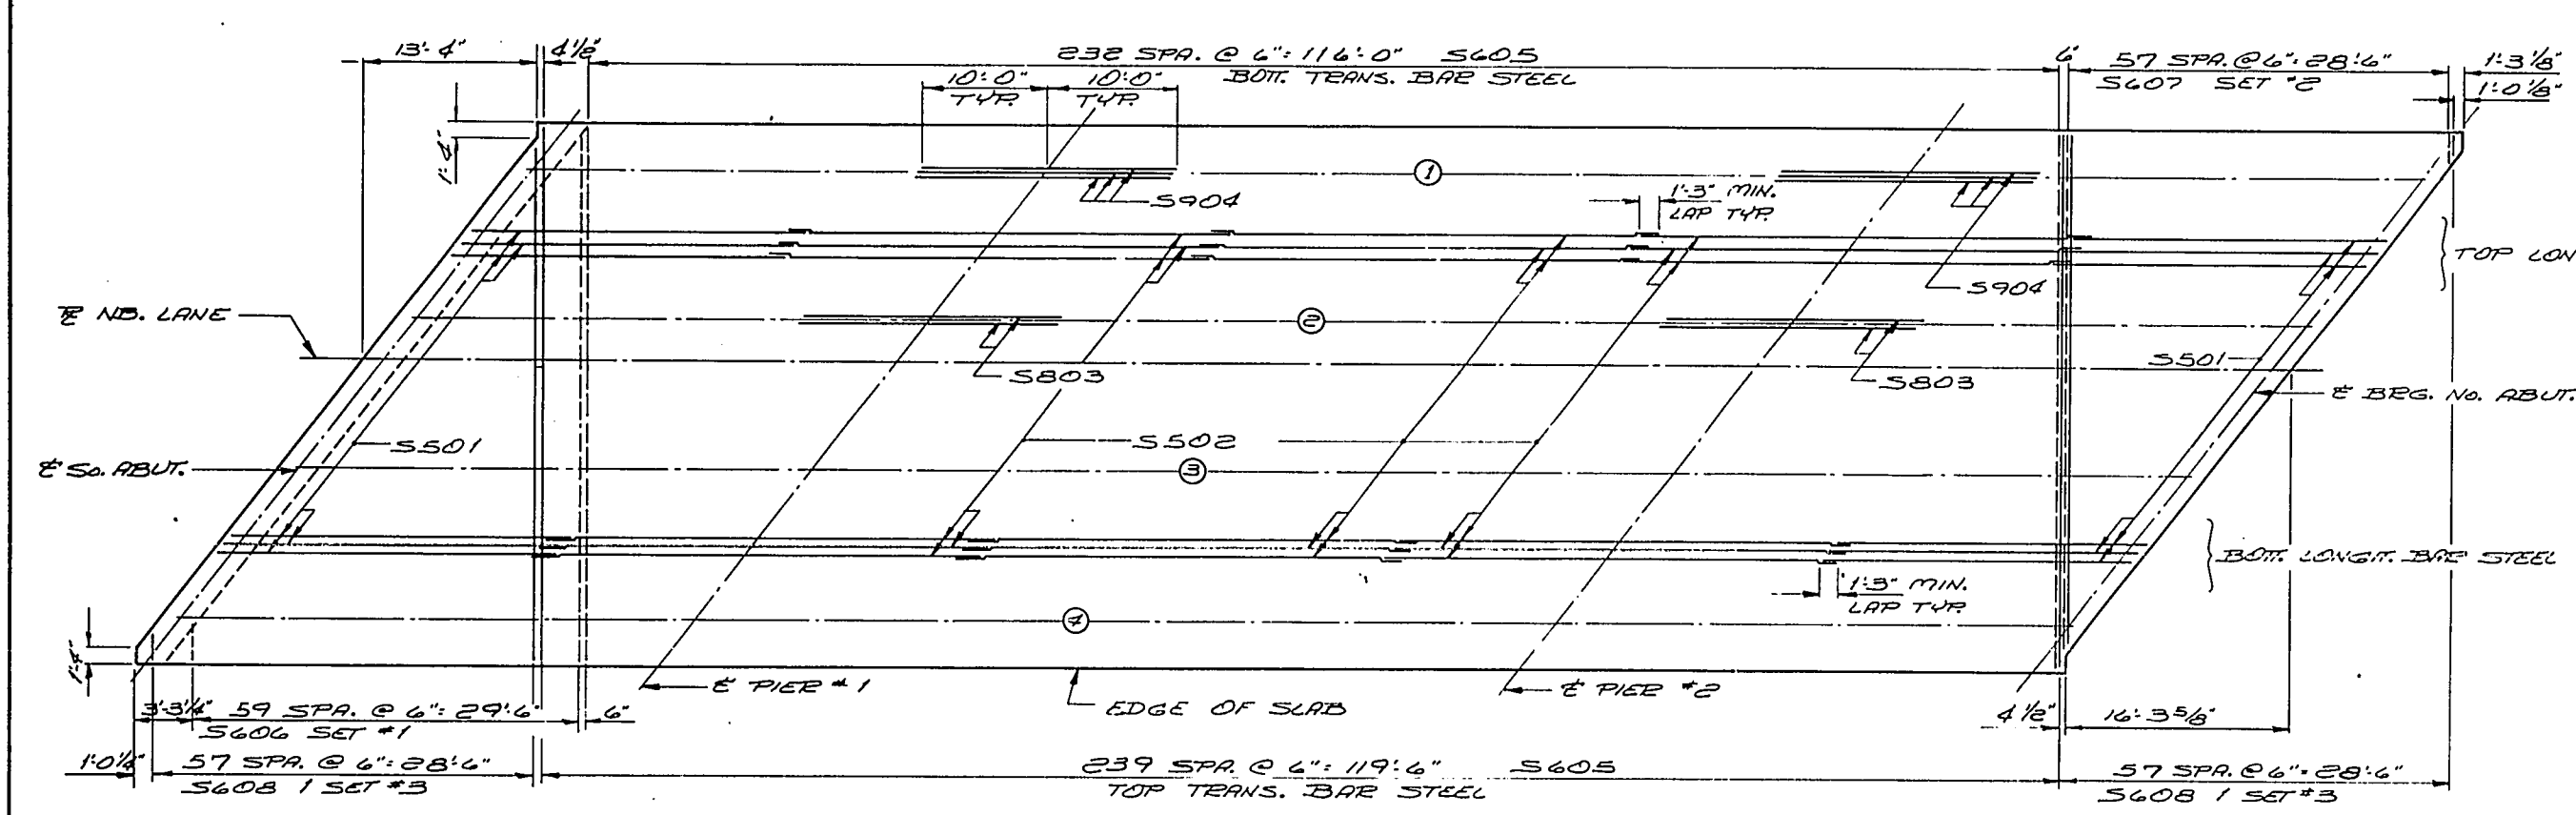

**PLAN SHOWING BAR STEEL REINFORCEMENT**

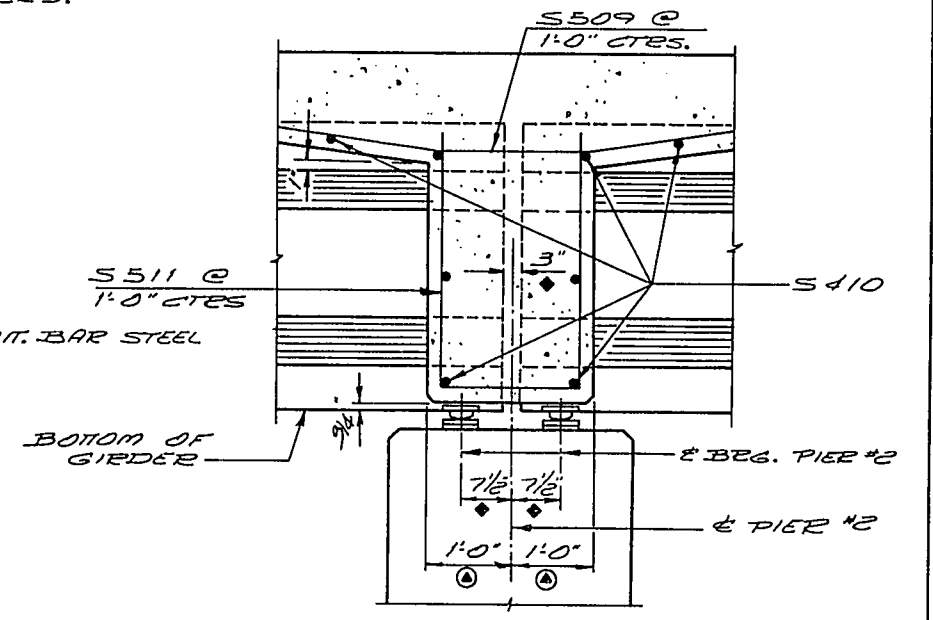


**PART LONGITUDINAL SECTION AT PIER 2**

No.	Date	Revision	By
STATE OF WISCONSIN DEPARTMENT OF TRANSPORTATION DIVISION OF HIGHWAYS			
<b>STRUCTURE B-3-17</b>			
Const Spec 1969	Drawn By BUDD	Plans Checked G. H. A.	
SUPERSTRUCTURE			SHEET 10 OF 16
			<b>X 46185</b>


## BILL OF BARS

DIMENSIONS ARE OUT TO OUT OF BAR.  
THE FIRST DIGIT OF A 3 DIGIT BAR MARK SIGNIFIES THE  
BAR SIZE.

BARE SIZE.			BENT		CUT. DIA.		LOCATION	
MARK	NO. RECD.	LENGTH						
S501	174	24.9					SLAB TOP & BOT.	LONGIT.
S502	261	35.0					" " " "	"
S803	8	20.0					" " C PIER GIRD. <sup>2</sup> 2' 3"	"
S904	12	20.0					" " " " 1' 4"	"
S605	473	42.4					" " & BOT.	TRANS.
S606	30	43.9			X		" BOT. SET 1	"
S607	29	43.3			X		" " " 2	"
S608	58	42.7			X		" TOP " 3	"
S509	66	10.10	X				" HAUNCH @ PIER	LONGIT.
S410	60	12.3					" " " "	TRANS.
S511	66	9.9	X				" " " "	"
S612	18	10.10					DIAPH. @ MID SPAN	"
S613	36	2.0					" " " " THREAD END 3" ONE	"
S514	36	14.0	X				" " So. ABUT.	"
S415	14	26.10					" " " "	"
S416	6	12.2					" " " "	"
S417	4	3.0					" " " "	"
S418	33	4.2	X				" " No. "	"
S419	6	12.7					" " " "	"
S620	9	13.3					" " " "	"
S421	50	3.11	X				PAVING NOTCH	"
S322	12	3.0	X				PILASTER @ PIER	"
S423	8	4.4	X				" " " "	VERT.
S424	8	3.4	X				" " " "	"
S525	20	17.6					RAIL PARAPET	HORIZ.
S526	20	23.0					" " " "	"
S527	20	21.9					" " " "	"
S528	10	22.5					" " " "	"
S529	298	5.0	X				" " " "	VERT.
S530	298	4.9	X				" " " "	"

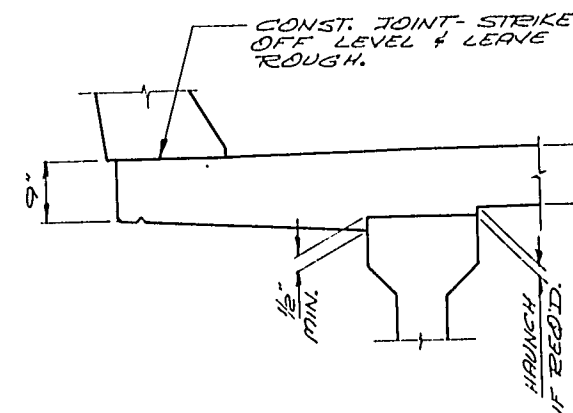



SLAB DETAIL AT EXTERIOR GIRDER

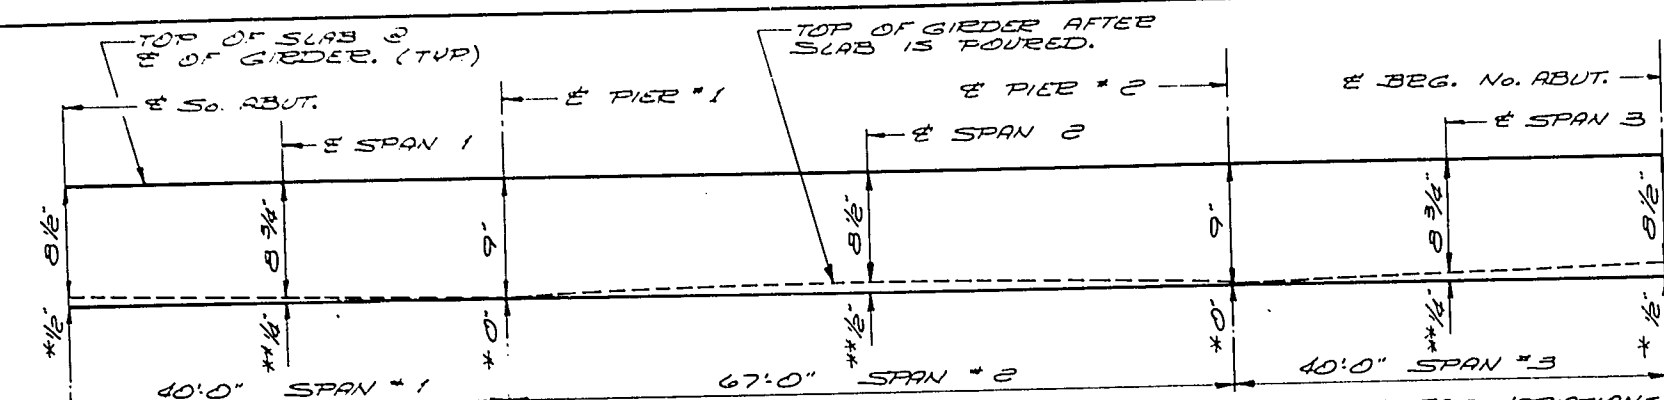

\* IF VARIATIONS IN PRESTRESS CAMBER & OTHER CONST. DISCREPANCIES ARE OF SUCH A MAGNITUDE THAT THE MAXIMUM ALLOWABLE IMBEDMENT AS NOTED ABOVE SHALL BE EXCEEDED THESE DIMENSIONS SHALL BE REVISED. THE 1/2" IMBEDMENT & THE PLAN SLAB THICKNESS SHALL BE ELID WHILE THE GRADE LINE WILL BE REVISED.

\*\* TO COMPENSATE FOR VARIATIONS IN PRESTRESS CAMBER & OTHER MINOR CONST. DISCREPANCIES THE EMBEDMENT AT THE E OF THE SPAN MAY BE VARIED WITH A MAXIMUM OF  $1\frac{1}{2}$ " ALLOWABLE IMBEDMENT & THE SLAB HELD TO PLAN THICKNESS.


### SLAB FORMING DIAGRAM

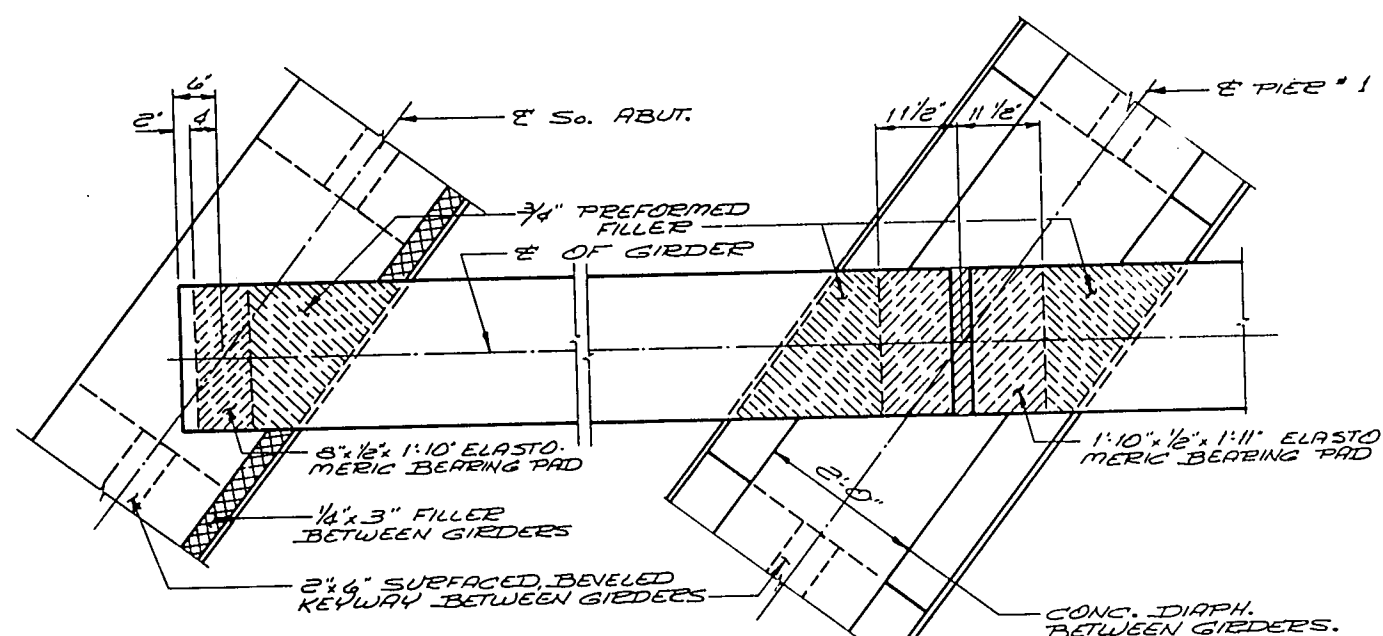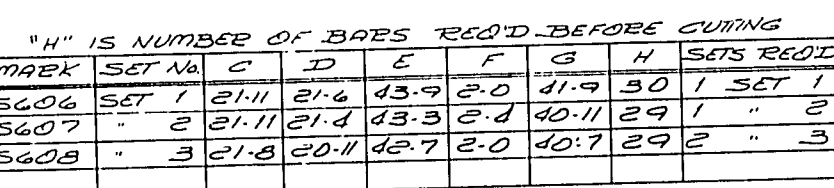



AT SO. ABUT.

AT PIER

### ELASTOMERIC BEARING PAD DETAILS

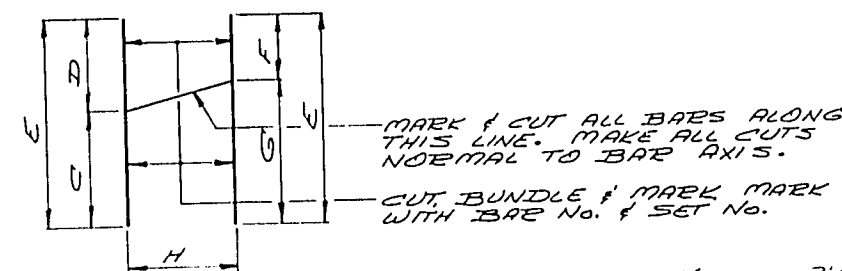

MARK	"J"	"K"
5514	2' 8 1/2"	3' 11"
5418	8"	1' 2"
5322	8"	8"

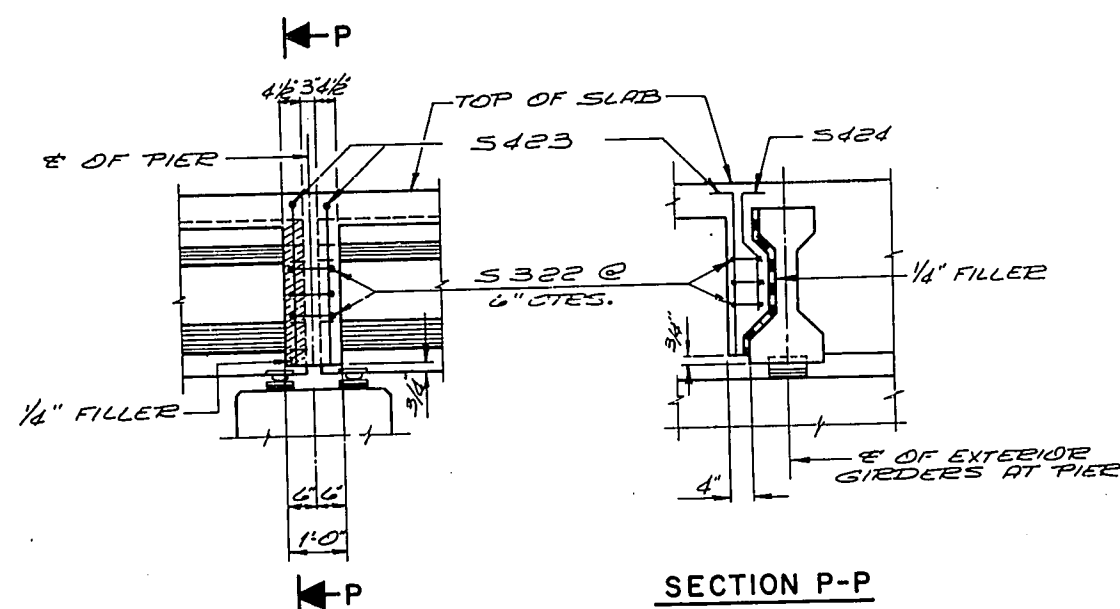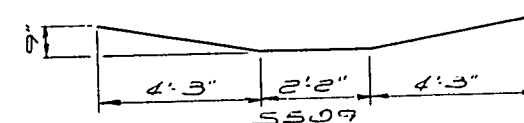


SECTION P-P


PILASTER DETAILS AT PIER

No.	Date	Revision		By
STATE OF WISCONSIN DEPARTMENT OF TRANSPORTATION DIVISION OF HIGHWAYS				
STRUCTURE B-3-17				
Const. Spec.	1969	Drawn By	BUDD	Plans Checked G.H.A.
SUPERSTRUCTURE			SHEET 11 OF 1	
			X46187	


B. P. R. Division	Project	Sheet Number	Total Sheets
4	1196-6-76 EMP FOR 4036	75	296

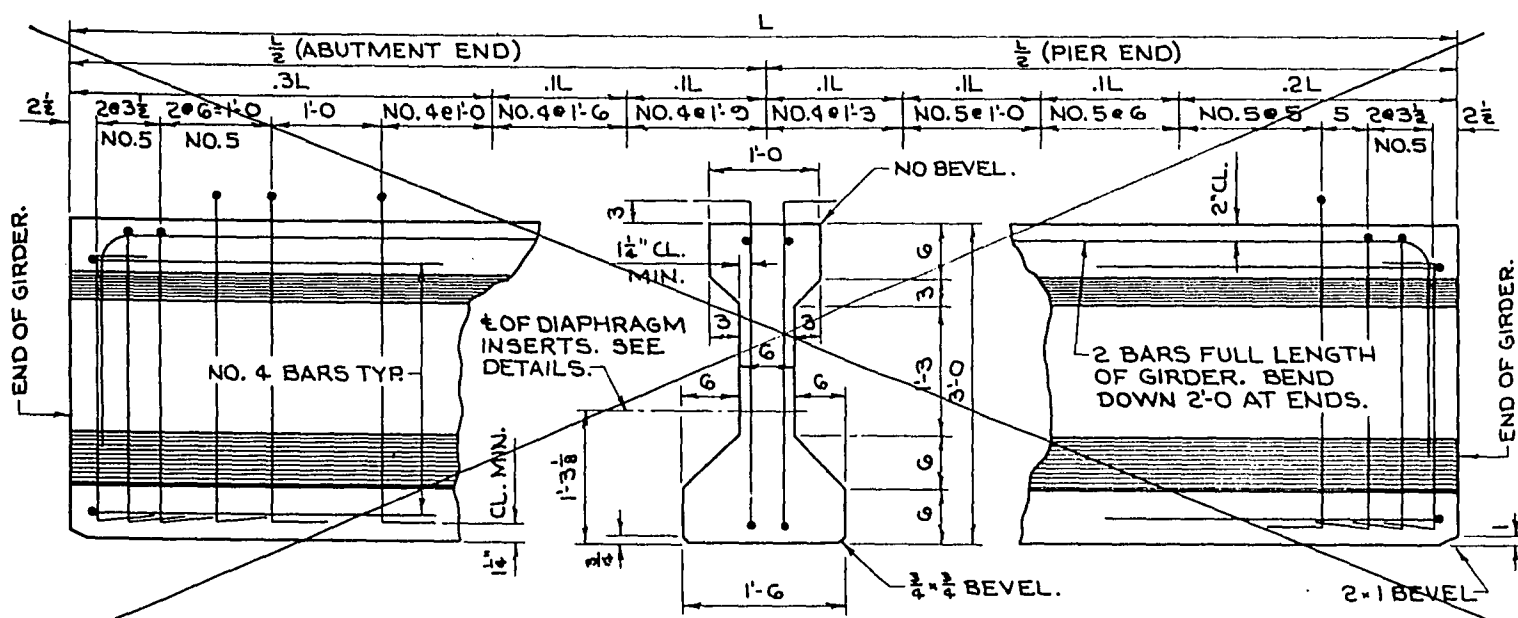


36" GIRDER - SIDE VIEW & TYPICAL SECTION IN SPAN

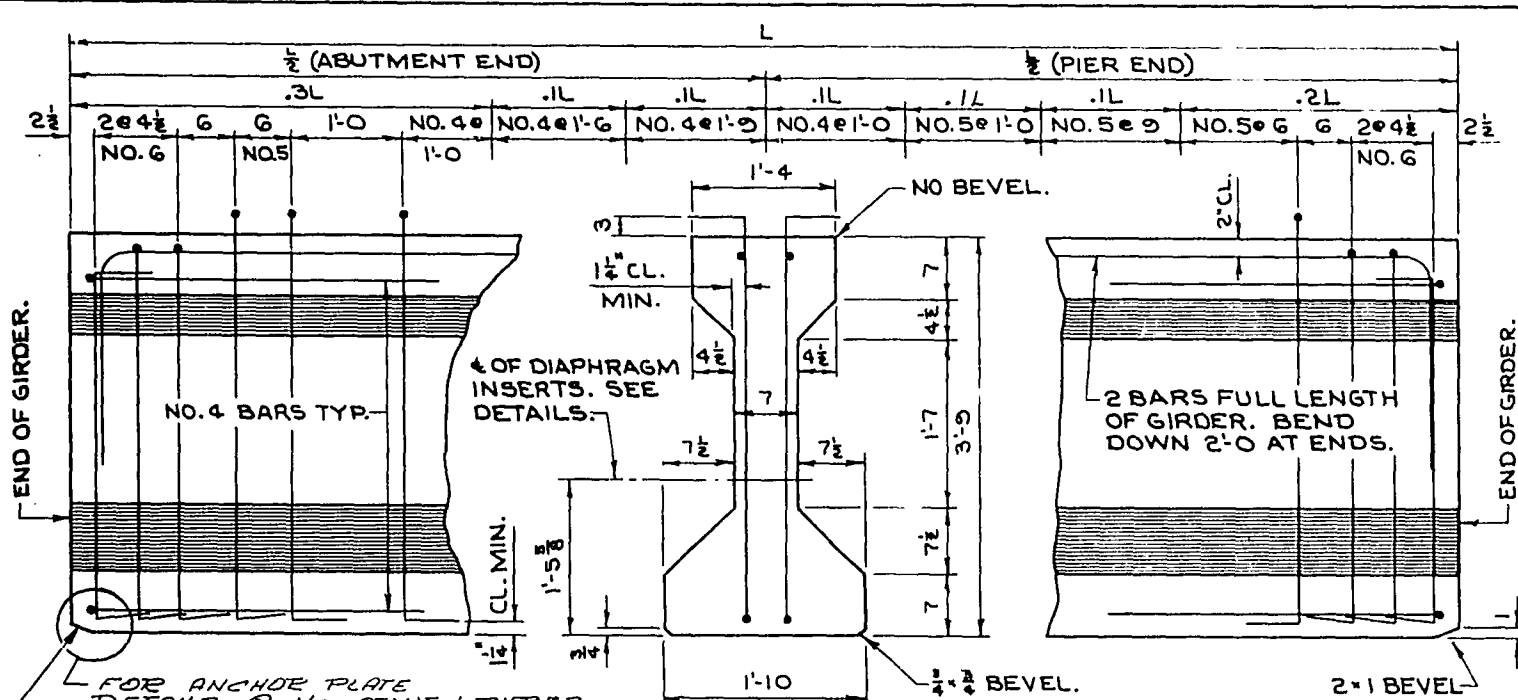


45" GIRDER - SIDE VIEW & TYPICAL SECTION IN SPAN

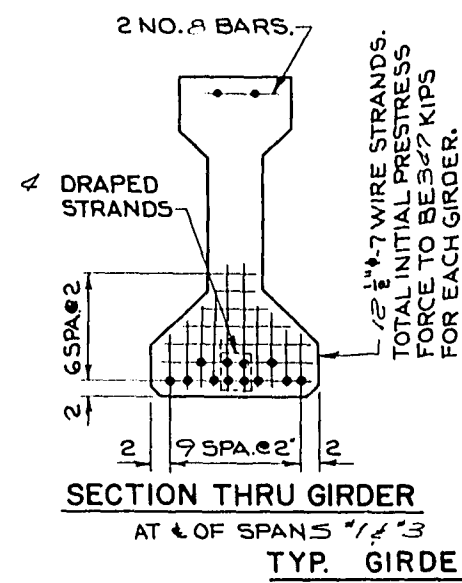

SECTION THRU GIRDER  
AT 1/4 OF SPAN  
TYP. GIRDER SECTIONS

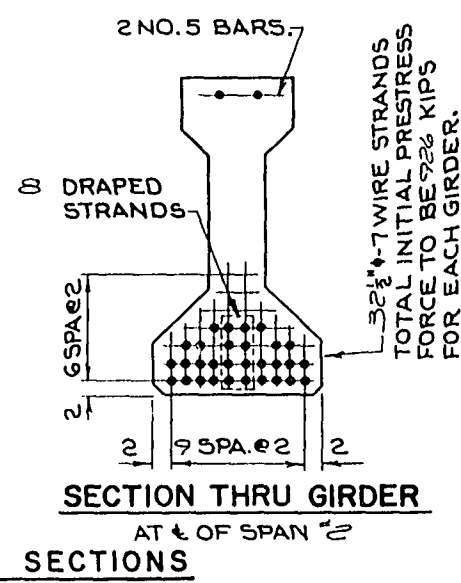

SECTION THRU GIRDER  
AT 1/2 OF SPAN

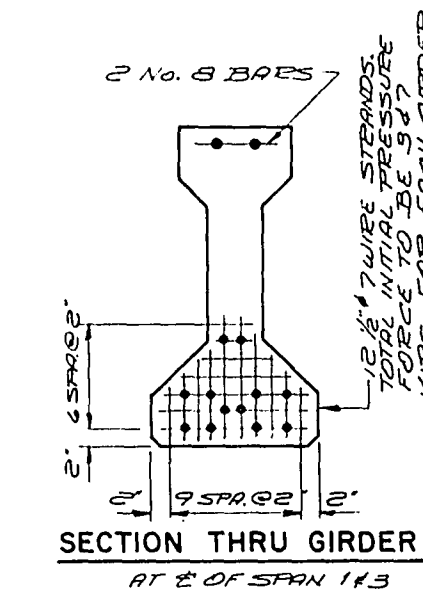

SECTION THRU GIRDER  
AT 1/3 OF SPAN

ALTERNATE GIRDER SECTIONS


NOTES

TOP OF GIRDERS TO BE ROUGH FLOATED AND BROOMED TRANSVERSELY FOR BONDING TO THE SLAB.  
THE GIRDER MANUFACTURER SHALL PROVIDE A SUITABLE LIFTING DEVICE FOR HANDLING AND ERECTING THE GIRDERS.

ALL GIRDERS SHALL BE CAST FULL LENGTH AS SHOWN. PRESTRESSING STRANDS SHALL HAVE AN ULTIMATE STRENGTH OF 270,000 psi AND SHALL BE FLUSH WITH THE ENDS OF THE GIRDER. INSERTS SHALL BE PLACED ON 6" CENTERS SYMMETRICALLY ABOUT THE 1/2 OF DIAPHRAGMS IN SPANS.


ALL STIRRUPS SHALL BE IN PAIRS AND THE SPACING SHOWN IN "SIDE VIEW" IS MAXIMUM. THE LOCATION SHALL BE SHOWN IN THE SHOP DRAWINGS. BEND EACH END OF NO. 4 AND NO. 5 STIRRUPS 6" AND NO. 6 STIRRUPS 6 1/2". ENDS OF STRANDS SHALL BE PAINTED WITH NON-STAINING GRAY NON BITUMINOUS JOINT SEALER. (THIS APPLIES ONLY TO THOSE ENDS OF GIRDERS THAT ARE FINALLY EXPOSED.)

TOP LONGITUDINAL BARS IN GIRDER MAY BE SPLICED BY USING 3S BAR DIAMETER LAPS. PLACE ONE LAP AT 1/4 OF GIRDER IF LENGTH IS 1' TO 1'-0. PLACE LAPS AT THE 1/3 RD POINTS OF GIRDER IF LENGTH IS 1' TO 1'-0.

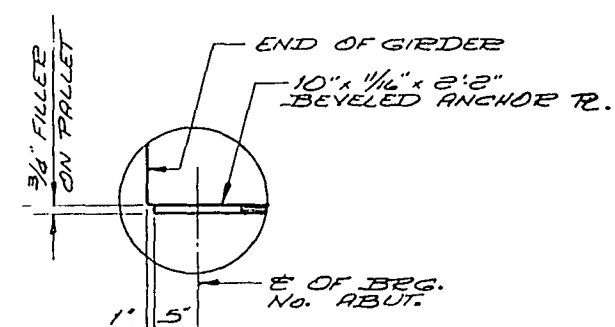


ANCHOR PLATE AT  
NO. ABUT.  
& PIER 2


		"A"	"B"		"C"
			MAX.	MIN.	
SPANS	1 & 3	29"	16"	13"	3"
	2	32"	14 3/4"	11 3/4"	5"
	ALT. 2	35"	14 3/4"	11 3/4"	4"

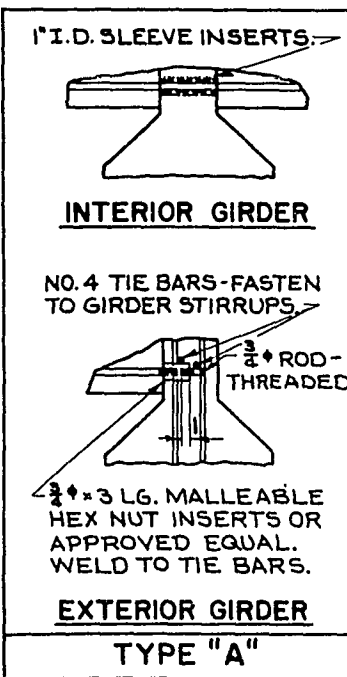


INTERIOR GIRDER

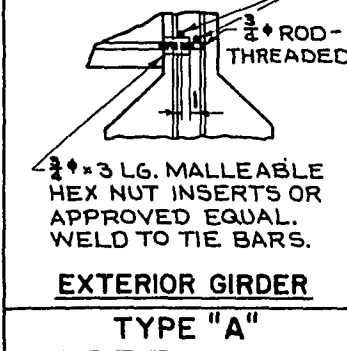

EXTERIOR GIRDER

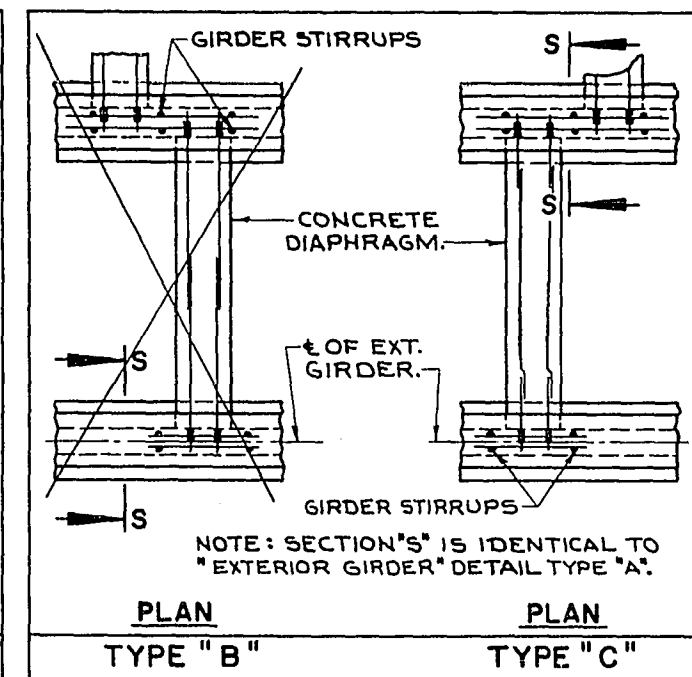


DIAPHRAGM INSERT DETAILS

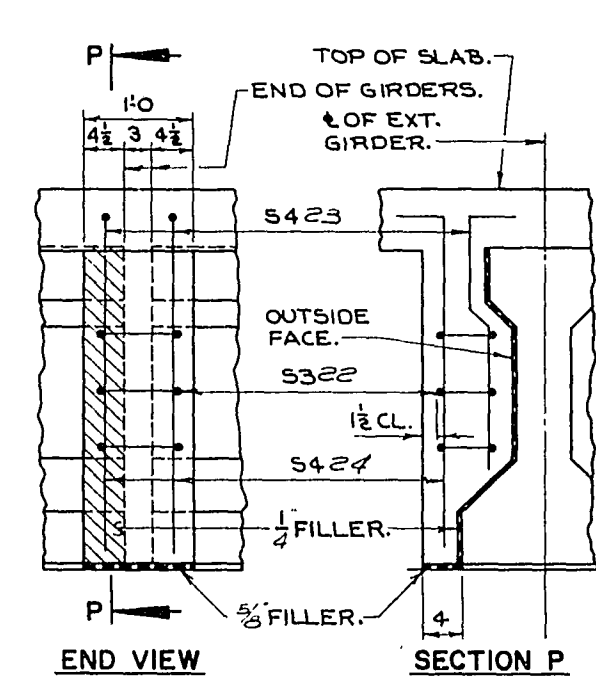


PILASTER DETAIL AT PIERS


\* MINIMUM CYLINDER STRENGTH OF CONCRETE AT TIME OF TRANSFER OF PRESTRESS FORCE.

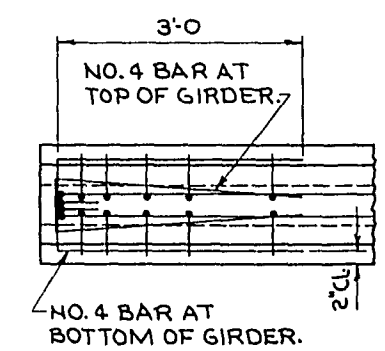

TOP VIEW OF GIRDER ENDS

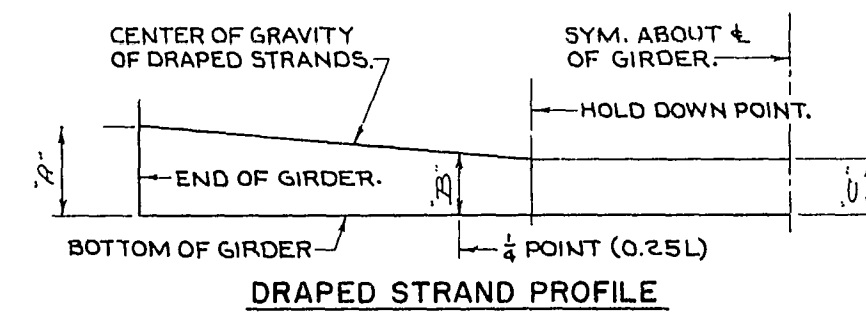

DRAPED STRAND PROFILE

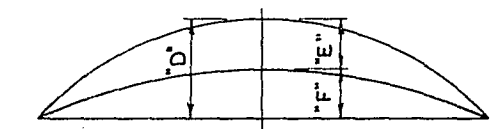


\*\* DATA SHOWN IS THEORETICAL AND MAY VARY WITH CONCRETE STRENGTH, VARIABLE PRESTRESS CONDITIONS AND PRESTRESS LOSSES.




GIRDER DATA				
GIRDER SIZE REQUIRED 45" ALTERNATE				
SPANS	1 & 3	2	1 & 3	
GIRDER LENGTH "L" REQUIRED	40'-4 1/2"	66'-9"	40'-4 1/2"	
f'ci (psi)*	4,800	5,000	4,800	
DRAPED PATTERN	4,800	5,000	4,800	
SPREAD PATTERN	4,800	5,000	4,800	
DEFLECTION DATA **				
PRESTRESS CAMBER "D"	1/4"	1 3/8"	1/4"	
DEAD LOAD DEFLECTION "E"	1/8"	1"	1/8"	
RESIDUAL CAMBER "F"	1/8"	5/8"	1/8"	
USE DIAPHRAGM INSERT DETAIL TYPE "C"				

No.	Date	Revision	By
STATE OF WISCONSIN DEPARTMENT OF TRANSPORTATION DIVISION OF HIGHWAYS			
STRUCTURE B-3-17			
Const. Spec.	1969	Drawn By	GUDD
Checked		G.H.A.	
PRESTRESSED GIRDER DETAILS		SHEET 12 OF 16	
		X 46188	



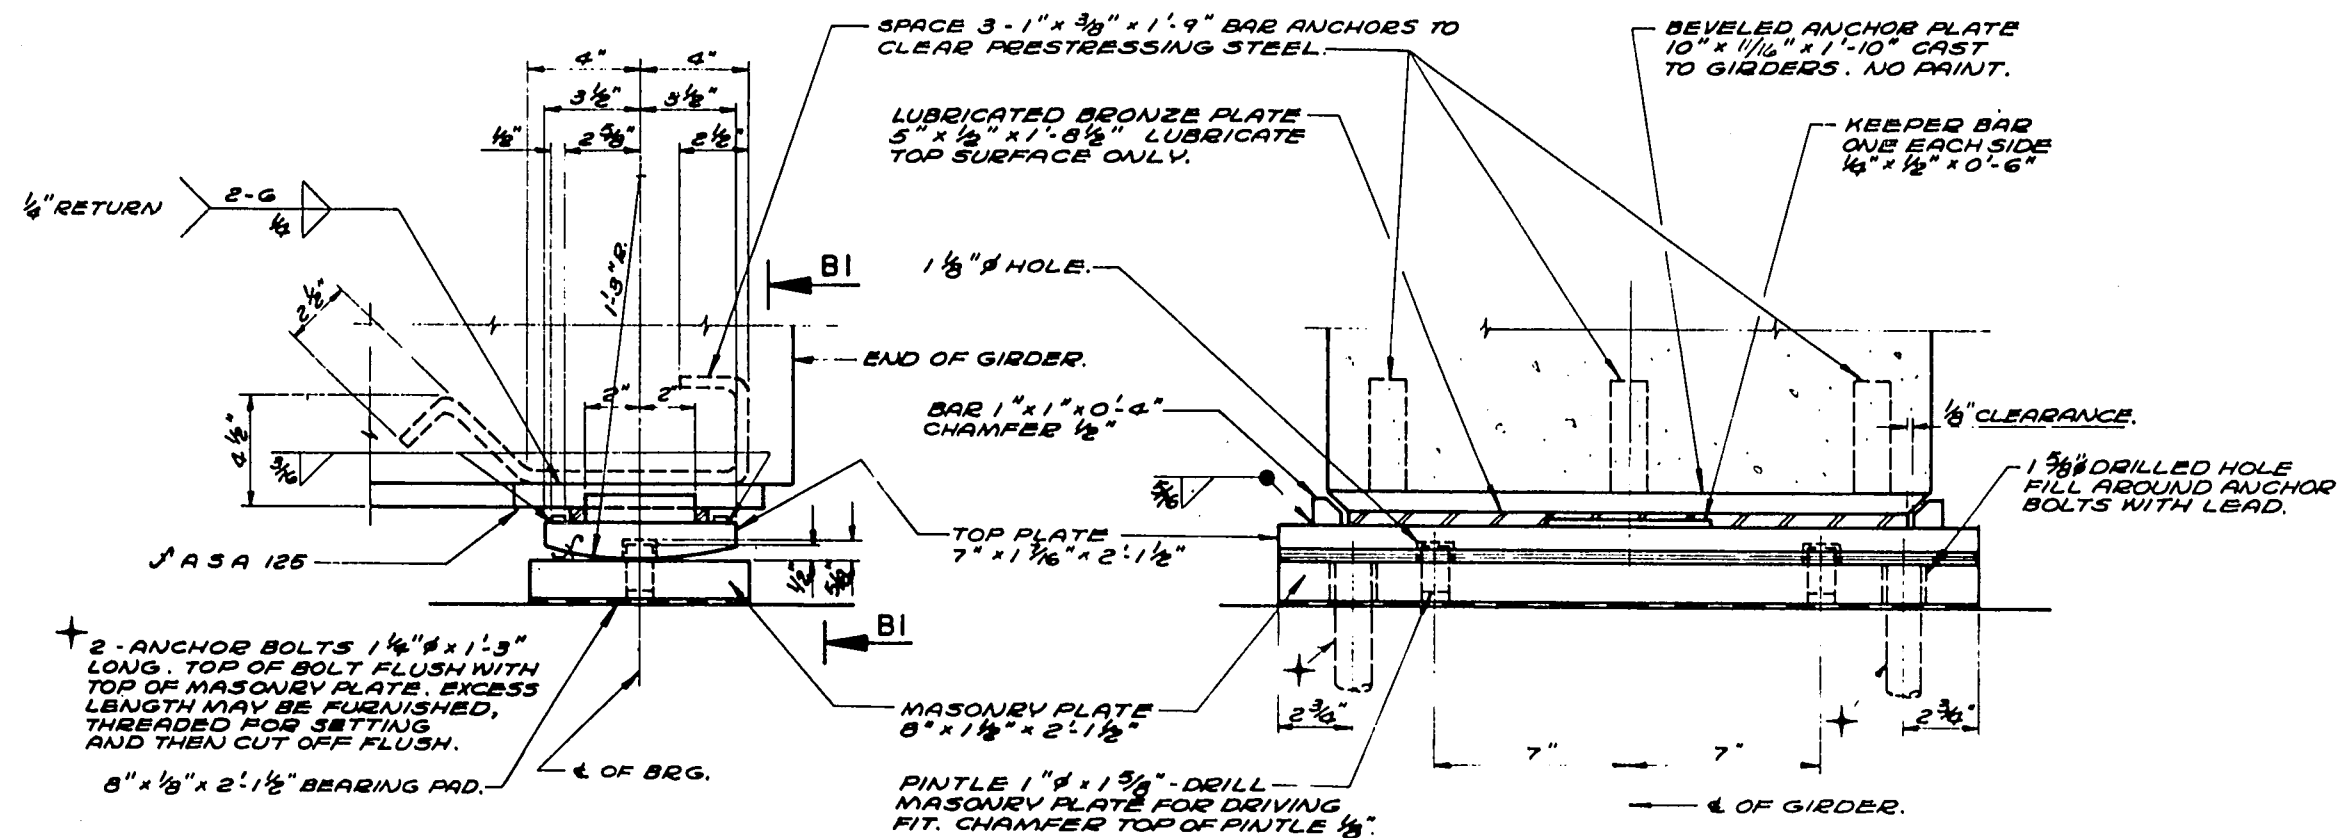

SECTION BI

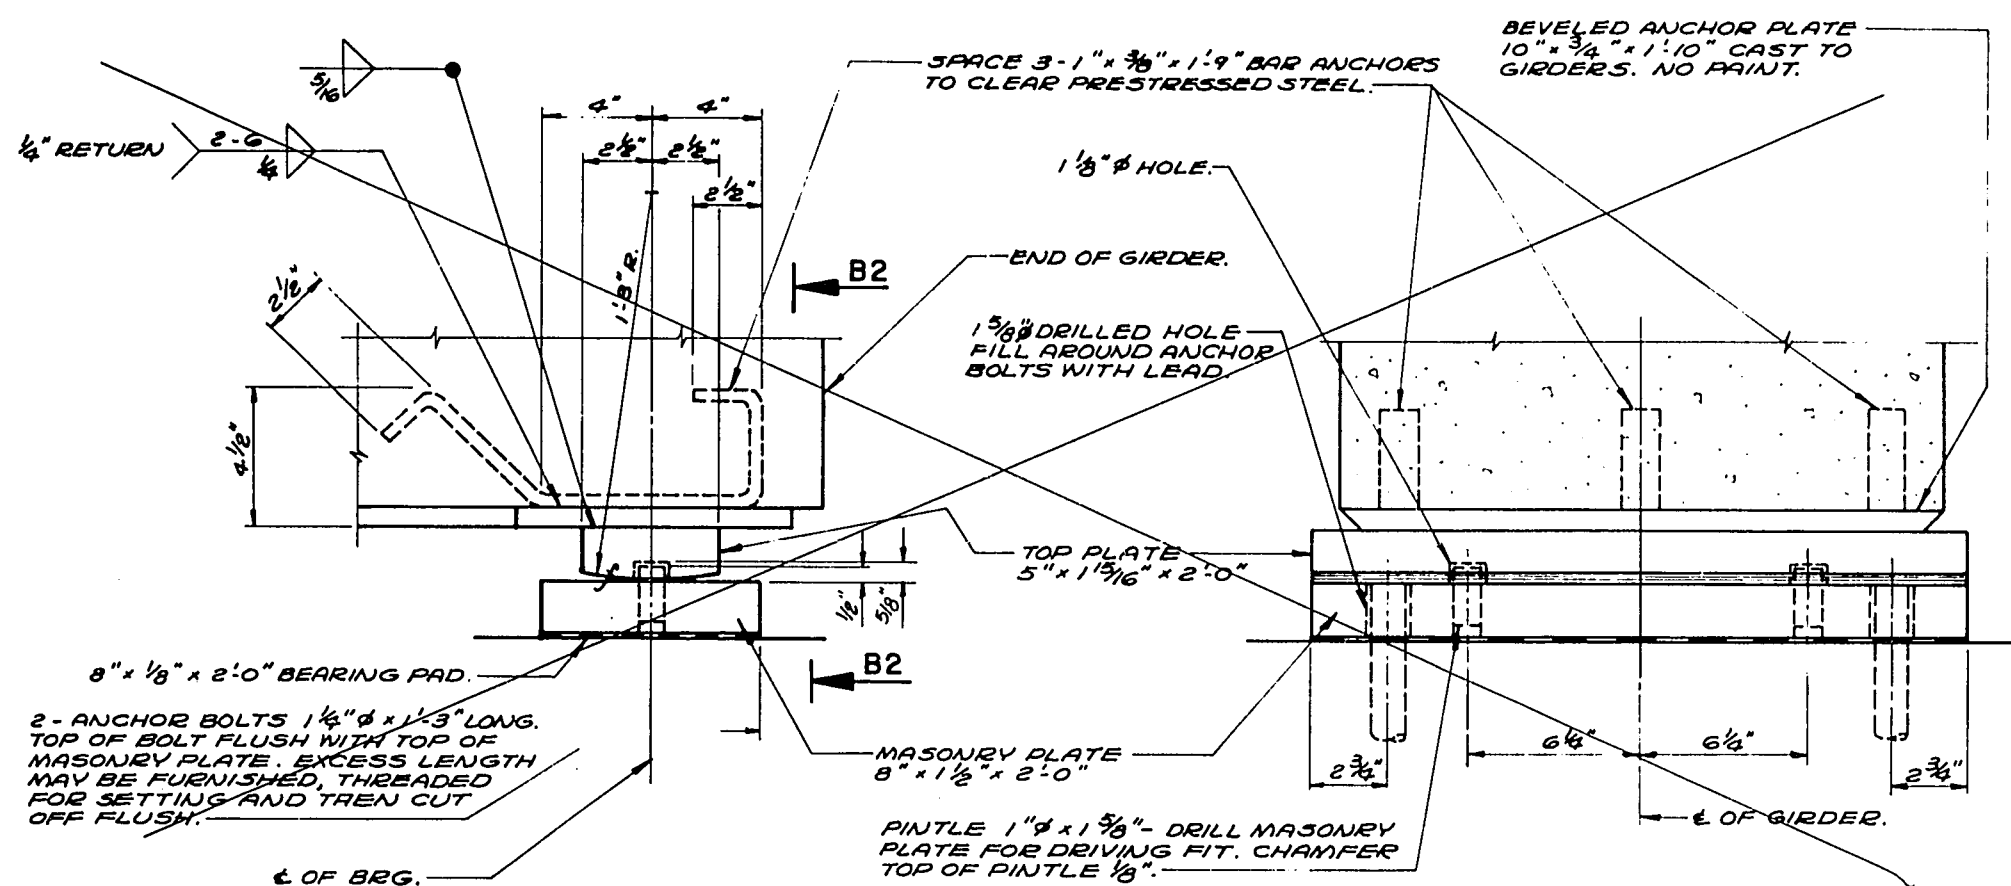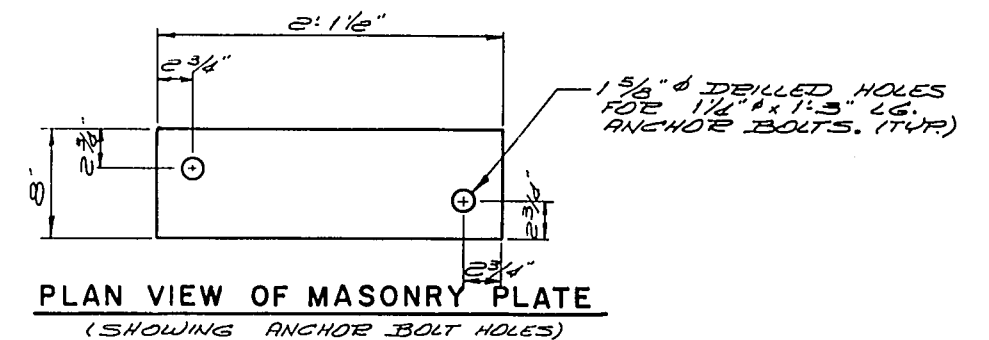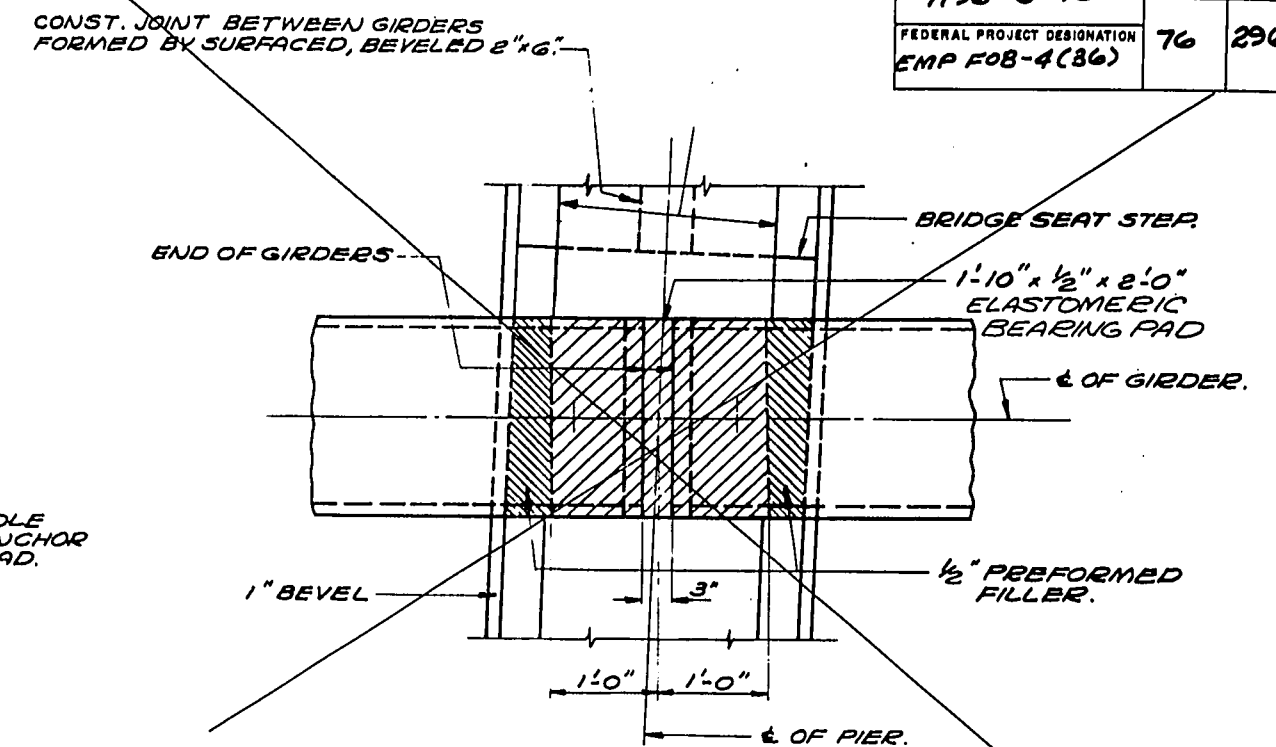

SECTION B2

## NOTES

ALL PLATE CUTS SHALL BE MACHINE OR MACHINE FLAME CUTS.


ALL SURFACES MARKED S SHALL BE MACHINE FINISHED, BY AN AUTOMATIC PROCESS.

ALL MATERIAL EXCEPT ANCHOR BOLTS SHALL BE MADE OF A242 STEEL WITH A CORROSIVE RESISTANCE OF 4 OR MORE TIMES THAT OF A36 STEEL.

ALL BEARING MATERIAL EXCEPT BRONZE PLATES, BEARING PADS, AND ANCHOR PLATES SHALL BE PAID FOR AT THE UNIT PRICE BID FOR "STRUCTURAL LOW ALLOY STEEL."

ALL STRUCTURAL STEEL PLATES SHALL BE FLAT ROLLED STEEL PLATES WITH ALL SURFACES SMOOTH AND FREE FROM WARP AND ALL EDGES SMOOTH, STRAIGHT AND VERTICAL.

No.	Date	Revision	By
STATE OF WISCONSIN DEPARTMENT OF TRANSPORTATION DIVISION OF HIGHWAYS			
<b>STRUCTURE      B - 3 - 17</b>			
Const. Spec.	1969	Drawn By BUDD	Plans Checked G. H. H.
BEARING DETAILS		SHEET 13 OF 16	
		<b>X 46189</b>	

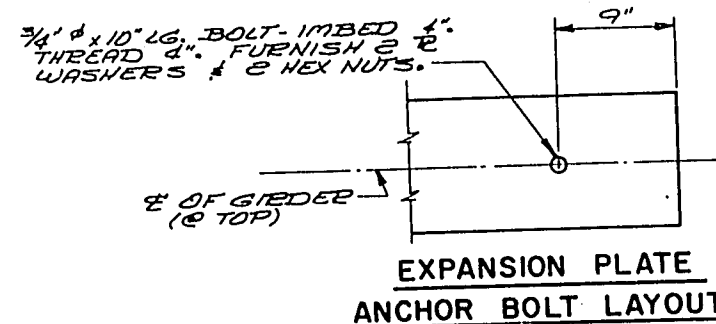

BAR 3" x 3/8" x 1'-0"

BAR 2 1/2" x 3/8" x 1'-0"

BAR 4 1/2" x 3/8" x 1'-0"

3/4" F.H. CSK. BOLTS

1/2 OF SPlice

G.F.

1/4"

1/4"

1/4"

BAR 2 1/2" x 3/8" x 1'-0" WITH 2 SLOTTED HOLES.

**FIELD SPlice DETAILS**

The image contains two technical drawings of a parapet wall. The left drawing is a cross-section labeled "SECTION THRU PARAPET" and the right drawing is an elevation labeled "ELEVATION AT PARAPET".

**SECTION THRU PARAPET:** This drawing shows a cross-section of the parapet wall. It includes a concrete slab on top, a vertical wall, and a base. Key dimensions and features include:
 

- Top of slab: 2 1/2"
- Wall thickness: 1"
- Base thickness: 2"
- Reinforcement: 17 (top), 15 (middle), 16 (bottom), 12 (bottom left), 1 (bottom right), 2 (bottom right).
- Labels: "TOP OF SLAB", "SECTION THRU PARAPET".

**ELEVATION AT PARAPET:** This drawing shows the front elevation of the parapet wall. It includes a grid of reinforcement bars and dimensions. Key dimensions and features include:
 

- Top of slab: 7 1/8", 2 1/8", 1 3/4", 2 1/8", 1 3/8".
- Wall height: 1 3/4".
- Base thickness: 2"
- Reinforcement: 17 (top), 15 (middle), 16 (bottom), 14 (bottom), 1 (bottom left), 2 (bottom right), 4 (bottom right), 9 (bottom right), 11 (bottom right).
- Labels: "ELEVATION AT PARAPET", "1/4" MAX WIDTH OF WELD".

[illegible]

DETAIL "A"

VIEW A-A

DETAIL "B"

NOTE: ONE FIELD SPICE SHALL BE PERMITTED IN ANGLES.  
ANGLE AND STUDS SHALL BE PAID FOR AS STRUCTURAL CARBON STEEL.

THIS EDGE  
TOWARD  
ABUTMENT

Ø 3/4" x ROLL WITH

WELDMENT OPTION FOR WT NO. 1

## LEGEND

1. WT 6 x 39.5 x RDWY. WIDTH. WELDMENT MAY BE USED. SEE DETAIL.
2. L 7" x 4" x 7/16" x RDWY. WIDTH. LONG DIM. OF 13/16" x 1 1/2" SLOTTED HOLE TO BE PARALLEL TO DIRECTION OF MOVEMENT.
3. BAR 1 1/2 x 3/4" x RDWY. WIDTH. WELD TO L #2 WITH 2 LINES OF 1/4" FILLET WELD, 2 @.
4. L 3 1/2 x 3" x 3/8" PROVIDE 3/8" Ø HOLE IN 3 1/2" LEG FOR 3/4" Ø x 10" BOLT. FILLET WELD TO FLANGE & WEB OF WT #1 NEAR SIDE & FAR SIDE.
5. 3/8" Ø FLAT HEAD CAP SCREW x 0.2" LONG WITH SQ. NUT - AT 4'0" CTRS. GREASE FOR EASY REMOVAL. 1/2" x 1/2" x 1/4" KEEPER BAR - WELD TO L #2 TO SEP SQ. NUT FROM TURNING. 13/16" x 1 1/2" SLOTTED HOLE IN L #2. 13/16" Ø HOLE C/SK. 7/16" DEEP IN WT #1. MAKE SLOT IN L #2 PARALLEL TO DIRECTION OF MOVEMENT.
6. 13/16" Ø VENT HOLES AT 2'0" CENTERS ON WT #1 AND L #2.
7. 3/8" STUDS x 0.6 3/8" LONG AT 6" ALTERNATE CTRS. BETWEEN GIRDERS. WELD TO WT #1.
8. 3/8" STUDS x 0.6 3/8" LONG AT 9" ALT. CTRS. WELD TO L #2.
9. L 3' x 2 1/2" x 3/8" x 0.3" LONG AT 3'0" CTRS. WELD TO L #2. PROVIDE 15/16" Ø HOLE IN 2 1/2" LEG FOR ROD #13.
10. 3/4" Ø ROD x 0.9" LONG AND NUT. TACK WELD NUT TO L #12. THREAD 3".
11. PLATE 3/8" x 6" x 8 13/16".
12. PLATE 3/8" x 6" x 15 1/8" FIELD WELD TO WT #1.
13. BAR 1 1/2" x 3/8" x 6". WELD TO BAR #14 WITH TWO LINES OF 3/16" FILLET WELD. FIELD WELD TO BAR #4.
14. 3/8" STUDS x 0.6 3/8" LONG. WELD TO BAR #14 AND L #15.
15. BLOCK AND BOLT FOR SHIPMENT WITH PIPE SLEEVE AND 1/2" Ø BOLT. PROVIDE 9/16" Ø HOLES @ 3'0" CTRS. IN WT #1 AND L #2 FOR 1/2" Ø BOLT.

## NOTES

EXPANSION JOINT SHALL BE BUILT TO CONFORM TO ROADWAY CROWN AND GRADE.  
ALL MATERIAL IN EXPANSION JOINT SHALL BE PAID FOR AS STRUCTURAL CARBON STEEL.  
AFTER CONCRETE HAS SET

1. THE JOINT OPENING SHALL BE THOROUGHLY CLEANED.
2. REMOVE BOLTS NO. 8.
3. APPLY 1/16" OF BITUMASTIC TO VERTICAL METAL SURFACES FORMING THE JOINT.
4. FILL OPENING AND HOLES FOR BOLT NO. 8 WITH HOT POURED ELASTIC TYPE JOINT SEALER CONFORMING TO A.S.T.M. D1190.

ONE FIELD SPLICE SHALL BE PERMITTED.

FIELD CUT 3" LEG OF ANGLE AS REQ'D.  
FOR BENDING ANGLE TO CONFORM TO ROWV.  
CROWN. ONE CUT SHALL BE AT CENTER OF  
CROWN.

L 3" x 2" x 5/16"  
ROWV WIDTH -

2"  
1 1/2"  
1 1/16" Ø HOLES  
@ 3'-0" CTES.










3"  
2 1/4"

3/8" Ø STUDS x 0'-4" LG.  
WELD TO ANGLE @ 6"  
ALTERNATE CTES.

6" 6" 1/8" TYP

3" TYP

No.	Date	Revision	By
STATE OF WISCONSIN DEPARTMENT OF TRANSPORTATION DIVISION OF HIGHWAYS			
STRUCTURE B-3-17			
Const Spec	1969	Drawn By: RUDD	Plans Checked G. H. A.
EXPANSION JOINT			SHEET 14 OF X 46190

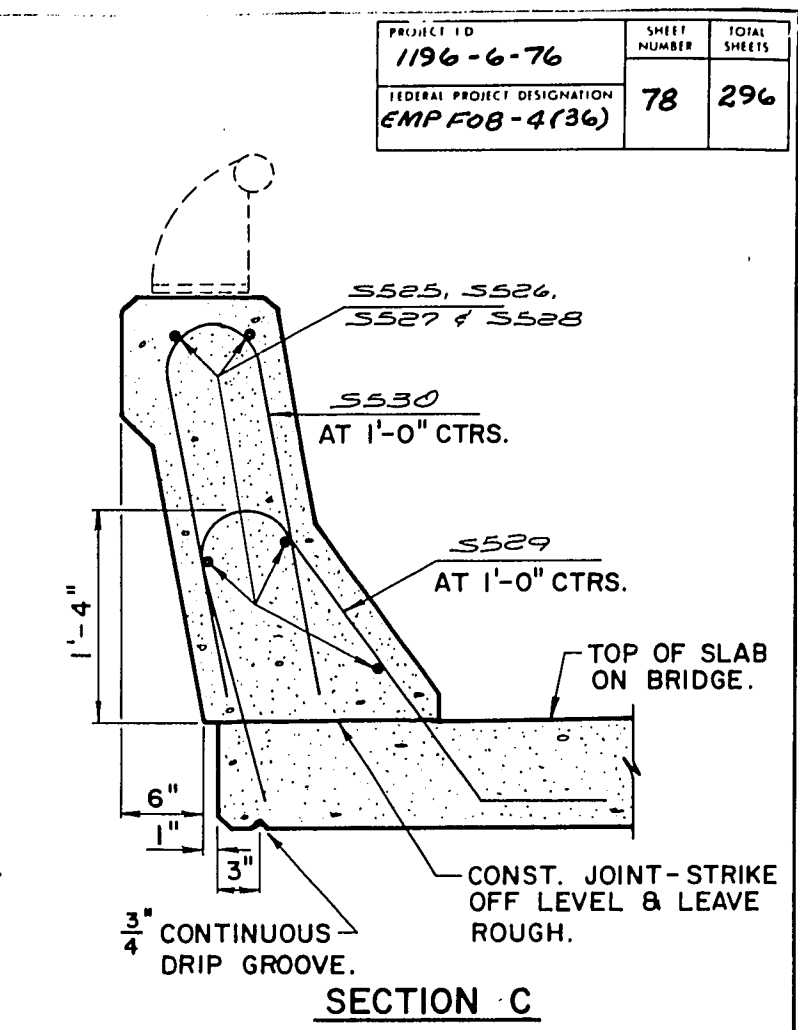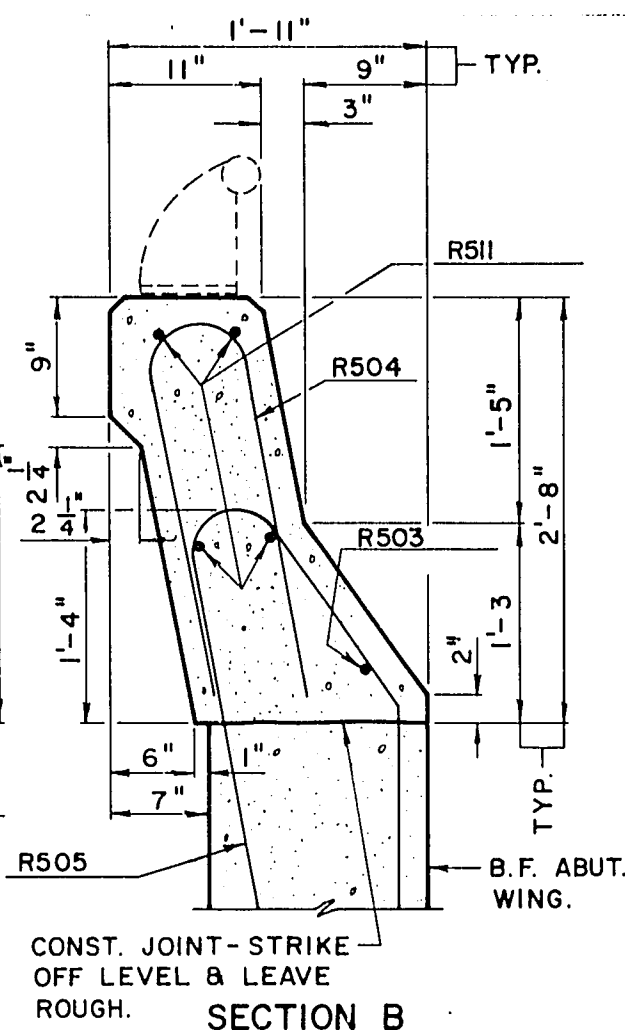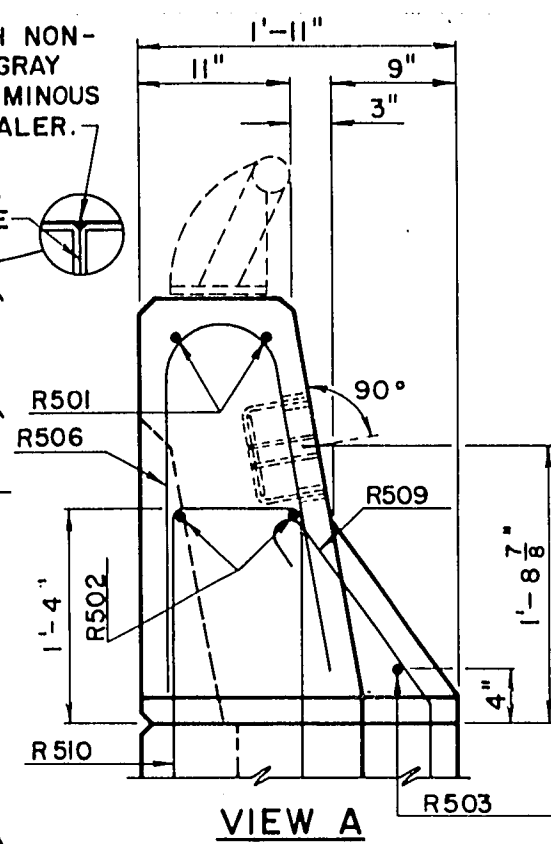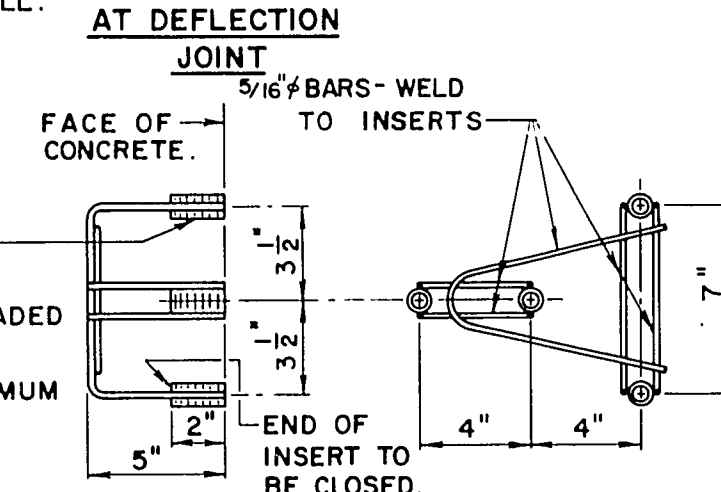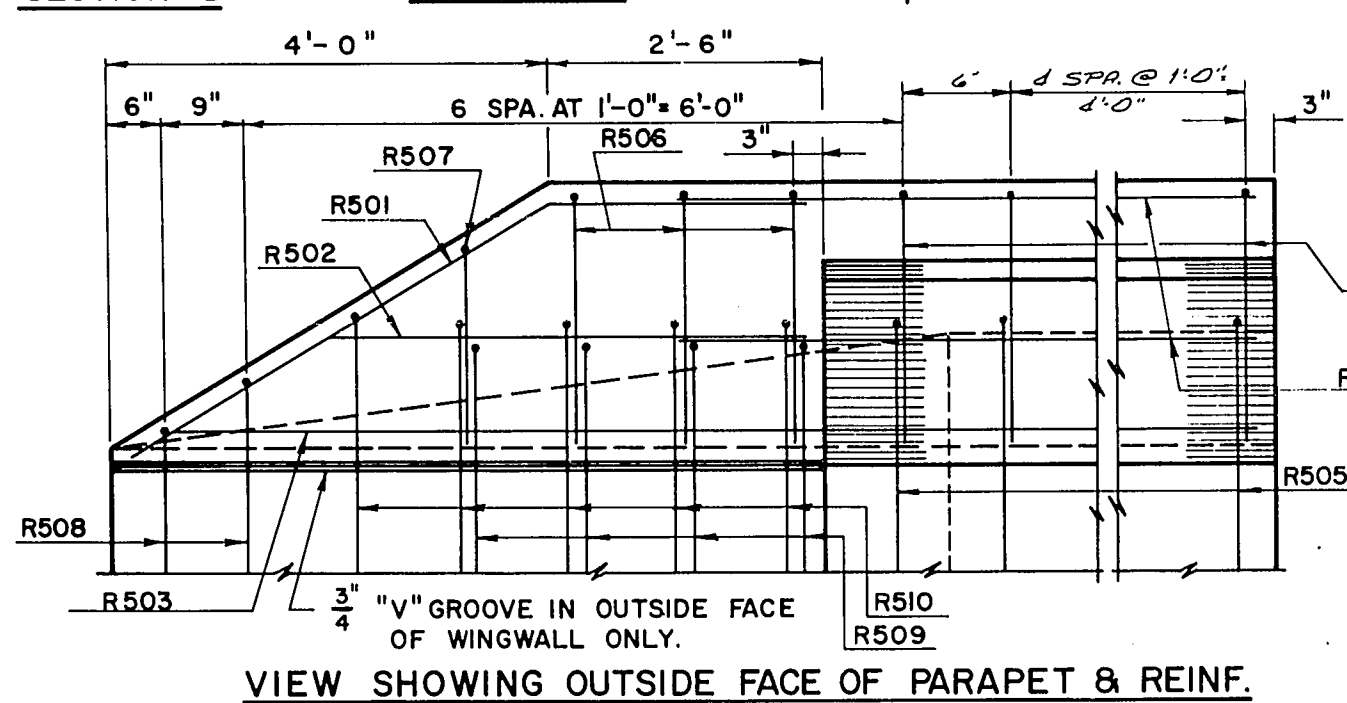
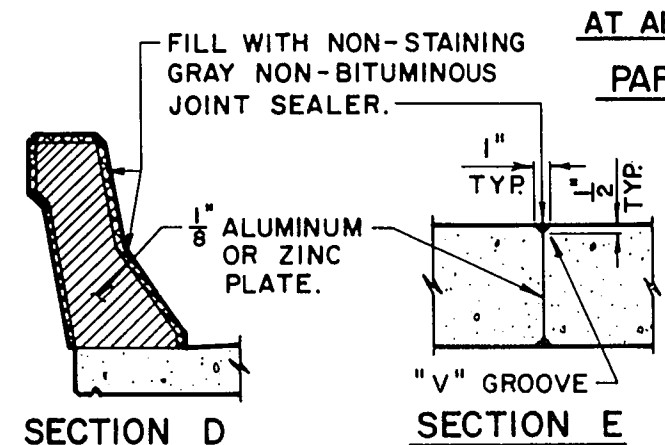
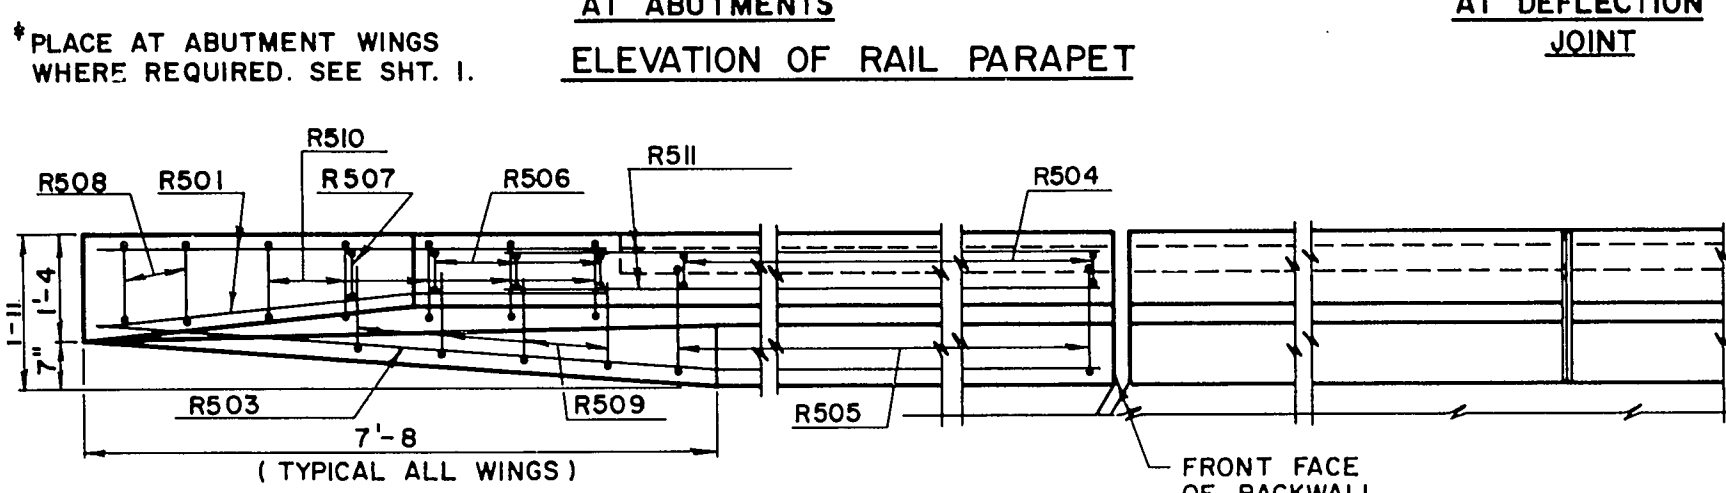
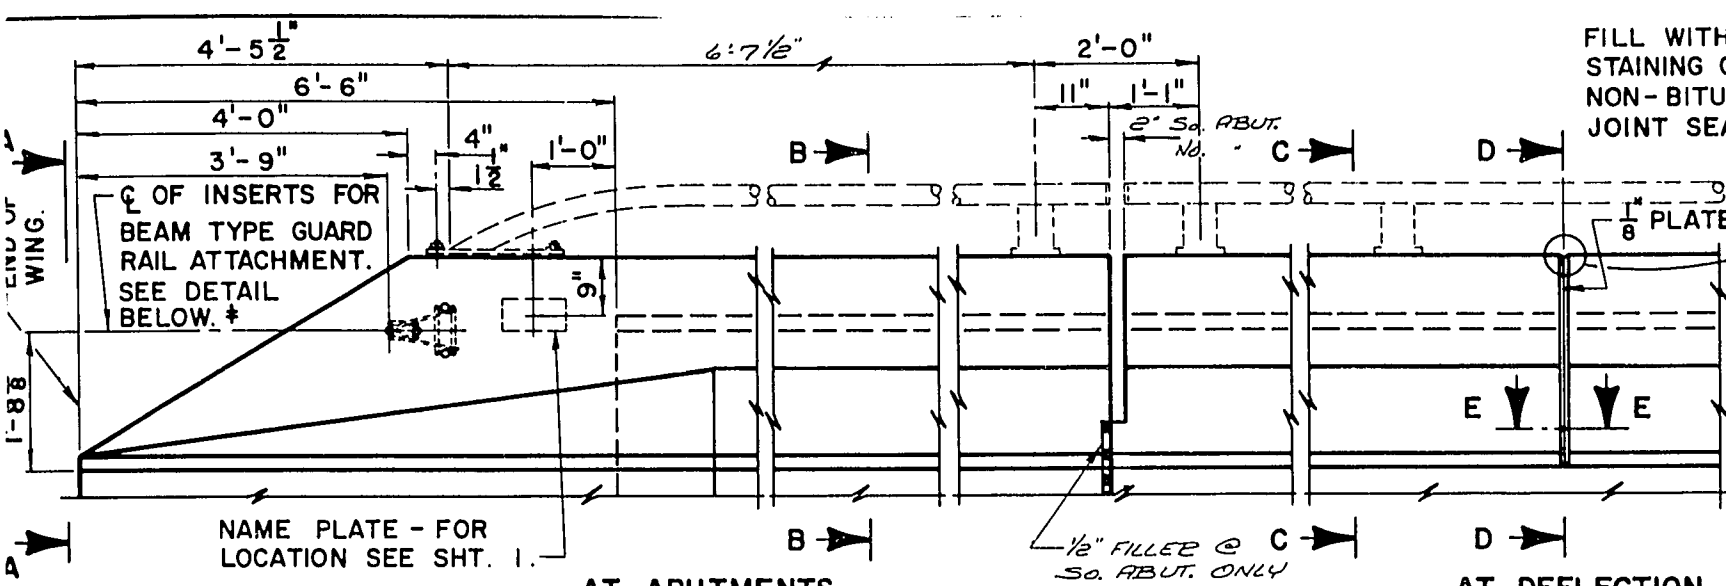
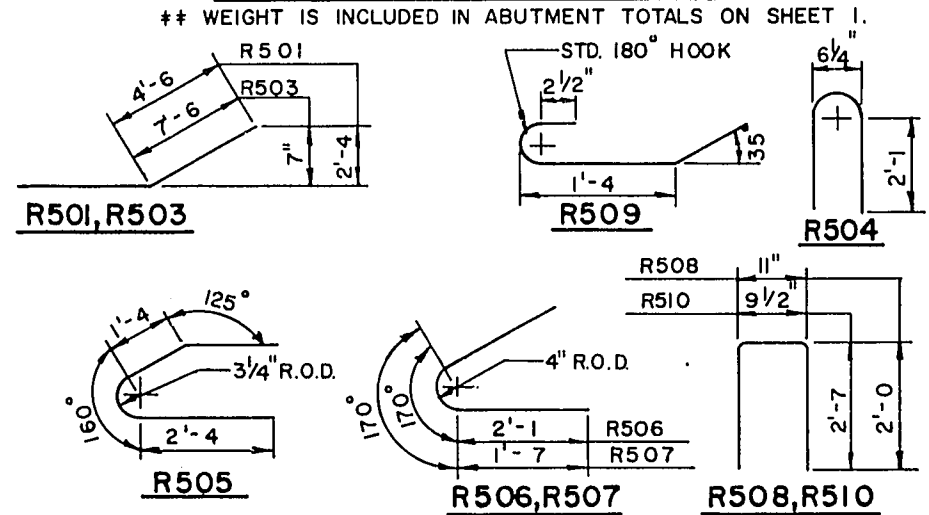
[illegible]

NOTES

WHEN PARAPETS ARE POURED CONTINUOUSLY FROM END TO END, THEY SHALL BE SEPARATED AT THE DEFLECTION JOINTS BY A PIECE OF  $\frac{1}{8}$  ZINC OR ALUMINUM PLATE CUT AS SHOWN IN SECTION "D" BY SHADED AREA. IF CONSTRUCTION JOINTS IN PARAPETS ARE USED AT THE DEFLECTION JOINTS, ONE SIDE OF JOINT SHALL BE COATED WITH BITUMINOUS PAINT AND PLATE SEPARATORS MAY BE OMITTED.

WORK THIS SHEET WITH SHEET TITLED "DETAILS FOR TYPE 'J' TUBULAR ALUMINUM OR STEEL RAILING".

No.	Date	Revision	By
STATE OF WISCONSIN DEPARTMENT OF TRANSPORTATION DIVISION OF HIGHWAYS			
STRUCTURE B-3-17			
Const. Spec.	1969	Drawn By	BUDD
		Plans Checked	G.H.R.
SLOPED FACE PARAPET "A"		SHEET 15 OF 16	
		X 46191	

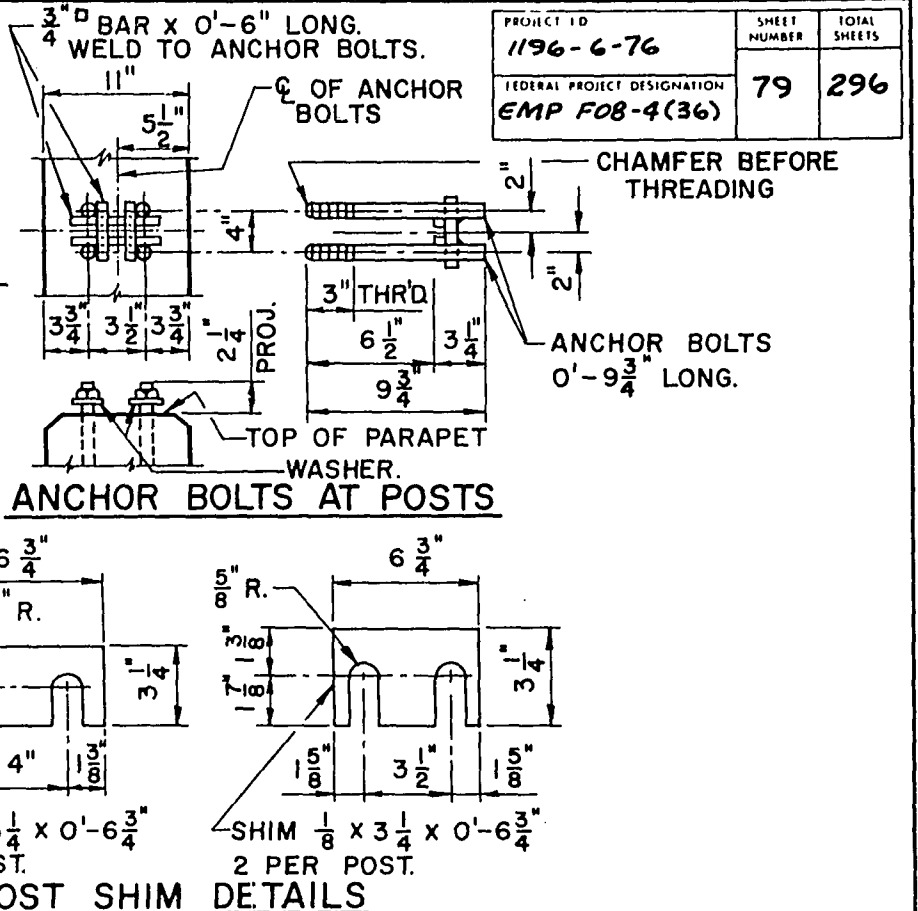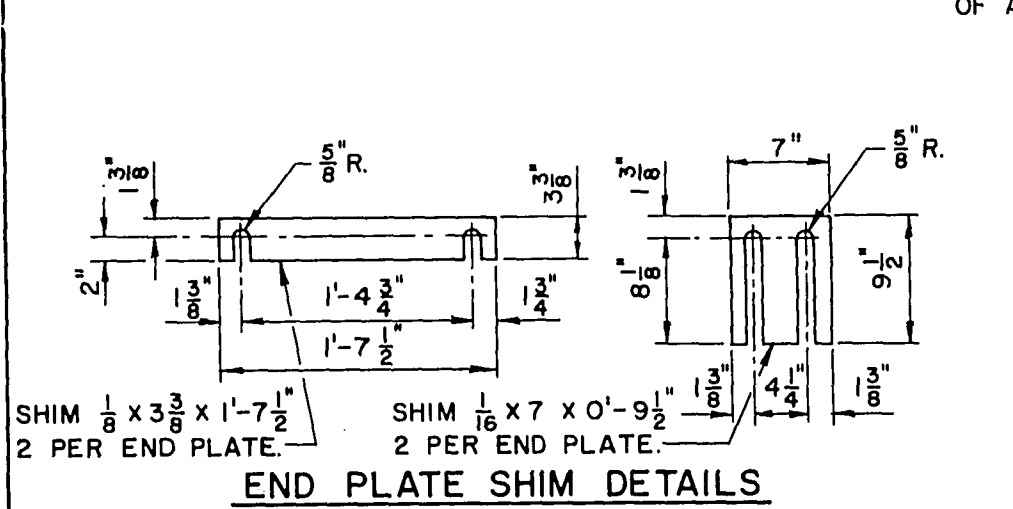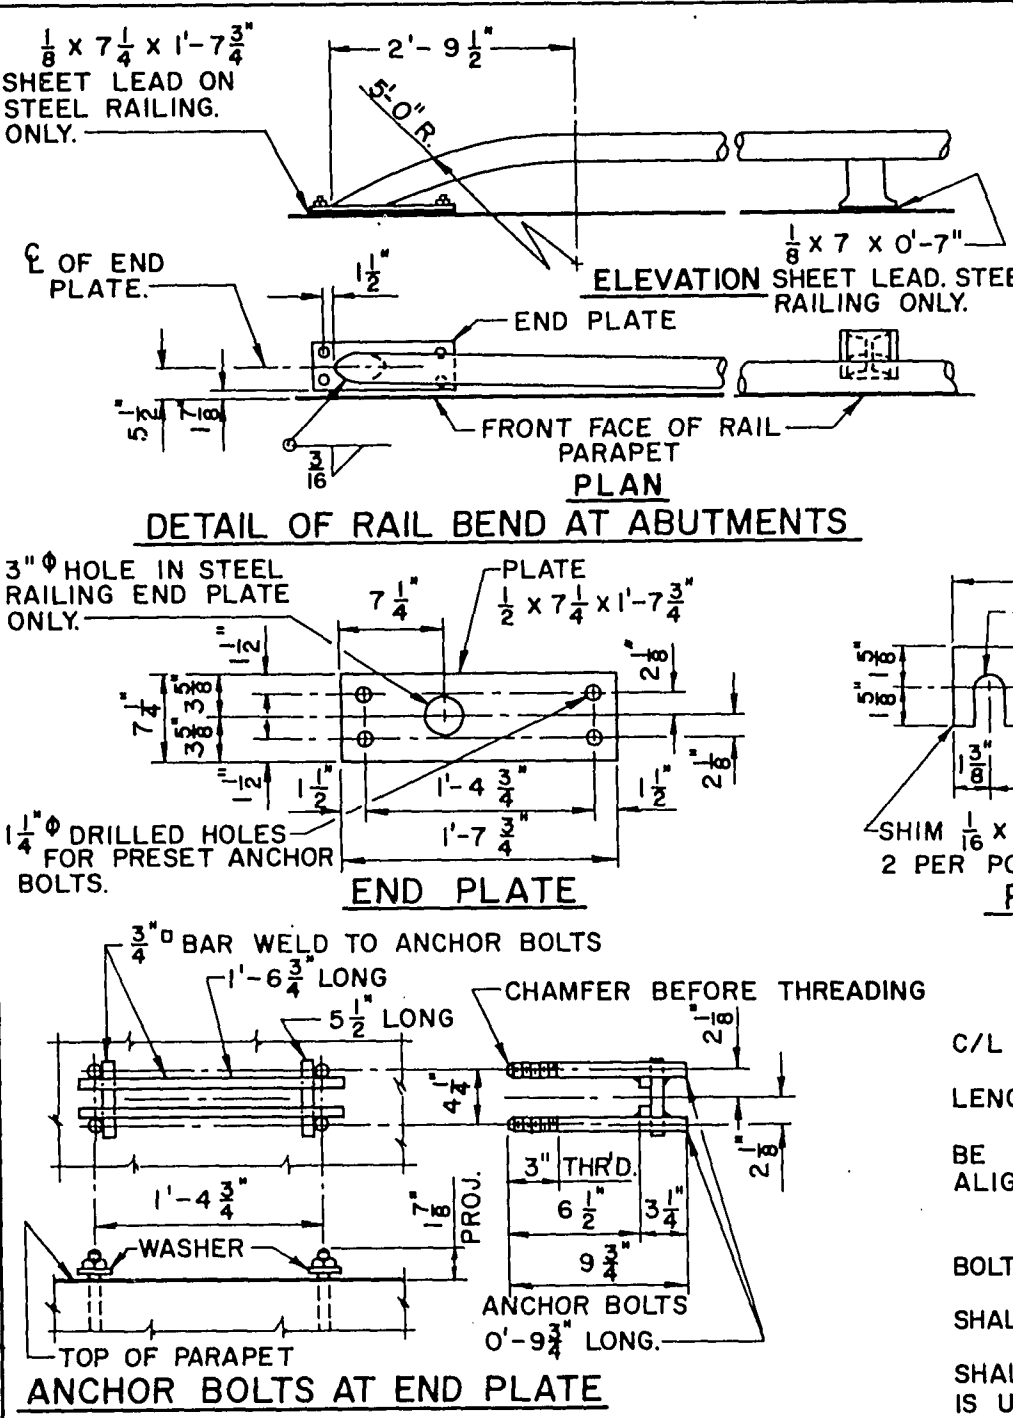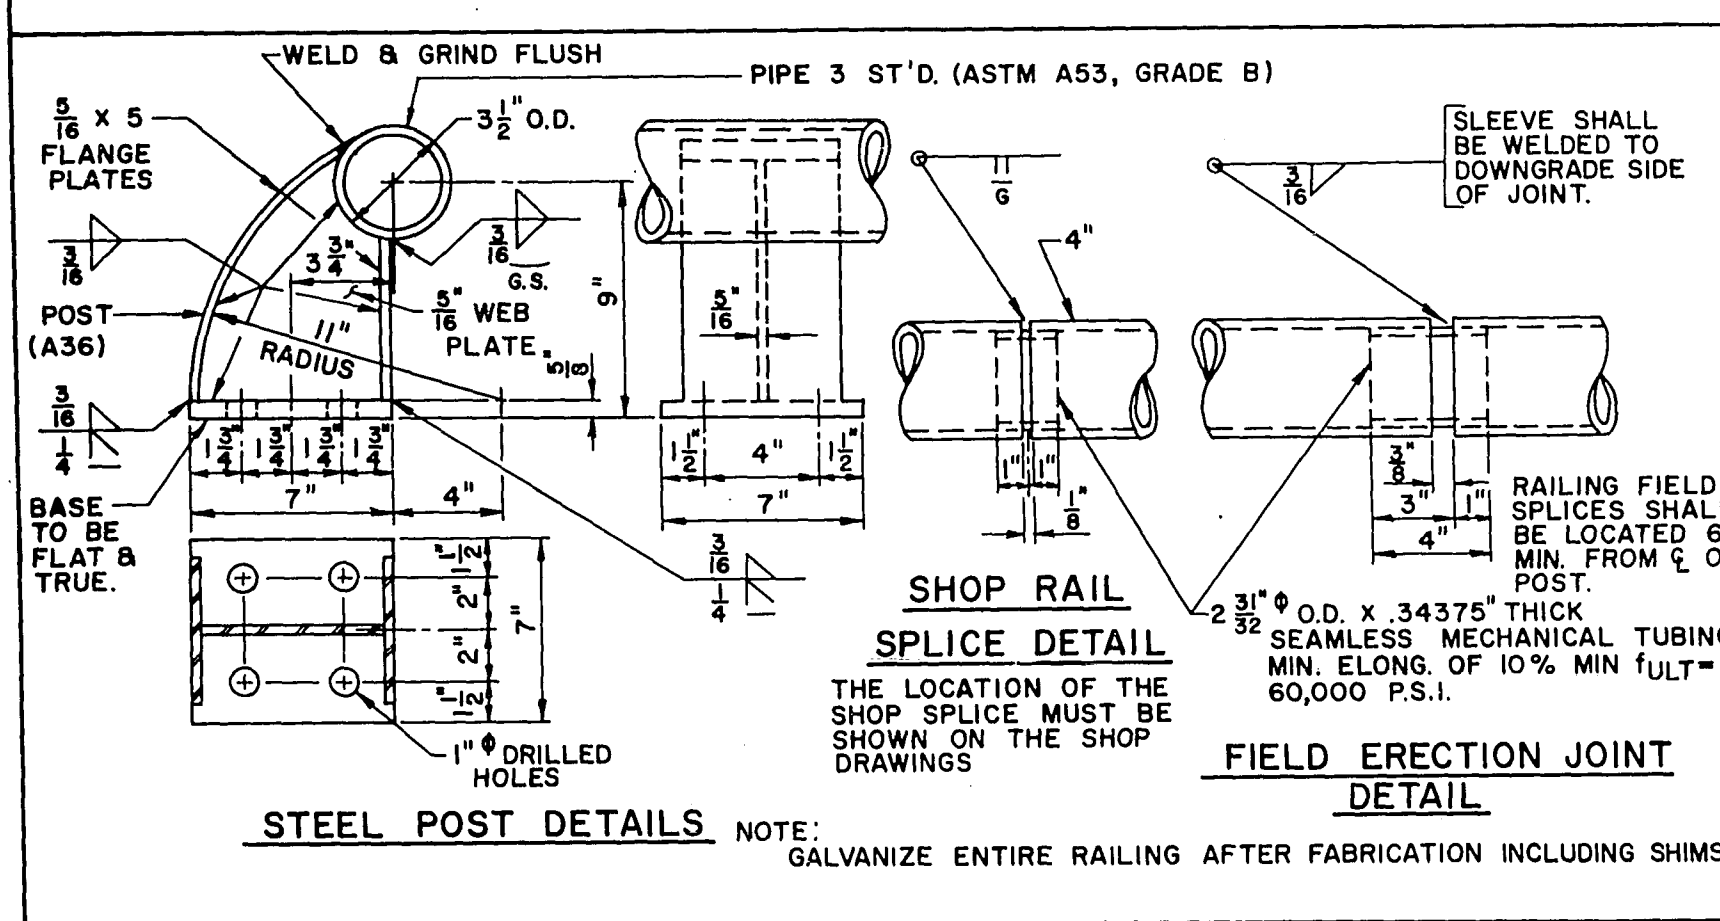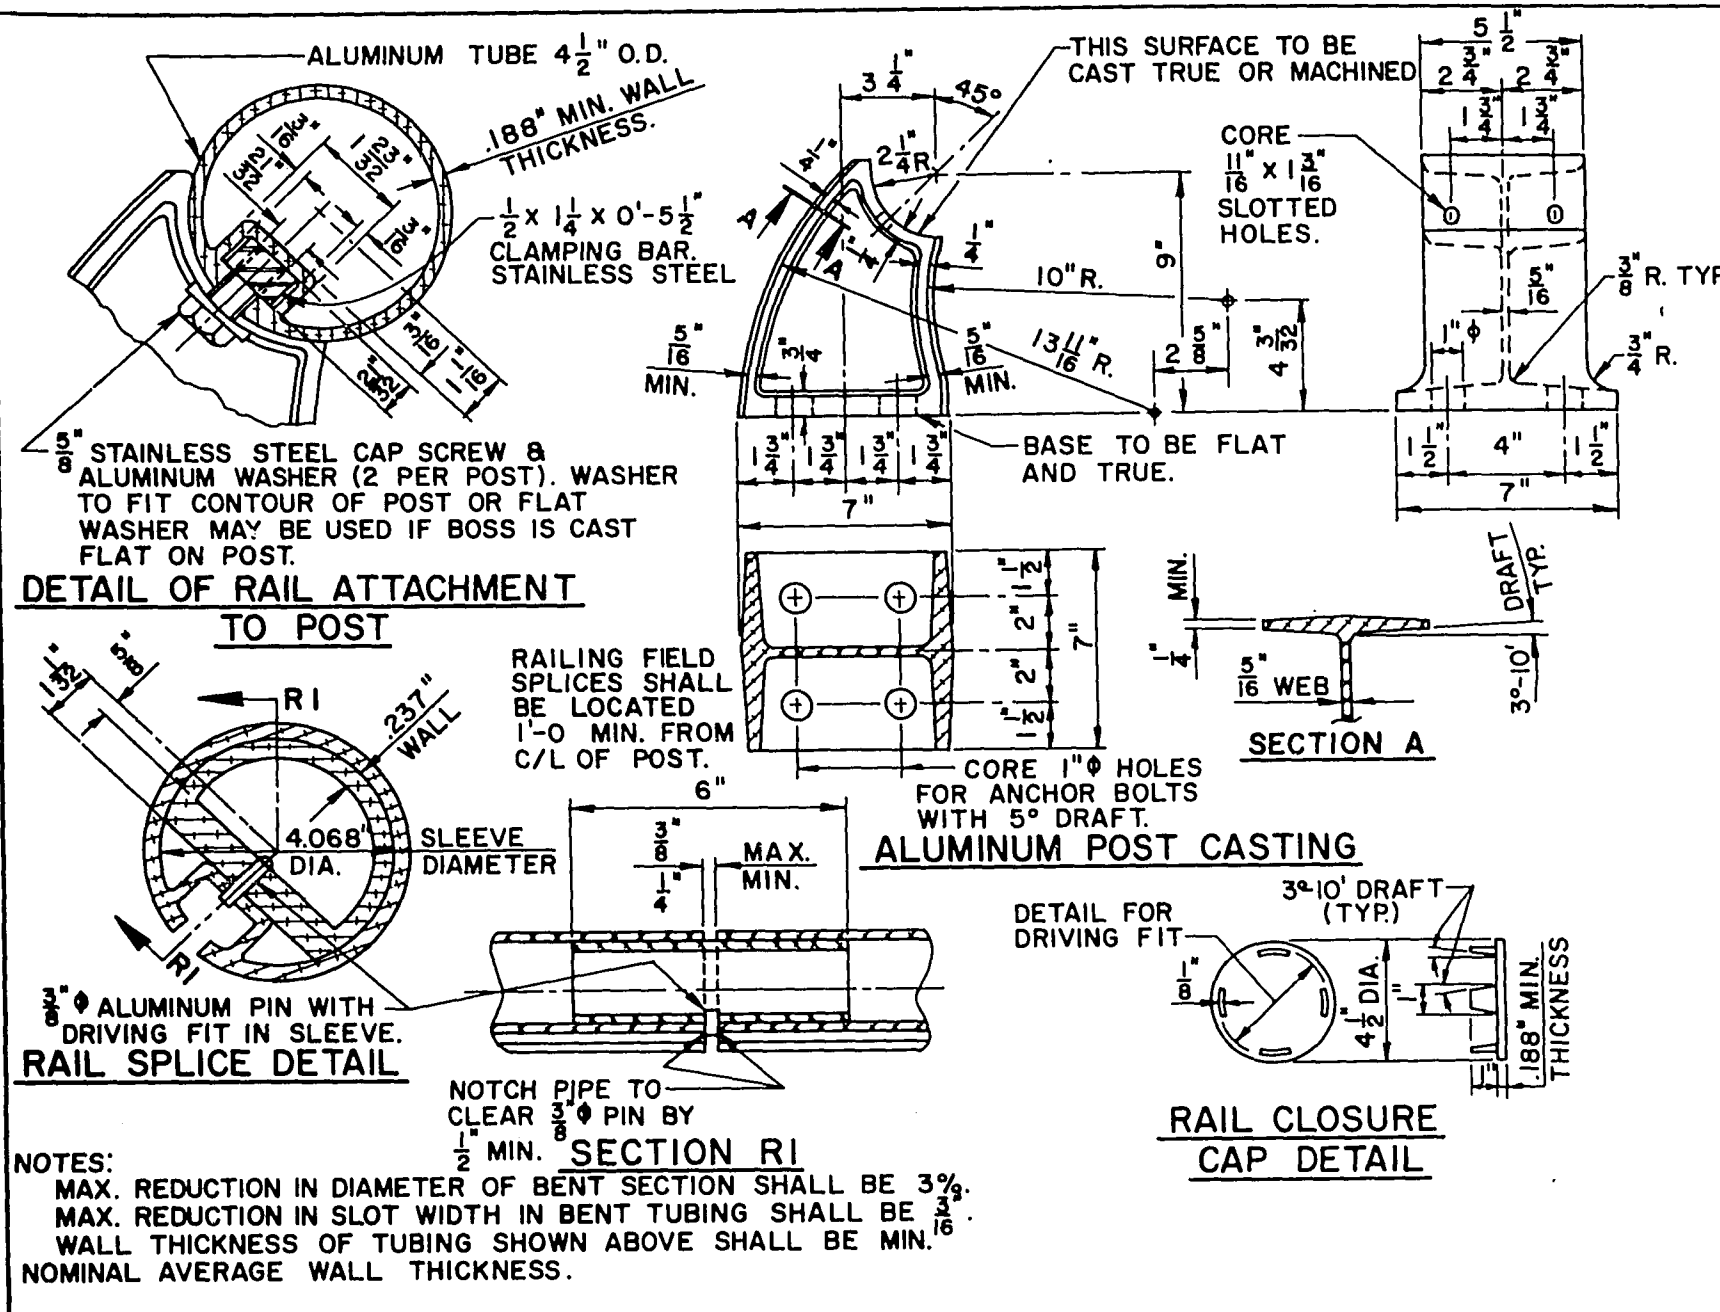

**GENERAL NOTES**

BID ITEM SHALL BE TUBULAR RAILING, TYPE 'J'.

ALL POST SPACINGS ARE TAKEN HORIZONTALLY ALONG C/L OF ANCHOR BOLTS.

RAILING SHALL BE FABRICATED IN TWO OR THREE PANEL LENGTHS.

SHIMS CONFORMING TO SAME MATERIAL AS POSTS SHALL BE USED UNDER POSTS AND END PLATES WHERE REQ'D FOR ALIGNMENT.


RAIL POSTS SHALL BE SET NORMAL TO GRADE.

THE SHANK AND ROOT OF THREAD DIAMETER FOR ANCHOR BOLTS SHALL BE A MIN. OF 0.62 INCHES.

ANCHOR BOLTS, NUTS & WASHERS FOR ALUMINUM RAILING SHALL BE STAINLESS STEEL.

ANCHOR BOLTS, NUTS & WASHERS FOR STEEL RAILING SHALL BE EITHER STAINLESS STEEL OR ASTM A307. IF A307 IS USED ELECTRO-GALVANIZE NUTS, WASHERS & TOP  $\frac{3}{2}"$  OF ANCHOR BOLTS.

SHIMS SHALL CONFORM TO SAME MATERIAL AS POSTS.

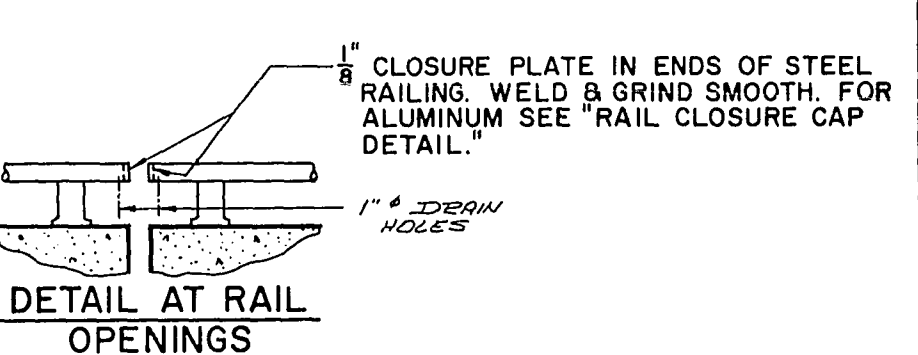

No.	Date	Revision	By
STATE OF WISCONSIN DEPARTMENT OF TRANSPORTATION DIVISION OF HIGHWAYS			
STRUCTURE B-3-17			
Const. Spec. 1969	Drawn By BUDD	Plans Checked G. H. A.	
TUBULAR RAILING TYPE 'J'			SHEET 16 OF 16 X 46192