



STATE OF WISCONSIN  
DEPARTMENT OF TRANSPORTATION

Inspection Report for  
B-03-019

USH 53 NB over A  
Jun 23, 2017



Type	Prior	Frequency (mos)	Performed
Routine	06-16-15	24	X
SIA Review	06-13-13	48	X

Latitude	Owner
45°17'25.89"N	STATE HIGHWAY DEPT
Longitude	Maintainer
91°38'36.37"W	STATE HIGHWAY DEPT

Time Log		Team members
Hours 1	Minutes 0	wjk

Name	Number	Signature	Date
Inspector Kovaleski, William J	8007	<i>William J Kovaleski</i>	09-08-17
		E-signed by Bill(dotwjk)	

**BRIDGE INSPECTION REPORT**  
**Wisconsin Department of Transportation**  
**DT2007 2003 s.84.17 Wis. Stats.**

page 2

**Identification & Location**

Feature On: USH 53 NB	Section Town Range: S05 T32N R10W	Structure Number: <b>B-03-019</b>
Feature Under: A	County: BARRON	
Location 7.2M N JCT CTH M TO E	Municipality: DOVRE	Structure Name:

**Geometry**

measurements in feet, except where noted

Approach Roadway Width: 40	Bridge Roadway Width: 40.0	Total Length: 271.7
Approach Pavement Width: 24	Deck Width: 43.8	Deck Area (sq ft): 11900

**Traffic**

	Lanes	ADT	ADT year	Traffic Pattern
On	2	5550	2014	ONE WAY TRAFFIC
Under	2	450	2011	TWO WAY TRAFFIC

**Capacity**

**Load Rating**

Inventory rating: HS17	Overburden depth (in): 2.0	Last rating date:	Controlling: INTERIOR DECK GIRDER Moment
Operating rating: HS29	Deck surface material: LOW SLUMP CONCRETE	Re-rate for capacity (Y/N):	Control location: 3.7 SPAN 1, 28.7
Posting:	Re-rate notes:		

**Hydraulic**

**Classification**

Scour Critical Code(113): (N) NO WATERWAY	Q100 (ft3/sec): 0	
High water elevation (ft): 0.0	Velocity (ft/sec): 0.0	Sufficiency #: 95.2

**Span(s)**

Span #	Material	Configuration	Depth (in)	Length (ft)	Main
1	CONT STEEL	DECK GIRDER		77.0	
2	CONT STEEL	DECK GIRDER		118.5	Y
3	CONT STEEL	DECK GIRDER		65.0	

**Expansion joint(s)**

**Temperature:**

File:	New:
-------	------

**Clearance**

Item	File Measurement (ft)	File Date	New Measurement (ft)
Highway Min Vertical Under Cardinal	14.5		
Highway Min Vertical Under Non-Cardinal			
Horizontal Under Cardinal	46.2		
Horizontal Under Non-Cardinal			
Highway Min Vertical On Cardinal			
Horizontal On Cardinal			

**Special Components**

Component	Year	Work Performed	Note
DECK - IOWA MIX	1989	OVERLAY - CONCRETE	

**Construction History**

Year	Work Performed	FOS id
1989	OVERLAY - CONCRETE	0003-84-01
1972	NEW STRUCTURE	1196-04-74

**BRIDGE INSPECTION REPORT**  
**Wisconsin Department of Transportation**  
**DT2007 2003 s.84.17 Wis. Stats.**

page 3

Structure No.: **B-03-019**

**Maintenance Items History**

Item	Recommended by	Status	Status change	Year completed
<b>Deck - Patching</b>	Harrington, Daniel J (8004)	COMPLETE	01/17/13	
approx 14 sq ft of deck patching				

**Maintenance Items**

Item	Priority	Recommended by	Status	Status change
<b>Misc - Tighten Bolts and Nuts</b>	HIGH	Kurtz, William G (8008)	IDENTIFIED	06/18/15
Tighten all bolts and replace missing bolts (2) on decorative rail.				
<b>Misc - Cut Brush</b>	LOW	Kurtz, William G (8008)	IDENTIFIED	06/18/15
Remove brush from four (4) quadrants.				
<b>Substructure - Other Work</b>	LOW	Kurtz, William G (8008)	IDENTIFIED	06/18/15
Seal concrete columns.				

**Elements**

Chk	Element	Defect	Description	UOM	Total	Quantity in Condition State			
						1	2	3	4
X	12		<b>Reinforced Concrete Deck</b>	SF	11,900	11,186	714	0	0
		1130	Cracking (RC) CRK CS2 714SF.	SF		0	714	0	0
	8514		Concrete Overlay Trans. and long. cracks over pier. random mapping cracks throughout. Spalls shoulder westside. Patched 2006. Six spalls in left lane and shoulder 20 SQ Ft total 2011	SF	11,900	0	11,879	21	0
		3210	Debonding/Spall/Patched Area/Pothole DELAM CS2 833SF. SPL CS3 21SF.	SF		0	833	21	0
		3220	Crack (Wearing Surface) CRKNG CS2 11,046SF.	SF		0	11,046	0	0
X	107		<b>Steel Open Girder</b>	LF	1,351	1,341	10	0	0
			Steel area for painting estimate 17,561 sq ft - 1,631 sq m Painted 06/05						
		1000	Corrosion Freckle rust CS2 10sf.	LF		0	10	0	0
	8516		Painted Steel Steel area for painting estimate 17,561 sq ft - 1,631 sq m Painted 06/05	SF	15,898	0	15,888	0	10
		3440	Effectiveness (Steel Protective Coatings) <b>Few rusted scrapes btwn G5 &amp; 4 Span 2. Signs of it chalking</b>	SF		0	15,888	0	10
X	205		<b>Reinforced Concrete Column</b>	EA	10	10	0	0	0
X	215		<b>Reinforced Concrete Abutment</b>	LF	209	155	53	1	0
			rust stains, <b>some sloughing</b> at S abut. Spall SW corner						
		1080	Delamination - Spall - Patched Area S ABUT G1 SPL CS3 1LF   G5 SPL CS2 1LF.	LF		0	1	1	0
		1130	Cracking (RC) S ABUT CRK CS2 30LF. N ABUT CRK CS2 22F.	LF		0	52	0	0

**BRIDGE INSPECTION REPORT**  
**Wisconsin Department of Transportation**  
**DT2007 2003 s.84.17 Wis. Stats.**

page 4

Structure No.: **B-03-019**

X	300		Strip Seal Expansion Joint	LF	200	200	0	0	0
X	311		Moveable Bearing painted 06/05	EA	15	0	15	0	0
		1000	Corrosion <b>Lt edge rust.</b> S ABUT CS2 5EA. N ABUT CS2 5EA. P2 CS2 5EA.	EA		0	15	0	0
X	313		Fixed Bearing P1.	EA	10	10	0	0	0
X	331		Reinforced Concrete Bridge Rail Tubular rail missing bolts. Spalls and Cracks in concrete 20 lf of spalling at toe of parapet southwest span 1.	LF	580	267	313	0	0
		1080	Delamination - Spall - Patched Area E RAIL CS2 3LF. W RAIL CS2 10LF.	LF		0	13	0	0
		1130	Cracking (RC) E RAIL CS2 150LF. W RAIL CS2 150LF.	LF		0	300	0	0
X	8400		Integral Wingwall	EA	4	0	4	0	0
		8902	Wall Movement SE 1/4" IN, 0" DOWN. SW 1/2" IN, 1/2" UP. NE 0" OUT, 1/2" UP.	EA		0	3	0	0
		8903	Wall Deterioration <b>Fine cracking on few</b>	EA		0	1	0	0

**Assessments**

Chk	Element	Defect	Description	UOM	Total	Quantity in Condition State			
						1	2	3	4
X	9001		Drainage - Approach Good condition.	EA	4	4	0	0	0
X	9030		Signs - Object Markers	EA	4	4	0	0	0
X	9033		Signs - Vertical Clearance	EA	2	2	0	0	0
X	9043		Slope Protection- Crushed Aggregate with Bit.	EA	2	2	0	0	0
X	9167		Steel Diaphragm Painted 06/05 <b>Lt edge rust.</b>	EA	52	41	11	0	0
X	9322		Approach Roadway - Concrete (non-structural) SW cracked, both N slabs have been overlaid w/bit. and have settlement and rutting. S APPR SPL CS3. N APPR overlaid w/bit.	EA	2	1	1	0	0
X	9335		Decorative Rail E DRAIL Bolt Missing (2)   Loose nuts (3). W DRAIL Loose nuts	EA	2	0	2	0	0

**NBI Ratings**

	File	New
Deck	5	5
Superstructure	7	7
Substructure	7	7
Culvert	N	N
Channel	N	N
Waterway	N	N

**BRIDGE INSPECTION REPORT**  
**Wisconsin Department of Transportation**  
**DT2007 2003 s.84.17 Wis. Stats.**

page 5

Structure No.: **B-03-019**

**Structure Specific Notes**

**OLD:** Overall, condition of structure is vg. Minor/moderate rusting of north abutment bearings should be cleaned/painted ASAP. Also tighten north abutment bearing plate holdown bolts. All other elements in **vg condition. Steel area 17,561 sq ft, 1631.47 sq m. Delam 7.2%- 1996. [98] Monitor delams @ const. joints 1,2,3,4 - 10 sq ft. total. Patch with SET 45. (99) spalls at expansion joints in overlay east lane NB. 6 spalls 2'x1' some filled with Bit. Overall structure in good shap. Need to work on spalls in spring. (01) Structure is in good condition. The deck is showing signs of distress with cracks and spalls both top and bottom. Railing system is in fair condition with damage to tubular top rail and spalls on concrete parapet. New traffic impact to G5 fascia girder bottom flange WB on CTH A under. 13-1/2'x7/8' gouge in flange. Should be ground. Measured 14.60' at spot of hit for clearance.**

**Inspection Specific Notes**

**Inspector Site-Specific Safety Considerations**

**Structure Inspection Procedures**

walk-thru

**Special Requirements**

Chk	Hours	Cost	Comments
-----	-------	------	----------

**Routine**

**Document Comment/Description**

Bay 4 south abutment - surface concrete deterioration



# STRUCTURE INVENTORY AND APPRAISAL FIELD REVIEW FORM

**B-03-019**  
**USH 53 NB over A**

## LOCATION

(3) Municipality:  
 (16) Latitude(° ' "):  
 (17) Longitude(° ' "):

DOVRE
45°17'25.89"N
91°38'36.37"W

## TRAFFIC SERVICE

(28A) Lanes On:  
 (28B) Lanes Under:  
 (102) Traffic Pattern On:  
 (102) Traffic Pattern Under:  
 (19) Detour Length(mi):

2
2
-NO TRAFFIC <input checked="" type="checkbox"/> -ONE WAY TRAFFIC -TWO WAY TRAFFIC
-NO TRAFFIC -ONE WAY TRAFFIC <input checked="" type="checkbox"/> -TWO WAY TRAFFIC
1

## GEOMETRY

(49) Structure Length(ft):  
 (50) Sidewalk Width(ft):  
 (50) Curb Width(ft):  
 (52) Culvert Barrel Length(ft):  
 (34) Skew:  
 (51) Bridge Roadway Width(ft):  
 (52) Deck Width(ft):  
 Right Wingwall Length(ft):  
 Left Wingwall Length(ft):  
 (32) Approach Roadway Width(ft):  
 (47) Minimum Horizontal(ft):  
 (55) Minimum Right Lateral(ft):  
 (56) Minimum Left Lateral(ft):

271.7	
Left: 0.0	Right: 0.0
3.8	
Angle(°): 66	Direction: <input checked="" type="checkbox"/> -RIGHT FORWARD -LEFT FORWARD
Cardinal	Non-Cardinal
40.0	40.0
43.8	43.8
40	0
Cardinal Under Clearance	Non-Cardinal Under Clearance
46.2	
12.1	
12.1	

## RAILING APPRAISAL

(36A) Bridge Rail Adequacy:  
 (36B) Transition Adequacy:  
 (36C) Approach Guardrail Adequacy:  
 (36D) Guardrail Termination Adequacy:  
 Outer Rail:

-SUB-STANDARD X-STANDARD -NOT APPLICABLE		
X-SUB-STANDARD -STANDARD -NOT APPLICABLE		
-SUB-STANDARD X-STANDARD -NOT APPLICABLE		
-SUB-STANDARD X-STANDARD -NOT APPLICABLE		
Left	Right	Type
		TYPE F (TWO SQUARE TUBES) - STEEL(8)
		TYPE F (3 SQUARE TUBES) - STEEL(65)
		TYPE F (4 SQUARE TUBES) - STEEL(72)
		TYPE M-STEEL 3 SQUARE TUBES(93)
		SLOPED FACE PARAPET LF(91)
		SLOPED FACE PARAPET HF(92)
		VERTICAL FACE PARAPET TYPE A(74)
		TYPE W-THRIE BEAM(79)
		TYPE H ON VERTICAL PARAPET(80)
		TIMBER(38)
X	X	OTHER(99) (Please specify)  Left: TYPE J (ALUMINUM) ON SLOPED PPT(45)  Right: TYPE J (ALUMINUM) ON SLOPED PPT(45)
		CONT GUARD RAIL
		NO APP GRDRL
		NO ATTACHMENT
5		22 MM(7/8") BOLT (Please enter quantity)
		25 MM(1") BOLT (Please enter quantity)
		OTHER (Please specify)
X		(01) ENERGY ABSORBING TERMINAL/EAT
		(02) TURN DOWN
		(99) OTHER (Please specify)

Transition Type:

Approach Attachment Rail Note:  
 Guardrail Termination Type:

Guardrail Termination Note:


## ROADWAY ALIGNMENT APPRAISAL

(72) Approach Alignment Appraisal:

	3 Intolerable- Substantial speed reduction
	6 Fair- Minor speed reduction
X	8 Good- No speed reduction



PROJECT NO. 1196-4-74	SHEET NUMBER 52	TOTAL SHEETS 413
--------------------------	--------------------	---------------------

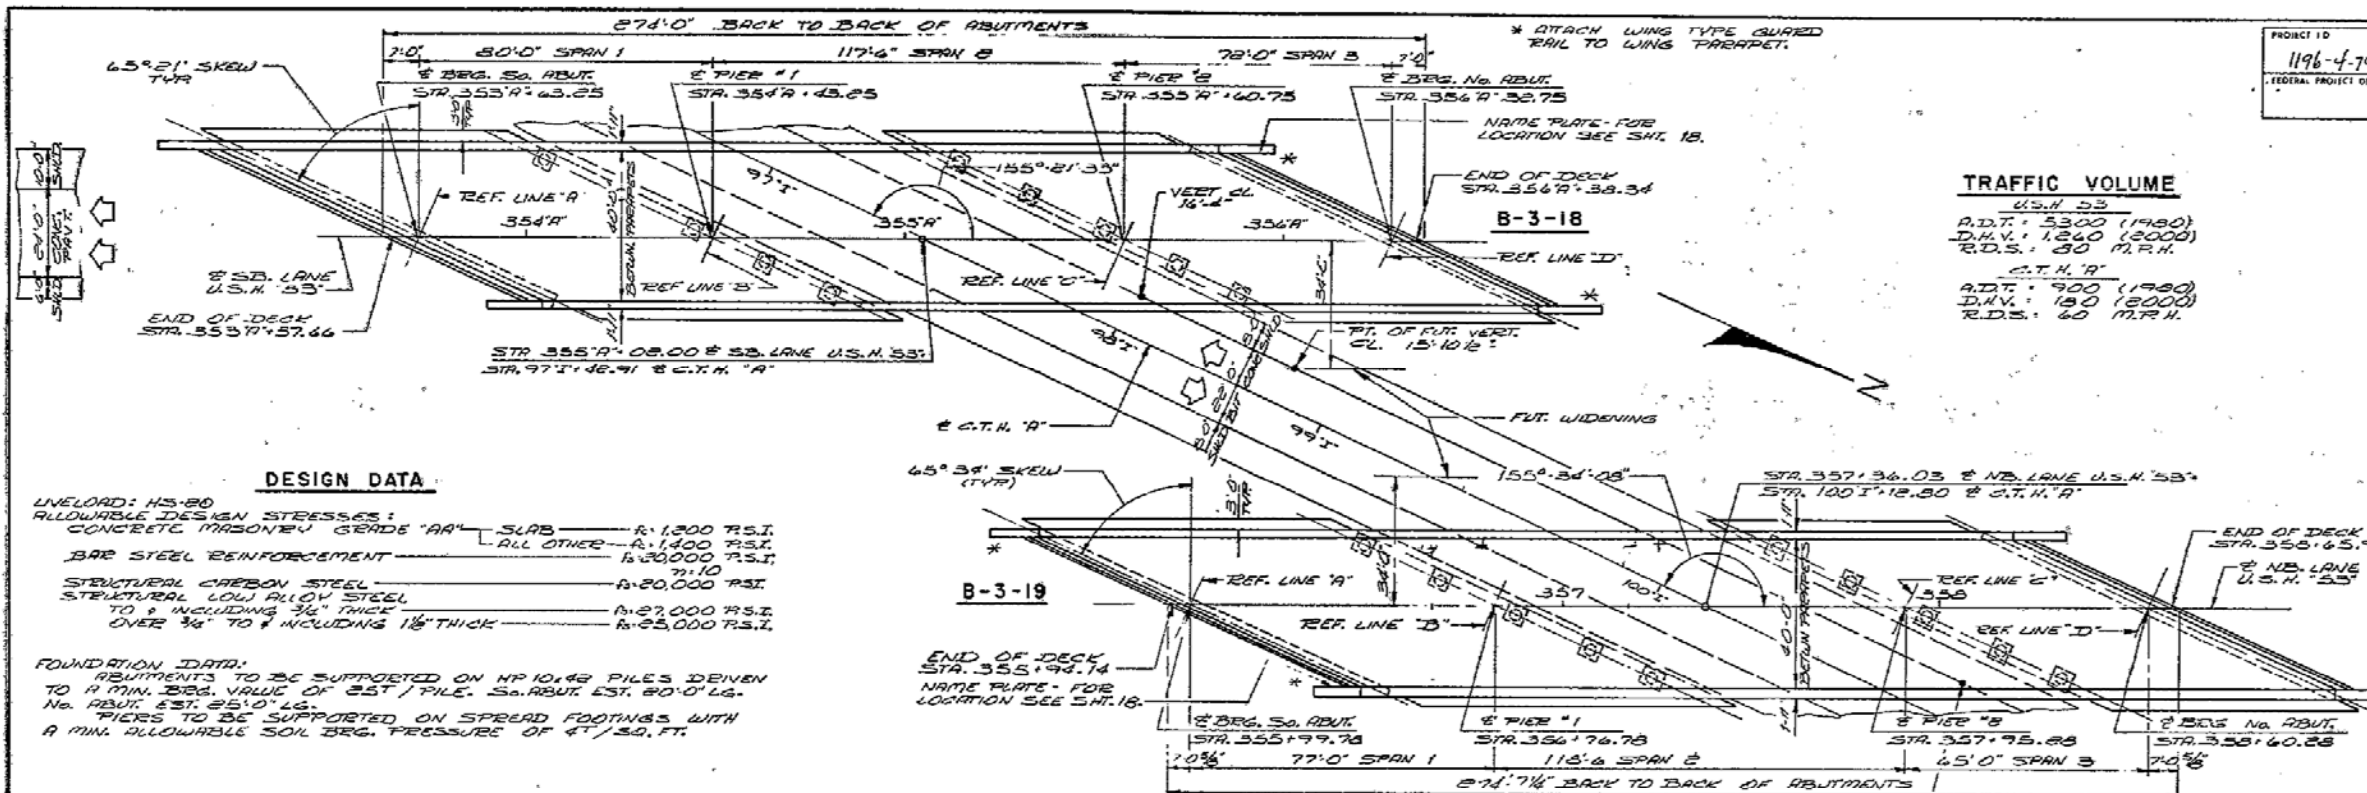

**TRAFFIC VOLUME**

U.S.H. 53	
A.D.T. (1980)	5300
D.A.V. (2000)	1260
R.D.S. (M.R.H.)	20

C.T.H. 'A'	
A.D.T. (1980)	900
D.A.V. (2000)	180
R.D.S. (M.R.H.)	60

**DESIGN DATA**

UNLOAD: HS-20  
ALLOWABLE DESIGN STRESSES:  
CONCRETE MASONRY GRADE "AA" SLAB R-1,200 P.S.I.  
ALL OTHER R-1,400 P.S.I.  
BAR STEEL REINFORCEMENT R-20,000 P.S.I.  
STRUCTURAL CARBON STEEL R-20,000 P.S.I.  
STRUCTURAL LOW ALLOY STEEL TO 1/2" INCLUDING 3/4" THICK R-27,000 P.S.I.  
OVER 3/4" TO 1" INCLUDING 1 1/2" THICK R-25,000 P.S.I.

**FOUNDATION DATA:**  
ABUTMENTS TO BE SUPPORTED ON HP 10x42 PILES DRIVEN TO A MIN. BBS. VALUE OF 25T / PILE. So. ABUT. EST. 80'-0" LG.  
No. ABUT. EST. 25'-0" LG.  
PIERS TO BE SUPPORTED ON SPREAD FOOTINGS WITH A MIN. ALLOWABLE SOIL BBS. PRESSURE OF 4T / SQ. FT.


**GENERAL NOTES**

DRAWINGS SHALL NOT BE SCALED.  
BAR STEEL REINFORCEMENT SHALL BE EMBEDDED 6" CLEAR UNLESS OTHERWISE SHOWN OR NOTED.  
ALL FIELD CONNECTIONS SHALL BE MADE WITH 3/4" DIA. FRICTION TYPE HIGH-TENSILE STRENGTH BOLTS UNLESS SHOWN OR NOTED OTHERWISE.  
THE SLOPE OF FILL IN FRONT OF THE ABUTMENTS SHALL BE COVERED WITH SLOPE PAVING, CRUSHED AGGREGATE, TO THE EXTENT SHOWN ON THIS SHEET IN THE ABUTMENT DETAILS.  
THE FINISHED GRADED SECTION WAS USED AS THE UPPER LIMITS OF EXCAVATION FOR COMPUTATION OF EXCAVATION QUANTITIES AT THE PIERS.  
THE UPPER LIMITS OF EXCAVATION FOR STRUCTURES FOR THE ABUTMENTS SHALL BE THE EXISTING GROUND LINE AND THE QUANTITIES WERE COMPUTED FROM THIS LINE.


**PLAN**  
(3 SPAN WELDED 2 GIRDERS)

**LIST OF DRAWINGS**

1. GENERAL PLAN	X47077
2. GENERAL PLAN	X47078
3. SUBSURFACE EXPLORATION	X47079
4. SOUTH ABUTMENT	X47080
5. SOUTH ABUTMENT DETAILS	X47081
6. SOUTH ABUTMENT DETAILS	X47082
7. NORTH ABUTMENT	X47083
8. NORTH ABUTMENT DETAILS	X47084
9. NORTH ABUTMENT DETAILS	X47085
10. PIER #1	X47086
11. PIER #2	X47087
12. SUPERSTRUCTURE	X47088
13. CROSS FRAMING OF SPANS	X47089
14. GIRDER ELEVATIONS OF SPANS	X47090
15. SUPERSTRUCTURE	X47091
16. BEARING DETAILS	X47092
17. EXPANSION JOINT	X47093
18. SLOPE FACE PARAPET "A"	X47094
19. TUBULAR RAILING, TYPE "J"	X47095

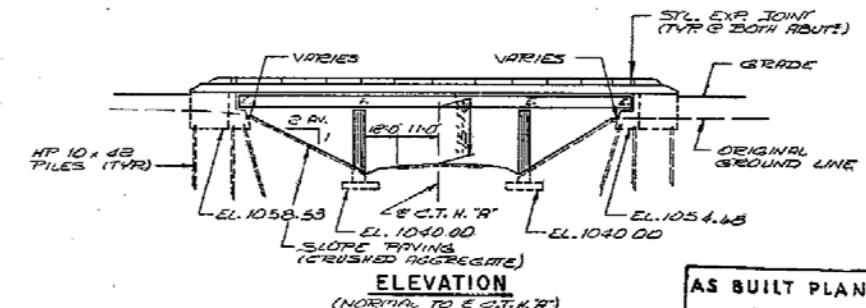

**AS BUILT PLAN**  
DATE 1-78 BY W.J.K.

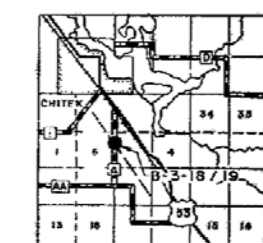


**LAYOUT**

No.	Date	Revision	By
STATE OF WISCONSIN DEPARTMENT OF TRANSPORTATION DIVISION OF HIGHWAYS			
<b>STRUCTURE B-3-19</b>			
<b>U.S.H. 53 OVER C.T.H. 'A'</b>			
County GARRON	City Village TN. DOVRE	Design Spec. A.A.S.H.O. 1969	Load HS-20
Designed G.H.A.	Design C.D.W.	Drawn BY BUDD	Plans Checked G.J.S.
Approved W.A. Kline	Chief Bridge Engineer	2-23-72	Date
<b>GENERAL PLAN</b>			SHEET 1 OF 19
			X47077




# TOTAL ESTIMATED QUANTITIES


BID ITEMS	UNIT	SUPPLY	5.0 ABUT	PIER #1	PIER #2	NO. ABUT.	TOTAL
EXCAVATION FOR STRUCTURES	C.Y.	---	415	365	820	145	1,145
CONCRETE MASONRY	C.Y.	347.0	169.1	89.8	44.1	144.0	836.0
BAR STEEL REINFORCEMENT	LBS.	91,930	6,340	25,440	11,900	4,600	141,770
STRUCTURAL CARBON STEEL	LBS.	190,000	---	---	---	---	190,000
STRUCTURAL LOW ALLOY STEEL	LBS.	99,620	---	---	---	---	99,620
SUBSTITUTED BRONZE PLATES	LBS.	256	---	---	---	---	256
SLABING PADS	S.F.	33	---	---	---	---	33
STEEL PILING, DELIVERED & DRIVEN 10' x 42"	L.F.	---	700	---	---	885	1,585
TUBULAR RAILING, TYPE T	L.F.	595	---	---	---	---	595
SLOPE PAVING, CRUSHED AGGREGATE (S.W.)	S.W.	---	510	---	---	445	955
NON BID ITEMS							
ALUMINUM OR ZINC PLATE	S.F.	72	---	---	---	---	72
POLYVINYL CHLORIDE WATERSTOP	L.F.	---	126	---	---	118	244

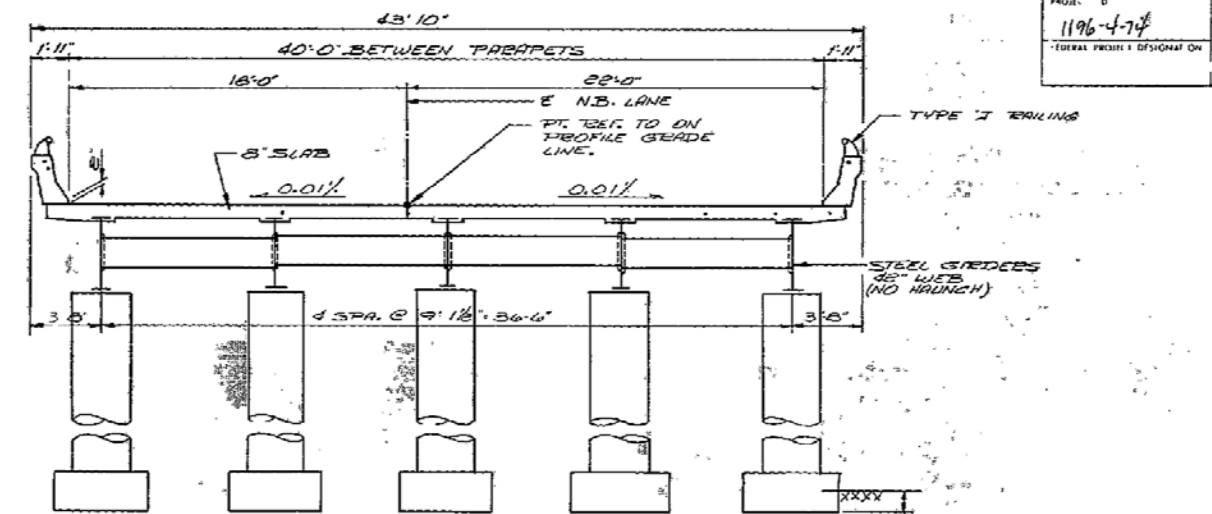

CROSS SECTION THRU ROADWAY LOOKING NORTH

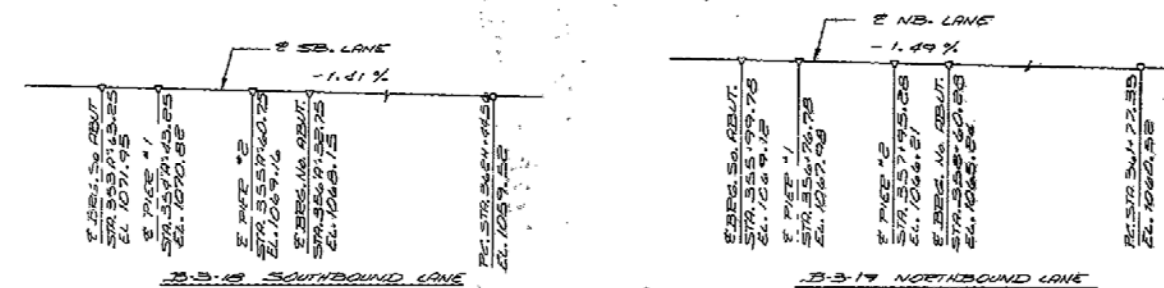

PROFILE GRADES U.S.H. 53

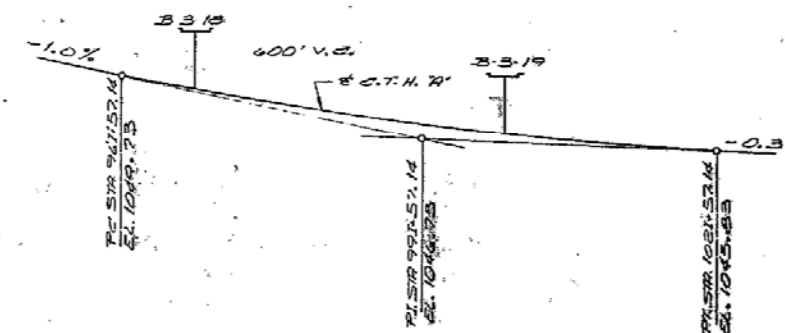

PROFILE GRADE C.T.H. "A"

No.	Date	Revision	By
STATE OF WISCONSIN DEPARTMENT OF TRANSPORTATION DIVISION OF HIGHWAYS			
STRUCTURE B-3-19			
Cost 1969	Drawn By BUDD	Plan Checked GJS	
GENERAL PLAN			SHEET 2 OF 19 X47078