



STATE OF WISCONSIN
DEPARTMENT OF TRANSPORTATION

Inspection Report for
B-03-031

USH 53 NB over 20TH ST
May 09,2017



Type	Prior	Frequency (mos)	Performed
Routine	05-20-15	24	X
SIA Review	06-19-13	48	X

Latitude	45°22'43.81"N	Owner	STATE HIGHWAY DEPT
Longitude	91°44'42.79"W	Maintainer	STATE HIGHWAY DEPT

Time Log		Team members
Hours	Minutes	wjk
1	0	

Name	Number	Signature	Date
Inspector	Kovaleski, William J	8007	<i>William J Kovaleski</i>
			E-signed by Bill(dotwjk)
			07-06-17

BRIDGE INSPECTION REPORT
Wisconsin Department of Transportation
DT2007 2003 s.84.17 Wis. Stats.

page 2

Identification & Location

Feature On: USH 53 NB	Section Town Range: S04 T33N R11W	Structure Number: B-03-031
Feature Under: 20TH ST	County: BARRON	
Location 7.2M N JCT CTH I TO E	Municipality: PRAIRIE LAKE	Structure Name:

Geometry

measurements in feet, except where noted

Approach Roadway Width: 40	Bridge Roadway Width: 40.0	Total Length: 158.1
Approach Pavement Width: 24	Deck Width: 43.8	Deck Area (sq ft): 6924

Traffic

	Lanes	ADT	ADT year	Traffic Pattern
On	2	5550	2014	ONE WAY TRAFFIC
Under	2	3000	2008	TWO WAY TRAFFIC

Capacity

Load Rating

Inventory rating: HS21	Overburden depth (in): 2.0	Last rating date: 08-21-13	Controlling: INTERIOR DECK GIRDER Positive Moment
Operating rating: HS30	Deck surface material: LOW SLUMP CONCRETE	Re-rate for capacity (Y/N):	Control location: SPAN 2
Posting:	Re-rate notes:		

Hydraulic

Classification

Scour Critical Code(113): (N) NO WATERWAY	Q100 (ft3/sec): 0	
High water elevation (ft): 0.0	Velocity (ft/sec): 0.0	Sufficiency #: 98.7

Span(s)

Span #	Material	Configuration	Depth (in)	Length (ft)	Main
1	CONT PREST CONC	DECK GIRDER	45	47.0	
2	CONT PREST CONC	DECK GIRDER	45	69.5	Y
3	CONT PREST CONC	DECK GIRDER	45	37.0	

Expansion joint(s)

Temperature:

File:	New:
-------	------

Clearance

Item	File Measurement (ft)	File Date	New Measurement (ft)
Highway Min Vertical Under Cardinal	14.93	20-May-2015	
Highway Min Vertical Under Non-Cardinal			
Horizontal Under Cardinal	50.0		
Horizontal Under Non-Cardinal			
Highway Min Vertical On Cardinal			
Horizontal On Cardinal			

Special Components

Component	Year	Work Performed	Note
DECK - IOWA MIX	1991	OVERLAY - CONCRETE	

Construction History

Year	Work Performed	FOS id
1991	OVERLAY - CONCRETE	1198-05-71
1972	NEW STRUCTURE	1196-05-73

BRIDGE INSPECTION REPORT
Wisconsin Department of Transportation
DT2007 2003 s.84.17 Wis. Stats.

page 3

Structure No.: **B-03-031**

Maintenance Items History

Item	Recommended by	Status	Status change	Year completed
Bearings - Clean Assemblies / Paint	Harrington, Daniel J (8004)	COMPLETE	01/17/13	
clean and paint bearings				
Expansion Joints - Seal	Harrington, Daniel J (8004)	COMPLETE	01/17/13	
repour joints over piers.				

Maintenance Items

Item	Priority	Recommended by	Status	Status change
Misc - Other Work	HIGH	Kurtz, William G (8008)	IDENTIFIED	06/04/15
Replace three (3) aluminum rail posts that have been damaged.				
Deck - Seal Surface Cracks	MEDIUM	Kovaleski, William J (8007)	IDENTIFIED	06/21/17
Fill midspan cut joints				
Misc - Tighten Bolts and Nuts	LOW	Kurtz, William G (8008)	IDENTIFIED	06/04/15
Replace missing nuts and tighten all nuts on decorative rail system.				
Substructure - Other Work	LOW	Kurtz, William G (8008)	IDENTIFIED	06/04/15
Seal the six (6) columns.				

Elements

Chk	Element	Defect	Description	UOM	Total	Quantity in Condition State			
						1	2	3	4
X	12		Reinforced Concrete Deck	SF	6,925	6,290	635	0	0
			Delamination - Spall - Patched Area	SF		0	575	0	0
		1080	Advanced concrete deterioration w/ rust staining and efflorescence (begin spall/delam) area 3ft adjacent to G3 extends entire span / north ends of Span 3. Spot location of full depth repair.						
			Cracking (RC)	SF		0	60	0	0
		1130	Both faces have few hrline vert cracks 2 w rust staining - most match parapets.						
		8514	Concrete Overlay	SF	6,925	0	6,925	0	0
X	109		Debonding/Spall/Patched Area/Pothole	SF		0	818	0	0
		3210	Delam approx. 11% (previous inspection)						
			Crack (Wearing Surface)	SF		0	6,107	0	0
		3220	Fine to some hrline map cracking throughout - say 91%.						
X	109		Prestressed Concrete Open Girder	LF	790	786	4	0	0
			Delamination - Spall - Patched Area	LF		0	4	0	0
		1080	2 areas of small impact edge spalls over both lanes.						
X	205		Reinforced Concrete Column	EA	6	6	0	0	0

BRIDGE INSPECTION REPORT
Wisconsin Department of Transportation
DT2007 2003 s.84.17 Wis. Stats.

page 4

Structure No.: **B-03-031**

X	215		Reinforced Concrete Abutment Includes diaphragms.	LF	107	92	13	2	0
		1080	Delamination - Spall - Patched Area SOUTH: 2 - 2in popouts Bay 2.	LF		0	1	0	0
		1130	Cracking (RC) SOUTH: Hrline vert cracks at G1, G2, Bay 2, 2 @ G3, and 4 @ Bay 3 (G3 & G4) / 2ft of fine surface map cracking at G5. NORTH: CS3 vertical crack @ G3 and Bay 1 diaphragm / Hrline vert at G2.	LF		0	12	2	0
X	234		Reinforced Concrete Cap	LF	98	98	0	0	0
X	300		Strip Seal Expansion Joint South end. Some scrapes on pving block. Missing bolt on SW plate.	LF	52	52	0	0	0
X	311		Moveable Bearing South rocker bearings.	EA	15	0	15	0	0
		1000	Corrosion Lt rust on edges with med/hvy rust on base plates.	EA		0	15	0	0
X	331		Reinforced Concrete Bridge Rail East rail bottom of super - worse.	LF	356	0	250	106	0
		1080	Delamination - Spall - Patched Area Select areas of CS3 spalling and delam some w/ rust staining - approx. 30%. NW wing worse - remove repair & connection.	LF		0	0	106	0
		1130	Cracking (RC) Hrline vert cracks and map cracking throughout Approx. 70% - E=120 lf. W=166 lf.	LF		0	250	0	0
X	8400		Integral Wingwall	EA	4	3	1	0	0
		8903	Wall Deterioration NW spall at ADW joint.	EA		0	1	0	0

Assessments

Chk	Element	Defect	Description	UOM	Total	Quantity in Condition State			
						1	2	3	4
X	9001		Drainage - Approach Shldr grvl. NE C&G inlet.	EA	4	4	0	0	0
X	9030		Signs - Object Markers	EA	2	2	0	0	0
X	9043		Slope Protection- Crushed Aggregate with Bit. Tight w/ slight veg at edges.	EA	2	2	0	0	0
X	9168		Concrete Diaphragm Spalled Bay 2 Pier 1 North side. Cracked span1 & 2 bay3. Cracked and broken P1 east fascia.	EA	20	16	4	0	0
X	9322		Approach Roadway - Concrete (non-structural) Concrete with asp shoulders except NE to inlet. Both spalled and cracked down CL filled w/ asp filler. SE shldr rutted.	EA	2	0	2	0	0
X	9335		Decorative Rail Scrapes and dents. E Rail: 4 posts damaged. W and E Rail: Missing nuts.	EA	2	0	2	0	0

NBI Ratings

	File	New
Deck	5	5
Superstructure	7	7
Substructure	6	6
Culvert	N	N
Channel	N	N
Waterway	N	N

BRIDGE INSPECTION REPORT
Wisconsin Department of Transportation
DT2007 2003 s.84.17 Wis. Stats.

page 5

Structure No.: **B-03-031**

Structure Specific Notes

OLD: Overall, condition of structure is vg. 11.8 % delam (1996) should be programed for overlay. All other elements in vg condition including PS girders, caps, abutments and slope paving. No 358/9 cracks.
(99) Very good condition
(01) Structure is in overall good condition. The delam and cracked deck is in the program for redeck. Slope are bleached and loose rock. Parapets showing rebar on east side shallow bars rusting through.

Inspection Specific Notes

Inspector Site-Specific Safety Considerations

Structure Inspection Procedures

Walk-thru

Special Requirements

Chk	Hours	Cost	Comments
-----	-------	------	----------

Routine
Document Comment/Description

N approach



Routine
Document Comment/Description

Span 1 deck concrete deterioration



Routine
Document Comment/Description

Joint plate - loose bolt.



STRUCTURE INVENTORY AND APPRAISAL FIELD REVIEW FORM

B-03-031
USH 53 NB over 20TH ST

LOCATION

(3) Municipality:
 (16) Latitude(° ' "):
 (17) Longitude(° ' "):

PRAIRIE LAKE
45°22'43.81"N
91°44'42.79"W

TRAFFIC SERVICE

(28A) Lanes On:
 (28B) Lanes Under:
 (102) Traffic Pattern On:
 (102) Traffic Pattern Under:
 (19) Detour Length(mi):

2
2
-NO TRAFFIC <input checked="" type="checkbox"/> -ONE WAY TRAFFIC -TWO WAY TRAFFIC
-NO TRAFFIC -ONE WAY TRAFFIC <input checked="" type="checkbox"/> -TWO WAY TRAFFIC
1

GEOMETRY

(49) Structure Length(ft):
 (50) Sidewalk Width(ft):
 (50) Curb Width(ft):
 (52) Culvert Barrel Length(ft):
 (34) Skew:

 (51) Bridge Roadway Width(ft):
 (52) Deck Width(ft):
 Right Wingwall Length(ft):
 Left Wingwall Length(ft):
 (32) Approach Roadway Width(ft):

 (47) Minimum Horizontal(ft):
 (55) Minimum Right Lateral(ft):
 (56) Minimum Left Lateral(ft):

158.1	
Left: 0.0	Right: 0.0
3.8	
Angle(°): 40	Direction: <input checked="" type="checkbox"/> -RIGHT FORWARD -LEFT FORWARD
Cardinal	Non-Cardinal
40.0	40.0
43.8	43.8
40	0
Cardinal Under Clearance	Non-Cardinal Under Clearance
50.0	
14.0	
14.0	

RAILING APPRAISAL

(36A) Bridge Rail Adequacy:
 (36B) Transition Adequacy:
 (36C) Approach Guardrail Adequacy:
 (36D) Guardrail Termination Adequacy:
 Outer Rail:

-SUB-STANDARD <input checked="" type="checkbox"/> -STANDARD -NOT APPLICABLE		
-SUB-STANDARD <input checked="" type="checkbox"/> -STANDARD -NOT APPLICABLE		
-SUB-STANDARD <input checked="" type="checkbox"/> -STANDARD -NOT APPLICABLE		
-SUB-STANDARD <input checked="" type="checkbox"/> -STANDARD -NOT APPLICABLE		
Left	Right	Type
		TYPE F (TWO SQUARE TUBES) - STEEL(8)
		TYPE F (3 SQUARE TUBES) - STEEL(65)
		TYPE F (4 SQUARE TUBES) - STEEL(72)
		TYPE M-STEEL 3 SQUARE TUBES(93)
		SLOPED FACE PARAPET LF(91)
		SLOPED FACE PARAPET HF(92)
		VERTICAL FACE PARAPET TYPE A(74)
		TYPE W-THRIE BEAM(79)
		TYPE H ON VERTICAL PARAPET(80)
		TIMBER(38)
X	X	OTHER(99) (Please specify) Left: TYPE J (ALUMINUM) ON SLOPED PPT(45) Right: TYPE J (ALUMINUM) ON SLOPED PPT(45)
		CONT GUARD RAIL
		NO APP GRDRL
		NO ATTACHMENT
5		22 MM(7/8") BOLT (Please enter quantity)
		25 MM(1") BOLT (Please enter quantity)
		OTHER (Please specify)
X		(01) ENERGY ABSORBING TERMINAL/EAT
		(02) TURN DOWN
		(99) OTHER (Please specify)

Transition Type:

Approach Attachment Rail Note:
 Guardrail Termination Type:

Guardrail Termination Note:

ROADWAY ALIGNMENT APPRAISAL

(72) Approach Alignment Appraisal:

	3 Intolerable- Substantial speed reduction
	6 Fair- Minor speed reduction
X	8 Good- No speed reduction

GENERAL NOTES

DRAWINGS SHALL NOT BE SCALED.
BAR STEEL REINFORCEMENT SHALL BE EMBEDDED 2" CLEAR UNLESS OTHERWISE SHOWN OR NOTED.
DIMENSIONS ARE BASED ON ORIGINAL PLANS THEREFORE THE CONTRACTOR SHALL VERIFY THEM IN THE FIELD BEFORE ACCEPTANCE.
CONCRETE MASONRY IN PAVING BLOCK IS INCLUDED IN PRICE BID FOR CONCRETE MASONRY OVERLAY.
FULL DEPTH DECK REPAIR AS DIRECTED BY THE ENGINEER.

DESIGN DATA

LOADING:
DESIGN RATING HS-20
INVENTORY RATING HS-22
OPERATIONAL RATING HS-36
MAX. STD. VEHICLE LOAD 250 KIPS

ALLOWABLE DESIGN STRESSES
CONCRETE MASONRY $f_c = 4,000$ P.S.I.
HIGH-STRENGTH BAR STEEL REINFORCEMENT, GRADE 60 $f_y = 60,000$ P.S.I.

BENCH MARK

BRIDGE BRASS CAP, NO. EAST COR. EL. 1000.00


LIST OF DRAWINGS

1. DECK OVERLAY
2. EXPANSION DEVICE

AS BUILT PLAN
DATE SEPT. 1992


BRIDGE OFFICE CONTACT:
ROBERT L. REESE (608) 268-8488

No.	Date	Revision	By
STATE OF WISCONSIN DEPARTMENT OF TRANSPORTATION DIVISION OF HIGHWAYS			
STRUCTURE B-3-31			
N.B. LANE U.S.H. 53 OVER TOWN ROAD			
County	BARRON	Township	PRairie LAKE
Design Spec	AASHTO 1985	Load	1985
Design	By S.D.R.	Checked	W.C.D.
By		By	A.G.
Approved	Checked		12-17-92
SHEET 1 OF 2		DECK OVERLAY	
		X 83198	

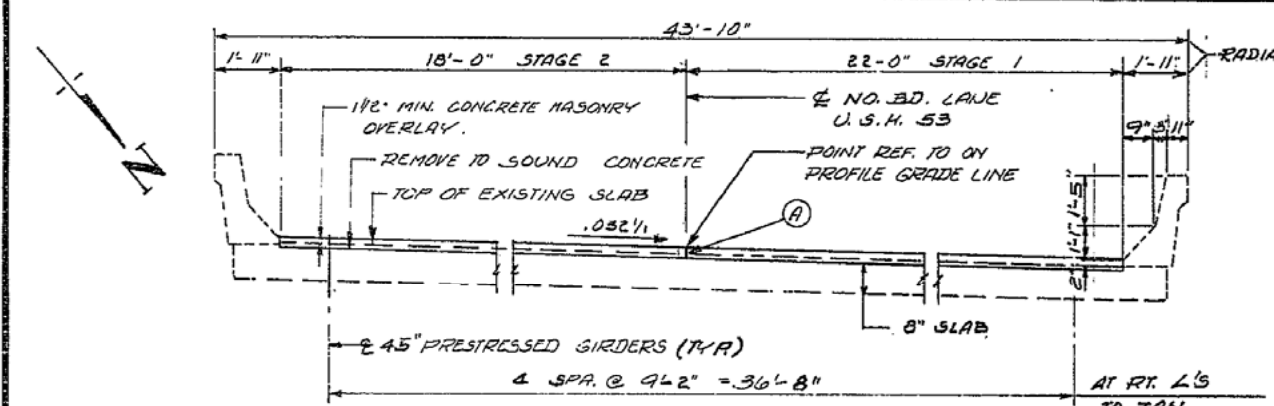


CROSS SECTION THRU ROADWAY

(LOOKING NORTH)

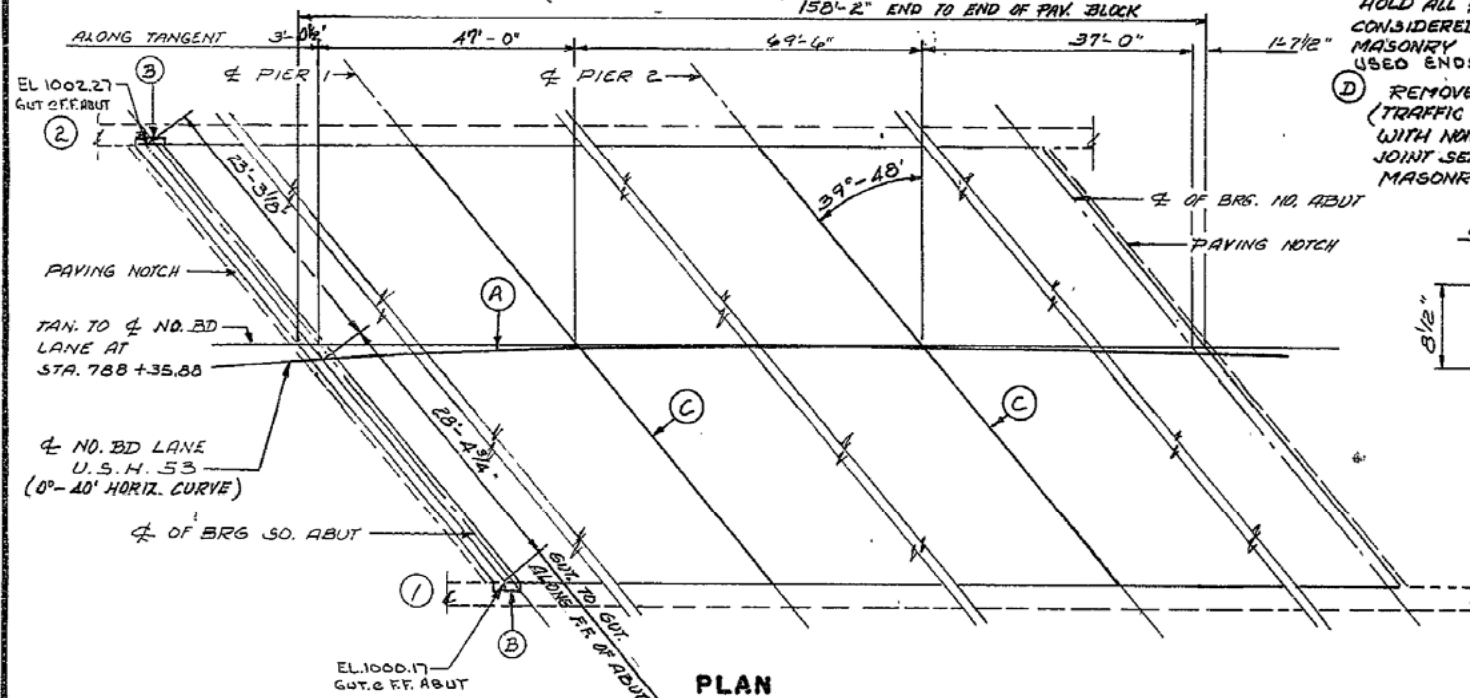

PLAN

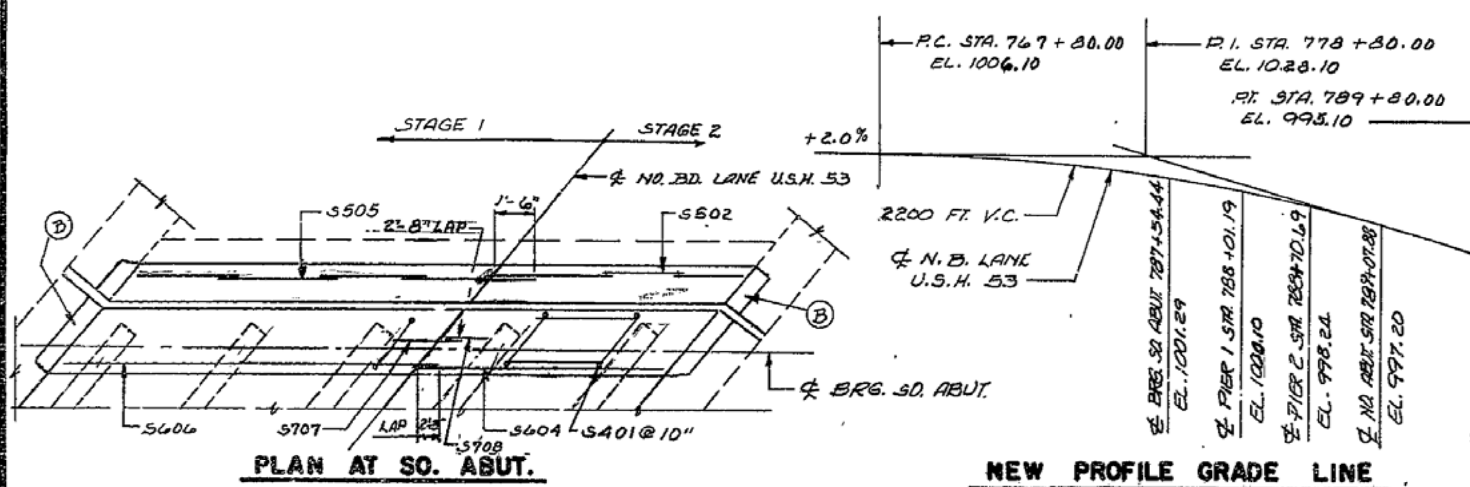


PLAN AT SO. ABUT.

NEW PROFILE GRADE LINE

- LONGITUDINAL CONST. JOINT IN CONCRETE MASONRY OVERLAY. TRAFFIC IS TO BE MAINTAINED DURING CONSTRUCTION.
- REMOVE PARAPET IN THIS AREA AS REQ'D. FOR JOINT WORK. LINE OF REMOVAL DEFINED BY A 1" DEEP SAW CUT. REBUILD TO MATCH EXISTING. SALVAGE & REUSE EXIST. BAR REINF. RESET EXIST. RAIL POST ANCHORAGES IF REQ'D.
- 1/4" SAW CUT, FULL DEPTH OF OVERLAY. PROVIDE EITHER:
1. INSTALL NEOPRENE COMP. SEAL ACME MO44 OR APPROVED EQUAL, IN ONE CONTINUOUS PIECE.
2. COLD APPLIED ELASTIC TYPE JOINT SEALER.
HOLD ALL 1/8" BELOW SURFACE OF OVERLAY. CONSIDERED INCIDENTAL TO "CONCRETE MASONRY OVERLAY". IF COMP SEAL IS USED ENDS TO BE SEALED.
- REMOVE SEALER FROM V-GROOVE (TRAFFIC SIDE ONLY) CLEAN & RESEAL WITH NON-STAINING GRAY NON-BITUMINOUS JOINT SEALER INCIDENTAL TO "CONCRETE MASONRY OVERLAY".

DEFLECTION JOINT REPAIR

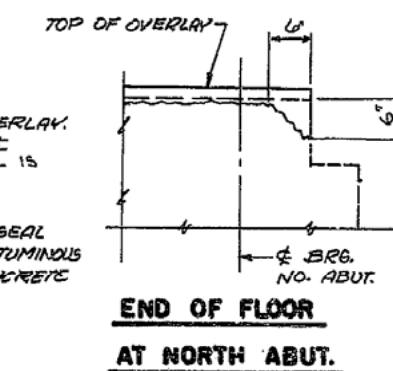

END OF FLOOR

AT NORTH ABUT.

NOTE: THE FIRST DIGIT OF A THREE DIGIT BAR MARK SIGNIFIES THE BAR SIZE.
DIMENSION IN BENDING DETAILS ARE OUT TO OUT OF BAR.

BILL OF BARS




MARK	NO. REQ'D.	LENGTH	BENT	LOCATION
S401	48	5'-3"	X	SLAB @ SO. ABUT.
S502	6	8'-5"		PAV. BLOCK @ SO. ABUT. ST. 2
S703	18	9'-3"		HAUNCH BOX " 142
S604	10	23'-3"		" " 2
S505	8	8'-3"		PAV. BLOCK @ SO. ABUT. ST. 1
S606	10	30'-8"		HAUNCH " 1
S707	6	4'-7"		" " 1
S708	6	7'-4"		" " 2

TOTAL ESTIMATED QUANTITIES

BID ITEMS	QTY	UNIT
CONCRETE MASONRY OVERLAY, DECKS	66	C.Y.
CLEANING, DECKS	675	S.Y.
PREPARATION, DECKS	167	S.Y.
JOINT REPAIR	27	L.S.
HIGH-STRENGTH BAR STEEL REINFORCEMENT, BRIDGES 1590	1	L.B.
EXPANSION DEVICE, B-3-31	1	L.S.
PROTECTIVE SURFACE TREATMENT	42	GAL.
FULL DEPTH DECK REPAIR	10	S.Y.


VARIATIONS TO NEW GRADE LINE OVER 1/4" MUST BE SUBMITTED TO THE BRIDGE SECTION FOR APPROVAL.

B-3-31

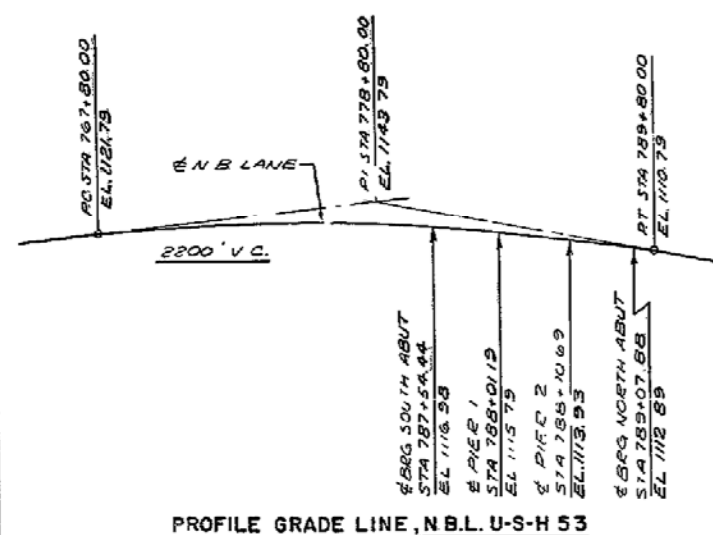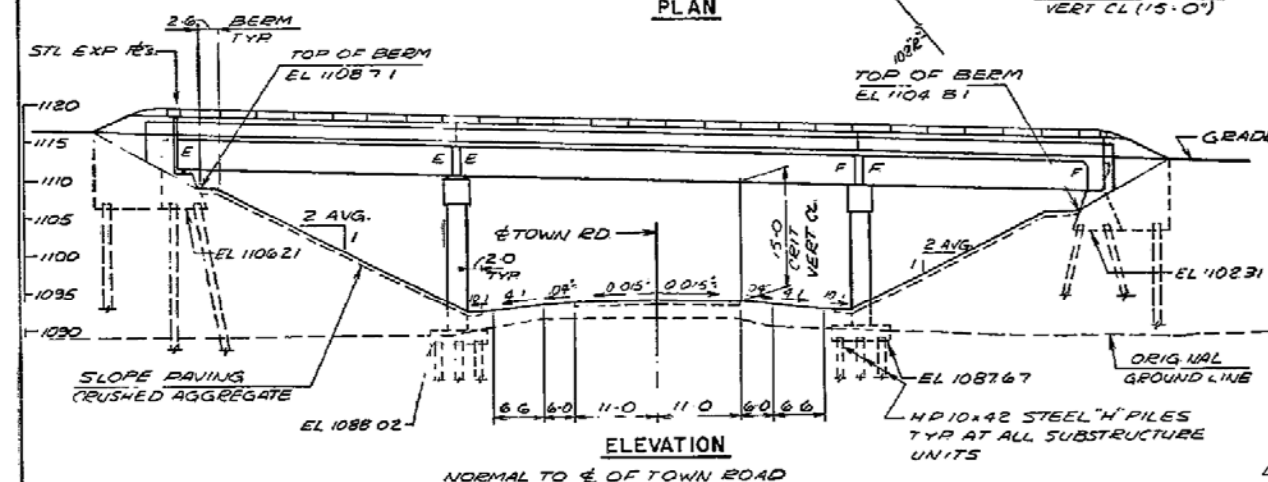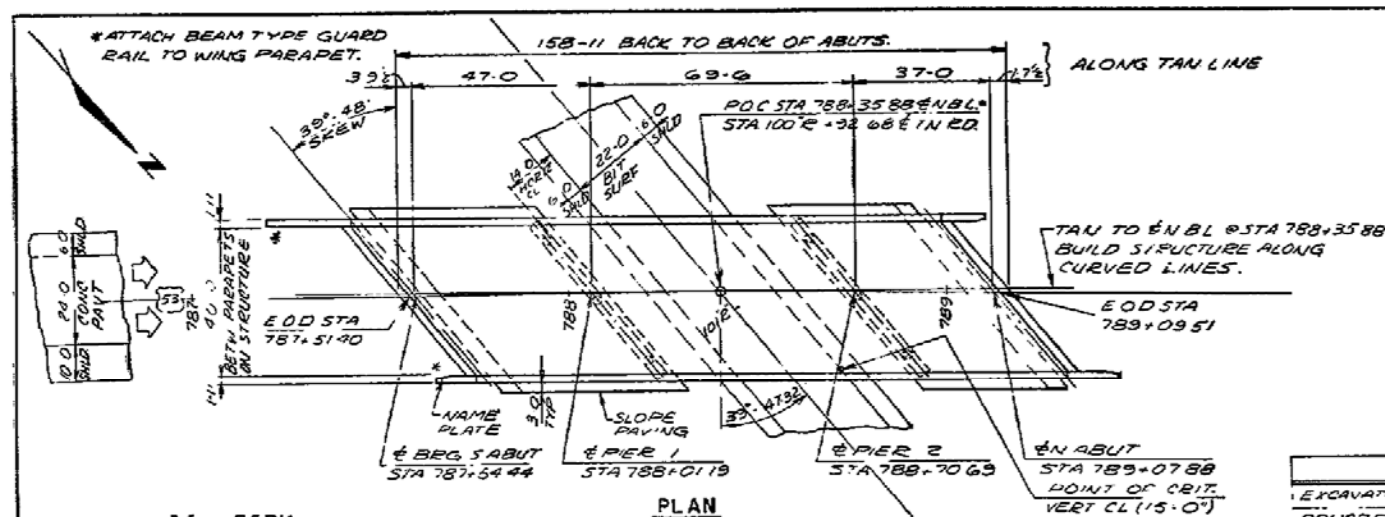


PROFILE GRADE LINE, N.B.L. U-S-H 53

CURVE DATA
 E N B LANE U-S-H 53
 P1 STA 809.7328 BK+STA 806+74.13 AH
 R = 8534.367 FT
 L = 6306.893 FT
 T = 3303.023 FT
 D = 0° 40' 00"
 Δ = 42° 02' 45.44"
 SE = 0.032 1/2

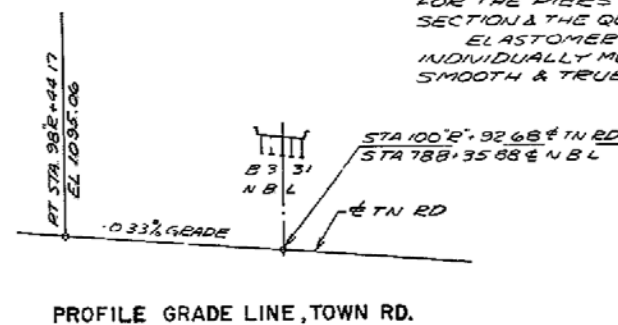

PROFILE GRADE LINE, TOWN RD.

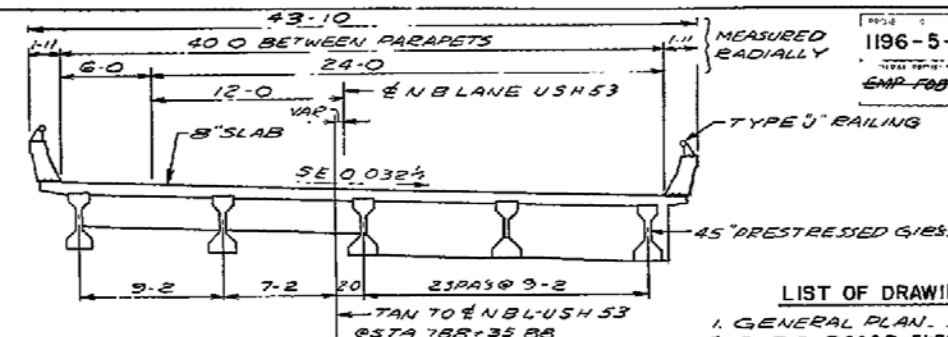CROSS SECTION THRU ROADWAY
NORMAL TO TAN TO ENBL, LOOKING NORTH

TOTAL ESTIMATED QUANTITIES

BID ITEMS	UNIT	SABUT	PIER 1	PIER 2	NABUT	SUPER	TOTAL
EXCAVATION FOR STRUCTURES	C Y	51	63	60	47		221
CONCRETE MASONRY	C Y	104	58	54	68	240	544
PRESTRESSED GIRDER, TYPE 45 INCH	L F					770	770
BAR STEEL REINFORCEMENT	LBS	5880	8140	8440	3890	6430	31440
STRUCTURAL CARBON STEEL	LBS					3960	3960
STRUCTURAL LOW ALLOY STEEL	LBS					2710	2710
LUBRICATED BRONZE PLATES	LBS					239	239
BEARING PADS	S F					22	22
BEARING PADS, ELASTOMERIC	S F					24	24
STEEL PILING, HP 10x42 DEL & DRIVEN	L F	990	880	720	900		3490
TUBULAR RAILING, TYPE U	L F					355	355
SLOPE PAVING, CRUSHED AGGREGATE	S Y	273			214		487
NON-BID ITEMS							
FILLER	SIZE					5 1/2"	5 1/2"
ALUMINUM OR ZINC	S F					45	45
POLYVINYL CHLORIDE WATERSTOP	L F					50	50

GENERAL NOTES

DRAWINGS SHALL NOT BE SCALED
 BAR STEEL REINFORCEMENT SHALL BE IMBEDDED 2" CL.
 UNLESS OTHERWISE SHOWN OR NOTED
 THE FIRST DIGIT OF A THREE DIGIT BAR MARK & THE
 FIRST TWO DIGITS OF A FOUR DIGIT BAR MARK SIGNIFIES
 THE BAR SIZE
 THE SLOPE OF THE FILL IN FRONT OF THE ABUTMENTS
 SHALL BE COVERED WITH CRUSHED AGGREGATE TO THE
 EXTENT SHOWN ON THIS SHEET & IN THE ABUTMENT DETAILS
 THE UPPER LIMITS OF EXCAVATION FOR STRUCTURES
 FOR THE ABUTMENTS SHALL BE THE BOTTOM OF SLOPE
 PROTECTION & THE QUANTITIES WERE COMPUTED FROM
 THIS LINE
 THE UPPER LIMITS OF EXCAVATION FOR STRUCTURES
 FOR THE PIERS SHALL BE THE FINISHED GRADED
 SECTION & THE QUANTITIES WERE COMPUTED FROM THIS LINE
 ELASTOMERIC BEARING PADS NEED NOT BE
 INDIVIDUALLY MOLDED PROVIDED THE CUT EDGES ARE
 SMOOTH & TRUE.

LIST OF DRAWINGS

1. GENERAL PLAN	X 45733
2. SUB SURFACE EXPLORATION	X 45734
3. SOUTH ABUTMENT	X 45735
4. ABUTMENT BILL OF BARS	X 45736
5. NORTH ABUTMENT	X 45737
6. PIER 1	X 45738
7. PIER 2	X 45739

8. PRESTRESSED GIRDER	X 45740
9. SUPERSTRUCTURE	X 45741
10. SUPERSTRUCTURE	X 45742
11. EXPANSION JOINT &	
BEARING DETAILS	X 45743
12. RAIL PARAPET DETAILS	X 45744
13. TUBULAR RAILING, TYPE U	X 45745

DESIGN DATA

LIVE LOAD: HS20
 ALLOWABLE DESIGN STRESSES:
 CONCRETE MASONRY, GRADE 4A
 SLAB $f_c = 1800$ PSI
 ALL OTHERS $f_c = 4000$ PSI
 BAR STEEL REINFORCEMENT $f_y = 20,000$ PSI
 PRESTRESSED GIRDERS
 CONCRETE MASONRY $f_c = 6,000$ PSI
 STRANDS 1/2" WITH ULTIMATE
 TENSILE STRENGTH OF 270,000 PSI


FOUNDATION DATA

ABUTS SHALL BE SUPPORTED ON HP 10x42
 STEEL H PILES DRIVEN TO A MIN BRG
 VALUE OF 25 T/PILE - EST 53.0' LG AT
 S ABUT & EST 50.0' LG AT N ABUT
 PIERS SHALL BE SUPPORTED ON
 HP 10x42 STEEL H PILES DRIVEN TO
 A MIN BRG VALUE OF 37 T/PILE - EST
 40.0' LG @ EACH PIER.

TRAFFIC VOLUME:

U-S-H 53 TOWN RD.
 (1980) QHV 780 53
 R DS 80 MPH 60 MPH

AS BUILT PLAN
 DATE 1-78 BY W.J.K.

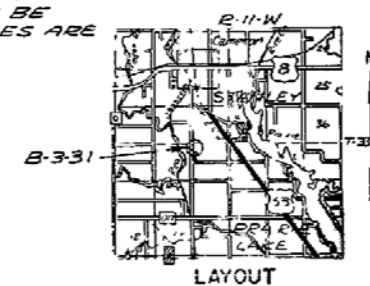

LAYOUT

No.	Date	Revision	By
STATE OF WISCONSIN DEPARTMENT OF TRANSPORTATION DIVISION OF HIGHWAYS			
STRUCTURE B-3-31			
NBL U-S-H 53 OVER TOWN ROAD			
County	BARRON	Town	PRairie LAKE
Design	SA & SHD '89	Scale	1" = 20'
Drawn	RTB	Checked	JG
Approved	W.A. Klem	Date	12-21-71
GENERAL		SHEET 1 OF 13	
PLAN		X 45733	


"AS BUILT PLAN"

Sheet Number	Total Sheets
1	188

Index of Sheets	
Sheet No. 1	Title
Sheet No. 2-2.4	Typical Cross Sections
Sheet No. 3-3.2	Estimate of Quantities
Sheet No. 3A-3D	Miscellaneous Quantities
Sheet No. 4-4.6	Right of Way Plat
Sheet No. 5-19	Plan and Profile Sta. 610+00 to Sta. 822+00
Sheet No. 20-20.9	Standard Details
Sheet No. 21-77	Drainage Structures
Sheet No. 78-189	Cross Sections

STATE OF WISCONSIN
DEPARTMENT OF TRANSPORTATION
DIVISION OF HIGHWAYS
PLAN AND PROFILE OF PROPOSED
NEW AUBURN - U.S.H. 8 ROAD
(CHETEK - U.S.H. 8 SECTION)
U.S. H. 53
BARRON COUNTY

PROJECT IDENTIFICATION NUMBER
1196-5-73

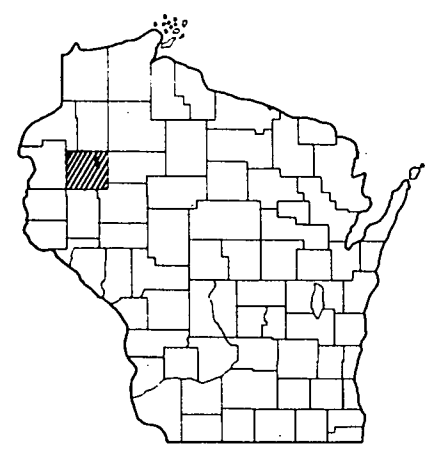

Scales
Plan 1 in. = 100 ft.
Profile Hor. 1 in. = 100 ft. Vert. 1 in. = 10 ft.
Cross Sections Hor. 1 in. = 10' Vert. 1 in. = 10'

Design Designation


CONTRC' OF ACCESS	=	FULL
A.D.T. (1980)	=	5200
A.D.T. (2000)	=	8200
D.H.V.	=	1005
D.	=	50-50
T.	=	11.7 %
V.	=	80 MPH.

END OF PROJECT 1196-5-71
STA. 822+00 N.B.R.
N. 570,980.84
E. 1,549,538.30
APPROX. 586 FT. EAST AND 267 FT. SOUTH OF THE
CENTER OF SEC. 32
T-34-N, R-11-W

BEGIN PROJECT 1196-5-71
STA. 610+00 N.B.R.
N. 555,881.72
E. 1,563,133.27
APPROX. 1101 FT. WEST AND 808 FT.
NORTH OF THE CENTER
OF SEC. 14, T-33-N, R-11-W.

Conventional Signs

State Line	-----	Culverts in Place	-----
County Line	-----	Culverts Required	-----
Township or Range Line	-----	Drop Inlet	-----
Section Line	-----	Power Pole	-----
New Right of Way Line	-----	Telephone or Telegraph Pole	-----
Present Right of Way Line	-----	Right of Way Markers	-----
Wire Fence { Woven	-----	Reference Stake for Hubs Only	-----
Barbed	-----	Marsh	-----
Lot Line	-----	Hedge	-----
Corporate or City Limits	-----	Trees	-----
Property Line	-----	Ground Elevation	Datum Line 73.9
Traveled Way or P.E.	-----	Grade Elevation	Datum Line 76.16
Railroads	-----		
Base or Survey Line	-----		

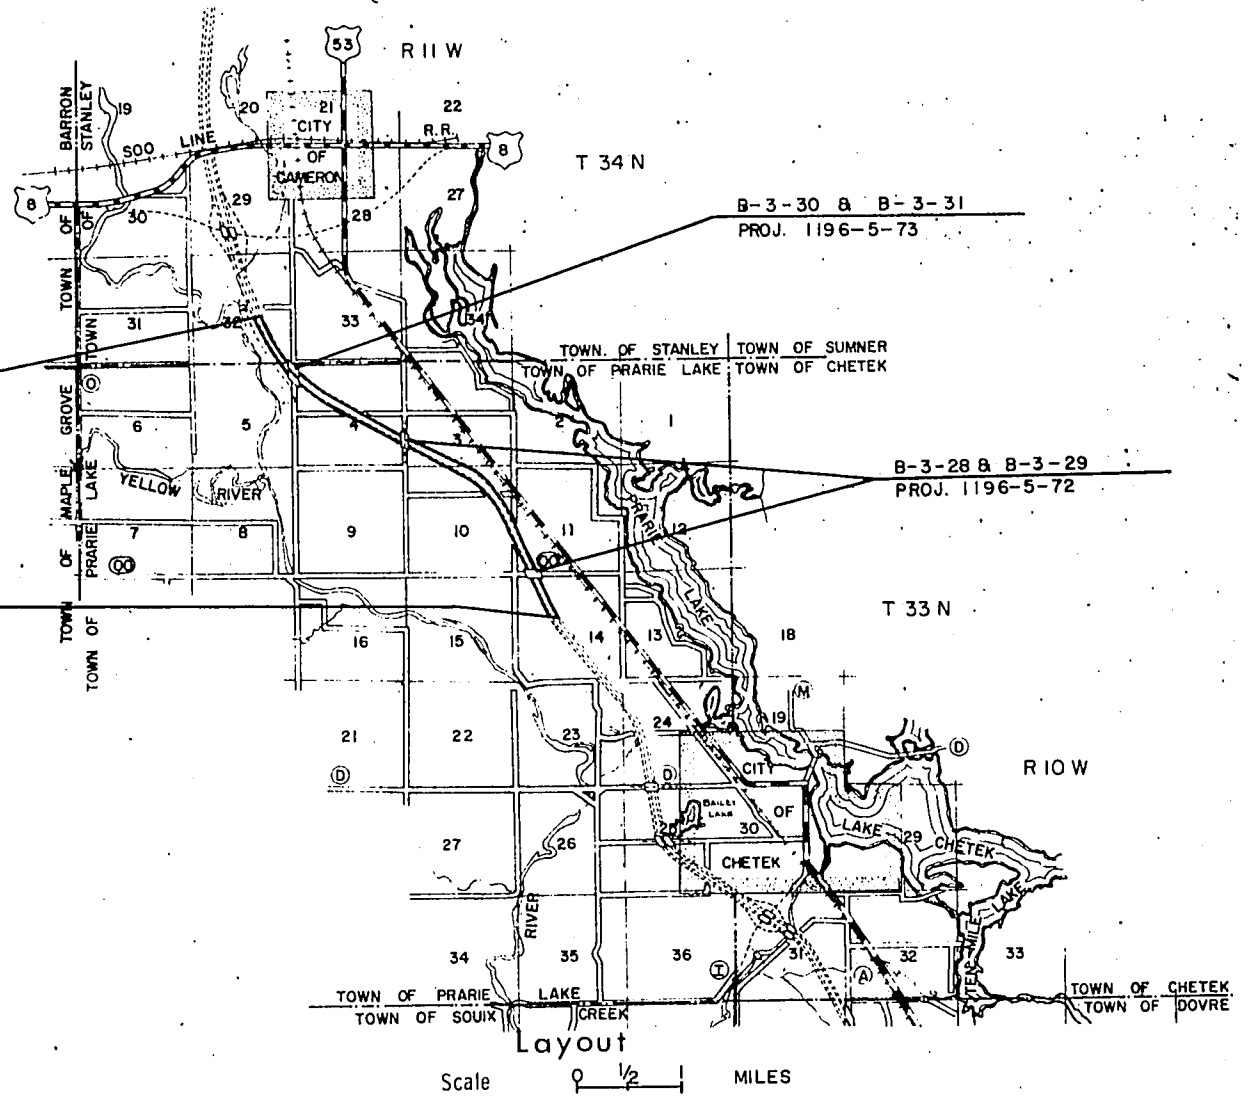

Layout
Scale 0 1/2 1 MILES
Total Net Length of Centerline = 4.015 Mi.

CONTROL OF ACCESS
WITHIN LIMITS OF THIS PROJECT WHERE
CONTROL OF ACCESS IS SHOWN THUS [|||||]
NO ACCESS IS PERMITTED TO U.S.H. 53
TRAFFIC LANES EXCEPT BY RAMPS AT
INTERCHANGES.

STATE OF WISCONSIN DEPARTMENT OF TRANSPORTATION DIVISION OF HIGHWAYS	
Surveyor <u>DIST. 8</u>	Note Book
District Computer <u>R.J.P.</u>	M.O. Checker <u>lib</u>
District Checker <u>D.R.K.</u>	Correct
Correct:	
Date <u>12-16-71</u> <u>Wm. T. Weinbach, Jr.</u>	District Engineer
Recommended for Approval:	
Date <u>1-14-72</u> <u>J. O. Korman</u>	Chief Design Engineer
Approved: <u>S. P. Hieber</u>	State Highway Engineer
U.S. DEPARTMENT OF TRANSPORTATION FEDERAL HIGHWAY ADMINISTRATION BUREAU OF PUBLIC ROADS WISCONSIN DIVISION	
Approved:	
Date	
Division Engineer	

ESTIMATE OF QUANTITIES

CONTRACT NO. 3
STRUCTURES
B-3-30 & B-3-31

PROJECT I.D.	SHEET NUMBER	TOTAL SHEETS
1196-5-73	3.2	188
FEDERAL PROJECT DESIGNATION		
EMP F00 4(40)		

~~THIS PROJECT IS TO BE EXECUTED UNDER THE STANDARD SPECIFICATIONS FOR ROAD AND BRIDGE CONSTRUCTION OF THE WISCONSIN DIVISION OF HIGHWAYS — EDITION OF 1969 .~~
~~APPROVED MARCH 3, 1968, FEDERAL AID REQUIRED CONTRACT PROVISIONS APPROVED NOVEMBER 15, 1968, AND SPECIAL PROVISION AS ATTACHED TO PROPOSALS.~~

[illegible][illegible][illegible]


3.1-8.4-23.33

SCHEDULE OF LANDS AND INTERESTS REQUIRED

[illegible][illegible]



STATE LINE		HIGHWAY SEPARATION		CEMETERY	
COUNTY LINE		HIGHWAY OVERPASS		FOUNDATION	
TOWNSHIP AND RANGE LINES		RAIL LINE OVERPASS		GAS PUMP ISLAND	
SECTION LINE		ALL OTHER BRIDGES		BUILDING	
QUARTER LINE		STREAM OR RIVER		IRON PIN	
SIXTEENTH LINE		LAKE		POWER POLE	
NEW CENTERLINE		CATTLE PASS		TELEPHONE POLE	
NEW R/W LINE		RELOCATED STREAM OR RIVER		RAIL LINE	
OLD R/W LINE		TRAVELED WAY (Shown only in area of Frontage Roads, Interchanges or Dual Lanes)		TRANSMISSION TOWER AND LINE	
PROPERTY LINE				UNDERGROUND CABLE MARKER	
CORPORATE LIMITS				WELL	
SLOPE INTERCEPTS				STONE MONUMENT	
LOT, TIE AND OTHER MINOR DASHED LINES				SEPTIC TANK	
UNDERGROUND FACILITY (POWER, TELEPHONE, TELEGRAPH, GAS, ETC.)				WINDMILL	
NO ACCESS					
LIMITED HIGHWAY EASEMENT					

REVISION DATE	PROJECT NO.	SHEET NUMBER	TOTAL SHEETS
MAY 3, 1971	1196-5-21	4.6	
JULY 20, 1971	FEDERAL PROJECT DESIGNATION		
DEC. 20, 1971			
NEW AUBURN - U.S.H. 8 ROAD C.T.H. D - U.S.H. 8 SECTION U.S.H. 53 BARRON CO.			
SCALE 0 100 200 400 FT. DATE FEB. 16, 1971			
CONST. PROJECT 1196-5-71.73 - EMP. 22-44-45 - 188			

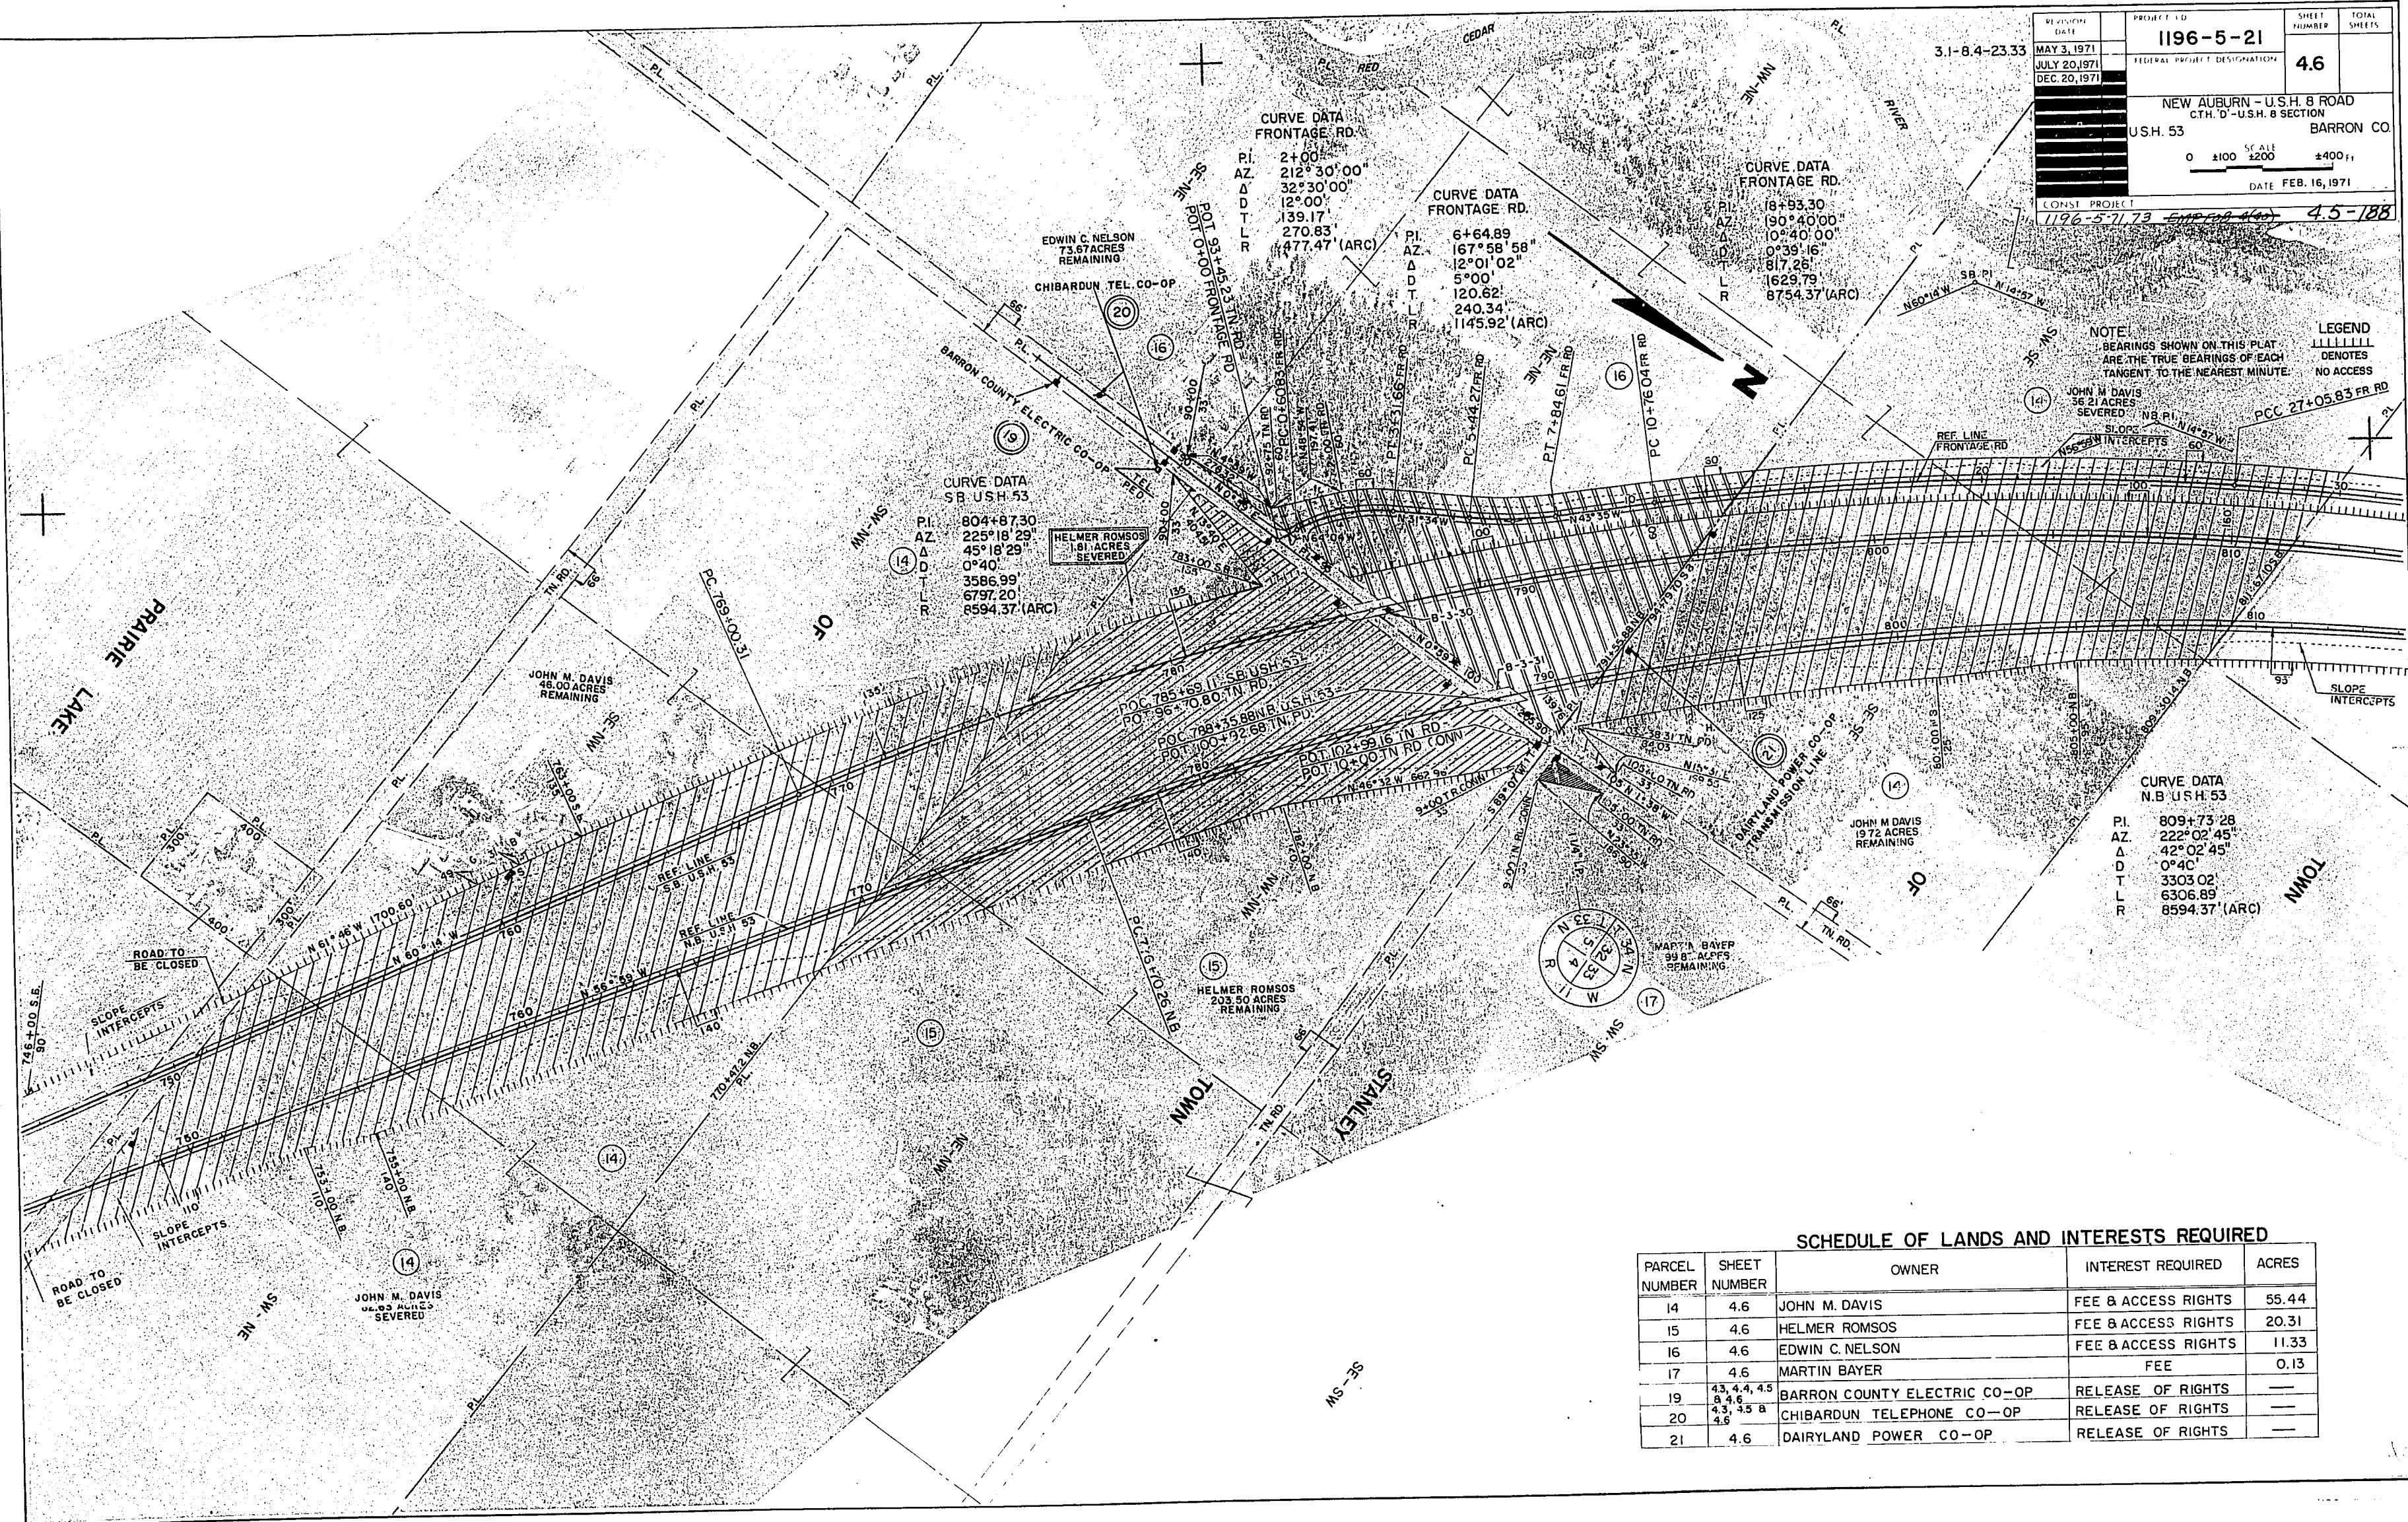

SCHEDULE OF LANDS AND INTERESTS REQUIRED

PARCEL NUMBER	SHEET NUMBER	OWNER	INTEREST REQUIRED	ACRES
14	4.6	JOHN M. DAVIS	FEE & ACCESS RIGHTS	55.44
15	4.6	HELMER ROMSOS	FEE & ACCESS RIGHTS	20.31
16	4.6	EDWIN C. NELSON	FEE & ACCESS RIGHTS	11.33
17	4.6	MARTIN BAYER	FEE	0.13
19	4.3, 4.4, 4.5	BARRON COUNTY ELECTRIC CO-OP	RELEASE OF RIGHTS	—
20	4.3, 4.5 & 4.6	CHIBARDUN TELEPHONE CO-OP	RELEASE OF RIGHTS	—
21	4.6	DAIRYLAND POWER CO-OP	RELEASE OF RIGHTS	—

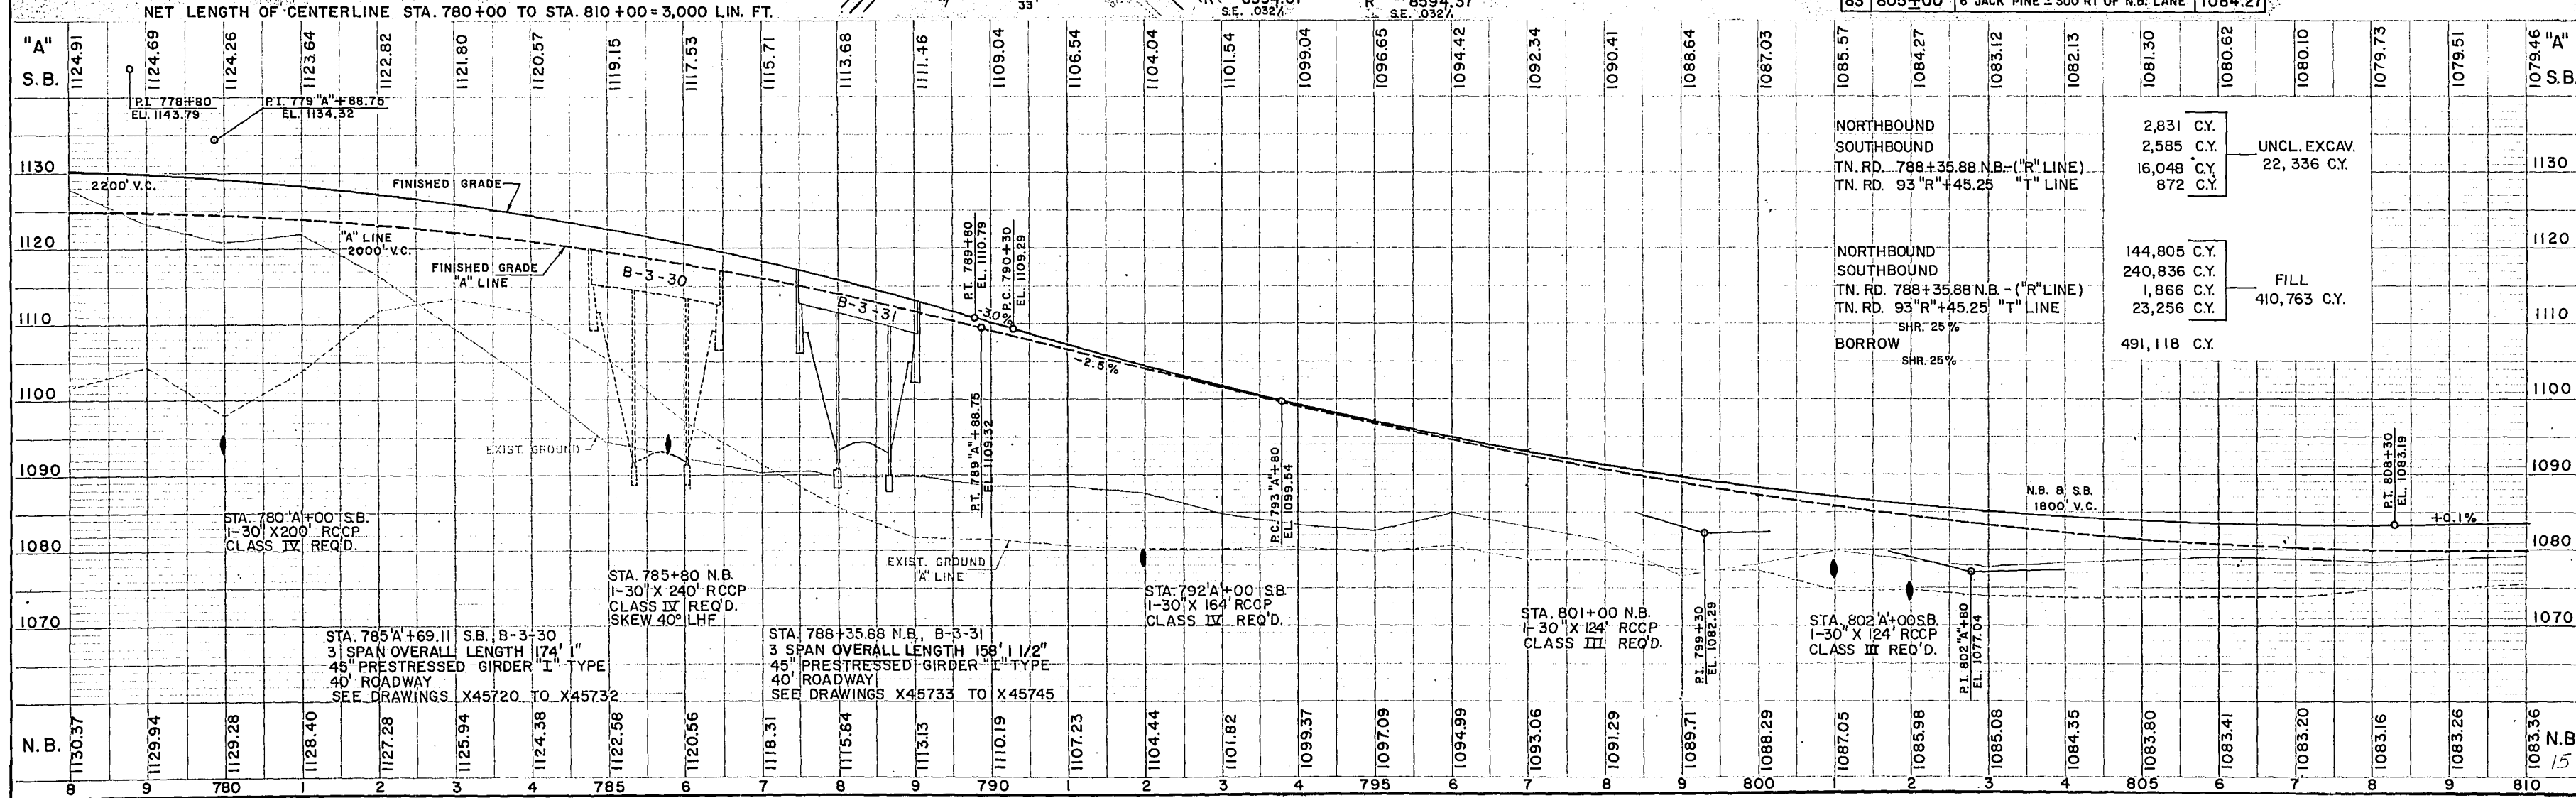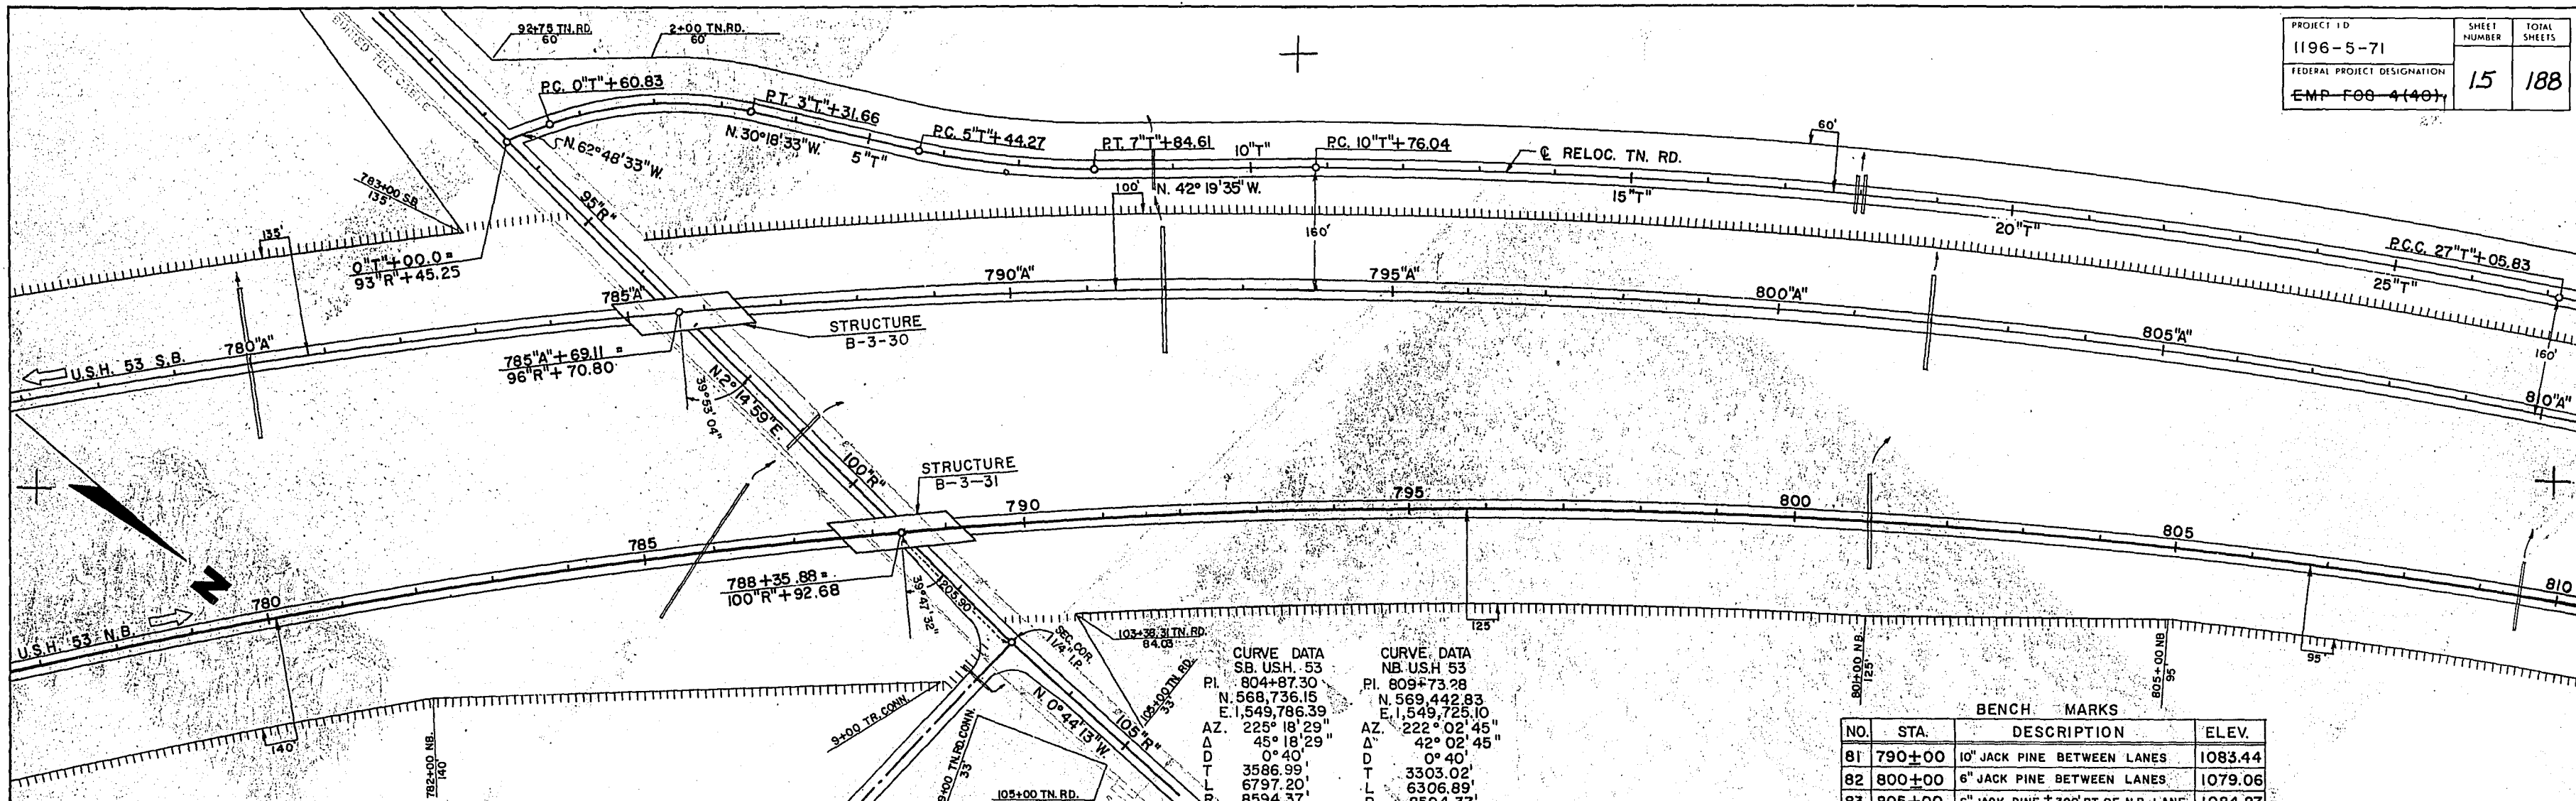

GENERAL NOTES

The contractor shall construct, place and maintain barricades as shown on the drawing and as required by the Standard Specifications or applicable Special Provisions.

CLASS 1 BARRICADE:

Class 1 Barricades shall be of variable length as indicated, and long barricades shall be assembled from these units. The Class 1 Barricade is the type normally required for major operations, where the barricade will remain in place for extended periods. Class 1 Barricades shall be used at points where the road is closed to traffic. Gates or movable sections of a barricade shall be provided when necessary, for access of equipment or other authorized vehicles. Wing Barricades are Class 1 Barricades erected on the shoulder on one or both sides of the pavement to give Traffic the perceptive effect of a narrowing or restricted roadway. The ends closest to traffic of all three members of a wing barricade shall be in a vertical line. If used in a series, they should start at the outer edge of the shoulder and be brought progressively closer to the pavement. Wing Barricades may be used as a mounting for the advance warning or guide signs or for flashers. When used on two-way roadways, the back of the wing barricade shall be painted reflectorized white.

CLASS 11 BARRICADE:

Class 11 Barricades may be used only where the hazard to traffic is relatively small, and for the more or less continuous delimiting of a restricted roadway, or for temporary daytime use.

MATERIAL & FABRICATION:

Lumber shall be of a grade structurally sound and sufficiently rigid to satisfactorily support and maintain the purpose and intent of a barricade facility. Metal shall be sufficiently rigid to satisfactorily support and maintain the purpose and intent of a barricade facility. The fabrication of the barricade shall be in accord with good pertinent woodworking and metalworking practices. All lumber or timber dimensions stated are nominal.

PAINING:

All barricades shall be painted in alternate 4" or 6" black and white stripes at a 45° angle. The width of stripe shall be consistent for each complete barricade installation. Black stripes shall be painted with weather resistant and durable black paint. White stripes shall be primed, followed by two coats of white reflectorized paint or reflective wide angle sheeting.

DIRECTION OF DIAGONAL STRIPES:


Where a barricade extends entirely across the roadway with no vehicle access provision, the stripes shall slope downward toward the highway centerline. Where vehicle access is permitted, the stripes shall slope downward in the direction toward which vehicles must turn in detouring. Where both right and left turns are provided for, the stripes shall slope downward in both directions from the center. The stripes on wing barricades shall point downward toward the roadway.

LIGHTING:


Lighting devices for barricades shall conform to the requirements of the Standard Specifications.

MEASUREMENT & PAYMENT:


All barricades, unless otherwise provided for in the plans and/or special provisions shall be furnished, placed, and maintained as noted above, and no additional compensation will be allowed but shall be construed to be included in the price bid for other items.

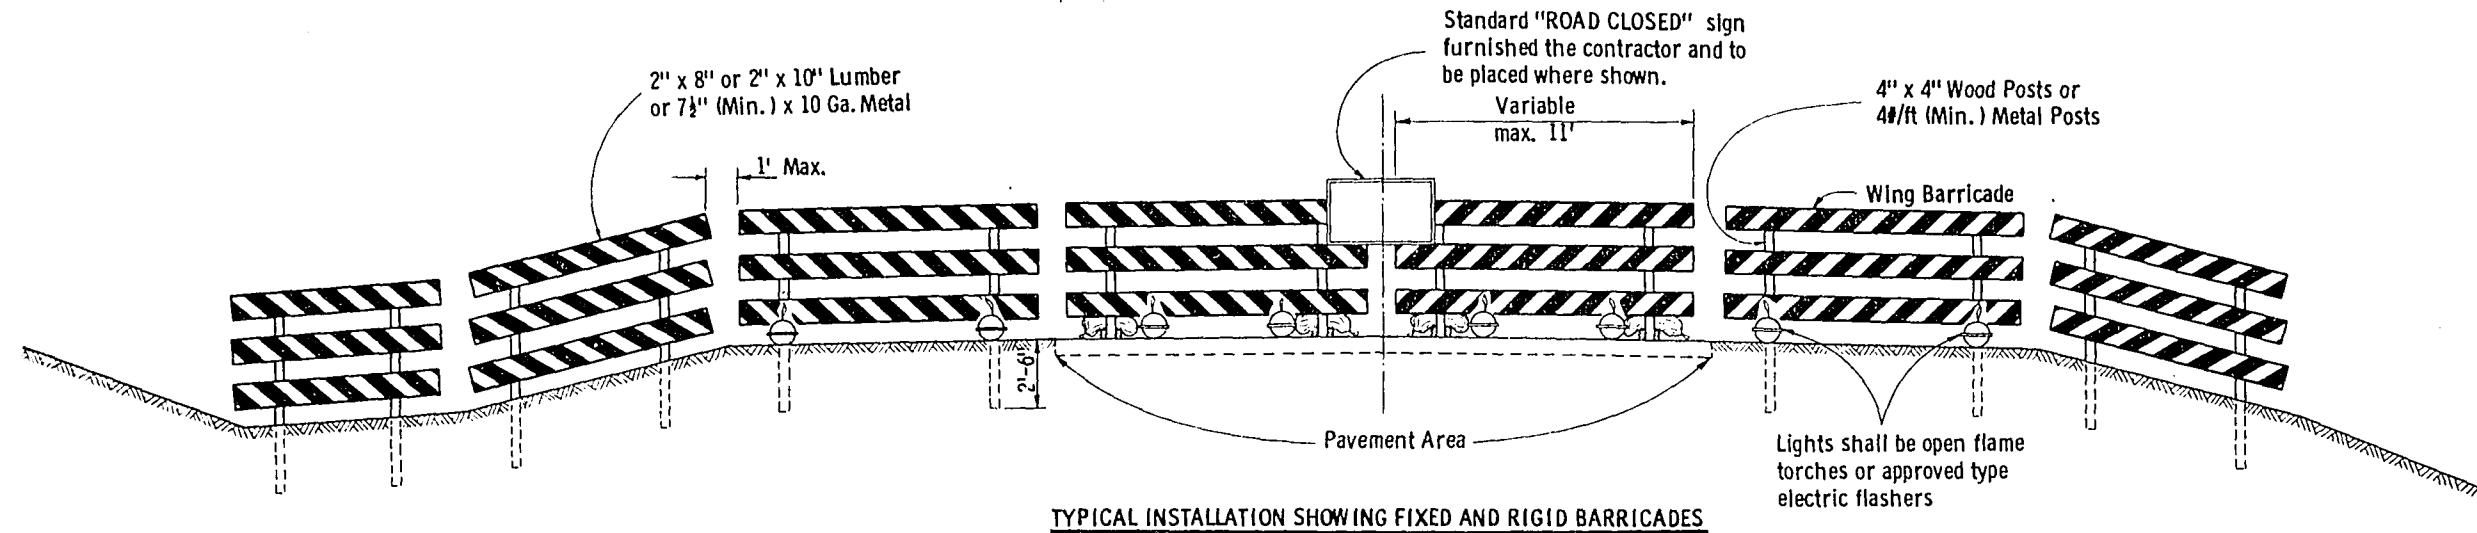

TYPICAL INSTALLATION SHOWING FIXED AND RIGID BARRICADES

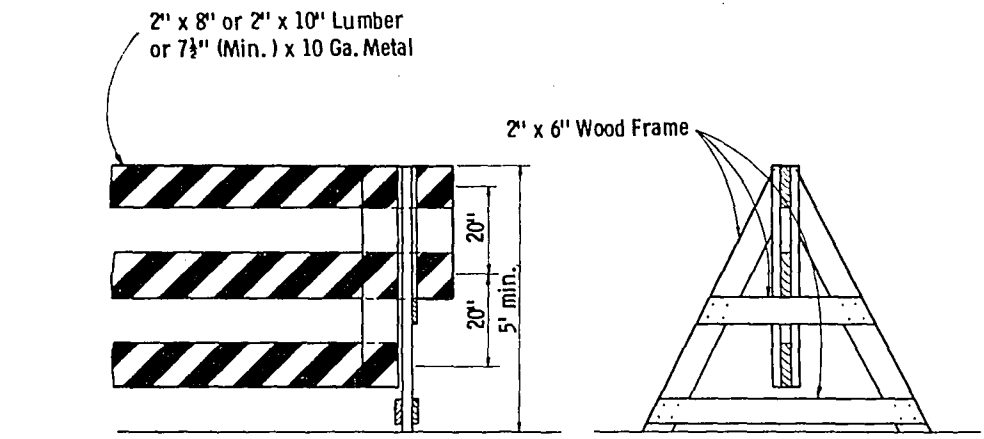


ALTERNATE TYPE INSTALLATION (DEMOUNTABLE)

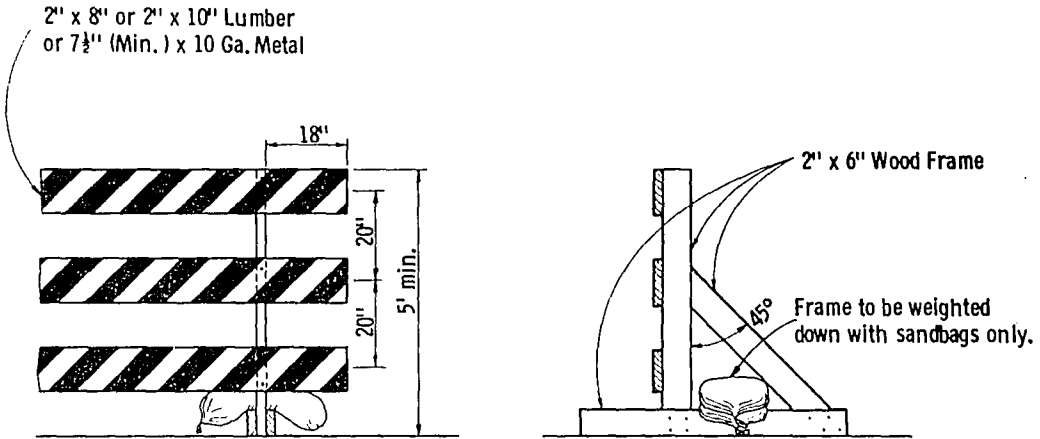


ALTERNATE TYPE INSTALLATION (RIGID)


CLASS I BARRICADES

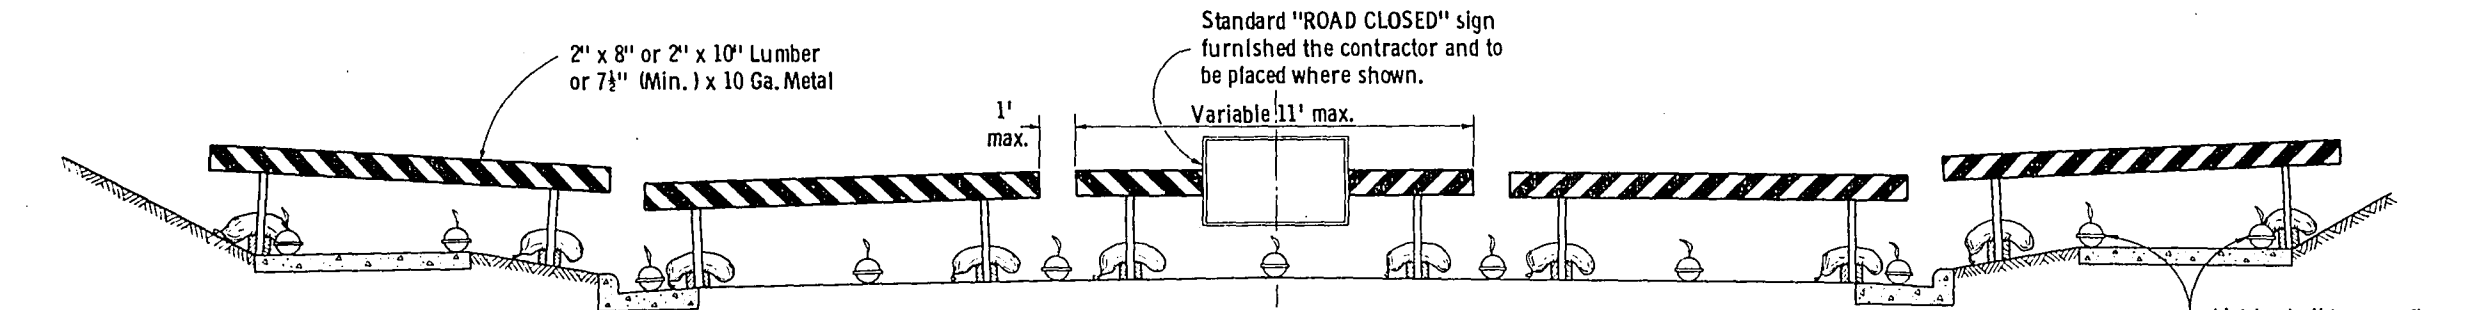


TYPICAL INSTALLATION SHOWING RIGID BARRICADES

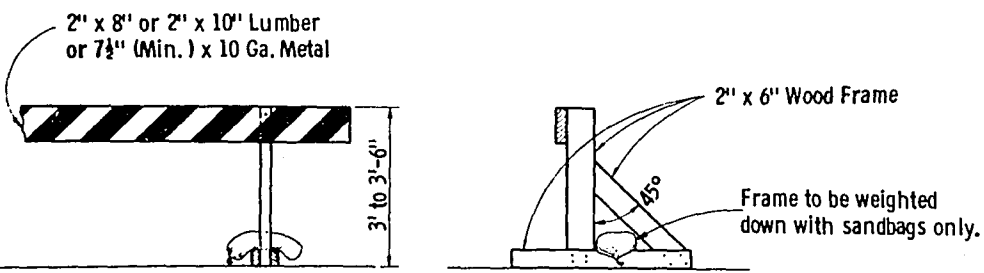

ALTERNATE TYPE INSTALLATION (RIGID)

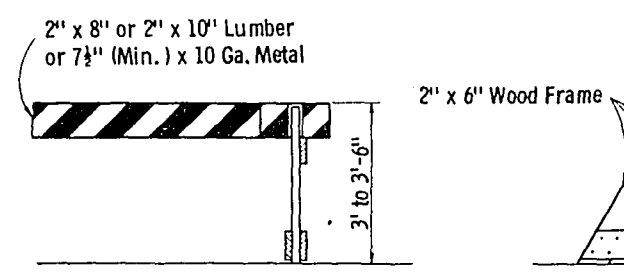


ALTERNATE TYPE INSTALLATION (DEMOUNTABLE)

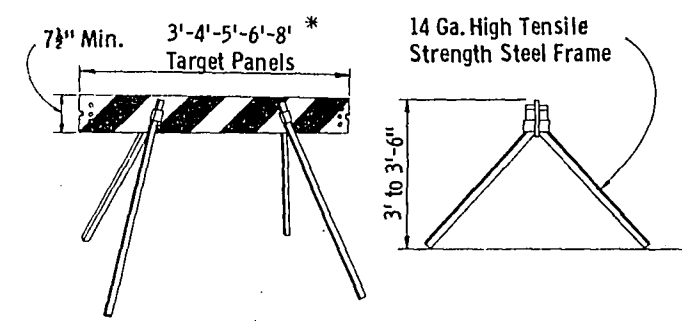

ALTERNATE TYPE INSTALLATION (DEMOUNTABLE)


CLASS II BARRICADES

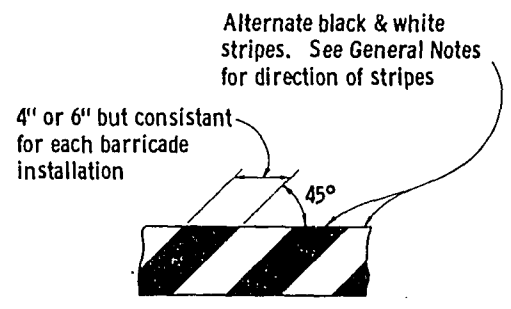


TYPICAL DIAGONAL STRIPES

Applies to all Classes & Types of Barricades


CONSTRUCTION BARRICADE	
State Highway Commission of Wisconsin	
RECOMMENDED FOR APPROVAL:	
DATE 1/11/67	DESIGNED BY E. J. B. [Signature]
APPROVED:	
DATE 1/13/67	CHECKED BY J. J. [Signature]
STATE HIGHWAY ENGINEER	

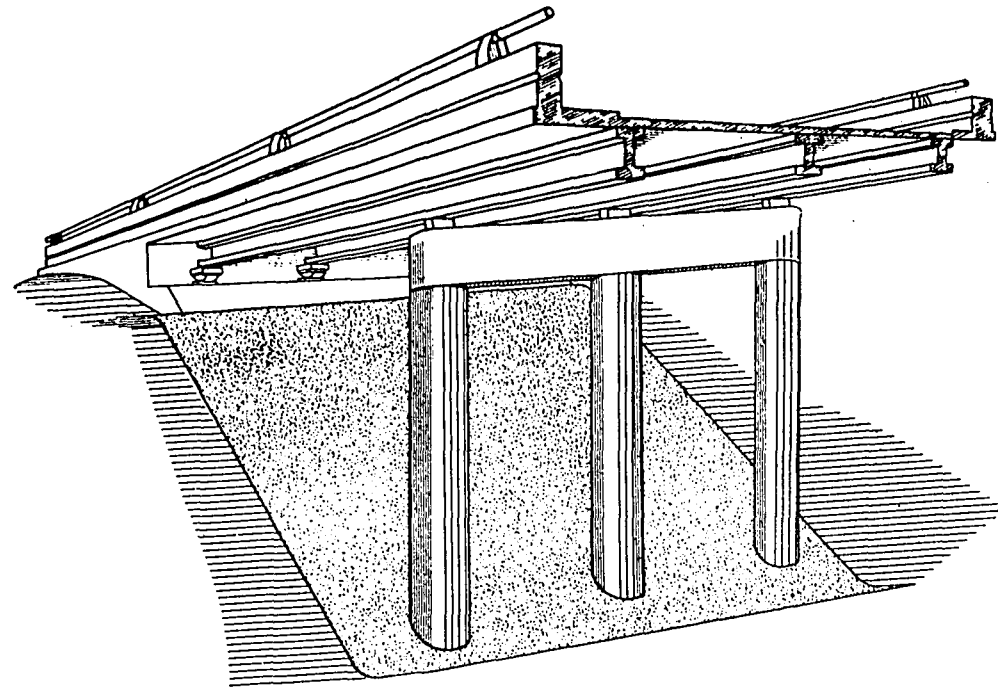


TYPICAL LOCATION DIAGRAM FOR SLOPE PAVING UNDER STRUCTURES

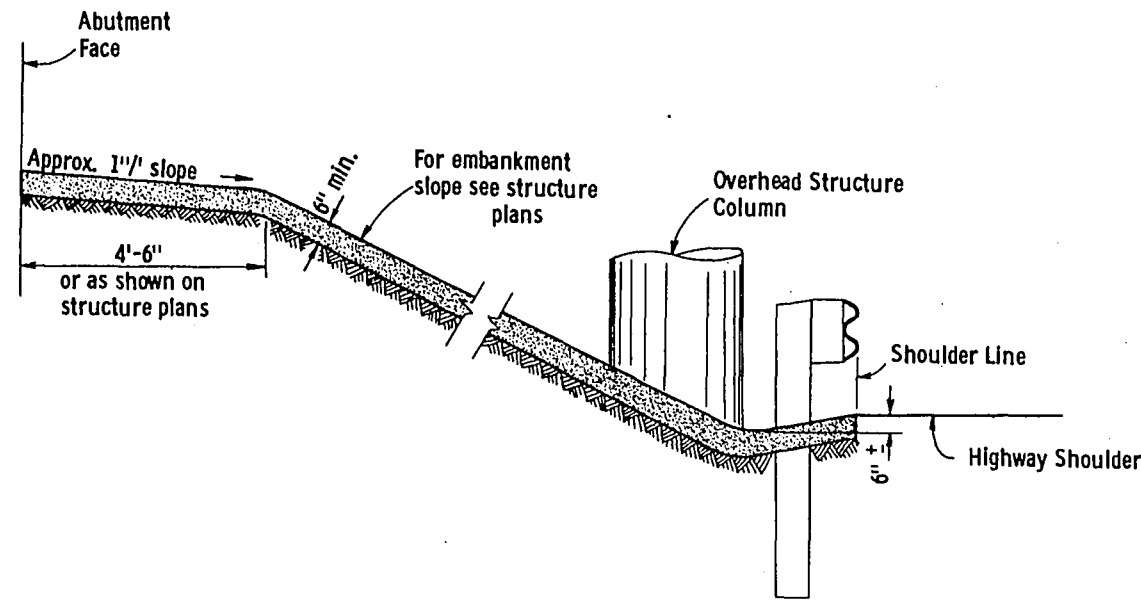


TYPICAL RURAL SECTION HIGHWAY GRADE SEPARATION SILL TYPE ABUTMENT

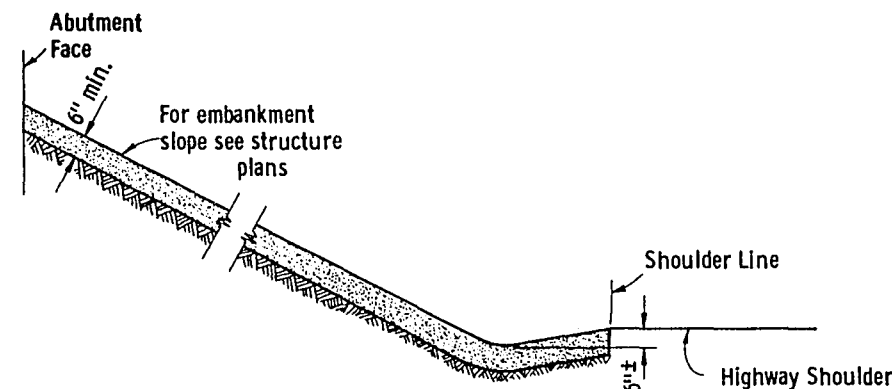

TYPICAL RURAL SECTION HIGHWAY GRADE SEPARATION SEMI-RETAINING TYPE ABUTMENT

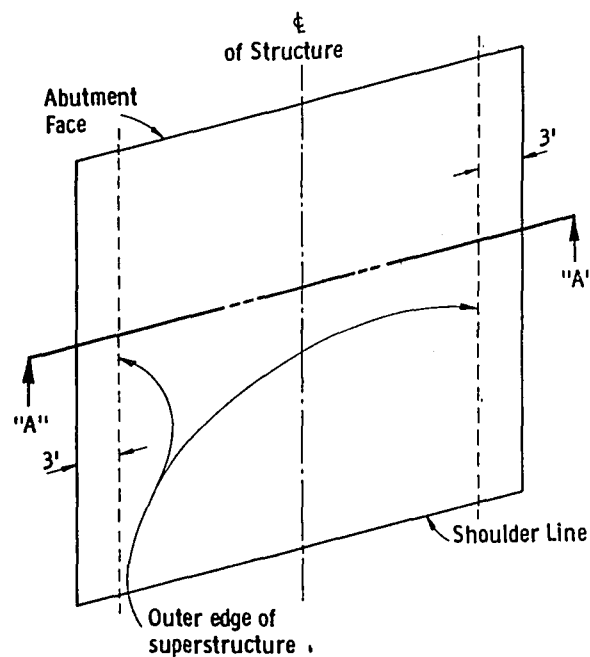

PLAN VIEW

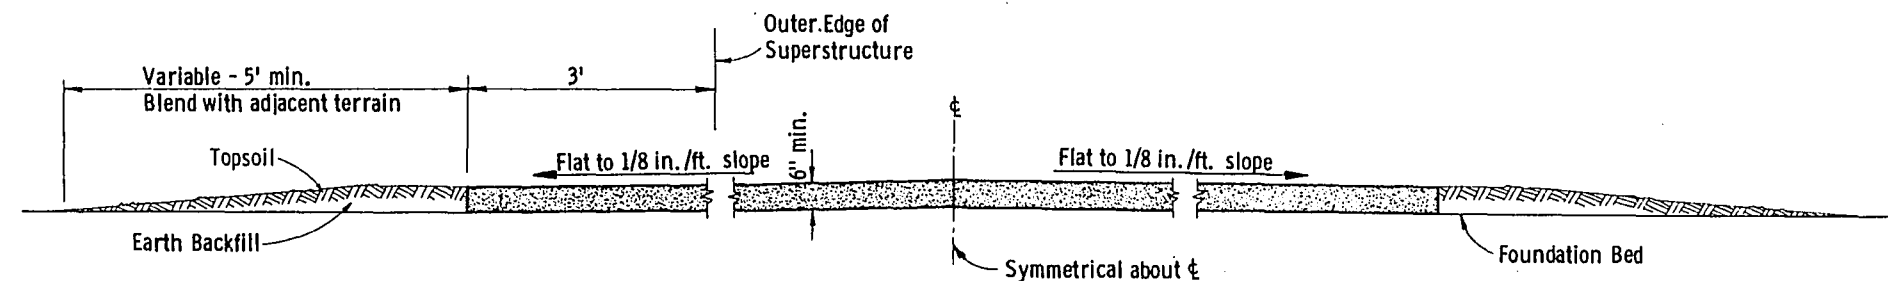

SECTION "A"-"A"

GENERAL NOTES

Details of construction not shown hereon shall conform to the pertinent requirements of the Standard Specifications and the applicable Special Provisions.

CRUSHED STONE

The material shall conform to the gradation requirements for coarse aggregate for concrete masonry, size No. 2 of either series No. 1 or series No. 2.

BITUMINOUS MATERIAL

The upper portion of the paving shall be stabilized by means of an application of bituminous material conforming to the requirements of the applicable Standard Specification or Special Provisions. The bituminous material shall be applied at a rate sufficient to assure penetration into and binding together of the particles in the upper two inches of the crushed stone. The surface of the adjacent structure shall be protected so as to prevent their being splattered or discolored with bituminous material.


METHOD OF MEASUREMENT & PAYMENT

This work shall be measured and paid for by the square yard, which yardage shall be the summation of the total area measured on the plane of the surface thereof, and as provided for in the Standard Specifications and applicable Special Provisions.



SLOPE PAVING CRUSHED STONE

State of Wisconsin
Department of Transportation
Division of Highways

RECOMMENDED FOR APPROVAL DATE 1/25/68 E. J. Burkitt CHIEF DESIGN ENGINEER	APPROVED DATE 2/8/68 J. J. Burmeister STATE HIGHWAY ENGINEER
--	---

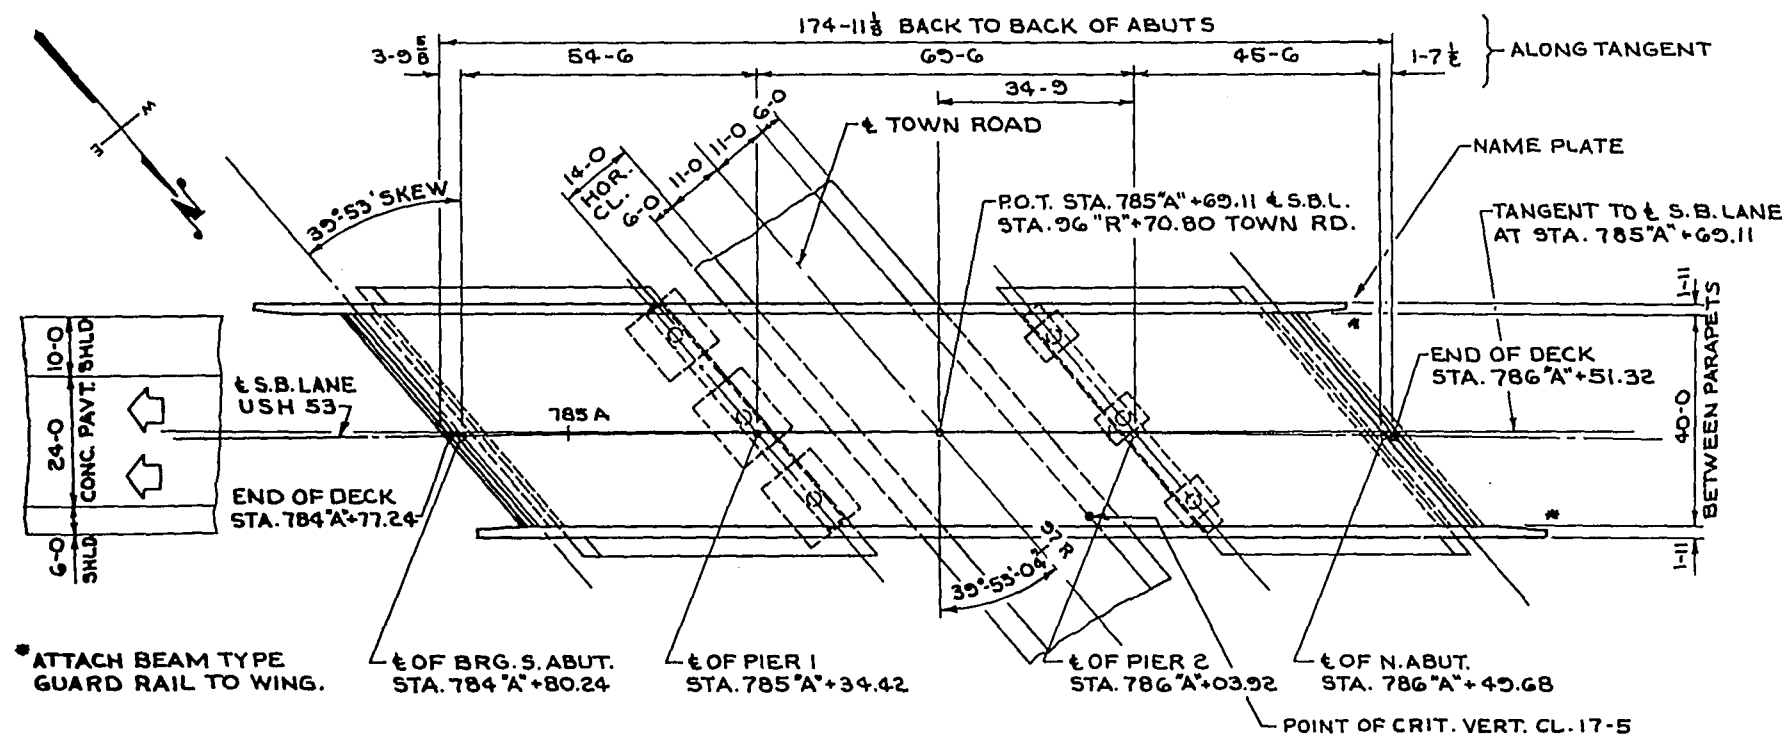

PLAN

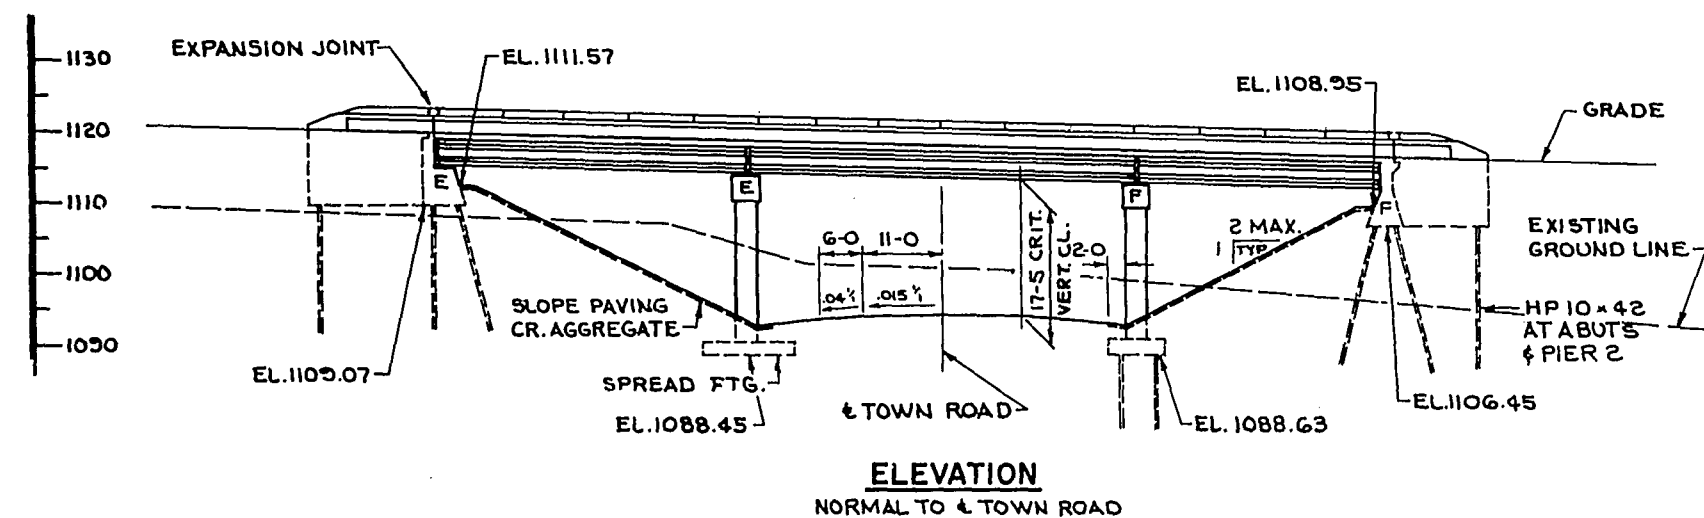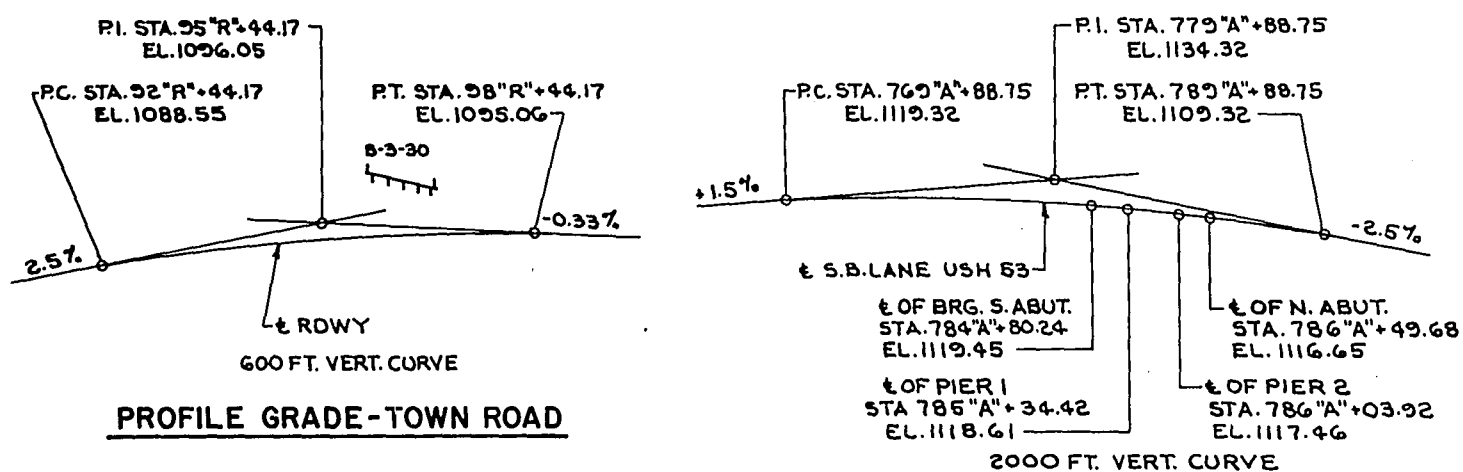ELEVATION
NORMAL TO S. B. LANE U.S.H. 53


PROFILE GRADE-TOWN ROAD

PROFILE GRADE-S.B. LANE U.S.H. 53

CURVE DATA

OF S.B. LANE U.S.H. 53
P.I. STA. 804'A+87.30

R = 8594.367 FT.
L = 6796.20 FT.
T = 3586.99 FT.
D = 0°-40'-00"
Δ = 45°-18'-29"
S.E. = 0.032 FT/FT

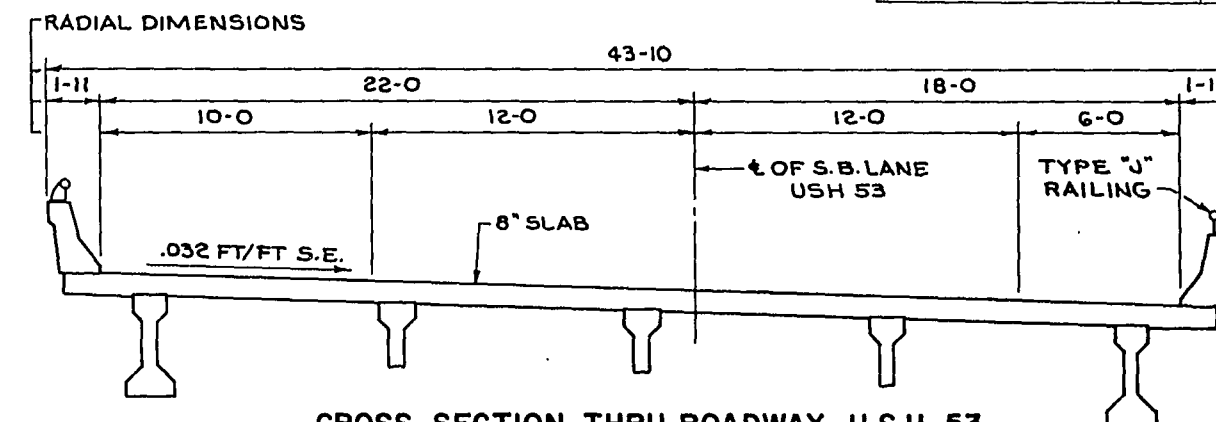CROSS SECTION THRU ROADWAY U.S.H. 53
PRESTRESSED GIRDER SUPERSTR.
(LOOKING NORTH)

GENERAL NOTES

DRAWINGS SHALL NOT BE SCALED.
BAR STEEL REINFORCEMENT SHALL BE EMBEDDED 2" CLEAR UNLESS SHOWN OR NOTED OTHERWISE.
THE FIRST DIGIT OF A THREE DIGIT BAR NO. AND THE FIRST TWO DIGITS OF A FOUR DIGIT BAR NO. SIGNIFIES THE BAR SIZE.
ELASTOMERIC BEARING PADS NEED NOT BE INDIVIDUALLY MOLDED PROVIDED THE CUT EDGES ARE SMOOTH AND TRUE.
THE SLOPE OF THE FILL IN FRONT OF THE ABUTMENTS SHALL BE COVERED WITH SLOPE PAVING TO THE EXTENT SHOWN ON THIS SHEET AND IN THE ABUTMENT DETAILS.
THE FINISHED GRADED SECTION WAS USED AS THE UPPER LIMITS OF EXCAVATION FOR COMPUTATION OF EXCAVATION QUANTITIES AT THE PIERS.
THE UPPER LIMITS OF EXCAVATION FOR STRUCTURES FOR THE ABUTMENTS SHALL BE THE BOTTOM OF SLOPE PROTECTION AND THE QUANTITIES WERE COMPUTED FROM THIS LINE.

TOTAL ESTIMATED QUANTITIES

BID ITEMS	UNIT	S. ABUT.	PIER 1	PIER 2	N. ABUT.	SUPER.	TOTAL
EXCAVATION FOR STRUCTURES	C.Y.	49	161	51	46	—	307
CONCRETE MASONRY	C.Y.	97	84	52	65	218	576
PRESTRESSED GIRDER "I" TYPE 45"	L.F.	—	—	—	—	850	850
BAR STEEL REINFORCEMENT	L.B.	5,510	16,450	9,180	3,240	72,990	107,370
STRUCTURAL CARBON STEEL	L.B.	—	—	—	—	3,950	3,950
STRUCTURAL LOW ALLOY STEEL	L.B.	—	—	—	—	2,660	2,660
LUBRICATED BRONZE PLATES	L.B.	—	—	—	—	239	239
BEARING PADS	S.F.	—	—	—	—	21	21
BEARING PADS, ELASTOMERIC	S.F.	—	—	—	—	24	24
STEEL PILING, DEL. & DRIVEN HP 10x42	L.F.	210	—	360	810	—	1,440
TUBULAR RAILING, TYPE "J"	L.F.	—	—	—	—	381	381
SLOPE PAVING, CRUSHED AGGREGATE	S.Y.	329	—	—	275	—	604
NON-BID ITEMS							
1" ALUMINUM OR ZINC PLATE	S.F.	—	—	—	—	51	51
FILLER	SIZE	—	—	—	—	1/2" & 1/4"	1/2" & 1/4"
POLYVINYL CHLORIDE WATERSTOP	L.F.	9	—	—	51	—	60

DESIGN DATA

LIVELOAD : HS 20
ALLOWABLE DESIGN STRESSES:
CONCRETE MASONRY, GRADE "AA" -
SLAB = f_c 1,200 psi
OTHER = f_c 1,400 psi
BAR STEEL REINFORCEMENT - f_s 20,000 psi
PRESTRESSED GIRDER -
CONCRETE = f_c 6,000 psi
STRANDS - f_s 270,000 psi
FOUNDATIONS:
ABUTMENTS TO BE SUPPORTED ON HP 10x42 AT 24 TONS/PILE MIN. BRG. EST. LENGTH AT S. ABUT. 15'-0", N. ABUT. 45'-0"
PIER 1 TO BE SUPPORTED ON SPREAD FOOTINGS. MAXIMUM DESIGN SOIL PRESSURE 15.2 TONS/SQ. FT.
PIER 2 TO BE SUPPORTED ON HP 10x42 AT 37 TONS/PILE MIN. BRG. EST. LENGTH 20'-0"


LIST OF DRAWINGS

1. GENERAL PLAN	X45720
2. SUBSURFACE EXPLORATION	X45721
3. SOUTH ABUTMENT	X45722
4. BILL OF BARS	X45723
5. NORTH ABUTMENT	X45724
6. PIER 1	X45725
7. PIER 2	X45726
8. PRESTRESSED GIRDER DETAILS	X45727
9. SUPERSTRUCTURE	X45728
10. SUPERSTRUCTURE	X45729
11. EXPANSION JOINT & BEARING DETAILS	X45730
12. RAIL PARAPET DETAILS	X45731
13. TUBULAR RAILING TYPE "J"	X45732

TRAFFIC DATA

S. B. LANE U.S.H. 53
DHV = 780 (1980)
RDS = 80 MPH

TN. ROAD
53
60

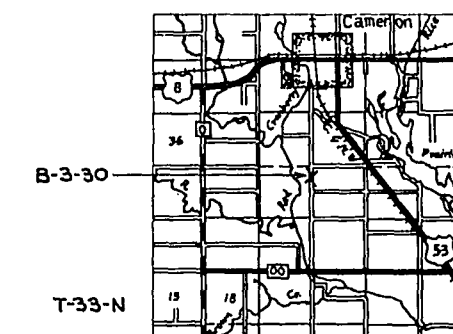LAYOUT
R-11-W

No.	Date	Revision	By
STATE OF WISCONSIN DEPARTMENT OF TRANSPORTATION DIVISION OF HIGHWAYS			
STRUCTURE B-3-30			
S.B. LANE U.S.H. 53 OVER TOWN ROAD			
County	BARRON	City/Village	
Design Spec	AASHO 1969	Load	HS 20
Designed By	CRD	Design Checked	RTB
Drawn By	FWG	Plans Checked	JG
Approved	W.A. Kline	Date	12-21-71
Chief Bridge Engineer			
GENERAL PLAN			SHEET 1 OF 13
			X45720

PROJECT ID 1196-5-73	SHEET 53	TOTAL 188
FEDERAL PROJECT DESIGNATION EMP 748-4(40)		

ABBREVIATIONS
F — Fine M — Medium C — Coarse
Ws — Weathered So — Sound

MATERIAL SYMBOLS		

LEGEND OF PROBING

95/6=95 Blows for 6"
Penetration
Probing taken with a
350# wt.
Falling 18" on a 2"
O. D. Point.

Probing No.
Sta.
Elevation
7 Average Blows Per Foot
Refusal 95/6

LEGEND OF BORING

Boring No.
Sta.
Elev.

Unconfined Strength — 7.7

Blows Per Ft. Using 140# Wt. Falling 30"

Wash Sample

Shelby Tube — S. T.

Ground Water Elevation

No Ground Water Observed Above This Elevation


Sandy Gravel
Boulders or Cobbles
Sand
Silty Clay
So
Limestone




Unless otherwise specified, the blows per foot at the locations indicated are based on driving a 2" O. D. x 1.4" I. D. split spoon sampler with a 140# hammer having a free fall of 30". The blow count is taken in undisturbed soil immediately below a cased or open hole eliminating side friction on the drive pipe.

SUBSURFACE EXPLORATION FOR FOUNDATION DESIGN AND BIDDERS INFORMATION



To obtain relative data concerning the character of material in and upon which the foundation might be built, borings and/or soundings were made at points approximately as indicated on this drawing. The data presented herein represents the findings of the subsurface explorations made. However, because the depths investigated are limited and the area of the borings and/or soundings is very small in relation to the entire area, the Division of Highways does not warrant conditions below the depths investigated or that the classification of material encountered in these investigations is necessarily typical of the entire site.

No.	Date	Revision	By
STATE OF WISCONSIN DEPARTMENT OF TRANSPORTATION DIVISION OF HIGHWAYS			
STRUCTURE B-3-30			
Const. Spec. 1969	Drawn By FWG	Plans Checked JG	
SUBSURFACE EXPLORATION			SHEET 2 OF 13 X45721

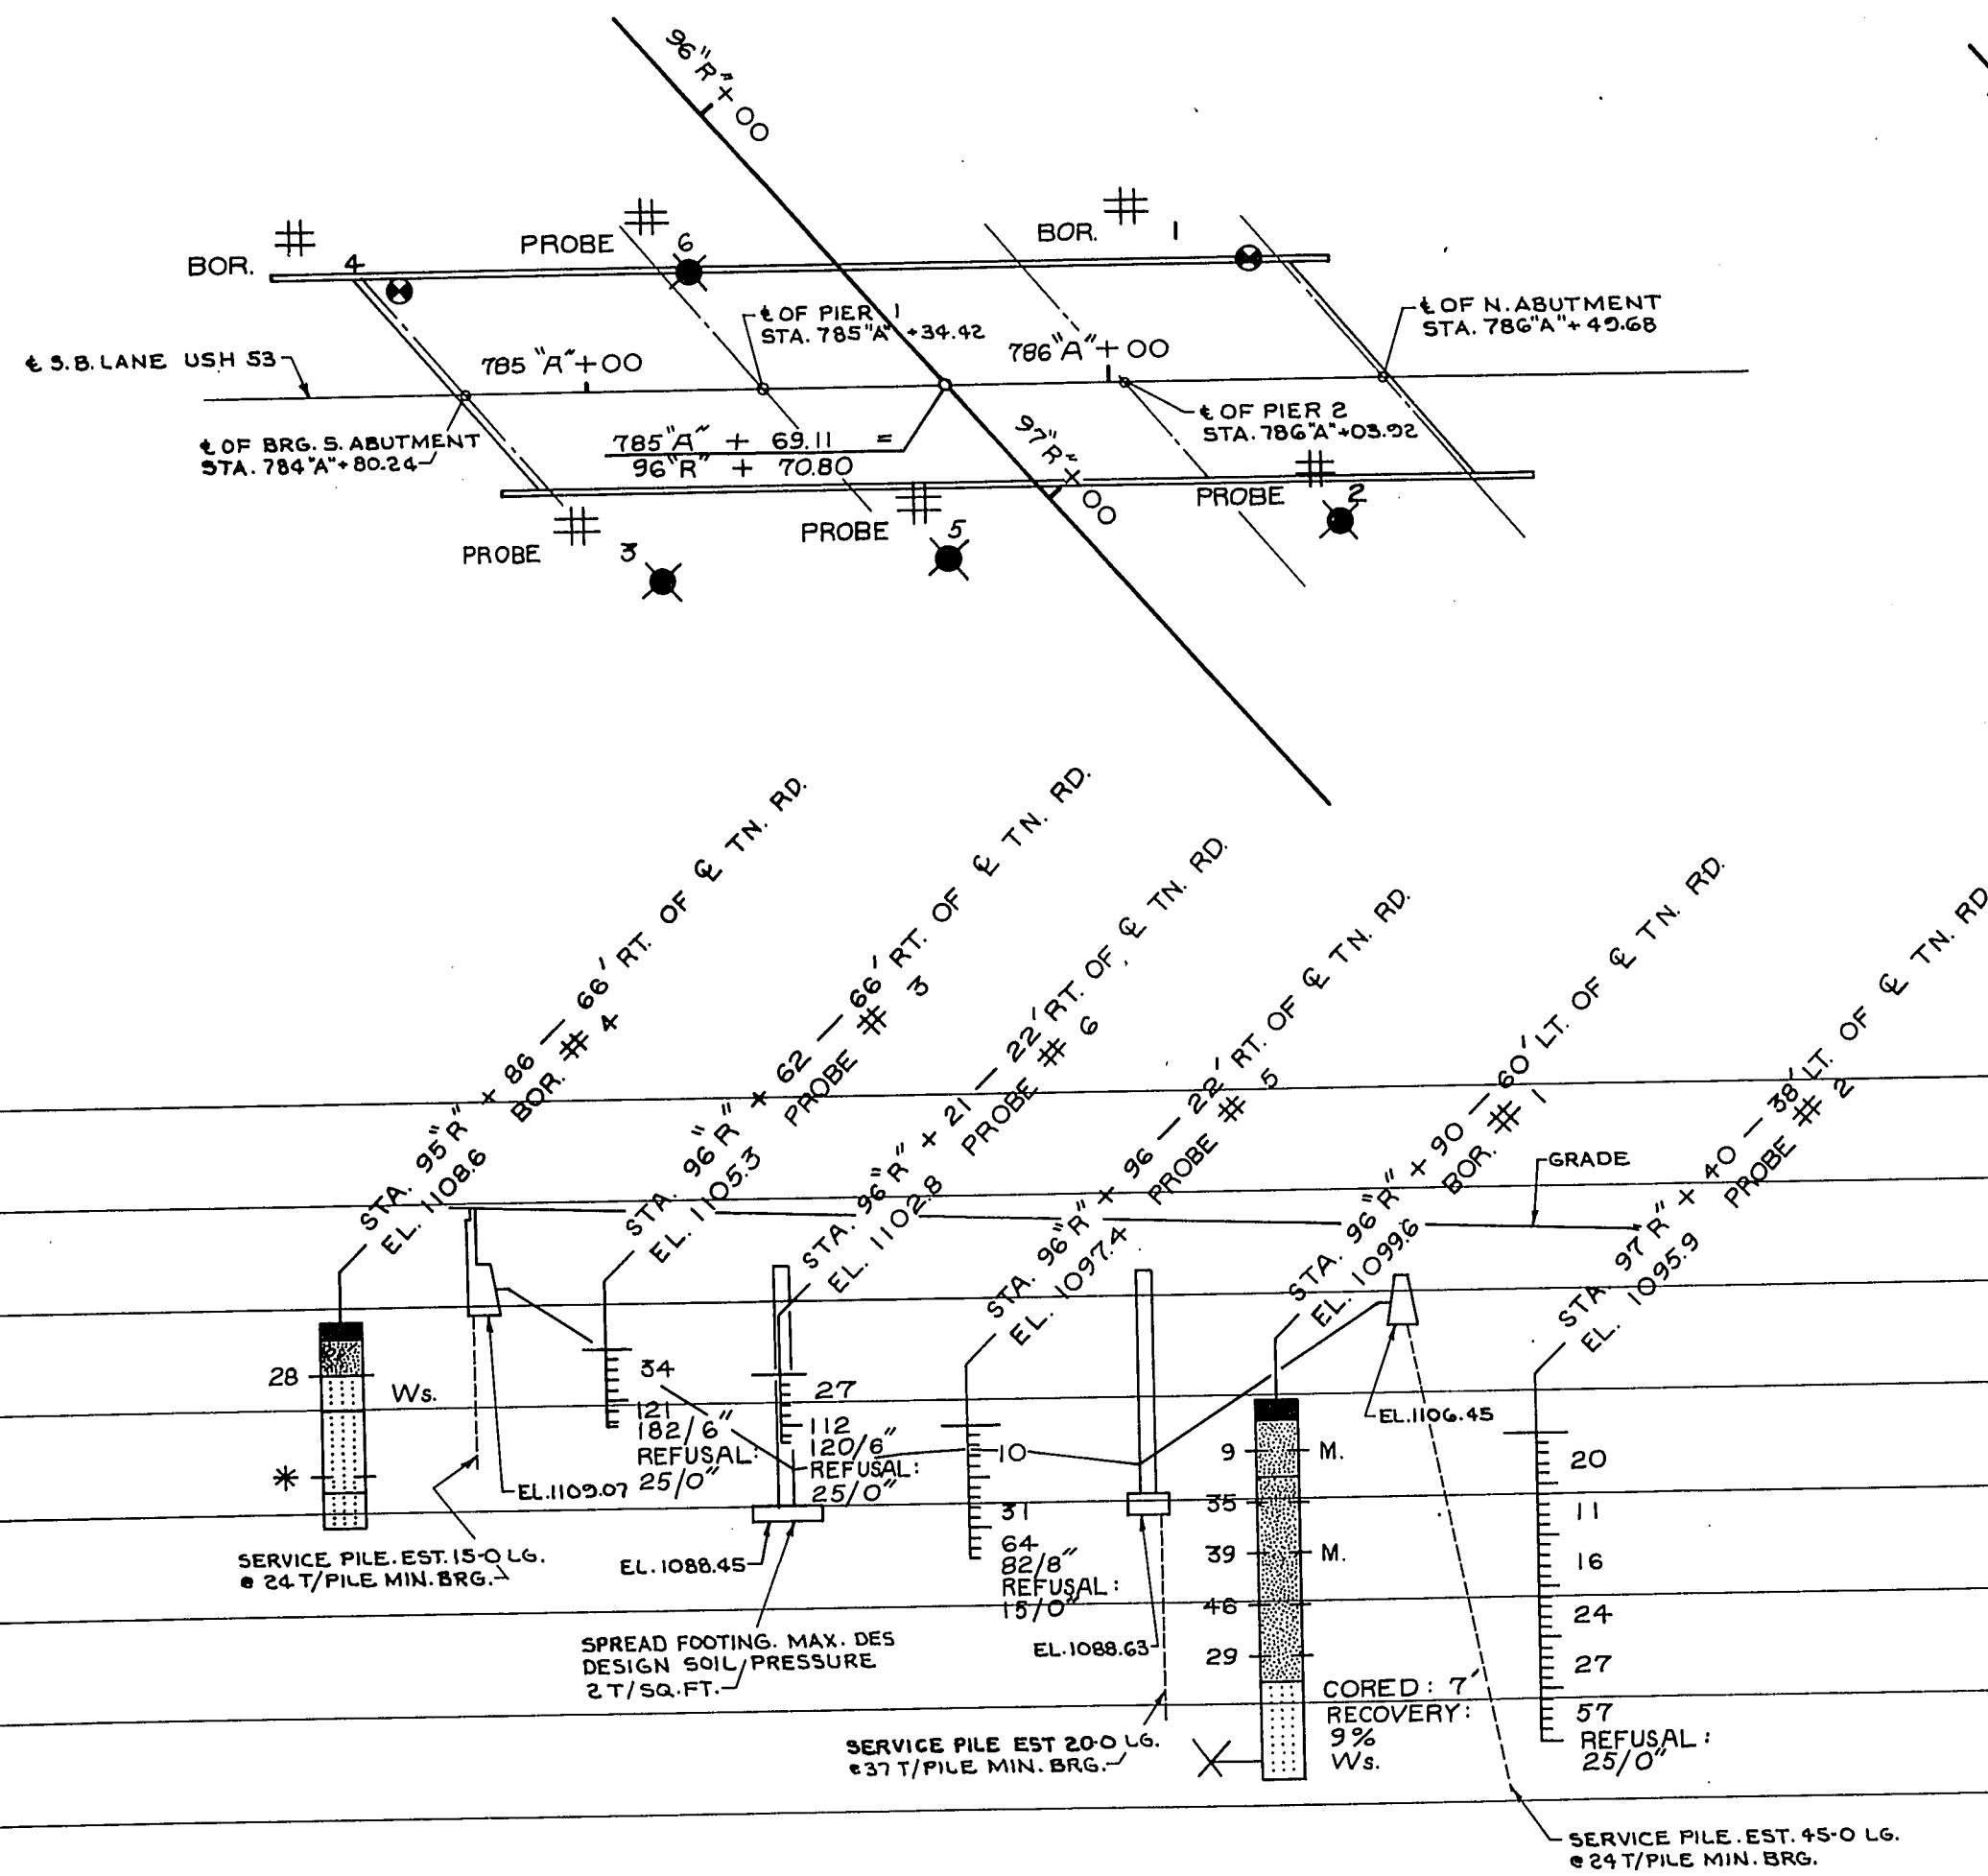

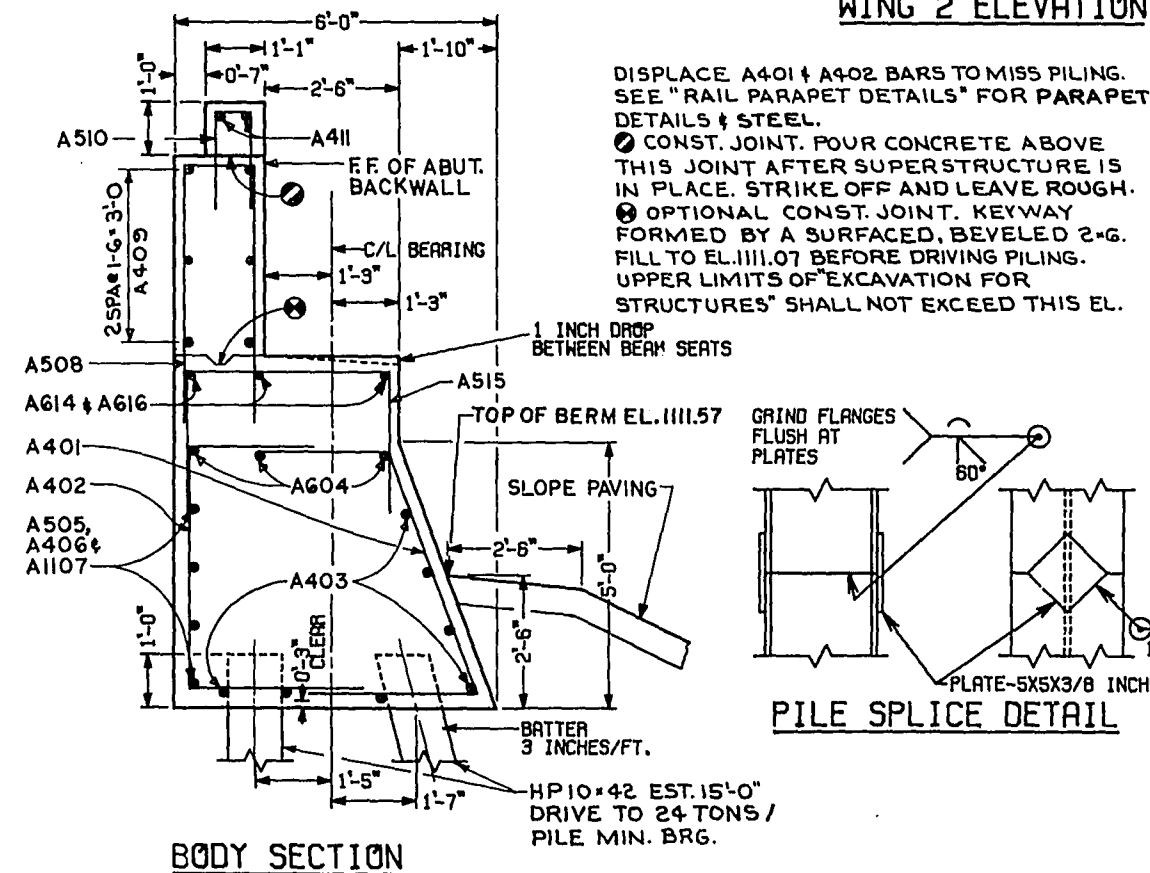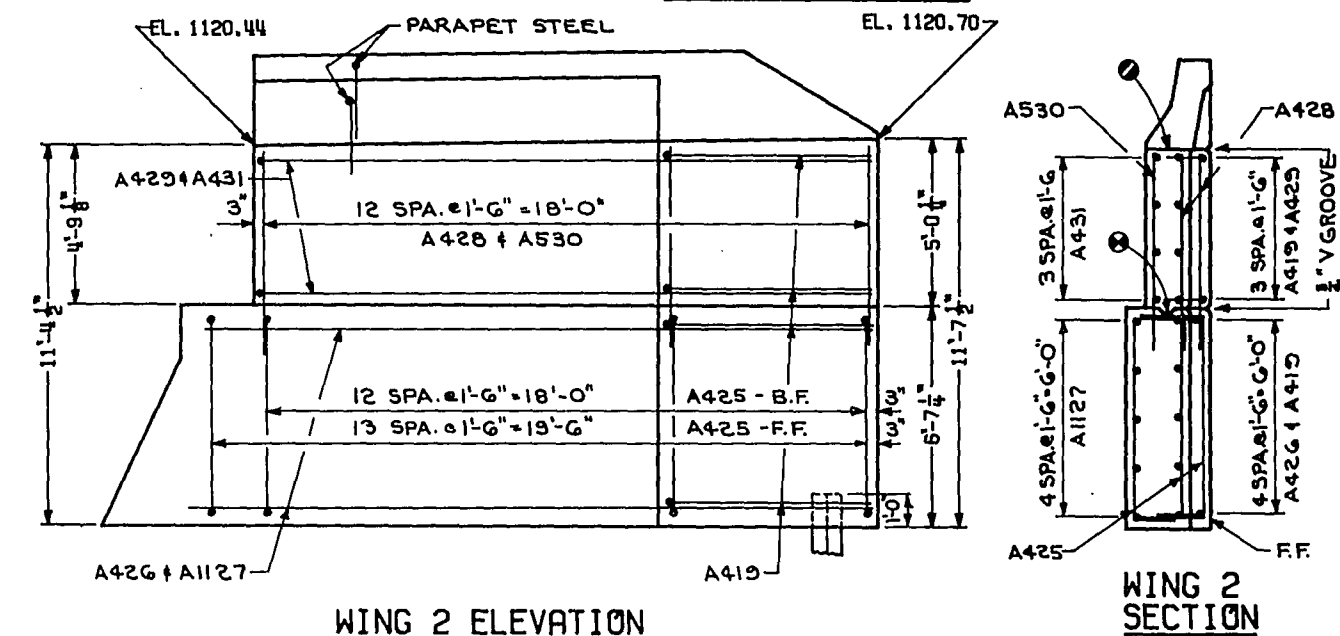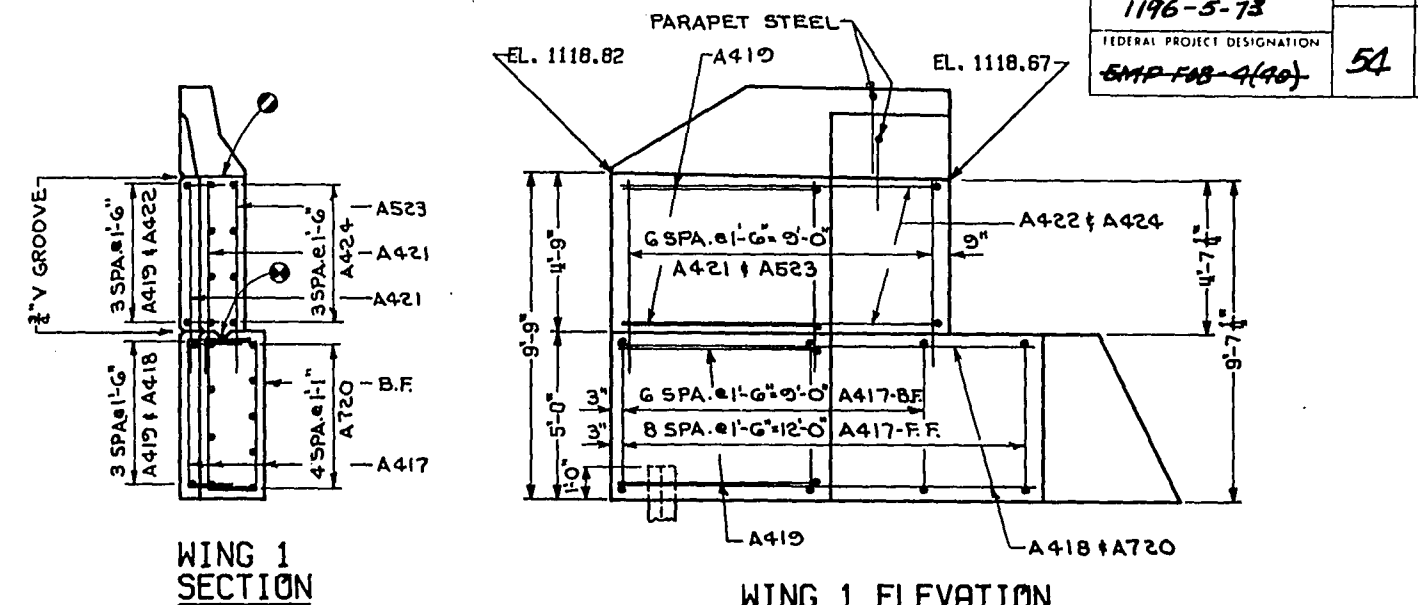

PILES 11 TO 18 SHALL
BE BATTERED 3"/FT.
NORMAL TO & OF BRG

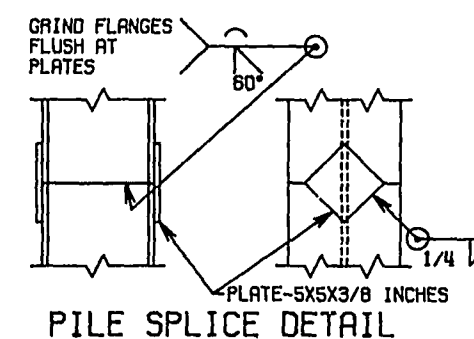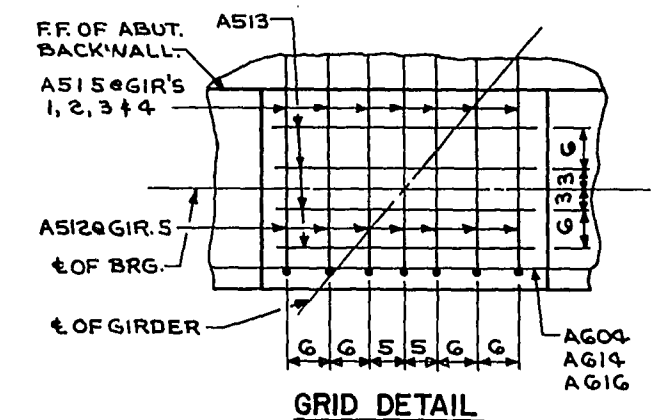


No.	Date	Revision	By
STATE OF WISCONSIN DEPARTMENT OF TRANSPORTATION DIVISION OF HIGHWAYS			
STRUCTURE B-3-30			
Const. Spec.	1969	Drawn By F W G	Plans Checked J G
SOUTH ABUTMENT		SHEET 3 OF 13 X45722	

SOUTH ABUTMENT 5,510'

BAR NO.	NO. REQ'D	LENGTH	BENT	LOCATION
A401	27	12-11	X	BODY - STIRRUPS
A402	27	7-7	X	" "
A403	14	27-9		" - HORIZ.
A604	6	28-2		" "
A505	4	12-0		" " - B.F. AT WING 1
A406	4	24-0		" " - B.F.
A1107	4	23-9	X	" " - B.F. AT WING 2
A508	52	11-9	X	BODY & BACKWALL - STIRRUPS
A409	12	27-9	X	BACKWALL - HORIZ.
A510	52	5-2	X	BACKWALL & PAVING BLOCK - STIRRUPS
A411	14	7-4		BACKWALL - HORIZ. - NO LAP
A512	7	4-10	X	STEPS - GRID DETAIL
A513	20	3-0		" " "
A614	9	14-1		" - HORIZ.
A515	52	9-6	X	" - STIRRUPS
A616	3	3-8		" - HORIZ.
A417	16	7-5	X	WING 1 - STIRRUPS
A418	4	7-3		" " - HORIZ. - F.F.
A419	17	7-7	X	WINGS 1 & 2 - HORIZ. - F.F.
A720	5	10-6		WING 1 - HORIZ. - B.F.
A421	7	5-9		" " - VERTICAL - F.F.
A422	4	5-5	X	" " - HORIZ. - F.F.
A523	7	6-0		" " - VERTICAL - B.F.
A424	4	10-7	X	" " - HORIZ. - B.F.
A425	27	10-2	X	WING 2 - STIRRUPS
A426	5	15-7		" " - HORIZ. - F.F.
A1127	5	23-9		" " " - B.F.
A428	13	6-0		" " - VERTICAL - F.F.
A429	4	14-3	X	" " - HORIZ. - F.F.
A530	13	6-3		" " - VERTICAL - B.F.
A431	4	19-1	X	" " - HORIZ. - B.F.
R501	4	4-10	X	WINGS & RAIL PARAPETS
R502	10	5-10	X	" " "
R503	8	3-3	X	" " "
R504	16	5-10	X	" " "
R505	4	4-5		RAIL PARAPETS
R506	2	4-2	X	" "
R507	4	6-10	X	" "
R508	6	5-2	X	" "
R509	16	5-1	X	" "
R510	1	9-8	X	" " - WING 1
R511	4	5-0		" " "
R512	1	18-2		" " - WING 2
R513	4	13-6		" " "







NORTH ABUTMENT 3,240'

BAR NO.	NO. REQ'D	LENGTH	BENT	LOCATION
B401	56	9-2	X	BODY - STIRRUPS
B402	12	28-7		" - HORIZ.
B803	4	13-0	X	" " - B.F. AT WING 1
B404	4	28-4		" " - B.F.
B905	4	17-7	X	" " - B.F. AT WING 2
B606	4	28-11		" - HORIZ.
B407	28	8-0	X	STEPS - STIRRUPS
B608	2	40-0		" - HORIZ.
B609	1	3-0		" "
B610	1	4-10		" "
B511	36	2-6		BODY - DOWEL
B412	17	9-3	X	WING 1 - STIRRUPS
B413	5	8-11		" " - HORIZ. - F.F.
B414	17	7-7	X	WINGS 1 & 2 - HORIZ. - F.F.
B915	5	13-7	X	WING 1 - HORIZ. - B.F.
B416	4	5-5	X	" " " - F.F.
B417	7	5-6		" " - VERTICAL - F.F.
B518	7	5-9		" " " - B.F.
B419	4	10-6	X	" " - HORIZ. - B.F.
B420	22	7-5	X	WING 2 - STIRRUPS
B421	4	11-2		" " - HORIZ. - F.F.
B1022	5	18-4	X	" " " - B.F.
B423	10	5-4		" " - VERTICAL - F.F.
B424	4	9-5	X	" " - HORIZ. - F.F.
B525	10	5-7		" " - VERTICAL - B.F.
B426	4	14-6	X	" " - HORIZ. - B.F.
R501	4	4-10	X	WINGS & RAIL PARAPETS
R502	10	5-10	X	" " "
R503	8	3-3	X	" " "
R504	12	5-10	X	" " "
R505	4	4-5		RAIL PARAPETS
R506	2	4-2	X	" "
R507	4	6-10	X	" "
R508	6	5-2	X	" "
R509	12	5-1	X	" "
R510	1	9-8	X	" " - WING 1
R511	4	5-0		" " "
R514	1	13-8		" " - WING 2
R515	4	9-0		" " "







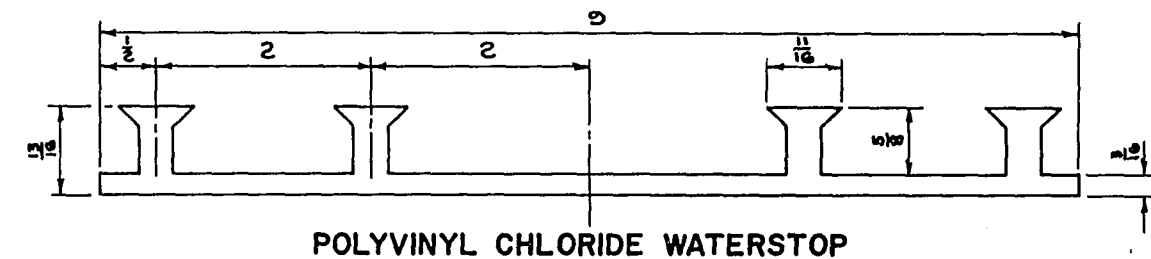


POLYVINYL CHLORIDE WATERSTOP

SEE "RAIL PARAPET DETAILS"
FOR "R BAR" BENDING DETAILS

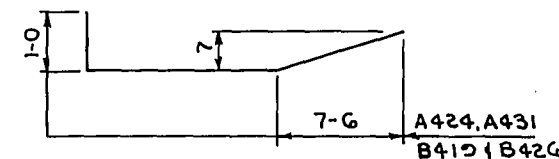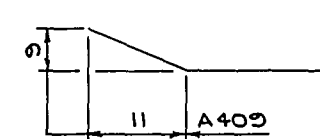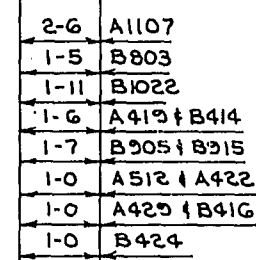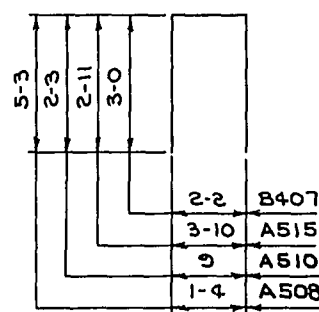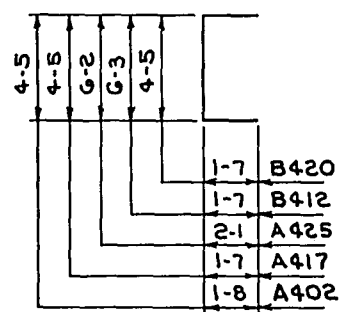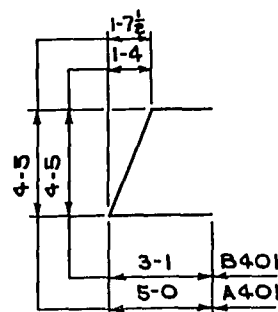

No.	Date	Revision	By
STATE OF WISCONSIN DEPARTMENT OF TRANSPORTATION DIVISION OF HIGHWAYS			
STRUCTURE B-3-30			
Const. Spec.	1969	Drawn By FWG	Plans Checked JG
BILL OF BARS			SHEET 4 OF 13 X45723

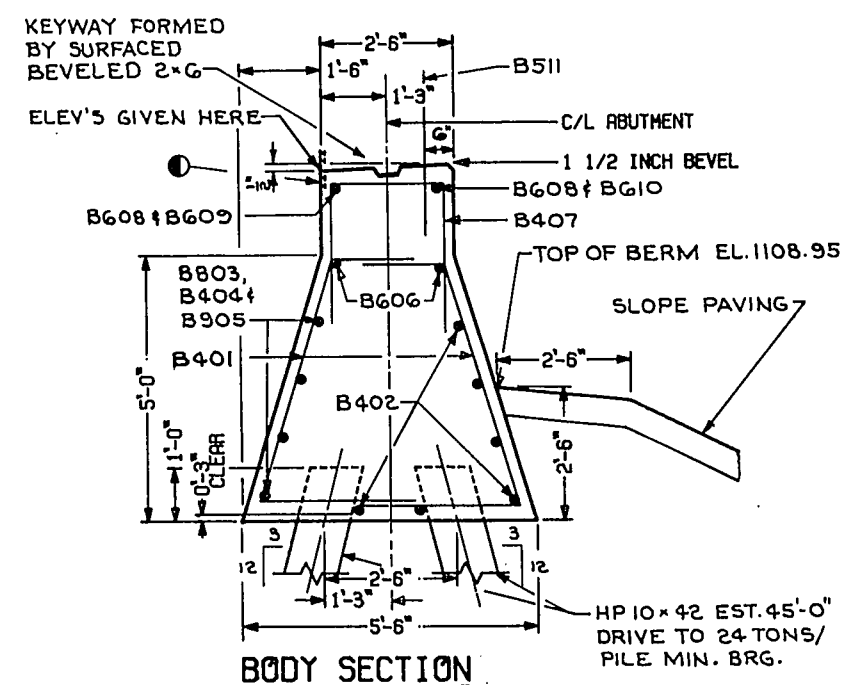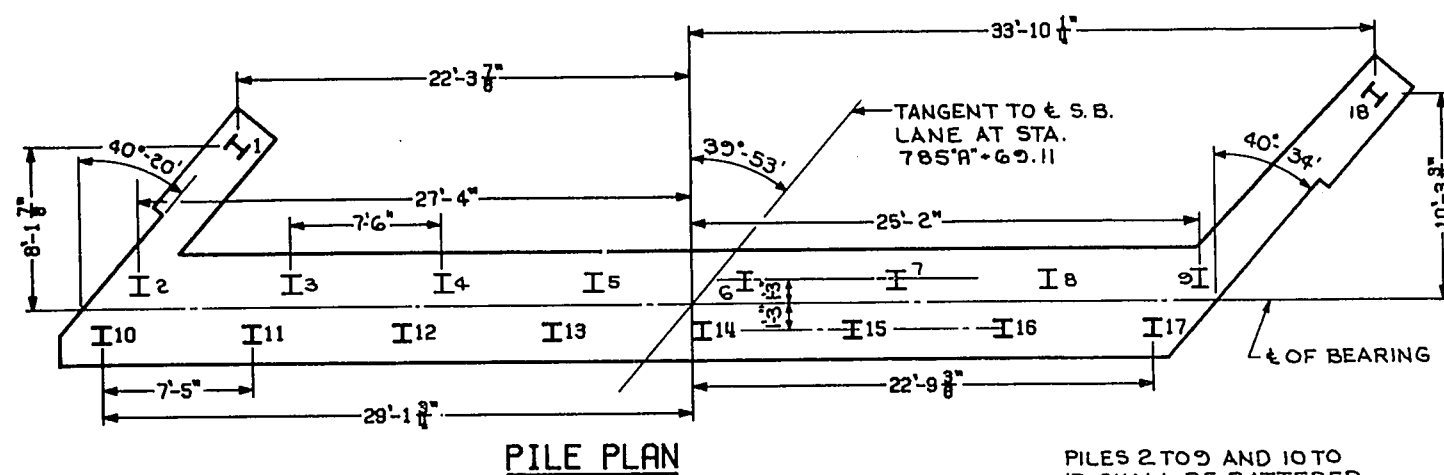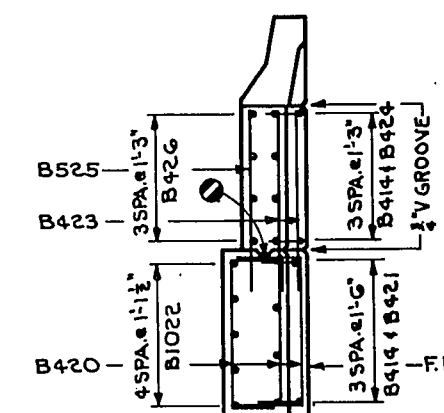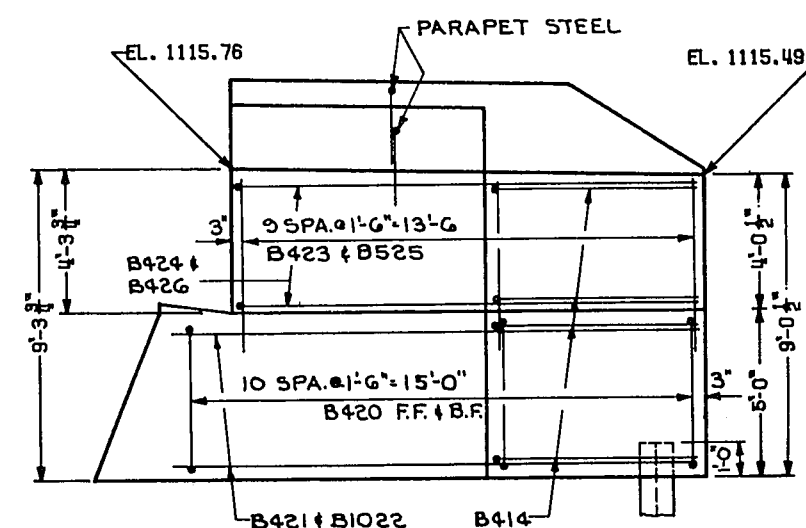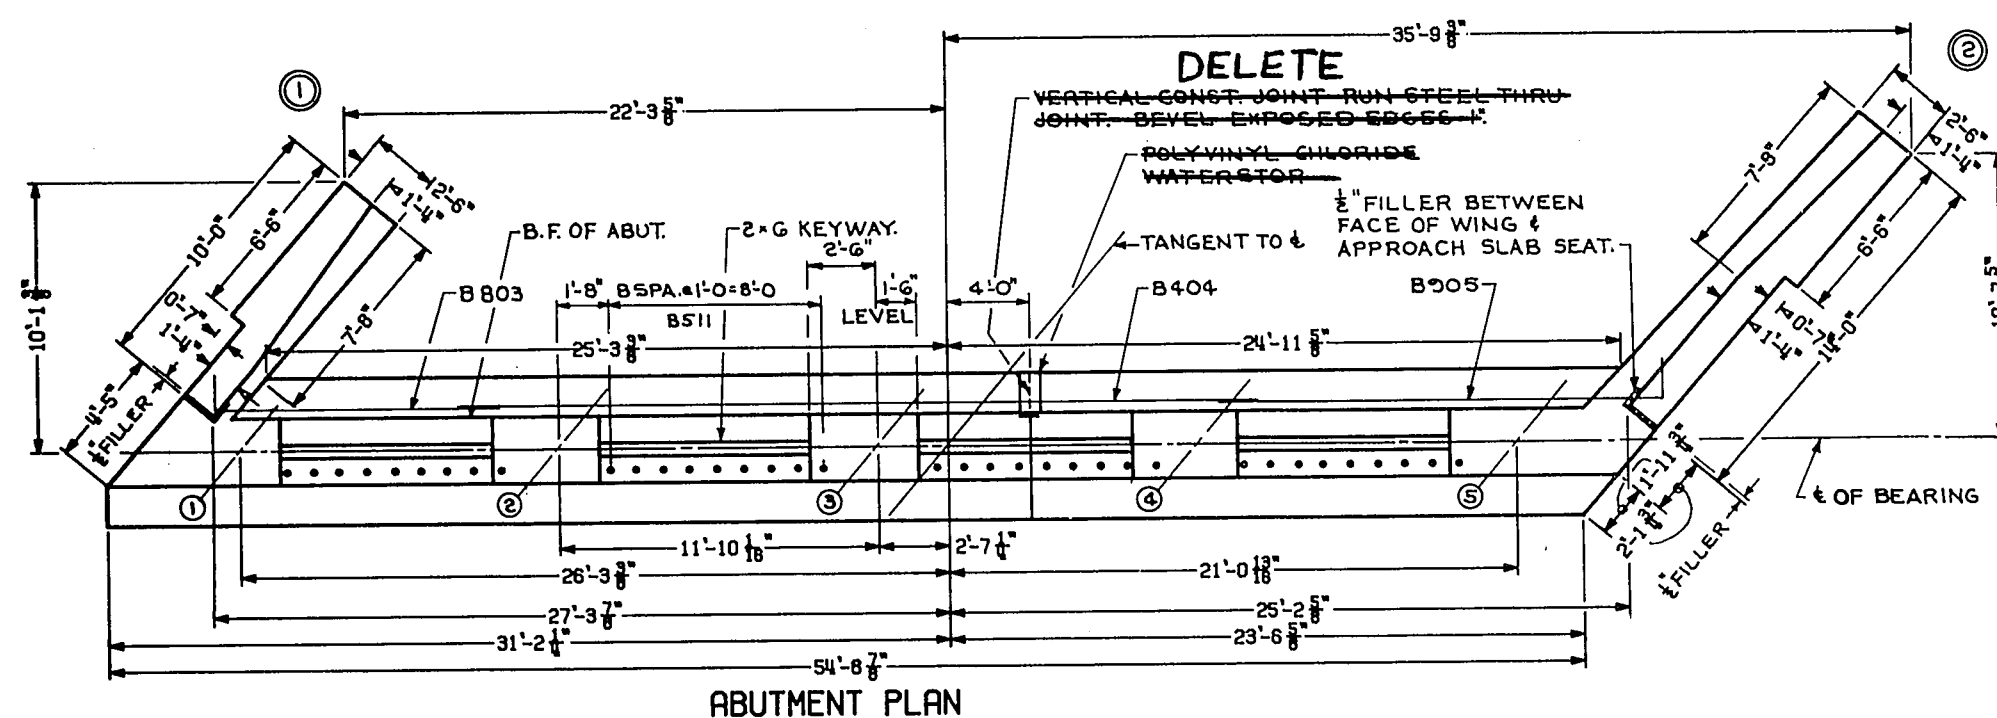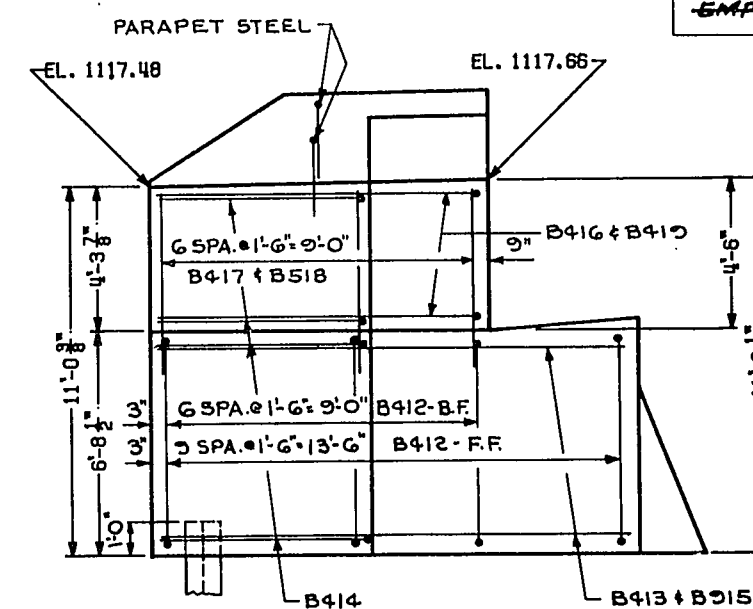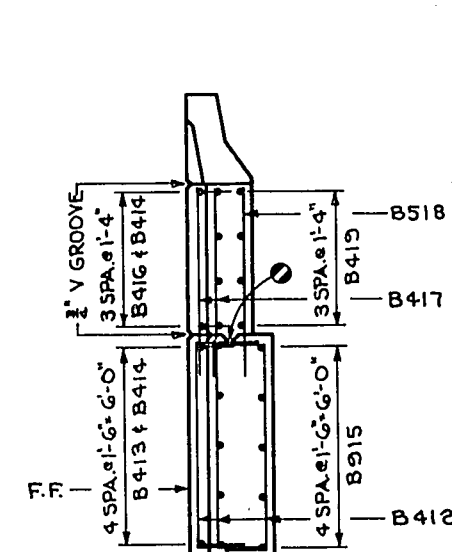

DISPLACE B401 BARS TO MISS PILING.
SEE "RAIL PARAPET DETAILS" FOR PARAPET
DETAILS & STEEL.



○ CONST. JOINT. KEYWAY FORMED BY SURFACED,
BEVELED 2"x6". POUR CONCRETE ABOVE THIS
JOINT AFTER SUPERSTRUCTURE IS IN PLACE.
SEAL ALL EXPOSED HORIZONTAL AND VERTICAL
SURFACES OF 1/2" FILLER WITH NON-STAINING GRAY
NON-BITUMINOUS JOINT SEALER. PLACE SEALER
1" DEEP AND HOLD 3/8" BELOW SURFACE OF CONCRETE.
FILL TO EL. 1108.45 BEFORE DRIVING PILING. UPPER
LIMITS OF "EXCAVATION FOR STRUCTURES" SHALL
NOT EXCEED THIS ELEVATION.

B511 MAY BE PLACED AFTER CONCRETE IS
POURED, BUT BEFORE INITIAL SET HAS TAKEN
PLACE. IMBED 1'-3" IN CONCRETE.

① POLYVINYL CHLORIDE
WATERSTOP TO EXTEND
BETWEEN BACKFACES
OF BOTTOM WING POUR.




No.	Date	Revision		By
STATE OF WISCONSIN DEPARTMENT OF TRANSPORTATION DIVISION OF HIGHWAYS				
STRUCTURE B-3-30				
Const. Spec.	1969	Drawn By	FWG	Plans Checked <i>JK</i>
NORTH ABUTMENT			SHEET 5 OF 13 X45724	

PROJECT ID 1196-5-73	SHEET NUMBER 57	TOTAL SHEETS 188
FEDERAL PROJECT DESIGNATION EMP-F-18-4(40)		

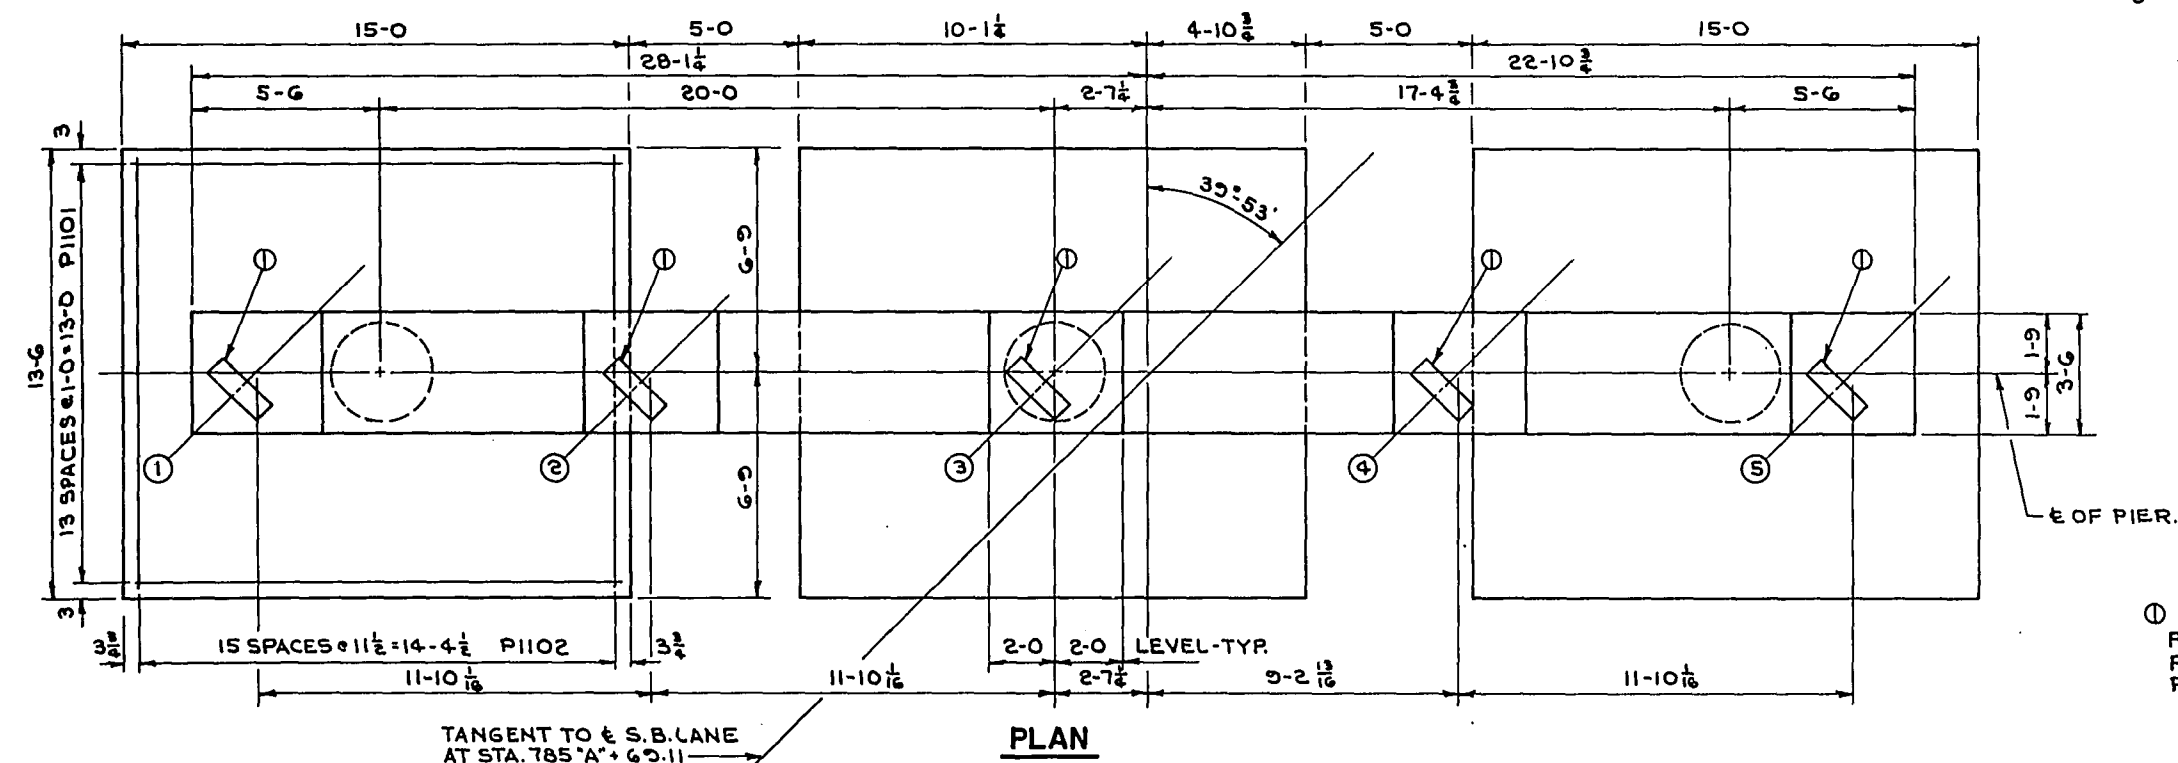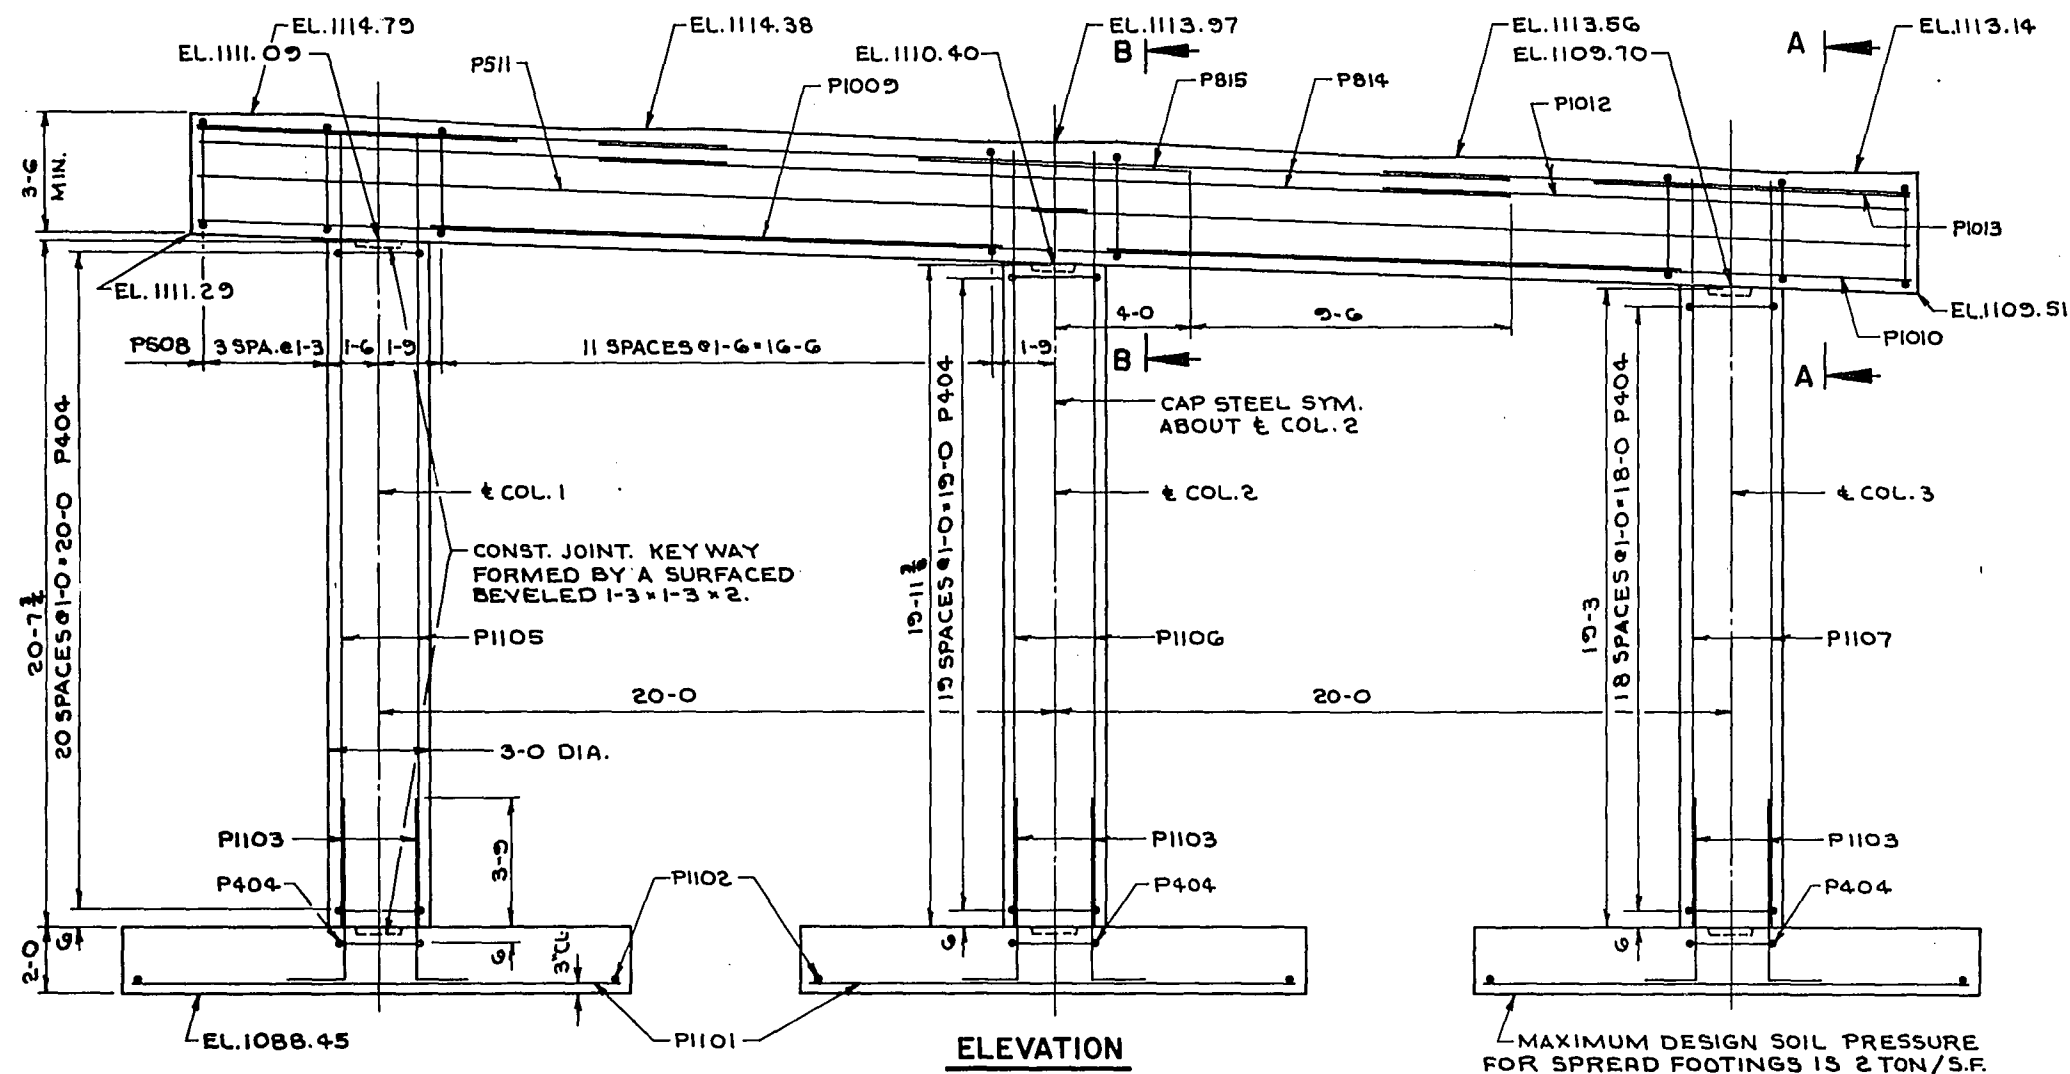


BILL OF BARS 16,450*

BAR NO.	NO. REQ'D	LENGTH	12" DIA.	18" DIA.	LOCATION
P1101	42	14-6			FOOTING
P1102	48	13-0			"
P1103	33	7-6	X		FOOTING & COLUMNS - DOWELS
P404	63	9-5	X		" " - HOOPS
P1105	11	23-6			COLUMN 1 - VERTICAL
P1106	11	22-10			COLUMN 2 - VERTICAL
P1107	11	22-3			COLUMN 3 - VERTICAL
P508	64	11-7	X		CAP - STIRRUPS
P1009	8	17-0	X		" - BOTTOM - HORIZ.
P1010	6	25-3	X		" " "
P511	4	26-4			" - SIDES - HORIZ.
P1012	16	15-6	X		" " - TOP - HORIZ.
P1013	8	9-6	X		" " "
P814	8	27-0	X		" " "
P815	4	8-0	X		" " "

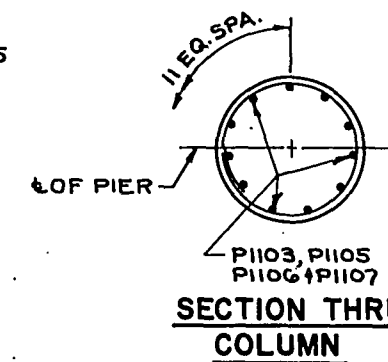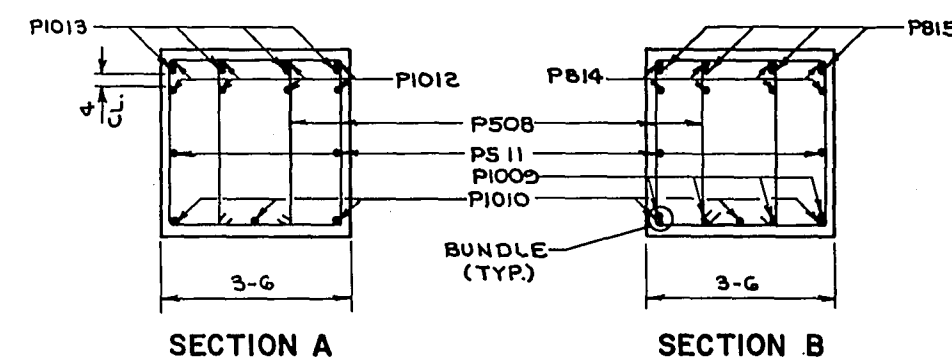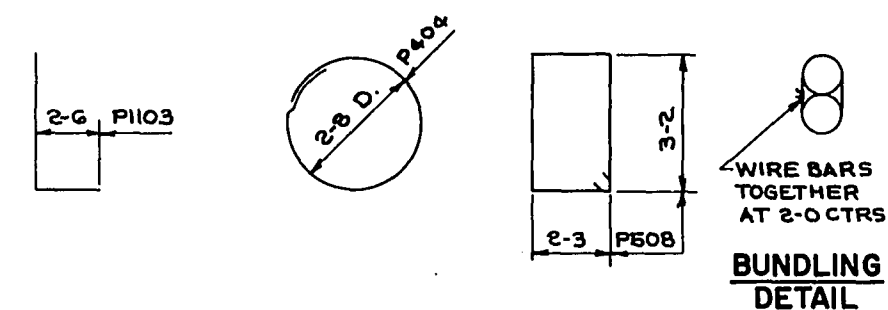





① PROVIDE 1/4" THICK SHIM PLATE TO MATCH MASONRY PLATE C. PLACE ON BRG. PAD.

No.	Date	Revision	By
STATE OF WISCONSIN DEPARTMENT OF TRANSPORTATION DIVISION OF HIGHWAYS			
STRUCTURE B-3-30			
Const. Spec.	1969	Drawn By	FWG
		Plans Checked	JG
PIER 1			SHEET 6 OF 13
			X45725

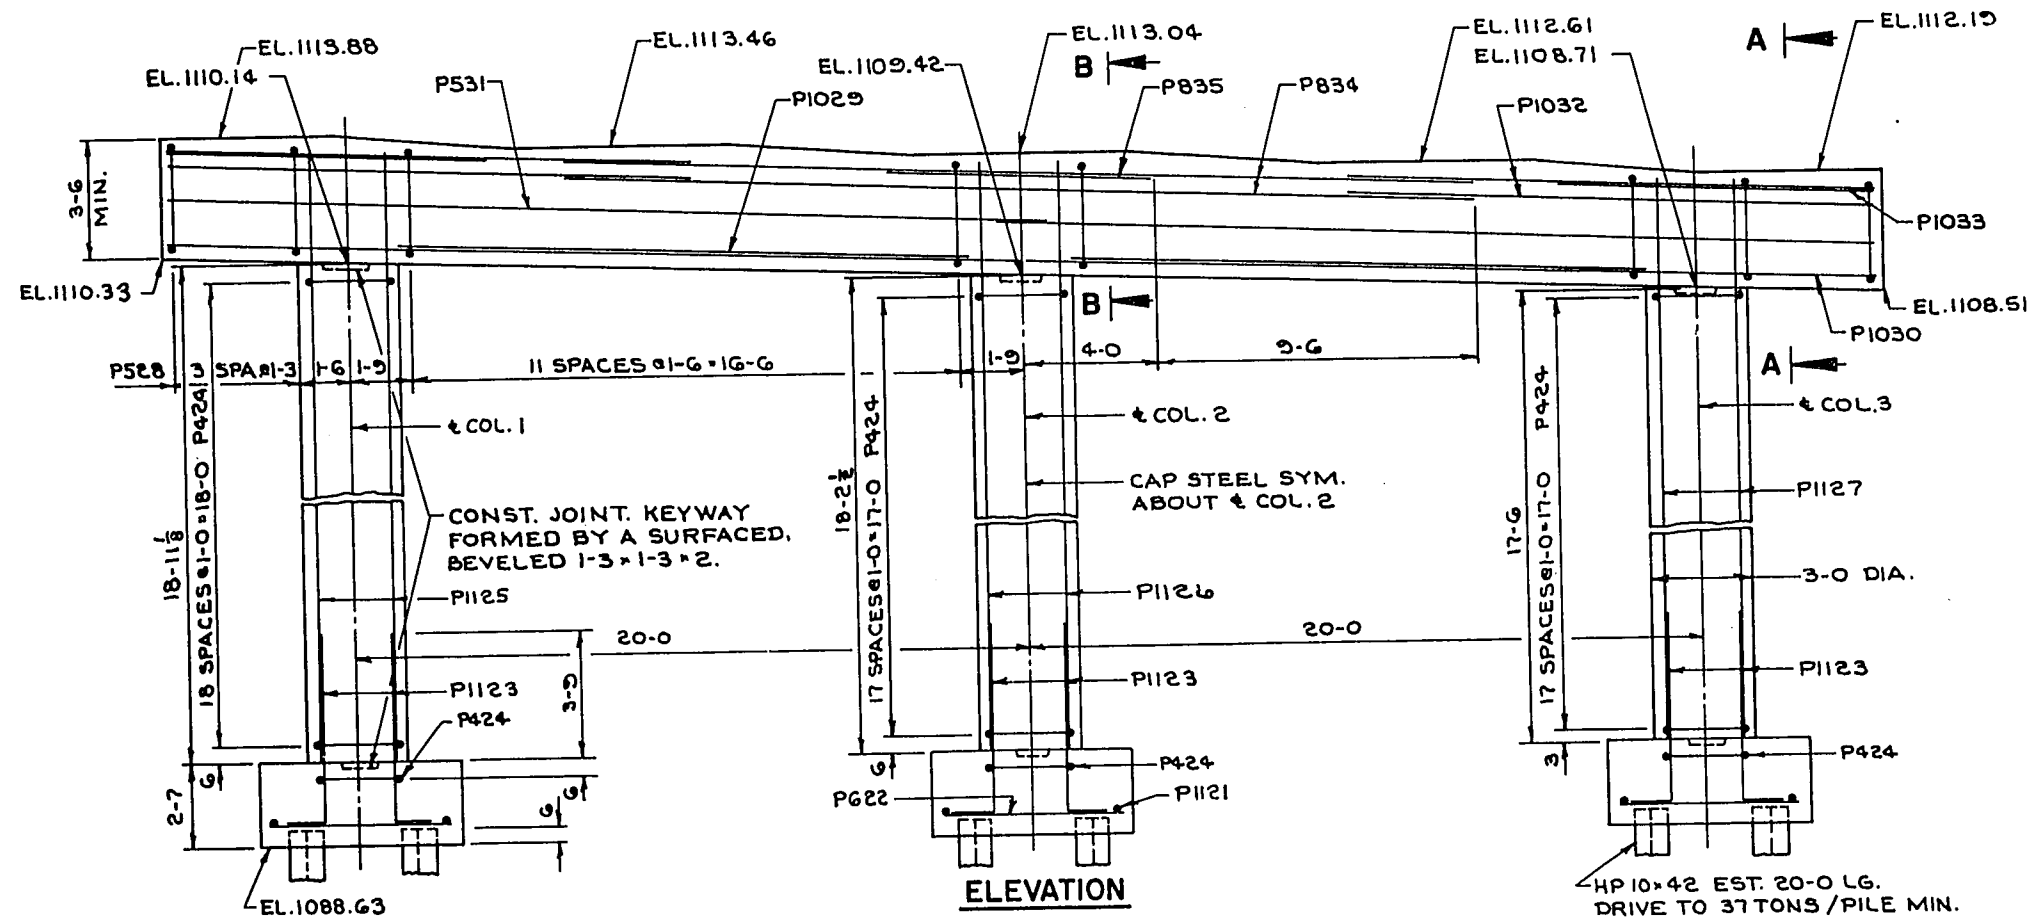


BILL OF BARS 9.180*

BAR NO.	NO. REQ'D	LENGTH	REMARKS	LOCATION
P1121	18	7-6		FOOTING
P622	24	5-6		"
P1123	24	7-6	X	FOOTING & COLUMNS - DOWELS
P424	58	9-5	X	" " - HOOPS
P1125	8	21-11		COLUMN 1 - VERTICAL
P1126	8	21-2		COLUMN 2 - VERTICAL
P1127	8	20-6		COLUMN 3 - VERTICAL
P528	64	11-7	X	CAP - STIRRUPS
P1029	8	17-0	X	" - BOTTOM - HORIZ.
P1030	6	25-3	X	" " "
P531	4	26-4		" - SIDES - HORIZ.
P1032	16	15-6	X	" - TOP - HORIZ.
P1033	8	9-6	X	" " "
P834	8	27-0	X	" " "
P835	4	8-0	X	" " "
P536	24	2-6		CAP - DOWELS - TOP

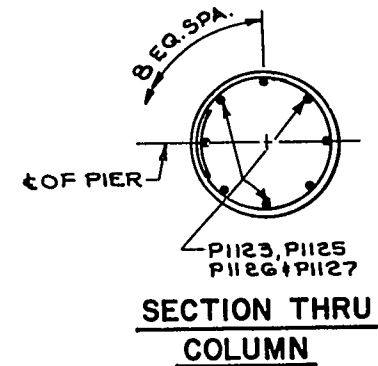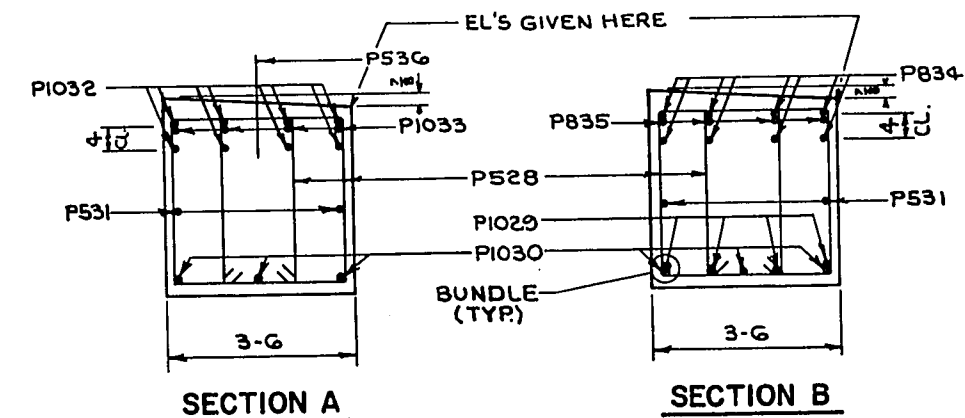
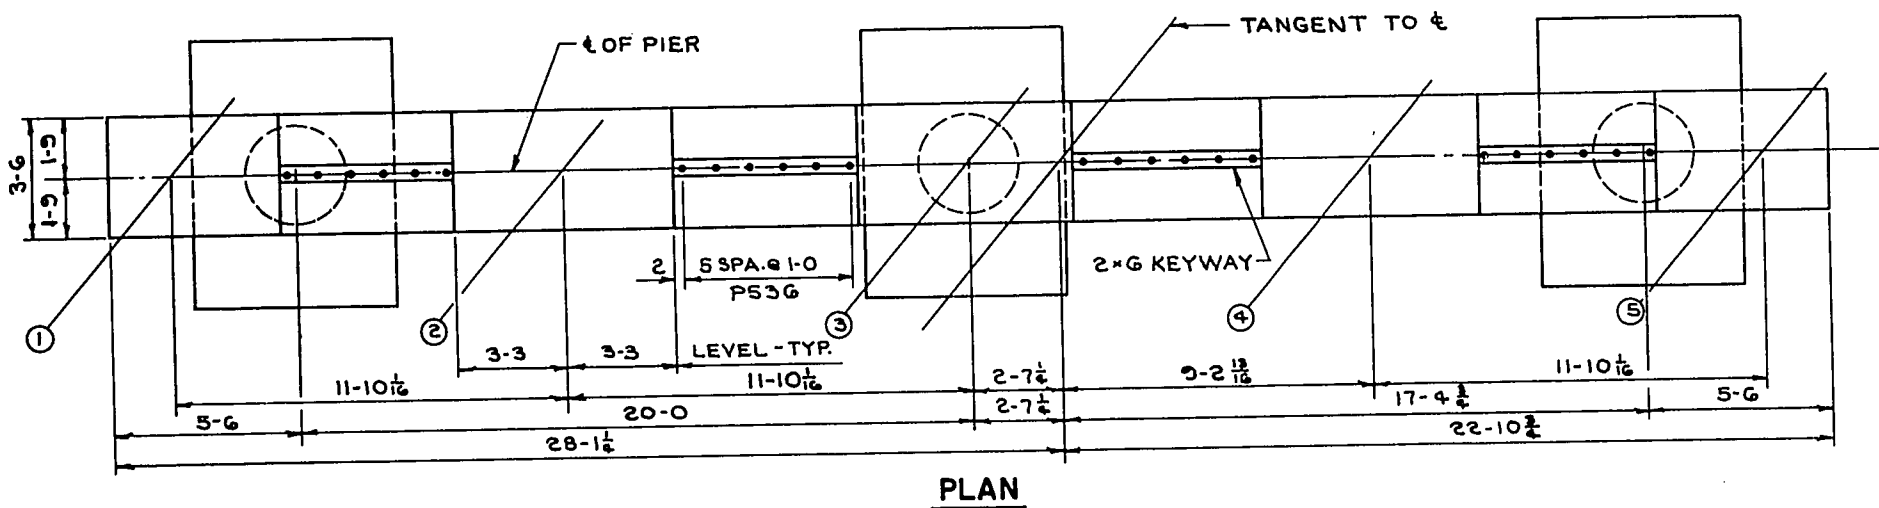
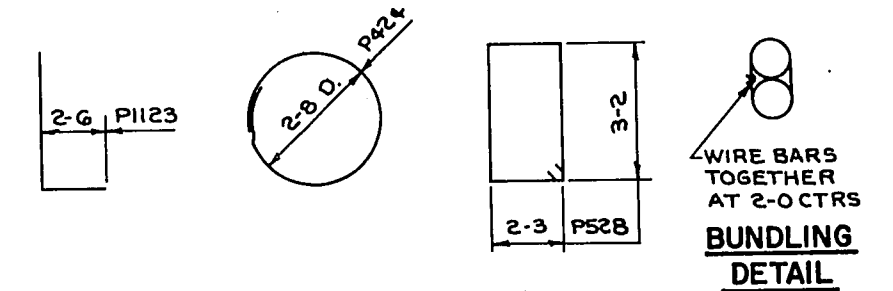


IMBED P536 BARS 1-3. P536 BARS MAY BE PLACED AFTER THE CONCRETE HAS BEEN POURED BUT BEFORE THE INITIAL SET HAS TAKEN PLACE.

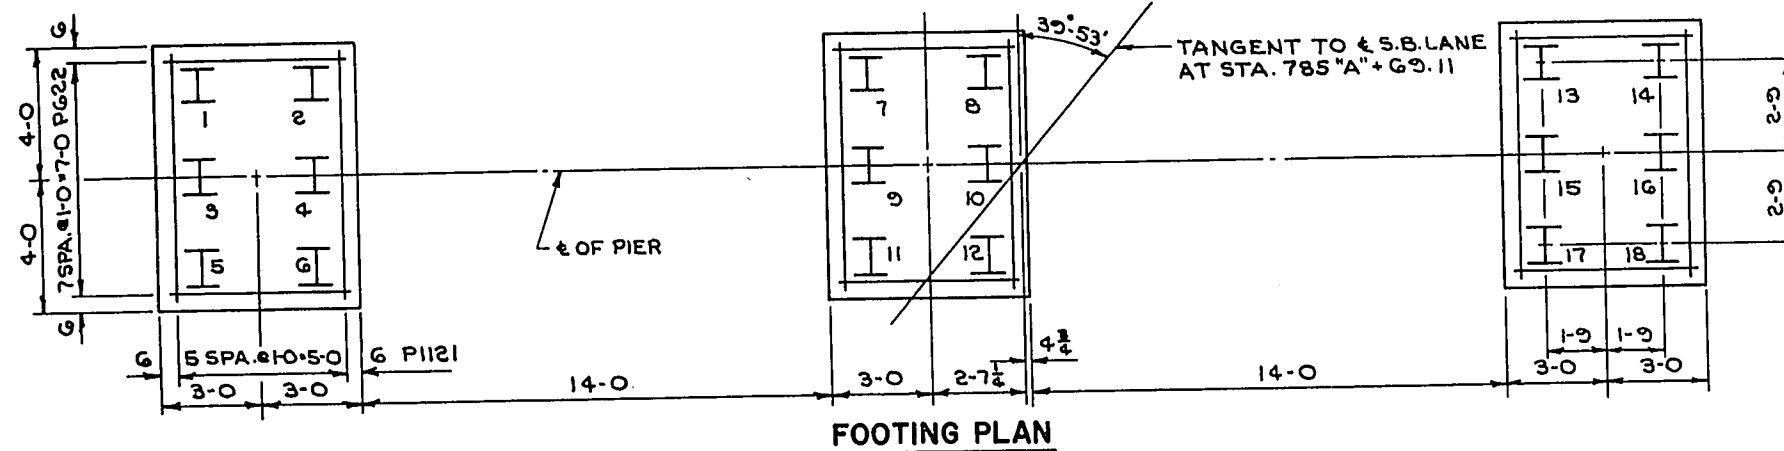

No.	Date	Revision	By
STATE OF WISCONSIN DEPARTMENT OF TRANSPORTATION DIVISION OF HIGHWAYS			
STRUCTURE B-3-30			
Const. Spec.	1969	Drawn By FWG	Plans Checked JH
PIER 2			SHEET 7 OF 13
			X45726

B. P. R. Division	Project	Sheet Number	Total Sheets
4	1196-5-73 EMP-FOO-440	59	188

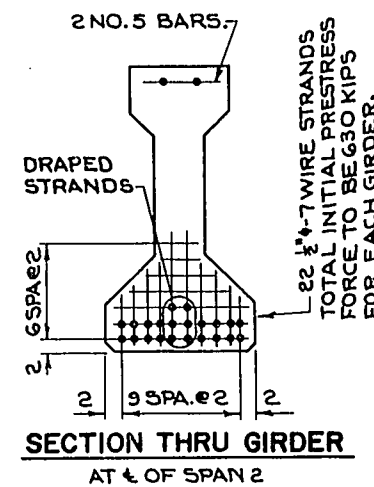
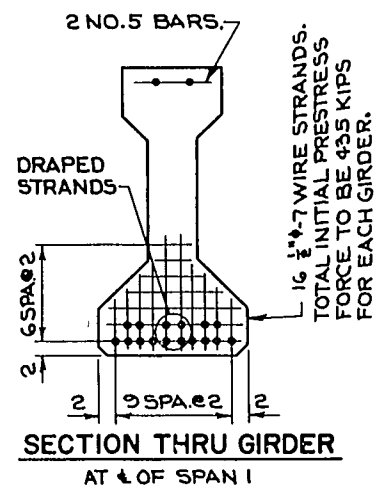
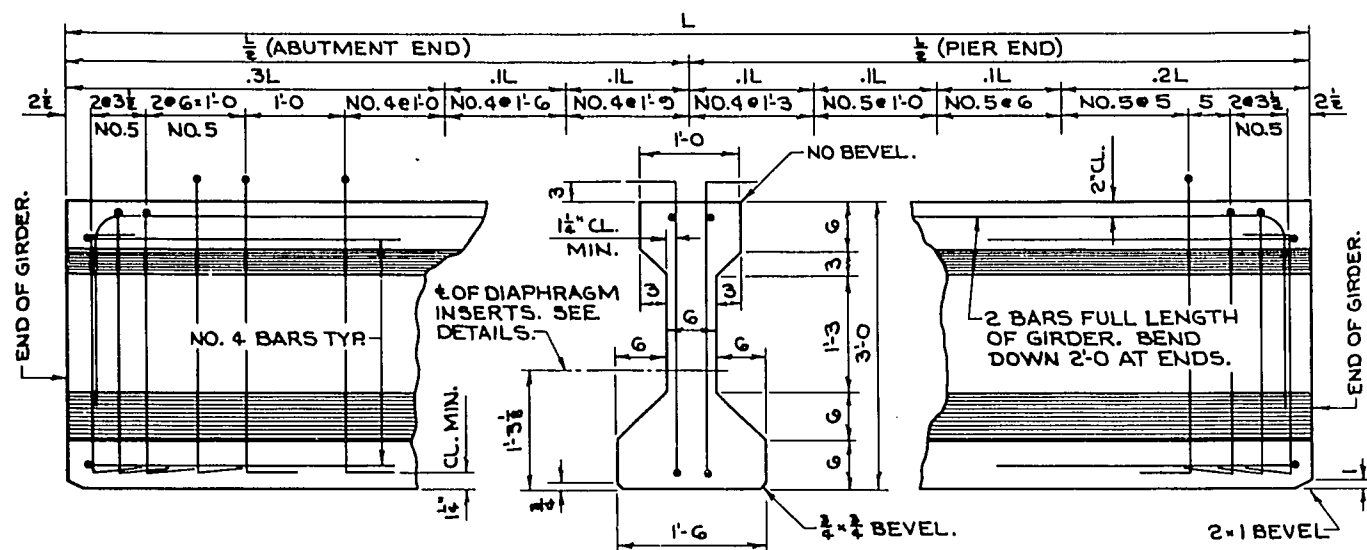


NOTES

TOP OF GIRDERS TO BE ROUGH FLOATED AND BROOMED TRANSVERSELY FOR BONDING TO THE SLAB.
THE GIRDER MANUFACTURER SHALL PROVIDE A SUITABLE LIFTING DEVICE FOR HANDLING AND ERECTING THE GIRDERS.




ALL GIRDERS SHALL BE CAST FULL LENGTH AS SHOWN.
PRESTRESSING STRANDS SHALL HAVE AN ULTIMATE STRENGTH OF 270,000 PSI AND SHALL BE FLUSH WITH THE ENDS OF THE GIRDER.
INSERTS SHALL BE PLACED ON 6" CENTERS SYMMETRICALLY ABOUT THE 1/2 OF DIAPHRAGMS IN SPANS.
ALL STIRRUPS SHALL BE IN PAIRS AND THE SPACING SHOWN IN "SIDE VIEW" IS MAXIMUM. THE LOCATION SHALL BE SHOWN IN THE SHOP DRAWINGS.
BEND EACH END OF NO. 4 AND NO. 5 STIRRUPS 6" AND NO. 6 STIRRUPS 6 1/2".
ENDS OF STRANDS SHALL BE PAINTED WITH NON-STAINING GRAY NON BITUMINOUS JOINT SEALER. (THIS APPLIES ONLY TO THOSE ENDS OF GIRDERS THAT ARE FINALLY EXPOSED.)

TOP LONGITUDINAL BARS IN GIRDER MAY BE SPICED BY USING 3/8 BAR DIAMETER LAPS. PLACE ONE LAP AT 1/4 OF GIRDER IF LENGTH IS < 70'-0". PLACE LAPS AT THE 1/3 RD POINTS OF GIRDER IF LENGTH IS > 70'-0".

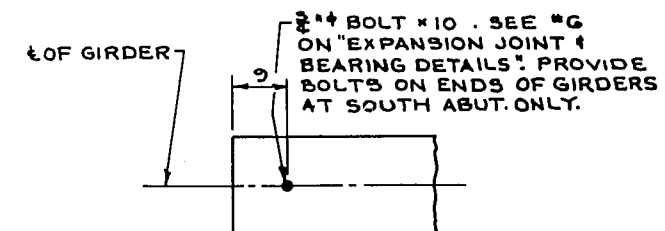
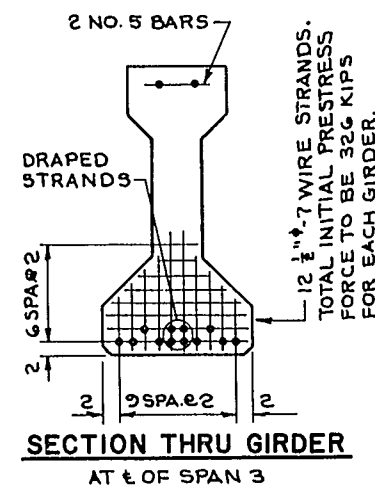
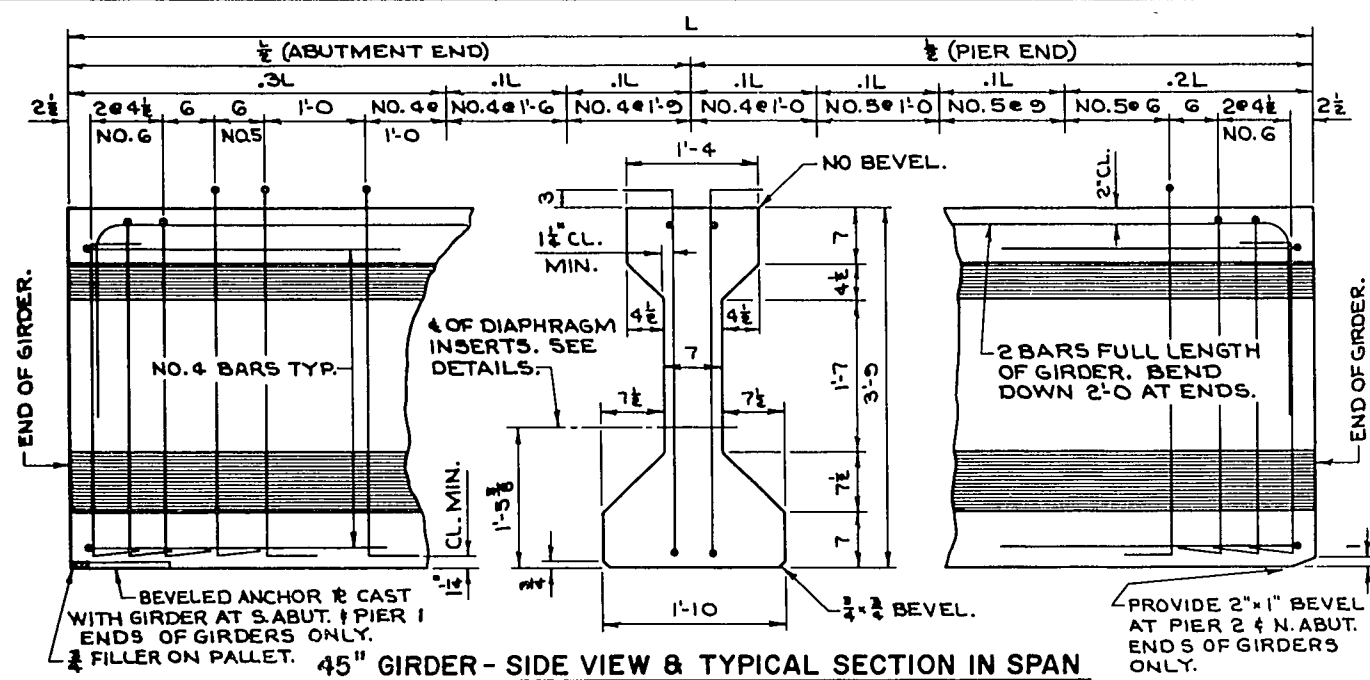


EXPANSION JOINT ANCHOR BOLT

	DIM. A	DIM. B MIN. MAX.	DIM. C
SPAN 1	31"	10" 13"	3"
SPAN 2	33"	11 1/2" 14 1/2"	4"
SPAN 3	27"	9" 12"	3"

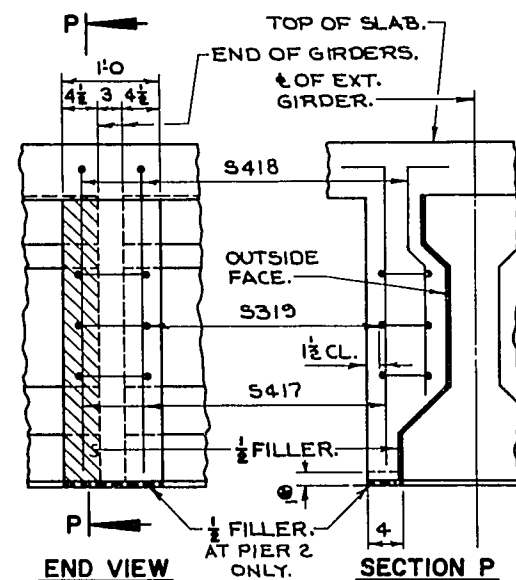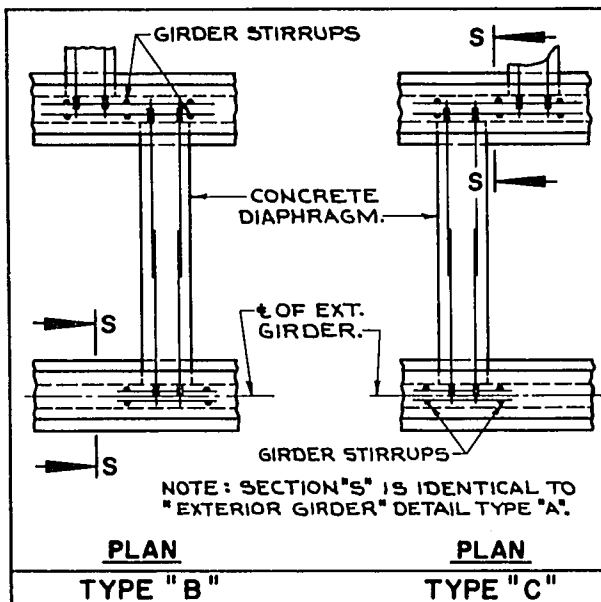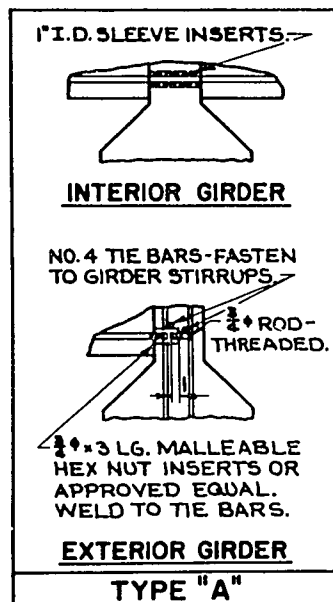


* MINIMUM CYLINDER STRENGTH OF CONCRETE AT TIME OF TRANSFER OF PRESTRESS FORCE.

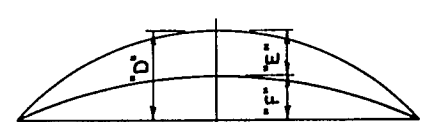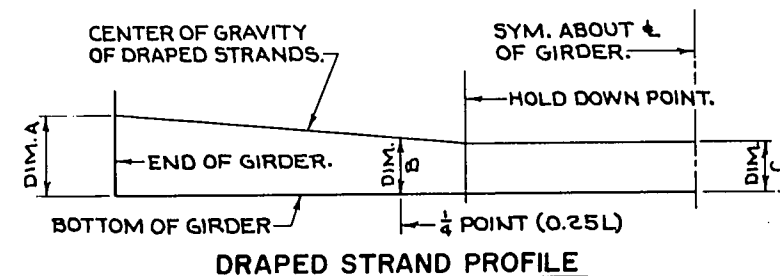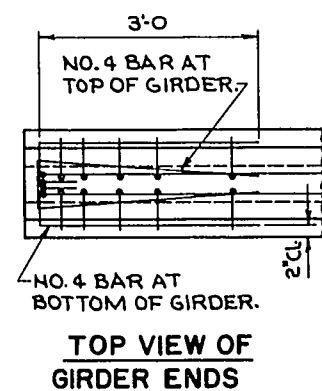


** DATA SHOWN IS THEORETICAL AND MAY VARY WITH CONCRETE STRENGTH, VARIABLE PRESTRESS CONDITIONS AND PRESTRESS LOSSES.

GIRDER DATA				
GIRDER SIZE REQUIRED 45"				
GIRDER LENGTH "L" REQUIRED	SPAN 1	SPAN 2	SPAN 3	
DRAPED PATTERN	54'-10 1/2"	60'-3"	45'-10 1/2"	
SPREAD PATTERN	4,800	4,800	4,800	
DEFLECTION DATA **				
PRESTRESS CAMBER "D"	5/8"	1 1/2"	5/8"	
DEAD LOAD DEFLECTION "E"	1/4"	3/8"	1/4"	
RESIDUAL CAMBER "F"	3/8"	1/4"	1/4"	
USE DIAPHRAGM INSERT DETAIL TYPE "B"				

No.	Date	Revision	By
STATE OF WISCONSIN DEPARTMENT OF TRANSPORTATION DIVISION OF HIGHWAYS			
STRUCTURE B-3-30			
Const. Spec.	1969	Drawn By	F.W.G.
		Plans Checked	J.G.
PRESTRESSED GIRDER DETAILS			SHEET 8 OF 13
			X45727

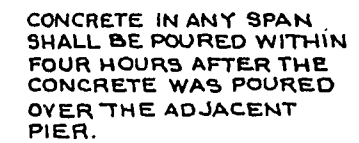

* OFFSETS & SLAB ELEVATIONS
MEASURED ALONG & TAKEN NORMAL
TO TAN TO & S.B. LANE. 'O' IS AT
STA. 785 "A" +69.11

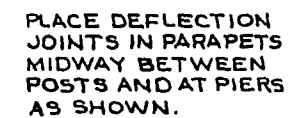

FEEL

BOTTOM STEEL
-TANGENT TO ϕ

LSRIANE

— E. N. ABUT.

5541 BARS

$$\frac{1}{2} = 33 - 6\frac{1}{2}$$

END

© 1997


0	100
---	-----

18	1117.00
5 1/2	9.7

5 $\frac{11}{16}$	18-7
-------------------	------

BILL OF MATERIALS					
					72,990*
BAR NO.	NO. REQ'D	LENGTH	WGT	CUT	LOCATION
S201	3	2-0			S. ABUT. DIAPHRAGM @ GIRDER 1
S202	12	9-8			" " " BETW. GIRDERS
S203	3	3-3			" " " @ GIRDER 5
S204	6	20-3			" " " - TOP
S405	43	4-6	X		" " " - STIRRUPS
S506	64	9-10	X		PIER DIAPHRAGM - STIRRUPS
S607	12	9-0			PIER 1 DIAPHRAGM - BOTTOM
S408	68	9-8			N. ABUT. & PIERS - DIAPHRAGM
S409	12	9-0			N. ABUT. & PIER 2 - DIAPHRAGM
S510	64	10-10	X		PIERS & SLAB - HAUNCH
* S611	48	5-5			DIAPHRAGM IN SPANS
S412	10	28-7			N. ABUT. - DIAPHRAGM & SEAT
S513	39	14-3	X		" " - DIAPHRAGM - STIRRUPS
S414	52	4-6	X		" " - SEAT - STIRRUPS
S415	2	2-4			N. ABUT. DIAPHRAGM @ GIRDER 1
S416	2	3-4			" " " @ GIRDER 5
S417	8	4-3	X		PILASTER
S418	8	3-4	X		"
S319	12	3-4	X		"
S620	57	42-4	X		SLAB - TRANSVERSE
S621	473	42-4			" "
S622	58	42-2	X		" "
S523	118	27-7			SLAB - LONGIT. - SPAN 1 BOTTOM
S724	12	15-0			SLAB - SYM. OVER PIERS AT EDGE
S525	118	33-6			SLAB - LONGIT. - SPAN 2 BOTTOM
S526	118	23-2			" " - SPAN 3 BOTTOM
S527	39	28-6			" " - SPAN 1 TOP
S828	16	45-0			" " - OVER PIERS-EDGE
S729	66	37-0			" " " " - TOP
S730	64	33-6			" " " " "
S531	39	39-0			" " - SPAN 2 TOP
S532	39	19-9			" " - SPAN 3 TOP
S533	346	4-9	X		SLAB & PARAPET
S534	346	5-1	X		PARAPET
S535	10	17-9			"
S536	30	22-8			"
S537	20	14-0			"
S538	10	8-3			"
S539	10	18-6			"
S540	10	10-7			"
S541	10	16-11			"

♦♦ BEND AROUND A 5" PIN.
* PLAIN BAR THREAD ONE
END 3"
Ⓢ BUNDLE AND MARK CUT
BARS WITH BAR NO.
Ⓢ MARK AND CUT ALL BARS
NORMAL TO BAR AXIS
ALONG THIS LINE.





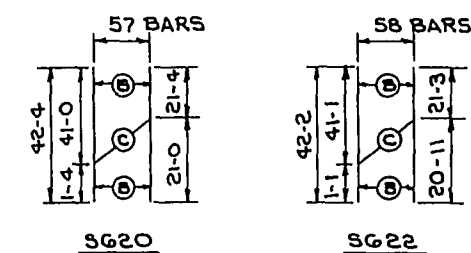


OFFSETS & SLAB ELEVATIONS																							
	-120	-110	-100	-90	-80	-70	-60	-50	-40	-30	-20	-10	0	10	20	30	40	50	60	70	80	90	100
DIM. A	21-2	21-3 $\frac{1}{8}$	21-5	21-6 $\frac{5}{16}$	21-7 $\frac{1}{2}$	21-8 $\frac{3}{8}$	21-9 $\frac{1}{2}$	21-10 $\frac{1}{2}$	21-10 $\frac{1}{8}$	21-11 $\frac{1}{8}$	21-11 $\frac{3}{8}$	21-11 $\frac{15}{16}$	22-0	21-11 $\frac{13}{16}$	21-11 $\frac{3}{4}$	21-11 $\frac{3}{8}$	21-10 $\frac{1}{8}$	21-10 $\frac{1}{4}$	21-9 $\frac{1}{2}$	21-8 $\frac{3}{8}$	21-7 $\frac{1}{2}$	21-6 $\frac{5}{16}$	21-5
EL. B	1120.60	1120.46	1120.31	1120.16	1120.02	1119.87	1119.71	1119.56	1119.40	1119.24	1119.08	1118.91	1118.75	1118.59	1118.42	1118.25	1118.08	1117.90	1117.72	1117.55	1117.37	1117.19	1117.00
DIM. C	0-10	0-8 $\frac{1}{2}$	0-7	0-5 $\frac{1}{8}$	0-4 $\frac{1}{8}$	0-3 $\frac{1}{8}$	0-2 $\frac{1}{2}$	0-1 $\frac{1}{2}$	0-1 $\frac{1}{8}$	0-0 $\frac{5}{8}$	0-0 $\frac{1}{4}$	0-0 $\frac{1}{8}$	0-0	0-0 $\frac{1}{8}$	0-0 $\frac{1}{4}$	0-0 $\frac{1}{8}$	0-1 $\frac{1}{8}$	0-1 $\frac{3}{8}$	0-2 $\frac{1}{2}$	0-3 $\frac{1}{8}$	0-4 $\frac{1}{8}$	0-5 $\frac{1}{8}$	0-7
EL. D	1119.90	1119.76	1119.61	1119.46	1119.32	1119.16	1119.01	1118.86	1118.70	1118.54	1118.38	1118.22	1118.05	1117.88	1117.71	1117.54	1117.37	1117.20	1117.02	1116.84	1116.66	1116.48	1116.29
DIM. E	18-10	18-8 $\frac{1}{2}$	18-7	18-5 $\frac{11}{16}$	18-4 $\frac{1}{8}$	18-3 $\frac{1}{8}$	18-2 $\frac{1}{2}$	18-1 $\frac{3}{4}$	18-1 $\frac{1}{8}$	18-0 $\frac{5}{8}$	18-0 $\frac{1}{4}$	18-0 $\frac{1}{8}$	18-0	18-0 $\frac{1}{8}$	18-0 $\frac{1}{4}$	18-0 $\frac{1}{8}$	18-1 $\frac{1}{8}$	18-1 $\frac{1}{4}$	18-2 $\frac{1}{2}$	18-3 $\frac{1}{8}$	18-4 $\frac{1}{8}$	18-5 $\frac{1}{8}$	18-7
EL. F	1119.33	1119.18	1119.04	1118.89	1118.74	1118.59	1118.44	1118.28	1118.12	1117.96	1117.80	1117.64	1117.47	1117.31	1117.14	1116.97	1116.79	1116.62	1116.44	1116.26	1116.08	1115.90	1115.71

SLAB ELE'S. WERE
LOWERED 0.04 FT.

No.	Date	Revision	By
STATE OF WISCONSIN DEPARTMENT OF TRANSPORTATION DIVISION OF HIGHWAYS			
STRUCTURE B-3-30			
Const. Spec.	1969	Drawn By	FWG
		Plans Checked	WJ
SUPERSTRUCTURE		SHEET 9 OF 13	
		X45728	




PROJECT ID 1196-5-73	SHEET NUMBER 61	TOTAL SHEETS 188
FEDERAL PROJECT DESIGNATION EMP-408-4(10)		

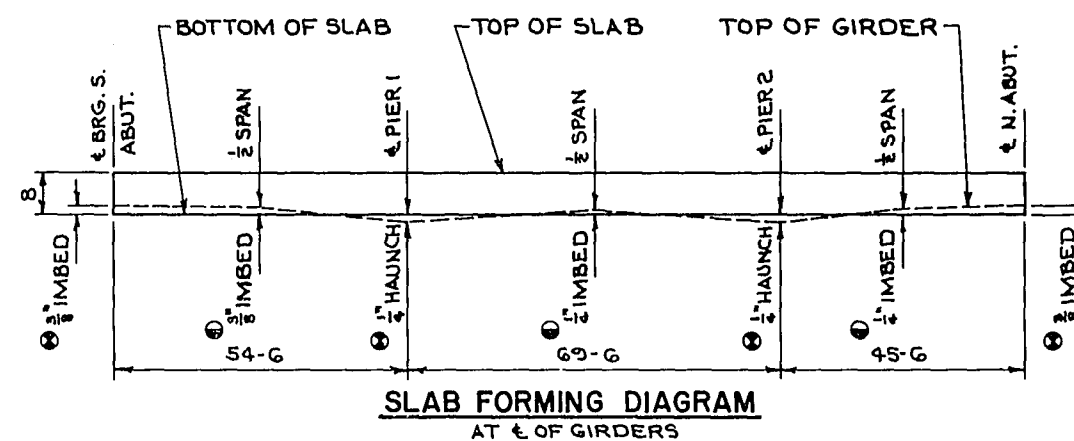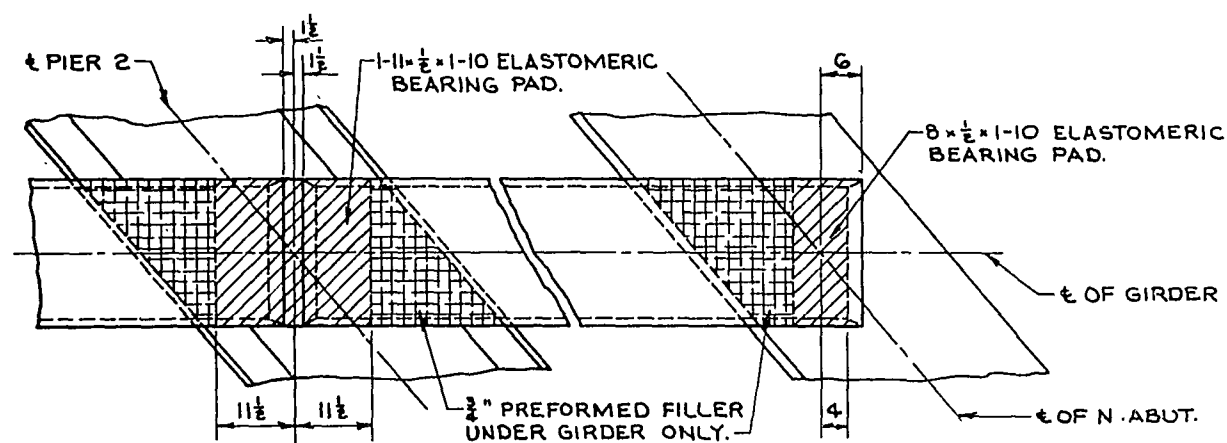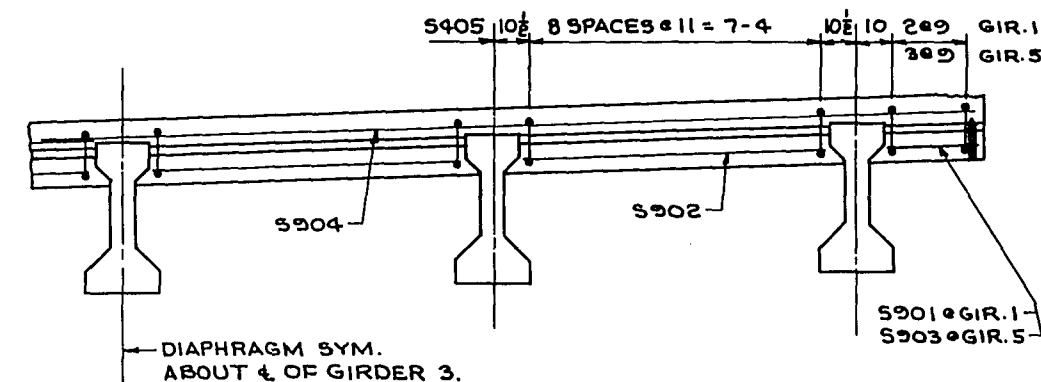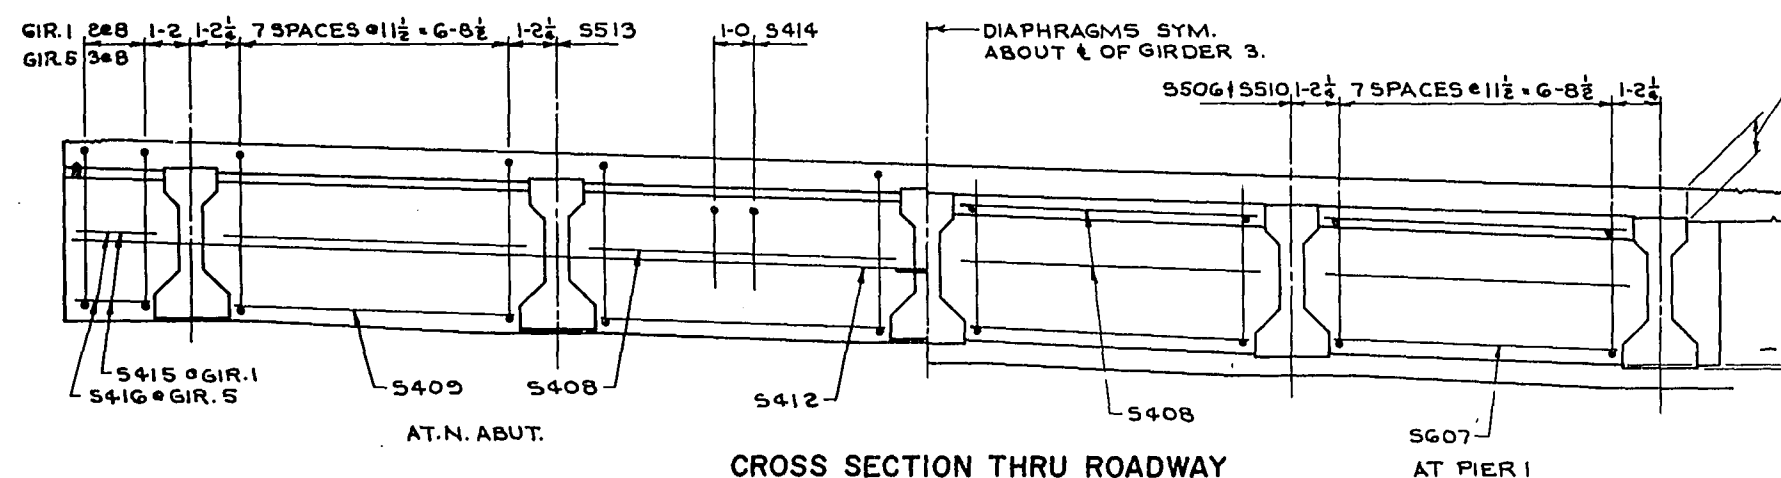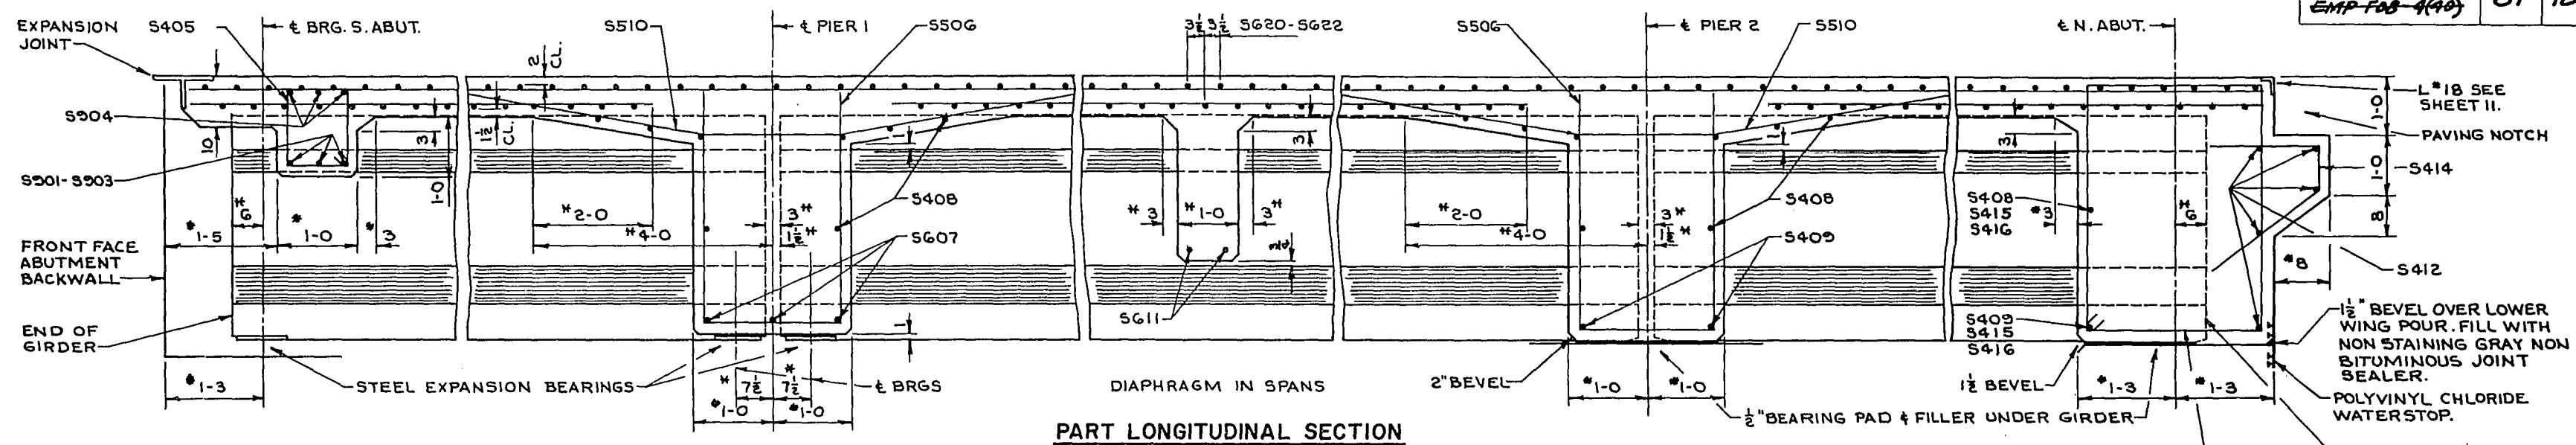

① TO COMPENSATE FOR VARIATIONS IN PRESTRESS CAMBER AND OTHER MINOR CONSTRUCTION DISCREPANCIES THE IMBEDMENT AT THE OF SPAN MAY BE VARIED WITH A MAXIMUM OF 1 1/2" ALLOWABLE IMBEDMENT AND THE SLAB HELD TO PLAN THICKNESS.

② IF VARIATIONS IN PRESTRESS CAMBER AND OTHER CONSTRUCTION DISCREPANCIES ARE OF SUCH A MAGNITUDE THAT THE MAXIMUM ALLOWABLE IMBEDMENT AS NOTED ABOVE SHALL BE EXCEEDED THESE DIMENSIONS SHALL BE REVISED. THE 1 1/2" IMBEDMENT AND THE PLAN SLAB THICKNESS SHALL BE HELD WHILE THE GRADE LINE WILL BE REVISED.

No.	Date	Revision	By
STATE OF WISCONSIN DEPARTMENT OF TRANSPORTATION DIVISION OF HIGHWAYS			
STRUCTURE B-3-30			
Const. Spec.	1969	Drawn By	FWG
		Plans Checked	JG
SUPERSTRUCTURE			SHEET 10 OF 13
			X45729

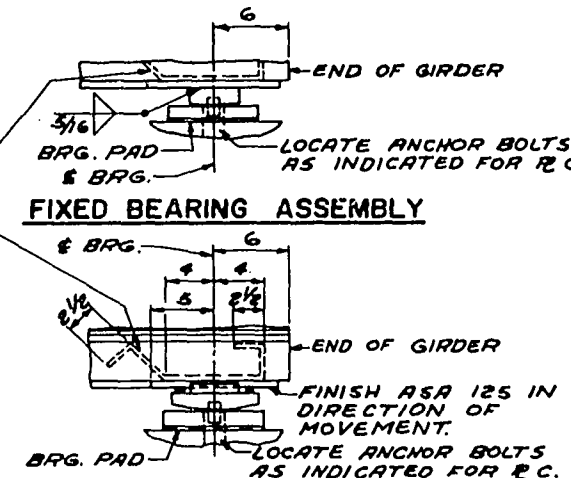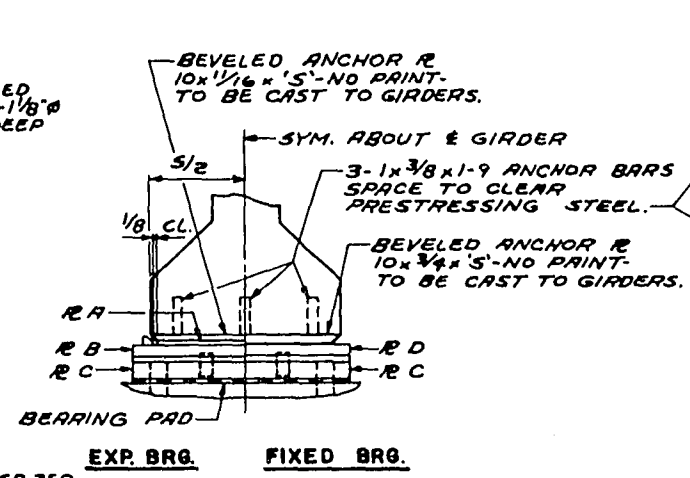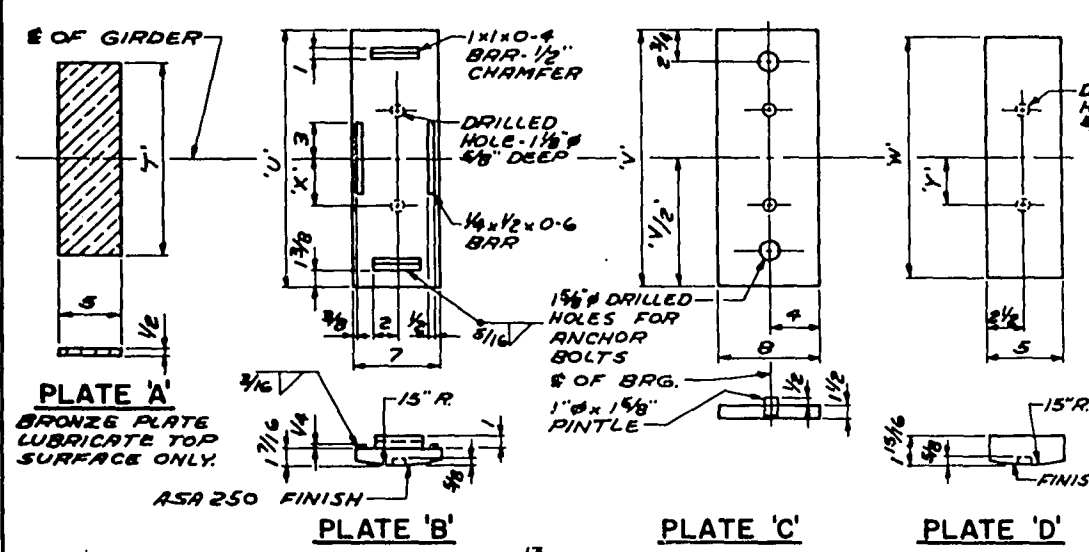

BEARING NOTES

ALL MATERIAL EXCLUDING ANCHOR BOLTS, PINTLES, NUTS AND WASHERS SHALL BE MADE OF A588 STEEL. PINTLES SHALL BE MADE OF A449 STEEL.

ALL STRUCTURAL STEEL BEARING PLATES SHALL BE FLAT ROLLED STEEL PLATES WITH ALL SURFACES SMOOTH AND FREE FROM WARP AND ALL EDGES SMOOTH, STRAIGHT AND VERTICAL.

ALL PLATE CUTS SHALL BE MACHINE OR MACHINE FLAME CUTS. MACHINE FINISH THE BOTTOM SURFACE ONLY OF PLATES SHOWN TO BE FINISHED.

ALL MATERIAL EXCLUDING BRONZE PLATES, BEARING PADS AND ANCHOR PLATES SHALL BE PAID FOR AT THE UNIT PRICE BID FOR "STRUCTURAL LOW ALLOY STEEL."

ALL ANCHOR BOLTS TO BE 1 1/4" x 1-3 LONG, SET FLUSH AND CAULK WITH LEAD TO THE TOP OF PLATE "C". EXCESS LENGTH MAY BE FURNISHED, THREADED FOR SETTING AND THEN CUT OFF FLUSH.

CHAMFER TOP OF PINTLES 1/8". DRILL HOLES FOR PINTLES IN PLATE "C" FOR DRIVING FIT.


PROVIDE 1/8" THICK BEARING PAD SAME SIZE AS PLATE "C" FOR EACH BEARING.

ALL BEARINGS ARE SYMMETRICAL ABOUT E OF GIRDER AND E OF BEARING.

PROVIDE SHIM R3 AS NOTED ON "PIER 1" SHEET.



GIRDER MFG. MAY PROPOSE AN ALTERNATE METHOD OF ATTACHING ANCHOR R3 TO GIRDER SUBJECT TO APPROVAL OF THE ENGINEER.

LEGEND

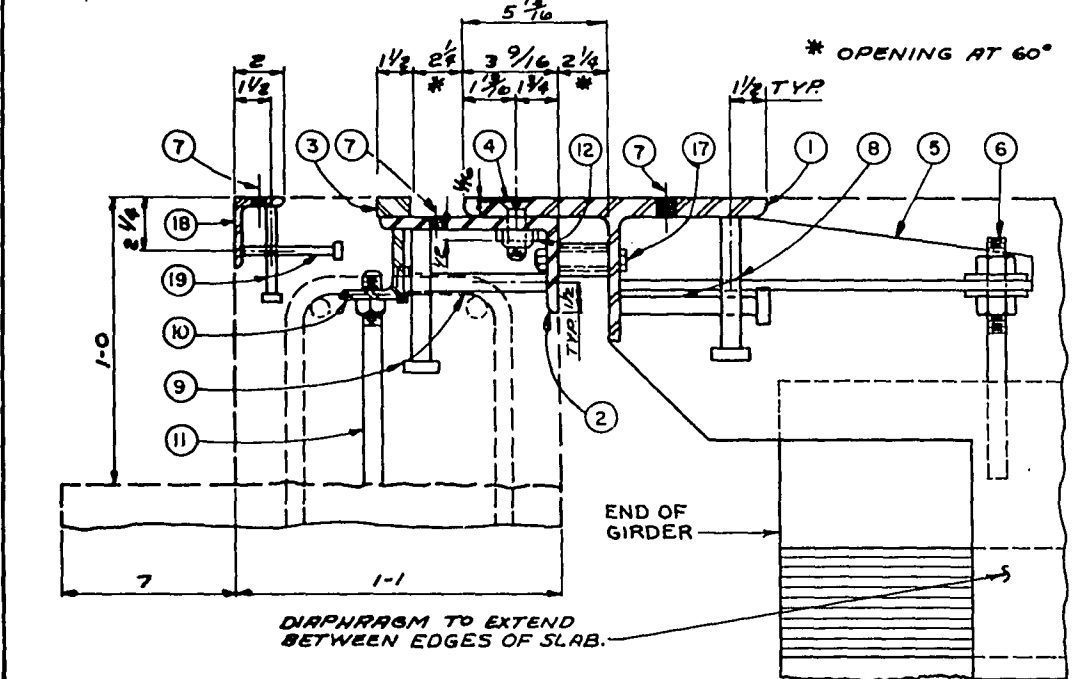


BEARING ELEVATION
BEARING DETAILS

	GIRDER SIZE	DIM. 'S'	DIM. 'T'	DIM. 'U'	DIM. 'V'	DIM. 'W'	DIM. 'X'	DIM. 'Y'	NO. OF BRGS. REQ'D.	LOCATION
EXP. BRG.	36"	1-6	1-4 1/2	1-9 1/2	1-9 1/2		4			
	48"	1-10	1-8 1/2	2-1 1/2	2-1 1/2		7		15	50 S. ABUT. & 10 PIER 1
	64"	2-2	2-0 1/2	2-5 1/2	2-5 1/2		9			
FIXED BRG.	36"	1-6			1-8	1-8		4		
	48"	1-10			2-0	2-0		6 1/4		
	64"	2-2			2-4	2-4		8		

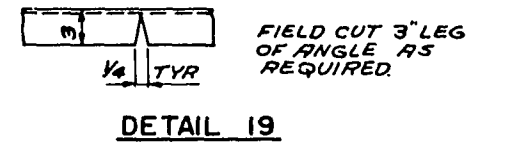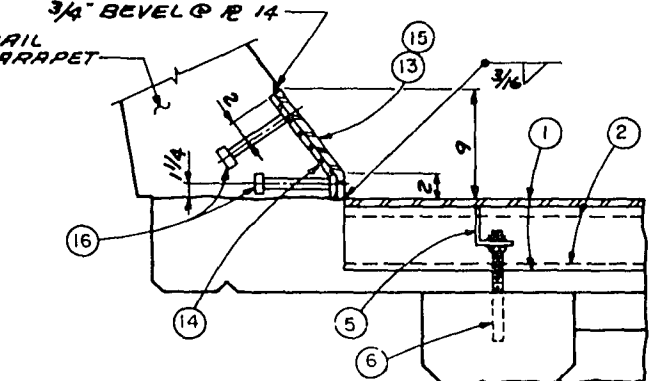


SECTION THRU JOINT AT CURB

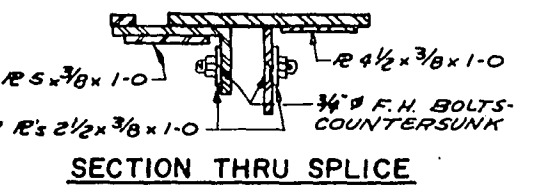

SECTION THRU SPLICE

OPTIONAL FIELD SPLICE DETAIL
ONE SPLICE SHALL BE PERMITTED IN JOINT.

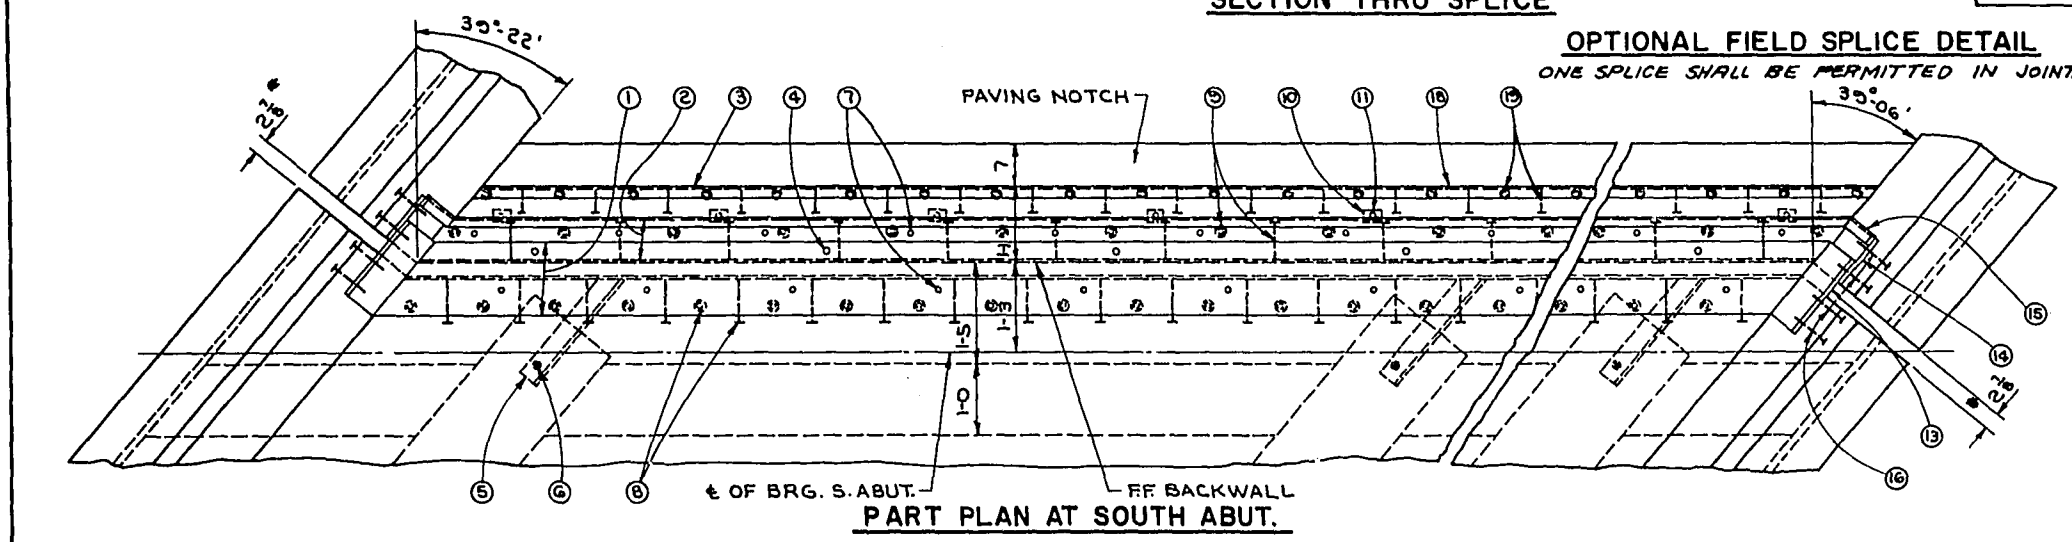

EXPANSION JOINT NOTES


EXPANSION JOINT SHALL BE BUILT TO CONFORM TO ROADWAY S.E. AND GRADE.

AFTER CONCRETE HAS SET THE JOINT OPENING SHALL BE THOROUGHLY CLEANED AND BOLTS #4 REMOVED AND THE HOLES FILLED WITH HOT POURED ELASTIC JOINT SEALER.

APPLY 1/2" COAT OF BITUMASTIC TO METAL SURFACES FORMING JOINT AND FILL OPENING WITH HOT POURED ELASTIC JOINT SEALER.






ALL MATERIAL SHALL BE PAID FOR AT THE UNIT PRICE BID FOR "STRUCTURAL CARBON STEEL."

PLACE L #18 AT BOTH ABUTMENTS.

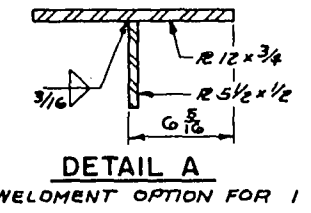

DETAIL A
WELDMENT OPTION FOR 1

No.	Date	Revision	By
STATE OF WISCONSIN DEPARTMENT OF TRANSPORTATION DIVISION OF HIGHWAYS			
STRUCTURE B-3-30			
Const. Spec.	1969	Drawn By	FWG
EXPANSION JOINT		SHEET 11 OF 13	
BEARING DETAILS		X45730	

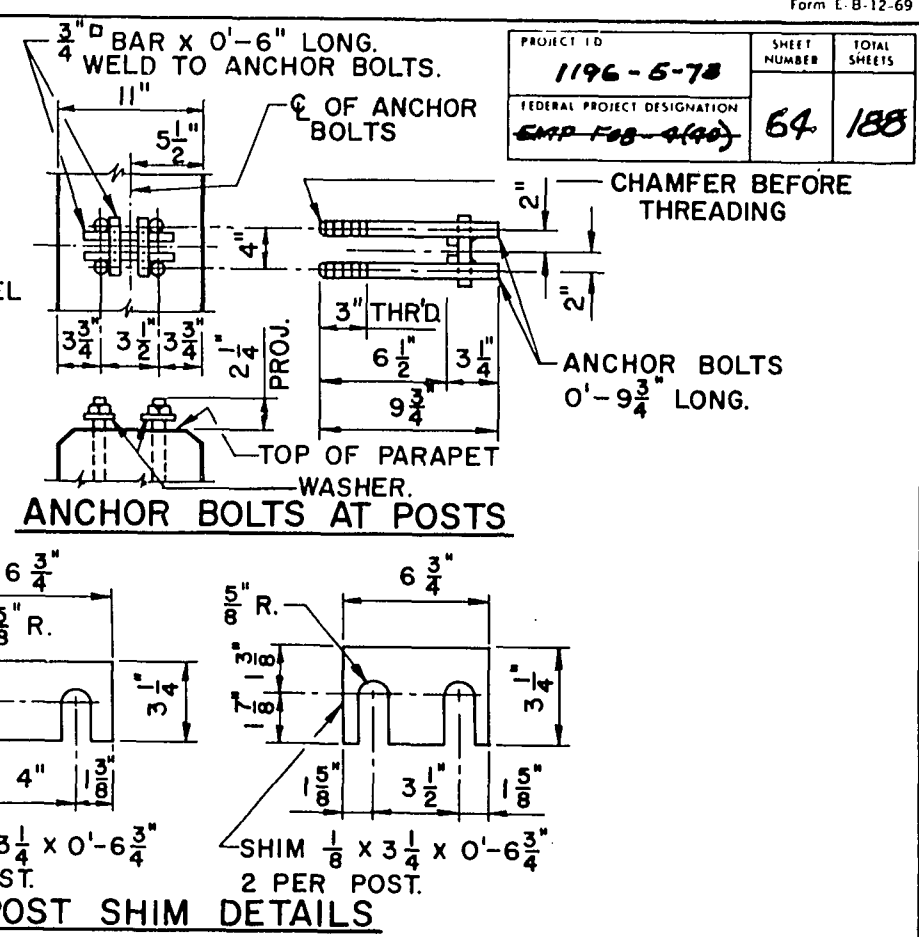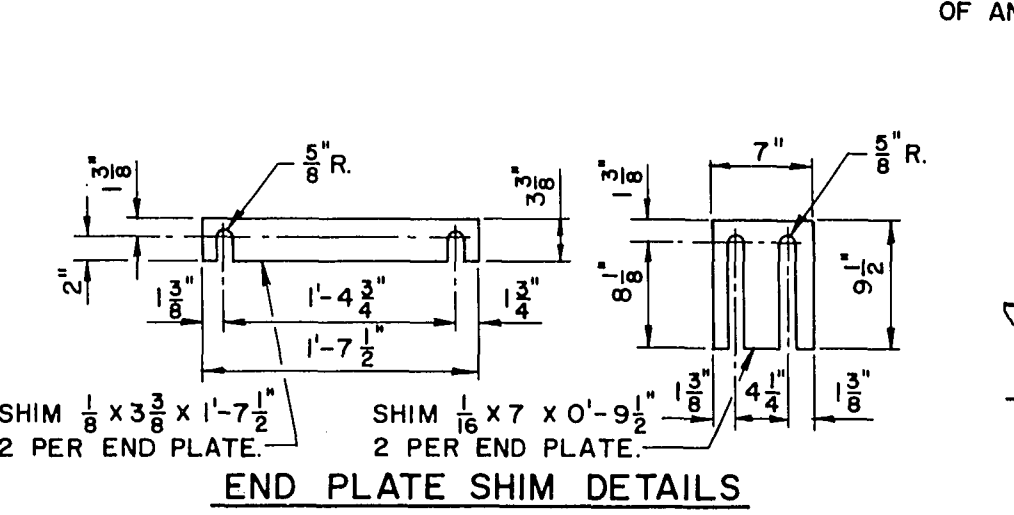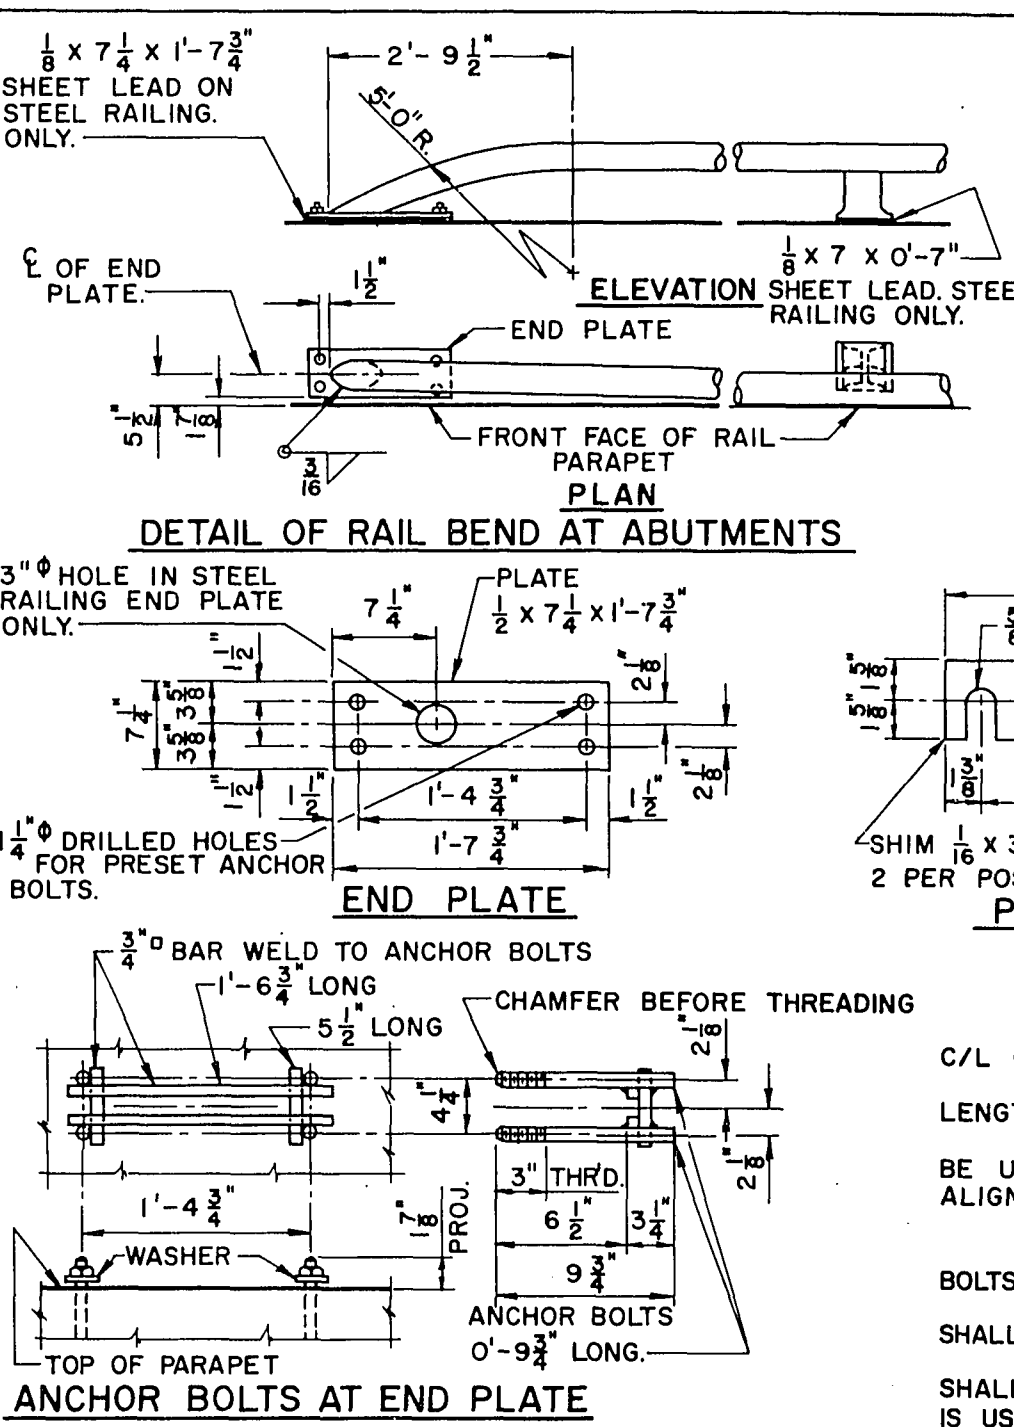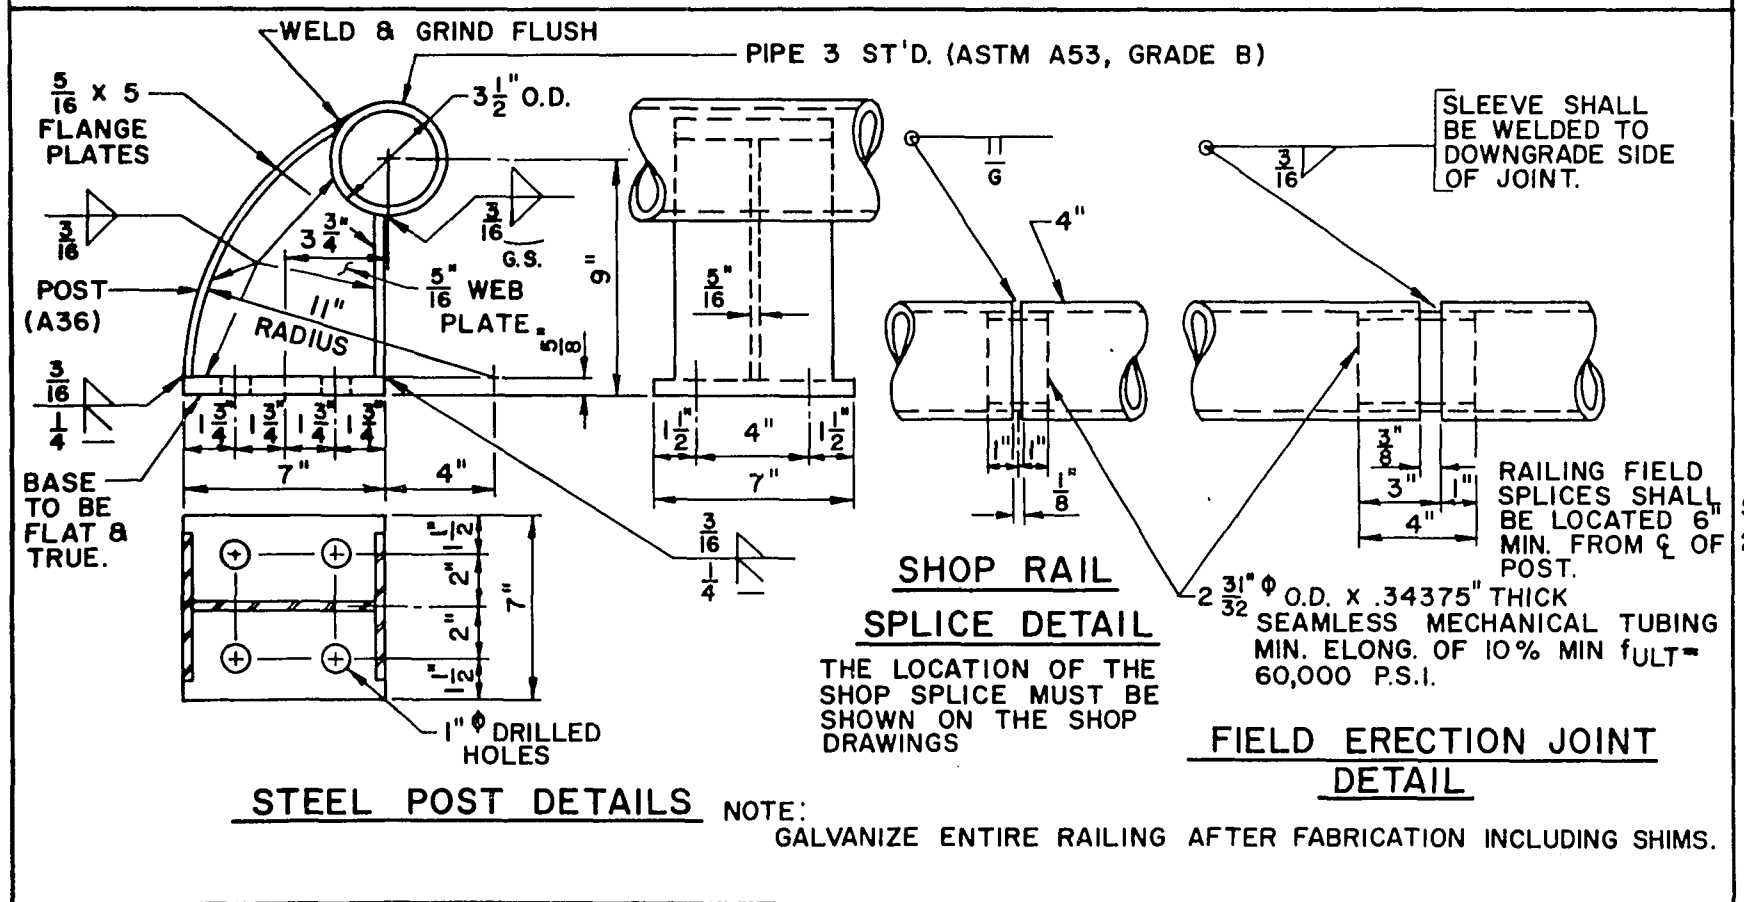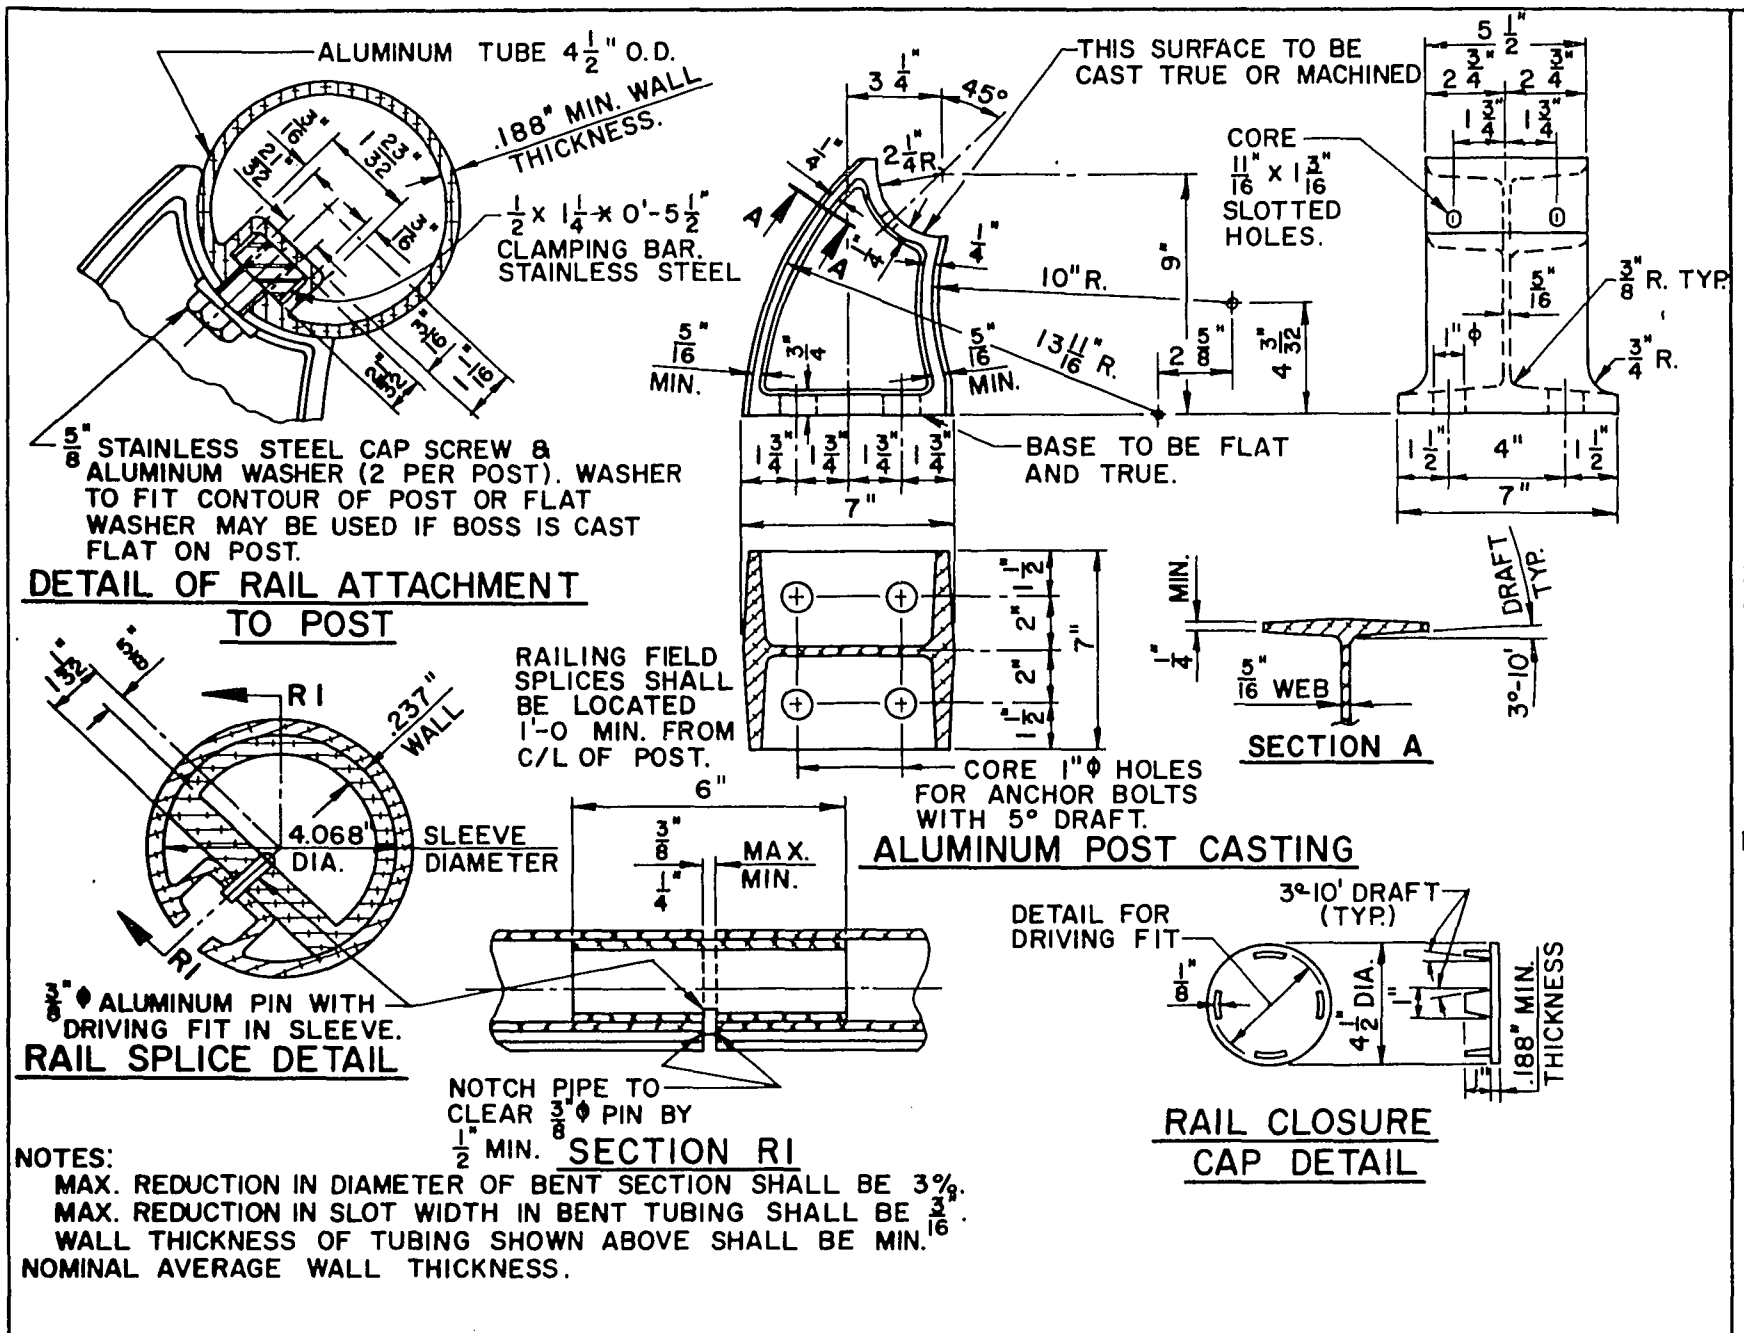

GENERAL NOTES

BID ITEM SHALL BE TUBULAR RAILING, TYPE 'J'.

ALL POST SPACINGS ARE TAKEN HORIZONTALLY ALONG C/L OF ANCHOR BOLTS.

RAILING SHALL BE FABRICATED IN TWO OR THREE PANEL LENGTHS.

SHIMS CONFORMING TO SAME MATERIAL AS POSTS SHALL BE USED UNDER POSTS AND END PLATES WHERE REQ'D FOR ALIGNMENT.

RAIL POSTS SHALL BE SET NORMAL TO GRADE.


THE SHANK AND ROOT OF THREAD DIAMETER FOR ANCHOR BOLTS SHALL BE A MIN. OF 0.62 INCHES.

ANCHOR BOLTS, NUTS & WASHERS FOR ALUMINUM RAILING SHALL BE STAINLESS STEEL.


ANCHOR BOLTS, NUTS & WASHERS FOR STEEL RAILING SHALL BE EITHER STAINLESS STEEL OR ASTM A307. IF A307 IS USED ELECTRO-GALVANIZE NUTS, WASHERS & TOP 3 1/2" OF ANCHOR BOLTS.

SHIMS SHALL CONFORM TO SAME MATERIAL AS POSTS.


RAILS SHALL BE BUILT STRAIGHT AND SPRUNG INTO PLACE.

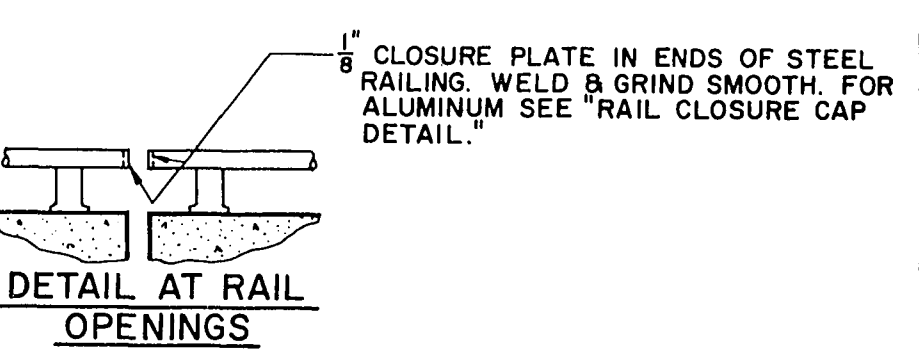

No.	Date	Revision	By
STATE OF WISCONSIN DEPARTMENT OF TRANSPORTATION DIVISION OF HIGHWAYS			
STRUCTURE B-3-30			
Const. Spec.	1969	Drawn By	FWG
		Plans Checked	JG
TUBULAR RAILING TYPE 'J'			SHEET 13 OF 13 X45732

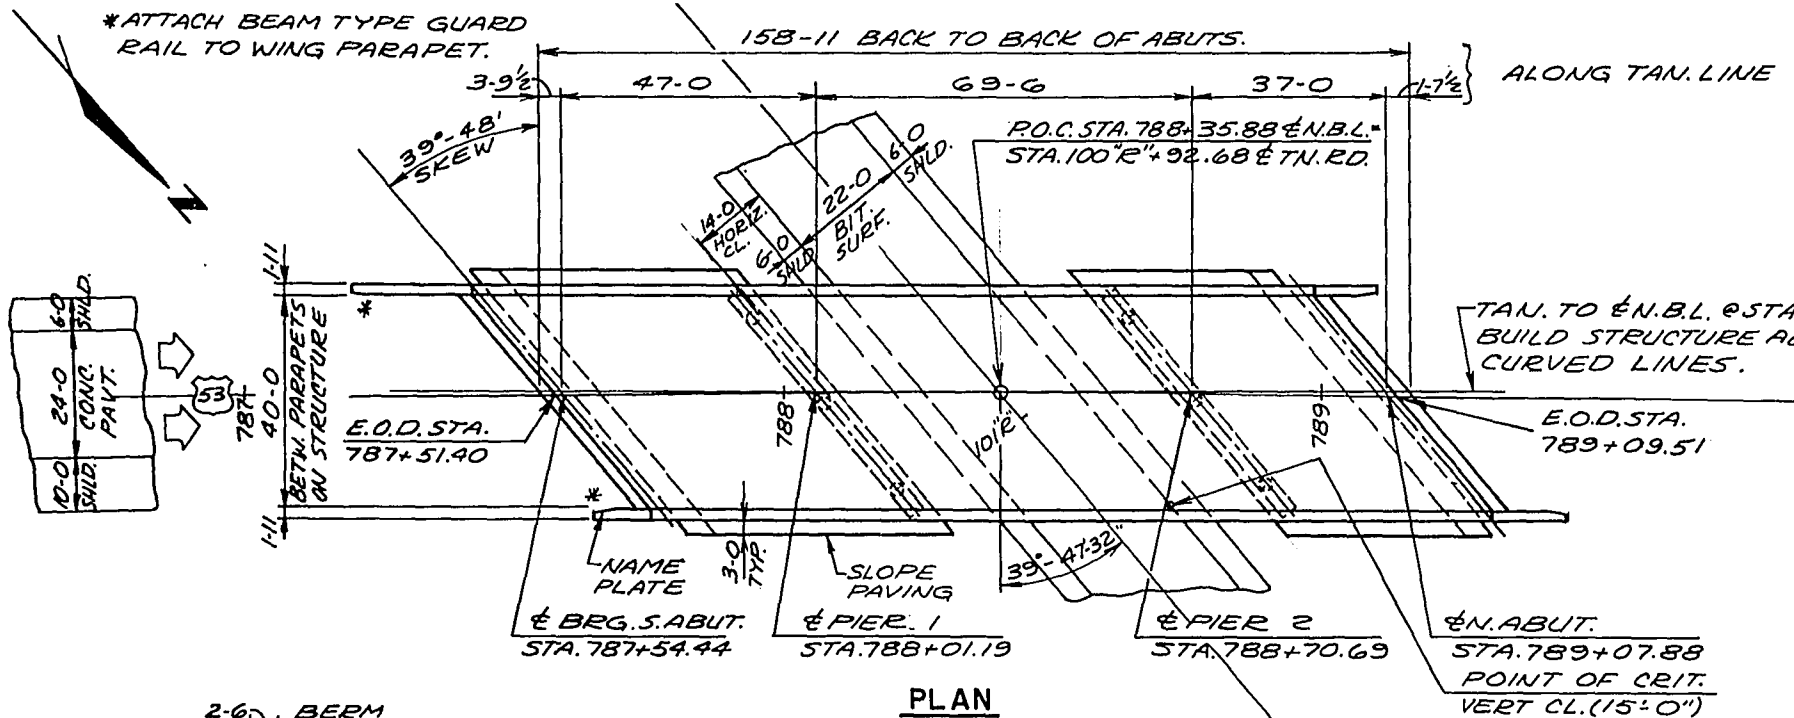


PLAN

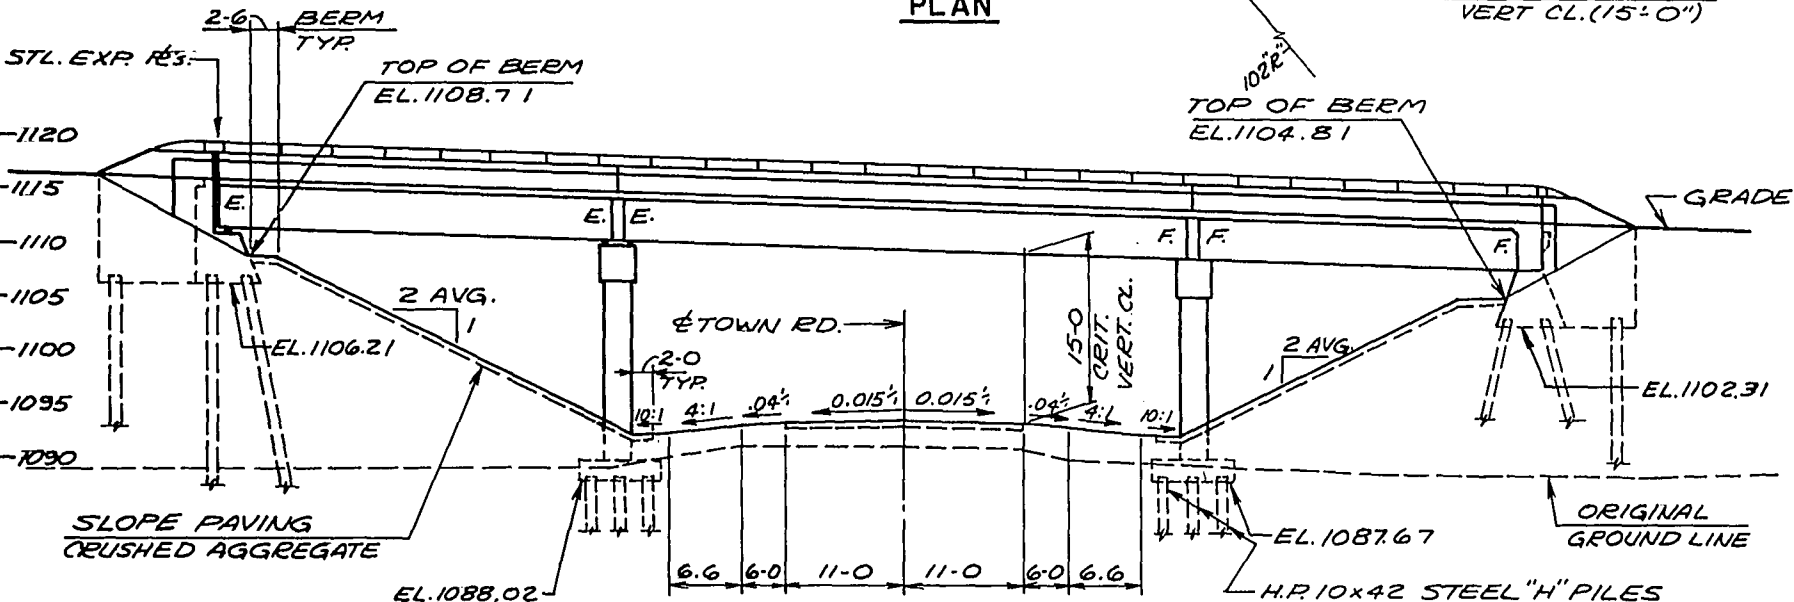


ELEVATION

NORMAL TO C.E. OF TOWN ROAD

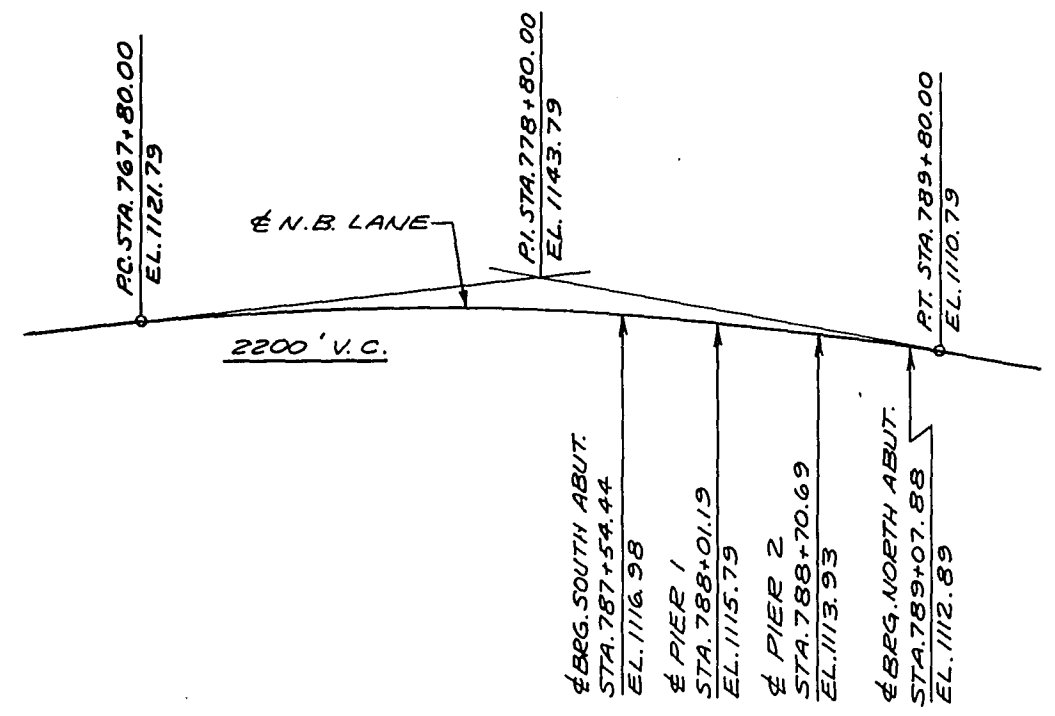


PROFILE GRADE LINE, N.B.L. U-S-H 53

CURVE DATA
 C.E. N.B. LANE U.S.H. 53
 P.I. STA. 809+73.28 BK= STA. 806+74.13 AH.
 R = 8594.367 FT.
 L = 6306.893 FT.
 T = 3303.023 FT.
 D = 0°-40'-00"
 Δ = 42°-02'-45.44"
 SE = 0.032 1/2

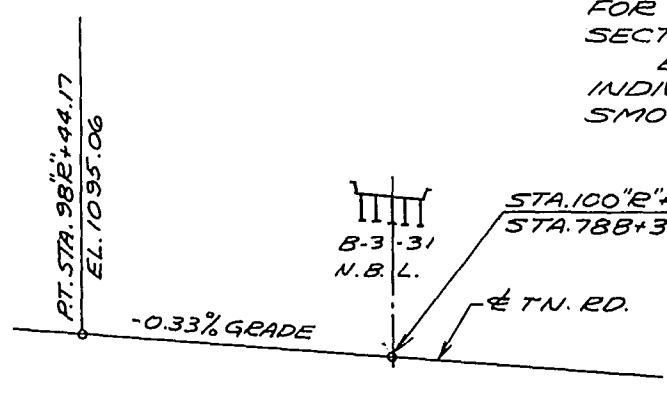

PROFILE GRADE LINE, TOWN RD.

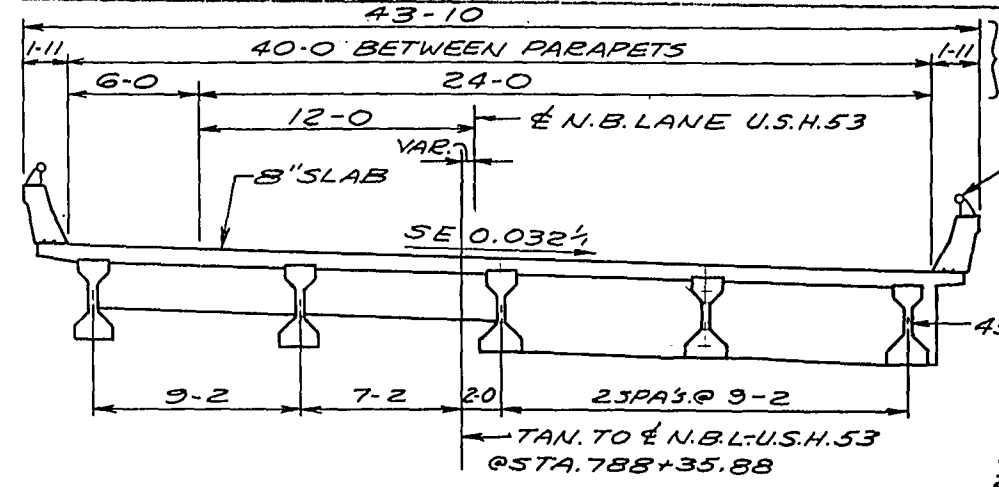

CROSS SECTION THRU ROADWAY


NORMAL TO TAN. TO C.E. N.B.L., LOOKING NORTH

TOTAL ESTIMATED QUANTITIES

BID ITEMS	UNIT	S.ABUT.	PIER 1	PIER 2	N.ABUT.	SUPER	TOTAL
EXCAVATION FOR STRUCTURES	C.Y.	51	63	60	47	—	221
CONCRETE MASONRY	C.Y.	104	58	54	68	260	544
PRESTRESSED GIRDER, I TYPE, 45 INCH	L.F.	—	—	—	—	770	770
BAR STEEL REINFORCEMENT	LBS.	5880	8740	8440	3890	64,490	91,440
STRUCTURAL CARBON STEEL	LBS.	—	—	—	—	3960	3960
STRUCTURAL LOW ALLOY STEEL	LBS.	—	—	—	—	2710	2710
LUBRICATED BRONZE PLATES	LBS.	—	—	—	—	239	239
BEARING PADS	S.F.	—	—	—	—	22	22
BEARING PADS, ELASTOMERIC	S.F.	—	—	—	—	24	24
STEEL PILING, H.P. 10x42 DEL. & DRIVEN	L.F.	990	880	720	900	—	3490
TUBULAR RAILING, TYPE "U"	L.F.	—	—	—	—	355	355
SLOPE PAVING, CRUSHED AGGREGATE	S.Y.	273	—	—	214	—	487
NON - BID ITEMS							
FILLER	SIZE	—	—	—	—	1/2" 3/4"	1/2" 3/4"
1/8" ALUMINUM OR ZINC F.	S.F.	—	—	—	—	45	45
POLYVINYL CHLORIDE WATERSTOP	L.F.	—	—	—	—	50	50

GENERAL NOTES

DRAWINGS SHALL NOT BE SCALED.
 BAR STEEL REINFORCEMENT SHALL BE IMBEDDED 2" CL. UNLESS OTHERWISE SHOWN OR NOTED.
 THE FIRST DIGIT OF A THREE DIGIT BAR MARK & THE FIRST TWO DIGITS OF A FOUR DIGIT BAR MARK SIGNIFIES THE BAR SIZE.
 THE SLOPE OF THE FILL IN FRONT OF THE ABUTMENTS SHALL BE COVERED WITH CRUSHED AGGREGATE TO THE EXTENT SHOWN ON THIS SHEET & IN THE ABUTMENT DETAILS.
 THE UPPER LIMITS OF EXCAVATION FOR STRUCTURES FOR THE ABUTMENTS SHALL BE THE BOTTOM OF SLOPE PROTECTION & THE QUANTITIES WERE COMPUTED FROM THIS LINE.
 THE UPPER LIMITS OF EXCAVATION FOR STRUCTURES FOR THE PIERS SHALL BE THE FINISHED GRADED SECTION & THE QUANTITIES WERE COMPUTED FROM THIS LINE.
 ELASTOMERIC BEARING PADS NEED NOT BE INDIVIDUALLY MOLDED PROVIDED THE CUT EDGES ARE SMOOTH & TRUE.

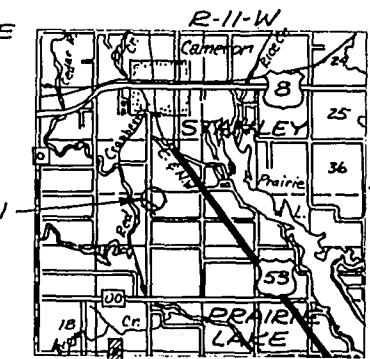

LAYOUT

PROJECT ID	1196-5-73	SHEET NUMBER	65	TOTAL SHEETS	188
FEDERAL PROJECT DESIGNATION	EMP-F00-4(40)				

LIST OF DRAWINGS

1. GENERAL PLAN X 45733
2. SUB SURFACE EXPLORATION X 45734
3. SOUTH ABUTMENT X 45735
4. ABUTMENT BILL OF BARS X 45736
5. NORTH ABUTMENT X 45737
6. PIER 1 X 45738
7. PIER 2 X 45739
8. PRESTRESSED GIRDER DETAILS X 45740
9. SUPERSTRUCTURE X 45741
10. SUPERSTRUCTURE X 45742
11. EXPANSION JOINT & BEARING DETAILS X 45743
12. RAIL PARAPET DETAILS X 45744
13. TUBULAR RAILING, TYPE "U" X 45745



DESIGN DATA

LIVE LOAD: HS20
 ALLOWABLE DESIGN STRESSES:
 CONCRETE MASONRY, GRADE "AA"
 SLAB $f_c = 1200$ PSI
 ALL OTHERS $f_c = 1400$ PSI
 BAR STEEL REINFORCEMENT $f_s = 20,000$ PSI
 PRESTRESSED GIRDERS
 CONCRETE MASONRY $f_c = 6,000$ PSI
 STRANDS 1/2" WITH ULTIMATE TENSILE STRENGTH OF 270,000 PSI

FOUNDATION DATA:
 ABUTS. SHALL BE SUPPORTED ON H.P. 10x42 STEEL "H" PILES DRIVEN TO A MIN. BRG. VALUE OF 25 T./PILE - EST. 55'-0" LG. AT S.ABUT. & EST. 50'-0" LG. AT N.ABUT.
 PIERS SHALL BE SUPPORTED ON H.P. 10x42 STEEL "H" PILES DRIVEN TO A MIN. BRG. VALUE OF 37 T./PILE - EST. 40'-0" LG. @ EACH PIER.

TRAFFIC VOLUME:
 U.S. 53 TOWN RD.
 (1980) D.H.V. 780 53
 R.D.S. 80 M.P.H. 60 M.P.H.



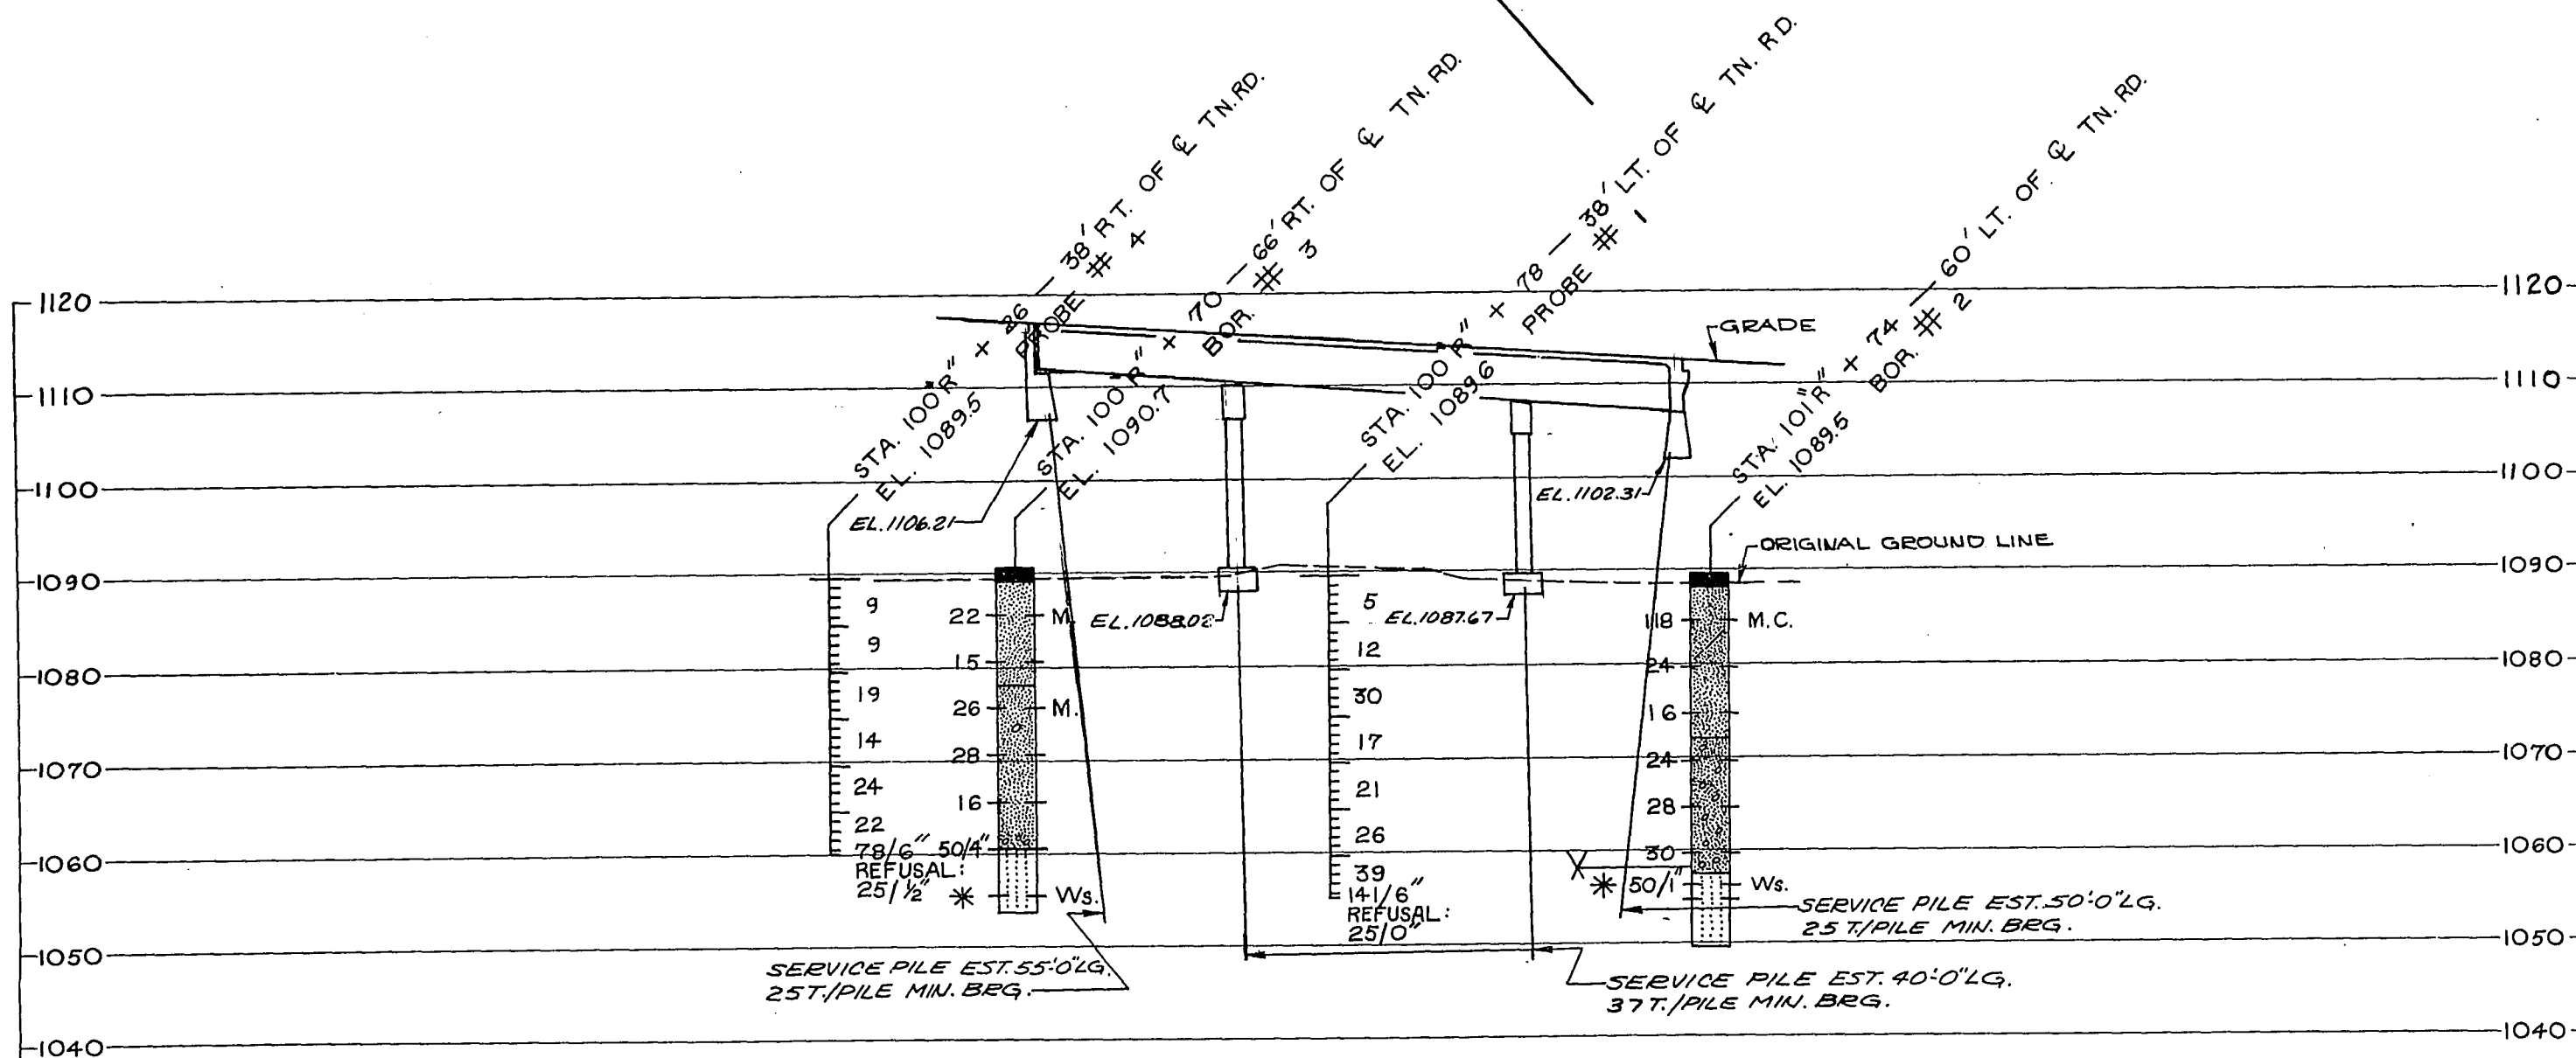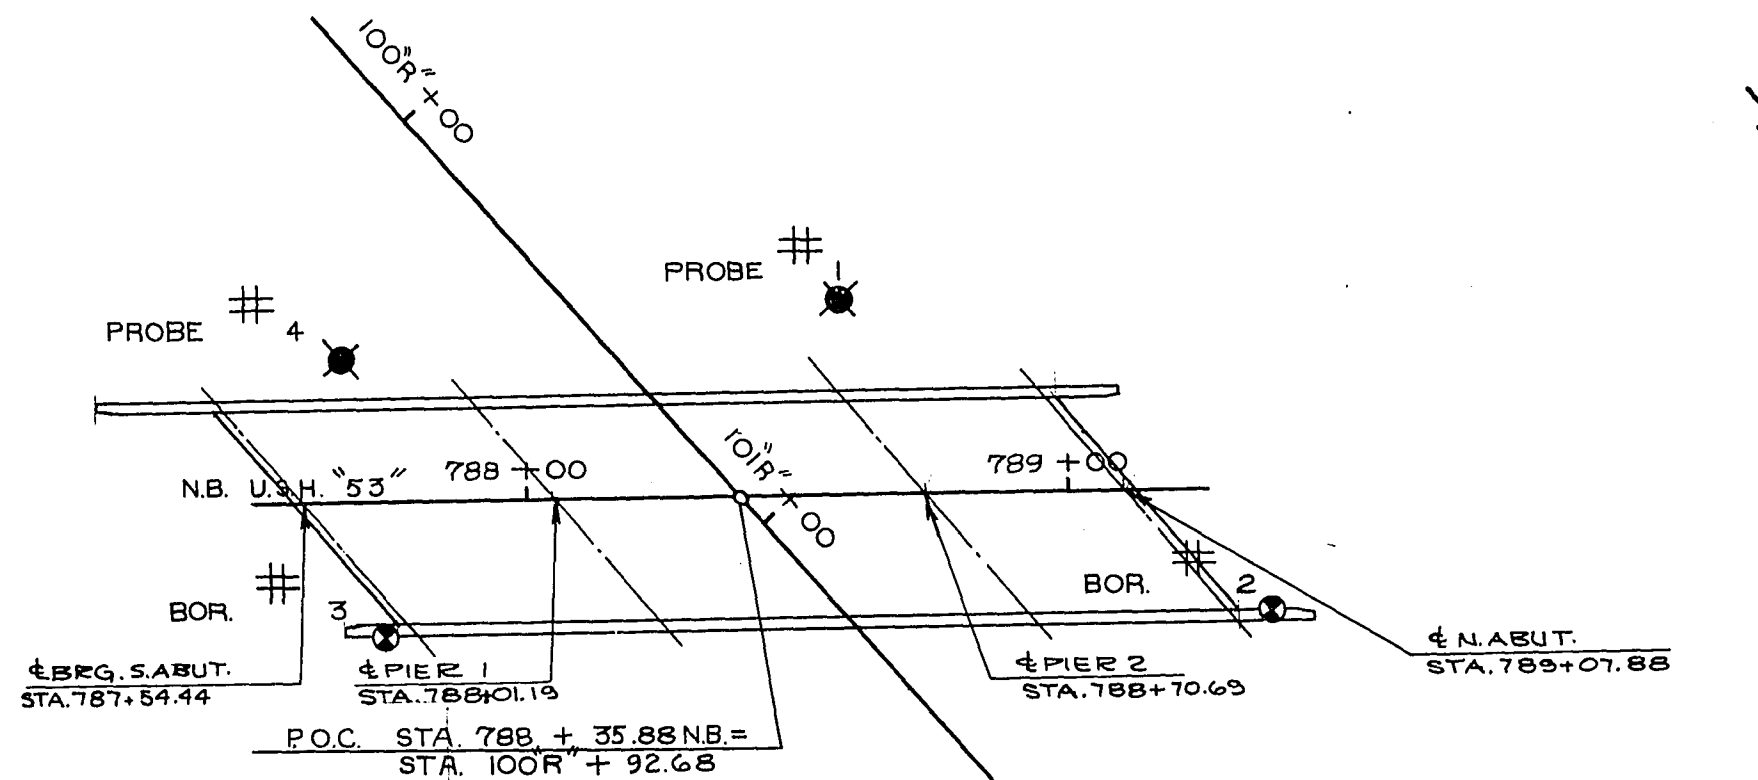






No.	Date	Revision	By
STATE OF WISCONSIN DEPARTMENT OF TRANSPORTATION DIVISION OF HIGHWAYS			
STRUCTURE B-3-31			
N.B.L. U-S-H 53 OVER TOWN ROAD			
County	BARRON	City	TN. OF PRAIRIE LAKE
Design Spec	A.A.S.H.O. '69	Load	HS-20
Designed By	R.T.B.	Design Checked	F.P.R.
Drawn By	J.G.	Plans Checked	DED.
Approved	W.A. Klein	Chief Bridge Engineer	12-21-71
GENERAL PLAN			SHEET 1 OF 13
			X 45733



ABBREVIATIONS

F — Fine	M — Medium	C — Coarse
Ws — Weathered	So — Sound	

 MATERIAL SYMBOLS

	Topsoil		Silt		Sandstone
	Sand		Peat		Limestone
	Gravel		Clay		Igneous Rock

LEGEND OF PROBING

95/6=95 Blows for 6" Penetration
 Probing taken with a 350# wt.
 Falling 18" on a 2" O. D. Point.

Probing No.
 Sta.
 Elevation
 7 Average Blows Per Foot
 Refusal 95/6

LEGEND OF BORING

The diagram illustrates a vertical borehole log with the following components and labels:

- Boring No. Sta.**: Located at the top right of the log.
- Elev.**: Located at the top left of the log.
- Unconfined Strength**: Points to a box containing the value **7.7**.
- 7**: A numerical value next to the unconfined strength box.
- Blows Per Ft. Using 140# Wt. Falling 30"**: Points to an asterisk symbol (*) on the log.
- Wash Sample**: Points to a section of the log.
- Shelby Tube**: Points to a section of the log labeled **S. T.**
- Ground Water Elevation**: Indicated by a triangle symbol and a horizontal line.
- No Ground Water Observed Above This Elevation**: Indicated by an 'X' symbol and a horizontal line.
- Soil Layers (from top to bottom)**:
 - Sandy Gravel**: Represented by a pattern of small circles and dots.
 - F. Boulders or Cobbles**: Represented by a pattern of larger circles and dots.
 - Sand**: Represented by a pattern of small dots.
 - Silty Clay**: Represented by a pattern of diagonal lines.
 - So Limestone**: Represented by a brick pattern.

Unless otherwise specified, the blows per foot at the locations indicated are based on driving a 2" O. D. x 1.4" I. D. split spoon sampler with a 140# hammer having a free fall of 30". The blow count is taken in undisturbed soil immediately below a cased or open hole eliminating side friction on the drive pipe.

SUBSURFACE EXPLORATION FOR FOUNDATION DESIGN AND BIDDERS INFORMATION

To obtain relative data concerning the character of material in and upon which the foundation might be built, borings and/or soundings were made at points approximately as indicated on this drawing. The data presented herein represents the findings of the subsurface explorations made. However, because the depths investigated are limited and the area of the borings and/or soundings is very small in relation to the entire area, the Division of Highways does not warrant conditions below the depths investigated or that the classification of material encountered in these investigations is necessarily typical of the entire site.




No.	Date	Revision	By
-----	------	----------	----

STATE OF WISCONSIN DEPARTMENT OF TRANSPORTATION DIVISION OF HIGHWAYS			
STRUCTURE B-3-31			
Const. Spec.	1969	Drawn By JLY	Plans Checked DEO.

SUBSURFACE EXPLORATION

SHEET 2 OF 13

X 45734

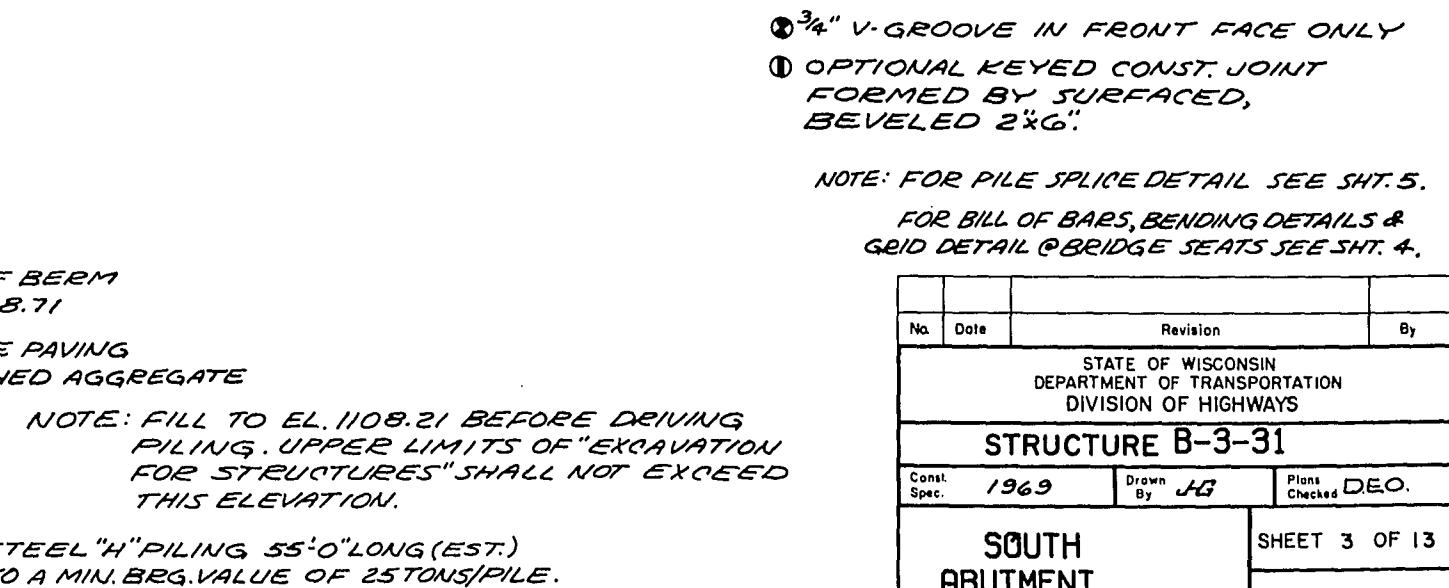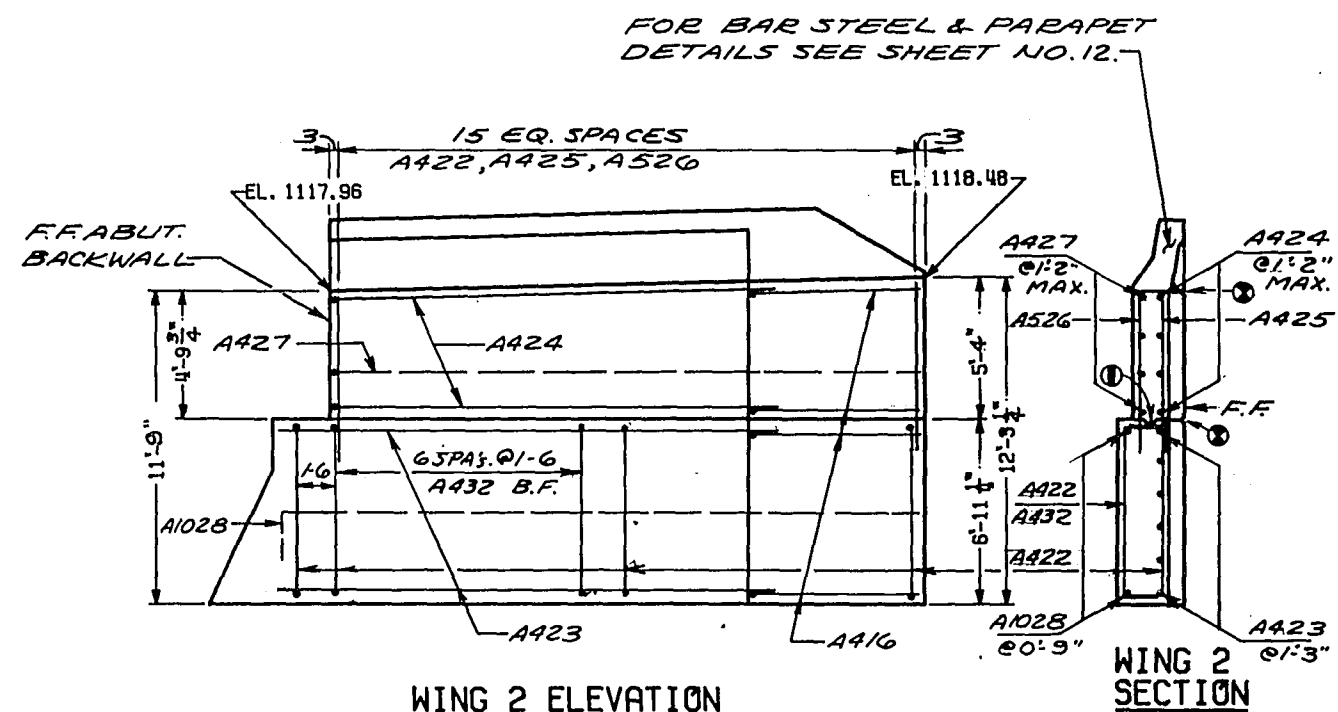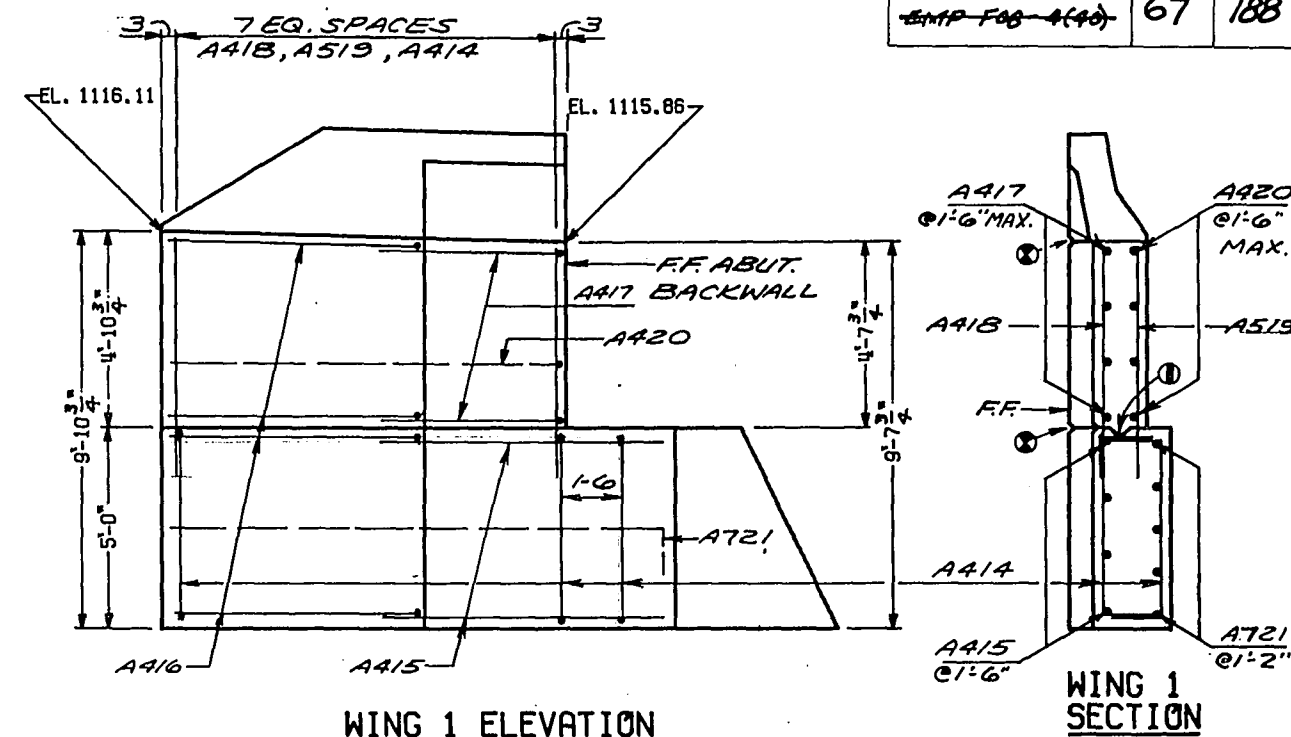

No.	Date	Revision	By
STATE OF WISCONSIN DEPARTMENT OF TRANSPORTATION DIVISION OF HIGHWAYS			
STRUCTURE B-3-31			
Const. Spec.	1969	Drawn By JG	Plans Checked DEO.
SOUTH ABUTMENT			SHEET 3 OF 13 X 45735

PROJECT ID 1196-5-73	SHEET NUMBER 68	TOTAL SHEETS 188
FEDERAL PROJECT DESIGNATION EMP F08-4(40)		

BILL OF BARS, SOUTH ABUT.



5,330 #

BAR MARK	NO. REQ'D	LENGTH	BENT	LOCATION
A401	23	10-9	X	BODY, STIRRUP, F.F.
A402	23	10-5	X	" " B.F.
A403	14	28-3		" HORIZ., F.F. & BOTT.
A504	4	11-11	X	" B.F.
A1105	5	26-3		" B.F. @ WING 2
A606	6	28-8		" TOP
A407	14	9-2	X	" STIRRUP
A608	6	14-2		" TOP
A609	5	3-4		" "
A510	52	10-7	X	" & BACKWALL, STIRRUP
A411	16	27-3		BACKWALL, HORIZ.
A512	52	4-7	X	" & PAVING BLOCK, STIRRUP
A413	14	7-4		PAVING BLOCK, HORIZ.
A414	17	7-6	X	WING 1, STIRRUPS, F.F. & B.F.
A415	4	7-6		" 1, HORIZ. F.F.
A416	18	7-7	X	" 1 & 2 " F.F.
A417	4	5-9	X	" 1 " F.F.
A418	8	5-9		" 1 VERT. F.F.
A519	8	6-0		" 1 " B.F.
A420	4	10-8	X	" 1 HORIZ. B.F.
A721	5	12-4	X	" 1 " B.F.
A422	26	10-1	X	" 2 STIRRUPS, F.F. & B.F.
A423	6	19-0		" 2 HORIZ., F.F.
A424	4	17-9	X	" 2 " F.F.
A425	16	6-2		" 2 VERT., F.F.
A526	16	6-5		" 2 " B.F.
A427	4	22-8	X	" 2 HORIZ., B.F.
A1028	9	26-4	X	" 2 " B.F.
A529	30	4-11	X	GRID @ BRIDGE SEAT
A530	20	2-8		" " " "
A431	4	18-9		BODY - HORIZ.
A432	7	11-9	X	WING 2 - STIRRUPS - B.F.


BILL OF BARS, NORTH ABUT.

3,440 #


BAR MARK	NO. REQ'D	LENGTH	BENT	LOCATION
A451	46	9-3	X	BODY STIRRUPS
A452	12	28-6		" HORIZ., F.F. & BOTT.
A453	4	25-0		" " B.F.
A954	8	17-3	X	" " B.F. @ WING 3 & 4
A655	4	28-8		" HORIZ.
A656	42	8-2	X	" STIRRUPS
A657	2	21-0		" HORIZ.
A658	2	41-6		" "
A559	32	2-6		" DOWELS
A460	20	10-4	X	WING 3, STIRRUPS, F.F. & B.F.
A461	6	11-3		" 3, HORIZ., F.F.
A462	18	7-7	X	" 3 & 4 " F.F.
A1063	5	15-5	X	" 3 " B.F.
A464	4	7-11	X	" 3 " F.F.
A465	4	12-8	X	" 3 " B.F.
A466	9	5-4		" 3 VERT., F.F.
A567	9	5-7		" 3 " B.F.
A468	21	8-4	X	" 4, STIRRUPS, F.F. & B.F.
A469	4	11-0		" 4, HORIZ., F.F.
A1070	5	18-0	X	" 4 " B.F.
A471	4	9-11	X	" 4 " F.F.
A472	4	14-8	X	" 4 " B.F.
A473	10	5-1		" 4 VERT., F.F.
A574	10	5-4		" 4 " B.F.

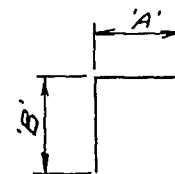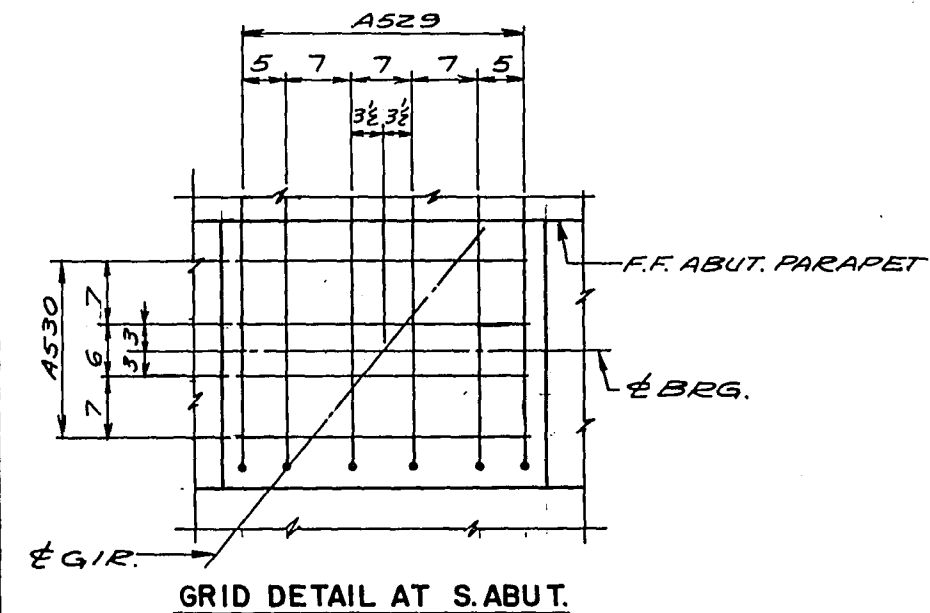

BAR MARK	DIM. 'A'	DIM. 'B'
A407	3-10	2-9
A510	1-4	4-9
A512	8"	2-1
A414	4-6	1-7
A422	6-5	1-11
A656	2-2	3-2
A460	6-6	2-0
A468	4-6	2-0
A432	6-5	2-9


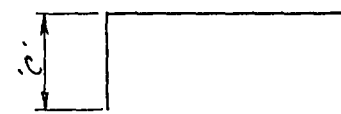


BAR MARK	DIM. 'C'
A417	1-0
A416, A462	1-6
A464, A471	1-0
A721	1-2 1/2
A529	1-3
A1028	1-11
A504	9"
A1063, A1070	1-11
A954	1-7

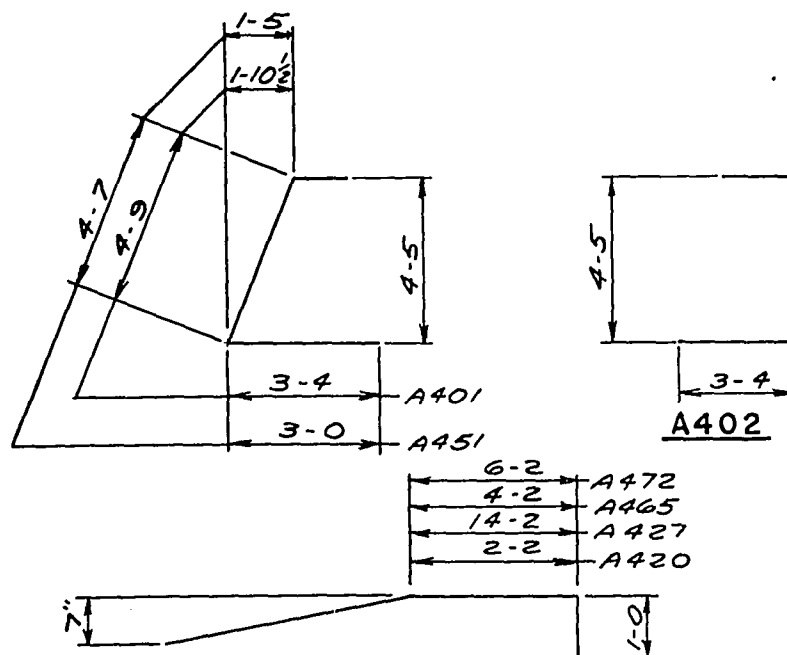


NOTE: FOR RAIL PARAPET BARS AT ABUT. WING WALLS SEE SHT. NO. 12.

No.	Date	Revision	By
STATE OF WISCONSIN DEPARTMENT OF TRANSPORTATION DIVISION OF HIGHWAYS			
STRUCTURE B-3-31			
Const. Spec.	1969	Drawn By	JHJ
		Plans Checked	DEO
ABUTMENT BILL OF BARS			SHEET 4 OF 13 X 45736

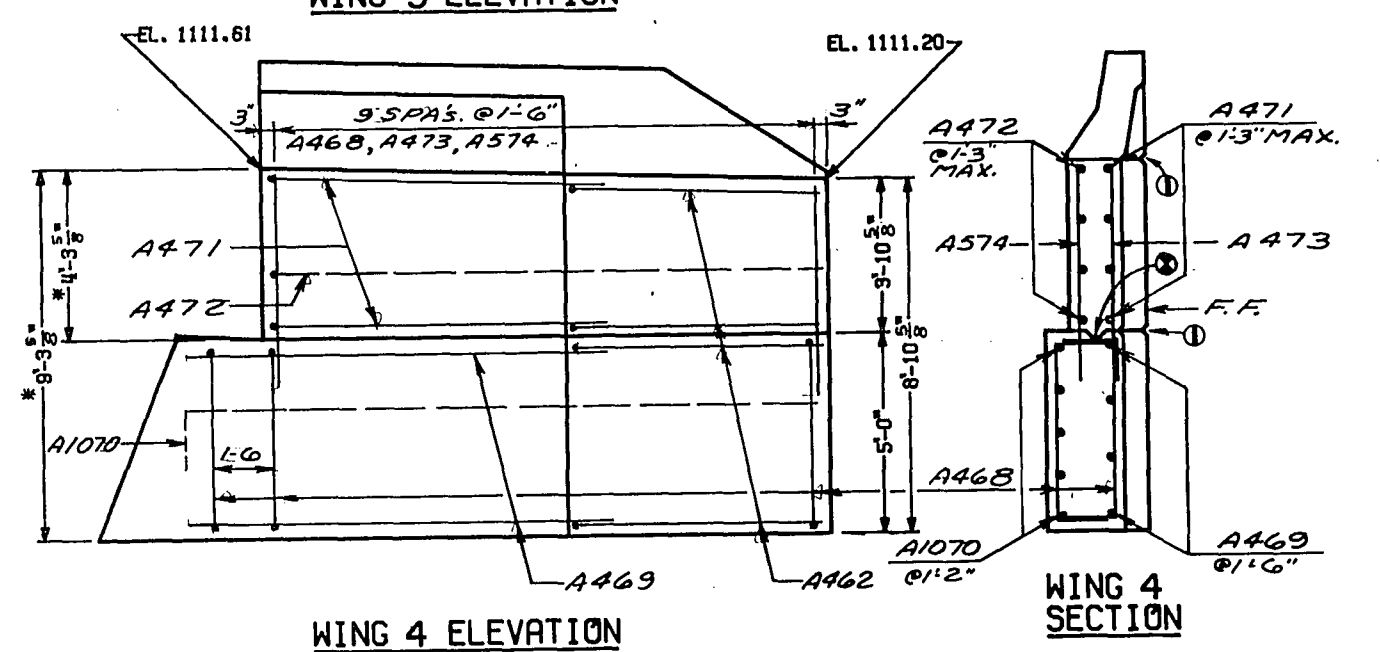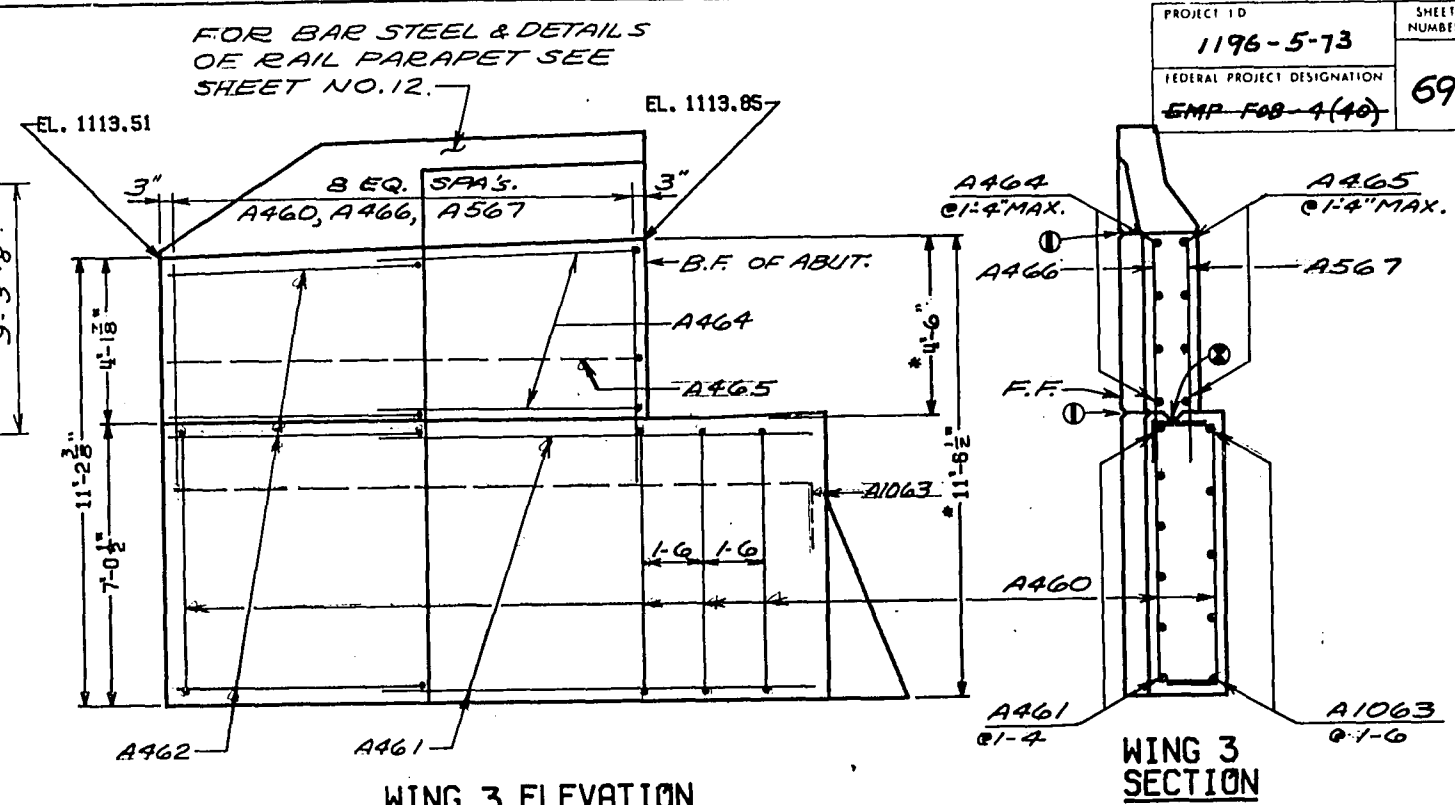


① KEYED CONST. JOINT FORMED BY SURFACED, BEVELED 2"x6". POUR CONC. ABOVE THIS JOINT AFTER SUPER. CONC. IS IN PLACE.

① $\frac{3}{4}$ " V-GROOVE IN FRONT FACE ONLY.

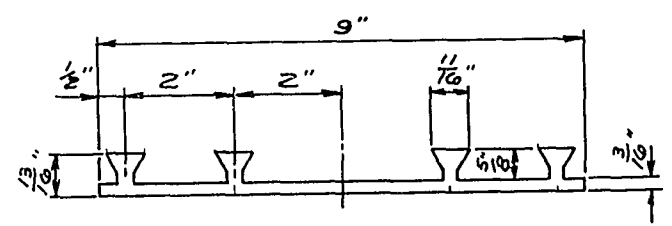


—A559 BARS MAY BE PLACED IMMEDIATELY AFTER CONC. IS POURED.

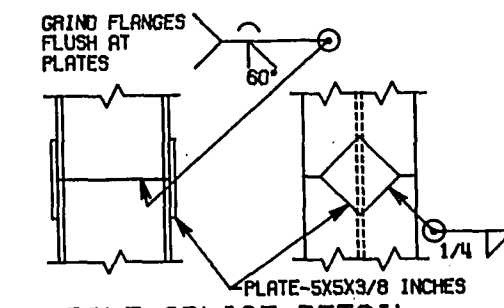








No.	Date	Revision	By
STATE OF WISCONSIN DEPARTMENT OF TRANSPORTATION DIVISION OF HIGHWAYS			
STRUCTURE B-3-31			
Const. Spec.	1969	Drawn By	JG Plans Checked DEO
NORTH ABUTMENT		SHEET 5 OF 13	
		X 45737	

▲ DENOTES DIRECTION OF BATTERED PILE.
BATTER 3" PER FT.



NOTE: FILL TO EL. 1104.31
BEFORE DRIVING PILING.
UPPER LIMITS OF "EXCAVATION
FOR STRUCTURES" SHALL NOT
EXCEED THIS ELEVATION.

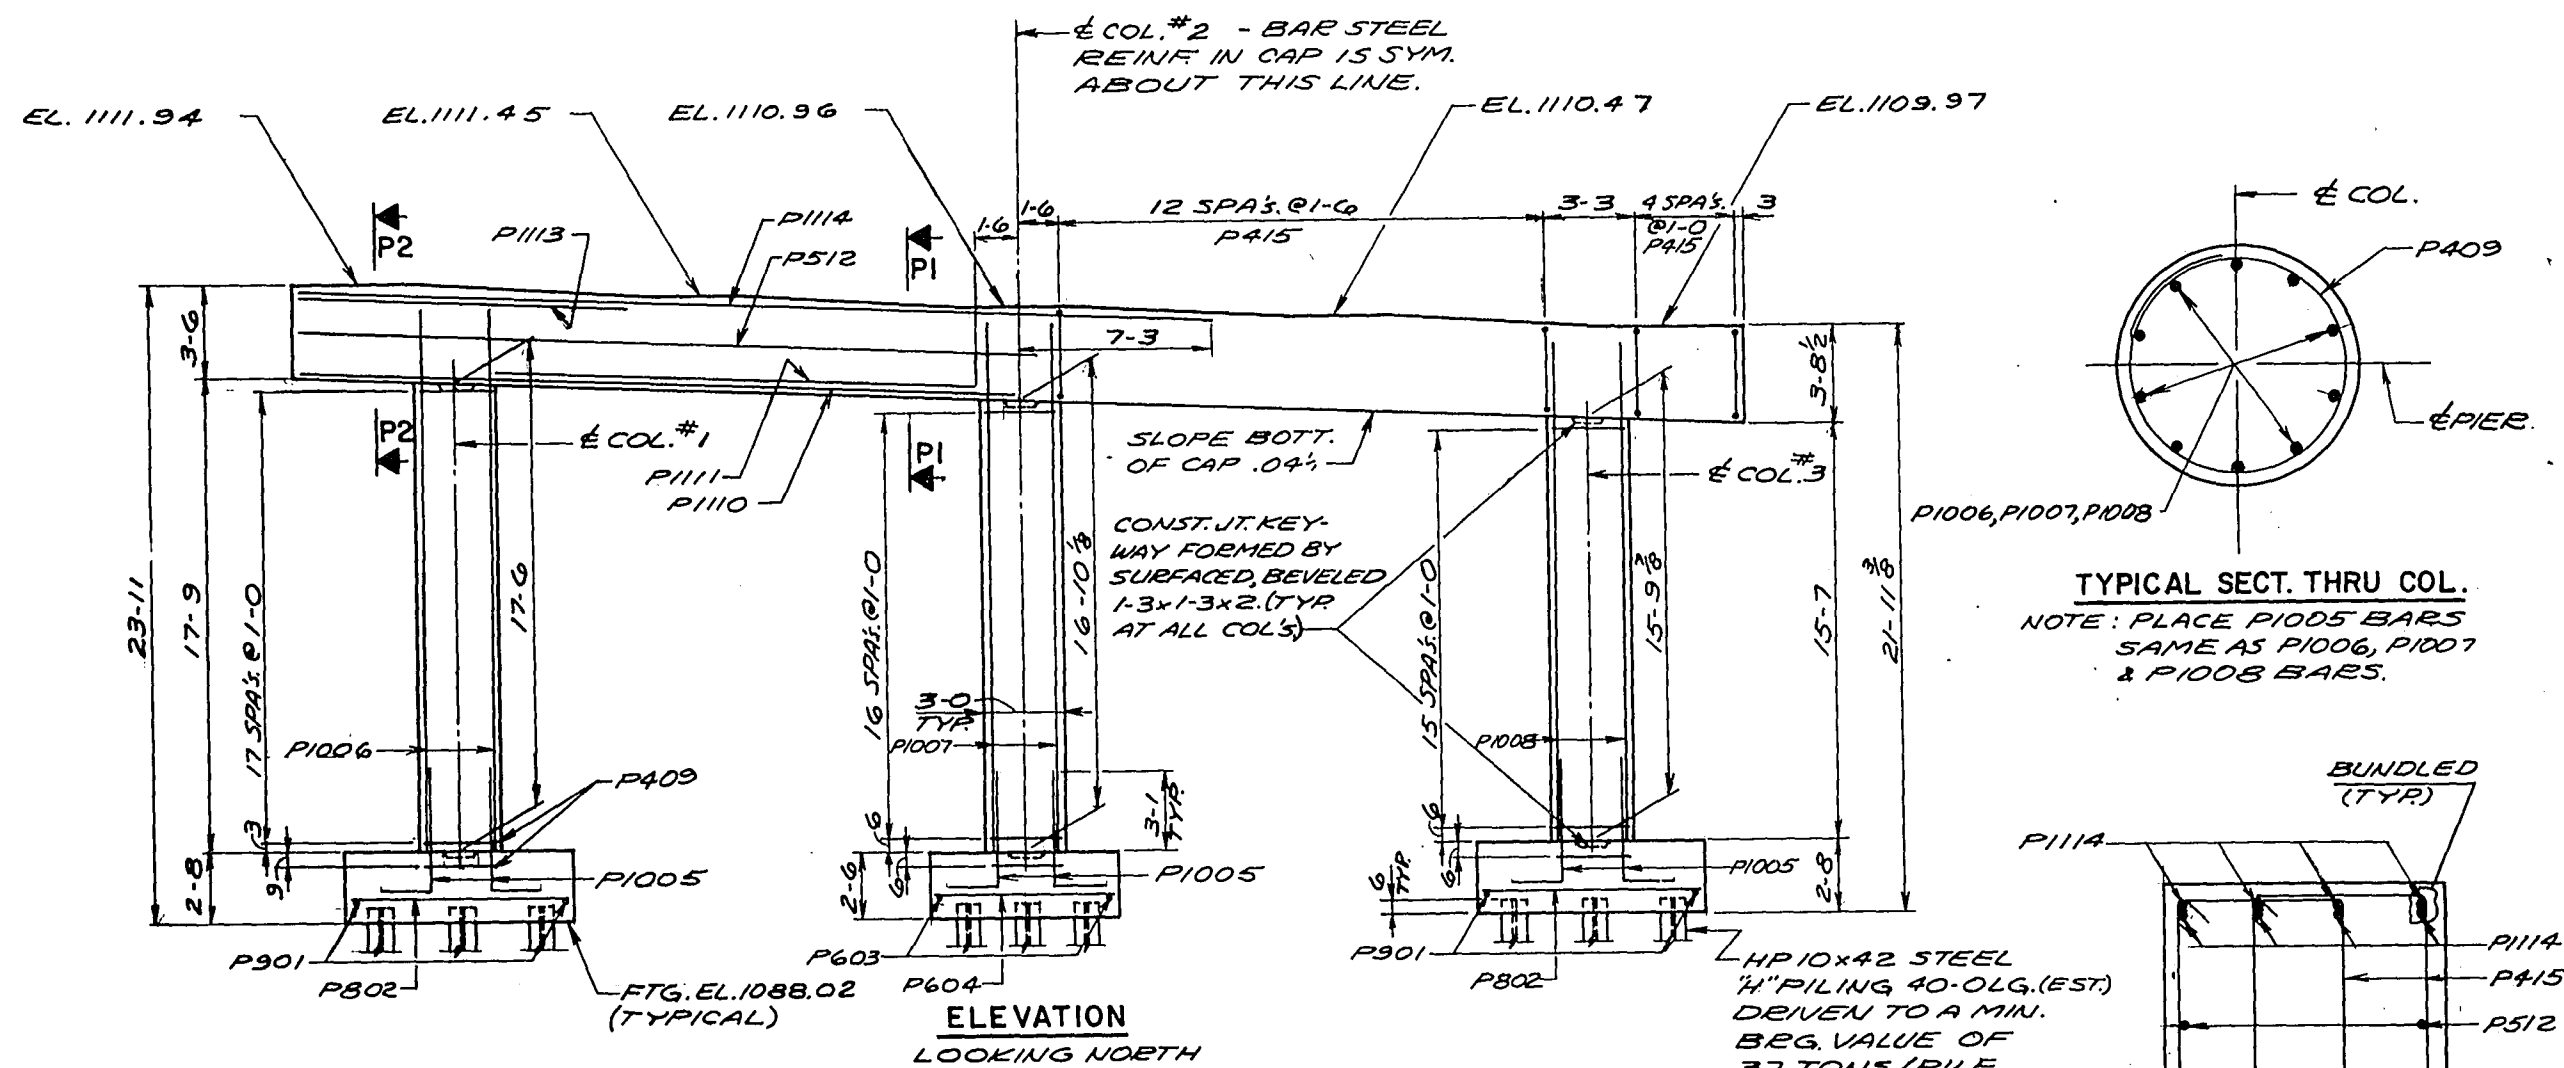



BILL OF BARS					8,740 #
BAR MARK	NO. REQ'D	LENGTH	BENT	BUNDLED	LOCATION
P901	16	7-6			EXTERIOR FOOTING
P802	16	8-0			" "
P603	8	7-0			INTERIOR "
P604	8	6-6			" "
P1005	30	6-4	X		FOOTING, COL. DOWELS
P1006	10	20-6			COL. #1 - VERT.
P1007	10	19-10			" #2 "
P1008	10	18-9			" #3 "
P409	54	9-5	X		" HOOPS - COL'S. & FTG'S.
P1110	8	26-6		X	CAP, BOTT
P1111	4	18-0		X	" "
P512	4	27-10			" SIDES
P1113	8	12-3		X	" TOP
P1114	8	34-0		X	" "
P415	72	11-3	X		" STIRRUPS

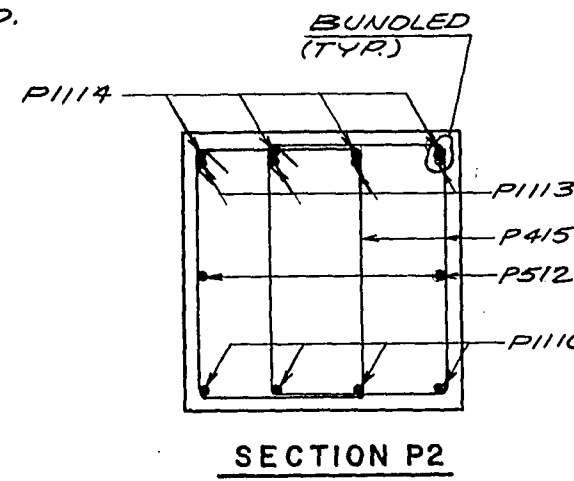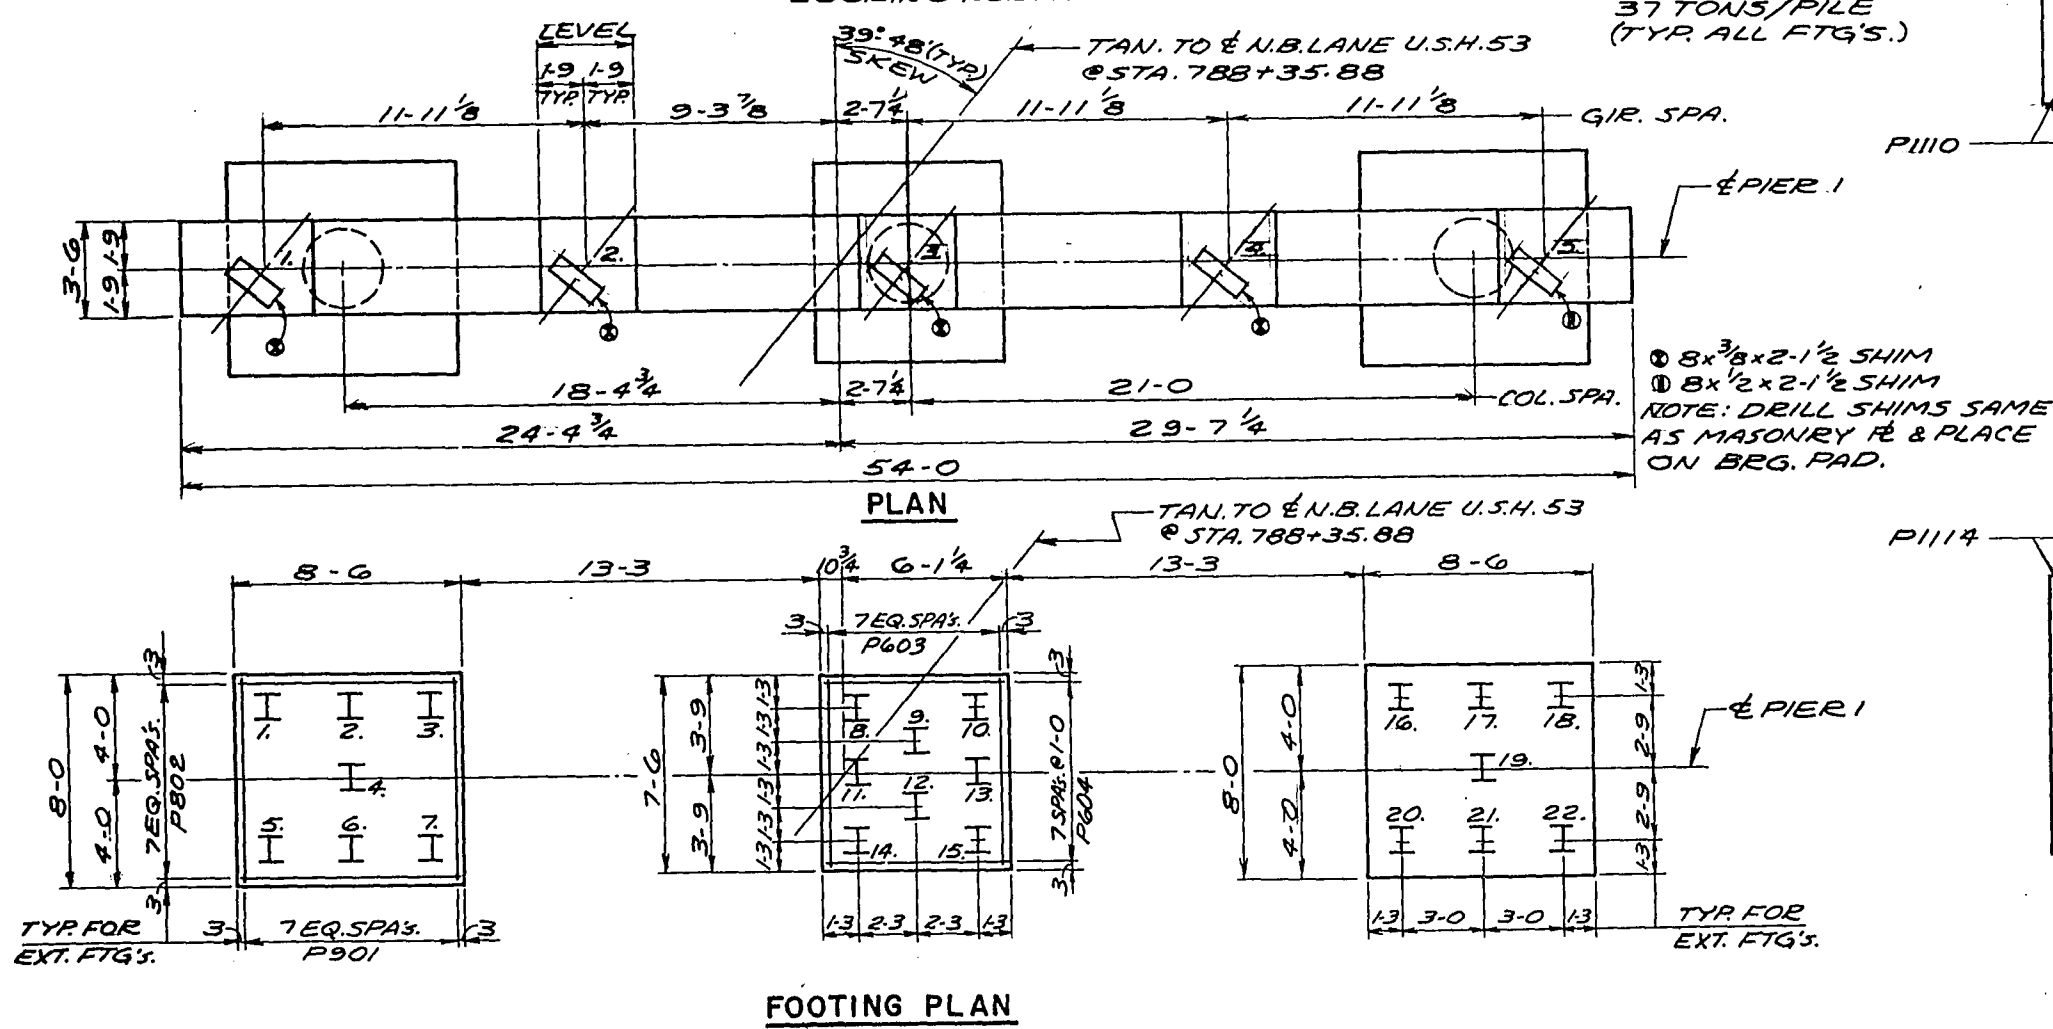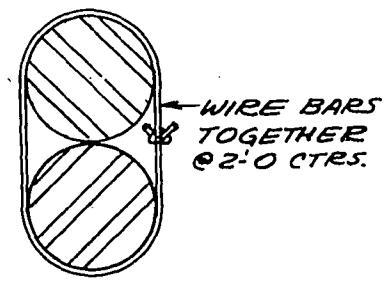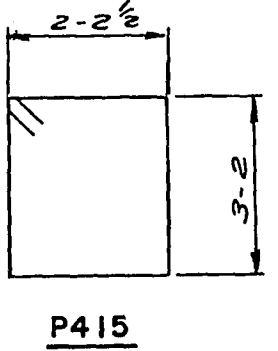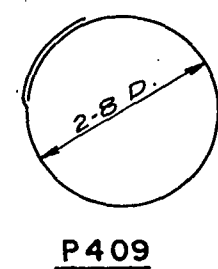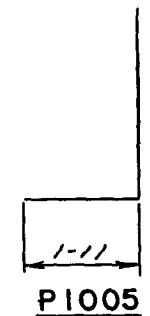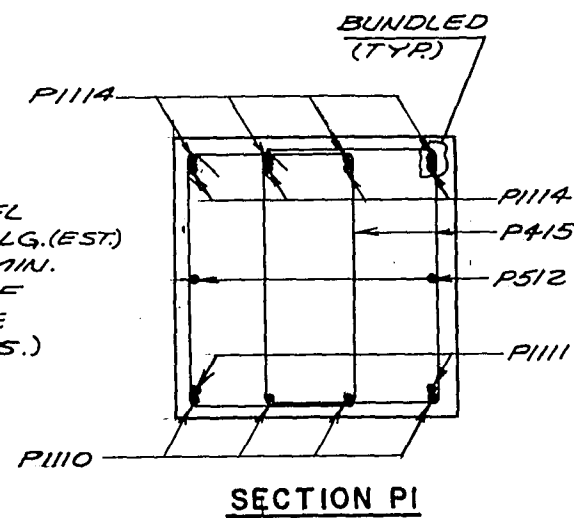

No.	Date	Revision	By
STATE OF WISCONSIN DEPARTMENT OF TRANSPORTATION DIVISION OF HIGHWAYS			
STRUCTURE B-3-31			
Const. Spec.	1969	Drawn By JG	Plans Checked DEO
PIER 1			SHEET 6 OF 13
			X 45738

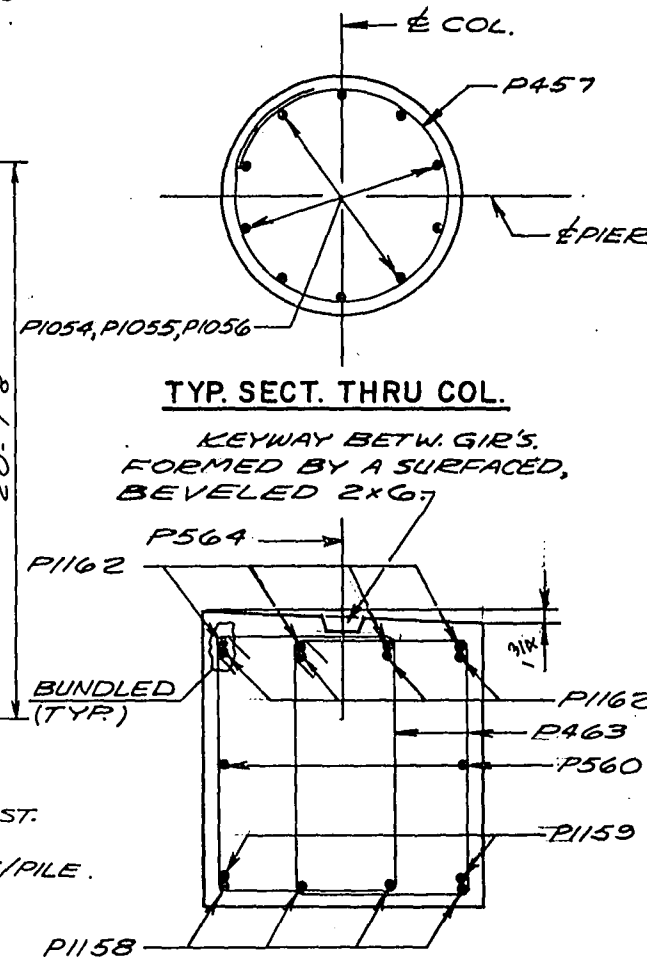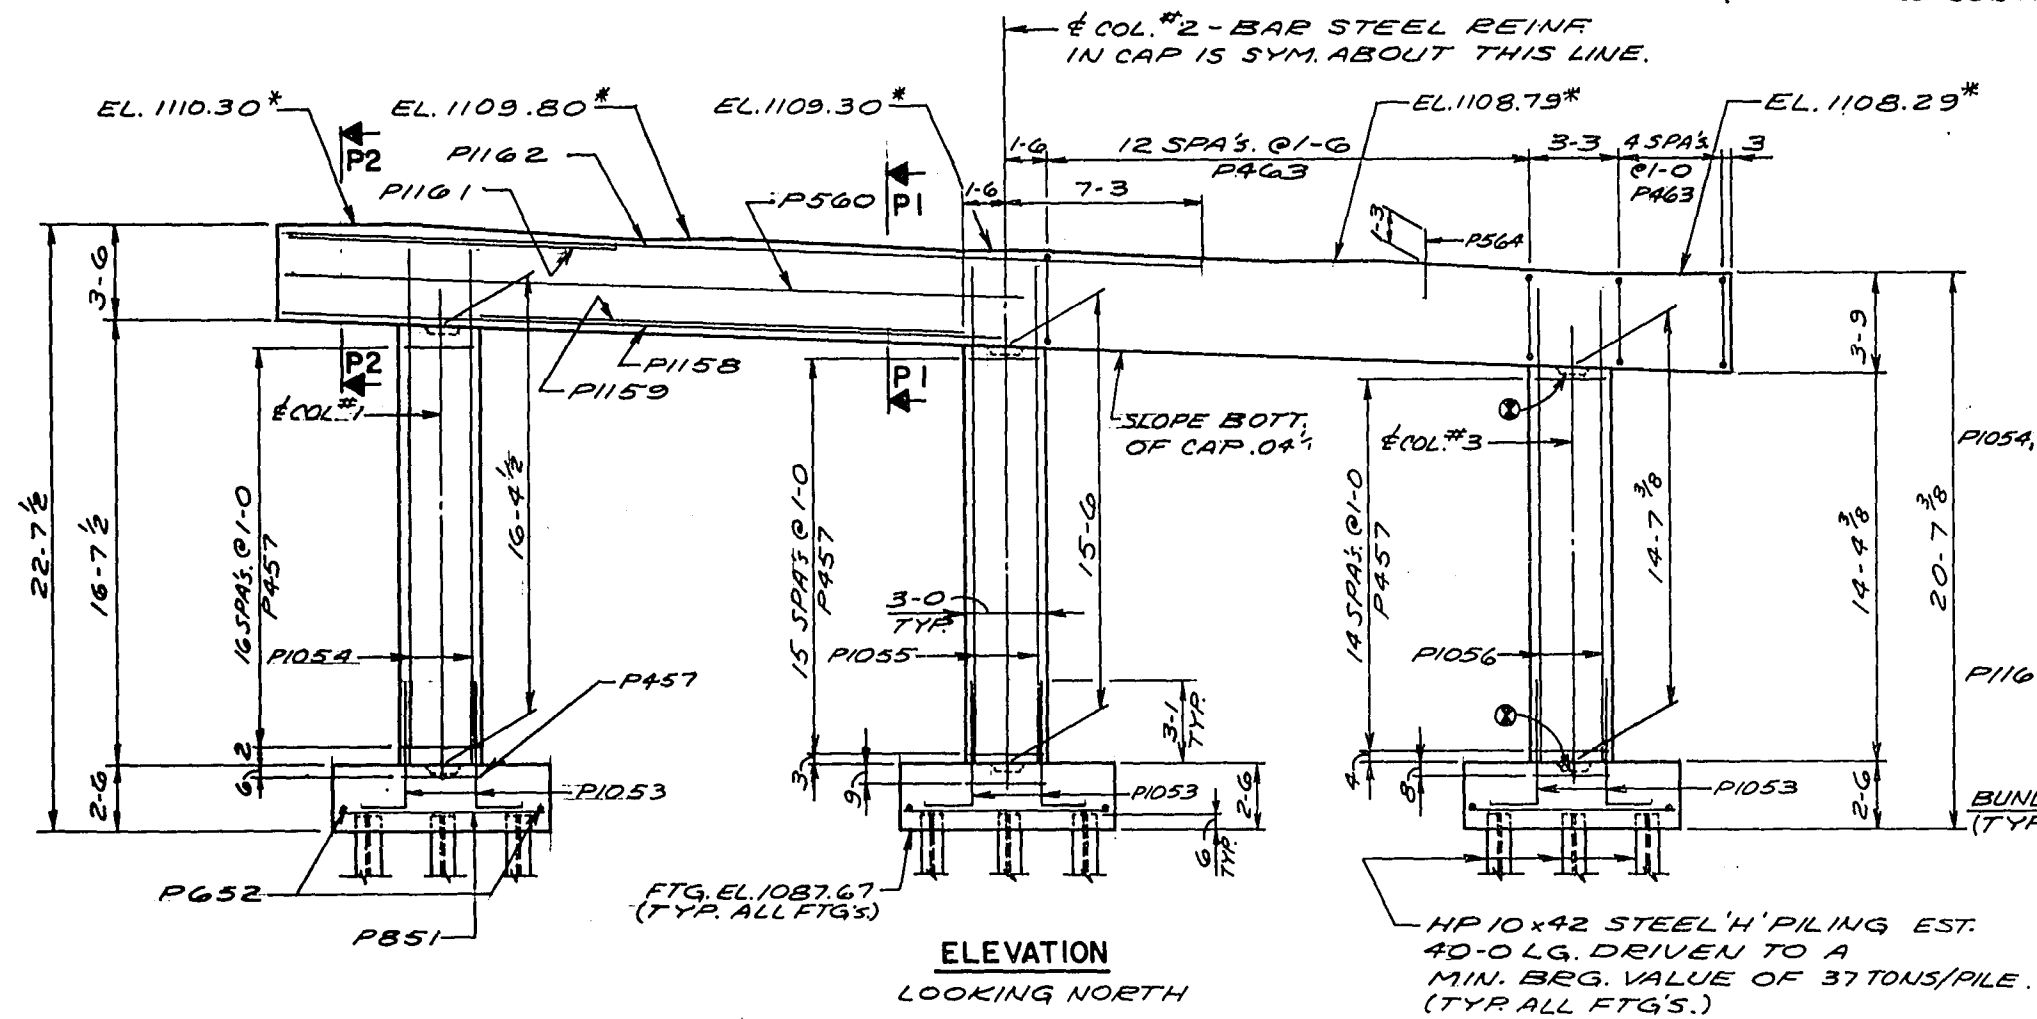


<u>BILL OF BARS</u>					8,440 #
BAR MARK	NO. REQ'D	LENGTH	BENT	BUN- DLED	LOCATION
P851	24	7-6			FOOTINGS
P652	24	6-6			"
P1053	30	6-4	X		" COL. DOWELS
P1054	10	19-4			COL. #1 - VERT
P1055	10	18-6			" #2 "
P1056	10	17-7			" #3 "
P457	51	9-5	X		" HOOPS - COL'S. & FTG'S.
P1158	8	26-6		X	CAP - BOTT.
P1159	4	18-0		X	" "
P560	4	27-10			" SIDES
P1161	8	12-3		X	" TOP
P1162	8	34-0		X	" "
P463	72	11-3	X		" STIRRUPS
P564	28	2-6			" DOWELS

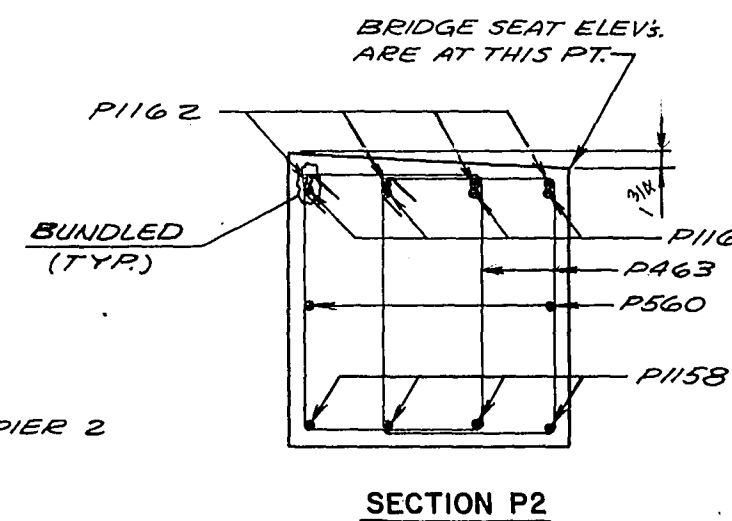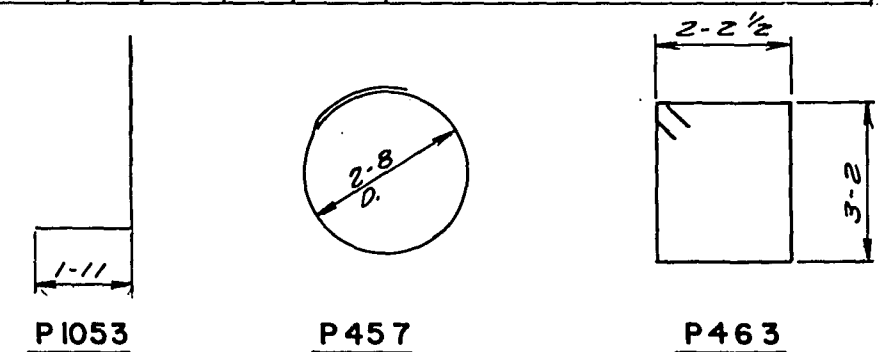


NOTE: FOR PILE SPLICE DETAIL SEE
SHEET NO. 5.
FOR BUNDLING DETAIL SEE
SHEET NO. 6.

No.	Date	Revision	By
STATE OF WISCONSIN DEPARTMENT OF TRANSPORTATION DIVISION OF HIGHWAYS			
STRUCTURE B-3-31			
Const. Spec.	1969	Drawn By	Plans Checked
PIER 2		SHEET 7 OF 13	
		X 45739	



S. P. R. Division	Project	Sheet Number	Total Sheets
4	1196-5-73 EMP-F08-440	72	188

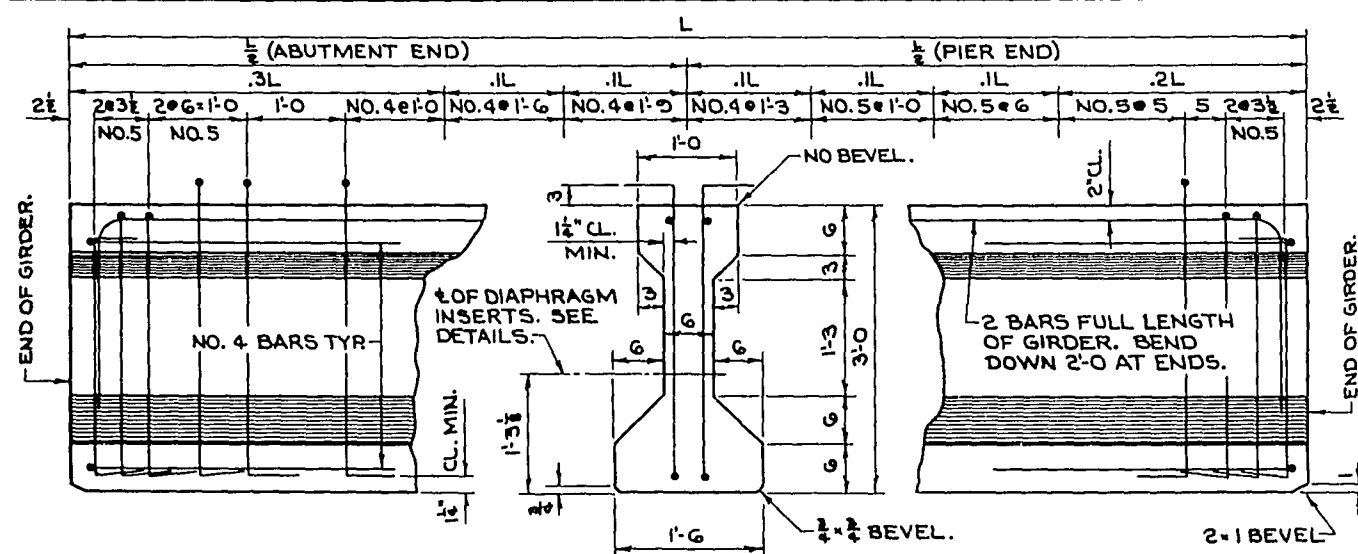

36" GIRDER - SIDE VIEW & TYPICAL SECTION IN SPAN

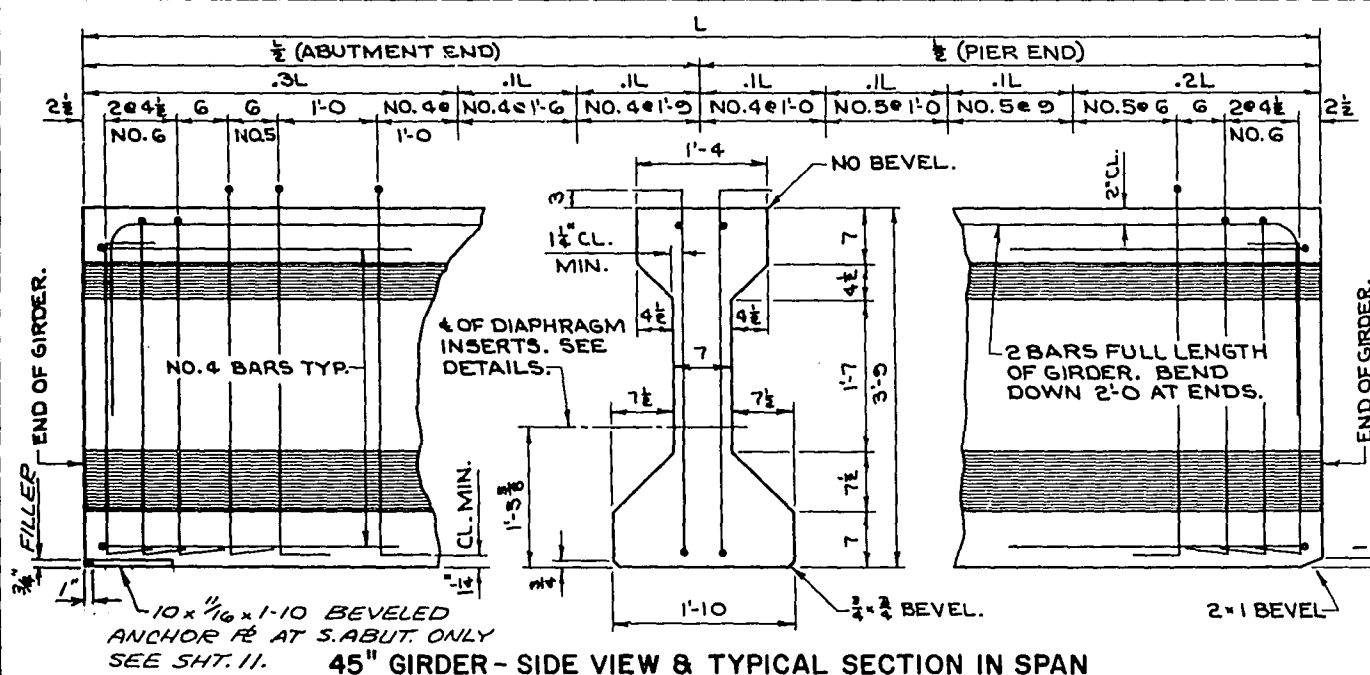



45" GIRDER - SIDE VIEW & TYPICAL SECTION IN SPAN

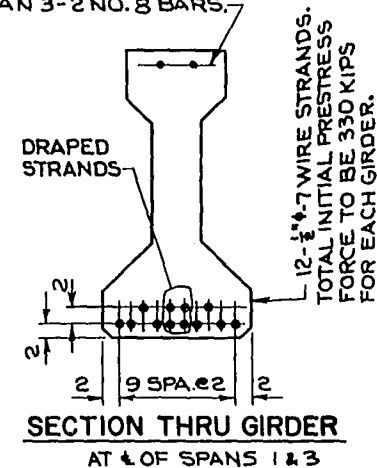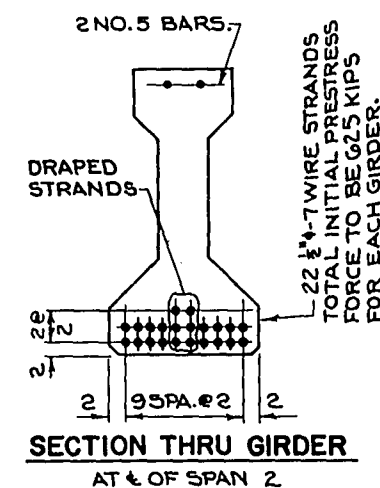SPAN 1 - 2 NO. 6 BARS.
SPAN 3 - 2 NO. 8 BARS.SECTION THRU GIRDER
AT 1/4 OF SPANS 1 & 3SECTION THRU GIRDER
AT 1/4 OF SPAN 2

NOTES


TOP OF GIRDERS TO BE ROUGH FLOATED AND BROOMED TRANSVERSELY FOR BONDING TO THE SLAB.
THE GIRDER MANUFACTURER SHALL PROVIDE A SUITABLE LIFTING DEVICE FOR HANDLING AND ERECTING THE GIRDERS.

ALL GIRDERS SHALL BE CAST FULL LENGTH AS SHOWN. PRESTRESSING STRANDS SHALL HAVE AN ULTIMATE STRENGTH OF 270,000 psi AND SHALL BE FLUSH WITH THE ENDS OF THE GIRDER. INSERTS SHALL BE PLACED ON 6" CENTERS SYMMETRICALLY ABOUT THE 1/2 OF DIAPHRAGMS IN SPANS. ALL STIRRUPS SHALL BE IN PAIRS AND THE SPACING SHOWN IN "SIDE VIEW" IS MAXIMUM. THE LOCATION SHALL BE SHOWN IN THE SHOP DRAWINGS. BEND EACH END OF NO. 4 AND NO. 5 STIRRUPS 6" AND NO. 6 STIRRUPS 6". ENDS OF STRANDS SHALL BE PAINTED WITH NON-STAINING GRAY SINGLE COMPONENT NON BITUMINOUS JOINT SEALER. (THIS APPLIES ONLY TO THOSE ENDS OF GIRDERS THAT ARE FINALLY EXPOSED.) TOP LONGITUDINAL BARS IN GIRDER MAY BE SPLICED BY USING 36 BAR DIAMETER LAPS. PLACE ONE LAP AT 1/4 OF GIRDER IF LENGTH IS < 70'-0". PLACE LAPS AT THE 1/3 RD POINTS OF GIRDER IF LENGTH IS > 70'-0".

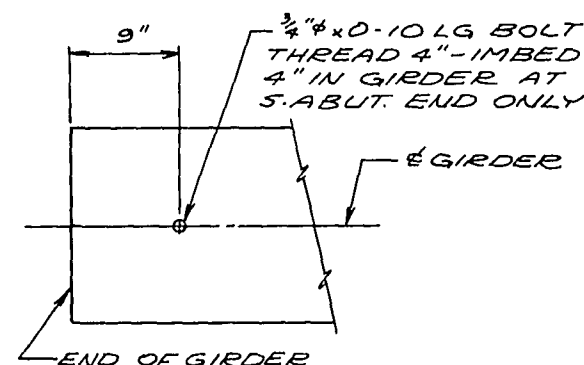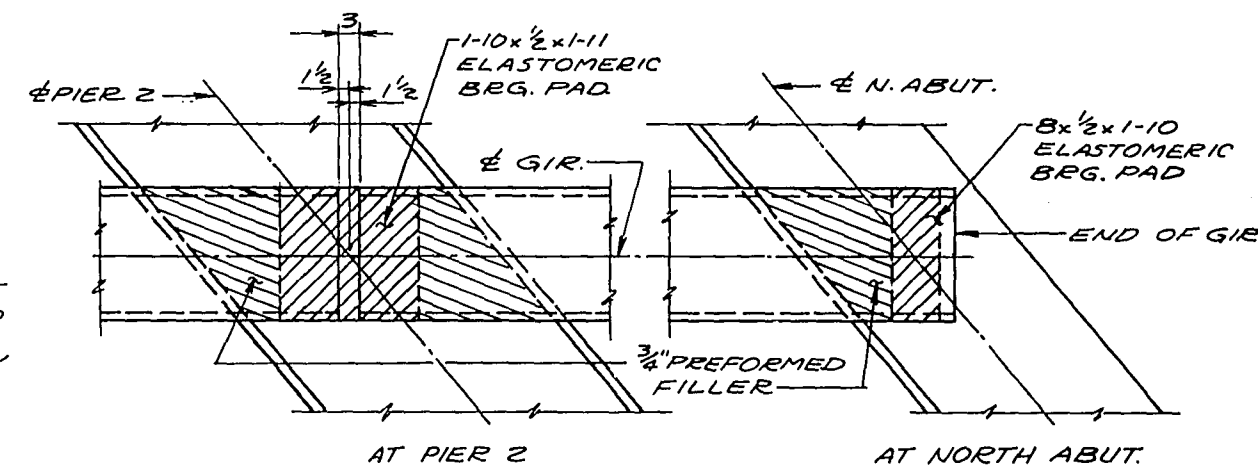ANCHOR BOLT LAYOUT
AT S. ABUT. ONLY

BEARING PAD LAYOUT



DIM.	SPAN 1	SPAN 2	SPAN 3
MAX.	11 1/4"	14 1/4"	10 1/2"
MIN.	8 1/2"	11 1/4"	7 1/2"
"A"	24"	33"	21"
"B"	3"	4"	3"

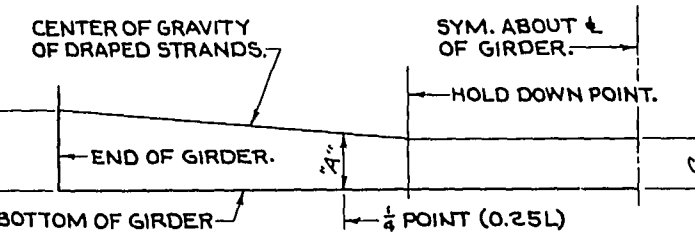


DRAPED STRAND PROFILE



DATA SHOWN IS THEORETICAL AND MAY VARY WITH CONCRETE STRENGTH, VARIABLE PRESTRESS CONDITIONS AND PRESTRESS LOSSES.

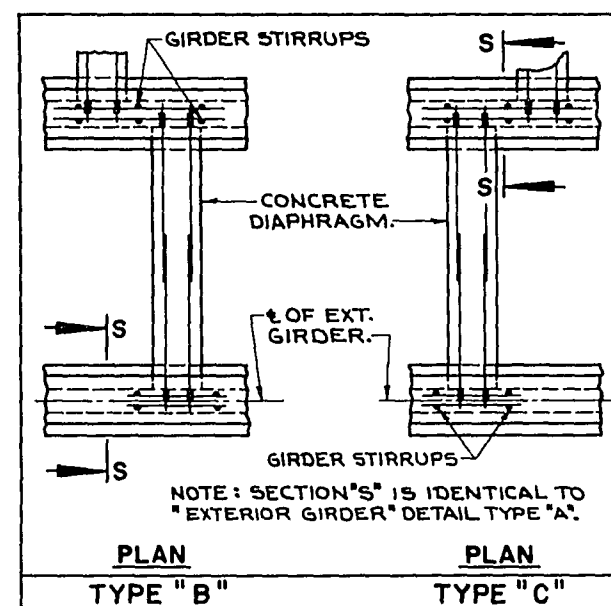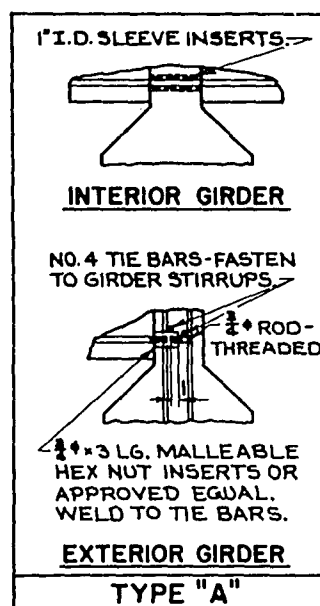


DIAPHRAGM INSERT DETAILS

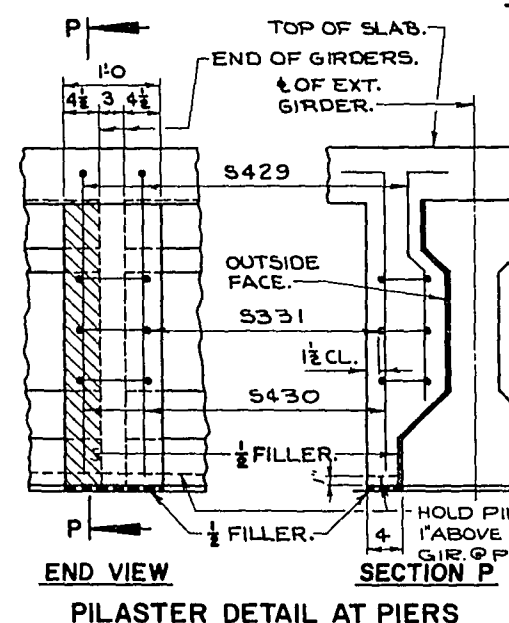

PILASTER DETAIL AT PIERS



* MINIMUM CYLINDER STRENGTH OF CONCRETE AT TIME OF TRANSFER OF PRESTRESS FORCE.

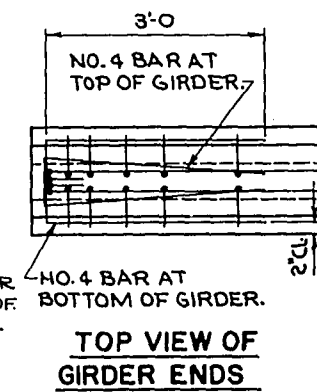

TOP VIEW OF GIRDER ENDS

GIRDER DATA				
GIRDER SIZE REQUIRED 45"				
GIRDER LENGTH "L" REQUIRED	SPAN 1	SPAN 2	SPAN 3	
47'-4 1/2"	69'-3"	37'-4 1/2"		
f'ci (psi)*	DRAPED PATTERN	4800	4800	4800
	SPREAD PATTERN			
DEFLECTION DATA**	PRESTRESS CAMBER "D"	3/8"	1 1/4"	1/4"
	DEAD LOAD DEFLECTION "E"	1/8"	3/4"	1/8"
	RESIDUAL CAMBER "F"	1/4"	1/2"	1/8"
USE DIAPHRAGM INSERT DETAIL TYPE "B"				


No.	Date	Revision	By
STATE OF WISCONSIN DEPARTMENT OF TRANSPORTATION DIVISION OF HIGHWAYS			
STRUCTURE B-3-31			
Const. Spec.	1969	Drawn By JAG	Plots Checked DEO
PRESTRESSED GIRDER DETAILS			SHEET 8 OF 13
			X 45740

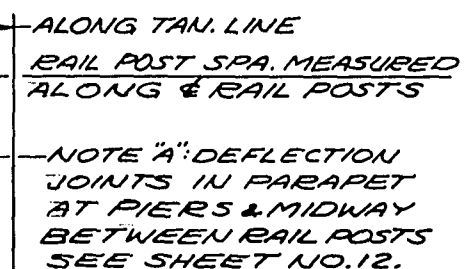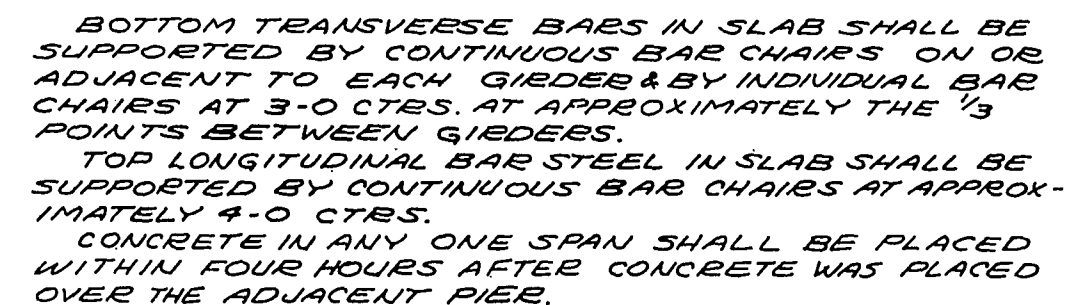

NORMAL TO TAN. TO E.N.B. LANE AT STA. 788+35.88

	-100	-90	-80	-70	-60	-50	-40	-30	-20	-10	0	10	20	30	40	50	60	70	80	90	100
DIM. "A"	17-5	17-6 ³ / ₈	17-7 ¹ / ₂	17-8 ⁵ / ₈	17-9 ¹ / ₂	17-10 ¹ / ₄	17-10 ³ / ₈	17-11 ³ / ₈	17-11 ³ / ₄	17-11 ⁷ / ₈	18-0	17-11 ⁷ / ₈	17-11 ³ / ₄	17-11 ³ / ₈	17-10 ³ / ₈	17-10 ¹ / ₄	17-9 ¹ / ₂	—	—	—	—
EL. "B"	1118.01	1117.76	1117.51	1117.26	1117.01	1116.76	1116.50	1116.24	1115.98	1115.72	1115.45	1115.19	1114.92	1114.64	1114.37	1114.09	1113.81	—	—	—	—
DIM. "C"	0-7	0-5 ⁵ / ₈	0-4 ¹ / ₂	0-3 ³ / ₈	0-2 ¹ / ₂	0-1 ³ / ₄	0-1 ¹ / ₈	0-0 ⁵ / ₈	0-0 ¹ / ₄	0-0 ¹ / ₈	0-0	0-0 ¹ / ₈	0-0 ¹ / ₄	0-0 ⁵ / ₈	0-1 ¹ / ₈	0-1 ³ / ₄	0-2 ¹ / ₂	0-3 ³ / ₈	0-4 ¹ / ₂	0-5 ⁵ / ₈	0-7
EL. "D"	1117.44	1117.19	1116.94	1116.69	1116.44	1116.19	1115.93	1115.67	1115.41	1115.14	1114.88	1114.61	1114.34	1114.07	1113.79	1113.51	1113.23	1112.95	1112.67	1112.38	1112.09
DIM. "E"	—	—	—	22-3 ³ / ₈	22-2 ¹ / ₂	22-1 ³ / ₄	22-1 ¹ / ₈	22-0 ⁵ / ₈	22-0 ¹ / ₄	22-0 ¹ / ₈	22-0	22-0 ¹ / ₈	22-0 ¹ / ₄	22-0 ⁵ / ₈	22-1 ¹ / ₈	22-1 ³ / ₄	22-2 ¹ / ₂	22-3 ³ / ₈	22-4 ¹ / ₂	22-5 ⁵ / ₈	22-7
EL. "F"	—	—	—	1115.99	1115.74	1115.48	1115.23	1114.97	1114.70	1114.44	1114.17	1113.90	1113.63	1113.36	1113.08	1112.80	1112.52	1112.24	1111.96	1111.67	1111.38

No.	Date	Revision	By
STATE OF WISCONSIN DEPARTMENT OF TRANSPORTATION DIVISION OF HIGHWAYS			
STRUCTURE B-3-31			
Const. Spec.	1969	Drawn By AG	Plans Checked DEO
SUPERSTRUCTURE			SHEET 9 OF 13 X 45741

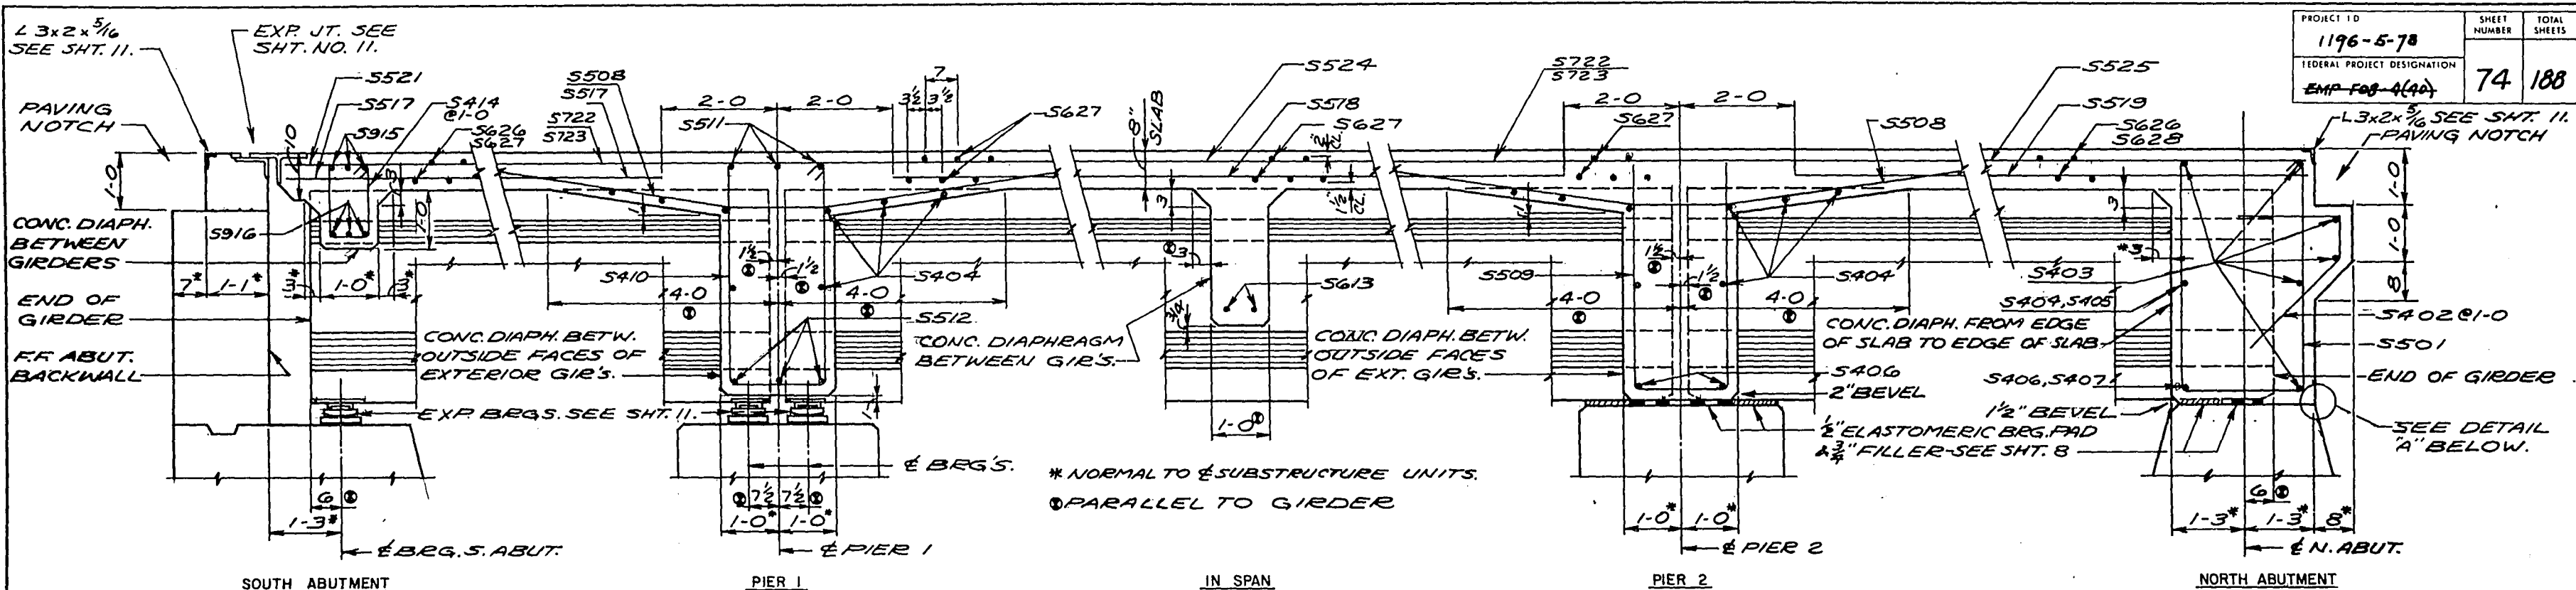


LONGITUDINAL SECTION THRU ROADWAY



BILL OF BARS 64,490 #

BAR MARK	NO. REQD	LENGTH	BENT	CUT. DIAG.	LOCATION
S501	38	14-5	X		DIAPHRAGM @ N. ABUT.
S402	34	4-5	X		" " " "
S403	12	28-6			" " " " & PIERS
S404	68	9-10			" " " " & PIER 2
S405	2	2-8			" " " " & PIER 2
S406	12	9-1			" " " " & PIER 2
S407	2	2-1			" " " " & PIER 2
S508	64	11-4	X		HAUNCH @ PIERS
S309	32	10-0	X		DIAPH. @ PIER 2
S410	32	12-8	X		" " " " & PIER 2
S511	6	24-10			" " " " & PIER 2
S512	12	9-1			" " " " & PIER 2
S413	48	5-4			" " " " IN SPANS
S414	32	4-10	X		" " " " @ S. ABUT.
S415	6	25-0			" " " " @ S. ABUT.
S416	12	10-0			" " " " @ S. ABUT.
S517	112	23-9			SLAB, BOT. SPAN 1
S518	112	33-5			" " " " " 2
S519	56	36-5			" " " " " 3
S520	16	15-0			" " " " SYM. ABOUT PIER 2
S521	38	18-7			" " " " TOP, SPAN 1
S722	66	41-0			" " " " OVER PIERS
S723	68	32-6			" " " " " "
S524	38	22-8			" " " " SPAN 2
S525	38	8-9			" " " " " 3
S426	56	42-6	X		" " " " TOP & BOT. TRANS, SPAN 1
S427	422	42-4			" " " " " " 1,2,3
S428	57	42-5	X		" " " " " " 3
S429	8	3-3	X		PILASTER @ PIERS
S430	8	4-2	X		" " " " " "
S331	12	3-4	X		" " " " " "
S532	314	4-9	X		SLAB & RAIL PARAPET
S533	314	5-1	X		RAIL PARAPET
S534	20	17-1			" " " " " "
S535	30	21-8			" " " " " "
S536	10	8-2			" " " " " "
S537	10	13-1			" " " " " "
S538	10	11-7			" " " " " "
S539	10	20-6			" " " " " "


* PLAIN BAR THREAD ONE END 3".

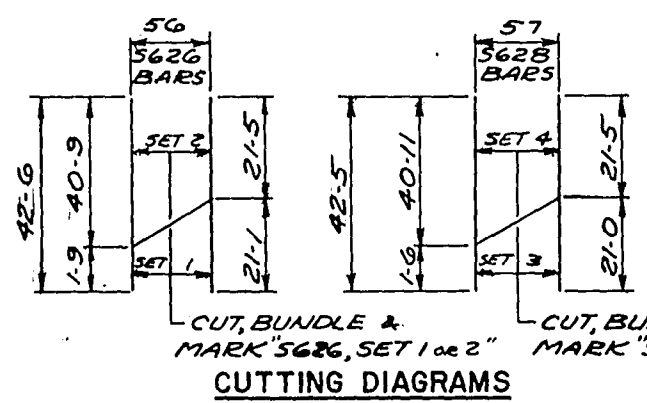

BAR MARK	DIM. "A"	DIM. "B"
S501	2-11	4-0
S410	2-3	3-10
S414	1-0	1-2
S331	0-8	0-9

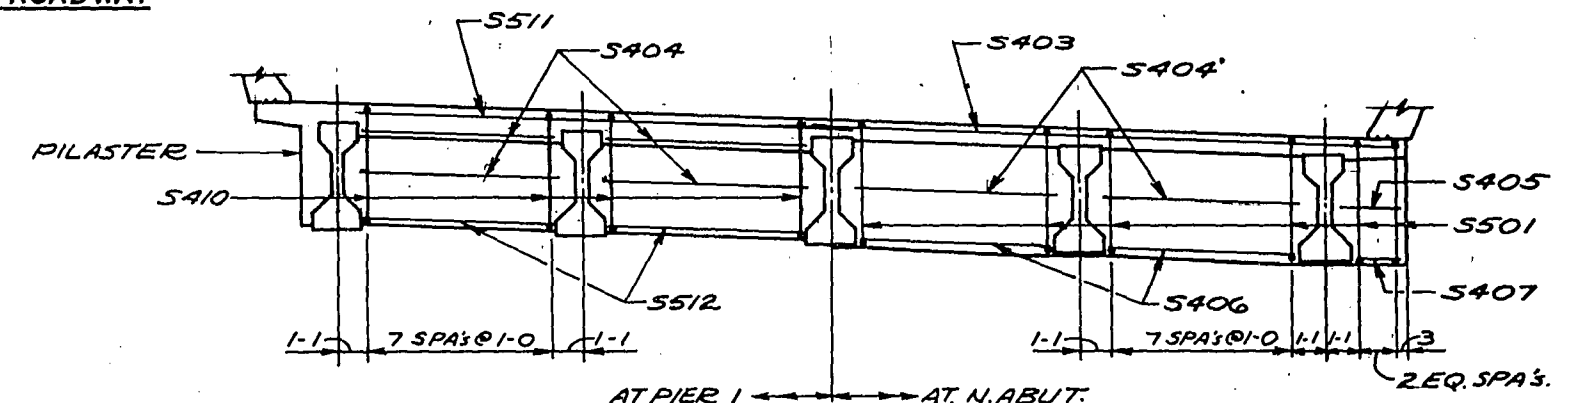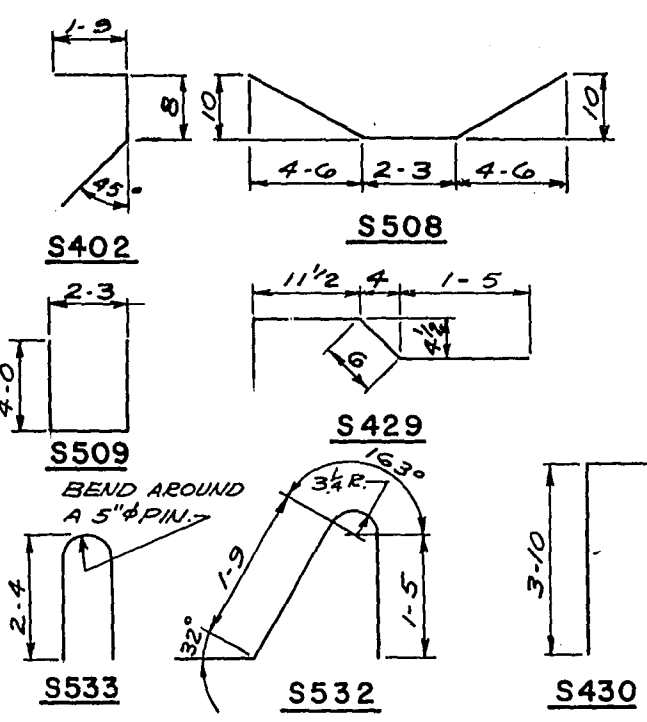


CROSS SECTION THRU ROADWAY (NORMAL TO TAN. TO E.N.B. LANE @ STA. 788+35.88)

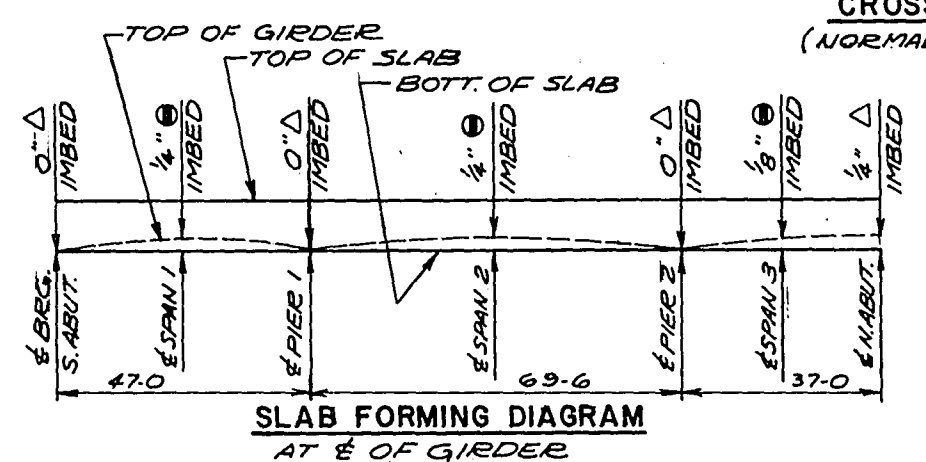

SLAB FORMING DIAGRAM AT E. OF GIRDER

TO COMPENSATE FOR VARIATIONS IN PRESTRESS CAMBER & OTHER MINOR CONSTRUCTION DISCREPANCIES THE IMBEDMENT AT THE E. OF THE SPAN MAY BE VARIED WITH A MAXIMUM OF 1 1/2" ALLOWABLE IMBEDMENT AND THE SLAB HELD TO PLAN THICKNESS.




IF VARIATIONS IN PRESTRESS CAMBER AND OTHER MINOR CONSTRUCTION DISCREPANCIES ARE OF SUCH A MAGNITUDE THAT THE MAXIMUM ALLOWABLE IMBEDMENT, AS NOTED ABOVE, SHALL BE EXCEEDED THESE DIMENSIONS SHALL BE REVISED. THE 1 1/2" IMBEDMENT AND THE PLAN SLAB THICKNESS SHALL BE HELD WHILE THE GRADE LINE WILL BE REVISED.

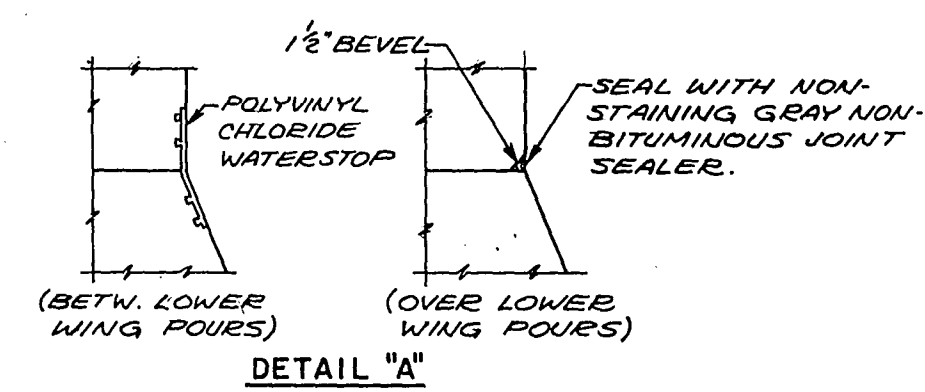

DETAIL "A"

No.	Date	Revision	By
STATE OF WISCONSIN DEPARTMENT OF TRANSPORTATION DIVISION OF HIGHWAYS			
STRUCTURE B-3-31			
Const. Spec.	1969	Drawn By JG	Plans Checked DEO
SUPERSTRUCTURE			SHEET 10 OF 13
			X 45742

S524 76 23'8"

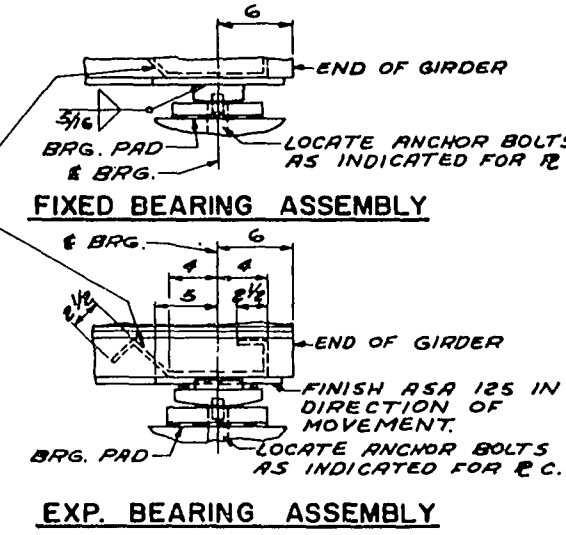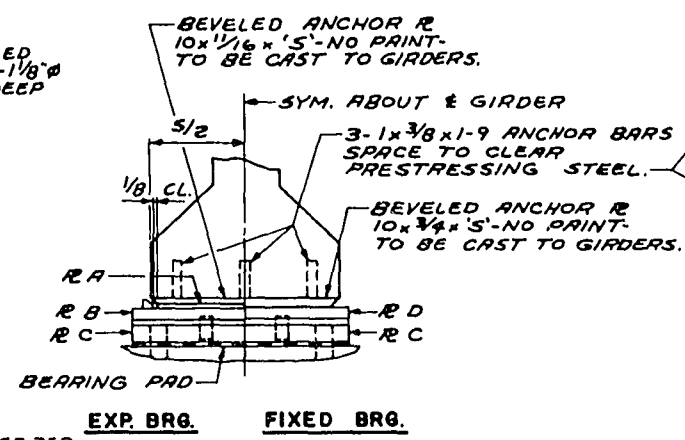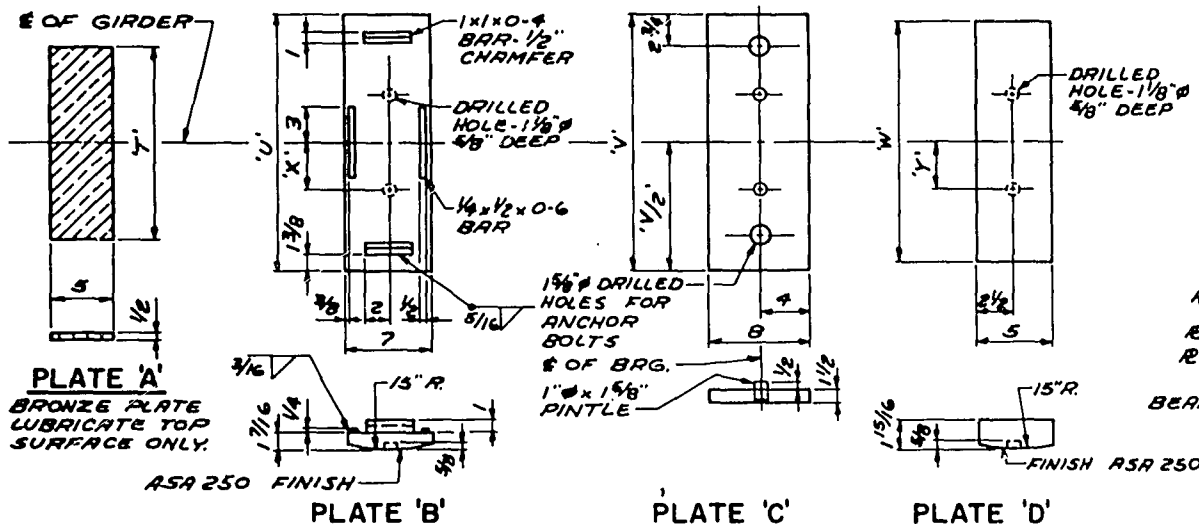

BEARING NOTES

ALL MATERIAL EXCLUDING ANCHOR BOLTS, PINTLES, NUTS AND WASHERS SHALL BE MADE OF A588 STEEL. PINTLES SHALL BE MADE OF A449 STEEL.

ALL STRUCTURAL STEEL BEARING PLATES SHALL BE FLAT ROLLED STEEL PLATES WITH ALL SURFACES SMOOTH AND FREE FROM WARP AND ALL EDGES SMOOTH, STRAIGHT AND VERTICAL. ALL PLATE CUTS SHALL BE MACHINE OR MACHINE FLAME CUTS. MACHINE FINISH THE BOTTOM SURFACE ONLY OF PLATES SHOWN TO BE FINISHED.

ALL MATERIAL EXCLUDING BRONZE PLATES, BEARING PADS AND ANCHOR PLATES SHALL BE PAID FOR AT THE UNIT PRICE BID FOR "STRUCTURAL LOW ALLOY STEEL."

ALL ANCHOR BOLTS TO BE 1 1/4" x 1-3 LONG, SET FLUSH AND CAULK WITH LEAD TO THE TOP OF PLATE 'C'. EXCESS LENGTH MAY BE FURNISHED, THREADED FOR SETTING AND THEN CUT OFF FLUSH.

CHAMFER TOP OF PINTLES 1/8". DRILL HOLES FOR PINTLES IN PLATE 'C' FOR DRIVING FIT.

PROVIDE 1/8" THICK BEARING PAD SAME SIZE AS PLATE 'C' FOR EACH BEARING.

ALL BEARINGS ARE SYMMETRICAL ABOUT E OF GIRDER AND E OF BEARING.

LEGEND

- WT 6x39.5 x ROADWAY WIDTH. WELDMENT MAY BE USED. SEE DETAIL 'A'.
- 2x9x7/16 x RDWY. WIDTH. LONG DIMENSION OF 1/4" x 1 1/2" SLOTTED HOLE TO BE PARALLEL TO DIRECTION OF MOVEMENT.
- BAR 1 1/2x3/4 x RDWY. WIDTH. WELD TO L#2 WITH 2 LINES OF 1/4" FILLET WELD, 20°C.
- 3/4" FLAT HEAD CAP SCREW x 2 3/4" LONG WITH SQ. NUT AT 4-0 CENTERS. GREASE FOR EASY REMOVAL. 1 3/8" x 1 1/2" SLOTTED HOLE IN L#2. 3/16" HOLE C/SK 7/16" DEEP IN WT #1. ALIGN HOLES WITH SLOT IN BAR #3.
- 2 3/4" x 3/4" FILLET WELD TO FLANGE AND STEM OF WT #1 NEAR SIDE AND FAR SIDE. PROVIDE 1 3/8" HOLE IN 3 1/2" LEG FOR ROD #10.
- 3/4" x 10" LONG ROD. THREAD 4". IMBED 9" IN GIRDER.
- PROVIDE 2 PLATE WASHERS AND 2 HEX NUTS PER BOLT.
- VENT HOLES, 1 3/8" x 2-0 CTRS. IN WT #1 AND L#2 AND 3-0 CTRS. IN L#2.
- 3/8" STUDS x 6 3/8" LONG. WELD TO WT #1 AT 6" ALTERNATE CENTERS BETWEEN GIRDERS.
- 3/8" STUDS x 6 3/8" LONG. WELD TO L#2 AT 9" ALTERNATE CENTERS.
- 2 3/8" x 1/2" x 3/8" LONG AT 3-0 CENTERS. WELD TO L#2. PROVIDE 1 3/8" HOLE IN 2 1/2" LEG FOR ROD #11.
- 1 1/4" x 1/2" x 1/4" LONG KEEPER BAR. ONE PER #4 BOLT. PLACE BAR WITH LONG DIMENSION PARALLEL TO E OF RDWY. 1/8" CLEAR FROM #4 SQUARE NUT AND WELD BAR AT SIDE FACING AWAY FROM NUT WITH 3/16" FILLET WELD 1 1/4" LONG TO L#2.
- 1 1/2" x 3/8" FIELD WELD TO WT #1.
- 1 1/2" x 3/8" WELD TO R#15 WITH ONE LINE OF 1/4" MAX. FILLET WELD, N.S. & F.S.
- 1 1/2" x 3/8" FIELD WELD TO BAR #3.
- 3/8" STUDS x 6 3/8" LONG. WELD TO R#13 AND #14.
- BLOCK AND BOLT FOR SHIPMENT WITH PIPE SLEEVE AND 1/2" BOLT. PROVIDE 7/16" HOLES AT 3-0 CENTERS IN WT #1 AND L#2 FOR BOLT.
- 2 3/8" x 1/2" x 3/8" RDWY. WIDTH. ONE WELDED FIELD SPLICE WILL BE PERMITTED. SEE DETAIL #19. PROVIDE ONE ANGLE PER ABUT.
- 3/8" STUDS x 4" LONG. WELD TO L#18 AT 6" ALTERNATE CENTERS.





EXPANSION JOINT NOTES

EXPANSION JOINT SHALL BE BUILT TO CONFORM TO ROADWAY CROWN AND GRADE.


AFTER CONCRETE HAS SET THE JOINT OPENING SHALL BE THOROUGHLY CLEANED AND BOLTS #4 REMOVED AND THE HOLES FILLED WITH HOT POURED ELASTIC JOINT SEALER.

APPLY 1/16" COAT OF BITUMASTIC TO METAL SURFACES FORMING JOINT AND FILL OPENING WITH HOT POURED ELASTIC JOINT SEALER.

ALL MATERIAL SHALL BE PAID FOR AT THE UNIT PRICE BID FOR "STRUCTURAL CARBON STEEL."

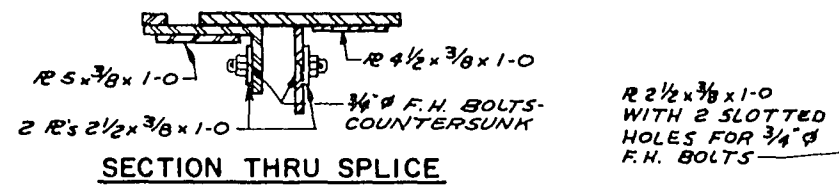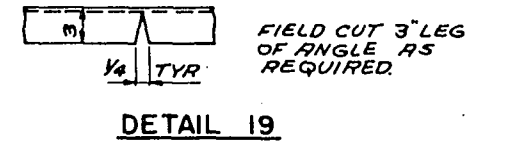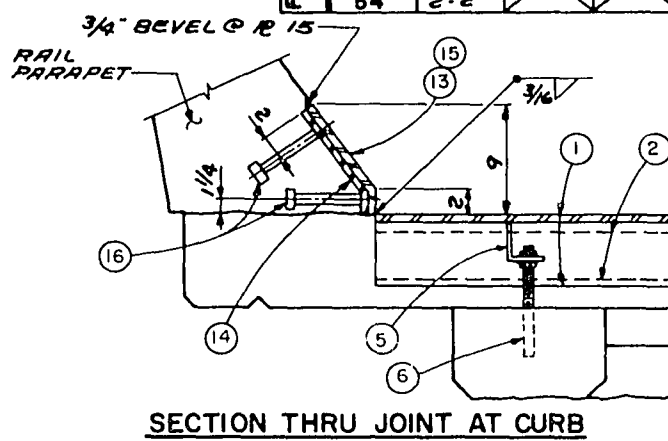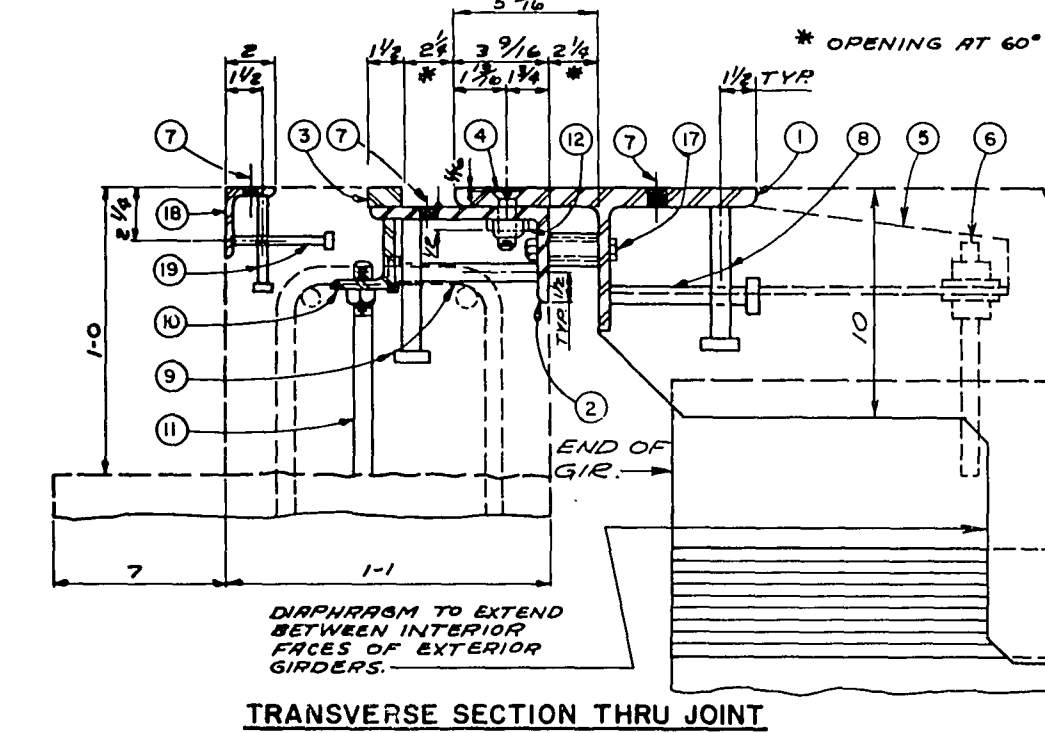

OPTIONAL FIELD SPLICE DETAIL
ONE SPLICE SHALL BE PERMITTED IN JOINT.

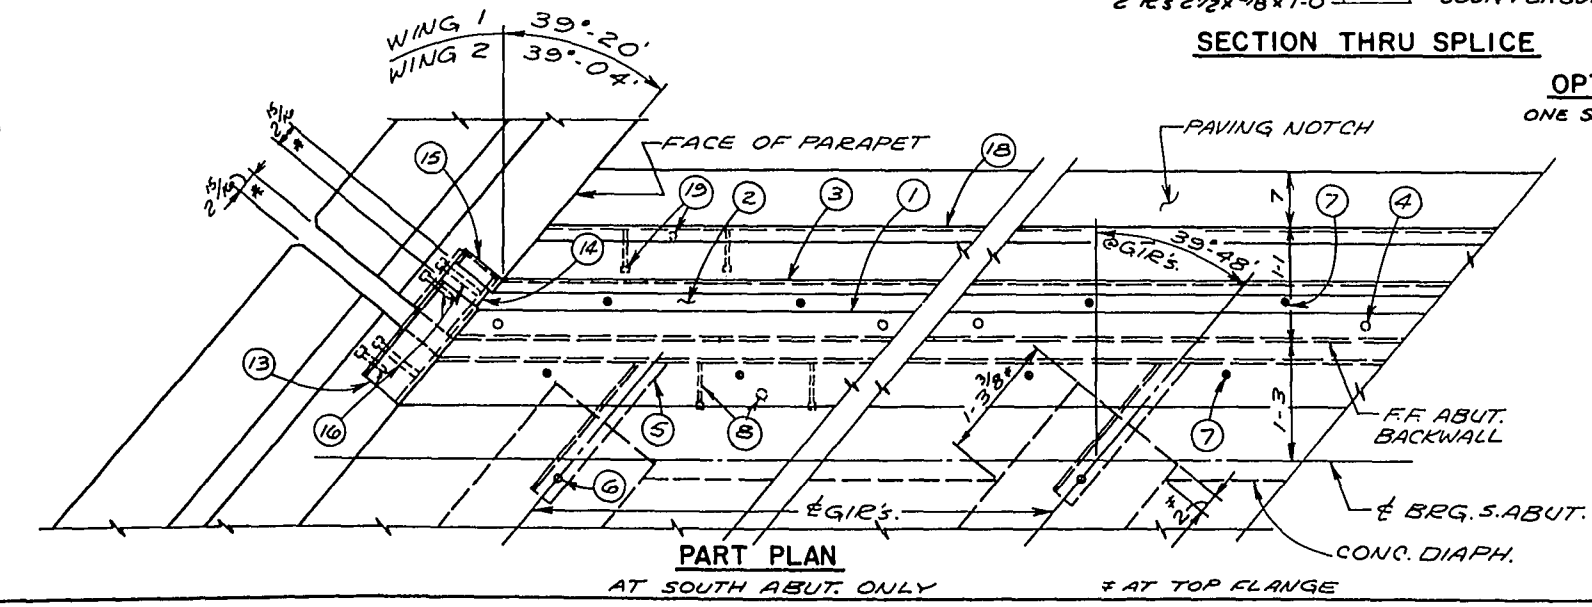

DETAIL A
WELDMENT OPTION FOR 1

No.	Date	Revision	By
STATE OF WISCONSIN DEPARTMENT OF TRANSPORTATION DIVISION OF HIGHWAYS			
STRUCTURE B-3-31			
Const. Spec.	1969	Drawn By	JG
		Plans Checked	DEO
EXPANSION JOINT			SHEET 11 OF 13
8			
BEARING DETAILS			X 45743

