



**STATE OF WISCONSIN
DEPARTMENT OF TRANSPORTATION**

**Inspection Report for
B-03-038 (USH 8)**

**USH 53 NB over USH 8
May 16,2017**



Type	Prior	Frequency (mos)	Performed
Routine	05-13-15	24	X
Interim	02-19-07	0	
SIA Review	06-11-13	48	X

Latitude 45°23'42.38"N
Longitude 91°45'27.10"W

Owner STATE HIGHWAY DEPT
Maintainer STATE HIGHWAY DEPT

Time Log

Team members

Hours	Minutes	Wjk
0	55	

Inspector	Name	Number	Signature	Date
	Kovaleski, William J	8007	<i>William J Kovaleski</i> E-signed by Bill(dotwj)k	08-07-17

BRIDGE INSPECTION REPORT
Wisconsin Department of Transportation
DT2007 2003 s.84.17 Wis. Stats.

page 2

Identification & Location

Feature On: USH 53 NB	Section Town Range: S29 T34N R11W	Structure Number: B-03-038
Feature Under: USH 8	County: BARRON	
Location 8.5M N JCT CTH I TO E	Municipality: STANLEY	Structure Name: USH 8

Geometry

measurements in feet, except where noted

Approach Roadway Width: 56	Bridge Roadway Width: 74.0	Total Length: 244.2
Approach Pavement Width: 40	Deck Width: 80.4	Deck Area (sq ft): 19633

Traffic

	Lanes	ADT	ADT year	Traffic Pattern
On	3	5400	2014	ONE WAY TRAFFIC
Under	4	7400	2014	TWO WAY TRAFFIC

Capacity

Load Rating

Inventory rating: HS21	Overburden depth (in): 2.0	Last rating date: 07-29-13	Controlling: INTERIOR DECK GIRDER Moment
Operating rating: HS36	Deck surface material: INTEGRAL CONCRETE	Re-rate for capacity (Y/N):	Control location: 1.0 SPAN 1, 118.5
Posting:	Re-rate notes:		

Hydraulic

Classification

Scour Critical Code(113): (N) NO WATERWAY	Q100 (ft3/sec): 0	
High water elevation (ft): 0.0	Velocity (ft/sec): 0.0	Sufficiency #:

Span(s)

Span #	Material	Configuration	Depth (in)	Length (ft)	Main
1	CONT STEEL	DECK GIRDER		118.5	
2	CONT STEEL	DECK GIRDER		121.5	Y

Expansion joint(s)

Temperature:

File:	New:
-------	------

Clearance

Item	File Measurement (ft)	File Date	New Measurement (ft)
Highway Min Vertical Under Cardinal	16.67		
Highway Min Vertical Under Non-Cardinal	17.29	16-Dec-1999	
Horizontal Under Cardinal	97.5		
Horizontal Under Non-Cardinal	97.5		
Highway Min Vertical On Cardinal			
Horizontal On Cardinal			

Special Components

Component	Year	Work Performed	Note
DECK - IOWA MIX	1994	OVERLAY - CONCRETE	

Construction History

Year	Work Performed	FOS id
1998	PAINTING	1197-10-71
1994	OVERLAY - CONCRETE	1190-22-60
1972	NEW STRUCTURE	1197-06-72

BRIDGE INSPECTION REPORT
Wisconsin Department of Transportation
DT2007 2003 s.84.17 Wis. Stats.

page 3

Structure No.: **B-03-038**

Maintenance Items History

Item	Recommended by	Status	Status change	Year completed
Deck - Patching	Bjorklund, Allan M (8003)	COMPLETE	12/17/15	2015
Patch both ends of deck along strip seal joints. Estimate 25lf on mainline south jt. North joint mainline 15lf, and 3lf on ramp.				
Deck - Patching	Harrington, Daniel J (8004)	COMPLETE	01/17/13	
patch spalls in top of backwalls 2 lf N and 10 lf S.				
Deck - Patching	Harrington, Daniel J (8004)	COMPLETE	01/17/13	
repair spalls on deck and backwalls approx. 40 SF.				
Deck - Patching	Bjorklund, Allan M (8003)	COMPLETE	12/17/15	2015
Patch paving blocks, est 60 sf, north 40sf south 20sf. Also, repour median end wall on north abutment to stabilize steel extrusion. Polymer patch concrete.				

Maintenance Items

Item	Priority	Recommended by	Status	Status change
Substructure - Other Work	MEDIUM	Bjorklund, Allan M (8003)	IDENTIFIED	06/24/15
Seal pier columns with a concrete sealer from the approved list, 5 columns.				

Elements

Chk	Element	Defect	Description	UOM	Total	Quantity in Condition State			
						1	2	3	4
X	12		Reinforced Concrete Deck	SF	19,634	4,633	15,000	1	0
		1080	Delamination - Spall - Patched Area Full depth failure along south joint in west flow line.	SF		0	0	1	0
		1130	Cracking (RC) Fine surface map cracking throughout - adjacent to girders. Few fine/hrline transverse cracks.	SF		0	15,000	0	0
		8514	Concrete Overlay	SF	19,634	0	19,591	43	0
		3210	Debonding/Spall/Patched Area/Pothole Spalled along joints. North joint has 12lf of repaired and 18 lf of unrepaired spalls. South joint has 12 lf of repaired and 25lf of unrepaired spalls.	SF		0	24	43	0
X	107	3220	Crack (Wearing Surface) Random map cracking through out - approx. 80%. Fine to hrline transverse cracking at Pier - approx. 30ft. Few fine longitudinal cracks at ends.	SF		0	19,567	0	0
			Steel Open Girder	LF	2,198	1,558	640	0	0
			Girders appear straight and plumb with no obvious indications of out-of-plane movement. Hit on Girder 8 span 1over EB USH 8 ground out Mag-particle tested and painted 2-19-07.						
		1000	Corrosion Spot locations on fascia girders of top-coat flaking. Approx. 70% of pin-size frckle rust on btm flange. Spot freckle rust at ends - approx. 1%. Approx 11% of all girds over driving lanes have bubbling and it flaking.	LF		0	640	0	0
		8516	Painted Steel Painted overcoat 9/98.	SF	30,628	10,720	15,314	3,063	1,531
		3440	Effectiveness (Steel Protective Coatings) Spot locations on fascia girders of top-coat flaking. Approx. 70% of pin-size frckle rust on btm flange. Spot freckle rust at ends - approx. 1%. Approx 11% of all girds over driving lanes have bubbling and it flaking. Estimate: 35% CS1 50% bleached CS2 10% rusted CS3 and 5% failed CS4.	SF		10,720	15,314	3,063	1,531

BRIDGE INSPECTION REPORT
Wisconsin Department of Transportation
DT2007 2003 s.84.17 Wis. Stats.

page 4

Structure No.: **B-03-038**

X	205		Reinforced Concrete Column	EA	5	4	1	0	0
		1080	Delamination - Spall - Patched Area	EA		0	1	0	0
			Column 5 btm west spall w/ exposed rebar - poor cover.						
X	215		Reinforced Concrete Abutment	LF	170	148	19	3	0
		1080	Delamination - Spall - Patched Area	LF		0	0	3	0
			SOUTH: Edge spalls at end - poor cover/ west end two 6in popout spalls w/ exposed rusty rebar. NORTH: CS3 spall w/ rust staining at Bays 5, 7, & 8 / top edge spalls at G5, 6, and 7						
		1130	Cracking (RC)	LF		0	19	0	0
			SOUTH: Few CS3 vert cracks w/ staining and begin delam. NORTH: Hrln vert cracks at G2 and 4 w/ lt rust staining / CS3 vert cracks at G3 and Bay 5 / surface map cracking at east end approx. 50%.						
X	234		Reinforced Concrete Cap	LF	78	75	3	0	0
			Consists of 2 units, Col 1 and 2 supports G 1-4, Cols 3,4,&5 support G 5-9.						
		1130	Cracking (RC)	LF		0	3	0	0
			Vry fine diag crack from col 5 in cantilever. Fine diag cracks from col 1&2 toward center of cap						
X	300		Strip Seal Expansion Joint	LF	160	0	160	0	0
		2360	Adjacent Deck or Header Damage	LF		0	160	0	0
			South mainline joint has 25lf repaired spall. South ramp jt has 12lf repaired spall. North joint mainline has 2lf repaired spall by repaired median end, and 15lf unrepaired spalling. Steel extrusions are rusted entire length.						
X	311		Moveable Bearing	EA	18	14	4	0	0
			At abutments						
		1000	Corrosion	EA		0	4	0	0
			Rust forming on exterior bearings.						
X	313		Fixed Bearing	EA	9	7	2	0	0
			At Pier						
		1000	Corrosion	EA		0	2	0	0
			Rust forming on exterior bearings.						
X	331		Reinforced Concrete Bridge Rail	LF	731	481	250	0	0
		1080	Delamination - Spall - Patched Area	LF		0	6	0	0
			Fair. Spall w/ exposed rebar center parapet @ S abut.						
		1130	Cracking (RC)	LF		0	244	0	0
			Median parapet random map cracking thru out.						
X	8400		Integral Wingwall	EA	4	1	3	0	0
		8903	Wall Deterioration	EA		0	3	0	0
			NW - hrln vert crack at mid w/ small edge spall top. NE - small spall top south.. SW - fine vertical crack at mid.						

BRIDGE INSPECTION REPORT
Wisconsin Department of Transportation
DT2007 2003 s.84.17 Wis. Stats.

page 5

Structure No.: **B-03-038**

Assessments

Chk	Element	Defect	Description	UOM	Total	Quantity in Condition State			
						1	2	3	4
X	9001		Drainage - Approach	EA	4	4	0	0	0
X	9030		Signs - Object Markers	EA	2	2	0	0	0
X	9043		Slope Protection- Crushed Aggregate with Bit. Most tightly adhered with lt bleaching and vegetation on edges.	EA	2	2	0	0	0
X	9167		Steel Diaphragm At abutments. Lt freckle rust on all edges.	EA	16	16	0	0	0
X	9250		Cross Bracing or Struts 32 over roadways with lt freckle rust.	EA	56	24	32	0	0
X	9322		Approach Roadway - Concrete (non-structural) NE & SW center slab broke. Nw shldr slab is broken with spall full width.	EA	4	2	2	0	0

NBI Ratings

	File	New
Deck	5	5
Superstructure	7	7
Substructure	6	6
Culvert	N	N
Channel	N	N
Waterway	N	N

Structure Specific Notes

OLD: (01) Structure is in very good condition. Deck has some small cracks serious. Paint applied in 1998 is weathering well except for a few peels in span 2. Slopes need to be resprayed. Other elements in **very good condition**.
Hit on lower flange repaired 2/19/07. Swallows present 2009, 2011.

Inspection Specific Notes

Inspector Site-Specific Safety Considerations

Structure Inspection Procedures

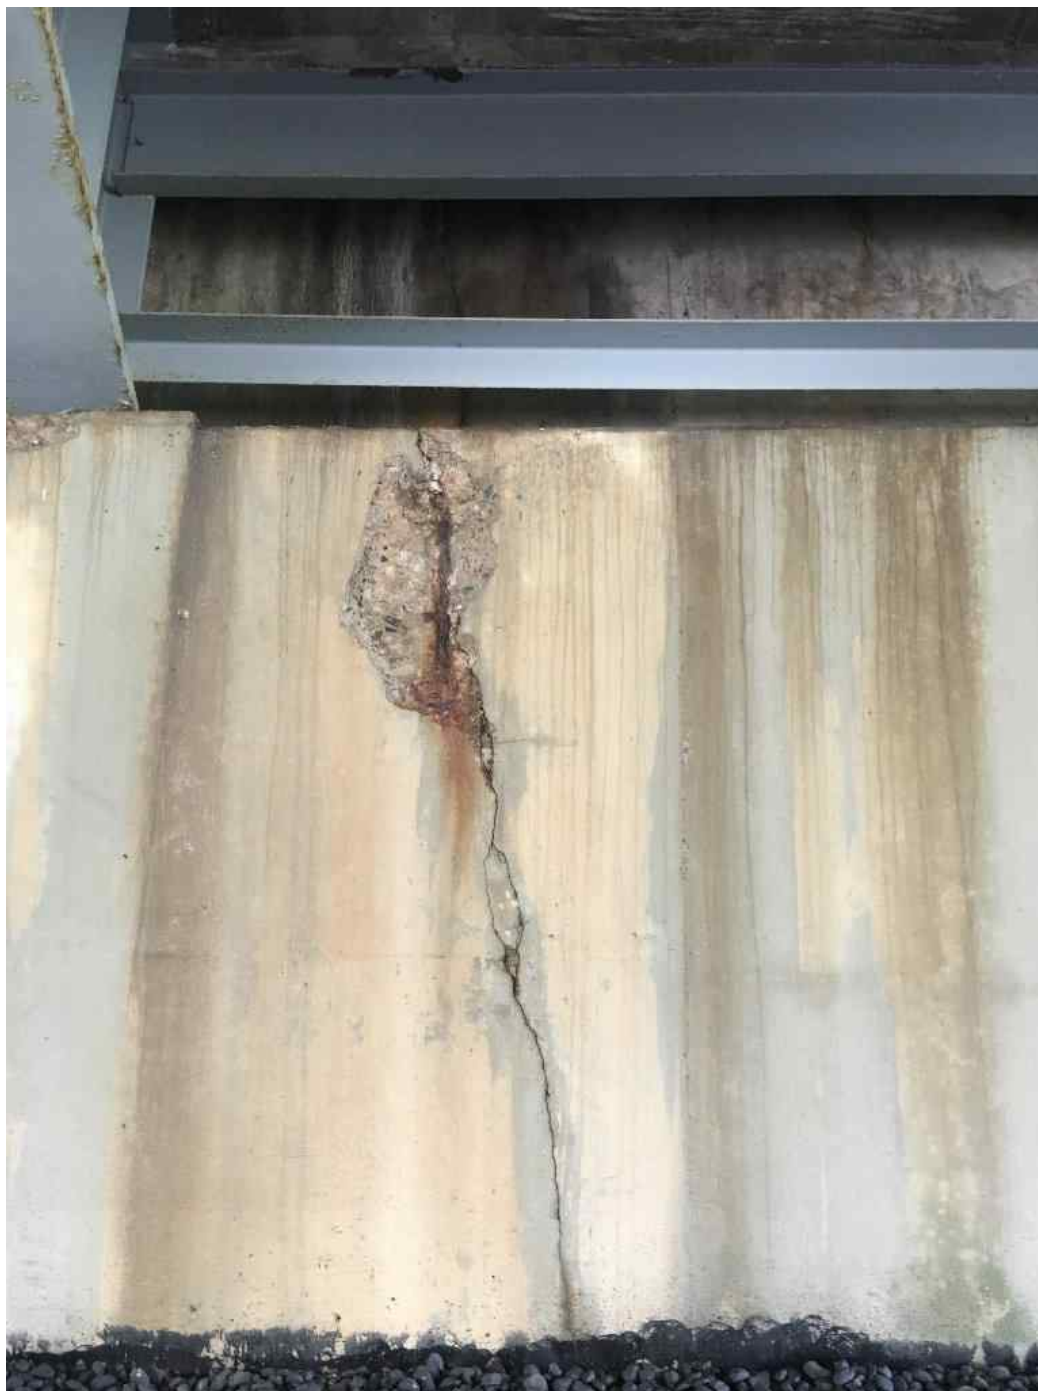
Walk-thru

Special Requirements

Chk Hours Cost Comments

Routine
Document Comment/Description

N abut Bay 5



Routine
Document Comment/Description

N abut Bay 7



Routine
Document Comment/Description

N abut G8



Routine

Document Comment/Description

SE abut - note joint location spall



STRUCTURE INVENTORY AND APPRAISAL FIELD REVIEW FORM

B-03-038
USH 53 NB over USH 8

LOCATION

(3) Municipality:
 (16) Latitude(° ' "):
 (17) Longitude(° ' "):

STANLEY
45°23'42.38"N
91°45'27.10"W

TRAFFIC SERVICE

(28A) Lanes On:
 (28B) Lanes Under:
 (102) Traffic Pattern On:
 (102) Traffic Pattern Under:
 (19) Detour Length(mi):

3
4
-NO TRAFFIC <input checked="" type="checkbox"/> ONE WAY TRAFFIC -TWO WAY TRAFFIC
-NO TRAFFIC -ONE WAY TRAFFIC <input checked="" type="checkbox"/> TWO WAY TRAFFIC
1

GEOMETRY

(49) Structure Length(ft):
 (50) Sidewalk Width(ft):
 (50) Curb Width(ft):
 (52) Culvert Barrel Length(ft):
 (34) Skew:

 (51) Bridge Roadway Width(ft):
 (52) Deck Width(ft):
 Right Wingwall Length(ft):
 Left Wingwall Length(ft):
 (32) Approach Roadway Width(ft):

 (47) Minimum Horizontal(ft):
 (55) Minimum Right Lateral(ft):
 (56) Minimum Left Lateral(ft):

244.2	
Left: 0.0	Right: 0.0
Angle(°): 11	Direction: -RIGHT FORWARD <input checked="" type="checkbox"/> LEFT FORWARD
Cardinal	Non-Cardinal
74.0	74.0
80.4	80.4
56	40
Cardinal Under Clearance	Non-Cardinal Under Clearance
97.5	97.5
33.0	33.0
40.5	40.5

RAILING APPRAISAL

(36A) Bridge Rail Adequacy:
 (36B) Transition Adequacy:
 (36C) Approach Guardrail Adequacy:
 (36D) Guardrail Termination Adequacy:
 Outer Rail:

-SUB-STANDARD <input checked="" type="checkbox"/> STANDARD -NOT APPLICABLE		
-SUB-STANDARD <input checked="" type="checkbox"/> STANDARD -NOT APPLICABLE		
-SUB-STANDARD <input checked="" type="checkbox"/> STANDARD -NOT APPLICABLE		
-SUB-STANDARD <input checked="" type="checkbox"/> STANDARD -NOT APPLICABLE		
Left	Right	Type
		TYPE F (TWO SQUARE TUBES) - STEEL(8)
		TYPE F (3 SQUARE TUBES) - STEEL(65)
		TYPE F (4 SQUARE TUBES) - STEEL(72)
		TYPE M-STEEL 3 SQUARE TUBES(93)
X	X	SLOPED FACE PARAPET LF(91)
		SLOPED FACE PARAPET HF(92)
		VERTICAL FACE PARAPET TYPE A(74)
		TYPE W-THRIE BEAM(79)
		TYPE H ON VERTICAL PARAPET(80)
		TIMBER(38)
		OTHER(99) (Please specify)
	CONT GUARD RAIL	
	NO APP GRDRL	
	NO ATTACHMENT	
5	22 MM(7/8") BOLT (Please enter quantity)	
	25 MM(1") BOLT (Please enter quantity)	
	OTHER (Please specify)	
X	(01) ENERGY ABSORBING TERMINAL/EAT	
	(02) TURN DOWN	
	(99) OTHER (Please specify)	

ROADWAY ALIGNMENT APPRAISAL

(72) Approach Alignment Appraisal:

	3 Intolerable- Substantial speed reduction
	6 Fair- Minor speed reduction
X	8 Good- No speed reduction

TYPE CODE = X

STATE PROJECT NUMBER

SHEET NO.

1190-22-60

8.9

GENERAL NOTES

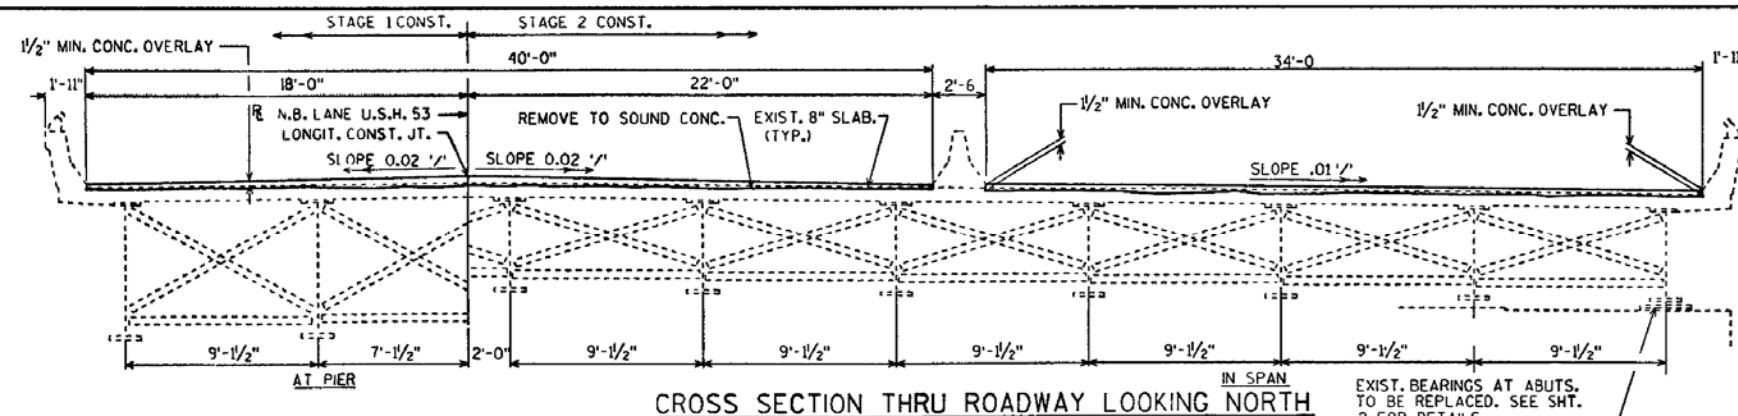
DRAWINGS SHALL NOT BE SCALED. DIMENSIONS ARE BASED ON ORIGINAL PLANS. THEREFORE CONTRACTOR TO FIELD VERIFY ALL DIMENSIONS. UTILIZE EXIST. REINF. AND EXTEND INTO NEW WORK. BAR STEEL REINFORCEMENT SHALL BE EMBEDDED 2" CLEAR UNLESS OTHERWISE SHOWN OR NOTED. PROTECTIVE SURFACE TREATMENT TO BE APPLIED AT A RATE OF 150 S.F. PER GALLON.

LIVE LOAD: DESIGN DATA

INVENTORY RATING: HS-19
OPERATIONAL RATING: HS-31
MAXIMUM STANDARD PERMIT VEHICLE LOAD = 210 KIPS.
ULTIMATE DESIGN STRESSES:
CONCRETE MASONRY SLAB $f'_c = 4,000$ P.S.I.
ALL OTHER $f'_c = 3,500$ P.S.I.
BAR STEEL REINFORCEMENT, GRADE 60 $f_y = 60,000$ P.S.I.


REMOVE EXIST. CAULKING AND REFILL WITH NON-STAINING GRAY NON-BITUMINOUS JOINT SEALER (APPROX. 22 LOCATIONS AT OUTSIDE PPTS. AND 11 LOCATIONS AT MEDIAN)

SECTION THRU PPT.




CROSS SECTION THRU ROADWAY LOOKING NORTH

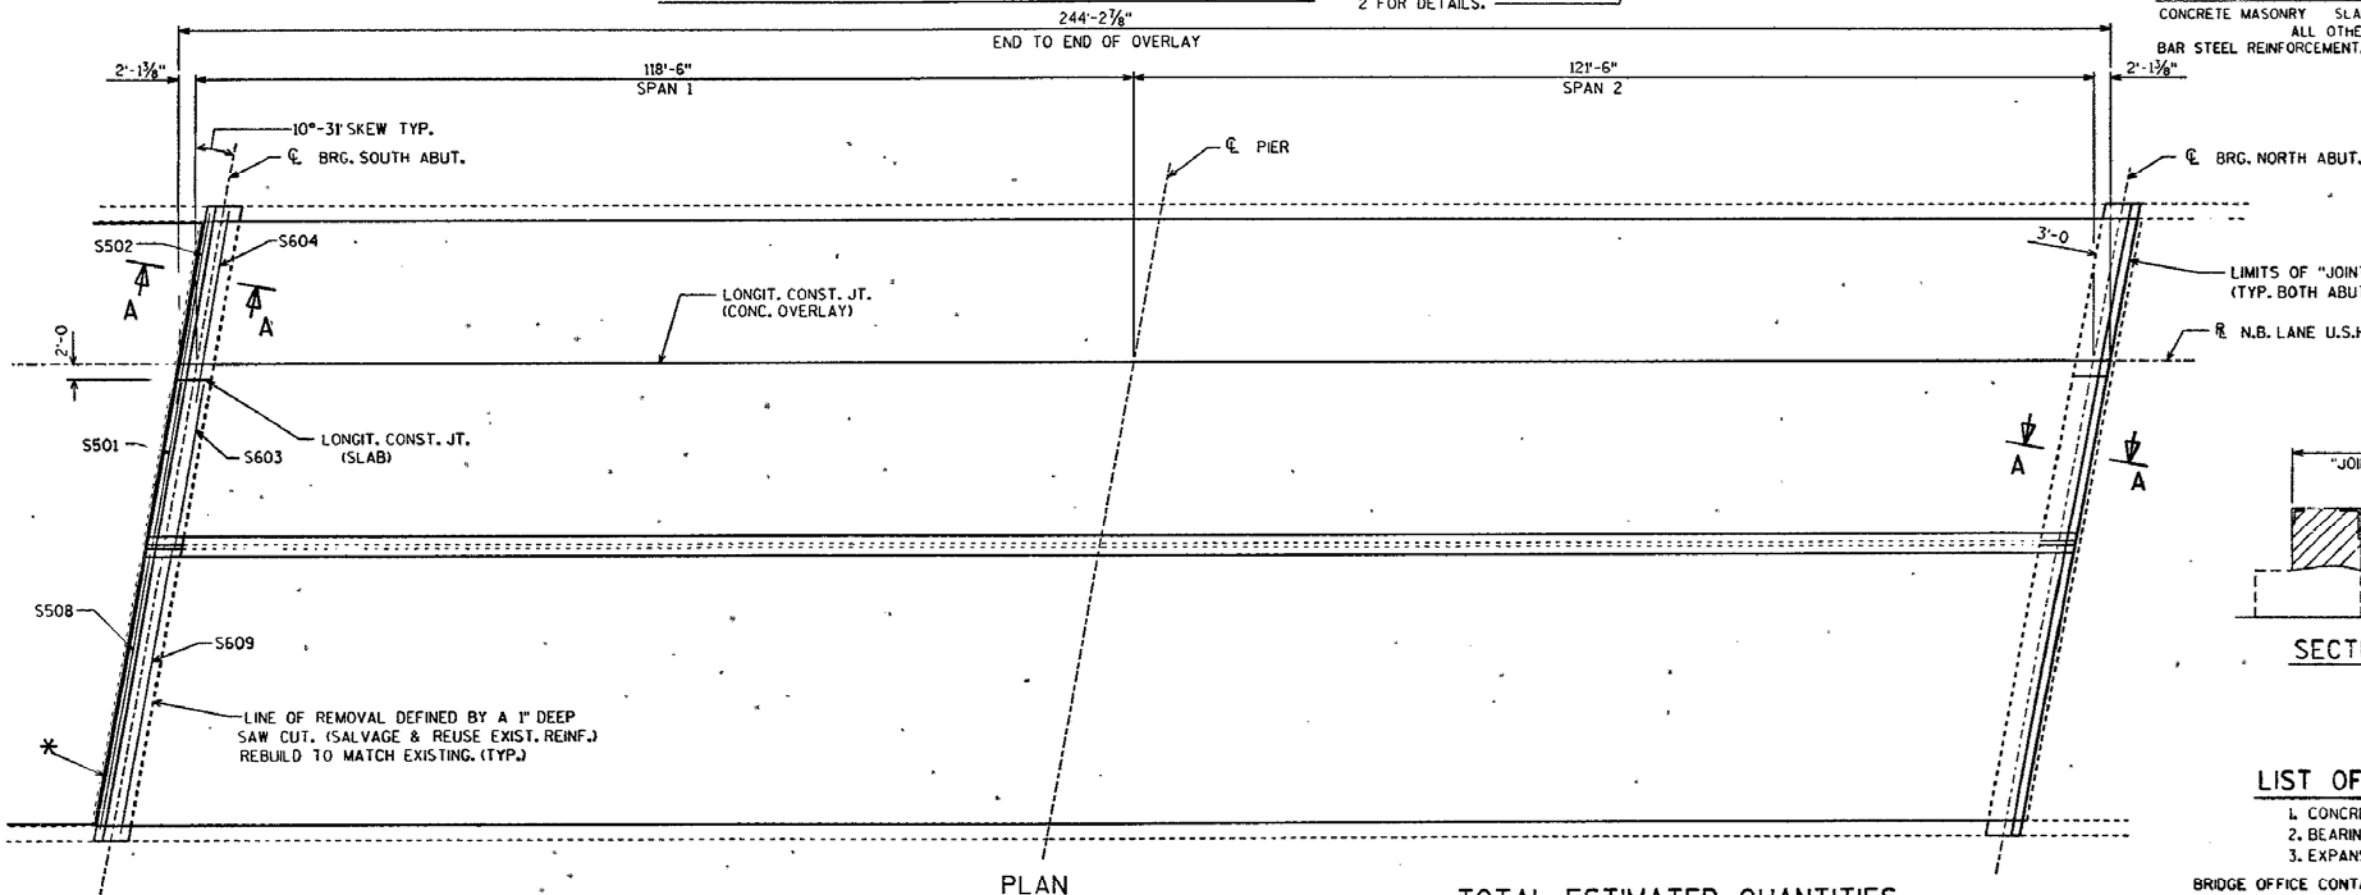EXIST. BEARINGS AT ABUTS. TO BE REPLACED. SEE SHT. 2 FOR DETAILS.



PLAN

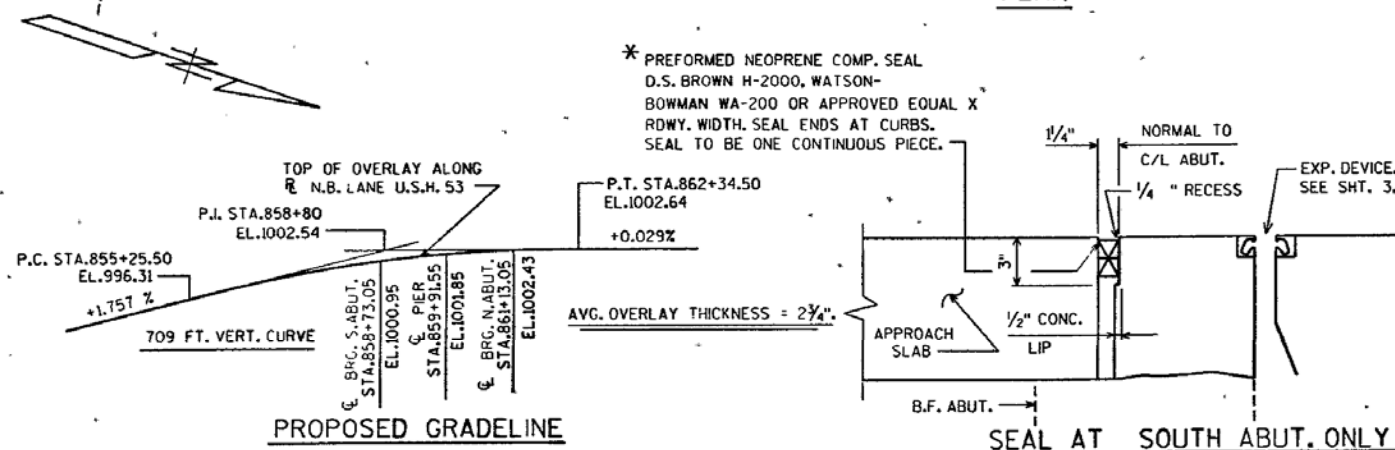

PROPOSED GRADELINE

SEAL AT SOUTH ABUT. ONLY

TOTAL ESTIMATED QUANTITIES

BID ITEMS	UNIT	TOTALS
CLEANING, DECKS	S.Y.	2,008
PREPARATION, DECKS	S.Y.	60
CONCRETE MASONRY, OVERLAY, DECKS	C.Y.	182
PROTECTIVE SURFACE TREATMENT	GAL.	142
EXPANSION DEVICE - B-3-38	L.S.	1
JOINT REPAIR	S.Y.	53
PREFORMED ELASTOMERIC COMPRESSION JOINT SEALER - 2"	L.F.	123
HIGH-STRENGTH BAR STEEL REINFORCEMENT, BRIDGES	LB.	2,150
EXPANSION BEARING ASSEMBLIES, B-3-38	EACH	18
REMOVING BEARINGS	EA.	18
FULL DEPTH DECK REPAIR	S.Y.	5

LIST OF DRAWINGS


1. CONCRETE OVERLAY
2. BEARING DETAILS
3. EXPANSION DEVICE

BRIDGE OFFICE CONTACT - R.L. REESE (608)266-8488
OR KENT BAHLER (608)266-8490


NO.	DATE	REVISION	BY
STATE OF WISCONSIN DEPARTMENT OF TRANSPORTATION DIVISION OF HIGHWAYS			
STRUCTURE B-3-38			
U.S.H. 53 N.B. LANE OVER U.S.H. 8			
COUNTY	BARRON	TOWN	STANLEY
DESIGN SPEC.	AASHTO 1990	LOAD SPEC.	1989
DESIGNED BY	D.K. LUKO	DRAWN BY	B.W. LUKO
APPROVED	[Signature]		
CONCRETE OVERLAY			SHEET 1 OF 3
			11-92

I.D. 11902230

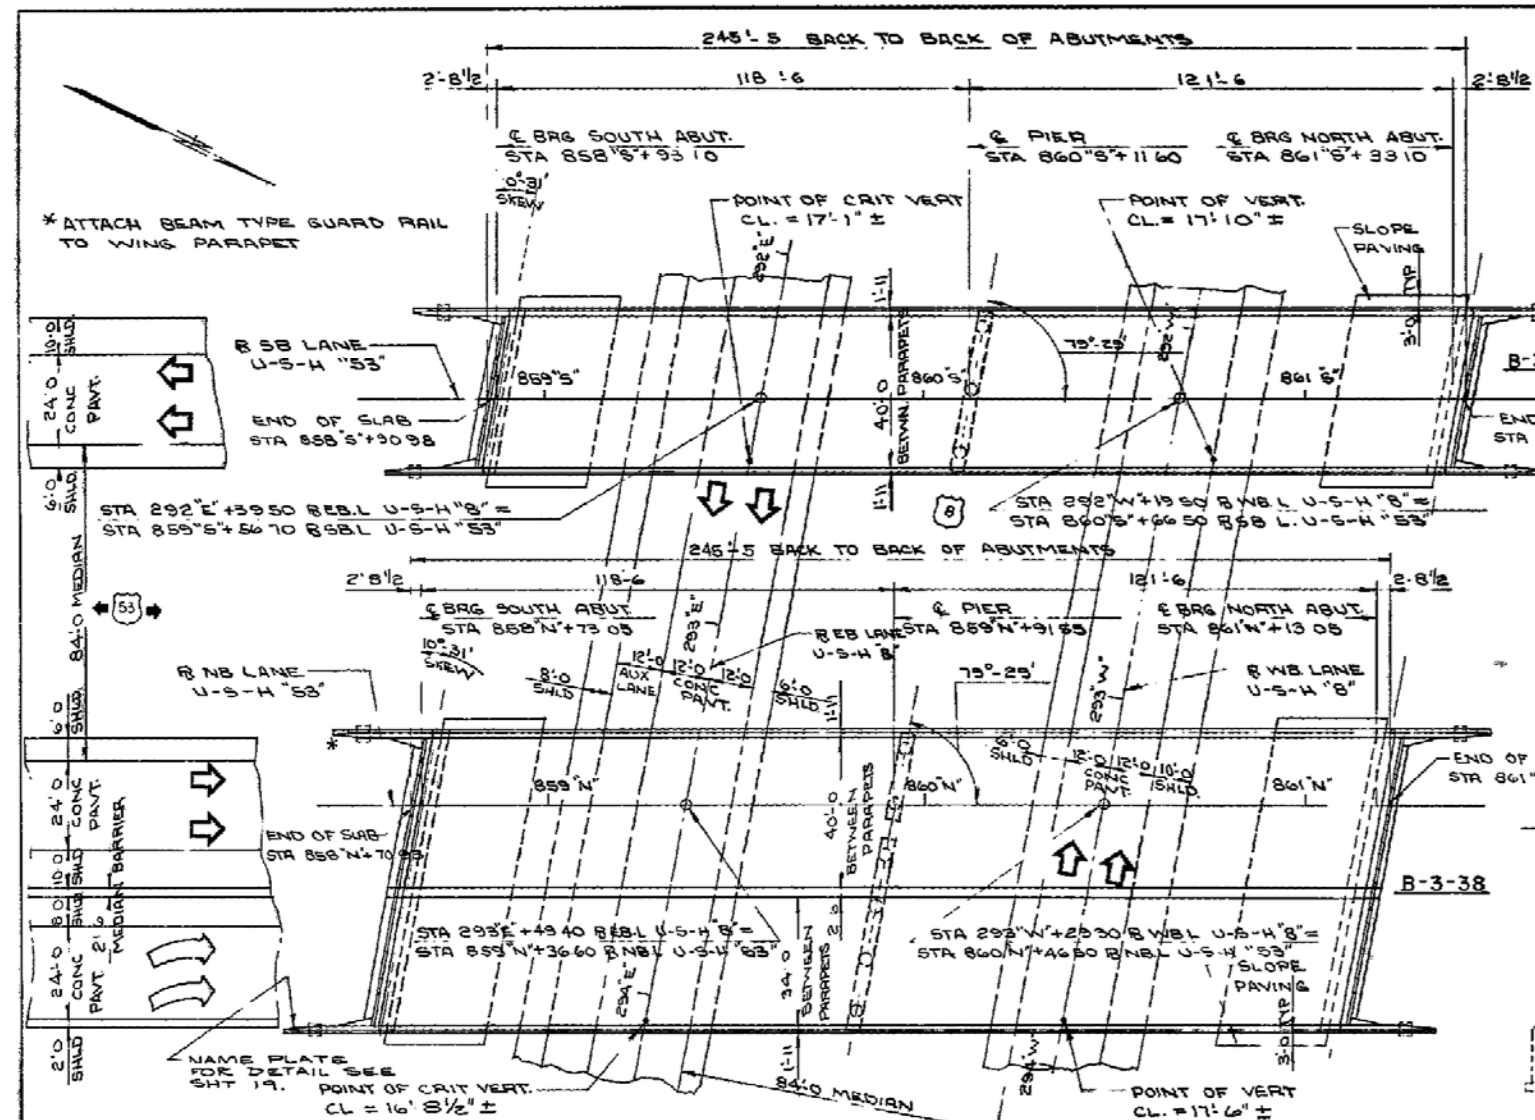B-3-38



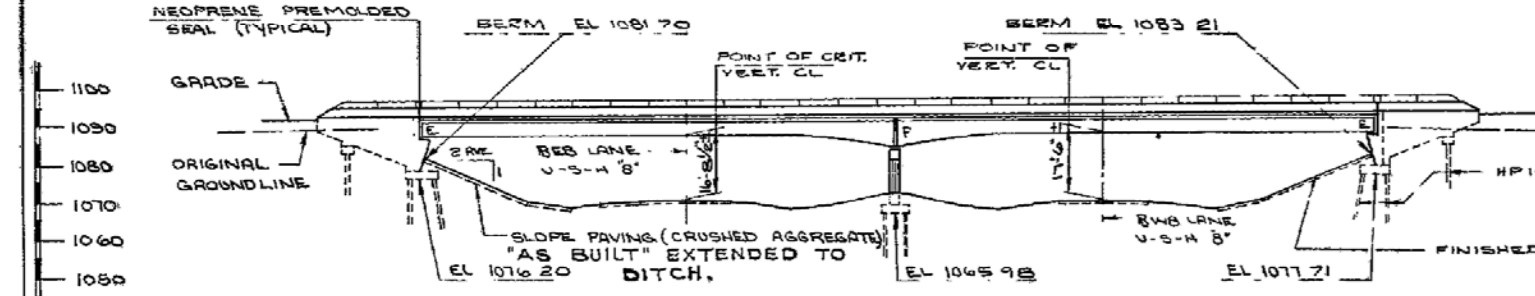
PLAN LAYOUT B-3-37/38
2 SPAN HAUNCHED GIRDERS




ELEVATION
NORMAL TO R & L B LANE U-S-H "8"

BENCH MARK			
NO	STATION	LOCATION	ELEV
15	295 E +75	18" N PINE 123 LT	1087.15


PROJECT	SHEET	TOTAL
1197-6-72 DPF08-4(4)	39	225

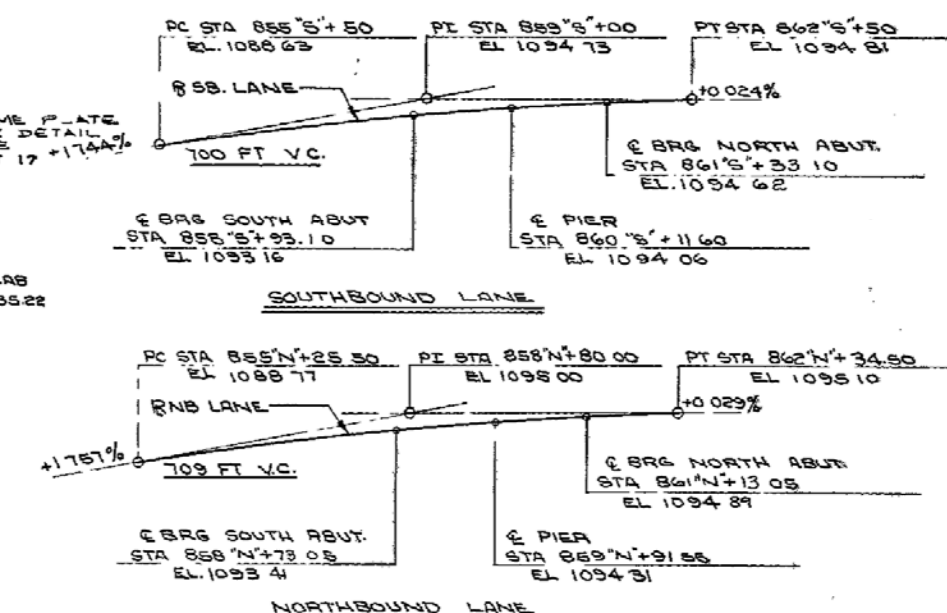


PROFILE GRADES U-S-H "53"

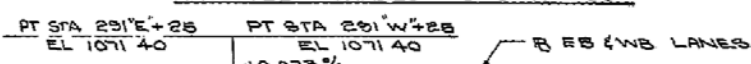

PROFILE GRADES U-S-H "8"

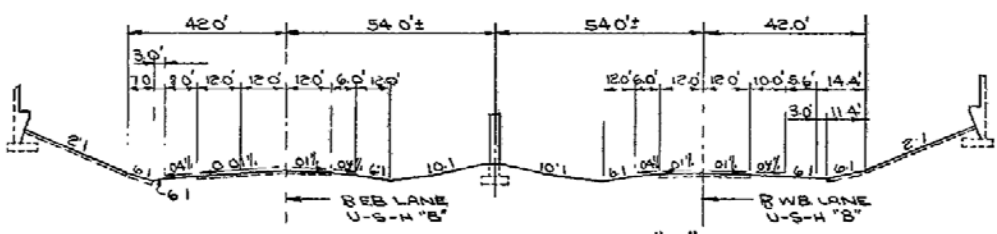

TYPICAL SECTION THRU U-S-H "8"

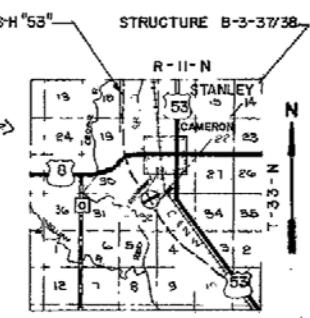


No	Date	Revision	By
1	3-9-72		

STATE OF WISCONSIN DEPARTMENT OF TRANSPORTATION DIVISION OF HIGHWAYS			
STRUCTURE B-3-38			
U-S-H "53" OVER U-S-H "8"			
County: BARRON	City: STANLEY	Design: A.A.S.H.O. 1989	Load: HS20
Design: C.D. W.	Design: RWA	Drawn: T.L.A.	Check: FOK
Approved: W.A. Kline	Chief Engr.:	Date: 3-9-72	
GENERAL PLAN			SHEET 1 OF 20
			X47261

GENERAL NOTES

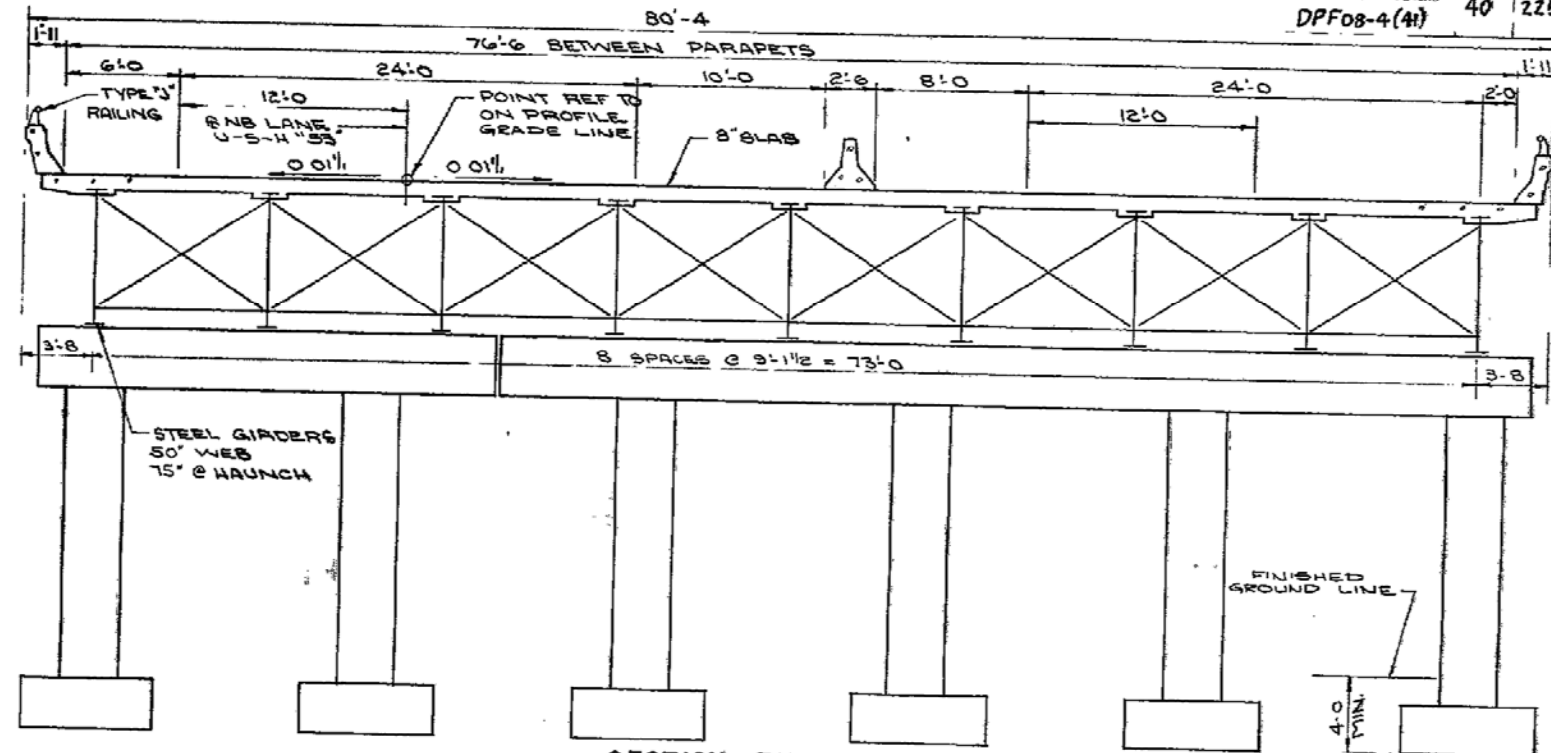DRAWINGS SHALL NOT BE SCALED.
ALL STEEL REINFORCING SHALL BE EMBEDDED
IN CONCRETE TO THE FULL LENGTH NOTED OTHERWISE.
THE SLOPE OF THE FILL IN FRONT OF THE ABUTMENTS
SHALL BE COVERED WITH SLOPE PAVING (CRUSHED AGGREGATE)
TO THE EXTENT SHOWN ON SHT. 4 IN THE ABUTMENT
DETAILS.
SEE SHT. 6 AND 9 FOR UPPER LIMITS OF EXCAVATION
AT THE ABUTMENTS.
THE FINISHED GRADED SECTION WAS USED AS THE
UPPER LIMITS OF EXCAVATION FOR COMPUTATION OF EX-
CAVATION QUANTITIES AT THE PIER.
AT THE ABUTMENTS ALL EXCAVATED VOLUME NOT
OCCUPIED BY THE NEW ABUTMENT SHALL BE FILLED WITH
GRANULAR BACKFILL FOR PAY LIMITS SEE SHT. 4 AND 9.
ALL FIELD CONNECTIONS SHALL BE MADE WITH 5/8"
DIAMETER FRICION TYPE HIGH-TENSILE STRENGTH BOLTS
UNLESS SHOWN OR NOTED OTHERWISE



TOTAL ESTIMATED QUANTITIES

BID ITEMS	UNIT	SUPER	SO ABUT	PIER	NO ABUT	TOTAL
EXCAVATION FOR STRUCTURES	C.Y.		190	80	190	460
GRANULAR BACKFILL	C.Y.		288		288	570
CONCRETE MASONRY	C.Y.	564.8	196.0	66.2	196.0	1043.0
BAR STEEL REINFORCEMENT	LB	159,000	12,980	23,200	12,980	208,160
STRUCTURAL CARBON STEEL	LB	420,710				420,710
STRUCTURAL LOW-ALLOY STEEL	LB	92,520				92,520
LUBRICATED BRONZE PLATES	LB	313				313
BEARING PADS	SF	52				52
NEOPRENE PRE-MOLDED SEAL	LF	162				162
STEEL PILING, DELIVERED & DRIVEN	LF		1,125	1,440	1,125	3,690
HP 10 INCH X 42 POUND	LF	587				587
TUBULAR RAILING, TYPE "J"	SF		230		260	490
SLOPE PAVING (CRUSHED AGG)	SF					
NON-BID ITEMS						
ALUMINUM OR ZINC PLATE	SF	100				100
POLYVINYL CHLORIDE WATERSTOP	LF		85		85	170

TRAFFIC VOLUME

U.S.H. "53" U.S.H. "8"
A.D.T. — 5,200 R.D.T. — 6,070
R.D.G. — 80 MPH D.H.V. — 1,320
D.H.V. — 1,180

LIST OF DRAWINGS

1. GENERAL PLAN	X 47261
2. GENERAL PLAN	X 47262
3. SUBSURFACE EXPLORE	X 47263
4. SOUTH ABUTMENT	X 47264
5. SOUTH ABUTMENT DETAILS	X 47265
6. SOUTH ABUTMENT DETAILS	X 47266
7. NORTH ABUTMENT	X 47267
8. NORTH ABUTMENT DETAILS	X 47268
9. NORTH ABUTMENT DETAILS	X 47269
10. PIER	X 47270
11. PIER DETAILS	X 47271
12. SUPERSTRUCTURE	X 47272
13. FRAMING PLAN	X 47273
14. GIRDER ELEVATIONS	X 47274
15. SUPERSTRUCTURE	X 47275
16. SUPERSTRUCTURE	X 47276
17. BEARING DETAILS	X 47277
18. NEOPRENE SEAL EXPANSION JOINT	X 47278
19. SLOPED FACE PARAPET "A"	X 47279
20. TUBULAR RAILING, TYPE "J"	X 47280

DESIGN DATA

LIVE LOAD HS20
ALLOWABLE DESIGN STRESSES:
CONCRETE, MASONRY, GRADE, "AA", SLAB — 1,200 PSI.
ALL OTHER — 1,400 PSI.
BAR STEEL REINFORCEMENT — 20,000 PSI.
STRUCTURAL CARBON STEEL — 20,000 PSI.
STRUCTURAL LOW-ALLOY STEEL — 27,000 PSI.
TO AND INCLUDING 3/4" THICK — 25,000 PSI.
3/4" TO AND INCLUDING 1 1/2" THICK — 25,000 PSI.
OVER 1 1/2" THICK — 22,000 PSI.


FOUNDATION DATA

ABUTMENTS TO BE SUPPORTED ON
HP 10" X 42" STEEL PILES EST. 45.0"
LG & DRIVEN TO A MIN. BCG VALUE OF 55 TONS/PILE
PIER TO BE SUPPORTED ON HP 10" X 42"
STEEL PILES EST. 40.0"
LG & DRIVEN TO A MIN.
BCG. VALUE OF 55 TONS PER PILE

No.	Date	Revision	By
STATE OF WISCONSIN DEPARTMENT OF TRANSPORTATION DIVISION OF HIGHWAYS			
STRUCTURE B-3-38			
Drawn Spec.	1969	Drawn By	TLA
		Check Checked	KOK
GENERAL PLAN			SHEET 2 OF 20
			X 47262

Index, of Sheets

Sheet No.	1	Title
Sheet No.	2-2.12	Typical Cross Sections
Sheet No.	3-3.2	Estimate of Quantities
Sheet No.	3A-36	Miscellaneous Quantities
Sheet No.	4-4.9	Right of Way Plat
Sheet No.	5-19	Plan and Profile Sta. 822N+00 to Sta. 948N+00 AND STA. 308E+01.8 TO STA. 351E+90.5
Sheet No.	20-20.11	Standard Details
Sheet No.	21-116	Drainage Structures
Sheet No.	117-225	Cross Sections

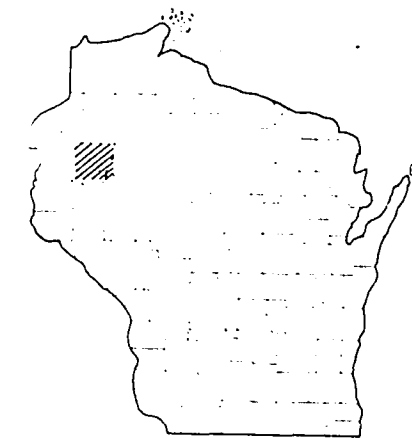

GN

Design Designation:			
US 53			
CONTROL OF ACCESS =	FULL	US 8	
A.D.T. (1975)	= 5,200	ADT (1968)	= 6,070
A.D.T. (1995)	= 7,800	ADT (1996)	= 8,800
D.H.V.	= 1,180	DHV	= 1,320
D.	= 60%	D	= 60%
T.	= 10%	T	= 4.7%
V.	= 80MPH	V	= 80 MPH

STATE OF WISCONSIN DEPARTMENT OF TRANSPORTATION DIVISION OF HIGHWAYS

PLAN AND PROFILE OF PROPOSED CHETEK - HAUGEN ROAD

(C.T.H. "00" - S.T.H. 48)

U.S.H. 53 - BARRON COUNTY

PROJECT IDENTIFICATION NUMBER	FEDERAL PROJECT DESIGNATION
1197-6-72, 72, 72	DPF 08-4(41)

BARRON - CTH "M" ROAD

(U.S.H. 53 - CAMERON)


USH 8 - BARRON COUNTY

PROJECT IDENTIFICATION NUMBER	FEDERAL PROJECT DESIGNATION
1572-1-72, 72	F 021-1(57)

CONTROL OF ACCESS

WITHIN THE LIMITS OF THE PROJECT, WHERE CONTROL OF ACCESS IS SHOWN THUS [|||||] NO ACCESS IS PERMITTED TO U. S. H. 53 TRAFFIC LANES EXCEPT AT DESIGNATED PUBLIC ROAD ACCESS POINT.

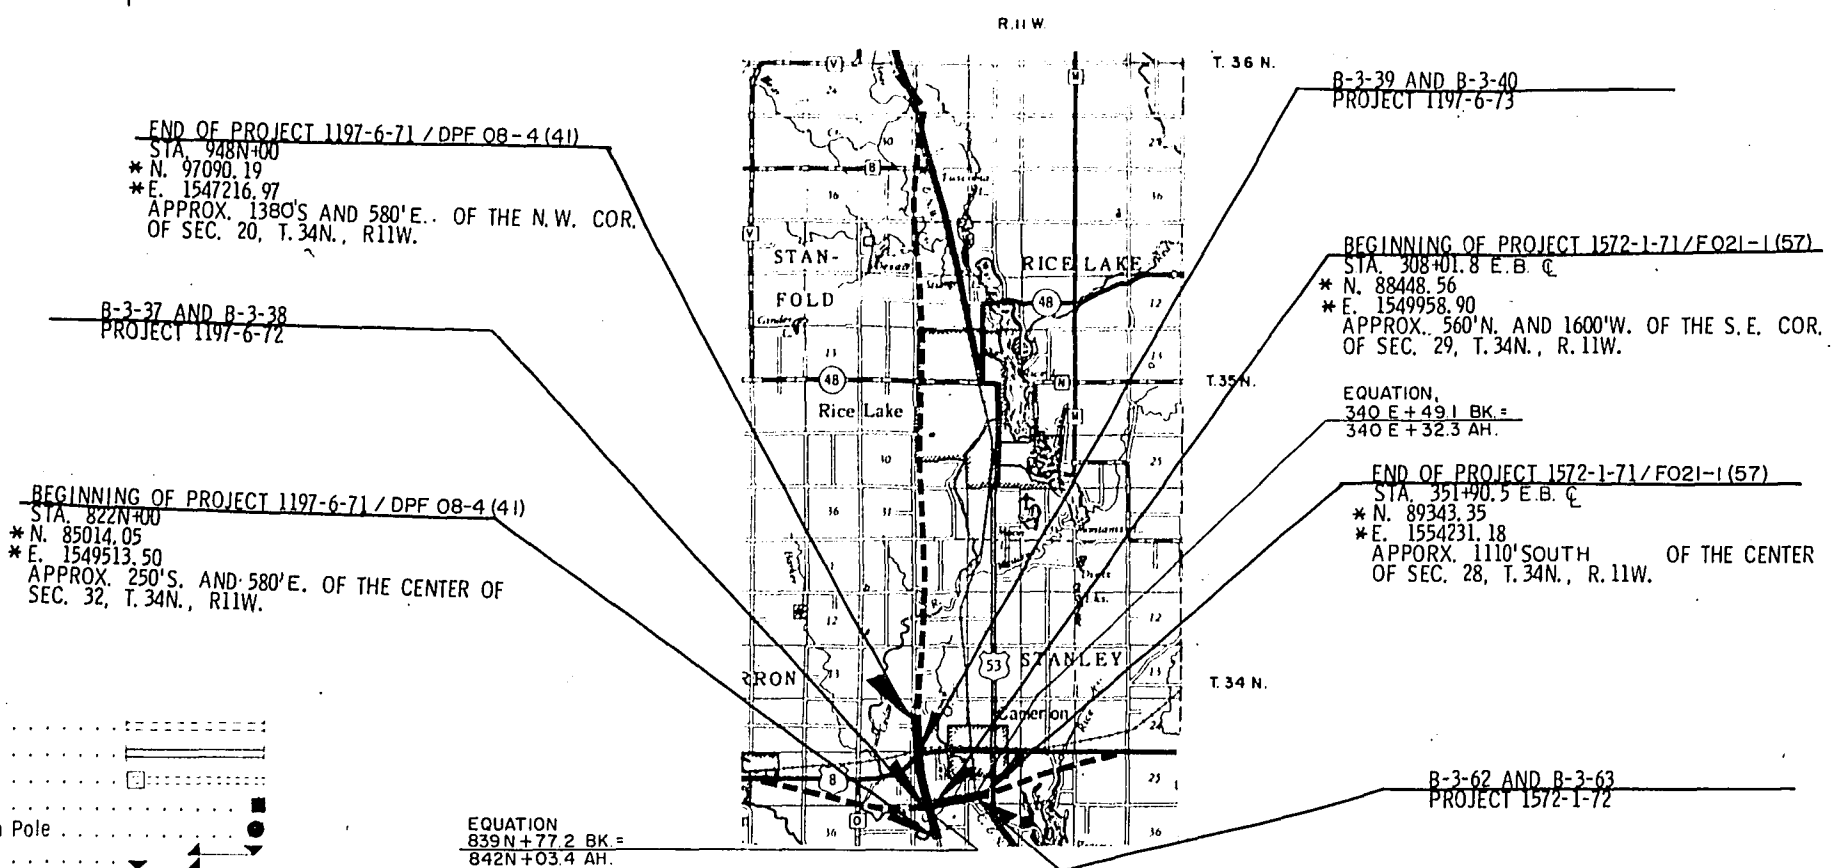SCALES { PLAN 1 INCH = 100 FT.
PROFILE HOR. 1 IN. = 100 FT. VERT. 1 IN. = 10 FT.
CROSS SECTIONS HOR. 1 IN. = 10 FT. VERT. 1 IN. = 10 FT.



Conventional Signs

State Line	-----	Culverts in Place	-----
County Line	-----	Culverts Required	-----
Township or Range Line	-----	Drop Inlet	-----
Section Line	-----	Power Pole	-----
New Right of Way Line	-----	Telephone or Telegraph Pole	-----
Present Right of Way Line	-----	Right of Way Markers	-----
Wire Fence	-----	Reference Stake for Hubs Only	-----
Lot Line	-----	Marsh	-----
Corporate or City Limits	-----	Hedge	-----
Property Line	-----	Trees	-----
Traveled Way or P.E.	-----	Ground Elevation	Datum Line
Railroads	-----	Grade Elevation	Datum Line
Base or Survey Line	-----		

Layout
Scale 0 1 2 Mi.

NET LENGTH OF CENTERLINE = 2.34 1/4 MILES. 1197-6-71 USH 53
NET LENGTH OF CENTERLINE = .834 MILES. 1572-1-71 USH 8
TOTAL NET LENGTH OF CENTERLINE = 3.178 MILES.

* ALL COORDINATES SHOWN ON THIS PLAN ARE REFERENCED TO THE WISCONSIN CO-ORDINATE SYSTEM NORTH ZONE.

STATE OF WISCONSIN DEPARTMENT OF TRANSPORTATION DIVISION OF HIGHWAYS	
Surveyor: M.G.W.	Note Book: L.L.
District Computer: R.A.B.	M.O. Checker: R.L.C.
District Checker: J.H.L.	Correct
Correct	
Date: 2/25/72	Wm. T. Wambach, Jr.
Recommended for Approval: District Engineer	
Date: 3/10/72	J. O. Farrell
Approved: Chief Design Engineer	
Date: 3/1/72	J. E. Hicks
Approved: State Highway Engineer	
DEPARTMENT OF TRANSPORTATION FEDERAL HIGHWAY ADMINISTRATION BUREAU OF PUBLIC ROADS	
Approved:	
Date:	
Division Engineer	

CONTRACT NO. 2
STRUCTURES B-3-37, B-3-38,
B-3-62 & B-3-63

PROJECT ID 1197-6-72 1572-1-72	SHEET NUMBER	TOTAL SHEETS
FEDERAL PROJECT DESIGNATION DPF 08-4(41) F 021-1(57)	3.1	225

[illegible]

SEC NO	STRUCTURE NUMBERS	EXCAVATION FOR STRUCTURES	BRIDGES (STRUCTURES OVER 20FT. SPAN)															ON THE JOB TRAINING	
			GRANULAR BACKFILL	CONCRETE MASONRY	BAR STEEL REINFORCEMENT.	STRUCTURAL CARBON STEEL	STRUCTURAL LOW-ALLOY STEEL	LUBRICATED BRONZE PLATES	BEARING PADS	PREBORING, CAST-IN-PLACE CONCRETE PILING	SLOPE PAVING CRUSHED AGGREGATE	FIELD OFFICE TYPE A	TUBULAR RAILING TYPE J	NEOPRENE PRE-MOULDED SEAL	STEEL PILING, DELIVERED AND DRIVEN HP 10 INCH X 42 LB.	CAST-IN-PLA CE CONCRETE PILING, DELIVERED & DRIVEN 10 3/4 INCH			
		20601	20901	50201	50501	50601	50605	50614	50621	51020	60405	64201	90001	90002	90003	90004	90005		
		C.Y.	C.Y.	C.Y.	LB. 106,526	LB.	LB.	LB.	S.F.	L.F.	S.Y.	L.S.	L.F.	L.F.	L.F.	L.F.	HOURS		
	B-3-37	290	320	597	104,778	230,700	50,750	174	29		277	1	557	87	1,980		1,000		
	B-3-38	460	570	1,043	205,160	420,710	92,520	313	52		490		557	162	3,690				
	TOTAL PROJ. DPF08-4(41)	750	890	1,640	309,930	651,410	143,270	487	81		767	1	1,114	249	5,670		1,000		
	B-3-62	226		485	97,650	450				281			276			1,860			
	B-3-63	226		486	97,850	450				282			276			1,860			
	TOTAL PROJ. F021-1(57)	452		971	195,500	900				563			552			3,720			
	PLAN TOTAL	1,202	890	2,611	505,430	652,310	143,270	487	81	563	767	1	1,666	249	5,670	3,720	1,000		

507	1166
-----	------

ERROR IN QUANTITY
SEE SHEET 2 of 18.

[illegible]

STANDARD ABBREVIATIONS

ABANDON	ABND.	MAILING ADDRESS	#0000
ABSTRACT	ABS.	MANHOLE	M.H.
ACCESS POINT	A. P.	MANUFACTURING	MFG.
ACRES	AC.	MAXIMUM	MAX.
ADDITION	ADD.	MEASURED	(M)
AGRICULTURAL	AGRI.	MILE	MI.
AHEAD	AH.	MILK ROOM	M.R.
AND OTHERS	ET. AL.	MINIMUM	MIN.
AND WIFE	ET. UX.	MONUMENT	MON.
APARTMENT	APT.	MOTEL	MO.
ASSUMED	(A)	MUNICIPAL	MCPL
AUXILIARY REFERENCE LINE	A. R.	NORTHEAST	NE
AVENUE	AVE.	NORTHWEST	NW
BACK	BK.	NUMBER	NO.
BARN	B.	OUTLOT	O. L.
BASE LINE	B	PARALLEL	PLL
BEARING LONG CHORD	B. L. C.	PAVEMENT	PAV'T.
BITUMINOUS	BIT.	PERMANENT	PERM.
BLOCK	BLK.	POINT OF CURVATURE	P. C.
BOULEVARD	BLVD.	POINT OF INTERSECTION	P. I.
BRICK	BRK.	POINT OF TANGENCY	P. T.
BUILDINGS	BLDGS.	POINT OF COMPOUND CURVE	P. C. C.
CATCH BASIN	C. B.	POINT OF REVERSE CURVE	P. R. C.
CEMETERY	CEM.	POINT ON CURVE	P. O. C.
CENTERLINE	C	PRIVATE DRIVE	P. D.
CENTRAL ANGLE	C	PROJECT	PROJ.
CHANNEL	CH.	PROPERTY LINE	P. L.
CHANNEL CHANGE	CH. CH.	QUIT CLAIM DEED	Q. C. D.
CHICKEN HOUSE	C. H.	RADIUS	R
COMMERCIAL	COMM.	RAILROAD	RR.
COMPANY	COM.	RAILWAY	RY.
COMPUTED	(C)	REFERENCE LINE	R
CONCRETE	CONC.	RELOCATED	REL
CONSTRUCTION	CONST.	REQUIRED	REQ'D.
CORN CRIB	C. C.	RESIDENTIAL	RES.
CORNER	COR.	RESTAURANT	REST.
CORPORATION	CORP.	RIGHT	RT.
CORRUGATED	CORR.	RIGHT OF WAY	R/W
COUNTY	CO.	ROAD	RD.
COUNTY TRUNK HIGHWAY	C. T. H.	ROADWAY	RDWY.
CREEK	CR.	SANITARY	SAN.
CULVERT	CULV.	SCALED	(S)
DEED	(D)	SCHOOL	SCH.
DEGREE OF CURVE	D	SECTION	SEC.
DISPOSAL	DISP.	SERVICE STATION	S. S.
DISTRICT	DIST.	SEPTIC TANK	SEP.
DRIVE	DR.	SIDEWALK	SWK.
DRIVEWAY	DWY.	SHED	S.
ESTATE	EST.	SOUTHEAST	SE
EXISTING	EX.	SOUTHWEST	SW
EXTERNAL DISTANCE	E	SPECIAL CROSSING	S. C.
FACTORY	FACT.	SPECIAL DRIVE	S. D.
FEDERAL AID PROJECT	F. A. P.	SQUARE	SQ.
FIELD ENTRANCE	F. E.	STANDARD	STD.
FIRE HYDRANT	F. H.	STATE TRUNK HIGHWAY	S. T. H.
FOOT (FEET)	FT.	STATION	STA.
FOUNDATION	FDN.	STORY	STY.
FRAME	FR.	STREET	ST.
GARAGE	G.	SUBDIVISION	SUBD.
GOVERNMENT	GOV'T.	SURVEY	(S)
GREEN HOUSE	G. H.	TANGENT	TAN.
HIGHWAY	HWY.	TANGENT LENGTH OF CURVE	T
HOTEL	HO.	TAPER	TAP.
HOUSE	H.	TAVERN	TAV.
HOUSE TRAILER	H. T.	TEMPORARY	TEMP.
INCHES	IN.	TRANSIT LINE	T
INCORPORATED	INC.	TRANSMISSION TOWER	T. T.
INCLUSIVE	INCL.	UNITED STATES COAST & GEODETIC SURVEY	U. S. C. & G. S.
INTERSECTION ANGLE	I	UNITED STATES GEOLOGICAL SURVEY	U. S. G. S.
INTERSTATE HIGHWAY	I. H.	UNITED STATE HIGHWAY	U. S. Highway
IRON PIN	I. P.	VENDEE	VDE.
ISLAND	IS.	VENDOR	VDR.
LEFT	LT.	VITRIFIED	VIT.
LENGTH OF CURVE	L	WAREHOUSE	WH.
LESSEE	LSE.	WATER TOWER	W. T.
LESSOR	LSR.	WELL	W.
LIMITED HIGHWAY EASEMENT	L. H. E.	WINDMILL	WM.
MACHINERY SHED	M. S.	WOOD	WD.
MAGNETIC	MAG.		

SCHEDULE OF LANDS AND INTERESTS REQUIRED

DP F08-4(41)/1197-6-71,72,73

SHEET NUMBER	TOTAL SHEETS
4	225

PARCEL NUMBER	SHEET NUMBER	OWNER	INTEREST REQUIRED	ACRES	OPERATIONS PROJECT I. D.	PARCEL NUMBER	SHEET NUMBER	OWNER	INTEREST REQUIRED	ACRES	OPERATIONS PROJECT I. D.
1	4.3 & 4.4	CLIFFORD N. AMUNDSON	FEE & ACCESS RIGHTS	19.03	1197-6-21						
2	4.3 & 4.4	ARTHUR E. MORK	FEE, L. H. E. & ACCESS RIGHTS	29.05	1197-6-21						
3	4.4	ELMER MALUM	FEE & ACCESS RIGHTS	63.27	1197-6-21						
4	4.4	SANNA, DIV. OF BEATRICE FOODS CO.	FEE, L. H. E. & ACCESS RIGHTS	25.72	1197-6-21						
5	4.4	WILLIAM ZABKA	FEE, L. H. E. & ACCESS RIGHTS	24.75	1197-6-21						
6	4.4	GRANT JENSON	FEE & ACCESS RIGHTS	5.62	1197-6-21						
7	4.4 & 4.5	LYLE G. ANDERSON	FEE & ACCESS RIGHTS	14.50	1197-6-21						
8	4.5	CHARLES MILLS	FEE & ACCESS RIGHTS	13.05	1197-6-21						
9	4.5	REUBEN BERZILL	FEE & ACCESS RIGHTS	12.16	1197-6-21						
10	4.5	CHARLES COOK	FEE, L. H. E. & ACCESS RIGHTS	27.55	1197-6-21						
11	4.5	WILLIAM D. BUTLER	L. H. E.	---	1197-6-21						
12	4.5	TOWN OF STANLEY	FEE & ACCESS RIGHTS	1.22	1197-6-21						
13	4.5	NORTHERN STATES POWER CO.	RELEASE OF RIGHTS	--	1197-6-40						
14	4.3 & 4.4	BARRON CO. ELECTRIC CO-OP	RELEASE OF RIGHTS	--	1197-6-40						
15	4.5	CHIBARDUN TELEPHONE COMPANY	RELEASE OF RIGHTS	--	1197-6-40						
16	4.5	SOO LINE RAILROAD	AGREEMENT	--	1197-6-50						

OFFICIAL PLAT ON FILE WITH
THE REGISTER OF DEEDS OFFICE

CONVENTIONAL SIGNS

STATE LINE	-----	HIGHWAY HIGHWAY SEPARATION	=====	CEMETERY	Cem.
COUNTY LINE	-----	HIGHWAY OVERPASS	=====	FOUNDATION	Fdn.
TOWNSHIP AND RANGE LINES	-----	RAIL LINE OVERPASS	=====	GAS PUMP ISLAND	Gas Pump
SECTION LINE	-----	ALL OTHER BRIDGES	=====	BUILDING	type
QUARTER LINE	-----	STREAM OR RIVER	=====	IRON PIN	I. P.
SIXTEENTH LINE	-----	LAKE	=====	POWER POLE	•
NEW R/W LINE	-----	CATTLE PASS	=====	TELEPHONE POLE	•
OLD R/W LINE	-----	RELOCATED STREAM OR RIVER	=====	RAIL LINE	---
PROPERTY LINE	-----	UNDERGROUND CABLE MARKER	=====	TRANSMISSION TOWER AND LINE	---
CORPORATE LIMITS	-----	WELL	=====	STONE MONUMENT	•
SLOPE INTERCEPTS	-----	SEPTIC TANK	=====	WINDMILL	•
LOT, TIE AND OTHER MINOR DASHED LINES	-----				
UNDERGROUND FACILITY (POWER, TELEPHONE, TELEGRAPH, GAS, ETC.)	-----				
NO ACCESS	=====				
LIMITED HIGHWAY EASEMENT	-----				

REVISION DATE	
9-28-71	
1-19-72	

STATE OF WISCONSIN
DEPARTMENT OF TRANSPORTATION
DIVISION OF HIGHWAYS

PLAT OF RIGHT OF WAY REQUIRED

PROJECT I.D. 1197-6-21
CHETEK — HAUGEN ROAD
(C.T.H. "00" — S.T.H. 48)
U.S. 53 BARRON COUNTY

SCALE
0 200 400
LENGTH 2.551 MILES
FEET

DATED MARCH 3, 1971

REVISION DATE	PROJECT NO.	SHEET NUMBER	TOTAL SHEETS
3-28-71	1197-6-21	4.4	
1-19-72			

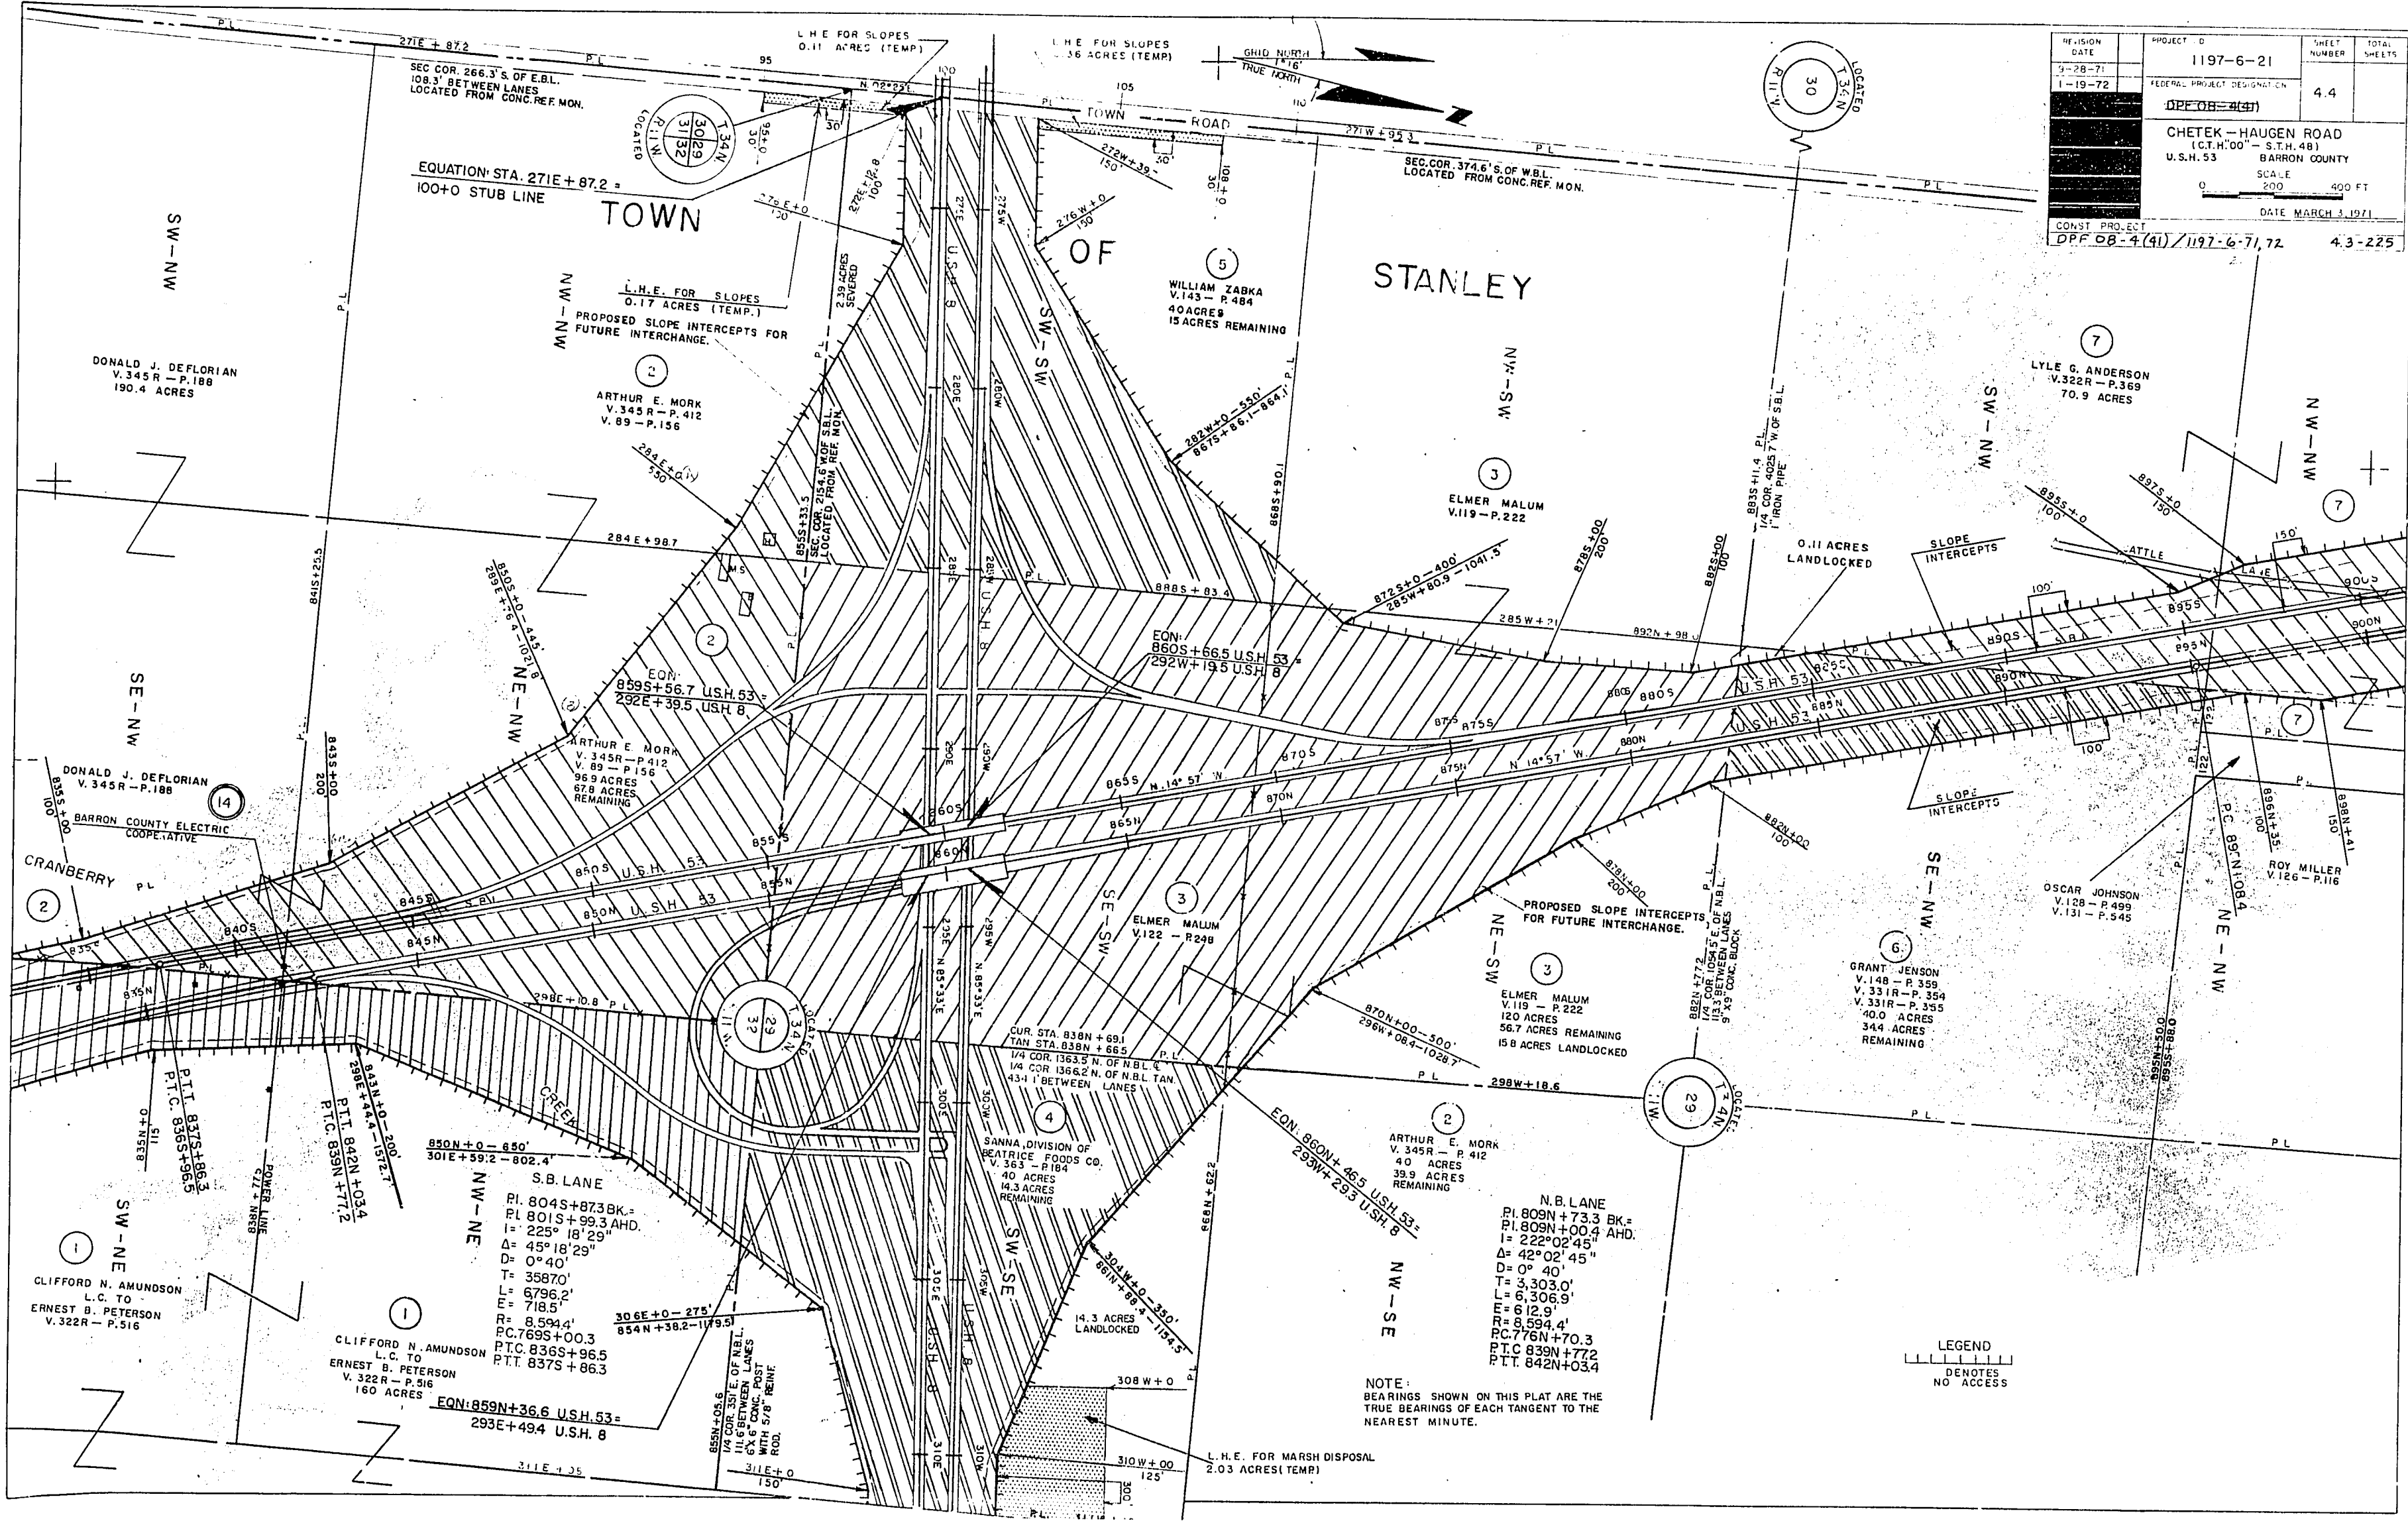
FEDERAL PROJECT DESIGNATION
DPF 08-4(41)

CHETEK - HAUGEN ROAD
(C.T.H. 00" - S.T.H. 48)
U.S.H. 53 BARRON COUNTY

SCALE
0 200 400 FT

DATE MARCH 3, 1971

CONST. PROJECT
DPF 08-4(41) / 1197-6-71, 72 4.3-225



NOTE:
BEARINGS SHOWN ON THIS PLAT ARE THE
TRUE BEARINGS OF EACH TANGENT TO THE
NEAREST MINUTE.

LEGEND
--- DENOTES
NO ACCESS



Speed	Time
Feet/Sec	Sec
4.5	22.5

PARCEL NUMBER	SHEET NUMBER	OWNER	INTEREST REQUIRED	ACRES	OPERATIONS PROJECT I. D.
1	4.4	MABEL SCHWAHN ET. AL.	FEE	3.32	1572-1-21
2	4.4	JAMES G. WHITEFORD	FEE	6.94	1572-1-21
3	4.4 & 4.5	JEROME W. JACKSON	FEE & ACCESS RIGHTS	1.25	1572-1-21
4	4.4	LLOYD G. ERICKSON	FEE & ACCESS RIGHTS	8.16	1572-1-21
5	4.5	ARTHUR FRISINGER	FEE, L.H.E., & ACCESS RIGHTS	29.07	1572-1-2
6	4.5	R.W. BARTLETT	FEE, L.H.E., & ACCESS RIGHTS	4.06	1572-1-21
7	4.5	ROBERT BRYNGELSON	FEE & ACCESS RIGHTS	0.75	1572-1-21
8	4.5	VERNON BRYNGELSON	FEE, L.H.E., & ACCESS RIGHTS	5.62	1572-1-21
9	4.5	KENNETH M. JUVE	FEE, L.H.E., & ACCESS RIGHTS	2.88	1572-1-21
10	4.5	EDWARD J. CHERMACK	FEE & ACCESS RIGHTS	8.59	1572-1-21
11	4.6	ELMER O. HUSSET	FEE & ACCESS RIGHTS	10.66	1572-1-21
12	4.6	GARY GRANUM	FEE, L.H.E., & ACCESS RIGHTS	8.98	1572-1-21
13	4.6	DONALD J. DEFLORIAN	L. H. E.	---	1572-1-21
14	4.8 & 4.9	VILLAGE OF CAMERON	FEE, L.H.E., & ACCESS RIGHTS	5.41	1572-1-21
15	4.8	LYLE H. KISLING	FEE & ACCESS RIGHTS	17.97	1572-1-21
16	4.8	P&B, INC.	FEE & ACCESS RIGHTS	1.06	1572-1-21
17	4.8	CHICAGO & NORTHWESTERN RAILROAD	AGREEMENT	---	1572-1-21
18	4.8 & 4.9	JEROME TURKEY FARMS, INC.	FEE, L.H.E., & ACCESS RIGHTS	12.96	1572-1-21
19	4.8	JOSEPH OPSAHL	L. H. E.	---	1572-1-21
20	4.9	ERMIN HANSEN (SEE PARCEL 41)	FEE, L.H.E., & ACCESS RIGHTS	15.13	1572-1-21
23	4.9	EDWARD P. KLEIN	FEE, L.H.E., & ACCESS RIGHTS	0.29	1572-1-21
24	4.9	REX W. GEBAUER	FEE & ACCESS RIGHTS	5.09	1572-1-21
25	4.9 & 4.10	JOSEPH L. SCHEYNOST	FEE, L.H.E., & ACCESS RIGHTS	10.88	1572-1-21
26	4.10	ROGER KIRCKOF	FEE	0.99	1572-1-21
27	4.10	ALVIN HAGNA	FEE, L.H.E., & ACCESS RIGHTS	0.10	1572-1-21
28	4.10	G.W. CUTSFORTH	FEE & ACCESS RIGHTS	0.18	1572-1-21
29	4.10	THADDEUS J. ZAJAC	FEE & ACCESS RIGHTS	11.87	1572-1-21
30	4.10	ARTHUR R. HEGNA	FEE & ACCESS RIGHTS	2.24	1572-1-21
31	4.10	LAZY "A" RANCH	FEE & ACCESS RIGHTS	0.20	1572-1-21
32	4.10	THADDEUS J. GONSOWSKI	L. H. E.	---	1572-1-21
33	4.10	ARLIE WETZEL	L. H. E.	---	1572-1-21
34	4.8 & 4.10	BARRON COUNTY ELECTRIC COOPERATIVE	RELEASE OF RIGHTS	---	1572-1-
35	4.4, 4.9 & 4.10	NORTHERN STATES POWER COMPANY	RELEASE OF RIGHTS	---	1572-1-
36	4.5	NORTHERN NATURAL GAS COMPANY	RELEASE OF RIGHTS	---	1572-1-
37	4.8, 4.9 & 4.10	CHIBARDUN TELEPHONE COMPANY, INC.	RELEASE OF RIGHTS	---	1572-1-

STATE LINE		HIGHWAY HIGHWAY SEPARATION		CEMETERY	
COUNTY LINE		HIGHWAY OVERPASS		FOUNDATION	
TOWNSHIP AND RANGE LINES		RAIL LINE OVERPASS		GAS PUMP ISLAND	
SECTION LINE		ALL OTHER BRIDGES		BUILDING	
QUARTER LINE		STREAM OR RIVER		IRON PIN	
SIXTEENTH LINE		LAKE		POWER POLE	
NEW CENTERLINE		CATTLE PASS		TELEPHONE POLE	
NEW R/W LINE		‡ RELOCATED STREAM OR RIVER		RAIL LINE	
OLD R/W LINE		TRAVELED WAY (Shown only in area of Frontage Roads, Interchanges or Dual Lanes)		TRANSMISSION TOWER AND LINE	
PROPERTY LINE				UNDERGROUND CABLE MARKER	
CORPORATE LIMITS				WELL	
SLOPE INTERCEPTS				STONE MONUMENT	
LOT, TIE AND OTHER MINOR DASHED LINES				SEPTIC TANK	
UNDERGROUND FACILITY (POWER, TELEPHONE, TELEGRAPH, GAS, ETC.)				WINDMILL	
NO ACCESS					
LIMITED HIGHWAY EASEMENT					


F021-1 (57)/1572-1-71,72

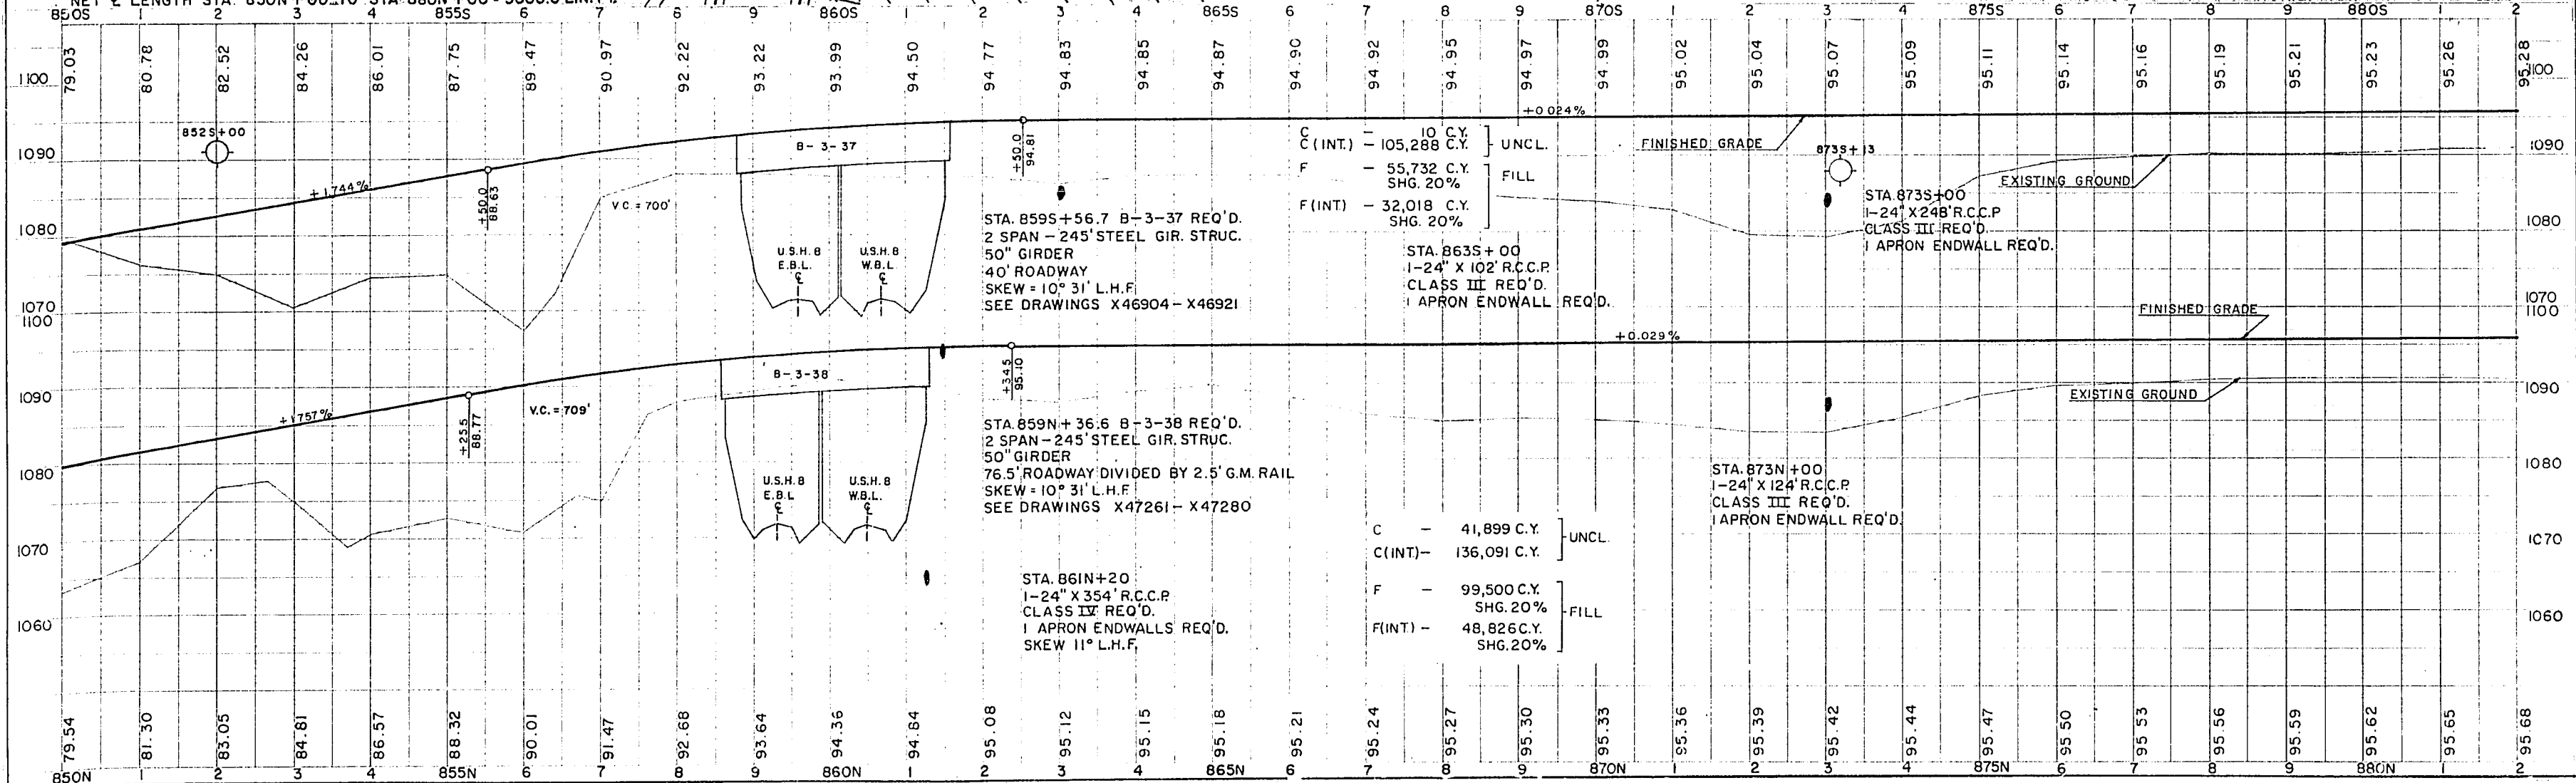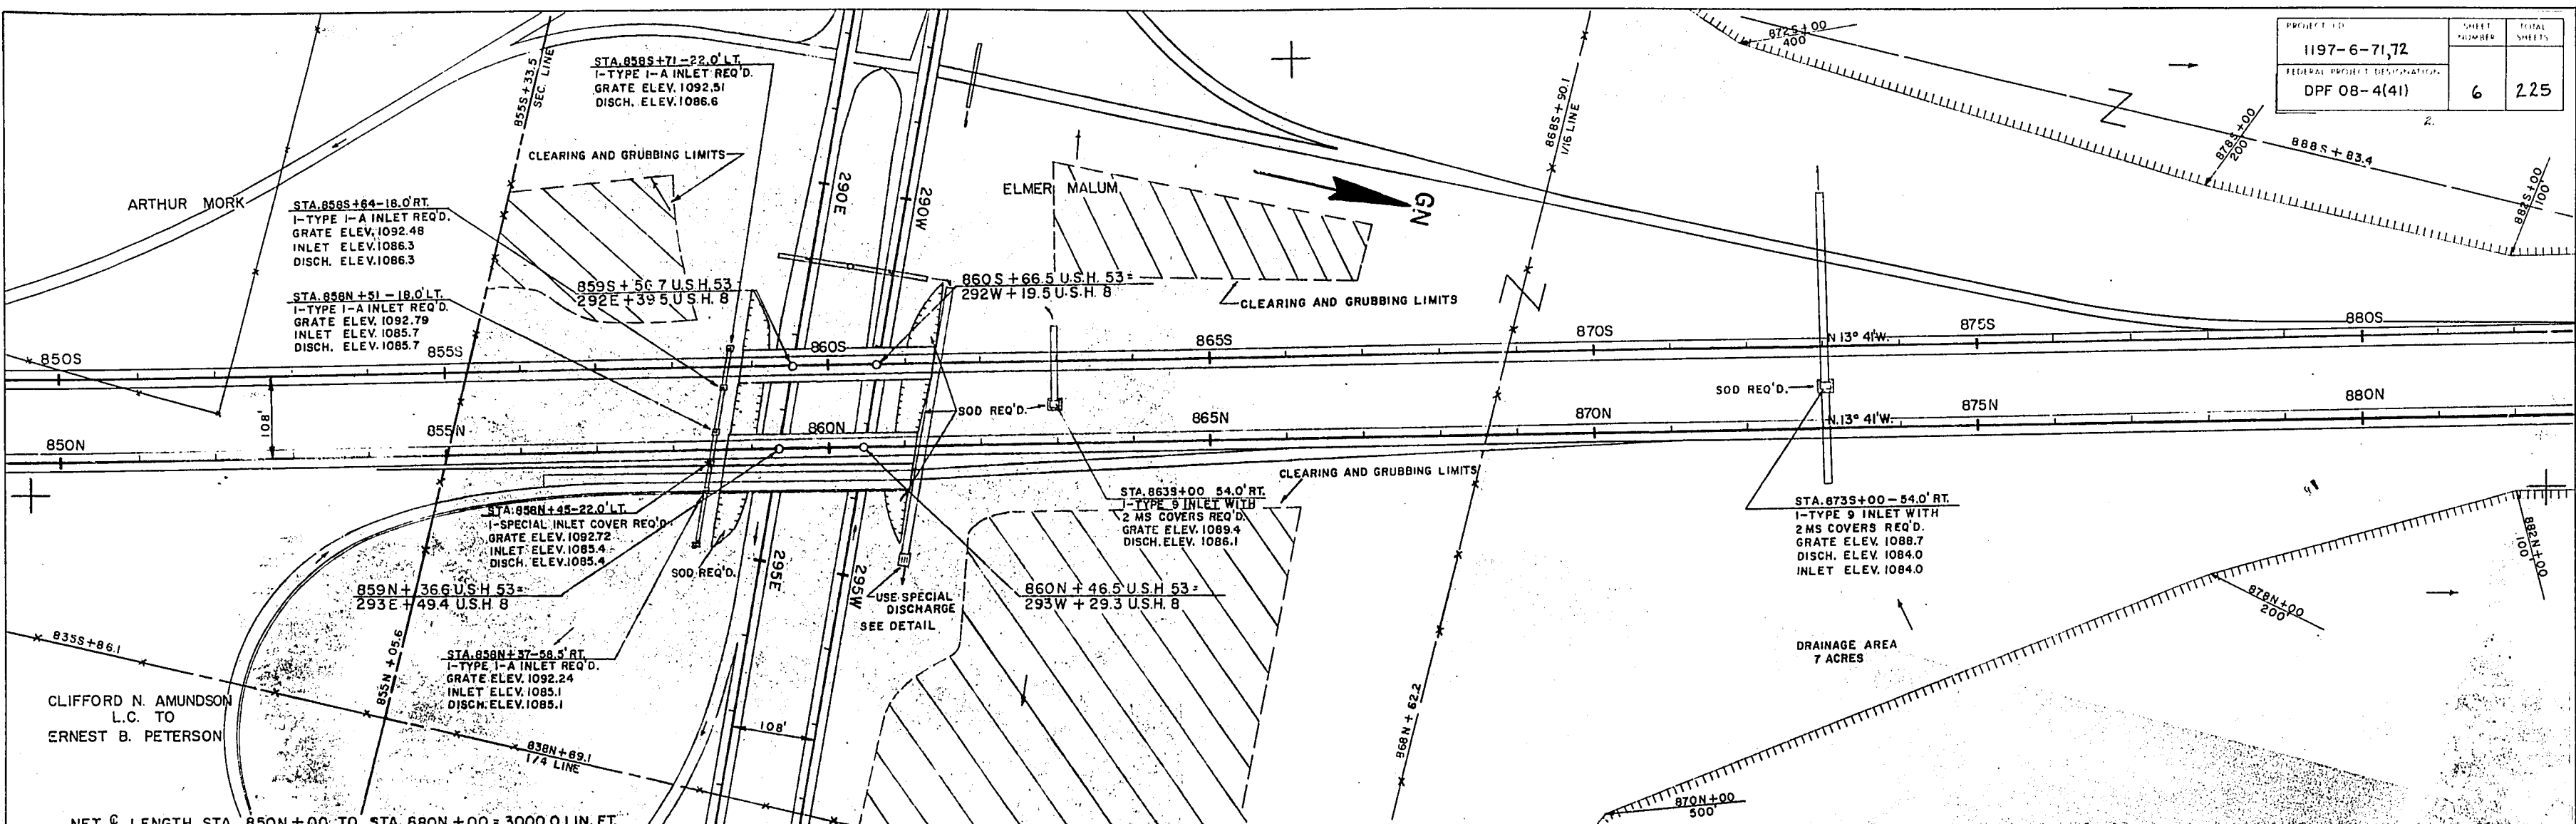[illegible][illegible]



NOTE: BOOK ALIGNMENT ORIENTED
ST. OF WAY ORIENTED

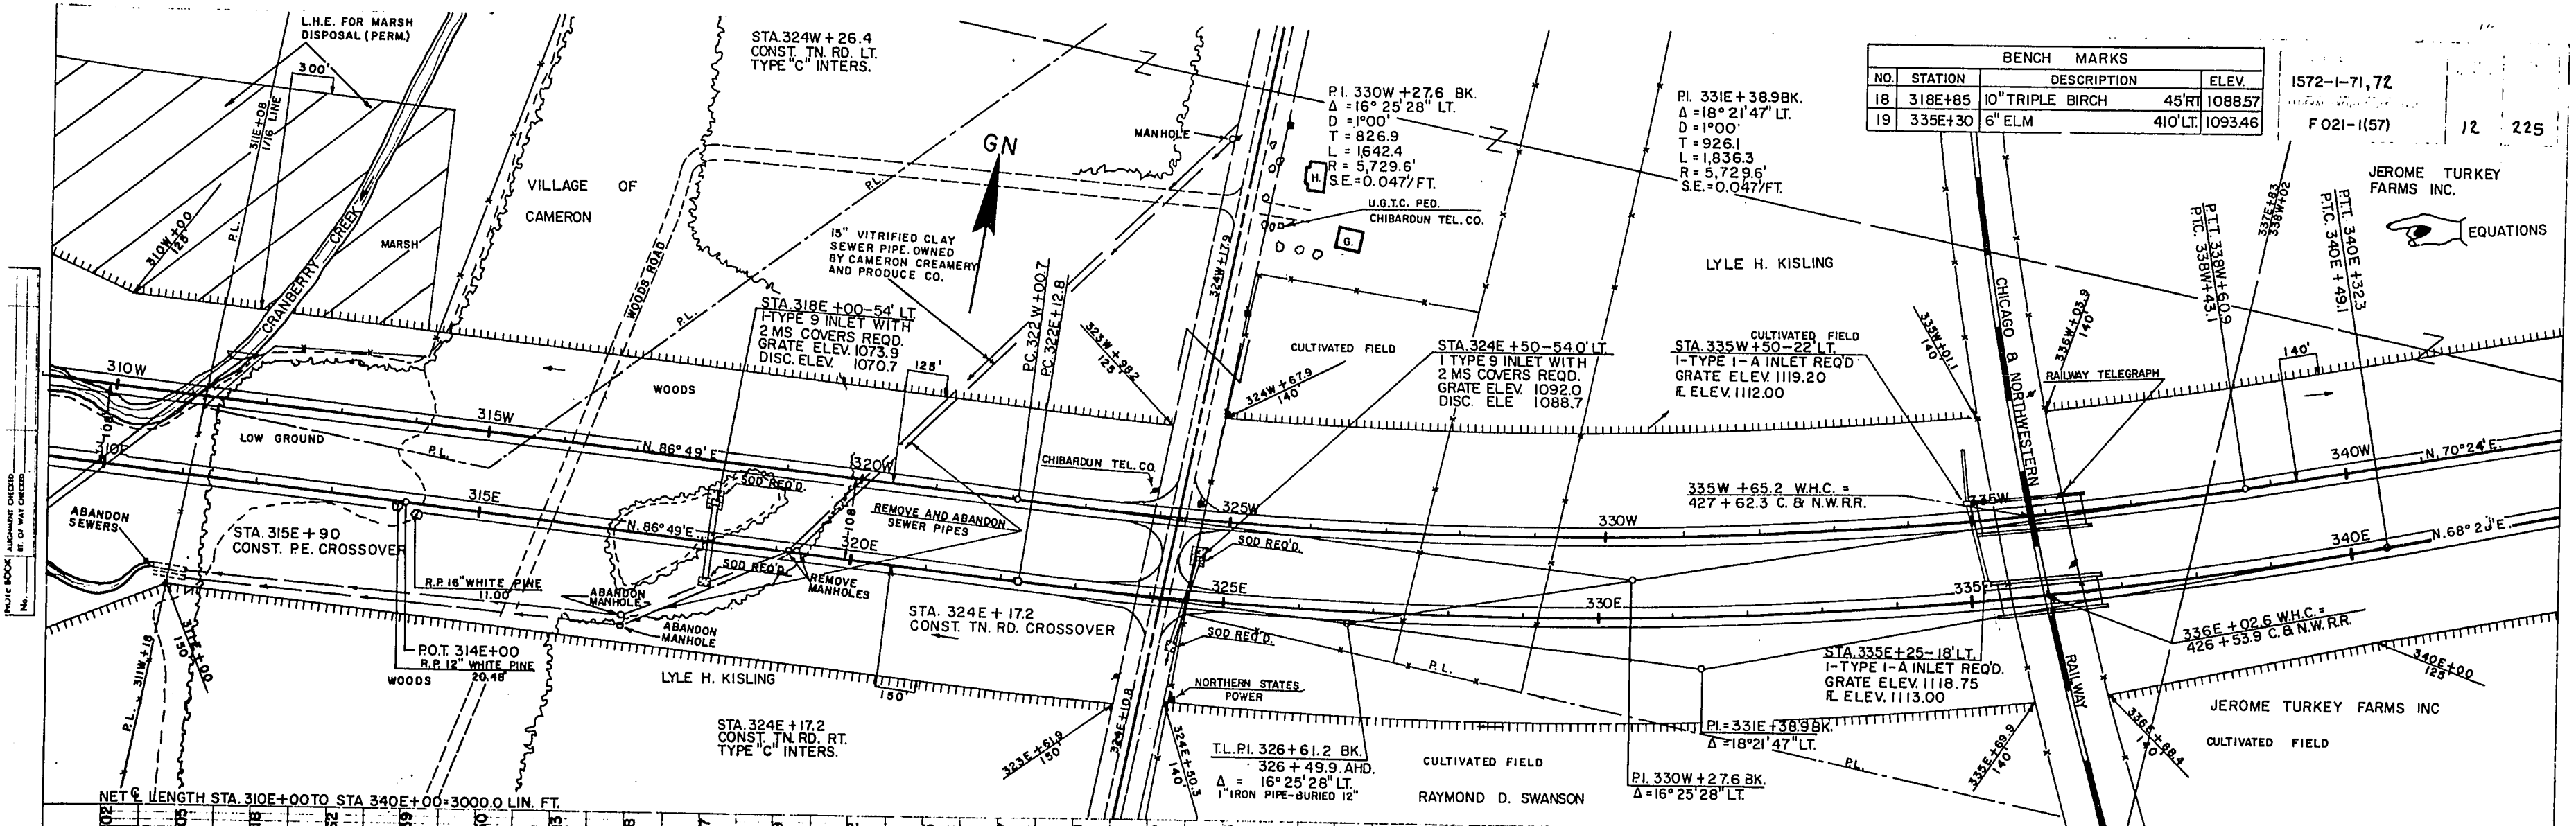
NO. 1
E. A. S. MOTOR
STRUCTURE NOTATIONS ORIENTED




BENCH MARKS			
NO.	STATION	DESCRIPTION	ELEV.
18	318E+85	10" TRIPLE BIRCH	45' 1088.57
19	335E+30	6" ELM	410' 1093.46


1572-1-71,72
F 021-1(57) 12 225

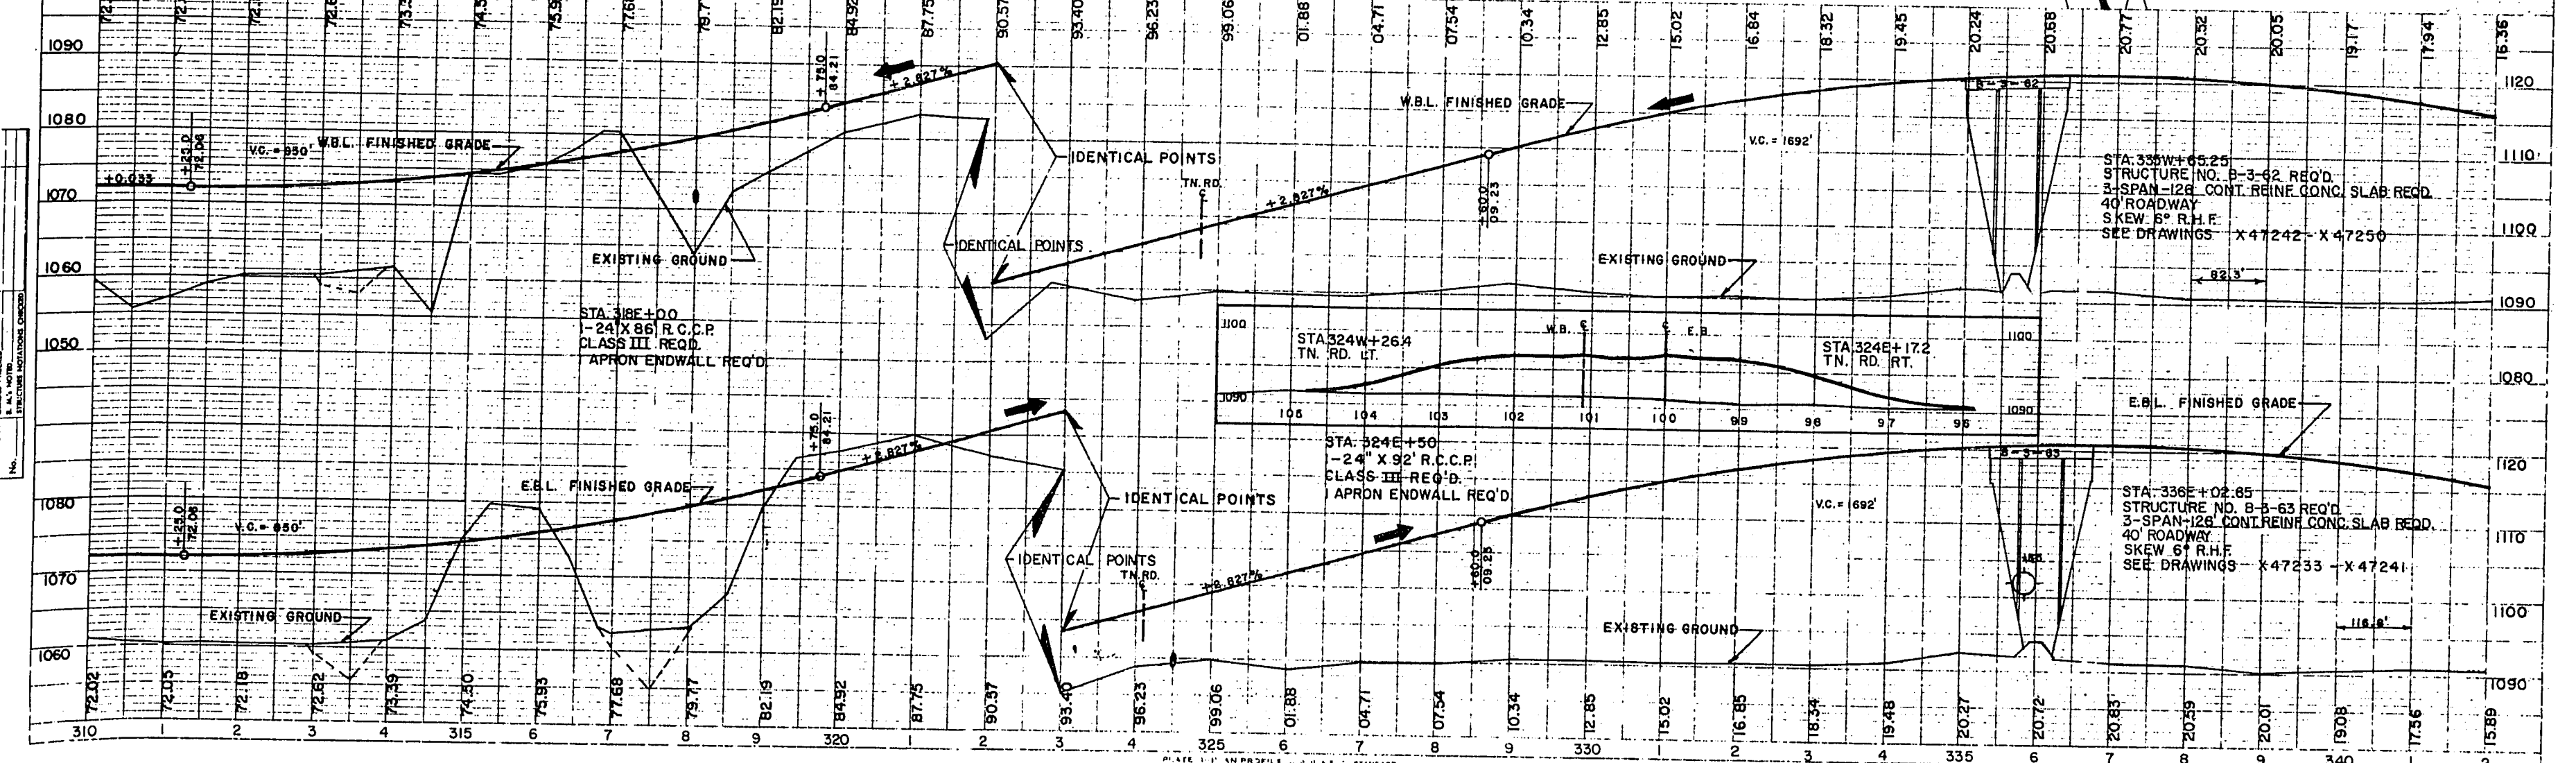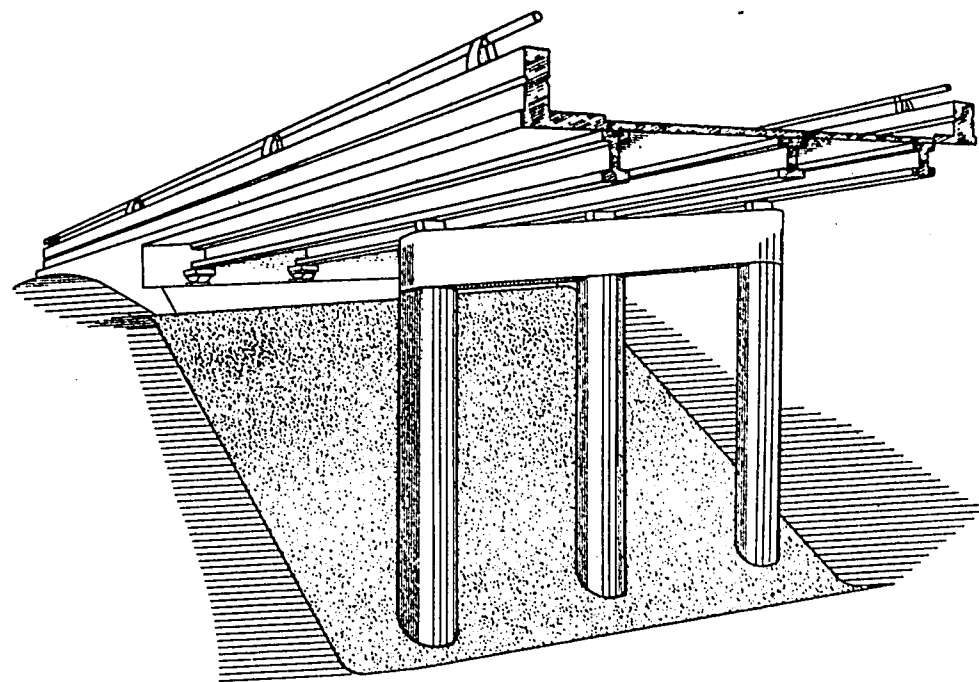JEROME TURKEY FARMS INC.
EQUATIONS






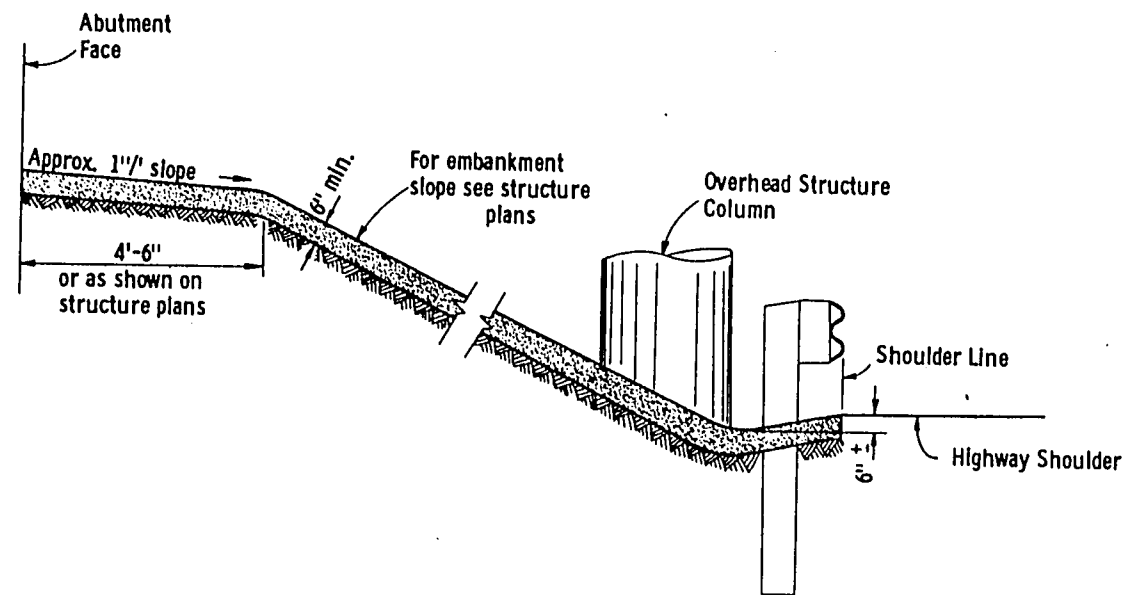
TYPICAL LOCATION DIAGRAM FOR SLOPE PAVING UNDER STRUCTURES



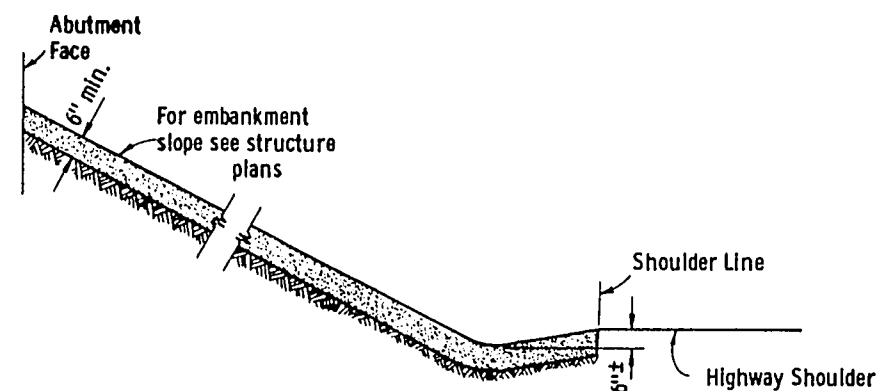
**TYPICAL RURAL SECTION
HIGHWAY GRADE SEPARATION
SILL TYPE ABUTMENT**



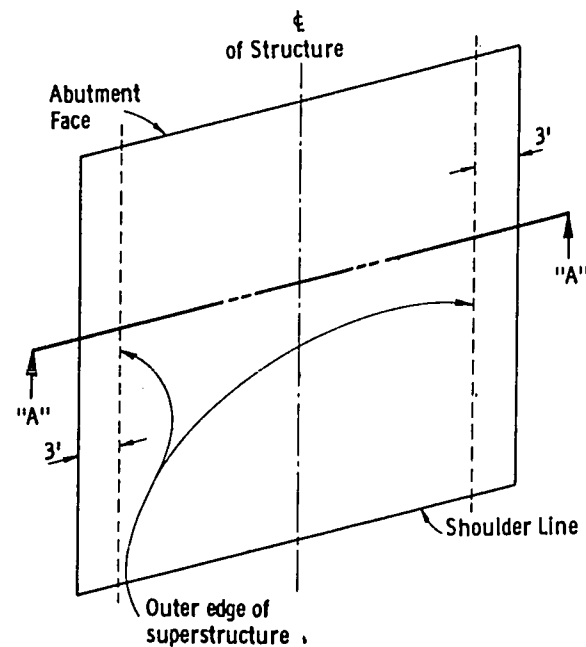**TYPICAL RURAL SECTION
HIGHWAY GRADE SEPARATION
SEMI-RETAINING TYPE ABUTMENT**



PLAN VIEW

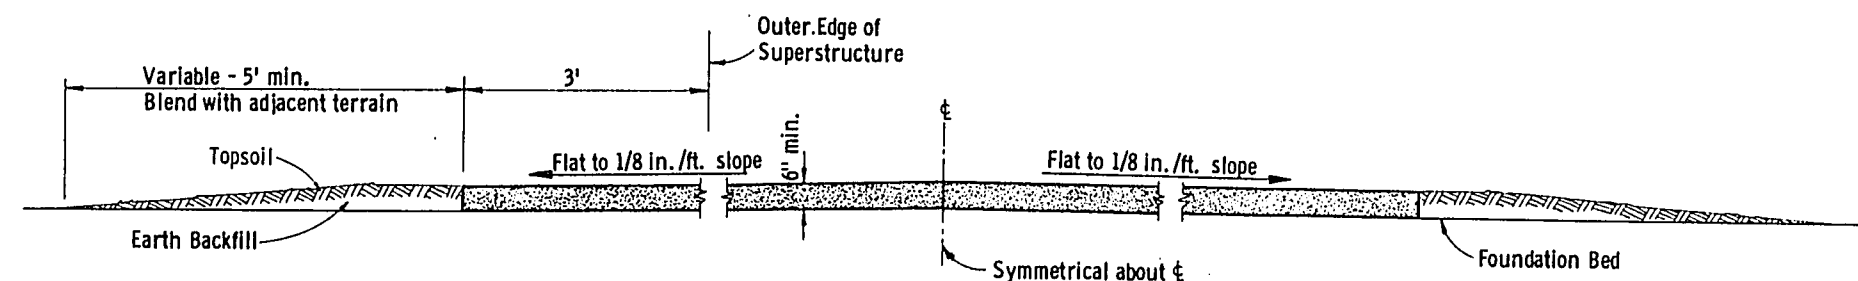

SECTION "A"-"A"

GENERAL NOTES

Details of construction not shown hereon shall conform to the pertinent requirements of the Standard Specifications and the applicable Special Provisions.

CRUSHED STONE

The material shall conform to the gradation requirements for coarse aggregate for concrete masonry, size No. 2 of either series No. 1 or series No. 2.

BITUMINOUS MATERIAL

The upper portion of the paving shall be stabilized by means of an application of bituminous material conforming to the requirements of the applicable Standard Specification or Special Provisions. The bituminous material shall be applied at a rate sufficient to assure penetration into and binding together of the particles in the upper two inches of the crushed stone. The surface of the adjacent structure shall be protected so as to prevent their being splattered or discolored with bituminous material.

METHOD OF MEASUREMENT & PAYMENT

This work shall be measured and paid for by the square yard, which yardage shall be the summation of the total area measured on the plane of the surface thereof, and as provided for in the Standard Specifications and applicable Special Provisions.

SLOPE PAVING CRUSHED STONE

State of Wisconsin
Department of Transportation
Division of Highways

RECOMMENDED FOR APPROVAL

1/25/68

DATE

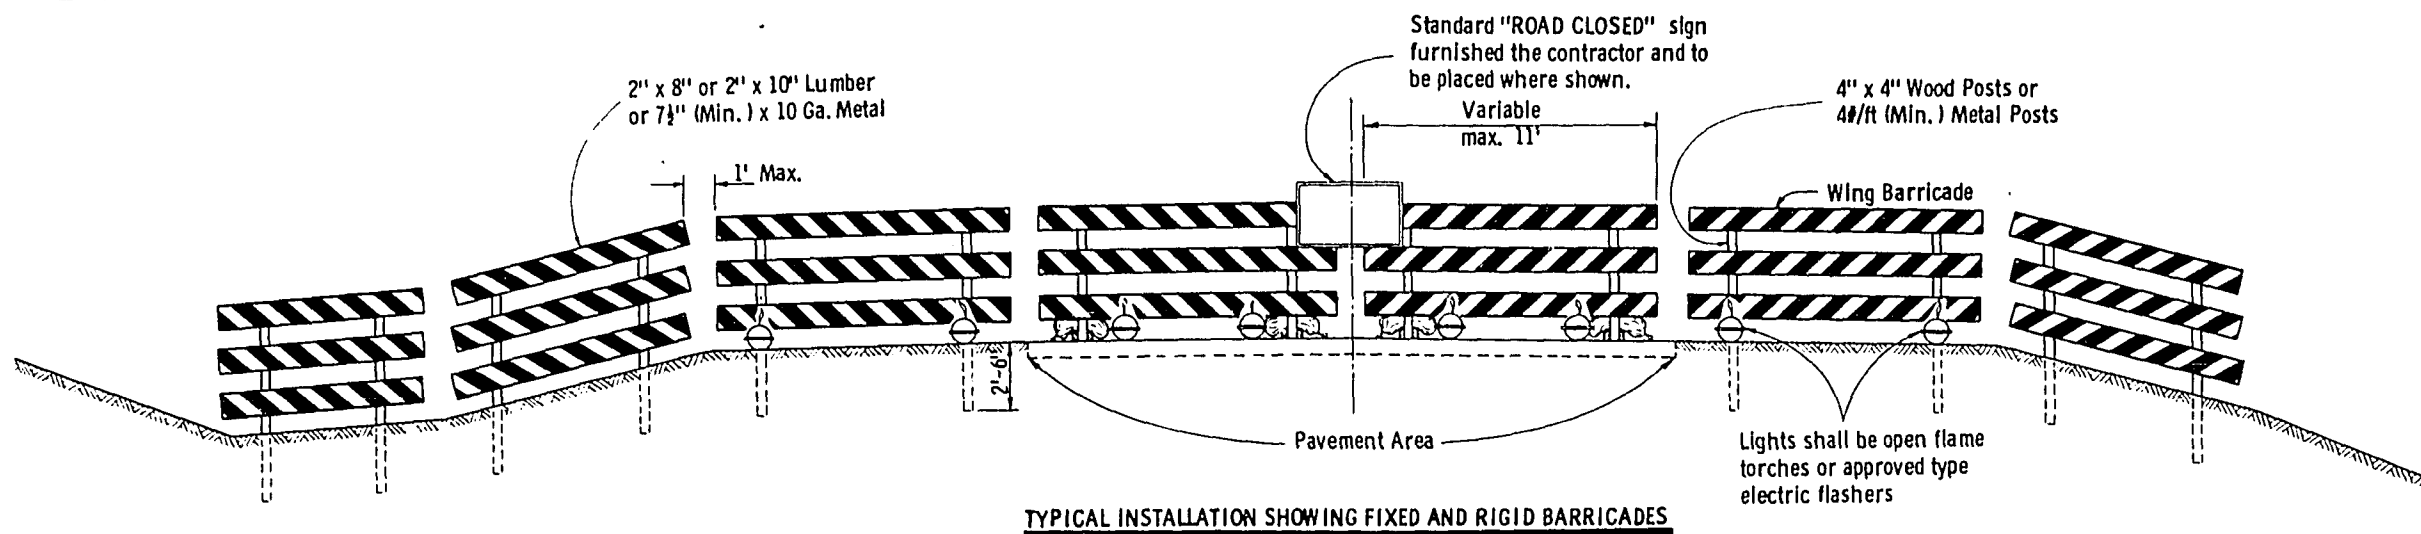
APPROVED

2/8/68


DATE

E. J. Bybit
CHIEF DESIGN ENGINEER


A. J. Larmister
STATE HIGHWAY ENGINEER



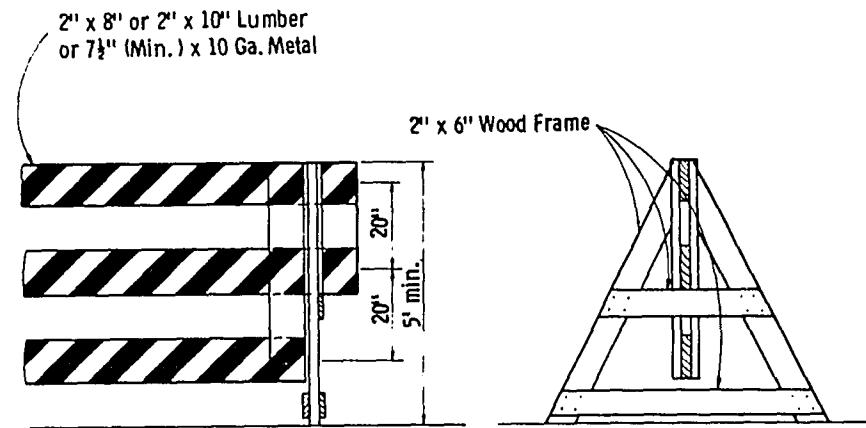TYPICAL INSTALLATION SHOWING FIXED AND RIGID BARRICADES




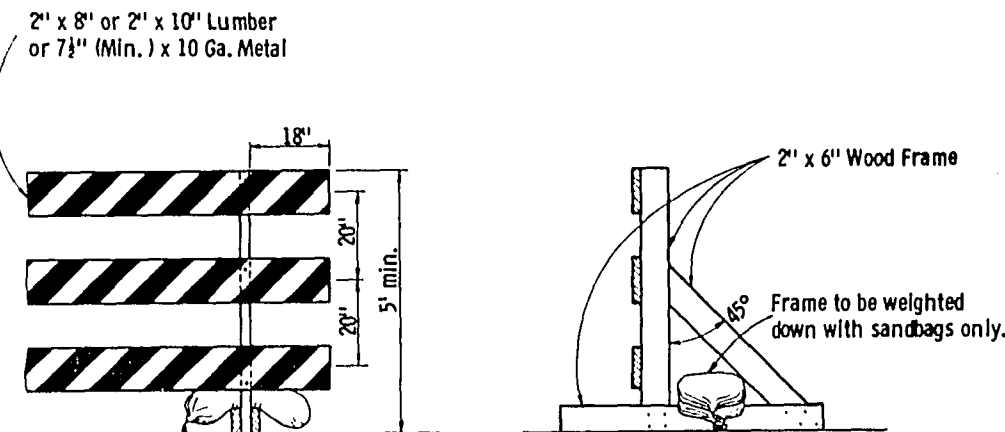ALTERNATE TYPE INSTALLATION (DEMOUNTABLE)




ALTERNATE TYPE INSTALLATION (RIGID)

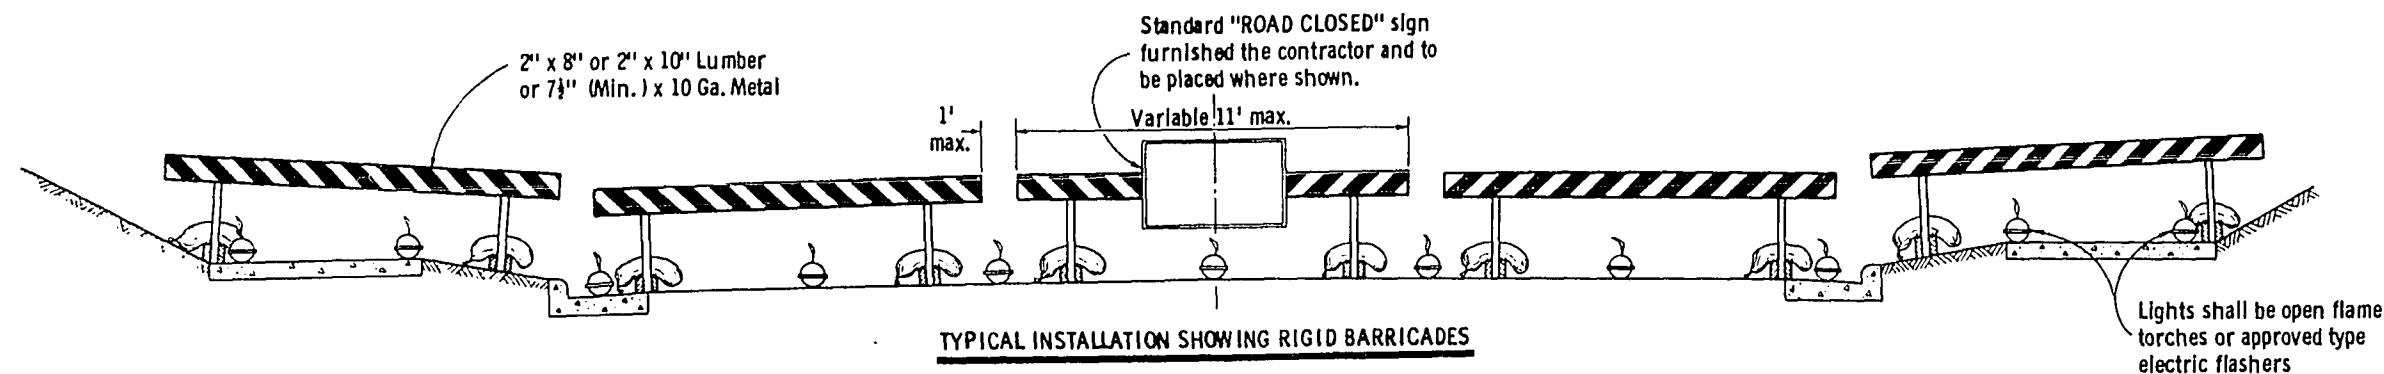
CLASS I BARRICADES



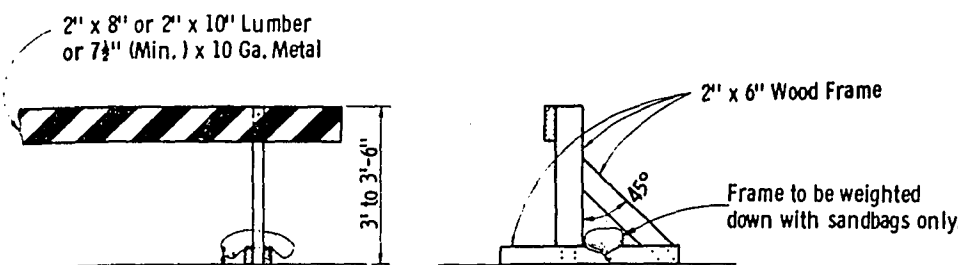TYPICAL INSTALLATION SHOWING RIGID BARRICADES




ALTERNATE TYPE INSTALLATION (RIGID)

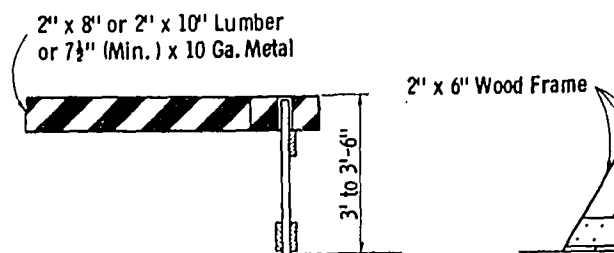

ALTERNATE TYPE INSTALLATION (DEMOUNTABLE)

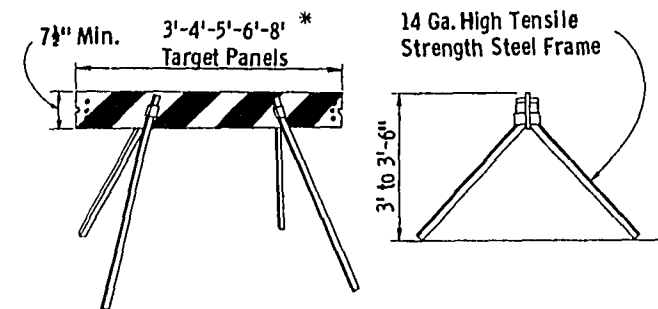CLASS II BARRICADES



ALTERNATE TYPE INSTALLATION (DEMOUNTABLE)

GENERAL NOTES

The contractor shall construct, place and maintain barricades as shown on the drawing and as required by the Standard Specifications or applicable Special Provisions.

CLASS 1 BARRICADE:

Class 1 Barricades shall be of variable length as indicated, and long barricades shall be assembled from these units. The Class 1 Barricade is the type normally required for major operations, where the barricade will remain in place for extended periods. Class 1 Barricades shall be used at points where the road is closed to traffic. Gates or movable sections of a barricade shall be provided when necessary, for access of equipment or other authorized vehicles. Wing Barricades are Class 1 Barricades erected on the shoulder on one or both sides of the pavement to give Traffic the perceptive effect of a narrowing or restricted roadway. The ends closest to traffic of all three members of a wing barricade shall be in a vertical line. If used in a series, they should start at the outer edge of the shoulder and be brought progressively closer to the pavement. Wing Barricades may be used as a mounting for the advance warning or guide signs or for flashers. When used on two-way roadways, the back of the wing barricade shall be painted reflectorized white.

CLASS 11 BARRICADE:

Class 11 Barricades may be used only where the hazard to traffic is relatively small, and for the more or less continuous delimiting of a restricted roadway, or for temporary daytime use.

MATERIAL & FABRICATION:

Lumber shall be of a grade structurally sound and sufficiently rigid to satisfactorily support and maintain the purpose and intent of a barricade facility. Metal shall be sufficiently rigid to satisfactorily support and maintain the purpose and intent of a barricade facility. The fabrication of the barricade shall be in accord with good pertinent woodworking and metalworking practices. All lumber or timber dimensions stated are nominal.

PAINTING:

All barricades shall be painted in alternate 4" or 6" black and white stripes at a 45° angle. The width of stripe shall be consistent for each complete barricade installation. Black stripes shall be painted with weather resistant and durable black paint. White stripes shall be primed, followed by two coats of white reflectorized paint or reflective wide angle sheeting.

DIRECTION OF DIAGONAL STRIPES:

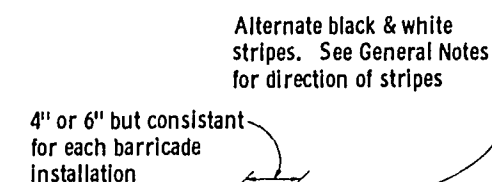
Where a barricade extends entirely across the roadway with no vehicle access provision, the stripes shall slope downward toward the highway centerline. Where vehicle access is permitted, the stripes shall slope downward in the direction toward which vehicles must turn in detouring. Where both right and left turns are provided for, the stripes shall slope downward in both directions from the center. The stripes on wing barricades shall point downward toward the roadway.

LIGHTING:

Lighting devices for barricades shall conform to the requirements of the Standard Specifications.

MEASUREMENT & PAYMENT:

All barricades, unless otherwise provided for in the plans and/or special provisions shall be furnished, placed, and maintained as noted above, and no additional compensation will be allowed but shall be construed to be included in the price bid for other items.



TYPICAL DIAGONAL STRIPES
Applies to all Classes & Types of Barricades

CONSTRUCTION BARRICADE

State Highway Commission of Wisconsin

RECOMMENDED FOR APPROVAL

DATE 1/11/67

APPROVED: 1/13/67

DATE

DATE

DATE 1/11/67

DATE 1/13/67

DATE

DATE

DATE

245'-5" BACK TO BACK OF ABUTMENTS

2'-8 1/2" 118'-6" 121'-6" 2'-8 1/2"

Q BRG. SOUTH ABUT. STA. 858"S+93.10

Q PIER STA. 860"S+11.60

Q BRG. NORTH ABUT. STA. 861"S+33.10

POINT OF CRIT. VERT. CL. = 17'-1" ±

POINT OF VERT. CL. = 17'-10" ±

SLOPE PAVING TIP

3'-0"

END OF SLAB STA. 858"S+90.98

STA. 892"E+39.50 R EB. L. U-S-H "8" = STA. 859"S+56.70 R SB. L. U-S-H "53"

STA. 292"W+19.50 R WB. L. U-S-H "8" = STA. 860"S+66.50 R SB. L. U-S-H "53"

245'-5" BACK TO BACK OF ABUTMENTS

2'-8 1/2" 118'-6" 121'-6" 2'-8 1/2"

Q BRG. SOUTH ABUT. STA. 858"N+73.05

Q PIER STA. 859"N+91.53

Q BRG. NORTH ABUT. STA. 861"N+13.05

POINT OF CRIT. VERT. CL. = 16'-8 1/2" ±

POINT OF VERT. CL. = 17'-6" ±

SLOPE PAVING TIP

3'-0"

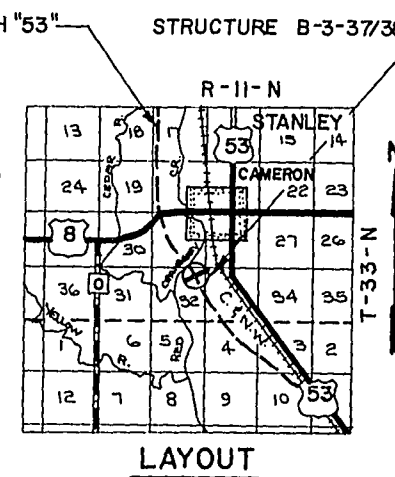
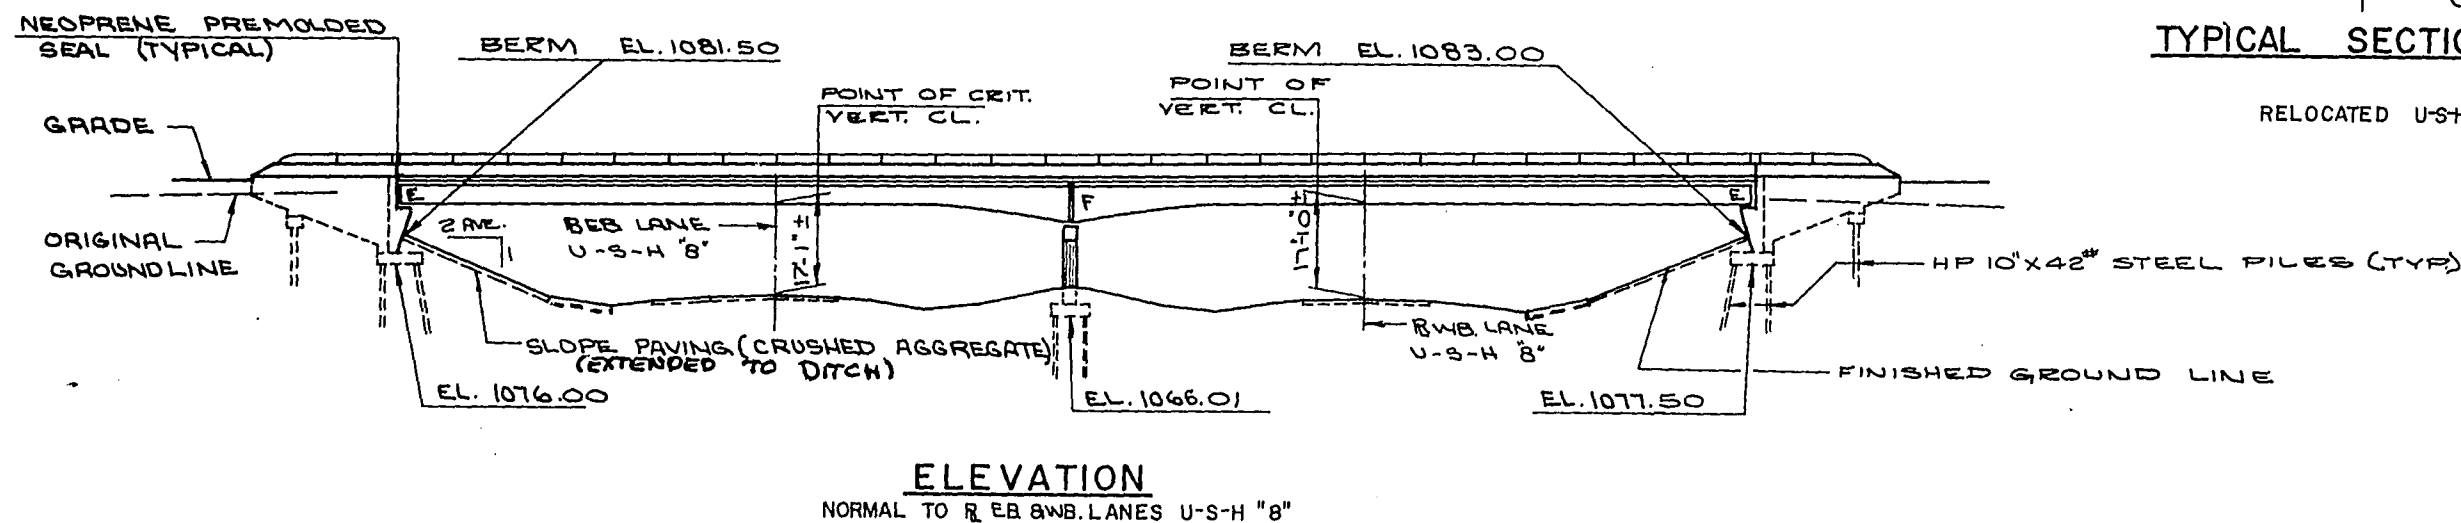
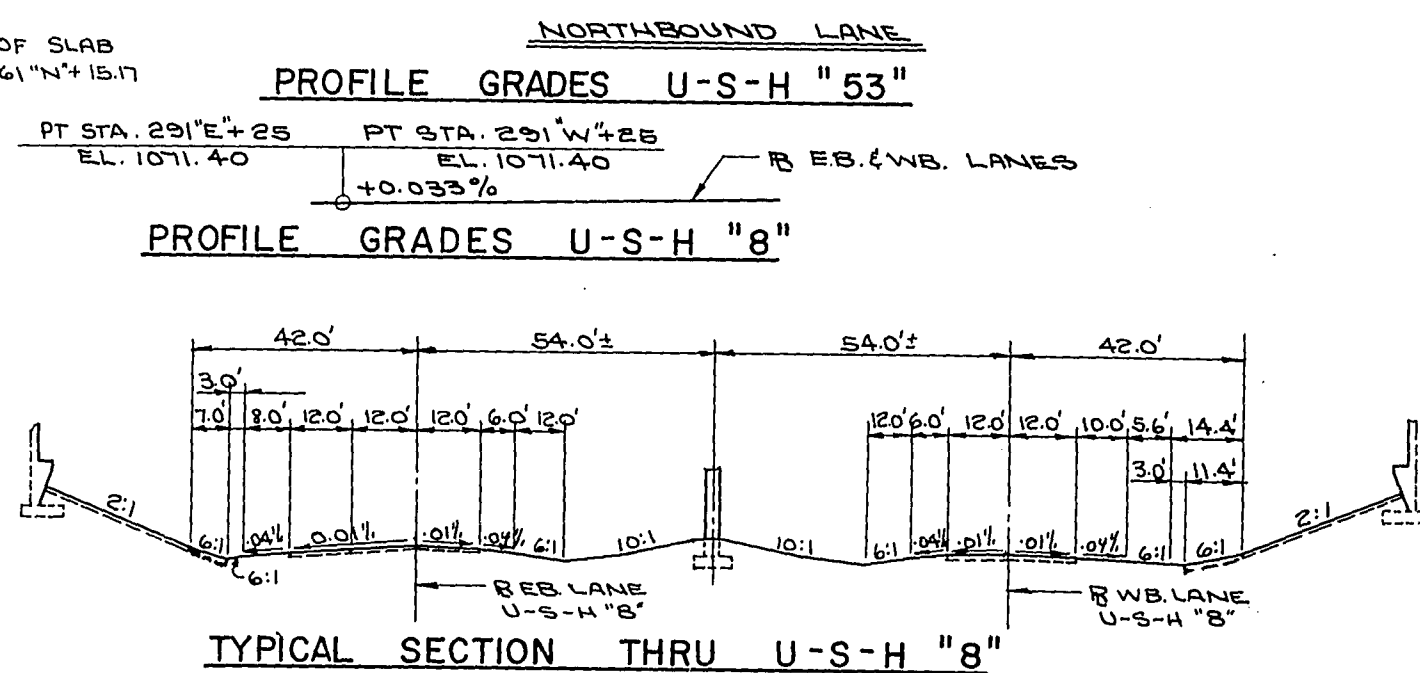
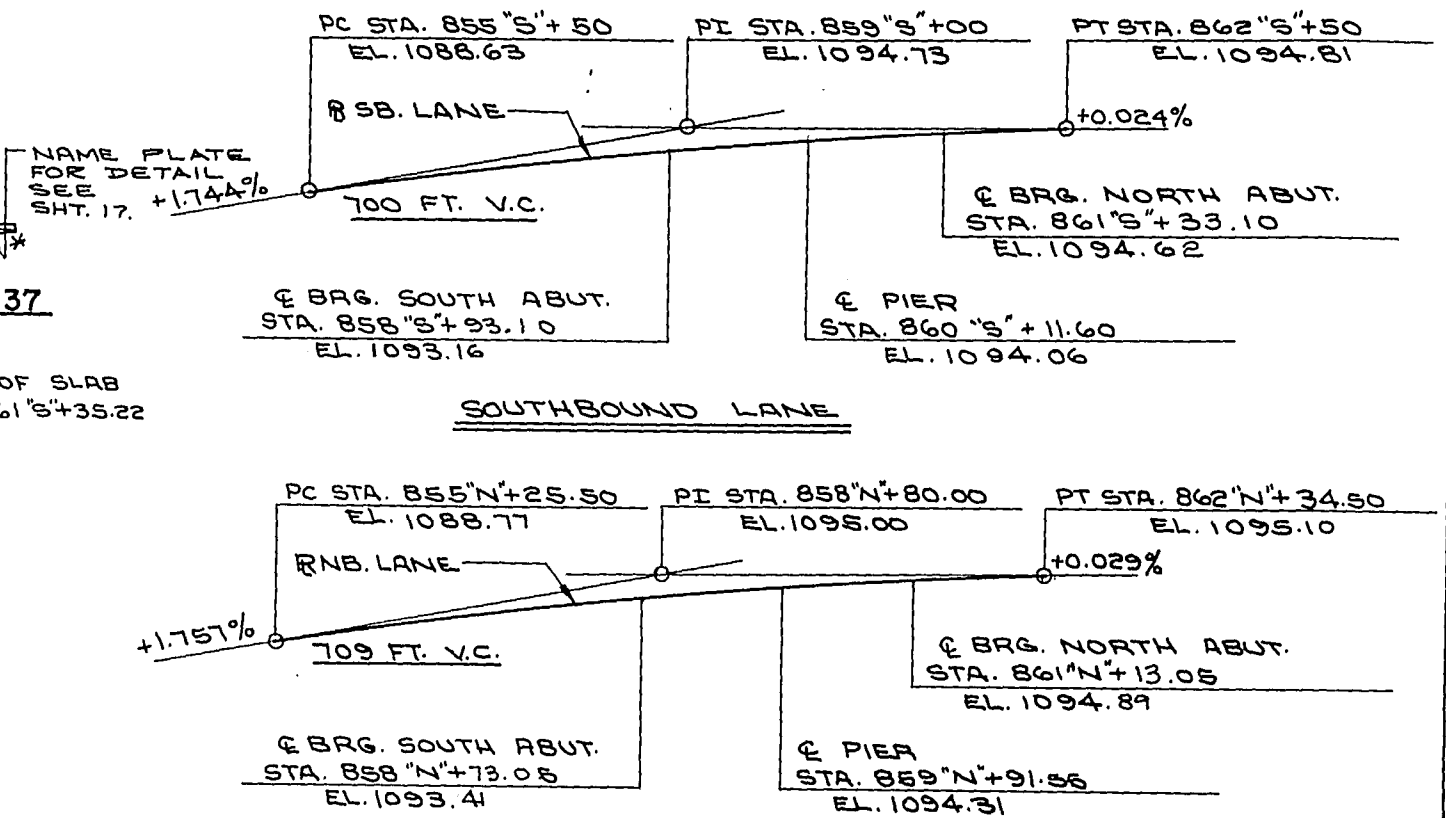
END OF SLAB STA. 858"N+70.95

STA. 293"E+49.40 R EB. L. U-S-H "8" = STA. 859"N+36.60 R NB. L. U-S-H "53"


STA. 293"W+29.30 R WB. L. U-S-H "8" = STA. 860"N+46.50 R NB. L. U-S-H "53"

NAME PLATE FOR DETAIL SEE SHT. 19.

PLAN LAYOUT B-3-37/38



7				
No.	Date	Revision		By
STATE OF WISCONSIN DEPARTMENT OF TRANSPORTATION DIVISION OF HIGHWAYS				
STRUCTURE B-3-37				
U-S-H "53" OVER U-S-H "8"				
County BARRON		City Valhalla TN: STANLEY		
Design Spec. A.A.S.H.O. 1969		Load H30	Const. Spec. 1969	
Designed By C D W	Design Checked RWA	Drawn By T L A	Plans Checked RLP	
Approved <u>W. A. Kline</u> Chief Bridge Engineer		<u>72</u> Date		
GENERAL PLAN		SHEET 1 OF 18		
		X46904		

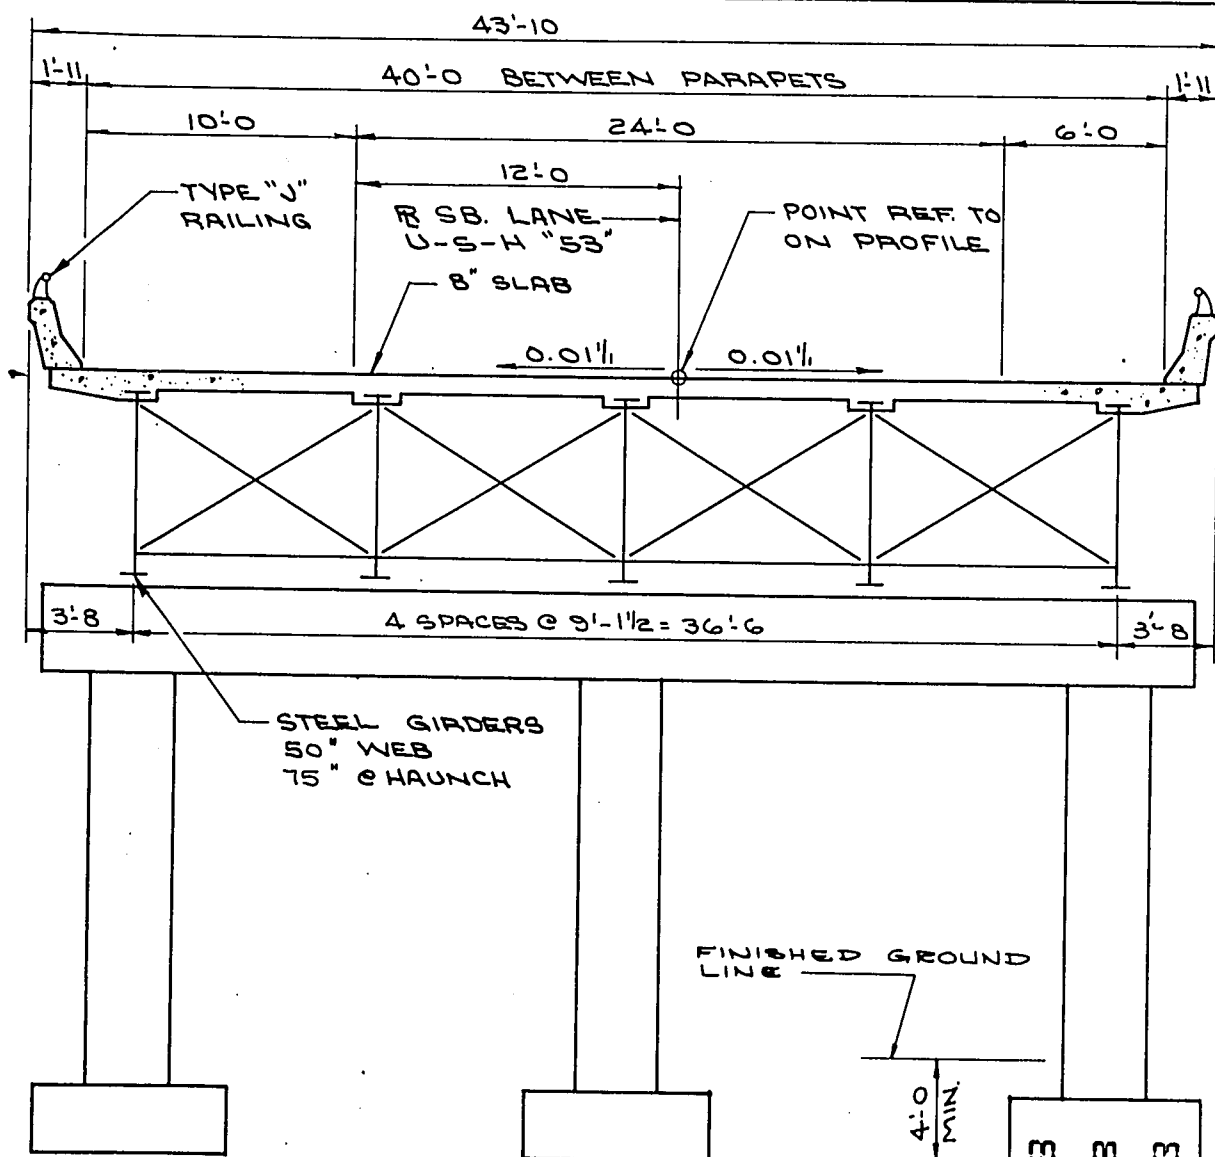

CROSS SECTION THRU RDWY.
LOOKING NORTH

TOTAL ESTIMATED QUANTITIES

BID ITEMS	UNIT	SUPER	SO. ABUT.	PIER	NO. ABUT.	TOTAL
EXCAVATION FOR STRUCTURES	C.Y.	—	115	60	115	290
GRANULAR BACKFILL	C.Y.	—	160	—	160	320
CONCRETE MASONRY	C.Y.	512.4	118.3	48.0	118.3	597.0
BAR STEEL REINFORCEMENT	L.B.	84,090	6,970	6,740	6,970	104,770
STRUCTURAL CARBON STEEL	L.B.	230,700	—	—	—	230,700
STRUCTURAL LOW-ALLOY STEEL	L.B.	50,750	—	—	—	50,750
LUBRICATED BRONZE PLATES	L.B.	174	—	—	—	174
BEARING PADS	S.F.	29	—	—	—	29
NEOPRENE PRE-MOLDED SEAL	L.F.	87	—	—	—	87
STEEL PILING, DELIVERED & DRIVEN HP 10 INCH X 42 POUND	L.F.	—	675	630	675	1,980
TUBULAR RAILING, TYPE "J"	L.F.	557	—	—	—	557
SLOPE PAVING (CRUSHED AGGR.)	S.Y.	—	129	—	148	277
NON-BID ITEMS						
ALUMINUM OR ZINC PLATE	S.F.	63	—	—	—	63
FILLER	SIZE	—	—	—	—	—
POLYVINYL CHLORIDE WATERSTOP	L.F.	—	34	—	34	68

GENERAL NOTES

DRAWINGS SHALL NOT BE SCALED.
REINFORCEMENT SHALL BE 6M-
OTHERWISE CLEAR UNLESS SHOWN OR NOTED
THE TOP OF THE FILL IN FRONT OF THE ABUT-
MENTS SHALL BE COVERED WITH CRUSHED AGGR.
TO THE DEPTH OF THE ABUTMENT DETAIL, SHOWING ON
SHT. 2. THE ABUTMENT DETAIL, SHOWING ON
SHT. 2. THE ABUTMENT DETAIL, SHOWING ON
CAVATION AT THE ABUTMENTS.
THE FINISHED GRADED SECTION WAS USED AS
THE UPPER LIMITS OF EXCAVATION. THE
OF EXCAVATION QUANTITIES AT THE PIER.
AT ABUTMENTS ALL EXCAVATED VOLUME NOT OC-
CUPIED BY THE NEW ABUTMENT SHALL BE FILLED
WITH GRANULAR BACKFILL. FOR PAY LIMITS SEE
SHT. 6.
ALL FIELD CONNECTIONS SHALL BE MADE WITH 3/4" DIA-
METER FRICTION TYPE HIGH-TENSILE STRENGTH BOLTS
UNLESS SHOWN OR NOTED OTHERWISE.

THE
~~PARAPET STEEL~~ (R 501 ETC) AT ABUTS.
WAS OMITTED FROM ESTIMATE FOR B-3-37. TOTAL
SHOULD BE 106, ~~183.6~~⁵⁰⁶

TRAFFIC VOLUME

U-S-H "53" U-S-H "8"
A.D.T. — 5,200 A.D.T. — 6,070
R.D.S. — 80 M.P.H.

LIST OF DRAWINGS

1. GENERAL PLAN	X46904
2. GENERAL PLAN	X46905
3. SUBSURFACE EXPLORATION	X46906
4. SOUTH ABUTMENT	X46907
5. SOUTH ABUTMENT	X46908
6. SOUTH ABUTMENT	X46909
7. NORTH ABUTMENT	X46910
8. NORTH ABUTMENT	X46911
9. NORTH ABUTMENT	X46912
10. PIER	X46913
11. SUPERSTRUCTURE	X46914
12. SUPERSTRUCTURE	X46915
13. SUPERSTRUCTURE	X46916
14. SUPERSTRUCTURE	X46917
15. BEARING DETAILS	X46918
16. NEOPRENE SEAL EXPANSION JOINT	X46919
17. SLOPED FACE PARAPET "A"	X46920
18. TUBULAR RAILING TYPE "J"	X46921



DESIGN DATA

LIVE LOAD: HS20
ALLOWABLE DESIGN STRESSES:
CONCRETE MASONRY, GRADE "AA", SLAB — 1,200 P.S.I.
ALL OTHER — 1,400 P.S.I.
BAR REINFORCING — 20,000 P.S.I.
n=10
STRUCTURAL CARBON STEEL — 20,000 P.S.I.
STRUCTURAL LOW ALLOY STEEL:
TO AND INCLUDING 3/4" THICK — 27,000 P.S.I.
3/4" TO AND INCLUDING 1 1/2" THICK — 25,000 P.S.I.

FOUNDATION DATA

PIER TO BE SUPPORTED ON
HP 10 INCH X 42 POUND STEEL PILES EST. 35' L.O.
LG. & DRIVEN TO A MIN. BRG. VALUE OF 55 TONS/PILE.
ABUTMENTS TO BE SUPPORTED
ON HP 10 INCH X 42 POUND STEEL PILES EST. 45' L.O.
LG. & DRIVEN TO A MIN. BRG. VALUE OF 55 TONS/PILE.


No.	Date	Revision	By
STATE OF WISCONSIN DEPARTMENT OF TRANSPORTATION DIVISION OF HIGHWAYS			
STRUCTURE B-3-37			
Const. Spec.	1969	Drawn By	TLA
		Plans Checked	RLP
GENERAL PLAN			SHEET 2 OF 18 X46905

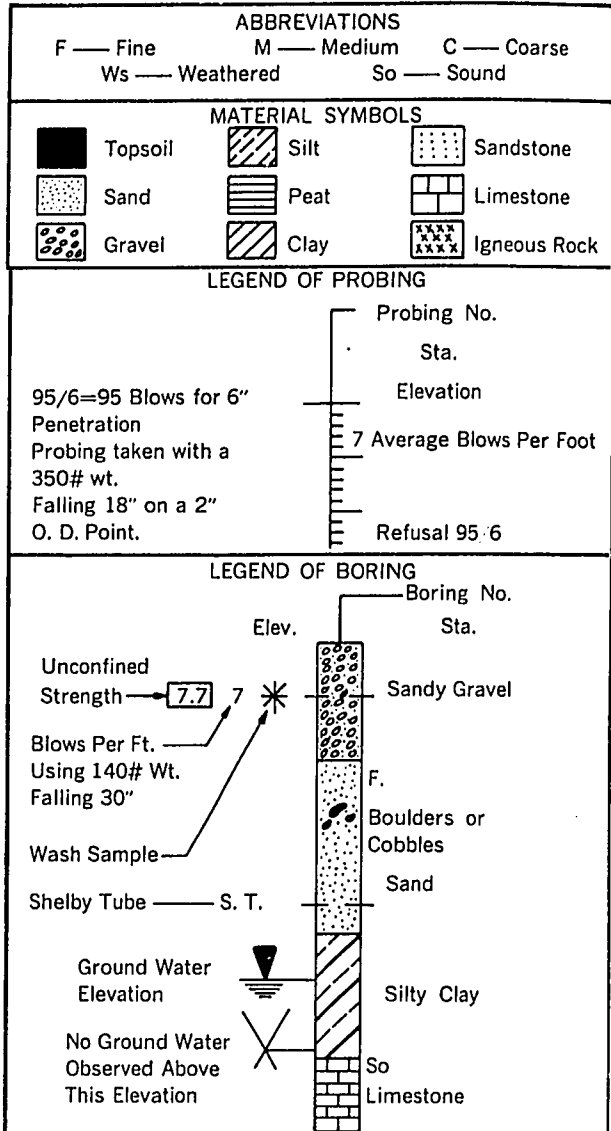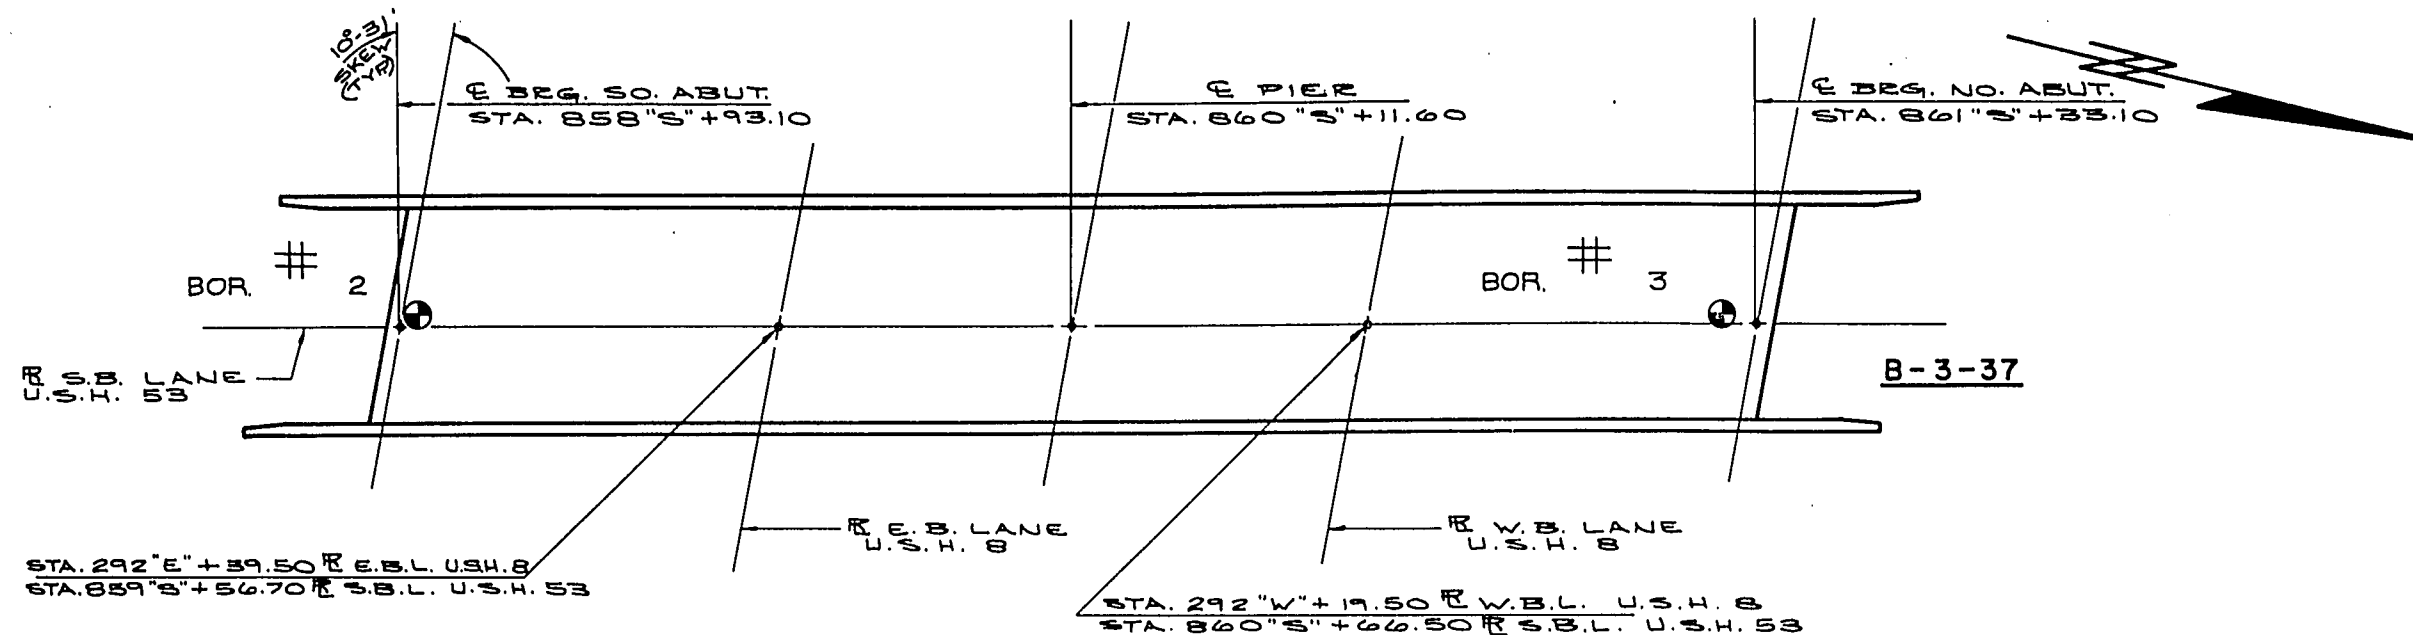

Unless otherwise specified, the blows per foot at the locations indicated are based on driving a 2" O. D. x 1.4" I. D. split spoon sampler with a 140# hammer having a free fall of 30". The blow count is taken in undisturbed soil immediately below a cased or open hole eliminating side friction on the drive pipe.

SUBSURFACE EXPLORATION FOR FOUNDATION DESIGN AND BIDDERS INFORMATION

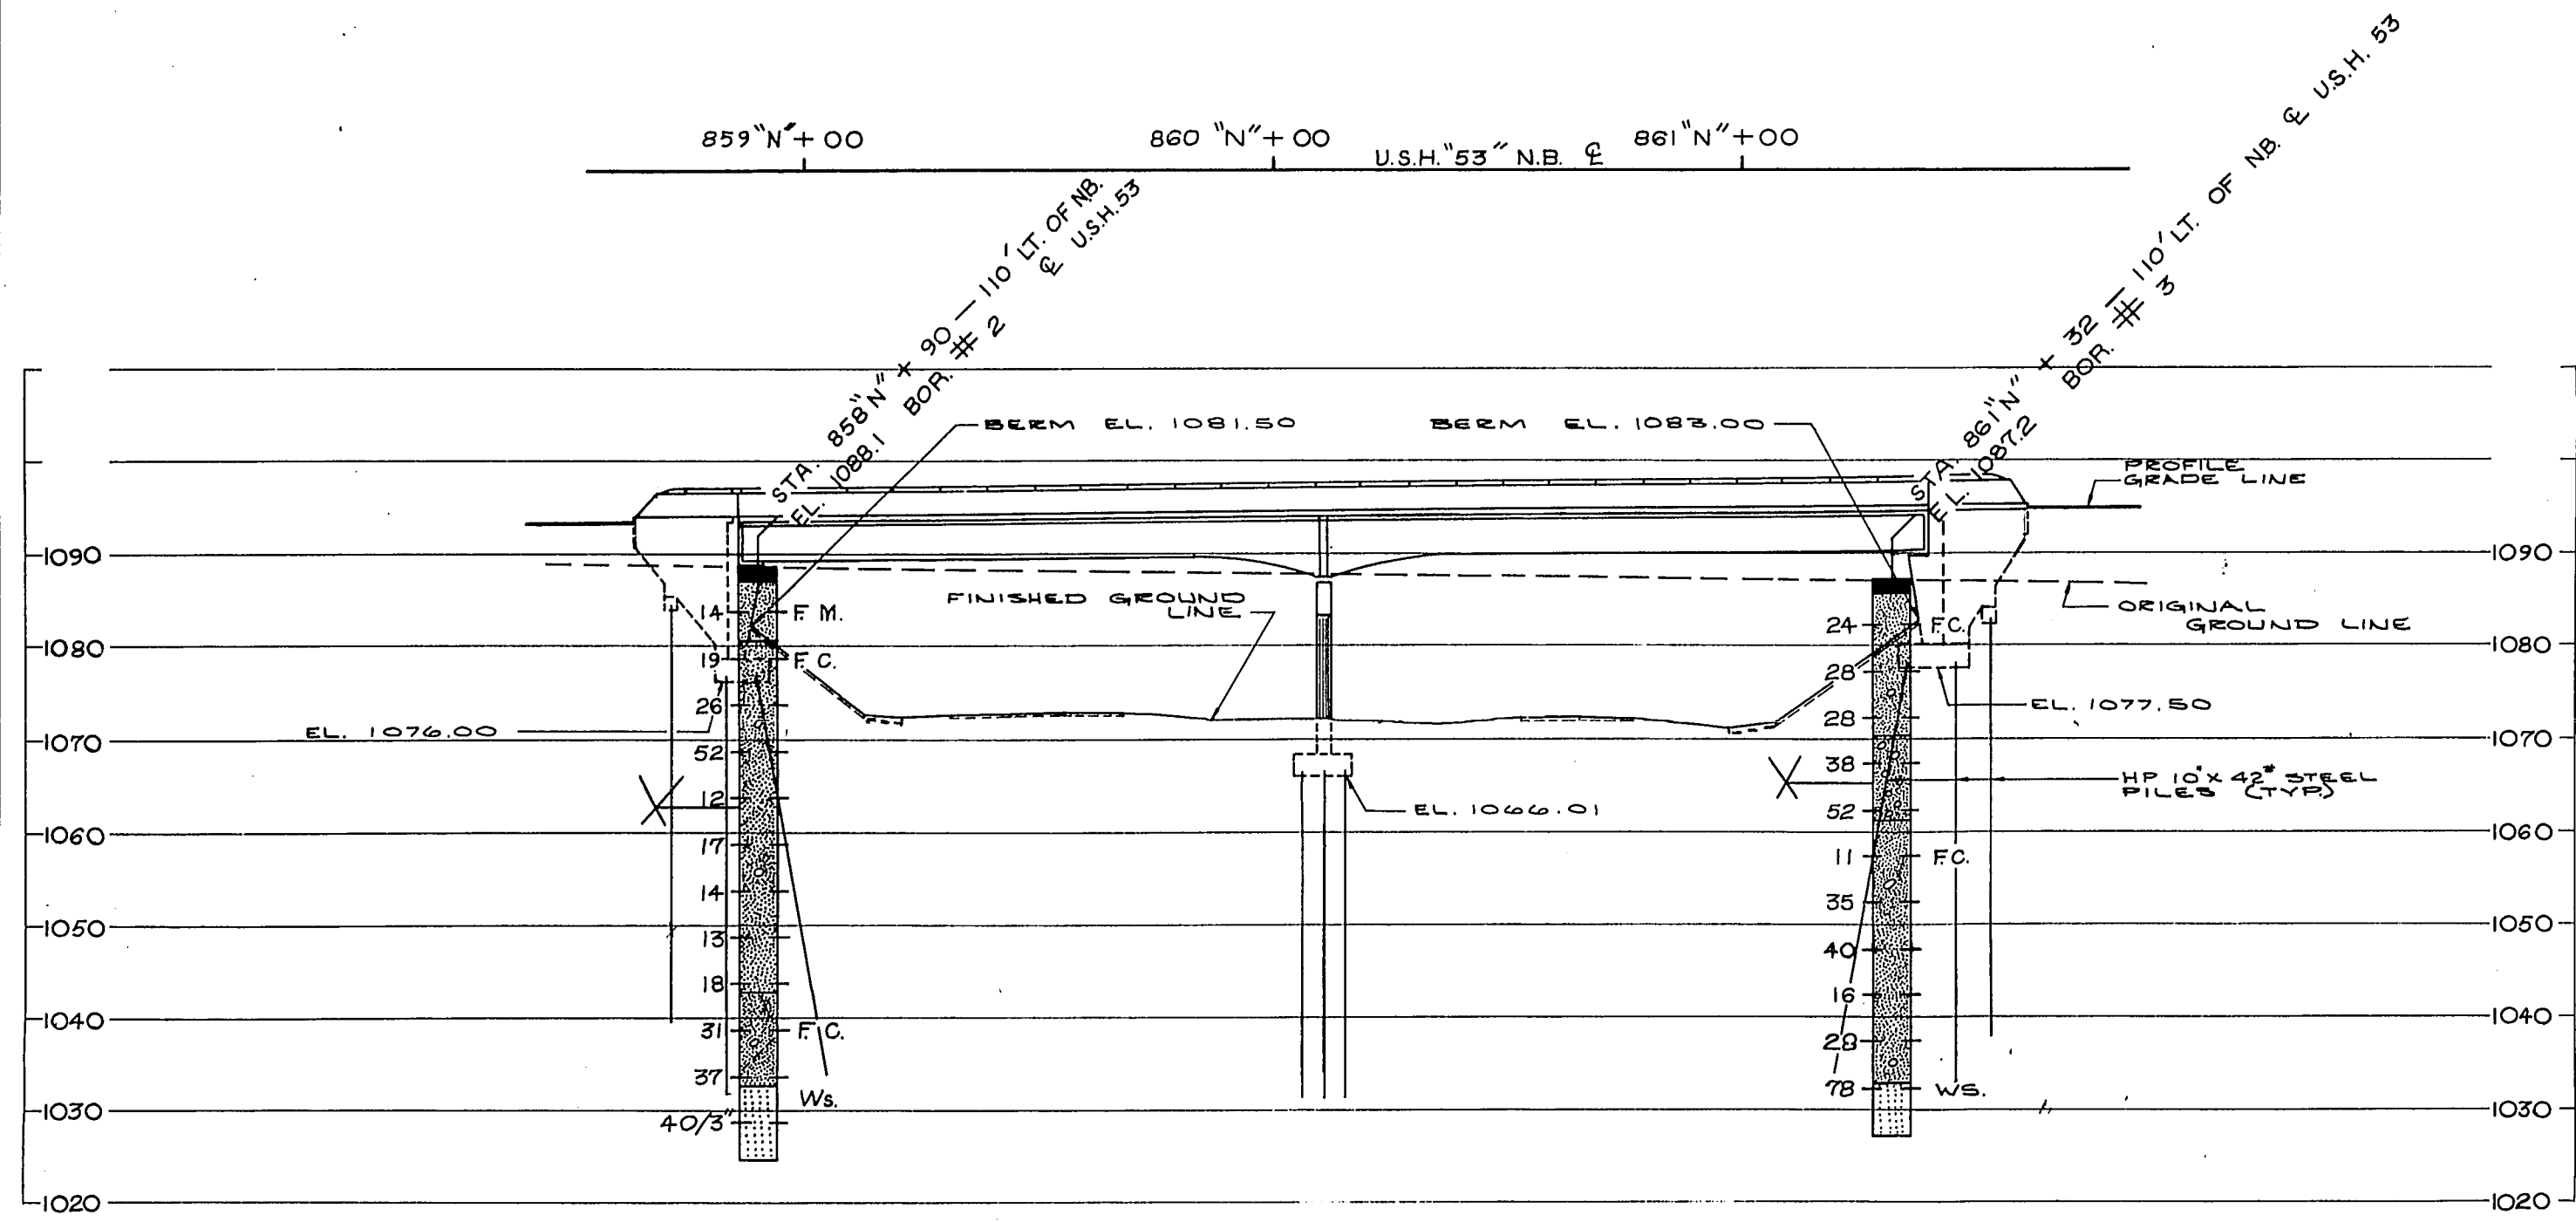To obtain relative data concerning the character of material in and upon which the foundation might be built, borings and/or soundings were made at points approximately as indicated on this drawing. The data presented herein represents the findings of the subsurface explorations made. However, because the depths investigated are limited and the area of the borings and/or soundings is very small in relation to the entire area, the Division of Highways does not warrant conditions below the depths investigated or that the classification of material encountered in these investigations is necessarily typical of the entire site.



No.	Date	Revision	By
STATE OF WISCONSIN DEPARTMENT OF TRANSPORTATION DIVISION OF HIGHWAYS			
STRUCTURE B-3-37			
Const. Spec. 1969	Drawn By TLA	Plans Checked RLP	
SUBSURFACE EXPLORATION			SHEET 3 OF 18 X46906

* ELEV.S ARE GIVEN @ E OF BEG.


**** DIMENSIONS ARE GIVEN @ F.F. ABUT. BACKWALL.**

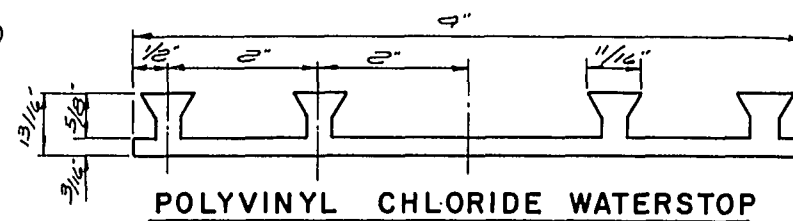*POUR CONC. ABOVE THIS JOINT AFTER SUPER. CONC. IS IN PLACE. STRIKE OFF LEVEL & LEAVE ROUGH.


● OPTIONAL CONST. JOINT. FORMED BY SURFACED, BEVELED 2"x6" KEYWAY.

⊕ CONST. JOINT - FORMED BY SURFACED, BEVELED
2" x 6" KEYWAY.

◆ POLYVINYL CHLORIDE WATERSTOP. TO EXTEND BETWEEN WING FILLETS. (TO BE FLUSH WITH FACE OF CONC.) (IF OPT. CONST. IT. IS USED.)



PROJECT ID	SHEET NUMBER	TOTAL SHEETS
1197-6-72		
FEDERAL PROJECT DESIGNATION	24	225
DPFOB-4(41)		

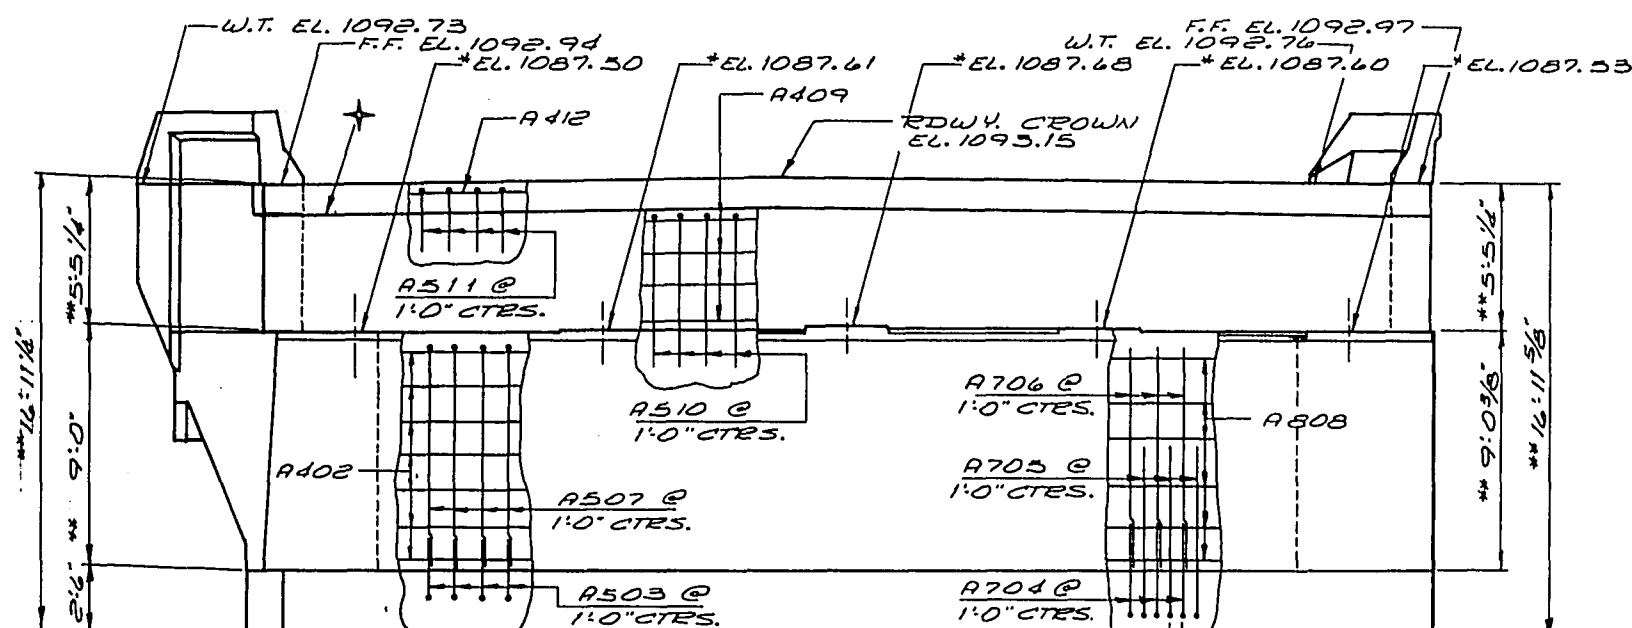


NOTE: LAP A402 & A409 BARS A
MIN. OF 24 BAR DIA.
NOTE: SPACE A507 BARS TO MISS
ANCHOR BOLTS.


NOTE: A704, A705, A706 !
A808 BARS PLACED BETWEEN
WING FILLETS.

EL. 1076.00

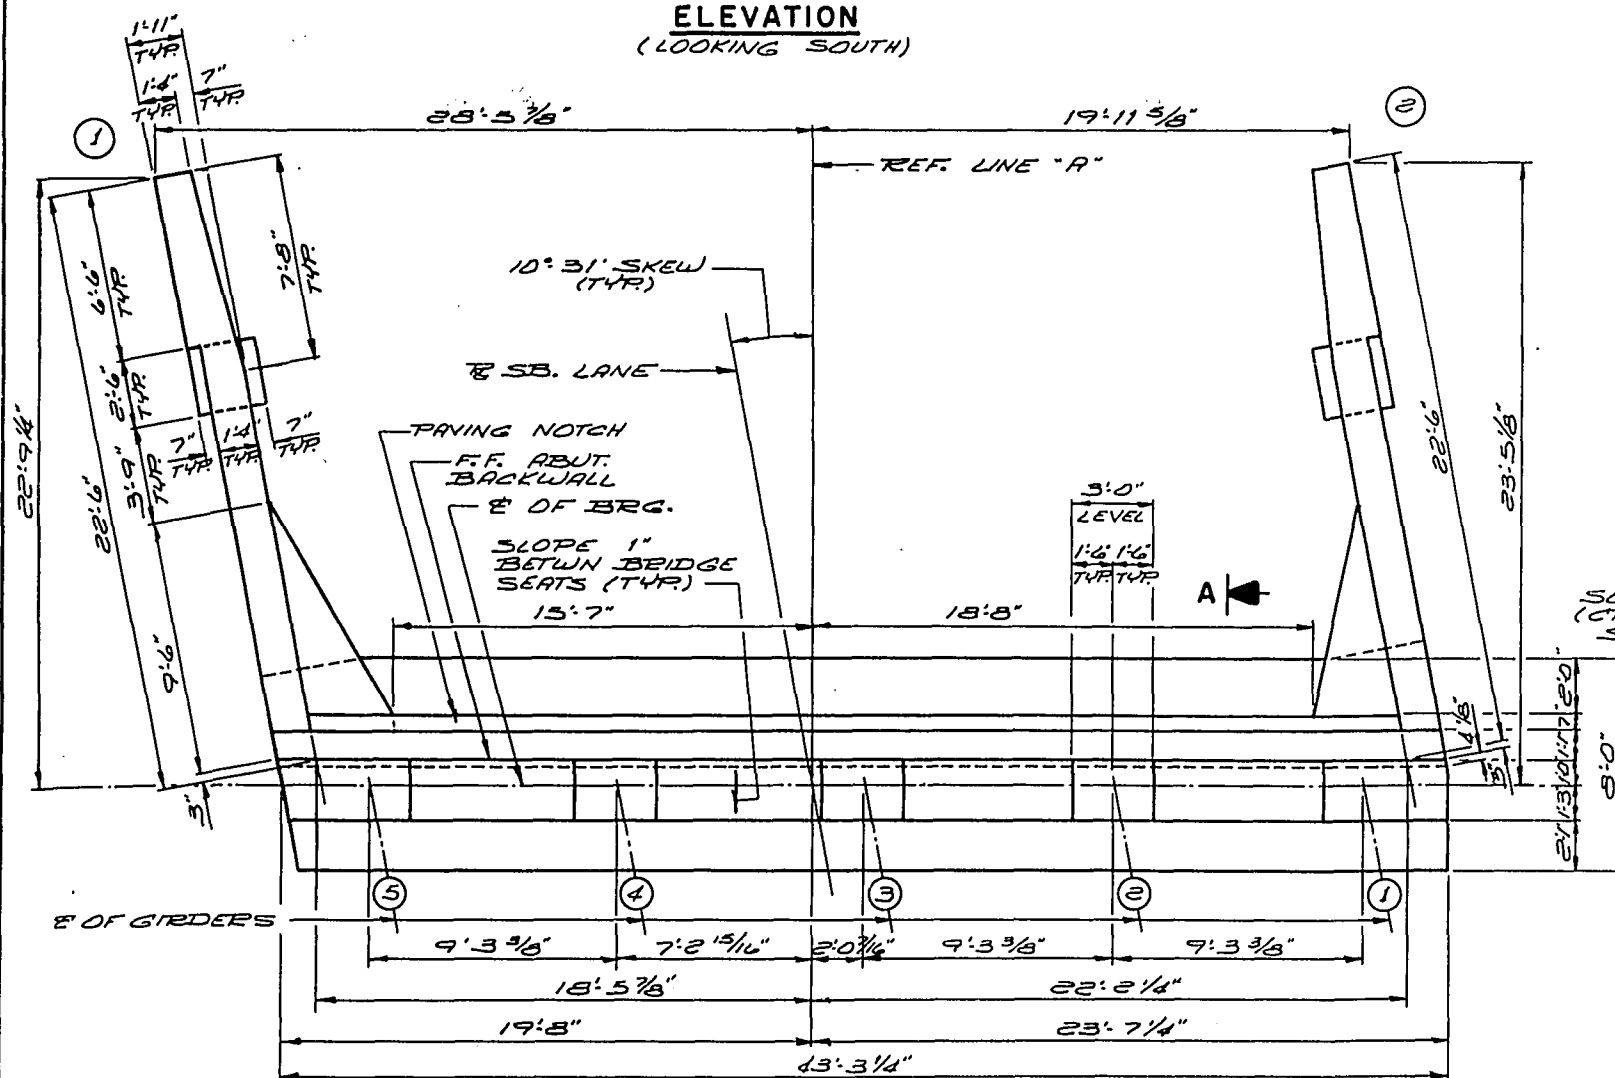ELEVATION
(LOOKING SOUTH)




PLAN

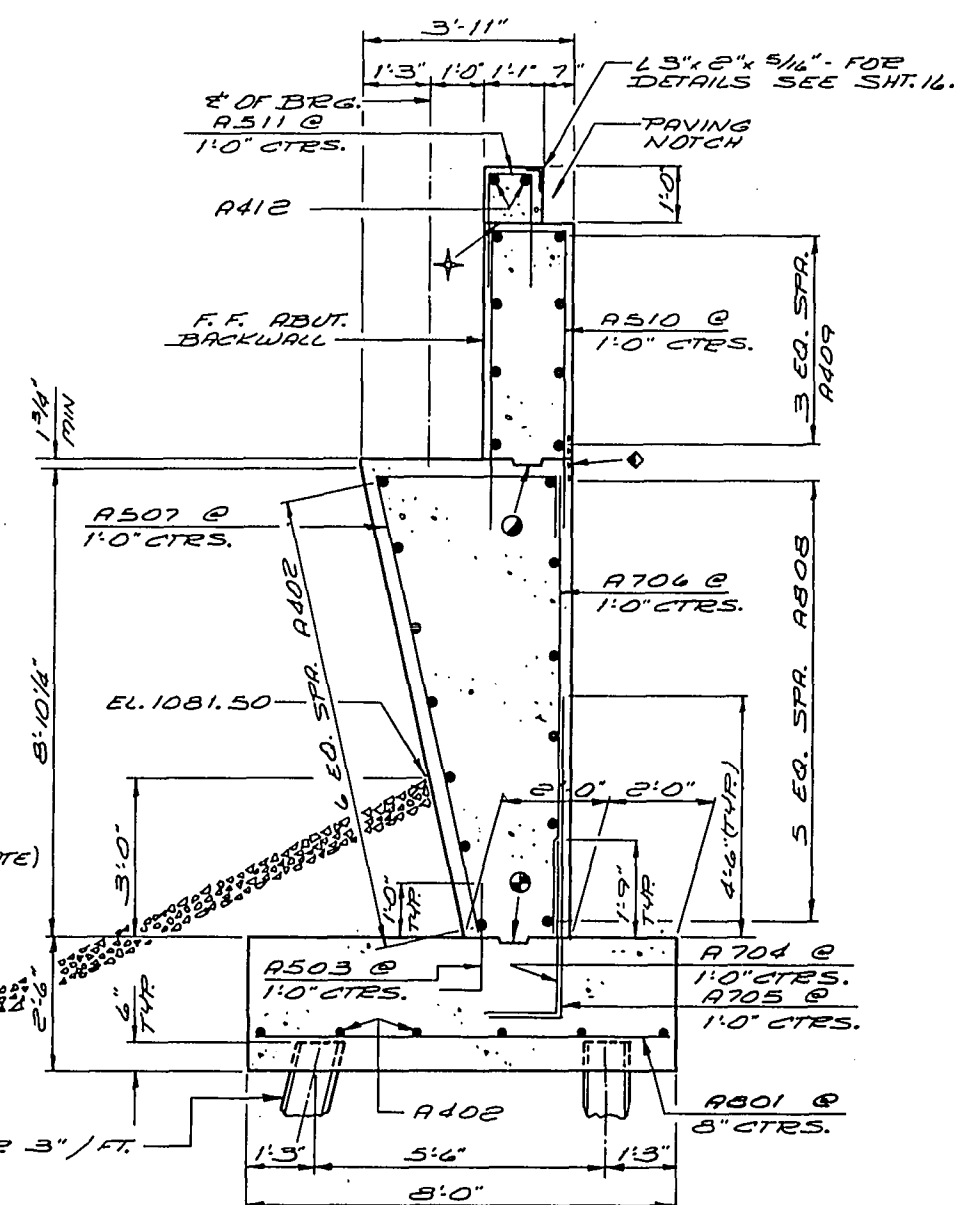


NOTE: PILES - HP 10x42 STEEL "H" PILES.
EST. 45' 0" LG. & DRIVEN TO A MIN. BRG. VALUE
OF 55T/PILE.

SECTION A-A

No.	Date	Revision	By
STATE OF WISCONSIN DEPARTMENT OF TRANSPORTATION DIVISION OF HIGHWAYS			
STRUCTURE B-3-37			
Const. Spec.	19 69	Drawn By	BUDD Plans Checked <i>RLP</i>
SOUTH ABUTMENT		SHEET 4 OF 18 X 46907	

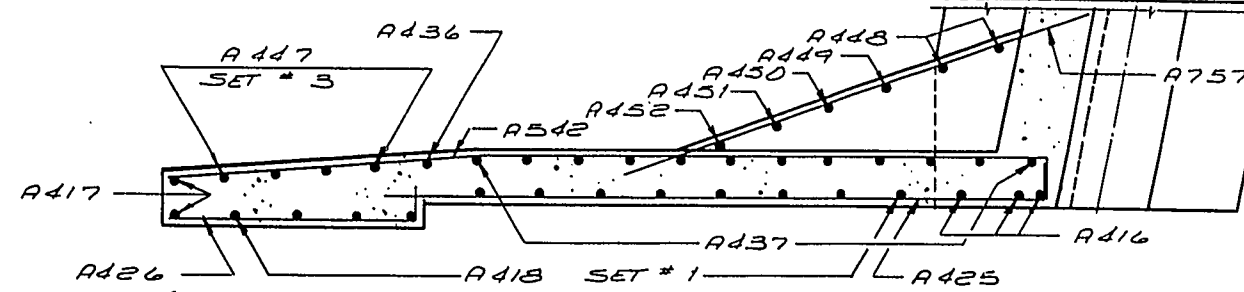

SECTION C-C

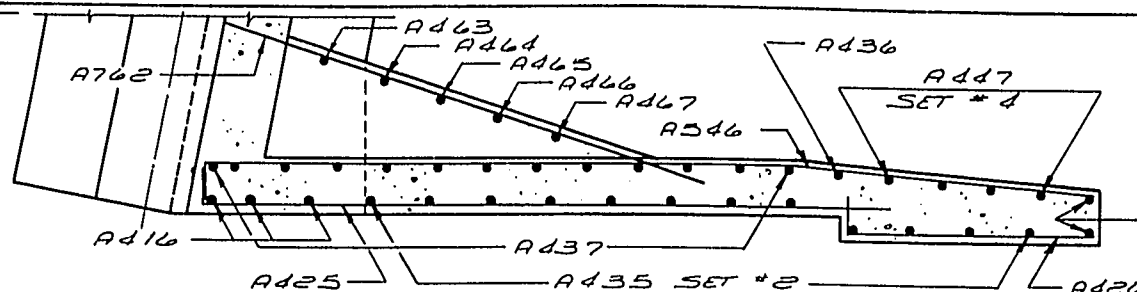


SECTION D-D


- POUR CONT. ABOVE THIS JOINT AFTER SUPER CONC. IS IN PLACE. STRIKE OFF LEVEL & LEAVE EDGTH.
- OPTIONAL CONST. JOINT FORMED BY SURFACED, BEVELED 2"x6" KEYWAY.
- CONST. JOINT FORMED BY SURFACED, BEVELED 2"x6" KEYWAY.

FOR RAIL PREPARE DETAILS SEE SHT. 17.


PROJECT ID	SHEET NUMBER	TOTAL SHEETS
1197-6-72	25	225
FEDERAL PROJECT DESIGNATION: DPF 08-4(41)		

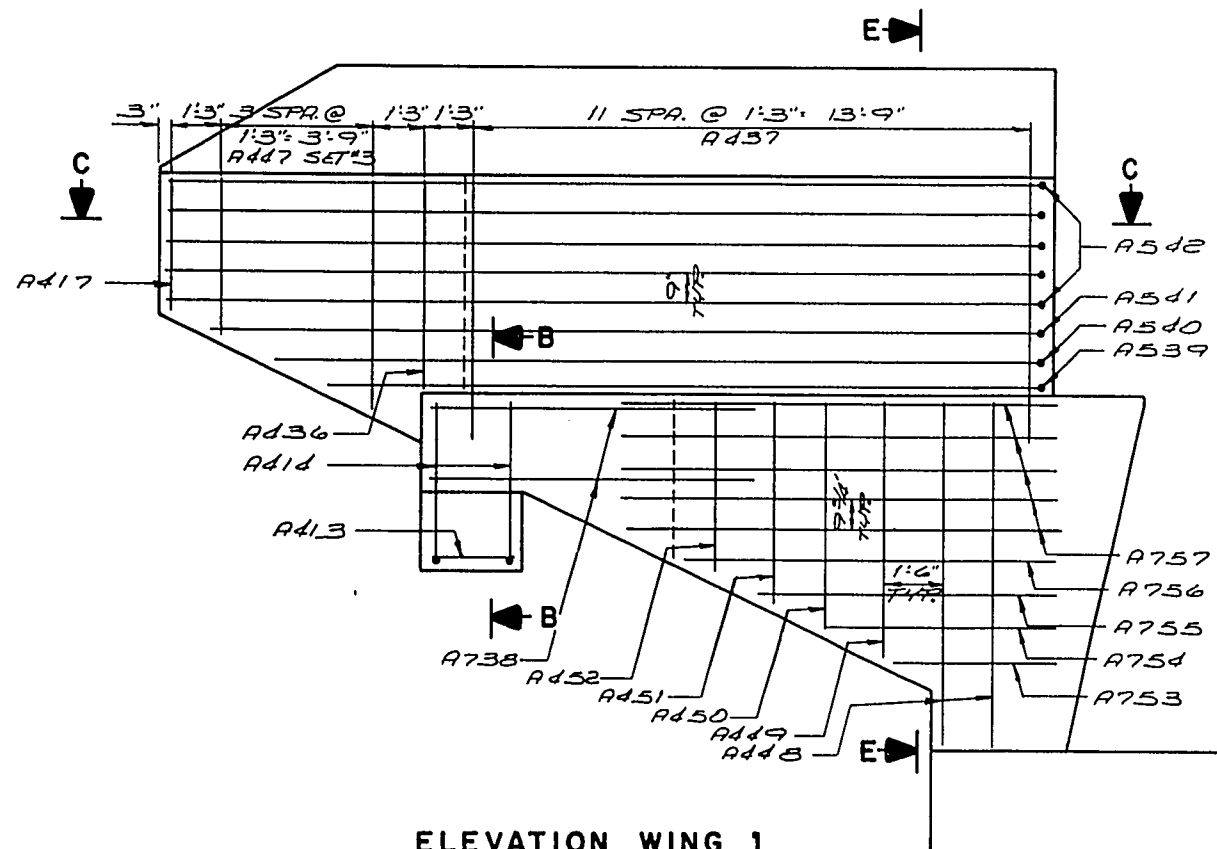

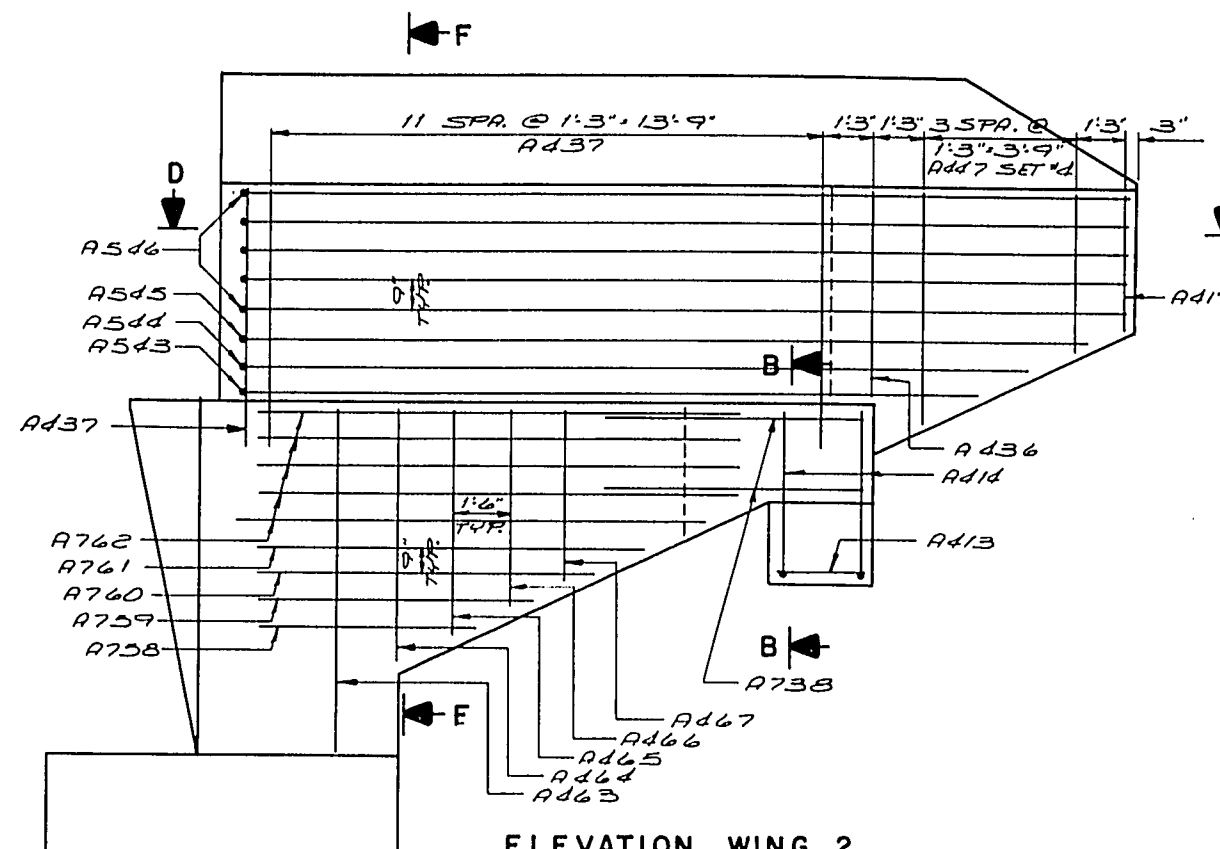
ELEVATION WING 1
(SHOWING B.F. BAR STEEL)



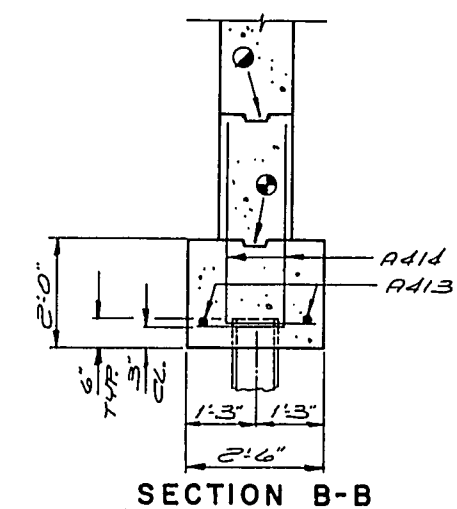
ELEVATION WING 2
(SHOWING B.F. BAR STEEL)




SECTION B-B

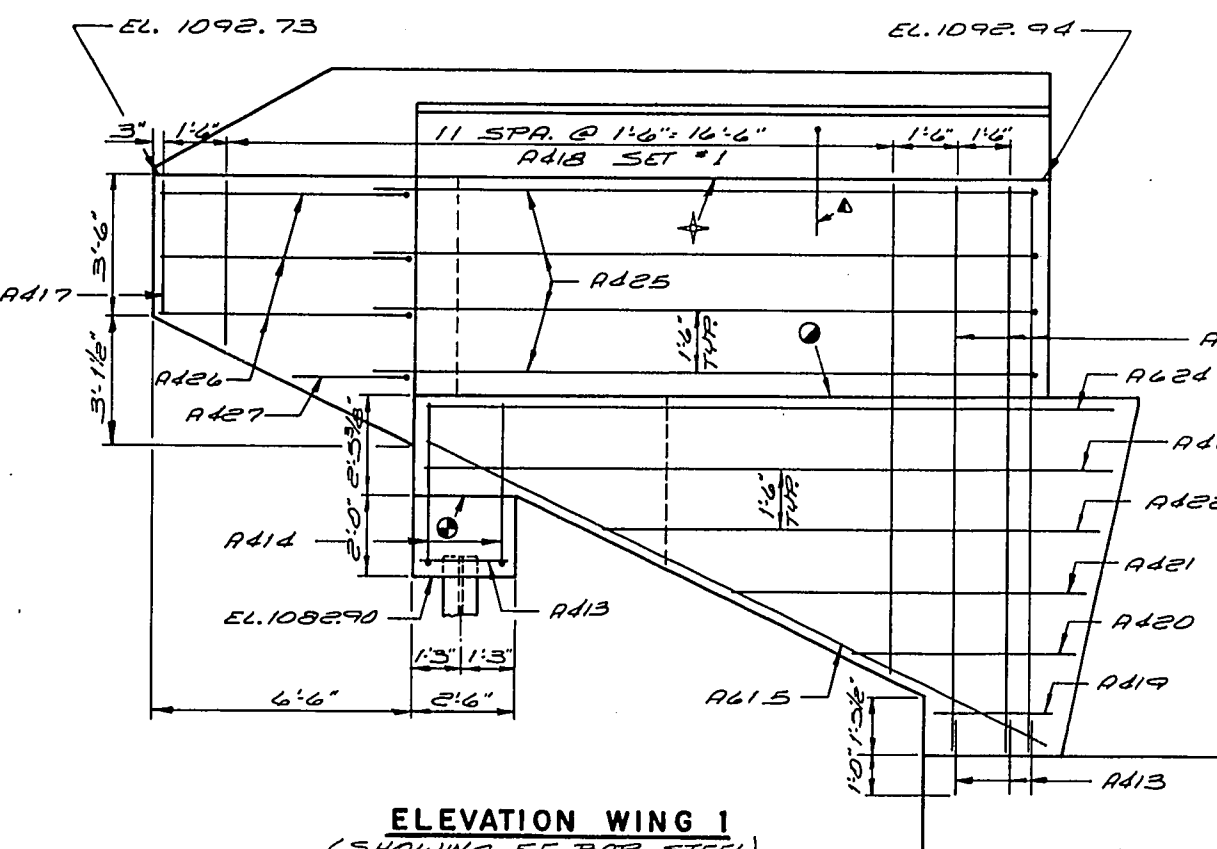

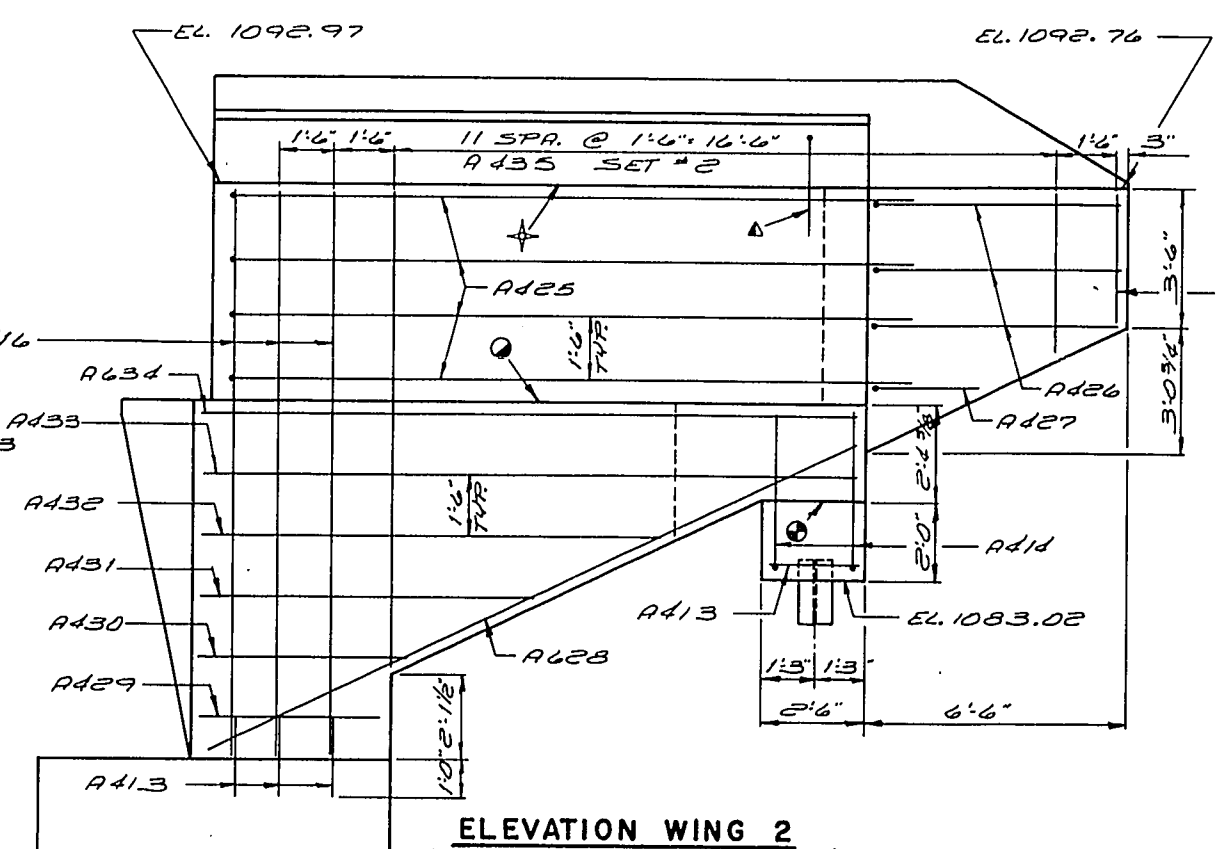ELEVATION WING 1
(SHOWING F.F. BAR STEEL)



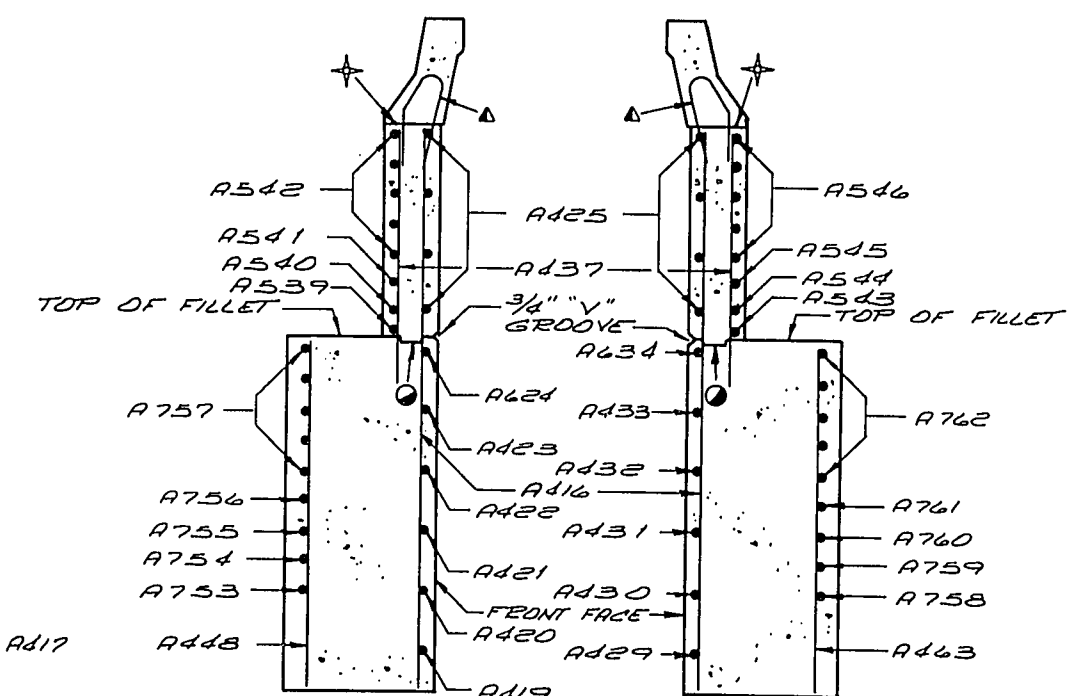ELEVATION WING 2
(SHOWING F.F. BAR STEEL)



SECTION E-E

SECTION F-F

No.	Date	Revision	By
STATE OF WISCONSIN DEPARTMENT OF TRANSPORTATION DIVISION OF HIGHWAYS			
STRUCTURE B-3-37			
Const. Spec. 1969	Drawn By BUDD	Plans Checked RLP	
SOUTH ABUTMENT			SHEET 5 OF 18
			X 46908

BILL OF BARS

BENDING DIMENSIONS ARE OUT TO OUT OF BAR.
THE FIRST DIGIT OF A 3 DIGIT MARK SIGNIFIES THE
BAR SIZE.
FOR RAIL PARAPET BARS SEE SHT. 17.

MARK	No. REQD.	LENGTH	BENT	CUT. DIR.	LOCATION	
A801	65	7-6			FOOTING	
A402	26	22-3			" # BODY	
A503	43	3-0	X		" DOWELS	VERT.
A704	36	4-6	X		" "	"
A705	36	7-3	X		" "	"
A706	36	8-10			BODY B.F.	"
A507	43	14-0	X		" F.F.	"
A808	6	38-0			" B.F.	NOE/2
A409	516	22-0			BACKWALL (ROOFED TO COMPLY "W DESIGN SHEET #4	
A510	41	12-1	X		"	VERT.
A511	41	4-3	X		PAVING NOTCH	"
A412	10	8-0			" "	NOE/2
A413	10	2-0			WINGS 1 # 2 FTG'S	
A414	8	5-4	X		" 1 # 2	VERT.
A415	1	17-3			" 1 BASE	"
A416	6	14-3			" 1 # 2 F.F.	"
A417	4	3-2			" 1 # 2 F.F. # B.F.	"
A418	6	15-9	X		" 1 F.F. SET # 1	"
A419	1	3-2			" 1 F.F.	NOE/2
A420	1	5-9			" 1 F.F.	"
A421	1	9-1			" 1 F.F.	"
A422	1	12-7			" 1 F.F.	"
A423	1	17-4			" 1 F.F.	"
A424	1	17-4			" 1 F.F.	"
A425	8	17-9	X		" 1 # 2 F.F.	"
A426	6	7-0	X		" 1 # 2 F.F.	"
A427	2	4-2	X		" 1 # 2 F.F.	"
A428	1	17-9			" 2 F.F.	"
A429	1	4-6			" 2 F.F.	"
A430	1	5-7			" 2 F.F.	"
A431	1	8-8			" 2 F.F.	"
A432	1	11-9			" 2 F.F.	"
A433	1	14-3			" 2 F.F.	"
A434	1	14-3			" 2 F.F.	"
A435	6	15-9	X		" 2 F.F. SET #2	VERT.
A436	2	5-2			" 1 # 2 B.F.	"



(CONTINUED)

ECONOMICS			WINGS 1 & 2 B.F.			VERT.
A 437	25	6-1				VERT.
A 738	2	8-0		"	1 & 2 B.F.	NOBIZ.
A 539	1	18-9	X	"	1 B.F.	"
A 540	1	20-0	X	"	1 B.F.	"
A 541	1	21-6	X	"	1 B.F.	"
A 542	5	22-9	X	"	1 B.F.	"
A 543	1	18-10	X	"	2 B.F.	"
A 544	1	20-0	X	"	2 B.F.	"
A 545	1	21-8	X	"	2 B.F.	"
A 546	5	22-10	X	"	2 B.F.	"
A 447	4	9-2	X	"	1 & 2 B.F. SETS "3 & 4	VERT.
A 448	2	8-6		"	1 FILLET	"
A 449	1	6-3		"	1 "	"
A 450	1	5-7		"	1 "	"
A 451	1	4-11		"	1 "	"
A 452	1	4-3		"	1 "	"
A 753	1	5-0		"	1 "	NOBIZ.
A 754	1	6-9		"	1 "	"
A 755	1	8-6		"	1 "	"
A 756	1	10-3		"	1 "	"
A 757	5	12-9		"	1 "	"
A 758	1	5-3		"	2 "	"
A 759	1	6-6		"	2 "	"
A 760	1	8-2		"	2 "	"
A 761	1	9-8		"	2 "	"
A 762	5	11-7		"	2 "	"
A 463	1	8-9		"	2 "	VERT.
A 464	1	6-9		"	2 "	"
A 465	1	6-0		"	2 "	"
A 466	1	5-3		"	2 "	"
A 467	1	4-6		"	2 "	"



CUTTING DIAGRAM

"H" IS NUMBER OF BARS REQ'D. BEFORE CUTTING.

MARK	SET No.	C	D	E	F	G	H	SETS RECD
A418	SET 1	8.3	7.6	15.9	3.10	11.11	6	1 SET 1
A435	SET 2	8.3	7.6	15.9	3.10	11.11	6	1 SET 2
A447	SET 3		5.7	9.4	3.9		4	1 SET 3
	SET 4	3.9				5.7		1 SET 4

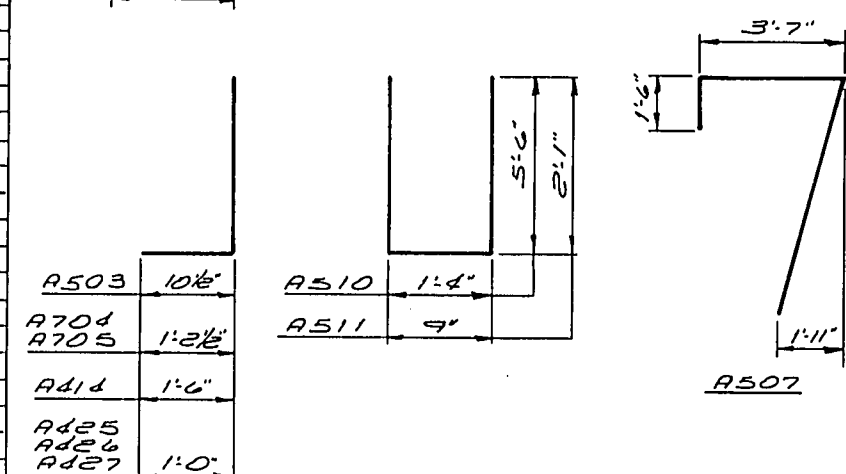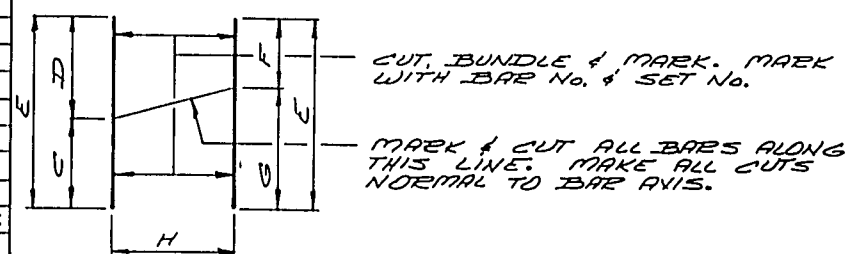

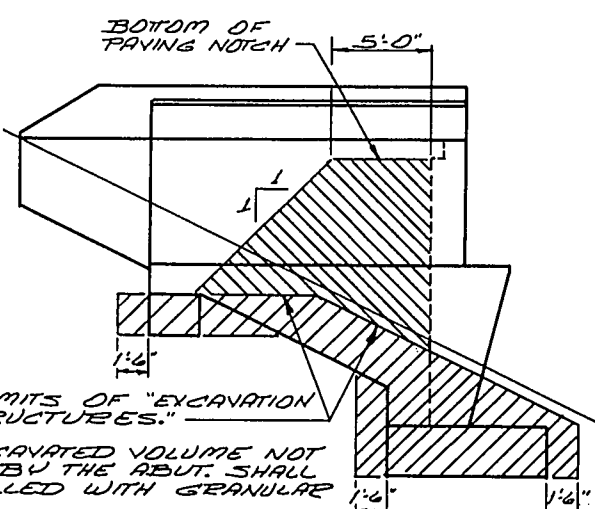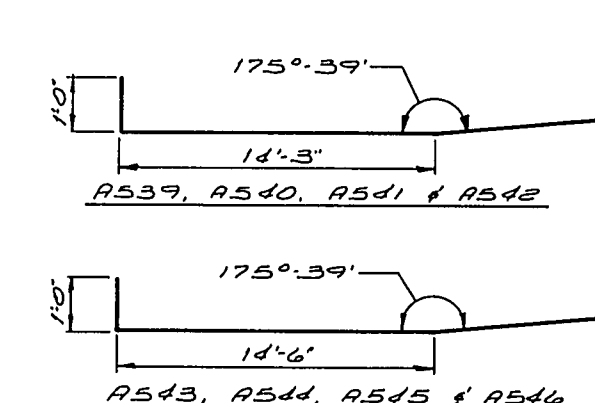

PROJECT ID	SHEET NUMBER	TOTAL SHEETS
1197-6-72	26	225
FEDERAL PROJECT DESIGNATION		
DPF08-4(41)		



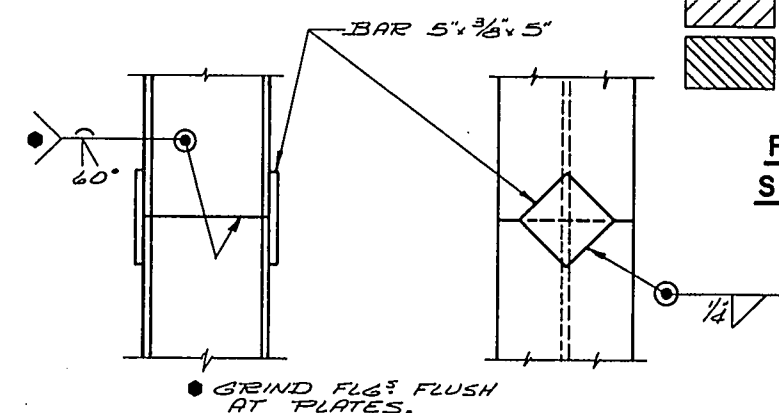
UPPER LIMITS OF "EXCAVATION
FOR STRUCTURES."

NOTE: ALL EXCAVATED VOLUME NOT
OCCUPIED BY THE ABUT. SHALL
BE BACKFILLED WITH GRANULAR
BACKFILL.

 EXCAVATION FOR STRUCTURES &
GRANULAR BACKFILL.


 GRANULAR BACKFILL BETWEEN INSIDE
FACES OF WING WALLS. MATERIAL SHALL
BE PLACED BEFORE SUPER CONC. IS
POURED.

PAY LIMITS FOR EXCAVATION FOR STRUCTURES & GRANULAR BACKFILL



PILE SPLICE DETAILS

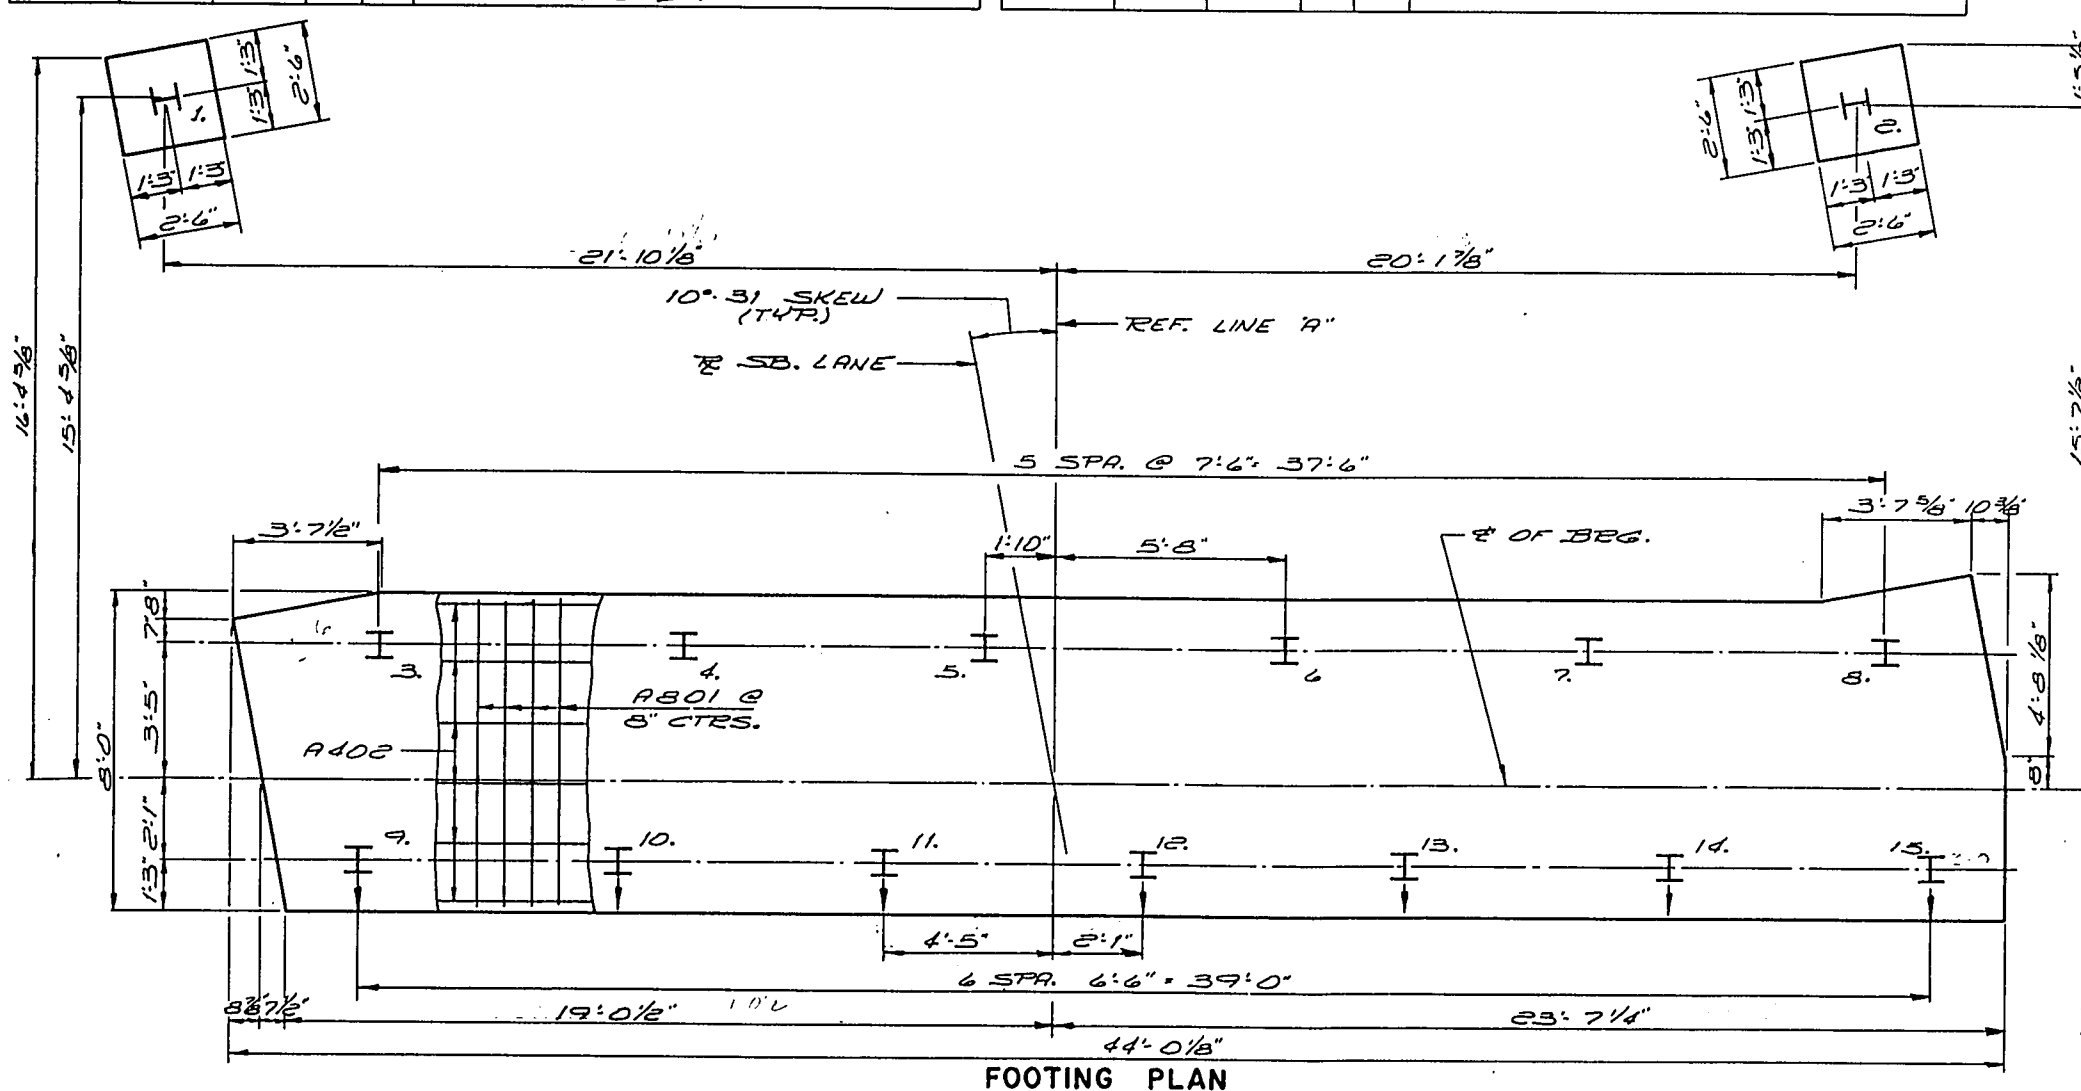
↑ INDICATES BATERED PILES.
BATER 3" / FT. IN DIRECTION SHOWN.




FOOTING PLAN

No.	Date	Revision	By
STATE OF WISCONSIN DEPARTMENT OF TRANSPORTATION DIVISION OF HIGHWAYS			
STRUCTURE B-3-37			
Const. Spec.	1969	Drawn By	BUDD Plans Checked <i>RLP</i>
SOUTH ABUTMENT		SHEET 6 OF 18 X 46909	


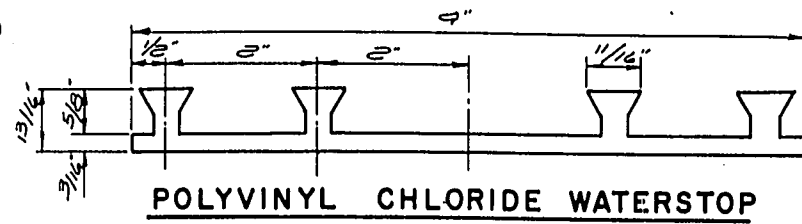
- * ELEV'S ARE GIVEN @ E OF BRG.
- ** DIMENSIONS ARE GIVEN @ F.F. ABUT. BACKWALL.
- * POUR CONC. ABOVE THIS JOINT AFTER SUPER. CONC. IS IN PLACE. STRIKE OFF LEVEL & LEAVE ROUGH.
- ① OPTIONAL CONST. JOINT. FORMED BY SURFACED, BEVELED 2"x6" KEYWAY.
- ② CONST. JOINT. FORMED BY SURFACED, BEVELED 2"x6" KEYWAY.
- ③ POLYVINYL CHLORIDE WATERSTOP. TO EXTEND BETWEEN WING FILLETS. (TO BE FLUSH WITH FACE OF CONC.) (IF OPT. CONST. JT. IS USED.)



PROJECT ID	1197-6-72	SHEET NUMBER	2.7	TOTAL SHEETS	225
FEDERAL PROJECT DESIGNATION	DPF08-4(41)				

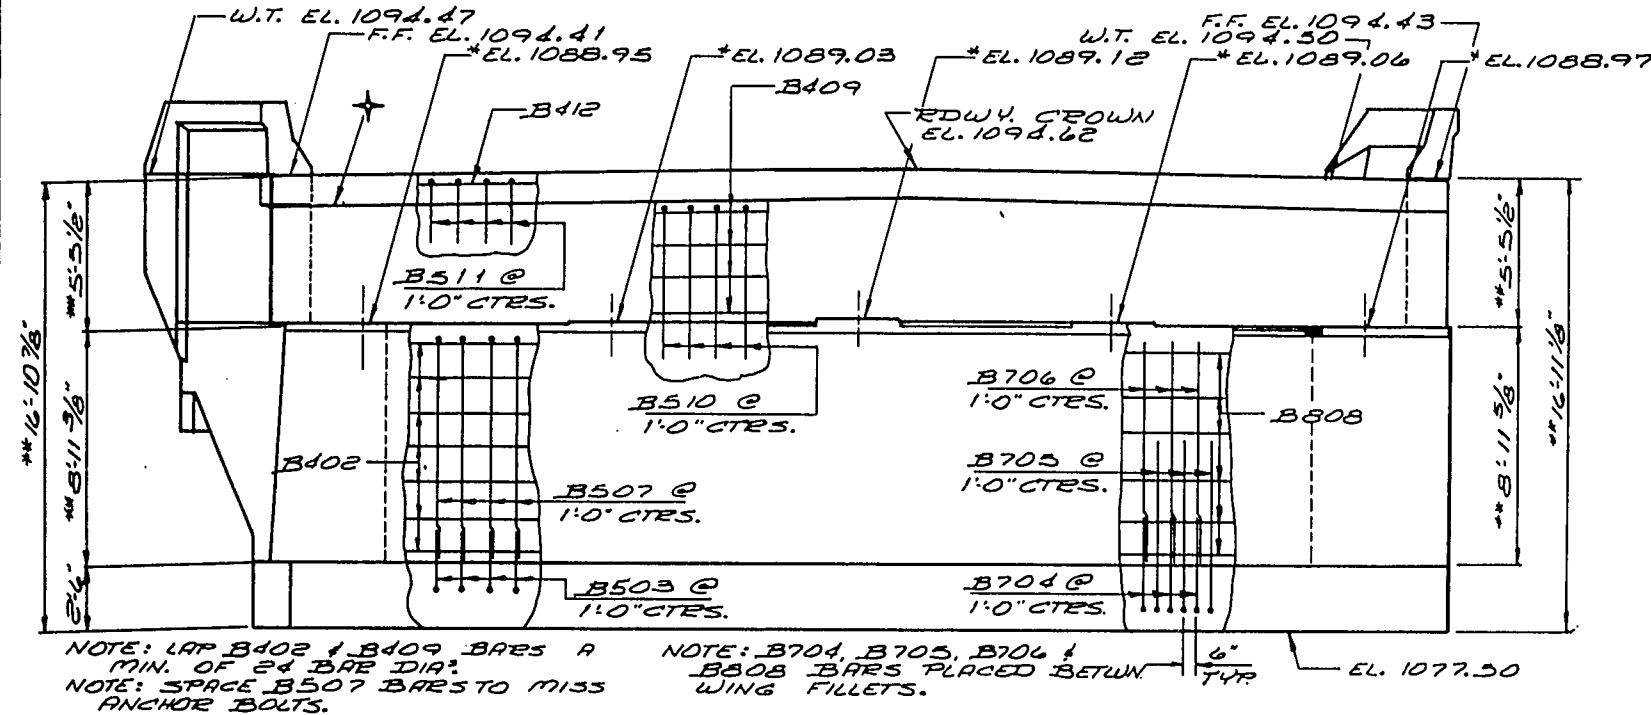



ELEVATION
(LOOKING NORTH)

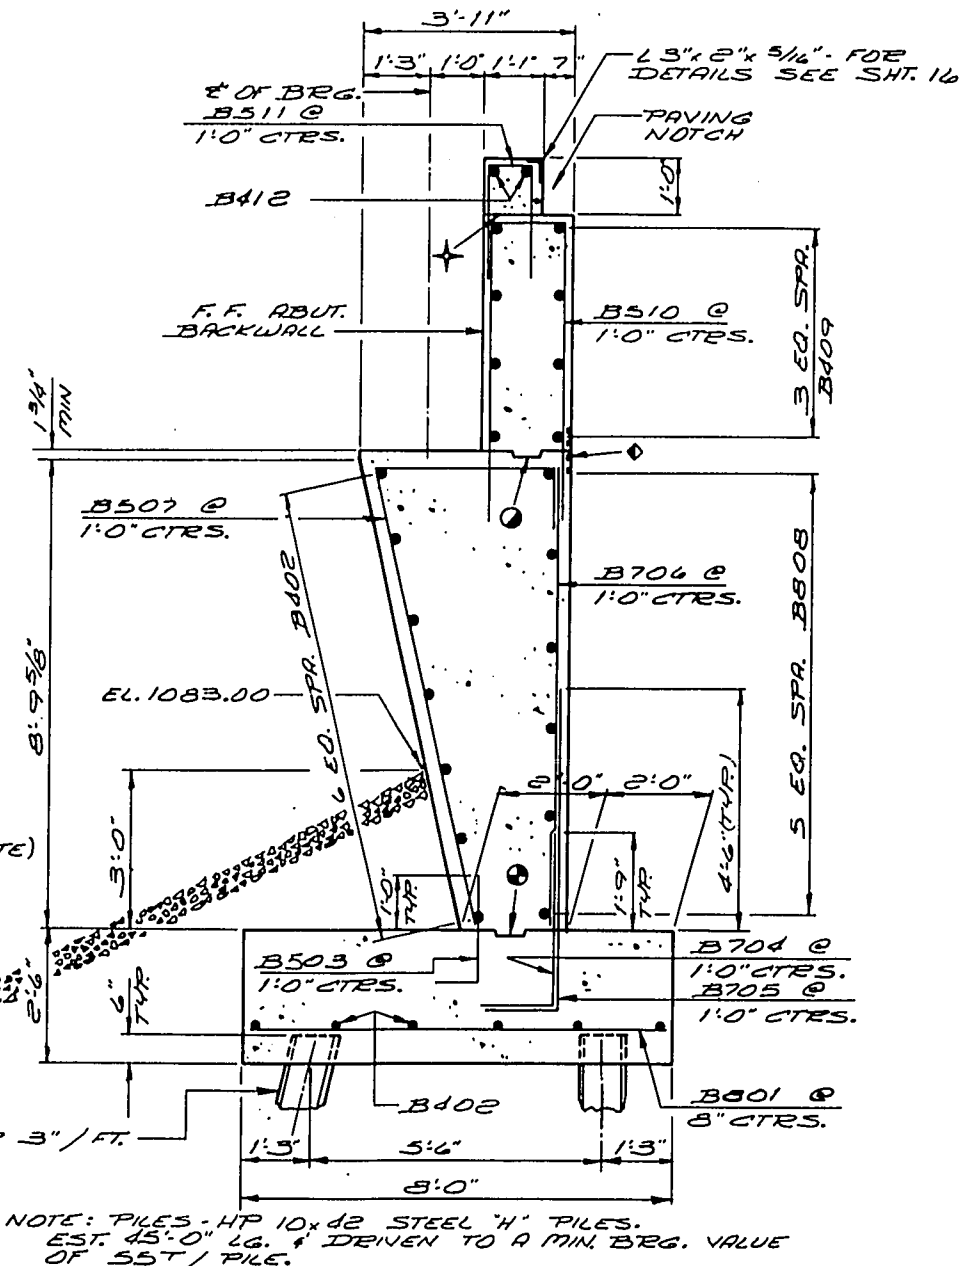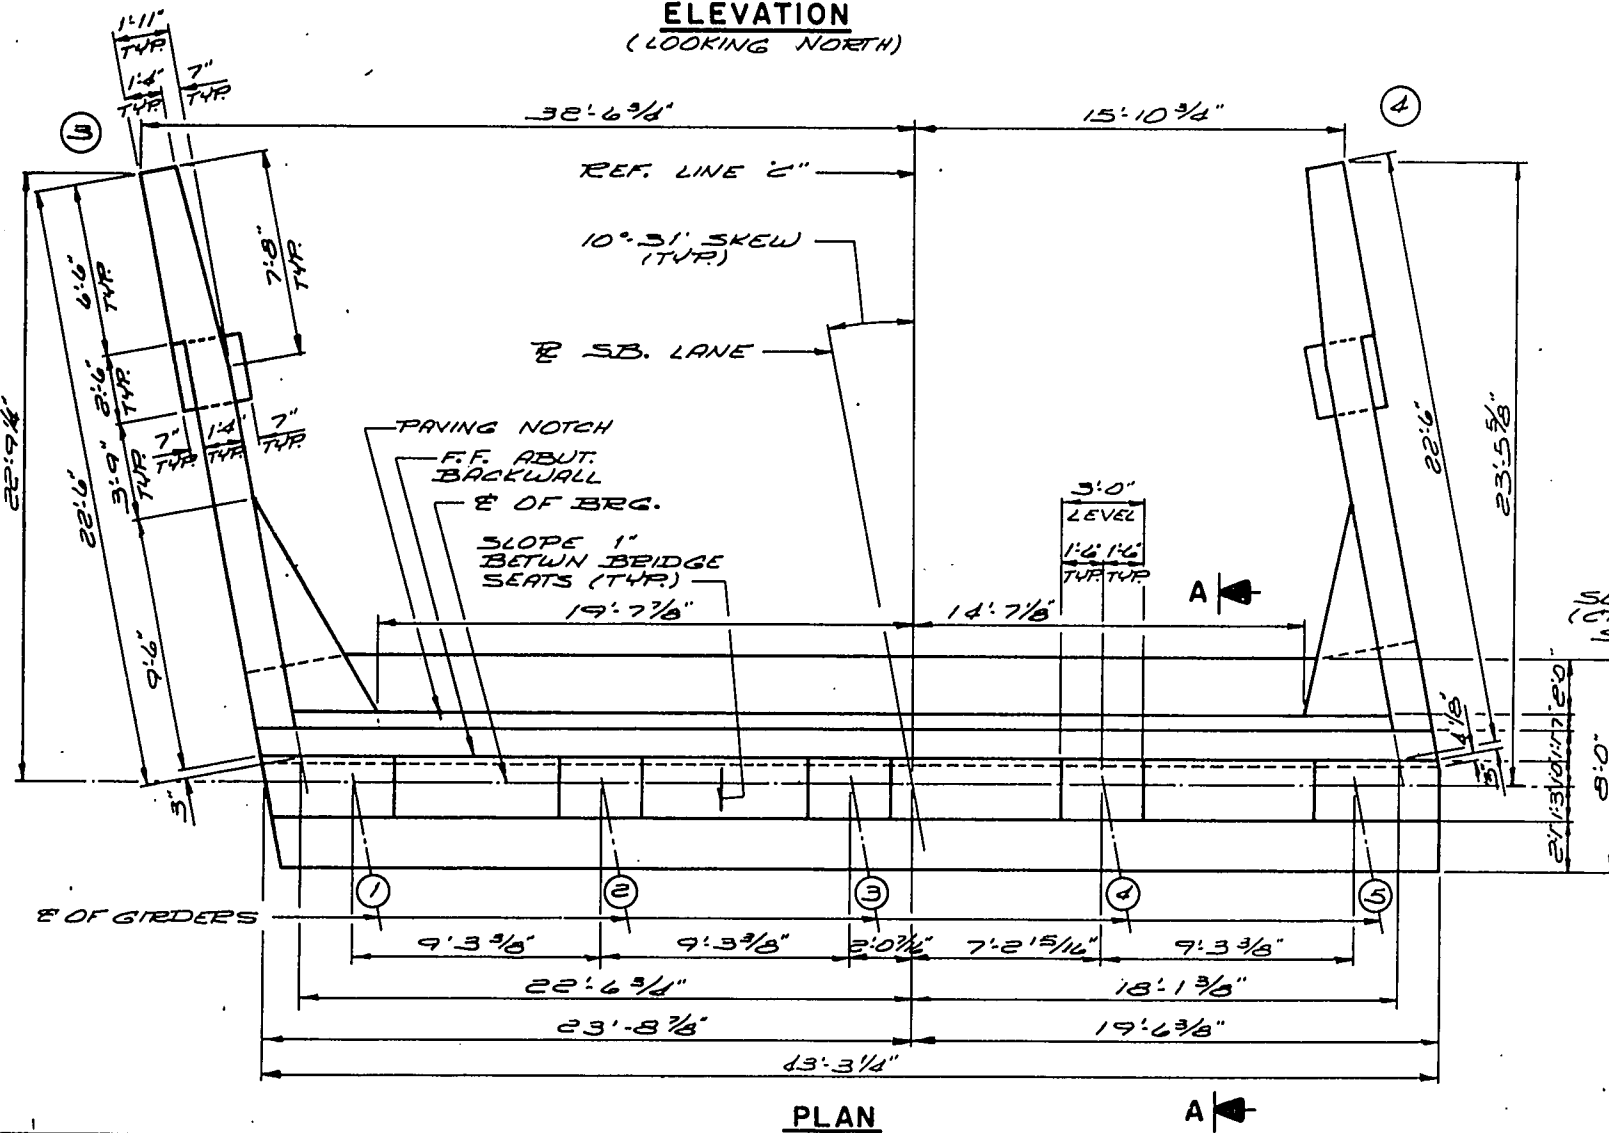

No.	Date	Revision	By
STATE OF WISCONSIN DEPARTMENT OF TRANSPORTATION DIVISION OF HIGHWAYS			
STRUCTURE B-3-37			
Const. Spec.	19 69	Drawn By	BUDD
		Plans Checked	RLP
NORTH ABUTMENT		SHEET 7 OF 18	
		X46910	



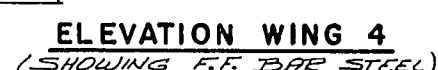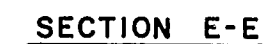117 ▲ FOR RAIL PARAPET DETAILS SEE SHT. 17.



No.	Date	Revision	By
STATE OF WISCONSIN DEPARTMENT OF TRANSPORTATION DIVISION OF HIGHWAYS			
STRUCTURE B - 3 - 37			
Const. Spec.	1969	Drawn By	B U D D
		Plans Checked	<i>RLP</i>
NORTH ABUTMENT		SHEET 8 OF 18 X46911	

BILL OF BARS

BENDING DIMENSIONS ARE OUT TO OUT OF BAR.
THE FIRST DIGIT OF A 3 DIGIT MARK SIGNIFIES THE
BAR SIZE.
FOR RAIL PARAPET BARS SEE SHT. 17.

MARK	No. REQ'D.	LENGTH	BENT	CUT. DIA.	LOCATION
B401	65	7-6			FOOTING
B402	26	22-3			" 4 BODY
B503	43	3-0	X		" DOWELS
B704	36	4-6	X		" "
B705	36	7-3	X		" "
B706	36	8-10			BODY B.F.
B507	43	14-0	X		" F.F.
B808	6	38-0			" B.F.
B409	46	22-0			BACKWALL (ADDED TO COMPLY WITH NOBIZ DESIGN SHEET 7 of 18)
B510	41	12-1	X		"
B511	41	4-8	X		PAVING NOTCH
B412	10	8-0			" "
B413	10	2-0			WINGS 3 # 4 FTG?
B414	8	5-4	X		" 3 # 4
B415	1	17-3			" 3 BASE
B416	6	14-3			" 3 # 4 F.F.
B417	4	3-2			" 3 # 4 F.F. & B.F.
B418	6	15-9	X		" 3 F.F. SET #1
B419	1	3-2			" 3 F.F.
B420	1	5-9			" 3 F.F.
B421	1	9-1			" 3 F.F.
B422	1	12-7			" 3 F.F.
B423	1	17-4			" 3 F.F.
B424	1	17-4			" 3 F.F.
B425	8	17-9	X		" 3 # 4 F.F.
B426	6	7-0	X		" 3 # 4 F.F.
B427	2	4-2	X		" 3 # 4 F.F.
B428	1	17-9			" 4 F.F.
B429	1	4-6			" 4 F.F.
B430	1	5-7			" 4 F.F.
B431	1	8-8			" 4 F.F.
B432	1	11-9			" 4 F.F.
B433	1	16-3			" 4 F.F.
B434	1	16-3			" 4 F.F.
B435	6	15-9	X		" 4 F.F. SET #2
B436	2	3-2			" 5 # 4 B.F.






(CONTINUED)

(CONTINUED)				WINGS		T.B.F.		VERT.	
B437	25	4.4			344	B.F.		VERT.	
B738	4	8.0			344	B.F.		NDE12	
B539	1	18.9	X		3	B.F.		"	
B540	1	20.0	X		3	B.F.		"	
B541	1	21.6	X		3	B.F.		"	
B542	5	22.9	X		3	B.F.		"	
B543	1	18.10	X		4	B.F.		"	
B544	1	20.0	X		4	B.F.		"	
B545	1	21.8	X		4	B.F.		"	
B546	5	22.10	X		4	B.F.		"	
B447	4	9.4		X	344	B.F. SETS	344	VERT.	
B448	2	8.6			3	FILLET		"	
B449	1	6.3			3	"		"	
B450	1	5.7			3	"		"	
B451	1	4.11			3	"		"	
B452	1	4.3			3	"		"	
B753	1	5.0			3	"		NDE12	
B754	1	6.9			3	"		"	
B755	1	8.6			3	"		"	
B756	1	10.3			3	"		"	
B757	5	12.9			3	"		"	
B758	1	5.3			4	"		"	
B759	1	6.6			4	"		"	
B760	1	8.2			4	"		"	
B761	1	9.8			4	"		"	
B762	5	11.7			4	"		"	
B463	1	8.9			4	"		VERT.	
B464	1	6.9			4	"		"	
B465	1	6.0			4	"		"	
B466	1	5.3			4	"		"	
B467	1	4.6			4	"		"	

CUTTING DIAGRAM

"H" IS NUMBER OF BARS REQ'D. BEFORE CUTTING.

MARK	SET No.	C	D	E	F	G	H	SETS REQ.
Bd18	SET 1	8.3	7.6	15.9	3.10	11.11	6	1 SET
Bd35	SET 2	8.3	7.6	15.9	3.10	11.11	6	1 SET
Bd17	SET 3		5.7		3.9		4	1 SET
	SET 4	3.9		9.4		5.7		1 SET

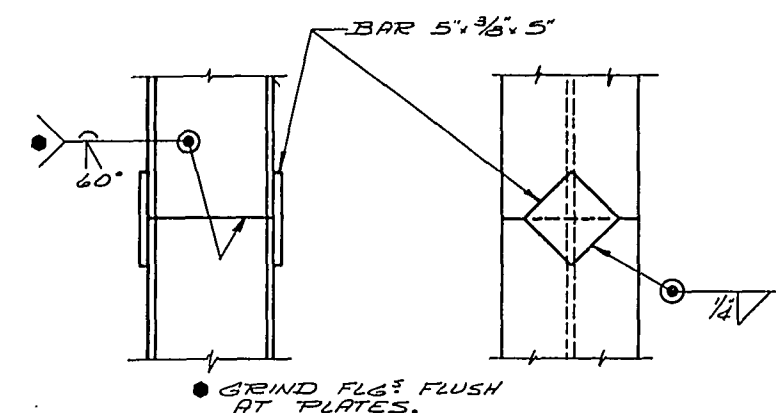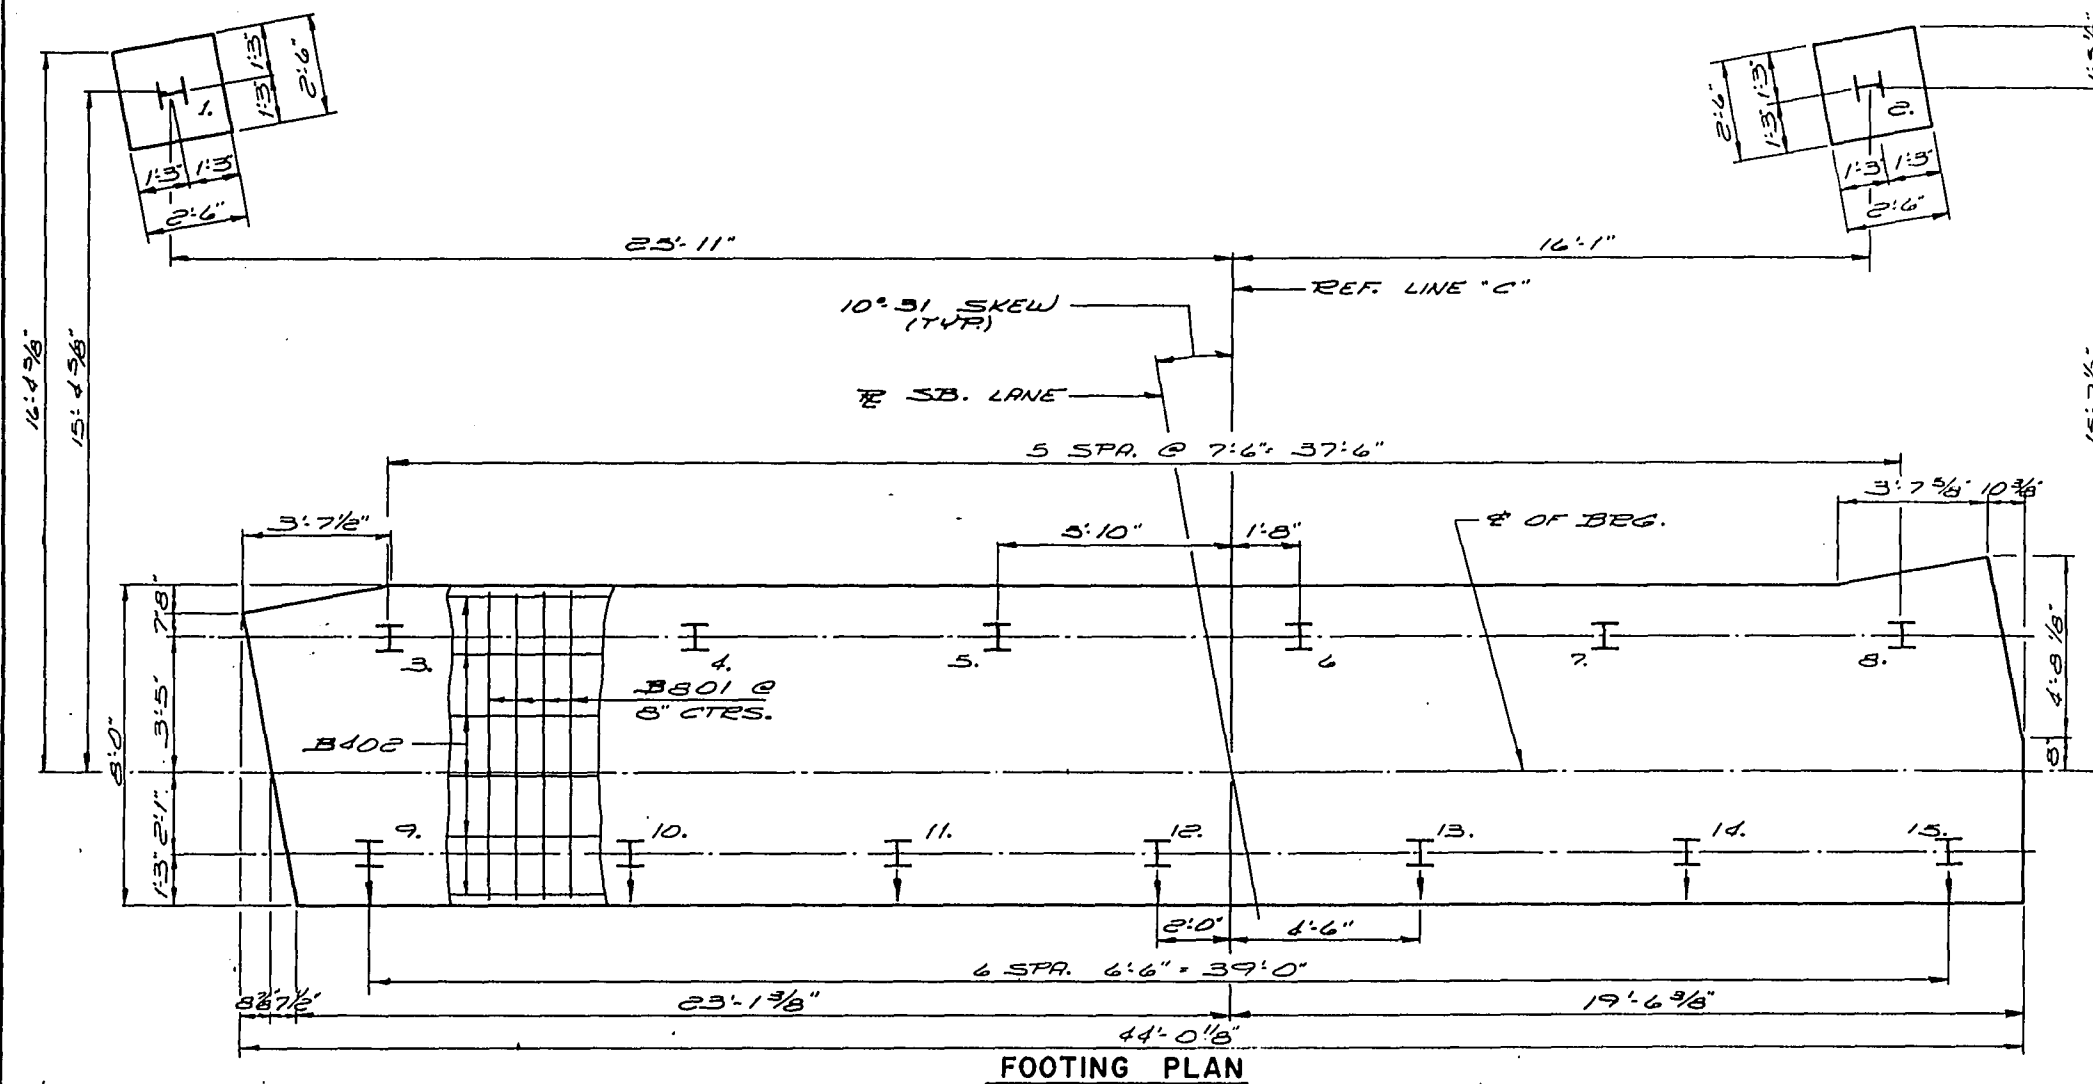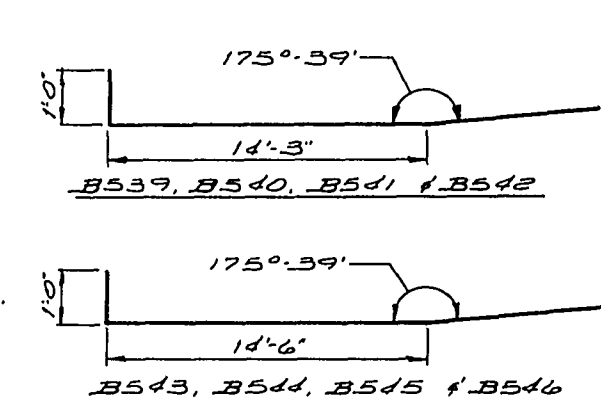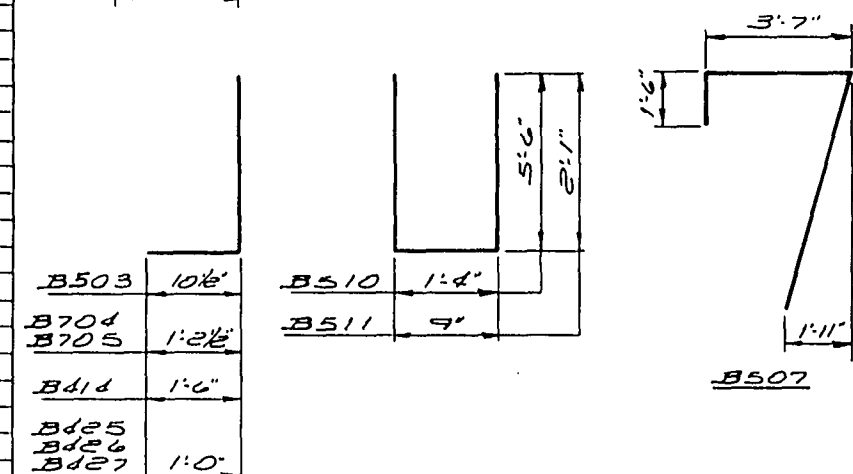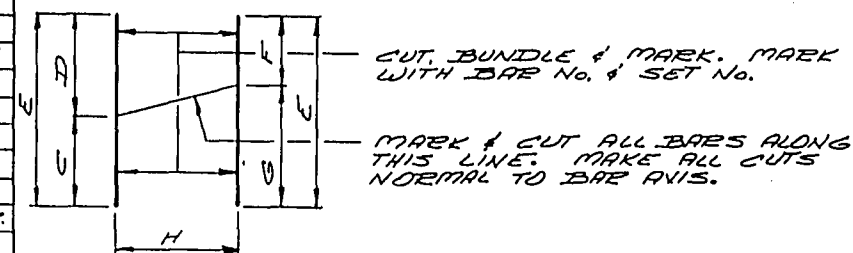


PILE SPLICE DETAILS

↑ INDICATES BATERED PILES.
BATER 3" / FT. IN DIRECTION SHOWN.

PROJECT ID	SHEET NUMBER	TOTAL SHEET
1197-6-72	29	22
FEDERAL PROJECT DESIGNATION DPF 08-4(41)		

No.	Date	Revision	By
STATE OF WISCONSIN DEPARTMENT OF TRANSPORTATION DIVISION OF HIGHWAYS			
STRUCTURE B-3-37			
Const. Spec.	1969	Drawn By	BUDD Plans Checked <i>RLP</i>
NORTH ABUTMENT		SHEET 9 OF 10 X 46912	

MARK	NO. REQ'D.	LENGTH	BENT	LOCATION
S501	823	43-0		SLAB - TOP AND BOTTOM - TRANS.
S502	630	35-7		" - " " " - LONGIT.
S503	10	15-0		" - TOP - LONGIT. - SYM. ABOUT E OF PIER
S504	484	4-9	X	RAIL PARAPET - VERT.
S505	484	5-0	X	" " - "
S506	20	17-8		" " - LONGIT.
S507	80	22-6		" " - "
S508	10	9-4		" " - "
S509	10	12-11		" " - "

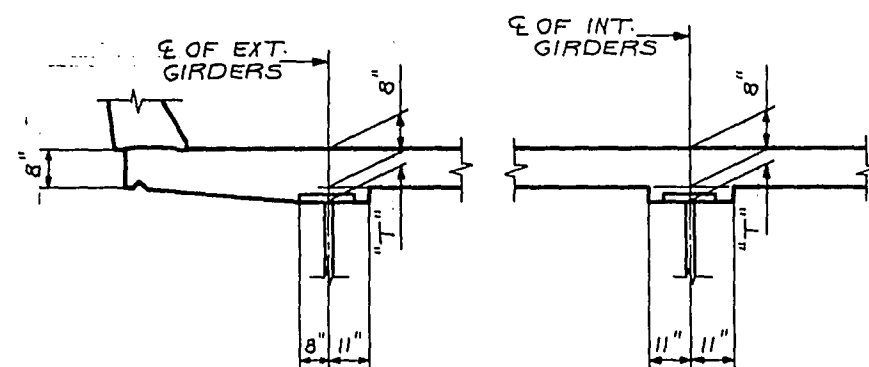


F.F. OF ABUT. PARAPET
 HEX. NUT
 WASHER
 1 1/2" x 1 1/2" SLOTTED HOLE IN L 5" x 5" x 5/16". (SLOTTED IN DIRECTION OF ANGLE.)
 2 1/2"
 1 1/2"
 1 1/2"
 6"
 AFTER SUPERSTRUCTURE CONC. IS POURED, BURN OFF BAR FLUSH WITH CONCRETE SURFACE.
 SECTION
 3/4" DIA. ROD ONE PER GIRDER

NOTE: THE TEMPORARY HOLD DOWN DEVICE SHALL BE PLACED AT ABUT. WHERE SLAB POUR TERMINATES. (TO BE PAID FOR AS STRUCTURAL CARBON STEEL.)



No.	Date	Revision	By
STATE OF WISCONSIN DEPARTMENT OF TRANSPORTATION DIVISION OF HIGHWAYS			
STRUCTURE B-3-37			
Const. Spec.	1969	Drawn By L.N.F.	Plans Checked R.L.P.
SUPERSTRUCTURE		SHEET II OF I X46914	


PROJECT ID	SHEET NUMBER	TOTAL SHEETS
1197-6-72	32	225
FEDERAL PROJECT DESIGNATION		
DPPF08-4(41)		

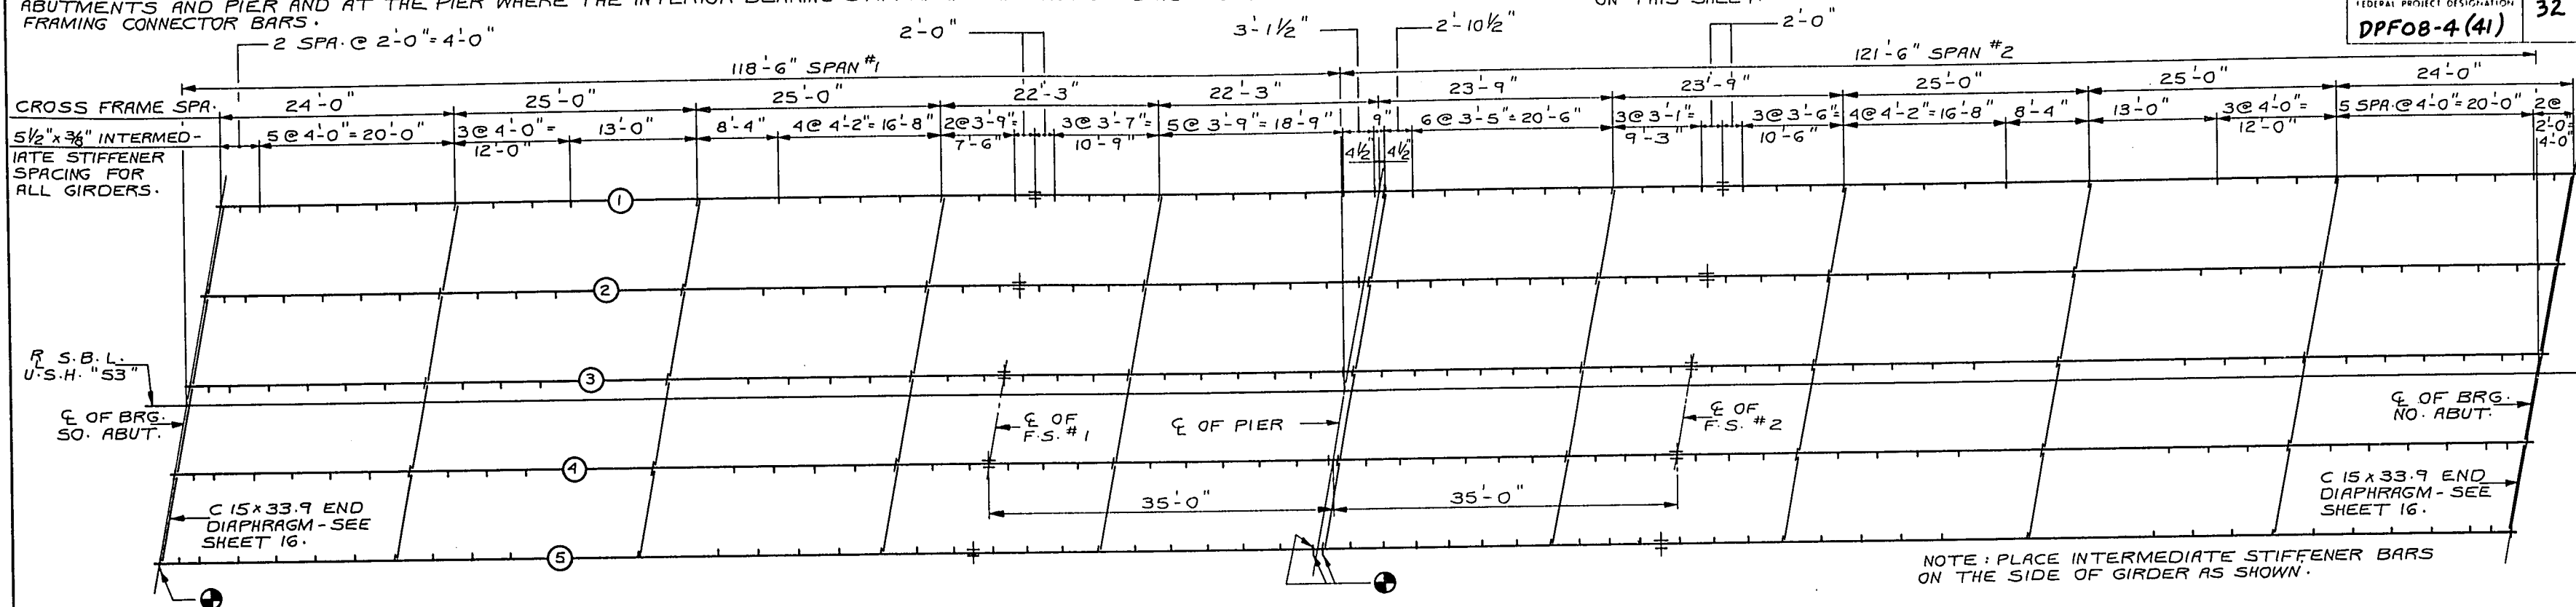

NOTE:
OPTIONAL BUTT WELDED FLANGE SPLICES MAY BE ELIMINATED AND A FLANGE PLATE OF THE LARGER SIZE MAY BE FURNISHED FULL LENGTH, BUT PAY WEIGHT SHALL BE BASED ON THE SECTIONS AS DETAILED.
OPTIONAL WELDED SHOP SPLICES MAY BE USED FOR ALL FLANGE AND WEB PLATES OVER 60'-0" LONG. IF USED, THE LOCATION OF THE SPLICE SHALL BE SHOWN ON THE SHOP DRAWINGS, AND WILL BE SUBJECT TO THE APPROVAL OF THE ENGINEER.

* WELD INTERMEDIATE STIFFENER AND CROSS FRAME BARS TO TOP FLANGE IN THIS AREA.
** WELD INTERMEDIATE STIFFENER AND CROSS FRAME BARS TO BOTTOM FLANGE IN THIS AREA.

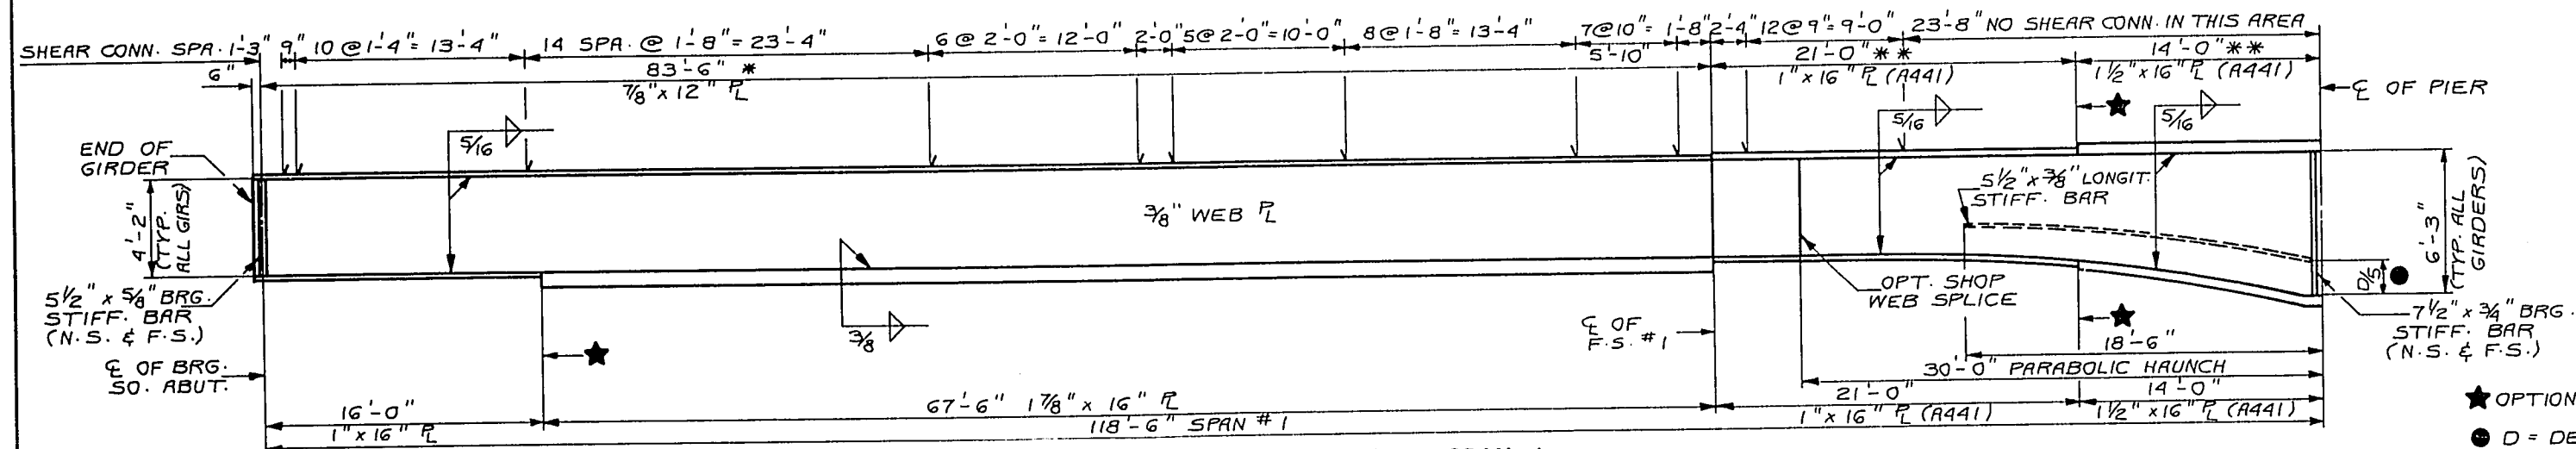
NOTE :
FIELD WELDING ON TOP FLANGE FOR CONSTRUCTION PURPOSES
IS PROHIBITED IN THE AREA OVER THE PIER BETWEEN THE SHEAR
CONNECTORS.
FOR SHEAR CONNECTOR DETAILS SEE SHEET 13.

[illegible]

GIRDER ELEVATION - SPAN 2




No.	Date	Revision	By
STATE OF WISCONSIN DEPARTMENT OF TRANSPORTATION DIVISION OF HIGHWAYS			
STRUCTURE B - 3 - 37			
Const. Spec.	1969	Drawn By L.N.F.	Plans Checked R.L.P.
SUPERSTRUCTURE			SHEET 12 OF 1 X46915

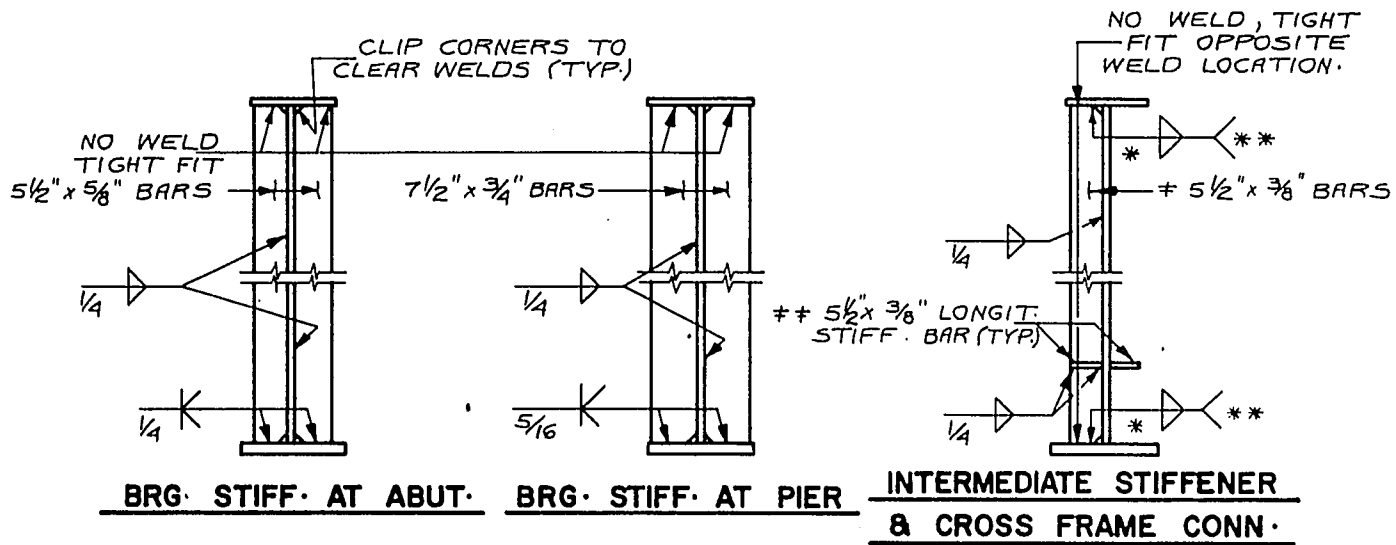* ALL INTERMEDIATE STIFF. BARS SHALL BE PLACED ON INSIDE FACE OF EXTERIOR GIRDERS AND ON FACE OF INTERIOR GIRDERS AS SHOWN ON SHEET 12.
 ** PLACE LONGIT. STIFF. BARS ON OPPOSITE FACE FROM INTER. STIFF. FOR INTERIOR GIRDERS AND THE SAME FACE AS INTER. STIFF. FOR EXTERIOR GIRDERS.



* 5/16" WELD WHEN WELDING TO A 7/8", 1" AND 1 1/2" FLANGE PLATE AND A 3/8" WELD WHEN WELDING TO A 1 7/8" AND 2" FLANGE PLATE.

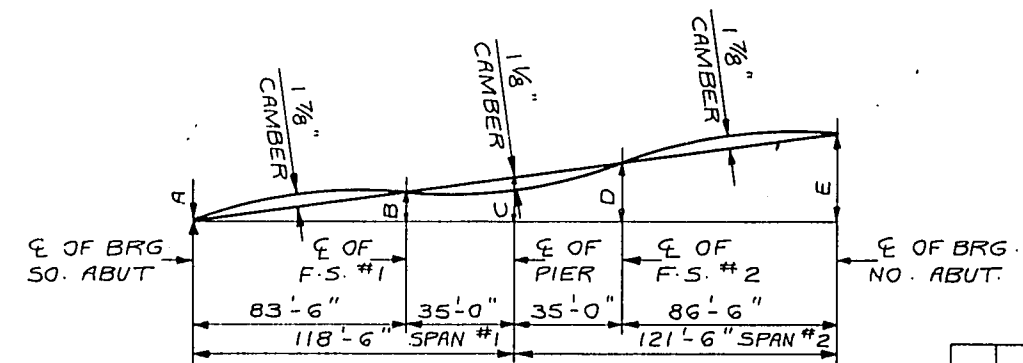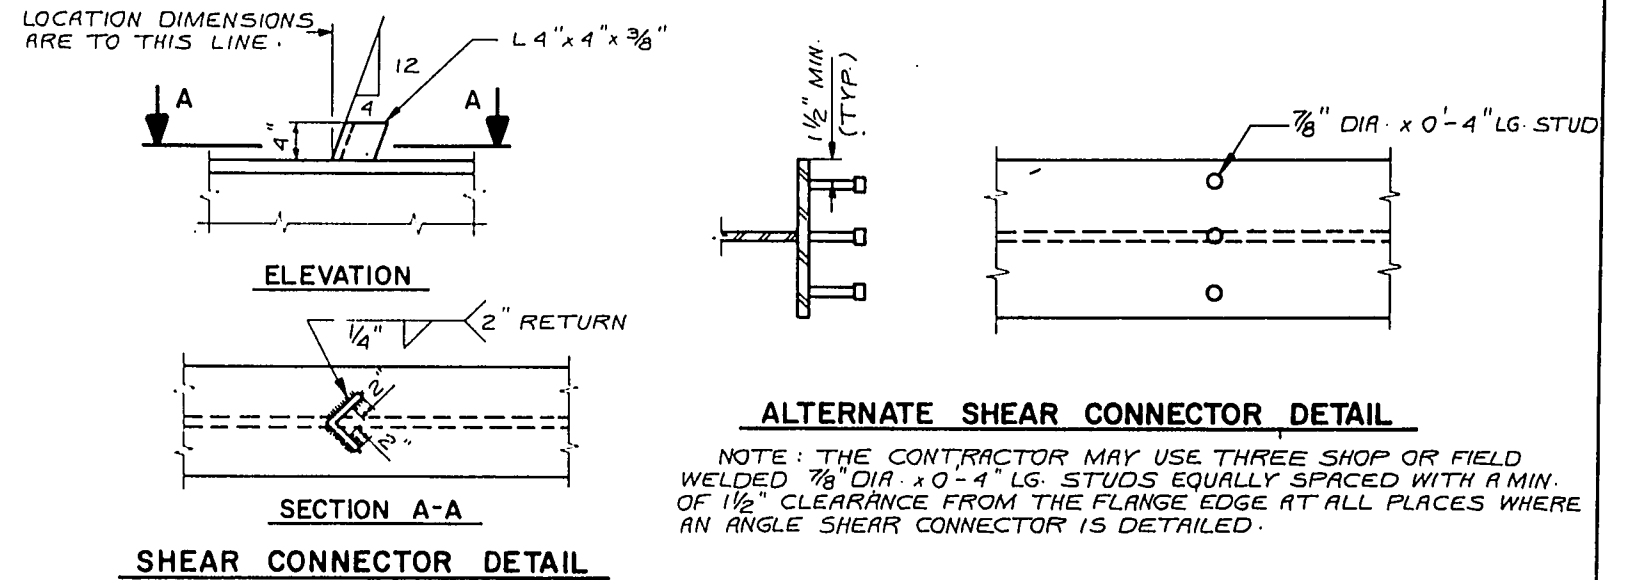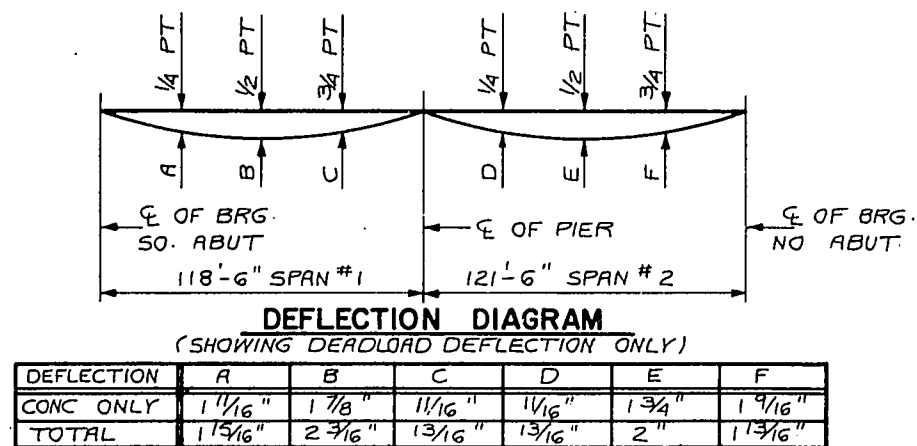** SEE GIRDER ELEVATION FOR LOCATION - SEE SHEET 12.




DIMENSIONS	A	B	C	D	E
GIRDER 1	0.0	.751	.863	1.164	1.432
GIRDER 2	0.0	.755	.868	1.170	1.442
GIRDER 3	0.0	.758	.873	1.177	1.453
GIRDER 4	0.0	.761	.878	1.183	1.463
GIRDER 5	0.0	.765	.883	1.190	1.473

No.	Date	Revision	By
STATE OF WISCONSIN DEPARTMENT OF TRANSPORTATION DIVISION OF HIGHWAYS			
STRUCTURE B-3-37			
Const. Spec.	1969	Drawn By L.N.F.	Plans Checked R.L.P.
SUPERSTRUCTURE			SHEET 13 OF 18
			X46916


ELEVATIONS AT TOP OF DECK (T.D.) AND TOP OF STEEL (T.S.)

GIRDER		℄ BRG S. ABUT	1/8 PT.	1/4 PT.	3/8 PT.	1/2 PT.	5/8 PT.	℄ OF F.S. #1	7/8 PT.	℄ PIER	1/8 PT.	℄ OF F.S. #2	3/8 PT.	1/2 PT.	5/8 PT.	3/4 PT.	7/8 PT.	℄ BRG N. ABUT.
1	T.D.	1092.99	1093.12	1093.25	1093.37	1093.48	1093.59	1093.65	1093.79	1093.88	1093.97	1094.07	1094.13	1094.20	1094.26	1094.32	1094.38	1094.43
	T.S.	1092.30						1093.08		1093.21		1093.50						1093.74
2	T.D.	1093.07	1093.20	1093.33	1093.44	1093.56	1093.67	1093.73	1093.87	1093.96	1094.05	1094.16	1094.21	1094.28	1094.35	1094.41	1094.46	1094.51
	T.S.	1092.37						1093.16		1093.29		1093.58						1093.83
3	T.D.	1093.15	1093.28	1093.40	1093.52	1093.64	1093.75	1093.81	1093.95	1094.04	1094.13	1094.24	1094.29	1094.37	1094.43	1094.49	1094.55	1094.60
	T.S.	1092.45						1093.24		1093.37		1093.67						1093.91
4	T.D.	1093.08	1093.21	1093.34	1093.46	1093.57	1093.68	1093.75	1093.89	1093.98	1094.07	1094.18	1094.23	1094.31	1094.37	1094.44	1094.49	1094.54
	T.S.	1092.38						1093.17		1093.31		1093.61						1093.85
5	T.D.	1092.97	1093.10	1093.23	1093.35	1093.47	1093.58	1093.65	1093.78	1093.88	1093.97	1094.08	1094.13	1094.21	1094.28	1094.34	1094.39	1094.45
	T.S.	1092.27						1093.07		1093.21		1093.51						1093.76


PROJECT NO.	1197-6-72	SHEET NUMBER	34	TOTAL SHEETS	225
FEDERAL PROJECT DESIGNATION	DPF08-4(41)				

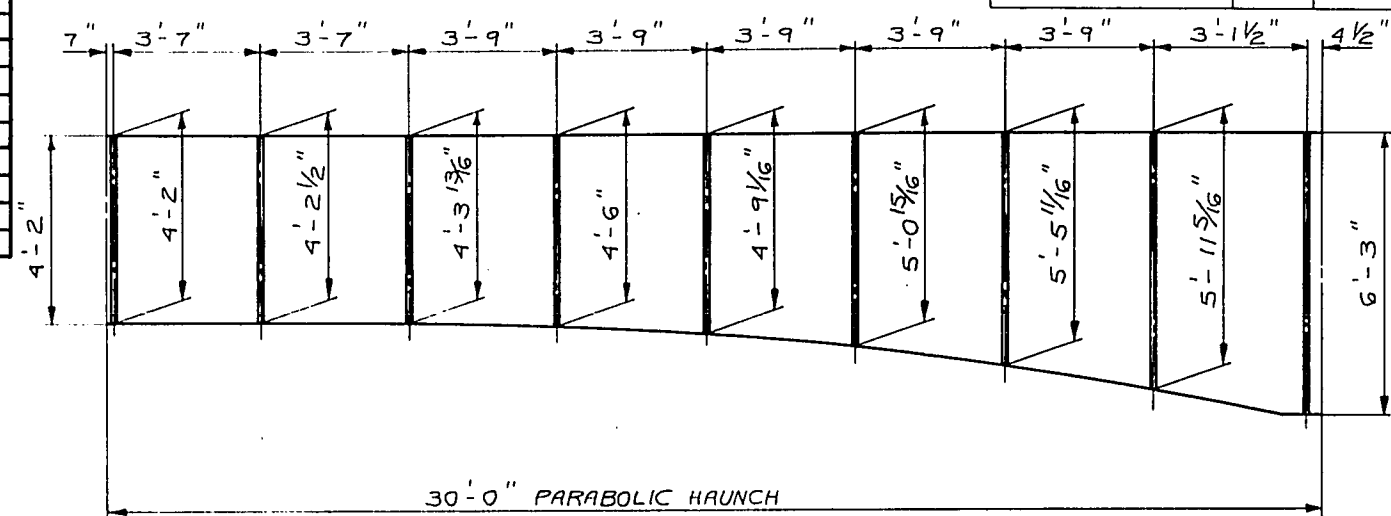

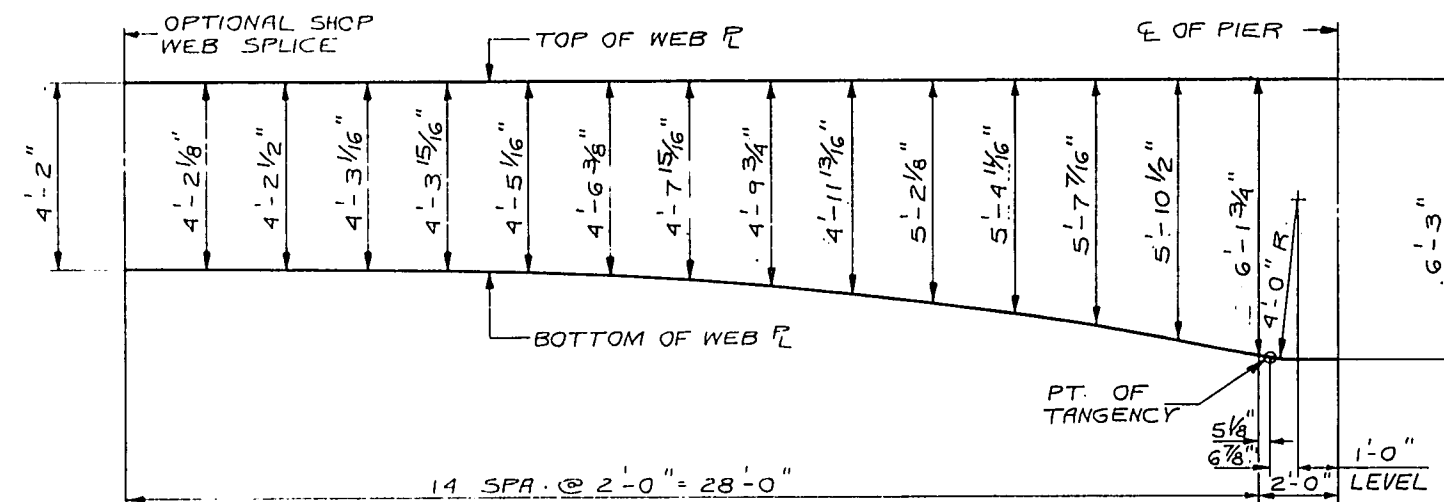DIMENSIONS OF STIFFENERS IN HAUNCH AREA - SPAN 1





PARABOLIC HAUNCH DETAILS

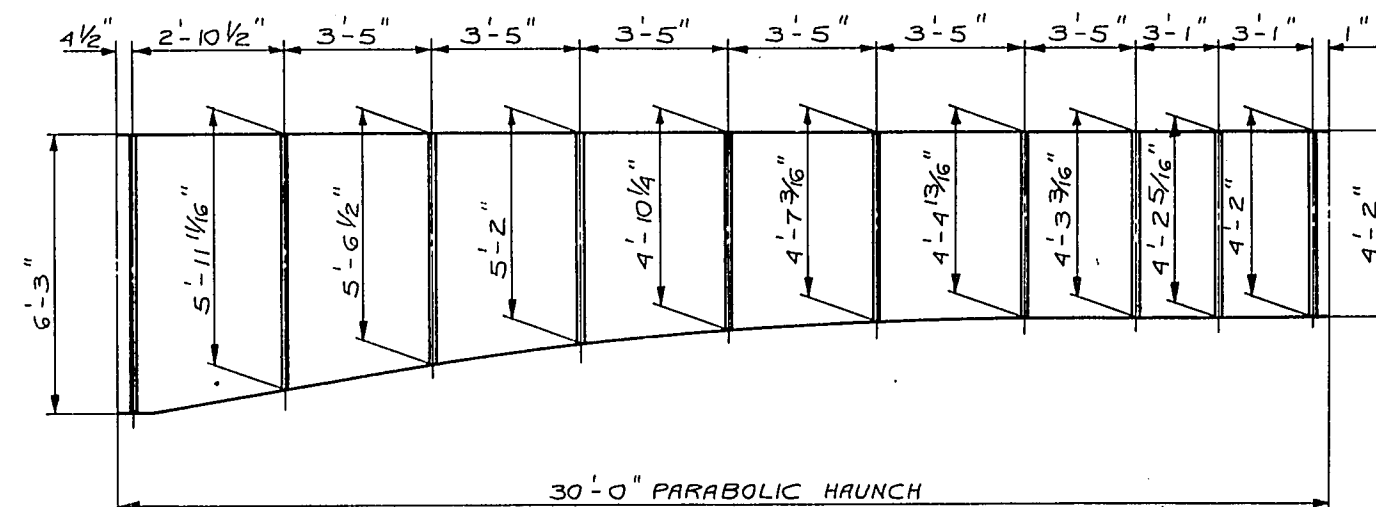

DIMENSIONS OF STIFFENERS IN HAUNCH AREA - SPAN 2

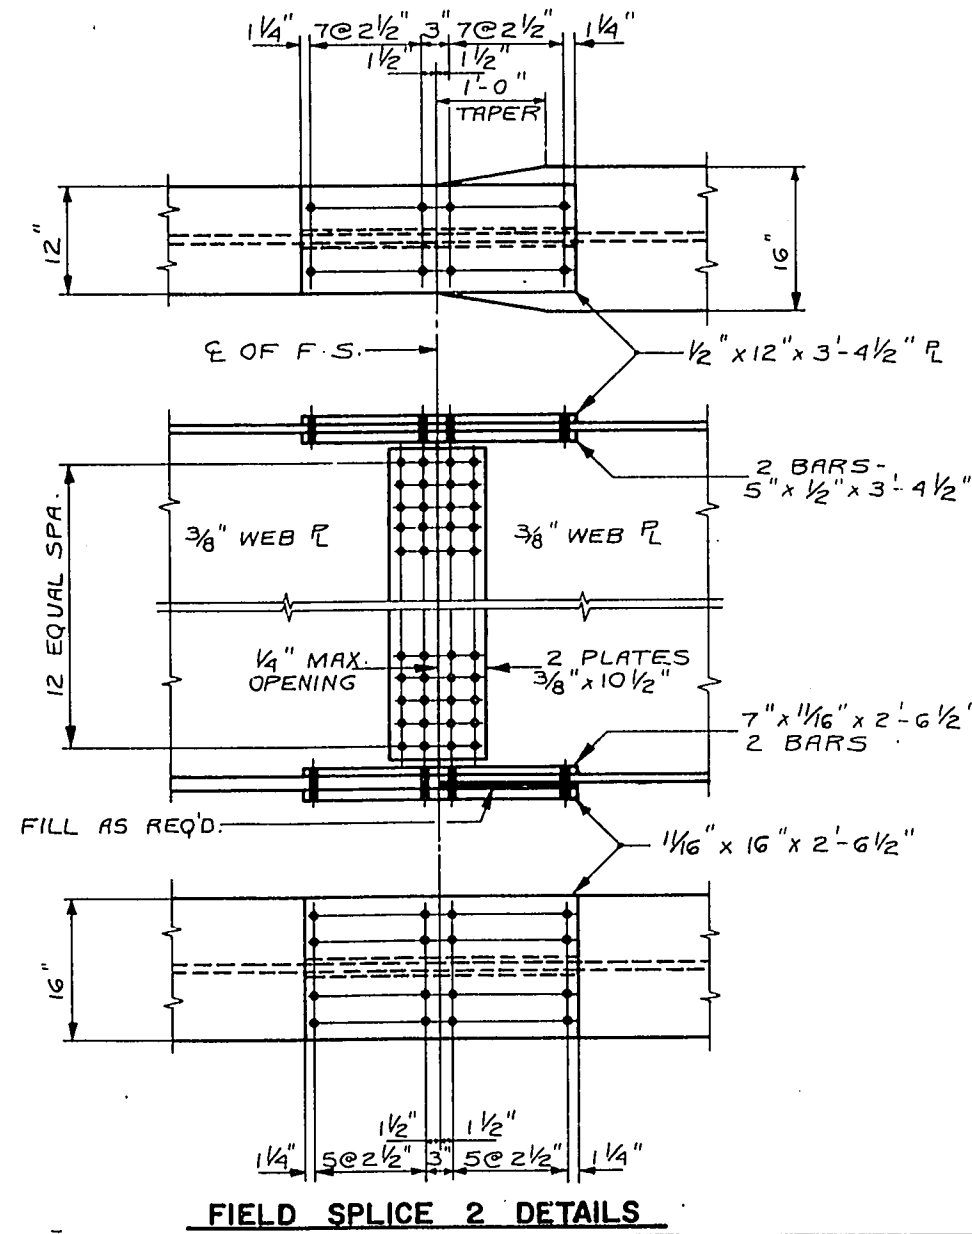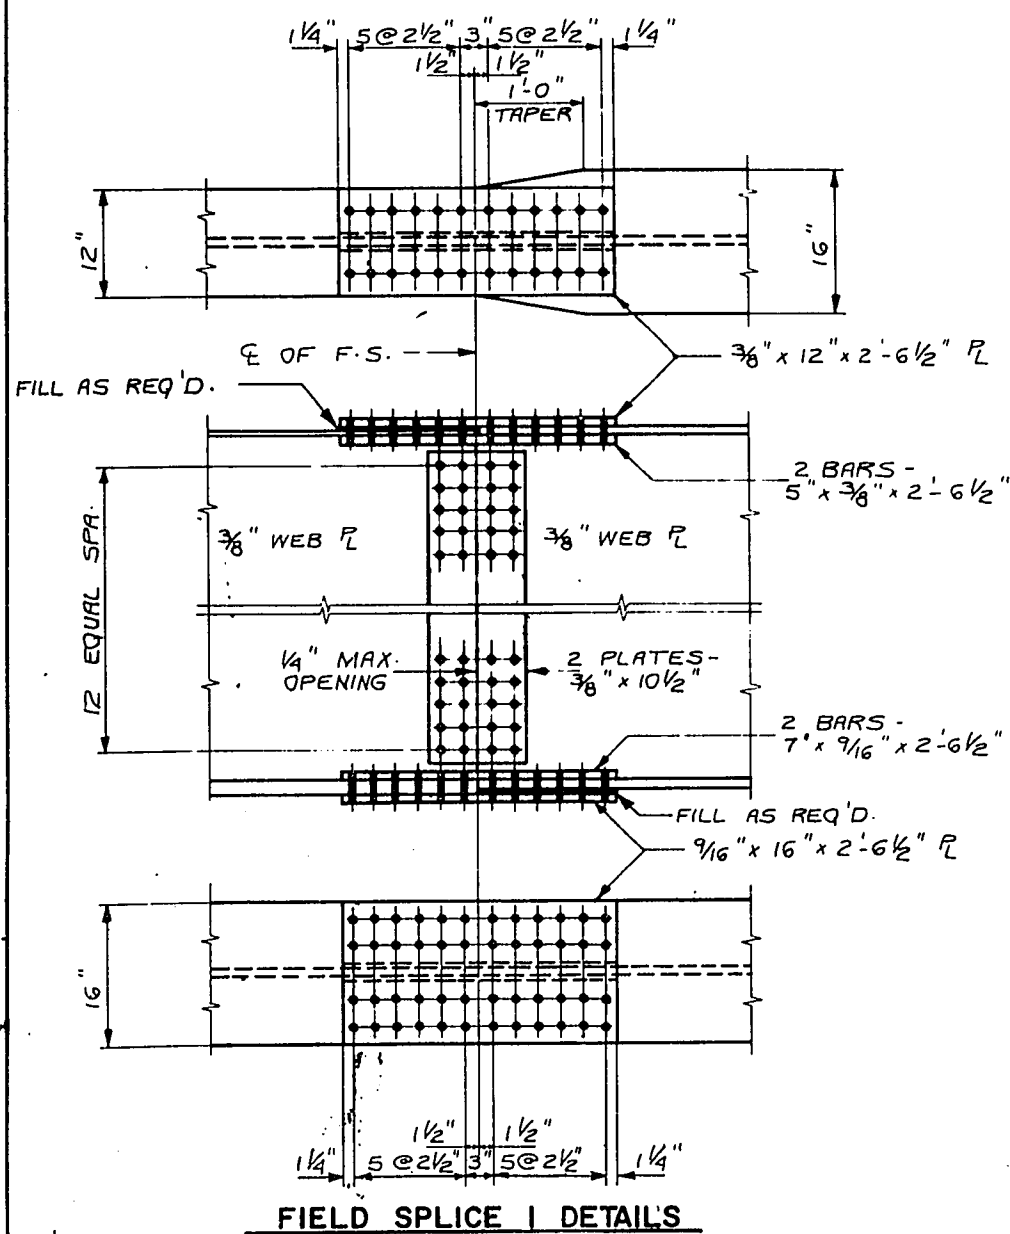✱ THESE ELEVATIONS ARE TO TOP OF STEEL (SPlice PLATE THICKNESS, IF APPLICABLE, IS ACCOUNTED FOR) AND THEY ARE FOR THE MATERIAL AS ERECTED. THE ELEVATION OF THE TOP OF STEEL AT THE FIELD SPlice POINTS SHALL BE CHECKED, AND CORRECTED, IF POSSIBLE, AFTER ERECTION AND BEFORE PERMANENTLY WELDING THE CROSS FRAMING IN PLACE.
NOTE: TOP OF STEEL ELEVATIONS ARE BASED ON GIRDER SECTIONS AS DETAILED. IF OPTIONAL BUTT SPICES ARE NOT USED, TOP OF STEEL ELEVATIONS AT FIELD SPICES WILL HAVE TO BE REVISED.



No.	Date	Revision	By
STATE OF WISCONSIN DEPARTMENT OF TRANSPORTATION DIVISION OF HIGHWAYS			
STRUCTURE B-3-37			
Const. Spec.	1969	Drawn By	L.N.F.
		Plans Checked	R.L.P.
SUPERSTRUCTURE			SHEET 14 OF 18
			X46917

B. P. R. Division	Project	Sheet Number	Total Sheets
4	1197-6-72 DPF08-4(4)	35	225

BEARING NOTES

ALL BEARINGS ARE SYMMETRICAL ABOUT ϵ OF GIRDER AND ϵ OF BEARING.
ALL STRUCTURAL STEEL BEARING PLATES SHALL BE FLAT ROLLED STEEL PLATES WITH ALL SURFACES SMOOTH AND FREE FROM WARP AND ALL EDGES SMOOTH, STRAIGHT AND VERTICAL.

ALL PLATE CUTS SHALL BE MACHINE OR MACHINE FLAME CUTS.

ANCHOR BOLTS SHALL BE THREADED 3". PROVIDE ONE STANDARD WROUGHT WASHER AND ONE HEX. NUT PER BOLT.

ALL MATERIAL INCLUDING SHIMS BUT EXCLUDING ANCHOR BOLTS, PINTLES, NUTS AND WASHERS SHALL BE MADE OF A588 STEEL. PINTLES SHALL BE MADE OF A449 STEEL.

ALL MATERIAL IN BEARINGS, EXCLUDING BRONZE PLATES AND BEARING PADS SHALL BE PAID FOR AT THE UNIT PRICE BID FOR "STRUCTURAL LOW ALLOY STEEL".

CHAMFER TOP OF PINTLES $\frac{1}{8}$ ". DRILL HOLES FOR PINTLES IN ALL MASONRY PLATES FOR DRIVING FIT.

PROVIDE $\frac{1}{8}$ " THICK BEARING PAD SAME SIZE AS MASONRY PLATE "D" FOR EACH BEARING.

ANCHOR BOLTS SHALL BE OF A SIZE AS GIVEN IN THE TABLE. LENGTH OF $1\frac{1}{4}$ " ϕ ANCHOR BOLTS TO BE 1-5. LENGTH OF $1\frac{1}{2}$ " ϕ ANCHOR BOLTS TO BE 1-10. PROJECT ANCHOR BOLTS "D" PLATE THICKNESS $+2\frac{1}{4}$ " ABOVE TOP OF CONCRETE. DRILLED HOLES FOR ANCHOR BOLTS IN PLATE "D" SHALL HAVE A DIAMETER $\frac{3}{8}$ " LARGER THAN THE ANCHOR BOLT DIAMETER.

ALL FINISHED SURFACES SHALL BE MACHINE FINISHED BY AN AUTOMATIC PROCESS.

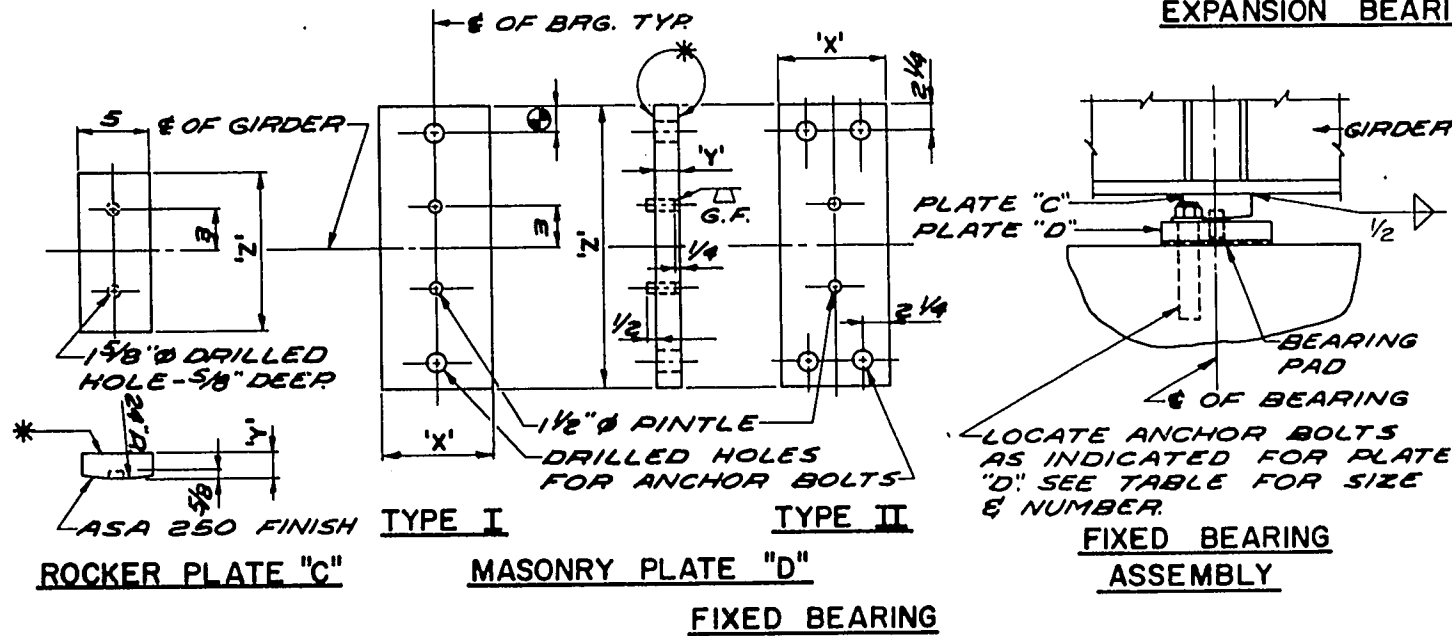
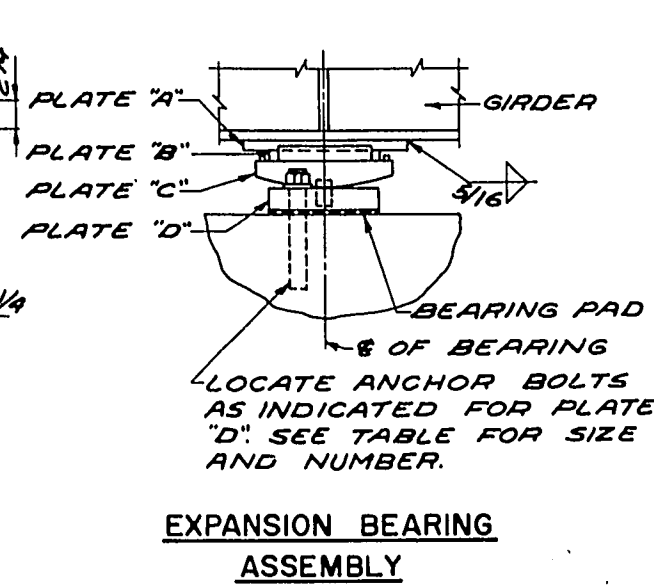
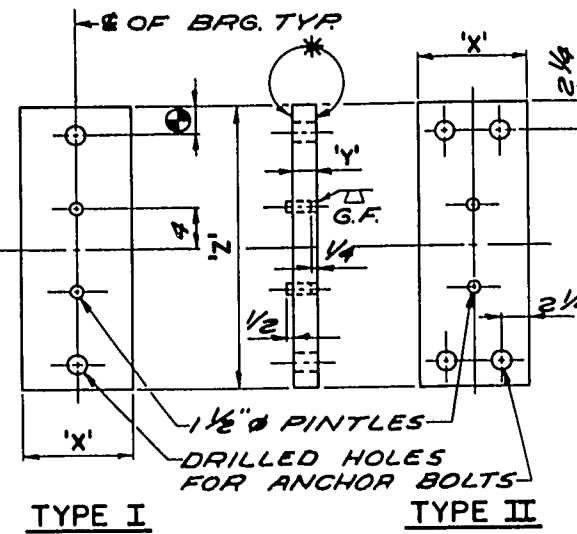
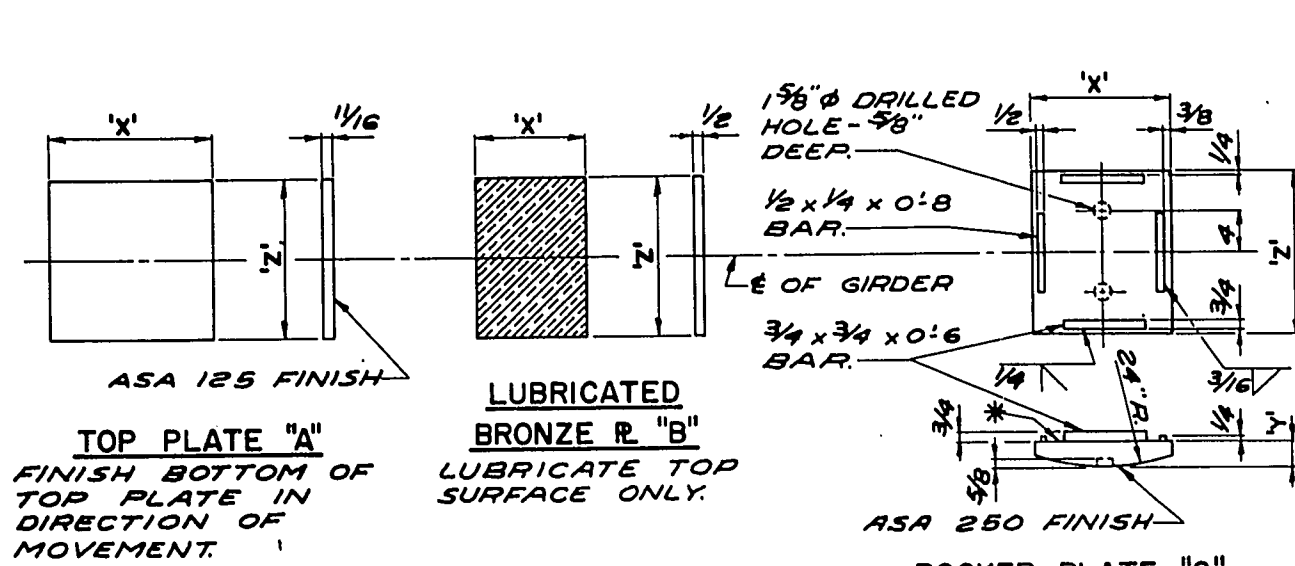


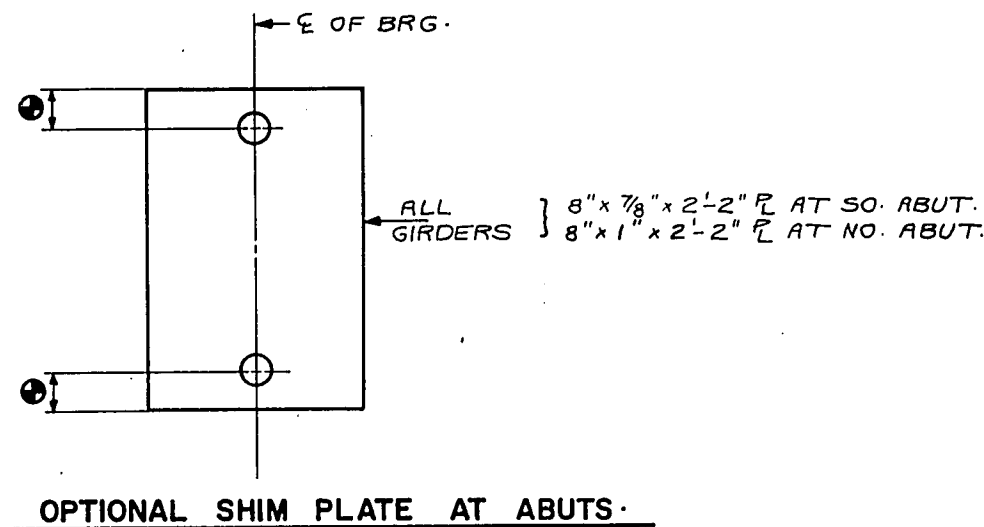


	PLATE 'A'		PLATE 'B'		PLATE 'C'			PLATE 'D'			PLATE 'D' TYPE	ANCHOR BOLT SIZE	NO. OF BRG'S. REQ'D.	LOCATION
	X	Z	X	Z	X	Y	Z	X	Y	Z				
EXPANSION BEARING	11"	1'-4"	7"	1'-4"	9"	1'11/16"	1'-6 1/4"	8"	1 1/2"	2'-2"	I	1 1/2" DIA.	10	AT ABUTS.
FIXED BEARING					—	2 3/8"	1'-4"	1'-4"	2 7/8"	2'-2"	I	1 1/2" DIA.	5	AT PIER
—														
—														

8" WHEN $1\frac{1}{4}$ " ϕ ANCHOR BOLTS ARE USED AND $2\frac{1}{4}$ " WHEN $1\frac{1}{2}$ " ϕ ANCHOR BOLTS ARE USED.
* FINISH ASA 250 IF DIMENSION "Y" IS GREATER THAN 2"











NOTE: SHIM PLATES TO BE USED AT ABUTS. IF OPTIONAL FLANGE BUTT SPLICE IS USED.

No.	Date	Revision	By
STATE OF WISCONSIN DEPARTMENT OF TRANSPORTATION DIVISION OF HIGHWAYS			
STRUCTURE B-3-37			
Const. Spec.	1969	Drawn By L. N. F.	Plans Checked R. L. P.
BEARING DETAILS			SHEET 15 OF 18
			X46918

PROJECT NO.	1197-6-72	SHEET NUMBER	36	TOTAL SHEETS	225
FEDERAL PROJECT DESIGNATION	DPF08-4(41)				

LEGEND

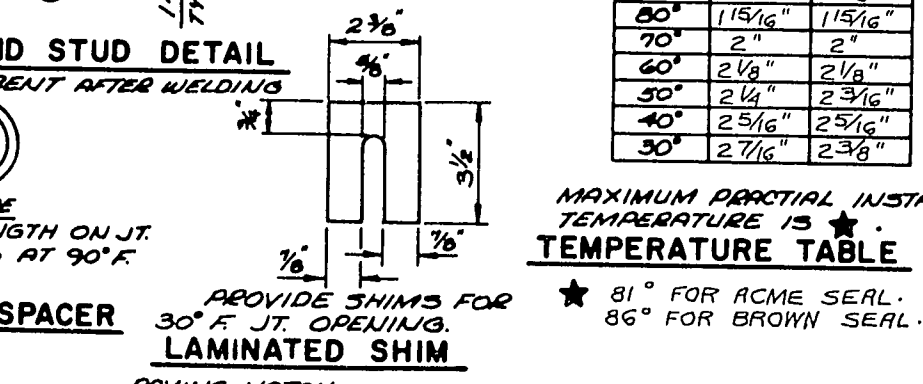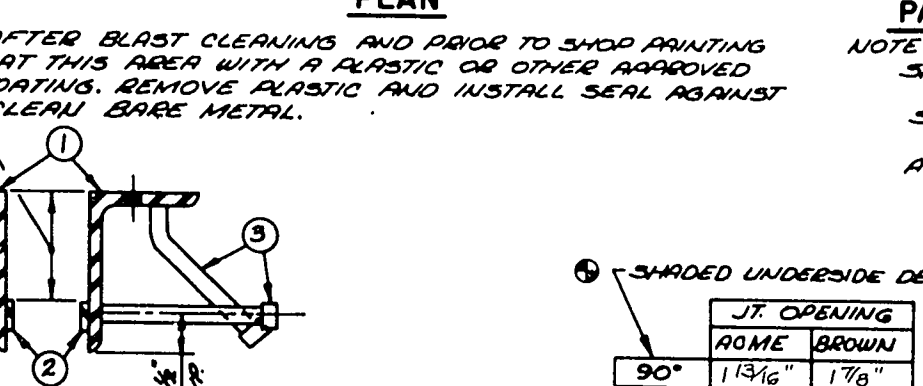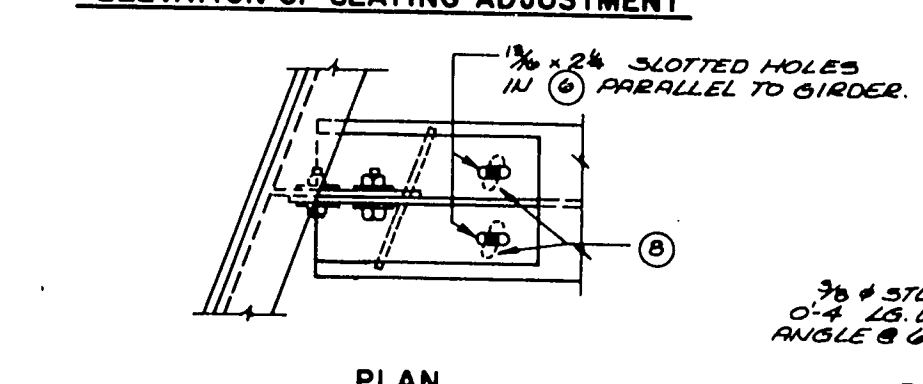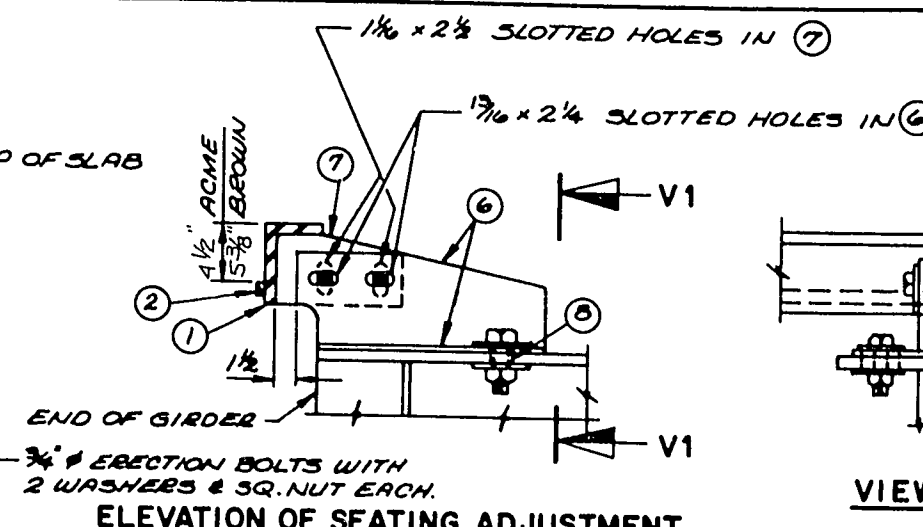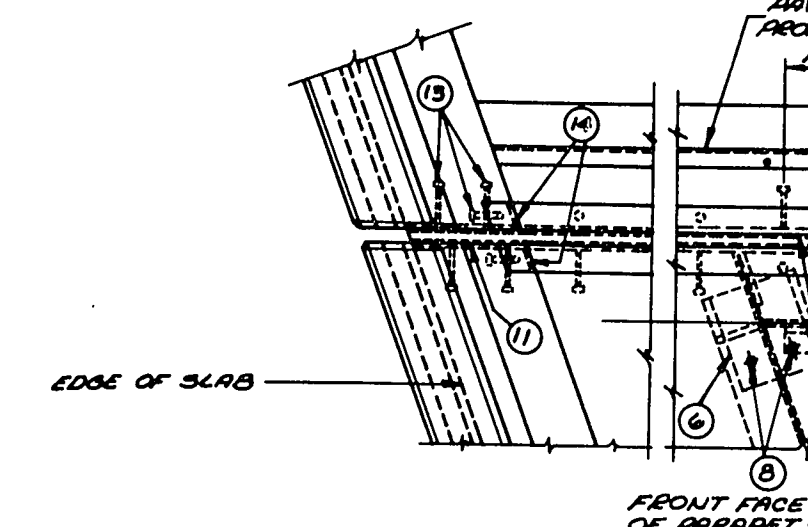
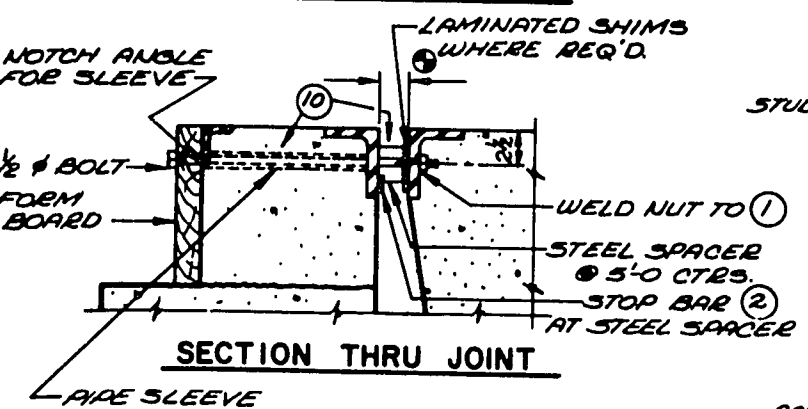
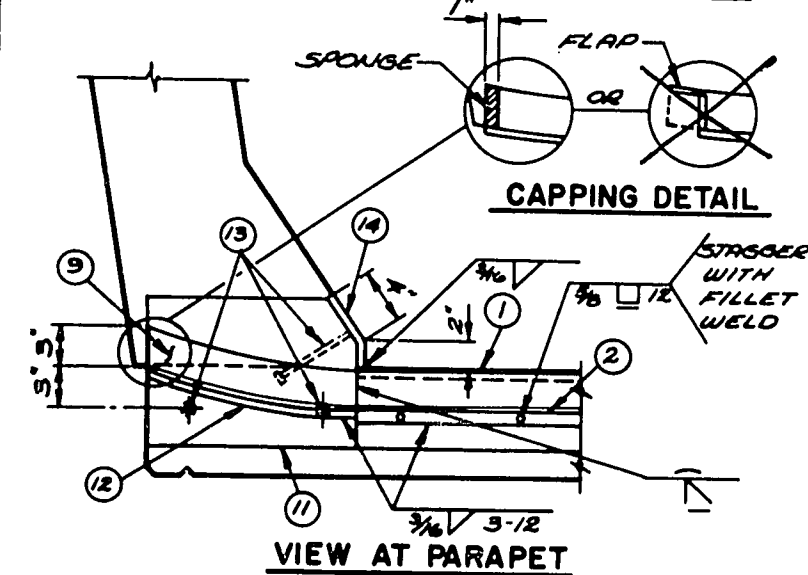
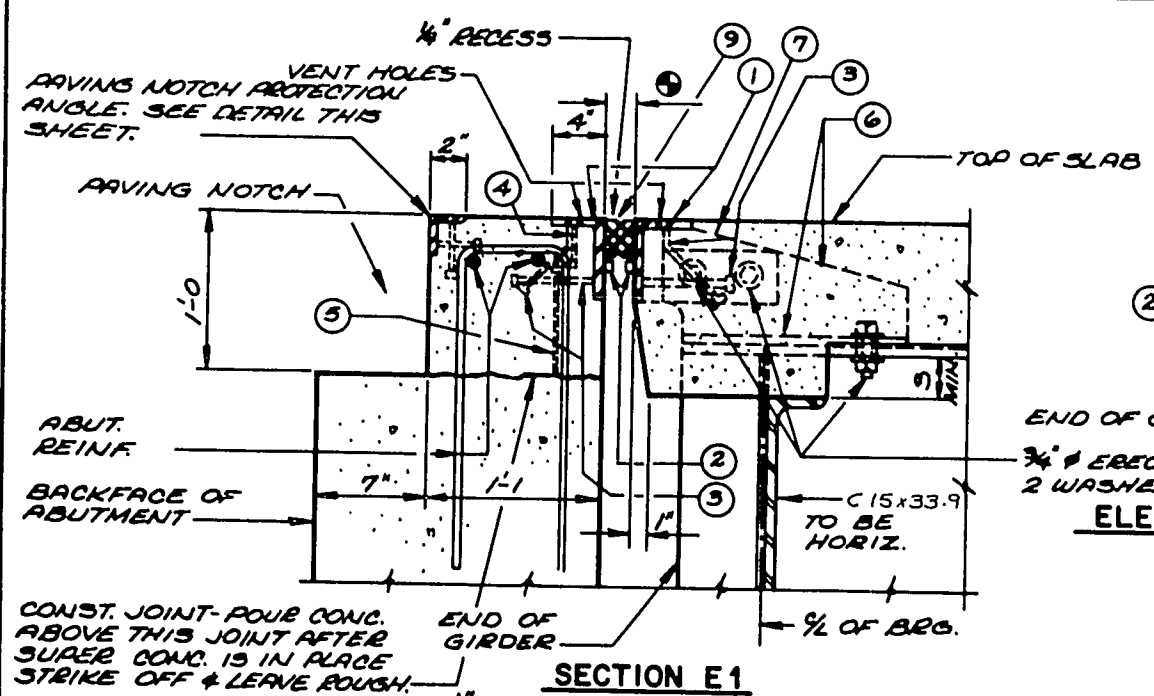
- ① *** WITH 1/8" VENT HOLES AT 2'-0" CTRS AND 3/8" HOLES FOR BOLT ⑩ AT 5'-0" CTRS. ANGLE FACES MUST BE PARALLEL WITHIN ± 1/16" BETWEEN STEEL SPACERS ⑪.
- ② RETAINER BAR 1" x 1/4" WELD TO ① AS SHOWN.
- ③ 3/8" x 0'-6" LONG STUDS AT 1'-0" ALTERNATE CTRS. WELD TO ①.
- ④ L 3 x 2 1/2 x 3/8 x 0'-3 3/4 CTRS. WELD TO ①. PROVIDE 1/8" HOLE IN 2 1/2" LEG FOR ROD ⑤.
- ⑤ 3/8" ROD x 0'-10" LONG WITH NUT. TACK WELD NUT TO BOTTOM OF ④. THREAD 3".
- ⑥ FABRICATE FROM 3/8" WELDED PLATES. 2-1/8" x 2 1/4" SLOTTED HOLES IN BASE PLATE PARALLEL TO 1/4" OF GIRDER. 2-1/8" x 2 1/4" SLOTTED HOLES IN STEM PLACED HORIZONTALLY.
- ⑦ 3/8" PLATE. WELD TO LEGS OF ① WITH 3/8" FILLET WELD NEAR SIDE AND FAR SIDE. 2-1/8" x 2 1/4" SLOTTED HOLES PLACED VERTICALLY.
- ⑧ 2-1/8" x 1 1/4" SLOTTED HOLES IN GIRDER FLANGE FOR 2-3/8" ERECTION BOLTS. SLOT TO BE PARALLEL TO 1/4" OF BEARING. CLEAR BEARING STIFFENER BY 1 1/2" MIN.
- ⑨ REFORMED B-610 ACME OR H-3500 BROWN NEOPRENE SEAL. EDGE OF SLAB TO EDGE OF SLAB.
- ⑩ BLOCK AND BOLT FOR SHIPMENT AND ERECTION WITH PIPE SLEEVE, STEEL SPACER AND 1/2" BOLT AT 5'-0" CTRS.
- ⑪ 3/8" PLATE - SHAPE TO FIT. SHOP WELD TO ①.
- ⑫ RETAINER BAR 1/2" x 1/4". WELD TO PLATE ⑪ AS SHOWN.
- ⑬ 3/8" x 0'-6" LONG STUDS. WELD TO PLATES ⑪ AND ⑫.
- ⑭ 3/8" PLATE - PLACE FLUSH WITH FACE OF RAIL PARAPET AS SHOWN. SHOP WELD TO ① AND PLATE ⑦.



SHADED UNDERSIDE DECK TEMP (F)

JT. OPENING	ACME	BROWN
90°	1 13/16"	1 7/8"
80°	1 15/16"	1 15/16"
70°	2"	2"
60°	2 1/8"	2 1/8"
50°	2 1/4"	2 3/16"
40°	2 5/16"	2 5/16"
30°	2 7/16"	2 3/8"

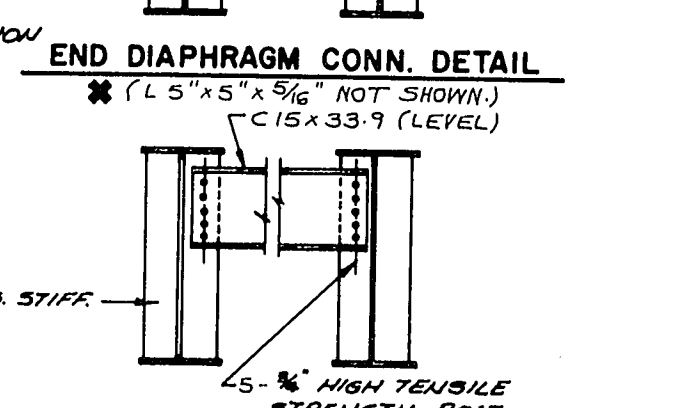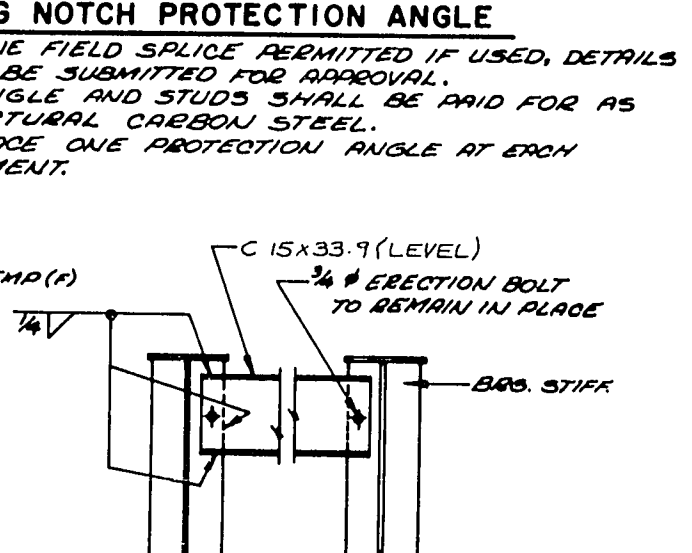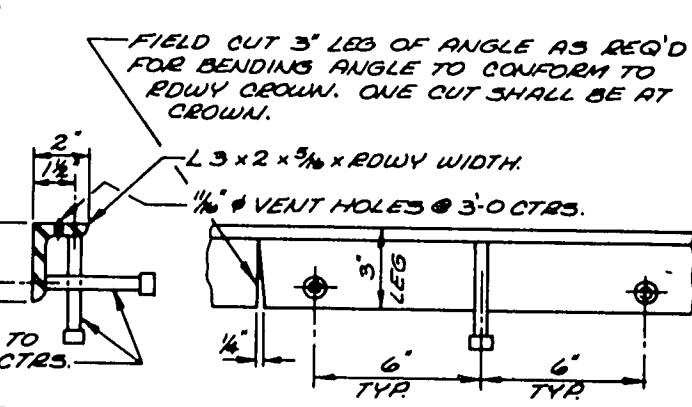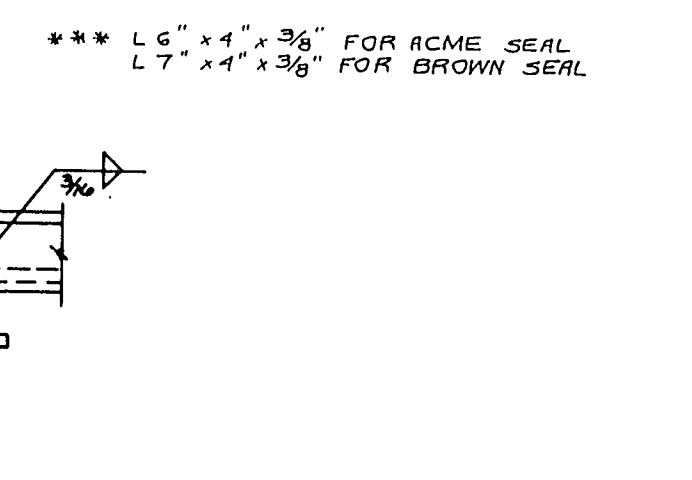
MAXIMUM PERMITAL INSTALLATION TEMPERATURE IS ★
 ★ 81° FOR ACME SEAL.
 ★ 86° FOR BROWN SEAL.








NOTES

- CAPPING DETAIL - PROVIDE EITHER:
 SCE-428 CLOSED CELL NEOPRENE SPONGE CONFORMING TO ASTM D1056-67T, 1" THICK CUT TO MATCH THE UNCOMPRESSED SEAL CROSS SECTION AND CEMENTED IN PLACE WITH THE LUBRICANT ADHESIVE, OR A FLAP FORMED BY CUTTING AWAY ALL BUT THE TOP SURFACE OF THE SEAL THEN BENT DOWN AND CEMENTED IN PLACE.
- EXPANSION JOINT SHALL BE BUILT TO CONFORM TO ROADWAY CROWN AND GRADE.
- ALL MATERIAL IN EXPANSION JOINT EXCEPT NEOPRENE SEAL SHALL BE PAID FOR AS STRUCTURAL CARBON STEEL.
- AFTER CONCRETE HAS SET, BLOCKING ⑩ SHALL BE REMOVED AND THE JOINT OPENING SHALL BE THOROUGHLY CLEANED.
- ONE FIELD SPlice PERMITTED. IF USED, DETAILS SHALL BE SUBMITTED FOR APPROVAL.


No.	Date	Revision	By
STATE OF WISCONSIN DEPARTMENT OF TRANSPORTATION DIVISION OF HIGHWAYS			
STRUCTURE B-3-37			
Const. Spec.	1969	Drawn By	L.N.F.
		Plans Checked	R.L.P.
NEOPRENE SEAL EXPANSION JOINT		SHEET 16 OF 18 X46919	

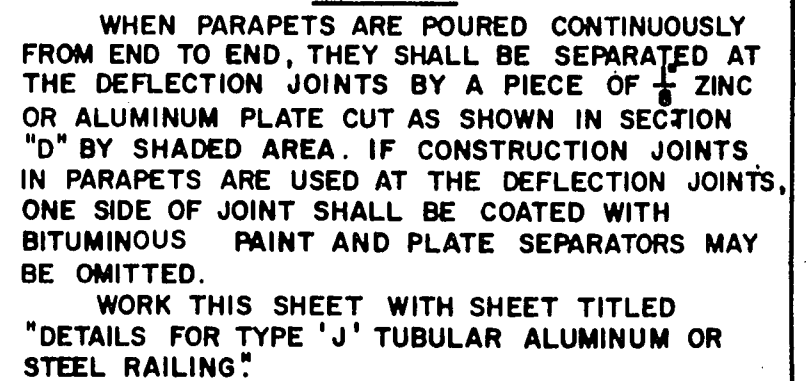


No.	Date	Revision	By
STATE OF WISCONSIN DEPARTMENT OF TRANSPORTATION DIVISION OF HIGHWAYS			
STRUCTURE B-3-37			
Const. Spec.	1969	Drawn By	Plans Checked
SLOPED FACE PARAPET "A"		SHEET 17 OF 18 X46920	

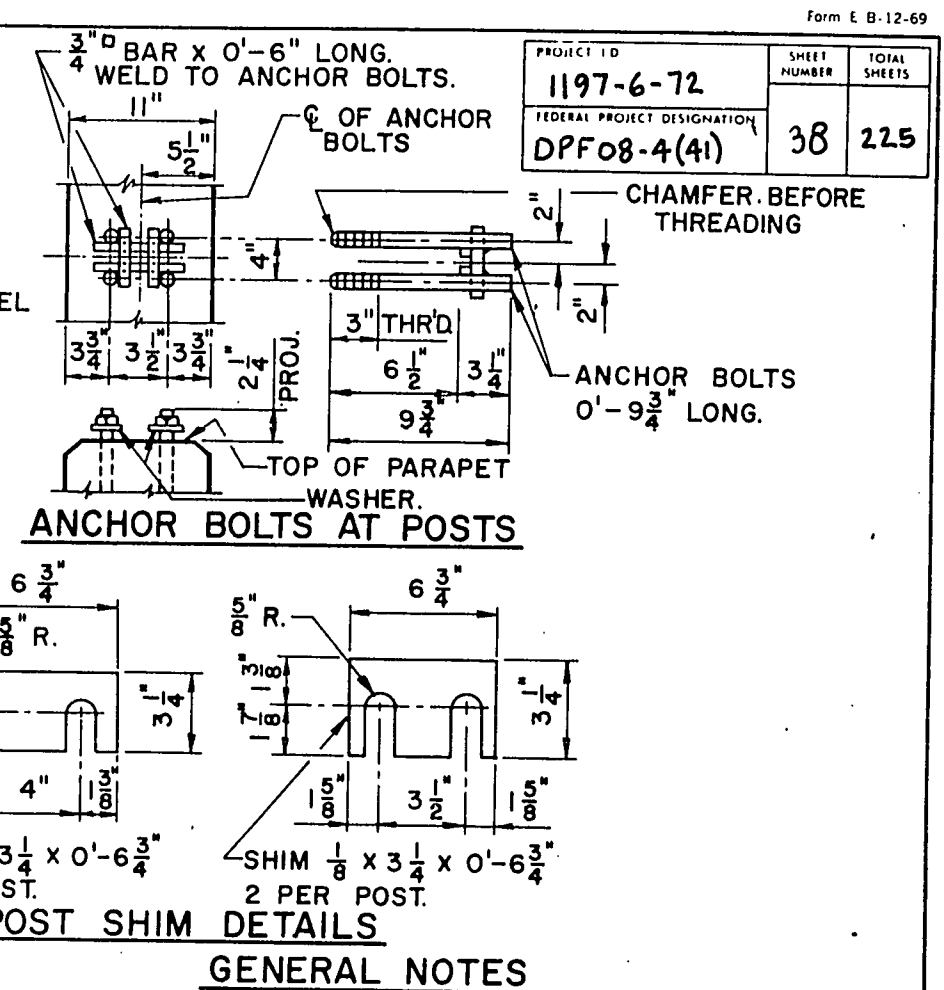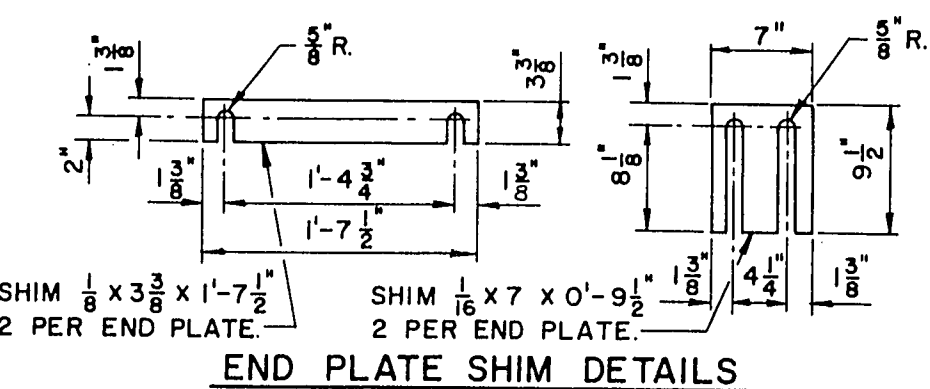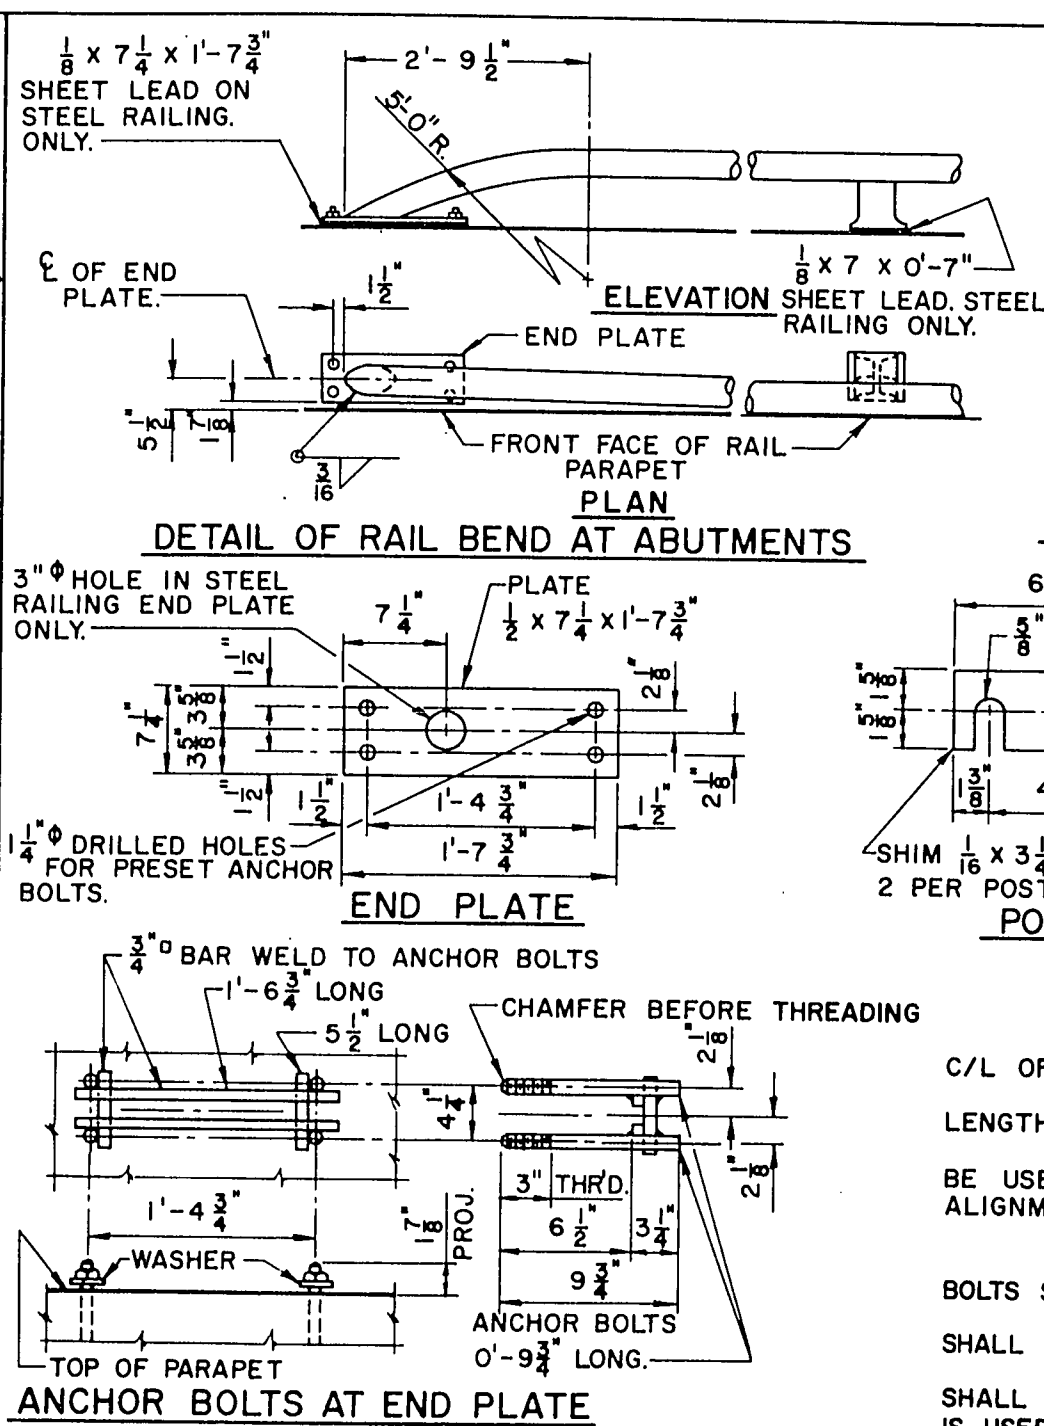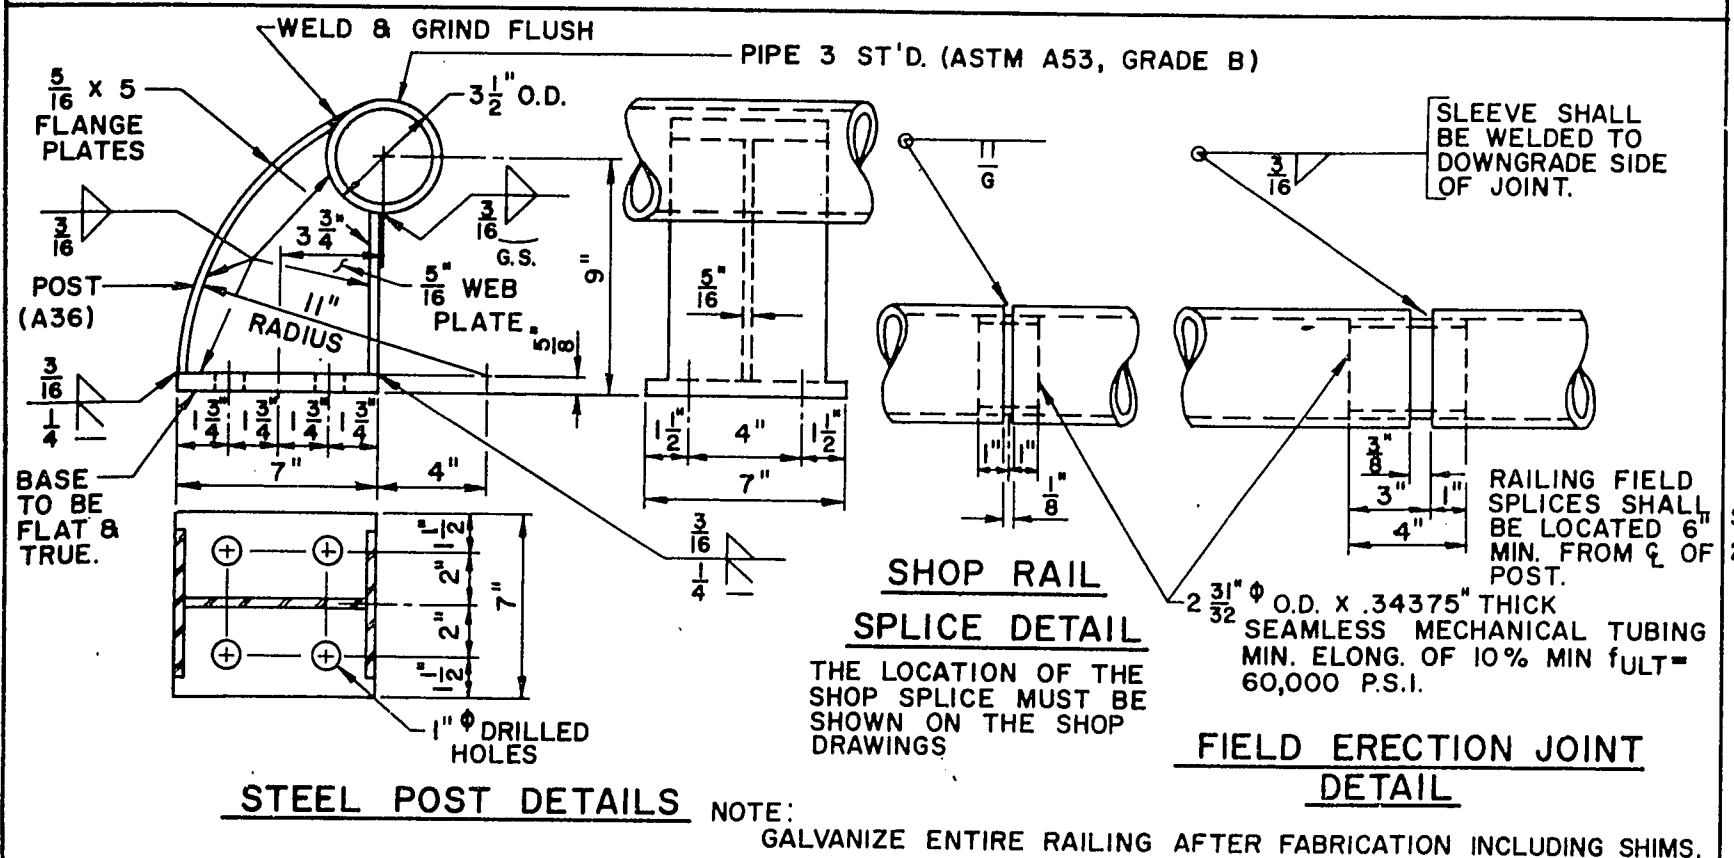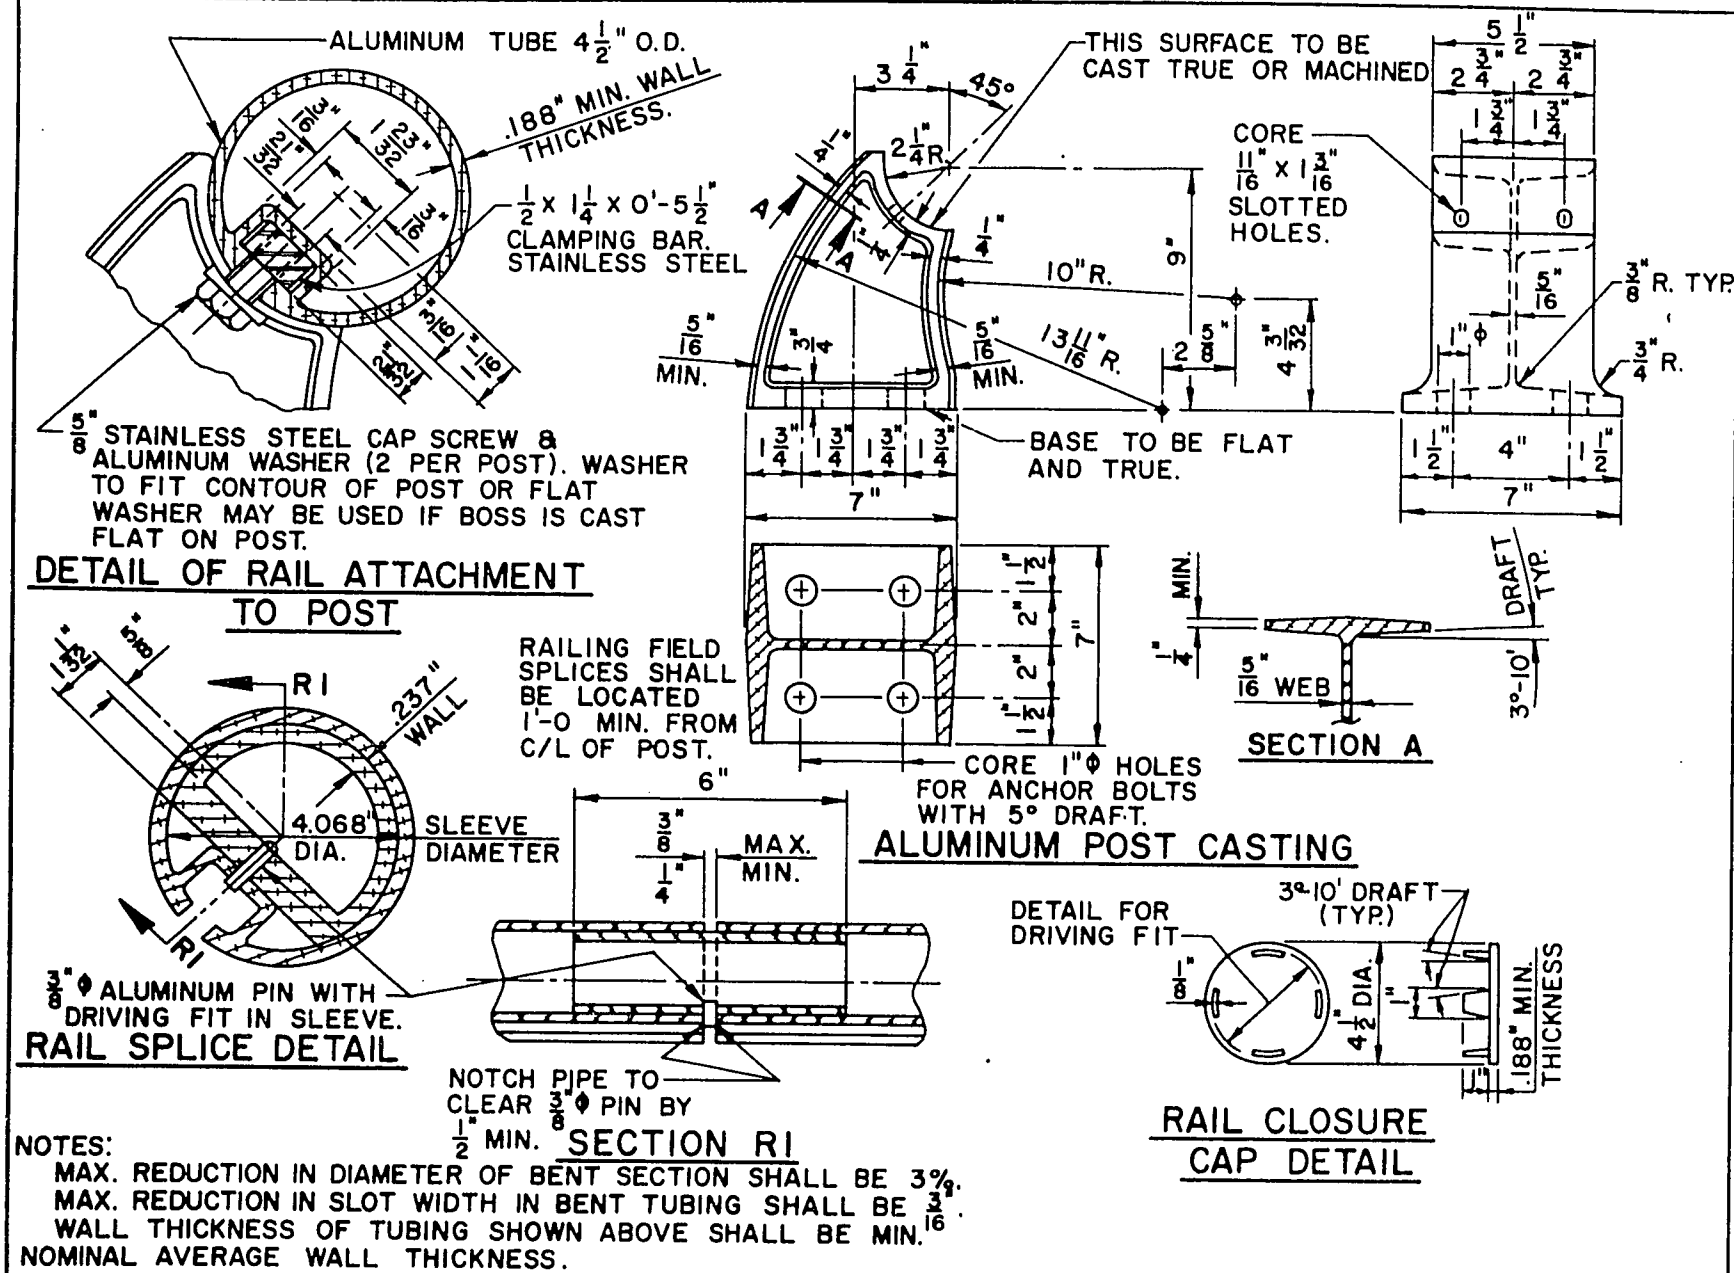

BID ITEM SHALL BE TUBULAR RAILING, TYPE 'J'.
ALL POST SPACINGS ARE TAKEN HORIZONTALLY ALONG
C/L OF ANCHOR BOLTS.
RAILING SHALL BE FABRICATED IN TWO OR THREE PANEL
LENGTHS.
SHIMS CONFORMING TO SAME MATERIAL AS POSTS SHALL
BE USED UNDER POSTS AND END PLATES WHERE REQ'D FOR
ALIGNMENT.
RAIL POSTS SHALL BE SET NORMAL TO GRADE.
THE SHANK AND ROOT OF THREAD DIAMETER FOR ANCHOR
BOLTS SHALL BE A MIN. OF 0.62 INCHES.
ANCHOR BOLTS, NUTS & WASHERS FOR ALUMINUM RAILING
SHALL BE STAINLESS STEEL.
ANCHOR BOLTS, NUTS & WASHERS FOR STEEL RAILING
SHALL BE EITHER STAINLESS STEEL OR ASTM A307. IF A307
IS USED ELECTRO-GALVANIZE NUTS, WASHERS & TOP 3/2"
OF ANCHOR BOLTS.



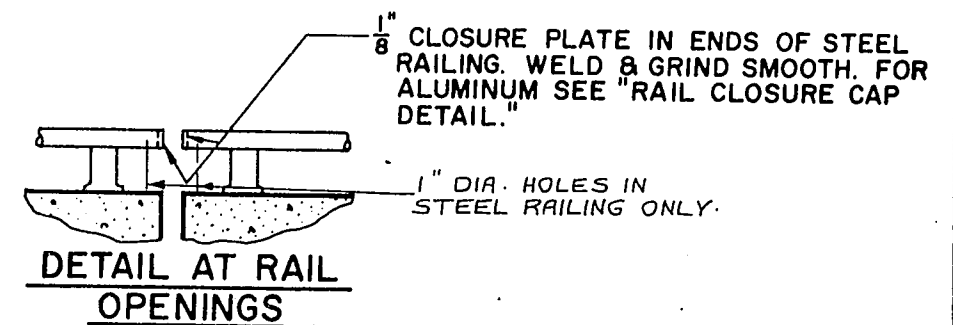


No.	Date	Revision	By
STATE OF WISCONSIN DEPARTMENT OF TRANSPORTATION DIVISION OF HIGHWAYS			
STRUCTURE B-3-37			
Const Spec.	1969	Drawn By	L.N.F. Plans Checked R.L.P.
TUBULAR RAILING TYPE 'J'		SHEET 18 OF 18	
		X46921	

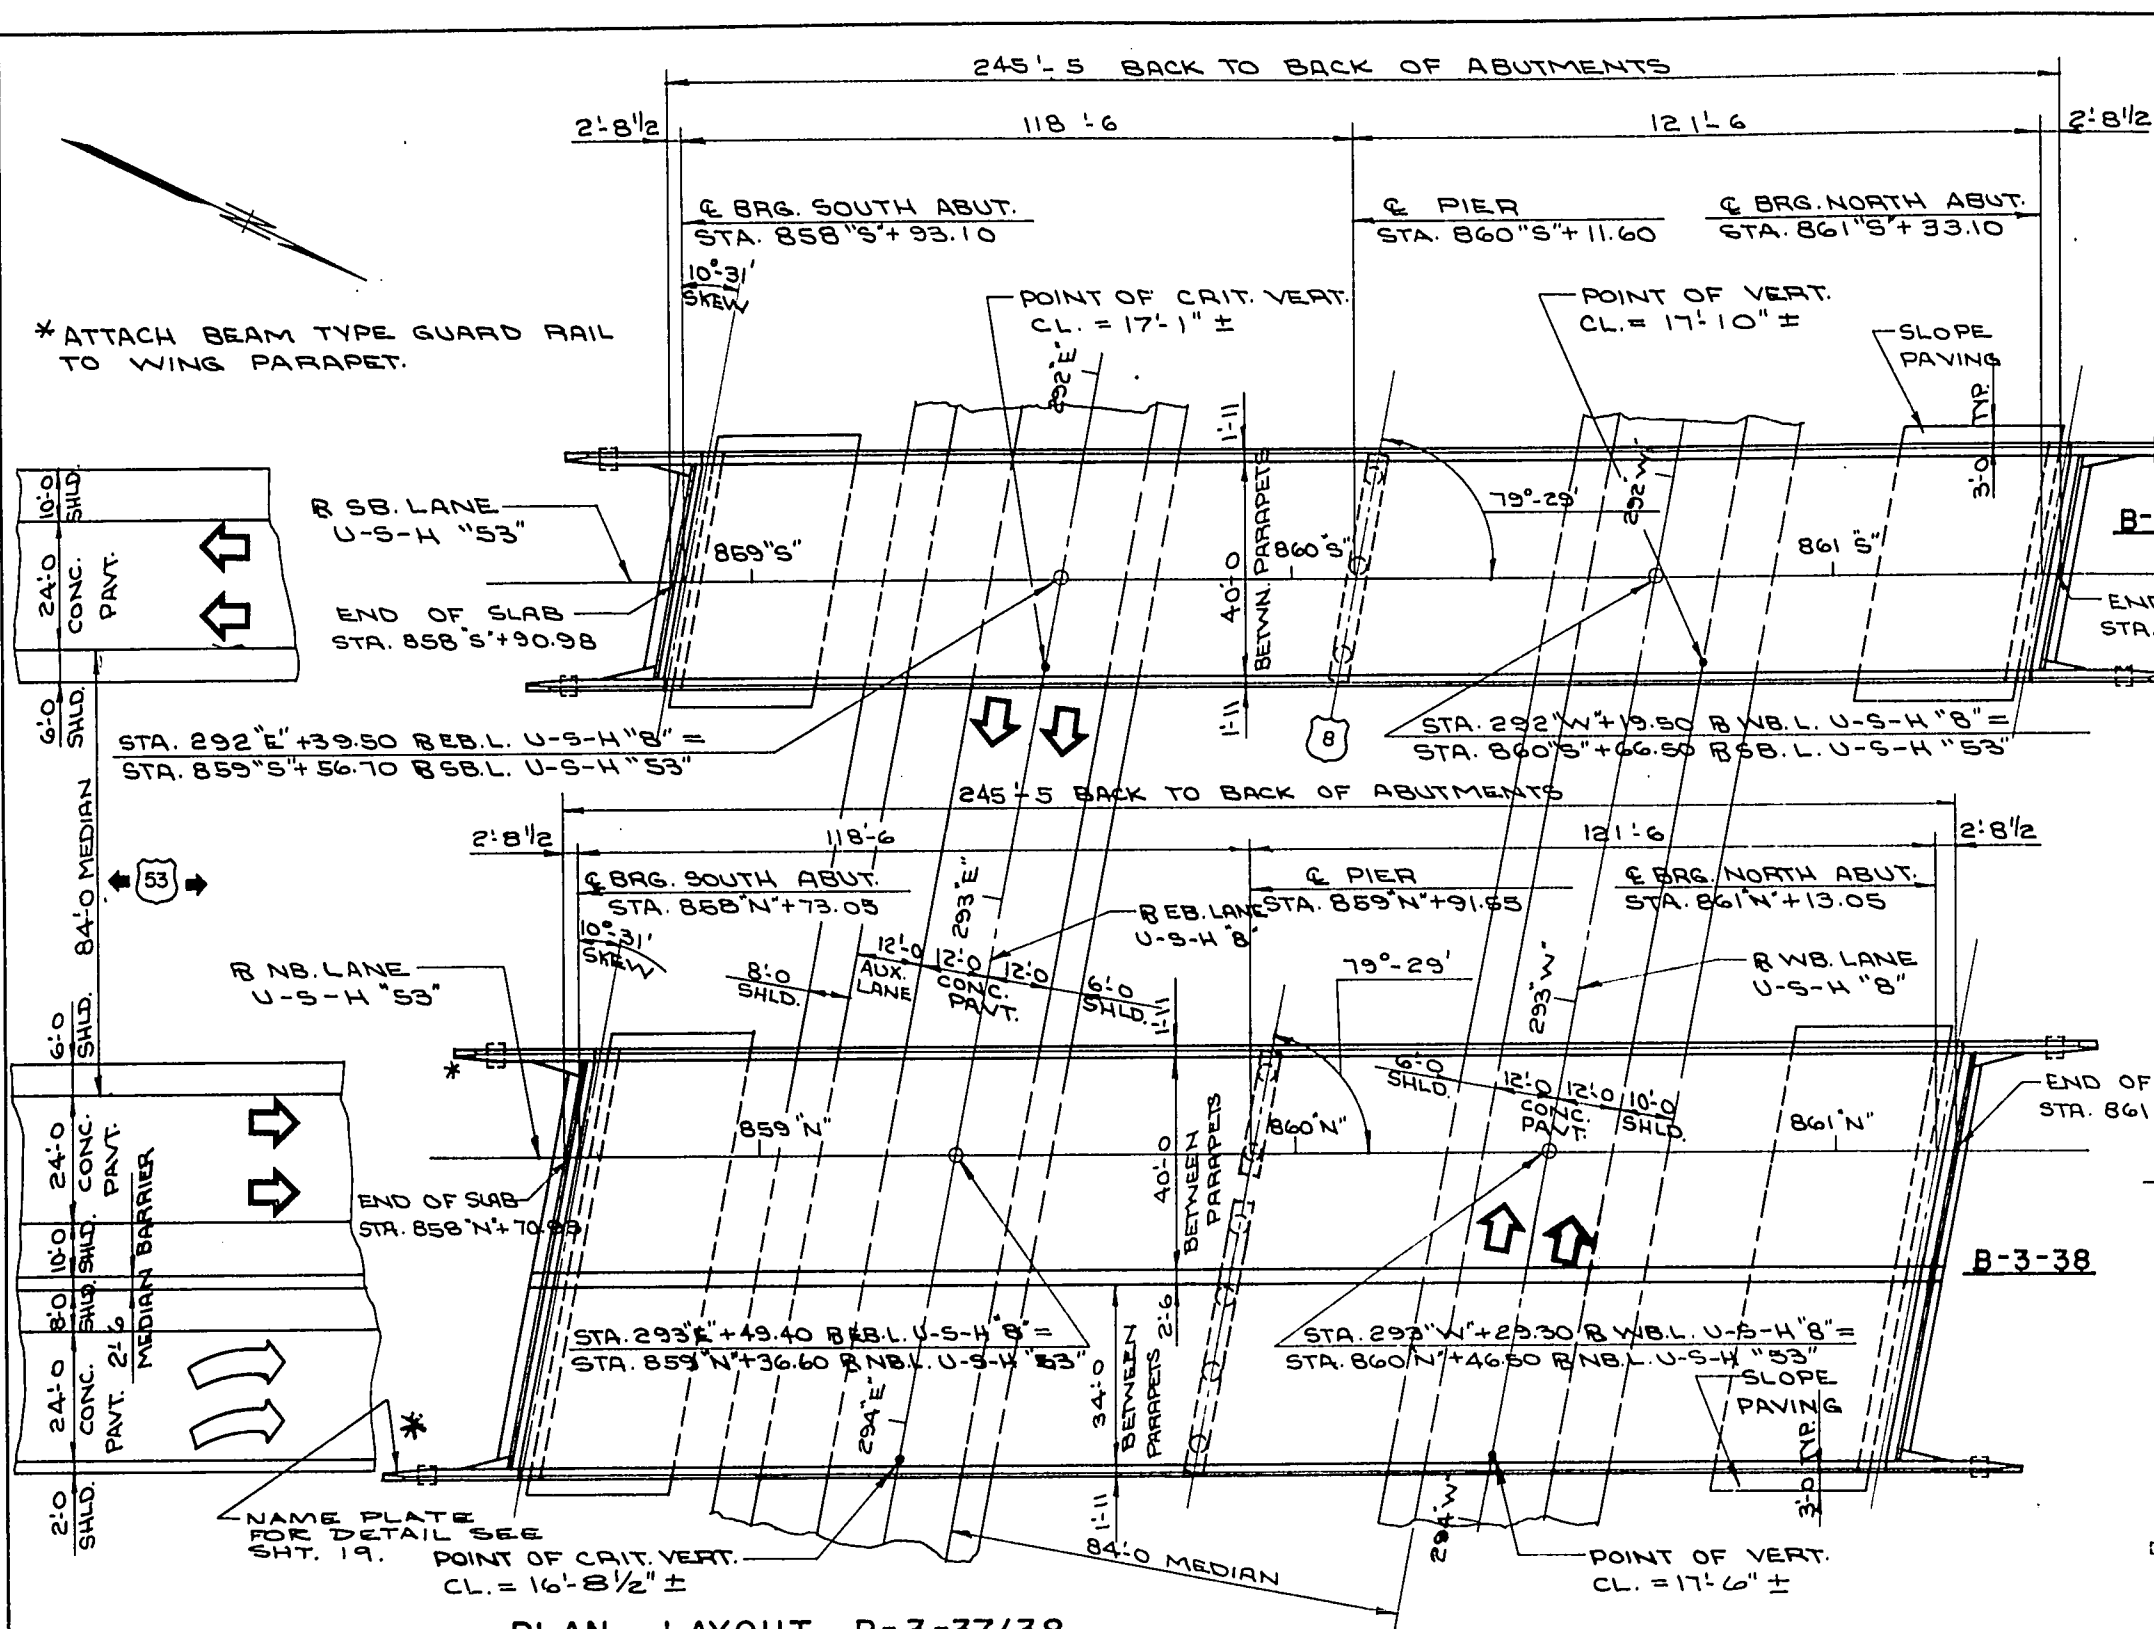


BENCH MARK			
NO	STATION	LOCATION	ELEV.
15	295 E+75	18" N. PINE	1087.15

PROJECT ID 1197-6-72	SHEET NUMBER 39	TOTAL SHEETS 225
FEDERAL PROJECT DESIGNATION DPF08-4(41)		

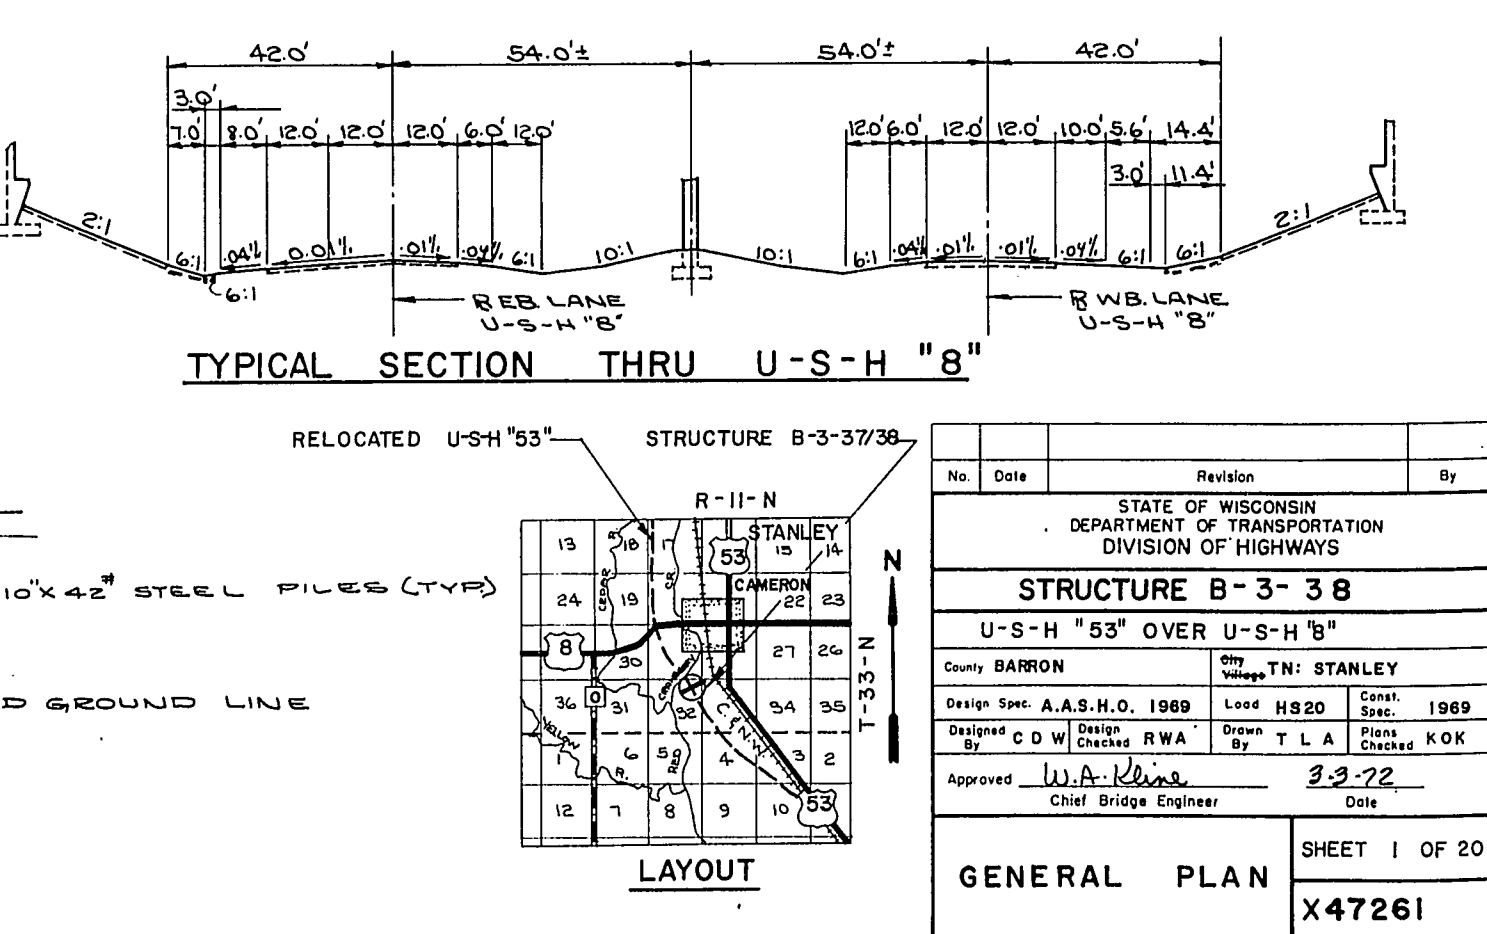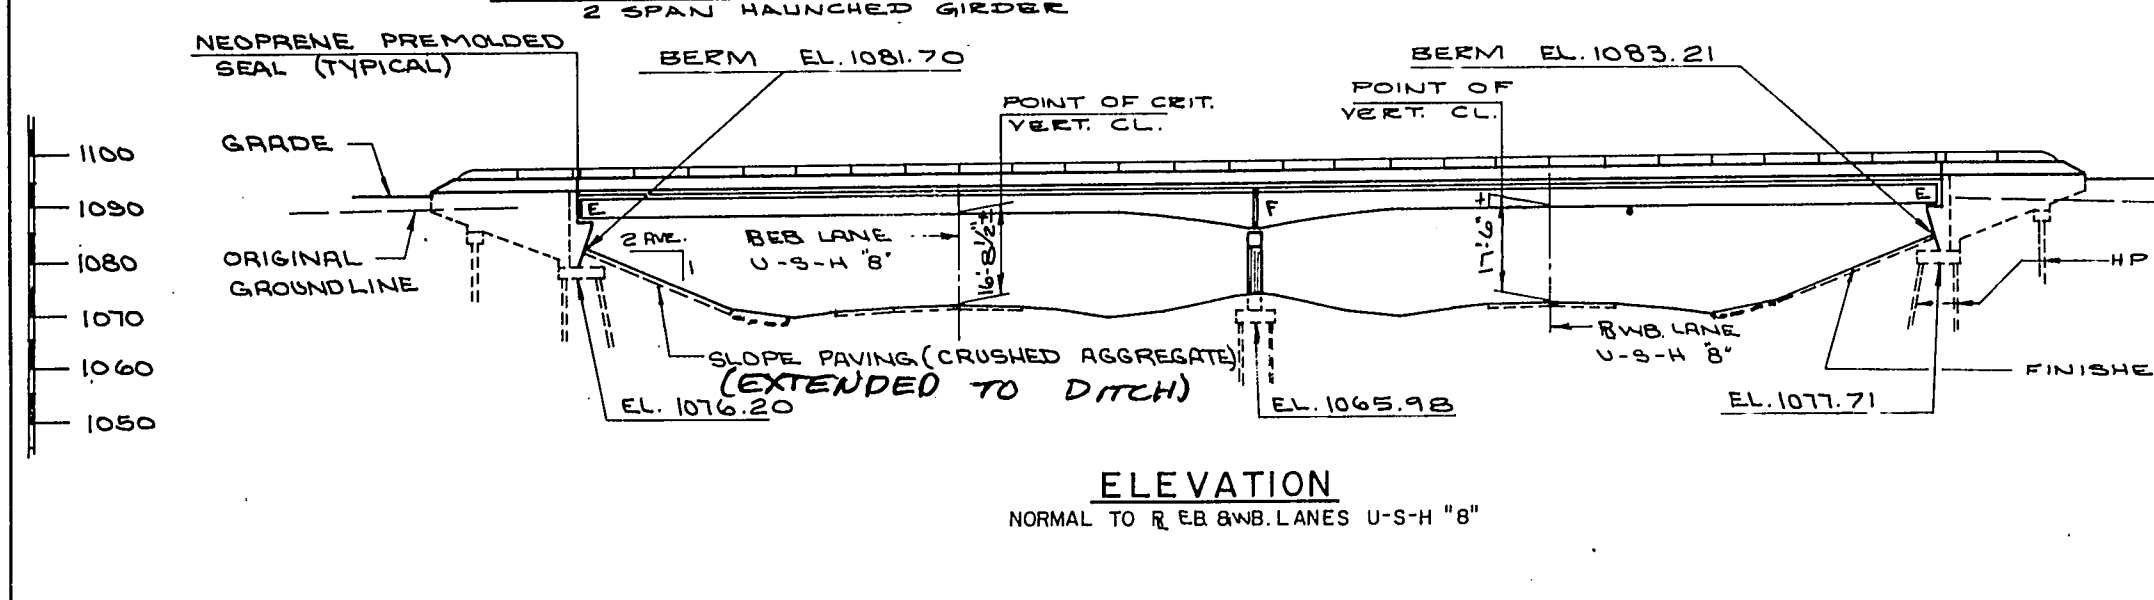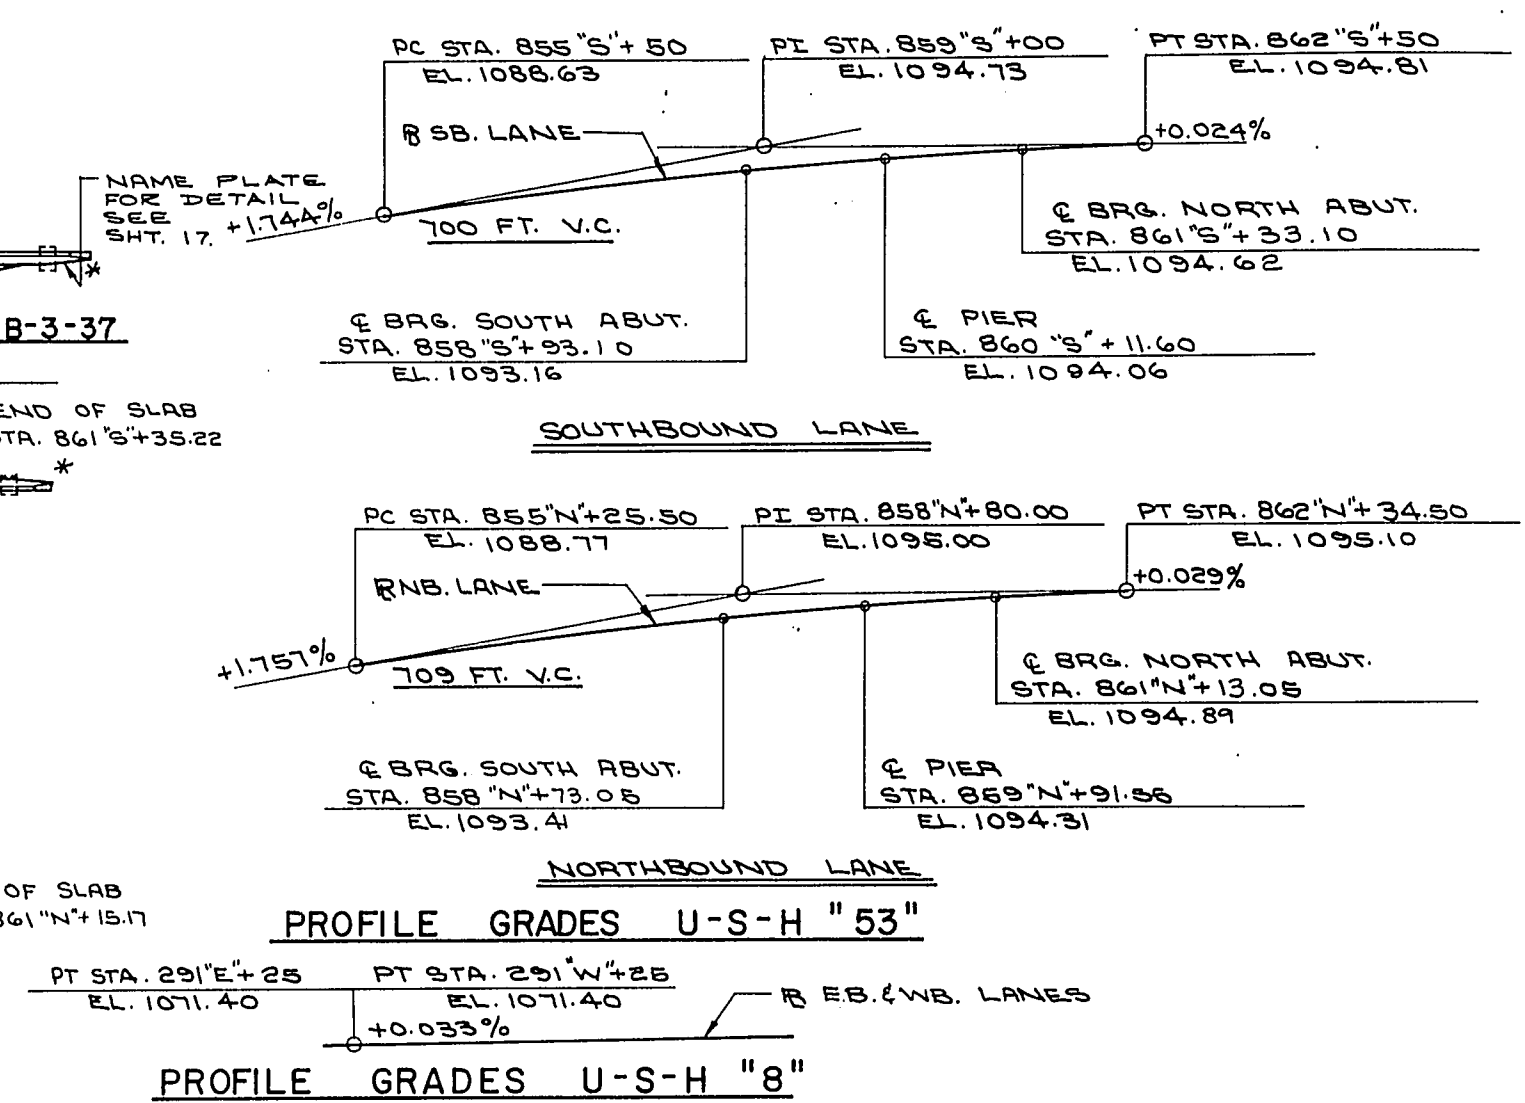

GENERAL NOTES

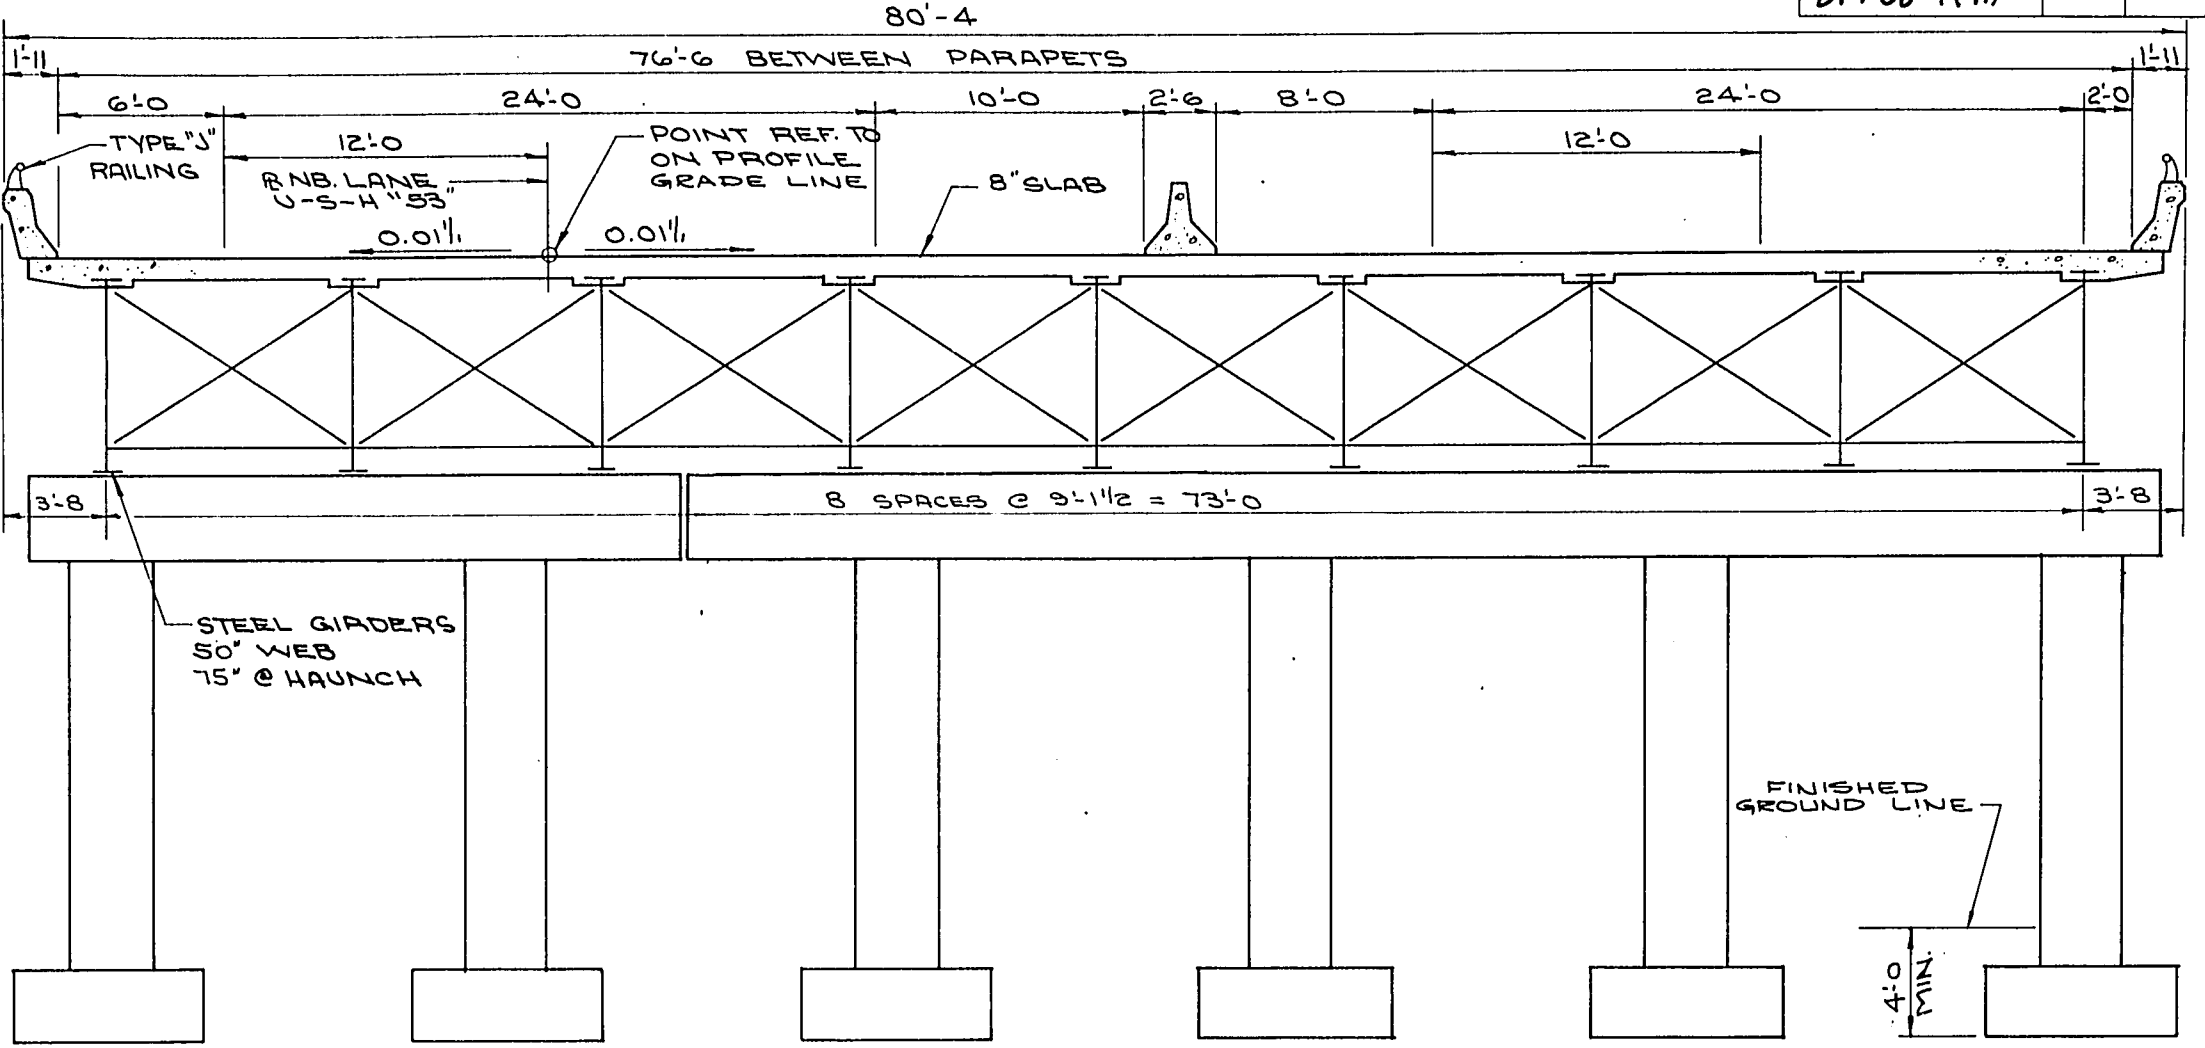DRAWINGS SHALL NOT BE USED FOR CONSTRUCTION UNLESS THEY ARE APPROVED BY THE ENGINEER. THE CONTRACTOR SHALL BE RESPONSIBLE FOR THE ACCURACY OF THE DATA AND THE RESULTS OF THE FIELD SURVEY. THE CONTRACTOR SHALL BE RESPONSIBLE FOR THE PROTECTION OF THE EXISTING UTILITIES AND THE ADJACENT PROPERTIES. THE CONTRACTOR SHALL BE RESPONSIBLE FOR THE PROTECTION OF THE EXISTING UTILITIES AND THE ADJACENT PROPERTIES. THE CONTRACTOR SHALL BE RESPONSIBLE FOR THE PROTECTION OF THE EXISTING UTILITIES AND THE ADJACENT PROPERTIES.



SECTION THRU ROADWAY
LOOKING NORTH

DESIGN DATA

LIVE LOAD: HS20
ALLOWABLE DESIGN STRESSES:
CONCRETE MASONRY, GRADE "AA", SLAB 1,200 P.S.I.
ALL OTHER 1,400 P.S.I.
BAR STEEL REINFORCEMENT 20,000 P.S.I.
n = 10
STRUCTURAL CARBON STEEL 20,000 P.S.I.
STRUCTURAL LOW ALLOY STEEL:
TO AND INCLUDING 3/4" THICK 27,000 P.S.I.
3/4" TO AND INCLUDING 1 1/2" THICK 28,000 P.S.I.
OVER 1 1/2" THICK 22,000 P.S.I.

FOUNDATION DATA

ABUTMENTS TO BE SUPPORTED ON
HP 10" X 42" STEEL PILES EST. 45'-0"
LG. & DRIVEN TO A MIN. BRG. VALUE OF 55 TONS/PIE.
PIER TO BE SUPPORTED ON HP 10" X 42"
STEEL PILES EST. 40'-0" LG. & DRIVEN TO A MIN.
BRG. VALUE OF 55 TONS PER PILE.

TOTAL ESTIMATED QUANTITIES

BID ITEMS	UNIT	SUPER	SO. ABUT.	PIER	NO. ABUT.	TOTAL
EXCAVATION FOR STRUCTURES	C.Y.	190	80	190	460	
GRANULAR BACKFILL	C.Y.	285	285	285	570	
CONCRETE MASONRY	C.Y.	564.8	196.0	86.2	196.0	1043.0
BAR STEEL REINFORCEMENT	L.B.	159,000	12,980	29,200	12,980	205,160
STRUCTURAL CARBON STEEL	L.B.	420,710	—	—	—	420,710
STRUCTURAL LOW-ALLOY STEEL	L.B.	92,520	—	—	—	92,520
LUBRICATED BRONZE PLATES	L.B.	313	—	—	—	313
BEARING PADS	S.F.	52	—	—	—	52
NEOPRENE PRE-MOLDED SEAL	L.F.	162	—	—	—	162
STEEL PILING, DELIVERED & DRIVEN HP 10 INCH X 42 POUND	L.F.	—	1,125	1,440	1,125	3,690
TUBULAR RAILING, TYPE "J"	L.F.	557	—	—	—	557
SLOPE PAVING (CRUSHED AGGR.)	S.Y.	—	230	—	260	490
NON-BID ITEMS						
ALUMINUM OR ZINC PLATE	S.F.	100	—	—	—	100
POLYVINYL CHLORIDE WATERSTOP	L.F.	—	85	—	85	170

TRAFFIC VOLUME

U-S-H "53" U-S-H "8"
A.D.T. 5,200 R.D.T. 6070
R.D.S. 80 M.P.H. D.H.V. 1,320
D.H.V. 1,180

LIST OF DRAWINGS

1. GENERAL PLAN X 47261
2. GENERAL PLAN X 47262
3. SUBSURFACE EXPLORATION X 47263
4. SOUTH ABUTMENT X 47264
5. SOUTH ABUTMENT DETAILS X 47265
6. SOUTH ABUTMENT DETAILS X 47266
7. NORTH ABUTMENT X 47267
8. NORTH ABUTMENT DETAILS X 47268
9. NORTH ABUTMENT DETAILS X 47269
10. PIER X 47270
11. PIER DETAILS X 47271
12. SUPERSTRUCTURE X 47272
13. FRAMING PLAN X 47273
14. GIRDER ELEVATIONS X 47274
15. SUPERSTRUCTURE X 47275
16. SUPERSTRUCTURE X 47276
17. BEARING DETAILS X 47277
18. NEOPRENE SEAL EXPANSION JOINT X 47278
19. SLOPED FACE PARAPET "A" X 47279
20. TUBULAR RAILING TYPE "J" X 47280

No.	Date	Revision	By
STATE OF WISCONSIN DEPARTMENT OF TRANSPORTATION DIVISION OF HIGHWAYS			
STRUCTURE B-3-38			
Const. Spec.	19 69	Drawn By	TLA
Plans Checked		KOK	
GENERAL PLAN		SHEET 2 OF 20	
		X 47262	

ABBREVIATIONS
 F — Fine M — Medium C — Coarse
 Ws — Weathered So — Sound

MATERIAL SYMBOLS

Topsoil	Silt	Sandstone
Sand	Peat	Limestone
Gravel	Clay	Igneous Rock

LEGEND OF PROBING

95/6=95 Blows for 6" Penetration
 Probing taken with a 350# wt. Falling 18" on a 2" O. D. Point.

Probing No. Sta. Elevation
 7 Average Blows Per Foot
 Refusal 95.6

LEGEND OF BORING

Unconfined Strength 7.7
 Blows Per Ft. Using 140# Wt. Falling 30"
 Wash Sample
 Shelby Tube S. T.
 Ground Water Elevation
 No Ground Water Observed Above This Elevation


Boring No. Sta. Elev.
 Sandy Gravel
 F.
 Boulders or Cobbles
 Sand
 Silty Clay
 So
 Limestone


Unless otherwise specified, the blows per foot at the locations indicated are based on driving a 2" O. D. x 1.4" I. D. split spoon sampler with a 140# hammer having a free fall of 30". The blow count is taken in undisturbed soil immediately below a cased or open hole eliminating side friction on the drive pipe.

SUBSURFACE EXPLORATION FOR FOUNDATION DESIGN AND BIDDERS INFORMATION

To obtain relative data concerning the character of material in and upon which the foundation might be built, borings and/or soundings were made at points approximately as indicated on this drawing. The data presented herein represents the findings of the subsurface explorations made. However, because the depths investigated are limited and the area of the borings and/or soundings is very small in relation to the entire area, the Division of Highways does not warrant conditions below the depths investigated or that the classification of material encountered in these investigations is necessarily typical of the entire site.

No.	Date	Revision	By
STATE OF WISCONSIN DEPARTMENT OF TRANSPORTATION DIVISION OF HIGHWAYS			
STRUCTURE B-3-38			
Const. Spec.	1 9 6 9	Drawn By	TLA
Plans Checked	KOK		
SUBSURFACE EXPLORATION			SHEET 3 OF 20
			X47263

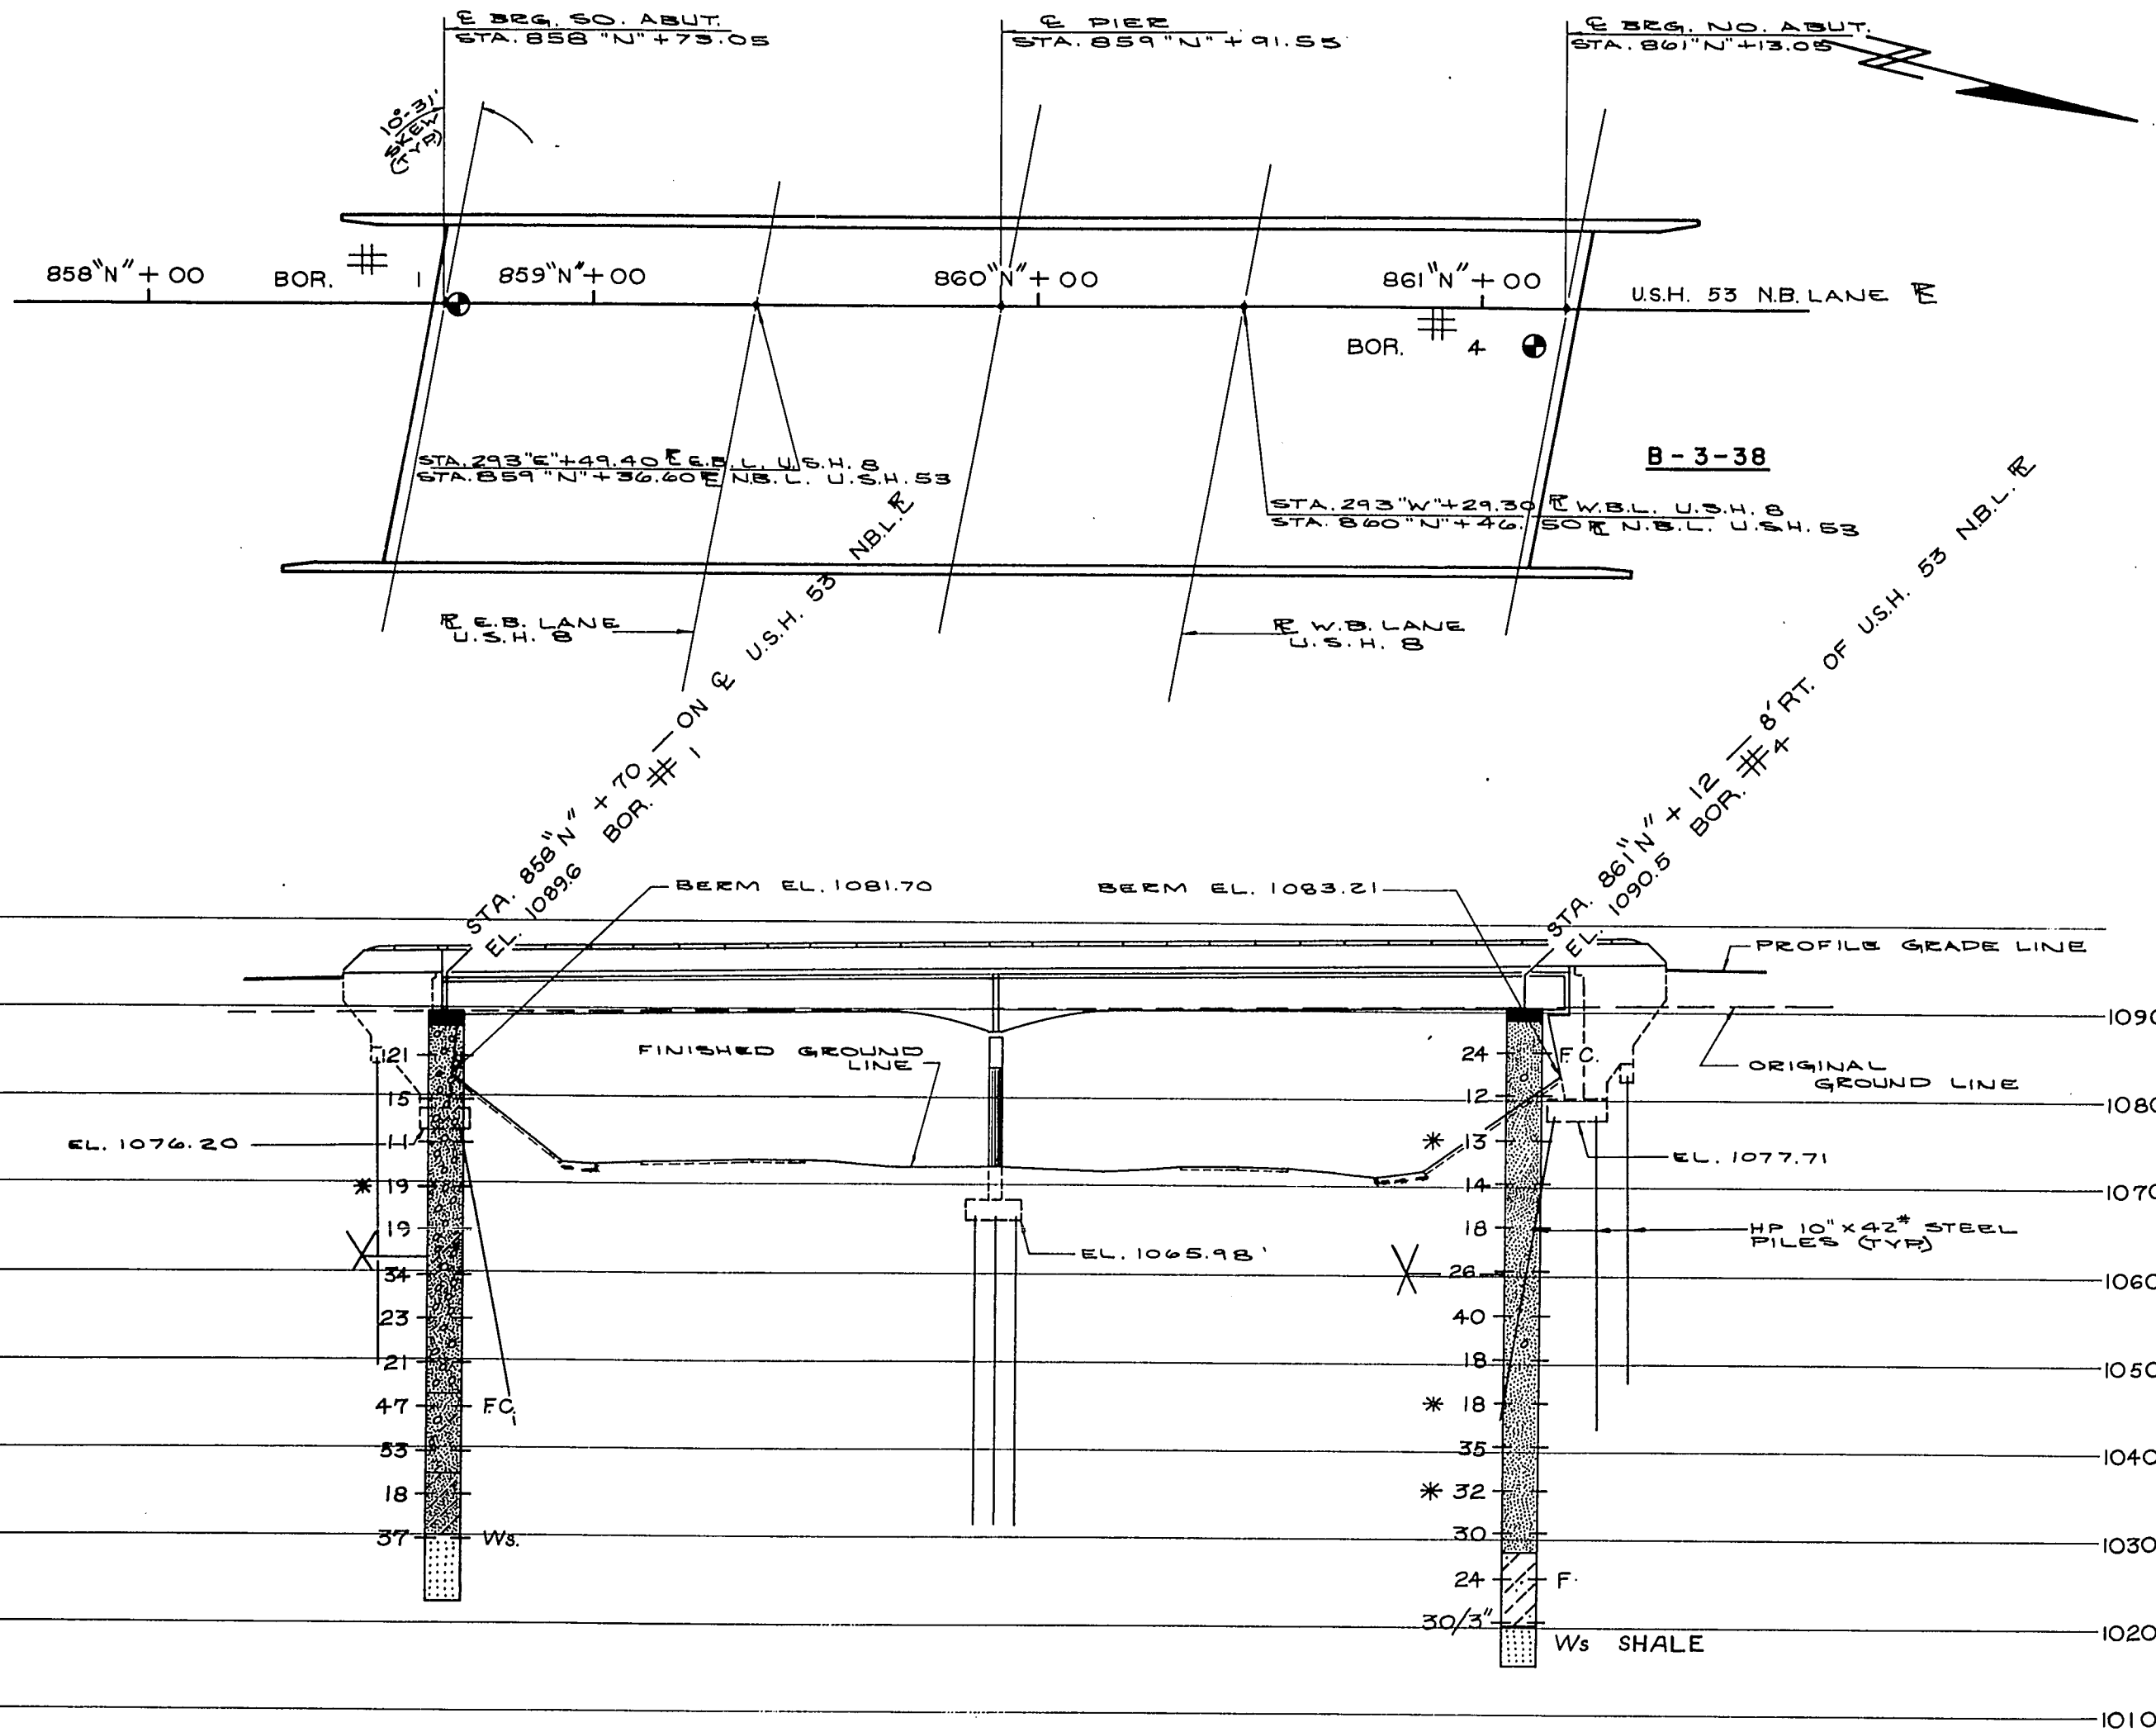







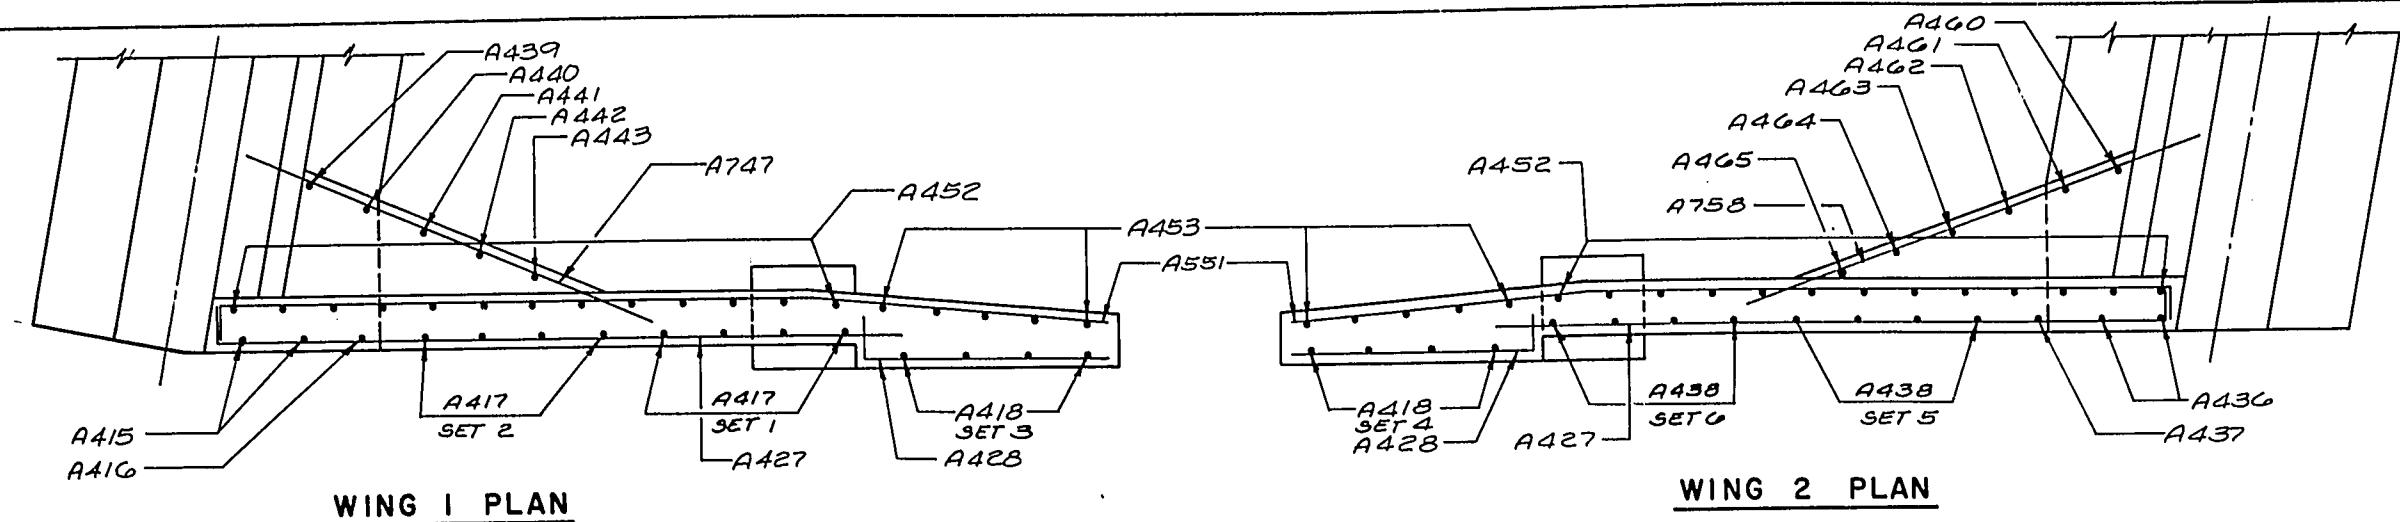


* CONST. JOINT - POUR CONC ABOVE THIS JOINT AFTER SUPER. CONC. IS IN PLACE STRIKE OFF & LEAVE ROUGH.



** OPTIONAL KEYED CONST. JOINT FORMED BY SURFACED BEVELED 2" X 6".

● CONST. JOINT FORMED BY SURFACED, BEVELED 2" X 6".

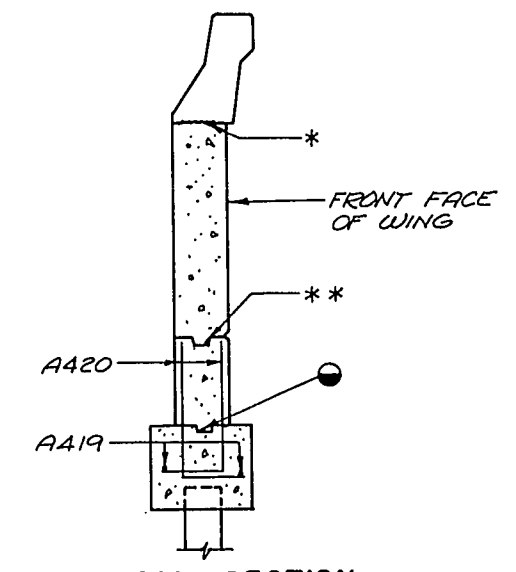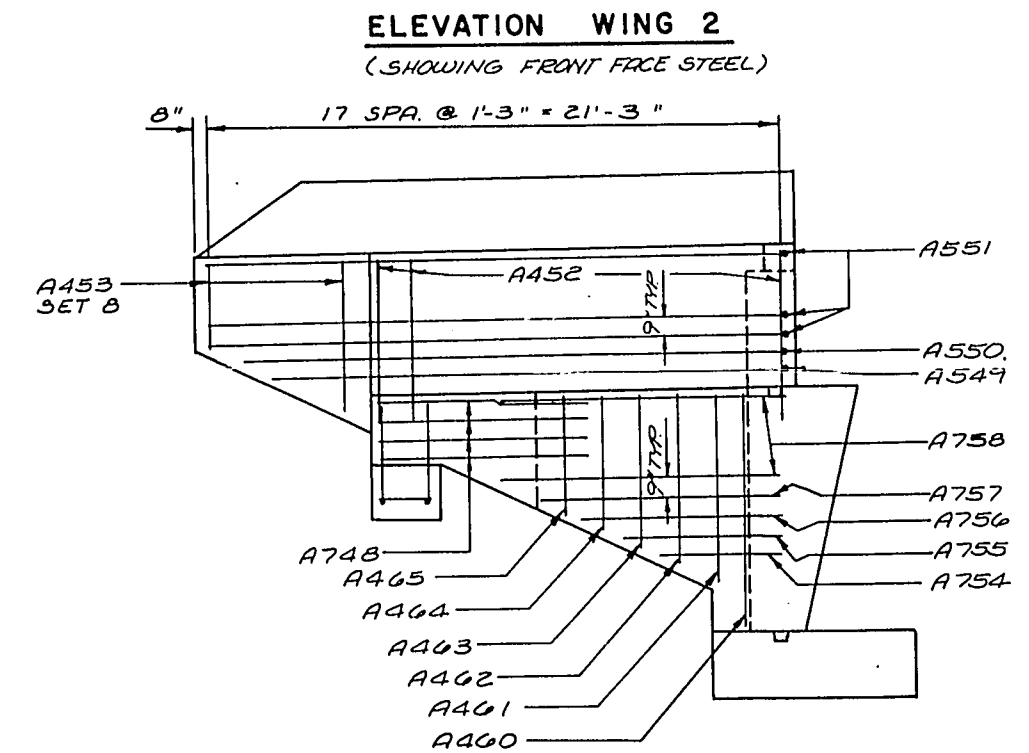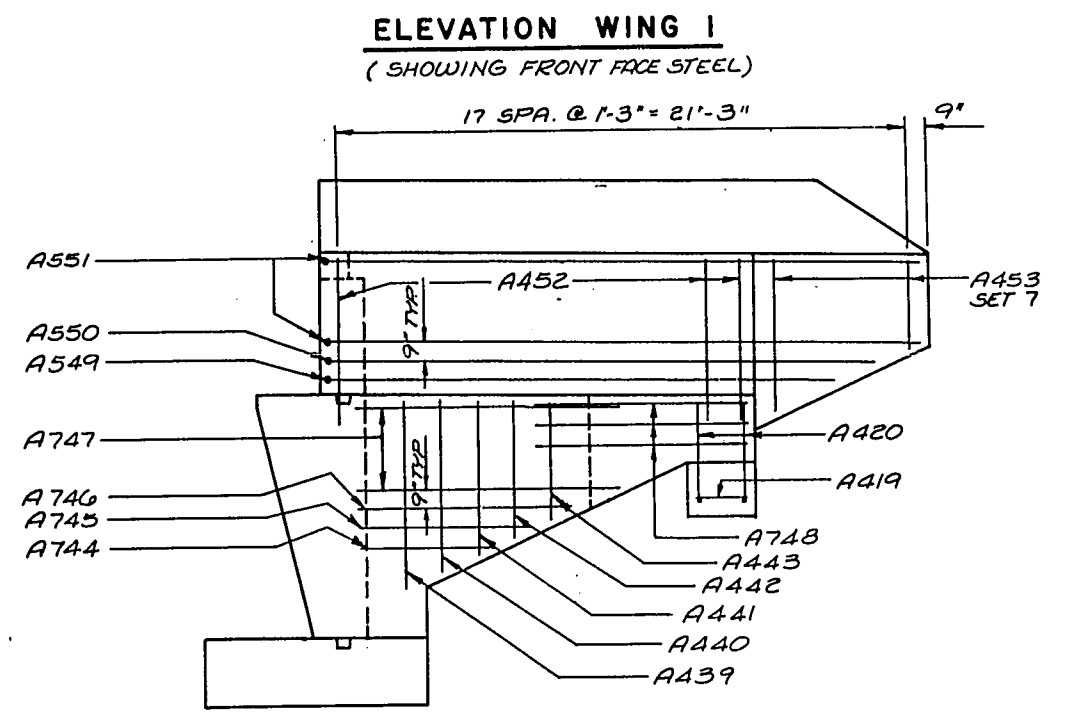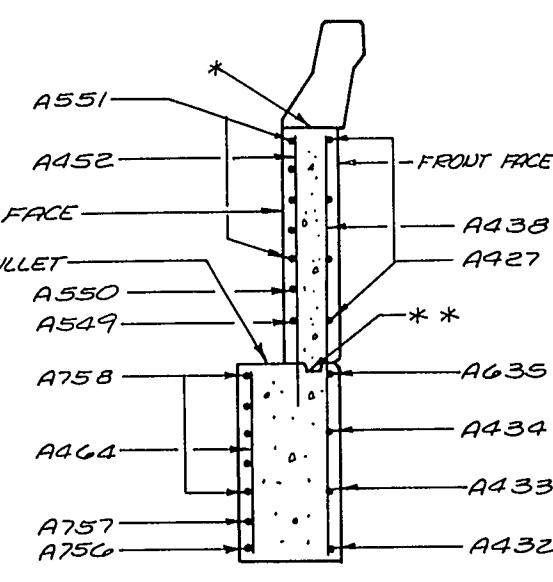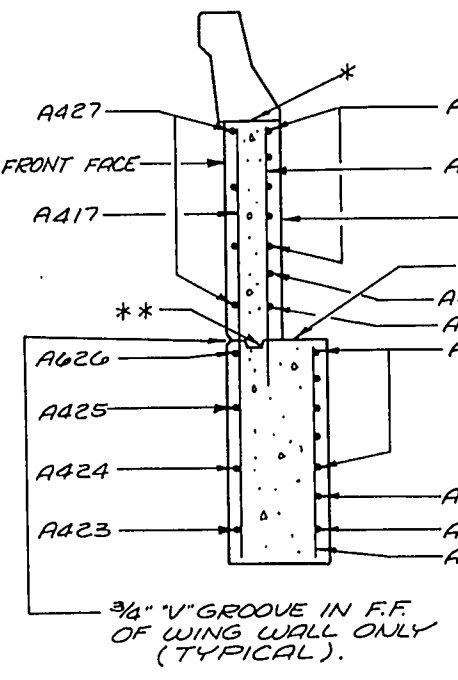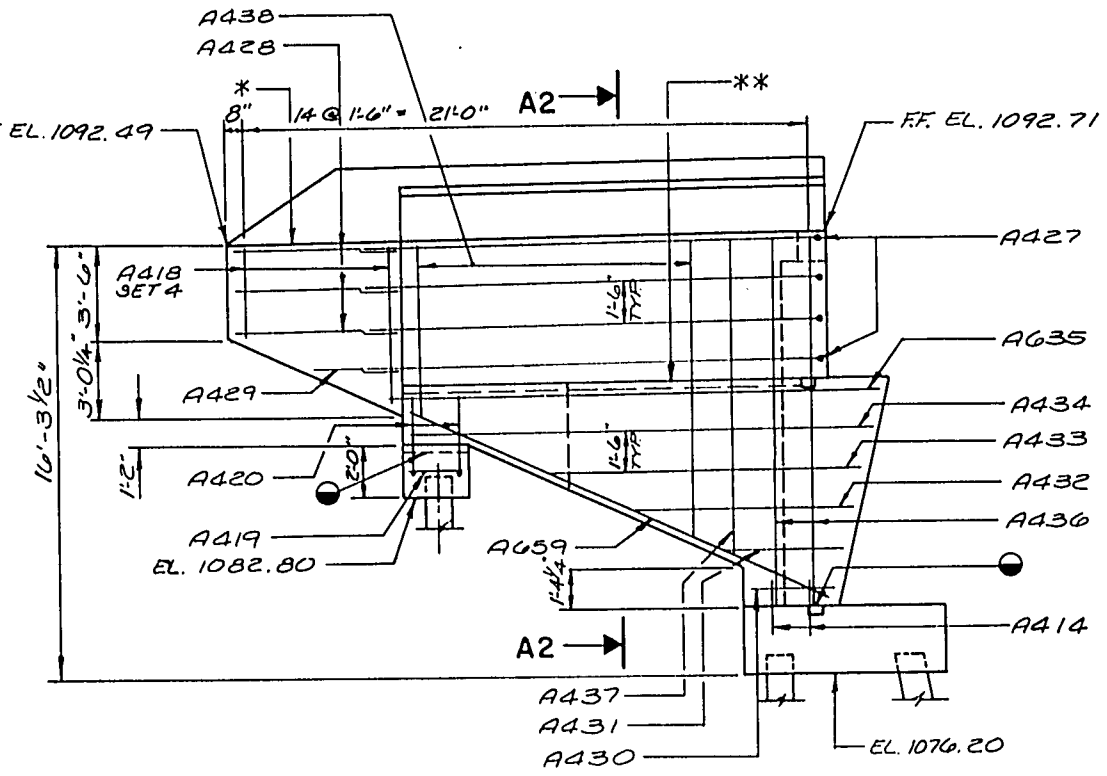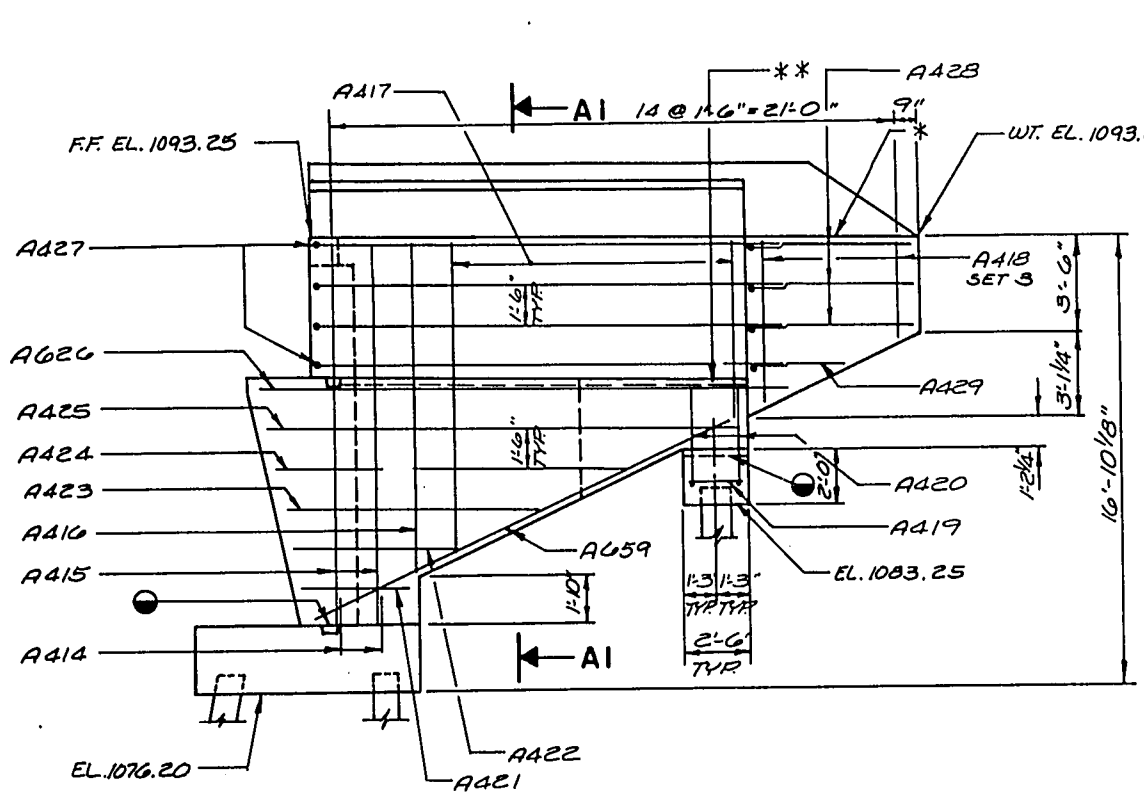NOTE: FOR BAIL PARAPET BARS & DETAILS SEE SHEET 19.



No.	Date	Revision	By
STATE OF WISCONSIN DEPARTMENT OF TRANSPORTATION DIVISION OF HIGHWAYS			
STRUCTURE B-3-38			
Const. Spec.	1969	Drawn By A. G.	Plans Checked KOK
SOUTH ABUTMENT DETAILS			SHEET 5 OF 20
			X 47265

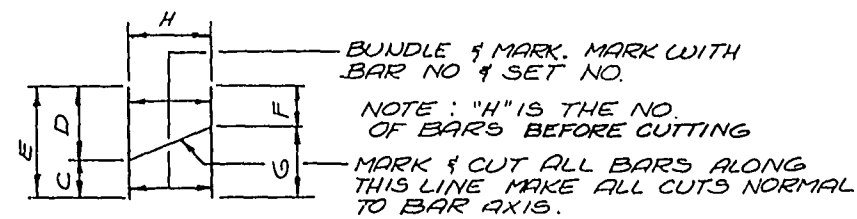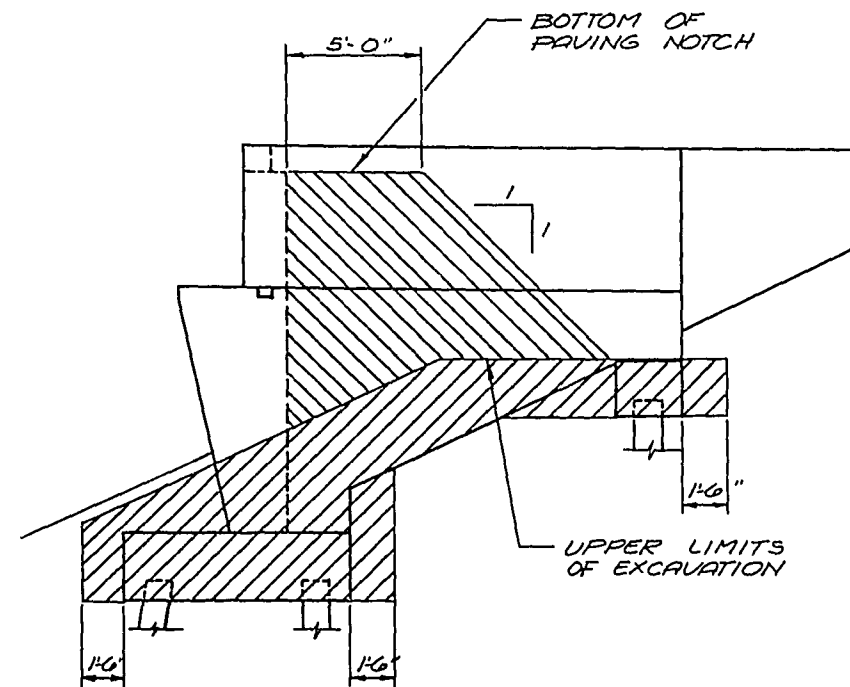


CUTTING DIAGRAM

MARK	C	D	E	F	G	H	REQ'D
A417	SET 1	6'-3"	17'-8"	9'-3"	8'-5"	4	1 SET 1
	SET 2	11'-5"	9'-3"	5'-7"	4	1 SET 2	
A418	SET 3	3'-4"	8'-11"	3'-4"	1 SET 3		
	SET 4	5'-7"	3'-4"	1 SET 4			
A438	SET 5	9'-0"	17'-4"	11'-2"	4	1 SET 5	
	SET 6	8'-4"	6'-2"	1 SET 6			
A453	SET 7	3'-4"	9'-1"	5'-9"	5	1 SET 7	
	SET 8	5'-9"	3'-4"	1 SET 8			

NOTE: ALL EXCAVATED VOLUME NOT OCCUPIED BY THE ABUTMENT SHALL BE BACKFILLED WITH GRANULAR BACKFILL.

- EXCAVATION FOR STRUCTURES AND GRANULAR BACKFILL.
- GRANULAR BACKFILL BETWEEN INSIDE FACES OF WINGWALLS. THIS MATERIAL SHALL BE PLACED BEFORE SUPERSTRUCTURE CONC. IS POURED.

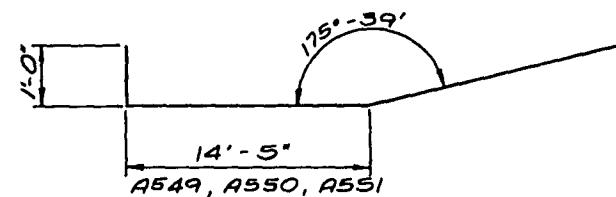
PAY LIMITS FOR EXCAVATION FOR STRUCTURES & GRANULAR BACKFILL




1'-2 1/2"	A703, A704
10 1/2"	A506
1'-6"	A420
1'-0"	A427, A428, A429

5'-6 1/2"	5/2	5/10
2'-1"	9"	1'-4"

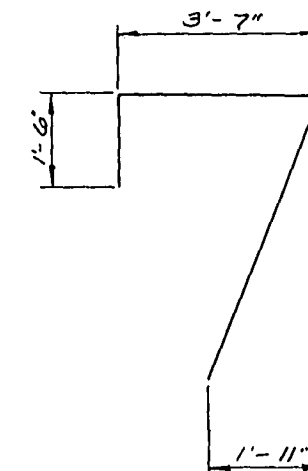A512, A510



A507

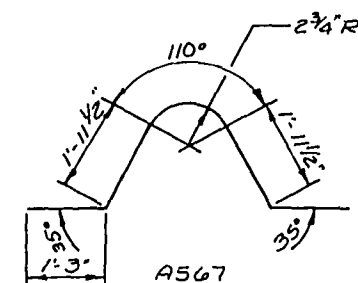


BILL OF BARS

MARK	NO. REQ'D	LENGTH	BENT	CUT. DIAG.	LOCATION
A801	121	7'-8"			FOOTING TRANS.
A402	18	27'-4"			" LONGIT.
A703	72	4'-6"	X		" DOWEL
A704	72	7'-3"	X		" " "
A705	72	8'-4"			BODY VERT. B.F.
A506	81	3'-9"	X		" " F.F.
A507	81	13'-6"	X		" " " "
A408	21	27'-4"			" LONGIT.
A809	12	37'-8"			" LONGIT.
A510	78	12'-2"	X		ABUTMENT BACK WALL VERT.
A411	24	27'-7"			" " LONGIT.
A512	78	4'-8"	X		" PAVING BLOCK
A413	20	7'-8"			" " " "
A414	4	2'-0"			FOOTING DOWELS
A415	2	14'-3"			WING 1 VERT. F.F.
A416	1	12'-3"			" " " "
A417	4	17'-8"		X	" " " "
A418	4	8'-11"		X	WING 1 & 2 " "
A419	4	2'-0"			" " " FOOTING
A420	8	5'-4"	X		" " " " "
A421	1	4'-0"			WING 1 HORIZ. F.F.
A422	1	6'-3"			" " " " "
A423	1	9'-7"			" " " " "
A424	1	13'-0"			" " " " "
A425	1	17'-5"			" " " " "
A426	1	19'-9"			" " " " "
A427	8	17'-9"	X		WING 1 & 2 HORIZ. " "
A428	6	7'-0"	X		" " " " "
A429	2	4'-3"	X		" " " " "
A430	1	3'-2"			" 2 HORIZ. " "
A431	1	5'-6"			" " " " "
A432	1	8'-9"			" " " " "
A433	1	12'-9"			" " " " "
A434	1	17'-3"			" " " " "
A435	1	19'-3"			" " " " "
A436	2	13'-10"			" " VERT. " "
A437	1	11'-11"			" " VERT. " "
A438	4	17'-4"	X		" " " " "
A439	1	8'-10"			WING 1 FILLET VERT.
A440	1	6'-10"			" " " " "
A441	1	6'-1"			" " " " "
A442	1	5'-5"			" " " " "
A443	1	4'-8"			" " " " "
A744	2	5'-0"			" " FILLET HORIZ.
A745	1	6'-9"			" " " " "
A746	1	8'-4"			" " " " "
A747	5	10'-10"			" " " " "
A748	7	7'-10"			" 1 & 2 B.F.


NOTE: FOR PILE SPLICE DETAIL SEE SHEET 11.

MARK	NO. REQ'D	LENGTH	BENT	CUT. DIAG.	LOCATION
A549	2	19'-8"	X		WING 1 & 2 B.F. HORIZ.
A550	2	21'-3"	X		" " " " "
A551	10	22'-10"	X		" " " " "
A452	26	6'-6"			" " " VERT.
A453	5	9'-1"	X		" " " " "
A754	1	5'-0"			WING 2 FILLET HORIZ.
A755	1	7'-0"			" " " " "
A756	1	8'-8"			" " " " "
A757	1	10'-5"			" " " " "
A758	5	12'-0"			" " " " "
A659	2	17'-0"			WING 1 & 2 F.F.
A460	1	8'-3"			WING 2 FILLET VERT.
A461	1	6'-10"			" " " " "
A462	1	6'-2"			" " " " "
A463	1	5'-6"			" " " " "
A464	1	4'-10"			" " " " "
A465	1	4'-2"			" " " " "
A566	2	2'-4"			MEDIAN PARAPET
A567	2	6'-10"	X		" " " "

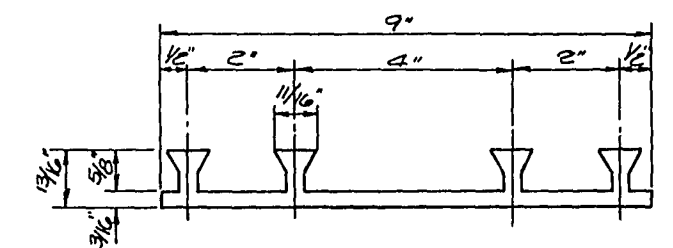NOTE: ALL BENDING DIMENSIONS ARE OUT TO OUT OF BAR.
THE FIRST DIGIT OF A THREE DIGIT BAR MARK SIGNIFIES THE BAR SIZE.
FOR BILL OF BARS FOR RAIL PARAPET SEE SHEET 19
FOR RAIL PARAPET DETAILS SEE SHEET 19



POLYVINYL CHLORIDE WATERSTOP DETAILS

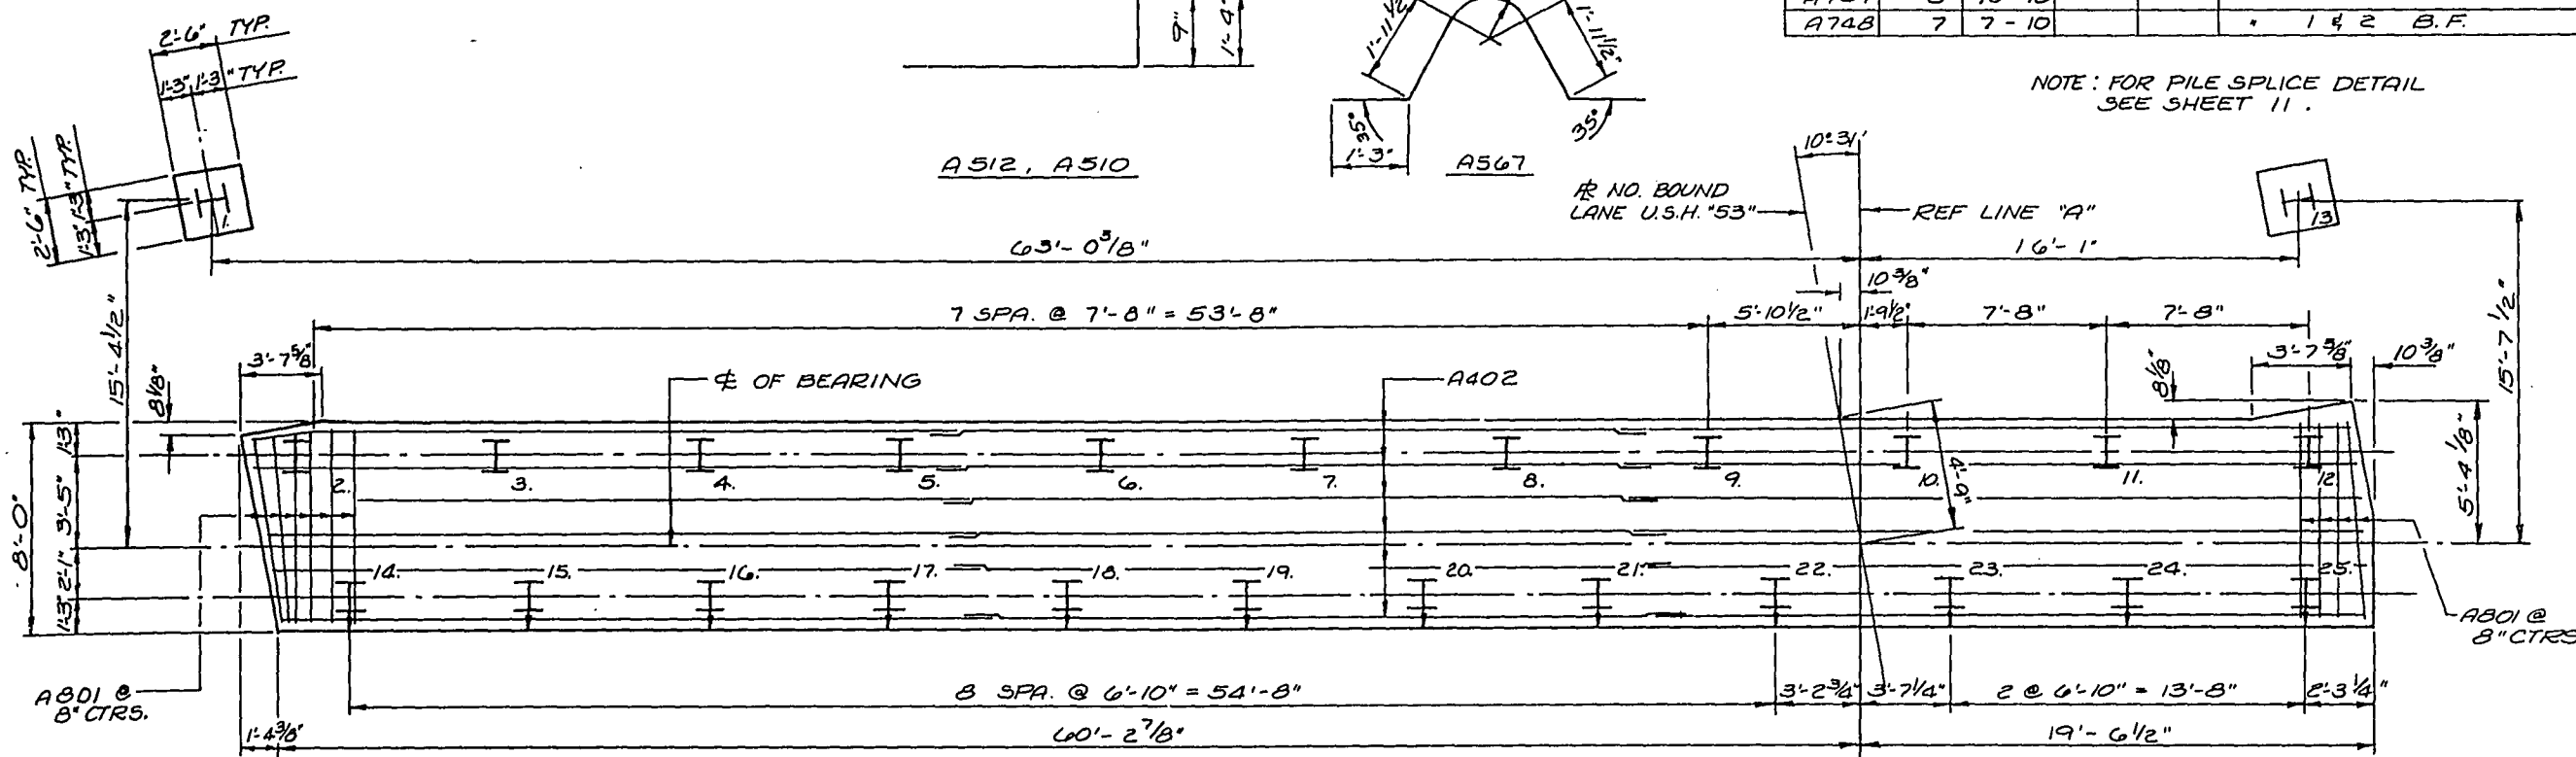

↑ DENOTES DIRECTION OF BATTERED PILING BATTER 3'/FT. IN DIRECTION SHOWN.

No.	Date	Revision	By
STATE OF WISCONSIN DEPARTMENT OF TRANSPORTATION DIVISION OF HIGHWAYS			
STRUCTURE B-3-38			
Const. Spec.	1989	Drawn By A. G.	Plans Checked KOK
SOUTH ABUTMENT DETAILS			SHEET 6 OF 20
			X 47266

* ELEVATIONS GIVEN AT
OF BEARING

* EL. 1089.26

* EL. 1089.34

* EL. 1089.39

* EL. 1089.29

* EL. 1089.17

* EL. 1089.10

* EL. 1089.00

* EL. 1088.90

* EL. 1088.80

WT. EL. 1094.79

FF. EL. 1094.72

CONST. JOINT

A566

A567

B411

B510
@ 10" CTRS

B512
@ 10" CTRS


B413

WT. EL. 1094.34

FF. EL. 1094.27

FOUR CONC. ABOVE
THIS JOINT AFTER
SUPER CONC. IS IN PLACE
STRIKE OFF AND LEAVE
ROUGH.

PROJECT ID	1197-6-72	SHEET NUMBER	45	TOTAL SHEETS	225
FEDERAL PROJECT DESIGNATION	DPF 08-4 (41)				

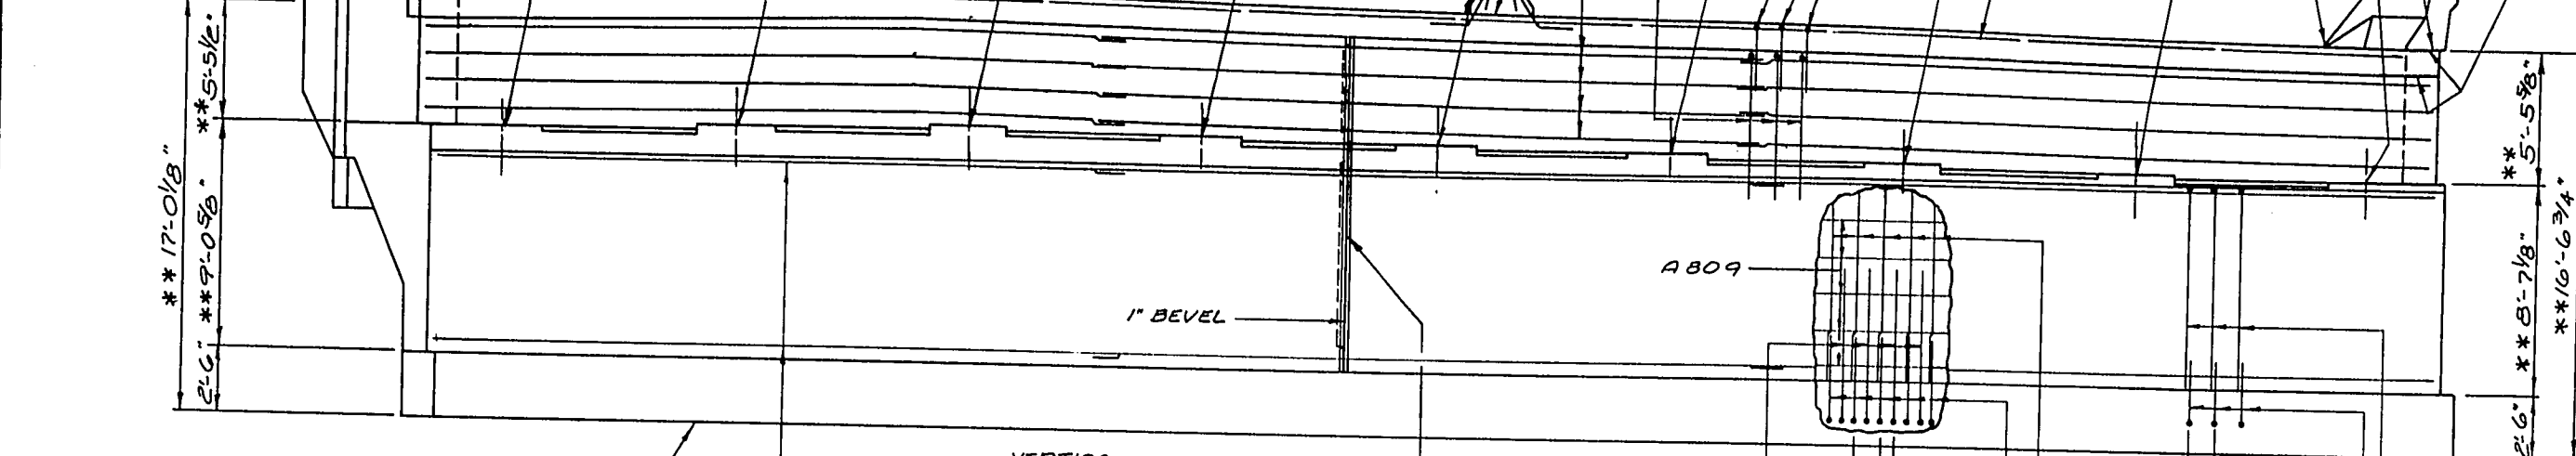


** DIMENSIONS ARE GIVEN
@ FF. OF ABUT. BACKWALL.

EL. 1077.71


NOTE: PLACE B703, B704, B809
B705 BARS BETWEEN
FILLET'S ONLY.

ELEVATION
(LOOKING NORTH)

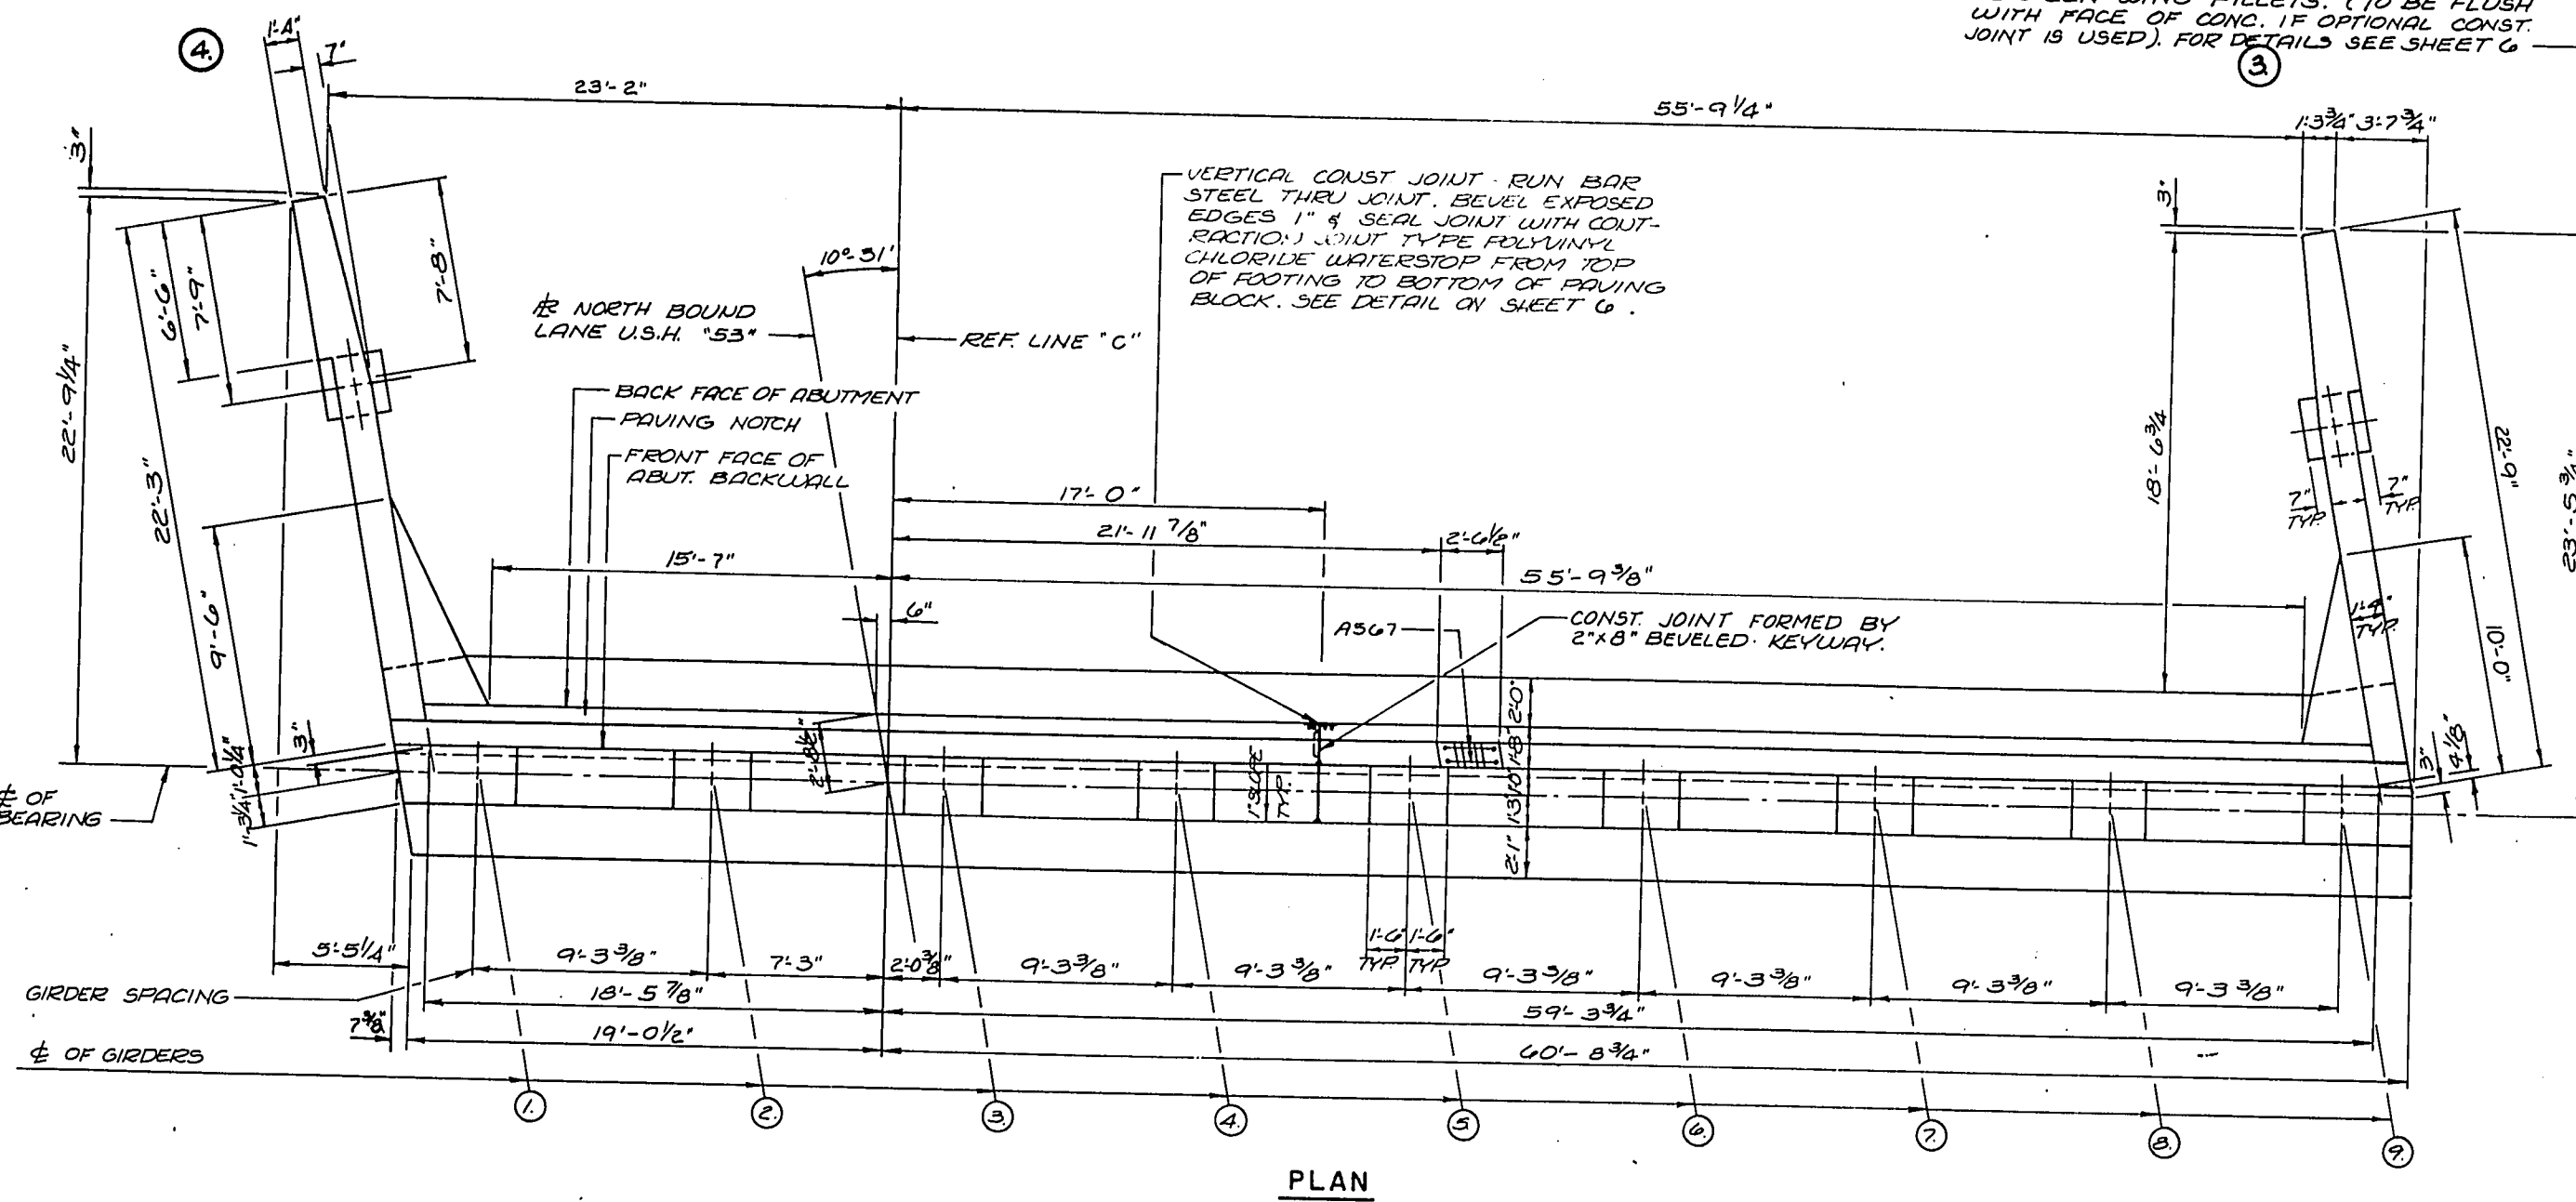POLYVINYL CHLORIDE WATERSTOP - TO EXTEND
BETWEEN WING FILLET'S. (TO BE FLUSH
WITH FACE OF CONC. IF OPTIONAL CONST.
JOINT IS USED). FOR DETAILS SEE SHEET 6





PLAN

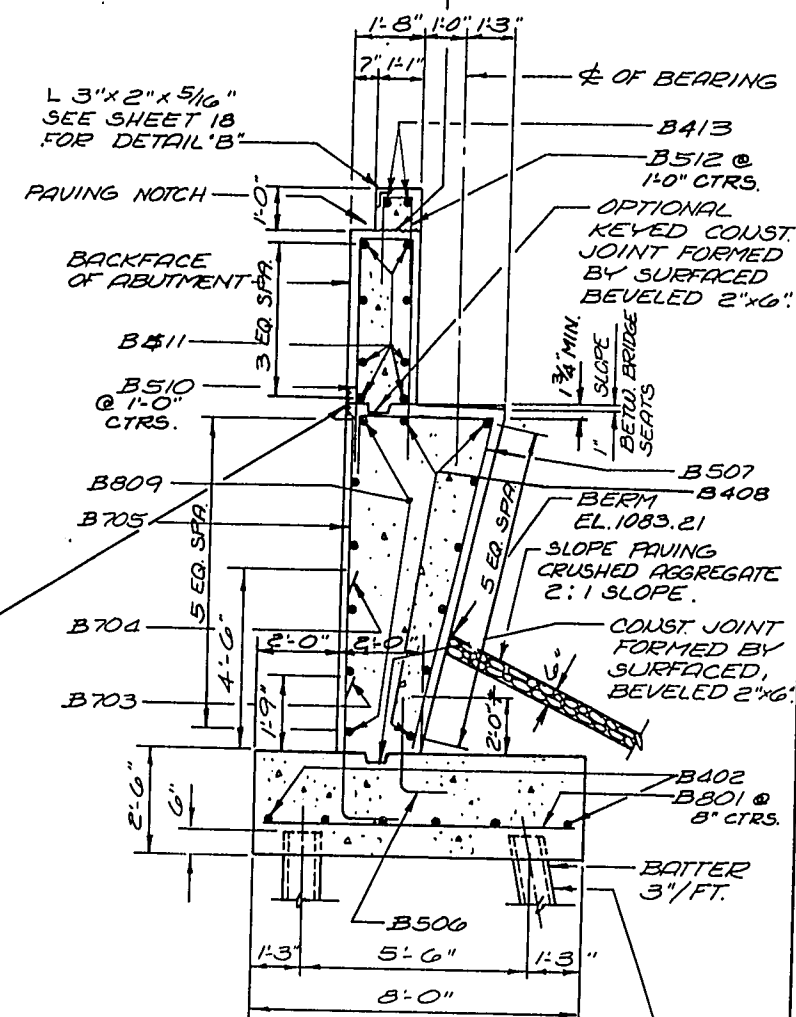



SECTION THRU BODY

* 1'-3" MIN. LAP B507 TO BE A MIN.
OF 2" CL. FROM TOP OF BRIDGE SEAT.

No.	Date	Revision	By
STATE OF WISCONSIN DEPARTMENT OF TRANSPORTATION DIVISION OF HIGHWAYS			
STRUCTURE B - 3 - 38			
Const. Spec.	1969	Drawn By	A. G.
		Plans Checked	KOK
NORTH ABUTMENT			SHEET 7 OF 20
			X 47267

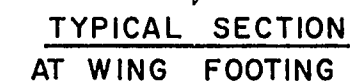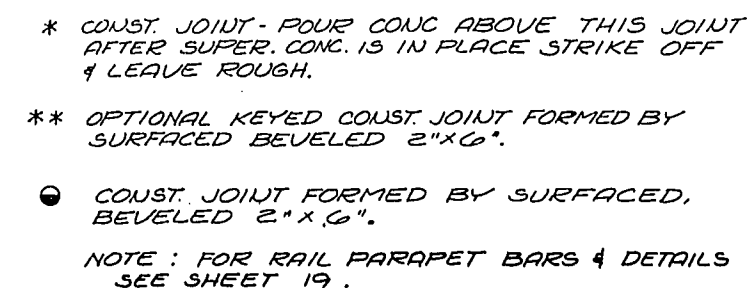

No.	Date	Revision	By
STATE OF WISCONSIN DEPARTMENT OF TRANSPORTATION DIVISION OF HIGHWAYS			
STRUCTURE B - 3 + 38			
Const. Spec.	1969	Drawn By A. G.	Plans Checked KOK
NORTH ABUTMENT		SHEET 8 OF 20	
DETAILS		X 47268	

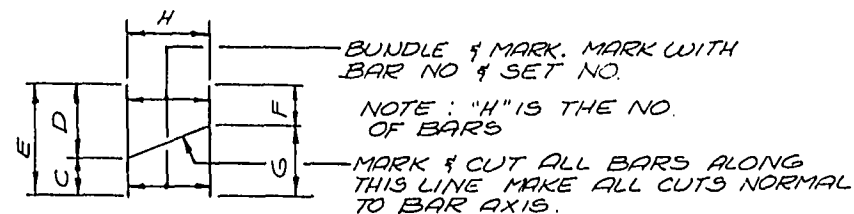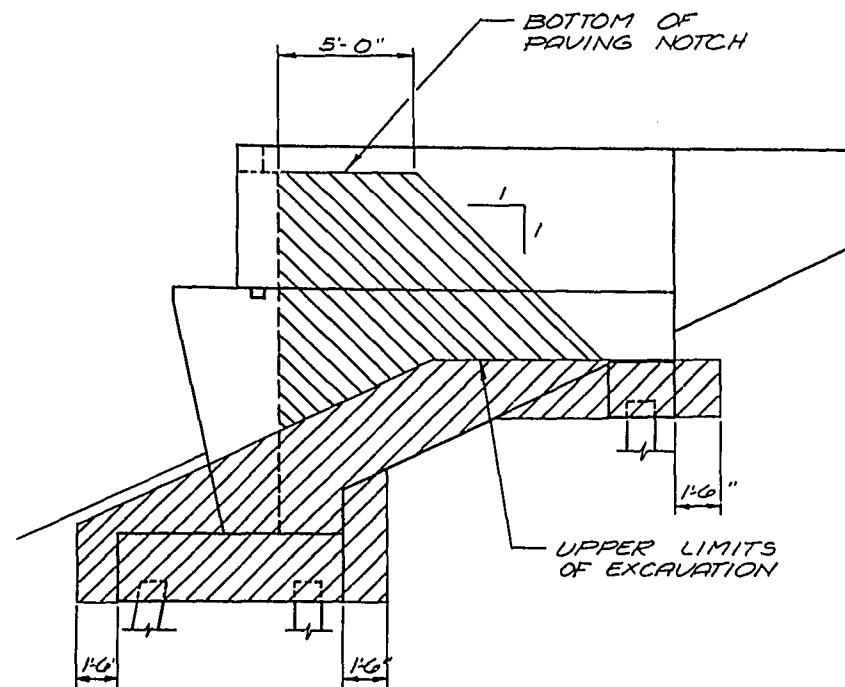

CUTTING DIAGRAM


MARK	C	D	E	F	G	H	REQ'D
B417 SET 1	6'-2"		17'-3"		8'-3"	4	1 SET 1
B417 SET 2		11'-1"		9'-0"			1 SET 2
B418 SET 3	3'-4"		8'-10"		5'-6"	4	1 SET 3
B418 SET 4		5'-6"		3'-4"			1 SET 4
B438 SET 5	9'-4"		17'-11"		11'-7"	4	1 SET 5
B438 SET 6		8'-7"		6'-4"			1 SET 6
B453 SET 7	3'-4"		9'-1"		5'-9"	5	1 SET 7
B453 SET 8		5'-9"		3'-4"			1 SET 8

NOTE: ALL EXCAVATED VOLUME NOT OCCUPIED BY THE ABUTMENT SHALL BE BACKFILLED WITH GRANULAR BACKFILL.


EXCAVATION FOR STRUCTURES AND GRANULAR BACKFILL.

GRANULAR BACKFILL BETWEEN INSIDE FACES OF WINGWALLS. THIS MATERIAL SHALL BE PLACED BEFORE SUPERSTRUCTURE CONC. IS POURED.

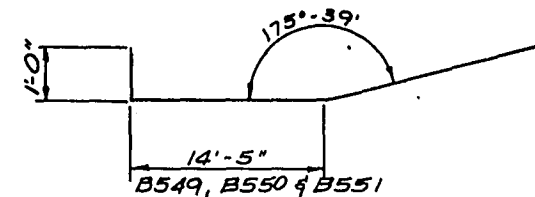
PAY LIMITS FOR EXCAVATION FOR STRUCTURES & GRANULAR BACKFILL



1'-2 1/2"	B703, B704
10 1/2"	B506
1'-6"	B420
1'-0"	B427, B428 & B429

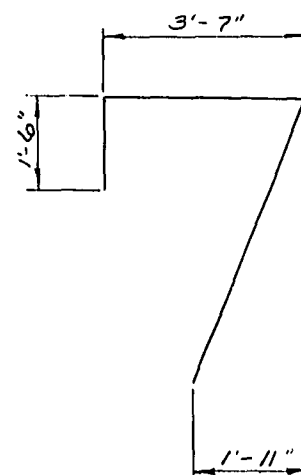

5'-6 1/2"	5/12	5/10
2'-1"	9"	1'-4"

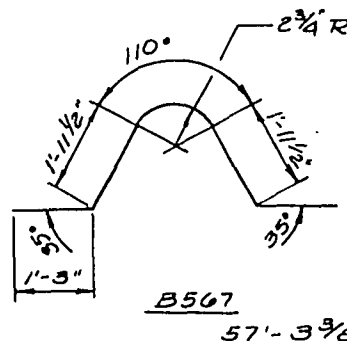


BILL OF BARS

MARK	NO. REQ'D	LENGTH	BENT	CUT. DIAG.	LOCATION
B801	121	7'-8"			FOOTING TRANS.
B402	18	27'-4"			" LONGIT.
B703	72	4'-6"	X		" DWEL
B704	72	7'-3"	X		" "
B705	72	8'-4"			BODY VERT. B.F.
B506	81	3'-9"	X		" " F.F.
B507	81	13'-6"	X		" " "
B408	21	27'-4"			" LONGIT.
B809	12	37'-8"			" LONGIT.
B510	78	12'-2"	X		ABUTMENT BACK WALL VERT.
B411	24	27'-7"			" " LONGIT.
B512	78	4'-8"	X		" PAVING BLOCK
B413	20	7'-8"			" " "
B414	4	2'-0"			FOOTING DOWELS
B415	2	13'-10"			WING 3 VERT. F.F.
B416	1	11'-10"			" " " "
B417	4	17'-3"		X	" 3 1/4 " "
B418	4	8'-10"		X	WING " 1/4 " "
B419	4	2'-0"			" " " FOOTING
B420	8	5'-4"	X		" " " "
B421	1	4'-6"			WING 3 HORIZ. F.F.
B422	1	5'-4"			" " " "
B423	1	8'-9"			" " " "
B424	1	12'-4"			" " " "
B425	1	17'-9"			" " " "
B426	1	18'-1"			" " " "
B427	8	17'-9"	X		WING 3 1/4 HORIZ. "
B428	6	7'-0"	X		" " " "
B429	2	4'-0"	X		" " " "
B430	1	3'-2"			" 4 HORIZ. "
B431	1	5'-9"			" " " "
B432	1	9'-2"			" " " "
B433	1	12'-6"			" " " "
B434	1	17'-2"			" " " "
B435	1	17'-5"			" " " "
B436	2	14'-4"			" " VERT. "
B437	1	12'-4"			" " VERT. "
B438	4	17'-11"		X	" " " "
B439	1	4'-8"			WING 3 FILLET VERT.
B440	1	6'-0"			" " " "
B441	1	5'-4"			" " " "
B442	1	4'-8"			" " " "
B443	1	4'-0"			" " " "
B744	1	5'-0"			" " FILLET HORIZ.
B745	1	6'-11"			" " " "
B746	1	8'-6"			" " " "
B747	6	10'-10"			" " " "
B748	7	7'-10"			" 3 1/4 B.F.

NOTE: ALL BENDING DIMENSIONS ARE OUT TO OUT OF BAR. THE FIRST DIGIT OF A THREE DIGIT BAR MARK SIGNIFIES THE BAR SIZE. FOR BILL OF BARS FOR RAIL PARAPET SEE SHEET 19. FOR RAIL PARAPET DETAILS SEE SHEET 19.

PROJECT ID	1197-6-72	SHEET NUMBER	47	TOTAL SHEETS	225
FEDERAL PROJECT DESIGNATION	DPF08-4 (41)				


MARK	NO. REQ'D	LENGTH	BENT	CUT. DIAG.	LOCATION
B549	2	20'-0"	X		WING 3 1/4 B.F. HORIZ.
B550	2	21'-7"	X		" " " "
B551	10	22'-10"	X		" " " "
B452	26	6'-6"			" " " VERT.
B453	5	9'-1"		X	" " " "
B754	1	5'-0"			WING 4 FILLET HORIZ.
B755	1	6'-7"			" " " "
B756	1	8'-5"			" " " "
B757	1	10'-3"			" " " "
B758	5	12'-0"			" " " "
B659	2	17'-0"			WING 3 1/4 F.F.
B460	1	7'-9"			WING 4 FILLET VERT.
B461	1	7'-1"			" " " "
B462	1	6'-4"			" " " "
B463	1	5'-8"			" " " "
B464	1	5'-0"			" " " "
B465	1	4'-4"			" " " "
B566	2	2'-4"			MEDIAN PARAPET
B567	2	6'-10"	X		" " "

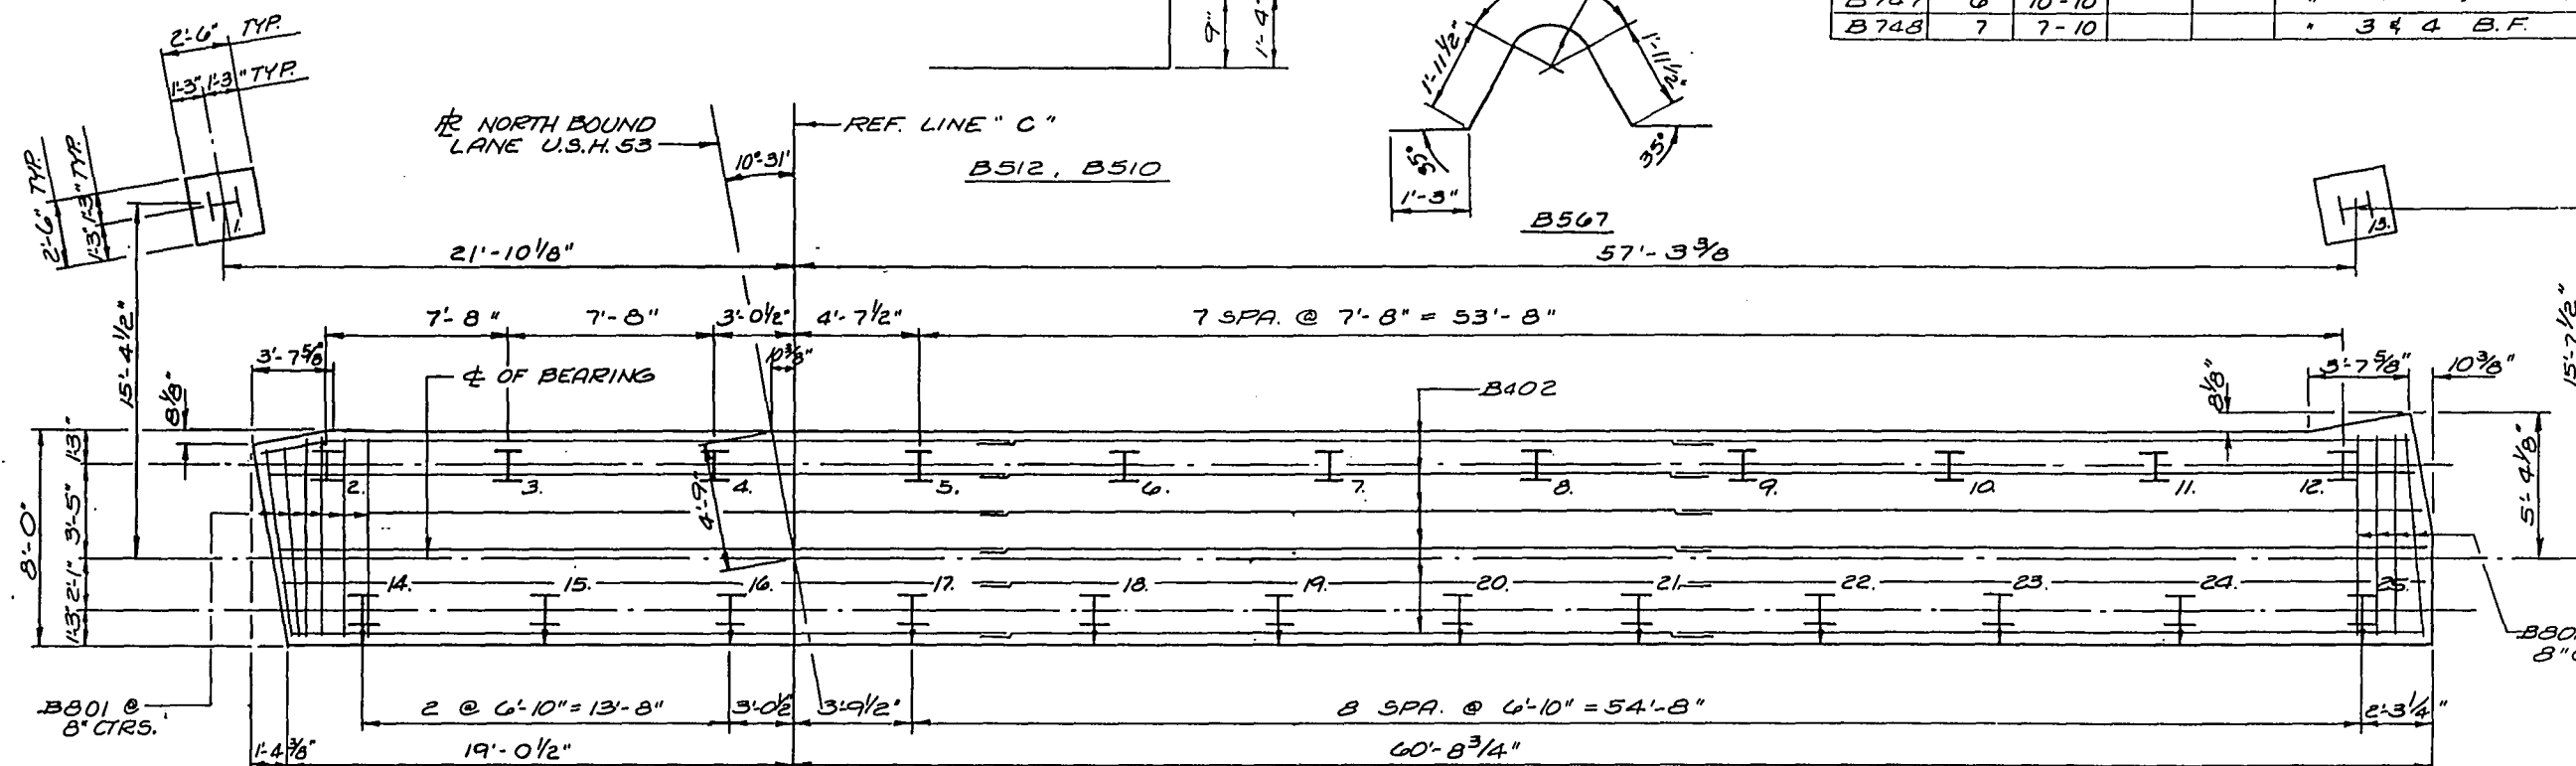

DEVOTES DIRECTION OF BATTERED PILING BATTER 3 1/2 FT. IN. DIRECTION SHOWN.

NOTE: FOR FILE SPLICE DETAIL SEE SHEET 11.



No.	Date	Revision	By
STATE OF WISCONSIN DEPARTMENT OF TRANSPORTATION DIVISION OF HIGHWAYS			
STRUCTURE B - 3 - 38			
Const. Spec.	1969	Drawn By	A. G.
		Plots Checked	KOK
NORTH ABUTMENT DETAILS			SHEET 9 OF 20 X 47269

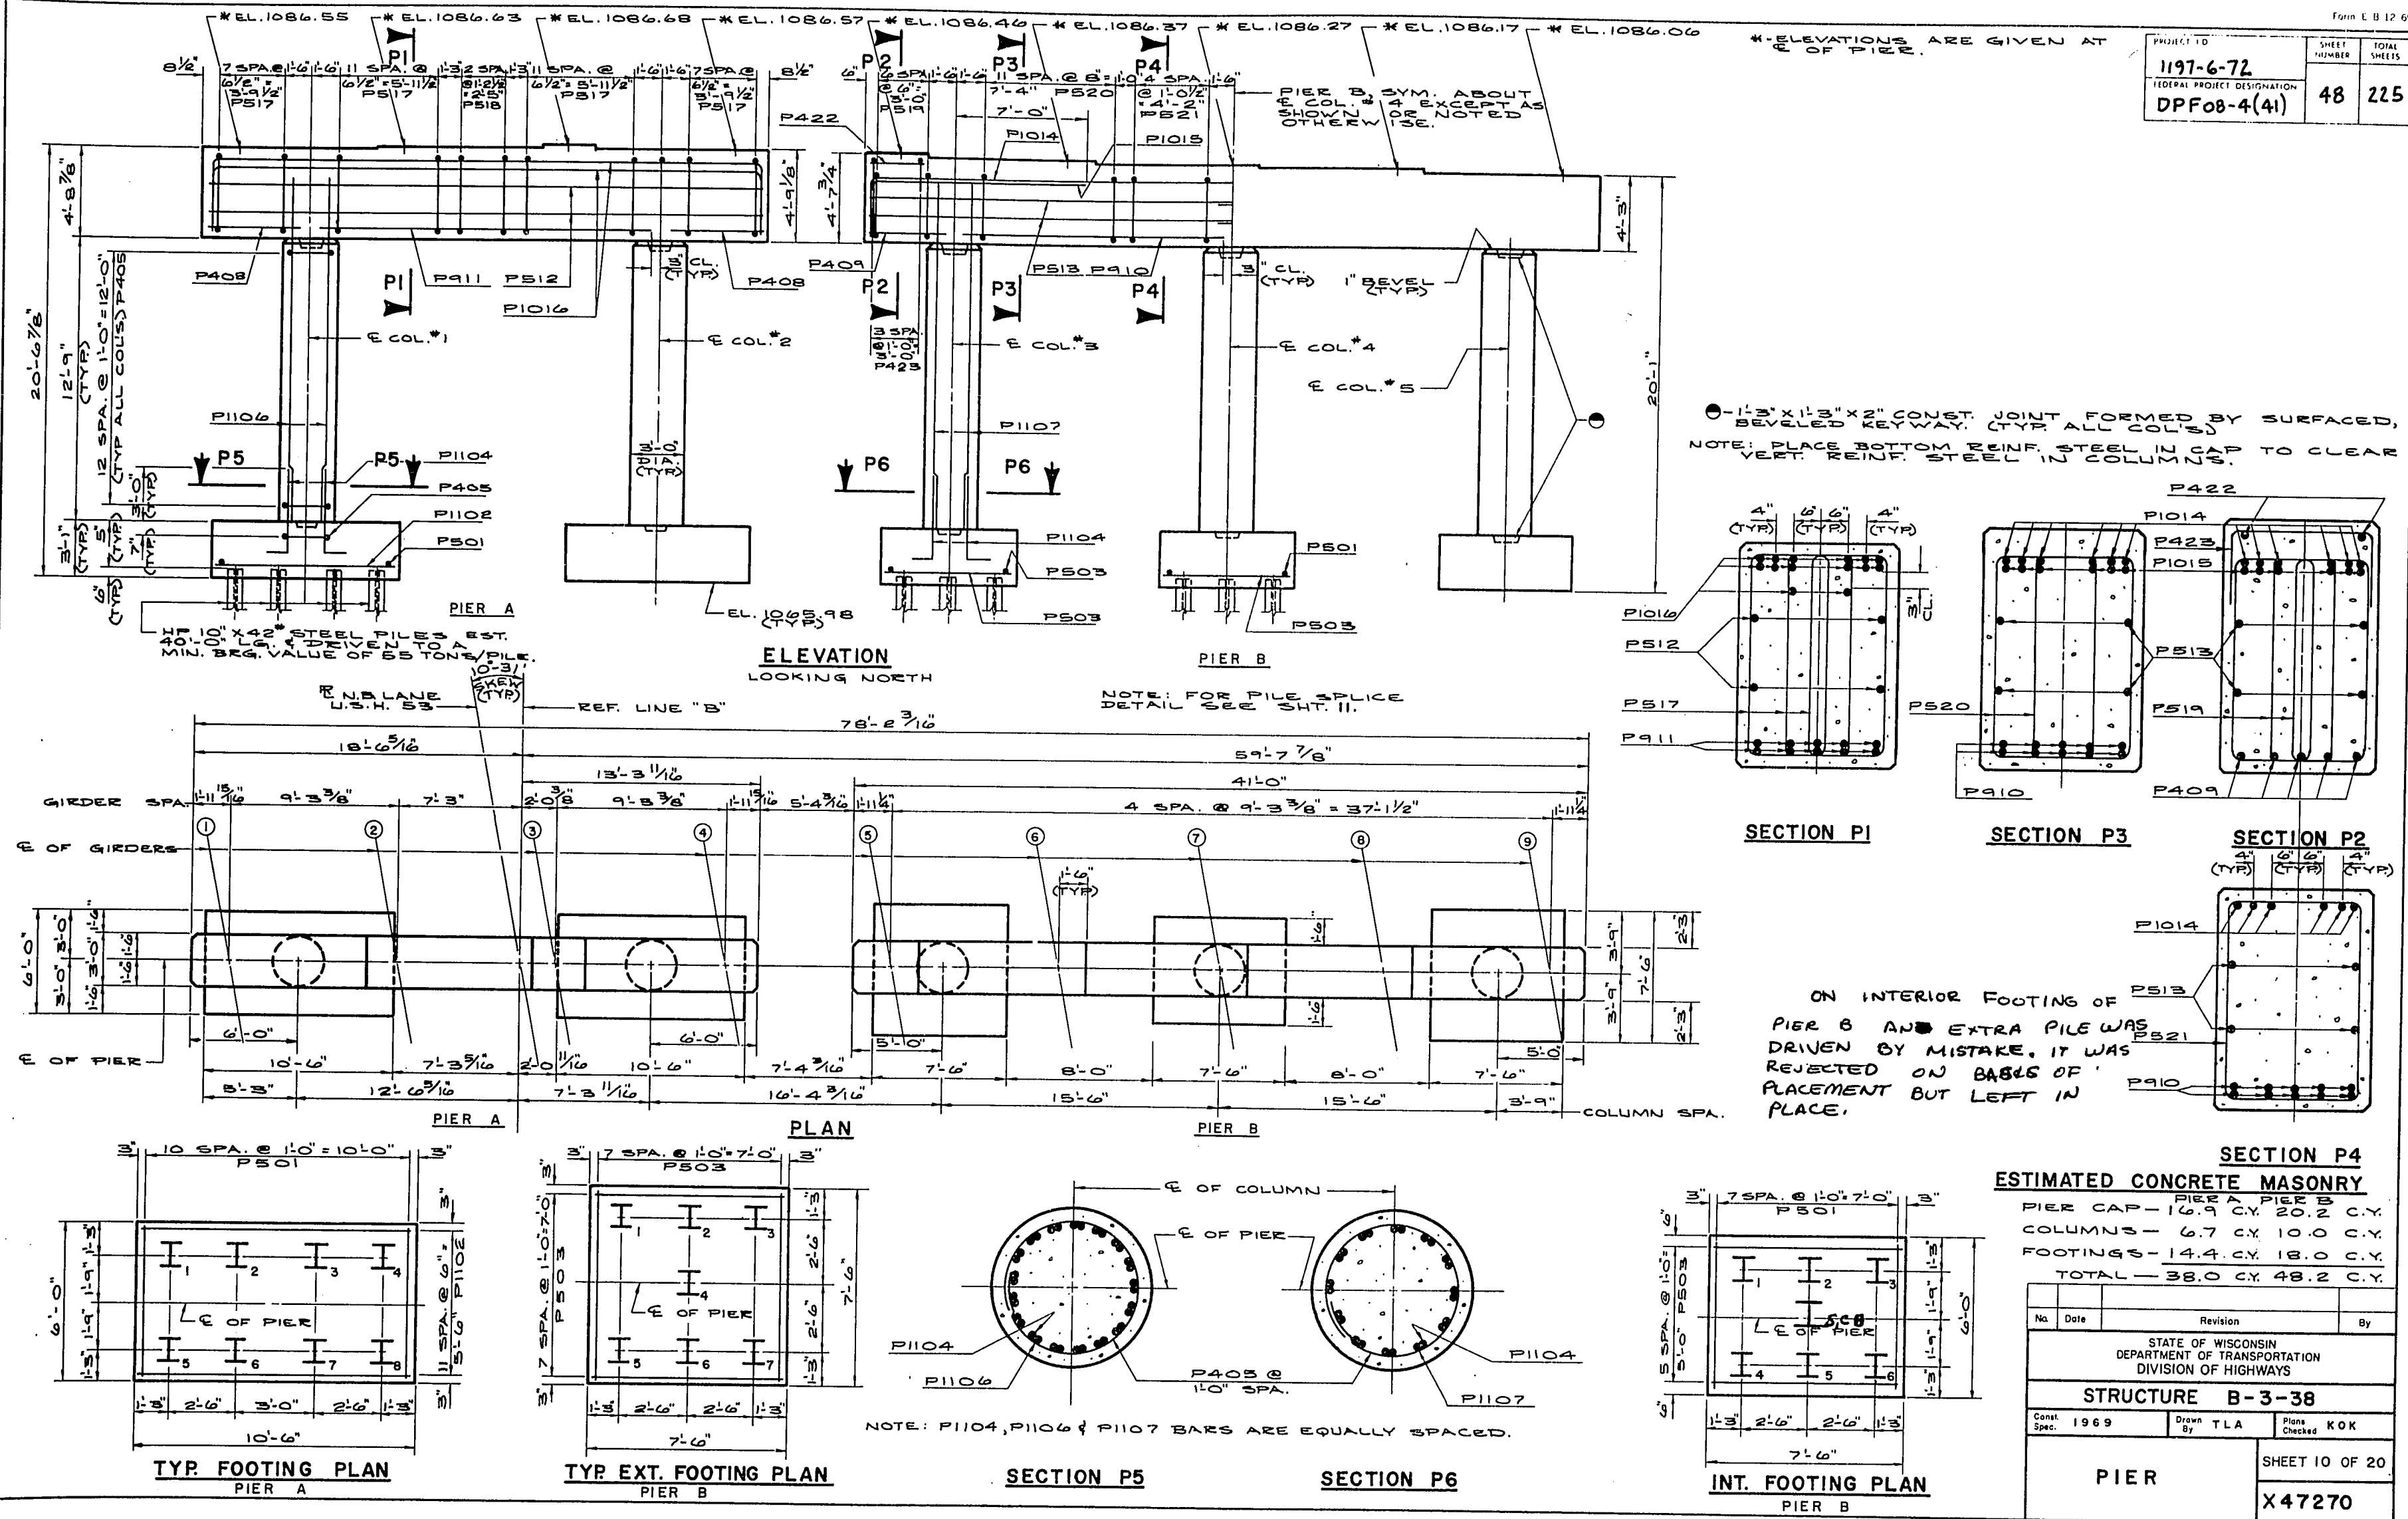

BILL OF BARS




MARK	NO. REQ'D.	LENGTH	BENT	BUND.	LOCATION
P501	30	5-8			FTGS.-PIER A, PIER B-INT.
P1102	24	10-2			" - " A
P503	38	7-2			" - " B-EXT. & INT.
P1104	70	6-5	X		" & COL'S.-DOWELS-PIER A&B
P405	70	9-5	X		" & " -HOOPS- " A&B
P1106	34	17-0			COL'S.-VERT-PIER A
P1107	36	16-6			" - " - " B
P408	10	5-7			CAP-ENDS-BOTT.-PIER A
P409	10	4-7			" - " - " - " B
P910	20	15-0		X	" - BOTTOM - " B
P911	10	19-4		X	" - " - " A
P512	4	31-6			" - MIDDLE - " A
P513	8	21-0			" - " - " B
P1014	6	47-9	X	X	" - TOP - " B
P1015	12	15-5	X	X	" - " - " B
P1016	14	39-5	X	X	" - " - " A
P517	120	12-7	X		" -STIRRUP-TRIPLE- " A
P518	3	14-9	X		" - " - SINGLE- " A
P519	42	11-9	X		" - " - TRIPLE- " B
P520	48	12-9	X		" - " - DOUBLE- " B
P521	10	13-11	X		" - " - SINGLE- " B
P422	2	3-1			" - SEATS PIER B
P423	4	5-2	X		" - " - " B

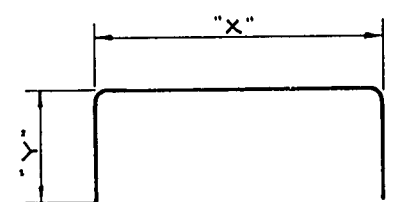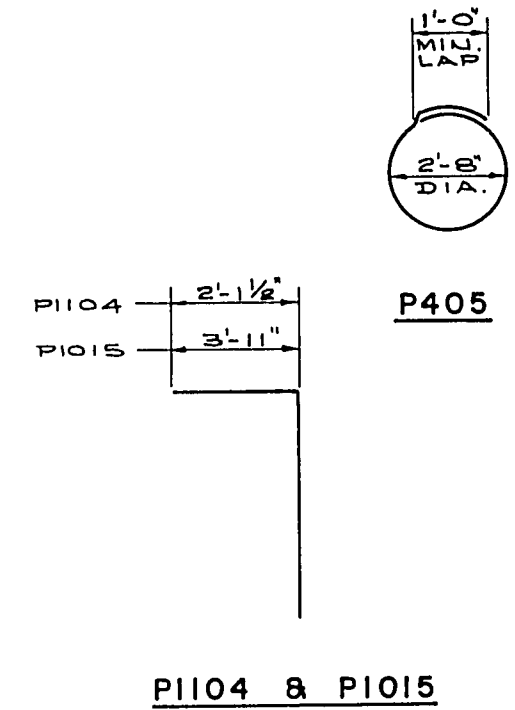NOTE: DIMENSIONS IN BENDING DETAILS ARE OUT TO OUT OF BARS.
THE FIRST TWO DIGITS OF A THREE DIGIT MARK & THE FIRST TWO DIGITS OF A FOUR DIGIT MARK SIGNIFIES THE BAR SIZE.



MARK	"X"	"Y"
P1014	40'-8"	3'-11"
P1016	31'-6"	4'-4"
P423	2'-8"	1'-4"

MARK	"X"	"Y"
P517	1'-7"	4'-4"
P518	2'-8"	4'-4"
P519	1'-7"	3'-11"
P520	2'-1"	3'-11"
P521	2'-8"	3'-11"

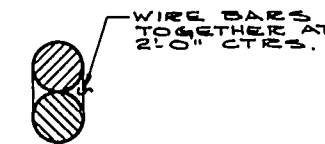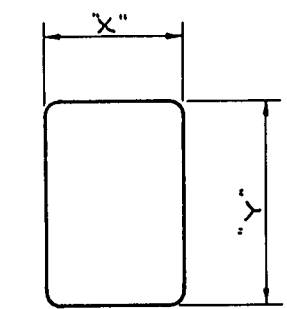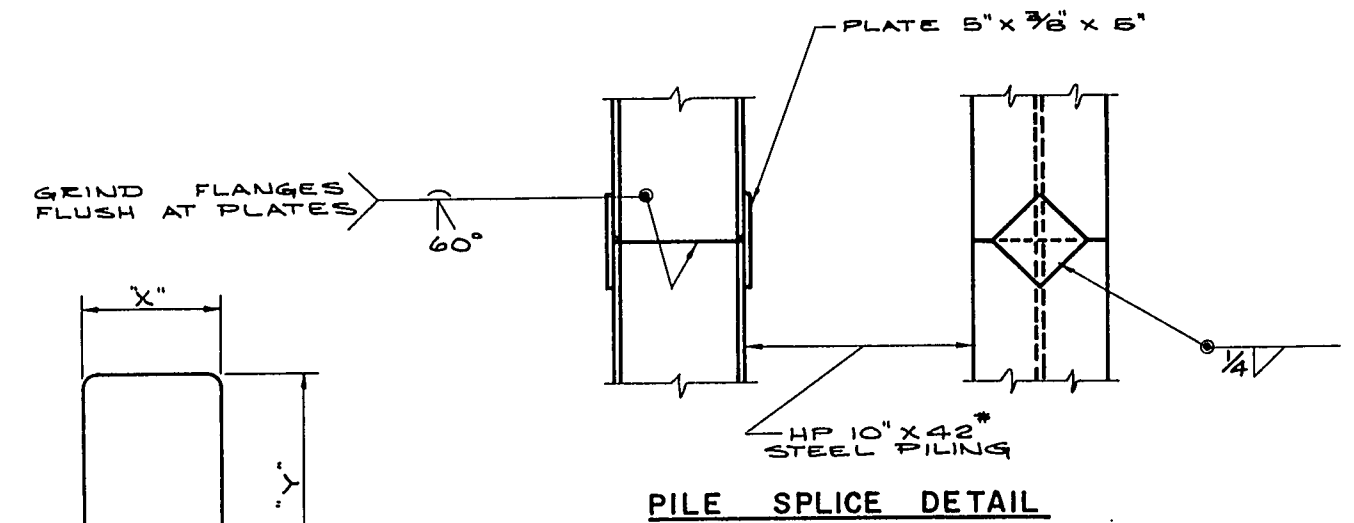


BUNDLING DETAIL

No.	Date	Revision	By
STATE OF WISCONSIN DEPARTMENT OF TRANSPORTATION DIVISION OF HIGHWAYS			
STRUCTURE B-3-38			
Const. Spec. 1969	Drawn By TLA	Plans Checked KOK	
PIER DETAILS			SHEET 11 OF 20 X47271

NOTE: ALL INTERMEDIATE STIFFENERS TO BE NORMAL TO C OF GIRDER, EXCEPT WHEN USED AS A CROSS FRAMING CONNECTOR BAR AS SHOWN ON THIS SHEET.

PROJECT ID	SHEET NUMBER	TOTAL SHEETS
1197-6-72	51	225
FEDERAL PROJECT DESIGNATION DPF08-4(41)		

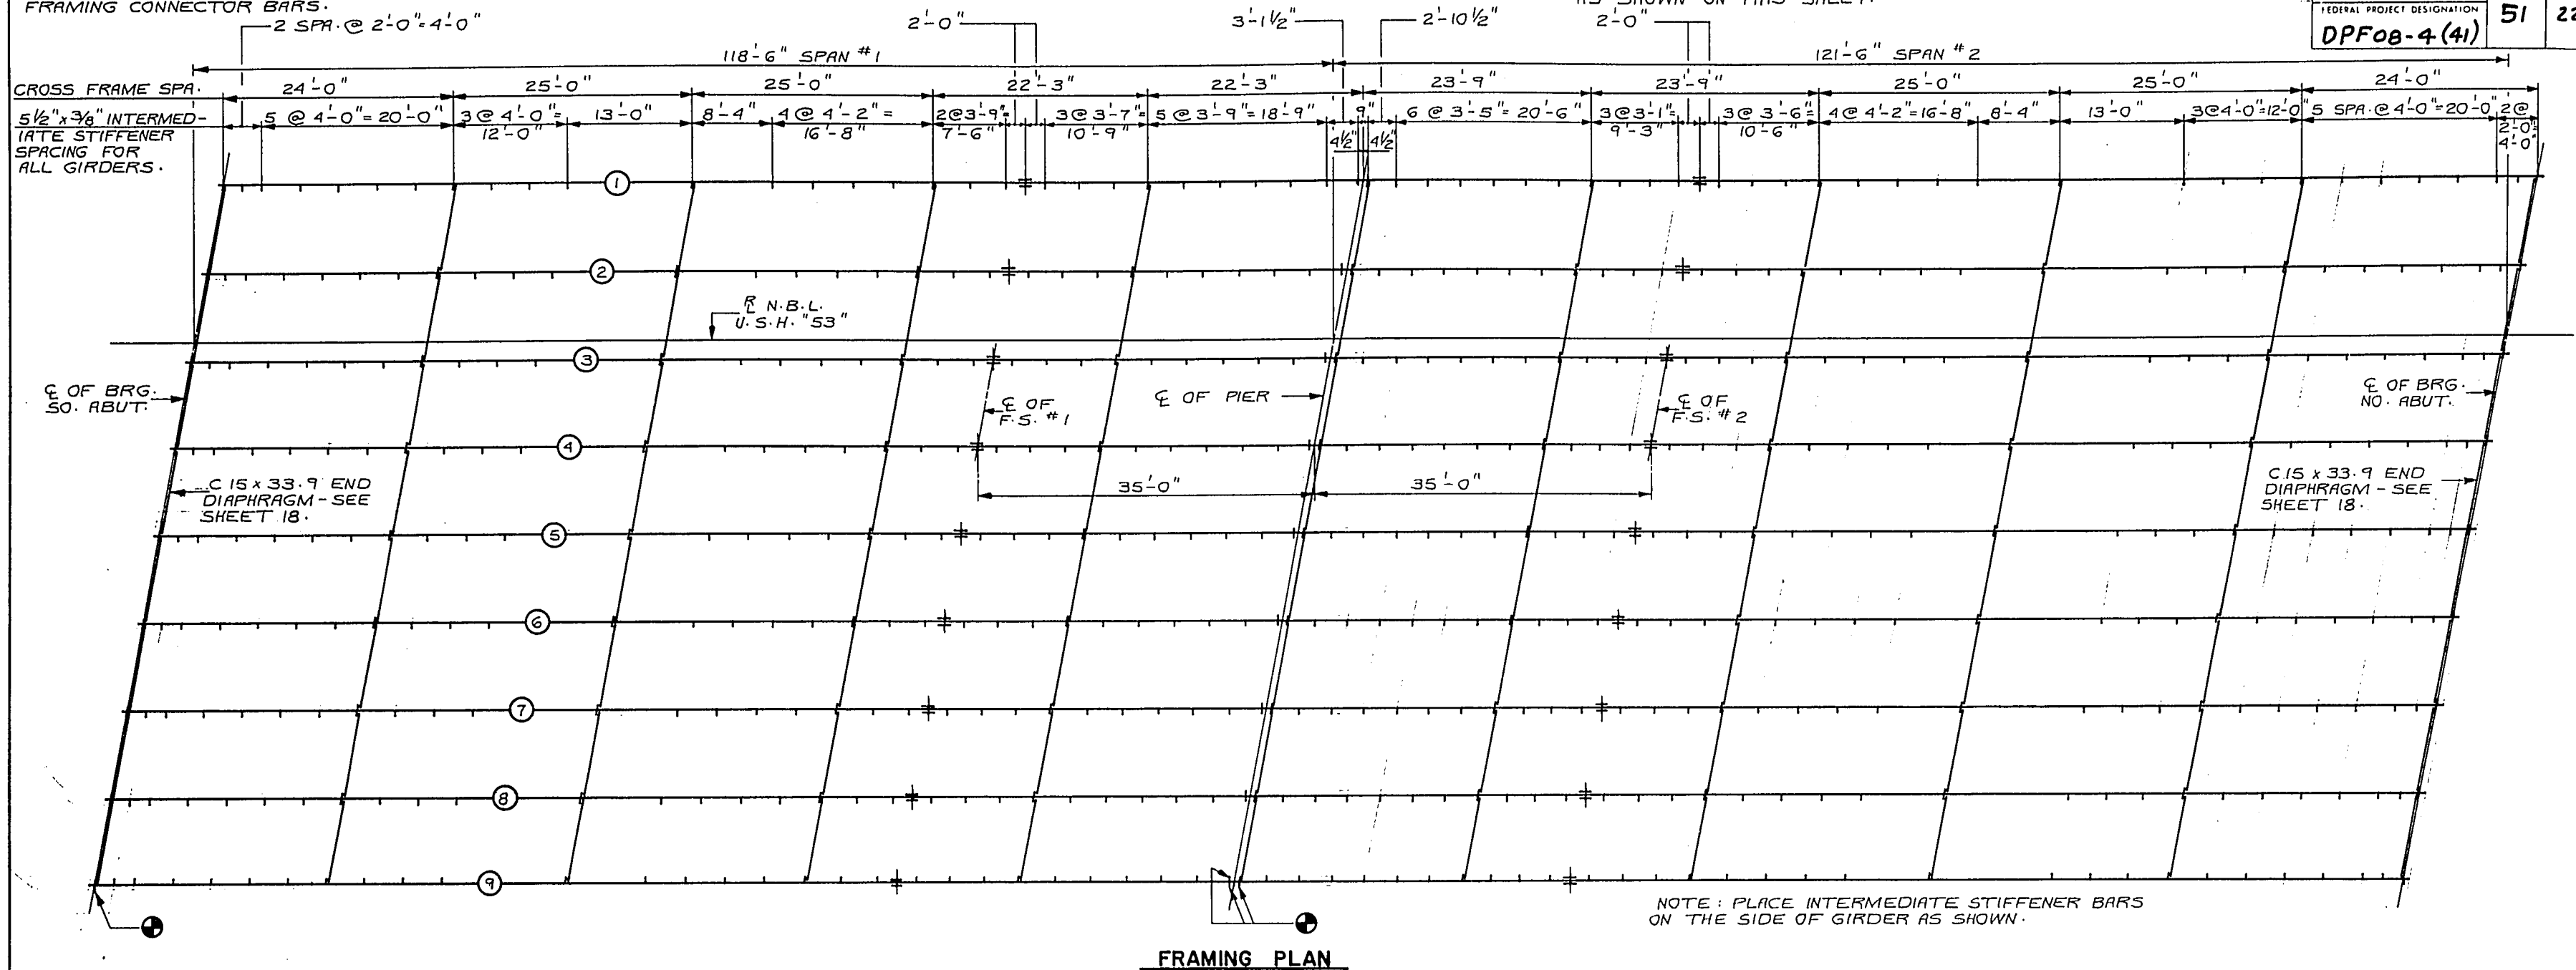

FRAMING PLAN

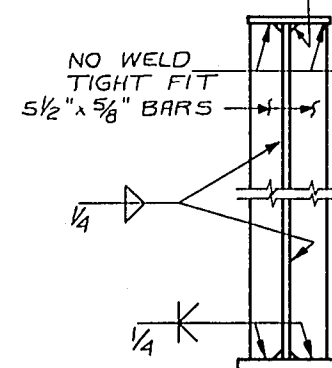
* ALL INTERMEDIATE STIFF. BARS SHALL BE PLACED ON INSIDE FACE OF EXTERIOR GIRDERS AND ON FACE OF INTERIOR GIRDERS AS SHOWN ABOVE. * 5/16" WELD WHEN WELDING TO A 7/8", 1", 1 1/8" AND 1 1/2" FLANGE PLATE AND A 3/8" WELD WHEN WELDING TO A 1 3/4", 1 7/8", 2", 2 1/8" AND 2 1/4" FLANGE PLATE.

** PLACE LONG. STIFF. BARS ON OPPOSITE FACE FROM INTER. STIFF. FOR INTERIOR GIRDERS AND THE SAME FACE AS INTER. STIFF. FOR EXTERIOR GIRDERS. NO WELD. TIGHT FIT


CLIP CORNERS TO
CLEAR WELDS (TYP.)

NO WELD, TIGHT FIT
OPPOSITE WELD LOCATION.


** SEE GIRDER ELEVATION FOR
LOCATION - SEE SHEET 14.



BRG. STIFF. AT ABUT.

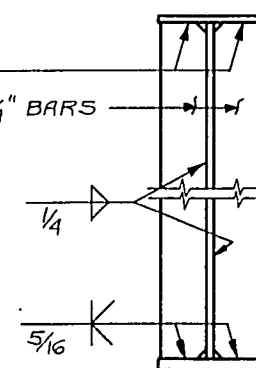


BRG. STIFF. AT PIER

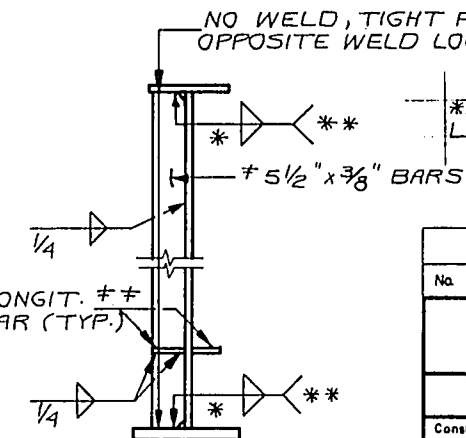

INTERMEDIATE STIFFENER
- & CROSS FRAME CONN.




No.	Date	Revision	By
STATE OF WISCONSIN DEPARTMENT OF TRANSPORTATION DIVISION OF HIGHWAYS			
STRUCTURE B - 3 - 38			
Const. Spec.	1969	Drawn By	L.N.F. Plans Checked KOK
FRAMING PLAN		SHEET 13 OF 20	
		X47273	

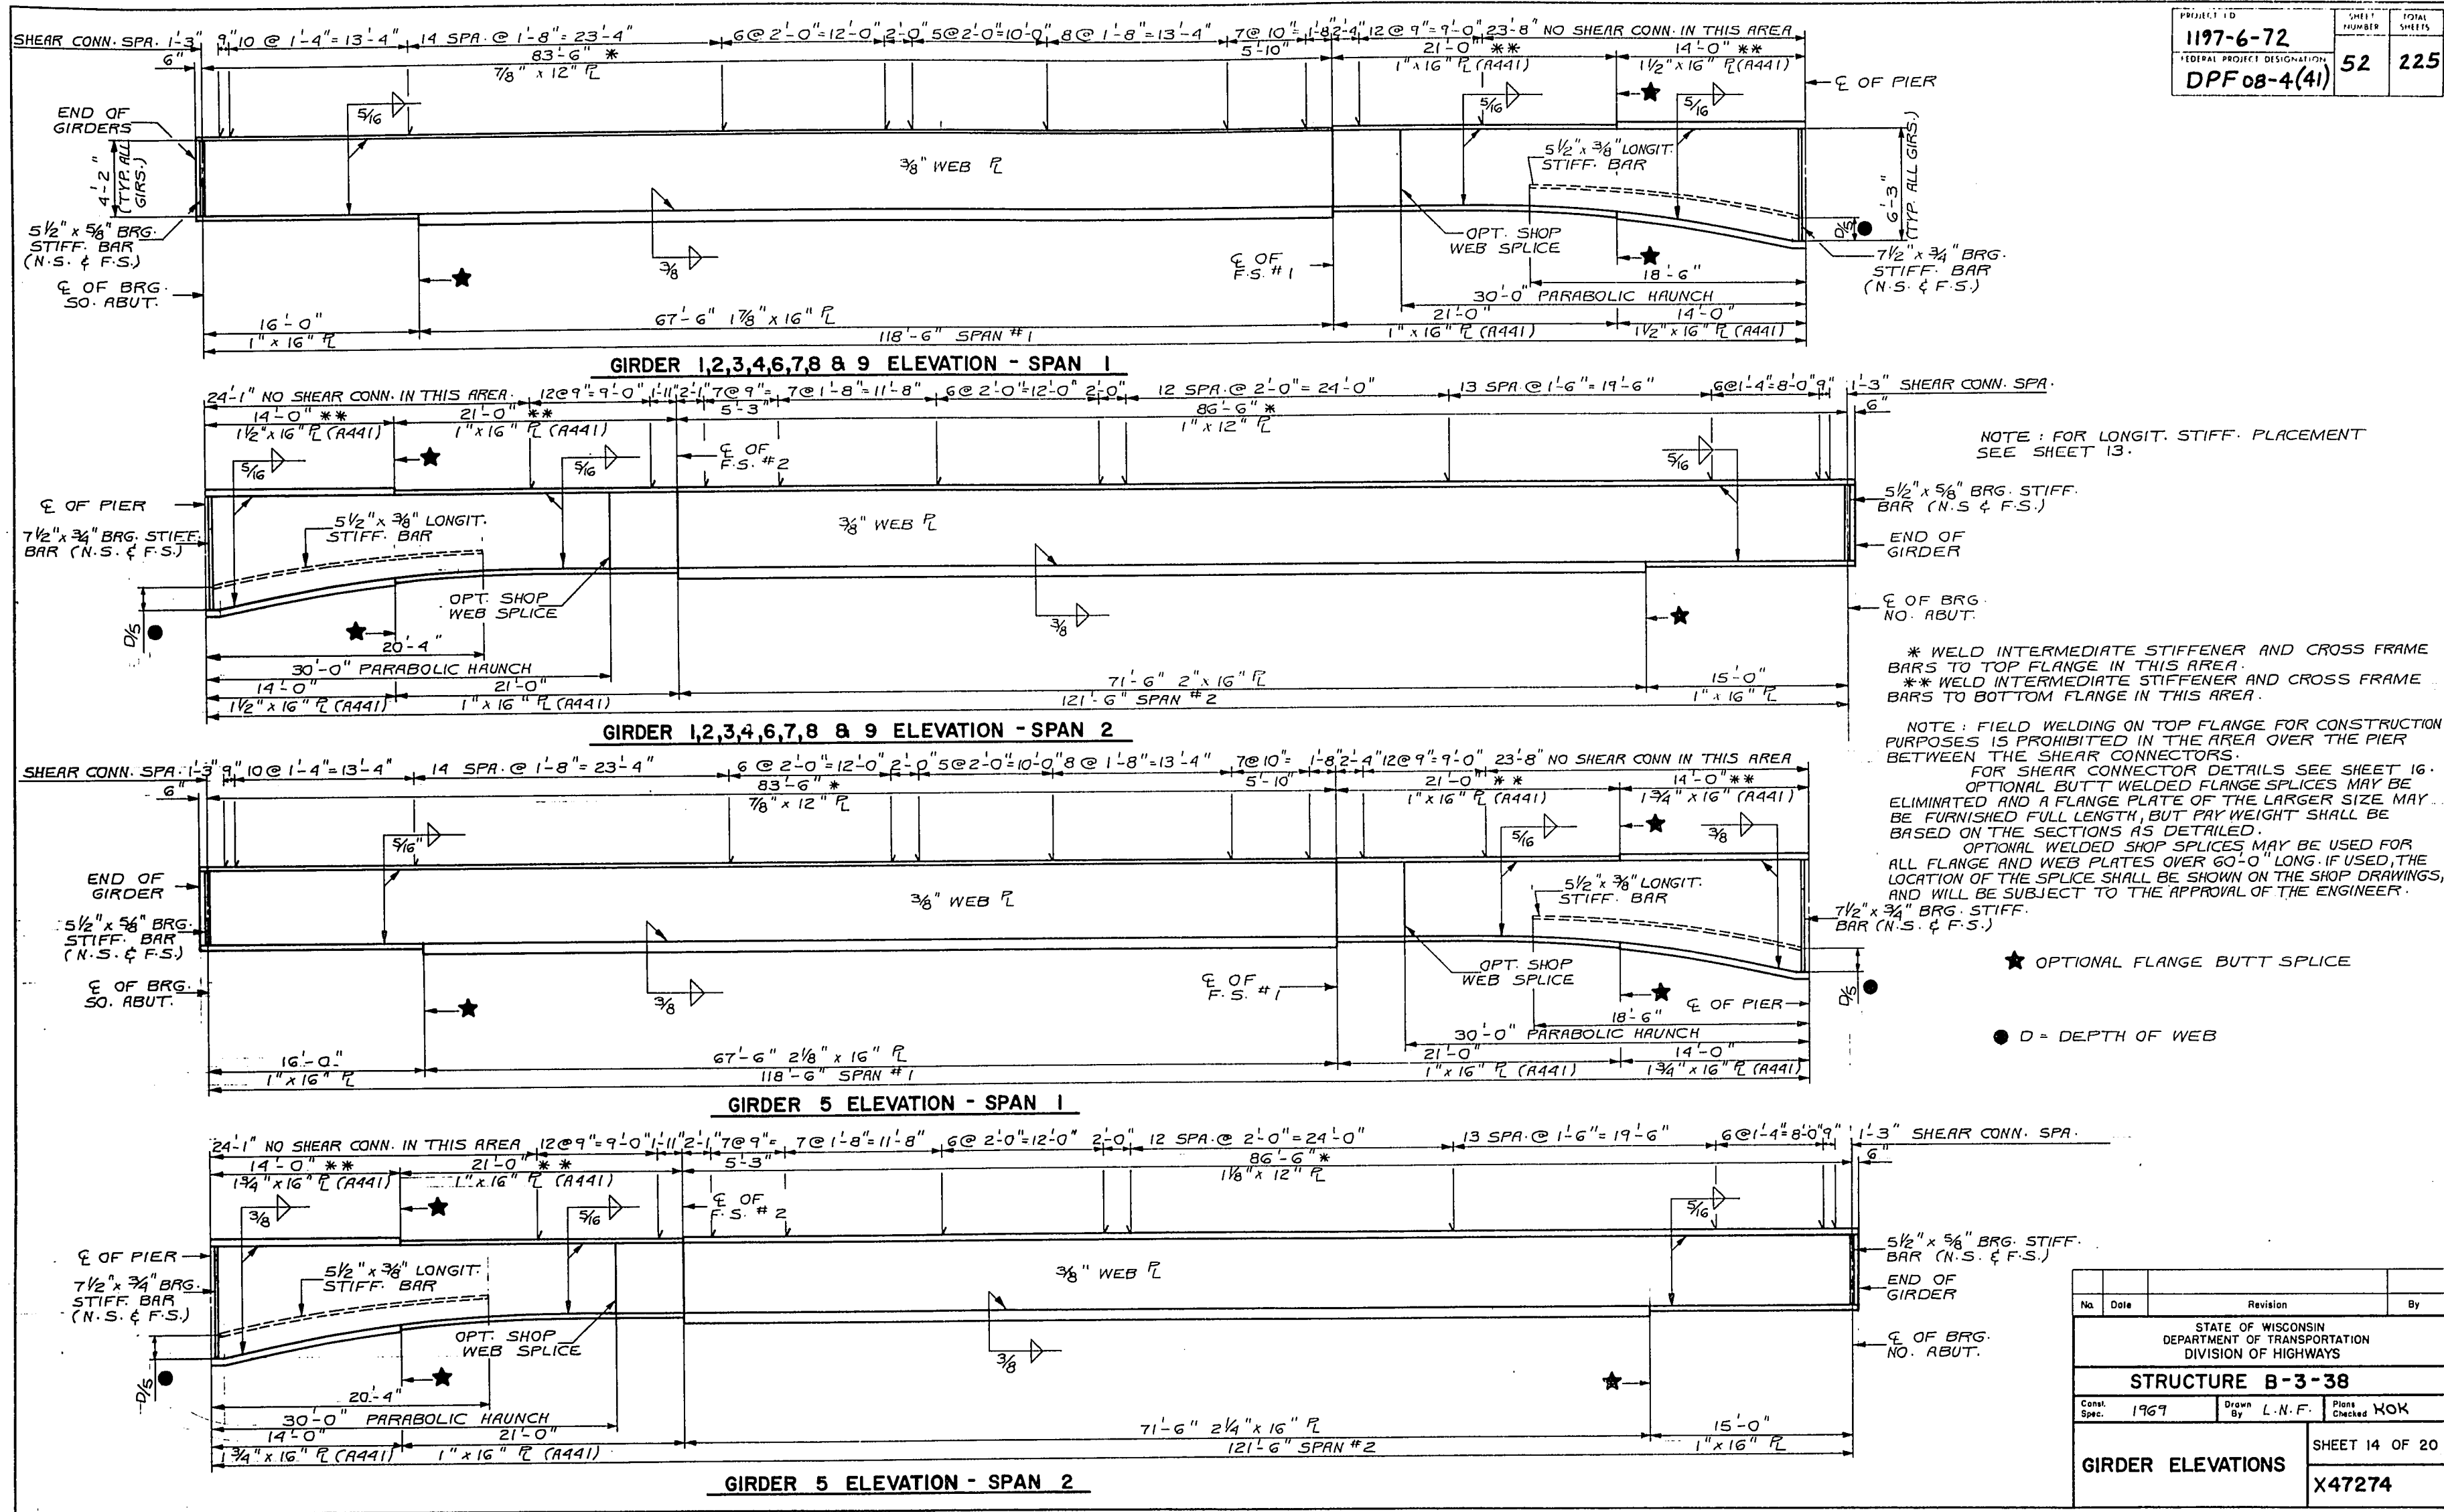


ELEVATIONS AT TOP OF DECK (T.D.) AND TOP OF STEEL (T.S.)

GIRDER	CL BRG. S. ABUT.	1/8 PT.	1/4 PT.	3/8 PT.	1/2 PT.	5/8 PT.	CL OF F.S. #1	7/8 PT.	CL PIER	1/8 PT.	CL OF F.S. #2	3/8 PT.	1/2 PT.	5/8 PT.	3/4 PT.	7/8 PT.	CL BRG. N. ABUT.
1	T.D. 1093.27	1093.40	1093.53	1093.65	1093.76	1093.87	1093.94	1094.08	1094.17	1094.26	1094.37	1094.42	1094.50	1094.56	1094.63	1094.68	1094.74
	T.S. 1092.56						1093.36		1093.50		1093.80		1094.16	1094.25	1094.34	1094.45	1094.05
2	T.D. 1093.35	1093.48	1093.60	1093.73	1093.84	1093.95	1094.02	1094.16	1094.25	1094.34	1094.45	1094.51	1094.58	1094.65	1094.71	1094.77	1094.82
	T.S. 1092.64						1093.44		1093.58		1093.88		1094.29	1094.38	1094.49	1094.55	1094.13
3	T.D. 1093.38	1093.51	1093.64	1093.76	1093.88	1093.99	1094.06	1094.20	1094.29	1094.38	1094.49	1094.55	1094.62	1094.69	1094.76	1094.81	1094.87
	T.S. 1092.67						1093.48		1093.62		1093.92		1094.33	1094.42	1094.50	1094.56	1094.18
4	T.D. 1093.28	1093.41	1093.54	1093.66	1093.77	1093.89	1093.95	1094.09	1094.19	1094.28	1094.39	1094.45	1094.52	1094.59	1094.66	1094.72	1094.77
	T.S. 1092.57						1093.38		1093.52		1093.82		1094.23	1094.30	1094.36	1094.42	1094.08
5	T.D. 1093.17	1093.30	1093.43	1093.55	1093.67	1093.78	1093.85	1093.99	1094.09	1094.18	1094.29	1094.35	1094.42	1094.50	1094.56	1094.62	1094.67
	T.S. 1092.47						1093.28		1093.45		1093.72		1094.13	1094.20	1094.27	1094.33	1094.38
6	T.D. 1093.06	1093.20	1093.32	1093.45	1093.57	1093.68	1093.75	1093.89	1093.98	1094.08	1094.19	1094.25	1094.33	1094.40	1094.46	1094.52	1094.58
	T.S. 1092.35						1093.17		1093.32		1093.63		1094.04	1094.11	1094.17	1094.23	1093.89
7	T.D. 1092.95	1093.09	1093.22	1093.34	1093.46	1093.57	1093.64	1093.79	1093.88	1093.98	1094.09	1094.15	1094.23	1094.30	1094.36	1094.42	1094.48
	T.S. 1092.25						1093.07		1093.22		1093.52		1093.93	1094.00	1094.06	1094.12	1093.79
8	T.D. 1092.85	1092.98	1093.11	1093.24	1093.36	1093.47	1093.54	1093.68	1093.78	1093.88	1093.99	1094.05	1094.13	1094.20	1094.27	1094.33	1094.38
	T.S. 1092.14						1092.96		1093.11		1093.42		1093.83	1093.90	1093.96	1094.02	1093.69
9	T.D. 1092.74	1092.88	1093.01	1093.13	1093.25	1093.37	1093.44	1093.58	1093.68	1093.77	1093.89	1093.95	1094.03	1094.10	1094.17	1094.23	1094.28
	T.S. 1092.03						1092.86		1093.01		1093.32		1093.73	1093.80	1093.86	1093.92	1093.60

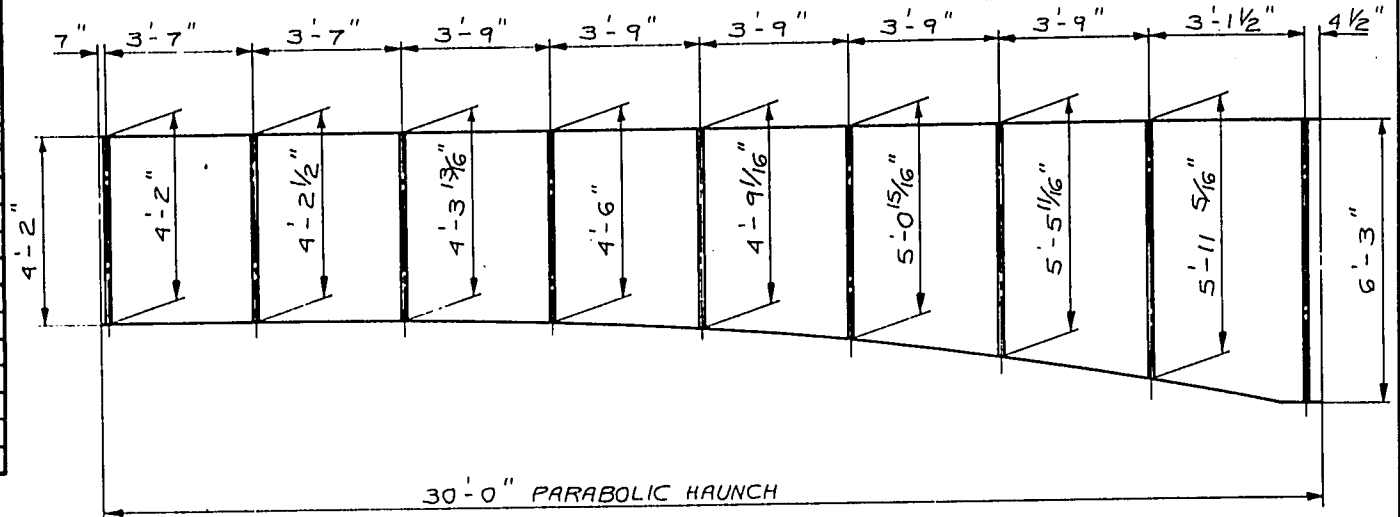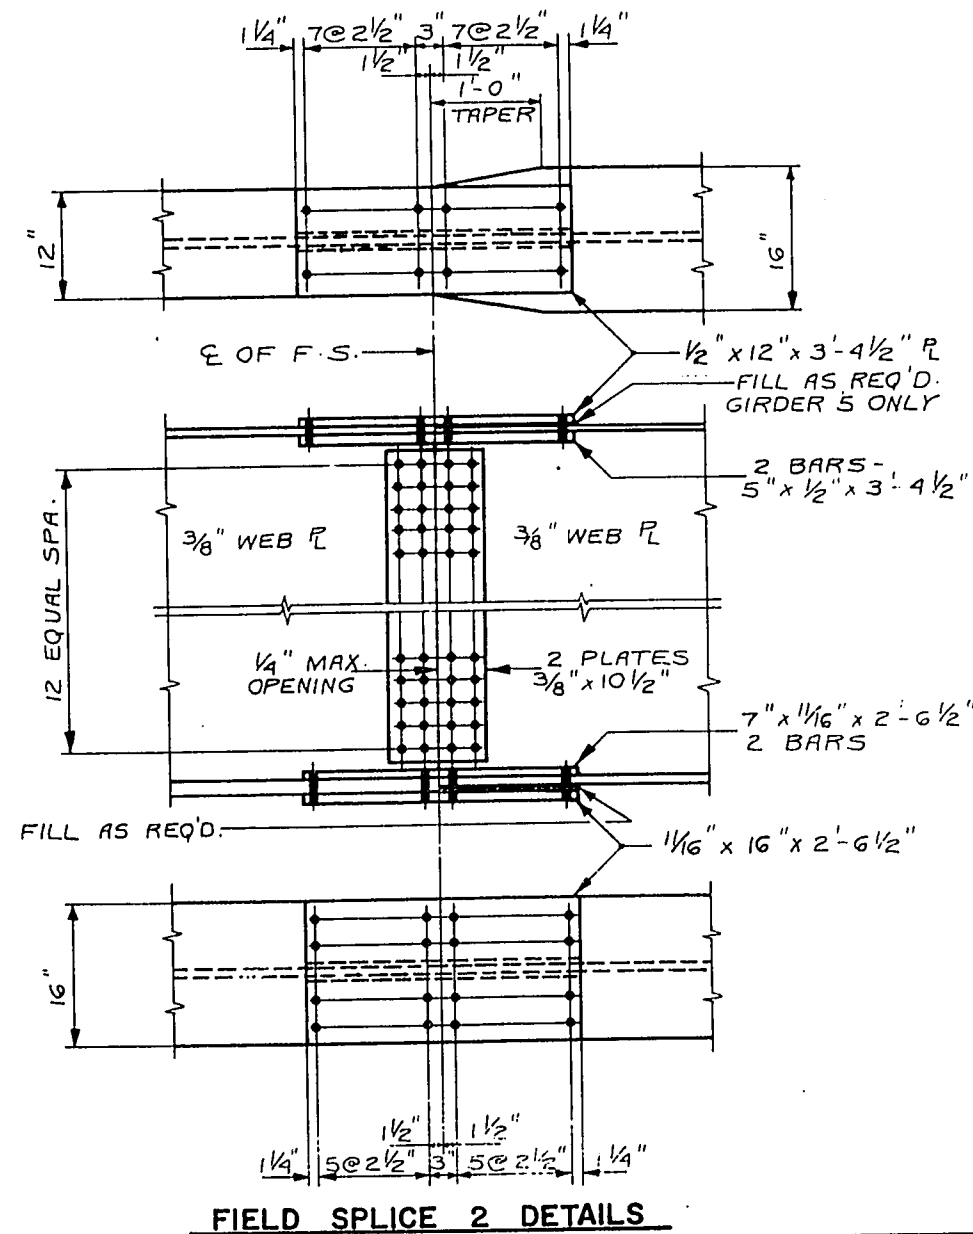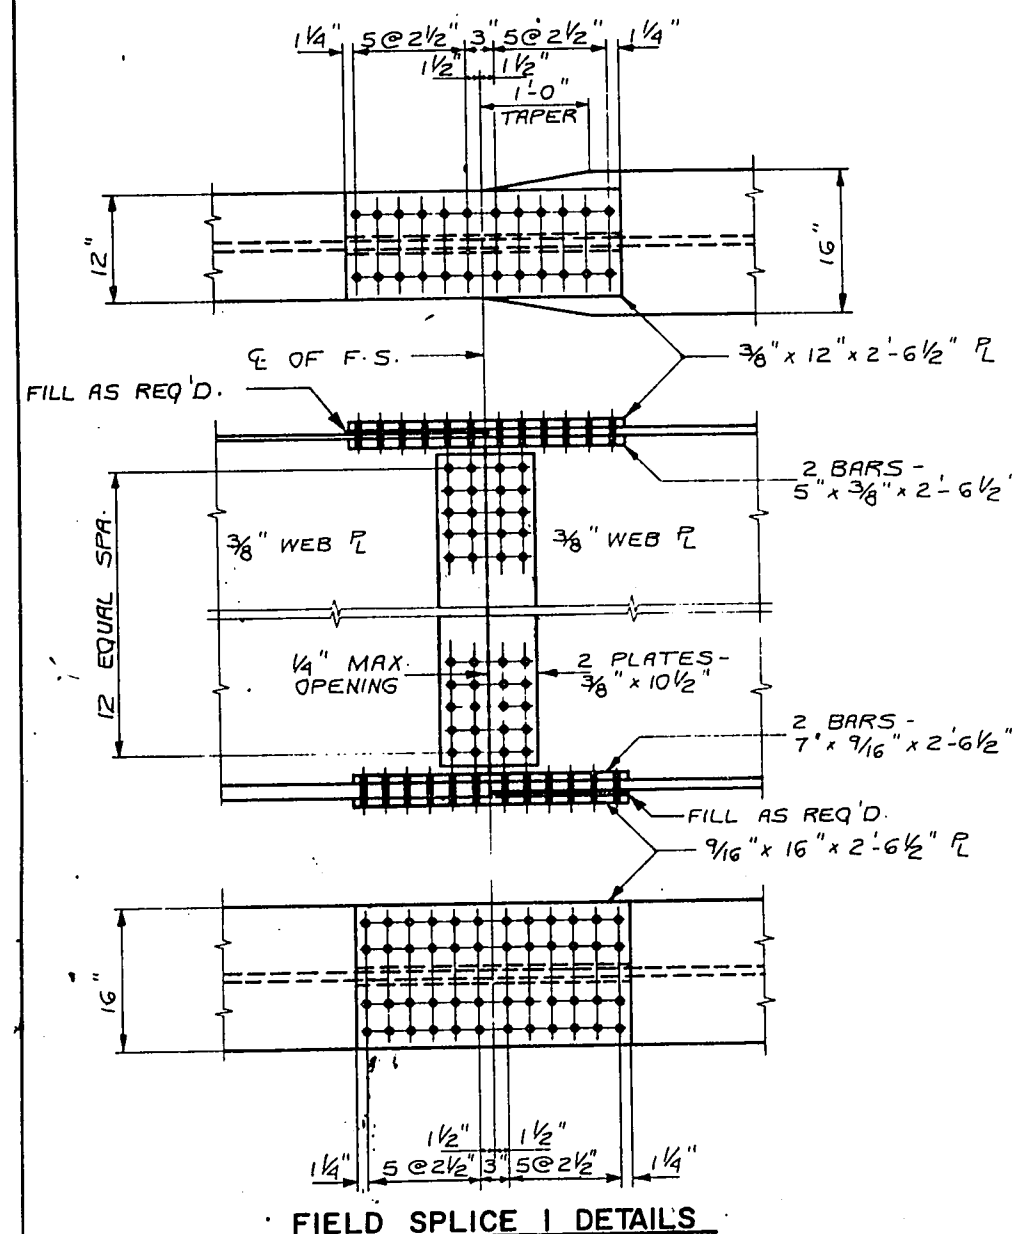
* THESE ELEVATIONS ARE TO TOP OF STEEL (SPlice PLATE THICKNESS, IF APPLICABLE, IS ACCOUNTED FOR) AND THEY ARE FOR THE MATERIAL AS ERECTED. THE ELEVATION OF THE TOP OF STEEL AT THE FIELD SPlice POINTS SHALL BE CHECKED, AND CORRECTED, IF POSSIBLE, AFTER ERECTION AND BEFORE PERMANENTLY WELDING THE CROSS FRAMING IN PLACE.
NOTE: TOP OF STEEL ELEVATIONS ARE BASED ON GIRDER SECTIONS AS DETAILED. IF OPTIONAL BUTT SPICES ARE NOT USED, TOP OF STEEL ELEVATIONS AT FIELD SPICES WILL HAVE TO BE REVISED.



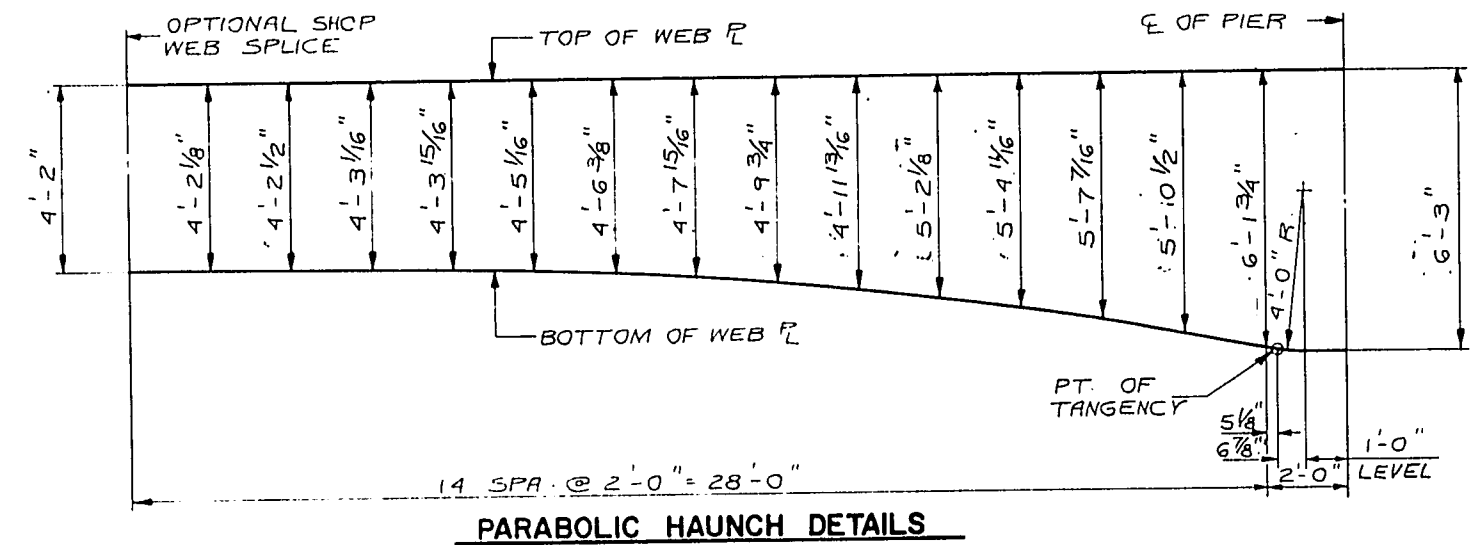DIMENSIONS OF STIFFENERS IN HAUNCH AREA - SPAN 1



PARABOLIC HAUNCH DETAILS

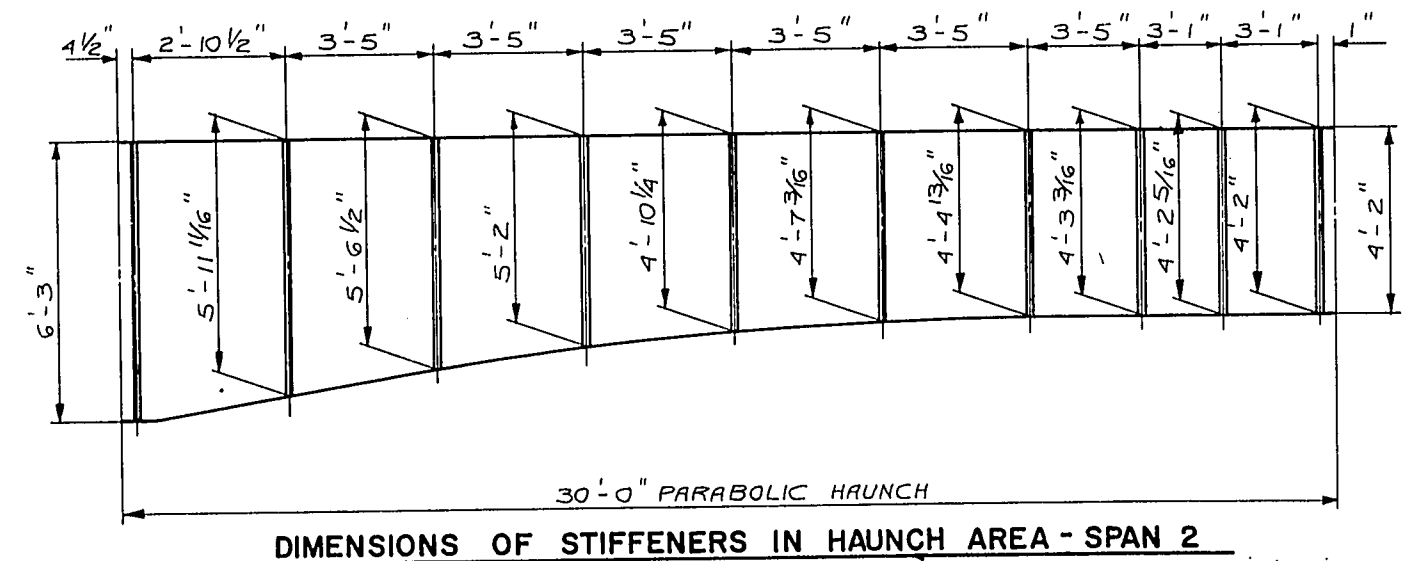

DIMENSIONS OF STIFFENERS IN HAUNCH AREA - SPAN 2


No.	Date	Revision	By
STATE OF WISCONSIN DEPARTMENT OF TRANSPORTATION DIVISION OF HIGHWAYS			
STRUCTURE B-3-38			
Const. Spec.	1967	Drawn By	L.N.F.
		Plans Checked	KOK
SUPERSTRUCTURE			SHEET 15 OF 20
			X47275

BILL OF BARS


DIMENSIONS IN BENDING DETAILS ARE OUT TO OUT OF BAR.
THE FIRST DIGIT OF THE BAR SIGNIFIES THE BAR SIZE.

MARK	NO. REQ'D	LENGTH	BENT	LOCATION
S601	823	21-3		SLAB-TOP AND BOTTOM-TRANS.
S602	823	34-7		" " " " " "
S603	823	27-6		" " " " " "
S504	1190	35-7		" " " " " - LONGIT.
S505	18	15-0		" - TOP - LONGIT. - SYM. ABOUT C. OF PIER
S506	242	6-10	X	MEDIAN PARAPET - VERT.
S507	484	2-4		" " " " " - HORIZ.
S508	484	4-9	X	RAIL PARAPET - VERT.
S509	484	5-0	X	" " " " " - HORIZ.
S510	20	17-8		RAIL PARAPET - HORIZ.
S511	120	22-6		RAIL AND MEDIAN PARAPET - HORIZ.
S512	15	9-4		" " " " " " " "
S513	15	12-11		" " " " " " " "
S514	5	17-11		MEDIAN PARAPET - HORIZ.
S515	5	17-5		" " " " " " " "


PROJECT NO.	1197-6-72	SHEET NUMBER	54	TOTAL SHEETS	225
FEDERAL PROJECT DESIGNATION	DPF08-4(41)				

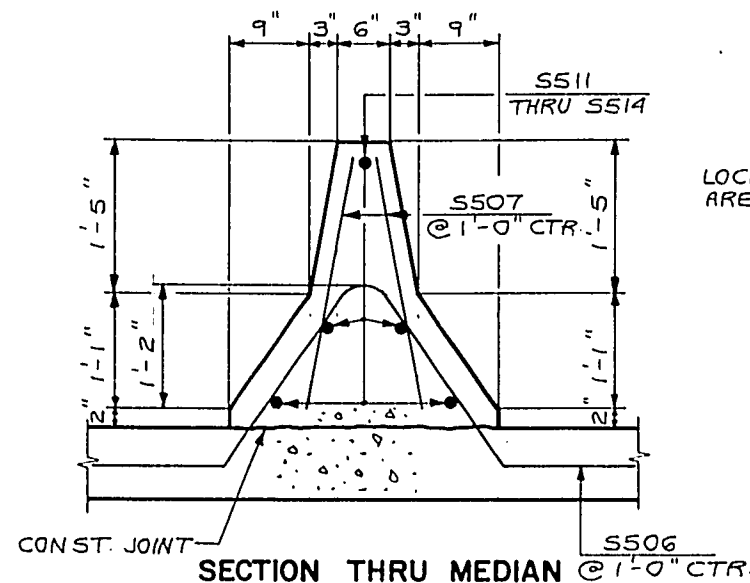

LOCATION DIMENSIONS ARE TO THIS LINE.


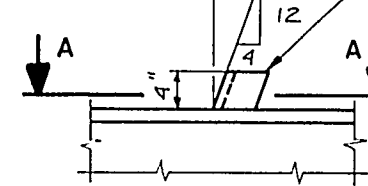


ELEVATION

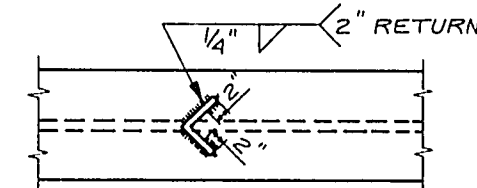


SECTION A-A

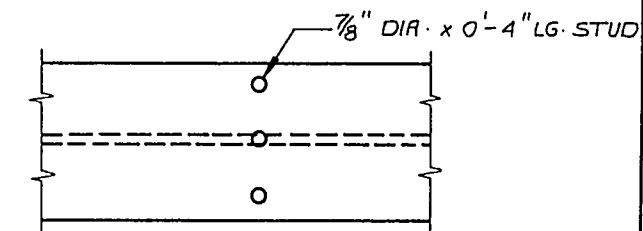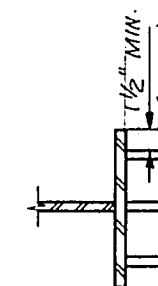SHEAR CONNECTOR DETAIL




ALTERNATE SHEAR CONNECTOR DETAIL

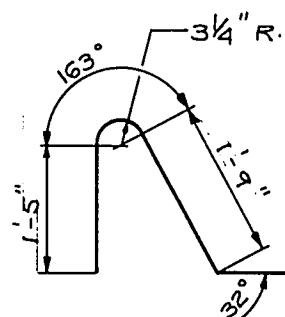
NOTE: THE CONTRACTOR MAY USE THREE SHOP OR FIELD WELDED 7/8" DIA. x 0'-4" LG. STUDS EQUALLY SPACED WITH A MIN. OF 1 1/2" CLEARANCE FROM THE FLANGE EDGE AT ALL PLACES WHERE AN ANGLE SHEAR CONNECTOR IS DETAILED.




S508

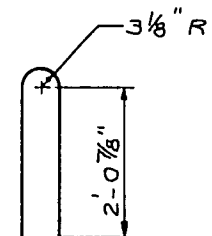

S509

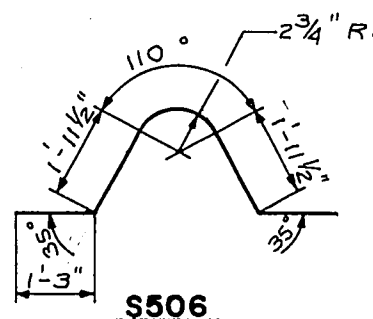


S506

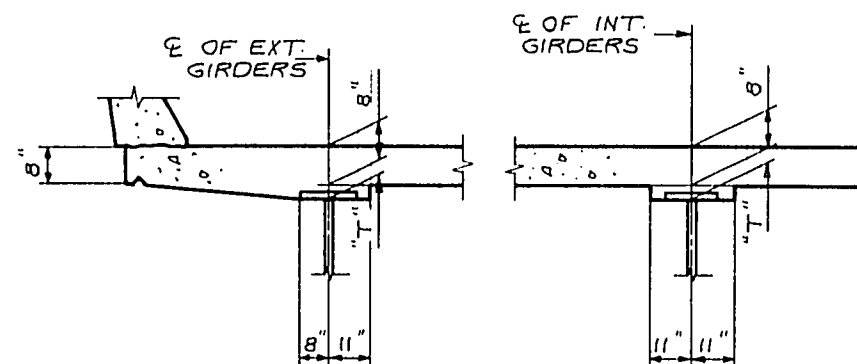


PART SECTION THRU SLAB

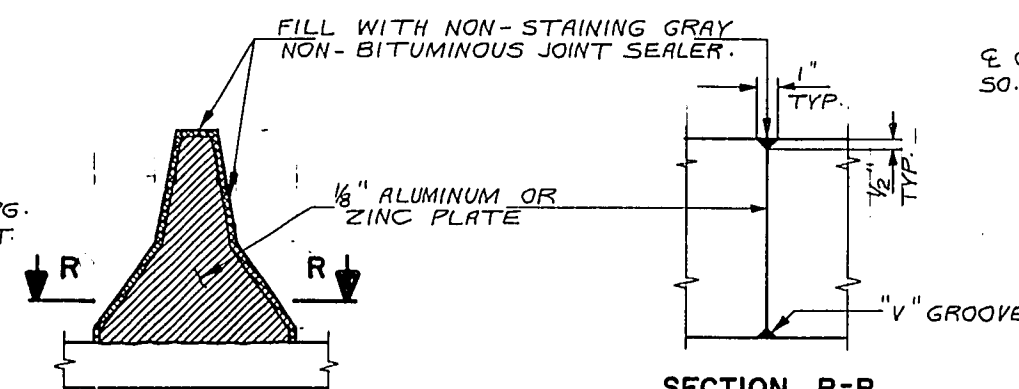NOTE: TO DETERMINE "T"; AFTER ALL STRUCTURAL STEEL HAS BEEN ERECTED, ELEVATIONS OF THE TOP FLANGES OR TOP OF SPLICE PLATES, WHICHEVER APPLIES, SHALL BE TAKEN AT CENTERLINE OF BEARINGS, CENTERLINE OF FIELD SPLICES AND AT EIGHTH POINTS OF EACH SPAN WHICH ARE MORE THAN SIX FEET FROM A FIELD SPLICE. THESE ELEVATIONS, SUBTRACTED FROM THE GRADE ELEVATIONS, ADJUSTED FOR DEADLOAD DEFLECTION OF THE CONCRETE, MINUS THE SLAB DEPTH, PLUS THE STEEL THICKNESS TO BOTTOM OF TOP FLANGE, EQUALS THE HAUNCH DEPTH "T".




DEFLECTION JOINT AT MEDIAN

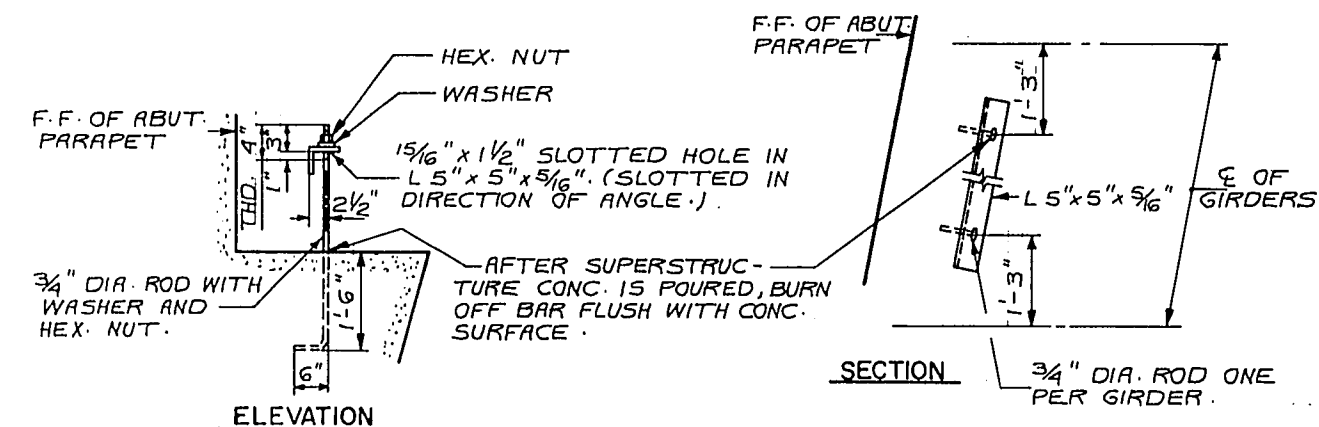

ELEVATION


TEMPORARY HOLD DOWN DEVICE

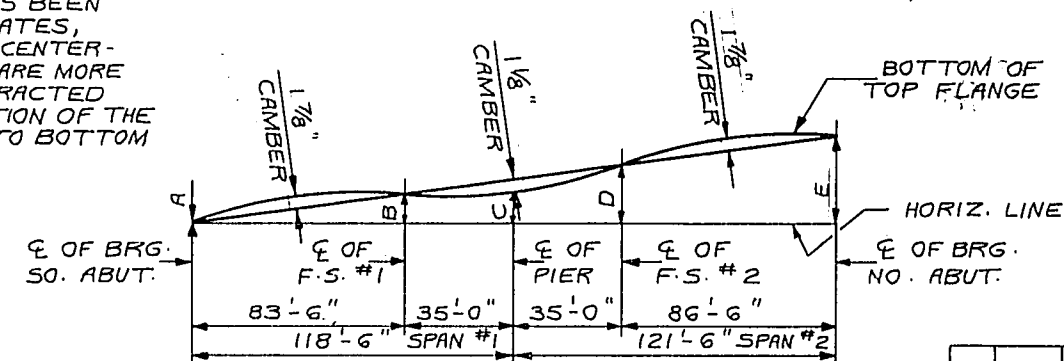NOTE: THE TEMPORARY HOLD DOWN DEVICE SHALL BE PLACED AT ABUT. WHERE SLAB POUR TERMINATES. (TO BE PAID FOR AS STRUCTURAL CARBON STEEL.)



BLOCKING DIAGRAM

DIMENSIONS	A	B	C	D	E
GIRDER 1	0.0	.761	.877	1.183	1.465
GIRDER 2	0.0	.764	.883	1.189	1.475
GIRDER 3	0.0	.768	.887	1.196	1.484
GIRDER 4	0.0	.771	.893	1.202	1.494
GIRDER 5	0.0	.785	.904	1.213	1.505
GIRDER 6	0.0	.778	.902	1.215	1.514
GIRDER 7	0.0	.781	.907	1.221	1.524
GIRDER 8	0.0	.785	.912	1.228	1.534
GIRDER 9	0.0	.788	.917	1.234	1.544

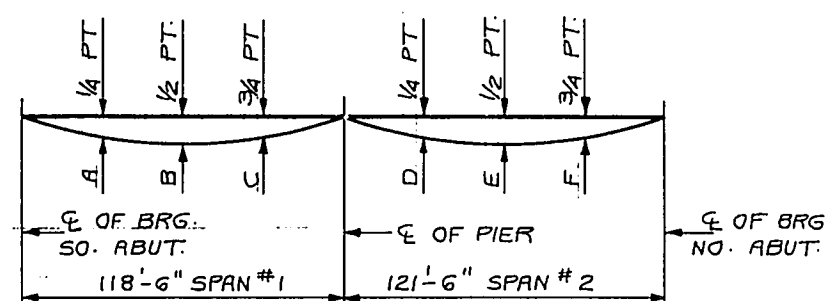DEFLECTION DIAGRAM
(SHOWING DEADLOAD DEFLECTION ONLY)

GIRDERS	DEFLECTION	A	B	C	D	E	F
1, 2, 3, 4, 6, 7, 8 & 9	CONC. ONLY	1 1/16"	1 7/8"	1 1/16"	1 1/16"	1 3/4"	1 9/16"
	TOTAL	1 15/16"	2 3/16"	1 3/16"	2"	1 13/16"	1 13/16"
GIRDER 5	CONC. ONLY	1 7/8"	2 1/16"	1 3/16"	3/4"	1 7/8"	1 5/8"
	TOTAL	2 1/8"	2 3/8"	1 5/16"	1 3/16"	2 1/8"	1 7/8"

No.	Date	Revision	By
STATE OF WISCONSIN DEPARTMENT OF TRANSPORTATION DIVISION OF HIGHWAYS			
STRUCTURE B-3-38			
Const. Spec.	1969	Drawn By	L.N.F. Plans Checked KOK
SUPERSTRUCTURE			SHEET 16 OF 20
			X47276

B. P. R. Division	Project	Sheet Number	Total Sheets
4	1197-6-72 DPF08-4(4)	55	225

BEARING NOTES

ALL BEARINGS ARE SYMMETRICAL ABOUT ϵ OF GIRDER AND ϵ OF BEARING.

ALL STRUCTURAL STEEL BEARING PLATES SHALL BE FLAT ROLLED STEEL PLATES WITH ALL SURFACES SMOOTH AND FREE FROM WARP AND ALL EDGES SMOOTH, STRAIGHT AND VERTICAL.

ALL PLATE CUTS SHALL BE MACHINE OR MACHINE FLAME CUTS.

ANCHOR BOLTS SHALL BE THREADED 3" PROVIDE ONE STANDARD WROUGHT WASHER AND ONE HEX. NUT PER BOLT.

ALL MATERIAL INCLUDING SHIMS BUT EXCLUDING ANCHOR BOLTS, PINTLES, NUTS AND WASHERS SHALL BE MADE OF A588 STEEL. PINTLES SHALL BE MADE OF A449 STEEL.

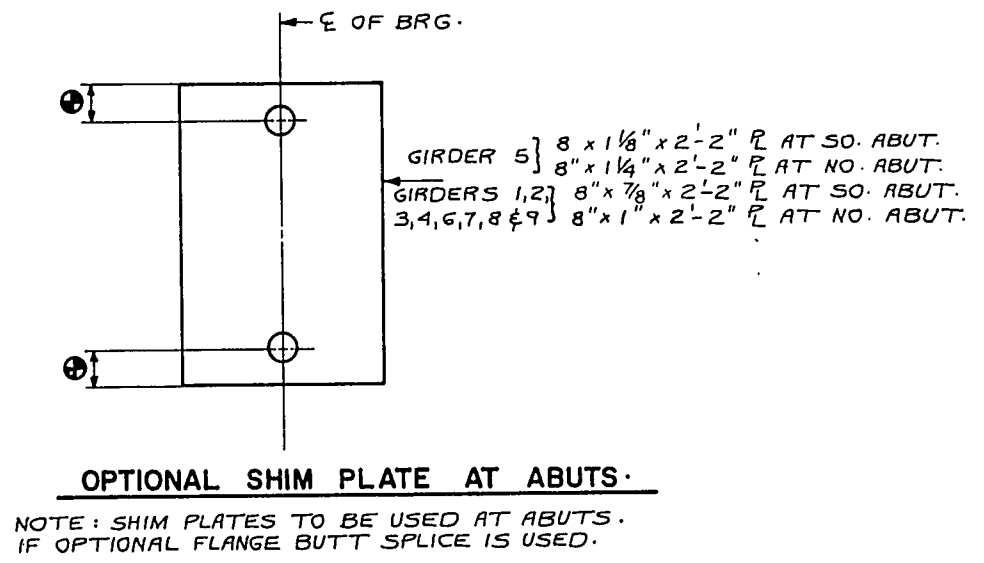
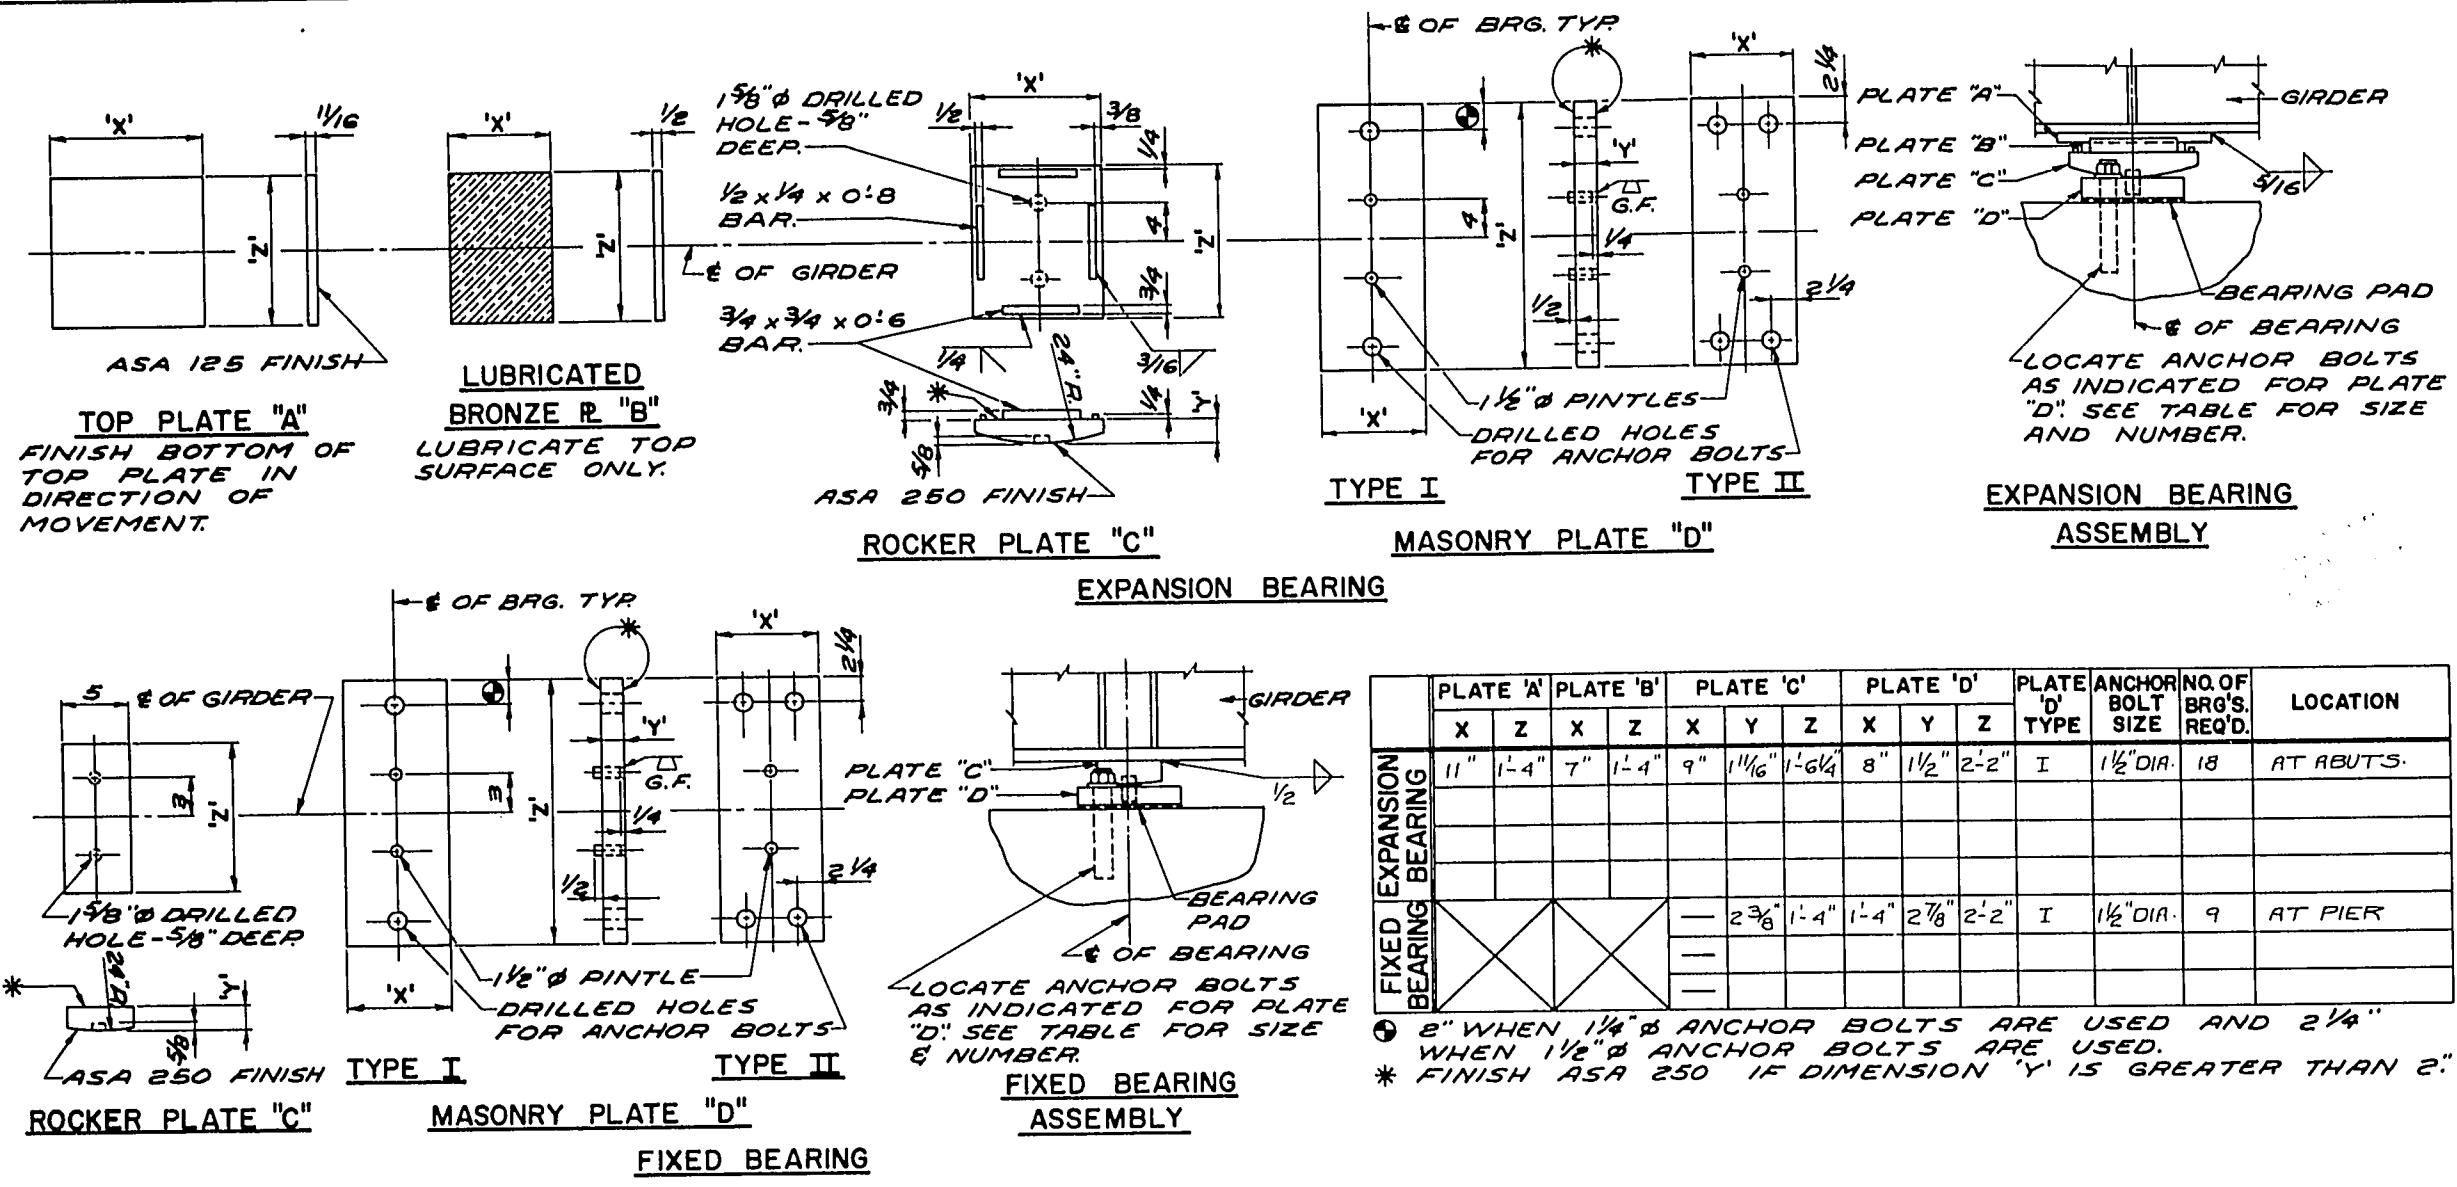
ALL MATERIAL IN BEARINGS, EXCLUDING BRONZE PLATES AND BEARING PADS SHALL BE PAID FOR AT THE UNIT PRICE BID FOR "STRUCTURAL LOW ALLOY STEEL".

CHAMFER TOP OF PINTLES $\frac{1}{8}$ " DRILL HOLES FOR PINTLES IN ALL MASONRY PLATES FOR DRIVING FIT.

PROVIDE $\frac{1}{8}$ " THICK BEARING PAD SAME SIZE AS MASONRY PLATE "D" FOR EACH BEARING.

ANCHOR BOLTS SHALL BE OF A SIZE AS GIVEN IN THE TABLE. LENGTH OF $1\frac{1}{4}$ " ϕ ANCHOR BOLTS TO BE 1-5. LENGTH OF $1\frac{1}{2}$ " ϕ ANCHOR BOLTS TO BE 1-10. PROJECT ANCHOR BOLTS "D" PLATE THICKNESS + $2\frac{1}{4}$ " ABOVE TOP OF CONCRETE. DRILLED HOLES FOR ANCHOR BOLTS IN PLATE "D" SHALL HAVE A DIAMETER $\frac{3}{8}$ " LARGER THAN THE ANCHOR BOLT DIAMETER.

ALL FINISHED SURFACES SHALL BE MACHINE FINISHED BY AN AUTOMATIC PROCESS.






No.	Date	Revision	By
STATE OF WISCONSIN DEPARTMENT OF TRANSPORTATION DIVISION OF HIGHWAYS			
STRUCTURE B-3-38			
Const. Spec.	1969	Drawn By	L.N.F.
		Plans Checked	KOK
BEARING DETAILS			SHEET 17 OF 20
			X47277

PROJECT ID	SHEET NUMBER	TOTAL SHEETS
1197-6-72	56	225
FEDERAL PROJECT DESIGNATION		
DPF08-4(41)		






LEGEND

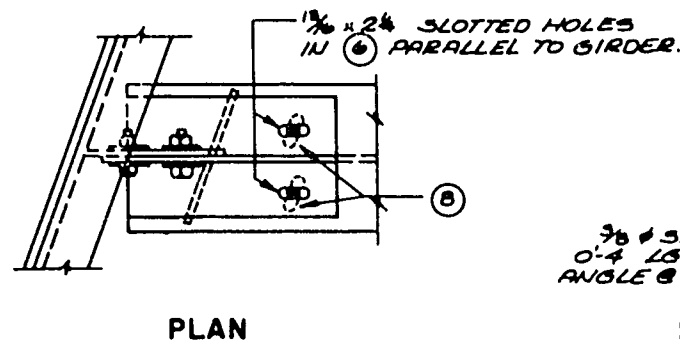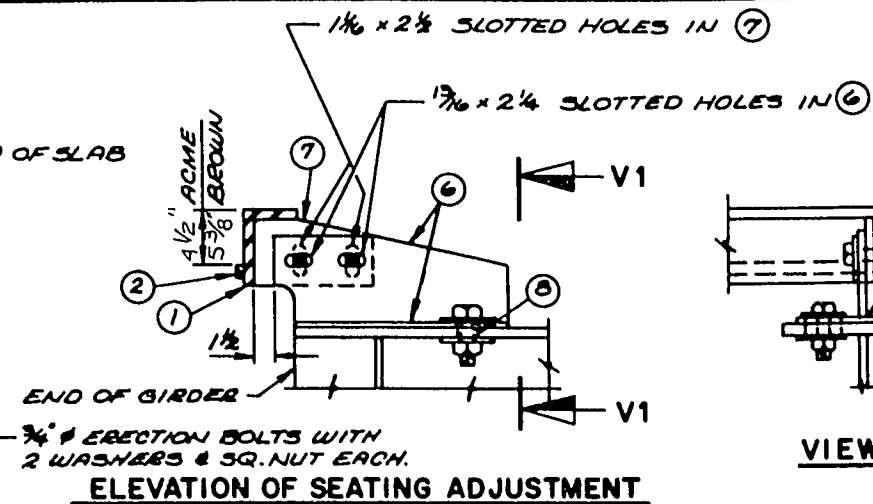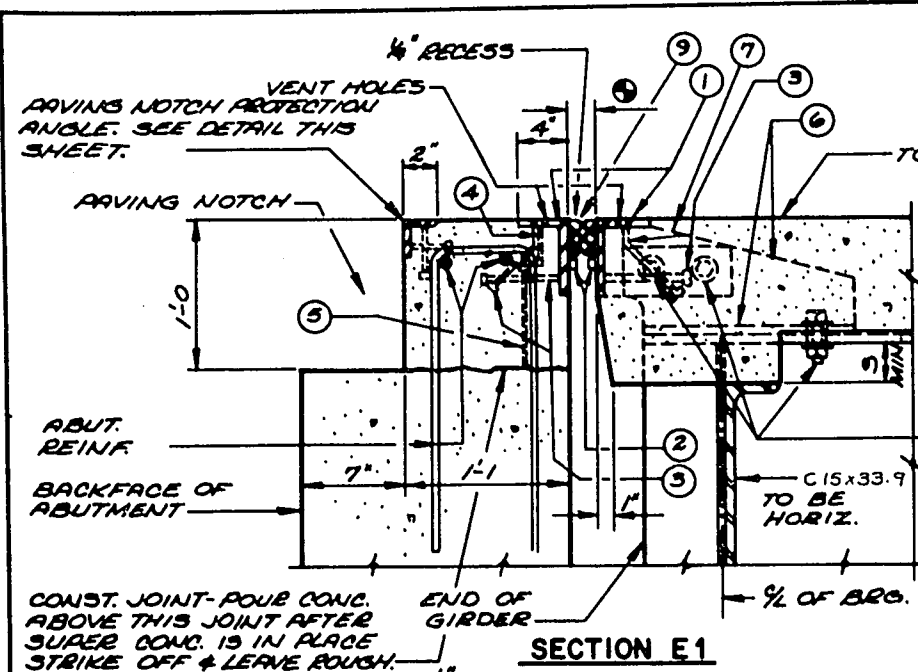- ① *** WITH $\frac{1}{8}$ " VENT HOLES AT 2'-0" CTRS AND $\frac{1}{8}$ " HOLES FOR BOLT ⑩ AT 5'-0" CTRS. ANGLE FACES MUST BE PARALLEL WITHIN $\pm \frac{1}{16}$ " BETWEEN STEEL SPACERS ⑪.
- ② RETAINER BAR 1" x $\frac{1}{4}$ " WELD TO ① AS SHOWN.
- ③ $\frac{3}{8}$ " x 0'-6" LONG STUDS AT 1'-0" ALTERNATE CTRS. WELD TO ①.
- ④ L 3" x 2 $\frac{1}{2}$ " x $\frac{3}{8}$ " x 0'-3" 5'-0" CTRS. WELD TO ①. PROVIDE $\frac{1}{8}$ " HOLE IN 2 $\frac{1}{2}$ " LEG FOR ROD ⑤.
- ⑤ $\frac{3}{8}$ " x 0'-10" LONG WITH NUT. TACK WELD NUT TO BOTTOM OF ④. THREAD 5".
- ⑥ FABRICATE FROM $\frac{3}{8}$ " WELDED PLATES. 2- $\frac{1}{4}$ " x 2 $\frac{1}{2}$ " SLOTTED HOLES IN BASE PLATE PARALLEL TO $\frac{1}{4}$ " OF GIRDER. 2- $\frac{1}{4}$ " x 2 $\frac{1}{2}$ " SLOTTED HOLES IN STEM PLACED HORIZONTALLY.
- ⑦ $\frac{3}{8}$ " PLATE. WELD TO LEGS OF ① WITH $\frac{3}{8}$ " FILLET WELD NEAR SIDE AND FAR SIDE. 2- $\frac{1}{4}$ " x 2 $\frac{1}{2}$ " SLOTTED HOLES PLACED VERTICALLY.
- ⑧ 2- $\frac{1}{4}$ " x 1 $\frac{1}{2}$ " SLOTTED HOLES IN GIRDER FLANGE FOR 2- $\frac{3}{8}$ " ERECTION BOLTS. SLOT TO BE PARALLEL TO $\frac{1}{4}$ " OF BEARING. CLEAR BEARING STIFFENER BY 1 $\frac{1}{2}$ " MIN.
- ⑨ REFORMED B-610 ACME OR H-3500 BROWN NEOPRENE SEAL. EDGE OF SLAB TO EDGE OF SLAB.
- ⑩ BLOCK AND BOLT FOR SHIPMENT AND ERECTION. PIPE SLEEVE, STEEL SPACER AND $\frac{1}{2}$ " BOLT AT 5'-0" CTRS.
- ⑪ $\frac{3}{8}$ " PLATE - SHAPE TO FIT. SHOP WELD TO ①.
- ⑫ RETAINER BAR $\frac{1}{2}$ " x $\frac{1}{4}$ ". WELD TO PLATE ⑪ AS SHOWN.
- ⑬ $\frac{3}{8}$ " x 0'-6" LONG STUDS. WELD TO PLATES ⑪ AND ⑫.
- ⑭ $\frac{3}{8}$ " PLATE - PLACE FLUSH WITH FACE OF RAIL AND MEDIAN PARAPET AS SHOWN. SHOP WELD TO ① AND PLATE ⑪ AT CURB. AT MEDIAN PARAPET, WELD TO ①.



PAVING NOTCH PROTECTION ANGLE

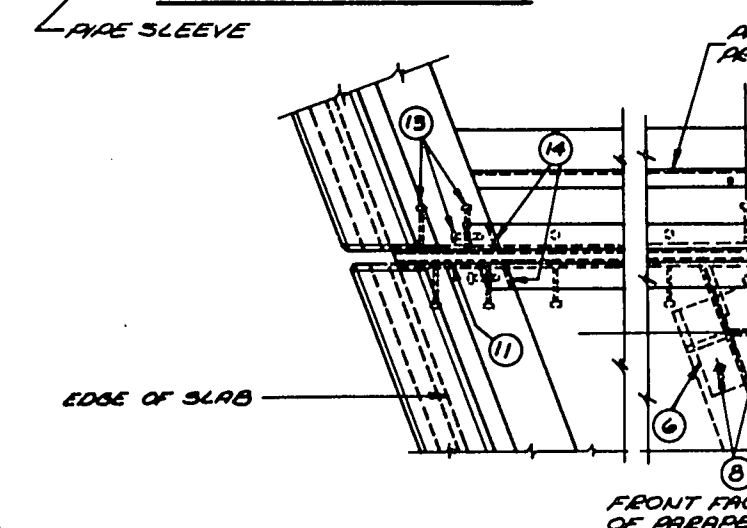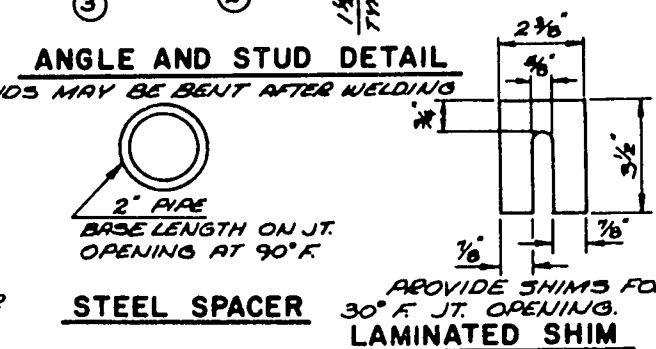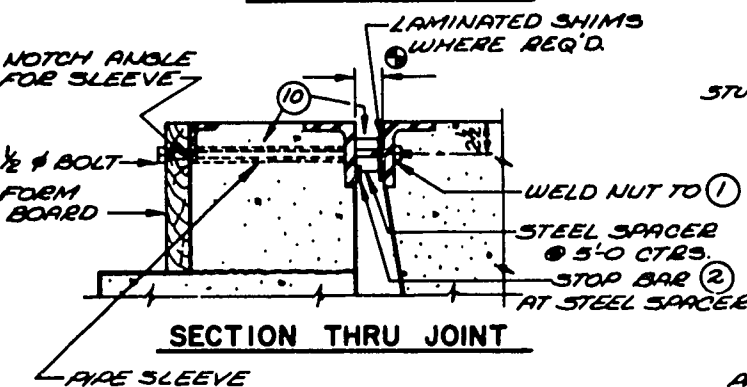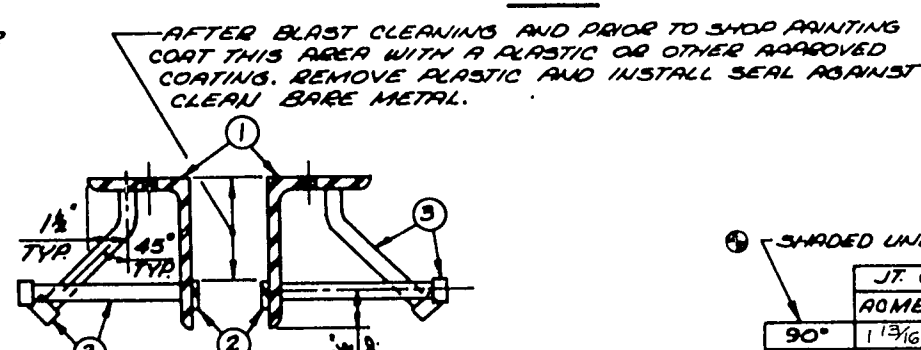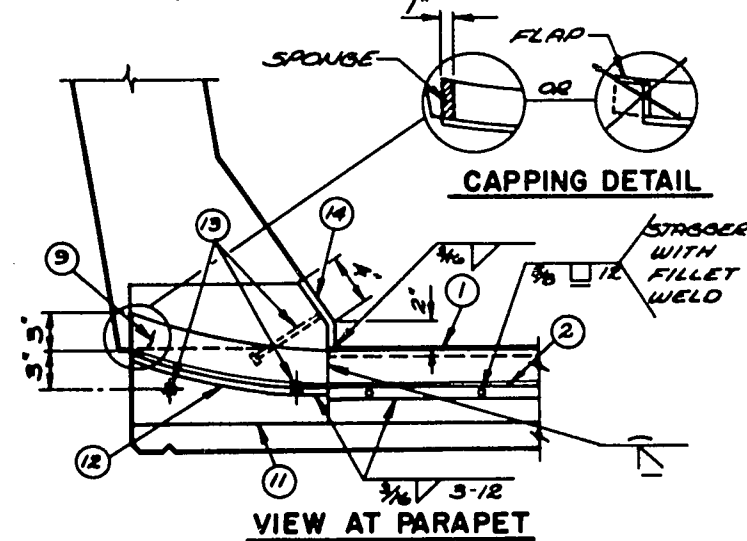
NOTE: ONE FIELD SPALICE PERMITTED IF USED, DETAILS SHALL BE SUBMITTED FOR APPROVAL. ANGLE AND STUDS SHALL BE PAID FOR AS STRUCTURAL CARBON STEEL. PLACE ONE PROTECTION ANGLE AT EACH ABUTMENT.



SHADED UNDERSIDE DECK TEMP (F)	JT. OPENING	ACME	BROWN
90°	1 13/16"	1 7/8"	
80°	1 15/16"	1 5/8"	
70°	2"	2"	
60°	2 1/8"	2 1/8"	
50°	2 1/4"	2 3/16"	
40°	2 5/16"	2 5/16"	
30°	2 7/16"	2 3/8"	


TEMPERATURE TABLE

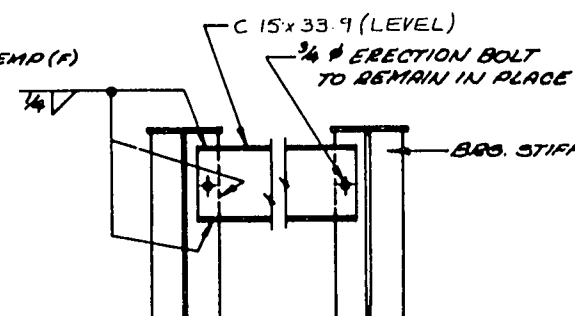MAXIMUM PRACTICAL INSTALLATION TEMPERATURE IS 81° FOR ACME SEAL. 86° FOR BROWN SEAL.



END DIAPHRAGM CONN. DETAIL

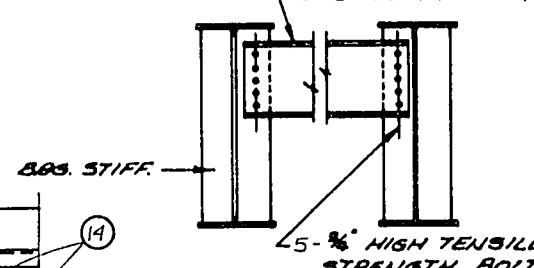
(L 5" x 5" x 5/16" NOT SHOWN) C 15 x 33.9 (LEVEL)



ALTERNATE BOLTED DIAPHRAGM DETAIL

(L 5" x 5" x 5/16" NOT SHOWN)

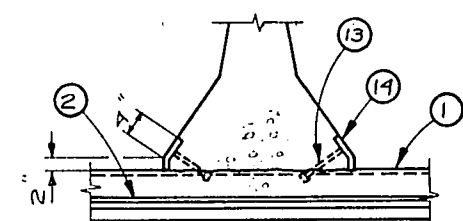L 5" x 5" x 5/16" TO BE PLACED THE SAME WAY AS THE PIER L 5" x 5" x 5/16"




SECTION THRU MEDIAN PARAPET AT JOINT

NOTES

CAPPING DETAIL - PROVIDE EITHER: SCE-42B CLOSED CELL NEOPRENE SPONGE CONFORMING TO ASTM D1056-67T, 1" THICK CUT TO MATCH THE UNCOMPRESSED SEAL CROSS SECTION AND CEMENTED IN PLACE WITH THE LUBRICANT ADHESIVE, OR A FLAP FORMED BY CUTTING AWAY ALL BUT THE TOP SURFACE OF THE SEAL THEN BENT DOWN AND CEMENTED IN PLACE. EXPANSION JOINT SHALL BE BUILT TO CONFORM TO ROADWAY CROWN AND GRADE. ALL MATERIAL IN EXPANSION JOINT EXCEPT NEOPRENE SEAL SHALL BE PAID FOR AS STRUCTURAL CARBON STEEL. AFTER CONCRETE HAS SET, BLOCKING ⑬ SHALL BE REMOVED AND THE JOINT OPENING SHALL BE THOROUGHLY CLEANED. ONE FIELD SPALICE PERMITTED. IF USED, DETAILS SHALL BE SUBMITTED FOR APPROVAL.

No.	Date	Revision	By
STATE OF WISCONSIN DIVISION OF TRANSPORTATION DIVISION OF HIGHWAYS			
STRUCTURE B-3-38			
Cons. Sect.	1969	Drawn By	L.N.F.
		Plant Checkers	KOK
NEOPRENE SEAL EXPANSION JOINT			SHEET 18 OF 20
			X47278

NR.	STATION	DESCRIPTION	ELEV.
19	335'E+20	6" ELM 510' LT.	1093.46

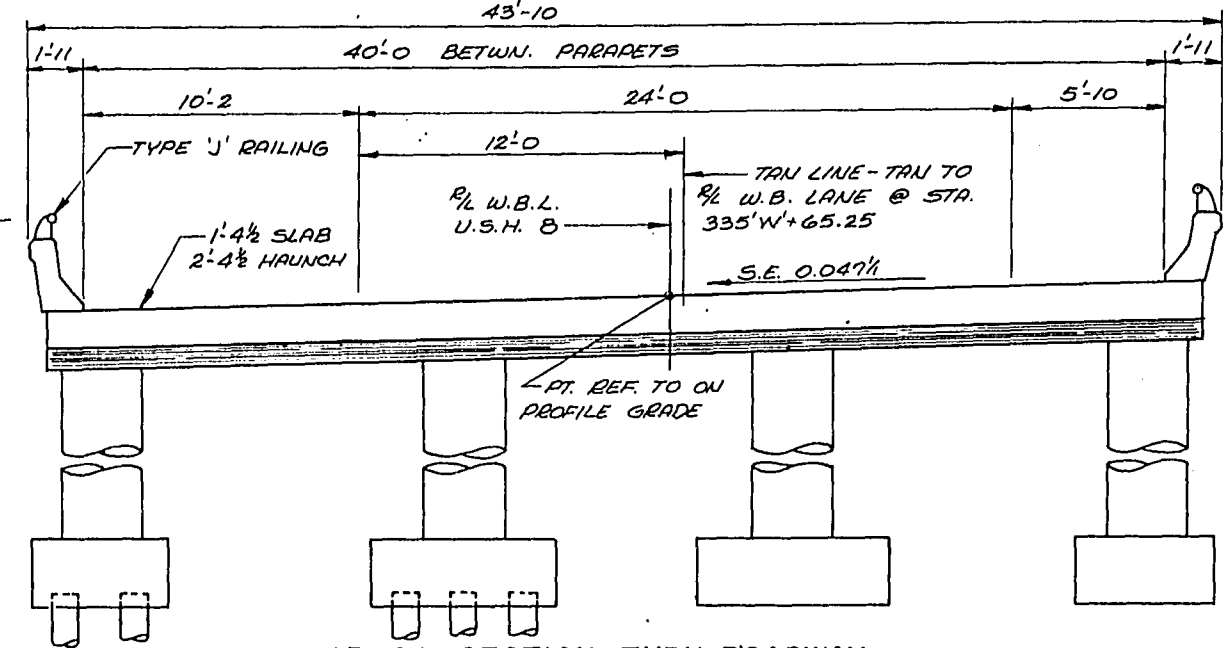

CROSS SECTION THRU ROADWAY
(LOOKING EAST)

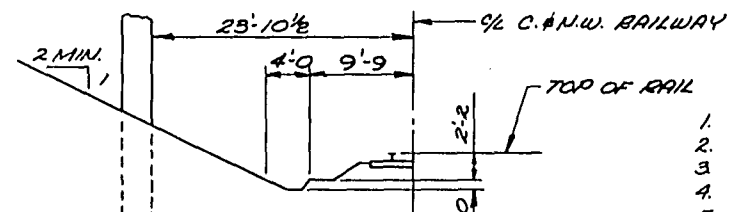
GENERAL NOTES

DRAWINGS SHALL NOT BE SCALED.
BAR STEEL REINFORCEMENT SHALL BE IMBEDDED 2" CL. UNLESS OTHERWISE SHOWN OR NOTED.
THE FINISHED GRADED SECTION WAS USED AS THE UPPER LIMITS OF EXCAVATION FOR COMPUTATION OF EXCAVATION QUANTITIES AT THE PIERS.
THE UPPER LIMITS OF EXCAVATION FOR STRUCTURES SHALL BE THE TOP OF BERM ELEVATION AT THE ABUTMENTS AND THE QUANTITIES WERE COMPUTED FROM THIS LINE.
PREBORE ABUTMENT PILING TO ORIGINAL GROUNDLINE.

DITCH WAS MODIFIED TO FIT EXISTING DRAINAGE REQUIREMENTS

LIST OF DRAWINGS

1. GENERAL PLAN X47233
2. SUBSURFACE EXPLORATION X47234
3. WEST ABUTMENT X47235
4. EAST ABUTMENT X47236
5. PIERS 1 & 2 X47237
6. SUPERSTRUCTURE X47238
7. SUPERSTRUCTURE X47239
8. SLOPED FACE PARAPET 'A' X47240
9. TUBULAR RAILING TYPE 'J' X47241



TYPICAL SECTION THRU
C. & N.W. RAILROAD
(NORMAL TO 1/2" RAILROAD)

DESIGN DATA

LIVELOAD: H320
ALLOWABLE DESIGN STRESSES:
CONCRETE MASONRY, GRADE 'AA'
BAR STEEL REINFORCEMENT
FUTURE WEARING SURFACE


$f_c = 4,400 \text{ p.s.i.}$
 $f_s = 20,000 \text{ p.s.i.}$
 20 LB/FT^2

FOUNDATION DATA




PLACE ABUTS ON 10 3/4" CAST-IN-PLACE CONCRETE PILING DRIVEN TO 40 TONS/PILE MIN. BEG. EST. PILE LENGTH 50'-0".
PLACE PIERS ON 10 3/4" CAST-IN-PLACE CONCRETE PILING DRIVEN TO 55 TONS/PILE MIN. BEG. EST. PILE LENGTH 35'-0".

TOTAL ESTIMATED QUANTITIES

BID ITEMS	UNIT	SUPER	W. ABUT.	PIER 1	PIER 2	E. ABUT.	TOTAL
EXCAVATION FOR STRUCTURES	C.Y.		36	77	77	36	226
CAST-IN-PLACE CONCRETE PILING	L.F.		137			144	281
CONCRETE MASONRY	C.Y.	332.5	33.4	42.8	42.9	33.4	485.0
BAR STEEL REINFORCEMENT	LB	84,630	2,325	5,670	5,700	2,325	97,650
STRUCTURAL CARBON STEEL	LB	450					450
CAST-IN-PLACE CONCRETE PILING, DELIVERED & DRIVEN 10 3/4" INCH	L.F.		300	630	630	300	1,860
TUBULAR RAILING - TYPE 'J'	L.F.	276					276
NON-BID ITEMS							
1/8" ALUMINUM OR ZINC PLATE	S.F.	40					40
FILLER	SIZE	1/2" # 1/2					1/2" # 1/2
POLYVINYL CHLORIDE WATERSTOP	L.F.	41				41	82

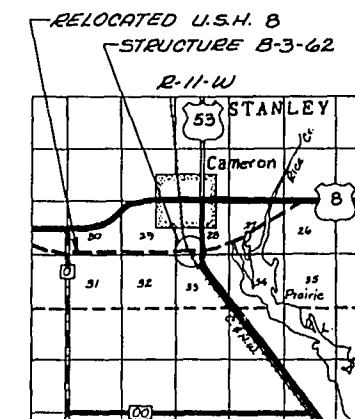

No.	Date	Revision	By
STATE OF WISCONSIN DEPARTMENT OF TRANSPORTATION DIVISION OF HIGHWAYS			
STRUCTURE B-3-62			
U.S. 8 OVER C. & N.W. RAILWAY			
County	BARRON	City	STANLEY
Design Spec.	A.A.S.H.O. '69	Load	HS20
Designed By	J.R.L.	Checked By	M.S.R.
Drawn By	R.J.G.	Planned By	B.W.
Approved	W.A. Klein	Date	3.3.12
Chief Bridge Engineer			Date
GENERAL PLAN			SHEET 1 OF 9
			X47233

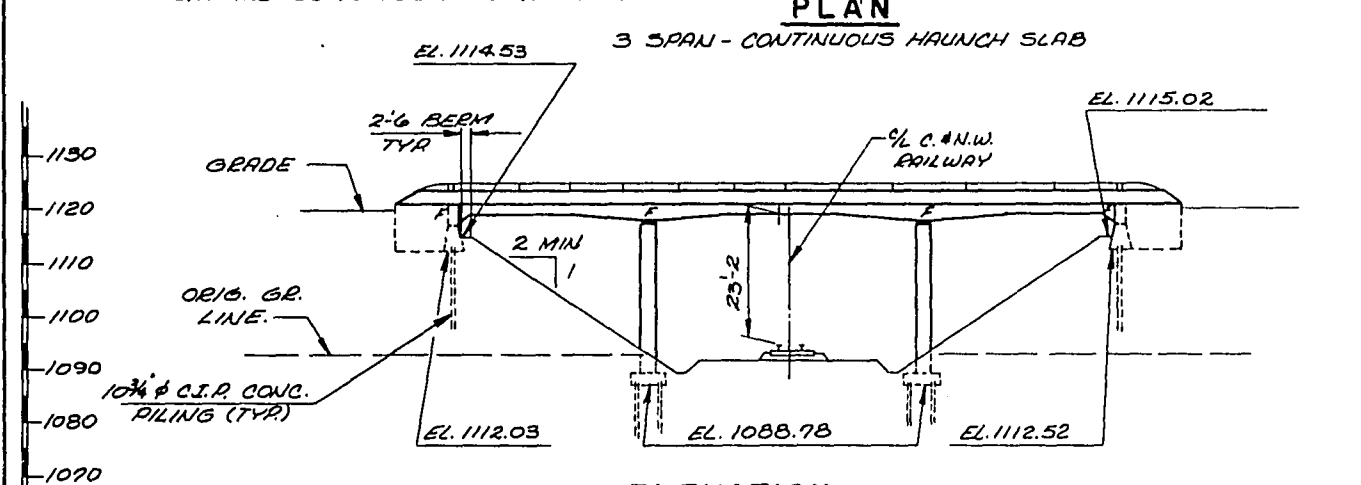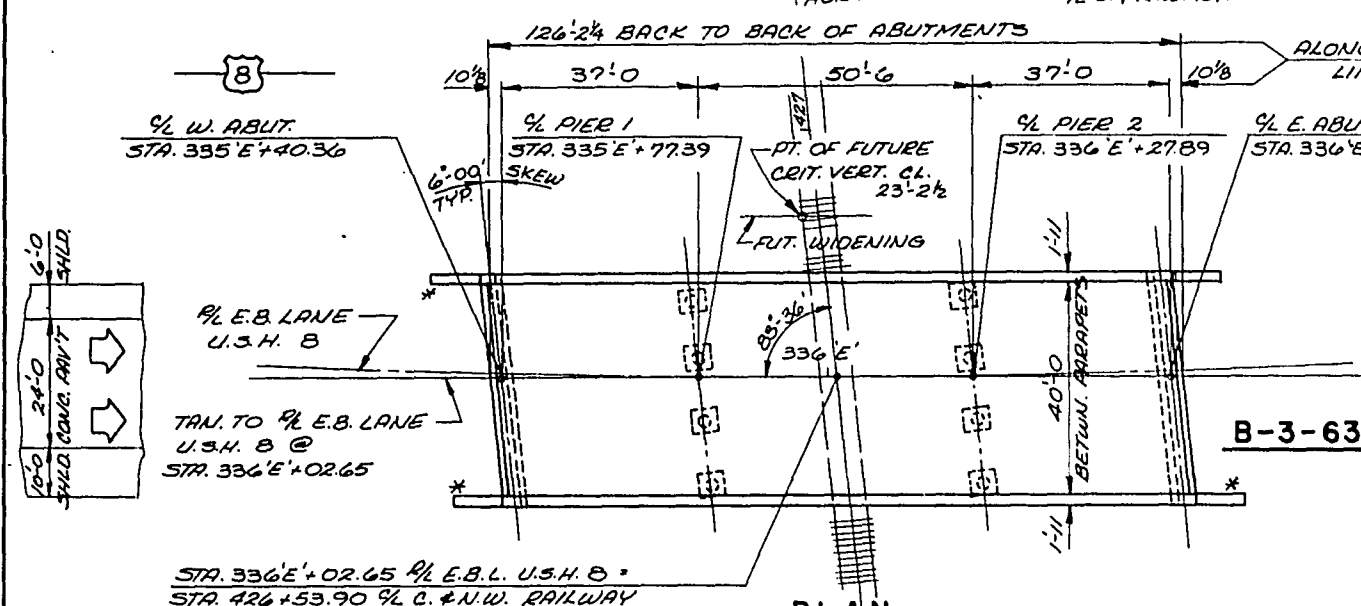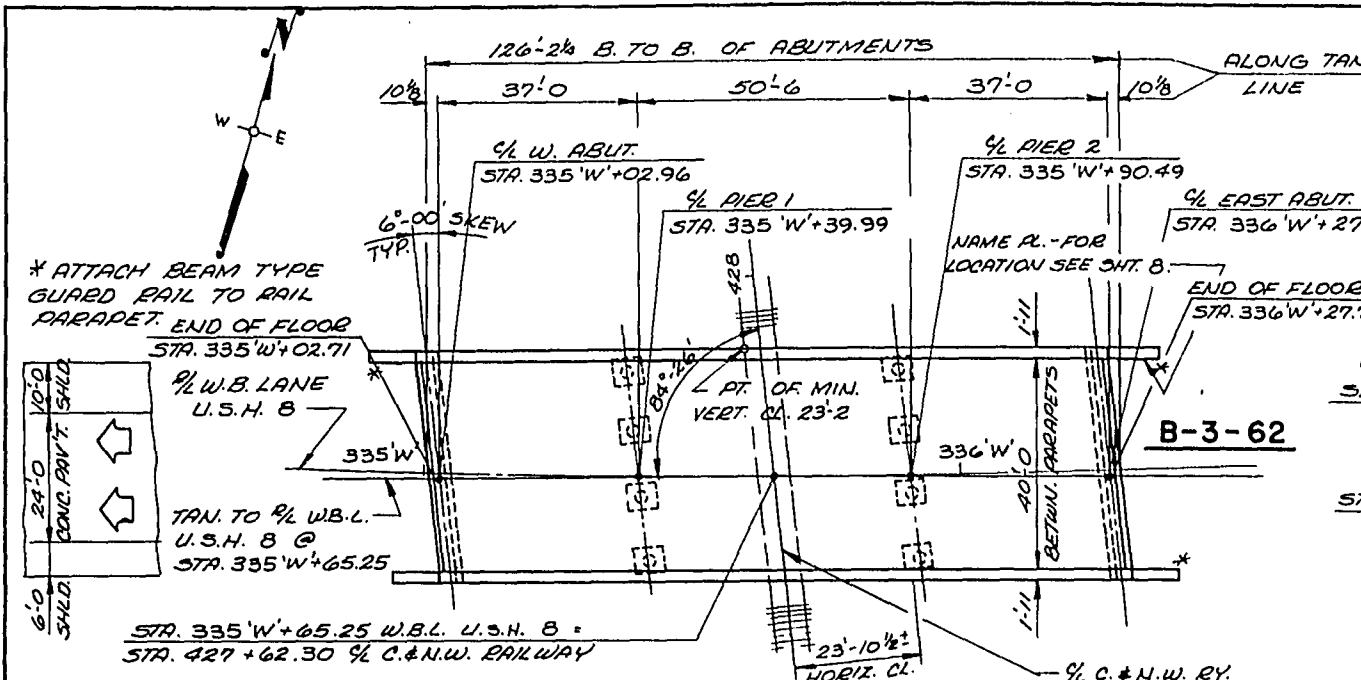

TRAFFIC VOLUME

A.D.T. = 6,100 (1996)
R.D.S. = 80 M.A.H.
D.H.V. = 915

CURVE DATA

W.B. LANE
RT. = 330'W+27.6 BK
Δ = 16'-25'-28" LT.
D = 1'-00'
T = 826.9'
L = 1,642.4'
P = 5,729.6'
SE = 0.047%

E.B. LANE
RT. = 331'E+38.9 BK
Δ = 18'-21'-47" LT.
D = 1'-00'
T = 926.1'
L = 1,836.3'
P = 5,729.6'
SE = 0.047%

PROFILE GRADE - C. & N.W. RAILWAY

STA. 98+12.00.00 EL. 1094.46
STA. 99+12.00.00 EL. 1094.56
STA. 100+12.00.00 EL. 1094.84
STA. 101+12.00.00 EL. 1094.97

PROJECT ID	1572-1-72	SHEET NUMBER	92	TOTAL SHEETS	225
FEDERAL PROJECT DESIGNATION	F021-1 (57)				

ABBREVIATIONS		
F — Fine	M — Medium	C — Coarse
Ws — Weathered	So — Sound	

MATERIAL SYMBOLS		
Topsoil	Silt	Sandstone
Sand	Peat	Limestone
Gravel	Clay	Igneous Rock

LEGEND OF PROBING	
Probing No.	Sta.
95/6=95 Blows for 6"	Elevation
Penetration	7 Average Blows Per Foot
Probing taken with a 350# wt.	
Falling 18" on a 2" O. D. Point.	Refusal 95/6


LEGEND OF BORING	
Boring No.	Sta.
Elev.	
Unconfined Strength	7.7
Blows Per Ft. Using 140# Wt. Falling 30"	7
Wash Sample	
Shelby Tube	S. T.
Ground Water Elevation	
No Ground Water Observed Above This Elevation	
	Sandy Gravel
	F.
	Boulders or Cobbles
	Sand
	Silty Clay
	So
	Limestone


Unless otherwise specified, the blows per foot at the locations indicated are based on driving a 2" O. D. x 1.4" I. D. split spoon sampler with a 140# hammer having a free fall of 30". The blow count is taken in undisturbed soil immediately below a cased or open hole eliminating side friction on the drive pipe.

SUBSURFACE EXPLORATION FOR FOUNDATION DESIGN AND BIDDERS INFORMATION

To obtain relative data concerning the character of material in and upon which the foundation might be built, borings and/or soundings were made at points approximately as indicated on this drawing. The data presented herein represents the findings of the subsurface explorations made. However, because the depths investigated are limited and the area of the borings and/or soundings is very small in relation to the entire area, the Division of Highways does not warrant conditions below the depths investigated or that the classification of material encountered in these investigations is necessarily typical of the entire site.

No.	Date	Revision	By
STATE OF WISCONSIN DEPARTMENT OF TRANSPORTATION DIVISION OF HIGHWAYS			
STRUCTURE B-3-62			
Const. Spec.	1969	Drawn By	DB
		Plans Checked	B. W.
SUBSURFACE EXPLORATION			SHEET 2 OF 9
			X 47234

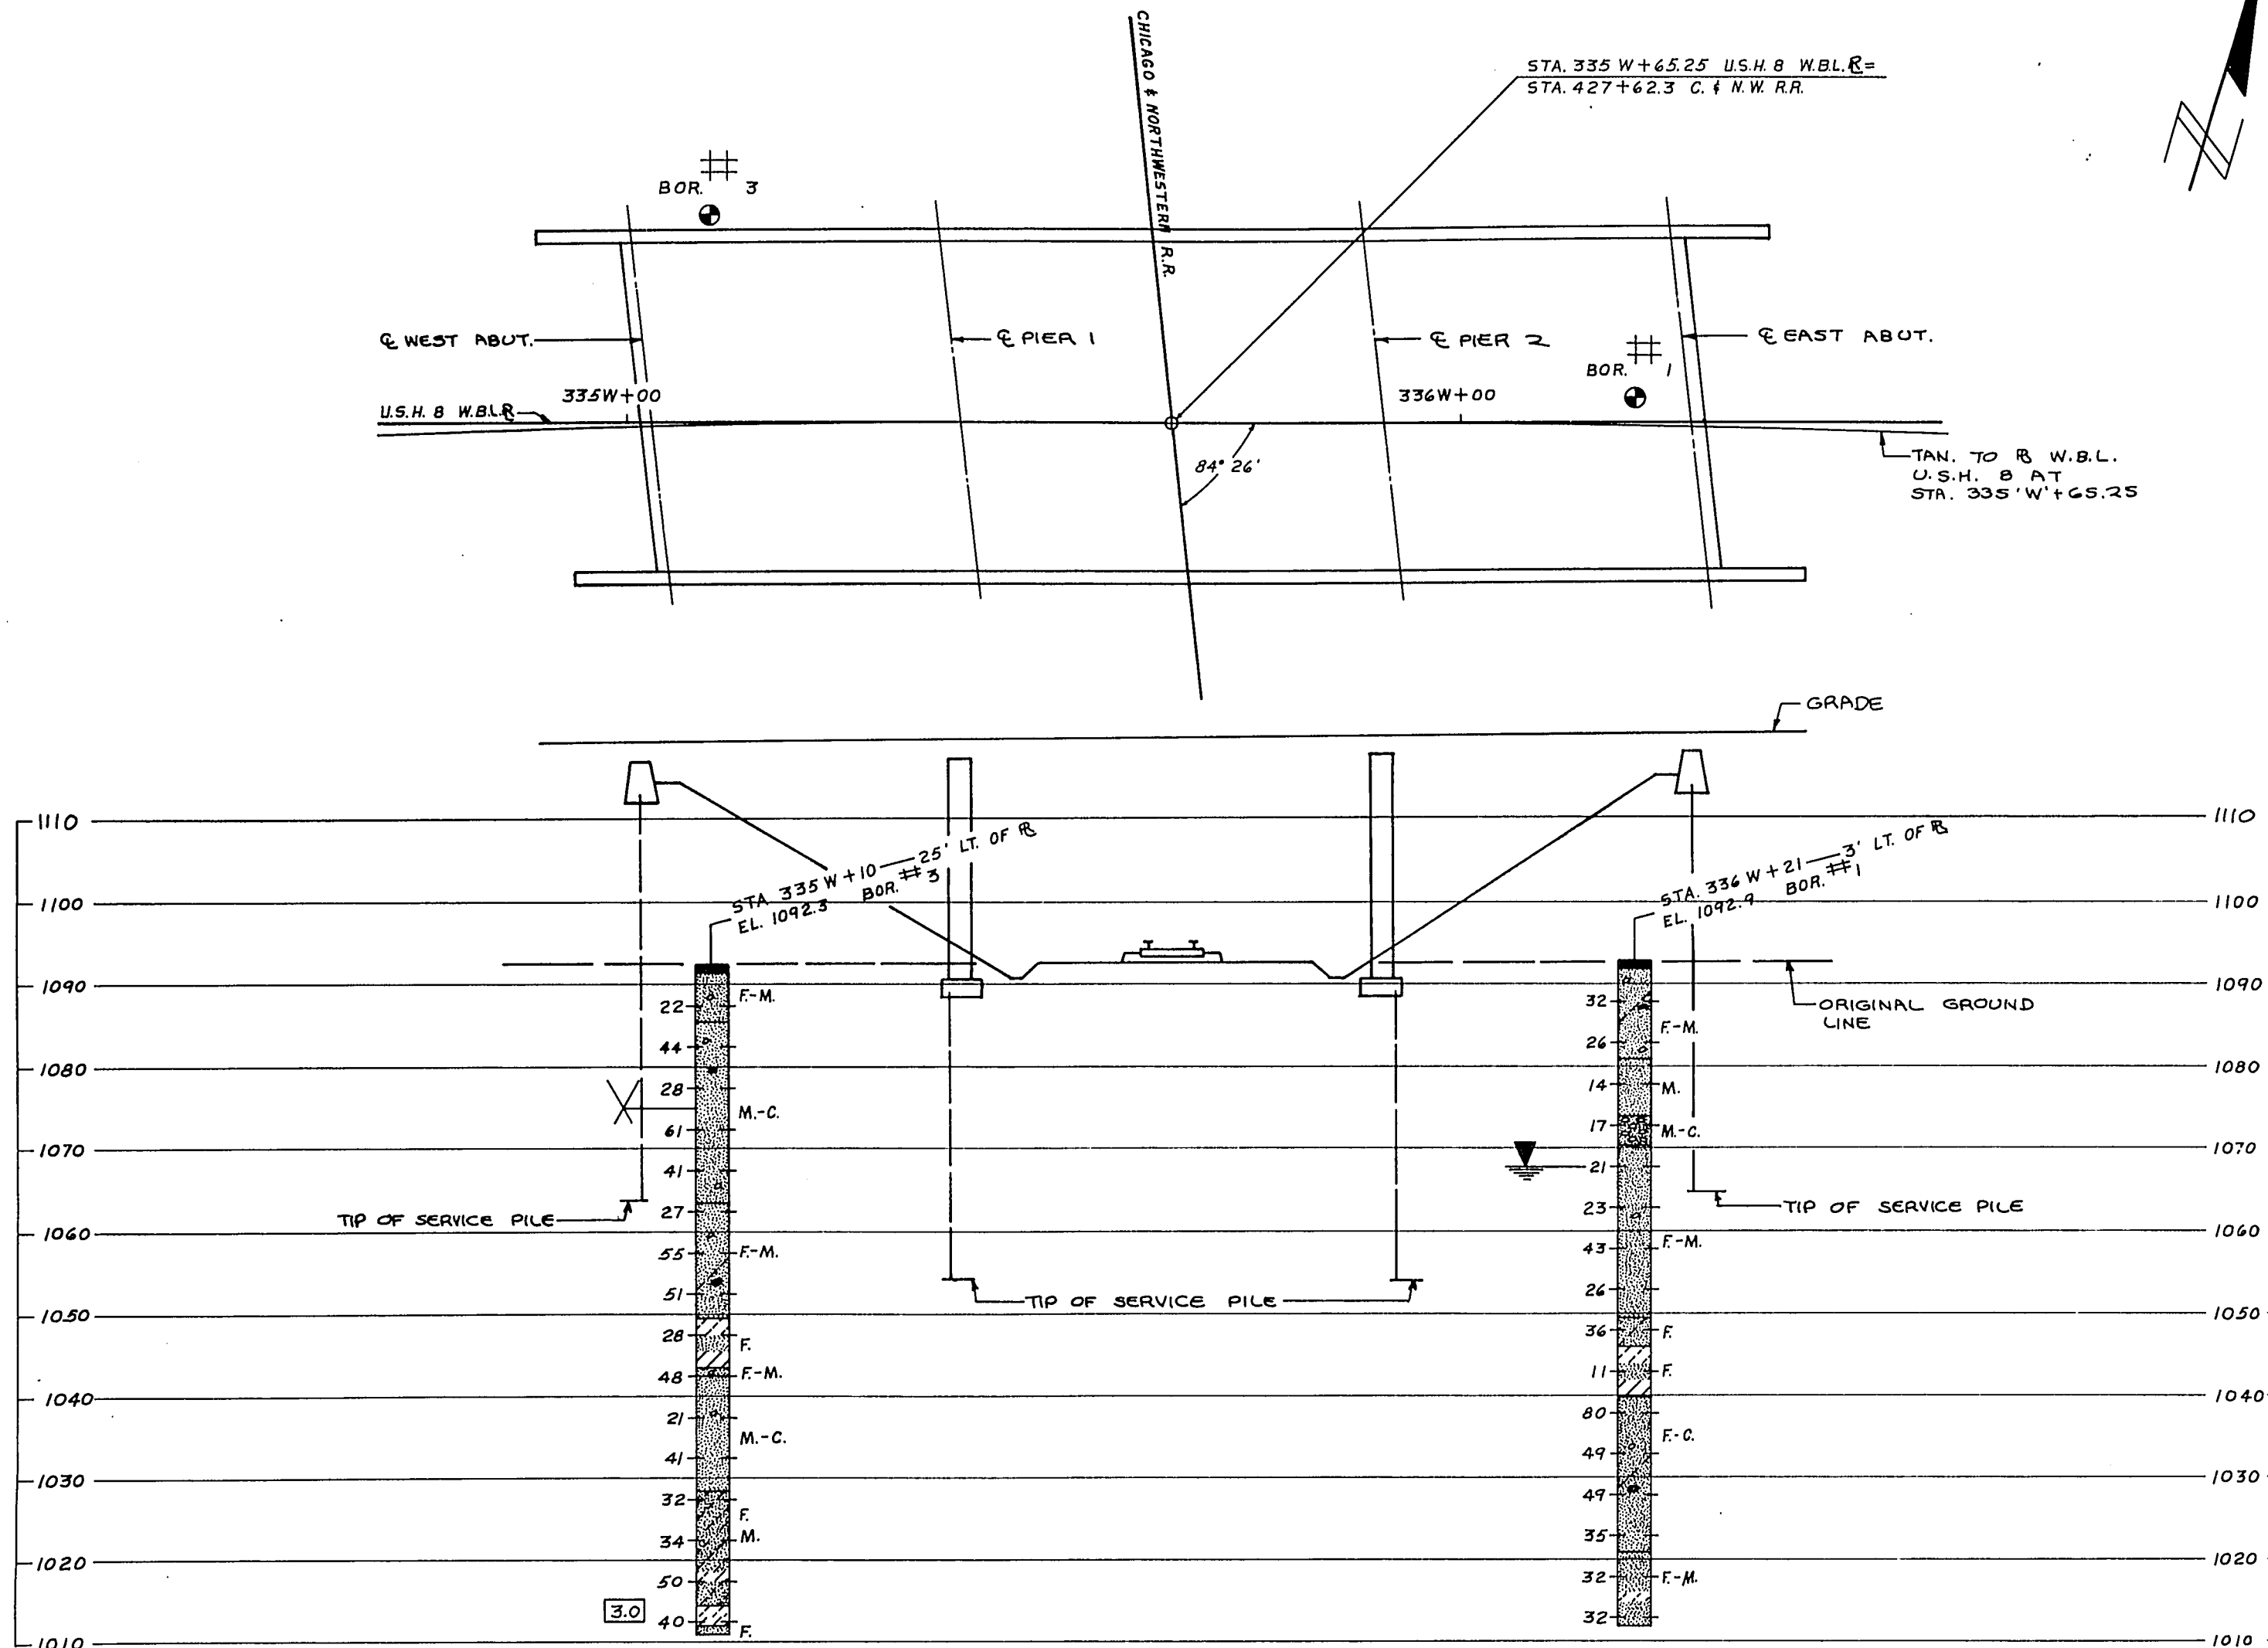

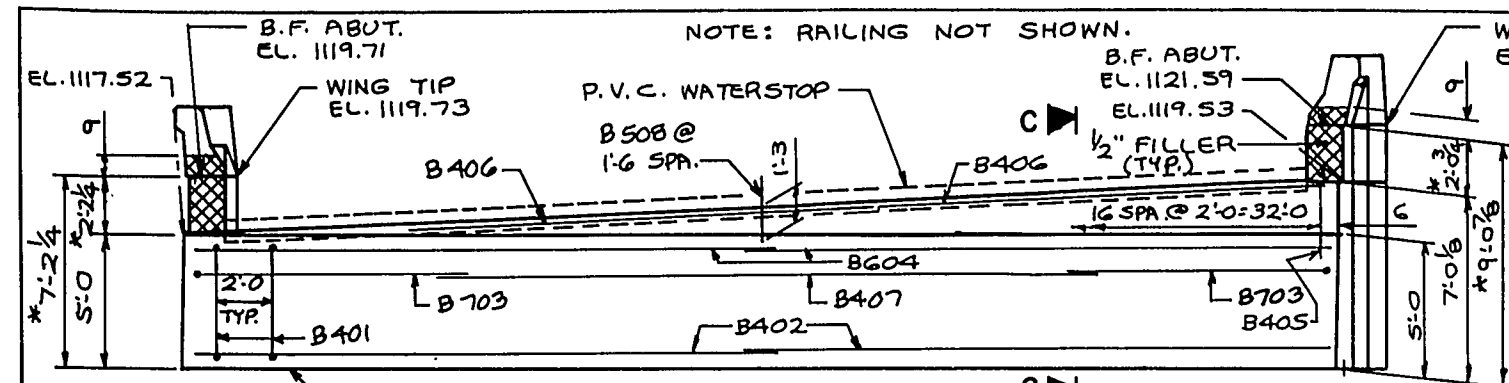


*DIMENSIONS GIVEN AT B.F. OF ABUT.

ELEVATION
(LOOKING EAST)

NOTE:
SEAL ALL EXPOSED HORIZ. AND VERT. SURFACES OF 1/2" FILLER WITH NON-STAINING GRAY NON-BITUMINOUS JOINT SEALER (1" DEEP AND HOLD 1/2" BELOW SURFACE OF CONCRETE)

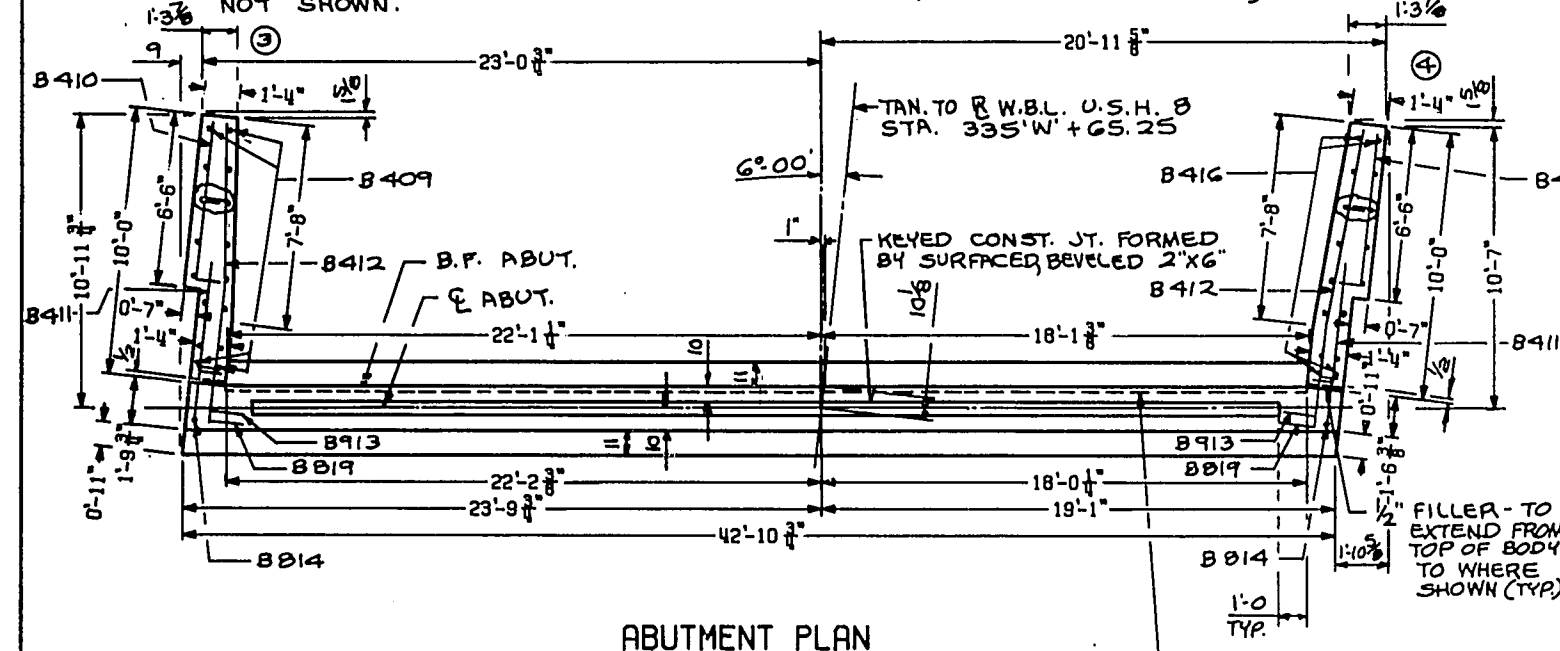NOTE:
RAILING AND RAIL PARAPET NOT SHOWN.




ABUTMENT PLAN

POLYVINYL CHLORIDE WATERSTOP TO EXTEND BETWEEN INSIDE FACES OF WINGS (FLUSH WITH FACE OF CONCRETE) SEE DETAIL ON SHEET 3.


KEYED CONST. JOINT FORMED BY SURFACED, BEVELED 2" X 6". POUR CONCRETE ABOVE THIS JOINT AFTER SUPER. CONCRETE IS IN PLACE.

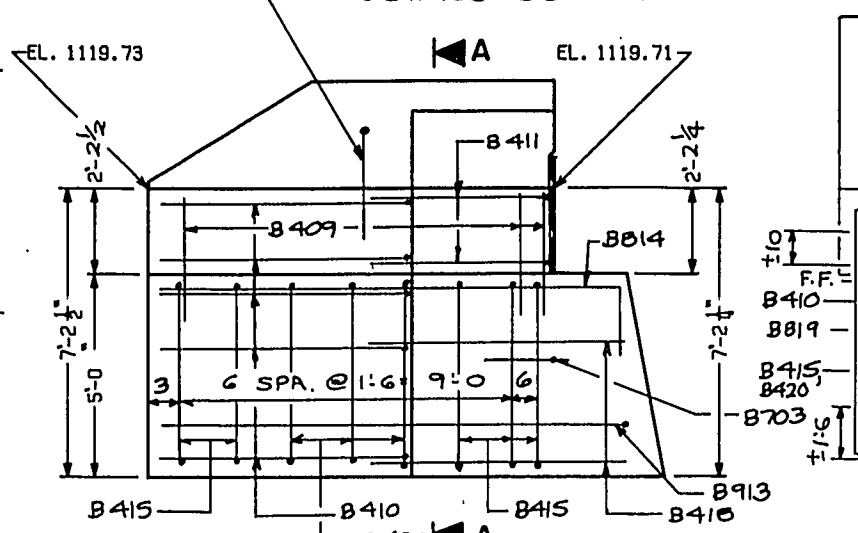FOR RAIL PARAPET REINF. AND DETAILS SEE SHEET 8.



WING 3 ELEVATION

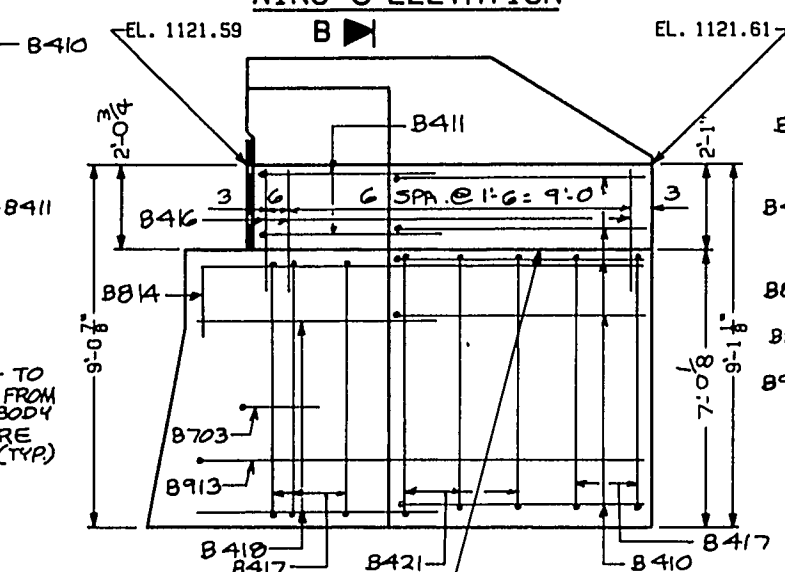SECTION A




WING 4 ELEVATION


SECTION B

NOTE:
FILL TO EL. 1115.02 BEFORE DRIVING PILING. UPPER LIMITS OF 'EXCAVATION FOR STRUCTURES' SHALL NOT EXCEED THIS ELEVATION.

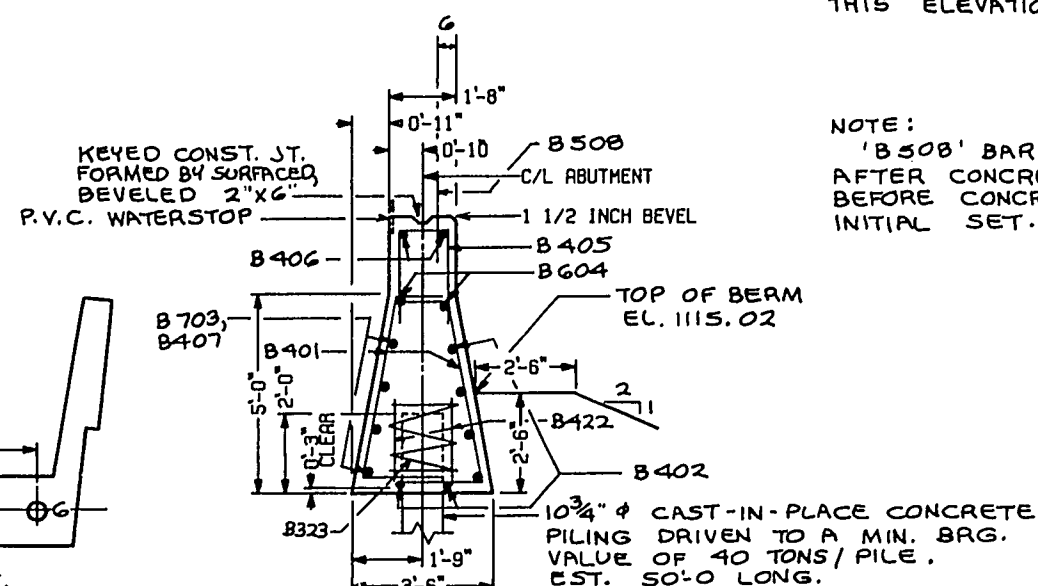NOTE:
'B508' BARS MAY BE PLACED AFTER CONCRETE IS POURED BUT BEFORE CONCRETE HAS TAKEN ITS INITIAL SET.



SECTION C

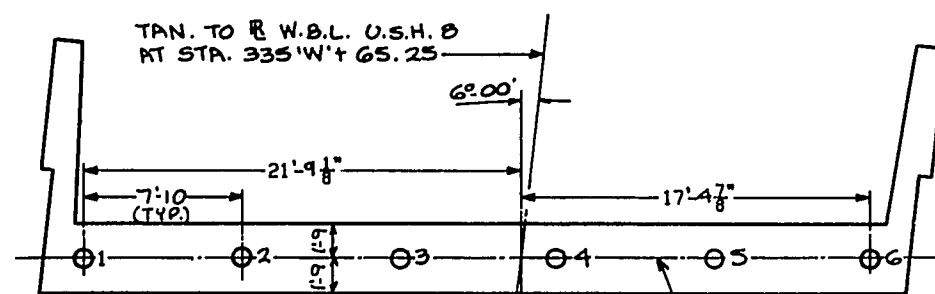


PILE PLAN

PROJECT NO.	1572-1-72	SHEET NUMBER	94	TOTAL SHEETS	225
FEDERAL PROJECT DESIGNATION	F021-1(57)				
1,980 #					

BILL OF BARS

MARK	NO.	LENGTH	BENT	LOCATION
B401	44	7-10	X	BODY
B402	12	21-9		BODY
B703	8	10-0	X	BODY
B604	4	22-0		BODY
B405	17	6-10	X	BODY
B406	4	16-9		BODY
B407	4	25-6		BODY
B508	26	2-6		BODY
B409	16	3-0		WING 3
B410	16	7-1	X	WINGS 3 & 4
B411	6	5-5	X	WINGS 3 & 4
B412	6	10-6	X	WINGS 3 & 4
B413	10	12-3	X	WINGS 3 & 4
B414	2	12-5	X	WINGS 3 & 4
B415	10	6-5	X	WING 3
B416	6	2-11		WING 4
B417	10	8-5	X	WING 4
B418	8	5-10		WINGS 3 & 4
B419	2	11-8	X	WINGS 3 & 4
B420	6	6-11	X	WING 3
B421	6	8-11	X	WING 4
B422	12	2-3		BODY - PILE
B323	6	28-0	X	BODY - PILE - SPIRAL

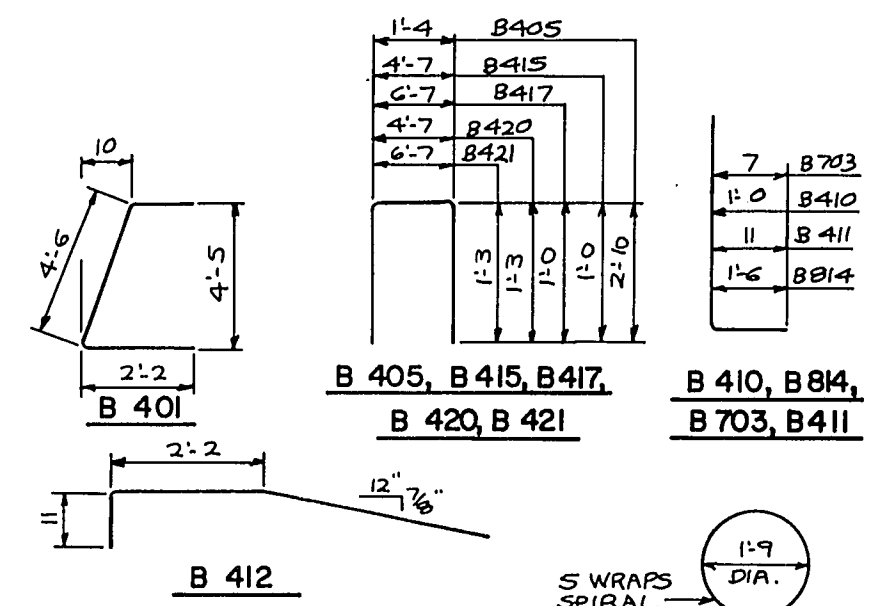


NOTE:
ALL DIMENSIONS IN BENDING ARE OUT TO OUT OF BAR.
THE FIRST DIGIT OF A BAR MARK SIGNIFIES THE BAR SIZE.

NOTE:
FOR 'PILE SPICE DETAIL' SEE SHEET 3.


No.	Date	Revision	By
STATE OF WISCONSIN DEPARTMENT OF TRANSPORTATION DIVISION OF HIGHWAYS			
STRUCTURE B-3-62			
Const. Spec.	1969	Drawn By DB	Plans Checked B.W.
EAST ABUTMENT			SHEET 4 OF 9
			X 47236

*TOP OF COLUMN ELEVATION AND COLUMN HEIGHTS ARE MEASURED AT \bar{C} OF PIER. TOP OF COL. ELEV. ARE GIVEN AT TOP OF CONC.

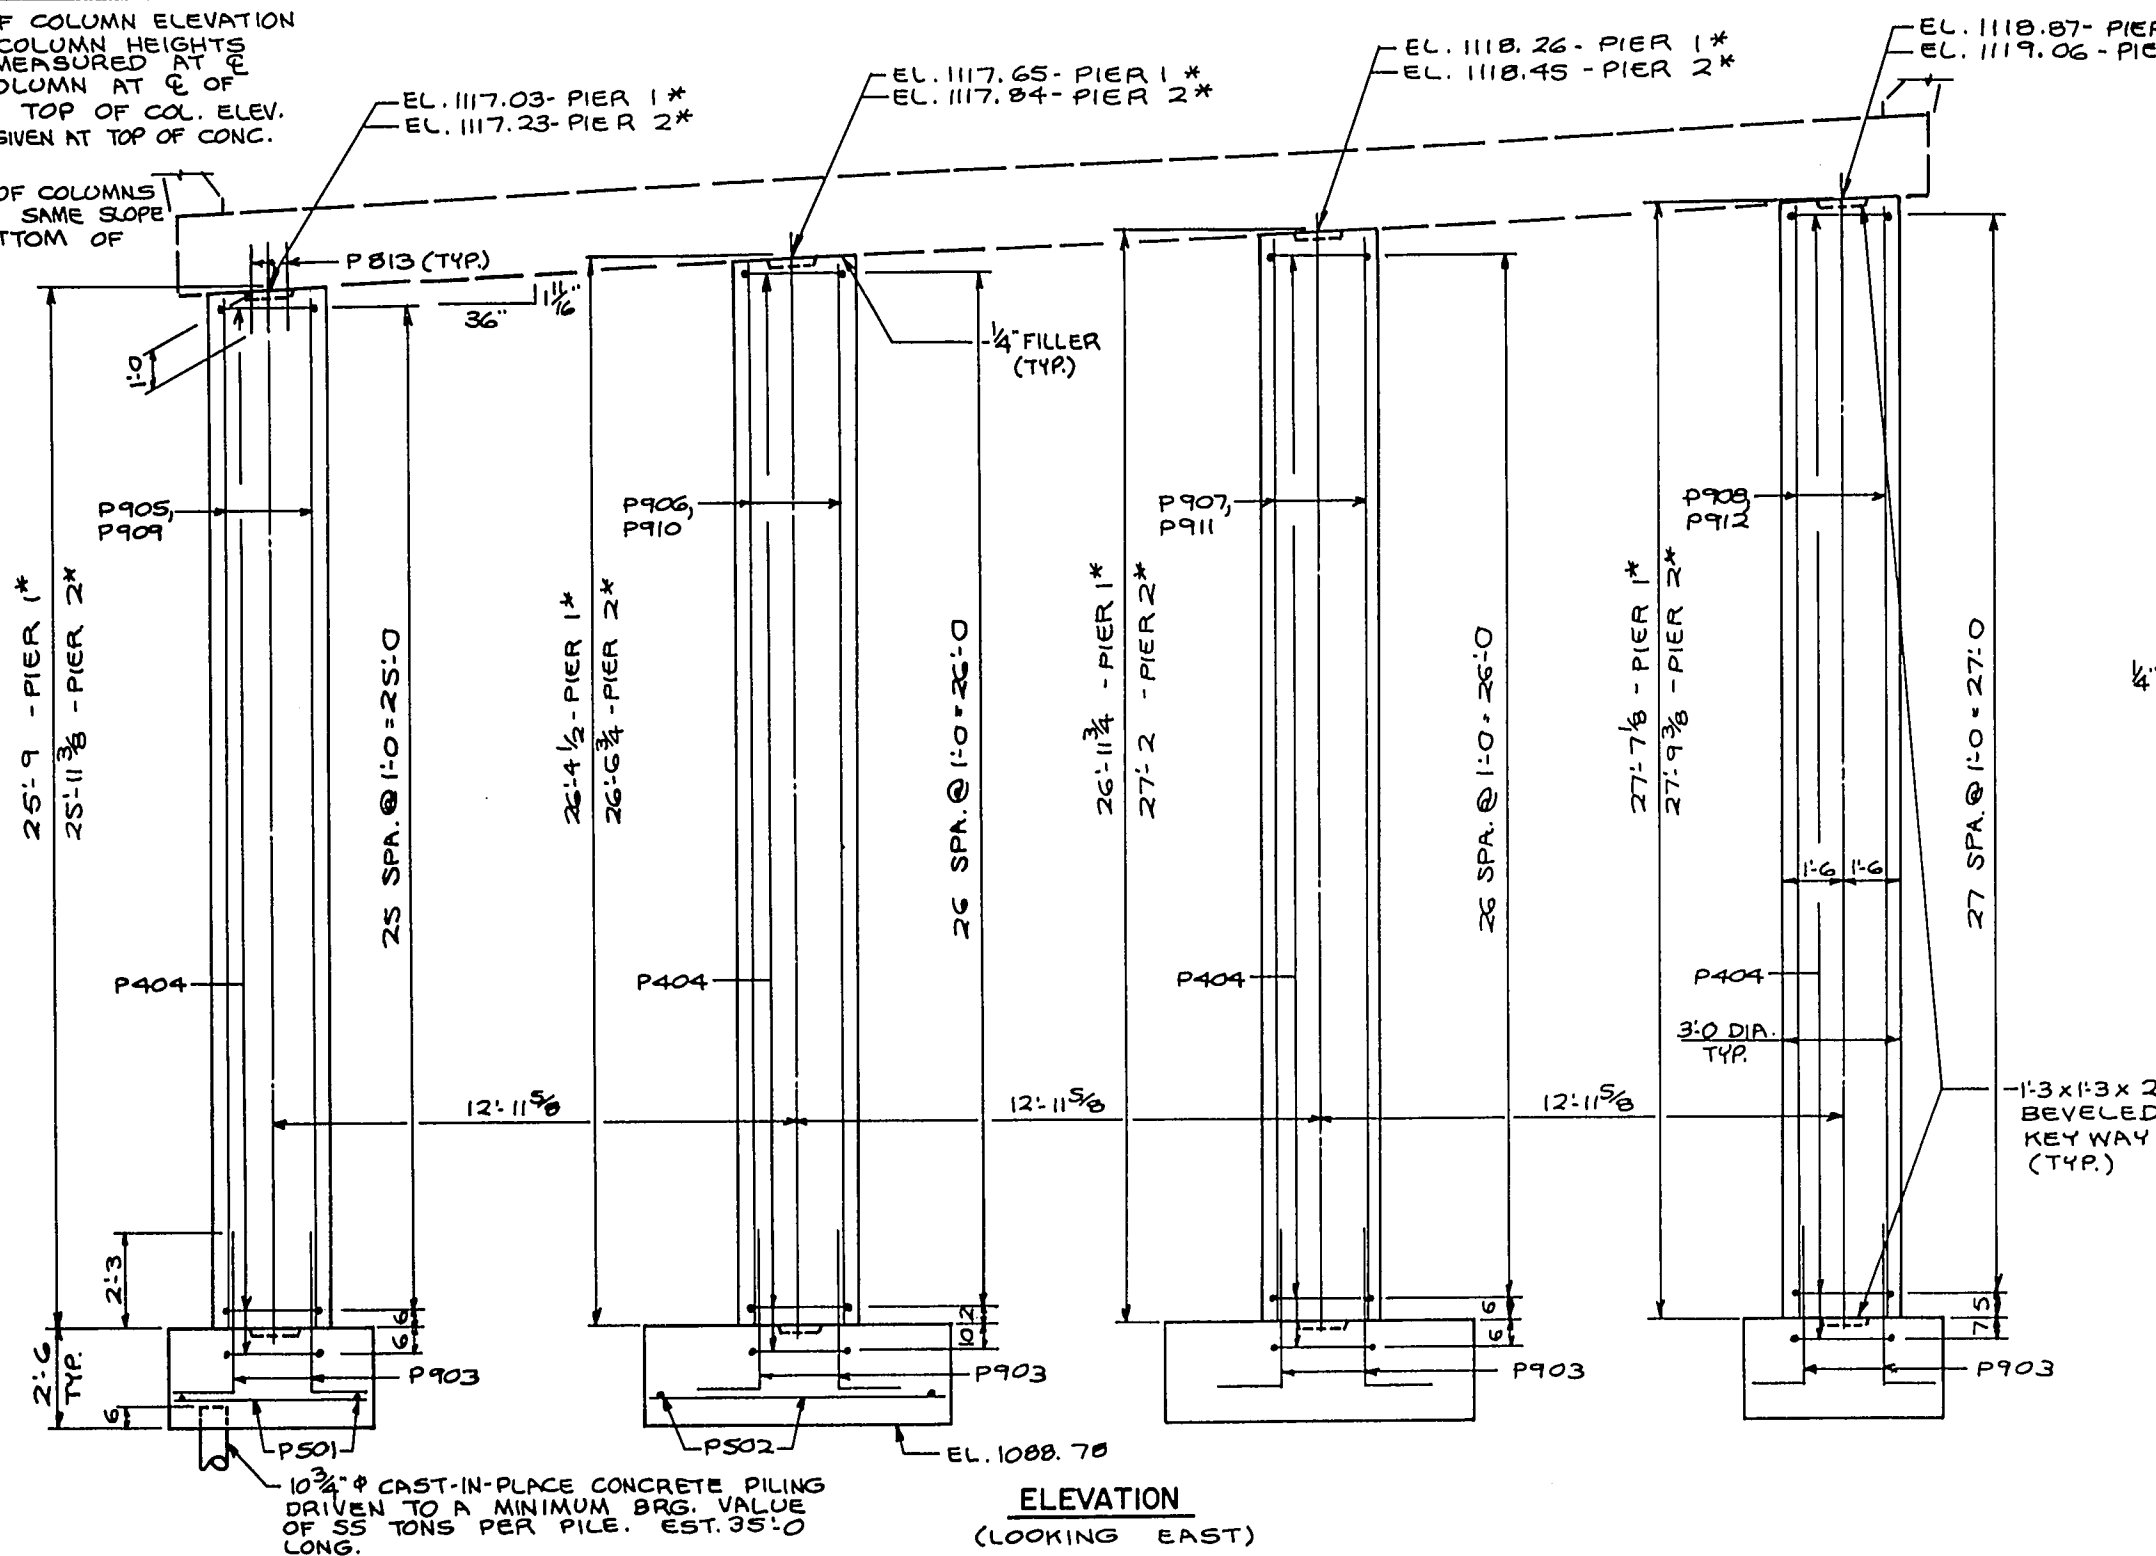
NOTE:
TOP OF COLUMNS TO HAVE SAME SLOPE AS BOTTOM OF SLAB.




ELEVATION
(LOOKING EAST)

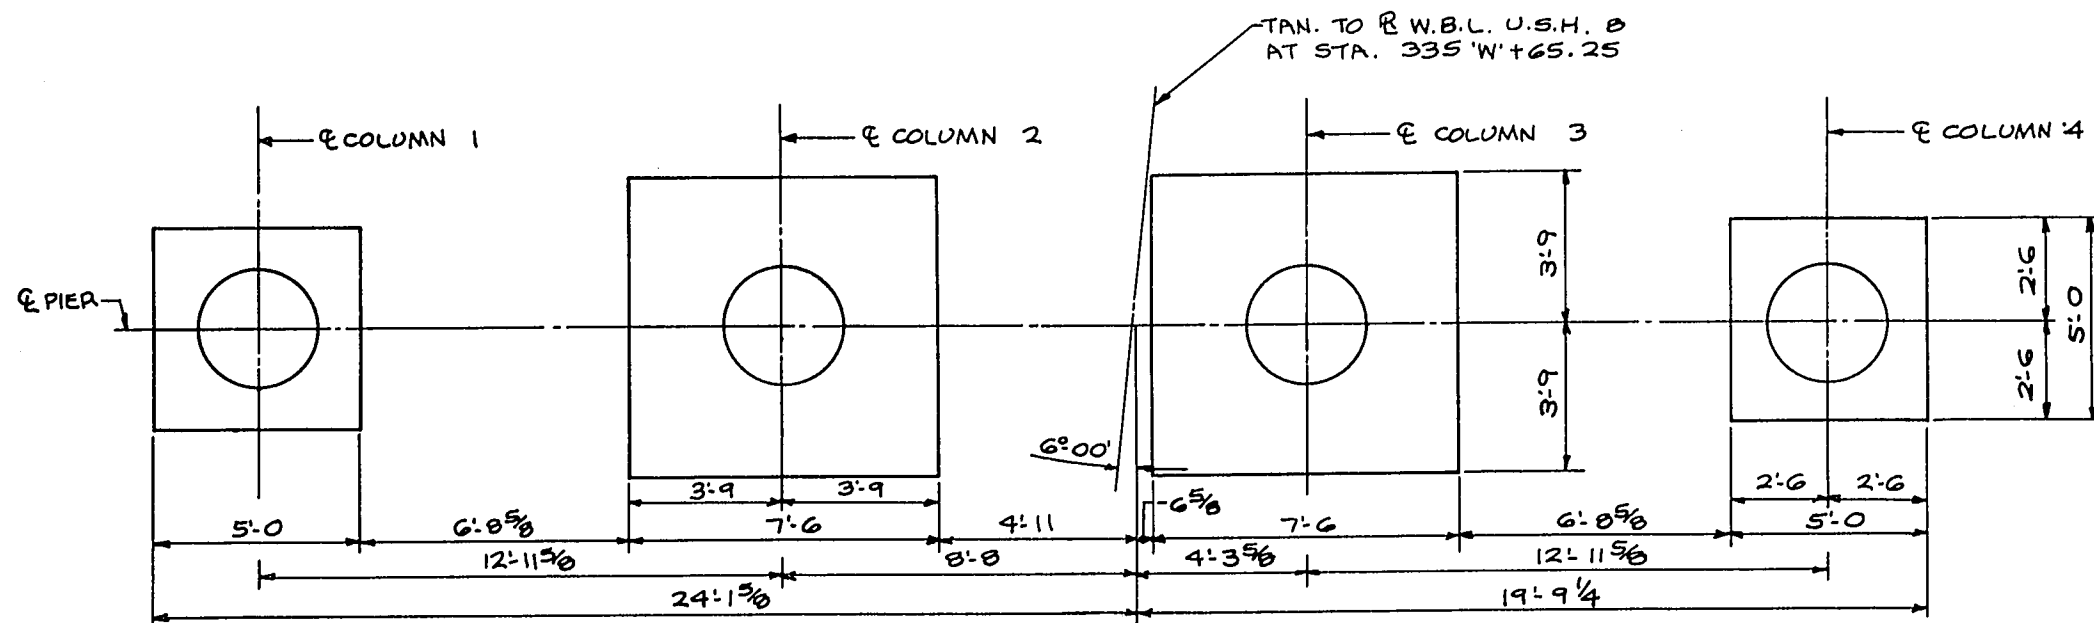


PLAN

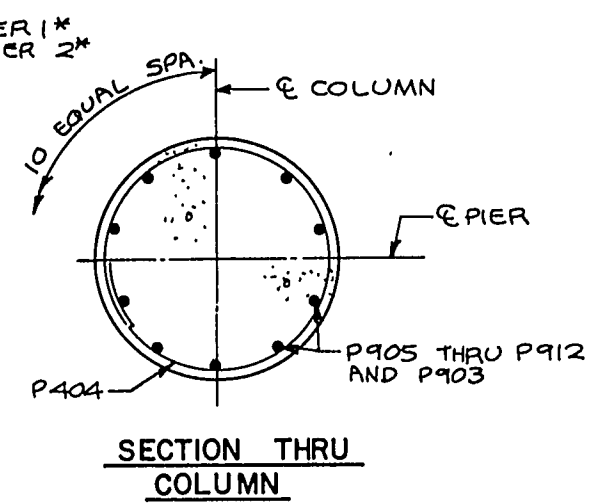


SECTION THRU
COLUMN

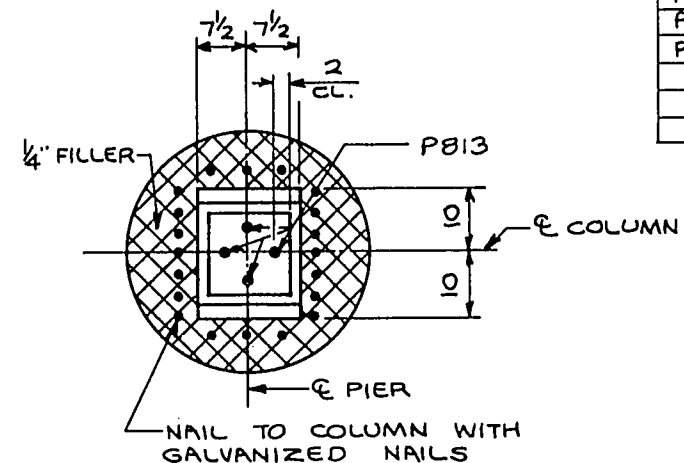

SECTION THRU
FILLER

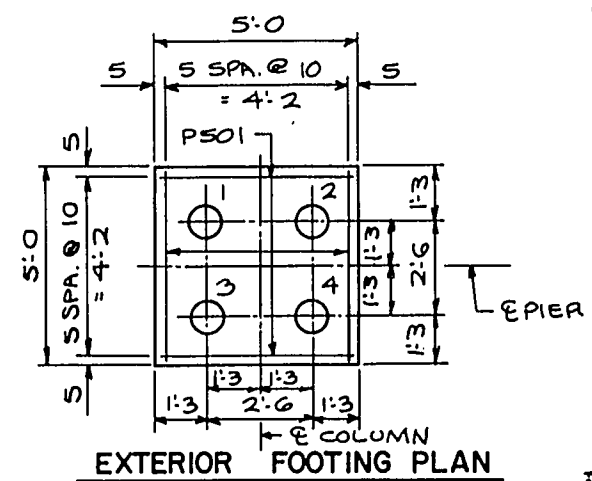

EXTERIOR FOOTING PLAN

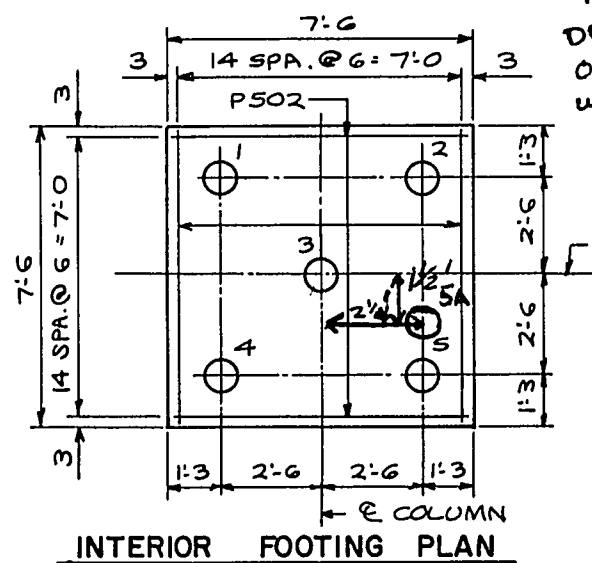

INTERIOR FOOTING PLAN

PROJECT ID	SHEET NUMBER	TOTAL SHEETS
1572-1-72	95	225
FEDERAL PROJECT DESIGNATION		
Fo21-1(57)		

BILL OF BARS

MARK	NO.	LENGTH	BENT	LOCATION
P501	48	4-8		FOOTING - EXTERIOR
P502	120	7-2		FOOTING - INTERIOR
P903	80	5-4	X	FOOTING & COLUMNS
P404	224	9-5	X	COLUMNS & FOOTINGS
P905	10	25-6		COLUMN 1 - PIER 1
P906	10	26-1		COLUMN 2 - PIER 1
P907	10	26-8		COLUMN 3 - PIER 1
P908	10	27-4		COLUMN 4 - PIER 1
P909	10	25-8		COLUMN 1 - PIER 2
P910	10	26-3		COLUMN 2 - PIER 2
P911	10	26-11		COLUMN 3 - PIER 2
P912	10	27-6		COLUMN 4 - PIER 2
P813	32	2-0		COLUMNS

11,370 # (TWO PIERS)


NOTES:
ALL DIMENSIONS IN BENDING ARE OUT TO OUT OF BAR.
THE FIRST DIGIT OF A MARK SIGNIFIES THE BAR SIZE.

NOTE:
'P813' BARS MAY BE PLACED AFTER CONCRETE HAS BEEN POURED BUT BEFORE IT HAS TAKEN ITS INITIAL SET.


FOR PIER 2 A PILE WAS DRIVEN TO REPLACE #5 ON BASIS OF STRUCTURAL DAMAGE. #5 WAS FILLED WITH CONCRETE AND LEFT IN PLACE.

NOTE:
FOR 'PILE SPLICE DETAIL' SEE SHEET 3.

No.	Date	Revision	By
STATE OF WISCONSIN DEPARTMENT OF TRANSPORTATION DIVISION OF HIGHWAYS			
STRUCTURE B-3-62			
Const. Spec.	1969	Drawn By DB	Plans Checked B.W.
PIERS 1 & 2			SHEET 5 OF 9
			X 47237

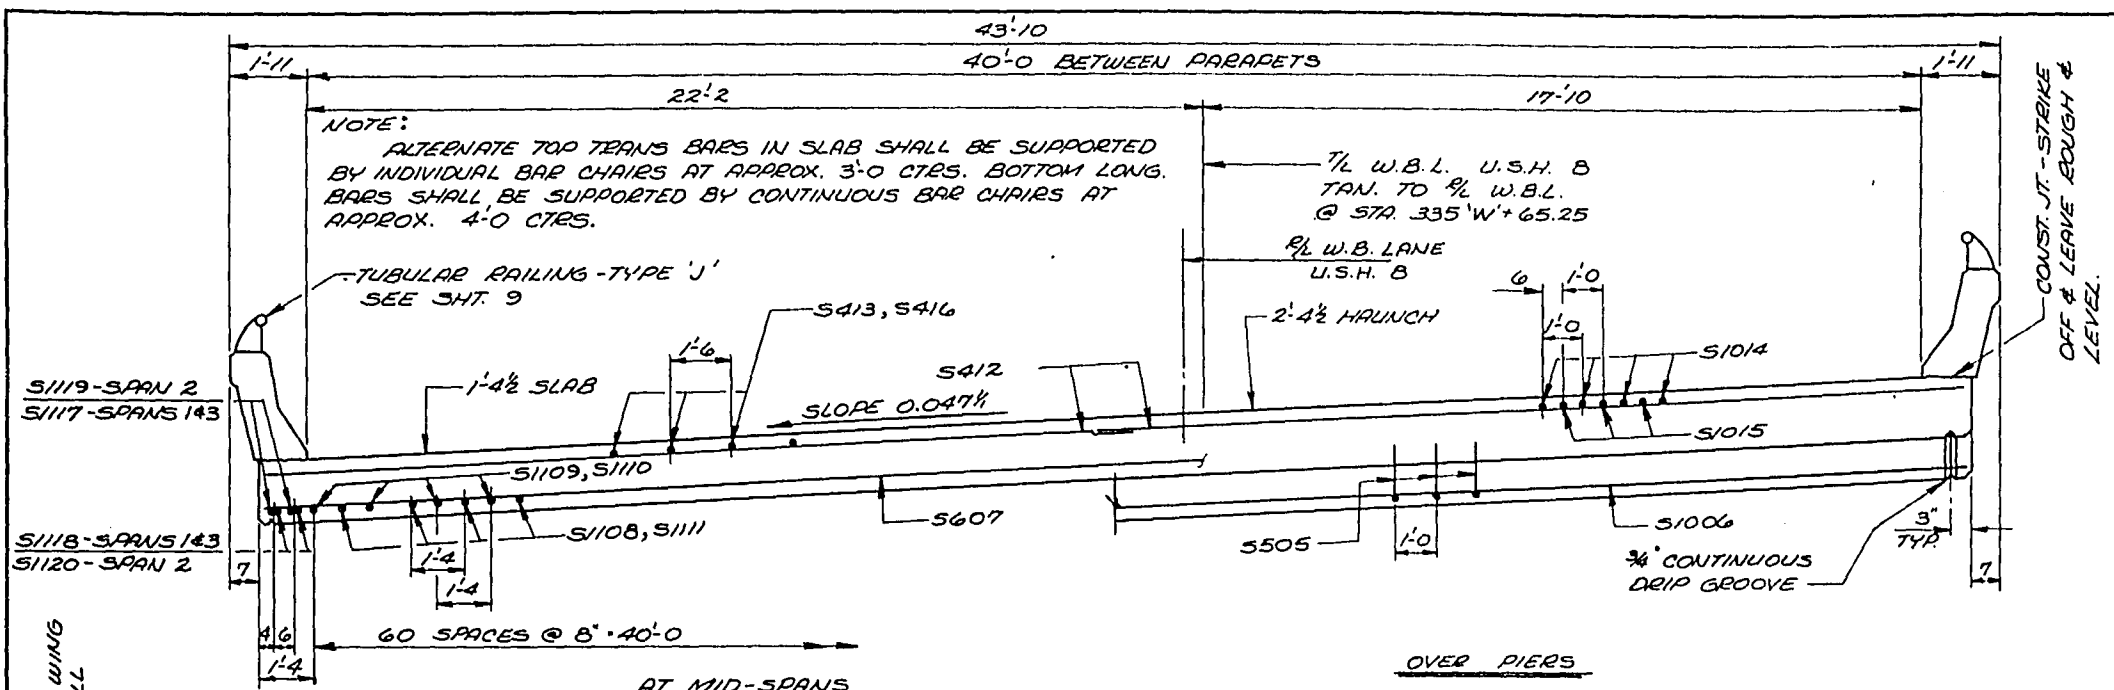


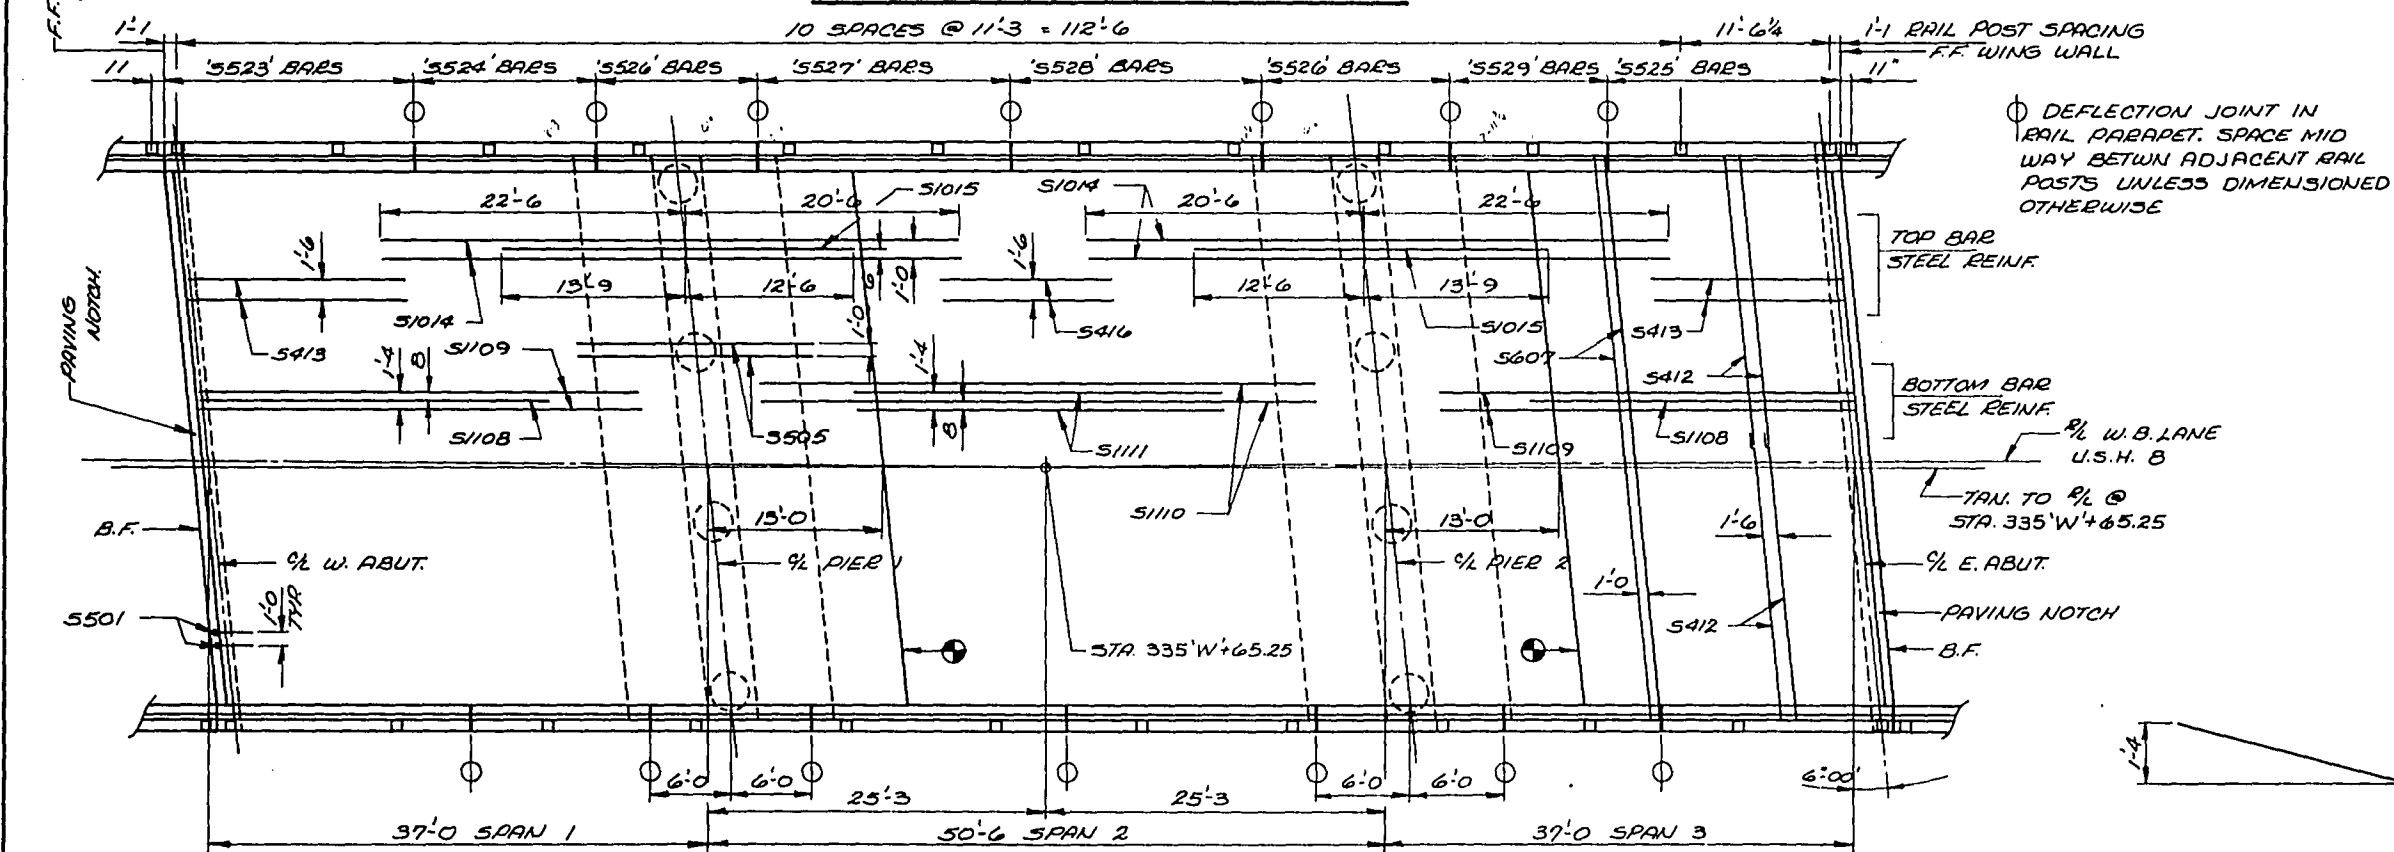CROSS SECTION THRU ROADWAY (LOOKING EAST)




PLAN

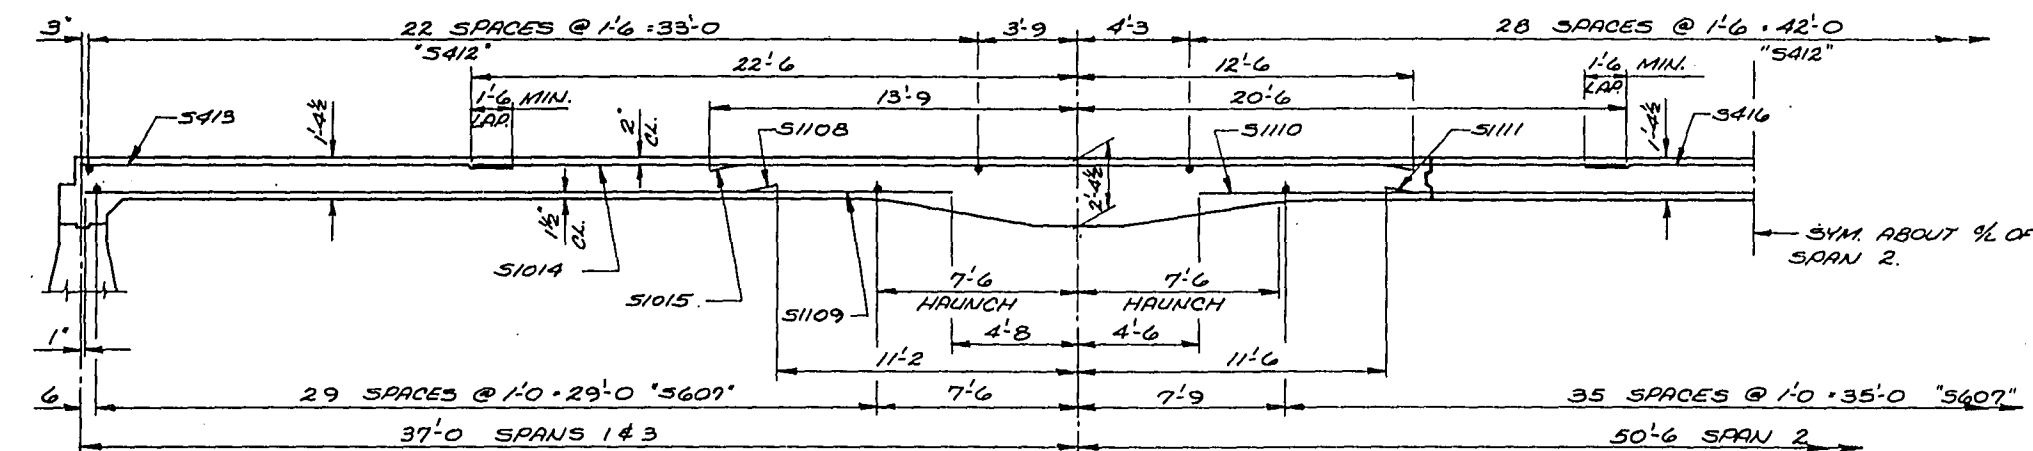OPT. TRANS. CONST. JT. FORMED BY SURF. BEVELD 2x8



LONGITUDINAL SECTION (ALONG 9/8 ROWY)

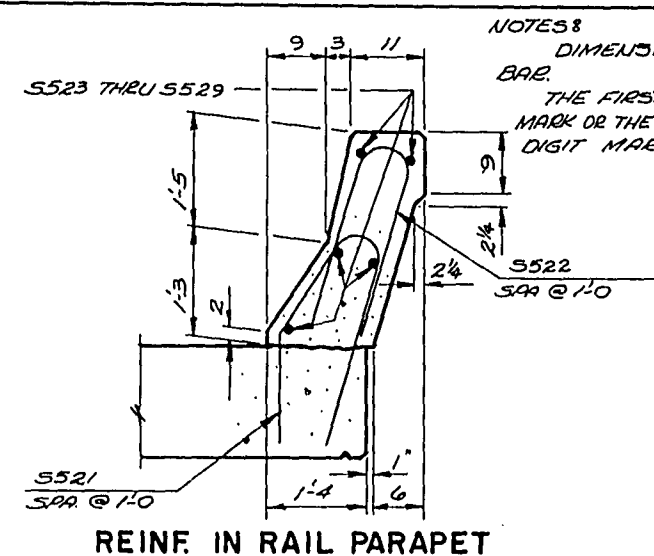

NOTES:
DIMENSIONS ARE OUT TO OUT OF BAR.
THE FIRST DIGIT OF A THREE DIGIT MARK OR THE FIRST TWO DIGITS OF A FOUR DIGIT MARK SIGNIFIES THE BAR SIZE.

PROJECT NO.	1572-1-72	SHEET NUMBER	96	TOTAL SHEETS	225
FEDERAL PROJECT DESIGNATION	FO21-1(51)				

BILL OF BARS					81,630#
MARK	Nº REQ'D	LENGTH	BENT	BUNDLED	LOCATION
S501	86	3'-1"	X		SLAB AT ABUTS.
S502	86	2'-6"	X		" " "
S503	86	3'-2"	X		" " "
S404	24	21'-10"			" " " & PIERS
S505	86	18'-4"	X		HAUNCH AT PIERS
S1006	34	42'-6"			" " "
S607	96	42'-5"			SLAB-BOT.-TRANS.
S1108	60	25'-9"			" " " - LONG.-SPANS 1 & 3
S1109	62	32'-3"			" " " " " " "
S1110	31	41'-6"			" " " " " " - SPAN 2
S1111	30	27'-6"			" " " " " " "
S412	150	22'-0"			" " " " " " - TOP-TRANS.
S413	58	16'-0"			" " " " " " - LONG.-SPANS 1 & 3
S1014	86	43'-0"			" " " " " " - OVER PIERS
S1015	84	26'-3"			" " " " " " "
S416	29	12'-6"			" " " " " " - SPAN 2
S1117	8	32'-3"	X		EDGE BEAM REINF. - SPANS 1 & 3
S1118	8	25'-9"	X		" " " " " " "
S1119	4	41'-6"	X		" " " " " " - SPAN 2
S1120	4	27'-6"	X		" " " " " " "
S521	250	5'-8"	X		SLAB & RAIL PARAPET
S522	250	5'-0"	X		RAIL PARAPET
S523	10	17'-5"			" " " " " " - HORIZ.
S524	10	13'-0"			" " " " " " "
S525	10	17'-8"			" " " " " " "
S526	20	11'-8"			" " " " " " "
S527	10	18'-9"			" " " " " " "
S528	10	19'-0"			" " " " " " "
S529	10	13'-3"			" " " " " " "

NOTE: BUNDLED BARS SHALL BE WIRED TOGETHER AT 2'-0" CTRS.

S501 & S502


S503

S505


S521

S522

No.	Date	Revision	By
STATE OF WISCONSIN DEPARTMENT OF TRANSPORTATION DIVISION OF HIGHWAYS			
STRUCTURE B-3-62			
Const. Spec.	1969	Drawn By R.J.G.	Plans Checked B.W.
SUPERSTRUCTURE			SHEET 6 OF 9
			X 47238


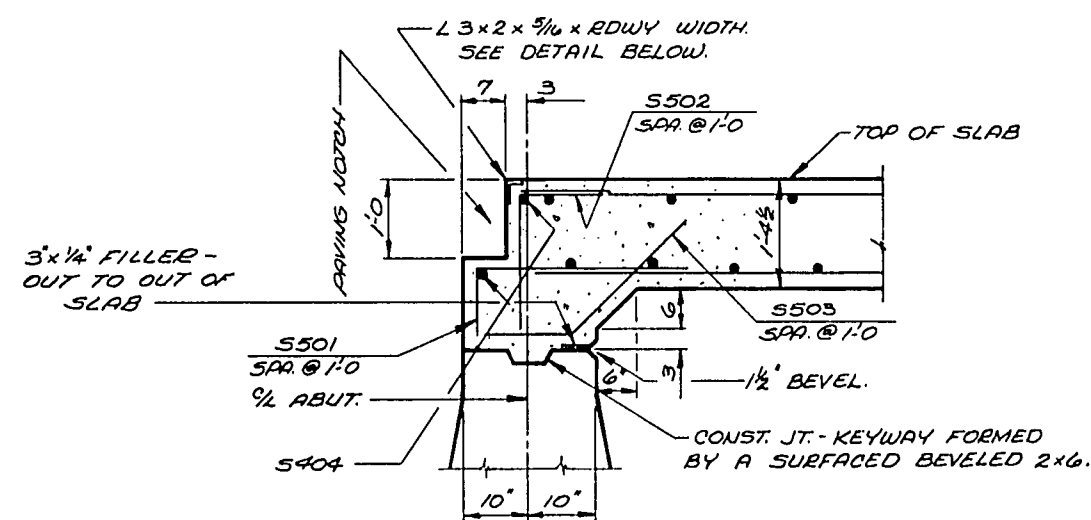


ABUTMENT DETAIL
(NORMAL TO 1/4 ABUT.)

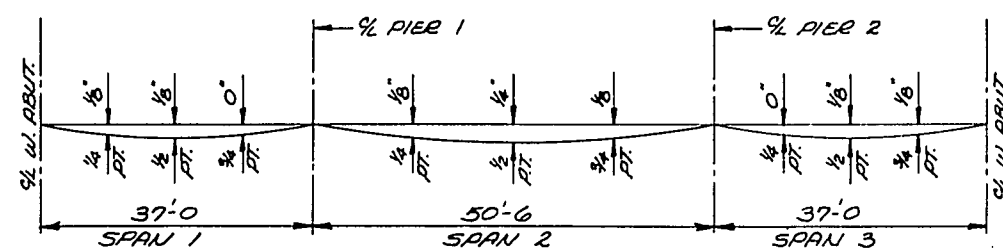

DEFLECTION DIAGRAM

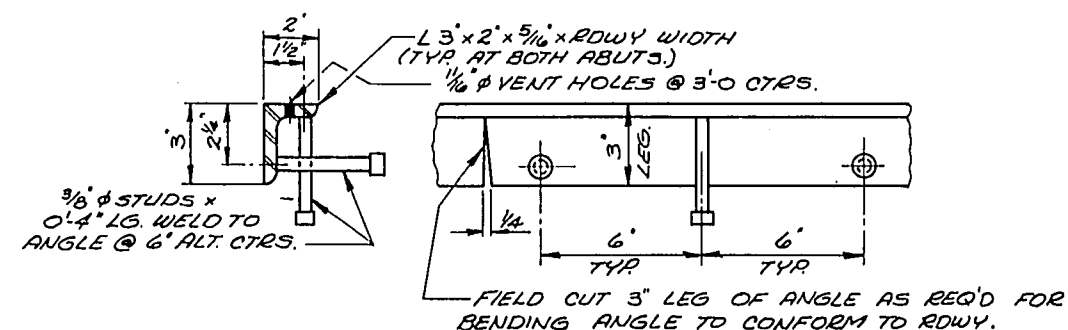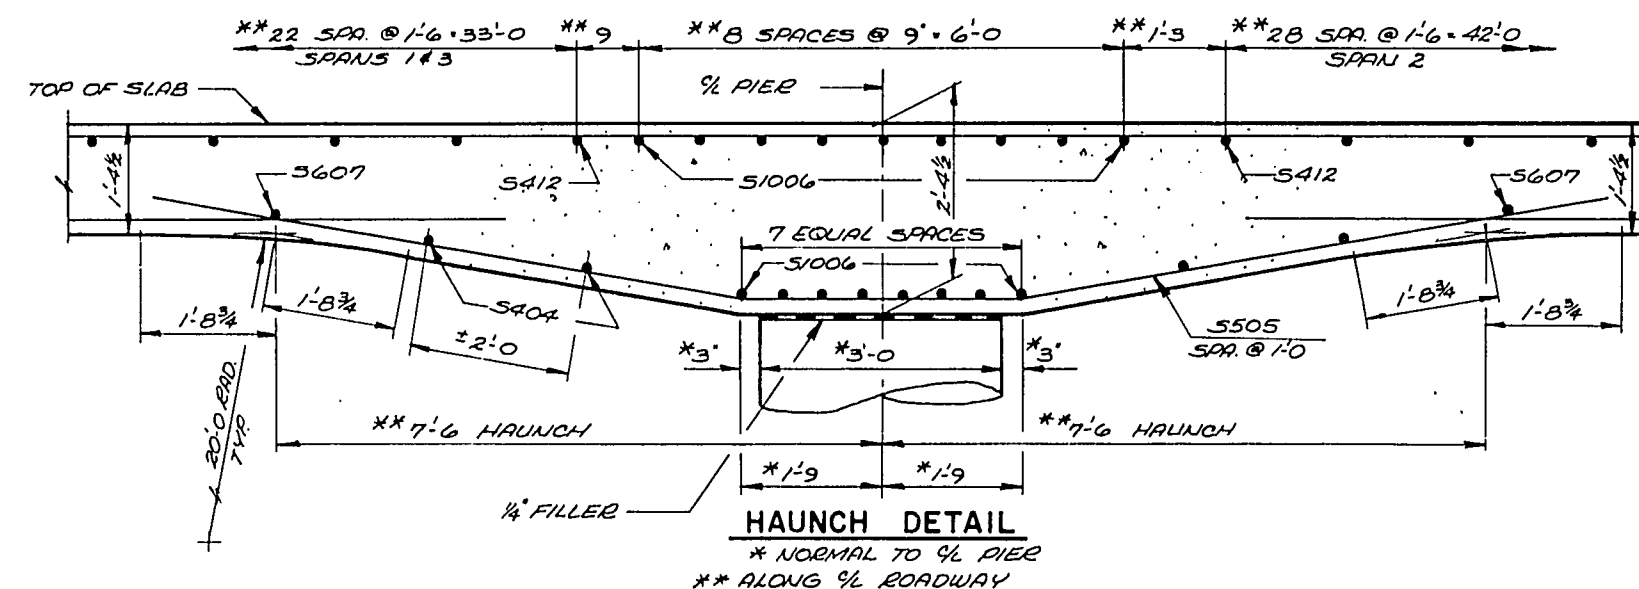
ALL SLAB THICKNESS DIMENSIONS ARE MINIMUM. ANY TOLERANCES NECESSARY TO CORRECT CONSTRUCTION DISCREPANCIES ARE TO BE PLUS (+). PARAPETS SHOWN ABOVE THE HORIZ. CONST. JT. SHALL BE POURED AFTER THE FALSEWORK HAS BEEN RELEASED. PROVIDE CAMBER OF 5/16" AT THE 1/2 PT. OF SPANS 1 & 3 AND 5/8" AT THE 1/2 PT. OF SPAN 2 TO PROVIDE FOR DEAD LOAD DEFLECTION AND FUTURE PLASTIC FLOW. THIS DOES NOT INCLUDE AN ALLOWANCE FOR FORM SETTLEMENT.



PROTECTION ANGLE DETAIL


NOTE: ANGLE AND STUDS SHALL BE PAID FOR AS STRUCTURAL CARBON STEEL. ONE FIELD SPICE PERMITTED, IF USED, DETAILS SHALL BE SUBMITTED FOR APPROVAL.

No.	Date	Revision	By
STATE OF WISCONSIN DEPARTMENT OF TRANSPORTATION DIVISION OF HIGHWAYS			
STRUCTURE B-3-62			
Const. Spec.	1969	Drawn By R.J.G.	Plans Checked B.W.
SUPERSTRUCTURE			SHEET 7 OF 9
			X47239

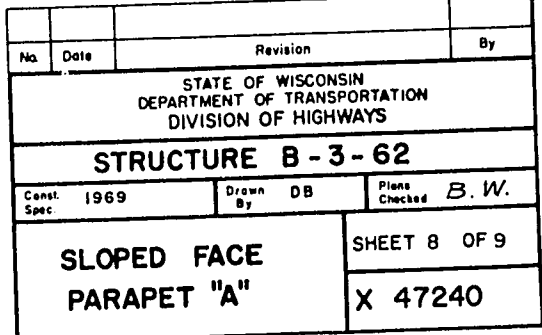

PROJECT NO.	1572-1-72	SHEET NUMBER	100	TOTAL SHEETS	225
FEDERAL PROJECT DESIGNATION	FO21-1 (57)				


BENCH MARK			
NR.	STATION	DESCRIPTION	ELEV.
19	335'E+20	6" ELM 510' LT.	1093.46

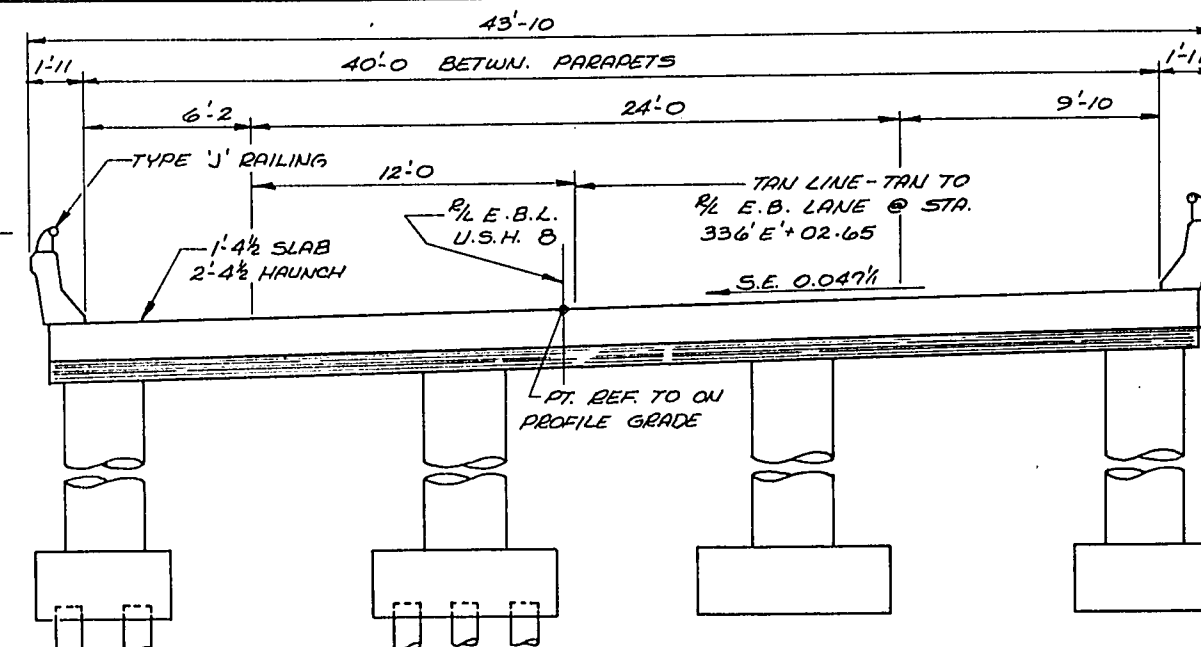

CROSS SECTION THRU ROADWAY
(LOOKING EAST)

GENERAL NOTES

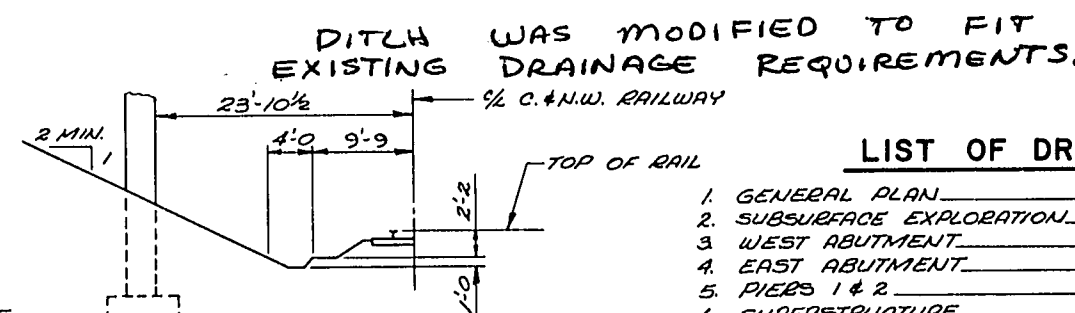
DRAWINGS SHALL NOT BE SCALED.
BAR STEEL REINFORCEMENT SHALL BE IMBEDDED 2" CL. UNLESS OTHERWISE SHOWN OR NOTED.
THE FINISHED GRADED SECTION WAS USED AS THE UPPER LIMITS OF EXCAVATION FOR COMPUTATION OF EXCAVATION QUANTITIES AT THE PIERS.
THE UPPER LIMITS OF EXCAVATION FOR STRUCTURES SHALL BE THE TOP OF BERM ELEVATION AT THE ABUTMENTS AND THE QUANTITIES WERE COMPUTED FROM THIS LINE.
PREBORE ABUTMENT PILING TO ORIGINAL GROUNDLINE.



TYPICAL SECTION THRU
C. & N.W. RAILROAD
(NORMAL TO 1/4 RAILROAD)


LIST OF DRAWINGS

1. GENERAL PLAN	X47242
2. SUBSURFACE EXPLORATION	X47243
3. WEST ABUTMENT	X47244
4. EAST ABUTMENT	X47245
5. PIERS 1 & 2	X47246
6. SUPERSTRUCTURE	X47247
7. SUPERSTRUCTURE	X47248
8. SLOPED FACE PARAPET 'A'	X47249
9. TUBULAR RAILING TYPE 'J'	X47250

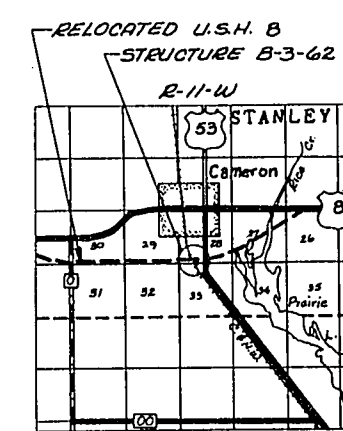


LAYOUT

No.	Date	Revision	By
STATE OF WISCONSIN DEPARTMENT OF TRANSPORTATION DIVISION OF HIGHWAYS			
STRUCTURE B-3-63			
U.S. 8 OVER C. & N.W. RAILWAY			
County	BARRON	City	STANLEY
Design Spec.	A.A.S.H.O. '69	Load	HS20
Designed By	J.R.L.	Const. Spec.	1969
Checked	M.S.R.	Drawn By	R.J.G.
Planned	B.W.	Planned	B.W.
Approved	W.A. Klein	Date	3-3-72
Chief Bridge Engineer			
GENERAL PLAN			SHEET 1 OF 9
			X47242

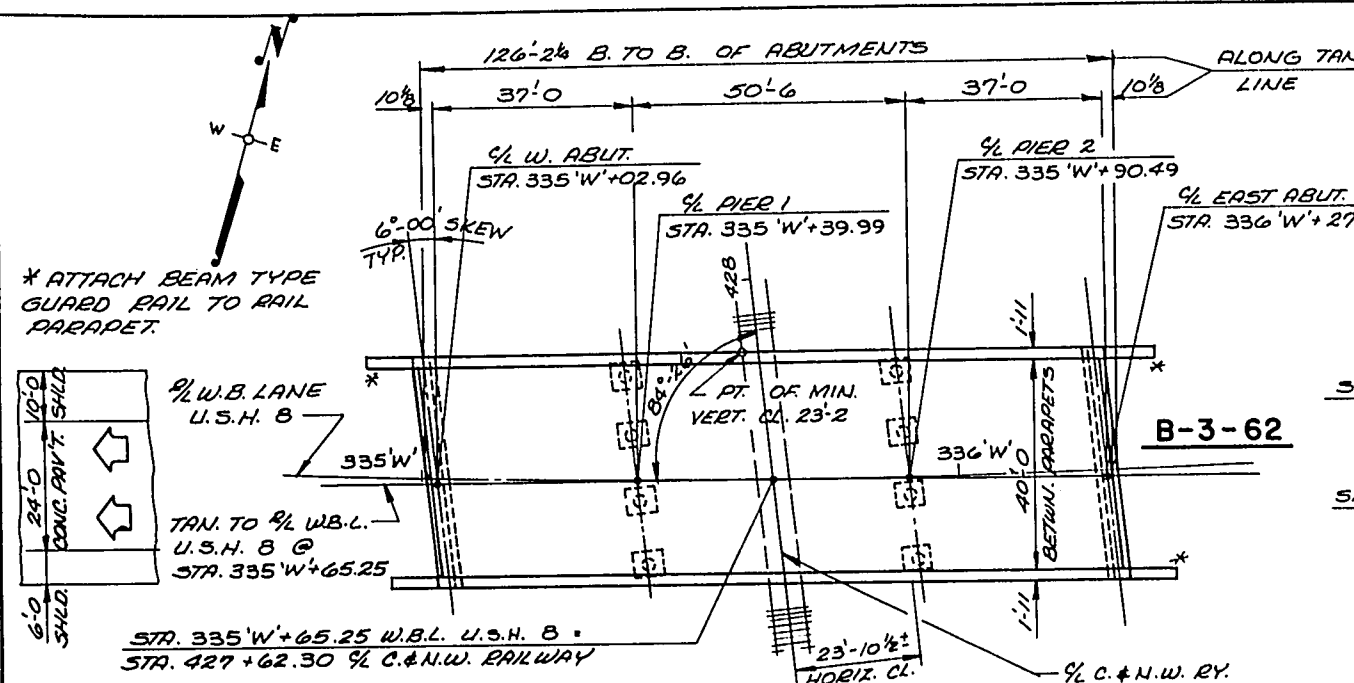


B-3-62

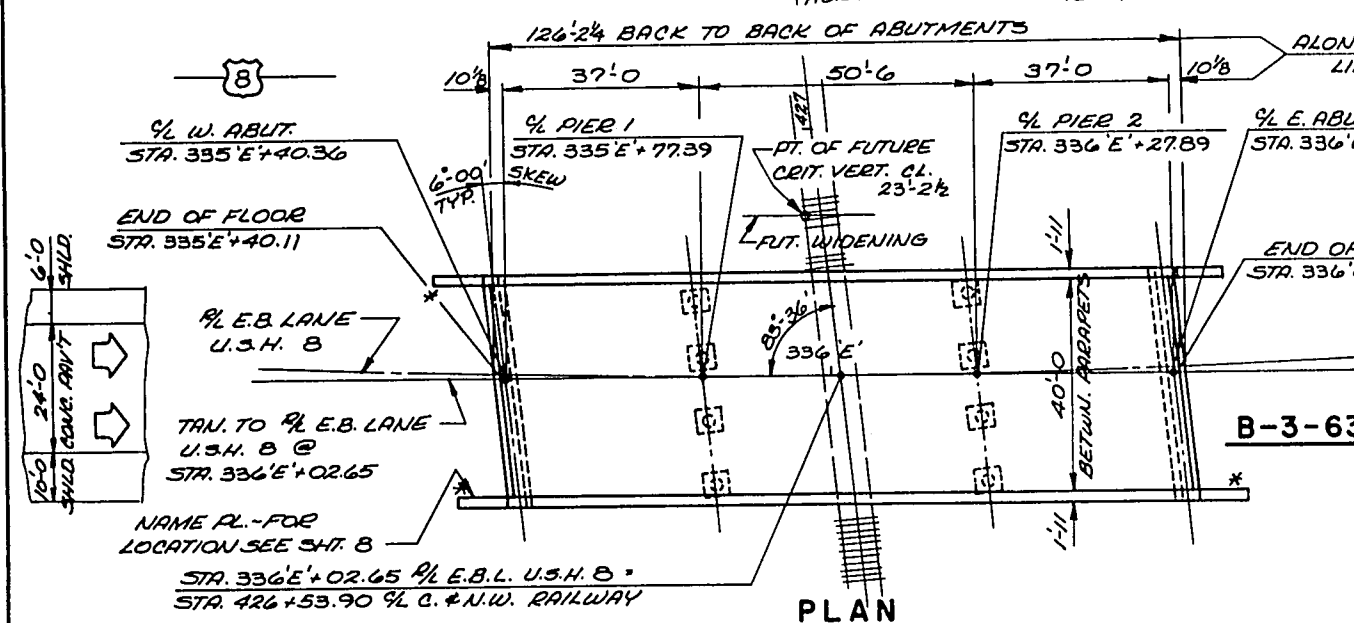

B-3-63

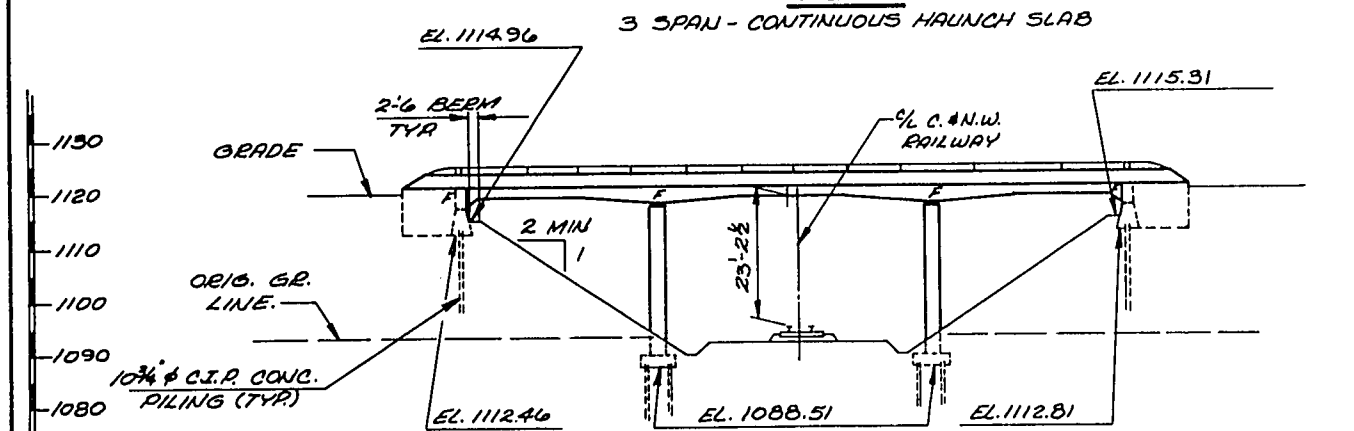PLAN



ELEVATION

CURVE DATA

W.B. LANE	E.B. LANE
RT. = 330'W+27.6 BK	RT. = 331'E+38.9 BK
Δ = 16°-25'-28" LT.	Δ = 18°-21'-47" LT.
D = 1°-00'	D = 1°-00'
T = 826.9'	T = 926.1'
L = 1,642.4'	L = 1,836.3'
R = 5,729.6'	R = 5,729.6'
SE = 0.047%	SE = 0.047%

TRAFFIC VOLUME

A.D.T. = 6,100 (1996)
R.D.S. = 80 M.A.H.
D.H.V. = 915

PROFILE GRADE - C. & N.W. RAILWAY

STA. 98+00.00	EL. 1094.46
STA. 99+00.00	EL. 1094.56
STA. 100+00.00	EL. 1094.84
STA. 101+00.00	EL. 1094.97

DESIGN DATA

LIVELOAD: HS20
ALLOWABLE DESIGN STRESSES:
CONCRETE MASONRY, GRADE 'AA'
BAR STEEL REINFORCEMENT
FUTURE WEARING SURFACE

FOUNDATION DATA

PLACE ABUTS ON 10 3/4" Ø CAST-IN-PLACE CONCRETE PILING DRIVEN TO 40 TONS/PILE MIN. BRG. EST. PILE LENGTH 50'-0".
PLACE PIERS ON 10 3/4" Ø CAST-IN-PLACE CONCRETE PILING DRIVEN TO 55 TONS/PILE MIN. BRG. EST. PILE LENGTH 35'-0".

TOTAL ESTIMATED QUANTITIES

BID ITEMS	UNIT	SUPER	W. ABUT.	PIER 1	PIER 2	E. ABUT.	TOTAL
EXCAVATION FOR STRUCTURES	C.Y.		36	77	77	36	226
CONCRETE MASONRY	C.Y.	332.5	33.3	43.4	43.5	33.3	486.0
BAR STEEL REINFORCEMENT	LB	81,630	232.5	5,770	5,800	232.5	97,850
STRUCTURAL CARBON STEEL	LB	450					450
CAST-IN-PLACE CONCRETE PILING, DELIVERED & DRIVEN 10 3/4" INCH	L.F.		300	630	630	300	1,860
TUBULAR RAILING - TYPE 'J'	L.F.	276					276
NON-BID ITEMS							
1/2" ALUMINUM OR ZINC PLATE	S.F.	40					40
FILLER	SIZE 1/4" & 1/2"						1/4" & 1/2"
POLYVINYL CHLORIDE WATERSTOP	L.F.		41			41	82

SURVEY STA. 100 "B" =
STA. 427+55.50 C. & N.W. RY.
TOP OF LEFT HAND (HIGH) RAIL.

PROJECT ID.	1572-1-72	SHEET NUMBER	101	TOTAL SHEETS	225
FEDERAL PROJECT DESIGNATION	F021-1 (57)				

ABBREVIATIONS					
F — Fine	M — Medium	C — Coarse			
Ws — Weathered	So — Sound				
MATERIAL SYMBOLS					
Topsoil	Silt	Sandstone			
Sand	Peat	Limestone			
Gravel	Clay	Igneous Rock			

LEGEND OF PROBING	
95/6=95 Blows for 6" Penetration Probing taken with a 350# wt. Falling 18" on a 2" O. D. Point.	<div> <div>Probing No.</div> <div>Sta.</div> <div>Elevation</div> <div>7 Average Blows Per Foot</div> <div>Refusal 95/6</div> </div>


LEGEND OF BORING	
<div> <div>Unconfined Strength → 7.7</div> <div>Blows Per Ft. Using 140# Wt. Falling 30"</div> <div>Wash Sample</div> <div>Shelby Tube — S. T.</div> <div>Ground Water Elevation</div> <div>No Ground Water Observed Above This Elevation</div> </div>	<div> <div>Boring No.</div> <div>Sta.</div> <div>Elev.</div> <div>Sandy Gravel</div> <div>F.</div> <div>Boulders or Cobbles</div> <div>Sand</div> <div>Silty Clay</div> <div>So</div> <div>Limestone</div> </div>


Unless otherwise specified, the blows per foot at the locations indicated are based on driving a 2" O. D. x 1.4" I. D. split spoon sampler with a 140# hammer having a free fall of 30". The blow count is taken in undisturbed soil immediately below a cased or open hole eliminating side friction on the drive pipe.

SUBSURFACE EXPLORATION FOR FOUNDATION DESIGN AND BIDDERS INFORMATION

To obtain relative data concerning the character of material in and upon which the foundation might be built, borings and/or soundings were made at points approximately as indicated on this drawing. The data presented herein represents the findings of the subsurface explorations made. However, because the depths investigated are limited and the area of the borings and/or soundings is very small in relation to the entire area, the Division of Highways does not warrant conditions below the depths investigated or that the classification of material encountered in these investigations is necessarily typical of the entire site.

No.	Date	Revision	By
STATE OF WISCONSIN DEPARTMENT OF TRANSPORTATION DIVISION OF HIGHWAYS			
STRUCTURE B-3-63			
Const. Spec.	1969	Drawn By DB	Plans Checked B.W.
SUBSURFACE EXPLORATION			SHEET 2 OF 9
			X 47243

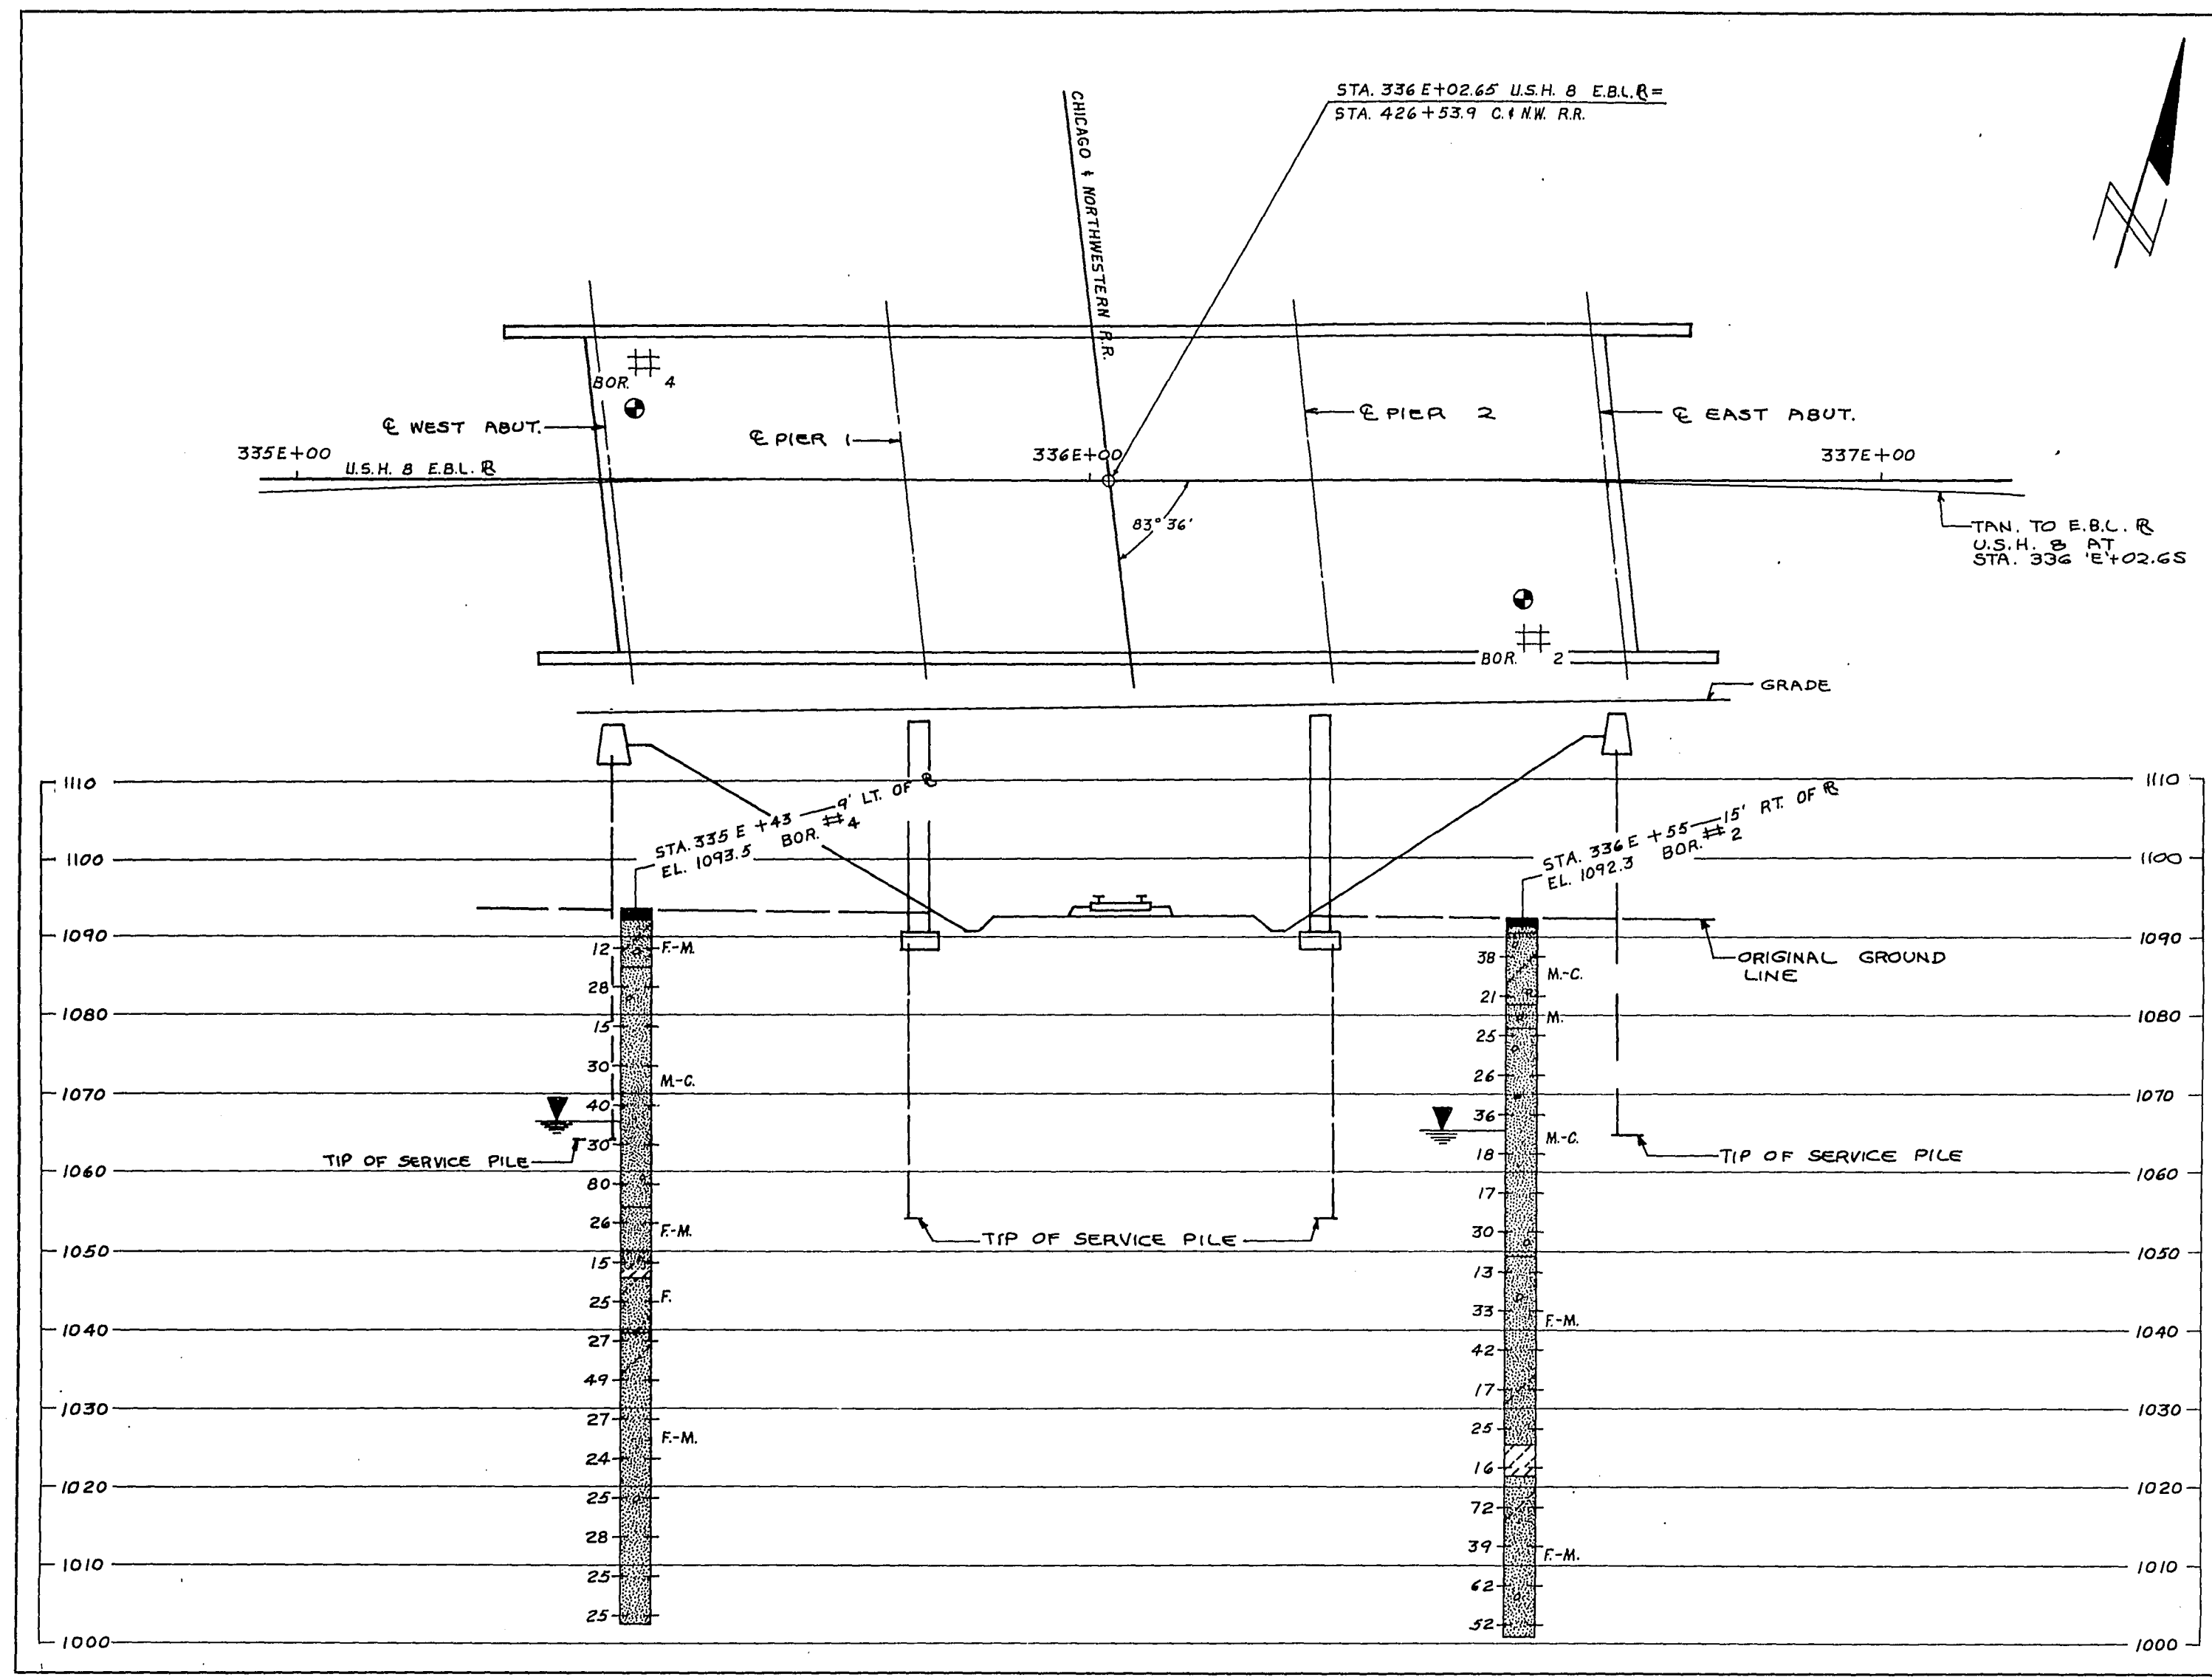

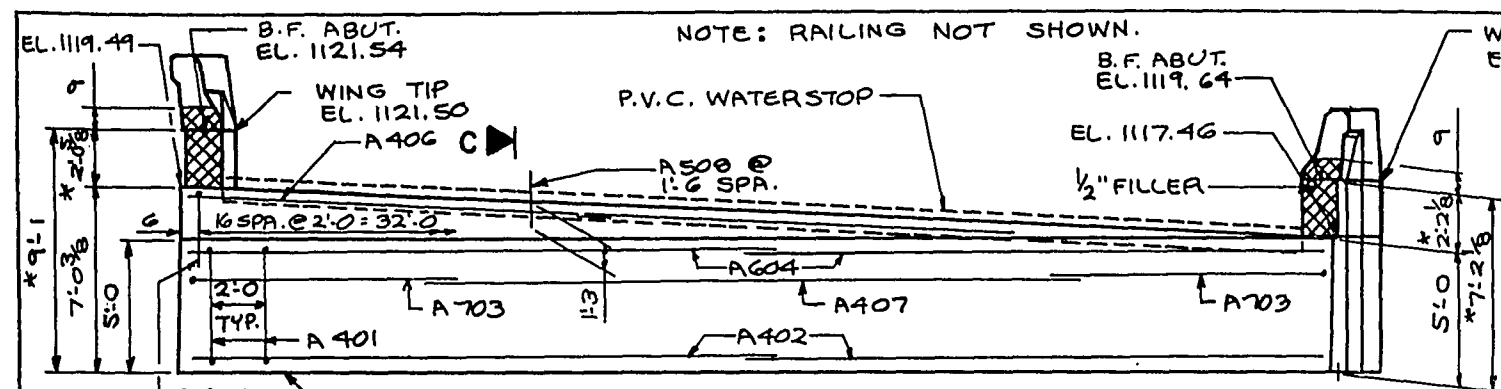


* DIMENSIONS GIVEN AT B.F. OF ABUTMENT.

NOTE: RAILING AND RAIL PARAPET NOT SHOWN.

ELEVATION (LOOKING WEST)

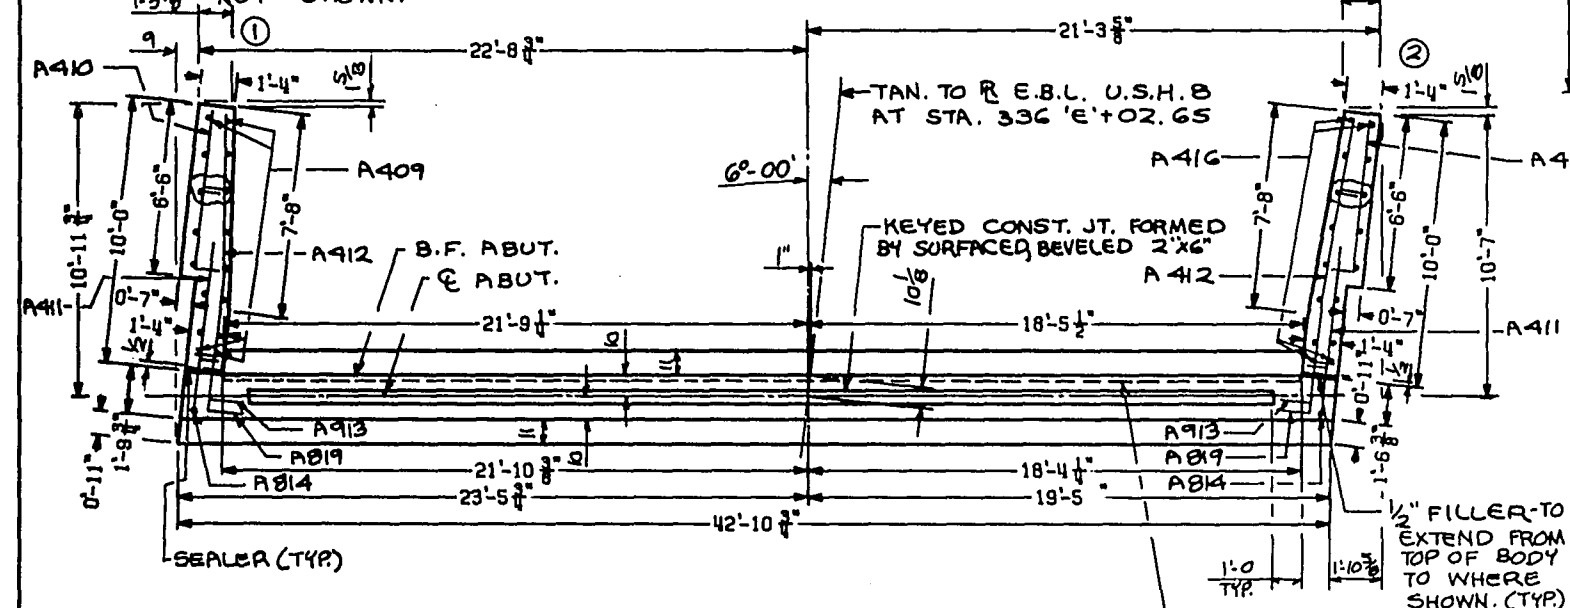
NOTE: SEAL ALL EXPOSED HORIZ. AND VERT. SURFACES OF 1/2\"/>




ABUTMENT PLAN

POLYVINYL CHLORIDE WATERSTOP- TO EXTEND BETWEEN (INSIDE FACES OF WINGS. (FLUSH WITH FACE OF CONCRETE) SEE DETAIL BELOW.

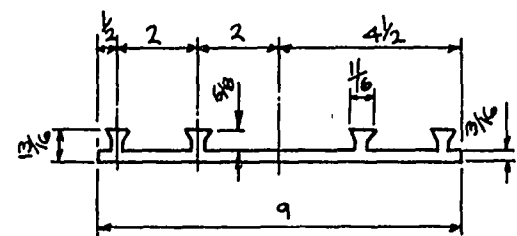
KEYED CONST. JOINT FORMED BY SURFACED, BEVELED 2\"/>




POLYVINYL CHLORIDE WATERSTOP

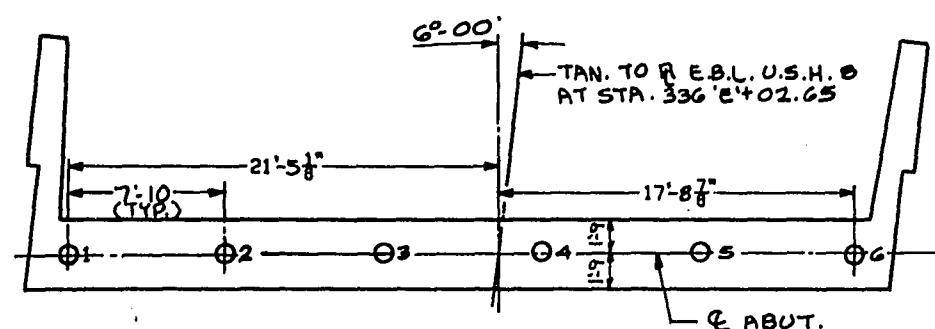


PILE PLAN

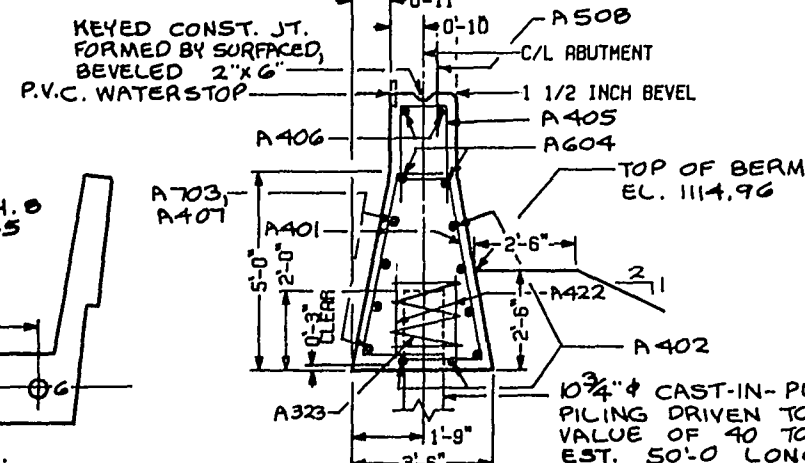


SECTION C

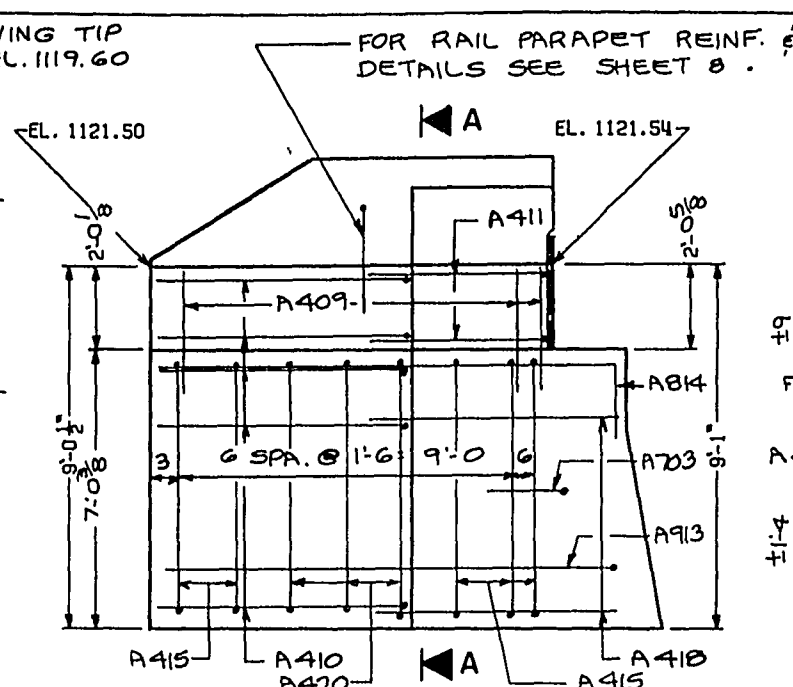


WING 1 ELEVATION

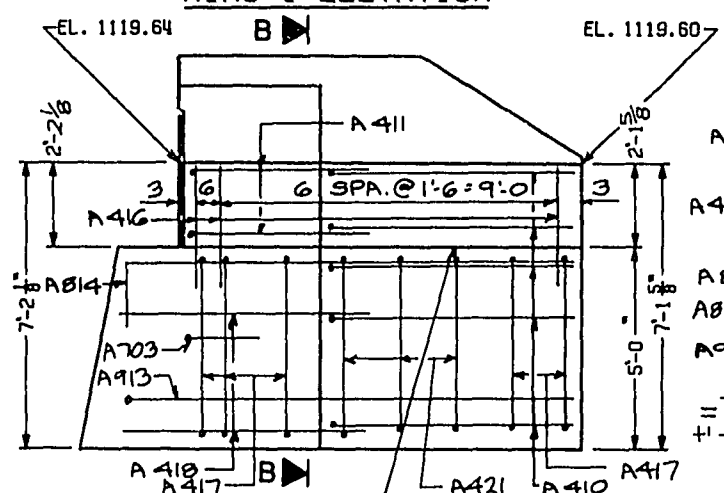


WING 2 ELEVATION

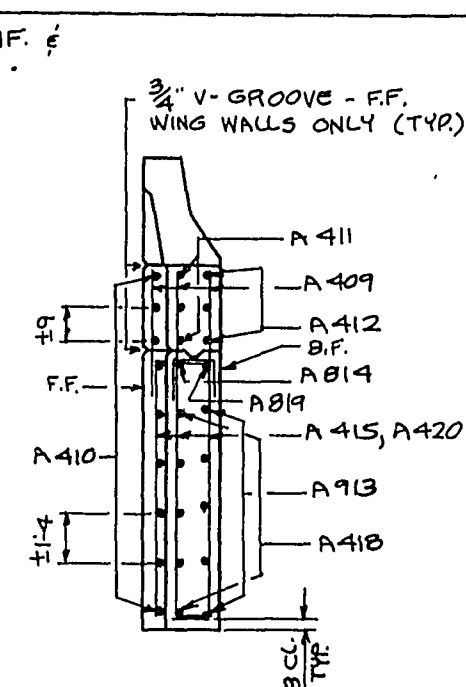


SECTION A

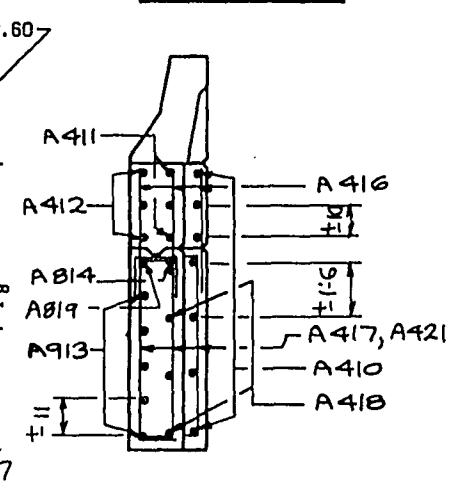


SECTION B

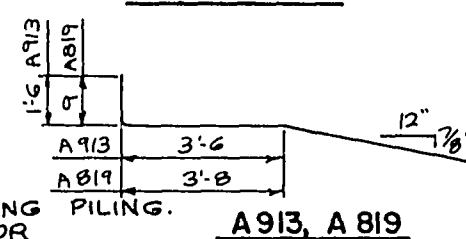


A 913, A 819

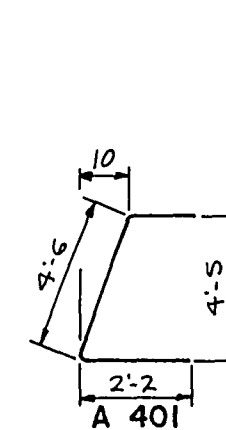


A 412

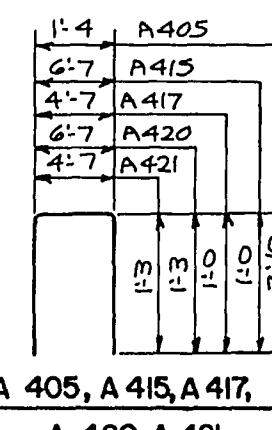

A 405, A 415, A 417, A 420, A 421

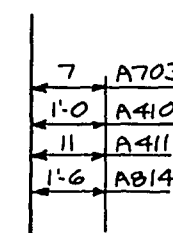

A 410, A 814, A 703, A 411

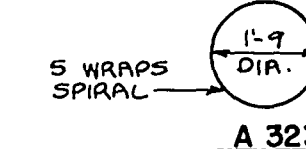


A 323

NOTE: FILL TO EL. 1114.96 BEFORE DRIVING UPPER LIMITS OF EXCAVATION FOR STRUCTURES SHALL NOT EXCEED THIS ELEVATION.

NOTE: 'A 508' BARS MAY BE PLACED AFTER CONCRETE IS POURED BUT BEFORE CONCRETE HAS TAKEN ITS INITIAL SET.

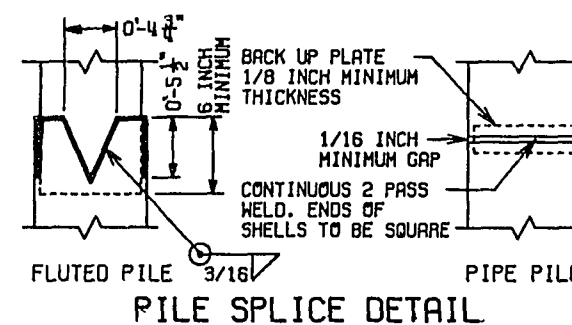NOTE: ALL DIMENSIONS IN BENDING ARE OUT TO OUT OF BAR. THE FIRST DIGIT OF A BAR MARK SIGNIFIES THE BAR SIZE.




PILE SPLICE DETAIL

PROJECT ID	1572-1-72	SHEET NUMBER	102	TOTAL SHEETS	225
FEDERAL PROJECT DESIGNATION	F021-1 (57)				
	1,980 #				

BILL OF BARS

MARK	NO.	LENGTH	BENT	LOCATION
A 401	44	7-10	X	BODY
A 402	12	21-9		BODY
A 703	8	10-0	X	BODY
A 604	4	22-0		BODY
A 405	17	6-10	X	BODY
A 406	4	16-9		BODY
A 407	4	25-6		BODY
A 508	26	2-6		BODY
A 409	16	2-10		WING 1
A 410	16	7-1	X	WINGS 1 & 2
A 411	6	5-5	X	WINGS 1 & 2
A 412	6	10-6	X	WINGS 1 & 2
A 913	10	12-3	X	WINGS 1 & 2
A 814	2	12-5	X	WINGS 1 & 2
A 415	10	8-5	X	WING 1
A 416	16	3-0		WING 2
A 417	10	6-5	X	WING 2
A 418	8	5-10		WINGS 1 & 2
A 819	2	11-8	X	WINGS 1 & 2
A 420	6	8-11	X	WING 1
A 421	6	6-11	X	WING 2
A 422	12	2-3		BODY - PILE
A 323	6	28-0	X	BODY - PILE - SPIRAL


No.	Date	Revision	By
STATE OF WISCONSIN DEPARTMENT OF TRANSPORTATION DIVISION OF HIGHWAYS			
STRUCTURE B-3-63			
Const. Spec.	1969	Drawn By	DB
		Plans Checked	B.W.
WEST ABUTMENT		SHEET 3 OF 9	
		X 47244	

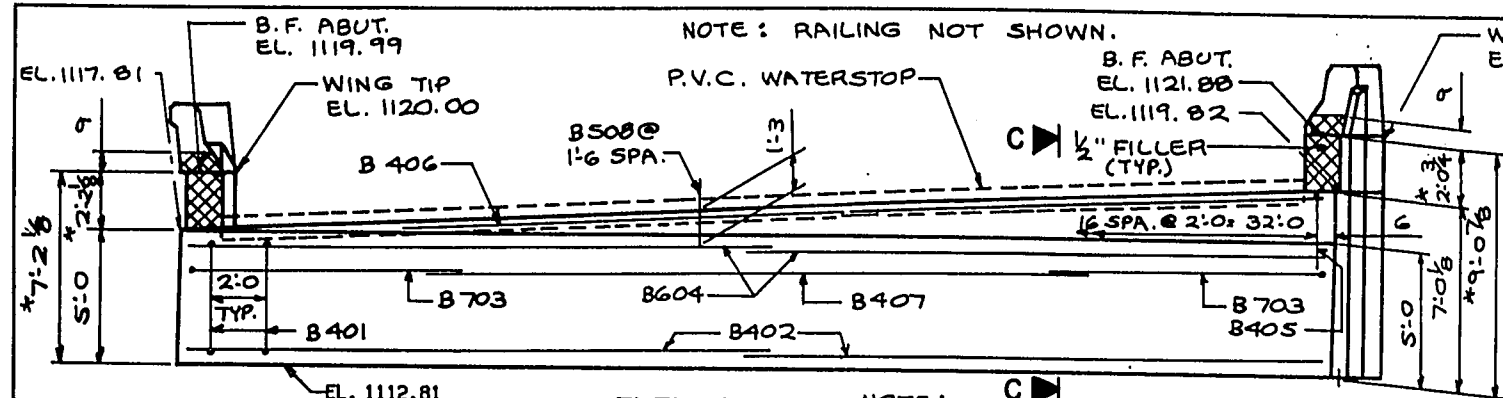

* DIMENSIONS GIVEN AT
B.F. OF ABUTMENT

ELEVATION
(LOOKING EAST)

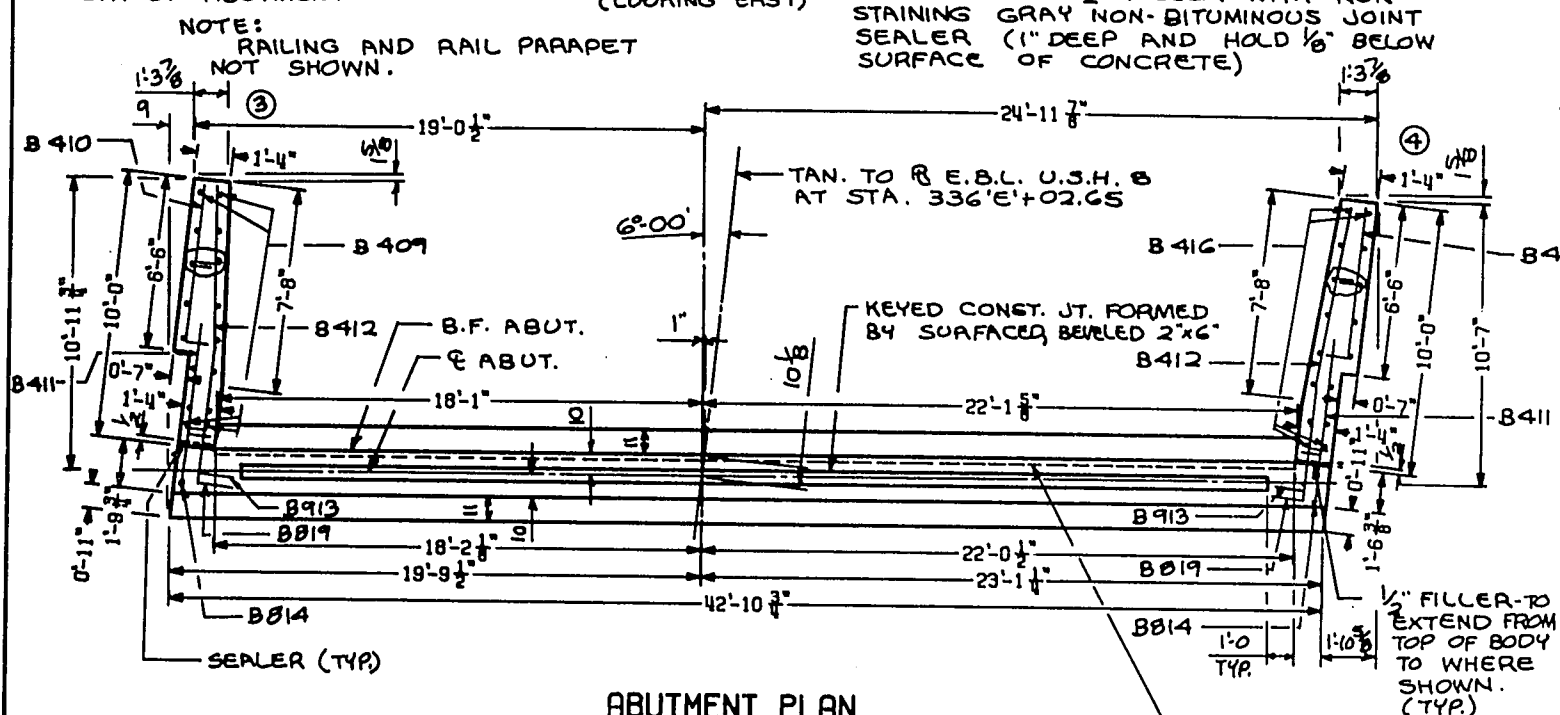
NOTE: SEAL ALL EXPOSED HORIZ. AND VERT. SURFACES OF 1/2" FILLER WITH NON-STAINING GRAY NON-BITUMINOUS JOINT SEALER (1" DEEP AND HOLD 1/8" BELOW SURFACE OF CONCRETE).




ABUTMENT PLAN

POLYVINYL CHLORIDE WATERSTOP.
TO EXTEND BETWEEN INSIDE FACES
OF WINGS. (FLUSH WITH FACE
OF CONCRETE) SEE DETAIL ON
SHEET 3.

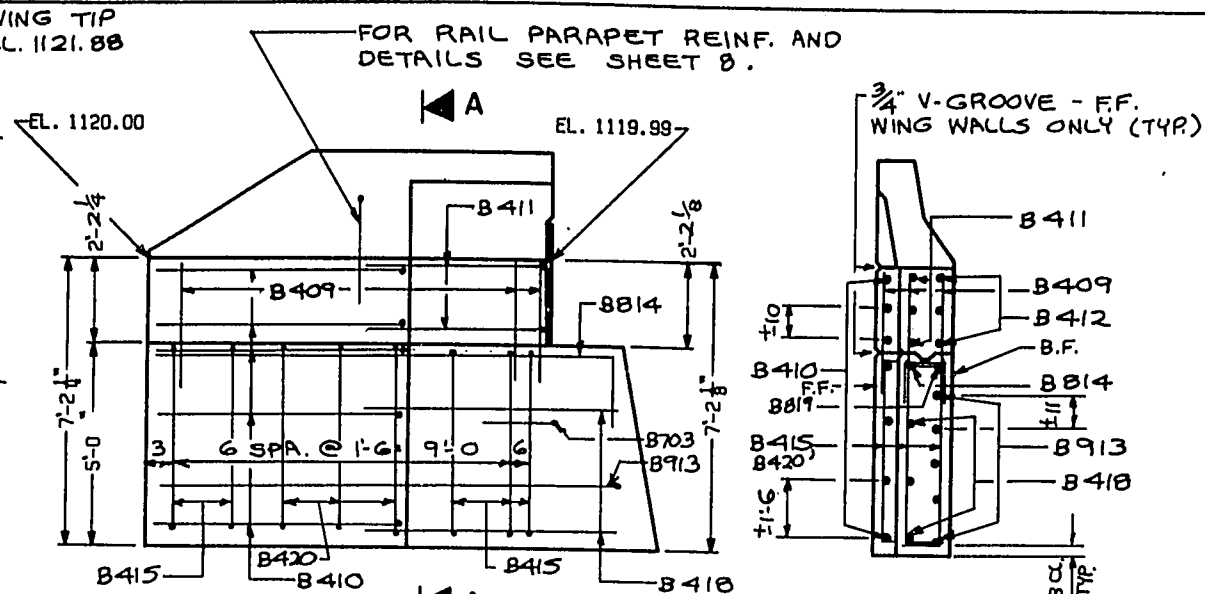
KEYED CONST. JOINT FORMED BY -
SURFACED, BEVELED 2"x6". POUR
CONCRETE ABOVE THIS JOINT
AFTER SUPER. CONCRETE IS IN
PLACE.




WING 3 ELEVATION

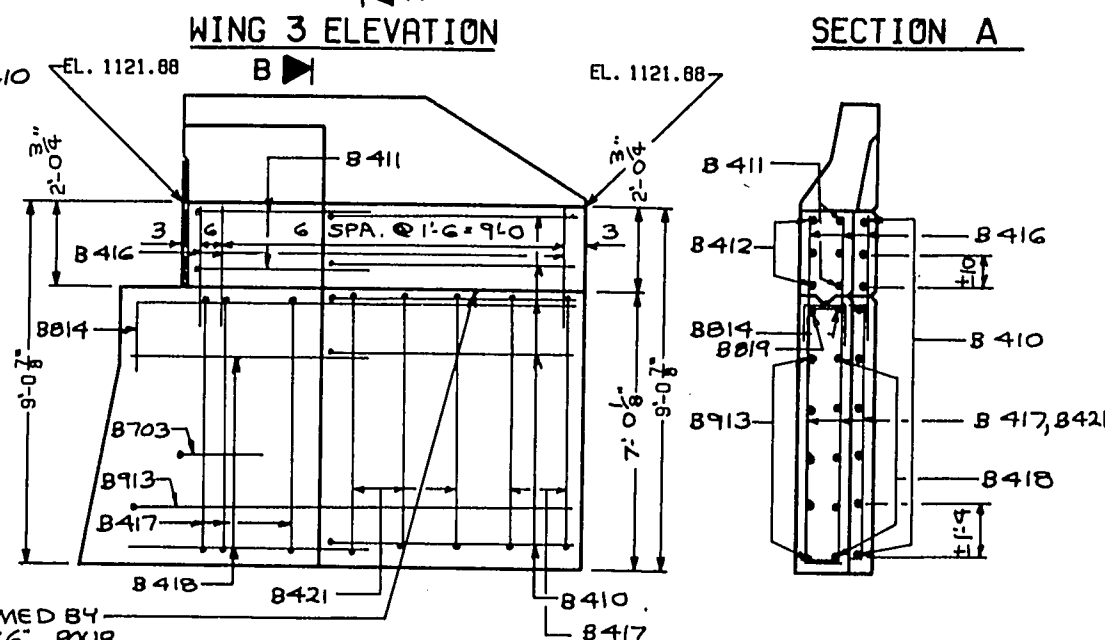


WING 4 ELEVATION

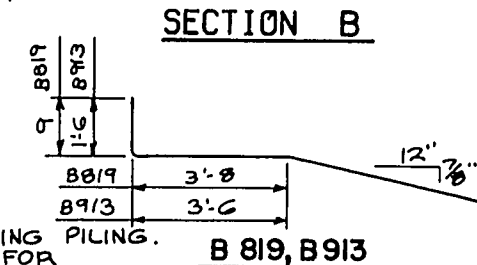

SECTION B

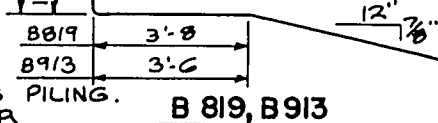


SECTION B

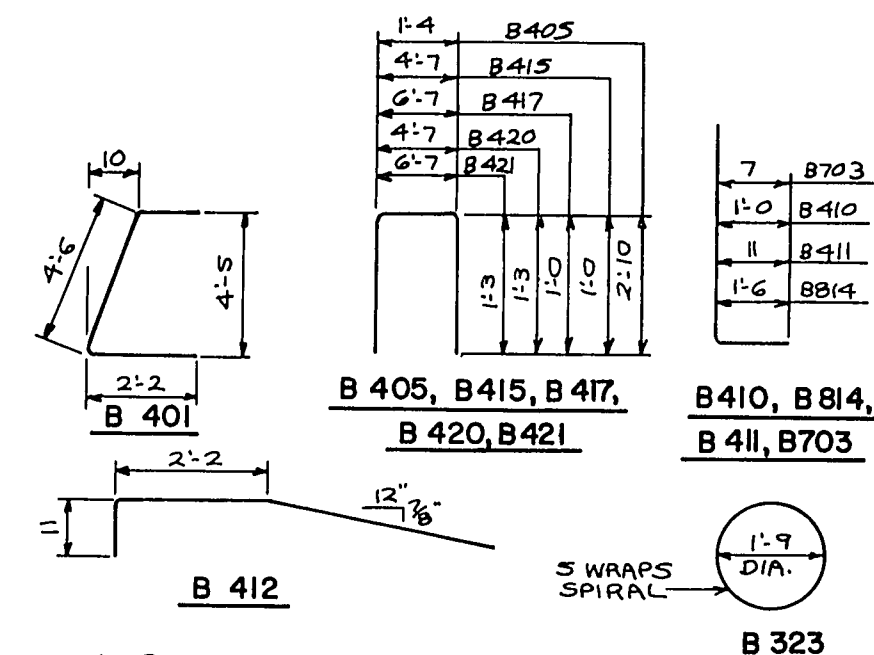


NOTE:

ALL DIMENSIONS IN BENDING ARE OUT TO OUT OF BAR.

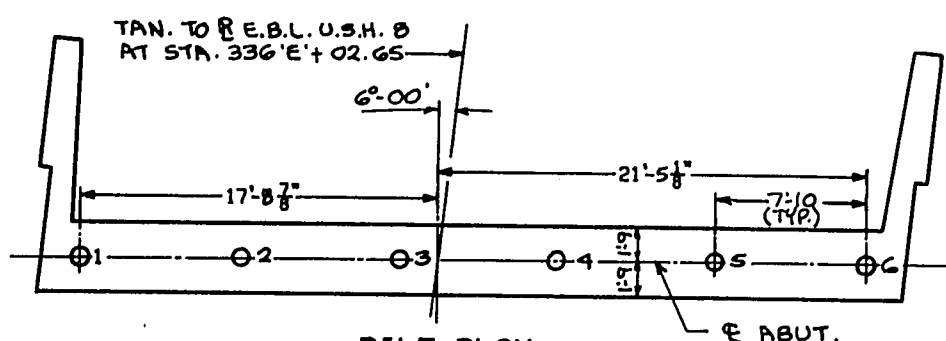THE FIRST DIGIT OF A BAR MARK SIGNIFIES THE BAR SIZE.



PILE PLAN

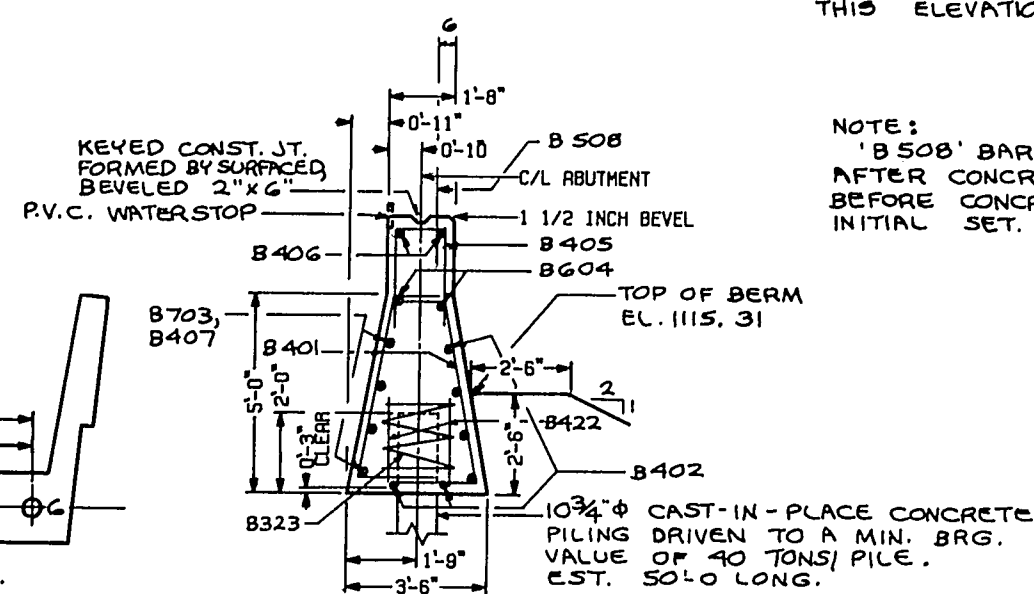

SECTION C

NOTE:
FILL TO EL. 1115.31 BEFORE DRIVING
UPPER LIMITS OF 'EXCAVATION FOR
STRUCTURES' SHALL NOT EXCEED
THIS ELEVATION.






NOTE:
'B508' BARS MAY BE PLACED
AFTER CONCRETE IS POURED BUT
BEFORE CONCRETE HAS TAKEN ITS
INITIAL SET.

NOTE:
FOR 'PILE SPLICE DETAIL'
SEE SHEET 3.

No.	Date	Revision		By
STATE OF WISCONSIN DEPARTMENT OF TRANSPORTATION DIVISION OF HIGHWAYS				
STRUCTURE B-3-63				
Const. Spec.	1969	Drawn By	DB	Plans Checked <i>B. W.</i>
EAST ABUTMENT			SHEET 4 OF 9 X 47245	

* TOP OF COLUMN ELEVATION AND COLUMN HEIGHTS ARE MEASURED AT \bar{C} OF COLUMN AT \bar{C} OF PIER. TOP OF COL. ELEV. ARE GIVEN AT TOP OF CONC.

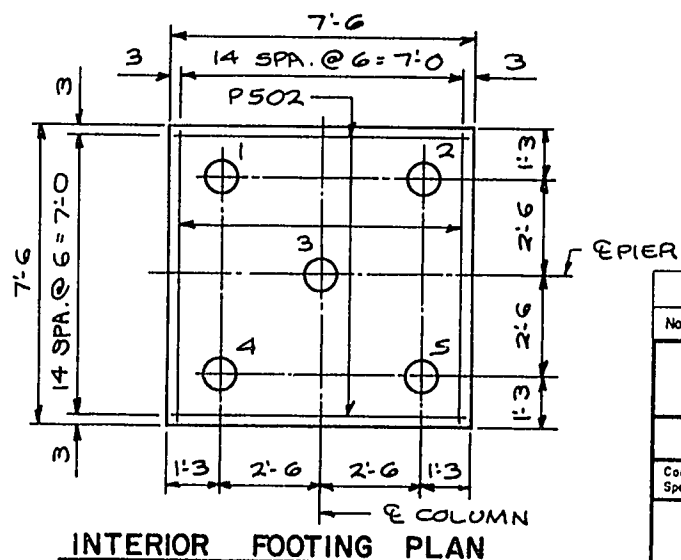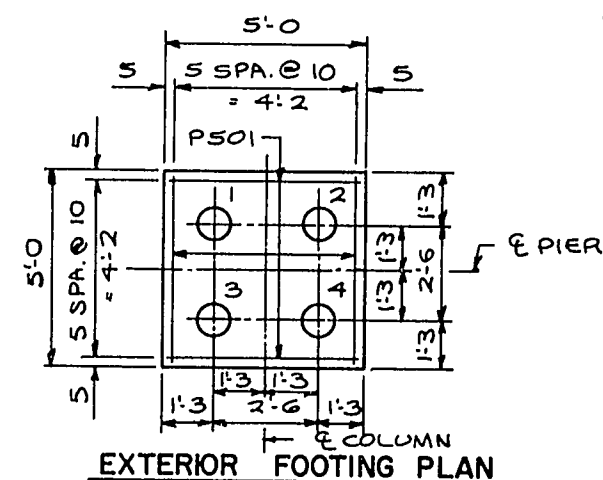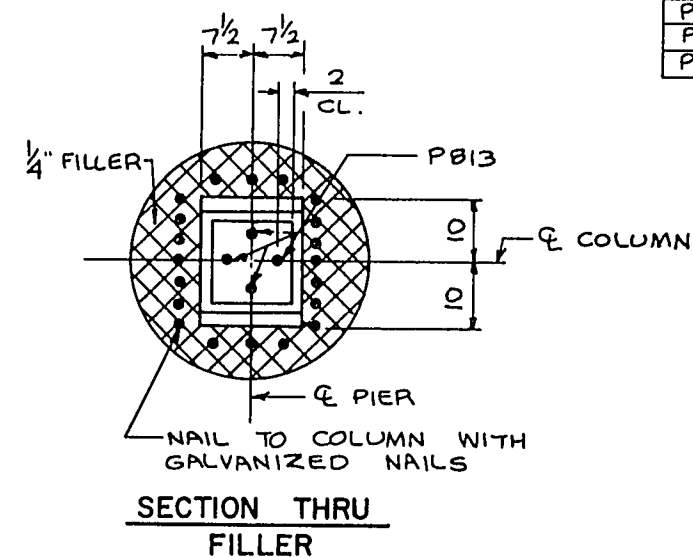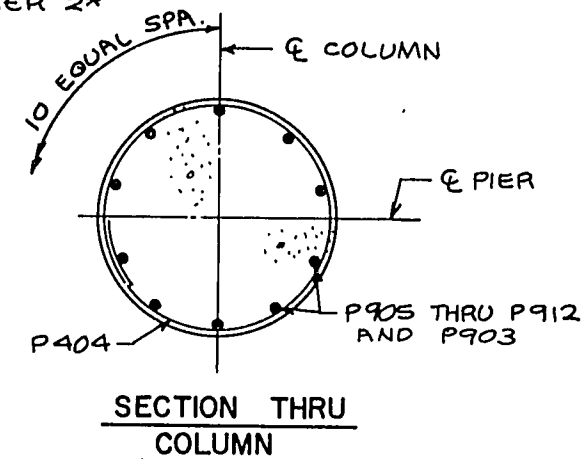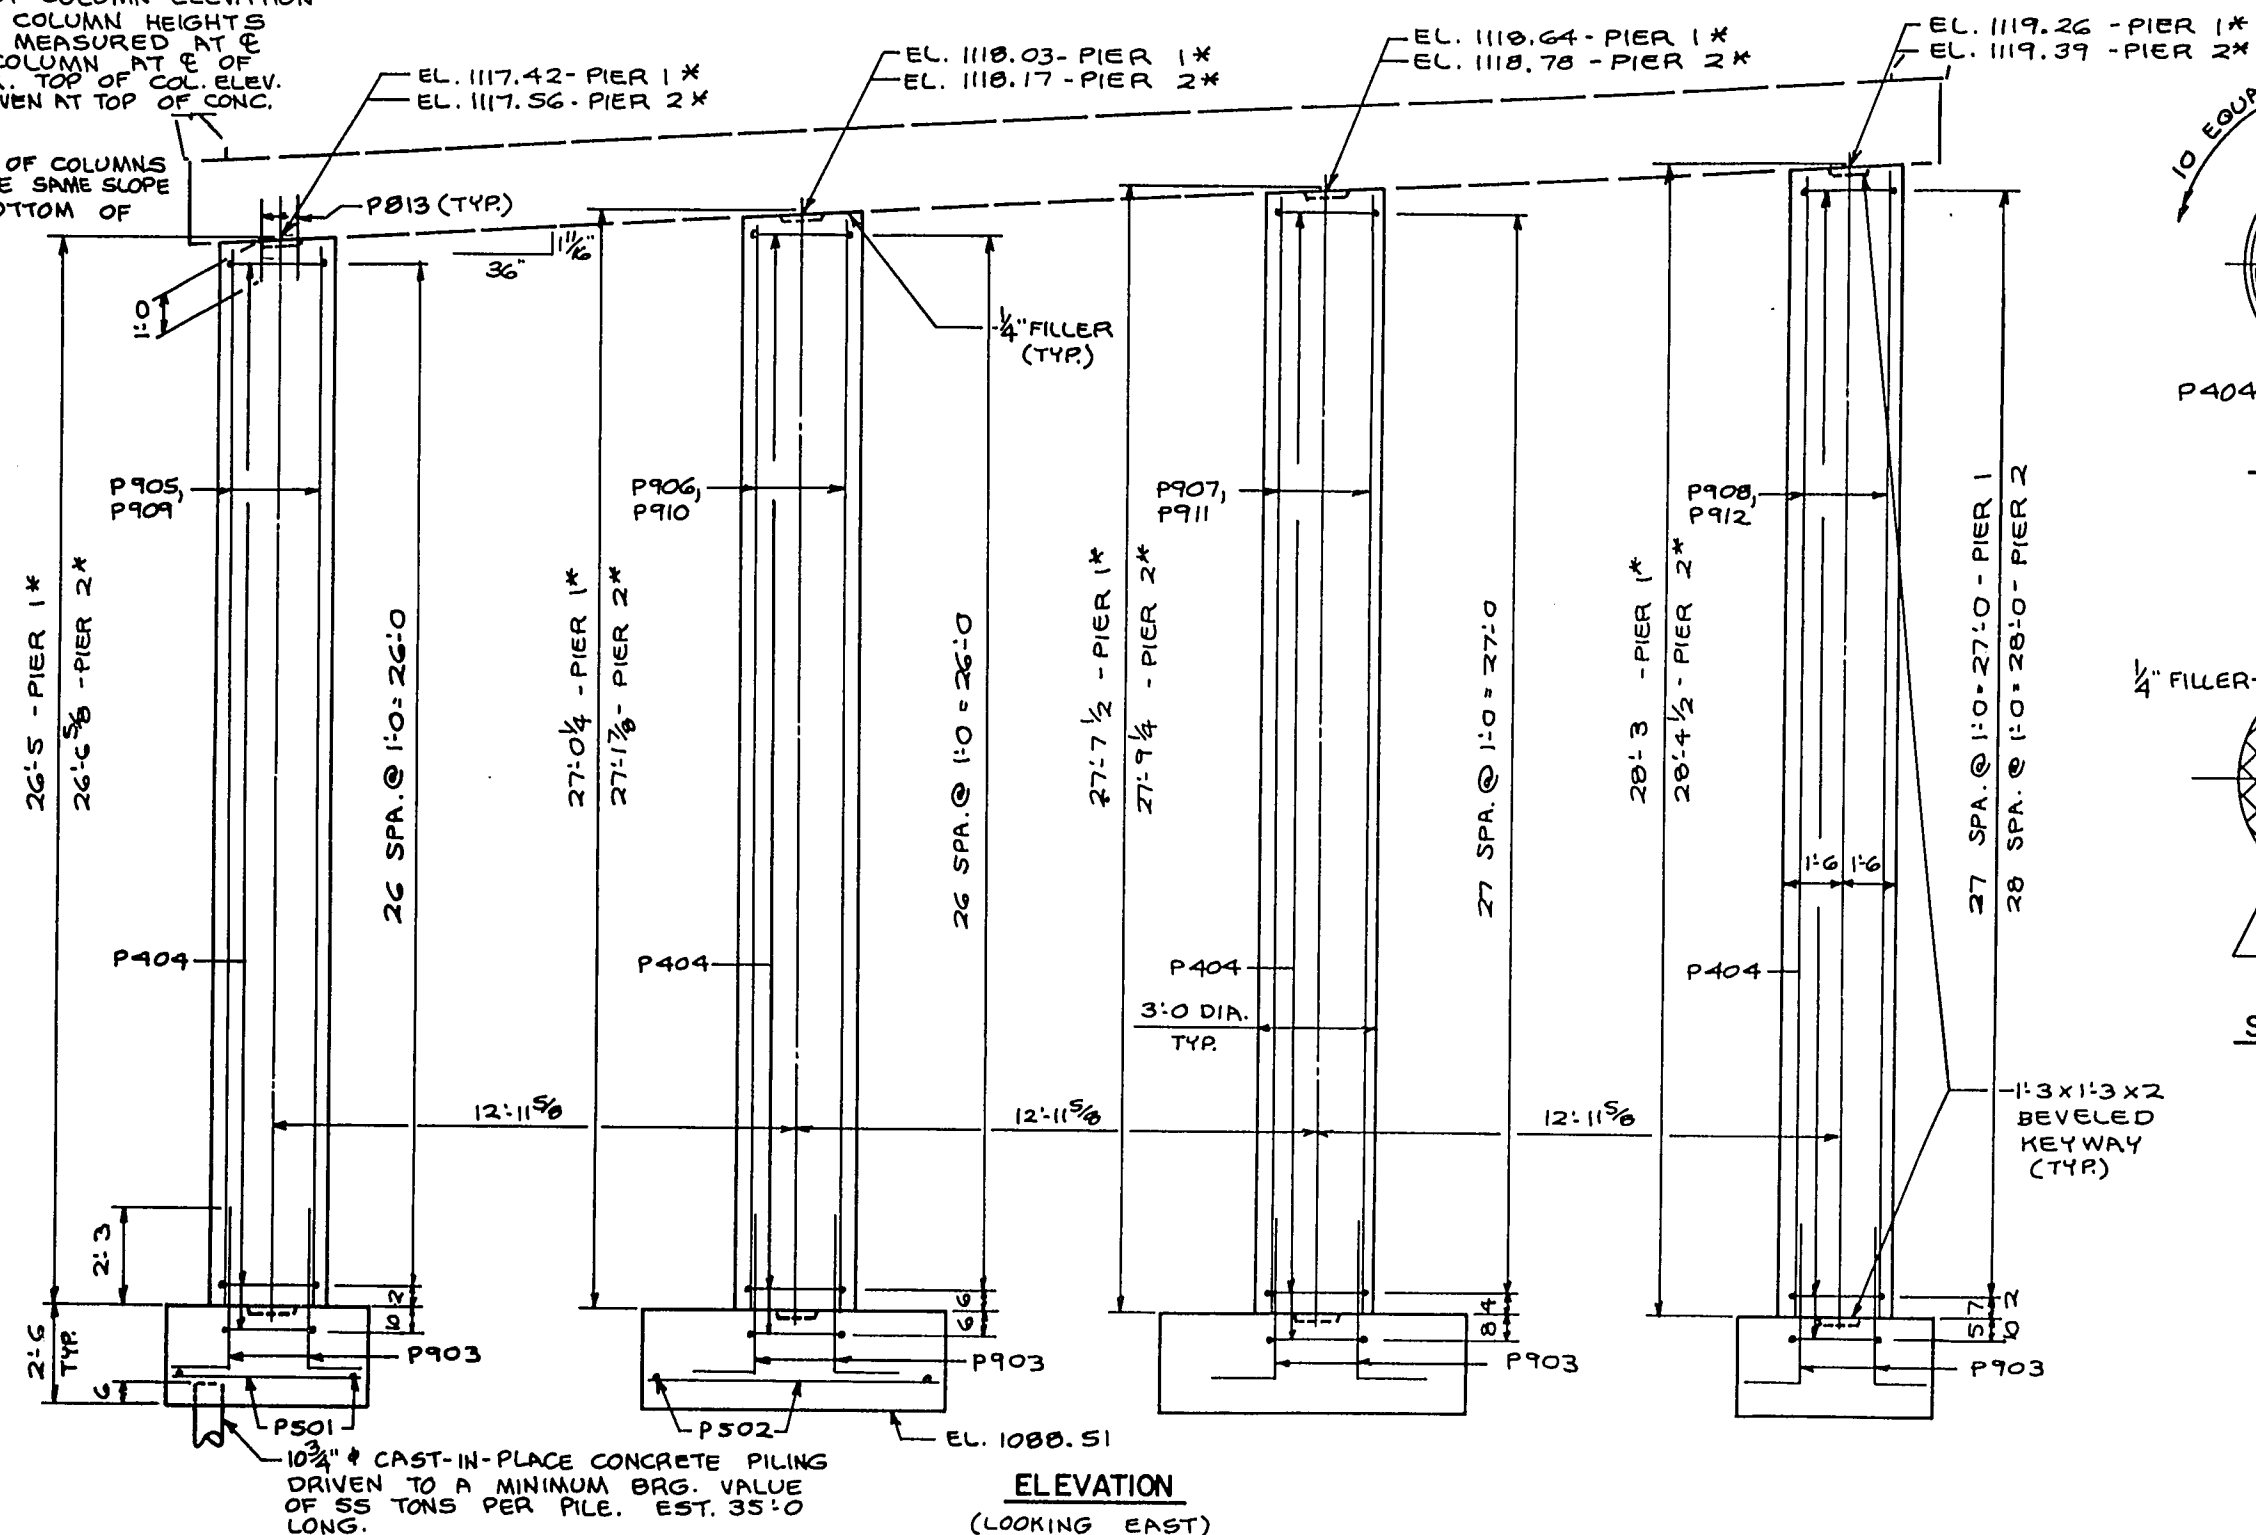NOTE:
TOP OF COLUMNS TO HAVE SAME SLOPE AS BOTTOM OF SLAB.



PROJECT NO.	1572-1-72	SHEET NUMBER	104	TOTAL SHEETS	225
FEDERAL PROJECT DESIGNATION	F021-1(57)				

BILL OF BARS 11,570* (TWO PIERS)





MARK	NO.	LENGTH	BENT	LOCATION
P501	48	4-8		FOOTING - EXTERIOR
P502	120	7-2		FOOTING - INTERIOR
P903	80	5-4	X	FOOTING & COLUMNS
P404	229	9-5	X	COLUMNS & FOOTINGS
P905	10	26-2		COLUMN 1 - PIER 1
P906	10	26-9		COLUMN 2 - PIER 1
P907	10	27-4		COLUMN 3 - PIER 1
P908	10	28-0		COLUMN 4 - PIER 1
P909	10	26-3		COLUMN 1 - PIER 2
P910	10	26-10		COLUMN 2 - PIER 2
P911	10	27-6		COLUMN 3 - PIER 2
P912	10	28-1		COLUMN 4 - PIER 2
P813	32	2-0		COLUMNS

NOTES:
ALL DIMENSIONS IN BENDING ARE OUT TO OUT OF BAR.
THE FIRST DIGIT OF A MARK SIGNIFIES THE BAR SIZE.

NOTE:
'P813' BARS MAY BE PLACED AFTER CONCRETE HAS BEEN POURED BUT BEFORE IT HAS TAKEN ITS INITIAL SET.

NOTE:
FOR 'PILE SPLICE DETAIL' SEE SHEET 3.

No.	Date	Revision	By
STATE OF WISCONSIN DEPARTMENT OF TRANSPORTATION DIVISION OF HIGHWAYS			
STRUCTURE B-3-63			
Const. Spec.	1969	Drawn By	DB
Plans Checked	B. W.		
PIERS 1 & 2			SHEET 5 OF 9
			X 47246

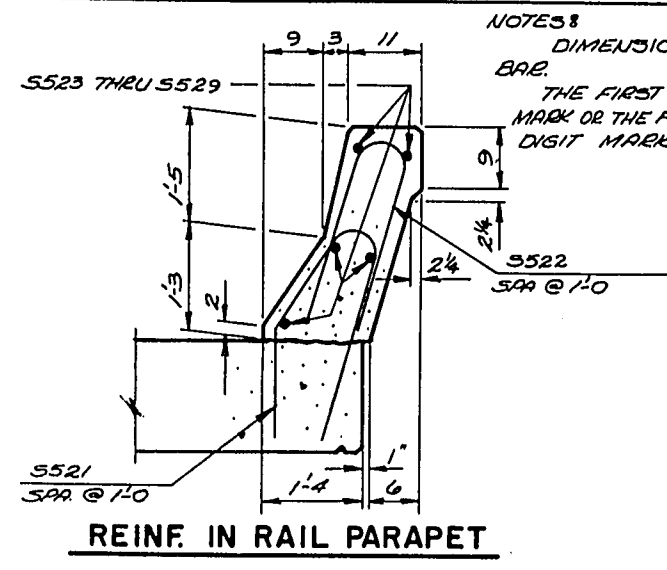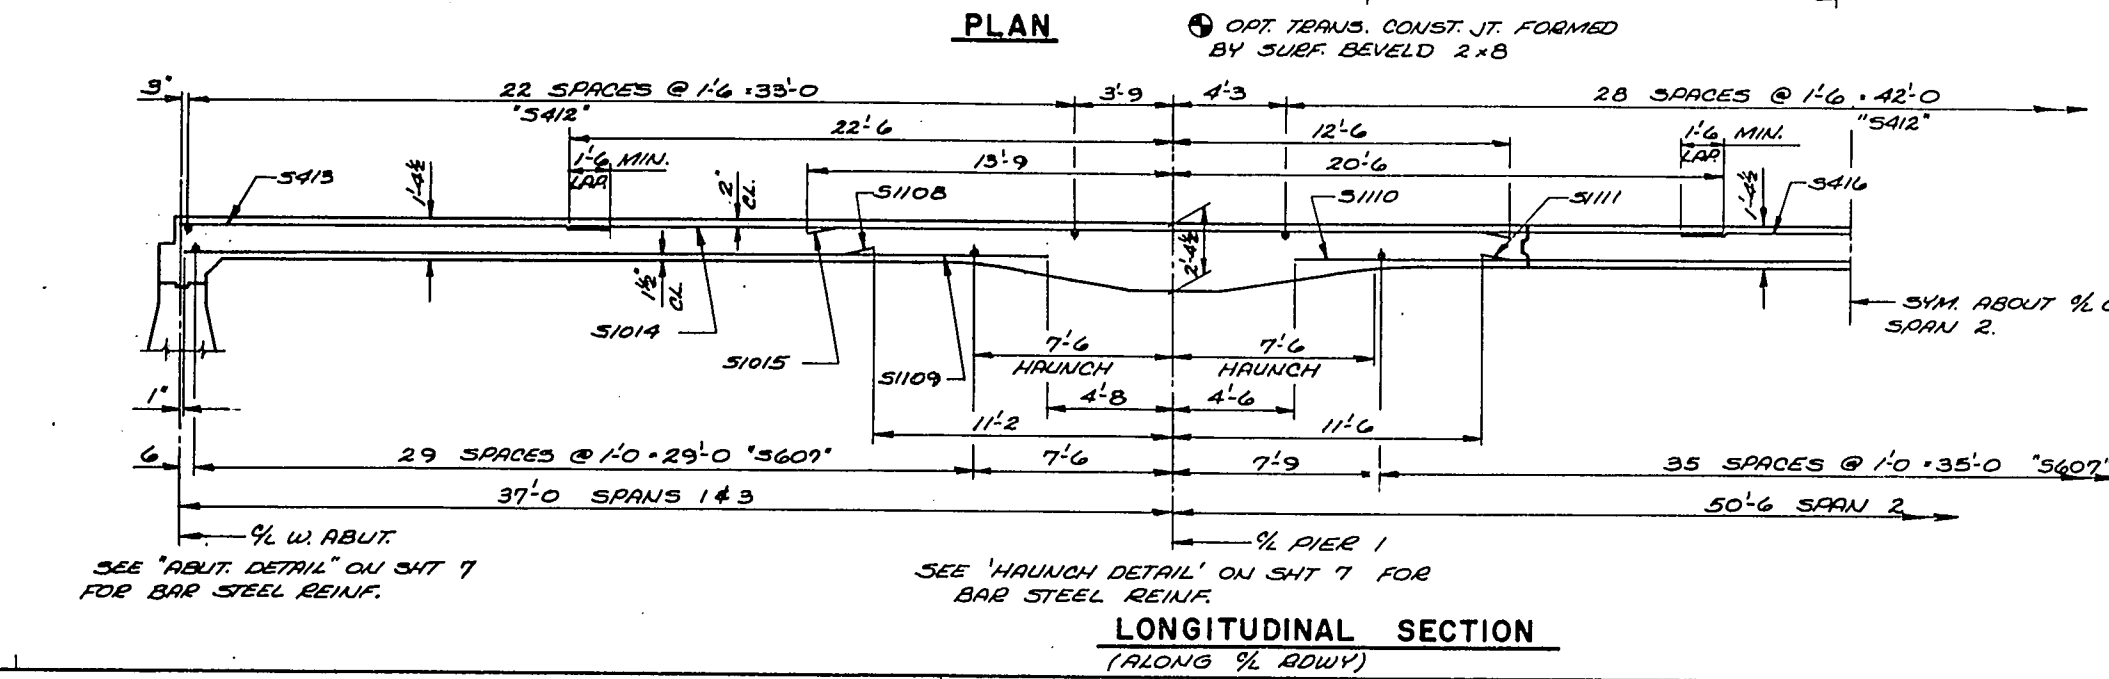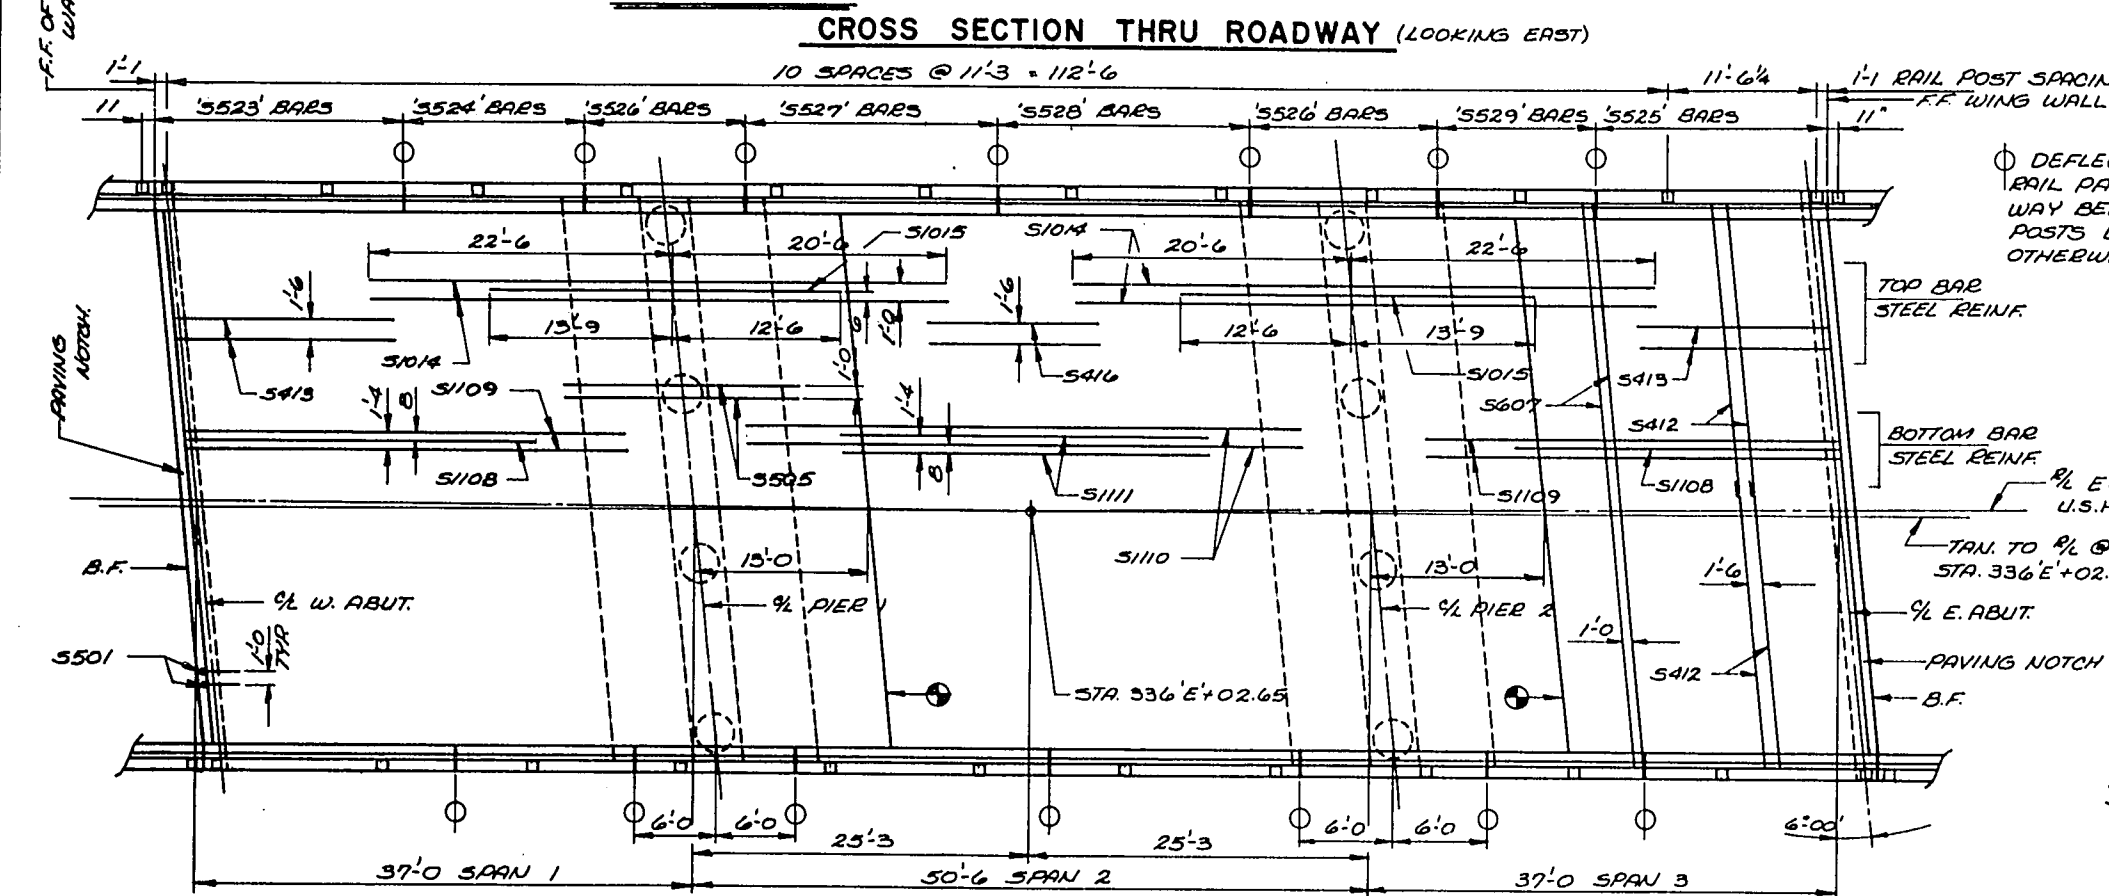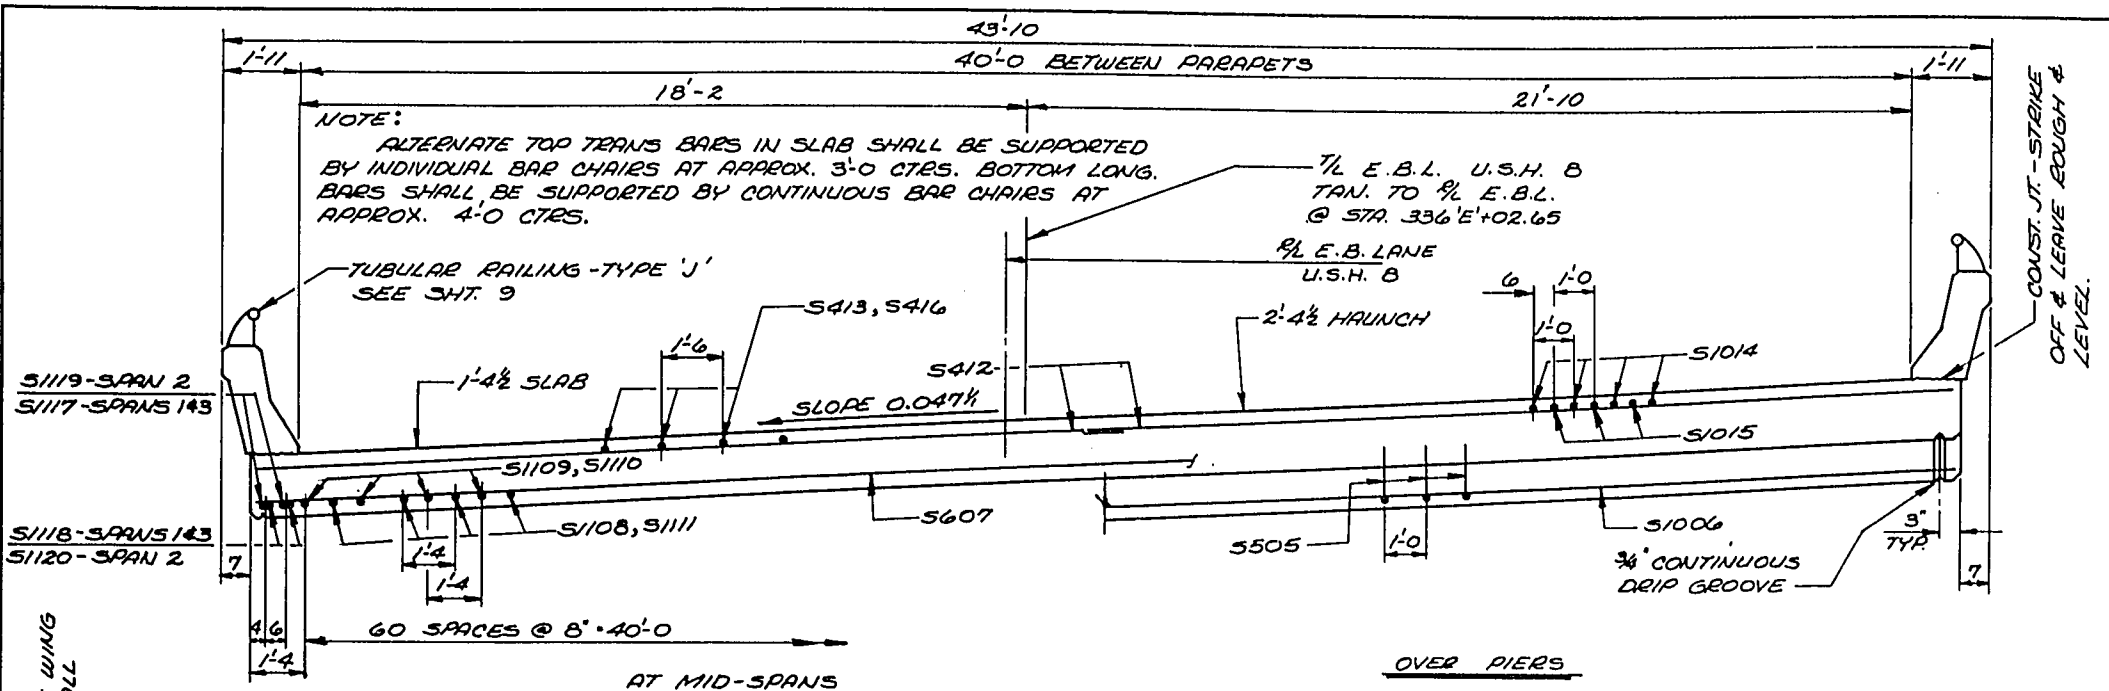

PROJECT ID	1572-1-72	SHEET NUMBER	105	TOTAL SHEETS	225
FEDERAL PROJECT DESIGNATION	FO21-1(57)				

BILL OF BARS						81,630
MARK	Nº REQ'D	LENGTH	BENT	BUNDLED	LOCATION	
S501	86	3'-1"	X		SLAB AT ABUTS.	
S502	86	2'-6"	X		" " "	
S503	86	3'-2"	X		" " "	
S404	24	21'-0"			" " " & PIERS	
S505	86	18'-4"	X		HAUNCH AT PIERS	
S506	34	42'-6"			" " "	
S607	96	42'-5"			SLAB BOT. TRANS.	
S1108	60	25'-9"			" " " - LONG. SPANS 1 & 3	
S1109	62	32'-3"			" " " " " " "	
S1110	31	41'-6"			" " " " - SPAN 2	
S1111	30	27'-6"			" " " " " " "	
S412	150	22'-0"			" " " - TOP TRANS.	
S413	58	16'-0"			" " " - LONG. SPANS 1 & 3	
S1014	86	43'-0"			" " " " - OVER PIERS	
S1015	84	26'-3"			" " " " " " "	
S416	29	12'-6"			" " " " - SPAN 2	
S1117	8	32'-3"	X		EDGE BEAM REINF. - SPANS 1 & 3	
S1118	8	25'-9"	X		" " " " " " "	
S1119	4	41'-6"	X		" " " " - SPAN 2	
S1120	4	27'-6"	X		" " " " " " "	
S521	250	5'-8"	X		SLAB & RAIL PARAPET	
S522	250	5'-0"	X		RAIL PARAPET	
S523	10	17'-5"			" " " - HORIZ.	
S524	10	13'-6"			" " " " " " "	
S525	10	17'-8"			" " " " " " "	
S526	20	11'-8"			" " " " " " "	
S527	10	18'-9"			" " " " " " "	
S528	10	19'-0"			" " " " " " "	
S529	10	13'-3"			" " " " " " "	

NOTE: BUNDLED BARS SHALL BE WIRED TOGETHER AT 2'-0" CTRS.

S501 & S502



S503

S505

S521


S522





No.	Date	Revision	By
STATE OF WISCONSIN DEPARTMENT OF TRANSPORTATION DIVISION OF HIGHWAYS			
STRUCTURE B-3-63			
Const. Spec.	1969	Drawn By	R.J.G.
		Plans Checked	B.W.
SUPERSTRUCTURE			SHEET 6 OF 9
			X47247

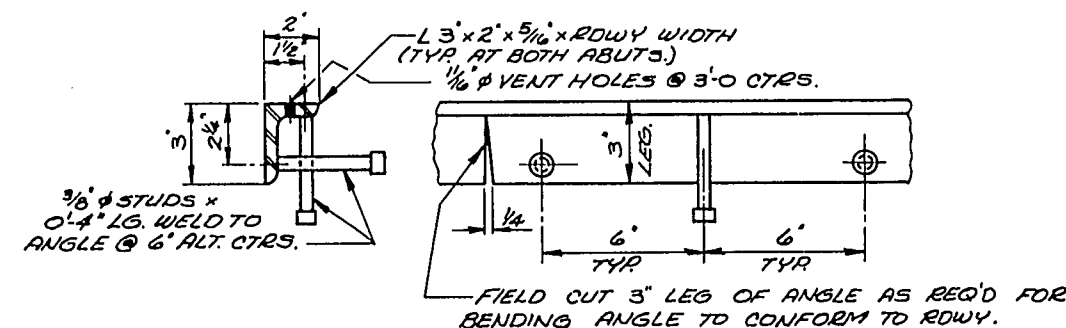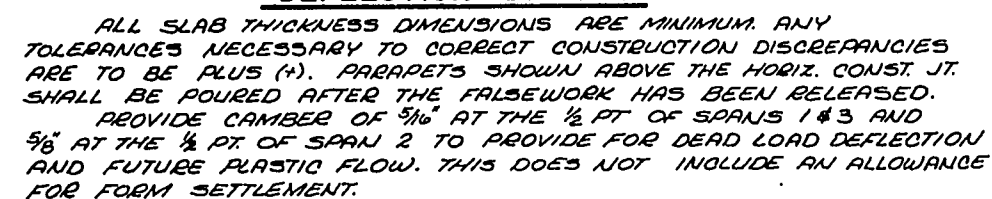

NOTE: ANGLE AND STUDS SHALL BE PAID FOR AS
STRUCTURAL CARBON STEEL.
ONE FIELD SPLICE PERMITTED, IF USED, DETAILS
SHALL BE SUBMITTED FOR APPROVAL.



No.	Date	Revision	By
STATE OF WISCONSIN DEPARTMENT OF TRANSPORTATION DIVISION OF HIGHWAYS			
STRUCTURE B-3-63			
Const. Spec.	1969	Drawn By	Plans Checked
SUPERSTRUCTURE		R. J. G.	
		<i>B. W.</i>	
SUPERSTRUCTURE		SHEET 7 OF 9	
		X47248	

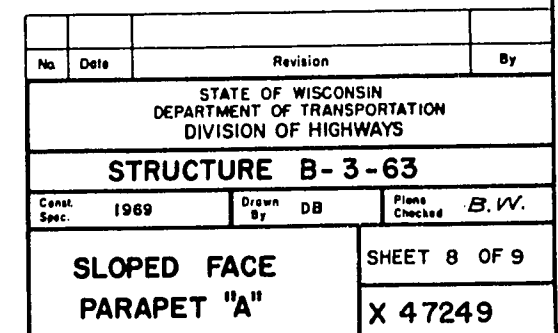

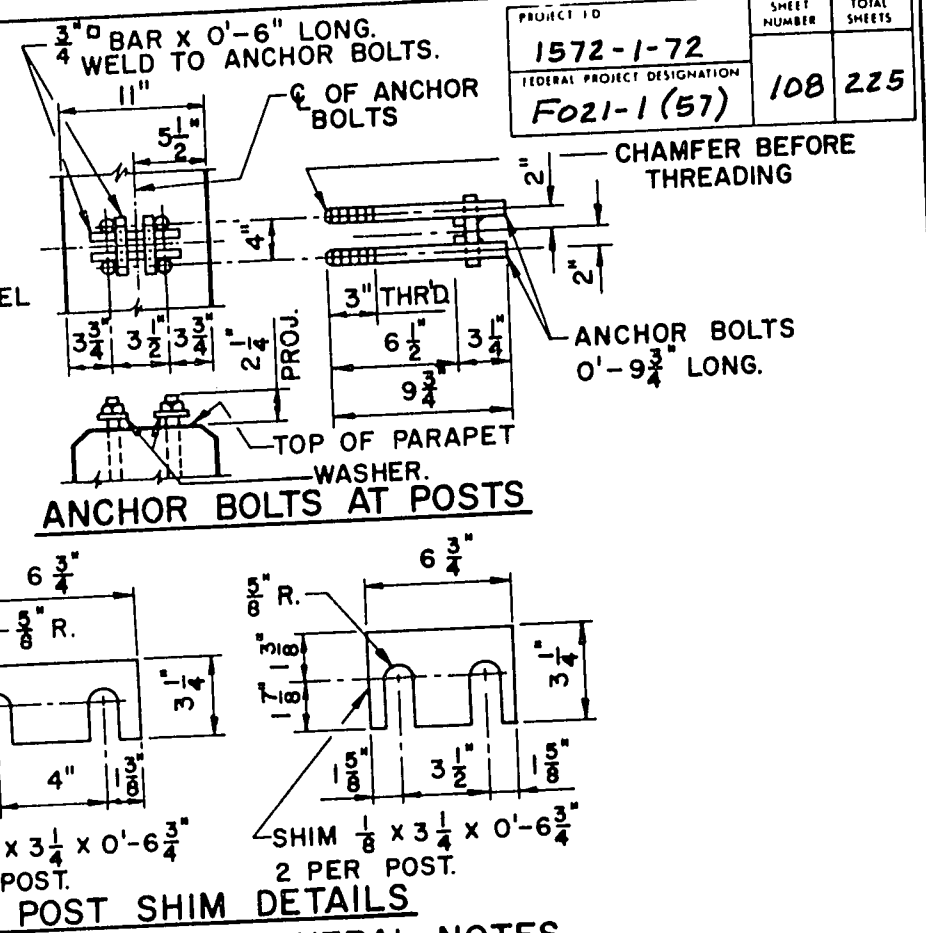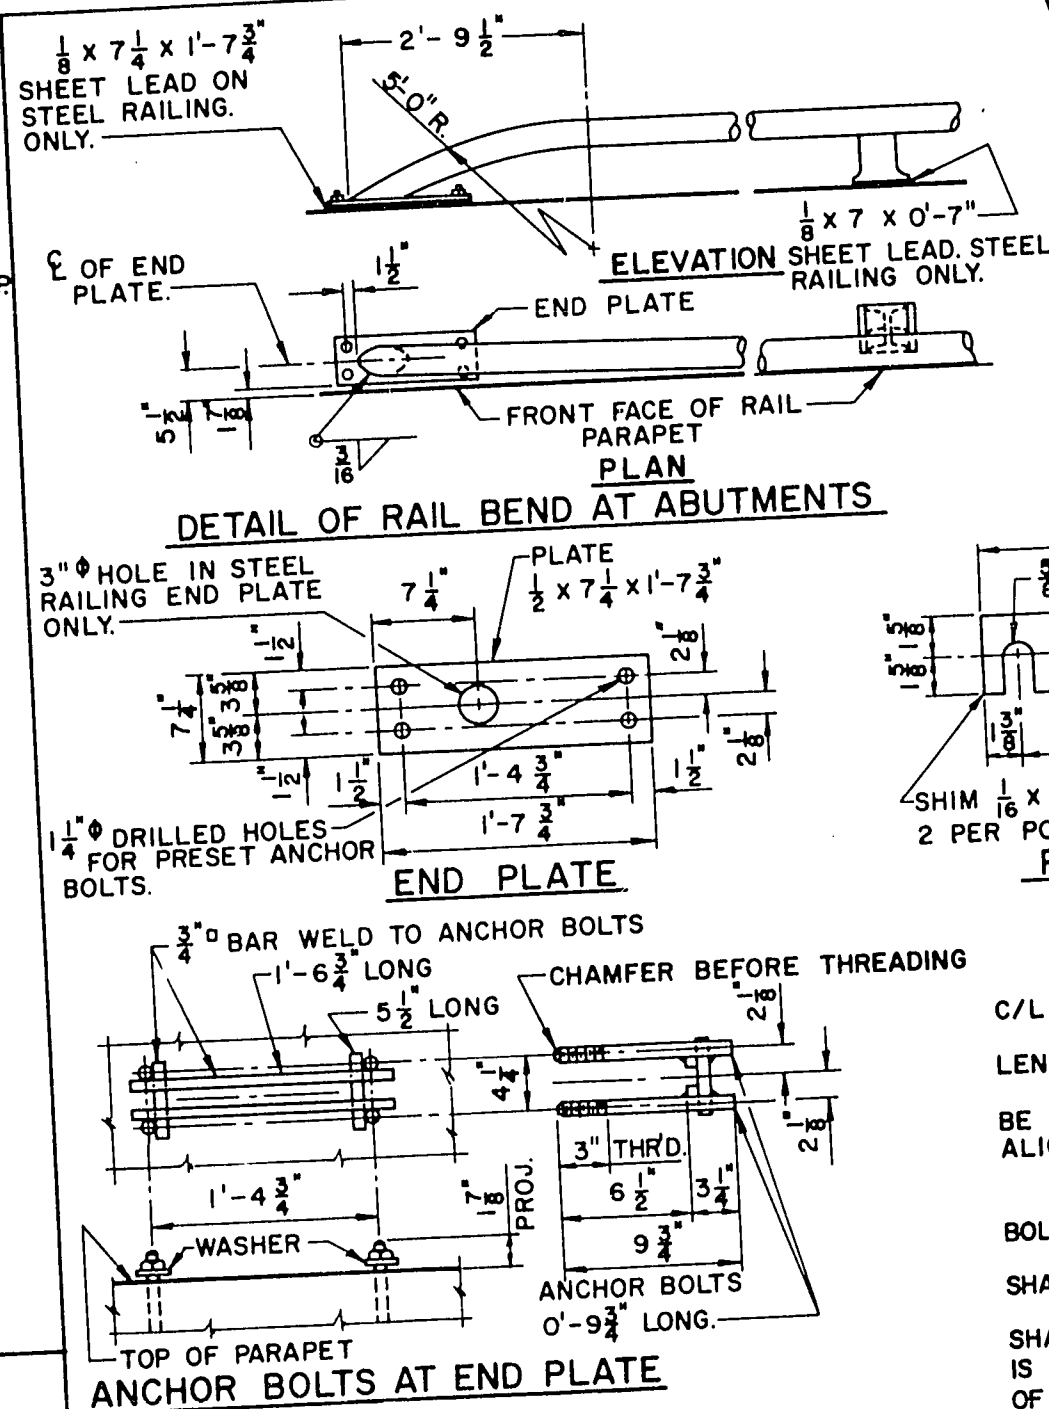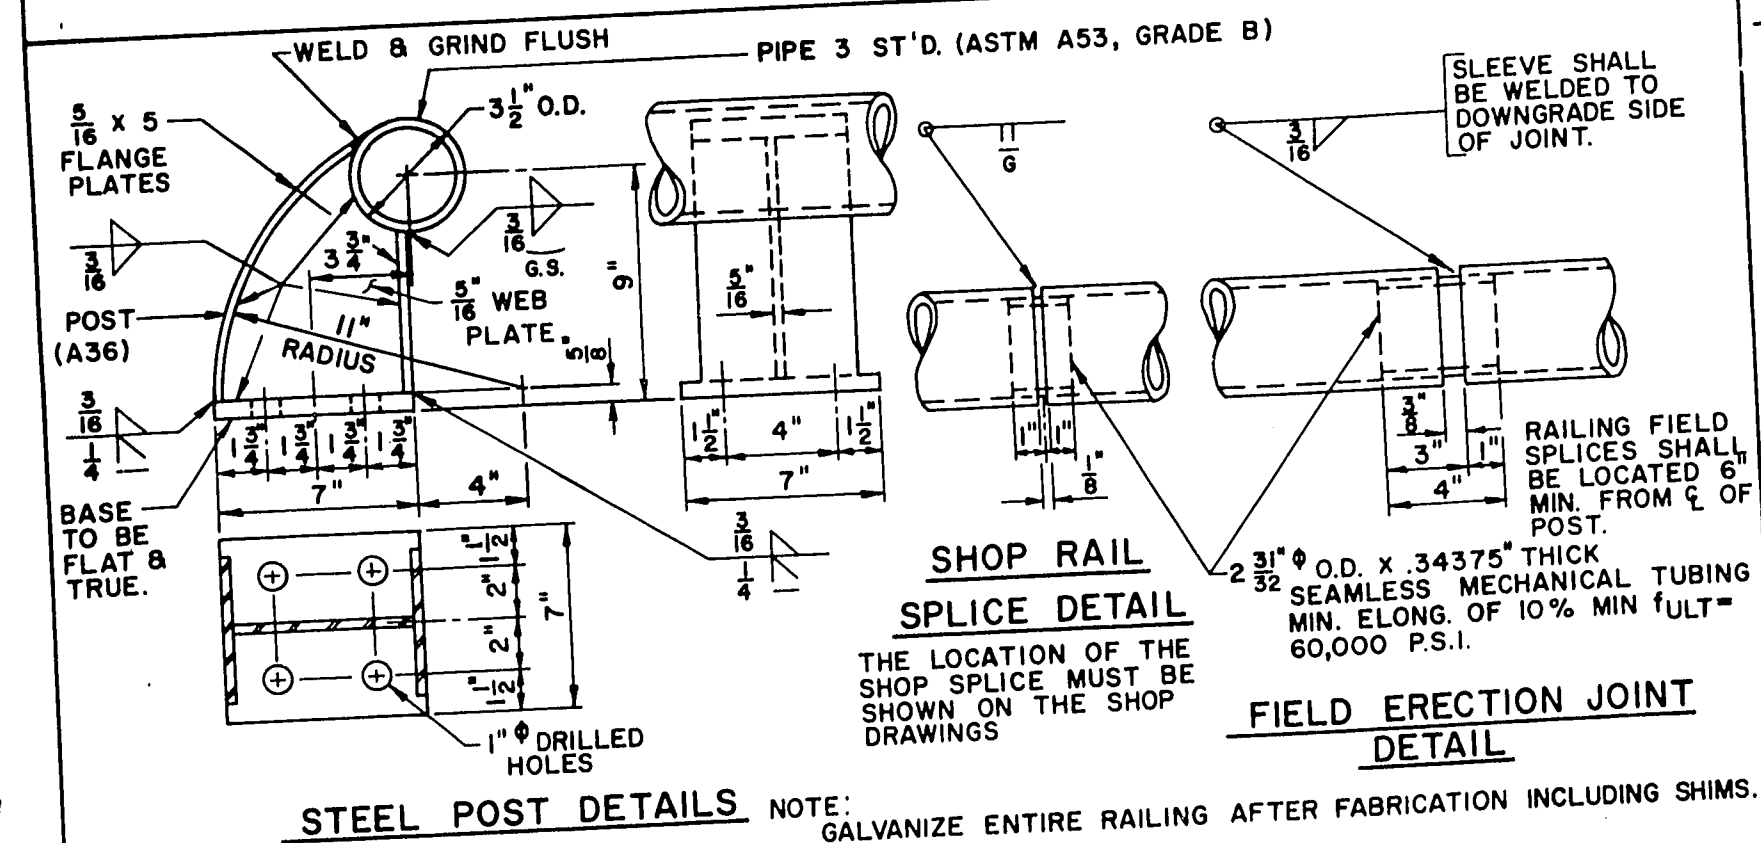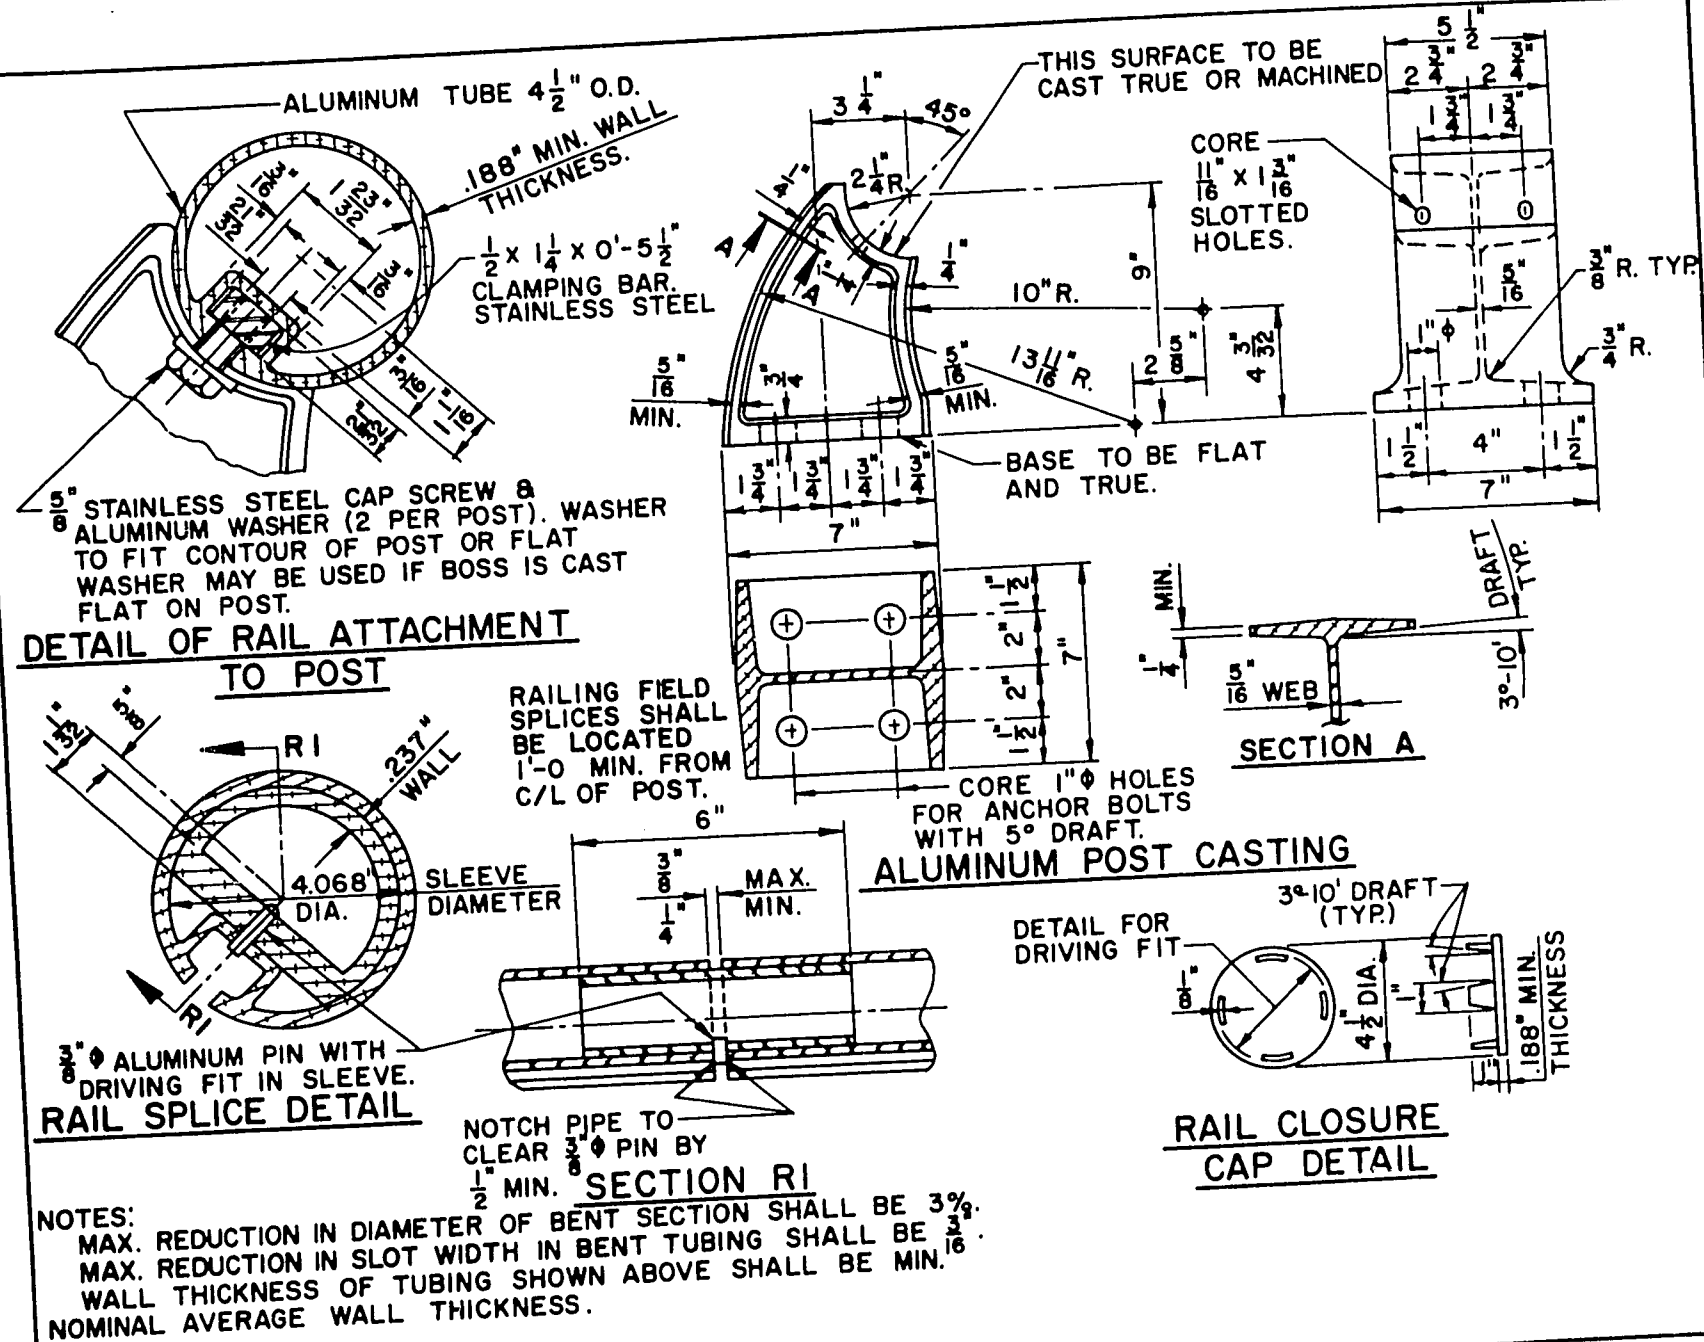

GENERAL NOTES

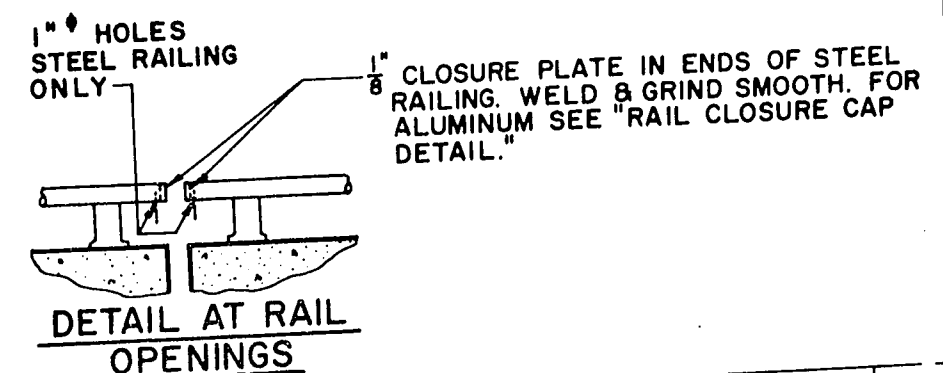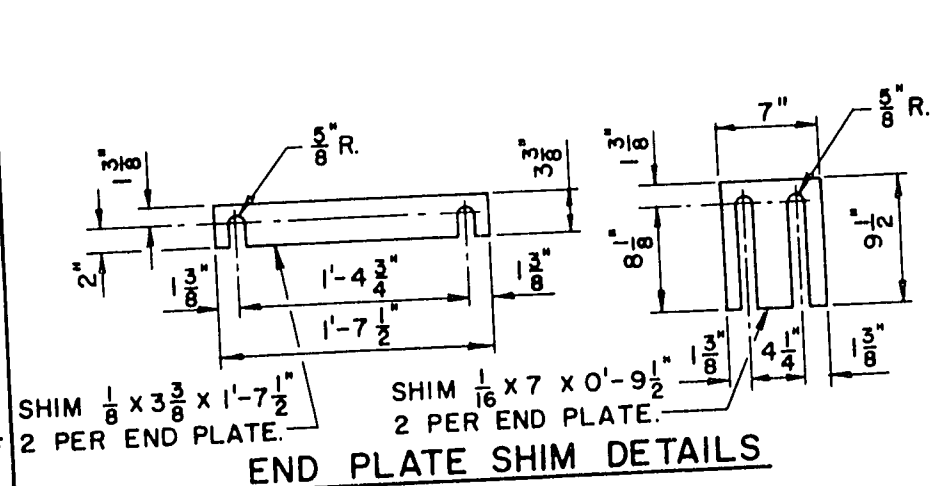BID ITEM SHALL BE TUBULAR RAILING, TYPE 'J'.
ALL POST SPACINGS ARE TAKEN HORIZONTALLY ALONG
C/L OF ANCHOR BOLTS.
RAILING SHALL BE FABRICATED IN TWO OR THREE PANEL
LENGTHS.
SHIMS CONFORMING TO SAME MATERIAL AS POSTS SHALL
BE USED UNDER POSTS AND END PLATES WHERE REQ'D FOR
ALIGNMENT.
RAIL POSTS SHALL BE SET NORMAL TO GRADE.
THE SHANK AND ROOT OF THREAD DIAMETER FOR ANCHOR
BOLTS SHALL BE A MIN. OF 0.62 INCHES.
ANCHOR BOLTS, NUTS & WASHERS FOR ALUMINUM RAILING
SHALL BE STAINLESS STEEL.
ANCHOR BOLTS, NUTS & WASHERS FOR STEEL RAILING
SHALL BE EITHER STAINLESS STEEL OR ASTM A307. IF A307
IS USED ELECTRO-GALVANIZE NUTS, WASHERS & TOP 3 1/2"
OF ANCHOR BOLTS.



No.	Date	Revision	By
STATE OF WISCONSIN DEPARTMENT OF TRANSPORTATION DIVISION OF HIGHWAYS			
STRUCTURE B-3-63			
Const. Spec.	1969	Drawn By	DB
		Plans Checked	B.W.
TUBULAR RAILING TYPE 'J'		SHEET 9 OF 9	
		X 47250	