



STATE OF WISCONSIN  
DEPARTMENT OF TRANSPORTATION

Inspection Report for  
B-36-071

IH 43 NB over USH 10 EB-STH 42 SB  
Jun 28,2017



Type	Prior	Frequency (mos)	Performed
Routine	09-09-15	24	X
Deck Evaluation	06-16-16	0	
SIA Review	09-09-15	48	

Latitude 44°06'33.41"N  
Longitude 87°43'50.10"W

Owner STATE HIGHWAY DEPT  
Maintainer STATE HIGHWAY DEPT

Time Log

Hours 0  
Minutes 30

Team members

Dale Weber

Name	Number	Signature	Date
Inspector Rades, Brady	3015	<i>Brady Rades</i> E-signed by Brady Rades(dotbpr)	06-28-17

**BRIDGE INSPECTION REPORT**  
**Wisconsin Department of Transportation**  
**DT2007 2003 s.84.17 Wis. Stats.**

page 2

**Identification & Location**

Feature On: IH 43 NB	Section Town Range: S15 T19N R23E	Structure Number: <b>B-36-071</b>
Feature Under: USH 10 EB-STH 42 SB	County: MANITOWOC	
Location 2.8M N JCT USH 151	Municipality: MANITOWOC RAPIDS	Structure Name:

**Geometry**

measurements in feet, except where noted

Approach Roadway Width: 40	Bridge Roadway Width: 40.0	Total Length: 157.8
Approach Pavement Width: 24	Deck Width: 43.0	Deck Area (sq ft): 6785

**Traffic**

	Lanes	ADT	ADT year	Traffic Pattern
On	2	10100	2017	ONE WAY TRAFFIC
Under	5	5000	2017	TWO WAY TRAFFIC

**Capacity**

**Load Rating**

Inventory rating: HS14	Overburden depth (in): 2.0	Last rating date: 07-22-15	Controlling: INTERIOR DECK GIRDER Positive Moment
Operating rating: HS21	Deck surface material: CONCRETE	Re-rate for capacity (Y/N):	Control location: SPAN 1
Posting:	Re-rate notes:		

**Hydraulic**

**Classification**

Scour Critical Code(113): (N) NO WATERWAY	Q100 (ft3/sec): 0	
High water elevation (ft): 0.0	Velocity (ft/sec): 0.0	Sufficiency #:

**Span(s)**

Span #	Material	Configuration	Depth (in)	Length (ft)	Main
1	CONT PREST CONC	DECK GIRDER	45	76.0	
2	CONT PREST CONC	DECK GIRDER	45	80.0	Y

**Expansion joint(s)**

**Temperature:**

File:	New:
-------	------

**Clearance**

Item	File Measurement (ft)	File Date	New Measurement (ft)
Highway Min Vertical Under Cardinal	17.39		
Highway Min Vertical Under Non-Cardinal	17.06		
Horizontal Under Cardinal	34.0		
Horizontal Under Non-Cardinal	46.0		
Highway Min Vertical On Cardinal			
Horizontal On Cardinal			

**Construction History**

Year	Work Performed	FOS id
2016	OVERLAY - CONCRETE	1224-21-71
9999	NOT BUILT	1224-71-21
2001	OVERLAY - BITUMINOUS	1224-07-71
1992	REPAIR DECK	
1979	NEW STRUCTURE	1225-01-87

**BRIDGE INSPECTION REPORT**  
**Wisconsin Department of Transportation**  
**DT2007 2003 s.84.17 Wis. Stats.**

page 3

Structure No.: **B-36-071**

**Maintenance Items**

Item	Priority	Recommended by	Status	Status change
<b>Approach - Seal Approach to Paving Block</b>	MEDIUM	Rades, Brady (3015)	IDENTIFIED	06/28/17
hot rubber				
<b>Deck - Seal Surface Cracks</b>	MEDIUM	Rades, Brady (3015)	IDENTIFIED	06/28/17
MMA				
<b>Expansion Joints - Seal</b>	MEDIUM	McDowell, Jim W (3008)	DEFERRED	04/07/16
With hot rubber				

**Elements**

Chk	Element	Defect	Description	UOM	Total	Quantity in Condition State			
						1	2	3	4
X	12		<b>Reinforced Concrete Deck</b>	SF	6,785	6,713	72	0	0
		1080	Delamination - Spall - Patched Area <b>CS-2: Full depth patch area in Span 1 (4sf)</b>	SF		0	4	0	0
		1130	Cracking (RC) <b>CS-2: Diagonal cracking at all abutment corners (68sf)</b>	SF		0	68	0	0
	8514		Concrete Overlay <b>Concrete overlay placed in 2016</b>	SF	6,785	0	6,785	0	0
		3220	Crack (Wearing Surface) <b>CS-2: Map cracking throughout entire deck. Some cracks sealed with TK-9030</b>	SF		0	6,785	0	0
X	109		<b>Prestressed Concrete Open Girder</b>	LF	770	770	0	0	0
		1080	Delamination - Spall - Patched Area	LF		0	0	0	0
X	205		<b>Reinforced Concrete Column</b>	EA	3	3	0	0	0
		1080	Delamination - Spall - Patched Area	EA		0	0	0	0
		1130	Cracking (RC)	EA		0	0	0	0
X	215		<b>Reinforced Concrete Abutment</b> CS-2 (S Abut 8" & N Abut 8")	LF	84	68	16	0	0
		1080	Delamination - Spall - Patched Area	LF		0	0	0	0
		1130	Cracking (RC) Under girders	LF		0	16	0	0
X	234		<b>Reinforced Concrete Cap</b>	LF	39	36	3	0	0
		1130	Cracking (RC) <b>CS-2: Vertical hairline cracks</b>	LF		0	3	0	0

**BRIDGE INSPECTION REPORT**  
**Wisconsin Department of Transportation**  
**DT2007 2003 s.84.17 Wis. Stats.**

page 4

Structure No.: **B-36-071**

X	331		Reinforced Concrete Bridge Rail	LF	364	339	25	0	0
			Rail patched and protective coating applied 2016.						
		1080	Delamination - Spall - Patched Area	LF		0	0	0	0
		1130	Cracking (RC)	LF		0	25	0	0
			CS-2: Horizontal cracking along top inside corner throughout (15' East, 10' West)						
X	8400		Integral Wingwall	EA	4	0	4	0	0
		8902	Wall Movement	EA		0	4	0	0
			NE Wing tipped 3/4" SE Wing Tipped 3/4" NW Wing Tipped 1/2" SW Wing Tipped 1/2"						
		8903	Wall Deterioration	EA		0	1	0	0

**Assessments**

Chk	Element	Defect	Description	UOM	Total	Quantity in Condition State			
						1	2	3	4
X	9001		Drainage - Approach	EA	4	4	0	0	0
			Inlets at NE and NW wing						
X	9045		Slope Protection- Riprap	EA	2	0	2	0	0
			Settled at both abutments						
X	9168		Concrete Diaphragm	EA	12	10	2	0	0
			Spalls over pier at outside diaphragms						
X	9322		Approach Roadway - Concrete (non-structural)	EA	1	1	0	0	0
			North Approach						
X	9323		Approach Roadway - Asphalt	EA	1	1	0	0	0
			South Approach						

**NBI Ratings**

	File	New
Deck	7	7
Superstructure	7	7
Substructure	7	7
Culvert	N	N
Channel	N	N
Waterway	N	N

**Structure Specific Notes**

**Inspection Specific Notes**

**BRIDGE INSPECTION REPORT**  
**Wisconsin Department of Transportation**  
**DT2007 2003 s.84.17 Wis. Stats.**

page 5

Structure No.: **B-36-071**

**Inspector Site-Specific Safety Considerations**

**Structure Inspection Procedures**

**Special Requirements**

Chk	Hours	Cost	Comments
-----	-------	------	----------

This page intentionally left blank

**Wisconsin Dept. of Transportation  
Structure Inventory Data**

**Bridge B360071**

<b>Structure No.:</b> B360071	<b>Municipality:</b> MANITOWOC RAPIDS	<b>Section:</b>	<b>Town:</b>	<b>Range:</b>	<b>Maintenance Agency:</b> STATE HIGHWAY DEPT	<b>Owner:</b> STATE HIGHWAY DEPT
<b>Replaced Structure No.:</b>	<b>Historical Sig.:</b> 5	<b>Latitude:</b> 440633. 41	<b>Longitude:</b> 874350.1		<b>County:</b> MANITOWOC (3 6)	<b>District:</b> 3

**ABUTMENT DATA (CARDINAL)**

<b>1. Abutment Type:</b> SILL FLEXIBLE
<b>2. Pile Type:</b> PILING - CAST IN PLACE (CIP)
<b>3. Pile Size:</b> 254 OR 273 MM (10 OR 10-3/4")
<b>4. Slope Protection Type:</b> HEAVY RIPRAP
<b>5. Rdwy. Width:</b> 40.0 ft
<b>6. Deck Width:</b> 43.0 ft
<b>7. Wing Type:</b>

**ABUTMENT DATA (NON-CARDINAL)**

<b>1. Abutment Type:</b> SILL FLEXIBLE
<b>2. Pile Type:</b> PILING - CAST IN PLACE (CIP)
<b>3. Pile Size:</b> 254 OR 273 MM (10 OR 10-3/4")
<b>4. Slope Protection Type:</b> SOLID CONC
<b>5. Rdwy. Width:</b> 40.0 ft
<b>6. Deck Width:</b> 43.0 ft
<b>7. Wing Type:</b>

**GEOMETRIC DATA**

<b>1. Structure Length:</b> 157.8 ft (Back to Back Abuts. Along Rdwy. Centerline)
<b>2. No. Lanes On:</b> 2
<b>3. L. Sdk. Width On:</b> 0.0 ft
<b>4. R. Sdk. Width On:</b> 0.0 ft
<b>5. Median Type:</b>
<b>6. Median Width:</b> 0.0 ft
<b>7. Skew Angle:</b> 4 Deg.
<b>8. Direction Skew Angle:</b> LEFT
<b>9. Horizontal Curve:</b> 0.0 Radius, ft
<b>10. Dir.-Hor. Curve:</b>
<b>11. Girder Spacing:</b> 8.7 ft
<b>12. Height:</b> 45.0 ft (Top Pier Footing to Top Deck or Streambed Elev. to Top Deck)
<b>13. NBI Bridge Length Met:</b> true

**APPROACH DATA**

<b>1. Appr. Pavement Width:</b> 24 ft
<b>2. Rt. Shoulder Width:</b> 10 ft
<b>3. Lt. Shoulder Width:</b> 6 ft
<b>4. Total Width (Sum Above):</b> 40 ft
<b>5. Guardrail Termination:</b> 1
<b>6. Guardrail Adequacy:</b> 1
<b>7. Railing Attachment Type:</b> 5 - 22 MM (7/8") BOLTS
<b>8. Railing Design Year:</b> 1965 AASHO
<b>9. Left Outer Railing Type:</b>
<b>10. Right Outer Railing Type:</b>
<b>11. Left Inner Railing Type:</b>
<b>12. Right Inner Railing Type:</b>

**CAPACITY DATA**

<b>1. Design MS:</b> HS20M
<b>2. Inventory MS:</b> HS14
<b>3. Operating MS:</b> HS21
<b>4. Max. Veh. Wt.:</b> 250 kips
<b>5. Load Rating Basis.:</b> LFR
<b>6. Load Governing Member:</b> INTERIOR DECK GIRDER
<b>7. Deck Composition:</b> NONE
<b>8a. Deck Membrane:</b> OTHER
<b>8b. Deck Surface:</b> CONCRETE

**HYDRAULIC DATA**

<b>1. Design Flood Frequency:</b> 0 yrs
<b>2. Design Discharge:</b> 0 cu-ft/s
<b>3. Max. Velocity:</b> 0.0 ft/s
<b>4. Drainage Area:</b> 0.0 sq. ft
<b>5. High Water Elev.:</b> 0.0 ft
<b>6. Scour Critical Code:</b> N
<b>7. Scour Calculated?:</b> false

**STRUCTURE SERVICE DATA**

<b>1. Hwy. On Detour Length:</b> 0 ft
<b>2. Type Service On:</b> HIGHWAY
<b>3. Type Service Under:</b> HIGHWAY

**APPRAISAL UPDATE**

<b>1. Load Capacity:</b> 5-LEGAL LOAD STRESS NOT EXCEEDED
<b>2. Geom. On:</b>
<b>3. Geom. Under:</b>
<b>4. Appr. Align:</b> 8-COND EQUAL DESIRABLE CRITERIA
<b>5. Horiz. Align:</b>
<b>6. Vert. Align:</b>

**PLANNING DATA**

<b>1. Functional Classification:</b> INTERSTATE-RURAL (01)
<b>2. ADT:</b> 10100
<b>3. ADT-Year:</b> 2017
<b>4. Truck ADT %:</b> 22
<b>5. Future ADT:</b> 21650
<b>6. Future ADT-Year:</b> 2016

**CONDITION DATA**

<b>Deck:</b>	<b>SuperStructure:</b>	<b>SubStructure:</b>	<b>Channel:</b>
<b>Culvert:</b>	<b>Waterway:</b>		

## Bridge B360071

### CONSTRUCTION DATE

Project ID	Construction Contractor	Construction Designer	Construction Year	Plans Reel Number	Letting Date	Survey Received	Work Performed
1224-21-71	NORTHEAST ASPHALT, INC.	OMNNI	2016		12-Jan-2016		OVERLAY - CONCRETE
1224-71-21		OMNNI	9999			01-Apr-2014	NOT BUILT
1224-07-71	NORTHEAST ASPHALT, INC.	BRIDGE SECTION DESIGN UNIT 1	2001		12-Oct-2000	22-Sep-1998	OVERLAY - BITUMINOUS
	UNKNOWN	UNKNOWN	1992				REPAIR DECK
1225-01-87	LUNDA CONST	BRIDGE SECTION	1979	C221		01-Aug-1975	NEW STRUCTURE

### CLEARANCE DATA

Clearance Lane Number	Minimum Vertical	Minimum Vertical Date	Minimum Horizontal Distance	Right Minimum Lateral
1	17.19	12-Jun-2018	34.0	3.0
1	16.82	12-Jun-2018	46.0	3.0

Left Minimum Lateral	Railroad Right Minimum Lateral	Railroad Left Minimum Lateral	Railroad Vertical Distance	Railroad Horizontal Distance
7.0				
7.0				

### ROUTE DATA

Number	Direction	Type	Structure Route On / Under	Structure Route Cardinal / NonCardinal
043	N		O	C
010	E		U	C
042	S		U	N

Number	Structure Route Location	Highway Feature Name	Structure Route Local System	Highway Feature Designation
043	2.8M N JCT USH 151	IH 43 NB	IH	MAINLINE
010	0.2M E JCT STH 42 TO S	USH 10 EB-STH 42 SB	USH	MAINLINE
042	0.9M S JCT USH 10 TO W	USH 10 EB-STH 42 SB	STH	MAINLINE

Number	Structure Route Primary Flag	Designed National Network Flag	Structure Defense Highway Designation	Highway On Inventory Route
043	Y	Y	1	NHI
010	Y	Y	0	NHS
042	N	Y	0	NON

### PIER DATA

Number	Pier Type	Piling Type	Piling Size	Pier Skew Angle	Direction of Skew
1	ROUND COL BENT	PILING - CAST IN PLACE (CIP)	254 OR 273 MM (10 OR 10-3/4")		


### SPAN DATA

Number	Type	Length	Configuration	Material	Girder or Truss Height	Girder or Truss Spacing
1		76.0	DECK GIRDER	CONT PREST CONC	45.0	8.7
2		80.0	DECK GIRDER	CONT PREST CONC	45.0	8.7

### EXPANSIONJOINT DATA

Number	Location	Type	Inactive Date
--------	----------	------	---------------



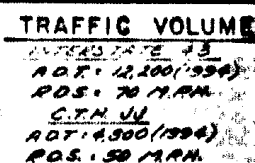

LIVE LOAD:  
DESIGN RATING; H320-MOD  
INVENTORY RATING; H325  
OPERATIONAL RATING; H335  
STRUCTURE IS DESIGNED FOR A FUTURE WEARING SURFACE  
OF 20 POUNDS PER SQUARE FOOT  
ALLOWABLE DESIGN STRESSES;


CONCRETE MASONRY SLAB  $f_c = 4,000$  P.S.I.  
ALL OTHER  $f_c = 3,500$  P.S.I.  
BAR STEEL REINFORCEMENT, GRADE 60  $f_y = 60,000$  P.S.I.  
45" PRESTRESSED GIRDERS, CONCRETE MASONRY  $f_c = 6,000$  P.S.I.  
STRANDS:  $\frac{1}{2}" \phi$  WITH ULTIMATE TENSILE STRENGTH OF 270,000 P.S.I.

SUBSTRUCTURE UNITS TO BE SUPPORTED ON 10 3/4" CAST-IN-PLACE CONCRETE PILING DRIVEN TO A MIN. BRG. VALUE OF 50 TONS/PILE AND EST. 45-0 LG. @ S.ABUT, 55-0 LG. @ N.ABUT. 135-0 LG. @ PIER WITH A MIN. BRG. VALUE OF 55 TONS/PIER AT PIER.


1. GENERAL PLAN	X58023
2. TOTAL ESTIMATED QUANTITIES	X58024
3. SUBSURFACE EXPLORATION	X58025
4. SOUTH ABUTMENT	X58026
5. ABUTMENT DETAILS	X58027
6. NORTH ABUTMENT	X58028
7. PIER	X58029
8. SUPERSTRUCTURE	X58030
9. 45" PRESTRESSED GIRDER DETAILS	X58031
10. SLOPED FACE PARAPET 'B'	X58032

East parapet  
1' x 3', 1' x 5', 2' x 2' & 1' x 4' = 16 SF  
Concrete Repair  
509.1500

AS BUILT PLAN  
DATE 11-81 BY W.J.K.

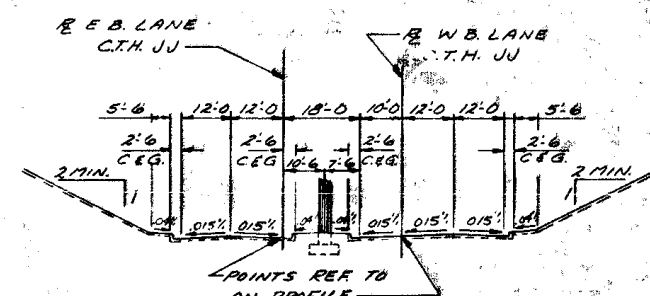


TYPICAL SECTION THRU C.T.H. JJ

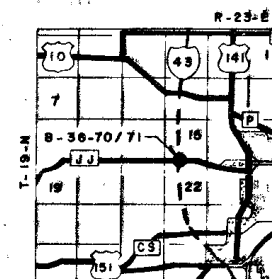

## LAYOUT

No	Date	Revision	By
STATE OF WISCONSIN DEPARTMENT OF TRANSPORTATION DIVISION OF HIGHWAYS			
STRUCTURE B-36 -71			
INTERSTATE 43 OVER C.T.H. JJ			
County	MANITOWOC	TN.	MANITOWOC RAPID
Design Spec	AASHTO 1973	Load	HSDG 100K
Design Spec	1978	Const Spec	1978
Drawn By	WUX	Checked	WV
Drawn By	WUX	Plan Checked	FW
Approved	W.A. Klinge	Date	10-21-77
Chief Bridge Engineer			
GENERAL PLAN		SHEET 1 OF 1	
		X58023	

1.D: 1225-01-00M

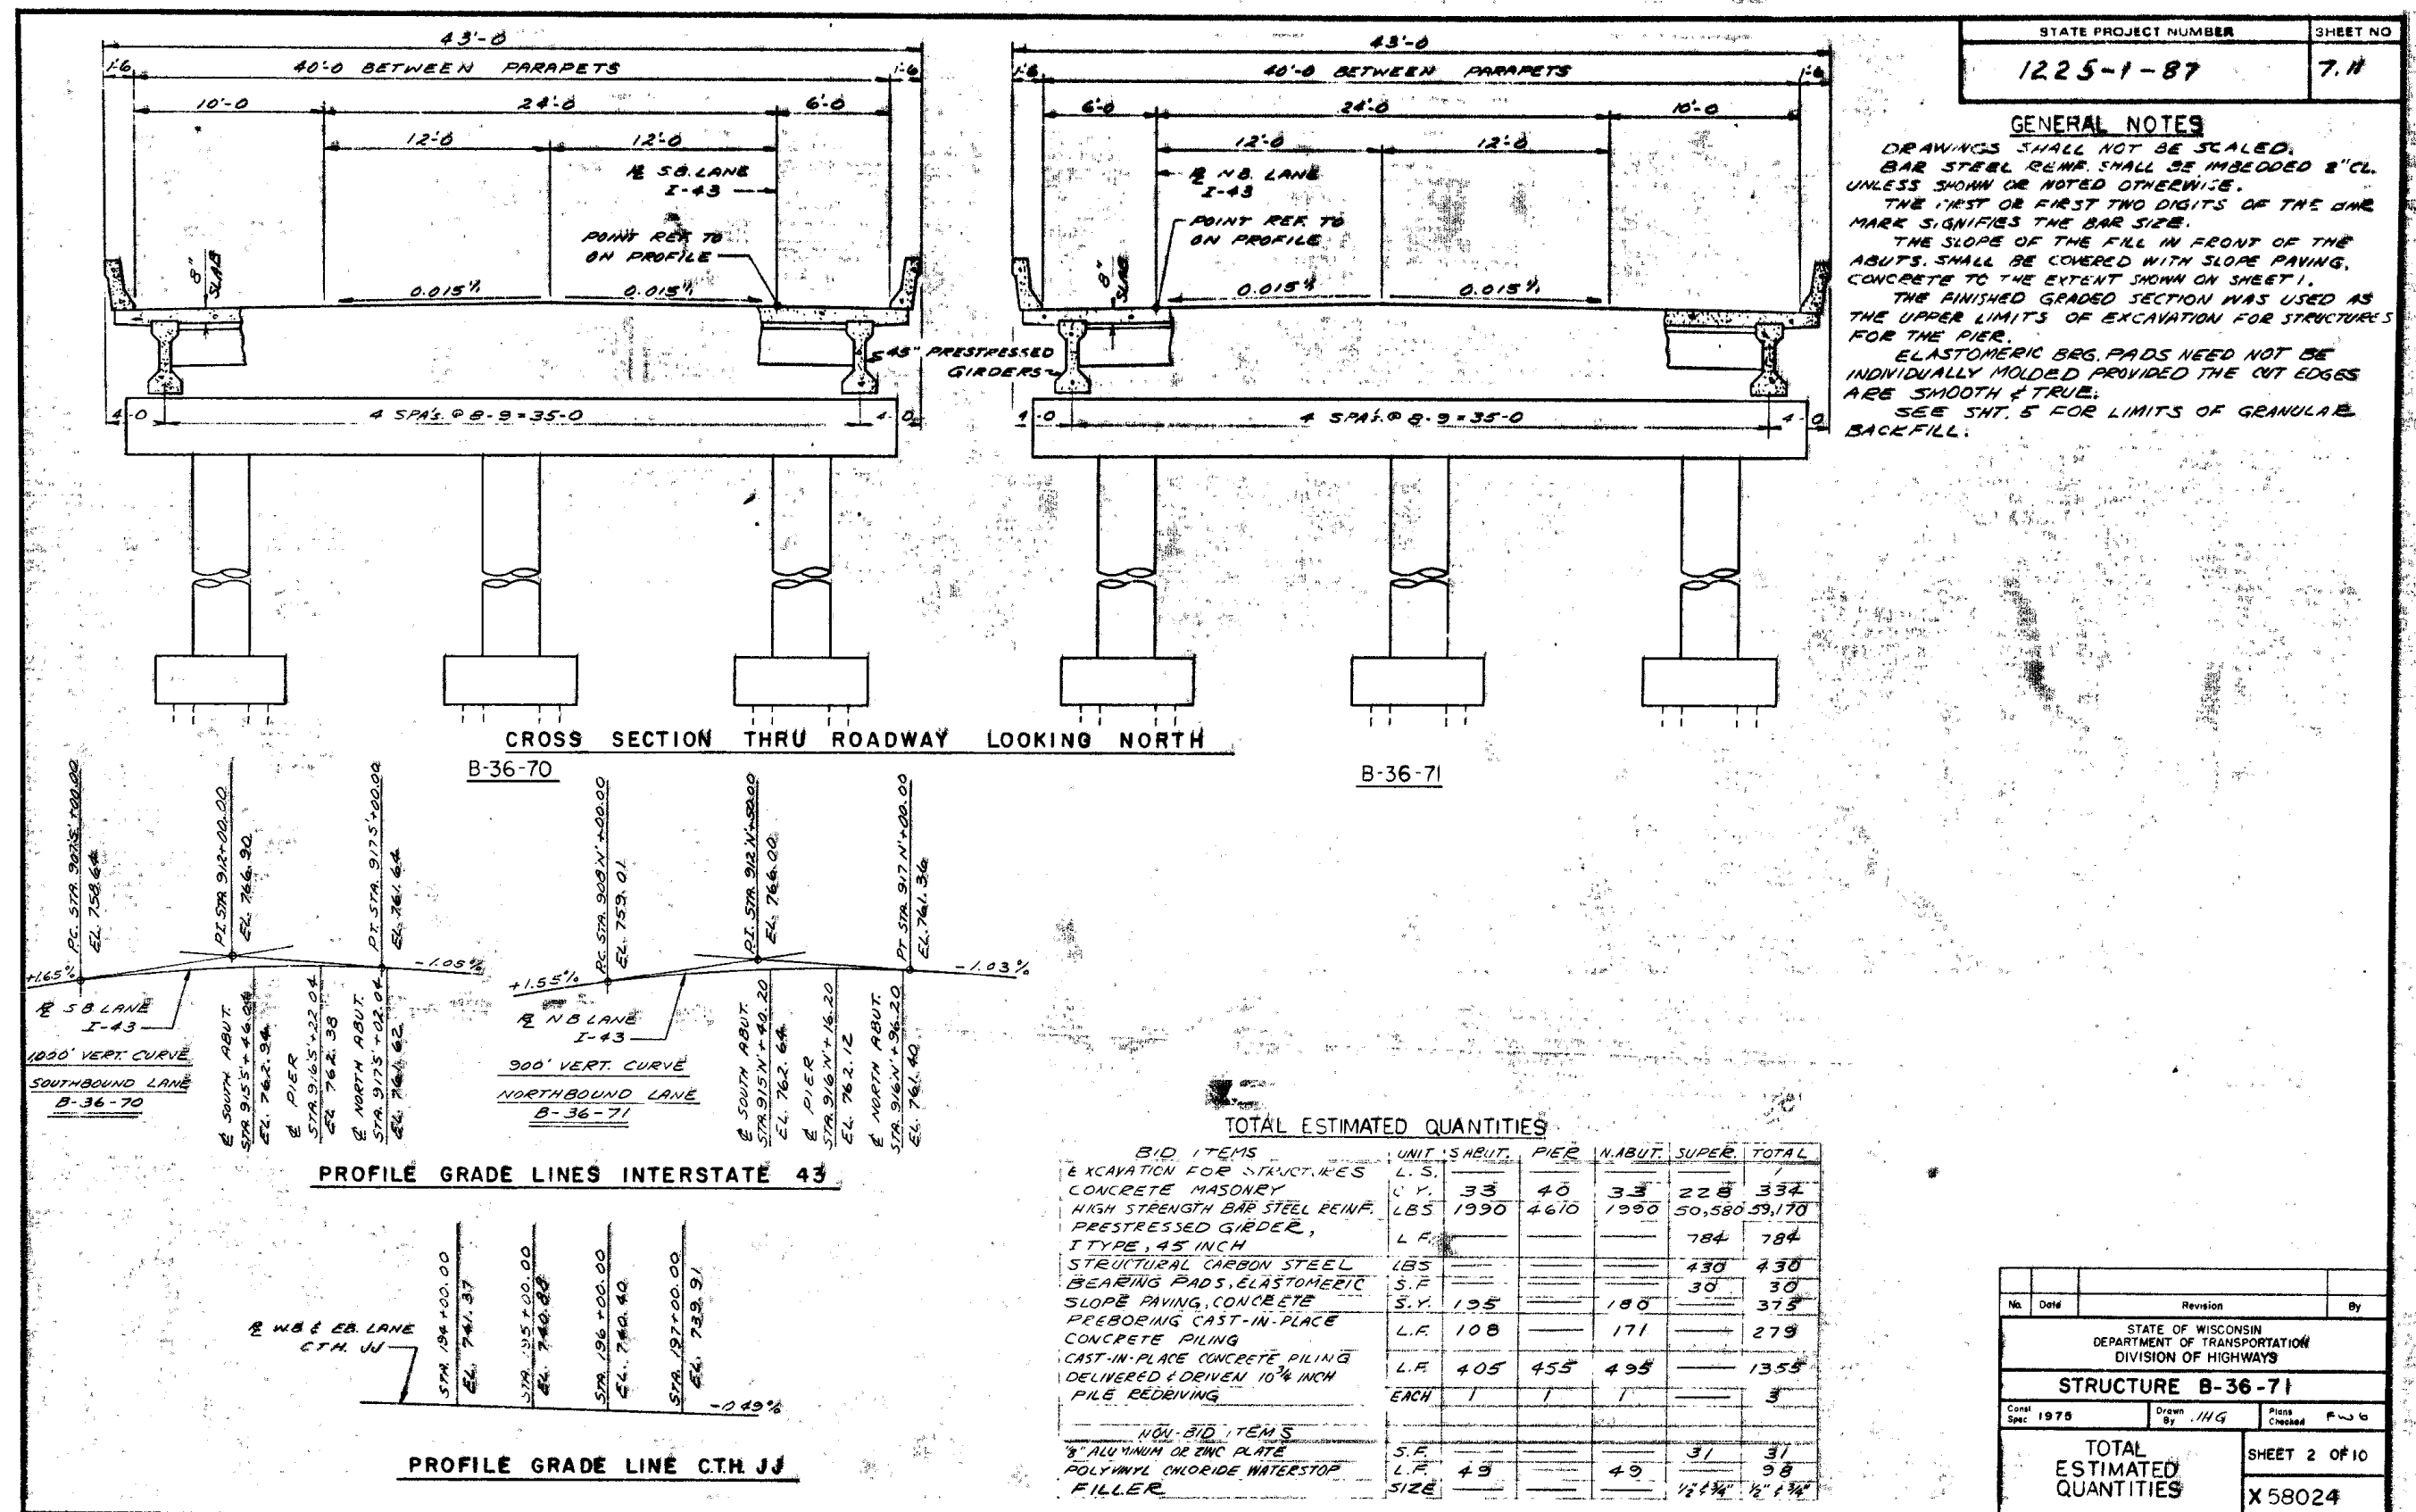







# BILL OF BARS

1730 #/ABUT.





STATE PROJECT NUMBER

1225-1-87

SHEET NO.

7.14


BAR MARK	NO. REQ'D	NO. REQ'D	LENGTH	UNIT	LOCATION
S. ABUT.	N. ABUT.				
A401	64	64	6-1	X	BODY - STIRRUPS
A402	3	3	4-11		- HORIZONTAL
A403	14	14	2-3		- PILES 2/PILE
A404	7	7	18-0	X	- "
A405	6	6	4-11		- HORIZONTAL
A406	24	24	2-0		- DOWELS
A407	12	12	13-5		- BACKFACE 2 WINGS
A408	3	3	16-1		- "
A409	18	18	8-6	X	WINGS - STIRRUPS
A410	20	20	5-6		- VERTICAL FF & BF
A411	5	5	9-0	X	- SET 1 & 2
A412	7	7	9-0	X	- SET 3 & 4
A513	10	10	7-0		124 - HORIZONTAL - BOTH FACES
A414	8	8	7-7	X	- "
A415	8	8	12-4	X	- "
A416	2	2	10-0	X	- "
A417	6	6	7-3	X	- "
A418	2	2	5-0	X	- "
A519	10	10	6-11		- "
A520	4	4	6-11		- 2x3 - BOTH FACES

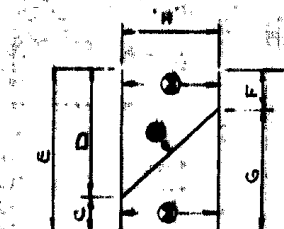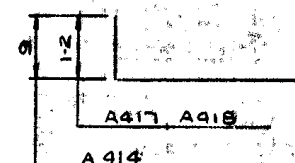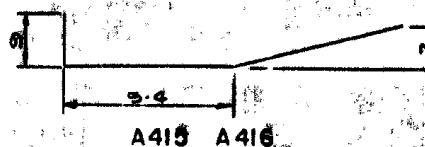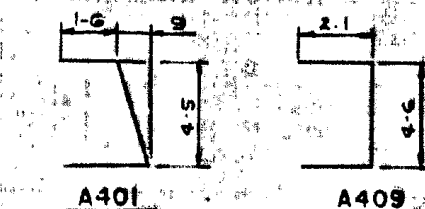


- H IS NUMBER OF BARS BEFORE CUTTING.
- BUNDLE AND MARK CUT BARS WITH BAR AND SET NUMBERS.
- MARK AND CUT ALL BARS ALONG THIS LINE. MAKE ALL CUTS NORMAL TO BAR AXIS.

CUTTING DIAGRAM


MARK	C	D	E	F	G	H	SETS REQ'D
A411	SET 1	3-2			5-10	5	2
	SET 2		5-10	9-0	3-2		2
A412	SET 3	3-2			5-10	7	2
	SET 4		5-10	9-0	3-2		2

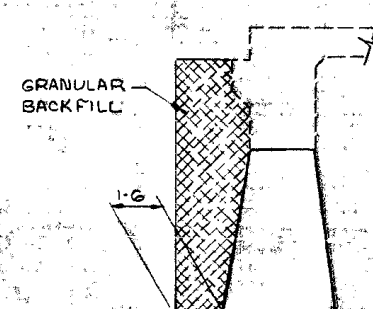

LIMITS OF GRANULAR BACKFILL AT ABUTMENTS

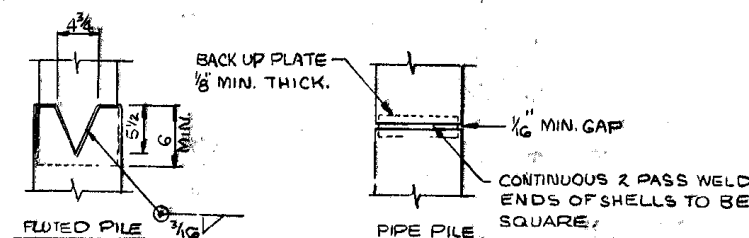


PILE SPLICE DETAIL

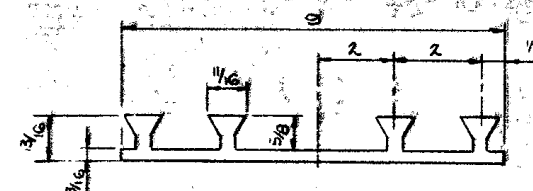


POLYVINYL CHLORIDE WATERSTOP


No.	Date	Revision	By
STATE OF WISCONSIN DEPARTMENT OF TRANSPORTATION DIVISION OF HIGHWAYS			
STRUCTURE B-36-71			
Const. Spec.	1975	Drawn By	DEO
		Plans Checked	F.W.G.
ABUTMENT DETAILS		SHEET 5 OF 10 X58027	

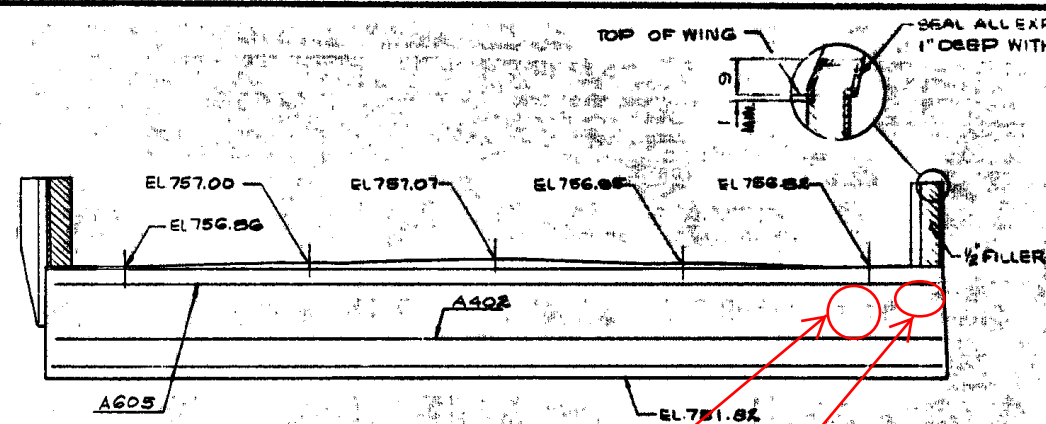


North abutment near NE corner  
 4' x 3' & 2' x 3' = 18 SF Concrete Repair  
 509.1500

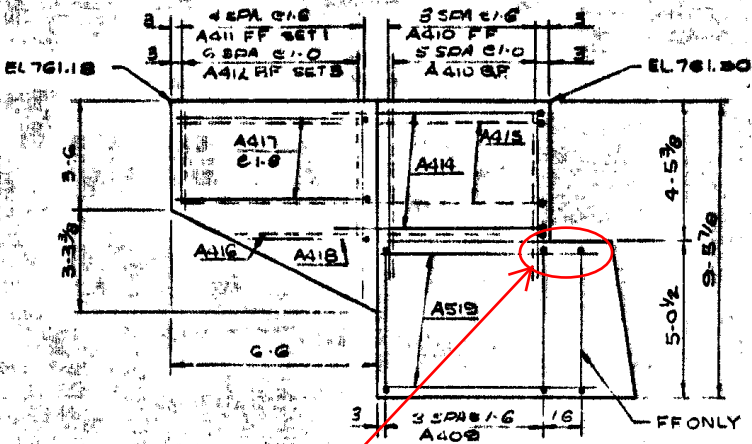


ELEVATION WING 3

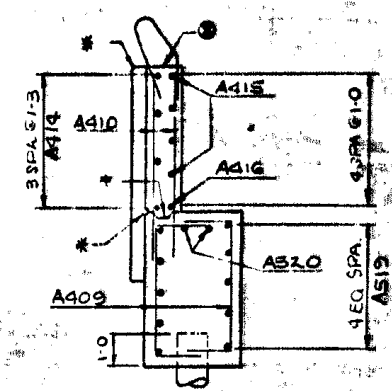


SECTION WING 3

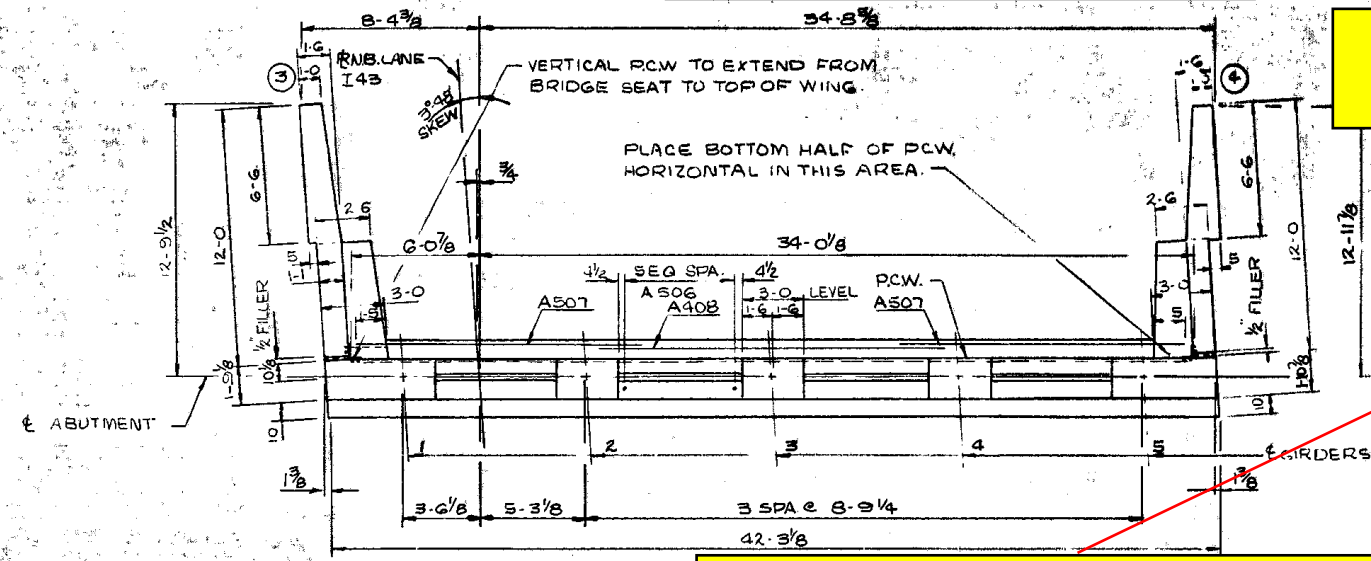


NW abutment/superstructure  
 3' x 4' = 12 SF Concrete Repair  
 509.1500

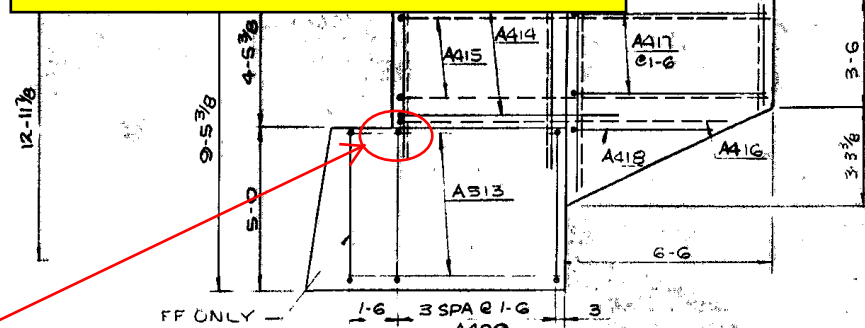


ELEVATION WING 4

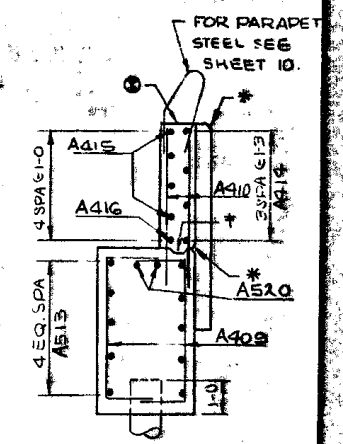

SECTION WING 4

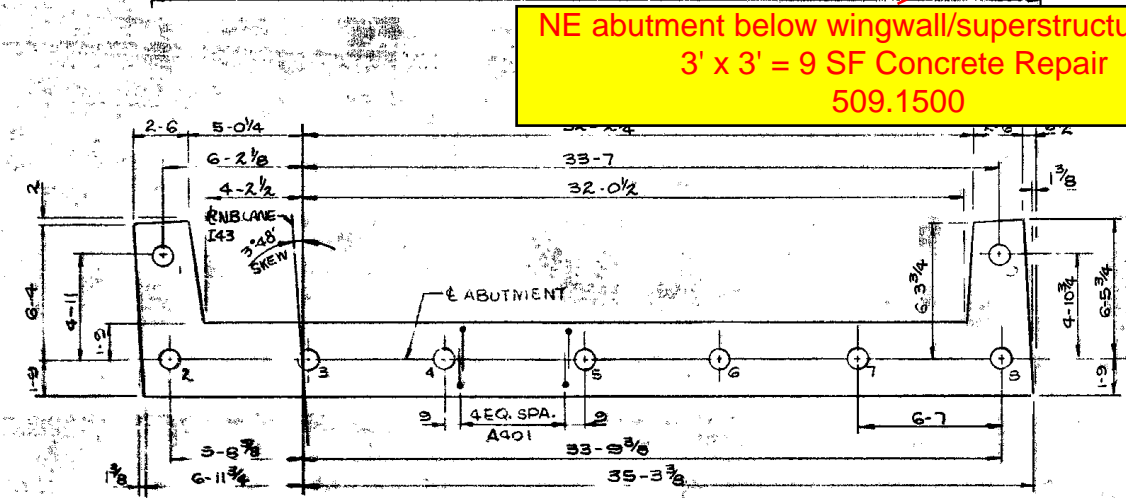

NE abutment below wingwall/superstructure corner  
 3' x 3' = 9 SF Concrete Repair  
 509.1500

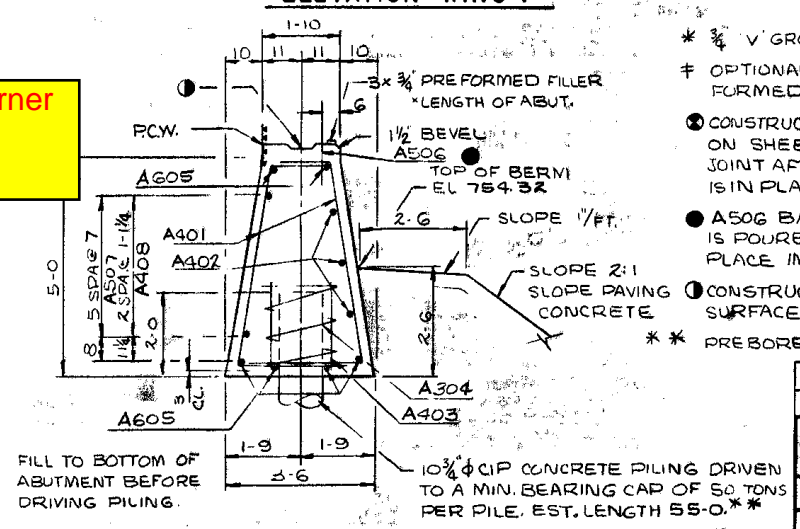


SECTION THRU ABUTMENT

- \* 3/4\" V GROOVE ON FRONT FACE OF WINGWALL.
- † OPTIONAL CONSTRUCTION JOINT KEYWAY FORMED BY A SURFACED, BEVELED 2 x 6.
- ① CONSTRUCTION JOINT-STRIKE OFF AS SHOWN ON SHEET 10. POUR CONCRETE ABOVE THIS JOINT AFTER SUPERSTRUCTURE CONCRETE IS IN PLACE.
- A506 BARS MAY BE PLACED AFTER CONCRETE IS POURED BUT BEFORE INITIAL SET HAS TAKEN PLACE IMBED 1'-0\".
- ① CONSTRUCTION JOINT-KEYWAY FORMED BY A SURFACED BEVELED 2 x 6.
- \*\* PREBORE ABUTMENT PILES TO ORIGINAL GROUND

PILE PLAN

No.	Date	Revision	By
STATE OF WISCONSIN DEPARTMENT OF TRANSPORTATION DIVISION OF HIGHWAYS			
STRUCTURE		B-36-71	
Cons. Spec.	1975	Drawn By	DEO
		Plans Checked	FJG
NORTH ABUTMENT		SHEET 6 OF 10	
		X58028	








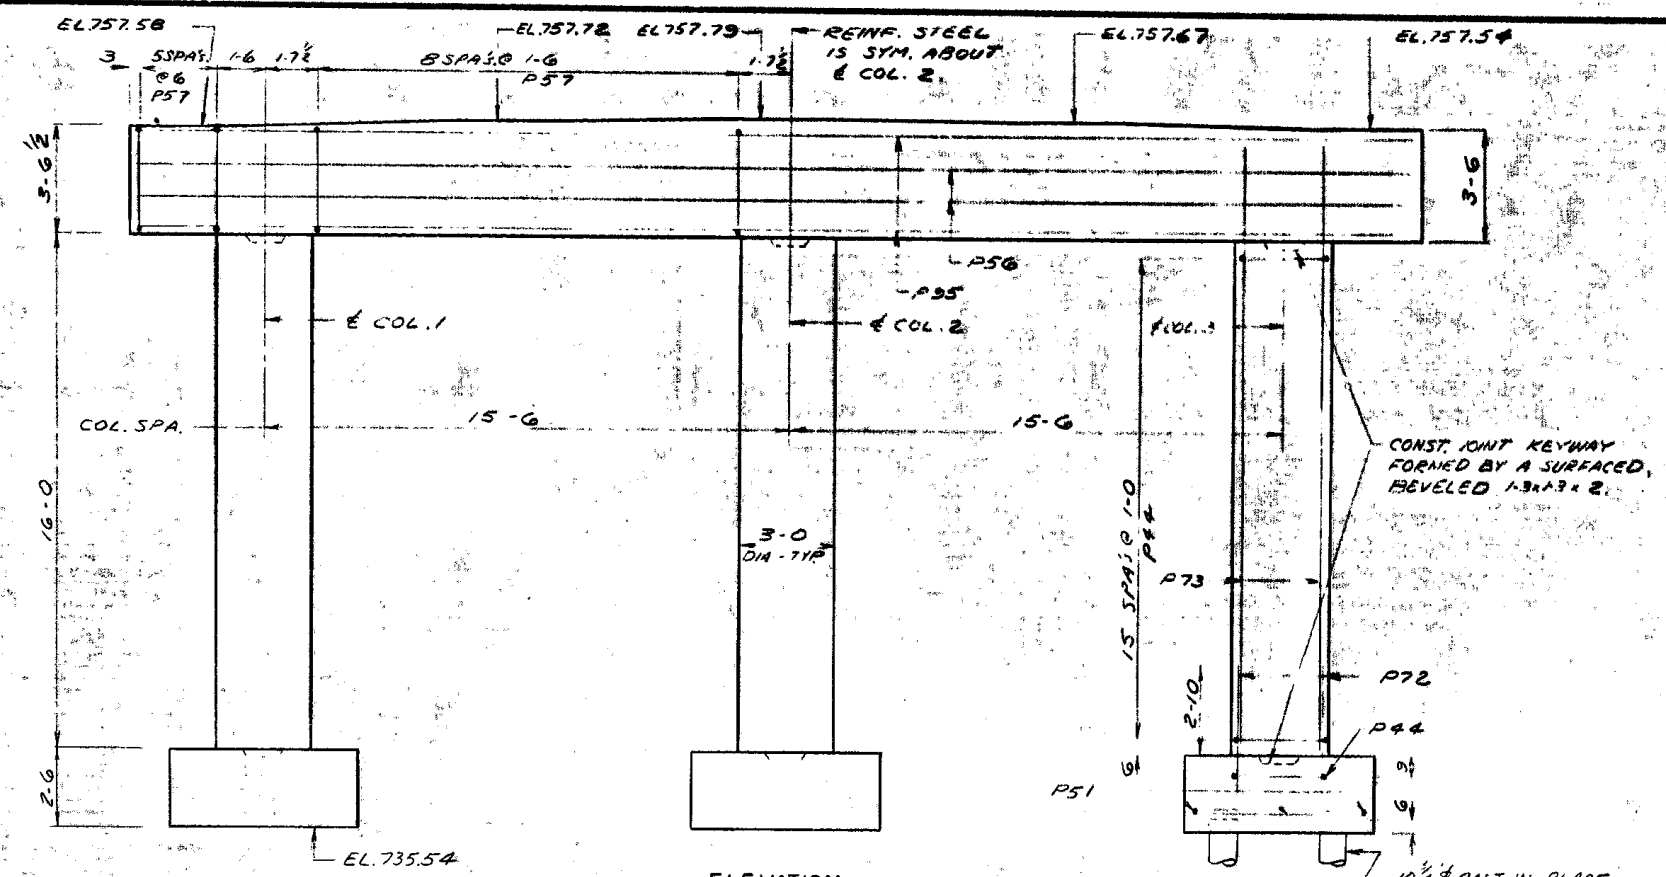

STATE PROJECT NUMBER	SHEET NO.
1225-1-87	7.16

**BILL OF BARS** 4610\*


BAR MARK	NO. REQ'D	LENGTH	BENT	LOCATION
P51	48	5'-8"		FOOTINGS
P72	36	5'-9"	X	" COL'S.
P73	36	13'-0"		COLUMNS
P44	51	9'-11"	X	" HOOPS
P55	12	39'-2"		CAP TOP & BOT.
P56	4	39'-2"		" SIDES
P57	30	12'-11"	X	" STIRRUPS
P58	20	2'-0"		" DOWELS

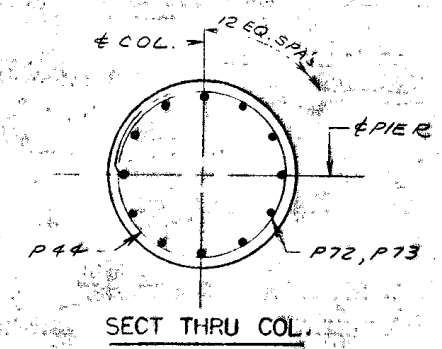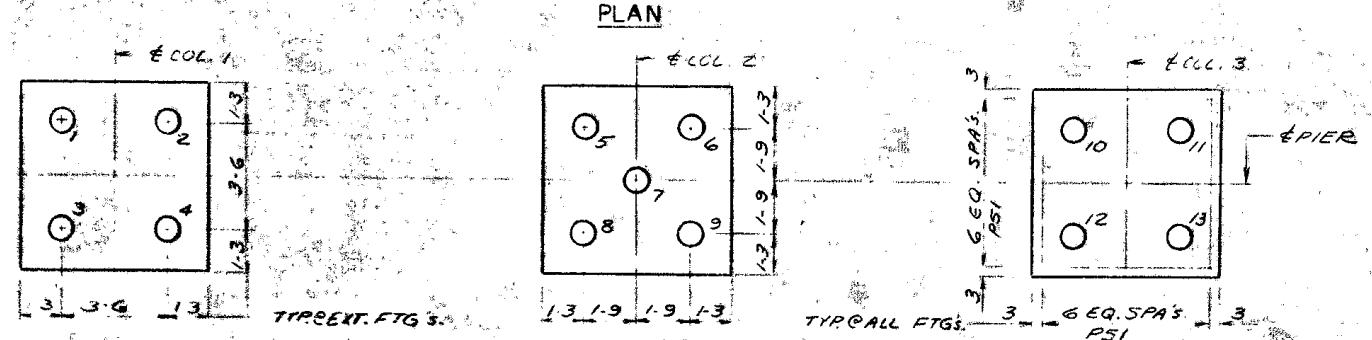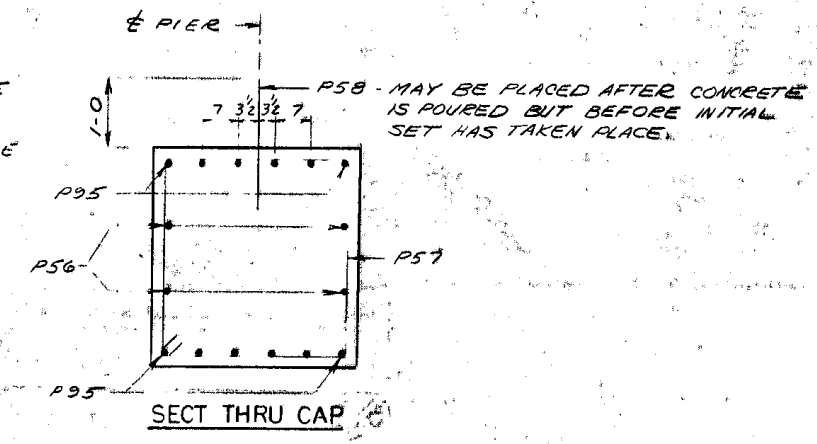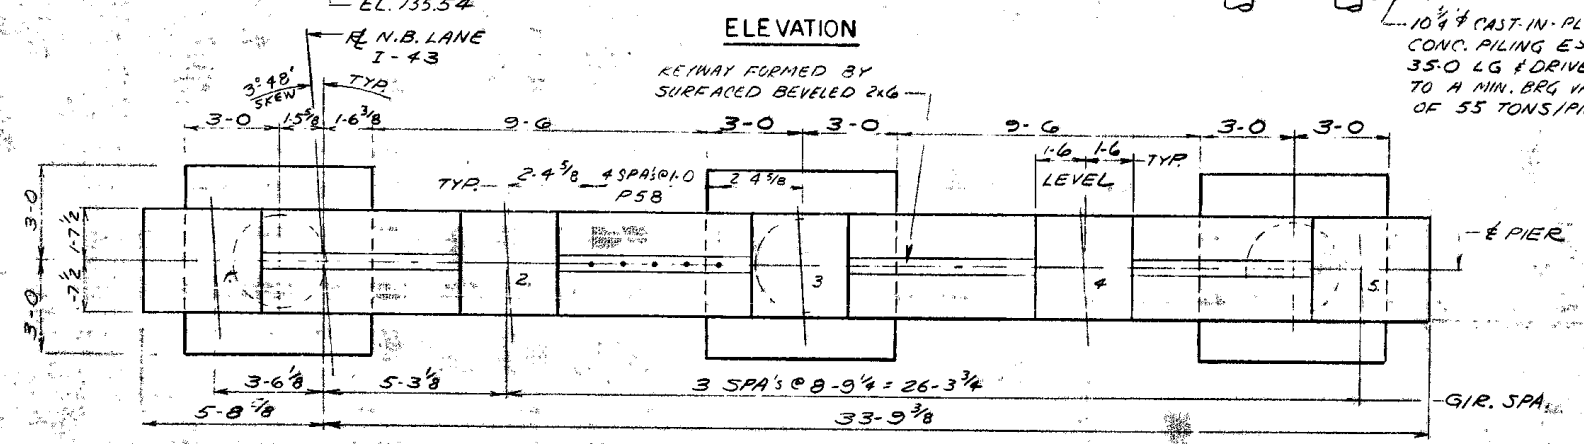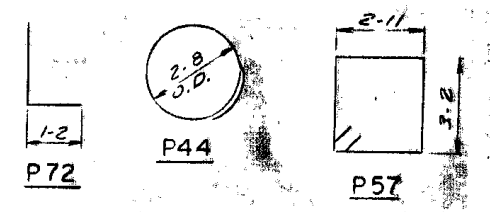




No.	Date	Revision	By
STATE OF WISCONSIN DEPARTMENT OF TRANSPORTATION DIVISION OF HIGHWAYS			
STRUCTURE B-36-71			
Const. Spec.	1975	Drawn By	JHG
		Plane Checked	FWG
PIER			SHEET 7 OF 10
			X58029








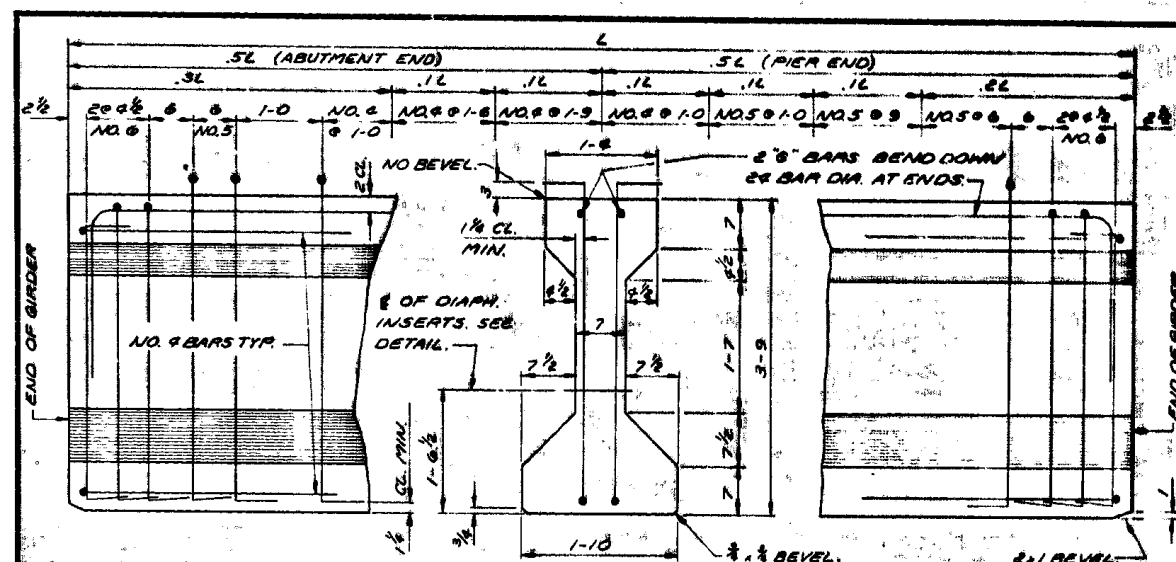



45" GIRDER - SIDE VIEW & TYPICAL SECTION IN SPAN

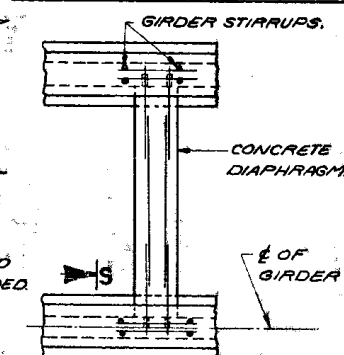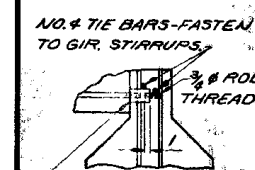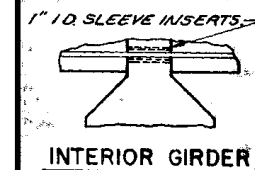



DIAPHRAGM INSERT DETAILS

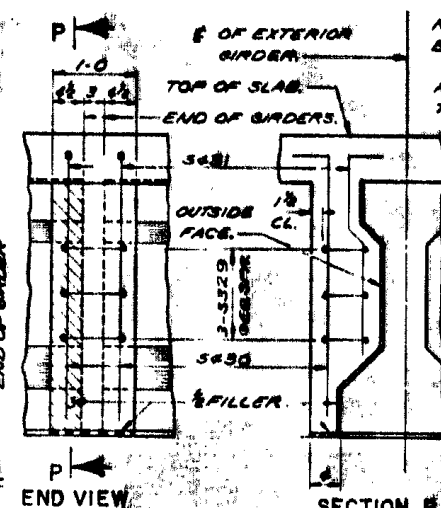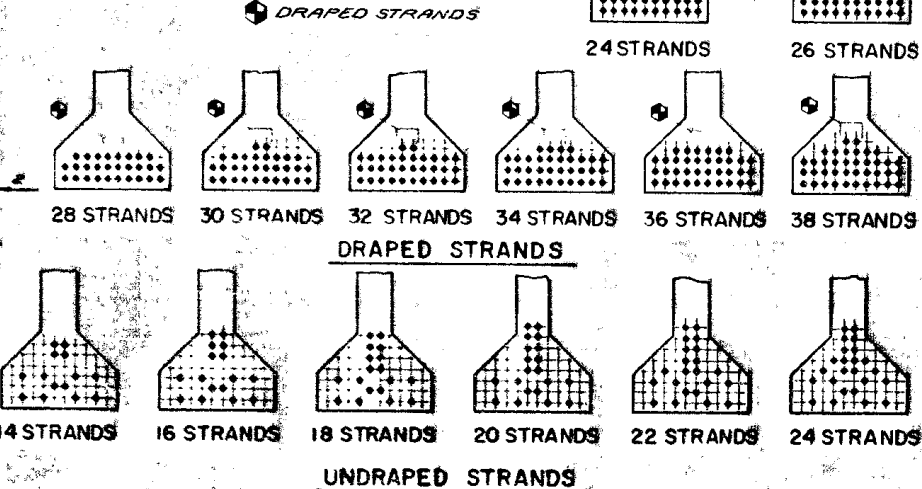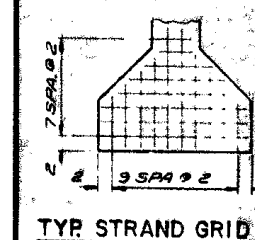

PILASTER DETAILS AT PIERS

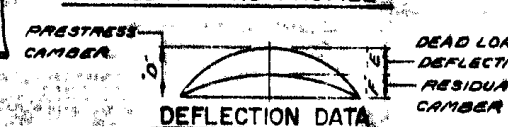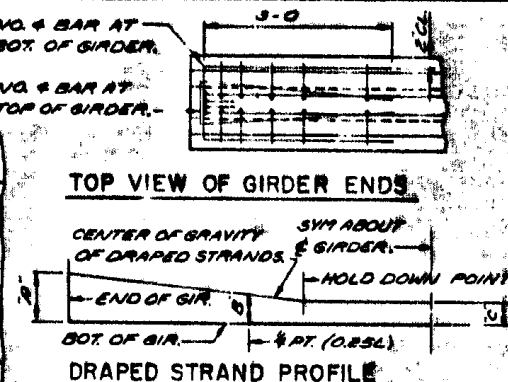

GIRDER DATA		USE DIAPHRAGM INSERT DETAIL TYPE "A"		USE NO. 4 "B" BARS WITH A 1-0 LG LAP	
SPAN LENGTH "L"	DEFLECTION DATA (IN.)	TYPE OF STRANDS	NO. OF STRANDS	DRAPED STRANDS	UNDRAPE STRANDS
	"D" "E" "F"			f'ci # "P"	f'ci # "P"
1	76-4 1/2	1 3/4	1 3/4	STRESS RELIEVED LOW RELAXATION	50
2	80-4 1/2	2 3/8	1 1/8	STRESS RELIEVED LOW RELAXATION	34

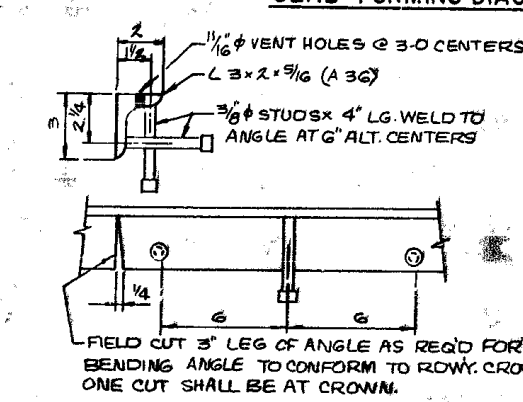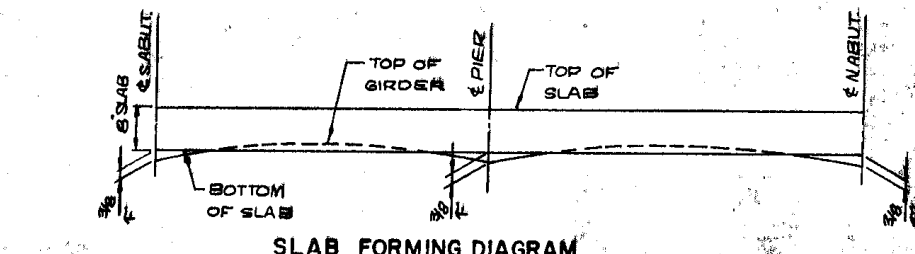

STRUCTURAL CARBON STEEL ANGLES SHALL NOT BE PAINTED

STATE PROJECT NUMBER	SHEET NO.
1225-1-87	7.15

**NOTES**

TOP OF GIRDERS TO BE ROUGH FLOATED AND BROOMED TRANSVERSELY FOR BONDING TO THE SLAB.

THE GIRDERS SHALL BE PROVIDED WITH A SUITABLE LIFTING DEVICE FOR HANDLING AND ERECTING THE GIRDERS.

ALL GIRDERS SHALL BE CAST FULL LENGTH AS SHOWN.

PRESTRESSING STRANDS SHALL BE 1/2" B-7 WIRE STRANDS WITH AN ULTIMATE STRENGTH OF 270,000 PSI AND SHALL BE FLUSH WITH THE ENDS OF THE GIRDERS.

INSERTS SHALL BE PLACED ON 6" CTAS, SYMMETRICALLY ABOUT THE C OF DIAPHRAGMS IN SPANS.

ALL STIRRUPS SHALL BE IN PAIRS AND THE SPACING SHOWN IN "SIDE VIEW" IS MAXIMUM. THE LOCATION SHALL BE SHOWN IN THE SHOP DRAWINGS.

BEND EACH END OF NO. 4 AND NO. 3 STIRRUPS 6" AND NO. 6 STIRRUPS 6 1/2".

ENDS OF STRANDS SHALL BE PAINTED WITH NON-STAINING GRAY NON-BITUMINOUS JOINT SEALER. (THIS APPLIES ONLY TO THOSE ENDS OF GIRDERS THAT ARE FINALLY EXPOSED.)

BARS "B" MAY BE SPLICED AT THE 1/8 POINTS OF GIRDER. USE LAP LENGTH SHOWN.

DATA SHOWN IN "DEFLECTION DATA" IS THEORETICAL AND MAY VARY WITH CONCRETE STRENGTH, VARIABLE PRESTRESS CONDITIONS AND PRESTRESS LOSSES.

No.	Date	Revision	By
STATE OF WISCONSIN DEPARTMENT OF TRANSPORTATION DIVISION OF HIGHWAYS			
STRUCTURE B-36-71			
Cons. Spec.	1975	Drawn By	DEC
45" PRESTRESSED GIRDER DETAILS		Checked	FWS
SHEET 9 OF 10		X58031	



PROJECT ID: 1224-07-71  
WITH: N/A

(DESIGN ID: 1224-07-00)


COUNTY: MANITOWOC

FILE  
1224-07-71  
7/5/00

# INDEX OF SHEETS

Sheet No. 1	Title
Sheet No. 2.1-2.9	Typical Sections and Details
Sheet No. 3.1-3.3	Estimate of Quantities
Sheet No. 3A-3S	Miscellaneous Quantities
Sheet No. 4	Right of Way Plat
Sheet No. 5.1-5.6	Plan and Profile
Sheet No. 6.1-6.25	Standard Detail Drawings
Sheet No. 7.1	Sign Plates
Sheet No. 8.1-8.16	Structure Plans
Sheet No. 9	Computer Earthwork Data
Sheet No. 10	Cross Sections

TOTAL SHEETS = 80

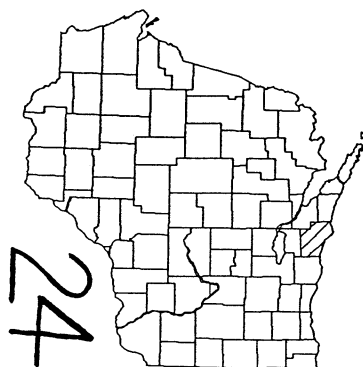


## DESIGN DESIGNATION

A.D.T. 2001	=	11,120 NB	11,640 SB
A.D.T. 2021	=	17,080 NB	17,890 SB
D.H.V.	=	2,289 NB	2,397 SB
D.	=	50/50	
T.	=	11.7%	
DESIGN SPEED	=	65 MPH	
ESALS	=	8,402,300	

## CONVENTIONAL SYMBOLS

COUNTY LINE	---
CORPORATE LIMITS	--- P.L. --- S.B. ---
PROPERTY LINE	---
LOT LINE	---
LIMITED EASEMENT	---
EXISTING RIGHT OF WAY	---
PROPOSED OR NEW R/W LINE	---
SURVEY LINE	---
SLOPE INTERCEPT	---
ORIGINAL GROUND	---
MARSH OR ROCK PROFILE (To be notes as such)	---
MARSH AREA	---
WOODED OR SHRUB AREA	---

COMBUSTIBLE FLUIDS	---
UNDERGROUND UTILITIES	---
GAS	---
ELECTRIC	---
TELEPHONE OR TELEGRAPH	---
COMMUNICATIONS LINE	---
SERVICE PEDESTAL	---
POWER POLE	---
TELEPHONE POLE	---
RAILROAD	---
SANITARY SEWER	---
STORM SEWER	---
WATER	---
EXISTING CULVERT	---
PROPOSED CULVERT (Box or Pipe)	---
CULVERT (Profile View)	---

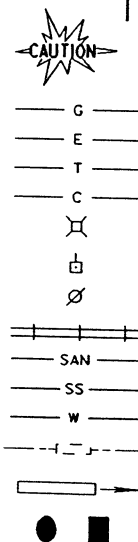

# STATE OF WISCONSIN DEPARTMENT OF TRANSPORTATION


## PLAN OF PROPOSED IMPROVEMENT

# CTH C - USH 10

IH 43

## MANITOWOC COUNTY

STATE PROJECT NUMBER  
1224-07-71

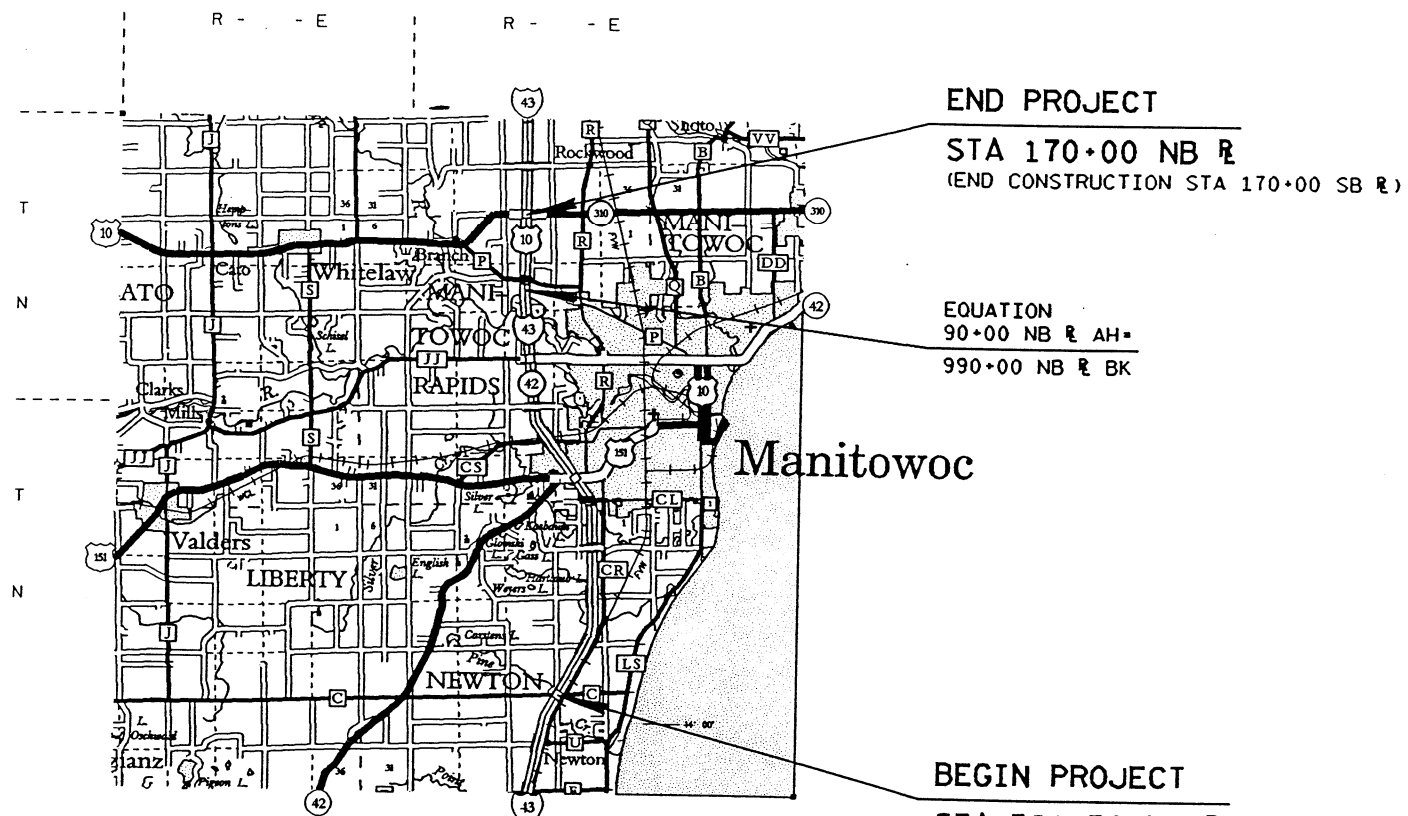

COORDINATES ARE SCALED FROM USGS TOPOGRAPHIC MAP  
MANITOWOC, WISCONSIN QUADRANGLE, FOR IDENTIFICATION ONLY.

STATE PROJECT	FEDERAL PROJECT	
	PROJECT	CONTRACT
1224-07-71	IM 2001 (023)	1

THIS PLAN IS SUBJECT TO FEDERAL OVERSIGHT

## STATE OF WISCONSIN DEPARTMENT OF TRANSPORTATION

PREPARED BY	
Surveyor	
Designer	J. J. GRAINGER, F. N. HEINTZ
District Examiner	
District Supervisor	S. C. NOEL
Proj. Dev. Engineer	
C.O. Examiner	N.R. AFFELDT

APPROVED FOR DISTRICT OFFICE	
DATE: 6/29/00	(Signature)

AUTHORIZED FOR BUREAU OF HIGHWAY DEVELOPMENT	
DATE: 7/5/00	(Signature)

FILE NAME : d3.122407.dgn

PLOT DATE: 5-15-2000

ORG DATE : 5-15-2000


PLOT NAME : 101d

Originator : Dist 3

PLOT SCALE :

WISDOT/CADDs SHEET 10

STATE PROJECT NUMBER	SHEET NO.
1224-07-71	8.14

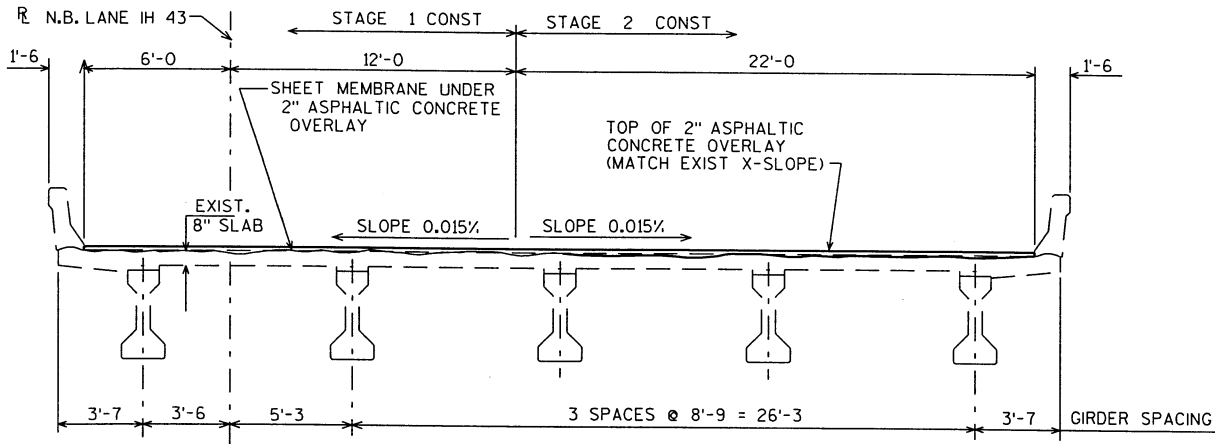

DESIGN DATA


LIVE LOAD :  
INVENTORY RATING : HS20  
OPERATIONAL RATING : HS39  
MAX. STANDARD PERMIT VEHICLE LOAD = 250 KIPS  
ULTIMATE DESIGN STRESSES :  
CONCRETE MASONRY, SLAB \_\_\_\_\_ f'c = 4,000 p.s.i.

GENERAL NOTES

DRAWINGS SHALL NOT BE SCALED.  
DIMENSIONS ARE BASED ON THE EXISTING ORIGINAL PLANS.

TOTAL ESTIMATED QUANTITIES


SHEET MEMBRANE WATERPROOFING	702 S.Y.
ASPHALTIC CONCRETE PAVEMENT, SUPERPAVE	76 TON
ASPHALTIC MATERIAL FOR PLANT MIXES	4.6 TON
CONCRETE MASONRY, DECK PATCHING	4 C.Y.
CURB RESURFACING	314 L.F.
PREPARATION, DECKS, TYPE 1	38 S.Y.
PREPARATION, DECKS, TYPE 2	8 S.Y.
GROUTING BRIDGE DECK	1 L.S.
SAWING PAVEMENT, DECK PREPARATION AREAS	209 L.F.

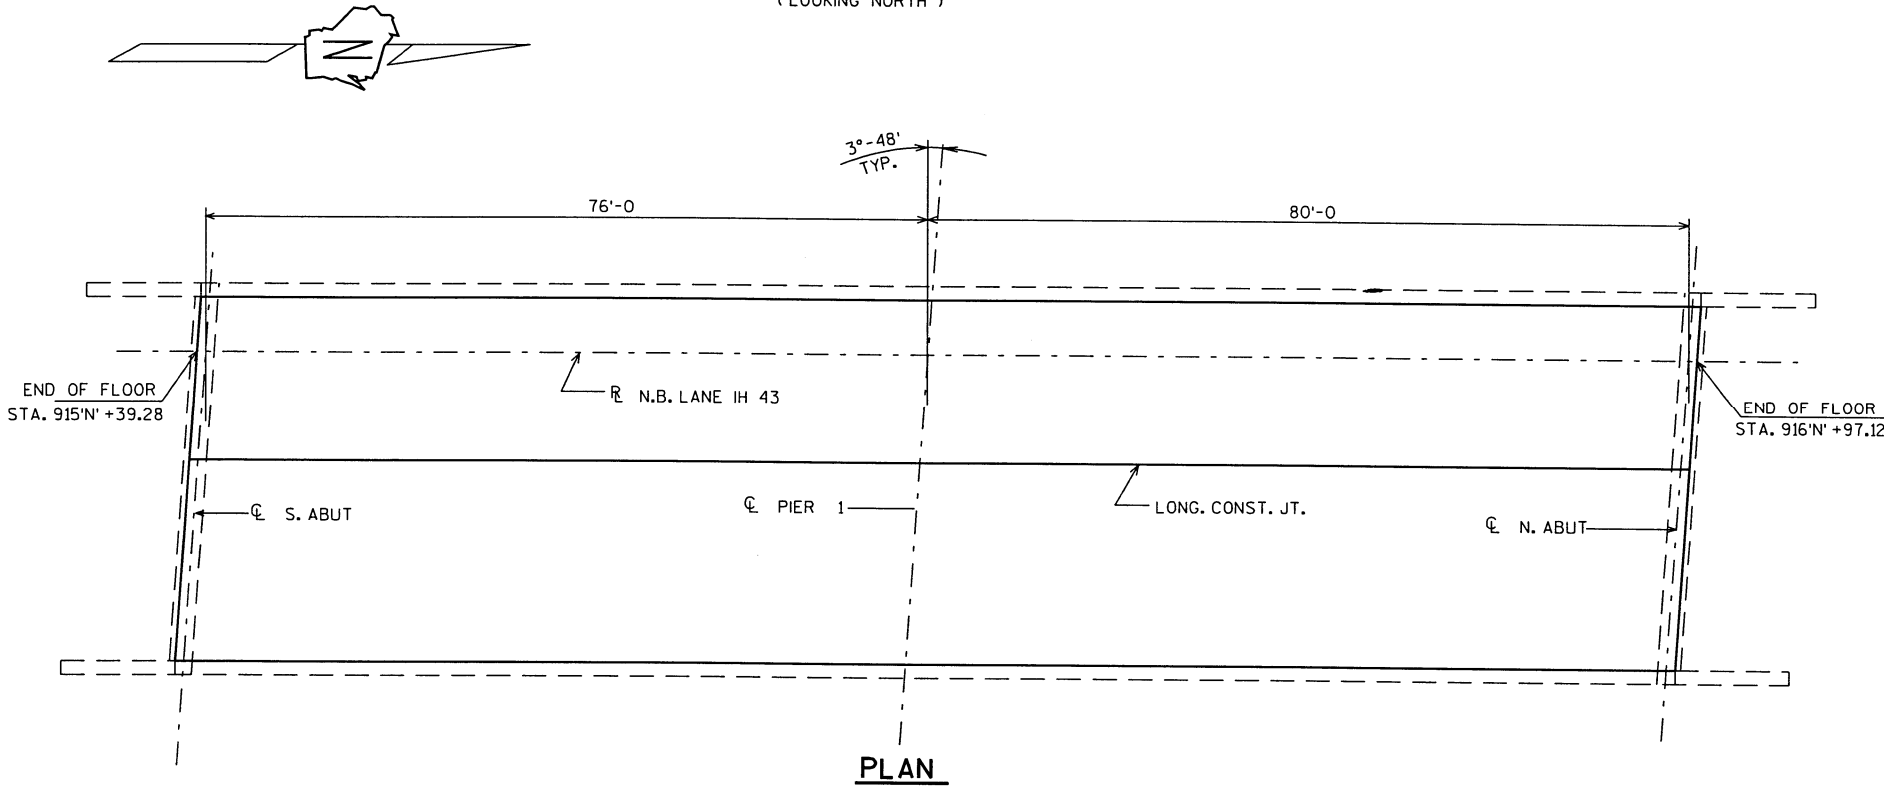

LIST OF DRAWINGS

1. ASPHALTIC OVERLAY

BRIDGE OFFICE CONTACTS :  
FINN HUBBARD (608) 266-8489  
DAVE KIEKBUSCH (608) 266-5084

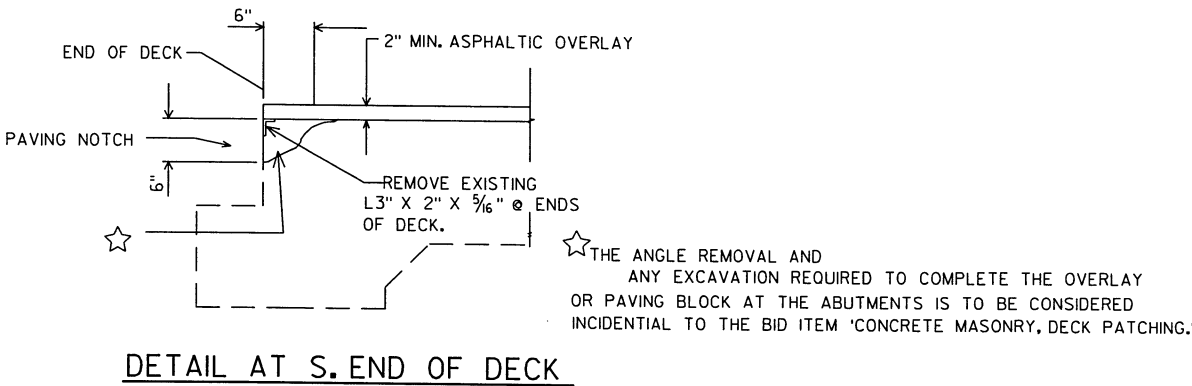

NO.	DATE	REVISION	BY
STATE OF WISCONSIN DEPARTMENT OF TRANSPORTATION STRUCTURES DESIGN SECTION			
STRUCTURE B-36-71			
IH 43 N.B. OVER C.T.H. JJ			
COUNTY	MANITOWOC	TOWN/CITY/VILLAGE	MANITOWOC RAPIDS
DESIGN SPEC.	AASHTO 1998	LOAD	CONST. SPEC. 1996
DESIGNED BY	DJK	DESIGN CK'D.	DRAWN BY RJK PLANS CK'D. DJK
APPROVED	08-03-00		
CHIEF STRUCTURAL DESIGN ENGINEER		DATE	
ASPHALTIC OVERLAY		SHEET 1 OF 1	
		DATE: APR '99	

DESIGN DATA

LIVE LOAD:

DESIGN LOADING: HS-20  
INVENTORY RATING: HS-xx  
OPERATING RATING: HS-xx  
WISCONSIN STANDARD PERMIT  
VEHICLE (Wis-SPV): 250 KIPS

MATERIAL PROPERTIES:

CONCRETE MASONRY OVERLAY  
DECKS & PARAPETS:  $f'_c = 4,000$  p.s.i.  
BAR STEEL REINFORCEMENT  
GRADE 60:  $f_y = 60,000$  p.s.i.

GENERAL NOTES

DRAWINGS SHALL NOT BE SCALED.  
DIMENSIONS ARE BASED ON EXISTING STRUCTURE PLANS.  
DECK SURFACE PREPARATION IS INCLUDED IN THE BID ITEM "POLYMER OVERLAY".

TOTAL ESTIMATED QUANTITIES

509.5100.S POLYMER OVERLAY 702 SY

TRAFFIC DATA

ADT = 11,800 (2036)  
RDS = 70 M.P.H.

LIST OF DRAWINGS


1. GENERAL PLAN

BRIDGE OFFICE CONTACT


WILLIAM DREHER  
(608) 266-8489

CONSULTANT CONTACT

KRISTOFER OLSON  
OMNI ASSOCIATES  
(920) 735-6900

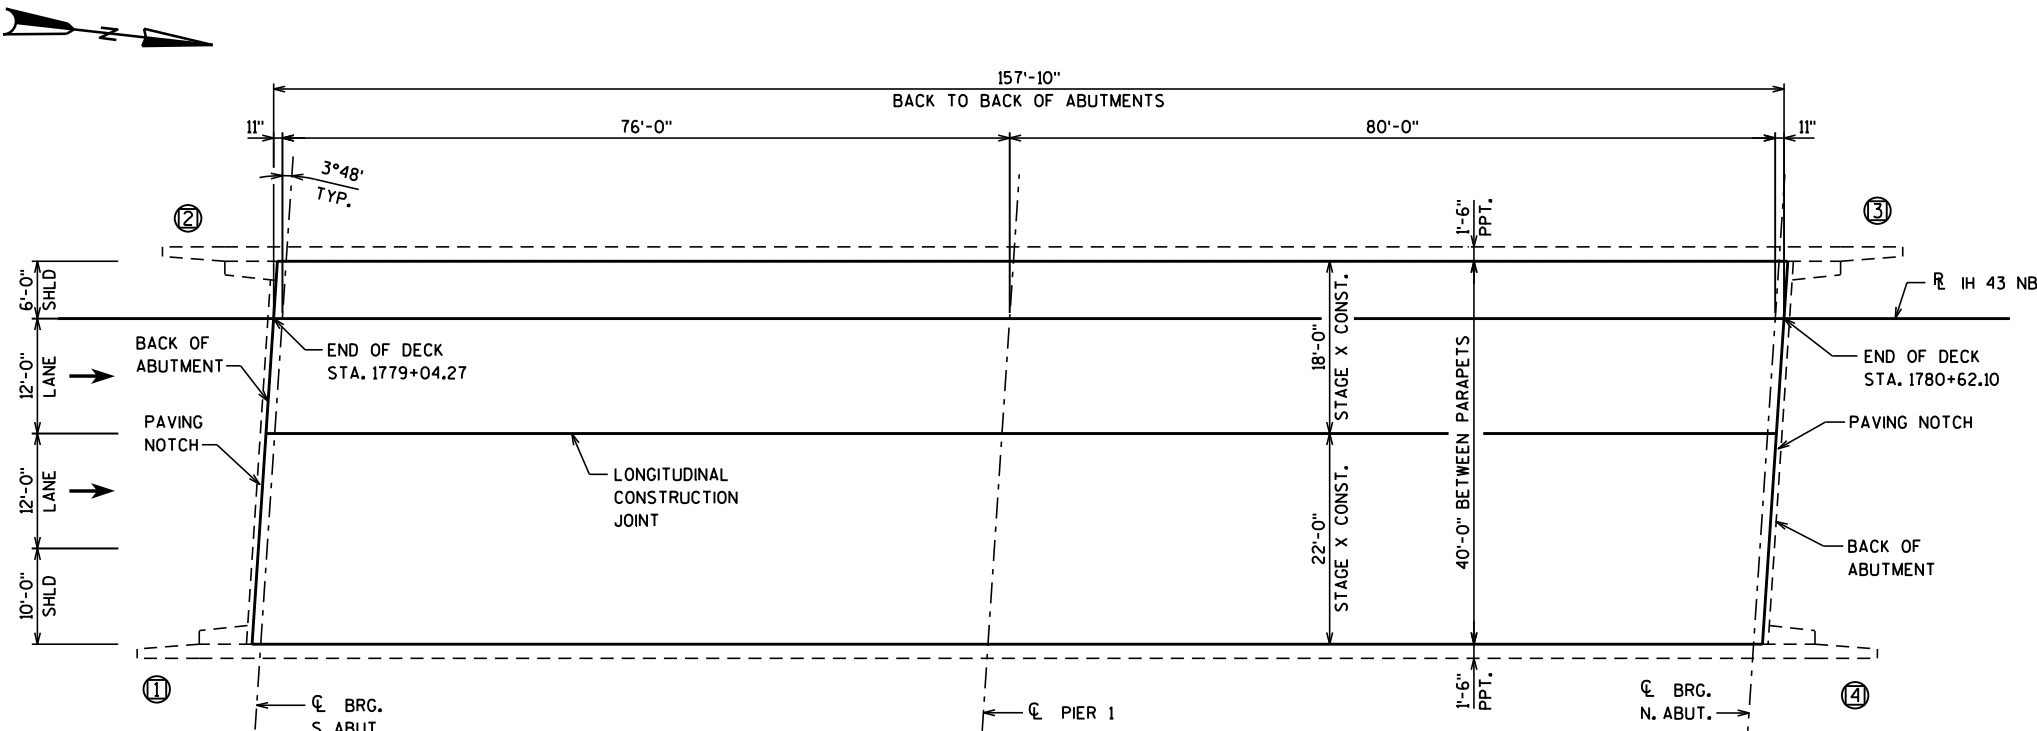

PLAN

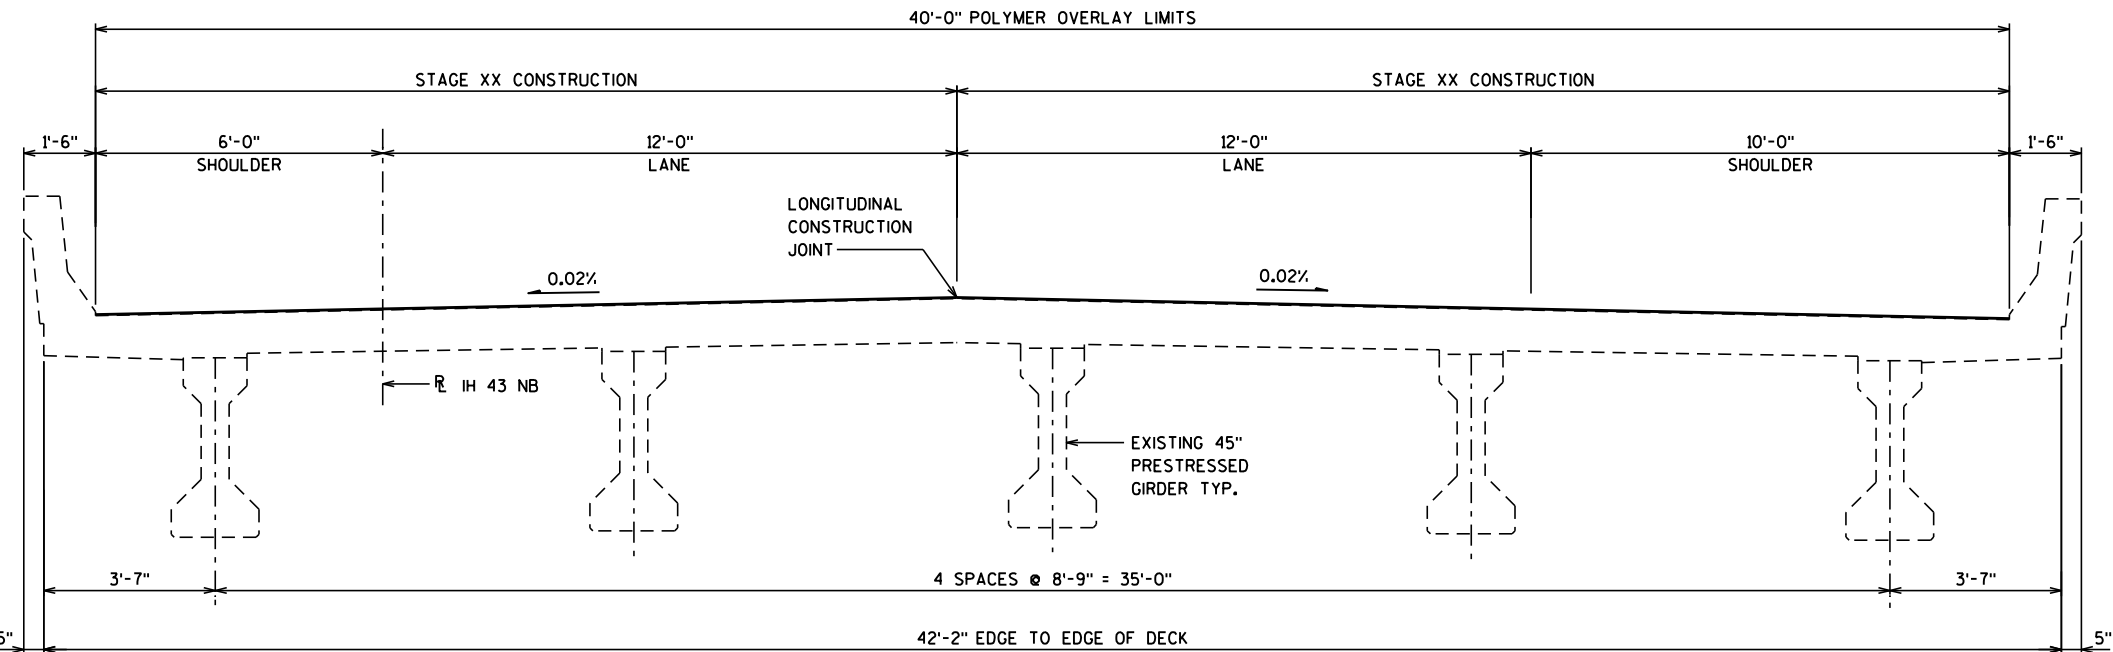

CROSS SECTION THRU EXISTING ROADWAY

(LOOKING NORTH)

NO.	DATE	REVISION	BY
ORIGINAL PLANS PREPARED BY			
<b>Omni</b> ASSOCIATES			
STATE OF WISCONSIN DEPARTMENT OF TRANSPORTATION			
ACCEPTED		CHIEF STRUCTURES DESIGN ENGINEER	DATE
STRUCTURE B-36-71			
IH 43 NB OVER USH 10/STH 42/CTH JJ			
COUNTY	MANITOWOC	TOWN	MANITOWOC RAPIDS
DESIGN SPEC. REHABILITATION N/A			
DESIGNED BY	BRE	DESIGN CK'D.	KRO
DRAWN BY	BRE	PLANS CK'D.	KRO
GENERAL PLAN			SHEET 1 OF 1

# WISCONSIN DEPARTMENT OF TRANSPORTATION BRIDGE LOAD RATING SUMMARY

## Bridge Data (used in this rating)

Bridge Number: B36-071	Section Loss(%): *
Feature Carried: IH 43 NB	SL Description: *
Rating Date: 24-May-2013	Overburden Depth(in): 2.0
Span Type: DECK GIRDER	Overburden Type: BITUMINOUS
Span Material: CONT PREST CONC	Last Inspection Date: 14-Sep-2011*

\* Inspection data reflects last inspection prior to rating. Latest inspection is on 09-Sep-2013

## Bridge Load Rating Summary

Rating Method: LFR	Rating Vehicle: HS20			
	Rating	Controlling Element	Controlling Location (ft)	Live Load Distribution Factor
Inventory:	HS19.6	DECK GIRDER Positive Moment	SPAN 1	1.59
Operating:	HS39.9	DECK GIRDER Positive Moment	SPAN 1	1.59

## Wisconsin Standard Permit Vehicle (Wis-SPV)

	MVW (kips)	Controlling Element	Controlling Location (ft)	Live Load Distribution Factor
:				
:				

Posting Vehicle Type*	Vehicle GVW (kips)	Operating Rating (kips)	Controlling Element/Controlling Check	Controlling Location (ft)	Live Load Distribution Factor
WISSPV 250	0.0	258	DECK GIRDER Positive Moment	SPAN 1	1.59
WISSPV 250	0.0	328	DECK GIRDER Positive Moment	SPAN 1	1.25

\* Posting Vehicle Analysis (Run only when HL-93 Operating RF <1.0 or when HS20 Operating RF <1.0)

## Remarks/Recommendations:

	Load Rating Engineer
	Name: Dietsche, Joshua
	Date: 24-May-2013
PE Stamp Here	

This page intentionally left blank