

## DESIGN DATA

## LIVE LOAD:

DESIGN LOADING \_\_\_\_\_ HL-93  
 INVENTORY RATING FACTOR \_\_\_\_\_ RF=X.XX  
 OPERATING RATING FACTOR \_\_\_\_\_ RF=X.XX  
 WISCONSIN STANDARD PERMIT VEHICLE (WIS-SPV) \_\_\_\_\_ 250 KIPS

STRUCTURE IS DESIGNED FOR A FUTURE WEARING SURFACE OF 20 P.S.F.

## MATERIAL PROPERTIES:

CONCRETE MASONRY, SLAB \_\_\_\_\_  $f'_c$  = 4,000 P.S.I.  
 ALL OTHER \_\_\_\_\_  $f'_c$  = 3,500 P.S.I.  
 HIGH-STRENGTH BAR STEEL \_\_\_\_\_  
 REINFORCEMENT, GRADE 60 \_\_\_\_\_  $f_y$  = 60,000 P.S.I.

## FOUNDATION DATA

ABUTMENTS TO BE SUPPORTED ON PILING CIP CONCRETE 10% X 0.25-INCH DRIVEN TO A REQUIRED DRIVING RESISTANCE OF 130 TONS PER PILE AS DETERMINED BY THE MODIFIED GATES DYNAMIC FORMULA. ESTIMATE 68 FT PILE LENGTHS AT BOTH ABUTMENTS.

\*\*THE FACTORED AXIAL RESISTANCE OF PILES IN COMPRESSION USED FOR DESIGN IS THE REQUIRED DRIVING RESISTANCE MULTIPLIED BY A RESISTANCE FACTOR OF 0.5 USING MODIFIED GATES TO DETERMINE DRIVEN PILE CAPACITY.

## TRAFFIC DATA

A.D.T. (2017) \_\_\_\_\_ 230  
 A.D.T. (2037) \_\_\_\_\_ 250  
 DESIGN SPEED \_\_\_\_\_ 25 M.P.H.

## HYDRAULIC DATA

100 YEAR FREQUENCY \_\_\_\_\_  
 DRAINAGE AREA \_\_\_\_\_ 12.2 SQ. MI.  
 $Q_{100}$  TOTAL \_\_\_\_\_ 1,040 C.F.S.  
 THROUGH STRUCTURE \_\_\_\_\_ 1,040 C.F.S.  
 OVERTOPPING ROADWAY \_\_\_\_\_ N/A  
 VELOCITY - THROUGH STRUCTURE \_\_\_\_\_ 6.35 F.P.S.  
 WATERWAY AREA - THROUGH STRUCTURE \_\_\_\_\_ 163.8 SQ. FT.  
 HIGH WATER<sub>100</sub> ELEVATION \_\_\_\_\_ 799.66  
 SCOUR CRITICAL CODE \_\_\_\_\_ 5

## EROSION CONTROL

$Q_2$  \_\_\_\_\_ 270 C.F.S.  
 HIGH WATER<sub>2</sub> ELEVATION \_\_\_\_\_ 797.02

## LIST OF DRAWINGS

GENERAL PLAN \_\_\_\_\_ 1.  
 CROSS SECTION AND QUANTITIES \_\_\_\_\_ 2.  
 SUBSURFACE EXPLORATION \_\_\_\_\_ 3.

INDICATES WING NUMBER

## RIPRAP HEAVY LAYOUT


POINT	STATION	OFFSET
A	11+58	49.7' LT.
B	11+75	49.7' LT.
C	12+04	18.7' LT.
D	12+15	38.7' LT.
E	12+24	33.9' LT.
F	12+35	24.3' RT.
G	12+30	32.4' RT.
H	12+16	24.7' RT.
I	11+92	19.7' RT.
J	11+84	33.0' RT.
K	11+73	33.0' RT.

## BENCH MARKS

NO.	STA.	DESCRIPTION	ELEV.
3	8+96	3/4" IRON REBAR SET, 27.3' RT.	808.38
2	11+24	3/4" IRON REBAR SET, 29.1' LT.	801.24
5	11+71	STAR SPIKE IN PP, 31.4' RT.	798.20
1	14+20	3/4" IRON REBAR SET, 14.3' LT.	800.54

## PLAN B-36-0222

(SINGLE-SPAN REINFORCED CONCRETE FLAT SLAB)

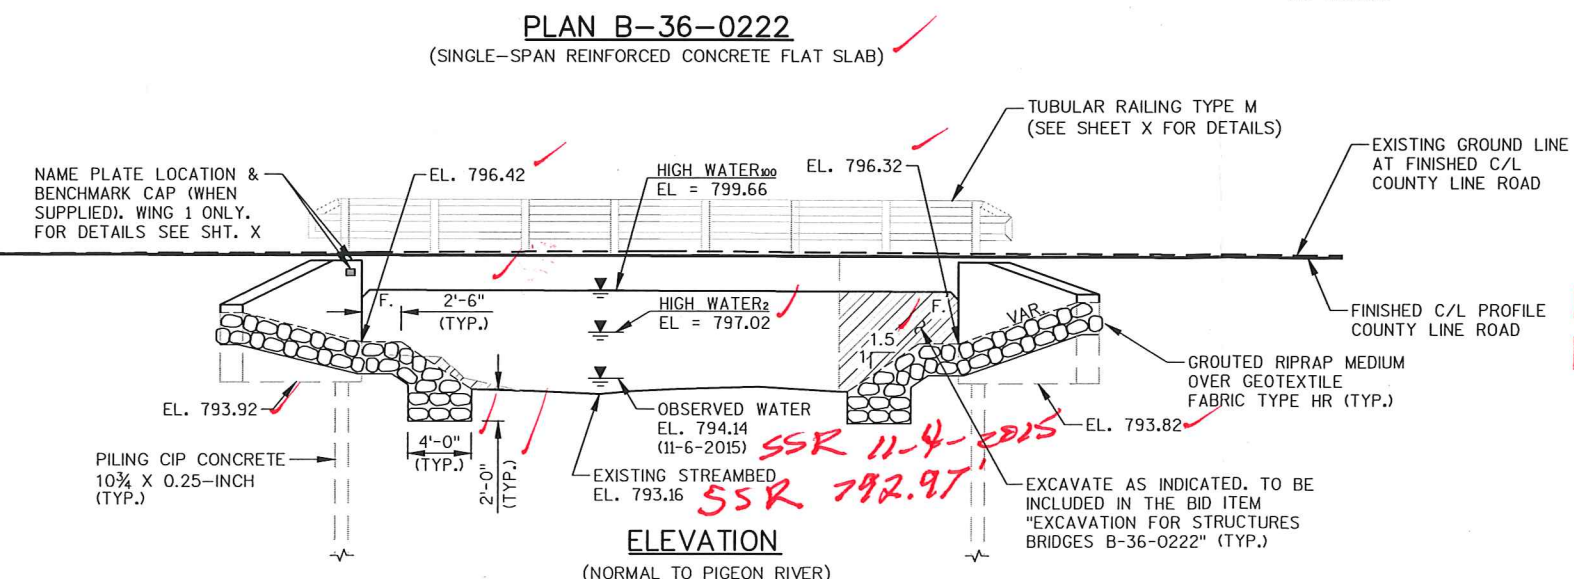

TYPE, SIZE  
& LOCATION  
APPROVED

BY MLH  
DATE 3-22-2016

DESIGN CONSULTANT  
PATRICK BOLAND, PE  
(608) 588-7484

BRIDGE OFFICE CONTACT  
WILLIAM DREHER, PE  
(608) 266-8489

NO.	DATE	REVISION	BY
<b>JEWELL</b> associates engineers, inc. Engineers - Surveyors - Architects			
560 SUNRISE DRIVE SPRING GREEN, WI 53588 PHONE: (608) 588-7484 FAX: (608) 588-9322			
STATE OF WISCONSIN DEPARTMENT OF TRANSPORTATION			
ACCEPTED _____ CHIEF STRUCTURES DESIGN ENGINEER _____ DATE _____			
STRUCTURE B-36-0222			
COUNTY LINE ROAD OVER PIGEON RIVER			
COUNTY	MANITOWOC	TOWN/VILLAGE	MEEME
DESIGN SPEC. _____ AASHTO LRFD BRIDGE DESIGN SPECIFICATIONS			
DESIGNED BY	DESIGN CK'D	DRAWN BY	PLANS CK'D PTB
GENERAL PLAN			SHEET 1 OF 3



GENERAL NOTES

DRAWINGS SHALL NOT BE SCALED. BAR STEEL REINFORCEMENT SHALL BE EMBEDDED 2" CLEAR UNLESS OTHERWISE SHOWN OR NOTED.

ELEVATIONS SHOWN ON THE PLAN ARE REFERENCED TO THE NORTH AMERICA VERTICAL DATUM OF 1988 (NAVD 88).

JOINT FILLER SHALL CONFORM TO A.A.S.H.T.O. DESIGNATION M153, TYPE I, II OR III OR A.A.S.H.T.O. DESIGNATION M213.

THE SLOPE OF FILL IN FRONT OF THE ABUTMENTS SHALL BE COVERED WITH RIPRAP HEAVY AND GEOTEXTILE FABRIC TYPE HR TO THE EXTENT SHOWN ON SHEET 1 AND IN THE ABUTMENT DETAILS, OR AS DIRECTED BY THE ENGINEER IN THE FIELD.

AT THE BACK FACE OF ABUTMENTS, ALL VOLUME WHICH CANNOT BE PLACED BEFORE ABUTMENT CONSTRUCTION AND IS NOT OCCUPIED BY THE NEW STRUCTURE SHALL BE BACKFILLED WITH BACKFILL STRUCTURE.

THE QUANTITY FOR BACKFILL STRUCTURE, BID ITEM 210.0100, IS CALCULATED BASED ON THE APPLICABLE FIGURES 12.6-1 AND 12.6-2 IN THE WISCONSIN DEPARTMENT OF TRANSPORTATION BRIDGE MANUAL.

THE GRADATION OF THE STRUCTURE BACKFILL SHALL MEET THE REQUIREMENTS OF SECTION 209.2.2 OF THE STANDARD SPECIFICATIONS FOR GRADE 1 MATERIAL.

APPLY PROTECTIVE SURFACE TREATMENT TO THE TOP OF THE DECK, THE SIDES OF THE DECK AND EXTERIOR 12" OF THE UNDERSIDE OF THE DECK (CONCRETE MATERIAL ONLY).


THE EXISTING STRUCTURE (P-36-0907) IS A SINGLE SPAN CONCRETE DECK GIRDER STRUCTURE, SUPPORTED ON CONCRETE ABUTMENTS. THE STRUCTURE HAS A 24.0' CLEAR ROADWAY WIDTH AND A 33.0' OVERALL LENGTH AND SHALL BE REMOVED.

ALL STATIONS AND ELEVATIONS SHOWN ARE IN FEET.



THE EXISTING GROUNDLINE SHALL BE THE UPPER LIMITS OF EXCAVATION FOR STRUCTURES.

SLAB FALSEWORK SHALL BE SUPPORTED ON PILES OR THE SUBSTRUCTURE UNLESS AN ALTERNATIVE METHOD IS APPROVED BY THE ENGINEER IN THE FIELD.

THE FIRST OR FIRST TWO DIGITS OF A BAR MARK SIGNIFIES THE BAR SIZE.

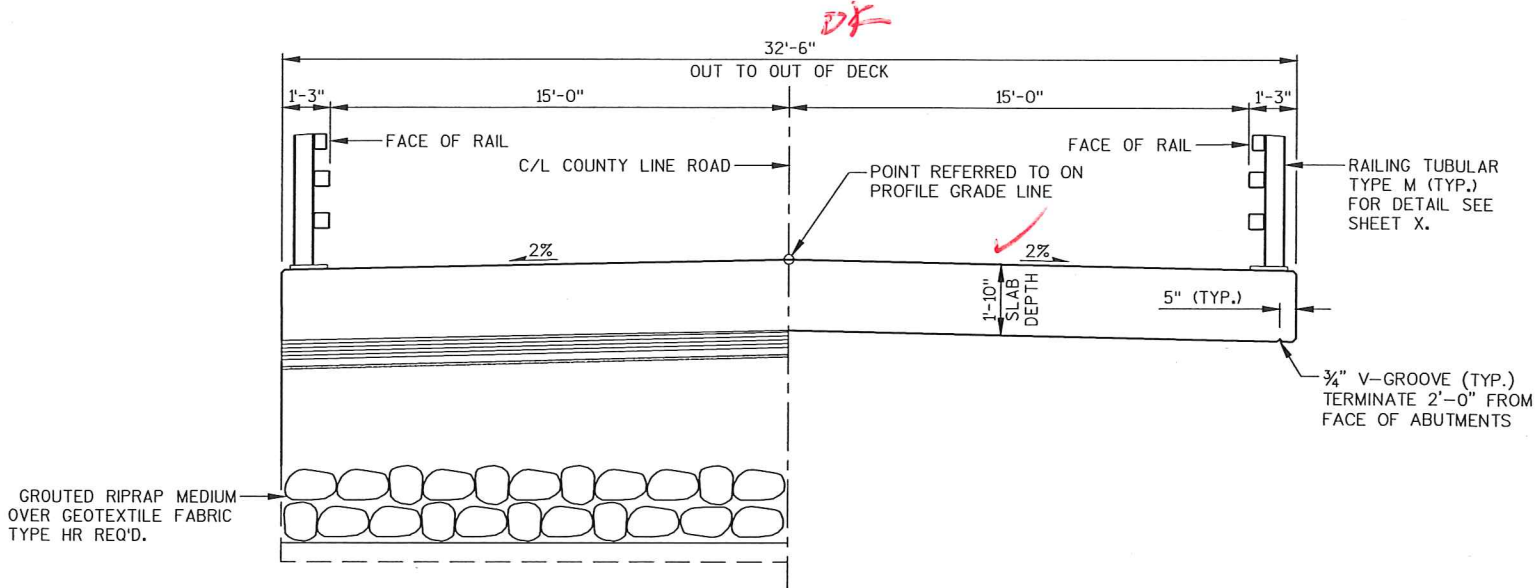

AT ABUTMENT IN SPAN  
PROPOSED CROSS-SECTION THROUGH ROADWAY  
(LOOKING EAST)

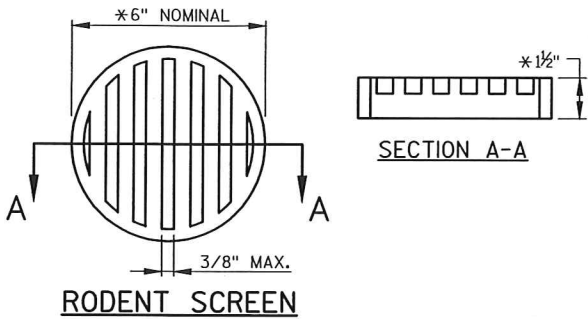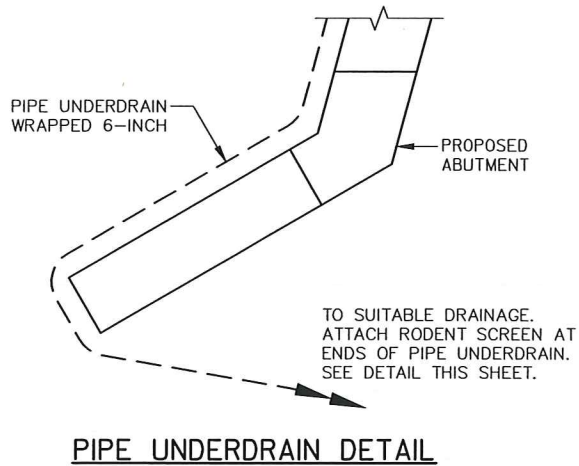



NOTES:

\*DIMENSIONS ARE APPROXIMATE. THE GRATE IS SIZED TO FIT INTO A PIPE COUPLING.

ORIENT SCREEN SO SLOTS ARE VERTICAL.

THE RODENT SCREEN, PIPE COUPLING AND SCREWS SHALL BE CONSIDERED INCIDENTAL TO THE BID ITEM "PIPE UNDERDRAIN WRAPPED 6-INCH".

THE RODENT SCREEN SHALL BE A PVC GRATE SIMILAR TO THIS DETAIL. THE GRATE IS COMMERCIALY AVAILABLE AS A FLOOR STRAINER. A PIPE COUPLING IS REQUIRED FOR THE ATTACHMENT OF THIS SCREEN TO THE EXPOSED ENDS OF THE PIPE UNDERDRAIN. THE SCREEN SHALL BE FASTENED TO THE PIPE COUPLING WITH TWO OR MORE NO. 10 X 1-INCH STAINLESS STEEL SHEET METAL SCREWS.

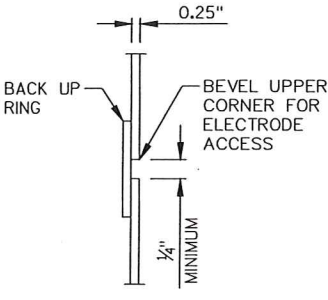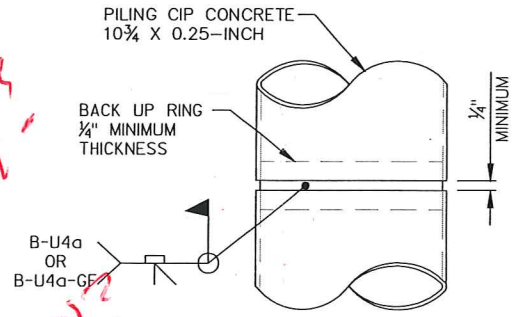


CAST-IN-PLACE  
CONCRETE PILE

C.I.P. PILE  
WELD DETAIL

NOTES:


CAST-IN-PLACE PILE SHELL MATERIAL SHALL BE IN ACCORDANCE WITH THE STANDARD SPECIFICATIONS

ITEM NUMBER	ITEM DESCRIPTION	UNIT	W. ABUT.	SUPER	E. ABUT.	TOTALS
203.0600.S	REMOVING OLD STRUCTURE OVER WATERWAY WITH MINIMAL DEBRIS STA. 11+97	LS	--	--	--	--
206.1000	EXCAVATION FOR STRUCTURES BRIDGES B-36-0222	LS	--	--	--	--
210.0100	BACKFILL STRUCTURE	CY	--	--	--	--
502.0100	CONCRETE MASONRY BRIDGES	CY	--	--	--	--
502.3200	PROTECTIVE SURFACE TREATMENT	SY	--	--	--	--
505.0400	BAR STEEL REINFORCEMENT HS STRUCTURES	LB	--	--	--	--
505.0600	BAR STEEL REINFORCEMENT HS COATED STRUCTURES	LB	--	--	--	--
513.4061	RAILING TUBULAR TYPE M B-36-0222	LF	--	--	--	--
516.0500	RUBBERIZED MEMBRANE WATERPROOFING	SY	--	--	--	--
550.2104	PILING CIP CONCRETE 10 3/4 X 0.25-INCH	LF	--	--	--	--
606.0600	GROUTED RIPRAP MEDIUM	CY	--	--	--	--
612.0406	PIPE UNDERDRAIN WRAPPED 6-INCH	LF	--	--	--	--
645.0120	GEOTEXTILE FABRIC TYPE HR	SY	--	--	--	--
NON-BID ITEMS						
	FILLER	SIZE	--	--	--	1/2" & 3/4"

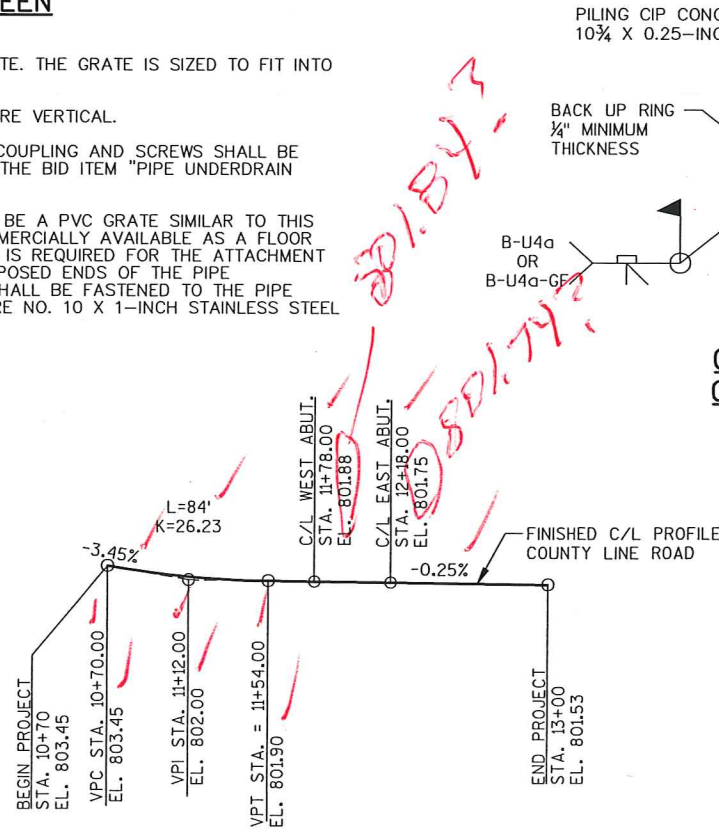

COUNTY LINE ROAD - PROFILE GRADE LINE

NO.	DATE	REVISION	BY
STATE OF WISCONSIN DEPARTMENT OF TRANSPORTATION			
STRUCTURE B-36-0222			
DRAWN BY RBH		PLANS CK'D. PTB	
CROSS SECTION AND QUANTITIES		SHEET 2 OF 3	

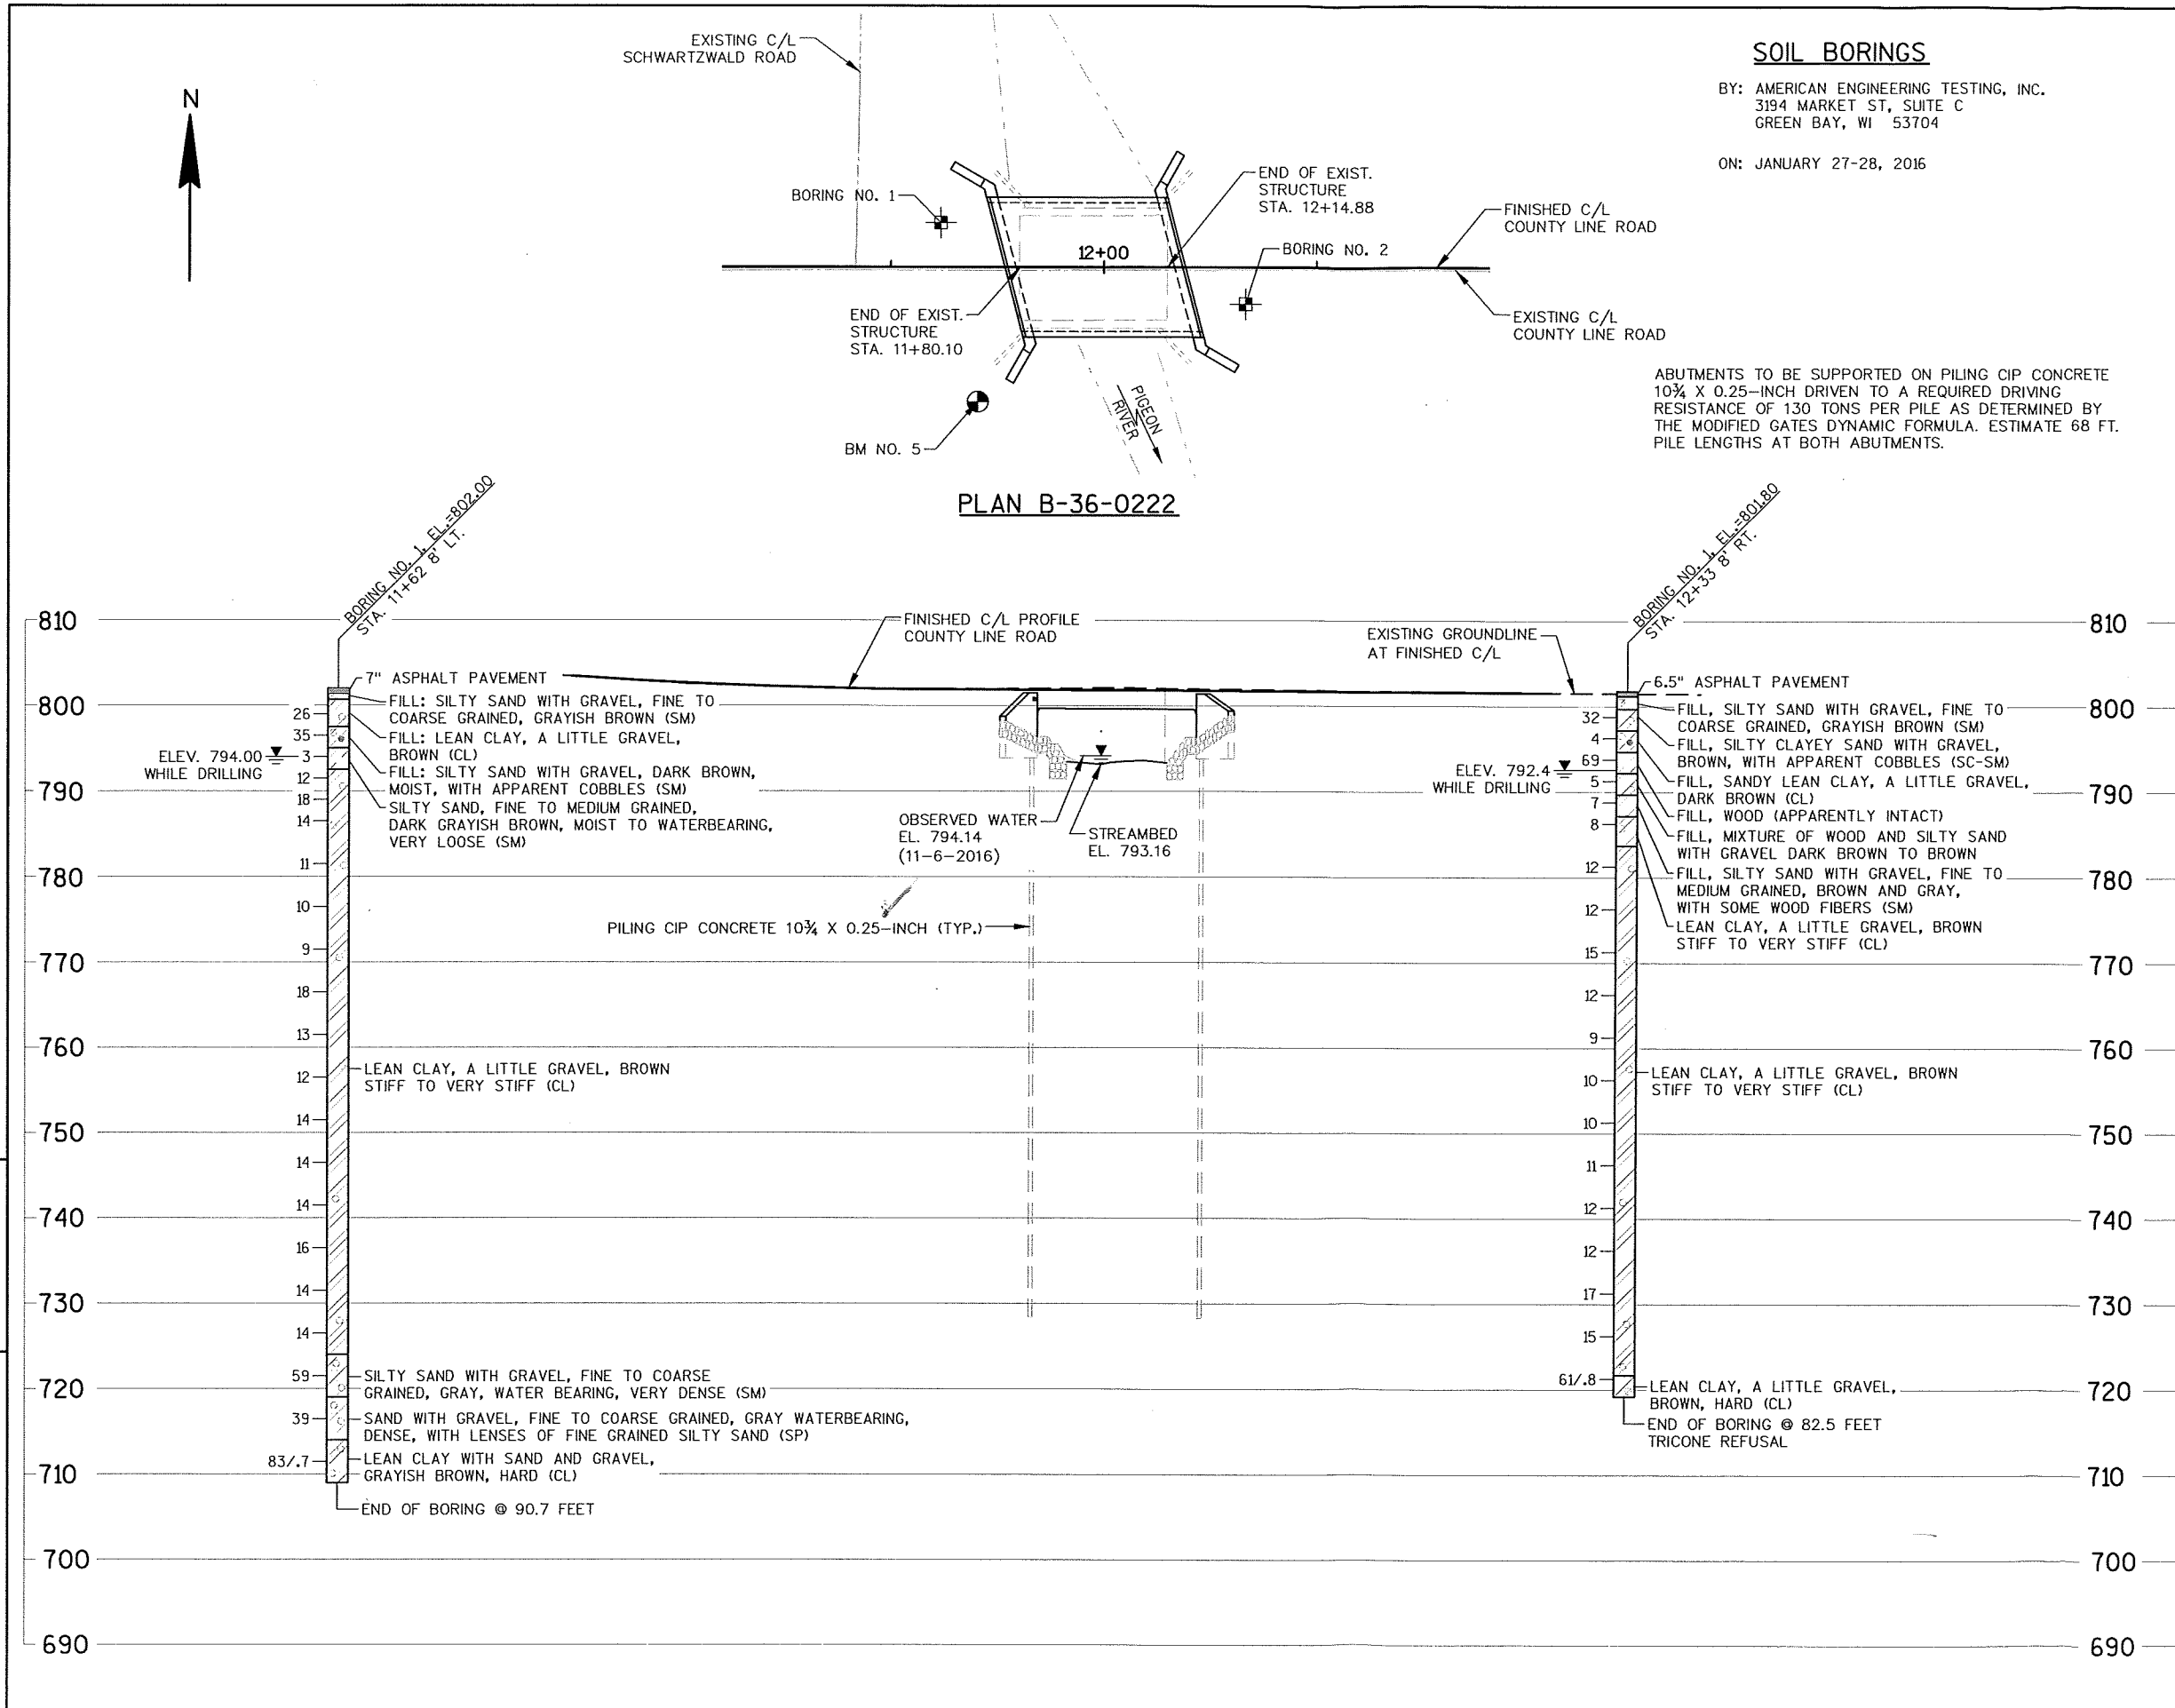

SOIL BORINGS

BY: AMERICAN ENGINEERING TESTING, INC.  
3194 MARKET ST, SUITE C  
GREEN BAY, WI 53704

ON: JANUARY 27-28, 2016

STATE PROJECT NUMBER

4313-10-71


ABBREVIATIONS

F—Fine M—Medium C—Course  
Ws—Weathered So—Sound


MATERIAL SYMBOLS

Asphalt	Silt	Sandstone
Sand	Peat	Limestone
Gravel	Clay	Igneous Rock

LEGEND OF PROBING

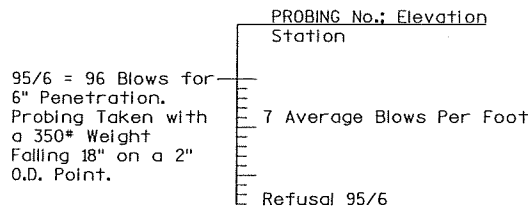

LEGEND OF BORING

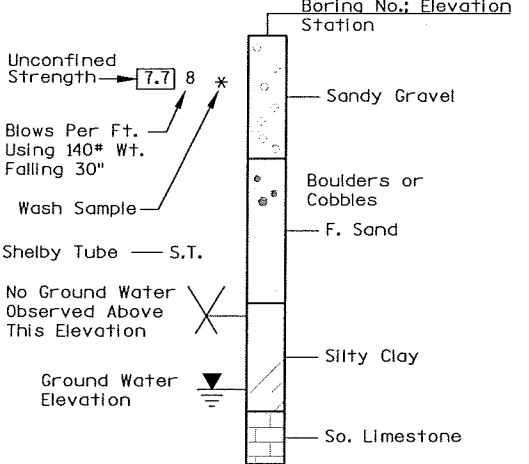

UNLESS OTHERWISE SPECIFIED, THE BLOWS PER FOOT AT THE LOCATIONS INDICATED ARE BASED ON DRIVING A 2" O.D. X 1.4" I.D. SPLIT SPOON SAMPLER WITH A 140# HAMMER HAVING A FREE FALL OF 30". THE BLOW COUNT IS TAKEN IN UNDISTURBED SOIL IMMEDIATELY BELOW A CASED OR OPEN HOLE ELIMINATING SIDE FRICTION ON THE DRIVE PIPE.

SUBSURFACE EXPLORATION FOR FOUNDATION DESIGN AND BIDDERS INFORMATION

TO OBTAIN RELATIVE DATA CONCERNING THE CHARACTER OF MATERIAL IN AND UPON WHICH THE FOUNDATION MIGHT BE BUILT, BORINGS AND/OR SOUNDINGS WERE MADE AT POINTS APPROXIMATELY AS INDICATED ON THIS DRAWING. THE DATA PRESENTED HEREIN REPRESENTS THE FINDINGS OF THE SUBSURFACE EXPLORATIONS MADE. HOWEVER, BECAUSE THE DEPTHS INVESTIGATED ARE LIMITED AND THE AREA OF THE BORINGS AND/OR SOUNDINGS IS VERY SMALL IN RELATION TO THE ENTIRE AREA, THE WISCONSIN DEPARTMENT OF TRANSPORTATION DOES NOT WARRANT CONDITIONS BELOW THE DEPTHS INVESTIGATED OR THAT THE CLASSIFICATION OF MATERIAL ENCOUNTERED IN THESE INVESTIGATIONS IS NECESSARILY TYPICAL OF THE ENTIRE SITE.

NO.	DATE	REVISION	BY
STATE OF WISCONSIN DEPARTMENT OF TRANSPORTATION			
STRUCTURE B-36-0222			
DRAWN BY		TMS	PLANS CK'D. PTB
SUBSURFACE EXPLORATION		SHEET 3 OF 3	



