


STATE PROJECT NUMBER

5025-00-71

* PROVIDE THE THRIE BEAM
GUARD RAIL ATTACHMENT

⊖ INDICATES WING NUMBER

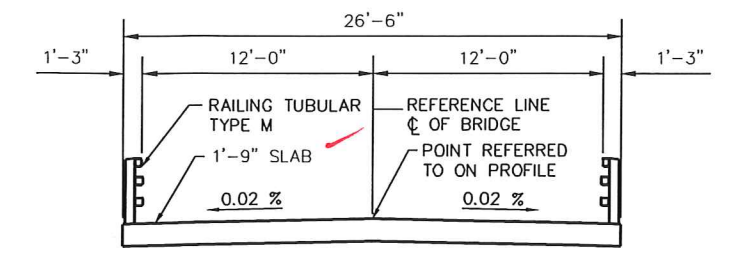

CROSS-SECTION THRU ROADWAY

DESIGN DATA

STRUCTURE IS DESIGNED FOR A FUTURE WEARING
SURFACE OF 20 POUNDS PER SQUARE FOOT.

LIVE LOAD:

DESIGN LOADING HL-93
INVENTORY RATING FACTOR RF = 1.XX
OPERATING RATING FACTOR RF = 1.XX
WISCONSIN STANDARD PERMIT VEHICLE (WIS-SPV) XXX KIPS

ULTIMATE DESIGN STRESSES:

CONCRETE MASONRY
SLAB f'c = 4,000 PSI
ALL OTHER f'c = 3,500 PSI
BAR STEEL REINFORCEMENT, GRADE 60 fy = 60,000 PSI

HYDRAULIC DATA

100 YEAR FREQUENCY
DRAINAGE AREA 9.5 SQ MILES
Q₁₀₀ TOTAL 2125 CFS
THRU STRUCTURE 924 CFS
OVERFLOW 1201 CFS
VELOCITY - THRU STRUCTURE 5.51 FPS
WATERWAY AREA THRU STRUCTURE 167.6 SQ FT
HIGH WATER₁₀₀ ELEVATION 977.56 FT
SCOUR CRITICAL CODE = 8
2 YEAR FREQUENCY
Q₂ TOTAL 410 CFS
HIGH WATER₂ ELEVATION 976.15 FT
FREQUENCY OF ROADWAY OVERTOPPING
Q₆ TOTAL 720 CFS
HIGH WATER₆ ELEVATION 976.30 FT
REGULATORY
Q REG 2125 CFS
HIGH WATER REG 977.40 FT

TRAFFIC DATA

AADT (2016) < 100
AADT (2036) < 100
DESIGN SPEED 55 MPH

BENCHMARK

STA 13+28±, 34.80' RT OF C/L, SET
4" NAIL INTO SIDE OF POWER POLE
EL 973.48'

LIST OF DRAWINGS


1. GENERAL PLAN
2. QUANTITIES & NOTES
3. SUBSURFACE EXPLORATION
4. WEST ABUTMENT
5. EAST ABUTMENT
6. ABUTMENT DETAILS
7. SUPERSTRUCTURE
8. TUBULAR STEEL RAILING TYPE "M"

DESIGN CONTACT:
TROY PETERSON
(715) 232-9081

BRIDGE OFFICE CONTACT:
WILLIAM DREHER
(608) 266-8489

FOUNDATION DATA



ABUTMENTS TO BE SUPPORTED ON PILING STEEL HP 10x42, WITH
A REQUIRED DRIVING RESISTANCE OF 180 TONS ± PER PILE AS
DETERMINED BY THE MODIFIED GATES DYNAMIC EQUATION.
ESTIMATED LENGTH XX' W ABUTMENT
ESTIMATED LENGTH XX' E ABUTMENT
± THE FACTORED AXIAL RESISTANCE OF PILES IN COMPRESSION
USED FOR DESIGN IS THE REQUIRED DRIVING RESISTANCE
MULTIPLIED BY A RESISTANCE FACTOR OF 0.5 USING MODIFIED
GATES TO DETERMINE DRIVEN PILE CAPACITY.

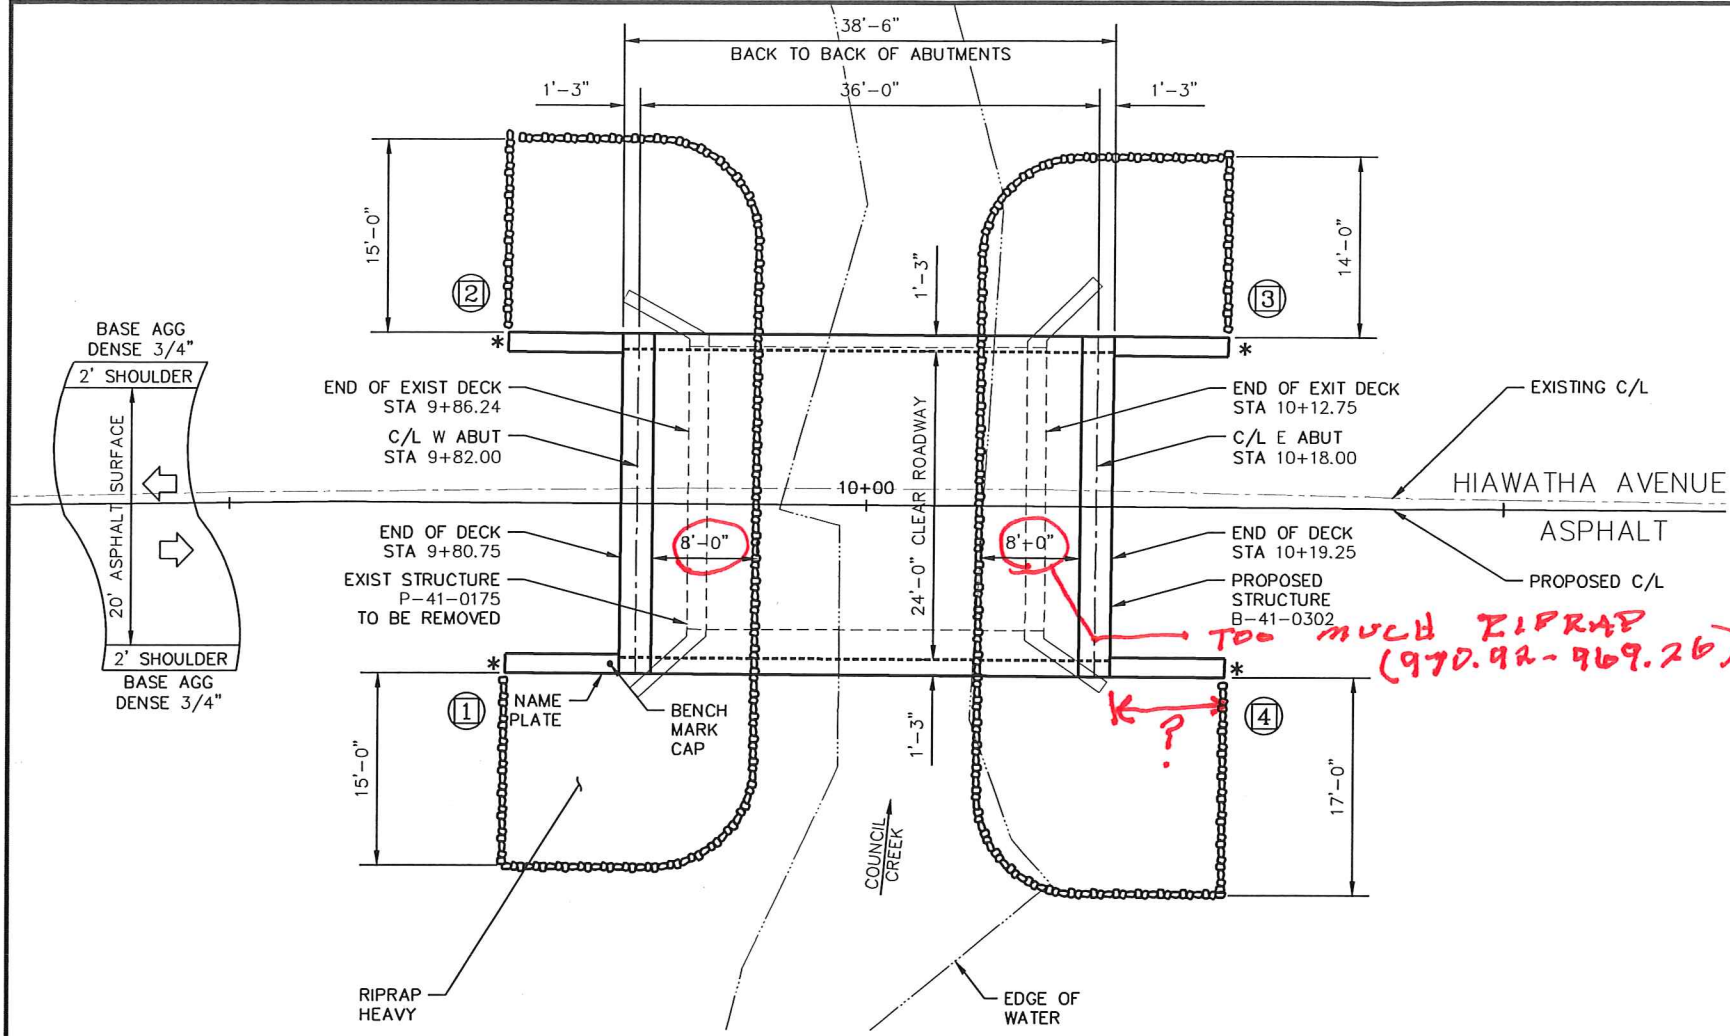

PLAN

SINGLE SPAN CONCRETE FLAT-SLAB BRIDGE

PROPOSED GRADE LINE

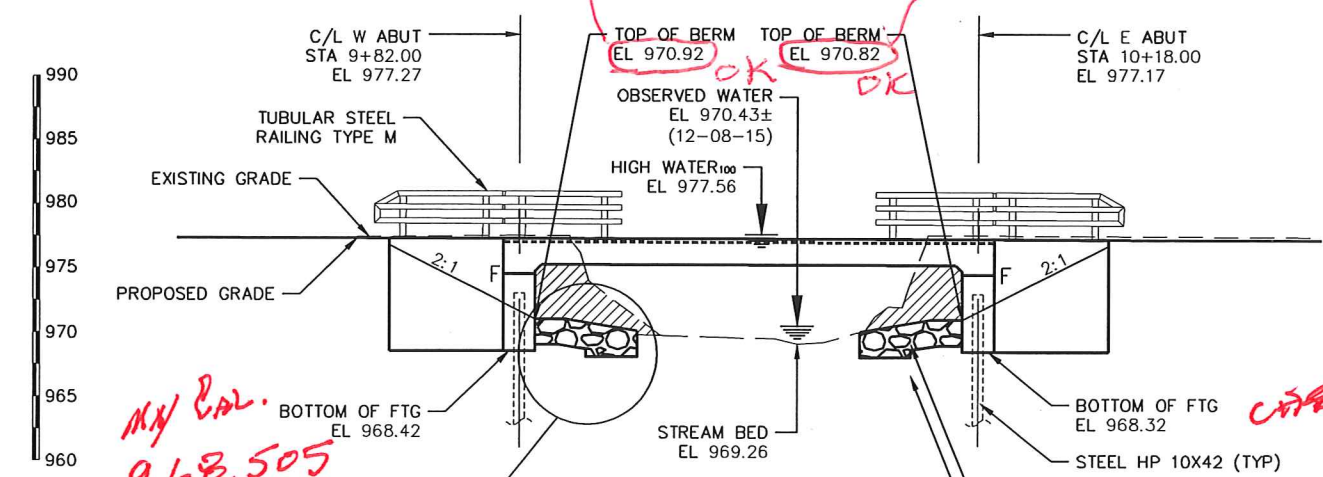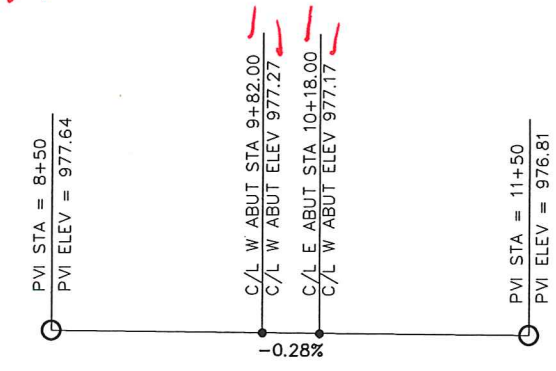

ELEVATION

NORMAL TO C/L OF COUNCIL CREEK

EXCAVATION IN THESE
AREAS SHALL BE
INCLUDED IN EXCAVATION
FOR STRUCTURE (TYP)

TYPE, SIZE
& LOCATION
APPROVED

BY MLH
DATE 7-22-2016

NOT STANDARD

NOT
NEEDED

NO.	DATE	REVISION	BY
ORIGINAL PLANS PREPARED BY			
Cedar corporation			
MENOMONIE - MADISON - GREEN BAY www.cedarcorp.com 800-472-7372			
STATE OF WISCONSIN DEPARTMENT OF TRANSPORTATION			
ACCEPTED _____ DATE _____			
CHIEF STRUCTURES DESIGN ENGINEER			
STRUCTURE B-41-0302			
HIAWATHA AVENUE OVER COUNCIL CREEK			
COUNTY MONROE		TOWN/CITY/VILLAGE TOMAH	
DESIGN SPEC. AASHTO LRFD BRIDGE DESIGN SPECIFICATIONS			
DESIGNED BY	DESIGN CK'D.	DRAWN BY	PLANS CK'D.
GENERAL PLAN			SHEET 1 OF 8

TOTAL ESTIMATED QUANTITIES

ITEM NUMBER	BID ITEMS	UNIT	W ABUT	E ABUT	SUPER	TOTALS
203.0600.S	REMOVING OLD STRUCTURE OVER WATERWAY WITH MINIMAL DEBRIS STA 10+00	LS	—	—	—	
206.1000	EXCAVATION FOR STRUCTURES BRIDGES B-41-0302	LS	—	—	—	
210.0100	BACKFILL STRUCTURE	CY			—	
502.0100	CONCRETE MASONRY BRIDGES	CY				
502.3200	PROTECTIVE SURFACE TREATMENT	SY	—	—		
505.0400	BAR STEEL REINFORCEMENT HS STRUCTURES	LB			—	
505.0600	BAR STEEL REINFORCEMENT HS COATED STRUCTURES	LB				
550.1100	PIILING STEEL HP 10-INCH x 42 LB	LF			—	
513.4061	RAILING TUBULAR TYPE M (STRUCTURE) B-41-0302	LF	—	—	—	
516.0500	RUBBERIZED MEMBRANE WATERPROOFING	SY			—	
606.0300	RIPRAP HEAVY	CY			—	
612.0406	PIPE UNDERDRAIN WRAPPED 6-INCH	LF			—	
645.0120	GEOTEXTILE FABRIC TYPE HR	SY			—	
	NON-BID ITEMS					
	FILLER	SIZE	—	—	—	

210.1500 Structure backfill type A, TON. Granular materials can be bid in units of cubic yard or tons. Structure plans (with a December 2016 letting or thereafter) should use the TON bid item, unless directed otherwise by the Region.

GENERAL NOTES

DRAWINGS SHALL NOT BE SCALED.

ALL STATIONS AND ALL ELEVATIONS ARE IN FEET.

BAR STEEL REINFORCEMENT SHALL BE EMBEDDED 2" CLEAR
UNLESS SHOWN OR NOTED OTHERWISE.

ALL REINFORCING BARS ARE ENGLISH. THE FIRST DIGIT OF A THREE-DIGIT BAR MARK OR THE FIRST TWO DIGITS OF A FOUR-DIGIT BAR MARK SIGNIFIES THE BAR SIZE.

JOINT FILLER SHALL CONFORM TO THE REQUIREMENTS OF
A.A.S.H.T.O. DESIGNATION M 153, TYPE I, II OR III OR
A.A.S.H.T.O. DESIGNATION M 213.

THE SLOPE OF THE FILL IN FRONT OF THE ABUTMENTS SHALL BE COVERED WITH RIPRAP HEAVY AND GEOTEXTILE FABRIC TYPE 'HR' TO THE EXTENT SHOWN ON SHEET 1 AND AND IN THE ABUTMENT DETAILS.


STEEL 'HP' PILE MATERIAL SHALL BE A.S.T.M. DESIGNATION A36.

THE EXISTING STRUCTURE (P-41-0175) IS A 28.5' LONG BY 22.5' WIDTH SINGLE-SPAN CONCRETE DECK BRIDGE.


THE PROTECTIVE SURFACE TREATMENT SHALL BE APPLIED TO THE TOP AND EDGES OF THE SLAB AND TO THE OUTSIDE 1'-0" OF THE UNDERSIDE OF THE SLAB.

AT THE BACKFACE OF ABUTMENT ALL VOLUME WHICH CANNOT BE IN PLACE BEFORE ABUTMENT CONSTRUCTION AND NOT OCCUPIED BY THE NEW STRUCTURE SHALL BE BACKFILLED WITH BACKFILL STRUCTURE.

THE GRADATION OF THE BACKFILL STRUCTURE SHALL MEET THE REQUIREMENTS OF SECTION 209.2.2 OF THE STANDARD SPECIFICATIONS FOR GRADE 1 MATERIAL.

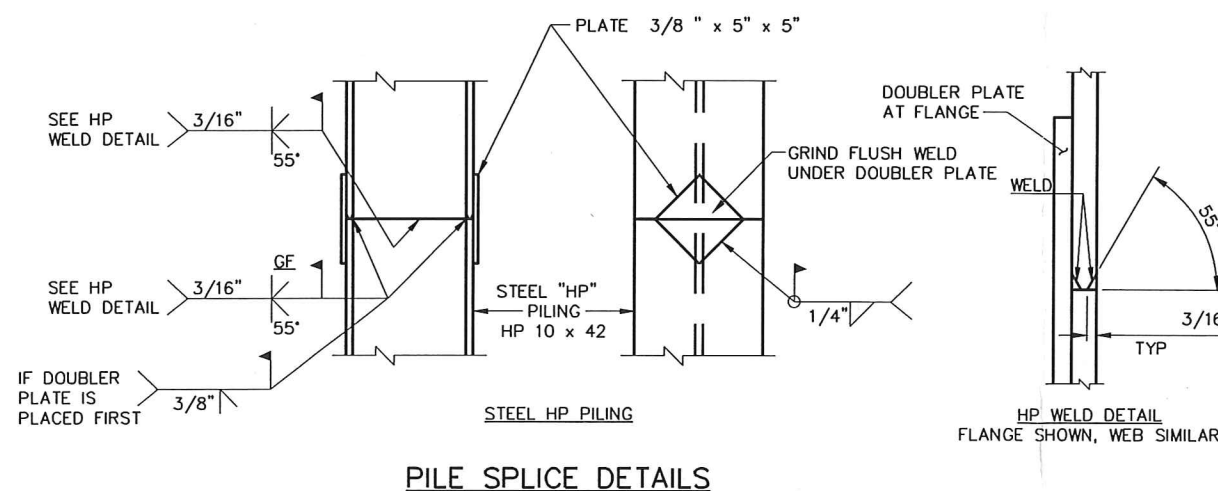

8

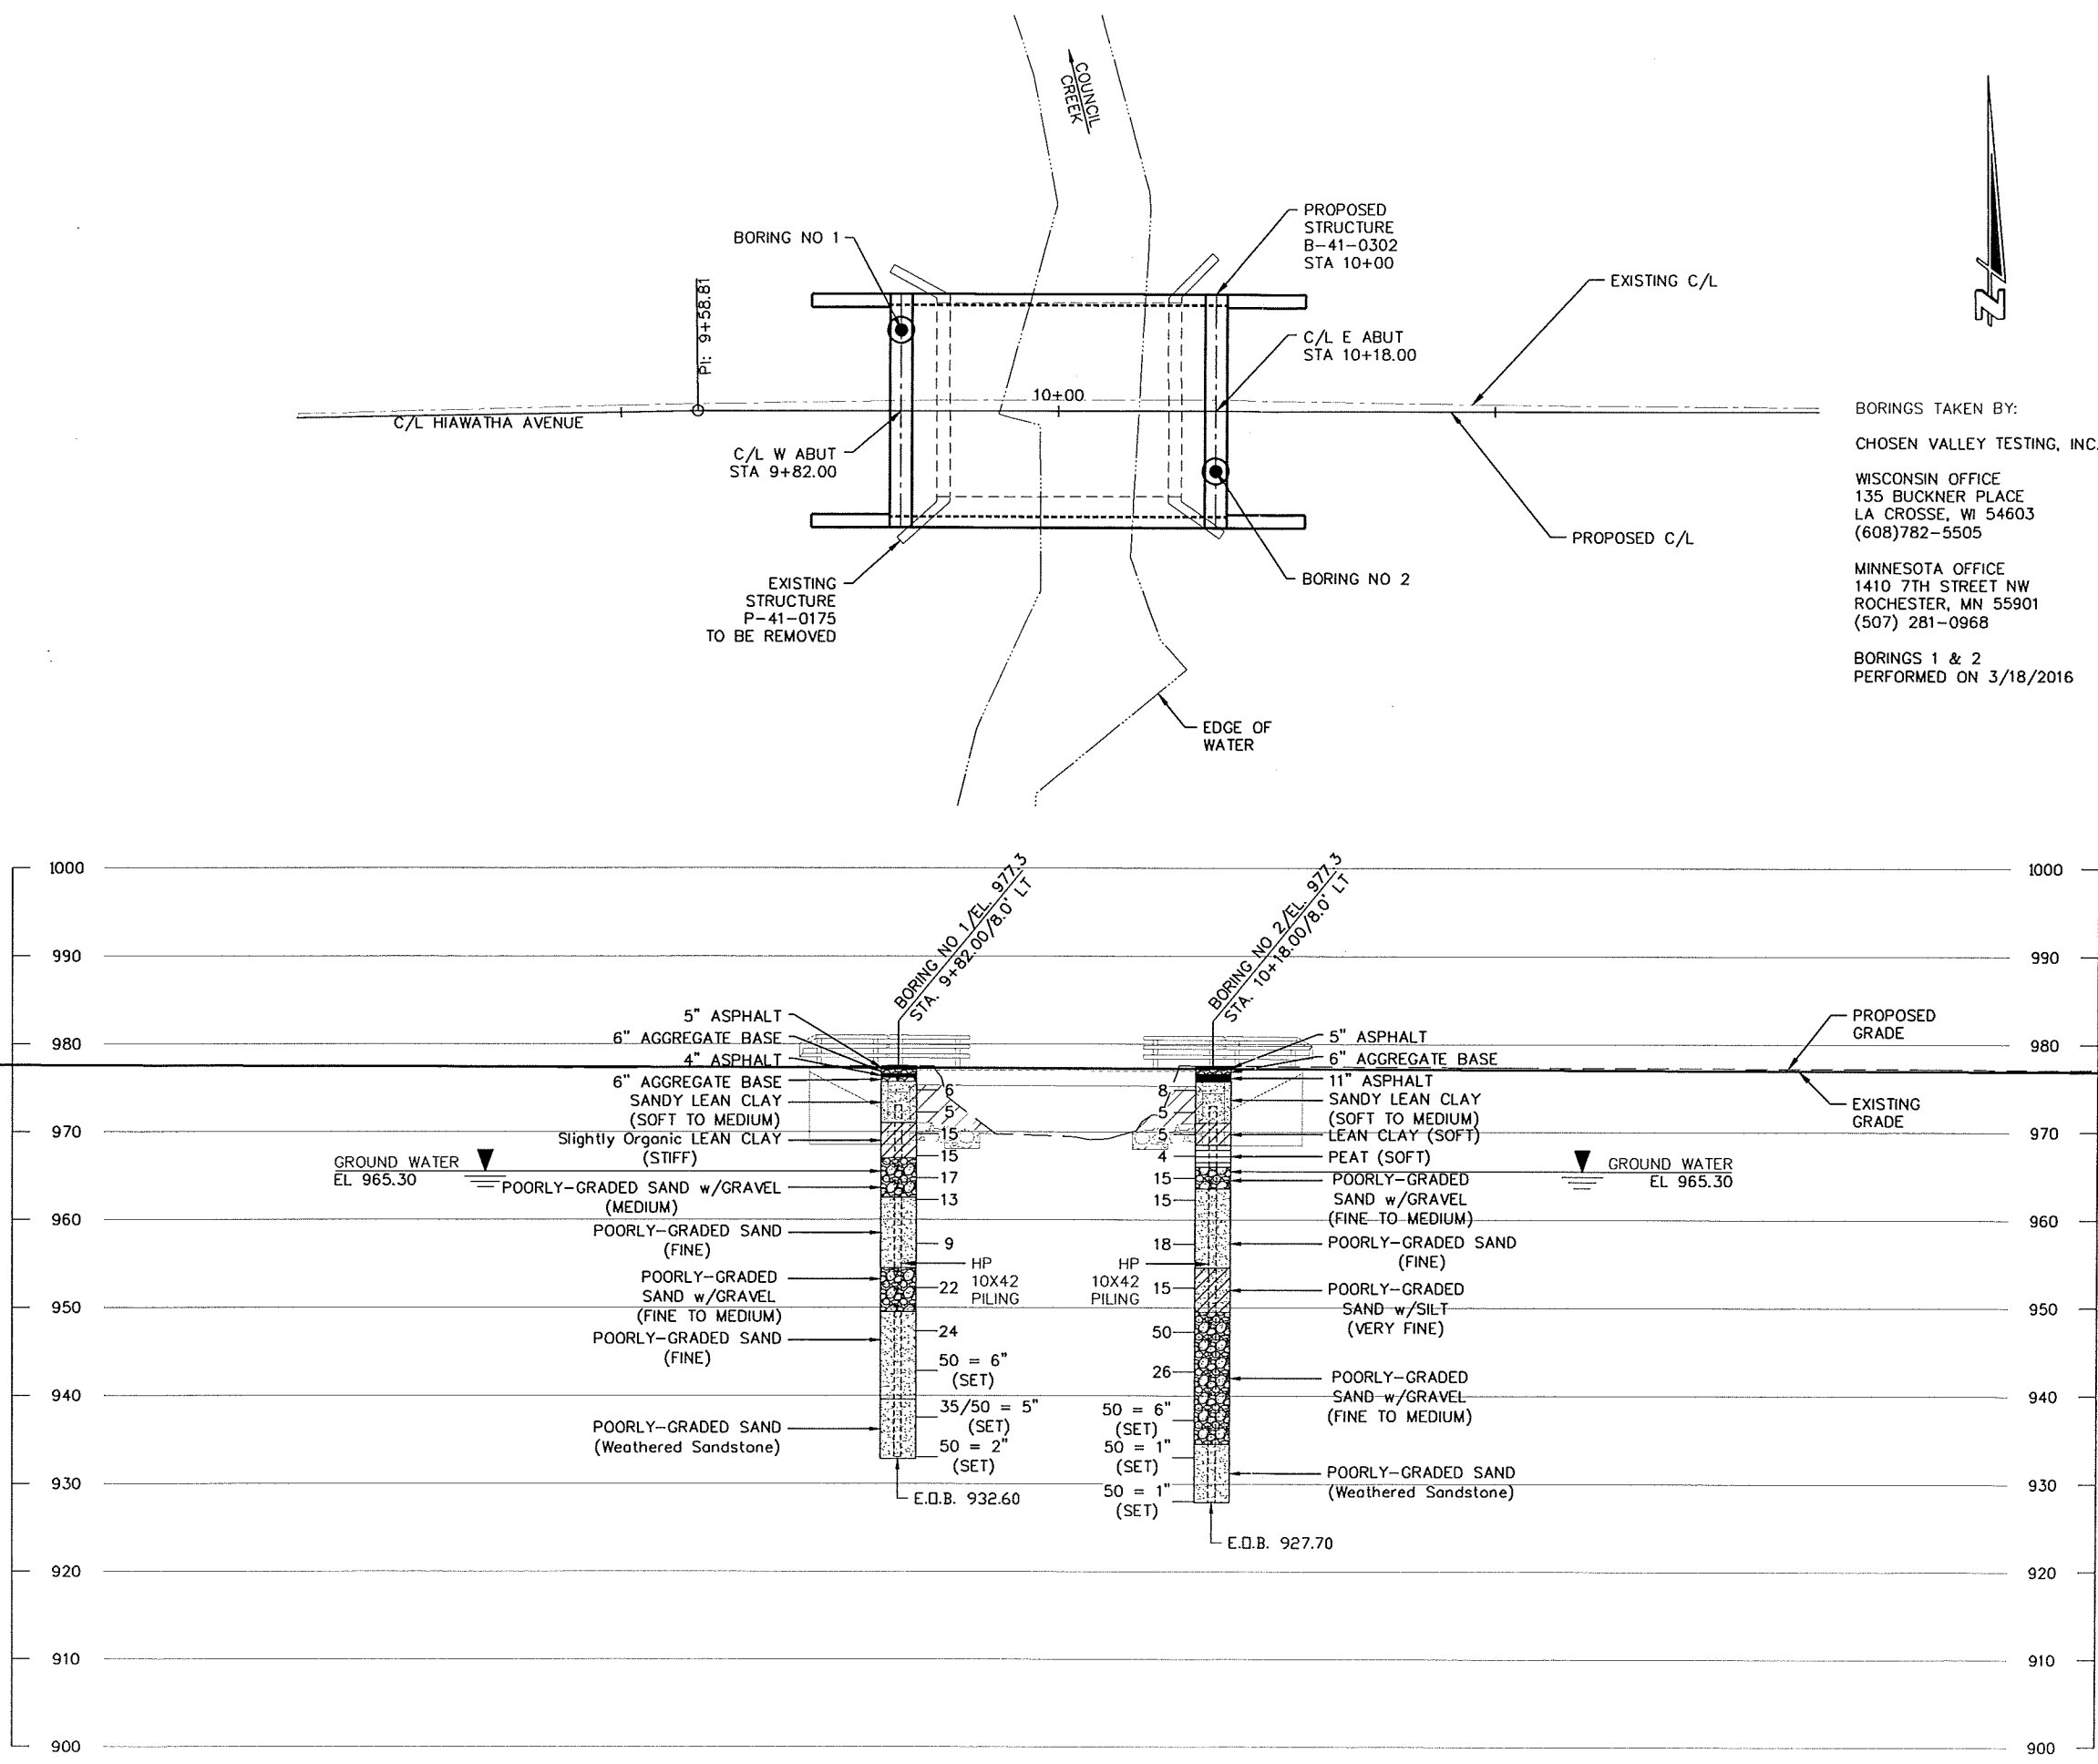

STATE PROJECT NUMBER

5025-00-71

ABBREVIATIONS

F — FINE M — MEDIUM C — COARSE
WS — WEATHERED SO — SOUND

MATERIAL SYMBOLS

TOPSOIL SILT SANDSTONE
SAND PEAT LIMESTONE
GRAVEL CLAY IGNEOUS ROCK

LEGEND OF PROBING

PROBING NO.
STA.
ELEVATION
7 AVERAGE BLOWS PER FOOT
95/6-95 BLOWS FOR 6" PENETRATION
PROBING TAKEN WITH A 350# WT. FALLING 18" ON A 2" O.D. POINT.
REFUSAL 95/6

LEGEND OF BORING

BORING NO.
STA.
ELEV.
UNCONFINED STRENGTH → 7.7
BLOWS PER FT. USING 140# WT. FALLING 30"
WASH SAMPLE
SHELBY TUBE — S.T.
GROUND WATER ELEVATION
NO GROUND WATER OBSERVED ABOVE THIS ELEVATION
SANDY GRAVEL
F. BOULDERS OR COBBLES
SAND
SILTY SAND
SO
LIMESTONE

UNLESS OTHERWISE SPECIFIED, THE BLOWS PER FOOT AT THE LOCATIONS INDICATED ARE BASED ON DRIVING A 2" O.D. X 1.4" I.D. SPLIT SPOON SAMPLER WITH A 140# HAMMER HAVING A FREE FALL OF 30". THE BLOW COUNT IS TAKEN IN UNDISTURBED SOIL IMMEDIATELY BELOW A CASED OR OPEN HOLE ELIMINATING SIDE FRICTION ON THE DRIVE PIPE.


SUBSURFACE EXPLORATION FOR FOUNDATION DESIGN AND BIDDERS INFORMATION

TO OBTAIN RELATIVE DATA CONCERNING THE CHARACTER OF MATERIAL IN AND UPON WHICH THE FOUNDATION MIGHT BE BUILT, BORINGS AND/OR SOUNDINGS WERE MADE AT POINTS APPROXIMATELY AS INDICATED ON THIS DRAWING. THE DATA PRESENTED HEREIN REPRESENTS THE FINDINGS OF THE SUBSURFACE EXPLORATIONS MADE. HOWEVER, BECAUSE THE DEPTHS INVESTIGATED ARE LIMITED AND THE AREA OF THE BORINGS AND/OR SOUNDINGS IS VERY SMALL IN RELATION TO THE ENTIRE AREA, THE WISCONSIN DEPARTMENT OF TRANSPORTATION DOES NOT WARRANT CONDITIONS BELOW THE DEPTHS INVESTIGATED OR THAT THE CLASSIFICATION OF MATERIAL ENCOUNTERED IN THESE INVESTIGATIONS IS NECESSARILY TYPICAL OF THE ENTIRE SITE.

NO.	DATE	REVISION	BY
STATE OF WISCONSIN DEPARTMENT OF TRANSPORTATION STRUCTURES DESIGN SECTION			
STRUCTURE B-41-0302			
DRAWN BY NJT		PLANS CK'D. TLP	
SUBSURFACE EXPLORATION		SHEET 3 OF 8	

SCALE = 1:2

8

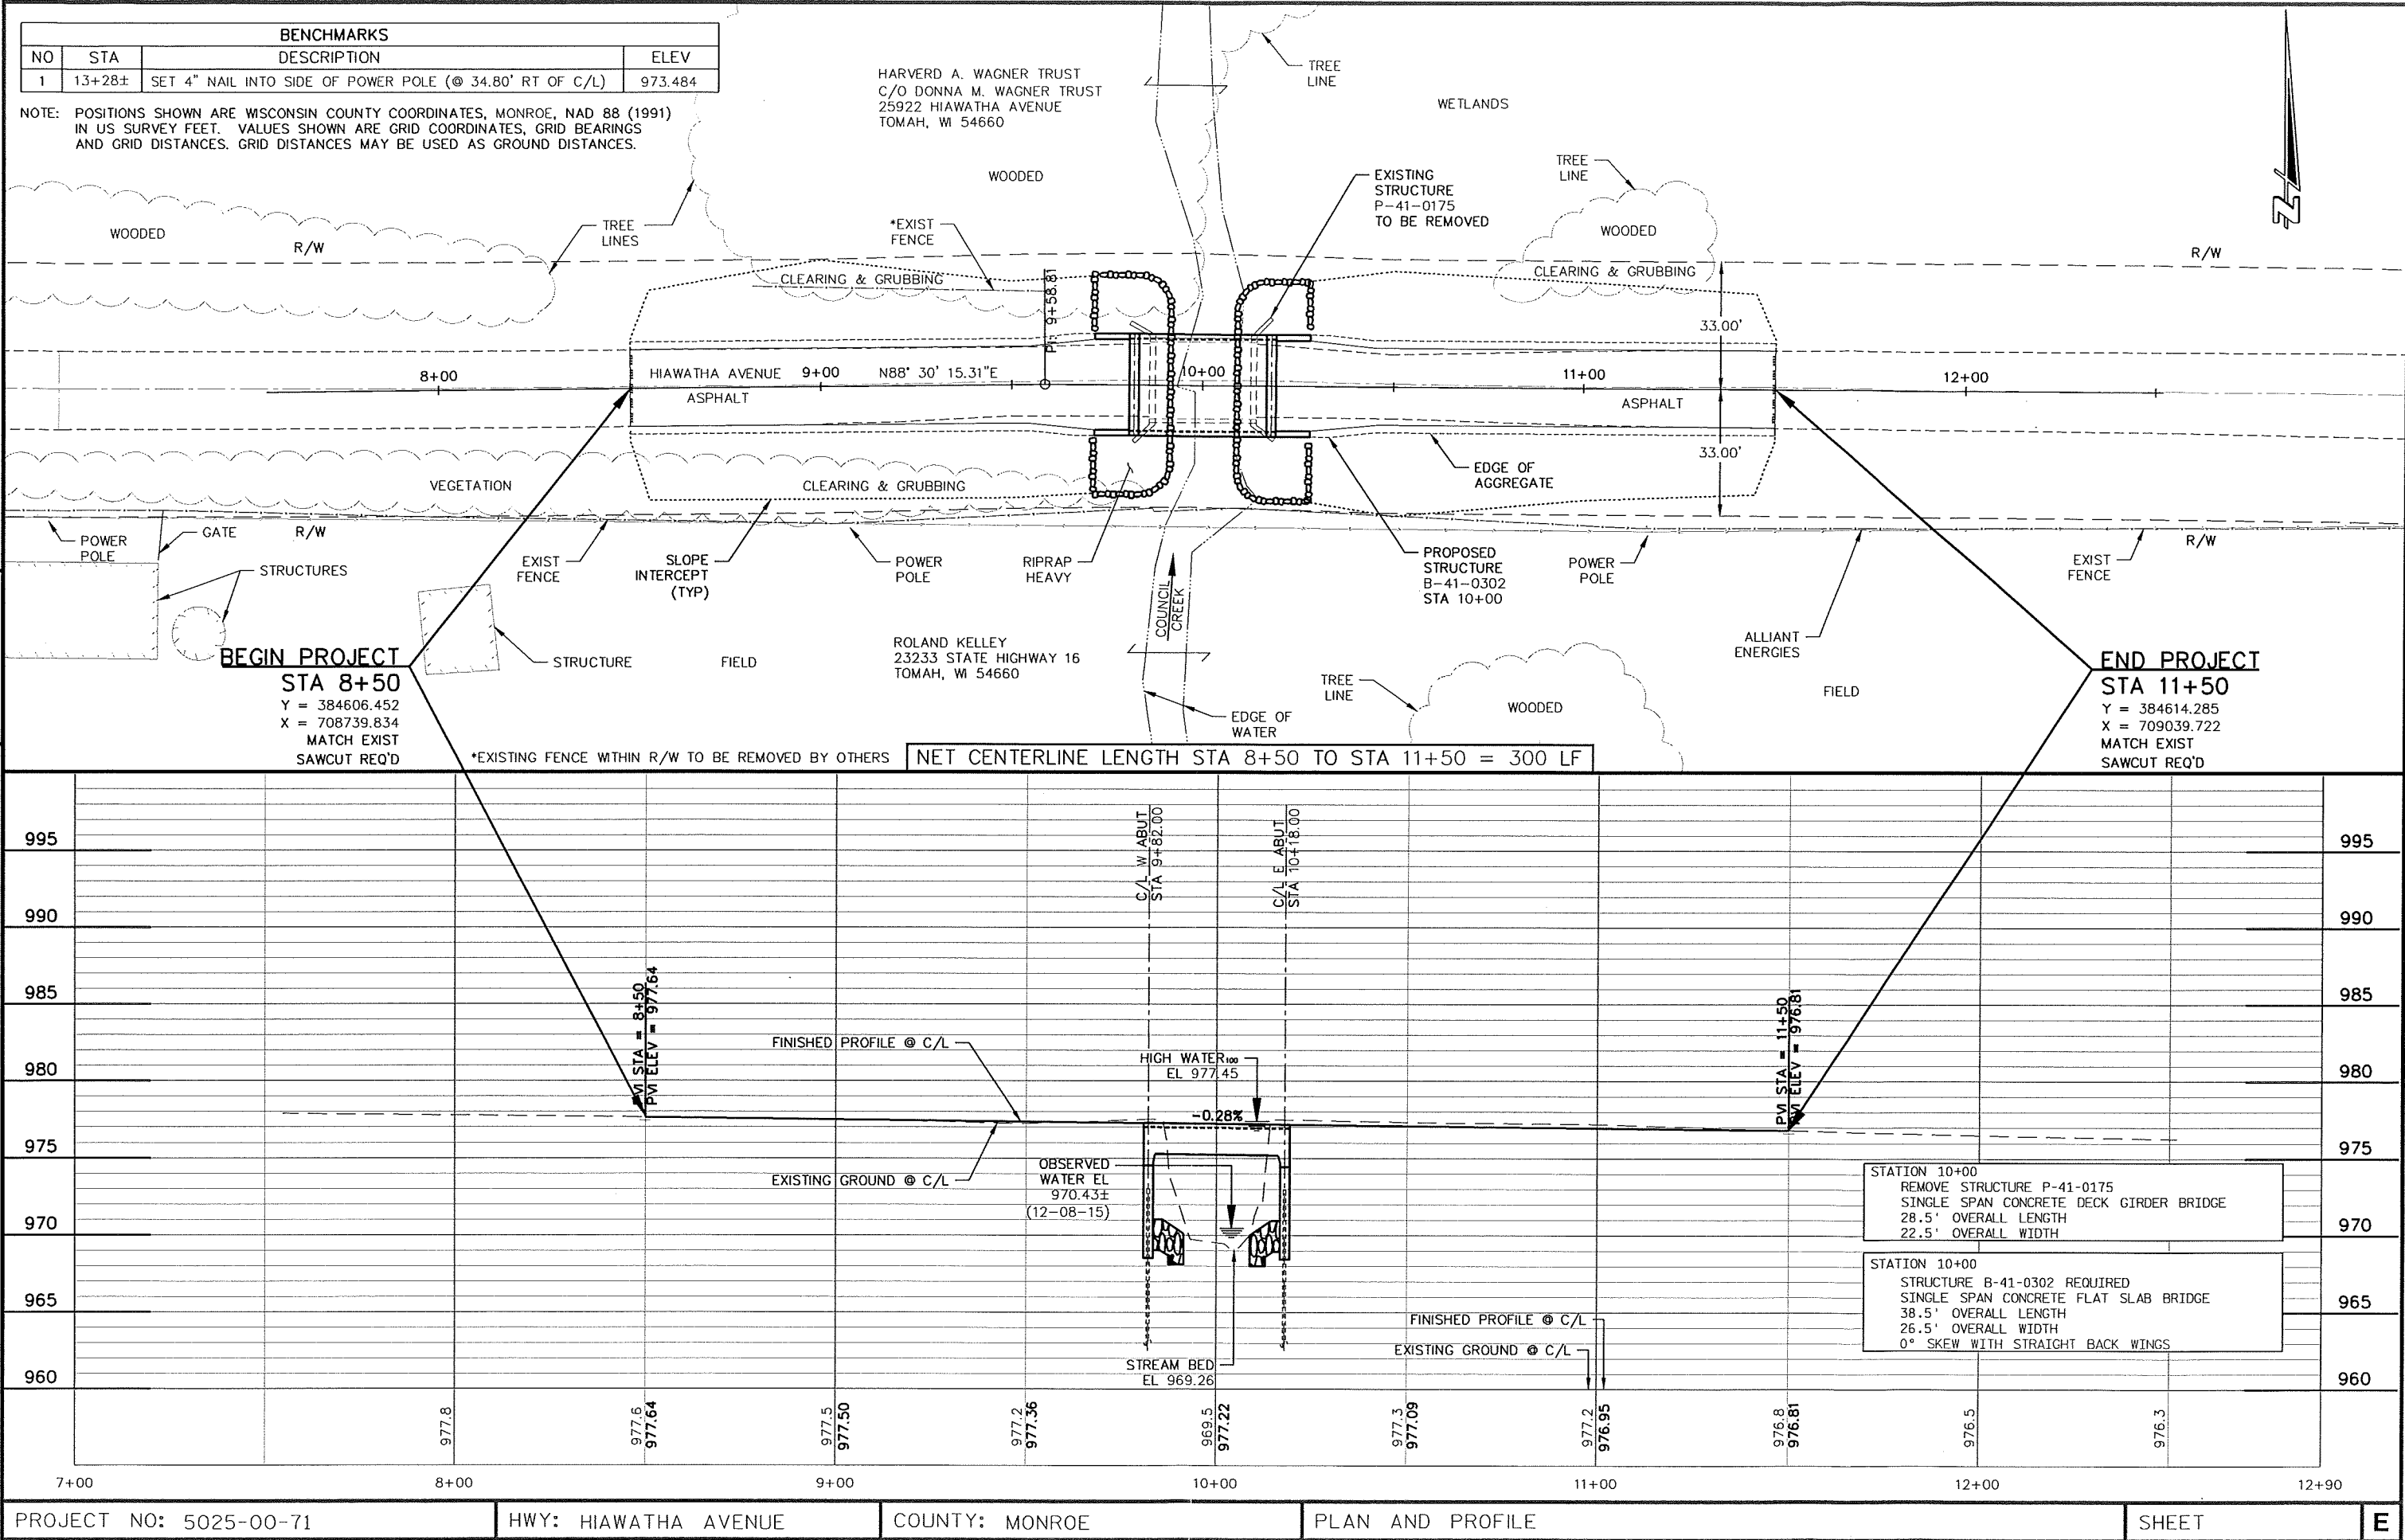

BENCHMARKS			
NO	STA	DESCRIPTION	ELEV
1	13+28±	SET 4" NAIL INTO SIDE OF POWER POLE (@ 34.80' RT OF C/L)	973.484

NOTE: POSITIONS SHOWN ARE WISCONSIN COUNTY COORDINATES, MONROE, NAD 88 (1991) IN US SURVEY FEET. VALUES SHOWN ARE GRID COORDINATES, GRID BEARINGS AND GRID DISTANCES. GRID DISTANCES MAY BE USED AS GROUND DISTANCES.

HARVERD A. WAGNER TRUST
C/O DONNA M. WAGNER TRUST
25922 HIAWATHA AVENUE
TOMAH, WI 54660

ROLAND KELLEY
23233 STATE HIGHWAY 16
TOMAH, WI 54660

STATION 10+00
REMOVE STRUCTURE P-41-0175
SINGLE SPAN CONCRETE DECK GIRDER BRIDGE
28.5' OVERALL LENGTH
22.5' OVERALL WIDTH

STATION 10+00
STRUCTURE B-41-0302 REQUIRED
SINGLE SPAN CONCRETE FLAT SLAB BRIDGE
38.5' OVERALL LENGTH
26.5' OVERALL WIDTH
0° SKEW WITH STRAIGHT BACK WINGS

2

