

GENERAL NOTES

NORTH

ABUT.

369

PIER

NORTH

APPROACH

TOTALS

738

SOLITH

PPROACH

SOLITH

ABUT.

369

DRAWINGS SHALL NOT BE SCALED.

BAR STEEL REINFORCEMENT SHALL BE PLACED WITH 2" OF CLEAR CONCRETE COVER UNLESS OTHERWISE NOTED. THE TOP LAYER OF BAR STEEL REINFORCEMENT IN THE DECK SHALL BE PLACED WITH $2\frac{1}{2}$ " OF CLEAR CONCRETE COVER.

BEVEL EXPOSED EDGES OF CONCRETE 3/4" UNLESS OTHERWISE NOTED.

ALL DIMENSIONS ARE IN FEET AND INCHES UNLESS OTHERWISE NOTED.

THE UTILITY INFORMATION SHOWN ON THESE DRAWINGS CONCERNING TYPE AND LOCATION OF UNDERGROUND UTILITIES IS NOT GUARANTEED TO BE ACCURATE OR ALL-INCLUSIVE. THE CONTRACTOR IS RESPONSIBLE FOR MAKING HIS OWN DETERMINATION AS TO TYPE AND LOCATION OF UNDERGROUND UTILITIES AS MAY BE NECESSARY TO AVOID DAMAGE. UTILITIES LABELED AS PROPOSED MAY BE INSTALLED BY OTHERS PRIOR TO THIS CONTRACT.

THE FIRST DIGIT OF A THREE DIGIT BAR MARK OR THE FIRST TWO DIGITS OF A FOUR DIGIT BAR MARK SIGNIFY THE

THE EXISTING GROUNDLINE SHALL BE THE UPPER LIMIT OF EXCAVATION AT THE PIERS.

AT THE BACK FACE OF ABUTMENTS ALL SPACES EXCAVATED AND NOT OCCUPIED BY THE NEW STRUCTURE OR MSE WALL SHALL BE BACKFILLED WITH STRUCTURE BACKFILL.

THE EXISTING STRUCTURE, B-30-15, IS A 3-SPAN HAUNCHED SLAB STRUCTURE WITH AN OVERALL WIDTH OF 60'-11" AND AN OVERALL LENGTH OF 110'-8" AND IS TO BE REMOVED. 2-WAY TRAFFIC ON 1-94 WILL BE MAINTAINED ON THE EXISTING SOUTHBOUND LANES AND BRIDGE OVER CTH KR DURING REMOVAL OF THE EXISTING 1-94 NORTHBOUND STRUCTURE, (B-30-15) AND THE CONSTRUCTION OF THE REPLACEMENT 1-94 NORTHBOUND STRUCTURE (B-30-114).

THE CONCRETE QUANTITY FOR PARAPETS, SUPERSTRUCTURE DECK, APPROACH SLABS, AND CONCRETE DIAPHRAGMS, SHALL BE PAID FOR UNDER BID ITEM "HPC CONCRETE MASONRY STRUCTURES".

THE RUSTICATIONS IN THE PIER COLUMNS ARE INCLUDED IN THE BID ITEM "HPC CONCRETE MASONRY STRUCTURES".

THE RUSTICATION IN THE BACK FACES OF THE PARAPET ARE INCLUDED IN THE BID ITEM "HPC CONCRETE

THE CONTRACTOR SHALL COORDINATE THE CONSTRUCTION OF BRIDGE B-30-114 WITH THE CONSTRUCTION OF RETAINING WALLS R-51-85 AND R-51-86.

APPLY PIGMENTED SURFACE SEALER TO THE TOP AND INSIDE FACE OF PARAPETS ON THE BRIDGE AND STRUCTURAL APPROACH SLABS.

APPLY PROTECTIVE SURFACE TREATMENT TO THE BRIDGE DECK, PAVING NOTCH AND STRUCTURAL APPROACH SLABS.

SEE RETAINING WALLS R-51-85 AND R-51-86 FOR TEMPORARY WIRE FACED MSE WALLS.

PRECAST PIER NON-BID ITEMS (PRECAST PIER COLUMNS, PRECAST PIER CAPS, GROUTED BAR COUPLERS) ARE FOR INFORMATIONAL PURPOSES ONLY, IF THE CONTRACTOR ELECTS TO UTILIZE PRECAST PIER COLUMNS, THE NON-BID ITEM SPECIAL PROVISIONS WITHIN THIS CONTRACT SHALL BE BASED ON THE QUANTITIES AND PRICES BID FOR THE ITEMS LISTED IN THE "TOTAL ESTIMATED QUANTITIES FOR THE CAST-IN-PLACE PIER.

THE HAUNCH GROUT QUANTITY SHALL BE INCIDENTAL TO THE PARTIAL DEPTH PRECAST PRESTRESSED CONCRETE

THE SLOPE OF THE FILL IN FRONT OF THE ABUTMENTS SHALL BE COVERED WITH SLOPE PAVING MATERIAL TO EXTENT SHOWN ON THE ABUTMENT SHEETS.

ELASTOMERIC BEARING PADS NEED NOT BE INDIVIDUALLY MOLDED PROVIDED THE CUT EDGES ARE SMOOTH AND TRUE.

THE EXISTING SOILS SURROUNDING B-30-15 PILING MAY BE CONTAMINATED. SEE SPECIAL PROVISION "EXCAVATION, HAULING, AND DISPOSAL OF CREOSOTE CONTAMINATED SOIL". REMOVAL OF CONTAMINATED SOILS IS PAID FOR UNDER

THE HAUNCH CONCRETE QUANTITY IS BASED ON THE AVERAGE HAUNCH SHOWN ON THE "54W PRESTRESSED GIRDER DETAILS 2" SHEET.

REVISION QUANTITIES FOR INFORMATIONAL PURPOSES ONLY.

7/20/18



NO.	DATE	F	Έ	VISION			BY	
	S	STATE O DEPARTMENT O TRUCTURES	F		ORTA		ļ	
STRUCTURE B-30-114								
				DRAWN BY	WWR	PLANS CK'D.	ABS	
	~	A N. T. T. C.		^	SHE	ET 3		

7/20/18 REMOVE PRECAST DECK PANELS MJK

QUANTITIES & GENERAL NOTES

210.1300	BACKIEL STRUCTURE THE A	1 1011			1 202		1 202		130
305.0125	BASE AGGREGATE DENSE 1 1/4-INCH	CY		113				113	226
416.0620	DRILLED DOWEL BARS					24			24
501,1000,5	CE HOT WEATHER CONCRETING.	→ B	4050	760~	~55Q~	1215	~55Q~~	750~~	7885
501.1000.S	ICE HOT WEATHER CONCRETING 📑	LB	1275						12 7 5
502.0100	CONCRETE MASONRY BRIDGES	CY		$\frac{1}{21}$	73	162	73	21	350
502.3200	PROTECTIVE SURFACE TREATMENT	SY	1865	160				160	2185
502.3210	PIGMENTED SURFACE SEALER	SY	225	20				20	265
503.0155	PRESTRESSED GIRDER TYPE I 54W-INCH	LF	1814						1814
505.0400	BAR STEEL REINFORCEMENT HS STRUCTURES	LB				2810			2810
505,0600	BAR STEEL REWEORCEMENT HS COATED STRUCTURES	₩,	105,535	16,660	6850	26-740	6850	16-660~	179,295
505.0600	BAR STEEL REINFORCEMENT HS COATED STRUCTURES 🚹	LB	42,460						42,460
505.0800.\$	BAR STEEL REINFORCEMENT HS STAINLESS STRUCTURES	TEM	2550		\overline{u}	\sim			2550
506.2605	BEARING PADS ELASTOMERIC NON-LAMINATED	EACH			8	16	8		32
506.4000.051	STEEL DIAPHRAGMS B-30-114	EACH	28						28
511.1200.015	TEMPORARY SHORING B-30-114	SF			905		1 7 50		2655
516.0500	RUBBERIZED MEMBRANE WATERPROOFING	SY	2		17		17		36
51 7. 1010.S.459	CONCRETE STAINING B-30-114	SF	6620	145	515	2485	515	145	10,425
51 7. 1050.S.015	ARCHITECTURAL SURFACE TREATMENT B-30-114	SF			16		16		32
550.0600	PILE REDRIVING	EACH			3	3	3		9
550.2126	PILING CIP CONCRETE 12 3/4 X 0.375-INCH	LF			1275	3360	12 7 5		5910
604.0400	SLOPE PAVING CONCRETE	SY			28		28		56
652.0125	CONDUIT RIGID METALLIC 2-INCH	LF		23				23	46
652.0225	CONDUIT RIGID NONMETALLIC SCHEDULE 40 2-INCH		224						224
653.0220	JUNCTION BOXES 18X6X6-INCH	EACH	2						2
SPV-0035-400	HPC_MASOURY_STRUCTURES	CY	540	~~80~~	~~~	~~~	~~~	80	700
SPV.0035.400	HPC MASONRY STRUCTURES ■	CY	170						170
SPV.0165.401	LUNGITUDINAL GROOVING BRIDGE DECK		16,45Z	1440				1440	19332
SPV.0165.466	PARTIAL DEPTH PRECAST PRESTRESSED CONCRETE DECK PANELS B-30-114	SF	9949						9949
				<u> </u>	····	····	·····		\sim
	NON-BID ITEMS								
	FILLER	SIZE							1/2", 3/4", 11/2"
	PRECAST PIER COLUMNS								
	PRECAST PIER CAPS								
	GROUTED BAR COUPLERS								
		11							

UNIT

LS

LS

LS

TON

SUPER.

TOTAL ESTIMATED QUANTITIES

REMOVING OLD STRUCTURE STA.658+00

BACKELL STRUCTURE TYPE A

BID ITEMS

ABATEMENT OF ASBESTOS CONTAINING MATERIAL B-30-15

EXCAVATION FOR STRUCTURES BRIDGES B-30-114

BID ITEM


NUMBER

203.0200.054

203.0210.5.022


206.1000.031

210.1500

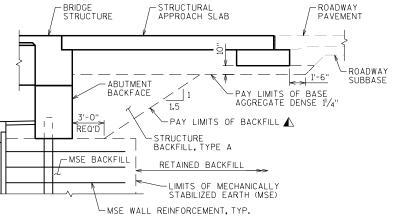

TYPICAL SECTION THRU ABUTMENT


⚠ BACKFILL PAY LIMITS. BACKFILL BEYOND BACKFILL PAY LIMITS SHALL BE INCIDENTAL TO EXCAVATION FOR STRUCTURES. LIMITS OF EXCAVATION SHALL BE DETERMINED BY THE CONTRACTOR.

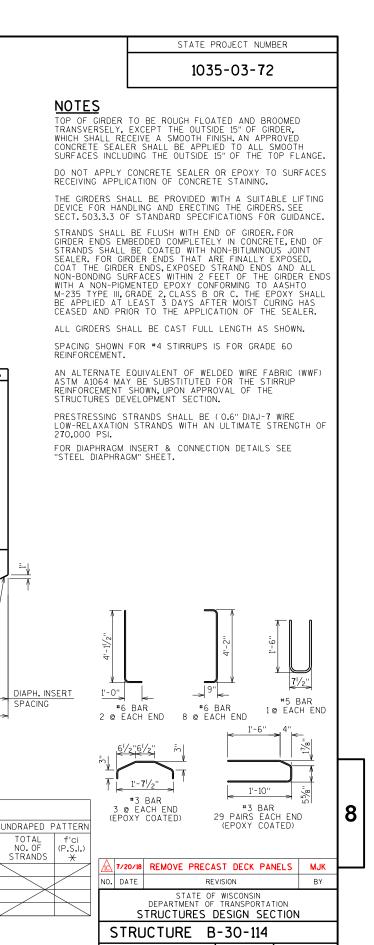

DRAWN BY ABS/WWR CK'D. ABS

SHEET 13

54W' **PRESTRESSED** GIRDER DETAILS 1

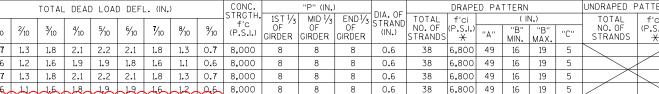

SPAN GIRDER (FEET) 1 1,8 113.375 0.6 1.2 2 2-7 113.375 0.7 | 1.3 | 1.8 | 2.1 | 2.2 | 2.1 | 1.8 | 1.3 | 0.7 | 8,000 8 PRECAST PANEL DEAD LOAD DEFL

GIRDER DATA

2-7 | 113.375

1,8 113.375 0.3 0.6 0.8 0.9 1.0 0.9 0.8

29 PAIRS EACH END BOTTOM FLANGE

#4 STIRRUPS $(4\frac{1}{2}" LEG)$

113/4"

18 SPA.@ 8" = 12'-0"

IMITS OF #3

11/2" DIA. HOLE AT ABUT. END ONLY TIRRUP PAIRS

GIRDEE

LENGT

 $A \bowtie$ SECTION A-A

A₩

TOP FLANGE

#5 U-SHAPED BAR

4 PAIRS #6 STIRRUPS

#6 BAR 1 PAIR EACH END-

PLACE AS SHOWN-

#6 BARS

1 PAIR EACH END

#6 STIRRLIPS

4 PAIRS FACH END

8

AT FNDS

#3 BARS-

 $\frac{1}{3^{1/4}} = \frac{1}{9^{1/4}}$ 3'-2[|]/₂" (A) 18 SPA. @ 5" (A) #4 STIRRUPS & = 7'-6" #3 BARS

37'-91/2" 37'-91/2" GIRDER LENGTH = "L" #3 BAR

SIDE VIEW & TYP. SECTION IN SPAN

STIRRUP PAIRS.

(A) DETAIL TYP. AT EACH END

(B) (6) #4 BARS, FULL LENGTH, MIN. LAP = 1'-11"

*4,2'-3" LONG. PLACE AT *4 STIRRUP SPACING BETWEEN LIMITS OF *3

imes MINIMUM CYLINDER STRENGTH OF CONCRETE $ilde{f e}$ TIME OF TRANSFER OF PRESTRESS FORCE.

44 SPA. @ 1'-6" = 66'-0"

4 STIRRLIPS

1'-83/4"

" MIN.

CLEAR

113/4"

(4¹/₂" LEG)

#4 BAR, EPOXY COATED.
PLACE @ STIRRUP SPACING.
EMBED INTO GIRDER 1'-3".

NO BEVEL

%₁₀ %₁₀

7/20/18

113/4"

— ¾" X ¾" BEVEL

3**7**'-91/2"

1'-83/4"


18 SPA. @ 8" = 12'-0" , STIRRUP

SPACING

2" X 1" BEVEL-


Plan Sheet WISDOT BUREAU OF STRUCTURES

SPACING

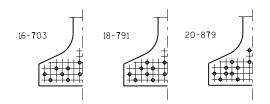


STANDARD ARRANGEMENTS TO RAISE CENTER OF GRAVITY TO AVOID DRAPING OF STRANDS


0.6"¢ STRANDS

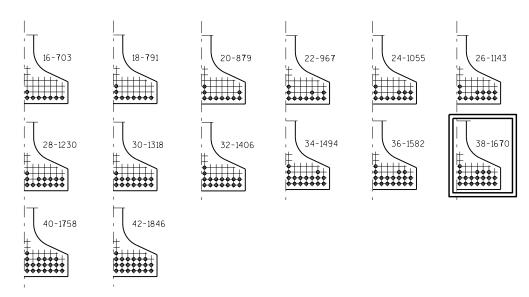

ARRANGEMENT AT & SPAN - FOR GIRDERS WITH DRAPED STRANDS

0.6"¢ STRANDS

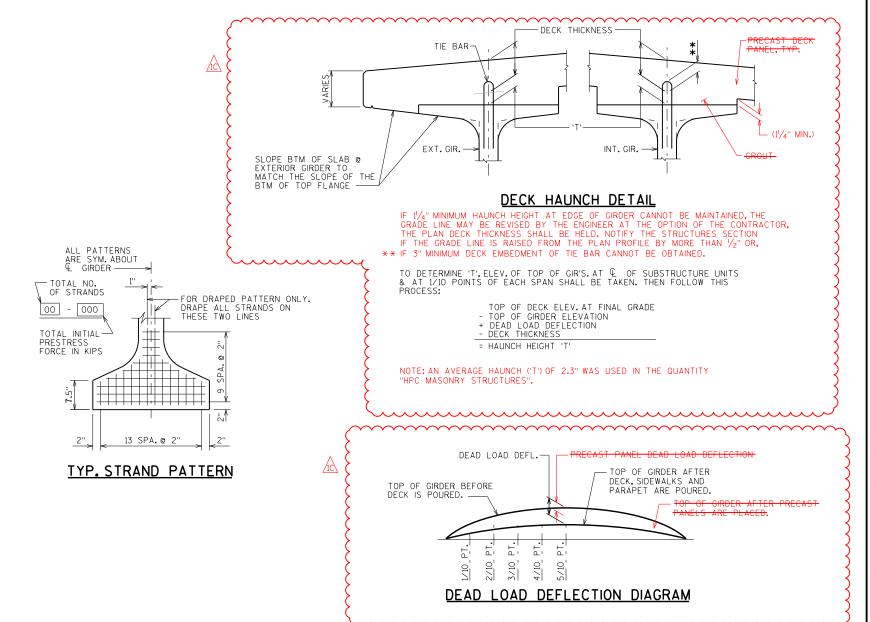

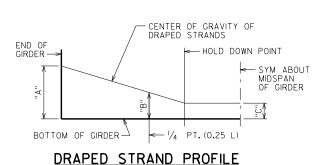

*THE THEORETICAL INITIAL CAMBER VALUE AT THE TIME OF STRAND RELEASE AT MIDSPAN MULTIPLIED BY A FACTOR OF 1.4 TO ACCOUNT FOR CAMBER GROWTH FROM THE TIME OF STRAND RELEASE TO JOBSITE PLACEMENT.

SPAN	CAMBER (IN.) *	
1	3.75	
2	3.75	

THESE VALUES ARE NOT TO BE USED IN DETERMINING 'T', USE ACTUAL GIRDER SHOTS.

THESE VALUES ARE FOR INFORMATIONAL PURPOSES ONLY.

7/20/18



<u>1d</u>	7/20/18	REMOVE	PRECA	ST	DEC	(PAN	IELS	MJK
NO.	DATE		RE	VISIO	ИС			BY
	STATE OF WISCONSIN DEPARTMENT OF TRANSPORTATION STRUCTURES DESIGN SECTION							
Ţ,	STRUCTURE B-30-114							
DRAWN BY WWR C							PLANS CK'D.	ABS
	54W" PRESTRESSED					SHE	ET 14	
	חח		CCE	_				
	PR		SSF	D				

8

