



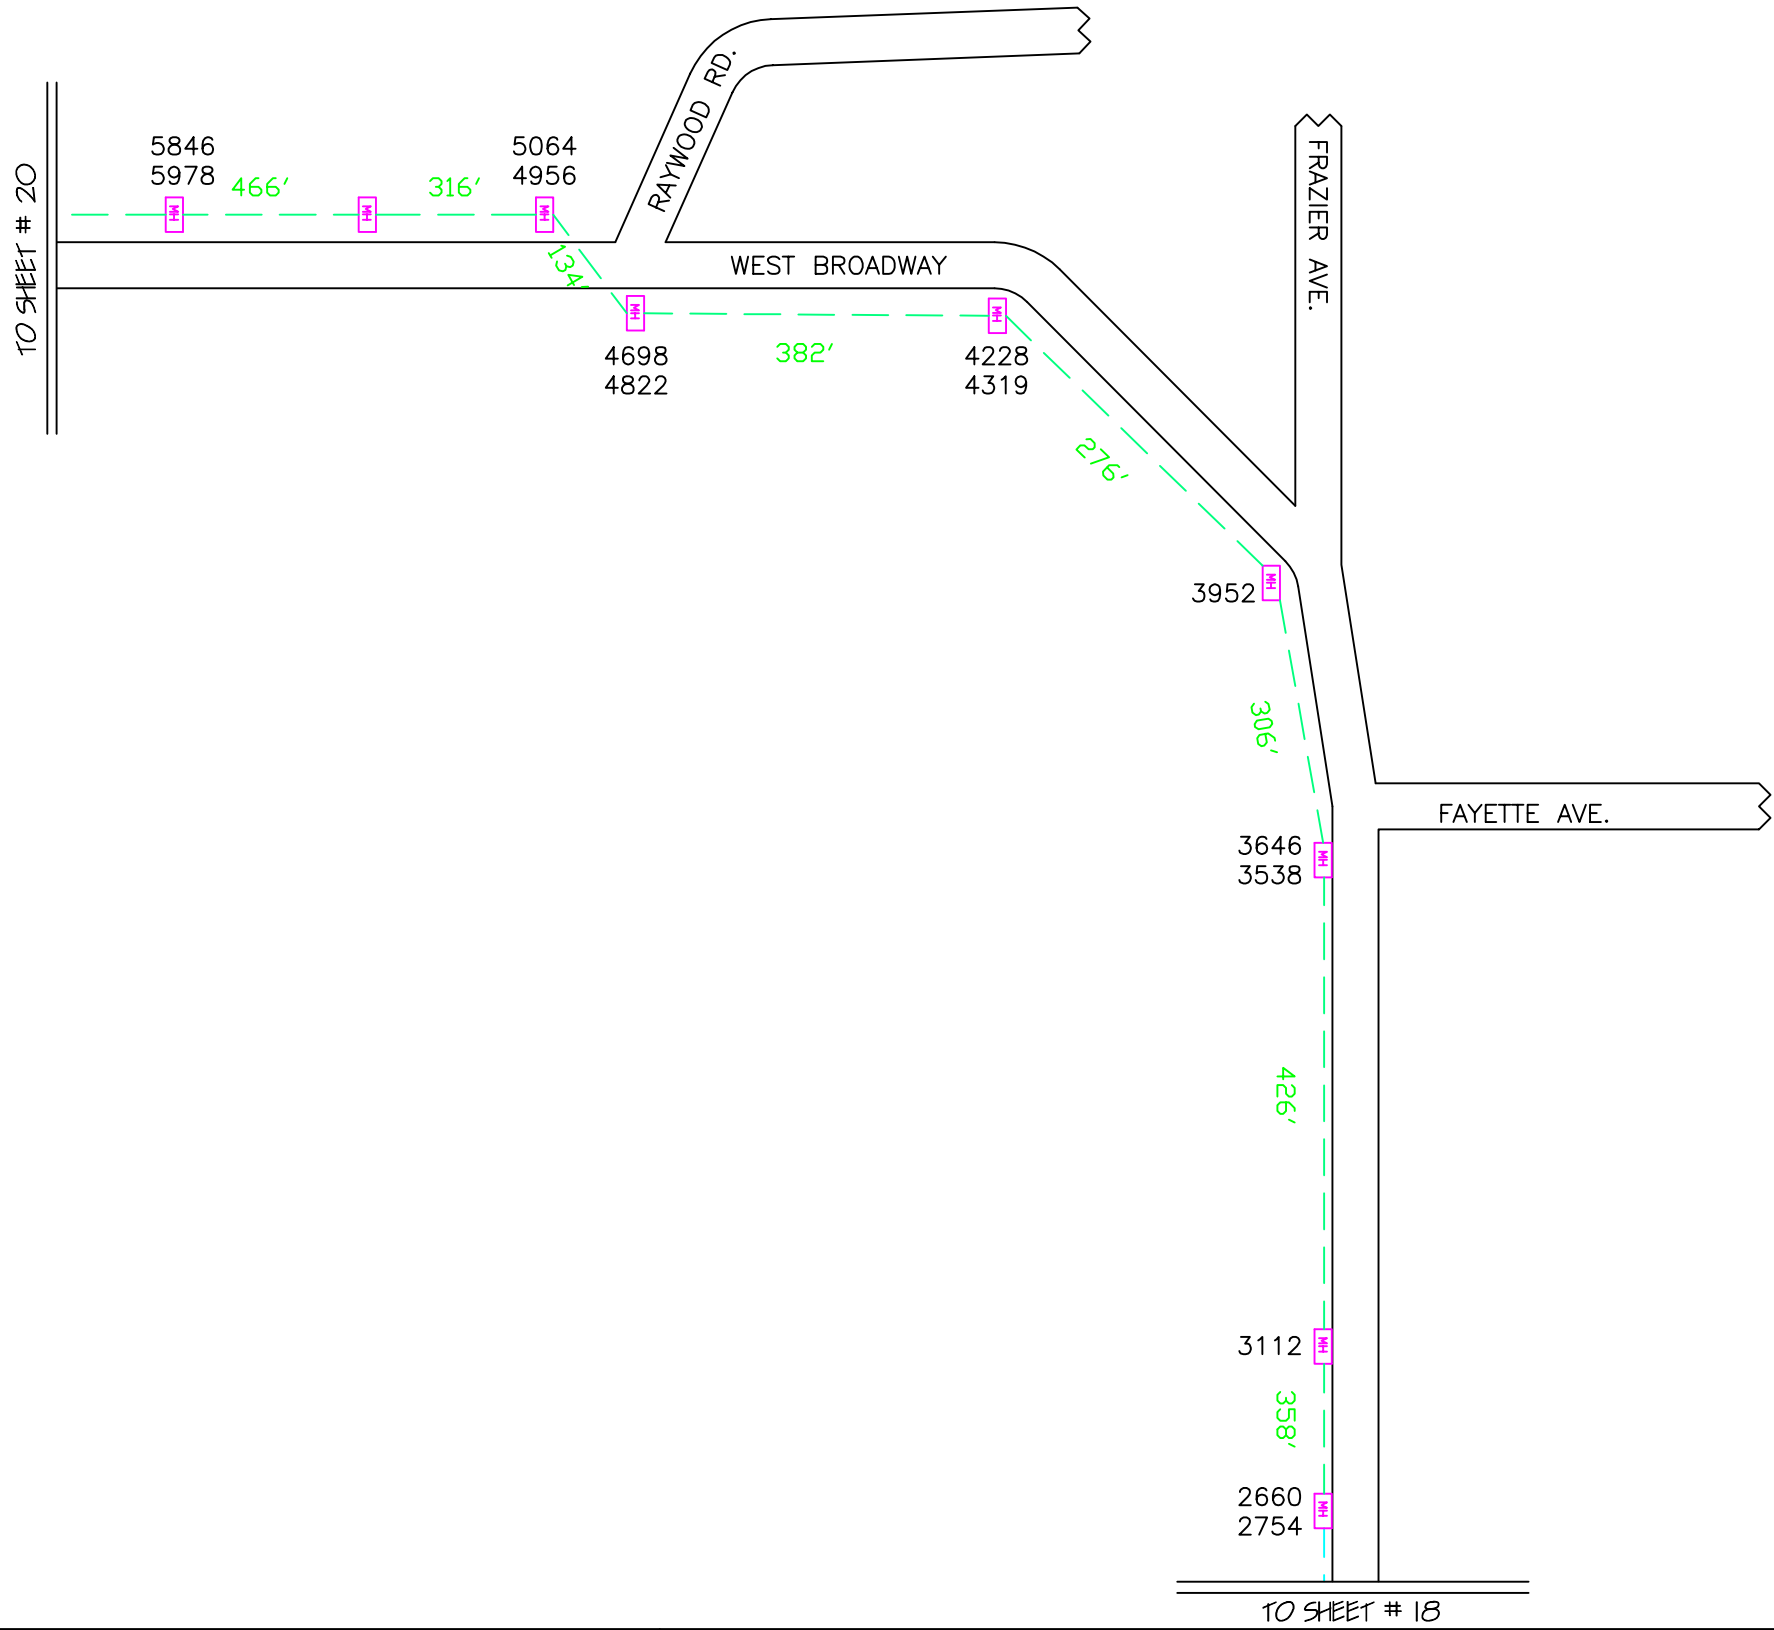


Notes:

County: Dane	Township:	City: Madison	Section:	Town:	Range:
--------------	-----------	---------------	----------	-------	--------

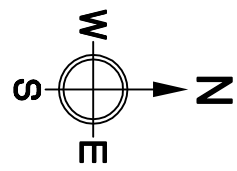


Madison Ring		
As-Builts		
		
44 Grandville Ave. NW, Ste. 400 Grand Rapids, MI 49503 616-493-7100 or 888-493-7100 fax: 616-493-7150		
DATE: 2/9/1998	DRAWN BY: MRO	SCALE: NONE
PROJECT NUMBER: JAS-AB010-MDWI	FILE VIEW:	
DRAWING NUMBER: 19	SHEET NUMBER: 19 of 50	

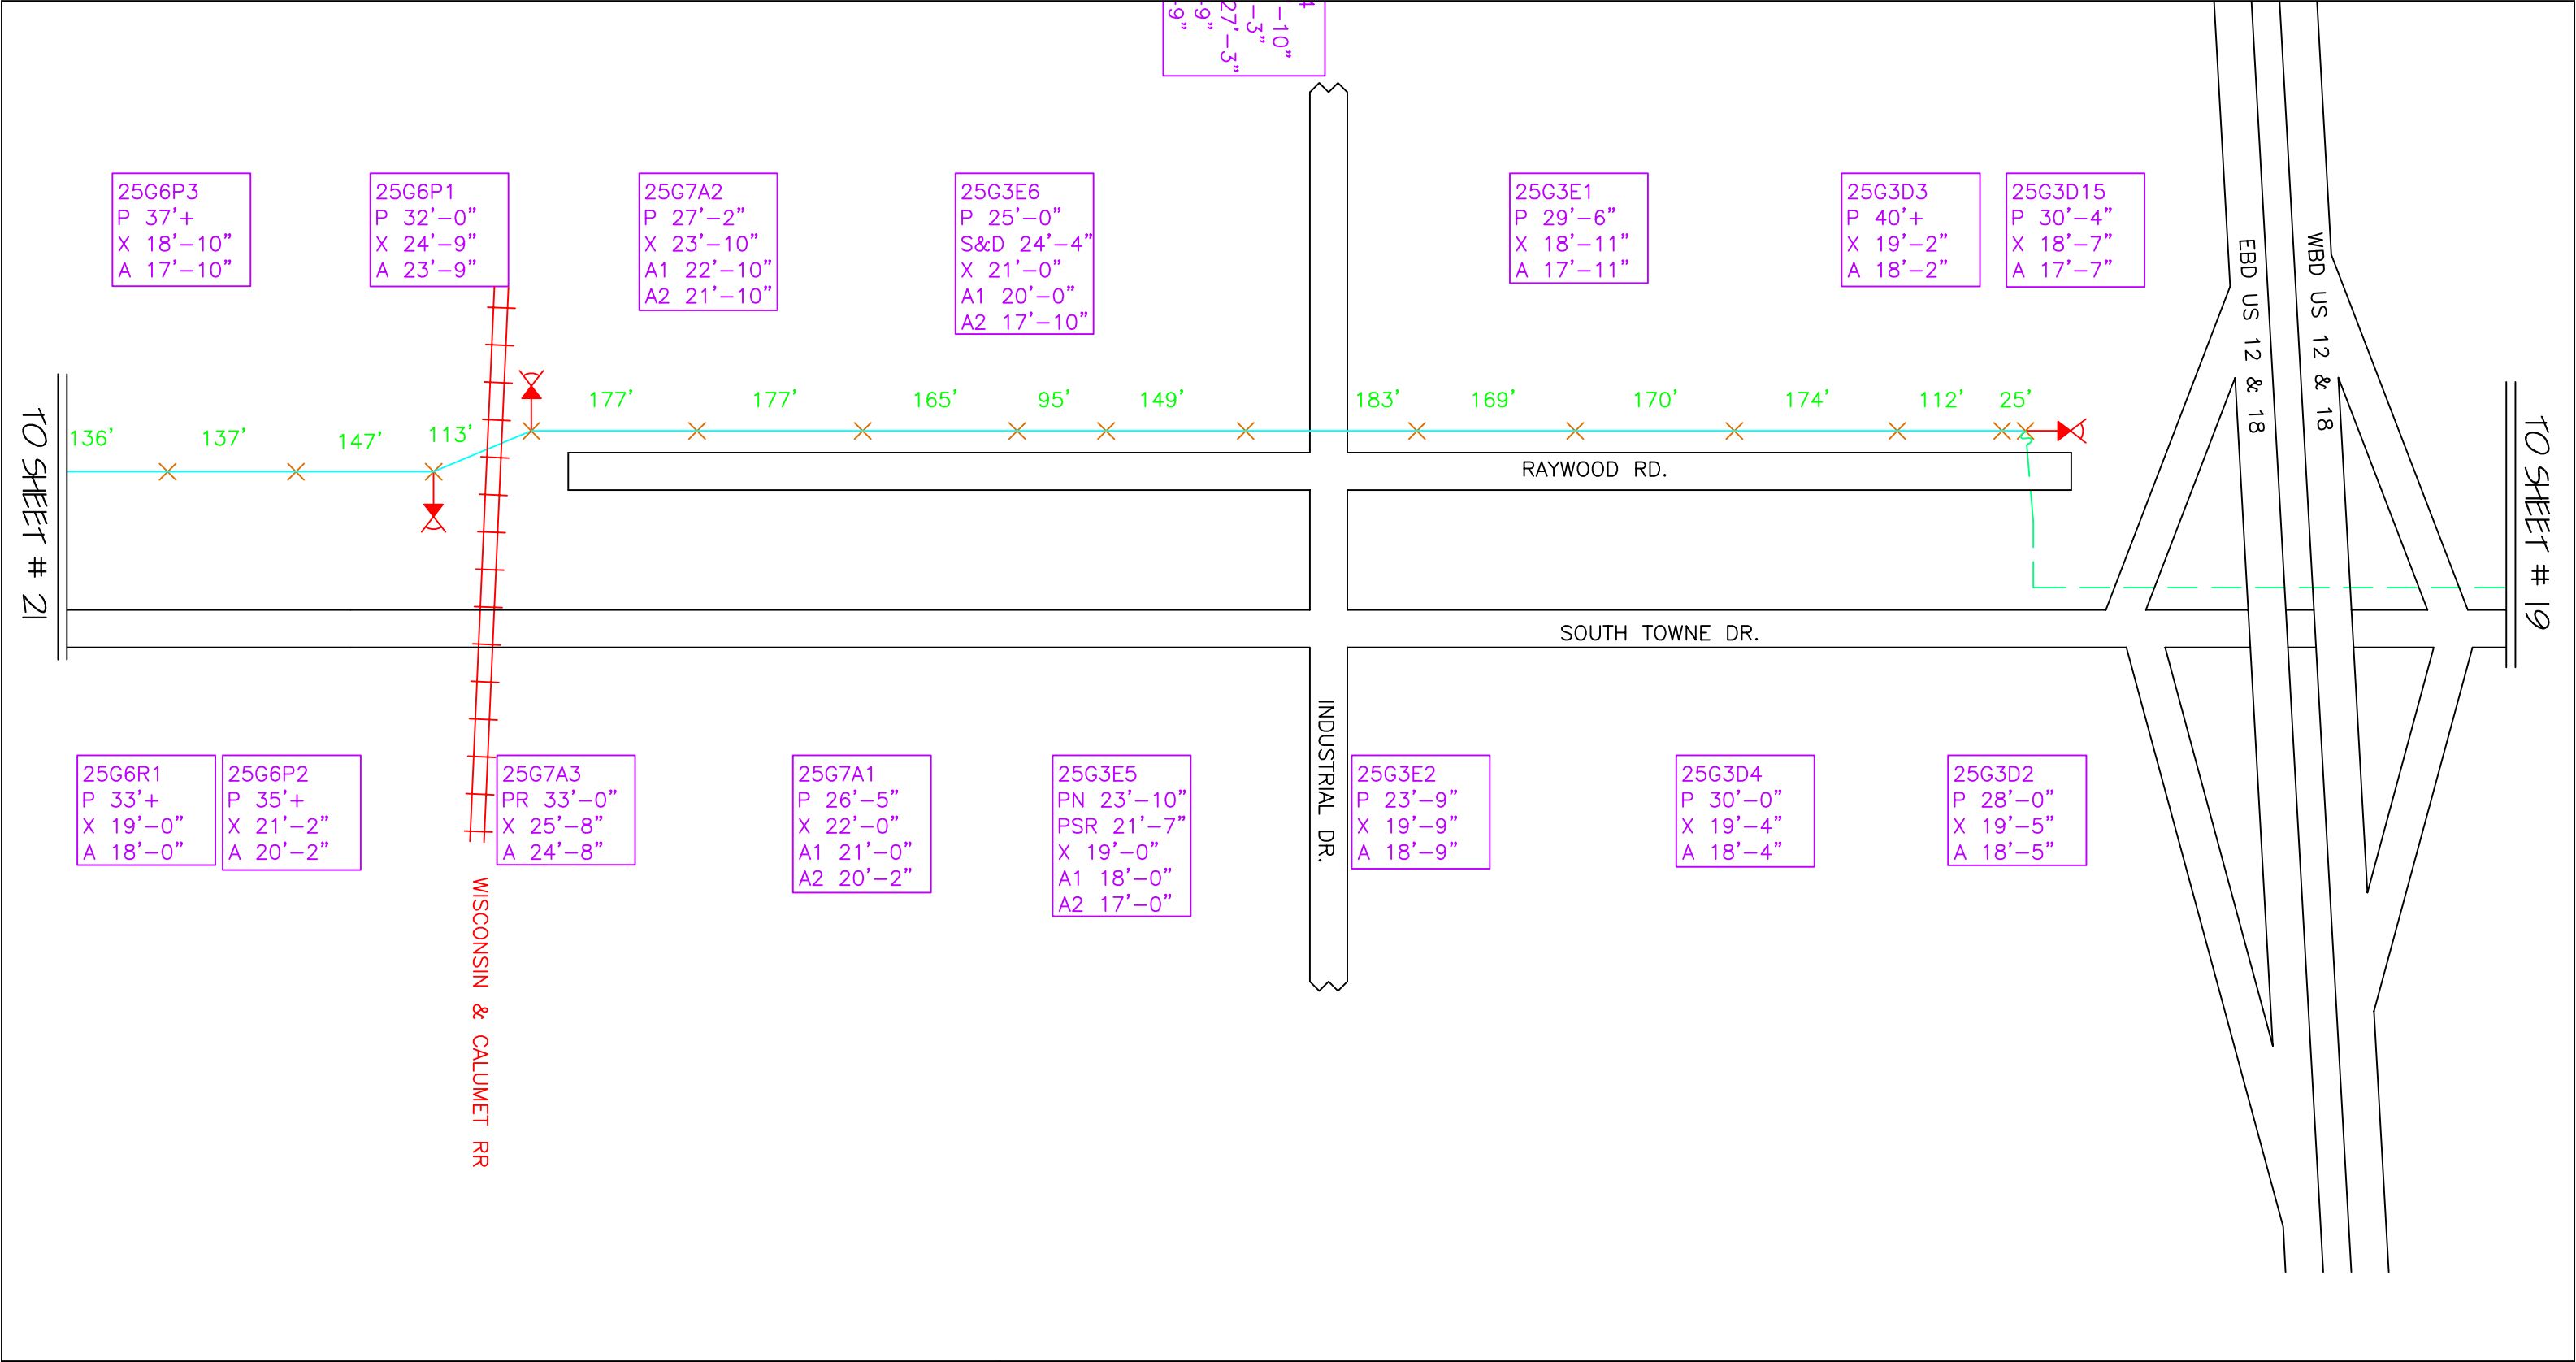

Notes:

County: Dane	Township:	City: Madison	Section:	Town:	Range:
--------------	-----------	---------------	----------	-------	--------

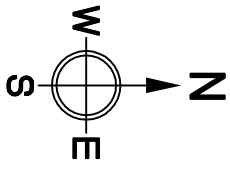

PROJECT NUMBER: JAS-AB010-MDWI		FILE VIEW:
DRAWING NUMBER: 20		SHEET NUMBER: 20 of 50

Madison Ring As-Builts



44 Grandville Ave. NW, Ste. 400
Grand Rapids, MI 49503
616-493-7100 or 888-493-7100 fax: 616-493-7150

DATE: 2/9/1998	DRAWN BY: MRO	SCALE: NONE
----------------	---------------	-------------