


See Dwg No 779-880-6 sta 2+94

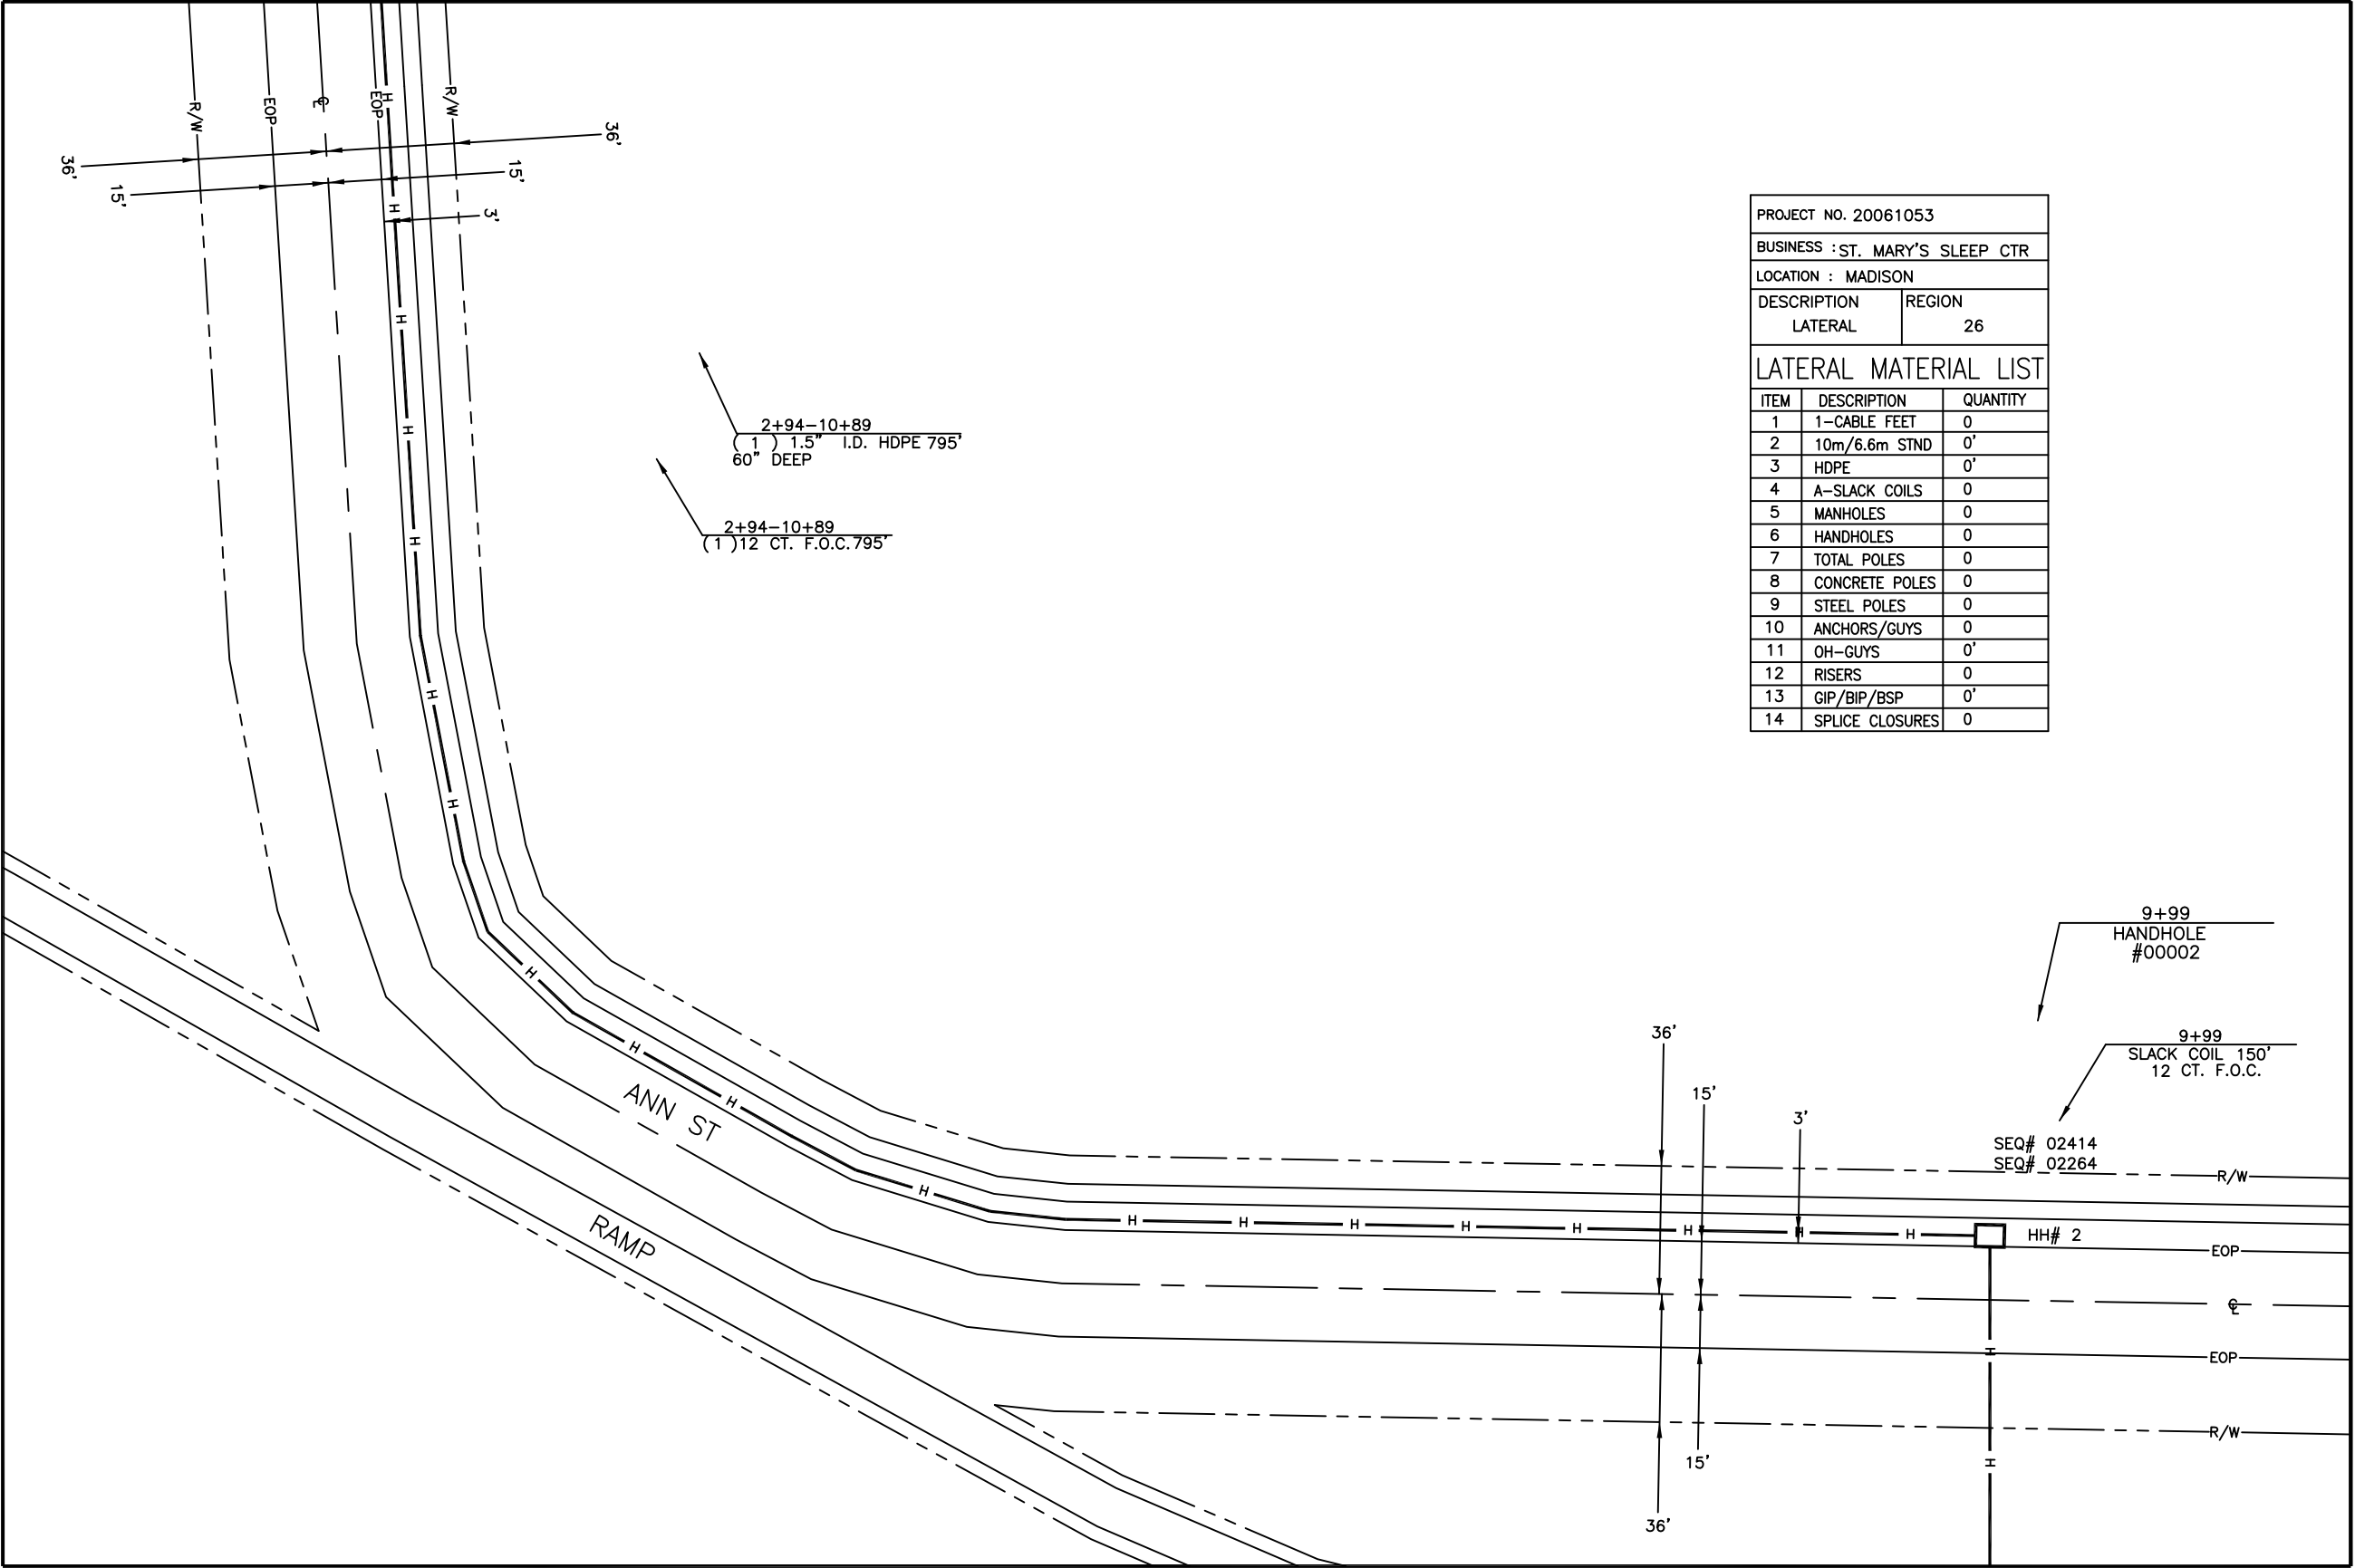

See Dwg No 779-881-4 sta 10+89

PROJECT NO. 20061053		
BUSINESS :ST. MARY'S SLEEP CTR		
LOCATION : MADISON		
DESCRIPTION		REGION
LATERAL		26
LATERAL MATERIAL LIST		
ITEM	DESCRIPTION	QUANTITY
1	1-CABLE FEET	0
2	10m/6.6m STND	0'
3	HDPE	0'
4	A-SLACK COILS	0
5	MANHOLES	0
6	HANDHOLES	0
7	TOTAL POLES	0
8	CONCRETE POLES	0
9	STEEL POLES	0
10	ANCHORS/GUYS	0
11	OH-GUYS	0'
12	RISERS	0
13	GIP/BIP/BSP	0'
14	SPLICE CLOSURES	0

PROJECT NO. 20061053	
PROJECT CITY - MADISON, WI	
FILENAME	FULL FILENAME
779-881-2	779-881-2.dwg
DATE	DESCRIPTION
3-28-06	GRID
DWG. NO.	DRAWN BY
779-881-2	CTS
SCALE	REGION
1"=50'	26

REVISIONS			
REV.	DESCRIPTION	INITIALS	DATE
1	REVISED	JDS	12-31-98
2	AB-REDLINES	MT	
3	RENUMBERING	MT	02-19-98
4	AB-REDLINES	JMW	09-14-99
5	GRID	JMW	11-03-99
6	OVERBUILD	KNT	02-12-01
7	AB-REDLINES	MBTSI	6-28-06

MATERIAL LIST		
ITEM	DESCRIPTION	QUANTITY
1	1-CABLE FEET	0
2	10m/6.6m STND	0'
3	HDPE	0'/0'
4	A-SLACK COILS	0
5	MANHOLES	0
6	HANDHOLES	0
7	TOTAL POLES	0
8	CONCRETE POLES	0
9	STEEL POLES	0
10	ANCHORS/GUYS	0
11	OH-GUYS	0'
12	RISERS	0
13	GIP/BIP/BSP	0'
14	SPLICE CLOSURES	0

SIGNATURE CYCLE	
OSP ENG:	
SIGNATURE:	
OSP MNGR:	
SIGNATURE:	
CAD SUP:	
SIGNATURE:	
CONST SUP	
SIGNATURE:	

779-880-5	779-880-6	780-880-5
779-881-1	779-881-2	780-881-1
779-881-3	779-881-4	780-881-3

DISCLAIMER

EXCEPT AS MAY BE OTHERWISE PROVIDED BY CONTRACT, THESE DRAWINGS AND SPECIFICATIONS SHALL REMAIN THE PROPERTY OF CENTURYTEL SOLUTIONS BEING ISSUED IN STRICT CONFIDENCE AND SHALL NOT BE REPRODUCED, COPIED, OR USED FOR ANY PURPOSE, WITHOUT SPECIFIC WRITTEN PERMISSION.